

# **AS-BUILT DRAWINGS**

## **Volume XIII**

**Operations & Maintenance Manual  
2016**











IF THIS SHEET IS NOT 22"x34" IT IS NOT PLOTTED TO SCALE

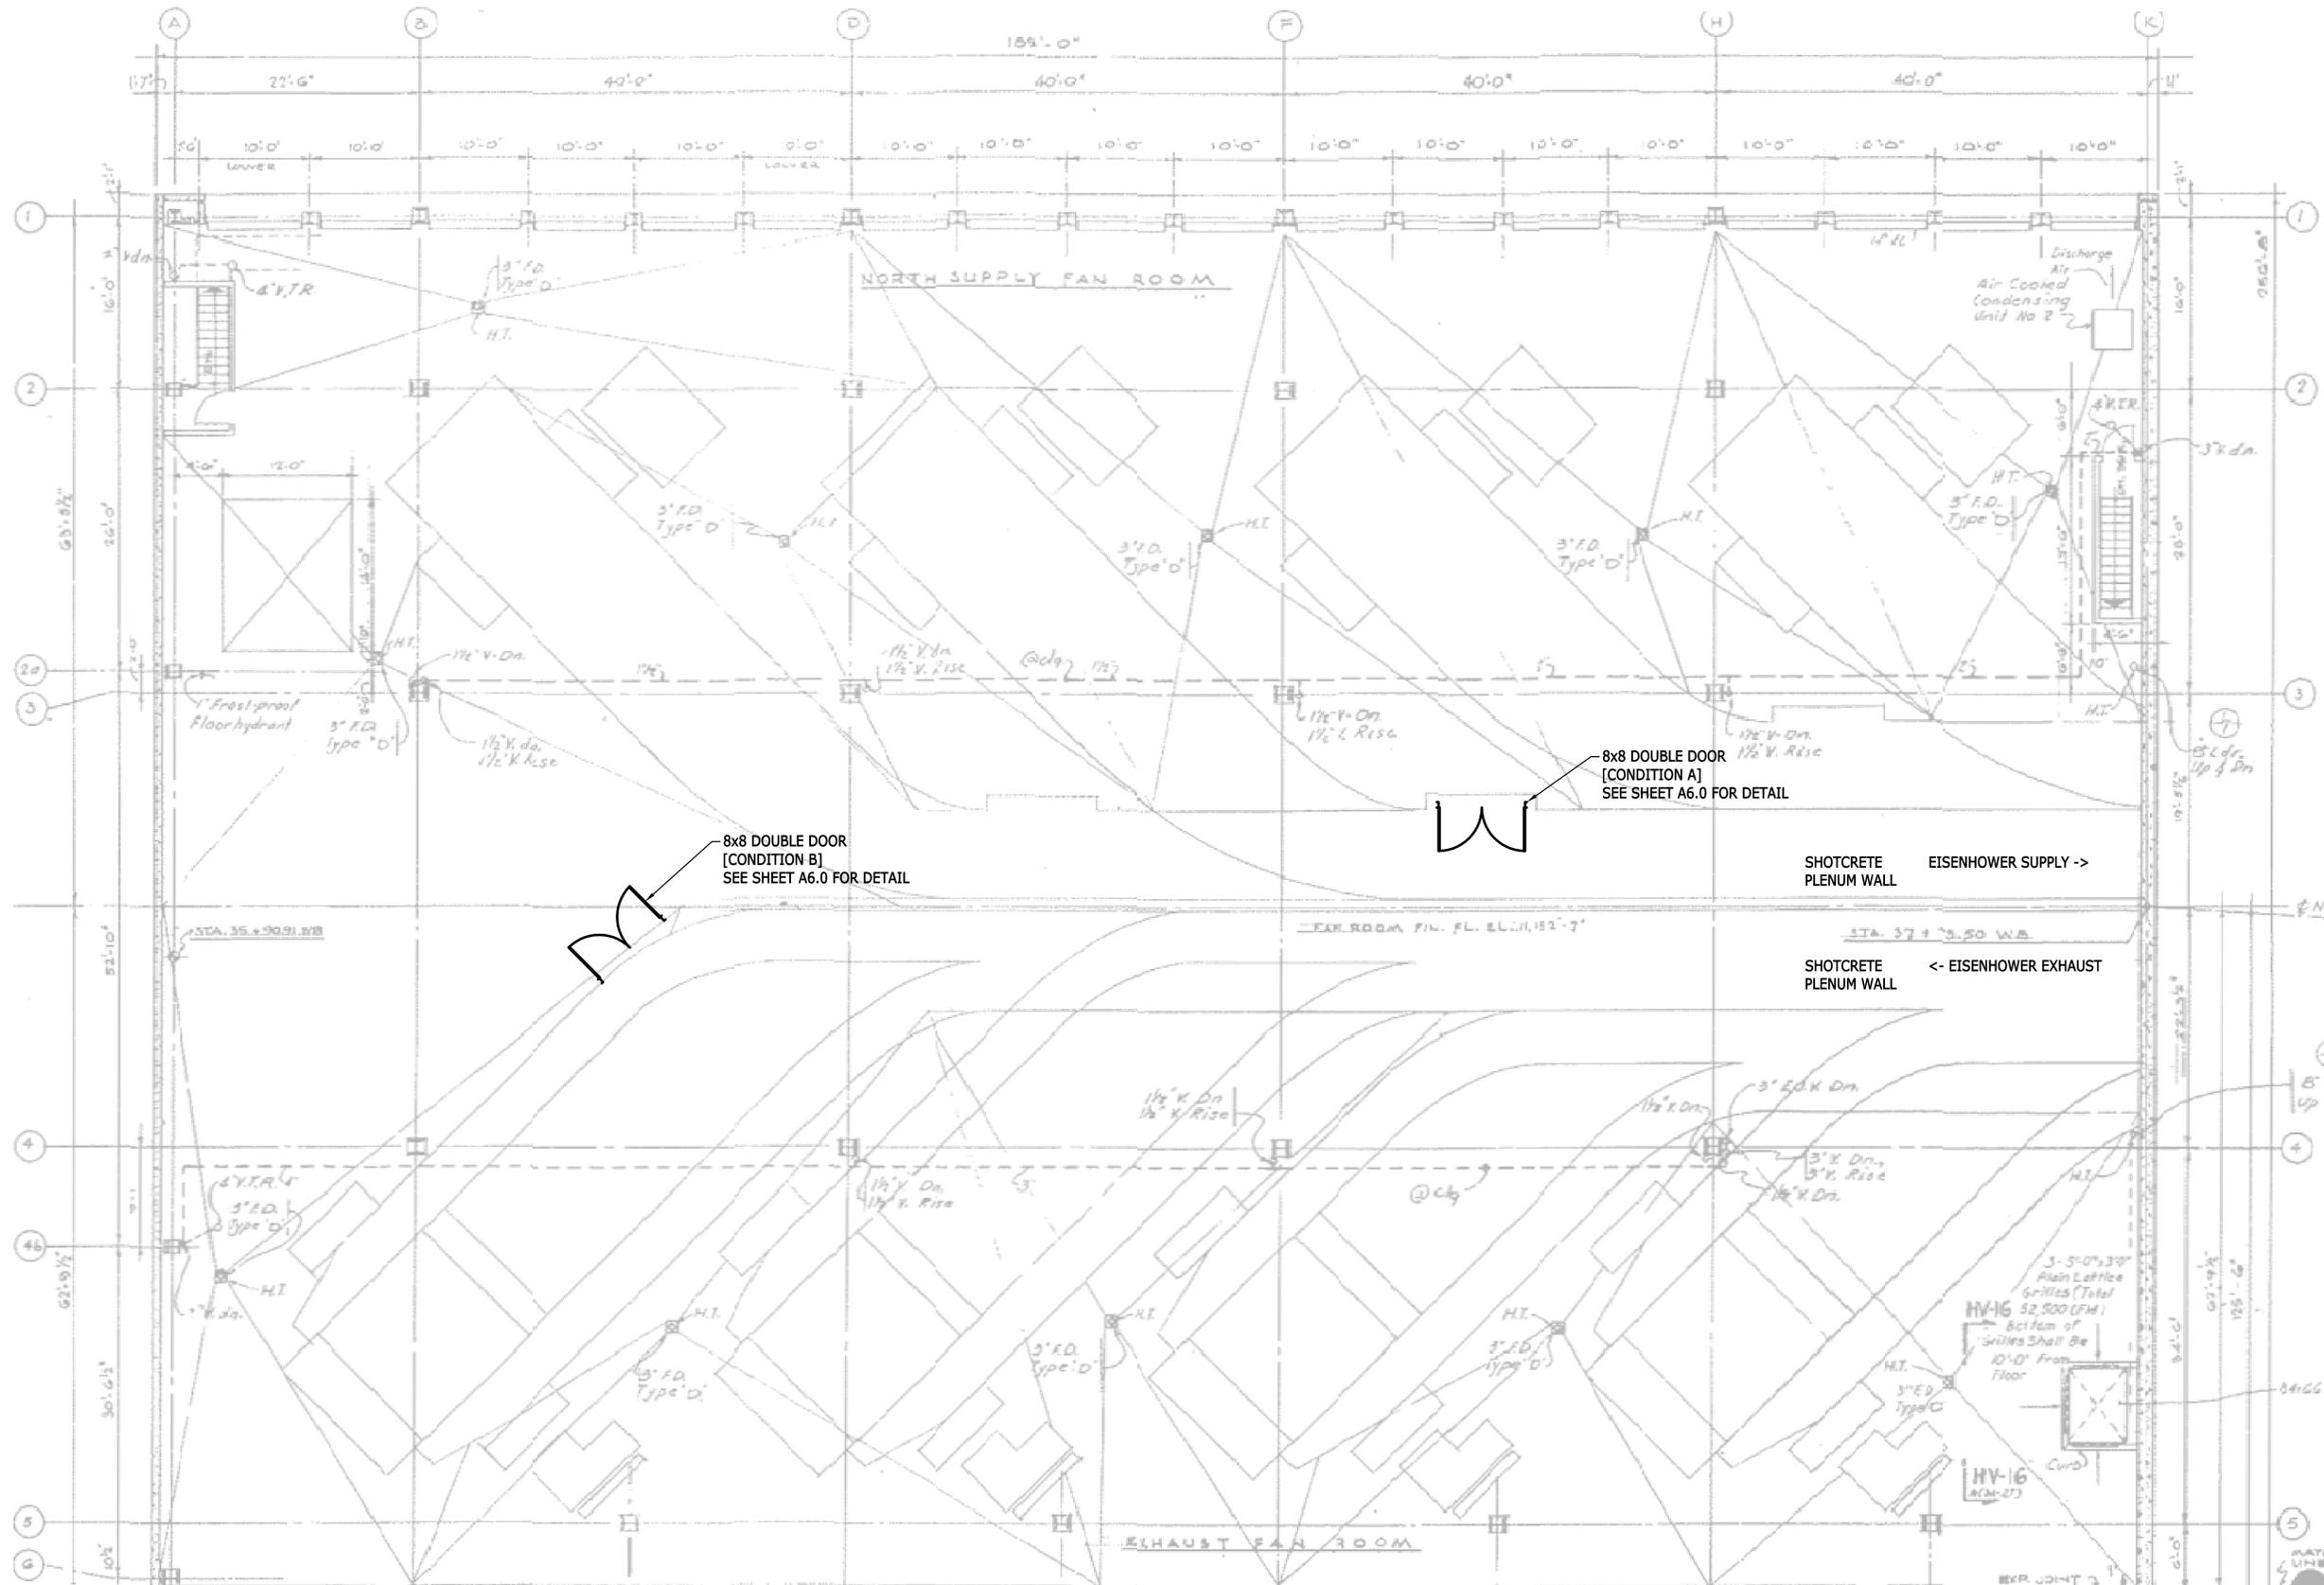


ARCHITECTURAL FAN LEVEL PLAN - WEST - NORTH (SHOTCRETE PLENUM CONDITION)  
SCALE: 1/8" = 1'-0"

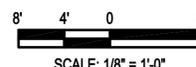

GENERAL NOTE:

1. MAINTAIN EXISTING DOORS INTO PLENUM.
2. CONTRACTOR TO VERIFY ALL DOOR LOCATIONS WITH CDOT PRIOR TO DEMOLITION.

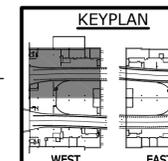

EISENHOWER/JOHNSON  
MEMORIAL TUNNEL  
FIXED FIRE SUPPRESSION SYSTEM  
DESIGN BUILD PROJECT

BARNARD EJMT TEAM

BCER  
Western States Fire Protection Co.  
BARNARD  
Sturgeon Electric  
RONDINELLI  
A BEER GROUP LIFE SAFETY  
ALF  
ENGINEERS

REVISIONS	Date
Num	Description


ARCHITECTURAL FAN LEVEL PLAN - WEST - NORTH  
Drawing Number  
**A2.0**

Project No. C0703-360  
Subcontract 17810  
RECORD DRAWINGS - 2015-11-16


DRAWN BY: JEB  
CHECKED BY: SCR



IF THIS SHEET IS NOT 22"x34" IT IS NOT PLOTTED TO SCALE

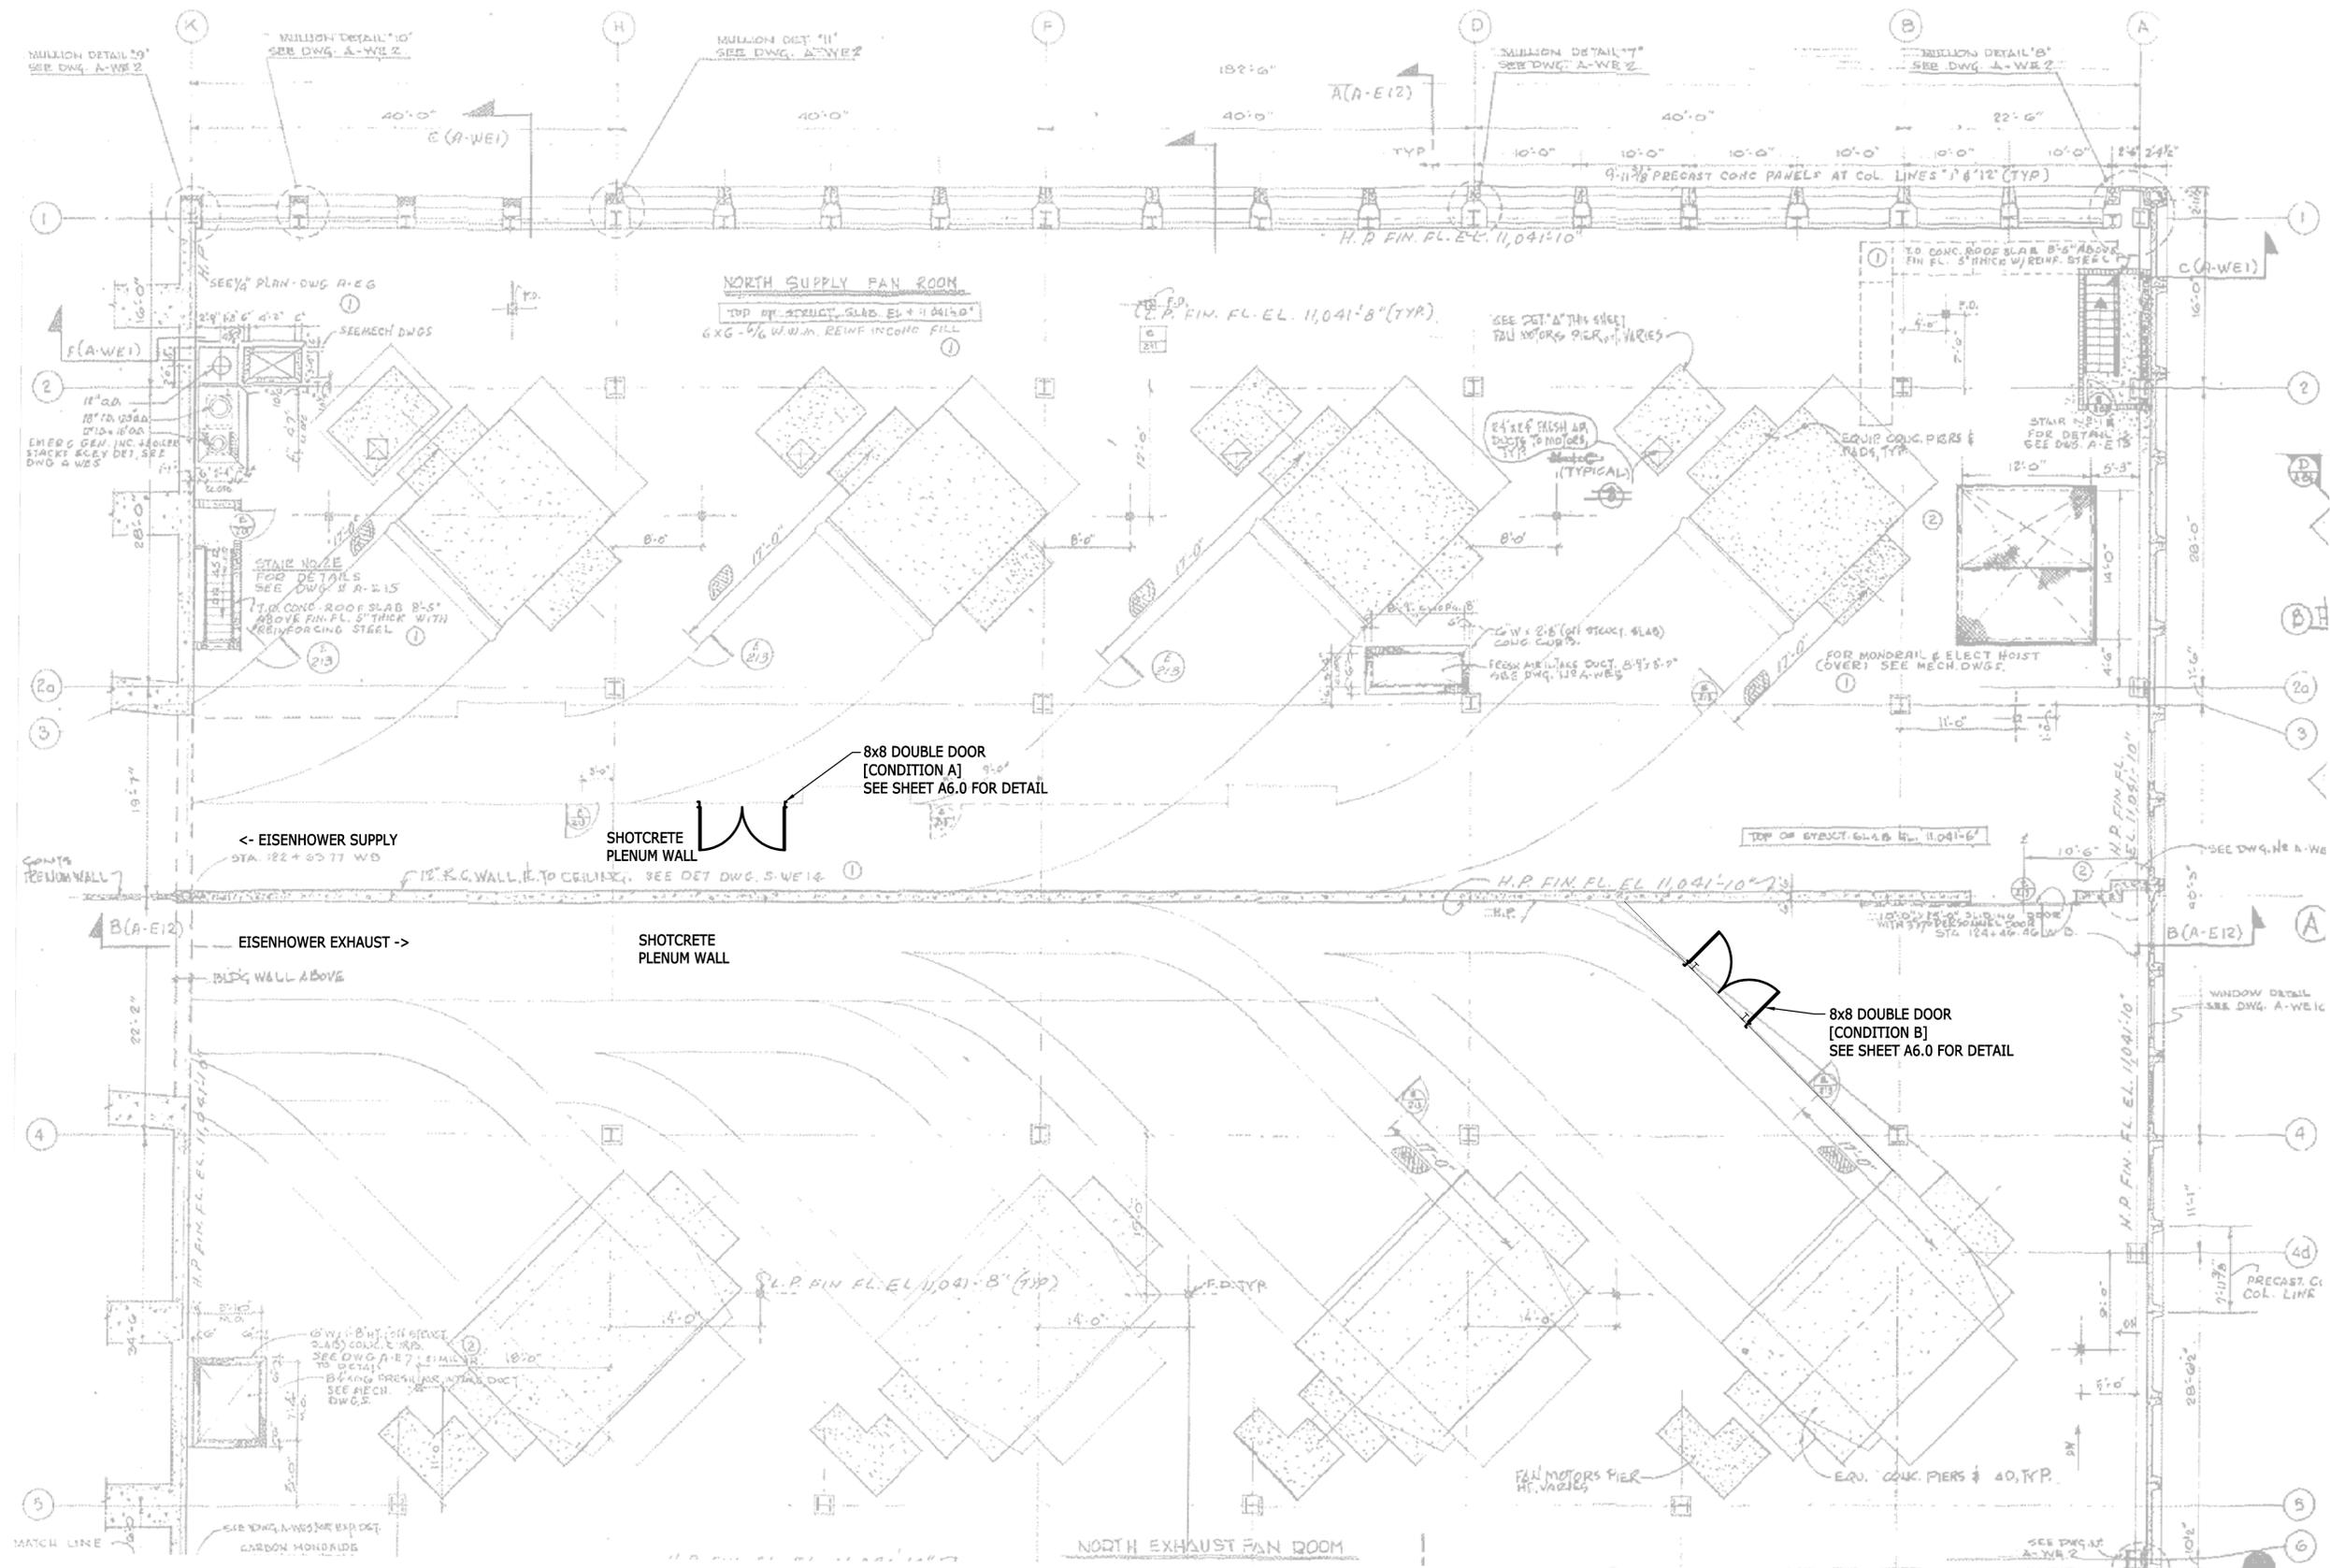


1 ARCHITECTURAL FAN LEVEL PLAN - EAST - NORTH (SHOTCRETE PLENUM CONDITION)  
SCALE: 1/8" = 1'-0"

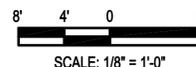

GENERAL NOTE:

1. MAINTAIN EXISTING DOORS INTO PLENUM.
2. CONTRACTOR TO VERIFY ALL DOOR LOCATIONS WITH CDOT PRIOR TO DEMOLITION.

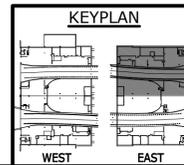

EISENHOWER/JOHNSON  
MEMORIAL TUNNEL  
FIXED FIRE SUPPRESSION SYSTEM  
DESIGN BUILD PROJECT

Revisions	Date
Num	Description

ARCHITECTURAL FAN LEVEL PLAN - EAST - NORTH  
Drawing Number  
**A2.2**

**BARNARD EJMT TEAM**

**BARNARD** **RONDINELLI**

**BCER** **Sturgeon Electric**


Western States Fire Protection Co. ENGINEERS

Subaccount 17810  
Project No. C0703-360  
RECORD DRAWINGS - 2015-11-16


DRAWN BY: JEB  
CHECKED BY: SCR



IF THIS SHEET IS NOT 22"x34" IT IS NOT PLOTTED TO SCALE

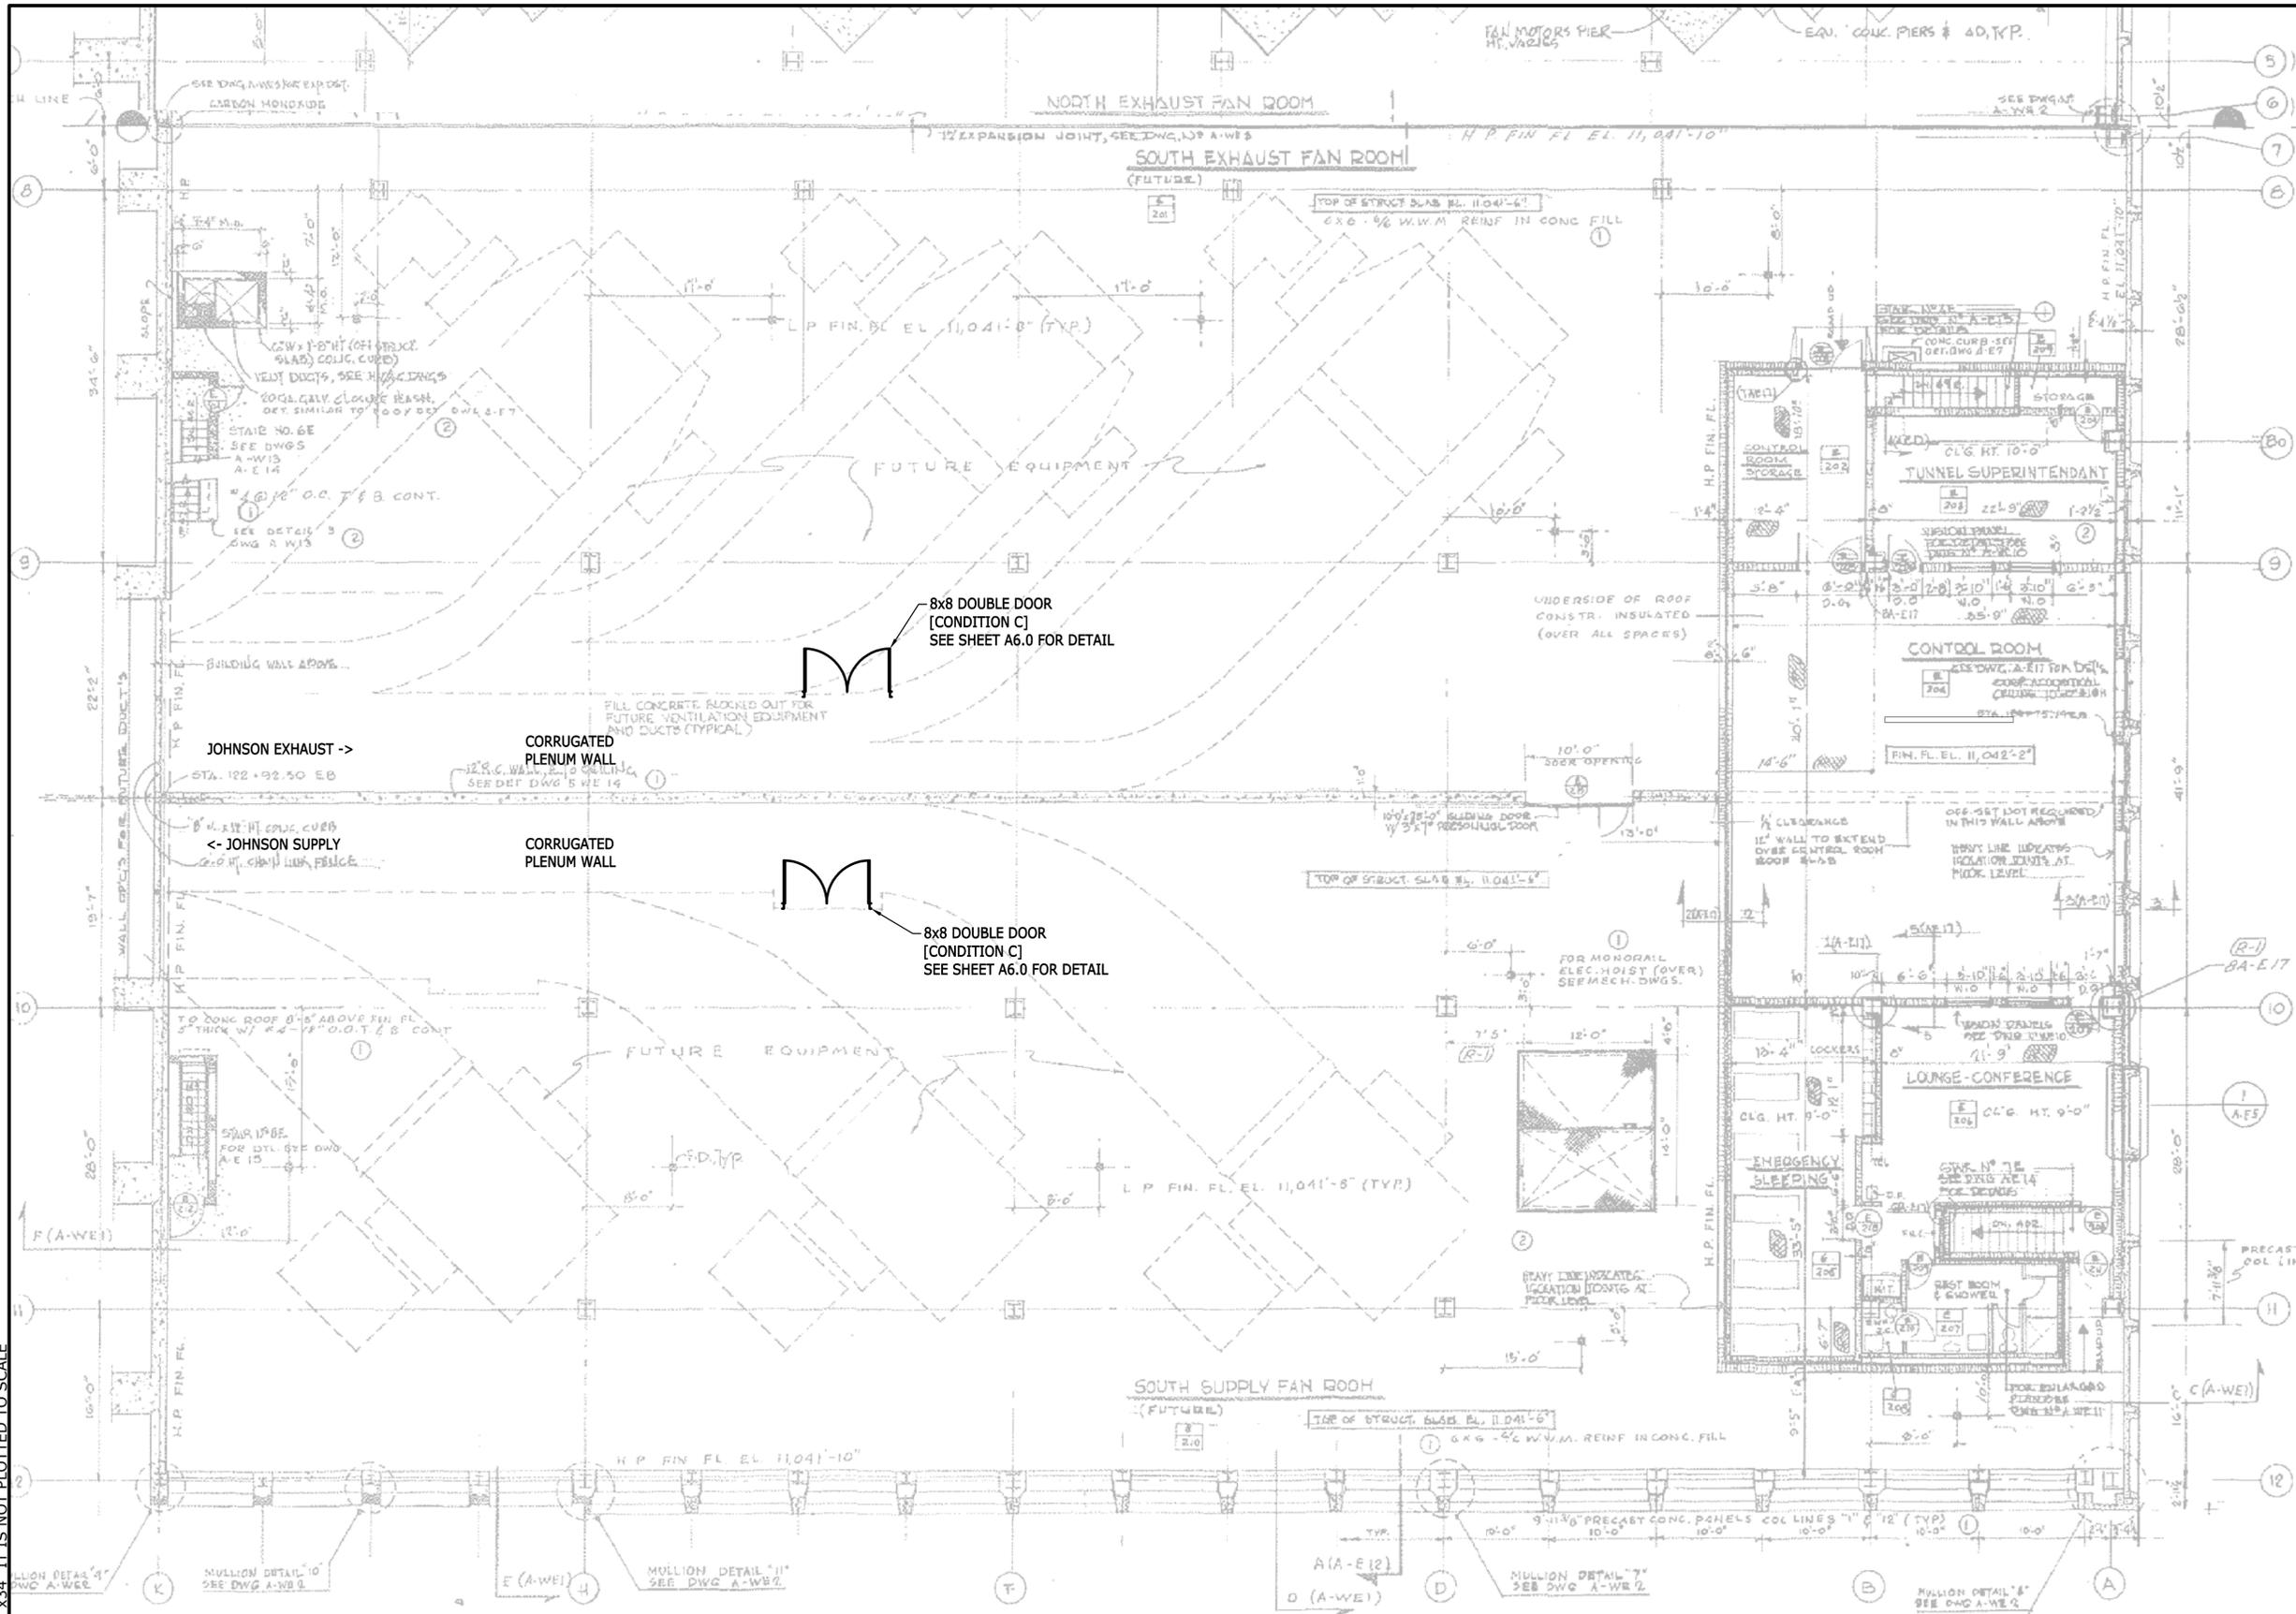


ARCHITECTURAL FAN LEVEL PLAN - EAST - SOUTH (CORRUGATED PLENUM CONDITION)  
SCALE: 1/8" = 1'-0"

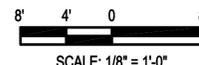

SCALE: 1/8" = 1'-0"

GENERAL NOTE:

1. MAINTAIN EXISTING DOORS INTO PLENUM.
2. CONTRACTOR TO VERIFY ALL DOOR LOCATIONS WITH CDOT PRIOR TO DEMOLITION.

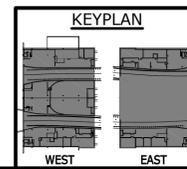

ARCHITECTURAL FAN LEVEL PLAN - EAST - SOUTH

Drawing Number

A2.3

EISENHOWER/JOHNSON MEMORIAL TUNNEL  
FIXED FIRE SUPPRESSION SYSTEM  
DESIGN BUILD PROJECT

Project No. C0703-360 Subaccount 17810  
RECORD DRAWINGS - 2015-11-16

BARNARD EJMT TEAM

BCER  
CONSULTING ENGINEERS

BARNARD

RONDINELLI  
A PER GROUP LIFE SAFETY

Sturgeon  
ELECTRIC

Western States  
Fire Protection Co.

ALF  
CONSULTING ENGINEERS

Num	Revisions	Date
	Description	

DRAWN BY: JEB  
CHECKED BY: SCR

Revisions	Num	Description	Date
	3	CONCRETE MIX	2015-07-29

ARCHITECTURAL EMERGENCY GENERATOR PLAN


Drawing Number **A2.4**

**GENERAL NOTES:**


1. SAW CUT AND REMOVE EXISTING ASPHALT FOR NEW CONCRETE PAD.
2. ATTACH GENERATOR SKID BRACKETS TO NEW CONCRETE PAD PER MANUFACTURER'S RECOMMENDATION.
3. SEE ELECTRICAL DRAWINGS FOR EMERGENCY GENERATOR INSTALLATION DETAILS.
4. PAINT EMERGENCY GENERATOR FOREST SERVICE BROWN (FEDERAL STANDARD COLOR 20059 OR THE EQUIVALENT SHERWIN WILLIAMS COLOR SW2838).
5. SET THREE 8' TYPE 7 BARRIERS (SEE M&S SHEET M-606-14) TO PROVIDE VEHICLE PROTECTION FOR THE EMERGENCY GENERATOR, WALL HYDRANT AND FIRE DEPARTMENT CONNECTIONS. PAINT BARRIERS FOREST SERVICE BROWN, FEDERAL STANDARD COLOR 20059 OR THE EQUIVALENT SHERWIN WILLIAMS COLOR SW2838. COAT TYPE 7 BARRIERS WITH SHERWIN WILLIAMS PRO INDUSTRIAL ANTI-GRAFFITI COATING.

**WORK NOTES:**


- 1 CORE DRILL FOR WALL HYDRANT AND FIRE DEPARTMENT CONNECTION. SEE FIRE PROTECTION DRAWINGS.
- 2 MAINTAIN POSITIVE DRAINAGE AROUND NEW CONCRETE PAD.
- 3 COORDINATE NEW CONCRETE PAD SIZE WITH ELECTRICAL DRAWINGS AND EMERGENCY GENERATOR SIZE.
- 4 CORE DRILL FOR ELECTRICAL (SHEET E5.0) AND GAS CONNECTIONS (SHEET M6.1). SEE SHEET A6.3 FOR CORE DETAIL. FIELD LOCATE.
- 5 METAL ICE AND SNOW GUARD, MOUNT ~23'-0" ABOVE FINISH GRADE SEE DETAIL SHEET A6.2.

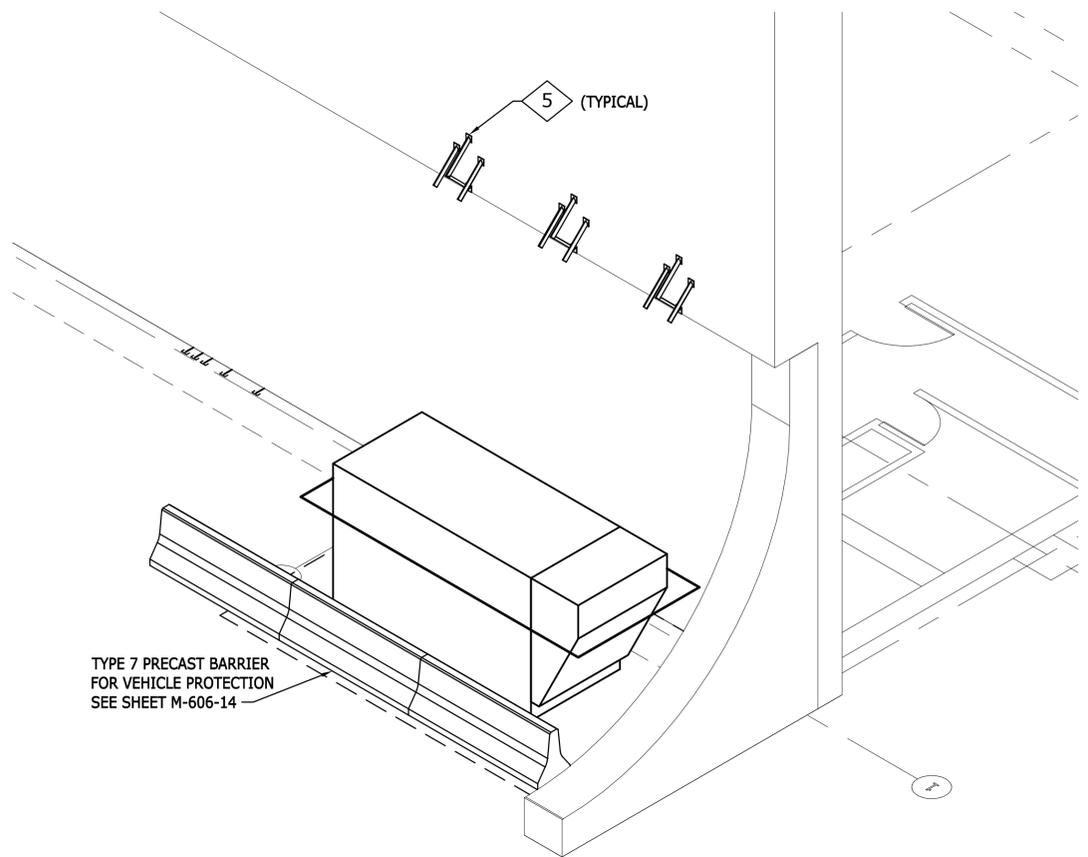

**1 ARCHITECTURAL EMERGENCY GENERATOR ISOMETRIC**  
SCALE: 1/4" = 1'-0"

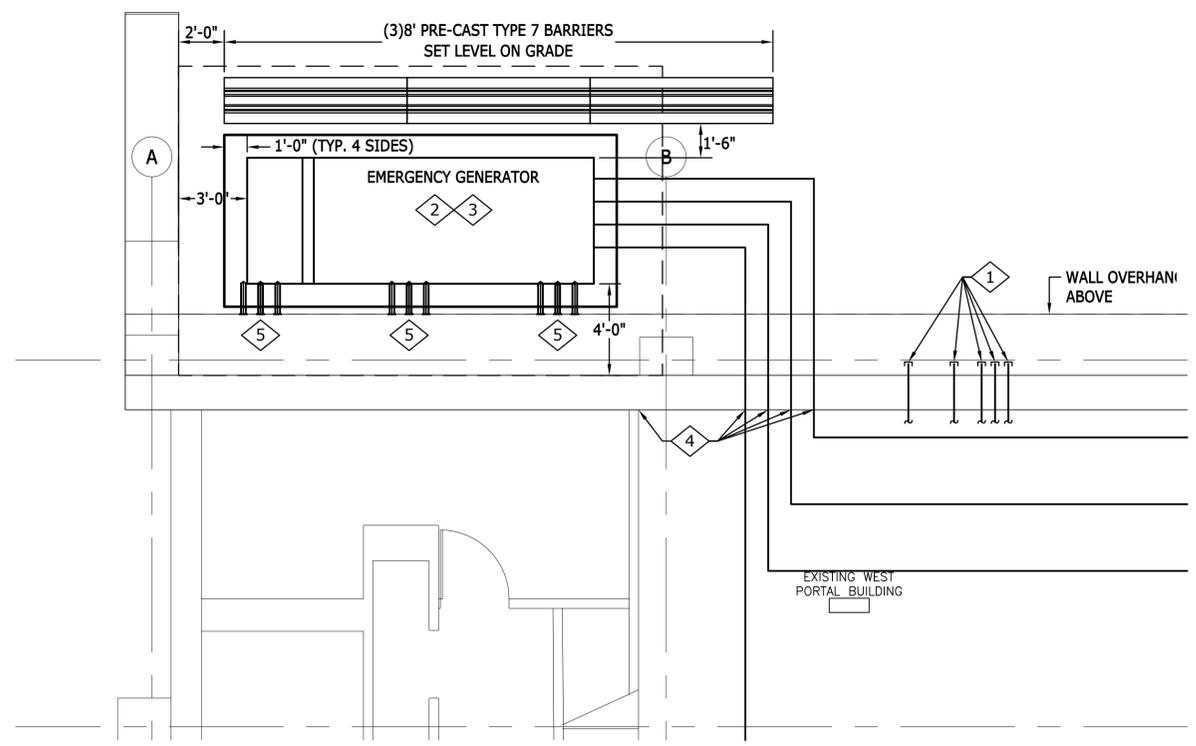

**2 ARCHITECTURAL EMERGENCY GENERATOR PLAN**  
SCALE: 1/4" = 1'-0"

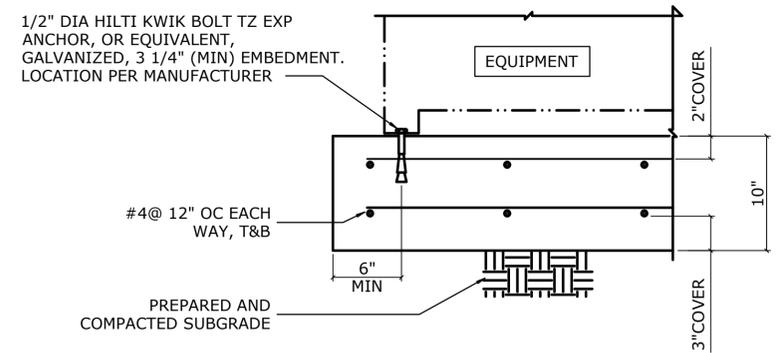


- DETAIL NOTES:**
1. CONTRACTOR TO PROVIDE MIX THAT MEETS THE REQUIREMENT OF CLASS D AS OUTLINED IN TABLE 601-1 OF CDOT STANDARD SPECIFICATIONS.
  2. TOP OF CONCRETE PAD SHALL BE STRAIGHT AND LEVEL IN ALL DIRECTIONS.
  3. CONTROL JOINTS:
    - 2" DEPTH
    - MAXIMUM ASPECT RATIO OF 1.5 TO 1 FOR LAYOUT
    - MAXIMUM SPACING OF 12 FEET
    - TOP LAYER OF REINFORCING DOES NOT CONTINUE THROUGH JOINT

**3 ARCHITECTURAL EMERGENCY GENERATOR PAD DETAIL**  
SCALE: 1-1/2" = 1'-0"


IF THIS SHEET IS NOT 22"x34" IT IS NOT PLOTTED TO SCALE

IF THIS SHEET IS NOT 22"X34" IT IS NOT PLOTTED TO SCALE


1 CONDITION A, HEADER PLAN  
SCALE: 1/2" = 1'-0"

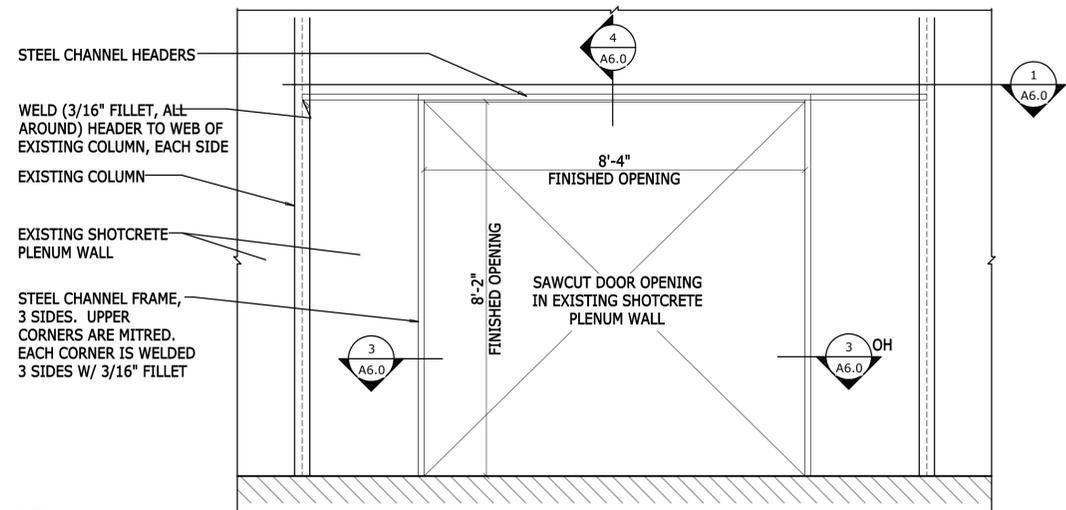


2 CONDITION A ELEVATION  
SCALE: 1/2" = 1'-0"

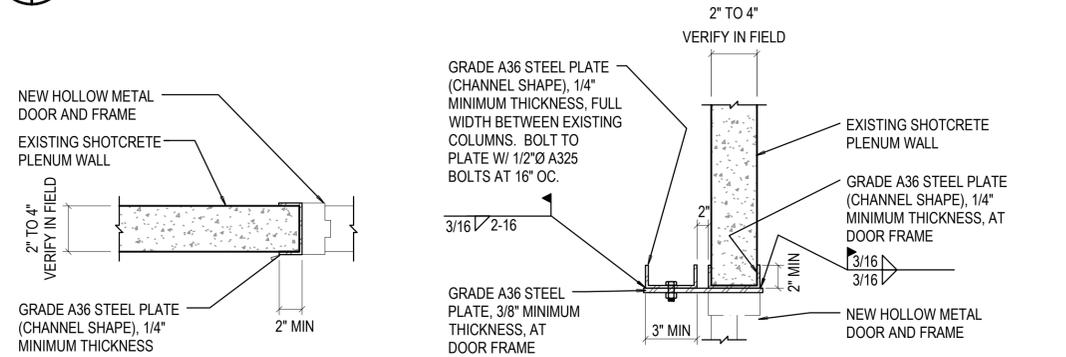


3 CONDITION A JAMB  
SCALE: 1-1/2" = 1'-0"

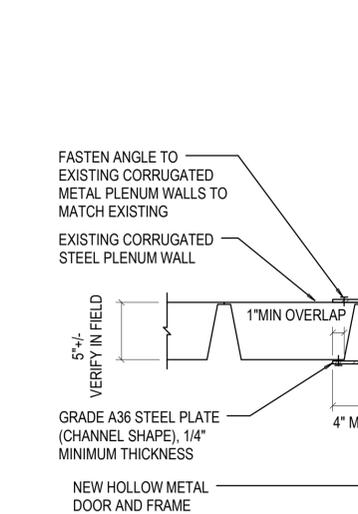


4 CONDITION A HEADER  
SCALE: 1-1/2" = 1'-0"

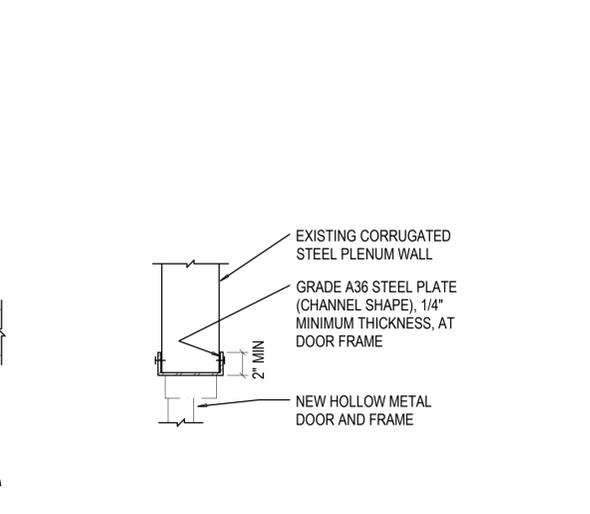


5 CONDITION B, HEADER PLAN  
SCALE: 1/2" = 1'-0"

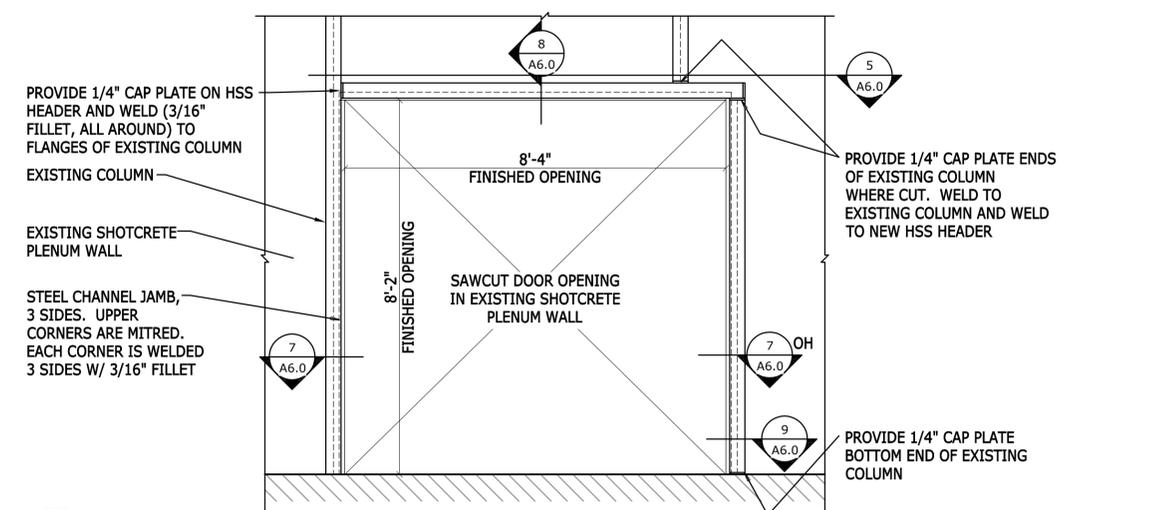


6 CONDITION B ELEVATION  
SCALE: 1/2" = 1'-0"

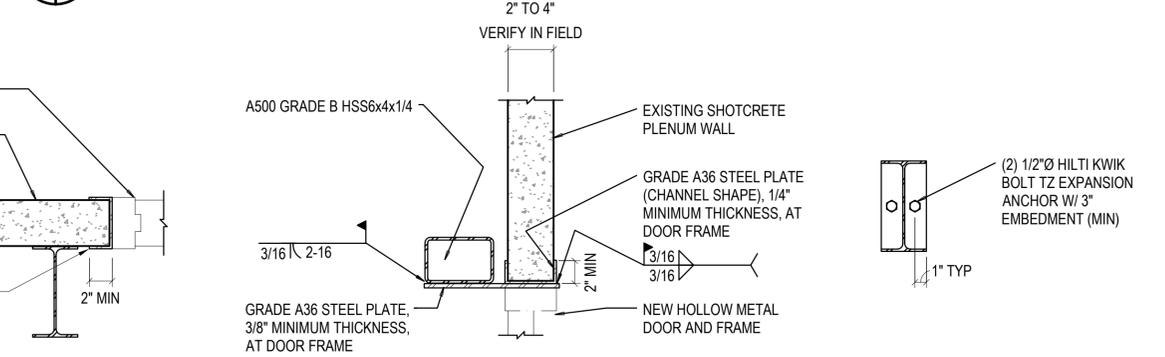


7 CONDITION B JAMB  
SCALE: 1-1/2" = 1'-0"

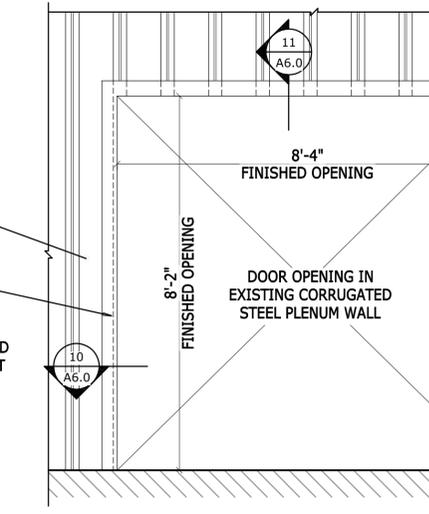


8 CONDITION B HEADER  
SCALE: 1-1/2" = 1'-0"

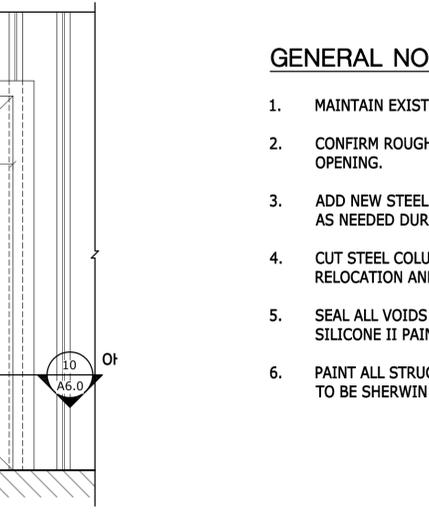


9 CONDITION B (E) COL BASE CONN  
SCALE: 1-1/2" = 1'-0"

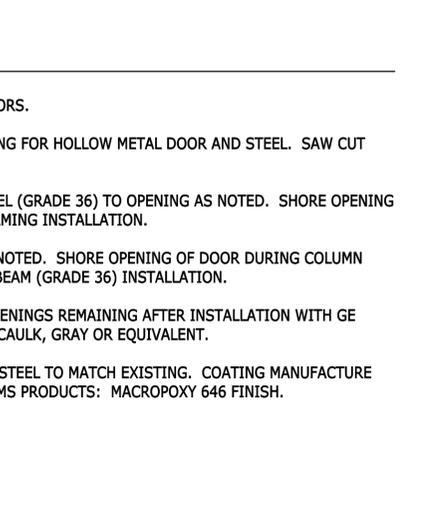


10 CONDITION C JAMB  
SCALE: 1-1/2" = 1'-0"

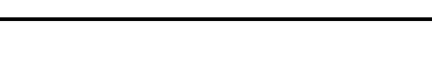

11 CONDITION C HEADER  
SCALE: 1-1/2" = 1'-0"

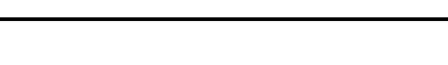

12 CONDITION C ELEVATION  
SCALE: 1/2" = 1'-0"

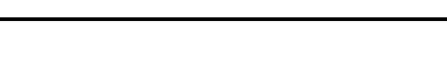

GENERAL NOTES:

- 1. MAINTAIN EXISTING DOORS.
2. CONFIRM ROUGH OPENING FOR HOLLOW METAL DOOR AND STEEL. SAW CUT OPENING.
3. ADD NEW STEEL CHANNEL (GRADE 36) TO OPENING AS NOTED. SHORE OPENING AS NEEDED DURING FRAMING INSTALLATION.
4. CUT STEEL COLUMN AS NOTED. SHORE OPENING OF DOOR DURING COLUMN RELOCATION AND NEW BEAM (GRADE 36) INSTALLATION.
5. SEAL ALL VOIDS AND OPENINGS REMAINING AFTER INSTALLATION WITH GE SILICONE II PAINTABLE CAULK, GRAY OR EQUIVALENT.
6. PAINT ALL STRUCTURAL STEEL TO MATCH EXISTING. COATING MANUFACTURE TO BE SHERWIN WILLIAMS PRODUCTS: MACROPOXY 646 FINISH.

EISENHOWER/JOHNSON MEMORIAL TUNNEL FIXED FIRE SUPPRESSION SYSTEM DESIGN BUILD PROJECT

BARNARD EJMT TEAM

Logos for BCER, BARNARD, RONDINELLI, Sturgeon Electric, and Western States Fire Protection Co.

Table with columns for Revisions (Num, Description, Date) and a row for ARCHITECTURAL DOOR DETAIL.



Project No. C0703-360 Subaccount 17810 RECORD DRAWINGS - 2015-11-16

A6.0

IF THIS SHEET IS NOT 22"x34" IT IS NOT PLOTTED TO SCALE

GENERAL NOTES:

- CONTRACTOR TO PROVIDE SHOP DRAWINGS FOR ENGINEER APPROVAL PRIOR TO FABRICATION AND INSTALLATION.

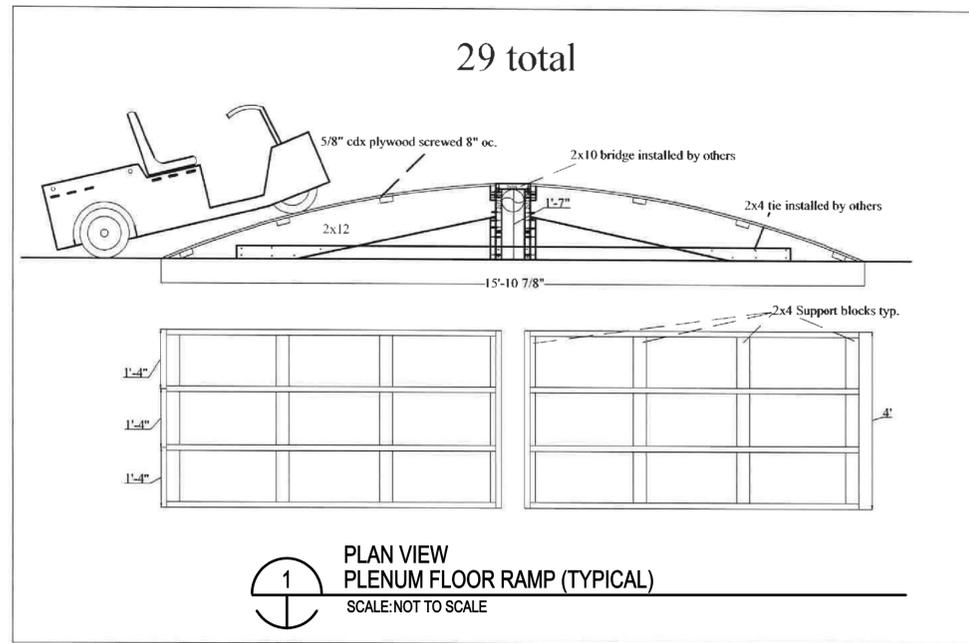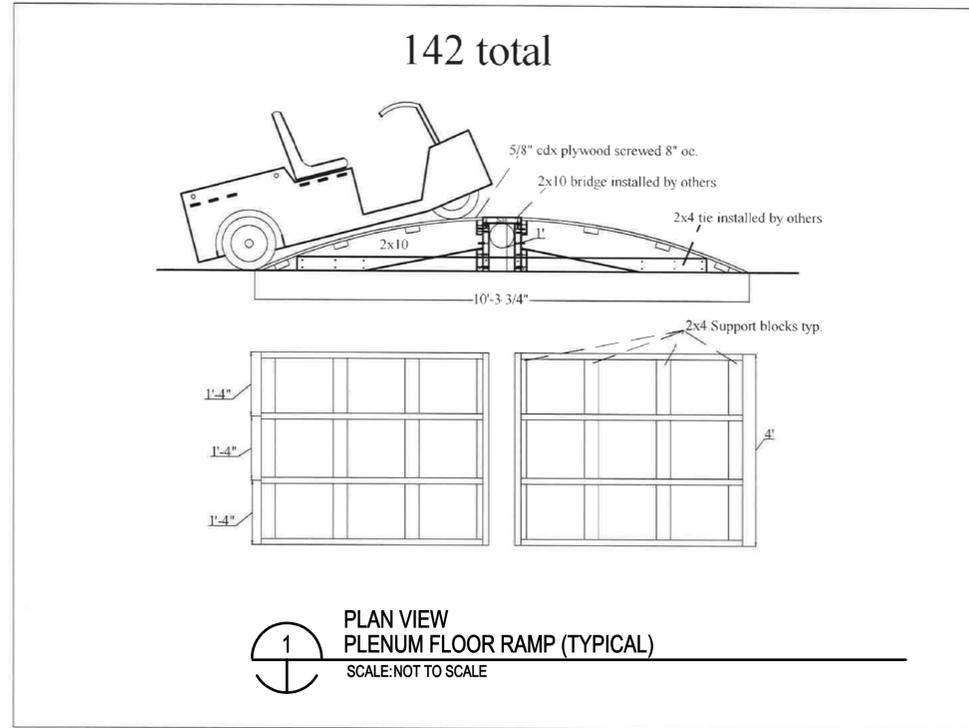

**BARNARD EJMT TEAM**

**BCER** CONSULTING ENGINEERS  
A BEER GROUP life safety

**BARNARD**

**RONDINELLI** CONSULTING ENGINEERS

**Sturgeon ELECTRIC**

Western States Fire Protection Co.

**EISENHOWER/JOHNSON**

**MEMORIAL TUNNEL**  
FIXED FIRE SUPPRESSION SYSTEM  
DESIGN BUILD PROJECT

Project No. C0703-360 Subaccount 17810  
RECORD DRAWINGS - 2015-11-16

Num	Revisions Description	Date

DRAWN BY: JEB CHECKED BY: SCR

ARCHITECTURAL RAMP DETAIL

Drawing Number  
**A6.1**





C0.2 CIVIL MISCELLANEOUS DETAILS

THE CIVIL DETAILS SHOWN ON C0.2 IDENTIFIES TYPICAL TRENCH AND ASPHALT REPLACEMENT DETAILS. ALL EXCAVATION AND BACKFILL FOR THE EJMT FFSS PROJECT SHALL BE IN ACCORDANCE WITH CDOT STANDARD PLAN NO. M-206-1.

C0.3 CIVIL NARRATIVE HYDRAULIC ANALYSIS

CONTAINS HYDRAULIC ANALYSIS REPORTS FOR DROP INLETS AND CONVEYANCE PIPING.

C1.0 - C3.0 EAST PORTAL BUILDING FFSS DRAINAGE PLAN VIEW:

THE CIVIL PLAN VIEWS FOR THE EAST PORTAL BUILDING FFSS DRAINAGE LAYOUT SHOW THE PROPOSED DRAINAGE WORK TO BE COMPLETED AS PART OF THE FFSS PROJECT. THE MAJORITY OF FLOW ASSOCIATED WITH THE FFSS AND THE EXISTING STANDPIPE SYSTEM WILL OCCUR WITHIN THE TUNNELS. IN THE TUNNELS THE FLOW WILL BE DIRECTED TO THE EXISTING DROP INLETS POSITIONED EVERY 150-FT (NOT SHOWN ON DRAWINGS). THIS FLOW WILL BE CAPTURED BY THE EXISTING DRAINAGE SYSTEM IN THE TUNNEL AND THE EAST PORTAL BUILDING BASEMENT SEWER TREATMENT PLANT. AS SHOWN IN THE MECHANICAL DRAWINGS, THE EXISTING 12-IN NORTH AND SOUTH INFLUENT VALVES WILL BE REPLACED WITH AUTOMATED VALVES CONTROLLED BY THE FIRE ALARM SYSTEM. A NEW 12-IN BYPASS PIPE WILL BE INSTALLED IN THE BASEMENT AND WILL CONNECT TO THE EXISTING 12-IN OBSOLETE PIPE WHICH WILL BE USED TO DIVERT THE FIRE WATER FROM THE SEWER TREATMENT PLANT TO MANHOLE 1. THE NORTH FLOW FROM THE BASEMENT WILL BE CAPTURED AT EXISTING MANHOLE 1. THIS FLOW WILL PASS THROUGH MANHOLE 1 (SHEET C5.0) AND INTO THE NEW MANHOLE 2 THROUGH THE 12-IN RCP 1.2. PIPE (SHEET C6.0).

SHEET C2.0 SHOWS THE PLAN VIEW CENTERED AROUND MANHOLE 2 WHERE MANHOLE 2 WILL CAPTURE THE FLOW FROM THE 12-IN RCP 1.2., EXISTING DROP INLET 1 THROUGH THE EXISTING 18-IN CSP LINE AND DROP INLET 2 THROUGH THE NEW 12-IN RCP D2.2. DROP INLETS DI4 AND DI3 WILL BE CONNECTED TO DROP INLETS D12 AND DI1 WITH 12-IN RCP CLASS V PIPE. DROP INLETS WILL BE CONNECTED TO THE NEW AND EXSITING DROP INLETS SUCH THAT THE FULL FLOW DISCHARGE WATER WILL BE CAPTURED OUTSIDE OF THE EAST PORTAL BUILDING AS DETAILED HYDRAULICALLY ON SHEET C0.3. ALL THREE INFLOW STREAMS WILL CONVERGE WITHIN THE MANHOLE VALVE ASSEMBLY, AS SHOWN ON SHEET C6.0. (SEE THE VALVE ORIENTATION TABLE ON SHEET C6.0 FOR FURTHER DETAILS ON THE VALVE ASSEMBLY AND VALVE POSITIONS) THE 18-IN OUTFLOW PIPE, 18-IN RCP 2.3., WILL ONLY CONTAIN FLOW WHEN THE FFSS IS ACTIVATED, AND DIRECT THIS FLOW TO THE STORAGE TANKS LOCATED IN THE TOP RIGHT CORNER OF THE SHEET C1.0 AND SHOWN AT AN ENLARGE SCALE ON SHEET C3.0.

THE PROVIDED CHANNEL ANALYSIS CALCULATIONS, SHOWN ON SHEET C0.3, SHOW THAT BOTH A 12-INCH PIPE AND 18-INCH PIPE ARE SUFFICIENT TO CARRY THE DESIGN FLOW RATE OF 4.076 CFS FOR THE DESIGN SLOPE OF THE PIPES; 1.0% FOR A 12-IN PIPE AND 1.00% AND 2.00% FOR THE 18-IN PIPES. THE DESIGN FLOW FROM MANHOLE 5 TO TANKS 2 AND 3 IS ASSUMED TO BE HALF OF THE FULL FLOW, 2.038 CFS FOR EACH OF THE 8-IN PVC PIPES FEEDING TANKS 2 AND 3. ALL MANHOLES SHALL BE CONSTRUCTED IN ACCORDANCE WITH M&S M-604-20.

ALL PIPES ARE SIZED FOR THE DESIGN FLOW RATE OF 4.076 CFS AS DETAILED IN THE FINAL DRAINAGE REPORT, WITH THE EXCEPTION OF THE 8-IN PIPES AS STATED ABOVE. DETAILS REGARDING THE PROPOSED PIPE SLOPES, INVERTS AND LENGTHS CAN BE FOUND ON THE TABLE ON SHEET C1.0.

ALL EXISTING PIPES SHOWN ON SHEETS C1.0 THROUGH C3.0 WILL REMAIN IN USE WITH THE EXCEPTION OF THE 18-IN CSP PIPE IN WHICH A SHORT SECTION OF PIPE SHALL BE REMOVED UPSTREAM OF THE EXISTING MANHOLE 2 AND BROUGHT INTO THE NEW MANHOLE 2, SEE SHEET C6.0.

C4.0 EAST PORTAL BUILDING FFSS DRAINAGE PROFILE VIEW:

THE THREE PROFILE VIEWS DEPICT THE THREE PRIMARY RUNS OF DRAINAGE PIPE FOR THE FFSS AT THE EAST PORTAL. PROFILE 1: FFSS DRAINAGE ALIGNMENT FROM EXISTING MANHOLE 1 TO THE TANK 1 SHOWS THE 12-IN RCP PIPE 1.2 CONNECTING TO MANHOLE 2 WHERE FLOW FROM AN ACTIVATED FFSS AND STANDPIPE WATER WOULD CONTINUE TO THE STORAGE TANK THROUGH 18-IN RCP 2.3., TO TANK 1 THROUGH MANHOLES 3, 4, AND 5. PIPING TO CONVEY FLOW FROM THE NEW DROP INLET2IN THE EAST BOUND LANE OF TRAVEL IS SHOWN IN PROFILE 2: FFSS DRAINAGE ALIGNMENT FROM DROP INLET. PIPING TO COMPLETE FLOW FROM MANHOLE 5 TO THE DRAINAGE TANKS IS SHOWN ON PROFILE 3: FFSS MANHOLE 5 TO DISCHARGE STORAGE TANKS.

TOTAL STORAGE TANK VOLUME IS PROVIDED IN THE BOTTOM RIGHT FIGURE DEPICTING TANK 1 NO LONGER FILLING TO CAPACITY BUT TO A STORAGE VOLUME OF 38,240 GALLONS WITH TANKS 2 AND 3 AT A TOTAL CAPACITY OF 80,000 GALLONS. THIS PROVIDES FOR A TOTAL STORAGE CAPACITY OF 118,240GALLONS. THE TANK VOLUME CAPACITY IS BASED OFF THE INLET PIPE 12-IN PVC 5.11. INVERT ELEVATION AT THE TANK 1 OF 10999.11 FT WHICH IS BELOW THE CROWN OF THE TANK 1 HOWEVER FLOW WILL START TO BACK UP AND FILL TANK 2 AND TANK 3 BEFORE TANK 1 FILLS TO EXISTING CAPACITY. TO ACHIEVE THE TOTAL STORAGE CAPACITY IT IS ASSUMED THAT FLOW WILL BACKUP TO THE INVERT OF PIPE RCP 18" 2.3. AT MANHOLE 2. CALCULATIONS ARE ALSO PROVIDED FOR THE MOST DEMANDING FFSS ACTIVATION OF TWO ZONES AND FULL USE OF THE EXISTING STANDPIPE SYSTEM.

C5.0 EXISTING MANHOLE 1

EXISTING MANHOLE 1 WILL BE MODIFIED TO CONNECT A 12-IN DIP PASS THROUGH PIPE THROUGH THE MANHOLE. THE NEW 12-IN DIP PIPE WILL CONNECT TO THE NEW 12-IN RCP 1.2. PIPE WHICH WILL REQUIRE CORING THROUGH THE EXISTING MANHOLE 1 EAST WALL. A DETAIL FOR CORING THROUGH THE EXISTING WALL IS PROVIDED.

C6.0 MANHOLE 2

THE MOTOR CONTROLLED BUTTERFLY VALVES LOCATED WITHIN MANHOLE 2 WILL BE CONTROLLED BY THE FIRE ALARM SYSTEM TO DIRECT FLOW TO CLEAR CREEK OR TO THE DISCHARGE STORAGE TANKS. UNDER NORMAL OPERATIONS THE VALVE 5, 12-IN VALVE, WILL BE OPEN AND VALVE 6, 12-IN VALVE, WILL BE CLOSED CAUSING ALL FLOW FROM THE INLETS TO BE DIRECTED TO THE EXISTING 36-IN CSP SEEPAGE LINE AND ON TO CLEAR CREEK. WHEN THE FFSS IS ACTIVATED, THE VALVE POSITIONS WILL SWITCH TO DIRECT FLOW TO THE DISCHARGE STORAGE TANKS. THE VALVES SHALL BE PENTAIR AR2 BUTTERFLY VALVES WITH A 150 PSI WORKING PRESSURE. THE VALVES SHALL BE FITTED WITH A PENTAIR KEYSTONE F777/778 ELECTRIC ACTUATORS WITH MODULATING CONTROLLER OPTION.

THE EXISTING 36-INCH CSP SHALL BE CUT TO ALLOW FOR FLOW CHANNELIZATION TO BE CONSTRUCTED WITHIN THE MANHOLE AS DETAILED IN M&S M-604-20.

C7.0 MANHOLE DETAILS

THE DRAWING SHOWS TYPICAL 48-IN DIAMETER MANHOLES (DETAILS 1 - 3) TO BE UTILIZED FOR ALL MANHOLE LOCATIONS WITH THE EXCEPTIONS OF MANHOLE 1, 2, 8 AND 9. MANHOLES 8 AND 9 SHALL BE CONSTRUCTED PER DETAIL 4, AS MANHOLES 8 AND 9 ARE FOR TANK ACCESS ONLY, THERE IS NO MANHOLE BASE, THE MANHOLE RISER SHALL BE PLACED ON THE CLASS 1 STRUCTURAL BACKFILLED AROUND THE TANK. MANHOLE INVERT AND RIM ELEVATIONS DETAILS ARE PROVIDED IN THE TABLE ON THE SHEET AND SHALL BE FIELD VERIFY PRIOR TO THE START OF CONSTRUCTION. ALL MANHOLES SHALL BE CONSTRUCTED IN ACCORDANCE WITH CDOT M&S M-604-20. NOTE, MANHOLES WITHIN THE ROAD WAY SHALL BE CONSTRUCTED WITH A FLAT TOP WHEN LIMITED COVER OVER THE CROWN OF PIPE IS ANTICIPATED, ALL OTHER MANHOLES SHALL BE CONSTRUCTED WITH ECCENTRIC CONE TOP. ALL MANHOLES SHALL BE CONSTRUCTED TO PROVIDE ADEQUATE SPACE FOR MAINTENANCE ACTIVES, ACCESS, AND CLEANOUTS. WHEN THE MANHOLE IS LOCATED IN UNPAVED AREAS, THE STRUCTURE RIM SHALL BE 6-INCHES ABOVE SURROUNDING GRADE (DIRT).

C8.0 DROP INLET STRUCTURE DETAILS

DETAILS ARE PROVIDED FOR DROP INLET STRUCTURES. ALL DROP INLET STRUCTURES SHALL BE CONSTRUCTED IN ACCORDANCE WITH CDOT STANDARD PLAN NO. M-604-25 AND SHALL BE HS-20 RATED. IT IS ASSUMED THAT THE ROADWAY SHOULDER FOR THE EAST BOUND LANE OF TRAVEL IS 9-FT WIDE AT THE DROP INLET LOCATIONS, CONTRACTOR TO CONFIRM SHOULDER WIDTH WITH SURVEY PRIOR TO THE START OF CONSTRUCTION. CURRENT LANE IMPACT WITH THE 5.5-FT INLET BOX, AND 2 FT APRON TRANSITION SHALL NOT IMPACT THE TRAVEL LANE AND APRON TRANSITION. THE APRON TRANSITION SHALL PROVIDE FOR A 1-IN SUMP AS SHOWN TO FACILITATE ROADWAY AND FFSS WATER DRAINAGE. THE CONCRETE AND/OR ASPHALT TO BE PLACED AT THE SURFACE OF THE DROP INLET BOX SHALL BE PLACED TO PROVIDE A CROSS-SLOPE GUTTER OF TO MATCH EXISTING CROSS SLOPES AND A MINIMUM GUTTER WIDTH OF 9.0FT. THE LONGITUDINAL SLOPE OF THE ROAD IS ASSUMED TO BE 0.016 (FT/FT) FOR THE EAST BOUND TRAVEL LANES AND 0.009 (FT/FT) FOR THE WEST BOUND TRAVEL LANES. CALCULATIONS COMPLETED FOR THE DESIGN OF THE DROP INLET ARE PROVIDED ON SHEET C0.3, CALCULATION WERE COMPLETED WITH THE USE OF THE HYDRAULIC TOOLBOX VERSION 4.2 FROM FEDERAL HIGHWAYS ADMINISTRATION.

C9.0 - C12.0 EATON TANK (1 - 4)

THE DRAWING SHOWN ON SHEETS C9.0 - C12.0 WERE CREATED BY EATON METAL PRODUCTS OF DENVER COLORADO. EATON WILL BE THE MANUFACTURER OF THE NEW FFSS STORAGE DISCHARGE TANKS 2 AND 3. THE TANKS AS DESIGNED BY EATON EACH PROVIDE FOR A STORAGE VOLUME OF 40,000 GALLONS.

THE TANKS ARE RATED FOR H2O LOADING AS NOTED BY EATON ON SHEET C9.0 WHEN BURIED 4-FT BELOW GRADE. PEA GRAVEL WILL BE USED FOR BACKFILL. THE TANKS SHALL SLOPE SLIGHTLY TO ENCOURAGE A COMPLETELY EMPTY SYSTEM WHEN SUCKED DRY. THERE ARE NO MECHANICAL COMPONENTS INSIDE THESE TANKS.

A LEVEL SENSOR SHALL BE INSTALLED AND WIRED TO THE FIRE ALARM SYSTEM FOR MONITORING.

C13.0 WEST SIDE FFSS SUPPLY PROFILE

THE 10-IN 150 CLASS DIP NEW SUPPLY LINE WILL CONNECT AT THE EXISTING 8-IN MAIN AT THE EXISTING STORAGE TANK. THE LINE WILL BE BURIED A MINIMUM OF 9-FT BELOW THE EXISTING GRADE. 4-IN OF BLUE BOARD INSULATION WILL BE PLACED ABOVE THE NEW 10-IN DIP TO FURTHER PROTECT AGAINST FREEZING. THE PIPE SHALL BE EXCAVATED AND BACKFILLED PER MS-206-1 WITH THE ADDITION OF THE BLUE BOARD INSULATION.

C14.0 - C15.0 SUPPLY TANK CONCRETE LINING DETAILS (1-2)

THE WATERPROOF CONCRETE LINING SHALL BE APPLIED AS INSTRUCTED TO THE AREAS SHOWN AND INDICATED ON THE DRAWINGS. THE COATING SHALL BE APPLIED TO ALL INTERIOR SURFACES OF THE EXISTING STORAGE TANK. AT A MINIMUM, THE CONTRACTOR SHALL FOLLOW THE WATERPROOF CONCRETE COATING APPLICATION SPECIFICATION LISTED WITHIN THE SHEET. ALL COATING MANUFACTURER APPLICATION INSTRUCTIONS SHALL SUPERSEDE APPLICATION SPECIFICATIONS LISTED.

THE VOLUME OF THE STORAGE TANK IS 121,064 GALLONS.

GENERAL NOTES:

- ALL CONCRETE FOR STRUCTURES AND PIPES SHALL CONFORM TO CDOT STANDARD SPECIFICATIONS 601.
- ALL REINFORCEMENT USED IN THE CONSTRUCTION OF DRAINAGE ELEMENTS SHALL CONFORM TO CDOT SECTION 701.1. ADDITIONALLY, REINFORCING SHALL CONSIST OF DEFORMED BARS ONLY PER ASTM A615.
- ALL EXCAVATIONS AND BACKFILL SHALL CONFORM TO CDOT STANDARD PLANS M-206-1. ALL SURFACES SHALL BE BROUGHT BACK TO MATCH EXISTING GRADES. ALL ITEMS IDENTIFIED TO BE ABANDONED OR REMOVED SHALL BE DONE IN ACCORDANCE WITH CDOT STANDARD SPECIFICATION SECTION 202.
- ALL MANHOLE STRUCTURES SHALL BE CONSTRUCTED IN ACCORDANCE WITH CDOT STANDARD PLAN M-204-20.
- ALL REINFORCED CONCRETE PIPE SHALL BE CONSTRUCTED AND PLACED IN ACCORDANCE WITH CDOT STANDARD PLAN M-603-2. ALL REINFORCED CONCRETE PIPE SHALL BE CLASS III WITH THE EXCEPTION OF THE 12-IN LINES CONNECTING DROP INLETS, THESE LINE SHALL BE CLASS IV.
- FOR ALL PVC PIPE WORK, DETECTION TAPE SHALE BE PLACED 6 TO 12 INCHES ABOVE PIPE.
- GEOTECHNICAL BORINGS HAVE NOT BEEN COMPLETED, THE CONTRACTOR SHALL CONFIRM EXISTING GROUND CONDITIONS DURING CONSTRUCTION AND SELECT THE PROPER BEDDING MATERIAL IN ACCORDANCE WITH M-206-1. THE CONTRACTOR SHOULD ANTICIPATE EXCAVATION IN SOILS, COMPACTED FILL AND ROCK
- NO DRAINAGE MODIFICATION WILL BE MADE TO THE WEST END OF THE TUNNEL OR ROADWAY SPACE OUTSIDE OF THE WEST END. IT IS ANTICIPATED THAT ACTIVATION OF THE TWO ZONES FURTHEST TO THE WEST IN BOTH TUNNELS MAY CAUSE A RELEASE OF FIRE FIGHTING WATER THAT IS NOT CAPTURED BY THE EXISTING OR MODIFIED EJMT DRAINAGE SYSTEM IN ACCORDANCE WITH THE CONTRACT.

UTILITIES:

WORK SHALL BE PERFORMED IN ACCORDANCE WITH CONTRACT BOOK 2 SECTION 7. THE UTILITY MEMORANDUM AND MAPS PROVIDED AS REFERENCE DOCUMENTS SHALL BE CONSULTED AS WELL AS THE UTILITY LINES SHOWN ON C1.1 WHICH ARE REPRESENTATIVE OF THE UTILITIES IN THE AREA. ALL UTILITIES SHALL BE LOCATED PRIOR TO THE START OF CONSTRUCTION. THE CONTRACTOR SHALL POTHOLE AND USE CAUTION WHEN EXCAVATING.

THE FOLLOWING IS A LIST OF UTILITY CONTACTS FOR THIS PROJECT:

XCEL ENERGY (GAS AND ELECTRIC) BUILDERS CALL LINE PHONE: 1-800-628-2121	CDOT TUNNEL UTILITIES TOM HURST PHONE: 1-303-512-5734	CENTURYLINK DAN LEWIS PHONE: 1-303-441-6021
COMCAST (CABLE) SCOTT MOORE PHONE: 1-720-413-0171	CDOT ITS (FIBER) JILL SCOTT PHONE: 1-303-512-5805	

ENVIRONMENTAL:

THE CONTRACTOR SHALL PROTECT ALL STORM SEWER FACILITIES AND WATERWAYS ADJACENT TO ANY WORK LOCATION INCLUDING, BUT NOT LIMITED TO, WHERE PAVEMENT CUTTING OPERATIONS INVOLVING SAW CUTTING, GRINDING, PAVING OR OTHER ACTIVITY THAT MAY RESULT IN POLLUTION PER THE STORM WATER MANAGEMENT PLAN OR AS DIRECTED BY THE ENGINEER. THE CONTRACTOR SHALL REMOVE AND PROPERLY DISPOSE OF ALL WATER PRODUCTS GENERATED BY OPERATIONS INCLUDING, BUT NOT LIMITED TO, SAID CUTTING OPERATIONS ON A DAILY BASIS. THE DISCHARGE OF ANY WATER CONTAMINATED BY WASTE PRODUCTS FROM CUTTING OPERATIONS TO THE STORM SEWER IS PROHIBITED. THERE SHALL BE NO STOCKPILING OR SIDE CASTING OF WATER MATERIALS ADJACENT TO ANY DRAINAGES.

THE CONTRACTOR SHALL MAINTAIN ADEQUATE DRAINAGE AT ALL TIMES DURING CONSTRUCTION.

THE CONTRACTOR SHALL BE RESPONSIBLE FOR MAINTAINING THE PRESENT CONDITION OF ANY EXISTING BUILDINGS, LANDSCAPING, FENCING, DRIVES, ETC. THE CONTRACTOR SHALL PROTECT ALL EXISTING SURVEY MONUMENTATION FROM DAMAGE DURING CONSTRUCTION ACTIVITIES.

THE CONTRACTOR SHALL ENSURE THAT NO MATERIALS, EQUIPMENT OF VEHICLES ARE STAGED OR PARKED WITHIN 50 FEET OF WETLAND AREAS. WORK IN WETLAND AREAS SHALL BE CONTAINED SO AS TO LIMIT THE DISTURBANCE.

ALL EROSION, SEDIMENT BMP'S SHALL BE PLACED AS NEEDED ACCORDING TO THE SWMP SITE MAPS AND AS APPROVED BY THE ENGINEER. ALL TEMPORARY BMP'S SHALL BE REMOVED AT THE END OF CONSTRUCTION.

CDOT STANDARD PLAN REFERENCES:

C1.0	- M-206-1 - M-603-2 - M-604-20 - M-604-25	C2.0	- M-206-1 - M-603-2 - M-604-20 - M-604-25 - M-627-1	C3.0	- M-604-20 - M-603-2 - M-627-1 - M-604-20	C5.0	- M-206-1 - M-603-2	C7.0	- M-603-2 - M-604-20
				C4.0	- M-604-20	C6.0	- M-604-20 - M-603-2	C8.0	- M-603.2 - M-604-25
								C13.0	- M-206-1

CIVIL ABBREVIATIONS:

- RCP - REINFORCED CONCRETE PIPE
- DIP - DUCTILE IRON PIPE
- CSP - CORRUGATED STEEL PIPE

IF THIS SHEET IS NOT 22"x34" IT IS NOT PLOTTED TO SCALE

**BARNARD EJMT TEAM**








**EISENHOWER/JOHNSON**

**MEMORIAL TUNNEL**  
FIXED FIRE SUPPRESSION SYSTEM  
DESIGN BUILD PROJECT

Project No. C0703-360 Subaccount 17810  
**RECORD DRAWINGS - 2015-11-16**

Revisions	Date
Num	Description

CIVIL NARRATIVE

Drawing Number  
**C0.1**





IF THIS SHEET IS NOT 22"x34" IT IS NOT PLOTTED TO SCALE

Hydraulic Analysis Report - EAST BOUND 2 DROP INLETS

**Project Data**  
 Project Title: EJMT FFSS EAST BOUND INLETS  
 Designer: JBC  
 Project Date: Thursday, May 28, 2015  
 Project Units: U.S. Customary Units  
 Notes:

**Curb and Gutter Analysis: DI4 - Eastbound inlet 2 of 2 NEW**  
 Notes: Assumes full flow with 25% Clogging factor taken after calculations

**Gutter Input Parameters**  
 Longitudinal Slope of Road 0.016 ft/ft  
 Cross-Slope of Pavement 0.04 ft/ft  
 Depressed Gutter Geometry  
 Cross-Slope of Gutter 0.05 ft/ft  
 Manning's n 0.015  
 Gutter Width 9 ft  
 Design Flow 4.076 cfs

**Gutter Result Parameters**  
 Width of Spread 6.154 ft  
 Gutter Depression 1.08 in  
 Area of Flow 1.162 ft^2  
 Eo (Gutter Flow to Total Flow) 1  
 Gutter Depth at Curb 4.034 in

**Inlet Input Parameters**  
 Inlet Location Inlet on Grade  
 Inlet Type Grate  
 Grate Type Curved Vane  
 Grate Width 4.5 ft  
 Grate Length 2.5 ft  
 Local Depression 0 in

**Inlet Result Parameters**  
 Intercepted Flow 3.997 cfs  
 Bypass Flow 0.079 cfs  
 Approach Velocity 4 ft/s  
 Splash-over Velocity 6.79 ft/s  
 Efficiency 0.98

**Clogging at 25%**  
 Percent Clogging 25 %  
 Intercepted flow after clogging 2.998  
 Bypass flow after clogging 1.078

**Curb and Gutter Analysis: DI2 - Eastbound inlet 1 of 2 (NEW)**  
 Notes:

**Gutter Input Parameters**  
 Longitudinal Slope of Road 0.016 ft/ft  
 Cross-Slope of Pavement 0.04 ft/ft  
 Depressed Gutter Geometry  
 Cross-Slope of Gutter 0.05 ft/ft  
 Manning's n 0.015  
 Gutter Width 9 ft  
 Design Flow 1.078 cfs

**Gutter Result Parameters**  
 Width of Spread 3.737 ft  
 Gutter Depression 1.08 in  
 Area of Flow 0.684 ft^2  
 Eo (Gutter Flow to Total Flow) 1  
 Gutter Depth at Curb 2.874 in

**Inlet Input Parameters**  
 Inlet Location Inlet on Grade  
 Inlet Type Grate  
 Grate Type Curved Vane  
 Grate Width 4.5 ft  
 Grate Length 2.5 ft  
 Local Depression 1 in

**Inlet Result Parameters**  
 Intercepted Flow 1.072 cfs  
 Bypass Flow 0.006 cfs  
 Approach Velocity 2.26 ft/s  
 Splash-over Velocity 6.79 ft/s  
 Efficiency 0.995

Hydraulic Analysis Report - WEST BOUND 2 DROP INLETS

**Project Data**  
 Project Title: EJMT FFSS EAST BOUND INLETS  
 Designer: JBC  
 Project Date: Thursday, May 28, 2015  
 Project Units: U.S. Customary Units  
 Notes:

**Curb and Gutter Analysis: DI1 - Westbound inlet 1 of 2 (Existing)**  
 Notes: Assumes full flow with 25% Clogging factor taken after calculations

**Gutter Input Parameters**  
 Longitudinal Slope of Road 0.009 ft/ft  
 Cross-Slope of Pavement 0.059 ft/ft  
 Depressed Gutter Geometry  
 Cross-Slope of Gutter 0.069 ft/ft  
 Manning's n 0.015  
 Gutter Width 9 ft  
 Design Flow 1.064 cfs

**Gutter Result Parameters**  
 Width of Spread 3.3874 ft  
 Gutter Depression 1.08 in  
 Area of Flow 0.7435 ft^2  
 Eo (Gutter Flow to Total Flow) 1  
 Gutter Depth at Curb 3.4783 in

**Inlet Input Parameters**  
 Inlet Location Inlet on Grade  
 Inlet Type Grate  
 Grate Type Reticuline  
 Grate Width 3.33 ft  
 Grate Length 1.25 ft  
 Local Depression 1 in

**Inlet Result Parameters**  
 Intercepted Flow 1.064 cfs  
 Bypass Flow 0.000 cfs  
 Approach Velocity 1.4311 ft/s  
 Splash-over Velocity 2.8684 ft/s  
 Efficiency 1.00

**Curb and Gutter Analysis: DI3 - Westbound inlet 2 of 2 (NEW)**  
 Notes:

**Gutter Input Parameters**  
 Longitudinal Slope of Road 0.009 ft/ft  
 Cross-Slope of Pavement 0.052 ft/ft  
 Depressed Gutter Geometry  
 Cross-Slope of Gutter 0.062 ft/ft  
 Manning's n 0.015  
 Gutter Width 9 ft  
 Design Flow 4.076 cfs

**Gutter Result Parameters**  
 Width of Spread 5.993 ft  
 Gutter Depression 1.08 in  
 Area of Flow 1.339 ft^2  
 Eo (Gutter Flow to Total Flow) 1  
 Gutter Depth at Curb 4.82 in

**Inlet Input Parameters**  
 Inlet Location Inlet on Grade  
 Inlet Type Grate  
 Grate Type Curved Vane  
 Grate Width 4.5 ft  
 Grate Length 2.5 ft  
 Local Depression 1 in

**Inlet Result Parameters**  
 Intercepted Flow 4.016 cfs  
 Bypass Flow 0.06 cfs  
 Approach Velocity 3.045 ft/s  
 Splash-over Velocity 6.79 ft/s  
 Efficiency 0.985

**Clogging at 25%**  
 Percent Clogging 25 %  
 Intercepted flow after clogging 3.012  
 Bypass flow after clogging 1.064

Hydraulic Analysis Report

**Project Data**  
 Project Title: EISENHOWER/JOHNSON MEMORIAL TUNNEL FFSS  
 Designer: JBC  
 Project Date: Thursday, May 28, 2015  
 Project Units: U.S. Customary Units  
 Notes:

**Channel Analysis: 18" RCP @ 0.02 - CHANNEL ANALYSIS**  
 Notes:

**Input Parameters**  
 Channel Type: Circular  
 Pipe Diameter: 1.5000 ft  
 Longitudinal Slope: 0.0200 ft/ft  
 Manning's n: 0.0120  
 Flow: 4.0760 cfs

**Result Parameters**  
 Depth: 0.5147 ft  
 Area of Flow: 0.5365 ft^2  
 Wetted Perimeter: 1.8775 ft  
 Hydraulic Radius: 0.2858 ft  
 Average Velocity: 7.5972 ft/s  
 Top Width: 1.4243 ft  
 Froude Number: 2.1814  
 Critical Depth: 0.7727 ft  
 Critical Velocity: 4.4419 ft/s  
 Critical Slope: 0.0046 ft/ft  
 Critical Top Width: 1.50 ft  
 Calculated Max Shear Stress: 0.6424 lb/ft^2  
 Calculated Avg Shear Stress: 0.3566 lb/ft^2

**Channel Analysis: 12" RCP @ 0.01 - CHANNEL ANALYSIS**  
 Notes:

**Input Parameters**  
 Channel Type: Circular  
 Pipe Diameter: 1.0000 ft  
 Longitudinal Slope: 0.0100 ft/ft  
 Manning's n: 0.0120  
 Flow: 4.0760 cfs

**Result Parameters**  
 Depth: 0.8828 ft  
 Area of Flow: 0.7338 ft^2  
 Wetted Perimeter: 2.4428 ft  
 Hydraulic Radius: 0.3004 ft  
 Average Velocity: 5.5545 ft/s  
 Top Width: 0.6433 ft  
 Froude Number: 0.9165  
 Critical Depth: 0.8540 ft  
 Critical Velocity: 5.7058 ft/s  
 Critical Slope: 0.0104 ft/ft  
 Critical Top Width: 0.71 ft  
 Calculated Max Shear Stress: 0.5509 lb/ft^2  
 Calculated Avg Shear Stress: 0.1875 lb/ft^2

**Channel Analysis: 8" PVC @ 0.1483 - CHANNEL ANALYSIS**  
 Notes:

**Input Parameters**  
 Channel Type: Circular  
 Pipe Diameter: 1.5000 ft  
 Longitudinal Slope: 0.1483 ft/ft  
 Manning's n: 0.0120  
 Flow: 2.0380 cfs

**Result Parameters**  
 Depth: 0.2202 ft  
 Area of Flow: 0.1611 ft^2  
 Wetted Perimeter: 1.1797 ft  
 Hydraulic Radius: 0.1366 ft  
 Average Velocity: 12.6485 ft/s  
 Top Width: 1.0618 ft  
 Froude Number: 5.7220  
 Critical Depth: 0.5383 ft  
 Critical Velocity: 3.5733 ft/s  
 Critical Slope: 0.0042 ft/ft  
 Critical Top Width: 1.44 ft  
 Calculated Max Shear Stress: 2.0379 lb/ft^2  
 Calculated Avg Shear Stress: 1.2640 lb/ft^2

**Channel Analysis: 8" PVC @ 0.1043 - CHANNEL ANALYSIS**  
 Notes:

**Input Parameters**  
 Channel Type: Circular  
 Pipe Diameter: 1.5000 ft  
 Longitudinal Slope: 0.1483 ft/ft  
 Manning's n: 0.0120  
 Flow: 2.0380 cfs

**Result Parameters**  
 Depth: 0.2202 ft  
 Area of Flow: 0.1611 ft^2  
 Wetted Perimeter: 1.1797 ft  
 Hydraulic Radius: 0.1366 ft  
 Average Velocity: 12.6485 ft/s  
 Top Width: 1.0618 ft  
 Froude Number: 5.7220  
 Critical Depth: 0.5383 ft  
 Critical Velocity: 3.5733 ft/s  
 Critical Slope: 0.0042 ft/ft  
 Critical Top Width: 1.44 ft  
 Calculated Max Shear Stress: 2.0379 lb/ft^2  
 Calculated Avg Shear Stress: 1.2640 lb/ft^2

EISENHOWER/JOHNSON

MEMORIAL TUNNEL

FIXED FIRE SUPPRESSION SYSTEM

DESIGN BUILD PROJECT

Project No. C0703-360 Subaccount 17810

RECORD DRAWINGS - 2015-11-16

Revisions	Date
Num	Description

CO.3 HYDRAULIC ANALYSIS REPORTS

Drawing Number  
**C0.3**

**BARNARD EJMT TEAM**

BCER  
A BEER GROUP  
A BEER GROUP  
engineering

BARNARD

RONDINELLI  
A BEER GROUP  
life safety


ALF  
CONSULTING  
ENGINEERS

Western States  
Fire Protection Co.

Sturgeon  
ELECTRIC

GENERAL NOTES:

- EXISTING UTILITIES SHOWN PER AS BUILT DRAWINGS, FIELD VERIFICATION TO BE COMPLETED PRIOR TO THE START OF CONSTRUCTION. ADDITIONALLY THE CONTRACTOR SHALL MARK ALL EXISTING UTILITIES AND IDENTIFY AND RESOLVE ALL CONFLICTS.
- STORAGE TANKS SHOWN ARE MANUFACTURED BY EATON METAL PRODUCTS, SEE SHEET C9.0 TO C12.0 FOR DETAILED DRAWINGS OF NEW EATON METAL STORAGE TANK (TANK 2 AND TANK 3).
- ALL EXCAVATION AND BACKFILL REQUIRED FOR PIPES AND STRUCTURES SHALL BE IN ACCORDANCE WITH CDOT STANDARD PLANS NO. M-206-1. ABANDONMENT OF EXISTING UTILITIES SHALL BE IN ACCORDANCE WITH CDOT STANDARD SPECIFICATIONS SECTION 202.
- THE EXISTING 8-IN SEEP DRAIN AND FLOW FROM DROP INLET (NOT NAMED) LINE FEEDING INTO DROP INLET 1 WILL NOT BE MODIFIED. FLOW FROM THE SEEP LINE AND DROP INLET WILL CONTINUE TO CLEAR CREEK THROUGH EXISTING 18-IN CSP LINE. DURING NORMAL TUNNEL OPERATIONS. IT IS ANTICIPATED THAT THE MINIMAL FLOW FROM THESE SOURCES WILL NOT AFFECT THE OVERALL STORAGE CAPACITY DURING A FIRE EVENT.
- GROUND SURFACES, PIPE LENGTHS AND INVERT ELEVATIONS ARE APPROXIMATE ON AS BUILT DRAWINGS AND ARE TO BE VERIFIED BY THE CONTRACTOR PRIOR TO THE START OF CONSTRUCTION WITH A SURVEY. ALL STRUCTURE RIM ELEVATIONS SHALL BE FINALIZED BY THE CONTRACTOR AFTER SURVEY.
- RCP SHALL BE CLASS III IN ACCORDANCE WITH CDOT STANDARD PLANS SHEET M-603-2 AND CDOT STANDARD SPECIFICATIONS SECTION 706; WITH THE EXCEPTION OF THE 12-IN RCP LINES CONNECTING DROP INLETS, WHICH SHALL BE CLASS IV. PVC PIPE SHALL BE SCHEDULE 40 IN ACCORDANCE WITH CDOT STANDARD PLANS SHEET M-603-5 AND CDOT STANDARD SPECIFICATION SECTION 712.13.

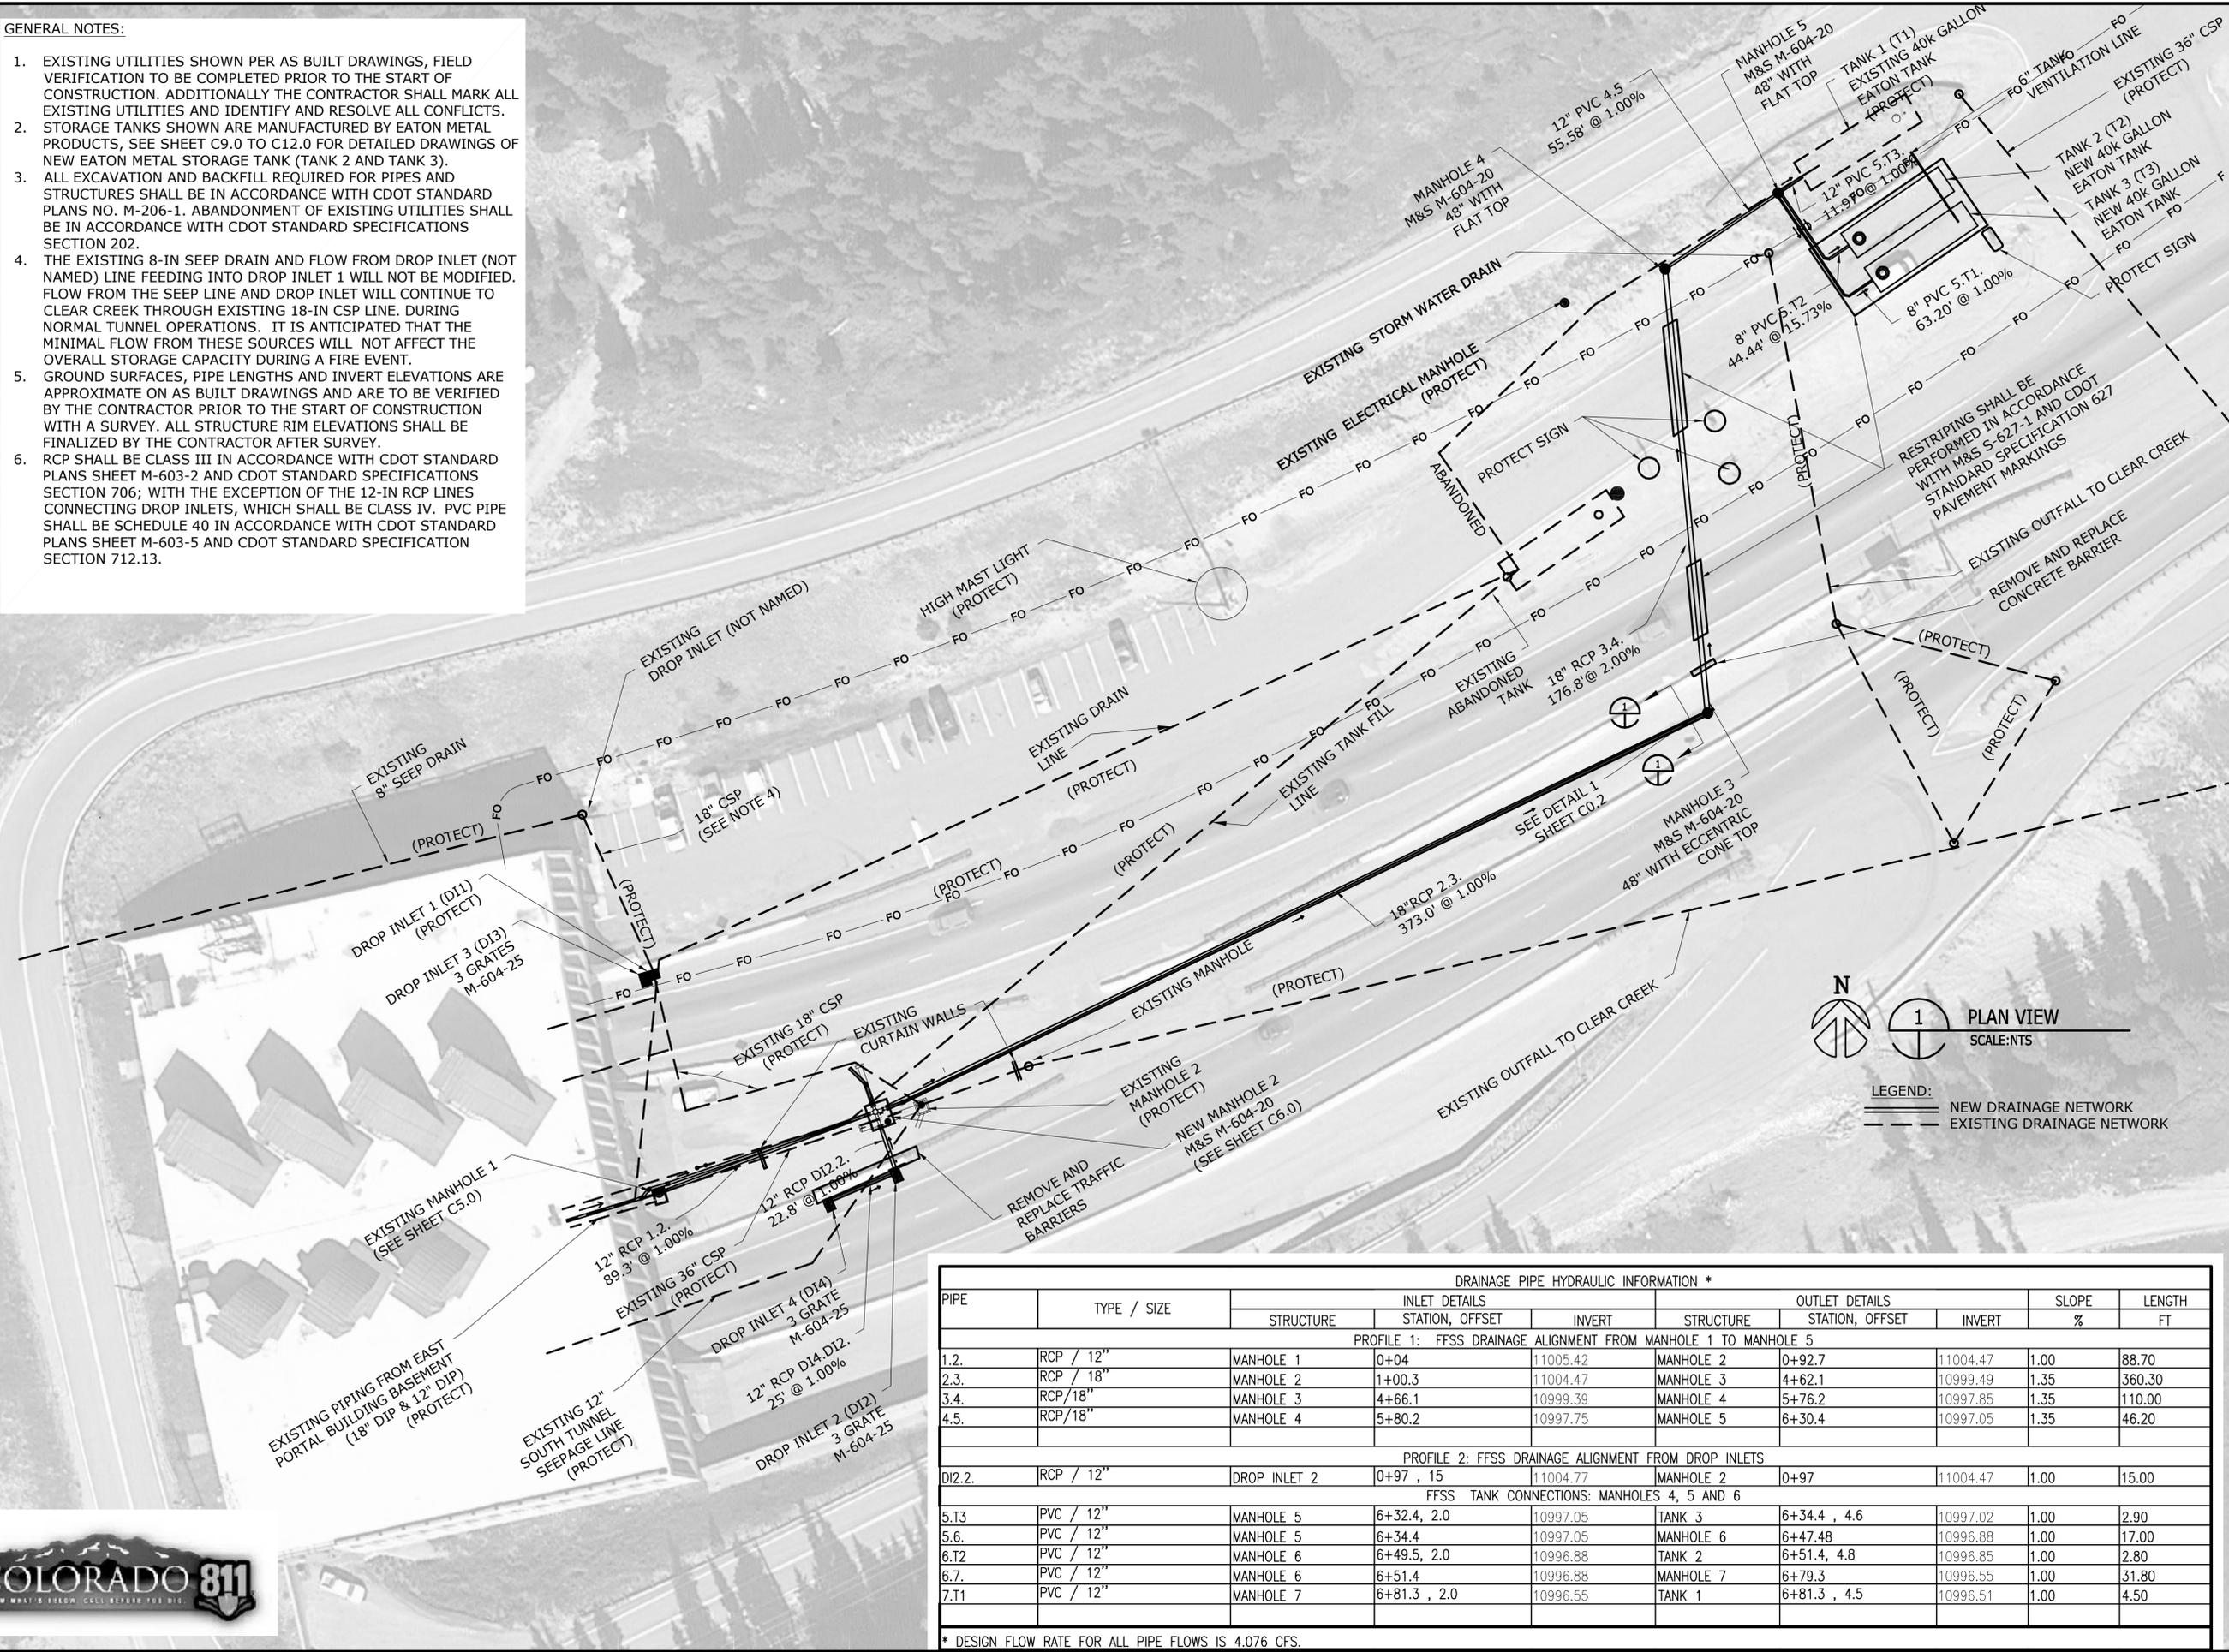

DRAINAGE PIPE HYDRAULIC INFORMATION *									
PIPE	TYPE / SIZE	INLET DETAILS			OUTLET DETAILS			SLOPE %	LENGTH FT
		STRUCTURE	STATION, OFFSET	INVERT	STRUCTURE	STATION, OFFSET	INVERT		
PROFILE 1: FFSS DRAINAGE ALIGNMENT FROM MANHOLE 1 TO MANHOLE 5									
1.2.	RCP / 12"	MANHOLE 1	0+04	11005.42	MANHOLE 2	0+92.7	11004.47	1.00	88.70
2.3.	RCP / 18"	MANHOLE 2	1+00.3	11004.47	MANHOLE 3	4+62.1	10999.49	1.35	360.30
3.4.	RCP/18"	MANHOLE 3	4+66.1	10999.39	MANHOLE 4	5+76.2	10997.85	1.35	110.00
4.5.	RCP/18"	MANHOLE 4	5+80.2	10997.75	MANHOLE 5	6+30.4	10997.05	1.35	46.20
PROFILE 2: FFSS DRAINAGE ALIGNMENT FROM DROP INLETS									
DI2.2.	RCP / 12"	DROP INLET 2	0+97 , 15	11004.77	MANHOLE 2	0+97	11004.47	1.00	15.00
FFSS TANK CONNECTIONS: MANHOLES 4, 5 AND 6									
5.T3	PVC / 12"	MANHOLE 5	6+32.4 , 2.0	10997.05	TANK 3	6+34.4 , 4.6	10997.02	1.00	2.90
5.6.	PVC / 12"	MANHOLE 5	6+34.4	10997.05	MANHOLE 6	6+47.48	10996.88	1.00	17.00
6.T2	PVC / 12"	MANHOLE 6	6+49.5, 2.0	10996.88	TANK 2	6+51.4, 4.8	10996.85	1.00	2.80
6.7.	PVC / 12"	MANHOLE 6	6+51.4	10996.88	MANHOLE 7	6+79.3	10996.55	1.00	31.80
7.T1	PVC / 12"	MANHOLE 7	6+81.3 , 2.0	10996.55	TANK 1	6+81.3 , 4.5	10996.51	1.00	4.50

\* DESIGN FLOW RATE FOR ALL PIPE FLOWS IS 4.076 CFS.

IF THIS SHEET IS NOT 22"x34" IT IS NOT PLOTTED TO SCALE



**EISENHOWER/JOHNSON**  
MEMORIAL TUNNEL  
FIXED FIRE SUPPRESSION SYSTEM  
DESIGN BUILD PROJECT

Project No. C0703-360  
Subaccount 17810  
RECORD DRAWINGS - 2015-11-16

Revisions

Num	Description	Date

Checked by: JIM

Drawn by: JBC

DATE

East Portal Building  
FFSS Drainage Plan

Drawing Number

C1.0

BCER  
BARNARD  
EISENHOWER/JOHNSON

BARNARD  
EISENHOWER/JOHNSON

Sturgeon  
ELECTRIC



RONDINELLI  
A BEE GROUP life safety

Western States  
Fire Protection Co.

O & M Manual

ASBUILT - 17

IF THIS SHEET IS NOT 22"x34" IT IS NOT PLOTTED TO SCALE

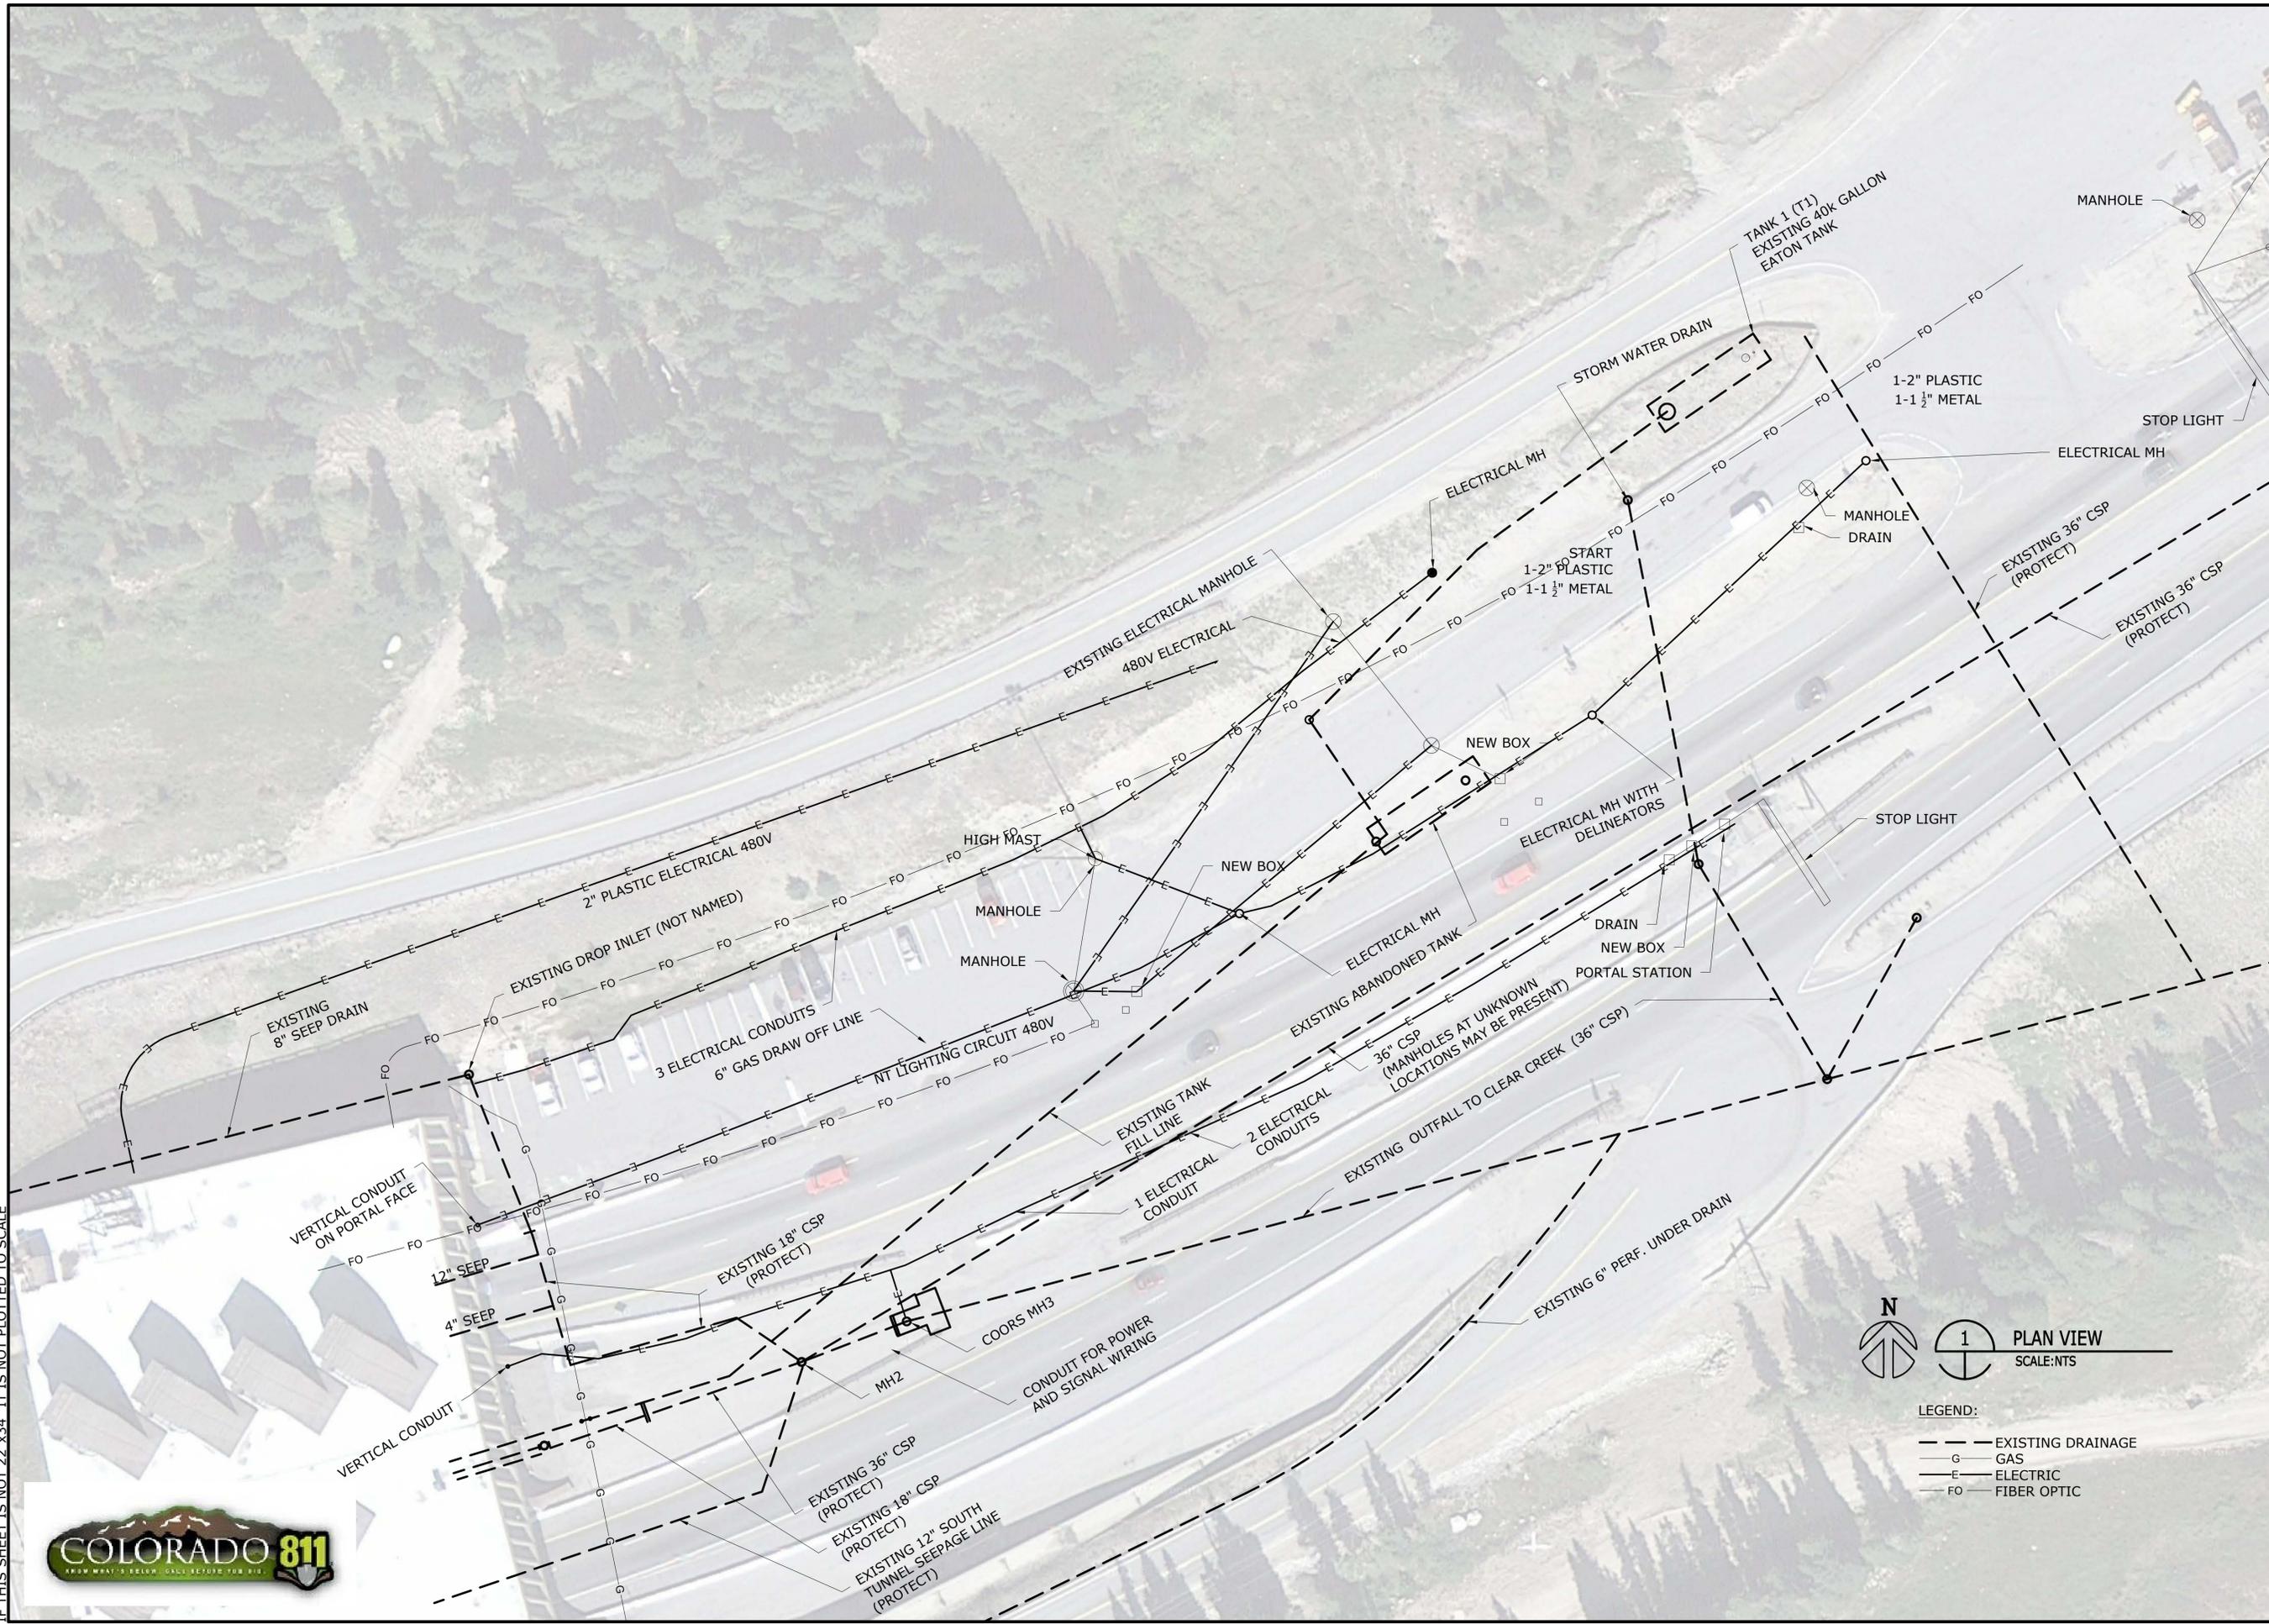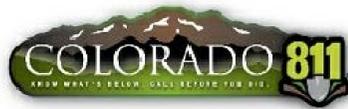

- LEGEND:
- EXISTING DRAINAGE
  - G- GAS
  - E- ELECTRIC
  - FO- FIBER OPTIC

# BARNARD EJMT TEAM

**BCER** **BARNARD** **BARNARD EJMT TEAM**

**RONDINELLI**  
A BEEB GROUP LIFE SAFETY  
CONSULTING ENGINEERS

**Sturgeon ELECTRIC**

Western States Fire Protection Co.

## EISENHOWER/JOHNSON

### MEMORIAL TUNNEL

FIXED FIRE SUPPRESSION SYSTEM  
DESIGN BUILD PROJECT

Project No. C0703-360 Subaccount 17810  
RECORD DRAWINGS - 2015-11-16

Revisions	Date
Num	Description

EAST PORTAL BUILDING  
EXISTING UTILITIES


Drawing Number  
**C1.1**

DRAWN BY: JBC  
CHECKED BY: JIM



GENERAL NOTES:

1. ALL EXCAVATION AND BACKFILL REQUIRED FOR PIPES AND STRUCTURES SHALL BE IN ACCORDANCE WITH CDOT STANDARD PLANS NO. M-206-1. ABANDONMENT OF EXISTING UTILITIES SHALL BE IN ACCORDANCE WITH CDOT STANDARD SPECIFICATIONS SECTION 202.
2. EXISTING UTILITIES SHOWN PER AS BUILT DRAWINGS, FIELD VERIFICATION TO BE COMPLETED PRIOR TO THE START OF CONSTRUCTION
3. THE EXISTING 8-IN SEEP DRAIN AND FLOW FROM THE DROP INLET (NOT NAMED) A LINE FEEDING INTO DROP INLET 1 WILL NOT BE MODIFIED. FLOW FROM THE SEEP LINE AND DROP INLET WILL CONTINUE TO CLEAR CREEK THROUGH THE EXISTING 18-IN CSP LINE DURING NORMAL TUNNEL OPERATIONS. IT IS ANTICIPATED THAT THE MINIMAL FLOW FROM THESE SOURCES WILL NOT AFFECT THE OVERALL STORAGE CAPACITY DURING A FIRE EVENT.
4. THE EXISTING 18-IN CSP PIPE TRANSITIONS TO THE EXISTING 36-IN CSP PIPE AT CURTAIN WALL 1.

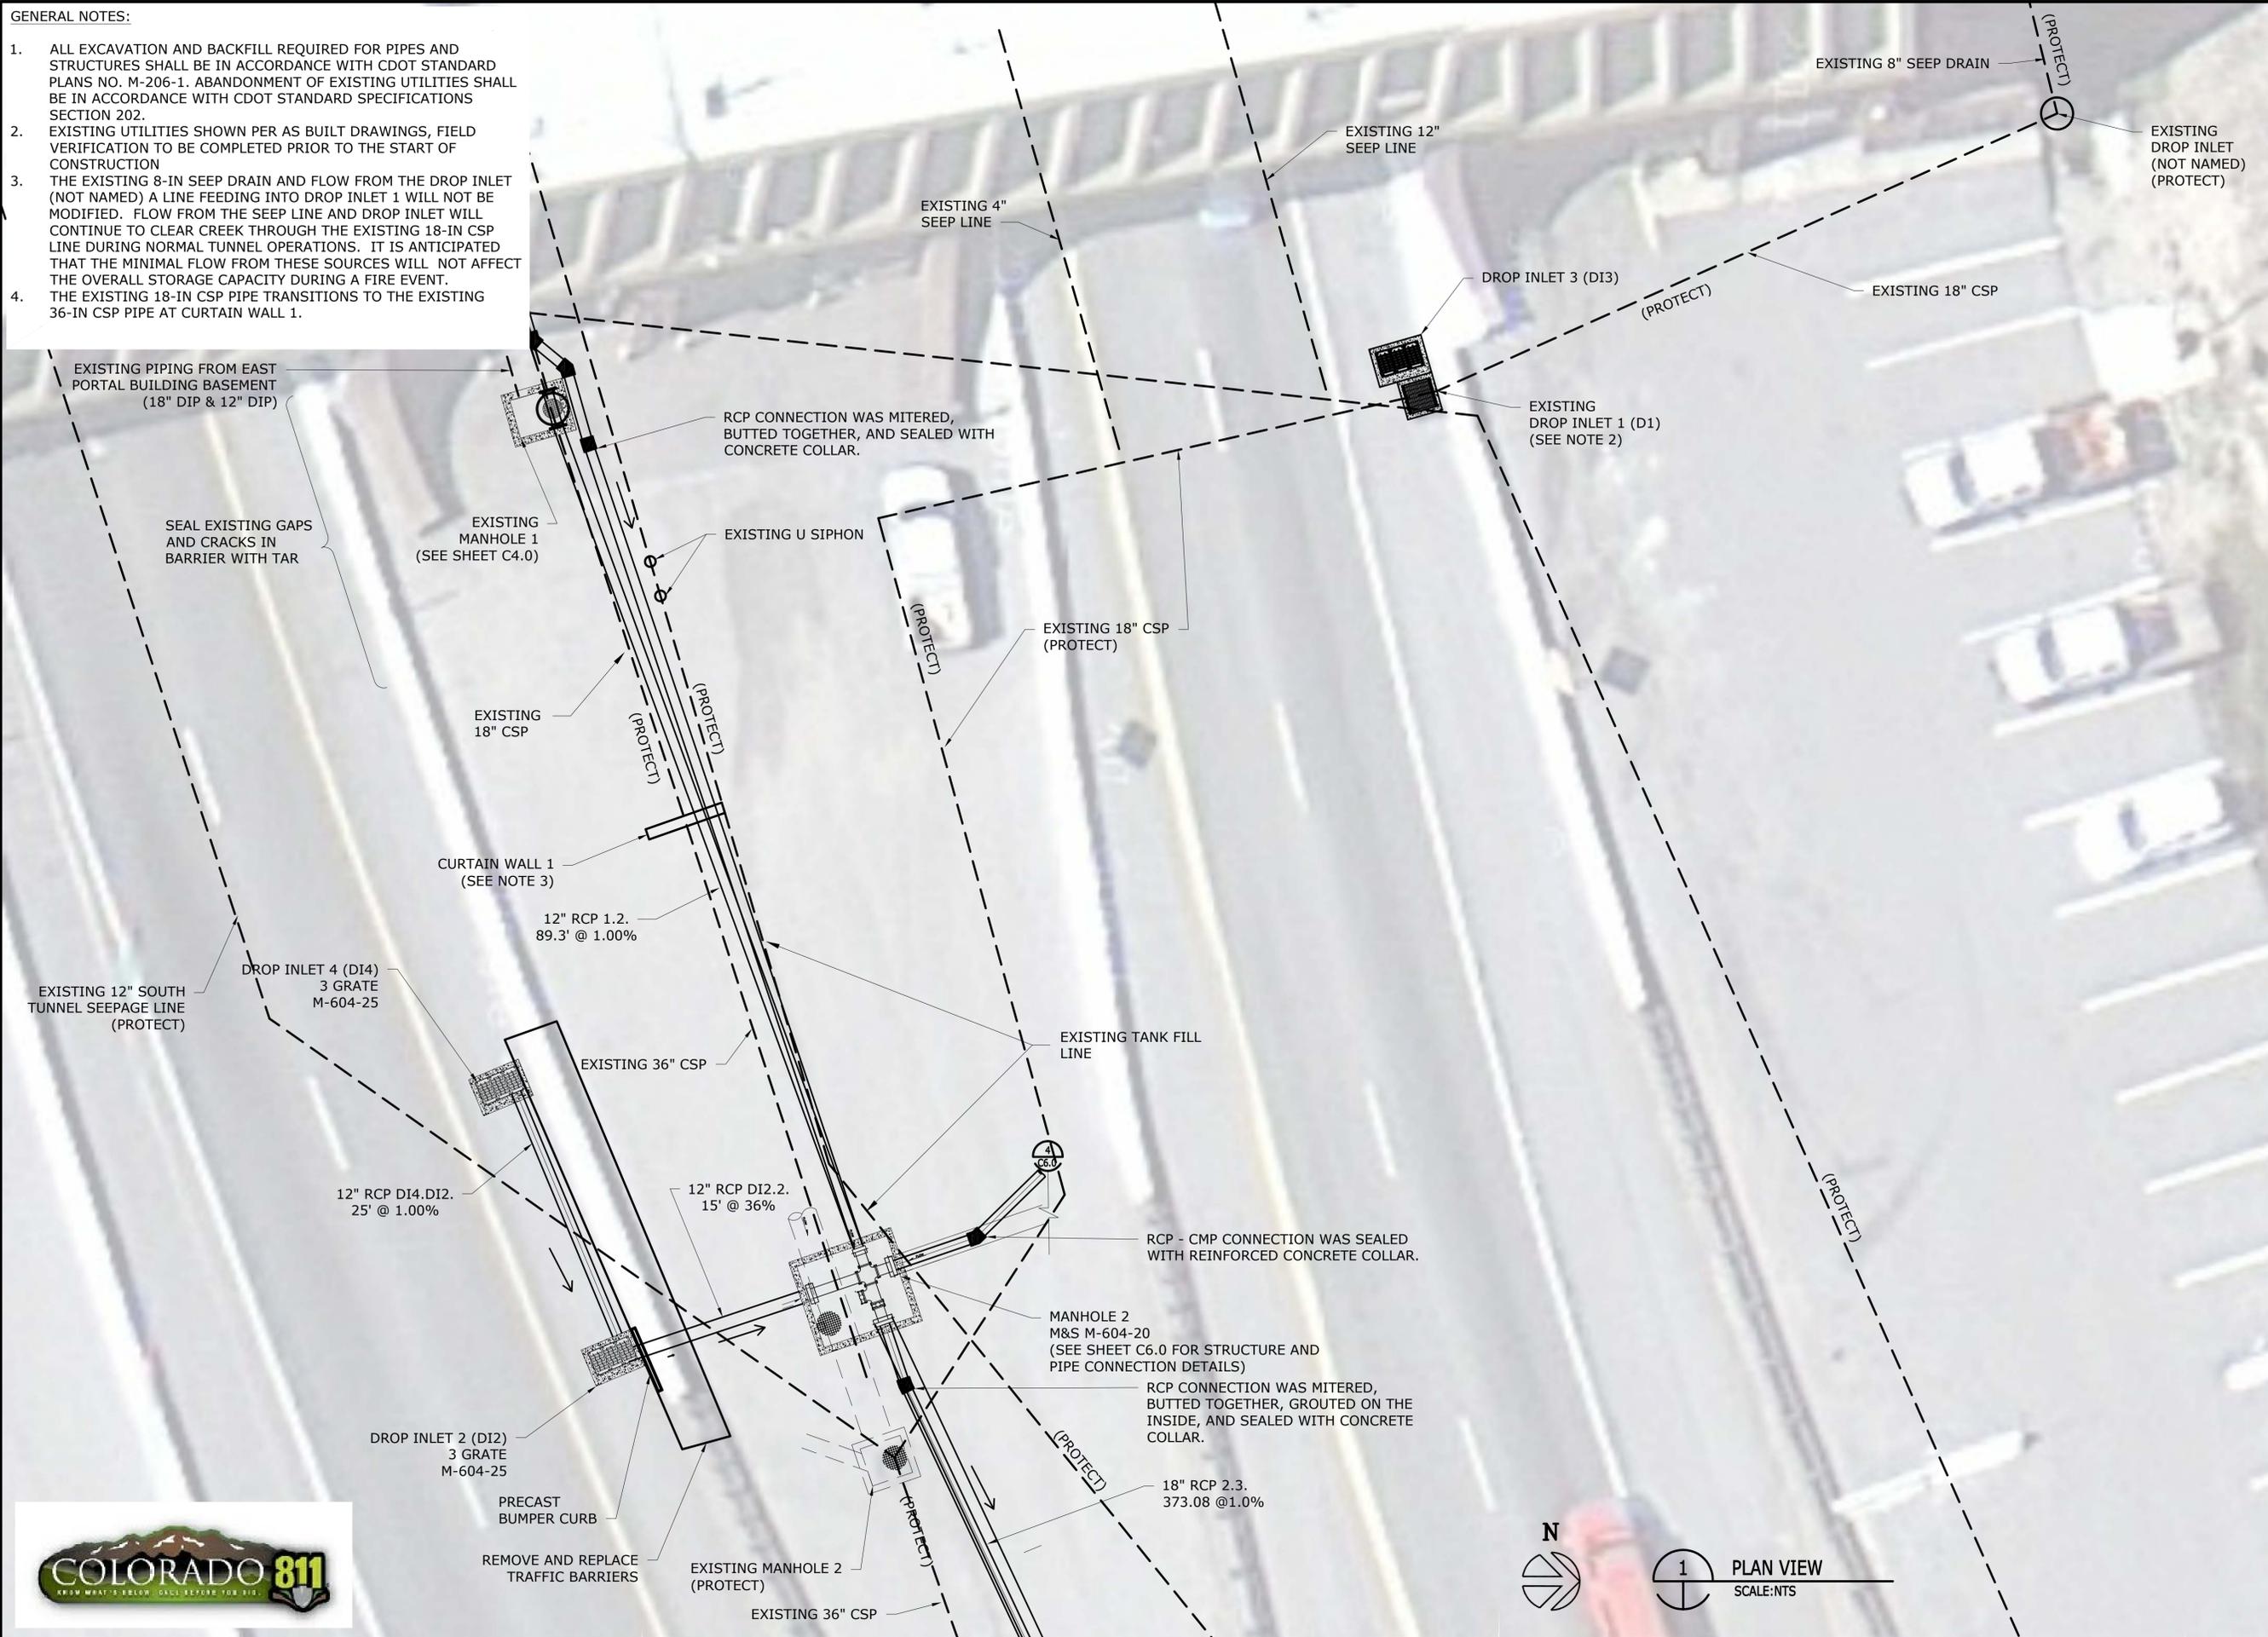

IF THIS SHEET IS NOT 22"x34" IT IS NOT PLOTTED TO SCALE



**BARNARD EJMT TEAM**

**BARNARD**  
**RONDINELLI**  
A TEAM GROUP  
life safety  
**BCER**  
CONSULTING ENGINEERS  
Western States Fire Protection Co.  
**Sturgeon**  
ELECTRIC

**EISENHOWER/JOHNSON  
MEMORIAL TUNNEL**


**FIXED FIRE SUPPRESSION SYSTEM  
DESIGN BUILD PROJECT**  
Project No. C0703-360 Subaccount 17810  
**RECORD DRAWINGS - 2015-11-16**

Revisions	Date
Num	Description


EAST PORTAL BUILDING  
FFSS DRAINAGE PLAN  
Drawing Number  
**C2.0**

DRAWN BY: JBC  
CHECKED BY: JM




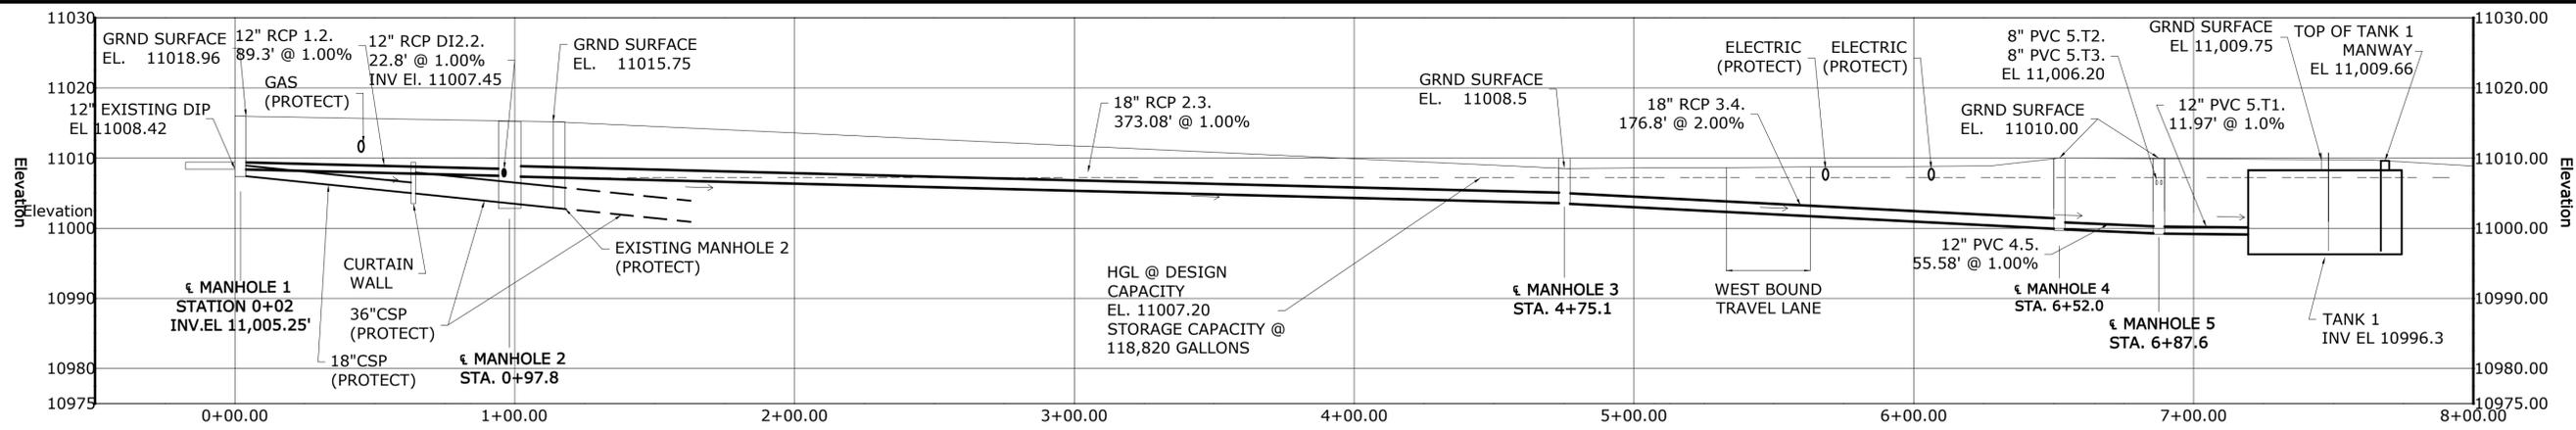

**1** PROFILE 1: FFSS DRAINAGE ALIGNMENT FROM MANHOLE 1 TO TANK 1  
SCALE: NTS

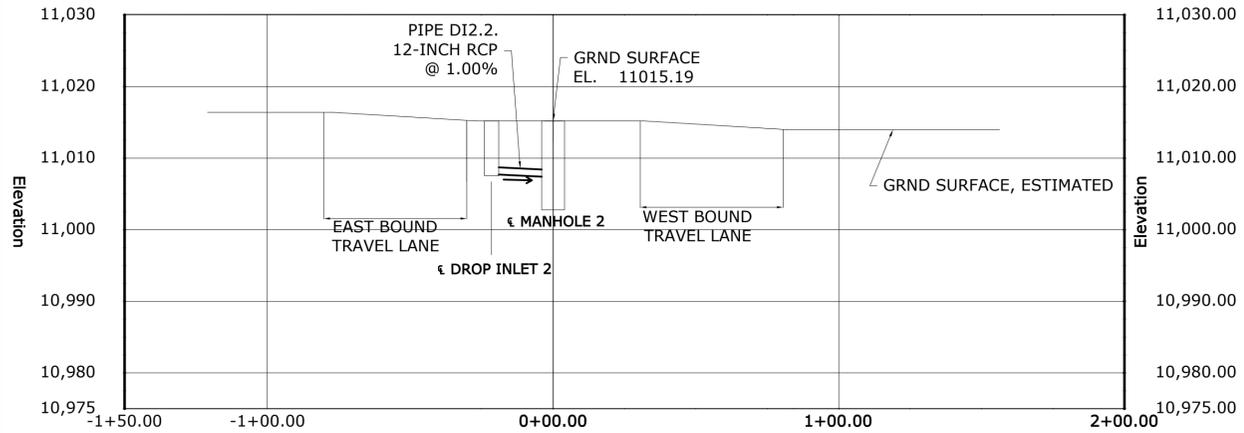


**2** PROFILE 2: FFSS PIPE D2.2 ALIGNMENT  
SCALE: NTS

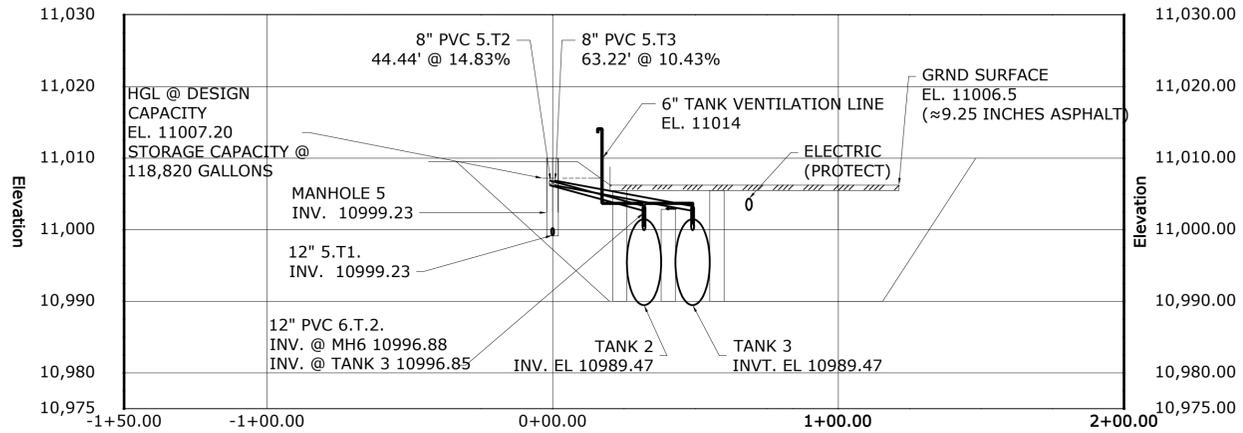

**3** PROFILE 3: FFSS DRAINAGE MANHOLE 5 TO DISCHARGE STORAGE TANKS  
SCALE: NTS

**GENERAL NOTES:**

- GROUND SURFACE ELEVATIONS ARE ASSUMED BASED ON THE PROVIDED AS BUILT DRAWINGS AND SURVEY ELEVATION POINTS TAKEN. ALL ELEVATIONS INCLUDING; GROUND SURFACE, PIPE INVERTS, AND STRUCTURE RIM AND INVERTS, SHALL BE FIELD VERIFIED PRIOR TO START OF CONSTRUCTION.
- DISCHARGE STORAGE TANKS SHOWN ARE MANUFACTURED BY EATON METAL PRODUCTS, SEE SHEETS C9.0 - C12.0 FOR DETAILED DRAWINGS OF NEW EATON METAL STORAGE TANK.
- DETAILS REGARDING ELECTRONIC TANK LEVEL EQUIPMENT ARE PROVIDED ON FA SHEETS.
- ALL NEW MANHOLES TO BE CONSTRUCTED SHALL CONFORM TO CDOT STANDARD PLAN NO. M-604-20.
- THE DESIGN FLOW RATE FOR ALL PIPES IS 4.076 CFS WITH THE EXCEPTION OF 5.T2. AND 5.T3. WHICH ASSUMES EACH 8 INCH PIPE WILL CARRY HALF THE DESIGN FLOW AT 2.038 CFS. THE STATED FLOW RATES CORRELATE TO THE MOST DEMANDING FFSS TWO ZONES ACTIVATED AND THE EXISTING STANDPIPE SYSTEM.

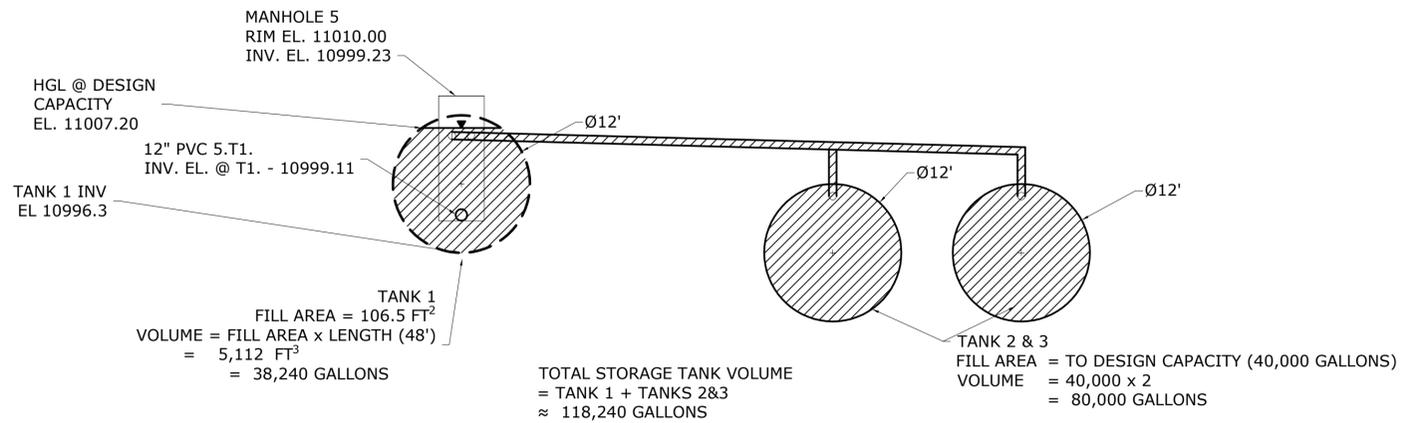

**4** VOLUME CALCULATIONS  
SCALE: NTS

**BARNARD EJMT TEAM**

**BARNARD** **RONDELLO** **BCER** **Sturgeon Electric**

**EISENHOWER/JOHNSON MEMORIAL TUNNEL**  
FIXED FIRE SUPPRESSION SYSTEM  
DESIGN BUILD PROJECT

Project No. C0703-360 Subaccount 17810  
RECORD DRAWINGS - 2015-11-16


Revisions	Num	Description	Date

DRAWN BY: JBC CHECKED BY: JIM

EAST PORTAL BUILDING  
FFSS DRAINAGE PROFILE

Drawing Number  
**C4.0**

IF THIS SHEET IS NOT 22"x34" IT IS NOT PLOTTED TO SCALE

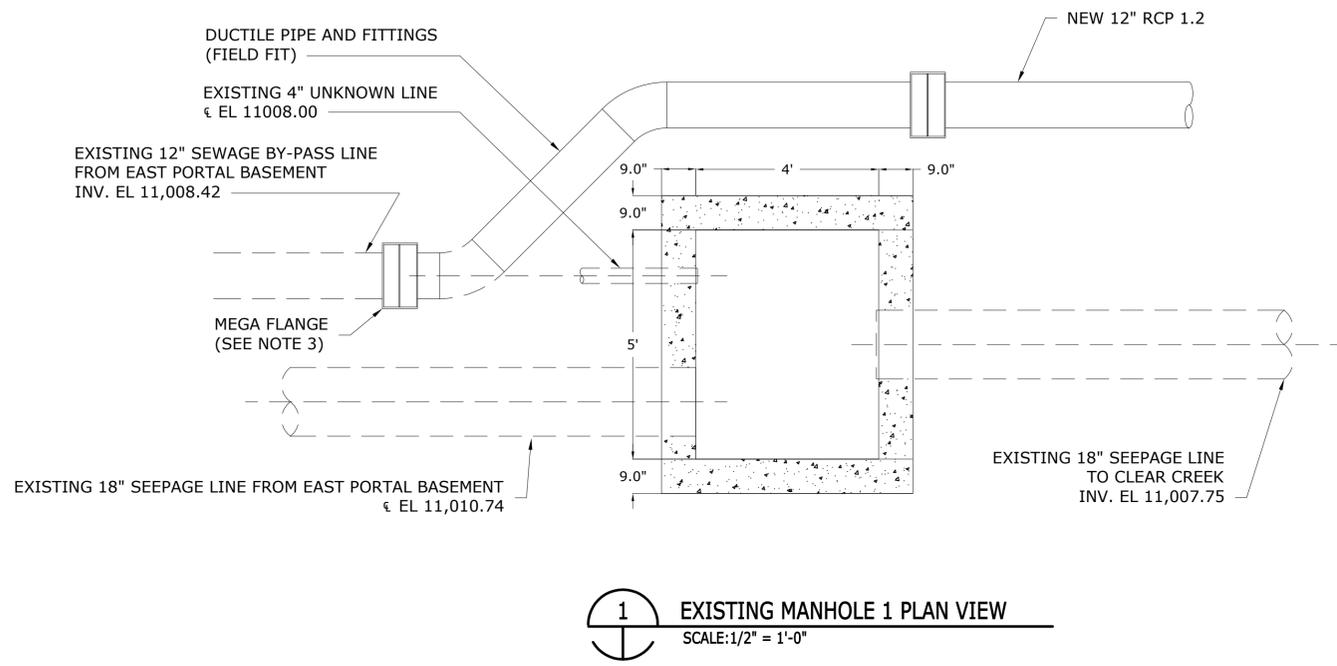

1 EXISTING MANHOLE 1 PLAN VIEW  
SCALE: 1/2" = 1'-0"

GENERAL NOTES:

1. ALL ELEVATIONS PROVIDED SHALL BE FIELD VERIFIED PRIOR TO START OF CONSTRUCTION.
2. CARE SHALL BE TAKEN TO LIMIT DAMAGE TO EXISTING PIPES AND STRUCTURES.
3. 150 CLASS FLANGE SHALL BE USED FOR CONNECTION OF 12-IN PIPE.
4. A PIPE JOINT SEALING COMPOUND SHALL BE USED IN ACCORDANCE WITH CDOT STANDARD SPECIFICATION 705.04 FOR ALL APPLICABLE PIPE JOINTS.
5. ALL EXCAVATIONS AND BACKFILL SHALL BE IN ACCORDANCE WITH CDOT STANDARD PLANS M-206-1.
6. THE CONTRACTOR SHALL VERIFY THE EXISTING ROADWAY MATERIAL PRIOR TO THE START OF CONSTRUCTION. MILL AND OVERLAY OF EXISTING ASPHALT WILL BE PROVIDED ADJACENT TO DRAINAGE PIPE IN ROADWAY.

**BARNARD EJMT TEAM**

BCER CONSULTING ENGINEERS  
BARNARD  
STURGEON ELECTRIC  
RONDINELLI  
A BEER GROUP LIFE SAFETY  
WESTERN STATES FIRE PROTECTION CO.  
ENGINEERS

EISENHOWER/JOHNSON  
MEMORIAL TUNNEL  
FIXED FIRE SUPPRESSION SYSTEM  
DESIGN BUILD PROJECT




Project No. C0703-360 Subaccount 17810  
RECORD DRAWINGS - 2015-11-16

Revisions	Date
Num	Description

DRAWN BY: JBC CHECKED BY: JM

EXISTING MANHOLE 1  
Drawing Number  
**C5.0**



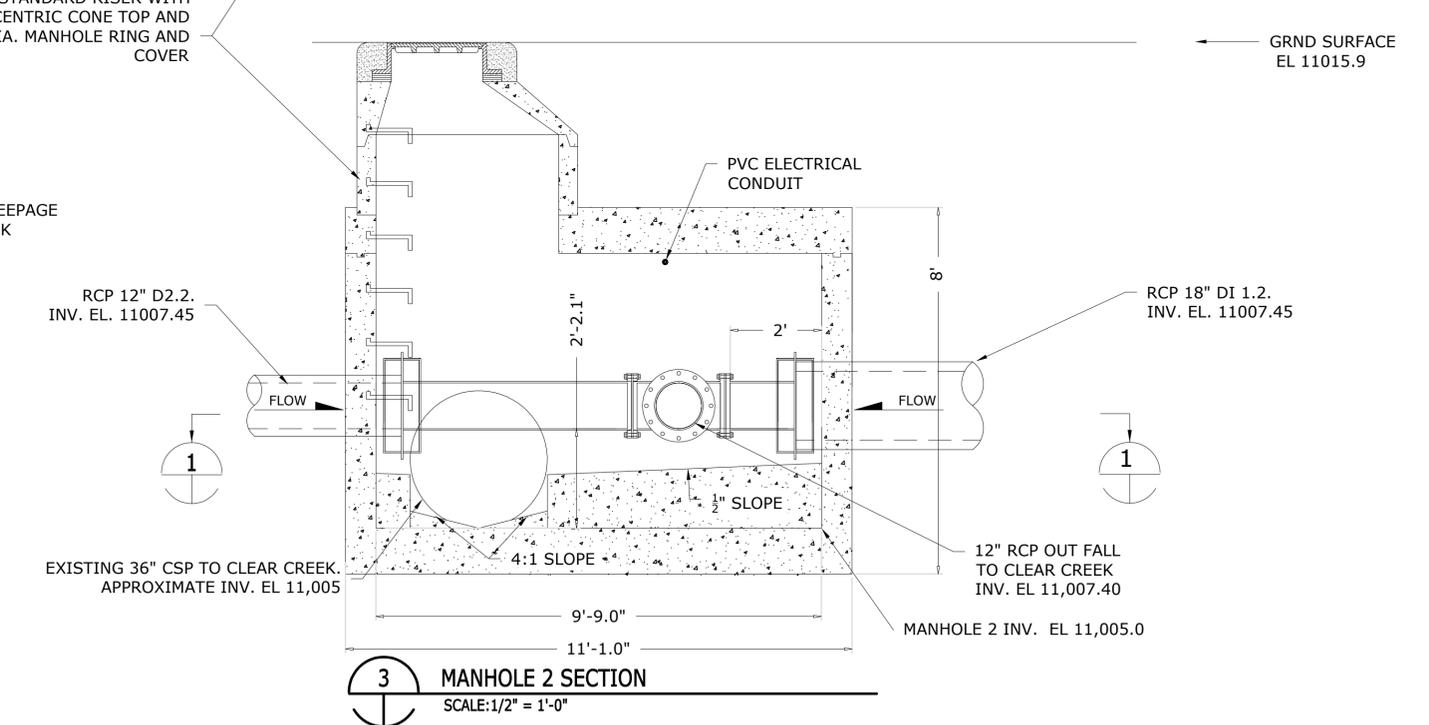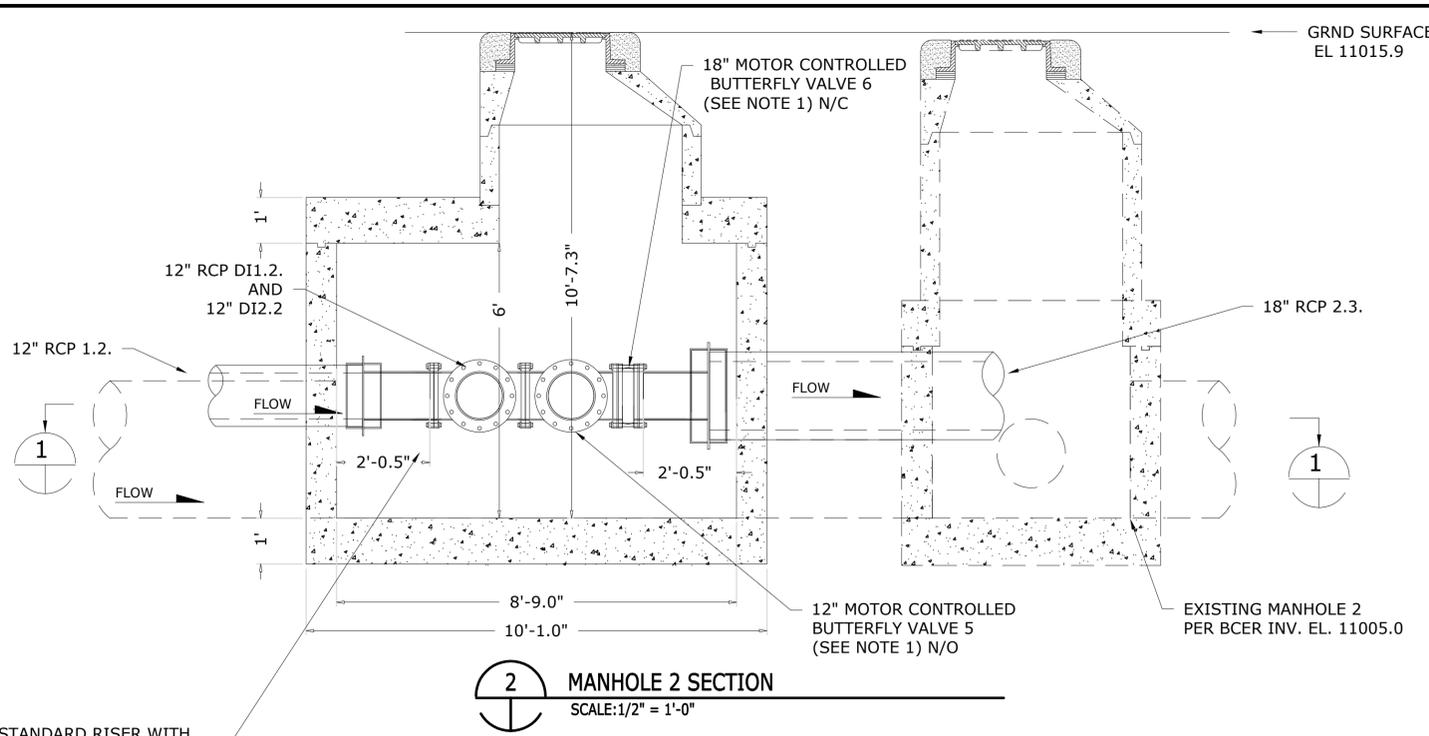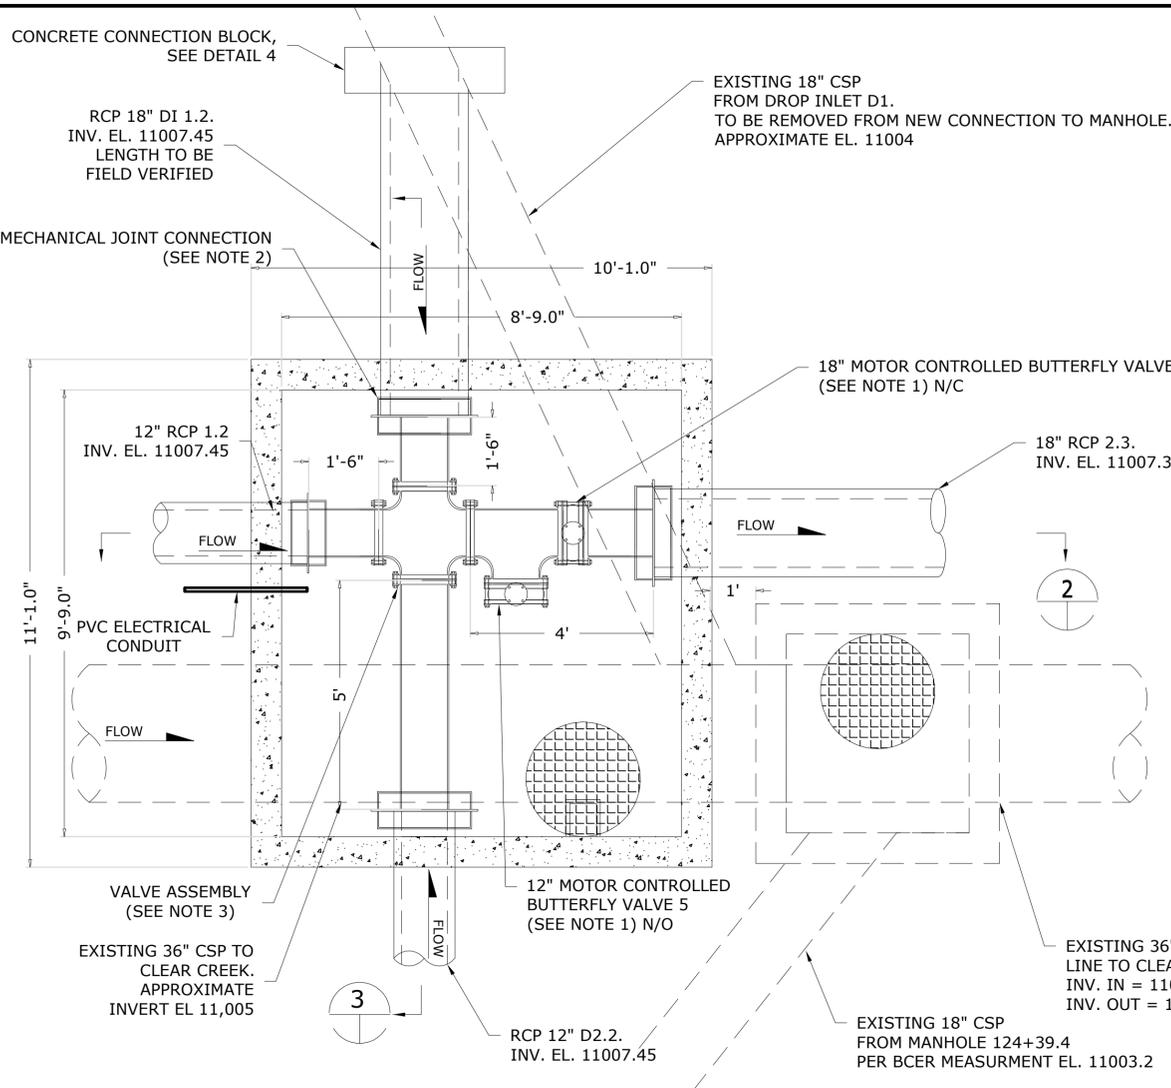


**GENERAL NOTES:**

- MOTOR CONTROLLED ELECTRONIC BUTTERFLY VALVES (SEE SHEET M6.4 FOR VALVE SPECIFICATIONS)
- A MECHANICAL JOINT CONNECTION SIMILAR TO ROMAC FC4000 FLANGED SHALL BE USED BETWEEN CONNECTION OF ALL RCP PIPES TO STEEL PIPES INSIDE OF THE MANHOLE BOX. THE MECHANICAL JOINT SHALL BE CONSTRUCTED SUCH THAT THE PIPE INVERTS ARE MATCHING. THE REINFORCED CONCRETE PIPES SHALL BE PASS THROUGH THE MANHOLE WALL AND BE HAND PACKED WITH GROUT AT THE MANHOLE WALL.
- THE VALVE ASSEMBLY SHALL BE FITTED TOGETHER UTILIZING 150 CLASS DIP CONNECTIONS AND VALVES. THE VALVE ASSEMBLY IS DISCUSSED AS ALL PIPE, FITTINGS AND VALVES CONNECTED WITHIN MANHOLE 2.
- ALL ELEVATIONS PROVIDED SHALL BE FIELD VERIFIED PRIOR TO START OF CONSTRUCTION.
- THE MANHOLE SHALL BE CONSTRUCTED IN ACCORDANCE WITH CDOT M&S M-604-20, INCLUDING BUT NOT LIMITED TO REINFORCEMENT, STEPS COVER AND FLOW CHANNEL. REINFORCEMENT SHALL CONSIST OF DEFORMED BARS ONLY PER ASTM A615.
- RCP SHALL BE CLASS II IN ACCORDANCE WITH CDOT STANDARD PLANS SHEET M-603-2 AND CDOT STANDARD SPECIFICATIONS SECTION 706.
- CARE SHALL BE TAKEN TO LIMIT DAMAGE TO EXISTING PIPES.
- A PIPE JOINT SEALING COMPOUND SHALL BE USED IN ACCORDANCE WITH CDOT STANDARD SPECIFICATION 705.04 FOR ALL APPLICABLE PIPE JOINTS. RCP PIPE PROTRUSIONS THROUGH STRUCTURE WALL SHALL BE HAND PACKED WITH GROUT TO PROVIDE WATER TIGHT SEAL THROUGH STRUCTURE WALL.
- THE PRECAST MANHOLE SUPPLIER SELECTED BY THE CONTRACTOR SHALL PROVIDE STAMPED STRUCTURAL REINFORCEMENT DRAWINGS AND CALCULATIONS FOR MANHOLE 2, PRIOR TO THE START OF MANHOLE 2 EXCAVATION AND PLACEMENT. CALCULATIONS SHALL SHOW THAT THE STRUCTURE IS DESIGNED FOR HS-20 LOADING.
- THE 36-IN CSP PIPE SHALL BE OPEN WITHIN THE NEW MANHOLE 2. A FLOW CHANNEL SHALL BE CONSTRUCTED IN ACCORDANCE WITH M&S M-604-20.

VALVE DURATION TABLE

INFLOW	OPERATION	V5 12" VALVE	V6 12" VALVE	OUTFLOW
RCP 1.2, RCP D1.2, RCP D2.2	NORMAL TUNNEL OPERATION	OPEN	CLOSED	36" CSP TO CLEAR CREEK
RCP 1.2, RCP D1.2, RCP D2.2	FFSS EVENT	CLOSED	OPEN	RCP 2.3. TO TANKS

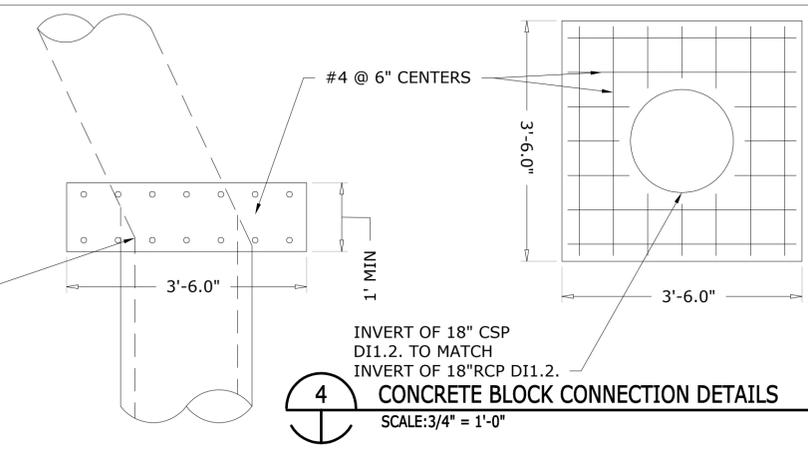

IF THIS SHEET IS NOT 22"x34" IT IS NOT PLOTTED TO SCALE



**BARNARD EJMT TEAM**

**BARNARD** **RONDINELLI**

Western States Fire Protection Co.

**Sturgeon Electric**

BCER **Sturgeon** **Engineering**

**EISENHOWER/JOHNSON MEMORIAL TUNNEL**

FIXED FIRE SUPPRESSION SYSTEM DESIGN BUILD PROJECT

Project No. C0703-360 Subaccount 17810


**RECORD DRAWINGS - 2015-11-16**

Num	Revisions Description	Date


MANHOLE 2

Drawing Number **C6.0**


DRAWN BY: JBC CHECKED BY: JM

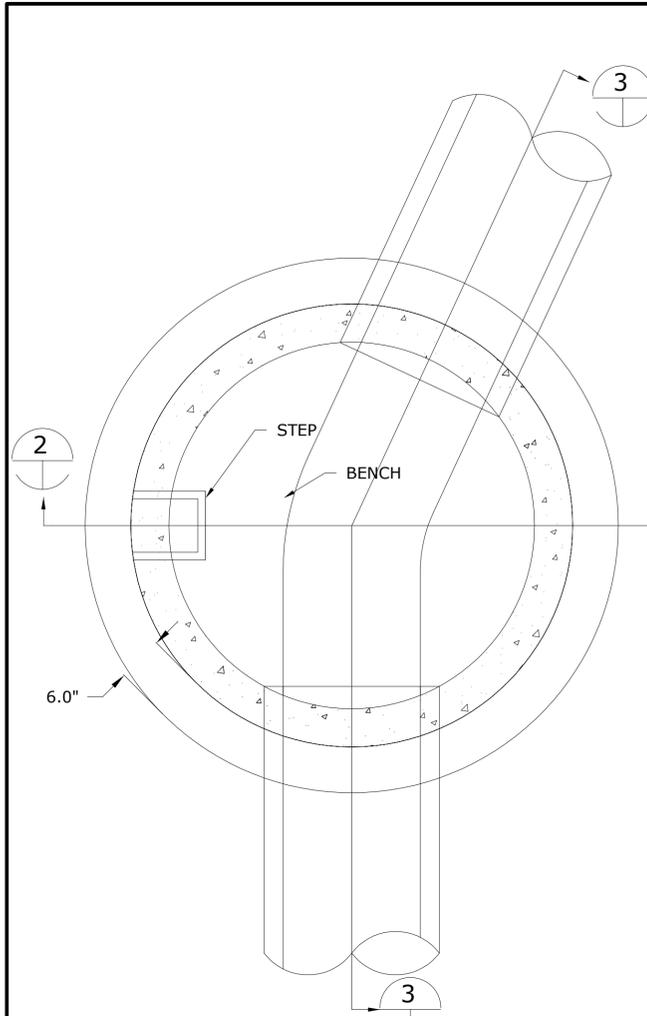


**1 PLAN VIEW TYPICAL MANHOLE**  
SCALE: 1" = 1'-0"

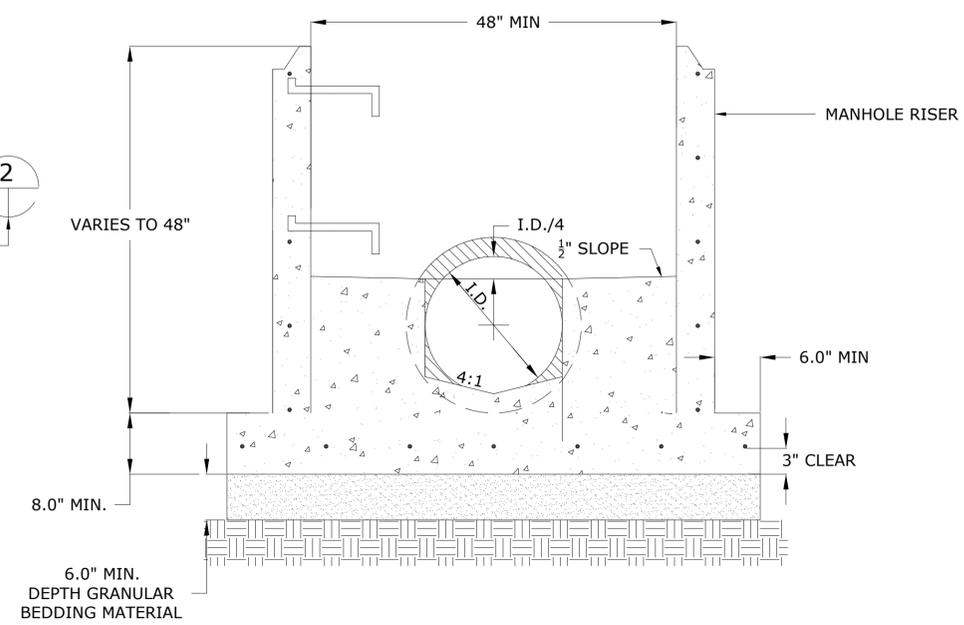

**2 SECTION VIEW TYPICAL MANHOLE**  
SCALE: 1" = 1'-0"

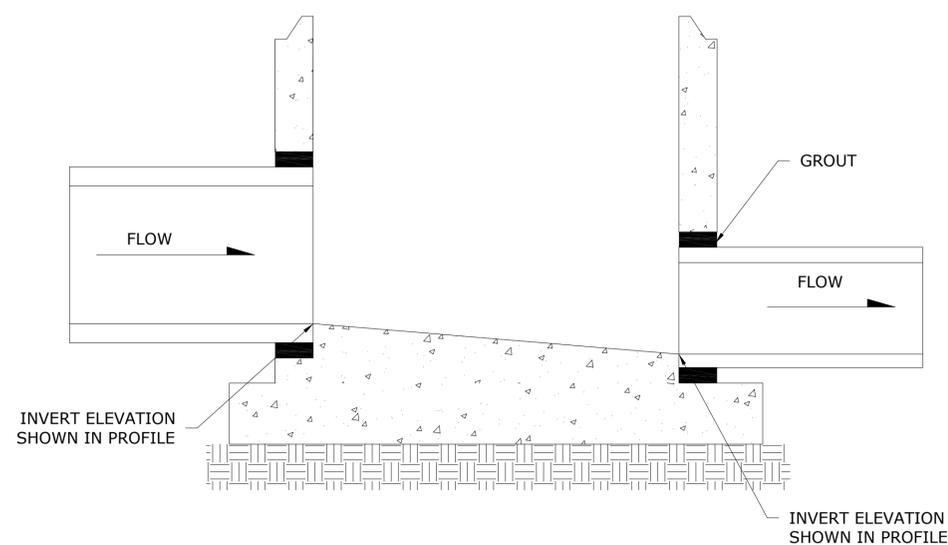

**3 SECTION VIEW TYPICAL MANHOLE**  
SCALE: 1" = 1'-0"

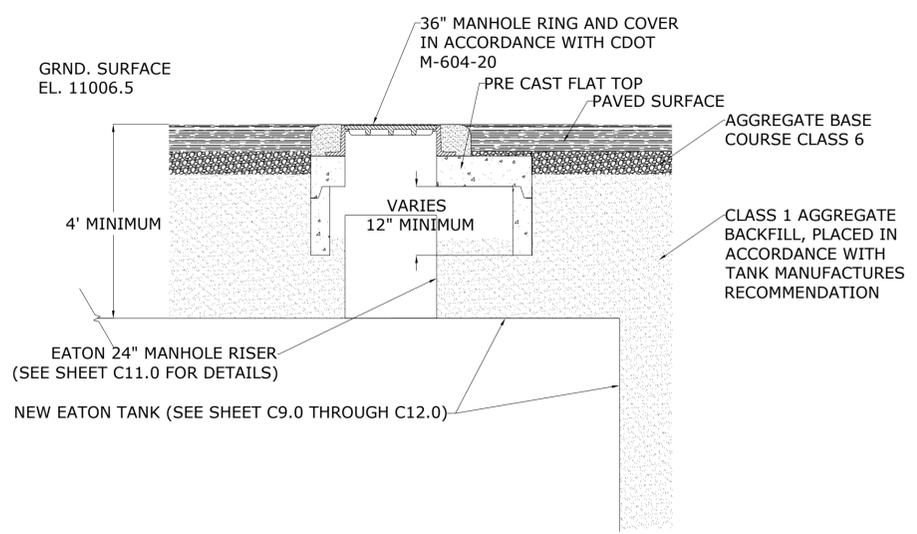

**4 SECTION VIEW MANHOLES 8 & 9**  
SCALE: 1" = 1'-0"

MANHOLE TABLE INFORMATION

STRUCTURE	TYPE / SIZE	STATION	OFFSET	INLET DETAILS			Angle deg	OUTLET DETAILS			DROP ACROSS MANHOLE FT
				PIPE	STATION	INVERT		PIPE	STATION	INVERT	
MANHOLE 3	PRECAST 48-in ROUND	4+64.2	0.00	2.3.	4+64.2	10999.49	113.00	3.4.	4+68.2	10999.39	0.10
MANHOLE 4	PRECAST 48-in ROUND	5+80.2	0.00	3.4.	5+78.2	10997.85	118.00	4.5.	5+82.2	10997.75	0.10
MANHOLE 5	PRECAST 48-in ROUND	6+32.4	0.00	4.5.	6+30.4	10997.05	0.00	5.6., 5.T3.	6+34.4	10997.05	0.00
MANHOLE 6	PRECAST 48-in ROUND	6+49.5	0.00	5.6.	6+34.4	10996.88	0.00	6.7., 6.T2	6+51.4	10996.88	0.00
MANHOLE 7	PRECAST 48-in ROUND	6+81.3	0.00	6.7.	6+51.4	10996.55	0.00	7.T1	6+51.4	10996.55	0.00
MANHOLE 8	PRECAST 48-in ROUND	6+32.4	41.50	NA			NA	NA			0.00
MANHOLE 9	PRECAST 48-in ROUND	6+49.5	41.50	NA			NA	NA			0.00

GENERAL NOTES:

1. THE BASE SLAB SHALL BE POURED MONOLITHICALLY WITH BOTTOM RISER SECTION.
2. PRECAST MANHOLE BASES SHALL FIT THE CONDITIONS AND LOCATIONS FOR WHICH THEY ARE INTENDED WITHOUT ANY FIELD MODIFICATIONS.
3. PRECAST MANHOLE BASES SHALL BE BEDDED ON AN APPROVED GRANULAR BEDDING MATERIAL AS SPECIFIED IN CDOT STANDARD SPECIFICATION SECTION 603.05.
4. CONTRACTOR TO SELECT STANDARD 12-IN DIA. AND 8-IN DIA. SCHD. 40 PVC FITTINGS, INCLUDING BUT NOT LIMITED TO FLANGES, TEES AND ELBOWS TO CONNECT LINES 4.5., 5.T1., 5.T2., AND 5.T3..
5. ALL MANHOLES SHALL BE CONSTRUCTED IN ACCORDANCE WITH CDOT M&S M-604-20, INCLUDING BUT NOT LIMITED TO REINFORCEMENT, STEPS, COVER AND FLOW CHANNEL. REINFORCEMENT SHALL CONSIST OF DEFORMED BARS ONLY PER ASTM A615.
6. MANHOLE FRAMES AND COVERS CONSTRUCTED OUTSIDE OF THE ROADWAY SHALL BE PLACED 6-IN ABOVE FINAL GRADE.



**BARNARD EJMT TEAM**

**BARNARD** **RONDINELLI**

**BCER** **Sturgeon Electric** **ALF**

Western States Fire Protection Co.

**EISENHOWER/JOHNSON MEMORIAL TUNNEL**

FIXED FIRE SUPPRESSION SYSTEM DESIGN BUILD PROJECT

Project No. C0703-360 Subaccount 17810

**RECORD DRAWINGS - 2015-11-16**

MANHOLE DETAILS

Drawing Number **C7.0**


Revisions Table:

Num	Description	Date


Checked by: JBC  
Drawn by: JMC

GENERAL NOTES:


- DROP INLET STRUCTURES SHALL CONFORM TO CDOT STANDARD PLANS M-604-25, VANE GRATE INLET INCLUDING BUT NOT LIMITED TO REINFORCING.
- PRECAST DROP INLET SHALL BE BEDDED ON AN APPROVED GRANULAR BEDDING MATERIAL AS SPECIFIED IN CDOT STANDARD SPECIFICATION SECTION 603.05.
- IT IS ASSUMED THAT THE SHOULDER OF THE TRAVEL LANES IS 9 FT. CONTRACTOR WILL CONFIRM SHOULDER WIDTH WITH SURVEY PRIOR TO START OF CONSTRUCTION. CURRENT LANE IMPACT WITH 5.5 FT WIDE DROP INLET BOX AND 2 FT WIDE APPROACH CHANNEL WILL NOT IMPACT LANE CONFIGURATION.
- CONTRACTOR TO CONFIRM SURFACE ELEVATION AND PROVIDE DROP INLET BOX WITH APPROPRIATE DEPTH SUCH THAT INVERT ELEVATIONS SHOWN IN THE DROP INLET INFORMATION TABLE AND THE SURFACE CAN BE LEVELED AS SHOWN IN THE DRAWINGS AND DISCUSSED IN NOTE 5 BELOW.
- THE CONCRETE AND/OR ASPHALT TO BE PLACED AT THE SURFACE OF THE DROP INLET BOX SHALL BE PLACED TO MATCH THE EXISTING CROSS-SLOPE GUTTER AND A MINIMUM GUTTER WIDTH OF 9.0FT. THE LONGITUDINAL SLOPE OF THE ROAD IS ASSUMED TO BE 0.016 (FT/FT) FOR THE EAST BOUND LANE OF TRAVEL WITH A CROSS-SLOPE OF PAVEMENT ASSUMED AT 0.04 (FT/FT) AND 0.009 (FT/FT) FOR THE WEST BOUND LANE OF TRAVEL WITH A CROSS-SLOPE OF PAVEMENT ASSUMED AT 0.05 (FT/FT).
- A PIPE JOINT SEALING COMPOUND SHALL BE USED IN ACCORDANCE WITH CDOT STANDARD SPECIFICATION 705.04 FOR ALL APPLICABLE PIPE JOINTS. RCP PIPE PROTRUSIONS THROUGH STRUCTURE WALL SHALL BE HAND PACKED WITH GROUT TO PROVIDE WATER TIGHT SEAL THROUGH STRUCTURE WALL.

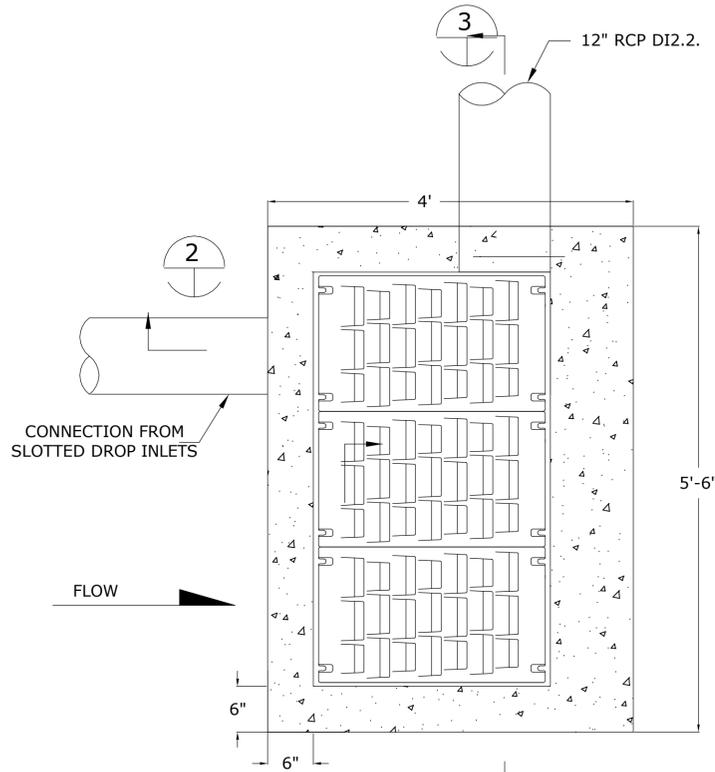

1 PLAN VIEW DROP INLET TYPICAL  
SCALE: 1/2" = 1'-0"

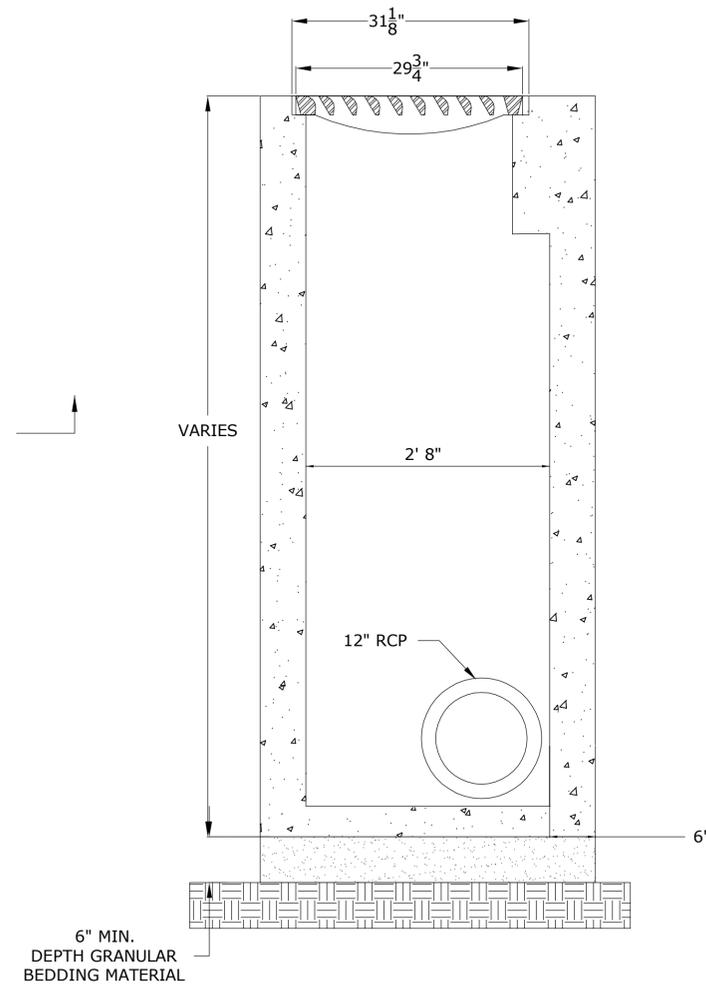

2 SECTION VIEW TYPICAL DROP INLET  
SCALE: 1/2" = 1'-0"

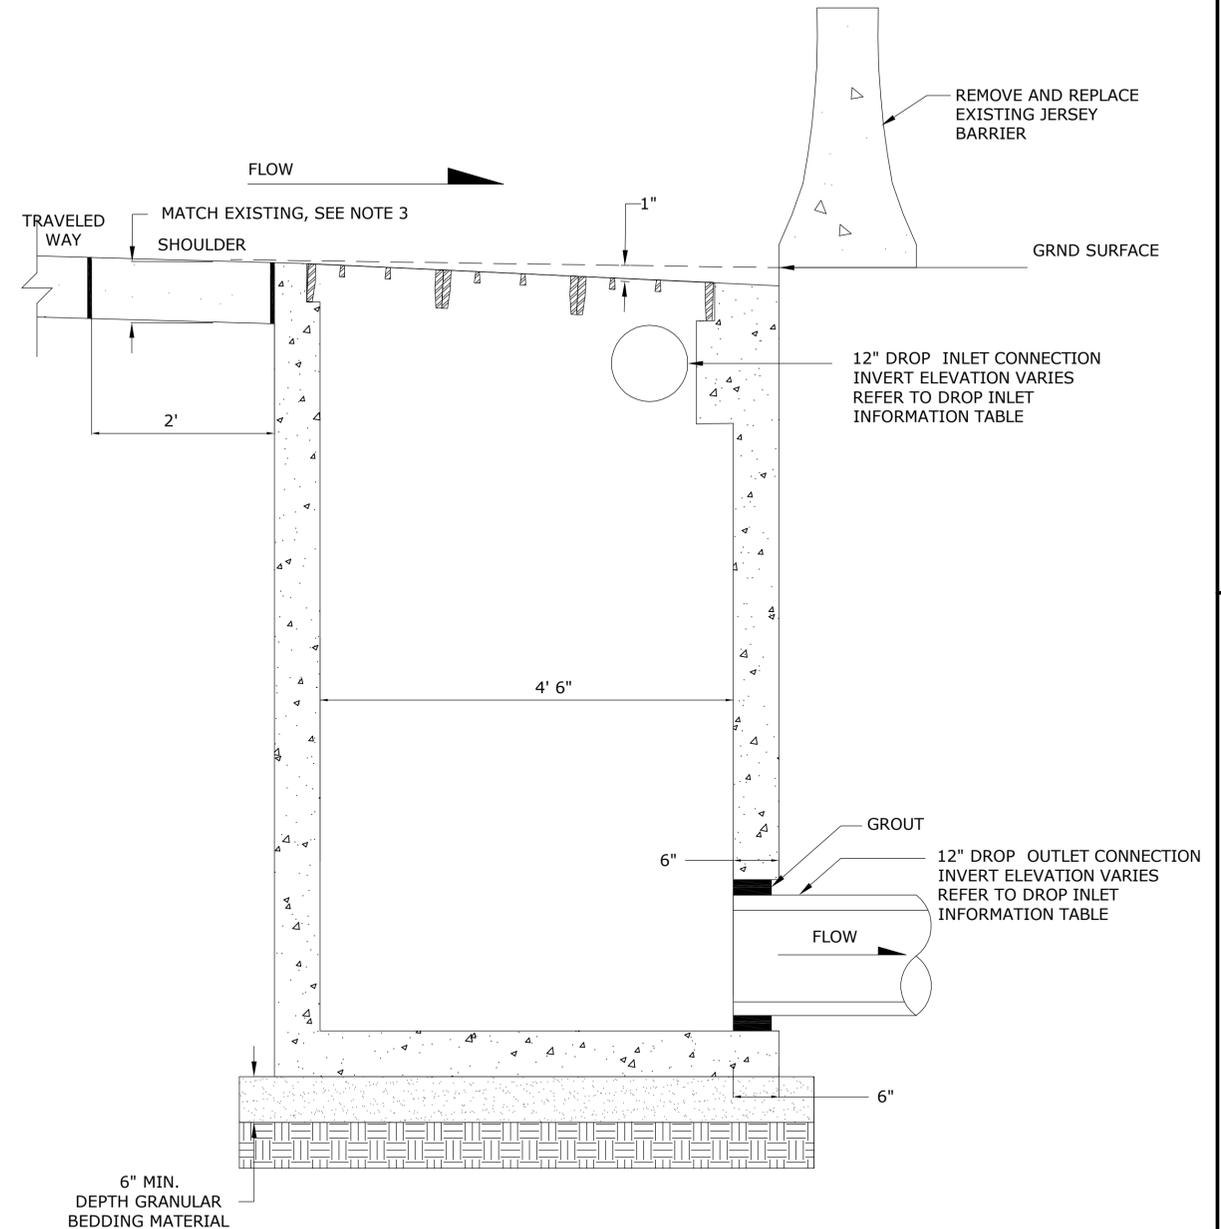

3 SECTION VIEW TYPICAL DROP INLET  
SCALE: 1/2" = 1'-0"

STRUCTURE	TYPE / SIZE	STATION	OFFSET	RIM ELEVATION	INLET DETAILS			Angle deg	OUTLET DETAILS		
					PIPE	STATION	INVERT		PIPE	STATION	INVERT
DROP INLET 1	EXISTING 40" X 40"	0+32.0	86.0	11015.5	DI3.DI1.	0+29.4	11012.22	0	EXISTING	NA	NA
DROP INLET 2	SEE SHEET 8.1 FOR DROP INLET 3 INFORMATION										
DROP INLET 3	VANE GRATE INLET (3 GRATE)	0+56.4	83.4	11015.5	NA	NA	NA	0	DI3.DI1.	0+54.3, 82.0	11012.47
DROP INLET 4	VANE GRATE INLET (3 GRATE)	0+61.3	26.0	11016.5	NA	NA	NA	0	DI4.DI2.	0+63.4, 27.4	11013.15

IF THIS SHEET IS NOT 22"x34" IT IS NOT PLOTTED TO SCALE



**BARNARD EJMT TEAM**

**BARNARD** **RONDINELLI**  
A REFERENCE life safety  
CONSULTING ENGINEERS  
Western States Fire Protection Co.  
**Sturgeon ELECTRIC**

**EISENHOWER/JOHNSON MEMORIAL TUNNEL**

FIXED FIRE SUPPRESSION SYSTEM  
DESIGN BUILD PROJECT  
Project No. C0703-360 Subaccount 17810  
**RECORD DRAWINGS - 2015-11-16**


Revisions	Date
Num	Description

DRAWN BY: JBC  
CHECKED BY: JMC  
DROP INLET DETAILS  
Drawing Number  
**C8.0**







IF THIS SHEET IS NOT 22"x34" IT IS NOT PLOTTED TO SCALE

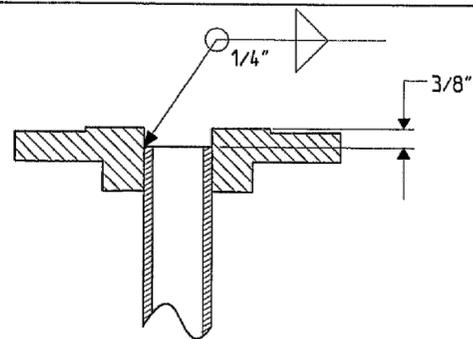


FLANGE DETAIL

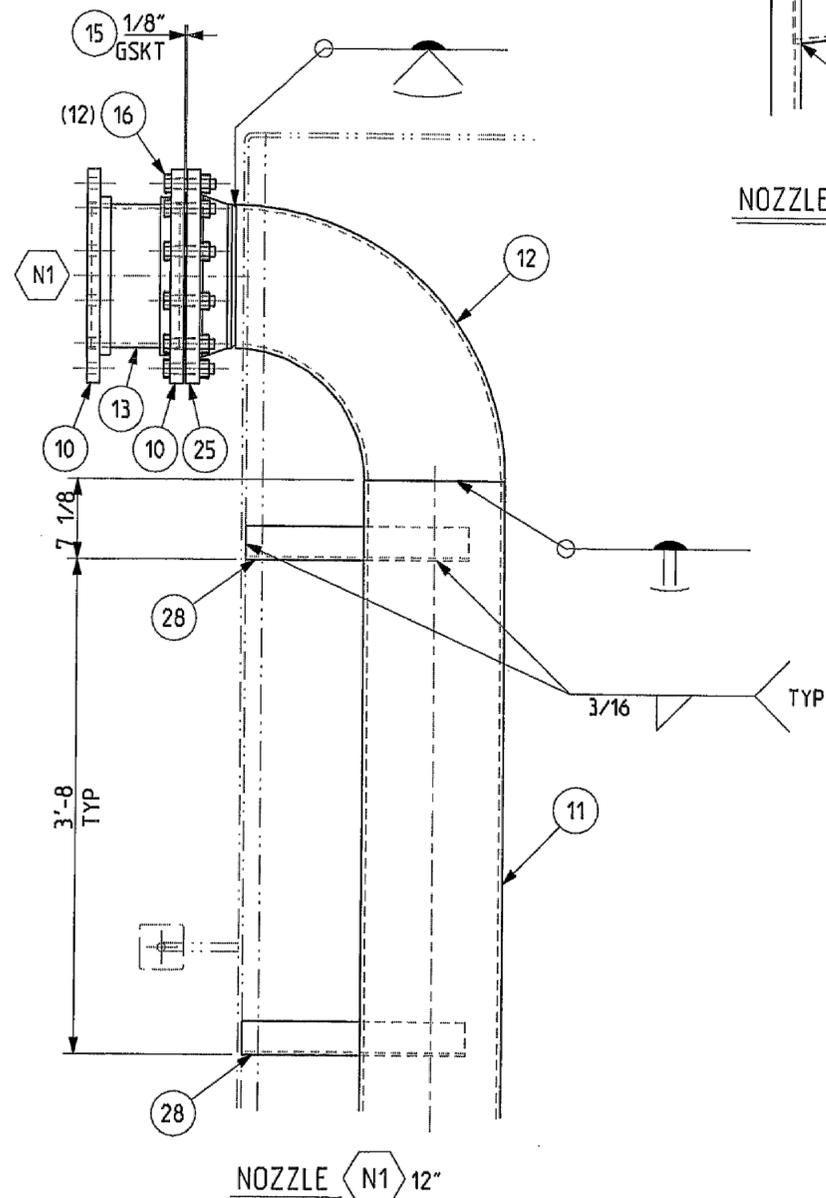

NOZZLE N1 12"

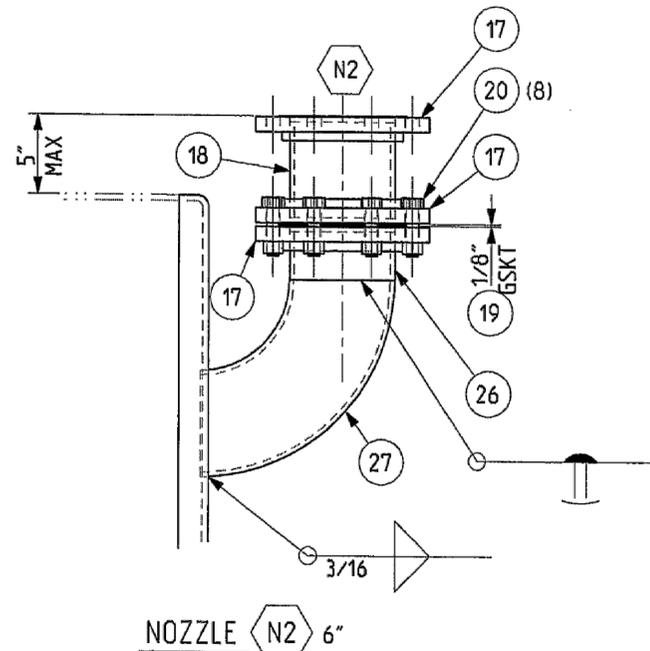

NOZZLE N2 6"

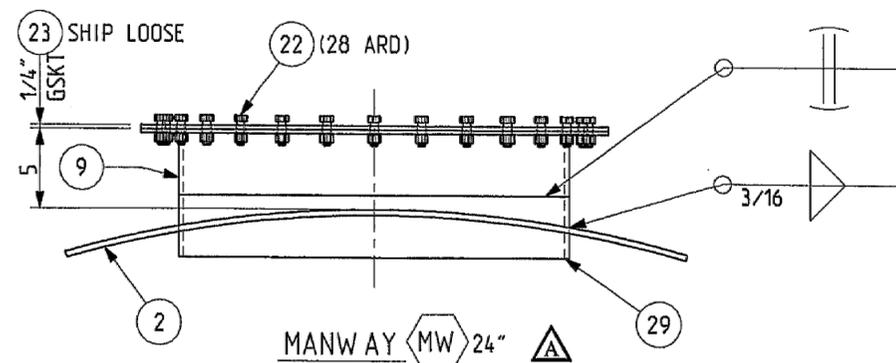

MANWAY MW 24"

SHIP MANWAY WITH COVER ATTACHED  
REMOVE COVER AND ATTACH MK-23 GASKET  
AND RISER (D-8839-1B) AFTER SHIPPING

NOTES:

1. TANK SHALL BE CONSTRUCTED IN ACCORDANCE WITH UNDERWRITERS LAB INC. STANDARDS FOR UNDERGROUND STORAGE TANKS SUBJECT TO UL-58 LATEST REVISION (SWRI LABEL APPLIED).
2. LEAK TEST AT MORE THAN 3 P.S.I AND LESS THAN 5 P.S.I.
3. TANK IS DESIGNED FOR ZERO PRESSURE FOR ATMOSPHERIC CONDITION ONLY.
4. ALL OPENINGS SHALL BE COVERED TO PREVENT ENTRANCE OF DIRT & MOISTURE DURING SHIPMENT.
5. OUTSIDE ONLY TO BE SANDBLASTED (COMMERCIAL) & COATED W/COAL TAR EPOXY - BARBOLINE BITUMASTIC 300.

**APPROVED**  
FOR CONSTRUCTION  
DATE.....BY.....

**FOR CUSTOMER APPROVAL**  
DATE 6/3/15 JG

WORK THIS DWG WITH D-8839-1

Revisions	No.	Date	By	Chk'd	Description
	B	2/13/15	CG	RT	REMOVED NOZZLE N3
	A	1/28/15	CG	RT	UPDATED NOZZLES PER CUSTOMER
Revision Description					
<b>EATON SALES &amp; SERVICE LLC</b> DENVER					
144" DIA x 48'-0" LONG - 40000 GALLON STI-P3					
HORIZONTAL UNDER GROUND STORAGE TANK UL-58					
P.O. # 0004718					
Loc: DENVER, COLORADO					
Cust: COLORADO DEPARTMENT OF TRANSPORTATION					
EMP No. <b>8839-D01</b> Dwg. No. <b>D-8839-1A</b> BY B					
Date: 1/14/15					



**EISENHOWER/JOHNSON**  
**MEMORIAL TUNNEL**  
 FIXED FIRE SUPPRESSION SYSTEM  
 DESIGN BUILD PROJECT  
 Project No. C0703-360 Subaccount 17810  
**RECORD DRAWINGS - 2015-11-16**



Revisions	No.	Date	By	Chk'd	Description

EATON TANK (2 OF 4)

Drawing Number  
**C10.0**

**BARNARD EJMT TEAM**  
**BARNARD**  
**RONDINELLI**  
**STURGEON ELECTRIC**  
 BCER  
 Western States Fire Protection Co.  
 CONSULTING ENGINEERS  
 A BEER GROUP life safety



IF THIS SHEET IS NOT 22"x34" IT IS NOT PLOTTED TO SCALE

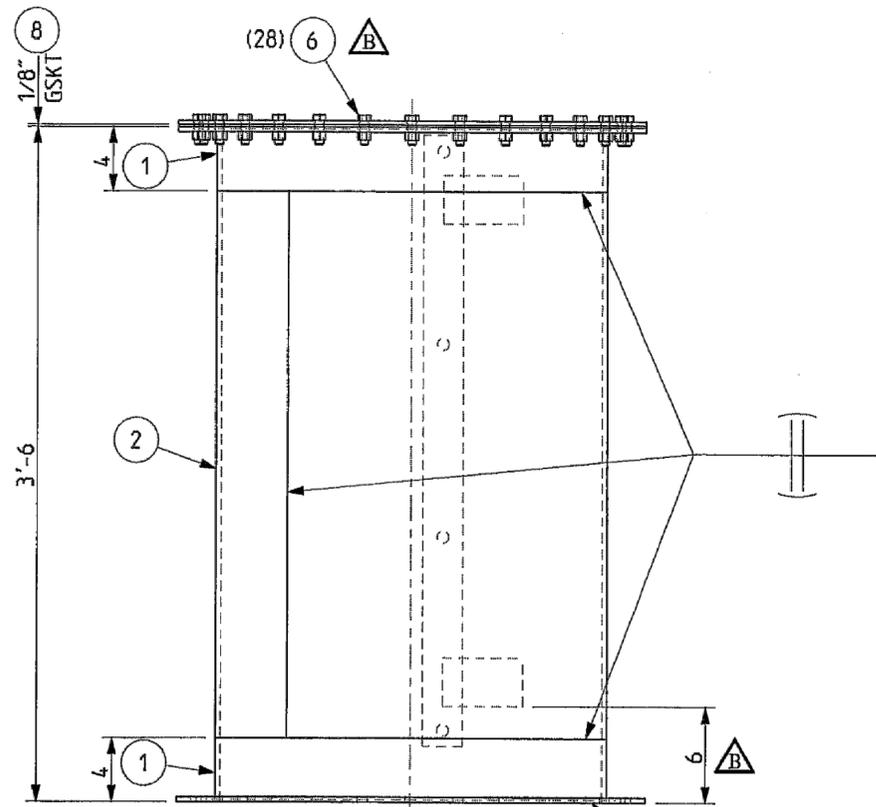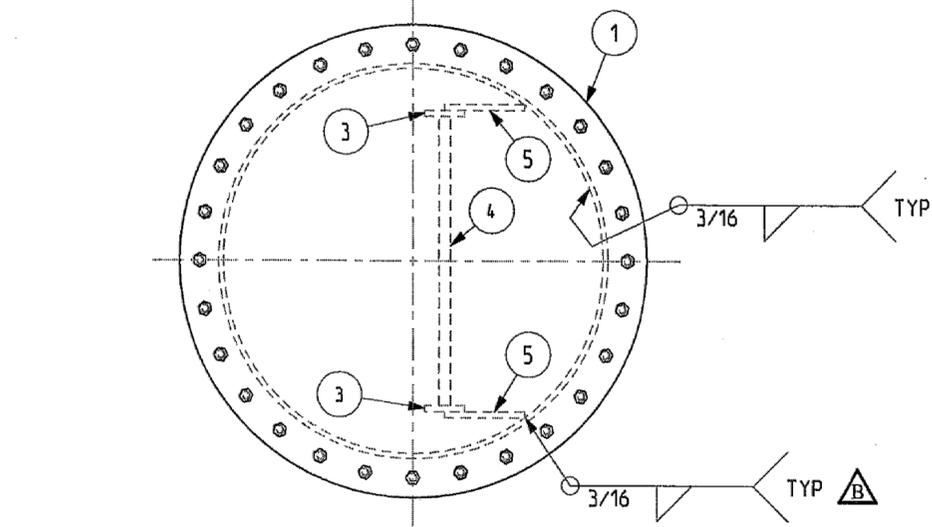

NOTE: COVER BOTTOM FLANGE DURING SHIPPING

BILL OF MATERIAL							
Ship Pcs	Mark No.	Assy Pcs	Description	Length Inches	Material Spec	Weights	Component Part No.
△ B	8839-1B-1	2	MANWAY 24" B/L		A-36	265	
△ B	8839-1B-2	1	PLATE, 5/16" x 34" ROLLED	76 3/8	A-36	230	
	8839-1B-3	2	FB, 3/8" x 2 1/2" LADDER RAIL	38	A-36	20	
	8839-1B-4	4	LADDER RUNG 3/4" DIA.	18	A-36	9	
△ B	8839-1B-5	4	FB, 3/8" x 3"	5	A-36	6	
△ B	8839-1B-6	28	1/2" BOLT W/ NUT	1 1/2	STEEL	4	
△ B	8839-1B-8	1	1/8" GSKT FOR 24" MANWAY		FIBER	-	

QTY SHOWN FOR (1) TANK.  
(2) TANKS REQUIRED

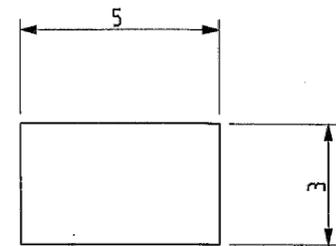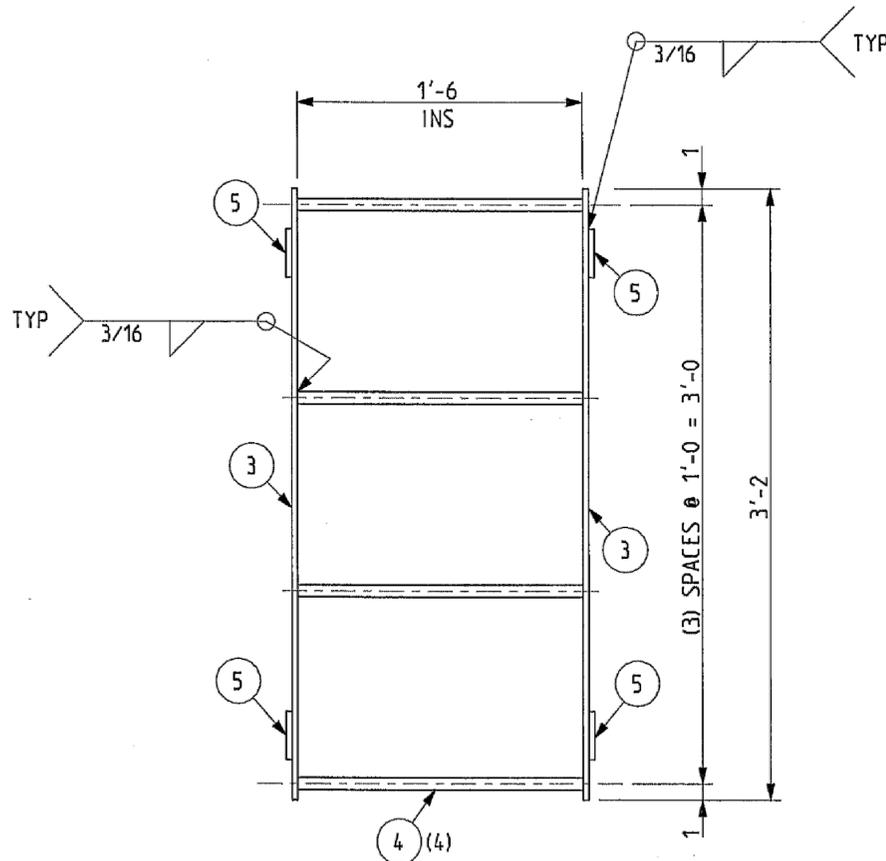

DETAIL 5  
3/8" PL.

**APPROVED**  
 FOR CONSTRUCTION  
 DATE.....BY.....

**FOR CUSTOMER APPROVAL**  
 DATE 2/12/15

WORK THIS DWG WITH D-8839-1 & -1A

No.	Date	By	Chk'd	Revision Description
B	2/13/15	CG	RT	CHGD MANWAY SIZE & LADDER CLIP
A	1/28/15	CG	RT	UPDATED MANWAY AND LADDER HEIGHT

**EATON**  
 EATON METAL PRODUCTS CO LLC  
 DENVER - SALT LAKE CITY  
 MANWAY RISER W/LADDER DETAIL  
 14 1/2" DIA x 48'-0" LONG - 40000 GALLON STI-P3  
 P.O. # 0004718  
 Loc: DENVER, COLORADO  
 Cust: COLORADO DEPARTMENT OF TRANSPORTATION  
 Drawn By: CG  
 Date: 1/12/15  
 Chk'd By: RT  
 Date: 1/14/15  
 Job No. 8839-D01  
 Dwg. No. D-8839-1B

**BARNARD EJMT TEAM**  
**BARNARD**  
**STURGEON ELECTRIC**  
**RONDINELLI**  
 A BEER GROUP LIFE SAFETY  
 CONSULTING ENGINEERS  
 Western States Fire Protection Co.

**EISENHOWER/JOHNSON**  
**MEMORIAL TUNNEL**  
 FIXED FIRE SUPPRESSION SYSTEM  
 DESIGN BUILD PROJECT  
 Project No. C0703-360  
 Subaccount 17810  
**RECORD DRAWINGS - 2015-11-16**

Revisions	Date



EATON TANK (3 OF 4)  
 Drawing Number  
**C11.0**

IF THIS SHEET IS NOT 22"x34" IT IS NOT PLOTTED TO SCALE


**BILL OF MATERIAL**

Ship Pcs	Mark No.	Assy Pcs	Description	Length Inches	Material Spec	Weights	Component Part No.
△ B	8839-1C-1	2	FB, 3/8" x 3" LADDER RAIL W/HOLE	143 1/2	A-36	92	
△ B	8839-1C-2	12	LADDER RUNG 3/4" DIA.	18	A-36	27	
△ B	8839-1C-3	2	FB, 3/8" x 3"	5	A-36	3	
△ B	8839-1C-4	2	1/2" HEX HEAD BOLTS W/ 2-NUTS	1 3/4	A-307	-	
△ B	8839-1C-5	2	FB, 3/8" x 3" W/SLOT	5	A-36	3	

QTY SHOWN FOR (1) TANK.  
(2) TANKS REQUIRED

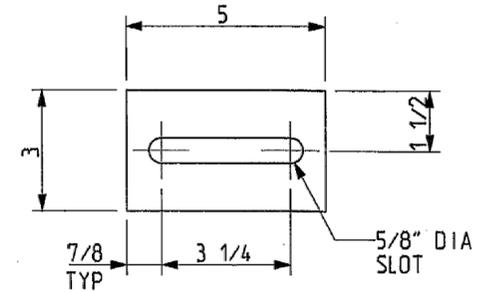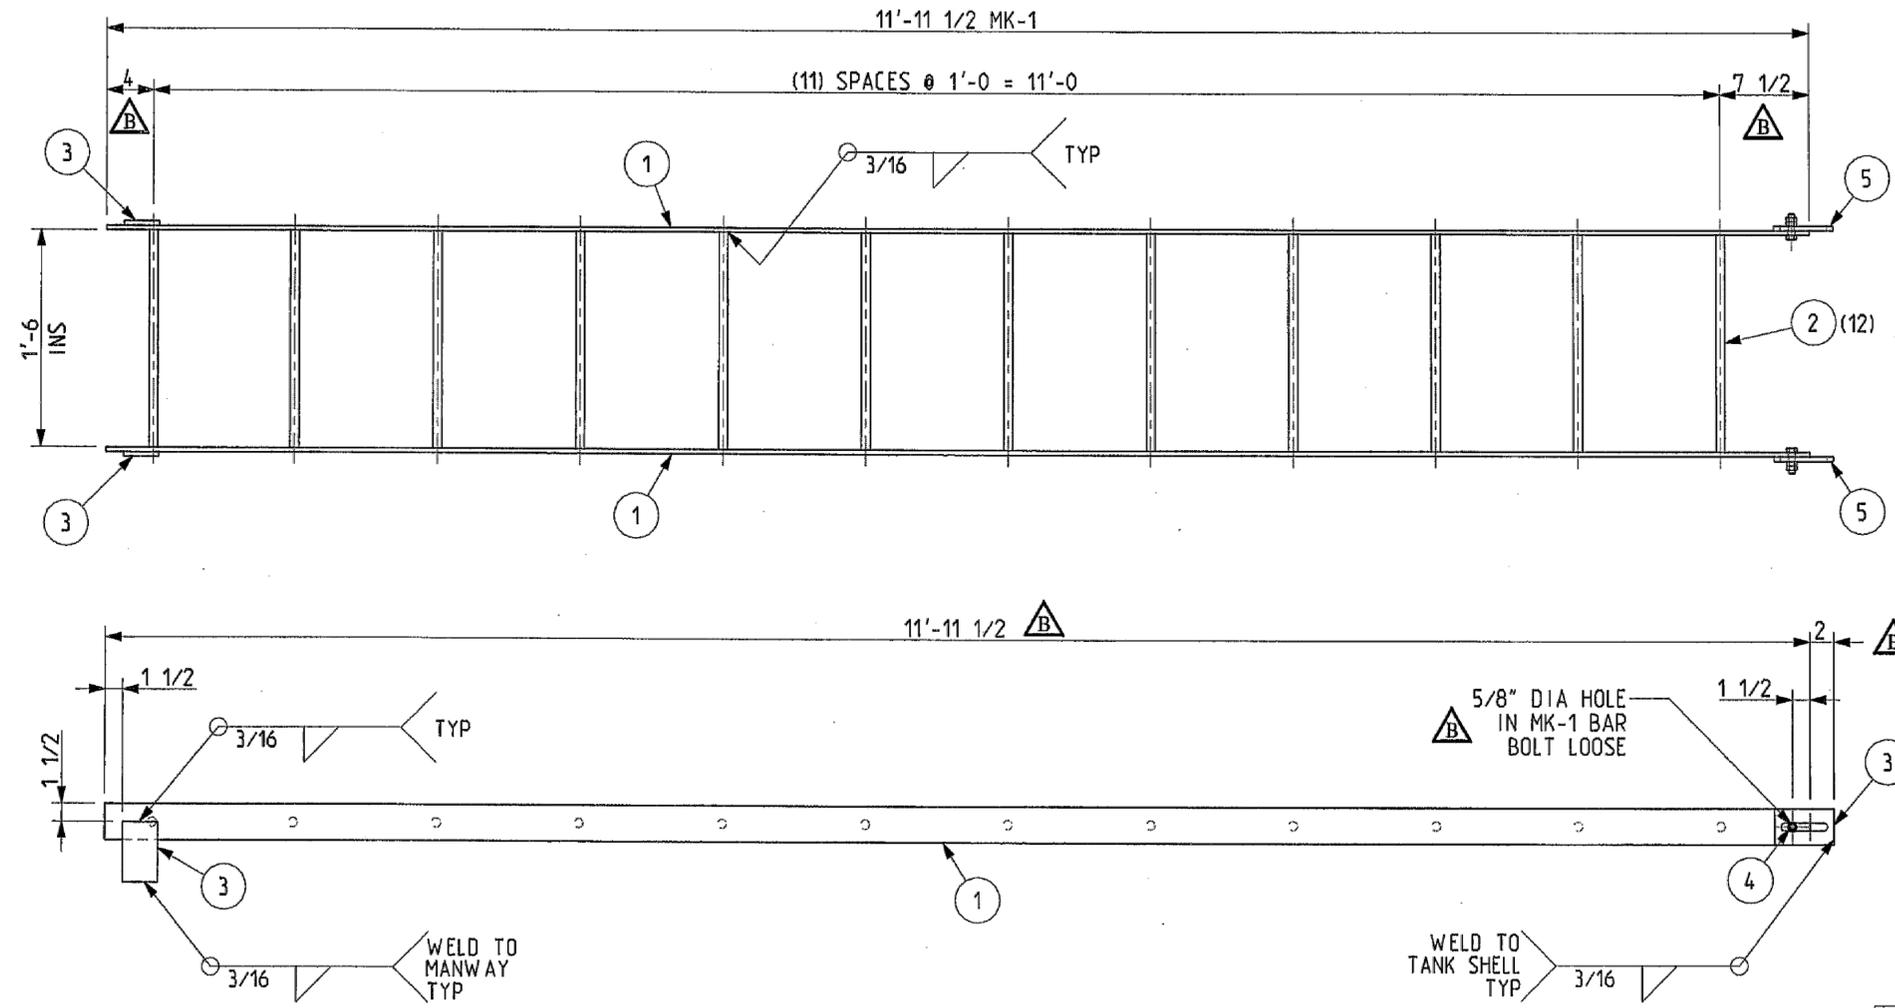

**DETAIL 5**  
1/4" PL

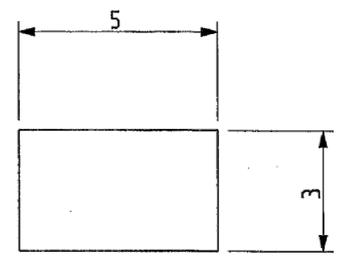

**DETAIL 3**  
3/8" PL

**APPROVED**  
FOR CONSTRUCTION  
DATE.....BY.....

**FOR CUSTOMER APPROVAL**  
DATE 2/17/15 JR

WORK THIS DWG WITH D-8839-1 & -1A

B	2/13/15	CG	RT	CHGD LADDER LENGTH AND TOP & BTM CLIPS
A	1/28/15	CG	RT	UPDATED LADDER RUNG SPACING
Revision Description				
<b>EATON</b>				
EATON METAL PRODUCTS CO LLC DENVER - SALT LAKE CITY				
INTERNAL LADDER DETAILS				
144" DIA x 48'-0" LONG - 40000 GALLON STI-P3				
P.O. # 0004718				
Drawn By:	CG			
Date:	1/12/15			
Chk'd By:	RT			
Date:	1/14/15			
Cust: COLORADO DEPARTMENT OF TRANSPORTATION		Job No. 8839-D01		
EMP		Dwg. No. D-8839-1C		B

**BARNARD EJMT TEAM**

BCER  
BARNARD  
RONDELLO  
STURGEON ELECTRIC

Western States Fire Protection Co.  
CONSULTING ENGINEERS

**EISENHOWER/JOHNSON MEMORIAL TUNNEL**  
FIXED FIRE SUPPRESSION SYSTEM  
DESIGN BUILD PROJECT

Project No. C0703-360 Subaccount 17810  
RECORD DRAWINGS - 2015-11-16

Num	Revisions	Date
	Description	

EATON TANK (4 OF 4)  
Drawing Number  
**C12.0**

















IF THIS SHEET IS NOT 22"x34" IT IS NOT PLOTTED TO SCALE

**PANEL: (N) EMWH1**

FEED FROM: ATS-EMWH1      NEUTRAL: 100%      MANUFACTURER: EATON  
 VOLTAGE: 480      GROUND: STANDARD      BUS AMPACITY: 250  
 PHASE: 3      ENCLOSURE: NEMA 1      MAIN: 150A MLO (LIMITED BY 150A ATS)  
 WIRE: 3      MOUNTING: SURFACE      AIC: 18,000

CKT NO	CKT DESCRIPTION	LOAD		CKT BREAKER			CKT BREAKER			LOAD		CKT DESCRIPTION	CKT NO
		VA	TYPE	P	A	NOTE	NOTE	A	P	TYPE	VA		
1	SPARE			3	100			100	3	M	10867	BOILER SKID	2
3	/			/	/			/	/	M	10867	/	4
5	/			/	/			/	/	M	10867	/	6
7	XFMR T-EMWL1			3	45			-	-			SPACE	8
9	/			/	/			-	-			/	10
11	/			/	/			-	-			/	12
13	EISENHOWER TUNNEL	1000	O	3	30			30	3	O	1000	JOHNSON TUNNEL	14
15	FIRE PROTECTION SYSTEM	1000	O	/	/			/	/	O	1000	FIRE PROTECTION SYSTEM	16
17	/	1000	O	/	/			/	/	O	1000	/	18
19	SPARE			3	15			15	3			SPARE	20
21	/			/	/			/	/			/	22
23	/			/	/			/	/			/	24
25	SPD			3	30	1		-	-			SPACE	26
27	/			/	/			-	-			/	28
29	/			/	/			-	-			/	30

SUBFED LOAD SUMMARY											
LOAD	PHASE	KVA									
		L	R	H	M	MLRG	CM	K	S	N	E
PANEL 'EMWL1'	A	-	-	-	1.5	0.9	-	-	-	-	5.3
	B	0.4	-	-	1.5	0.9	-	-	-	-	4.5
	C	-	-	-	1.5	0.9	-	-	-	-	4.2

LOAD TYPE	CONNECTED (KVA)				DEMAND FACTOR	DEMAND (KVA)			
	A	B	C	TOTAL		A	B	C	TOTAL
LIGHTING (L)	0.0	0.4	0.0	0.4	1.25	0.0	0.5	0.0	0.5
RECEPTACLE (R)	0.0	0.0	0.0	0.0	1.00	0.0	0.0	0.0	0.0
REC (>10000VA) (R)	0.0	0.0	0.0	0.0	0.50	0.0	0.0	0.0	0.0
HEATER (H)	0.0	0.0	0.0	0.0	1.00	0.0	0.0	0.0	0.0
LARGEST MOTOR (M)	10.9	10.9	10.9	32.6	1.25	13.6	13.6	13.6	40.8
REMAIN MOTOR (M)	1.5	1.5	1.5	4.5	1.00	1.5	1.5	1.5	4.5
CONTINUOUS LOAD (CL)	0.0	0.0	0.0	0.0	1.25	0.0	0.0	0.0	0.0
KITCHEN LOADS (K)	0.0	0.0	0.0	0.0	1.00	0.0	0.0	0.0	0.0
SPECIFIC LOADS (S)	0.0	0.0	0.0	0.0	1.00	0.0	0.0	0.0	0.0
NONCOINCIDENTAL (N)	0.0	0.0	0.0	0.0	0.00	0.0	0.0	0.0	0.0
OTHER LOAD (O)	7.3	6.5	6.2	20.0	1.00	7.3	6.5	6.2	20.0
<b>TOTAL DEMAND (KVA)</b>	<b>22.4</b>	<b>22.1</b>	<b>21.3</b>	<b>65.7</b>					
SPARE (KVA)	19.2	19.5	20.3	59.0					
<b>TOTAL (A/PH)</b>	<b>80.8</b>	<b>79.7</b>	<b>76.8</b>	<b>79.1</b>					
SPARE (A/PH)	69.2	70.3	73.2	70.9					

**NOTES:**  
 1. PROVIDE PANEL WITH INTERNALLY MOUNTED TYPE-2, 50kA SURGE PROTECTION DEVICE.

**PANEL: (E) DP-EV**

FEED FROM: ATS-1200A      NEUTRAL: 100%      MANUFACTURER: —  
 VOLTAGE: 480/277      GROUND: STANDARD      BUS AMPACITY: 1200  
 PHASE: 3      ENCLOSURE: NEMA 1      MAIN: 1200A MLO  
 WIRE: 4      MOUNTING: SURFACE      AIC: 65,000

CKT NO	CKT DESCRIPTION	LOAD		CKT BREAKER			CKT BREAKER			LOAD		CKT DESCRIPTION	CKT NO
		VA	TYPE	P	A	NOTE	NOTE	A	P	TYPE	VA		
1	XFMR T-EMEL1 (N)			3	45			100	3	O	16667	INVERTER (BY OTHERS) (N)	2
3	/			/	/			/	/	O	16667	/	4
5	/			/	/			/	/	O	16667	/	6
7	TX-EVND (300kVA) (E)	16667	O	3	400	1	1	-	-			NON-USABLE SPACE (E)	8
9	/	16667	O	/	/			-	-			/	10
11	/	16667	O	/	/			-	-			/	12
13	EVS-1 (E)	16667	O	3	150	1	1	150	3	O	16667	EVN-1 (E)	14
15	/	16667	O	/	/			/	/	O	16667	/	16
17	/	16667	O	/	/			/	/	O	16667	/	18
19	T-EVSD (E)	16667	O	3	225	1	1	-	-			NON-USABLE SPACE (E)	20
21	/	16667	O	/	/			-	-			/	22
23	/	16667	O	/	/			-	-			/	24
25	JOHNSON TUNNEL (N)	1000	O	3	30			30	3	O	1000	EISENHOWER TUNNEL (N)	26
27	FIRE PROTECTION SYSTEM	1000	O	/	/			/	/	O	1000	FIRE PROTECTION SYSTEM	28
29	/	1000	O	/	/			/	/	O	1000	/	30

SUBFED LOAD SUMMARY											
LOAD	PHASE	KVA									
		L	R	H	M	MLRG	CM	K	S	N	E
PANEL 'EMEL1'	A	-	-	-	-	-	-	-	-	-	5.6
	B	-	-	-	-	-	-	-	-	-	3.6
	C	-	-	-	-	-	-	-	-	-	3.6

LOAD TYPE	CONNECTED (KVA)				DEMAND FACTOR	DEMAND (KVA)			
	A	B	C	TOTAL		A	B	C	TOTAL
LIGHTING (L)	0.0	0.0	0.0	0.0	1.25	0.0	0.0	0.0	0.0
RECEPTACLE (R)	0.0	0.0	0.0	0.0	1.00	0.0	0.0	0.0	0.0
REC (>10000VA) (R)	0.0	0.0	0.0	0.0	0.50	0.0	0.0	0.0	0.0
HEATER (H)	0.0	0.0	0.0	0.0	1.00	0.0	0.0	0.0	0.0
LARGEST MOTOR (M)	0.0	0.0	0.0	0.0	1.25	0.0	0.0	0.0	0.0
REMAIN MOTOR (M)	0.0	0.0	0.0	0.0	1.00	0.0	0.0	0.0	0.0
CONTINUOUS LOAD (CL)	0.0	0.0	0.0	0.0	1.25	0.0	0.0	0.0	0.0
KITCHEN LOADS (K)	0.0	0.0	0.0	0.0	1.00	0.0	0.0	0.0	0.0
SPECIFIC LOADS (S)	0.0	0.0	0.0	0.0	1.00	0.0	0.0	0.0	0.0
NONCOINCIDENTAL (N)	0.0	0.0	0.0	0.0	0.00	0.0	0.0	0.0	0.0
OTHER LOAD (O)	90.9	88.9	88.9	268.8	1.00	90.9	88.9	88.9	268.8
<b>TOTAL DEMAND (KVA)</b>	<b>90.9</b>	<b>88.9</b>	<b>88.9</b>	<b>268.8</b>					
SPARE (KVA)	241.5	243.5	243.5	728.5					
<b>TOTAL (A/PH)</b>	<b>328.3</b>	<b>321.1</b>	<b>321.1</b>	<b>323.3</b>					
SPARE (A/PH)	871.7	878.9	878.9	876.7					

**NOTES:**  
 1. LOADS ON EXISTING 500kW GENERATOR IS 200kW.  
 NEW LOAD ADDED = 18.8kW  
 TOTAL LOAD = 218.8kW  
 SPARE = 281.2kW

**PANEL: (N) EMWL1**

FEED FROM: 30KVA XFMR      NEUTRAL: 100%      MANUFACTURER: EATON  
 VOLTAGE: 208/120      GROUND: STANDARD      BUS AMPACITY: 100  
 PHASE: 3      ENCLOSURE: NEMA 1      MAIN: 100A MCB  
 WIRE: 4      MOUNTING: SURFACE      AIC: 10,000

CKT NO	CKT DESCRIPTION	LOAD		CKT BREAKER			CKT BREAKER			LOAD		CKT DESCRIPTION	CKT NO
		VA	TYPE	P	A	NOTE	NOTE	A	P	TYPE	VA		
1	VF-1	933	M	3	15			20	1	O	200	TANK LVL SENSOR	2
3	/	933	M	/	/			20	1	L	384	LTG - BOILER ROOM	4
5	/	933	M	/	/			20	1			SPARE	6
7	CCTV WORKSTATION UPS	1800	O	1	20			20	1			SPARE	8
9	FA FIREWORKS UPS	1800	O	1	20			20	1			SPARE	10
11	FACP WEST CNTRL RM	1800	O	1	20			20	1			SPARE	12
13	CCTV RACKS	1800	O	1	20			20	1			SPARE	14
15	GEN. BATTERY CHARGER	1200	O	1	20			20	1			SPARE	16
17	GEN. WARMING PAD	1200	O	1	20			20	1	O	1000	GEN. JACKET HEATER	18
19	VF-2	567	M	3	15			30	2	O	1500	GEN. OIL HEATER	20
21	/	567	M	/	/			/	/	O	1500	/	22
23	/	567	M	/	/			20	1	O	200	VFD CONTROLLER	24
25	SPD			3	30	1		-	-			SPACE	26
27	/			/	/			-	-			SPACE	28
29	/			/	/			-	-			SPACE	30
31	SPACE			-	-			-	-			SPACE	32
33	SPACE			-	-			-	-			SPACE	34
35	SPACE			-	-			-	-			SPACE	36

LOAD TYPE	CONNECTED (KVA)				DEMAND FACTOR	DEMAND (KVA)			
	A	B	C	TOTAL		A	B	C	TOTAL
LIGHTING (L)	0.0	0.4	0.0	0.4	1.25	0.0	0.5	0.0	0.5
RECEPTACLE (R)	0.0	0.0	0.0	0.0	1.00	0.0	0.0	0.0	0.0
REC (>10000VA) (R)	0.0	0.0	0.0	0.0	0.50	0.0	0.0	0.0	0.0
HEATER (H)	0.0	0.0	0.0	0.0	1.00	0.0	0.0	0.0	0.0
LARGEST MOTOR (M)	0.9	0.9	0.9	2.8	1.25	1.2	1.2	1.2	3.5
REMAIN MOTOR (M)	0.6	0.6	0.6	1.7	1.00	0.6	0.6	0.6	1.7
CONTINUOUS LOAD (CL)	0.0	0.0	0.0	0.0	1.25	0.0	0.0	0.0	0.0
KITCHEN LOADS (K)	0.0	0.0	0.0	0.0	1.00	0.0	0.0	0.0	0.0
SPECIFIC LOADS (S)	0.0	0.0	0.0	0.0	1.00	0.0	0.0	0.0	0.0
NONCOINCIDENTAL (N)	0.0	0.0	0.0	0.0	0.00	0.0	0.0	0.0	0.0
OTHER LOAD (O)	5.3	4.5	4.2	14.0	1.00	5.3	4.5	4.2	14.0
<b>TOTAL DEMAND (KVA)</b>	<b>7.0</b>	<b>6.7</b>	<b>5.9</b>	<b>19.7</b>					
SPARE (KVA)	3.0	3.3	4.1	10.3					
<b>TOTAL (A/PH)</b>	<b>58.6</b>	<b>55.9</b>	<b>49.4</b>	<b>54.6</b>					
SPARE (A/PH)	24.7	27.3	33.8	28.6					


**NOTES:**  
 1. PROVIDE PANEL WITH INTERNALLY MOUNTED TYPE-2, 20KA SURGE PROTECTION DEVICE.

**PANEL: (N) EMEL1**

FEED FROM: 30KVA XFMR      NEUTRAL: 100%      MANUFACTURER: EATON  
 VOLTAGE: 208/120      GROUND: STANDARD      BUS AMPACITY: 100  
 PHASE: 3      ENCLOSURE: NEMA 1      MAIN: 100A MCB  
 WIRE: 4      MOUNTING: SURFACE      AIC: 65,000

CKT NO	CKT DESCRIPTION	LOAD		CKT BREAKER			CKT BREAKER			LOAD		CKT DESCRIPTION	CKT NO
		VA	TYPE	P	A	NOTE	NOTE	A	P	TYPE	VA		
1	MAIN			3	100			-	-			SPACE	2
3	/			/	/			-	-			/	4
5	/			/	/			-	-			/	6
7	FACP CONTROL RM	1800	O	1	20			20	1	O	1800	FACP FM OFFICE	8
9	CCTV RACKS	1800	O	1	20			20	1	O	1800	CCTV WKST. UPS FMO	10
11	CCTV WKST. UPS	1800	O	1	20			20	1	O	1800	FA WKST. UPS FMO	12
13	FA WKST. UPS	1800	O	1	20			20	1	O	200	CONTROL VALVES - LL EAS	14
15	SPARE			1	20			20	1			SPARE	16
17	SPARE			1	20			20	1			SPARE	18
19	SPARE			-	-			20	1			SPARE	20
21	SPARE			-	-			20	1			SPARE	22
23													

XREFS=(xx-14) Layouts=(E2.1 WEST ELECTRICAL ONE-LINE DIAGRAM) Sheets\Electrical\E2.1 WEST ELECTRICAL ONE-LINE DIAGRAM.dwg JAN 29, 2015 10:20AM JBANKER  
 DIMSCALE=1/8"=1'-0" Plot Date: 1/29/2015 10:20:00 AM Plotter: HP DesignJet 5000 PS  
 IF THIS SHEET IS NOT 22"x34" IT IS NOT PLOTTED TO SCALE

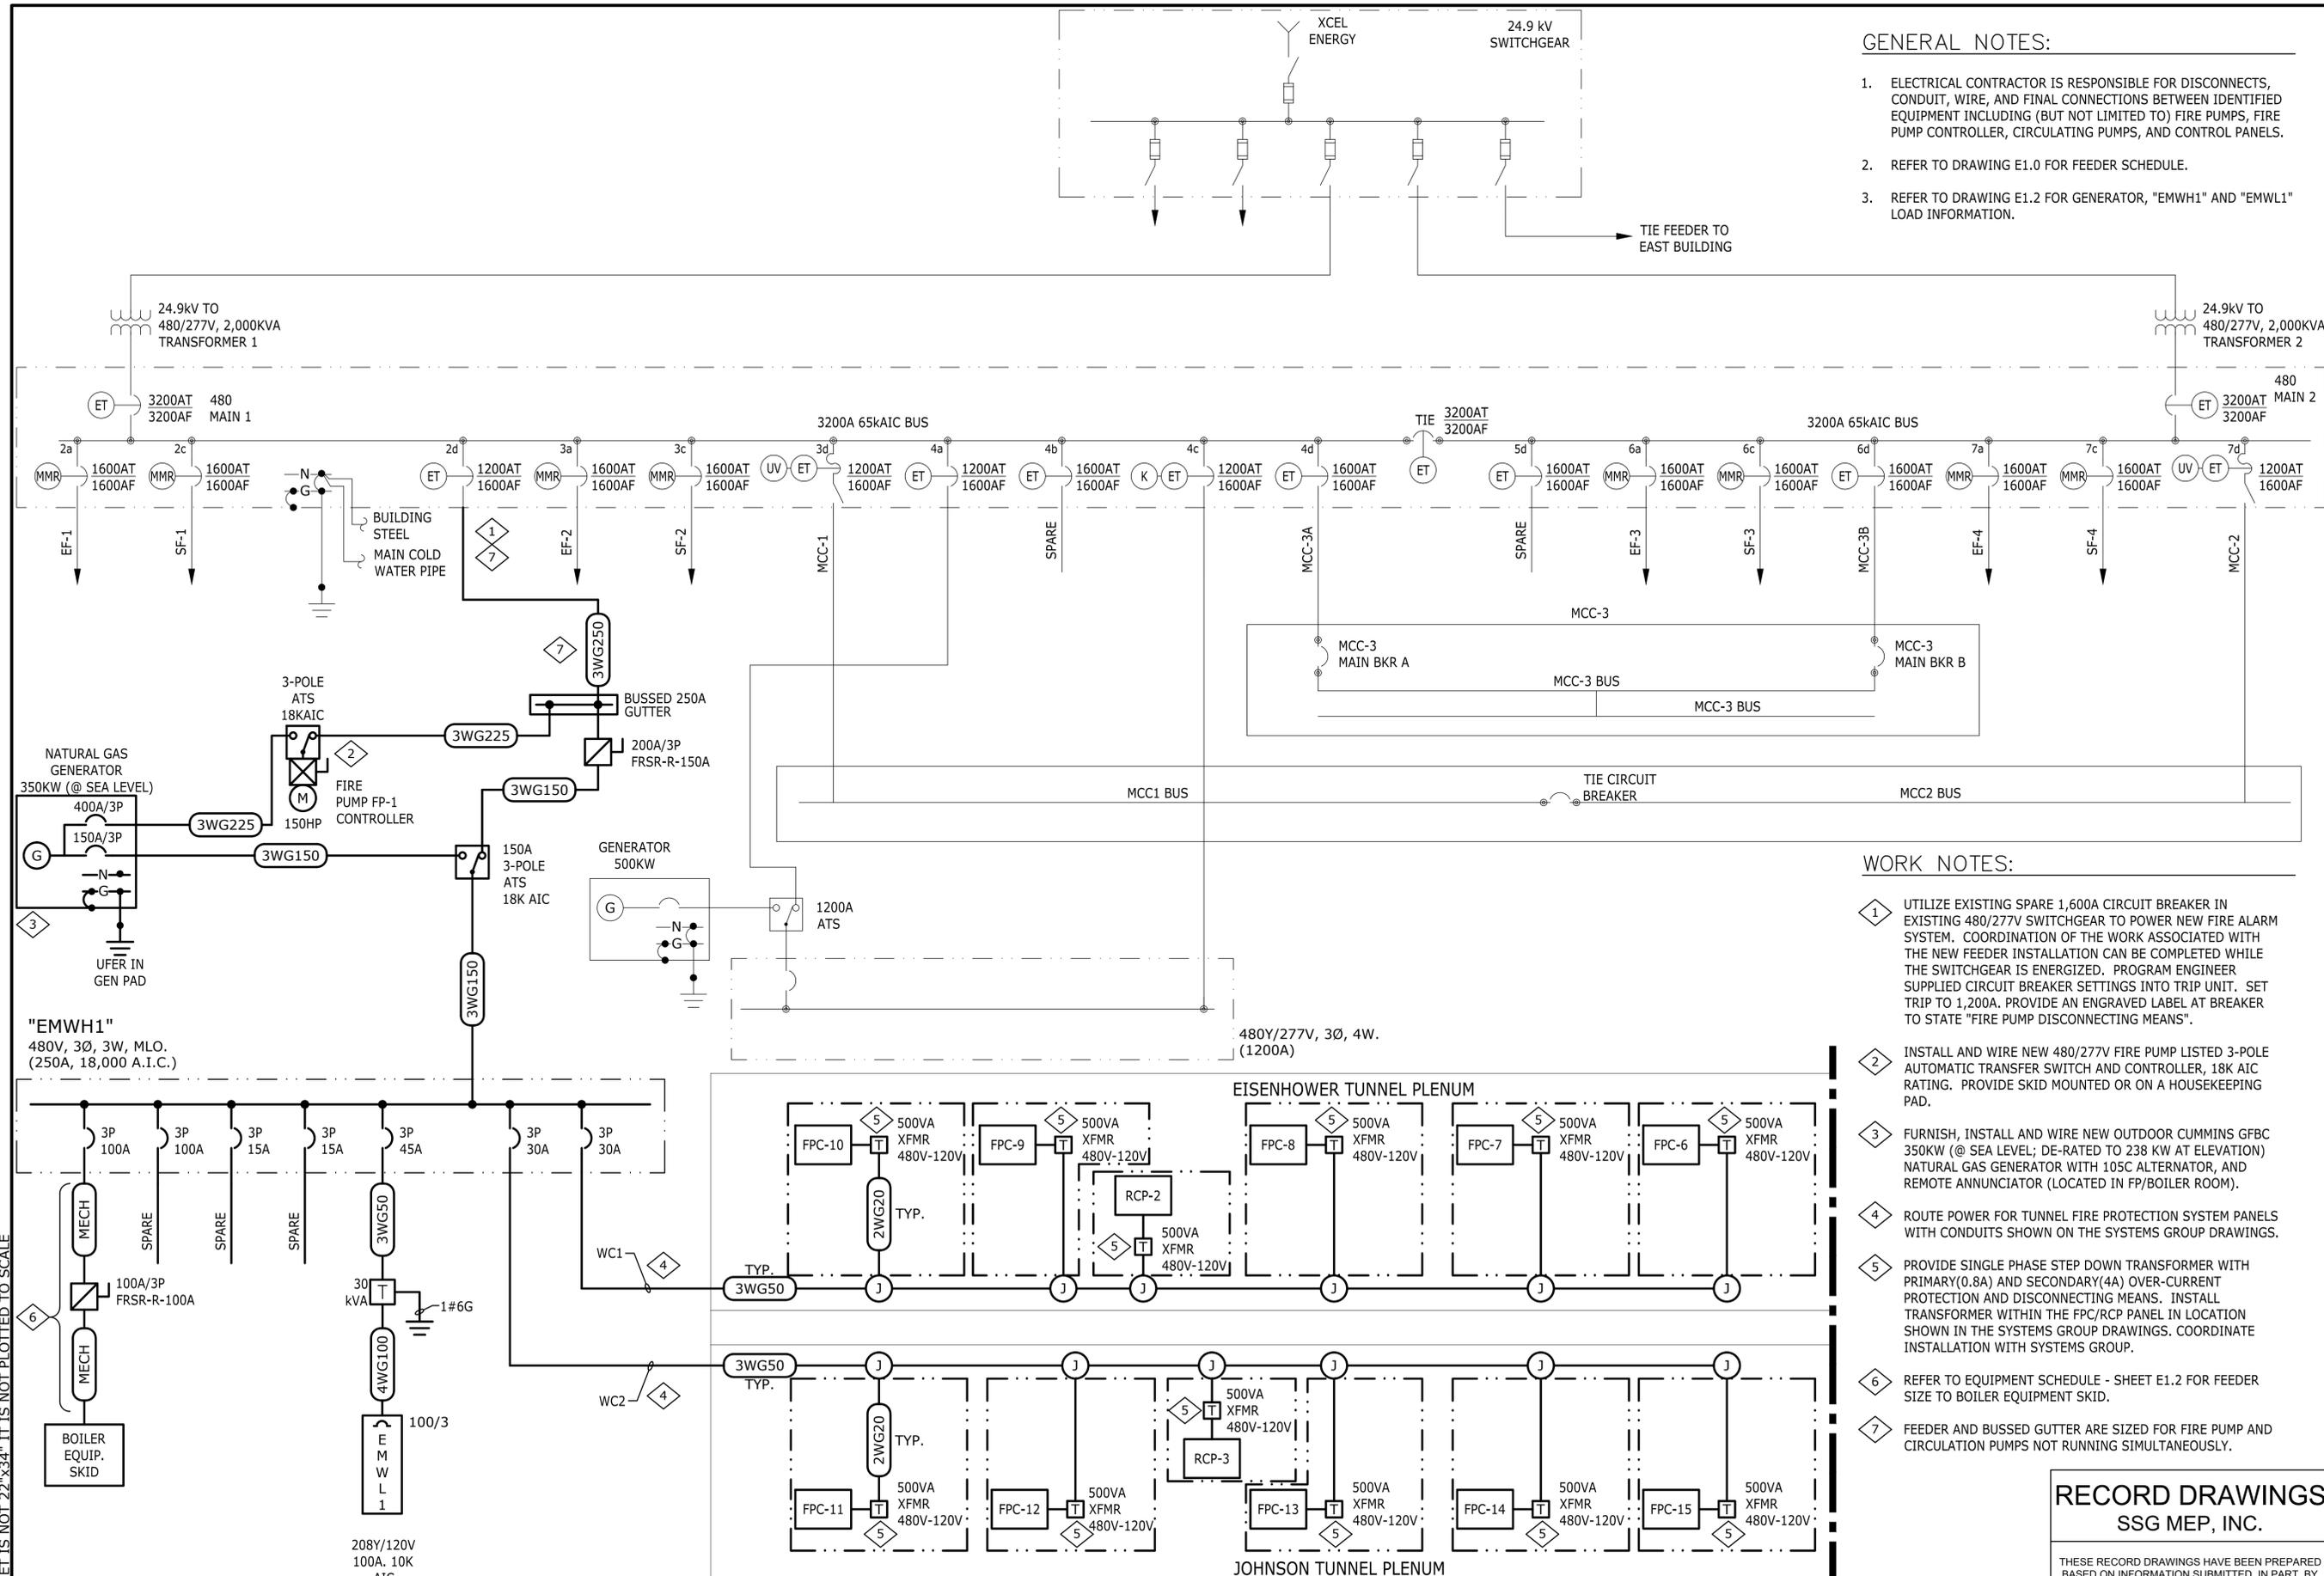

- GENERAL NOTES:**
1. ELECTRICAL CONTRACTOR IS RESPONSIBLE FOR DISCONNECTS, CONDUIT, WIRE, AND FINAL CONNECTIONS BETWEEN IDENTIFIED EQUIPMENT INCLUDING (BUT NOT LIMITED TO) FIRE PUMPS, FIRE PUMP CONTROLLER, CIRCULATING PUMPS, AND CONTROL PANELS.
  2. REFER TO DRAWING E1.0 FOR FEEDER SCHEDULE.
  3. REFER TO DRAWING E1.2 FOR GENERATOR, "EMWH1" AND "EMWL1" LOAD INFORMATION.

- WORK NOTES:**
1. UTILIZE EXISTING SPARE 1,600A CIRCUIT BREAKER IN EXISTING 480/277V SWITCHGEAR TO POWER NEW FIRE ALARM SYSTEM. COORDINATION OF THE WORK ASSOCIATED WITH THE NEW FEEDER INSTALLATION CAN BE COMPLETED WHILE THE SWITCHGEAR IS ENERGIZED. PROGRAM ENGINEER SUPPLIED CIRCUIT BREAKER SETTINGS INTO TRIP UNIT. SET TRIP TO 1,200A. PROVIDE AN ENGRAVED LABEL AT BREAKER TO STATE "FIRE PUMP DISCONNECTING MEANS".
  2. INSTALL AND WIRE NEW 480/277V FIRE PUMP LISTED 3-POLE AUTOMATIC TRANSFER SWITCH AND CONTROLLER, 18K AIC RATING. PROVIDE SKID MOUNTED OR ON A HOUSEKEEPING PAD.
  3. FURNISH, INSTALL AND WIRE NEW OUTDOOR CUMMINS GFBC 350KW (@ SEA LEVEL; DE-RATED TO 238 KW AT ELEVATION) NATURAL GAS GENERATOR WITH 105C ALTERNATOR, AND REMOTE ANNUNCIATOR (LOCATED IN FP/BOILER ROOM).
  4. ROUTE POWER FOR TUNNEL FIRE PROTECTION SYSTEM PANELS WITH CONDUITS SHOWN ON THE SYSTEMS GROUP DRAWINGS.
  5. PROVIDE SINGLE PHASE STEP DOWN TRANSFORMER WITH PRIMARY(0.8A) AND SECONDARY(4A) OVER-CURRENT PROTECTION AND DISCONNECTING MEANS. INSTALL TRANSFORMER WITHIN THE FPC/RCP PANEL IN LOCATION SHOWN IN THE SYSTEMS GROUP DRAWINGS. COORDINATE INSTALLATION WITH SYSTEMS GROUP.
  6. REFER TO EQUIPMENT SCHEDULE - SHEET E1.2 FOR FEEDER SIZE TO BOILER EQUIPMENT SKID.
  7. FEEDER AND BUSSED GUTTER ARE SIZED FOR FIRE PUMP AND CIRCULATION PUMPS NOT RUNNING SIMULTANEOUSLY.

"EMWH1"  
 480V, 3Ø, 3W, MLO.  
 (250A, 18,000 A.I.C.)

**EISENHOWER TUNNEL PLENUM**

**JOHNSON TUNNEL PLENUM**

**1 WEST VENTILATION BLDG 480V SWITCHGEAR ONE-LINE DIAGRAM**  
 SCALE:N.T.S.

BARNARD EJMT TEAM

EISENHOWER/JOHNSON  
MEMORIAL TUNNEL  
FIXED FIRE SUPPRESSION SYSTEM  
DESIGN BUILD PROJECT

RECORD DRAWINGS - 2015-11-16

BCER  
Engineering

BARNARD

RONDINELLI  
A LIFE SAFETY TEAM

Sturgeon  
ELECTRIC

Western States  
Fire Protection Co.

ALF  
ENGINEERS

Revisions

Num	Description	Date

DRAWN BY: ART  
CHECKED BY: GEP

Project No. C0703-360

Subaccount 17810

E2.1 WEST ELECTRICAL ONE-LINE DIAGRAM

Drawing Number

E2.1


RECORD DRAWINGS  
SSG MEP, INC.

THESE RECORD DRAWINGS HAVE BEEN PREPARED BASED ON INFORMATION SUBMITTED. IN PART, BY OTHERS. WHILE THIS INFORMATION IS BELIEVED TO BE RELIABLE, THE ENGINEER IS NOT RESPONSIBLE FOR ITS ACCURACY, NOR FOR ERRORS OR OMISSIONS WHICH MAY HAVE BEEN INCORPORATED INTO THIS DOCUMENT AS A RESULT.



XREFS-(x-b) Layouts-E2.2 EAST ELECTRICAL ONE-LINE DIAGRAM) D:\SCALE-1 (lib\vips\6791402\dwg\mim - fixed fire suppression system\Sheets\Electrical\E2.2 EAST ELECTRICAL ONE-LINE DIAGRAM.dwg JAN 27, 2015 2:44PM CHENDERSON

IF THIS SHEET IS NOT 22"x34" IT IS NOT PLOTTED TO SCALE

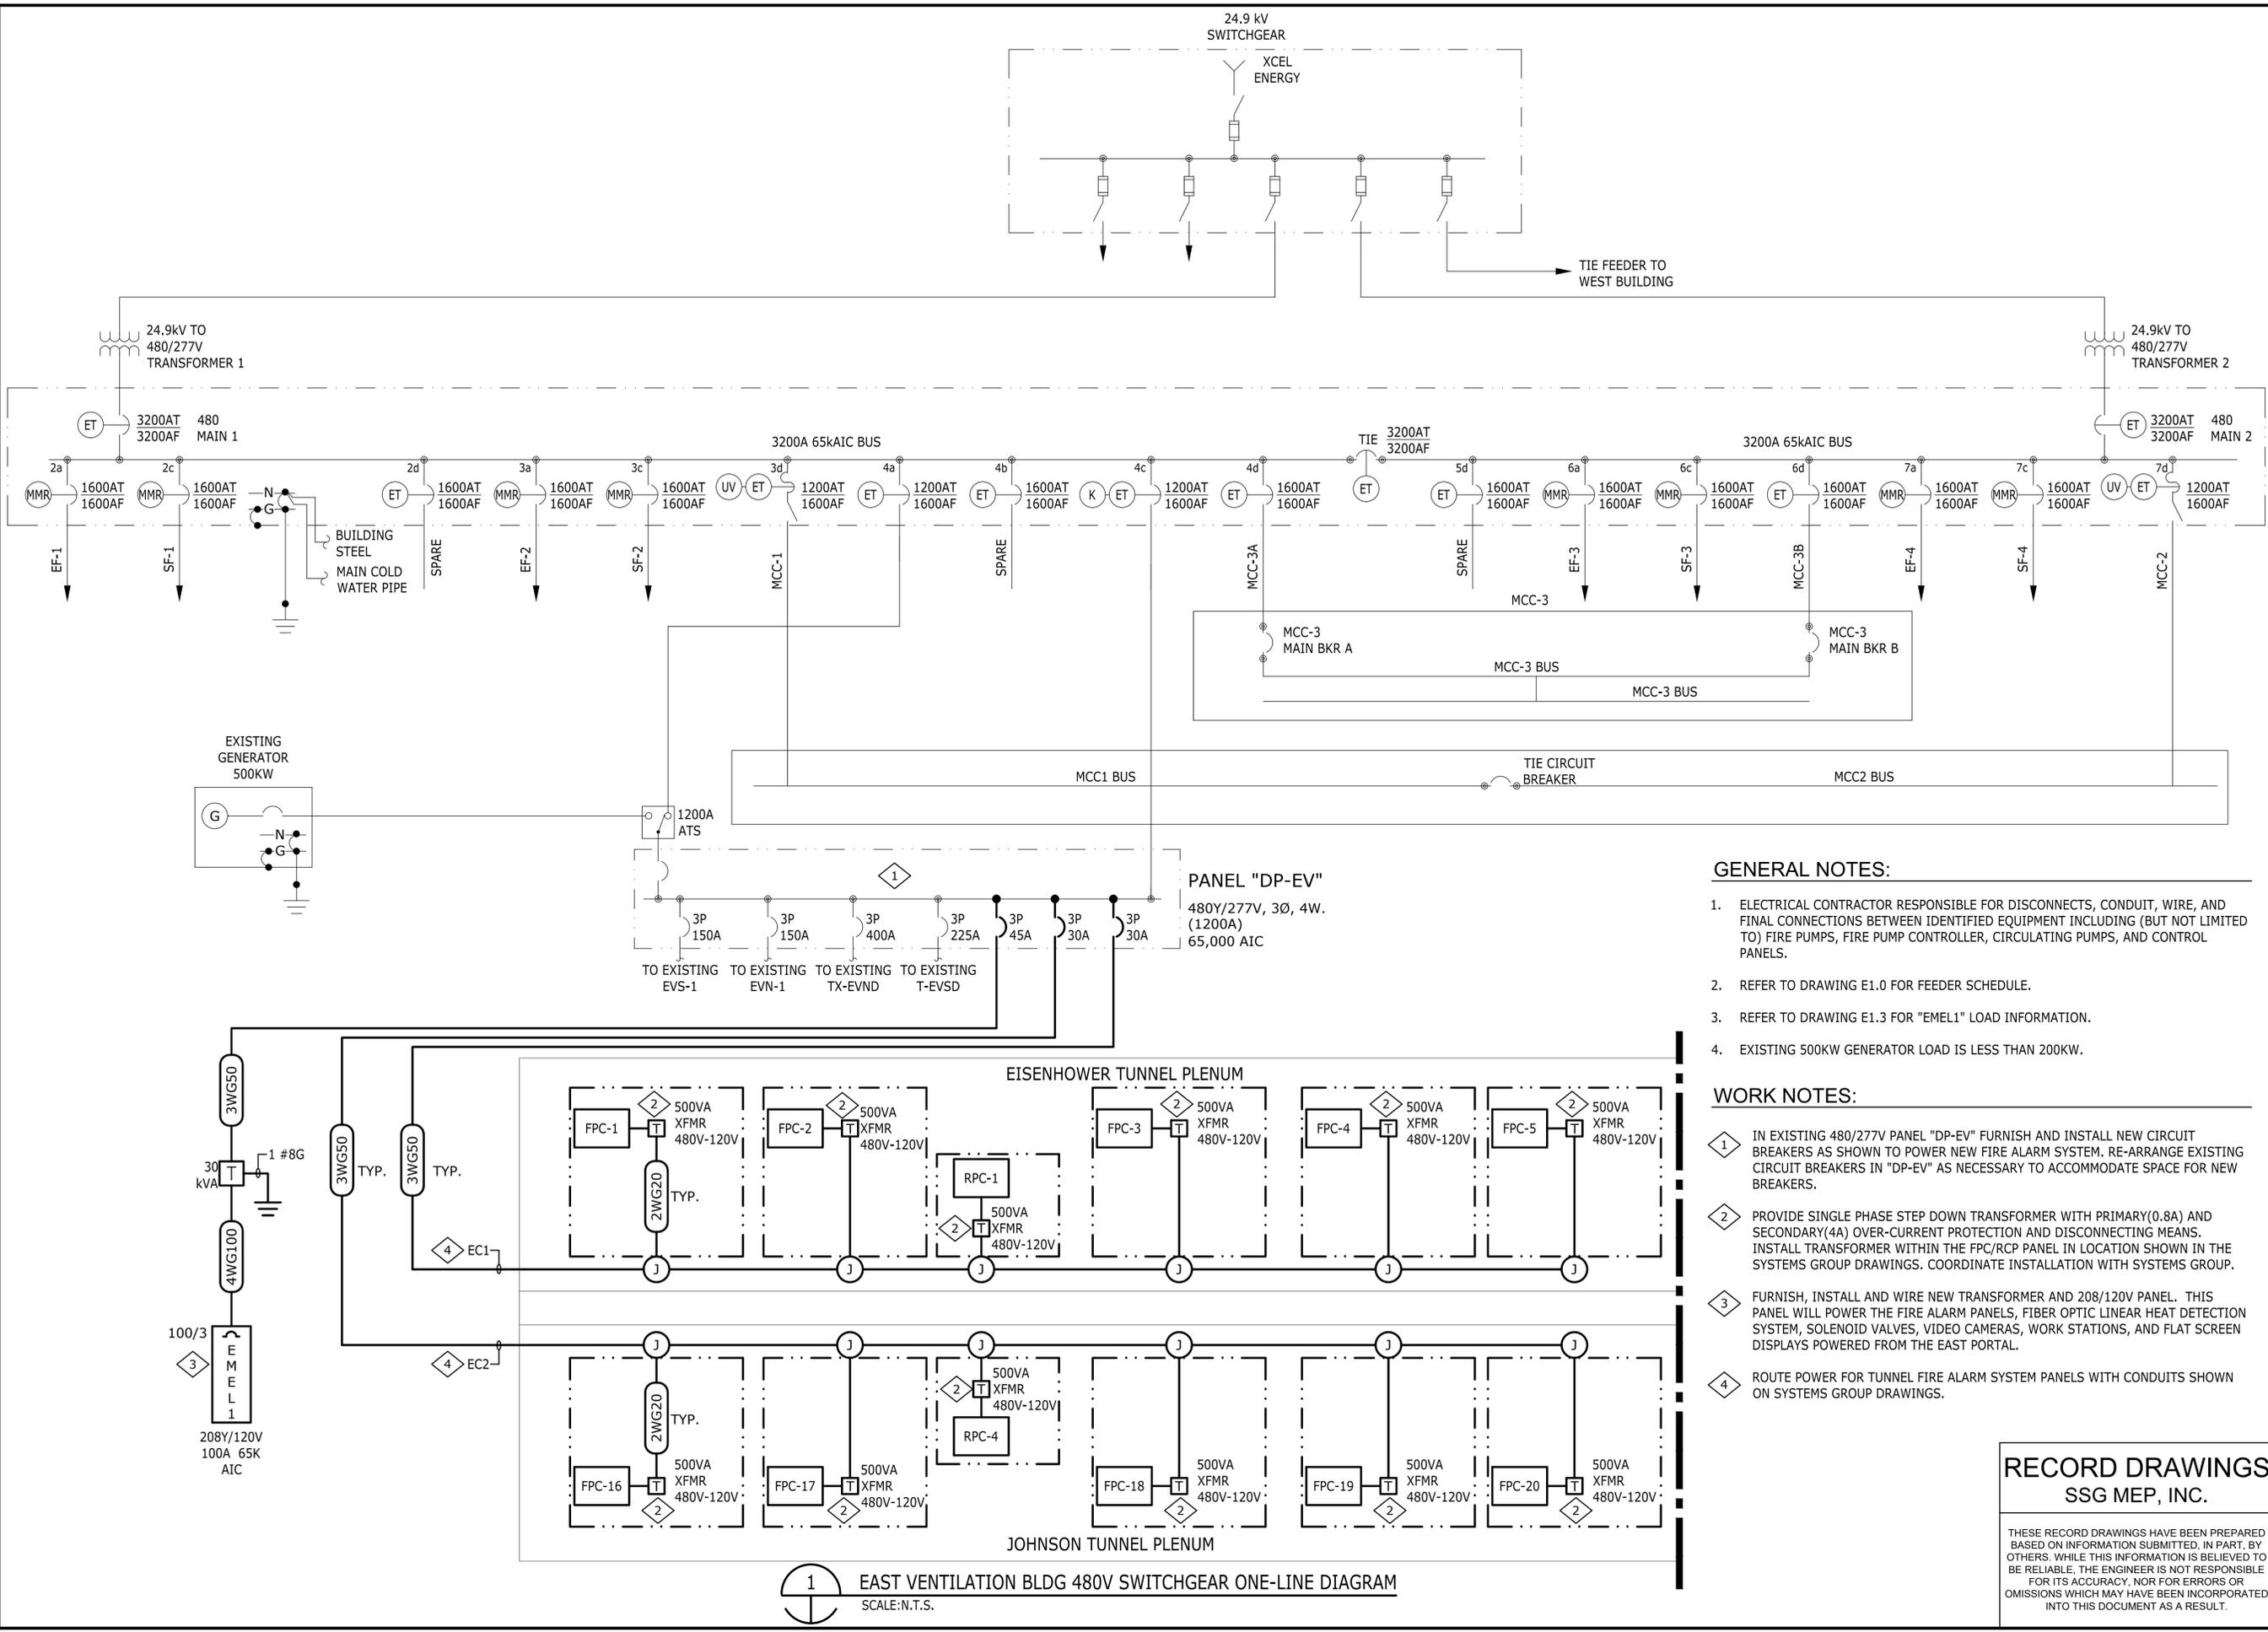

**1 EAST VENTILATION BLDG 480V SWITCHGEAR ONE-LINE DIAGRAM**  
SCALE:N.T.S.

**GENERAL NOTES:**

1. ELECTRICAL CONTRACTOR RESPONSIBLE FOR DISCONNECTS, CONDUIT, WIRE, AND FINAL CONNECTIONS BETWEEN IDENTIFIED EQUIPMENT INCLUDING (BUT NOT LIMITED TO) FIRE PUMPS, FIRE PUMP CONTROLLER, CIRCULATING PUMPS, AND CONTROL PANELS.
2. REFER TO DRAWING E1.0 FOR FEEDER SCHEDULE.
3. REFER TO DRAWING E1.3 FOR "EMEL1" LOAD INFORMATION.
4. EXISTING 500KW GENERATOR LOAD IS LESS THAN 200KW.

**WORK NOTES:**

1. IN EXISTING 480/277V PANEL "DP-EV" FURNISH AND INSTALL NEW CIRCUIT BREAKERS AS SHOWN TO POWER NEW FIRE ALARM SYSTEM. RE-ARRANGE EXISTING CIRCUIT BREAKERS IN "DP-EV" AS NECESSARY TO ACCOMMODATE SPACE FOR NEW BREAKERS.
2. PROVIDE SINGLE PHASE STEP DOWN TRANSFORMER WITH PRIMARY(0.8A) AND SECONDARY(4A) OVER-CURRENT PROTECTION AND DISCONNECTING MEANS. INSTALL TRANSFORMER WITHIN THE FPC/RCP PANEL IN LOCATION SHOWN IN THE SYSTEMS GROUP DRAWINGS. COORDINATE INSTALLATION WITH SYSTEMS GROUP.
3. FURNISH, INSTALL AND WIRE NEW TRANSFORMER AND 208/120V PANEL. THIS PANEL WILL POWER THE FIRE ALARM PANELS, FIBER OPTIC LINEAR HEAT DETECTION SYSTEM, SOLENOID VALVES, VIDEO CAMERAS, WORK STATIONS, AND FLAT SCREEN DISPLAYS POWERED FROM THE EAST PORTAL.
4. ROUTE POWER FOR TUNNEL FIRE ALARM SYSTEM PANELS WITH CONDUITS SHOWN ON SYSTEMS GROUP DRAWINGS.

**RECORD DRAWINGS**  
SSG MEP, INC.

THESE RECORD DRAWINGS HAVE BEEN PREPARED BASED ON INFORMATION SUBMITTED. IN PART, BY OTHERS. WHILE THIS INFORMATION IS BELIEVED TO BE RELIABLE, THE ENGINEER IS NOT RESPONSIBLE FOR ITS ACCURACY, NOR FOR ERRORS OR OMISSIONS WHICH MAY HAVE BEEN INCORPORATED INTO THIS DOCUMENT AS A RESULT.

**EISENHOWER/JOHNSON**  
**MEMORIAL TUNNEL**  
FIXED FIRE SUPPRESSION SYSTEM  
DESIGN BUILD PROJECT

Project No. C0703-360  
Subaccount 17810  
**RECORD DRAWINGS - 2015-11-16**

REVISIONS

Num	Description	Date

DRAWN BY: ART  
CHECKED BY: GEP

BARNARD  
EJMT TEAM

Western States  
Fire Protection Co.  
ENGINEERS

BCER  
Engineering

Sturgeon  
ELECTRIC

BARNARD  
EJMT TEAM

RONDINELLI  
A LIFE SAFETY TEAM  
ENGINEERS

O & M Manual


ASBUILT - 40

**GENERAL NOTES:**

1. ELECTRICAL CONTRACTOR RESPONSIBLE FOR ALL CONDUIT, WIRE, AND FINAL CONNECTIONS BETWEEN IDENTIFIED EQUIPMENT.
2. TANK LEVEL SENSOR INSTALLED AND WIRED BY ELECTRICAL CONTRACTOR.

**WORK NOTES:**

1. INSTALL 3/4" CONDUIT AND WIRING BETWEEN FIRE ALARM CONTROL PANEL AND CONTROL RELAY/MONITOR MODULE LOCATION. REFER TO SYSTEMS GROUP DRAWINGS FOR PANEL INSTALLATION LOCATION, CONDUCTOR SIZES AND ADDITIONAL INFORMATION.
2. INSTALL CONDUIT AND WIRING FROM CONTROL RELAY/MONITOR MODULE LOCATION AT BUILDING TO (2) VALVES LOCATED IN MANHOLE #2. REFER TO SYSTEMS GROUP DRAWINGS FOR PANEL LOCATION, CONDUCTOR SIZES AND ADDITIONAL INFORMATION. PROVIDE 120V CIRCUIT WIRING IN SEPARATE CONDUIT FROM LOW VOLTAGE WIRING.
3. INSTALL 1" PVC BETWEEN MANHOLES FOR SENSOR AND CONTROL WIRING. LOCATE CONDUIT IN-GROUND ABOVE UNDERGROUND WATER PIPES. STUB UP INTO JUNCTION BOXES WITH CONDUIT END BRUSHINGS.
4. PROVIDE CONDUIT EXTENSION FROM ADJACENT IN-GROUND JUNCTION BOX. INSTALL WIRING FROM TANK MOUNTED LEVEL SENSOR TO MONITOR MODULE LOCATION AT BUILDING. REFER TO SYSTEMS GROUP DRAWINGS FOR CONDUCTOR SIZE.
5. PROVIDE AND INSTALL CONCAST TYPE IN-GROUND JUNCTION BOX WITH 12" X 12" NOMINAL TOP OPENING AND COVER, WITH OPEN BOTTOM. USE LISTED WEATHERPROOF SPLICES FOR CONDUCTORS.

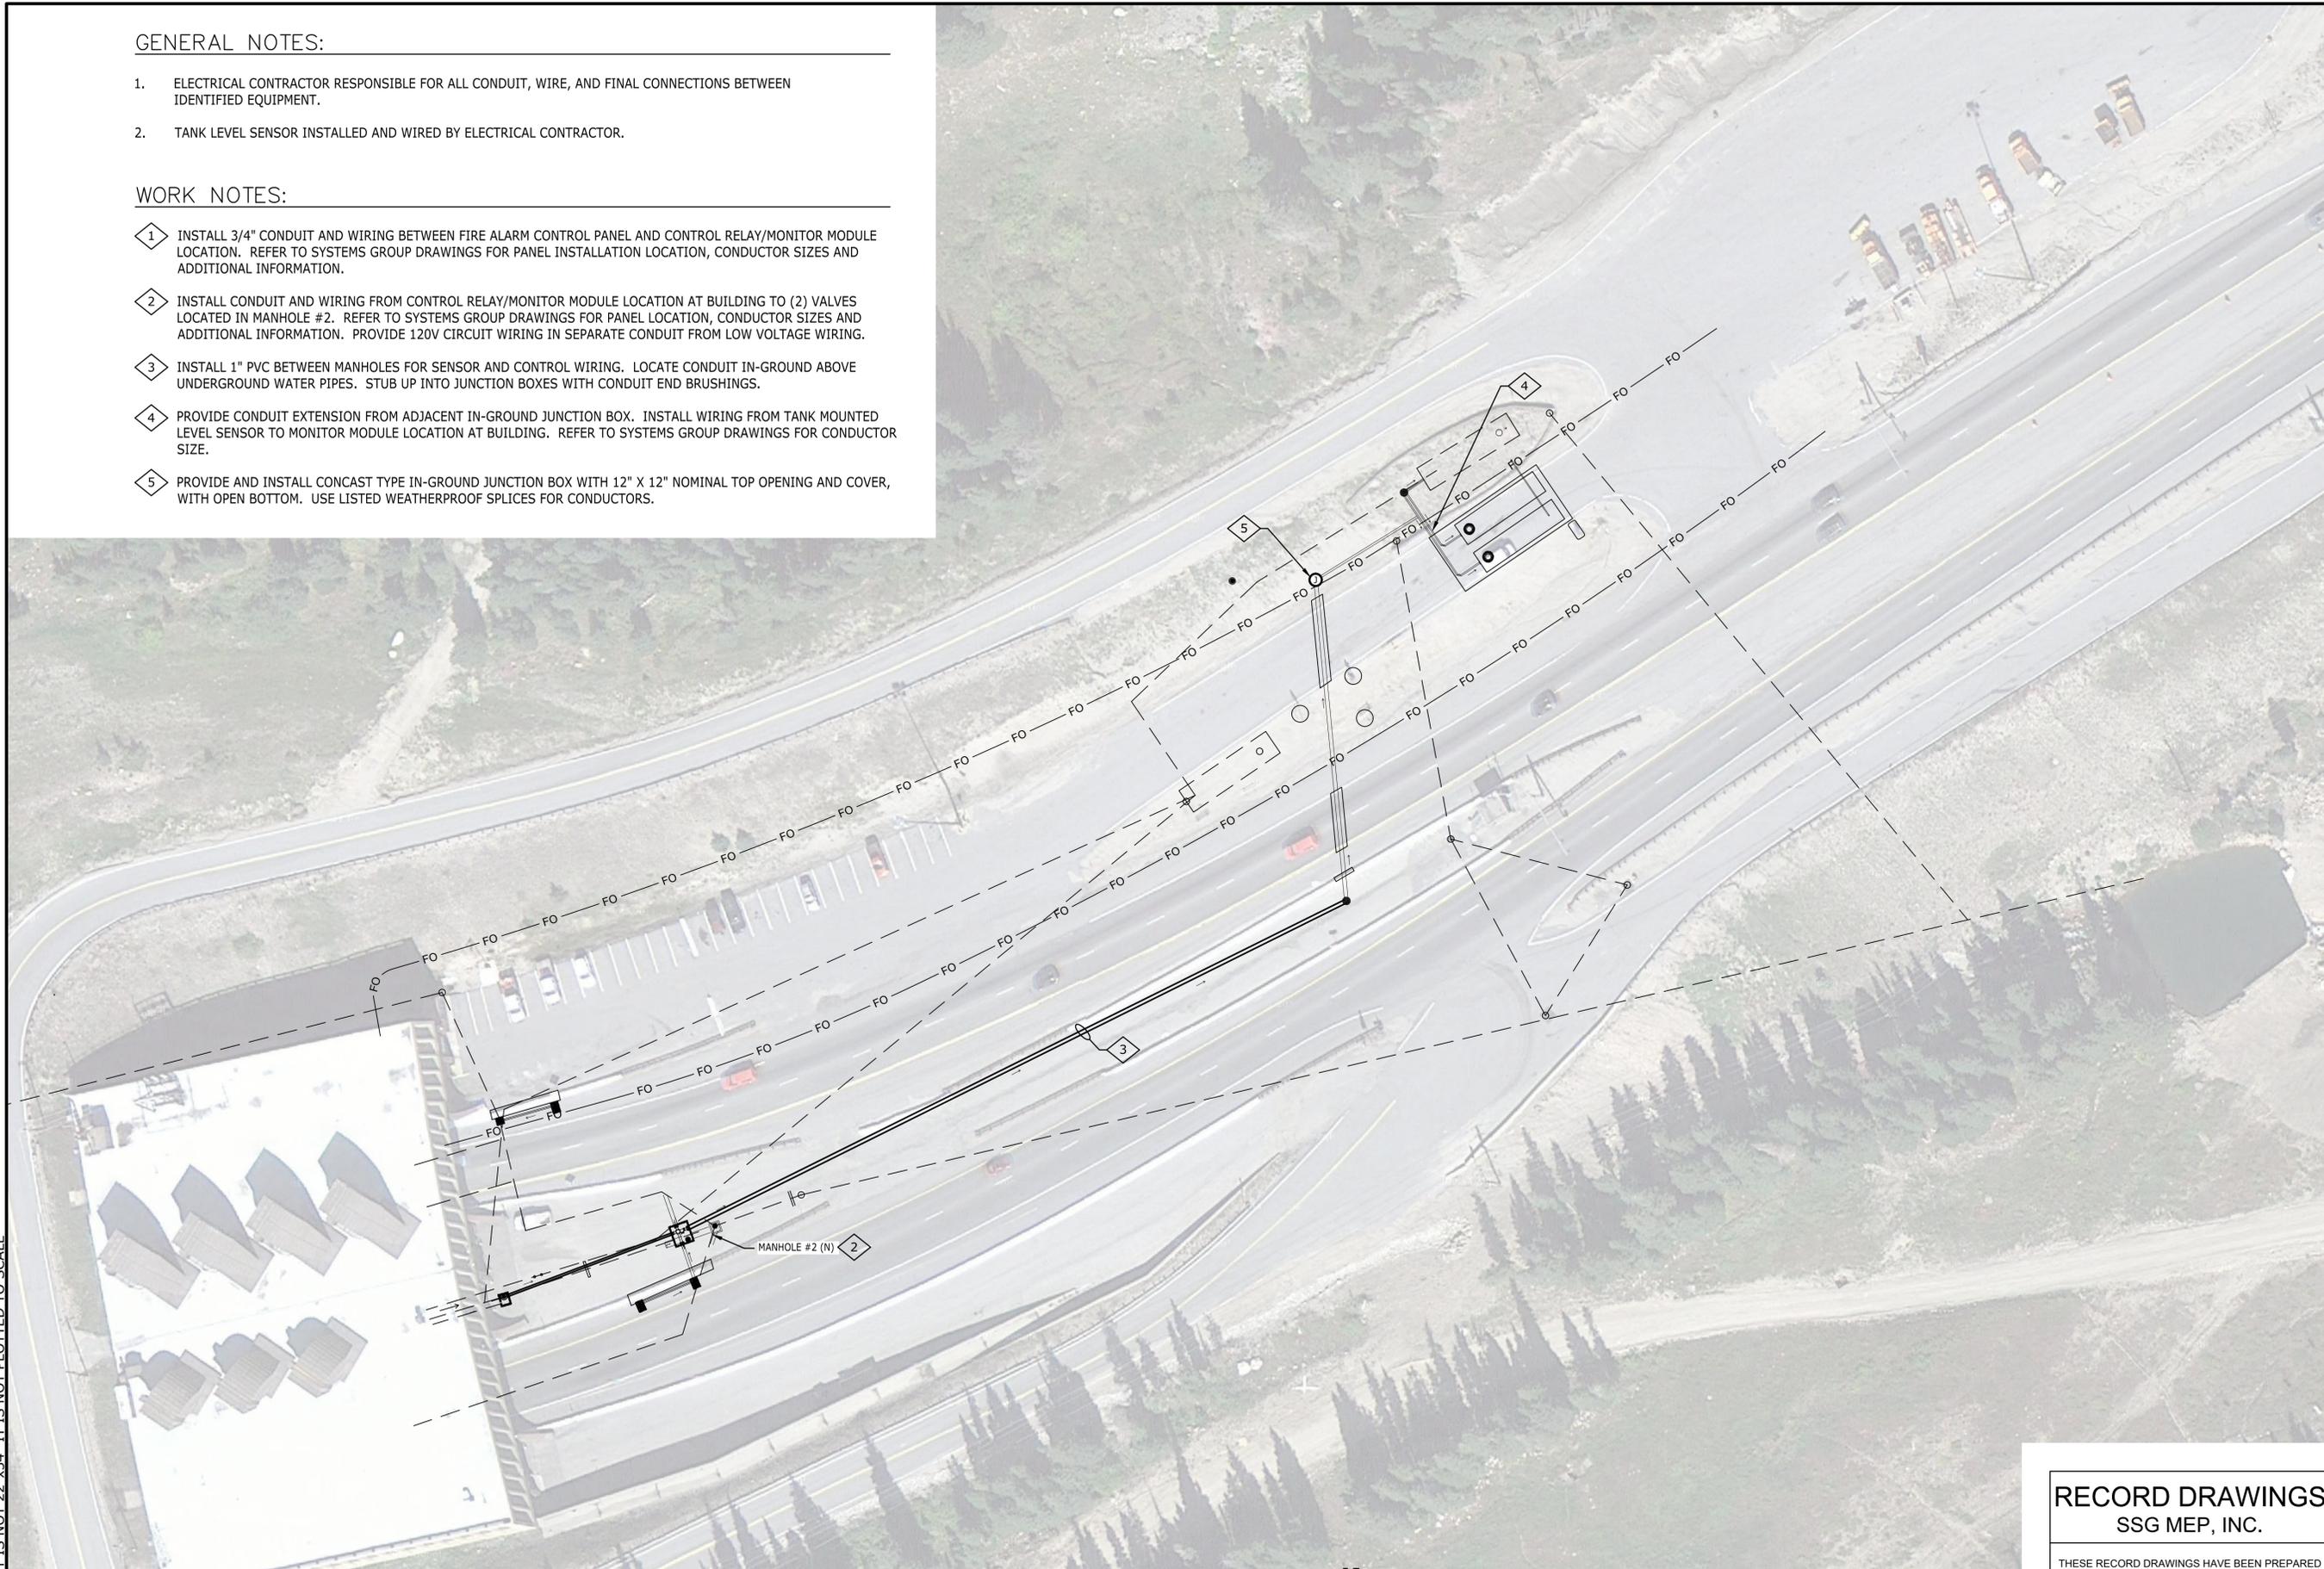

IF THIS SHEET IS NOT 22"x34" IT IS NOT PLOTTED TO SCALE

**BARNARD EJMT TEAM**

**BCER** CONSULTING ENGINEERS  
**BARNARD** CONSULTING ENGINEERS  
**STURGEON ELECTRIC**  
**RONDINELLI** A LIFE SAFETY SPECIALTY  
 Western States Fire Protection Co.

EISENHOWER/JOHNSON

**MEMORIAL TUNNEL**  
 FIXED FIRE SUPPRESSION SYSTEM  
 DESIGN BUILD PROJECT

Project No. C0703-360 Subaccount 17810  
**RECORD DRAWINGS - 2015-11-16**

REVISIONS	Date
Num	Description

ELECTRICAL SITE PLAN - EAST


Drawing Number  
**E3.2**

**RECORD DRAWINGS**  
 SSG MEP, INC.

THESE RECORD DRAWINGS HAVE BEEN PREPARED BASED ON INFORMATION SUBMITTED, IN PART, BY OTHERS. WHILE THIS INFORMATION IS BELIEVED TO BE RELIABLE, THE ENGINEER IS NOT RESPONSIBLE FOR ITS ACCURACY, NOR FOR ERRORS OR OMISSIONS WHICH MAY HAVE BEEN INCORPORATED INTO THIS DOCUMENT AS A RESULT.



**ELECTRICAL SITE PLAN - EAST**  
 SCALE: 1" = 40'-0"

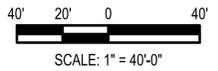











IF THIS SHEET IS NOT 22"x34" IT IS NOT PLOTTED TO SCALE

2.14 WIRING DEVICES

- A. PROVIDE SPECIFICATION GRADE RECEPTACLES AND SPECIFICATION GRADE SWITCHES AS MANUFACTURED BY, HUBBELL, LEVITON, COOPER, OR PASS AND SEYMOUR. ALL DEVICES SHALL BE OF THE SAME MANUFACTURER.
B. SWITCHES SHALL BE RATED FOR THE LOAD CONTROLLED. SWITCHES SHALL BE HEAVY-DUTY SPECIFICATION-GRADE RATED 125 VOLTS, 20A. ALL OTHER SWITCHES SHALL BE OF SIMILAR PREMIUM SPECIFICATION GRADE QUALITY.
C. THERMAL OVERLOAD SWITCHES SHALL BE PROPERLY SIZED OVERLOAD HEATER ELEMENTS.
D. RECEPTACLES SHALL BE RATED FOR THE CIRCUIT LOAD SERVED. RECEPTACLES SHALL BE RATED 125 VOLTS, 20 AMPERES NEMA 5-20R CONFIGURATION, UNLESS OTHERWISE NOTED.
E. PROVIDE STEEL COVERPLATES FOR ALL DEVICES ASSOCIATED WITH SURFACE MOUNTED RACEWAYS, IN AREAS WHERE RACEWAY IS SUBJECT TO DAMAGE OR ABUSE PROVIDE 0.140 INCH SMOOTH NYLON MATCHING COVERPLATES FOR ALL DEVICES IN FINISHED AREAS. COVERPLATES IN EXISTING ESTABLISHED BUILDINGS SHALL MATCH THE BUILDING STANDARD.

- B. TRANSFORMERS SHALL BE CAPABLE OF CONTINUOUS OPERATION AT RATED KVA, 24 HOURS A DAY, 365 DAYS A YEAR, WITH NORMAL LIFE EXPECTANCY AS DEFINED IN IEEE #65.
C. OPEN, VENTILATED, DRIP-PROOF ENCLOSURE, SELF-BRACING, WITH REMOVABLE FRONT AND REAR COVER PANELS TO PROVIDE ACCESS TO A TERMINAL COMPARTMENT LOCATED BELOW THE CORE AND COILS.
D. COILS SHALL BE INSULATED WITH A UL RATED 220°C SYSTEM HAVING AN AVERAGE RISE BY RESISTANCE OF 150°C IN A MAXIMUM AMBIENT OF 40°C, AVERAGE 30°C FOR 24 HOURS. TAPS IN THE HIGH-VOLTAGE WINDING SHALL CONSIST OF TWO 2.5 PERCENT FCAN AND FOUR 2.5 PERCENT FCBN. MINIMUM 2.8 PERCENT IMPEDANCE. THREE PHASE, 480 VOLT DELTA PRIMARY, 208/120 VOLT WYE TYPE SECONDARY UNLESS NOTED OTHERWISE. COIL SHALL BE ALUMINUM FOR TRANSFORMERS RATED 15 KVA AND ABOVE, AND COPPER FOR TRANSFORMERS RATED BELOW 15 KVA. PROVIDE VIBRATION ISOLATION PADS WITH TRANSFORMERS.
E. APPROVED MANUFACTURERS ARE: EATON/CUTLER HAMMER, SORGEL, SIEMENS, GENERAL ELECTRIC, SQUARE D, OR APPROVED EQUAL.

- E. GIVE RIGHT OF WAY TO PIPING SYSTEMS INSTALLED AT A REQUIRED SLOPE.
3.2 SITE EXAMINATION
A. THE CONTRACTOR SHALL EXAMINE PROJECT SITE AND ALL CONDITIONS THEREON AND SHALL TAKE INTO CONSIDERATION ALL SUCH CONDITIONS AS MAY AFFECT THE WORK HEREUNDER.
B. SPECIAL ATTENTION IS DIRECTED TO THAT PORTION OF THE WORK THAT IS IN EXISTING AREAS. THE EXISTING ELECTRICAL EQUIPMENT SHOWN ON THE PLANS ARE ONLY AS ACCURATE AS CAN BE DETERMINED FROM EXISTING ELECTRICAL PLANS, SITE OBSERVATION, ETC., AND SUCH EXISTING CONDITIONS SHALL BE VERIFIED BY THE CONTRACTOR PRIOR TO BEGINNING WORK.
3.3 SLEEVES, INSERTS, AND EMBEDDED ITEMS
A. SLEEVES, INSERTS, HANGERS, ETC., FURNISHED UNDER THIS DIVISION AND INSTALLED UNDER ANOTHER DIVISION SHALL BE SUPPLIED IN SUCH A MANNER AS WILL PERMIT ORDERLY PROGRESS OF WORK BY OTHERS.
3.4 COORDINATION
A. COORDINATE ARRANGEMENT, MOUNTING, AND SUPPORT OF ELECTRICAL EQUIPMENT WITH OTHER TRADES:
1. TO ALLOW MAXIMUM POSSIBLE HEADROOM UNLESS SPECIFIC MOUNTING HEIGHTS THAT REDUCE HEADROOM ARE INDICATED.
2. TO PROVIDE FOR EASE OF DISCONNECTING THE EQUIPMENT WITH MINIMUM INTERFERENCE TO OTHER INSTALLATIONS.
3. TO ALLOW RIGHT OF WAY FOR PIPING AND CONDUIT INSTALLED AT REQUIRED SLOPE.
4. SO CONNECTING RACEWAYS, CABLES, WIREWAYS, CABLE TRAYS, AND BUSWAYS WILL BE CLEAR OF OBSTRUCTIONS AND OF THE WORKING AND ACCESS SPACE OF OTHER EQUIPMENT.
B. COORDINATE INSTALLATION OF REQUIRED SUPPORTING DEVICES AND SET SLEEVES IN CAST-IN-PLACE CONCRETE, MASONRY WALLS, AND OTHER STRUCTURAL COMPONENTS AS THEY ARE CONSTRUCTED.
C. DETAILS OF EQUIPMENT FURNISHED BY TRADES OTHER THAN ELECTRICAL, BUT INSTALLED AS PART OF THE DIVISION 26 WORK WILL BE FOUND ON THE DRAWINGS AND SPECIFICATIONS ASSOCIATED WITH THE DIVISION SUPPLYING THE EQUIPMENT.
D. COORDINATE LOCATION OF ACCESS PANELS AND DOORS FOR ELECTRICAL ITEMS THAT ARE BEHIND FINISHED SURFACES OR OTHERWISE CONCEALED. COORDINATE ACCESS DOORS AND PANELS WITH ARCHITECT.
E. COORDINATE SLEEVE SELECTION AND APPLICATION WITH SELECTION AND APPLICATION OF FIRESTOPPING. COORDINATE FIRESTOPPING REQUIREMENTS WITH ARCHITECT.
F. COORDINATE WORK WITH OTHER TRADES TO AVOID CONFLICT AND TO PROVIDE CORRECT ROUGH-IN AND CONNECTIONS FOR EQUIPMENT FURNISHED BY OTHERS THAT REQUIRE ELECTRICAL CONNECTIONS. INFORM CONTRACTORS OF OTHER TRADES ABOUT THE REQUIRED ACCESS TO AND CLEARANCES AROUND ELECTRICAL EQUIPMENT TO COMPLY WITH CODE AND MAINTAIN SERVICEABILITY.
G. VERIFY EQUIPMENT DIMENSIONS AND REQUIREMENTS WITH PROVISIONS SPECIFIED UNDER THIS SECTION. CHECK ACTUAL JOB CONDITIONS BEFORE FABRICATING WORK. CHANGES OR

ADDITIONS SUBJECT TO ADDITIONAL COMPENSATION WHICH ARE MADE WITHOUT WRITTEN AUTHORIZATION BY THE OWNER ON AN AGREED UPON PRICE SHALL BE AT THE CONTRACTOR'S RISK AND EXPENSE.

3.5 SELECTIVE DEMOLITION

- A. ALL OUTLETS AND WIRING WHICH ARE TO REMAIN SHALL BE RECONNECTED TO REMAIN OPERABLE. REWORK AND EXTEND EXISTING CIRCUITS, CONDUIT, AND RELOCATE OUTLETS AS NECESSARY TO MAINTAIN FUNCTIONALITY OF ALL ITEMS TO REMAIN.
B. EXISTING ITEMS THAT CONFLICT WITH NEW CONSTRUCTION SHALL BE REWORKED AND RELOCATED TO AVOID CONFLICTS WITH THE NEW CONSTRUCTION.
C. ALL WIRING, EXCEPT WHERE INDICATED TO BE REUSED, SHALL BE DISCONNECTED FROM BOTH THE POWER SUPPLY AND UTILIZATION EQUIPMENT AND REMOVED FROM THE CONDUIT.
D. ALL EXPOSED CONDUIT, BOXES, AND OUTLETS, THAT ARE INDICATED TO BE DEMOLISHED, SHALL BE REMOVED. CONDUIT THAT IS NOT ACCESSIBLE SHALL BE CUT, CAPPED, AND ABANDONED IN PLACE.
E. ITEMS NOT WANTED BY THE OWNER SHALL BECOME THE PROPERTY OF THE CONTRACTOR AND SHALL BE REMOVED FROM THE SITE.
F. REGULATORY REQUIREMENTS: COMPLY WITH GOVERNING EPA NOTIFICATION REGULATIONS BEFORE BEGINNING SELECTIVE DEMOLITION. COMPLY WITH HAULING AND DISPOSAL REGULATIONS OF AUTHORITIES HAVING JURISDICTION.
G. CLEANING: CLEAN ADJACENT STRUCTURES AND IMPROVEMENTS OF DUST, DIRT, AND DEBRIS CAUSED BY SELECTIVE DEMOLITION OPERATIONS. RETURN ADJACENT AREAS TO EXISTING CONDITION BEFORE SELECTIVE DEMOLITION OPERATIONS BEGAN.

3.6 CUTTING AND PATCHING

- A. ALL CUTTING AND PATCHING WORK SHALL BE LAID OUT IN ADVANCE.
B. WHERE CUTTING, CHANNELING, CHASING, OR DRILLING OF FLOORS, WALLS, PARTITIONS, CEILINGS, OR OTHER SURFACES IS NECESSARY FOR PROPER INSTALLATION, SUPPORT, OR ANCHORAGE OF RACEWAYS, OUTLETS, OR OTHER ELECTRICAL EQUIPMENT THE WORK SHALL BE CAREFULLY DONE.
C. ANY DAMAGE TO WOODWORK, METALWORK, OR FINISHED SURFACE SHALL BE REPAIRED BY SKILLED MECHANICS OF THE TRADES INVOLVED AT NO ADDITIONAL COST TO THE OWNER.
D. ANY REQUIRED OPENINGS IN CONCRETE WALLS OR FLOORS SHALL BE CORE DRILLED.
E. THE CONTRACTOR SHALL NOT CUT OR DRILL ANY STRUCTURAL MEMBER WITHOUT FIRST OBTAINING WRITTEN APPROVAL OF THE ENGINEER AND GENERAL CONTRACTOR

3.7 IDENTIFICATION

- A. LETTERING AND GRAPHICS: COORDINATE NAMES, ABBREVIATIONS, COLORS, AND OTHER DESIGNATIONS USED IN ELECTRICAL IDENTIFICATION WORK WITH CORRESPONDING DESIGNATIONS SPECIFIED OR INDICATED. INSTALL NUMBERS, LETTERING, AND COLORS AS SPECIFIED, AS APPROVED IN SUBMITTALS, AND AS REQUIRED BY THE NEC.
B. INSTALL IDENTIFICATION DEVICES IN ACCORDANCE WITH MANUFACTURERS WRITTEN INSTRUCTIONS AND REQUIREMENTS OF THE NEC.
C. VERIFY IDENTITY OF EACH ITEM BEFORE INSTALLING IDENTIFICATION PRODUCTS.

- D. APPLY IDENTIFICATION DEVICES TO SURFACES THAT REQUIRE FINISH AFTER COMPLETING FINISH WORK.
E. ADHESIVE IDENTIFICATION PRODUCTS: CLEAN SURFACES BEFORE APPLICATION, USING MATERIALS AND METHODS RECOMMENDED BY MANUFACTURER OF IDENTIFICATION DEVICE.
F. ATTACH SIGNS AND PLASTIC LABELS THAT ARE NOT SELF-ADHESIVE TYPE WITH MECHANICAL FASTENERS.
1. EQUIPMENT TO BE LABELED:
a. PANELBOARDS.
b. CIRCUIT DIRECTORIES: TYPEWRITTEN DIRECTORY OF CIRCUITS IN THE LOCATION PROVIDED BY PANELBOARD MANUFACTURER.
c. ENCLOSURES AND ELECTRICAL CABINETS.
d. ACCESS DOORS AND PANELS FOR CONCEALED ELECTRICAL ITEMS.
e. SWITCHBOARDS.
f. TRANSFORMERS: EMERGENCY SYSTEM BOXES AND ENCLOSURES.
g. ENCLOSED SWITCHES.
h. BRANCH CIRCUIT IDENTIFICATION ON RECEPTACLES.
i. ENCLOSED CIRCUIT BREAKERS.
j. LIGHTING CONTROL EQUIPMENT.
k. DISCONNECT SWITCHES.
l. GENERATOR

3.8 INSPECTIONS AND TESTS

- A. WORK SHALL BE SUBJECT TO INSPECTION BY GENERAL CONTRACTOR AND/OR ENGINEER AT ALL TIMES.
B. AFTER ELECTRICAL INSTALLATION IS COMPLETED AND AT SUCH TIME AS THE ARCHITECT OR ENGINEER MAY DIRECT, THE CONTRACTOR SHALL CONDUCT AN OPERATING TEST FOR APPROVAL. INSTALLATION SHALL BE DEMONSTRATED TO BE IN ACCORDANCE WITH REQUIREMENTS OF THE DRAWINGS AND THIS SPECIFICATION. ANY DEFECTS REVEALED SHALL BE CORRECTED PROMPTLY AND THE TESTS RECONDUCTED.
C. THE CONTRACTOR SHALL REPAIR AND/OR REPLACE ALL DEFECTIVE AND/OR FAULTY WORKMANSHIP, MATERIALS, AND/OR EQUIPMENT AND SHALL REPAIR AND/OR REPLACE ALL OTHER WORK DAMAGED AS A RESULT OF SUCH DEFECTIVE AND/OR FAULTY INSTALLATION, MATERIALS AND/OR EQUIPMENT WITHOUT CHARGE TO OWNER DURING GUARANTEE PERIOD.
D. THE FOLLOWING SYSTEMS SHALL BE TESTED:
1. POWER DISTRIBUTION.
2. GENERATOR AND TRANSFER SWITCH(ES).
3. FIRE ALARM.

3.9 DEMONSTRATION AND TRAINING

- A. AT COMPLETION OF THE PROJECT AT SUCH TIME DESIGNATED BY THE OWNER, THE CONTRACTOR SHALL INSTRUCT THE OWNER AS TO THE LOCATION AND OPERATION OF ALL ELECTRICAL EQUIPMENT AND SYSTEMS INSTALLED AS PART OF THIS CONTRACT. THE CONTRACTOR SHALL ALSO BRIEF THE OWNER ON THE ROUTING OF FEEDERS TO MAJOR PIECES OF MECHANICAL EQUIPMENT AND OTHER LARGE EQUIPMENT PROVIDED BY OTHER TRADES AND CONNECTED UNDER THIS SCOPE.

- B. PROVIDE DEMONSTRATION AND TRAINING AS REQUIRED AND AS FOLLOWS:
1. ELECTRICAL SERVICE AND DISTRIBUTION, INCLUDING SWITCHBOARDS PANELBOARDS.
2. PACKAGED ENGINE GENERATORS, INCLUDING TRANSFER SWITCHES.

3.10 DELIVERY AND STORAGE

- A. ELECTRICAL CONTRACTOR SHALL MAKE PROVISIONS FOR DELIVERY AND SAFE STORAGE OF MATERIALS FOR THIS CONTRACT AND SHALL ASSUME FULL RESPONSIBILITY FOR CONDITION AND/OR SAFEKEEPING OF MATERIALS FURNISHED BY OTHERS ON ACCEPTANCE OF MATERIALS.

3.11 OUTAGES

- A. THE ENTIRE FACILITY MUST REMAIN OPERATIONAL DURING THE WORK. ONE OR MORE OUTAGES OF THE ELECTRICAL DISTRIBUTION SYSTEM WITHIN THE BUILDING MAY BE REQUIRED TO COMPLETE INSTALLATION AND CONNECTION OF THE NEW DISTRIBUTION EQUIPMENT. THE NUMBER AND LENGTH OF THESE OUTAGES MUST BE KEPT TO A MINIMUM.
B. THE CONTRACTOR SHALL BE REQUIRED TO PREPARE A DETAILED METHOD OF PROCEDURE (MOP) FOR EACH OUTAGE. EACH MOP SHALL DETAIL THE START AND END TIMES FOR THE OUTAGE, THE STEPS TO BE PERFORMED DURING THE OUTAGE, THE APPROXIMATE TIME ALLOTTED FOR EACH STEP, AND A BACK-OUT PROCEDURE SHOULD SOMETHING UNEXPECTED OCCUR OR BE DISCOVERED DURING THE OUTAGE.
C. THE MOP SHALL BE PREPARED SUFFICIENTLY IN ADVANCE OF THE OUTAGE TO PERMIT REVIEW AND COMMENT BY THE OWNER, ENGINEER, AND ARCHITECT. THE CONTRACTOR SHALL INCORPORATE ALL COMMENTS INTO THE MOP AND SUBMIT COPIES FOR FINAL REVIEW AND SIGNOFF BY ALL PARTIES. ONCE APPROVED, THE CONTRACTOR SHALL NOTIFY THE OWNER 72 HOURS IN ADVANCE OF THE OUTAGE AND RECEIVE FINAL WRITTEN PERMISSION TO PROCEED.

2.17 BUSSED GUTTER ASSEMBLIES

- A. NEOPRENE GASKETED 14 GAUGE GALVANIZED STEEL HOUSING WITH CORROSION RESISTANT HARDWARE AND HIGH QUALITY WELDS WHERE REQUIRED. BUS BARS MOUNTED TO STAIR STEP BRACKETS MAXIMUM 24 INCHES ON CENTER, WITH BUS BARS SEPARATED APPROXIMATELY 2 INCHES HORIZONTAL AND 3 INCHES VERTICAL. PROVIDE APPROVED STANDOFF INSULATORS. BRACKETS SHALL BE WELDED TO THE HOUSING. WALL MOUNTING LUGS SHALL BE PROVIDED AND WELDED TO THE HOUSING. COVER SHALL BE SCREW-TYPE WITH TAPPED HOUSING AND BRASS SCREWS MAXIMUM 6 INCHES ON CENTER. COVER SHALL BE SPLIT INTO 24 INCH SEGMENTS. PROVIDE TWO ¼ INCH DEEP HOLES AT EACH END OF ASSEMBLY.
B. FINISH SHALL BE ANSI 61 GREY ENAMEL. BUS BARS SHALL BE DRILLED AND TAPPED 3/8-16 NC THREAD ON 3 INCH CENTERS FOR FUTURE SUBFEED LUGS. BUSSING SHALL BE BRACED FOR AIC RATING SHOWN ON DRAWINGS AND SHALL HAVE THE UL LABEL OF APPROVAL. ELECTRICAL RATING: 208/120 VOLT, 3 PHASE, 4 WIRE WITH AMPERE RATING AS SHOWN ON THE DRAWINGS. CUTLER HAMMER, YOUNG ELECTRIC MANUFACTURING COMPANY, OR EQUAL.

PART 3 - EXECUTION

- 3.1 COMMON REQUIREMENTS FOR ELECTRICAL INSTALLATION
A. COMPLY WITH NECA 1.
B. MEASURE INDICATED MOUNTING HEIGHTS TO BOTTOM OF UNIT FOR SUSPENDED ITEMS AND TO CENTER OF UNIT FOR WALL-MOUNTING ITEMS.
C. HEADROOM MAINTENANCE: IF MOUNTING HEIGHTS OR OTHER LOCATION CRITERIA ARE NOT INDICATED, ARRANGE AND INSTALL COMPONENTS AND EQUIPMENT TO PROVIDE MAXIMUM POSSIBLE HEADROOM CONSISTENT WITH THESE REQUIREMENTS.
D. EQUIPMENT: INSTALL TO FACILITATE SERVICE, MAINTENANCE, AND REPAIR OR REPLACEMENT OF COMPONENTS OF BOTH ELECTRICAL EQUIPMENT AND OTHER NEARBY INSTALLATIONS. CONNECT IN SUCH A WAY AS TO FACILITATE FUTURE DISCONNECTING WITH MINIMUM INTERFERENCE WITH OTHER ITEMS IN THE VICINITY.

2.16 DRY TYPE TRANSFORMERS

- A. DESIGNS SHALL BE IN FULL ACCORDANCE WITH THE LATEST REVISIONS OF ANSI C89.2, NEMA ST-20, NEMA TR-27, NEMA TP-1 AND LISTED BY UL.

EISENHOWER/JOHNSON MEMORIAL TUNNEL FIXED FIRE SUPPRESSION SYSTEM DESIGN BUILD PROJECT
Project No. C0703-360 Subaccount 17810
RECORD DRAWINGS - 2015-11-16

BARNARD EJMT TEAM
BARNARD
BCER
Sturgeon Electric
RONDINELLI
Western States Fire Protection Co.
EJMT

RECORD DRAWINGS
SSG MEP, INC.
THESE RECORD DRAWINGS HAVE BEEN PREPARED BASED ON INFORMATION SUBMITTED. IN PART, BY OTHERS. WHILE THIS INFORMATION IS BELIEVED TO BE RELIABLE, THE ENGINEER IS NOT RESPONSIBLE FOR ITS ACCURACY, NOR FOR ERRORS OR OMISSIONS WHICH MAY HAVE BEEN INCORPORATED INTO THIS DOCUMENT AS A RESULT.

Table with 2 columns: Revisions (Date, Description), Electrical Specifications, Drawing Number (E7.1), and Checked By: GEP.





IF THIS SHEET IS NOT 22"x34" IT IS NOT PLOTTED TO SCALE



LEGEND	
	RESTORED VEGETATION

THE FOLLOWING APPROVED USFS SEED MIX SHALL BE USED FOR RESEEDING:

SPECIES	PLS lbs./acre
ROCKY MOUNTAIN FESCUE (FESTUCA SAXIMONTANA)	2.00
TUFTED HAIRGRASS (DESCHAMPSIA CESPITOSA)	1.50
ALPINE BLUEGRASS (POA ALPINE)	2.00
ALPINE TIMOTHY (PHLEUM ALPINUM)	1.50
WESTERN YARROW (ACHILLEA MILLEFOLIUM VAR. OCCIDENTALIS)	0.10
BLUE MOUNTAIN PENSTEMON (PENSTEMON RYDBERGII)	0.20
MOUNTAIN PHLOX (LINANTHUS GRANDIFLORAS)	0.20
ICELAND POPPY (PAPAVER NUDICAULE)	0.20
<b>TOTAL:</b>	<b>7.70</b>

INSTALL NETLESS BLANKETS ON SLOPES GREATER THAN 4H:1V.


NOTE: USFS TO PROVIDE SEED MIX WITH A MINIMUM OF ONE MONTH'S NOTICE FROM CONTRACTOR. SEED MIX INFORMATION WILL BE UPDATED ONCE THIS IS RECEIVED FROM THE USFS.

CONTACT: PAUL SEMMER, 970-262-3448, PSEMMER@FS.FED.US

RESEEDING TO TAKE PLACE AFTER SEPTEMBER 1, 2015 AND BEFORE NOVEMBER 1, 2015. CLEARING AND WORK LIMITS TO BE CONFINED TO WITHIN 20-FT OF THE TRENCHLINE.



**WEST PORTAL LANDSCAPE PLAN**  
SCALE: 1" = 100'

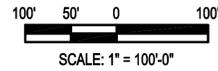

**BARNARD EJMT TEAM**

**BCER** AN IRVING COMPANY **engineering**  
**BARNARD**  
**RONDINELLI** A TREE GROUP LIFE SAFETY  
**ALF** ALF CONSULTING ENGINEERS

**EISENHOWER/JOHNSON**  
**MEMORIAL TUNNEL**  
 FIXED FIRE SUPPRESSION SYSTEM  
 DESIGN BUILD PROJECT  
 Project No. C0703-360 Subaccount 17810  
**RECORD DRAWINGS - 2015-11-16**

Revisions	Date
Num	Description

WEST PORTAL LANDSCAPE PLAN

Drawing Number  
**L1.0**





IF THIS SHEET IS NOT 22"x34" IT IS NOT PLOTTED TO SCALE

FIRE ALARM LEGEND			
SYMBOL	DESCRIPTION	MODEL	BACK BOX
	FIRE ALARM CONTROL PANEL	EST3	3-CAB5, OR 3-CAB7B
	FIRE PROTECTION CABINET	31-40SF & 41-50SF	SUPPLIED
	REMOTE CONTROL PANEL	31-40SF	SUPPLIED
	MONITOR MODULE, SINGLE CIRCUIT	SIGA-CT1	4 SQUARE (2-1/8" (D) x W/ ONE GANG)
	MONITOR MODULE, DUAL CIRCUIT	SIGA-CT2	4 SQUARE (2-1/8" (D) x W/ ONE GANG)
	UNIVERSAL INPUT/OUTPUT MOTHERBOARD, 6 SLOT	SIGA-UIO6R	N/A
	UNIVERSAL INPUT/OUTPUT MOTHERBOARD, 2 SLOT	SIGA-UIO2R	N/A
	DELUGE ZONE DESIGNATION	N/A	N/A
	PHOTOELECTRIC SMOKE DETECTOR W/ BASE P = Photoelectric	SIGA2-PS & SIGA-SB	4" SQUARE, 2-1/8" DEEP, 3-0 RING
	HEAT AND CO DETECTOR, ADDRESSABLE, FIXED AT 135 DEGREE	SIGA2-HCOS & SIGA-SB	4" SQUARE, 2-1/8" DEEP, 3-0 RING
	CONTROL RELAY MODULE	SIGA-CR	4" SQUARE, 2-1/8" DEEP, 1-GANG PLASTER RING
	MULTI-VOLTAGE RELAY	RIC-1	4" SQUARE, 2-1/8" DEEP, BLANK COVER
	FIBER SPLICE BOX	28024033	SUPPLIED
	DELUGE ZONE VALVE	BERMAD FP400E-3DC-66	N/A
	DELUGE SERVICE DISCONNECT SWITCH	RELA-SRV-1	4 SQUARE (2-1/8" (D) x W/ ONE GANG)
	TANK LEVEL SENSOR	DONT HAVE YET	N/A
	FIBER OPTIC LINEAR HEAT DETECTOR	LIOS LHD3-04	PART OF CONTROL ROOM EQUIPMENT RACK
	JUNCTION BOX	SIZE VARIES DEPENDING ON APPLICATION	N/A
	END OF LINE RESISTOR	RATING VARIES DEPENDING ON APPLICATION	N/A
	FLOW SWITCH	PART OF BERMAD DELUGE VALVE ABOVE	N/A
	TAMPER SWITCH	705W	N/A
	CCTV CAMERA	AVIGILON 2.0W-H3PTZ-DP20	1 GANG 2 1/2" DEEP BACK BOX
	SUPERVISED END OF LINE DEVICE	RELA-EOL	1 GANG 2 1/2" DEEP BACK BOX
	AIR TEMPERATURE SWITCH	STEGO KT-011 TYPE	N/A
	PRESSURE SWITCH	PS-40-2	N/A
	SURGE PROTECTION DEVICE	MODEL VARIES DEPENDING ON APPLICATION	N/A
	FIBER CALIBRATION BOX	N/A	N/A

**WIRE SPECIFICATIONS:**

FIBER OPTIC LINEAR HEAT DETECTION CABLE - 2/C, 62.5/125u MULTI-MODE ARMORED CABLE. LIOS TYPE 28030504 IN TUNNEL ROADWAY AREAS. LIOS TYPE 28030606 IN NON-TUNNEL ROADWAY AREAS. E2000 APC CONNECTORS. FIBER, CONNECTORS, AND BREAK-OUT PIGTAILS PROVIDED BY SYSTEMS GROUP.

FIRE ALARM FIBER OPTIC CABLE - 4/C, 62.5/125u MULTI-MODE FIBER, 820nm, OUTSIDE PLANT (OSP) DISTRIBUTION TYPE CABLE, KEVLAR STRENGTH MEMBER. BREAK-OUT FIBER KIT FOR "ST" TYPE CONNECTOR. "ST" CONNECTORS PROVIDED BY ELECTRICAL CONTRACTOR. FIBER TRANSCEIVER PROVIDED BY SYSTEMS GROUP.

CCTV FIBER OPTIC CABLE - 6/C, 62.5/125u SINGLE-MODE FIBER, 850nm, OUTSIDE PLANT (OSP) DISTRIBUTION TYPE CABLE, KEVLAR STRENGTH MEMBER, BREAK-OUT KIT FOR "LC" CONNECTOR. "LC" CONNECTORS PROVIDED BY ELECTRICAL CONTRACTOR. FIBER TRANSCEIVER PROVIDED BY SYSTEMS GROUP.

CAT 5e ETHERNET CABLE - 1000BASE-T, 4-PAIR UTP CAT 5e. RJ-45 CONNECTORS PROVIDED BY ELECTRICAL CONTRACTOR.

#18 TFN CONDUCTOR - STRANDED, TFN JACKET INSULATION. SEE COLOR CODES. PROVIDED BY ELECTRICAL CONTRACTOR.

#16 THHN CONDUCTOR - STRANDED, THHN JACKET INSULATION. SEE COLOR CODES. PROVIDED BY ELECTRICAL CONTRACTOR.

#14 THHN CONDUCTOR - STRANDED, THHN JACKET INSULATION. SEE COLOR CODES. PROVIDED BY ELECTRICAL CONTRACTOR.

#12 THHN CONDUCTOR - STRANDED, THHN JACKET INSULATION. SEE COLOR CODES. PROVIDED BY ELECTRICAL CONTRACTOR.

#16 TWISTED PAIR - 2/C, #16 CONDUCTORS, STRANDED, TFN JACKET INSULATION, MINIMUM 6 TWISTS PER FOOT. SEE COLOR CODES BELOW. PROVIDED BY ELECTRICAL CONTRACTOR.

#12 TWISTED PAIR - 2/C, #12 CONDUCTORS, STRANDED, THHN JACKET INSULATION, MINIMUM 6 TWISTS PER FOOT. SEE COLOR CODES. PROVIDED BY ELECTRICAL CONTRACTOR.

#10 THHN CONDUCTOR - SOLID, THHN JACKET, GREEN. PROVIDED BY ELECTRICAL CONTRACTOR.

#6 THHN CONDUCTOR - SOLID, THHN JACKET. PROVIDED BY ELECTRICAL CONTRACTOR.

**COLOR CODES FOR TUNNEL PLENUMS:**

WATERFLOW IDC CKT - YELLOW/BLUE


TAMPER IDC CKT - ORANGE/BROWN

DELUGE VALVE RELEASING CIRCUIT - PINK/PURPLE

SIGNALING DEVICE LOOP SLC CIRCUIT - RED/BLACK

CAMERA POWER CIRCUIT - RED/BLACK

\*LIGHTER COLOR (+), DARKER COLOR (-)

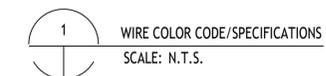

**EISENHOWER/JOHNSON**

**MEMORIAL TUNNEL**

FIXED FIRE SUPPRESSION SYSTEM

DESIGN BUILD PROJECT

Project No. C0703-360 Subaccount 17810

**RECORD DRAWINGS - 2015-11-16**

**BARNARD EJMT TEAM**

**BARNARD**

**RONDINELLI**

Western States Fire Protection Co.

Revisions	Date
Num	Description

DRAWN BY: B.T.L. | CHECKED BY: AEE-JR

FIRE ALARM:  
LEGEND

Drawing Number  
**FA0.01**



FIRE ALARM SEQUENCE OF OPERATIONS MATRIX FOR THE EISENHOWER/JOHNSON MEMORIAL TUNNEL

INPUTS		OUTPUT																												
		A	B	C	D	E	F	G	H	I	J	K	L	M	N	O	P	Q	R	S	T	U	V	W	X	Y	Z	AA	BB	
GENERAL DETECTION DEVICES	AREA SMOKE DETECTOR	1	X		X					X																				
	AREA HEAT/CO DETECTOR	2	X		X					X																				
FIRE SPRINKLER SYSTEM	DELUGE SYSTEM WATERFLOW	3	X		X					X																				
	DELUGE SYSTEM VALVE TAMPER	4		X		X				X																				
	MISC PUMP ROOM VALVE TAMPER	5		X		X				X																				
	ISOLATION VALVE TAMPER	6		X		X				X																				
	FIRE PUMP RUN STATUS	7		X		X				X									X											
	FIRE PUMP POWER LOSS	8		X		X				X																				
	FIRE PUMP PHASE REVERSAL	9		X		X				X																				
	FIRE PUMP ON EMERGENCY POWER	10		X		X				X																				
	EISENHOWER (NORTH) TUNNEL DELUGE RELEASE (NOTE #8 & #9)	11	X		X					X										X	X	NC	NC	X	X					
	JOHNSON (SOUTH) TUNNEL DELUGE RELEASE (NOTE #8 & #9)	12	X		X					X																				
FIBER OPTIC LINEAR HEAT DETECTION	EVENT 1 PRE-ALARM	13	X		X			X	X	X				X																
REDUNDANT FIBERS OPERATION	EVENT 1 ALARM (NOTE #1)	14	X		X			X	X	X			X		X				X											
MISCELLANEOUS DEVICES	DRAINAGE TANK "HIGH" LEVEL	15		X		X				X																				
	BOILER "TROUBLE"	16		X		X				X																				
	WATER TANK "EMPTY" LEVEL (NOTE #10)	17	X		X					X						X		X												
	IVE LOW TEMPERATURE	18		X		X				X																				
	WATER TANK "60 MINUTE" LEVEL	19		X		X				X																				
	WATER TANK "30 MINUTE" LEVEL	20		X		X				X																				
	EMERGENCY GENERATOR "RUN"	21		X		X				X																				
	EMERGENCY GENERATOR TROUBLE"	22		X		X				X																				
	FPC CABINET POWER SUPPLY "TROUBLE" (NOTE #5)	23			X					X																				
	FPC CABINET CCTV SYSTEM "TROUBLE"	24			X					X																				
	EQUIPMENT RACK UPS "TROUBLE" (NOTE #7)	25																												
	EQUIPMENT RACK POWER SUPPLY "TROUBLE" (NOTE #6)	26			X					X																				
	CCTV WORKSTATION UPS "TROUBLE" (NOTE #7)	27																												
	FA WORKSTATION UPS "TROUBLE" (NOTE #7)	28									X																			
	CONTROL OUTPUT FEEDBACK STATUS (NOTE #4)	29				X																								

NOTE #1: IN REDUNDANT FIBER OPERATION, DELUGE ZONE RELEASE IS SINGLE ALARM SIGNAL FROM PRIMARY FIBER "A". ALARM SIGNALS, CCTV PRE-ALARM IS TRIGGERED BY PRE-ALARM SIGNAL ON SECONDARY FIBER "B". CCTV PRE-ALARM SIGNAL REPORTS TO SYSTEM AS AN ALARM SIGNAL, PER CDOT REQUEST.

NOTE #2: IN DEGRADED MODE FOR FIBER OPERATION (LOSS OF SECONDARY FIBER "B"), DELUGE ZONE RELEASE IS SINGLE ALARM SIGNAL FROM PRIMARY FIBER "A" ONLY. CCTV IS TRIGGERED BY ALARM SIGNAL ON PRIMARY FIBER "A".

NOTE #3: IN DEGRADED MODE FOR FIBER OPERATION (LOSS OF PRIMARY FIBER "A"), DELUGE ZONE RELEASE IS SINGLE ALARM SIGNAL FROM SECONDARY FIBER "B" ONLY. CCTV PRE-ALARM IS TRIGGERED BY PRE-ALARM SIGNAL ON SECONDARY FIBER "B". CCTV PRE-ALARM SIGNAL REPORTS TO SYSTEM AS AN ALARM SIGNAL, PER CDOT REQUEST.

NOTE #4: CONTROL OUTPUT STATUS FEEDBACK IS REPORTED TO FIREWORKS DISPLAY UNITS AND LIGHTS THE ASSOCIATED DEVICE ICON ONLY. THIS FEEDBACK WILL NOT REPORT TO THE FACP PANELS, NOR PRINT-OUT ON THE SYSTEM PRINTER.

NOTE #5: FPC CABINET "TROUBLE" IS A COMMON TROUBLE INDICATION FOR CIRCUITS ASSOCIATED WITH THE CABINET POWER SUPPLY ONLY, INCLUDING BATTERY AND AC POWER ISSUES.

NOTE #6: EQUIPMENT RACK "TROUBLE" IS A COMMON TROUBLE INDICATION FOR CIRCUITS ASSOCIATED WITH THE CABINET POWER SUPPLY ONLY, INCLUDING BATTERY AN AC POWER ISSUES.

NOTE #7: UPS "TROUBLE" WILL ONLY REPORT TO THE ASSOCIATED WORKSTATION AS INDICATED. THE UPS TROUBLE CONDITION WILL NOT REPORT THRU THE FIRE ALARM SYSTEM, NOR PRINT-OUT ON THE SYSTEM PRINTER.

NOTE #8: NC = NO CHANGE

NOTE #9: DRAINAGE SYSTEM WILL PRE-POSITION TO THE EISENHOWER (NORTH) TUNNEL DRAINAGE SOO IF AUTOMATIC DELUGE RELEASE ALARM OR MANUAL ACTIVATION SWITCH FOR AN EISENHOWER (NORTH) TUNNEL ZONE; OR WILL PRE-POSITION TO THE JOHNSON (SOUTH) TUNNEL DRAINAGE SOO IF AUTOMATIC DELUGE RELEASE OR MANUAL ACTIVATION SWITCH FOR JOHNSON (SOUTH) TUNNEL ZONE. DRAINAGE VALVE POSITION LATCHES TO INITIAL POSITION (NORTH OR SOUTH) BASED ON INITIAL AUTOMATIC DELUGE RELASE ALARM OR MANUAL ACTIVATION SWITCH.

NOTE #10: FIRE PUMP CAN BE MANUALLY TURNED ON AND OFF BY THE SYSTEM OPERATOR AS WARRANTED BY THE SYSTEM EVENT. ONCE WATER TANK "EMPTY" LEVEL IS RECEIVED, THE FIRE PUMP IS LOCKED OUT AND WILL NOT RESTART UNTIL WATER TANK "EMPTY" LEVEL ALARM IS RESTORED. ONCE WATER IS RESTORED TO THE SYSTEM AND THE WATER TANK LEVEL ALARM IS RESTORED, THE FIRE PUMP CAN BE MANUALLY RESTARTED VIA THE FIRE PUMP OVERRIDE SWITCH LOCATED AT THE ECR, WCR, OR FMO FACP PANELS.

NOTE #11: "PRE-ALARM" AND "ALARM" STROBES ARE ONLY LOCATED IN THE EAST CONTROL ROOM.

NOTE #12: THE SYSTEM DESIGN ALLOWSFOR A MAXIMUM OF TWO (2) DELUGE ZONES ACTIVATED AT ANY GIVEN TIME. IF THE SYSTEM OPERATOR ELECTS TO MANUALLY MOVE THE DELUGE RELEASE TO ANOTHER TUNNEL ZONE,THE OPERATOR MUST ACTIVATE THE NEXT DELUGE ZONE, PRIOR TO SHUTTING OFF ANY ACTIVATED ZONE TO AVOID WATER HAMMER ISSUES IN THE FIRE SUPPRESSION PIPING. THIS APPLIES IN THE EVENT OF THE MAXIMUM TWO (2) ACTIVATED SCENARIOS, AS WELL.

NOTE #13: THE DRAINAGE VALVES ARE LATCHED INTO THE INITIAL ALARM CONDITION (NORTH OR SOUTH) POSITION UNTIL THE DRAINAGE VALVE RESET SWITCH IS OPERATED ON THE ECR, WCR, OR FMO FACP PANELS; EVEN AFTER SYSTEM IS FULLY RESET. THE DRAINAGE VALVES CAN BE OVERRIDEN VIA DRAINAGE VALVE OVERRIDE SWITCH ON THE ECR, WCR, OR FMO FACP.

IF THIS SHEET IS NOT 22"x34" IT IS NOT PLOTTED TO SCALE



FIRE ALARM/CCTV SYSTEM SEQUENCE OF OPERATIONS PART #1  
SCALE: N.T.S.

**BARNARD EJMT TEAM**

**BARNARD** **STURGEON ELECTRIC** **BCER** **RONDINELLI** **ELF** **Western States Fire Protection Co.**

**EISENHOWER/JOHNSON MEMORIAL TUNNEL**

FIXED FIRE SUPPRESSION SYSTEM DESIGN BUILD PROJECT  
Project No. C0703-360 Subaccount 17810  
**RECORD DRAWINGS - 2015-11-16**

Revisions	Date
Num	Description

FIRE ALARM: SEQUENCE OF OPERATIONS PART #1  
Drawing Number  
**FA0.03**  
DRAWN BY: B.T.L. | CHECKED BY: AEE-JF

IF THIS SHEET IS NOT 22"x34" IT IS NOT PLOTTED TO SCALE

FIRE ALARM SEQUENCE OF OPERATIONS MATRIX FOR THE EISENHOWER/JOHNSON MEMORIAL TUNNEL		OUTPUT	A	B	C	D	E	F	G	H	I	J	K	L	M	N	O	P	Q	R	S	T	U	V	W	X	Y	Z	AA	BB		
INPUTS																																
FACP/RCP/FPC PANELS	AC POWER FAILURE (NOTE #5)	30			X			X			X																					
	LOW BATTERY (NOTE #5)	31			X			X			X																					
	GROUND FAULT	32			X			X			X																					
	OPEN CIRCUIT	33			X			X			X																					
	ALARM SILENCE BUTTON	34			X			X			X																					
	MANUALLY ACTIVATED PANEL SWITCH	35			X			X			X																				X	
	RCP HIGH TEMPERATURE	36		X				X			X																					
	RCP LOW TEMPERATURE	37		X				X			X																					
	FCP HIGH TEMPERATURE	38		X				X			X																					
	FCP LOW TEMPERATURE	39		X				X			X																					
MISCELLANEOUS CONTROLS	FIREWORKS MANUAL "ON" SWITCH	40								X				X	X	X														X		
	FIREWORKS MANUAL "OFF" SWITCH	41								X																				X		
	FACP/RCP PANEL SWITCH	42			X					X																				X		
	CCTV MANUAL PAN/TILT CONTROL	43								X																		X				
DEGRADED FIBER "B" OPERATION	EVENT 1 PRE-ALARM	45	← NOT AVAILABLE IN FIBER MODE "B" →																													
	EVENT 1 ALARM (NOTE #2)	46	X			X			X	X	X			X	X	X			X	X												
DEGRADED FIBER "A" OPERATION	EVENT 1 PRE-ALARM	47	X			X			X	X	X			X	X	X			X	X												
	EVENT 1 ALARM (NOTE #3)	48	X			X			X	X	X			X	X	X			X	X												
	LIOS FOLHD TROUBLE	49			X				X	X	X			X	X	X			X	X												
	LIOS FOLHD LOSS OF PRIMARY "A" FIBER	50			X				X	X	X			X	X	X			X	X												
LIOS FOLHD LOSS OF SECONDARY "B" FIBER	51			X				X	X	X			X	X	X			X	X													

NOTE #1: IN REDUNDANT FIBER OPERATION, DELUGE ZONE RELEASE IS SINGLE ALARM SIGNAL FROM PRIMARY FIBER "A". ALARM SIGNALS, CCTV PRE-ALARM IS TRIGGERED BY PRE-ALARM SIGNAL ON SECONDARY FIBER "B". CCTV PRE-ALARM SIGNAL REPORTS TO SYSTEM AS AN ALARM SIGNAL, PER CDOT REQUEST.

NOTE #2: IN DEGRADED MODE FOR FIBER OPERATION (LOSS OF SECONDARY FIBER "B"), DELUGE ZONE RELEASE IS SINGLE ALARM SIGNAL FROM PRIMARY FIBER "A" ONLY. CCTV IS TRIGGERED BY ALARM SIGNAL ON PRIMARY FIBER "A".

NOTE #3: IN DEGRADED MODE FOR FIBER OPERATION (LOSS OF PRIMARY FIBER "A"), DELUGE ZONE RELEASE IS SINGLE ALARM SIGNAL FROM SECONDARY FIBER "B" ONLY. CCTV PRE-ALARM IS TRIGGERED BY PRE-ALARM SIGNAL ON SECONDARY FIBER "B". CCTV PRE-ALARM SIGNAL REPORTS TO SYSTEM AS AN ALARM SIGNAL, PER CDOT REQUEST.

NOTE #4: CONTROL OUTPUT STATUS FEEDBACK IS REPORTED TO FIREWORKS DISPLAY UNITS AND LIGHTS THE ASSOCIATED DEVICE ICON ONLY. THIS FEEDBACK WILL NOT REPORT TO THE FACP PANELS, NOR PRINT-OUT ON THE SYSTEM PRINTER.

NOTE #5: FPC CABINET "TROUBLE" IS A COMMON TROUBLE INDICATION FOR CIRCUITS ASSOCIATED WITH THE CABINET POWER SUPPLY ONLY, INCLUDING BATTERY AND AC POWER ISSUES.

NOTE #6: EQUIPMENT RACK "TROUBLE" IS A COMMON TROUBLE INDICATION FOR CIRCUITS ASSOCIATED WITH THE CABINET POWER SUPPLY ONLY, INCLUDING BATTERY AN AC POWER ISSUES.

NOTE #7: UPS "TROUBLE" WILL ONLY REPORT TO THE ASSOCIATED WORKSTATION AS INDICATED. THE UPS TROUBLE CONDITION WILL NOT REPORT THRU THE FIRE ALARM SYSTEM, NOR PRINT-OUT ON THE SYSTEM PRINTER.

NOTE #8: NC = NO CHANGE

NOTE #9: DRAINAGE SYSTEM WILL PRE-POSITION TO THE EISENHOWER (NORTH) TUNNEL DRAINAGE SOO IF AUTOMATIC DELUGE RELEASE ALARM OR MANUAL ACTIVATION SWITCH FOR AN EISENHOWER (NORTH) TUNNEL ZONE; OR WILL PRE-POSITION TO THE JOHNSON (SOUTH) TUNNEL DRAINAGE SOO IF AUTOMATIC DELUGE RELEASE OR MANUAL ACTIVATION SWITCH FOR JOHNSON (SOUTH) TUNNEL ZONE. DRAINAGE VALVE POSITION LATCHES TO INITIAL POSITION (NORTH OR SOUTH) BASED ON INITIAL AUTOMATIC DELUGE RELASE ALARM OR MANUAL ACTIVATION SWITCH.

NOTE #10: FIRE PUMP CAN BE MANUALLY TURNED ON AND OFF BY THE SYSTEM OPERATOR AS WARRANTED BY THE SYSTEM EVENT. ONCE WATER TANK "EMPTY" LEVEL IS RECEIVED, THE FIRE PUMP IS LOCKED OUT AND WILL NOT RESTART UNTIL WATER TANK "EMPTY" LEVEL ALARM IS RESTORED. ONCE WATER IS RESTORED TO THE SYSTEM AND THE WATER TANK LEVEL ALARM IS RESTORED, THE FIRE PUMP CAN BE MANUALLY RESTARTED VIA THE FIRE PUMP OVERRIDE SWITCH LOCATED AT THE ECR, WCR, OR FMO FACP PANELS.

NOTE #11: "PRE-ALARM" AND "ALARM" STROBES ARE ONLY LOCATED IN THE EAST CONTROL ROOM.

NOTE #12: THE SYSTEM DESIGN ALLOWSFOR A MAXIMUM OF TWO (2) DELUGE ZONES ACTIVATED AT ANY GIVEN TIME. IF THE SYSTEM OPERATOR ELECTS TO MANUALLY MOVE THE DELUGE RELEASE TO ANOTHER TUNNEL ZONE,THE OPERATOR MUST ACTIVATE THE NEXT DELUGE ZONE, PRIOR TO SHUTTING OFF ANY ACTIVATED ZONE TO AVOID WATER HAMMER ISSUES IN THE FIRE SUPPRESSION PIPING. THIS APPLIES IN THE EVENT OF THE MAXIMUM TWO (2) ACTIVATED SCENARIOS, AS WELL.

NOTE #13: THE DRAINAGE VALVES ARE LATCHED INTO THE INITIAL ALARM CONDITION (NORTH OR SOUTH) POSITION UNTIL THE DRAINAGE VALVE RESET SWITCH IS OPERATED ON THE ECR, WCR, OR FMO FACP PANELS; EVEN AFTER SYSTEM IS FULLY RESET. THE DRAINAGE VALVES CAN BE OVERRIDEN VIA DRAINAGE VALVE OVERRIDE SWITCH ON THE ECR, WCR, OR FMO FACP.

1

FIRE ALARM/CCTV SYSTEM SEQUENCE OF OPERATIONS PART #2

SCALE: N.T.S.

Revisions	Description	Date

DRAWN BY: B.T.L. | CHECKED BY: AEE-JR

FIRE ALARM:  
SEQUENCE OF  
OPERATIONS PART #2

Drawing Number

# FA0.04

EISENHOWER/JOHNSON MEMORIAL TUNNEL
RECORD DRAWINGS - 2015-11-16

FIXED FIRE SUPPRESSION SYSTEM
Subaccount 17810

DESIGN BUILD PROJECT
Project No. C0703-360

## BARNARD EJMT TEAM











**GENERAL NOTES:**


1. IF FIELD CONDITIONS RESULT IN A CHANGE TO THE SHOP DRAWING INSTALLATION IN ANY WAY, CONTACT FAS SYSTEMS GROUP TO VERIFY PROPOSED CHANGES ARE COMPLIANT WITH NFPA 72 AND PROJECT REQUIREMENTS.
2. EACH CONTROL CABINET AND ADDRESSABLE DEVICE SHALL BEAR A TYPED LABEL INDICATING ITS ADDRESS OR DESIGNATION, WHICH CAN BE SEEN WITHOUT A LADDER OR LIFT. SMOKE AND HEAT DETECTORS SHALL HAVE THEIR LABEL ON ITS BASE.

**DETAIL NOTES:**

1. WEATHERPROOF BACK BOX PROVIDED BY ELECTRICAL CONTRACTOR.
2. ELECTRICAL CONTRACTOR TO CONNECT TANK HIGH LEVEL SWITCH TO THE TANK HIGH LEVEL IDC CIRCUIT. LEVEL SWITCH ACCESSED BY WEST MANHOLE.
3. NOTE NOT USED.
4. PVC RACEWAY TO UTILIZE THE SAME TRENCH AS THE NEW 12" DISCHARGE LINE.
5. FOR CONTINUATION, SEE JUNCTION BOXES ON SHEET FA2.E01.
6. ELECTRICAL CONTRACTOR TO CONNECT FIRE ALARM CONTROL CIRCUITRY TO DRAINAGE SYSTEM CONTROL VALVES (V-5 AND V-6) IN MANHOLE #2. SEE CIVIL SHEET C6.0.

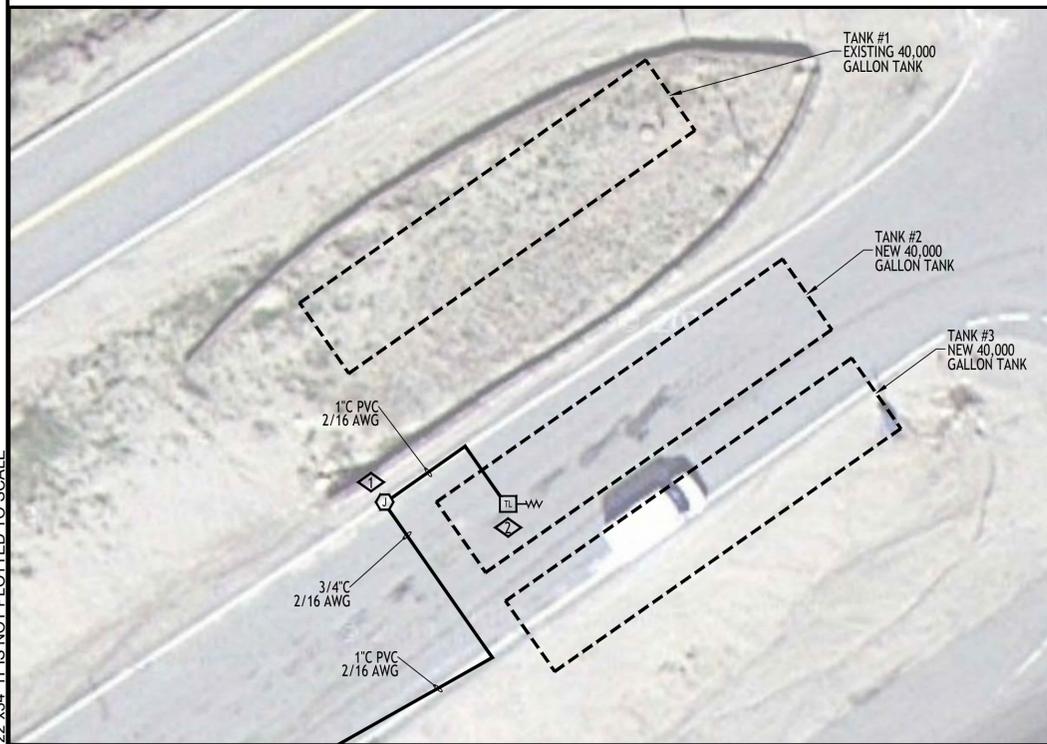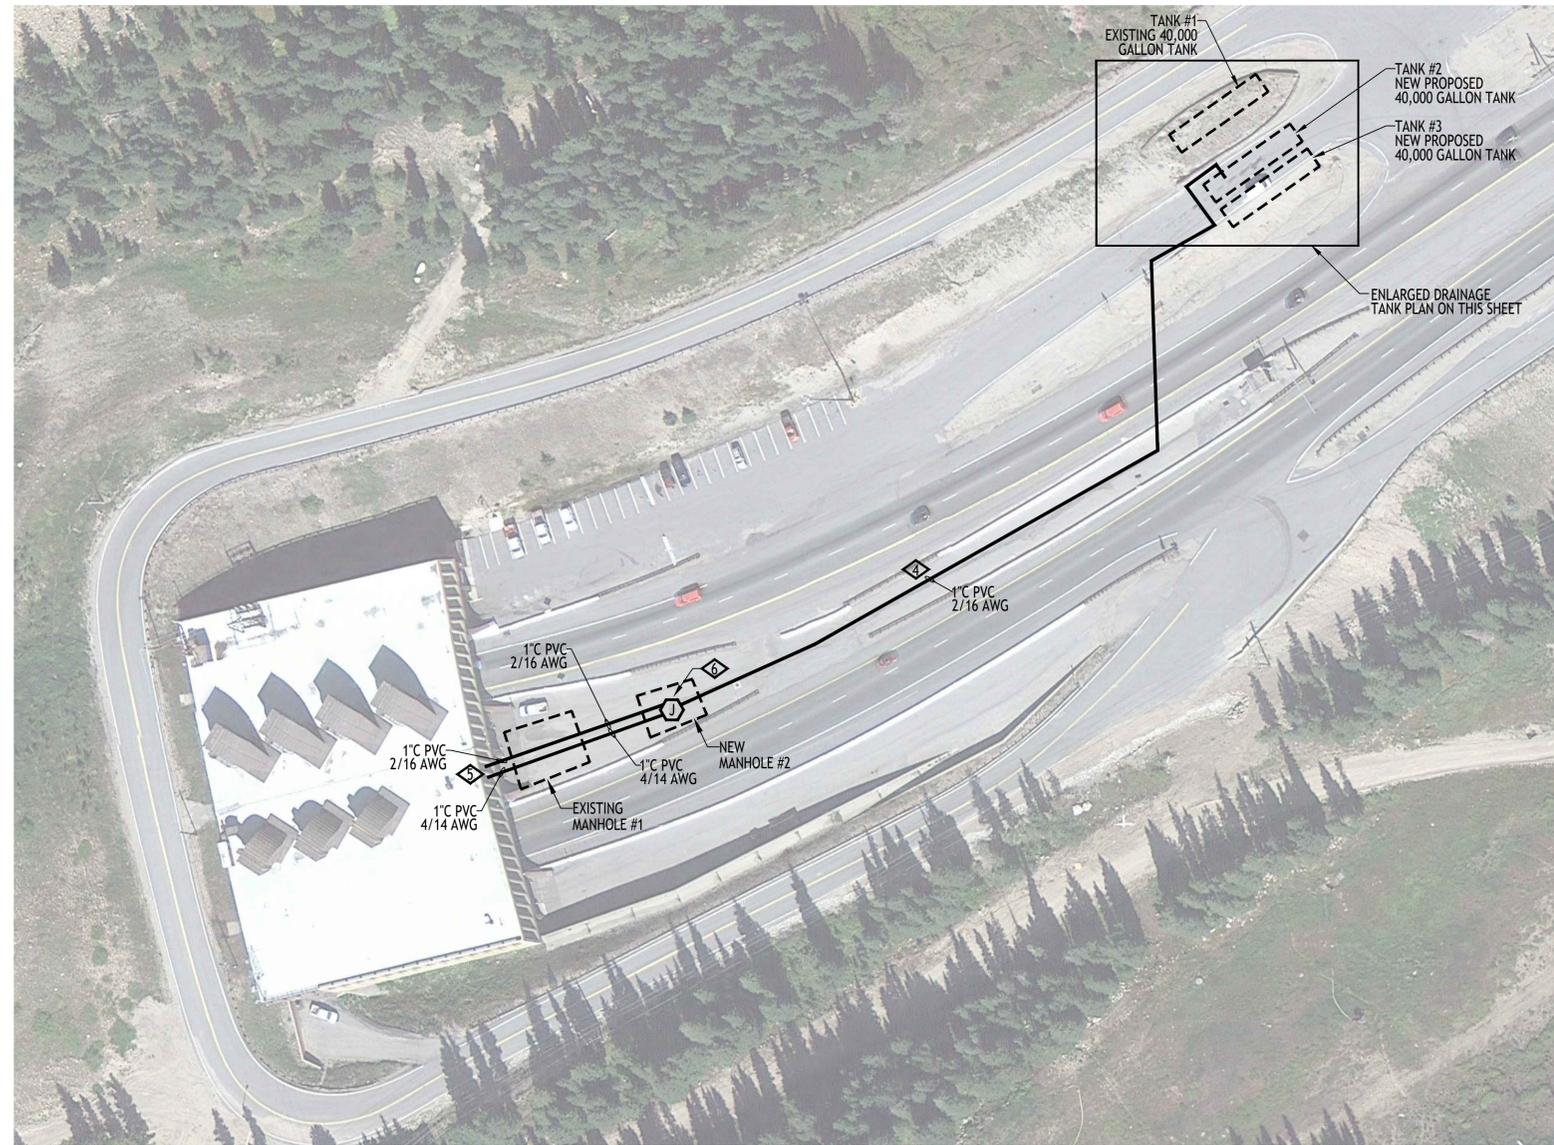

FIRE ALARM - SITE PLAN - EAST  
SCALE: 1/64" = 1'-0"

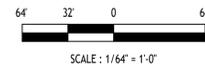

ENLARGED DRAINAGE TANK PLAN  
SCALE: 1/16" = 1'-0"



IF THIS SHEET IS NOT 22"x34" IT IS NOT PLOTTED TO SCALE

**BARNARD EJMT TEAM**

**BCER** **BARNARD** **BARNARD** **RONDINELLI** **Sturgeon Electric** **Western States Fire Protection Co.** **ALF CONSULTING ENGINEERS**

**EISENHOWER/JOHNSON MEMORIAL TUNNEL**

FIXED FIRE SUPPRESSION SYSTEM  
DESIGN BUILD PROJECT

Project No. C0703-360 Subaccount 17810  
**RECORD DRAWINGS - 2015-11-16**

Revisions	Date
Num	Description

FIRE ALARM:  
SITE PLAN - EAST  
Drawing Number  
**FA1.01**

DRAWN BY: B.T.L. | CHECKED BY: AEE-JR

IF THIS SHEET IS NOT 22"x34" IT IS NOT PLOTTED TO SCALE

GENERAL NOTES:


1. IF FIELD CONDITIONS RESULT IN A CHANGE TO THE SHOP DRAWING INSTALLATION IN ANY WAY, CONTACT FAS SYSTEMS GROUP TO VERIFY PROPOSED CHANGES ARE COMPLIANT WITH NFPA 72 AND PROJECT REQUIREMENTS.
2. EACH CONTROL CABINET AND ADDRESSABLE DEVICE SHALL BEAR A TYPED LABEL INDICATING ITS ADDRESS OR DESIGNATION, WHICH CAN BE SEEN WITHOUT A LADDER OR LIFT. SMOKE AND HEAT DETECTORS SHALL HAVE THEIR LABEL ON ITS BASE.

DETAIL NOTES:

- ◊ LOCATION OF EMERGENCY GENERATOR.
- ◊ FOR CONTINUATION, SEE JUNCTION BOX ON SHEET FA2.W01.
- ◊ BLU/YEL WIRE PAIR - GEN RUN STATUS  
ORG/BRN WIRE PAIR - GEN TROUBLE



1  
FIRE ALARM - SITE PLAN - WEST  
SCALE: 1/64" = 1'-0"

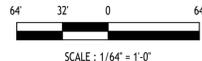

**BARNARD EJMT TEAM**



**EISENHOWER/JOHNSON  
MEMORIAL TUNNEL  
FIXED FIRE SUPPRESSION SYSTEM  
DESIGN BUILD PROJECT**

Project No. C0703-360 Subaccount 17810  
**RECORD DRAWINGS - 2015-11-16**

Num	Description	Date

FIRE ALARM:  
SITE PLAN - WEST

Drawing Number  
**FA1.02**

DRAWN BY: B.T.L. | CHECKED BY: AEE-Jr























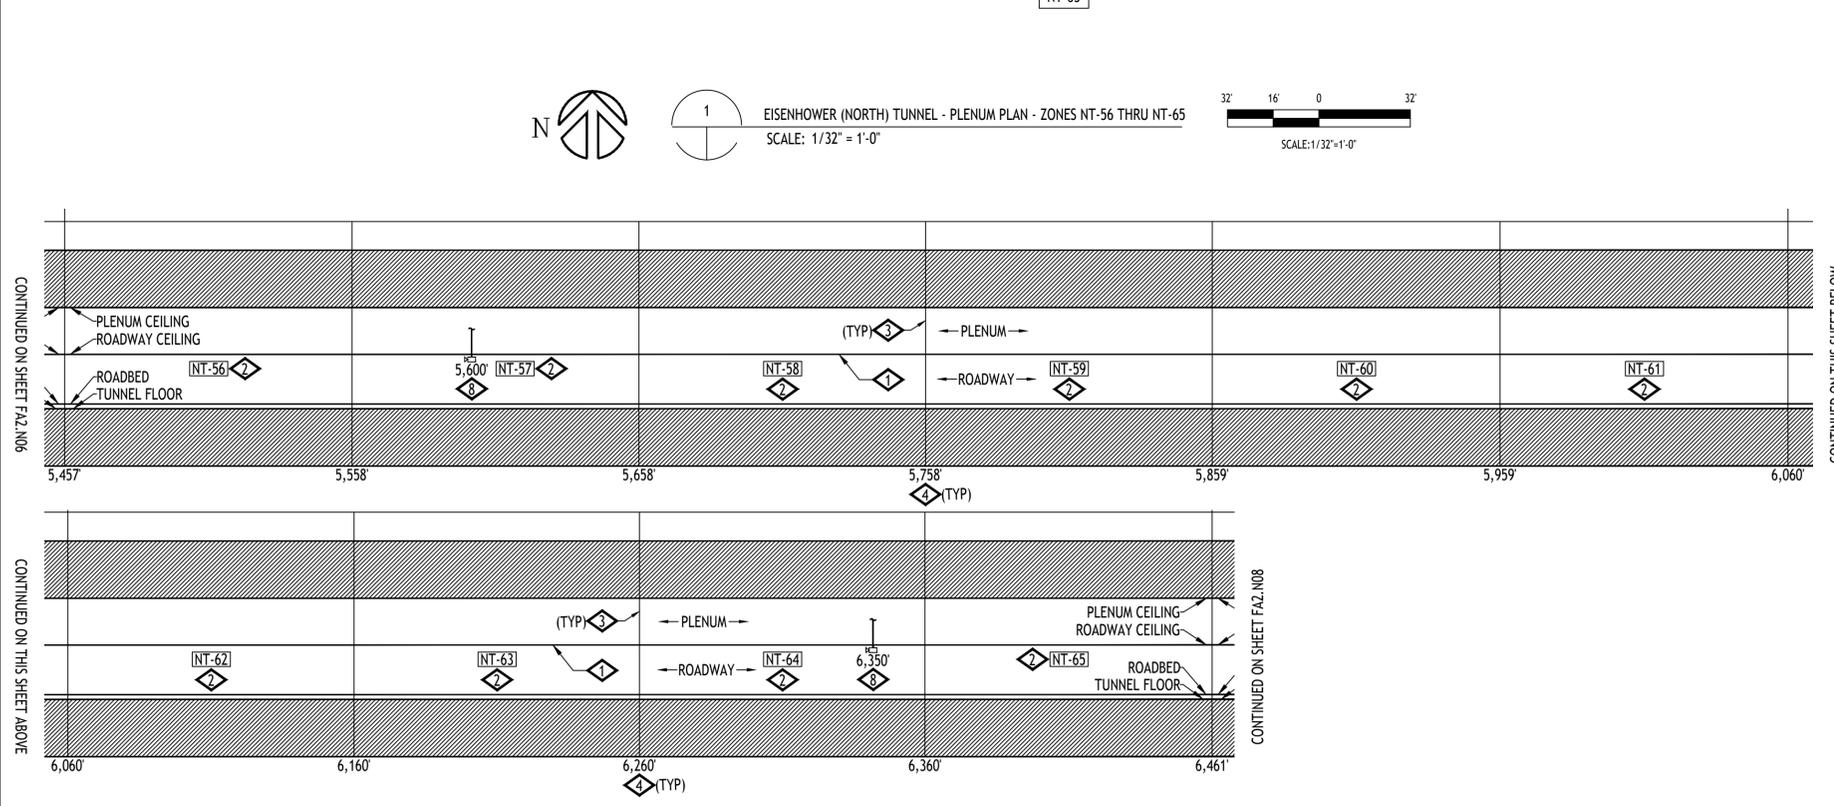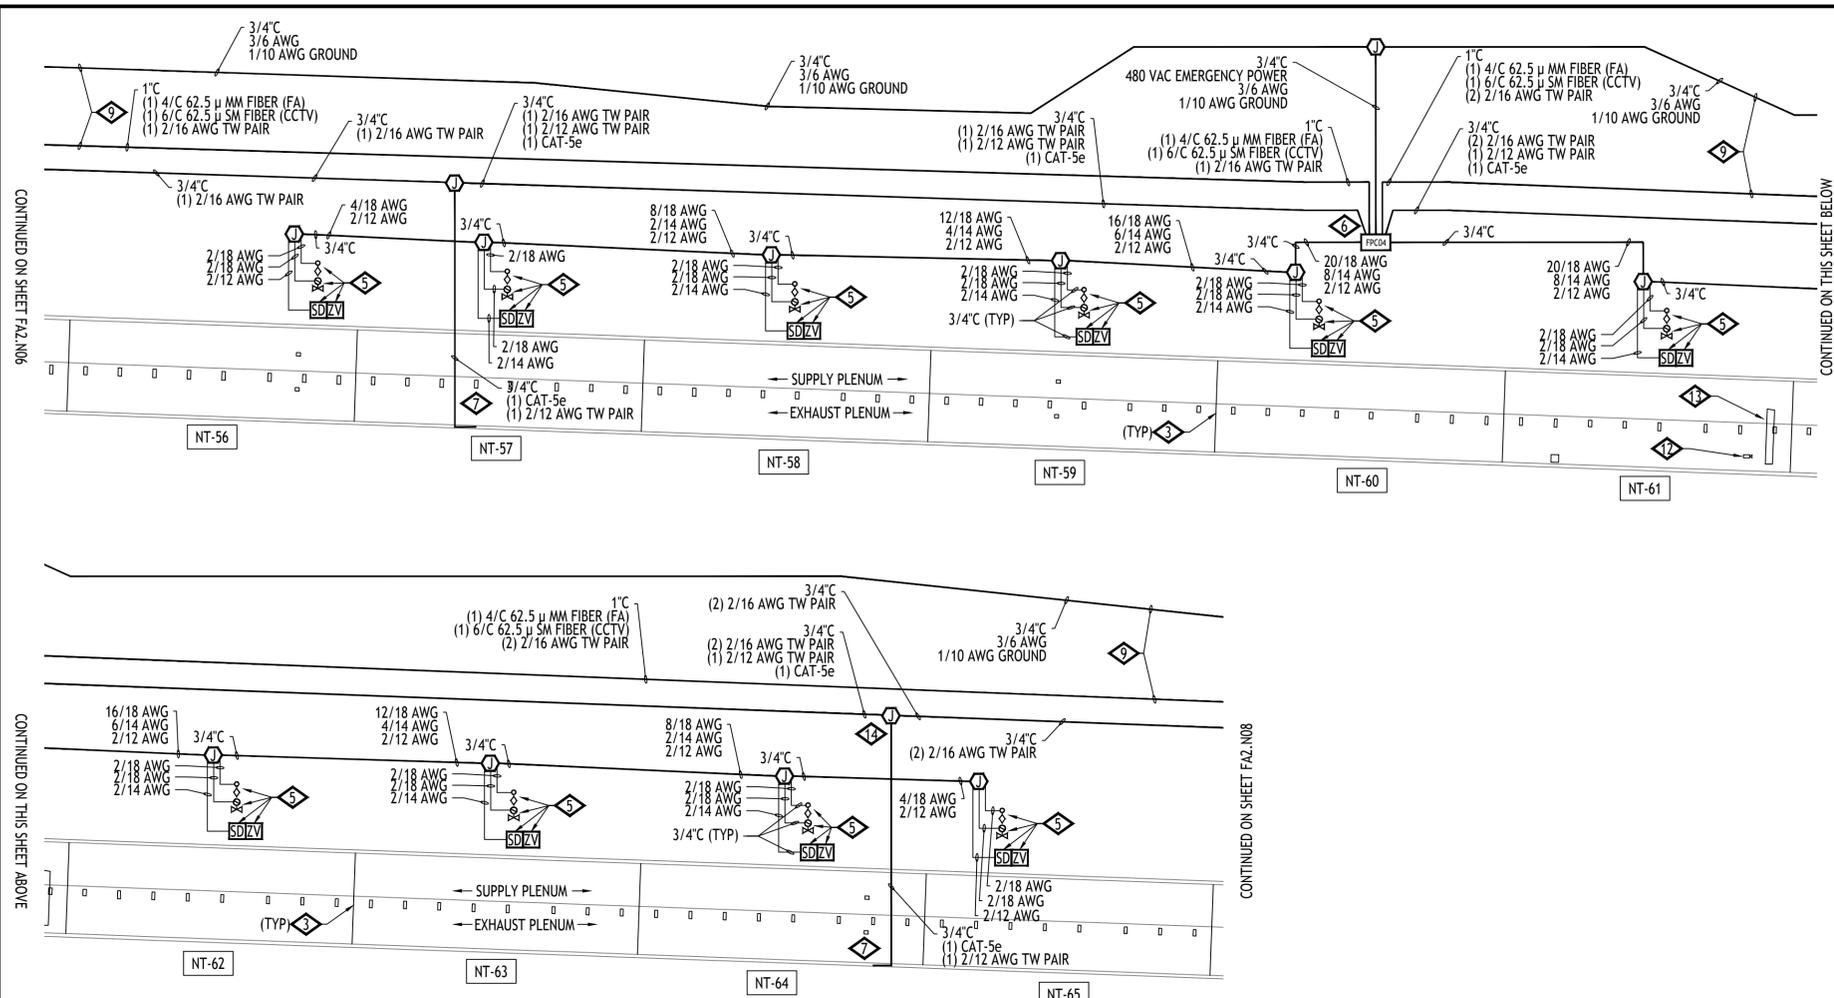

- GENERAL NOTES:**
- IF FIELD CONDITIONS RESULT IN A CHANGE TO THE SHOP DRAWING INSTALLATION IN ANY WAY, CONTACT FAS SYSTEMS GROUP TO VERIFY PROPOSED CHANGES ARE COMPLIANT WITH NFPA 72 AND PROJECT REQUIREMENTS.
  - EACH CONTROL CABINET AND ADDRESSABLE DEVICE SHALL BEAR A TYPED LABEL INDICATING ITS ADDRESS OR DESIGNATION, WHICH CAN BE SEEN WITHOUT A LADDER OR LIFT. SMOKE AND HEAT DETECTORS SHALL HAVE THEIR LABEL ON ITS BASE.
- DETAIL NOTES:**
- FIBER OPTIC LINEAR HEAT DETECTION (FOLHD) FIBER CABLE IN FOLHD HANGER. CABLE TO BE MOUNTED APPROXIMATELY 2 INCHES BELOW ROADWAY CEILING TILE. SEE SHEETS FA6.01, FA6.14 AND FA6.15.
  - DELUGE ZONE SIGNS MOUNTED AT MOST CENTER-POINT OF DELUGE ZONE AND +84" FROM WALKWAY FLOOR. SEE SHEET FA6.02.
  - DELUGE ZONE BOUNDARY.
  - DIMENSION INDICATED APPROXIMATE DISTANCE OF DELUGE ZONE BOUNDARY TO WEST END PORTAL.
  - DELUGE SPRINKLER SYSTEM EQUIPMENT LOCATED IN SUPPLY PLENUM. SEE FIRE PROTECTION SHEETS FOR EQUIPMENT LOCATIONS.
  - EQUIPMENT LOCATED IN SUPPLY PLENUM.
  - ROUTE CAMERA ETHERNET AND POWER RACEWAY AND CIRCUITRY IN A CONCEALED FASHION THRU EXISTING EXHAUST PLENUM OPENING TO BACKSIDE OF ROADWAY WALL TO WALL MOUNTED LOCATION.
  - MOUNT CCTV CAMERA TO ROADWAY WALL TILE ABOVE EXIT PATHWAY. SEE SHEET FA6.02. DIMENSION INDICATES APPROXIMATE DISTANCE OF CAMERA TO WEST PORTAL END.
  - MAINTAIN MAXIMUM SEPARATION POSSIBLE BETWEEN 480 VAC POWER AND FIRE ALARM RACEWAYS. SEE SHEETS FA6.14 AND FA6.15.
  - FIRE LOOP ISOLATION VALVE TAMPER. SEE FIRE PROTECTION SHEETS FOR EQUIPMENT LOCATIONS.
  - MOUNT AIR TEMPERATURE SENSOR INSIDE INSULATED VALVE ENCLOSURE (IVE), OF ASSOCIATED TUNNEL DELUGE ZONE.
  - EXISTING CCTV TRAFFIC CAMERA, SHOWN FOR REFERENCE PURPOSES, TO REMAIN.
  - EXISTING TRAFFIC CONTROL MESSAGE BOARD, SHOWN FOR REFERENCE PURPOSES, TO REMAIN. ROUTE FOLHD FIBER AND HANGER ABOVE THE MESSAGE BOARD. IT IS ACCEPTABLE TO RUN THE FOLHD CABLE WITHOUT THE HANGER WHERE THERE IS INSUFFICIENT CLEARANCE BETWEEN THE EXISTING MESSAGE BOARD AND THE EXISTING CEILING TILE, WHERE APPLICABLE. LIMIT THE FOLHD CABLE RUNS WITHOUT THE HANGER TO THE MINIMUM DISTANCE POSSIBLE TO CLEAR THE OBSTRUCTION.
  - LONGSPAN VLS-1N-L CAT5e EXTENDER LOCATED IN JUNCTION BOX AS SHOWN.

ADDRESSING	
03020456	FPC04 HI TEMP
03020457	FPC04 LO TEMP
03020458	FPC04 CCTV TROUBLE
03020459	FPC04 BPS TROUBLE

ADDRESSING	
03020377	NT-56 MANUAL INPUT
03020378	NT-56 DELUGE RELEASE
03020436	NT-56 WATER FLOW
03020437	NT-56 TAMPER
05020183	NT-56 PRIMARY ALARM
01030168	NT-56 SECONDARY ALARM

ADDRESSING	
03020383	NT-57 MANUAL INPUT
03020384	NT-57 DELUGE RELEASE
03020438	NT-57 WATER FLOW
03020439	NT-57 TAMPER
05020184	NT-57 PRIMARY ALARM
01030169	NT-57 SECONDARY ALARM

ADDRESSING	
03020389	NT-58 MANUAL INPUT
03020390	NT-58 DELUGE RELEASE
03020440	NT-58 WATER FLOW
03020441	NT-58 TAMPER
05020185	NT-58 PRIMARY ALARM
01030170	NT-58 SECONDARY ALARM

ADDRESSING	
03020395	NT-59 MANUAL INPUT
03020396	NT-59 DELUGE RELEASE
03020442	NT-59 WATER FLOW
03020443	NT-59 TAMPER
05020186	NT-59 PRIMARY ALARM
01030171	NT-59 SECONDARY ALARM

ADDRESSING	
03020401	NT-60 MANUAL INPUT
03020402	NT-60 DELUGE RELEASE
03020444	NT-60 WATER FLOW
03020445	NT-60 TAMPER
05020187	NT-60 PRIMARY ALARM
01030172	NT-60 SECONDARY ALARM

ADDRESSING	
03020407	NT-61 MANUAL INPUT
03020408	NT-61 DELUGE RELEASE
03020446	NT-61 WATER FLOW
03020447	NT-61 TAMPER
05020188	NT-61 PRIMARY ALARM
01030173	NT-61 SECONDARY ALARM

ADDRESSING	
03020413	NT-62 MANUAL INPUT
03020414	NT-62 DELUGE RELEASE
03020448	NT-62 WATER FLOW
03020449	NT-62 TAMPER
05020189	NT-62 PRIMARY ALARM
01030174	NT-62 SECONDARY ALARM

ADDRESSING	
03020419	NT-63 MANUAL INPUT
03020420	NT-63 DELUGE RELEASE
03020450	NT-63 WATER FLOW
03020451	NT-63 TAMPER
05020190	NT-63 PRIMARY ALARM
01030175	NT-63 SECONDARY ALARM

ADDRESSING	
03020425	NT-64 MANUAL INPUT
03020426	NT-64 DELUGE RELEASE
03020452	NT-64 WATER FLOW
03020453	NT-64 TAMPER
05020191	NT-64 PRIMARY ALARM
01030176	NT-64 SECONDARY ALARM

ADDRESSING	
03020431	NT-65 MANUAL INPUT
03020432	NT-65 DELUGE RELEASE
03020454	NT-65 WATER FLOW
03020455	NT-65 TAMPER
05020192	NT-65 PRIMARY ALARM
01030177	NT-65 SECONDARY ALARM

**BARNARD EJMT TEAM**

**BARNARD** **RONDINELLI**

**BCER** **Sturgeon Electric**

Western States Fire Protection Co.

**EISENHOWER/JOHNSON MEMORIAL TUNNEL**

FIXED FIRE SUPPRESSION SYSTEM DESIGN BUILD PROJECT

Project No. C0703-360 Subaccount 17810

RECORD DRAWINGS - 2015-11-16

Num	Date	Description

Drawn by: B.T.L. Checked by: AEE-JF

**FIRE ALARM:**  
EISENHOWER TUNNEL  
FP ZONES NT-56 TO NT-65


Drawing Number **FA2.N07**










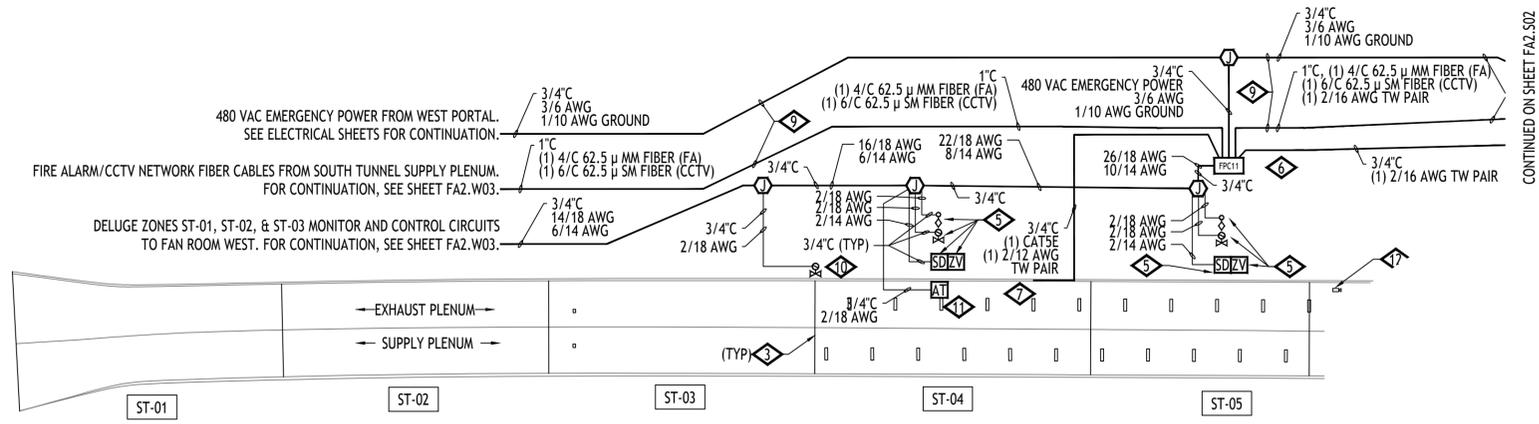


CONTINUED ON SHEET FA2.S02



JOHNSON (SOUTH) TUNNEL - PLENUM PLAN - ZONES ST-01 THRU ST-05  
SCALE: 1/32" = 1'-0"

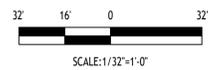

- GENERAL NOTES:**
- IF FIELD CONDITIONS RESULT IN A CHANGE TO THE SHOP DRAWING INSTALLATION IN ANY WAY, CONTACT FAS SYSTEMS GROUP TO VERIFY PROPOSED CHANGES ARE COMPLIANT WITH NFPA 72 AND PROJECT REQUIREMENTS.
  - EACH CONTROL CABINET AND ADDRESSABLE DEVICE SHALL BEAR A TYPED LABEL INDICATING ITS ADDRESS OR DESIGNATION, WHICH CAN BE SEEN WITHOUT A LADDER OR LIFT. SMOKE AND HEAT DETECTORS SHALL HAVE THEIR LABEL ON ITS BASE.
- DETAIL NOTES:**
- FIBER OPTIC LINEAR HEAT DETECTION (FOLHD) FIBER CABLE IN FOLHD HANGER. CABLE TO BE MOUNTED APPROXIMATELY 2 INCHES BELOW ROADWAY CEILING TILE. SEE SHEETS FA6.01, FA6.14 AND FA6.15.
  - DELUGE ZONE SIGNS MOUNTED AT MOST CENTER-POINT OF DELUGE ZONE AND +84" FROM WALKWAY FLOOR. SEE SHEET FA6.02.
  - DELUGE ZONE BOUNDARY.
  - DIMENSION INDICATED APPROXIMATE DISTANCE OF DELUGE ZONE BOUNDARY TO WEST END PORTAL.
  - DELUGE SPRINKLER SYSTEM EQUIPMENT LOCATED IN SUPPLY PLENUM. SEE FIRE PROTECTION SHEETS FOR EQUIPMENT LOCATIONS.
  - EQUIPMENT LOCATED IN SUPPLY PLENUM.
  - ROUTE CAMERA ETHERNET AND POWER RACEWAY AND CIRCUITRY IN A CONCEALED FASHION THRU EXISTING EXHAUST PLENUM OPENING TO BACKSIDE OF ROADWAY WALL TO WALL MOUNTED LOCATION.
  - MOUNT CCTV CAMERA TO ROADWAY WALL TILE ABOVE EXIT PATHWAY. SEE SHEET FA6.02. DIMENSION INDICATES APPROXIMATE DISTANCE OF CAMERA TO WEST PORTAL END.
  - MAINTAIN MAXIMUM SEPARATION POSSIBLE BETWEEN 480 VAC POWER AND FIRE ALARM RACEWAYS. SEE SHEETS FA6.14 AND FA6.15.
  - FIRE LOOP ISOLATION VALVE TAMPER. SEE FIRE PROTECTION SHEETS FOR EQUIPMENT LOCATIONS.
  - MOUNT AIR TEMPERATURE SENSOR INSIDE INSULATED VALVE ENCLOSURE (IVE), OF ASSOCIATED TUNNEL DELUGE ZONE.
  - EXISTING CCTV TRAFFIC CAMERA, SHOWN FOR REFERENCE PURPOSES, TO REMAIN.
  - EXISTING TRAFFIC CONTROL MESSAGE BOARD, SHOWN FOR REFERENCE PURPOSES, TO REMAIN. ROUTE FOLHD FIBER AND HANGER ABOVE THE MESSAGE BOARD. IT IS ACCEPTABLE TO RUN THE FOLHD CABLE WITHOUT THE HANGER WHERE THERE IS INSUFFICIENT CLEARANCE BETWEEN THE EXISTING MESSAGE BOARD AND THE EXISTING CEILING TILE, WHERE APPLICABLE. LIMIT THE FOLHD CABLE RUNS WITHOUT THE HANGER TO THE MINIMUM DISTANCE POSSIBLE TO CLEAR THE OBSTRUCTION.

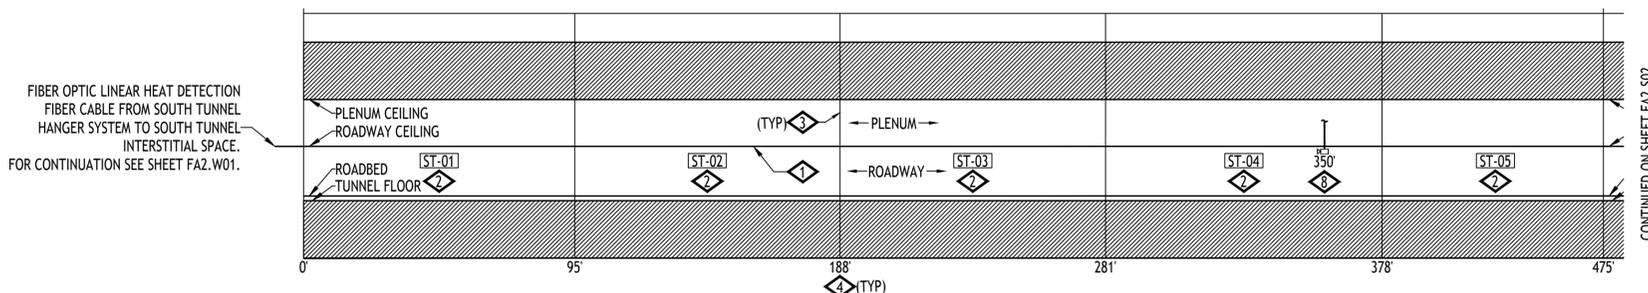

CONTINUED ON SHEET FA2.S02



JOHNSON (SOUTH) TUNNEL - ROADWAY SECTIONAL ELEVATION PLAN - NORTH VIEW - ZONES ST-01 THRU ST-05  
SCALE: 1/32" = 1'-0"



IF THIS SHEET IS NOT 22"x34" IT IS NOT PLOTTED TO SCALE

ADDRESSING		
06020166	FPC11	HI TEMP
06020167	FPC11	LO TEMP
06020168	FPC11	CCTV TROUBLE
06020169	FPC11	BPS TROUBLE

ADDRESSING		
06020145	ST-04	MANUAL INPUT
06020146	ST-04	DELUGE RELEASE
06020162	ST-04	WATER FLOW
06020163	ST-04	TAMPER
01020129	ST-04	PRIMARY ALARM
05020221	ST-04	SECONDARY ALARM
06020170	ST-04	IVE LOW TEMP
06020172	ST-04	ISO VALVE TAMPER



ADDRESSING		
06020151	ST-05	MANUAL INPUT
06020152	ST-05	DELUGE RELEASE
06020164	ST-05	WATER FLOW
06020165	ST-05	TAMPER
01020130	ST-05	PRIMARY ALARM
05020222	ST-05	SECONDARY ALARM

**EISENHOWER/JOHNSON  
MEMORIAL TUNNEL**  
 FIXED FIRE SUPPRESSION SYSTEM  
 DESIGN BUILD PROJECT  
 Project No. C0703-360 Subaccount 17810  
**RECORD DRAWINGS - 2015-11-16**



Revisions	Date	Description

DRAWN BY: B.T.L. | CHECKED BY: AEE-JR  
 FIRE ALARM:  
 JOHNSON TUNNEL  
 FP ZONES ST-01 TO ST-05  
 Drawing Number  
**FA2.S01**


**BARNARD EJMT TEAM**  
**BARNARD**  
**RONDINELLI**  
**Sturgeon Electric**  
**BCER**  
**Western States Fire Protection Co.**  
**ALF CONSULTING ENGINEERS**

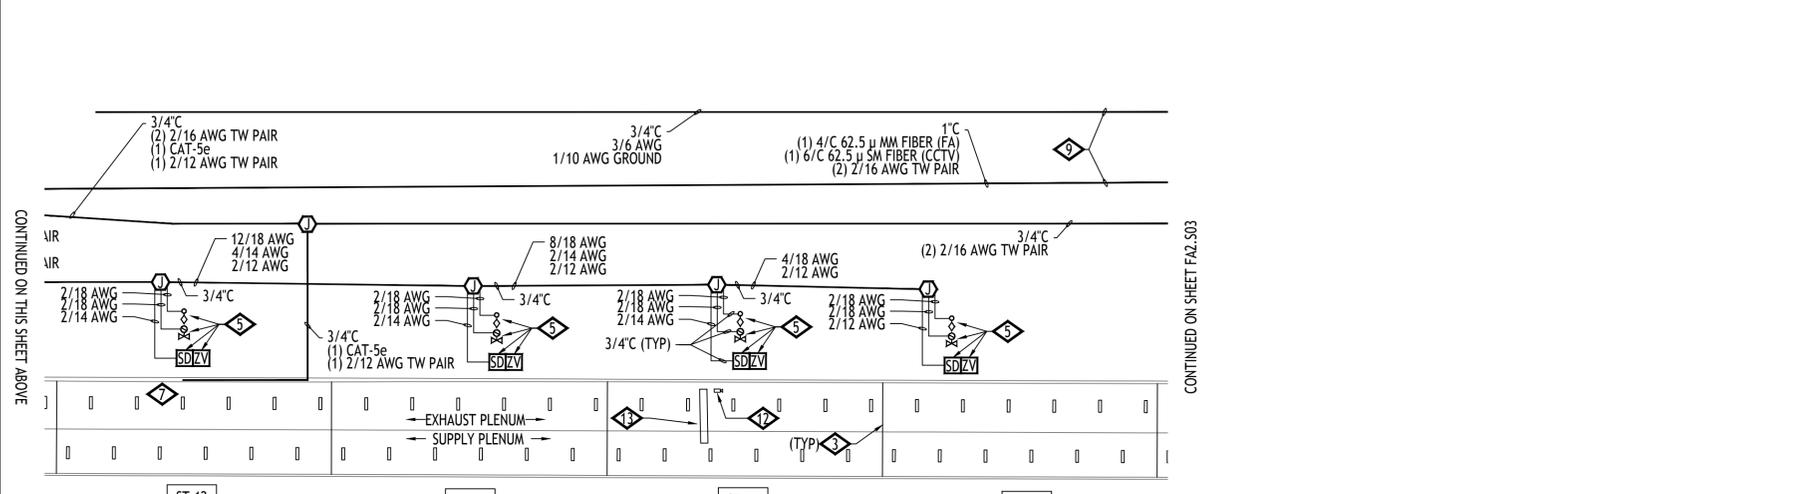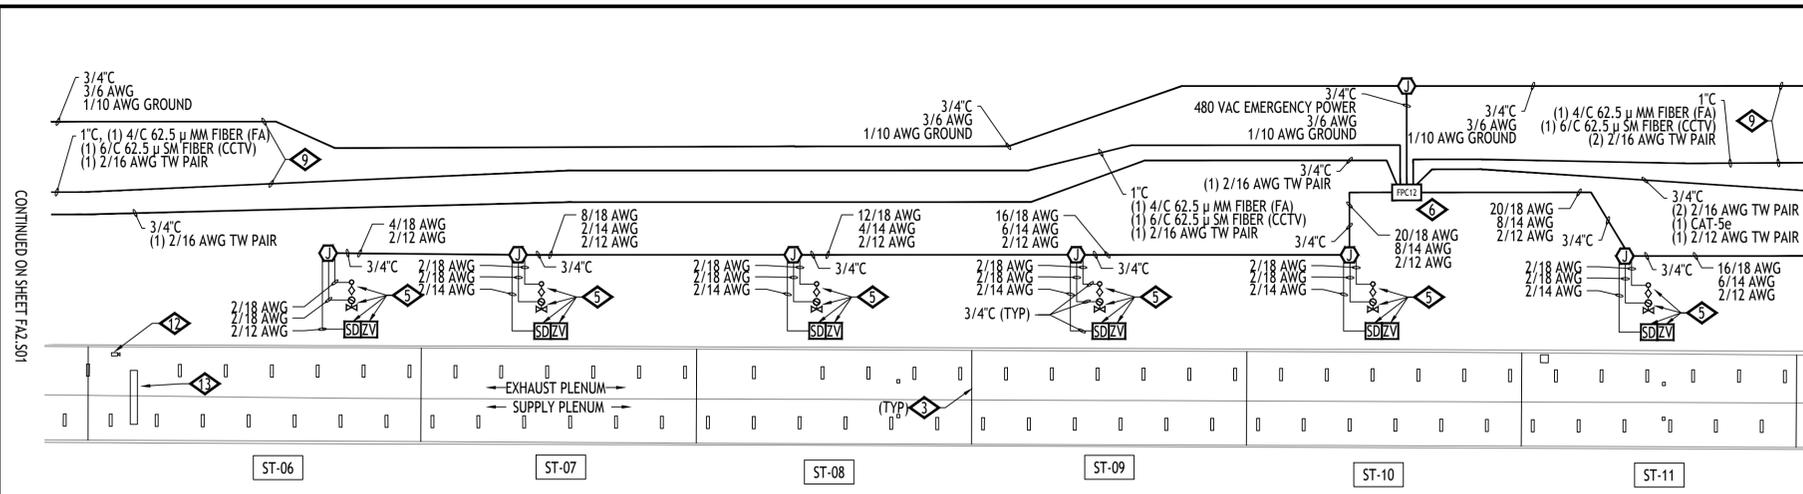

JOHNSON (SOUTH) TUNNEL - PLENUM PLAN - ZONES ST-06 THRU ST-15  
SCALE: 1/32" = 1'-0"

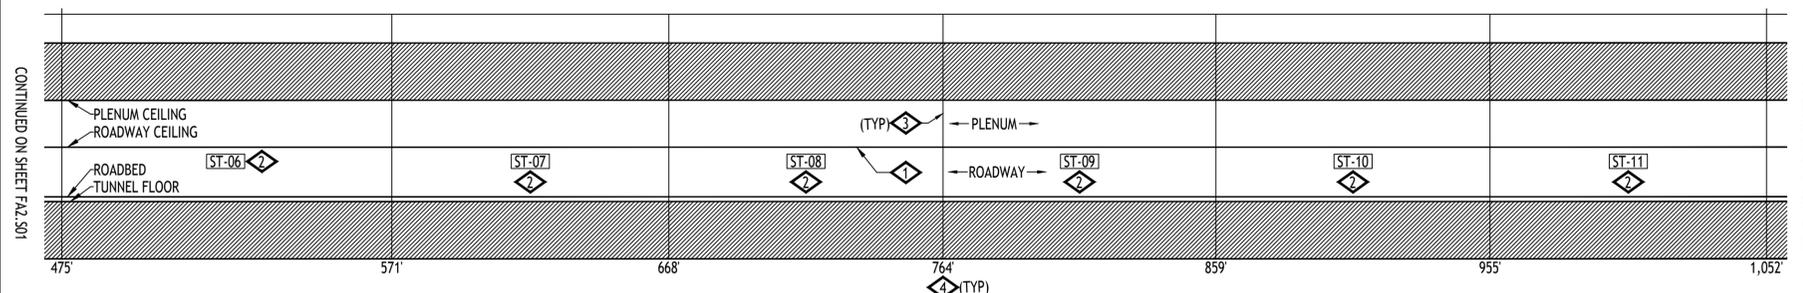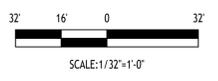

JOHNSON (SOUTH) TUNNEL - ROADWAY SECTIONAL ELEVATION PLAN - NORTH VIEW - ZONES ST-06 THRU ST-15  
SCALE: 1/32" = 1'-0"

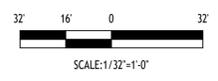

- GENERAL NOTES:
- IF FIELD CONDITIONS RESULT IN A CHANGE TO THE SHOP DRAWING INSTALLATION IN ANY WAY, CONTACT FAS SYSTEMS GROUP TO VERIFY PROPOSED CHANGES ARE COMPLIANT WITH NFPA 72 AND PROJECT REQUIREMENTS.
  - EACH CONTROL CABINET AND ADDRESSABLE DEVICE SHALL BEAR A TYPED LABEL INDICATING ITS ADDRESS OR DESIGNATION, WHICH CAN BE SEEN WITHOUT A LADDER OR LIFT. SMOKE AND HEAT DETECTORS SHALL HAVE THEIR LABEL ON ITS BASE.
- DETAIL NOTES:
- FIBER OPTIC LINEAR HEAT DETECTION (FOLHD) FIBER CABLE IN FOLHD HANGER. CABLE TO BE MOUNTED APPROXIMATELY 2 INCHES BELOW ROADWAY CEILING TILE. SEE SHEETS FA6.01, FA6.14 AND FA6.15.
  - DELUGE ZONE SIGNS MOUNTED AT MOST CENTER-POINT OF DELUGE ZONE AND +84" FROM WALKWAY FLOOR. SEE SHEET FA6.02.
  - DELUGE ZONE BOUNDARY.
  - DIMENSION INDICATED APPROXIMATE DISTANCE OF DELUGE ZONE BOUNDARY TO WEST END PORTAL.
  - DELUGE SPRINKLER SYSTEM EQUIPMENT LOCATED IN SUPPLY PLENUM. SEE FIRE PROTECTION SHEETS FOR EQUIPMENT LOCATIONS.
  - EQUIPMENT LOCATED IN SUPPLY PLENUM.
  - ROUTE CAMERA ETHERNET AND POWER RACEWAY AND CIRCUITRY IN A CONCEALED FASHION THRU EXISTING EXHAUST PLENUM OPENING TO BACKSIDE OF ROADWAY WALL TO WALL MOUNTED LOCATION.
  - MOUNT CCTV CAMERA TO ROADWAY WALL TILE ABOVE EXIT PATHWAY. SEE SHEET FA6.02. DIMENSION INDICATES APPROXIMATE DISTANCE OF CAMERA TO WEST PORTAL END.
  - MAINTAIN MAXIMUM SEPARATION POSSIBLE BETWEEN 480 VAC POWER AND FIRE ALARM RACEWAYS. SEE SHEETS FA6.14 AND FA6.15.
  - FIRE LOOP ISOLATION VALVE TAMPER. SEE FIRE PROTECTION SHEETS FOR EQUIPMENT LOCATIONS.
  - MOUNT AIR TEMPERATURE SENSOR INSIDE INSULATED VALVE ENCLOSURE (IVE), OF ASSOCIATED TUNNEL DELUGE ZONE.
  - EXISTING CCTV TRAFFIC CAMERA, SHOWN FOR REFERENCE PURPOSES, TO REMAIN.
  - EXISTING TRAFFIC CONTROL MESSAGE BOARD, SHOWN FOR REFERENCE PURPOSES, TO REMAIN. ROUTE FOLHD FIBER AND HANGER ABOVE THE MESSAGE BOARD. IT IS ACCEPTABLE TO RUN THE FOLHD CABLE WITHOUT THE HANGER WHERE THERE IS INSUFFICIENT CLEARANCE BETWEEN THE EXISTING MESSAGE BOARD AND THE EXISTING CEILING TILE, WHERE APPLICABLE. LIMIT THE FOLHD CABLE RUNS WITHOUT THE HANGER TO THE MINIMUM DISTANCE POSSIBLE TO CLEAR THE OBSTRUCTION.

ADDRESSING		
06020456	FPC12	HI TEMP
06020457	FPC12	LO TEMP
06020458	FPC12	CCTV TROUBLE
06020459	FPC12	BPS TROUBLE

ADDRESSING		
06020377	ST-06	MANUAL INPUT
06020378	ST-06	DELUGE RELEASE
06020436	ST-06	WATER FLOW
06020437	ST-06	TAMPER
01020131	ST-06	PRIMARY ALARM
05020223	ST-06	SECONDARY ALARM

ADDRESSING		
06020383	ST-07	MANUAL INPUT
06020384	ST-07	DELUGE RELEASE
06020438	ST-07	WATER FLOW
06020439	ST-07	TAMPER
01020132	ST-07	PRIMARY ALARM
05020224	ST-07	SECONDARY ALARM

ADDRESSING		
06020389	ST-08	MANUAL INPUT
06020390	ST-08	DELUGE RELEASE
06020440	ST-08	WATER FLOW
06020441	ST-08	TAMPER
01030133	ST-08	PRIMARY ALARM
05020225	ST-08	SECONDARY ALARM

ADDRESSING		
06020395	ST-09	MANUAL INPUT
06020396	ST-09	DELUGE RELEASE
06020442	ST-09	WATER FLOW
06020443	ST-09	TAMPER
01030134	ST-09	PRIMARY ALARM
05020226	ST-09	SECONDARY ALARM

ADDRESSING		
06020401	ST-10	MANUAL INPUT
06020402	ST-10	DELUGE RELEASE
06020444	ST-10	WATER FLOW
06020445	ST-10	TAMPER
01030135	ST-10	PRIMARY ALARM
05020227	ST-10	SECONDARY ALARM

ADDRESSING		
06020407	ST-11	MANUAL INPUT
06020408	ST-11	DELUGE RELEASE
06020446	ST-11	WATER FLOW
06020447	ST-11	TAMPER
01030138	ST-11	PRIMARY ALARM
05020228	ST-11	SECONDARY ALARM

ADDRESSING		
06020413	ST-12	MANUAL INPUT
06020414	ST-12	DELUGE RELEASE
06020448	ST-12	WATER FLOW
06020449	ST-12	TAMPER
01030139	ST-12	PRIMARY ALARM
05020229	ST-12	SECONDARY ALARM

ADDRESSING		
06020419	ST-13	MANUAL INPUT
06020420	ST-13	DELUGE RELEASE
06020450	ST-13	WATER FLOW
06020451	ST-13	TAMPER
01030140	ST-13	PRIMARY ALARM
05020230	ST-13	SECONDARY ALARM

ADDRESSING		
06020425	ST-14	MANUAL INPUT
06020426	ST-14	DELUGE RELEASE
06020452	ST-14	WATER FLOW
06020453	ST-14	TAMPER
01030141	ST-14	PRIMARY ALARM
05020231	ST-14	SECONDARY ALARM

ADDRESSING		
06020431	ST-15	MANUAL INPUT
06020432	ST-15	DELUGE RELEASE
06020454	ST-15	WATER FLOW
06020455	ST-15	TAMPER
01030142	ST-15	PRIMARY ALARM
05020232	ST-15	SECONDARY ALARM

**BARNARD EJM TEAM**

**BARNARD** **RONDINELLI**

**BCER** **Sturgeon ELECTRIC**

Western States Fire Protection Co.

**EISENHOWER/JOHNSON MEMORIAL TUNNEL**

FIXED FIRE SUPPRESSION SYSTEM DESIGN BUILD PROJECT

Project No. C0703-360 Subaccount 17810

RECORD DRAWINGS - 2015-11-16

Num	Revisions	Date
	Description	

FIRE ALARM: JOHNSON TUNNEL FP ZONES ST-06 TO ST-15

Drawing Number **FA2.S02**

DRAWN BY: B.T.L. CHECKED BY: AEE-JT


















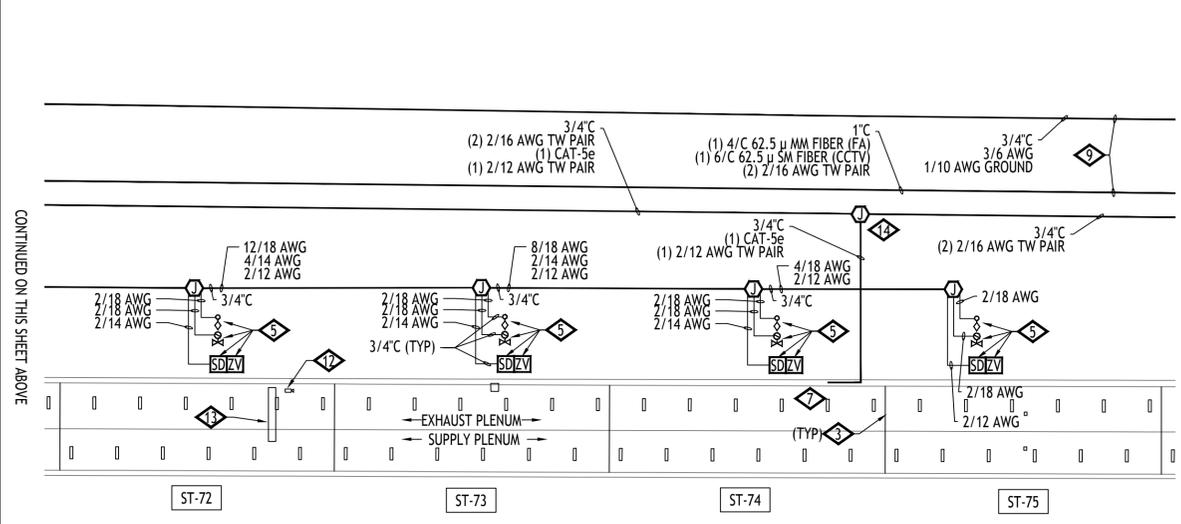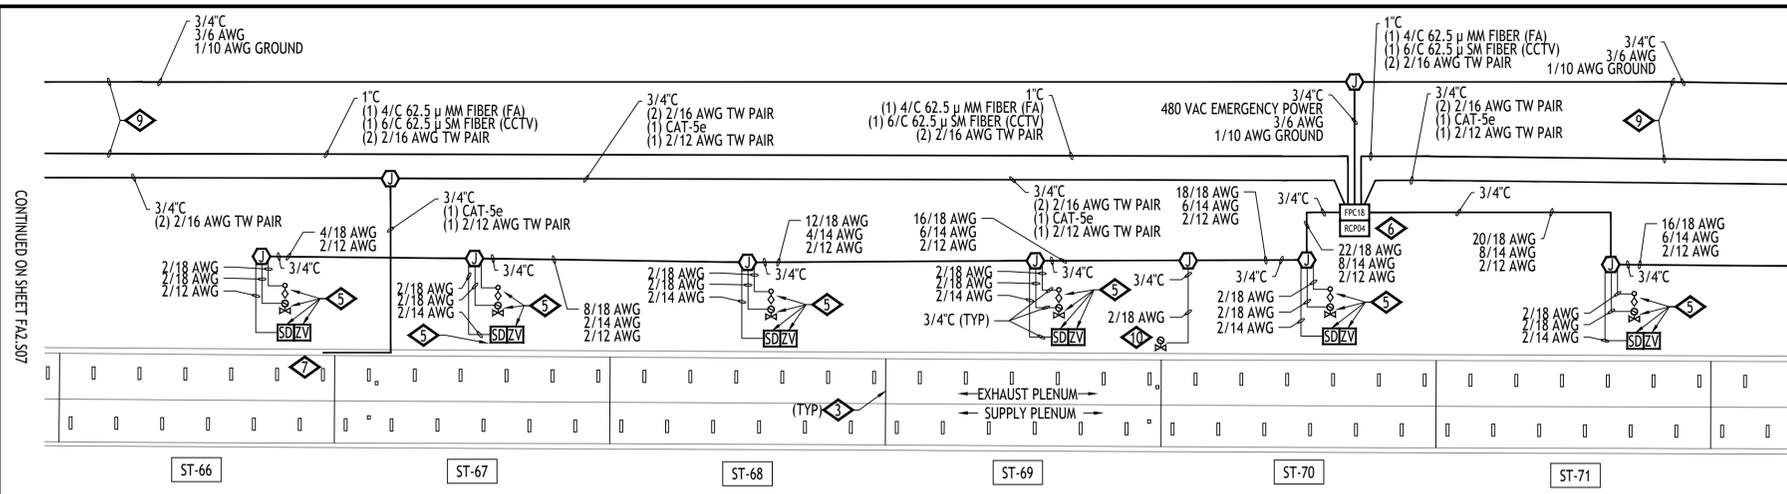

JOHNSON (SOUTH) TUNNEL - PLENUM PLAN - ZONES ST-66 THRU ST-75  
SCALE: 1/32" = 1'-0"

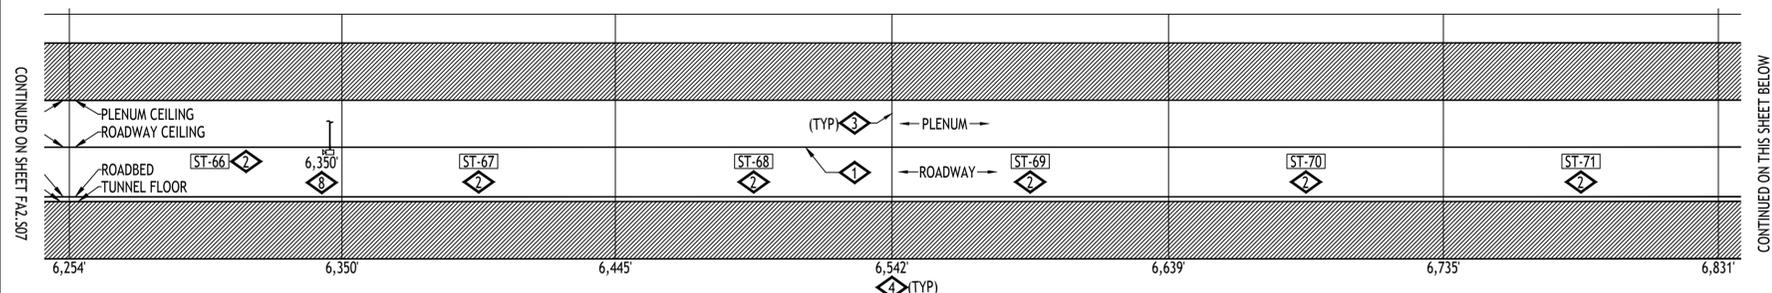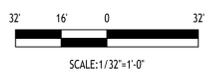

JOHNSON (SOUTH) TUNNEL - ROADWAY SECTIONAL ELEVATION PLAN - NORTH VIEW - ZONES ST-66 THRU ST-75  
SCALE: 1/32" = 1'-0"

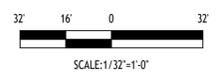

- GENERAL NOTES:**
- IF FIELD CONDITIONS RESULT IN A CHANGE TO THE SHOP DRAWING INSTALLATION IN ANY WAY, CONTACT FAS SYSTEMS GROUP TO VERIFY PROPOSED CHANGES ARE COMPLIANT WITH NFPA 72 AND PROJECT REQUIREMENTS.
  - EACH CONTROL CABINET AND ADDRESSABLE DEVICE SHALL BEAR A TYPED LABEL INDICATING ITS ADDRESS OR DESIGNATION, WHICH CAN BE SEEN WITHOUT A LADDER OR LIFT. SMOKE AND HEAT DETECTORS SHALL HAVE THEIR LABEL ON ITS BASE.
- DETAIL NOTES:**
- FIBER OPTIC LINEAR HEAT DETECTION (FOLHD) FIBER CABLE IN FOLHD HANGER. CABLE TO BE MOUNTED APPROXIMATELY 2 INCHES BELOW ROADWAY CEILING TILE. SEE SHEETS FA6.01, FA6.14 AND FA6.15.
  - DELUGE ZONE SIGNS MOUNTED AT MOST CENTER-POINT OF DELUGE ZONE AND +84" FROM WALKWAY FLOOR. SEE SHEET FA6.02.
  - DELUGE ZONE BOUNDARY.
  - DIMENSION INDICATED APPROXIMATE DISTANCE OF DELUGE ZONE BOUNDARY TO WEST END PORTAL.
  - DELUGE SPRINKLER SYSTEM EQUIPMENT LOCATED IN SUPPLY PLENUM. SEE FIRE PROTECTION SHEETS FOR EQUIPMENT LOCATIONS.
  - EQUIPMENT LOCATED IN SUPPLY PLENUM.
  - ROUTE CAMERA ETHERNET AND POWER RACEWAY AND CIRCUITRY IN A CONCEALED FASHION THRU EXISTING EXHAUST PLENUM OPENING TO BACKSIDE OF ROADWAY WALL TO WALL MOUNTED LOCATION.
  - MOUNT CCTV CAMERA TO ROADWAY WALL TILE ABOVE EXIT PATHWAY. SEE SHEET FA6.02. DIMENSION INDICATES APPROXIMATE DISTANCE OF CAMERA TO WEST PORTAL END.
  - MAINTAIN MAXIMUM SEPARATION POSSIBLE BETWEEN 480 VAC POWER AND FIRE ALARM RACEWAYS. SEE SHEETS FA6.14 AND FA6.15.
  - FIRE LOOP ISOLATION VALVE TAMPER. SEE FIRE PROTECTION SHEETS FOR EQUIPMENT LOCATIONS.
  - MOUNT AIR TEMPERATURE SENSOR INSIDE INSULATED VALVE ENCLOSURE (IVE), OF ASSOCIATED TUNNEL DELUGE ZONE.
  - EXISTING CCTV TRAFFIC CAMERA, SHOWN FOR REFERENCE PURPOSES, TO REMAIN.
  - EXISTING TRAFFIC CONTROL MESSAGE BOARD, SHOWN FOR REFERENCE PURPOSES, TO REMAIN. ROUTE FOLHD FIBER AND HANGER ABOVE THE MESSAGE BOARD. IT IS ACCEPTABLE TO RUN THE FOLHD CABLE WITHOUT THE HANGER WHERE THERE IS INSUFFICIENT CLEARANCE BETWEEN THE EXISTING MESSAGE BOARD AND THE EXISTING CEILING TILE, WHERE APPLICABLE. LIMIT THE FOLHD CABLE RUNS WITHOUT THE HANGER TO THE MINIMUM DISTANCE POSSIBLE TO CLEAR THE OBSTRUCTION.
  - LONGSPAN VLS-1N-L CAT5e EXTENDER LOCATED IN JUNCTION BOX AS SHOWN.

ADDRESSING	
07030231	RCP04 HI TEMP
07030232	RCP04 LO TEMP
07030206	FPC18 HI TEMP
07030207	FPC18 LO TEMP
07030208	FPC18 CCTV TROUBLE
07030209	FPC18 BPS TROUBLE

ADDRESSING		
07030127	ST-66	MANUAL INPUT
07030128	ST-66	DELUGE RELEASE
07030186	ST-66	WATER FLOW
07030187	ST-66	TAMPER
01020193	ST-66	PRIMARY ALARM
05030175	ST-66	SECONDARY ALARM

ADDRESSING		
07030133	ST-67	MANUAL INPUT
07030134	ST-67	DELUGE RELEASE
07030188	ST-67	WATER FLOW
07030189	ST-67	TAMPER
01020194	ST-67	PRIMARY ALARM
05030176	ST-67	SECONDARY ALARM

ADDRESSING		
07030139	ST-68	MANUAL INPUT
07030140	ST-68	DELUGE RELEASE
07030190	ST-68	WATER FLOW
07030191	ST-68	TAMPER
01020195	ST-68	PRIMARY ALARM
05030177	ST-68	SECONDARY ALARM

ADDRESSING		
07030145	ST-69	MANUAL INPUT
07030146	ST-69	DELUGE RELEASE
07030192	ST-69	WATER FLOW
07030193	ST-69	TAMPER
01020196	ST-69	PRIMARY ALARM
05030178	ST-69	SECONDARY ALARM
07020210	ST-69	ISO VALVE TAMPER

ADDRESSING		
07030151	ST-70	MANUAL INPUT
07030152	ST-70	DELUGE RELEASE
07030194	ST-70	WATER FLOW
07030195	ST-70	TAMPER
01020197	ST-70	PRIMARY ALARM
05030179	ST-70	SECONDARY ALARM

ADDRESSING		
07030157	ST-71	MANUAL INPUT
07030158	ST-71	DELUGE RELEASE
07030196	ST-71	WATER FLOW
07030197	ST-71	TAMPER
01020198	ST-71	PRIMARY ALARM
05030180	ST-71	SECONDARY ALARM

ADDRESSING		
07030163	ST-72	MANUAL INPUT
07030164	ST-72	DELUGE RELEASE
07030198	ST-72	WATER FLOW
07030199	ST-72	TAMPER
01020199	ST-72	PRIMARY ALARM
05030181	ST-72	SECONDARY ALARM

ADDRESSING		
07030169	ST-73	MANUAL INPUT
07030170	ST-73	DELUGE RELEASE
07030200	ST-73	WATER FLOW
07030201	ST-73	TAMPER
01020200	ST-73	PRIMARY ALARM
05030182	ST-73	SECONDARY ALARM

ADDRESSING		
07030175	ST-74	MANUAL INPUT
07030176	ST-74	DELUGE RELEASE
07030202	ST-74	WATER FLOW
07030203	ST-74	TAMPER
01020201	ST-74	PRIMARY ALARM
05030183	ST-74	SECONDARY ALARM

ADDRESSING		
07030181	ST-75	MANUAL INPUT
07030182	ST-75	DELUGE RELEASE
07030204	ST-75	WATER FLOW
07030205	ST-75	TAMPER
01020202	ST-75	PRIMARY ALARM
05030184	ST-75	SECONDARY ALARM

**BARNARD EJMT TEAM**

**BARNARD** **RONDINELLI**

**Sturgeon ELECTRIC**

**BCER** **Western States Fire Protection Co.**

**EISENHOWER/JOHNSON MEMORIAL TUNNEL**

FIXED FIRE SUPPRESSION SYSTEM DESIGN BUILD PROJECT

Project No. C0703-360 Subaccount 17810

RECORD DRAWINGS - 2015-11-16

Revisions

Num	Description	Date

Drawn by: B.T.L. Checked by: AEE-JT


FIRE ALARM: JOHNSON TUNNEL FP ZONES ST-66 TO ST-75

Drawing Number **FA2.S08**





IF THIS SHEET IS NOT 22"x34" IT IS NOT PLOTTED TO SCALE


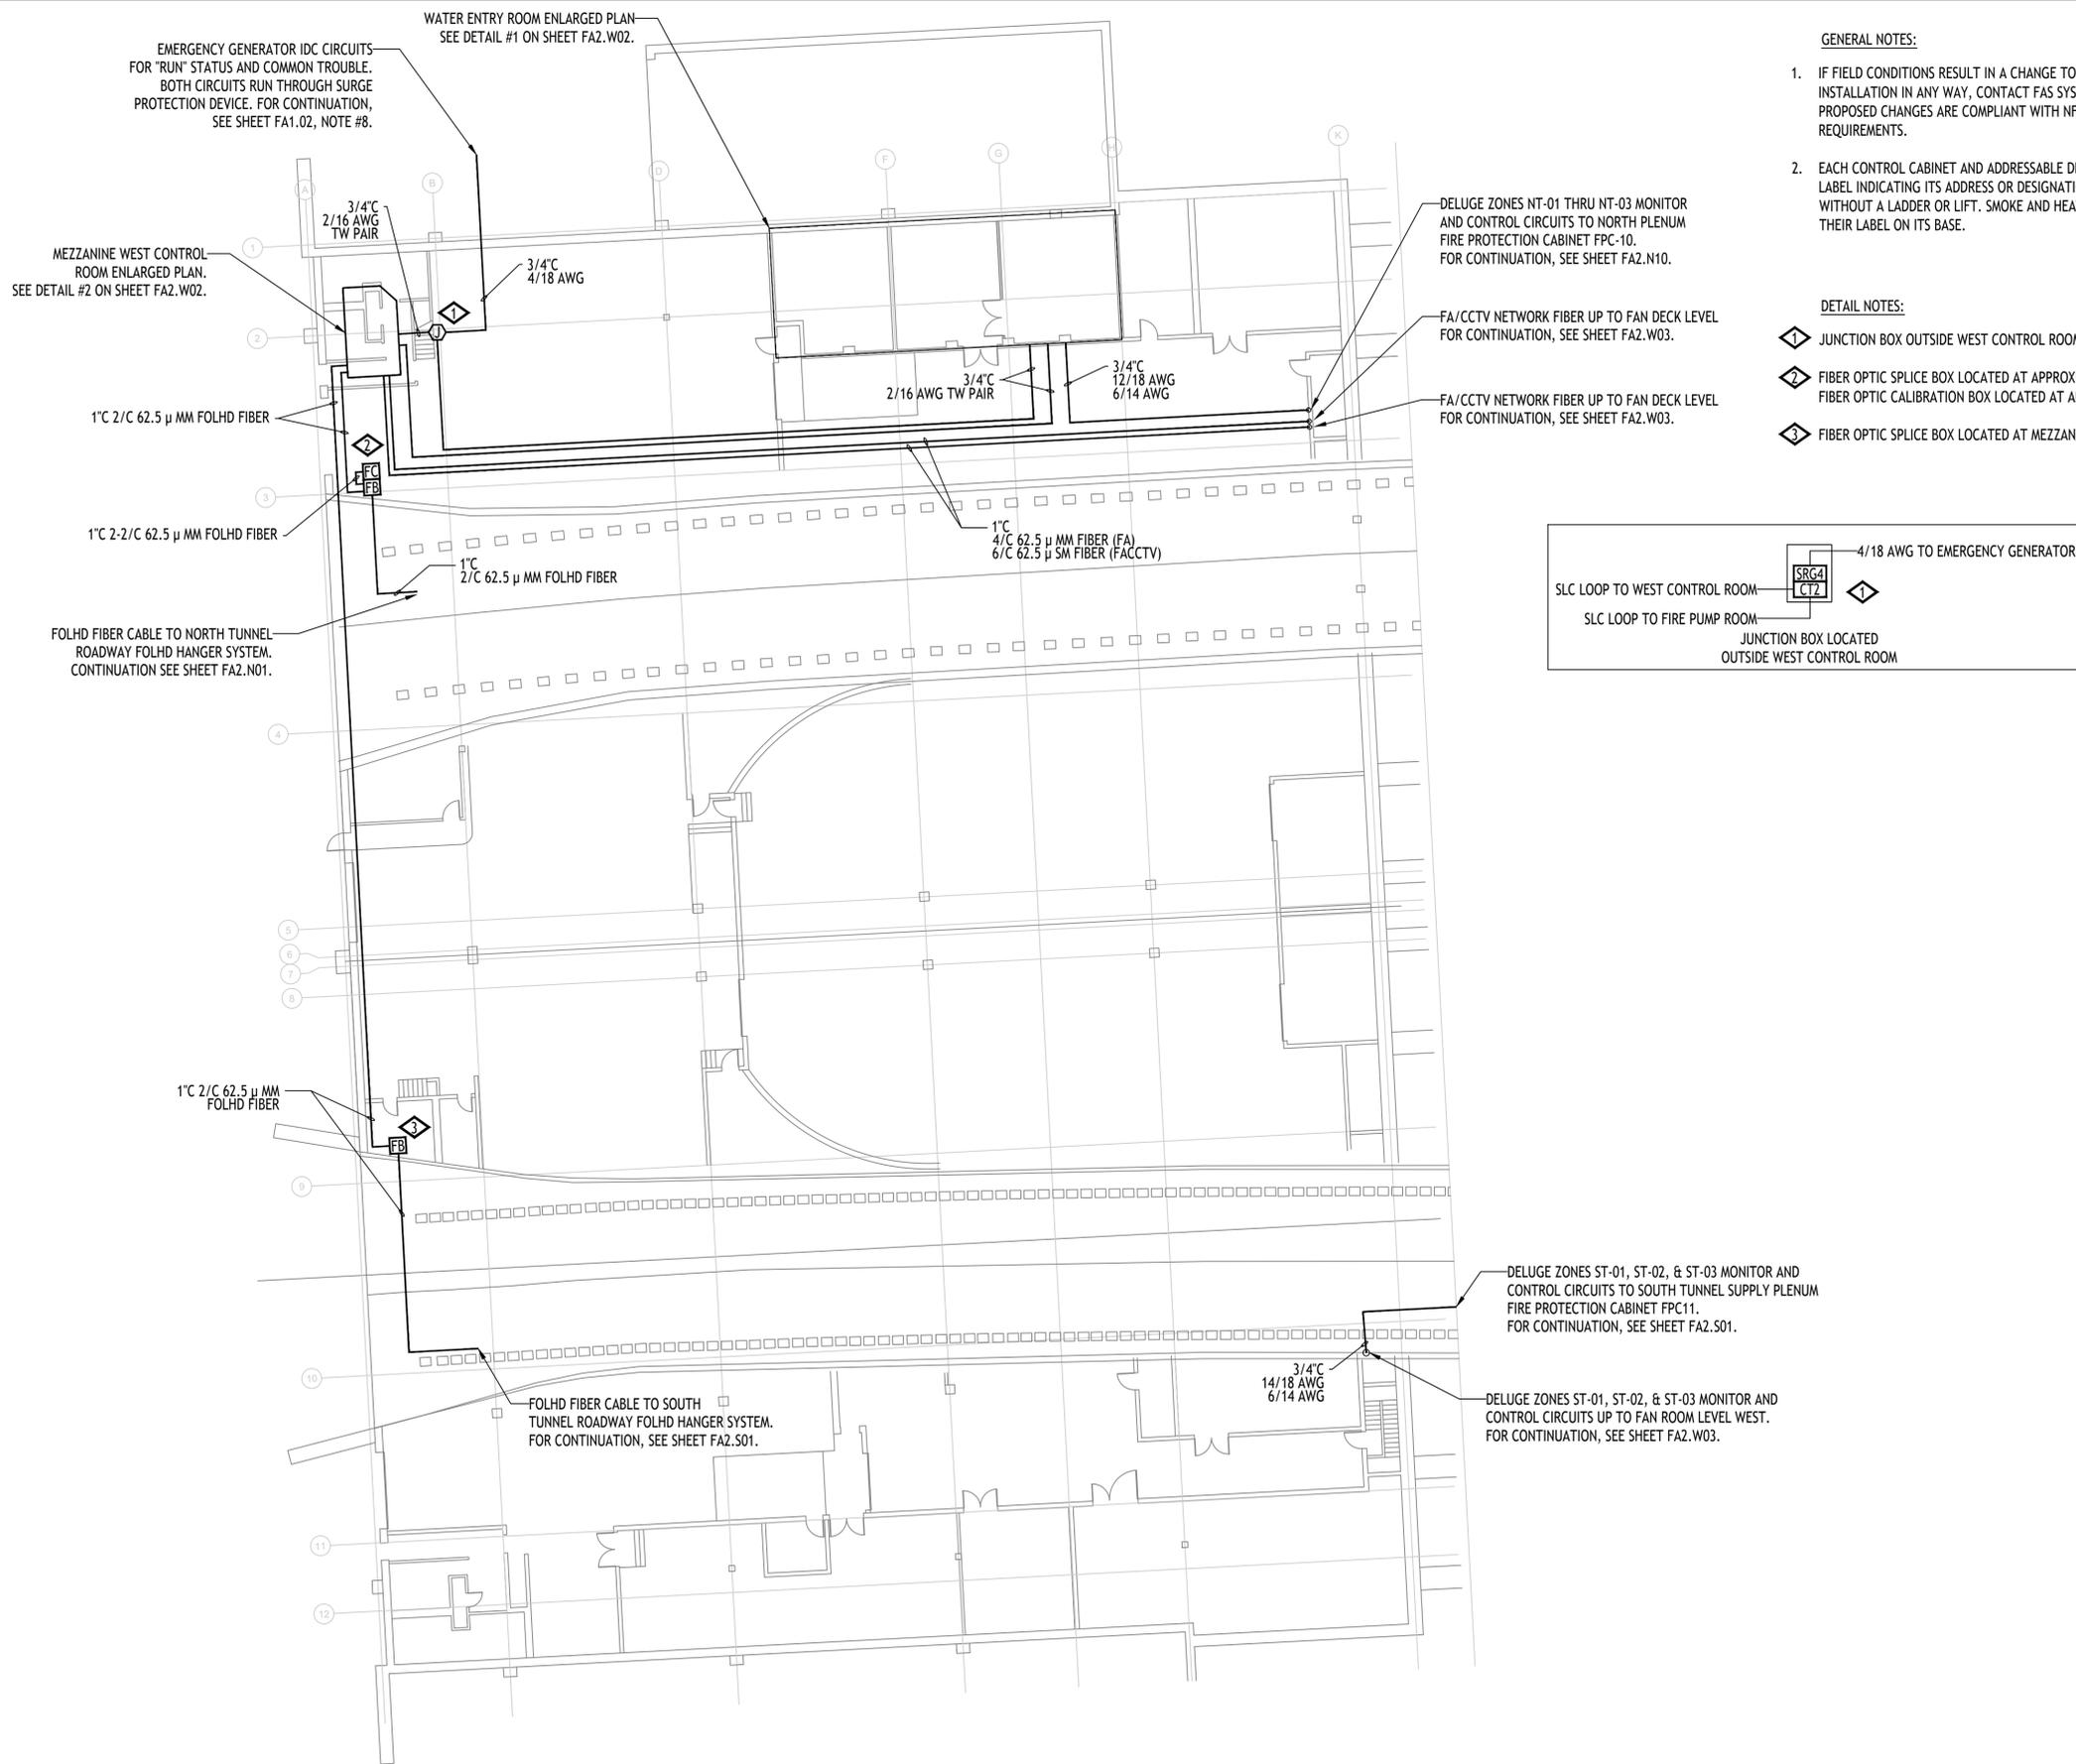


**GENERAL NOTES:**

1. IF FIELD CONDITIONS RESULT IN A CHANGE TO THE SHOP DRAWING INSTALLATION IN ANY WAY, CONTACT FAS SYSTEMS GROUP TO VERIFY PROPOSED CHANGES ARE COMPLIANT WITH NFPA 72 AND PROJECT REQUIREMENTS.
2. EACH CONTROL CABINET AND ADDRESSABLE DEVICE SHALL BEAR A TYPED LABEL INDICATING ITS ADDRESS OR DESIGNATION, WHICH CAN BE SEEN WITHOUT A LADDER OR LIFT. SMOKE AND HEAT DETECTORS SHALL HAVE THEIR LABEL ON ITS BASE.

**DETAIL NOTES:**

- 1. JUNCTION BOX OUTSIDE WEST CONTROL ROOM.
- 2. FIBER OPTIC SPLICE BOX LOCATED AT APPROXIMATELY 12' A.F.F. FIBER OPTIC CALIBRATION BOX LOCATED AT APPROXIMATELY 5' A.F.F.
- 3. FIBER OPTIC SPLICE BOX LOCATED AT MEZZANINE LEVEL STAIR LANDING.

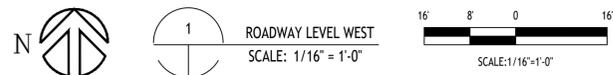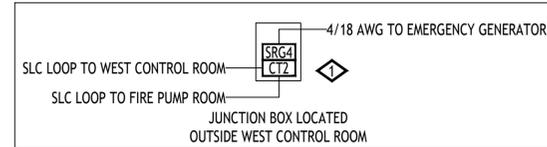

**BARNARD EJMT TEAM**

**BARNARD**

**STURGEON ELECTRIC**

**BCER**

**RONDINELLI**

**Western States Fire Protection Co.**

**ALF CONSULTING ENGINEERS**

**EISENHOWER/JOHNSON MEMORIAL TUNNEL**

FIXED FIRE SUPPRESSION SYSTEM DESIGN BUILD PROJECT

Project No. C0703-360 Subaccount 17810

**RECORD DRAWINGS - 2015-11-16**

Revisions	Date
Num	Description

DRAWN BY: B.T.L. CHECKED BY: AEE-JF

FIRE ALARM:  
ROADWAY LEVEL WEST

Drawing Number  
**FA2.W01**











IF THIS SHEET IS NOT 22"x34" IT IS NOT PLOTTED TO SCALE

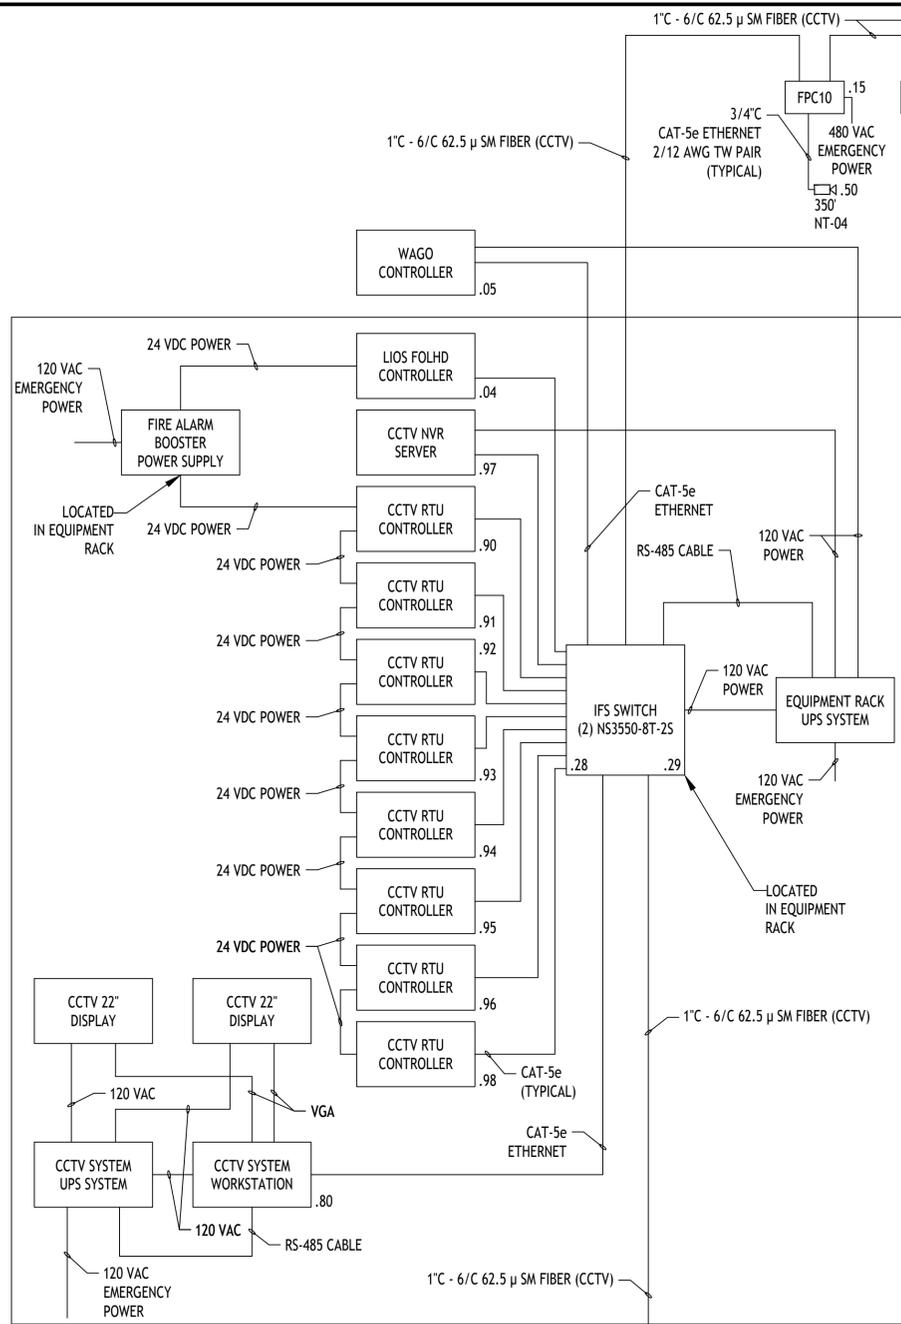


EISENHOWER (NORTH) TUNNEL SUPPLY PLENUM/ROADWAY

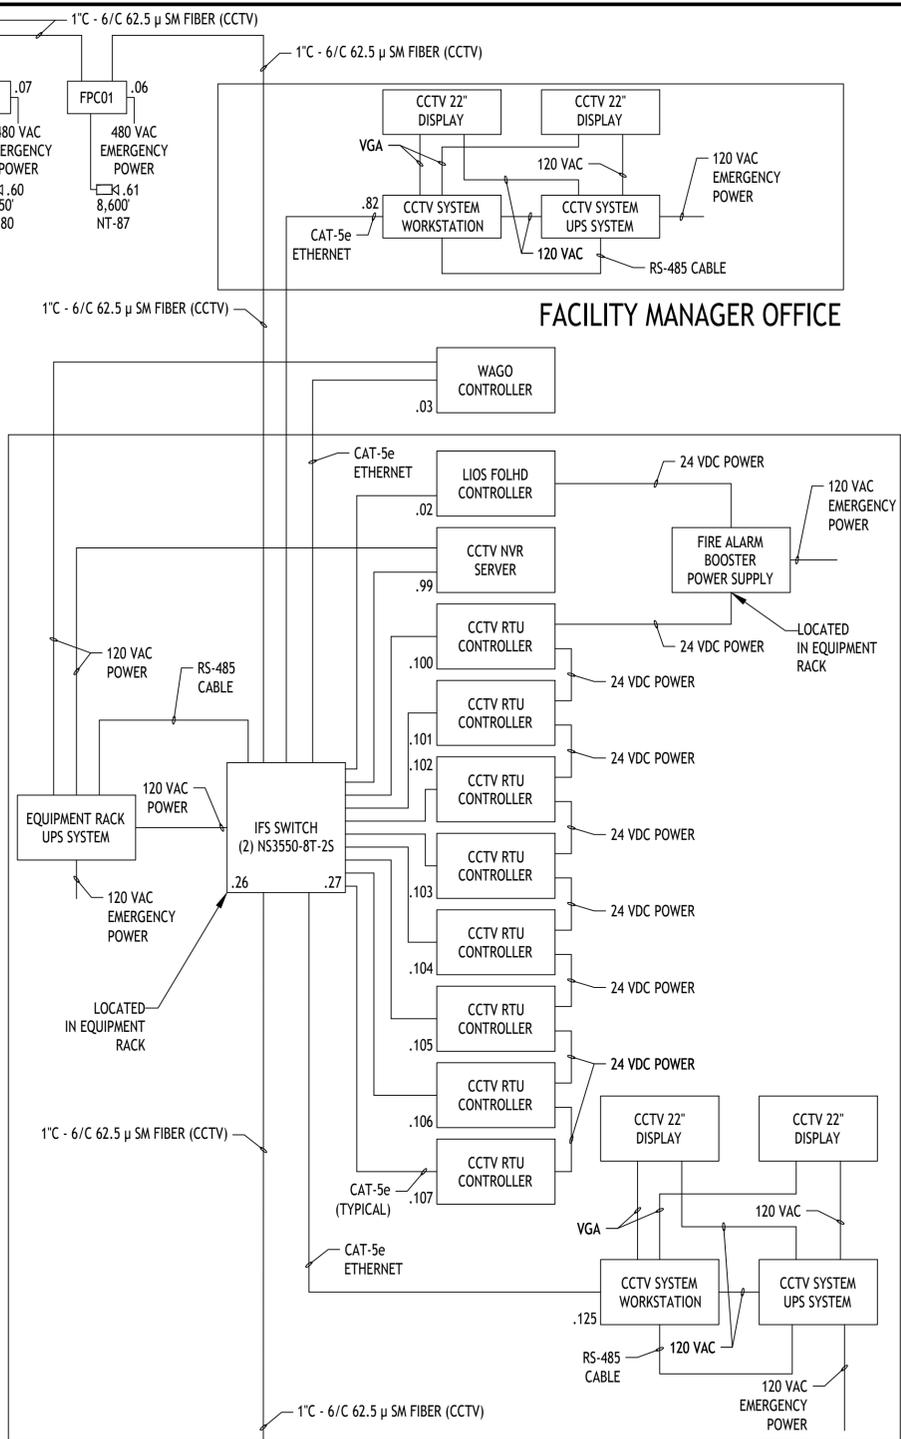

FACILITY MANAGER OFFICE

EAST CONTROL ROOM

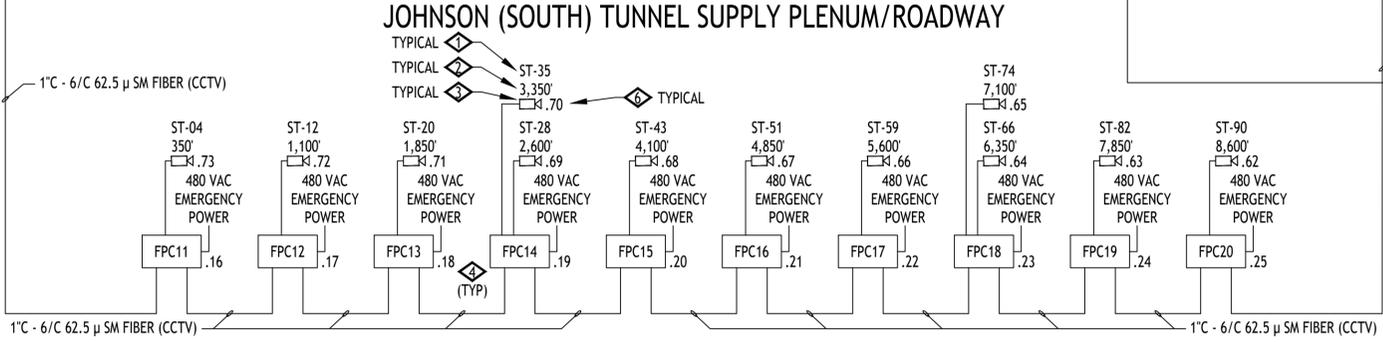

JOHNSON (SOUTH) TUNNEL SUPPLY PLENUM/ROADWAY

EISENHOWER - JOHNSON MEMORIAL TUNNEL  
FIBER OPTICS BUDGET CALCULATION

**FA CCTV FIBER NETWORK**

LONGEST FIBER RUN BETWEEN ANY 2 SWITCHES = 1,000 FEET  
 MULTI-MODE FIBER CABLE LOSS = 3.5dB/KM = 3.5dB/3,280.8 FEET  
 LC CONNECTOR dB LOSS (AVERAGE) = 0.2dB  
 LC CONNECTOR dB LOSS (MAXIMUM) = 0.75dB  
 ALLOWABLE dB LOSS (POWER BUDGET) BETWEEN CCTV SWITCHES = 7.5dB

MAXIMUM ALLOWABLE dB LOSS = 7.50 dB  
 FIBER CABLE dB LOSS @ 4,500 FEET = 1.07 dB  
 CONNECTOR DB LOSS X 2 CONNECTORS = 1.50 dB  
 SPARE dB LOSS AVAILABLE = 4.93 dB

2 CCTV SYSTEM FIBER OPTIC BUDGET CALCULATION  
SCALE: NOT TO SCALE

1 CCTV SYSTEM ONE-LINE RISER DIAGRAM  
SCALE: NOT TO SCALE

- DETAIL NOTES:**
- ◇ INDICATES TUNNEL DELUGE ZONE.
  - ◇ DIMENSION INDICATES APPROXIMATE DISTANCE OF CAMERA TO WEST PORTAL END.
  - ◇ CCTV CAMERA LOCATED ON TUNNEL ROADWAY WALL TILE ABOVE ROADWAY EXIT.
  - ◇ FIRE PROTECTION CABINET (FPC) LOCATED IN TUNNEL SUPPLY PLENUM.
  - ◇ FIRE ALARM AND FACCTV NETWORK FIBERS ARE INSTALLED IN SAME RACEWAY.
  - ◇ ADDRESSING SCHEME 223.223.223.XX

BARNARD EJMT TEAM

BARNARD

RONDINELLI

BCER

Western States Fire Protection Co.

ALF

Sturgeon Electric

Western States Fire Protection Co.

ALF

EISENHOWER/JOHNSON  
MEMORIAL TUNNEL  
FIXED FIRE SUPPRESSION SYSTEM  
DESIGN BUILD PROJECT

Subaccount 17810

Project No. C0703-360

RECORD DRAWINGS - 2015-11-16

Revisions	Date	Description

DRAWN BY: B.T.L. | CHECKED BY: AEE-JF


FIRE ALARM:  
ONE LINE DIAGRAM  
CCTV

Drawing Number

FA3.02



IF THIS SHEET IS NOT 22"x34" IT IS NOT PLOTTED TO SCALE

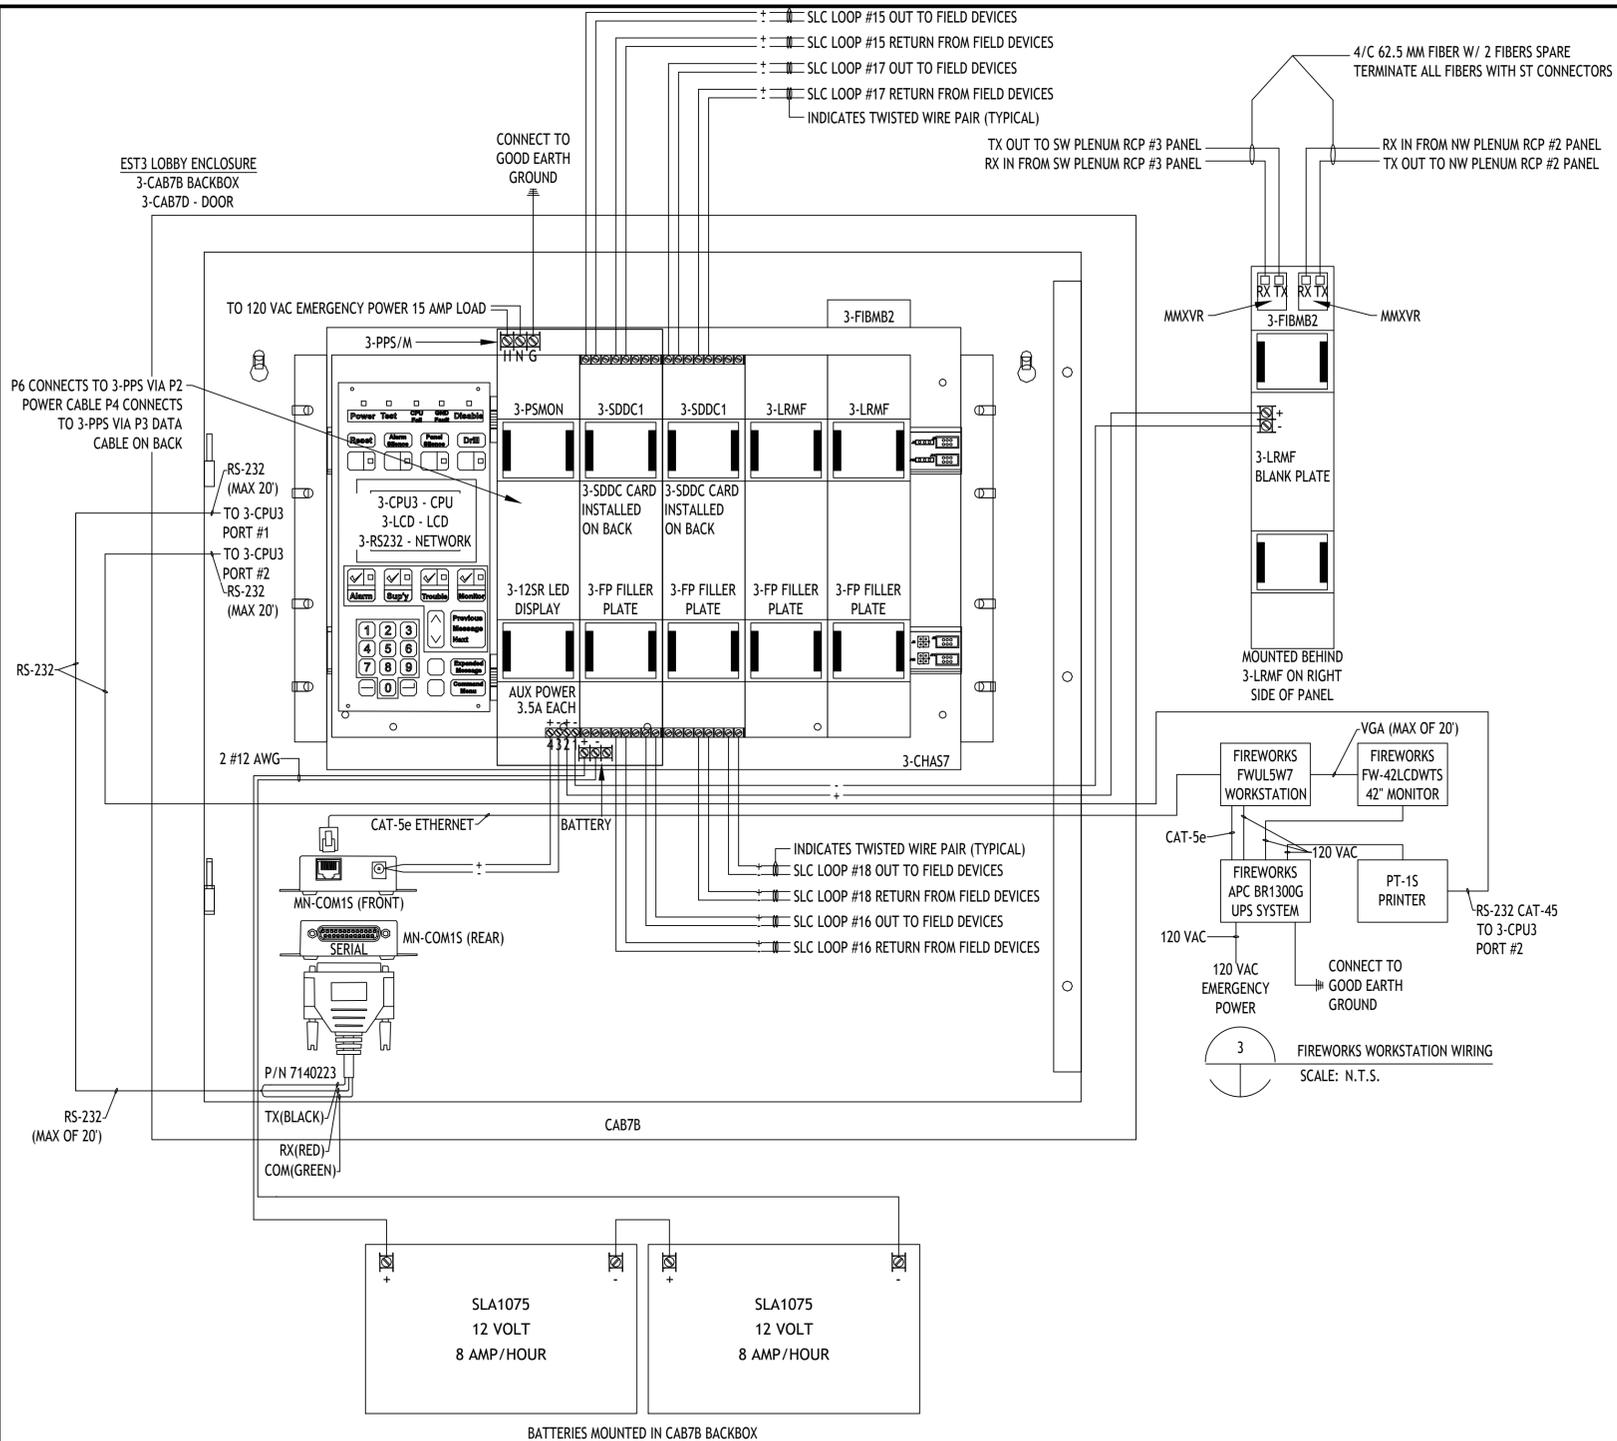

1 WEST CONTROL ROOM - FACP PANEL LAYOUT & WIRING  
SCALE: N.T.S.

3 FIREWORKS WORKSTATION WIRING  
SCALE: N.T.S.

2 WEST CONTROL ROOM - CCTV RACK BPS10A CALCULATION  
SCALE: N.T.S.

Supply Voltage & Battery Periods  
120 VAC Supply Voltage  
EJMT - WEST CONTROL ROOM - EST3

QTY.	Model	Description	Stby mA	Alm mA
4		Standby Hours		
5		Alarm Minutes		
1	3-CPU3	Central Processor Module	155	165
1	3-RS232	RS232 Communication Card	58	58
2	3-SDDC1	Signature Dual Driver Controller (LRM)	528	672
1	3-LCD	Liquid Crystal Display Module	40	42
2	3-PPS/M	Primary Power Supply (Included in 3-CPU3 Current)	0	0
1	3-12SR	Control Display Module, 12 Switches, 12 Led's (Red)	20	20
1	MN-COM1S	MN/EC Serial Communications/LAN Interface	60	60
1	3-FIBM2	Fiber Optic Communications Interface	105	105
2	MMXVR	Plug-In Standard Output Multi Mode Transceiver	40	40
TOTAL LOAD			1006	1162
Total Stand-By and Alarm Current			1006	1162
Standby Hours * Total Standby Current (Alarm Minutes/60) * Total Alarm Current			4024	96.833
Total Standby/Alarm Current Battery De-Rating Factor +20%			4120.833	4945.000
4.95	Calculated Battery Ampere Hours			
Quantity	Model	Description		
2	SLA1075	8.0 AH Battery		

4 WEST CONTROL ROOM - EST3 FACP PANEL CALCULATION  
SCALE: N.T.S.

Supply Voltage & Battery Periods  
120 VAC Supply Voltage  
EJMT - West Control Room Equipment Rack - BPS10A

QTY.	Model	Description	Stby mA	Alm mA	Total Stby mA	Total Alm mA
4		Standby Hours				
5		Alarm Minutes				
8	IoLogik E2210	CCTV Controller	203	350	1624	2800
1	LIOS LHD3-02	Controller	1875	1875	1875	1875
0	TOTAL load for the 200mA Auxiliary Power Source					
1		Aux STANDBY load delivered during a power fail	12		12	0
1		Aux ALARM current delivered during a power fail		12	0	12
Total NAC & AUX Load					3511	4687
1	BPS10A	Remote Booster Power Supply, 10A, 120Vac, Red			70	270
TOTAL LOAD					3581	4957
Total Stand-By and Alarm Current					3581	4957
Standby Hours * Total Standby Current (Alarm Minutes/60) * Total Alarm Current					14324	413.083
Total Standby + Alarm Current Battery De-Rating Factor +20%					14737.083	17684.500
17.68	Calculated Battery Ampere Hours					
Quantity	Model	Description				
2	SLA1116	SLA1116 18.0 AH Battery				

UPS System Calculations  
EJMT - WEST CONTROL ROOM - FA WORK STATION

Description	Qty	Load (W)	Total Load (W)
Fireworks Workstation	1	350	350
42" Monitor	1	180	180
PT-15 Printer	1	48	48
Total Load			578
20% Spare Capacity			115.6
UPS Capacity			693.6

UPS System Calculations  
EJMT - WEST CONTROL ROOM - CCTV WORK STATION

Description	Qty	Load (W)	Total Load (W)
CCTV Workstation	1	635	635
22" Monitor	2	25	50
Total Load			685
20% Spare Capacity			137
UPS Capacity			822

UPS System Calculations  
EJMT - WEST CONTROL ROOM - CCTV RACK EQUIPMENT

Description	Qty	Load (W)	Total Load (W)
SG300-20 Switch	1	16.05	16.05
System 750 WAGO	3	102	306
DVR Server	1	495	495
Total Load			817.05
20% Spare Capacity			163.41
UPS Capacity			980.46

5 WEST CONTROL ROOM - UPS CALCULATIONS  
SCALE: N.T.S.

**BARNARD EJMT TEAM**

**BARNARD**

**Sturgeon ELECTRIC**

**RONDINELLI**

Western States Fire Protection Co.

**EISENHOWER/JOHNSON**

**MEMORIAL TUNNEL**

FIXED FIRE SUPPRESSION SYSTEM

DESIGN BUILD PROJECT

Project No. C0703-360

Subaccount 17810

**RECORD DRAWINGS - 2015-11-16**

Revisions

Num	Description	Date

DATE

BY

CHECKED BY: AEE-JF

DRAWN BY: B.T.L.

FIRE ALARM:


W. CONT. RM EST3 PANEL LAYOUT & CALCULATIONS

Drawing Number

# FA4.02



IF THIS SHEET IS NOT 22"x34" IT IS NOT PLOTTED TO SCALE

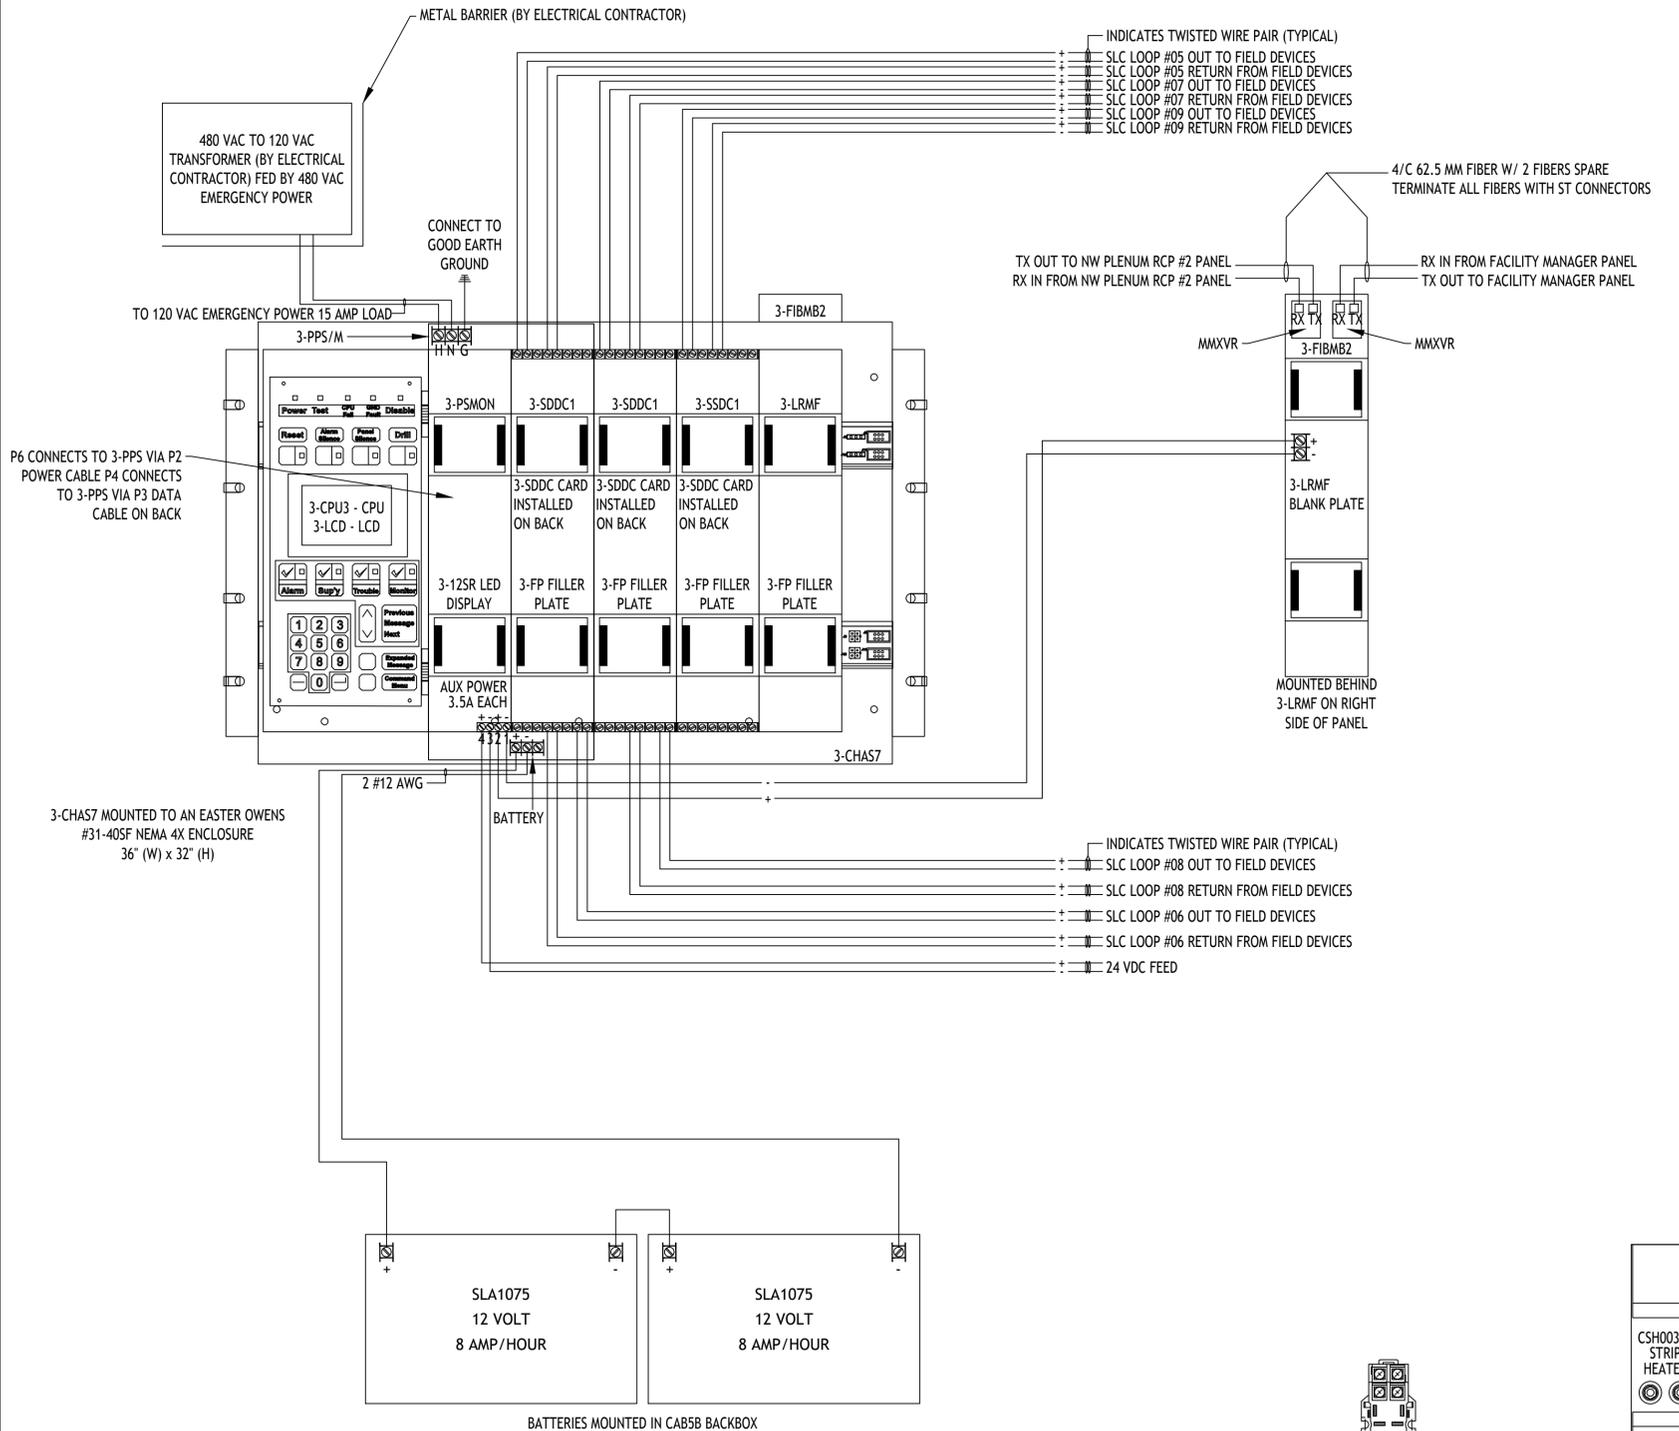

Supply Voltage & Battery Periods  
120 VAC Supply Voltage  
EJMT - RCP #1 - NORTHEAST PLENUM - EST3



QTY.	Model	Description	Stby mA	Alm mA
1	3-CPU3	Central Processor Module	155	165
1	3-RS232	RS232 Communication Card	58	58
1	3-SDDC1	Signature Driver Controller (LRM)	144	204
2	3-SDDC1	Signature Dual Driver Controller (LRM)	528	672
1	3-LCD	Liquid Crystal Display Module	40	42
1	3-PPS/M	Primary Power Supply (Included in 3-CPU3 Current)	0	0
1	3-12SR	Control Display Module, 12 Switches, 12 Led's (Red)	20	20
1	MN-COM1S	MN/EC Serial Communications/LAN Interface	60	60
1	3-FIBMB2	Fiber Optic Communications Interface	105	105
2	MMXVR	Plug-In Standard Output Multi Mode Transceiver	40	40
TOTAL LOAD			1150	1366
Total Stand-By and Alarm Current			1150	1366
Standby Hours * Total Standby Current			4600	
(Alarm Minutes/60) * Total Alarm Current				113.833
Total Standby/Alarm Current			4713.833	
Battery De-Rating Factor +20%			5656.600	

Quantity	Model	Description
5.66		Calculated Battery Ampere Hours
2	SLA1075	8.0 AH Battery

2 NORTHEAST PLENUM - RCP #1 PANEL CALCULATION  
SCALE: N.T.S.

1 NORTHEAST PLENUM RCP #1 - FACP PANEL LAYOUT & WIRING  
SCALE: N.T.S.

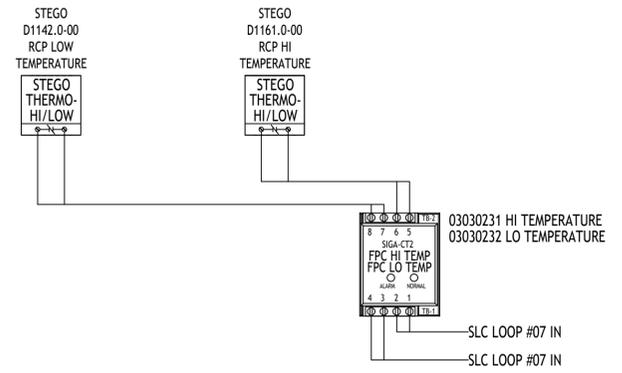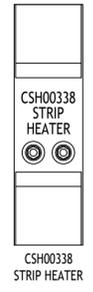

**EISENHOWER/JOHNSON**  
**MEMORIAL TUNNEL**  
 FIXED FIRE SUPPRESSION SYSTEM  
 DESIGN BUILD PROJECT  
 Project No. C0703-360 Subaccount 17810  
**RECORD DRAWINGS - 2015-11-16**


**BARNARD EJM TEAM**  
**BARNARD**  
**RONDINELLI**  
**Sturgeon Electric**  
**BCER**  
**Western States Fire Protection Co.**  
**ALF CONSULTING ENGINEERS**

Revisions	Date
Num	Description

FIRE ALARM:  
RCP #1 EST3 PANEL  
LAYOUT & CALCULATIONS

Drawing Number  
**FA4.04**

IF THIS SHEET IS NOT 22"x34" IT IS NOT PLOTTED TO SCALE


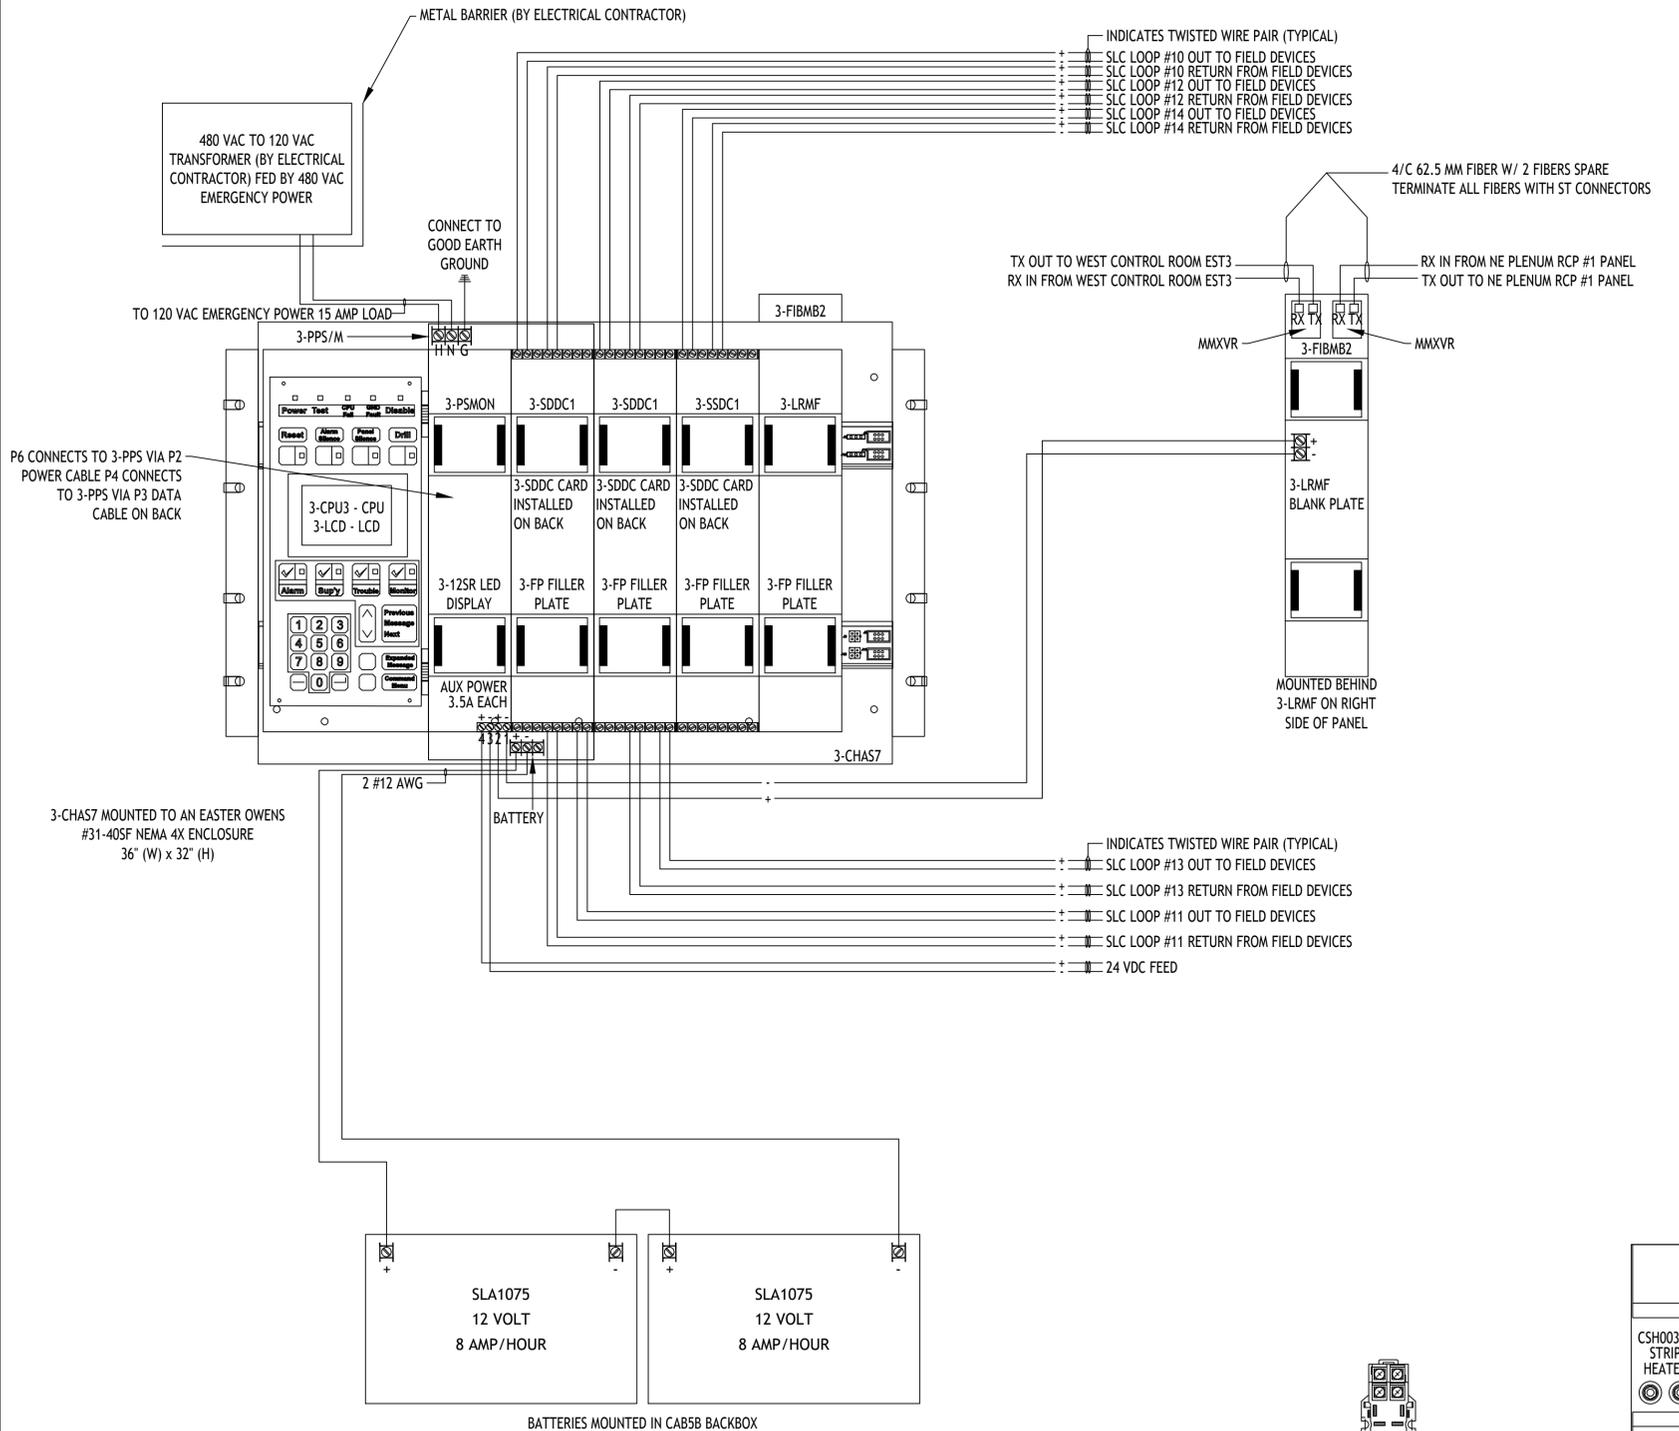


1 NORTHWEST PLENUM RCP #2 - FACP PANEL LAYOUT & WIRING  
SCALE: N.T.S.

Supply Voltage & Battery Periods  
120 VAC Supply Voltage  
EJMT - RCP #2 - NORTHWEST PLENUM - EST3

QTY.	Model	Description	Stby mA	Alm mA
4		Standby Hours		
5		Alarm Minutes		
1	3-CPU3	Central Processor Module	155	165
1	3-RS232	RS232 Communication Card	58	58
1	3-SDDC1	Signature Driver Controller (LRM)	144	204
2	3-SDDC1	Signature Dual Driver Controller (LRM)	528	672
1	3-LCD	Liquid Crystal Display Module	40	42
1	3-PPS/M	Primary Power Supply (Included in 3-CPU3 Current)	0	0
1	3-12SR	Control Display Module, 12 Switches, 12 Led's (Red)	20	20
1	MN-COM1S	MN/EC Serial Communications/LAN Interface	60	60
1	3-FIBM2	Fiber Optic Communications Interface	105	105
2	MMXVR	Plug-In Standard Output Multi Mode Transceiver	40	40
TOTAL LOAD			1150	1366
Total Stand-By and Alarm Current			1150	1366
Standby Hours * Total Standby Current			4600	
(Alarm Minutes/60) * Total Alarm Current				113.833
Total Standby/Alarm Current			4713.833	
Battery De-Rating Factor +20%			5656.600	
5.66	Calculated Battery Ampere Hours			
Quantity	Model	Description		
2	SLA1075	8.0 AH Battery		

2 NORTHWEST PLENUM - RCP #2 PANEL CALCULATION  
SCALE: N.T.S.

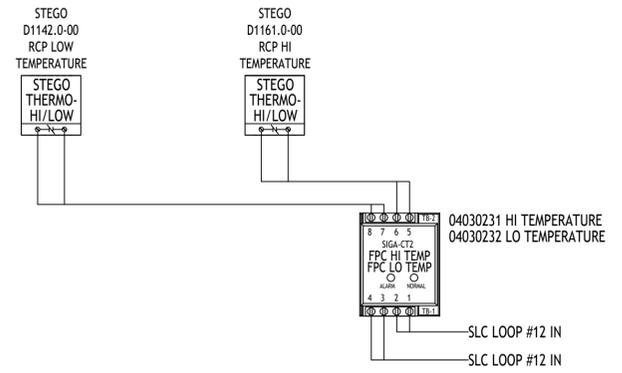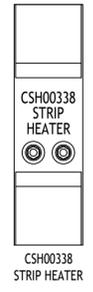

**BARNARD EJMT TEAM**

**BARNARD** **RONDINELLI**

**BCER** **Sturgeon ELECTRIC**

Western States Fire Protection Co. CONSULTING ENGINEERS

**EISENHOWER/JOHNSON MEMORIAL TUNNEL**  
FIXED FIRE SUPPRESSION SYSTEM  
DESIGN BUILD PROJECT

Project No. C0703-360 Subaccount 17810  
RECORD DRAWINGS - 2015-11-16


Revisions	Date
Num	Description

DATE: \_\_\_\_\_  
DRAWN BY: B.T.L. | CHECKED BY: AEE-JT

FIRE ALARM:  
RCP #2 EST3 PANEL  
LAYOUT & CALCULATIONS

Drawing Number  
**FA4.05**

IF THIS SHEET IS NOT 22"x34" IT IS NOT PLOTTED TO SCALE


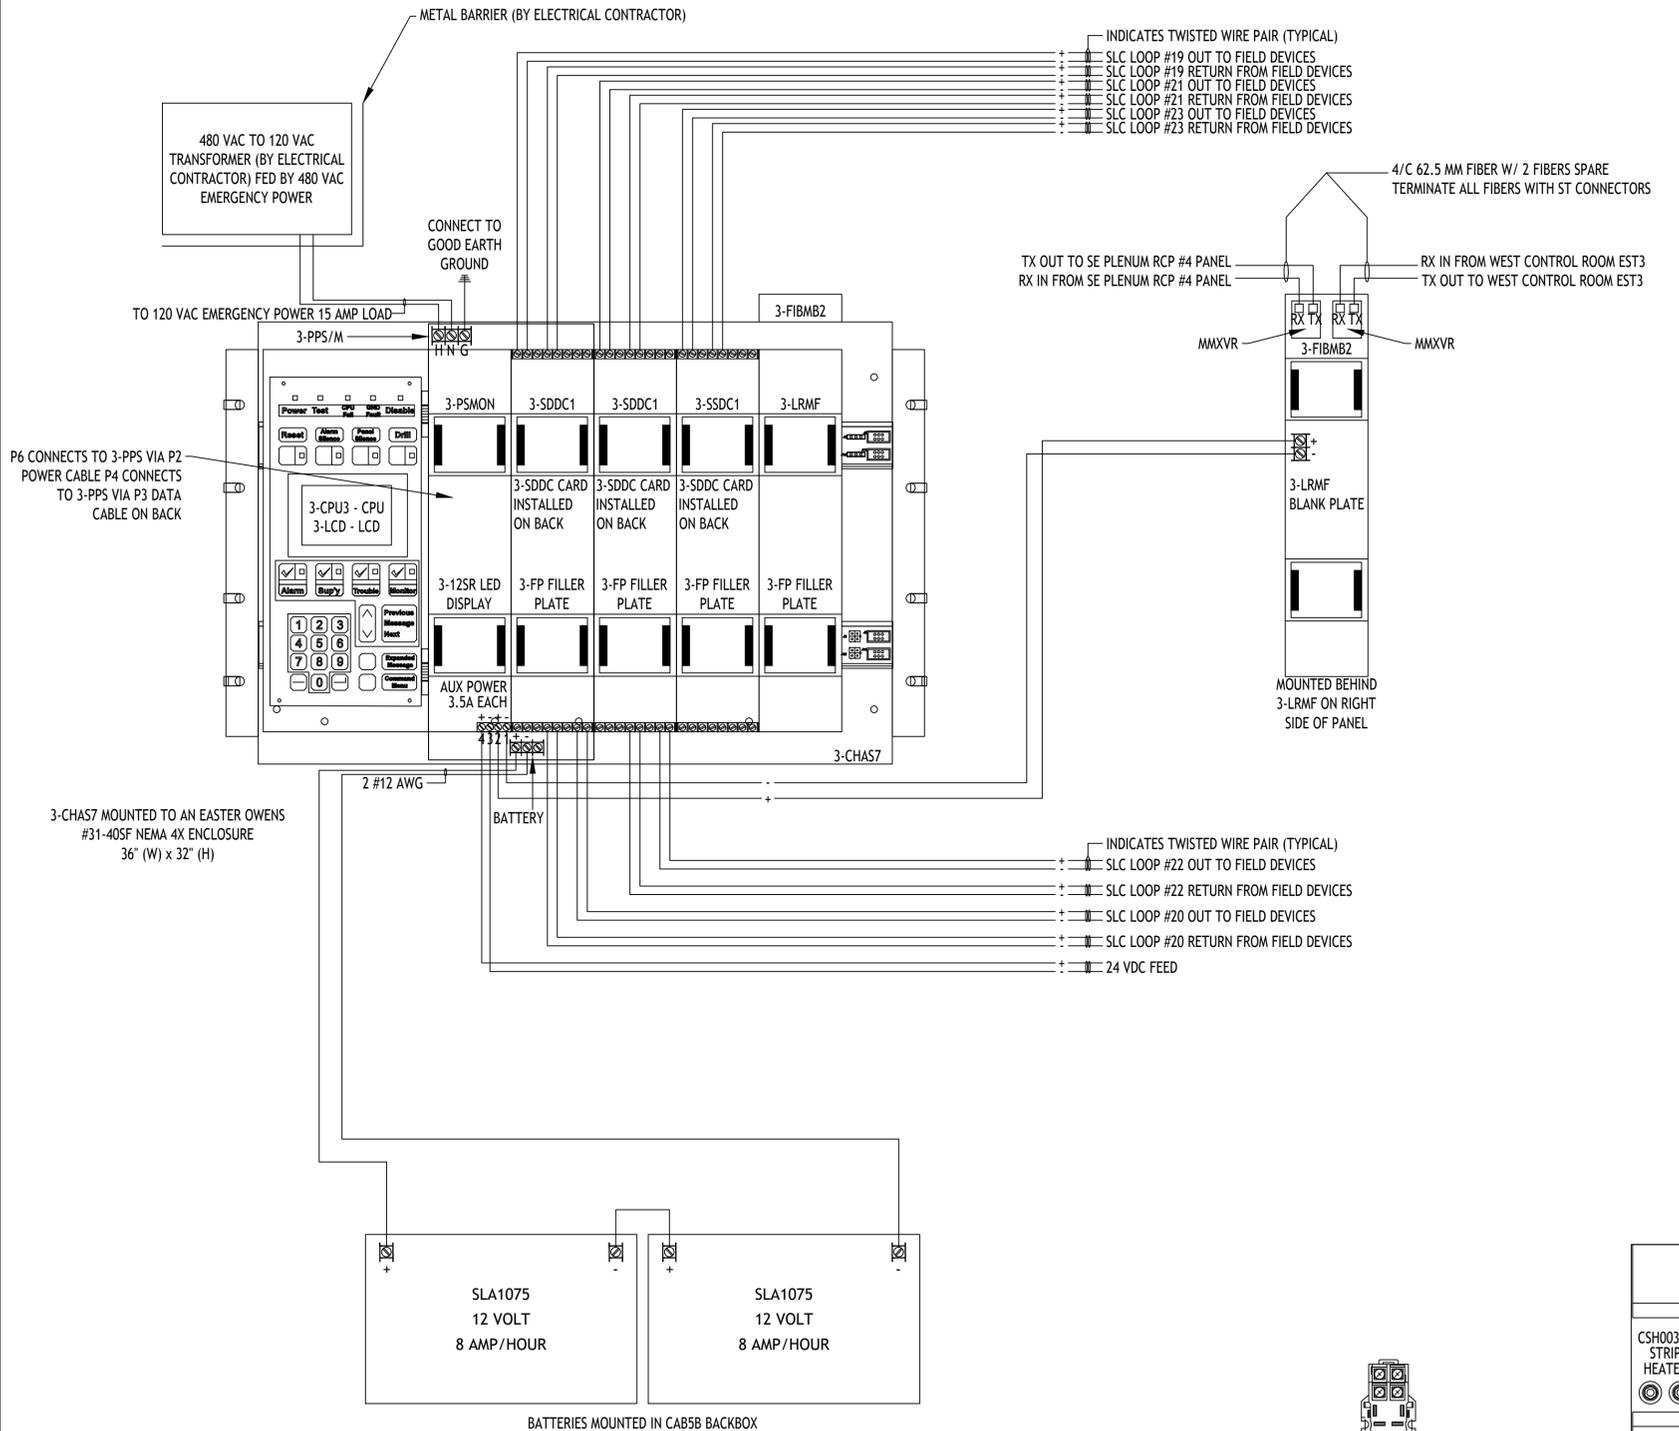


1 SOUTHWEST PLENUM RCP #3 - FACP PANEL LAYOUT & WIRING  
SCALE: N.T.S.

Supply Voltage & Battery Periods  
120 VAC Supply Voltage  
EJMT - RCP #3 - SOUTHWEST PLENUM - EST3

QTY.	Model	Description	Stby mA	Alm mA
4		Standby Hours		
5		Alarm Minutes		
1	3-CPU3	Central Processor Module	155	165
1	3-RS232	RS232 Communication Card	58	58
1	3-SDDC1	Signature Driver Controller (LRM)	144	204
2	3-SDDC1	Signature Dual Driver Controller (LRM)	528	672
1	3-LCD	Liquid Crystal Display Module	40	42
1	3-PPS/M	Primary Power Supply (Included in 3-CPU3 Current)	0	0
1	3-12SR	Control Display Module, 12 Switches, 12 Led's (Red)	20	20
1	MN-COM1S	MN/EC Serial Communications/LAN Interface	60	60
1	3-FIBM2	Fiber Optic Communications Interface	105	105
2	MMXVR	Plug-In Standard Output Multi Mode Transceiver	40	40
TOTAL LOAD			1150	1366
Total Stand-By and Alarm Current			1150	1366
Standby Hours * Total Standby Current			4600	
(Alarm Minutes/60) * Total Alarm Current				113.833
Total Standby/Alarm Current			4713.833	
Battery De-Rating Factor +20%			5656.600	
5.66	Calculated Battery Ampere Hours			
Quantity	Model	Description		
2	SLA1075	8.0 AH Battery		

2 SOUTHWEST PLENUM - RCP #3 PANEL CALCULATION  
SCALE: N.T.S.

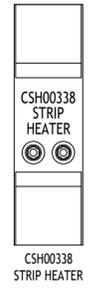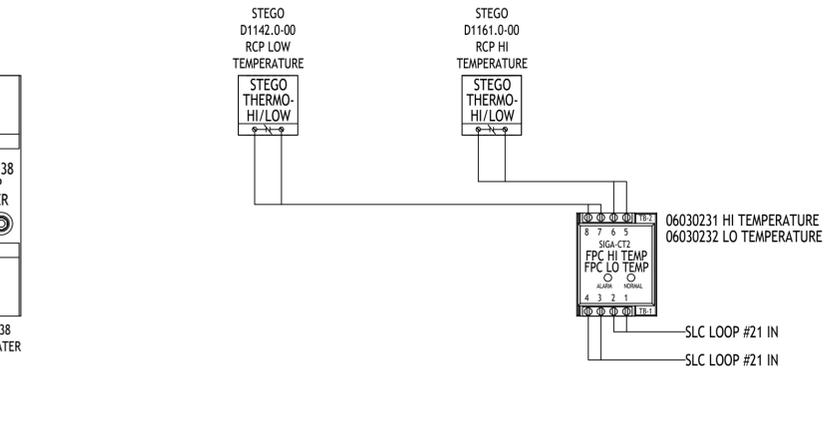

**BARNARD EJMT TEAM**

**BARNARD** **RONDINELLI**

**BCER** **Sturgeon ELECTRIC**

Western States Fire Protection Co.

**EISENHOWER/JOHNSON MEMORIAL TUNNEL**  
FIXED FIRE SUPPRESSION SYSTEM  
DESIGN BUILD PROJECT

Project No. C0703-360 Subaccount 17810  
RECORD DRAWINGS - 2015-11-16

Revisions	Date
Num	Description

FIRE ALARM:  
RCP #3 EST3 PANEL  
LAYOUT & CALCULATIONS

Drawing Number  
**FA4.06**

DRAWN BY: B.T.L. | CHECKED BY: AEE-JF







Supply Voltage & Battery Periods					
120 VAC Supply Voltage					
Fire Protection Cabinet #1					
4	Standby Hours	Stby mA	Alm mA	Total Stby mA	Total Alm mA
5	Alarm Minutes				
5	SIGA-REL	25	170	125	850
1	NS3550-8T-2S Managed Switch	417	417	417	417
2	S35-ZMLC SFP Transceiver	7.5	7.5	15	15
1	PTZ Camera	44	44	44	44
2	ASCO HT8210G027 Solenoids	442	442	884	884
0	TOTAL load for the 200mA Auxiliary Power Source			0	0
1	Aux STANDBY load delivered during a power fail	12		12	0
1	Aux ALARM current delivered during a power fail		12	0	12
	Total NAC & AUX Load			1497	2222
1	BPS10A Remote Booster Power Supply, 10A, 120Vac, Red			70	270
TOTAL LOAD				1567	2492
Total Stand-By and Alarm Current				1567	2492
Standby Hours * Total Standby Current (Alarm Minutes/60) * Total Alarm Current				6268	207.667
Total Standby + Alarm Current Battery De-Rating Factor +20%				6475.667	7770.800
7.77	Calculated Battery Ampere Hours				
Quantity	Model	Description			
2	SLA1097	SLA1097 10.0 AH Battery			

1 FPC01 BATTERY CALCULATIONS  
SCALE: N.T.S.

Supply Voltage & Battery Periods					
120 VAC Supply Voltage					
Fire Protection Cabinet #2					
4	Standby Hours	Stby mA	Alm mA	Total Stby mA	Total Alm mA
5	Alarm Minutes				
10	SIGA-REL	25	170	250	1700
1	NS3550-8T-2S Managed Switch	417	417	417	417
2	S35-ZMLC SFP Transceiver	7.5	7.5	15	15
1	PTZ Camera	44	44	44	44
2	ASCO HT8210G027 Solenoids	442	442	884	884
0	TOTAL load for the 200mA Auxiliary Power Source			0	0
1	Aux STANDBY load delivered during a power fail	12		12	0
1	Aux ALARM current delivered during a power fail		12	0	12
	Total NAC & AUX Load			1622	3072
1	BPS10A Remote Booster Power Supply, 10A, 120Vac, Red			70	270
TOTAL LOAD				1692	3342
Total Stand-By and Alarm Current				1692	3342
Standby Hours * Total Standby Current (Alarm Minutes/60) * Total Alarm Current				6768	278.500
Total Standby + Alarm Current Battery De-Rating Factor +20%				7046.500	8455.800
8.46	Calculated Battery Ampere Hours				
Quantity	Model	Description			
2	SLA1097	SLA1097 10.0 AH Battery			

2 FPC02 BATTERY CALCULATIONS  
SCALE: N.T.S.

Supply Voltage & Battery Periods					
120 VAC Supply Voltage					
Fire Protection Cabinet #3					
4	Standby Hours	Stby mA	Alm mA	Total Stby mA	Total Alm mA
5	Alarm Minutes				
10	SIGA-REL	25	170	250	1700
1	NS3550-8T-2S Managed Switch	417	417	417	417
2	S35-ZMLC SFP Transceiver	7.5	7.5	15	15
2	PTZ Camera	44	44	88	88
2	ASCO HT8210G027 Solenoids	442	442	884	884
0	TOTAL load for the 200mA Auxiliary Power Source			0	0
1	Aux STANDBY load delivered during a power fail	12		12	0
1	Aux ALARM current delivered during a power fail		12	0	12
	Total NAC & AUX Load			1666	3116
1	BPS10A Remote Booster Power Supply, 10A, 120Vac, Red			70	270
TOTAL LOAD				1736	3386
Total Stand-By and Alarm Current				1736	3386
Standby Hours * Total Standby Current (Alarm Minutes/60) * Total Alarm Current				6944	282.167
Total Standby + Alarm Current Battery De-Rating Factor +20%				7226.167	8671.400
8.67	Calculated Battery Ampere Hours				
Quantity	Model	Description			
2	SLA1097	SLA1097 10.0 AH Battery			

3 FPC03 BATTERY CALCULATIONS  
SCALE: N.T.S.

Supply Voltage & Battery Periods					
120 VAC Supply Voltage					
Fire Protection Cabinet #4					
4	Standby Hours	Stby mA	Alm mA	Total Stby mA	Total Alm mA
5	Alarm Minutes				
10	SIGA-REL	25	170	250	1700
1	NS3550-8T-2S Managed Switch	417	417	417	417
2	S35-ZMLC SFP Transceiver	7.5	7.5	15	15
1	PTZ Camera	44	44	44	44
2	ASCO HT8210G027 Solenoids	442	442	884	884
0	TOTAL load for the 200mA Auxiliary Power Source			0	0
1	Aux STANDBY load delivered during a power fail	12		12	0
1	Aux ALARM current delivered during a power fail		12	0	12
	Total NAC & AUX Load			1622	3072
1	BPS10A Remote Booster Power Supply, 10A, 120Vac, Red			70	270
TOTAL LOAD				1692	3342
Total Stand-By and Alarm Current				1692	3342
Standby Hours * Total Standby Current (Alarm Minutes/60) * Total Alarm Current				6768	278.500
Total Standby + Alarm Current Battery De-Rating Factor +20%				7046.500	8455.800
8.46	Calculated Battery Ampere Hours				
Quantity	Model	Description			
2	SLA1097	SLA1097 10.0 AH Battery			

4 FPC04 BATTERY CALCULATIONS  
SCALE: N.T.S.

IF THIS SHEET IS NOT 22"x34" IT IS NOT PLOTTED TO SCALE

**BARNARD EJMT TEAM**

**BCER** CONSULTING ENGINEERS  
**BARNARD** Western States Fire Protection Co.  
**RONDINELLI** A fire safety life safety  
**STURGEON ELECTRIC**

**EISENHOWER/JOHNSON**

**MEMORIAL TUNNEL**  
 FIXED FIRE SUPPRESSION SYSTEM  
 DESIGN BUILD PROJECT  
 Project No. C0703-360 Subaccount 17810  
**RECORD DRAWINGS - 2015-11-16**

Num	Revisions	Date
	Description	

FIRE ALARM:  
 FPC01 THRU FPC04  
 BATTERY CALCULATIONS  
 Drawing Number  
**FA4.09**

DRAWN BY: B.T.L. CHECKED BY: AEE-JF











Cable Information	OD (in)	Area	Quantity	Total Area
18 awg TFN	0.07830	0.00482	16	0.07704
16 awg TFN	0.08880	0.00619		0.00000
14 awg THHN	0.10200	0.00817	6	0.04903
12 awg THHN	0.11900	0.01112	2	0.02224
16/2 Tw awg TFN	0.15500	0.01887		0.00000
4/c MM Fiber (FA)	0.19000	0.02835		0.00000
4/c MM Fiber (CC)	0.19000	0.02835		0.00000
Cable Eight		0.00000		0.00000
Cable Nine		0.00000		0.00000
Cable Ten		0.00000		0.00000
<b>Total</b>			<b>24</b>	<b>0.14831</b>

Intermediate Metal Conduit (IMC)				
Trade Size	ID (in)	Area	Permissible Area	Fill (%)
1/2	0.660	0.3421	0.1368	n/a
3/4	0.864	0.5863	0.2345	25.30
1	1.105	0.9590	0.3836	15.47
1 1/4	1.448	1.6467	0.6587	9.01
1 1/2	1.683	2.2246	0.8899	6.67
2	2.150	3.6305	1.4522	4.09
2 1/2	2.557	5.1351	2.0541	2.89
3	3.176	7.9223	3.1689	1.87
3 1/2	3.671	10.5842	4.2337	1.40
4	4.166	13.6310	5.4524	1.09



CONDUIT FILL CALCULATIONS - (4) DELUGE ZONES  
SCALE: N.T.S.

Cable Information	OD (in)	Area	Quantity	Total Area
18 awg TFN	0.07830	0.00482	20	0.09630
16 awg TFN	0.08880	0.00619		0.00000
14 awg THHN	0.10200	0.00817	8	0.06537
12 awg THHN	0.11900	0.01112	2	0.02224
16/2 Tw awg TFN	0.15500	0.01887		0.00000
4/c MM Fiber (FA)	0.19000	0.02835		0.00000
4/c MM Fiber (CC)	0.19000	0.02835		0.00000
Cable Eight		0.00000		0.00000
Cable Nine		0.00000		0.00000
Cable Ten		0.00000		0.00000
<b>Total</b>			<b>30</b>	<b>0.18392</b>

Intermediate Metal Conduit (IMC)				
Trade Size	ID (in)	Area	Permissible Area	Fill (%)
1/2	0.660	0.3421	0.1368	n/a
3/4	0.864	0.5863	0.2345	31.37
1	1.105	0.9590	0.3836	19.18
1 1/4	1.448	1.6467	0.6587	11.17
1 1/2	1.683	2.2246	0.8899	8.27
2	2.150	3.6305	1.4522	5.07
2 1/2	2.557	5.1351	2.0541	3.58
3	3.176	7.9223	3.1689	2.32
3 1/2	3.671	10.5842	4.2337	1.74
4	4.166	13.6310	5.4524	1.35



CONDUIT FILL CALCULATIONS - (5) DELUGE ZONES  
SCALE: N.T.S.

Cable Information	OD (in)	Area	Quantity	Total Area
18 awg TFN	0.0783	0.00482	24	0.11556
16 awg TFN	0.0888	0.00619		0
14 awg THHN	0.102	0.00817	10	0.08171
12 awg THHN	0.119	0.01112		0
16/2 Tw awg TFN	0.155	0.01887		0
4/c MM Fiber (FA)	0.19	0.02835		0
4/c MM Fiber (CC)	0.19	0.02835		0
Cable Eight		0		0
Cable Nine		0		0
Cable Ten		0		0
<b>Total</b>			<b>34</b>	<b>0.19728</b>

Intermediate Metal Conduit (IMC)				
Trade Size	ID (in)	Area	Permissible Area	Fill (%)
1/2	0.660	0.3421	0.1368	n/a
3/4	0.864	0.5863	0.2345	33.65
1	1.105	0.9590	0.3836	20.57
1 1/4	1.448	1.6467	0.6587	11.98
1 1/2	1.683	2.2246	0.8899	8.87
2	2.150	3.6305	1.4522	5.43
2 1/2	2.557	5.1351	2.0541	3.84
3	3.176	7.9223	3.1689	2.49
3 1/2	3.671	10.5842	4.2337	1.86
4	4.166	13.6310	5.4524	1.45



CONDUIT FILL CALCULATIONS - (5) DELUGE ZONES, ISOVALVE, AND AIR TEMP  
SCALE: N.T.S.

Cable Information	OD (in)	Area	Quantity	Total Area
6 awg THHN	0.162	0.02061	3	0.06184
8 awg THHN	0.15	0.01767	1	0.01767
Cable Three		0		0
Cable Four		0		0
Cable Five		0		0
Cable Six		0		0
Cable Seven		0		0
Cable Eight		0		0
Cable Nine		0		0
Cable Ten		0		0
<b>Total</b>			<b>4</b>	<b>0.07951</b>

Intermediate Metal Conduit (IMC)				
Trade Size	ID (in)	Area	Permissible Area	Fill (%)
1/2	0.660	0.3421	0.1368	23.24
3/4	0.864	0.5863	0.2345	13.56
1	1.105	0.9590	0.3836	8.29
1 1/4	1.448	1.6467	0.6587	4.83
1 1/2	1.683	2.2246	0.8899	3.57
2	2.150	3.6305	1.4522	2.19
2 1/2	2.557	5.1351	2.0541	1.55
3	3.176	7.9223	3.1689	1.00
3 1/2	3.671	10.5842	4.2337	0.75
4	4.166	13.6310	5.4524	0.58



CONDUIT FILL CALCULATIONS - 480 VAC POWER  
SCALE: N.T.S.

IF THIS SHEET IS NOT 22"x34" IT IS NOT PLOTTED TO SCALE

**BARNARD EJMT TEAM**



**EISENHOWER/JOHNSON  
MEMORIAL TUNNEL**

FIXED FIRE SUPPRESSION SYSTEM  
DESIGN BUILD PROJECT

Project No. C0703-360 Subaccount 17810  
RECORD DRAWINGS - 2015-11-16

Num	Description	Date

FIRE ALARM:  
CONDUIT FILL  
CALCULATIONS  
Drawing Number  
**FA4.15**


DRAWN BY: B.T.L. | CHECKED BY: AEE-JF





IF THIS SHEET IS NOT 22"x34" IT IS NOT PLOTTED TO SCALE

TYPICAL SIGA-REL SWITCH SETTINGS  
 SW1 = OFF SW5 = OFF  
 SW2 = OFF SW6 = OFF  
 SW3 = OFF SW7 = OFF  
 SW4 = OFF SW8 = OFF

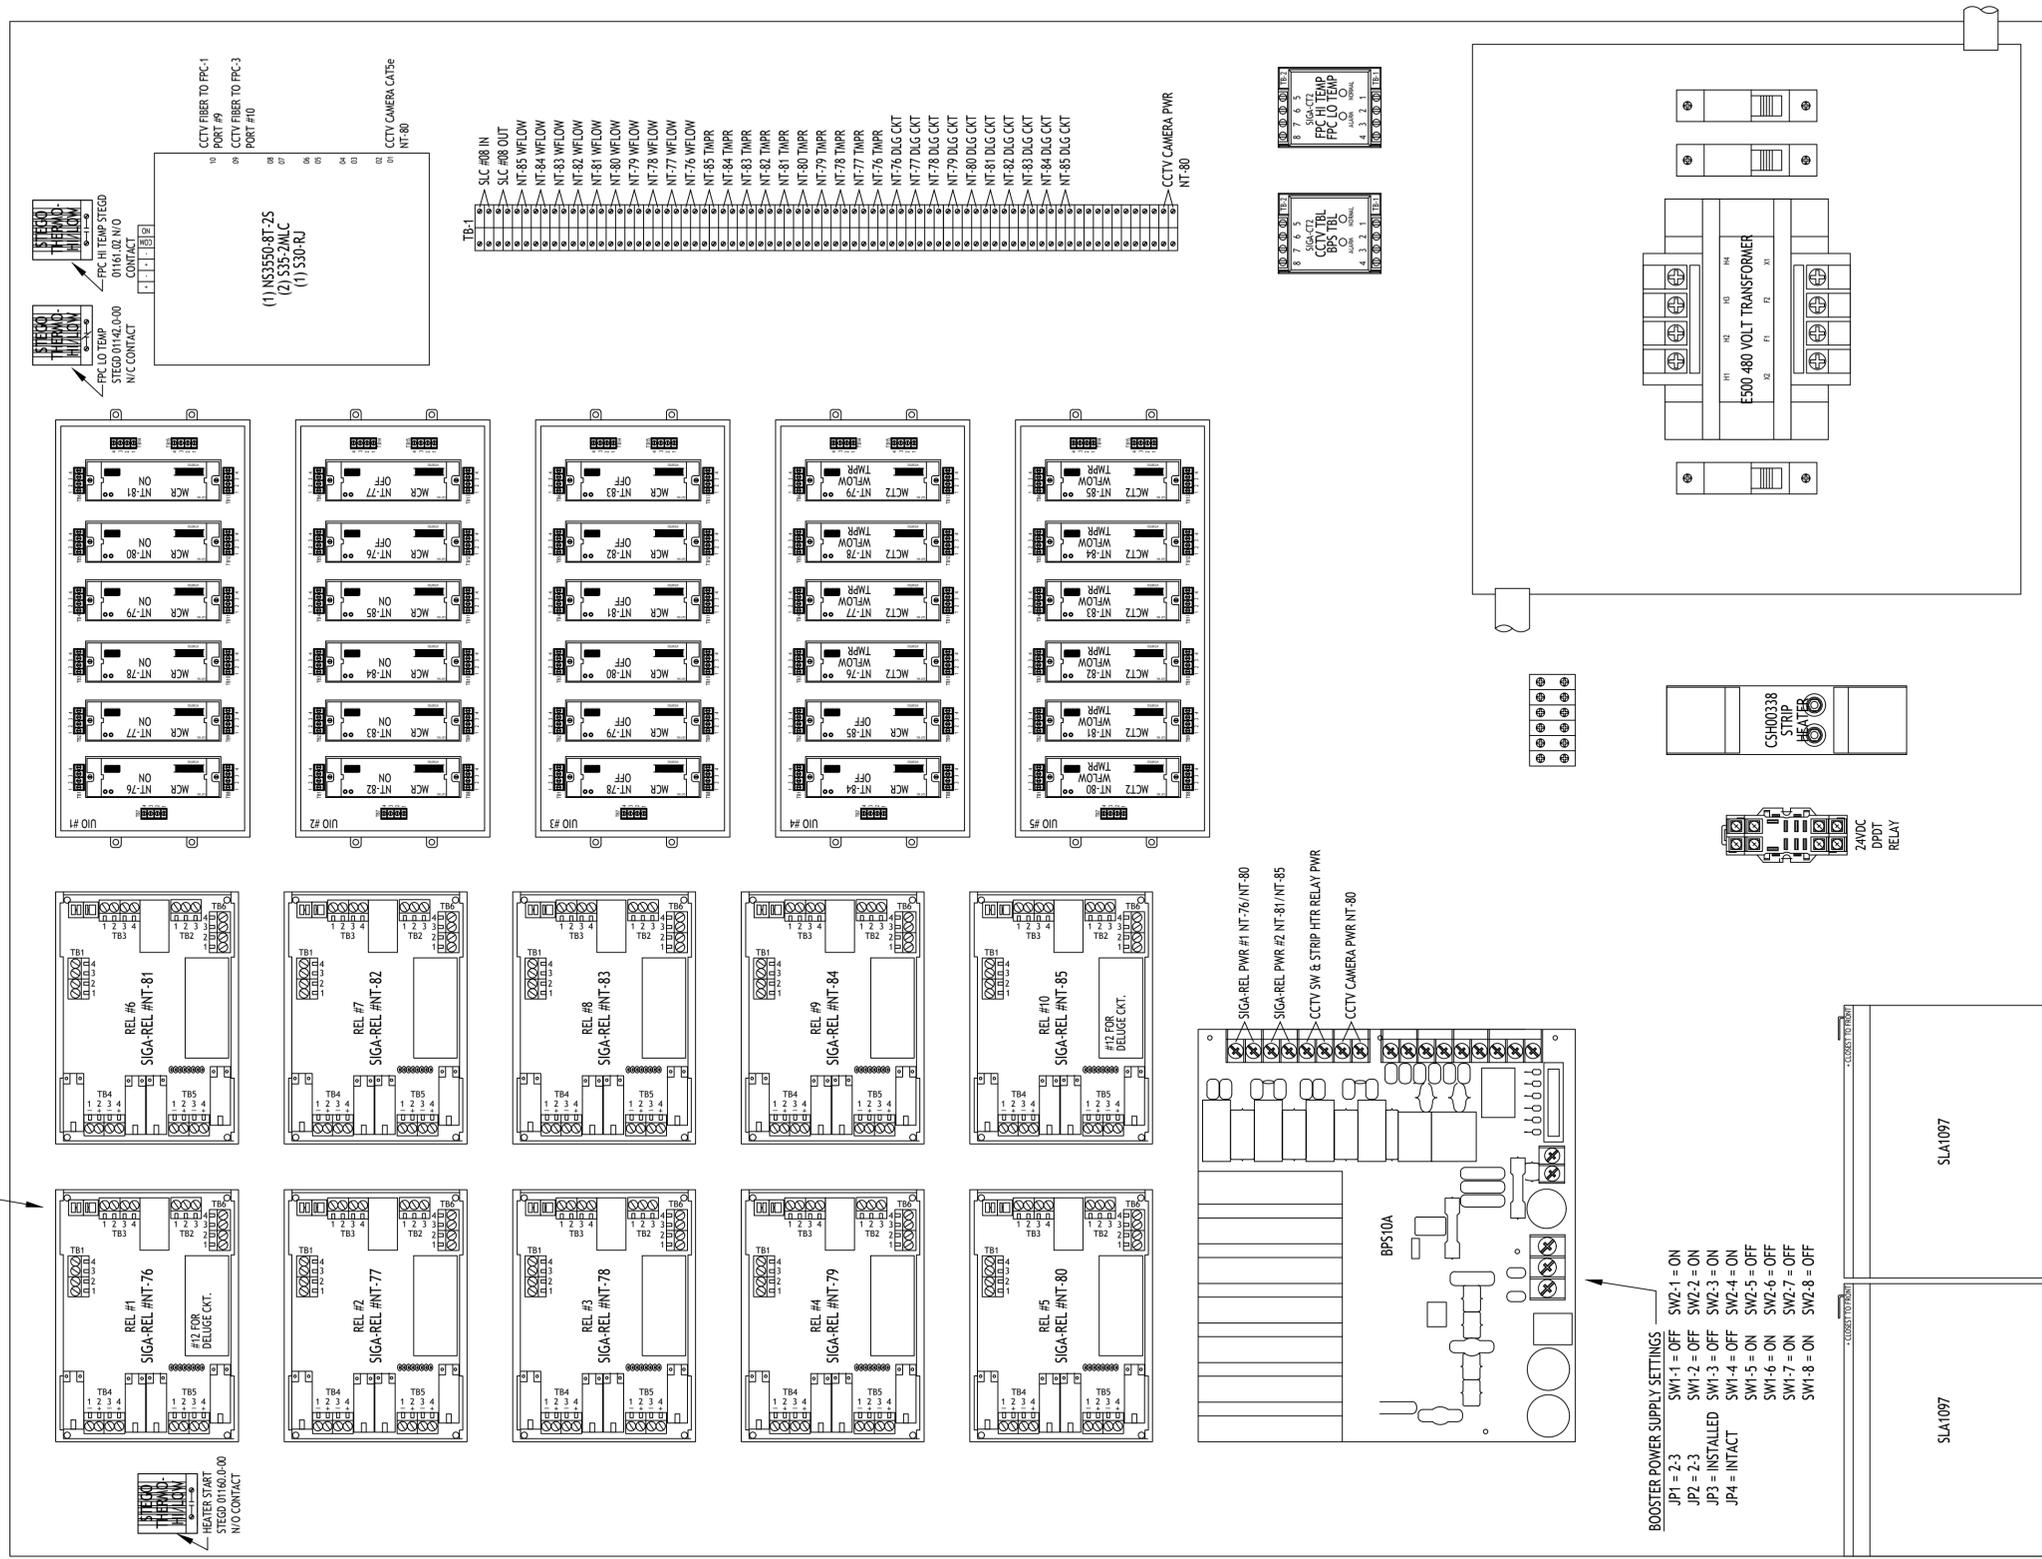

ADDRESSES = 0303XXXX

1 FPC #02 PANEL LAYOUT  
 SCALE: 1/2" SCALE

PANEL LAYOUT FOR FPC #02  
 EASTER OWENS NEMA 4X ENCLOSURE #41-50SF  
 SHOWN AT HALF SCALE (ACTUAL SIZE: 36" W x 48" H)

EISENHOWER/JOHNSON  
 MEMORIAL TUNNEL  
 FIXED FIRE SUPPRESSION SYSTEM  
 DESIGN BUILD PROJECT  
 Project No. C0703-360 Subaccount 17810  
 RECORD DRAWINGS - 2015-11-16

**BARNARD EJMT TEAM**

BCER **BARNARD** **STURGEON ELECTRIC** **RONDINELLI** **WESTERN STATES FIRE PROTECTION CO.**


Western States Fire Protection Co. CONSULTING ENGINEERS

Revisions	Num	Description	Date

FIRE ALARM:  
 FIRE PROTECTION PANEL  
 FPC #02 WIRING DIAGRAM  
 Drawing Number  
**FA5.02**

IF THIS SHEET IS NOT 22"x34" IT IS NOT PLOTTED TO SCALE

TYPICAL SIGA-REL SWITCH SETTINGS  
 SW1 = OFF SW5 = OFF  
 SW2 = OFF SW6 = OFF  
 SW3 = OFF SW7 = OFF  
 SW4 = OFF SW8 = OFF

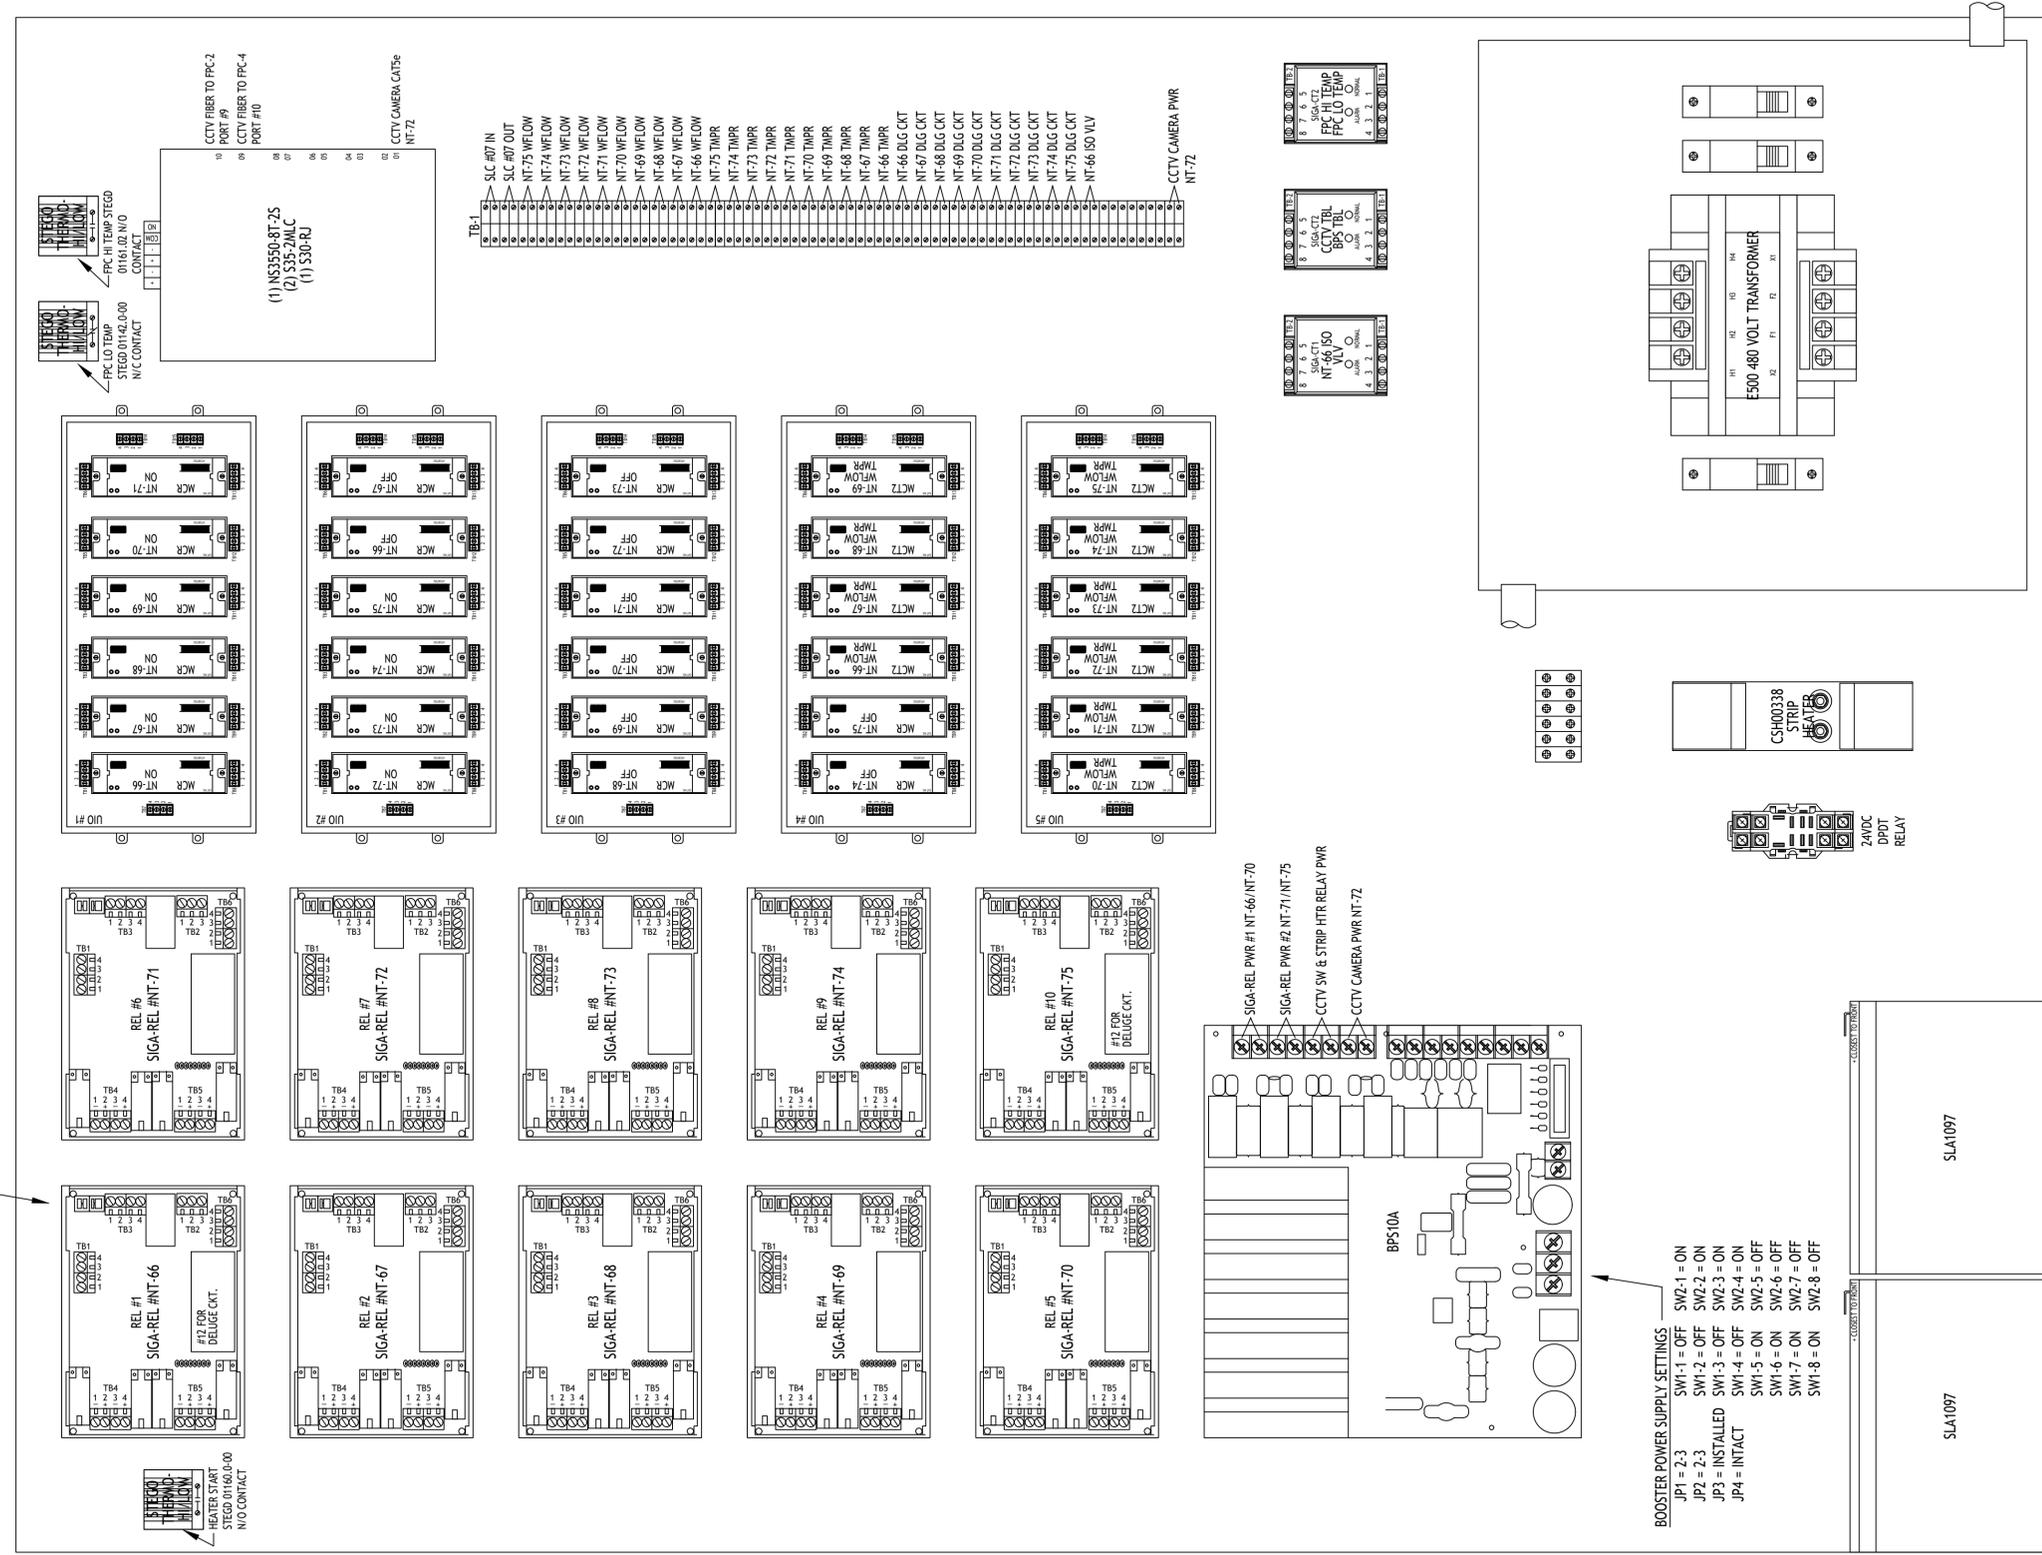

ADDRESSES = 0303XXXX

1 FPC #03 PANEL LAYOUT  
 SCALE: 1/2" SCALE

PANEL LAYOUT FOR FPC #03  
 EASTER OWENS NEMA 4X ENCLOSURE #41-50SF  
 SHOWN AT HALF SCALE (ACTUAL SIZE: 36" W x 48" H)

EISENHOWER/JOHNSON  
 MEMORIAL TUNNEL  
 FIXED FIRE SUPPRESSION SYSTEM  
 DESIGN BUILD PROJECT

Project No. C0703-360 Subaccount 17810  
 RECORD DRAWINGS - 2015-11-16

Revisions	Num	Description	Date

FIRE ALARM:  
 FIRE PROTECTION PANEL  
 FPC #03 WIRING DIAGRAM

Drawing Number  
**FA5.03**

**BARNARD EJMT TEAM**


BCER **BARNARD** **STURGEON ELECTRIC**

RONDINELLI **Western States Fire Protection Co.**

Western States Fire Protection Co. CONSULTING ENGINEERS

IF THIS SHEET IS NOT 22"x34" IT IS NOT PLOTTED TO SCALE

TYPICAL SIGA-REL SWITCH SETTINGS  
 SW1 = OFF SW5 = OFF  
 SW2 = OFF SW6 = OFF  
 SW3 = OFF SW7 = OFF  
 SW4 = OFF SW8 = OFF

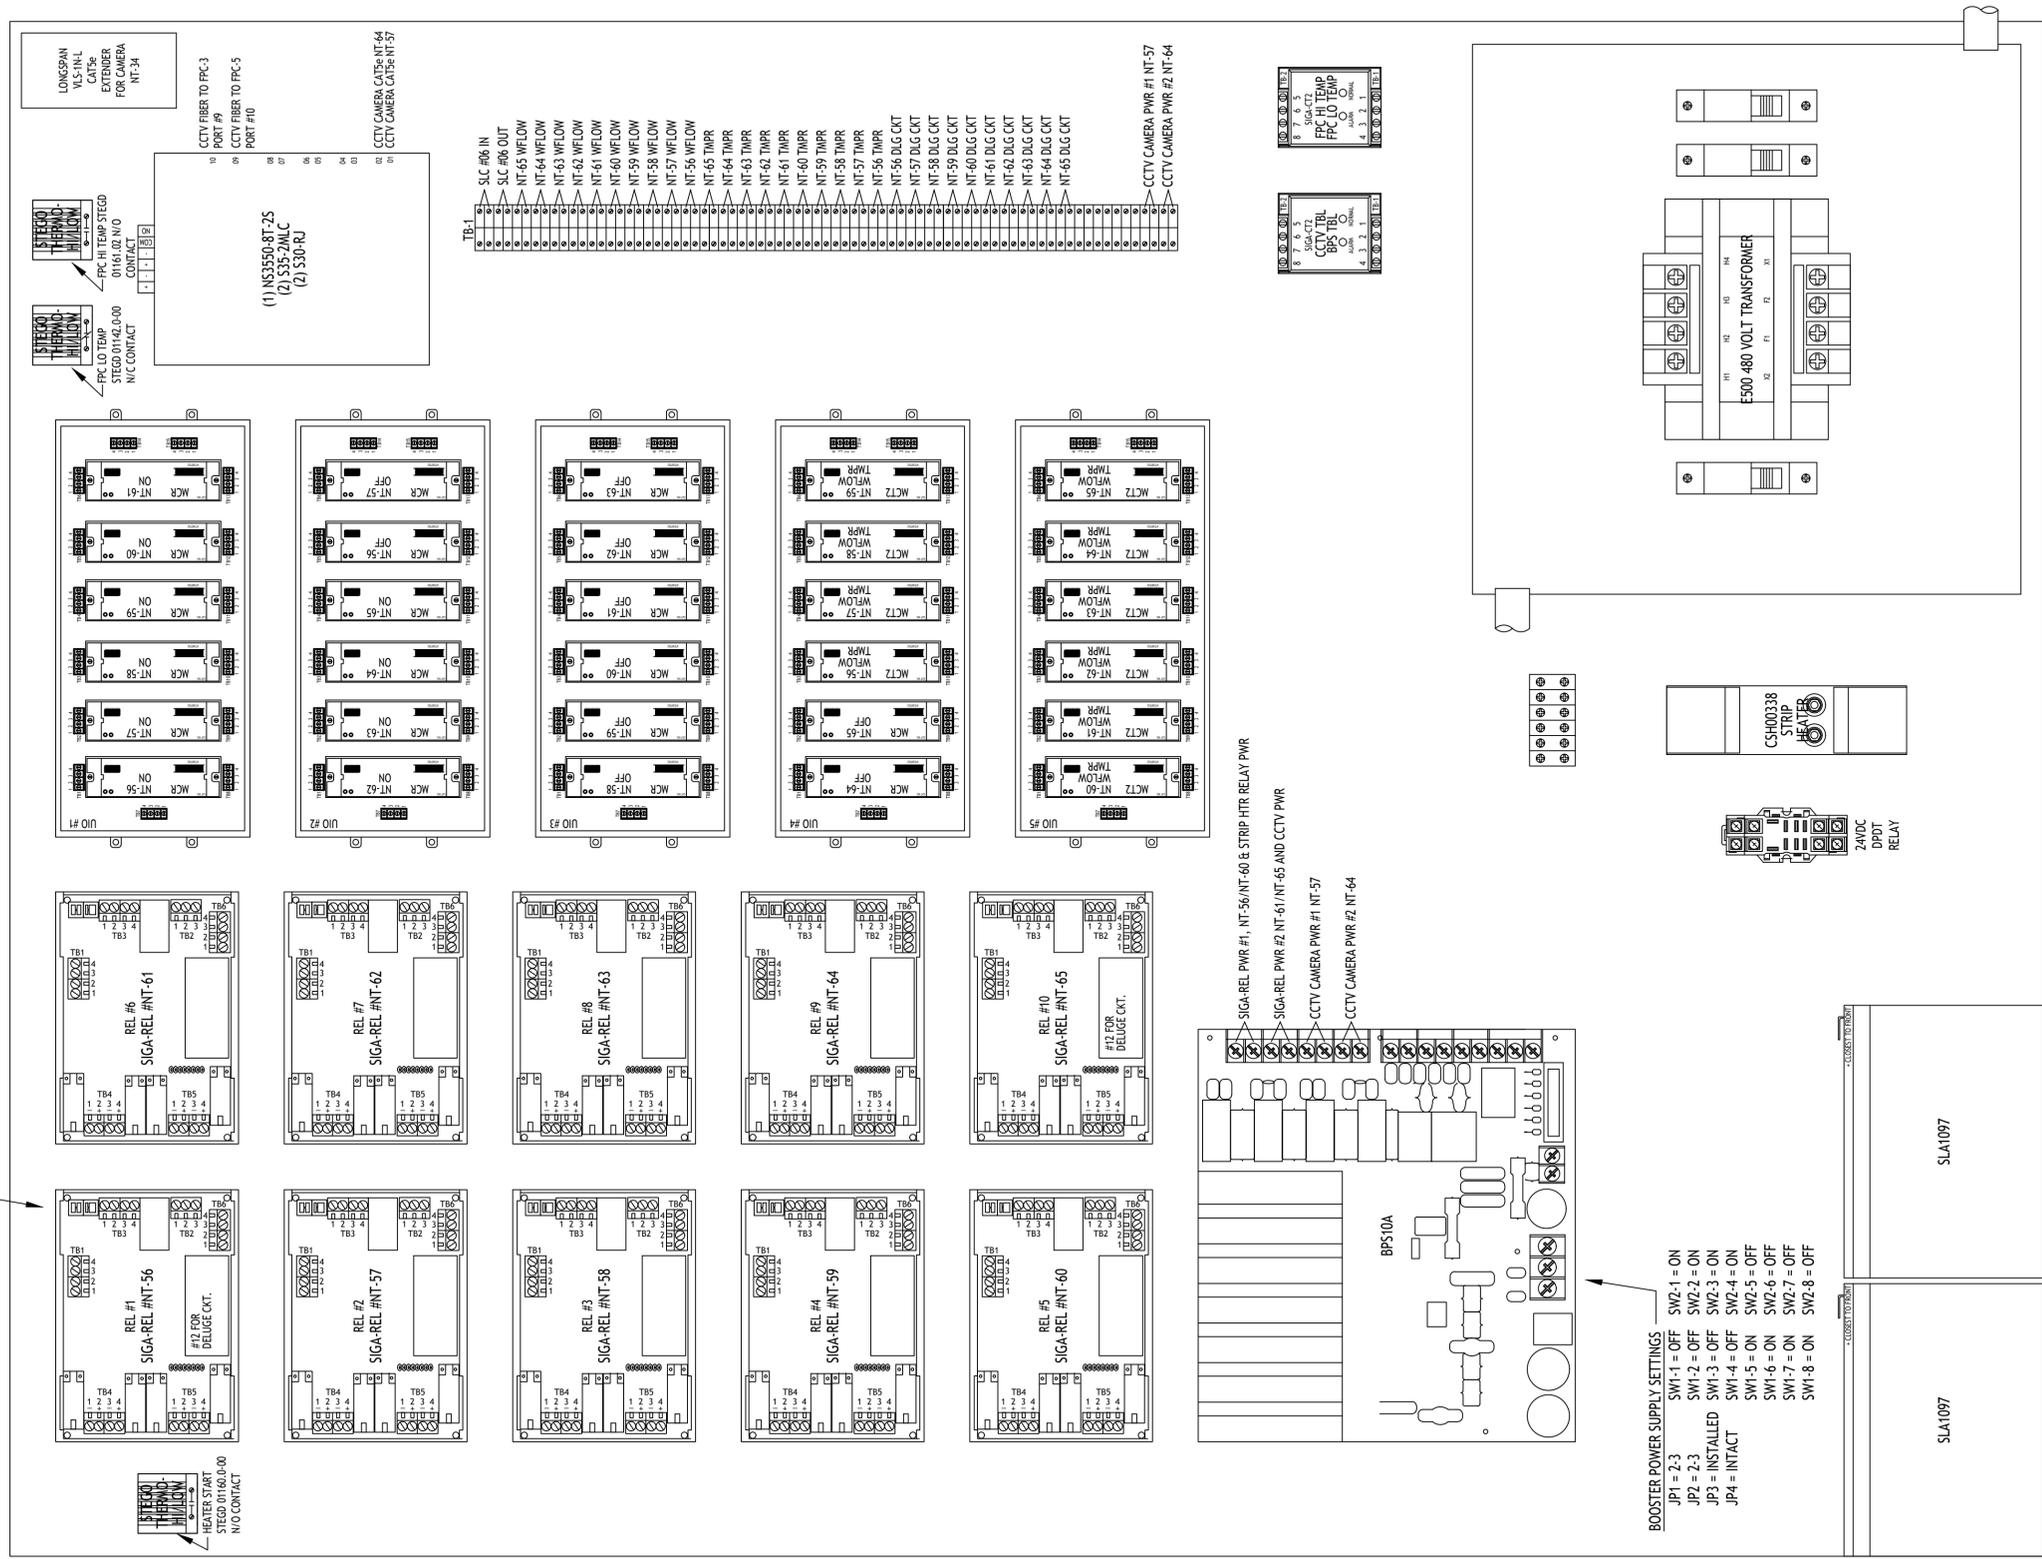

ADDRESSES = 0302XXXX

1 FPC #04 PANEL LAYOUT  
 SCALE: 1/2" SCALE

PANEL LAYOUT FOR FPC #04  
 EASTER OWENS NEMA 4X ENCLOSURE #41-50SF  
 SHOWN AT HALF SCALE (ACTUAL SIZE: 36" W x 48" H)

EISENHOWER/JOHNSON  
 MEMORIAL TUNNEL  
 FIXED FIRE SUPPRESSION SYSTEM  
 DESIGN BUILD PROJECT  
 Project No. C0703-360 Subaccount 17810  
 RECORD DRAWINGS - 2015-11-16


**BARNARD EJMT TEAM**  
**BARNARD**  
**Sturgeon ELECTRIC**  
**RONDINELLI**  
 Western States Fire Protection Co.  
**ALF**  
 CONSULTING ENGINEERS

Revisions	Num	Description	Date

FIRE ALARM:  
 FIRE PROTECTION PANEL  
 FPC #04 WIRING DIAGRAM  
 Drawing Number  
**FA5.04**  
 DRAWN BY: B.T.L. CHECKED BY: AEE-JF  
 ASBUILT - 109

IF THIS SHEET IS NOT 22"x34" IT IS NOT PLOTTED TO SCALE

TYPICAL SIGA-REL SWITCH SETTINGS  
 SW1 = OFF SW5 = OFF  
 SW2 = OFF SW6 = OFF  
 SW3 = OFF SW7 = OFF  
 SW4 = OFF SW8 = OFF

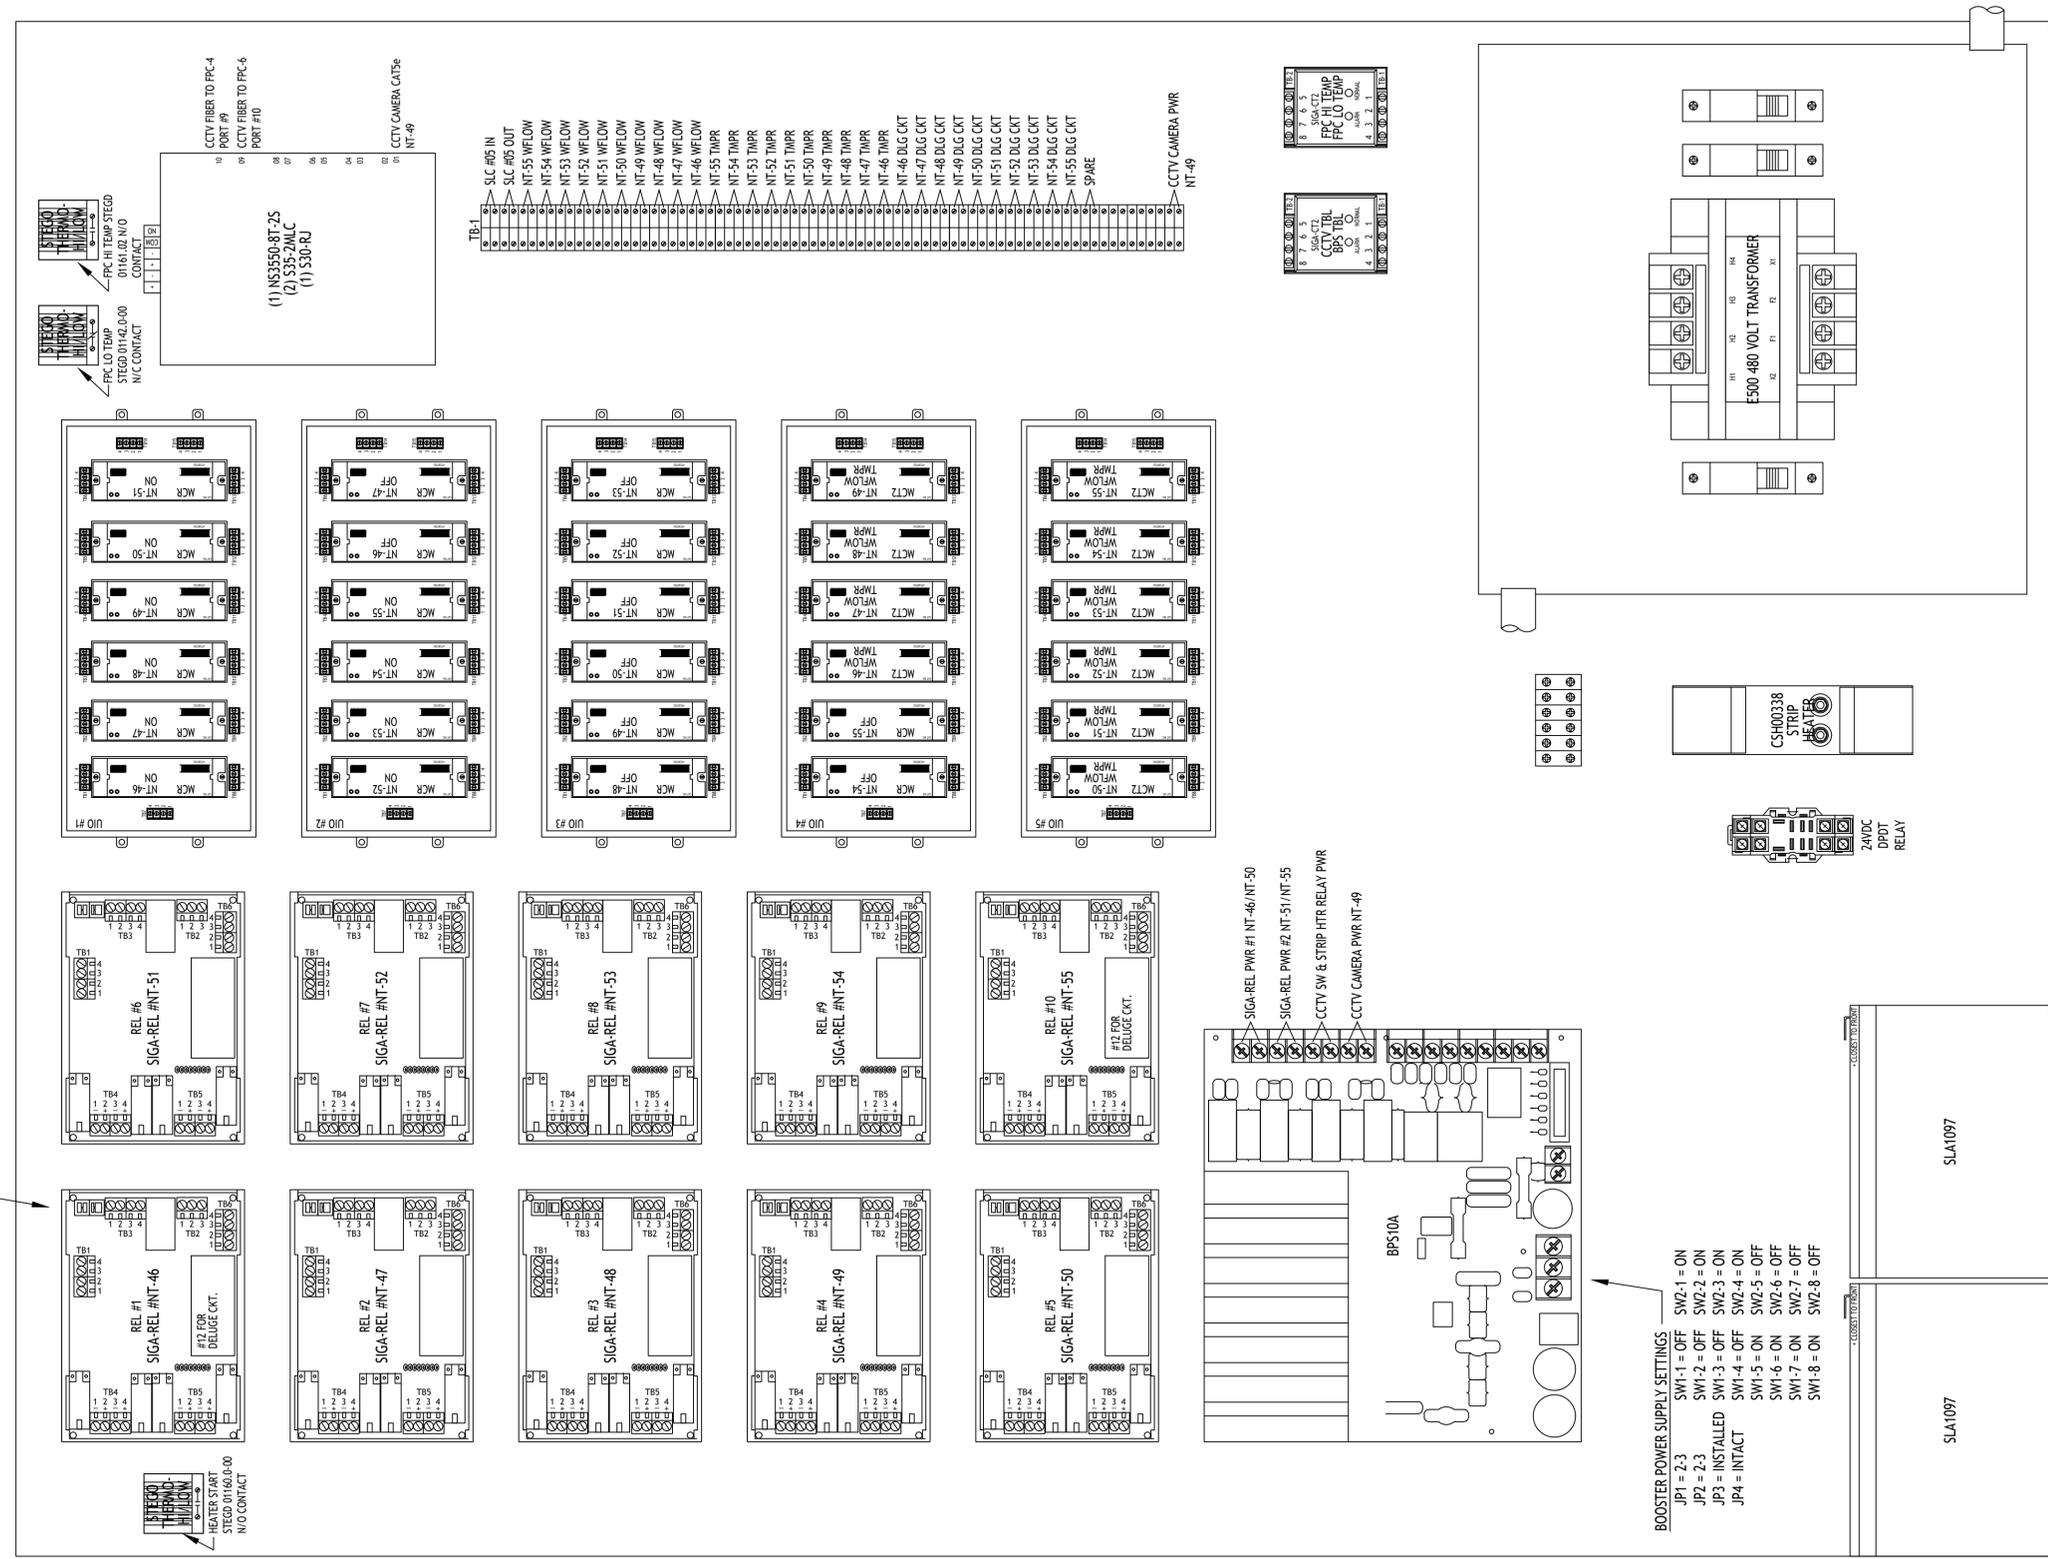

ADDRESSES = 0302XXXX

1 FPC #05 PANEL LAYOUT  
 SCALE: 1/2" SCALE

PANEL LAYOUT FOR FPC #05  
 EASTER OWENS NEMA 4X ENCLOSURE #41-50SF  
 SHOWN AT HALF SCALE (ACTUAL SIZE: 36" W x 48" H)

**EISENHOWER/JOHNSON**  
**MEMORIAL TUNNEL**  
 FIXED FIRE SUPPRESSION SYSTEM  
 DESIGN BUILD PROJECT

**BARNARD EJMT TEAM**

**BARNARD** **STURGEON ELECTRIC** **RONDINELLI**

BCER **Western States Fire Protection Co.**

Sturgeon Electric logo: **Sturgeon ELECTRIC**

Rondinelli logo: **RONDINELLI** A COMMITMENT TO SAFETY

BCF logo: **BCF** CONSULTING ENGINEERS

Revisions	Num	Description	Date

FIRE ALARM:  
 FIRE PROTECTION PANEL  
 FPC #05 WIRING DIAGRAM


Project No. C0703-360 Subaccount 17810  
 RECORD DRAWINGS - 2015-11-16

Drawing Number  
**FA5.05**

DRAWN BY: B.T.L. CHECKED BY: AEE-JF

IF THIS SHEET IS NOT 22"x34" IT IS NOT PLOTTED TO SCALE

TYPICAL SIGA-REL SWITCH SETTINGS  
 SW1 = OFF SW5 = OFF  
 SW2 = OFF SW6 = OFF  
 SW3 = OFF SW7 = OFF  
 SW4 = OFF SW8 = OFF

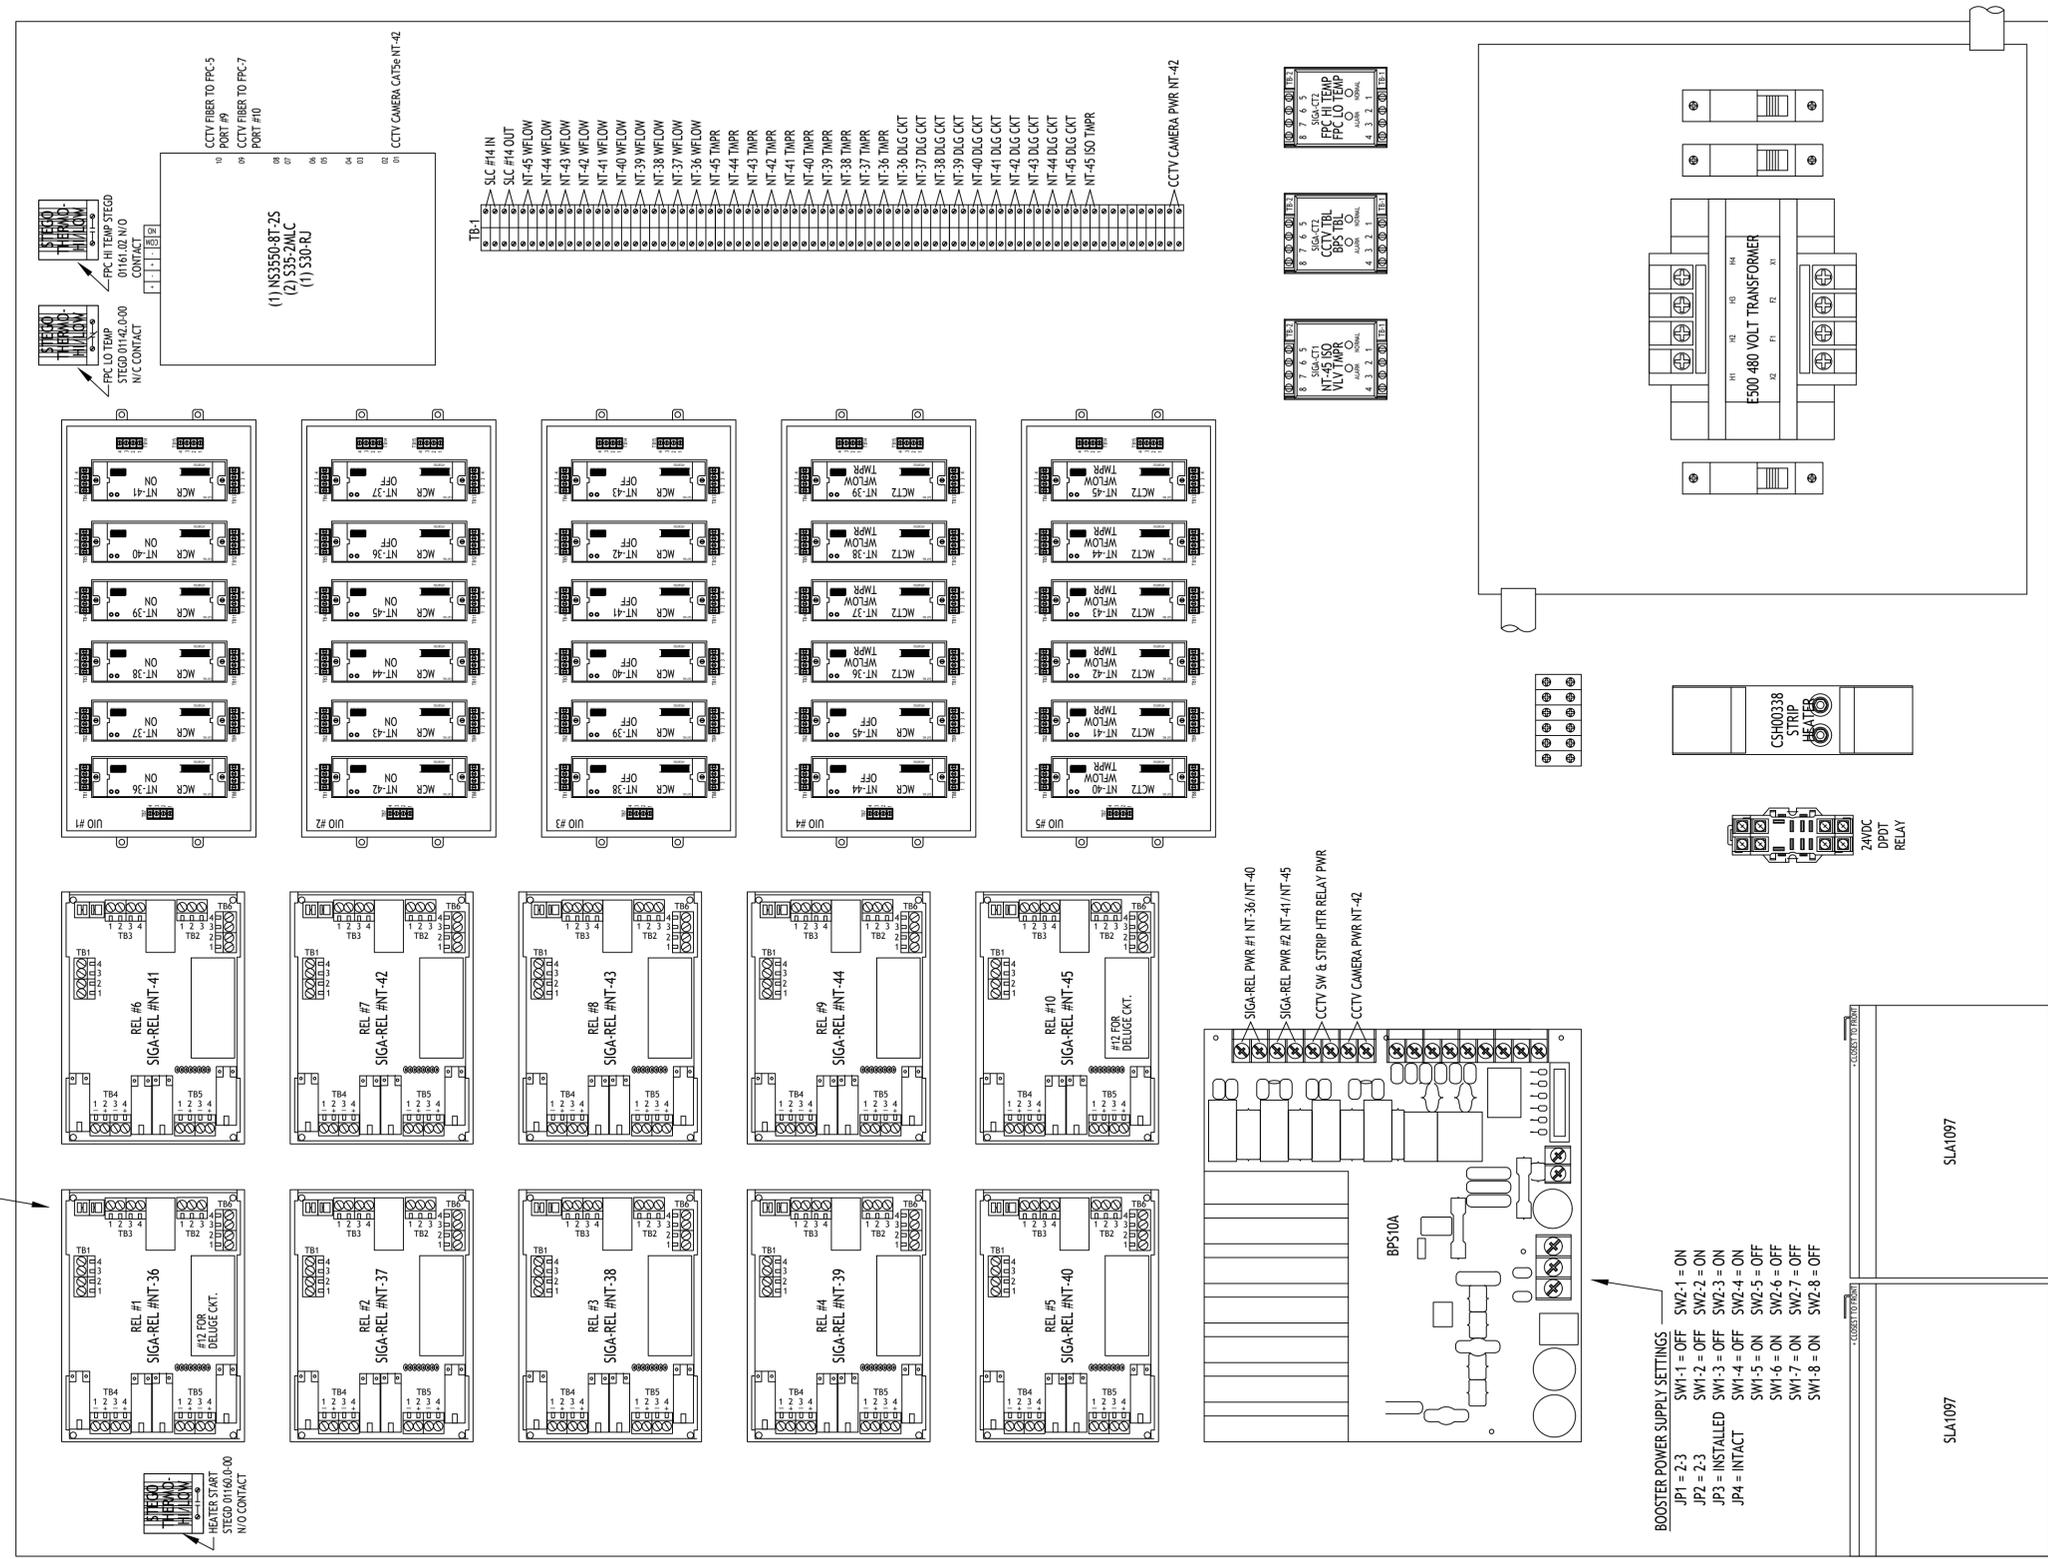

ADDRESSES = 0404XXXX

1 FPC #06 PANEL LAYOUT  
 SCALE: 1/2" SCALE

PANEL LAYOUT FOR FPC #06  
 EASTER OWENS NEMA 4X ENCLOSURE #41-50SF  
 SHOWN AT HALF SCALE (ACTUAL SIZE: 36" W x 48" H)

EISENHOWER/JOHNSON  
 MEMORIAL TUNNEL  
 FIXED FIRE SUPPRESSION SYSTEM  
 DESIGN BUILD PROJECT

Project No. C0703-360 Subaccount 17810  
 RECORD DRAWINGS - 2015-11-16

Revisions	Num	Description	Date

FIRE ALARM:  
 FIRE PROTECTION PANEL  
 FPC #06 WIRING DIAGRAM

Drawing Number  
**FA5.06**

**BARNARD EJMT TEAM**

**BARNARD** **STURGEON ELECTRIC** **RONDINELLI**


BCER **Sturgeon Electric** **Rondinelli** **Western States Fire Protection Co.**

Western States Fire Protection Co. ENGINEERS



IF THIS SHEET IS NOT 22"x34" IT IS NOT PLOTTED TO SCALE

TYPICAL SIGA-REL SWITCH SETTINGS  
 SW1 = OFF SW5 = OFF  
 SW2 = OFF SW6 = OFF  
 SW3 = OFF SW7 = OFF  
 SW4 = OFF SW8 = OFF

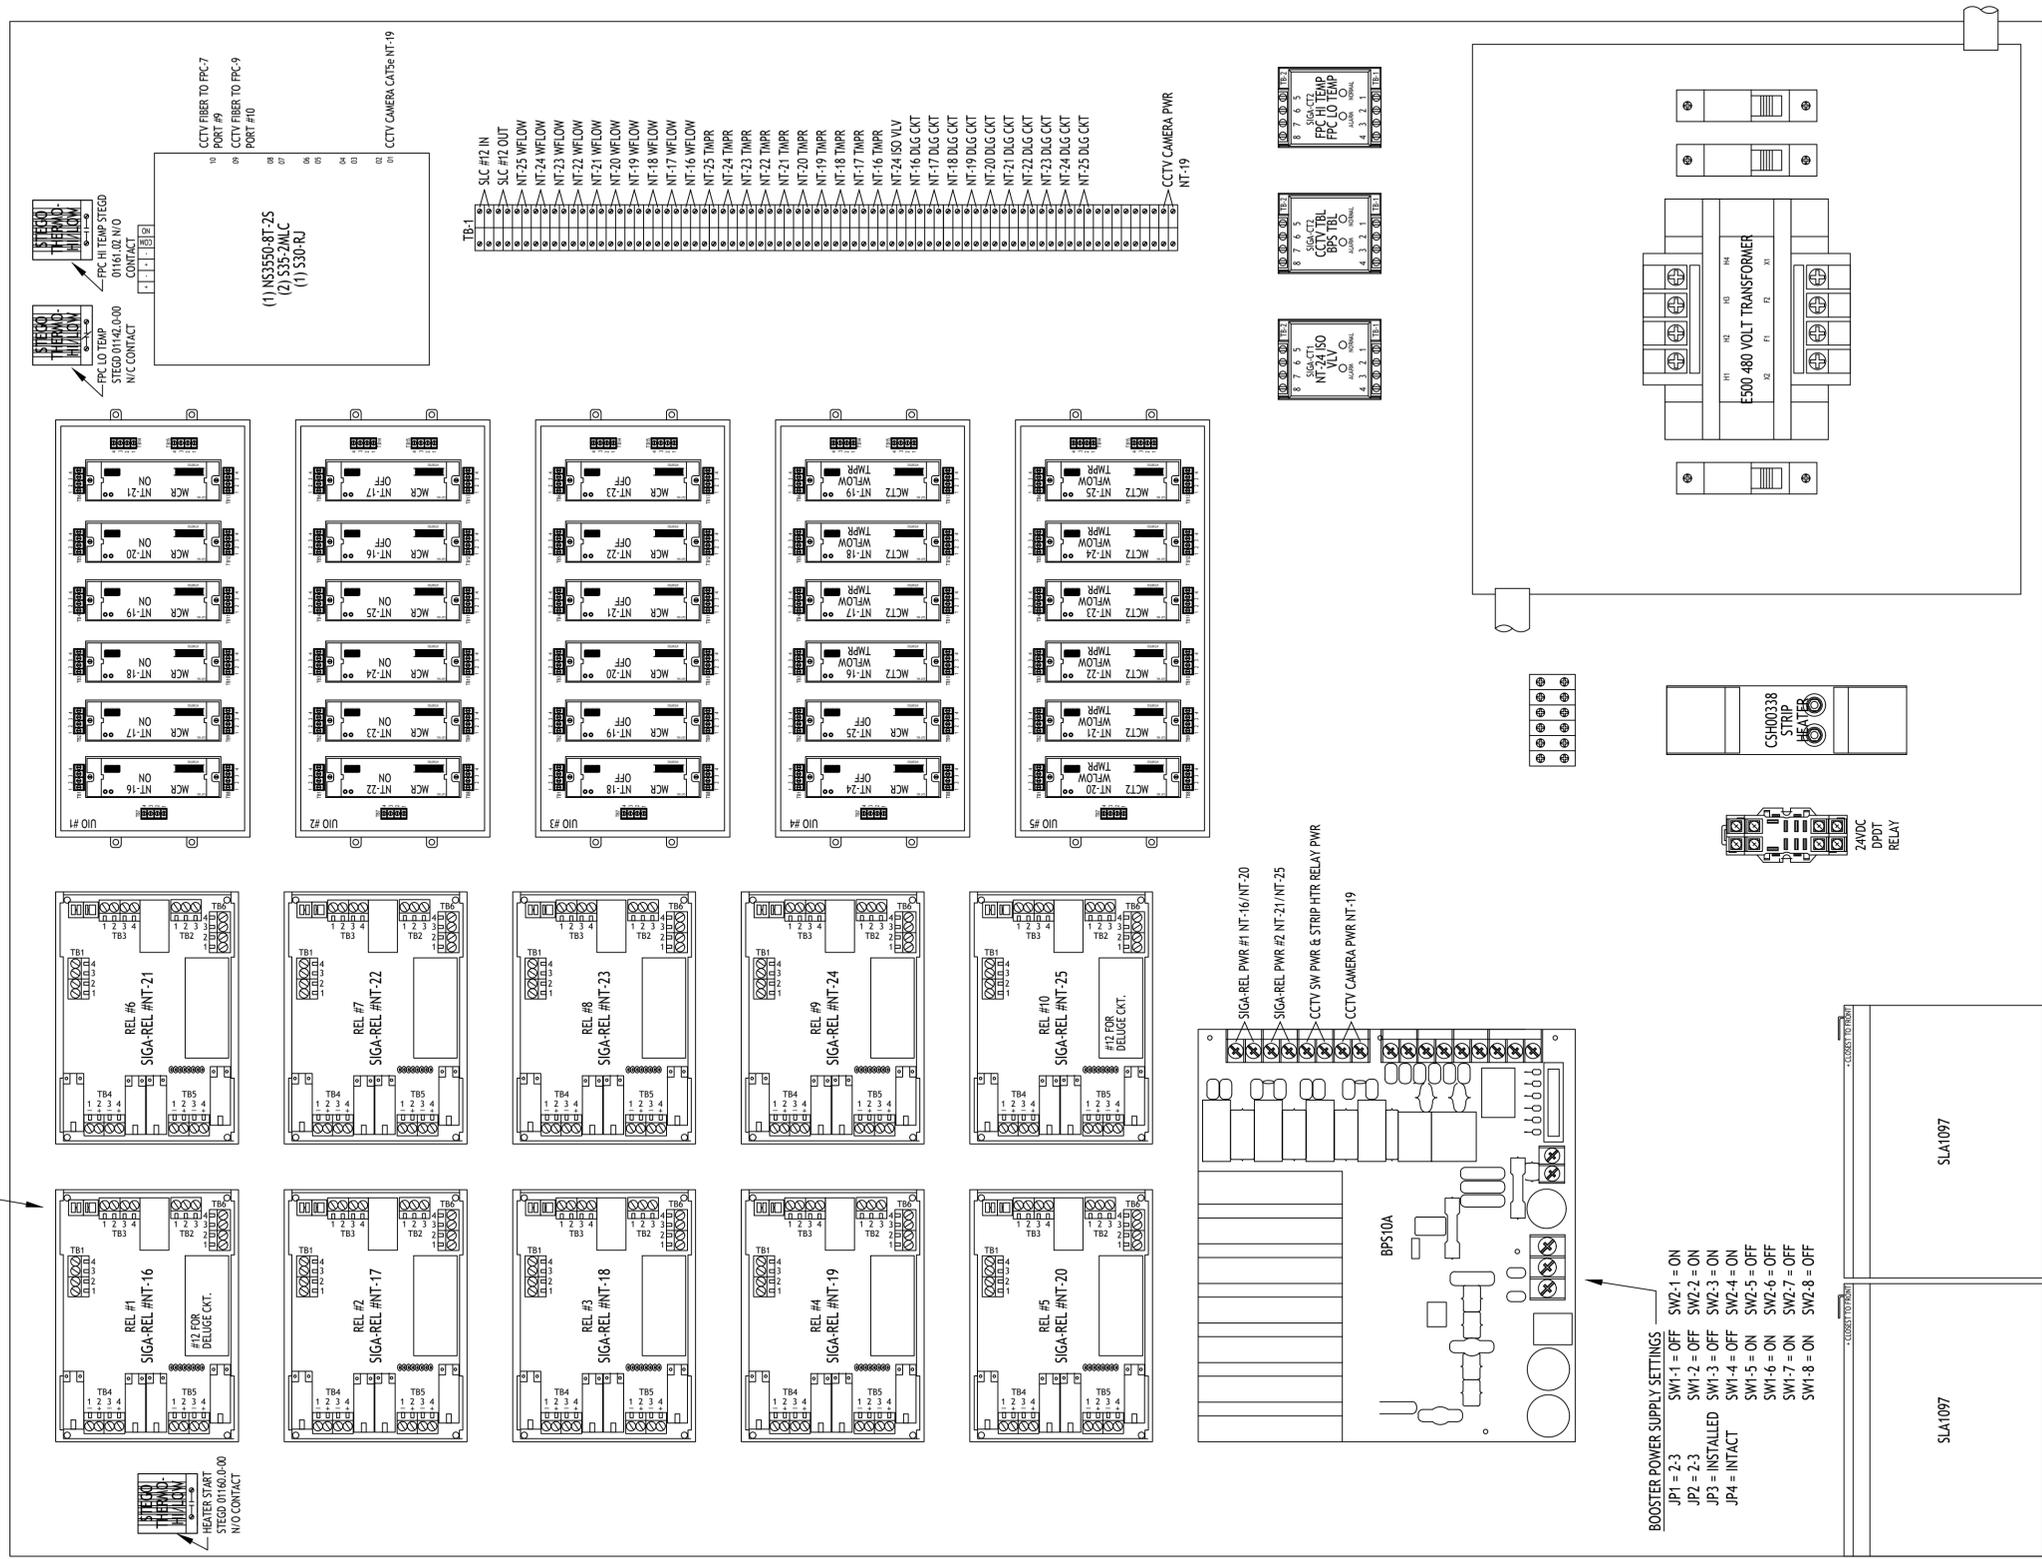

ADDRESSES = 0403XXXX

1 FPC #08 PANEL LAYOUT  
 SCALE: 1/2" SCALE

PANEL LAYOUT FOR FPC #08  
 EASTER OWENS NEMA 4X ENCLOSURE #41-50SF  
 SHOWN AT HALF SCALE (ACTUAL SIZE: 36" W x 48" H)

EISENHOWER/JOHNSON  
 MEMORIAL TUNNEL  
 FIXED FIRE SUPPRESSION SYSTEM  
 DESIGN BUILD PROJECT

BARNARD EJMT TEAM

BCER  
 BARNARD  
 RONDINELLI  
 Sturgeon Electric  
 Western States Fire Protection Co.  
 ALF  
 CONSULTING ENGINEERS

Revisions	Date

FIRE ALARM:  
 FIRE PROTECTION PANEL  
 FPC #08 WIRING DIAGRAM

Drawing Number  
**FA5.08**


Project No. C0703-360  
 Subaccount 17810  
 RECORD DRAWINGS - 2015-11-16

DRAWN BY: B.T.L. CHECKED BY: AEE-JF



IF THIS SHEET IS NOT 22"x34" IT IS NOT PLOTTED TO SCALE

TYPICAL SIGA-REL SWITCH SETTINGS  
 SW1 = OFF SW5 = OFF  
 SW2 = OFF SW6 = OFF  
 SW3 = OFF SW7 = OFF  
 SW4 = OFF SW8 = OFF

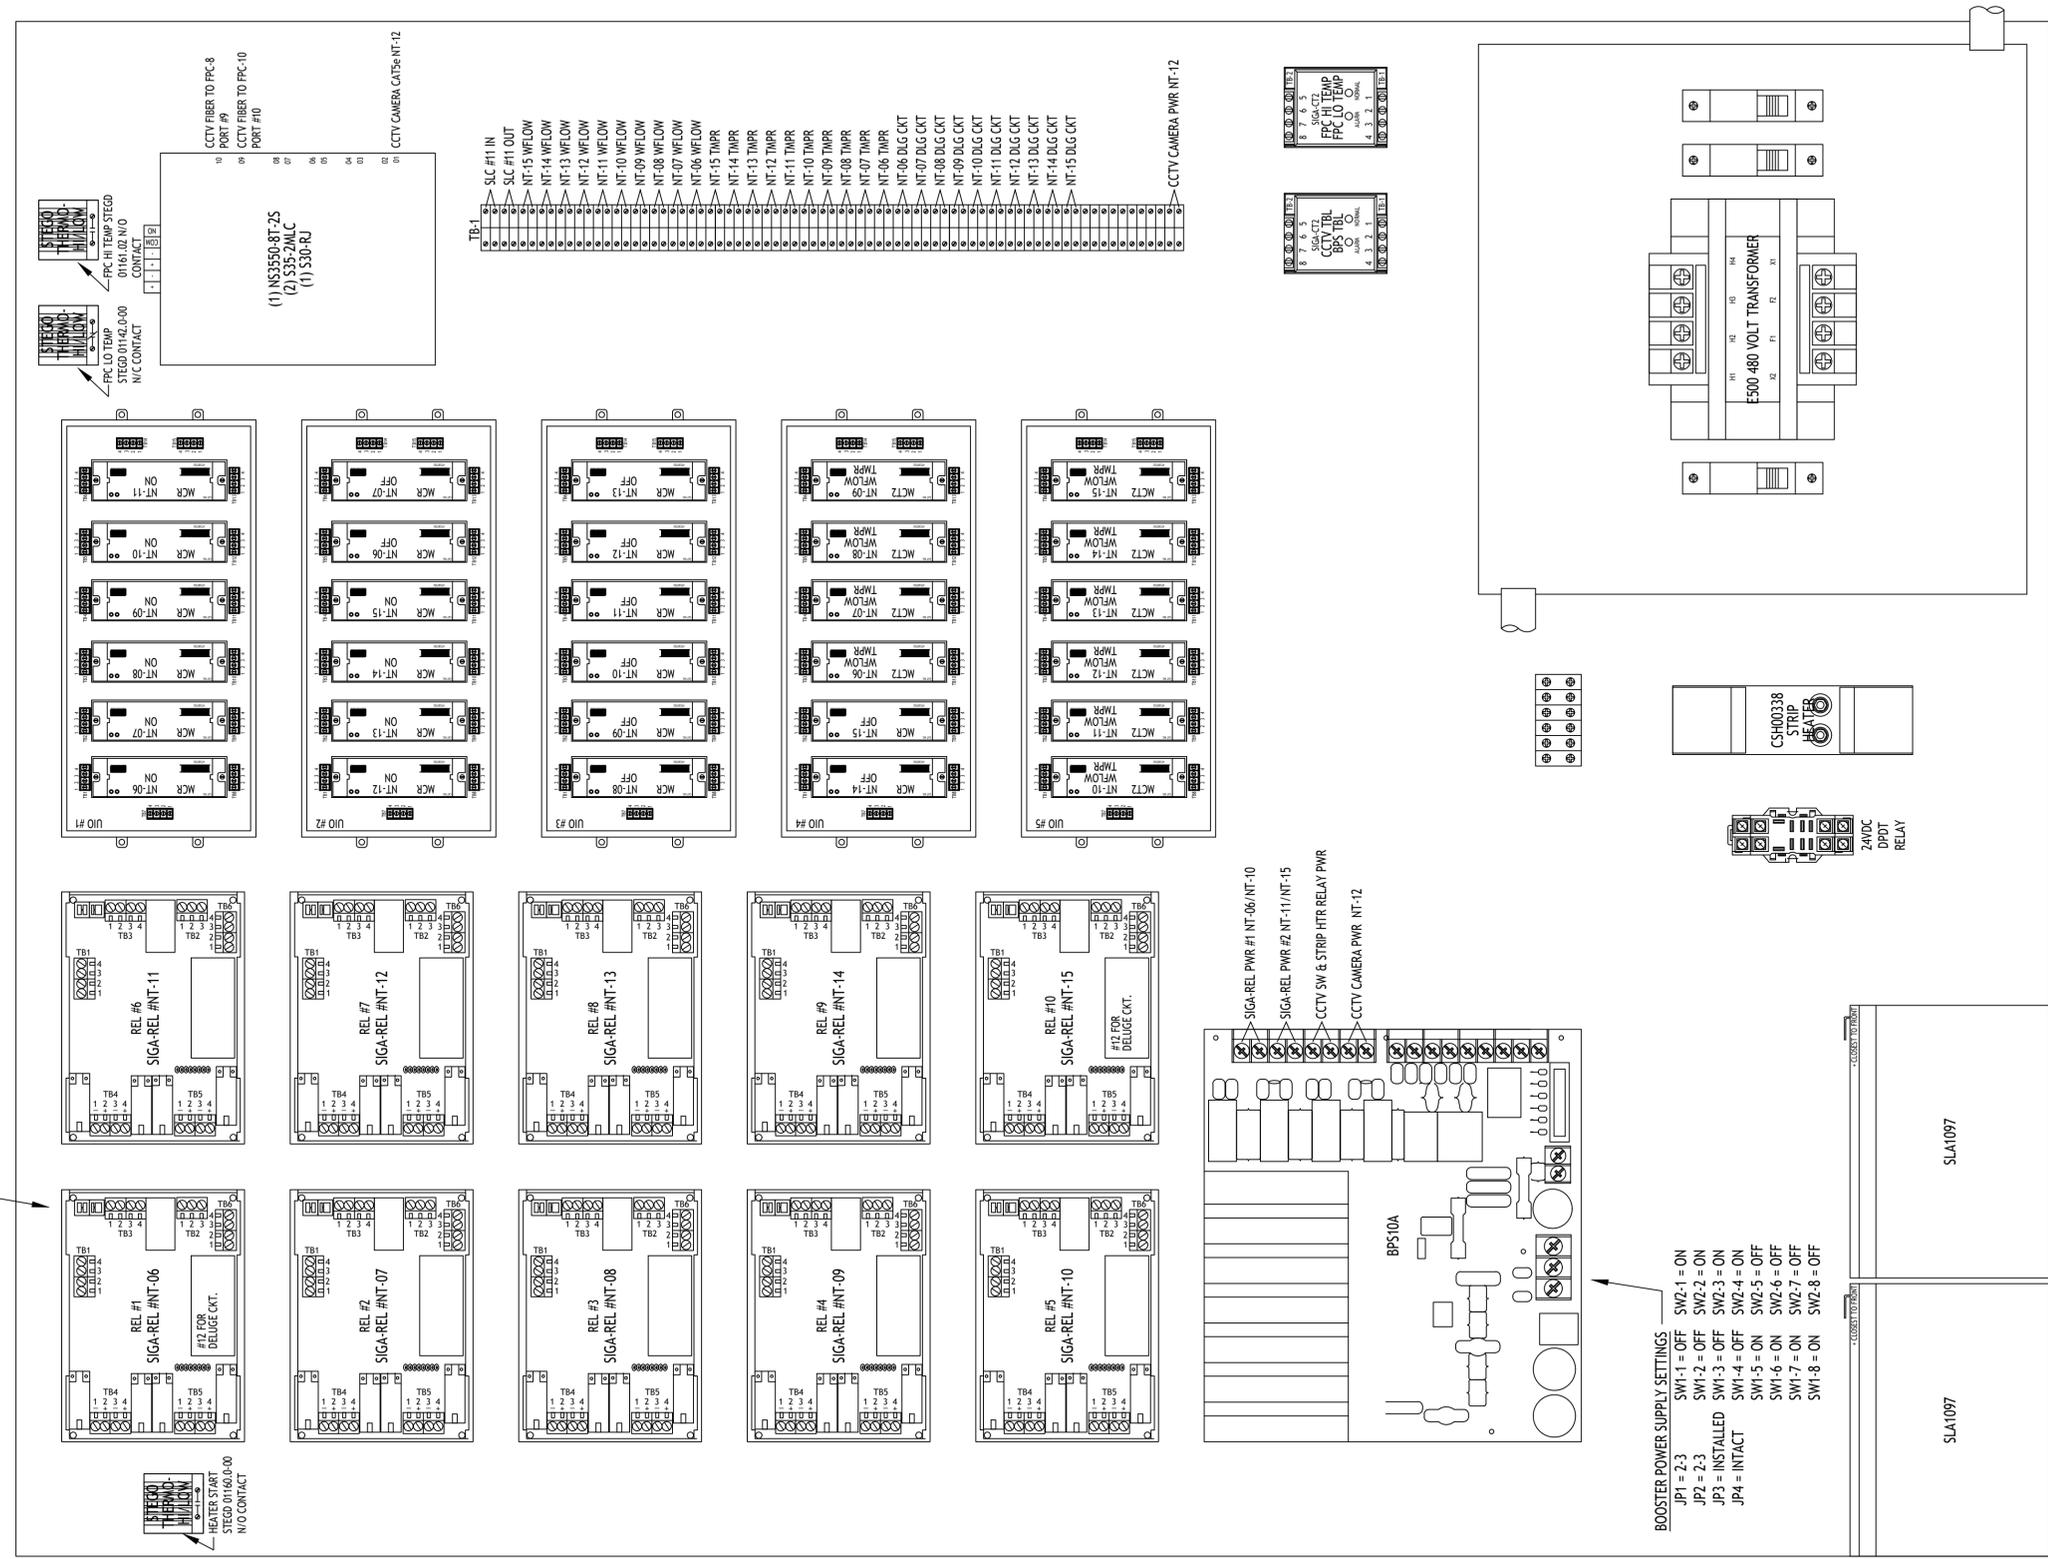

ADDRESSES = 0402XXXX

1 FPC #09 PANEL LAYOUT  
 SCALE: 1/2" SCALE

PANEL LAYOUT FOR FPC #09  
 EASTER OWENS NEMA 4X ENCLOSURE #41-50SF  
 SHOWN AT HALF SCALE (ACTUAL SIZE: 36" W x 48" H)

EISENHOWER/JOHNSON  
 MEMORIAL TUNNEL  
 FIXED FIRE SUPPRESSION SYSTEM  
 DESIGN BUILD PROJECT  
 Project No. C0703-360 Subaccount 17810  
 RECORD DRAWINGS - 2015-11-16


**BARNARD EJMT TEAM**  
**BARNARD**  
**Sturgeon ELECTRIC**  
**RONDINELLI**  
 Western States Fire Protection Co.  
**ALF**  
 CONSULTING ENGINEERS

Revisions	Num	Description	Date

FIRE ALARM:  
 FIRE PROTECTION PANEL  
 FPC #09 WIRING DIAGRAM  
 Drawing Number  
**FA5.09**

IF THIS SHEET IS NOT 22"x34" IT IS NOT PLOTTED TO SCALE

TYPICAL SIGA-REL SWITCH SETTINGS  
 SW1 = OFF SW5 = OFF  
 SW2 = OFF SW6 = OFF  
 SW3 = OFF SW7 = OFF  
 SW4 = OFF SW8 = OFF

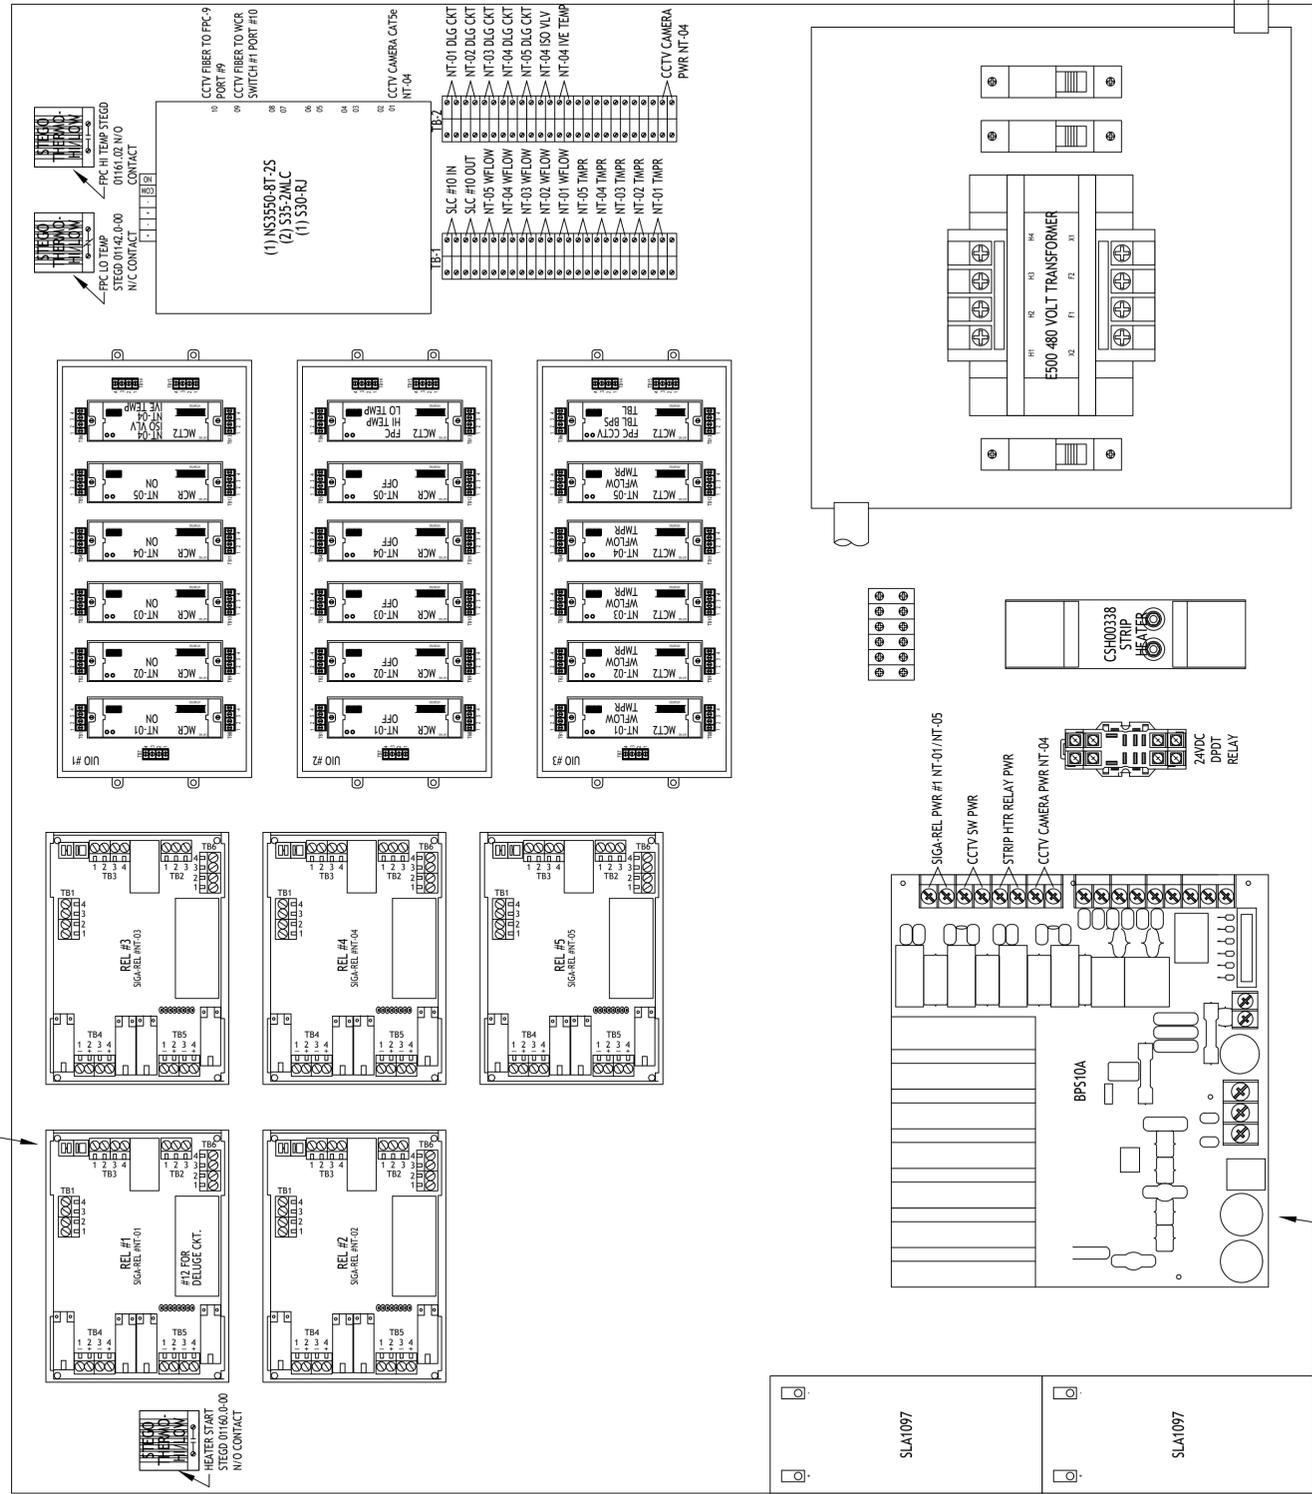

ADDRESSES = 0402XXXX

1 FPC #10 PANEL LAYOUT  
 SCALE: 1/2" SCALE

PANEL LAYOUT FOR FPC #10  
 EASTER OWENS NEMA 4X ENCLOSURE #31-40SF  
 SHOWN AT HALF SCALE (ACTUAL SIZE: 36" W x 32" H)

EISENHOWER/JOHNSON  
 MEMORIAL TUNNEL  
 FIXED FIRE SUPPRESSION SYSTEM  
 DESIGN BUILD PROJECT

BARNARD EJMT TEAM



Revisions	Date

FIRE ALARM:  
 FIRE PROTECTION PANEL  
 FPC #10 WIRING DIAGRAM  
 Drawing Number  
**FA5.10**

Project No. C0703-360 Subaccount 17810  
 RECORD DRAWINGS - 2015-11-16


DRAWN BY: B.T.L. CHECKED BY: AEE-JF





IF THIS SHEET IS NOT 22"x34" IT IS NOT PLOTTED TO SCALE

TYPICAL SIGA-REL SWITCH SETTINGS  
 SW1 = OFF SW5 = OFF  
 SW2 = OFF SW6 = OFF  
 SW3 = OFF SW7 = OFF  
 SW4 = OFF SW8 = OFF

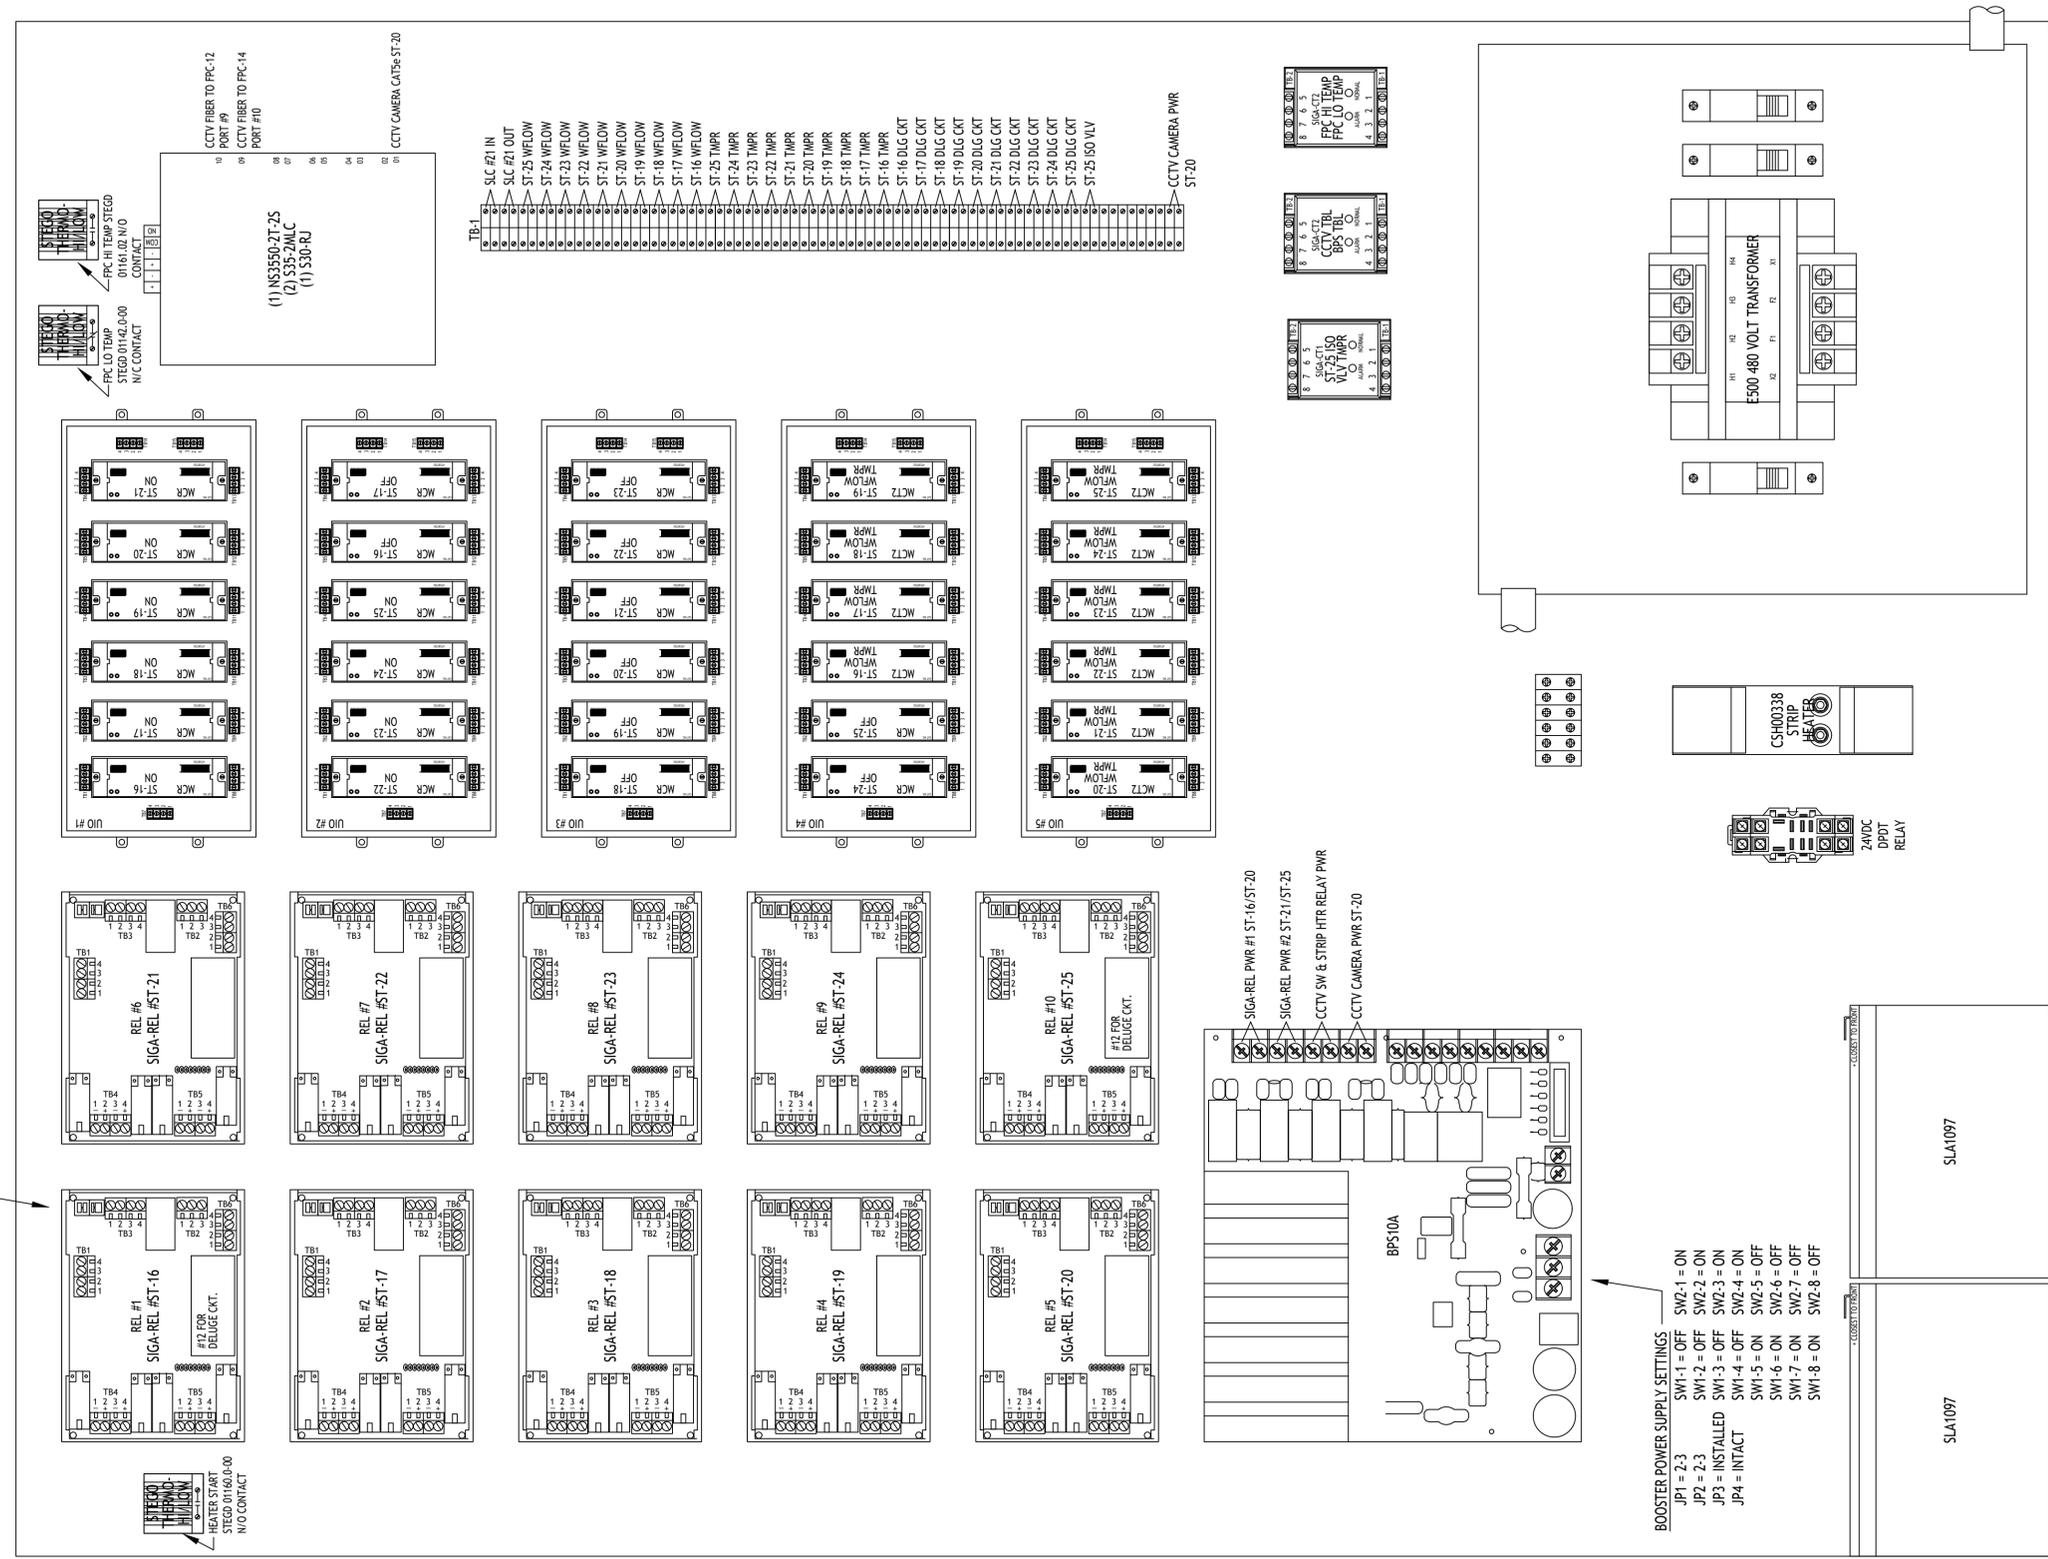

ADDRESSES = 0603XXXX

1 FPC #13 PANEL LAYOUT  
 SCALE: 1/2" SCALE

PANEL LAYOUT FOR FPC #13  
 EASTER OWENS NEMA 4X ENCLOSURE #41-50SF  
 SHOWN AT HALF SCALE (ACTUAL SIZE: 36" W x 48" H)

EISENHOWER/JOHNSON  
 MEMORIAL TUNNEL  
 FIXED FIRE SUPPRESSION SYSTEM  
 DESIGN BUILD PROJECT

BARNARD EJMT TEAM

BCER  
 BARNARD  
 RONDINELLI  
 Sturgeon Electric  
 Western States Fire Protection Co.  
 CONSULTING ENGINEERS

Revisions	Date

FIRE ALARM:  
 FIRE PROTECTION PANEL  
 FPC #13 WIRING DIAGRAM


Drawing Number  
**FA5.13**

Project No. C0703-360  
 Subaccount 17810  
 RECORD DRAWINGS - 2015-11-16

DRAWN BY: B.T.L. CHECKED BY: AEE-JF

IF THIS SHEET IS NOT 22"x34" IT IS NOT PLOTTED TO SCALE

TYPICAL SIGA-REL SWITCH SETTINGS  
 SW1 = OFF SW5 = OFF  
 SW2 = OFF SW6 = OFF  
 SW3 = OFF SW7 = OFF  
 SW4 = OFF SW8 = OFF

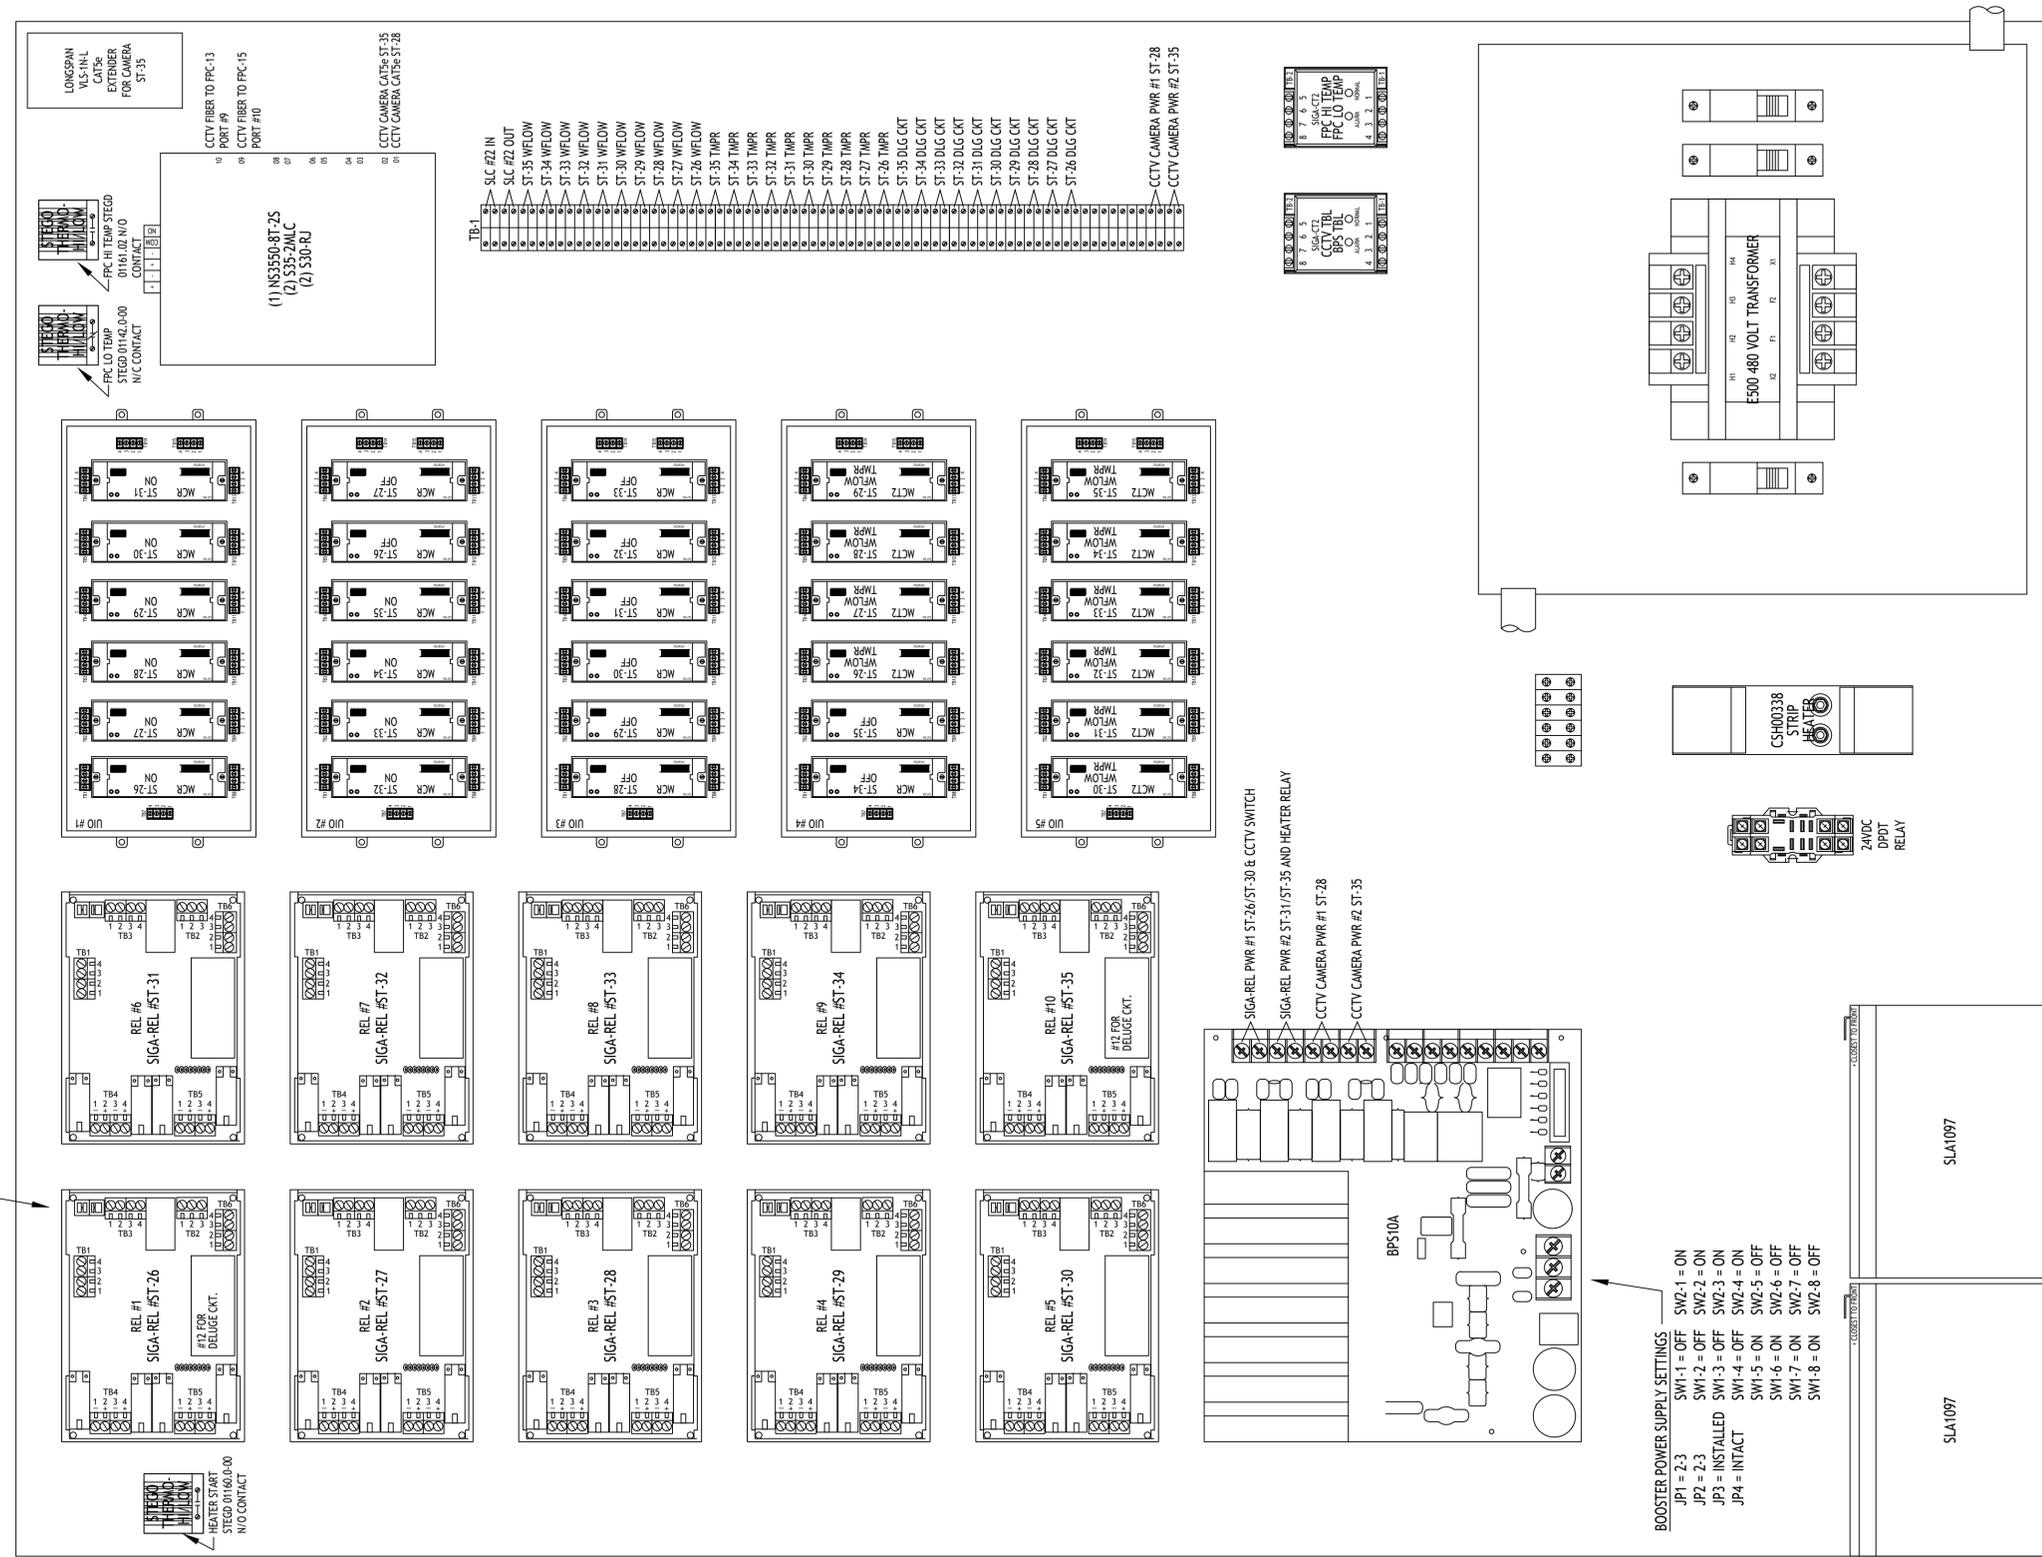

ADDRESSES = 0603XXXX

1 FPC #14 PANEL LAYOUT  
 SCALE: 1/2" SCALE

PANEL LAYOUT FOR FPC #14  
 EASTER OWENS NEMA 4X ENCLOSURE #41-50SF  
 SHOWN AT HALF SCALE (ACTUAL SIZE: 36" W x 48" H)

EISENHOWER/JOHNSON  
 MEMORIAL TUNNEL  
 FIXED FIRE SUPPRESSION SYSTEM  
 DESIGN BUILD PROJECT  
 Project No. C0703-360 Subaccount 17810  
 RECORD DRAWINGS - 2015-11-16


**BARNARD EJMT TEAM**  
**BARNARD**  
**Sturgeon ELECTRIC**  
**BCER**  
**Sturgeon**  
**Western States Fire Protection Co.**  
**RONDINELLI**  
**Western States Fire Protection Co.**  
**ALF**  
**Western States Fire Protection Co.**

Revisions	Date
Num	Description

FIRE ALARM:  
 FIRE PROTECTION PANEL  
 FPC #14 WIRING DIAGRAM  
 Drawing Number  
**FA5.14**  
 DRAWN BY: B.T.L. CHECKED BY: AEE-JF  
 ASBUILT - 11

IF THIS SHEET IS NOT 22"x34" IT IS NOT PLOTTED TO SCALE

TYPICAL SIGA-REL SWITCH SETTINGS  
 SW1 = OFF SW5 = OFF  
 SW2 = OFF SW6 = OFF  
 SW3 = OFF SW7 = OFF  
 SW4 = OFF SW8 = OFF

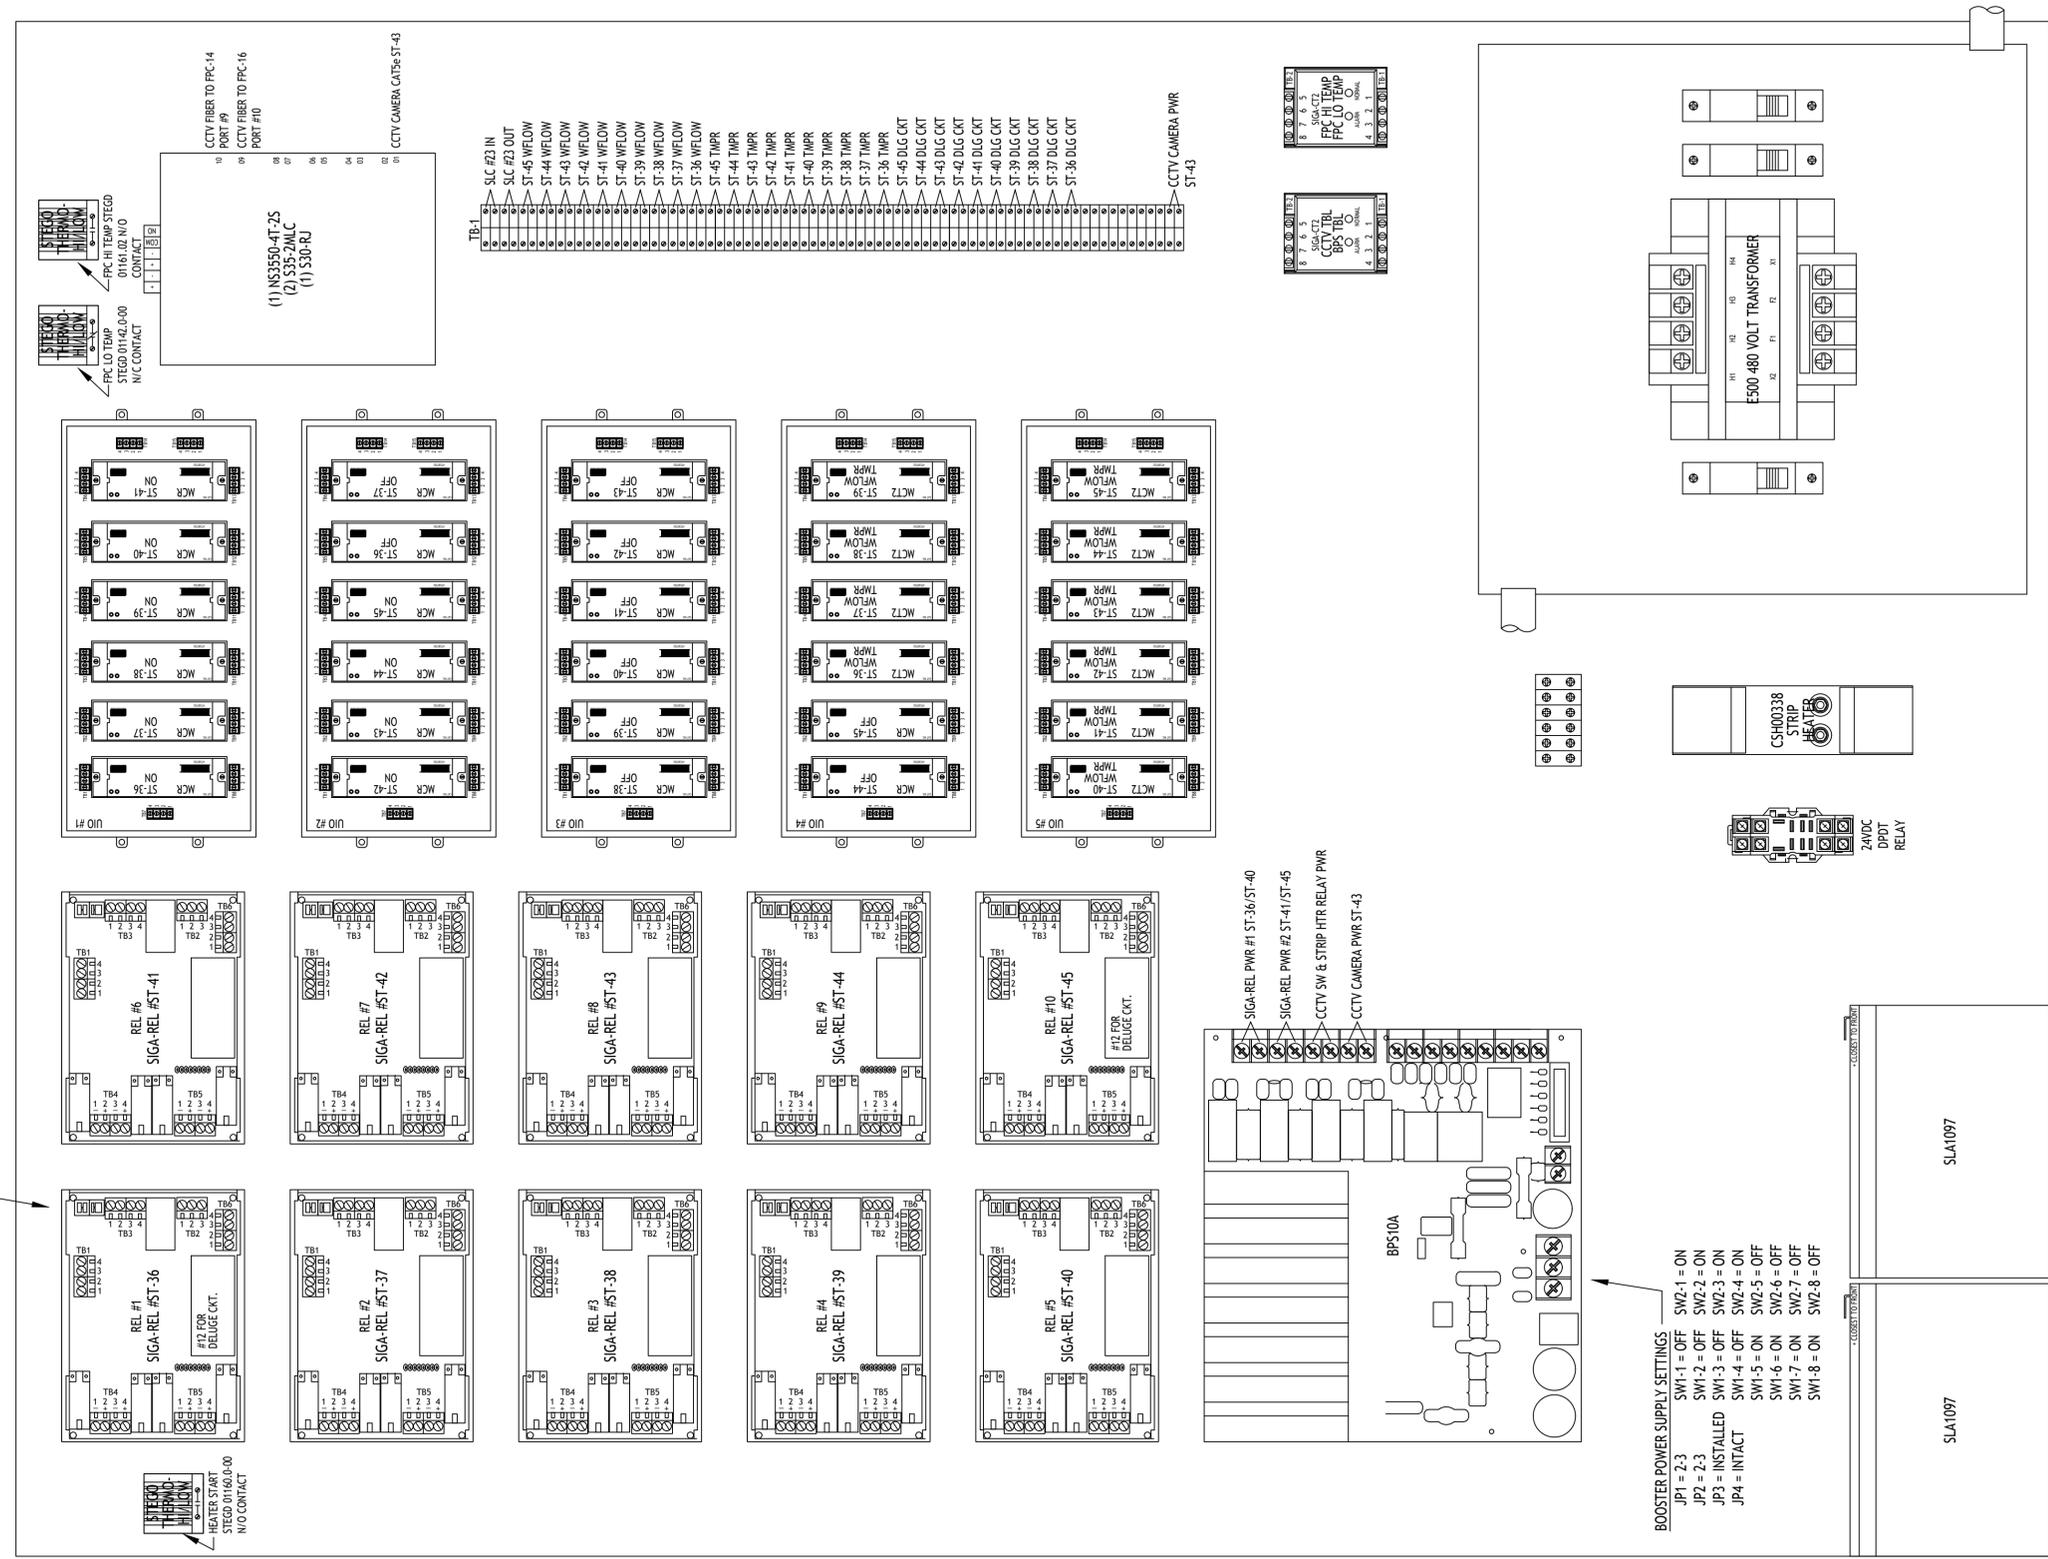

ADDRESSES = 0604XXXX

1 FPC #15 PANEL LAYOUT  
 SCALE: 1/2" SCALE

PANEL LAYOUT FOR FPC #15  
 EASTER OWENS NEMA 4X ENCLOSURE #41-50SF  
 SHOWN AT HALF SCALE (ACTUAL SIZE: 36" W x 48" H)

EISENHOWER/JOHNSON  
 MEMORIAL TUNNEL  
 FIXED FIRE SUPPRESSION SYSTEM  
 DESIGN BUILD PROJECT

Project No. C0703-360 Subaccount 17810  
 RECORD DRAWINGS - 2015-11-16

Revisions	Date

FIRE ALARM:  
 FIRE PROTECTION PANEL  
 FPC #15 WIRING DIAGRAM

Drawing Number  
**FA5.15**

**BARNARD EJMT TEAM**


**BARNARD** **RONDINELLI**  
 A COMMITMENT TO EXCELLENCE IN SAFETY

**Sturgeon Electric** **Western States Fire Protection Co.**

**BCER** **Sturgeon Electric** **Western States Fire Protection Co.** **Rondinelli** **Sturgeon Electric**

IF THIS SHEET IS NOT 22"x34" IT IS NOT PLOTTED TO SCALE

TYPICAL SIGA-REL SWITCH SETTINGS  
 SW1 = OFF SW5 = OFF  
 SW2 = OFF SW6 = OFF  
 SW3 = OFF SW7 = OFF  
 SW4 = OFF SW8 = OFF

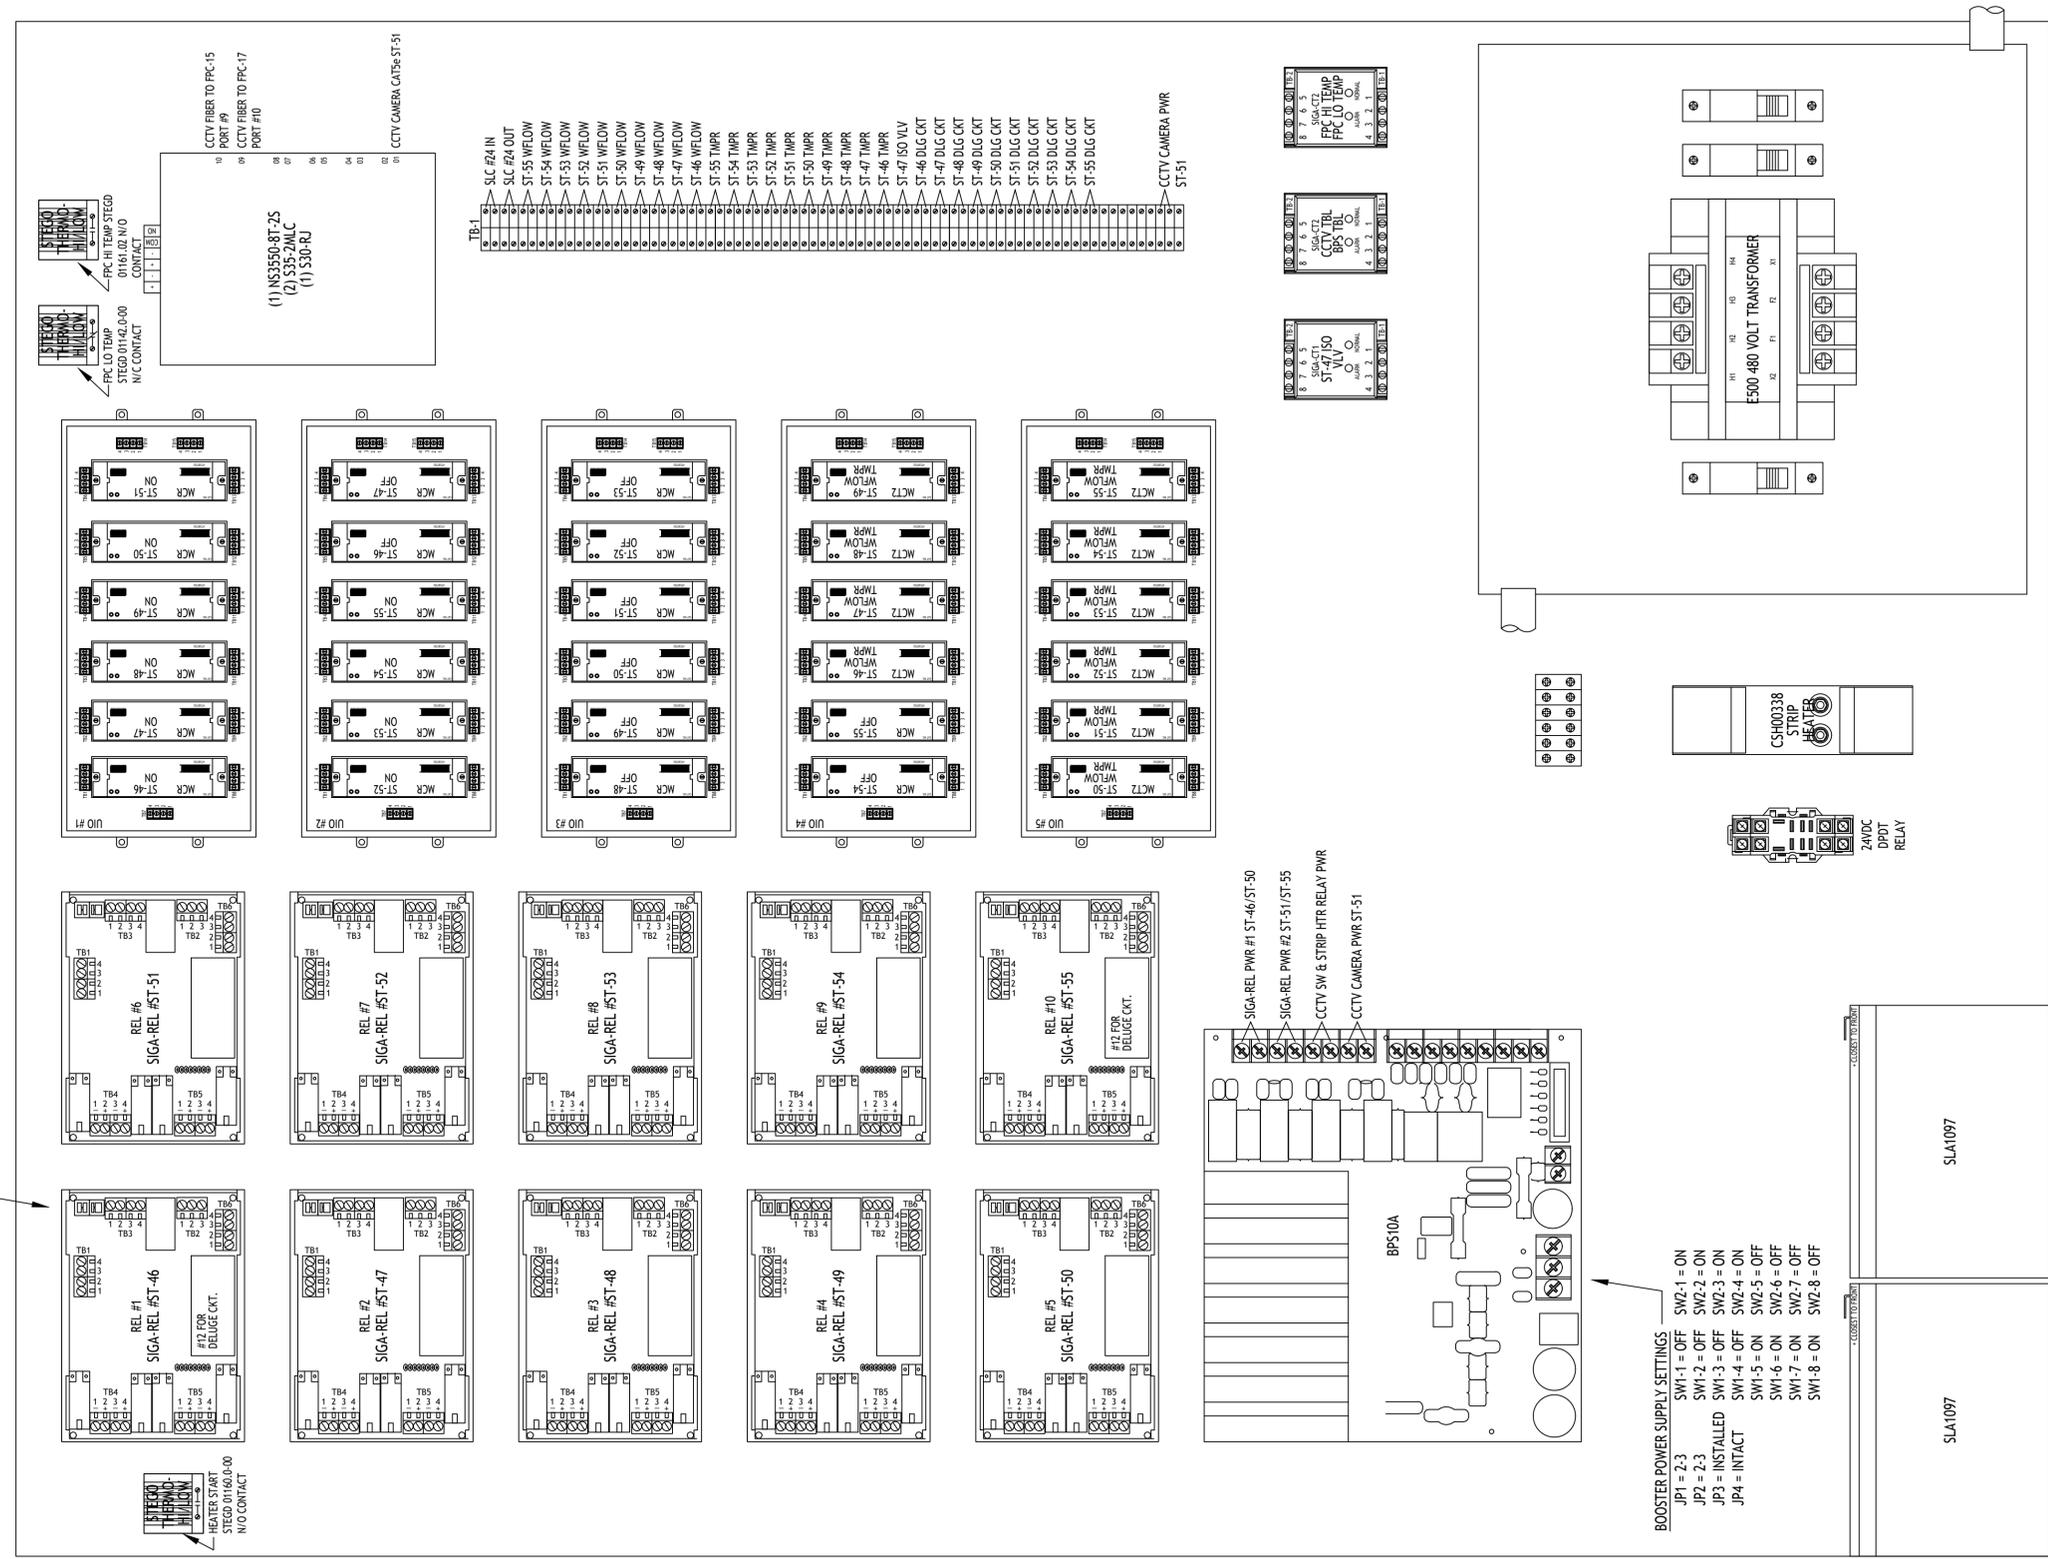

ADDRESSES = 0702XXXX

1 FPC #16 PANEL LAYOUT  
 SCALE: 1/2" SCALE

PANEL LAYOUT FOR FPC #16  
 EASTER OWENS NEMA 4X ENCLOSURE #41-50SF  
 SHOWN AT HALF SCALE (ACTUAL SIZE: 36" W x 48" H)

**EISENHOWER/JOHNSON  
 MEMORIAL TUNNEL  
 FIXED FIRE SUPPRESSION SYSTEM  
 DESIGN BUILD PROJECT**

**BARNARD EJMT TEAM**

**BARNARD** **STURGEON ELECTRIC** **RONDINELLI**

BCER **Western States Fire Protection Co.**

Western States Fire Protection Co. ENGINEERS

Revisions	Date

FIRE ALARM:  
 FIRE PROTECTION PANEL  
 FPC #16 WIRING DIAGRAM

Project No. C0703-360 Subaccount 17810  
 RECORD DRAWINGS - 2015-11-16

Num Description  
 Date


FA5.16

DRAWN BY: B.T.L. CHECKED BY: AEE-JF



IF THIS SHEET IS NOT 22"x34" IT IS NOT PLOTTED TO SCALE

TYPICAL SIGA-REL SWITCH SETTINGS  
 SW1 = OFF SW5 = OFF  
 SW2 = OFF SW6 = OFF  
 SW3 = OFF SW7 = OFF  
 SW4 = OFF SW8 = OFF

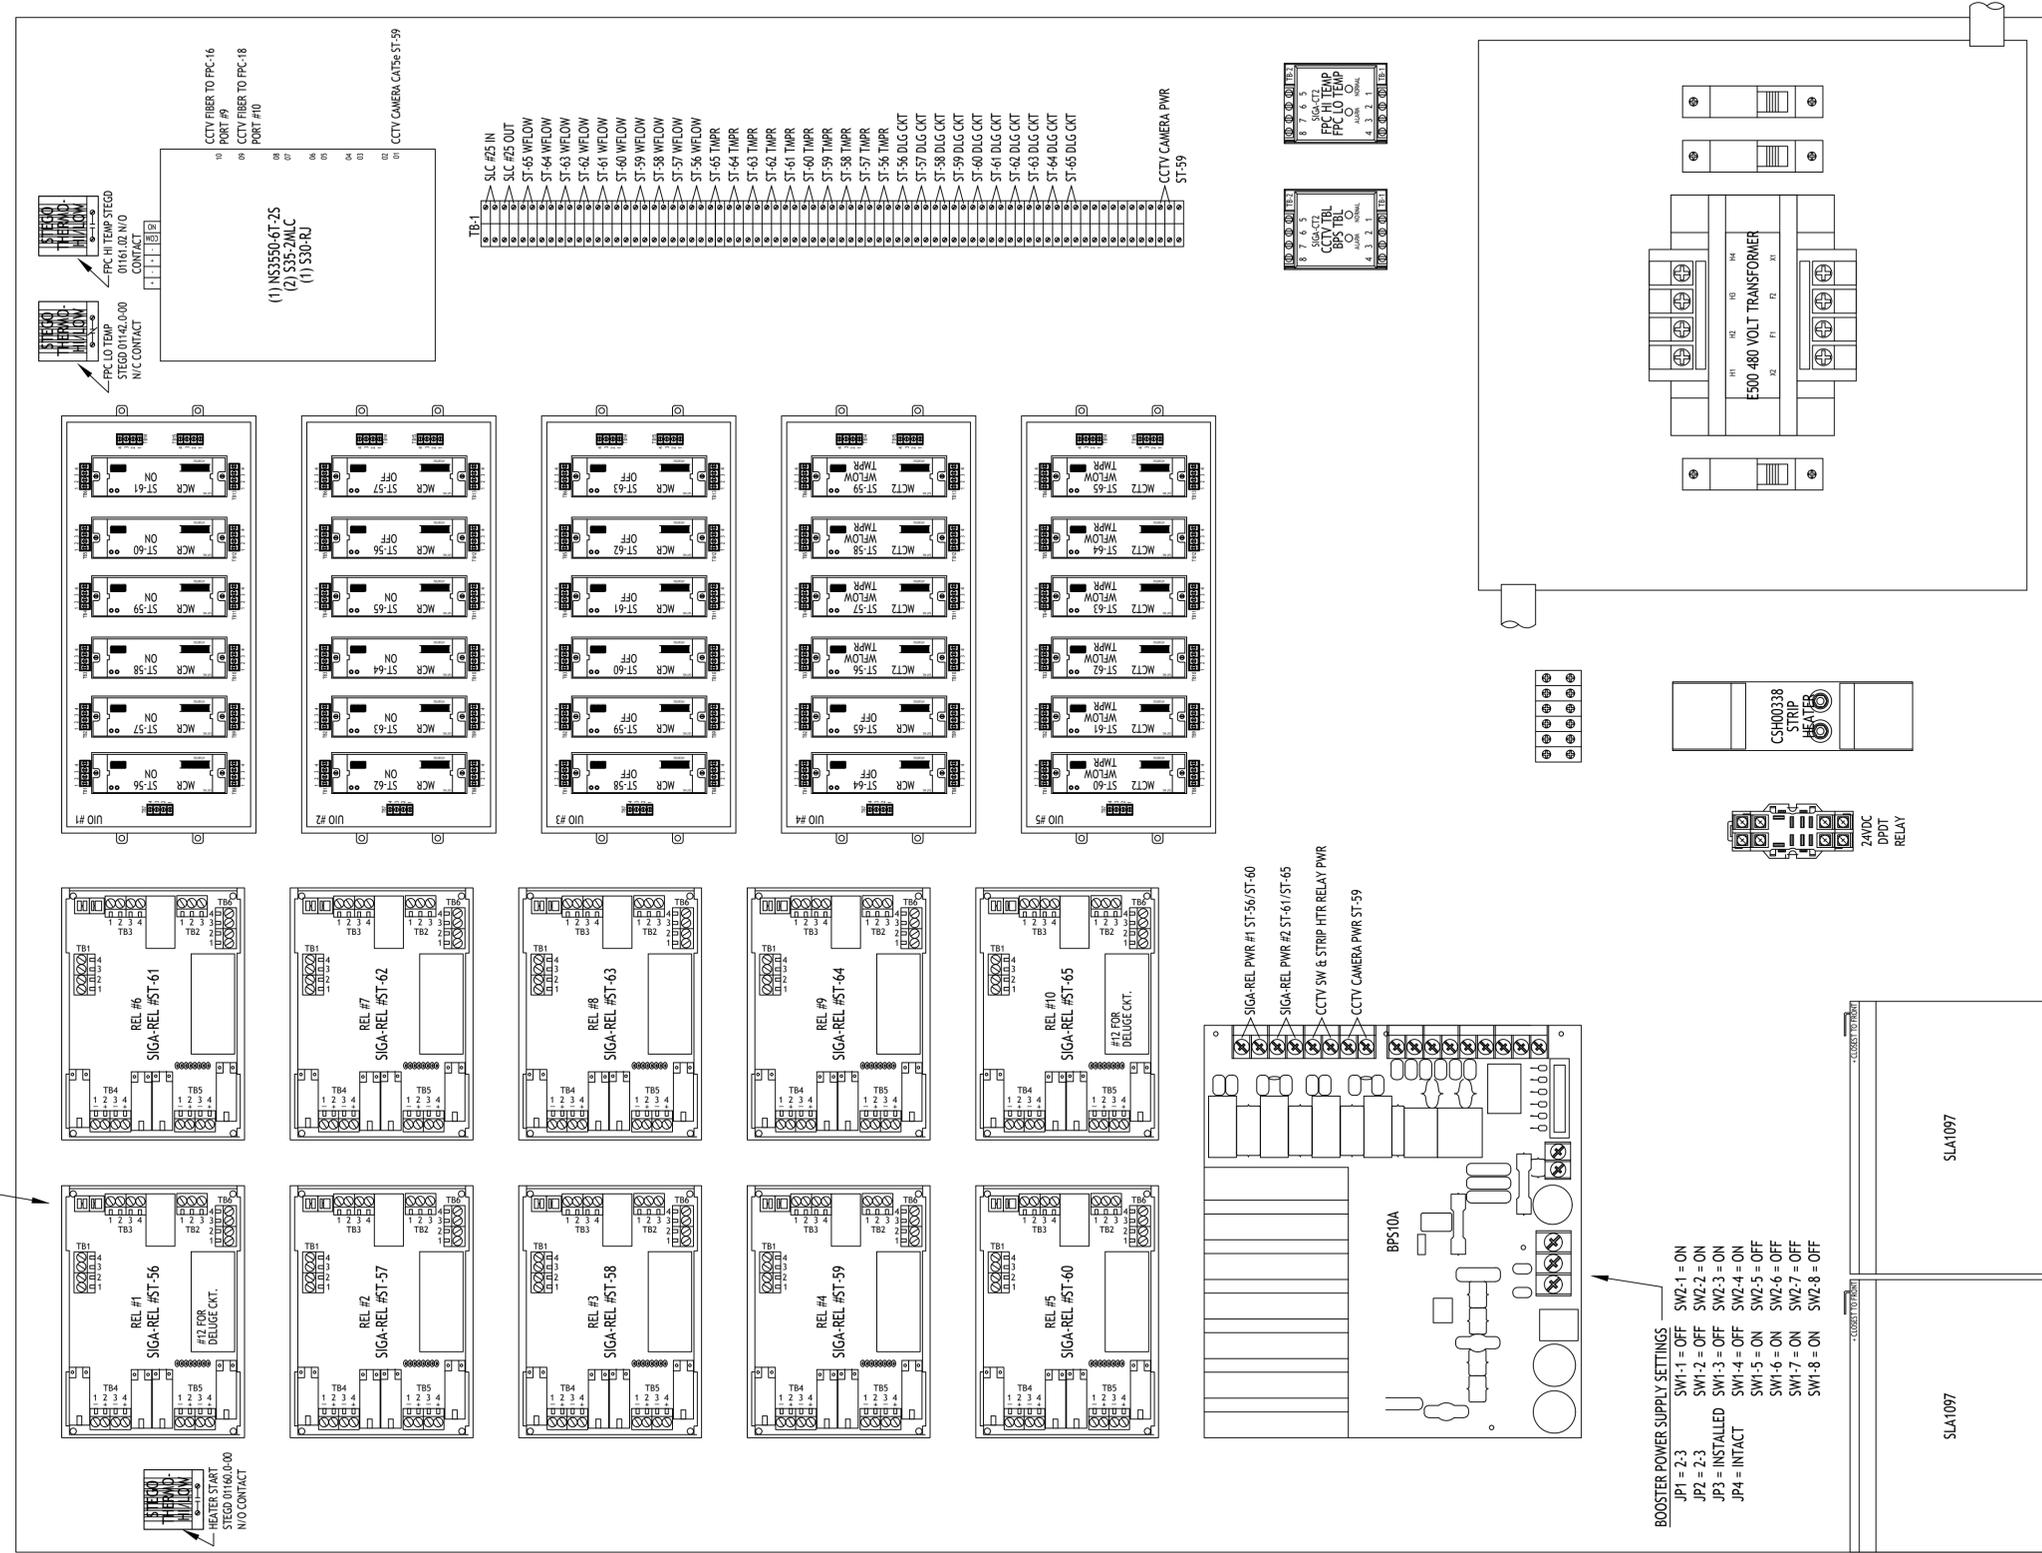

1 FPC #17 PANEL LAYOUT  
 SCALE: 1/2" SCALE

ADDRESSES = 0702XXXX

PANEL LAYOUT FOR FPC #17  
 EASTER OWENS NEMA 4X ENCLOSURE #41-50SF  
 SHOWN AT HALF SCALE (ACTUAL SIZE: 36" W x 48" H)

EISENHOWER/JOHNSON  
 MEMORIAL TUNNEL  
 FIXED FIRE SUPPRESSION SYSTEM  
 DESIGN BUILD PROJECT

Project No. C0703-360 Subaccount 17810  
 RECORD DRAWINGS - 2015-11-16

Revisions	Num	Description	Date

FIRE ALARM:  
 FIRE PROTECTION PANEL  
 FPC #17 WIRING DIAGRAM  
 Drawing Number  
**FA5.17**


**BARNARD EJMT TEAM**

BCER  
 BARNARD  
 Sturgeon ELECTRIC  
 RONDINELLI  
 Western States Fire Protection Co.  
 Western States Fire Protection Co. ENGINEERS



IF THIS SHEET IS NOT 22"x34" IT IS NOT PLOTTED TO SCALE

TYPICAL SIGA-REL SWITCH SETTINGS  
 SW1 = OFF SW5 = OFF  
 SW2 = OFF SW6 = OFF  
 SW3 = OFF SW7 = OFF  
 SW4 = OFF SW8 = OFF

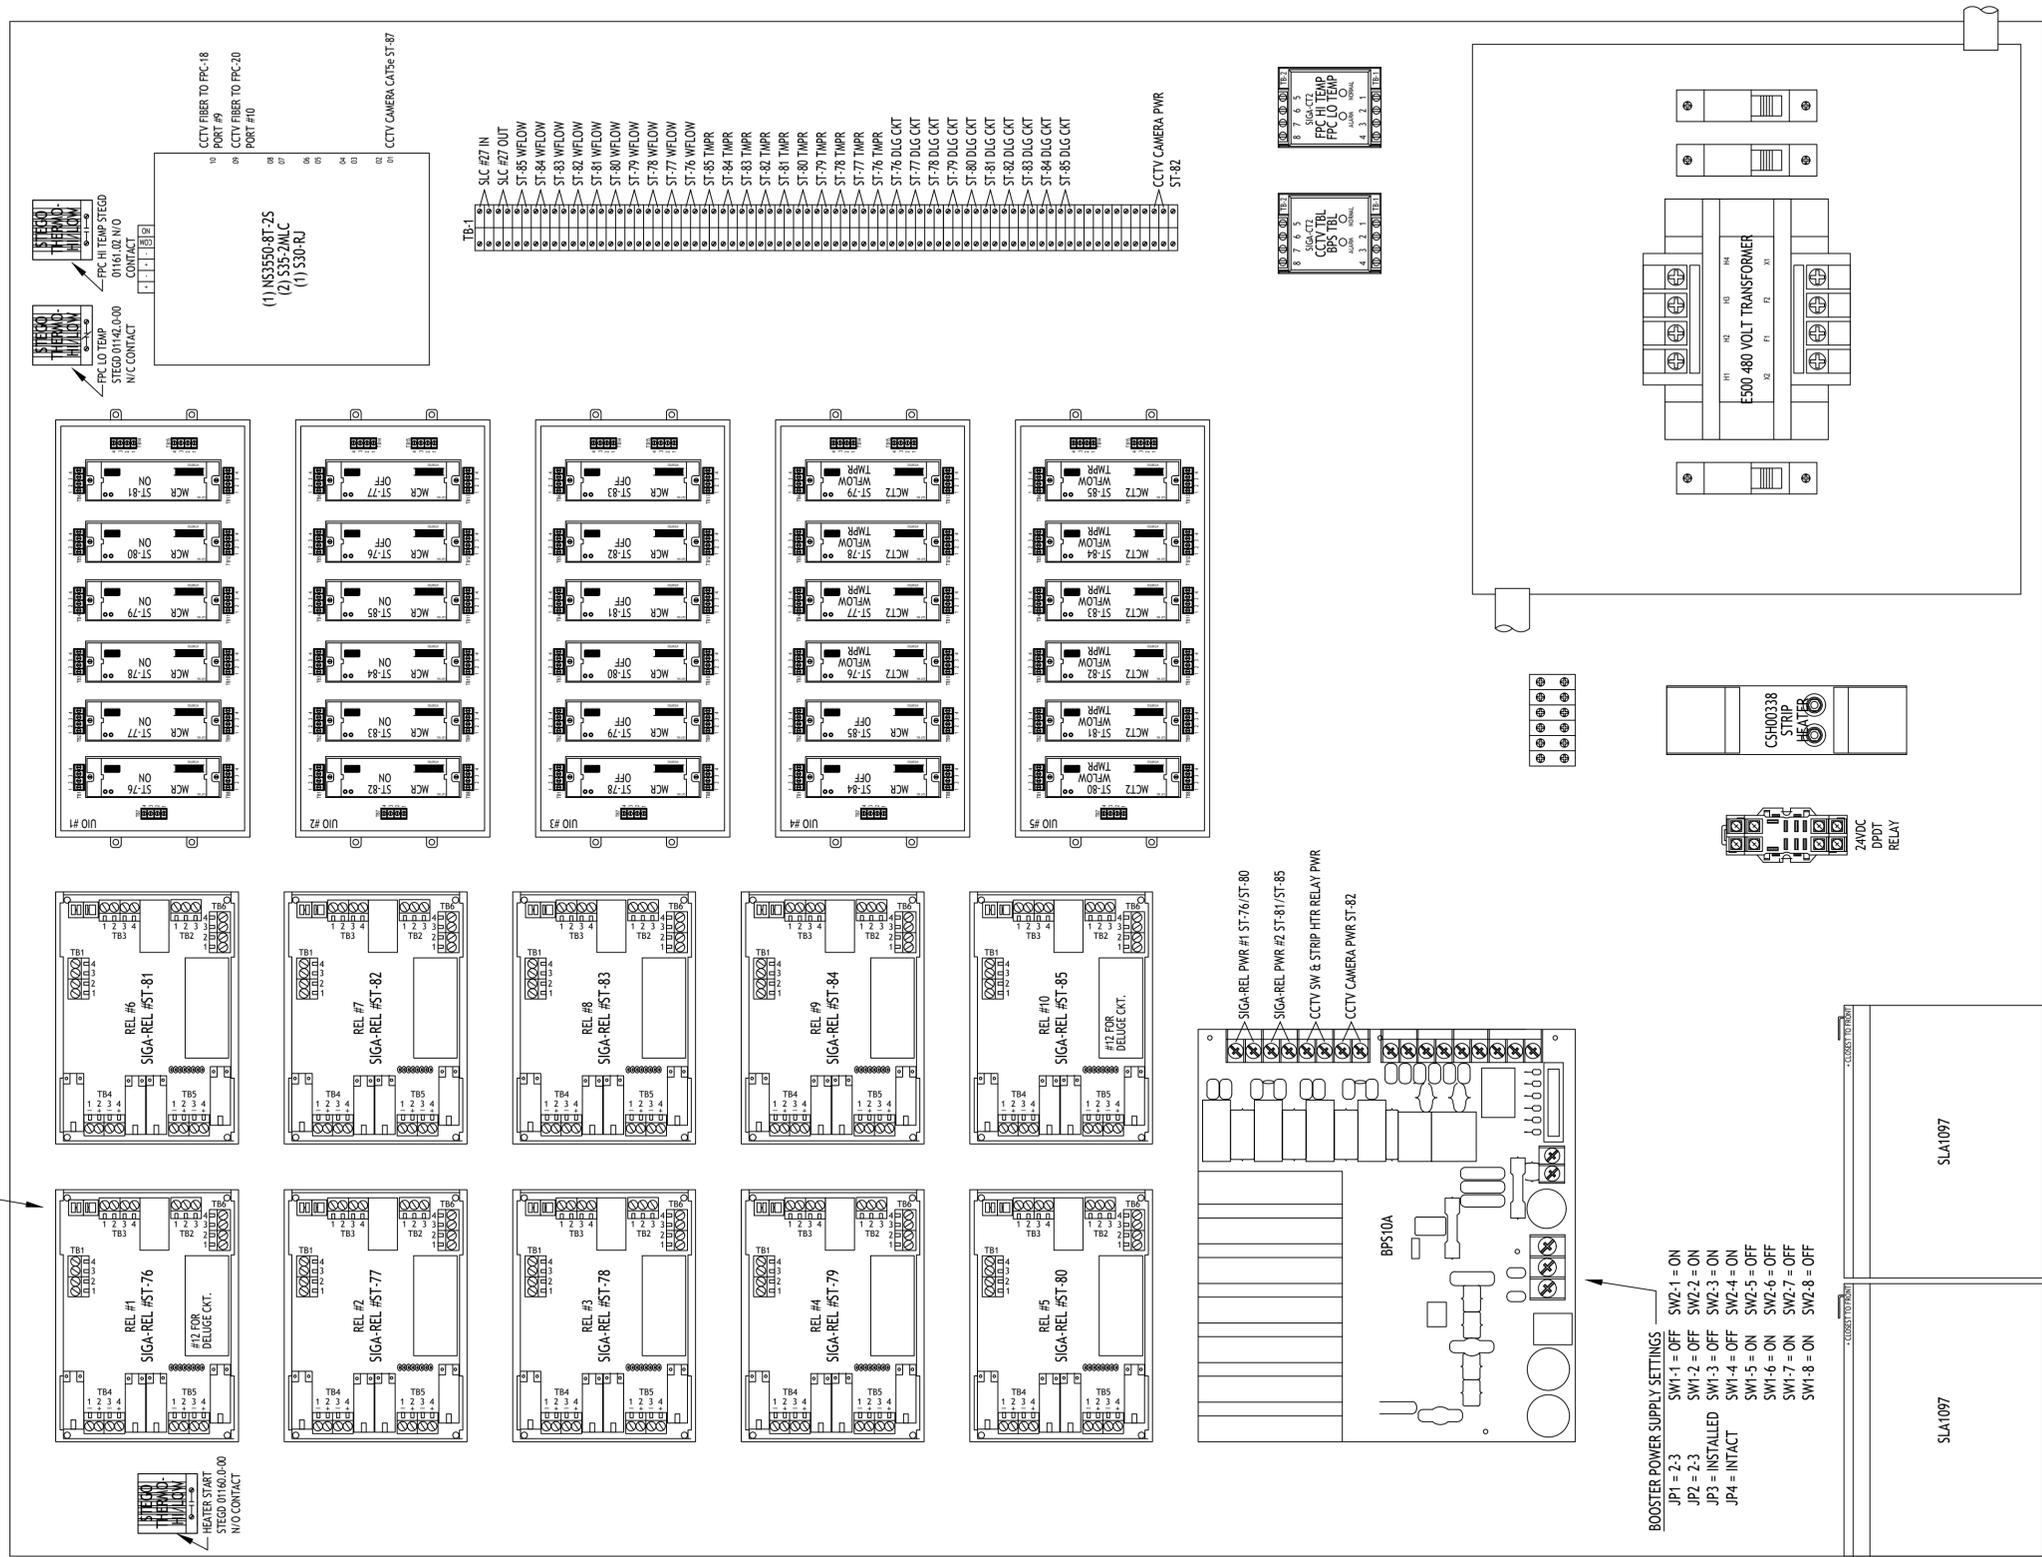

1 FPC #19 PANEL LAYOUT  
 SCALE: 1/2" SCALE

ADDRESSES = 0703XXXX

PANEL LAYOUT FOR FPC #19  
 EASTER OWENS NEMA 4X ENCLOSURE #41-50SF  
 SHOWN AT HALF SCALE (ACTUAL SIZE: 36" W x 48" H)

EISENHOWER/JOHNSON  
 MEMORIAL TUNNEL  
 FIXED FIRE SUPPRESSION SYSTEM  
 DESIGN BUILD PROJECT  
 Project No. C0703-360 Subaccount 17810  
 RECORD DRAWINGS - 2015-11-15

**BARNARD EJMT TEAM**


BCER **BARNARD** **STURGEON** **RONDINELLI**  
 Western States Fire Protection Co.  
 CONSULTING ENGINEERS

Revisions	Num	Description	Date

FIRE ALARM:  
 FIRE PROTECTION PANEL  
 FPC #19 WIRING DIAGRAM  
 Drawing Number  
**FA5.19**




IF THIS SHEET IS NOT 22"x34" IT IS NOT PLOTTED TO SCALE

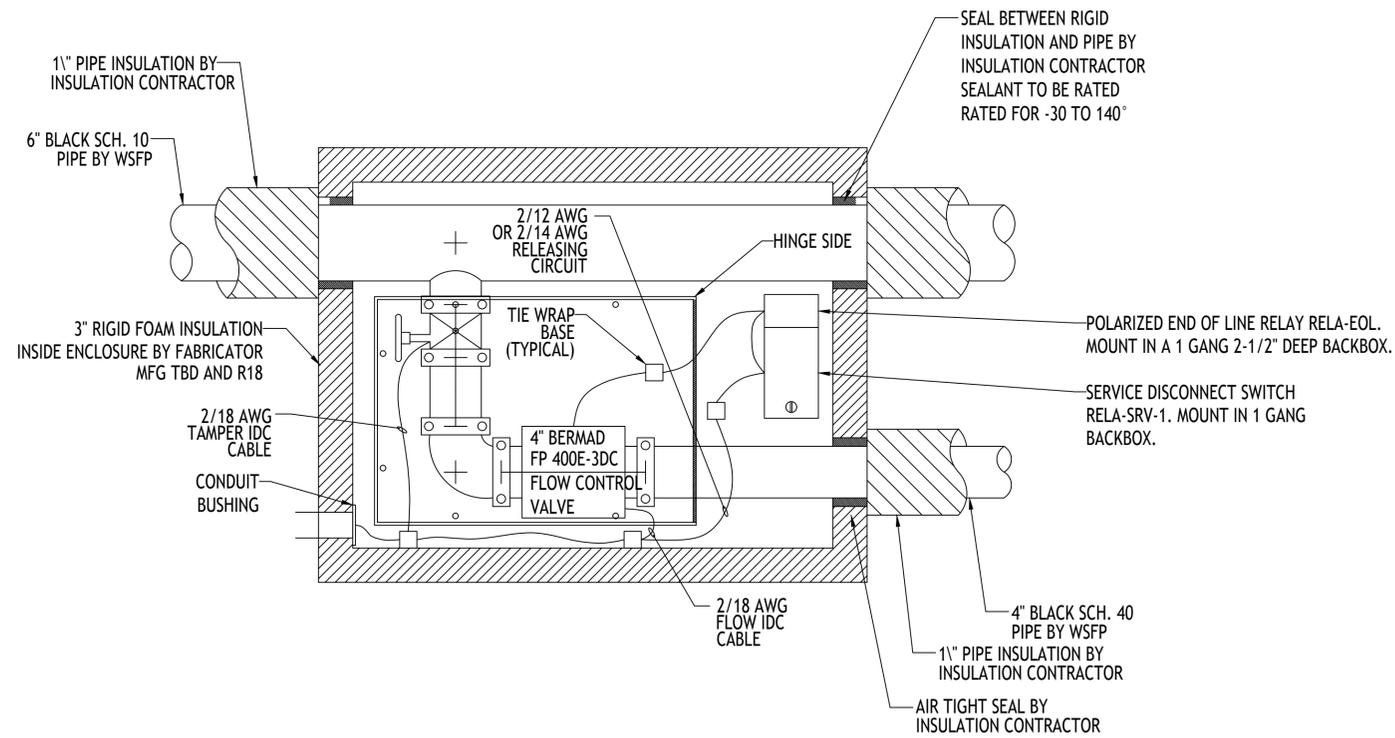

1 IVE CABINET - FRONT VIEW  
SCALE: N.T.S.

PINCH POINT THIS EDGE OF ENCLOSURE IS CLOSE TO CURVED TUNNEL WALL AND CAN NOT BE INCREASED TO ALLOW FOR INSTALLATION

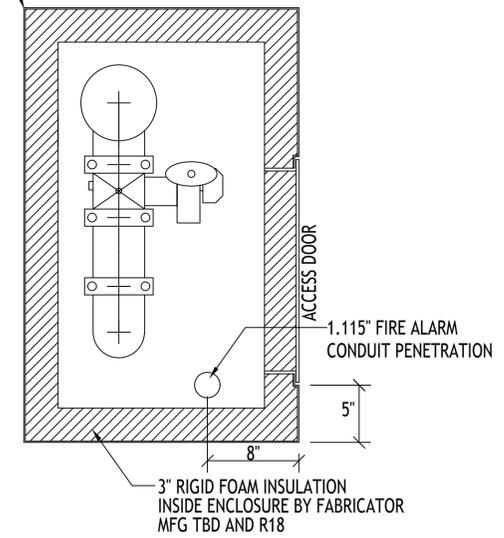

2 IVE CABINET - SIDE VIEW  
SCALE: N.T.S.

**BARNARD EJMT TEAM**

**BCER** *consulting engineers*

**BARNARD**

**STURGEON ELECTRIC**

**RONDINELLI** *A fire alarm life safety*

**Western States Fire Protection Co.**

**ELF** CONSULTING ENGINEERS

**EISENHOWER/JOHNSON MEMORIAL TUNNEL**  
FIXED FIRE SUPPRESSION SYSTEM  
DESIGN BUILD PROJECT

Project No. C0703-360 Subaccount 17810  
**RECORD DRAWINGS - 2015-11-16**

Num	Revisions	Description	Date

FIRE ALARM:  
IVE CABINET DETAILS

Drawing Number  
**FA5.21**

DRAWN BY: B.T.L. | CHECKED BY: AEE-JR

















IF THIS SHEET IS NOT 22"x34" IT IS NOT PLOTTED TO SCALE

00.00"

00.00"

38.50"

38.50"

38.50"

38.50"

77.00"

77.00"

44U BLANK PANEL

44U BLANK PANEL

MIDDLE ATLANTIC EQUIPMENT RACK WRK-44SA-32LRD  
OVERALL DIMENSIONS ARE: 22-3/8"(W) x 32-5/8"(D) x 83-1/8"(H)  
USEABLE DIMENSIONS ARE: 19-1/2"(W) x 30-3/4"(D) x 77-1/8"(H)  
EAST CONTROL ROOM - RACK #2  
FRONT VIEW



EAST CONTROL ROOM - RACK #2 - FRONT VIEW  
SCALE: 1/2

CONTINUED ON THIS SHEET CONT'D

CONTINUED

CONTINUED ON THIS SHEET CONT'D

CONTINUED ON THIS SHEET CONT'D

CONTINUED

CONT'D

CONTINUED ON THIS SHEET

CONTINUED ON THIS SHEET CONT'D

CONTINUED

CONTINUED ON THIS SHEET CONT'D

**BARNARD EJMT TEAM**

**BCER**  
BARNARD EJMT TEAM  
CONSULTING ENGINEERS

**BARNARD**

**BARNARD**

**RONDINELLI**  
A COMMITMENT TO SAFETY  
CONSULTING ENGINEERS

**STURGEON**  
ELECTRIC

Western States  
Fire Protection Co.



EISENHOWER/JOHNSON

MEMORIAL TUNNEL

FIXED FIRE SUPPRESSION SYSTEM

DESIGN BUILD PROJECT

Project No. C0703-360 Subaccount 17810

RECORD DRAWINGS - 2015-11-16

Revisions	Date
Num	Description

FIRE ALARM:  
DETAILS - EAST CONTROL  
RACK #2 - FRONT VIEW

Drawing Number

**FA6.05A**

DRAWN BY: B.T.L. | CHECKED BY: AEE-Jr















IF THIS SHEET IS NOT 22"x34" IT IS NOT PLOTTED TO SCALE

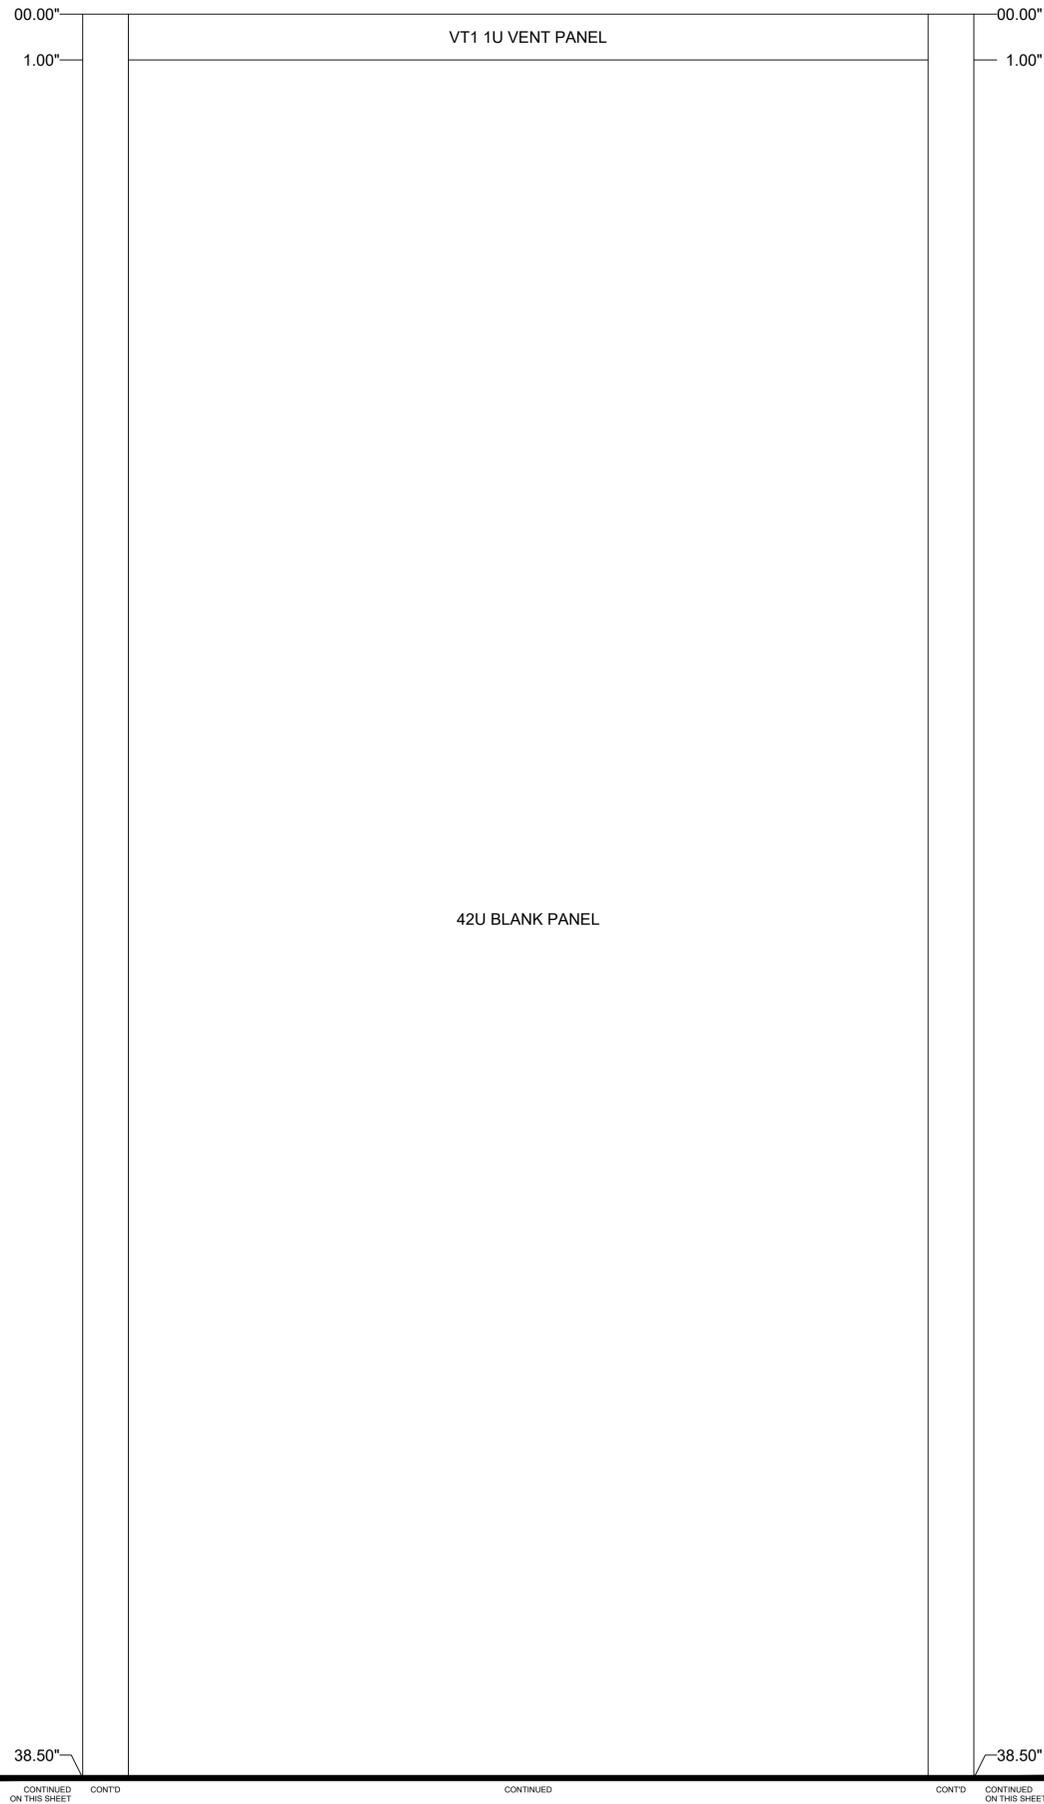

MIDDLE ATLANTIC EQUIPMENT RACK WRK-44SA-32  
 OVERALL DIMENSIONS ARE: 22-3/8"(W) x 32-5/8"(D) x 83-1/8"(H)  
 USEABLE DIMENSIONS ARE: 19-1/2"(W) x 30-3/4"(D) x 77-1/8"(H)  
 WEST CONTROL ROOM - RACK #1  
 REAR VIEW



WEST CONTROL ROOM - RACK #1 - REAR VIEW  
 SCALE: 1/2

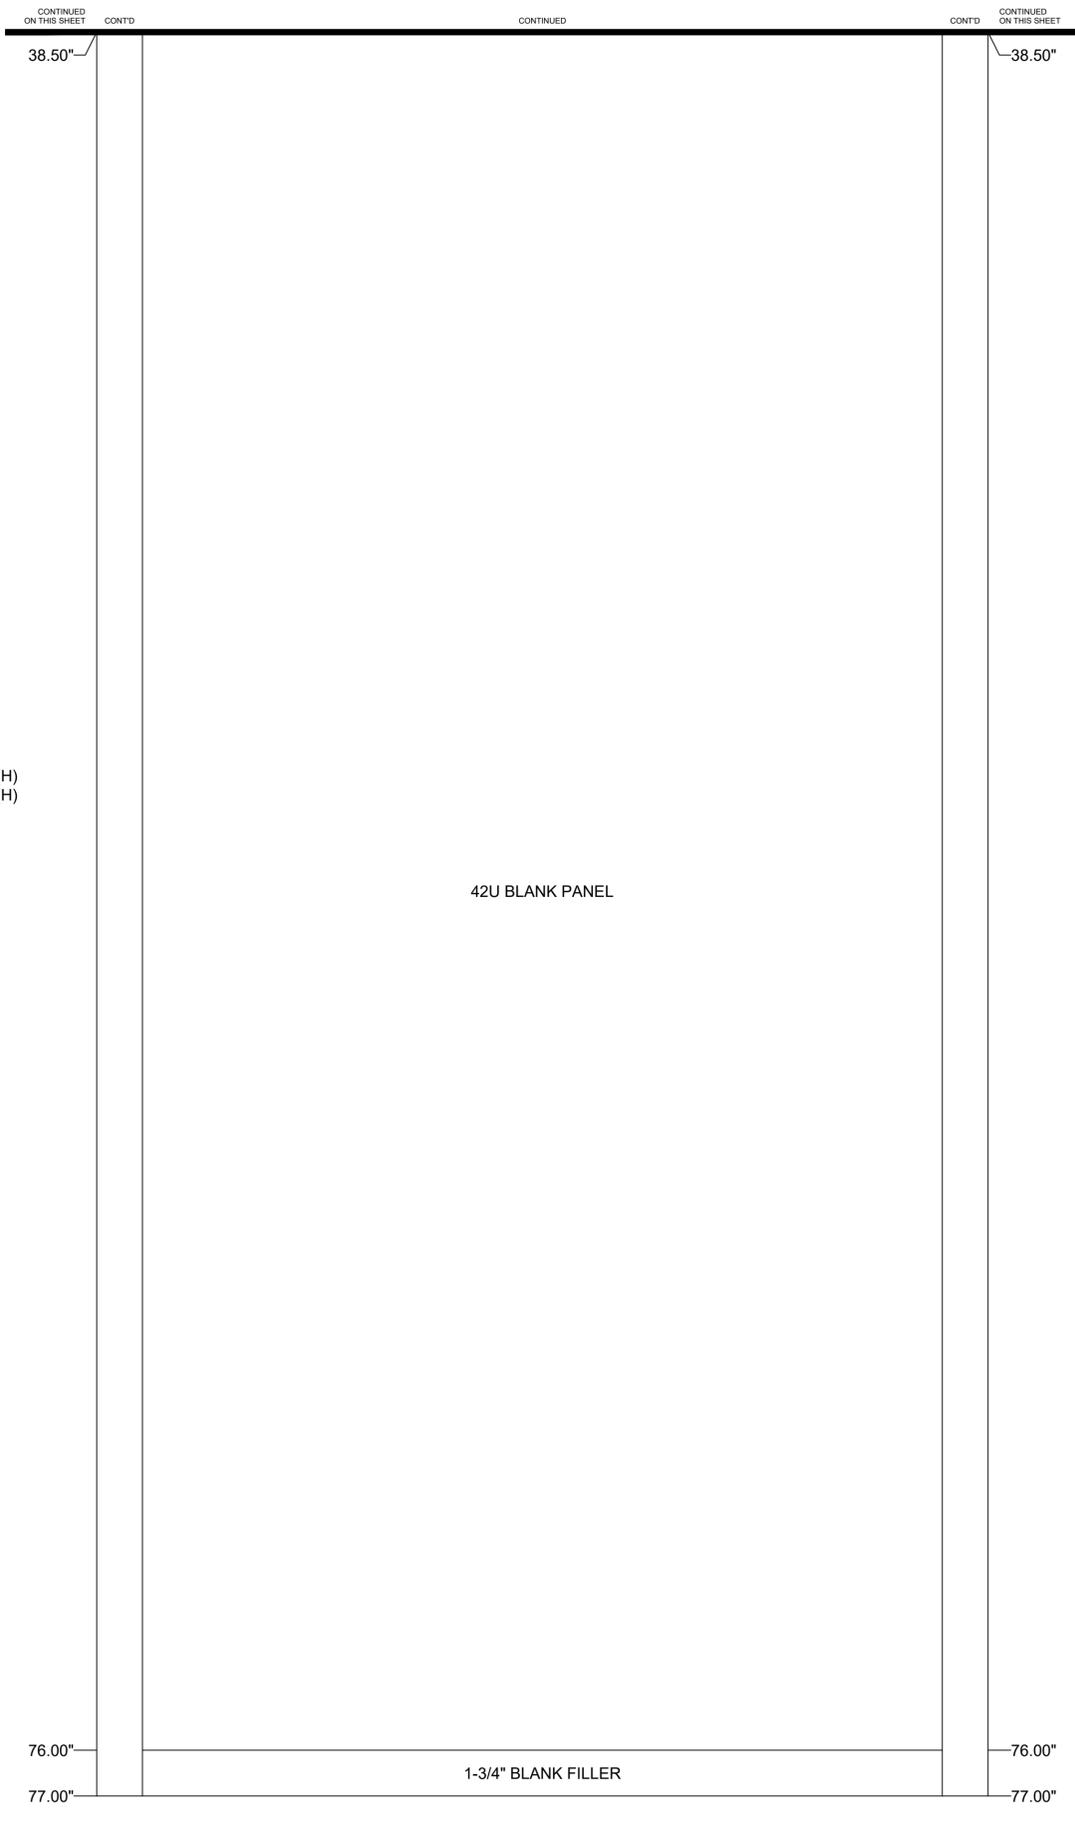

**EISENHOWER/JOHNSON**  
**MEMORIAL TUNNEL**  
 FIXED FIRE SUPPRESSION SYSTEM  
 DESIGN BUILD PROJECT  
 Project No. C0703-360 Subaccount 17810  
**RECORD DRAWINGS - 2015-11-16**

Revisions	Date
Num	Description

DRAWN BY: B.T.L. | CHECKED BY: AEE-Jr

FIRE ALARM:  
 DETAILS - WEST CONTROL  
 RACK #1 - REAR VIEW


Drawing Number  
**FA6.08A**

**BARNARD EJMT TEAM**


**BCER** **BARNARD** **RONDINELLI**  
*FOR THE ENGINEERING* *A COMMITMENT TO SAFETY*

**STURGEON ELECTRIC** **Western States Fire Protection Co.** **ALF CONSULTING ENGINEERS**

IF THIS SHEET IS NOT 22"x34" IT IS NOT PLOTTED TO SCALE

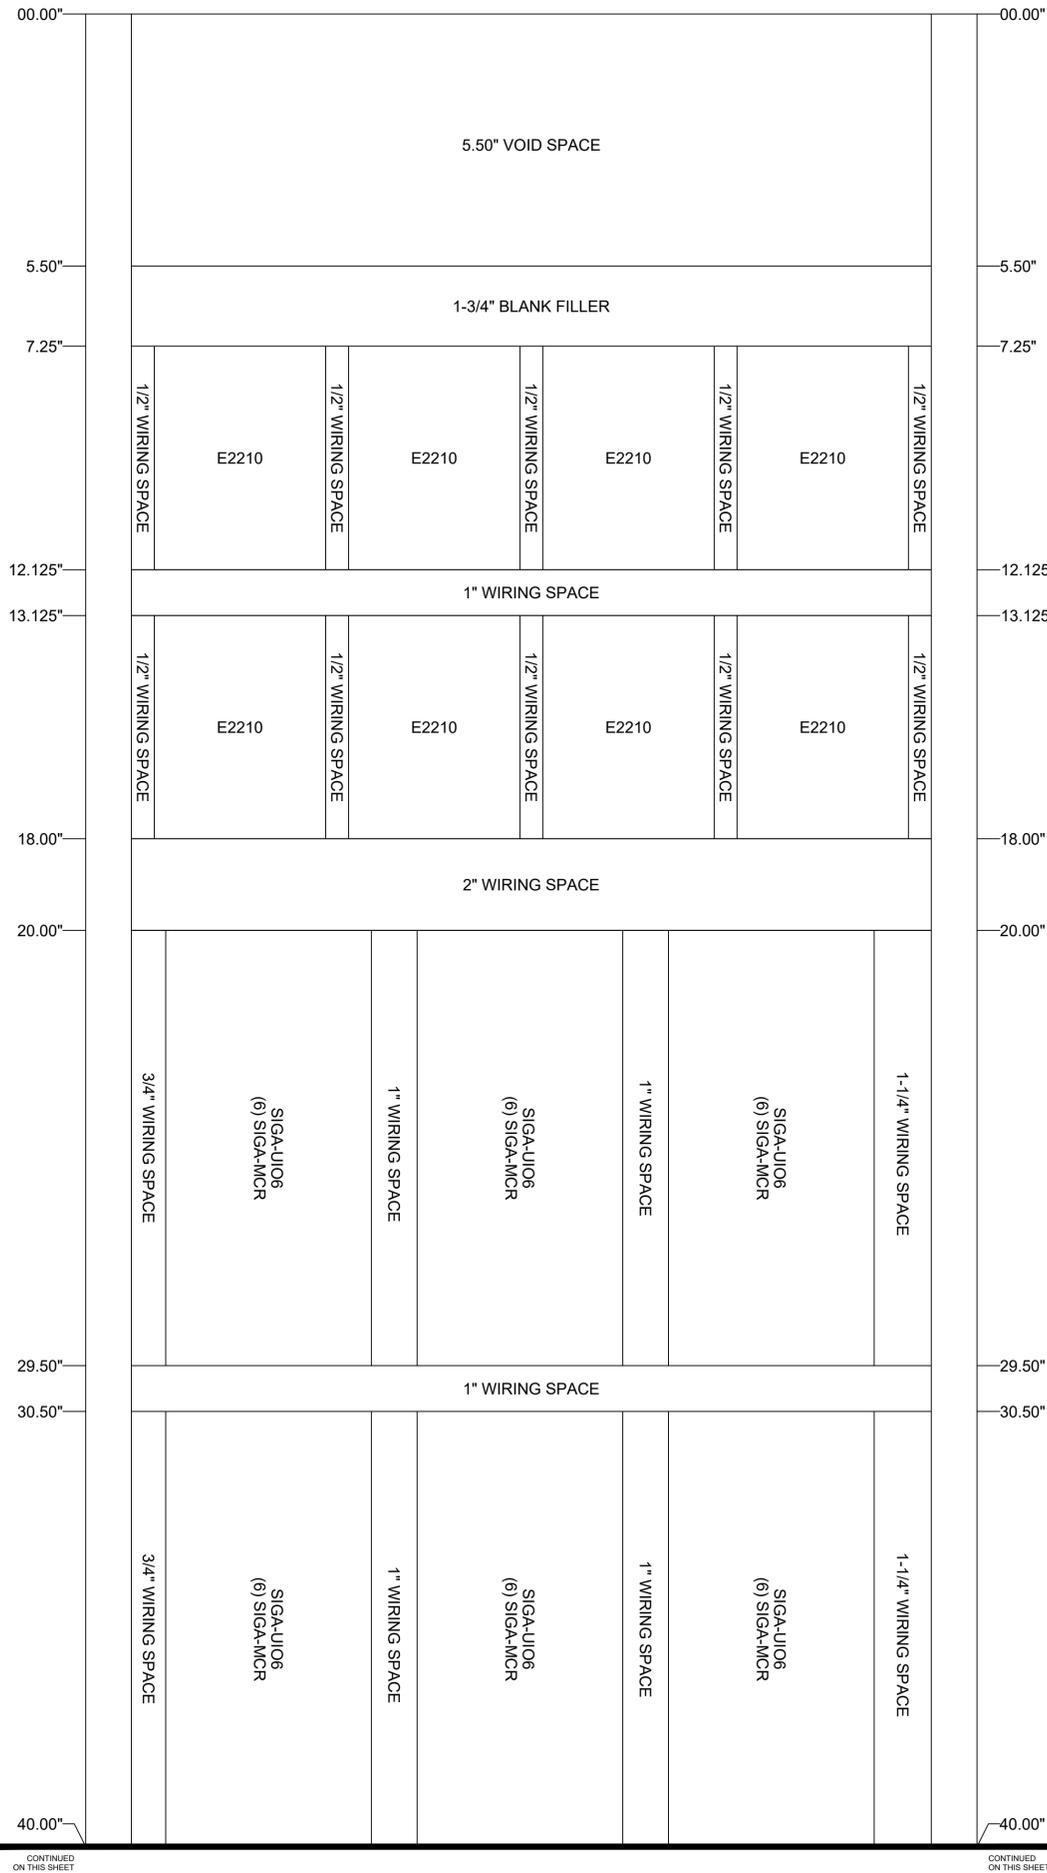

MIDDLE ATLANTIC EQUIPMENT RACK WRK-44SA-32LRD  
 OVERALL DIMENSIONS ARE: 22-3/8"(W) x 32-5/8"(D) x 83-1/8"(H)  
 USEABLE DIMENSIONS ARE: 19-1/2"(W) x 30-3/4"(D) x 77-1/8"(H)  
 WEST CONTROL ROOM - RACK #1  
 MID-REAR VIEW  
 (6" SET BACK FROM FRONT MODULE LEVEL)

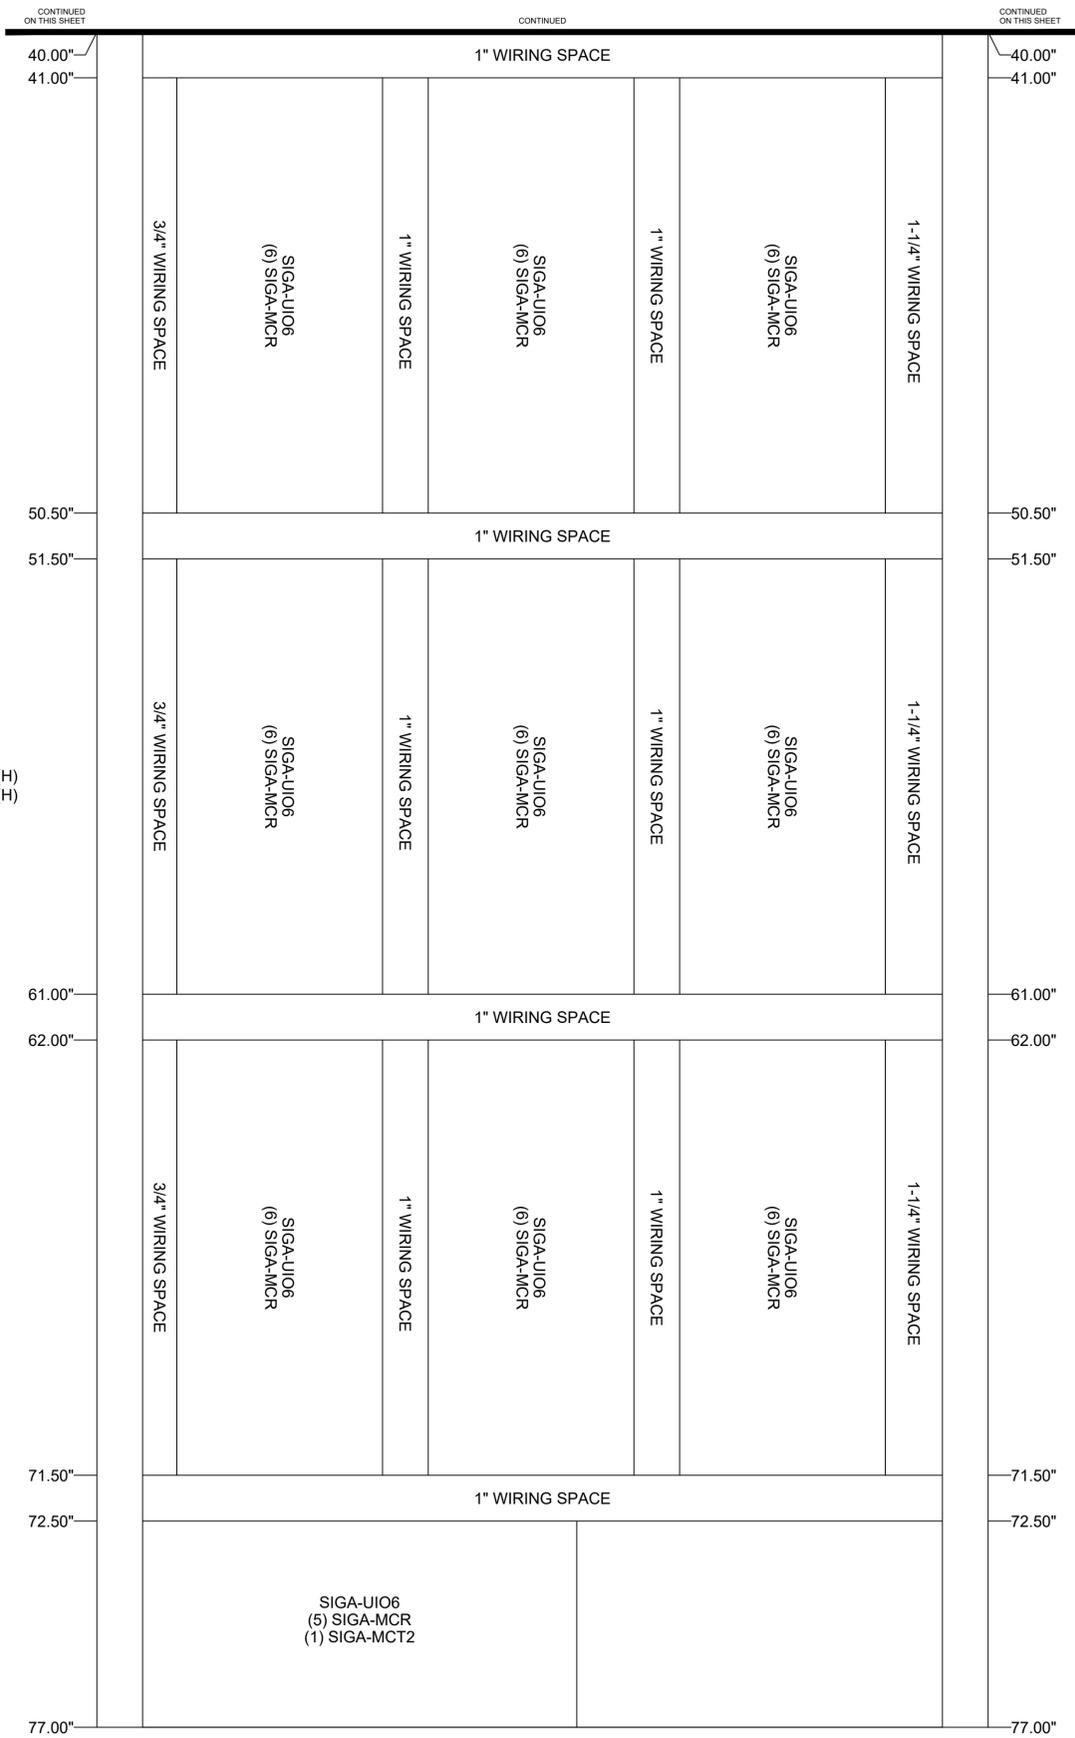

**EISENHOWER/JOHNSON**  
**MEMORIAL TUNNEL**  
 FIXED FIRE SUPPRESSION SYSTEM  
 DESIGN BUILD PROJECT

**BARNARD EJMT TEAM**

**BCER** **BARNARD** **RONDINELLI**  
*A TEAM WITH YOUR LIFE SAFETY*  
**Sturgeon Electric** **Western States Fire Protection Co.** **ALF CONSULTING ENGINEERS**

Revisions	Date
Num	Description

FIRE ALARM:  
 DETAILS - WEST CONTROL  
 RACK #1 - MID-REAR VIEW

Drawing Number  
**FA6.08B**

Project No. C0703-360 Subaccount 17810  
**RECORD DRAWINGS - 2015-11-16**

DRAWN BY: B.T.L. CHECKED BY: AEE-JF

IF THIS SHEET IS NOT 22"x34" IT IS NOT PLOTTED TO SCALE

00.00"

00.00"

CONTINUED ON THIS SHEET  
38.50"

CONTINUED

CONTINUED ON THIS SHEET  
38.50"

44U BLANK PANEL

MIDDLE ATLANTIC EQUIPMENT RACK WRK-44SA-32LRD  
OVERALL DIMENSIONS ARE: 22-3/8"(W) x 32-5/8"(D) x 83-1/8"(H)  
USEABLE DIMENSIONS ARE: 19-1/2"(W) x 30-3/4"(D) x 77-1/8"(H)  
WEST CONTROL ROOM - RACK #2  
FRONT VIEW



WEST CONTROL ROOM - RACK #2 - FRONT VIEW  
SCALE: 1/2

44U BLANK PANEL

38.50"

38.50"

77.00"

77.00"

**BARNARD EJMT TEAM**

**BCER** **BARNARD** **RONDINELLI**  
WESTERN STATES FIRE PROTECTION CO.



EISENHOWER/JOHNSON

MEMORIAL TUNNEL

FIXED FIRE SUPPRESSION SYSTEM

DESIGN BUILD PROJECT

Project No. C0703-360 Subaccount 17810

RECORD DRAWINGS - 2015-11-16

Revisions	Description	Date

FIRE ALARM:  
DETAILS - WEST CONTROL  
RACK #2 - FRONT VIEW

Drawing Number

**FA6.09A**

DRAWN BY: B.T.L. | CHECKED BY: AEE-Jr























IF THIS SHEET IS NOT 22"x34" IT IS NOT PLOTTED TO SCALE

SEE SHEET  
FA6.16

SEE SHEET  
FA6.16

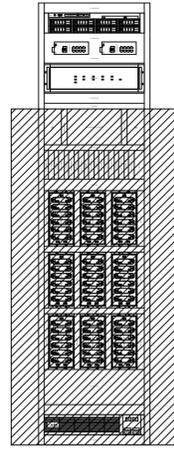

1 EAST CONTROL ROOM - RACK #1 - FRONT VIEW - KEY PLAN  
SCALE: 1 : 16

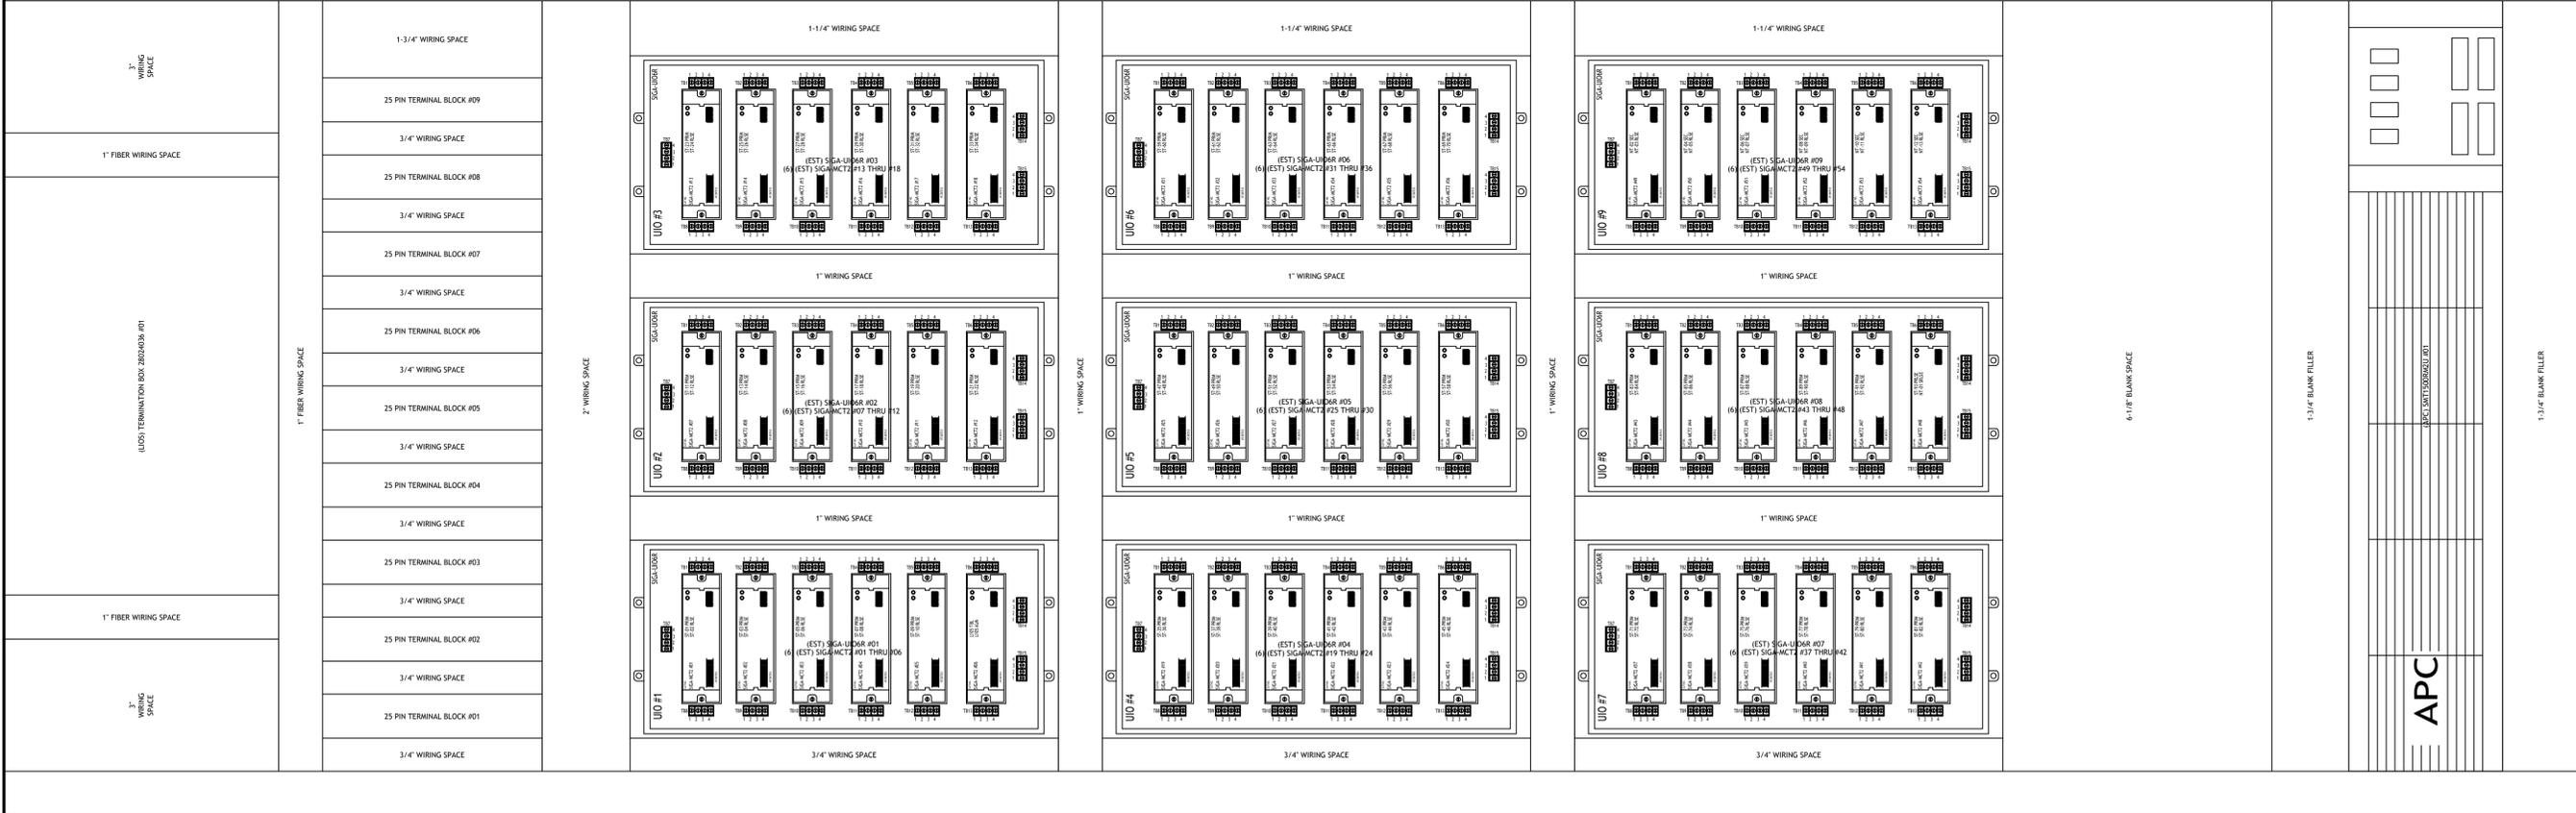

1 EAST CONTROL ROOM - RACK #1 - FRONT VIEW - BOTTOM SECTION  
SCALE: 1 : 2

**EISENHOWER/JOHNSON**  
**MEMORIAL TUNNEL**  
 FIXED FIRE SUPPRESSION SYSTEM  
 DESIGN BUILD PROJECT

**BARNARD EJMT TEAM**

**BCER** INCORPORATED *engineering*  
**BARNARD**  
**RONDINELLI** A LIFE SAVING TECHNOLOGY  
**STURGEON** ELECTRIC  
 Western States Fire Protection Co.  
 CONSULTING ENGINEERS

Revisions	Date	Description

FIRE ALARM:  
 DETAILS-EAST CNTRL-RACK  
 #1-WIRE-FRONT-BOTTOM

Drawing Number  
**FA6.17**

Project No. C0703-360 Subaccount 17810  
 RECORD DRAWINGS - 2015-11-16

DRAWN BY: B.T.L. | CHECKED BY: AEE-JF






IF THIS SHEET IS NOT 22"x34" IT IS NOT PLOTTED TO SCALE




EAST CONTROL ROOM - RACK #1 - REAR VIEW - KEY PLAN  
SCALE: 1 : 16

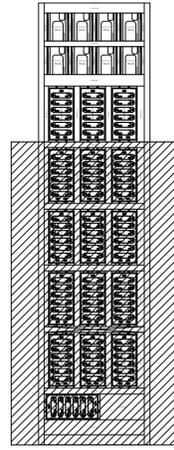

SEE SHEET  
FA6.18

SEE SHEET  
FA6.18

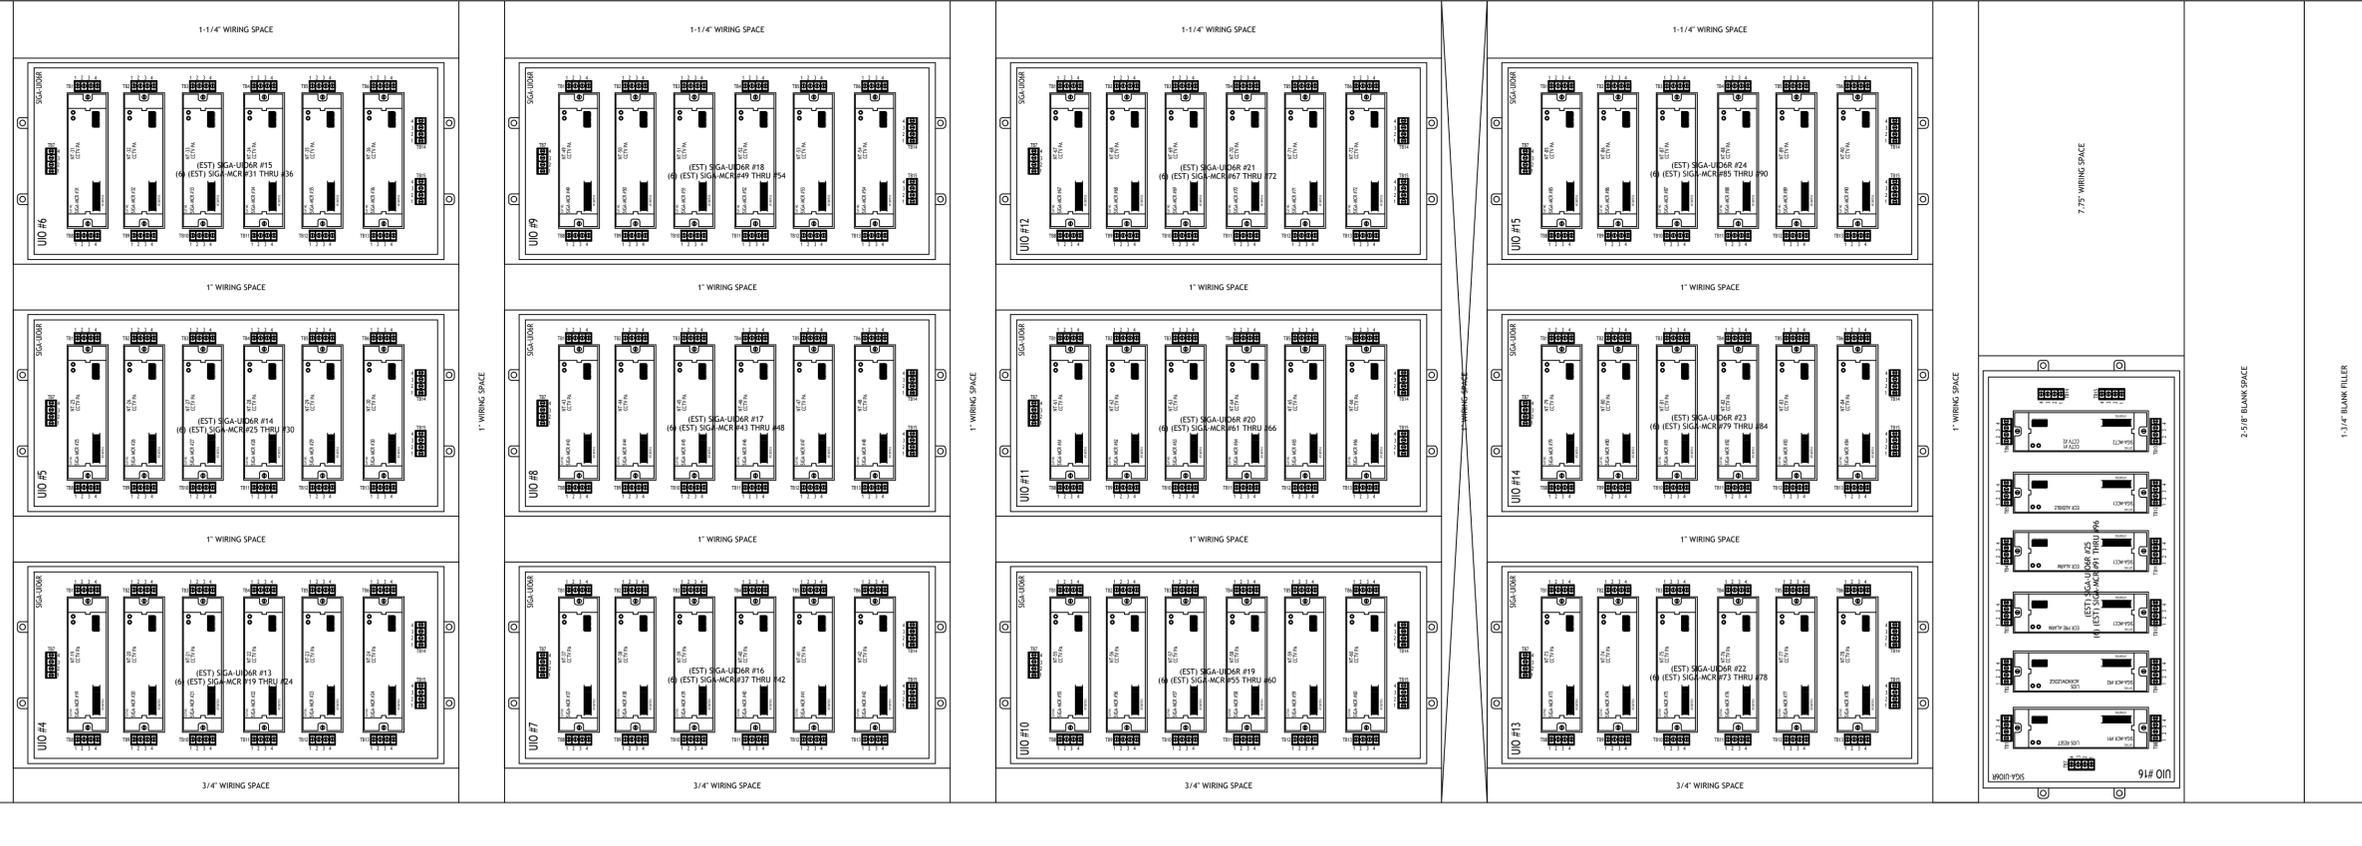

EAST CONTROL ROOM - RACK #1 - REAR VIEW - BOTTOM SECTION  
SCALE: 1 : 2

MIDDLE ATLANTIC EQUIPMENT RACK WRK-445A-32  
OVERALL DIMENSIONS ARE: 22-3/8" (W) x 32-5/8" (D) x 83-1/8" (H)  
USEABLE DIMENSIONS ARE: 19-1/2" (W) x 30-3/4" (D) x 77-1/8" (H)  
EAST CONTROL ROOM - RACK #1  
REAR VIEW - BOTTOM SECTION

EISENHOWER/JOHNSON  
MEMORIAL TUNNEL  
FIXED FIRE SUPPRESSION SYSTEM  
DESIGN BUILD PROJECT

Project No. C0703-360 Subaccount 17810  
RECORD DRAWINGS - 2015-11-16

Revisions	Date
Num	Description

FIRE ALARM:  
DETAILS-EAST CNTRL-RACK  
#1-WIRE-REAR-BOTTOM

Drawing Number

FA6.19



DRAWN BY: B.T.L. CHECKED BY: AEE-JF

**BARNARD EJMT TEAM**

BCER  
BARNARD  
RONDINELLI  
Sturgeon ELECTRIC  
Western States Fire Protection Co.  
ALF  
ENGINEERS

IF THIS SHEET IS NOT 22"x34" IT IS NOT PLOTTED TO SCALE

1 EAST CONTROL ROOM - RACK #2 - FRONT VIEW - KEY PLAN  
SCALE: 1 : 16

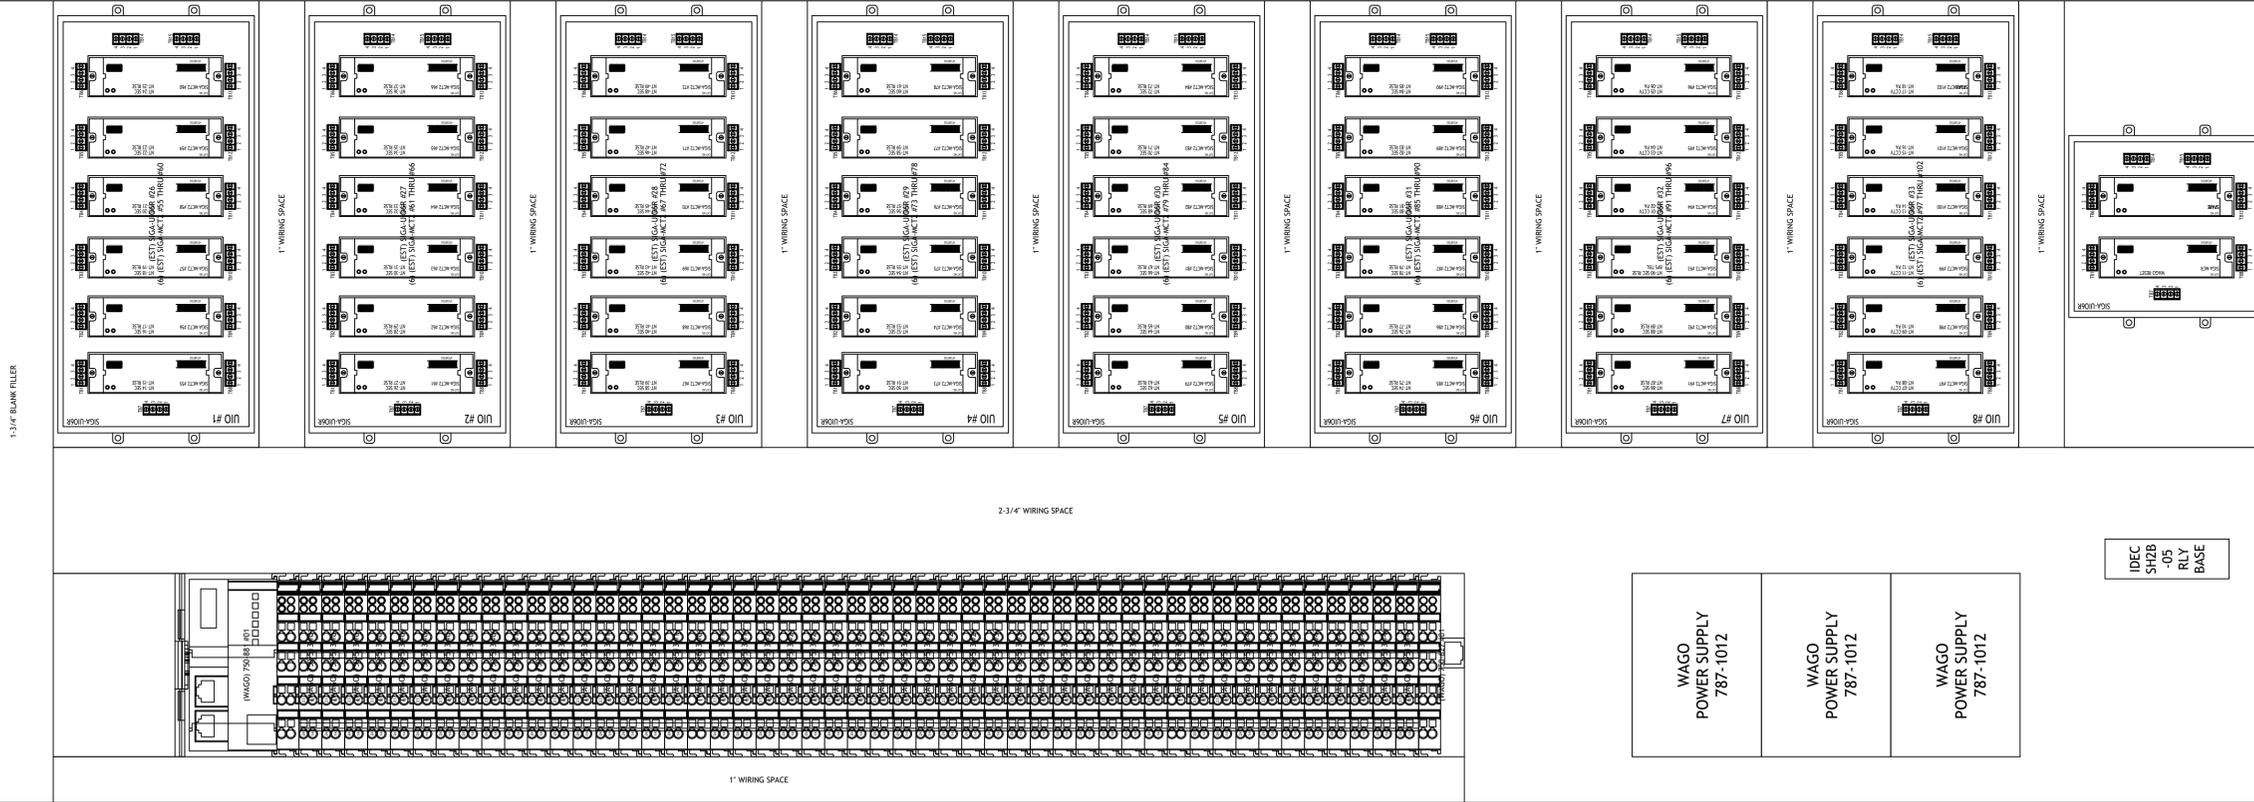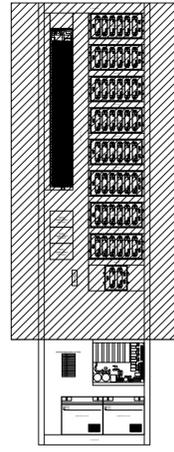

MIDDLE ATLANTIC EQUIPMENT RACK WRK-445A-32  
OVERALL DIMENSIONS ARE: 22-3/8" (W) x 32-5/8" (D) x 83-1/8" (H)  
USEABLE DIMENSIONS ARE: 19-1/2" (W) x 30-3/4" (D) x 77-1/8" (H)  
EAST CONTROL ROOM - RACK #2  
FRONT VIEW - TOP SECTION

2 EAST CONTROL ROOM - RACK #2 - FRONT VIEW - TOP SECTION  
SCALE: 1 : 2

SEE SHEET  
FA6.21

**EISENHOWER/JOHNSON**  
**MEMORIAL TUNNEL**  
FIXED FIRE SUPPRESSION SYSTEM  
DESIGN BUILD PROJECT

Project No. C0703-360 Subaccount 17810  
**RECORD DRAWINGS - 2015-11-16**

Revisions	Date
Num	Description

FIRE ALARM:  
DETAILS-EAST CNTRL-RACK  
#2-WIRE-FRONT-TOP

Drawing Number

**FA6.20**

DRAWN BY: B.T.L. | CHECKED BY: AEE-JT

SEE SHEET  
FA6.21

**BARNARD EJMT TEAM**

**BCER** *electrical engineering*

**BARNARD**

**RONDINELLI**  
*A fire is only as safe as the life safety*

**Sturgeon** **ELECTRIC**

**Western States**  
Fire Protection Co.

**ELF**  
CONSULTING  
ENGINEERS











IF THIS SHEET IS NOT 22"x34" IT IS NOT PLOTTED TO SCALE

SEE SHEET  
FA6.24

SEE SHEET  
FA6.24

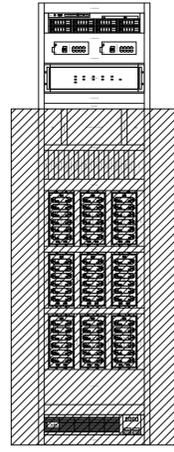

1 WEST CONTROL ROOM - RACK #1 - FRONT VIEW - KEY PLAN  
SCALE: 1 : 16

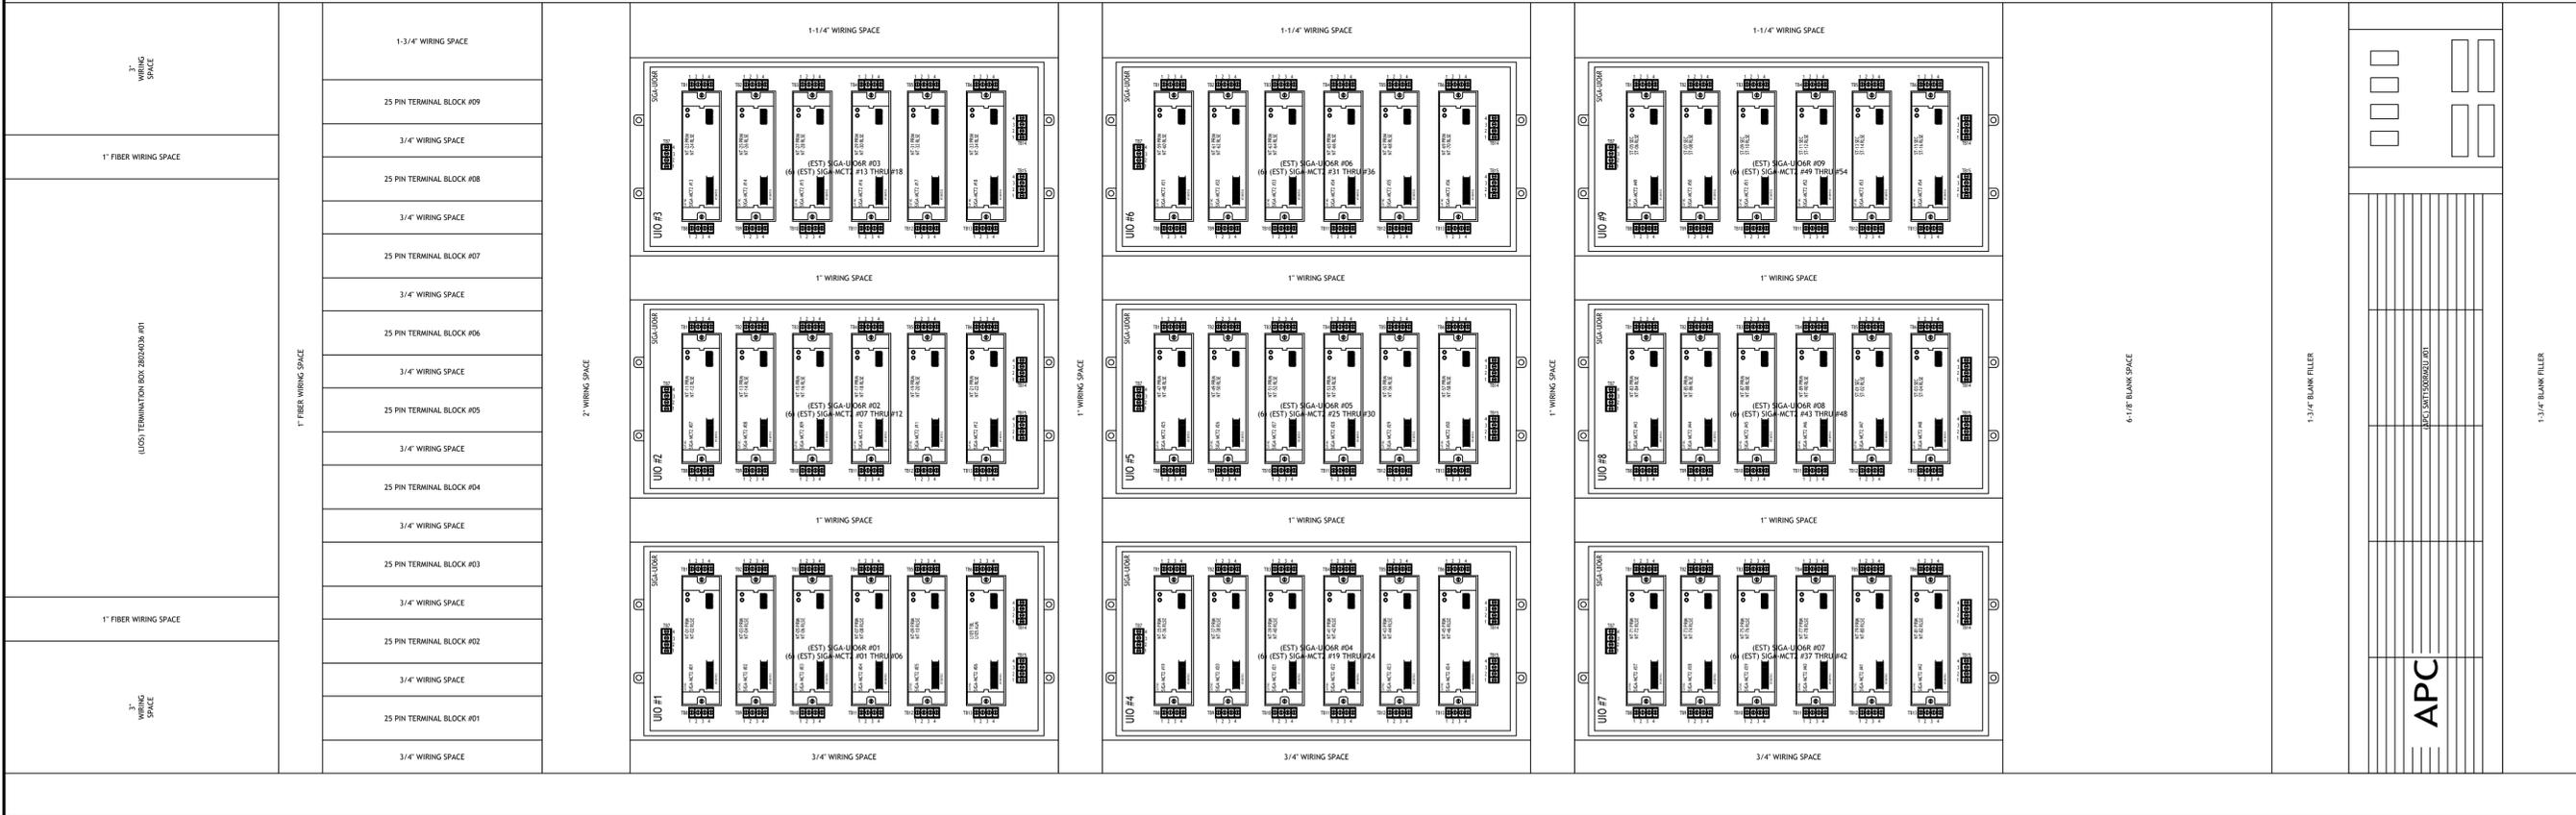

MIDDLE ATLANTIC EQUIPMENT RACK WRK-445A-32  
OVERALL DIMENSIONS ARE: 22-3/8\"(W) x 32-5/8\"(D) x 83-1/8\"(H)  
USEABLE DIMENSIONS ARE: 19-1/2\"(W) x 30-3/4\"(D) x 77-1/8\"(H)  
WEST CONTROL ROOM - RACK #1  
FRONT VIEW - BOTTOM SECTION

1 WEST CONTROL ROOM - RACK #1 - FRONT VIEW - BOTTOM SECTION  
SCALE: 1 : 2

EISENHOWER/JOHNSON  
MEMORIAL TUNNEL  
FIXED FIRE SUPPRESSION SYSTEM  
DESIGN BUILD PROJECT

BARNARD EJMT TEAM

BCER  
BARNARD  
RONDINELLI  
Sturgeon Electric  
Western States Fire Protection Co.  
ALF  
CONSULTING ENGINEERS

Revisions table with columns: Num, Description, Date

FIRE ALARM:  
DETAILS-WEST CNTRL-RACK  
#1-WIRE-FRONT-BOTTOM

Drawing Number  
FA6.25

Project No. C0703-360 Subaccount 17810  
RECORD DRAWINGS - 2015-11-16

DRAWN BY: B.T.L. | CHECKED BY: AEE-JF







IF THIS SHEET IS NOT 22"x34" IT IS NOT PLOTTED TO SCALE



WEST CONTROL ROOM - RACK #1 - REAR VIEW - KEY PLAN  
SCALE: 1 : 16

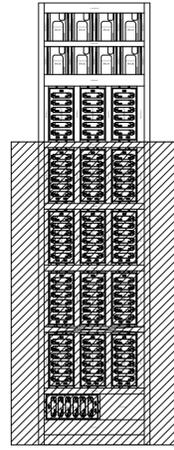

SEE SHEET  
FA6.26

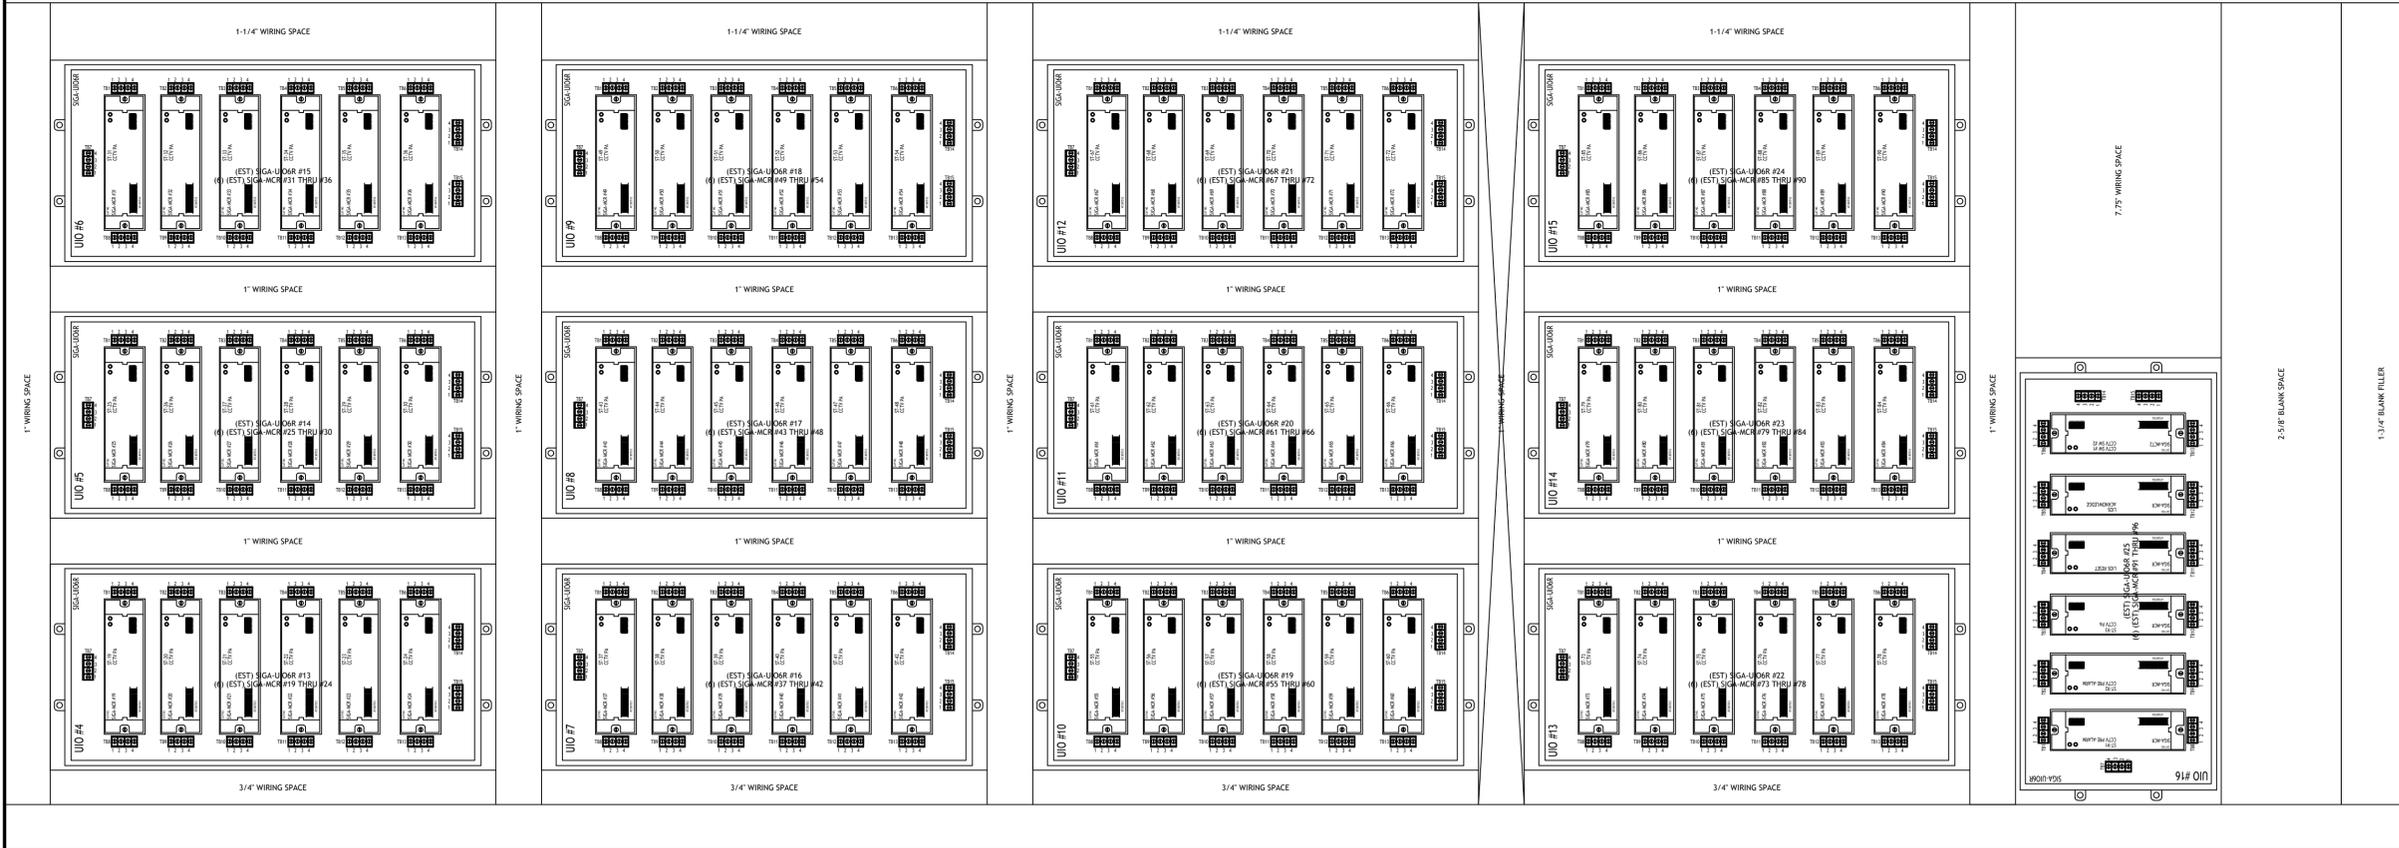

SEE SHEET  
FA6.26

MIDDLE ATLANTIC EQUIPMENT RACK WRK-445A-32  
OVERALL DIMENSIONS ARE: 22-3/8" (W) x 32-5/8" (D) x 83-1/8" (H)  
USEABLE DIMENSIONS ARE: 19-1/2" (W) x 30-3/4" (D) x 77-1/8" (H)  
WEST CONTROL ROOM - RACK #1  
REAR VIEW - BOTTOM SECTION



WEST CONTROL ROOM - RACK #1 - REAR VIEW - BOTTOM SECTION  
SCALE: 1 : 2

**EISENHOWER/JOHNSON  
MEMORIAL TUNNEL  
FIXED FIRE SUPPRESSION SYSTEM  
DESIGN BUILD PROJECT**

**BARNARD EJM TEAM**

BCER  
BARNARD  
STURGEON ELECTRIC  
RONDINELLI  
Western States Fire Protection Co.  
ALF  
ENGINEERS

Revisions	Date

FIRE ALARM:  
DETAILS-WEST CNTRL-RACK  
#1-WIRE-REAR-BOTTOM



Drawing Number  
**FA6.27**

Project No. C0703-360  
Subaccount 17810  
RECORD DRAWINGS - 2015-11-16

DRAWN BY: B.T.L. | CHECKED BY: AEE-JF

IF THIS SHEET IS NOT 22"x34" IT IS NOT PLOTTED TO SCALE

1 WEST CONTROL ROOM - RACK #2 - FRONT VIEW - KEY PLAN  
SCALE: 1 : 16

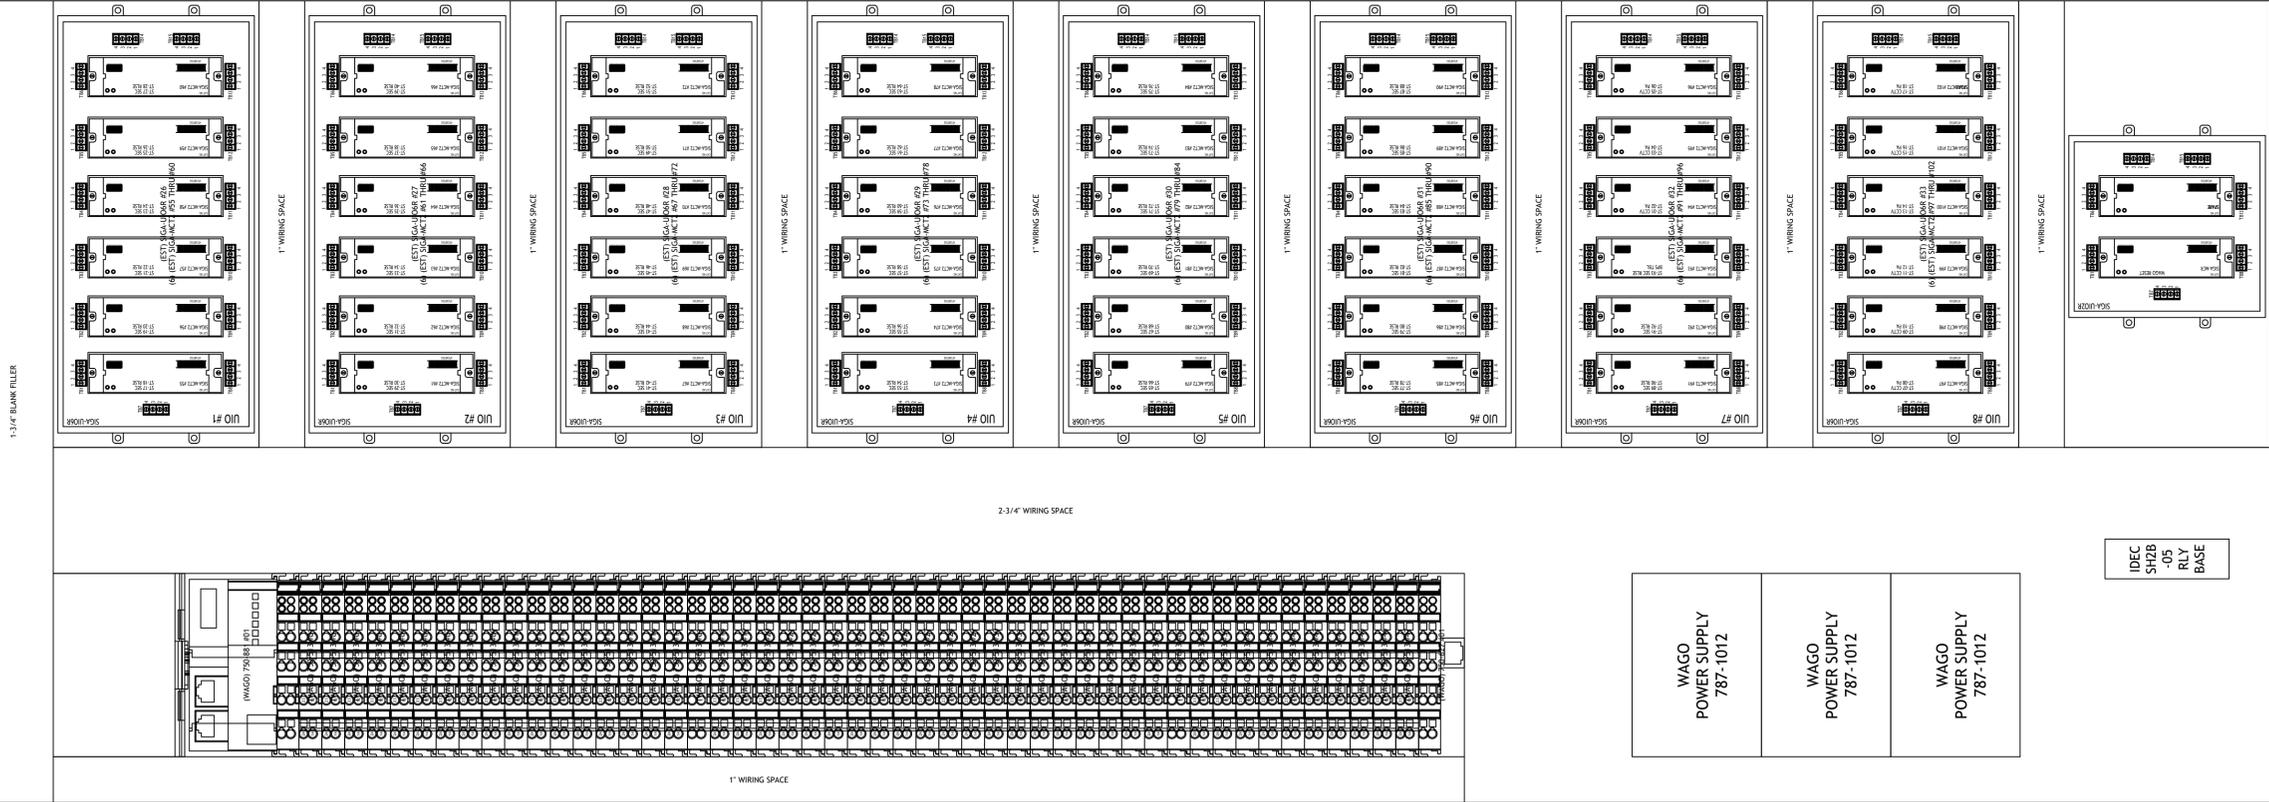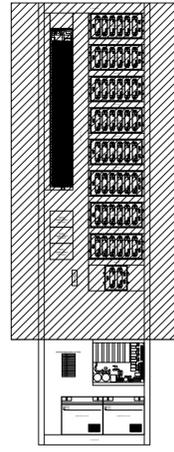

MIDDLE ATLANTIC EQUIPMENT RACK WRK-445A-32  
OVERALL DIMENSIONS ARE: 22-3/8" (W) x 32-5/8" (D) x 83-1/8" (H)  
USEABLE DIMENSIONS ARE: 19-1/2" (W) x 30-3/4" (D) x 77-1/8" (H)  
WEST CONTROL ROOM - RACK #2  
FRONT VIEW - TOP SECTION

2 WEST CONTROL ROOM - RACK #2 - FRONT VIEW - TOP SECTION  
SCALE: 1 : 2

SEE SHEET  
FA6.29

SEE SHEET  
FA6.29

**EISENHOWER/JOHNSON**  
**MEMORIAL TUNNEL**  
FIXED FIRE SUPPRESSION SYSTEM  
DESIGN BUILD PROJECT

Project No. C0703-360 Subaccount 17810  
**RECORD DRAWINGS - 2015-11-16**

Revisions	Date
Num	Description

FIRE ALARM:  
DETAILS-WEST CNTRL-RACK  
#2-WIRE-FRONT-TOP

Drawing Number  
**FA6.28**

**BARNARD EJMT TEAM**



**BCER** **BARNARD** **RONDINELLI**  
Western States Fire Protection Co.

**Sturgeon Electric** **ALF** **ALF**  
CONSULTING ENGINEERS



IF THIS SHEET IS NOT 22"x34" IT IS NOT PLOTTED TO SCALE

1 WEST CONTROL ROOM - RACK #2 - REAR VIEW - KEY PLAN  
SCALE: 1 : 16

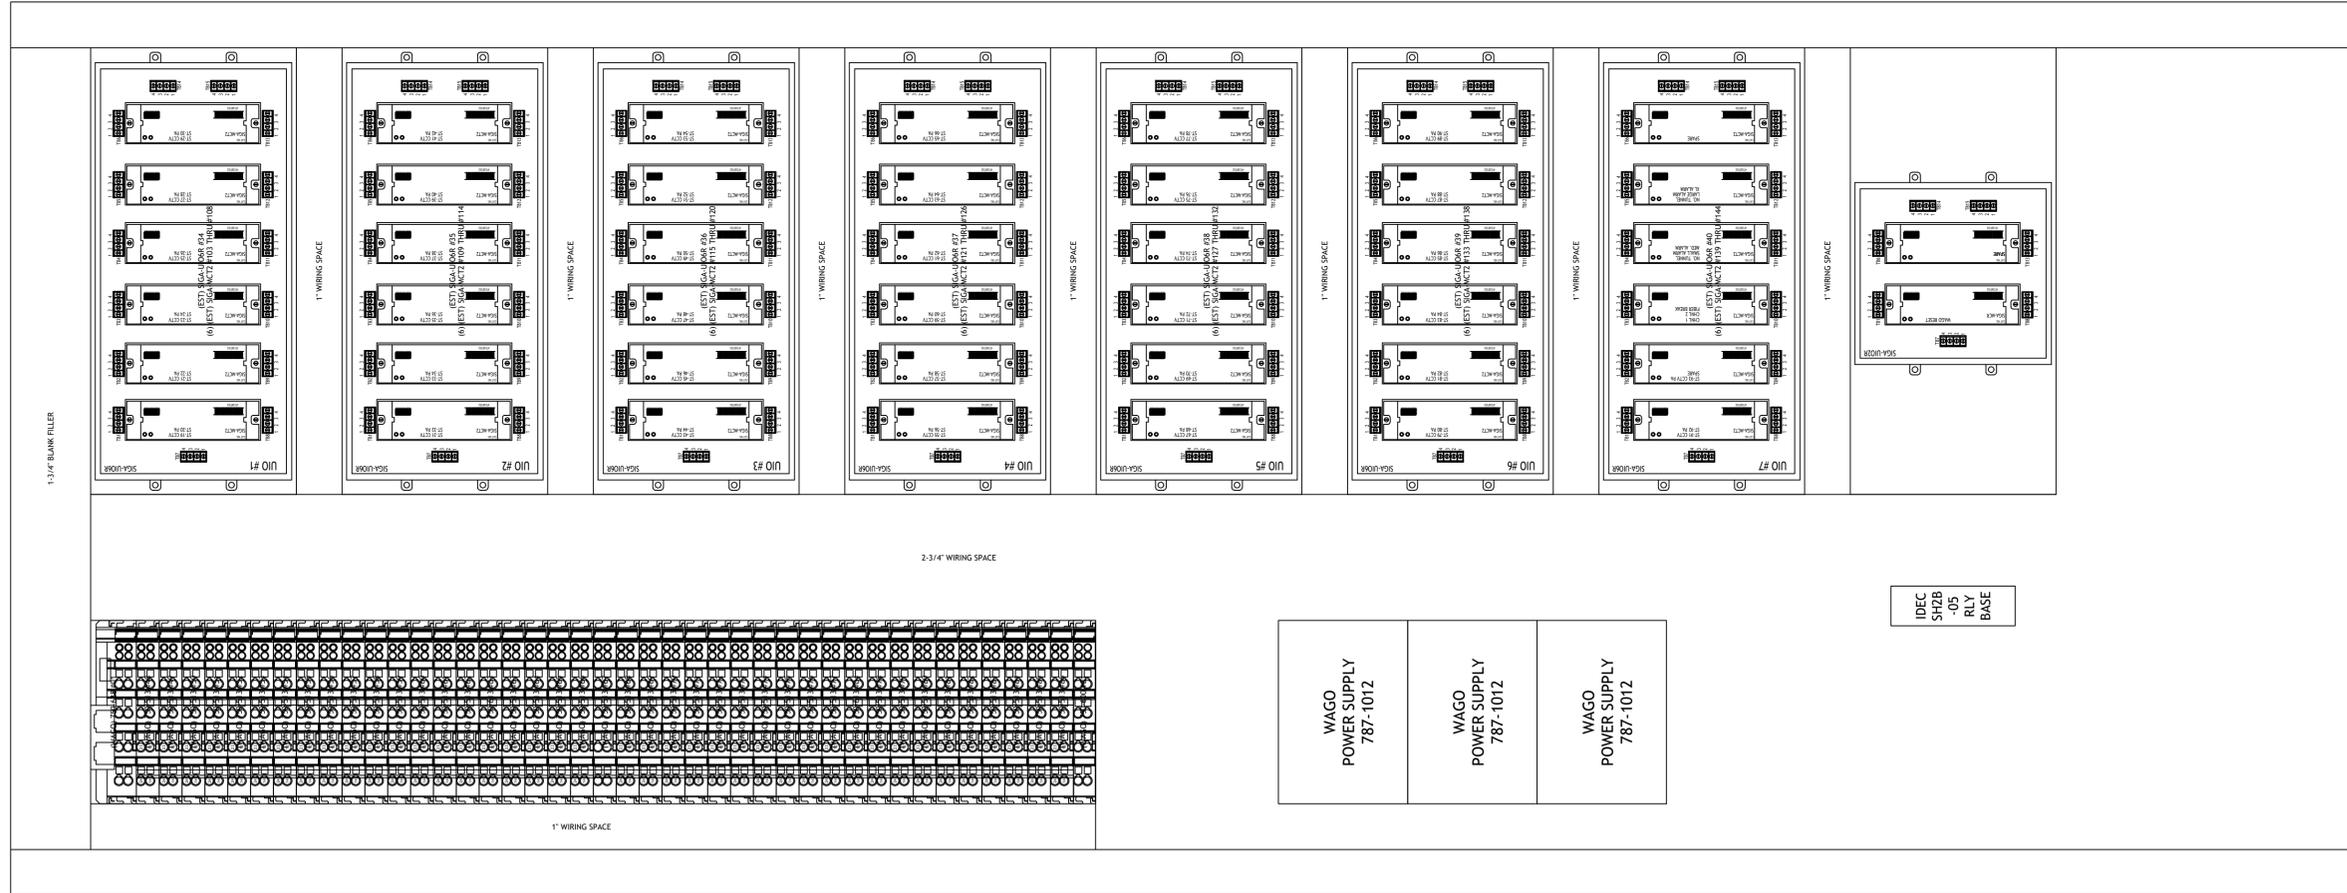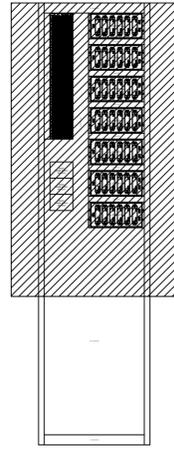

SEE SHEET  
FA6.31

SEE SHEET  
FA6.31

MIDDLE ATLANTIC EQUIPMENT RACK WRK-445A-32  
OVERALL DIMENSIONS ARE: 22-3/8" (W) x 32-5/8" (D) x 83-1/8" (H)  
USEABLE DIMENSIONS ARE: 19-1/2" (W) x 30-3/4" (D) x 77-1/8" (H)  
WEST CONTROL ROOM - RACK #2  
REAR VIEW - TOP SECTION

2 WEST CONTROL ROOM - RACK #2 - REAR VIEW - TOP SECTION  
SCALE: 1 : 2

**EISENHOWER/JOHNSON**  
**MEMORIAL TUNNEL**  
FIXED FIRE SUPPRESSION SYSTEM  
DESIGN BUILD PROJECT

Project No. C0703-360 Subaccount 17810  
RECORD DRAWINGS - 2015-11-16

**BARNARD EJMT TEAM**

**BCER** **BARNARD** **RONDINELLI**  
WESTERN STATES FIRE PROTECTION CO.  
**STURGEON ELECTRIC**  
A COMMITMENT TO SAFETY

Revisions	Date
Num	Description

FIRE ALARM:  
DETAILS-WEST CNTRL-RACK  
#2-WIRE-REAR-TOP

Drawing Number  
**FA6.30**

DRAWN BY: B.T.L. | CHECKED BY: AEE-JF





**FIXED FIRE SUPPRESSION SYSTEM NARRATIVE**

THE FIXED FIRE SUPPRESSION SYSTEM (FFSS) IS SUPPLIED BY THE EXISTING WATER STORAGE TANK FED FROM STRAIGHT CREEK, NORTH OF THE WEST PORTAL. A NEW 10-IN UNDERGROUND PIPE WILL BE INSTALLED FROM THE EXISTING TANK TO WITHIN CLOSE PROXIMITY OF THE PORTAL WHERE THE EXISTING 8-IN DOMESTIC AND STANDPIPE IS SUPPLIED. THE LINE WILL TEE INTO THE EXISTING AT THIS POINT AND REDUCE DOWN TO 8-IN TO SUPPLY THE NEW 1,250 GPM ELECTRIC FIRE PUMP LOCATED IN THE WEST VENTILATION BUILDING.

THE WATER SUPPLY TO THE FIRE PUMP WAS HYDRAULICALLY CALCULATED. THIS CALCULATION ASSUMES THE WORST CASE SCENARIO WITH THE TANK EMPTY. THE ADDITIONAL 5 PSI STATIC PRESSURE AVAILABLE WHEN THE TANK IS FULL WAS NOT UTILIZED. THE ADJUSTED WATER SUPPLY TO THE FIRE PUMP SUCTION FLANGE IS 56.9 PSI STATIC PRESSURE WITH 49.6 PS AT 1,250 GPM. THIS ADJUSTMENT INCLUDES THE ADDITIONAL 500 GPM HOSE ALLOWANCE FOR THE EXISTING STANDPIPE SYSTEM. THE TOTAL FLOW FOR THIS CALCULATION IS 1,750 GPM.

THE 115 PSI @ 1,250 GPM FIRE PUMP IS SIZED TO PROVIDE THE REQUIRED PRESSURE AND FLOW FOR ANY TWO DELUGE SYSTEMS FLOWING AT THE SAME TIME. THE MOST DEMANDING SYSTEM IS THE EISENHOWER 3 NOZZLE SYSTEM WITH A FLOW OF 1,264.7 GPM. ALL DELUGE SYSTEM HYDRAULIC CALCULATIONS PROVIDE AT LEAST A 10% PRESSURE SAFETY FACTOR TO ALLOW FOR MINOR INSTALLATION CHANGES.

THE FIRE PUMP ASSEMBLY WILL BE PROVIDED WITH BOTH A FLOW METER AND A TEST HEADER. THE FLOW METER ALLOWS TESTING THE PERFORMANCE OF THE FIRE PUMP BY FLOWING WATER BACK TO THE PUMP SUCTION. THE TEST HEADER IS REQUIRED FOR THE ACCEPTANCE TEST AND TO VERIFY THE WATER SUPPLY FROM THE TANK EVERY 5 YEARS. THE FLOW METER CAN BE USED 4 OUT OF 5 YEARS WITH THE BENEFIT OF NOT FLOWING AND WASTING WATER OUTSIDE THE BUILDING FROM THE TEST HEADER.

A NEW WALL HYDRANT WILL BE PROVIDED CLOSE TO A NEW FIRE DEPARTMENT CONNECTION (FDC) AT THE NORTHWEST CORNER OF THE WEST VENTILATION BUILDING. THE WALL HYDRANT CAN SUPPLY A FIRE PUMPER TRUCK THAT CAN SUPPLEMENT THE WATER PRESSURE WITHIN THE FFSS THROUGH THE FDC. THE WALL HYDRANT WILL ALSO SERVE AS THE PUMP TEST HEADER WHEN REQUIRED. AN FDC WILL NOT BE PROVIDED AT THE EAST VENTILATION BUILDING BECAUSE THERE IS NO WATER SUPPLY FROM WHICH A PUMP TRUCK COULD DRAW TO SUPPLY ADDITIONAL WATER TO THE FFSS. JUST TO CLARIFY, A FIRE PUMPER TRUCK IS NOT REQUIRED FOR THE OPERATION OF THE SYSTEM BUT A RESPONDING FIRE DEPARTMENT COULD ASSIST IN THE EVENT OF A FIRE BY SUPPLEMENTING OR REPLACING THE FIRE PUMP.

DURING WINTER MONTHS A WATER TRUCK MAY NOT BE ABLE TO ACCESS THE WATER TANK FOR RE-SUPPLY. AN ARRANGEMENT OF VALVES WITH A BYPASS THAT IS NORMALLY CLOSED WILL BE PROVIDED TO ALLOW A WATER TRUCK LOCATED BELOW AT THE NORTHWEST VENTILATION BUILDING TO FILL THE WATER SUPPLY TANK UTILIZING THE FIRE PUMP.

IN THE EVENT OF A POWER OUTAGE, THE FIRE PUMP CONTROLLER IS EQUIPPED WITH AN AUTOMATIC TRANSFER SWITCH TO ALLOW OPERATION FROM THE EMERGENCY GENERATOR. ADDITIONALLY THE FIRE PUMP CONTROLLER IS OF THE SOFT START TYPE TO REDUCE THE INRUSH DEMAND ON THE EMERGENCY GENERATOR.

THERE ARE 183 DELUGE SYSTEMS PROVIDING COVERAGE OVER THE TUNNEL ROADWAY. THERE ARE 90 SYSTEMS IN THE EISENHOWER TUNNEL AND 93 SYSTEMS IN THE JOHNSON TUNNEL. THREE (3) OF THE DELUGE VALVES ARE LOCATED WITHIN THE FIRE PUMP ROOM. THE REMAINDERS OF THE DELUGE VALVES ARE LOCATED ON THE 6-IN. X 18,100 FT. LOOP LOCATED WITHIN THE SUPPLY PLENUMS AND THE FAN DECK OF THE VENTILATION BUILDINGS. THE CAPACITY OF THE 6-IN. LOOP IS APPROXIMATELY 30,000 GALLONS.

TEN (10) 6-IN. ISOLATION VALVES WILL BE PROVIDED ON THE 6-IN X 18,100 FT. LOOP. THESE VALVES WILL ALLOW SYSTEM REPAIRS IF REQUIRED TO OCCUR WITHOUT DRAINING THE ENTIRE SYSTEM. EACH OF THESE VALVES WILL HAVE A TAMPERS SWITCH. IN THE EVENT A VALVE IS CLOSED, A TROUBLE SIGNAL WILL BE DISPLAYED AT THE FIRE CONTROL PANEL (FCP).

BOILERS, EXPANSION TANKS, AND CIRCULATION PUMPS WILL BE PROVIDED WITHIN THE FIRE PUMP ROOM TO HEAT THE 6-IN. LOOP PIPING. THE SYSTEM HEAT WILL PROVIDE PROTECTION OF THE ZONE DELUGE VALVES LOCATED WITHIN INSULATED VALVE ENCLOSURE (IVE) CABINETS INSTALLED AROUND EACH ZONE VALVE IN THE PLENUM. THE VALVE ENCLOSURE WILL BE HEATED BY CONVECTIVE HEAT TRANSFER FROM THE CIRCULATING HOT WATER IN THE 6-IN. WET SUPPLY LOOP. THE HEATED WATER WILL BE DIRECTED EAST THRU THE SUPPLY PLENUM OF THE EISENHOWER TUNNEL WHERE IT WILL CROSS THROUGH THE EAST VENTILATION BUILDING ON THE FAN DECK AND RETURN WEST WITHIN THE SUPPLY PLENUM OF THE JOHNSON TUNNEL.

IN THE EVENT OF A FIRE, THE WATER SUPPLY TO THE DELUGE SYSTEMS CAN THEN TRAVEL EAST THRU BOTH SUPPLY PLENUMS TO THE ACTIVATED DELUGE SYSTEM ALLOWING WATER TO DISCHARGE FROM THE NOZZLES.

THERE ARE FOUR DIFFERENT TYPES OF DELUGE SYSTEMS WITHIN THE PROJECT. EACH SYSTEM IS DESIGNED TO PROVIDE AT LEAST 0.16 GALLONS PER SQUARE FOOT OVER THE ROADWAY WHILE TWO SYSTEMS ARE FLOWING. THE HYDRAULIC CALCULATIONS PROVIDED ARE FOR THE MOST DEMANDING AREA FOR EACH SYSTEM TYPE. THE LOCATION WAS DETERMINED BY CHANGING THE HYDRAULIC LOCATION UNTIL THE MOST DEMANDING CONDITION WAS FOUND.

THE DIFFERENCES BETWEEN EACH OF THE SYSTEM TYPES INCLUDE THE SIZE, NOZZLE TYPE, SPACING, PRESSURE, AND FLOW. EACH SYSTEM IS SIMILAR IN THAT IT PROVIDES THE DENSITY OF 0.16 GALLONS PER SQUARE FOOT. ALL OF THE DELUGE SYSTEMS WILL HAVE A MANUAL ISOLATION VALVE WITH A TAMPER SWITCH. IN THE EVENT A VALVE IS CLOSED, A TROUBLE SIGNAL WILL BE DISPLAYED AT THE FIRE CONTROL PANEL (FCP). IN THE EVENT A DELUGE SYSTEM IS ACTUATED, A PRESSURE SWITCH WILL INDICATE AN ALARM AT THE FCP.

THE DELUGE VALVE ASSEMBLIES ARE LOCATED APPROXIMATELY EVERY 100 FEET IN THE EISENHOWER SUPPLY PLENUM AND 96 FEET IN THE JOHNSON SUPPLY PLENUM. EACH DELUGE SYSTEM IS CONTROLLED BY A 4-IN. FLOW CONTROL VALVE. THIS VALVE IS HELD IN THE CLOSED POSITION BY A SMALL PRIME LINE. THE UPSTREAM SYSTEM WATER PRESSURE HOLDS THE VALVE CLOSED AND WHEN A SOLENOID VALVE IS OPENED BY A 24 VOLT CURRENT FROM THE FCP. THE FLOW CONTROL VALVE WILL OPEN. WHEN THE SOLENOID VALVE IS CLOSED, THE VALVE WILL CLOSE. ADDITIONALLY, THE FLOW CONTROL VALVE CAN OPERATE LIKE A PRESSURE REDUCING VALVE ALLOWING FOR ADJUSTMENT OF THE DOWNSTREAM PRESSURE. WITH THIS FEATURE, A HIGHER UPSTREAM PRESSURE WILL NOT OVER FLOW WHICH WOULD EFFECTIVELY REDUCE THE MINIMUM WATER SUPPLY DURATION OF ONE HOUR.

A 4-IN. CROSS MAIN WILL SUPPLY THE BRANCH LINES THAT SUPPLY THE ASSORTED NOZZLES. THE 4-IN. CROSS MAIN WILL NEED TO PENETRATE THE PLENUM WALL FOR EACH TUNNEL SYSTEM TO ALLOW ACCESS TO THE EXHAUST PLENUM VENTS. WITH EACH DELUGE SYSTEM LOCATED BELOW THE VALVE ASSEMBLY ALL CROSS MAINS AND BRANCH LINES WILL BE REQUIRED TO DRAIN AUTOMATICALLY TO AVOID TRAPPED WATER THAT COULD FREEZE WITHIN THE PIPE. THE BRANCH LINE PIPE WILL AUTOMATICALLY DRAIN FROM NOZZLES. THE CROSS MAIN WILL REQUIRE A ½-IN BALL DRIP THAT WILL AUTOMATICALLY DRAIN TO THE PLENUM FLOOR. THE BALL DRIP WILL AUTOMATICALLY OPEN AFTER THE SYSTEM IS SHUT DOWN AND THE PIPE IS NO LONGER PRESSURIZED.

THE EISENHOWER TUNNEL HAS TWO TYPES OF DELUGE SYSTEMS. BOTH SYSTEMS HAVE THE SAME LARGE BETE NOZZLES WITH THE DIFFERENCE BEING THREE (3) NOZZLES VERSES FOUR (4) NOZZLES. THE THREE NOZZLE SYSTEM REQUIRES MORE PRESSURE AT EACH NOZZLE TO PROVIDE THE 0.16 GALLONS PER SQUARE FOOT TO THE ROADWAY BELOW. THE LOCATION OF THE NOZZLES IS DETERMINED BY THE EXISTING PLENUM VENTS WITHIN THE EXHAUST PLENUM.

THE JOHNSON TUNNEL DELUGE SYSTEMS UTILIZE TWELVE (12) SMALLER BETE NOZZLES TO PROVIDE THE 0.16 GALLONS PER SQUARE FOOT TO THE ROADWAY BELOW. THE LOCATION OF THE NOZZLES IS DETERMINED BY THE EXISTING VENTS WITHIN THE SUPPLY AND EXHAUST PLENUM.

THE VENTILATION BUILDING DELUGE SYSTEMS UTILIZE TWELVE (12) HORIZONTAL SIDEWALL SPRINKLERS AS NOZZLES TO PROVIDE THE 0.16 GALLONS PER SQUARE FOOT TO THE ROADWAY BELOW. THE BRANCH LINES SUPPLYING THE NOZZLES AT THE PORTALS WILL BE EXPOSED ON THE WALL JUST BELOW THE LIGHTS. TO ADDRESS CONCERNS REGARDING CORROSION FROM ANTI-ICE SPRAY THAT CAN BECOME AIRBORNE FROM THE ROADWAY AT THE VENTILATION BUILDINGS, WE ARE PROVIDING GALVANIZED PIPE FOR THE BRANCH LINES AND NOZZLES WITH A CORROSION RESISTANT COATING.

CUSTOM BRACKETS AND TRAPEZE SUPPORTS WILL BE PROVIDED WITHIN THE SUPPLY PLENUM TO SUPPORT THE 6-IN. LOOP PIPING. THESE SUPPORTS WILL BE LOCATED AT A MAXIMUM OF 12.5 FT. ON CENTER. THE ENTIRE 6-IN. LOOP PIPING WILL BE PROVIDED WITH 1-½-IN FIBERGLASS INSULATION WITH A K-VALUE OF 0.23. ADDITIONALLY, RIGID 1-½-IN INSULATED PIPE SUPPORTS WILL BE PROVIDED FOR ALL HANGERS AND SUPPORTS.

THE VALVE ASSEMBLY FOR EACH DELUGE SYSTEM WILL BE INSIDE AN AIR TIGHT IVE. THE IVE'S ARE PROVIDED WITH 3-IN RIGID INSULATION WITH AN R-VALUE OF 18. THE IVE'S WILL HAVE AN ACCESS DOOR ALLOWING FOR EASE OF INSPECTION, TESTING, AND MAINTENANCE.

THE 6-IN. LOOP PIPING AND ITS SUPPLY WILL BE SEISMICALLY BRACED. CALCULATIONS ARE PROVIDED WITHIN THE DRAWINGS FOR THE MOST DEMANDING LONGITUDINAL AND LATERAL BRACE REQUIREMENTS. LONGITUDINAL BRACES WILL BE PROVIDED AT 100 FT. MAXIMUM DISTANCES WITHIN THE SUPPLY PLENUM AND WILL BE LOCATED AS CLOSE AS POSSIBLE TO THE VALVE ASSEMBLIES. EACH OF THE CUSTOM BRACKETS AND TRAPEZE SUPPORTS WITHIN THE PLENUM SERVE AS LATERAL BRACES AT 12.5 FT. MAXIMUM ON CENTER. THE LOOP AND SUPPLY PIPING WITHIN THE PORTALS WILL BE BRACED BY STANDARD METHODS WITH LONGITUDINAL BRACES AT 80 FT. MAXIMUM AND LATERAL BRACES AT 40 FT. MAXIMUM AND LOCATED WITHIN 1 FT. IN A CHANGE OF DIRECTION. ALL RISERS OR VERTICAL PIPING WILL BE PROVIDED WITH FOUR-WAY BRACING IN ACCORDANCE WITH NFPA-13.

A 4-IN. PRESSURE RELIEF VALVE WILL BE PROVIDED AT THE SOUTHEAST VENTILATION BUILDING TO PROVIDE PROTECTION OF SYSTEM COMPONENTS FROM THE POTENTIAL OF WATER HAMMERS THAT MAY OCCUR. WATER HAMMER IS USED TO DESCRIBE A PRESSURE SURGE THAT IS CAUSED WHEN A FLUID IS FORCED TO STOP OR CHANGE DIRECTION SUDDENLY. THE POTENTIAL FOR WATER HAMMER EXIST WHEN A DELUGE VALVE IS CLOSED.

EACH TUNNEL, AND THEIR RESPECTIVE AIR PLENUMS, CURVE NORTH AND SOUTH THROUGH THE MOUNTAIN AND CHANGE IN ELEVATION INCREASING FROM EAST TO WEST. THE CURVATURE OF THE TUNNELS OCCURS SLIGHTLY OVER A LARGE DISTANCE MAKING THE INSTALLATION OF ADDITIONAL FITTINGS AND SWING JOINTS UNNECESSARY. THE DEFLECTION IS MINIMAL BUT MUST BE ADDRESSED.

IN ADDITION, THE AIR PLENUMS ARE SUBJECT TO FREEZING TEMPERATURES IN THE WINTER MONTHS. TO PREVENT THE WATER IN THE PIPE FROM FREEZING, HOT WATER STARTING AT 100°F WITH A MAXIMUM DESIGN BOILER TEMPERATURE OF 130°F, WILL BE CIRCULATED THROUGH THE 6-IN. MAIN SUPPLY LOOP. MAIN PIPING WILL BE INSTALLED WHEN TEMPERATURES HAVE THE POTENTIAL TO BE -30°F. THE WORST CASE TEMPERATURE CHANGE WAS CALCULATED TO BE FROM -30°F TO 130°F. DUE TO DRASTIC CHANGES IN TEMPERATURE, THE 6-IN. PIPE WILL EXPAND AND CONTRACT. WHEN THE PIPE IS TO BE INSTALLED DURING THE COLD WEATHER SEASONS OR WHEN COLD WATER FROM THE STORAGE TANK IS INTRODUCED INTO THE PIPE DURING A FIRE OR TESTING SITUATION, THE STEEL PIPE WILL SHRINK. WHEN THE HOT WATER IS CIRCULATED THROUGH THE PIPE, THE STEEL PIPE WILL EXPAND. THE EXPANSION FROM THE CHANGE IN TEMPERATURE WILL CAUSE A PARALLEL DEFLECTION THAT IS ADDRESSED IN THIS DESIGN.

TO ACCOMMODATE CHANGES IN THE PIPE LENGTH AND DIRECTION, EXPANSION AND DEFLECTION WILL BE ADDRESSED CONTINUALLY FOR EVERY STICK OF PIPE ALONG THE ENTIRE LENGTH OF THE TUNNEL BY USING VICTAULIC STYLE 75 FLEXIBLE COUPLINGS AND VICTAULIC STYLE 155 EXPANSION JOINT 6-IN. NIPPLES. THROUGH PRODUCT DATA AS WELL AS EXPANSION AND DEFLECTION CALCULATIONS FOR A 25 FT. SECTION OF PIPE, A SOLUTION WAS DETERMINED TO PROVIDE EXPANSION JOINTS TO ACCOMMODATE THE EXPANSION AND DEFLECTION WITHIN EACH 25 FT. SECTION OF PIPE.

EXPANSION JOINTS SHALL BE INSTALLED AT EACH END OF PIPE APPROXIMATELY EVERY 25 FT. AN EXPANSION JOINT WILL CONSIST OF (2) STYLE 75 COUPLINGS WITH (1) STYLE 155 6-IN. SCHEDULE 40 NIPPLE, 4 INCHES IN LENGTH BETWEEN THE COUPLINGS. EACH EXPANSION JOINT WILL BE INSTALLED IN COLD WEATHER CONDITIONS, THUS EACH COUPLING SHALL BE INSTALLED TO SEPARATE THE TWO ENDS OF THE PIPE TO ALLOW FOR MAXIMUM POSSIBLE SEPARATION. WHEN THE PIPE EXPANDS DUE TO HOT WATER, THERE WILL BE ZERO DEFLECTION BETWEEN EACH PIECE OF PIPE. THE EXPANSION JOINT WILL PROVIDE 0.346-IN. OF EXPANSION WHICH EXCEEDS THE REQUIRED THERMAL EXPANSION LENGTH OF 0.3216-IN.

WHEN ANGULAR DEFLECTION IS REQUIRED, AN ADDITIONAL COUPLING AND NIPPLE SHALL BE ADDED TO ACCOMMODATE THE ANGULAR DEFLECTION BETWEEN THE COUPLINGS THAT ARE PROVIDED FOR THE EXPANSION JOINT. THIS COUPLING WILL NOT BE ABLE TO DEFLECT IN THE PARALLEL DIRECTION AND WILL NOT BE USED AS AN EXPANSION COUPLING.

IN ADDITION, TWO BRACKETS SHALL BE PROVIDED FOR EACH 25 FT. LENGTH OF PIPE. BOTH BRACKETS SHALL BE BRACED TO ALLOW MINIMAL DEFLECTION BETWEEN EACH 25 FT. STICK OF PIPE. A LONGITUDINAL BRACE SHALL BE INSTALLED EVERY 100 FT. WITH THE BRACED SUPPORT CLOSEST TO THE INSULATED VALVE ENCLOSURE TO LIMIT MOVEMENT AT THE DELUGE VALVE ASSEMBLIES AND TO PROVIDE THE REQUIRED SEISMIC BRACING.

**BARNARD EJMT TEAM**

**BCER** *the engineering*  
**BARNARD**  
**RONDINELLI** *A fire is worth the safety*  
**ELF** CONSULTING ENGINEERS  
 Western States Fire Protection Co.  
**Sturgeon** *ELECTRIC*

**EISENHOWER/JOHNSON MEMORIAL TUNNEL**

**FIXED FIRE SUPPRESSION SYSTEM DESIGN BUILD PROJECT**  
 Project No. C0703-360 Subaccount 17810  
**RECORD DRAWINGS - 2015-11-16**

Revisions	Description	Date
Num		

FFSS NARRATIVE

Drawing Number  
**FPO.1**

DRAWN BY: AMB CHECKED BY: JUH












TUNNEL ARCH PLENUM BRACKET NARRATIVE


THE TUNNEL ARCH PLENUM BRACKETS ARE TO BE INSTALLED IN THE EISENHOWER (NORTH) SUPPLY AIR PLENUM ON THE NORTH TUNNEL ARCH WALL AND IN THE JOHNSON (SOUTH) SUPPLY AIR PLENUM ON THE SOUTH TUNNEL ARCH WALL. EACH BRACKET SHALL BE SPACED AT A MAXIMUM OF 12'-6" APART. THE BRACKETS ARE TO SUPPORT THE 6" INCH SUPPLY LOOP FOR THE FFSS. EVERY 25 FEET TWO BRACKETS SHALL SUPPORT ONE STICK OF 6" INCH BY 24 FEET OF SCHEDULE 10 PIPE WITH THE REQUIRED EXPANSION AND DEFLECTION JOINTS REQUIRED FOR EACH SECTION OF PIPE AND 25 FEET OF 4 SEPARATE CONDUITS. IN ADDITION, EVERY 100 FEET THE PIPE SHALL ALSO SUPPORT THE IVE ASSEMBLY FOR A SINGLE DELUGE SYSTEM. THE LOCATION FOR THE CONDUITS HAS BEEN DETERMINED TO ALLOW FOR INSTALLATION OF THE IVE AFTER THE IVE VALVES AND CONDUITS HAVE BEEN INSTALLED.

EACH BRACKET SHALL BE DESIGNED TO HOLD 12 FEET OF 6" INCH SCHEDULE 10 PIPE, 6 INCHES OF 6" INCH SCHEDULE 40 EXPANSION AND DEFLECTION JOINTS. THE WEIGHT OF THE IVE ASSEMBLY AND 4 SECTIONS OF CONDUIT 12'-6" IN LENGTH. ALL PIPE WEIGHTS, THE WEIGHTS FOR THE IVE ASSEMBLY, THE WEIGHTS FOR THE CONDUITS AND THE DESIGN LOADS FOR EACH BRACKET COMPONENT CAN BE FOUND IN TABLES LOCATED ON THIS SHEET. THE BRACKETS ARE DESIGNED TO HOLD 1000 LBS. IT HAS BEEN DETERMINED THAT THE JOHNSON (SOUTH) TUNNEL BRACKET - OPTION 1 IN DETAIL 3, HAS THE WORST CASE LOADING DUE TO THE LOCATION OF THE LOAD AND THE LARGER LENGTHS OF THE UNISTRUT THUS CALCULATIONS WERE PROVIDED FOR THIS ASSEMBLY. FOR DETAILS 2 AND 4 EACH BRACKET IS DESIGNED FOR A TRAPEZE HANGER PER NFPA-13, CH. 9, 2010 EDITION.

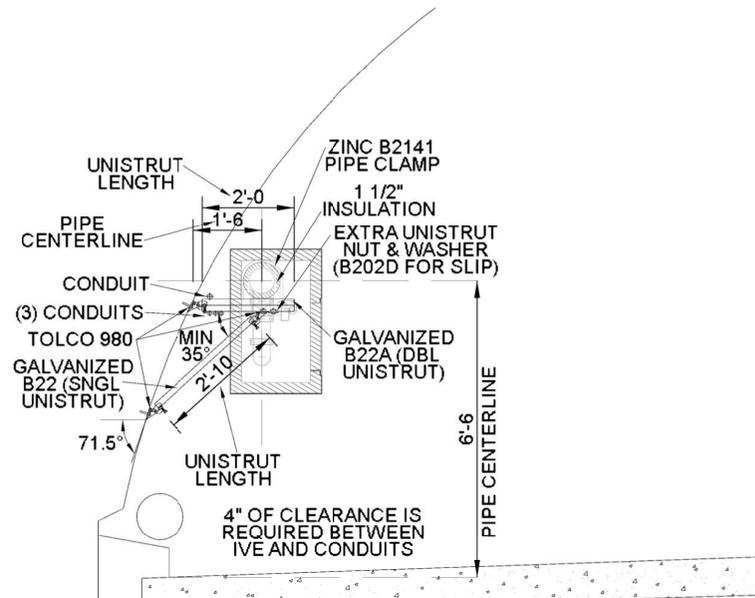


BRACKET DESIGNED IN ACCORDANCE WITH NFPA-13, CH.9, SECTION 9.1.1.2 AND THE CODES AND STANDARDS ANALYSIS FOR THIS PROJECT. SEE WORST CASE LOAD CALCULATION FOR SOUTH BRACKET LOCATED IN TUNNEL HANGER SYSTEM SUBMITTAL

1 EISENHOWER (NORTH) TUNNEL BRACKET  
SCALE: 1/2" = 1'

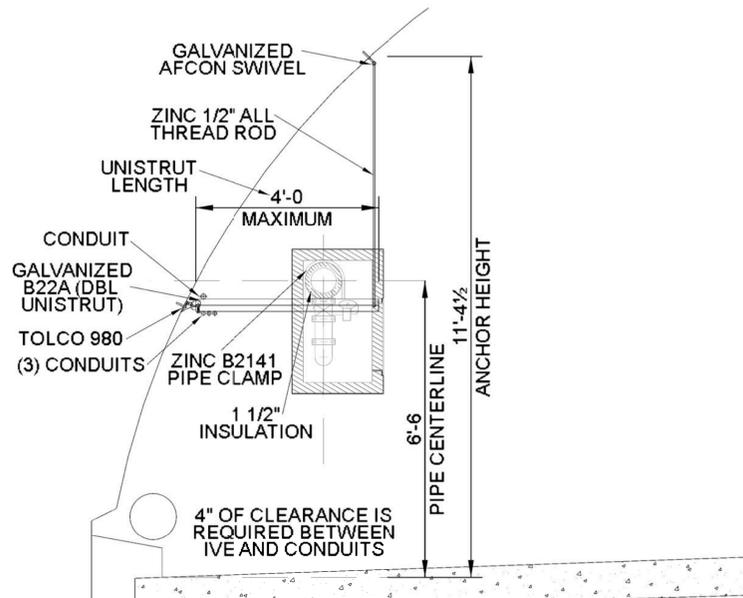


BRACKET DESIGNED FOR TRAPEZE HANGERS PER NFPA-13, CH. 9 WITH A MINIMUM SECTION MODULUS OF 0.48 FOR A MAXIMUM SPAN OF 4'-0" LOCATED ON THIS SHEET IN THE MATERIAL LOAD LIMIT TABLE

2 EISENHOWER (NORTH) TUNNEL BRACKET - WALL OBSTRUCTION  
SCALE: 1/2" = 1'

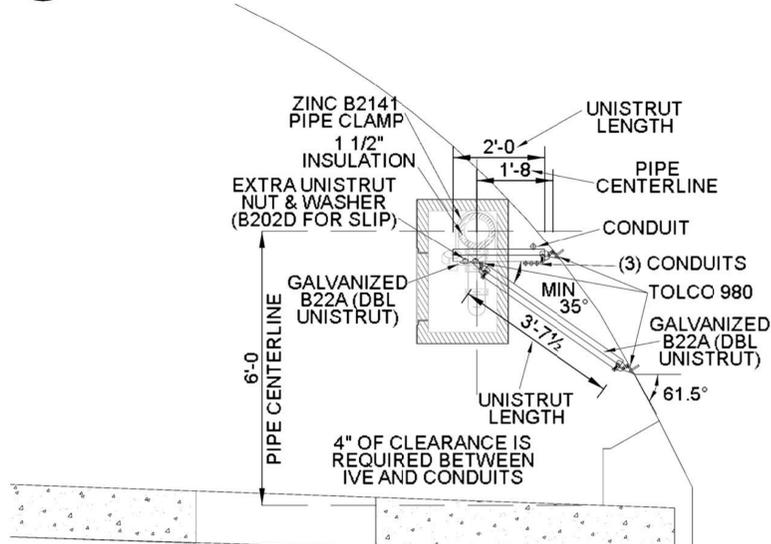

BRACKET DESIGNED IN ACCORDANCE WITH NFPA-13, CH.9, SECTION 9.1.1.2 AND THE CODES AND STANDARDS ANALYSIS FOR THIS PROJECT. WORST CASE LOAD, SEE SOUTH BRACKET LOAD CALCULATION LOCATED IN TUNNEL HANGER SYSTEM SUBMITTAL

3 JOHNSON (SOUTH) TUNNEL BRACKET - OPTION 1  
SCALE: 1/2" = 1'

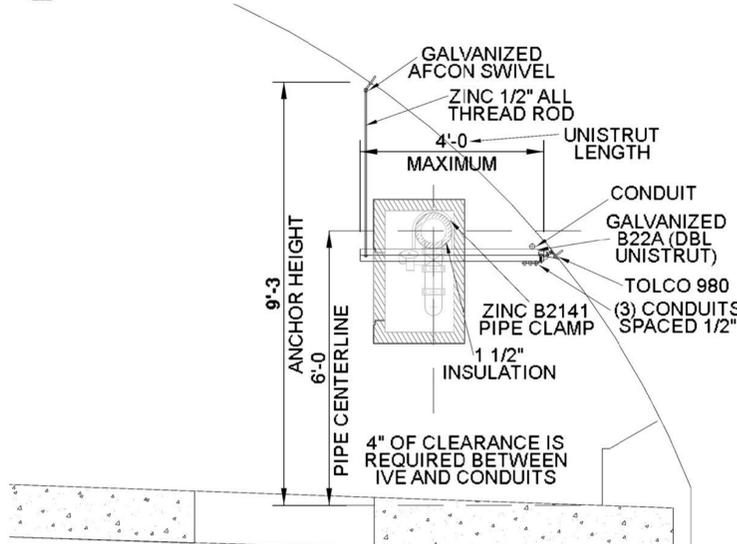

BRACKET DESIGNED FOR TRAPEZE HANGERS PER NFPA-13, CH. 9 WITH A MINIMUM SECTION MODULUS OF 0.48 FOR A MAXIMUM SPAN OF 4'-0" LOCATED ON THIS SHEET IN THE MATERIAL LOAD LIMIT TABLE

4 JOHNSON (SOUTH) TUNNEL BRACKET - OPTION 2  
SCALE: 1/2" = 1'



EJMT PIPE AND INSULATED VALVE ENCLOSURE WEIGHTS (LBS) (FOR MAXIMUM BRACKET SPAN OF 12'-6")

ITEM	QTY.	WEIGHT	TOTAL
6" SCHEDULE 10 PIPE WITH WATER (BY FOOT)	12.0	23.052	276.62
6" SCH. 40 PIPE WITH WATER (BY FOOT)	0.5	31.502	15.75
4" SCH. 40 PIPE WITH WATER (BY FOOT)	5.0	16.311	81.56
6" VIC 705W (BUTTERFLY VALVE)	1.0	28.7	28.70
4" VIC 705W (BUTTERFLY VALVE)	1.0	14.0	14.00
6" GROOVED COUPLING #75	2.0	7.0	14.00
4" GROOVED COUPLING #75	7.0	4.1	28.70
4" VIC FLK GROOVED 90 #001	2.0	6.7	13.40
4" GROOVED OUTLET	1.0	1.4	1.40
BERMAD VALVE	1.0	75.0	75.00
3/8" ATR FIG. 100	1.0	0.29	0.29
6" TOLCO FIG. 200 HANGER	1.0	1.0	1.00
4" TOLCO FIG. 200 HANGER	1.0	1.0	1.00
1.5" INSULATION	12.0	0.5	6.00
CABINET	1.0	104.0	104.00
4 CONDUITS @ 12'-6" LENGTHS	1.0	100.0	100.00
<b>ACTUAL WEIGHT</b>			<b>761.42</b>

PRODUCT	MAXIMUM LOAD (cULus)	UNIT
FIG. 980	2,015	LBS

PRODUCT	FRACTURE LOAD	Fc (PSI)-CONCRETE TENSION	UNIT
1/2" KWIK BOLT TZ (3.25" EMBED)	11,240	3,000	LBS

PRODUCT	FRACTURE LOAD	Fc (PSI)-CONCRETE SHEAR	UNIT
1/2" KWIK BOLT TZ (3.25" EMBED)	7,419	7,640	LBS

PRODUCT	SHEAR MOMENT	UNIFORM LOAD				UNIT
		24"	30"	36"	42"	
B22 (SINGLE UNISTRUT)	0.5989	1,702	1,361	1,135	972	LBS
B22A (DOUBLE UNISTRUT)	1.7019	2,610	2,610	2,610	2,610	LBS

PRODUCT	24"	30"	36"	42"	48"	UNIT
B22 (SINGLE UNISTRUT)	3,993	3,802	3,589	3,360	3,118	LBS
B22A (DOUBLE UNISTRUT)	6,898	6,821	6,728	6,620	6,496	LBS

PRODUCT	RESISTANCE PULL				UNIT
	TO SLIP	OUT	TENSION	SHEAR	
1/2" BOLT	-	-	18,000	14,000	LBS
1/2" N225 UNISTRUT NUT	1,500	2,000	-	-	LBS

PRODUCT	MAXIMUM PIPE SIZE	UNIT
1/2" AFCON 615 SWIVEL	8	IN

PRODUCT	MAXIMUM LOAD	UNIT
1/2" FIG. 70 ROD COUPLING	1,130	LBS

**BARNARD EJMT TEAM**

**BARNARD** **RONDELLO**

BCER **Sturgeon ELECTRIC**

Western States Fire Protection Co.

**EISENHOWER/JOHNSON MEMORIAL TUNNEL**

FIXED FIRE SUPPRESSION SYSTEM DESIGN BUILD PROJECT

Project No. C0703-360 Subaccount 17810

RECORD DRAWINGS - 2015-11-16

REVISIONS

Num	Description	Date

TUNNEL ARCH PLENUM BRACKET

Drawing Number **FP1.2**


Checked by: JUH  
Drawn by: AMB








WEST PORTAL BUILDING  
(SEE FP4.0 & FP4.1)

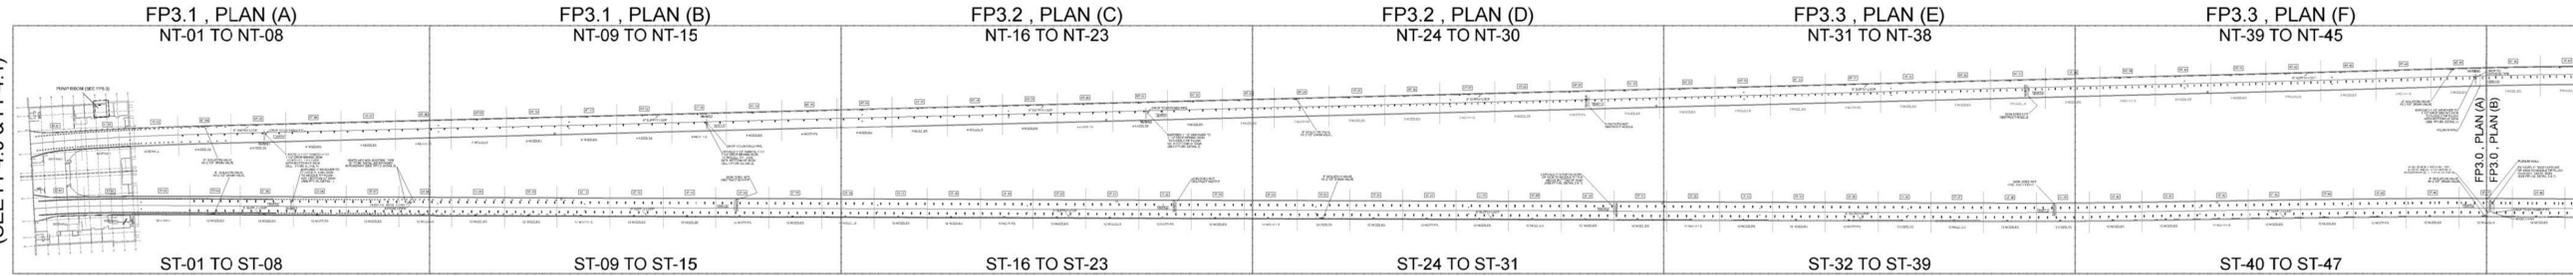

1 PLAN (A) - DELUGE SYSTEMS , NT-01 TO NT-45 , ST-01 TO ST-47  
NOT TO SCALE

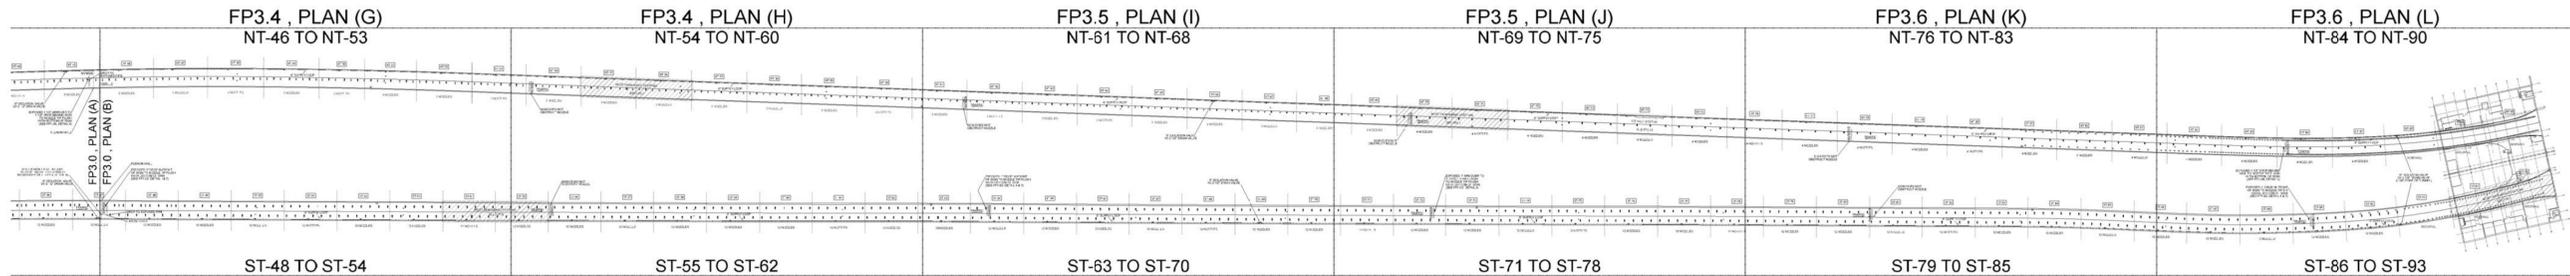

2 PLAN (B) - DELUGE SYSTEMS , NT-46 TO NT-90 , ST-48 TO ST-93  
NOT TO SCALE

LEGEND - SHEETS FP-3.0 TO FP-3.6

LINE TYPE	
	SYSTEM LENGTH
	SYSTEM BOUNDARY LINES
	MOST DEMANDING SYSTEMS
	MATCHLINES

VALVE COUNTS	
	IVE CABINET: QTY. 180
	DELUGE VALVE: QTY. 183
	ISOLATION / DRAIN VALVE: QTY. 10

ABBREVIATION LIST	
NT-##	= NORTH TUNNEL - ID NUMBER
ST-##	= SOUTH TUNNEL - ID NUMBER
NVMS#	= NORTH VARIABLE MESSAGE SIGN ID NUMBER
SVMS#	= SOUTH VARIABLE MESSAGE SIGN ID NUMBER

EISENHOWER/JOHNSON

MEMORIAL TUNNEL

FIXED FIRE SUPPRESSION SYSTEM

DESIGN BUILD PROJECT

BARNARD EJMT TEAM

BARNARD

STURGEON ELECTRIC

RONDELLI

WESTERN STATES FIRE PROTECTION CO.

REVISIONS	Date
Num	Description

DELUGE SYSTEM LOCATION KEY


Drawing Number  
**FP3.0**

Project No. C0703-360 Subaccount 17810  
RECORD DRAWINGS - 2015-11-16


CHECKED BY: JUH

DRAWN BY: AMB




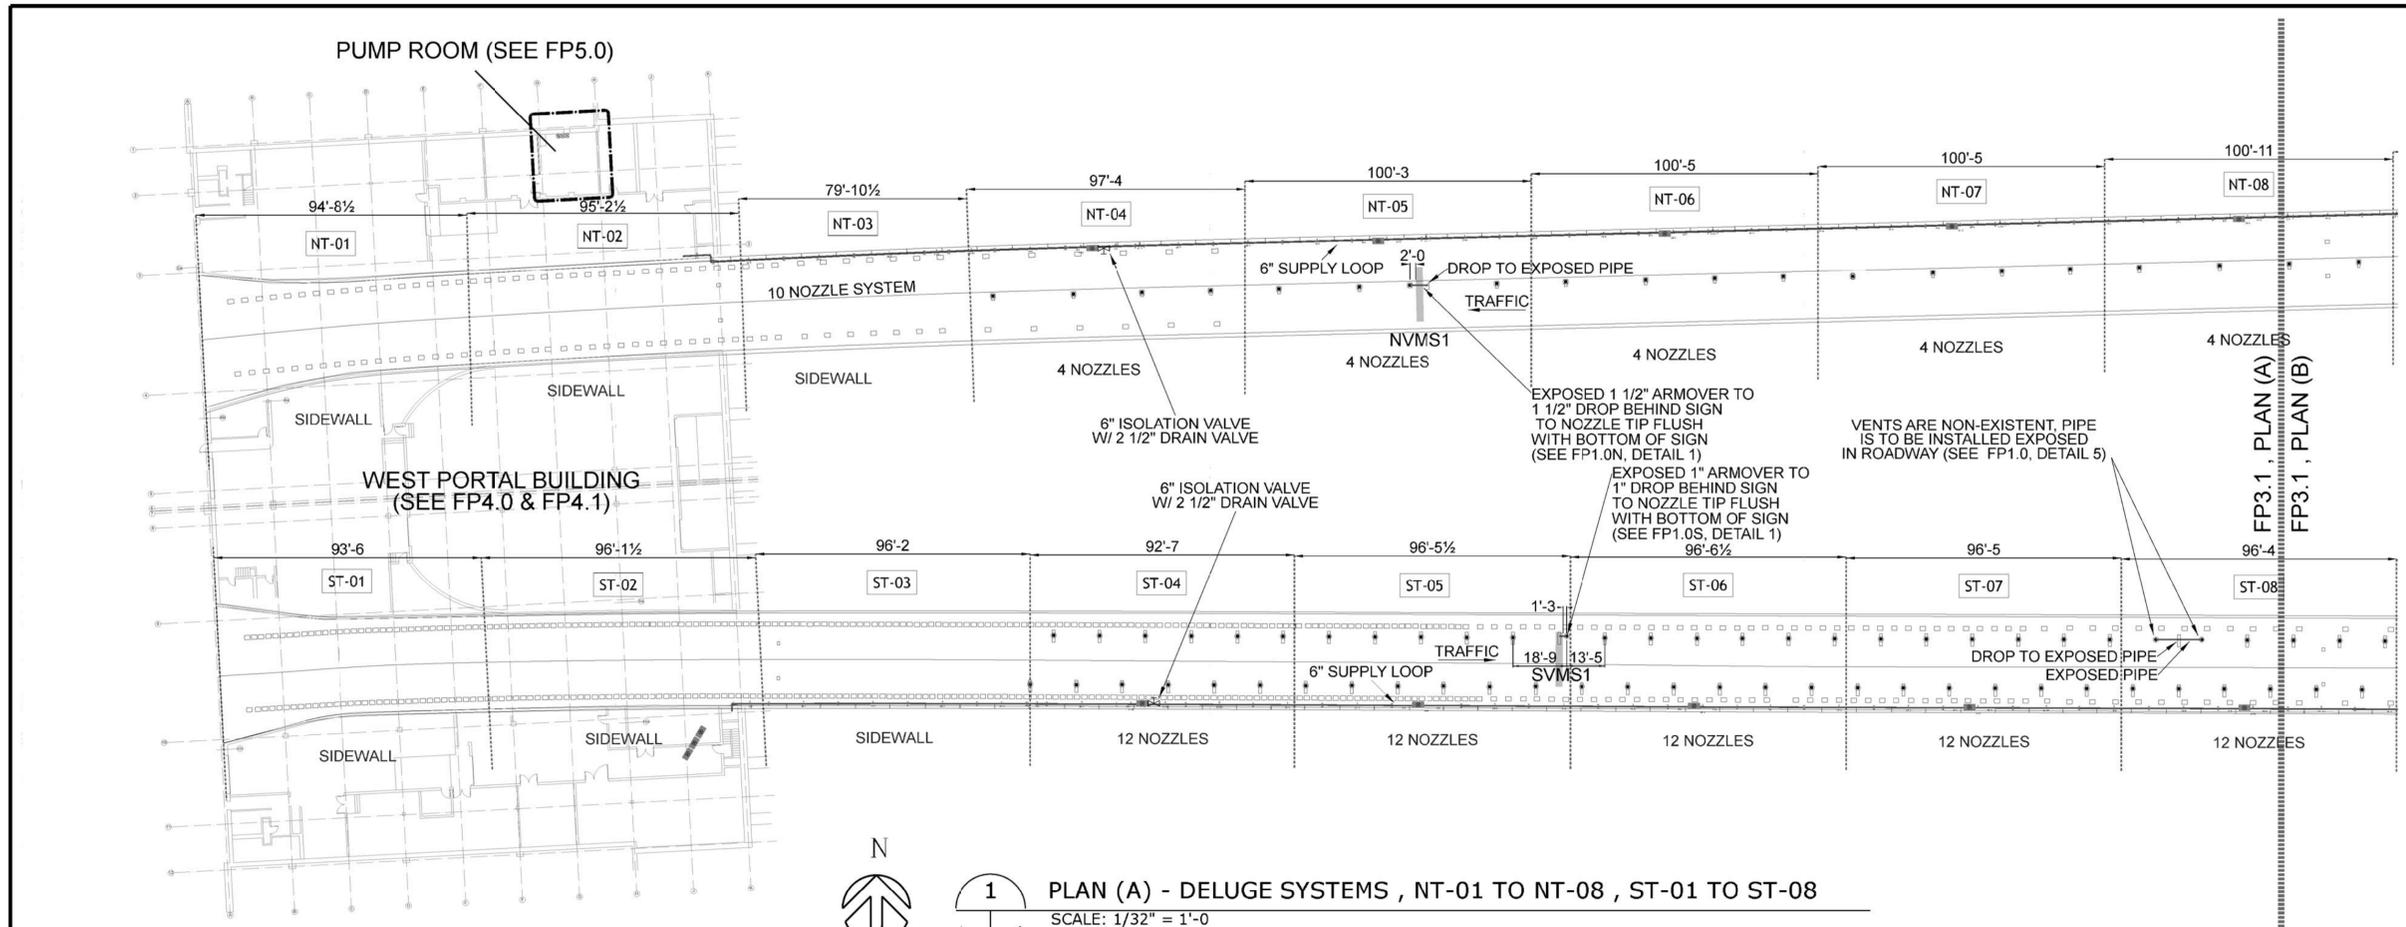

1 PLAN (A) - DELUGE SYSTEMS , NT-01 TO NT-08 , ST-01 TO ST-08  
SCALE: 1/32" = 1'-0"

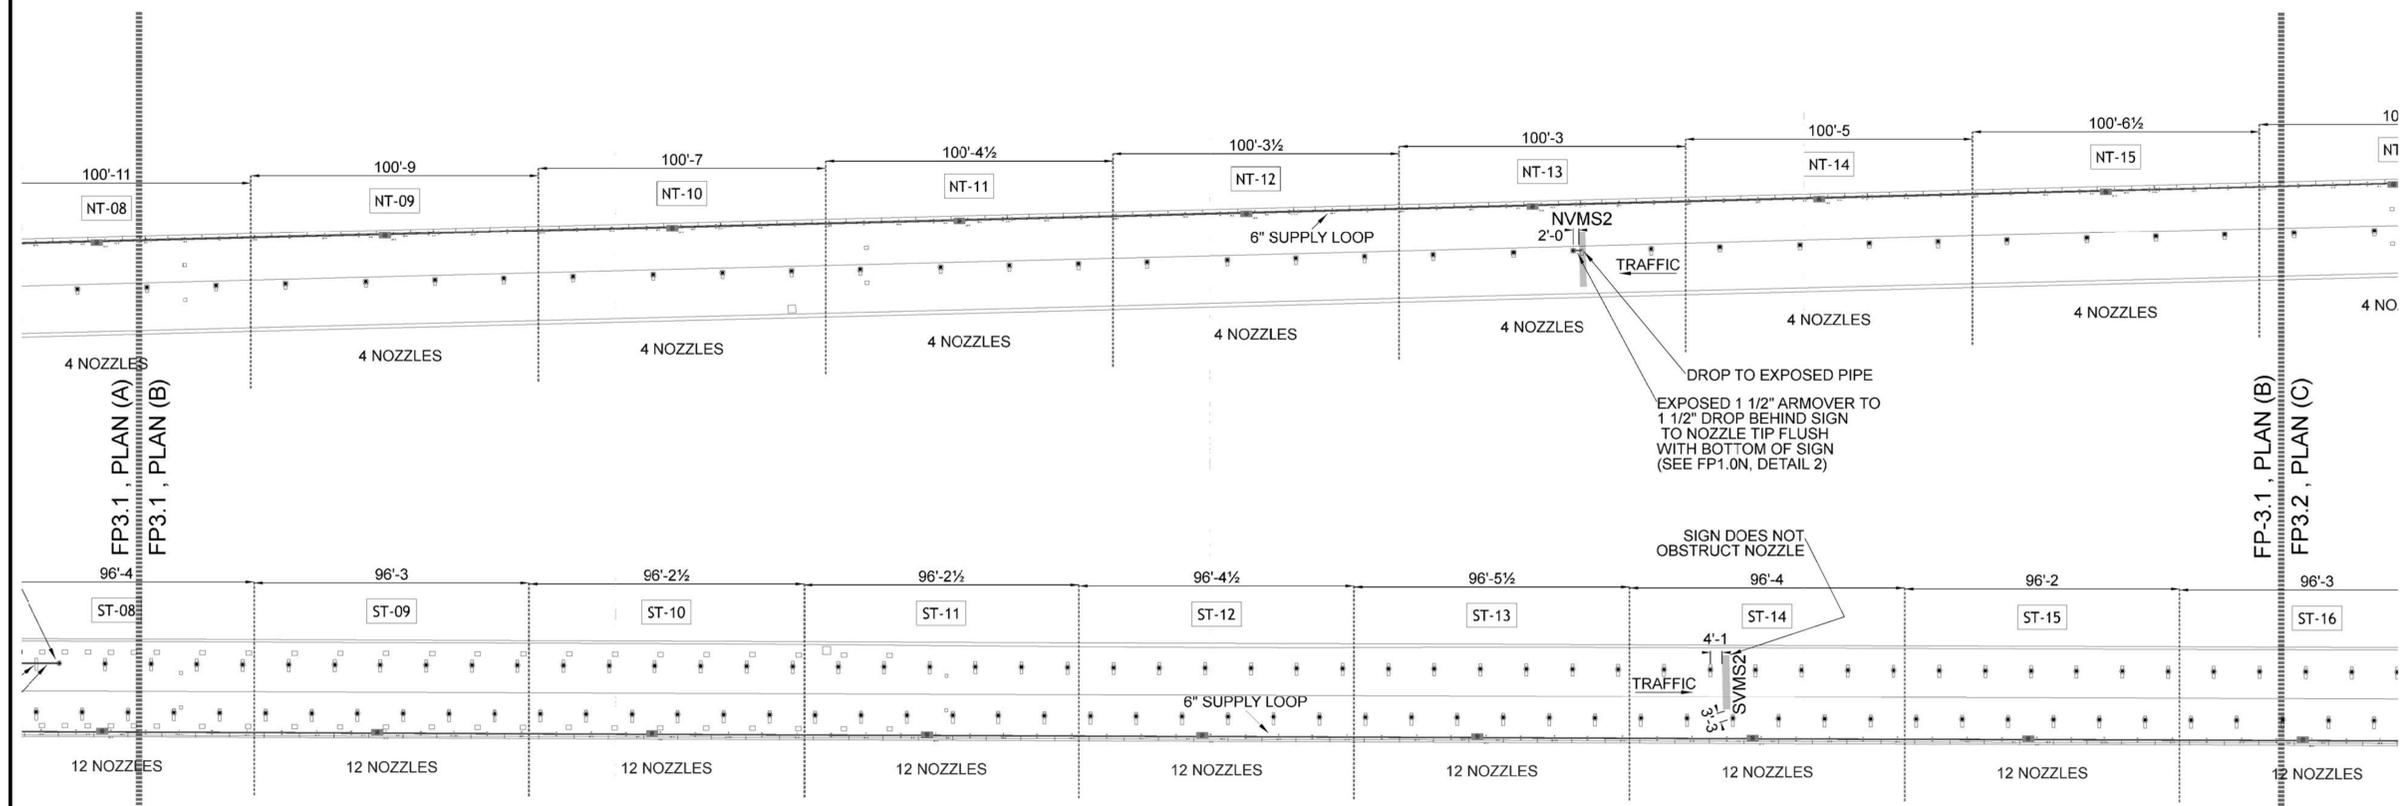

2 PLAN (B) - DELUGE SYSTEMS , NT-09 TO NT-15 , ST-09 TO ST-15  
SCALE: 1/32" = 1'-0"

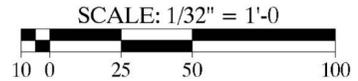

**BARNARD EJMT TEAM**

**BARNARD**

**STURGEON ELECTRIC**

**RONDELLI**

**WESTERN STATES FIRE PROTECTION CO.**

**BCER**

**Western States Fire Protection Co.**

**EISENHOWER/JOHNSON**

**MEMORIAL TUNNEL**

**FIXED FIRE SUPPRESSION SYSTEM**

**DESIGN BUILD PROJECT**

Project No. C0703-360 Subaccount 17810

**RECORD DRAWINGS - 2015-11-16**


Num	Description	Date

DELUGE SYSTEM LOCATION  
WEST, NT-01 TO NT-15  
WEST, ST-01 TO ST-15


Drawing Number  
**FP3.1**







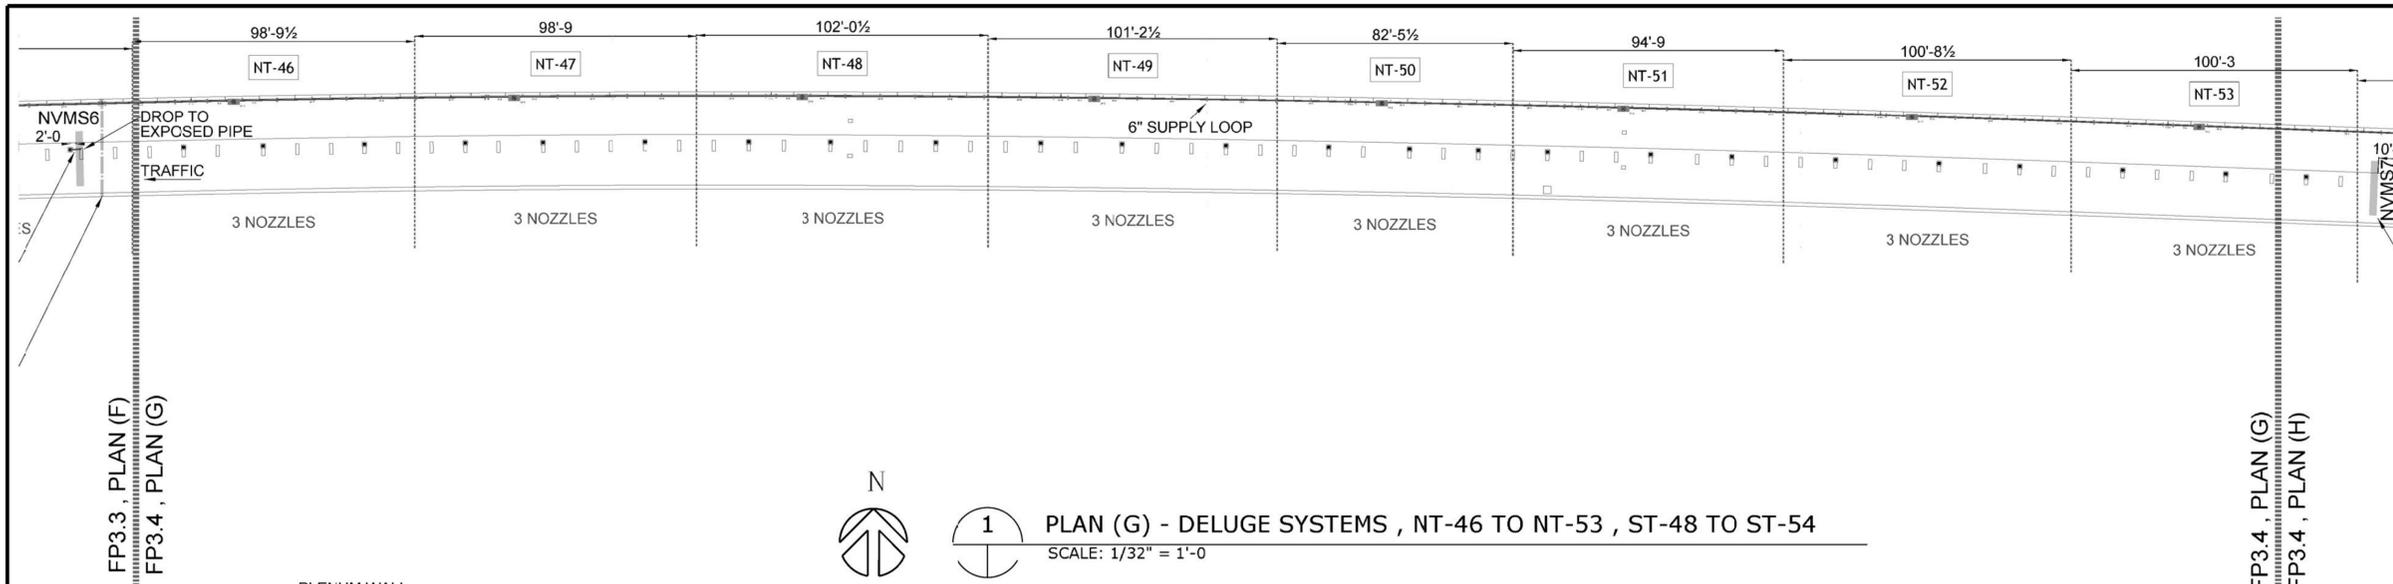

1 PLAN (G) - DELUGE SYSTEMS , NT-46 TO NT-53 , ST-48 TO ST-54  
SCALE: 1/32" = 1'-0

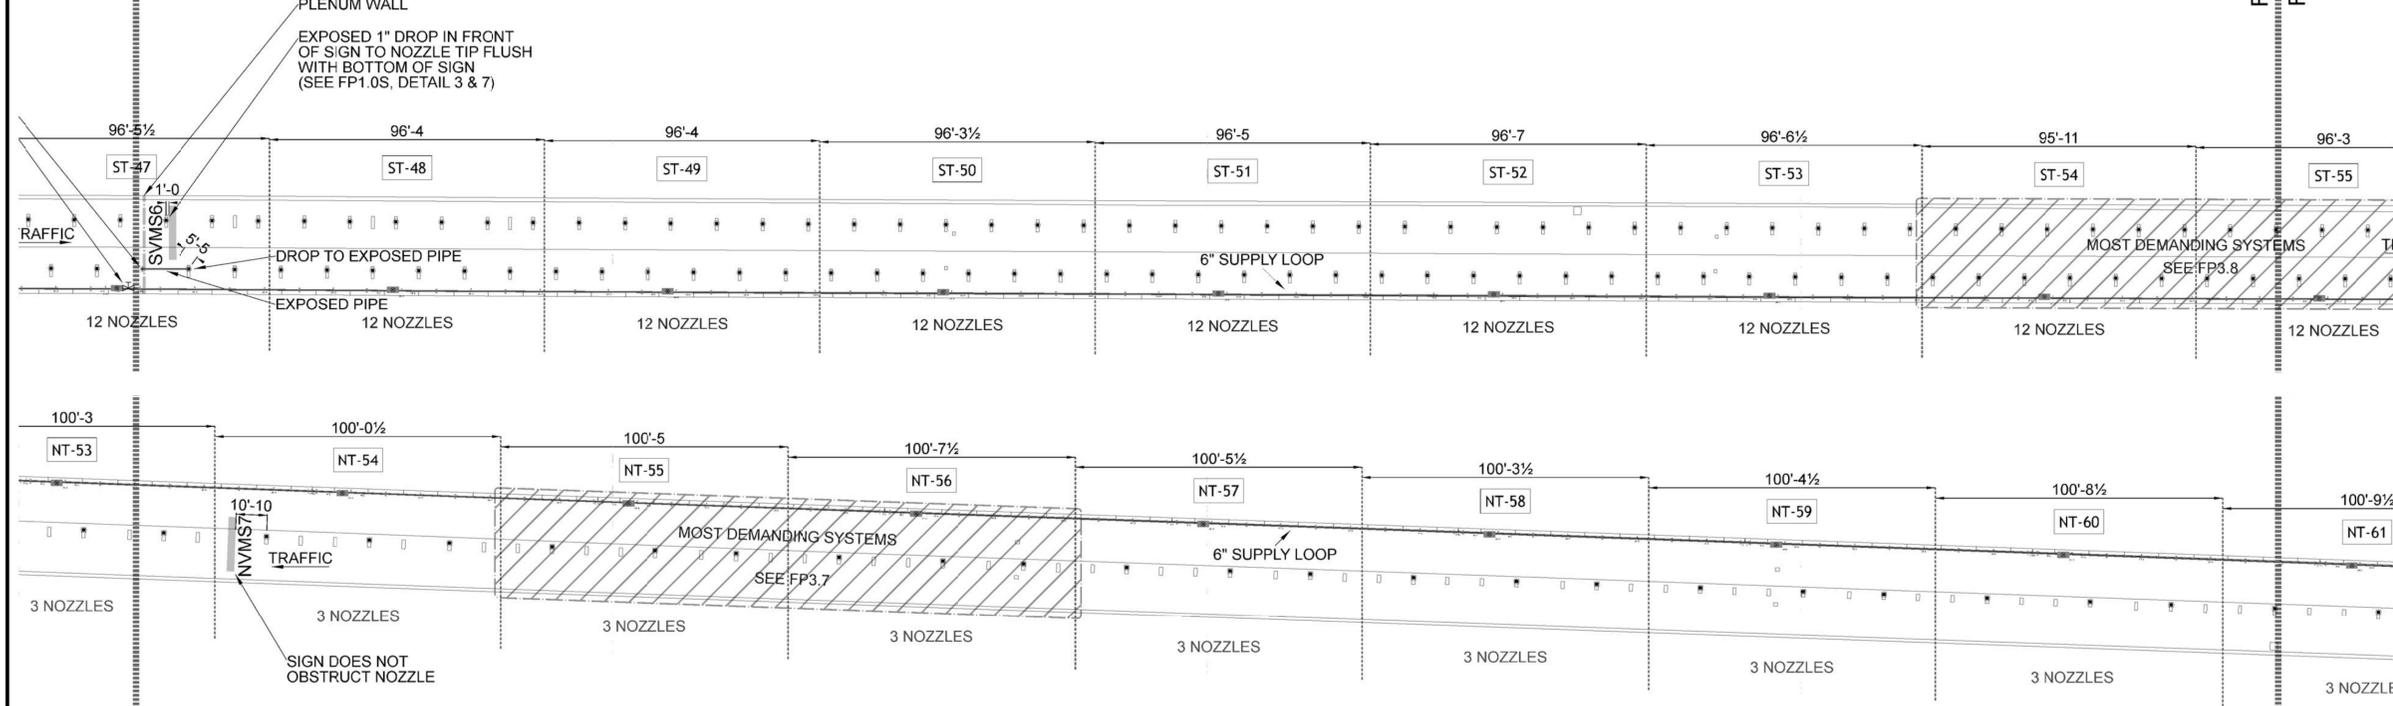

2 PLAN (H) - DELUGE SYSTEMS , NT-54 TO NT-60 , ST-55 TO ST-62  
SCALE: 1/32" = 1'-0

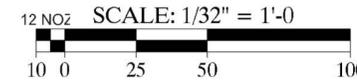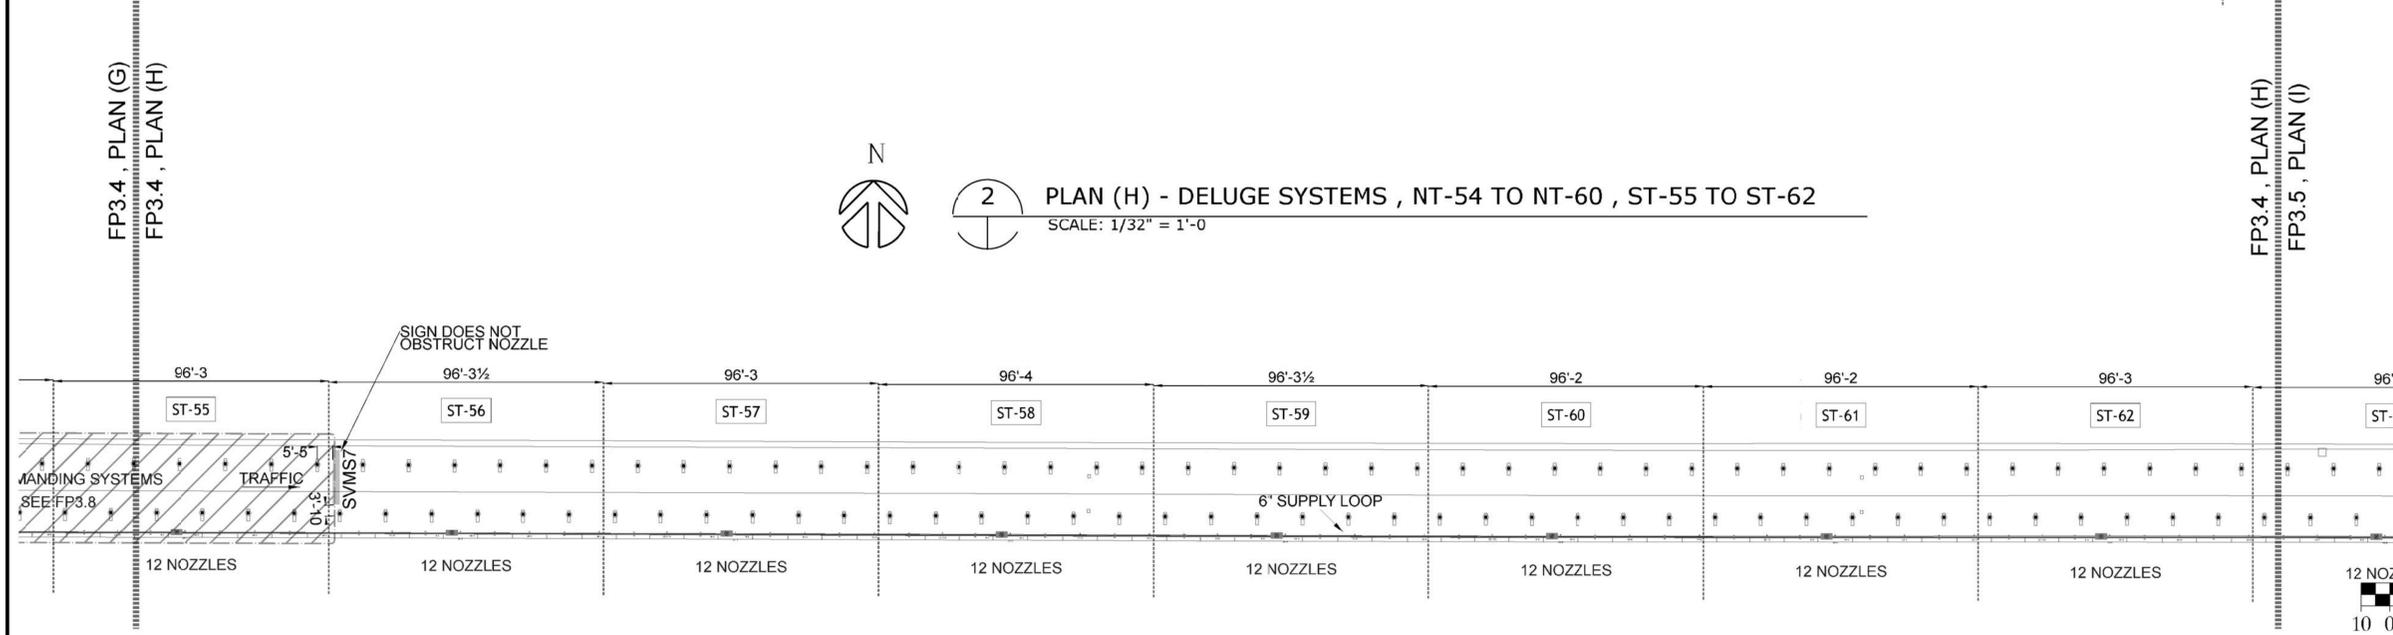

**BARNARD EJMT TEAM**

**BARNARD** **RONDELLI**

Western States Fire Protection Co.

Sturgeon Electric

BCER

**EISENHOWER/JOHNSON**  
**MEMORIAL TUNNEL**  
FIXED FIRE SUPPRESSION SYSTEM  
DESIGN BUILD PROJECT

Project No. C0703-360 Subaccount 17810  
RECORD DRAWINGS - 2015-11-16

Num	Revisions Description	Date

DELUGE SYSTEM LOCATION  
EAST, NT-46 TO NT-60  
EAST, ST-48 TO ST-62

Drawing Number  
**FP3.4**

DRAWN BY: AMB  
CHECKED BY: JUH





### Deluge System Testing


North Tunnel Test Date: 11/15/2015

Zone	Required Outlet (Factory Set) Pressure (psi)	Flow Control Valve Inlet Static (psi)	Flow Control Valve Inlet Residual (psi)	Flow Control Valve Outlet Residual (psi)	Fire Pump Supply Residual (psi)	Fire Pump Outlet Residual (psi)	Interpolated Flow from Fire Pump (gpm)	Flow Meter Reading (gpm)	Time for Flow Control Valve to Shut (sec)	Nozzle Spray Pattern	Notes:
NT-03	84	60	175	74	59	182.5	759	-	3 to 4	OK	Portal System - 10 Nozzle
NT-09	66	157	175	62	59	184	671	-	3 to 4	OK	4 Nozzle
NT-21	66	170	170	65	59	185	607	-	3 to 4	OK	4 Nozzle
NT-31	79	170	175	75	59	185	607	-	3 to 4	OK	3 Nozzle
NT-40	79	175	180	70	59	184	671	-	3 to 4	OK	3 Nozzle
NT-46	79	185	175	70	59	184	671	-	3 to 4	OK	3 Nozzle
NT-54	79	190	185	70	59	184	671	675	3 to 4	OK	3 Nozzle
NT-72	66	200	190	61	59	184	671	715	3 to 4	OK	4 Nozzle
NT-74	66	210	195	58	59	184	671	675	3 to 4	OK	4 Nozzle - ICE FALL AREA
NT-84	66	215	205	54	59	184	671	-	3 to 4	OK	4 Nozzle

Hydraulic Information	
Remote Area NORTH - 3 NOZZLES	
OCCUPANCY CLASSIFICATION	NORTH TUNNEL
DENSITY	0.16gpm/ft <sup>2</sup> for 6865.00ft <sup>2</sup> (Actual 6866.67ft <sup>2</sup> )
TOTAL HEADS FLOWING	6
K-FACTOR	30.4
TOTAL WATER REQUIRED	1218.1
TOTAL PRESSURE REQUIRED	146.1
BASE of RISER (gpm)	1218.1
BASE of RISER (psi)	146.1
SAFETY MARGIN (psi)	+19.3 (11.7%)

FACTORY SET  
EISENHOWER 3 NOZZLE  
FLOW CONTROL VALVE  
SYSTEM DEMAND  
75.2 PSI @ 609 GPM  
75.2X1.05 = 78.96 PSI  
SET AT 79 PSI

BETE NOZZLE TF72FC  
150 DEGREE SPRAY BRASS  
34" X 36" = 1224 SF  
1224 X 0.16 DENSITY = 196 GPM  
P = 41.6 PSI  
K = 30.4  
Q = 196 GPM

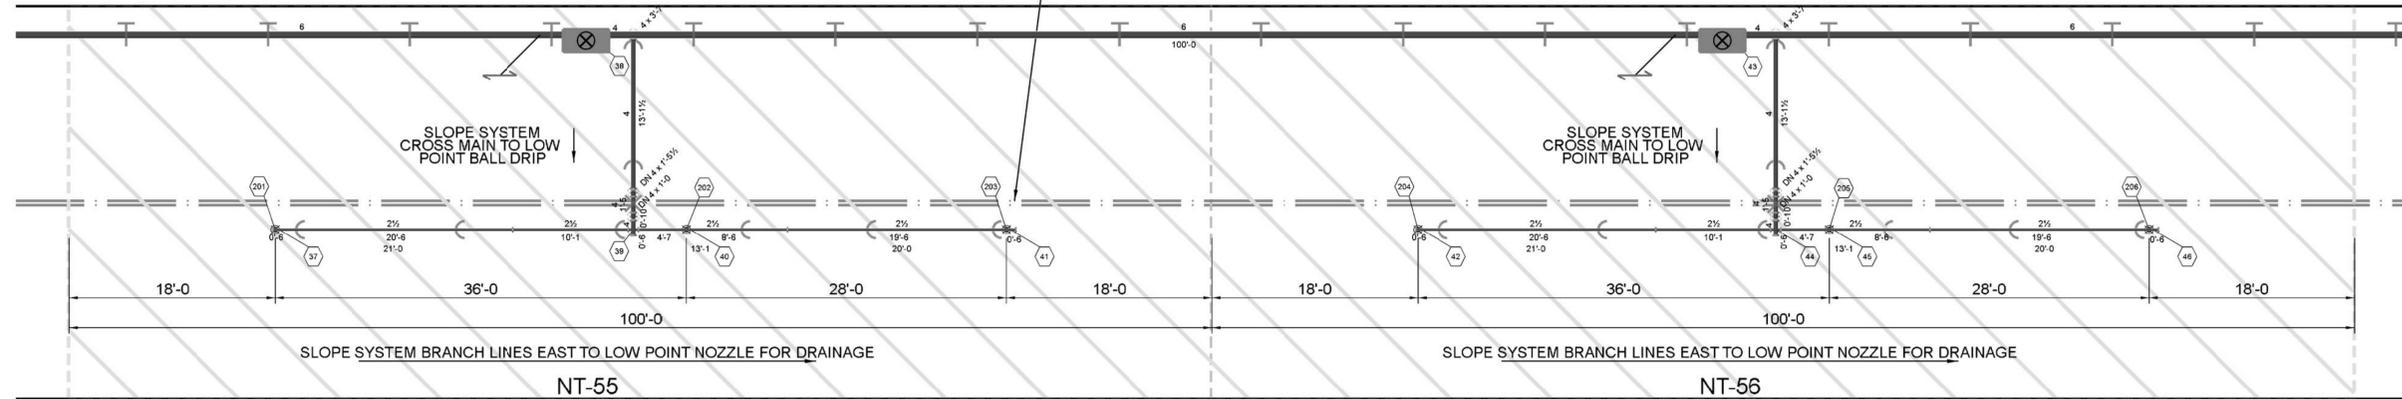

1 NT-55 & NT-56 - EISENHOWER (NORTH) TUNNEL - 3 NOZZLE SYSTEM  
SCALE: 1/8" = 1'-0"


Hydraulic Information	
Remote Area NORTH - 4 NOZZLES	
OCCUPANCY CLASSIFICATION	NORTH TUNNEL
DENSITY	0.16gpm/ft <sup>2</sup> for 6865.00ft <sup>2</sup> (Actual 6866.21ft <sup>2</sup> )
TOTAL HEADS FLOWING	8
K-FACTOR	30.4
TOTAL WATER REQUIRED	1264.7
TOTAL PRESSURE REQUIRED	140.1
BASE of RISER (gpm)	1264.7
BASE of RISER (psi)	140.1
SAFETY MARGIN (psi)	+24.1 (14.7%)

FACTORY SET  
EISENHOWER 4 NOZZLE  
FLOW CONTROL VALVE  
SYSTEM DEMAND  
62.7 PSI @ 630.8 GPM  
62.7X1.05 = 65.83 PSI  
SET AT 66 PSI


60 MINUTE WATER SUPPLY

MOST DEMANDING: 1,264.7 GPM  
(4 NOZZLE SYSTEM - 2 ZONES)  
SAFETY FACTOR: 5%  
1,264.7 GPM X 1.05 = 1,327.9 GPM  
1,327.9 GPM X 60 MIN. = 79,676 GAL

BETE NOZZLE TF72FC  
150 DEGREE SPRAY BRASS  
34" X 28" = 925 SF  
925 X 0.16 DENSITY = 152.32 GPM  
P = 25.1 PSI  
K = 30.4  
Q = 152.32 GPM

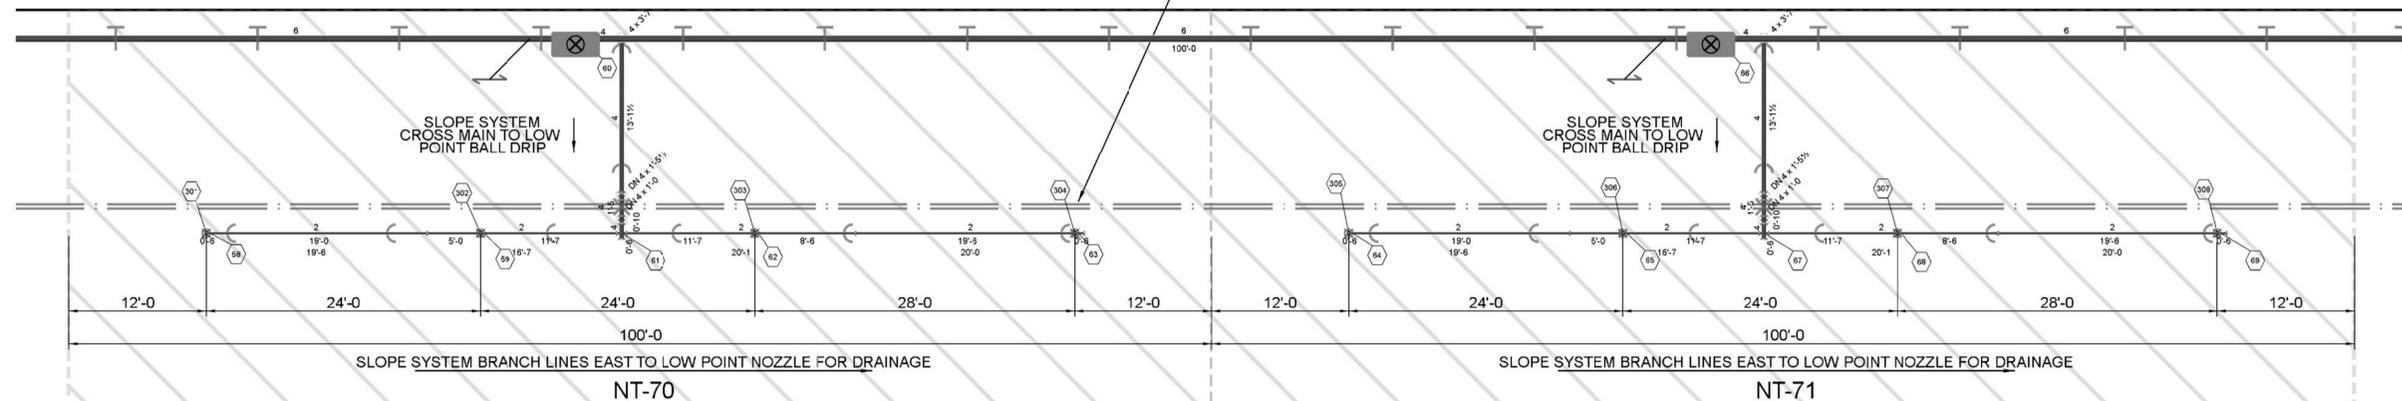

2 NT-70 & NT-71 - EISENHOWER (NORTH) TUNNEL - 4 NOZZLE SYSTEM  
SCALE: 1/8" = 1'-0"

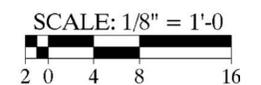

**BARNARD EJMT TEAM**

**BARNARD**

**RONNELL**

A FIRE SERVICE LIFE SAFETY  
CONSULTING ENGINEERS

Western States  
Fire Protection Co.



**Sturgeon**  
ELECTRIC



**EISENHOWER/JOHNSON**

**MEMORIAL TUNNEL**

FIXED FIRE SUPPRESSION SYSTEM

DESIGN BUILD PROJECT

Project No. C0703-360 Subaccount 17810

RECORD DRAWINGS - 2015-11-16

Num	Revisions	Date
	Description	

DELUGE SYSTEMS  
EISENHOWER  
(NORTH) TUNNEL

Drawing Number

**FP3.7**

CHECKED BY: JUH  
DRAWN BY: AMB

**FACTORY SET**  
JOHNSON  
FLOW CONTROL VALVE  
SYSTEM DEMAND  
71.9 PSI @ 578.6 GPM  
71.9X1.05 = 75.50 PSI  
SET AT 76 PSI


Hydraulic Information	
Remote Area SOUTH	
OCCUPANCY CLASSIFICATION	SOUTH TUNNEL
DENSITY	0.16gpm/ft <sup>2</sup> for 6590.00ft <sup>2</sup> (Actual 6590.70ft <sup>2</sup> )
TOTAL HEADS FLOWING	24
K-FACTOR	6.6
TOTAL WATER REQUIRED	1159.5
TOTAL PRESSURE REQUIRED	136.0
BASE of RISER (gpm)	1159.5
BASE of RISER (psi)	136.0
SAFETY MARGIN (psi)	+30.8 (18.5%)

BETE NOZZLE N6W  
120 DEGREE SPRAY BRASS  
17" X 17" = 289 SF  
289 X 0.16 DENSITY = 46.24 GPM  
P = 48.5 PSI  
K = 6.64  
Q = 46.24 GPM


**Deluge System Testing**

South Tunnel Test Date: 11/9/2015

Zone	Required Outlet (Factory Set) Pressure (psi)	Flow Control Valve Inlet Static (psi)	Flow Control Valve Inlet Residual (psi)	Flow Control Valve Outlet Residual (psi)	Fire Pump Supply Residual (psi)	Fire Pump Outlet Residual (psi)	Interpolated Flow from Fire Pump (gpm)	Flow Meter Reading (gpm)	Time for Flow Control Valve to Shut (sec)	Nozzle Spray Pattern	Notes:
ST-03	66	145	160	70	61	190	0	-	3 to 4	OK	Portal System - 12 Nozzle
ST-08	76	150	170	81	59	185	607	-	3 to 4	OK	12 Nozzle
ST-19	76	160	170	70	59	185	607	625	3 to 4	OK	12 Nozzle
ST-30	76	205	170	65	59	184	671	-	3 to 4	OK	12 Nozzle
ST-38	76	152	170	76	58	184	671	-	3 to 4	OK	12 Nozzle
ST-48	76	160	180	65	59	185	607	-	3 to 4	OK	12 Nozzle
ST-56	76	190	190	70	59	185	607	600	3 to 4	OK	12 Nozzle
ST-84	76	215	200	65	58	185	607	-	3 to 4	OK	12 Nozzle
ST-93	66	147	200	60	58	184	671	600	3 to 4	OK	Portal System - 12 Nozzle

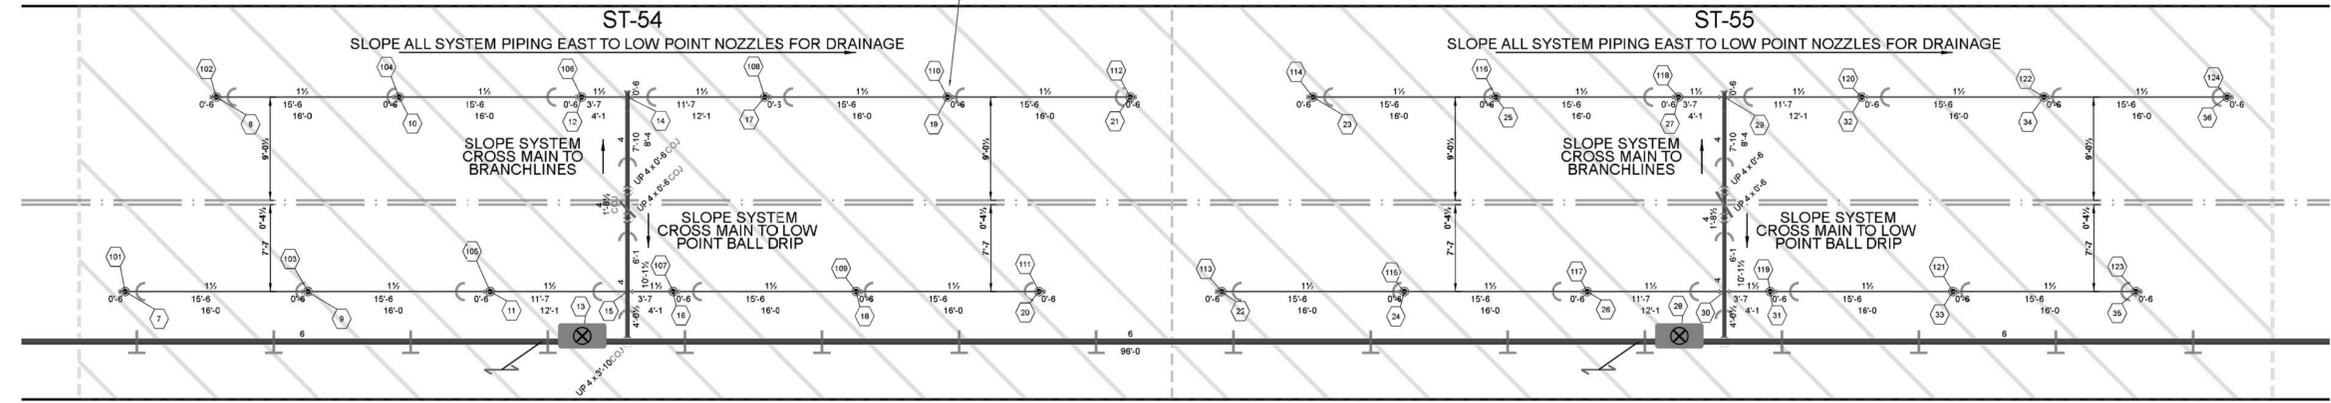

1 ST-54 & ST-55 - JOHNSON (SOUTH) TUNNEL - 12 NOZZLE SYSTEM  
SCALE: 1/8" = 1'-0"

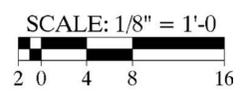

**EISENHOWER/JOHNSON  
MEMORIAL TUNNEL**  
FIXED FIRE SUPPRESSION SYSTEM  
DESIGN BUILD PROJECT

Project No. C0703-360 Subaccount 17810  
**RECORD DRAWINGS - 2015-11-16**

REVISIONS	Date
Num	Description

DELUGE SYSTEMS  
JOHNSON  
(SOUTH) TUNNEL

Drawing Number  
**FP3.8**


**BARNARD EJMT TEAM**

**BARNARD** **RONDNELLI**  
Western States Fire Protection Co.  
CONSULTING ENGINEERS


**BCER** **Sturgeon ELECTRIC**






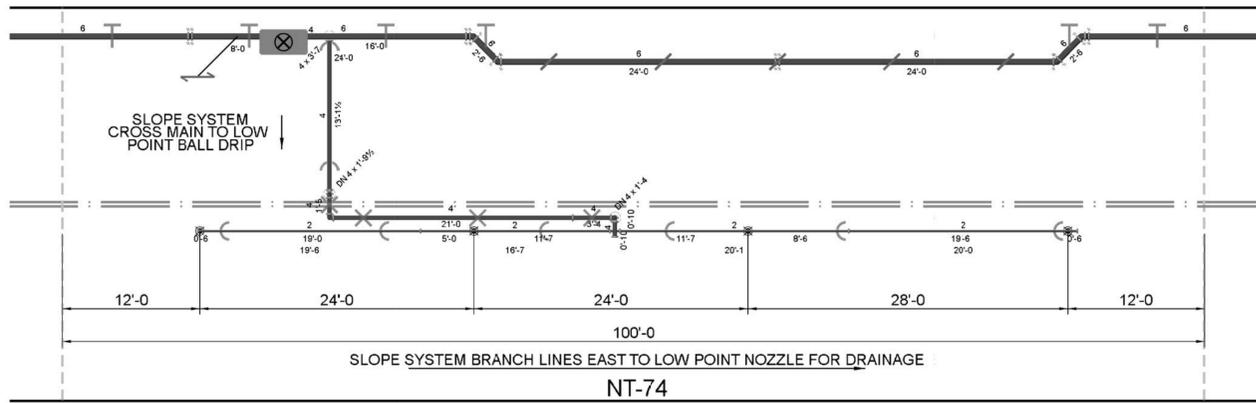

NT-74 - EISENHOWER (NORTH) TUNNEL - ICE FALL SYSTEM  
SCALE: 1/8" = 1'-0"

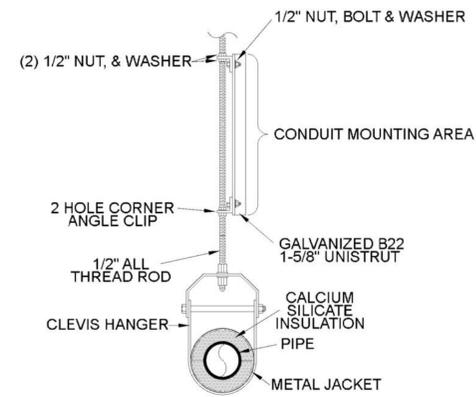

CLEVIS HANGER - ICE FALL  
EISENHOWER (NORTH) TUNNEL - NT-74  
NOT TO SCALE

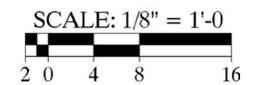

**BARNARD EJMT TEAM**



EISENHOWER/JOHNSON

MEMORIAL TUNNEL

FIXED FIRE SUPPRESSION SYSTEM

DESIGN BUILD PROJECT

Project No. C0703-360 Subaccount 17810  
RECORD DRAWINGS - 2015-11-16

Num	Description	Date

DELUGE SYSTEMS  
EISENHOWER (NORTH)  
TUNNEL - ICE FALL

Drawing Number  
**FP3.10**

DRAWN BY: AMB  
CHECKED BY: JUH









TANK LEVEL READINGS  
 60 MINUTES REMAINING = 60.2 PSI  
 30 MINUTES REMAINING = 43.7 PSI  
 0 MINUTES REMAINING = 5.0 PSI

LOW TANK LEVEL = 30.4 PSI

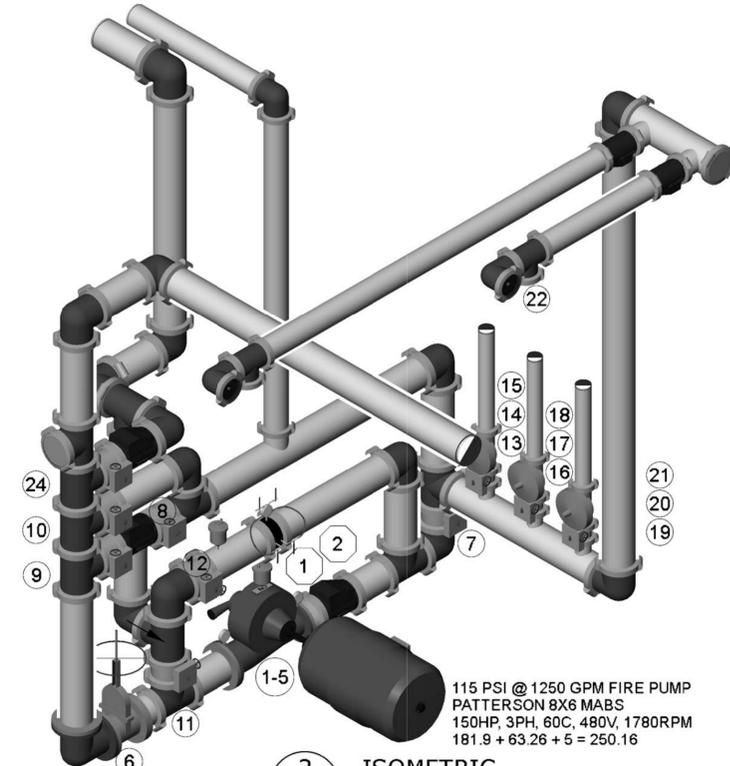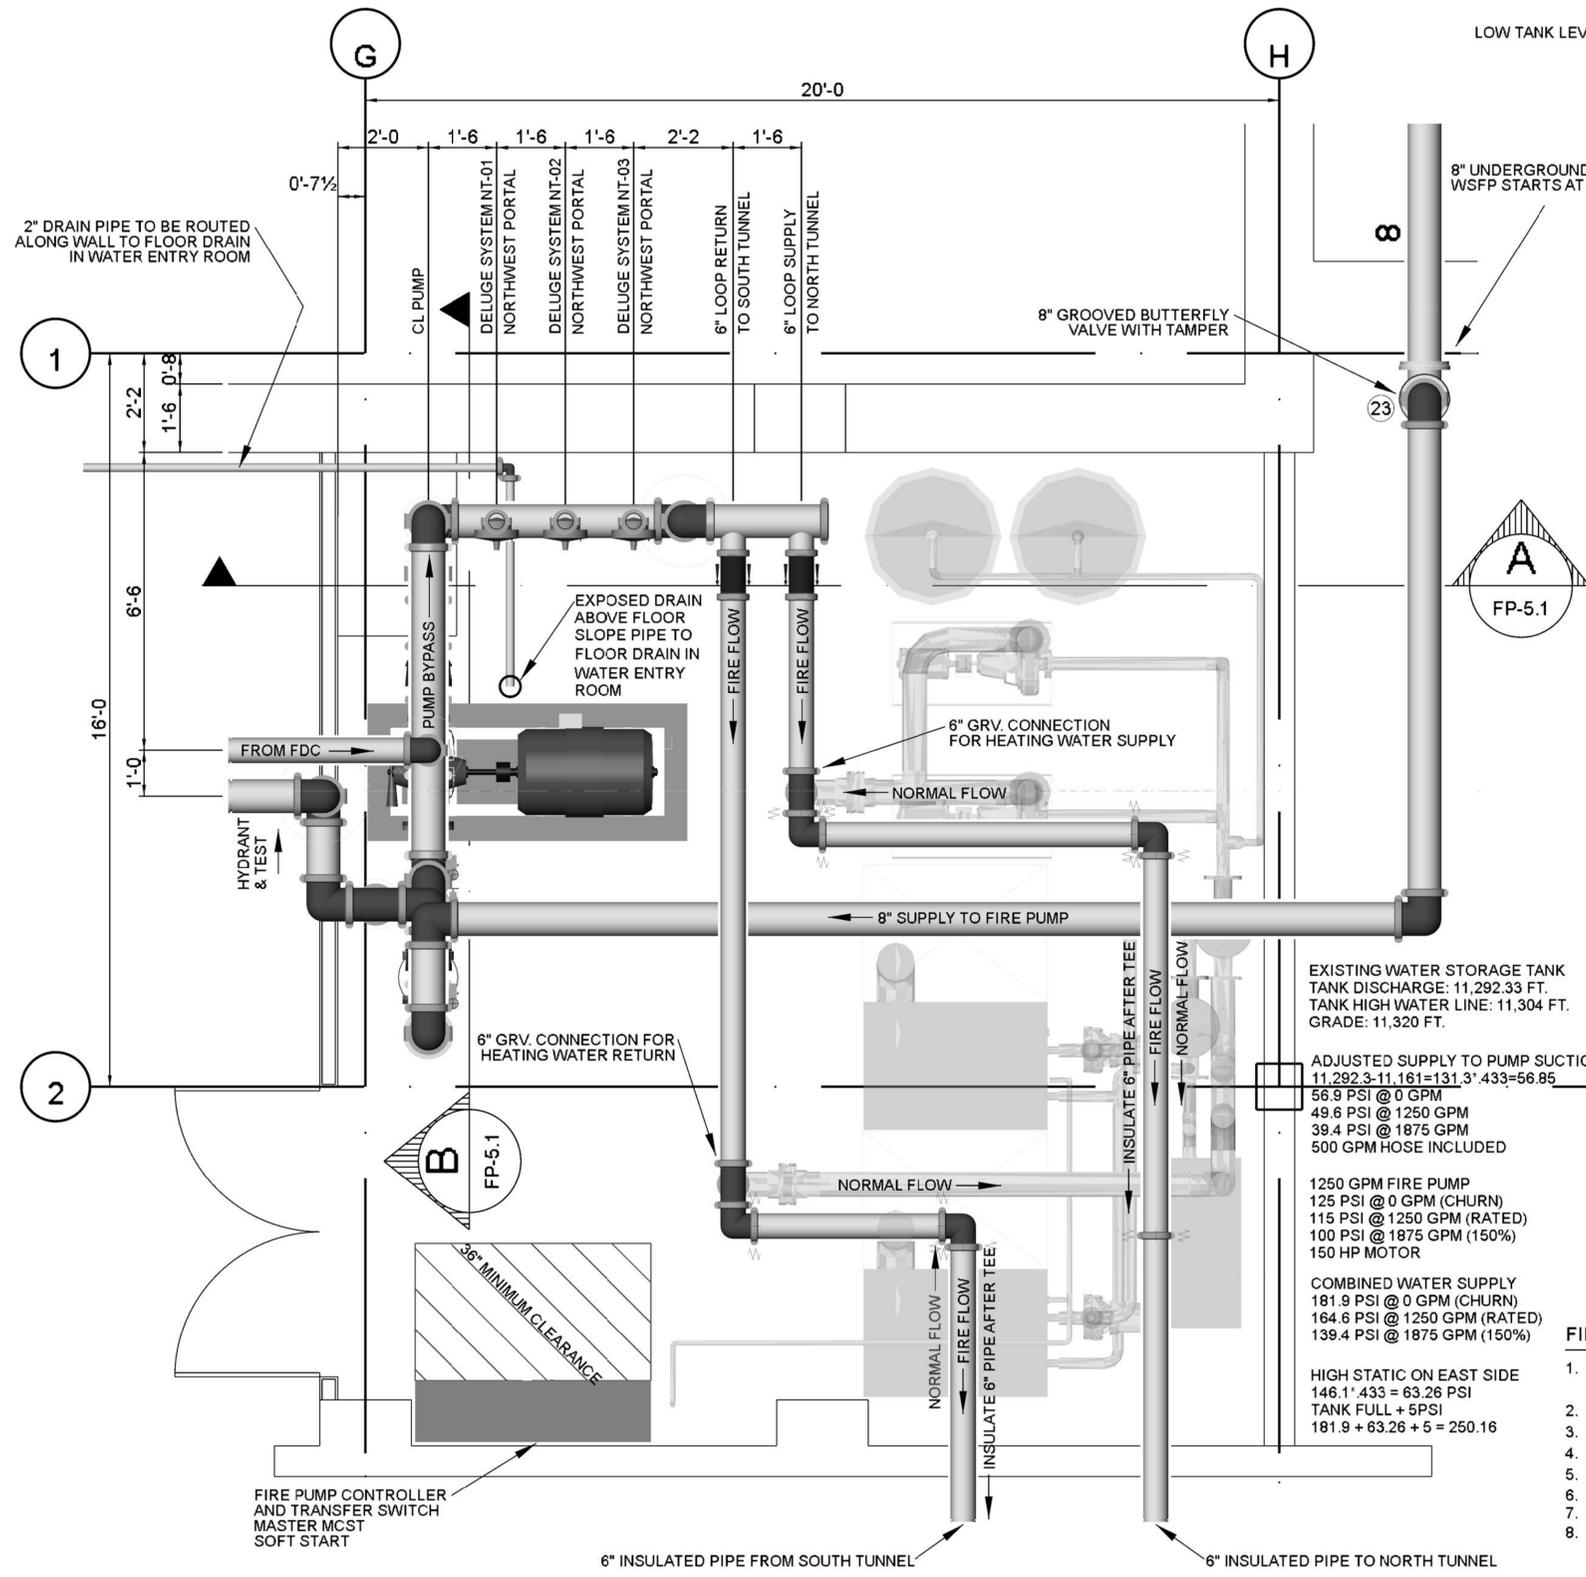

115 PSI @ 1250 GPM FIRE PUMP  
 PATTERSON 8X6 MABS  
 150HP, 3PH, 60C, 480V, 1780RPM  
 181.9 + 63.26 + 5 = 250.16

2 ISOMETRIC  
 NOT TO SCALE

FIRE PUMP TAG LEGEND  
 # WIRED DEVICE # HYDRAULIC REFERENCE

DEVICES IN PUMP ROOM SUPERVISED AND ACTUATED BY FIRE ALARM PANEL

#	DEVICE	VALVE POSITION PER FLOW CONDITION		
		NORMAL FLOW	FIRE/FDC FLOW	STORAGE TANK RE-FILL
1	PUMP START	.	.	.
2	PUMP RUNNING	.	.	.
3	PUMP PHASE REVERSAL	.	.	.
4	PUMP LOSS OF PHASE	.	.	.
5	PUMP EMERGENCY POWER	.	.	.
6	PUMP SUPPLY - TAMPER SWITCH	N/O	OPEN	CLOSED
7	PUMP DISCHARGE - TAMPER SWITCH	N/O	OPEN	OPEN
8	PUMP BYPASS - TAMPER SWITCH	N/O	OPEN	CLOSED
9	PUMP BYPASS - TAMPER SWITCH	N/O	OPEN	CLOSED
10	RE-FILL BYPASS - TAMPER SWITCH	N/C	CLOSED	OPEN
11	RE-FILL - TAMPER SWITCH	N/C	CLOSED	OPEN
12	PUMP TEST - TAMPER SWITCH	N/C	CLOSED	CLOSED
13	NT-01 TAMPER SWITCH	N/O	OPEN	OPEN
14	NT-01 PRESSURE SWITCH	.	.	.
15	NT-01 SOLENOID VALVE	N/C	OPEN (FIRE IN ZONE)	CLOSED
16	NT-02 TAMPER SWITCH	N/O	OPEN	OPEN
17	NT-02 PRESSURE SWITCH	.	.	.
18	NT-02 SOLENOID VALVE	N/C	OPEN (FIRE IN ZONE)	CLOSED
19	NT-03 TAMPER SWITCH	N/O	OPEN	OPEN
20	NT-03 PRESSURE SWITCH	.	.	.
21	NT-03 SOLENOID VALVE	N/C	OPEN (FIRE IN ZONE)	CLOSED
22	6" LOOP PRESSURE SWITCH	.	.	.
23	UNDERGROUND LEAD-IN - TAMPER	N/O	OPEN	OPEN
24	WALL HYDRANT SUPPLY - TAMPER	N/O	OPEN	CLOSED

FIRE PUMP GENERAL NOTES

- ALL MATERIAL AND INSTALLATIONS OF THIS FIRE PUMP SHALL BE UL LISTED FOR FIRE PROTECTION USE AND CONFORM TO NFPA 20, 2010 EDITION.
- ELECTRICAL POWER WIRING AND ALARM WIRING IS BY ELECTRICAL CONTRACTOR.
- ALL FITTINGS TO BE GROOVED FIRELOCK OR GROOVED STANDARD BY VICTAULIC.
- ALL PIPING TO BE SCHEDULE 10 BLACK ASTM A-795 WITH GROOVED ENDS UNLESS NOTED OTHERWISE.
- ALL PAINTING TO BE IN ACCORDANCE WITH NFPA AND MANUFACTURERS DATA.
- FIRE PUMP FRAME TO BE ANCHORED TO CONCRETE PUMP ROOM FLOOR.
- LOW POINTS IN FIRE PUMP PIPING TO HAVE PROVISIONS FOR DRAINING.
- SUCTION AND DISCHARGE PIPING SHALL BE HYDROSTATICALLY TESTED AT NOT LESS THAN 200 PSI (13.8 BAR) PRESSURE, OR AT 50 PSI (3.4 BAR) IN EXCESS OF THE MAXIMUM PRESSURE TO BE MAINTAINED IN THE SYSTEM, WHICHEVER IS GREATER, FOR 2 HOURS.
- ALL CONTROL VALVES ARE TO HAVE TAMPER SWITCHES.
- CASING RELIEF VALVE TO BE PIPED TO FLOOR DRAIN SEPARATELY.
- FIRE PUMP PACKING GLAND TO BE PIPED TO THE FLOOR DRAIN SEPARATELY.
- HANGERS AND SUPPORTS TO BE PROVIDED IN ACCORDANCE WITH NFPA-13.
- SEISMIC BRACING TO BE PROVIDED IN ACCORDANCE WITH NFPA-13.
- ALL VALVES TO BE LABELED IN ACCORDANCE WITH NFPA-13.
- REFER TO PUMP SUBMITTAL FOR DETAILED INFORMATION ON PUMP AND CONTROLLER.
- PUMP SKID TO BE MOUNTED TO GROUT PAD.

EXISTING WATER STORAGE TANK  
 TANK DISCHARGE: 11,292.33 FT.  
 TANK HIGH WATER LINE: 11,304 FT.  
 GRADE: 11,320 FT.



ADJUSTED SUPPLY TO PUMP SUCTION  
 11,292.3-11,161=131.3' 433=56.85  
 56.9 PSI @ 0 GPM  
 49.6 PSI @ 1250 GPM  
 39.4 PSI @ 1875 GPM  
 500 GPM HOSE INCLUDED

1250 GPM FIRE PUMP  
 125 PSI @ 0 GPM (CHURN)  
 115 PSI @ 1250 GPM (RATED)  
 100 PSI @ 1875 GPM (150%)  
 150 HP MOTOR

COMBINED WATER SUPPLY  
 181.9 PSI @ 0 GPM (CHURN)  
 164.6 PSI @ 1250 GPM (RATED)  
 139.4 PSI @ 1875 GPM (150%)

HIGH STATIC ON EAST SIDE  
 146.1' 433 = 63.26 PSI  
 TANK FULL + 5PSI  
 181.9 + 63.26 + 5 = 250.16






1 PUMP ROOM PLAN  
 SCALE: 1/2" = 1'-0"

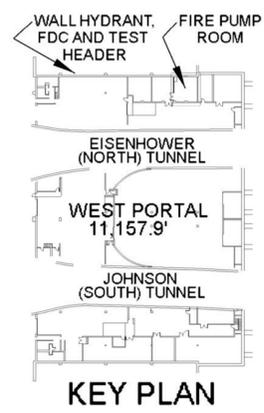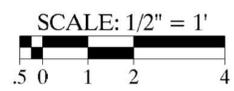

EISENHOWER/JOHNSON  
 MEMORIAL TUNNEL  
 FIXED FIRE SUPPRESSION SYSTEM  
 DESIGN BUILD PROJECT

**BARNARD EJMT TEAM**  
**BARNARD**  
**RONDINELLI**  
**Sturgeon Electric**  
 BCER  
 Western States Fire Protection Co.  
 RUF  
 CONSULTING ENGINEERS

Project No. C0703-360 Subaccount 17810  
 RECORD DRAWINGS - 2015-11-16  
 FIRE PUMP ROOM PLAN AND ISOMETRIC  
 Drawing Number **FP5.0**  
 REVISIONS: Date, Description, Num  
 DRAWN BY: AMB CHECKED BY: JUH

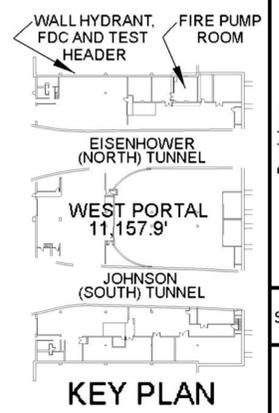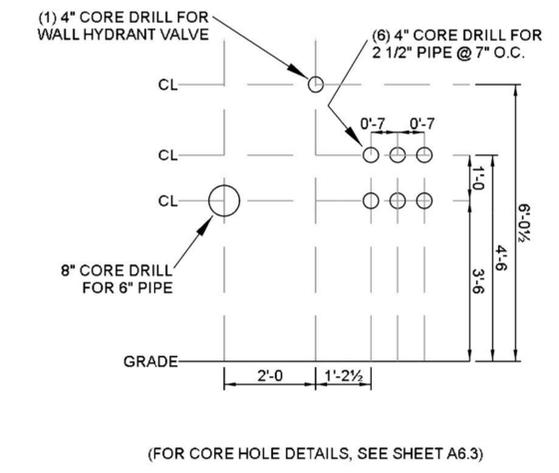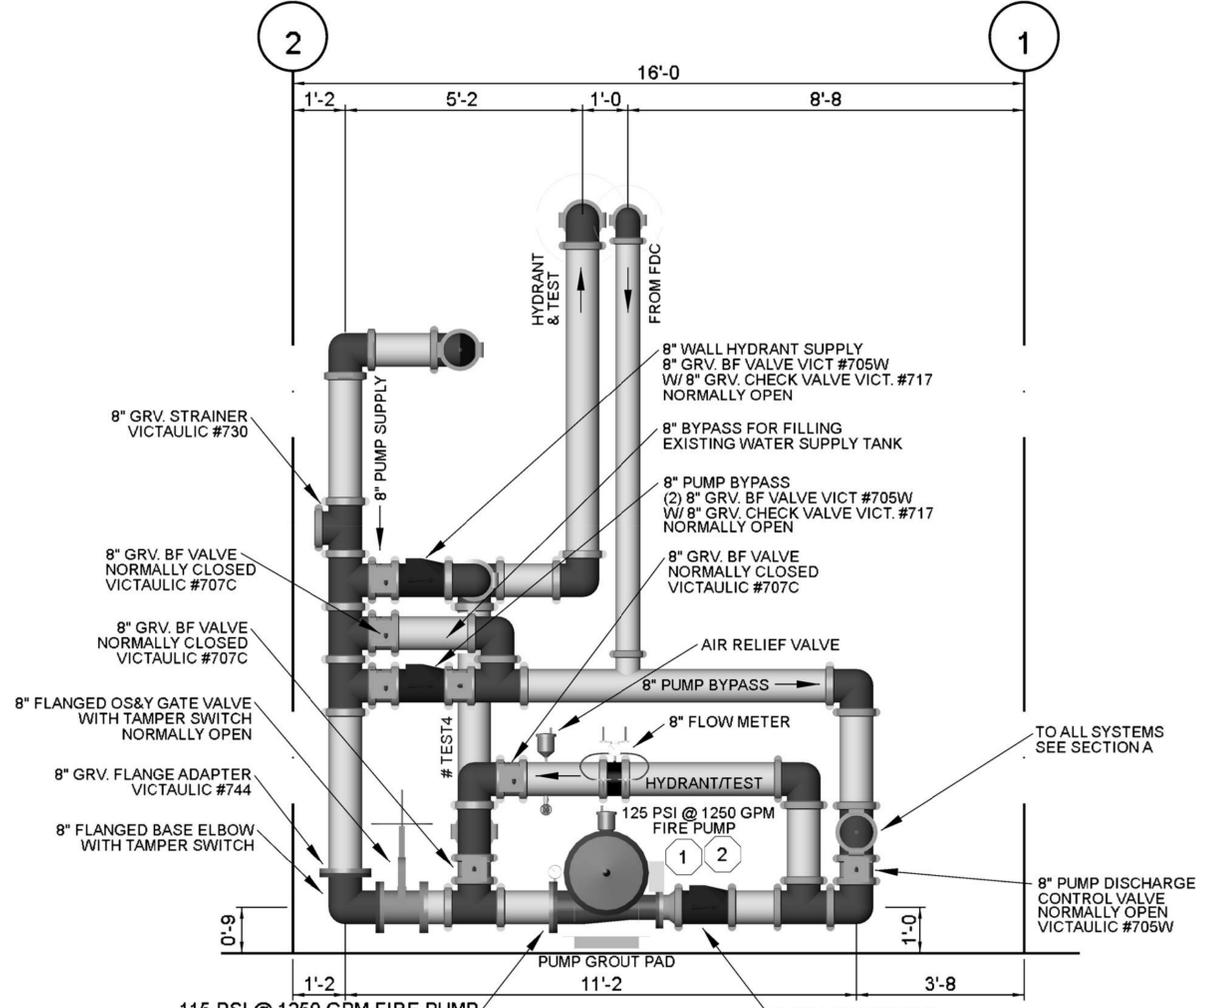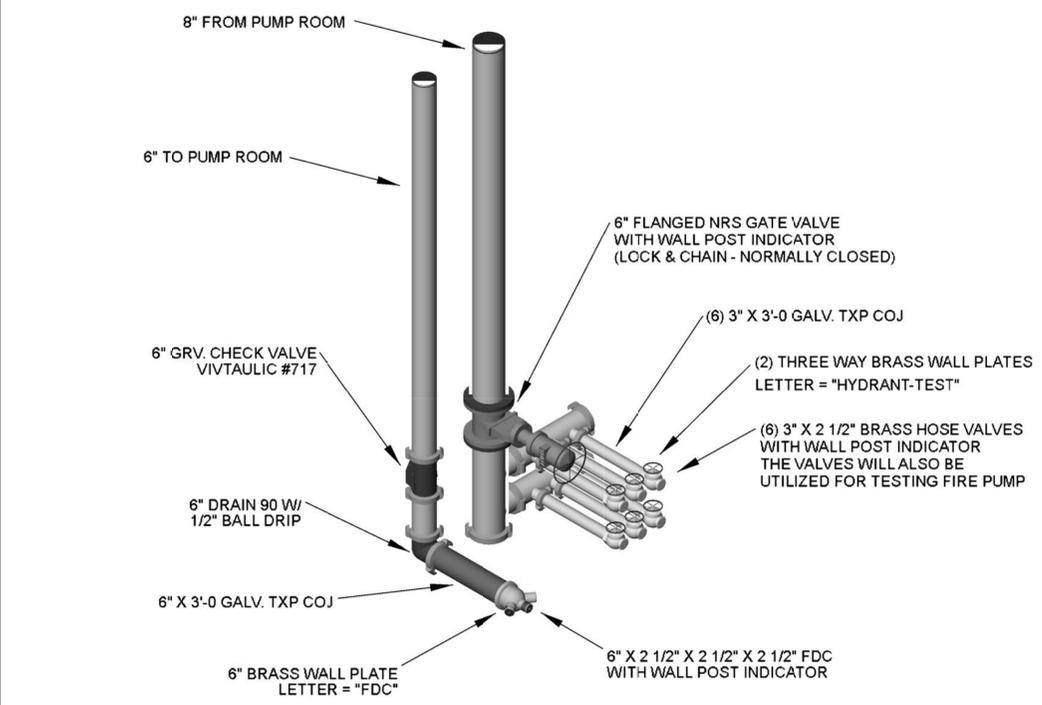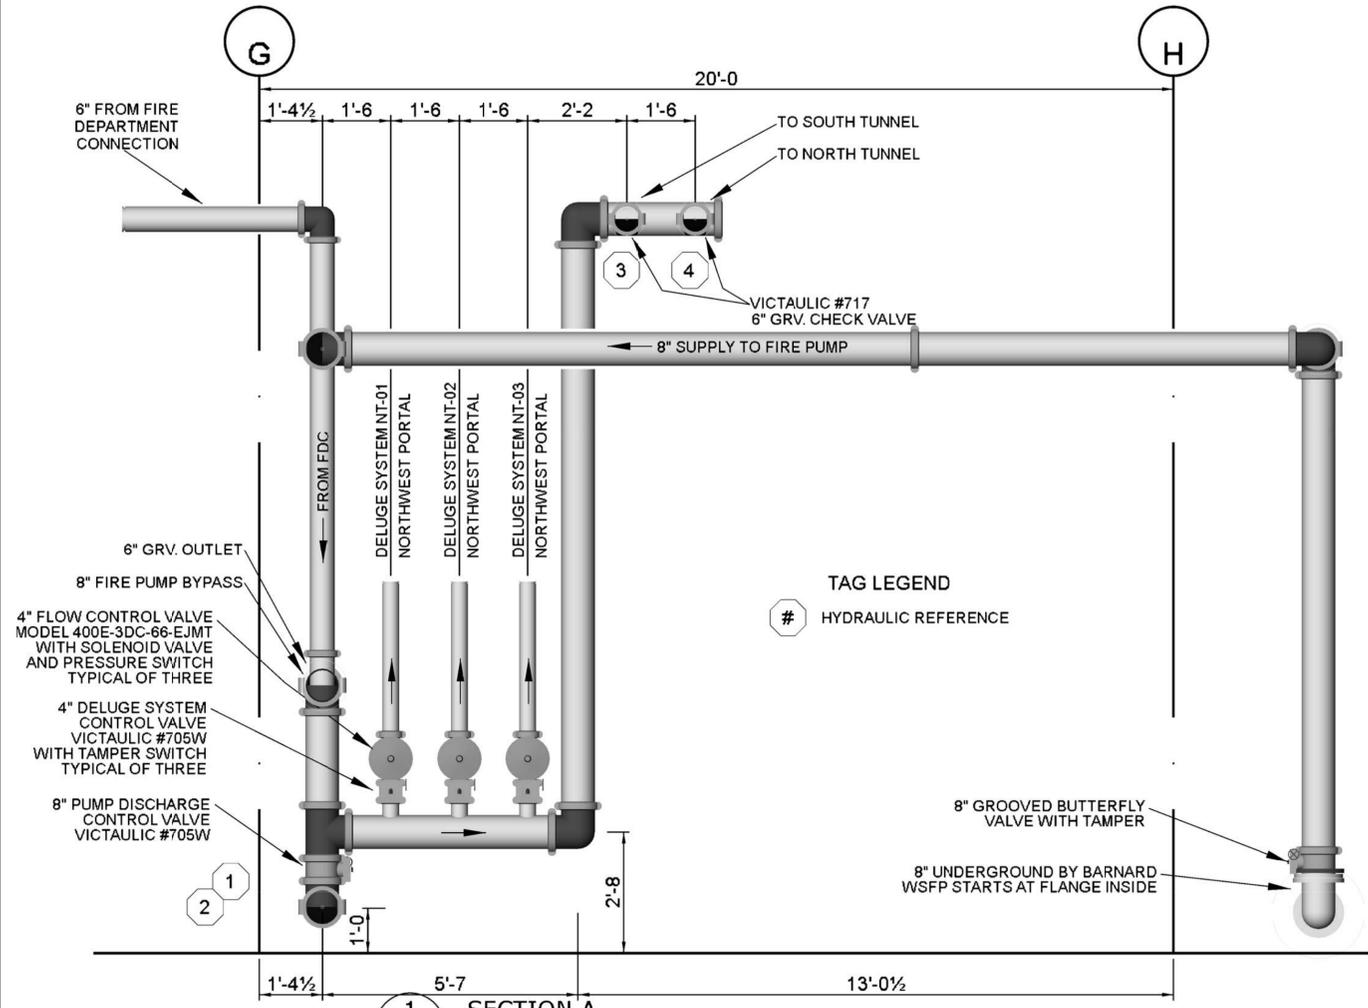

**BARNARD EJMT TEAM**

**BARNARD RONDINELLI**  
A FIRE SUPPRESSION LIFE SAFETY

**Western States Fire Protection Co.**

**Sturgeon Electric**

**BCER**  
Engineering

**Western States Fire Protection Co.**

**EISENHOWER/JOHNSON MEMORIAL TUNNEL**  
FIXED FIRE SUPPRESSION SYSTEM  
DESIGN BUILD PROJECT

Project No. C0703-360 Subaccount 17810


**RECORD DRAWINGS - 2015-11-16**

Num	Revisions	Date


FIRE PUMP ROOM SECTIONS, WALL HYDRANT, FDC & TEST HEADER

Drawing Number **FP5.1**


DRAWN BY: AMB CHECKED BY: JUH

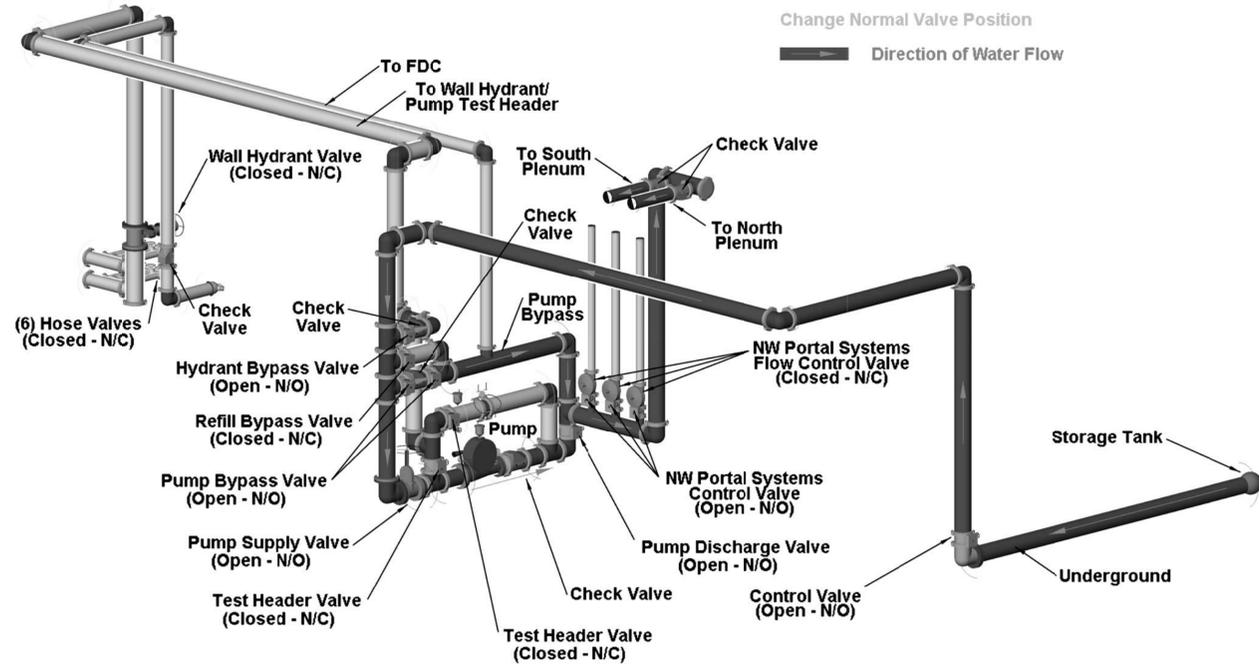


1 FIRE FLOW  
 NOT TO SCALE

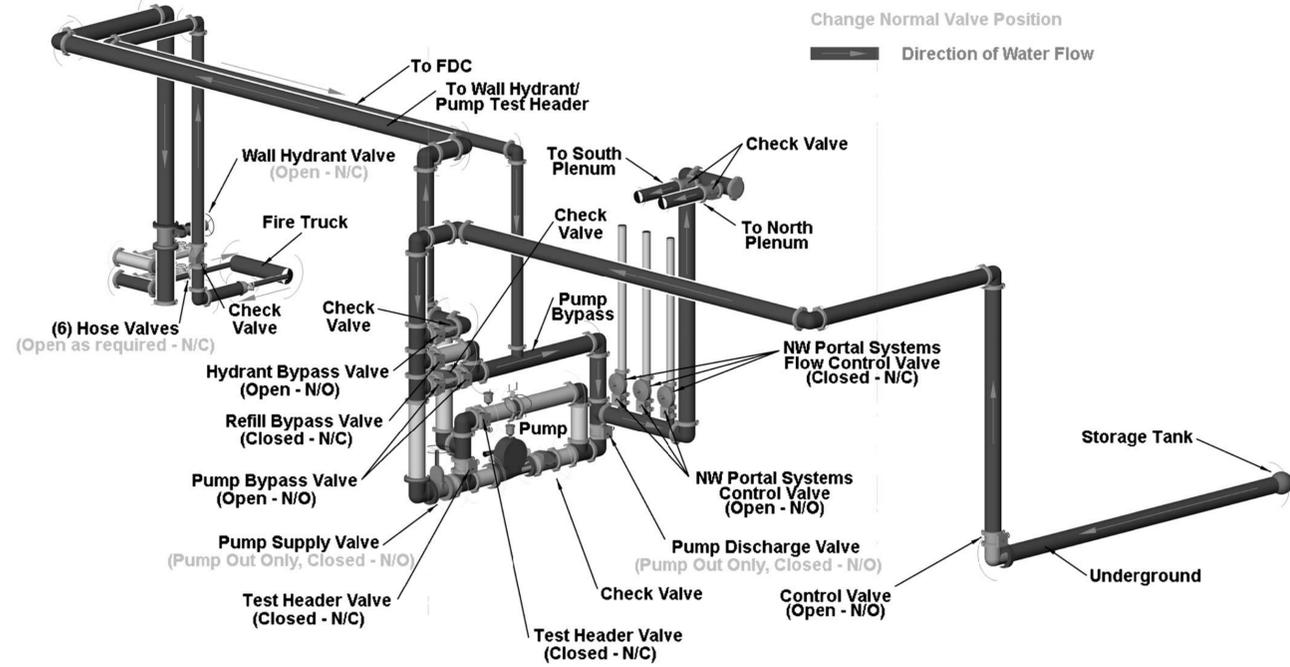

2 WALL HYDRANT AND FDC FLOW  
 NOT TO SCALE

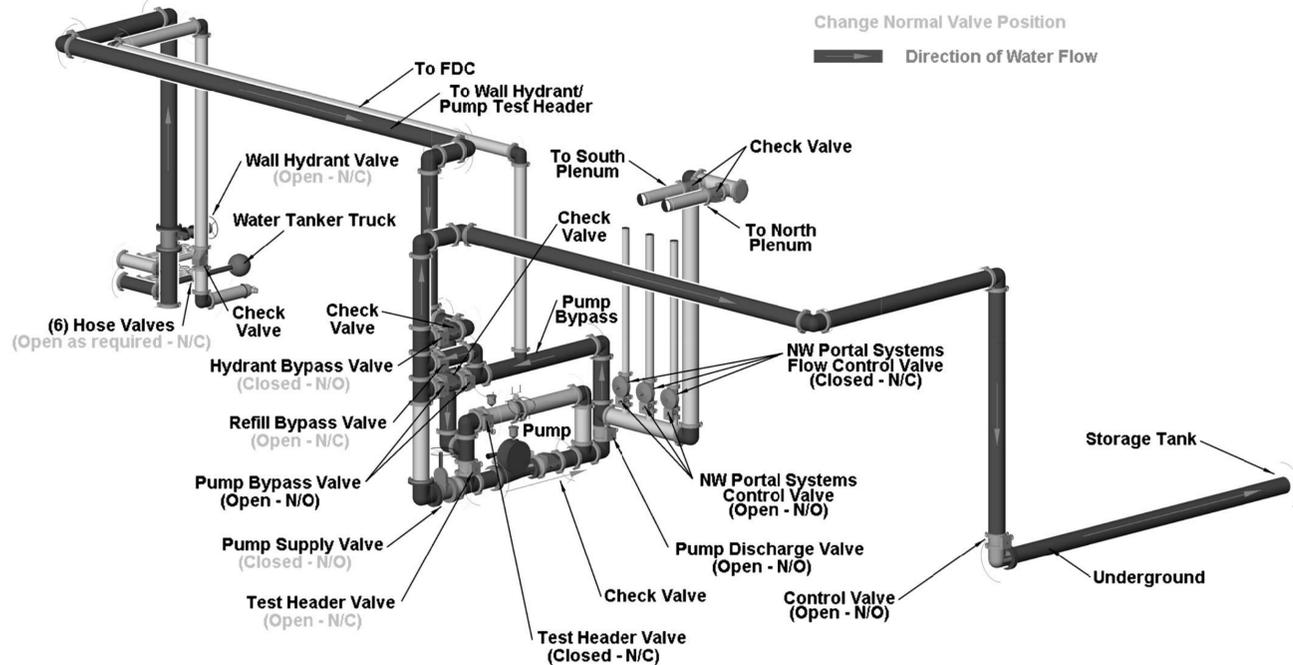

3 STORAGE TANK REFILL FLOW  
 NOT TO SCALE

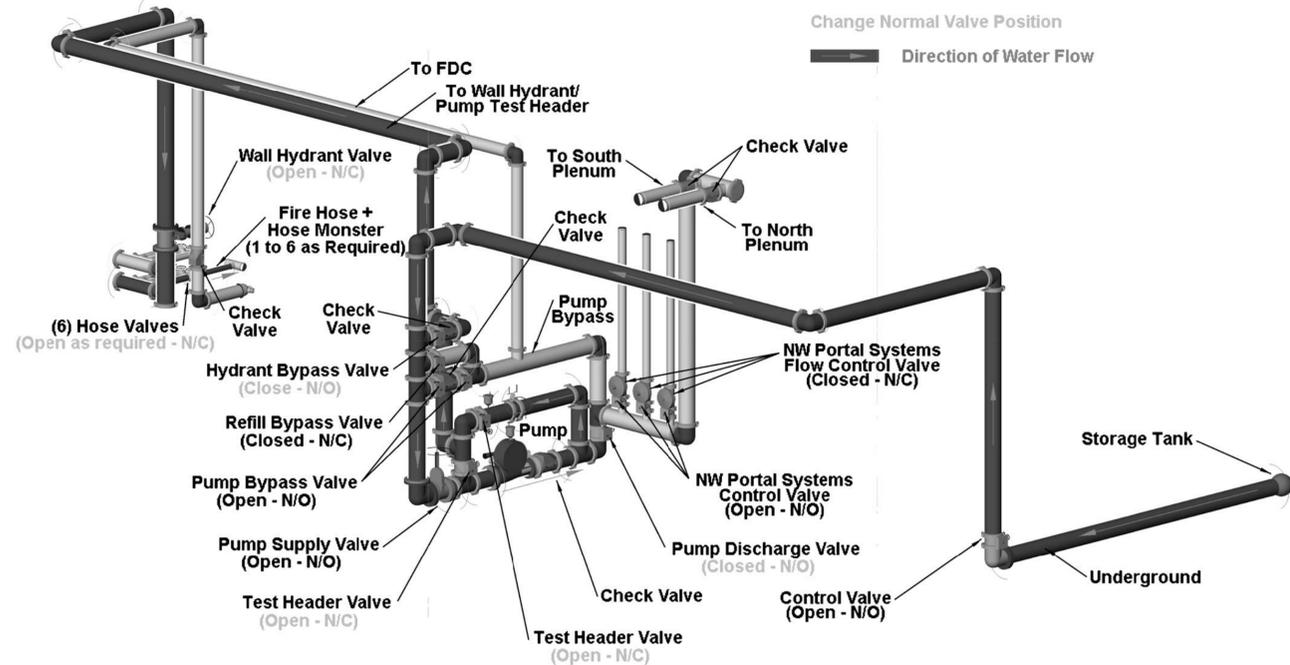

4 PUMP TEST FLOW  
 NOT TO SCALE

**BARNARD EJMT TEAM**

**BARNARD RONDINELLI**  
*A fire above life safety*

**Sturgeon Electric**

**BCER**  
*Engineering*

**Western States Fire Protection Co.**

**ASPE**  
 CONSULTING ENGINEERS

**EISENHOWER/JOHNSON MEMORIAL TUNNEL**  
 FIXED FIRE SUPPRESSION SYSTEM  
 DESIGN BUILD PROJECT

Project No. C0703-360  
 Subaccount 17810

**RECORD DRAWINGS - 2015-11-16**

Num	Description	Date

PUMP ROOM FLOW CONDITIONS

Drawing Number  
**FP5.2**

DRAWN BY: AMB  
 CHECKED BY: JUH











**EISENHOWER JOHNSON TUNNEL, FIRE SPRINKLER PIPE FREEZE PROTECTION MECHANICAL SYSTEM NARRATIVE**

LOOP PIPING HEATING SYSTEM  
 THE NEW FIXED FIRE SUPPRESSION SYSTEM (FFSS) REQUIRES A MEANS TO KEEP THE 6" LOOP PIPING WATER FROM FREEZING IN THE PLENUMS. A NEW BOILER SYSTEM WILL PROVIDE A CIRCULATING HEATED WATER SYSTEM USING A PLATE AND FRAME HEAT EXCHANGER TO DECOUPLE THE HEATING WATER FROM THE "OPEN" FFSS PIPING. THE BOILERS WILL MAINTAIN A MINIMUM LOOP TEMPERATURE 80°F TEMPERATURE WHEN THE TUNNEL TEMPERATURE REACHES -30°F WHEN ONLY ONE BOILER OPERATES. THE PIPING WILL BE INSULATED COMPLETELY FROM THE BOILER/FIRE PUMP ROOM TO THE ENTIRE LOOP SERVING BOTH TUNNELS.

THE PIPING SYSTEM INCLUDES APPROXIMATELY 18,100 FEET OF 6 INCH PIPING. THE ENVIRONMENT THAT THE PIPE IS EXPOSED TO IS THE VENTILATION AIR PLENUMS ABOVE THE TRAFFIC TUNNELS. THIS AIR TEMPERATURE HAS BEEN MODELED USING -30°F AIR AND AN AVERAGE AIR VELOCITY DUE TO THE VENTILATING FANS OF 18. MPH. (NOTE: THE HEAT LOSS FROM THE INSULATED PIPE INCREASES 1.6% WHEN AIR VELOCITY REACHES 140 MPH).

THE ELEVATION OF THE TUNNEL IS 11,013 FT. (EAST) TO 11,158 FT. (WEST) ABOVE SEA LEVEL.

THE ENTIRE PIPING SYSTEM HEAT LOSS IS CALCULATED USING 1.5 INCHES OF FIBERGLASS INSULATION WITH AN "ALL-SERVICE" VAPOR BARRIER JACKETING.

THE PIPING INCLUDES A METAL JACKET TO PREVENT HIGH VELOCITY AIR DEGRADATION OF THE INSULATION.

THE PIPE HEAT LOSS MODEL USING 80°F MINIMUM WATER TEMPERATURE INDICATES 80°F WILL BE THE MINIMUM TEMPERATURE TO PROVIDE FOR VALVE CABINET HEAT LOSS.

THE SUMMARY OF HEAT LOSS (AT ALTITUDE) FROM THE SYSTEM IS AS FOLLOWS FOR 80° SWT:

18,100 FT OF 6 INCH PIPE	611,960 BTU/HR
180 VALVE CABINETS	36,360 BTU/HR
<b>TOTAL</b>	<b>648,320 BTU/HR</b>

THE NEW NON-CONDENSING TYPE BOILER SYSTEM INSTALLATION WILL BE LOCATED IN THE FIRE PUMP/MECH ROOM.

THE BOILER EFFICIENCY WILL BE 85%. THE ALTITUDE CORRECTION FOR THE BOILER INCLUDES A DERATION OF 44% (I.E. THE ALTITUDE OUTPUT WILL BE 56% OF TOTAL SEA LEVEL OUTPUT VALUE OF THE BOILER(S)).

USING THIS EFFICIENCY AND ALTITUDE DERATION INDICATES A TOTAL BOILER INPUT MINIMUM OF 1,363 MBH BASED ON THE TOTAL LOAD REQUIRED. WE HAVE ELECTED TO SET THE FFSS WATER TEMPERATURE TO 100°F FOR ADDED SAFETY OF THE VALVE CABINET HEATING.

THE SYSTEM HAS BEEN SIZED WITH TWO BOILERS (LEAD-LAG CONTROL) EACH WITH 1440 MBH INPUT. EACH BOILER HAS A CIRCULATION PUMP TO PROVIDE HEAT TO THE FFSS CIRCULATION PUMPING SYSTEM THROUGH A PLATE AND FRAME HEAT EXCHANGER. THE BOILER(S) WILL OPERATE TO PROVIDE 160°F SUPPLY WATER TO THE EXCHANGER THAT HEATS THE FFSS LOOP CIRCULATING WATER TO ~100°F SWT. REFER TO CALCULATIONS ON SHEET M1.2.

THE PRIMARY PUMPING SYSTEM FOR THE LOOP PIPING WILL BE PROVIDED BY TWO PUMPS. EACH WILL BE SIZED AT FULL FLOW CAPACITY OF 320 GPM FOR NORMAL OPERATION. THESE PUMPS WILL OPERATE IN LEAD-STANDBY FUNCTION AND WILL BE PROVIDED WITH TIME FUNCTION FOR EQUALIZING THE OPERATION TIME.

THE BOILERS ARE CLOSED COMBUSTION TYPE. THE INTAKE AND VENTING WILL BE ROUTED DIRECTLY TO THE OUTSIDE OF THE BUILDING USING INLINE FANS.

THE AUTOMATIC ZONE VALVE CABINETS WILL BE HEATED USING THE LOOP PIPING AS THE SOURCE. THE CABINETS WILL BE FULLY INSULATED.

THE BOILERS WILL BE PROVIDED WITH NATURAL GAS USING THE EXISTING BRANCH PIPING THAT WAS USED TO SERVE THE TUNNEL HEATERS. THE GAS IS DISTRIBUTED FROM THE WEST END, SOUTH BOILER ROOM GAS REGULATOR. EACH BOILER WILL BE PROVIDED WITH A GAS PRESSURE REGULATOR.

THE BOILER ROOM WILL BE PROVIDED WITH AN "EMERGENCY DISCONNECTING MEANS" IN ACCORDANCE WITH ASME CSD-2009, SECTION CE-110. THIS WILL ALLOW MANUAL REMOTE SHUT DOWN LOCATED JUST OUTSIDE THE BOILER ROOM.

**WASTE PIPING DRAINAGE CONTROL**

THE EXISTING WASTE PIPING FROM THE TUNNELS WILL BE MODIFIED BY THE ADDITION OF CONTROL VALVES IN THE EAST SEWER TREATMENT ROOM AND THE WASTE MANHOLE OUTSIDE OF THE EAST PORTAL BUILDING.

THE CONTROL VALVES SHALL BE CONTROLLED THROUGH THE FIRE ALARM SYSTEM.

THE VALVES WILL BE PROVIDED TO ALLOW WASTE TO FLOW TO THE EXISTING INDOOR SEDIMENTATION TANKS DURING NORMAL OPERATION. IF THE VALVES LOSE POWER DURING NORMAL OPERATION THEY WILL FAIL TO ALLOW FLOW TO THE SEDIMENTATION TANKS.

THE VALVES ARE ARRANGED SUCH THAT DURING A FIRE EVENT, THE AFFECTED TUNNEL (NORTH OR SOUTH) INFLUENT LINE WILL BE DIVERTED TO THE FFSS DRAINAGE SYSTEM. A NEW 12 INCH BYPASS LINE WILL BE INSTALLED TO DIVERT ANY FIRE WATER FROM THE SOUTH ROADWAY FROM ENTERING THE SEDIMENTATION TANKS. THE EXISTING 12 INCH OBSOLETE PIPE WILL BE USED TO FLOW ANY FIRE WATER TO THE NEW FFSS DRAINAGE SYSTEM OUTSIDE THE BUILDING.

IF THIS SHEET IS NOT 22"x34" IT IS NOT PLOTTED TO SCALE

**BARNARD EJMT TEAM**

**RONDINELLI**  
*A REEF GROUP life safety*



**BARNARD**  
 Western States Fire Protection Co.



**BCER**  
 1918.com engineering



**Sturgeon**  
 ELECTRIC

**EISENHOWER/JOHNSON  
 MEMORIAL TUNNEL  
 FIXED FIRE SUPPRESSION SYSTEM  
 DESIGN BUILD PROJECT**

Project No. C0703-360 Subaccount 17810

**RECORD DRAWINGS - 2015-11-16**

Num	Revisions Description	Date

MECHANICAL NARRATIVE

Drawing Number

**M1.1**

DRAWN BY: JEB | CHECKED BY: RDM



## MECHANICAL/ELECTRICAL COORDINATION (HYDRONICS)

M=Mech Contractor      P - Provided  
E=Elec Contractor      F - Furnished  
C=Control Contractor

REVISED DATE	PLAN CODE	EQUIPMENT DESCRIPTION	LOCATION	EQUIPMENT INPUT						STARTERS					EMERG. POWER	REMARKS	
				HP	KW	AMPS	MCA	MOCP	VOLT/PH	MANUAL	MAG	COMB. MAG/DISCONNECT	VFD	COMB. VFD/DISCONNECT			
	B1	BOILER	BOILER/FIRE PUMP ROOM	-	-	5.0				120/1	F	-	-	-	-	YES	1,2,3
	B2	BOILER	BOILER/FIRE PUMP ROOM	-	-	5.0				120/1	F	-	-	-	-	YES	1,2,3
	P1	PUMP	BOILER/FIRE PUMP ROOM	40	-	-				480/3	-	-	-	-	P	YES	1,2,3
	P2	PUMP	BOILER/FIRE PUMP ROOM	40	-	-				480/3	-	-	-	-	P	YES	1,2,3
	P3	PUMP	BOILER/FIRE PUMP ROOM	3	-	-				480/3	-	-	P	-	-	YES	1,2,3
	P4	PUMP	BOILER/FIRE PUMP ROOM	3	-	-				480/3	-	-	P	-	-	YES	1,2,3
	VF-1	BOILER FLUE VENT FAN	LEVEL 1, STORAGE ROOM	2.0	-	-				208/3	-	-	-	-	F	YES	1,2
	VF-2	BOILER INTAKE VENT FAN	LEVEL 1, STORAGE ROOM	1.0	-	-				208/3	-	-	-	-	F	YES	1,2

1. EQUIPMENT IS INTERLOCKED WITH LIGHT OR WALL SWITCH, TIMER, CONTROLS...ETC.
2. EQUIPMENT HAS A SINGLE POINT CONNECTION.
3. SYSTEM OPERATES AS RUN/STANDBY OR IF MULTIPLE EQUIPMENT CAN OPERATE SIMULTANEOUSLY.

## PUMP SCHEDULE

PLAN CODE	SERVICE	LOCATION	PUMP TYPE	MFR.	MODEL	PUMP SIZE	GPM	HEAD FT.	EFF %	APPROX. IMP. DIA.	SUCTION DIA.	DISCHARGE DIA.	% OF PROPYLENE GLYCOL	H.P.	RPM	ELEC. VOLT/PH.	REMARKS
P1	HEATING CIRCULATION	MECH ROOM	CENTR.	ARMSTRONG	SERIES 4030	3x2.5x8	320	200	74	7-1/2	3"	2-1/2	0	40	3600	480/3	PROVIDE VFD, (1)
P2	HEATING CIRCULATION	MECH ROOM	CENTR.	ARMSTRONG	SERIES 4030	3x2.5x8	320	200	74	7-1/2	3"	2-1/2	0	40	3600	480/3	PROVIDE VFD, (1)
P3	BOILER CIRCULATION	MECH ROOM	CENTR.	ARMSTRONG	SERIES 4360	3D	120	45	70	7	3"	3	0	3.0	1800	480/3	
P4	BOILER CIRCULATION	MECH ROOM	CENTR.	ARMSTRONG	SERIES 4360	3D	120	45	70	7	3"	3	0	3.0	1800	480/3	

(1) PROVIDE PUMP CONSTRUCTION TO ALLOW OPERATION UP TO 250 PSIG SYSTEM PRESSURE. (i.e. DUCTILE IRON)

## HOT WATER BOILER SCHEDULE - (NATURAL GAS)

PLAN CODE	MFR.	MODEL	INSTALLED		BOILER H.P.	EWT (°F)	LWT (°F)	GPM	MBH INPUT @ S.L.	MBH GROSS OUTPUT @ S.L.	MBH OUTPUT @ ALT.	MIN. SURFACE AREA (SF)	MAX. FIRING RATE (CFH)	MIN. GAS PRESSURE (IN. W.C.)	MAX. GAS PRESSURE (IN. W.C.)	GLYCOL %	FLUE OUTLET DIAMETER	AIR INLET DIAMETER	ELEC. VOLT/PH	OPERATING WEIGHT (LBS)	REMARKS
			MFR.	MODEL																	
B1	LOCHINVAR	CHN1442			30	148.6	160	120.0	1440	1224	685	144	1735	4.5	14.0	0%	12	12	110/1	1100	ALL
B2	LOCHINVAR	CHN1442			30	148.6	160	120.0	1440	1224	685	144	1735	4.5	14.0	0%	12	12	110/1	1100	ALL

**NOTES:**

- (1) COMBUSTION EFFICIENCY: **85%**
- (2) OPERATION AT 11,000 FOOT ELEVATION. REQUIRES 44% REDUCTION IN BOILER INPUT CAPACITY TO PROVIDE OUPUT AT ALTITUDE.
- (3) **125** PSIG RATED.
- (4) PROVIDE NEW IRI APPROVED NATURAL GAS TRAIN FOR 2 PSI INLET GAS PRESSURE, FACTORY PIPED AND WIRED WITH UNION ENDS AND INCLUDING; GAS PRESSURE GAUGE; GAS PRESSURE REGULATOR; LOW GAS PRESSURE SWITCH; AUTO MOTORIZED OPERATING VALVE; AUTO MOTORIZED SAFETY GAS VALVE; GAS CHECKING COCK; HIGH GAS PRESSURE SWITCH; N.O. VENT VALVE.
- (5) GAS/ELECTRIC IGNITION ASSEMBLY INCLUDING; GAS PRESSURE REGULATOR; GAS COCK; GAS SOLENOID VALVE, DUAL; GAS/ELECTRIC IGNITION SWITCH.
- (6) PROVIDE BURNER W/ MODULATING BURNER OPERATION.
- (7) PROVIDE UNIT WITH ENERGY USAGE COMPLIANCE TO ASHRAE 90.1 - **2010** REQUIREMENTS.
- (8) PROVIDE GAS PRESSURE REGULATOR TO REGULATE GAS INLET PRESSURE TO 14 IN. W.C. (APPROX. 1 PSIG AVAILABLE)
- (9) PROVIDE 1" PRESSURE RELIEF VALVE WITH BOILER. RELIEF VALVE RATING OF 1352 MBH, 50 PSI RELIEF PRESSURE.

IF THIS SHEET IS NOT 22"x34" IT IS NOT PLOTTED TO SCALE

**BARNARD EJMT TEAM**

BCER  
CONSULTING ENGINEERS

BARNARD  
CONSULTING ENGINEERS

RONDINELLI  
CONSULTING ENGINEERS

Sturgeon  
ELECTRIC

Western States  
Fire Protection Co.

**EISENHOWER/JOHNSON  
MEMORIAL TUNNEL**

FIXED FIRE SUPPRESSION SYSTEM  
DESIGN BUILD PROJECT  
Project No. C0703-360      Subaccount 17810  
**RECORD DRAWINGS - 2015-11-16**

Revisions	Date	Description


MECHANICAL SCHEDULES

Drawing Number

# M2.0





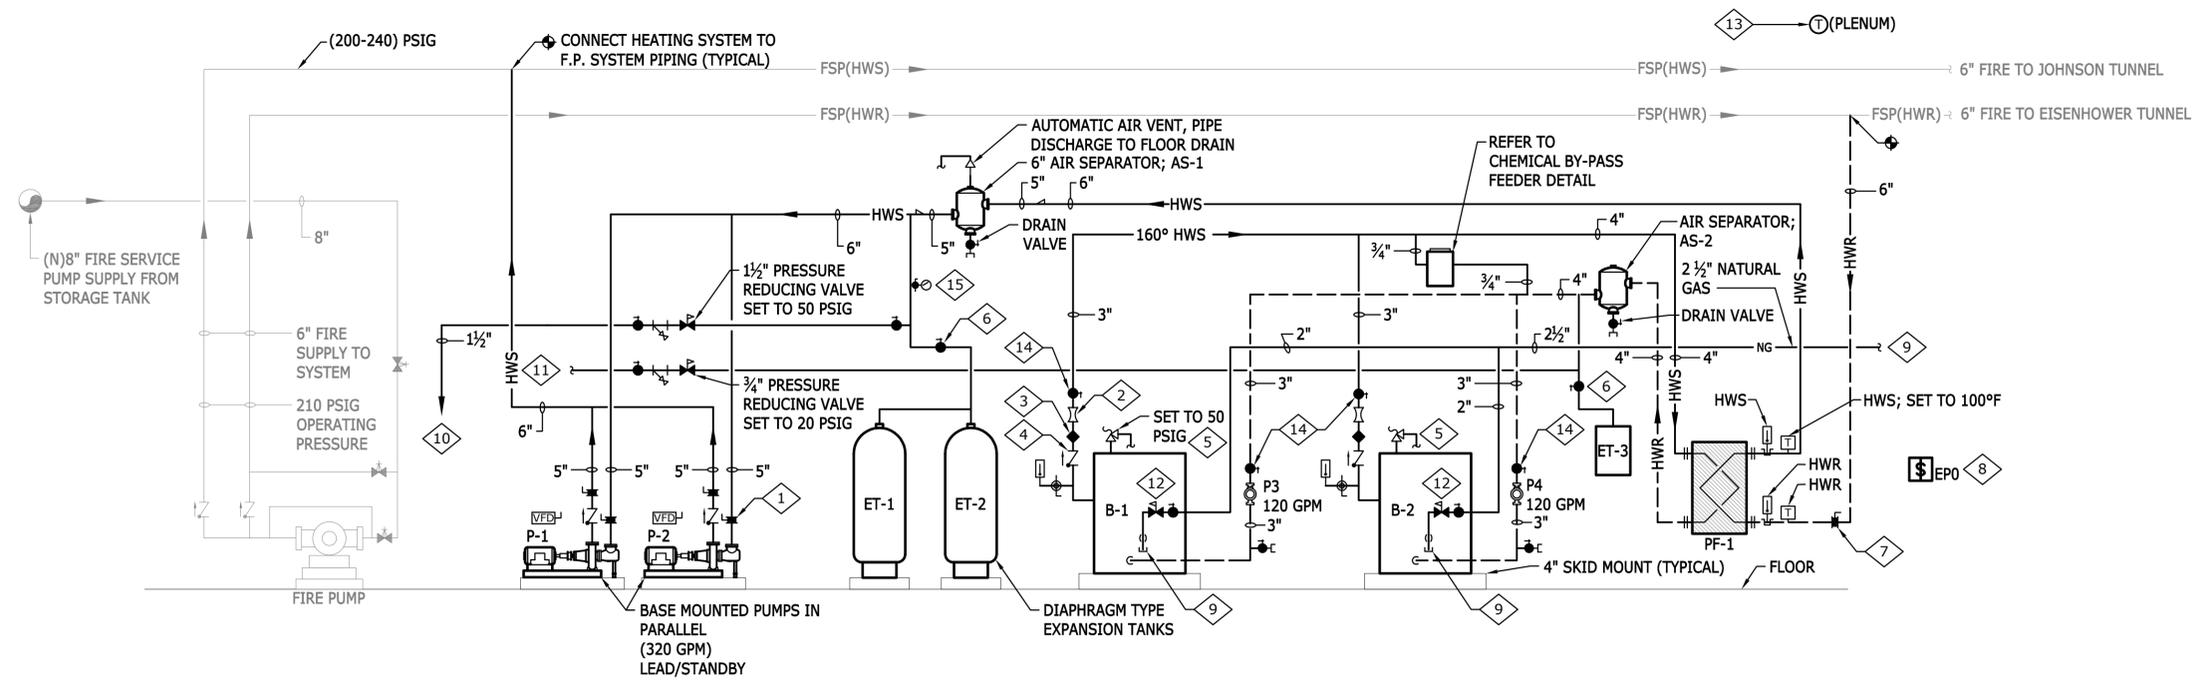

**1 BOILER SYSTEM SCHEMATIC**  
SCALE: NOT TO SCALE

**WORK NOTES:**

NOTE: THESE ITEMS ARE TO BE LOCATED IN THIS SYSTEM ARRANGEMENT AND NOT AS ADDITIONAL ITEMS TO THOSE SHOWN ON THE DETAIL ON SHEET M7.0.

- 1 BUTTERFLY VALVE (TYPICAL).
- 2 FLOW MEASURING STATION OR CALIBRATED BALANCING VALVE ASSEMBLY (TYPICAL).
- 3 BALANCING VALVE (TYPICAL).
- 4 CHECK VALVE (TYPICAL).
- 5 RELIEF VALVE; PIPE FROM OUTLET TO NEAREST DRAIN.
- 6 LOCKING BALL VALVE; LOCK IN THE NORMALLY OPEN POSITION.
- 7 HEATING SYSTEM MANUAL ISOLATION VALVE. REFER ALSO TO P/F DETAIL, USE THIS VALVE TO ISOLATE EQUIPMENT. (NOT REDUNDANT)
- 8 PROVIDE EMERGENCY POWER OFF (EPO) SWITCH OUTSIDE OF BOILER ROOM EXIT DOOR.
- 9 REFER TO GAS PIPING DETAIL ON SHEET M7.2 & M4.0.
- 10 CONNECT 1 1/2" FIRE LINE "FILL LINE" FROM 8" FIRE ENTRY TO EXISTING RAW WATER DOMESTIC WATER SERVICE IN WATER ENTRY ROOM UPSTREAM OF EXISTING FILTERS.
- 11 CONNECT TO DOMESTIC WATER DOWNSTREAM OF FILTERS IN WATER ENTRY ROOM.
- 12 NATURAL GAS PRV 2 PSIG TO 12" WC
- 13 AMBIENT AIR TEMPERATURE SENSOR LOCATED IN TUNNEL AIR PLENUM.
- 14 BUTTERFLY VALVE.
- 15 PROVIDE SYSTEM PRESSURE SENSOR. PROVIDE ALARM TO FIRE ALARM SYSTEM IF PRESSURE DROPS TO 40PSIG (ADJUSTABLE).

**BOILER SYSTEM SEQUENCE OF OPERATION**

THE BOILER SYSTEM SHALL OPERATE TO MAINTAIN THE FIRE SUPPRESSION DISTRIBUTION PIPING ABOVE FREEZING.

THE BOILER SYSTEM SHALL OPERATE ANYTIME THE AMBIENT TEMPERATURE OF PLENUM IS LESS THAN 45°F.

ACTIVATE THE BOILER CONTROL SYSTEM AND START THE LEAD PRIMARY DISTRIBUTION PUMP (P1 OR P2).

PROVIDE EPO IN ACCORDANCE WITH ASME CSD-1, 2009; CE1102.

THE PRIMARY PUMPS SHALL OPERATE IN A LEAD-STANDBY CONFIGURATION. IF LEAD PUMP FAILS UPON ACTIVATION, THEN THE STANDBY PUMP SHALL AUTOMATICALLY START. ALARM SHALL BE SENT TO FAS AS A GENERAL SYSTEM FAILURE ALONG WITH BOILER, SWT SETPOINT FAILURE AND VF FAILURE.

THE PRIMARY PUMPS SHALL DISTRIBUTE A CONSTANT FLOW RATE TO THE SYSTEM THROUGH THE PUMP(S) VFD. SET CONTROLS TO EQUALIZE PUMP RUN TIME. PRIMARY PUMPS SHALL SHUT DOWN DURING FIRE MODE.

NOTE:  
WHEN RESTARTING HEATING SYSTEM AFTER FIRE EVENT BOTH PRIMARY PUMPS CAN BE MANUALLY OPERATED. THE TOTAL FLOW WILL BE LESS THAN THE COMBINED TOTAL. THIS WILL ALLOW FASTER LOOP CIRCULATION THAT SHOULD NOT BE NECESSARY. SEE CALCULATIONS.

THE BOILER CONTROL SHALL OPERATE THE BOILER(S) IN LEAD-LAG MANNER TO DELIVER 160°F WATER TO THE SYSTEM P/F EXCHANGER. THE RELATED BOILER PUMP SHALL OPERATE BASED ON THE BOILER CALL FOR HEATING FROM THE FFSS SUPPLY WATER TEMPERATURE SENSOR. (100°F)

THE LAG BOILER SHALL ACTIVATE IF SUPPLY WATER TEMPERATURE DROPS 5°F BELOW PUMP SETPOINT (100°F). PROVIDE ALARM POINT.

PROVIDE ALARM POINT IF EITHER BOILER OR BOILER PUMP(S) FAIL TO OPERATE.

THE BOILER SYSTEM SHALL REMAIN DEACTIVATED WHEN THE FIRE SUPPRESSION SYSTEM IS CALLED TO BE ACTIVATED. START THE FIRE PUMP. STOP THE CIRCULATION PUMPS P1/P2.

THE BOILERS SHALL IDLE DURING FIRE MODE TO MAINTAIN 160°F SWT, BOILER CIRCULATION PUMPS(P3&P4) SHALL BE ON. BOILER SYSTEM SHALL BE OFF IF AMBIENT TEMPERATURE IS GREATER THAN 50°F.

PROVIDE INTERLOCK BETWEEN VF-1 AND VF-2 TO ASSURE FAN OPERATION WHEN EITHER BOILER IS REQUIRED TO OPERATE. FANS SHALL BE PROVEN ON BEFORE BOILERS ARE ALLOWED TO OPERATE. VENT FAN VFD'S SHALL OPERATE TO MAINTAIN FLUE PIPE NEGATIVE PRESSURE SETPOINT AND/OR POSITIVE PRESSURE ON MAKEUP COMBUSTION AIR. PRESSURES SHALL BE FIELD ADJUSTED. PROVIDE ALARM POINT.

IF THIS SHEET IS NOT 22"x34" IT IS NOT PLOTTED TO SCALE

**EISENHOWER/JOHNSON  
MEMORIAL TUNNEL  
FIXED FIRE SUPPRESSION SYSTEM  
DESIGN BUILD PROJECT**

Project No. C0703-360 Subaccount 17810  
RECORD DRAWINGS - 2015-11-16

Revisions	Date
Num	Description

BOILER SYSTEM SCHEMATIC

Drawing Number  
**M3.0**


**BARNARD EJMT TEAM**

**BARNARD**  
Western States Fire Protection Co.


**STURGEON ELECTRIC**

**RONDINELLI**  
A BEER GROUP LIFE SAFETY  
CONSULTING ENGINEERS


**BCER**  
Western States Fire Protection Co.

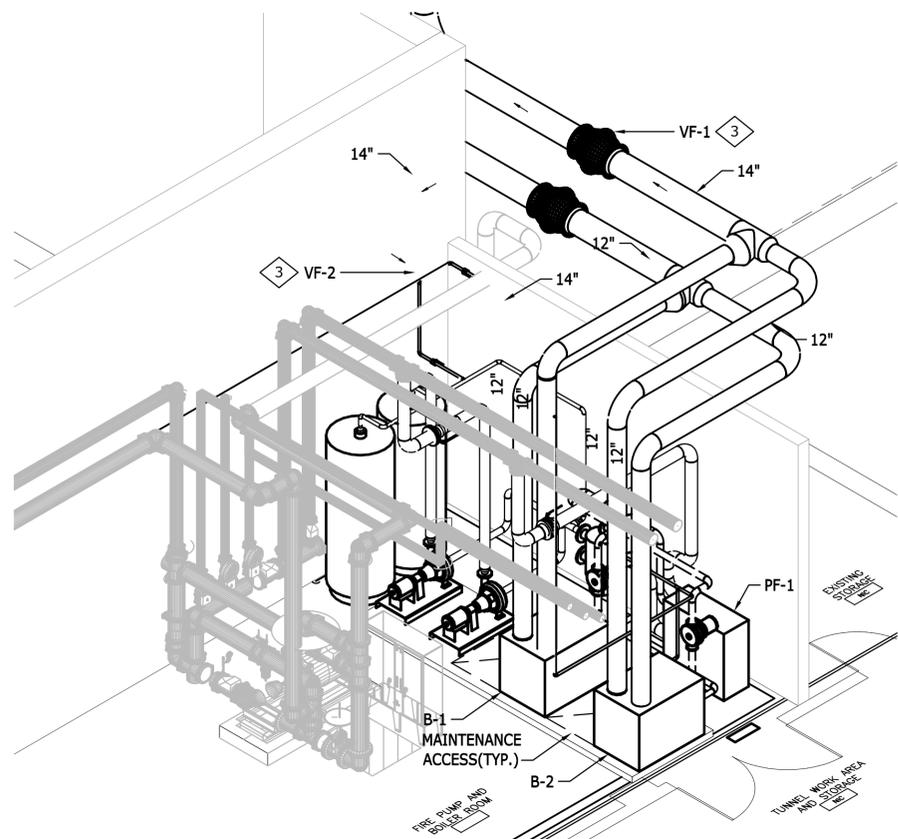

**1 BOILER ROOM SW ISOMETRIC**  
SCALE: M4.0

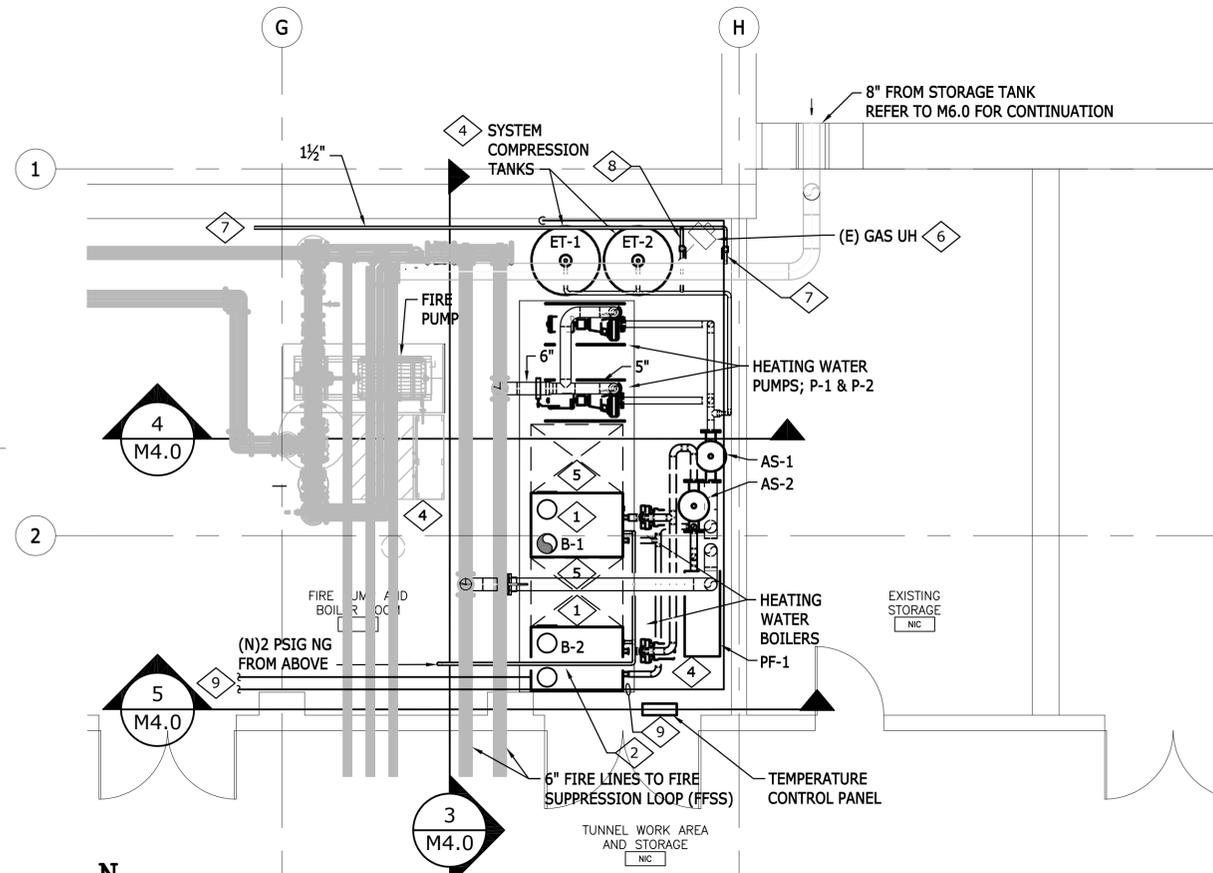


**2 MECHANICAL BOILER ROOM**  
SCALE: 1/4" = 1'-0"

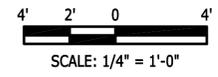


**WORK NOTES (THIS DRAWING):**


- 1 ROUTE BOILER RELIEF VALVES TO EXISTING FLOOR DRAIN IN WATER ENTRY ROOM.
- 2 4" CONCRETE BASE OR I-BEAM RAILS FOR BOILER INSTALLATION.
- 3 PROVIDE CLEARANCE UNDER FAN TO ALLOW FOR MAINTENANCE ACCESS (MOTOR REPLACEMENT, FAN REPLACEMENT).
- 4 PROVIDE INSTALLATION OF EQUIPMENT & PIPING TO ALLOW FOR ALL EQUIPMENT REMOVAL AND REPLACEMENT.
- 5 PROVIDE INSTALLATION TO ALLOW FOR BOILER MAINTENANCE ACCESS PER MANUFACTURER'S REQUIREMENTS.
- 6 COORDINATE EXISTING GAS UNIT HEATER WITH MECHANICAL ROOM LAYOUT.
- 7 CONNECT (N) 1 1/2" PIPE BETWEEN (N) 8" FIRE LINE IN MECHANICAL ROOM AND (E) WATER ENTRY PIPE IN WATER ENTRY ROOM UPSTREAM OF FILTERS.
- 8 CONNECT 1 1/2" FIRE LINE "FILL LINE" FROM 8" FIRE ENTRY TO PRIMARY PUMPING SYSTEM. REFER TO BOILER PIPING SCHEMATIC ON SHEET M3.0.
- 9 CONNECT 1" MAKEUP TO "BOILER SYSTEM" PER SCHEMATIC.

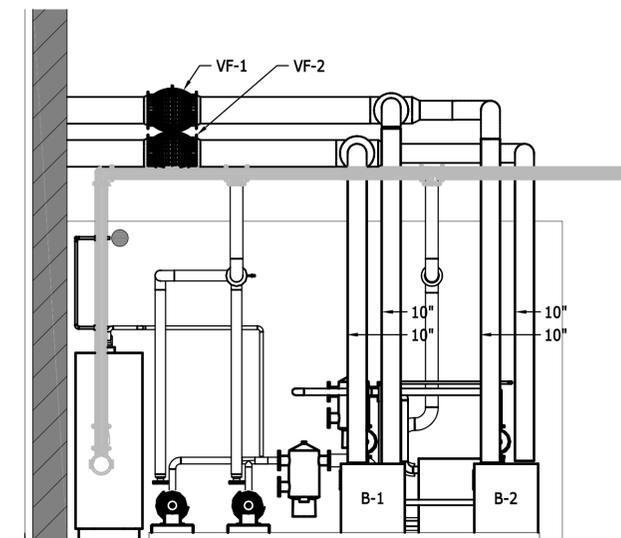


**3 BOILER ROOM SECTION**  
SCALE: 1/4" = 1'-0"

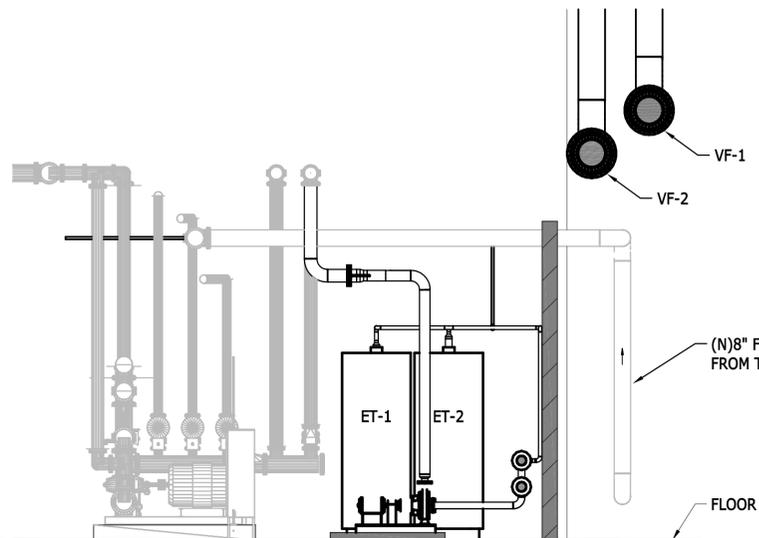

**4 BOILER ROOM SECTION**  
SCALE: 1/4" = 1'-0"

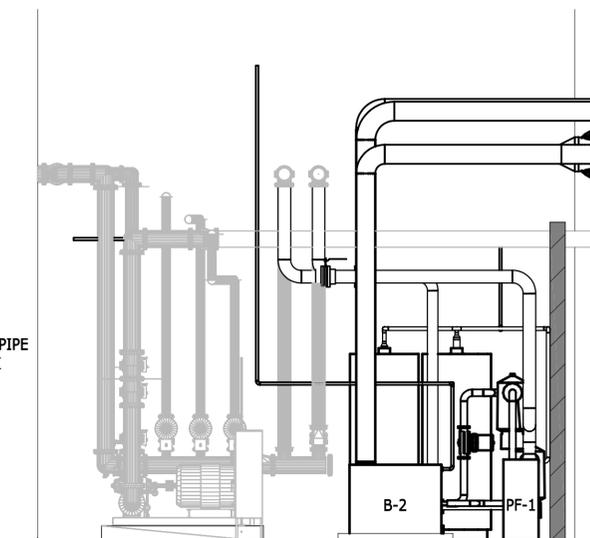

**5 BOILER ROOM SECTION**  
SCALE: 1/4" = 1'-0"

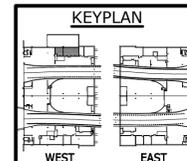

MECHANICAL BOILER ROOM  
Drawing Number  
**M4.0**

IF THIS SHEET IS NOT 22" X 34" IT IS NOT PLOTTED TO SCALE

**EISENHOWER/JOHNSON**  
**MEMORIAL TUNNEL**  
FIXED FIRE SUPPRESSION SYSTEM  
DESIGN BUILD PROJECT  
Project No. C0703-360  
Subcontract 17810  
RECORD DRAWINGS - 2015-11-16

Revisions	Date
Num	Description

DRAWN BY: JEB  
CHECKED BY: RDM

**BARNARD EJMT TEAM**

**BARNARD**  
Western States Fire Protection Co.


**STURGEON ELECTRIC**

**BCER**  
CONSULTING ENGINEERS

**RONDELLO**  
A BEER GROUP life safety

**ELF**  
ENGINEERS


IF THIS SHEET IS NOT 22"x34" IT IS NOT PLOTTED TO SCALE

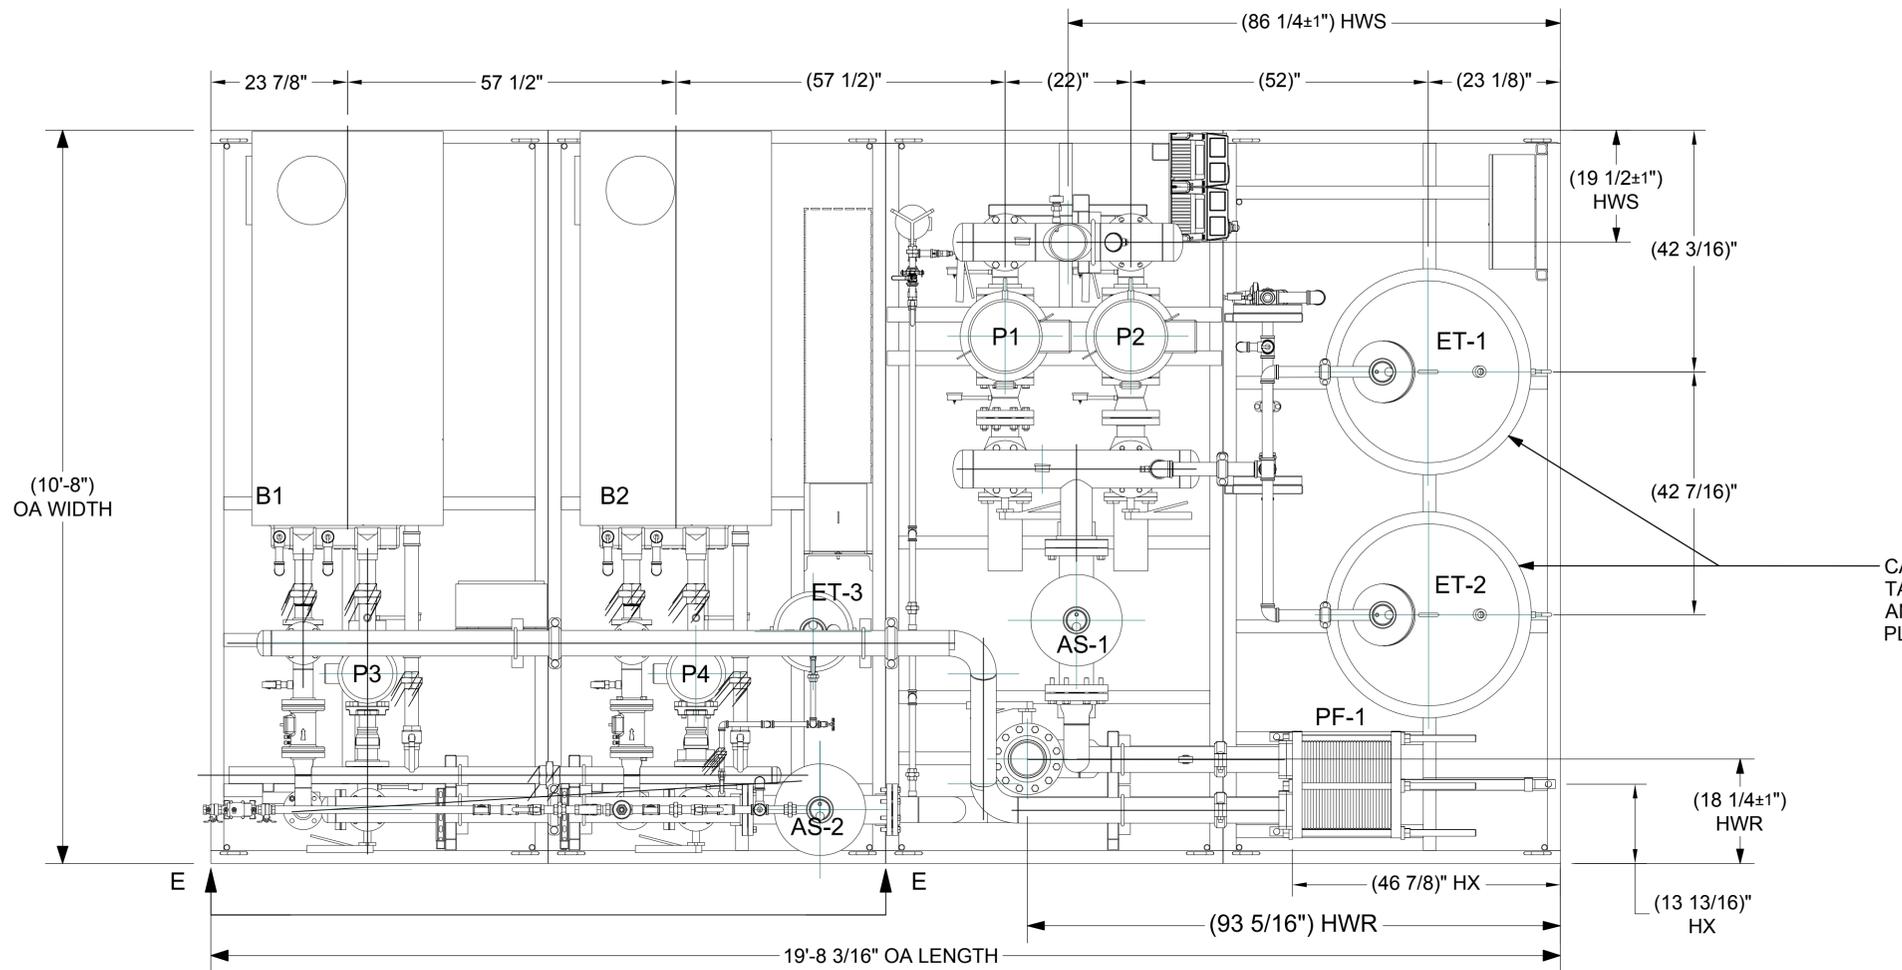

**NOTES:**

1. FINISH: GRAY PAINT.
2. CONDITION POINT: 320 GPM @ 86.7 PSI  
SUCTION PRESSURE: 0 PSI MIN. / 0 PSI MAX
3. ALL DIMENSIONS SUBJECT TO CHANGE WITHOUT NOTICE:  
DO NOT USE FOR CONSTRUCTION PURPOSED UNLESS CERTIFIED.
4. (XX) INDICATE REFERENCE DIMENSIONS.
5. FILL BASE WITH NON-SHRINKING, NON-FERROUS GROUT:  
FAILURE TO DO SO VOIDS TIGERFLOW WARRANTY.
6. ALL STRUCTURAL WELDING SHALL BE PERFORMED BY AWS D1.1 QUALIFIED WELDERS.
7. ALL PIPE WELDING SHALL BE PERFORMED BY ASME SECTION 9 QUALIFIED WELDERS.
8. 48" CLEARANCE (CLEAR TO GROUND) REQUIRED IN FRONT OF CONTROL PANELS PER 2011 NEC TABLE 110-26 (A) (1).
9. 12" MINIMUM CLEARANCE AROUND SYSTEM FOR SYSTEM SERVICEABILITY.
10. VENT PIPING FOR BOILERS BY OTHERS.
11. GAS REGULATOR INTERNAL TO PACKAGED BOILER.
12. BACKFLOW PREVENTER ON BOILER MWL NOT PROVIDED.
13. SEISMIC CALCULATIONS W/ COLORADO P.E. STAMP.
14. EACH SKID MUST FIT THROUGH 5' X 7' DOOR.

CA-1400 EXPANSION TANK SHIPPED LOOSE AND ASSEMBLED ON PLACEMENT (BOLT-ON)

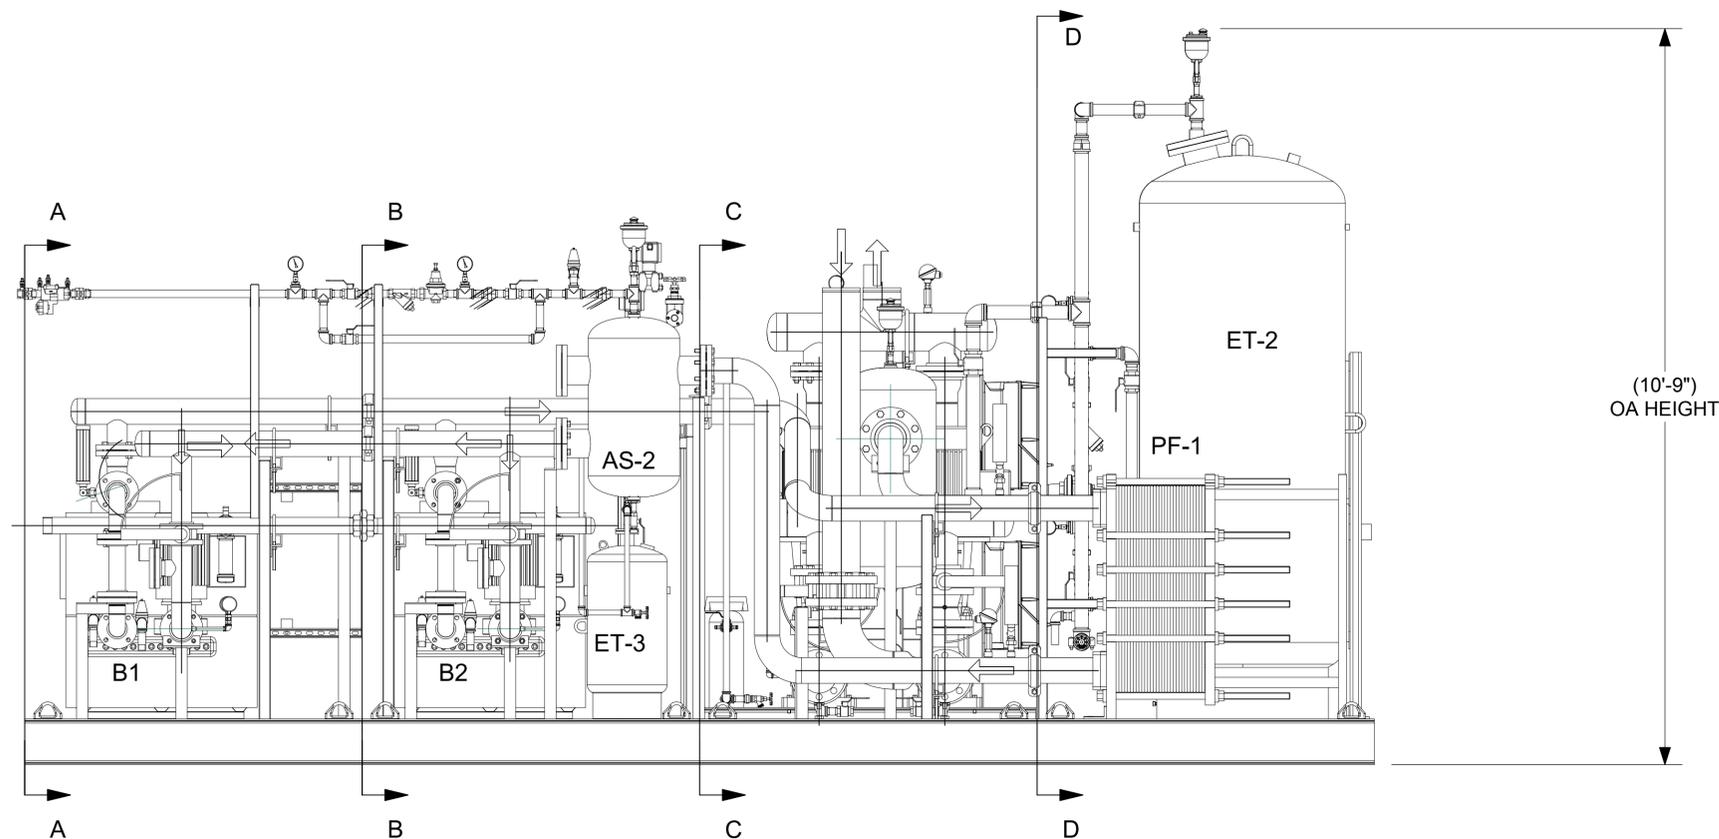

**EISENHOWER/JOHNSON**  
**MEMORIAL TUNNEL**  
 FIXED FIRE SUPPRESSION SYSTEM  
 DESIGN BUILD PROJECT  
 Project No. C0703-360 Subaccount 17810  
**RECORD DRAWINGS - 2015-11-16**

Revisions	Date
Num	Description

MECHANICAL SKID PLAN AND ELEVATION








Drawing Number  
**M4.1**

**BARNARD EJMT TEAM**

**BARNARD** **RONDELLO**  
 A BEE GROUP life safety  
 CONSULTING ENGINEERS

**BCER** **BARNARD** **STURGEON ELECTRIC**  
 WESTERN STATES Fire Protection Co.  
 ENGINEERING

IF THIS SHEET IS NOT 22"x34" IT IS NOT PLOTTED TO SCALE

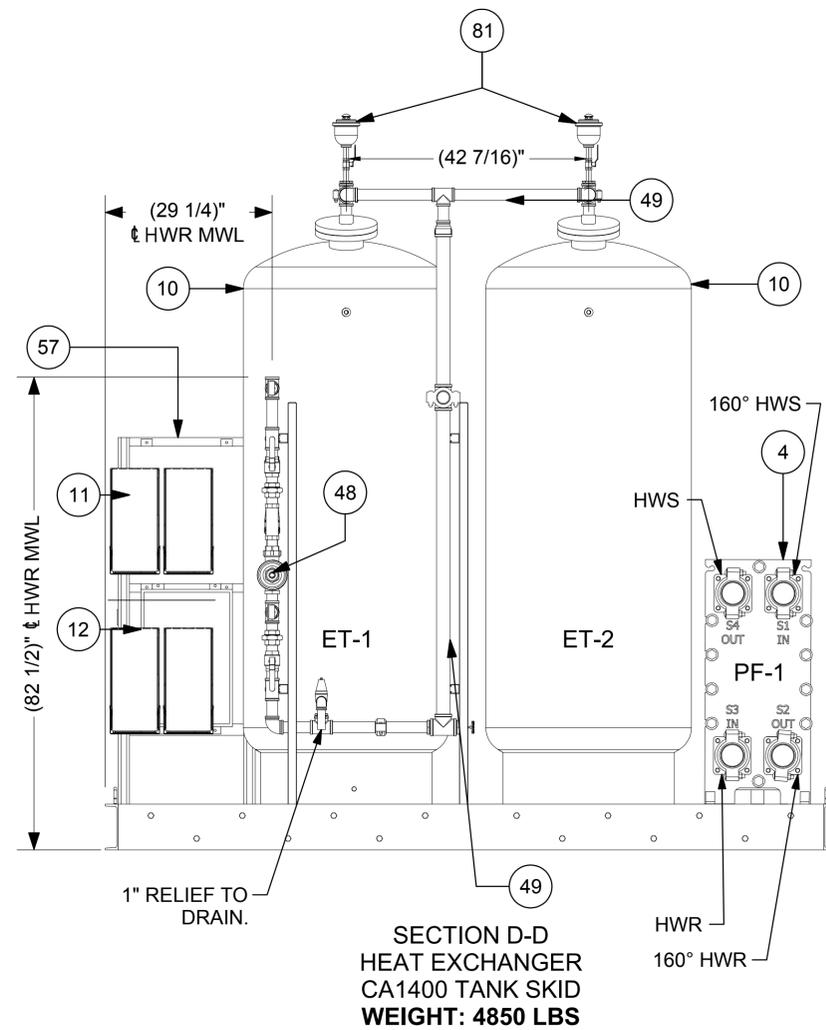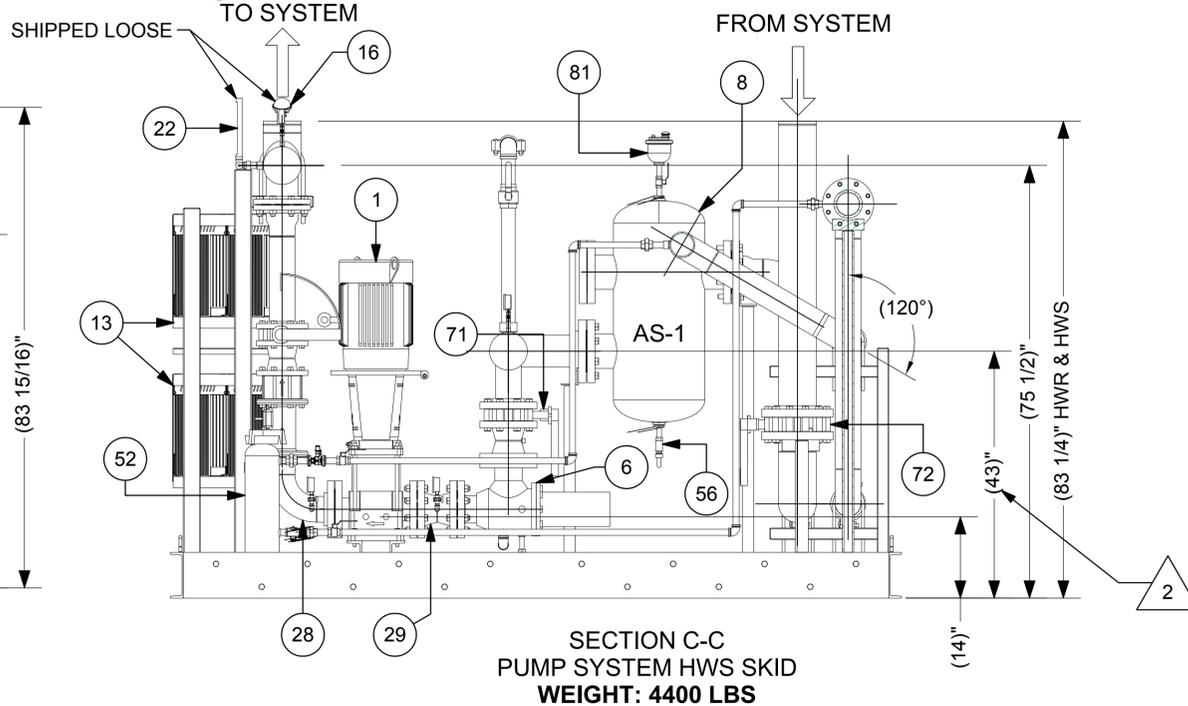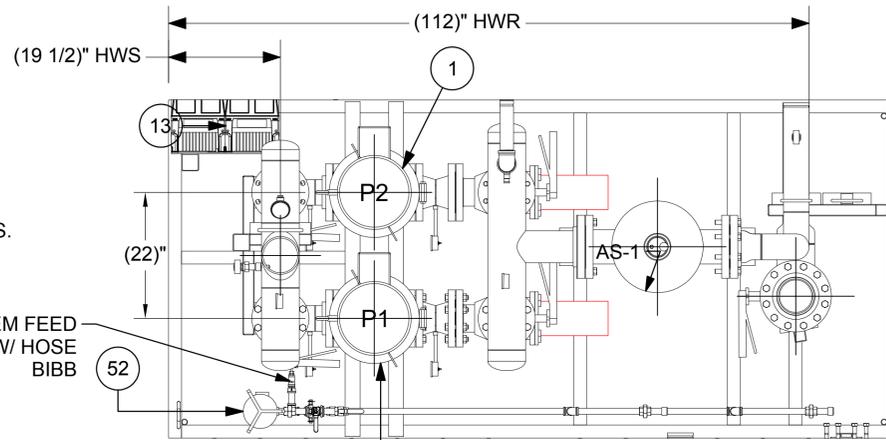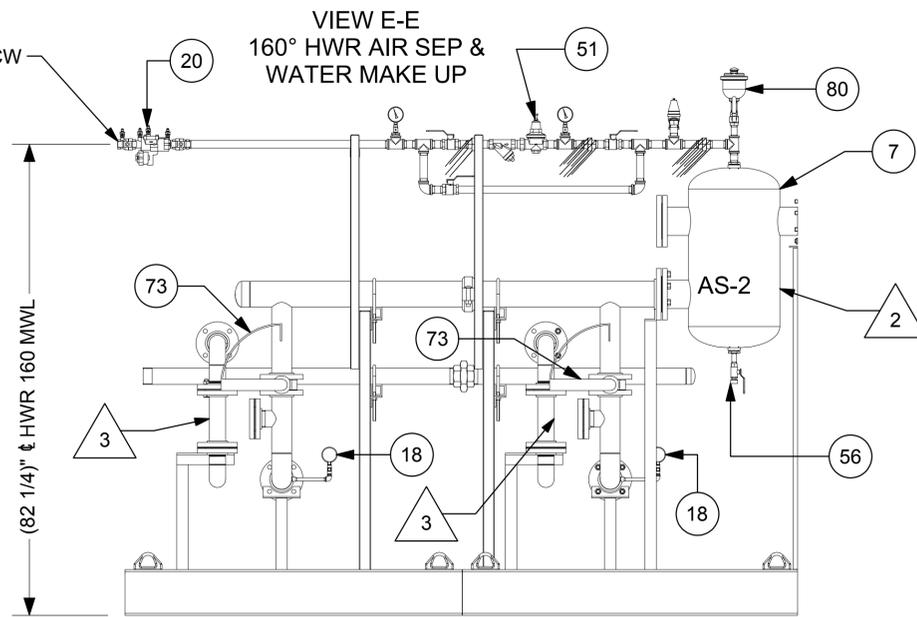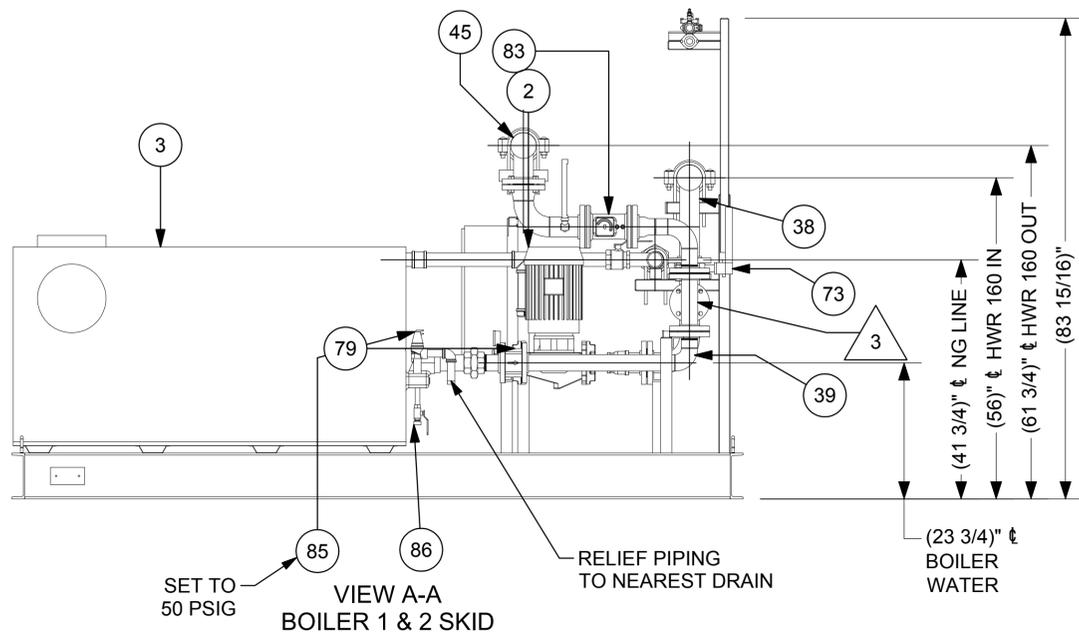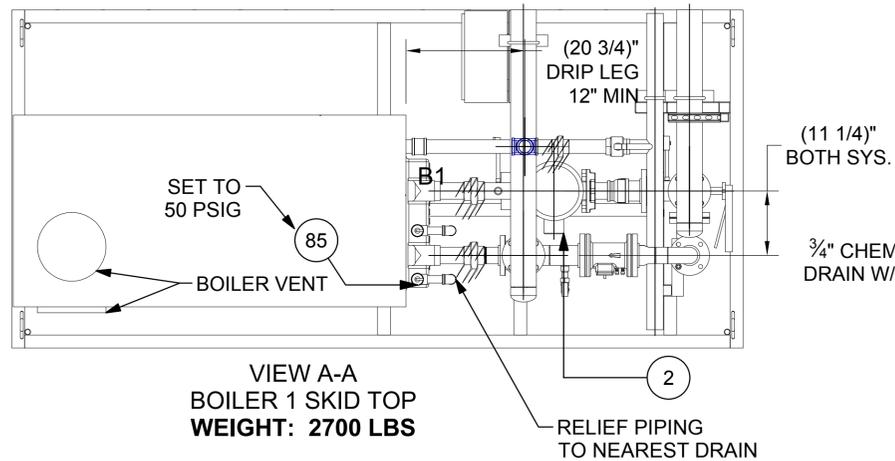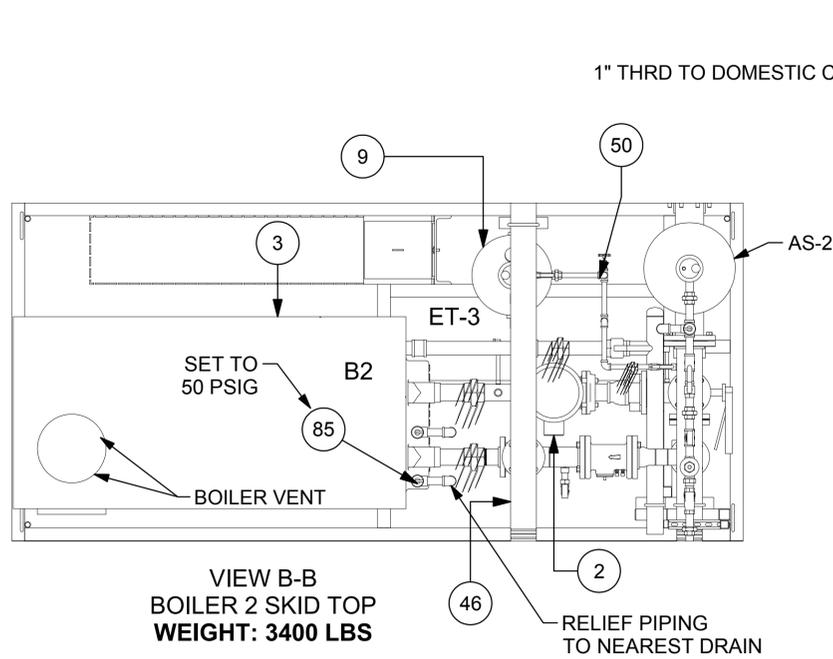

**EISENHOWER/JOHNSON**  
**MEMORIAL TUNNEL**  
FIXED FIRE SUPPRESSION SYSTEM  
DESIGN BUILD PROJECT  
Project No. C0703-360  
Subaccount 17810  
RECORD DRAWINGS - 2015-11-16

Revisions	Date
Num	Description

MECHANICAL SKID VIEWS

Drawing Number  
**M4.2**

**BARNARD EJMT TEAM**

**BARNARD**  
Western States Fire Protection Co.

**STURGEON ELECTRIC**

**BCER**  
A BEER GROUP life safety


**RONDELLO**  
CONSULTING ENGINEERS



IF THIS SHEET IS NOT 22"x34" IT IS NOT PLOTTED TO SCALE



MECHANICAL SITE PLAN - WEST  
SCALE: 1" = 40'-0"

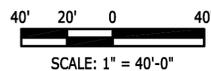

EISENHOWER/JOHNSON  
MEMORIAL TUNNEL  
FIXED FIRE SUPPRESSION SYSTEM  
DESIGN BUILD PROJECT

Project No. C0703-360 Subaccount 17810  
RECORD DRAWINGS - 2015-11-16

Num	Revisions	Description	Date

MECHANICAL SITE PLAN - WEST

Drawing Number  
**M5.0**

**BARNARD EJMT TEAM**

BCER  
Aerial Engineering

BARNARD

RONDINELLI  
Aerial Engineering  
Safety


ALF  
Consulting Engineers

Western States  
Fire Protection Co.



Sturgeon  
Electric



IF THIS SHEET IS NOT 22"x34" IT IS NOT PLOTTED TO SCALE

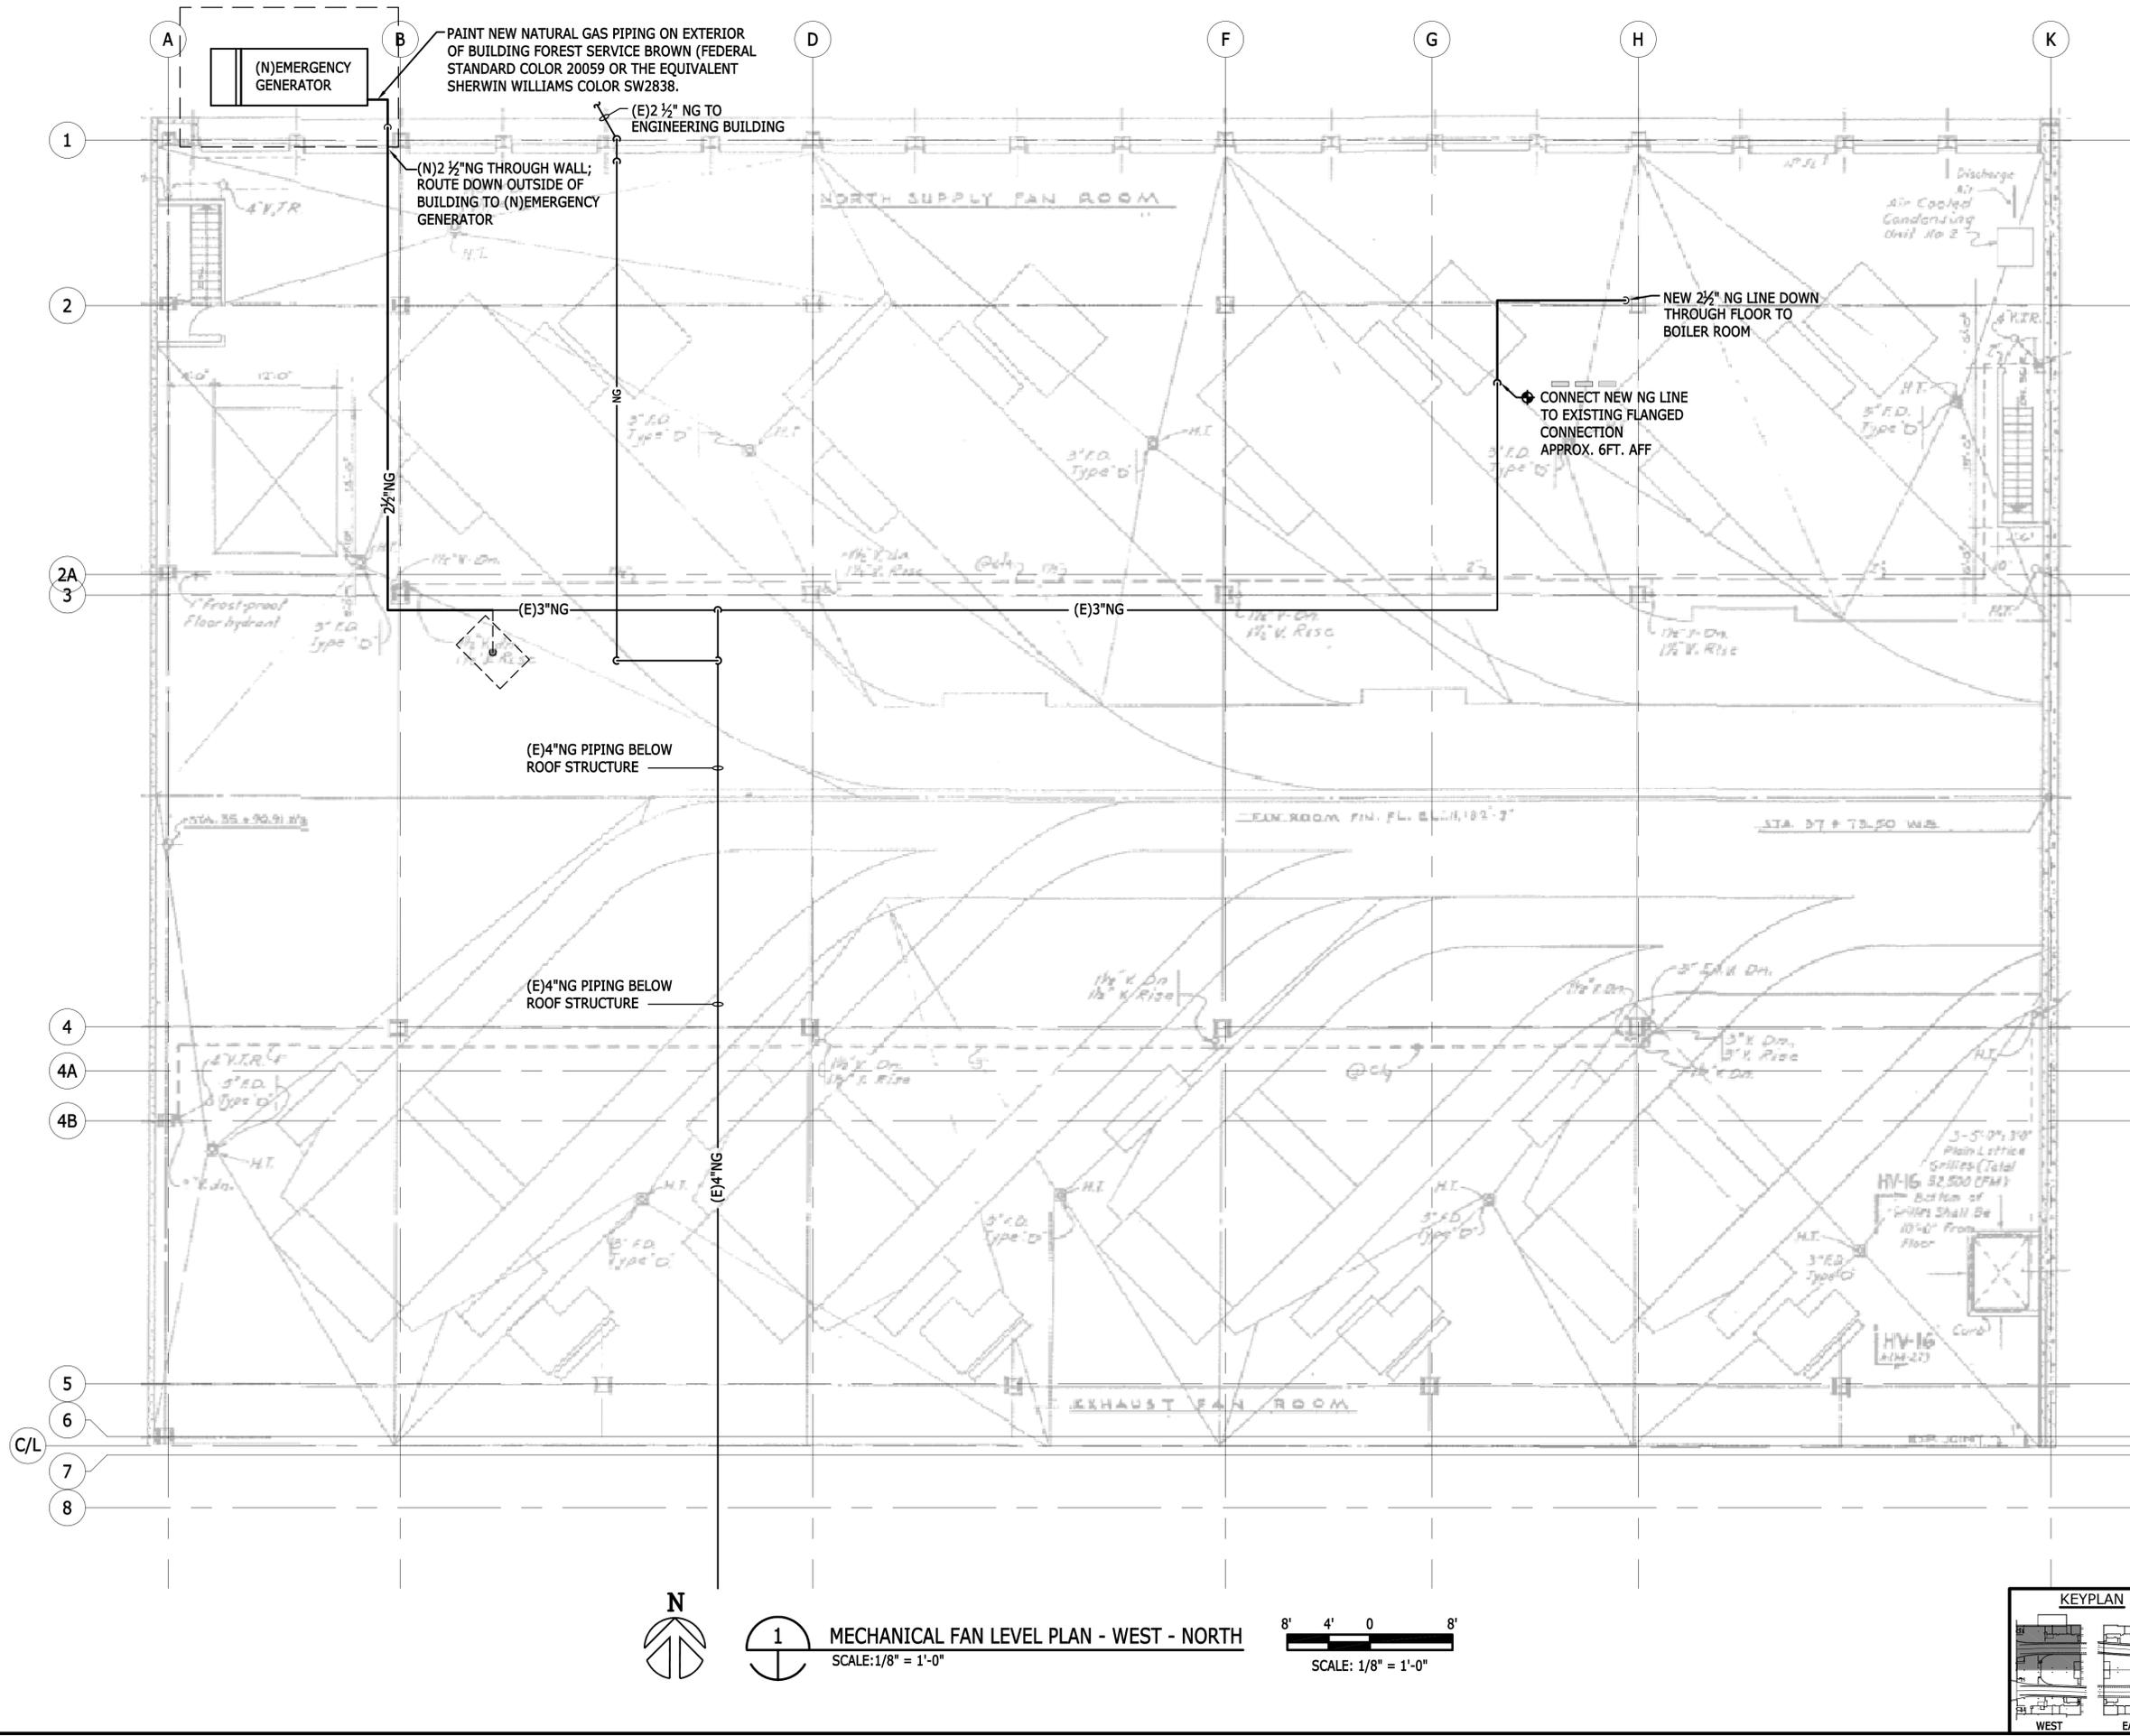

MECHANICAL FAN LEVEL PLAN - WEST - NORTH  
SCALE: 1/8" = 1'-0"

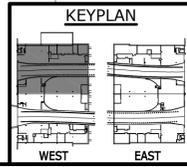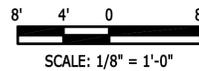

EISENHOWER/JOHNSON  
MEMORIAL TUNNEL  
FIXED FIRE SUPPRESSION SYSTEM  
DESIGN BUILD PROJECT

**BARNARD EJMT TEAM**

BCER  
Western States Fire Protection Co.  
Sturgeon Electric  
BARNARD  
RONDINELLI  
A BEEB GROUP life safety  
Western States Fire Protection Co.  
ENGINEERS

Num	Revisions	Date
	Description	

MECHANICAL FAN LEVEL PLAN - WEST - NORTH  
Drawing Number  
**M6.1**


Project No. C0703-360  
Subaccount 17810  
RECORD DRAWINGS - 2015-11-16

DRAWN BY: JEB  
CHECKED BY: RDM







IF THIS SHEET IS NOT 22"x34" IT IS NOT PLOTTED TO SCALE

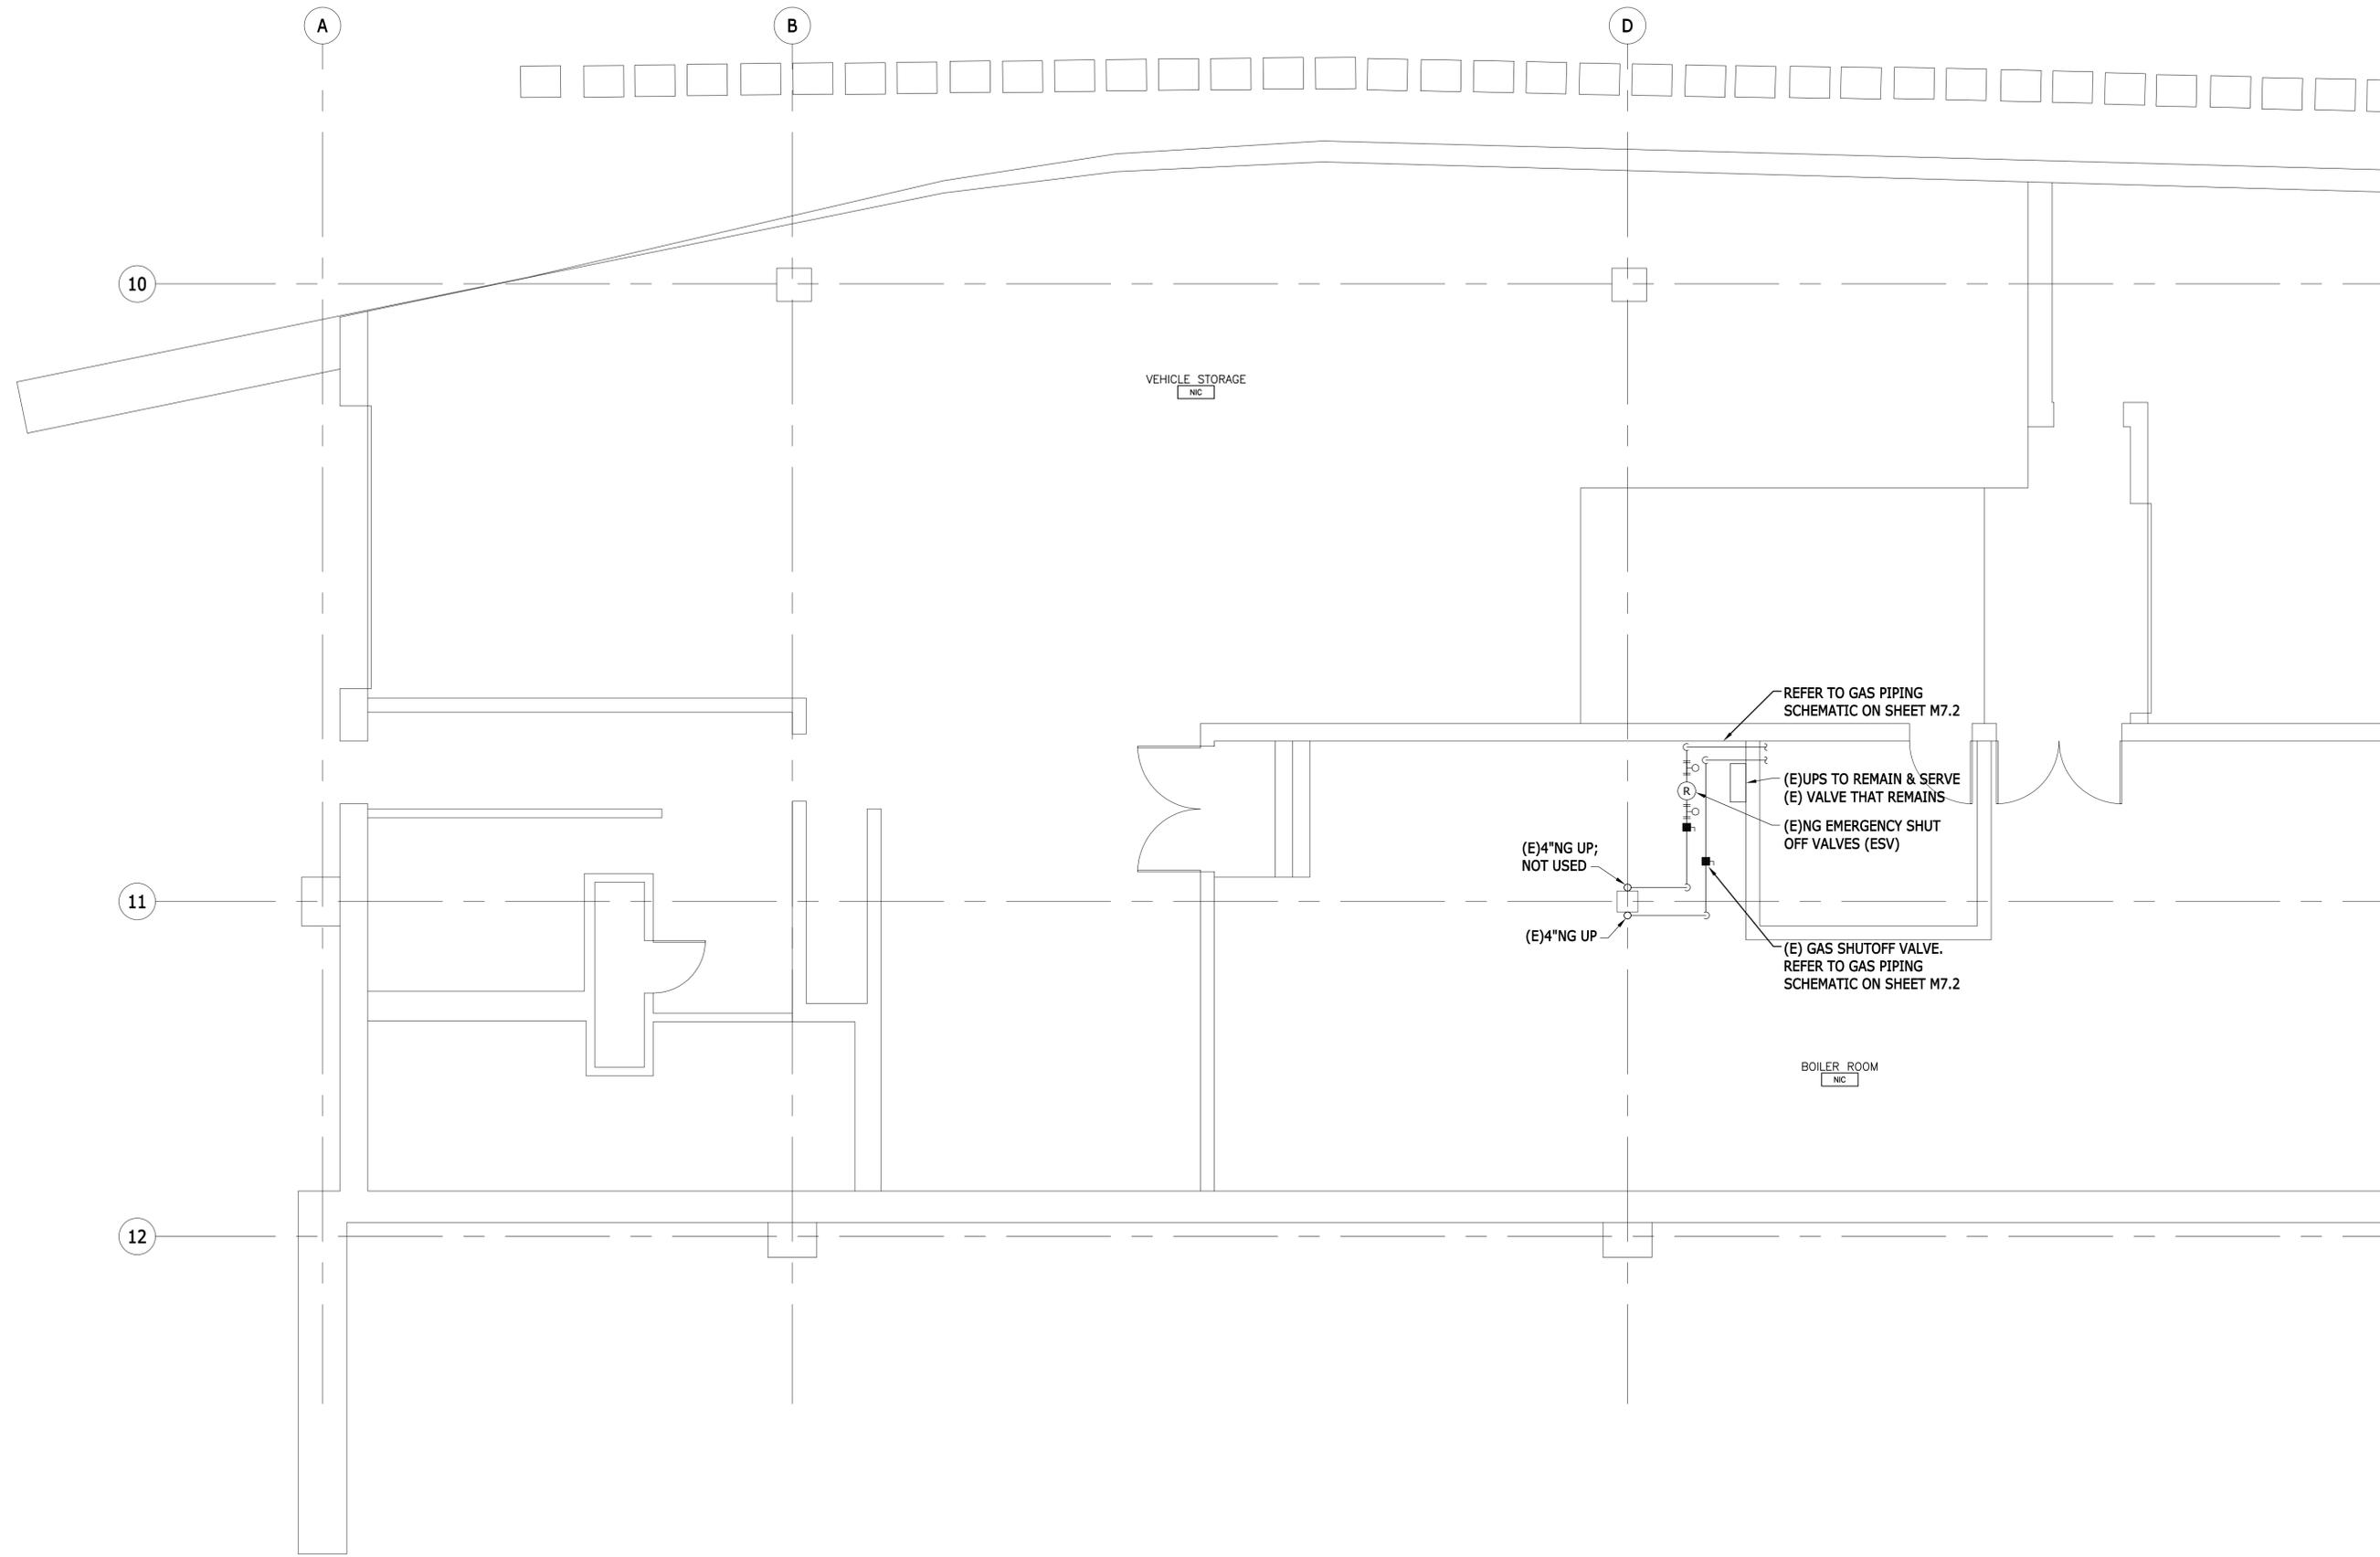

**MECHANICAL ROADWAY LEVEL PLAN - WEST - SOUTH**  
SCALE: 1/8" = 1'-0"

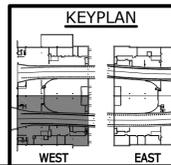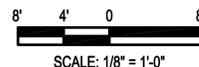

**EISENHOWER/JOHNSON**  
**MEMORIAL TUNNEL**  
FIXED FIRE SUPPRESSION SYSTEM  
DESIGN BUILD PROJECT

**BARNARD EJMT TEAM**




Revisions	Date
Num	Description

MECHANICAL ROADWAY  
LEVEL PLAN - WEST -  
SOUTH  
Drawing Number  
**M6.3**


Project No. C0703-360 Subaccount 17810  
**RECORD DRAWINGS - 2015-11-16**

DRAWN BY: JEB CHECKED BY: RDM




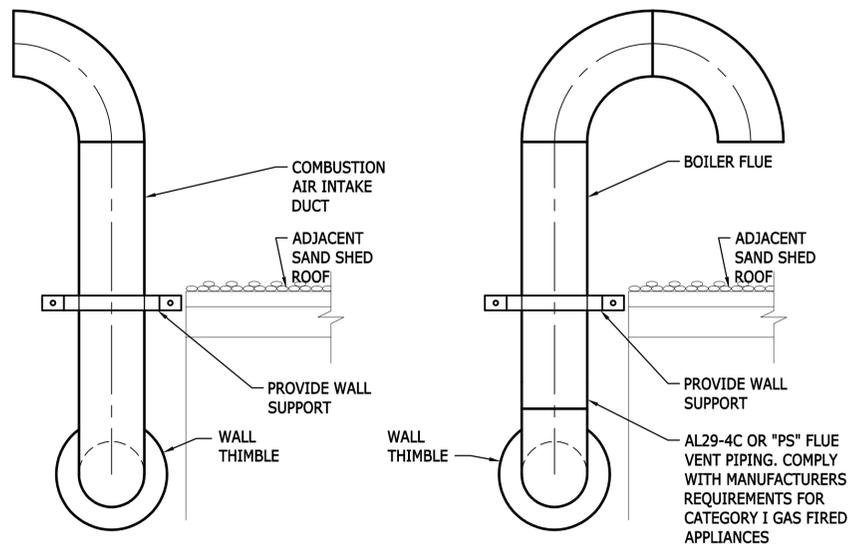

**1 BOILER FLUE AND COMBUSTION AIR INTAKE DETAIL**  
SCALE: NOT TO SCALE

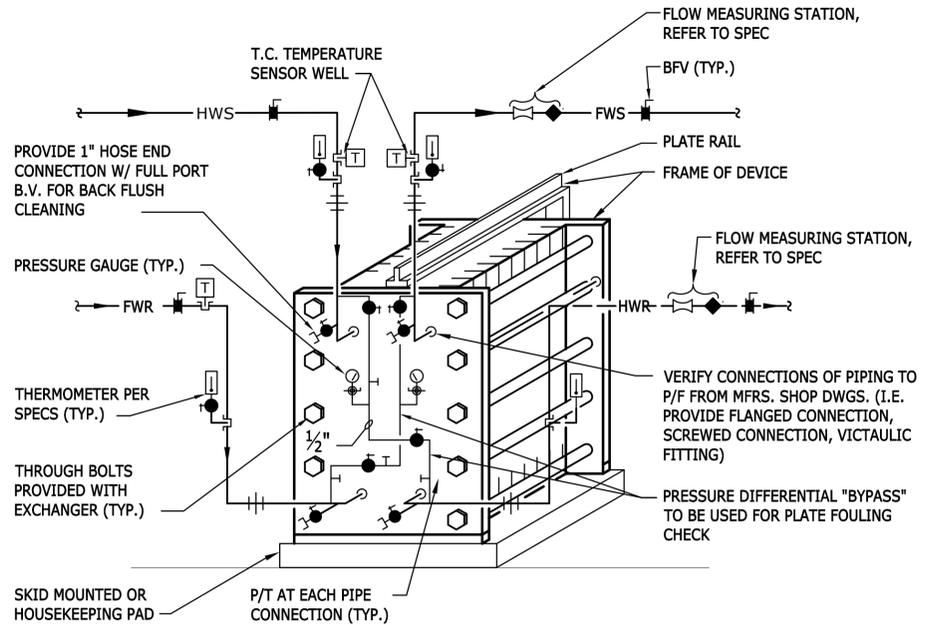


**2 PLATE AND FRAME HEAT EXCHANGER PIPING DETAIL**  
SCALE: NOT TO SCALE

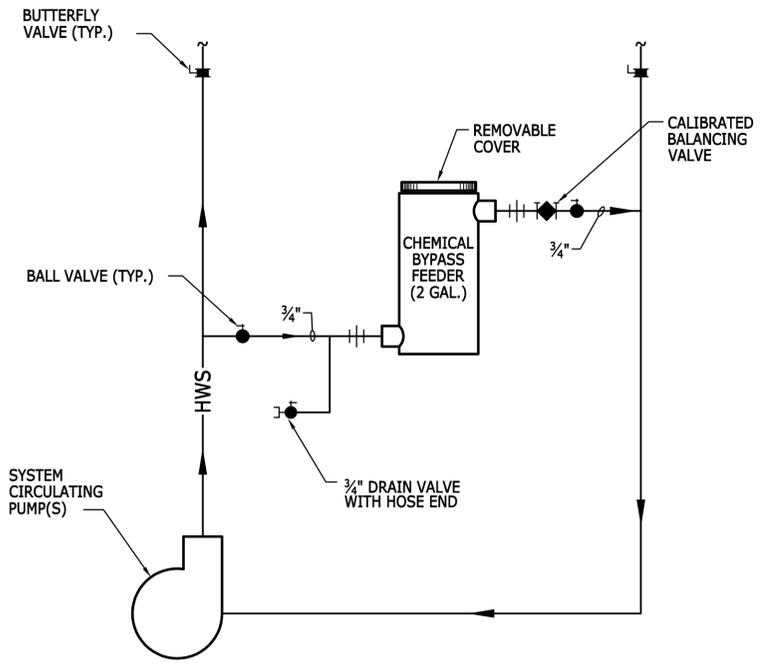


**3 CHEMICAL POT FEEDER DETAIL**  
SCALE: NOT TO SCALE

**NOTES:**  
 1. DELETE UNIONS IF USING VICTAULIC OR FLANGED PIPE CONNECTIONS.  
 2. FIRE (FFSS) SIDE FLOW (FWS/FWR)  
 3. BOILER SIDE FLOW (HWS/HWR)

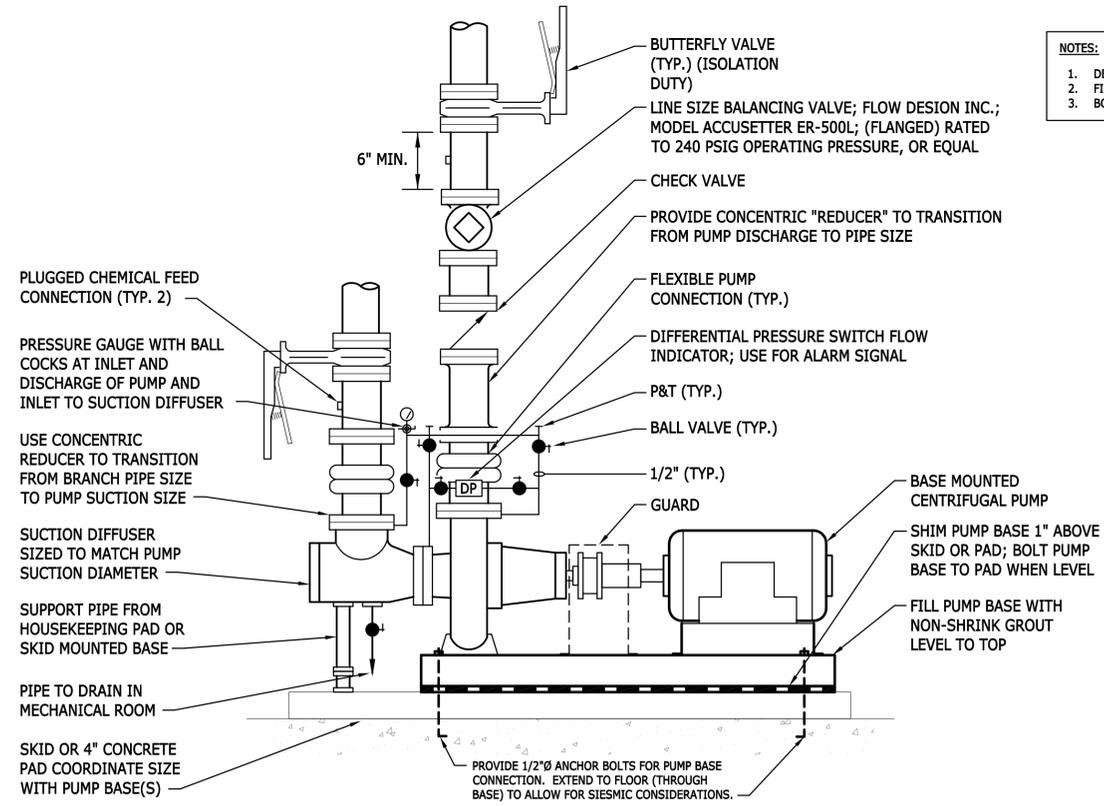

**4 END SUCTION PUMP DETAIL**  
SCALE: NOT TO SCALE

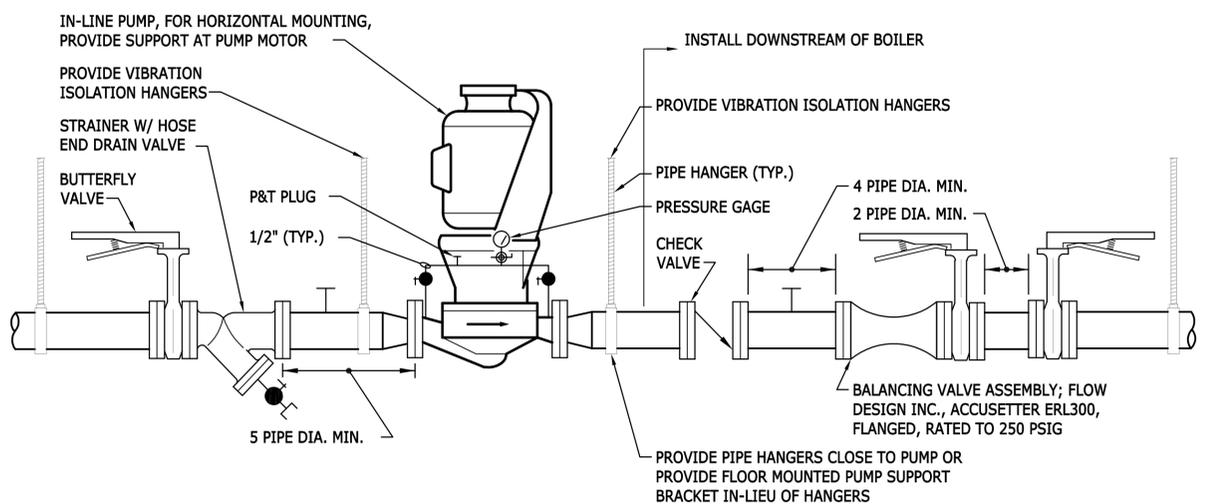

**5 INLINE PUMP ASSEMBLY**  
SCALE: NOT TO SCALE (2 1/2" PIPE AND SMALLER)

IF THIS SHEET IS NOT 22"x34" IT IS NOT PLOTTED TO SCALE

**EISENHOWER/JOHNSON  
MEMORIAL TUNNEL  
FIXED FIRE SUPPRESSION SYSTEM  
DESIGN BUILD PROJECT**

Project No. C0703-360 Subaccount 17810  
RECORD DRAWINGS - 2015-11-16

**BARNARD EJMT TEAM**

**BARNARD** **RONDELLO**  
A TEAM GROUP LIFE SAFETY

**Sturgeon ELECTRIC**  
Western States Fire Protection Co.

**ALF**  
CONSULTING ENGINEERS

Revisions	Date
Num	Description

MECHANICAL DETAILS

Drawing Number  
**M7.0**

CHECKED BY: RDM  
DRAWN BY: JEB











**MECHANICAL SPECIFICATIONS**

- G. CARRIER FREQUENCY RANGE: 1 TO 6 KHZ THROUGH 100 HP AND 1 TO 3 KHZ ABOVE 100 HP.
- H. OUTPUT FREQUENCY RANGE: 0 TO 80 HZ MINIMUM RANGE.
- I. ALL DRIVE PARAMETERS SHALL BE STORED IN NON-VOLATILE MEMORY (EEPROM).

**PROTECTIVE FEATURES**

- A. VFD SHALL HAVE BUILT-IN PROTECTION FOR POWER SOURCE TRANSIENTS, OVER-VOLTAGE, UNDER-VOLTAGE, AND PHASE LOSS. VFD SHALL NOT REQUIRE AN INPUT ISOLATION TRANSFORMER FOR TRANSIENT PROTECTION.
- B. DC BUS OVER-VOLTAGE PROTECTION.
- C. INSTANTANEOUS SHUTDOWN WHEN LOAD CURRENT EXCEEDS 150 PERCENT.
- D. ADJUSTABLE ELECTRONIC CLASS 20 INVERSE TIME CHARACTERISTIC OVER-CURRENT OVERLOAD PROTECTION FOR THE MOTOR.
- E. THE VFD SHALL BE CAPABLE OF WITHSTANDING RANDOMLY APPLIED SHORT CIRCUIT CURRENT APPLIED ACROSS THE OUTPUT TERMINALS WITHOUT DAMAGE.
- F. PROTECTION OF VFD FOR ANY EXTERNAL DISCONNECTS BETWEEN THE DRIVE AND THE MOTOR. PROVIDE CONTROL TERMINALS FOR CONNECTION OF DISCONNECT SWITCH AUXILIARY CONTACTS, WHICH WILL IMMEDIATELY STOP THE DRIVE WHEN OPENED.
- G. DC BUS DISCHARGE CIRCUIT FOR PROTECTION OF SERVICE PERSONNEL, WITH "BUS CHARGED" INDICATOR.
- H. TROUBLESHOOTING DIAGNOSTIC FEATURES:
  - 1. INDICATOR LIGHTS ON INVERTER POWER MODULE TO INDICATE CORRECT OPERATION (OR FAILURE) OF INDIVIDUAL POWER SWITCHING DEVICES.
  - 2. INDICATOR LIGHTS TO SHOW DRIVE FAULT/READY STATES, AND REASON FOR FAULT SHUTDOWN, INCLUDING: INSTANTANEOUS OVERLOAD, MOTOR OVERLOAD, OUTPUT OR DC BUS OVER-VOLTAGE, OR SOURCE OVER-VOLTAGE, UNDER-VOLTAGE, OR PHASE LOSS. THE VFD SHALL STORE IN MEMORY AT MINIMUM THE PREVIOUS FIVE (5) ALARMS.

**FABRICATION**

- A. WIRING TERMINATIONS: MATCH CONDUCTOR MATERIALS AND SIZES INDICATED.
- B. ENCLOSURE: FOR DRY, INDOOR APPLICATIONS: NEMA 250, TYPE 12.
- C. FINISH: MANUFACTURER'S STANDARD ENAMEL.

**SOURCE QUALITY CONTROL**

- A. INSPECT AND PRODUCTION\_TEST EACH PRODUCT SPECIFIED IN THIS SECTION.

**EXECUTION**

- A. VERIFY THAT SURFACE IS SUITABLE FOR CONTROLLER INSTALLATION.
- B. DO NOT INSTALL CONTROLLER UNTIL BUILDING ENVIRONMENT CAN BE MAINTAINED WITHIN THE SERVICE CONDITIONS REQUIRED BY THE MANUFACTURER.
- C. INSTALL CONTROLLER WHERE INDICATED, IN ACCORDANCE WITH MANUFACTURER'S WRITTEN INSTRUCTIONS AND NEMA ICS 3.1.
- D. TIGHTEN ACCESSIBLE CONNECTIONS AND MECHANICAL FASTENERS AFTER PLACING CONTROLLER.
- E. INSTALL FUSES IN FUSIBLE SWITCHES.
- F. PROVIDE ENGRAVED PLASTIC NAMEPLATES.
- G. PROVIDE NEATLY TYPED LABEL INSIDE EACH MOTOR CONTROLLER DOOR IDENTIFYING MOTOR SERVED, NAMEPLATE HORSEPOWER, FULL LOAD AMPERES, CODE LETTER, SERVICE FACTOR, AND VOLTAGE/PHASE RATING.
- H. INSPECT COMPLETED INSTALLATION FOR PHYSICAL DAMAGE, PROPER ALIGNMENT, ANCHORAGE, AND GROUNDING.
- I. PROVIDE MINIMUM TWO (2) HOURS OF START-UP SERVICE FOR EACH VFD. SERVICE SHALL BE PERFORMED BY FACTORY-TRAINED SERVICE TECHNICIANS.
- J. TECHNICIAN SHALL VERIFY CORRECT INSTALLATION, START-UP THE DRIVE, ADJUST ALL REQUIRED OPERATING PARAMETERS, AND VERIFY PROPER OPERATION IN ALL OPERATING MODES.
- K. OWNER TRAINING: PROVIDE MINIMUM EIGHT (8) HOURS TRAINING IN OPERATION AND TROUBLE-SHOOTING PROCEDURES FOR THE INSTALLED DRIVES.

- L. MAKE FINAL ADJUSTMENTS TO INSTALLED DRIVE TO ASSURE PROPER OPERATION OF FAN SYSTEM. OBTAIN PERFORMANCE REQUIREMENTS FROM INSTALLER OF DRIVEN LOADS.
- M. TOUCH UP SCRATCHED OR MARRED SURFACES TO MATCH ORIGINAL FINISH.

**SECTION 235200 - BOILERS**

- A. MANUFACTURER'S QUALIFICATIONS: FIRMS REGULARLY ENGAGED IN MANUFACTURE OF BOILERS, OF TYPES AND CAPACITIES REQUIRED, WHOSE PRODUCTS HAVE BEEN IN SATISFACTORY USE IN SIMILAR SERVICE FOR NOT LESS THAN FIVE (5) YEARS.
- B. MANUFACTURER'S TEST: ALL BOILERS SHALL BE FACTORY ASSEMBLED AND TESTED. SUBMIT TEST RESULTS TO CONTRACT/ENGINEER PRIOR TO SHIPPING.
- C. PRODUCT DATA: SUBMIT MANUFACTURER'S TECHNICAL PRODUCT DATA, INCLUDING RATED CAPACITIES OF SELECTED MODEL CLEARLY INDICATED, WEIGHTS (SHIPPING, INSTALLED, AND OPERATING), FURNISHED SPECIALTIES, FLUE SIZING RECOMMENDATIONS AND ACCESSORIES; AND INSTALLATION AND START-UP INSTRUCTIONS.
- D. SHOP DRAWINGS: SUBMIT MANUFACTURER'S ASSEMBLY-TYPE SHOP DRAWINGS INDICATING DIMENSIONS, WEIGHTS, LOADINGS, REQUIRED CLEARANCES, AND METHOD OF FIELD ASSEMBLY, COMPONENTS AND LOCATION AND SIZE OF EACH FIELD CONNECTION.
- E. WIRING DIAGRAMS: SUBMIT MANUFACTURER'S ELECTRICAL REQUIREMENTS FOR POWER SUPPLY WIRING TO CAST IRON BOILERS. SUBMIT MANUFACTURER'S LADDER-TYPE WIRING DIAGRAMS FOR INTERLOCK AND CONTROL WIRING REQUIRED FOR FINAL INSTALLATION OF CAST IRON BOILERS AND CONTROLS. CLEARLY DIFFERENTIATE BETWEEN PORTIONS OF WIRING THAT ARE FACTORY INSTALLED AND PORTIONS TO BE FIELD-INSTALLED.
- F. RECORD DRAWINGS: AT PROJECT CLOSEOUT, SUBMIT RECORD DRAWINGS OF INSTALLED SYSTEMS PRODUCTS IN ACCORDANCE WITH REQUIREMENTS OF THE MAIN CONTRACT.
- G. MAINTENANCE DATA: SUBMIT MAINTENANCE DATA AND PARTS LIST FOR EACH CAST IRON BOILER, CONTROL, AND ACCESSORY; INCLUDING "TROUBLE-SHOOTING" MAINTENANCE GUIDE. INCLUDE THIS DATA, PRODUCT DATA, SHOP DRAWINGS, AND WIRING DIAGRAMS IN MAINTENANCE MANUAL; IN ACCORDANCE WITH REQUIREMENTS OF THE MAIN CONTRACT.
- H. FINNED WATER TUBE BOILERS:
  - 1. LOCHINVAR WATER HEATER CO.
  - 2. PATTERSON - KELLY CO.
  - 3. RHEEM MANUFACTURING CO.
  - 4. A.O. SMITH, WATER PRODUCTS CO.
- I. FINNED WATER TUBE BOILERS
  - 1. THE WATER CONTAINING SECTION SHALL CONSIST OF A HEAT EXCHANGER CONSTRUCTED OF A "FIN TUBE" DESIGN, WITH STRAIGHT COPPER TUBES HAVING EXTRUDED INTEGRAL FINS SPACED SEVEN (7) FINS PER INCH. THESE TUBES SHALL BE "ROLLED" SECURELY INTO GLASS-LINED, CAST IRON HEADERS. THERE SHALL BE NO BOLTS, GASKETS OR "O" RINGS IN THE HEAD CONFIGURATION. REMOVABLE ACCESS PLUGS SHALL BE PROVIDED ON THE HEAT EXCHANGER HEADERS FOR THE PURPOSES OF INSPECTION, CLEANING OR REPAIR. BOILER DRAINS SHALL BE PROVIDED, HAVING EXTERNAL ACCESS. THE HEAT EXCHANGER SHALL BE MOUNTED IN A STRESS FREE JACKET ASSEMBLY IN ORDER TO PROVIDE A "FREE FLOATING DESIGN" ABLE TO WITHSTAND THE EFFECTS OF THERMAL SHOCK. THE BOILER SHALL BEAR THE ASME "H" STAMP FOR 160 PSI WORKING PRESSURE AND SHALL BE NATIONAL BOARD LISTED. THE COMPLETE HEAT EXCHANGER ASSEMBLY SHALL CARRY A TEN (10) YEAR WARRANTY AGAINST FAILURE CAUSED BY DEFECTIVE WORKMANSHIP OR MATERIAL.
  - 2. THE COMBUSTION CHAMBER SHALL BE CONSTRUCTED OF STAINLESS STEEL AND SEALED FOR COMBUSTION EMPLOYING THE POWER BURNER CONCEPT. THE BURNER SURFACE SHALL BE CONSTRUCTED OF HIGH TEMPERATURE ALUMINUM/CHROMIUM ALLOY WOVEN MESH AND FIRE IN A VERTICAL PLANE WITHIN THE COMBUSTION CHAMBER. THE BURNER SHALL EMPLOY A SPECIAL PERFORATED FLAME INJECTION TUBE EXTENDING THE ENTIRE LENGTH OF THE HEAT EXCHANGER. A COMPLETE FIVE-YEAR WARRANTY FROM THE BOILER MANUFACTURER MUST BE PROVIDED. THE BURNER MUST BE CAPABLE OF FIRING AT BOTH A COMPLETE BLUE FLAME WITH MAXIMUM GAS AND AIR INPUT AS WELL AS FIRING INFRARED WHEN GAS AND AIR ARE REDUCED. BURNER MUST BE CAPABLE OF FIRING FROM 50 PERCENT UP TO 100 PERCENT OF RATED INPUT WHEN SUPPLIED WITH 4-INCHES WATER COLUMN OF INLET GAS PRESSURE TO THE BOILER. THIS WILL INSURE AVAILABILITY OF FULL RATE FIRING UNDER HEAVY DEMAND CONDITIONS, NO EXCEPTIONS. THE BURNER SHALL FIRE IN A FULL 360 DEGREE PATTERN RESULTING IN UNIFORM HEAT TRANSFER UPON EVERY INCH OF HEATING SURFACE. A VIEWING PORT SHALL BE PROVIDED, PERMITTING VISUAL OBSERVATION OF BURNER OPERATION.

- 3. THE HOT WATER BOILER SHALL USE A COMBUSTION AIR BLOWER TO PRECISELY CONTROL THE FUEL/AIR MIXTURE FOR MAXIMUM EFFICIENCY. THE BLOWER HOUSING SHALL BE A FULLY SEALED, NON-SPARKING, CAST ALUMINUM ASSEMBLY. THE BLOWER ASSEMBLY SHALL BE MOUNTED ON THE BURNER AND DRAW GAS AND AIR FROM A PREMIXING CHAMBER. A MULTI SPEED OR DRIVE SHALL BE USED TO INFINITELY VARY BLOWER SPEED AND VOLUME OF AIR DELIVERED TO THE COMBUSTION PROCESS. THE COMBUSTION AIR BLOWER SHALL OPERATE FOR A PRE-PURGE PERIOD BEFORE BURNER IGNITION AND A POST-PURGE PERIOD AFTER BURNER OPERATION TO CLEAR THE COMBUSTION CHAMBER. A DIFFERENTIAL AIR PRESSURE SWITCH SHALL BE PROVIDED TO PROVE OPERATION OF THE COMBUSTION AIR BLOWER, MONITOR COMBUSTION CHAMBER PRESSURES AND MONITOR OPERATION OF THE FLUE.

- 4. THE GAS TRAIN SHALL CONSIST OF A RATIO GAS VALVE TO SUPPLY GAS IN A 1:1 RATIO TO COMBUSTION AIR ALLOWING BURNER INPUT TO VARY BASED ON LOAD. THE RATIO GAS VALVE SHALL PERFORM THE FUNCTIONS OF SAFETY SHUTOFF, CONSTANT PRESSURE REGULATION AND AIR/GAS RATION CONTROL. OPERATION OF THE RATIO GAS VALVE SHALL BE ACCOMPLISHED BY OPERATION OF AN ELECTRO-HYDRAULIC CYLINDER PROVIDING A SLOW OPENING AND QUICK CLOSING OF THE VALVE SEAT. FULL CLOSING OF THE VALVE SEAT SHALL OCCUR IN LESS THAN 0.8 SECONDS WHEN THE VALVE IS DE-ENERGIZED. A VISUAL STROKE POSITION INDICATOR SHALL BE PROVIDED ON THE VALVE ASSEMBLY TO INDICATE THE POSITION OF THE VALVE SEAT. AN ADDITIONAL GAS VALVE SHALL BE PROVIDED IN THE GAS TRAIN TO PROVIDE REDUNDANT VALVE SEATS IN THE BURNER GAS SUPPLY.

- 5. THE BOILER SHALL BE CONSTRUCTED WITH A 16 GAUGE GALVANIZED STEEL JACKET ASSEMBLY. THE INTERIOR OF THE COMBUSTION CHAMBER AND FLUE COLLECTOR SHALL BE CONSTRUCTED COMPLETELY OF STAINLESS STEEL TO ENSURE CORROSION PROTECTION. ALL INNER AND OUTER JACKET PANELS SHALL BE FULLY GASKETED AND SEALED. THE EXTERIOR OF THE JACKET ASSEMBLY SHALL BE FINISHED IN A 3-COAT ACRYLIC ENAMEL FINISH. ALL MODELS SHALL BE CERTIFIED FOR INSTALLATION ON COMBUSTIBLE FLOORS WITHOUT ADDITIONAL SAFETY PROVISIONS.

- 6. THE BOILER SHALL BE DESIGNED TO ALLOW FIELD INSTALLATION OF MULTIPLE VENTING OPTIONS. THE BOILER SHALL BE VENTED WITH A VERTICAL DIRECTAIRE SYSTEM USING A TWO-PIPE SYSTEM INSTALLED WITH CATEGORY I VENT PIPE.

- 7. A 24 VAC CONTROL CIRCUIT AND COMPONENTS SHALL BE USED. ALL COMPONENTS SHALL BE EASILY ACCESSED AND SERVICEABLE FROM THE FRONT AND TOP OF THE UNIT. STANDARD OPERATING CONTROLS SHALL UTILIZE IMMERSION THERMISTERS TO SENSE WATER TEMPERATURES, FOR THE DIGITAL TEMPERATURE CONTROL MODULE. AN ADJUSTABLE IMMERSION TYPE, MANUAL RESET SAFETY HIGH LIMIT SHALL BE PROVIDED TO LIMIT BOILER WATER TEMPERATURE. THE CONTROL PANEL SHALL CONTAIN A LIGHTED ON/OFF MAIN POWER SWITCH, DIGITAL TEMPERATURE DISPLAY AND LED'S FOR OPERATION AND ALARM FAULTS. SUPPLY VOLTAGE SHALL BE 120-1 PHASE.

- 8. THE BOILER SHALL BE EQUIPPED WITH AN ELECTRONIC TEMPERATURE CONTROL MODULE WITH A MICROPROCESSOR BASED PLATFORM INCORPORATING SOFTWARE CUSTOMIZED FOR OPERATION OF THE BOILER. ALL INTERNAL SAFETY, OPERATING AND IGNITION CONTROLS SHALL INTERFACE WITH THE ELECTRONIC TEMPERATURE CONTROL MODULE. THE ELECTRONIC TEMPERATURE CONTROL MODULE SHALL PROVIDE ON/OFF CONTROL OF THE GAS SUPPLY TO THE BURNER, OPERATION OF THE VFD TO CONTROL THE VARIABLE SPEED COMBUSTION AIR BLOWER, INTERFACE WITH THE IGNITION CONTROL SYSTEM, CONTROL OF WATER TEMPERATURE SET POINTS, AND MONITORING OF ALL SAFETY FUNCTIONS. LOCAL COMMUNICATION, PROGRAMMING AND A DISPLAY OF OPERATING AND ALARM STATUS CONDITIONS SHALL BE ACCESSIBLE THROUGH A DIAGNOSTIC INFORMATION CENTER WITH A DIGITAL DISPLAY. THE DIAGNOSTIC INFORMATION CENTER SHALL BE INTEGRALLY MOUNTED ON THE FRONT CONTROL PANEL OF THE BOILER. THE DIAGNOSTIC INFORMATION CENTER SHALL CONTAIN A LIGHTED ON/OFF MAIN POWER SWITCH, A DIGITAL DISPLAY OF A TEMPERATURE FUNCTIONS AND A SERIES OF LED'S TO INDICATE DATA CURRENTLY SHOWN IN THE DIGITAL DISPLAY, THE OPERATIONAL STATUS OF THE BOILER, OR AN ACTIVE ALARM FAULT. DATA POINTS VISIBLE IN THE DIGITAL DISPLAY INCLUDE INLET WATER TEMPERATURE, OUTLET WATER TEMPERATURE, WATER TEMPERATURE DIFFERENTIAL, PERCENT FIRING RATE, SETPOINT TEMPERATURES AND SETPOINT DIFFERENTIAL. OPERATIONAL STATUS LED'S SHALL BE PROVIDED FOR CALL FOR HEAT, LOW AIR, PURGE, TRIAL FOR IGNITION AND BURNER ON. FAULT STATUS LED'S SHALL BE PROVIDED FOR HIGH LIMIT, GAS PRESSURE, LOW WATER, MOTOR DRIVE AND IGNITION MODULE STATUS. THE BOILER ELECTRONIC TEMPERATURE MODULE SHALL SERVE AS AN OPERATING TEMPERATURE CONTROL TO TRACK DEMAND AND REGULATE THE AMOUNT OF HEAT ADDED TO THE WATER SYSTEM FOR HEATING BOILERS.

- 9. THE BOILER SHALL FEATURE THE "SMART SYSTEM" CONTROL WITH A 2-LINE, 16 CHARACTER LCD DISPLAY, PASSWORD SECURITY OUTDOOR RESET, PUMP DELAY WITH FREEZE PROTECTION, PUMP EXERCISE AND PC PORT CONNECTION. THE BOILER SHALL ALLOW 0-10 VDC INPUT CONNECTION FOR BMS CONTROL AND HAVE BUILT-IN "CASCADE" TO SEQUENCE AND ROTATE WHILE MAINTAIN STAGE FIRING OF TWO BOILERS WITHOUT UTILIZATION OF AN EXTERNAL CONTROLLER.

- 10. LOCAL COMMUNICATION, PROGRAMMING AND A DISPLAY OF OPERATING AND ALARM STATUS CONDITIONS SHALL BE ACCESSIBLE THROUGH THE SMART SYSTEM CONTROL PANEL. THE SMART SYSTEM CONTROL PANEL SHALL CONTAIN AN ON/OFF MAIN POWER SWITCH, A DIGITAL DISPLAY OF A TEMPERATURE FUNCTIONS, THE OPERATIONAL STAUUS OF THE BOILER, OR AN ACTIVE ALARM FAULT. DATA POINTS VISIBLE IN THE DIGITAL DISPLAY INCLUDE INLET WATER TEMPERATURE, OUTLET WATER TEMPERATURE, WATER TEMPERATURE DIFFERENTIAL, PERCENT FIRING RATE, SETPOINT TEMPERATURES, SETPOINT DIFFERENTIAL, OUTDOOR AIR TEMPERATURE, MINIMUM TEMPERATURE, MAXIMUM TEMPERATURE AND MAXIMUM RESET TEMPERATURE. OPERATIONAL STATUS SHALL BE DISPLAYED FOR OFF, STANDBY, PRE-PURGE, IGNITION, SPACE HEATING, DHW HEATING, AND POST-PURGE. FAULT STAUUS SHALL BE PROVIDED FOR HIGH LIMIT, GAS PRESSURE (OPTIONAL), LOW WATER, BLOCKED DRAIN, LOUVER PROVING, AND AIR PRESSURE SWITCH STATUS.

- 11. THE STANDARD OPERATING CONTROL SYSTEM SHALL INCLUDE REDUNDANT PROVEN PILOT HOT SURFACE IGNITION WITH FULL FLAME MONITORING CAPABILITY. THE IGNITION SYSTEM SHALL BE ABLE TO FUNCTION INDEPENDENTLY IN THE EVENT OF A FAILURE IN ONE SYSTEM. MULTIPLE MAIN GAS VALVES WITH REDUNDANT VALVE SEATS AND BUILT IN LOW GAS PRESSURE REGULATORS SHALL BE SUPPLIED AS STANDARD. GAS VALVES WILL BE REFERENCED TO THE COMBUSTION CHAMBER TO ENSURE PROPER AIR/GAS MIXTURE FOR EFFICIENT COMBUSTION.

- 12. ADDITIONAL STANDARD CONTROLS SHALL INCLUDE A FLOW SWITCH, LOW AIR/BLOCKED FLUE PRESSURE SWITCH FOR EACH FAN, LOW VOLTAGE TRANSFORMER FOR THE CONTROL CIRCUIT, 7 AMP CIRCUIT BREAKER AND AN ASME PRESSURE RELIEF VALVE. ALL NATURAL GAS MODELS WILL BE EQUIPPED WITH AN AUTOMATIC RESET LOW GAS PRESSURE SWITCH. THE MANUFACTURER SHALL VERIFY PROPER OPERATION OF THE BURNERS, ALL CONTROLS AND THE HEAT EXCHANGER BY CONNECTION TO WATER AND VENTING FOR A FACTORY FIRE TEST PRIOR TO SHIPPING. A QUALITY TEST REPORT SHALL BE SHIPPED WITH EACH UNIT AND SUBMITTED TO THE CONTRACTOR/ENGINEER.

- 13. A 24 VAC CONTROL CIRCUIT AND COMPONENTS SHALL BE USED. ALL COMPONENTS SHALL BE EASILY ACCESSED AND SERVICEABLE. ALL COMPONENTS SHALL HAVE MULTI-PIN, PLUG IN TYPE CONNECTORS TO EASE SERVICE, TROUBLESHOOTING AND LOWER REMOVAL AND REPLACEMENT COST. THE BOILER MUST BE ABLE TO MAINTAIN APPROXIMATELY 50% OPERATING CAPACITY IN THE EVENT OF A FAILURE OF ANY ONE (1) CONTROL COMPONENT, I.E. GAS VALVE, COMBUSTION AIR FAN, IGNITION CONTROL, IGNITER OR PRESSURE SWITCH.

- 14. THE BOILER SHALL BE APPROVED FOR INDOOR INSTALLATION. THE BOILER SHALL BE APPROVED FOR SIDEWALL, DIRECTAIRE VERTICAL, DIRECTAIRE VERTICAL WITH SIDEWALL AIR INLET, DIRECTAIRE HORIZONTAL, AIRELOCK DIRECT VENT AND CONVENTIONAL VENTING (SEE MECHANICAL DETAIL). VENTING SHALL BE CLASSIFIED CATEGORY I, NEGATIVE DRAFT, NON-CONDENSING, TO USE TYPE "B" DOUBLE WALL VENTING MATERIALS. DIRECT VENT INSTALLATIONS REQUIRE THE USE OF AL294C VENT MATERIALS.

- 15. THE BOILER SHALL HAVE AN INDEPENDENT LABORATORY RATING FOR OXIDES OF NITROGEN (NOx) OF LESS THAN 20 PPM CORRECTED TO 3% O2.

- 16. THE FIRING CONTROL SYSTEM SHALL BE M9.
  - c. M-9 - TWO HOT SURFACE IGNITIONS WITH ELECTRONIC SUPERVISION (STANDARD)

- 18. THE ELECTRONIC TEMPERATURE CONTROL MODULE SHALL BE CAPABLE OF VARYING BURNER INPUT FROM 35 PERCENT UP TO 100 PERCENT OF RATED INPUT. BURNER INPUT MAY VARY IN STEPS AS SMALL 1 PERCENT OF INPUT ALLOWING UP TO 50 ADJUSTABLE STEPS WHILE TRACKING THE HEATING LOAD. ACCESS TO THE BOILER ELECTRONIC TEMPERATURE CONTROL AND THE DIGITAL DISPLAY SHALL BE FROM A FRONT MOUNTED DIAGNOSTIC INFORMATION CENTER. THE ELECTRICAL COMPONENTS, RELAYS AND CIRCUIT BOARDS SHALL BE ACCESSIBLE FROM THE FRONT CONTROL PANEL ACCESS. ALL ELECTRICAL CONNECTIONS FROM THE SAFETY AND OPERATING CONTROLS TO THE ELECTRONIC TEMPERATURE CONTROL MODULE SHALL BE MADE BY A WIRING HARNESS WITH UNIQUE MULTIPLE PIN TERMINATIONS FOR EACH CONNECTION POINT.

- 19. THE IGNITION CONTROL SYSTEM SHALL INCLUDE AN ELECTRONICALLY PROVEN HOT SURFACE IGNITION SYSTEM WITH FULL FLAME MONITORING CAPABILITY. ADDITIONAL STANDARD CONTROLS SHALL INCLUDE A LOW VOLTAGE TRANSFORMER FOR THE CONTROL CIRCUIT, A FLOW SWITCH TO PROVE WATER FLOW, TEMPERATURE-PRESSURE GAUGE AND A FACTORY INSTALLED ASME PRESSURE RELIEF VALVE. ALL INTERNAL AND EXTERNAL WIRING HARNESS CONNECTIONS SHALL HAVE MULTI-PIN PLUG-IN TYPE CONNECTORS TO EASE SERVICE, TROUBLESHOOTING AND REDUCE REMOVAL AND REPLACEMENT COST. THE MANUFACTURER SHALL VERIFY PROPER OPERATION OF THE BURNERS, ALL CONTROLS AND THE HEAT EXCHANGER BY CONNECTION TO GAS, WATER AND VENTING FOR A FULL FACTORY FIRE TEST PRIOR TO SHIPPING. A QUALITY TEST REPORT SHALL BE SHIPPED WITH EACH UNIT.

- 20. THE BOILER SHALL BE CERTIFIED AND LISTED BY THE CSA INTERNATIONAL UNDER THE LATEST EDITION OF THE ANSI Z21.13 TEST STANDARD. THE BOILER SHALL COMPLY WITH THE ENERGY EFFICIENCY REQUIREMENTS OF THE LATEST EDITION OF THE ASHRAE 90.1 STANDARD. THE BOILER SHALL BE CERTIFIED AND LISTED IN CANADA BY THE CANADIAN GAS ASSOCIATION UNDER THE LATEST EDITION OF STANDARDS CAN1-3.1 AND CSA C22.2. THE BOILER SHALL OPERATE AT UP TO 85 PERCENT THERMAL EFFICIENCY.

- 21. M9 - INFINITELY PROPORTIONAL COMBUSTION: PEAK EFFICIENCY IS ACHIEVED BY ADJUSTING THE FIRING RATE BETWEEN 35 AND 100 PERCENT OF RATED OUTPUT. INCLUDES HOT SURFACE IGNITION WITH ELECTRONIC FLAME SUPERVISION TO PROVIDE MAIN BURNER SHUTDOWN UPON FLAME FAILURE. CSA/ANSI CERTIFIED SAFETY CONTROL SYSTEM. CONTROL CIRCUIT IS 24 VOLT.

**J. INSTALLATION OF BOILERS**

- 1. GENERAL: INSTALL BOILERS IN ACCORDANCE WITH MANUFACTURER'S INSTALLATION INSTRUCTIONS, IN ACCORDANCE WITH STATE AND LOCAL CODE REQUIREMENTS, AND IN ACCORDANCE WITH REQUIREMENTS OF LOCAL UTILITY COMPANY. INSTALL UNITS PLUMB AND LEVEL, TO TOLERANCE OF 1/8-INCH IN 10' - 0" IN BOTH DIRECTIONS. MAINTAIN MANUFACTURER'S RECOMMENDED CLEARANCES AROUND AND OVER BOILERS.
- 2. SUPPORT: INSTALL BOILERS ON 4-INCH BASE, 6-INCH LARGER ON EACH SIDE THAN BASE OF UNIT OR STEEL FRAME WITH MINIMUM OF 4" HEIGHT.

**235100 - BOILER VENTING**

**GENERAL**

- A. THIS SECTION SPECIFIES THE FOLLOWING:

- 1. DOUBLE WALL METAL VENTS AND ACCESSORIES FOR GAS-FIRED APPLIANCES

- B. CODES AND STANDARDS:

- 1. NFPA: COMPLY WITH NFPA 211 "STANDARD FOR CHIMNEYS, FIREPLACES, VENTS AND SOLID FUEL BURNING APPLIANCES".
- 2. UL: COMPLY WITH APPLICABLE PORTIONS OF UL SAFETY STANDARDS; PROVIDE PRODUCTS WHICH HAVE BEEN UL LISTED AND LABELED.
- 3. SMACNA: COMPLY WITH SMACNA LOW PRESSURE DUCT STANDARDS FOR FABRICATED BREECHING AND SMOKEPIPE.
- 4. ASHRAE: COMPLY WITH THE ASHRAE EQUIPMENT HANDBOOK, CHAPTER 27, FOR CHIMNEY, GAS VENT, AND FIREPLACE SYSTEMS, MATERIAL REQUIREMENTS AND DESIGN CRITERIA.
- 5. UMC: COMPLY WITH THE INTERNATIONAL MECHANICAL CODE AND INTERNATIONAL FUEL GAS CODE FOR CHIMNEY APPLICATION AND REQUIREMENTS OF STACK TYPE, HEIGHT, AND CLEARANCES.

- C. SHOP DRAWINGS: SUBMIT SHOP DRAWINGS INCLUDING REQUIRED CLEARANCES, ASSEMBLY AND INSTALLATION INSTRUCTIONS, AND SUPPORT OF COMPONENTS.

- 1. THE SHEET METAL CONTRACTOR SHALL SUBMIT A COMPUTERIZED VENT SIZING ANALYSIS FOR THE ACTUAL BOILERS AND WATER HEATERS BEING FURNISHED. THE COMPUTER ANALYSIS SHALL LIST THE MAKE, MODEL NUMBER, FIRING RATE, AND THE ALLOWABLE BACK PRESSURE FOR EACH APPLIANCE, THE QUANTITY AND TYPE OF EACH COMPONENT, THE DRAFT CONDITIONS WITH EACH APPLIANCE FIRING INDIVIDUALLY AND WITH ALL APPLIANCES FIRING. THE CONTRACTOR SHALL ALSO PROVIDE DRAWINGS SHOWING ALL COMPONENTS AND THEIR LOCATION IN THE SYSTEM.

- D. ALL PARTS EXPOSED TO OUTSIDE ATMOSPHERE SHALL BE COATED BY THE INSTALLER, WITH ONE (1) BASE COAT AND ONE (1) FINISH COAT OF GLIDDEN, METALLITE, OR EQUAL.

- E. QUALITY CONTROL SUBMITTALS:

- 1. CERTIFICATES: SUBMIT CERTIFICATES OF MATERIALS COMPLIANCE WITH SPECIFIED ASTM, UL, AND ASHRAE REQUIREMENTS.
- 2. CERTIFICATES: SUBMIT WELDERS' QUALIFICATION CERTIFICATES.

**EISENHOWER/JOHNSON**

**MEMORIAL TUNNEL**

FIXED FIRE SUPPRESSION SYSTEM

DESIGN BUILD PROJECT

Project No. C0703-360 Subaccount 17810

**RECORD DRAWINGS - 2015-11-16**

Num	Revisions	Description	Date

MECHANICAL SPECIFICATIONS

Drawing Number

**M8.2**

DRAWN BY: JEB CHECKED BY: RDM

**BARNARD EJMT TEAM**

**BARNARD**

**BCER**

**Sturgeon ELECTRIC**


**RONDINELLI**

**ELF**

**Western States Fire Protection Co.**


IF THIS SHEET IS NOT 22"x34" IT IS NOT PLOTTED TO SCALE



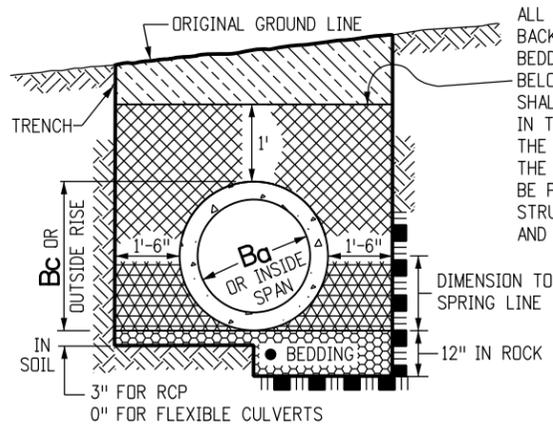

**PIPE IN TRENCH**


- THE BEDDING MATERIAL FOR RIGID PIPE IN SOIL SHALL BE 3 IN. OF LOOSE STRUCTURE BACKFILL (CLASS 1 OR 2). BEDDING IS NOT REQUIRED FOR FLEXIBLE PIPE IN SOIL. BEDDING MATERIAL FOR RIGID OR FLEXIBLE PIPE IN ROCK SHALL BE 12 IN. OF LOOSE STRUCTURE BACKFILL, CLASS 1.

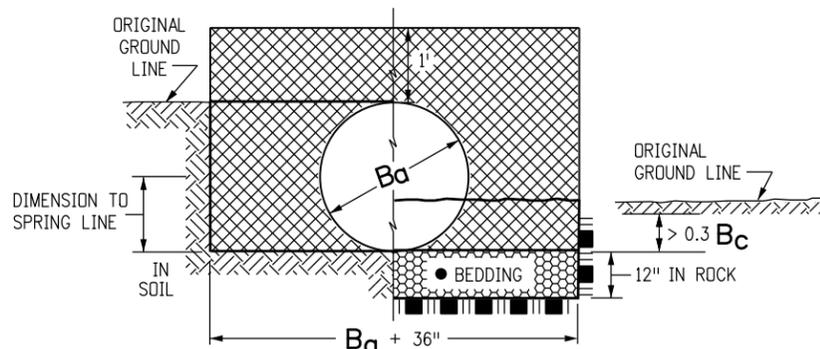


**CIRCULAR PIPE**

(WHERE ORIGINAL GROUND LINE IS BETWEEN 0.3  $B_c$  AND  $B_c + 1$  FT. ABOVE FLOWLINE)


- ▲ WHEN TWO OR MORE CONDUITS ARE LAID SIDE-BY-SIDE, THEY SHALL BE PLACED SO THAT THEY ARE  $\frac{1}{2}$  OUTSIDE DIAMETER, OR  $\frac{1}{2}$  OUTSIDE SPAN, OR 3 FT. APART, WHICHEVER IS LESS. HOWEVER, IF END SECTIONS ARE USED, THE MINIMUM SPACING SHALL BE 1 FT. BETWEEN END SECTIONS.

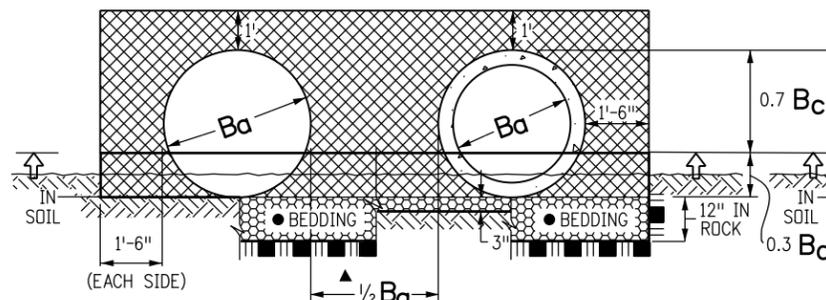

**CIRCULAR PIPE IN FILL**

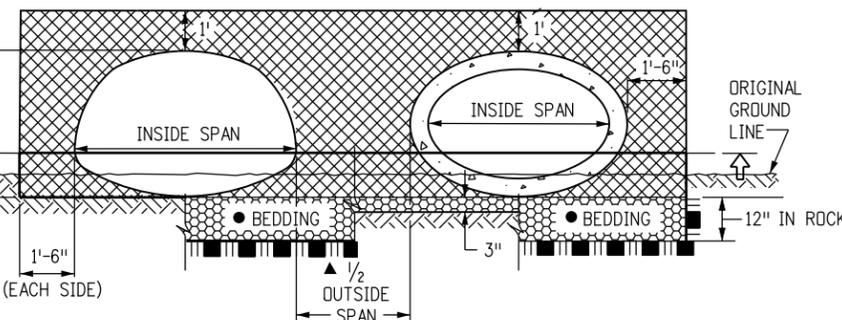


**ARCH OR ELLIPTICAL PIPE IN FILL**

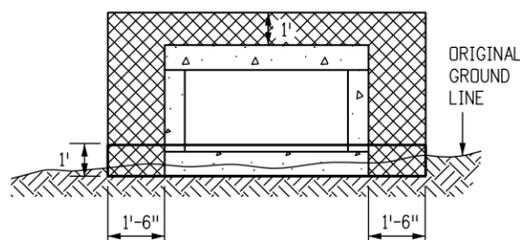

**CASE 1**

APPLIES WHEN THE ORIGINAL GROUND LINE IS LESS THAN 1 FT. ABOVE THE BOTTOM OF THE BOX CULVERT. THE EMBANKMENT SHALL BE BUILT UP TO 1 FT. ABOVE THE BOTTOM OF THE BOX CULVERT AND THEN EXCAVATED TO THE BOTTOM OF THE BOX CULVERT. THIS EMBANKMENT AND EXCAVATION WILL NOT BE MEASURED AND PAID FOR SEPARATELY BUT SHALL BE INCLUDED IN THE COST OF THE WORK.

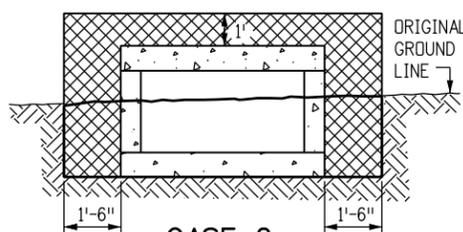


**CASE 2**


APPLIES WHEN THE ORIGINAL GROUND LINE IS MORE THAN 1 FT. ABOVE THE BOTTOM OF THE BOX CULVERT.

**CONCRETE BOX CULVERT**


IN BOTH CASES, THE TRENCH (OUTLINED BY THE THICK SOLID LINE) SHALL THEN BE EXCAVATED TO ACCOMMODATE CONSTRUCTION OF THE BOX CULVERT.

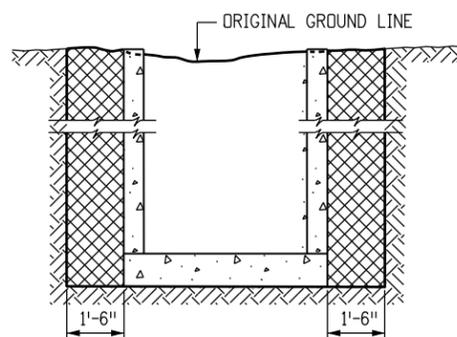

**DROP INLETS AND DIVISION BOXES**

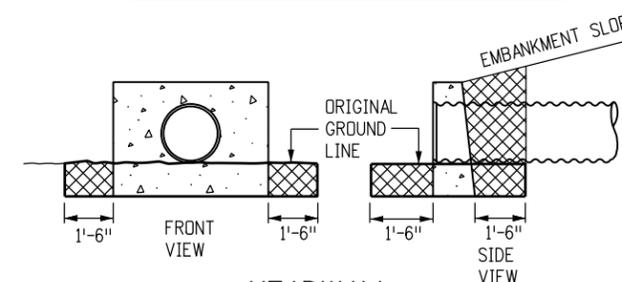

**HEADWALL**

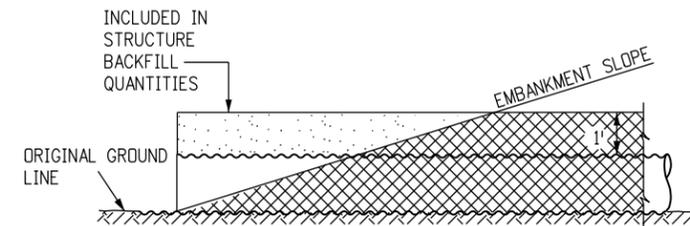

**END OF PIPE**

**GENERAL NOTES**

1. EXCAVATION AND BACKFILL PATTERNS DIFFERENT FROM THOSE INDICATED ON THESE SHEETS WILL BE SHOWN ELSEWHERE ON THE PLANS.
2. EXCAVATION FOR CHANNEL CHANGE OR CHANNEL IMPROVEMENT WILL BE EITHER UNCLASSIFIED EXCAVATION OR MUCK EXCAVATION AND WILL BE NOTED ON THE PLANS. EXCAVATION FROM THE CHANNEL FLOWLINE TO THE DEPTH REQUIRED FOR THE NEW STRUCTURE AND INCIDENTAL CHANNEL EXCAVATION WILL BE PAID FOR AS STRUCTURE EXCAVATION.
3. STRUCTURE FOOTINGS WHICH ARE LOCATED IN ROCK SHALL BE POURED OUT TO UNDISTURBED ROCK WITHOUT FORMING IN CONFORMANCE WITH SUBSECTION 601.09(b).
4. STRUCTURAL PLATE CULVERTS SHALL BE CONSTRUCTED AS SHOWN ON THE PLANS.
5.  $B_o$  EQUALS THE INSIDE DIAMETER OF A PIPE AND  $B_c$  EQUALS THE OUTSIDE DIAMETER OF A PIPE. FOR THIN WALLED PIPES, IT IS ASSUMED THAT  $B_o = B_c$ .
6. APPROXIMATE STRUCTURE EXCAVATION AND BACKFILL QUANTITIES, UP TO 1 FT. OVER THE PIPE WILL BE SHOWN ON THE PLANS, FOR INFORMATION ONLY.

**LEGEND**

- STRUCTURE EXCAVATION LIMITS
- STRUCTURE BACKFILL, CLASS 1 OR 2, AS SHOWN ON PLANS
- STRUCTURE BACKFILL, CLASS 1
- EMBANKMENT MATERIAL
- EARTH
- ROCK
- BEDDING
- CONCRETE
- WHEN FLOW LINE OF CULVERT IS LESS THAN 0.3  $B_c$  BELOW THE ORIGINAL GROUND LINE, EMBANKMENT SHALL BE BUILT UP TO 0.3  $B_c$  ABOVE THE FLOW LINE AND TRENCH EXCAVATED TO THE BOTTOM OF PIPE OR AS SHOWN.

**CONDUIT WITH END SECTIONS**

**Computer File Information**

Creation Date: 07/04/12	Initials: DD
Last Modification Date: 07/04/12	Initials: LTA
Full Path: www.coloradodot.info/business/designsupport	
Drawing File Name: 206010102.dgn	
CAD Ver.: MicroStation V8 Scale: Not to Scale Units: English	

**Sheet Revisions**

Date:	Comments:
(R-X)	
(R-X)	
(R-X)	
(R-X)	

**Colorado Department of Transportation**

4201 East Arkansas Avenue  
Denver, Colorado 80222  
Phone: (303) 757-9083  
Fax: (303) 757-9820

Project Development Branch DD/LTA


**EXCAVATION AND BACKFILL FOR STRUCTURES**

Issued By: Project Development Branch July 4, 2012


**STANDARD PLAN NO.**

M-206-1


Sheet No. 1 of 2

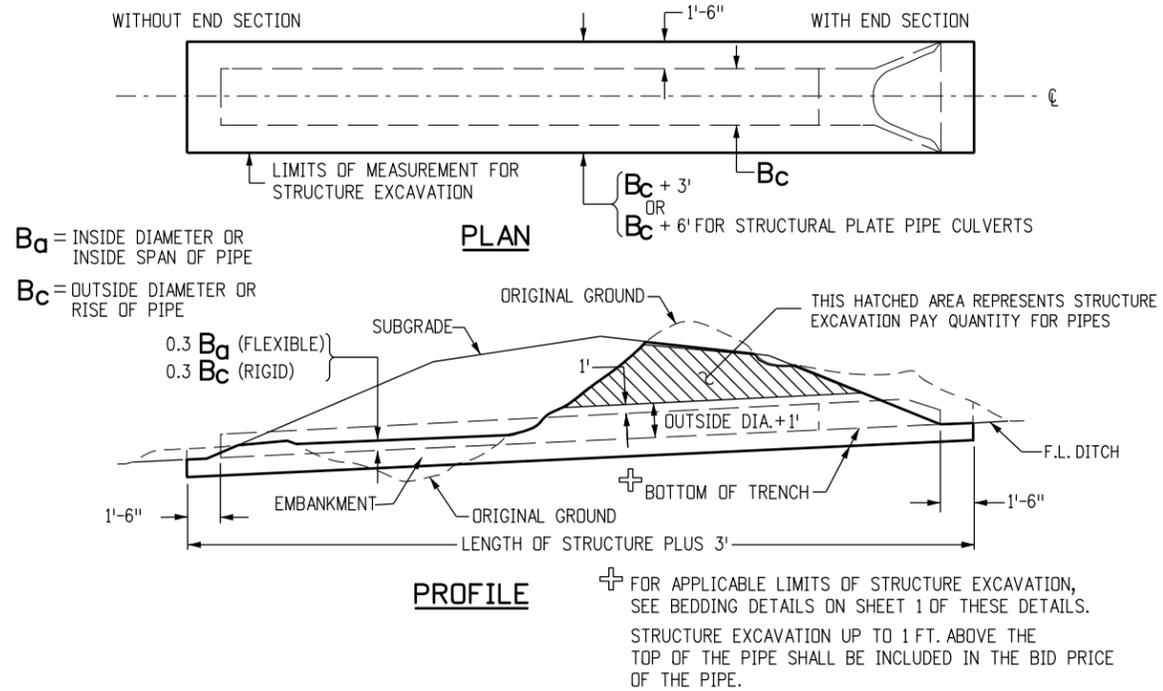


**STRUCTURE EXCAVATION MEASUREMENT FOR PIPE CULVERTS**

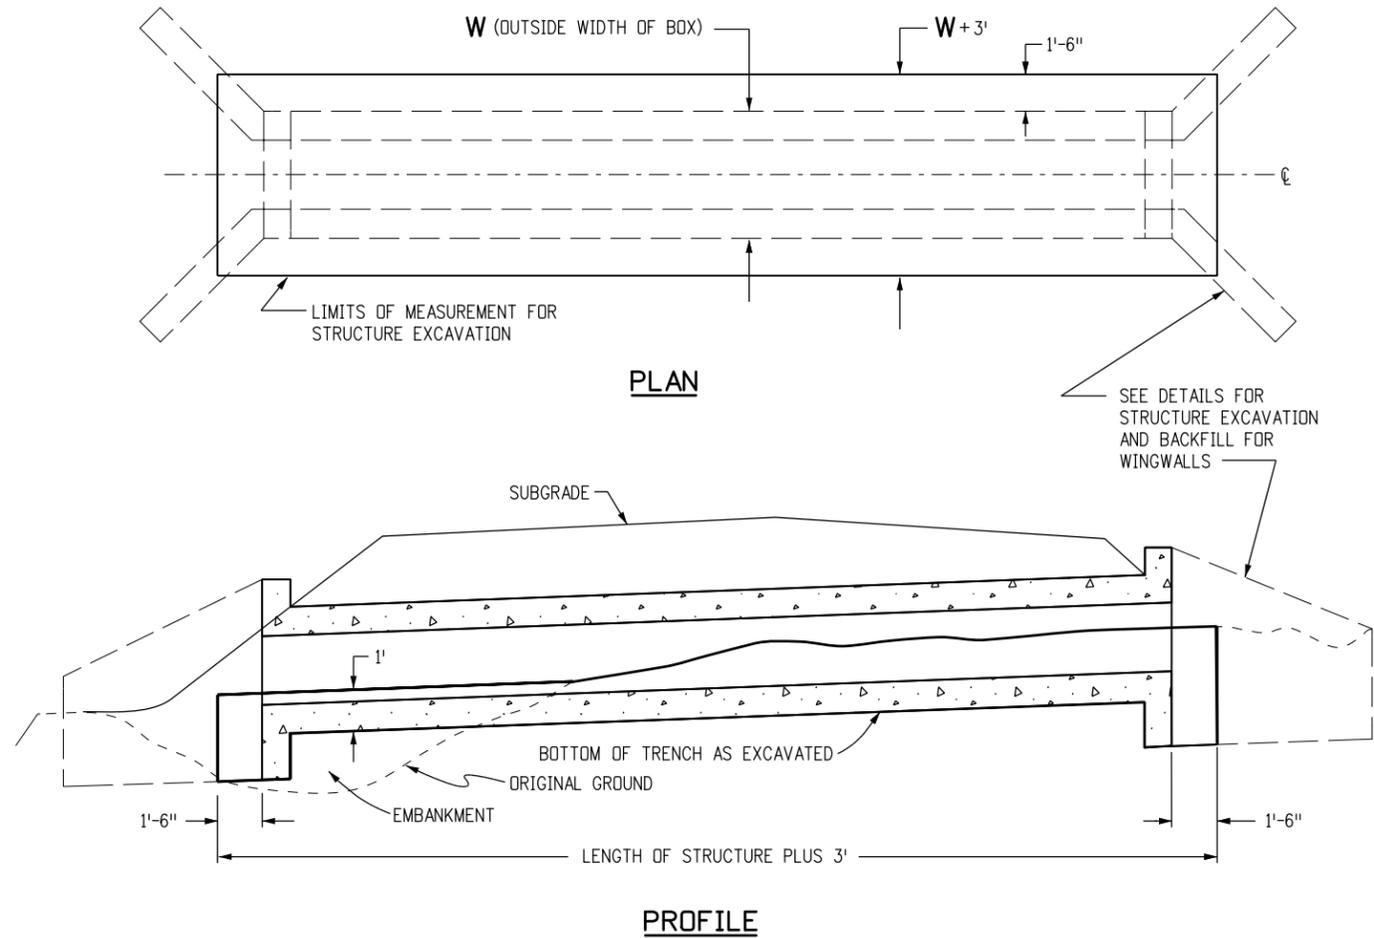

**STRUCTURE EXCAVATION MEASUREMENT FOR CONCRETE BOX CULVERTS**

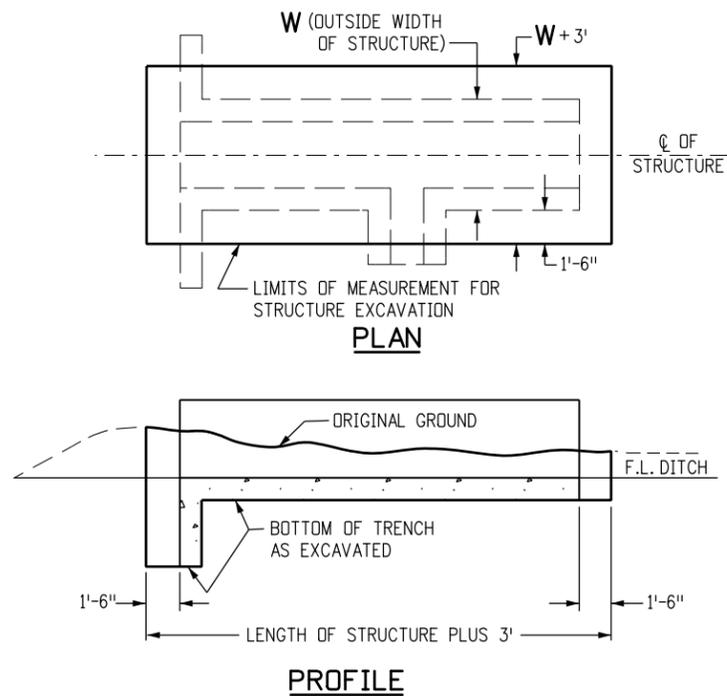

**STRUCTURE EXCAVATION MEASUREMENT FOR DIVISION BOXES**

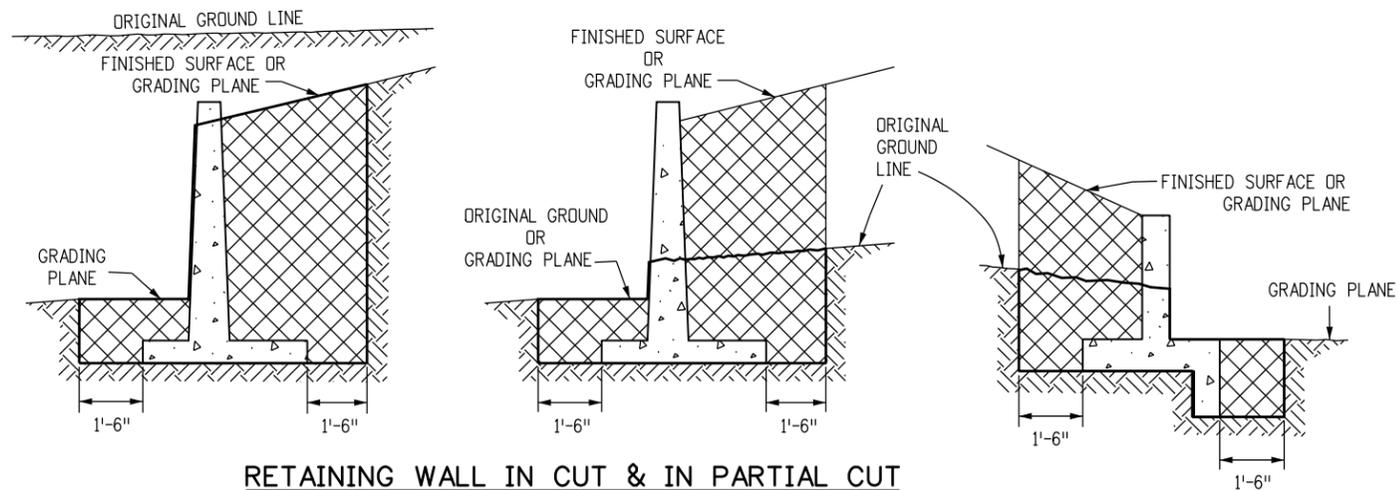

**WINGWALL**

**LEGEND**

- STRUCTURE EXCAVATION LIMITS
- STRUCTURE BACKFILL, CLASS 1 OR 2, AS SHOWN ON PLANS
- CONCRETE

Computer File Information	
Creation Date: 07/04/12	Initials: DD
Last Modification Date: 07/04/12	Initials: LTA
Full Path: www.coloradodot.info/business/designsupport	
Drawing File Name: 206010202.dgn	
CAD Ver.: MicroStation V8 Scale: Not to Scale Units: English	

Sheet Revisions	
Date:	Comments
(R-X)	
(R-X)	
(R-X)	
(R-X)	

**Colorado Department of Transportation**

4201 East Arkansas Avenue  
 Denver, Colorado 80222  
 Phone: (303) 757-9083  
 Fax: (303) 757-9820

**Project Development Branch DD/LTA**

**EXCAVATION AND BACKFILL FOR STRUCTURES**

Issued By: Project Development Branch July 4, 2012

**STANDARD PLAN NO.**

M-206-1

Sheet No. 2 of 2

**GENERAL NOTES**

**REINFORCED CONCRETE PIPE**

1. ADEQUATE COVER SHALL BE PROVIDED DURING CONSTRUCTION TO PROTECT THE PIPE FROM DAMAGE. THE MINIMUM COVER SHALL BE AS SHOWN ON THESE TABLES OR CONFORM TO AASHTO REQUIREMENTS, WHICHEVER IS GREATER. THE MINIMUM COVER FOR REINFORCED CONCRETE PIPE IS MEASURED FROM THE TOP OF THE PIPE TO THE BOTTOM OF THE PAVEMENT: HMA OR PCCP.
2. FILL HEIGHTS GREATER THAN MAXIMUM ALLOWED IN THE HEIGHTS OF FILL TABLE ON THIS SHEET REQUIRE SPECIAL DESIGN OF STRUCTURE.
3. PIPE DESIGN IS BASED ON SAFETY FACTOR OF 1.33 ON ULTIMATE STRENGTH.
4. THE HEIGHTS OF FILL OVER TOP OF PIPE ARE BASED ON UNIT WEIGHT OF SOIL AT 135 LBS. PER CUBIC FT.
5. PIPE CLASS IS DETERMINED FROM 0.01 IN. CRACK D-LOAD.
6. BEDDING IS CLASS B (MODIFIED) (FROM CONCRETE PIPE DESIGN MANUAL-AMERICAN CONCRETE PIPE ASSOCIATION) WITH SETTLEMENT RATIO  $R = 0.0 s_d$  (YIELDING BED). BEDDING MATERIAL FOR RIGID PIPE IN SOIL SHALL BE 3 IN. LOOSE THICKNESS STRUCTURE BACKFILL CLASS 2. BEDDING MATERIAL FOR RIGID PIPE IN ROCK SHALL BE 12 IN. LOOSE THICKNESS STRUCTURE BACKFILL CLASS 1.
7. CHANGES IN DESIGN FACTORS REQUIRE COMPENSATING CHANGES IN PIPE DESIGN.
8. MINIMUM WALL THICKNESS DIMENSIONS ARE BASED ON AASHTO M 170 (WALL B) FOR CIRCULAR PIPE, AND AASHTO M 207 FOR ELLIPTICAL PIPE.
9. SPACING FOR MULTIPLE PIPE INSTALLATIONS SHALL CONFORM TO THE DETAILS SHOWN ON STANDARD PLAN M-206-1.
10. WHEN A PIPE IS TO BE EXTENDED, THE SAME PIPE MATERIAL AND SIZE AS IN THE ORIGINAL PIPE INSTALLATION SHALL BE USED.

**NONREINFORCED CONCRETE PIPE**


1. AT THE OPTION OF THE CONTRACTOR, NONREINFORCED CONCRETE PIPE CONFORMING TO AASHTO M 86 MAY BE USED IN LIEU OF REINFORCED CONCRETE PIPE FOR ALL SIZES 36 INCHES IN DIAMETER AND SMALLER. THE NONREINFORCED CONCRETE PIPE SHALL MEET THE SAME D-LOAD TO PRODUCE THE ULTIMATE LOAD UNDER THE THREE-EDGE BEARING METHOD AS SPECIFIED FOR REINFORCED CONCRETE PIPE IN CONFORMANCE WITH AASHTO M 170. THE CONTRACTOR SHALL PROVIDE WRITTEN CERTIFICATION OF CONFORMANCE. THE WALL THICKNESS OF THE NONREINFORCED PIPE MAY BE INCREASED AS REQUIRED TO MEET D-LOAD REQUIREMENT.
2. ALL REQUIREMENTS FOR REINFORCED CONCRETE PIPE, EXCEPT THOSE REFERRING TO REINFORCEMENT, SHALL APPLY TO NONREINFORCED CONCRETE PIPE.

CIRCULAR (CIR)			VERTICAL ELLIPTICAL (VE)				HORIZONTAL ELLIPTICAL (HE)			
PIPE SIZE = $B_a$ (INSIDE DIA)	WALL THICKNESS	0.3 $B_c$ (OUTSIDE DIA)	SPAN	RISE	WALL THICKNESS	0.3 OUTSIDE RISE	SPAN	RISE	WALL THICKNESS	0.3 OUTSIDE RISE
IN.		FT.	IN.				IN.			
			FT.				FT.			
12	2	0.40					23	14	2-3/4	0.49
15	2-1/4	0.49								
18	2-1/2	0.58								
21	2-3/4	0.66					30	19	3-1/4	0.66
24	3	0.75					34	22	3-1/2	0.73
27	3-1/4	0.84								
30	3-1/2	0.92					38	24	3-3/4	0.79
33	3-3/4	1.01								
36	4	1.10	29	45	4-1/2	1.35	45	29	4-1/2	0.95
42	4-1/2	1.28	34	53	5	1.58	53	34	5	1.10
48	5	1.45	38	60	5-1/2	1.78	60	38	5-1/2	1.23
54	5-1/2	1.62	43	68	6	2.00	68	43	6	1.38
60	6	1.80	48	76	6-1/2	2.23	76	48	6-1/2	1.53
66	6-1/2	1.97	53	83	7	2.43	83	53	7	1.68
72	7	2.15	58	91	7-1/2	2.65	91	58	7-1/2	1.83
78	7-1/2	2.32	63	98	8	2.85	98	63	8	1.98
84	8	2.50	68	106	8-1/2	3.08	106	68	8-1/2	2.13
90	8-1/2	2.68	72	113	9	3.28	113	72	9	2.25
96	9	2.85	77	121	9-1/2	3.50	121	77	9-1/2	2.40
102	9-1/2	3.02	82	128	9-3/4	3.69	128	82	9-3/4	2.54
108	10	3.20	87	136	10	3.90	136	87	10	2.68

△ ALSO EQUIVALENT ROUND DIMENSION FOR ELLIPTICAL PIPE.

**DIMENSIONS FOR REINFORCED CONCRETE PIPE**


(FOR INFORMATION ONLY)

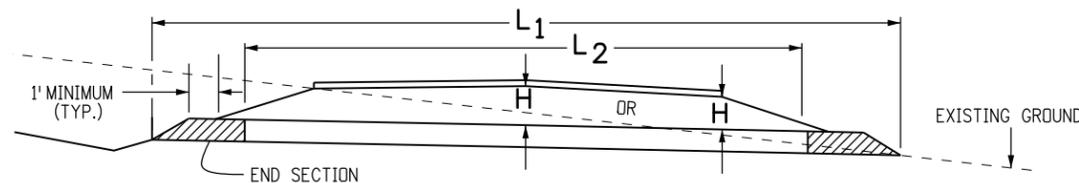


**CONCRETE PIPE WITH END SECTIONS**

NOTE: USE THE  $H$  THAT IS GREATER FOR MAXIMUM ALLOWABLE FILL HEIGHT.

- $H$  = MAXIMUM HEIGHT OF FILL OVER TOP OF PIPE, EXCLUDING PAVEMENT THICKNESS.
- $L_1$  = LENGTH OF PIPE TO BE MEASURED WHEN PLACED IN ACCORDANCE WITH SECTION 617 OR 624.
- $L_2$  = LENGTH OF PIPE TO BE MEASURED WHEN PLACED IN ACCORDANCE WITH SECTION 603.

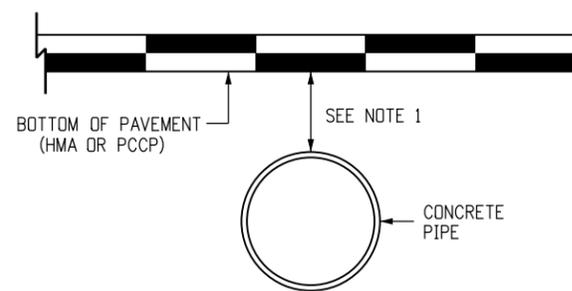

**MINIMUM COVER FOR RIGID PIPE**

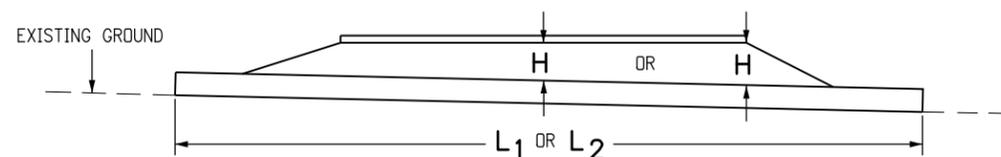

**CONCRETE PIPE WITHOUT END SECTIONS**

NOTE: USE THE  $H$  THAT IS GREATER FOR MAXIMUM ALLOWABLE FILL HEIGHT.

TYPE OF PIPE	HEIGHT OF FILL OVER TOP OF PIPE, $H$ (FEET)				
	CLASS OF PIPE (0.01 IN. CRACK D-LOAD)				
	CLASS CIR II CLASS VE II CLASS HE II 1000 D	CLASS CIR III CLASS VE III CLASS HE III 1350 D	CLASS CIR IV CLASS VE IV CLASS HE IV 2000 D	CLASS CIR V CLASS VE V 3000 D	CLASS VE VI 4000 D
CIRCULAR (CIR)	MIN. TO 18	MIN. TO 25	± 25 TO 37	± 37 TO 45	
VERTICAL ELLIPTICAL (VE)	MIN. TO 18	MIN. TO 25	± 25 TO 37	± 37 TO 45	± 45 TO 62
HORIZONTAL ELLIPTICAL (HE)	MIN. TO 18	MIN. TO 25	± 25 TO 37		

**ALLOWABLE RANGE OF HEIGHTS FOR FILL OVER REINFORCED CONCRETE PIPE**

(ALL SIZES)

Computer File Information	
Creation Date: 07/04/12	Initials: DD
Last Modification Date: 07/04/12	Initials: LTA
Full Path: www.coloradodot.info/business/designsupport	
Drawing File Name: 603020101.dgn	
CAD Ver.: MicroStation V8 Scale: Not to Scale Units: English	

Sheet Revisions	
Date:	Comments
(R-X)	
(R-X)	
(R-X)	
(R-X)	

Colorado Department of Transportation  
 4201 East Arkansas Avenue  
 Denver, Colorado 80222  
 Phone: (303) 757-9083  
 Fax: (303) 757-9820

**Project Development Branch DD/LTA**




**REINFORCED CONCRETE PIPE**

Issued By: Project Development Branch on July 4, 2012

**STANDARD PLAN NO.**

**M-603-2**

**Sheet No. 1 of 1**

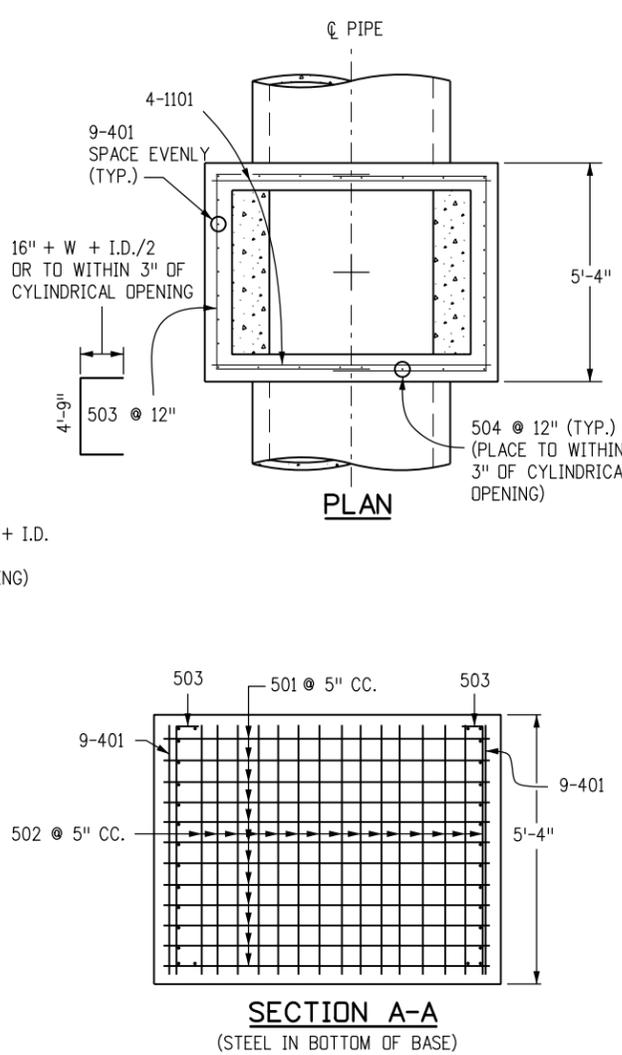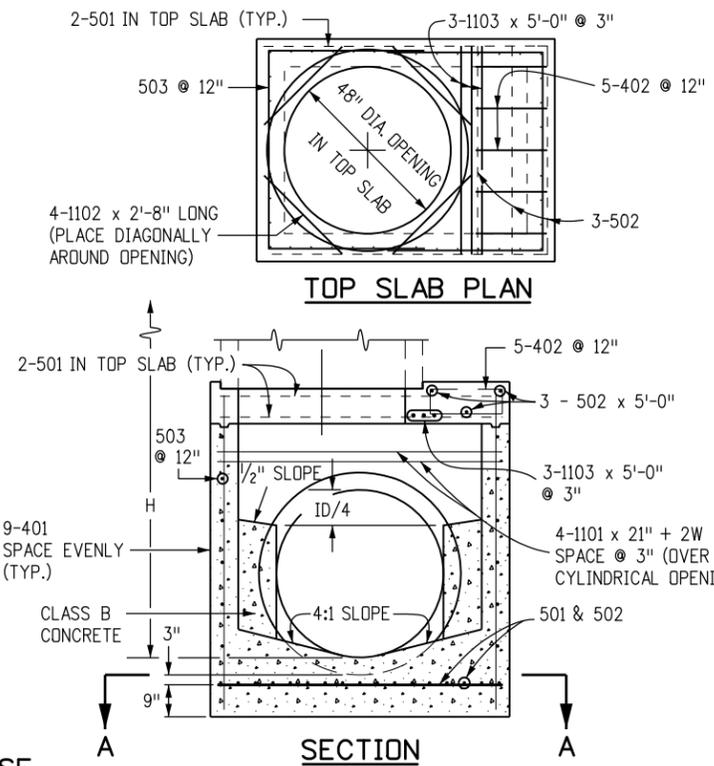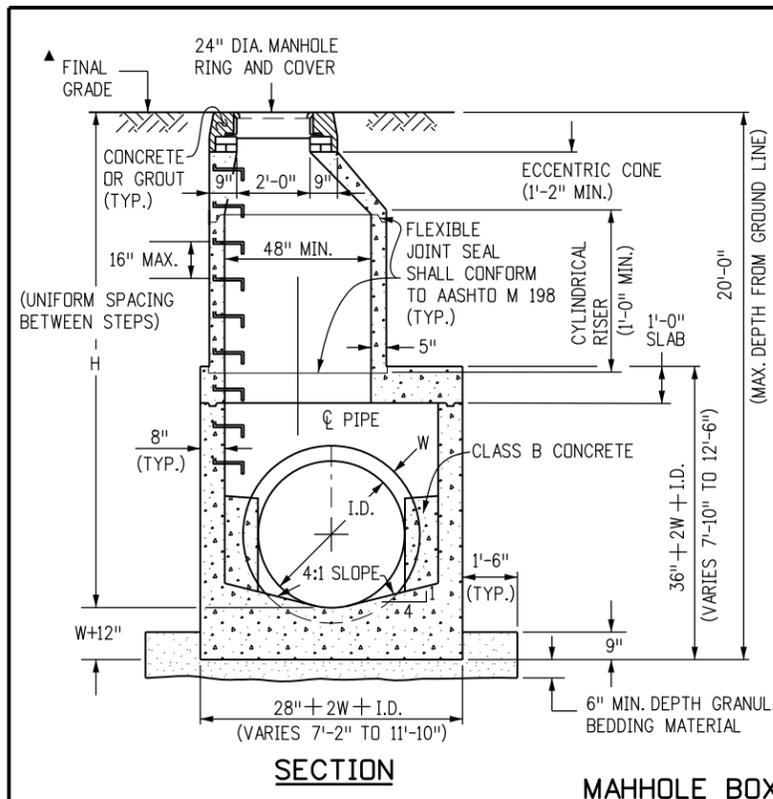


- ### GENERAL NOTES
1. SINCE ALL PIPE ENTRIES INTO THE BASE ARE VARIABLE, THE DIMENSIONS SHOWN ARE TYPICAL. ACTUAL DIMENSIONS AND QUANTITIES FOR CONCRETE AND REINFORCEMENT SHALL BE AS REQUIRED IN THE WORK.
  2. THE PRECAST FLAT TOP MAY BE USED ON ANY MANHOLE. THE ECCENTRIC CONE MAY BE USED WHEN THE MANHOLE "H" HEIGHT IS AT LEAST 8 FT.
  3. THE MANHOLE RING FRAME SHALL BE SET IN A BED OF GROUT. THE FRAME SHALL BE SURROUNDED WITH A CEMENT GROUT IN UNPAVED AREA, OR A CONCRETE COLLAR IN PAVED AREA. SEE DETAILS ON SHEETS 2 AND 3.
  4. DESIGN OF BOX BASE IS BASED ON STRAIGHT RUNS OF PIPE OR CHANGE IN DIRECTION OF LESS THAN 45°. SPECIAL DESIGN IS REQUIRED FOR 45° OR GREATER.
  5. PRECAST MANHOLES AND REINFORCEMENT SHALL CONFORM TO AASHTO M 199 (ASTM C 478).
  6. CAST-IN-PLACE MANHOLES SHALL BE CLASS B CONCRETE.
  7. STEPS SHALL BE REQUIRED WHEN THE MANHOLE DEPTH EXCEEDS 3 FT.-6 IN. AND SHALL CONFORM TO AASHTO M 199.
  8. ALL REINFORCING STEEL SHALL BE GRADE 60 AND EPOXY COATED. VERTICAL STEEL SHALL BE PLACED AT CENTERLINE OF WALL. ALL BARS SHALL HAVE A 2 IN. MINIMUM CLEARANCE.
  9. ALL PIPE ENTRIES INTO THE BASE OF MANHOLE SHALL BE CONNECTED BY OPEN CHANNELIZATION ADJUSTED FOR PIPE SIZE, SHAPE, SLOPE, AND DIRECTION OF FLOW. DETAILS SHOWN ARE TYPICAL FOR INSTALLATIONS WITH ALL INVERTS OF SAME RELATIVE ELEVATION. FOR EXCESSIVE ELEVATION DIFFERENCE BETWEEN INVERTS, SPECIAL BASE/CHANNEL DETAILS WILL BE SHOWN ON THE PLANS.
  10. FLOW CHANNELS AND INVERTS SHALL BE FORMED BY SHAPING WITH CLASS B CONCRETE OR APPROVED GROUT.
  11. STUB-OUTS SHALL EXTEND 2 FT. MINIMUM BEYOND OUTSIDE WALL SURFACE OF MANHOLE AND BE SATISFACTORILY PLUGGED.
  12. THE SLOPE OF THE MANHOLE COVER SHALL MATCH THE ROADWAY PROFILE AND CROSS SLOPE.
- ▲ WHEN FINAL GRADE IS PAVEMENT SURFACE, RECESS MANHOLE RING AND COVER 1/4" MIN. TO 1/2" MAX.

MARK	SIZE	TYPE	WT. #/FT.	BARS	I.D.						FORMULAS
					54"	60"	66"	72"	84"	96"	
401	4	I	0.668	{ NO. REQ'D. LENGTH WEIGHT * 18 8'-1" 97.2 18 8'-8" 104.2 18 9'-3" 111.2 18 9'-10" 118.2 18 11'-0" 132.3 18 12'-2" 146.3	401 BAR LENGTH = 32" + 2W + I.D.						
402	4	III	0.668	{ NO. REQ'D. LENGTH WEIGHT * 5 5'-5" 18.1 5 6'-0" 20.0 5 6'-7" 22.0 5 7'-2" 23.9 5 8'-4" 27.8 5 9'-6" 31.7	402 BAR LENGTH = I.D. + 2W						
501	5	I	1.043	{ NO. REQ'D. LENGTH WEIGHT * 17 7'-5" 131.5 17 8'-0" 141.8 17 8'-7" 152.2 17 9'-2" 162.5 17 10'-4" 183.2 17 11'-6" 203.9	501 BAR LENGTH = 24" + I.D. + 2W						
502	5	I	1.043	{ NO. REQ'D. LENGTH WEIGHT * 22 5'-0" 114.7 23 5'-0" 119.9 25 5'-0" 130.4 26 5'-0" 135.6 29 5'-0" 151.2 32 5'-0" 166.9	502 NUMBER BARS REQ'D. = $3 + \frac{(24+I.D.+2W)}{5} + 1$						
503	5	II	1.043	{ NO. REQ'D. LENGTH WEIGHT * 16 12'-10" 214.2 16 13'-5" 223.9 18 14'-0" 262.8 18 14'-7" 273.8 20 15'-9" 328.5 24 16'-11" 423.5	503 NUMBER BARS REQ'D. = $2 \left( \frac{13+I.D.+2W}{12} + 1 \right)$ BAR LENGTH = $4'-9" + 2(16+W+I.D./2)$						
504	5	I	1.043	{ NO. REQ'D. LENGTH WEIGHT * 12 8'-1" 101.2 14 8'-8" 126.6 14 9'-3" 135.1 16 9'-10" 164.1 18 11'-0" 206.5 20 12'-2" 253.8	504 NUMBER BARS REQ'D. = $2 \left( \frac{2W+I.D.-4}{12} + 1 \right)$ BAR LENGTH = $32" + 2W + I.D.$						
1101	11	I	5.313	{ NO. REQ'D. LENGTH WEIGHT * 4 7'-2" 152.3 4 7'-9" 164.7 4 8'-4" 177.1 4 8'-11" 189.5 4 10'-1" 214.3 4 11'-3" 239.1	1101 BAR LENGTH = 21" + I.D. + 2W						
1102	11	I	5.313	{ NO. REQ'D. LENGTH WEIGHT * 4 2'-8" 56.7 4 2'-8" 56.7 4 2'-8" 56.7 4 2'-8" 56.7 4 2'-8" 56.7 4 2'-8" 56.7	BENDING TYPE I STRAIGHT						
1103	11	I	5.313	{ NO. REQ'D. LENGTH WEIGHT * 3 5'-0" 79.7 3 5'-0" 79.7 3 5'-0" 79.7 3 5'-0" 79.7 3 5'-0" 79.7 3 5'-0" 79.7	TYPE II 16" + W + I.D./2						
* REINFORCING STEEL TOTAL					965.6	1,037.5	1,127.2	1,204.0	1,380.2	1,601.6	
CONCRETE - CUBIC YARDS - TOTAL					6.0	6.6	7.3	8.0	9.5	11.1	

NOTE: QUANTITIES ARE BASED ON SAME SIZE PIPE ENTRANCE TO AND EXIT FROM, BASE AND A 4 FT. MANHOLE ENTRANCE INTO TOP SLAB OF BASE.

### QUANTITIES FOR CONCRETE MANHOLE BOX BASE

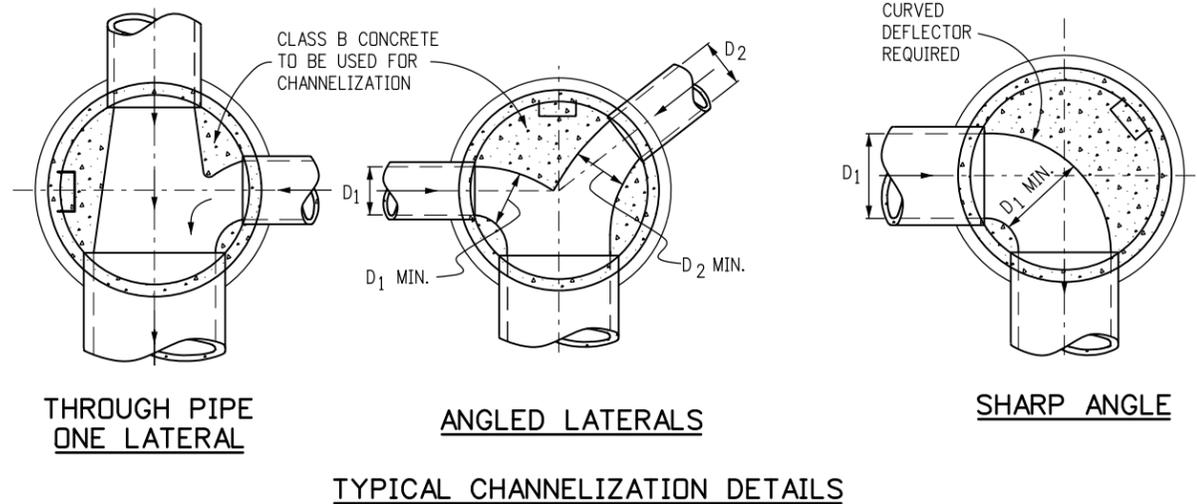

#### Computer File Information

Creation Date: 07/04/12	Initials: DD
Last Modification Date: 07/04/12	Initials: LTA
Full Path: www.coloradodot.info/business/designsupport	
Drawing File Name: M06040200103.dgn	
CAD Ver.: MicroStation V8	Scale: Not to Scale Units: English

#### Sheet Revisions

Date:	Comments:
(R-X)	
(R-X)	
(R-X)	
(R-X)	

Colorado Department of Transportation  
 4201 East Arkansas Avenue  
 Denver, Colorado 80222  
 Phone: (303) 757-9083  
 Fax: (303) 757-9820

Project Development Branch DD/LTA


# MANHOLES

Issued By: Project Development Branch July 4, 2012


## STANDARD PLAN NO.

M-604-20



Sheet No. 1 of 3

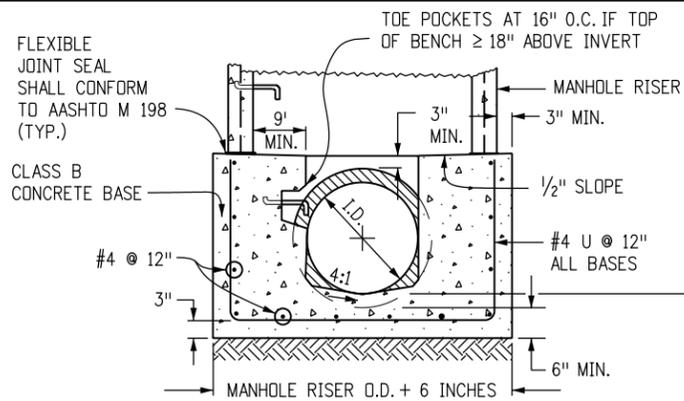


**SECTION B-B**

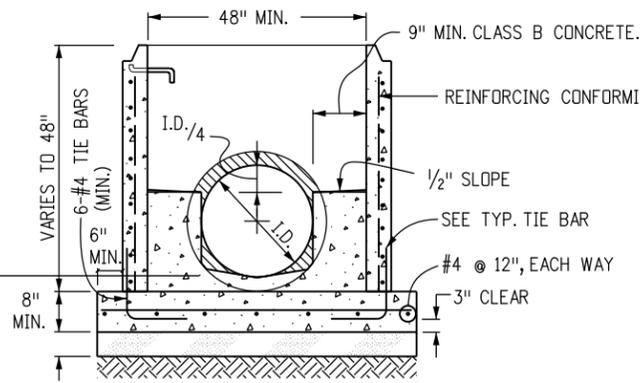

**SECTION D-D**

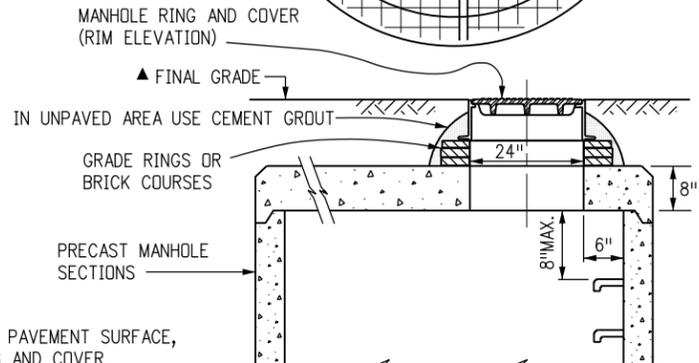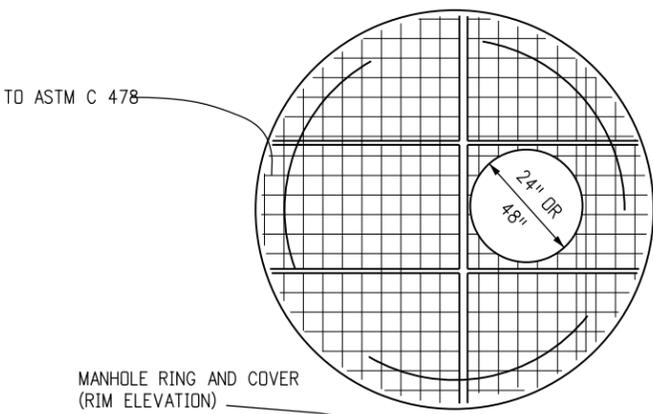


**FLAT TOP SECTION DETAIL**

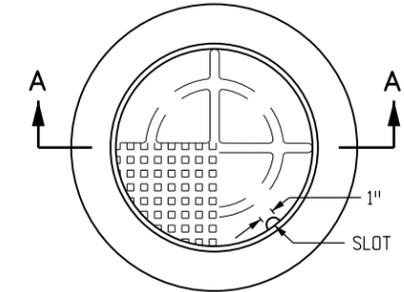


TOTAL WEIGHT: APPROXIMATELY 400 LBS. SHALL BE GRAY OR DUCTILE CAST IRON IN ACCORDANCE WITH SUBSECTION 712.06.

**SECTION A-A  
MANHOLE RING AND COVER**

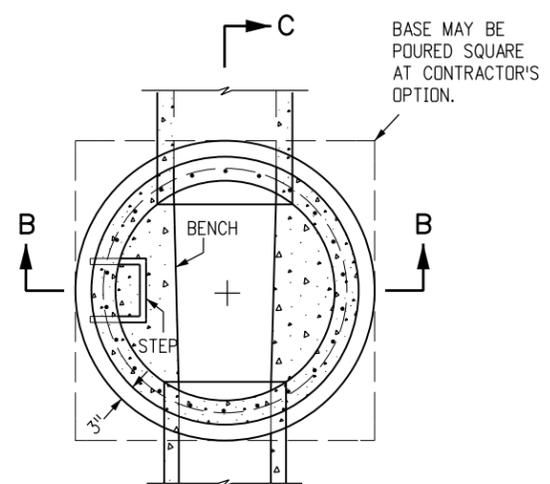


**PLAN**

**TYPICAL TIE BAR**

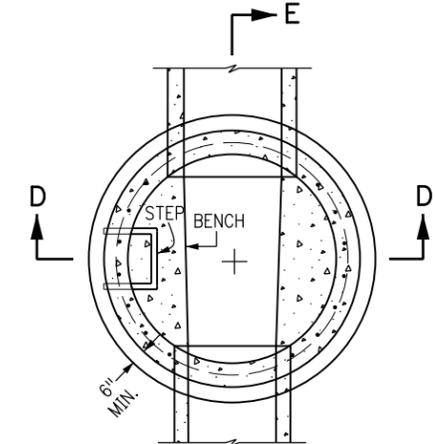


**PLAN**

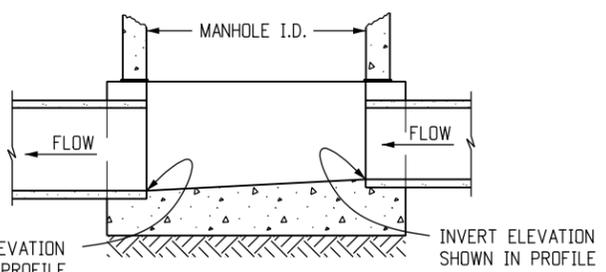


**SECTION C-C**

**CAST-IN-PLACE SLAB BASE**

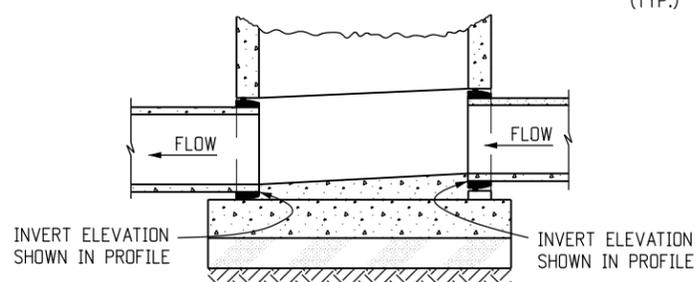

**SECTION E-E**

**PRECAST SLAB BASE**

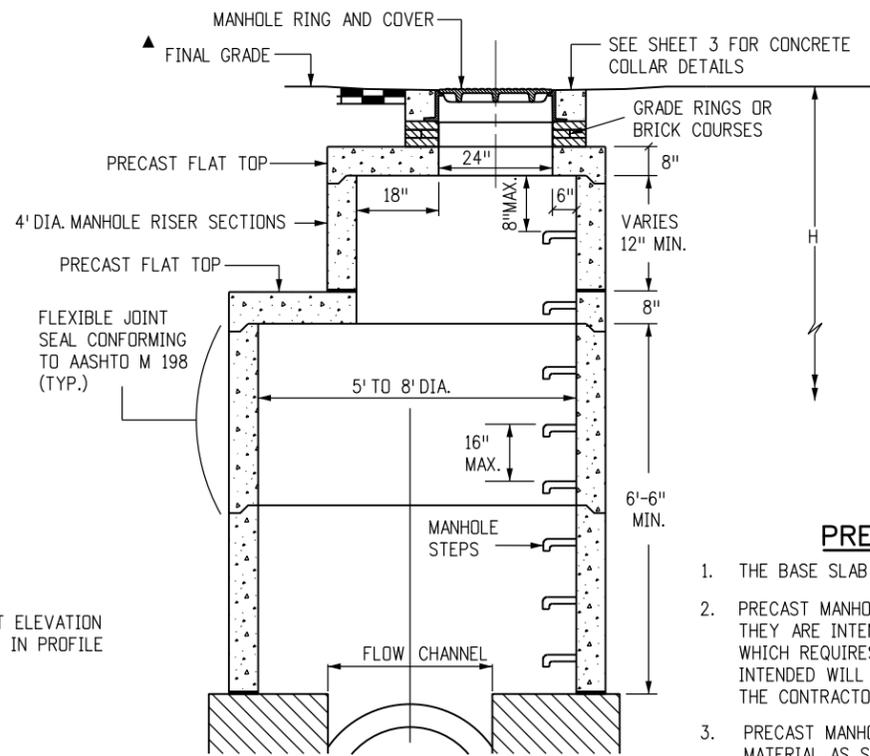

**MANHOLE RISER DETAIL**

**LEGEND**

	SUITABLE SUBGRADE
	GRANULAR BEDDING MATERIAL
	CONCRETE

**PRECAST MANHOLE BASES NOTES:**

1. THE BASE SLAB SHALL BE POURED MONOLITHICALLY WITH BOTTOM RISER SECTION.
2. PRECAST MANHOLE BASES SHALL FIT THE CONDITIONS AND LOCATIONS FOR WHICH THEY ARE INTENDED WITHOUT ANY FIELD MODIFICATIONS. ANY MANHOLE BASE WHICH REQUIRES FIELD CUTTING OR MODIFICATION IN ORDER TO FIT THE LOCATIONS INTENDED WILL BE REJECTED BY THE ENGINEER AND REMOVED AND REPLACED BY THE CONTRACTOR AT NO COST TO THE DEPARTMENT.
3. PRECAST MANHOLE BASES SHALL BE BEDDED ON AN APPROVED GRANULAR BEDDING MATERIAL AS SHOWN ABOVE.

**Computer File Information**

Creation Date: 07/04/12	Initials: DD
Last Modification Date: 07/04/12	Initials: LTA
Full Path: www.coloradodot.info/business/designsupport	(R-X)
Drawing File Name: M06040200203.dgn	(R-X)
CAD Ver.: MicroStation V8	Scale: Not to Scale
Units: English	(R-X)

**Sheet Revisions**

Date:	Comments

Colorado Department of Transportation  
 4201 East Arkansas Avenue  
 Denver, Colorado 80222  
 Phone: (303) 757-9083  
 Fax: (303) 757-9820

Project Development Branch DD/LTA

**MANHOLES**

Issued By: Project Development Branch July 4, 2012

**STANDARD PLAN NO.**


M-604-20

Sheet No. 2 of 3


**T-BASE MANHOLES NOTES**

1. THE T-BASE SECTION SHALL BE SHOP-FABRICATED FOR DELIVERY TO THE CONSTRUCTION SITE AS A COMPLETE UNIT.
2. THESE DETAILS SHOW ONLY THE CONCEPTUAL AND STANDARD DIMENSIONAL REQUIREMENTS FOR TYPE T-BASE MANHOLES. THE CONTRACTOR SHALL FURNISH DETAILED SHOP DRAWINGS FOR APPROVAL PRIOR TO FABRICATION. THE DETAILS SHOWN HEREIN APPLY ONLY TO 48 IN. AND GREATER DIAMETER PIPES.
3. EXCEPT FOR CLASS OF PIPE, SPECIFICATIONS FOR THE MANHOLE SHALL BE THE SAME AS THOSE REQUIRED FOR THE ADJOINING PIPE.
4. THE T-BASE SECTION SHALL MAINTAIN ITS INTERNAL SHAPE AND FLOW AREA. GROUTING OR FILLING SHALL BE APPLIED SO AS TO NOT DISTURB THE NORMAL FLOW OR REDUCE THE AREA.

WHEN ADJUSTMENT HEIGHT IS 3 IN. OR LESS, METAL ADJUSTMENT RINGS COMPATIBLE WITH THE EXISTING MANHOLE RING AND COVER MAY BE USED IF APPROVED BY THE ENGINEER.

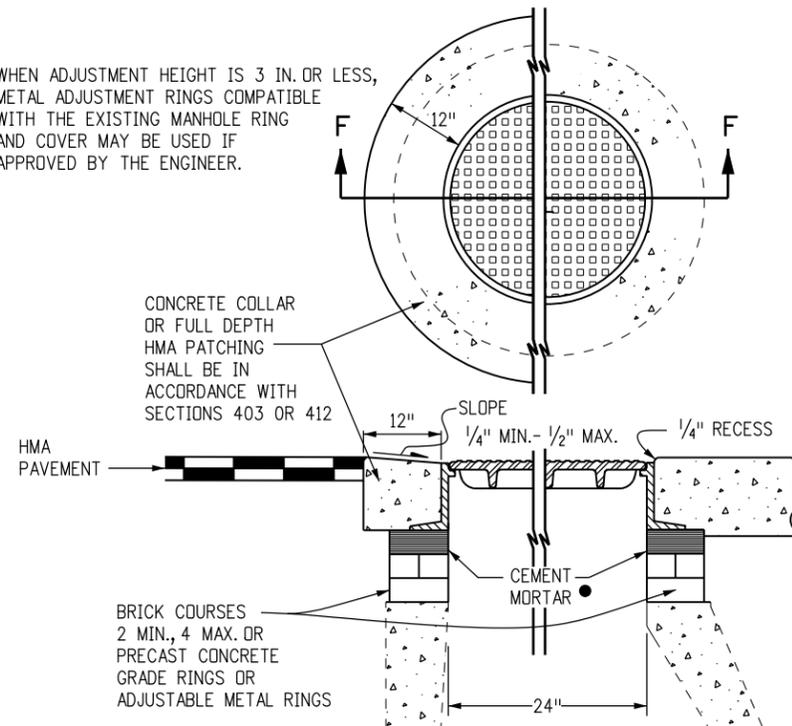


**SECTION F-F  
ADJUST MANHOLE 20 IN. OR LESS**

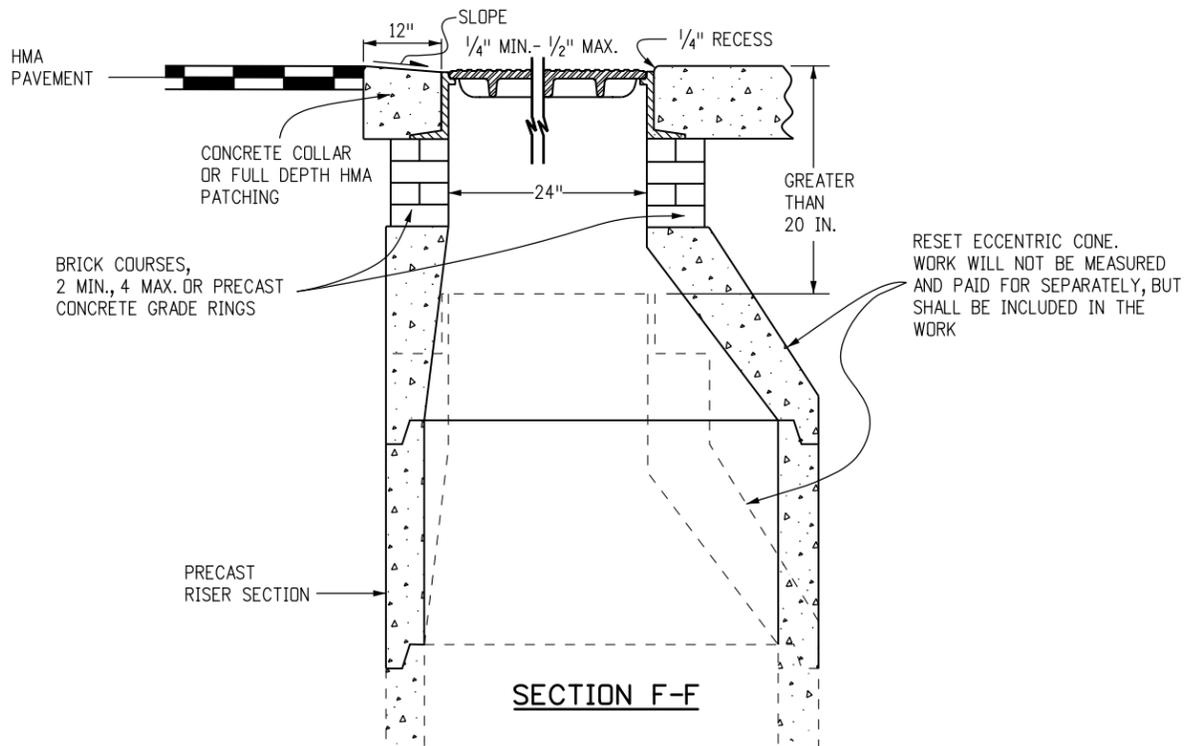

**SECTION F-F  
MODIFY MANHOLE GREATER THAN 20 IN.**

▲ WHEN FINAL GRADE IS PAVEMENT SURFACE, RECESS MANHOLE RING AND COVER 1/4" MIN. TO 1/2" MAX.

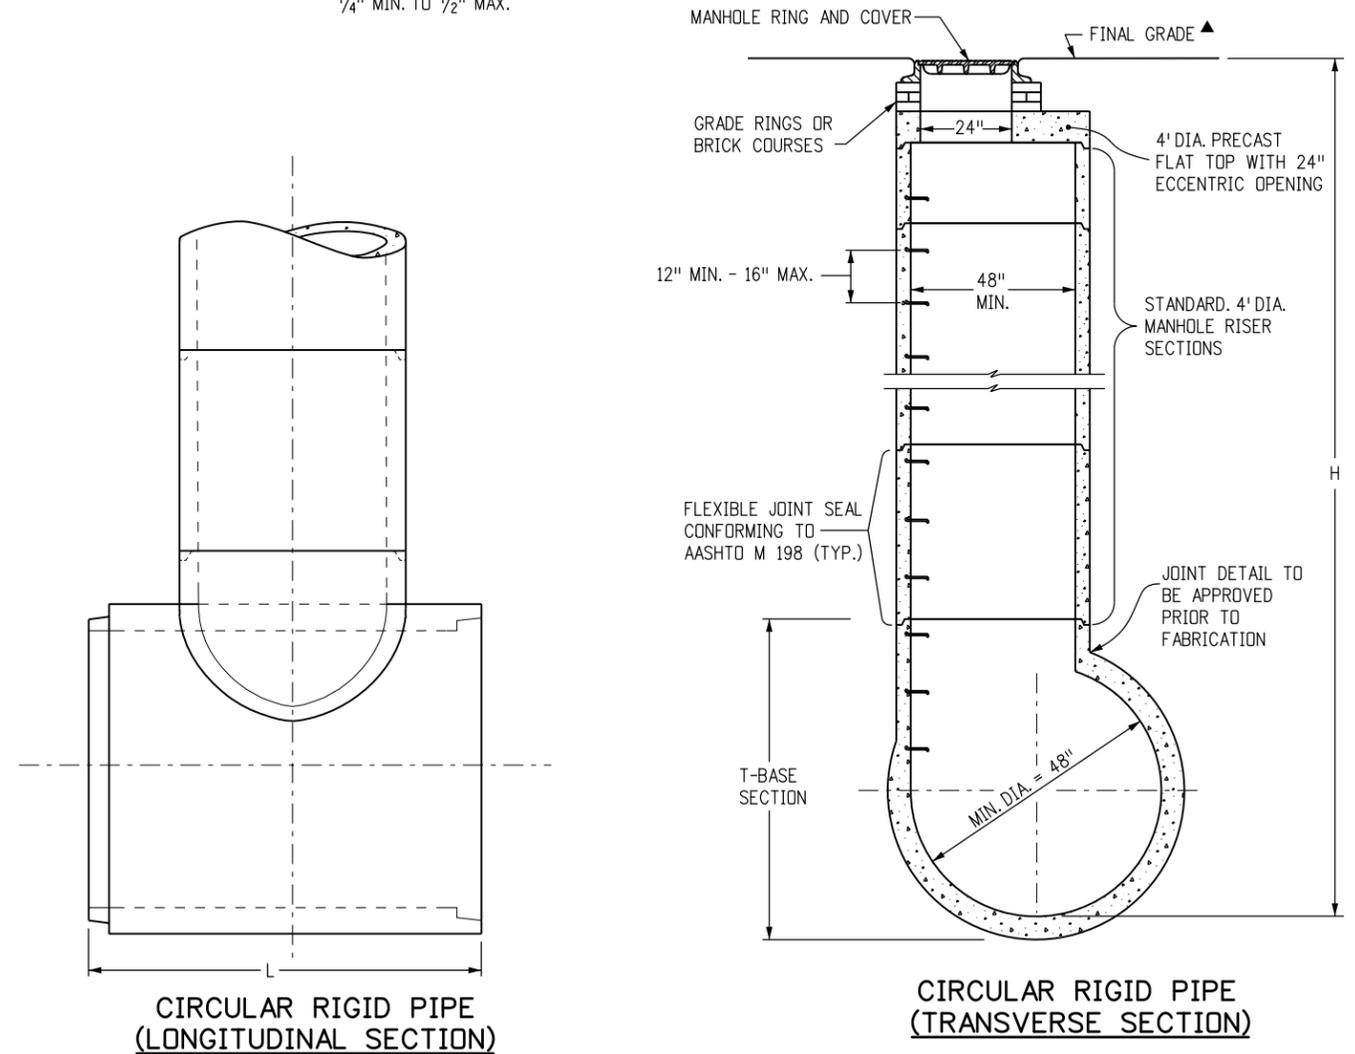

**MANHOLE T-BASE**

Computer File Information	
Creation Date: 07/04/12	Initials: DD
Last Modification Date: 07/04/12	Initials: LTA
Full Path: www.coloradodot.info/business/designsupport	(R-X)
Drawing File Name: 6040200303.dgn	(R-X)
CAD Ver.: MicroStation V8	(R-X)
Scale: Not to Scale	Units: English

Sheet Revisions	
Date:	Comments

Colorado Department of Transportation  
 4201 East Arkansas Avenue  
 Denver, Colorado 80222  
 Phone: (303) 757-9083  
 Fax: (303) 757-9820


**Project Development Branch**     **DD/LTA**

**MANHOLES**

Issued By: Project Development Branch July 4, 2012



STANDARD PLAN NO.  
**M-604-20**  
 Sheet No. 3 of 3



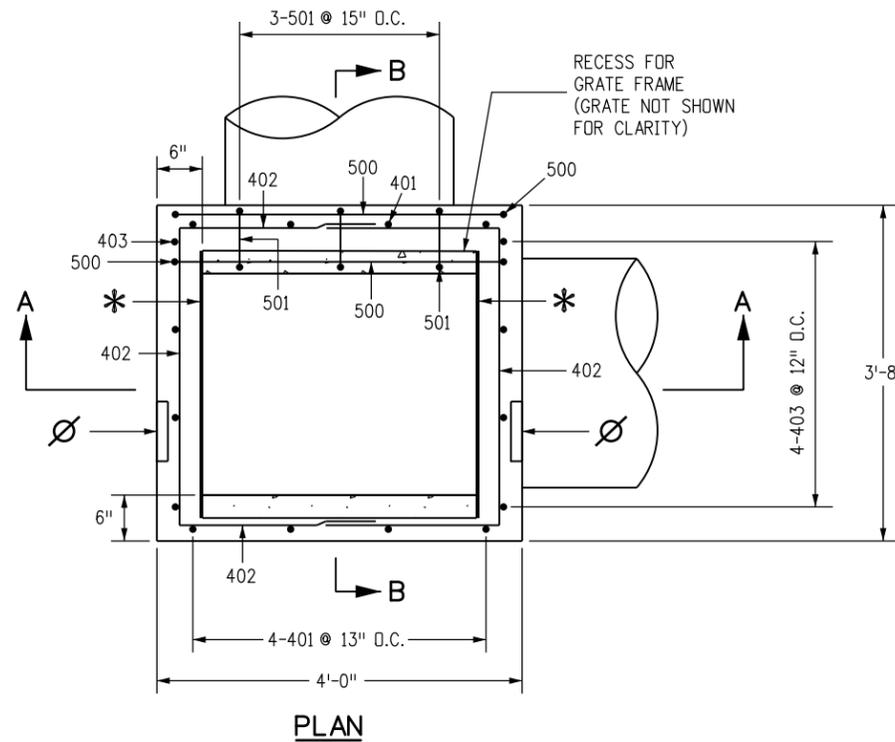

**GENERAL NOTES**

1. FOR THE 32 INCH AND 36 INCH INSIDE INLET DIMENSIONS, THE ALLOWABLE PIPE I.D. IS 30 INCHES OR LESS. FOR THE 72 INCH INSIDE INLET DIMENSION, THE ALLOWABLE PIPE I.D. IS "H" MINUS 18 INCHES, OR LESS, UP TO A MAXIMUM OF 66 INCHES FOR "H" OF 7 FEET OR MORE.
2. ALL CONCRETE SHALL BE CLASS B.
3. INLET MAY BE CAST-IN-PLACE OR PRECAST.
4. REINFORCING BARS SHALL BE #4 UNLESS SHOWN OTHERWISE.
5. ALL REINFORCING BARS SHALL BE GRADE 40 AND EPOXY COATED. REINFORCING BARS SHALL HAVE A MINIMUM CLEARANCE OF 2 IN.
6. ALL EDGE DISTANCES NOT MARKED "CLEAR" ARE TO THE CENTERLINE OF THE BAR.
7. CUT OR BEND REINFORCING BARS AROUND PIPES AS REQUIRED.
8. STEPS SHALL BE REQUIRED WHEN THE INLET DEPTH "H" IS EQUAL TO OR GREATER THAN 4 FT. AND SHALL CONFORM TO AASHTO M 199.
9. THE INVERT OF THE BOX SHALL BE SLOPED TO DRAIN.
10. THE CONTRACTOR SHALL STAMP FLOW ARROWS INTO THE TOP SURFACE OF THE INLET BOX SIDEWALLS TO INDICATE THE DIRECTION OF RUNOFF. THE STAMPED ARROWS SHALL BE 6 IN. LONG, 1 IN. HIGH, AND 3/8 IN. DEEP. FOR INLETS IN SUMP CONDITIONS, THE STAMPED FLOW ARROWS SHALL INDICATE THE PREDOMINATE DIRECTION OF RUNOFF FLOW.
11. A 4 IN. DIA. STAINLESS STEEL MEDALLION WITH "NO DUMPING DRAINS TO STREAM" OR SIMILAR MESSAGE SHALL BE FIRMLY ATTACHED TO TOP OF THE INLET SURFACE WITH A PERMANENT FASTENER. THE MEDALLION WILL HAVE A FISH SYMBOL AND BLUE COLOR BACKGROUND. ALTERNATIVELY, THIS MESSAGE MAY BE CAST WITH 1 IN. HEIGHT LETTERS INTO THE TOP OF THE INLET'S CONCRETE SURFACE OR SURROUNDING CONCRETE APRON. THE NO DUMPING MESSAGE SHALL BE ELIMINATED FOR INLETS LOCATED WITHIN THE SHOULDER OF CONTROLLED ACCESS FREEWAYS WHEN SPECIFIED IN THE PLANS.

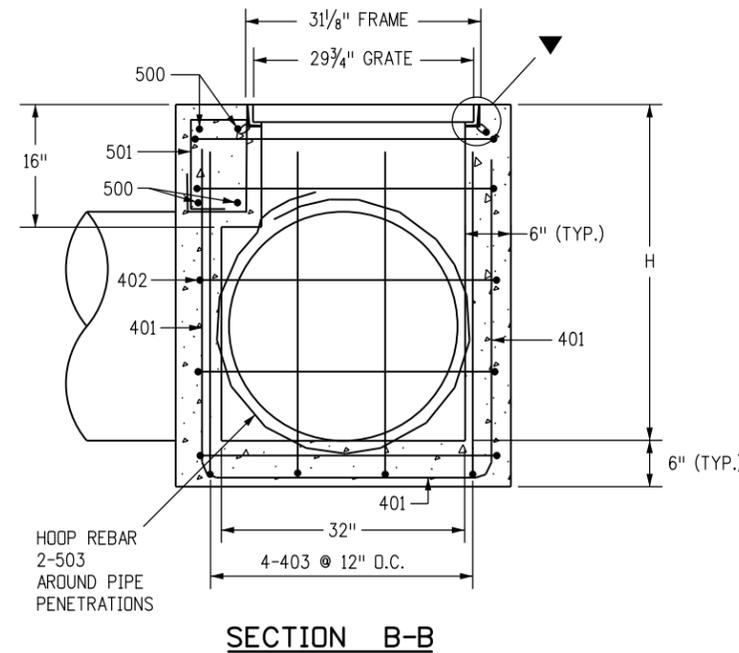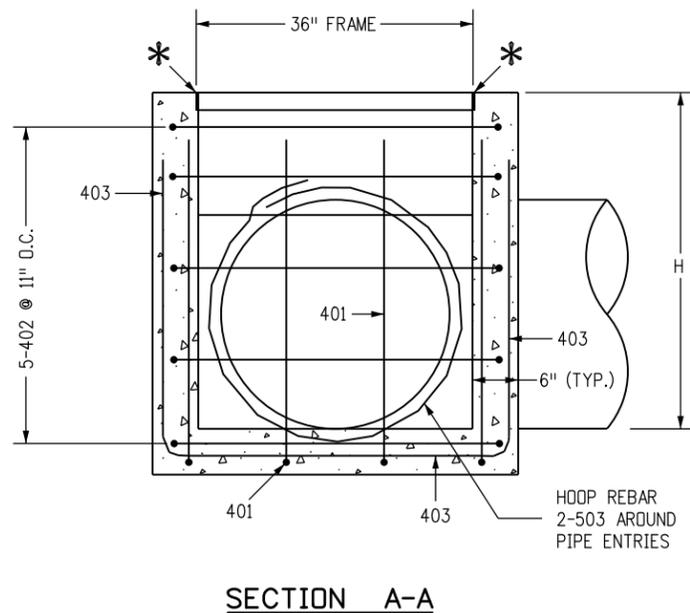

**LEGEND**

- ▼ GRATE TO BE INSTALLED DURING CONSTRUCTION OF THE BOX WITH THE VANE GRATE BOLTED IN PLACE TO THE FRAME.
- \* TO FACILITATE REMOVAL OF THE GRATE, PLACE PLYWOOD 3 IN. x 1/4 IN. x 31-3/8 IN. ALONG EDGE OF THE GRATE AS SHOWN.
- ∅ FLOW ARROW STAMP IN DIRECTION OF FLOW (TYP.). FLOW →

Computer File Information	
Creation Date: 07/04/12	Initials: DD
Last Modification Date: 07/04/12	Initials: LTA
Full Path: www.coloradodot.info/business/designsupport	
Drawing File Name: 6040250105.dgn	
CAD Ver.: MicroStation V8 Scale: Not to Scale Units: English	

Sheet Revisions	
Date:	Comments


Colorado Department of Transportation  
 4201 East Arkansas Avenue  
 Denver, Colorado 80222  
 Phone: (303) 757-9083  
 Fax: (303) 757-9820

**Project Development Branch DD/LTA**


**VANE GRATE INLET**

Issued By: Project Development Branch July 4, 2012


STANDARD PLAN NO.
M-604-25
Sheet No. 1 of 5

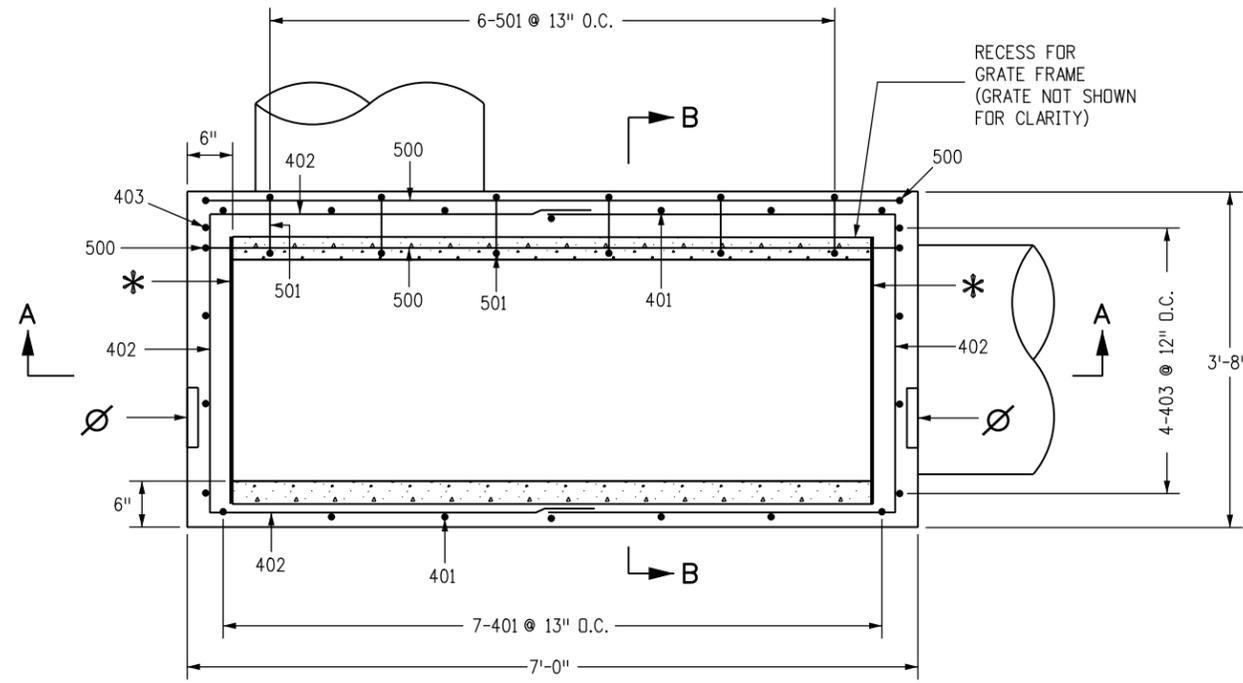

PLAN

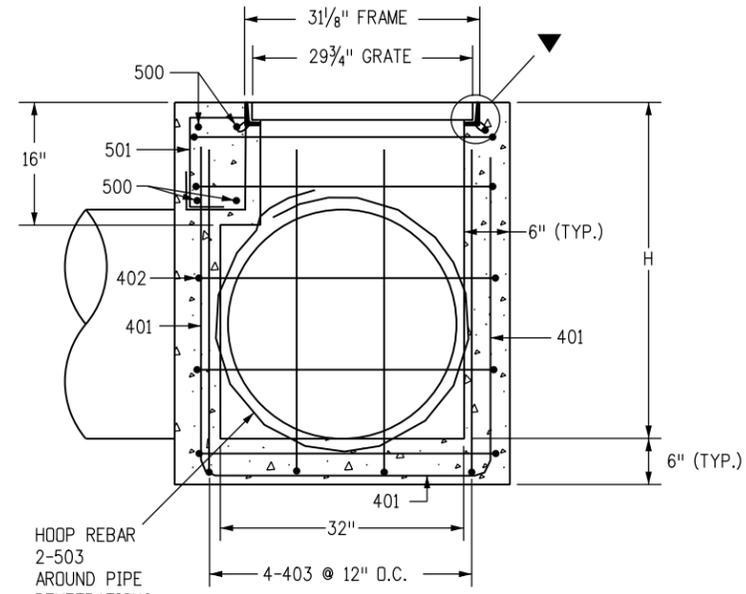

SECTION B-B

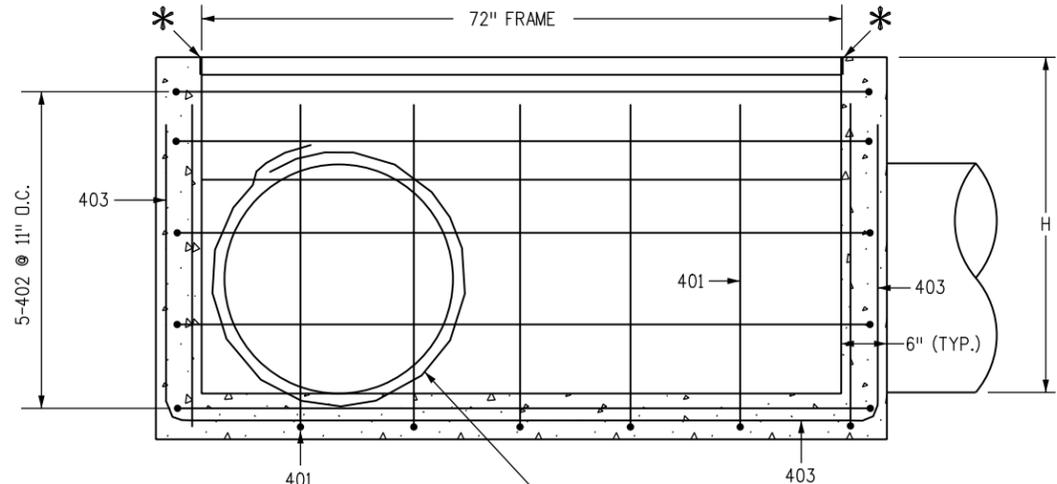

SECTION A-A

LEGEND

- ▼ GRATE TO BE INSTALLED DURING CONSTRUCTION OF THE BOX WITH THE VANE GRATE BOLTED IN PLACE TO THE FRAME.
- \* TO FACILITATE REMOVAL OF THE GRATE, PLACE PLYWOOD 3 IN. x 1/4 IN. x 31-3/8 IN. ALONG EDGE OF THE GRATE AS SHOWN.
- ∅ FLOW ARROW STAMP IN DIRECTION OF FLOW (TYP.). FLOW →

Computer File Information	
Creation Date: 07/04/12	Initials: DD
Last Modification Date: 07/04/12	Initials: LTA
Full Path: www.coloradodot.info/business/designsupport	(R-X)
Drawing File Name: 6040250205.dgn	(R-X)
CAD Ver.: MicroStation V8	(R-X)
Scale: Not to Scale	Units: English

Sheet Revisions	
Date:	Comments



Colorado Department of Transportation  
 4201 East Arkansas Avenue  
 Denver, Colorado 80222  
 Phone: (303) 757-9083  
 Fax: (303) 757-9820

**Project Development Branch**     DD/LTA

# VANE GRATE INLET

Issued By: Project Development Branch July 4, 2012

STANDARD PLAN NO.
M-604-25
Sheet No. 2 of 5

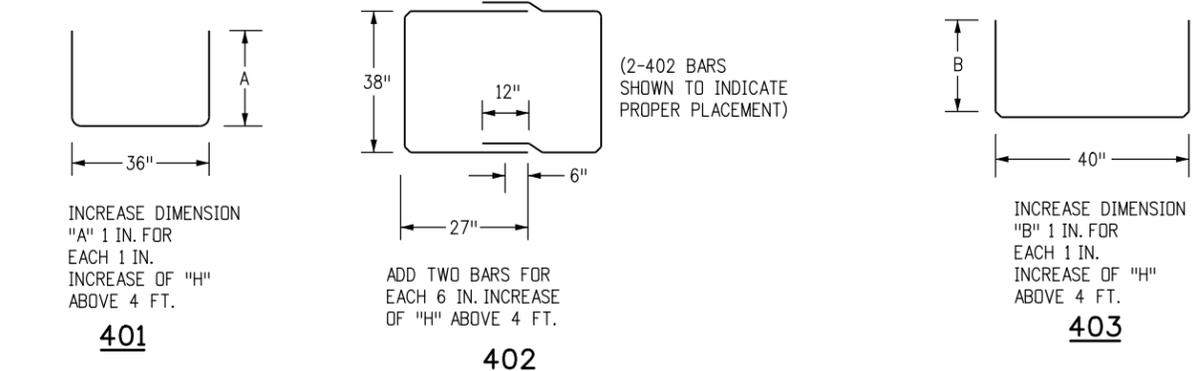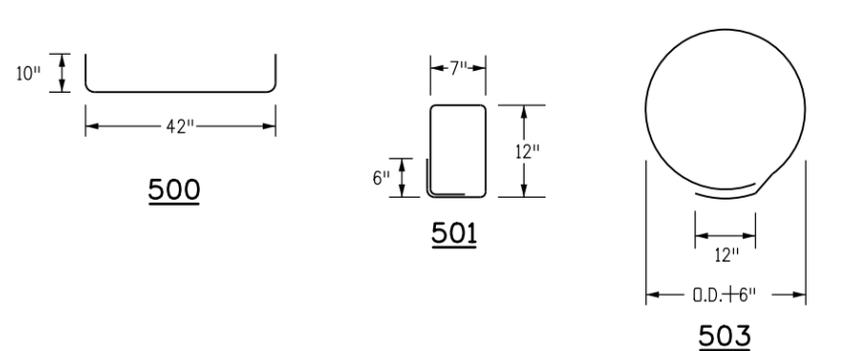


**36 IN. INLET BOX BENDING DIAGRAM**

INCREASE DIMENSION "A" 1 IN. FOR EACH 1 IN. INCREASE OF "H" ABOVE 4 FT.

ADD TWO BARS FOR EACH 6 IN. INCREASE OF "H" ABOVE 4 FT.

INCREASE DIMENSION "B" 1 IN. FOR EACH 1 IN. INCREASE OF "H" ABOVE 4 FT.

(2-402 BARS SHOWN TO INDICATE PROPER PLACEMENT)

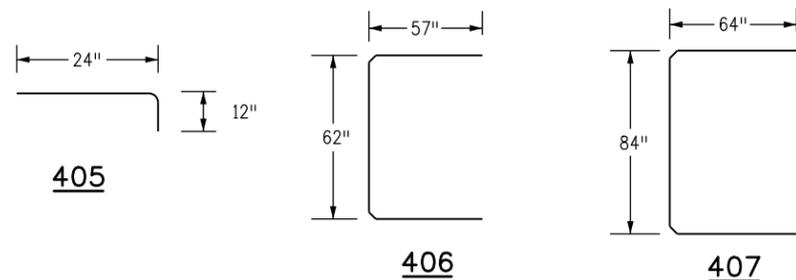



**INLET APRON BENDING DIAGRAM FOR 36 IN. INLET**

MARK	NO. REQ'D	LENGTH (EACH)
405	9	3'-0"
406	1	14'-8"
407	1	17'-8"

**BAR LIST FOR CONCRETE APRON**  
(FOR INFORMATION ONLY)

MARK	NO. REQ'D	HEIGHT "A"	HEIGHT "B"	LENGTH (EACH)
500	4			5'-2"
501	3			4'-2"
503	4			10'-5"
401	4	3'-10"		10'-8"
402	10			7'-8"
403	4		4'-0"	11'-4"

**BAR LIST FOR H = 4'-0" 36 IN. INLET**

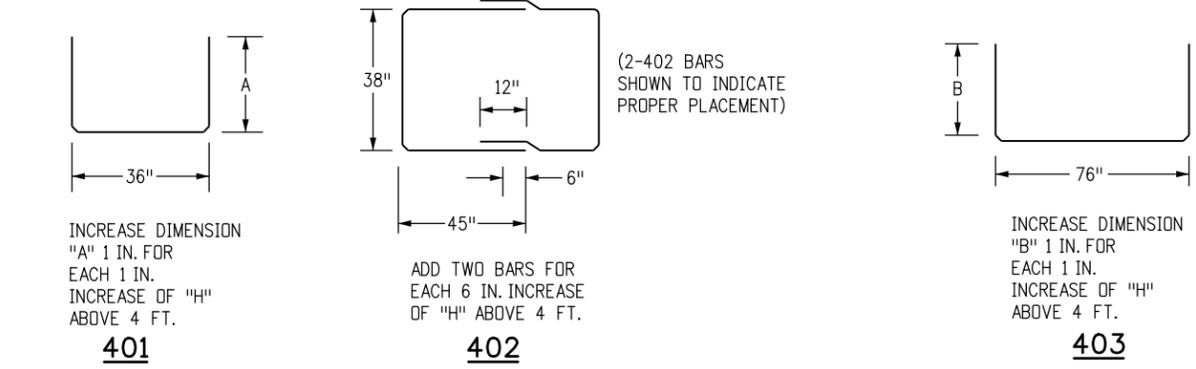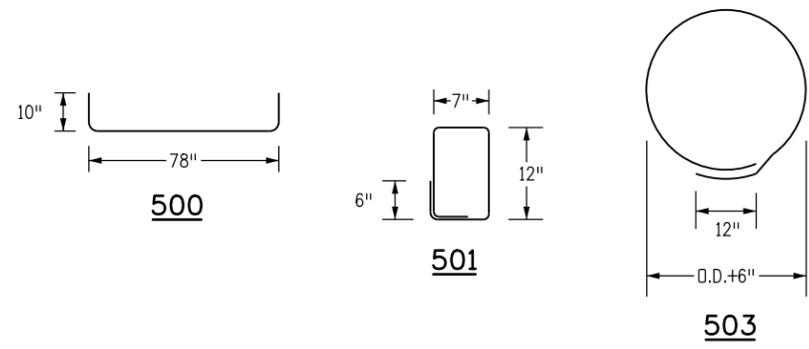


**72 IN. INLET BOX BENDING DIAGRAM**

INCREASE DIMENSION "A" 1 IN. FOR EACH 1 IN. INCREASE OF "H" ABOVE 4 FT.

ADD TWO BARS FOR EACH 6 IN. INCREASE OF "H" ABOVE 4 FT.

INCREASE DIMENSION "B" 1 IN. FOR EACH 1 IN. INCREASE OF "H" ABOVE 4 FT.

(2-402 BARS SHOWN TO INDICATE PROPER PLACEMENT)

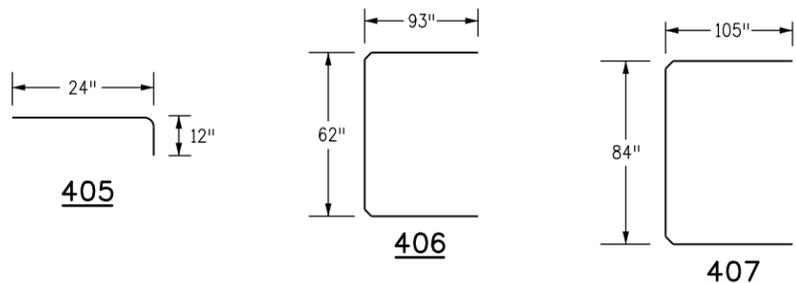

**INLET APRON BENDING DIAGRAM FOR 72 IN. INLET**

MARK	NO. REQ'D	LENGTH (EACH)
405	13	3'-0"
406	1	20'-8"
407	1	24'-6"

**BAR LIST FOR CONCRETE APRON**  
(FOR INFORMATION ONLY)

MARK	NO. REQ'D	HEIGHT "A"	HEIGHT "B"	LENGTH (EACH)
500	4			8'-2"
501	6			4'-2"
503	4			10'-5"
401	7	3'-10"		10'-8"
402	10			10'-8"
403	4		4'-0"	14'-4"

**BAR LIST FOR H = 4'-0" 72 IN. INLET**

**QUANTITIES FOR ONE 36 IN. INLET**

H	NUMBER OF STEPS REQUIRED	CONC. CU. YD.	STEEL LBS.
4'-0"	1	1.3	180
4'-6"	2	1.5	186
5'-0"	2	1.6	201
5'-6"	2	1.7	207
6'-0"	3	1.8	222
6'-6"	3	1.9	227
7'-0"	3	2.1	243
7'-6"	4	2.2	248
8'-0"	4	2.3	263
8'-6"	4	2.4	269
9'-0"	5	2.5	285
9'-6"	5	2.7	289
10'-0"	5	2.8	306
10'-6"	6	2.9	310
11'-0"	6	3.0	326
11'-6"	6	3.1	331

**NOTES**

1. CONCRETE QUANTITY INCLUDES VOLUME OCCUPIED BY PIPES.
2. REINFORCING STEEL QUANTITY ASSUMES TWO 503 HOOPS FOR EACH 24 IN. PIPE.
3. BARS NUMBERED IN 400 SERIES INDICATES #4 SIZE BAR. BARS NUMBERED IN 500 SERIES INDICATES #5 SIZE BAR.
4. ALL REINFORCING BARS SHALL BE GRADE 40 AND EPOXY COATED.

**QUANTITIES FOR ONE 72 IN. INLET**

H	NUMBER OF STEPS REQUIRED	CONC. CU. YD.	STEEL LBS.
4'-0"	1	2.1	253
4'-6"	2	2.3	260
5'-0"	2	2.4	282
5'-6"	2	2.6	289
6'-0"	3	2.8	310
6'-6"	3	3.0	318
7'-0"	3	3.2	339
7'-6"	4	3.3	346
8'-0"	4	3.5	369
8'-6"	4	3.7	376
9'-0"	5	3.9	397
9'-6"	5	4.1	405
10'-0"	5	4.2	426
10'-6"	6	4.4	433
11'-0"	6	4.6	455
11'-6"	6	4.8	462

Computer File Information	
Creation Date: 07/04/12	Initials: DD
Last Modification Date: 07/04/12	Initials: LTA
Full Path: www.coloradodot.info/business/designsupport	(R-X)
Drawing File Name: 6040250305.dgn	(R-X)
CAD Ver.: MicroStation V8	Scale: Not to Scale
Units: English	(R-X)

Sheet Revisions	
Date:	Comments

Colorado Department of Transportation  
 4201 East Arkansas Avenue  
 Denver, Colorado 80222  
 Phone: (303) 757-9083  
 Fax: (303) 757-9820

**Project Development Branch**      **DD/LTA**


**VANE GRATE INLET**

Issued By: Project Development Branch July 4, 2012

**STANDARD PLAN NO.**


**M-604-25**

**Sheet No. 3 of 5**

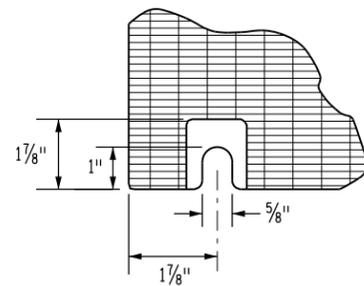


**DETAIL A**


**BOLT SLOT AT CORNER (TYP.)**

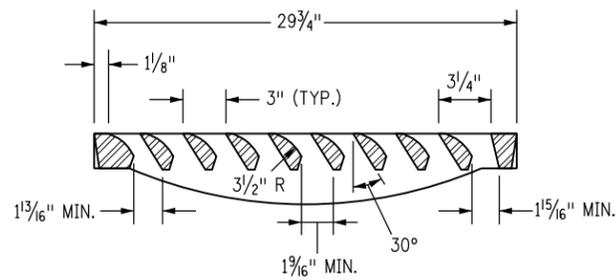

**SECTION A-A**

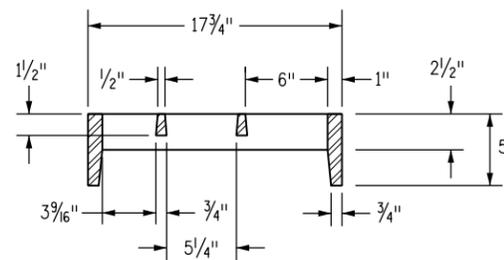


**SECTION B-B**

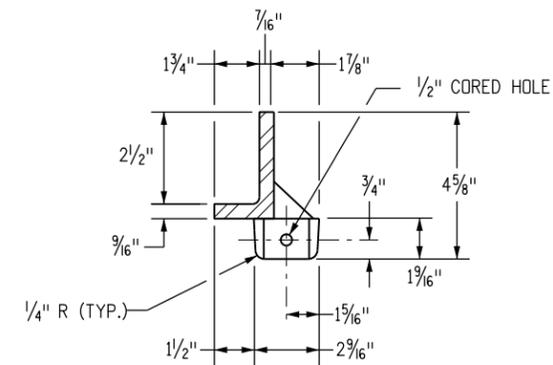


**DETAIL B**

**NOTES**


1. FREE OPEN AREA: 190 SQ. IN./GRATE.
2. MATERIAL: CAST GRAY IRON ASTM A-48 CLASS 35B.
3. FINISH: NO PAINT.
4. WEIGHT: GRATE 170 LBS. EACH; FRAME 29 LBS. EACH.
5. ALL REINFORCING BARS SHALL BE EPOXY COATED.

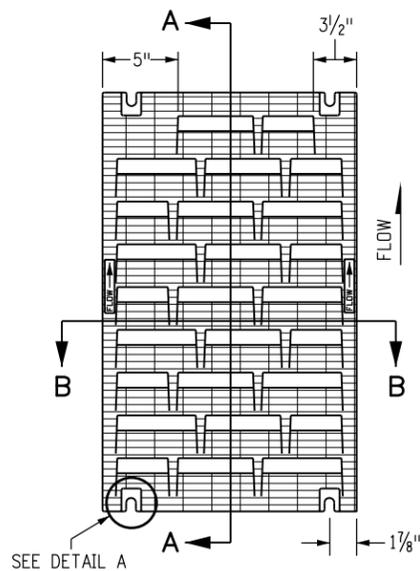


**GRATE PLAN**

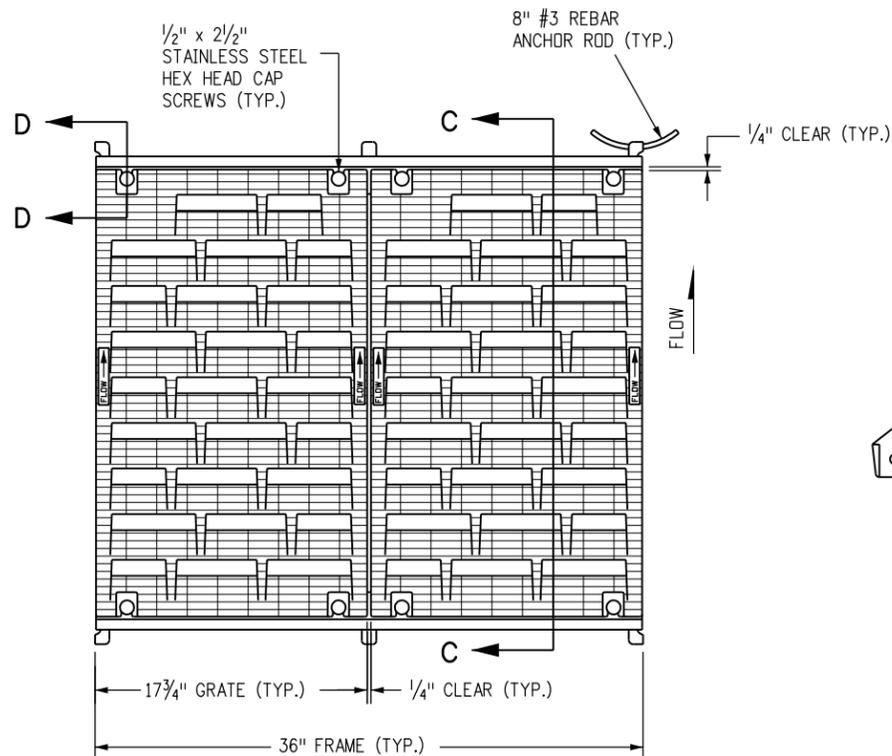

**MULTIPLE GRATE WITH FRAME PLAN**

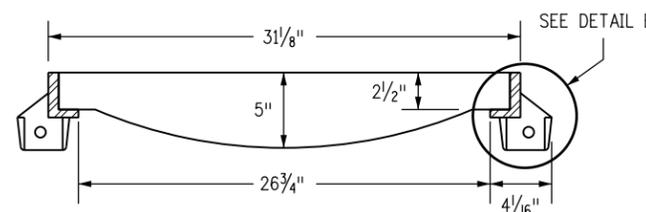

**SECTION C-C**

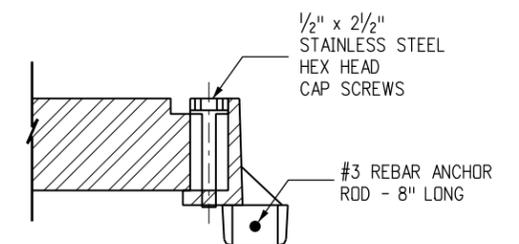

**SECTION D-D**

**Computer File Information**

Creation Date: 07/04/12	Initials: DD
Last Modification Date: 07/04/12	Initials: LTA
Full Path: www.coloradodot.info/business/designsupport	(R-X)
Drawing File Name: 6040250405.dgn	(R-X)
CAD Ver.: MicroStation V8	(R-X)
Scale: Not to Scale	Units: English

**Sheet Revisions**

Date:	Comments:

**Colorado Department of Transportation**



4201 East Arkansas Avenue  
Denver, Colorado 80222  
Phone: (303) 757-9083  
Fax: (303) 757-9820

**Project Development Branch DD/LTA**


**VANE GRATE INLET**

Issued By: Project Development Branch July 4, 2012


**STANDARD PLAN NO.**

**M-604-25**


**Sheet No. 4 of 5**

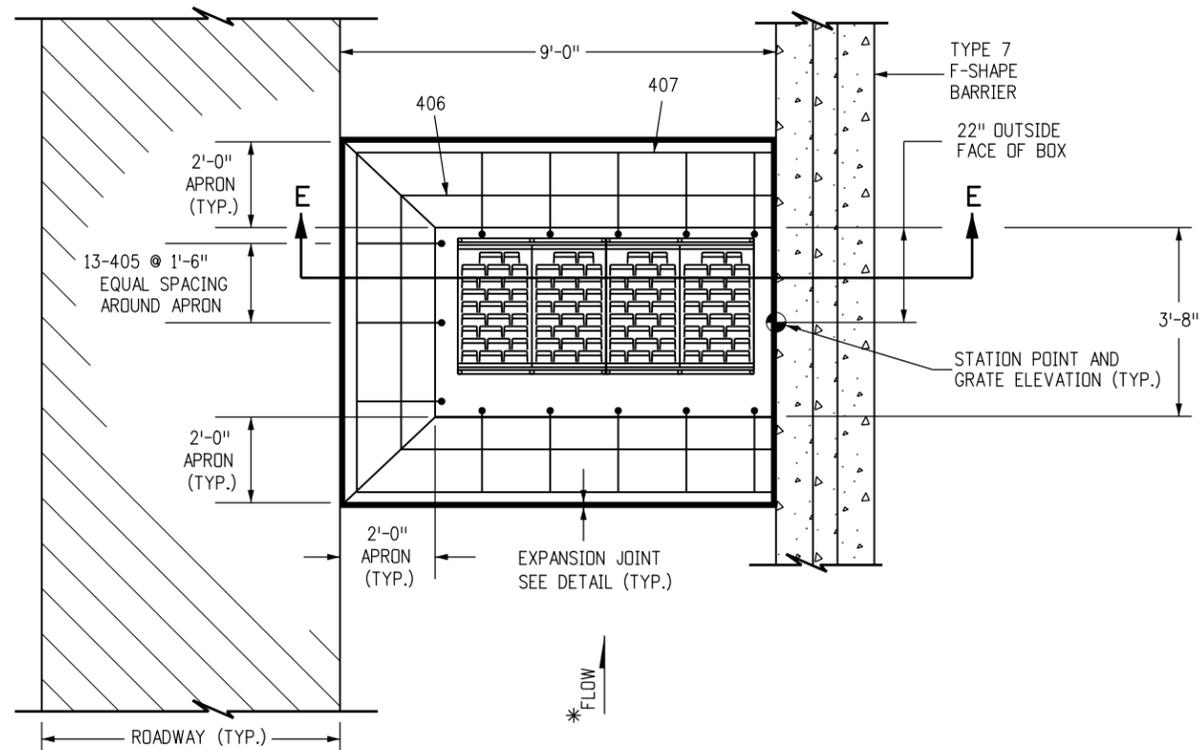


**CONCRETE APRON FOR 72 IN. INLET**

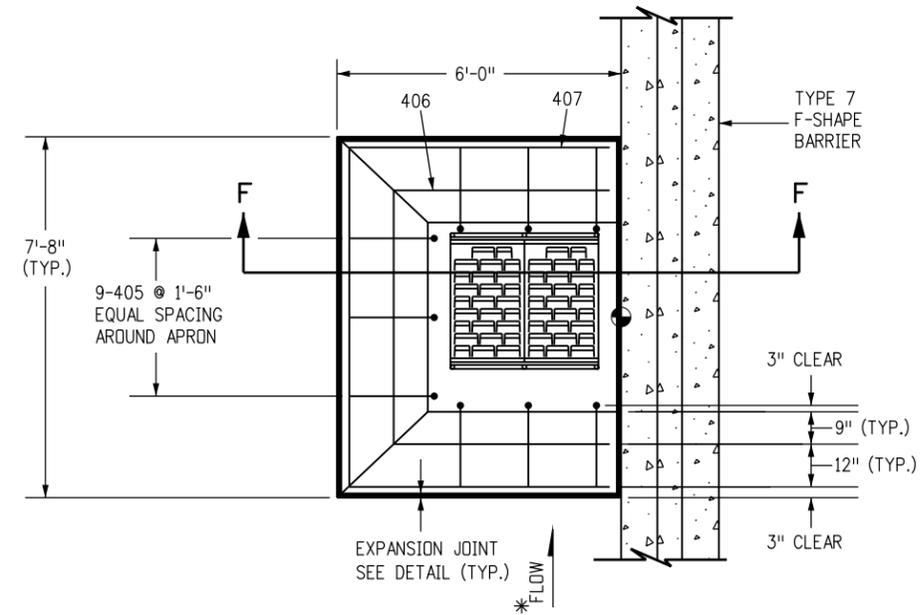


**CONCRETE APRON FOR 36 IN. INLET**

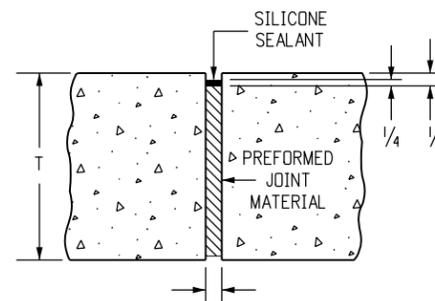

**EXPANSION JOINT (TYP.)**

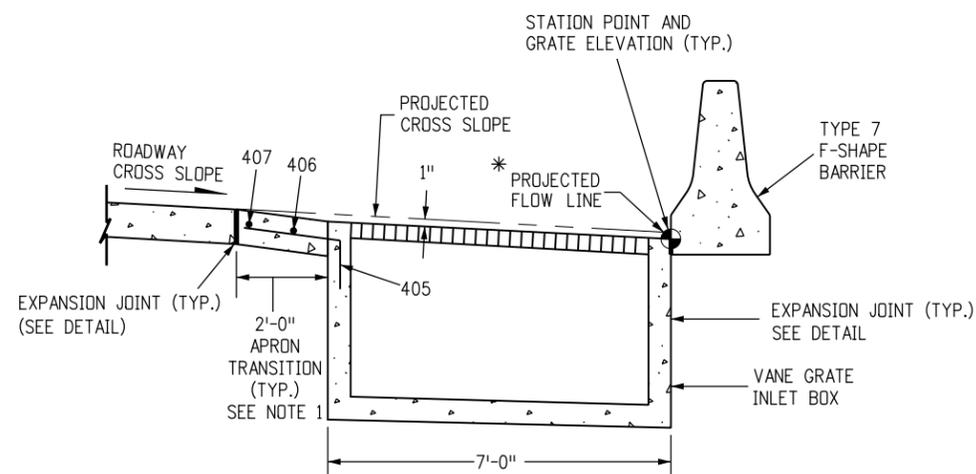

**SECTION E-E**

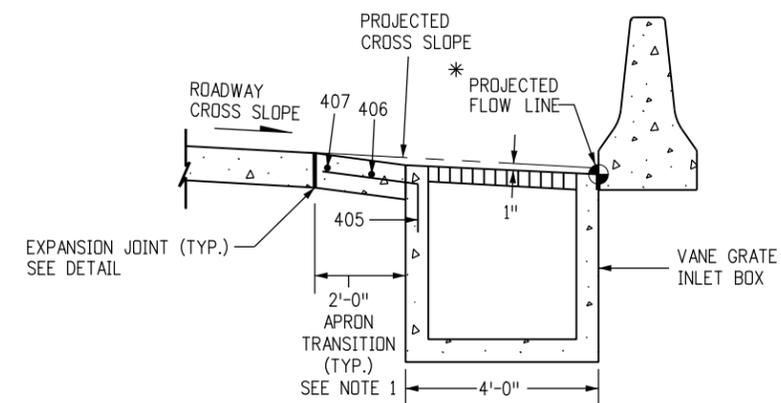

**SECTION F-F**

**NOTES**

1. A 2 FT. CONCRETE TRANSITION APRON SHALL BE CONSTRUCTED AS SHOWN AND SHALL BE KEYED INTO THE INLET.
  2. CONCRETE APRON SHALL BE THE SAME THICKNESS AND TYPE AS THE SURROUNDING CONCRETE.
  3. THE COST OF THE CONCRETE APRON SHALL BE INCLUDED THE COST OF THE INLET.
- \* IF THE INLET IS OFFSET FROM THE BARRIER, SLOPE THE APRON ADJACENT TO THE BARRIER TO DIRECT FLOW TOWARD THE GRATE.

**Computer File Information**

**Sheet Revisions**

Colorado Department of Transportation

**VANE GRATE INLET**

STANDARD PLAN NO.

Creation Date: 07/04/12	Initials: DD
Last Modification Date: 07/04/12	Initials: LTA
Full Path: www.coloradodot.info/business/designsupport	(R-X)
Drawing File Name: 6040250505.dgn	(R-X)
CAD Ver.: MicroStation V8 Scale: Not to Scale Units: English	(R-X)

Date:	Comments



4201 East Arkansas Avenue  
Denver, Colorado 80222  
Phone: (303) 757-9083  
Fax: (303) 757-9820

Project Development Branch DD/LTA


Issued By: Project Development Branch July 4, 2012

M-604-25


Sheet No. 5 of 5

**GENERAL NOTES**


1. ALL STEEL REINFORCING SHALL BE 2 IN. CLEAR OF THE NEAREST SURFACE OF CONCRETE UNLESS OTHERWISE SHOWN. REINFORCING STEEL SHALL BE GRADE 40 MINIMUM.
2. CONCRETE SHALL BE CLASS D.
3. ALL PERMANENT PRECAST BARRIERS USED TO REPLACE OTHER CONCRETE BARRIERS, SHALL BE IN NEW CONDITION, UNDAMAGED, AND WITH NO REPAIRS.
4. FOR TEMPORARY INSTALLATIONS, INSTALL WITH A MINIMUM 4 FT. DISTANCE FROM THE CENTERLINE OF THE CONCRETE BARRIER TO ANY OBSTRUCTIONS BEHIND IT. FOR TEMPORARY INSTALLATIONS WITH LESS THAN A 4 FT. MINIMUM DISTANCE, STABILIZATION PINS SHALL BE USED ON EACH BARRIER UNIT ADJACENT TO, AND WITHIN 10 FT. OF BOTH SIDES OF THE OBSTRUCTION. SEE SHEET 3 FOR STABILIZATION PINNING DETAILS.
5. THE FLARE RATE FOR TEMPORARY INSTALLATIONS SHALL BE 10:1 OR FLATTER UNLESS OTHERWISE APPROVED BY THE ENGINEER FOR PERMANENT INSTALLATIONS. SEE THE FLARE RATES TABLE ON STANDARD M-606-13, SHEET 3.
6. STABILIZATION PINS SHALL BE USED TO ANCHOR EACH 10 FT. UNIT IN ALL PERMANENT INSTALLATIONS. SEE SHEET 3 FOR STABILIZATION PINNING DETAILS.
7. FOR ALL PERMANENT INSTALLATIONS THAT REQUIRE END ANCHORAGES. SEE STANDARD PLAN M-606-13, SHEET 1, FOR ANCHORAGE DETAILS.
8. THE MONTH AND YEAR THE PRECAST TYPE 7 CONCRETE BARRIER WAS MANUFACTURED SHALL BE MOLDED INTO ONE END OF EACH 10 FT. BARRIER UNIT.
9. APPROVED NON-SHRINK GROUT SHALL BE USED FOR GROUTING OVER ALL PINS AND GROUTING OF SCUPPERS.
10. WHEN HYDRAULIC ANALYSIS ALLOWS, SCUPPERS MAY NOT BE NEEDED ON:
  - A. MEDIAN INSTALLATION WITH INLET DRAINAGE.
  - B. SHOULDER BARRIER ON HIGH EDGE OF A SUPERELEVATED SHOULDER.
  - C. MEDIAN BARRIER ON A CREST VERTICAL CURVE.
  - D. PERMANENT BARRIER, IF SPECIFIED ON PLANS.
11. ALL INCIDENTAL WORK AND MATERIALS SUCH AS CONNECTING PINS, ANCHORS BOLTS, GROUT, AND EXCAVATION FOR END ANCHORAGE, WILL NOT BE PAID FOR SEPARATELY, BUT SHALL BE INCLUDED IN THE COST OF THE WORK.
12. ONE IN. DIAMETER THREADED INSERTS MAY BE CAST-IN-PLACE TO FACILITATE LIFTING FOR TEMPORARY BARRIER APPLICATIONS ONLY.
13. RETROREFLECTORIZATION IS REQUIRED ON BARRIERS. SEE BARRIER RETROREFLECTOR NOTES ON STANDARD PLAN S-612-1.

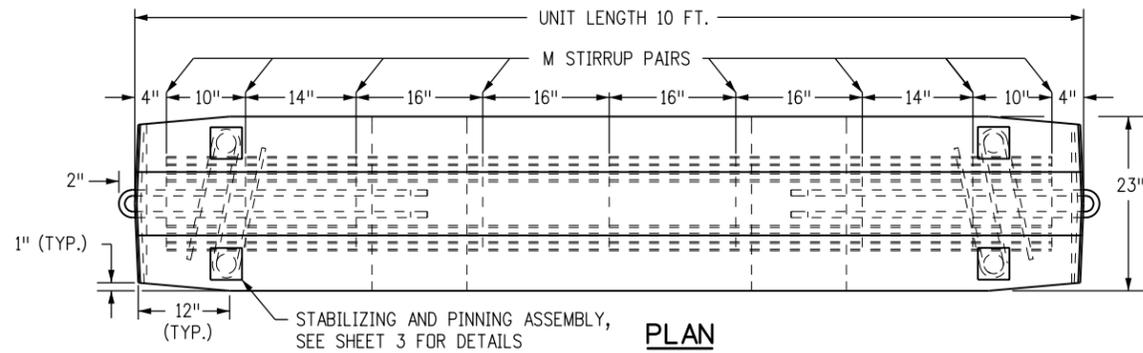


**PLAN**

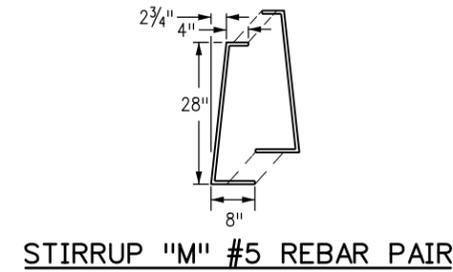


**STIRRUP "M" #5 REBAR PAIR**

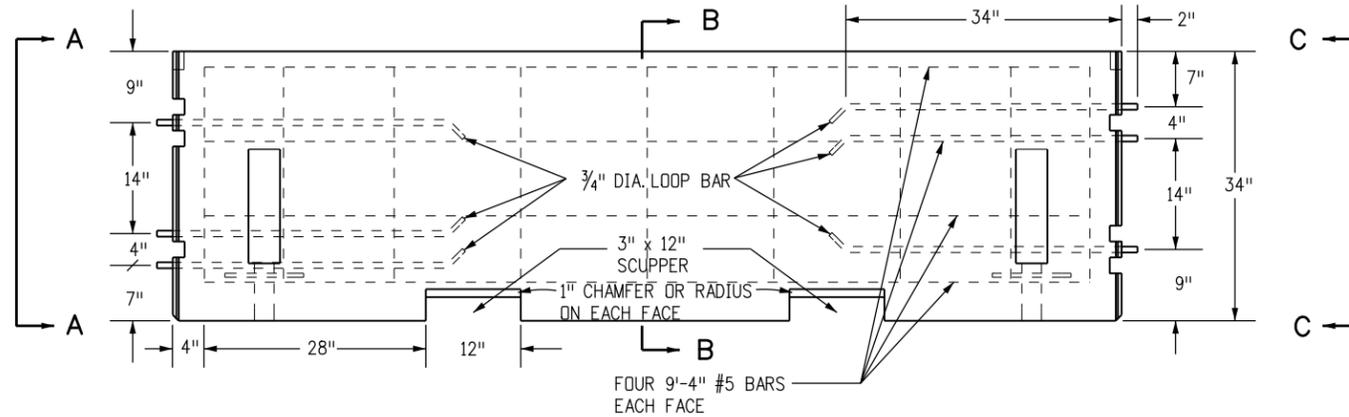


**ELEVATION BARRIER**

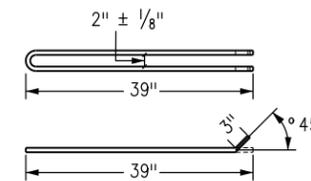


**LOOP BAR BENDING DETAIL (ASTM A36)**  
(HOT-DIP GALVANIZED AFTER FABRICATION)

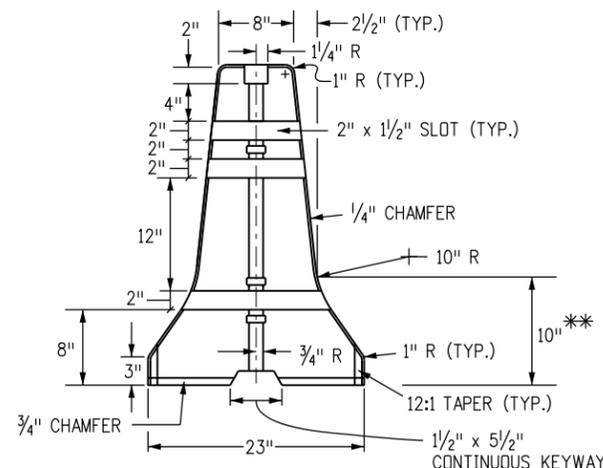


**SECTION A-A**

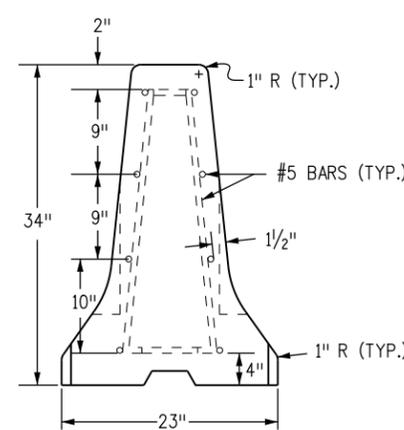


**SECTION B-B**

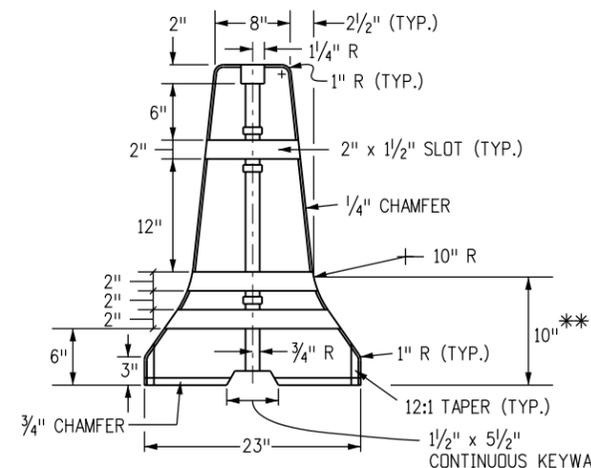

**SECTION C-C**

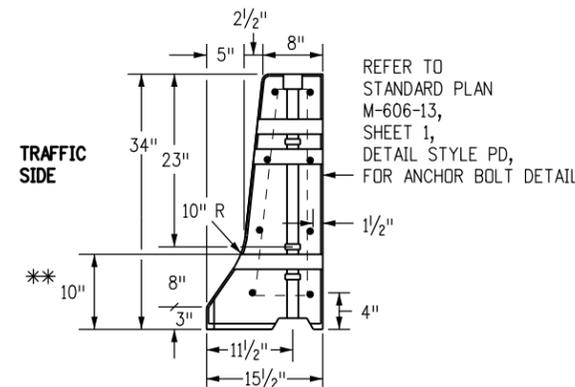

**NARROW BASE SHOULDER BARRIER**

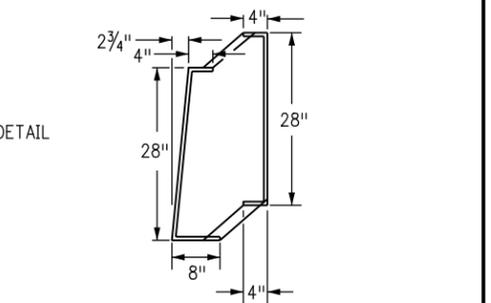

**NARROW BASE STIRRUP "M" #5 REBAR PAIR**

\*\* DIMENSIONS MARKED ARE TO THE INTERSECTION POINT OF THE BARRIER SLOPES. CONSTRUCT THE 10 IN. RADIUS TO PROVIDE A SMOOTH TRANSITION BETWEEN THE SLOPES.

Computer File Information	
Creation Date: 07/04/12	Initials: DD
Last Modification Date: 07/04/12	Initials: LTA
Full Path: www.coloradodot.info/business/designsupport	
Drawing File Name: 6060140103.dgn	
CAD Ver.: MicroStation V8	Scale: Not to Scale Units: English

Sheet Revisions	
Date:	Comments
(R-X)	
(R-X)	
(R-X)	
(R-X)	






Colorado Department of Transportation  
 4201 East Arkansas Avenue  
 Denver, Colorado 80222  
 Phone: (303) 757-9083  
 Fax: (303) 757-9820

**Project Development Branch** DD/LTA

**PRECAST TYPE 7 CONCRETE BARRIER**

Issued By: Project Development Branch July 4, 2012

STANDARD PLAN NO.
M-606-14
Sheet No. 1 of 3

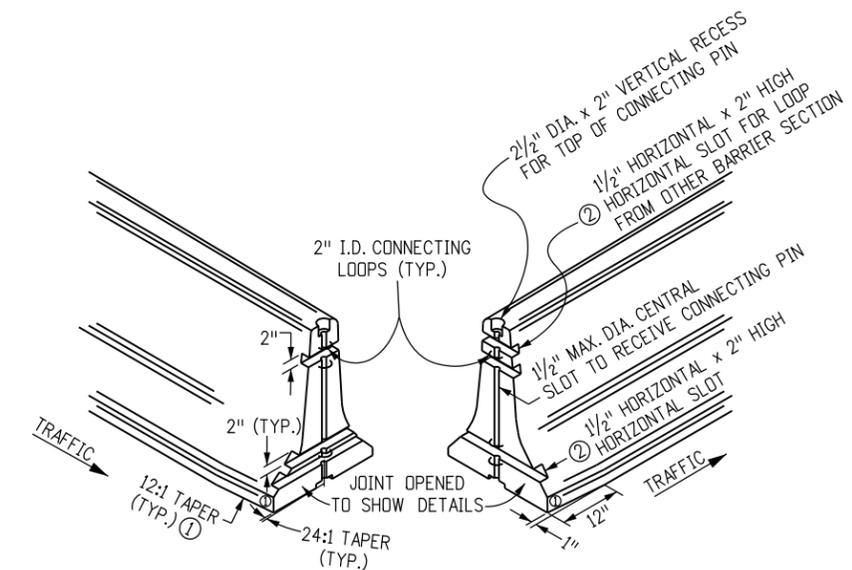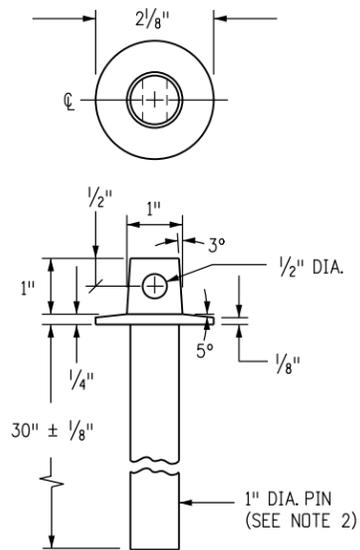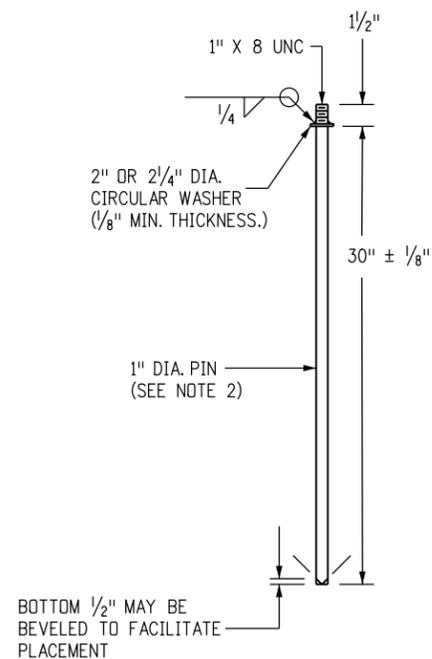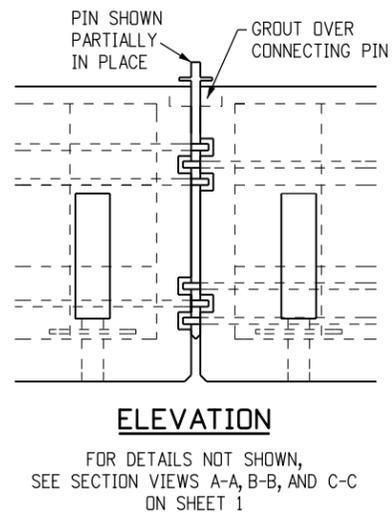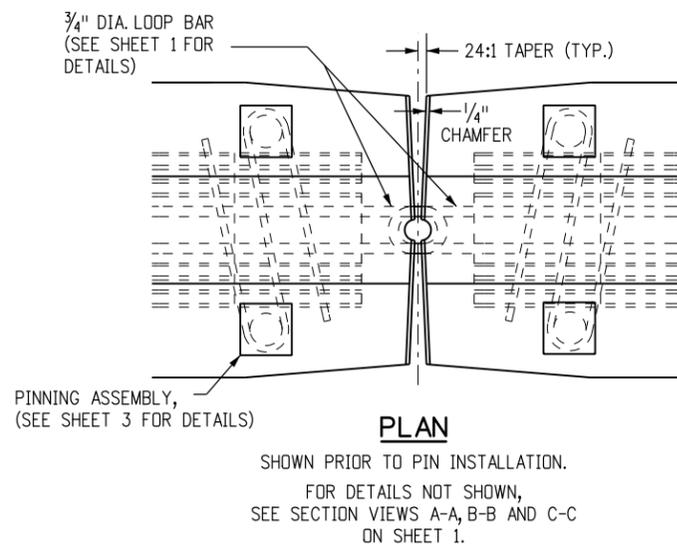


- NOTES**
1. WASHERS SHALL BE FORGED AS AN INTEGRAL PART OF THE PIN, OR SHALL BE WELDED AS SHOWN.
  2. PINS SHALL BE HOT-DIPPED GALVANIZED AFTER FABRICATION.
  3. IF AN ALTERNATIVE TOP CONFIGURATION IS USED FOR LIFTING, THE LIFTING PIN SHALL BE PROVIDED. PINS SHALL CONFORM TO CRITICAL DIMENSIONS (PIN LENGTH DIAMETER).
  4. PINS SHALL CONFORM TO ASTM A449.
  5. APPROVED NON-SHRINK GROUT SHALL BE USED FOR GROUTING OVER ALL PINS, AND GROUTING OF SCUPPERS.
  6. BOTH ENDS OF THE BARRIER SHALL HAVE A 24:1 TAPER IN EACH DIRECTION FROM THE CENTER PIN RECESS TO ITS OUTER EDGE TO FACILITATE PLACEMENT ON CURVES.
  7. JOINTS BETWEEN CAST-IN-PLACE GUARDRAIL TYPE 7 AND PERMANENT INSTALLATION PRECAST TYPE 7 CONCRETE BARRIER SHALL INCLUDE ALL REGRESSES AND LOOPS IN THE CAST-IN-PLACE END, ALONG WITH THE PIN TO COMPLETE THE TYPICAL PRECAST TYPE 7 CONCRETE BARRIER JOINT.


- ① A 1 IN. BY 12 IN. TAPER IS REQUIRED AT THE BOTTOM OF ALL FOUR CORNERS OF THE BARRIER SECTIONS TO ELIMINATE SNAGGING OF SNOW PLOW BLADES. THE TAPER IS OPTIONAL ON PERMANENT INSTALLATIONS.
- ② THE HORIZONTAL SLOTS SHALL BE 1/2 IN. IN DEPTH AT THE CENTER OF THE BARRIER AND MAY DECREASE IN DEPTH AT THE EDGE OF THE BARRIER DUE TO THE (24:1) TAPER.

**DETAILS FOR PIN AND LOOP CONNECTION**


<b>Computer File Information</b>		<b>Sheet Revisions</b>		<b>Colorado Department of Transportation</b>  4201 East Arkansas Avenue Denver, Colorado 80222 Phone: (303) 757-9083 Fax: (303) 757-9820 <b>Project Development Branch DD/LTA</b>	<b>PRECAST TYPE 7 CONCRETE BARRIER</b>	<b>STANDARD PLAN NO.</b>
Creation Date: 07/04/12	Initials: DD	Date:	Comments:			M-606-14
Last Modification Date: 07/04/12	Initials: LTA					
Full Path: www.coloradodot.info/business/designsupport	(R-X)				<b>Sheet No. 2 of 3</b>	
Drawing File Name: 6060140203.dgn	(R-X)					
CAD Ver.: MicroStation V8 Scale: Not to Scale Units: English	(R-X)			Issued By: Project Development Branch July 4, 2012		

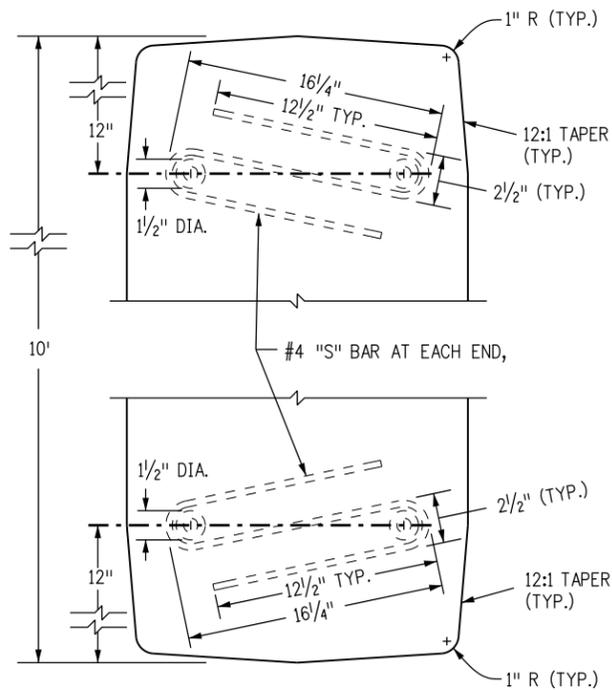

**PLAN VIEW OF S BAR ENDS**

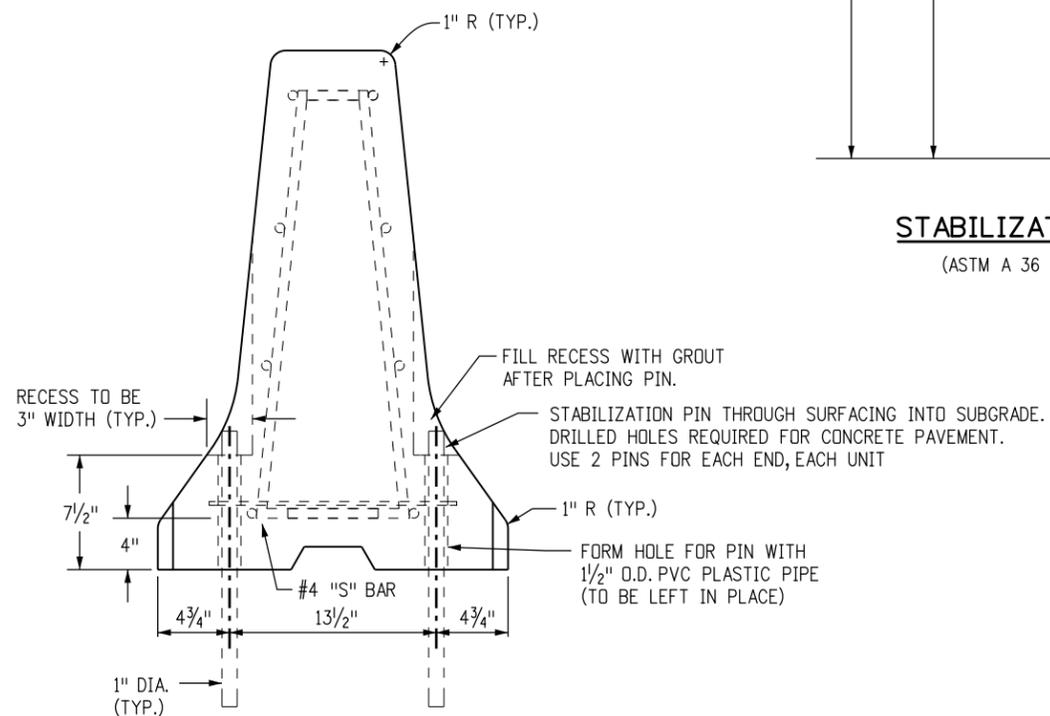


**ELEVATION VIEW WITH PINS**

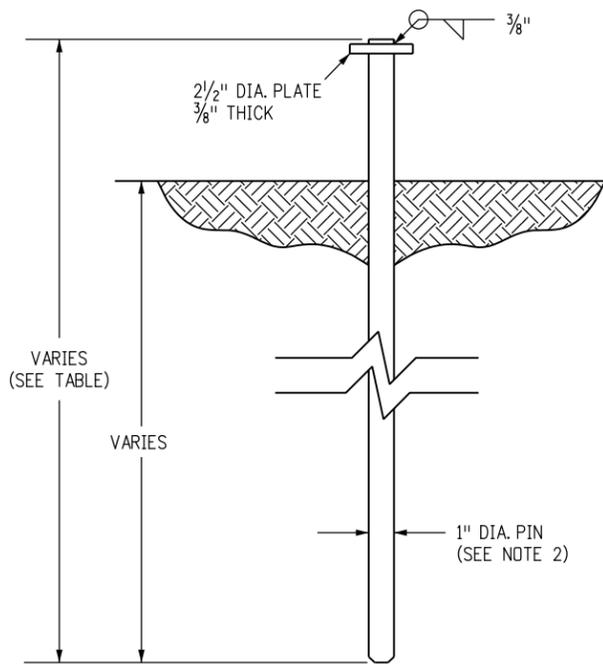

**STABILIZATION PIN**

(ASTM A 36 STEEL)

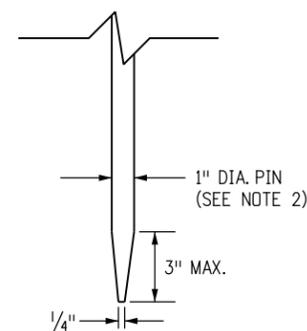

**OPTIONAL TAPERED END PIN**

(SEE NOTE 4)

**NOTES**

1. SEE SHEET 1 FOR REINFORCEMENT AND OTHER DETAILS NOT SHOWN HERE.
2. PINS SHALL BE HOT-DIPPED GALVANIZED AFTER FABRICATION
3. FOR TERMINAL ANCHORING OF THE PERMANENT INSTALLATION OF PRECAST TYPE 7 CONCRETE BARRIER, SEE THE END ANCHORAGE DETAIL ON STANDARD PLAN M-606-13, SHEET 1.
4. AN OPTIONAL 3 IN. MAXIMUM TAPERED END POINT MAY BE PROVIDED ON THE STABILIZATION PIN TO FACILITATE DRIVING.


ROAD SURFACE	PIN LENGTH
CONCRETE	2 FT.-6 IN.
HMA	3 FT.
SOIL	3 FT.-6 IN.

**TABLE OF STABILIZATION PIN LENGTHS**

**DETAILS FOR STABILIZATION OF PERMANENT OR TEMPORARY PINNED PRECAST TYPE 7 CONCRETE BARRIER**

Computer File Information		Sheet Revisions		Colorado Department of Transportation 4201 East Arkansas Avenue Denver, Colorado 80222 Phone: (303) 757-9083 Fax: (303) 757-9820 Project Development Branch DD/LTA	PRECAST TYPE 7 CONCRETE BARRIER	STANDARD PLAN NO.
Creation Date: 07/04/12	Initials: DD	Date:	Comments:			M-606-14
Last Modification Date: 07/04/12	Initials: LTA					Sheet No. 3 of 3
Full Path: www.coloradodot.info/business/designsupport	(R-X)			Issued By: Project Development Branch July 4, 2012		
Drawing File Name: 6060140303.dgn	(R-X)					
CAD Ver.: MicroStation V8 Scale: Not to Scale Units: English	(R-X)					



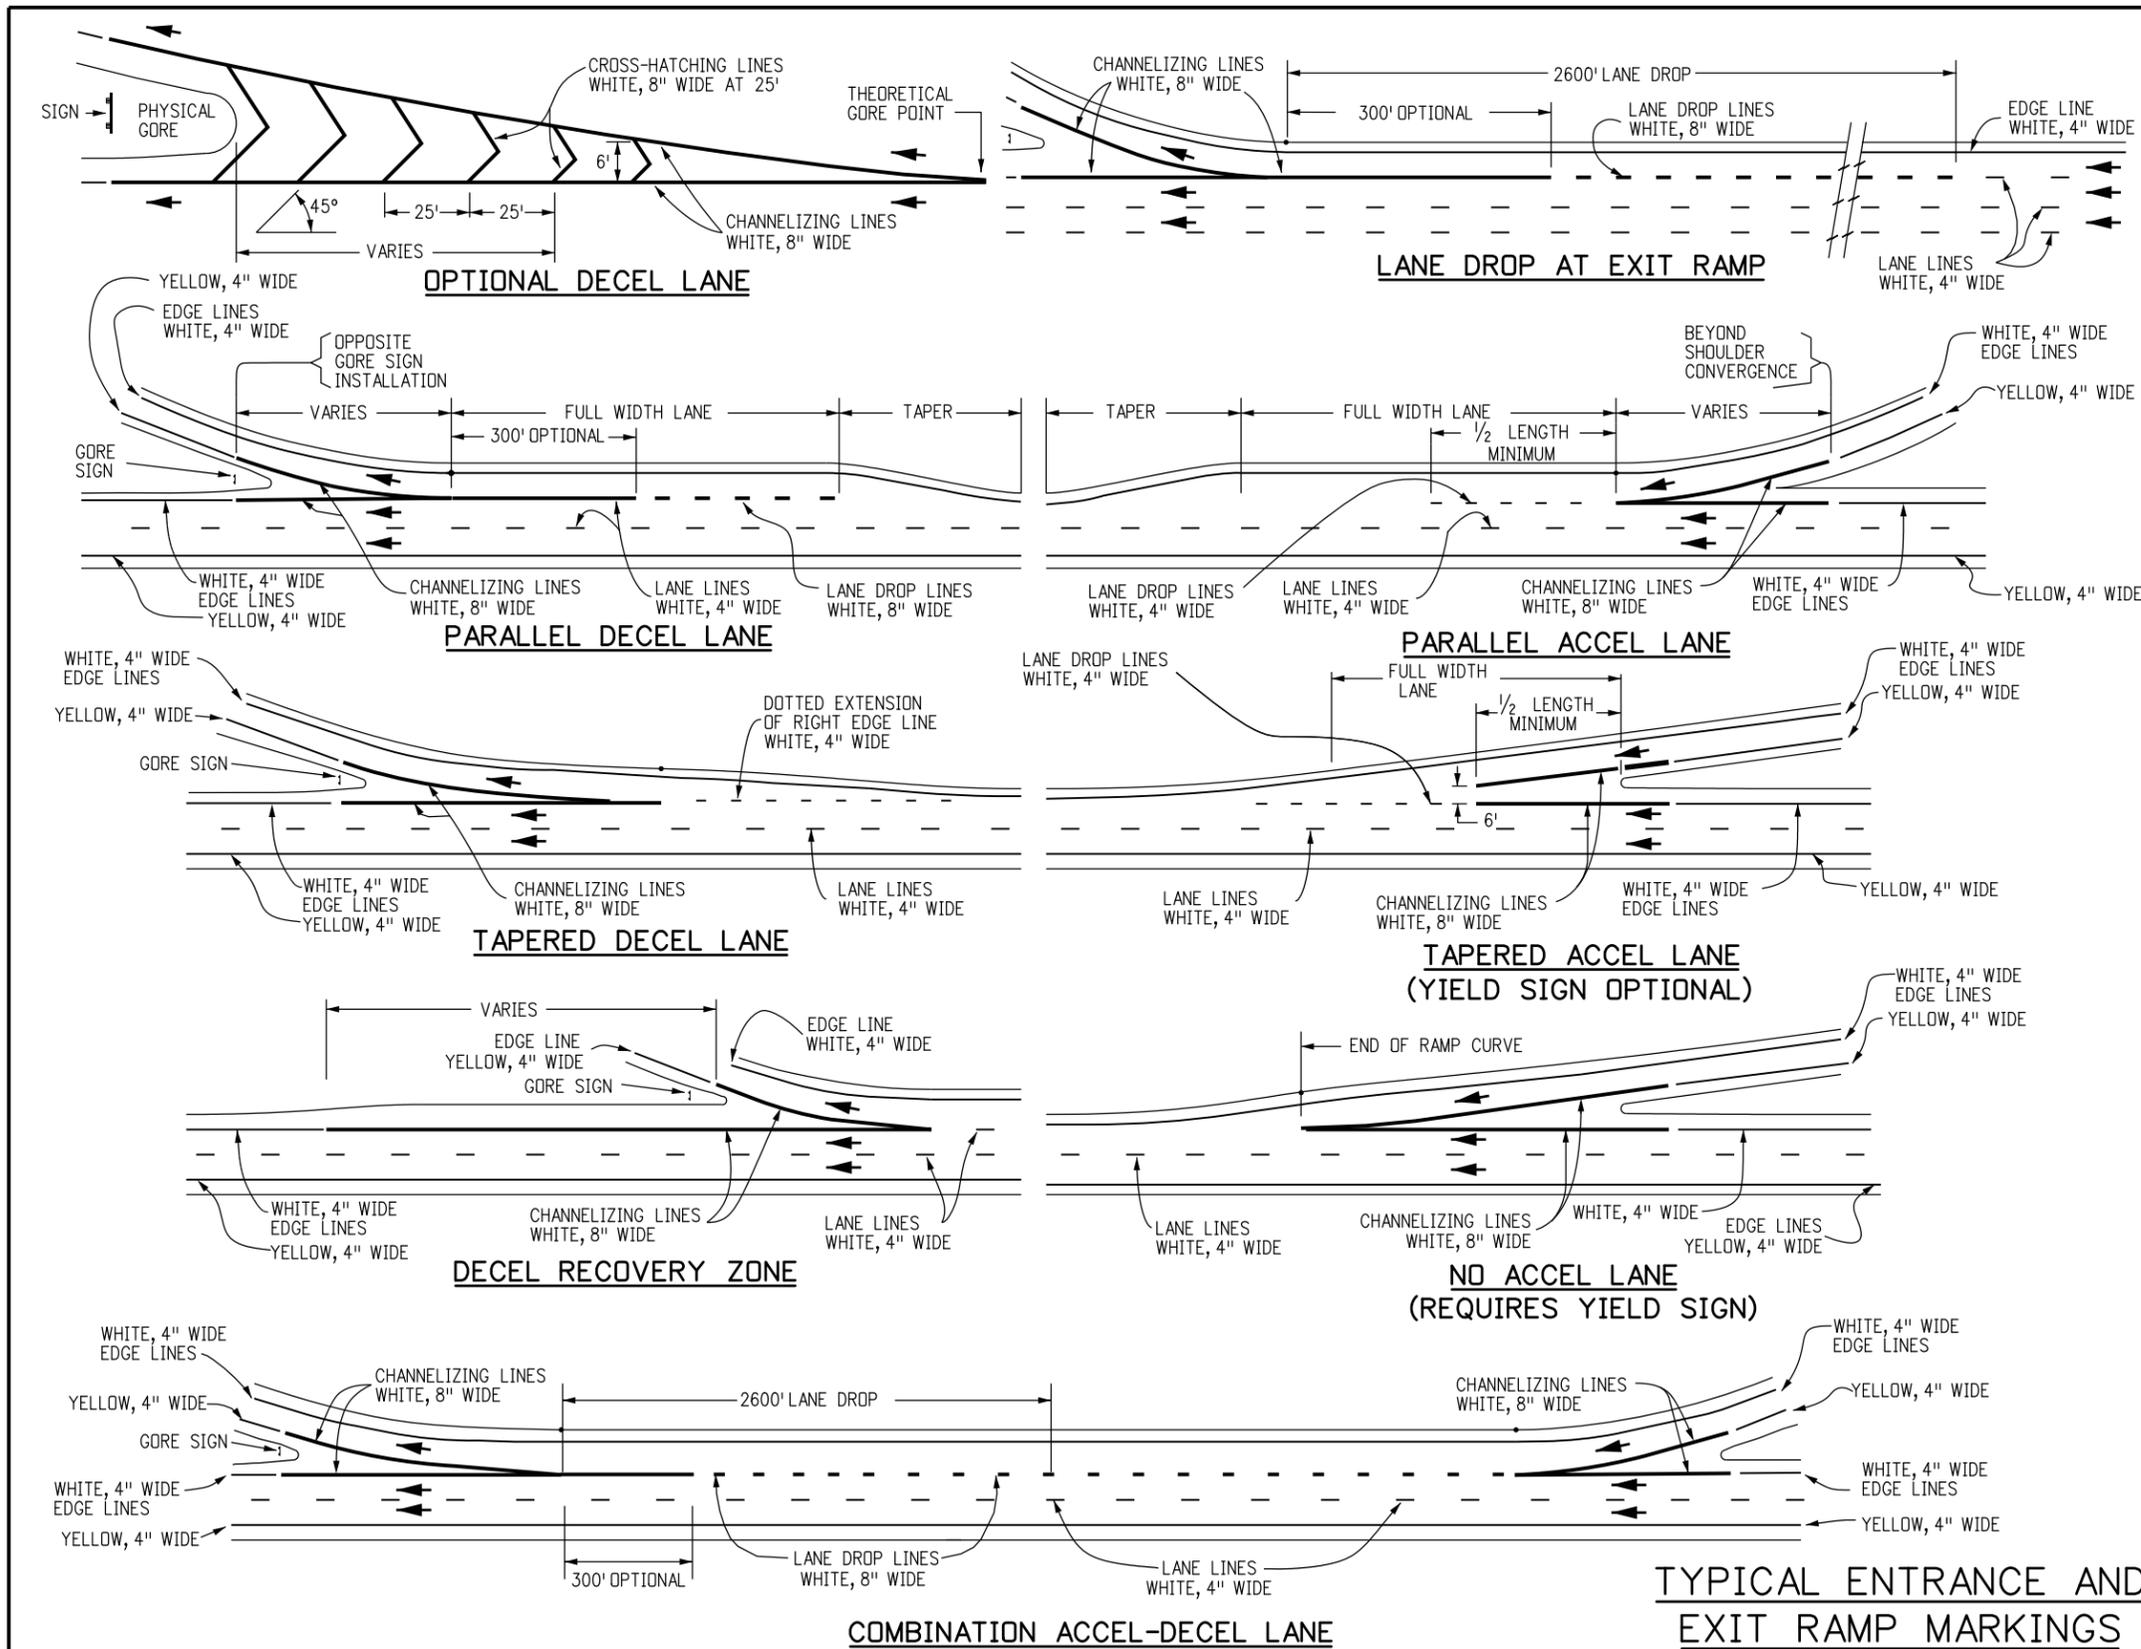









**GENERAL NOTES**

1. **CENTER LINES**  
 BROKEN YELLOW, 4 IN. WIDE - 10 FT. SEGMENTS WITH 30 FT. GAPS.  
 SOLID YELLOW, 4 IN. WIDE.  
 THESE LINES SEPARATE ADJACENT-OPPOSITE DIRECTION TRAFFIC LANES. DOUBLE LINES SHALL BE SPACED 4 IN. APART.
2. **LANE LINES**  
 BROKEN WHITE, 4 IN. WIDE - 10 FT. SEGMENTS WITH 30' GAPS.  
 SOLID WHITE, 4 IN. WIDE.  
 THESE LINES SEPARATE ADJACENT-SAME DIRECTION TRAFFIC LANES. A SOLID LINE MAY BE USED TO DISCOURAGE LANE CHANGING, WHILE TWO PARALLEL SOLID WHITE LINES ARE REQUIRED TO PROHIBIT LANE CHANGING.
3. **EDGE LINES**  
 SOLID WHITE OR YELLOW EDGE LINES SHALL BE 4 IN. WIDE. YELLOW EDGE LINES SHALL BE USED ONLY FOR LEFT EDGE, IN THE DIRECTION OF TRAVEL OF DIVIDED STREETS AND HIGHWAYS (SEPARATED BY OTHER THAN A PAINTED MEDIAN) AND ONE-WAY ROADWAYS (INCLUDING RAMP).  
 EDGE LINES ARE NOT CONTINUED THROUGH INTERSECTIONS AND ARE NOT BROKEN FOR DRIVEWAYS. CARE MUST BE TAKEN TO AVOID EDGE LINE APPEARING AS LANE LINE ALONG ROADWAYS WITH WIDE SHOULDERS AND/OR CLOSELY SPACED DRIVEWAYS.
4. **DOTTED LINES**  
 BROKEN WHITE, WIDTH MATCHING THE LINE BEING EXTENDED-2 FT. SEGMENTS WITH 4 FT. GAPS. THESE LINES ARE USED TO DELINEATE THE EXTENSION OF A LINE THROUGH AN INTERSECTION OR INTERCHANGE AREA.
5. **CHANNELIZING LINES**  
 SOLID WHITE, 8 IN. WIDE. THESE LINES ARE USED WITH ACCELERATION-DECELERATION LANES, PAVEMENT WIDTH TRANSITIONS, AND LEFT-RIGHT TURN SLOTS OR ISLANDS.
6. **CROSS-HATCHING LINES**  
 SOLID WHITE OR YELLOW, 8 IN. WIDE-45 DEGREE DIAGONAL, SPACED AT 25 FT. INTERVALS. THESE LINES ARE OPTIONAL AND MAY BE PLACED AT LOCATIONS INDICATED ON THE PLANS OR DETERMINED BY THE ENGINEER. YELLOW SHALL BE USED FOR PAINTED MEDIANS OR PAVEMENT WIDTH TRANSITIONS ONLY.  
 OPTIONAL DIAGONAL SHOULDER MARKINGS SHALL BE SOLID WHITE, 8 IN. WIDE, SPACED AT INTERVALS OF 20 FT. MINIMUM TO 100 FT. MAXIMUM.
7. **PARKING LINES**  
 SOLID WHITE, 3 IN. WIDE-DIAGONAL OR PARALLEL AS SHOWN ON THE PLANS OR DIRECTED BY THE ENGINEER.
8. **STOP LINES**  
 SOLID WHITE, 24 IN. WIDE-EXTEND PARALLEL TO INTERSECTED ROADWAY ACROSS ALL APPROACH LANES OR AS INDICATED AT LOCATIONS ON THE PLANS. LOCATE AT THE DESIRED STOPPING POINT, NOT MORE THAN 30 FT. NOR LESS THAN 4 FT. FROM THE NEAREST EDGE OF THE INTERSECTED TRAFFIC LANE.
9. **LANE DROP MARKINGS**  
 BROKEN WHITE, 8 IN. WIDE - 3 FT. SEGMENTS WITH 9 FT. GAPS. THESE LINES SHOULD BEGIN 2600 FT. IN ADVANCE OF THE THEORETICAL GORE POINT TO DISTINGUISH THE LANE DROP FROM A CONTINUOUS LANE. THE CHANNELIZING LINE MAY BE EXTENDED APPROXIMATELY 300 FT. UPSTREAM.

(CONTINUED ON SHEET NO. 2)

**TYPICAL ENTRANCE AND EXIT RAMP MARKINGS**

<b>Computer File Information</b>		<b>Sheet Revisions</b>		Colorado Department of Transportation  4201 East Arkansas Avenue Denver, Colorado 80222 Phone: (303) 757-9543 Fax: (303) 757-9219 <b>Safety &amp; Traffic Engineering Branch</b> <b>KCM/KEN</b>	<b>PAVEMENT MARKINGS</b>	<b>STANDARD PLAN NO.</b>
Creation Date: 07/04/12	Initials: SCL	Date: 10/18/12	Comments: SHEET 2 - ADDED "D" NOTE			S-627-1
Last Modification Date: 06/10/14	Initials: KEN	Date: 06/27/13	Comments: SHEET 5 - UPDATED BICYCLIST SYMBOL			Sheet No. 1 of 5
Full Path: www.coloradodot.info/library/traffic/traffic-s-standard-plans		Date: 09/16/13	Comments: UPDATED TYPICAL ISLAND MARKINGS DETAIL			
Drawing File Name: S-627-01_1of5.dgn		Date: 06/16/14	Comments: CORRECTED STRIPING ERROR IN PARALLEL ACCEL LANE DETAIL			
CAD Ver.: MicroStation V8	Scale: Not to Scale	Units: English		Issued By: Safety & Traffic Engineering Branch July 4, 2012		

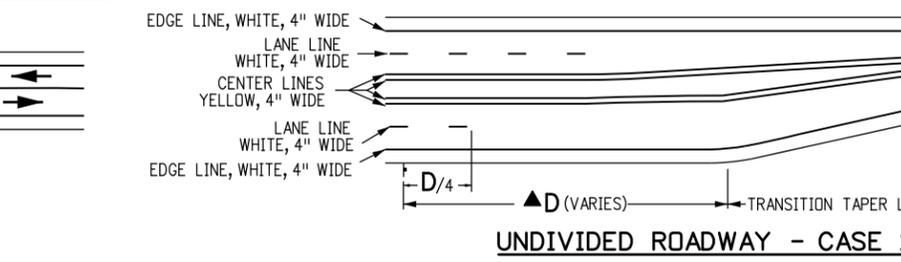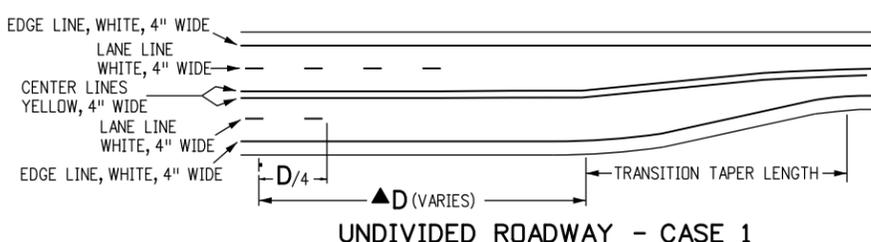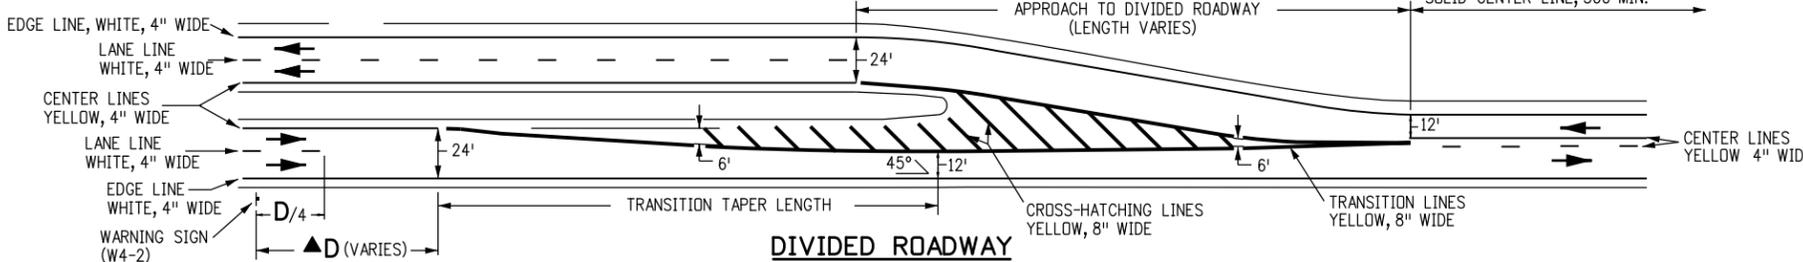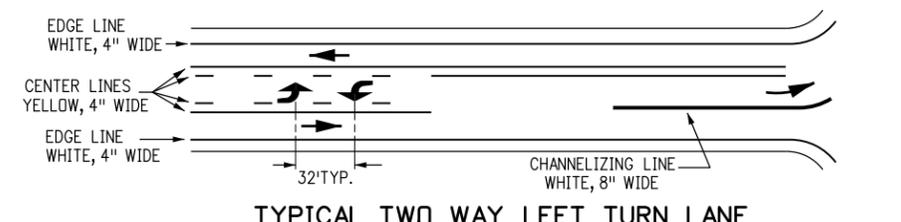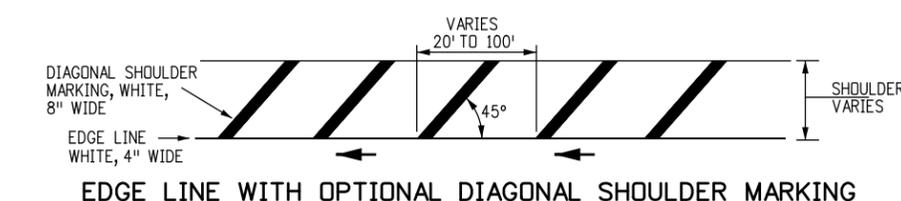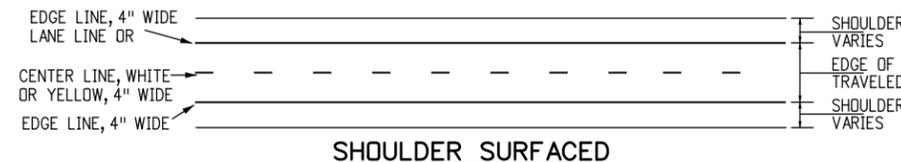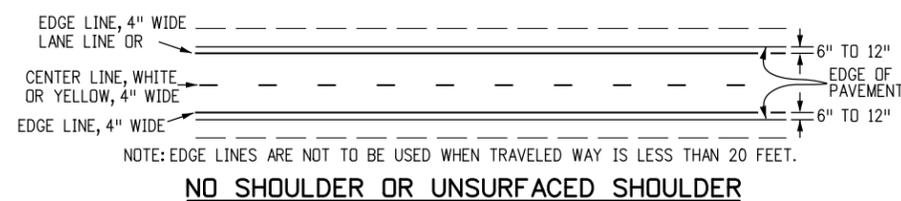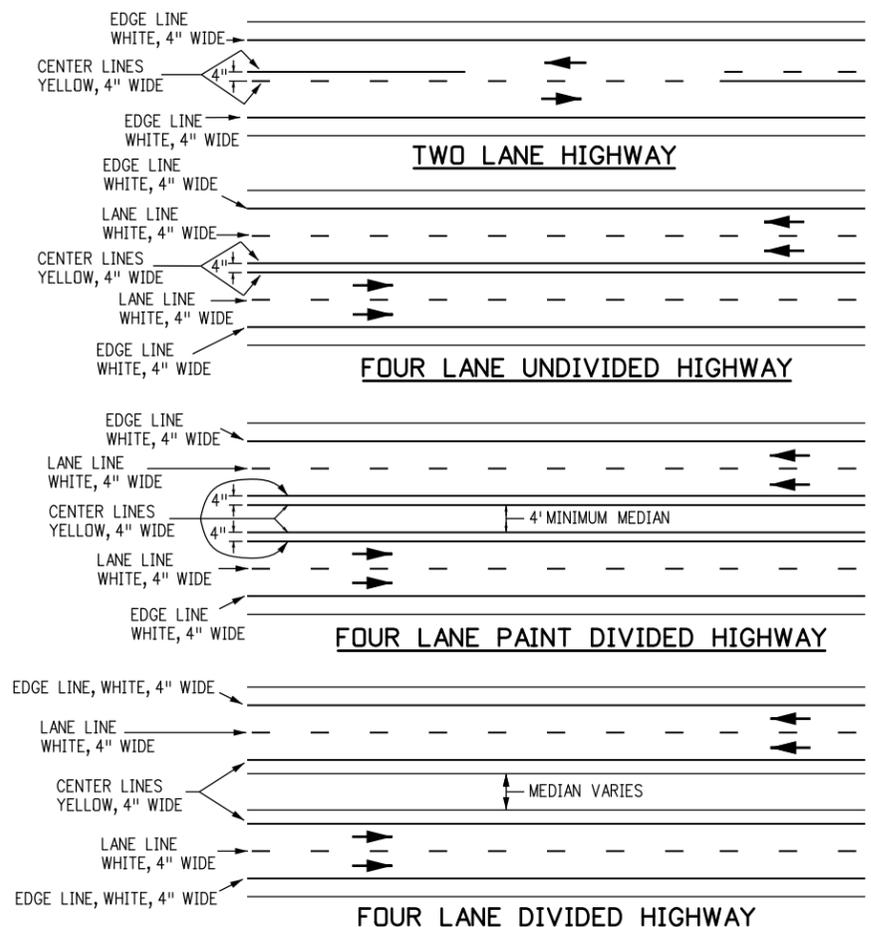

**GENERAL NOTES**  
(CONTINUED FROM SHEET NO. 1)

- CROSSWALK LINES**  
SOLID WHITE, 12 IN. WIDE FOR TRANSVERSE LINE TYPE - EXTEND ACROSS ENTIRE WIDTH OF PAVEMENT. IF NO ADVANCE STOP LINE IS PROVIDED, INCREASE THE WIDTH OF THE CROSSWALK LINES TO 24 IN. THE DISTANCE BETWEEN THE LINES IS USUALLY DETERMINED BY THE WIDTH OF THE SIDEWALKS SO CONNECTED, HOWEVER, IN NO CASE SHALL THIS BE LESS THAN 6 FT.
- COMPLICATED AND/OR CHANNELIZED INTERSECTIONS AND MID-BLOCK CROSSWALKS** SHALL BE SOLID WHITE, 12 IN. TO 24 IN. WIDE AND 8 FT. TO 10 FT. LONG FOR LONGITUDINAL LINE TYPE AS DETAILED IN THE PLANS OR AS DIRECTED BY THE ENGINEER.
- WORD, ARROW AND SYMBOL MARKINGS**  
ALL LETTERS, ARROWS AND SYMBOLS SHALL BE IN CONFORMANCE WITH "THE STANDARD ALPHABETS FOR HIGHWAY SIGNS AND PAVEMENT MARKINGS" ADOPTED BY THE FEDERAL HIGHWAY ADMINISTRATION.
- TRANSITION TAPER LENGTH**  
L = MINIMUM LENGTH OF TAPER.  
S = DESIGN SPEED FOR NEW CONSTRUCTION OR NUMERICAL VALUE OF THE POSTED SPEED LIMIT OF THE 85TH PERCENTILE SPEED OF EXISTING TRAFFIC.  
W = WIDTH TRANSITIONED  
FORMULA: FOR SPEED 45 MPH OR MORE,  $L = S \times W$   
FOR SPEED 40 MPH OR LESS,  $L = \frac{WS^2}{60}$
- TRANSITION LINES**  
SOLID YELLOW, 8 IN. WIDE. THESE LINES ARE USED WHERE ADDITIONAL EMPHASIS OR VISIBILITY IS DESIRABLE AT PAVEMENT WIDTH TRANSITIONS. PLACE AT LOCATIONS INDICATED ON THE PLANS OR AS DIRECTED BY THE ENGINEER.
- SPEED MEASURING MARKING**  
SOLID WHITE, 24 IN. - EXTEND 4 FT. FROM OUTSIDE OF EDGE LINES ON SHOULDERS.

**NOTE:**  
D = THE DISTANCE FROM THE PAVEMENT WIDTH TRANSITION SIGN (W4-2) TO THE BEGINNING OF THE TRANSITION TAPER. FOR MORE INFORMATION ON THE "D" VALUE REGARDING SIGN AND PAVEMENT MARKING PLACEMENT, SEE THE "MANUAL ON UNIFORM TRAFFIC CONTROL DEVICES", TABLE 2C-4, CONDITION A: SPEED REDUCTION AND LANE CHANGING IN HEAVY TRAFFIC AND FOOTNOTE 2 REGARDING TYPICAL CONDITIONS.

**TYPICAL PAVEMENT WIDTH TRANSITION MARKINGS**

Computer File Information	
Creation Date: 07/04/12	Initials: KEN
Last Modification Date: 10/18/12	Initials: SCL
Full Path: www.coloradodot.info/library/traffic/traffic-s-standard-plans	
Drawing File Name: S-627-01_2of5.dgn	
CAD Ver.: MicroStation V8	Scale: Not to Scale Units: English

Sheet Revisions	
Date:	Comments
10/18/12	ADDED MORE NOTES ON "D" VALUE

Colorado Department of Transportation






4201 East Arkansas Avenue  
Denver, Colorado 80222  
Phone: (303) 757-9543  
Fax: (303) 757-9219

**Safety & Traffic Engineering Branch**      **KCM/SCL**

**PAVEMENT MARKINGS**

Issued By: Safety & Traffic Engineering Branch July 4, 2012

STANDARD PLAN NO.
S-627-1
Sheet No. 2 of 5

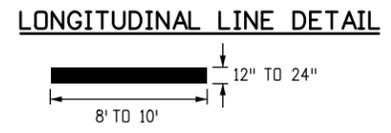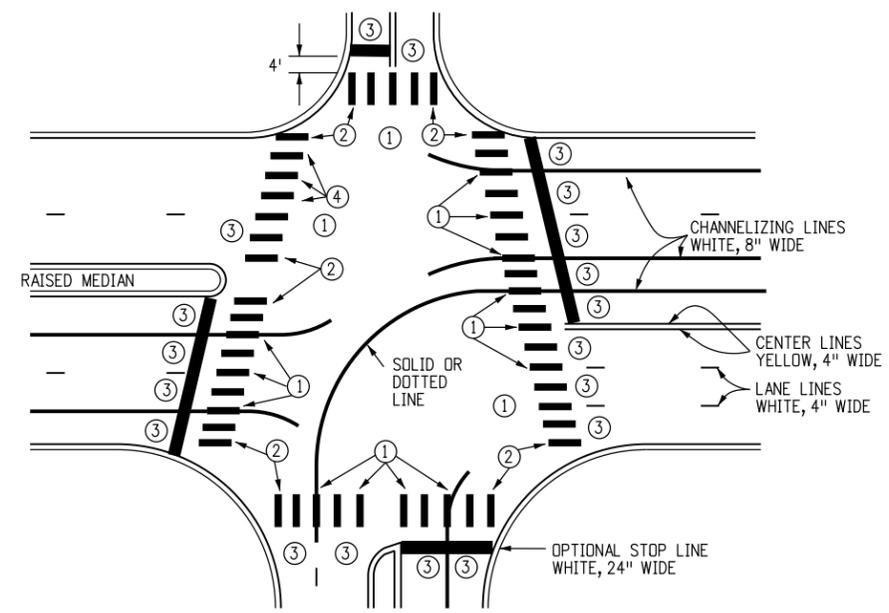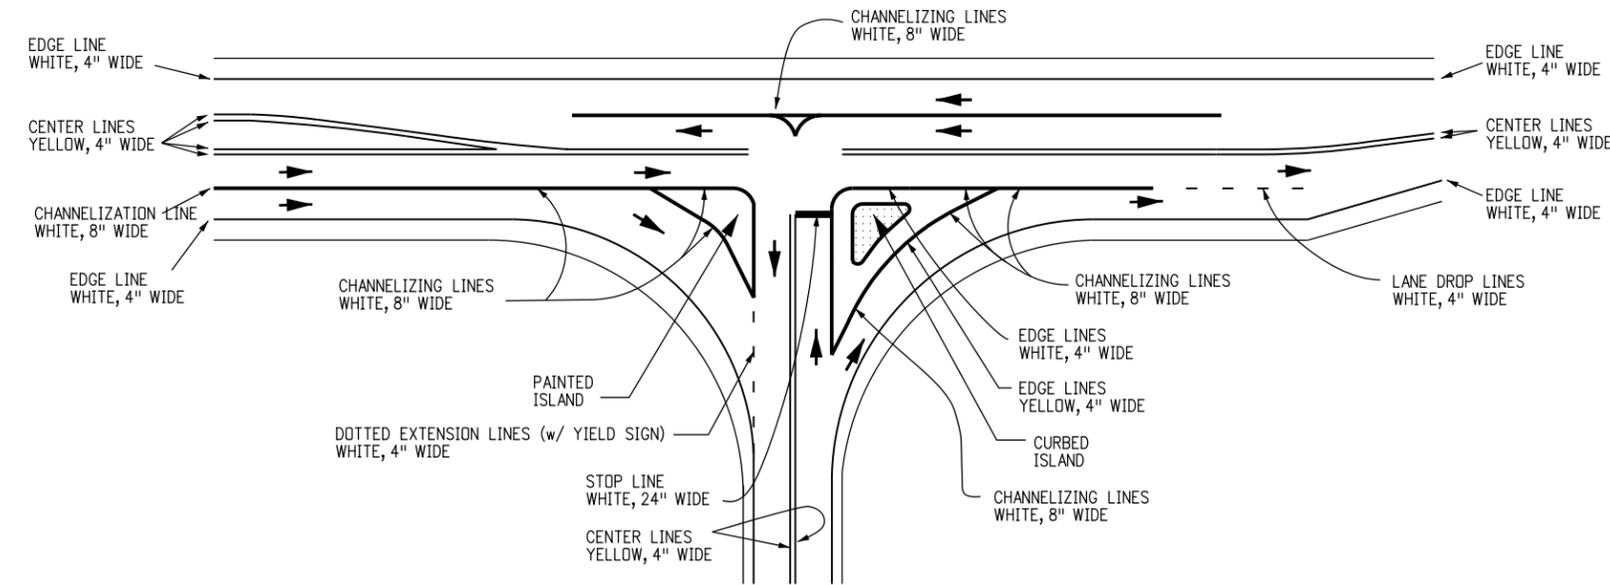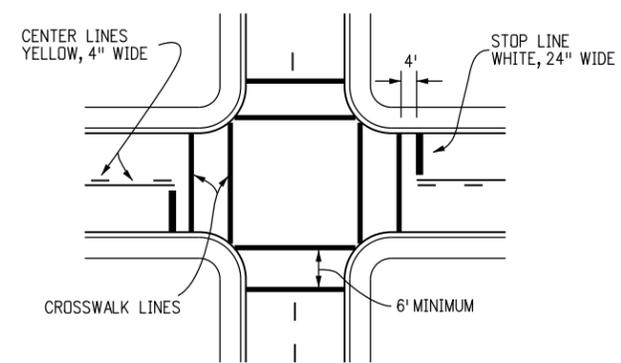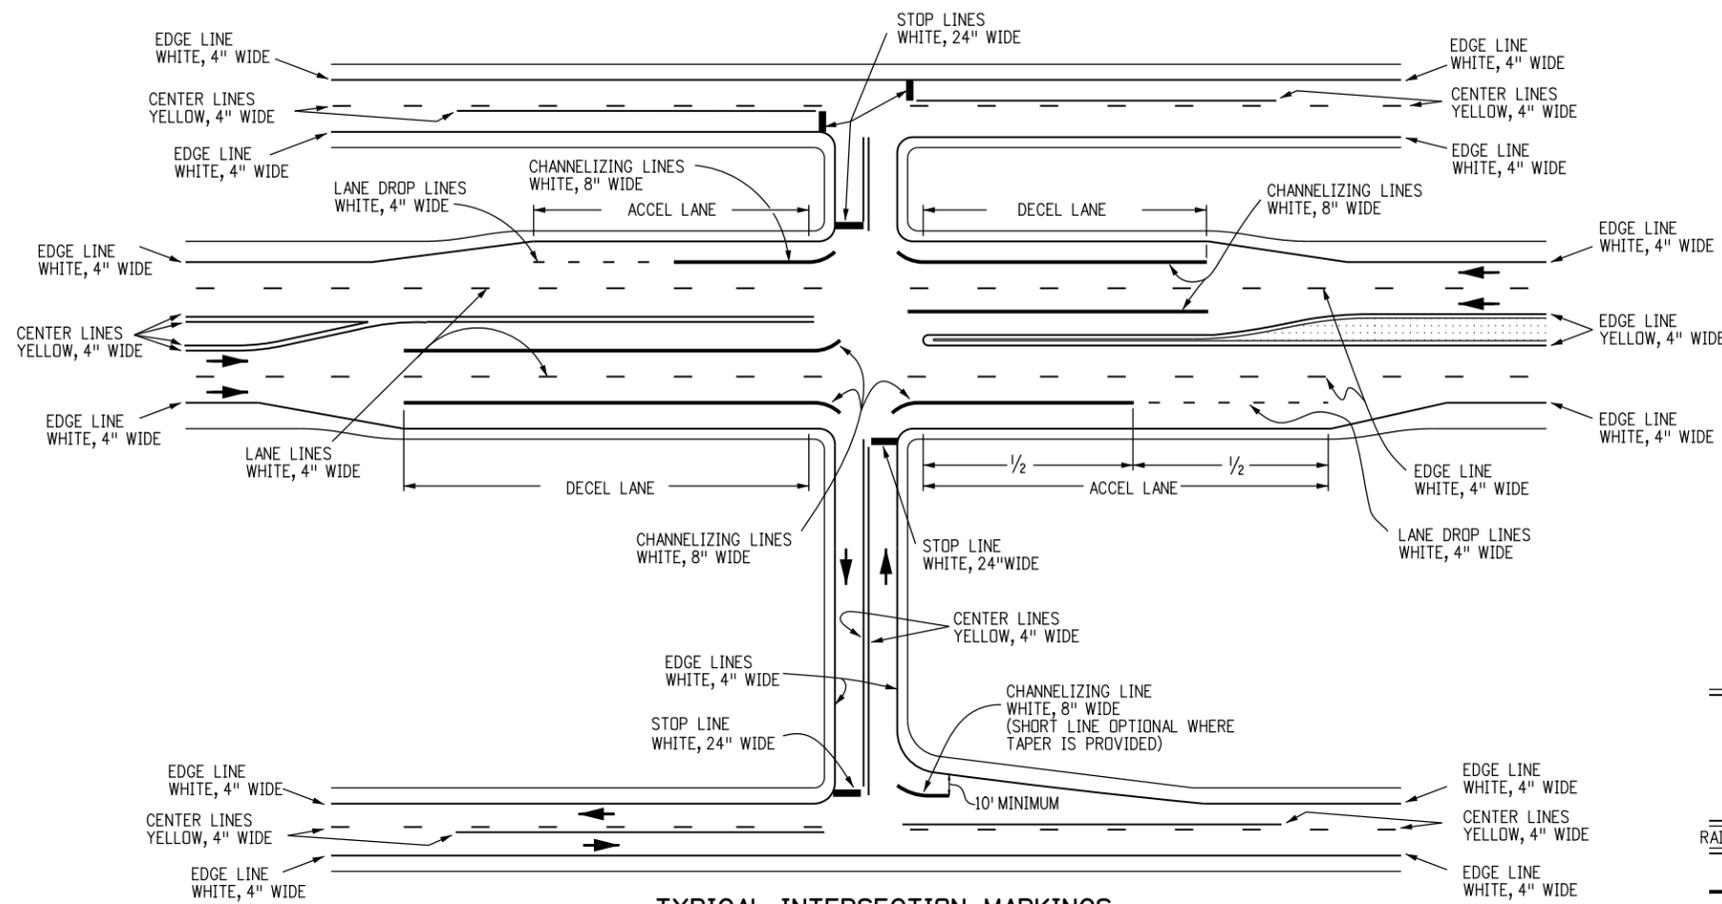

- CROSSWALK NOTES**
- CENTER CROSSWALKS ON CURB RAMPS. IF SUCH RAMPS ARE NOT PROVIDED CENTER ON SIGNAL POLES WHEREVER PRACTICAL.
- ① CENTER ON LANE, CENTER OR CHANNELIZING LINE.
  - ② CENTER OR EXTENDED FLOW LINE.
  - ③ CENTER BETWEEN ADJACENT LINES.
  - ④ LINES AND SPACES TO APPROXIMATE ADJACENT PATTERN.

**INTERSECTIONS, ISLANDS AND CROSSWALKS**

**Computer File Information**

Creation Date: 07/04/12	Initials: JSW
Last Modification Date: 09/16/13	Initials: KEN
Full Path: www.coloradodot.info/library/traffic/traffic-s-standard-plans	
Drawing File Name: S-627-01_3of5.dgn	
CAD Ver.: MicroStation V8	Scale: Not to Scale Units: English

**Sheet Revisions**

Date:	Comments
09/16/13	ADDED ACCEL LANE IN TYP. ISLAND MARKING DETAIL

Colorado Department of Transportation  
 4201 East Arkansas Avenue  
 Denver, Colorado 80222  
 Phone: (303) 757-9543  
 Fax: (303) 757-9219

**Safety & Traffic Engineering Branch**      **KCM/KEN**


**PAVEMENT MARKINGS**

Issued By: Safety & Traffic Engineering Branch July 4, 2012


**STANDARD PLAN NO.**

S-627-1


Sheet No. 3 of 5

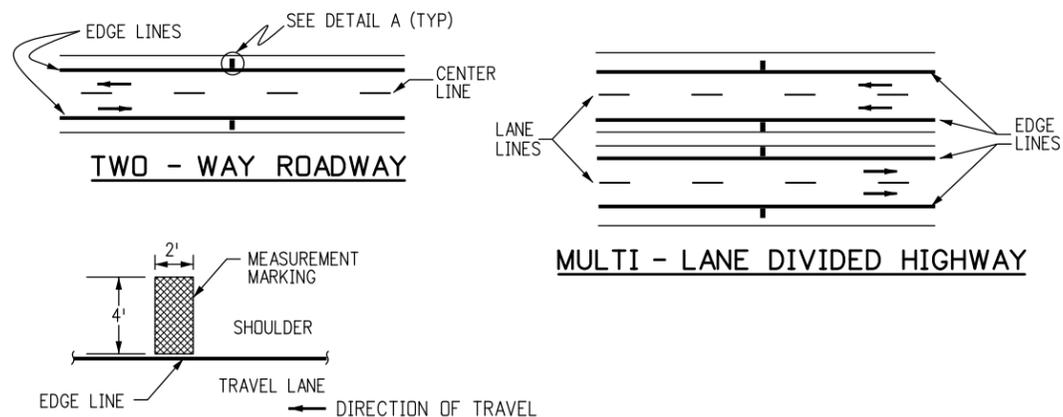

**DETAIL A**  
**TYPICAL SPEED MEASUREMENT MARKING**

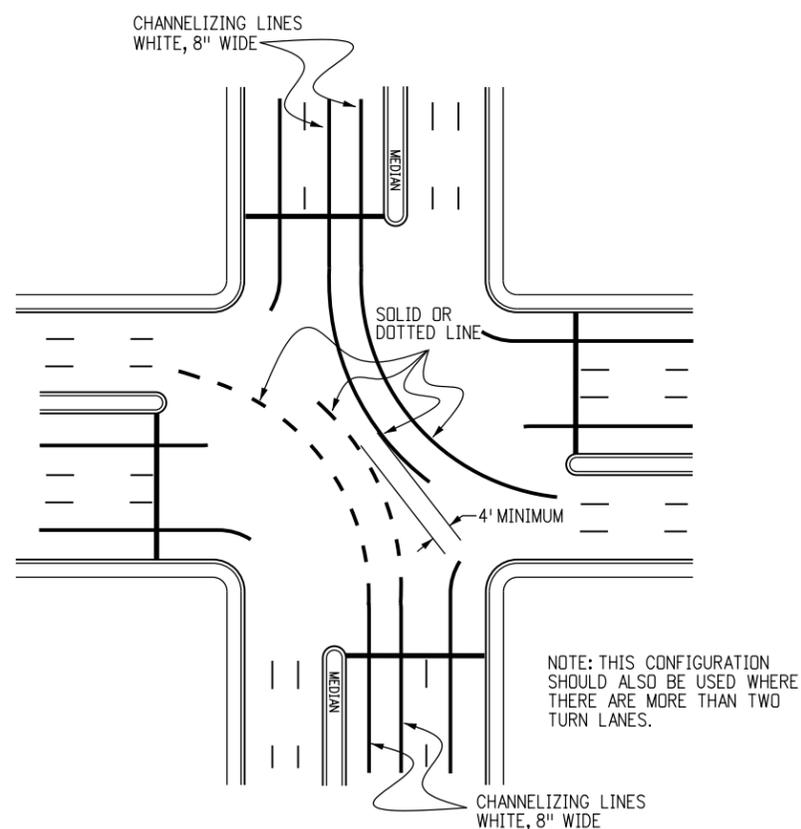

**TYPICAL DOUBLE LEFT TURN MARKINGS**

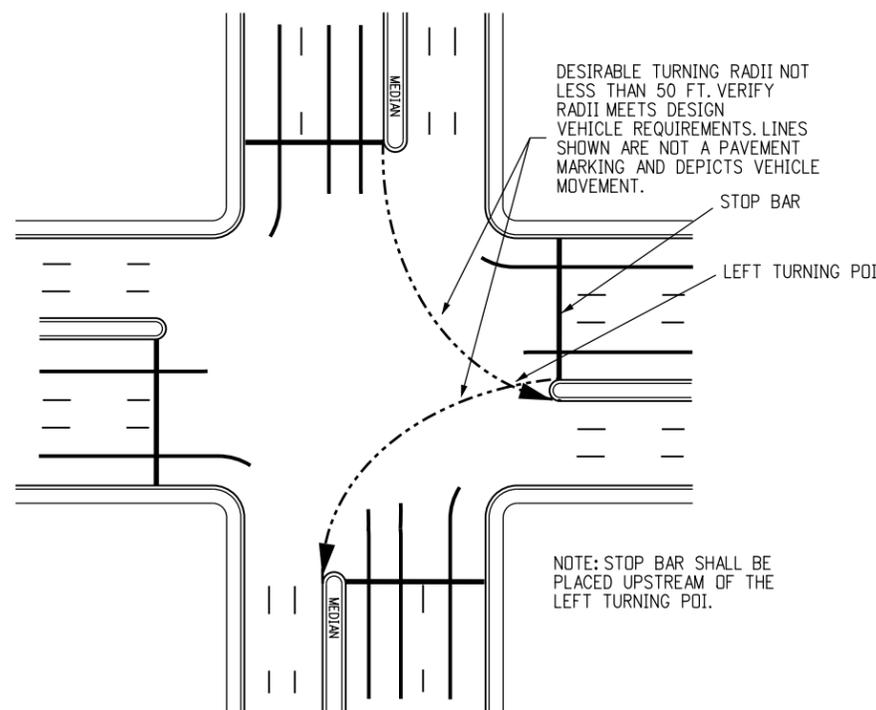

**TYPICAL STOP BAR PLACEMENT**

Computer File Information	
Creation Date: 07/04/12	Initials: SCL
Last Modification Date:	Initials:
Full Path: www.coloradodot.info/library/traffic/traffic-s-standard-plans	(R-X)
Drawing File Name: S-627-01_4of5.dgn	(R-X)
CAD Ver.: MicroStation V8 Scale: Not to Scale Units: English	(R-X)

Sheet Revisions	
Date:	Comments




Colorado Department of Transportation  
 4201 East Arkansas Avenue  
 Denver, Colorado 80222  
 Phone: (303) 757-9543  
 Fax: (303) 757-9219

**Safety & Traffic Engineering Branch**      **KCM/SCL**

**PAVEMENT MARKINGS**

Issued By: Safety & Traffic Engineering Branch July 4, 2012

STANDARD PLAN NO.
S-627-1
Sheet No. 4 of 5

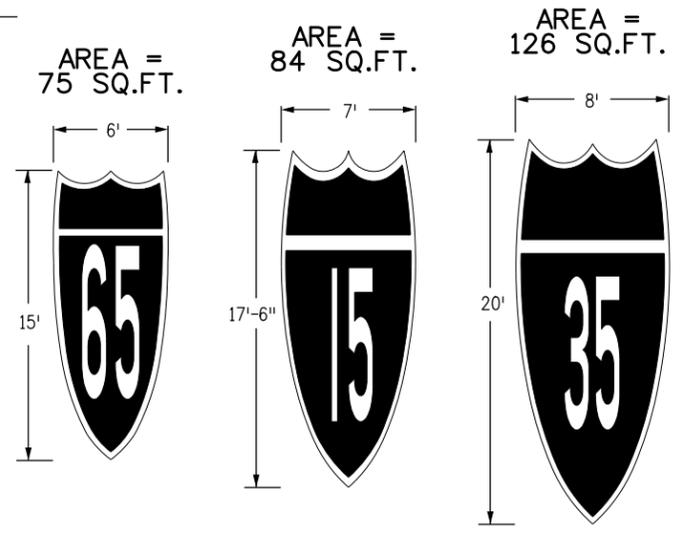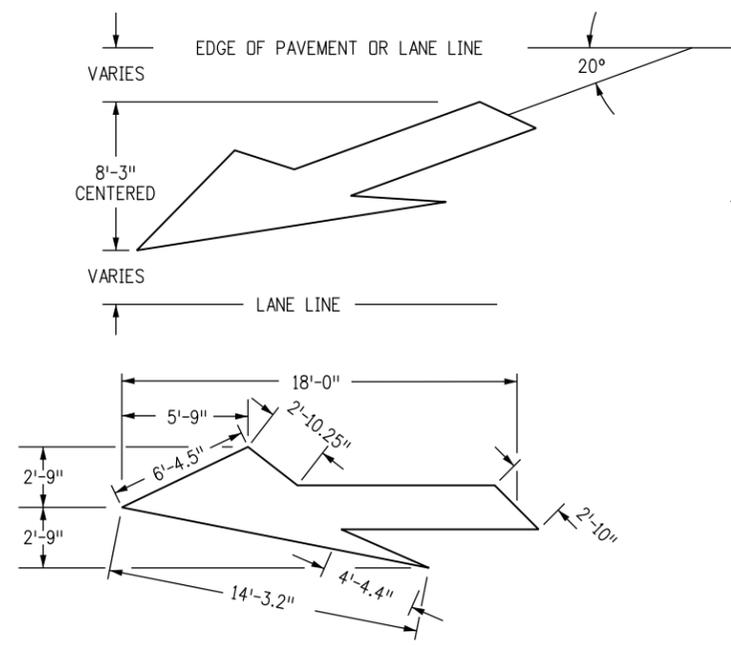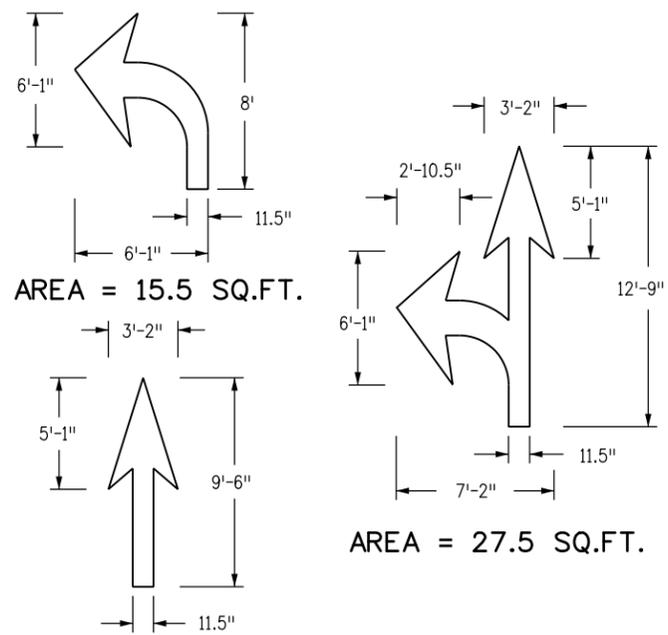


**ELONGATED ROUTE SHIELDS**

**ELONGATED ROUTE SHIELD NOTES**

ELONGATED ROUTE SHIELDS SHALL BE AT LEAST 8'x20' WHEN USED ON HIGH SPEED ROADWAYS (45 MPH OR MORE).  
 PER FIGURE 3B-25 OF THE 2009 MUTCD ELONGATED ROUTE SHIELD COLORS SHALL CONFORM WITH THE STANDARD HIGHWAY SIGNS AND MARKINGS BOOK.

**DESIGNATED PAYMENT AREAS**

- FOR THE FOLLOWING H, W, AND S DIMENSIONS PAY:
- H = 4' WORDS**
- BIKE - 5.5 SQ.FT.
  - LANE - 6.0 SQ.FT.
  - ONLY - 6.0 SQ.FT.
  - XING - 5.0 SQ.FT.
- H = 8' WORDS**
- STOP - 23.0 SQ.FT.
  - ONLY - 22.5 SQ.FT.
  - AHEAD - 29.0 SQ.FT.
  - BUS - 18.5 SQ.FT.
  - THRU - 22.0 SQ.FT.
  - PED - 17.5 SQ.FT.
  - XING - 20.0 SQ.FT.
  - LANE - 22.5 SQ.FT.
  - BIKE - 21.0 SQ.FT.
  - HWY - 16.5 SQ.FT.
  - SCHOOL(1L) - 33.0 SQ.FT.
  - SCHOOL(2L) - 85.0 SQ.FT.


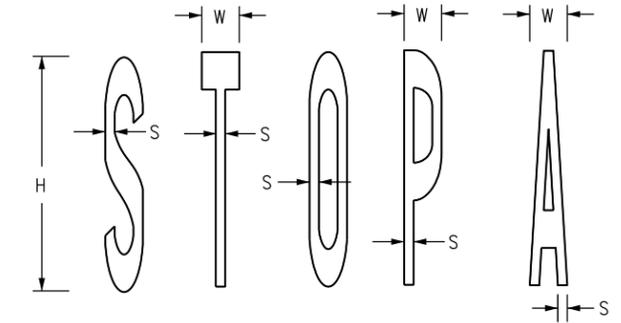


H = HEIGHT  
 W = WIDTH  
 S = STROKE


H = 8'  
 W = 1'-3.4" TO 1'-4"  
 S = 3.8" TO 4"

H = 4'  
 W = 7.7" TO 8"  
 S = 1.9" TO 2"


**TYPICAL LETTER MEASUREMENTS**

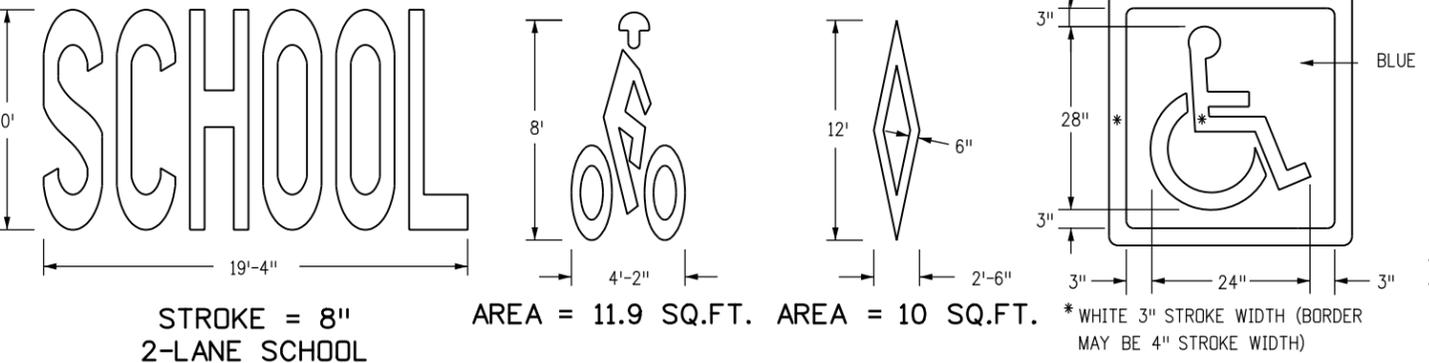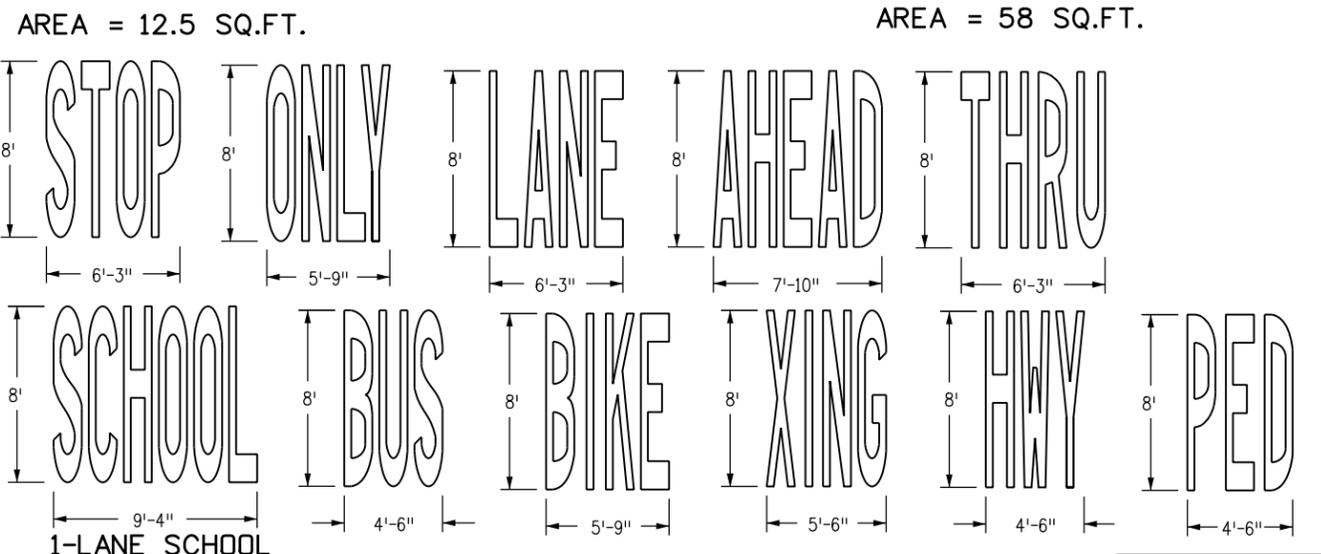

**PAVEMENT MARKING WORDS AND SYMBOLS**

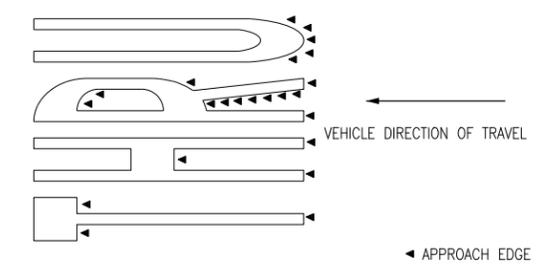

**TYPICAL APPROACH EDGE TAPERING PROFILE VIEW**

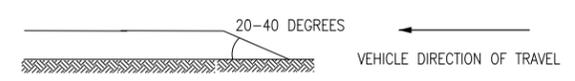

**WORD AND SYMBOL NOTES**

IF HEIGHT IS INCREASED OR DECREASED THEN ALL MEASUREMENTS CHANGE PROPORTIONATELY. EXAMPLE: "H" MEASUREMENT FOR STOP IS REDUCED TO 4' FROM 8' THEN SQUARE FEET = 5.75 (1/4 OF 23.0 SQ. FT.).

PAVEMENT WORD AND SYMBOL MARKINGS, TRANSVERSE AND LONGITUDINAL (CONTINENTAL) CROSSWALK LINES, AND STOP LINES WILL BE PAID FOR IN SQUARE FEET USING THEIR SPECIFIC BID ITEMS.

**TAPERING NOTES**

ALL PAVEMENT MARKING APPROACH EDGES FROM THE VEHICLE DIRECTION OF TRAVEL SHALL BE TAPERED USING A PUTTY KNIFE OR SIMILAR TOOL.

Computer File Information	
Creation Date: 07/04/12	Initials: SCL
Last Modification Date: 06/27/13	Initials: KEN
Full Path: www.coloradodot.info/library/traffic/traffic-s-standard-plans	
Drawing File Name: S-627-01_5of5.dgn	
CAD Ver.: MicroStation V8 Scale: Not to Scale Units: English	

Sheet Revisions	
Date:	Comments
06/27/13	UPDATED BICYCLIST SYMBOL

Colorado Department of Transportation

4201 East Arkansas Avenue  
 Denver, Colorado 80222  
 Phone: (303) 757-9543  
 Fax: (303) 757-9219

**Safety & Traffic Engineering Branch** KCM/KEN

**PAVEMENT MARKINGS**

Issued By: Safety & Traffic Engineering Branch July 4, 2012

**STANDARD PLAN NO.**

S-627-1

Sheet No. 5 of 5