

AS CONSTRUCTED		
NO REVISIONS <input type="checkbox"/>	REVISED <input checked="" type="checkbox"/>	VOID <input type="checkbox"/>

9/19/97  
Construction Subaccount: 10486

REVISIONS			

**COLORADO  
DEPARTMENT OF TRANSPORTATION**

COLORADO PROJECT NO. MC C510-005

EISENHOWER-JOHNSON MEMORIAL TUNNEL

INDEX OF PLANS

	<u>Page No.</u>
INDEX OF PLANS.....	1
PROJECT LOCATION MAP.....	2
STANDARD PLANS LIST.....	3
DESCRIPTION OF PROJECT.....	4
GENERAL NOTES.....	5-6
SUMMARY OF <del>APPROXIMATE</del> <sup>FINAL</sup> QUANTITIES.....	7
SITE PLAN.....	8
UNDERGROUND STORAGE SYSTEM ELEVATION.....	9
UNDERGROUND STORAGE SYSTEM DETAIL.....	10
PIPE DETAIL.....	11
SILT DIKE DETAIL.....	12
SURVEY TABULATION SHEET.....	13-14

No REVISIONS

3 - 6, 8 - 10, 12 - 14

FWHA OVERSIGHT  
YES  NO

AS CONSTRUCTED  
NO REVISIONS  REVISED 9/19/97 VOID


EISENHOWER-JOHNSON MEMORIAL TUNNEL  
CONSTRUCTION SUBACCOUNT NO 10486

COLORADO  
DEPARTMENT OF TRANSPORTATION

COLORADO PROJECT NUMBER MC C510-005

STATE HIGHWAY NO. 1-70

CLEAR CREEK COUNTY

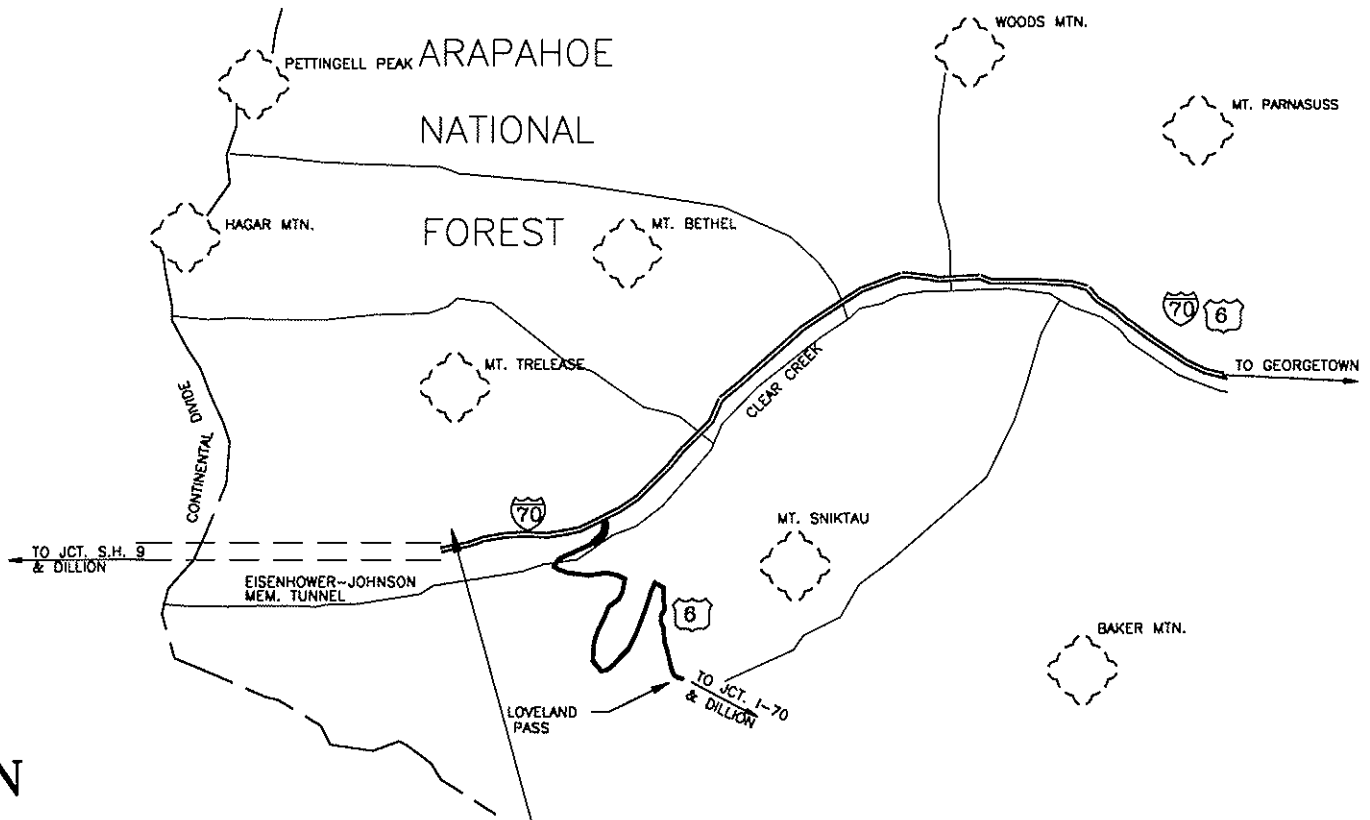

MAP NOT TO SCALE

LOCATION OF PROJECT  
M.P. 216 ON I-70 EAST BOUND

AS CONSTRUCTED INFORMATION

CONTRACTOR	<u>Duckels Construction</u>
PROJECT ENGINEER	<u>Brian Gilbert</u>
(Project or Resident)	
PROJECT STARTED	<u>8/01/97</u>
PROJECT COMPLETED	<u>9/12/97</u>
AS CONSTRUCTED PLANS	
APPROVED	<i>[Signature]</i>
TITLE	<u>11/6/97</u>
DATE	

G.L.M./REGION 1



AS CONSTRUCTED					
NO REVISIONS	<input checked="" type="checkbox"/>	REVISED	<input type="checkbox"/>	VOID	<input type="checkbox"/>

9/19/97

## DESCRIPTION OF PROJECT

This project is located on State Highway I-70 Westbound in Clear Creek County, Colorado. The project site is located at Mile Post 216 outside East Portal of the Eisenhower Tunnel within north-eastern parking lot.

The work shall consist of:

1. Provide and install a new 40,000 gal. emergency spill underground storage system at the specified location.
2. Provide and install a double wall delivery piping system from the existing pipe to the new tank as shown.
3. After the new system is operational, fill and plug the existing 20,000 gal. underground metal storage tank (tank has never been used).

AS CONSTRUCTED					
NO REVISIONS	<input checked="" type="checkbox"/>	REVISED	<input type="checkbox"/>	VOID	<input type="checkbox"/>
	9/19/97				

## GENERAL NOTES

It is estimated that one 20,000 gal. underground metal storage tank will be filled and plugged on this project. This work will be paid for as a pay item 202-Plug Storage Tank. Removal of vent and manhole will be incidental to the work and will not be paid for separately. Contractor shall supply method of filling and plugging the tank to the Engineer for approval.

It is estimated that 1000 lineal feet of temporary fence will be required on this project.

It is estimated that 100 lineal feet of silt dike will be required on this project.

All excess excavation on this project shall become the property of the Contractor.

New piping system shall be connected to the existing 6 inch cast iron pipe at the indicated location. Contractor shall submit the detail to the Engineer for approval.

The Contractor is responsible to maintain a continuous traffic flow and an asphalt surface of the approach to the parking lot and the loop road.

Concrete barriers Type 4 (temporary) will be required on this project along both roadways. The length of the barrier along each roadway shall be extended 75 feet beyond each side of the excavated trench. Barriers shall be in accordance with M & S Standards M-606-12 and S-603-2. Barrier reflectors shall be placed at 30 ft intervals and will not be paid for separately. Placement of the barriers shall be approved by the Engineer. Barriers will not be paid for separately but included in the price of the work.

The existing utility lines are as shown on the drawings. Any additional information regarding utility lines at the project site can be obtained by the Contractor from the Eisenhower Tunnel Maintenance Section tel. (303) 623-7705, Rick Steele. All affected utility lines protection will be responsibility of the Contractor and shall not be paid for separately.

All traffic control required will be incidental to the work and will not be paid for separately.

CDOT will provide all required traffic cones and drum channelizing devices.

Contractor is to protect the existing culverts during construction operations.

HBP design shall be submitted to the Engineer for approval.

AS CONSTRUCTED		
NO REVISIONS	<input checked="" type="checkbox"/>	REVISED
	9/19/97	VOID

**NATIVE SEEDING**

Soil preparation, fertilizer, seeding and mulching will be required for an estimated 0.3 acres of disturbed area within the right-of-way limits which are not surfaced. The following types and rates shall be used:

COMMON NAME	BOTANICAL NAME	LBS PLS/ACRE
Alpine bluegrass	Poa alpina	2
Canada bluegrass v. Reubens	Poa compressa	1
Sheep fescue v. Durar	Festuca ovina	2.5
Tufted hairgrass	Deschampsia caespitosa	0.5
Sandberg bluegrass	Poa sandbergii	2
Alsike clover	Trifolium hybridum	1
Yarrow	Achillea millefolium	0.1
Rocky Mtn. Penstemon	Penstemon strictus	1
	<b>TOTAL:</b>	10.1

FERTILIZER	LBS/ACRE AVAILABLE
NITROGEN:	80
PHOSPHORUS:	40
POTASSIUM:	75

**SEEDING APPLICATION:** Hand place and rake to a depth of .25"-.5" into the topsoil.

**MULCHING APPLICATION:** 1 ½ tons of certified weed free native hay per acre crimped into the topsoil.

**SPECIAL REQUIREMENTS:** Delete the fertilizer where sites are adjacent to water ways.

**Project Totals:**

212 Seeding (Native)	0.3 acre
213 Mulching (Weed Free)	0.3 acre
◆212 Fertilizer (Available N)	24.0 lbs
◆212 Fertilizer (Available K)	12.0 lbs
◆212 Fertilizer (Available P)	22.5 lbs
◆212 Soil Preparation	0.3 acre
Note: ◆ For Information Only	

AS CONSTRUCTED			
NO REVISIONS	<input type="checkbox"/>	REVISED	<input checked="" type="checkbox"/>
		9/19/97	VOID <input type="checkbox"/>


~~APPROXIMATE~~ <sup>FINAL</sup> SUMMARY OF QUANTITIES

CONTRACT ITEM No.	CONTRACT ITEM	UNIT	ROADWAY			
			PLAN	AS CONST.		
202	PLUG STORAGE TANK	EACH	1	1		
206	STRUCTURE BACKFILL (SPECIAL) (FLOW-FILL)	CY	77	72		
208	SILT DIKE	LF	100	100		
212	SEEDING (NATIVE)	AC	0.30	0.30		
213	MULCHING (WEED FREE)	AC	0.30	0.30		
603	6" PLASTIC PIPE (SPECIAL)(FRP)	LF	210	222		
607	FENCE (TEMPORARY)	LF	1000	1000		
622	STORAGE TANK (40,000 GAL.)	EACH	1	1		
625	CONSTRUCTION SURVEYING	LS	1	1		
626	MOBILIZATION	LS	1	1		
	<u>FORCE ACCOUNT</u>					
700	F/A MINOR CONTRACT REVISIONS	FA	1	0		
700	F/A OJT PILOT	FA	1	0		
700	F/A ESB	FA	1	0		


AS CONSTRUCTED		
NO REVISIONS	<input checked="" type="checkbox"/>	REVISED
		VOID

9/19/97

SITE PLAN

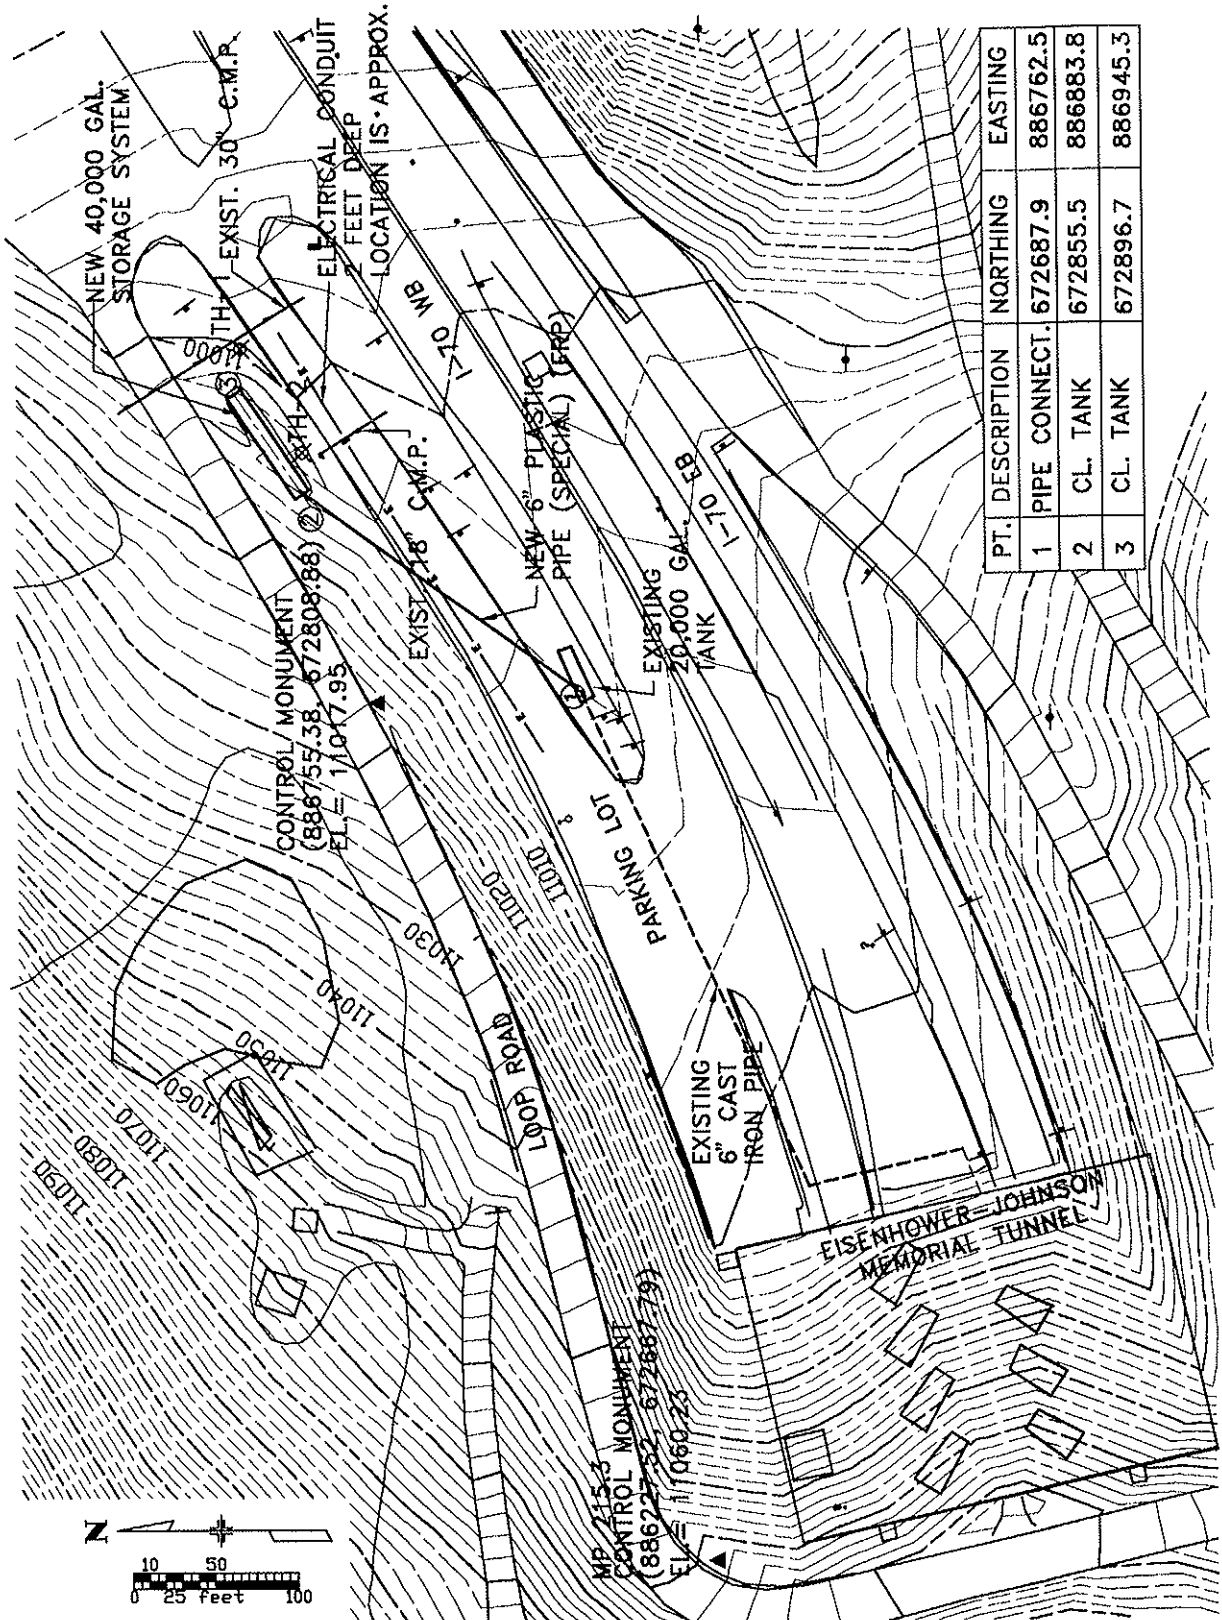

PT.	DESCRIPTION	NORTHING	EASTING
1	PIPE CONNECT.	672687.9	886762.5
2	CL. TANK	672855.5	886883.8
3	CL. TANK	672896.7	886945.3

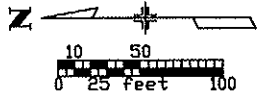






AS CONSTRUCTED			
NO REVISIONS	<input checked="" type="checkbox"/>	REVISED	<input type="checkbox"/>
	9/19/97		<input type="checkbox"/>

**UNDERGROUND STORAGE SYSTEM  
DETAIL**

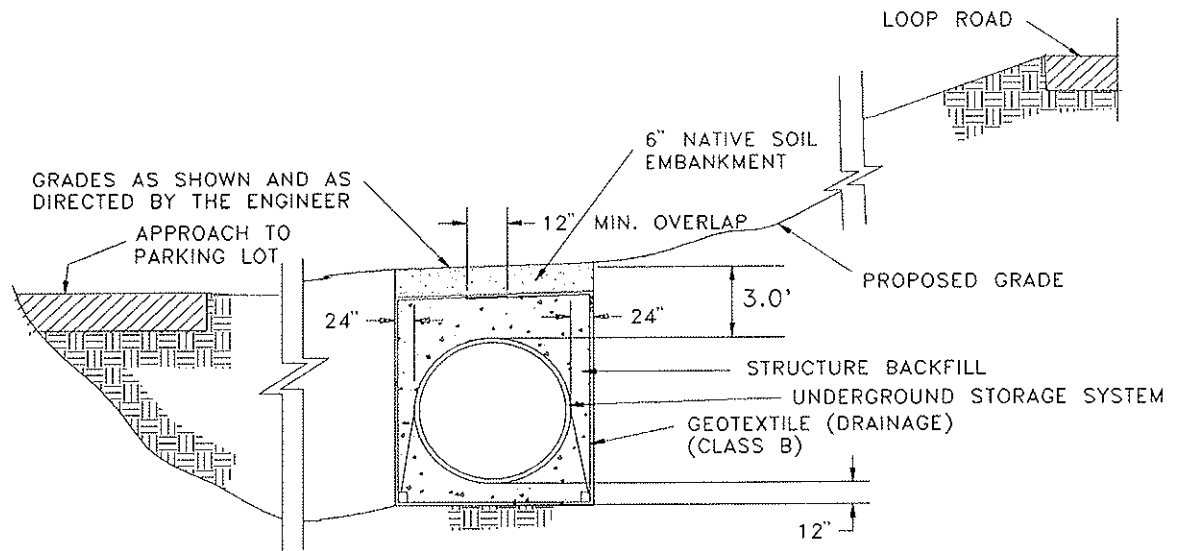

**NOTE:**

1. Final grading will be incidental to the tank(s) installation and will not be paid for separately.
2. Underground storage system will be paid for as a pay item 622 Storage Tank (40,000 gal.).

**QUANTITIES**

ITEM No.	DESCRIPTION	UNIT	QUANTITY
622	STORAGE TANK (40,000 GAL.)	EACH	1

**(FOR INFORMATION ONLY)**

ITEM No.	DESCRIPTION	UNIT	QUANTITY
203	EMBANKMENT (CIP)	CU. YD.	222.0 ▲
206	STRUCTURE EXCAVATION	CU. YD.	639.0
206	STRUCTURE BACKFILL	CU. YD.	390.0 ❖
420	GEOTEXTILE (DRAINAGE) (CLASS B)	SQ. YD.	21.0

❖ Excludes volume of the tank

▲ Includes 22 cu. yd. of 6" native soil embankment and 200 cu. yd. of final grading.


**Note:** Quantities are based on dimensions shown and a tank size 10.5' dia. X 74' long.

AS CONSTRUCTED		
NO REVISIONS	<input checked="" type="checkbox"/>	REVISED <input type="checkbox"/>
		VOID <input type="checkbox"/>


9/19/97

## SILT DIKE DETAIL

TRIANGULAR SILT DIKE INSTALLATION  
 FOR  
 ROADWAY DITCH OR DRAINAGE DITCH

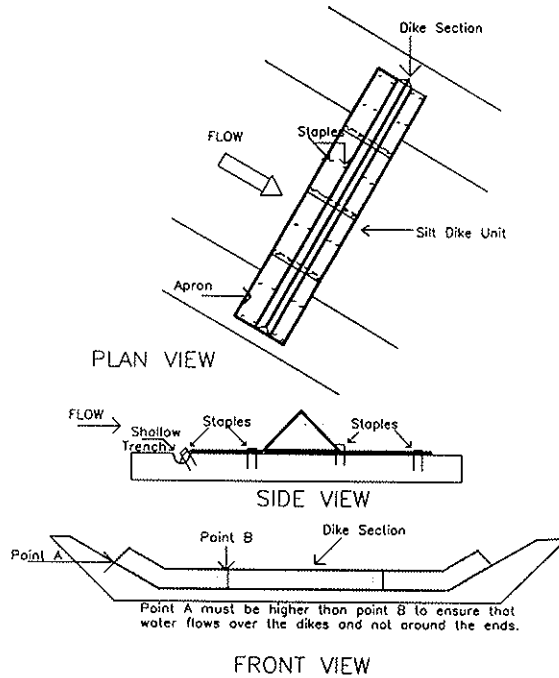

TRIANGULAR SILT DIKE INSTALLATION  
 FOR  
 CONTINUOUS BARRIER

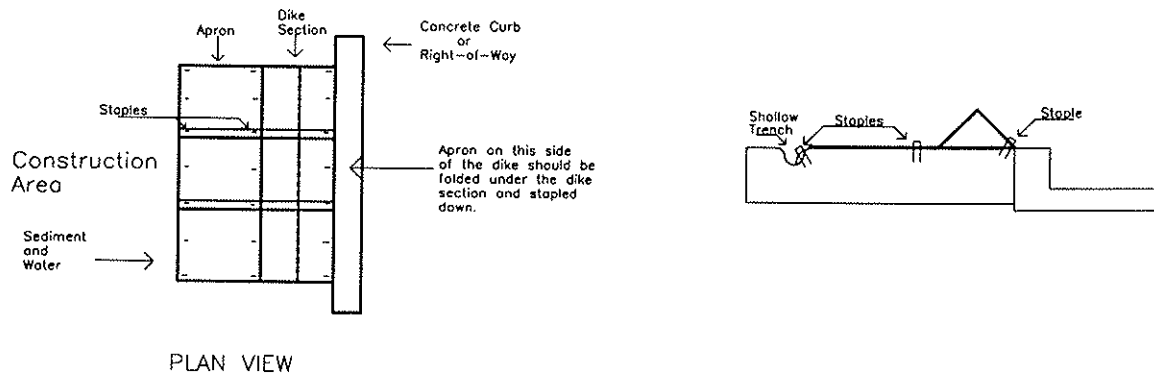

**TO ESTABLISH GEOMETRIC CONTROL FOR THE CONSTRUCTION OF THIS PROJECT, THE DEPARTMENT HAS PROVIDED THE FOLLOWING INFORMATION:**

- Format: \_\_\_\_\_  
 Horizontal Control \_\_\_\_\_  
 Vertical Control \_\_\_\_\_  
 Roadway Alignment \_\_\_\_\_  
 Original Terrain Data \_\_\_\_\_  
 Other: \_\_\_\_\_

\*Specify the information format, ie., plan sheet, computer disk, computer printout, or other.  
 The information marked is either contained on the plans or is available from the Engineer.

**TYPE OF PROJECT**

- Landscaping
- Signization
- Safety Improvement
- Asphalt Overlay
- Concrete Overlay
- Minor Widening
- Major Reconstruction
- New Roadway Construction
- Bridge Replacement
- Bridge Widening
- New Bridge
- Other: Storage Tank

SURVEY WORK TO BE PERFORMED BY OTHERS: \_\_\_\_\_

**WORK PERFORMED BY THE CONTRACTOR'S SURVEYOR UNDER ITEM 625:**

- Establish and Maintain Project Centerline or Engineer Approved Offset Line(s)
- Verification and Maintenance of Horizontal and Vertical Control
- Verify or Determine existing grades and alignments
- Verify or Determine existing topography
- Clearing and Grubbing Limits
- Removal Limits
- Excavation and Embankment
  - Excavation
    - Unclassified
    - Stripping
    - Rock
    - Borrow
    - Other: \_\_\_\_\_
  - Embankment
  - Site Grading
  - Erosion Control (Perm)
  - Other: \_\_\_\_\_
- As Staked Earthwork Quantities

SLOPE STAKING	GRID	GRADE STAKES	SPECIAL INTERVAL
-	-	-	-
-	-	-	-
- Landscaping
  - Top Soil
  - Seeding
  - Mulching
  - Planting
  - Other: \_\_\_\_\_

- Erosion Control
  - Seeding (Temp)
  - Sit Fences
  - Straw Bales
  - Temporary Berm
  - Riprap (Temp)
  - Other (Temp Diversion, Temp Slope Drain, Bush Barrier, Check Dam, Other: \_\_\_\_\_)

GRADE STAKES	GRID	SPECIAL INTERVAL	SPECIAL OFFSET
-	-	-	-
-	-	-	-
- Roadway Bases
  - Untreated Subgrade
  - Treated Subgrade
  - Aggregate Base Course
  - Other: \_\_\_\_\_

- Pavements
  - PWB -- Plant Mix Bituminous Base
  - HBP -- Hot Bituminous Pavement
  - Concrete
  - Other: \_\_\_\_\_

- Roadway Elements
  - Curb and Gutter
  - Drop inlets - alignment and grades
  - Retaining Walls
  - Guard Rail
  - Sidewalk
  - Other: \_\_\_\_\_

**As Constructed**

No Revisions: 9/19/97

Revised:

Void:

**GENERAL NOTES FOR AND WORK PERFORMED BY THE CONTRACTOR'S SURVEYOR UNDER ITEM 629 WILL BE FOUND ON SURVEY SUBSET SHEET S2 OF 2.**

- Riprap (Perm)
- Slope and Ditch Paving
- Minor Structures
  - Structure Excavation Limits
  - Culverts
  - Culverts w/ Headwalls and Wingwalls
  - Concrete Box Culverts w/ Headwalls and Wingwalls
  - Pipes
    - Sanitary Sewer
    - Storm Sewer
    - Water
    - Irrigation
    - Miscellaneous
  - Manholes
  - Inlets
  - Other: Storage Tank
- Major Structures - Overhead Signs, Concrete Box Culverts, Bridges - and all other structures assigned a structure number
  - Structure Excavation Limits
  - Concrete Box Culverts w/ Headwalls and Wingwalls
  - Piling locations and cut off elevations
  - Caisson locations and elevations
  - Footing locations, alignment, and elevations
  - Abutment/Pier locations, alignment, and elevations
  - Wingwall skew angles/offsets
  - Structural concrete form locations
  - Substructure survey (See Revision of Subsection 601.12(m))
  - Bridge expansion joint(s) alignment and grade (longitudinal and transverse)
  - Deck grades of Girder 10th or "n" th point locations and elevations
  - Slope and Ditch Paving
  - Other: \_\_\_\_\_
- Fencing
  - Temporary
  - Permanent
  - Sound Barriers
  - Other: \_\_\_\_\_
- Delineators
  - Temporary
  - Permanent
- Lighting and Traffic Control Devices (Perm)
  - Signal pole locations and elevations
  - Light pole locations and elevations
  - Signs
  - Field verify sign post locations, elevations, and lengths before fabrication.
  - Other: \_\_\_\_\_
- Pavement Marking
  - Striping (Temp)
  - Striping (Perm)
  - Symbols
  - Other: \_\_\_\_\_
- Temporary Lighting and Construction Traffic Control Devices
  - Signal pole locations and elevations (Temp)
  - Light pole locations and elevations (Temp)
  - Signs (Temp)
  - Other: \_\_\_\_\_
- Easement (Temp)(Staking)

Computer File Information				Survey Tabulation 1 of 2		Project No./Code	
Creation Date:	Initials:	JPC	Issued By:	S.C. & M. Branch	Revised	04/15/96	MC C510-005
Last Modification Date:	Initials:	JPC					10486
Full Path:	C:\tab\						Sheet Number 13
Drawing File Name:	10486 tab.dwg						
Acad Ver.	R12	Scale:	1:2	Units:	Feet	Sheet Subst:	Survey
						Sheet:	S1 of 2



As Constructed

No Revisions: 9/19/97

Revised:

Void:

WORK PERFORMED BY THE CONTRACTOR'S SURVEYOR UNDER ITEM 629:

- Monumentation
  - Control
  - Right of Way (Temp) (Staking)
  - Right of Way
  - Land corners, Aliquot corners
  - Easement (Temp)(Staking)
  - Easement (Perm)
  - Reference the specified existing monuments: \_\_\_\_\_
  - Relocate the specified existing monuments: \_\_\_\_\_
  - Locate monuments. It is estimated \_\_\_\_\_ hours are required.

\*\* A Tabulation of Survey Monuments may be provided on the plans.

GENERAL NOTES:

All work shall be done in accordance with the latest edition of the entire CDOT Survey Manual including all revisions to date.  
- Chapter 5 - Construction Surveying, revised 02/07/96.

Adequate information for establishing lines, grades, and locations for all work items have been specified on the plans. Any additional information required to stake the item or element shall be generated by the Contractor's surveyor.

The Contractor's surveyor shall provide an estimate of the man-hours necessary to complete the work items indicated on this sheet. A copy of this sheet, with the estimated man-hours written on the blank line to the left of the specified items, shall be submitted with the Survey Schedule to the Engineer \_\_\_\_\_ days prior to the Presurvey Conference.

The following surveying notebooks are required:

- Alignment Notebook
- Benchmark Notebook
- Control Survey/Monumentation Notebook
- Minor Structure Notebook
- Major Structure Notebook
- Slope Staking Notebook
- Grade Notebook
- Other Notebook(s): \_\_\_\_\_

Stakes and Monuments which are damaged or destroyed by the progress of construction shall be replaced by the Contractor at no additional cost to the Department.


The Contractor shall furnish an As Staked earthwork quantity to the Engineer prior to completion of twenty percent (20%) of the planned earthwork in any phase as per the CDOT Survey Manual.  
A printed copy of the As Staked earthwork data and a computer disk in the specified format shall be submitted to the Engineer.  
The Contractor shall field verify original ground cross sections at maximum 160 m (500 ft) intervals.

Prior to beginning work on any subsequent operation, such as placing base course or paving, the Contractor shall certify in writing to the Engineer that the final grade is within the specified tolerance.

The Contractor shall perform all field surveying and calculations necessary to tie plan grades into field grades.


The Contractor shall coordinate construction staking on the project with any utility work.

The control survey shown on the plans was performed by KJH-TriConsultants.

<b>Computer File Information</b>		<b>Survey Tabulation 2 of 2</b> Issued By: S.C. & M. Branch Revised 04/15/96	<b>Project No./Code</b>
Creation Date: _____	Initials: JPC		MC C510-005
Last Modification Date: _____	Initials: JPC		10486
Full Path: C:\Tab\			Sheet Number 14
Drawing File Name: 10486 tab.dwg		Sheet: S2 of 2	
Acad Ver. R12	Scale: 1:2	Units: Feet	Sheet Subset: Survey

AS CONSTRUCTED			
NO REVISIONS	<input type="checkbox"/>	REVISED	<input checked="" type="checkbox"/>
		9/19/97	VOID <input type="checkbox"/>

**PIPE DETAIL**

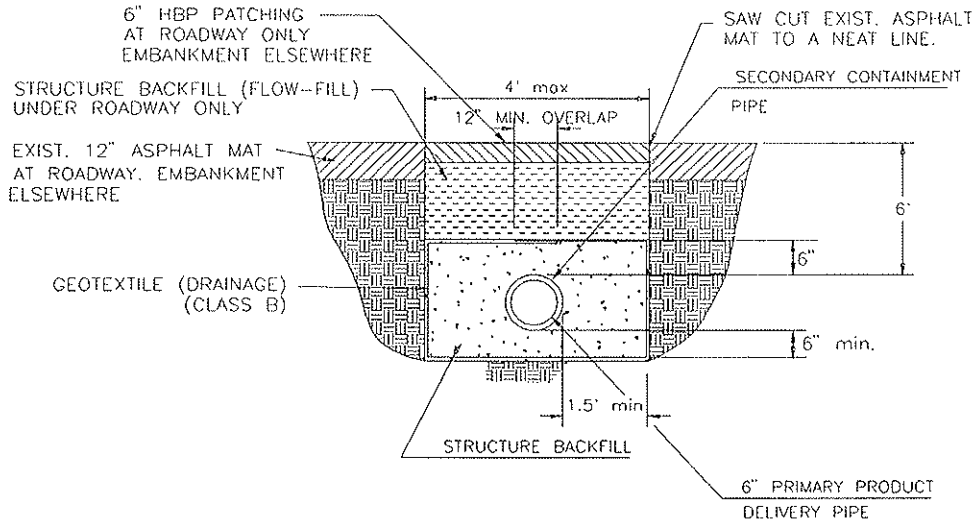

**NOTE:** Final grading will be incidental to the pipe installation and will not be paid for separately.

**QUANTITIES**

ITEM No.	DESCRIPTION	UNIT	QUANTITY
206	STRUCTURE BACKFILL (SPECIAL) (FLOW-FILL)	CU. YD.	<del>720</del> 72
603	6" PLASTIC PIPE (SPECIAL) (FRP)	LF	<del>2100</del> 222

**(FOR INFORMATION ONLY)**

ITEM No.	DESCRIPTION	UNIT	QUANTITY
202	REMOVAL OF ASPHALT MAT	SQ. YD.	42.0
203	EMBANKMENT (CIP)	CU. YD.	112.0
206	STRUCTURE EXCAVATION	CU. YD.	252.0
206	STRUCTURE BACKFILL	CU. YD.	56.0 ❖
403	HBP (PATCHING) (ASPHALT)	SQ. YD.	42.0
420	GEOTEXTILE (DRAINAGE) (CLASS B)	SQ. YD.	47.0

❖ Includes volume of the pipe.

**Note:** Quantities are based on the max./min. dimensions shown.