

DEPARTMENT OF TRANSPORTATION STATE OF COLORADO

Related Projects:
P.E. UNDER PROJECT:
Project Number IM 0703-242
Project Code 12117

HIGHWAY CONSTRUCTION BID PLANS OF PROPOSED

NORTH BORE TUNNEL LIGHTING / VMS

FEDERAL AID PROJECT NO. IM-0703-269

STATE HIGHWAY NO. 70

SUMMIT AND CLEAR CREEK COUNTIES

PROJECT CODE NO. 13166

TABULATION OF LENGTH & DESIGN DATA

STATION	LINEAR FEET	
	ROADWAY FEET	MAJOR STRUCTURE
APPROACH TO THE PROJECT MILE POST 212.0 TO MILE POST 213.0		
STA. 105+00 BEGIN IM-0703-269 (I-70 WESTBOUND)	3100	NONE
BEGIN STRUCTURES STA. 136+00 EISENHOWER/JOHNSON MEMORIAL TUNNEL SOUTH TUNNEL (JOHNSON/I-70 EASTBOUND) STRUCTURE NO. F-13-X NORTH TUNNEL (EISENHOWER/I-70 WESTBOUND) STRUCTURE NO. F-12-Y STA. 225+31	8931	EJMT-NORTH TUNNEL & VENTILATION BUILDINGS
STA. 280+30 END IM-0703-269	5499	NONE
APPROACH TO THE PROJECT MILE POST 216.3 TO MILE POST 217.3		
TOTAL	17530	

SUMMARY OF PROJECT LENGTH	FEET	MILES
ROADWAY (NET LENGTH)	8931	1.70
MAJOR STRUCTURE		
PROJECT GROSS LENGTH	17530	3.32


DESIGN DATA	
MINIMUM RADIUS OF CURVE (EXISTING)	3°30'
MAXIMUM GRADE (EXISTING)	2.23%
MINIMUM S.S.D HORIZONTAL (EXISTING)	350'
MINIMUM S.S.D VERTICAL (EXISTING)	490'
MAXIMUM DESIGN SPEED	*65 MPH
2023 DESIGN TRAFFIC	47,271 ADT
DHV % TRUCKS	10.62 %
CLEARZONE DISTANCE (TANGENT)	
CLEARZONE DISTANCE (3 3')	

* - POSTED SPEED LIMIT = 50 MPH.



SUMMIT AND CLEAR CREEK COUNTIES

SCALES OF ORIGINAL DRAWINGS
ON PLANS AS SHOWN

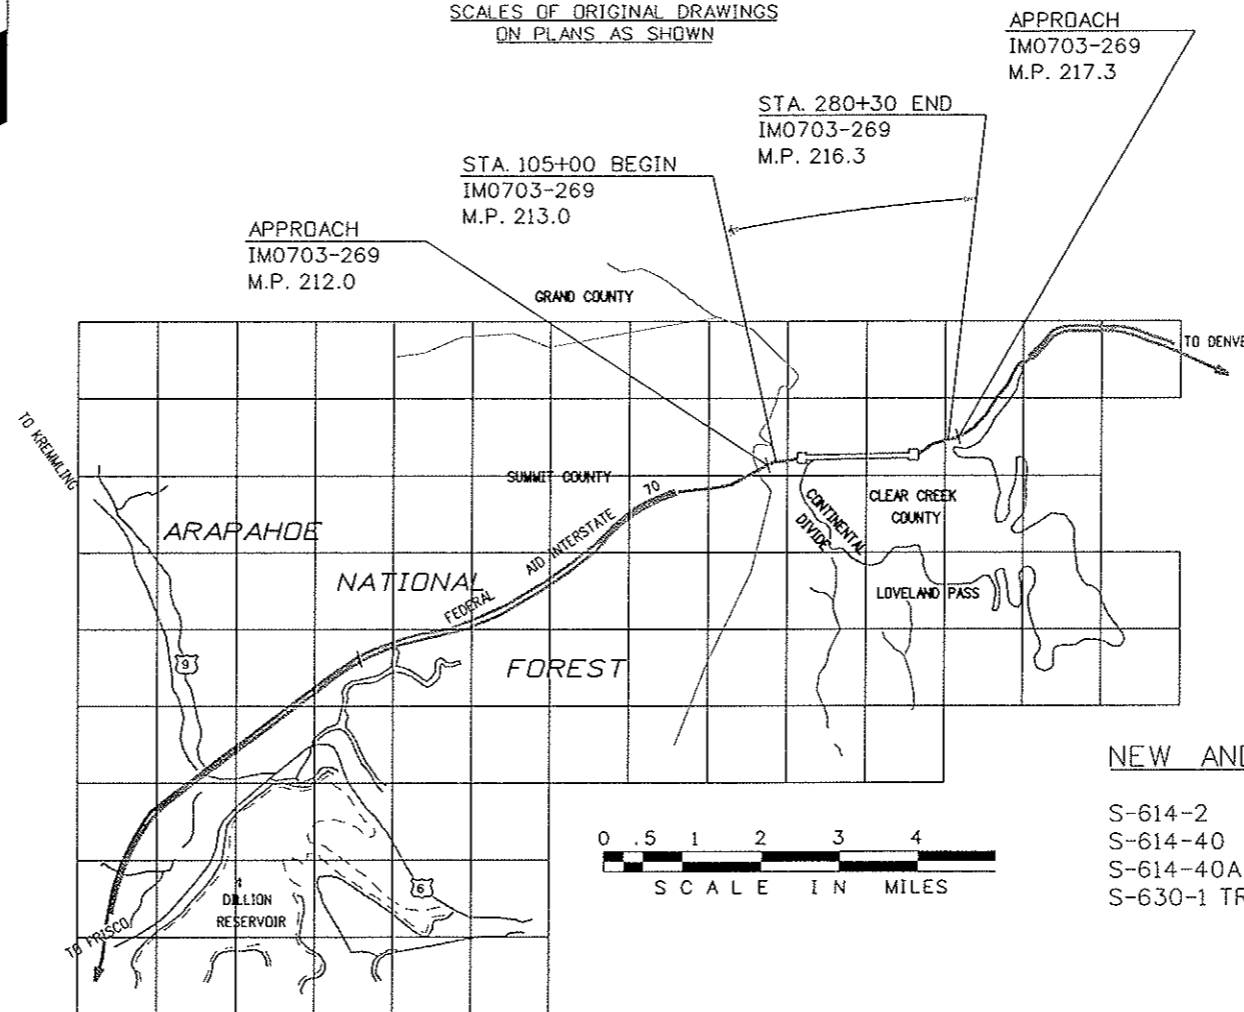

APPROACH
IM0703-269
M.P. 217.3

STA. 280+30 END
IM0703-269
M.P. 216.3

STA. 105+00 BEGIN
IM0703-269
M.P. 213.0

APPROACH
IM0703-269
M.P. 212.0

NEW AND REVISED STANDARDS


- S-614-2 CLASS I GROUND SIGN INSTALLATIONS 8/22/2002
- S-614-40 TYPICAL TRAFFIC SIGNAL INSTALLATION DETAILS 3/18/2002
- S-614-40A ALTERNATE TRAFFIC SIGNAL INSTALLATION DETAILS 11/01/2003
- S-630-1 TRAFFIC CONTROLS FOR HIGHWAY CONSTRUCTION 9/3/2003

Sverdrup

260 MADISON AVENUE
NEW YORK, NEW YORK
212-481-9460


Design File Name: D:\NS\PL\...
Plot File Name: S-13166.PLT
Date of Plot: 08/26/99

Creation Date: 02/26/99	Initials: DJB	07/03/07	ASBUILT	DJB	P.O. BOX 399 DUMONT, CO. 80436 Phone: 303-512-5750 FAX: 303-512-5775 Region 1 Mountain Residency I.N.Z.	No Revisions:	Contractor	IM 0703-269 13166 Sheet Number 1
Last Modification Date: 12/04/03	Initials: DJB					Revised:	Resident Engineer - Inessa N. Zisman	
Full Path: 14102\700CADD\710STD\						Void:	Project Engineer -	
Drawing File Name: gets01n.plt							PROJECT STARTED - ACCEPTED -	
Acad Ver. R14	Scale: AS NOTED	Units: Feet					Comments: -	

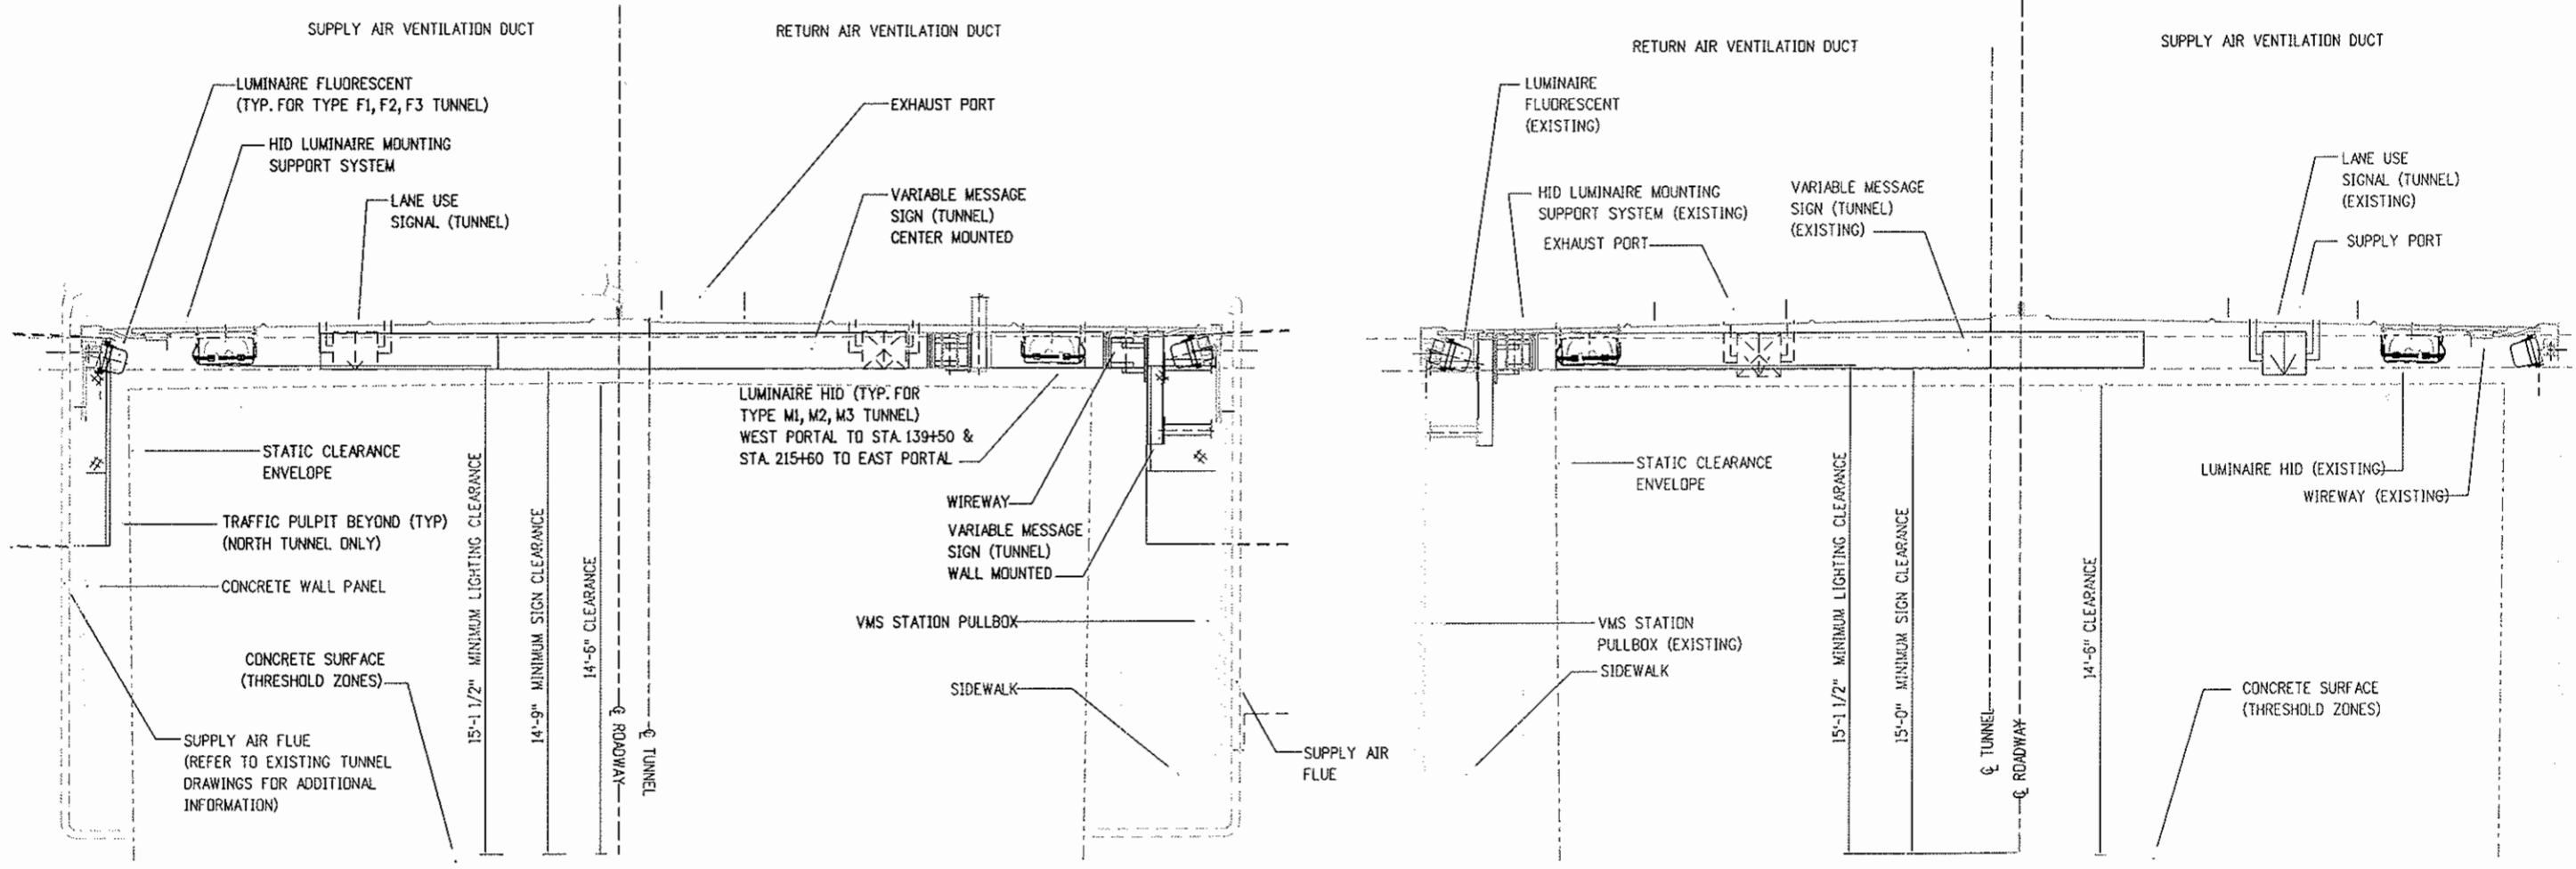

NORTH TUNNEL
TYPICAL SECTION LOOKING EAST **1**
(AGAINST TRAFFIC)

SOUTH TUNNEL
TYPICAL SECTION LOOKING EAST **2**
(WITH TRAFFIC)
(FOR REFERENCE ONLY)

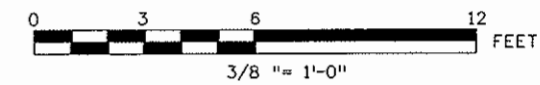


Design File Name: D:\SSPEC*
 Plot File Name: \$PLOTFILE*
 Date of Plot: \$\$\$DATE\$\$\$

Computer File Information	
Creation Date:	06/23/99 Initials: DJB
Last Modification Date:	02/08/01 Initials: DJB
Full Path:	014102\700cadd\710stds\
Drawing File Name:	genty01n.plt
Acad Ver.	R14 Scale: 3/8" = 1'-0" Units: English

Sheet Revisions	
07/03/07	ASBUILT DJB

Colorado Department of Transportation



P.O. BOX 399
DUMONT, CO. 80436
Phone: 303-512-5750 FAX: 303-512-5775

Region 1 Mountain Residency I.N.Z.


As Constructed
No Revisions:
Revised:
Void:

TYPICAL SECTION			
Designer:	J. KROLL	Structure	
Detailer:	D. BURROUGHS	Numbers	
Sheet Subset:	GENERAL	Subset Sheets:	1 of 2

Project No./Code	
IM 0703-269	
13166	
Sheet Number	3


- NOTES:
- A. ALL CLEARANCES ARE BASED ON PHYSICAL DESIGN DIMENSIONS AS INDICATED ON DESIGN DRAWINGS. ACTUAL DIMENSIONS MAY VARY.
 - B. ALL VERTICAL DIMENSIONS ARE TAKEN FROM THE HIGHPOINT OF THE ROADWAY.
 - C. LANE USE SIGNALS AND LUMINAIRES (HID) ARE REMOVABLE WHEN REQUIRED.

- LEGEND:
- = 14'-6" DESIGN ENVELOPE
 - = 15'-0" MIN. SIGN CLEARANCE
 - = 16'-0" MILITARY CLEARANCE

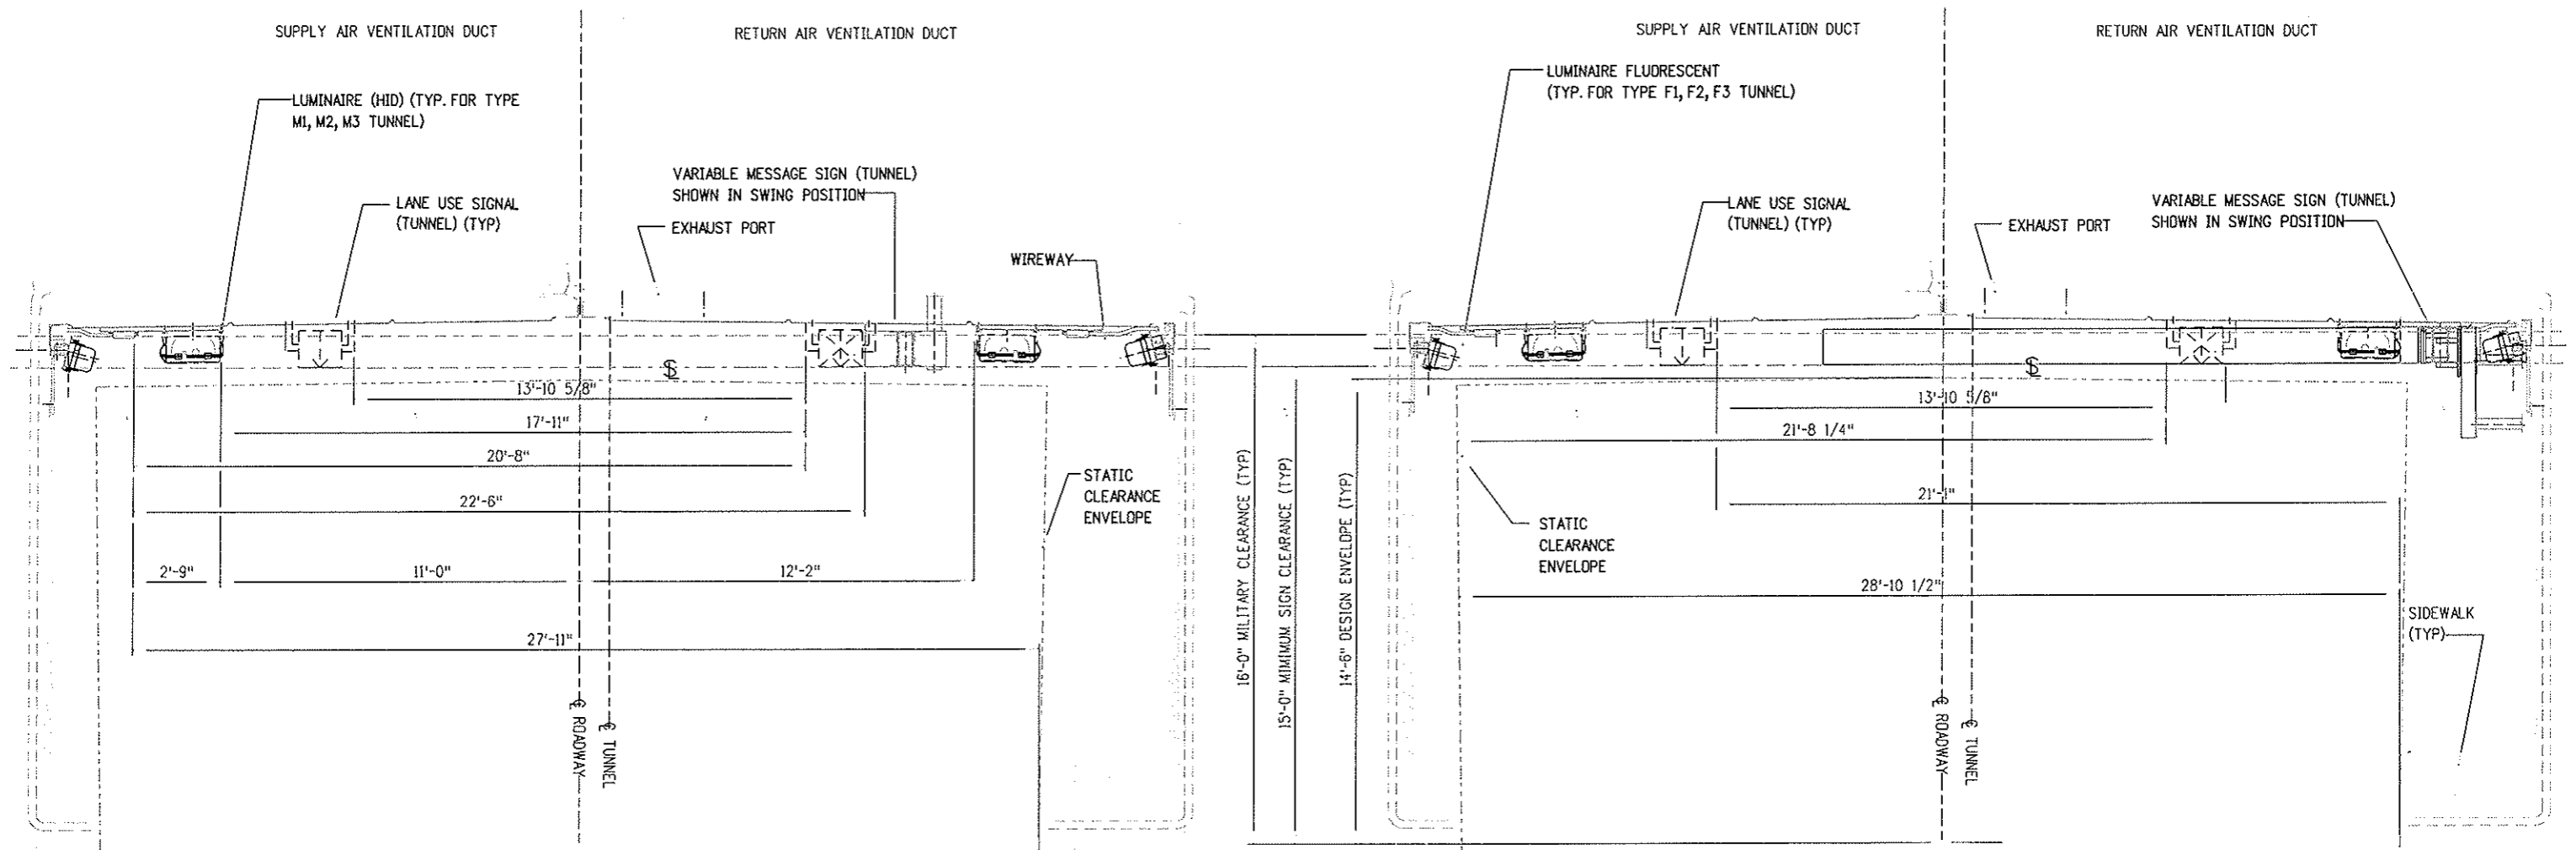

NORTH TUNNEL
TYPICAL SECTION LOOKING EAST
AT VMS #1

NORTH TUNNEL
TYPICAL SECTION LOOKING EAST
AT VMS #2 THROUGH #11

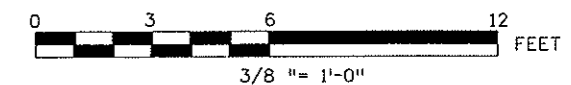


Design File Name: DGN\$SPEC*
 Plot File Name: \$PLOTFILE*
 Date of Plot: \$\$\$DATE\$\$\$

Computer File Information	
Creation Date:	10/23/99 Initials: DJB
Last Modification Date:	02/08/01 Initials: DJB
Full Path:	014102\700cadd\710stds\
Drawing File Name:	genty02n.dwg
Acad Ver.	R14 Scale: 3/8" = 1'-0" Units: ENGLISH

Sheet Revisions	
<input type="checkbox"/>	07/03/07 ASBUILT DJB
<input type="checkbox"/>	
<input type="checkbox"/>	
<input type="checkbox"/>	

Colorado Department of Transportation



P.O. BOX 399
DUMONT, CO. 80436
Phone: 303-512-5750 FAX: 303-512-5775

Region 1 Mountain Residency I.N.Z.

As Constructed	
No Revisions:	
Revised:	
Void:	

TYPICAL SECTION CLEARANCES (NORTH TUNNEL)			
Designer:	D. BURROUGHS	Structure Numbers	
Detailer:	D. BURROUGHS		
Sheet Subset:	GENERAL	Subset Sheets:	2 of 2


Project No./Code	
IM 0703-269	
13166	
Sheet Number	4

INDEX	CONTRACT ITEM NO.	CONTRACT ITEM	UNIT	ROADWAY																PROJECT TOTALS		
				PLAN	AS CONST.																PLAN	AS CONST.
	202-00700	Removal of Light Standard	EACH	16																	16	
	202-00725	Removal of Existing Lighting System	L S	1																	1	
	202-00750	Removal of Luminaire	EACH	2,407																	2,407	
	202-00828	Removal of Traffic Signal Equipment	LS	1																	1	
	250-00010	Environmental Health and Safety Management	L S	1																	1	
	606-00301	Guardrail Type 3 (6-3 Post Spacing)	LF	315																	315	
	606-01340	End Anchorage Type 3D	EACH	5																	5	
	606-02005	End Anchorage (Flored)	EACH	5																	5	
	613-00075	3/4 Inch Electrical Conduit	LF	1,000																	1,000	
	613-00100	1 Inch Electrical Conduit	LF	41,000																	41,000	
	613-00125	1-1/4 Inch Electrical Conduit	LF	18,400																	18,400	
	613-00150	1-1/2 Inch Electrical Conduit	LF	19,000																	19,000	
	613-00200	2 Inch Electrical Conduit	LF	700																	700	
	613-00300	3 Inch Electrical Conduit	LF	48,000																	48,000	
	613-00303	3 Inch Electrical Conduit Body (Type BUB)	EACH	8																	8	
	613-00350	3-1/2 Inch Electrical Conduit	LF	200																	200	
	613-01300	3 Inch Electrical Conduit (Plastic)	LF	2,500																	2,500	
	613-03501	HID Fixtures (Type M1 Tunnel Luminaire)	EACH	483																	483	
	613-03502	HID Fixtures (Type M2 Tunnel Luminaire)	EACH	66																	66	
	613-03503	HID Fixtures (Type M3 Tunnel Luminaire)	EACH	36																	36	
	613-03511	HID Fixtures (Type M1 Tunnel Luminaire)(Furnish Only)	EACH	15																	15	
	613-04125	1-1/4 Inch Electrical Conduit (Liquidtight Flexible Metal)	LF	400																	400	
	613-04250	2-1/2 Inch Electrical Conduit (Liquidtight Flexible Metal)	LF	50																	50	
	613-04300	3 Inch Electrical Conduit (Liquidtight Flexible Metal)	LF	20																	20	
	613-05000	Direct-Burial Cable	LF	8,200																	8,200	
	613-05500	Wireway	LF	1,620																	1,620	
	613-07024	Pull Box (24"x24"x8") Deep	EACH	2																	2	
	613-07026	Pull Box (16"x24"x12") Deep	EACH	38																	38	
	613-07027	Pull Box (28"x28"x12") Deep	EACH	2																	2	
	613-07029	Pull Box (24"x24"x12") Deep	EACH	8																	8	
	613-07030	Pull Box (24"x16"x24") Deep	EACH	4																	4	
	613-07033	Pull Box (24"x20"x12") Deep	EACH	8																	8	
	613-07035	Pull Box (32"x24"x12") Deep	EACH	14																	14	
	613-07037	Pull Box (37"x37"x12") Deep	EACH	2																	2	
	613-07180	Pull Box (24"x36"x36") Deep	EACH	15																	15	
	613-07190	Pull Box (36"x16"x12") Deep	EACH	4																	4	
	613-07200	2 Inch Electrical Body (Type LB)	EACH	2																	2	
	613-07210	2 Inch Electrical Conduit Body (Type TEE)	EACH	84																	84	
	613-07300	3 Inch Electrical Conduit Body (Type LB)	EACH	4																	4	
	613-10000	Wiring	L S	1																	1	
	613-12100	Luminaire Fluorescent (Type F1 Tunnel)	EACH	1798																	1798	
	613-12101	Luminaire Fluorescent (Type F1 Tunnel)(Furnish Only)	EACH	20																	20	
	613-12200	Luminaire Fluorescent (Type F2 Tunnel)	EACH	72																	72	
	613-12201	Luminaire Fluorescent (Type F2 Tunnel)(Furnish Only)	EACH	5																	5	
	613-12300	Luminaire Fluorescent (Type F3 Tunnel)	EACH	268																	268	
	613-12301	Luminaire Fluorescent (Type F3 Tunnel)(Furnish Only)	EACH	5																	5	
	613-15750	HID Luminaire Mounting Support System	L S	1																	1	
	613-20400	Lens Assemblies (Furnish Only)	EACH	50																	50	
	613-32400	Light Standard Steel (40 Foot)	EACH	33																	33	
	613-40000	Concrete Foundation Pad	EACH	33																	33	

Design File Name: D:\SPEC*
 Plot File Name: S:\OUTFILE*
 Date of Plot: 3/26/99

Computer File Information			
Creation Date:	02/26/99	Initials:	DJB
Last Modification Date:	12/26/98	Initials:	DJB
Full Path:	14102\700CADD\710stds\		
Drawing File Name:	geno01n.plt		
Acad Ver.	R14	Scale:	1" = 10'-0"
		Units:	English

Sheet Revisions			
<input type="checkbox"/>	07/03/07	ASBUILT	DJB
<input type="checkbox"/>			
<input type="checkbox"/>			
<input type="checkbox"/>			

Colorado Department of Transportation

 P.O. BOX 399
 DUMONT, CO. 80436
 Phone: 303-512-5750 FAX: 303-512-5775
 Region 1 Mountain Residency I.N.Z.

As Constructed	
No Revisions:	
Revised:	
Void:	



SUMMARY OF APPROXIMATE QUANTITIES			
Designer:	D. BURROUGHS	Structure Numbers	
Detailer:	D. BURROUGHS	Subset Sheets:	1 of 3

Project No./Code	
IM 0703-269	
13166	
Sheet Number	5



PI CURVE COORDINATES AND CURVE DATA											
I-70 & NORTH TUNNEL											
CURVE NO.	PC STATION	PC COORDINATES		Δ	R	L	T	PI TO PI DIRECTION	PT COORDINATES		PT STATION
		NORTH	EAST						NORTH	EAST	
WEST APPROACH											
PDB	50+00	670709.4520	869349.6220	-	-	616.8486	-	N 87°02'12.59" E	670741.3394	869965.6459	56+17
(1)	56+17	670741.3394	869965.6459	29°13'38.62"	-1550.0	790.6771	404.1405	N 57°48'33.98" E	670977.5315	870711.2624	64+08
(2)	75+33	671577.1382	871663.7695	32°15'59.07"	1630.0	917.9427	471.4988	S 89°55'26.95" E	671827.6988	872534.2884	84+51
(3)	94+83	671826.3331	873566.0240	09°31'55.18"	5600.0	931.6422	466.8984	S 80°23'31.78" E	671747.7879	874493.2714	104+14
(4)	107+24	671696.0614	874798.8427	21°16'14.66"	-2090.0	775.9009	392.4684	N 78°20'13.56" E	671709.8957	875570.1715	115+00
(5)	116+01	671730.3632	875669.3286	16°00'08.48"	-1915.0	534.8476	269.1758	N 62°20'05.08" E	671909.7577	876171.3494	121+36
(6)	129+62	672292.9873	876902.3709	26°14'59.62"	1770.000	810.9204	412.7044	N 88°35'04.70" E	672494.8019	877680.4715	137+73
NORTH TUNNEL											
(7)	180+33	672600.0342	881939.5564	03°25'03.19"	11459.0	683.5011	341.8519	S 87°59'52.11" E	672596.5345	882622.9472	187+16
(8)	220+45	672480.2436	885949.4334	05°15'01.32"	-1920.0	175.9414	88.0323	N 86°45'06.57" E	672482.1560	886125.3029	222+21
EAST APPROACH											
(9)	222+31	672482.7530	886135.8219	29°51'58.90"	-1660.0	865.3021	442.7214	N 56°53'07.67" E	672749.7031	886948.6466	230+97
(10)	283+96	673186.3925	887618.1555	33°51'04.45"	1575.0	930.5344	479.2909	S 89°15'47.88" E	673442.0735	888498.8513	248+27
(11)	258+40	673429.0484	889511.8078	54°11'43.52"	-1875.0	1773.5410	959.3915	N 36°32'28.60" E	674187.5151	891042.3434	276+13
(12)	300+70	676161.7387	892505.3942	03°45'21.11"	3500.0	229.4327	114.7574	N 40°17'49.71" E	676341.4636	892647.9406	303+00
(13)	321+07	677719.4974	893816.4801	14°45'16.21"	5900.0	1519.3364	763.8943	N 55°03'05.92" E	678739.7076	894936.6702	336+26
(14)	363+40	680294.3600	897161.2089	33°00'09.08"	2000.0	1152.0053	592.4749	N 88°03'15.00" E	680653.8693	898238.9752	374+92
PDE	-	680653.8693	898238.9752	-	-	-	-	-	680772.9830	901744.9730	410+00

PI CURVE COORDINATES AND CURVE DATA											
SOUTH TUNNEL											
PDB	27+00	672082.9820	876661.1460	-	-	173.3296	-	N 62°20'05.33" E	672163.4596	876814.6598	28+73
(5)	28+73	672163.4596	876814.6598	27°51'47.82"	1800.0	875.3509	446.5100	S 89°48'06.85" E	672369.2322	877656.6304	37+49
	72+98	672369.2322	877656.6304	-	-	3549.2308	-	-	672356.9610	881205.8400	80+01
	80+01	672356.9610	881205.8400	-	-	703.5004	-	N 89°16'04.96" E	672365.9480	881909.2830	115+59
	115+59	672365.9480	881909.2830	-	-	3557.7375	-	S 89°47'19.55" E	672352.8315	885466.9964	116+46
(6)	116+46	672352.8315	885466.9964	02°22'44.53"	4160.0	172.7316	86.3782	-	672348.6093	885639.6640	117+32
(7)	118+61	672342.7813	885768.4877	03°00'57.51"	-2500.0	131.5967	65.8136	S 87°24'35.02" E	672340.2960	885900.0457	119+92
(8)	120+75	672340.9084	885982.4733	33°46'35.74"	-1637.0	965.0325	496.9934	N 89°34'27.47" E	672623.9692	886890.4954	130+40
PDE	-	672623.9692	886890.4954	-	-	-	-	N 55°47'51.73" E	672713.8340	887022.7160	132+00

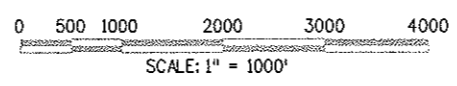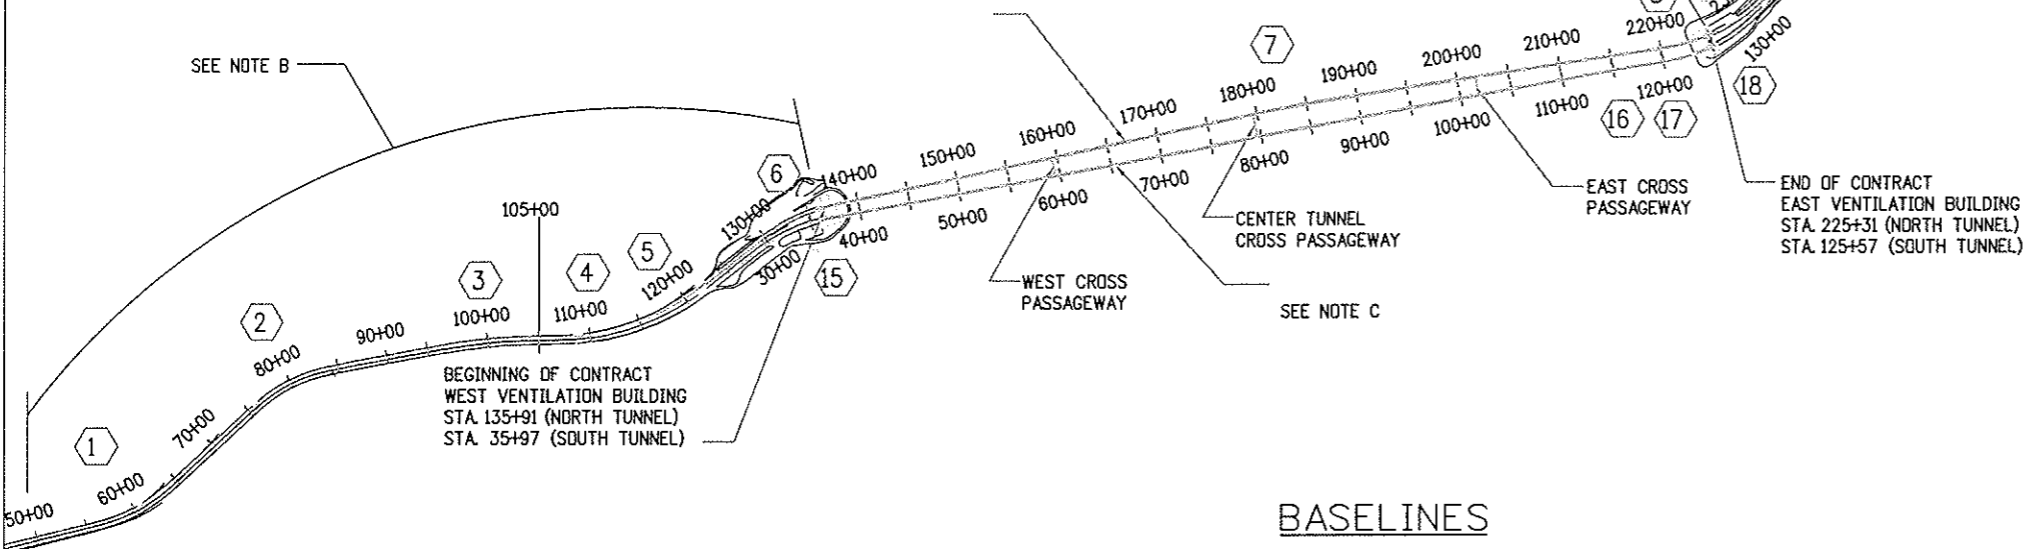

SEE NOTE D

SEE NOTE B

SEE NOTE C

BASELINE POB AND POE POSITIONS				
I-70/NORTH TUNNEL				
	MILE POST	MP COORDINATES		DISTANCE FROM MILE POST
		NORTH	EAST	
POB	211.9	670737.7923	868934.7200	416.0293
	212.1	670682.7980	870130.7474	778.5981
POE	218.7	680629.3994	901080.6995	769.6934
	219.0	680858.9601	902190.7931	453.9516

BASELINE POB AND POE POSITIONS		
SOUTH TUNNEL		
	170/NORTH TUNNEL BASELINE STATION	OFFSET
POB	231+39.21	70.51' R
POE	126+50.51	73.99' R

NOTE:


- A. THESE BASELINES WERE DRAWN FROM ELECTRONIC FILES (THAT WERE TAKEN FROM AERIAL PHOTOGRAPHS) SUPPLIED TO JE SVERDRUP BY THE COLORADO DEPARTMENT OF TRANSPORTATION. BASELINES ARE SPECIFIC TO PROJECT IM-0703-242 AND IM-0703-269.
- B. WEST APPROACH BASELINE COORDINATE DATA SHOWN FOR REFERENCE ONLY.
- C. SOUTH TUNNEL BASELINE COORDINATE DATA SHOWN FOR REFERENCE ONLY.
- D. EAST APPROACH BASELINE COORDINATE DATA SHOWN FOR REFERENCE ONLY.
- E. ALL SURVEYING & LAYOUTS REQUIRED TO COMPLETE THE WORK WILL NOT BE PAID SEPARATELY, BUT WILL BE INCIDENTAL TO THE WORK.

Design File Name: DGN\SPEC*
 Plot File Name: SPLOTFILE*
 Date of Plot: \$\$\$DATE\$\$\$\$

Computer File Information	
Creation Date:	04/02/99 Initials: CWB
Last Modification Date:	11/22/00 Initials: DJB
Full Path:	014102\700cadd\710stds\
Drawing File Name:	gepl01n.plt
Acad Ver.:	R14 Scale: As Shown Units: ENGLISH

Sheet Revisions	
07/03/07	ASBUILT DJB

Colorado Department of Transportation



P.O. BOX 399
 DUMONT, CO. 80436
 Phone: 303-512-5750 FAX: 303-512-5775

Region 1 Mountain Residency I.N.Z.

As Constructed
No Revisions:
Revised:
Void:

GENERAL PLAN AND BASELINES	
Designer: L F KEEGAN	Structure Numbers
Detailer: C W BAISLY	
Sheet Subset: GENERAL	Subset Sheets: 1 of 1

Project No./Code	
IM 0703-269	
13166	
Sheet Number	8

CONDUIT, WIRE AND PLAN SYMBOLS



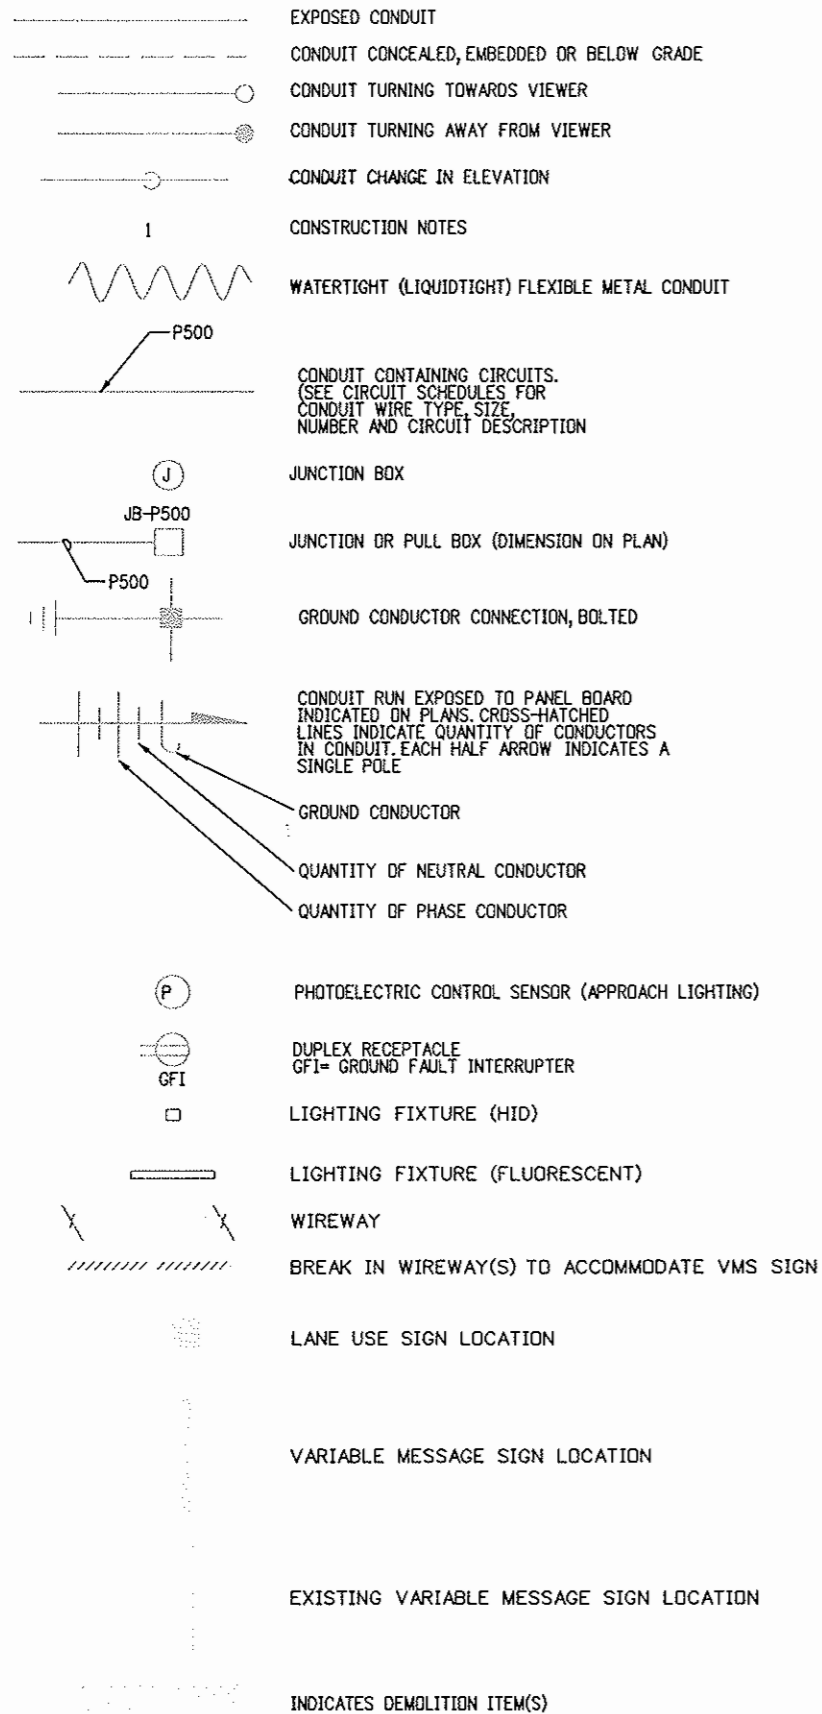


DIAGRAM SYMBOLS

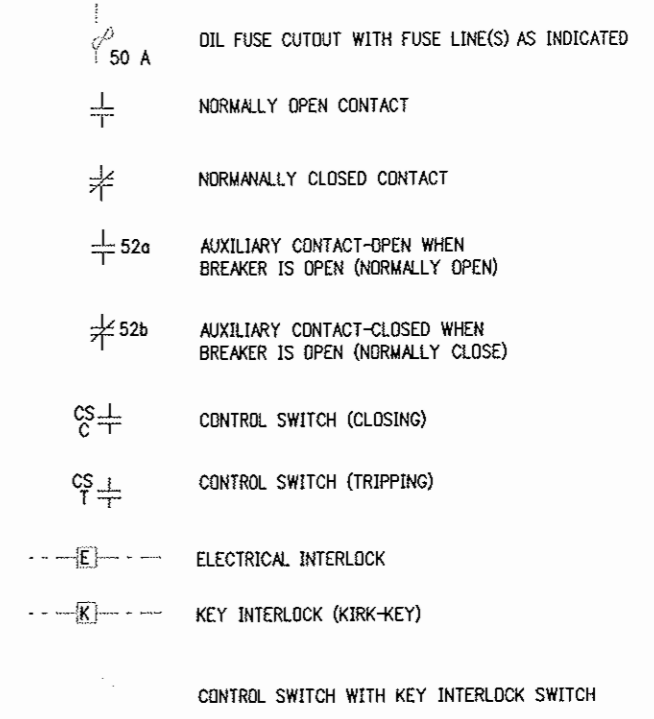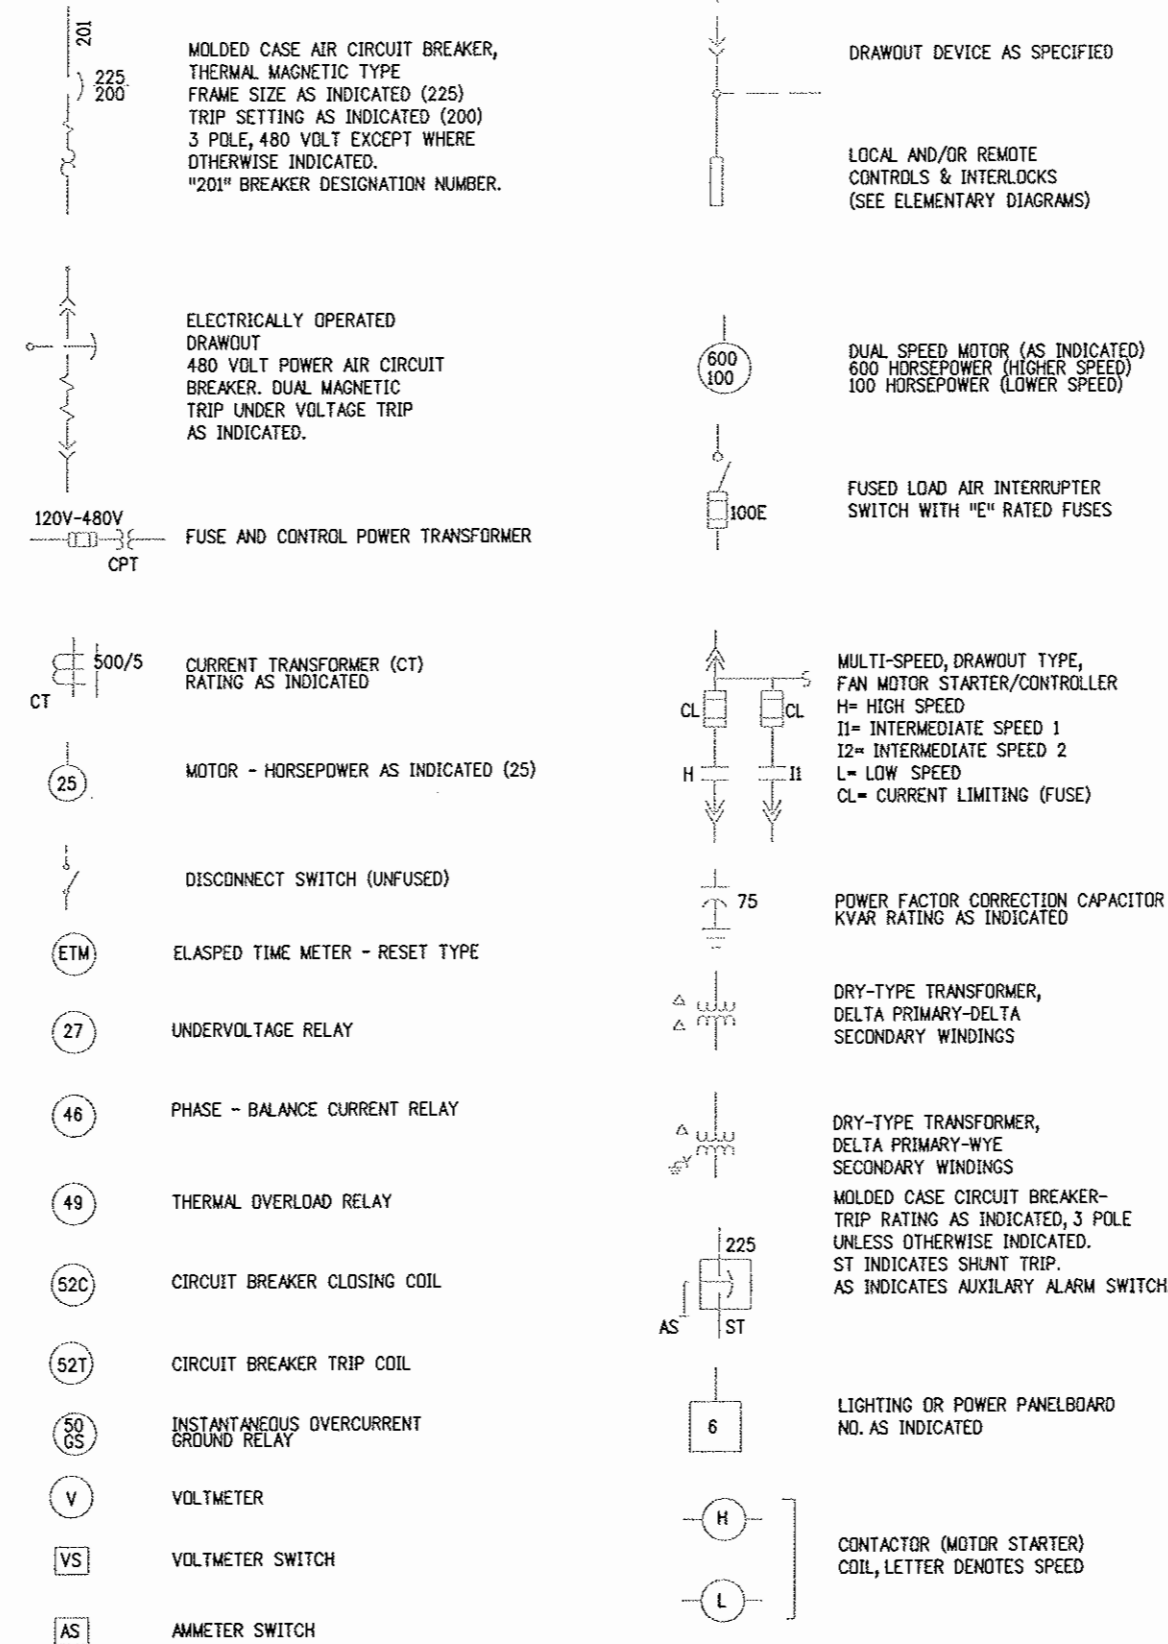

ABBREVIATIONS

A	AMP
AWG	AMERICAN WIRE GAGE
BKR, CB, OR C/B	CIRCUIT BREAKER
BLDG	BUILDING
C	CONDUIT
CC	CROSSCUT
CKT	CIRCUIT
CPT	CONTROL POWER TRANSFORMER
CT	CURRENT TRANSFORMER
CU	COPPER
E	EVEN (NUMBER)
ELEC	ELECTRICAL
EM	EMERGENCY
EXIST.	EXISTING
GND	GROUND
GS	GROUND SENSOR
HID	HIGH INTENSITY DISCHARGE (LUMINAIRE)
HT	HEAT TRACE
INCL	INCLUDING
INT	INTERIOR ZONE
KV	KILOVOLT
LTG	LIGHTING
LUS	LANE USE SIGN
MB	MESSAGE BOARD
MV	MEDIUM VOLTAGE (2.4 KV TO 5.0 KV)
NO.	NORTH
O	ODD (NUMBER)
R1	CALLOUT FOR CONCRETE ROAD SURFACE
SO.	SOUTH
SS	STAINLESS STEEL
ST	SHUNT TRIP
STA	STATION
TH	THRESHOLD ZONE
THRESH	THRESHOLD
TR1	TRANSITION ZONE 1
TR2	TRANSITION ZONE 2
TR3	TRANSITION ZONE 3
TYP.	TYPICAL
V	VOLT
VENT	VENTILATION (BUILDING)
VMS	VARIABLE MESSAGE SIGN

Plot File Name: P:\LIT\FILE\ Date of Plot: 09/15/99

Computer File Information	
Creation Date:	09/15/99 Initials: DMO
Last Modification Date:	11/20/99 Initials: DMO
Full Path:	14102\700CADD\710stds
Drawing File Name:	14102.dwg
Acad Ver.	R14
Scale:	NTS
Units:	ENGLISH

Sheet Revisions		
07/03/07	ASBUILT	DJB

Colorado Department of Transportation

 P.O. BOX 399
 DUMONT, CO. 80436
 Phone: 303-512-5750 FAX: 303-512-5775
 Region 1 Mountain Residency I.N.Z.

As Constructed	
No Revisions:	
Revised:	
Void:	

LEGEND TO ELECTRICAL SYMBOLS			
Designer:	J. KRQLL	Structure	
Detailer:	C. BAISLY	Numbers	
Sheet Subset:	GENERAL	Subset Sheets:	1 of 1

Project No./Code	
IM 0703-269	
13166	
Sheet Number	9

ELECTRICAL DEMOLITION NOTES:

- THE MAIN OBJECTIVE SHALL BE TO MAINTAIN A FULLY FUNCTIONAL TUNNEL DURING CONSTRUCTION. ALL LIGHTING, VMS, LUS OR ELECTRICAL DISTRIBUTION, DEMOLITION OR MOBILIZATION THAT REQUIRES LANE CLOSURE SHALL BE PERFORMED DURING OFF-PEAK TRAFFIC PERIODS AND COORDINATED WITH THE ENGINEER. SEE CONTRACT DOCUMENTS AND SPECIAL PROVISIONS TO THE SPECIFICATIONS FOR OTHER RESTRICTIONS.
- PRIOR TO RE-OPENING OF A LANE TO TRAFFIC, INSURE EQUIPMENT, DEVICES AND ANCHORAGE ARE SECURE AND MEET CLEARANCE REQUIREMENTS. CLEAN-UP SHALL BE PERFORMED CONTINUOUSLY AND SHALL REMOVE AND PROPERLY DISPOSE OF ALL DEBRIS ON A DAILY BASIS.
- DRAWINGS REPRESENT DIAGRAMMATIC LOCATIONS AND APPROXIMATE QUANTITIES. THE CONTRACTOR SHALL VERIFY THE LOCATION OF EXISTING UTILITIES AND SHALL EXERCISE SUITABLE CARE TO AVOID DISRUPTION OR DAMAGE OF UTILITIES OR EQUIPMENT TO REMAIN IN SERVICE. REPAIR DAMAGE ACCORDING TO THE PROVISIONS.
- REFER TO ELECTRICAL DRAWINGS TO COORDINATE SUITABLE PHASING OF DEMOLITION AND NEW CONSTRUCTION. IMMEDIATELY NOTIFY THE ENGINEER IF CONCEALED UTILITIES, CONDUIT OR CONDITIONS ARE DISCOVERED THAT WILL INHIBIT NEW CONSTRUCTION INDICATED ON THE CONTRACT DOCUMENTS. CONTRACTOR TO PROPOSE RESOLUTIONS FOR APPROVAL BY THE ENGINEER.
- MAINTAIN EMERGENCY CIRCUITING UNTIL RAPID CHANGE-OVER TO NEW EMERGENCY CIRCUITING OCCURS. ALL TEMPORARY WIRING SHALL COMPLY WITH THE NATIONAL ELECTRICAL CODE AND BE PRE-APPROVED BY THE ENGINEER. RE-LABEL ALL CIRCUIT BREAKERS WITH REVISED LOAD DESCRIPTIONS WHERE CONNECTED LOAD CHANGES HAVE OCCURED.
- REUSE EXISTING PULLBOXES, CONDUIT OR PENETRATIONS WHERE SUITABLE, SUCH AS WHERE THE ELECTRICAL ROOM CONDUIT INTERFACES WITH THE TUNNEL. ANY ANTICIPATED REUSE OF EXISTING ITEMS SHALL FIRST BE APPROVED IN WRITING BY THE ENGINEER.
- WHERE EQUIPMENT OR DEVICE IS INDICATED AS REMOVED, REMOVE EXISTING EXPOSED CONDUIT IN ITS ENTIRETY TO WHERE IT IS EMBEDDED OR CONCEALED. RETAIN 18" OF SURPLUS CONDUCTOR LENGTH, TAPE ENDS AND PERMANENTLY MARK TO IDENTIFY SOURCE. INSTALL NEW JUNCTION BOX AND INSERT SURPLUS CONDUCTOR LENGTH INTO BOX, PLUG ALL HOLES AND ADD BLANK COVERPLATE. INSIDE OF TUNNELS, PROVIDE HIGH DENSITY POLYETHYLENE GASKETS TO WITHSTAND HIGH PRESSURE WASHDOWN. AT SUPPLY END, DISCONNECT CONDUCTOR AND MAKE SAFE. ABANDON IN THE SAME MANNER WITH PERMANENT MARKING TO INDICATE DESTINATION, SUCH AS "TUNNEL SO. WALL, STA 60+00".
- WHERE CONDUIT IS PERMANENTLY REMOVED ON BOTH SIDES OF A PENETRATION, SEAL HOLE WITH 2-HOUR RATED FIRESTOP. PATCH HOLES IN TUNNEL GLAZED CERAMIC WALLS AND ENAMELED CEILING PANELS PER TUNNEL MAINTENANCE PROCEDURES, TO MATCH EXISTING FINISH.
- SAWCUT AND CAREFULLY REMOVE THE MINIMUM AMOUNT OF TUNNEL GLAZED CERAMIC WALL AS REQUIRED TO INSTALL (RECESS) THE VMS/LUS SIGN CONTROLLER CABINETS AND ASSOCIATED CONDUIT. STORE SALVAGABLE GLAZED UNITS FOR FUTURE REUSE AND/OR PATCHING.
- ASBESTOS ABATEMENT PROCEDURES SHALL BE UTILIZED IN THE VENTILATION BUILDING FIRST FLOOR AREA & CONTROL ROOM CEILINGS. TEST OTHER AREAS THAT MAY BE SUSPECT AND PROVIDE A WRITTEN REPORT OF FINDINGS TO THE ENGINEER. ASBESTOS ABATEMENT SHALL BE HANDLED IN ACCORDANCE TO SECTION 250 OF THE SPECIFICATIONS.
- LOW LEVEL OF HEAVY METALS MAY BE PRESENT IN VENTILATION DUCTS AND SHALL BE HANDLED IN ACCORDANCE WITH SECTION 250 OF THE SPECIFICATIONS.
- PROVIDE TEMPORARY CONNECTION BETWEEN ADJACENT FLUORESCENT LIMINAIRES AT VMS LOCATIONS AS REQUIRED. INSTALL LIQUIDTIGHT FLEXIBLE CONDUIT WITH EQUIVALENT SIZE AND TYPE OF CIRCUIT CONDUCTORS, SEE SPECIFICATIONS, "SPECIAL CONSTRUCTION REQUIREMENTS".
- REMOVE EXISTING LUMINAIRE, CONDUIT AND WIRING.
- STAGE REMOVAL OF WALL MOUNTED LUMINAIRES, CONDUIT AND WIRING AS DESCRIBED IN THE SPECIAL CONSTRUCTION REQUIREMENTS.

LIGHTING DEMOLITION NOTES:

- REMOVE NORTH TUNNEL FLUORESCENT & HPS LIGHTING AND ASSOCIATED WIRING AS INDICATED ON PLAN, DRAWINGS AND IN ACCORDANCE WITH THE REQUIREMENTS OF THE SPECIFICATIONS. ALL REMOVED HPS FIXTURES WILL BECOME PROPERTY OF THE CONTRACTOR.
- FOR NORTH TUNNEL FLUORESCENT LIGHTING DEMOLITION DETAIL, SEE ELECT DEMO SUBSET SHEET 5.
- CONTRACTOR SHALL BE RESPONSIBLE FOR PROPER DISPOSAL OF LUMINAIRES INCLUDING BALLASTS AND LAMPS IN ACCORDANCE WITH THE STATE OF COLORADO RULES AND REGULATIONS GOVERNING ALL SUCH DISPOSAL. REFER TO SECTION 250 OF THE SPECIFICATIONS SPECIAL PROVISIONS FOR ADDITIONAL INFORMATION.
- AFTER REMOVAL OF EXISTING HID LUMINAIRES, CONTRACTOR SHALL PROVIDE SNAP-IN PLUGS TO SEAL UP LEFTOVER HOLES. FINISH TO MATCH EXISTING CEILING PANEL AND MATERIAL.
- WHEN REMOVING EXISTING HID FIXTURES WHERE THE CEILING SYSTEM IS A HUNG CEILING, CONTRACTOR SHALL REMOVE ALL HARDWARE USED TO SUPPORT FIXTURE WHICH EXTENDS THROUGH THE CEILING PANEL TO THE STRUT. LEAVE EXISTING STRUT ABOVE IN PLACE.
- BEYOND HUNG CEILING AREA, REMOVE AND DISPOSE OF ALL FIXTURE HARDWARE AND PLATES IN DUCTS WHICH ARE REMOVABLE WITHOUT REMOVING THE CEILING PANEL. IN AREAS WHERE THE PLATE RESTS ON THE CEILING PANEL, PUSH THREADED BOLT/PLATE BEYOND LOWER SURFACE OF CEILING PANEL. PRIOR TO INSTALLATION, PLUG MATERIAL SHALL BE SUBMITTED TO THE ENGINEER FOR APPROVAL.
- CONTRACTOR SHALL PROVIDE PLANKING IN AREA OF SUSPENDED CEILINGS AT TUNNEL PORTAL AREAS.


QUANTITIES - NORTH TUNNEL ELECTRICAL DEMOLITION

ITEM NUMBER	DESCRIPTION	UNIT	ROADWAY	
			PLAN	AS CONST.
202	REMOVAL OF LUMINAIRE	EACH	2407	
202	REMOVAL OF EXISTING LIGHTING & VMS/LUS SYSTEM	LS	1	
250	ENVIRONMENTAL HEALTH AND SAFETY MANAGEMENT	LS	1	

Design File Name: DGNMSPEC*
 Plot File Name: SPL01.PLOT*
 Date of Plot: 06/20/2008

Computer File Information			
Creation Date:	06/20/2008	Initials:	SFD
Last Modification Date:	06/20/2008	Initials:	DJR
Full Path:	I:\102\700cadd\703select\		
Drawing File Name:	gesno01n.dgn		
Acad Ver.	R14	Scale:	NTS
		Units:	ENGLISH

Sheet Revisions			
<input type="checkbox"/>	07/03/07	ASBUILT	DJB
<input type="checkbox"/>			
<input type="checkbox"/>			
<input type="checkbox"/>			


Colorado Department of Transportation

 P.O. BOX 399
 DUMONT, CO. 80436
 Phone: 303-512-5750 FAX: 303-512-5775
 Region 1 Mountain Residency I.N.Z.

As Constructed
No Revisions:
Revised:
Void:


**TUNNEL ELECTRICAL DEMO
 NOTES & QUANTITIES**
 Designer: E.A. GAYAMAT
 Detailer: R. MILLER
 Sheet Subset: ELECT DEMO

Project No./Code	IM 0703-269
	13166
Sheet Number	10

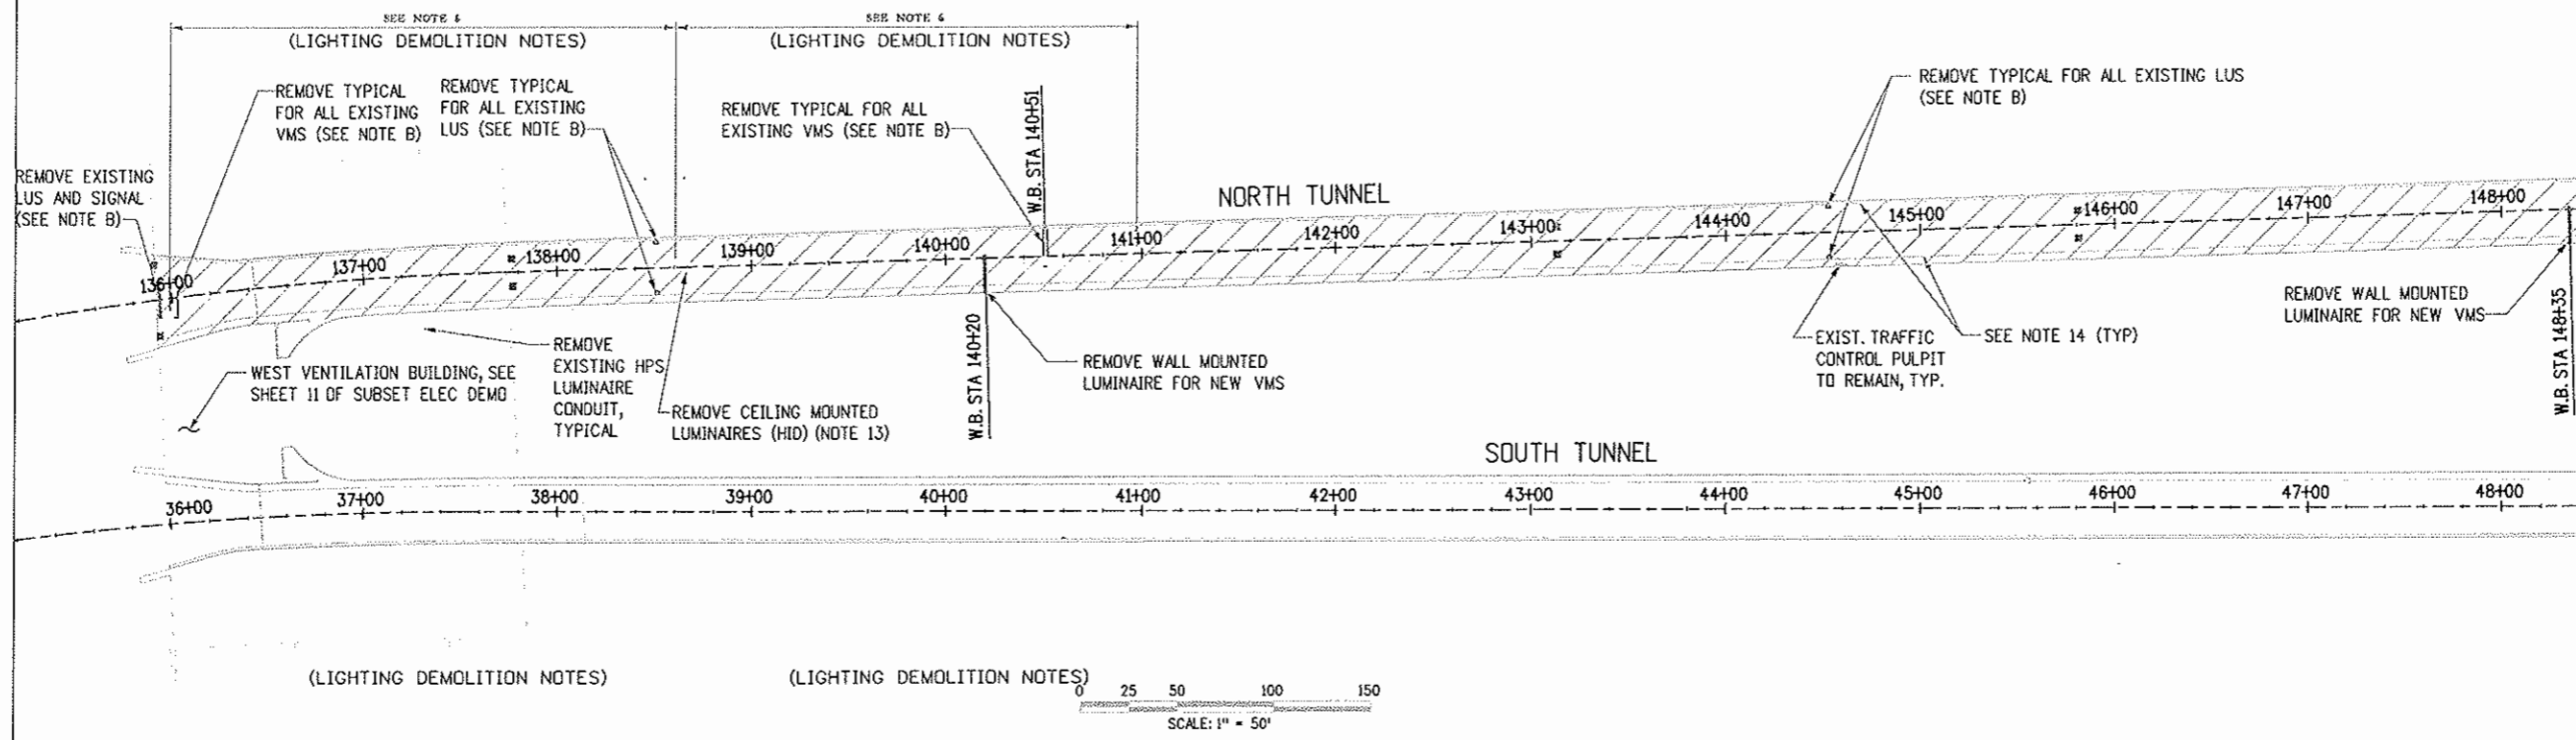Structure Numbers: 1 of 15
Subset Sheets: 1 of 15



PLAN 1

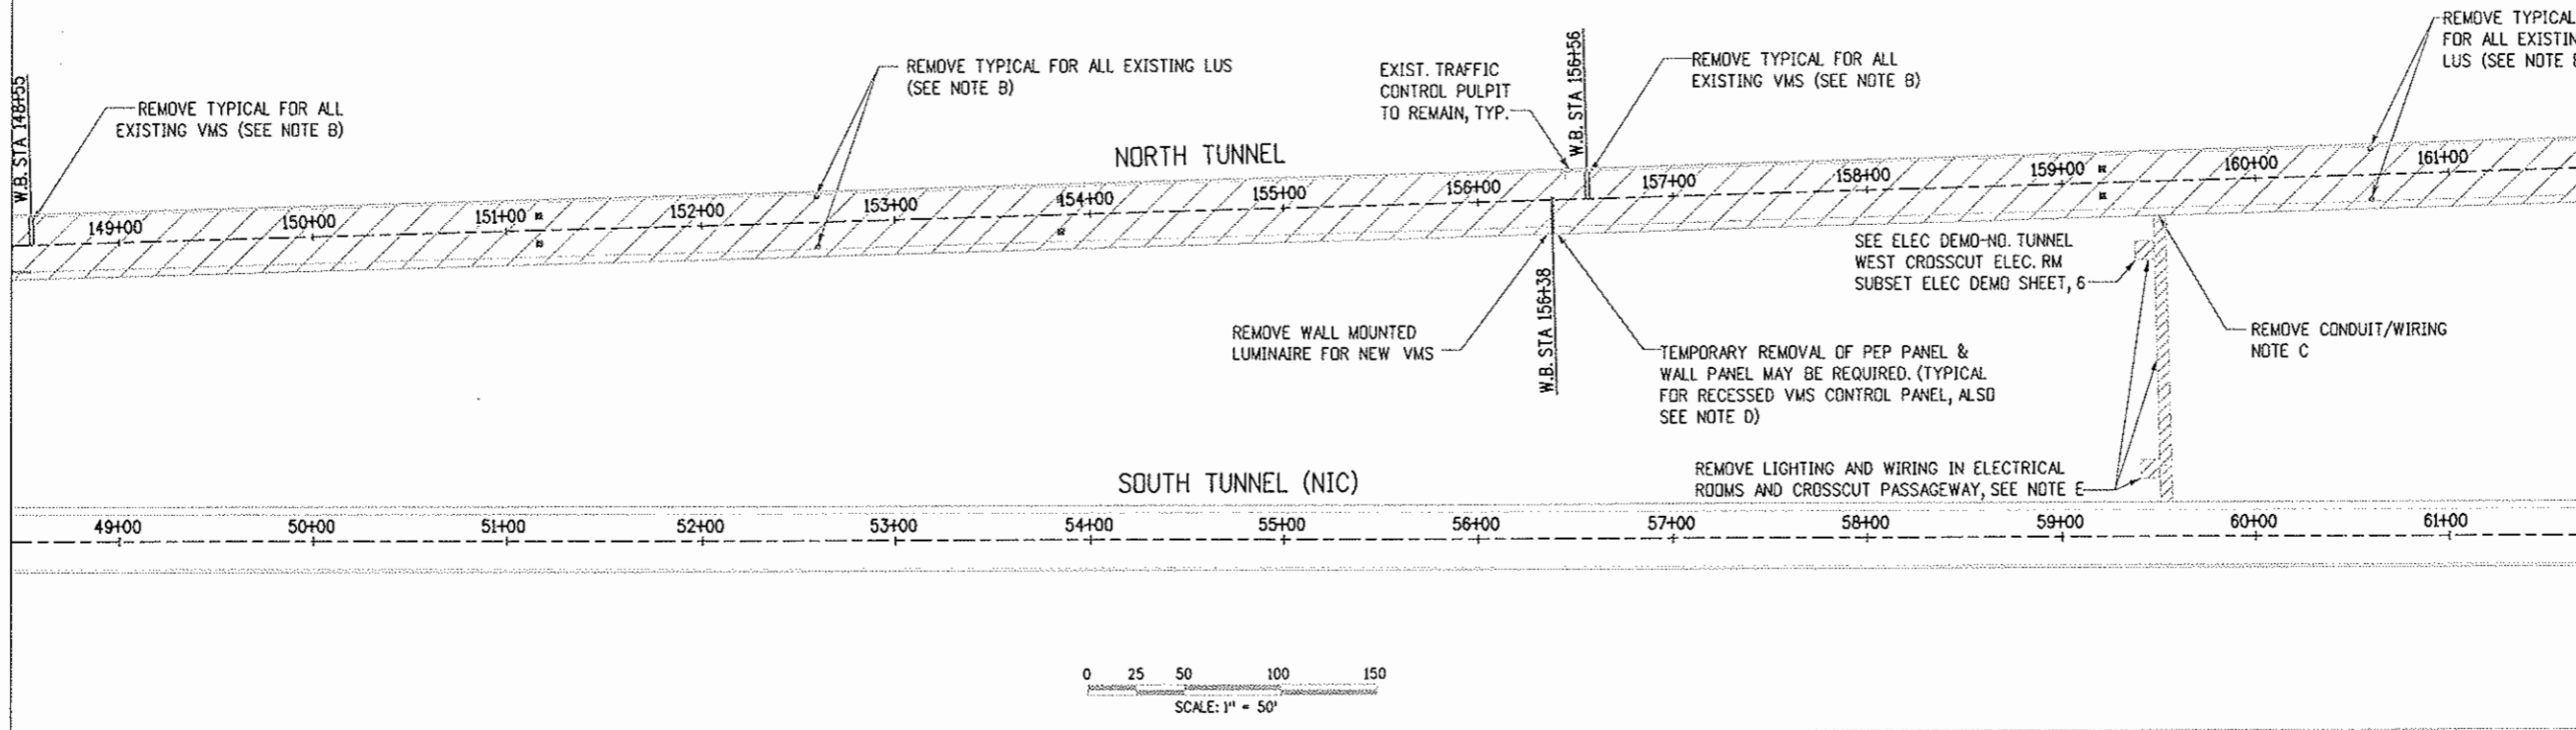

PLAN 2

NOTES

- A. SEE GENERAL DEMOLITION NOTES, SHEET 1 OF SUBSET ELECT DEMO.
- B. REFER TO VMS DRAWINGS FOR REMOVALS AND ASSOCIATED WORK.
- C. SPACE FOR CONDUIT ROUTING FROM TUNNEL INTO CROSSCUT PASSAGEWAY IS LIMITED. CONTRACTOR SHALL COORDINATE PHASING SUITABLE TO MAINTAIN THE TUNNEL OPERATION, PROVIDE TEMPORARY WIRING AS REQUIRED.
- D. STRUCTURAL WALL VARIES BEHIND THE SURFACE OF THE PEP PANEL & WALL PANEL, CONTRACTOR SHALL VERIFY IN FIELD. SEE VMS SUBSET.
- E. REMOVE AND DISPOSE OF EXISTING CONDUIT/WIRING, SWITCHES AND LUMINAIRE (APPROX. 14 INCANDESCENT FIXTURES).

Design File Name: DONSPEC*
 Plot File Name: 9PLUTFILE*
 Date of Plot: 3/30/99

Computer File Information	
Creation Date:	02/26/99 Initials: SFD
Last Modification Date:	02/27/99 Initials: DMO
Full Path:	14102\700cadd\703elect\
Drawing File Name:	rme101n.dwg
Acad Ver.:	R14 Scale: 1"=50' Units: ENGLISH


Sheet Revisions	
<input type="checkbox"/>	07/03/07 ASBUILT DJB
<input type="checkbox"/>	
<input type="checkbox"/>	
<input type="checkbox"/>	

Colorado Department of Transportation
 P.O. BOX 399
 DUMONT, CO. 80436
 Phone: 303-512-5750 FAX: 303-512-5775
 Region 1 Mountain Residency I.N.Z.


As Constructed
No Revisions:
Revised:
Void:

TUNNEL ELECTRICAL DEMO	
PLAN - SHEET 1 OF 4	
Designer: E.A. GAYAMAT	Structure Numbers:
Detailer: R. MILLER	
Sheet Subset: ELECT DEMO	Subset Sheets: 2 of 15

Project No./Code	IM 0703-269
	13166
Sheet Number	11

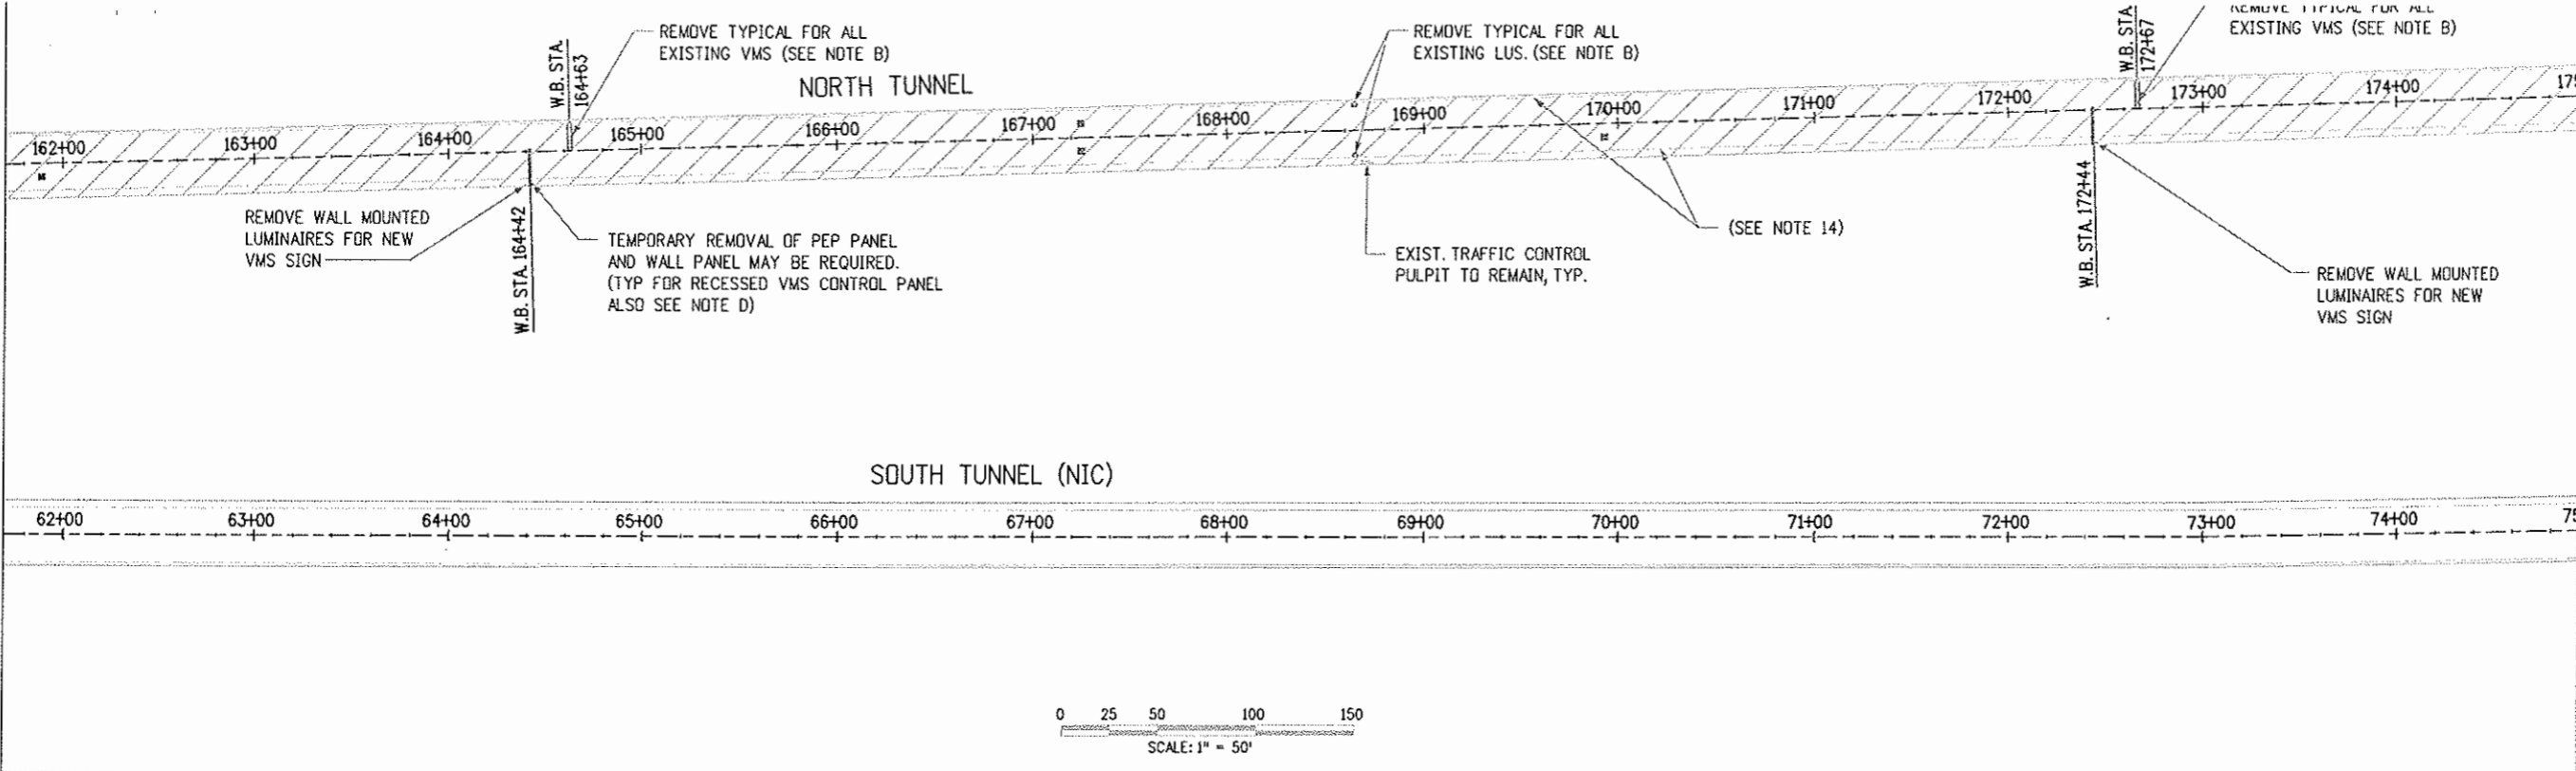

PLAN 1

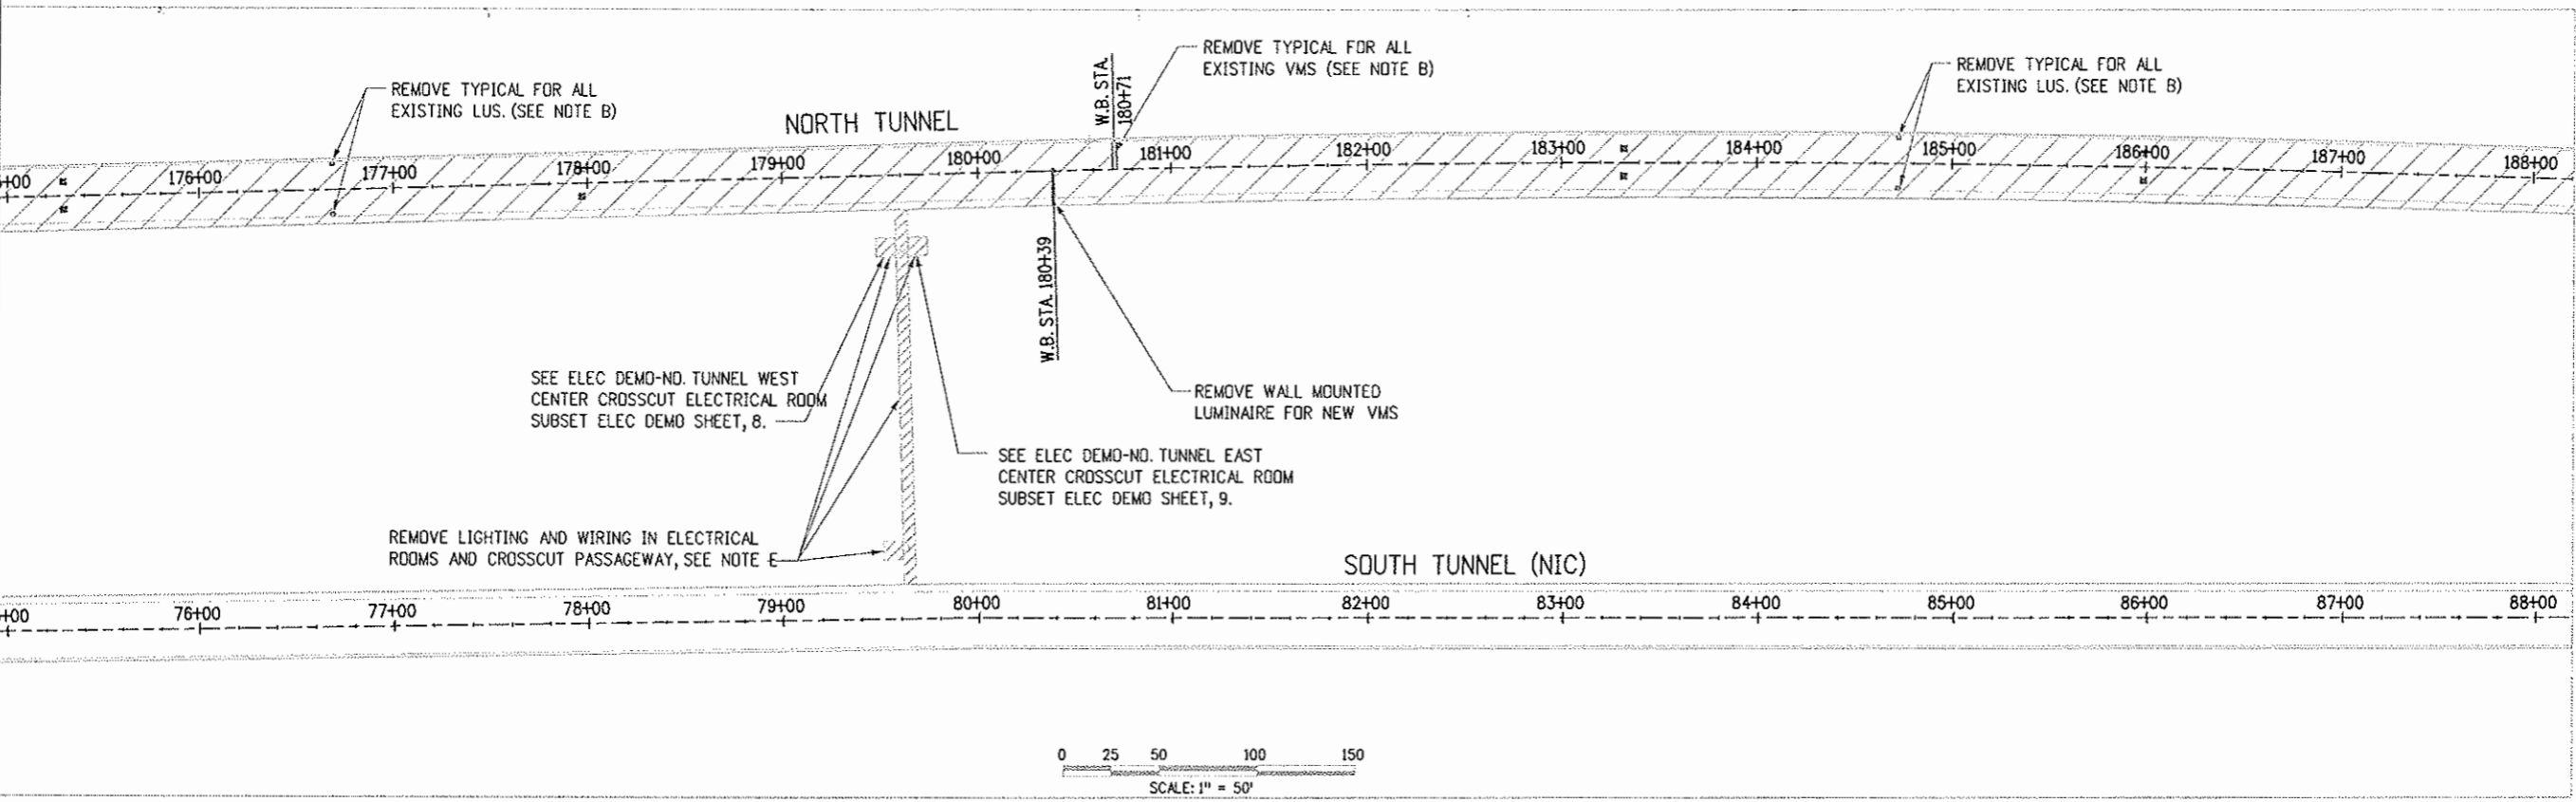

PLAN 2

NOTES


- A. SEE GENERAL DEMOLITION NOTES, SHEET 1 OF SUBSET ELECT DEMO.
- B. REFER TO VMS DRAWINGS FOR REMOVALS AND ASSOCIATED WORK.
- C. SPACE FOR CONDUIT ROUTING FROM TUNNEL INTO CROSSCUT PASSAGEWAY IS LIMITED. CONTRACTOR SHALL COORDINATE PHASING SUITABLE TO MAINTAIN THE TUNNEL OPERATION, PROVIDE TEMPORARY WIRING AS REQUIRED.
- D. STRUCTURAL WALL VARIES BEHIND THE SURFACE OF THE PEP PANEL & WALL PANEL, CONTRACTOR SHALL VERIFY IN FIELD. SEE VMS SUBSET.
- E. REMOVE AND DISPOSE OF EXISTING CONDUIT/WIRING, SWITCHES AND LUMINAIRE (APPROX. 16 INCANDESCENT FIXTURES).

Design File Name: DGN6SPEC*
 Plot File Name: \$PLDTFILE*
 Date of Plot: \$\$\$DATE\$\$\$

Computer File Information	
Creation Date:	Initials:
Last Modification Date:	Initials:
Full Path:	14102\700cadd\703elet\
Drawing File Name:	
Acad Ver. R14	Scale: 1"=50'-0"
Units:	ENGLISH

Sheet Revisions		
<input type="checkbox"/>	07/03/07	ASBUILT DJB
<input type="checkbox"/>		
<input type="checkbox"/>		
<input type="checkbox"/>		

Colorado Department of Transportation



P.O. BOX 399
 DUMONT, CO. 80436
 Phone: 303-512-5750 FAX: 303-512-5775

Region 1 Mountain Residency I.N.Z.



As Constructed
No Revisions:
Revised:
Void:

TUNNEL ELECTRICAL DEMO PLAN - SHEET 2 OF 4		
Designer: E.A. GAYAMAT	Structure Numbers	
Detailer: R. MILLER		
Sheet Subset: ELECT DEMO	Subset Sheets: 3 of 15	

Project No./Code
IM 0703-269
13166
Sheet Number 12

NOTES

- A. SEE GENERAL DEMOLITION NOTES, SHEET 1 OF SUBSET ELECT DEMO.
- B. REFER TO VMS DRAWINGS FOR REMOVALS AND ASSOCIATED WORK.
- C. SPACE FOR CONDUIT ROUTING FROM TUNNEL INTO CROSSCUT PASSAGEWAY IS LIMITED. CONTRACTOR SHALL COORDINATE PHASING SUITABLE TO MAINTAIN THE TUNNEL OPERATION, PROVIDE TEMPORARY WIRING AS REQUIRED.
- D. STRUCTURAL WALL VARIES BEHIND THE SURFACE OF THE PEP PANEL & WALL PANEL, CONTRACTOR SHALL VERIFY IN FIELD. SEE VMS SUBSET.
- E. REMOVE AND DISPOSE OF EXISTING CONDUIT/WIRING, SWITCHES AND LUMINAIRES (APPROX. 14 INCANDESCENT FIXTURES).

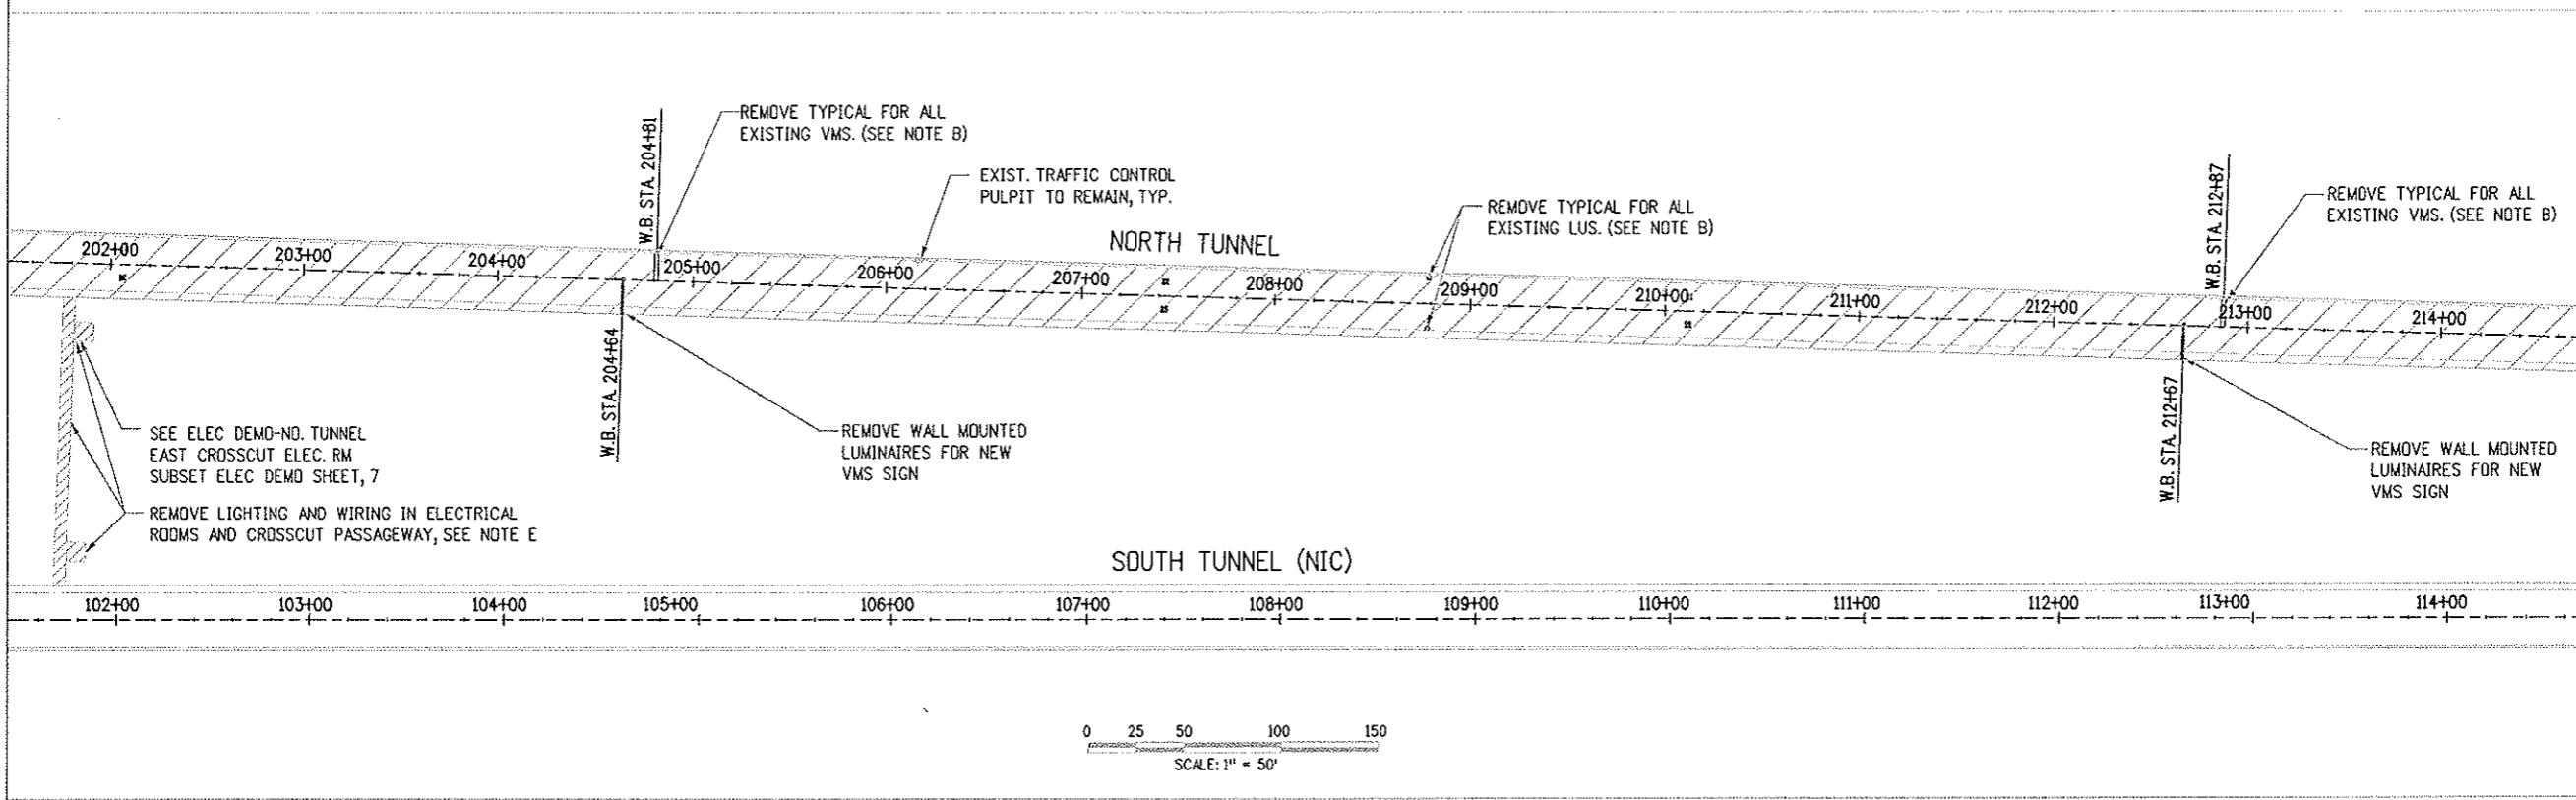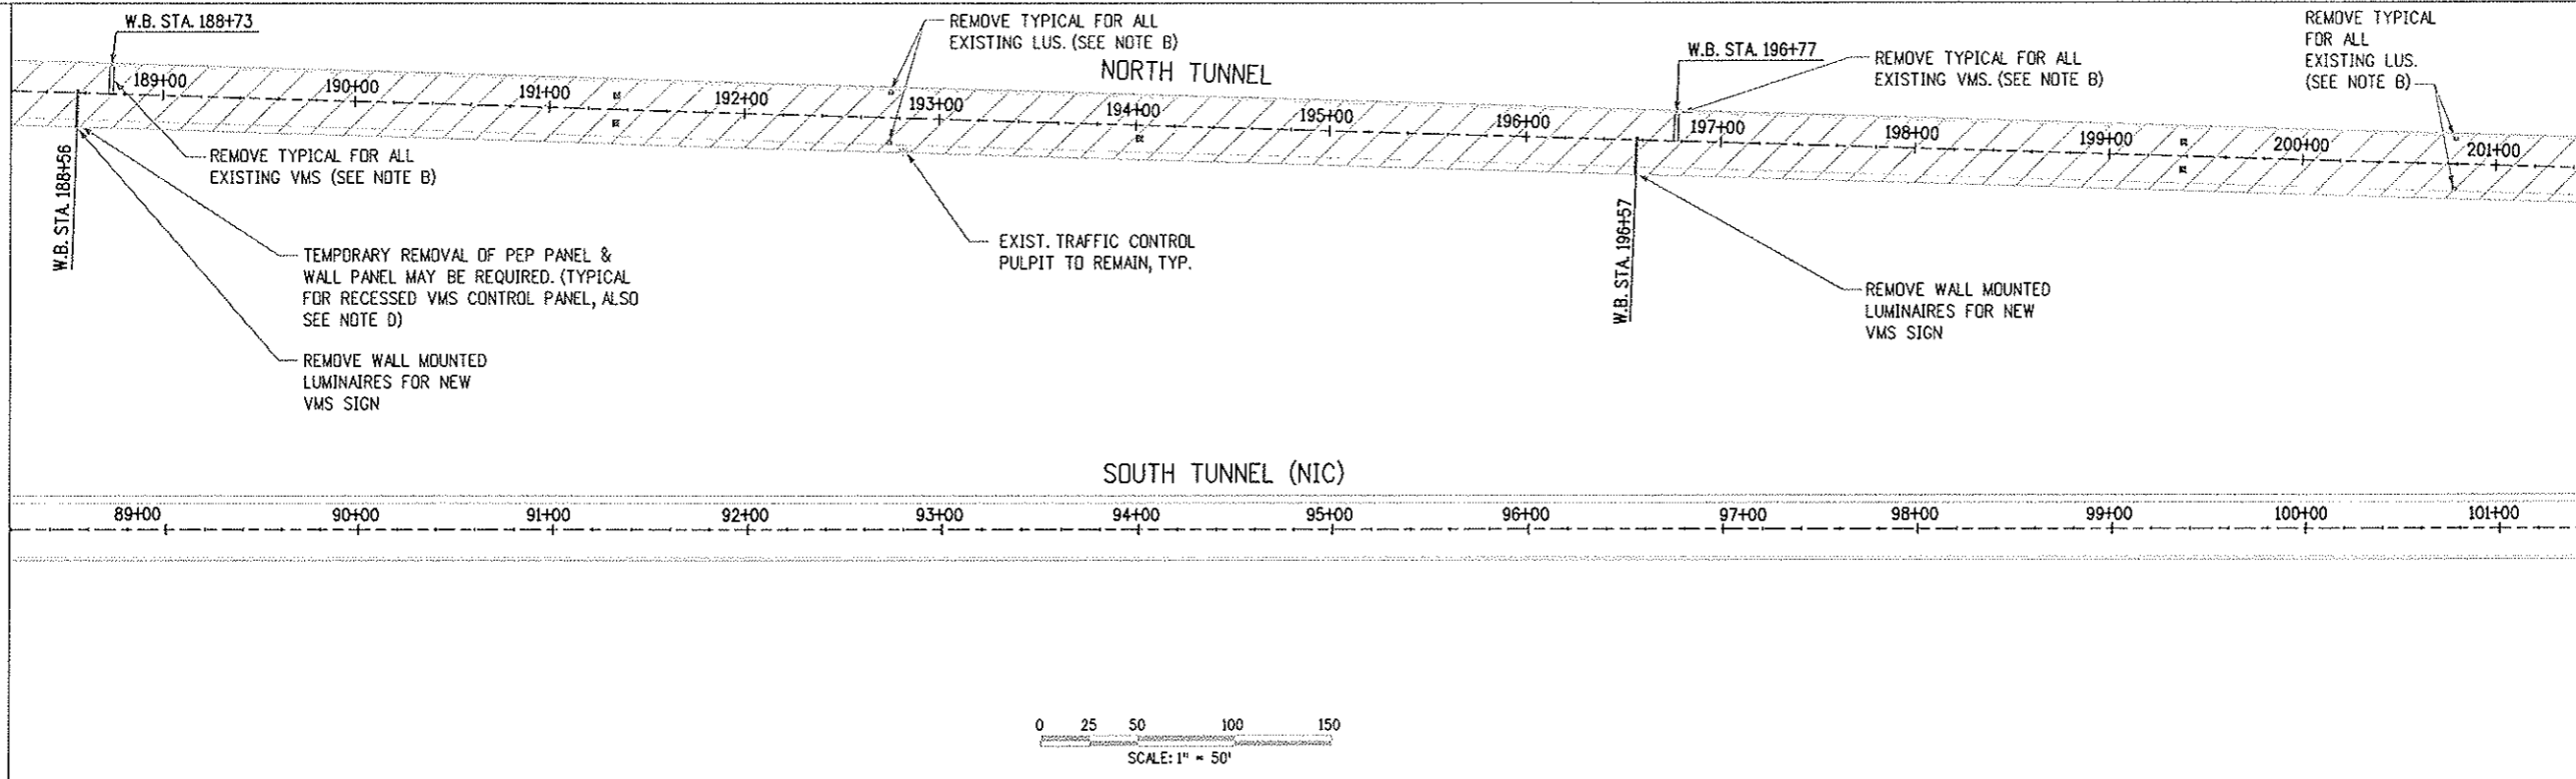

Design File Name: DGNSSPEC*
 Plot File Name: \$PLOTFILE*
 Date of Plot: \$\$\$DATE\$\$\$

Computer File Information	
Creation Date:	Initials:
Last Modification Date:	Initials:
Full Path:	14102\700cadd\703elect\
Drawing File Name:	ma101.dwg
Acad Ver. R14	Scale: 1"=50'-0"
Units:	ENGLISH

Sheet Revisions		
<input type="checkbox"/>	07/03/07	ASBUILT DJB
<input type="checkbox"/>		
<input type="checkbox"/>		
<input type="checkbox"/>		

Colorado Department of Transportation


P.O. BOX 399
 DUMONT, CO. 80436
 Phone: 303-512-5750 FAX: 303-512-5775

Region 1 Mountain Residency I.N.Z.


As Constructed
No Revisions:
Revised:
Void:

TUNNEL ELECTRICAL DEMO PLAN - SHEET 3 OF 4	
Designer: E.A. GAYAMAT	Structure Numbers:
Detailer: R. MILLER	
Sheet Subset: ELECT DEMO	Subset Sheets: 4 of 15


Project No./Code
IM 0703-269
13166
Sheet Number 13

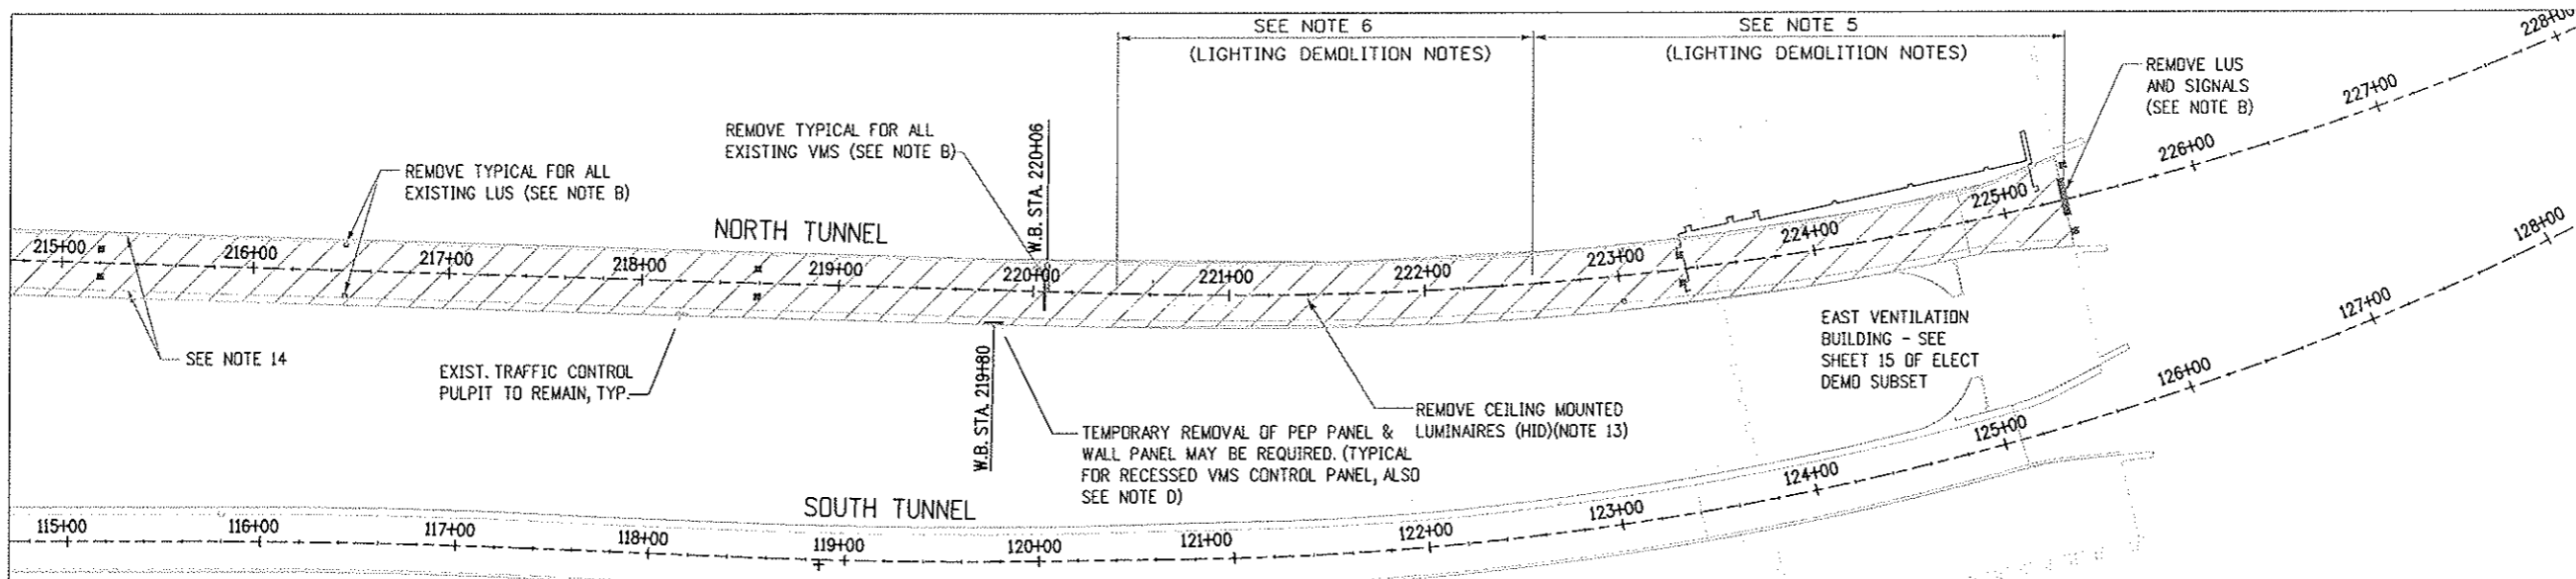

- NOTES**
- A. SEE GENERAL DEMOLITION NOTES, SHEET 1 OF SUBSET ELECT DEMO.
 - B. REFER TO VMS DRAWINGS FOR REMOVALS AND ASSOCIATED WORK.
 - C. SPACE FOR CONDUIT ROUTING FROM TUNNEL INTO CROSSCUT PASSAGEWAY IS LIMITED. CONTRACTOR SHALL COORDINATE PHASING SUITABLE TO MAINTAIN THE TUNNEL OPERATION, PROVIDE TEMPORARY WIRING AS REQUIRED.
 - D. STRUCTURAL WALL VARIES BEHIND THE SURFACE OF THE PEP PANEL & WALL PANEL, CONTRACTOR SHALL VERIFY IN FIELD. SEE VMS SUBSET.

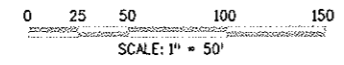

PLAN 1

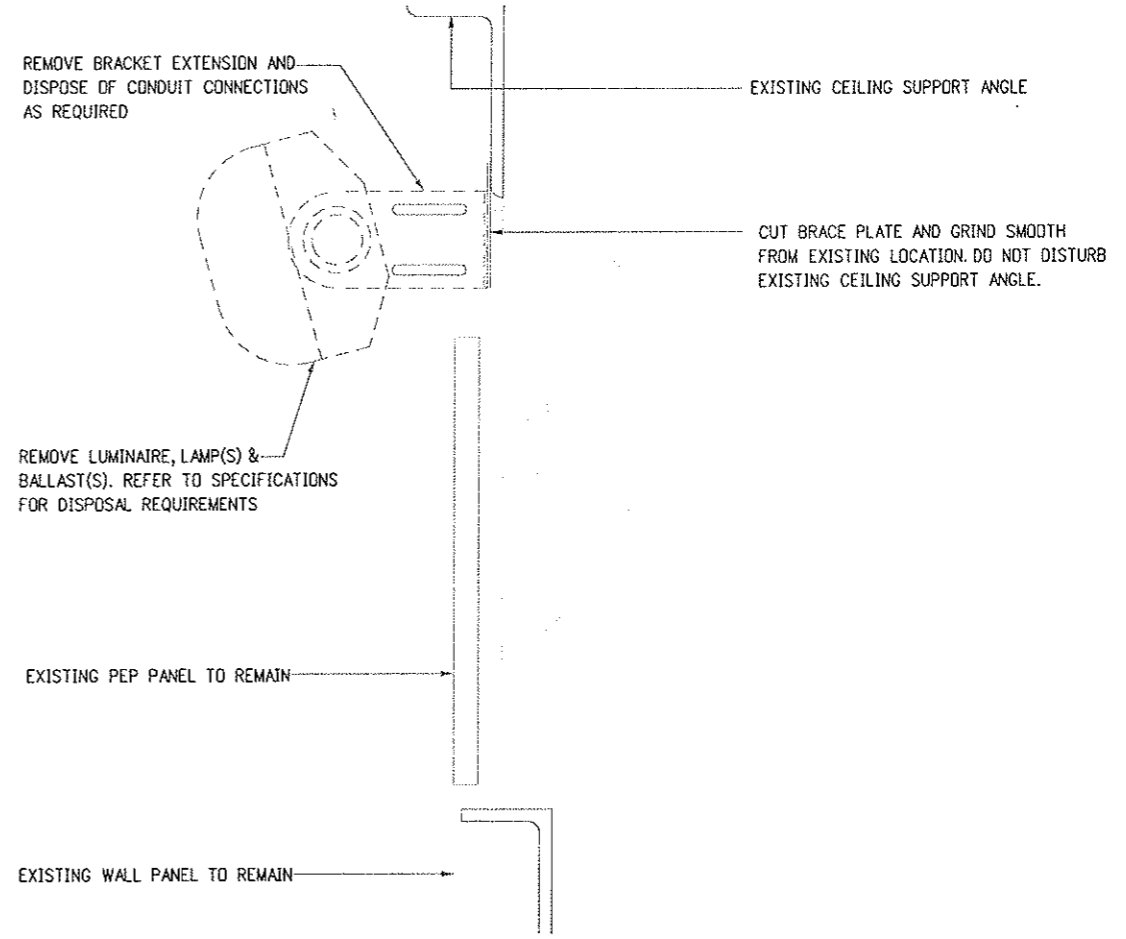


**NORTH TUNNEL WALL
TYPICAL DETAIL (NOT TO SCALE)**

Design File Name: DONSSPEC*
 Plot File Name: \$PLOTFILE*
 Date of Plot: \$\$\$DATE\$\$\$

Computer File Information	
Creation Date:	02/26/99 Initials: SFD
Last Modification Date:	02/07/01 Initials: SL
Full Path:	14102\700cadd\703elect\
Drawing File Name:	rmel04n.dwg
Acad Ver.:	R14 Scale: 1"=50' Units: ENGLISH


Sheet Revisions		
<input type="checkbox"/>	07/03/07	ASBUILT DJB
<input type="checkbox"/>		
<input type="checkbox"/>		
<input type="checkbox"/>		

Colorado Department of Transportation

 P.O. BOX 399
 DUMONT, CO. 80436
 Phone: 303-512-5750 FAX: 303-512-5775
 Region 1 Mountain Residency I.N.Z.

As Constructed
No Revisions:
Revised:
Void:

TUNNEL ELECTRICAL DEMO PLAN - SHEET 4 OF 4		
Designer:	E.A. GAYAMAT	Structure Numbers
Detailer:	R. MILLER	
Sheet Subset:	ELECT DEMO	Subset Sheets: 5 of 15

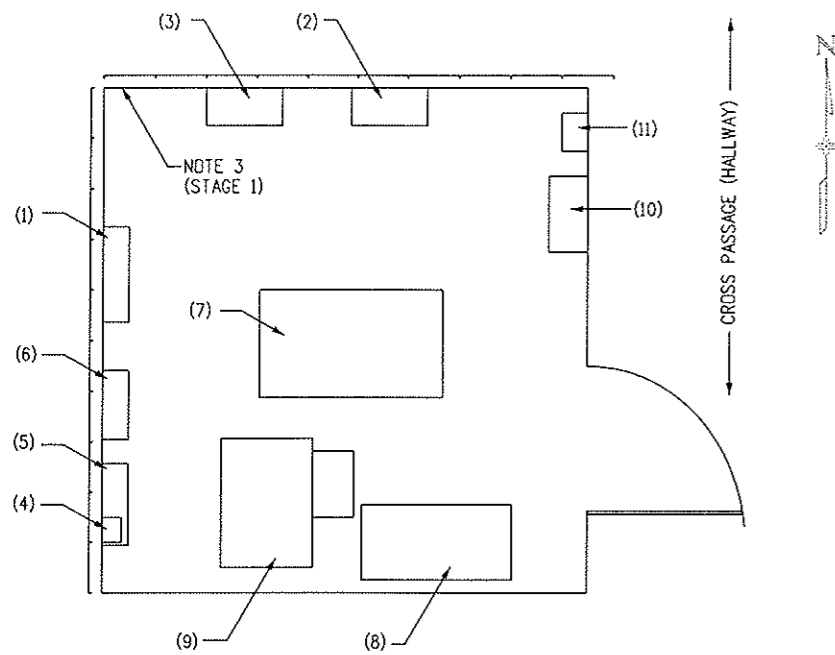Project No./Code
IM 0703-269
13166
Sheet Number 14




EXISTING PLAN

SCALE: 1/2" = 1'-0"

EXISTING PLAN LEGEND

- (1) 277 / 480 V PANEL- 22"W x 65"H x 6"D
- (2) LIGHTING AND HEATING CONTACTOR PANEL- 18"W x 32"H x 9"D
- (3) LIGHTING CONTROL PANEL- 18"W x 20"H x 9"D
- (4) 3 KVA, 480 V - 120 / 240 V TRANSFORMER- 6"W x 11"H x 5"D
- (5) 120 / 240 V PANELBOARD - 20" W x 17"H x 6"D
- (6) 30A / ASCO SWITCH - 16"W x 21"H x 6"D
- (7) 150 kVA, 2400 V - 277 / 480 V TRANSFORMER- 40"W x 41"H x 25"D
- (8) MV FUSED OIL CUTOFF SWITCH- 35"W x 38"(55")H x 18"D
- (9) FIBER OPTIC CABINET- 22"W x 75"H x 31"D
- (10) CABINET- 14"W x 38"H x 9"D
- (11) JUNCTION BDX- 8"W x 8"H x 4"D

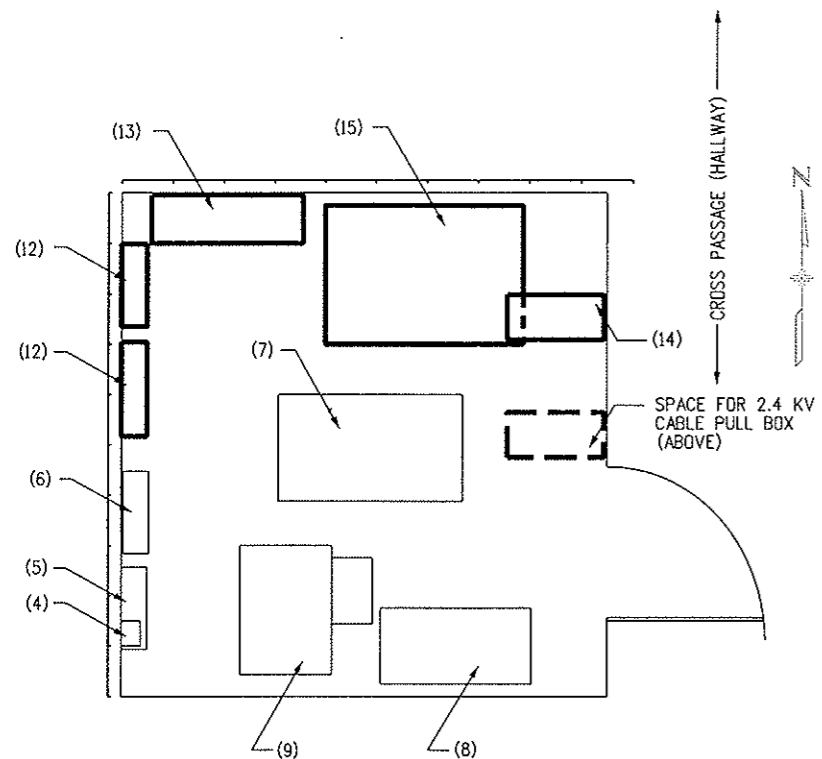

INTERIM PLAN

SCALE: 1/2" = 1'-0"

INTERIM PLAN LEGEND

- (1) REMOVED - 277 / 480 V PANEL- 22"W x 65"H x 6"D
- (2) REMOVED - LIGHTING AND HEATING CONTACTOR PANEL- 18"W x 32"H x 9"D
- (3) REMOVED - LIGHTING CONTROL PANEL- 18"W x 20"H x 9"D
- (4) 3 KVA, 480 V - 120 / 240 V TRANSFORMER- 6"W x 11"H x 5"D (EXIST)
- (5) 120 / 240 V PANELBOARD - 20" W x 17"H x 6"D (EXIST)
- (6) 30A / ASCO SWITCH - 16"W x 21"H x 6"D (EXIST.)
- (7) 150 kVA, 2400 V - 277 / 480 V TRANSFORMER- 40"W x 41"H x 25"D (EXIST), NOTE 10.
- (8) MV FUSED OIL CUTOFF SWITCH- 35"W x 38"(55")H x 18"D (EXIST)
- (9) FIBER OPTIC CABINET- 22"W x 75"H x 31"D (EXIST)
- (10) REMOVED - CABINET- 14"W x 38"H x 9"D
- (11) REMOVED - JUNCTION BOX- 8"W x 8"H x 4"D
- (12) NEW 277 / 480 V PANEL- 22"W x 65"H x 6"D
- (13) NEW CONTACTOR CABINET
- (14) NEW 2.4 KV CABLE PULL BOX - 24" W x 20"H x 12"D
- (15) NEW 150 kVA, 2400 V - 277 / 480 V TRANSFORMER- 48"W x 58"H x 32"D, NOTE 10.

STAGE 1 CONSTRUCTION NOTES:


1. STEP 1 OF THE FIRST STAGE OF CONSTRUCTION FOR EACH CROSSCUT ELECTRICAL ROOM INVOLVES THE CONSECUTIVE TEMPORARY DEENERGIZING OF INDIVIDUAL TUNNEL LIGHTING CIRCUITS USING THE THREE-POLE CIRCUIT BREAKERS IN THE PANELBOARDS SERVING THESE LIGHTING LOADS.
2. FOLLOWING THE DEENERGIZATION OF AN INDIVIDUAL THREE-PHASE LIGHTING CIRCUIT, STEP 2 REQUIRES THAT THE LINE AND LOAD CIRCUIT CONNECTIONS TO THE LIGHTING CONTACTOR CONTROLLING THAT CIRCUIT BE REMOVED AND EXTENDED TO A TEMPORARY WIREWAY. THE WIREWAY SHALL EXTEND OVER AND BETWEEN THE PANELBOARD AND CONTACTOR PANEL AND BE MOUNTED AT A HEIGHT ABOVE THE HORIZONTAL RUNS OF LIGHTING CIRCUIT CONDUITS THAT ARE ROUTED TO THE CONTACTOR PANEL. IN LOCATING THE WIREWAY, AVOID INTERFERENCE WITH ANY NEW EQUIPMENT INDICATED TO BE INSTALLED IN THE ELECTRICAL ROOM. THE EXTENDED CIRCUIT CONDUCTORS FROM THE CONTACTOR PANEL WOULD BE TEMPORARILY SPLICED IN THE WIREWAY TO NEW CIRCUIT CONDUCTORS FROM THE PANELBOARD. THE ONLY CONTROL FOR EACH REROUTED LIGHTING CIRCUIT WOULD BE THE THREE-POLE CIRCUIT BREAKER IN THE PANELBOARD. ONCE THE CHANGES FOR ONE LIGHTING CIRCUIT HAVE BEEN COMPLETED, THE REROUTING OF THE NEXT CIRCUIT CAN PROCEED.
3. STEP 3 REQUIRES THE TEMPORARY DEENERGIZATION OF THE THREE-PHASE HEAT TRACE CIRCUIT USING THE THREE-POLE CIRCUIT BREAKER IN THE PANELBOARD SERVING THIS HEATING LOAD. DISCONNECT THE LINE AND LOAD CIRCUIT CONNECTIONS TO THE HEATING CONTACTOR CONTROLLING THE CIRCUIT AND RELOCATE THE HEATING CONTACTOR TO AN ENCLOSURE MOUNTED ADJACENT TO THE WIREWAY. THE ENCLOSURE SHALL BE LOCATED TO AVOID INTERFERENCE WITH NEW EQUIPMENT INDICATED TO BE INSTALLED IN THE ELECTRICAL ROOM. EXTEND THE HEATING CIRCUIT TO THE RELOCATED HEATING CONTACTOR AND MAKE THE NECESSARY LINE AND LOAD CIRCUIT CONNECTIONS. EXTEND THE THERMOSTATIC CONTROL CIRCUIT TO THE HEATING CONTACTOR AND MAKE THE NECESSARY CONTROL CIRCUIT CONNECTIONS TO OPERATE IT AUTOMATICALLY FROM THE REMOTE THERMOSTAT. THE CONTRACTOR MAY REQUEST PERMISSION FROM THE STATE ENGINEER TO OMIT THE TEMPORARY RECONNECTION OF THE THERMOSTATIC CONTROL CIRCUIT FOR THE CONSTRUCTION WORK THAT IS TO BE COMPLETED DURING SUMMER MONTHS.
4. STEP 4 REQUIRES THAT THE LIGHTING AND HEATING CONTACTOR PANEL, THE LIGHTING CONTROL PANEL AND ASSOCIATED CONDUIT/WIRING BE REMOVED FROM THE ELECTRICAL ROOM. THIS WORK CAN PROCEED ONCE ALL LIGHTING AND HEATING CIRCUITS HAVE BEEN EXTENDED AND REROUTED THROUGH THE NEW WIREWAY/CONTACTOR ENCLOSURE AND ARE FULLY OPERATIONAL AS DESCRIBED ABOVE.


STAGE 2 CONSTRUCTION NOTES:

1. STEP 1 OF THE SECOND STAGE OF CONSTRUCTION FOR EACH CROSSCUT ELECTRICAL ROOM INVOLVES INSTALLING THE NEW 2400 V - 480Y / 277 VOLT TRANSFORMER, THE NEW MEDIUM VOLTAGE CABLE PULLBOX AND THE TRANSFORMER MEDIUM VOLTAGE FEEDER WHICH ORIGINATES FROM THE VENTILATION BUILDING.
2. FOLLOWING THE INSTALLATION OF THE NEW TRANSFORMER AND PRIMARY FEEDER, STEP 2 REQUIRES THAT THE NEW 480Y / 277 VOLT PANELBOARD NWN-1 AND SECONDARY FEEDER BETWEEN THE TRANSFORMER AND PANELBOARD BE INSTALLED IN THE ELECTRICAL ROOM.
3. STEP 3 REQUIRES THAT THE NEW CONTACTOR CABINET BE INSTALLED AT THE LOCATION INDICATED ON THE PLAN. INSTALL A 120 VOLT POWER CIRCUIT FROM THE EXISTING 240 / 120 VOLT PANEL LOCATED IN THE CROSSCUT ELECTRICAL ROOM TO THE NEW CONTACTOR CABINET. INSTALL ANY REQUIRED CONTROL / SIGNAL CIRCUITS TO THE NEW CONTACTOR CABINET FROM THE NEAREST CROSSCUT ELECTRICAL ROOM(S) AND / OR VENTILATION BUILDING. ALSO, INSTALL THE FOUR NEW THREE-PHASE LIGHTING CIRCUITS FROM THE PANELBOARD TO THEIR ASSOCIATED CONTACTORS IN THE CONTACTOR CABINET. A MAXIMUM OF TWO THREE-PHASE FOUR-WIRE CIRCUITS SHALL BE INSTALLED IN ANY ONE CONDUIT. MAKE ALL CONDUCTOR TERMINATIONS TO THE CIRCUIT BREAKERS, NEUTRAL AND GROUND BUS AND LIGHTING CONTACTORS.
4. STEP 4 REQUIRES THAT THE EXISTING THREE-PHASE LIGHTING CIRCUITS THAT SERVE A SECTION OF THE TUNNEL WALL (ONE SIDE), BE DEENERGIZED AND THE CONDUCTORS REMOVED BETWEEN THE PANEL AND THE NEAREST TUNNEL LIGHTING CIRCUIT PULLBOX. TAPE THE ENDS OF THE ABANDONED CIRCUIT CONDUCTORS IN THE PULLBOX, LEAVING A MINIMUM OF THREE FEET SURPLUS OF EACH CONDUCTOR COILED IN THE PULLBOX. REMOVE THE CONDUIT FOR THESE CIRCUITS BETWEEN THE PANEL AND THE PULLBOX LOCATED ABOVE THE ENTRANCE TO THE CROSSCUT PASSAGE. THIS CONSTRUCTION STEP FACILITATES THE INSTALLATION OF A SEGMENT OF THE TUNNEL INTERIOR FLUORESCENT LIGHTING AND THE CONDUITS AND CONDUCTORS WHICH WILL BE USED TO SUPPLY POWER TO THEM.
5. STEP 5 REMOVE THE EXISTING LUMINAIRES THAT WERE DEENERGIZED IN STEP 4. CONTRACTOR SHALL OWN AND DISPOSE LUMINAIRES INCLUDING BALLASTS AND LAMPS. PROVIDE CERTIFICATION TO STATE THAT DISPOSAL METHOD UTILIZED FOR LUMINAIRES, BALLASTS AND LAMPS MEETS STATE OF COLORADO AND FEDERAL REGULATIONS.
6. STEP 6 REQUIRES THAT THE FLUORESCENT LUMINAIRES ON ONE SIDE OF THE TUNNEL BE INSTALLED. ONCE INSTALLED, THE NEW LIGHTING CIRCUITS SHALL BE TERMINATED ON THE LOAD SIDE OF THEIR RESPECTIVE LIGHTING CONTACTORS IN THE CONTACTOR CABINET.
7. STEP 7 REQUIRES THAT THE THREE-PHASE CIRCUIT CONDUCTORS FOR THE HEAT TRACE CIRCUIT BE INSTALLED BETWEEN THE CONTACTOR CABINET AND THE NEW 480 / 277 VOLT PANELBOARD. DEENERGIZE THE EXISTING THREE-PHASE HEAT TRACE CIRCUIT THAT SERVES THE ADJACENT SECTIONS OF THE TUNNEL AT THE EXISTING 480 VOLT PANEL AND EXTEND THE CIRCUIT TO THE NEW CONTACTOR CABINET. INSTALL JUNCTION BOXES AS REQUIRED FOR SPLICING CIRCUIT CONDUCTORS.
8. STEP 8 REQUIRES THAT ALL OTHER 480 AND 277 VOLT LOADS, EXCLUDING THE FOUR REMAINING TUNNEL LIGHTING CIRCUITS, BE TRANSFERRED FROM THE EXISTING 480 VOLT PANEL TO THE NEW 480 / 277 VOLT PANELBOARD. THESE CIRCUITS INCLUDE THE FEEDER TO THE 480 - 240/120 VOLT TRANSFORMER (WHICH SUPPLIES THE EXISTING 120/240 VOLT PANEL), MESSAGE BOARD FEEDERS AND TELEVISION CAMERA FEEDERS. DEENERGIZE THE EXISTING CIRCUITS FROM THE EXISTING 480 VOLT PANEL AND EXTEND THE CIRCUITS TO THE NEW 480 / 277 VOLT PANELBOARD. INSTALL JUNCTION BOXES AS REQUIRED FOR SPLICING CIRCUIT CONDUCTORS.
9. STEP 9 REQUIRES THAT THE EXISTING 480V PANEL BE REMOVED AND A SECOND NEW 480/277 PANELBOARD NWS-1 BE INSTALLED IN ITS PLACE. PRIOR TO INSTALLING THE SECOND PANELBOARD, THE MEDIUM VOLTAGE OIL CUTOFF SWITCH CAN BE OPENED AND THE SECONDARY FEEDER FROM THE TRANSFORMER TO THE EXISTING 480 VOLT PANEL CAN BE REMOVED. NEXT, THE CONDUCTORS FOR THE REMAINING THREE-PHASE LIGHTING CIRCUITS THAT SERVE THE OPPOSITE SIDE OF THE TUNNEL SHALL BE REMOVED BETWEEN THE PANEL AND THE NEAREST TUNNEL LIGHTING CIRCUIT PULLBOX. TAPE THE ENDS OF THE ABANDONED CIRCUIT CONDUCTORS IN THE PULLBOX, LEAVING A MINIMUM OF THREE FEET SURPLUS OF EACH CONDUCTOR COILED IN THE PULLBOX. THE EXISTING 480 VOLT PANEL SHALL THEN BE REMOVED. THIS CONSTRUCTION STEP FACILITATES THE INSTALLATION OF PANEL NWS-1 AND REMOVAL AND REPLACEMENT OF THE EXISTING 2400V-480Y/277V TRANSFORMER. IT ALSO FACILITATES THE REMOVAL OF THE EXISTING MEDIUM VOLTAGE CABLE PULL AND OIL CUTOFF SWITCH. ALSO, THE INSTALLATION OF THE REMAINING SEGMENT OF THE TUNNEL INTERIOR FLUORESCENT LIGHTING AND THE ASSOCIATED LIGHTING CIRCUITS SUPPLIED FROM THIS ELECTRICAL ROOM CAN PROCEED FOLLOWING THIS CONSTRUCTION STEP.
10. DE-ENERGIZE, DISCONNECT AND RELOCATE (TEMPORARILY) THE EXISTING TRANSFORMER AND APPURTENANCES FOR THE INSTALLATION OF THE NEW TRANSFORMER (TX-NWN-1) AND COORDINATE STAGING OF WORK WITH INSTALLATION OF ALL EQUIPMENT AS INDICATED ON THE FINAL PLANS AS REQUIRED.

NOTE:

THE INTENT OF STAGING IS TO MAINTAIN A FULLY OPERATIONAL TUNNEL DURING CONSTRUCTION. SEE SPECIAL CONSTRUCTION REQUIREMENTS (K).

Computer File Information		Sheet Revisions		Colorado Department of Transportation		As Constructed		ELEC DEMO - NO. TUNNEL WEST CROSSCUT ELEC RM		Project No./Code	
Creation Date:	Initials:	07/03/07	ASBUILT					No Revisions:		IM 0703-269	
Last Modification Date:	12/04/03 Initials: DJB							Revised:		13166	
Full Path:	014102\700cadd\703elect\							Void:		Sheet Number 15	
Drawing File Name:	102ep150n.dgn			 P.O. BOX 399 DUMONT, CO. 80436 Phone: 303-512-5750 FAX: 303-512-5775		Designer: E.A. GAYAMAT Detailer: R. MILLER		Structure Numbers		Sheet Subset: ELEC DEMO Subset Sheets: 6 of 15	
Acad Ver. R14	Scale: Units: ENGLISH			Region 1 Mountain Residency I.N.Z.						Sheet Number 15	

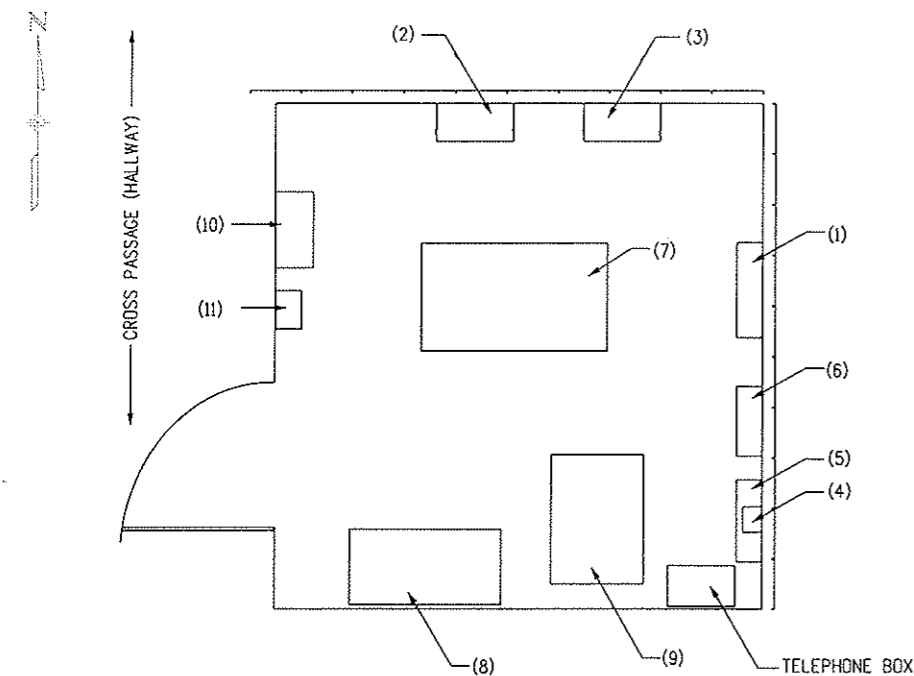


EXISTING PLAN

SCALE: 1/2" = 1'-0"

EXISTING PLAN LEGEND

- (1) 277 / 480 V PANEL- 22"W x 65"H x 6"D
- (2) LIGHTING AND HEATING CONTACTOR PANEL- 18"W x 32"H x 9"D
- (3) LIGHTING CONTROL PANEL- 18"W x 20"H x 9"D
- (4) 3 KVA, 480 V - 120 / 240 V TRANSFORMER- 6"W x 11"H x 5"D
- (5) 120 / 240 PANEL- 16"W x 21"H x 6"D
- (6) 120 / 240 V 30A, ASCO SWITCH - 20" W x 17"H x 6"D
- (7) 150 KVA, 2400 V - 277 / 480 V TRANSFORMER- 40"W x 41"H x 25"D
- (8) MV FUSED OIL CUTOFF SWITCH - 35"W x 38"(55")H x 18"D
- (9) FIBER OPTIC CABINET- 22"W x 75"H x 31"D
- (10) CABINET- 14"W x 38"H x 9"D
- (11) JUNCTION BOX- 8"W x 8"H x 4"D

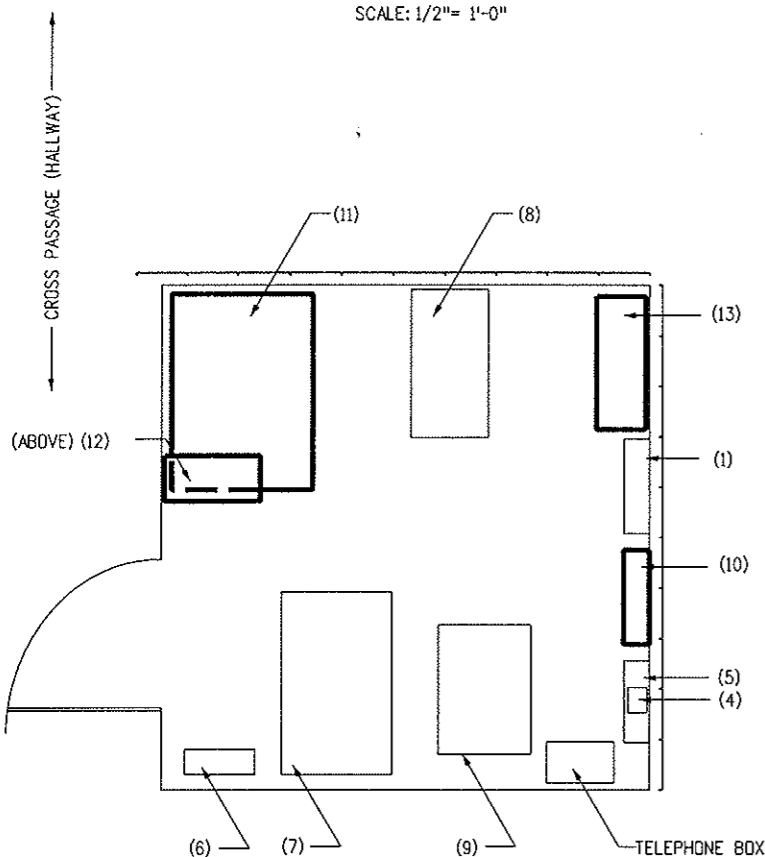

INTERIM PLAN

SCALE: 1/2" = 1'-0"

INTERIM PLAN LEGEND

- (1) 480 / 277 V PANEL- 22"W x 65"H x 6"D (EXIST)
- (2) REMOVED - LIGHTING AND HEATING CONTACTOR PANEL
- (3) REMOVED - LIGHTING CONTROL PANEL
- (4) 3 KVA, 480 V - 120 / 240 V TRANSFORMER- 6"W x 11"H x 5"D (EXIST.)
- (5) 120 / 240 PANEL- 16"W x 21"H x 6"D
- (6) RELOCATED - 120 / 240 V 30A, ASCO SWITCH- 20" W x 17"H x 6"D (EXIST.)
- (7) 150 KVA, 2400 V - 480Y / 277 V TRANSFORMER (EXIST), NOTE 10
- (8) RELOCATED - MV FUSED OIL CUTOFF SWITCH- 35"W x 38"H x 18"D (EXIST.)
- (9) FIBER OPTIC CABINET
- (10) NEW 480 / 277 V PANEL- 22"W x 65"H x 6"D
- (11) 150 KVA, 2400 V - 480Y / 277 V TRANSFORMER TX-NEN-1 48"W x 58"H x 32"D, NOTE 10
- (12) NEW MV CABLE PULL BOX- 24"W x 20"H x 12"D
- (13) NEW CONTACTOR CABINET

STAGE 1 CONSTRUCTION NOTES:


1. STEP 1 OF THE FIRST STAGE OF CONSTRUCTION FOR EACH CROSSCUT ELECTRICAL ROOM INVOLVES THE CONSECUTIVE TEMPORARY DEENERGIZING OF INDIVIDUAL TUNNEL LIGHTING CIRCUITS USING THE THREE-POLE CIRCUIT BREAKERS IN THE PANELBOARDS SERVING THESE LIGHTING LOADS.
2. FOLLOWING THE DEENERGIZING OF AN INDIVIDUAL THREE-PHASE LIGHTING CIRCUIT, STEP 2 REQUIRES THAT THE LINE AND LOAD CIRCUIT CONNECTIONS TO THE LIGHTING CONTACTOR CONTROLLING THAT CIRCUIT BE REMOVED AND EXTENDED TO A TEMPORARY WIREWAY. THE WIREWAY SHALL EXTEND OVER AND BETWEEN THE PANELBOARD AND CONTACTOR PANEL AND BE MOUNTED AT A HEIGHT ABOVE THE HORIZONTAL RUNS OF LIGHTING CIRCUIT CONDUITS THAT ARE ROUTED TO THE CONTACTOR PANEL. IN LOCATING THE WIREWAY, AVOID INTERFERENCE WITH ANY NEW EQUIPMENT INDICATED TO BE INSTALLED IN THE ELECTRICAL ROOM. THE EXTENDED CIRCUIT CONDUCTORS FROM THE CONTACTOR PANEL WOULD BE TEMPORARILY SPLICED IN THE WIREWAY TO NEW CIRCUIT CONDUCTORS FROM THE PANELBOARD. THE ONLY CONTROL FOR EACH REROUTED LIGHTING CIRCUIT WOULD BE THE THREE-POLE CIRCUIT BREAKER IN THE PANELBOARD. ONCE THE CHANGES FOR ONE LIGHTING CIRCUIT HAVE BEEN COMPLETED, THE REROUTING OF THE NEXT CIRCUIT CAN PROCEED.
3. STEP 3 REQUIRES THE TEMPORARY DEENERGIZING OF THE THREE-PHASE HEAT TRACE CIRCUIT USING THE THREE-POLE CIRCUIT BREAKER IN THE PANELBOARD SERVING THIS HEATING LOAD. DISCONNECT THE LINE AND LOAD CIRCUIT CONNECTIONS TO THE HEATING CONTACTOR CONTROLLING THE CIRCUIT AND RELOCATE THE HEATING CONTACTOR TO AN ENCLOSURE MOUNTED ADJACENT TO THE WIREWAY. THE ENCLOSURE SHALL BE LOCATED TO AVOID INTERFERENCE WITH NEW EQUIPMENT INDICATED TO BE INSTALLED IN THE ELECTRICAL ROOM. EXTEND THE HEATING CIRCUIT TO THE RELOCATED HEATING CONTACTOR AND MAKE THE NECESSARY LINE AND LOAD CIRCUIT CONNECTIONS. EXTEND THE THERMOSTATIC CONTROL CIRCUIT TO THE HEATING CONTACTOR AND MAKE THE NECESSARY CONTROL CIRCUIT CONNECTIONS TO OPERATE IT AUTOMATICALLY FROM THE REMOTE THERMOSTAT. THE CONTRACTOR MAY REQUEST PERMISSION FROM THE STATE ENGINEER TO OMIT THE TEMPORARY RECONNECTION OF THE THERMOSTATIC CONTROL CIRCUIT FOR THE CONSTRUCTION WORK THAT IS TO BE COMPLETED DURING SUMMER MONTHS.
4. STEP 4 REQUIRES THAT THE LIGHTING AND HEATING CONTACTOR PANEL AND THE LIGHTING CONTROL PANEL BE REMOVED FROM THE ELECTRICAL ROOM. THIS WORK CAN PROCEED ONCE ALL LIGHTING AND HEATING CIRCUITS HAVE BEEN EXTENDED AND REROUTED THROUGH THE NEW WIREWAY / CONTACTOR ENCLOSURE AND ARE FULLY OPERATIONAL AS DESCRIBED ABOVE.


STAGE 2 CONSTRUCTION NOTES:

1. STEP 1 OF THE SECOND STAGE OF CONSTRUCTION FOR EACH CROSSCUT ELECTRICAL ROOM INVOLVES INSTALLING THE NEW 2400 V - 480Y / 277 VOLT TRANSFORMER, THE NEW MEDIUM VOLTAGE CABLE PULLBOX AND THE TRANSFORMER MEDIUM VOLTAGE FEEDER WHICH ORIGINATES FROM THE VENTILATION BUILDING.
2. FOLLOWING THE INSTALLATION OF THE NEW TRANSFORMER AND PRIMARY FEEDER, STEP 2 REQUIRES THAT THE NEW 480Y / 277 VOLT PANELBOARD NEN-1 AND SECONDARY FEEDER BETWEEN THE TRANSFORMER AND PANELBOARD BE INSTALLED IN THE ELECTRICAL ROOM.
3. STEP 3 REQUIRES THAT THE NEW CONTACTOR CABINET BE INSTALLED AT THE LOCATION INDICATED ON THE PLAN. INSTALL A 120 VOLT POWER CIRCUIT FROM THE EXISTING 208 / 120 VOLT PANEL LOCATED IN THE CROSSCUT ELECTRICAL ROOM TO THE NEW CONTACTOR CABINET. INSTALL ANY REQUIRED CONTROL / SIGNAL CIRCUITS TO THE NEW CONTACTOR CABINET FROM THE NEAREST CROSSCUT ELECTRICAL ROOM(S) AND / OR VENTILATION BUILDING. ALSO, INSTALL THE FOUR NEW THREE-PHASE LIGHTING CIRCUITS FROM THE PANELBOARD TO THEIR ASSOCIATED CONTACTORS IN THE CONTACTOR CABINET. A MAXIMUM OF TWO THREE-PHASE FOUR-WIRE CIRCUITS SHALL BE INSTALLED IN ANY ONE CONDUIT. MAKE ALL CONDUCTOR TERMINATIONS TO THE CIRCUIT BREAKERS, NEUTRAL AND GROUND BUS AND LIGHTING CONTACTORS.
4. STEP 4 REQUIRES THAT THE EXISTING THREE-PHASE LIGHTING CIRCUITS THAT SERVE A SECTION OF THE TUNNEL WALL (ONE SIDE), BE DEENERGIZED AND THE CIRCUIT CONDUCTORS REMOVED BETWEEN THE PANEL AND THE NEAREST TUNNEL LIGHTING CIRCUIT PULLBOX. TAPE THE ENDS OF THE ABANDONED CIRCUIT CONDUCTORS IN THE PULLBOX, LEAVING A MINIMUM OF THREE FEET SURPLUS OF EACH CONDUCTOR COILED IN THE PULLBOX. REMOVE THE CONDUIT FOR THESE CIRCUITS BETWEEN THE PANEL AND THE PULLBOX LOCATED ABOVE THE ENTRANCE TO THE CROSSCUT PASSAGE. THIS CONSTRUCTION STEP FACILITATES THE INSTALLATION OF A SEGMENT OF THE TUNNEL INTERIOR FLUORESCENT LIGHTING AND THE CONDUITS AND CONDUCTORS WHICH WILL BE USED TO SUPPLY POWER TO THEM.
5. STEP 5 REMOVE THE EXISTING LUMINAIRES THAT WERE DEENERGIZED IN STEP 4. CONTRACTOR SHALL OWN AND DISPOSE LUMINAIRES INCLUDING BALLASTS AND LAMPS. PROVIDE CERTIFICATION TO STATE THAT DISPOSAL METHOD UTILIZED FOR LUMINAIRES, BALLASTS AND LAMPS MEETS STATE OF COLORADO AND FEDERAL REGULATIONS.
6. STEP 6 REQUIRES THAT THE FLUORESCENT LUMINAIRES ON ONE SIDE OF THE TUNNEL BE INSTALLED. ONCE INSTALLED, THE NEW LIGHTING CIRCUITS SHALL BE TERMINATED ON THE LOAD SIDE OF THEIR RESPECTIVE LIGHTING CONTACTORS IN THE CONTACTOR CABINET.
7. STEP 7 REQUIRES THAT THE THREE-PHASE CIRCUIT CONDUCTORS FOR THE HEAT TRACE CIRCUIT BE INSTALLED BETWEEN THE CONTACTOR CABINET AND THE NEW 480 / 277 VOLT PANELBOARD. DEENERGIZE THE EXISTING THREE-PHASE HEAT TRACE CIRCUIT THAT SERVES THE ADJACENT SECTIONS OF THE TUNNEL AT THE EXISTING 480 VOLT PANEL AND EXTEND THE CIRCUIT TO THE NEW CONTACTOR CABINET. INSTALL JUNCTION BOXES REQUIRED OF SPLICED CIRCUIT CONDUCTORS.
8. STEP 8 REQUIRES THAT ALL OTHER 480 AND 277 VOLT LOADS, EXCLUDING THE FOUR REMAINING TUNNEL LIGHTING CIRCUITS, BE TRANSFERRED FROM THE EXISTING 480 VOLT PANEL TO THE NEW 480 / 277 VOLT PANELBOARD. THESE CIRCUITS INCLUDE THE FEEDER TO THE 480 - 208Y / 120 VOLT TRANSFORMER (WHICH SUPPLIES THE EXISTING 208 VOLT PANEL), MESSAGE BOARD FEEDERS AND TELEVISION CAMERA FEEDERS. DEENERGIZE THE EXISTING CIRCUITS FROM THE EXISTING 480 VOLT PANEL AND EXTEND THE CIRCUITS TO THE NEW 480 / 277 VOLT PANELBOARD. INSTALL JUNCTION BOXES REQUIRED OF SPLICED CIRCUIT CONDUCTORS.
9. STEP 9 REQUIRES THAT THE EXISTING 480V PANEL BE REMOVED AND A SECOND NEW 480/277 VOLT PANELBOARD NES-1 BE INSTALLED IN ITS PLACE. PRIOR TO THE REMOVAL OF THE CABINET, THE CONTRACTOR SHALL COORDINATE WITH THE STATE ENGINEER REGARDING THE REROUTING OF THE EXISTING CABLES THAT ARE ROUTED THROUGH THIS CABINET. ONCE THE SECOND NEW PANELBOARD IS INSTALLED, THE MEDIUM VOLTAGE OIL CUTOFF SWITCH CAN BE OPENED AND THE SECONDARY FEEDER FROM THE TRANSFORMER TO THE EXISTING 480 VOLT PANEL CAN BE REMOVED. NEXT, THE CONDUCTORS FOR THE REMAINING THREE-PHASE LIGHTING CIRCUITS THAT SERVE THE OPPOSITE SIDE OF THE TUNNEL SHALL BE REMOVED BETWEEN THE PANEL AND THE NEAREST TUNNEL LIGHTING CIRCUIT PULLBOX. TAPE THE ENDS OF THE ABANDONED CIRCUIT CONDUCTORS IN THE PULLBOX, LEAVING A MINIMUM OF THREE FEET SURPLUS OF EACH CONDUCTOR COILED IN THE PULLBOX. THE EXISTING 480VOLT PANEL SHALL THEN BE REMOVED. THIS CONSTRUCTION STEP FACILITATES THE INSTALLATION OF PANEL NES-1 AND THE REMOVAL AND REPLACEMENT OF THE EXISTING 2400 V - 480Y / 277 VOLT TRANSFORMER. IT ALSO FACILITATES THE REMOVAL OF THE EXISTING MEDIUM VOLTAGE CABLE PULLBOX AND OIL CUTOFF SWITCH. ALSO, THE INSTALLATION OF THE REMAINING SEGMENT OF THE TUNNEL INTERIOR FLUORESCENT LIGHTING AND THE ASSOCIATED LIGHT CIRCUITS SUPPLIED FROM THIS ELECTRICAL ROOM CAN PROCEED FOLLOWING THIS CONSTRUCTION SETP.
10. DE-ENERGIZE, DISCONNECT AND REMOVE (TEMPORARY) THE EXISTING TRANSFORMER AND APPURTENANCES FOR THE INSTALLATION OF THE NEW TRANSFORMER (TX-NEN-1) AND COORDINATE STAGING OF WORK WITH INSTALLATION OF ALL EQUIPMENT AS INDICATED ON THE FINAL PLANS AS REQUIRED.

NOTE:

THE INTENT OF STAGING IS TO MAINTAIN A FULLY OPERATIONAL TUNNEL DURING CONSTRUCTION. SEE SPECIAL CONSTRUCTION REQUIREMENTS (K).


Computer File Information		Sheet Revisions		Colorado Department of Transportation  P.O. BOX 399 DUMONT, CO. 80436 Phone: 303-512-5750 FAX: 303-512-5775 Region 1 Mountain Residency I.N.Z.	As Constructed	ELEC DEMO - NO. TUNNEL		Project No./Code	
Creation Date:	Initials:	07/03/07	ASBUILT		DJB	No Revisions:	EAST CROSSCUT ELEC RM		IM 0703-269
Last Modification Date:	Initials:	02/07/02				Revised:	Designer: E.A. GAYAMAT	Structure Numbers	13166
Full Path:		014102\700cadd\703elect\				Void:	Detailer: R. MILLER		
Drawing File Name:		102ep151n.dgn				Sheet Subset: ELEC DEMO	Subset Sheets:	7 of 15	Sheet Number 16
Acad Ver. R14	Scale:	Units: ENGLISH							

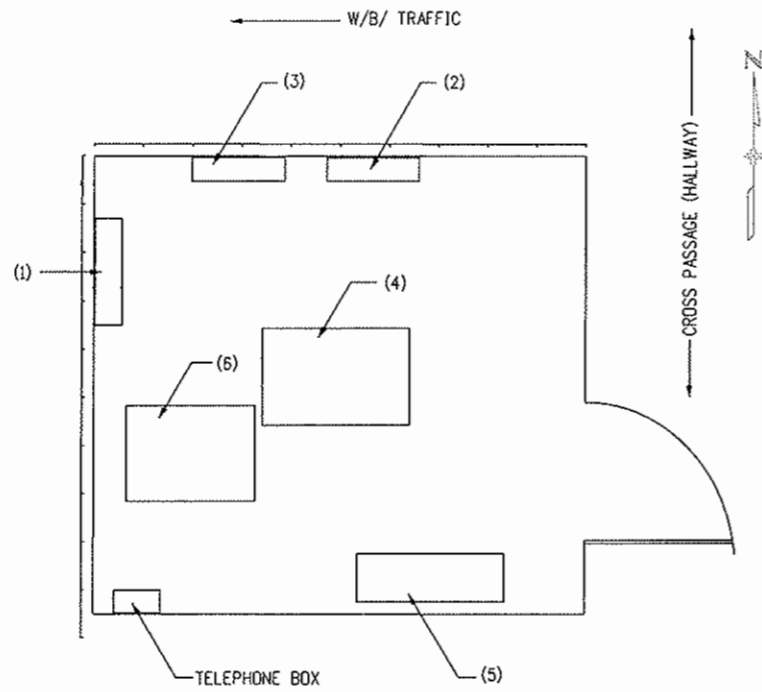

EXISTING PLAN
SCALE: 1/2" = 1'-0"

EXISTING PLAN LEGEND

- (1) 480 / 277 V PANEL - 22"W x 65"H x 6"D
- (2) LIGHTING AND HEATING CONTACTOR PANEL
- (3) LIGHTING CONTROL CABINET - 15"W x 20"H x 9"D
- (4) 75 KVA, 2400 V - 480Y / 277 V TRANSFORMER
- (5) MV FUSED OIL CUTOFF SWITCH - 35"W x 38"H x 18"D
- (6) F.O. CABINET

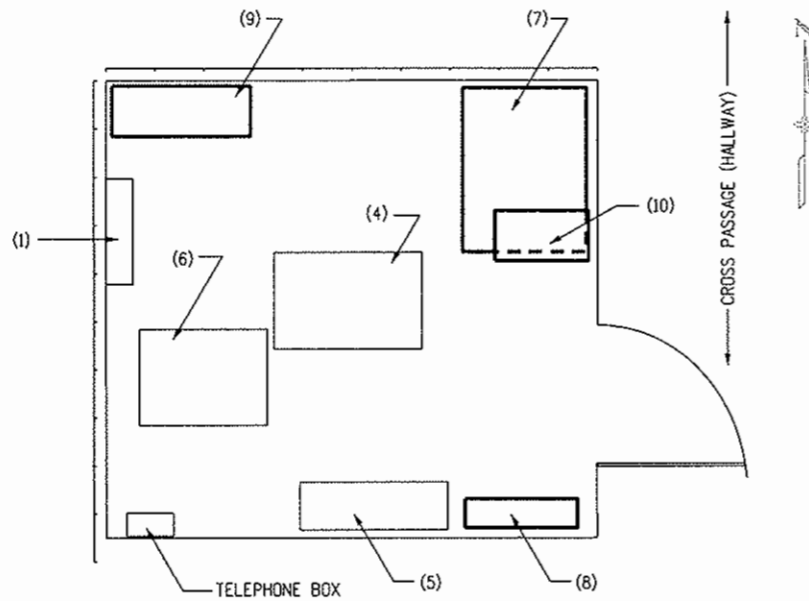

INTERIM PLAN
SCALE: 1/2" = 1'-0"

INTERIM PLAN LEGEND

- (1) 480 / 277 V PANEL - 22"W x 65"H x 6"D (EXIST)
- (2) REMOVED - LIGHTING AND HEATING CONTACTOR PANEL
- (3) REMOVED - LIGHTING CONTROL PANEL
- (4) 75 KVA, 2400 V - 480Y / 277 V TRANSFORMER (EXIST), NOTE 10
- (5) MV FUSED OIL CUTOFF SWITCH - 35"W x 38"H x 18"D (EXIST), NOTE 10
- (6) F.O. CABINET (EXIST)
- (7) NEW 150 KVA, 2400 V - 480Y / 277 V TRANSFORMER TX-NCS-2W 48"W x 58"H x 32"D, NOTE 10
- (8) NEW 480 / 277 V PANEL - 22"W x 65"H x 6"D
- (9) NEW CONTACTOR CABINET
- (10) NEW MV CABLE PULLBOX - 24"W x 20"H x 12"D

STAGE 1 CONSTRUCTION NOTES:

1. STEP 1 OF THE FIRST STAGE OF CONSTRUCTION FOR EACH CROSSCUT ELECTRICAL ROOM INVOLVES THE CONSECUTIVE TEMPORARY DEENERGIZING OF INDIVIDUAL TUNNEL LIGHTING CIRCUITS USING THE THREE-POLE CIRCUIT BREAKERS IN THE PANELBOARDS SERVING THESE LIGHTING LOADS.
2. FOLLOWING THE DEENERGIZATION OF AN INDIVIDUAL THREE-PHASE LIGHTING CIRCUIT, STEP 2 REQUIRES THAT THE LINE AND LOAD CIRCUIT CONNECTIONS TO THE LIGHTING CONTACTOR CONTROLLING THAT CIRCUIT BE REMOVED AND EXTENDED TO A TEMPORARY WIREWAY. THE WIREWAY SHALL EXTEND OVER AND BETWEEN THE PANELBOARD AND CONTACTOR PANEL AND BE MOUNTED AT A HEIGHT ABOVE THE HORIZONTAL RUNS OF LIGHTING CIRCUIT CONDUITS THAT ARE ROUTED TO THE CONTACTOR PANEL. IN LOCATING THE WIREWAY, AVOID INTERFERENCE WITH ANY NEW EQUIPMENT INDICATED TO BE INSTALLED IN THE ELECTRICAL ROOM. THE EXTENDED CIRCUIT CONDUCTORS FROM THE CONTACTOR PANEL WOULD BE TEMPORARILY SPLICED IN THE WIREWAY TO NEW CIRCUIT CONDUCTORS FROM THE PANELBOARD. THE ONLY CONTROL FOR EACH REROUTED LIGHTING CIRCUIT WOULD BE THE THREE-POLE CIRCUIT BREAKER IN THE PANELBOARD. ONCE THE CHANGES FOR ONE LIGHTING CIRCUIT HAVE BEEN COMPLETED, THE REROUTING OF THE NEXT CIRCUIT CAN PROCEED.
3. STEP 3 REQUIRES THE TEMPORARY DEENERGIZATION OF THE THREE-PHASE HEAT TRACE CIRCUIT USING THE THREE-POLE CIRCUIT BREAKER IN THE PANELBOARD SERVING THIS HEATING LOAD. DISCONNECT THE LINE AND LOAD CIRCUIT CONNECTIONS TO THE HEATING CONTACTOR CONTROLLING THE CIRCUIT AND RELOCATE THE HEATING CONTACTOR TO AN ENCLOSURE MOUNTED ADJACENT TO THE WIREWAY. THE ENCLOSURE SHALL BE LOCATED TO AVOID INTERFERENCE WITH NEW EQUIPMENT INDICATED TO BE INSTALLED IN THE ELECTRICAL ROOM. EXTEND THE THERMOSTATIC CONTROL CIRCUIT TO THE HEATING CONTACTOR AND MAKE THE NECESSARY LINE AND LOAD CIRCUIT CONNECTIONS. EXTEND THE THERMOSTATIC CONTROL CIRCUIT TO THE HEATING CONTACTOR AND MAKE THE NECESSARY CONTROL CIRCUIT CONNECTIONS TO OPERATE IT AUTOMATICALLY FROM THE REMOTE THERMOSTAT. THE CONTRACTOR MAY REQUEST PERMISSION FROM THE STATE ENGINEER TO OMIT THE TEMPORARY RECONNECTION OF THE THERMOSTATIC CONTROL CIRCUIT FOR THE CONSTRUCTION WORK THAT IS TO BE COMPLETED DURING SUMMER MONTHS.
4. STEP 4 REQUIRES THAT THE LIGHTING AND HEATING CONTACTOR PANEL AND THE LIGHTING CONTROL PANEL BE REMOVED FROM THE ELECTRICAL ROOM. THIS WORK CAN PROCEED ONCE ALL LIGHTING AND HEATING CIRCUITS HAVE BEEN EXTENDED AND REROUTED THROUGH THE NEW WIREWAY / CONTACTOR ENCLOSURE AND ARE FULLY OPERATIONAL AS DESCRIBED ABOVE.

STAGE 2 CONSTRUCTION NOTES:

1. STEP 1 OF THE SECOND STAGE OF CONSTRUCTION FOR EACH CROSSCUT ELECTRICAL ROOM INVOLVES INSTALLING THE NEW 2400 V - 480Y / 277 VOLT TRANSFORMER, THE NEW MEDIUM VOLTAGE CABLE PULLBOX AND THE TRANSFORMER MEDIUM VOLTAGE FEEDER WHICH ORIGINATES FROM THE VENTILATION BUILDING.
2. FOLLOWING THE INSTALLATION OF THE NEW TRANSFORMER AND PRIMARY FEEDER, STEP 2 REQUIRES THAT THE NEW 480Y / 277 VOLT PANELBOARD AND NCS-2W SECONDARY FEEDER BETWEEN THE TRANSFORMER AND PANELBOARD BE INSTALLED IN THE ELECTRICAL ROOM.
3. STEP 3 REQUIRES THAT THE NEW CONTACTOR CABINET BE INSTALLED AT THE LOCATION INDICATED ON THE PLAN. INSTALL A 120 VOLT POWER CIRCUIT FROM THE EXISTING 208 / 120 VOLT PANEL LOCATED IN THE CROSSCUT ELECTRICAL ROOM TO THE NEW CONTACTOR CABINET. INSTALL ANY REQUIRED CONTROL / SIGNAL CIRCUITS TO THE NEW CONTACTOR CABINET FROM THE NEAREST CROSSCUT ELECTRICAL ROOM(S) AND / OR VENTILATION BUILDING. ALSO, INSTALL THE FOUR NEW THREE-PHASE LIGHTING CIRCUITS FROM THE PANELBOARD TO THEIR ASSOCIATED CONTACTORS IN THE CONTACTOR CABINET. A MAXIMUM OF TWO THREE-PHASE FOUR-WIRE CIRCUITS SHALL BE INSTALLED IN ANY ONE CONDUIT. MAKE ALL CONDUIT TERMINATIONS TO THE CIRCUIT BREAKERS, NEUTRAL AND GROUND BUS AND LIGHTING CONTACTORS.
4. STEP 4 REQUIRES THAT THE EXISTING THREE-PHASE LIGHTING CIRCUITS THAT SERVE A SECTION OF THE TUNNEL WALL (ONE SIDE), BE DEENERGIZED AND THE CIRCUIT CONDUCTORS REMOVED BETWEEN THE PANEL AND THE NEAREST TUNNEL LIGHTING CIRCUIT PULLBOX. TAPE THE ENDS OF THE ABANDONED CIRCUIT CONDUCTORS IN THE PULLBOX, LEAVING A MINIMUM OF THREE FEET SURPLUS OF EACH CONDUCTOR COILED IN THE PULLBOX. REMOVE THE CONDUIT FOR THESE CIRCUITS BETWEEN THE PANEL AND THE PULLBOX LOCATED ABOVE THE ENTRANCE TO THE CROSSCUT PASSAGE. THIS CONSTRUCTION STEP FACILITATES THE INSTALLATION OF A SEGMENT OF THE TUNNEL INTERIOR FLUORESCENT LIGHTING AND THE CONDUITS AND CONDUCTORS WHICH WILL BE USED TO SUPPLY POWER TO THEM.
5. STEP 5 REMOVE THE EXISTING LUMINAIRES THAT WERE DEENERGIZED IN STEP 4. CONTRACTOR SHALL OWN AND DISPOSE LUMINAIRES INCLUDING BALLASTS AND LAMPS. PROVIDE CERTIFICATION TO STATE THAT DISPOSAL METHOD UTILIZED FOR LUMINAIRES, BALLASTS AND LAMPS MEETS STATE OF COLORADO AND FEDERAL REGULATIONS.
6. STEP 6 REQUIRES THAT THE FLUORESCENT LUMINAIRES ON ONE SIDE OF THE TUNNEL BE INSTALLED. ONCE INSTALLED, THE NEW LIGHTING CIRCUITS SHALL BE TERMINATED ON THE LOAD SIDE OF THEIR RESPECTIVE LIGHTING CONTACTORS IN THE CONTACTOR CABINET.
7. STEP 7 REQUIRES THAT THE THREE-PHASE CIRCUIT CONDUCTORS FOR THE HEAT TRACE CIRCUIT BE INSTALLED BETWEEN THE CONTACTOR CABINET AND THE NEW 480 / 277 VOLT PANELBOARD. DEENERGIZE THE EXISTING THREE-PHASE HEAT TRACE CIRCUIT THAT SERVES THE ADJACENT SECTIONS OF THE TUNNEL AT THE EXISTING 480 VOLT PANEL AND EXTEND THE CIRCUIT TO THE NEW CONTACTOR CABINET. INSTALL JUNCTION BOXES REQUIRED OF SPLICED CIRCUIT CONDUCTORS.
8. STEP 8 REQUIRES THAT ALL OTHER 480 AND 277 VOLT LOADS, EXCLUDING THE FOUR REMAINING TUNNEL LIGHTING CIRCUITS, BE TRANSFERRED FROM THE EXISTING 480 VOLT PANEL TO THE NEW 480 / 277 VOLT PANELBOARD. THESE CIRCUITS INCLUDE THE FEEDER TO THE 480 - 208Y / 120 VOLT TRANSFORMER (WHICH SUPPLIES THE EXISTING 208 VOLT PANEL), MESSAGE BOARD FEEDERS AND TELEVISION CAMERA FEEDERS. DEENERGIZE THE EXISTING CIRCUITS FROM THE EXISTING 480 VOLT PANEL AND EXTEND THE CIRCUITS TO THE NEW 480 / 277 VOLT PANELBOARD. INSTALL JUNCTION BOXES REQUIRED OF SPLICED CIRCUIT CONDUCTORS.
9. STEP 9 REQUIRES THAT EXISTING 480 VOLT PANEL BE REMOVED. PRIOR TO THE REMOVAL OF THE EXISTING 480V PANEL, THE MEDIUM VOLTAGE OIL CUTOFF SWITCH CAN BE OPENED AND THE SECONDARY FEEDER FROM THE TRANSFORMER TO THE EXISTING 480 VOLT PANEL CAN BE REMOVED. NEXT, THE CONDUCTORS FOR THE REMAINING THREE-PHASE LIGHTING CIRCUITS THAT SERVE THE OPPOSITE SIDE OF THE TUNNEL SHALL BE REMOVED BETWEEN THE PANEL AND THE NEAREST TUNNEL CIRCUIT PULLBOX. TAPE THE ENDS OF THE ABANDONED CIRCUIT CONDUCTORS IN THE PULLBOX, LEAVING A MINIMUM OF THREE FEET SURPLUS OF EACH CONDUCTOR COILED IN THE PULLBOX. THE EXISTING 480 VOLT PANEL SHALL THEN BE REMOVED. THIS CONSTRUCTION STEP FACILITATES THE REMOVAL AND REPLACEMENT OF EXISTING 2400 V - 480Y / 277 VOLT TRANSFORMER. IT ALSO FACILITATES THE REMOVAL OF THE EXISTING MEDIUM VOLTAGE CABLE PULLBOX AND OIL CUTOFF SWITCH. ALSO, THE INSTALLATION OF THE REMAINING SEGMENT OF THE TUNNEL INTERIOR FLUORESCENT LIGHTING AND THE ASSOCIATED LIGHTING CIRCUITS SUPPLIED FROM ELECTRICAL ROOM CAN PROCEED FOLLOWING THIS CONSTRUCTION STEP.
10. DE-ENERGIZE, DISCONNECT AND REMOVE (TEMPORARY) THE EXISTING TRANSFORMER AND APPURTENANCES FOR THE INSTALLATION OF THE NEW TRANSFORMER (TX-NCS-2W) AND COORDINATE STAGING OF WORK WITH INSTALLATION OF ALL EQUIPMENT AS INDICATED ON THE FINAL PLANS AS REQUIRED.

NOTE:


THE INTENT OF STAGING IS TO MAINTAIN A FULLY OPERATIONAL TUNNEL DURING CONSTRUCTION. SEE SPECIAL CONSTRUCTION REQUIREMENTS (K).

Design File Name: DGN\$SPEC*
 Plot File Name: \$PLOTFILE*
 Date of Plot: \$\$\$DATE\$\$\$

Computer File Information	
Creation Date:	Initials:
Last Modification Date: 02/07/02	Initials: DJR
Full Path: 014102\700cadd\703elect\	
Drawing File Name: 102epf52n.dgn	
Acad Ver. R14	Scale: Units: ENGLISH

Sheet Revisions			
<input type="checkbox"/>	07/03/07	ASBUILT	DJB
<input type="checkbox"/>			
<input type="checkbox"/>			
<input type="checkbox"/>			

Colorado Department of Transportation




P.O. BOX 399
DUMONT, CO. 80436
Phone: 303-512-5750 FAX: 303-512-5775

Region 1 Mountain Residency I.N.Z.

As Constructed
No Revisions:
Revised:
Void:

ELEC DEMO - NO. TUNNEL CENTER CROSSCUT WEST ELECTRICAL ROOM	
Designer: E.A. GAYAMAT	Structure Numbers
Detailer: R. MILLER	
Sheet Subst: ELEC DEMO	Subst Sheets: 8 of 15

Project No./Code	
IM 0703-269	
13166	
Sheet Number	17

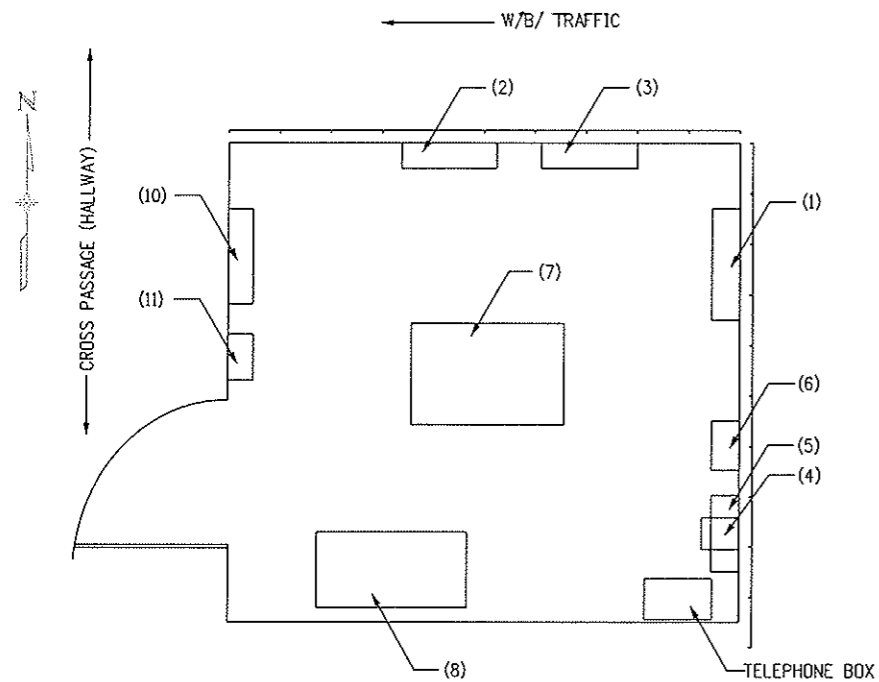

EXISTING PLAN
SCALE: 1/2" = 1'-0"

EXISTING PLAN LEGEND


- (1) 480 / 277 V PANEL - 22"W x 65"H x 6"D
- (2) LIGHTING AND HEATING CONTACTOR PANEL
- (3) LIGHTING CONTROL PANEL - 15"W x 20"H x 9"D
- (4) 3 KVA, 480 V - 208Y / 120 V TRANSFORMER
- (5) 120 / 240 V PANEL - 16"W x 21"H x 6"D
- (6) 30A, 2P, 120/240 V ASCO SW. (ATS)
- (7) 75 KVA, 2400 V - 480Y / 277 V TRANSFORMER
- (8) MV FUSED OIL CUTOFF SWITCH - 35"W x 38"H x 18"D
- (9) NOT USED
- (10) CABINET
- (11) J-BOX

STAGE 1 CONSTRUCTION NOTES:

1. STEP 1 OF THE FIRST STAGE OF CONSTRUCTION FOR EACH CROSSCUT ELECTRICAL ROOM INVOLVES THE CONSECUTIVE TEMPORARY DEENERGIZING OF INDIVIDUAL TUNNEL LIGHTING CIRCUITS USING THE THREE-POLE CIRCUIT BREAKERS IN THE PANELBOARDS SERVING THESE LIGHTING LOADS.
2. FOLLOWING THE DEENERGIZING OF AN INDIVIDUAL THREE-PHASE LIGHTING CIRCUIT, STEP 2 REQUIRES THAT THE LINE AND LOAD CIRCUIT CONNECTIONS TO THE LIGHTING CONTACTOR CONTROLLING THAT CIRCUIT BE REMOVED AND EXTENDED TO A TEMPORARY WIREWAY. THE WIREWAY SHALL EXTEND OVER AND BETWEEN THE PANELBOARD AND CONTACTOR PANEL AND BE MOUNTED AT A HEIGHT ABOVE THE HORIZONTAL RUNS OF LIGHTING CIRCUIT CONDUITS THAT ARE ROUTED TO THE CONTACTOR PANEL. IN LOCATING THE WIREWAY, AVOID INTERFERENCE WITH ANY NEW EQUIPMENT INDICATED TO BE INSTALLED IN THE ELECTRICAL ROOM. THE EXTENDED CIRCUIT CONDUCTORS FROM THE CONTACTOR PANEL WOULD BE TEMPORARILY SPLICED IN THE WIREWAY TO NEW CIRCUIT CONDUCTORS FROM THE PANELBOARD. THE ONLY CONTROL FOR EACH REROUTED LIGHTING CIRCUIT WOULD BE THE THREE-POLE CIRCUIT BREAKER IN THE PANELBOARD. ONCE THE CHANGES FOR ONE LIGHTING CIRCUIT HAVE BEEN COMPLETED, THE REROUTING OF THE NEXT CIRCUIT CAN PROCEED.
3. STEP 3 REQUIRES THE TEMPORARY DEENERGIZING OF THE THREE-PHASE HEAT TRACE CIRCUIT USING THE THREE-POLE CIRCUIT BREAKER IN THE PANELBOARD SERVING THIS HEATING LOAD. DISCONNECT THE LINE AND LOAD CIRCUIT CONNECTIONS TO THE HEATING CONTACTOR CONTROLLING THE CIRCUIT AND RELOCATE THE HEATING CONTACTOR TO AN ENCLOSURE MOUNTED ADJACENT TO THE WIREWAY. THE ENCLOSURE SHALL BE LOCATED TO AVOID INTERFERENCE WITH NEW EQUIPMENT INDICATED TO BE INSTALLED IN THE ELECTRICAL ROOM. EXTEND THE HEATING CIRCUIT TO THE RELOCATED HEATING CONTACTOR AND MAKE THE NECESSARY LINE AND LOAD CIRCUIT CONNECTIONS. EXTEND THE THERMOSTATIC CONTROL CIRCUIT TO THE HEATING CONTACTOR AND MAKE THE NECESSARY CONTROL CIRCUIT CONNECTIONS TO OPERATE IT AUTOMATICALLY FROM THE REMOTE THERMOSTAT. THE CONTRACTOR MAY REQUEST PERMISSION FROM THE STATE ENGINEER TO OMIT THE TEMPORARY RECONNECTION OF THE THERMOSTATIC CONTROL CIRCUIT FOR THE CONSTRUCTION WORK THAT IS TO BE COMPLETED DURING SUMMER MONTHS.
4. STEP 4 REQUIRES THAT THE LIGHTING AND HEATING CONTACTOR PANEL AND THE LIGHTING CONTROL PANEL BE REMOVED FROM THE ELECTRICAL ROOM. THIS WORK CAN PROCEED ONCE ALL LIGHTING AND HEATING CIRCUITS HAVE BEEN EXTENDED AND REROUTED THROUGH THE NEW WIREWAY / CONTACTOR ENCLOSURE AND ARE FULLY OPERATIONAL AS DESCRIBED ABOVE.

STAGE 2 CONSTRUCTION NOTES:

1. STEP 1 OF THE SECOND STAGE OF CONSTRUCTION FOR EACH CROSSCUT ELECTRICAL ROOM INVOLVES INSTALLING THE NEW 2400 V - 480Y / 277 VOLT TRANSFORMER, THE NEW MEDIUM VOLTAGE CABLE PULLBOX AND THE TRANSFORMER MEDIUM VOLTAGE FEEDER WHICH ORIGINATES FROM THE VENTILATION BUILDING.
2. FOLLOWING THE INSTALLATION OF THE NEW TRANSFORMER AND PRIMARY FEEDER, STEP 2 REQUIRES THAT THE NEW 480Y / 277 VOLT PANELBOARD NCS-2E AND SECONDARY FEEDER BETWEEN THE TRANSFORMER AND PANELBOARD BE INSTALLED IN THE ELECTRICAL ROOM.
3. STEP 3 REQUIRES THAT THE NEW CONTACTOR CABINET BE INSTALLED AT THE LOCATION INDICATED ON THE PLAN. INSTALL A 120 VOLT POWER CIRCUIT FROM THE EXISTING 208 / 120 VOLT PANEL LOCATED IN THE CROSSCUT ELECTRICAL ROOM TO THE NEW CONTACTOR CABINET. INSTALL ANY REQUIRED CONTROL / SIGNAL CIRCUITS TO THE NEW CONTACTOR CABINET FROM THE NEAREST CROSSCUT ELECTRICAL ROOM(S) AND / OR VENTILATION BUILDING. ALSO, INSTALL THE FOUR NEW THREE-PHASE LIGHTING CIRCUITS FROM THE PANELBOARD TO THEIR ASSOCIATED CONTACTORS IN THE CONTACTOR CABINET. A MAXIMUM OF TWO THREE-PHASE FOUR-WIRE CIRCUITS SHALL BE INSTALLED IN ANY ONE CONDUIT. MAKE ALL CONDUCTOR TERMINATIONS TO THE CIRCUIT BREAKERS, NEUTRAL AND GROUND BUS AND LIGHTING CONTACTORS.
4. STEP 4 REQUIRES THAT THE EXISTING THREE-PHASE LIGHTING CIRCUITS THAT SERVE A SECTION OF THE TUNNEL WALL (ONE SIDE), BE DEENERGIZED AND THE CONDUCTORS REMOVED BETWEEN THE PANEL AND THE NEAREST TUNNEL LIGHTING CIRCUIT PULLBOX. TAPE THE ENDS OF THE ABANDONED CIRCUIT CONDUCTORS IN THE PULLBOX, LEAVING A MINIMUM OF THREE FEET SURPLUS OF EACH CONDUCTOR COILED IN THE PULLBOX. REMOVE THE CONDUIT FOR THESE CIRCUITS BETWEEN THE PANEL AND THE PULLBOX LOCATED ABOVE THE ENTRANCE TO THE CROSSCUT PASSAGE. THIS CONSTRUCTION STEP FACILITATES THE INSTALLATION OF A SEGMENT OF THE TUNNEL INTERIOR FLUORESCENT LIGHTING AND THE CONDUITS AND CONDUCTORS WHICH WILL BE USED TO SUPPLY POWER TO THEM.
5. STEP 5 REMOVE THE EXISTING LUMINAIRES THAT WERE DEENERGIZED IN STEP 4. CONTRACTOR SHALL DOWN AND DISPOSE LUMINAIRES INCLUDING BALLASTS AND LAMPS. PROVIDE CERTIFICATION TO STATE THAT DISPOSAL METHOD UTILIZED FOR LUMINAIRES, BALLASTS AND LAMPS MEETS STATE OF COLORADO AND FEDERAL REGULATIONS.
6. STEP 6 REQUIRES THAT THE FLUORESCENT LUMINAIRES ON ONE SIDE OF THE TUNNEL BE INSTALLED. ONCE INSTALLED, THE NEW LIGHTING CIRCUITS SHALL BE TERMINATED ON THE LOAD SIDE OF THEIR RESPECTIVE LIGHTING CONTACTORS IN THE CONTACTOR CABINET.
7. STEP 7 REQUIRES THAT THE THREE-PHASE CIRCUIT CONDUCTORS FOR THE HEAT TRACE CIRCUIT BE INSTALLED BETWEEN THE CONTACTOR CABINET AND THE NEW 480 / 277 VOLT PANELBOARD. DEENERGIZE THE EXISTING THREE-PHASE HEAT TRACE CIRCUIT THAT SERVES THE ADJACENT SECTIONS OF THE TUNNEL AT THE EXISTING 480 VOLT PANEL AND EXTEND THE CIRCUIT TO THE NEW CONTACTOR CABINET. INSTALL JUNCTION BOXES REQUIRED OF SPLICED CIRCUIT CONDUCTORS.
8. STEP 8 REQUIRES THAT ALL OTHER 480 AND 277 VOLT LOADS, EXCLUDING THE FOUR REMAINING TUNNEL LIGHTING CIRCUITS, BE TRANSFERRED FROM THE EXISTING 480 VOLT PANEL TO THE NEW 480 / 277 VOLT PANELBOARD. THESE CIRCUITS INCLUDE THE FEEDER TO THE 480 - 208Y / 120 VOLT TRANSFORMER (WHICH SUPPLIES THE EXISTING 208 VOLT PANEL), MESSAGE BOARD FEEDERS AND TELEVISION CAMERA FEEDERS. DEENERGIZE THE EXISTING CIRCUITS FROM THE EXISTING 480 VOLT PANEL AND EXTEND THE CIRCUITS TO THE NEW 480 / 277 VOLT PANELBOARD. INSTALL JUNCTION BOXES REQUIRED OF SPLICED CIRCUIT CONDUCTORS.
9. STEP 9 REQUIRES THAT THE EXISTING 480V PANEL IMMEDIATELY ADJACENT TO THE DOOR OF THE ELECTRICAL ROOM BE REMOVED AND A SECOND NEW 480/277 VOLT PANELBOARD BE INSTALLED IN ITS PLACE. PRIOR TO THE REMOVAL OF THE EXISTING 480V PANEL, THE MEDIUM VOLTAGE OIL CUTOFF SWITCH CAN BE OPENED AND THE SECONDARY FEEDER FROM THE TRANSFORMER TO THE EXISTING 480 VOLT PANEL CAN BE REMOVED. NEXT, THE CONDUCTORS FOR THE REMAINING THREE-PHASE LIGHTING CIRCUITS THAT SERVE THE OPPOSITE SIDE OF THE TUNNEL SHALL BE REMOVED BETWEEN THE PANEL AND THE NEAREST TUNNEL LIGHTING CIRCUIT PULLBOX. TAPE THE ENDS OF THE ABANDONED CIRCUIT CONDUCTORS IN THE PULLBOX, LEAVING A MINIMUM OF THREE FEET SURPLUS OF EACH CONDUCTOR COILED IN THE PULLBOX. THE EXISTING 480 VOLT PANEL SHALL THEN BE REMOVED. THIS CONSTRUCTION STEP FACILITATES THE REMOVAL AND REPLACEMENT OF THE EXISTING 2400 V - 480Y / 277 VOLT TRANSFORMER. IT ALSO FACILITATES THE REMOVAL OF THE EXISTING MEDIUM VOLTAGE CABLE PULLBOX AND OIL CUTOFF SWITCH, ALSO, THE INSTALLATION OF THE REMAINING SEGMENT OF THE TUNNEL INTERIOR FLUORESCENT LIGHTING AND THE ASSOCIATED LIGHTING CIRCUITS SUPPLIED FROM THE ELECTRICAL ROOM CAN PROCEED FOLLOWING THIS CONSTRUCTION STEP.
10. DE-ENERGIZE, DISCONNECT AND REMOVE (TEMPORARY) THE EXISTING TRANSFORMER AND APPURTENANCES FOR THE INSTALLATION OF THE NEW TRANSFORMER (TX-NCS-1E) AND COORDINATE STAGING OF WORK WITH INSTALLATION OF ALL EQUIPMENT AS INDICATED ON THE FINAL PLANS AS REQUIRED.

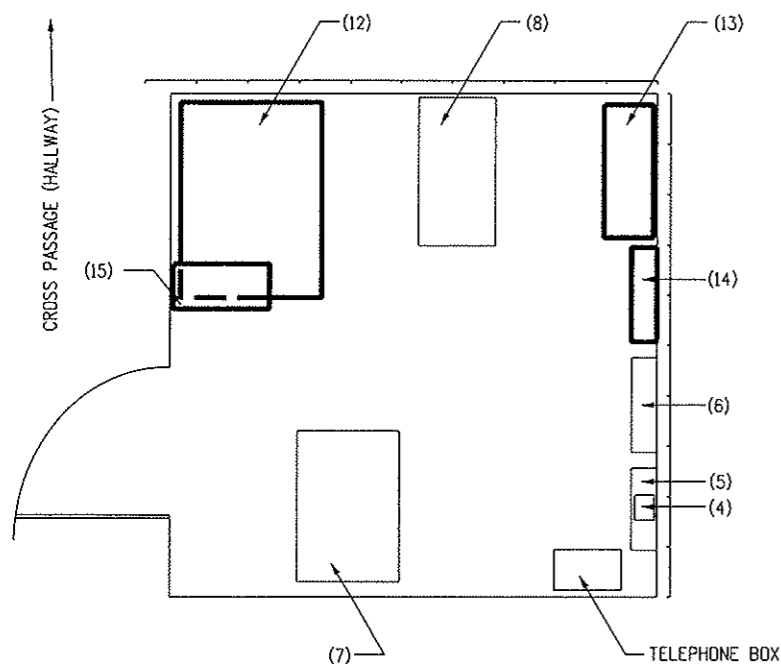

INTERIM PLAN
SCALE: 1/2" = 1'-0"

INTERIM PLAN LEGEND

- (1) REMOVED - 480 / 277 V PANEL - 22"W x 65"H x 6"D
- (2) REMOVED - LIGHTING AND HEATING CONTACTOR PANEL
- (3) REMOVED - LIGHTING CONTROL PANEL
- (4) 3 KVA, 480 V - 208Y / 120 V TRANSFORMER (EXIST)
- (5) 120 / 240 V PANEL - 16"W x 21"H x 6"D (EXIST)
- (6) 30A, 2P, 120/240 V ASCO SW. (ATS) (EXIST)
- (7) RELOCATED - 75 KVA, 2400 V - 480Y / 277 V TRANSFORMER, NOTE 10
- (8) RELOCATED - MV FUSED OIL CUTOFF SWITCH - 35"W x 38"H x 18"D (EXIST), NOTE 10
- (9) NOT USED
- (10) REMOVED - CABINET - 14"W x 38"H x 9"D
- (11) REMOVED - J-BOX
- (12) NEW 150 KVA, 2400 V - 480Y / 277 V TRANSFORMER TX-NCS-2E 48"W x 58"H x 32"D
- (13) NEW CONTACTOR CABINET
- (14) NEW 480 / 277 V PANEL - 22"W x 65"H x 6"D
- (15) NEW MV CABLE PULL BOX - 24"W x 20"H x 12"D

NOTE:


THE INTENT OF STAGING IS TO MAINTAIN A FULLY OPERATIONAL TUNNEL DURING CONSTRUCTION. SEE SPECIAL CONSTRUCTION REQUIREMENTS (K).

Plot File Name: 3PLU11-ILL* \$\$\$\$\$\$DATE\$\$\$\$\$

Computer File Information	
Creation Date:	Initials:
Last Modification Date: 12/04/03	Initials: DJB
Full Path: 014102\700cadd\703elect\	
Drawing File Name: 102ep153n.dgn	
Acad Ver. R14	Scale: Units: ENGLISH

Sheet Revisions		
<input type="checkbox"/>	07/03/07	ASBUILT DJB
<input type="checkbox"/>		
<input type="checkbox"/>		
<input type="checkbox"/>		

Colorado Department of Transportation




P.O. BOX 399
DUMONT, CO. 80436
Phone: 303-512-5750 FAX: 303-512-5775

Region 1 Mountain Residency I.N.Z.


As Constructed
No Revisions:
Revised:
Void:

ELEC DEMO - NO. TUNNEL CENTER CROSSCUT EAST ELECTRICAL ROOM	
Designer: E.A. GAYAMAT	Structure Numbers
Detailer: R. MILLER	
Sheet Subset: ELEC DEMO	Subset Sheets: 9 of 15


Project No./Code	IM 0703-269
	13166
Sheet Number	18

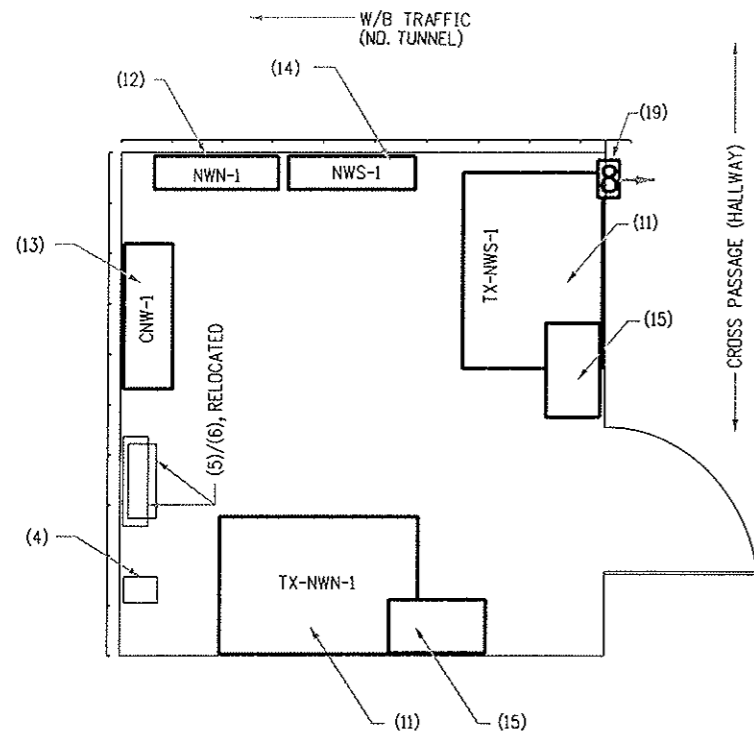


**FINAL PLAN
CROSSCUT WEST**
SCALE: 1/2" = 1'-0"

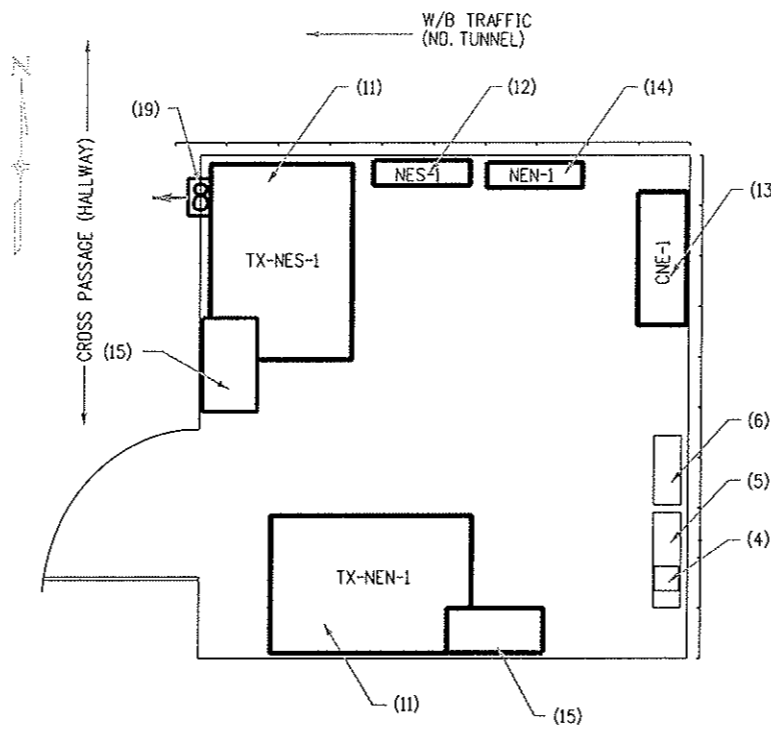

**FINAL PLAN
CROSSCUT EAST**
SCALE: 1/2" = 1'-0"

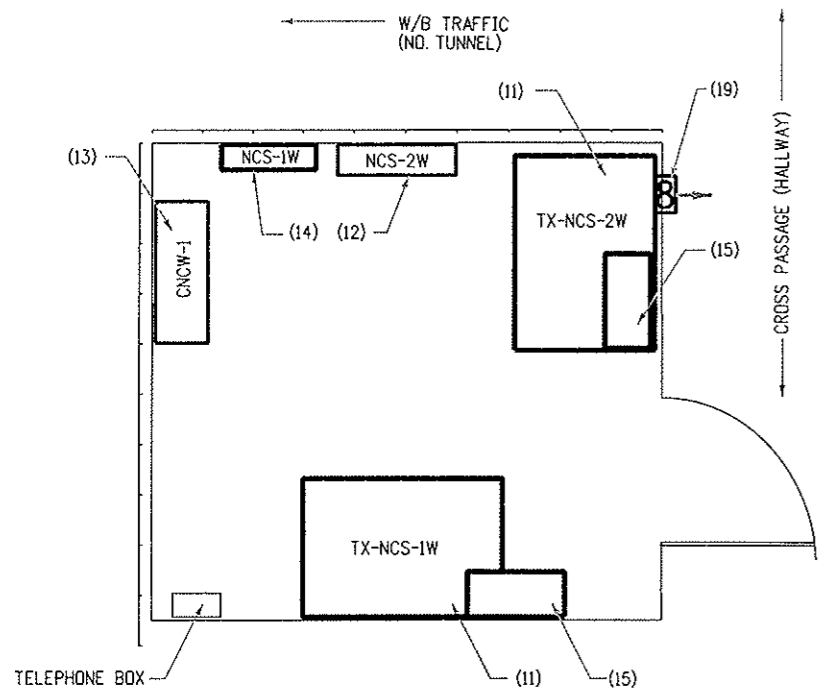

**FINAL PLAN
CENTER CROSSCUT WEST**
SCALE: 1/2" = 1'-0"

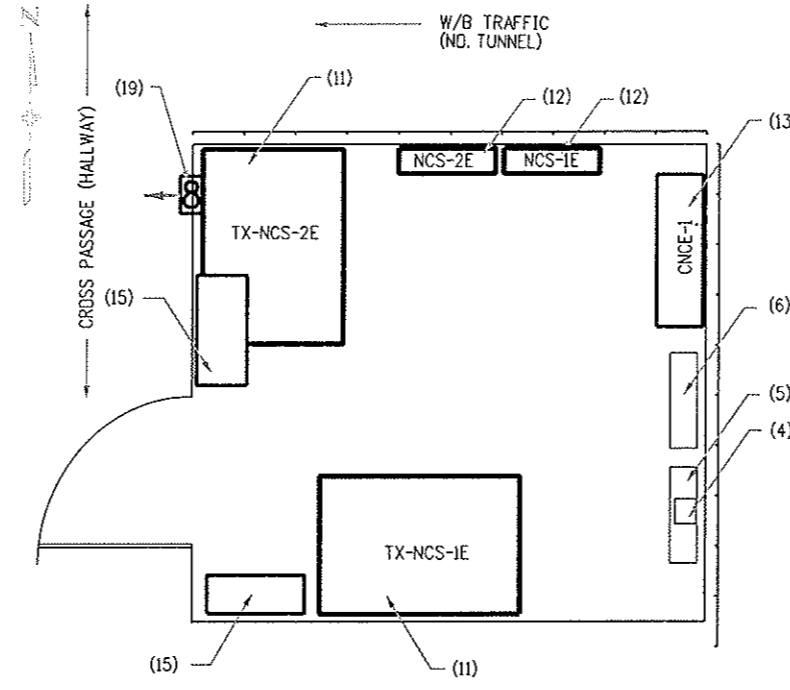

**FINAL PLAN
CENTER CROSSCUT EAST**
SCALE: 1/2" = 1'-0"

NOTES


- A. SUPPORT MV PULLBOX FROM WALL BRACKETS FABRICATED FROM STEEL STRUT AND FROM CEILING THREADED RODS.
- B. REFERENCE THE NORTH TUNNEL CROSSCUT ELECTRICAL ROOM PLANS FOR CONSTRUCTION STAGING REQUIREMENTS AS FOLLOWS:
WEST: "NORTH TUNNEL WEST CROSSCUT ELECTRICAL ROOM"
CENTER: "NORTH TUNNEL CENTER CROSSCUT ELECTRICAL ROOM"
EAST: "NORTH TUNNEL EAST CROSSCUT ELECTRICAL ROOM"
- C. REFERENCE THE "NORTH TUNNEL POWER PLAN"- SHEET FOR TUNNEL CIRCUITS WHICH ROUTE TO PANEL NWN-1 AND CONTACTOR CABINET CNW-1
- D. REFERENCE THE "NORTH TUNNEL POWER PLAN"- SHEET FOR TUNNEL CIRCUITS WHICH ROUTE TO PANEL NCN-1 AND CONTACTOR CABINET CNC-1.
- E. REFERENCE THE "NORTH TUNNEL POWER PLAN"- SHEET FOR TUNNEL CIRCUITS WHICH ROUTE TO PANEL NEN-1 AND CONTACTOR CABINET CNE-1.
- F. INSTALL A JUNCTION BOX IN PLACE OF THE TEMPORARILY RELOCATED CONTACTOR FOR THE EXISTING WATER MAIN HEAT TAPE CIRCUITS. REFERENCE STAGE 1 CONSTRUCTION NOTE 3 ON THE "NORTH TUNNEL CROSSCUT ELECTRICAL ROOM" PLAN SHEETS. INSTALL NEW 5#10 AWG CIRCUIT CONDUCTORS FROM THE CONTACTOR CABINET (CNW-1, CNC-1 OR CNE-1) TO THIS JUNCTION BOX. A #10 AWG GROUNDING CONDUCTOR IS INCLUDED IN THE CONDUCTOR COUNT. SPLICE THE EXISTING HEAT TRACE CIRCUIT CONDUCTORS TO THE NEW CONDUCTORS IN THE JUNCTION BOX. INSTALL A JUNCTION BOX FOR THE HEAT TRACE CONTROL CIRCUIT. INSTALL NEW THERMOSTATIC CONTROL CIRCUIT CONDUCTORS, NUMBER AND SIZE TO MATCH EXISTING, BETWEEN THE JUNCTION BOX AND THE CONTACTOR CABINET. SPLICE THE EXISTING HEAT TRACE CONTROL CIRCUIT CONDUCTORS TO THE NEW CONDUCTORS IN THE JUNCTION BOX.

LEGEND:


- (4) 3 KVA, 480 V - 208Y / 120 V TRANSFORMER (EXIST)
- (5) 120 / 240 V PANEL - 16"W x 21"H x 6"D (EXIST)
- (6) 30A, 2P, 120/240 V ASCO SW. (ATS) (EXIST)
- (11) NEW 150 KVA, 2400 V - 480Y/277 V TRANSFORMER-48"W x 58"H x 32"D
- (12) NEW 480 / 277 V PANEL - 22"W x 65"H x 6"D
- (13) NEW CONTACTOR CABINET - 20"W x 30"H x 8"D
- (14) NEW 480 / 277 V PANEL - 22"W x 50"H x 6"D
- (15) NEW - MV CABLE PULLBOX - 24"W x 20"H x 12"D
- (18) NOT USED
- (19) NEW THRU-WALL EXHAUST FAN (3000 CFM)

NOTE:
THE INTENT OF STAGING IS TO MAINTAIN A FULLY OPERATIONAL TUNNEL DURING CONSTRUCTION. SEE SPECIAL CONSTRUCTION REQUIREMENTS (K).

Computer File Information		Sheet Revisions		Colorado Department of Transportation P.O. BOX 399 DUMONT, CO. 80436 Phone: 303-512-5750 FAX: 303-512-5775 Region 1 Mountain Residency I.N.Z.	As Constructed	ELEC PLANS - NO. TUNNEL FINAL CROSSCUT ELECTRICAL ROOMS		Project No./Code IM 0703-269
Creation Date: 01/31/07	Initials: DJB	07/03/07	ASBUILT			No Revisions:	Designer: E.A. GAYAMAT	
Last Modification Date: 01/31/07	Initials: DJB				Revised:	Detailer: R. MILLER		Sheet Number 19
Full Path: 014102\800Deliv\AsBuilt					Void:	Sheet Subset: ELEC DEMO	Subset Sheets: 10 of 15	
Drawing File Name: 102ep154n								
Acad Ver. R14	Scale:	Units: ENGLISH						

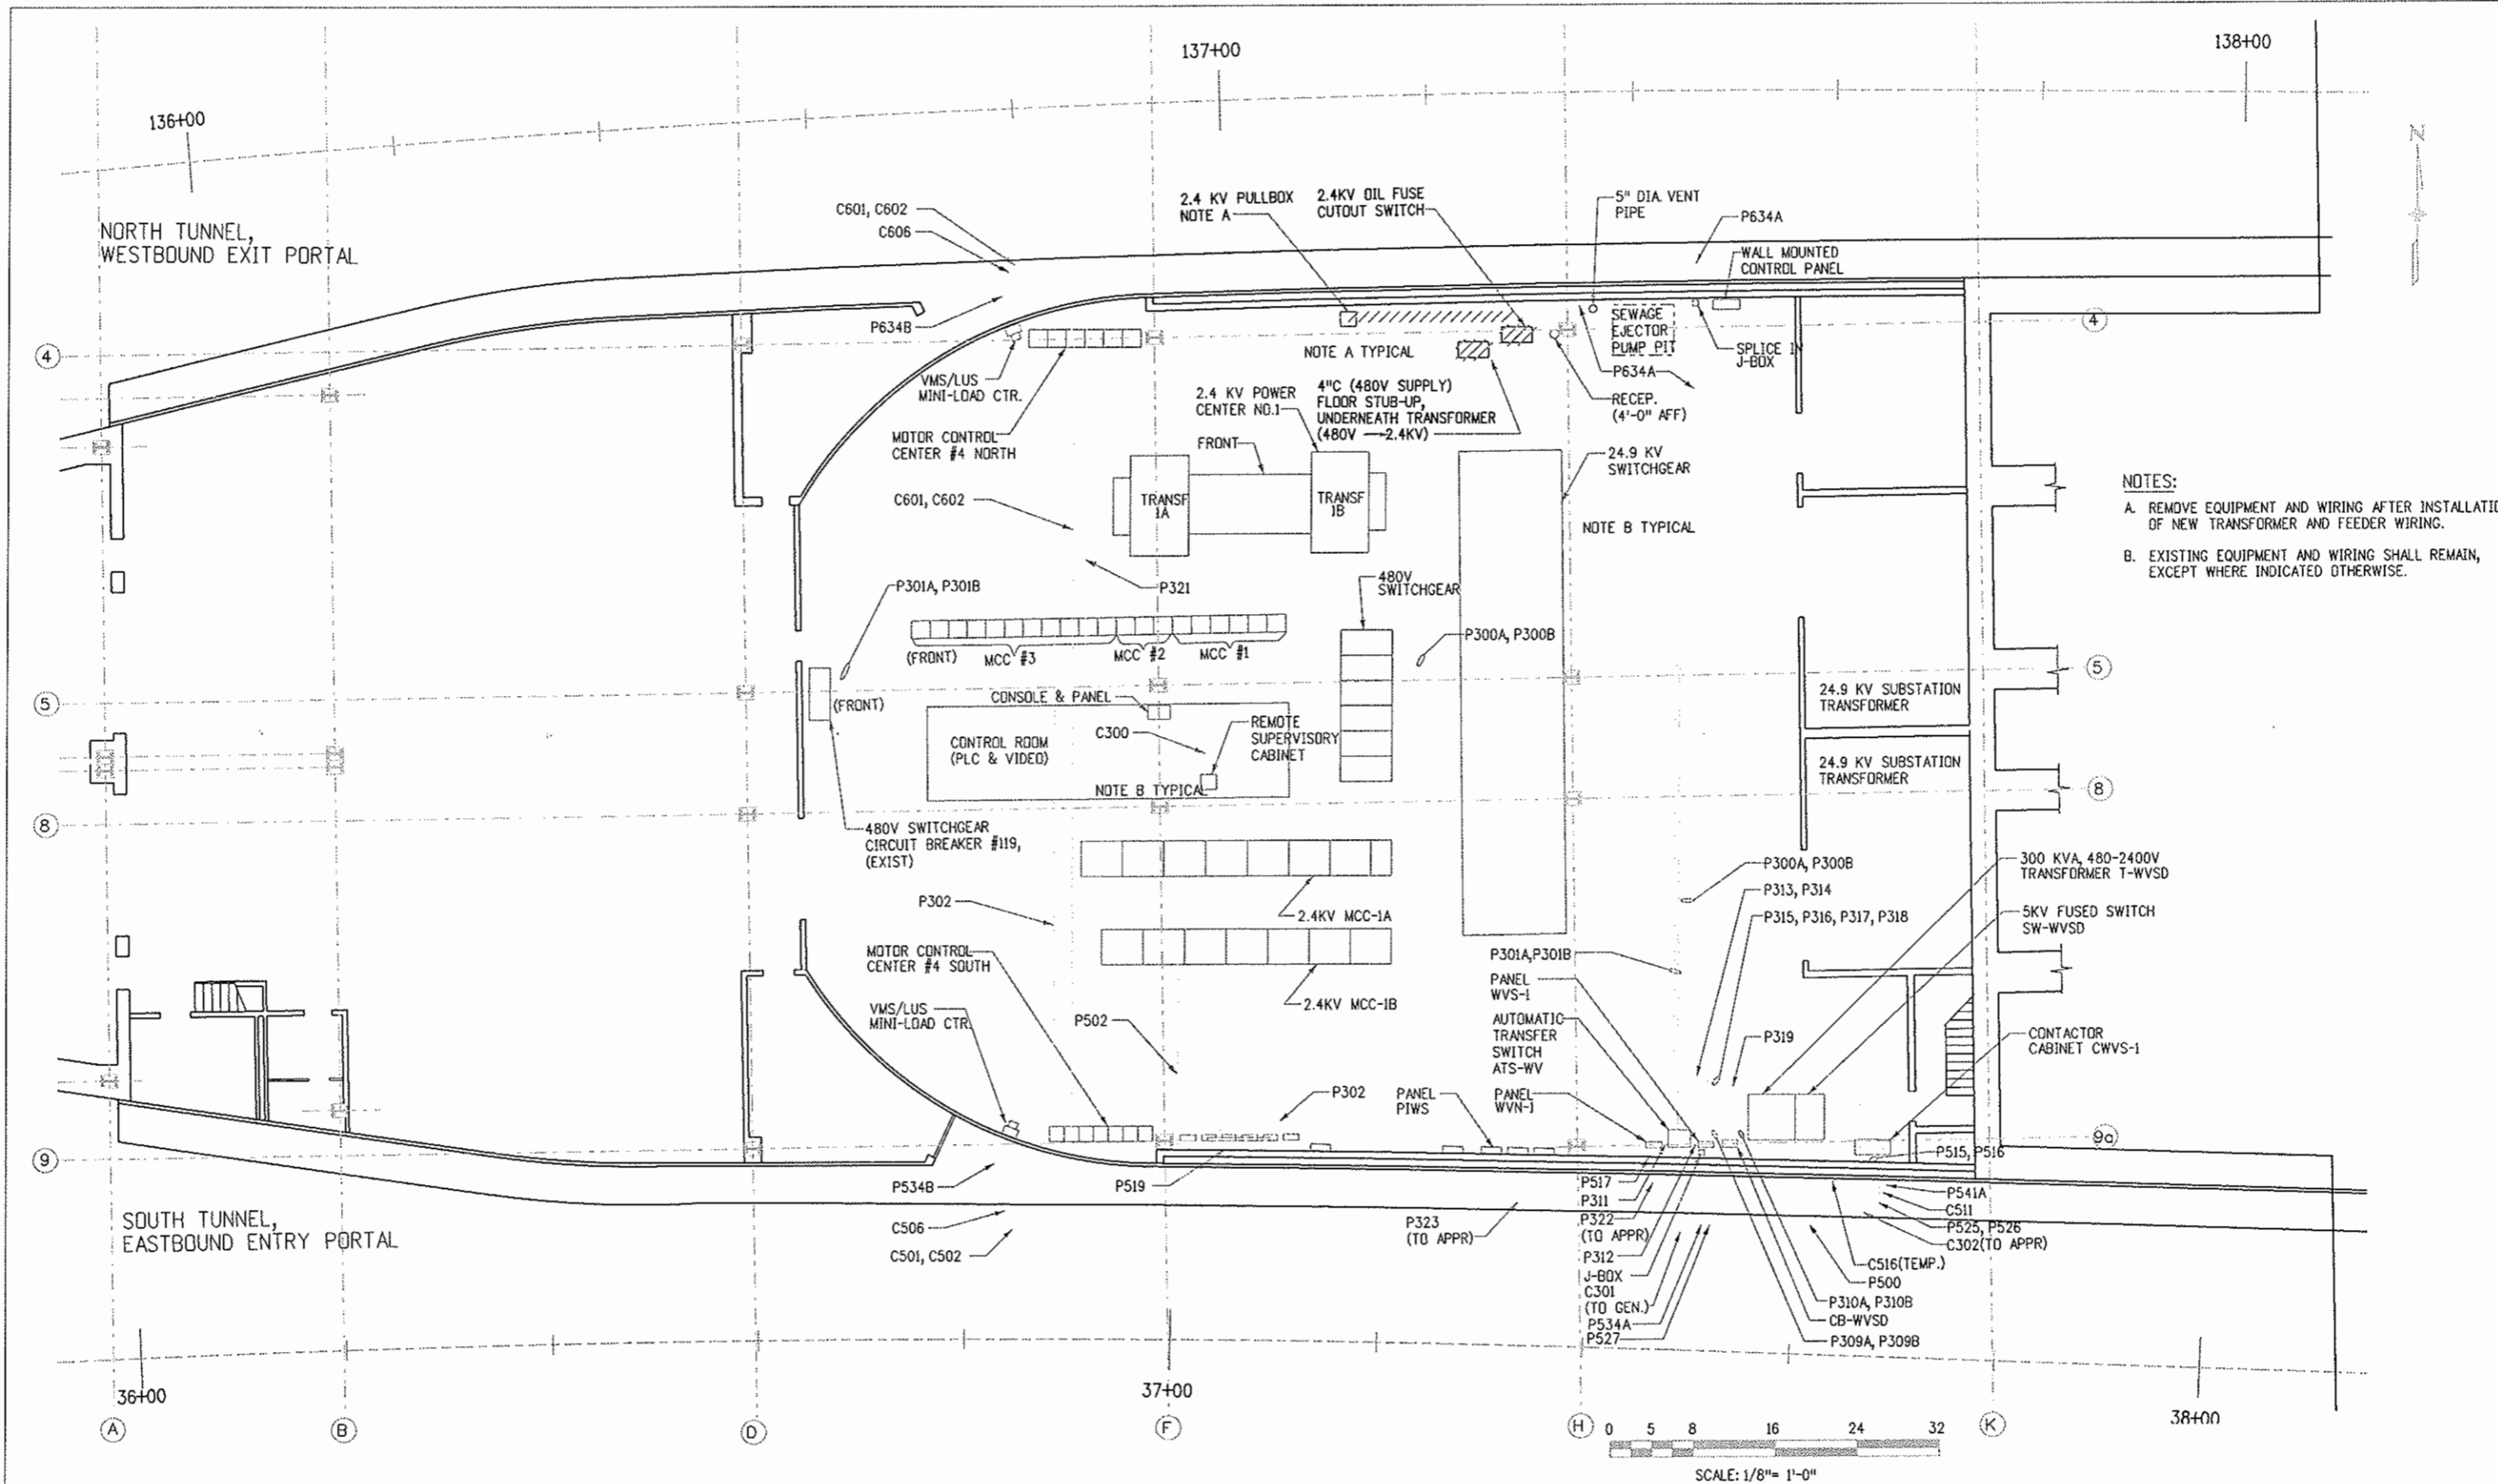


NOTES:
 A. REMOVE EQUIPMENT AND WIRING AFTER INSTALLATION OF NEW TRANSFORMER AND FEEDER WIRING.
 B. EXISTING EQUIPMENT AND WIRING SHALL REMAIN, EXCEPT WHERE INDICATED OTHERWISE.

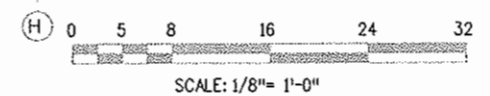

Design File Name: DGN&SPEC*
 Plot File Name: \$PLOTFILE*
 Date of Plot: \$\$\$DATE\$\$\$

Computer File Information	
Creation Date:	Initials:
Last Modification Date:	Initials:
Full Path:	14102\700cadd\703elect\
Drawing File Name:	rmple05wn.dgn
Acad Ver.:	R14
Scale:	1/8" = 1'-0"
Units:	ENGLISH


Sheet Revisions		
<input type="checkbox"/>	07/03/07	ASBUILT DJB
<input type="checkbox"/>		
<input type="checkbox"/>		
<input type="checkbox"/>		

Colorado Department of Transportation

 P.O. BOX 399
 DUMONT, CO. 80436
 Phone: 303-512-5750 FAX: 303-512-5775
 Region 1 Mountain Residency I.N.Z.

As Constructed
 No Revisions:
 Revised:
 Void:

ELECTRICAL DEMOLITION
WEST VENT BUILDING PLAN
 Designer: E.A. GAYAMAT
 Detailer: R. MILLER
 Sheet Subset: ELEC DEMO
 Structure Numbers:
 Subset Sheets: 11 OF 15

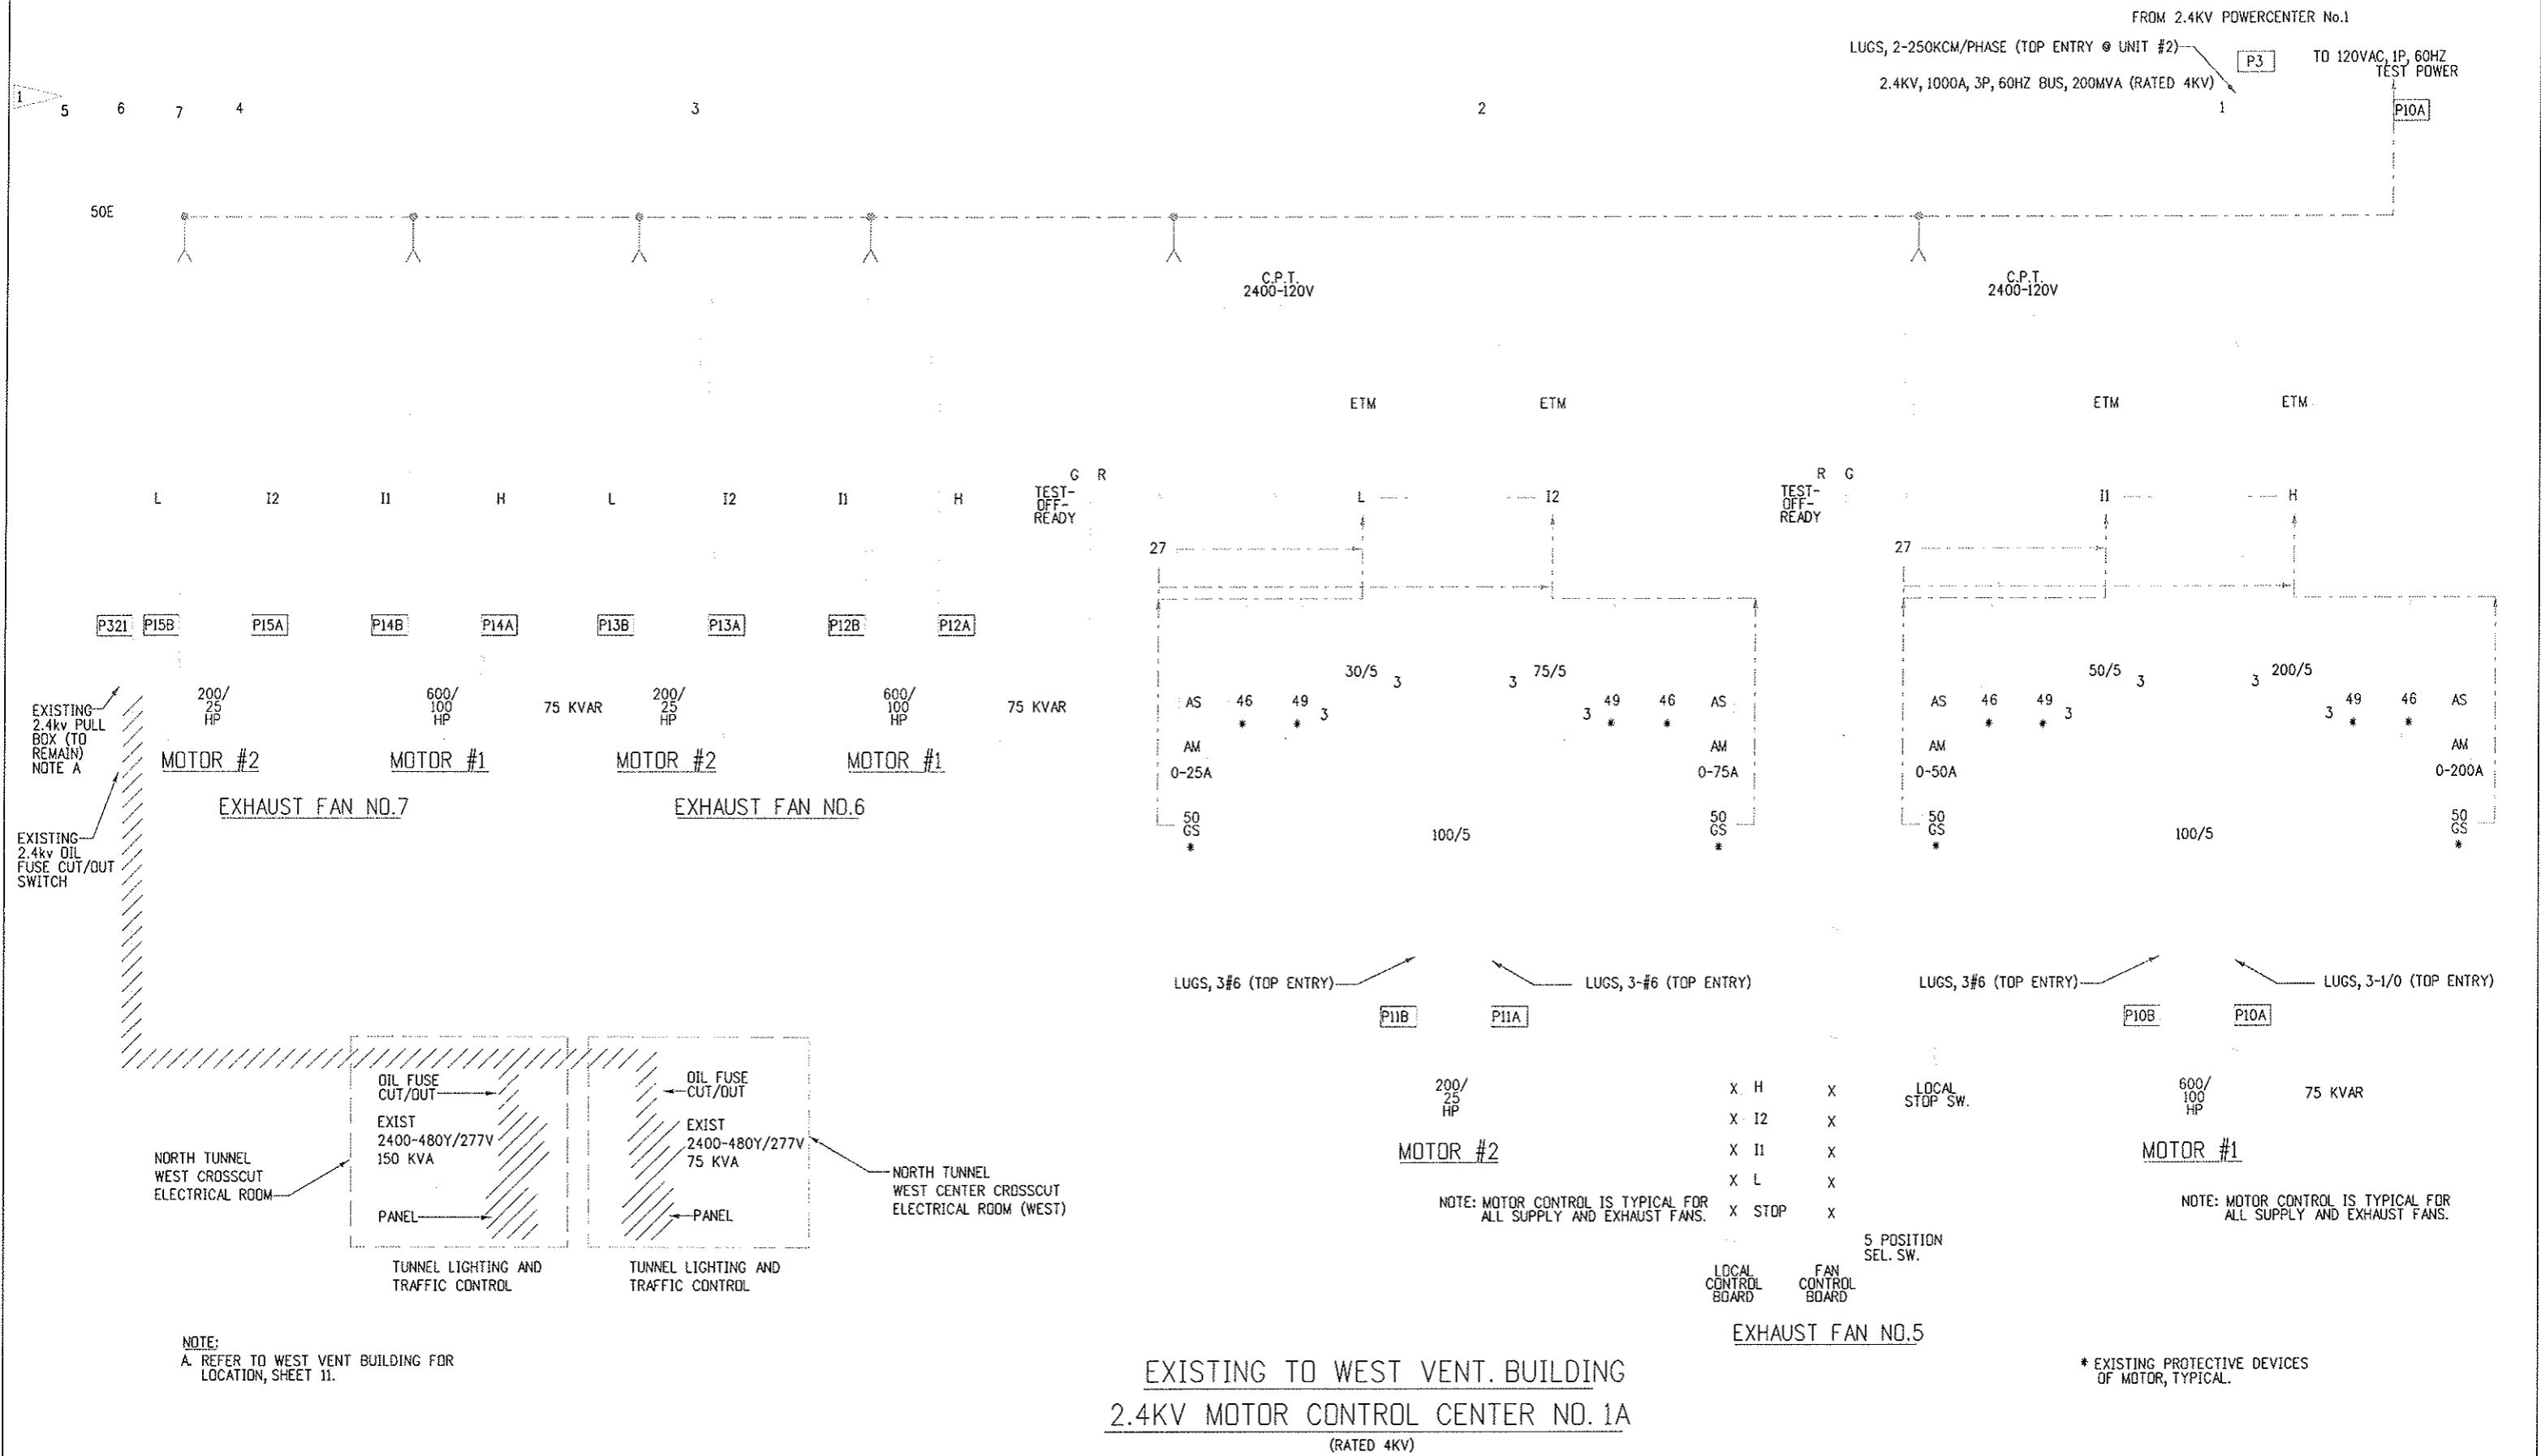
Project No./Code
 IM 0703-269
 13166
 Sheet Number 20



NOTE:
A. REFER TO WEST VENT BUILDING FOR LOCATION, SHEET 11.

EXISTING TO WEST VENT. BUILDING
2.4KV MOTOR CONTROL CENTER NO. 1A
(RATED 4KV)

* EXISTING PROTECTIVE DEVICES OF MOTOR, TYPICAL.

Computer File Information		Sheet Revisions		Colorado Department of Transportation		As Constructed		ELECTRICAL DEMOLITION WEST 2.4KV MCC NO. 1A		Project No./Code			
Creation Date:	Initials:	07/03/07	ASBUILT	DJB									
Last Modification Date:	Initials:	02/07/02											
Full Path:		14102\700CADD\703elec											
Drawing File Name:		rmel05wn.dgn											
Acad Ver.	Scale:	R14	NONE	Units:	ENGLISH								
 P.O. BOX 399 DUMONT, CO. 80436 Phone: 303-512-5750 FAX: 303-512-5775 Region 1 Mountain Residency I.N.Z.						No Revisions:		Designer: E.A. GAYAMAT		Structure Numbers			
						Revised:		Detailer: R. MILLER		Sheet Subset: ELEC DEMO		Subset Sheets: 12 of 15	
						Void:							
										IM 0703-269			
										13166			
										Sheet Number 21			



TD 2000KVA 24.9 - 480V
TRANSFORMER NO.2
SEE DWG.---

TO 2000KVA 24.9 - 480V
TRANSFORMER NO.1
SEE DWG.---

LEGEND

480 VOLT SWITCHGEAR NO.1

3000A BUS NO.1

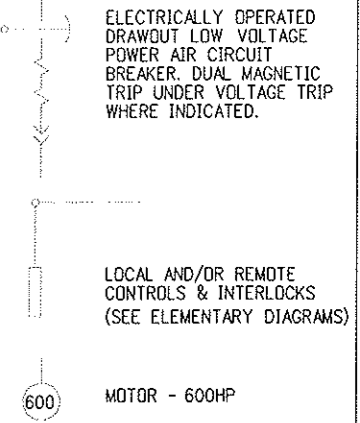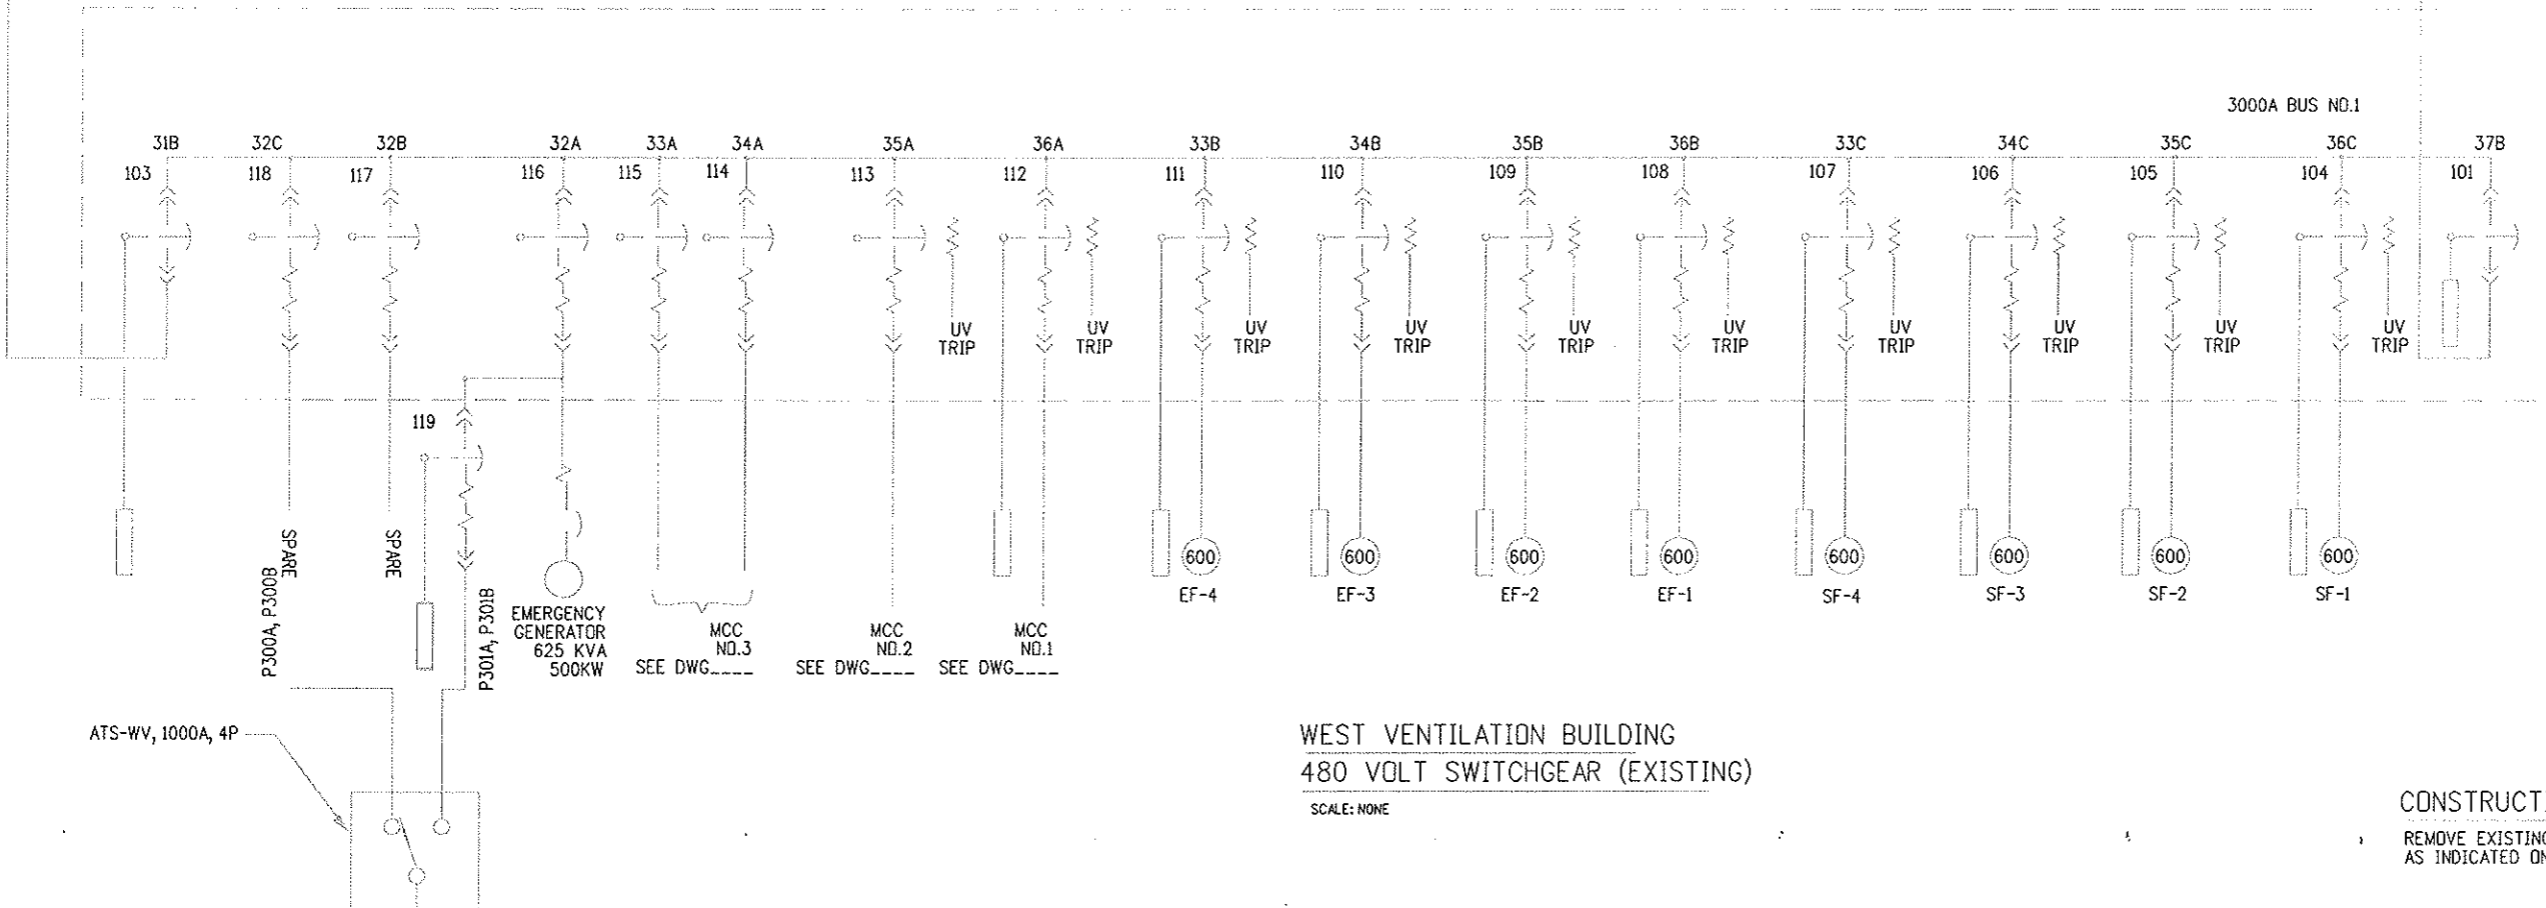


WEST VENTILATION BUILDING
480 VOLT SWITCHGEAR (EXISTING)

SCALE: NONE

CONSTRUCTION NOTE:

REMOVE EXISTING SPARE CIRCUIT BREAKER. PROVIDE WIRING AS INDICATED ON PLANS. SEE SHEET 136.

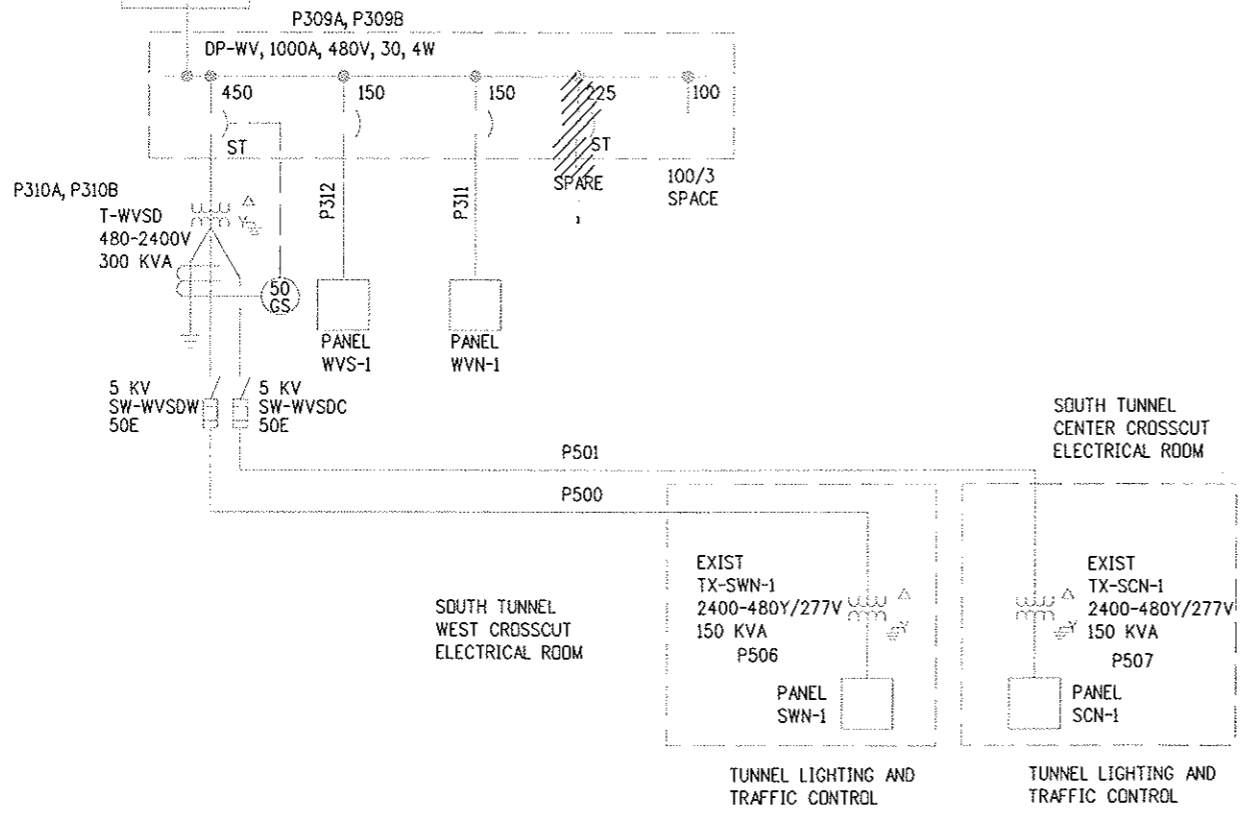

WEST VENTILATION BUILDING - 480V SWITCHGEAR

	31	32	33	34	35	36	37
A	A	A	A	A	A	A	A
B	B	B	B	B	B	B	B
C	C	C	C	C	C	C	C

480 VOLT SWITCHGEAR ELEVATION (EXISTING)

SCALE: NONE

Computer File Information	
Creation Date:	Initials:
Last Modification Date:	Initials:
Full Path:	14102\700CADD\703elec\
Drawing File Name:	102esd27n.dgn
Acad Ver. R14	Scale: NONE Units: ENGLISH

Sheet Revisions	
07/03/07	ASBUILT DJB

Colorado Department of Transportation

P.O. BOX 399
DUMONT, CO. 80436
Phone: 303-512-5750 FAX: 303-512-5775


Region 1 Mountain Residency I.N.Z.

As Constructed
No Revisions:
Revised:
Void:

ELECTRICAL DEMOLITION WEST 480V SWITCHGEAR	
Designer: E.A. GAYAMAT	Structure Numbers
Detailer: R. MILLER	
Sheet Subset: ELEC DEMO	Subset Sheets: 13 of 15

Project No./Code
IM 0703-269
13166
Sheet Number 22


EAST VENTILATION BUILDING (MCC) NO. 2

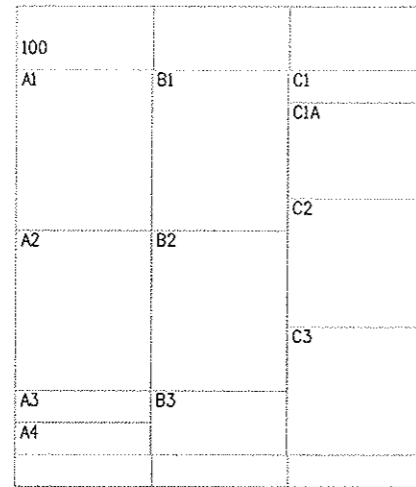

MCC NO.2 ELEVATION
SCALE: NONE

FROM 480V SWITCHGEAR BUS NO.1
CIRCUIT BREAKER 113

480 VOLT MCC NO.2 (1200A BUS)

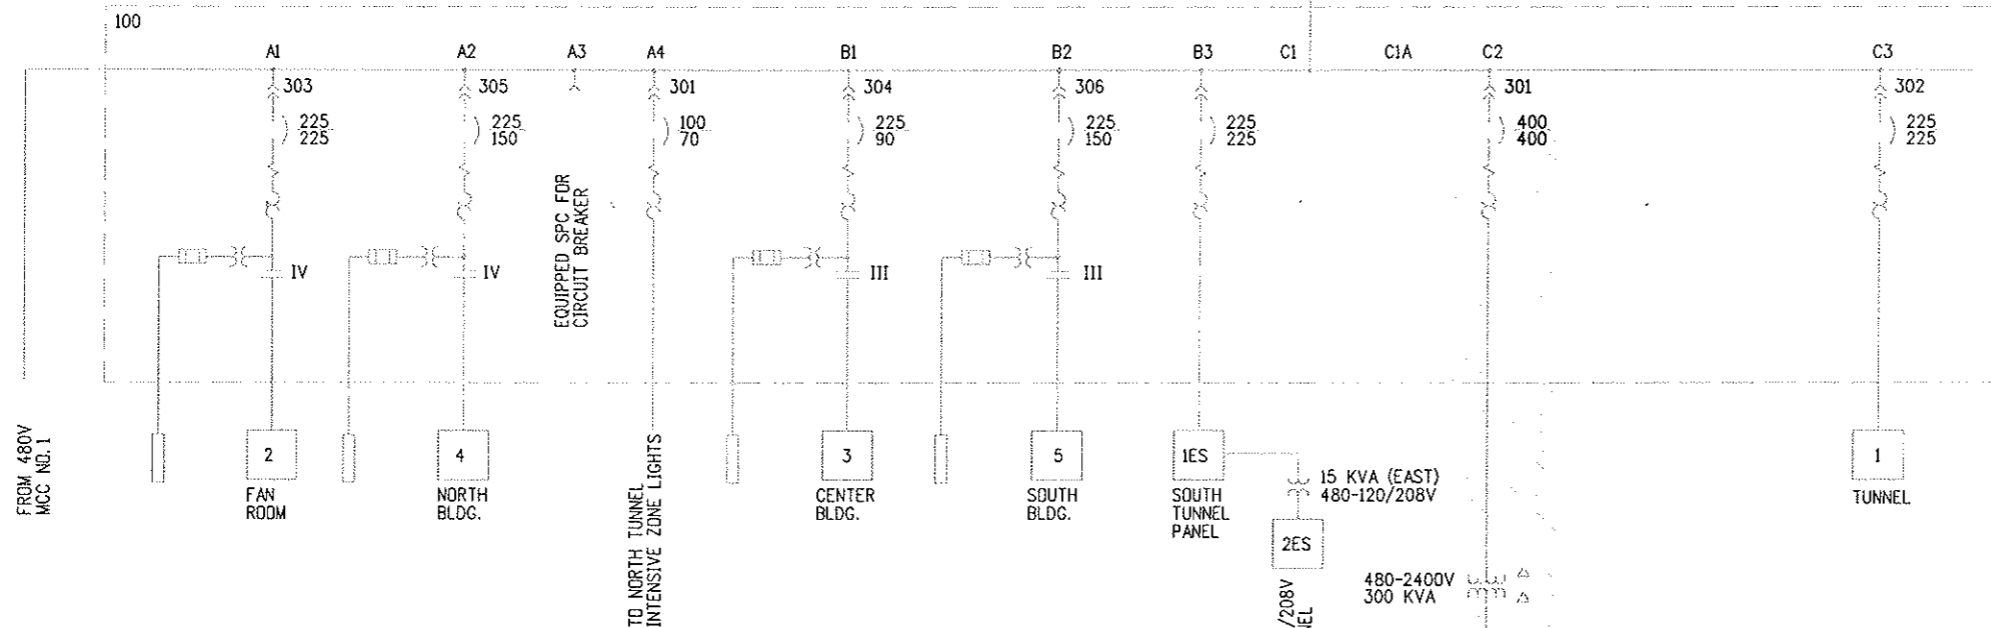

NAMEPLATE SCHEDULE			
REF	FIRST LINE	SECOND LINE	THIRD LINE
100	480 VOLT	MCC NO. 2	NORTH
A1	FAN ROOM	POWER DIST.	PANEL NO. 2
A2	NORTH BLDG.	POWER DIST.	PANEL NO. 4
A3	EQUIPD. SPC. FOR CIRCUIT		BREAKER
A4	NO. TUNNEL	INTENSIVE	ZONE LIGHTS
B1	CENTER BLDG.	POWER DIST.	PANEL NO. 3
B2	SOUTH BLDG.	POWER DIST.	PANEL NO. 5
B3	PANEL IES	SOUTH	TUNNEL
C1	INCOMING	FEEDER	BUS
C1A	CABLING	300 KVA	TRANSFORMER
C2	300 KVA	TRANSFORMER	PRIMARY
C3	TUNNEL SUPPLY	POWER DIST.	PANEL NO. 1

EAST VENTILATION BUILDING
MOTOR CONTROL CENTER NO.2
SCALE: NONE

Design File Name: DGNSSPEC*
 Plot File Name: \$PLTFILE*
 Date of Plot: \$\$\$DATE\$\$\$

Computer File Information			
Creation Date:	02/26/99	Initials:	
Last Modification Date:	02/27/2002	Initials:	DJR
Full Path:	14102\700CADD\703elec		
Drawing File Name:	102esd22n.dwg		
Acad Ver.	R14	Scale:	NONE
		Units:	ENGLISH

Sheet Revisions			
	07/03/07	ASBUILT	DJB

Colorado Department of Transportation

P.O. BOX 399
DUMONT, CO. 80436
Phone: 303-512-5750 FAX: 303-512-5775

Region 1 Mountain Residency I.N.Z.


As Constructed
No Revisions:
Revised:
Void:

ELECTRICAL DEMOLITION EAST MCC NO.2			
Designer:	E.A. GAYAMAT	Structure Numbers	
Detailer:	R. MILLER		
Sheet Subset:	ELEC DEMO	Subset Sheets:	14 of 15

Project No./Code	
IM 0703-269	
13166	
Sheet Number	23

NOTES:


- A. REMOVE EQUIPMENT AND WIRING AFTER INSTALLATION OF NEW TRANSFORMER AND FEEDER WIRING.
- B. EXISTING EQUIPMENT AND WIRING SHALL REMAIN, EXCEPT WHERE INDICATED OTHERWISE.

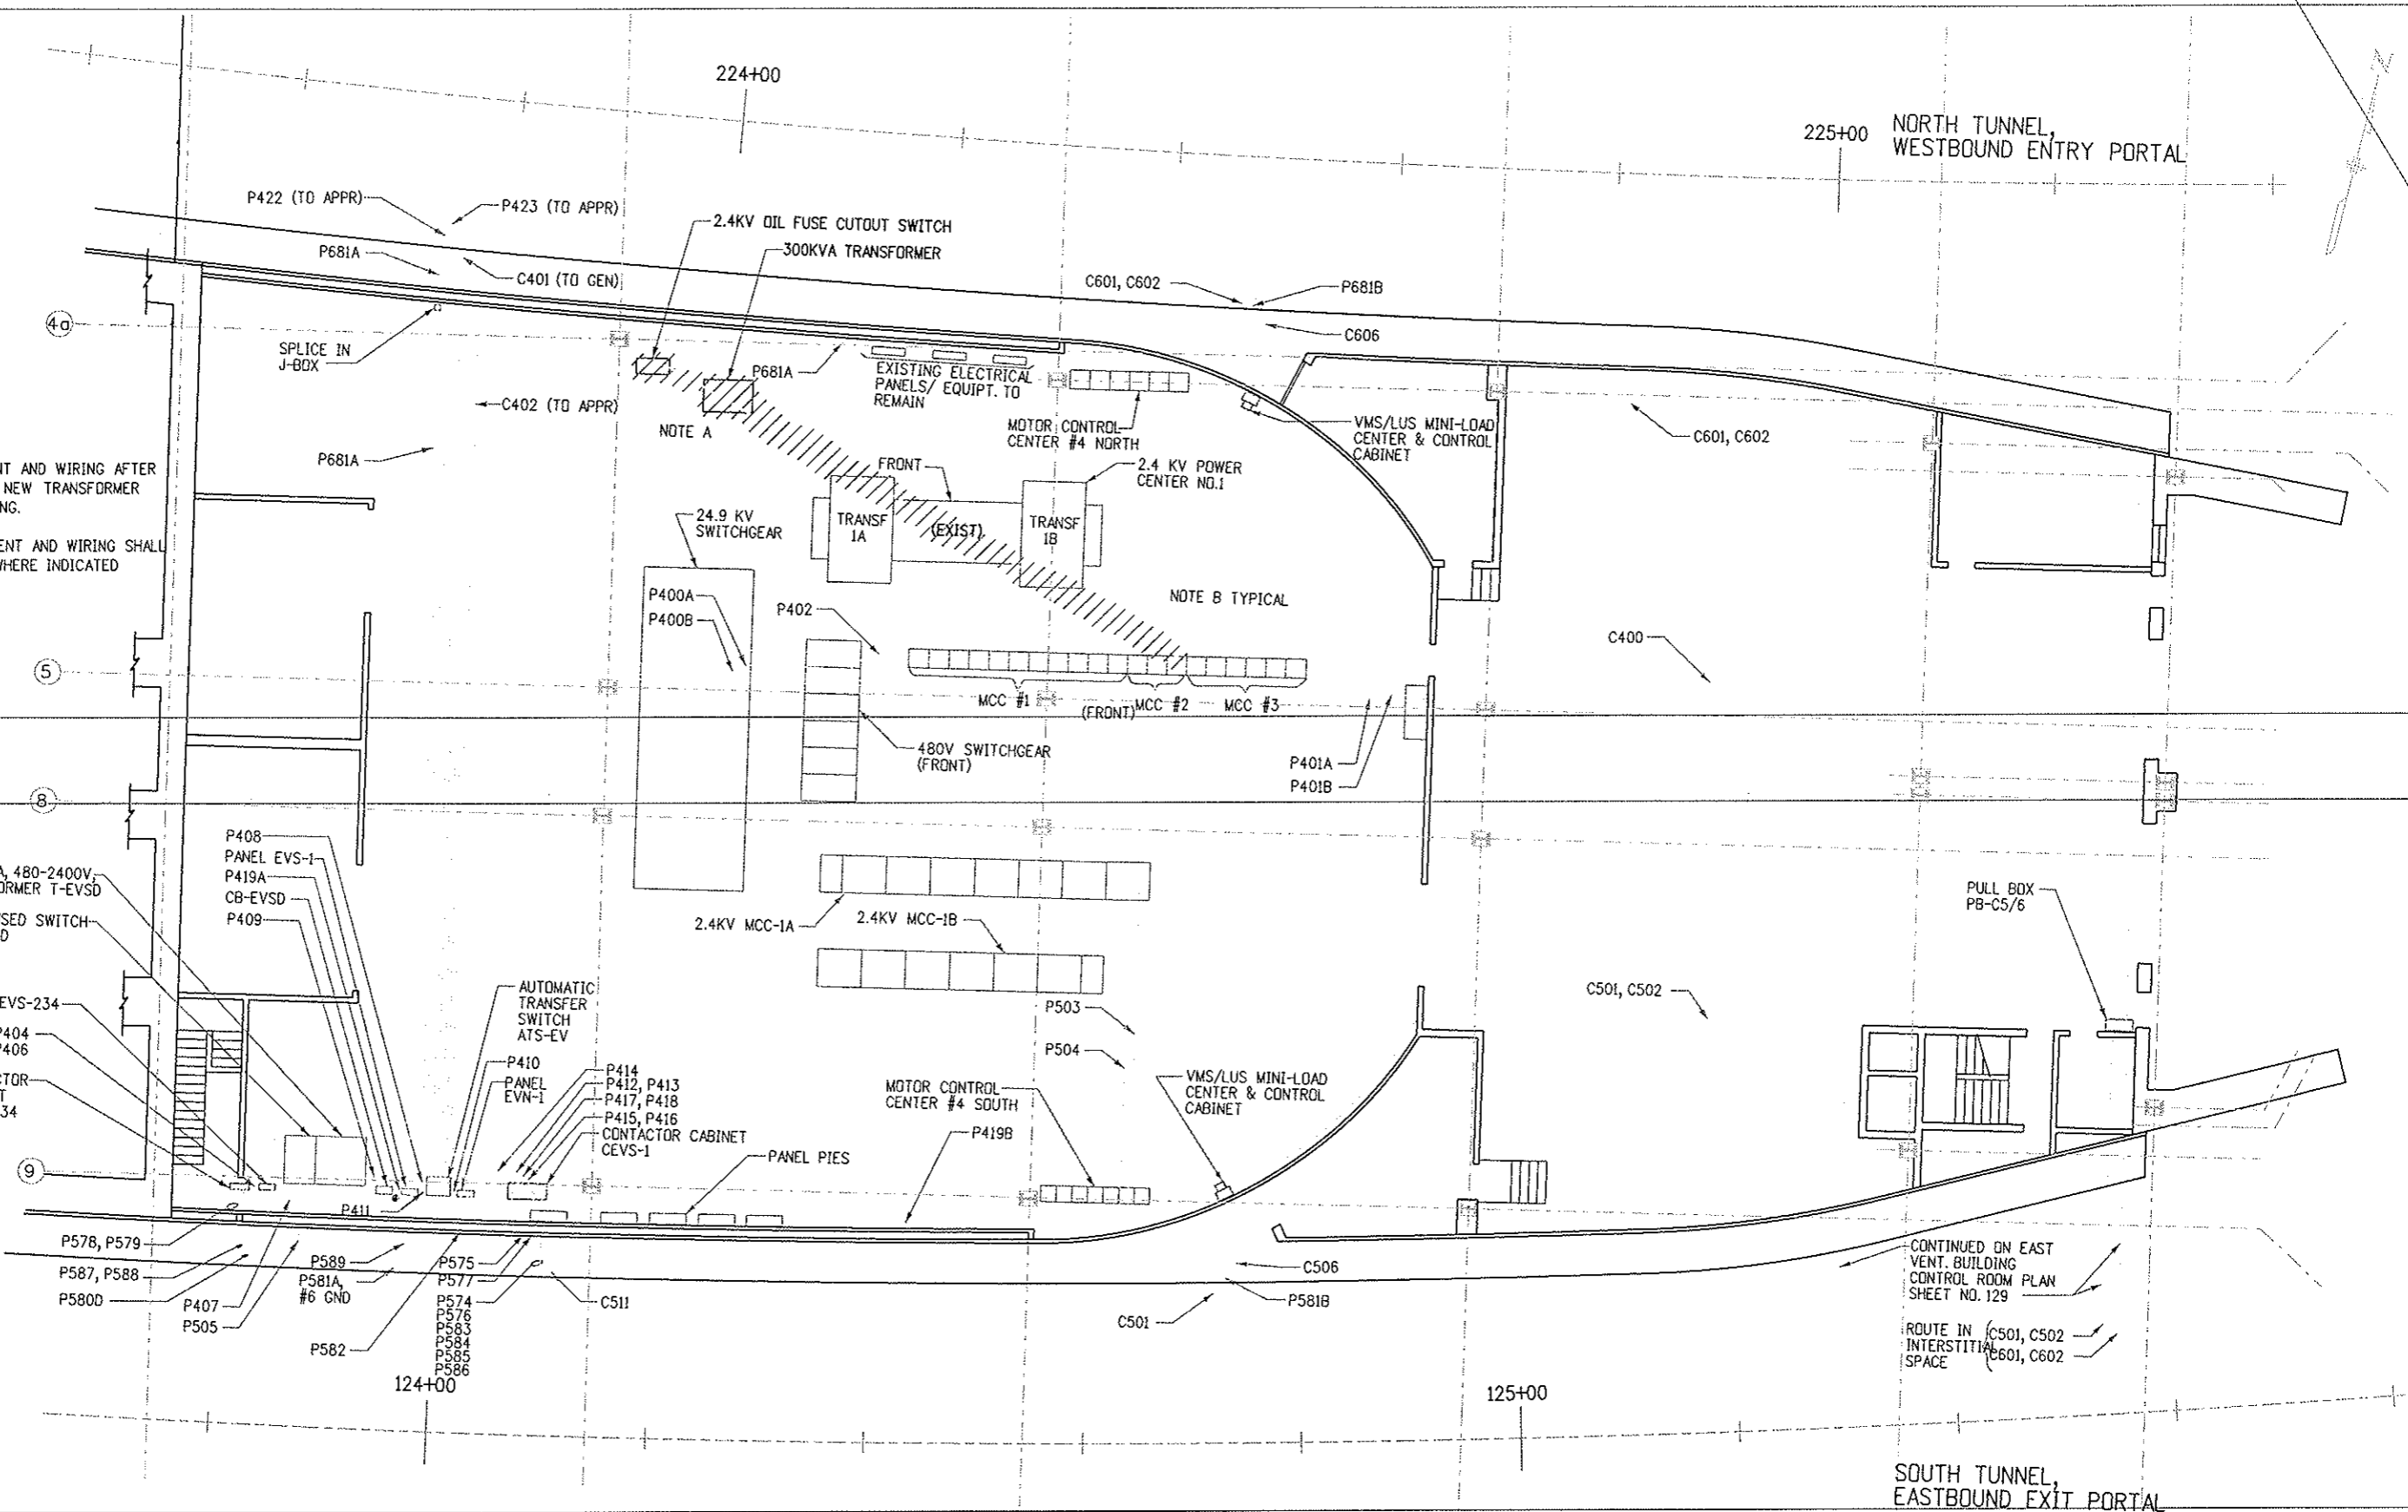

Design File Name: DGN\$SPEC*
 Plot File Name: PLOT\$FILE*
 Date of Plot: \$\$\$DATE\$\$\$

Computer File Information	
Creation Date:	Initials:
Last Modification Date:	Initials:
Full Path:	014102\700cadd\703elect\
Drawing File Name:	rmple05en.dgn
Acad Ver.:	R14
Scale:	1/8" = 1'-0"
Units:	ENGLISH

Sheet Revisions		
07/03/07	ASBUILT	DJB

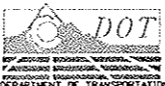Colorado Department of Transportation

 P.O. BOX 399
 DUMONT, CO. 80436
 Phone: 303-512-5750 FAX: 303-512-5775
 Region 1 Mountain Residency I.N.Z.

As Constructed
No Revisions:
Revised:
Void:

ELECTRICAL DEMOLITION EAST VENT BUILDING PLAN	
Designer:	E.A. GAYAMAT
Detailer:	R. MILLER
Structure Numbers:	
Sheet Subset:	ELEC DEMO
Subset Sheets:	15 of 15

Project No./Code
IM 0703-269
13166
Sheet Number
24

TUNNEL LIGHTING NOTES

- UNLESS OTHERWISE NOTED, ALL LUMINAIRES SHALL BE MOUNTED IN ACCORDANCE TO THE TYPICAL MOUNTING DETAILS SHOWN ON SUBSET "TLD" TUNNEL LIGHTING DETAILS SHEETS.
- PLAN DRAWINGS ARE SCHEMATIC FOR LUMINAIRE LOCATION AND INFORMATION ONLY. REFER TO TUNNEL LIGHTING DETAILS FOR PROPOSED PLACEMENT ON WALLS AND CEILINGS.
- UNDER THIS CONTRACT, LIGHTING WORK IS TO BE COMPLETED IN CROSS PASSAGEWAY AREAS AS SHOWN ON SUBSET "TUN. LTG." SHEET 20.
- AT VMS LOCATIONS WITHIN THE TUNNEL, THE ROW OF FLUORESCENT TUNNEL LUMINAIRES (INCLUDING WIREWAYS) END APPROXIMATELY 3'-0" IN FRONT OF THE C OF SIGN, AND RESUMES APPROXIMATELY 3'-0" AFTER C OF THE SIGN. SEE SUBSET "TLD", SHEET 5 FOR DETAILS.
- AT BREAKS IN THE ROW OF LUMINAIRES FLUORESCENT, WHERE WIREWAY IS NOT CONTINUOUS, POWER FEED BOXES SHALL BE PROVIDED AT BOTH STARTING AND STOPPING POINTS OF TUNNEL LIGHTING RUN. TO CONTINUE CIRCUIT RUNS ACROSS INTERRUPTION POINTS USE 1 1/4" RGS CONDUIT, COMPLETE CONNECTION USING LIQUIDTIGHT FLEXIBLE METAL CONDUIT TO POWER FEED ENTRY, SEE SUBSET "TLD" SHEET 6 FOR INTERCONNECT REQUIREMENTS.
- CONTRACTOR SHALL COORDINATE TUNNEL LIGHTING WIREWAY POWER FEED LOCATIONS AS INDICATED ON THE TUNNEL POWER PLANS, REFER TO SUBSET "TUN POWER" FOR LOCATIONS.
- SEE SUBSET "TLD" TUNNEL LIGHTING DETAILS DRAWING SHEETS FOR SPECIFIC MOUNTING REQUIREMENTS OF EACH SYSTEM COMPONENT.
- FOR TABULATION OF TUNNEL MOUNTING CONDITIONS, REFER TO SUBSET "TLD" TUNNEL LIGHTING DETAILS, SHEET 1.
- PROVIDE ONE EXTRA SUPPLEMENTAL MOUNTING PLATE WITH A LUMINAIRE MOUNTING BRACKET AT THE END OF EACH RUN OF FLUORESCENT LUMINAIRES (TYPES F1, F2 AND F3 TUNNEL).
- PROVIDE A CAST ALUMINUM CAP AT THE END OF EACH RUN OF FLUORESCENT LUMINAIRES AND WIREWAYS TO ENSURE AGAINST WATER INTRUSION, CONTRACTOR SHALL COORDINATE ACTUAL NUMBER REQUIRED.
- LUMINAIRES HID MOUNTED TO LESS THAN 8'-0" ON CENTER SHALL BE MOUNTED IN CONJUNCTION WITH A CONTINUOUS WIREWAY. WHEN TRANSITIONING FROM 5'-0" ON CENTER SPACING TO 8'-0" ON CENTER SPACING, BEGIN 8'-0" ON CENTER SPACING FROM THE NEXT JOINT BETWEEN CEILING SLABS. PROVIDE A MINIMUM OF 5'-0" (MAXIMUM OF 8'-0") BETWEEN MOUNTING METHODS. SEE SUBSET "TLD" TUNNEL LIGHTING DETAILS SHEET 11.
- THE LOCATIONS SHOWN ON THE TUNNEL LIGHTING PLANS AND DETAILS, DEPICTING BEGINNING AND ENDING OF MOUNTING CONDITIONS FOR THE TUNNEL LUMINAIRES ARE APPROXIMATE. CONTRACTOR TO VERIFY EXACT LOCATION, LAYOUT, MOUNTING CHANNEL, AND ANCHOR POINTS ACCORDINGLY.
- THE NOTATIONS FOR R1 (CONCRETE) PAVEMENT ARE FOR REFERENCE ONLY.
- ALL QUANTITIES SHOWN ON THE SHEETS NOTED BETWEEN STATIONS ARE APPROXIMATE. DUE TO THE FLEXIBLE NATURE OF THE TUNNEL LIGHTING SYSTEM DESIGN, LUMINAIRES MAY SHIFT TO ADJACENT CALLOUT AREAS. CONTRACTOR SHALL BE RESPONSIBLE FOR COORDINATING ALL CHANGES WHICH ARE REQUIRED.
- ACCESS HATCH SHOWN FOR REFERENCE. LUMINAIRES SHOULD BE COORDINATED SO AS NOT TO AFFECT ACCESS. ROUTE ALL CONDUIT AROUND HATCH IF REQUIRED.
- NOT USED
- REFER TO SUBSET TUN. POWER OF THE NORTH TUNNEL POWER PLANS FOR POWER REQUIREMENTS.
- NOTE TYPE A FLUORESCENT TUNNEL FIXTURES LOCATED IN TUNNEL CROSS PASSAGEWAY AREAS SHALL BE MOUNTED TO CROSS PASSAGEWAY CEILING AS SHOWN ON THE PLANS SO AS NOT TO INTERFERE WITH OTHER EQUIPMENT IN THE AREA. REFER TO FIXTURE SPECIFICATION FOR COMPLETE DESCRIPTION OF REQUIREMENTS.


LUMINAIRE LOCATION TABULATION - NORTH TUNNEL										
	LUMINAIRE LOCATION		QUANTITIES (UNIT EACH)							HID WIREWAY (UNIT LF)
	FROM	TO	F1	F2	F3	M1	M2	M3		
TH	135+98.6	138+02			25	39				200
	138+02	138+54			6		7			
TR1	138+54	139+50			12			6		
TR2	139+50	140+13			7					
	140+13	140+24	VMS BREAK (SEE NOTES 4 & 6)							
TR3	140+24	140+50			3					
	140+50	141+48			12					
A	141+48	144+55			37					
	144+55	144+65	PULPIT BREAK (SEE NOTES 5 & 6)							
INT	144+65	148+29			44					
	148+29	148+41	VMS BREAK (SEE NOTES 4 & 6)							
SOUTH WALL	148+41	156+34			96					
	156+34	156+43	VMS BREAK (SEE NOTES 4 & 6)							
INT	156+43	159+45			37					
	159+45	164+36			59					
SOUTH WALL	164+36	164+45	VMS BREAK (SEE NOTES 4 & 6)							
	164+45	168+66.5			51					
INT	168+66.5	168+75	PULPIT BREAK (SEE NOTES 5 & 6)							
	168+75	172+39			44					
SOUTH WALL	172+39	172+48	VMS BREAK (SEE NOTES 4 & 6)							
	172+48	179+62			87					
INT	179+62	180+33			8					
	180+33	180+42	VMS BREAK (SEE NOTES 4 & 6)							
SOUTH WALL	180+42	188+52.4			98					
	188+52.4	188+62.5	VMS BREAK (SEE NOTES 4 & 6)							
INT	188+62.5	192+76			50					
	192+76	192+87.5	PULPIT BREAK (SEE NOTES 5 & 6)							
SOUTH WALL	192+87.5	196+51			44					
	196+51	196+62	VMS BREAK (SEE NOTES 4 & 6)							
INT	196+62	201+75			62					
	201+75	204+55			34					
SOUTH WALL	204+55	204+67	VMS BREAK (SEE NOTES 4 & 6)							
	204+67	212+60			96					
INT	212+60	212+72	VMS BREAK (SEE NOTES 4 & 6)							
	212+72	213+26			7					
SOUTH WALL	213+26	215+58			28					
	215+58	217+64			25			12		
INT	217+64	218+18			6		4			
	218+18	218+25	PULPIT BREAK (SEE NOTES 5 & 6)							
SOUTH WALL	218+25	219+70			17		22			60
	219+70	225+23			68		201			550
TOTALS			894	35	134	240	33	18		810

NOTE: LUMINAIRE LOCATION TABULATION TOTALS DO NOT INCLUDE FURNISH ONLY ITEM AMOUNTS.

RECOMMENDED EXPANSION JOINTS SPACING FOR LUMINAIRE FLUORESCENT				
TEMPERATURE AT TIME OF CONSTRUCTION (DEGREES F)	NUMBER OF LUMINAIRE FLUORESCENT BETWEEN EXPANSION JOINTS			
	5	10	15	20
MINIMUM EXPANSION JOINT IN INCHES				
30 - 40	.5"	1"	1.5"	2"
45 - 60	.375"	.75"	1.25"	1.5"
65 - 80	.25"	.5"	.75"	1"
85 - 100	.125"	.25"	.375"	.5"

NOTE: IF THE NUMBER OF LUMINAIRES ON BOTH SIDES OF AN EXPANSION JOINT ARE DIFFERENT, THE AVERAGE EXPANSION JOINT WIDTH MAY BE USED.

LEGEND

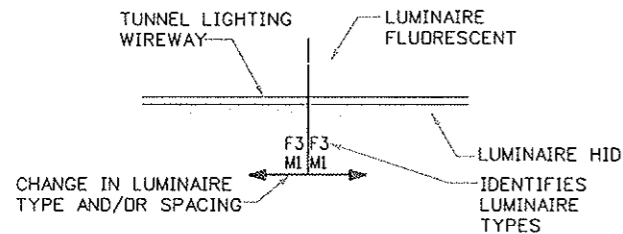

QUANTITIES - NORTH TUNNEL LIGHTING PROJECT

ITEM NUMBER	DESCRIPTION	UNIT	ROADWAY	
			PLAN	AS CONST.
CONSTRUCTION				
613	LUMINAIRE FLUORESCENT (TYPE F1 TUNNEL)	EA	1798	
613	LUMINAIRE FLUORESCENT (TYPE F2 TUNNEL)	EA	72	
613	LUMINAIRE FLUORESCENT (TYPE F3 TUNNEL)	EA	268	
613	LUMINAIRE FLUORESCENT (TYPE A TUNNEL)	EA	39	
613	WIREWAY	LF	1620	
613	HID LUMINAIRE MOUNTING SUPPORT SYSTEM	LS	1	
613	HID FIXTURES (TYPE M1 TUNNEL LUMINAIRE)	EA	479	
613	HID FIXTURES (TYPE M2 TUNNEL LUMINAIRE)	EA	66	
613	HID FIXTURES (TYPE M3 TUNNEL LUMINAIRE)	EA	36	
613	LUMINAIRE FLUORESCENT (TYPE F1 TUNNEL)(FURNISH ONLY)	EA	20	
613	LUMINAIRE FLUORESCENT (TYPE F2 TUNNEL)(FURNISH ONLY)	EA	5	
613	LUMINAIRE FLUORESCENT (TYPE F3 TUNNEL)(FURNISH ONLY)	EA	5	
613	HID FIXTURES (TYPE M1 TUNNEL LUMINAIRE) (FURNISH ONLY)	EA	19	
613	LENS ASSEMBLIES (FURNISH ONLY)	EA	50	


LUMINAIRE LOCATION TABULATION - NORTH TUNNEL

	LUMINAIRE LOCATION		QUANTITIES (UNIT EACH)							HID WIREWAY (UNIT LF)
	FROM	TO	F1	F2	F3	M1	M2	M3		
TH	135+99	138+02			25	39				200
	138+02	138+54			6		7			
TR1	138+54	139+50			12			6		
TR2	139+50	140+50			12					
	140+50	141+49			12					
TR3	141+49	156+38			180					
	156+38	156+51	PULPIT BREAK (SEE NOTES 5 & 6)							
INT	156+51	159+48			36					
	159+48	179+62			244					
SOUTH WALL	179+62	180+55			11					
	180+55	180+70	PULPIT BREAK (SEE NOTES 5 & 6)							
INT	180+70	201+75			255					
	201+75	206+13			53					
SOUTH WALL	206+13	206+27	PULPIT BREAK (SEE NOTES 5 & 6)							
	206+27	213+29			85					
TR3	213+29	215+61			28					
	215+61	217+67			25			12		
TR2	217+67	219+73			24		26			60
	219+73	225+24			67		200			550
TOTALS			904	37	134	239	33	18		810


NOTE: LUMINAIRE LOCATION TABULATION TOTALS DO NOT INCLUDE FURNISH ONLY ITEM AMOUNTS.

Design File Name: DONSPEC* Plot File Name: SLDIFILE* Date of Plot: 03/03/07

Computer File Information Creation Date: 01/26/07 Initials: DJB Last Modification Date: 01/26/07 Initials: DJB Full Path: 14102\800deliv\AsBuilt Drawing File Name: lltx02 Acad Ver: R14 Scale: NTS Units: English		Sheet Revisions 07/03/07 ASBUILT DJB		Colorado Department of Transportation P.O. BOX 399 DUMONT, CO. 80436 Phone: 303-512-5750 FAX: 303-512-5775 Region 1 Mountain Residency I.N.Z.		As Constructed No Revisions: Revised: Void:		NORTH TUNNEL LIGHTING NOTES Designer: J. KROLL Detailer: D. BURROUGHS Sheet Subst: TUN. LTG. Subst Sheets: 1 of 20		Project No./Code IM 0703-269 13166 Sheet Number 25	
--	--	--	--	--	--	---	--	--	--	--	--

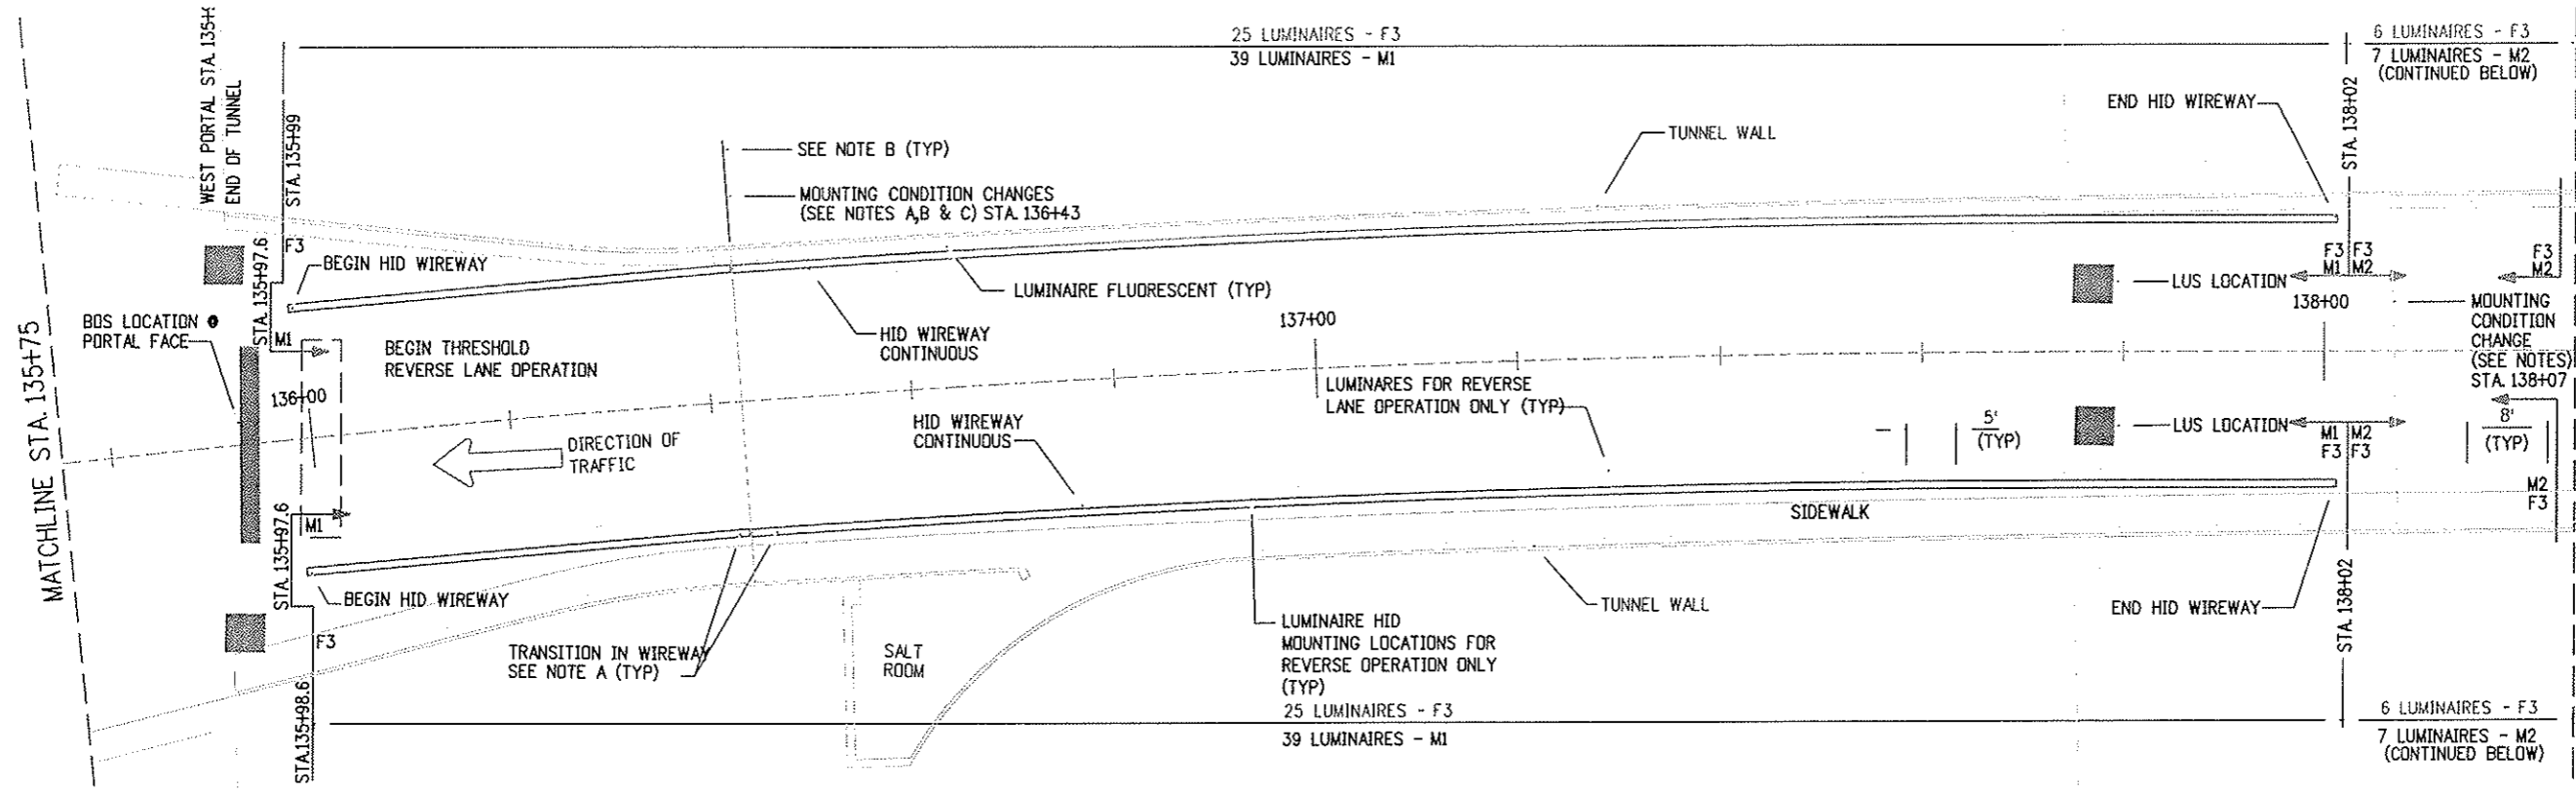

PLAN 1

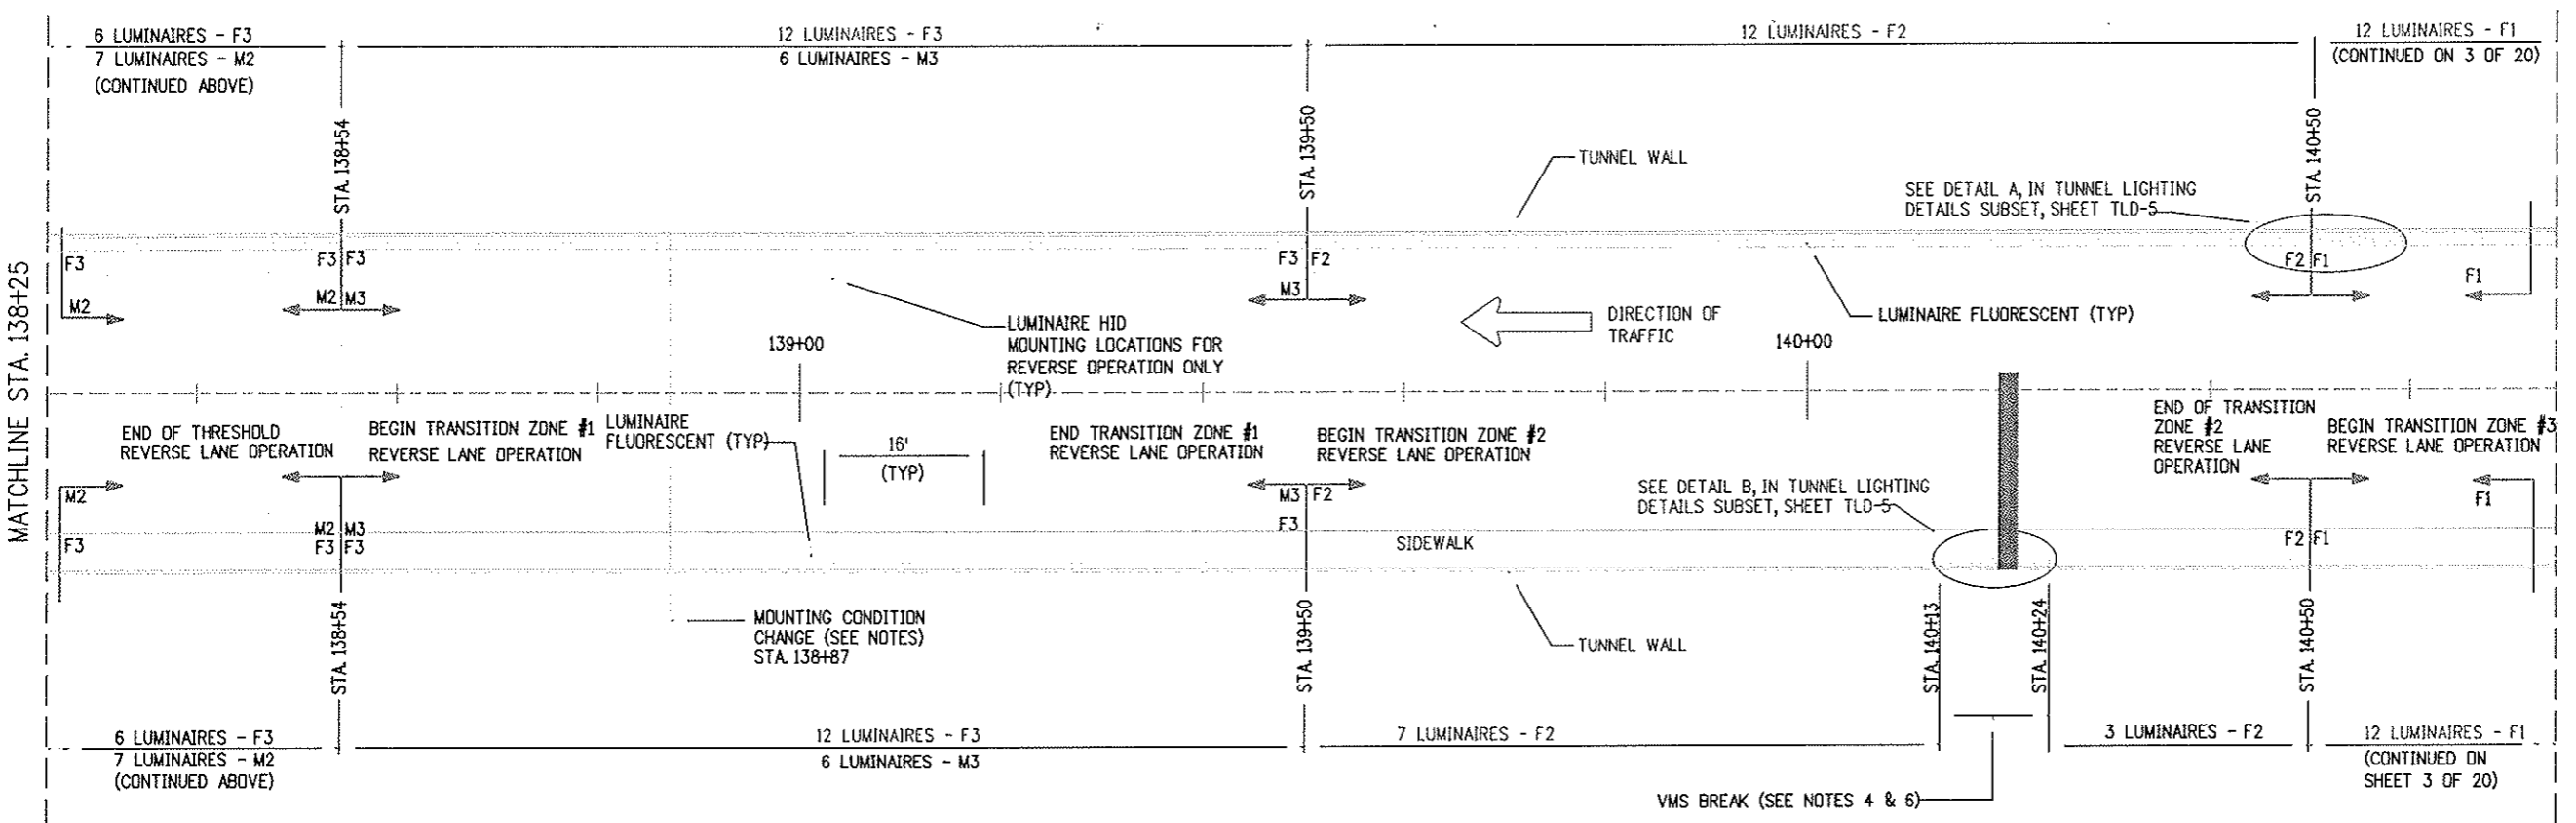


PLAN 2

- NOTES:
- A. AN ABRUPT CHANGE IN CEILING ANGLE OCCURS AT STA 136+43.1. CONTRACTOR SHALL COORDINATE TRANSITION TO MAINTAIN CONTINUANCE OF WIREWAY.
 - B. CONTRACTOR SHALL MAINTAIN CONTINUANCE OF FLUORESCENT LUMINAIRES THROUGH TRANSITION IN TUNNEL CEILING AT STA 136+43.
 - C. ROADWAY AT P.G. TO CEILING DISTANCE TAPERS FROM 20'-0" AT STA 135+91.1 TO 16'-4" AT STA 136+43.1. AT WHICH POINT DISTANCE IS RELATIVELY CONSTANT.

Computer File Information	
Creation Date:	02/26/99 Initials: DJB
Last Modification Date:	02/21/07 Initials: DJB
Full Path:	14102\800Deliv\AsBuilt
Drawing File Name:	ltp101n
Acad Ver.	R14 Scale: 1" = 10'-0" Units: English

Sheet Revisions	
07/03/07	ASBUILT DJB

Colorado Department of Transportation




P.O. BOX 399
DUMONT, CO. 80436
Phone: 303-512-5750 FAX: 303-512-5775
Region 1 Mountain Residency I.N.Z.


As Constructed
No Revisions:
Revised:
Void:

NORTH TUNNEL LIGHTING PLANS	
Designer:	D. BURROUGHS
Detoiler:	D. BURROUGHS
Sheet Subset:	TUN. LTG.
Structure Numbers:	
Subset Sheets:	2 of 20

Project No./Code	
IM 0703-269	
13166	
Sheet Number	26

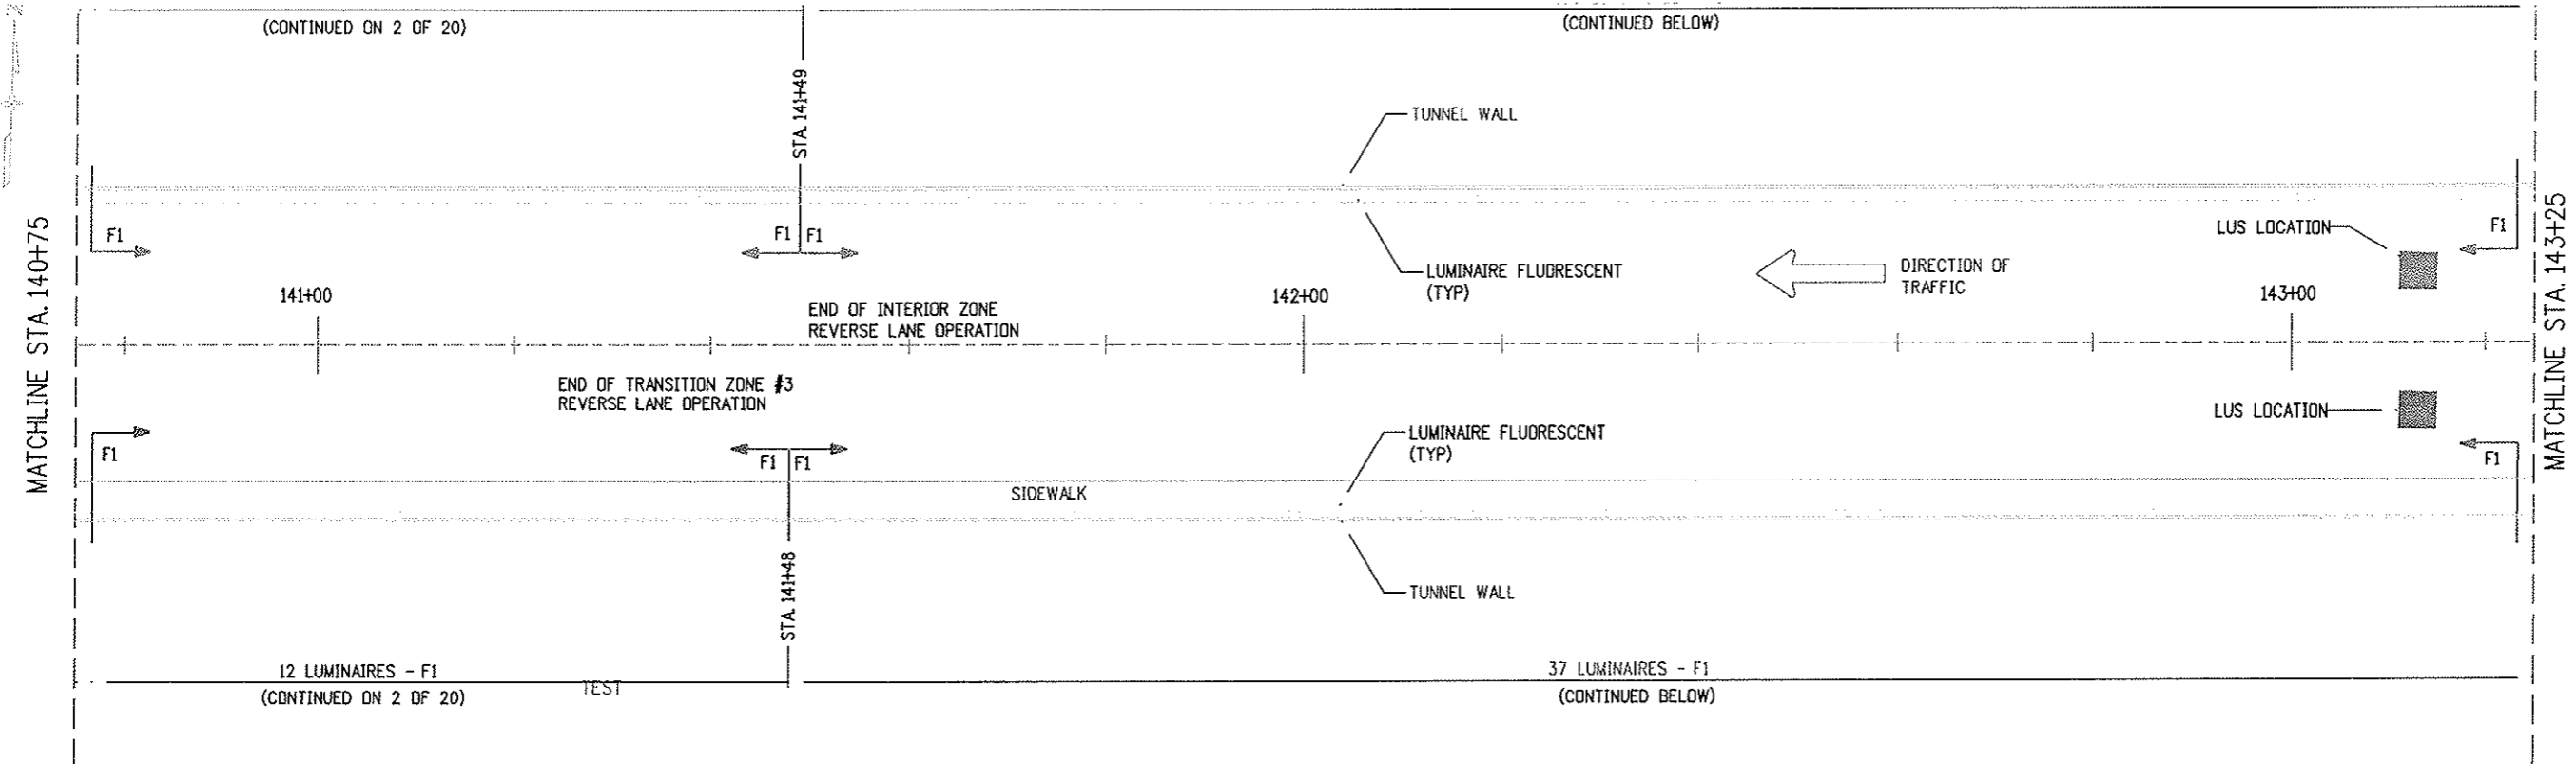

PLAN 1

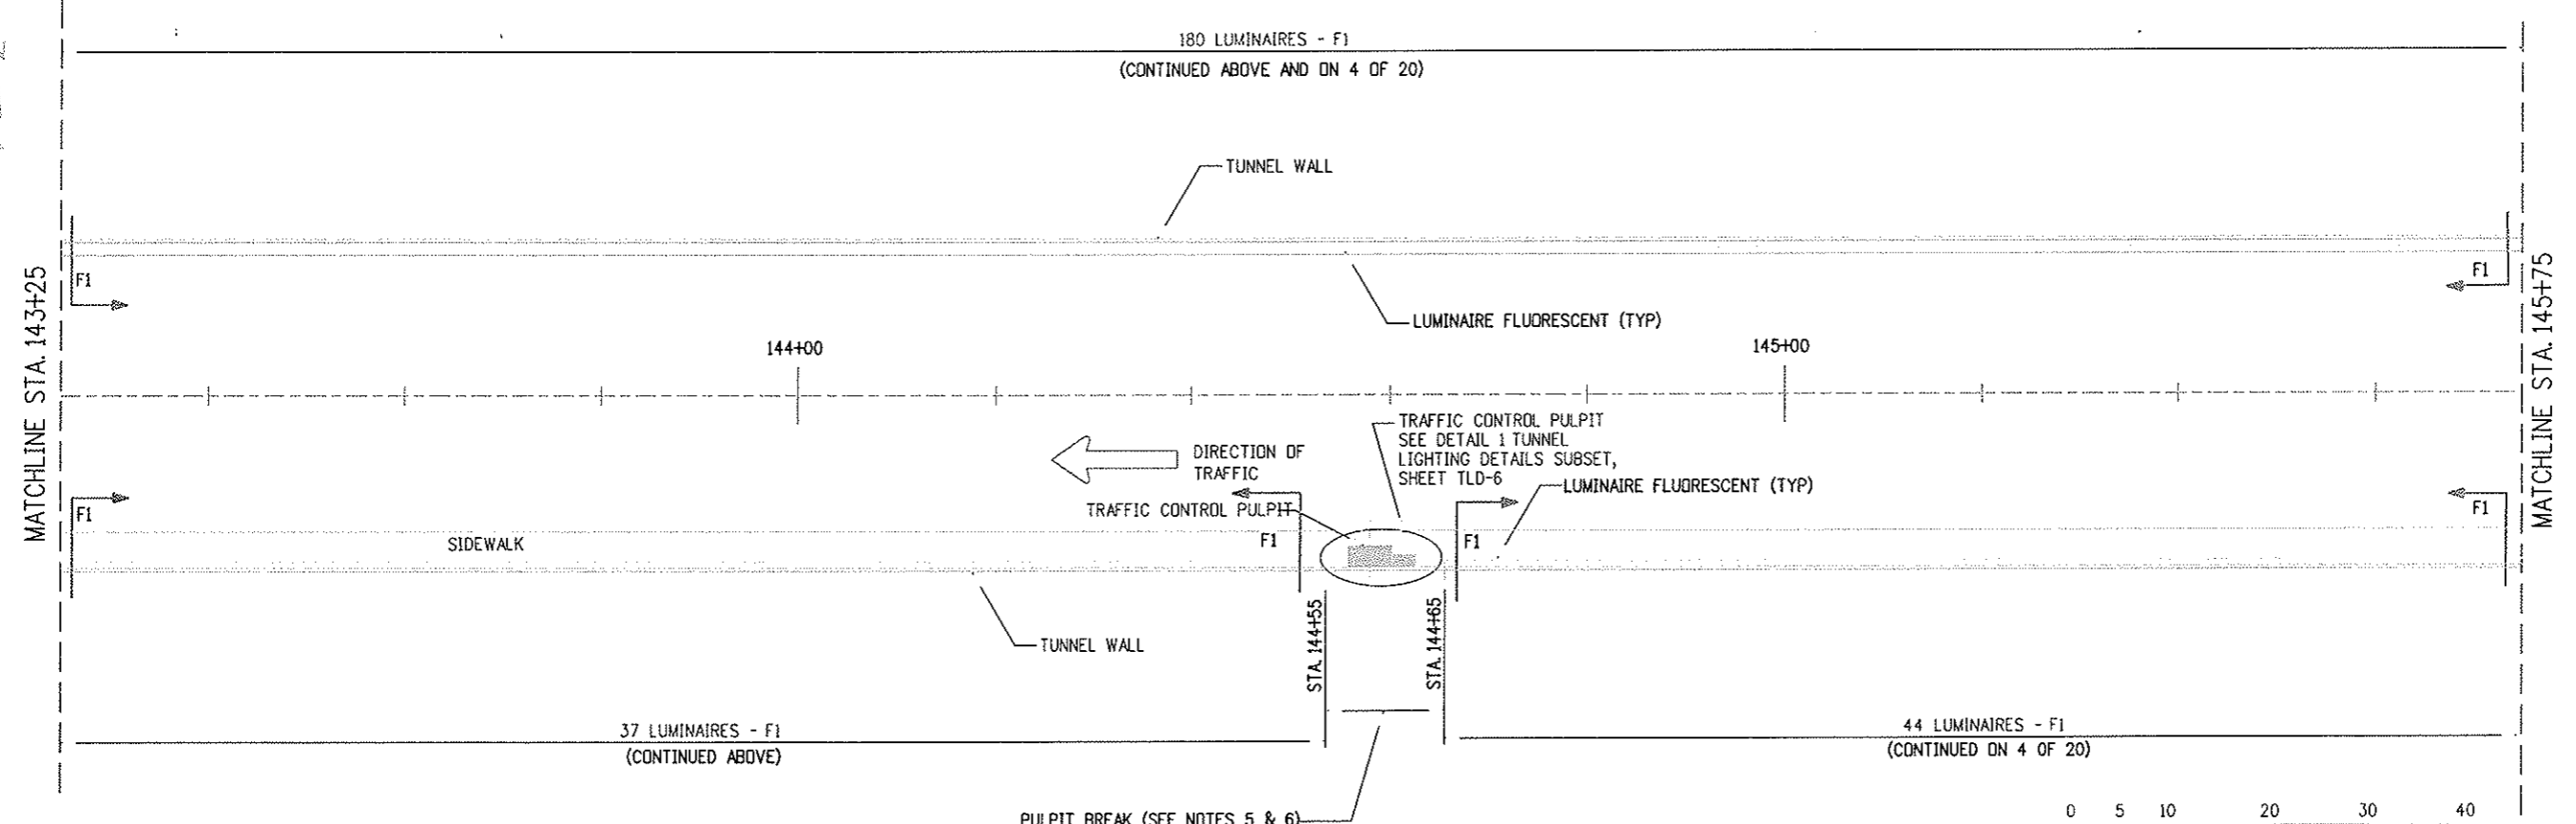


PLAN 2

Computer File Information	
Creation Date:	02/26/99 Initials: DJB
Last Modification Date:	11/20/00 Initials: DJB
Full Path:	14102\700CADD\703ELEC\
Drawing File Name:	ltpl02n.dwg
Acad Ver.	R14 Scale: 1" = 10'-0" Units: Feet

Sheet Revisions	
07/03/07	ASBUILT DJB

Colorado Department of Transportation




P.O. BOX 399
DUMONT, CO. 80436
Phone: 303-512-5750 FAX: 303-512-5775

Region 1 Mountain Residency I.N.Z.


As Constructed	
No Revisions:	
Revised:	
Void:	

NORTH TUNNEL LIGHTING PLANS			
Designer:	D. BURROUGHS	Structure Numbers	
Detailer:	D. BURROUGHS		
Sheet Subset:	TUN. LTG.	Subset Sheets:	3 of 20

Project No./Code	
IM	0703-269
	13166
Sheet Number	27

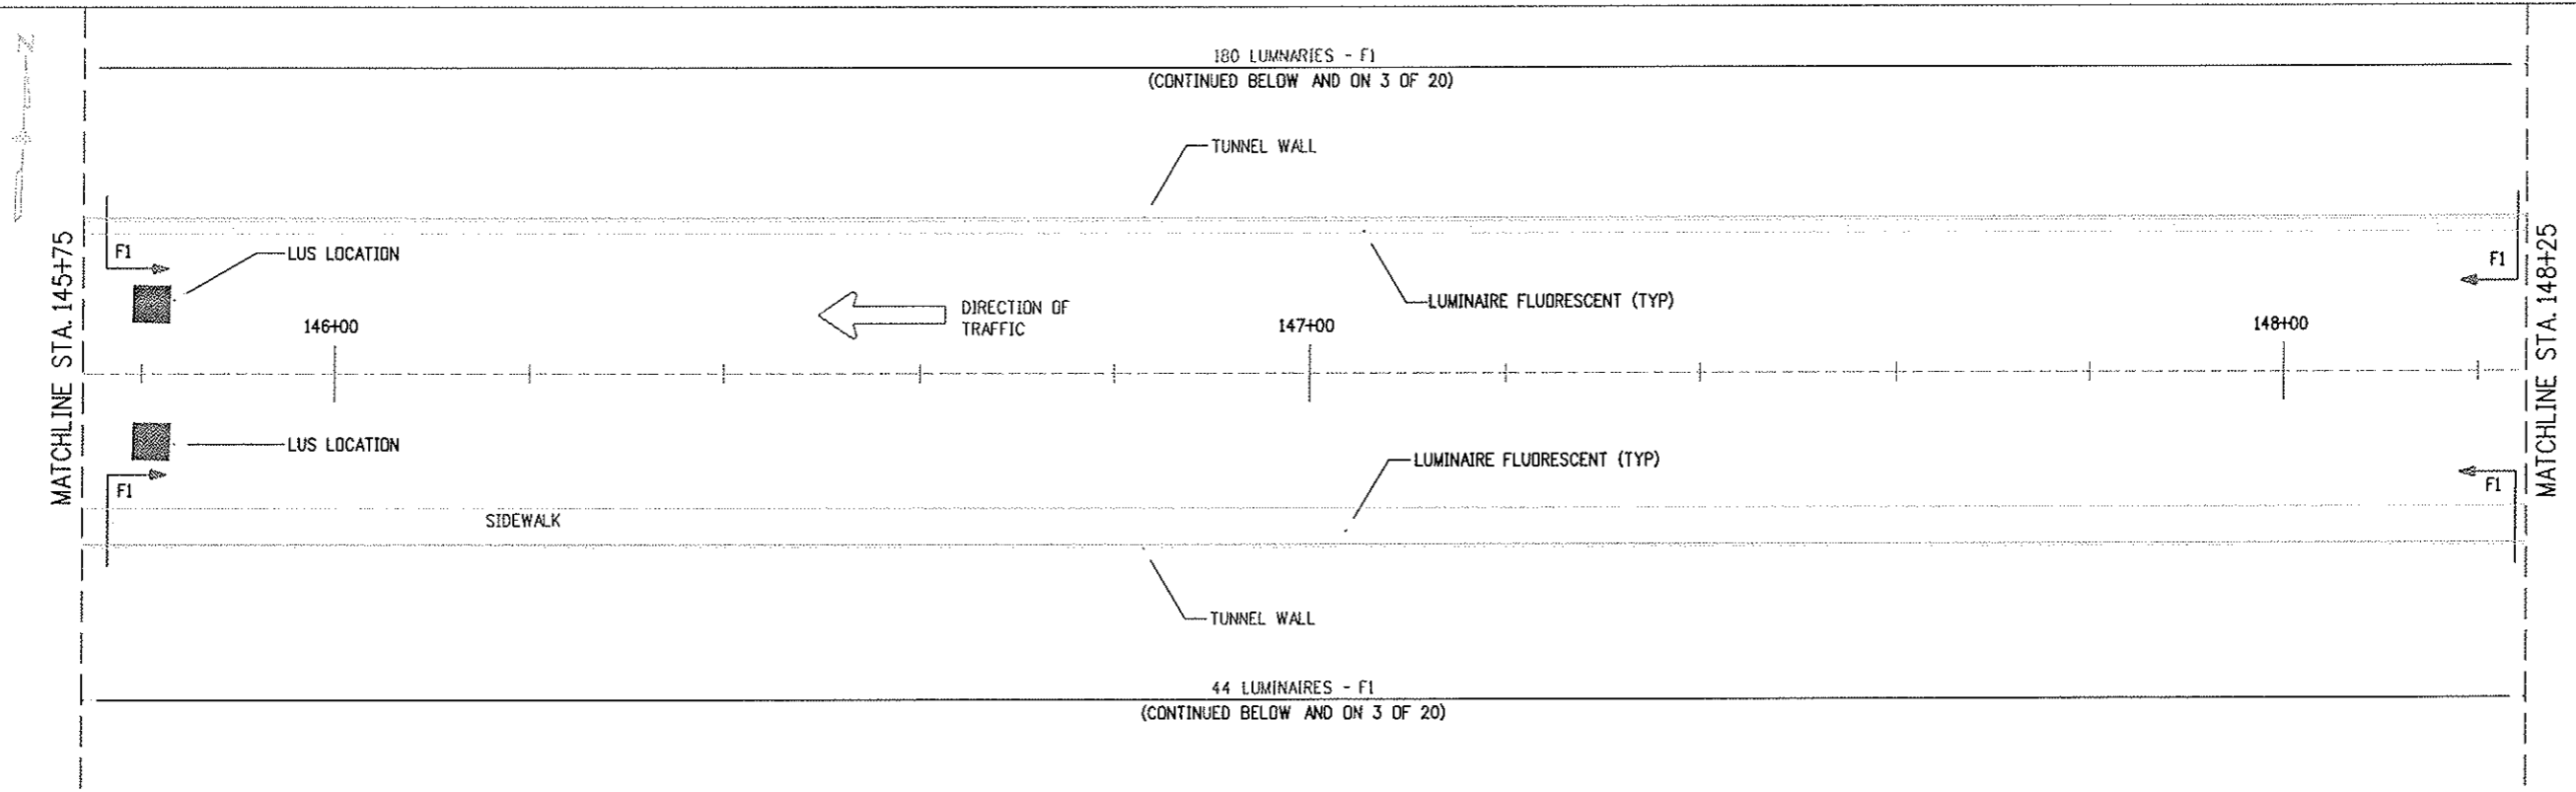

PLAN 1

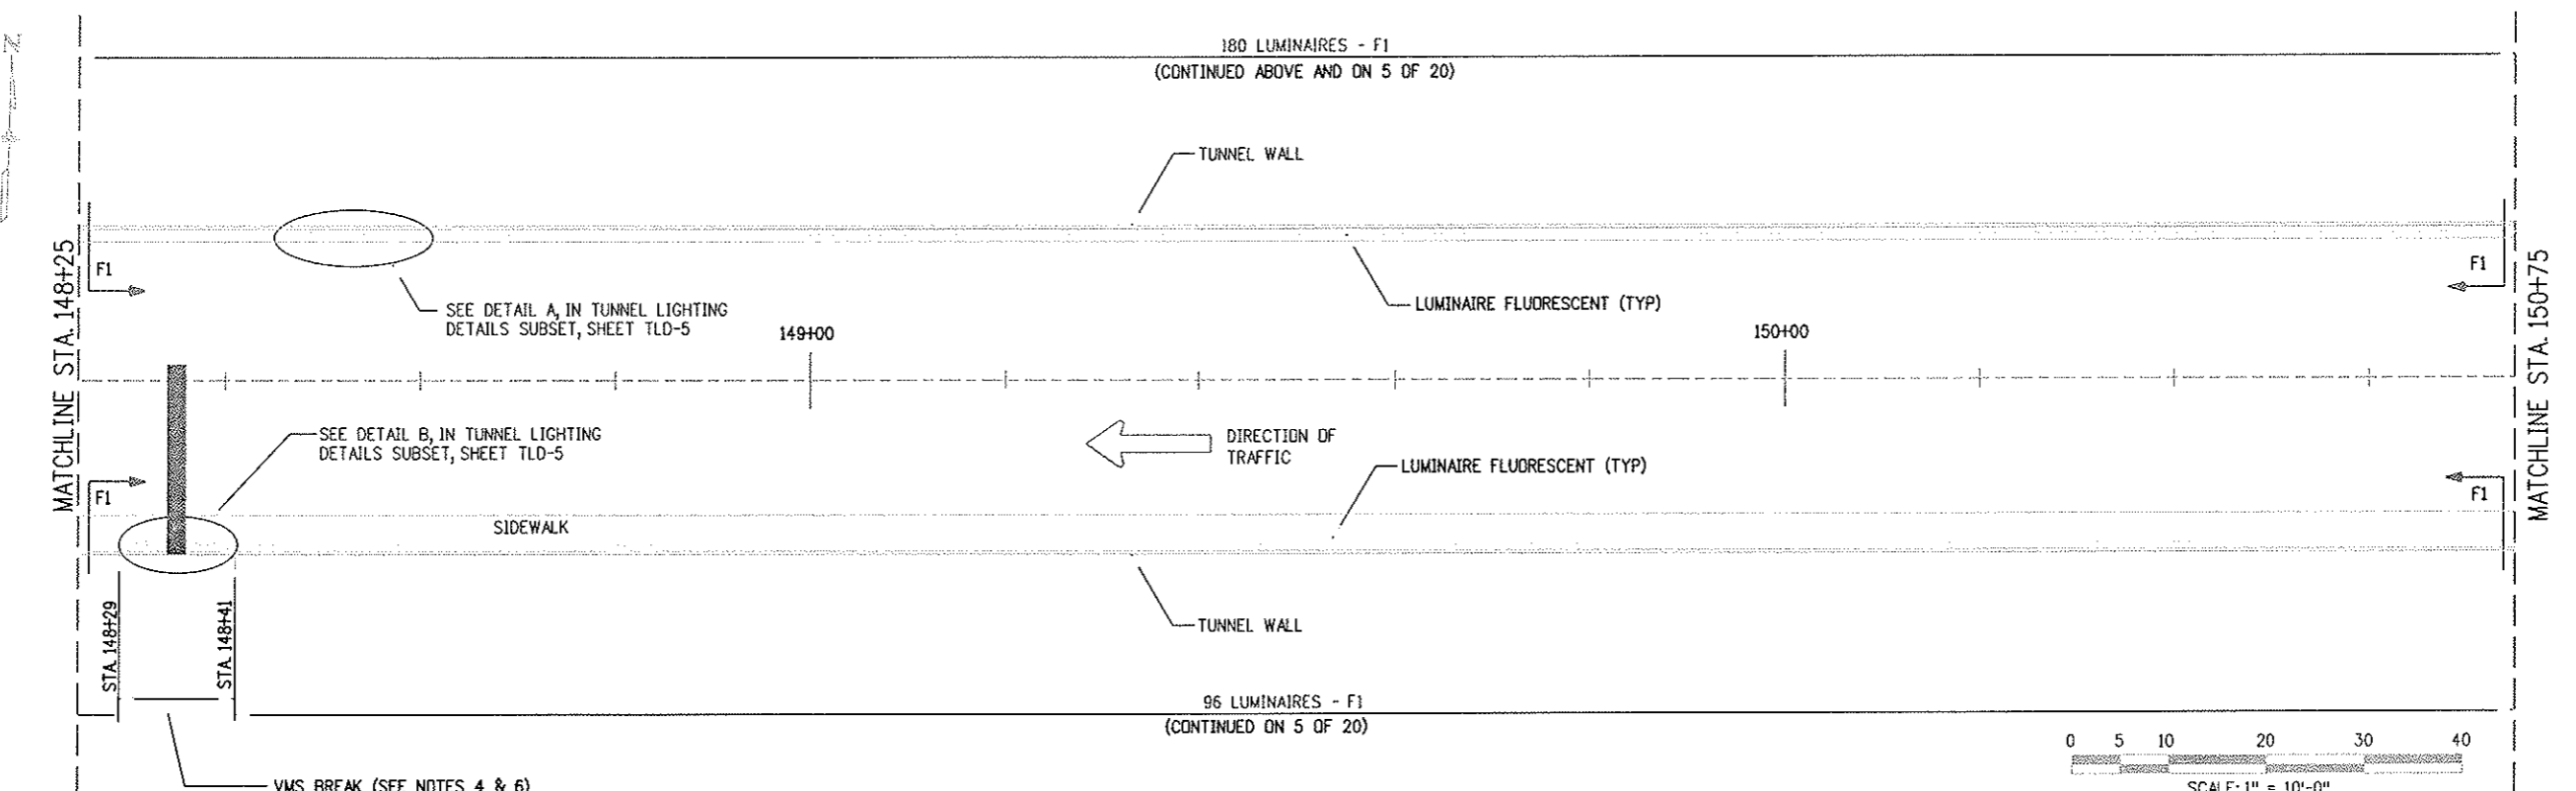


PLAN 2

Design File Name: DGNRSPEC
 Plot File Name: 94LDTFILE
 Date of Plot: 3/30/2007 10:33:33

Computer File Information	
Creation Date:	02/26/99 Initials: DJB
Last Modification Date:	02/26/01 Initials: DJB
Full Path:	14102\700CADD\703elec\
Drawing File Name:	ltpl03n.dwg
Acad Ver.:	R14 Scale: 1" = 10'-0" Units: English

Sheet Revisions	
<input type="checkbox"/>	07/03/07 ASBUILT DJB
<input type="checkbox"/>	
<input type="checkbox"/>	
<input type="checkbox"/>	

Colorado Department of Transportation




P.O. BOX 399
 DUMONT, CO. 80436
 Phone: 303-512-5750 FAX: 303-512-5775

Region 1 Mountain Residency I.N.Z.


As Constructed
No Revisions:
Revised:
Void:

NORTH TUNNEL LIGHTING PLANS	
Designer:	D. BURROUGHS
Detailer:	D. BURROUGHS
Sheet Subset:	TUN. LTG.
Structure Numbers:	
Subset Sheets:	4 of 20


Project No./Code
IM 0703-269
13166
Sheet Number 28

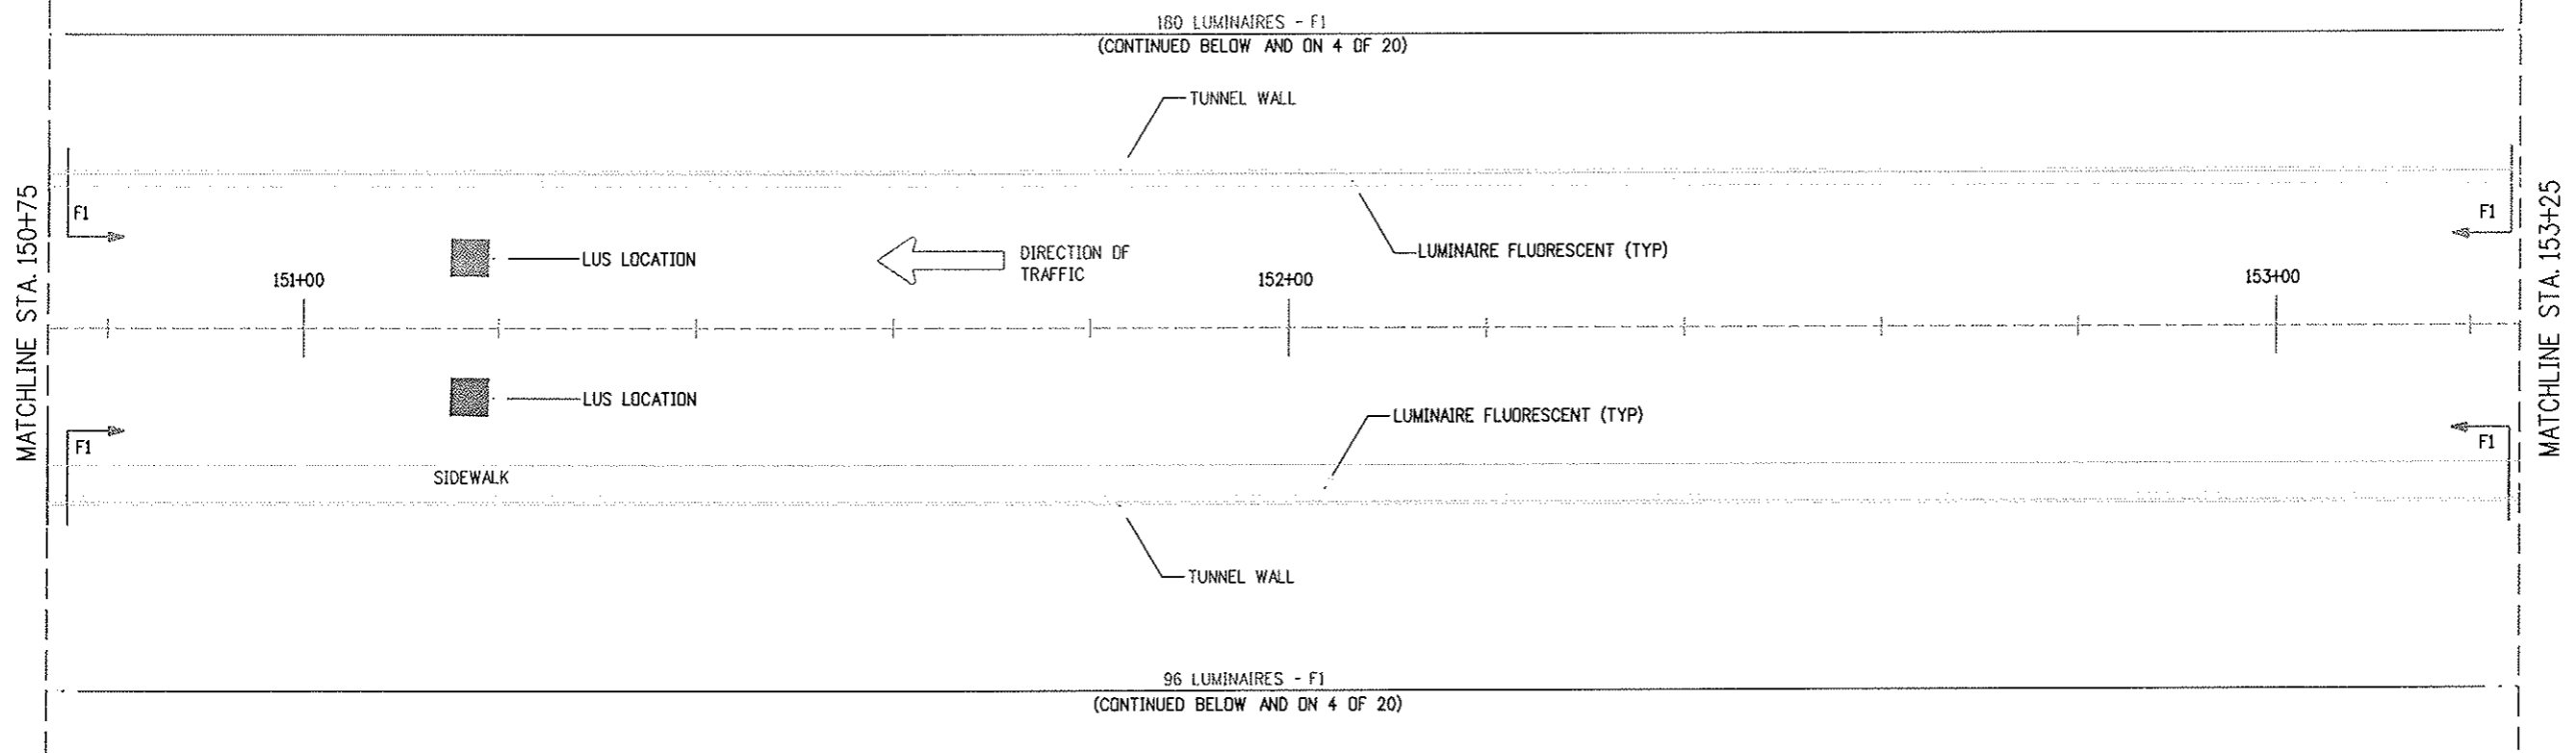


PLAN1

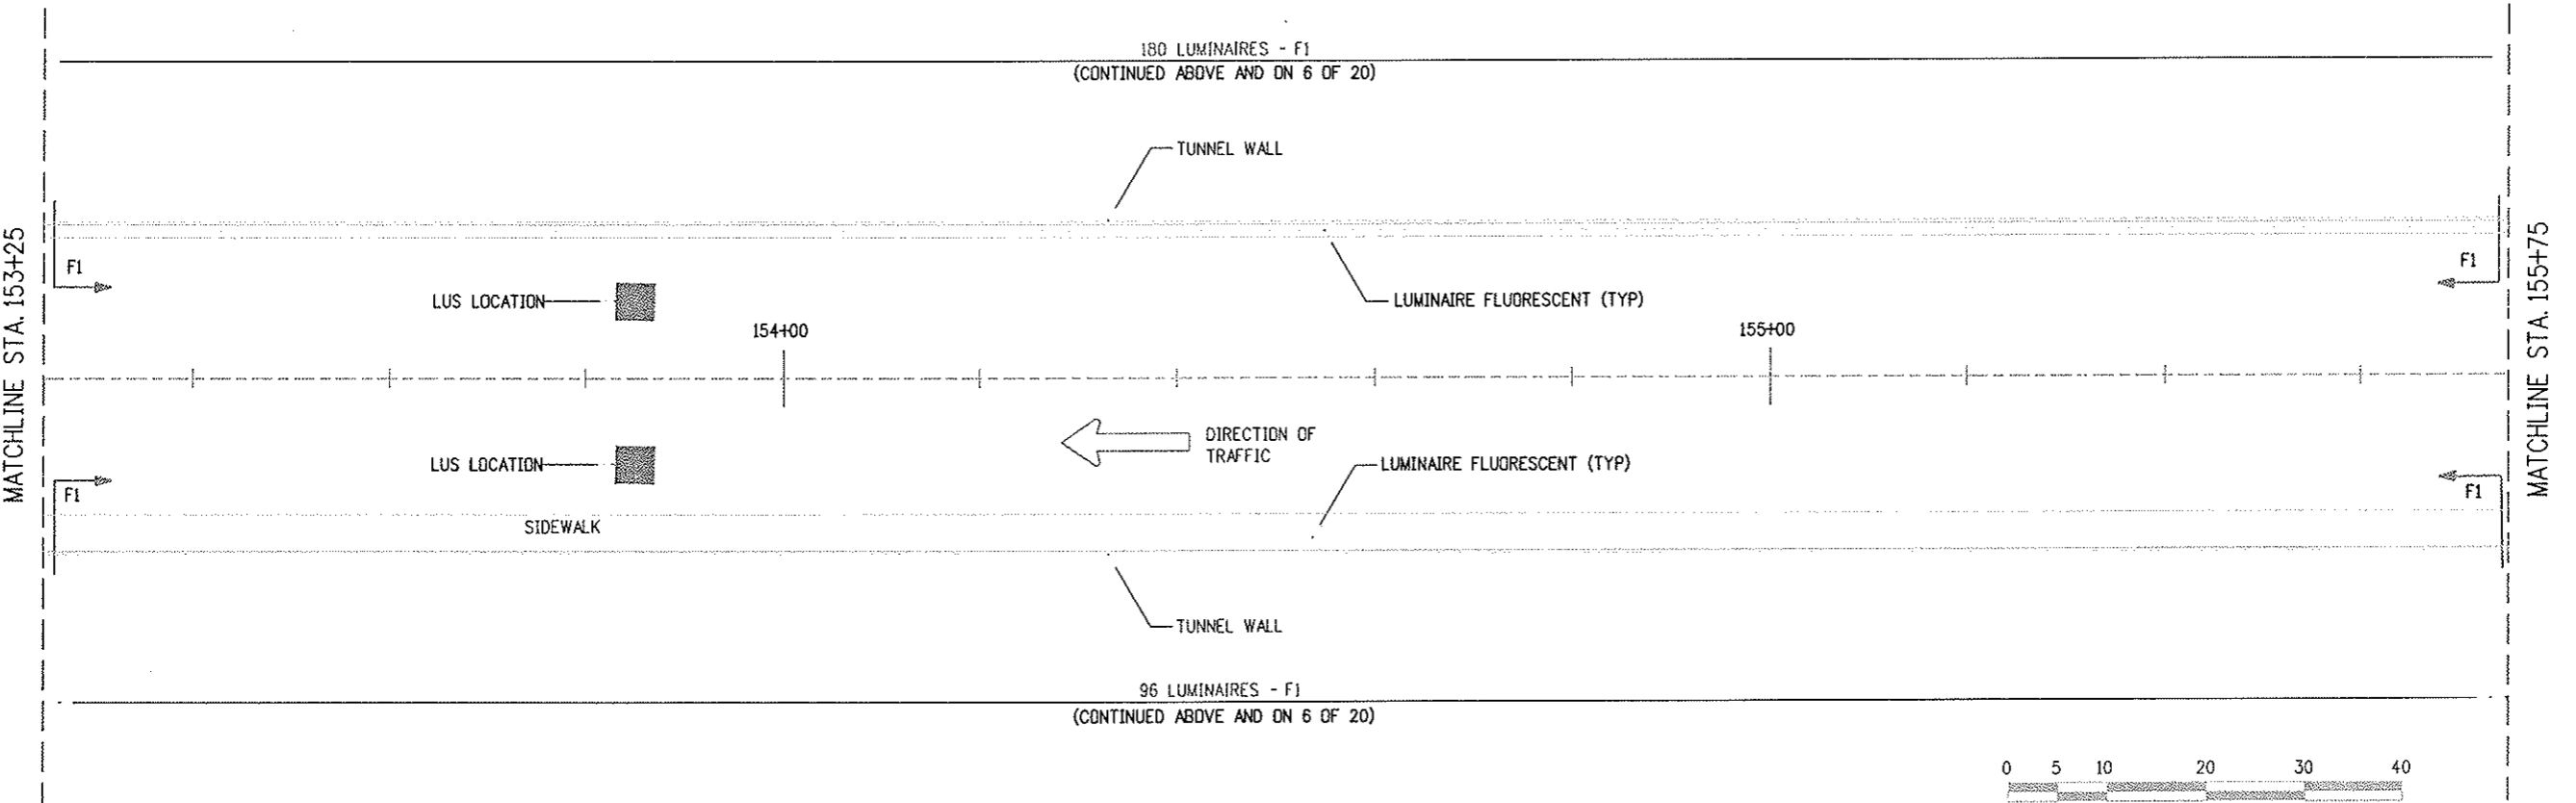


PLAN2

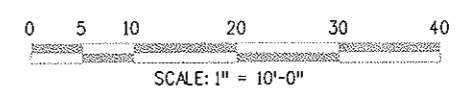


Computer File Information		Sheet Revisions		Colorado Department of Transportation		As Constructed		NORTH TUNNEL LIGHTING PLANS		Project No./Code		
Creation Date:	02/26/99	Initials:	DJB	07/03/07	ASBUILT	DJB	No Revisions:	IM 0703-269		13166		
Last Modification Date:	11/20/00	Initials:	DJB				Revised:	Designer:	D. BURROUGHS	Structure		
Full Path:	14102\700CADD\703elec\						Void:	Detailer:	D. BURROUGHS	Numbers		
Drawing File Name:	ltpl04n.dwg							Sheet Subset:	TUN. LTG.	Subset Sheets:	5 of 20	
Acad Ver.	R14	Scale:	1" = 10'-0"	Units:	English						Sheet Number	29



 P.O. BOX 399
 DUMONT, CO. 80436
 Phone: 303-512-5750 FAX: 303-512-5775
 Region 1 Mountain Residency I.N.Z.

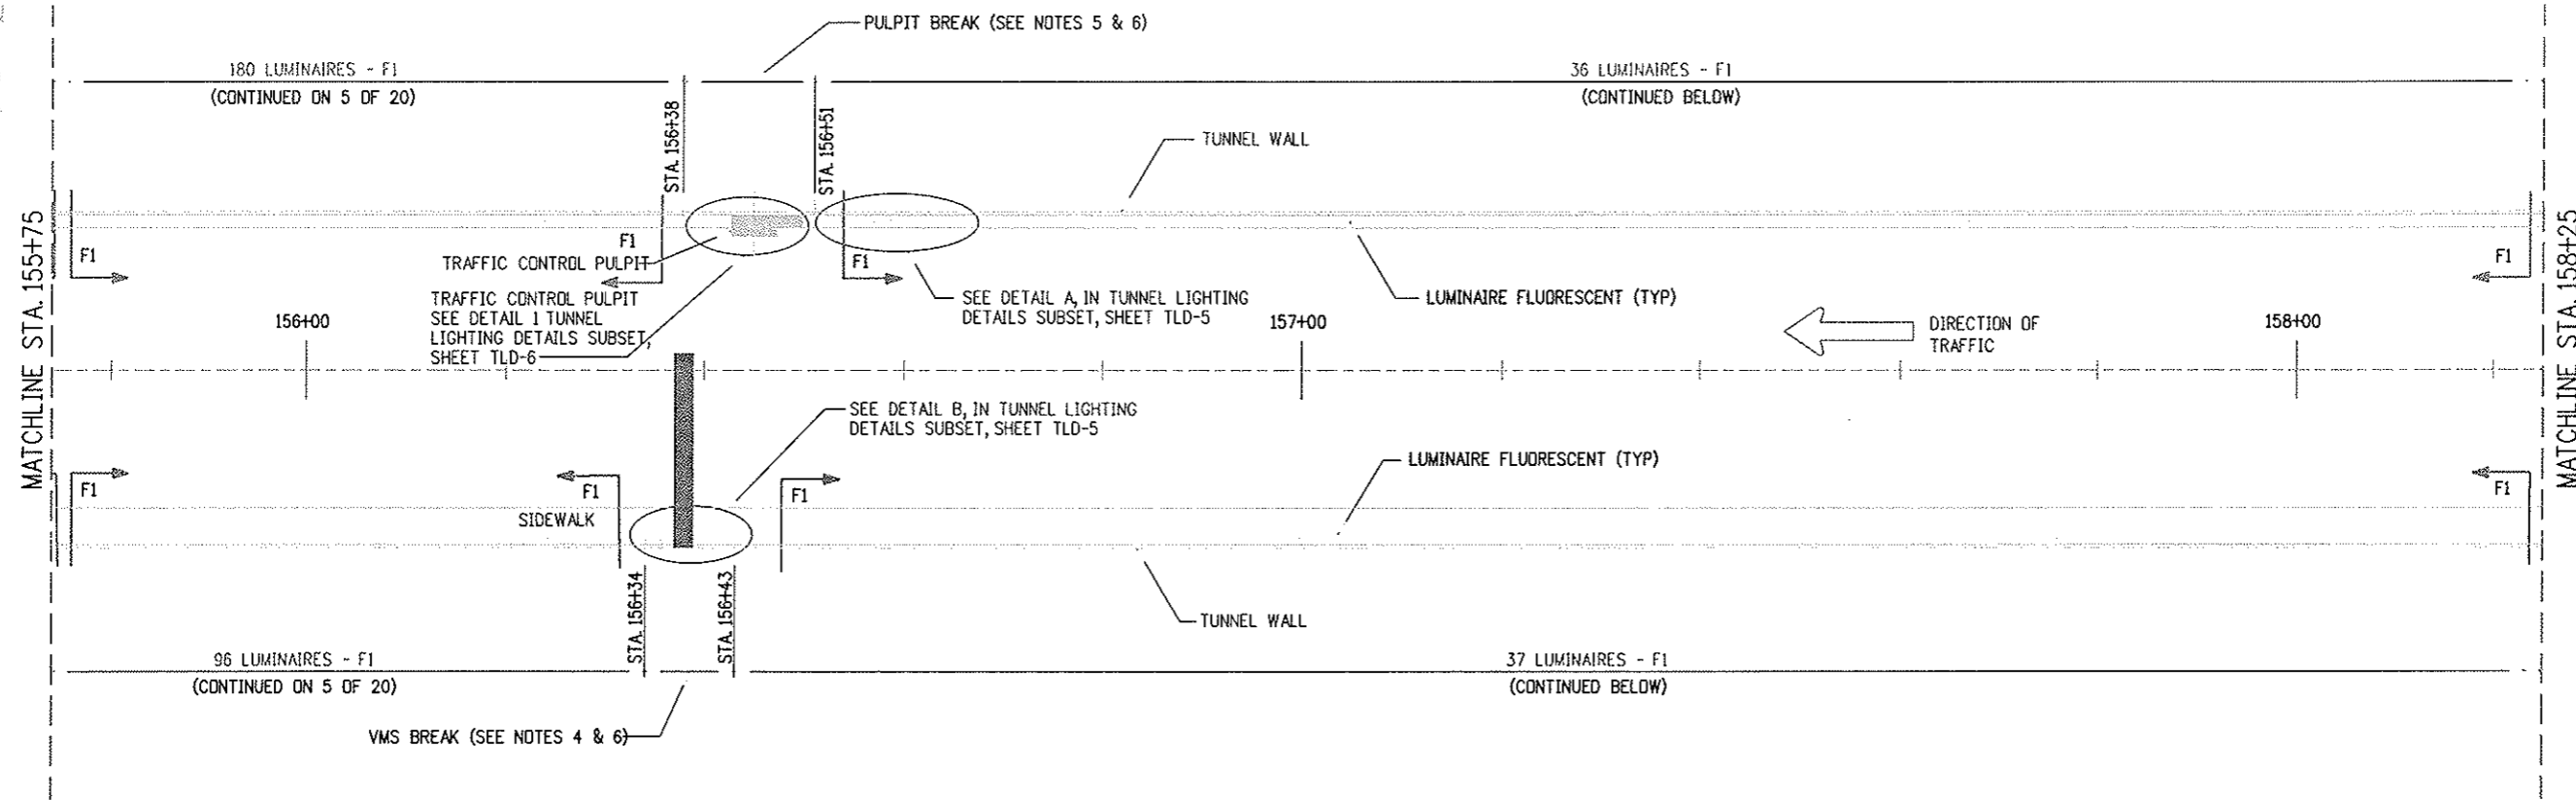

PLAN 1

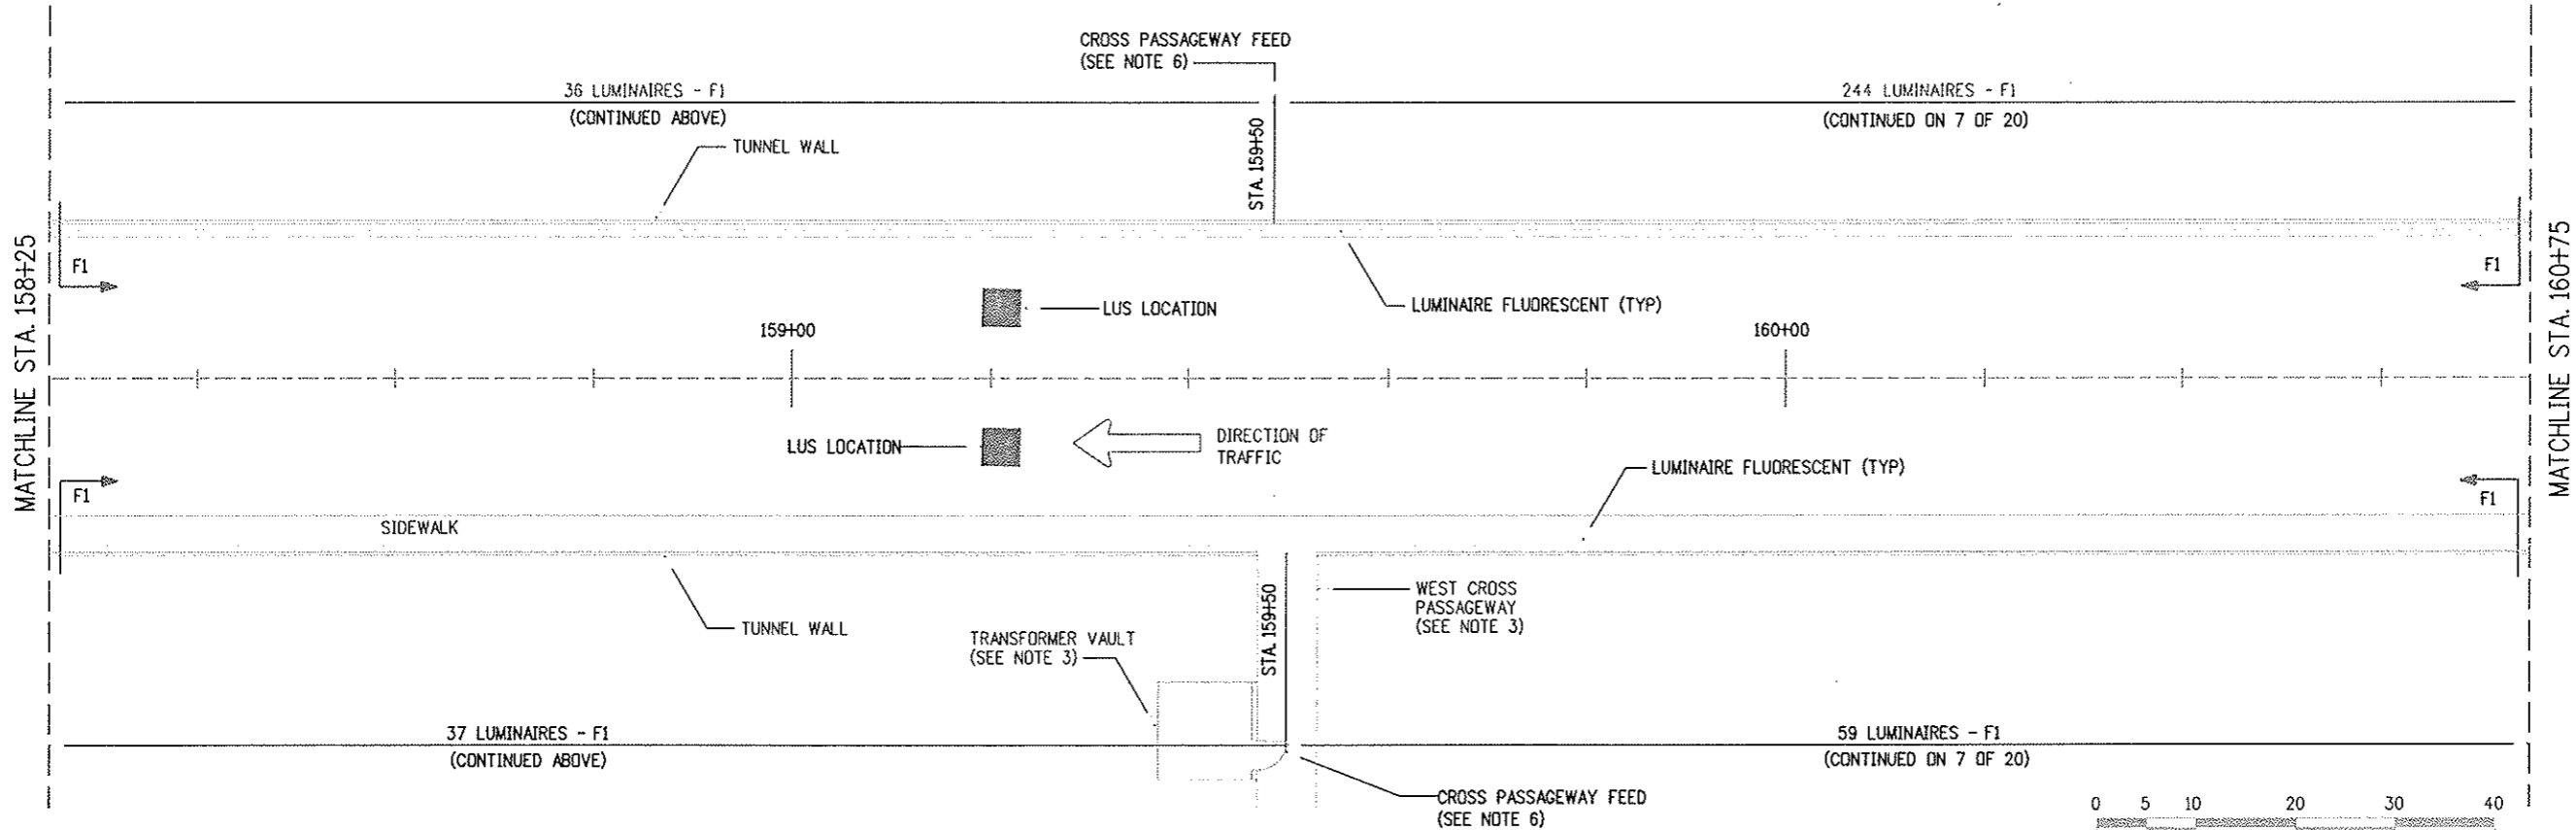


PLAN 2

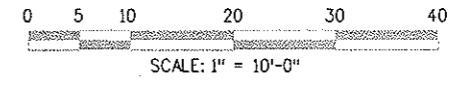

Plot File Name: \$PLOTFILE*
Date of Plot: \$\$\$DATE\$\$\$\$

Computer File Information	
Creation Date:	02/26/99 Initials: DJB
Last Modification Date:	02/26/01 Initials: DJB
Full Path:	14102\700CADD\703elec\
Drawing File Name:	ltpl05n.dwg
Acad Ver.	R14 Scale: 1" = 10'-0" Units: English


Sheet Revisions	
07/03/07	ASBUILT DJB

Colorado Department of Transportation
 P.O. BOX 399
 DUMONT, CO. 80436
 Phone: 303-512-5750 FAX: 303-512-5775
 Region 1 Mountain Residency I.N.Z.


As Constructed
No Revisions:
Revised:
Void:

NORTH TUNNEL LIGHTING PLANS		
Designer:	D. BURROUGHS	Structure Numbers
Detailer:	D. BURROUGHS	
Sheet Subset:	TUN. LTG.	Subset Sheets: 6 of 20

Project No./Code
IM 0703-269
13166
Sheet Number 30

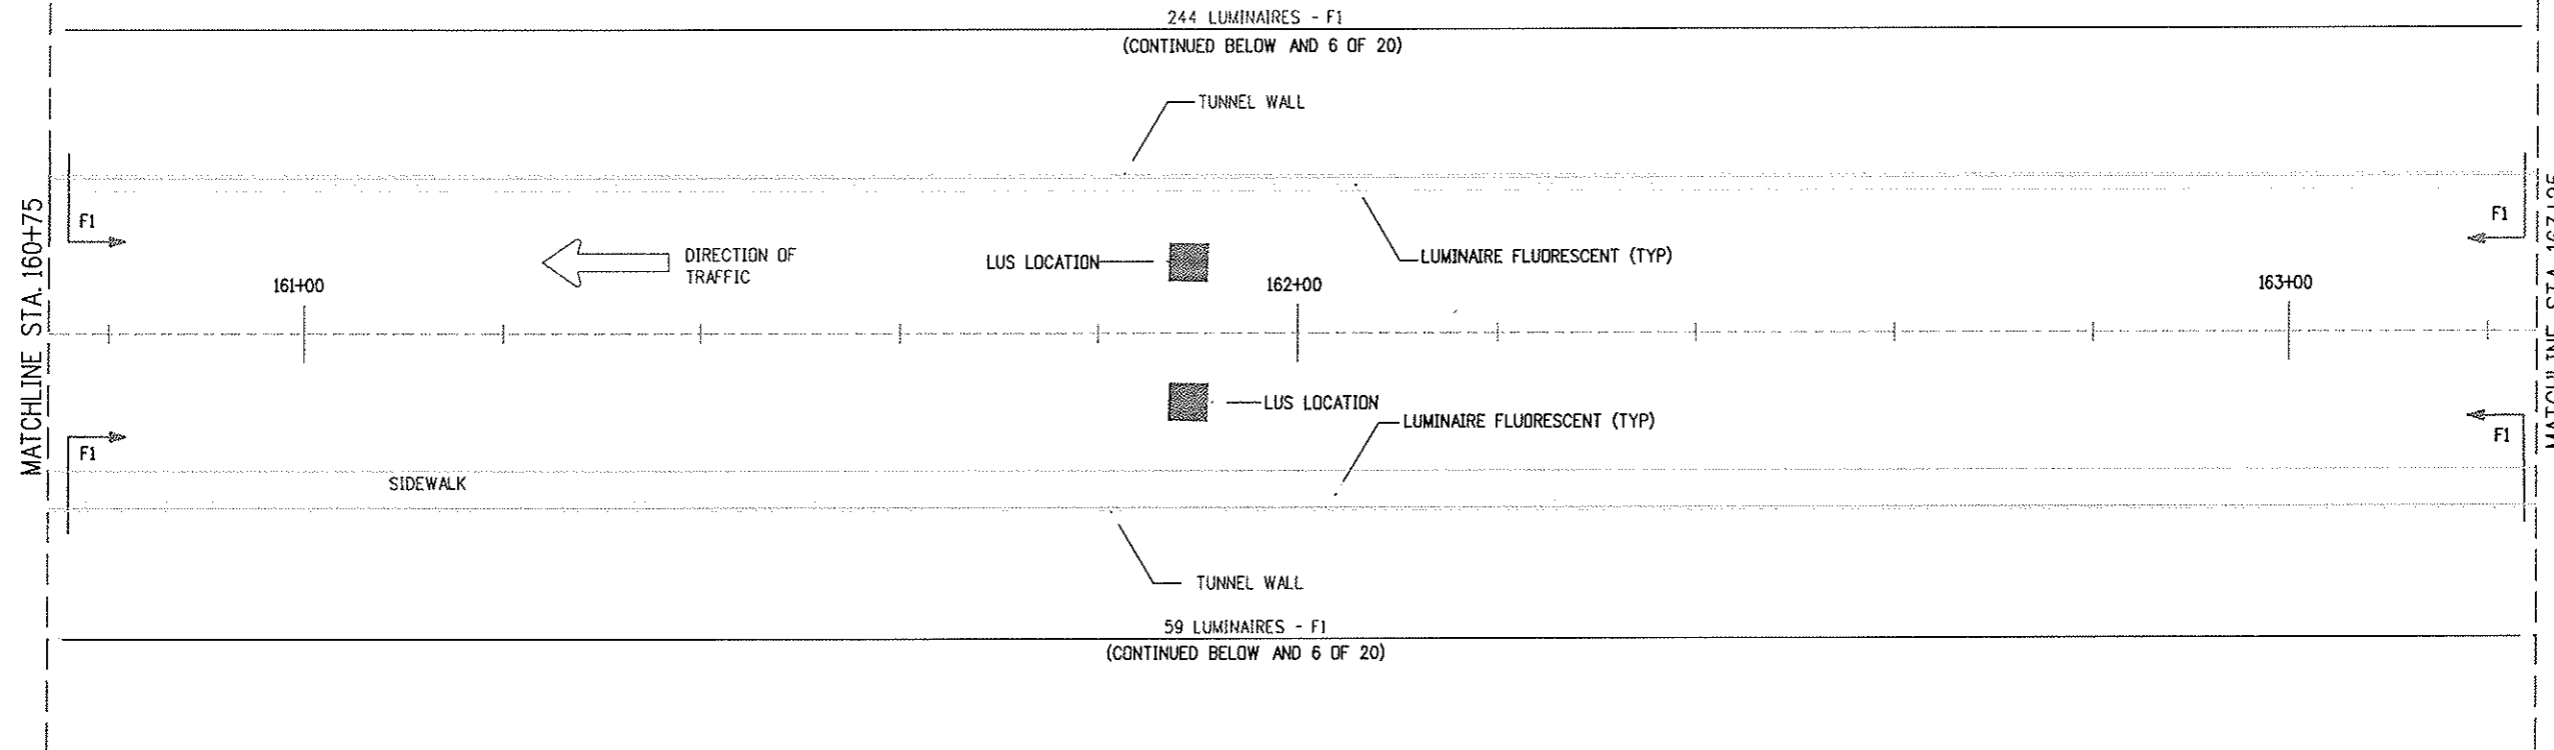

PLAN1

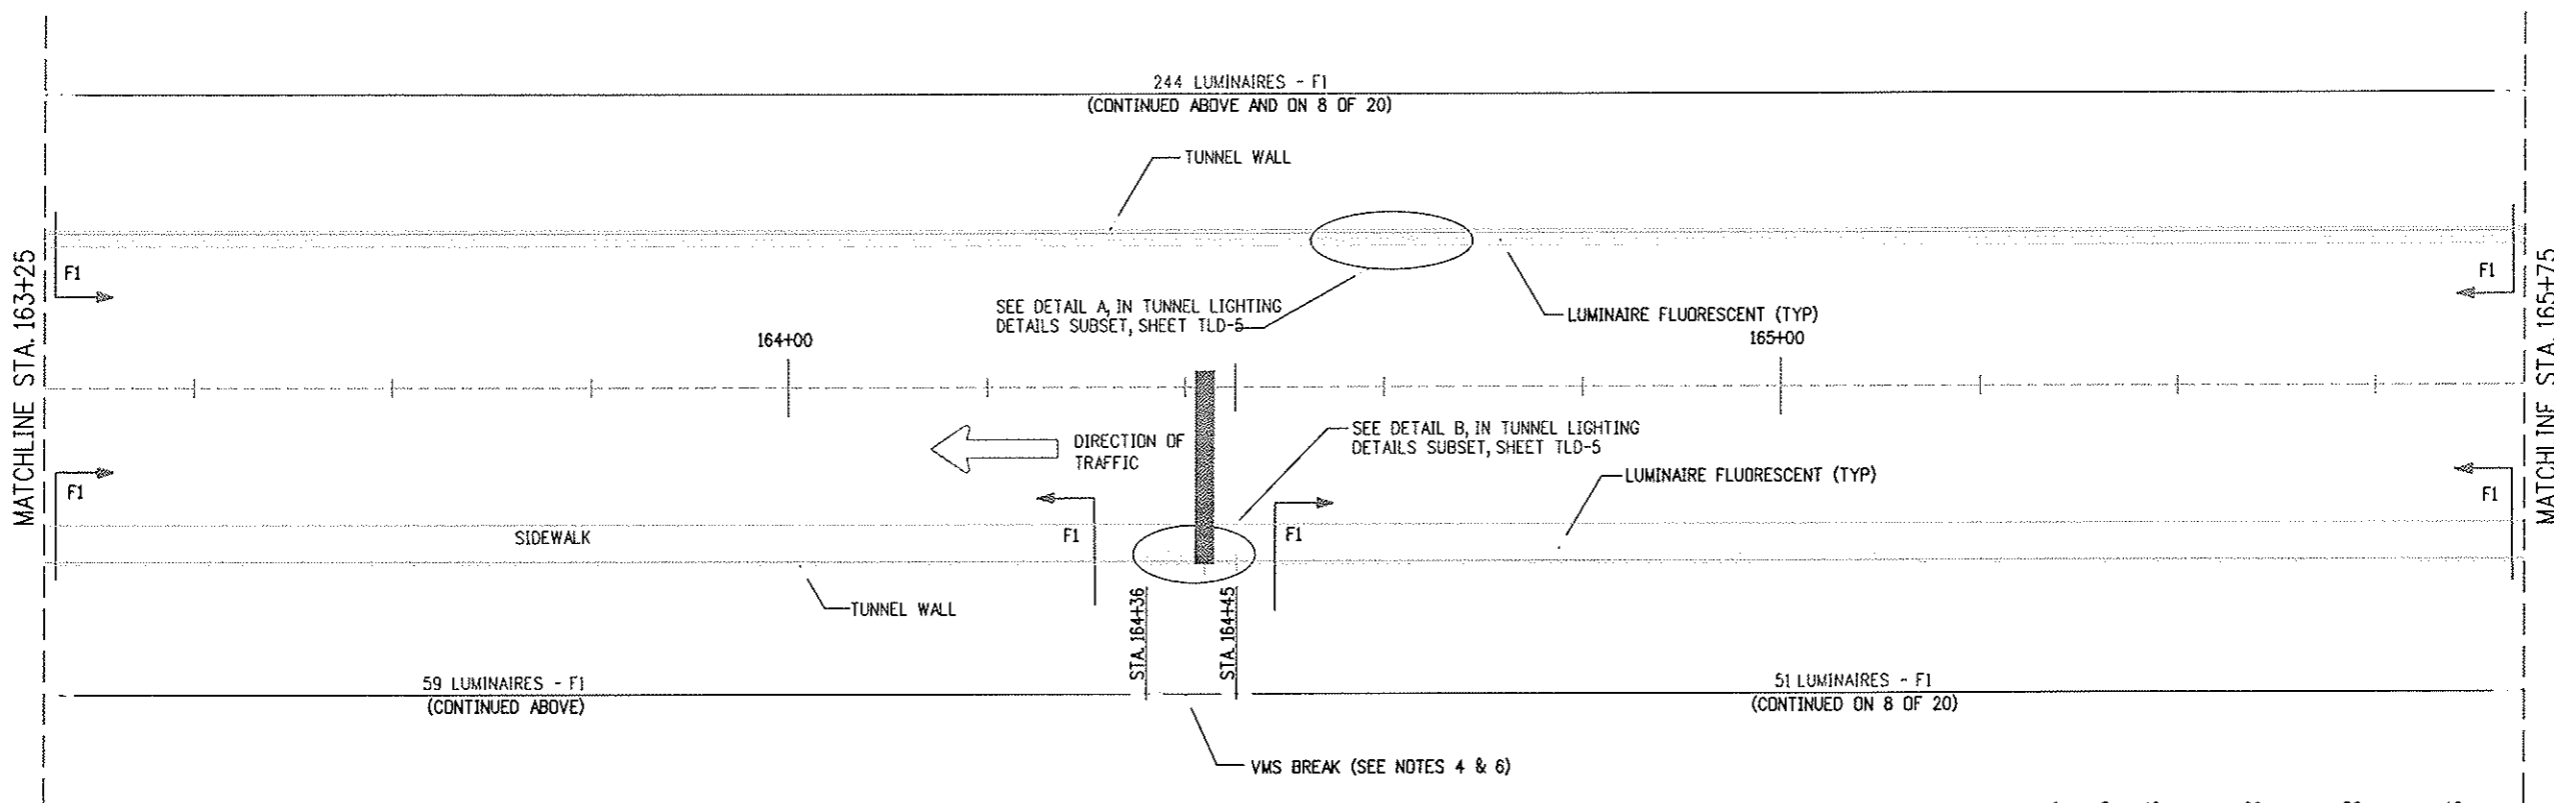


PLAN2

Design File Name: DGN\$SPEC*
 Plot File Name: \$PLOTFILE*
 Date of Plot: \$\$\$DATE\$\$\$

Computer File Information	
Creation Date:	02/216/99 Initials: DJB
Last Modification Date:	02-206-001 Initials: DJB
Full Path:	14102\700CADD\703elec\
Drawing File Name:	ltpl06n.dwg
Acad Ver.	R14 Scale: 1" = 10'-0" Units: English

Sheet Revisions	
<input type="checkbox"/>	07/03/07 ASBUILT DJB
<input type="checkbox"/>	
<input type="checkbox"/>	
<input type="checkbox"/>	

Colorado Department of Transportation




P.O. BOX 399
 DUMONT, CO. 80436
 Phone: 303-512-5750 FAX: 303-512-5775

Region 1 Mountain Residency I.N.Z.


As Constructed
No Revisions:
Revised:
Void:

NORTH TUNNEL LIGHTING PLANS	
Designer: D. BURROUGHS	Structure Numbers
Detailer: D. BURROUGHS	
Sheet Subset: TUN. LTG.	Subset Sheets: 7 of 20

Project No./Cod
IM 0703-269
13166
Sheet Number 31

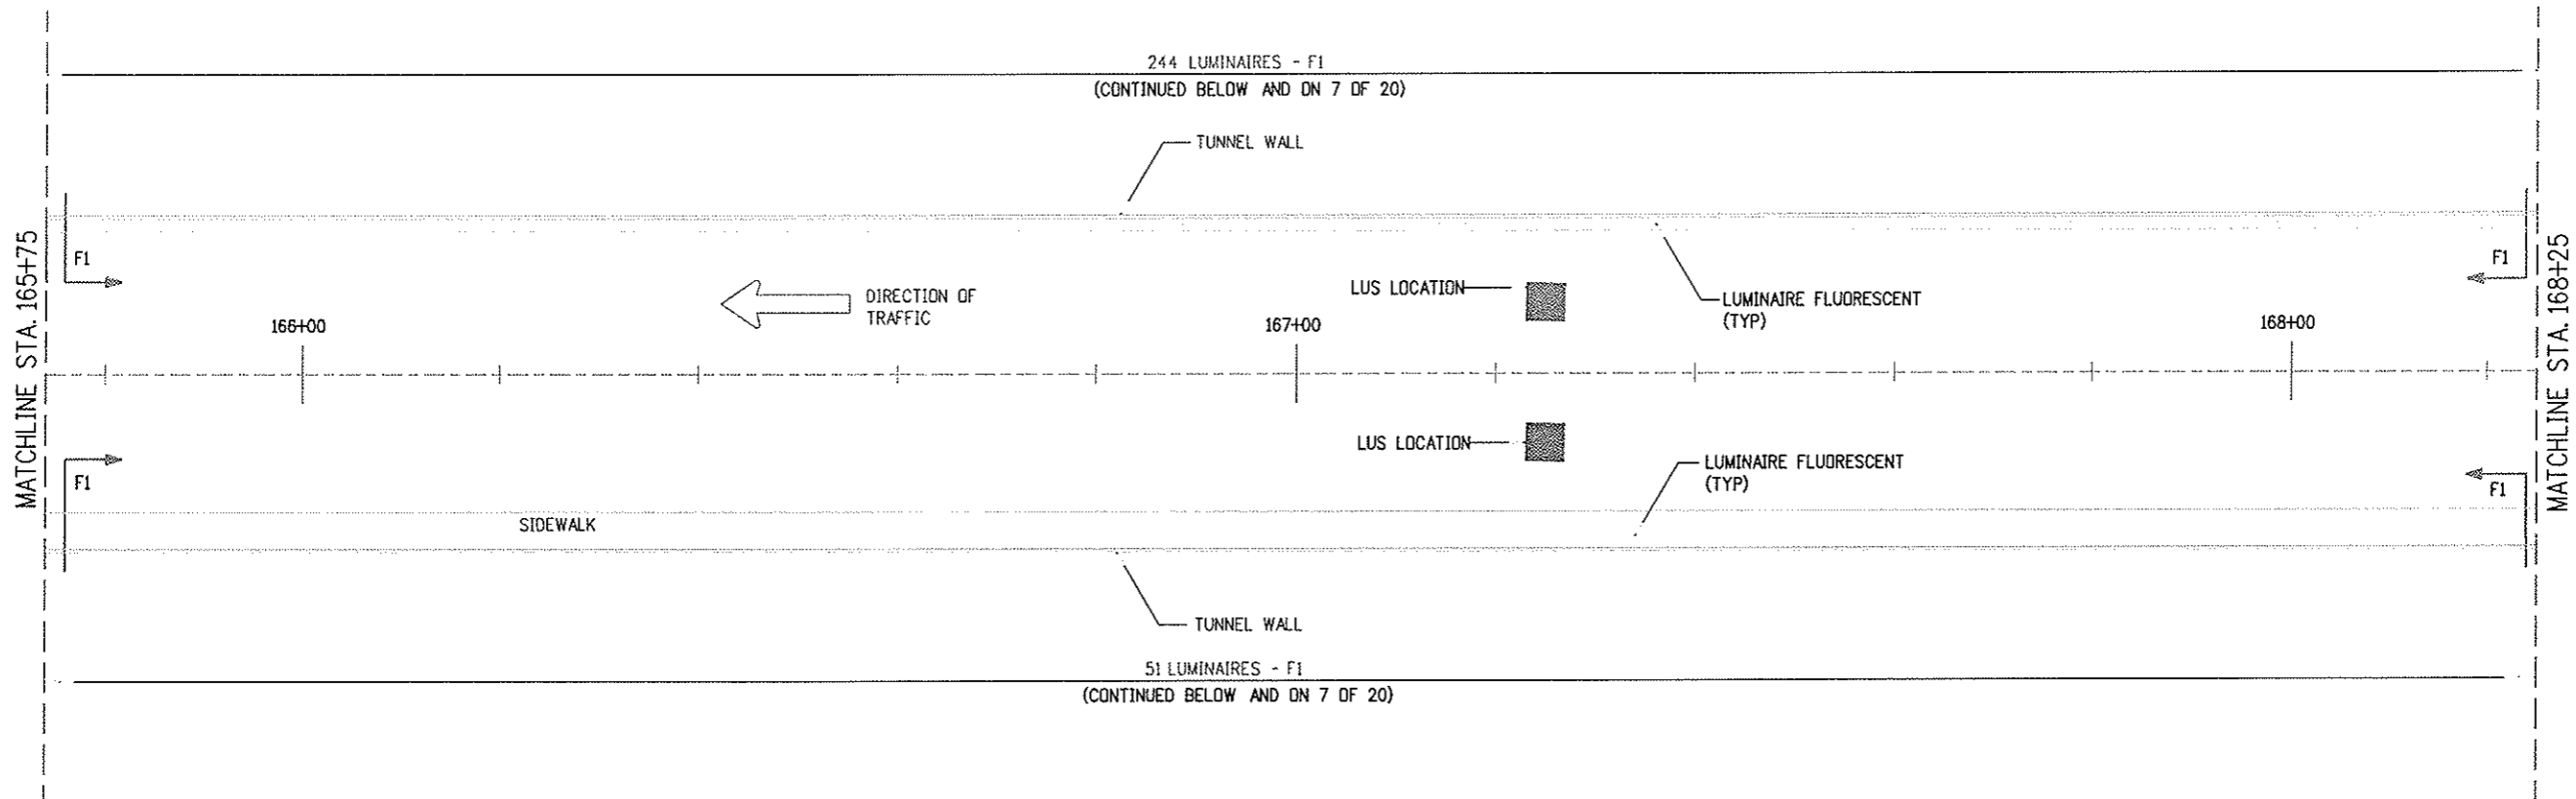

PLAN 1

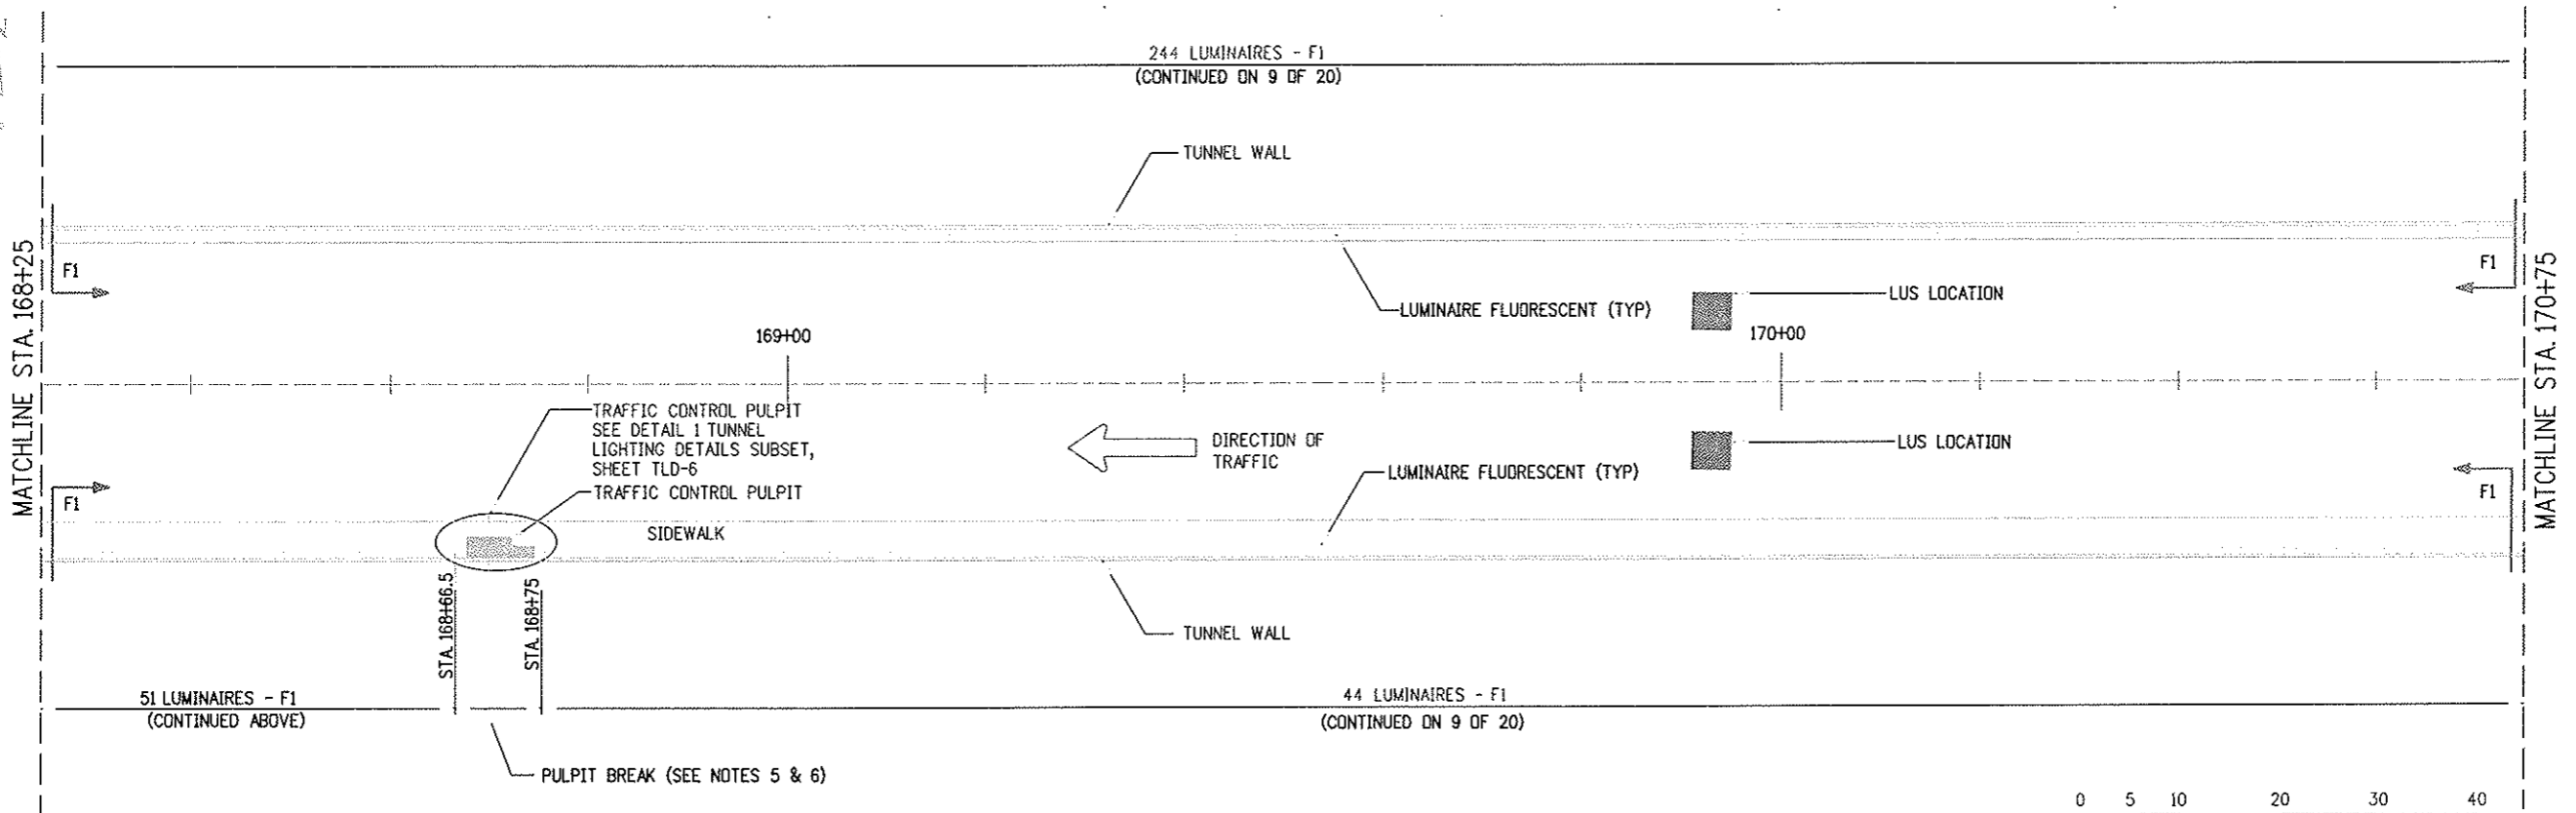


PLAN 2

Design File Name: DGN\$SPEC*
 Plot File Name: \$PLOTFILE*
 Date of Plot: \$\$\$DATE\$\$\$

Computer File Information	
Creation Date:	02/216/99 Initials: DJB
Last Modification Date:	02/206/01 Initials: DJB
Full Path:	14102\700CADD\703elec\
Drawing File Name:	ltpl07n.dwg
Acad Ver.	R14 Scale: 1" = 10'-0" Units: English

Sheet Revisions	
<input type="checkbox"/>	07/03/07 ASBUILT DJB
<input type="checkbox"/>	
<input type="checkbox"/>	
<input type="checkbox"/>	

Colorado Department of Transportation




P.O. BOX 399
 DUMONT, CO. 80436
 Phone: 303-512-5750 FAX: 303-512-5775

Region 1 Mountain Residency I.N.Z.


As Constructed
No Revisions:
Revised:
Void:

NORTH TUNNEL LIGHTING PLANS	
Designer:	D.BURROUGHS
Detailer:	D.BURROUGHS
Sheet Subset:	TUN. LTG.
Structure Numbers	
Subset Sheets:	8 of 20

Project No./Code
IM 0703-269
13166
Sheet Number 32

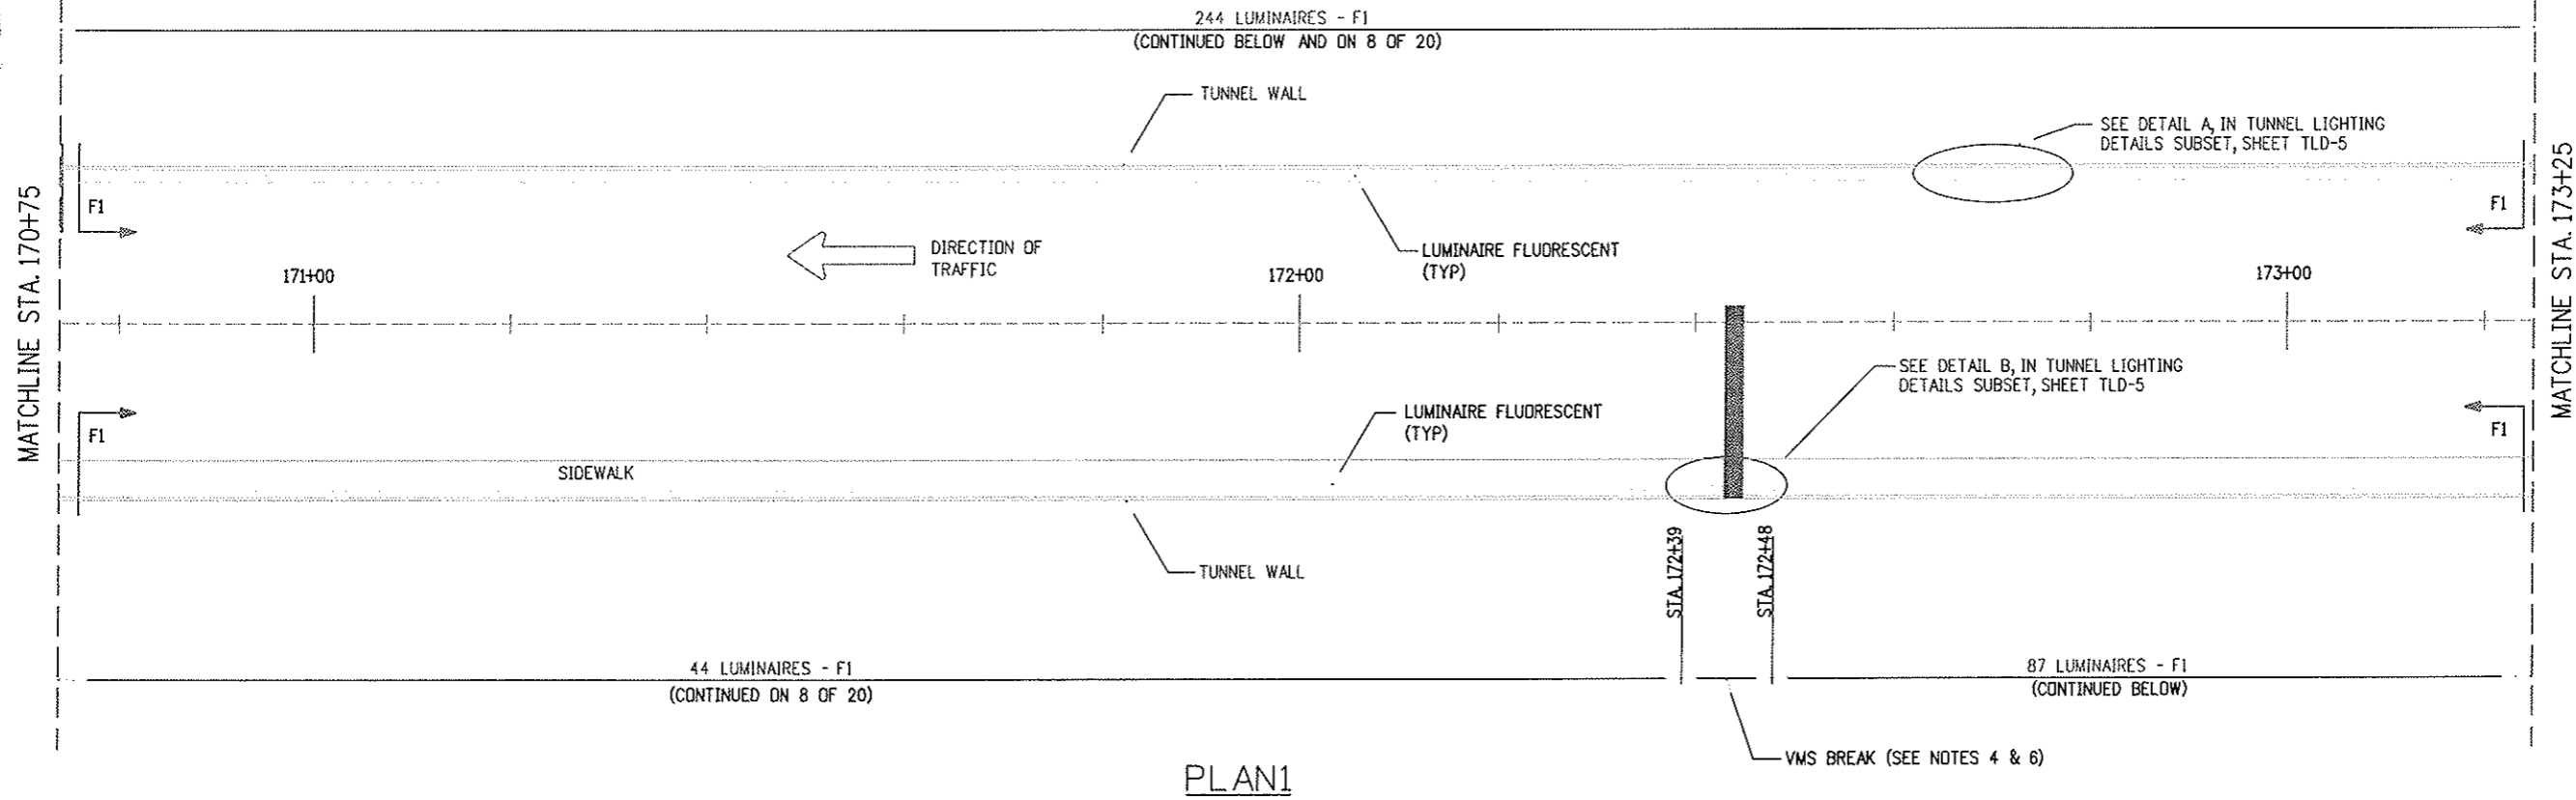

PLAN1

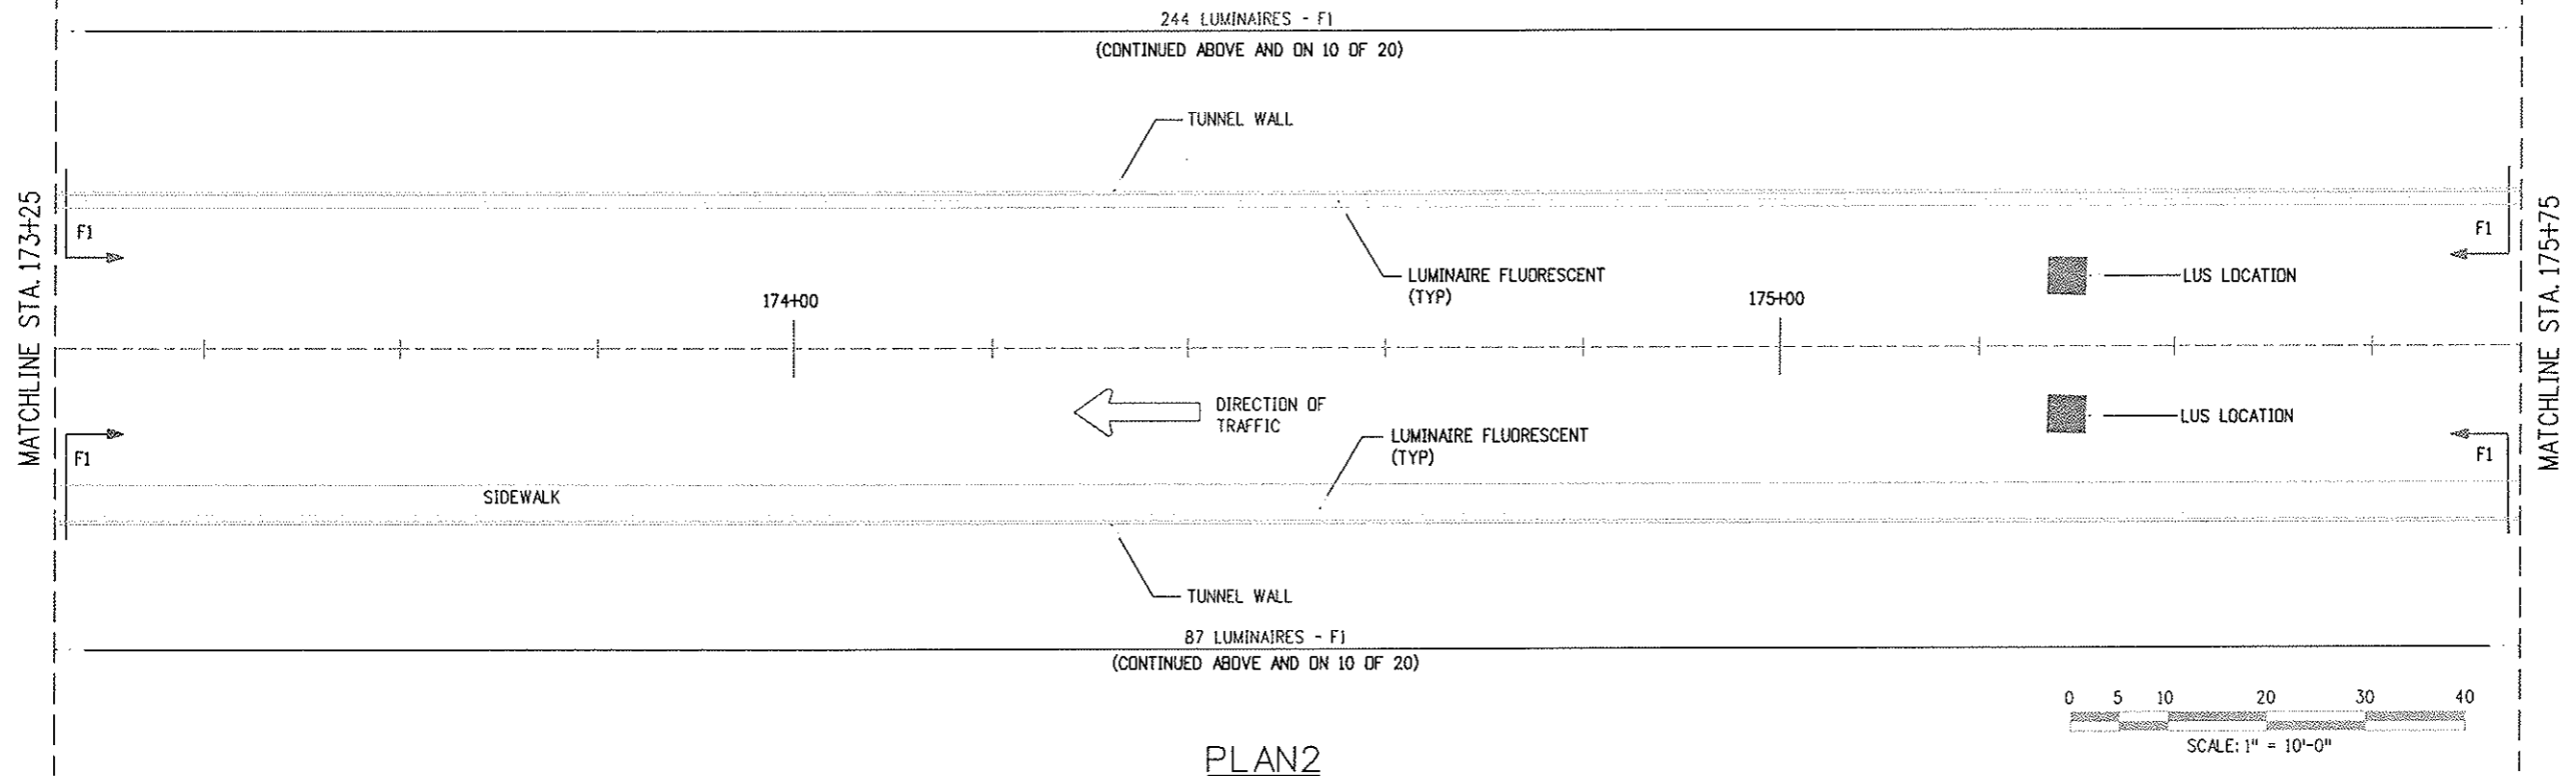


PLAN2

Plot File Name: 3PLU1FILE* Date of Plot: 03/08/00 03:33

Computer File Information	
Creation Date:	02/26/99 Initials: DJB
Last Modification Date:	02/26/01 Initials: DJB
Full Path:	14102\700CADD\703elec\
Drawing File Name:	ltpl08n.dwg
Acad Ver.:	R14 Scale: 1" = 10'-0" Units: English

Sheet Revisions	
<input type="checkbox"/>	07/03/07 ASBUILT DJB
<input type="checkbox"/>	
<input type="checkbox"/>	
<input type="checkbox"/>	

Colorado Department of Transportation

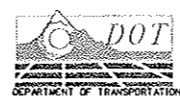



P.O. BOX 399
DUMONT, CO. 80436
Phone: 303-512-5750 FAX: 303-512-5775

Region 1 Mountain Residency I.N.Z.

As Constructed
No Revisions:
Revised:
Void:

NORTH TUNNEL LIGHTING PLANS		
Designer:	D BURROUGHS	Structure Numbers
Detailer:	D BURROUGHS	
Sheet Subset:	TUN. LTG.	Subset Sheets: 9 of 20


Project No./Code
IM 0703-269
13166
Sheet Number 33

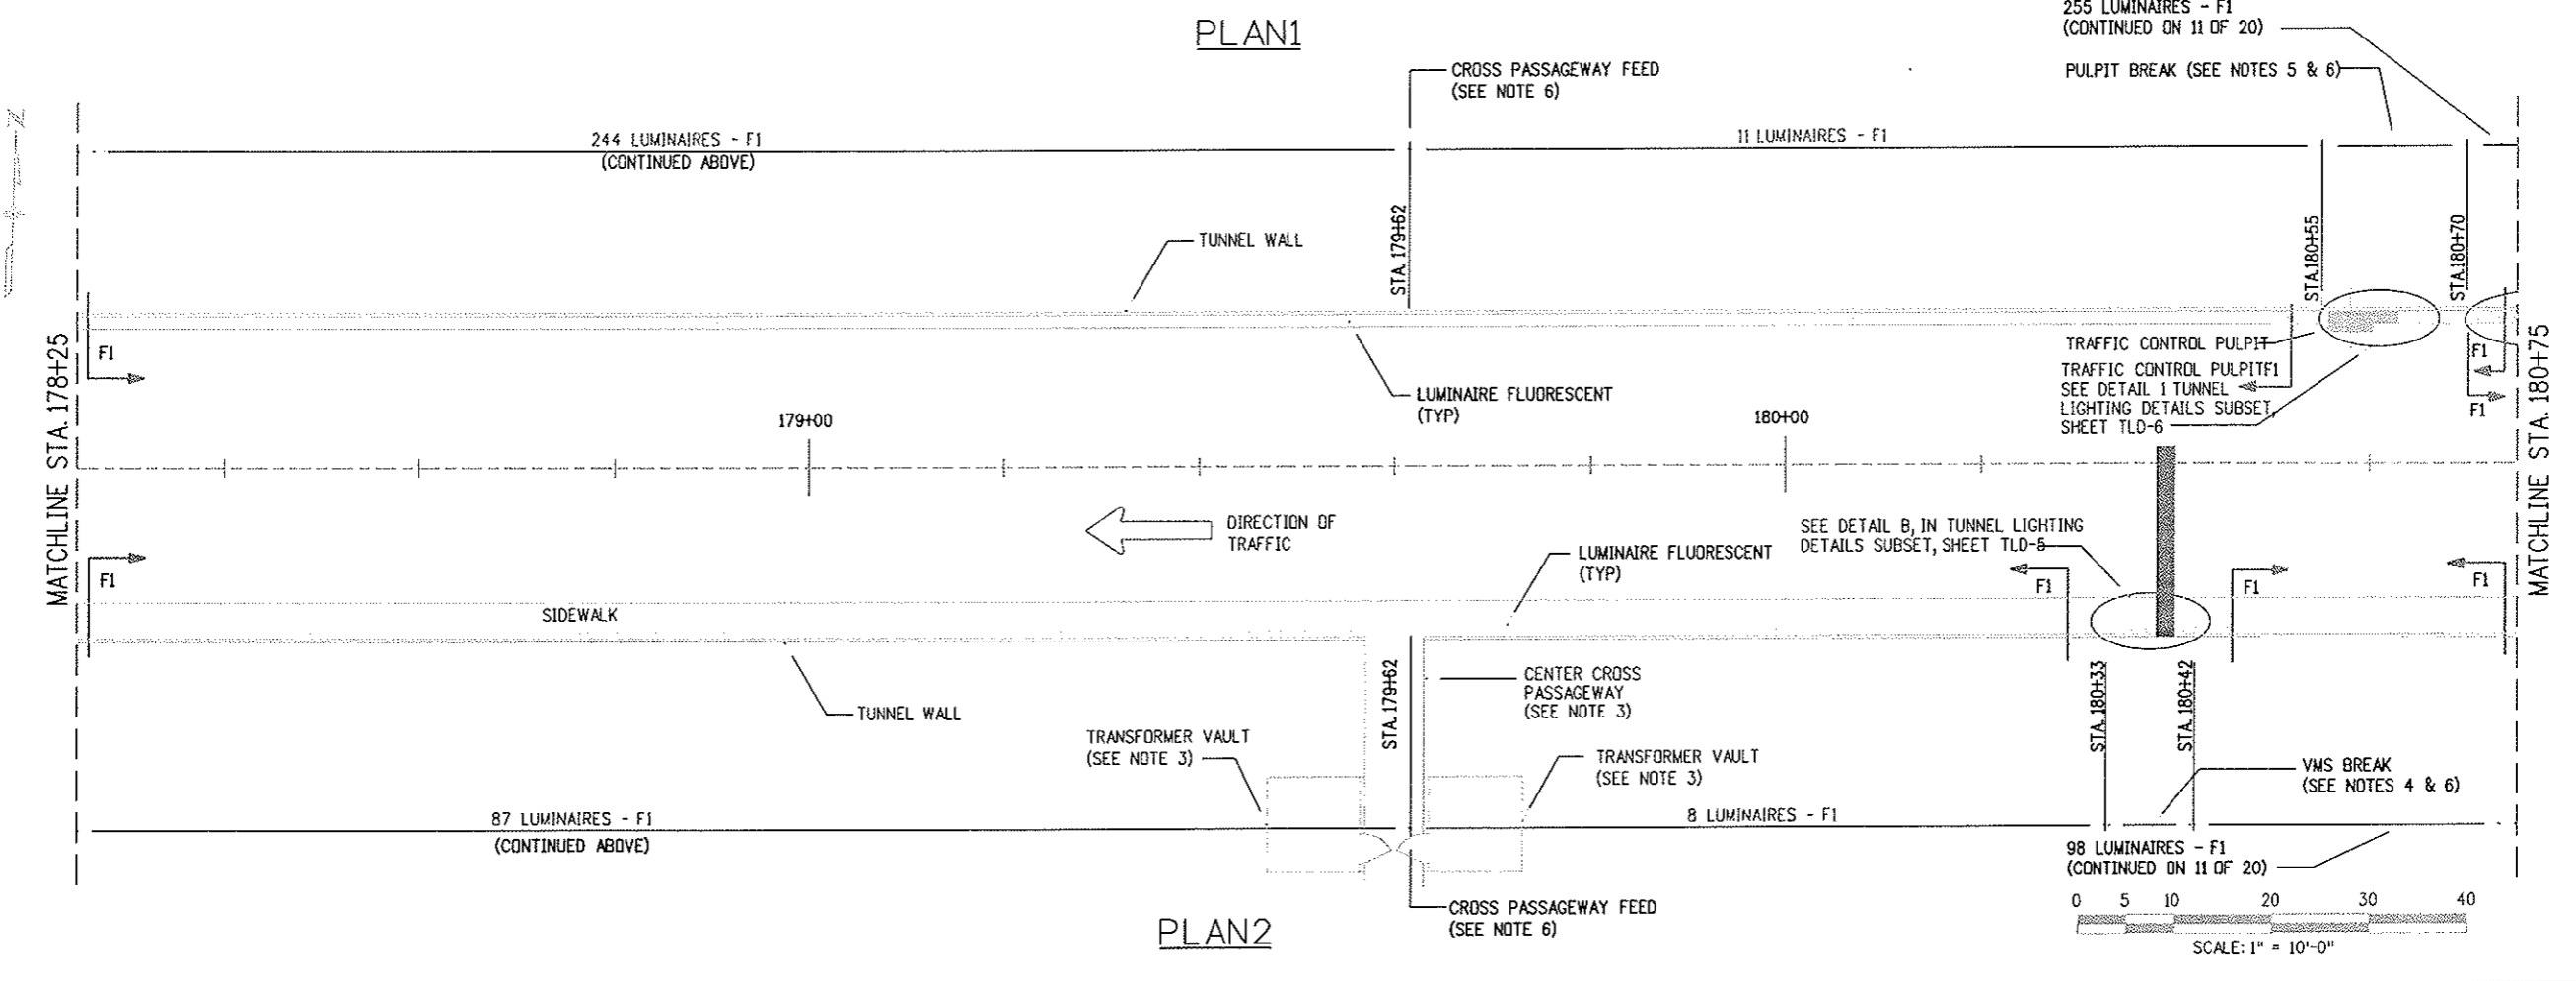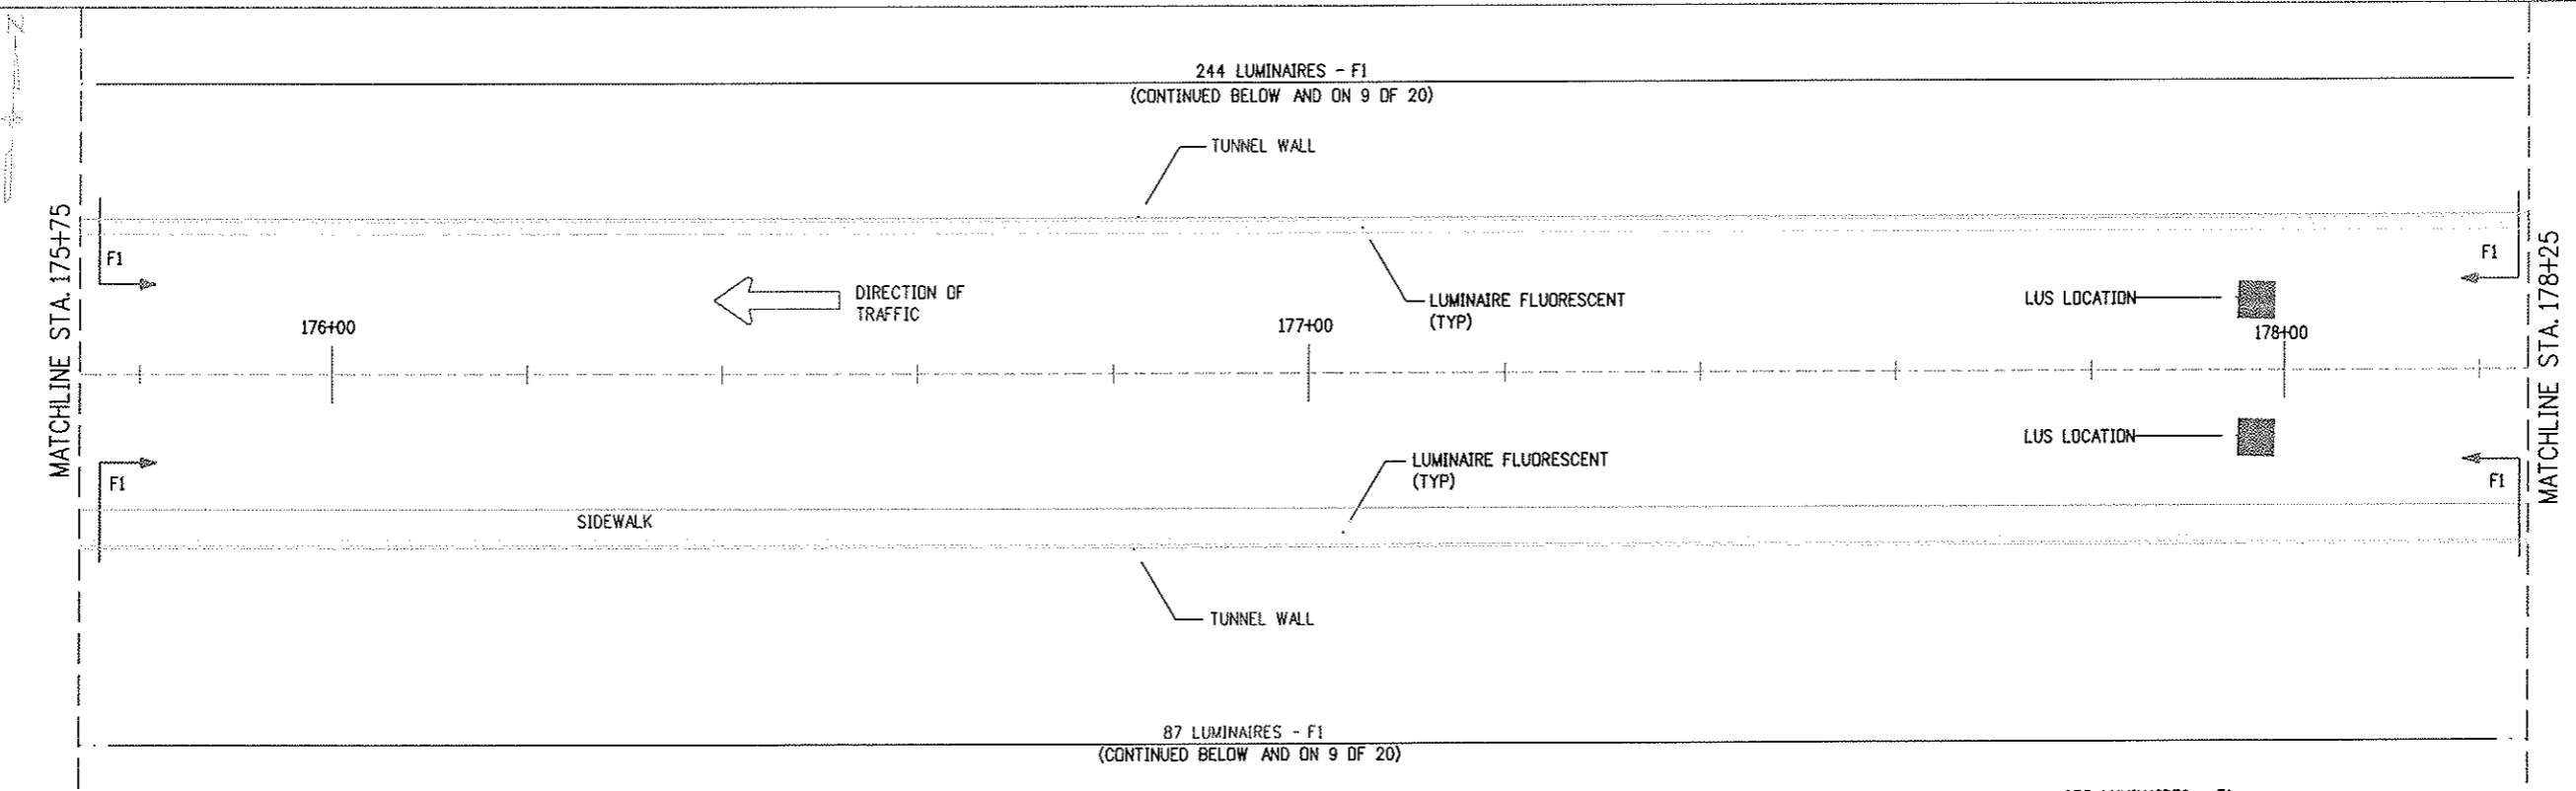

Design File Name: DGNSSPEC
 Plot File Name: SLD07FILE
 Date of Plot: 5/5/2007 10:55:58 AM

Computer File Information	
Creation Date:	02/26/99 Initials: DJB
Last Modification Date:	02/06/01 Initials: DJB
Full Path:	14102\700CADD\703elec\
Drawing File Name:	tlp109n.dwg
Acad Ver.	R14 Scale: 1" = 10'-0" Units: English


Sheet Revisions	
07/03/07	ASBUILT DJB

Colorado Department of Transportation

 P.O. BOX 399
 DUMONT, CO. 80436
 Phone: 303-512-5750 FAX: 303-512-5775
 Region 1 Mountain Residency I.N.Z.


As Constructed
No Revisions:
Revised:
Void:

NORTH TUNNEL LIGHTING PLANS	
Designer:	D. BURROUGHS
Detailer:	D. BURROUGHS
Sheet Subset:	TUN. LTC.
Structure Numbers:	
Subset Sheets:	10 of 20

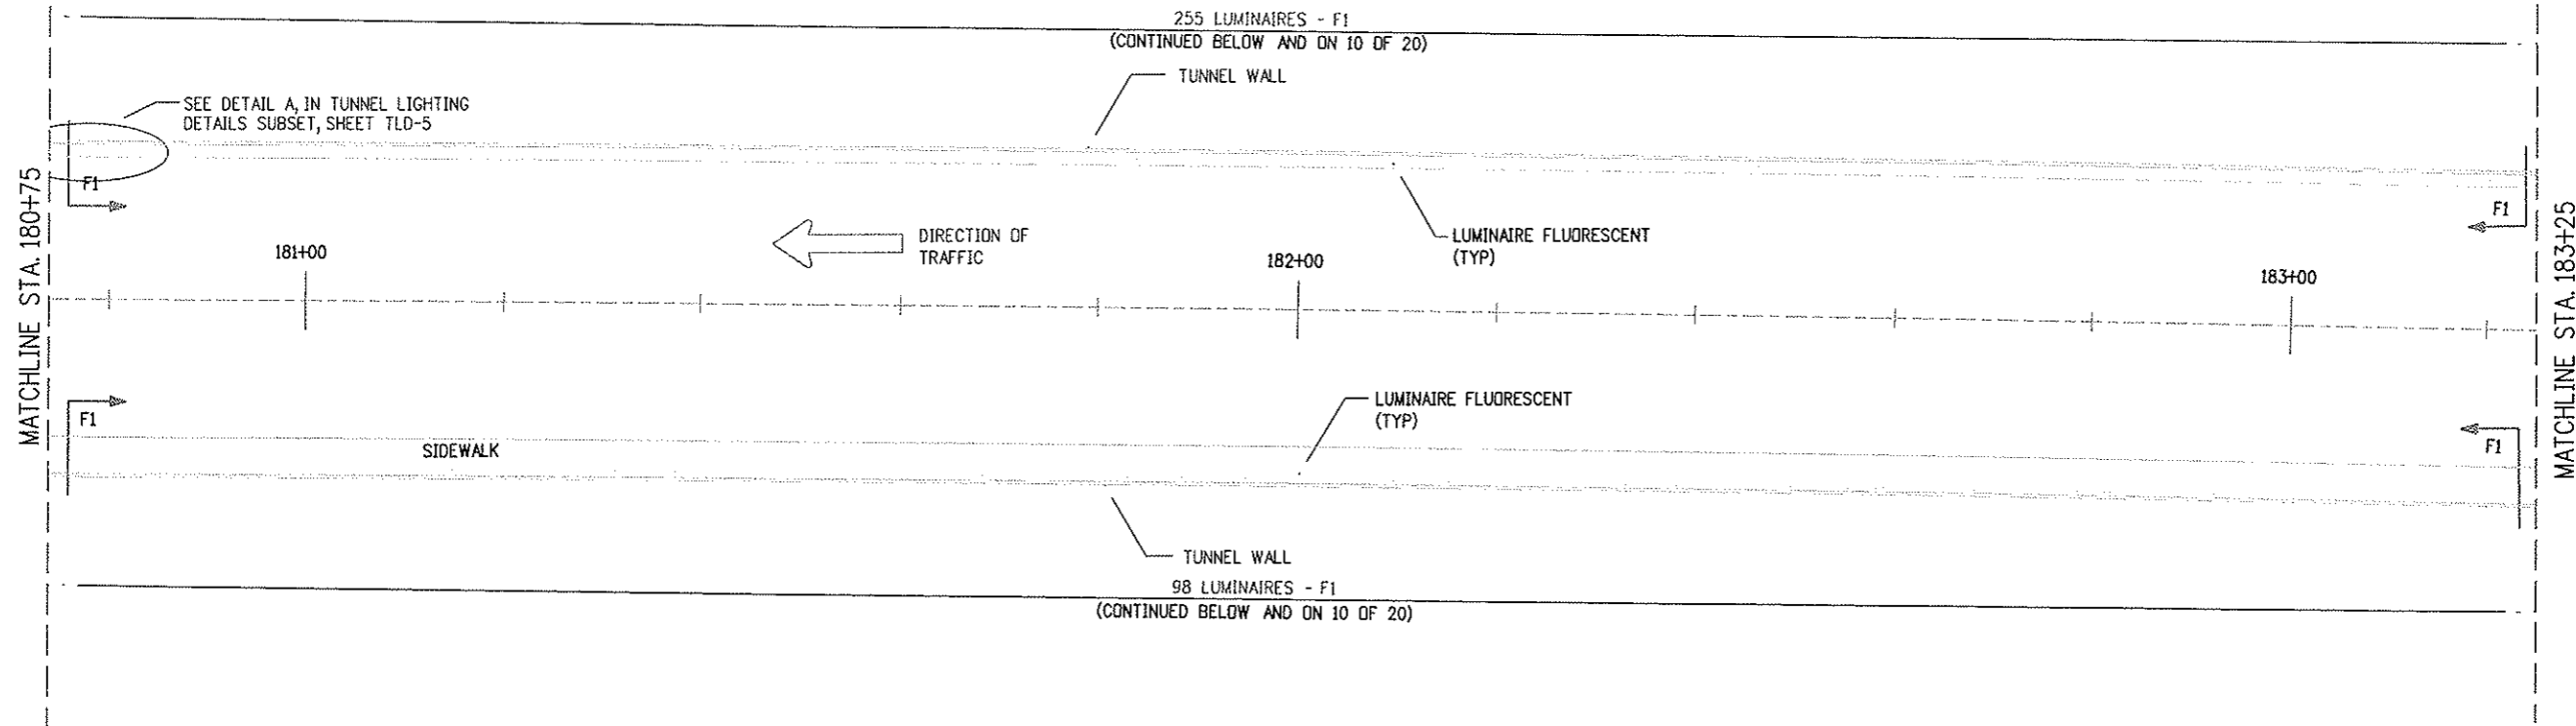
Project No./Code	
IM 0703-269	13166
Sheet Number	34



PLAN1

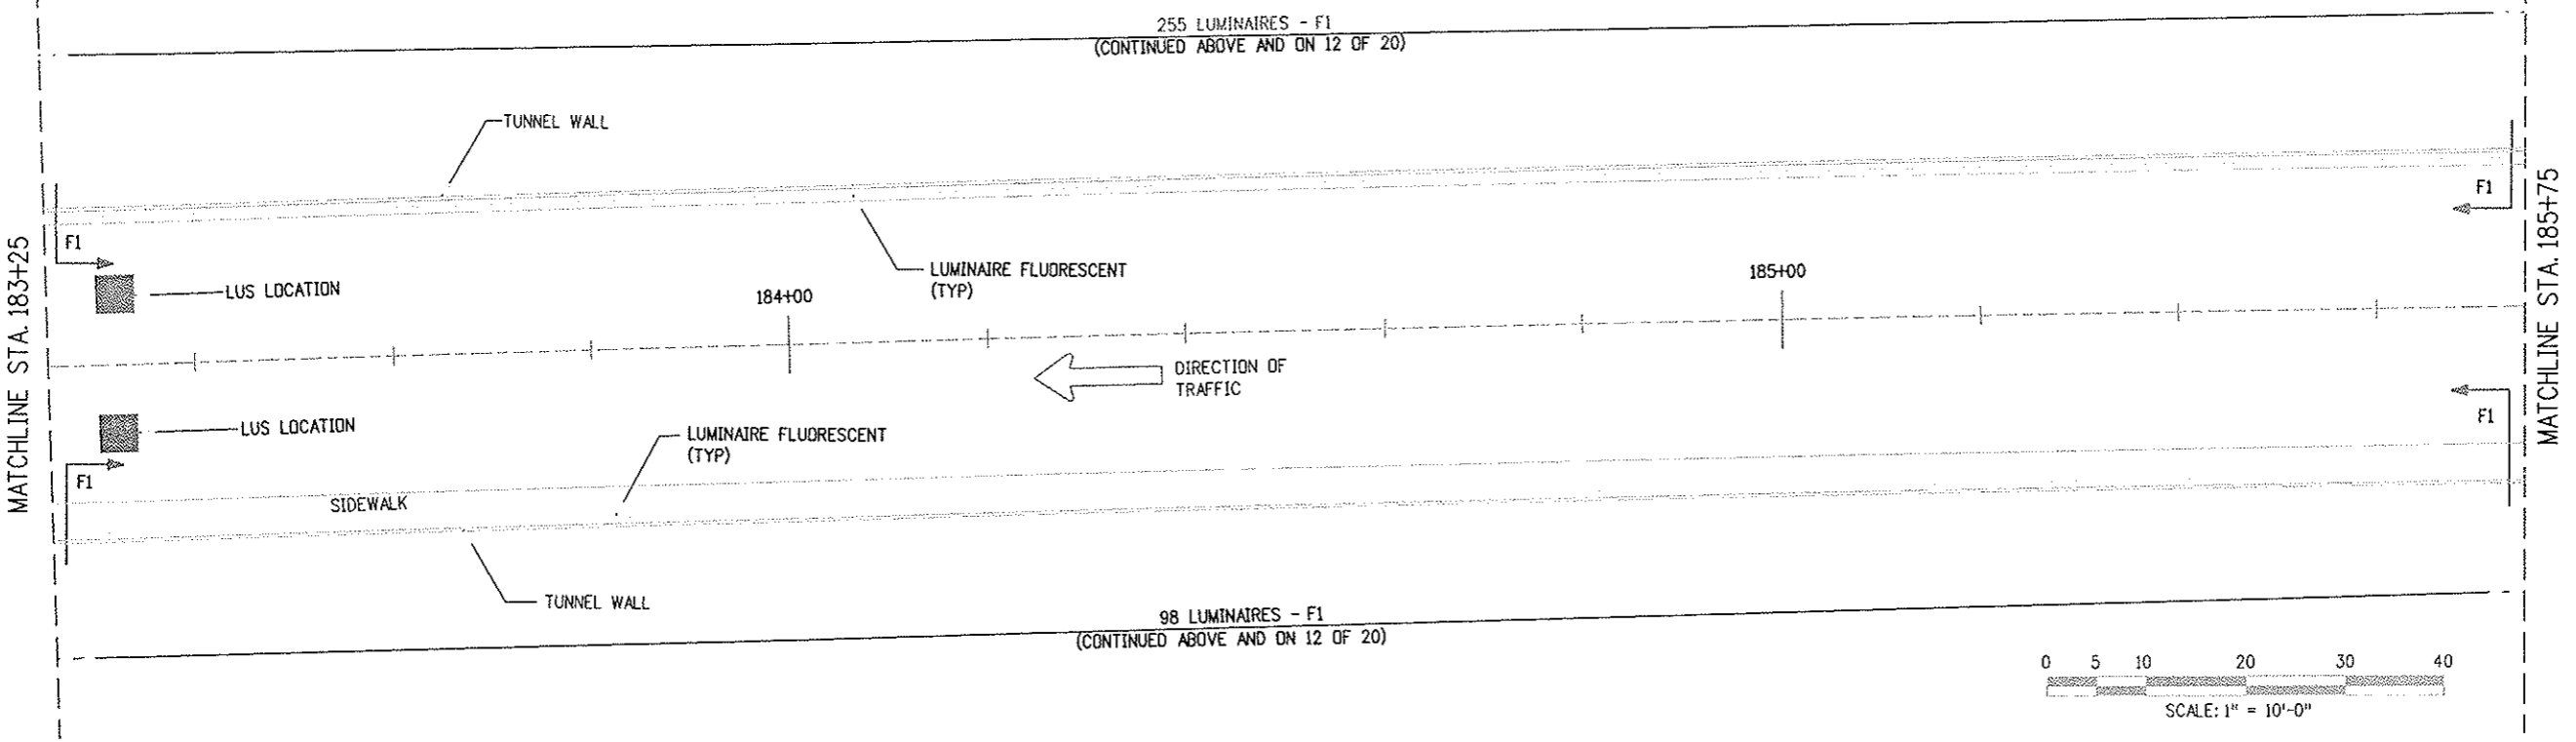

PLAN2

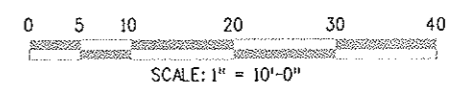


Design File Name: D:\NS\PLUP
 Plot File Name: \$PLOTFILE\$
 Date of Plot: \$\$\$DATE\$\$\$

Computer File Information	
Creation Date:	02/26/99 Initials: DJB
Last Modification Date:	02/26/01 Initials: DJB
Full Path:	14102\700CADD\703elec\
Drawing File Name:	ltpl10n.dwg
Acad Ver.	R14 Scale: 1" = 10'-0" Units: English

Sheet Revisions		
<input type="checkbox"/>	07/03/07	ASBUILT DJB
<input type="checkbox"/>		
<input type="checkbox"/>		
<input type="checkbox"/>		

Colorado Department of Transportation






P.O. BOX 399
 DUMONT, CO. 80436
 Phone: 303-512-5750 FAX: 303-512-5775

Region 1 Mountain Residency I.N.Z.

As Constructed
No Revisions:
Revised:
Void:

NORTH TUNNEL LIGHTING PLANS		
Designer:	D. BURROUGHS	Structure Numbers
Detailer:	D. BURROUGHS	
Sheet Subset:	TUN. LTG.	Subset Sheets: 11 of 20

Project No./Code
IM 0703-269
13166
Sheet Number 35

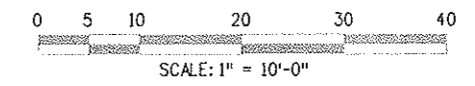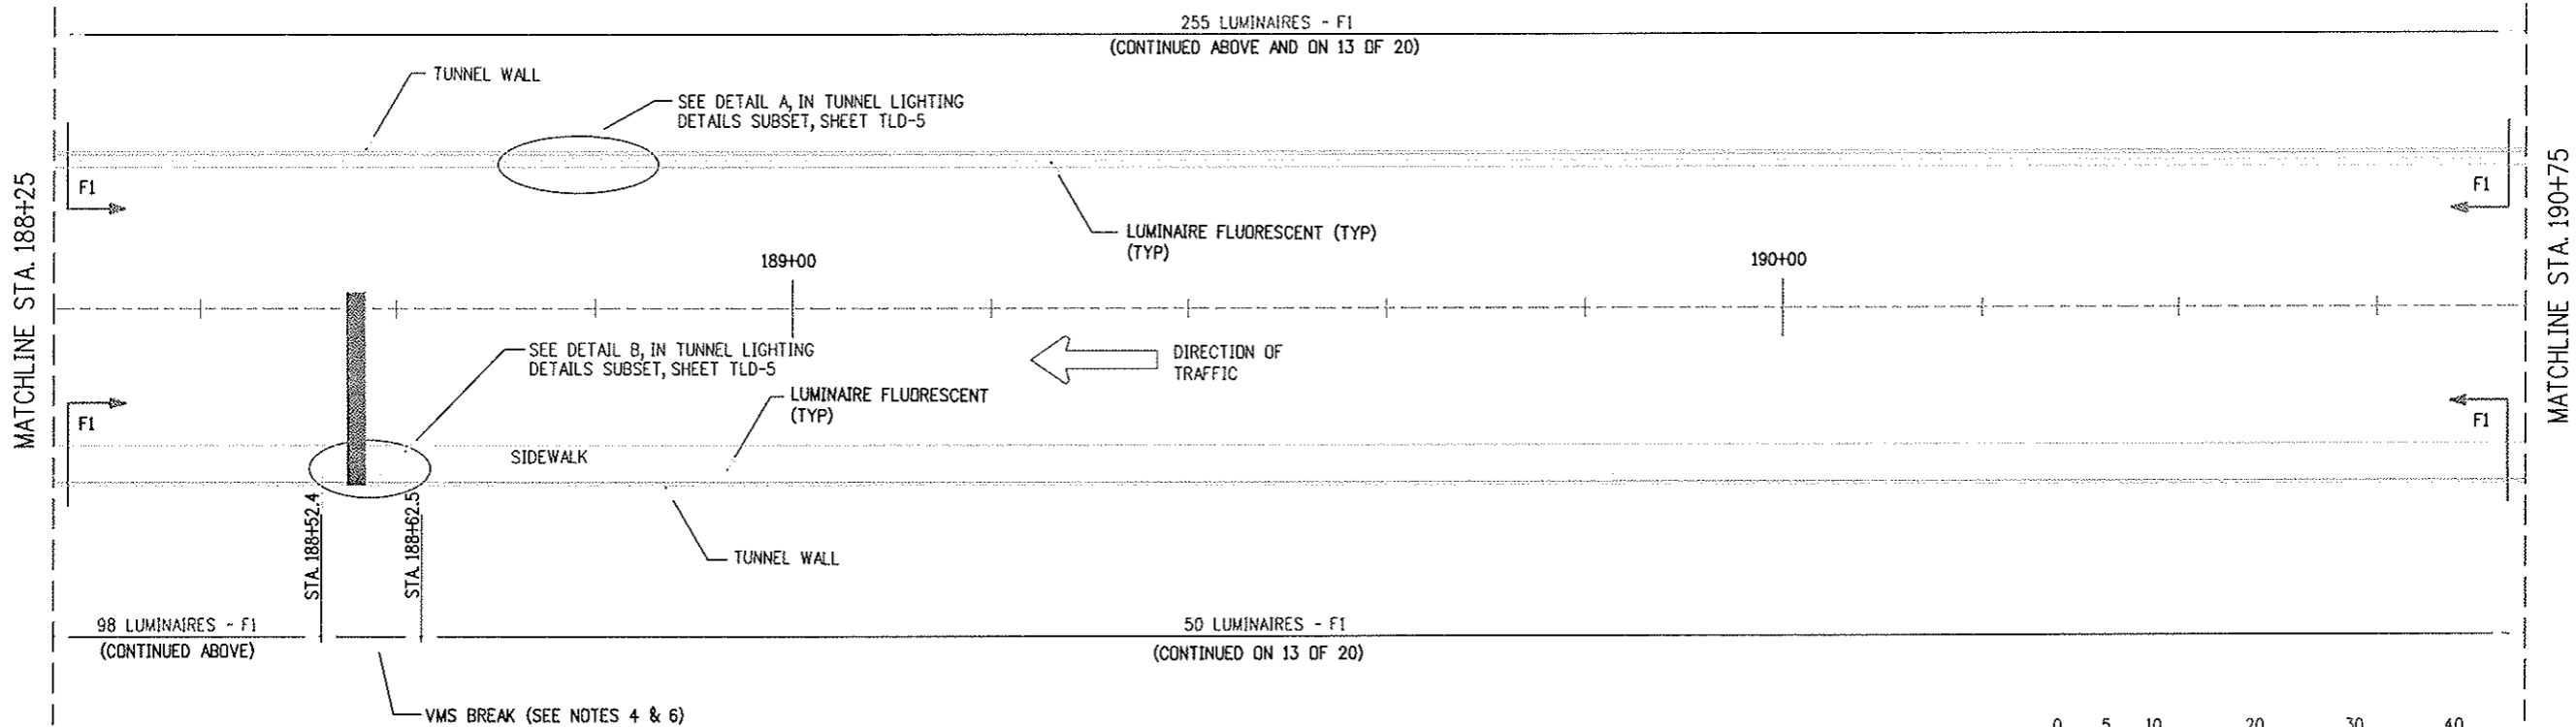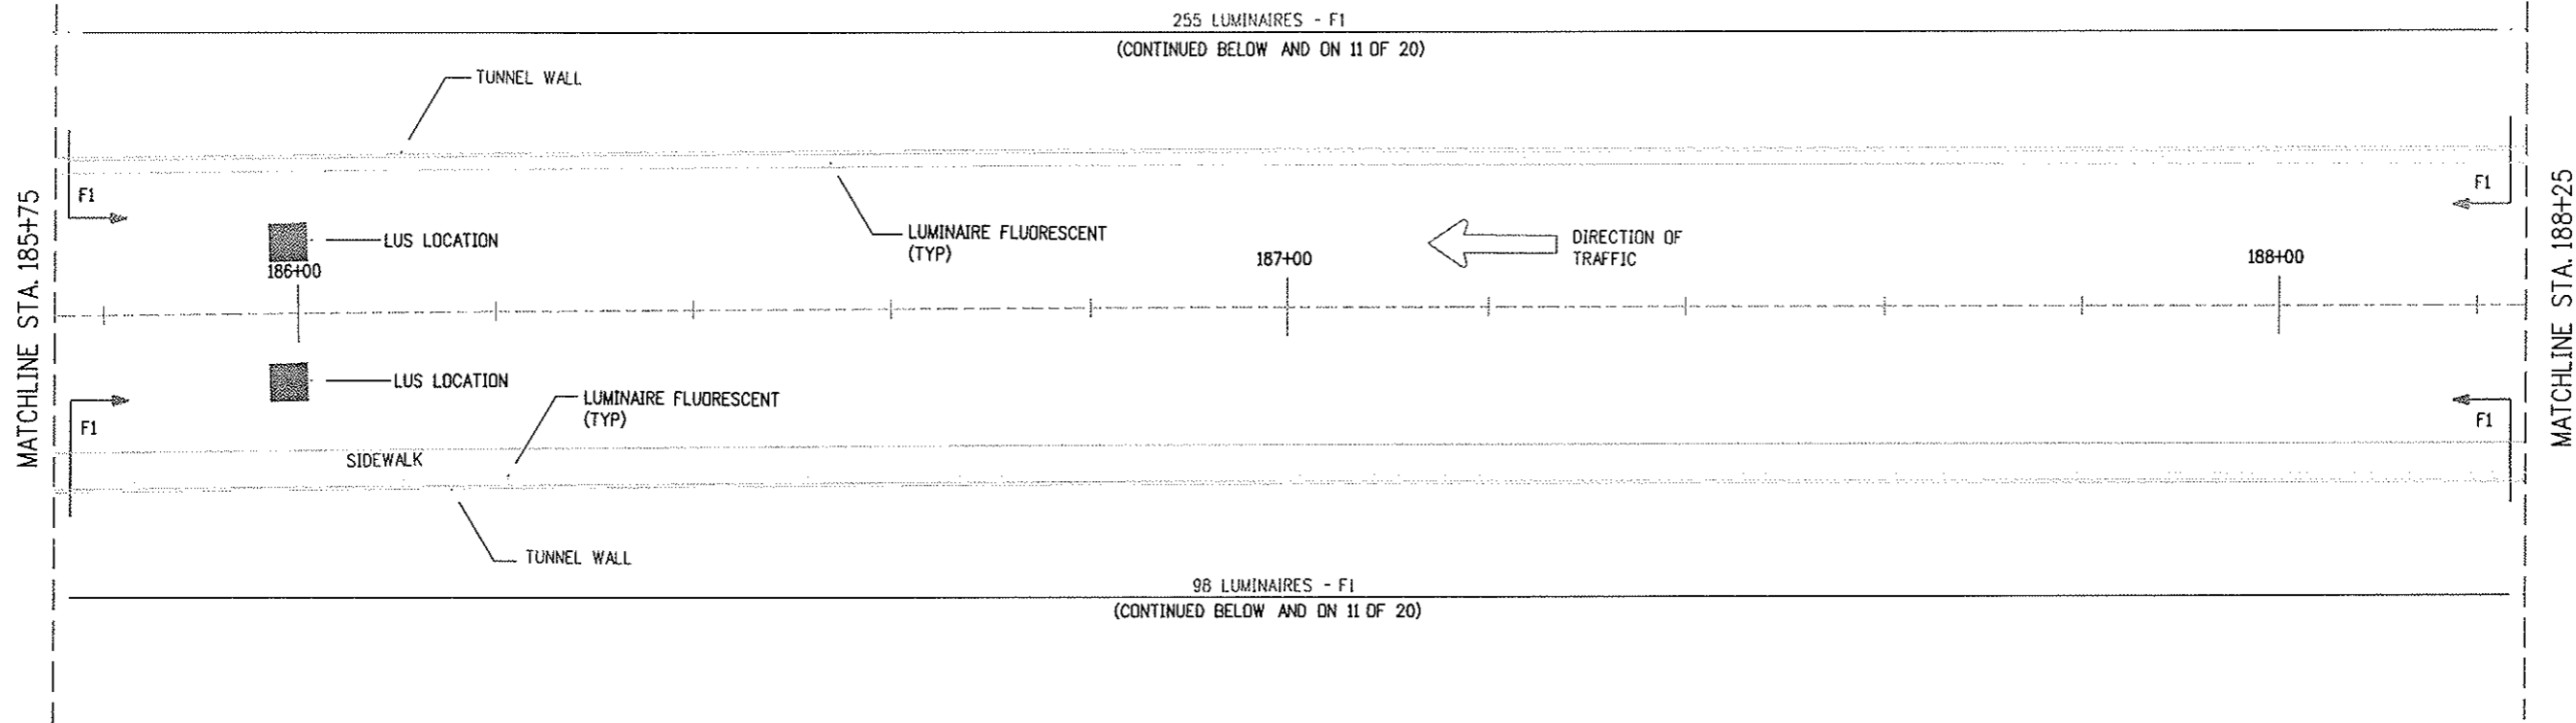


Design File Name: DGN5P1C*
 Plot File Name: \$PLOTFILE*
 Date of Plot: \$\$\$DATE\$\$\$

Computer File Information	
Creation Date:	02/26/99 Initials: DJB
Last Modification Date:	11/20/00 Initials: DJB
Full Path:	14102\700CADD\703elec\
Drawing File Name:	tlp11n.dwg
Acad Ver.	R14 Scale: 1" = 10'-0" Units: English

Sheet Revisions	
<input type="checkbox"/>	07/03/07 ASBUILT DJB
<input type="checkbox"/>	
<input type="checkbox"/>	
<input type="checkbox"/>	

Colorado Department of Transportation


 P.O. BOX 399
 DUMONT, CO. 80436
 Phone: 303-512-5750 FAX: 303-512-5775

Region 1 Mountain Residency I.N.Z.


As Constructed
No Revisions:
Revised:
Void:

NORTH TUNNEL LIGHTING PLANS		
Designer:	D. BURROUGHS	Structure Numbers
Detailer:	D. BURROUGHS	
Sheet Subset:	TUN. LTG.	Subset Sheets: 12 of 20


Project No./Code
IM 0703-269
13166
Sheet Number 36

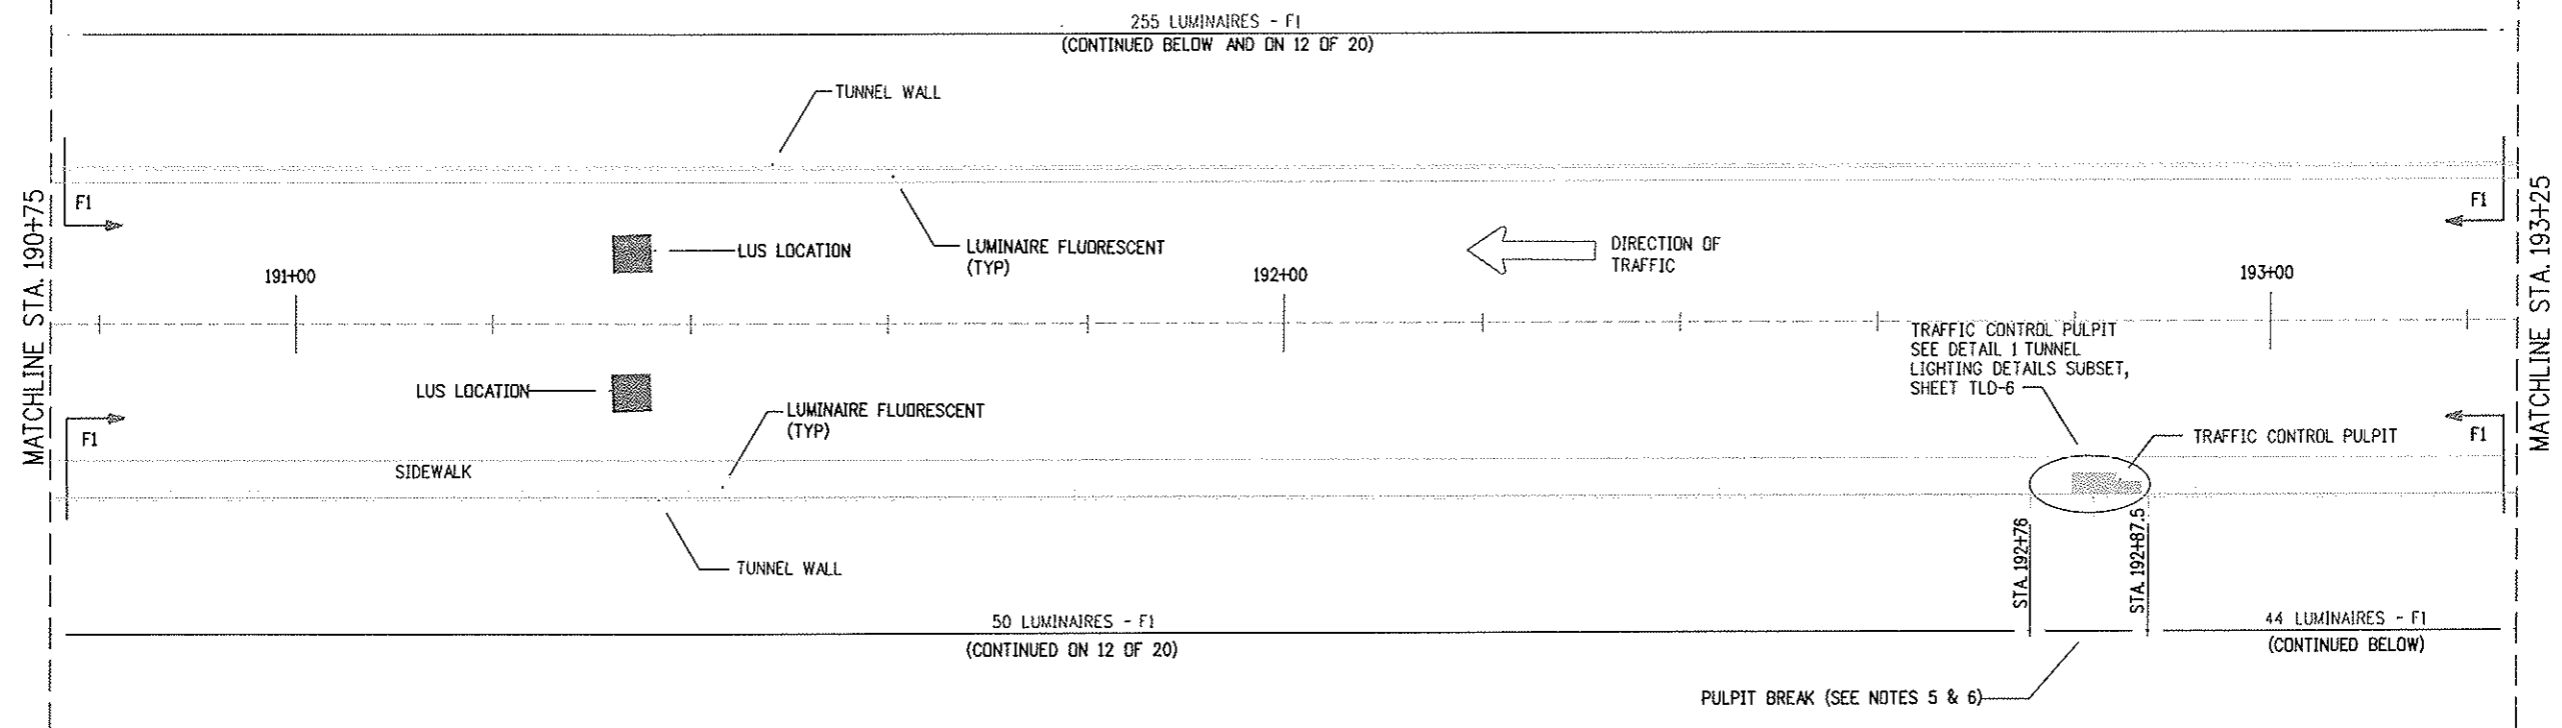

PLAN1

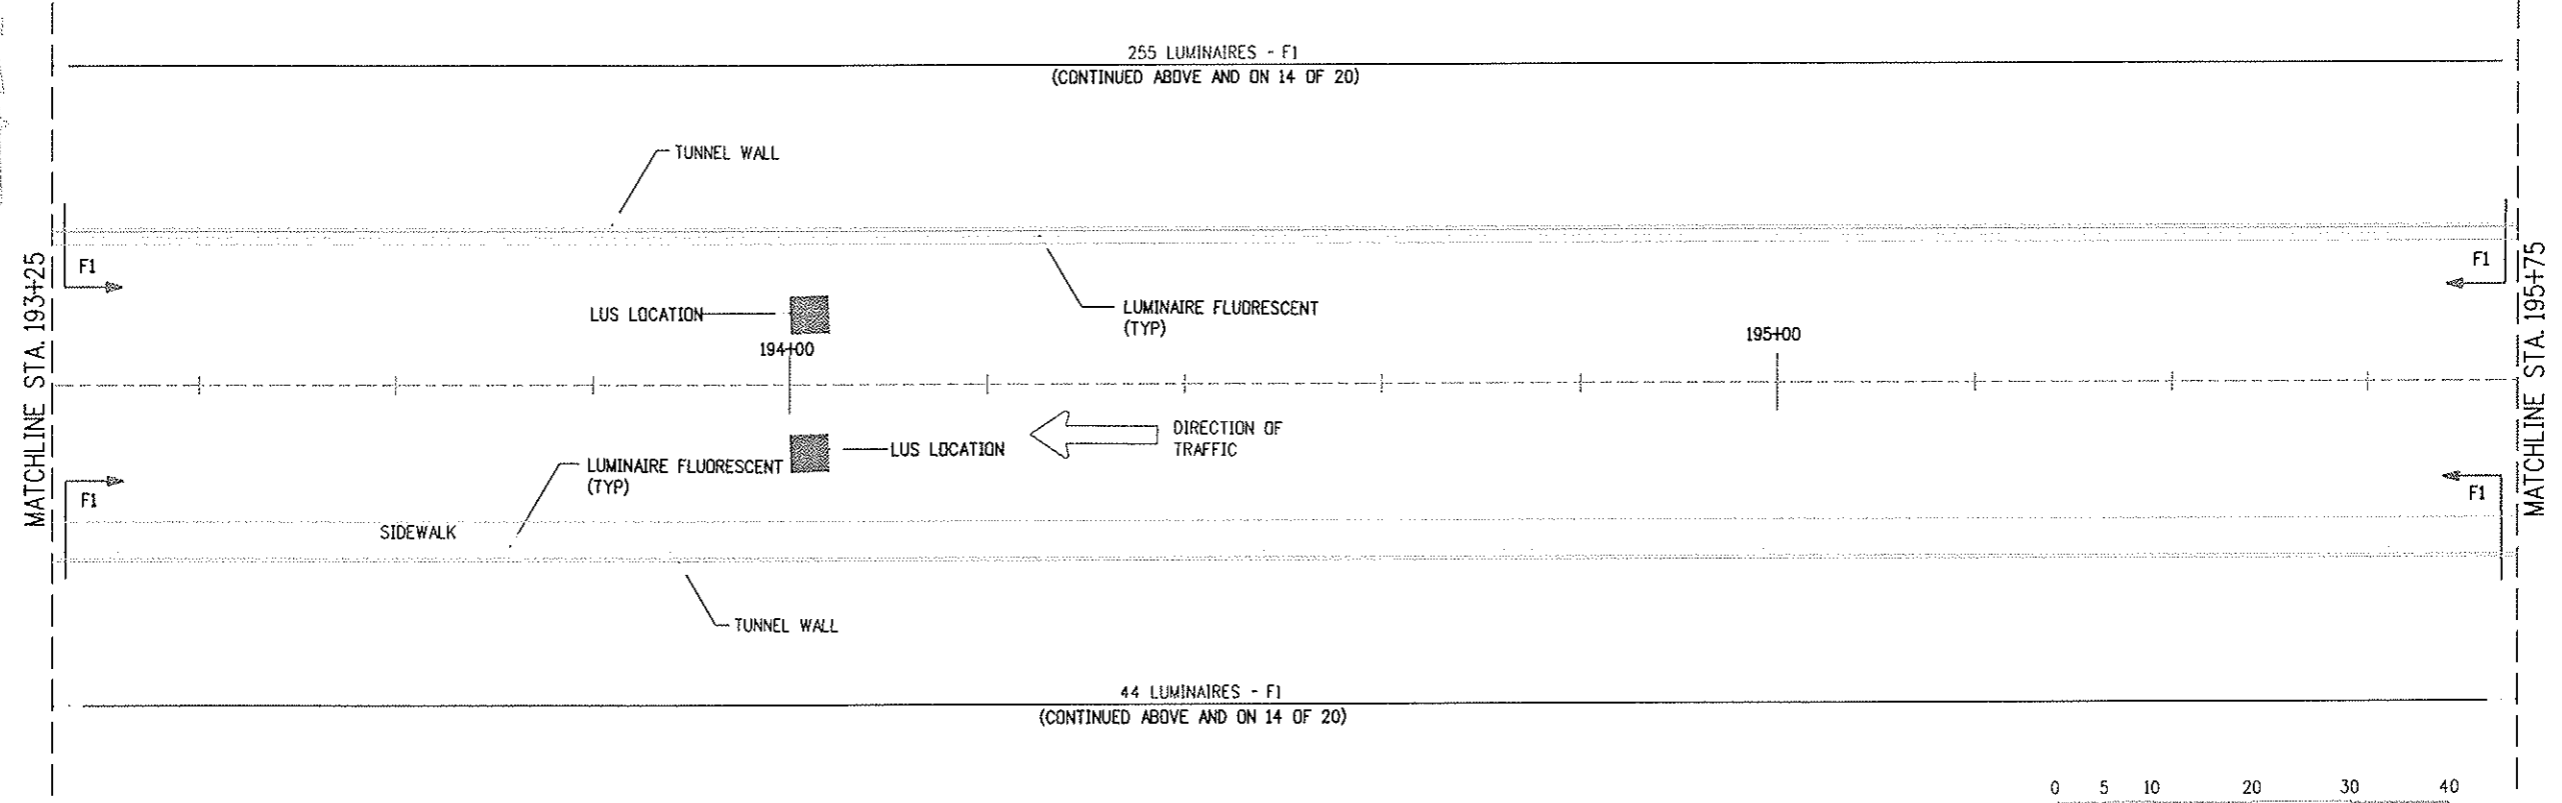

PLAN2

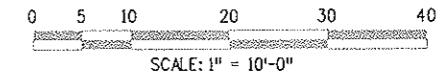


Design File Name: DGN\$SPEC*
 Plot File Name: \$PLD\$FILE*
 Date of Plot: \$\$\$DATE\$\$\$

Computer File Information	
Creation Date:	02/26/99 Initials: DJB
Last Modification Date:	02/26/99 Initials: DJB
Full Path:	14102\700CADD\703elec\
Drawing File Name:	ltpl12n.dwg
Acad Ver.	R14 Scale: 1" = 10'-0" Units: Feet

Sheet Revisions	
<input type="checkbox"/>	07/03/07 ASBUILT DJB
<input type="checkbox"/>	
<input type="checkbox"/>	
<input type="checkbox"/>	

Colorado Department of Transportation

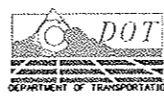

P.O. BOX 399
DUMONT, CO. 80436
Phone: 303-512-5750 FAX: 303-512-5775

Region 1 Mountain Residency I.N.Z.

As Constructed
No Revisions:
Revised:
Void:


NORTH TUNNEL LIGHTING PLANS	
Designer:	D. BURROUGHS
Detailer:	D. BURROUGHS
Sheet Subset:	TUN. LTC.
Structure Numbers	
Subset Sheets:	13 of 20

Project No./Code
IM 0703-269
13166
Sheet Number 37

MATCHLINE STA. 195+75

MATCHLINE STA. 198+25

255 LUMINAIRES - F1
(CONTINUED BELOW AND ON 13 OF 20)

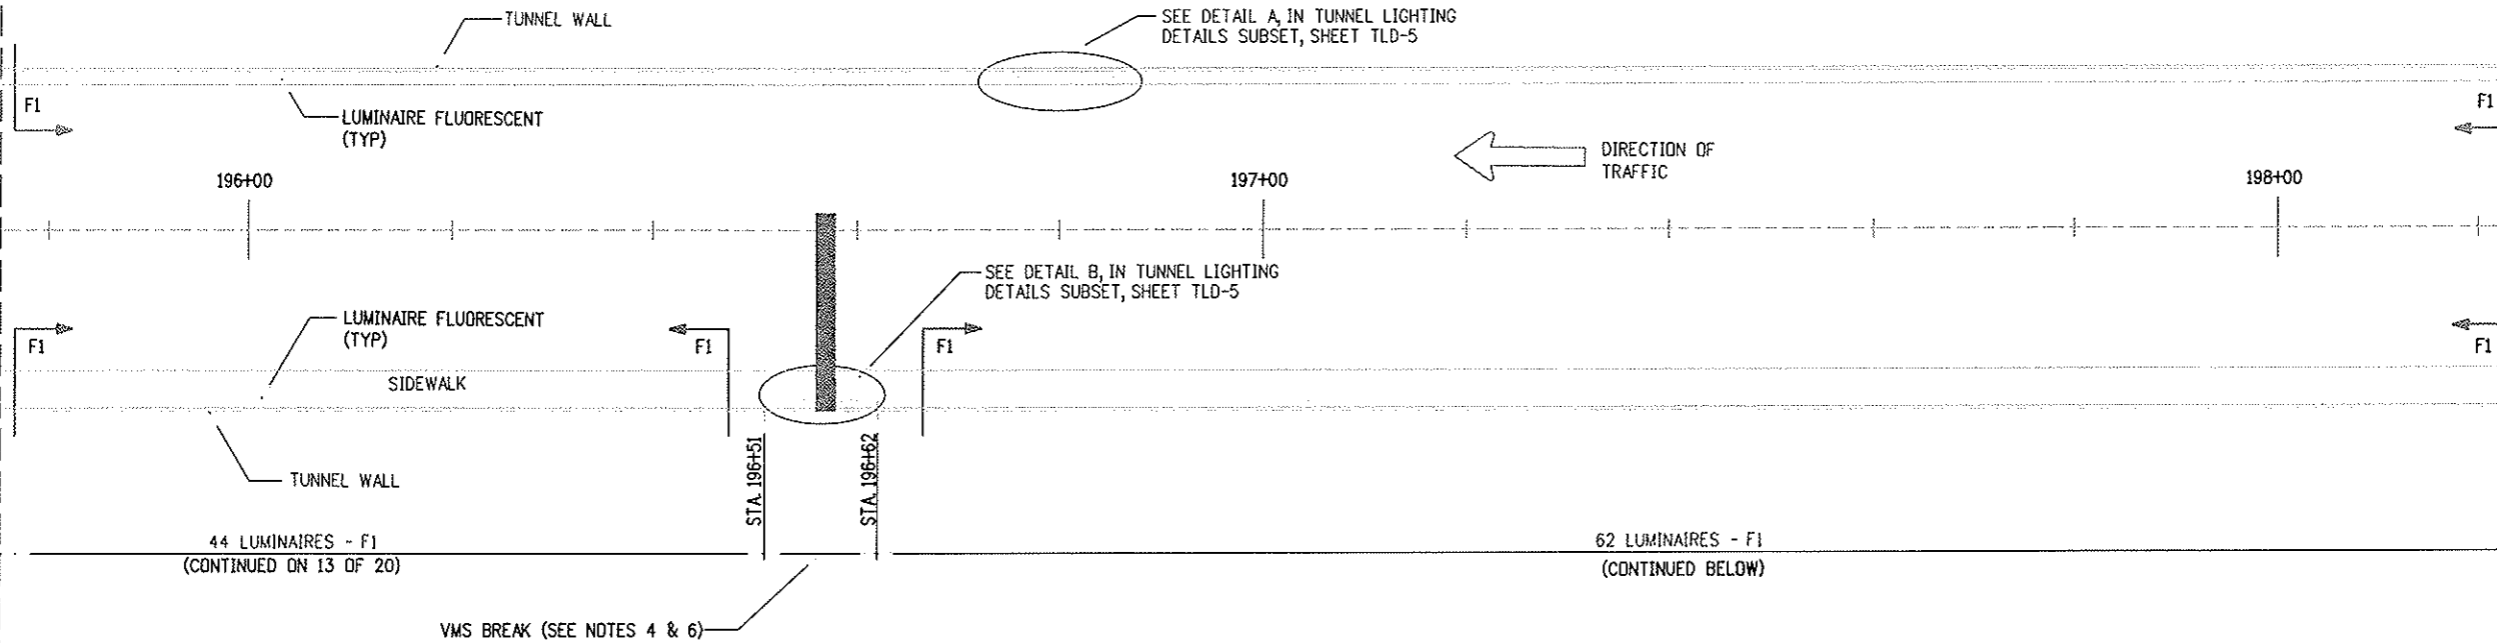


PLAN 1


MATCHLINE STA. 198+25

MATCHLINE STA. 200+75

255 LUMINAIRES - F1
(CONTINUED ABOVE AND ON 15 OF 20)

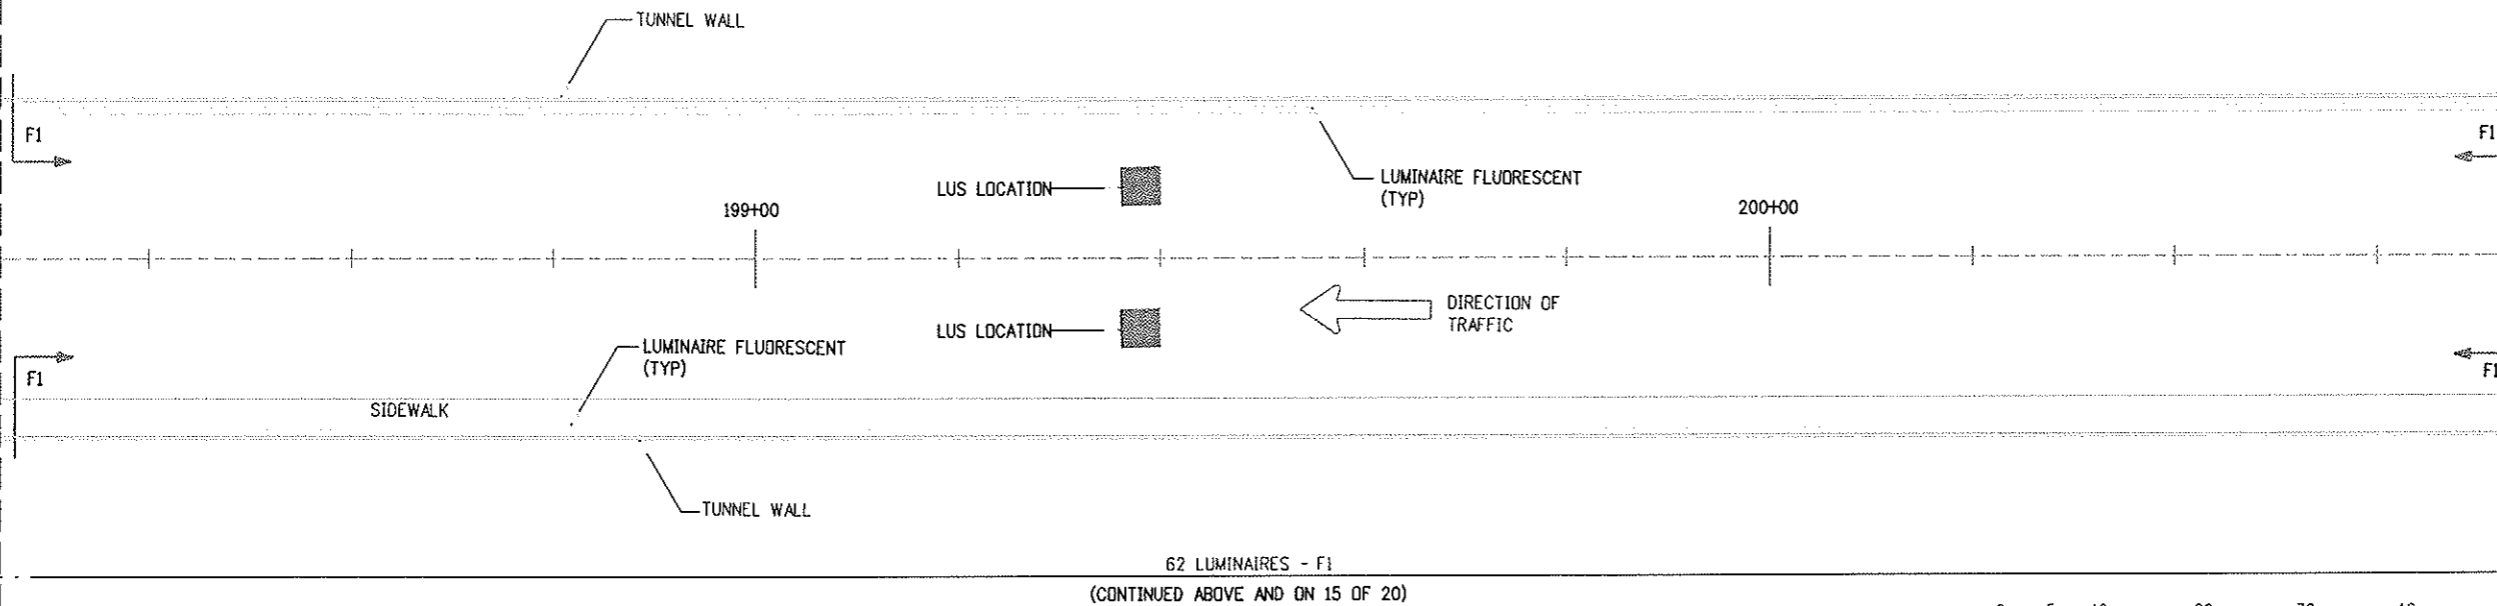


PLAN 2

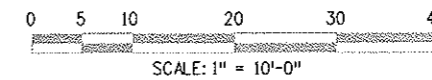

DATE OF PLOT: 03/03/07

Computer File Information	
Creation Date:	02/26/99 Initials: DJB
Last Modification Date:	07/03/07 Initials: DJB
Full Path:	14102\700CADD\703elec\
Drawing File Name:	ltpl13n.dwg
Acad Ver.	R14
Scale:	1" = 10'-0"
Units:	English




Sheet Revisions	
07/03/07	ASBUILT DJB

Colorado Department of Transportation
 P.O. BOX 399
 DUMONT, CO. 80436
 Phone: 303-512-5750 FAX: 303-512-5775
 Region 1 Mountain Residency I.N.Z.

As Constructed
No Revisions:
Revised:
Void:

NORTH TUNNEL LIGHTING PLANS		
Designer:	D. BURROUGHS	Structure Numbers
Detailer:	D. BURROUGHS	
Sheet Subset:	TUN. LTG.	Subset Sheets: 14 of 20

Project No./Code
IM 0703-269
13166
Sheet Number 38

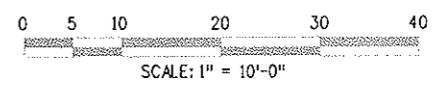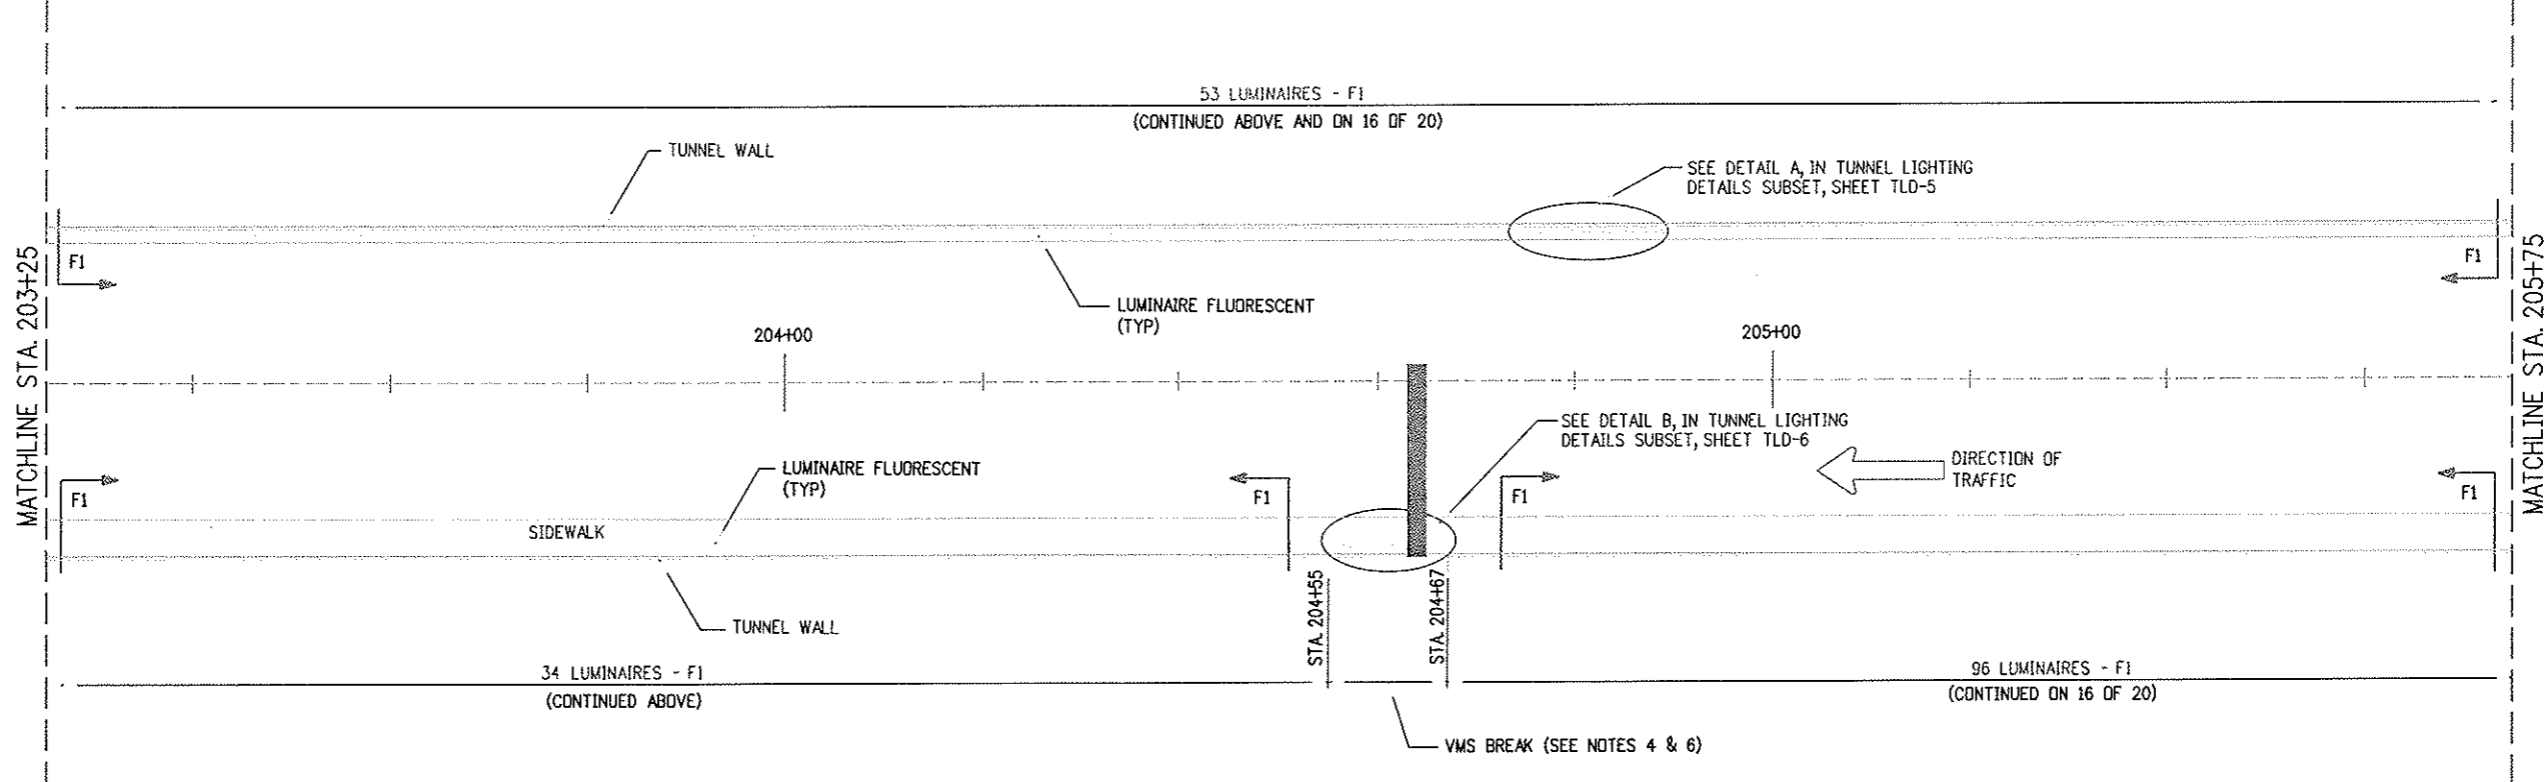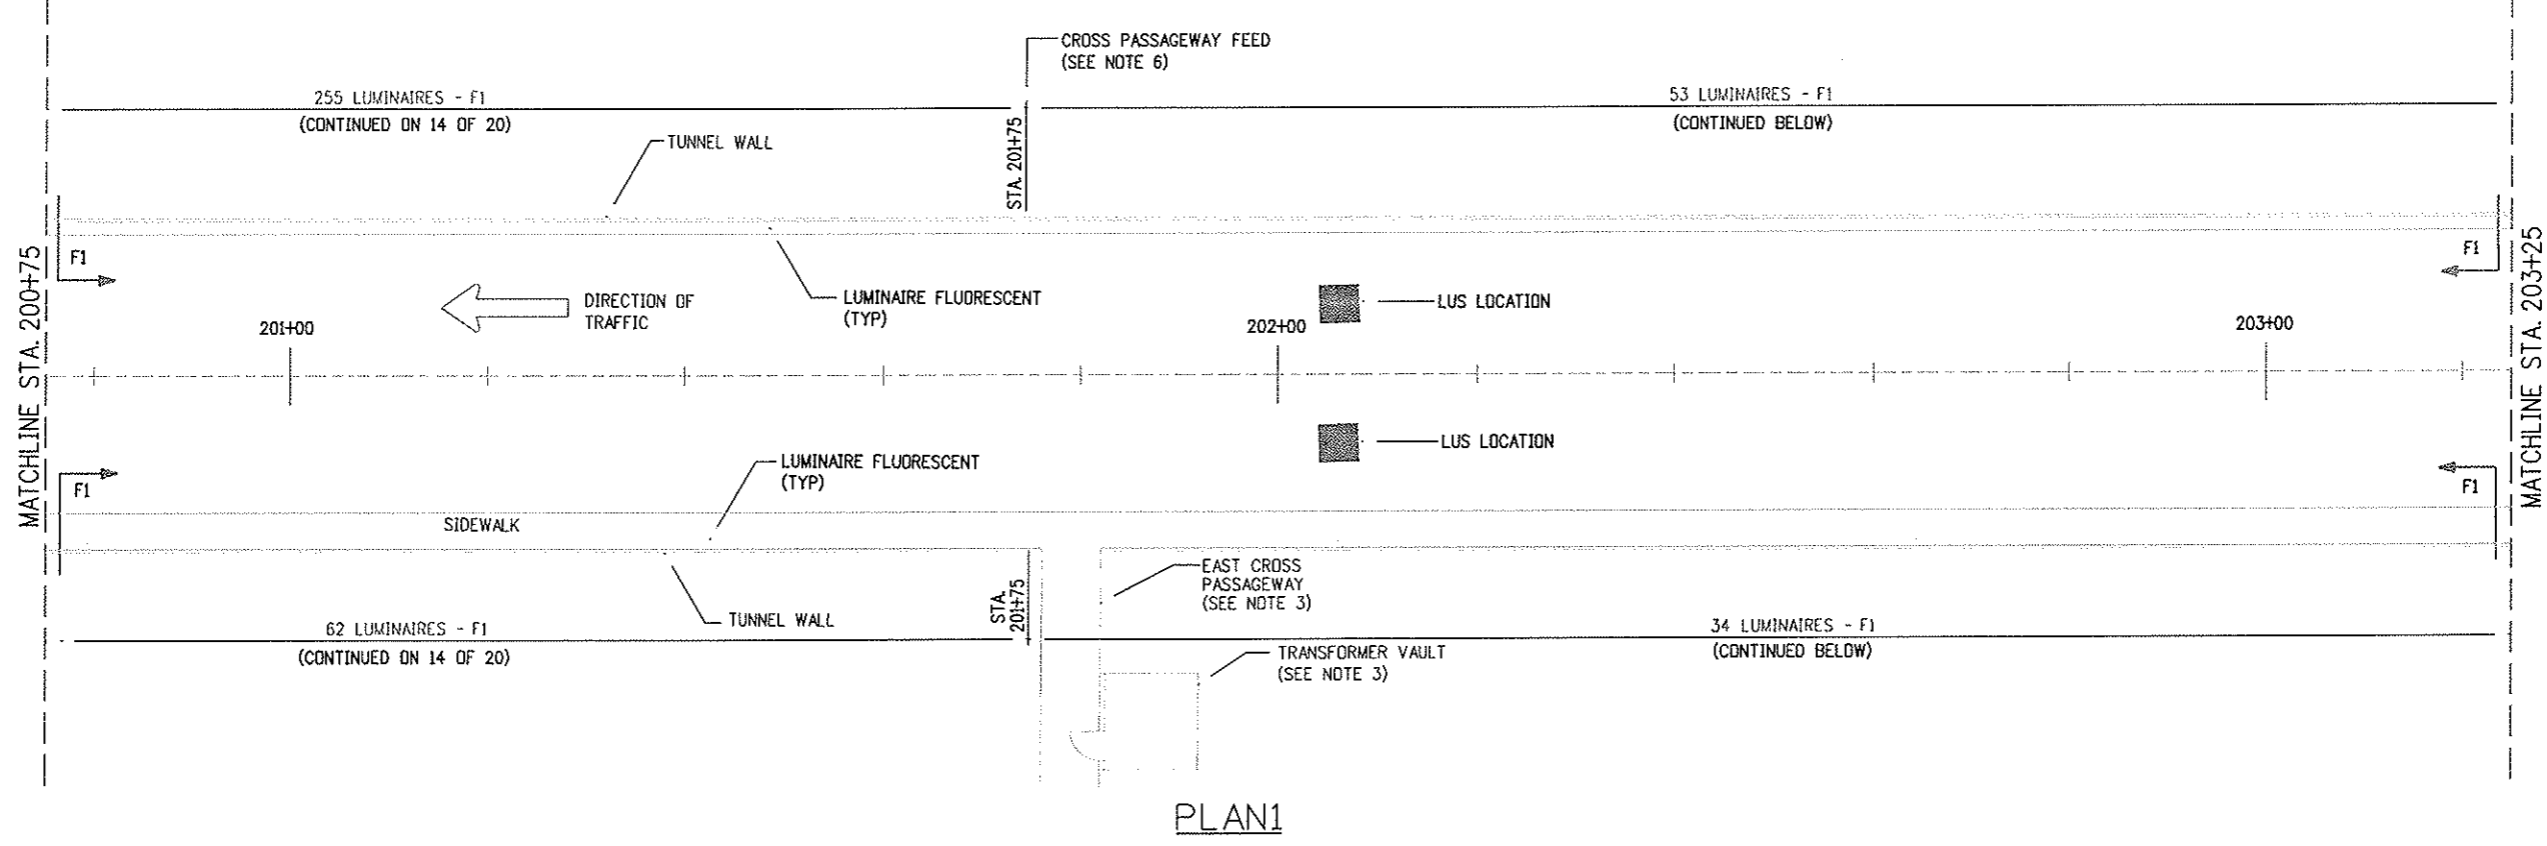


Design File Name: DGNSSPEC*
 Plot File Name: SPL01FILE*
 Date of Plot: 03/04/2001

Computer File Information	
Creation Date:	02/26/99 Initials: DJB
Last Modification Date:	03/04/01 Initials: DJB
Full Path:	14202\700CADD\703elec\
Drawing File Name:	tlpl14n.dwg
Acad Ver.	R14 Scale: 1" = 20'-0" Units: English

Sheet Revisions	
07/03/07	ASBUILT DJB

Colorado Department of Transportation





P.O. BOX 399
 DUMONT, CO. 80436
 Phone: 303-512-5750 FAX: 303-512-5775

Region 1 Mountain Residency I.N.Z.

As Constructed
No Revisions:
Revised:
Void:

NORTH TUNNEL LIGHTING PLANS		
Designer:	D. BURROUGHS	Structure Numbers
Detailer:	D. BURROUGHS	
Sheet Subset:	TUN. LTG.	Subset Sheets: 15 of 20

Project No./Code	
IM 0703-269	
13166	
Sheet Number	39

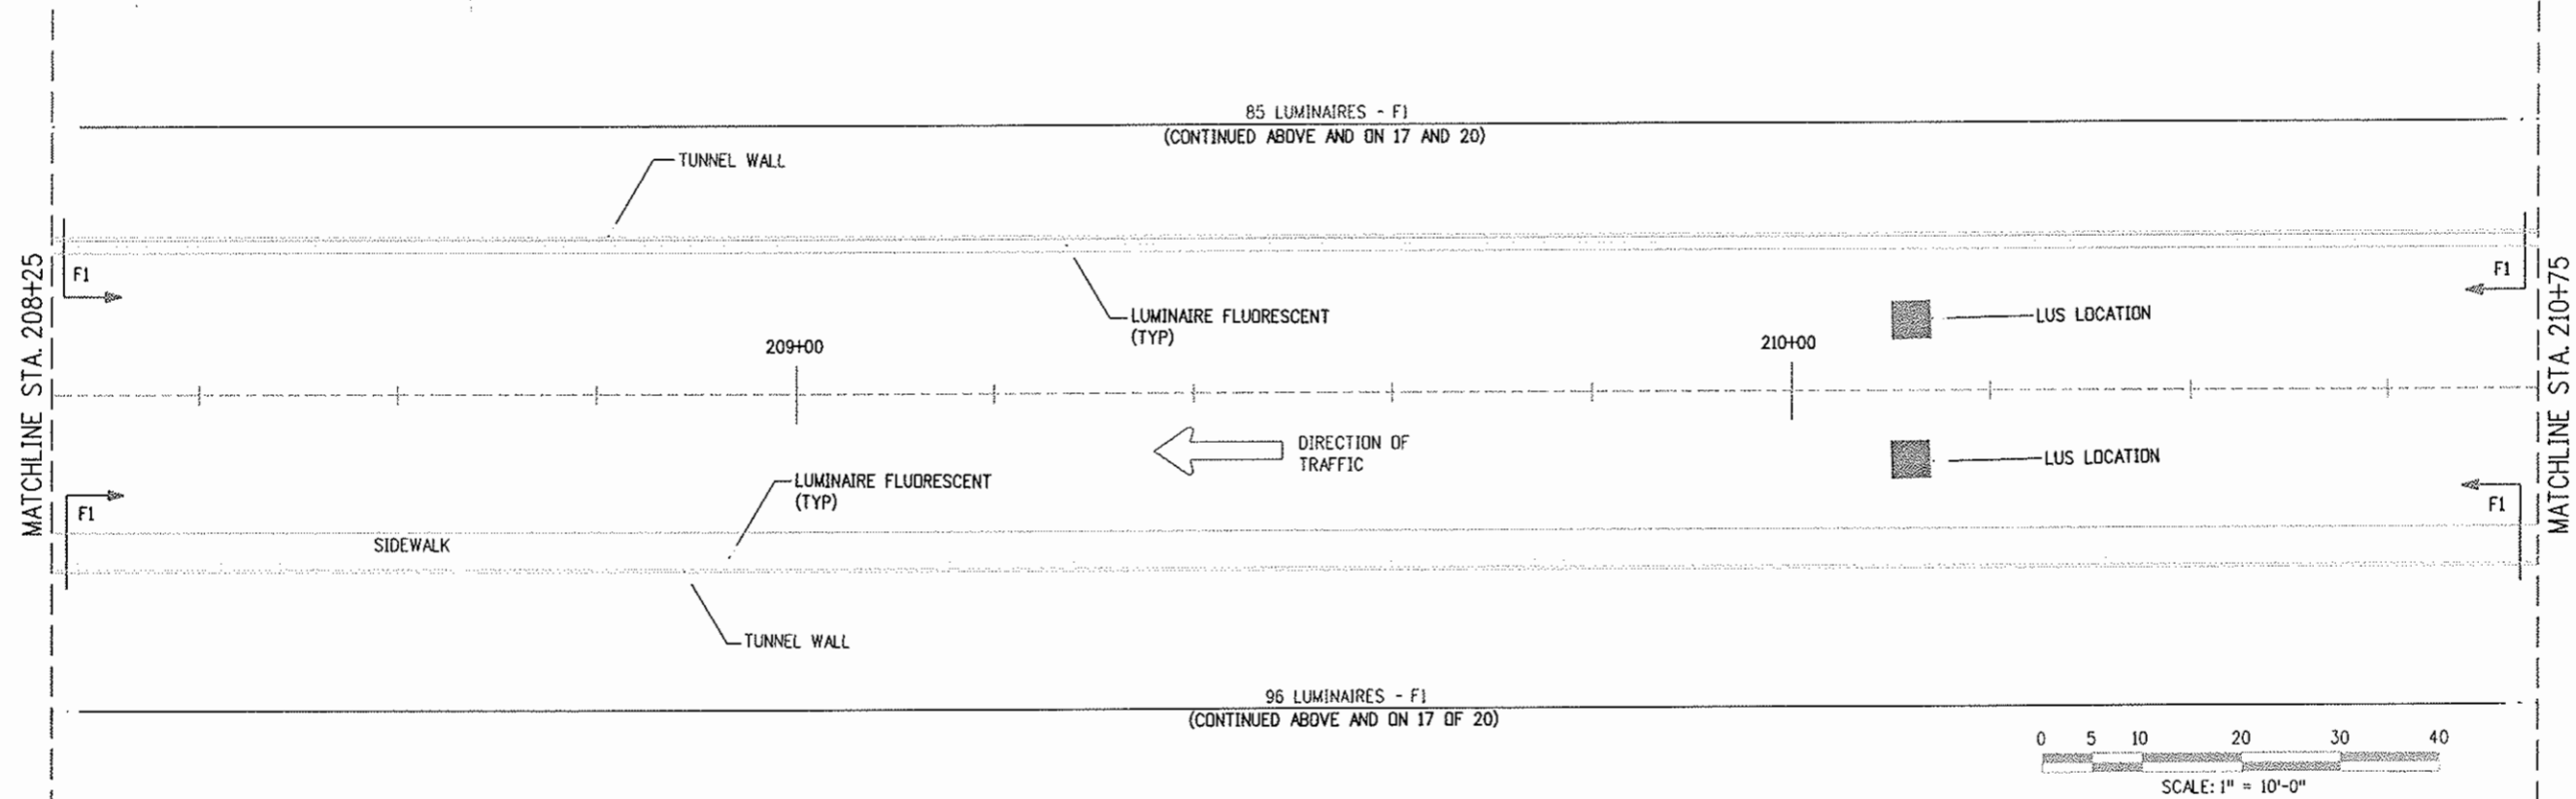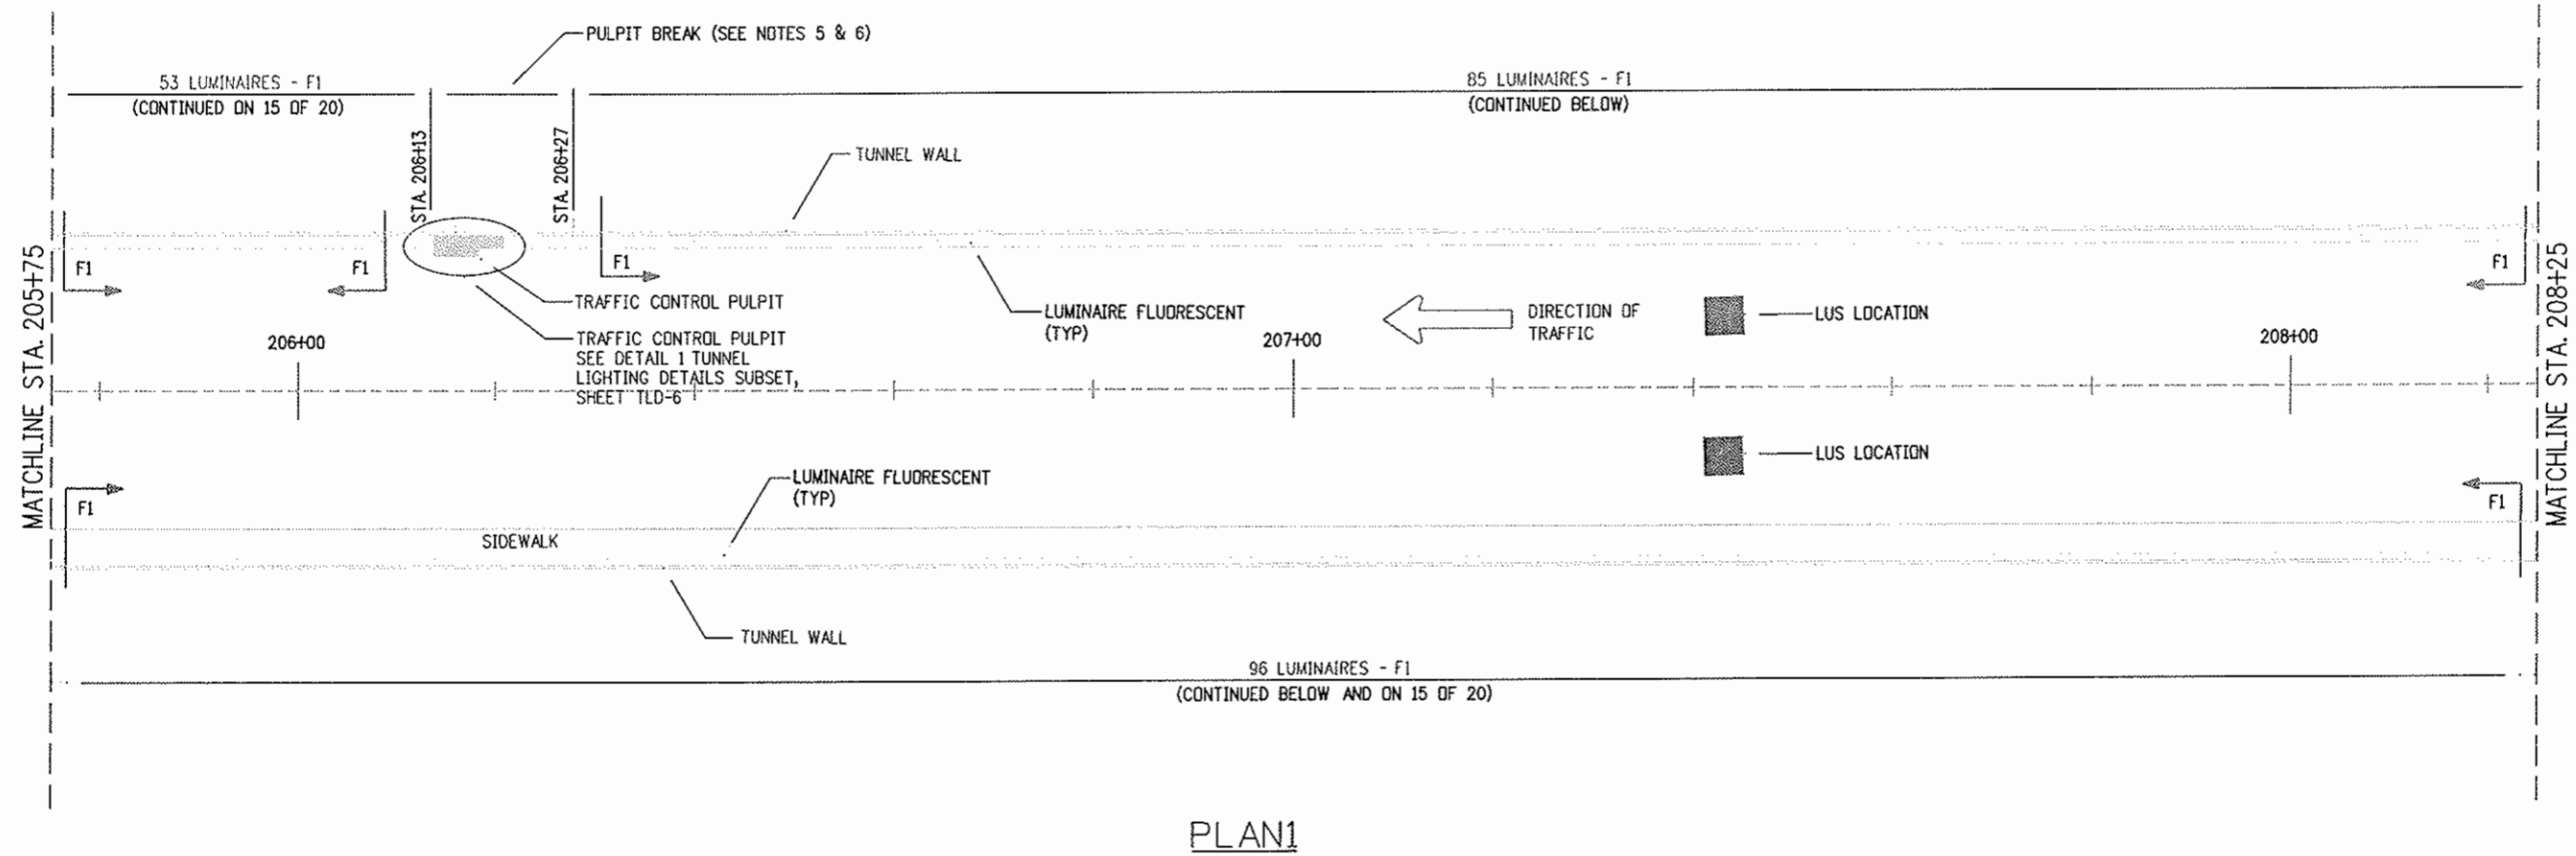


Plot File Name: SPLD1FILE*
 Date of Plot: \$\$\$DATE\$\$\$\$

Computer File Information	
Creation Date:	02/26/99 Initials: DJB
Last Modification Date:	02/06/01 Initials: DJB
Full Path:	14202\700CADD\703elec\
Drawing File Name:	tlpl15n.dwg
Acad Ver.:	R14 Scale: 1" = 20'-0" Units: English

Sheet Revisions	
07/03/07	ASBUILT DJB

Colorado Department of Transportation

 P.O. BOX 399
 DUMONT, CO. 80436
 Phone: 303-512-5750 FAX: 303-512-5775

Region 1 Mountain Residency I.N.Z.

As Constructed


No Revisions:

Revised:


Void:

NORTH TUNNEL LIGHTING PLANS	
Designer:	D BURROUGHS
Detailer:	D BURROUGHS
Sheet Subset:	TUN. LTC.
Structure Numbers:	
Subset Sheets:	16 of 20


Project No./Code	
IM	0703-269
Sheet Number	40

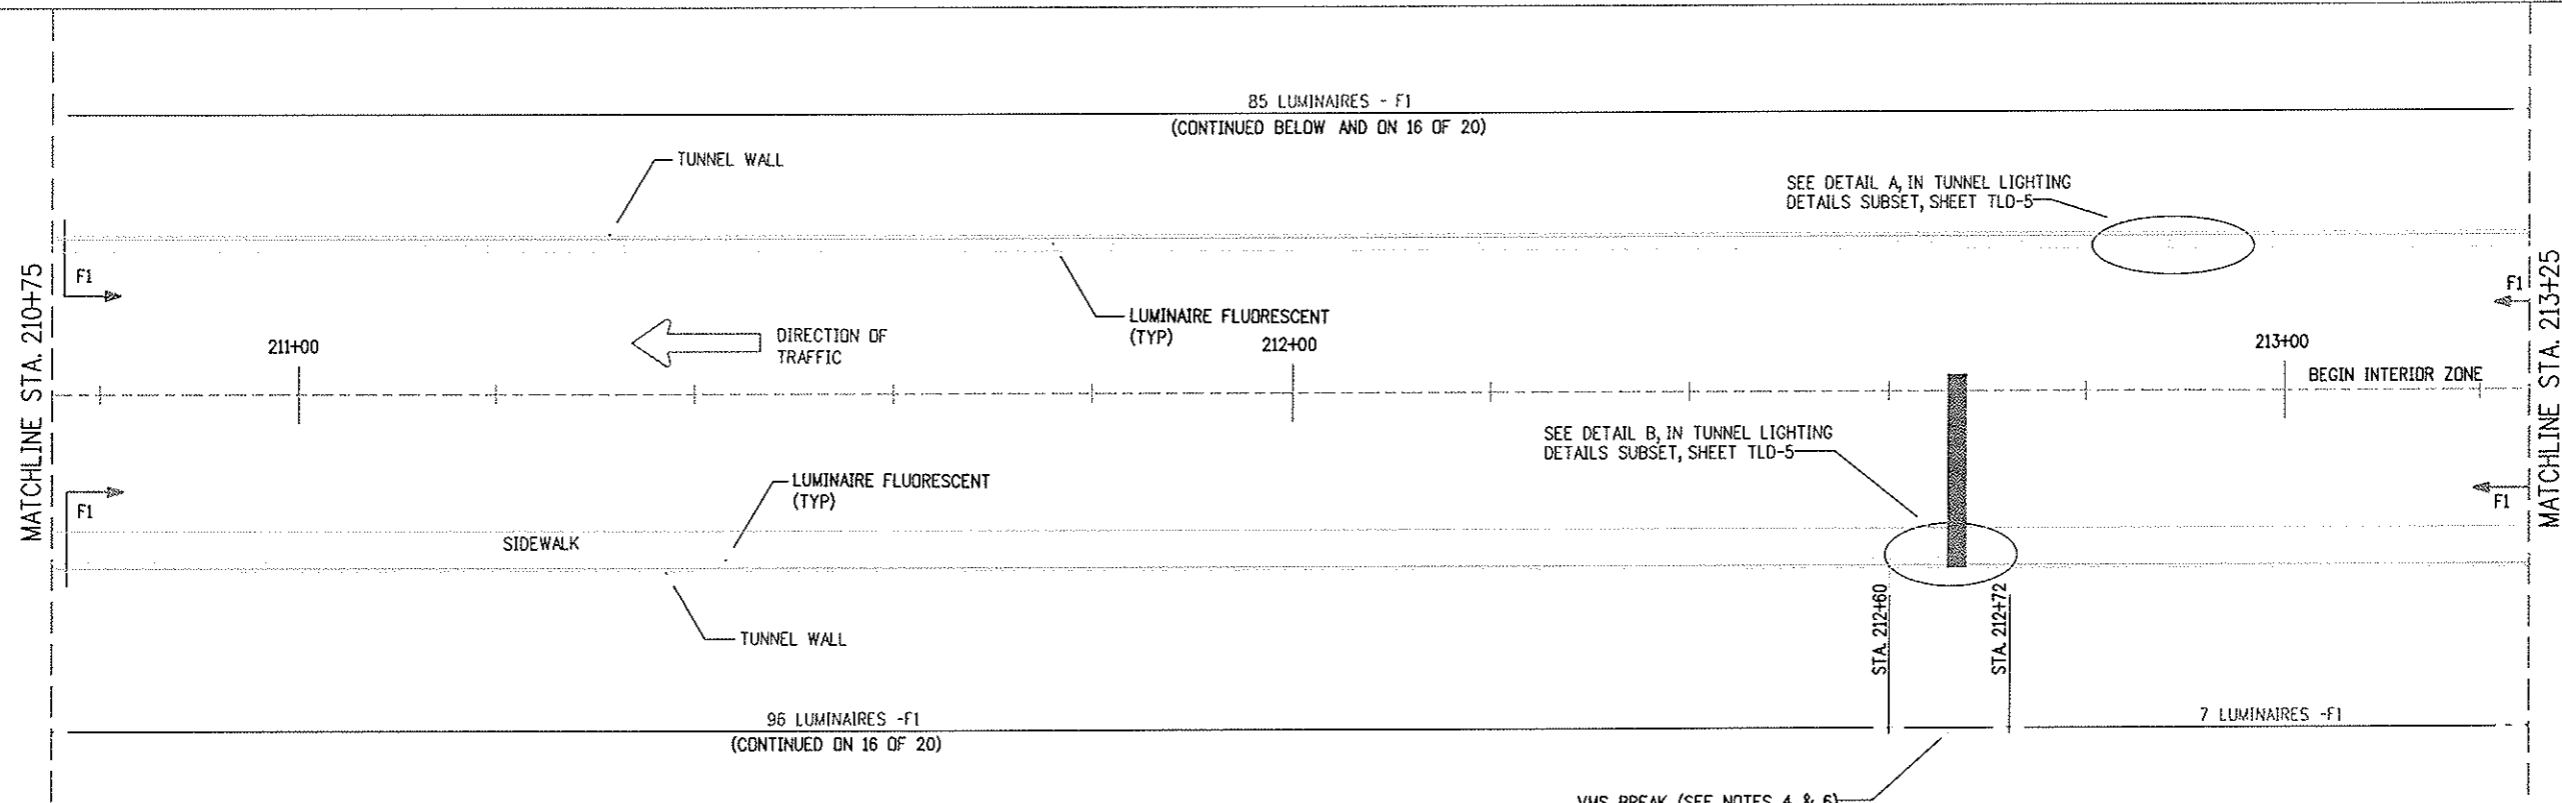

PLAN 1

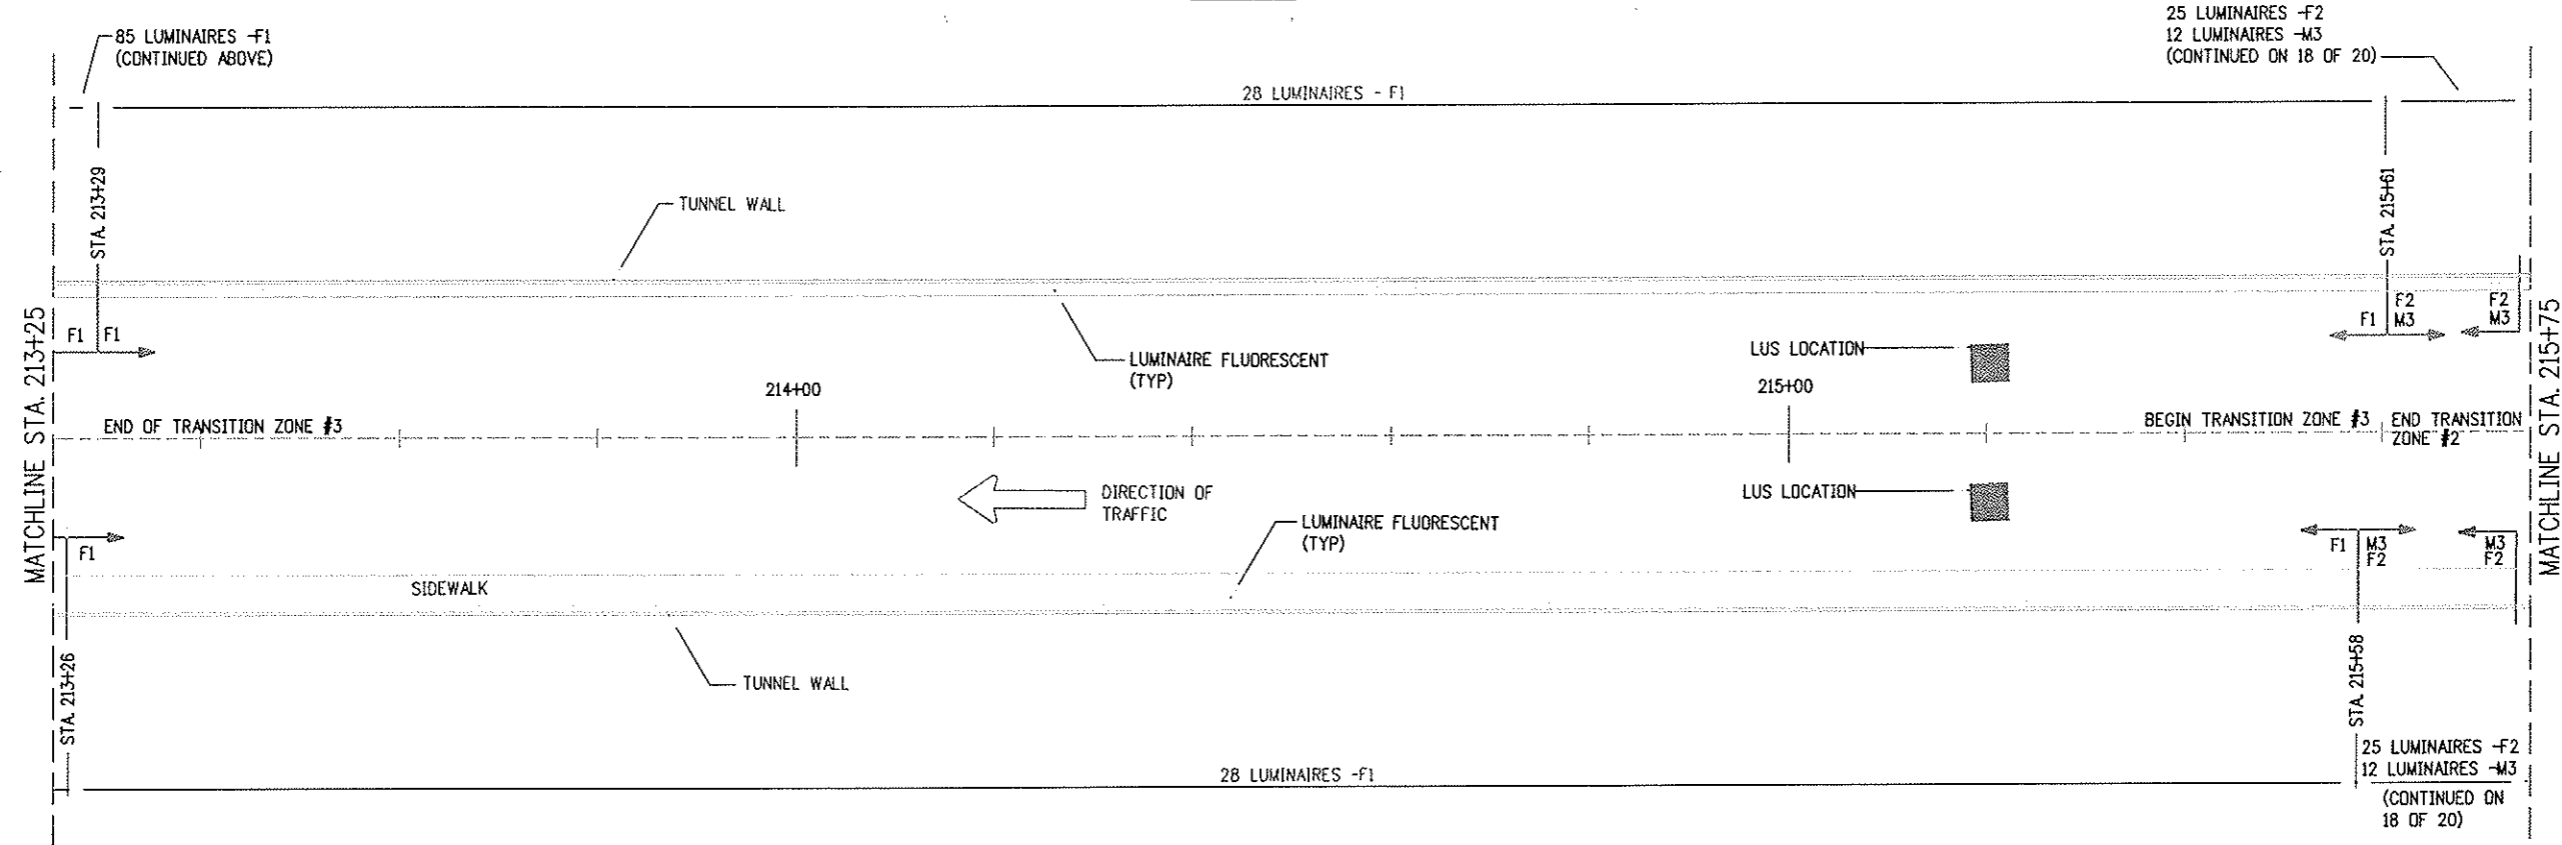


PLAN 2

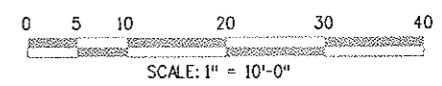

Design File Name: DGN\$SPEC*
 Plot File Name: \$PLOTFILE*
 Date of Plot: \$\$\$DATE\$\$\$

Computer File Information	
Creation Date:	02/26/99 Initials: DJB
Last Modification Date:	02/26/2001 Initials: DJB
Full Path:	14102\700CADD\703elec\
Drawing File Name:	itpl16n.dwg
Acad Ver.	R14 Scale: 1" = 10'-0" Units: English


Sheet Revisions	
07/03/07	ASBUILT DJB

Colorado Department of Transportation

 P.O. BOX 399
 DUMONT, CO. 80436
 Phone: 303-512-5750 FAX: 303-512-5775
 Region 1 Mountain Residency I.N.Z.


As Constructed
No Revisions:
Revised:
Void:

NORTH TUNNEL LIGHTING PLANS	
Designer:	D. BURROUGHS
Detailer:	D. BURROUGHS
Sheet Subset:	TUN. LTG.
Structure Numbers:	
Subset Sheets:	17 of 20

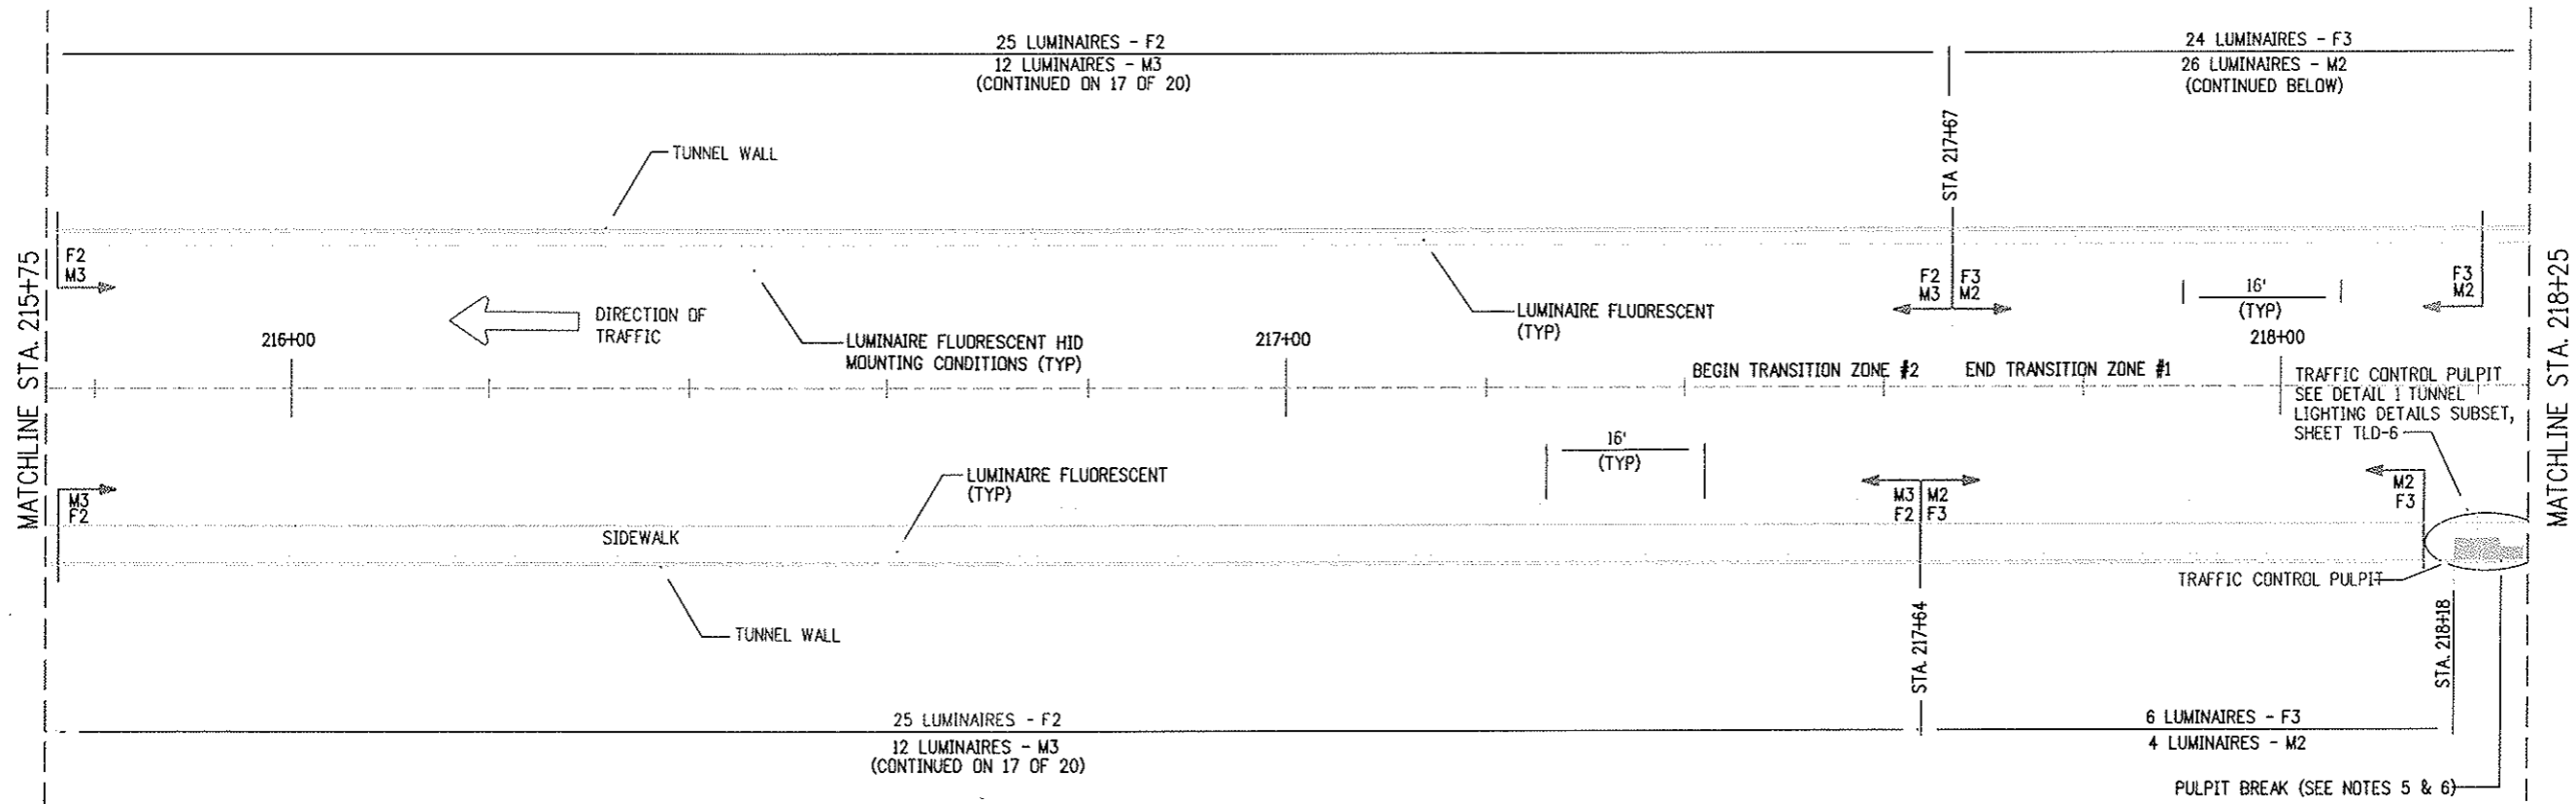
Project No./Code
IM 0703-269
13166
Sheet Number 41



PLAN 1

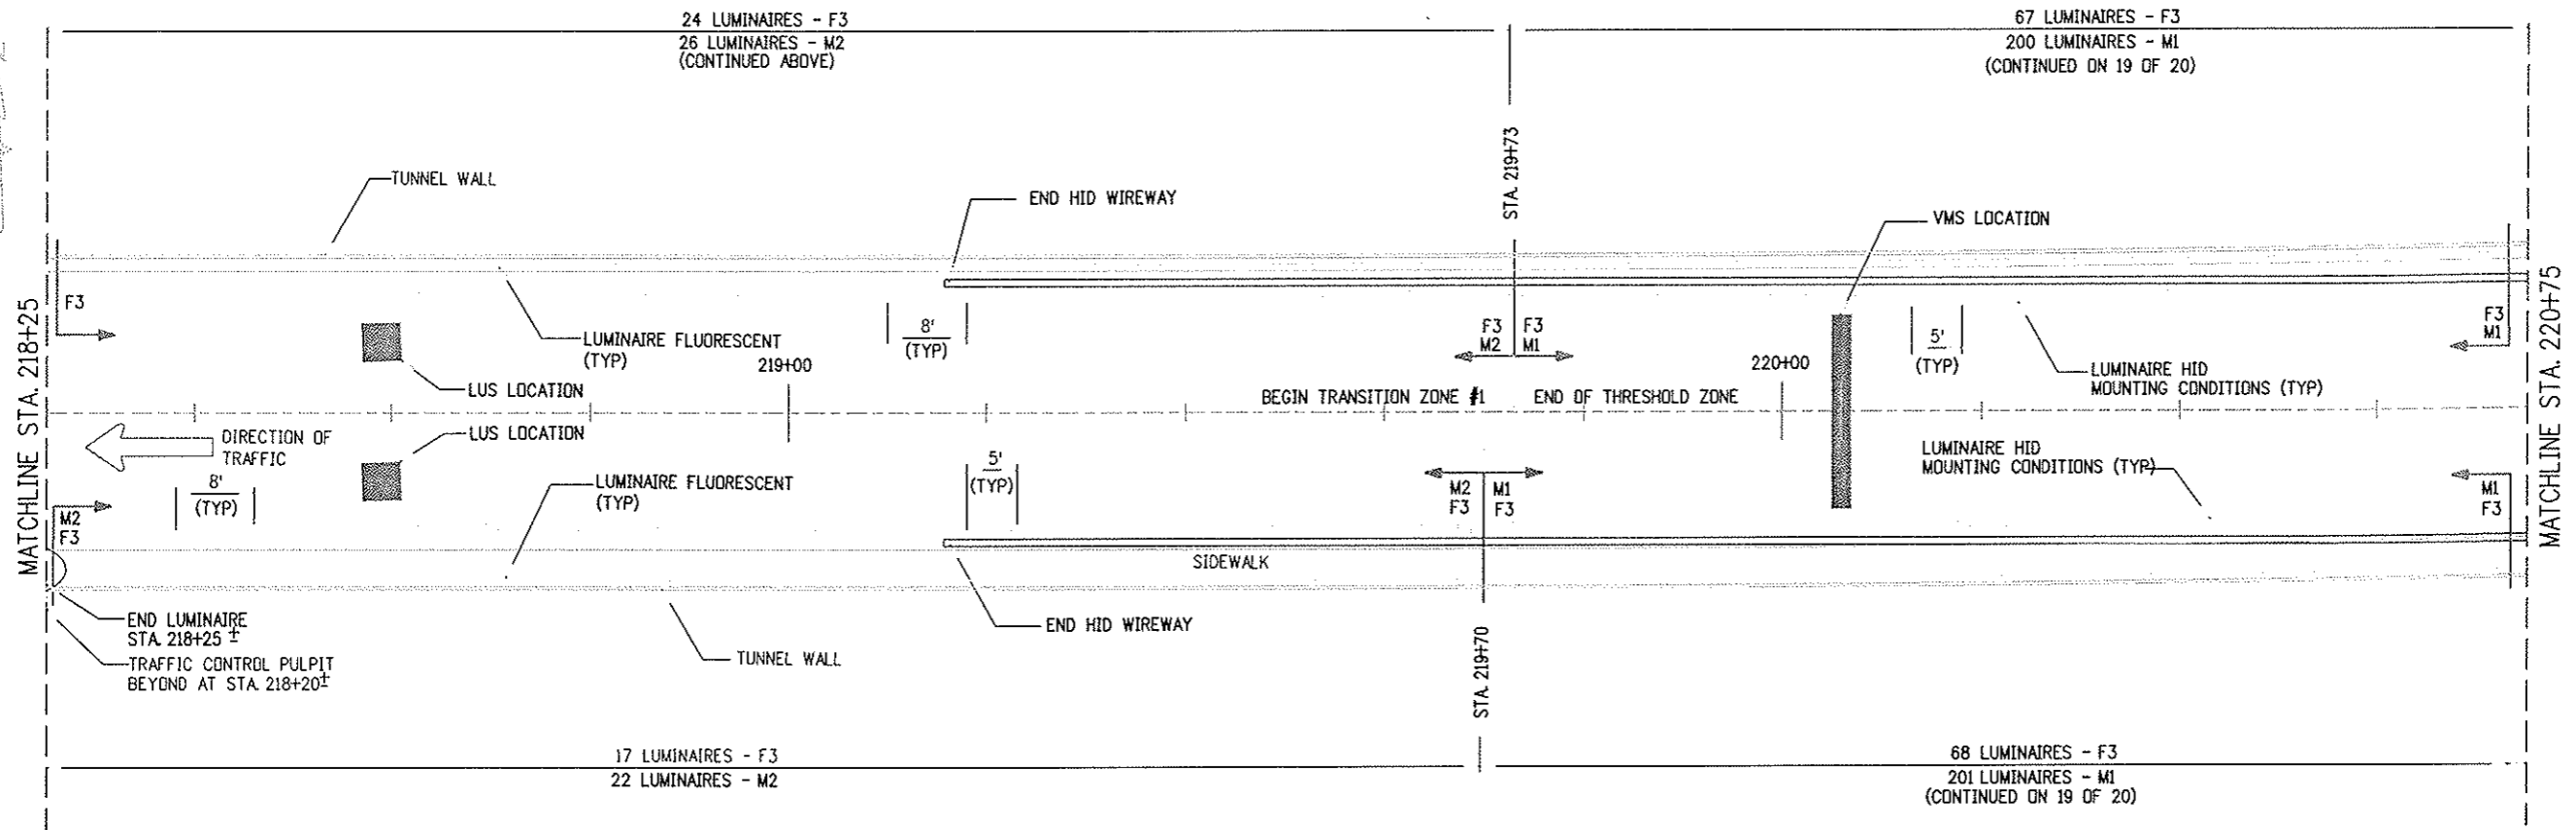

PLAN 2

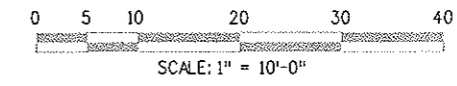

Plot File Name: \$PLOTFILE* \$\$\$\$DATE\$\$\$\$ Date of Plot: \$\$\$\$DATE\$\$\$\$

Computer File Information	
Creation Date:	02/26/99 Initials: DJB
Last Modification Date:	11/20/00 Initials: DJB
Full Path:	14102\700CADD\703elec\
Drawing File Name:	tlp117n.dwg
Acad Ver.:	R14 Scale: 1" = 10'-0" Units: English

Sheet Revisions	
07/03/07	ASBUILT DJB

Colorado Department of Transportation

P.O. BOX 399
DUMONT, CO. 80436
Phone: 303-512-5750 FAX: 303-512-5775


Region 1 Mountain Residency I.N.Z.

As Constructed
No Revisions:
Revised:
Void:


NORTH TUNNEL LIGHTING PLANS		
Designer:	D BURROUGHS	Structure Numbers
Detailer:	D BURROUGHS	
Sheet Subset:	TUN. LTG.	Subset Sheets: 18 of 20

Project No./Code	
IM 0703-269	
13166	
Sheet Number	42

- NOTES:
- A. AN ABRUPT CHANGE IN CEILING ANGLE OCCURS AT STA 224+78. CONTRACTOR SHALL COORDINATE TRANSITION TO MAINTAIN CONTINUANCE OF WIREWAY.
 - B. CONTRACTOR SHALL MAINTAIN CONTINUANCE OF FLUORESCENT LUMINAIRES THROUGH TRANSITION IN TUNNEL CEILING AT STA 224+78.
 - C. THE TUNNEL CEILING IS RELATIVELY CONSTANT AT 16'-4" TO STA 224+78 AND GRADUALLY RISES TO 24'-0" AT STA 225+31.

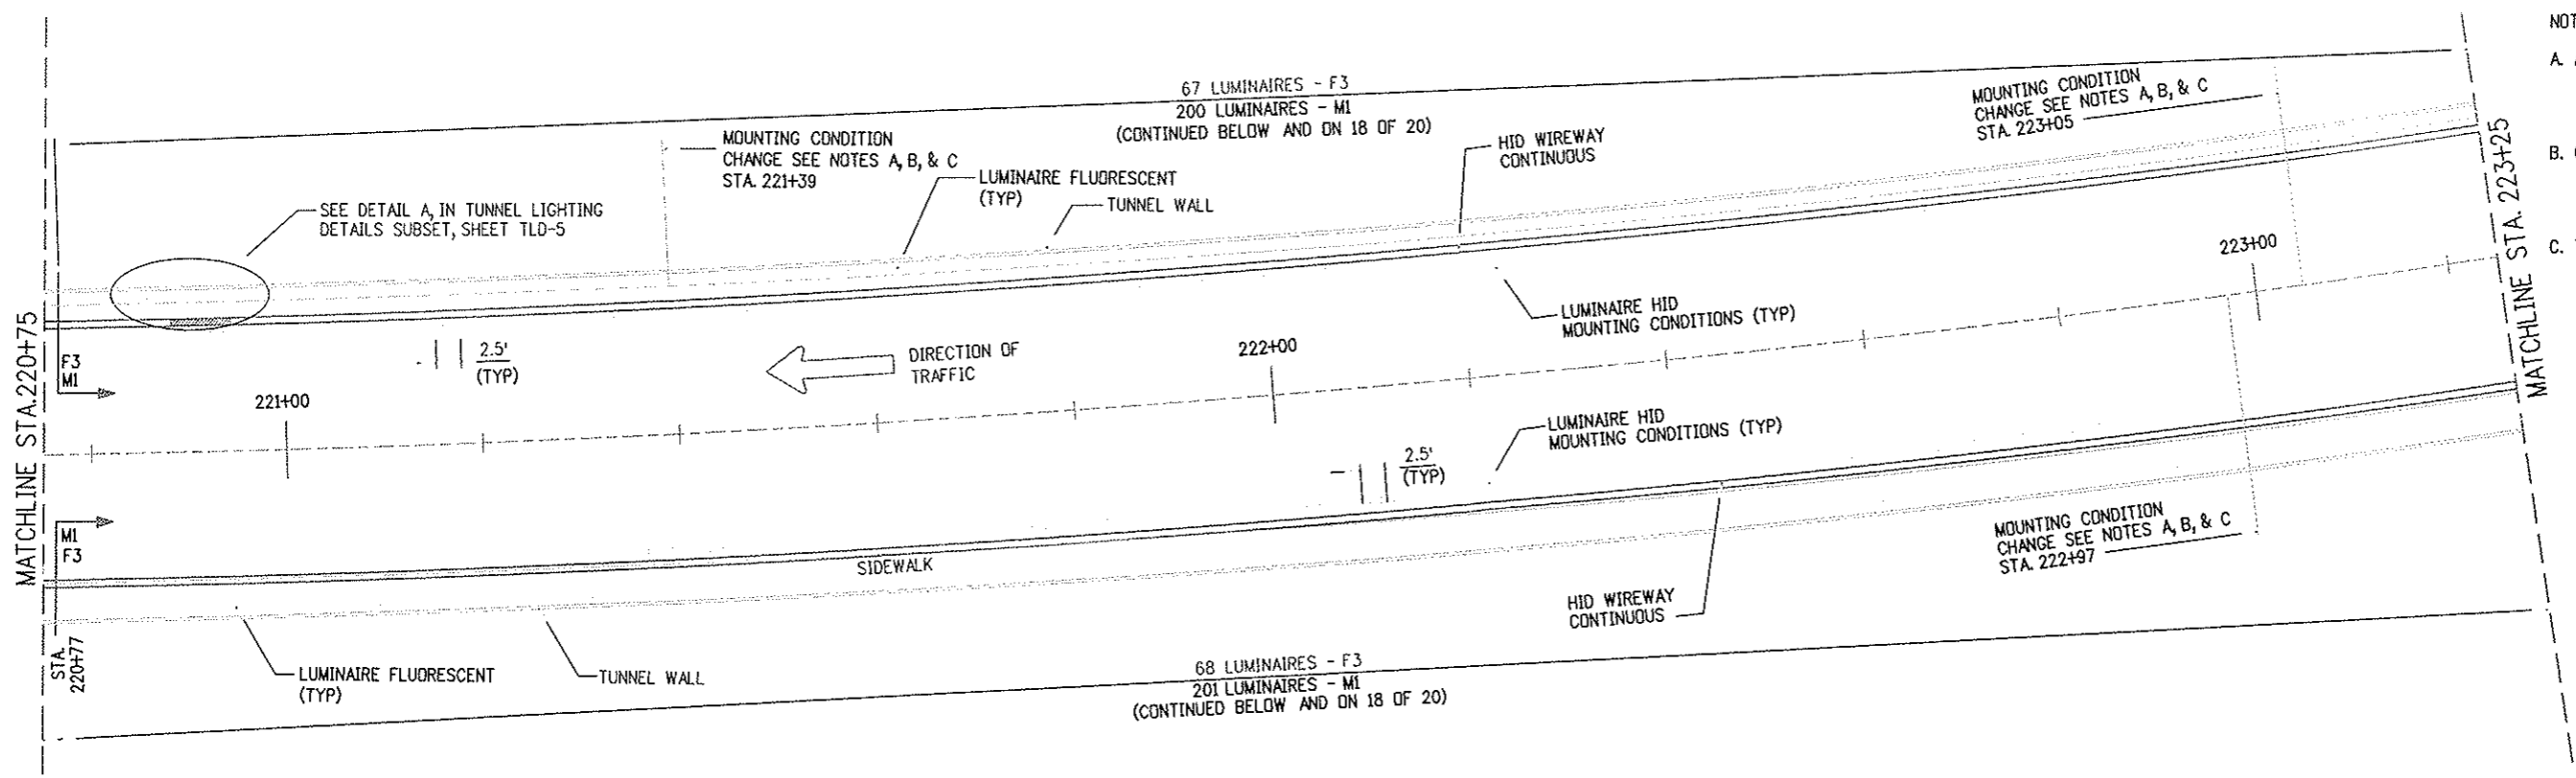

PLAN 1

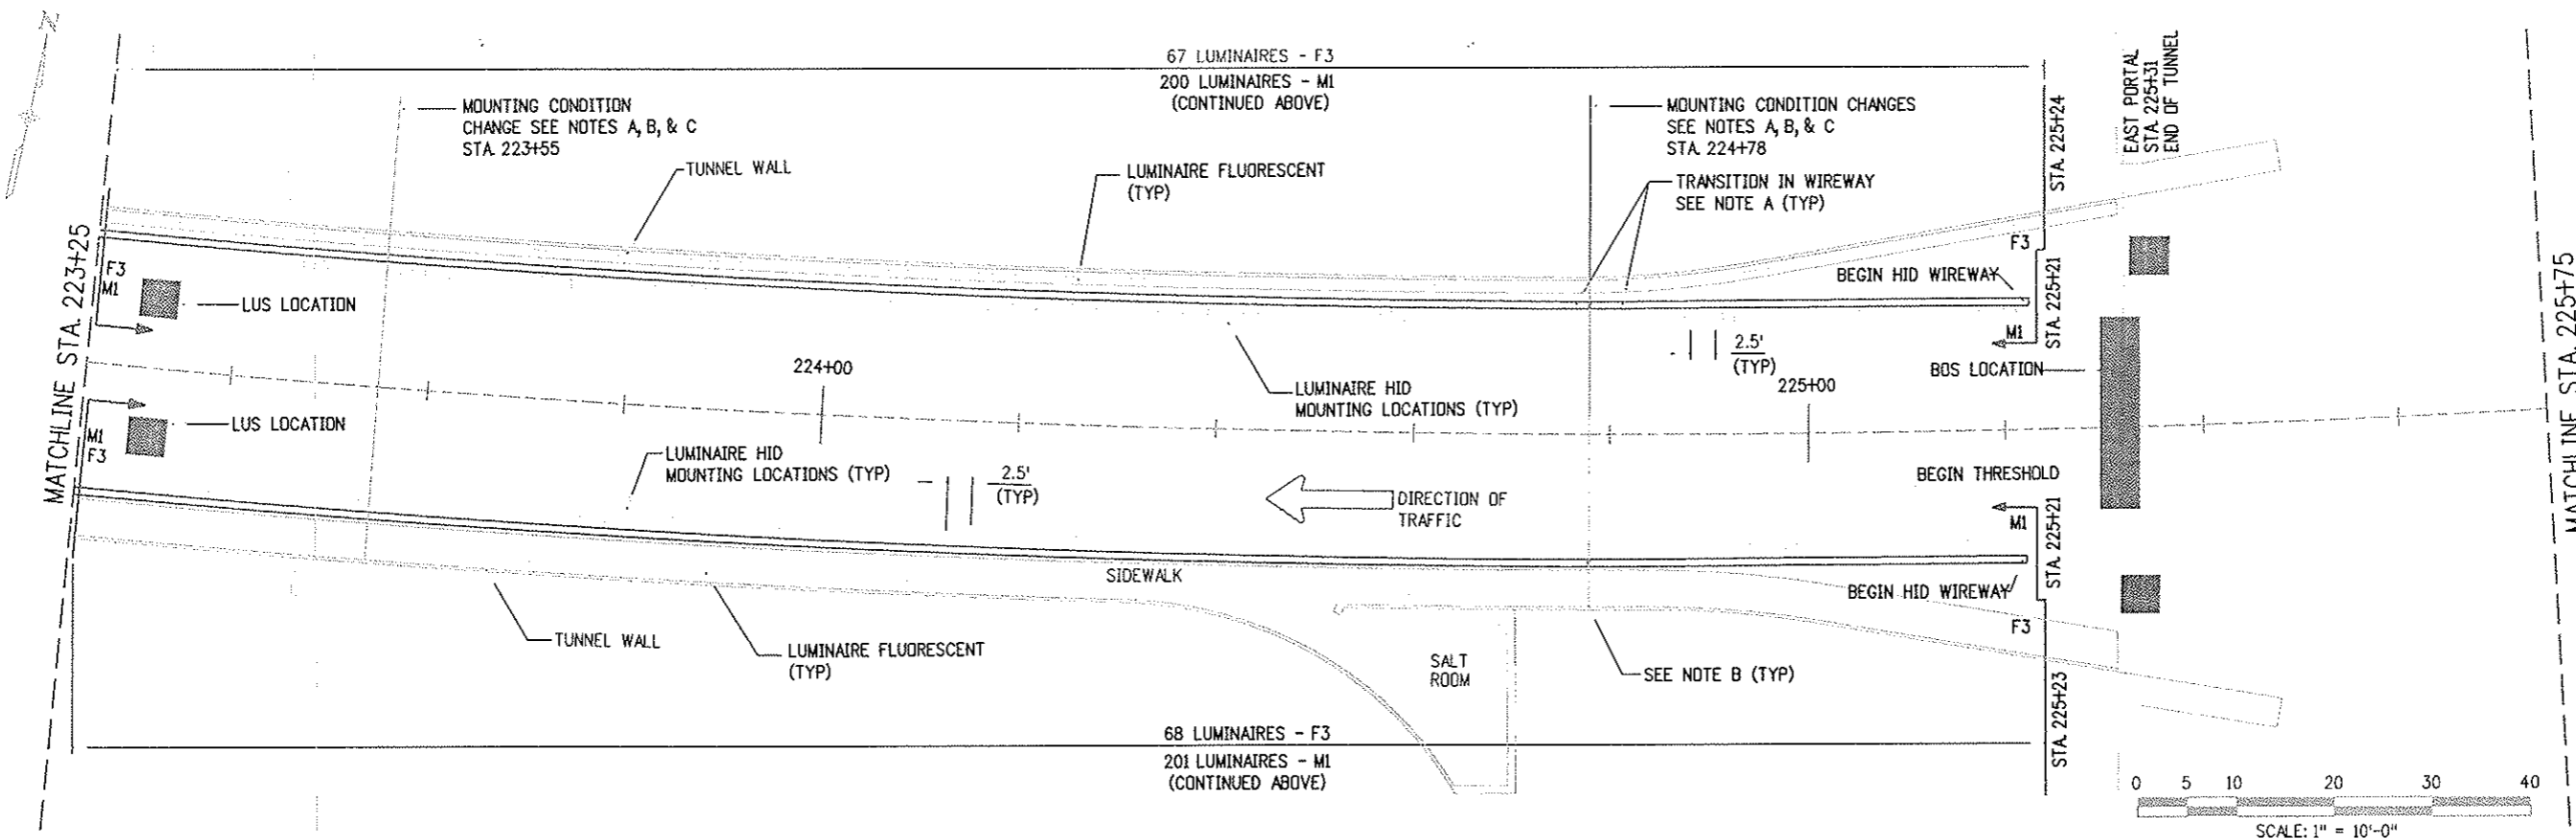

PLAN 2


Computer File Information		Sheet Revisions		Colorado Department of Transportation		As Constructed		NORTH TUNNEL LIGHTING PLANS		Project No./Code	
Creation Date:	02/26/99	Initials:	DJB	07/03/07	ASBUILT					IM 0703-269	
Last Modification Date:	02/26/01	Initials:	DJB							13166	
Full Path:	14102\700CADD\703elec\									Sheet Number 43	
Drawing File Name:	ltp18n.dwg									19 of 20	
Acad Ver.	R14	Scale:	1" = 10'-0"	Units:	English					Sheet Number 43	



P.O. BOX 399
 DUMONT, CO. 80436
 Phone: 303-512-5750 FAX: 303-512-5775


Region 1 Mountain Residency I.N.Z.

Designer: D. BURROUGHS
 Detailer: D. BURROUGHS
 Sheet Subset: TUN. LTG. Subset Sheets: 19 of 20

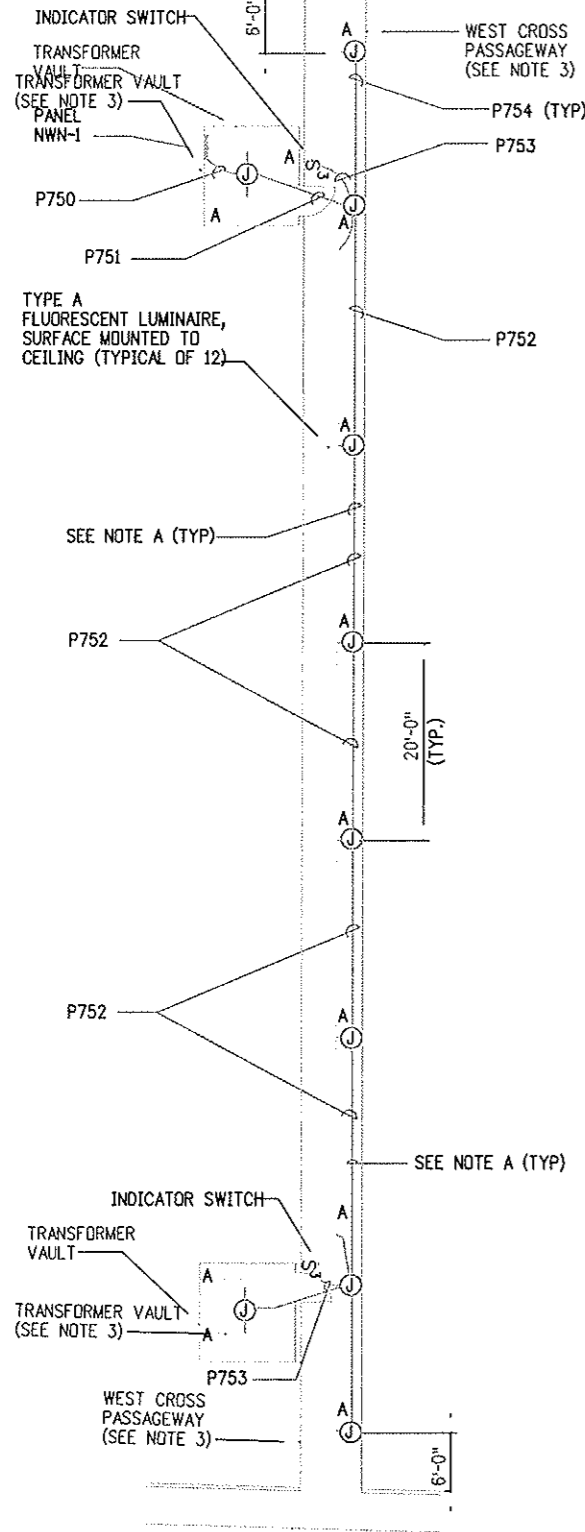


WEST CROSS PASSAGEWAY PLAN

SCALE: 1" = 10'

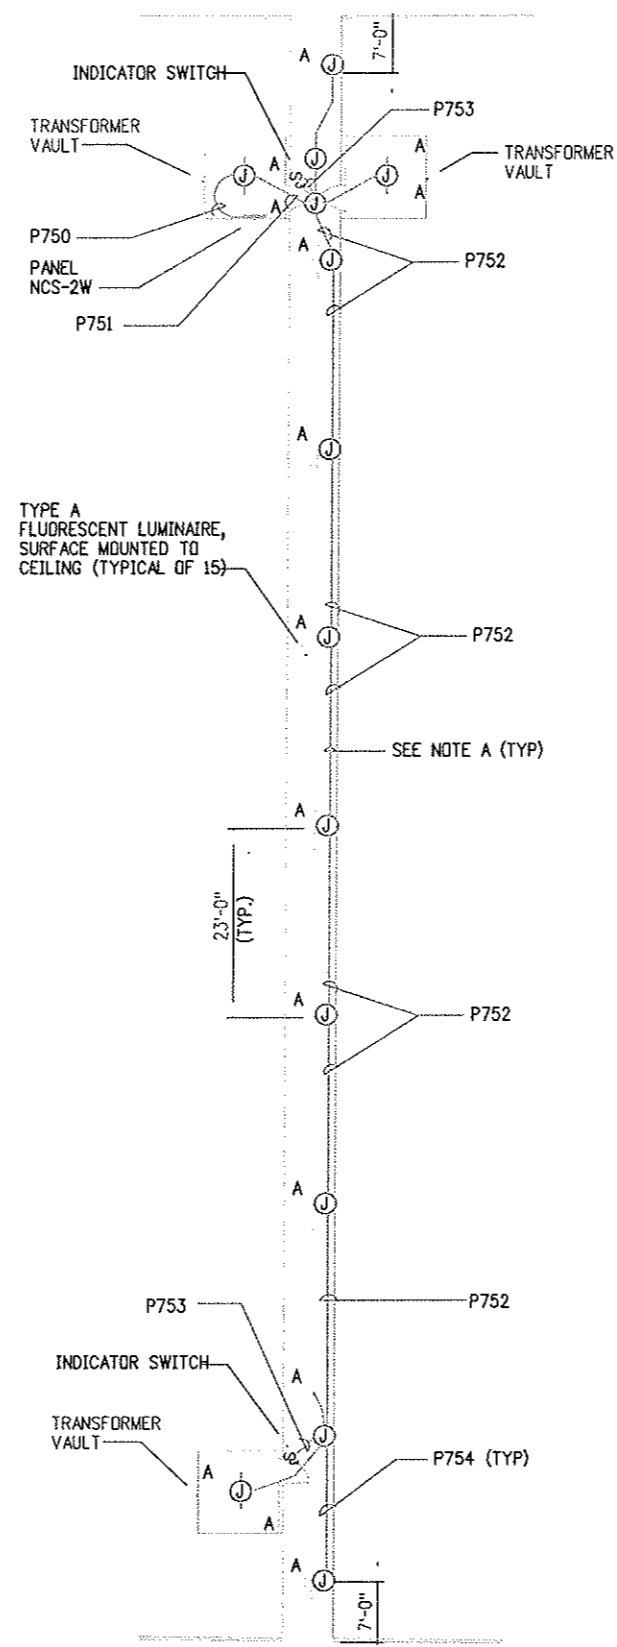

CENTER CROSS PASSAGEWAY PLAN

SCALE: 1" = 10'

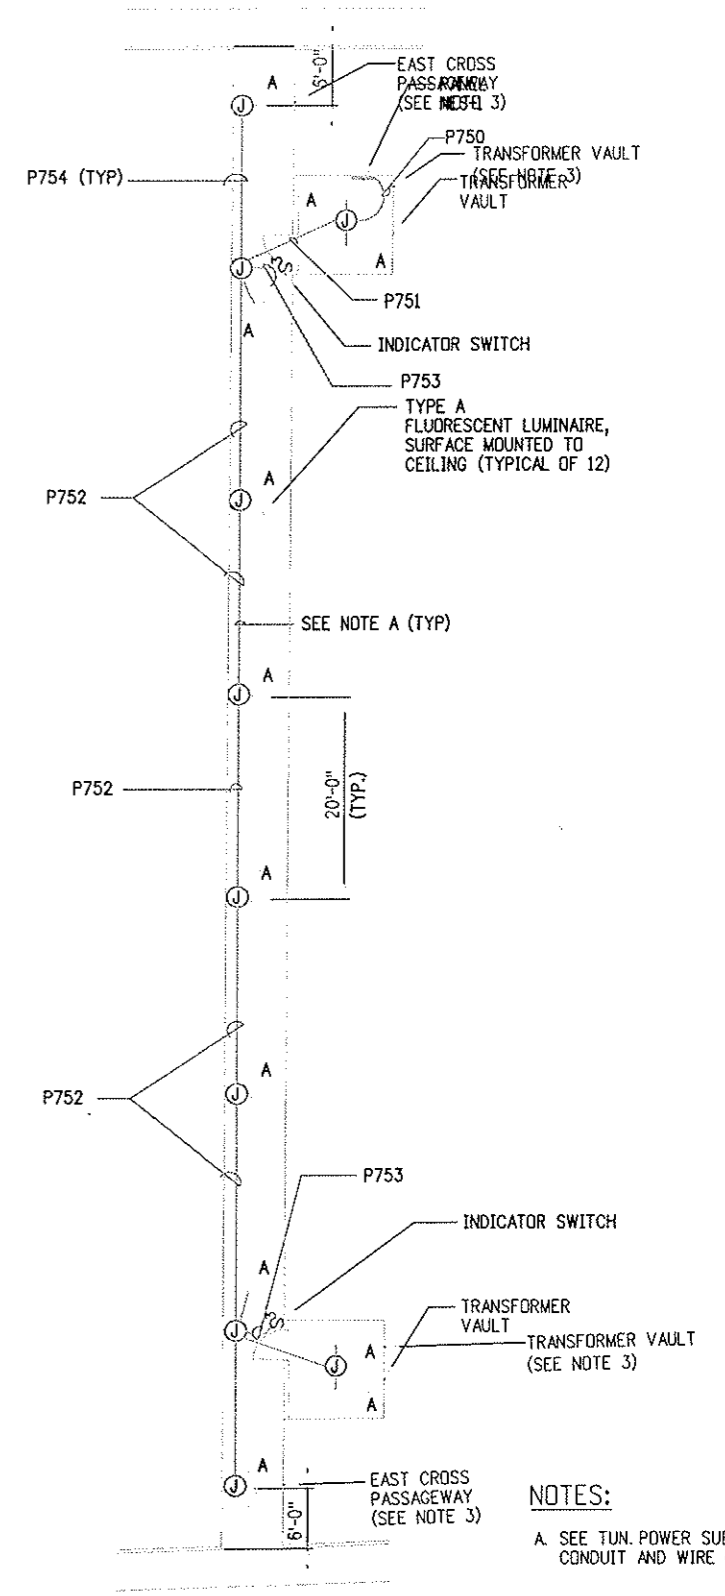

EAST CROSS PASSAGEWAY PLAN

SCALE: 1" = 10'


NOTES:
A. SEE TUN. POWER SUBSET FOR CONDUIT AND WIRE QUANTITIES

Design File Name: DGNSSPEC*
Plot File Name: PLOTFILE*
Date of Plot: \$\$\$DATE\$\$\$

Computer File Information	
Creation Date:	05/06/99 Initials: SFD
Last Modification Date:	01/31/02 Initials: DJB
Full Path:	14102\700cadd\703elec\
Drawing File Name:	1410201.dwg
Acad Ver.	R14 Scale: As Shown Units: English

Sheet Revisions		
07/03/07	ASBUILT	DJB

Colorado Department of Transportation



P.O. BOX 399
DUMONT, CO. 80436
Phone: 303-512-5750 FAX: 303-512-5775

Region 1 Mountain Residency I.N.Z.



As Constructed
No Revisions:
Revised:
Void:

CROSS PASSAGEWAY LIGHTING & POWER PLAN		
Designer:	J. KROLL	Structure Numbers
Detailer:	D. BURROUGHS	
Sheet Subset:	TUN. LTG.	Subset Sheets: 20 of 20

Project No./Code	
IM 0703-269	
13166	
Sheet Number	44

NOTES:

- A. SEE DETAILS TLD-10 (B & D) FOR STARTING DIMENSION TO POSITION TRANSVERSE LUMINAIRE MOUNTING SUPPORT CHANNEL.
- B. NUMBER IN PARENTHESIS ON TABULATION SCHEDULE INDICATE MOUNTING CONDITION FOR FLUORESCENT AND HID LUMINAIRE AS SHOWN ON THE ASSOCIATED TLD SUBSET SHEETS.

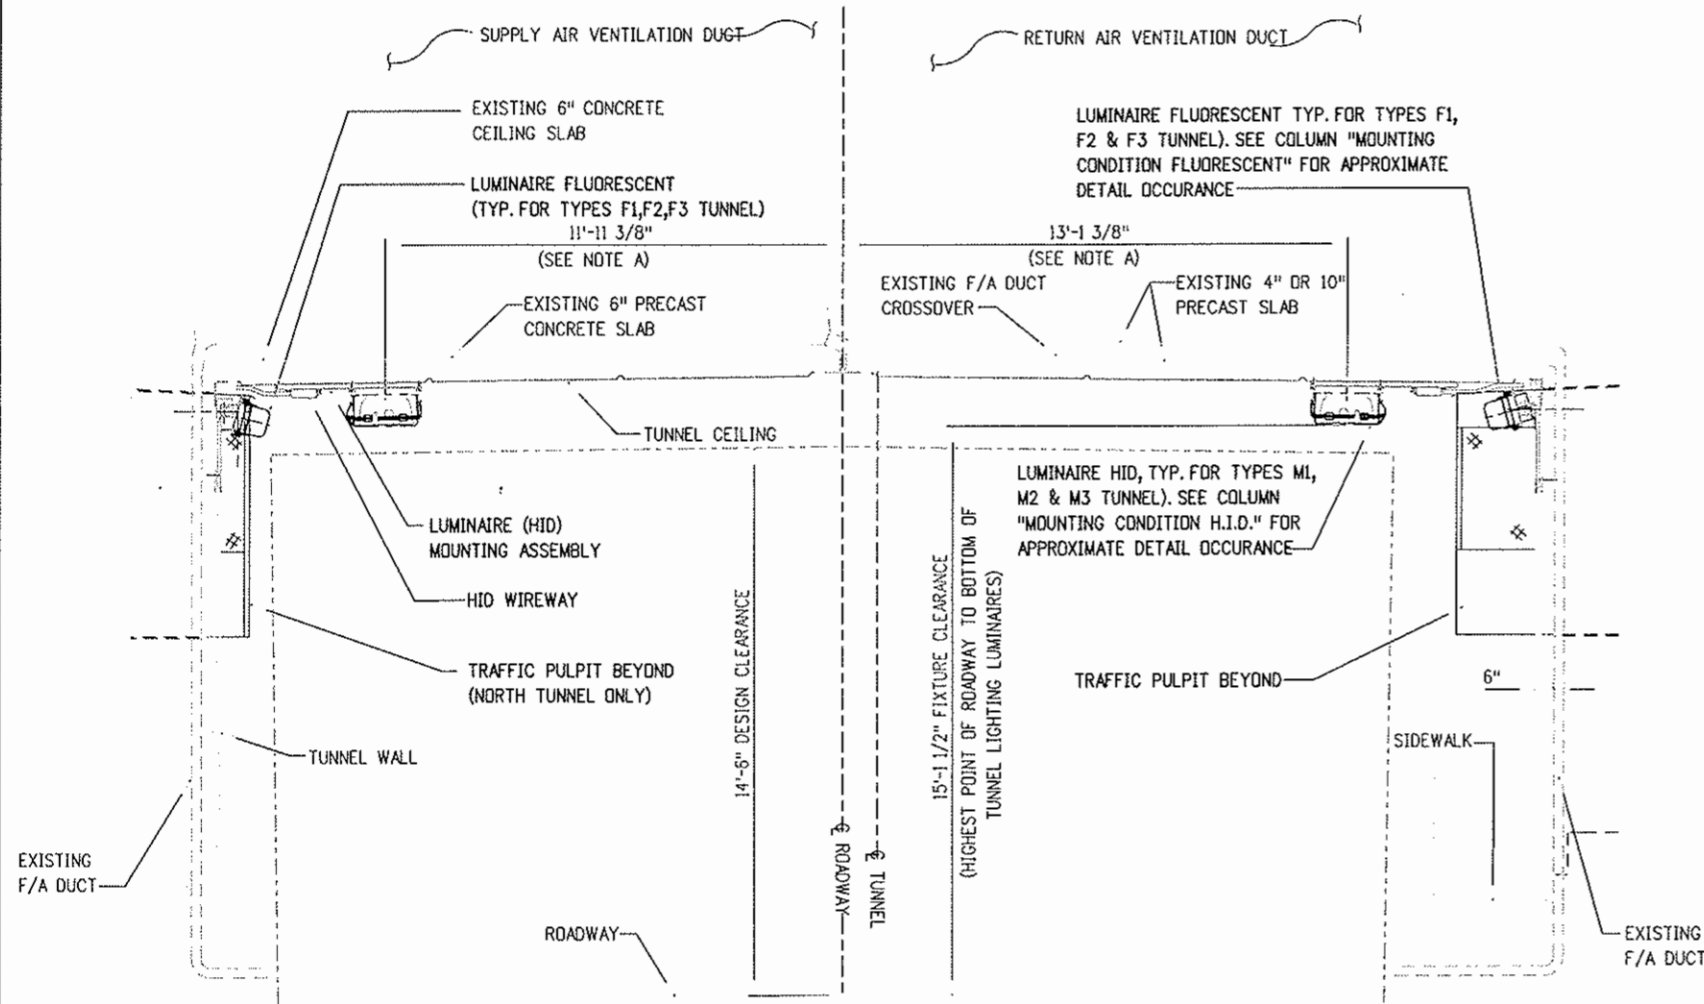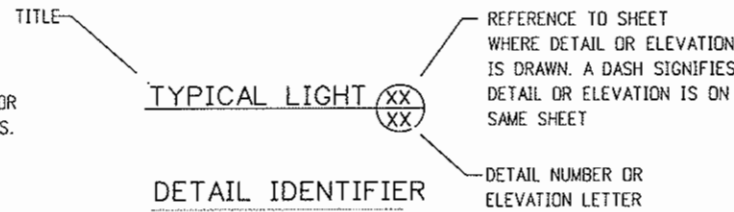


NORTH TUNNEL
TYPICAL SECTION LOOKING EAST (1)
(AGAINST TRAFFIC)
STA. 135+99 TO STA. 139+50
STA. 215+82 TO STA. 225+24

NORTH TUNNEL LUMINAIRE FLUORESCENT TUNNEL MOUNTING TABULATION												
STATION	DESCRIPTION	MOUNTING CONDITION FLUORESCENT	SUPPLEMENTAL MOUNTING PLATE			QUANTITY OF LUMINAIRE FLUORESCENT MOUNTING BRACKET (BY TYPE/HAND)						
			TYPE A	TYPE B	TYPE C	1R	1L	2R	2L	3R	3L	
FROM TO		DETAIL										
135+91 135+99	NO LUMINAIRES	N/A	N/A	N/A	N/A	N/A	N/A	N/A	N/A	N/A	N/A	N/A
135+99 138+07	REVERSE LANE OPERATION THRESHOLD	TLD-3 (1)	N/A	50	N/A	50	25					
138+07 138+87	REVERSE LANE OPERATION THRESHOLD AND TRANSITION ZONE #1	TLD-3 (2)	N/A	20	20	20	10					
138+87 221+39	THRESHOLD, TRANSITIONS #1,#2 & #3, INTERIOR AND REVERSE LANE OPERATION TRANSITION ZONE #3,#2 & #1	TLD-4 (3)	N/A	1990	N/A	1987	992					
221+39 223+05	THRESHOLD ZONE	TLD-4 (4)	N/A	40	N/A	40	20					
223+05 223+55	THRESHOLD ZONE	TLD-3 (2)	N/A	12	12	12	6					
223+55 225+24	PORTAL / THRESHOLD ZONE	TLD-3 (1)	N/A	42	N/A	42	21					
225+24 225+31	NO LUMINAIRES	N/A	N/A	N/A	N/A	N/A	N/A	N/A	N/A	N/A	N/A	N/A
TOTAL			N/A	4295	66	4278	2136	N/A	N/A	N/A	N/A	N/A

REFER TO TLD-3 "DETAIL KEY" FOR GENERAL LOCATION OF FLUORESCENT MOUNTING CONDITION NUMBERS.

SEE SHEET NUMBER 45A FOR HID SUPPORT SYSTEM TABULATION

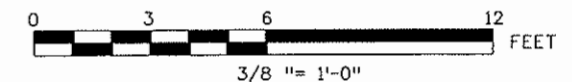


Plot File Name: \$PLT\$FILE* \$\$\$\$DATE\$\$\$\$ Date of Plot: \$\$\$\$DATE\$\$\$\$

Computer File Information	
Creation Date:	08/2/99 Initials: DJB
Last Modification Date:	12/04/03 Initials: DJB
Full Path:	014102\800deliv\AsBuilt\
Drawing File Name:	ltty03n.plt
Acad Ver.	R14 Scale: 3/8" = 1'-0" Units: English

Sheet Revisions	
07/03/07	ASBUILT DJB

Colorado Department of Transportation



P.O. BOX 399
DUMONT, CO. 80436
Phone: 303-512-5750 FAX: 303-512-5775

Region 1 Mountain Residency I.N.Z.

As Constructed
No Revisions:
Revised:
Void:

TUNNEL LIGHTING DETAILS	
Designer:	JPK/DJB
Detailer:	D. BURROUGHS
Structure Numbers	
Sheet Subset:	TLD
Subset Sheets:	1 of 13

Project No./Code	
IM 0703-269	
13166	
Sheet Number	45

HID SUPPORT SYSTEM TABULATION


NOTES:

- A. SEE DETAILS TLD-10 (B & D) FOR STARTING DIMENSION TO POSITION TRANSVERSE LUMINAIRE MOUNTING SUPPORT CHANNEL
- B. NUMBER IN PARENTHESIS ON TABULATION SCHEDULE INDICATE MOUNTING CONDITION FOR FLUORESCENT AND HID LUMINAIRE AS SHOWN ON THE ASSOCIATED TLD SUBSET SHEETS

NORTH WALL - WEST PORTAL																	
WIREWAY - RACK MOUNT																	
SUPPORT STRUT - GALV. - LENGTH TO BE DETERMINED																	
FROM	TO	LENGTH															
FROM	TO	LENGTH	DETAIL	QUANTITY	LONGITUNDINAL STRUT - SS	TRANSVERSE STRUT - SS	SUPPORT STRUT - GALV.	SUPPORT	SUPPORT	SUPPORT	SUPPORT	SUPPORT	SUPPORT	SUPPORT	SUPPORT	SUPPORT	CONNECTION
					QUANTITY	LENGTH	QUANTITY	LENGTH	QUANTITY	LENGTH	TLD-11(1)	TLD-11(2)	TLD-12(1)	TLD-12(2)	TLD-13(1)	TLD-13(2)	TLD-11(3)
135+99	138+02	200'															
135+97.6	136+43	45.4'	TLD-11	0	2 x 45.4'	90.8	13 x 4'	52	7 x 6'	42	21	0	0	0	0	0	12
136+43	138+00	157'	TLD-11	0	2 x 157'	314	43 x 4'	172	21 x 6'	126	63	0	0	0	0	0	44
CEILING - MOUNT																	
FROM	TO	LENGTH															
138+02	139+50	148'															
FROM	TO	LENGTH	DETAIL	QUANTITY	LONGITUNDINAL STRUT - SS	TRANSVERSE STRUT - SS	SUPPORT STRUT - GALV.	SUPPORT	SUPPORT	SUPPORT	SUPPORT	SUPPORT	SUPPORT	SUPPORT	SUPPORT	SUPPORT	CONNECTION
138+00	138+54	54'	TLD-11	7	0	0	8 x 2'	16	15 x 6'	90	0	22	0	0	0	0	0
138+54	139+50	96'	TLD-12	6	0	0	12 x 2'	24	0	0	0	0	0	24	0	0	0
SOUTH WALL - WEST PORTAL																	
WIREWAY - RACK MOUNT																	
SUPPORT STRUT - GALV. - LENGTH TO BE DETERMINED																	
FROM	TO	LENGTH															
FROM	TO	LENGTH	DETAIL	QUANTITY	LONGITUNDINAL STRUT - SS	TRANSVERSE STRUT - SS	SUPPORT STRUT - GALV.	SUPPORT	SUPPORT	SUPPORT	SUPPORT	SUPPORT	SUPPORT	SUPPORT	SUPPORT	SUPPORT	CONNECTION
					QUANTITY	LENGTH	QUANTITY	LENGTH	QUANTITY	LENGTH	TLD-11(1)	TLD-11(2)	TLD-12(1)	TLD-12(2)	TLD-13(1)	TLD-13(2)	TLD-11(3)
135+98.6	138+02	203.4'															
135+97.6	136+43	45.4'	TLD-11	0	2 x 45.4'	90.8	13 x 4'	52	7 x 6'	42	21	0	0	0	0	0	12
136+43	138+00	157'	TLD-11	0	2 x 157'	314	43 x 4'	172	21 x 6'	126	63	0	0	0	0	0	44
CEILING - MOUNT																	
FROM	TO	LENGTH															
138+02	139+50	148'															
FROM	TO	LENGTH	DETAIL	QUANTITY	LONGITUNDINAL STRUT - SS	TRANSVERSE STRUT - SS	SUPPORT STRUT - GALV.	SUPPORT	SUPPORT	SUPPORT	SUPPORT	SUPPORT	SUPPORT	SUPPORT	SUPPORT	SUPPORT	CONNECTION
138+00	138+54	54'	TLD-11	7	0	0	8 x 2'	16	15 x 6'	90	0	22	0	0	0	0	0
138+54	139+50	96'	TLD-13	6	0	0	12 x 2'	24	0	0	0	0	0	0	0	24	0
NORTH WALL - EAST PORTAL																	
WIREWAY - RACK MOUNT																	
SUPPORT STRUT - GALV. - LENGTH TO BE DETERMINED																	
FROM	TO	LENGTH															
FROM	TO	LENGTH	DETAIL	QUANTITY	LONGITUNDINAL STRUT - SS	TRANSVERSE STRUT - SS	SUPPORT STRUT - GALV.	SUPPORT	SUPPORT	SUPPORT	SUPPORT	SUPPORT	SUPPORT	SUPPORT	SUPPORT	SUPPORT	CONNECTION
					QUANTITY	LENGTH	QUANTITY	LENGTH	QUANTITY	LENGTH	TLD-11(1)	TLD-11(2)	TLD-12(1)	TLD-12(2)	TLD-13(1)	TLD-13(2)	TLD-11(3)
225+24	219+16	608'															
224+78	225+21	43'	TLD-11	0	2 x 43'	86	12 x 4'	36	7 x 6'	42	21	0	0	0	0	0	10
222+57	224+78	221'	TLD-11	0	2 x 221'	442	60 x 4'	240	28 x 6'	126	84	0	0	0	0	0	64
219+16	222+57	341'	TLD-12	0	2 x 341'	682	88 x 4'	352	0	0	0	0	129	0	0	0	90
CEILING - MOUNT																	
FROM	TO	LENGTH															
219+16	215+16	355'															
FROM	TO	LENGTH	DETAIL	QUANTITY	LONGITUNDINAL STRUT - SS	TRANSVERSE STRUT - SS	SUPPORT STRUT - GALV.	SUPPORT	SUPPORT	SUPPORT	SUPPORT	SUPPORT	SUPPORT	SUPPORT	SUPPORT	SUPPORT	CONNECTION
218+26	219+16	90'	TLD-12	13	0	0	13 x 2'	26	0	0	0	0	0	39	0	0	0
215+80	218+26	246'	TLD-12	16	0	0	31 x 2'	62	0	0	0	0	0	63	0	0	0
SOUTH WALL - EAST PORTAL																	
WIREWAY - RACK MOUNT																	
SUPPORT STRUT - GALV. - LENGTH TO BE DETERMINED																	
FROM	TO	LENGTH															
FROM	TO	LENGTH	DETAIL	QUANTITY	LONGITUNDINAL STRUT - SS	TRANSVERSE STRUT - SS	SUPPORT STRUT - GALV.	SUPPORT	SUPPORT	SUPPORT	SUPPORT	SUPPORT	SUPPORT	SUPPORT	SUPPORT	SUPPORT	CONNECTION
					QUANTITY	LENGTH	QUANTITY	LENGTH	QUANTITY	LENGTH	TLD-11(1)	TLD-11(2)	TLD-12(1)	TLD-12(2)	TLD-13(1)	TLD-13(2)	TLD-11(3)
225+23	219+16	607'															
224+78	225+23	43'	TLD-11	0	2 x 43'	90	13 x 4'	52	7 x 6'	42	21	0	0	0	0	0	12
222+57	224+78	221'	TLD-11	0	2 x 221'	442	60 x 4'	240	28 x 6'	168	84	0	0	0	0	0	64
219+16	222+57	341'	TLD-13	0	2 x 341'	682	88 x 4'	352	0	0	0	0	0	0	129	0	90
CEILING - MOUNT																	
FROM	TO	LENGTH															
219+16	215+16	355'															
FROM	TO	LENGTH	DETAIL	QUANTITY	LONGITUNDINAL STRUT - SS	TRANSVERSE STRUT - SS	SUPPORT STRUT - GALV.	SUPPORT	SUPPORT	SUPPORT	SUPPORT	SUPPORT	SUPPORT	SUPPORT	SUPPORT	SUPPORT	CONNECTION
218+26	219+16	90'	TLD-13	13	0	0	13 x 2'	26	0	0	0	0	0	0	0	39	0
215+80	218+26	246'	TLD-13	16	0	0	31 x 2'	62	0	0	0	0	0	0	0	63	0
TOTALS				84		3233.6		1976		936	378	44	129	126	129	126	442

Computer File Information		Sheet Revisions		Colorado Department of Transportation		As Constructed		TUNNEL LIGHTING DETAILS		Project No./Code	
Creation Date:	01/4/07 Initials: DJB	07/03/07	ASBUILT	P.O. BOX 399 DUMONT, CO. 80436 Phone: 303-512-5750 FAX: 303-512-5775		No Revisions:		IM 0703-269		13166	
Last Modification Date:	01/4/07 Initials: DJB			Region 1 Mountain Residency I.N.Z.		Revised:		Designer:		Structure Numbers	
Full Path:	014102\800deliv\AsBuilt\					Void:		Detailer:		Sheet Subset: TLD	
Drawing File Name:	Itly03on.pit							Sheet Subsets:		1A of 13	
Acad Ver. R14	Scale: AS NOTED	Units: English						Sheet Number		45A	

8'-2 1/2" NOMINAL

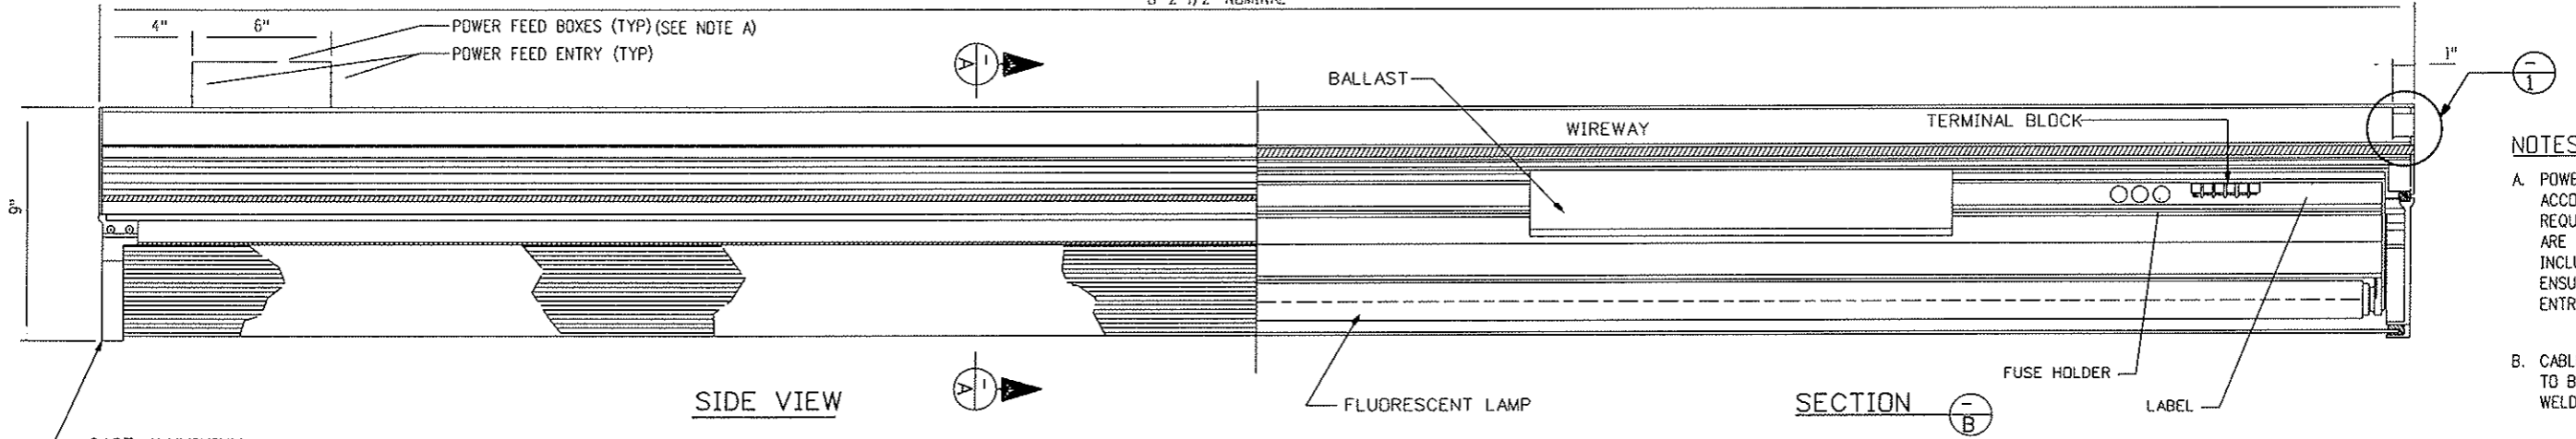



SIDE VIEW

SECTION B



LUMINAIRE FLUORESCENT (TYPES F1, F2 & F3 TUNNEL)
(THREE LAMP VERSION SHOWN)

- NOTES:**
- A. POWER FEEDER BOXES TO ACCOMMODATE CONDUIT REQUIREMENTS. ALL BOXES ARE TO BE WELDED AND TO INCLUDE THREADED PLUG TO ENSURE AGAINST WATER ENTRY WHEN NOT IN USE.
 - B. CABLE SUPPORT STRAPS TO BE CONTINUOUSLY WELDED IN PLACE.
 - C. TERMINATE END OF WIREWAY DIVIDER, (FOR SPLIT WIREWAY) 1" FROM END OF LUMINAIRE. (TYP. BOTH ENDS)
 - D. LABEL TO BE LOCATED SO AS TO BE EASILY VIEWED WHEN LENS IS OPENED. LABEL WILL CLEARLY INDICATE FIXTURE TYPE F1, F2 OR F3.
 - E. SEE CHART ON SHEET 1 OF TUNNEL LIGHTING SUBSET.


PHOTOMETRIC KEY

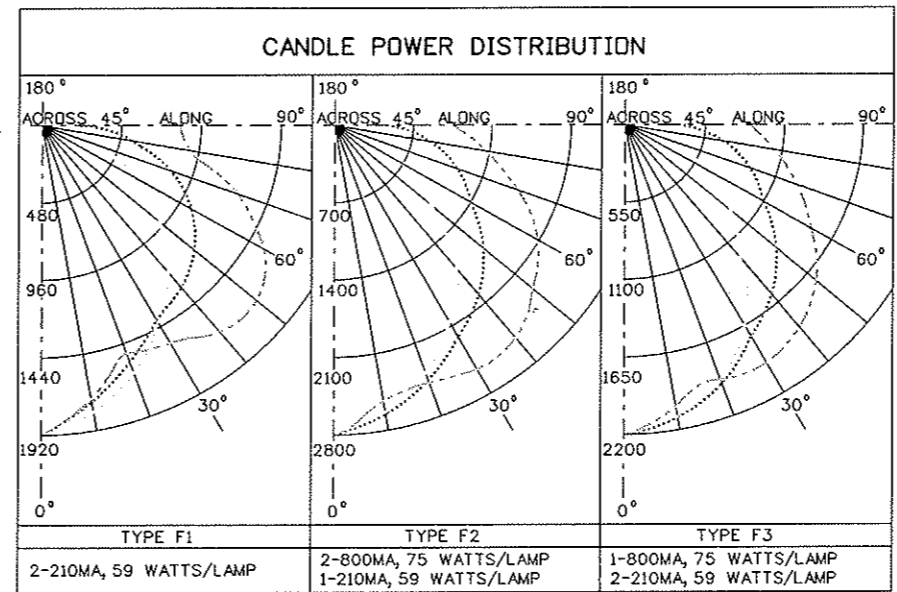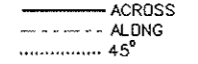

PHOTOMETRIC DATA

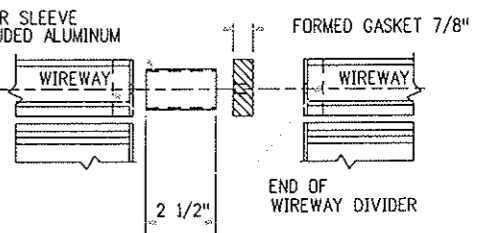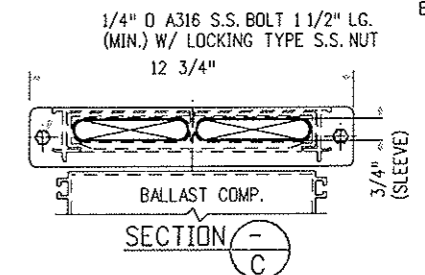


SIDE VIEW (UNCOMPRESSED)

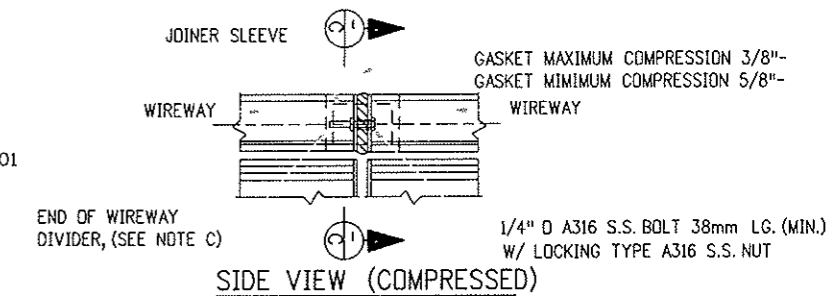


SIDE VIEW (COMPRESSED)

JOINER SLEEVE FOR WIREWAY

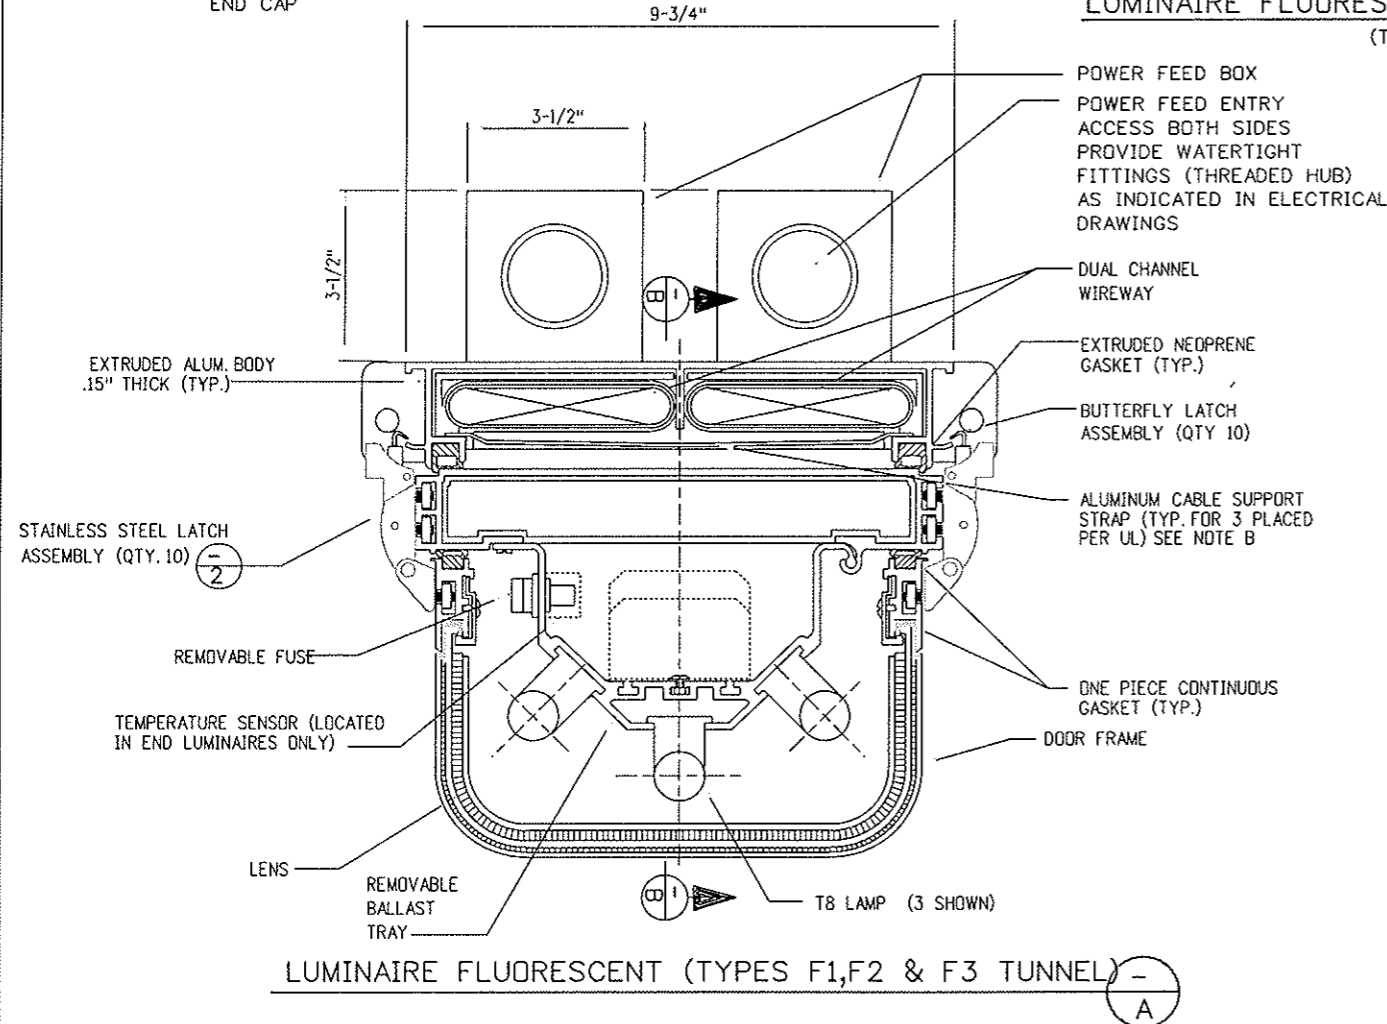

LUMINAIRE FLUORESCENT (TYPES F1, F2 & F3 TUNNEL) - A

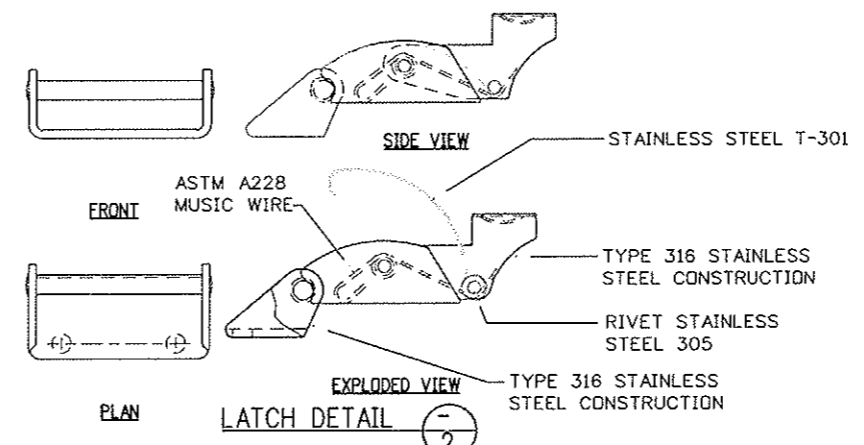

EXPLODED VIEW LATCH DETAIL

Design File Name: DONSPEC*
 Plot File Name: \$PLOTFILE*
 Date of Plot: \$\$\$DATE\$\$\$

Computer File Information	
Creation Date:	02/26/99 Initials: DJB
Last Modification Date:	11/27/00 Initials: DJB
Full Path:	14102\700CADD\703elec\
Drawing File Name:	ltd05n.dwg
Acad Ver.:	R14 Scale: NTS Units: English


Sheet Revisions	
07/03/07	ASBUILT DJB

Colorado Department of Transportation
 P.O. BOX 399
 DUMONT, CO. 80436
 Phone: 303-512-5750 FAX: 303-512-5775
 Region 1 Mountain Residency I.N.Z.

As Constructed
 No Revisions:
 Revised:
 Void:

TUNNEL LIGHTING DETAILS		
Designer:	JPK/DJB	Structure Numbers
Detailer:	D. BURROUGHS	
Sheet Subset:	TLD	Subset Sheets: 2 of 13

Project No./Code	
IM 0703-269	
13166	
Sheet Number	46

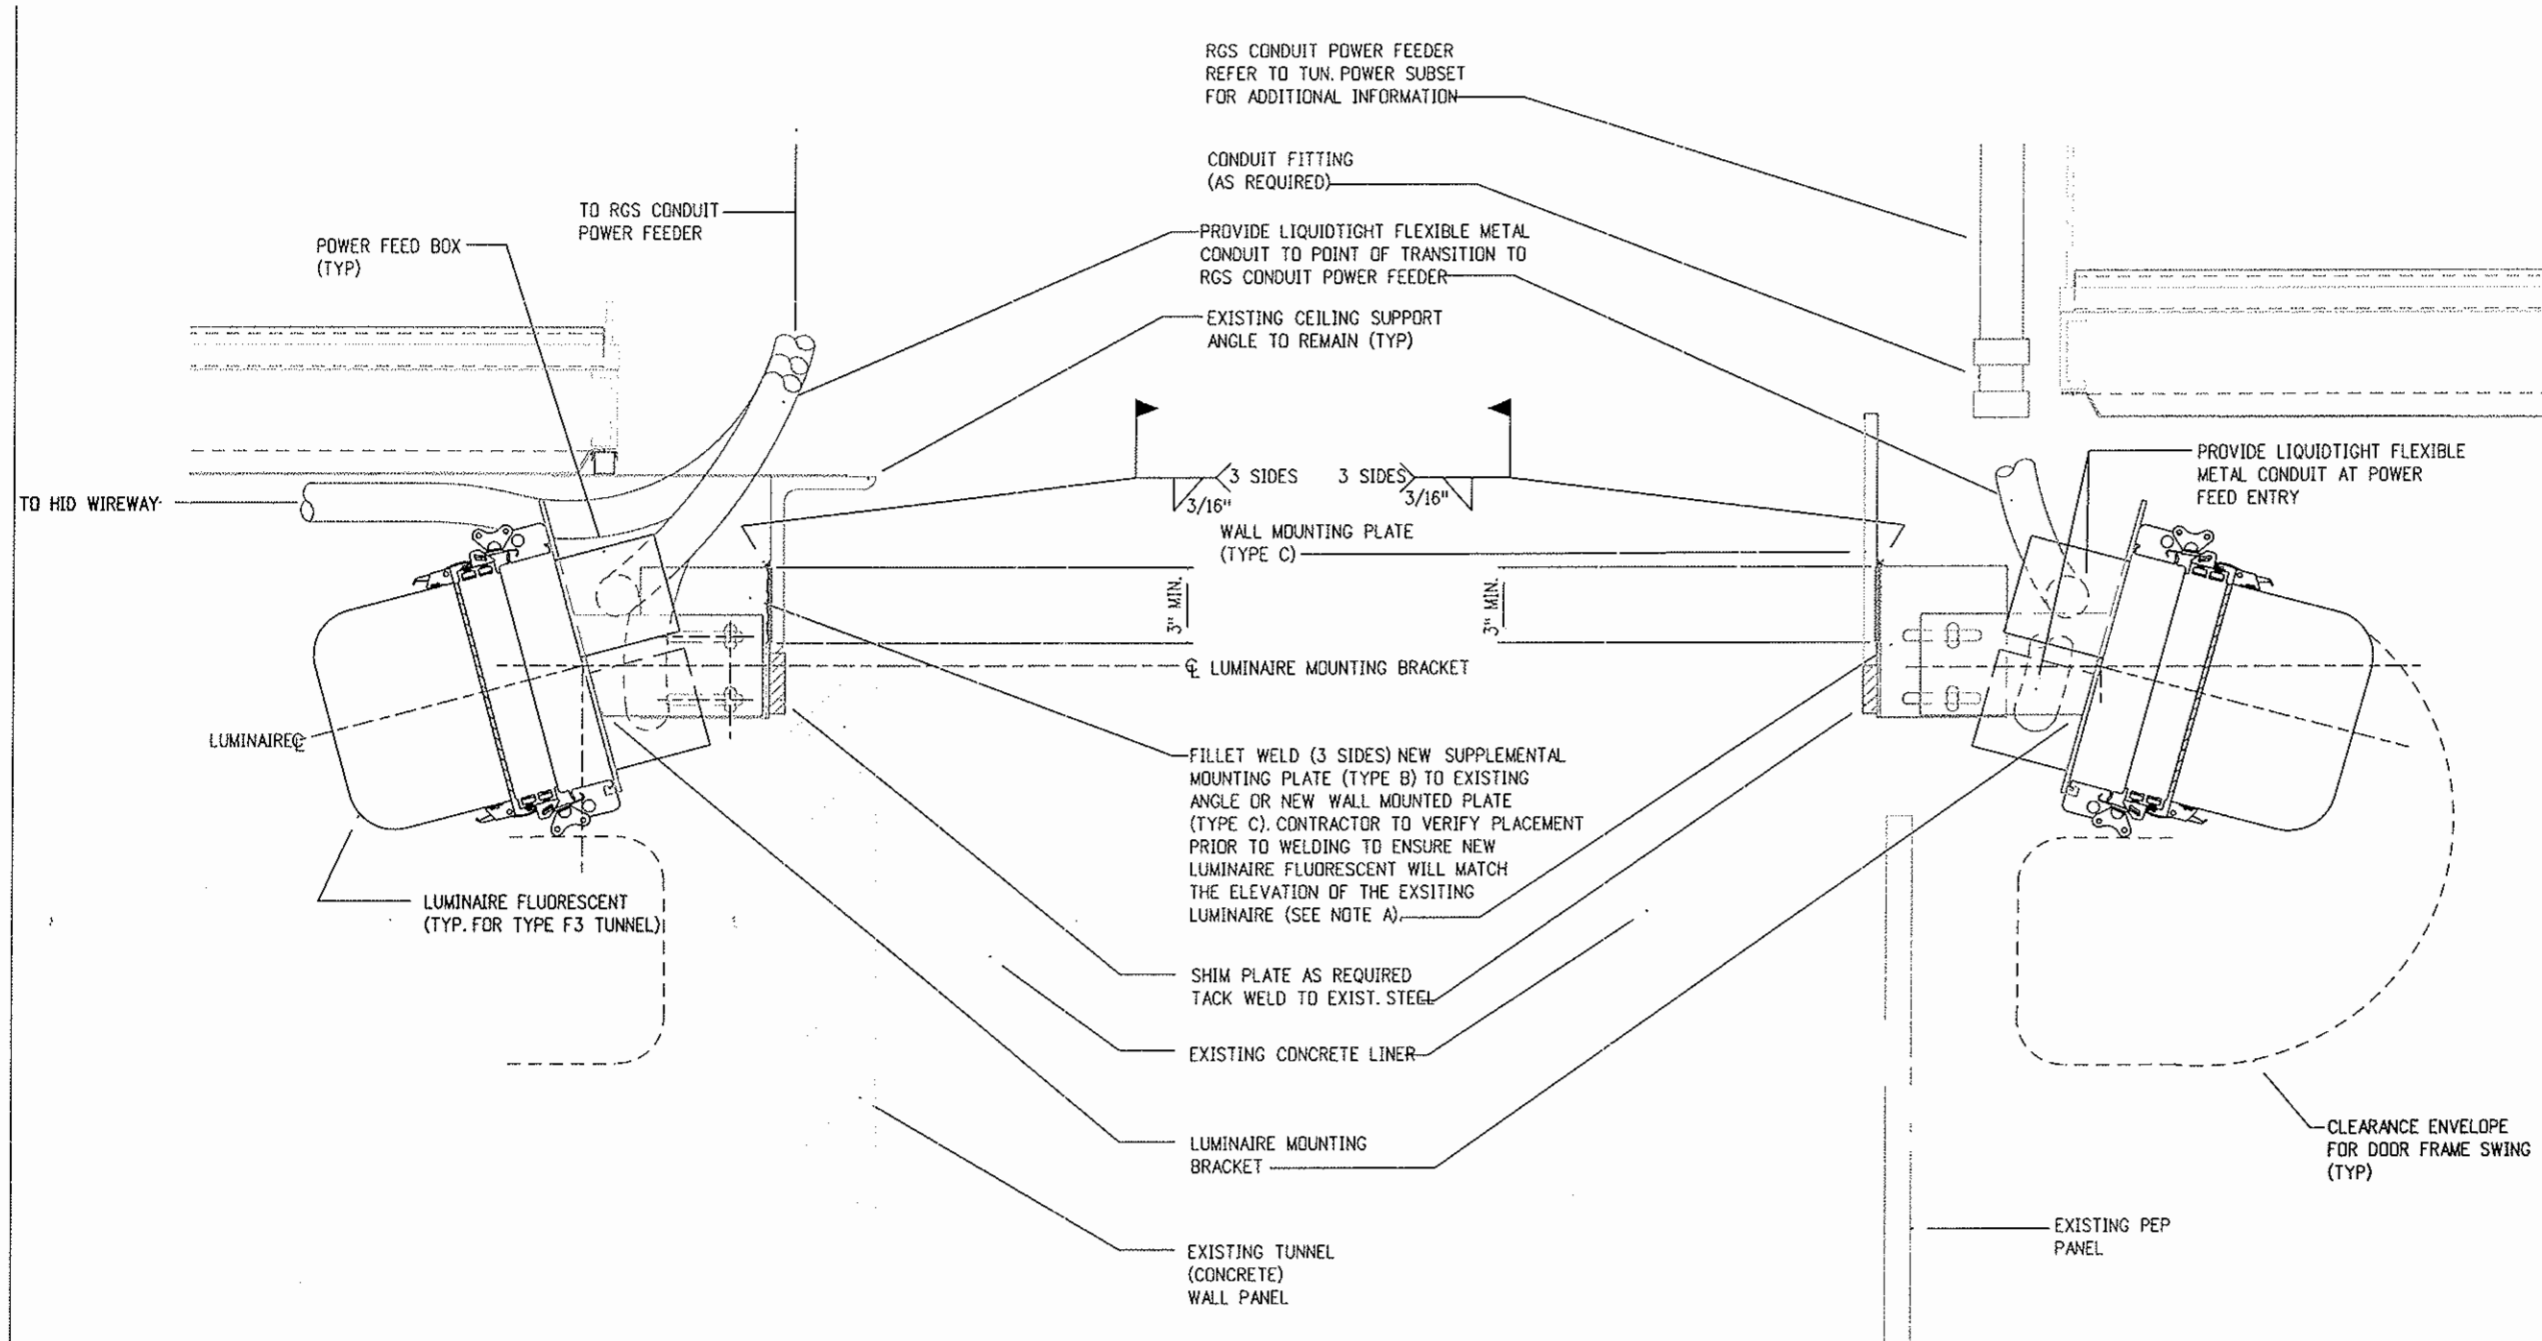

- A. PROVIDE 3 TYPE B SUPPLEMENTAL MOUNTING PLATES FOR EACH LUMINAIRE, ONE AT EACH END AND ONE IN THE MIDDLE. WHERE FIXTURES ARE INSTALLED END TO END IN A ROW, ONE TYPE B SUPPLEMENTAL MOUNTING PLATE WILL BE PROVIDED AT THE JOINT AND WILL BE SHARED BY ADJACENT FIXTURES. SEE SUBSET TLD SHEET 7 DETAILS AND NOTES FOR ADDITIONAL REQUIREMENTS.
- B. POWER FEEDERS ARE SHOWN TO ILLUSTRATE APPROXIMATE LOCATION AND METHOD TO FEED FLUORESCENT TUNNEL LUMINAIRES. FOR LOCATIONS REFER TO TUNNEL POWER SHEETS.

TUNNEL PORTAL TRANSITION (MOUNTING CONDITION #1)

NORTH BORE
 NORTH WALL - WEST SIDE
 STA. 135+99 TO STA. 138+07
 NORTH WALL - EAST SIDE
 STA. 223+55 TO STA. 225+24
 SOUTH WALL - WEST SIDE
 STA. 135+98.6 TO STA. 138+07
 SOUTH WALL - EAST SIDE
 STA. 223+55 TO STA. 225+23

TLD-3
1


TUNNEL TRANSITION (MOUNTING CONDITION #2)


NORTH BORE
 NORTH WALL - WEST SIDE
 STA. 138+07 TO 138+87
 NORTH WALL - EAST SIDE
 STA. 223+05 TO 223+55
 SOUTH WALL - WEST SIDE
 STA. 138+07 TO 138+87
 SOUTH WALL - EAST SIDE
 STA. 222+97 TO 223+55

TLD-3
2

MOUNTING CONDITION NO.	(#1)	(#2)	(#3)	(#4)	(#2)	(#1)
PANEL NO.	1076	1077	1103	1104	1113	1137
	NORTH WALL		NORTH TUNNEL		EAST SIDE	
	WEST SIDE		NORTH TUNNEL		EAST SIDE	
	SOUTHWALL		NORTH TUNNEL		EAST SIDE	
PANEL NO.	1092	1101	1102	1127		
MOUNTING CONDITION NO.	(#1)	(#2)	(#3)	(#2)	(#1)	

DETAIL KEY

Computer File Information		Sheet Revisions		Colorado Department of Transportation		As Constructed		TUNNEL LIGHTING DETAILS		Project No./Code	
Creation Date:	02/26/99 Initials: DJB	07/03/07	ASBUILT	 P.O. BOX 399 DUMONT, CO. 80436 Phone: 303-512-5750 FAX: 303-512-5775 Region 1 Mountain Residency I.N.Z.		No Revisions:		Designer: JPK/DJB Structure Detailer: D. BURROUGHS Numbers		IM 0703-269	
Last Modification Date:	12/04/05 Initials: DJB					Revised:				Sheet Subset: TLD Subset Sheets: 3 of 13	
Full Path:	14102\700CADD\703elec\					Void:					
Drawing File Name:	ltdtl4n.dwg										
Acad Ver. R14	Scale: 1 1/2"=1'-0" Units: English										

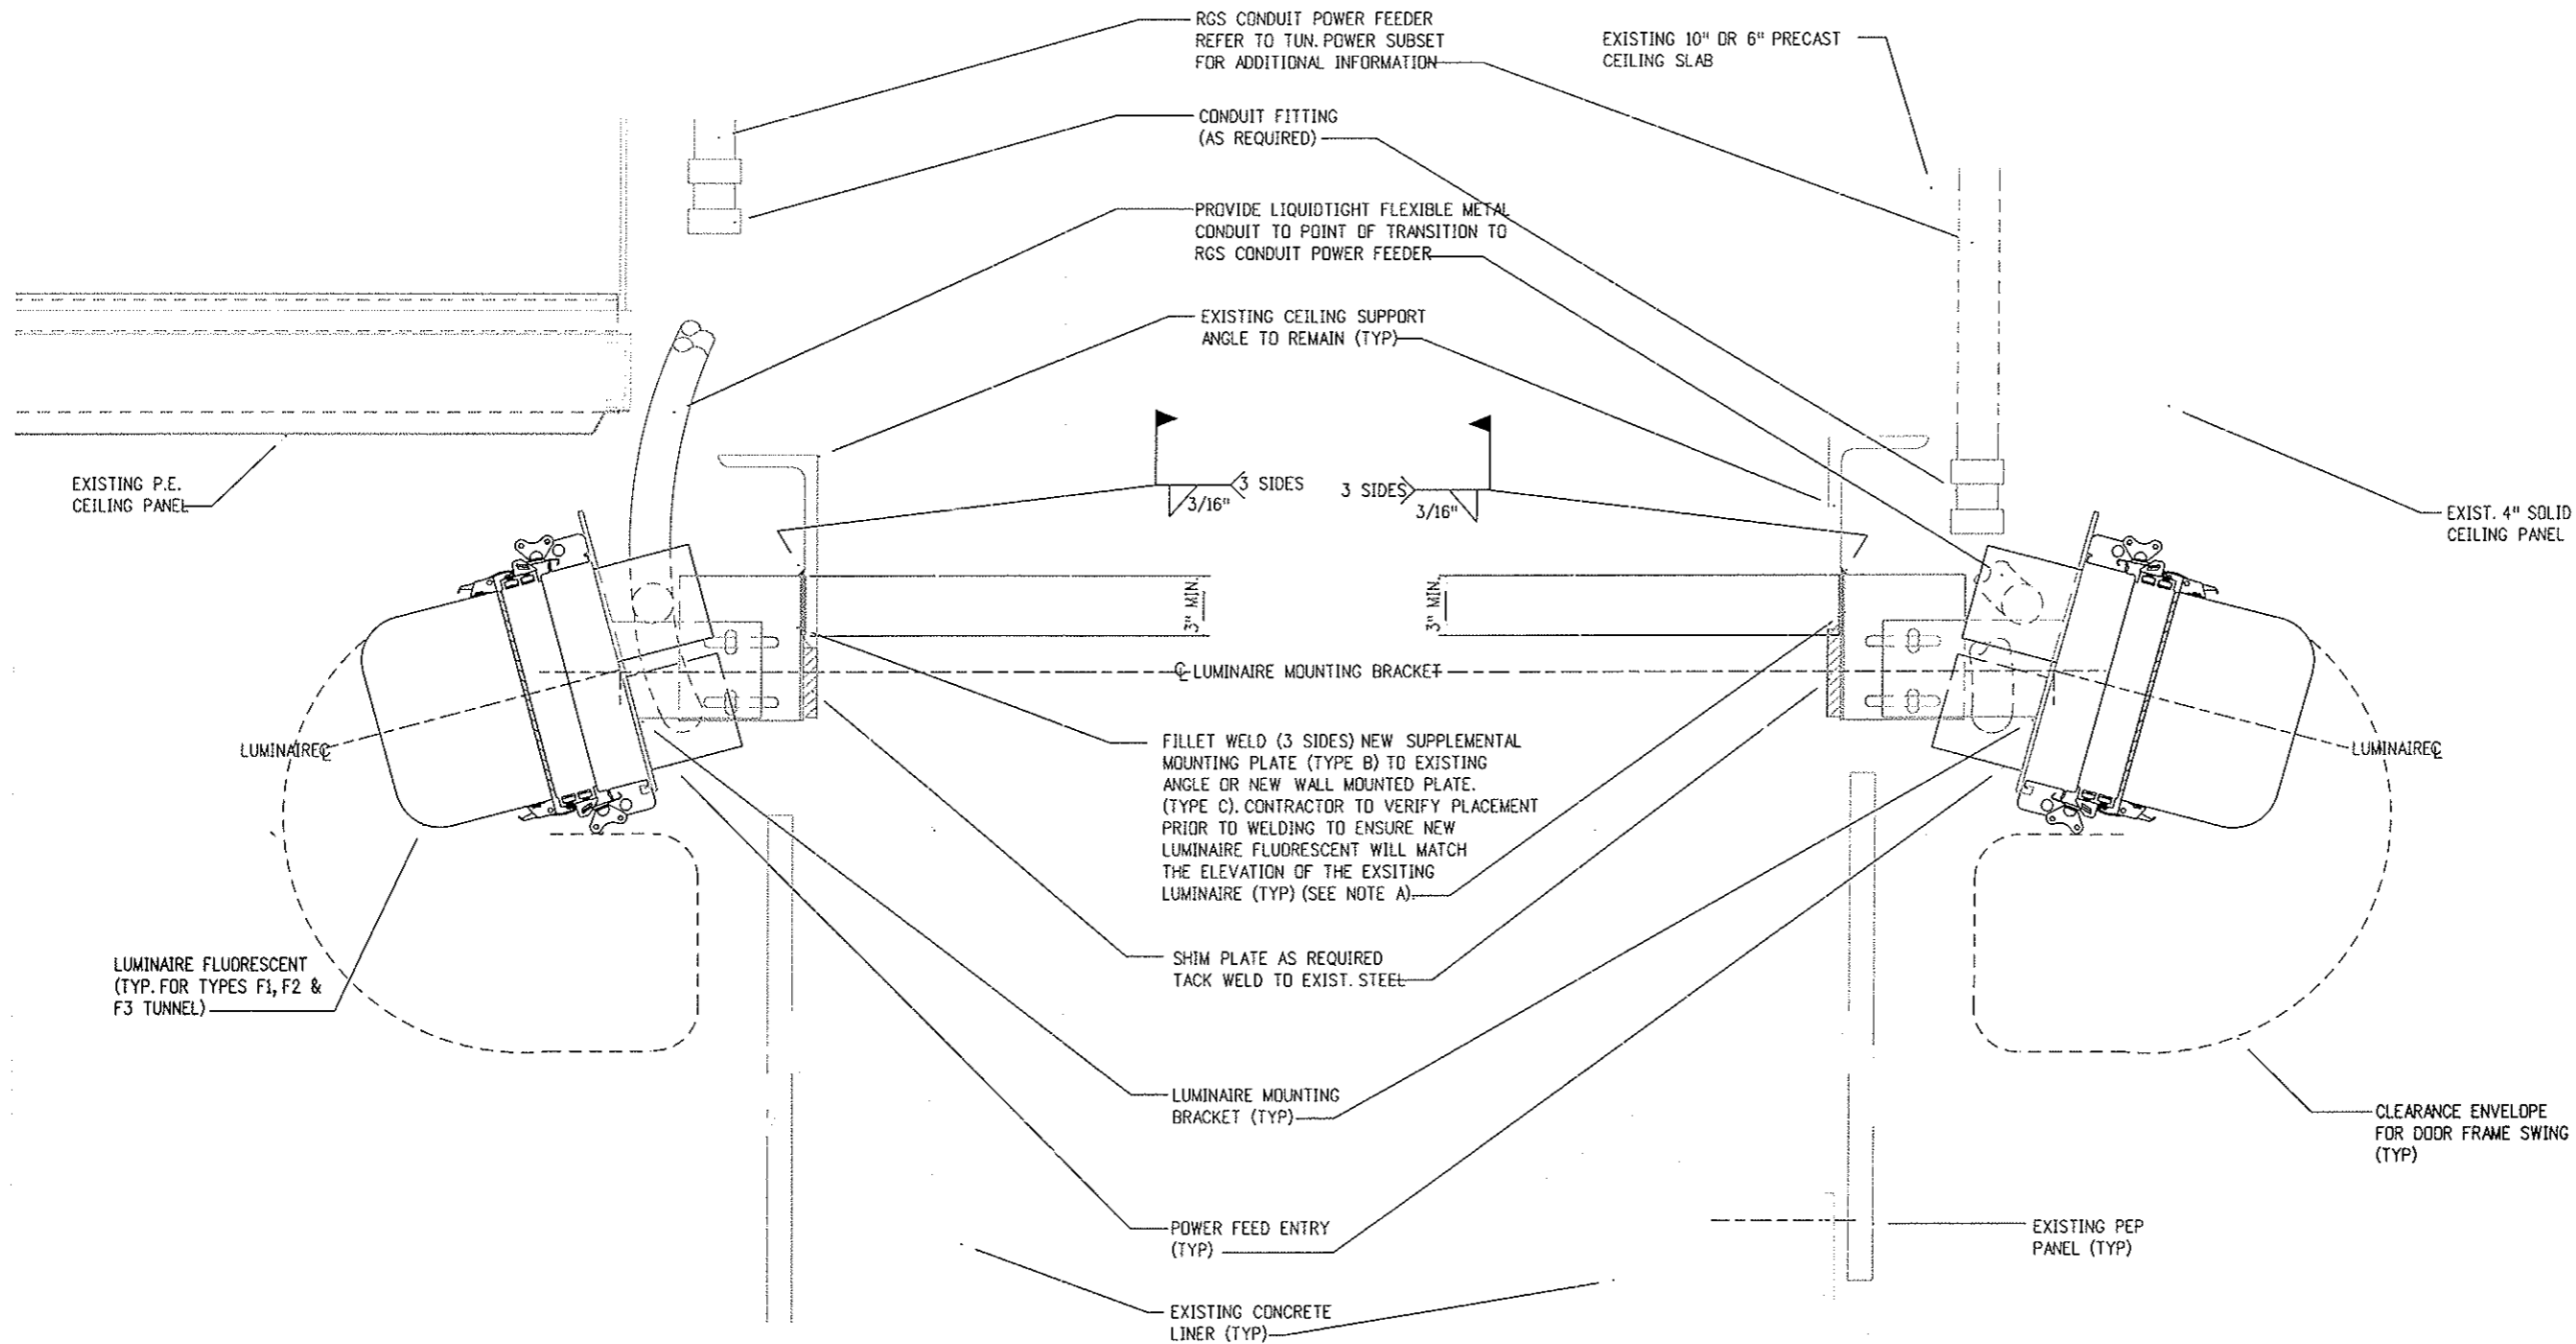

**TYPICAL INTERIOR ZONE
(MOUNTING CONDITION #3)**

NORTH BORE
NORTH WALL - INTERIOR
STA. 138+87 TO 221+39
SOUTH WALL - INTERIOR
STA. 138+87 TO 222+97

TLD-4
1


NOTES:

- A. PROVIDE 3 TYPE B SUPPLEMENTAL MOUNTING PLATES FOR EACH LUMINAIRE, ONE AT EACH END AND ONE IN THE MIDDLE. WHERE FIXTURES ARE INSTALLED END TO END IN A ROW, ONE TYPE B SUPPLEMENTAL MOUNTING PLATE WILL BE PROVIDED AT THE JOINT AND WILL BE SHARED BY ADJACENT FIXTURES. SEE SUBSET TLD SHEET 7 DETAILS AND NOTES FOR ADDITIONAL REQUIREMENTS.
- B. POWER FEEDERS ARE SHOWN TO ILLUSTRATE APPROXIMATE LOCATION AND METHOD TO FEED FLUORESCENT TUNNEL LUMINAIRES. FOR LOCATIONS REFER TO TUNNEL POWER SHEETS.

**TYPICAL INTERIOR ZONE
(MOUNTING CONDITION #4)**

NORTH BORE
NORTH WALL - EAST SIDE
STA. 221+39 TO 223+05


TLD-4
2

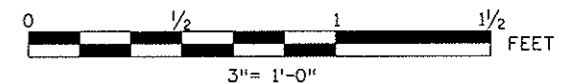

Computer File Information	
Creation Date:	06/26/99 Initials: DJB
Last Modification Date:	12/01/03 Initials: DJB
Full Path:	14102\700CADD\703elec\
Drawing File Name:	ltd115n.dwg
Acad Ver. R14	Scale: 3" = 1'-0" Units: Feet

Sheet Revisions	
07/03/07	ASBUILT DJB

Colorado Department of Transportation



P.O. BOX 399
DUMONT, CO. 80436
Phone: 303-512-5750 FAX: 303-512-5775


Region 1 Mountain Residency I.N.Z.

As Constructed
No Revisions:
Revised:
Void:


TUNNEL LIGHTING DETAILS	
Designer:	JPK/DJB
Detailer:	D. BURROUGHS
Sheet Subset:	TLD

Project No./Code	
IM 0703-269	
13166	
Sheet Number	48

Structure Numbers	
Subset Sheets:	4 of 13

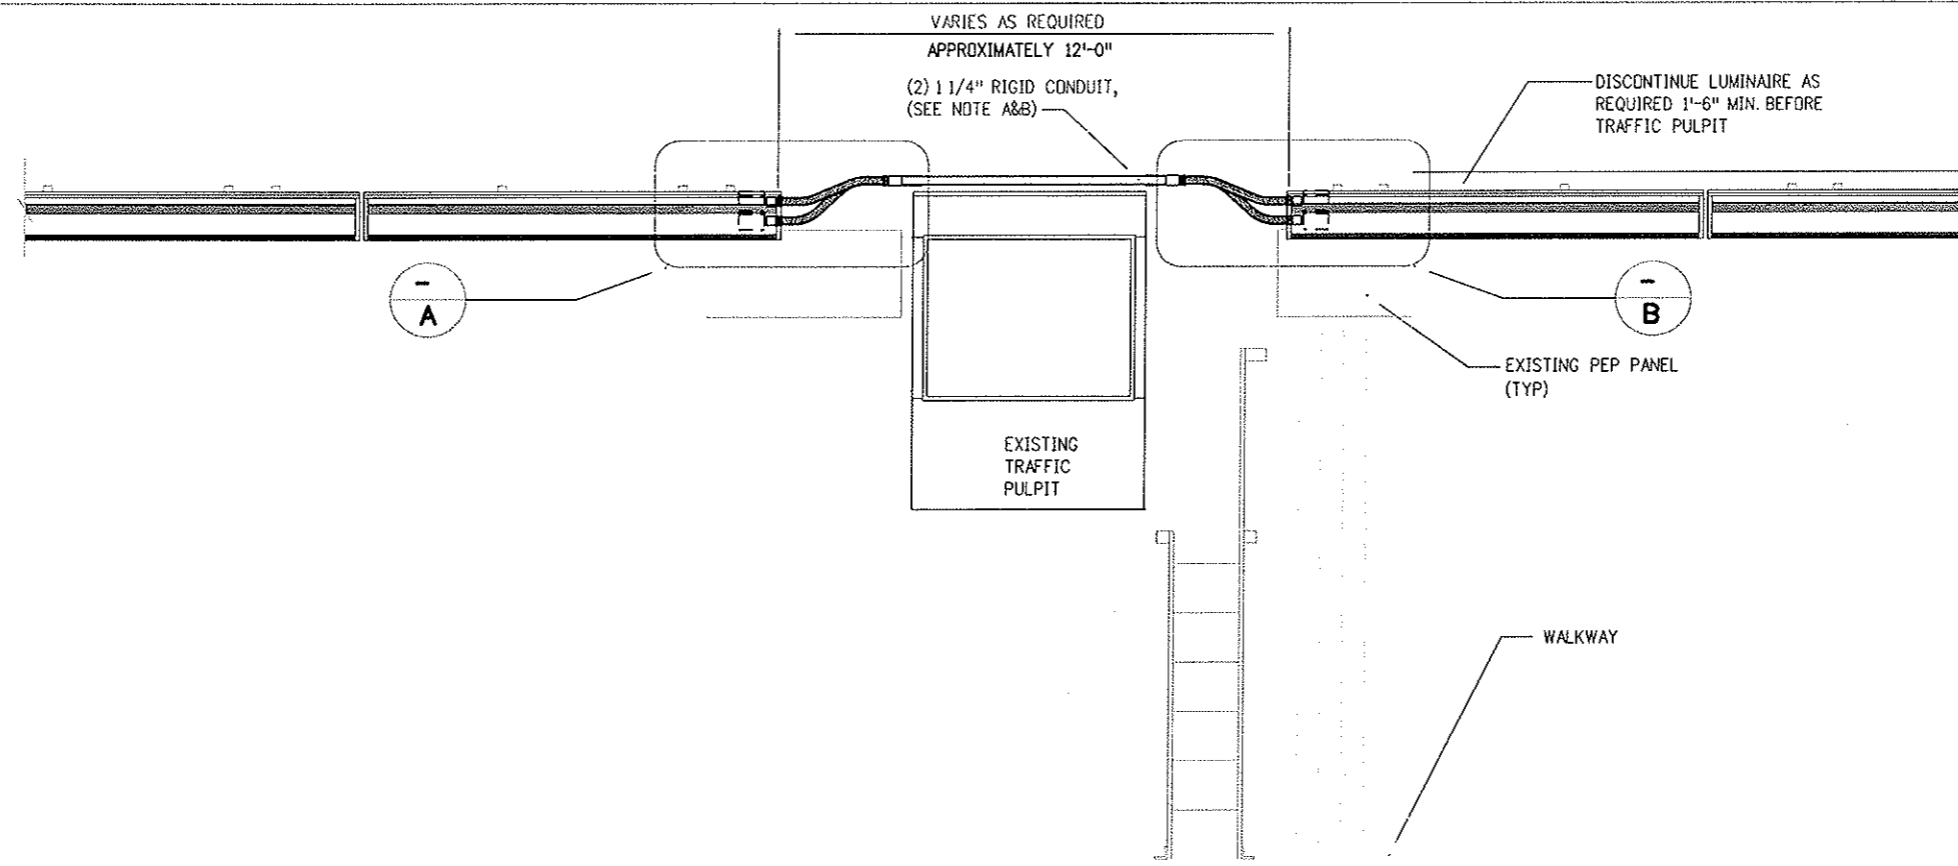


- NOTES**
- A. FOR ACTUAL CONDUIT SIZES AND REQUIREMENTS REFER TO TUNNEL POWER SUBSET SHEETS, UNLESS NOTED OTHERWISE.
 - B. FOR SPACING BETWEEN FIXTURES LESS THAN 3'-0" RGS CONDUIT IS NOT REQUIRED.
 - C. LUMINAIRE INTERRUPTION FEED FOR BREAKS IN LUMINAIRES AT VMS SIGNS SIMILAR.

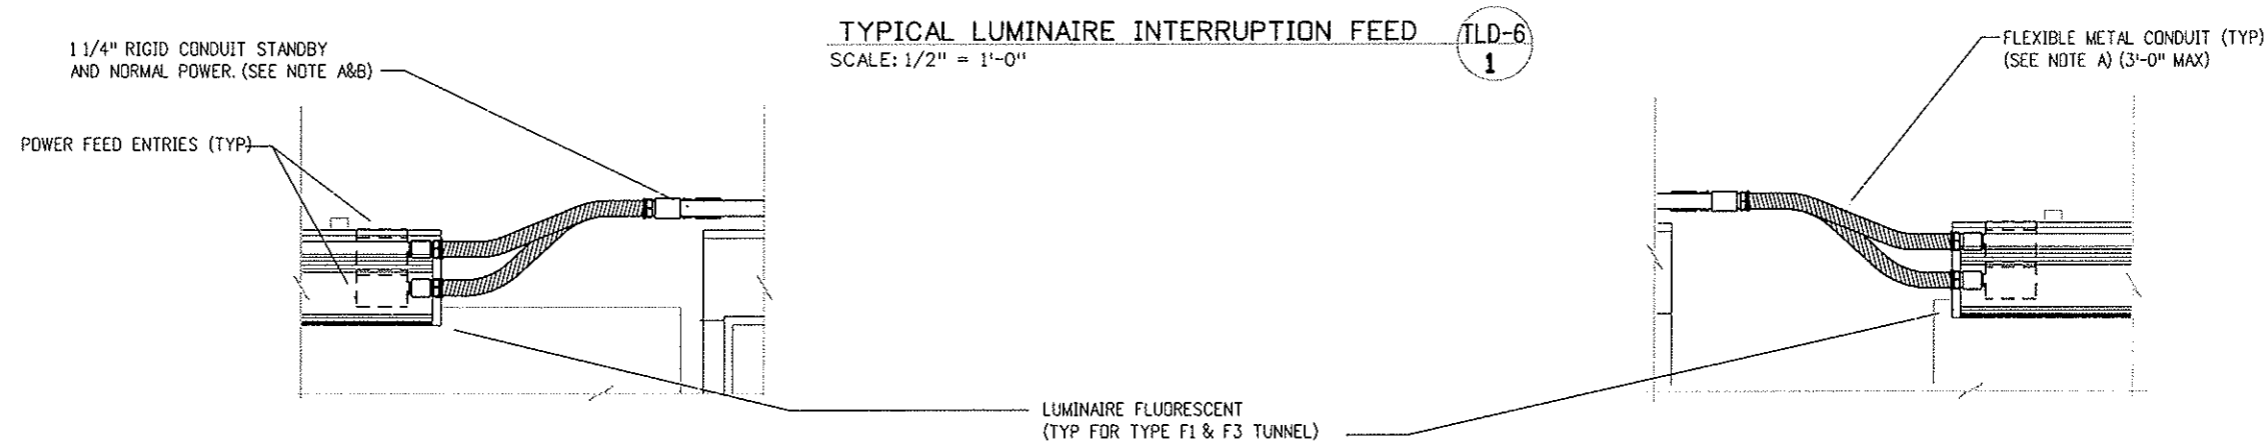

INTERRUPTION FEED LEFT SIDE - A
SCALE: 1" = 1'-0"

INTERRUPTION FEED RIGHT SIDE - B
SCALE: 1" = 1'-0"

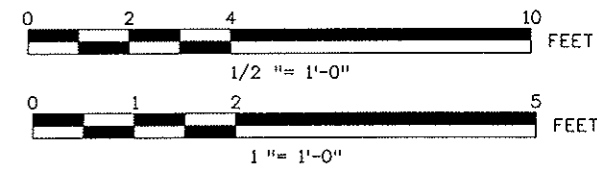


Design File Name: DGN\$SPEC*
 Plot File Name: \$PLOTFILE*
 Date of Plot: \$\$\$DATE\$\$\$\$

Computer File Information	
Creation Date:	03/23/99 Initials: DJB
Last Modification Date:	02/04/02 Initials: DJB
Full Path:	P:014102\700cadd\703elec\
Drawing File Name:	ltd107e.plt
Acad Ver.	R14 Scale: AS NOTED Units: ENGLISH

Sheet Revisions		
<input type="checkbox"/>	07/03/07	ASBUILT DJB
<input type="checkbox"/>		
<input type="checkbox"/>		
<input type="checkbox"/>		

Colorado Department of Transportation




P.O. BOX 399
 DUMONT, CO. 80436
 Phone: 303-512-5750 FAX: 303-512-5775

Region 1 Mountain Residency I.N.Z.


As Constructed
No Revisions:
Revised:
Void:

LIGHTING FIXTURE BREAK DETAILS		
Designer:	JPK/DJB	Structure Numbers
Detailer:	D. BURROUGHS	
Sheet Subset:	TLD	Subset Sheets: 6 of 13


Project No./Code
IM 0703-269
13166
Sheet Number 50

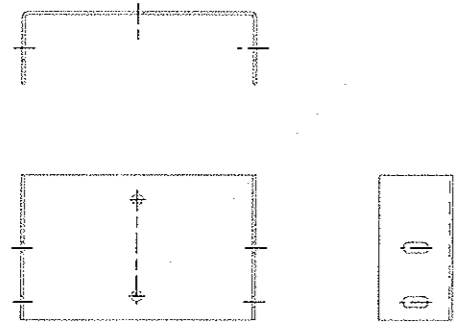

WALL MOUNTING PLATE
TYPE A

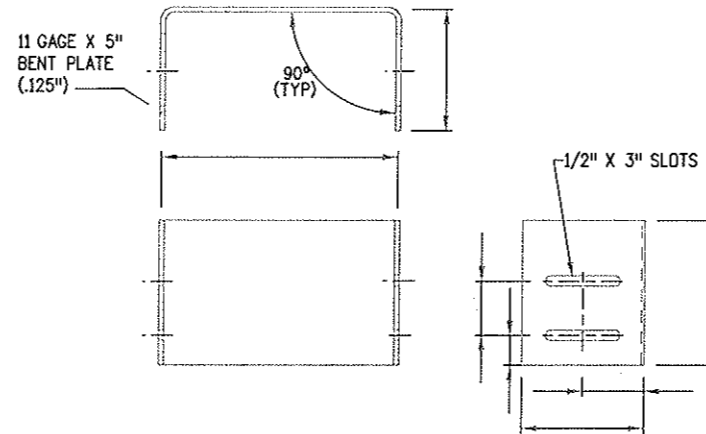


SUPPLEMENTAL MOUNTING PLATE
TYPE B

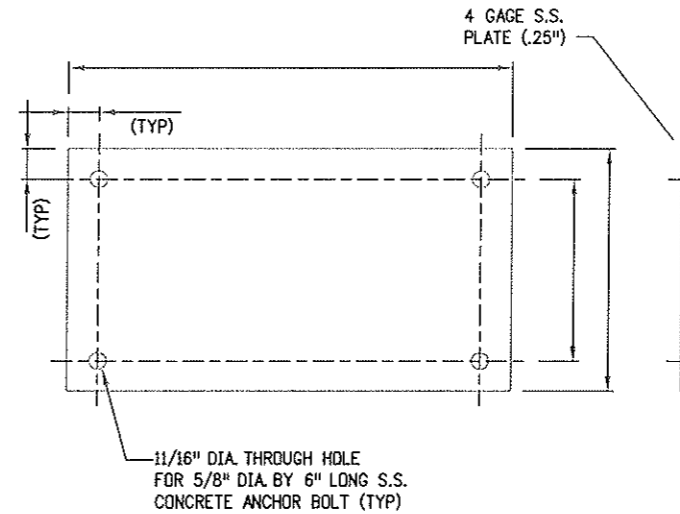

WALL MOUNTING PLATE
TYPE C


NOTES:

- A. BRACKET SHALL BE MODIFIED AS REQUIRED TO ACCOMMODATE FLUORESCENT TUNNEL LUMINAIRE.
- B. COORDINATE BRACKET BEND WITH LUMINAIRE TO CREATE AN INTERLOCK.
- C. THE DESIGN INTENT IS TO HAVE BRACKET FORMED USING A SINGLE PIECE OF METAL PLATE USING A 3/8" R BEND. A CONTINUOUS WELD ON BOTH SIDES CAN BE SUBSTITUTED BY VENDOR AS APPROVED.
- D. CUT-OFF EXISTING FIXTURE MOUNTING BRACKET THAT EXTENDS BEYOND EXISTING ANGLE OR WALL PLATE.
- E. PROVIDE 3 TYPE B SUPPLEMENTAL MOUNTING PLATES FOR EACH LUMINAIRE, ONE AT EACH END AND ONE IN THE MIDDLE. WHERE FIXTURES ARE INSTALLED END TO END IN A ROW, ONE TYPE B SUPPLEMENTAL MOUNTING PLATE WILL BE PROVIDED AT THE JOINT AND WILL BE SHARED BY ADJACENT FIXTURES.
- F. * DIMENSION IS APPROXIMATE DEPENDING ON WIDTH OF LUMINAIRE.
- G. ** DIMENSION SHALL BE SUPPLIED BY CONTRACTOR ON SHOP DRAWING FOR APPROVAL.
- H. PROVIDE ONE LUMINAIRE MOUNTING BRACKET (RIGHT OR LEFT HANDED) PER SUPPLEMENTAL TYPE B MOUNTING PLATE AS REQUIRED. DESIGN INTENT IS TO HAVE 3 LUMINAIRE MOUNTING BRACKETS PER FLUORESCENT TUNNEL LUMINAIRE.
- J. FOR REFERENCE ONLY: SUPPLEMENTAL MOUNTING PLATE SIMILAR SHAPE AND DIMENSION TO TYPE B AS USED IN SOUTH TUNNEL. THE LUMINAIRE MOUNTING BRACKET (RIGHT OR LEFT HANDED) SIMILAR SHAPE AND DIMENSION TO TYPE 1 AS USED IN SOUTH TUNNEL.

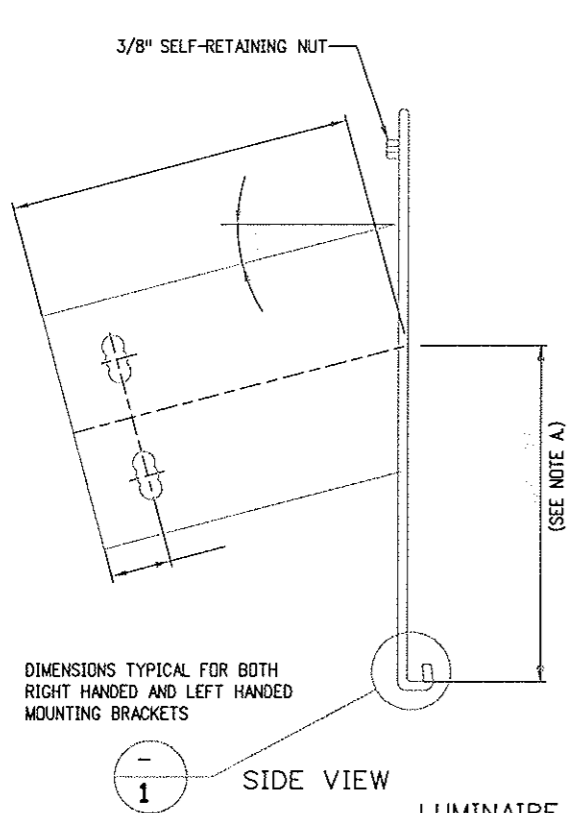


DIMENSIONS TYPICAL FOR BOTH
RIGHT HANDED AND LEFT HANDED
MOUNTING BRACKETS

1 SIDE VIEW

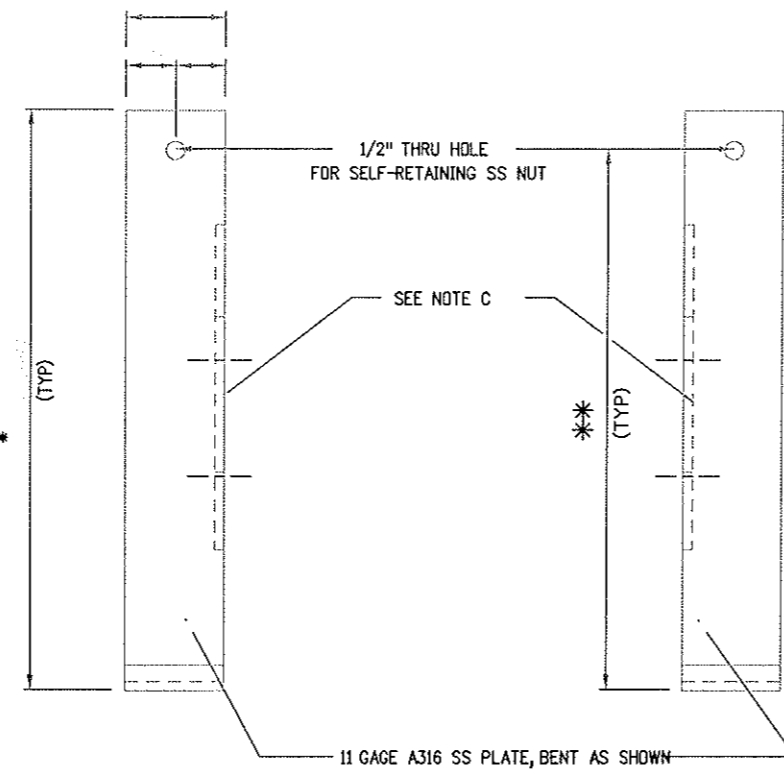

FRONT VIEW
FRONT VIEW

LUMINAIRE MOUNTING BRACKET
LEFT HANDED
(SEE NOTE J)

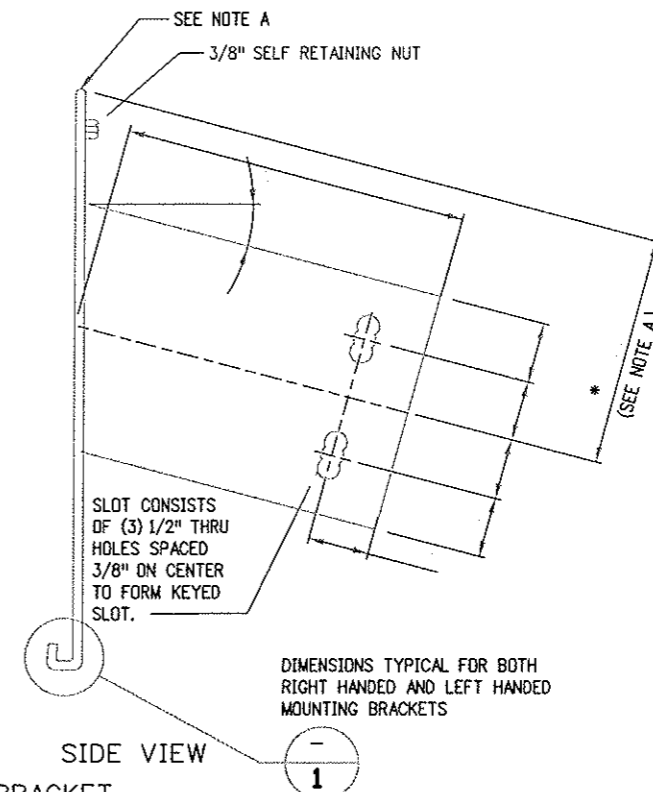


SLOT CONSISTS
OF (3) 1/2" THRU
HOLES SPACED
3/8" ON CENTER
TO FORM KEYED
SLOT.

DIMENSIONS TYPICAL FOR BOTH
RIGHT HANDED AND LEFT HANDED
MOUNTING BRACKETS

1 SIDE VIEW

LUMINAIRE MOUNTING BRACKET
RIGHT HANDED
(SEE NOTE J)


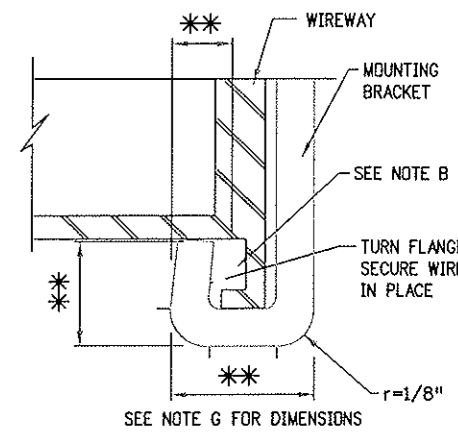


SEE NOTE G FOR DIMENSIONS


DETAIL
1

Design File Name: DGN\SPEC*
Plot File Name: \$PLTFILE*
Date of Plot: \$\$\$DATE\$\$\$

Computer File Information			Sheet Revisions			Colorado Department of Transportation		As Constructed		TUNNEL LIGHTING DETAILS		Project No./Code	
Creation Date:	02/26/99	Initials: DJB	07/03/07	ASBUILT	DJB	P.O. BOX 399 DUMONT, CO. 80436		No Revisions:	Designer: JPK/DJB		IM 0703-269		
Last Modification Date:	12/04/2005	Initials: DJB				Phone: 303-512-5750 FAX: 303-512-5775		Revised:	Detailer: D. BURROUGHS		Structure Numbers		
Full Path:	14102\700CADD\703elec\					Region 1 Mountain Residency I.N.Z.		Void:	Sheet Subset: TLD		13166		
Drawing File Name:	ltd102n.dwg								Subset Sheets:		7 of 13		
Acad Ver.:	R14	Scale: N.T.S.									Sheet Number 51		

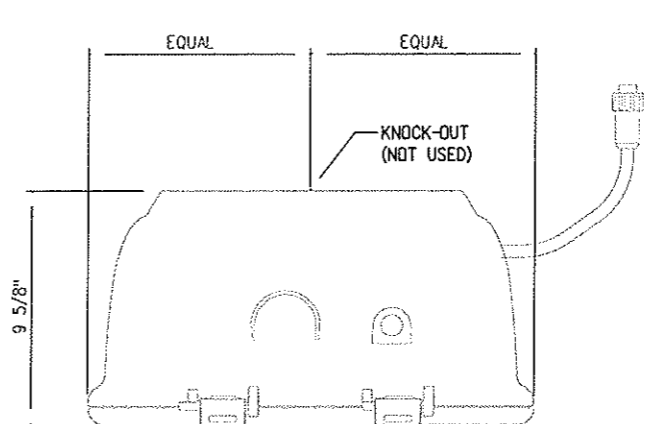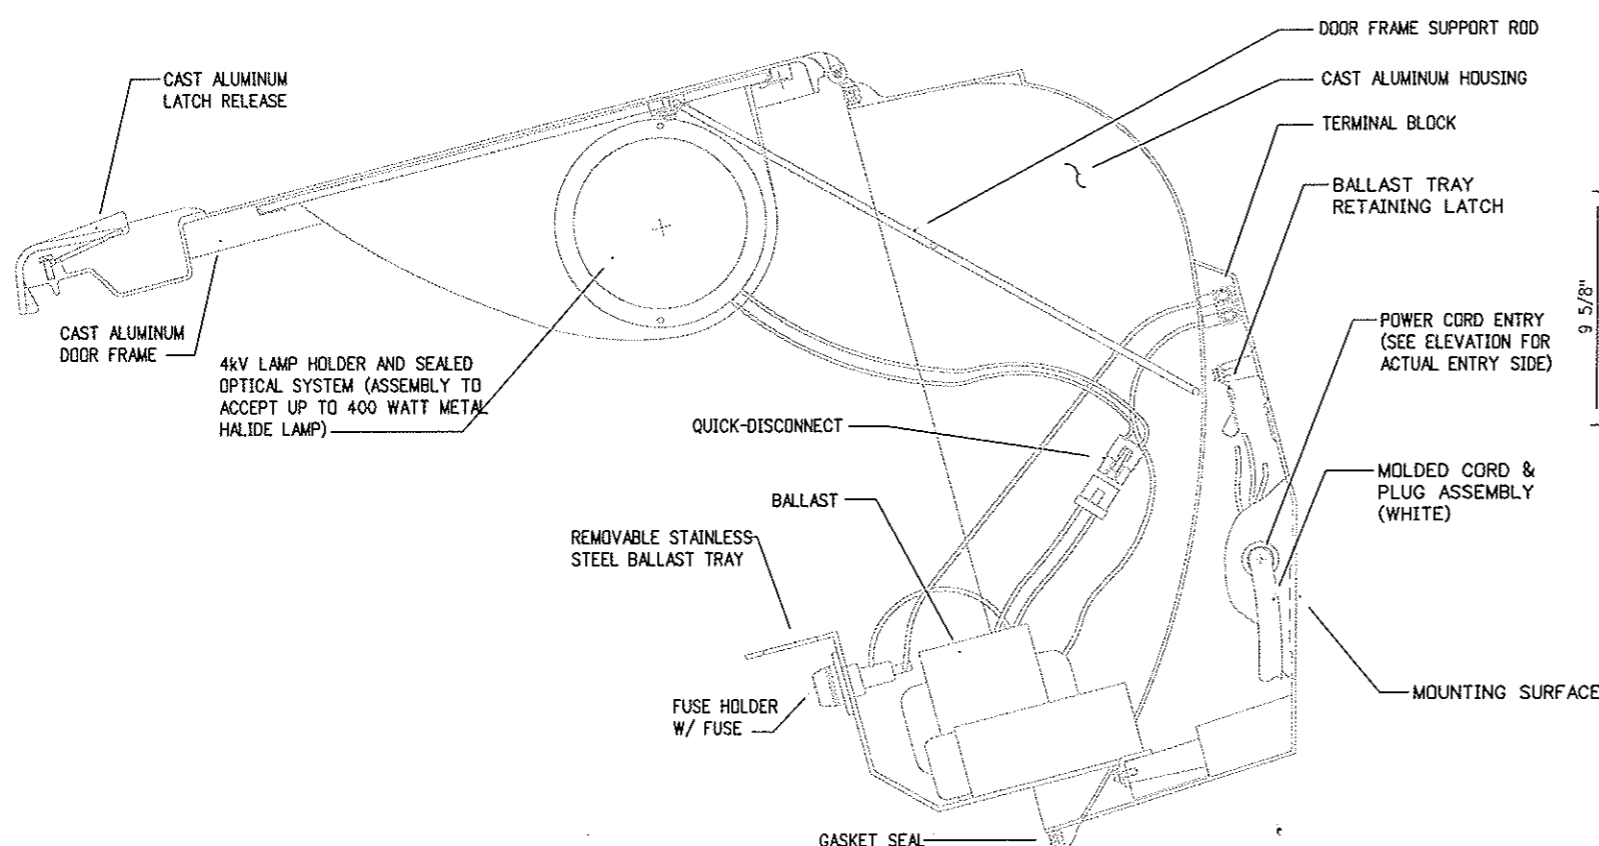


TOP VIEW

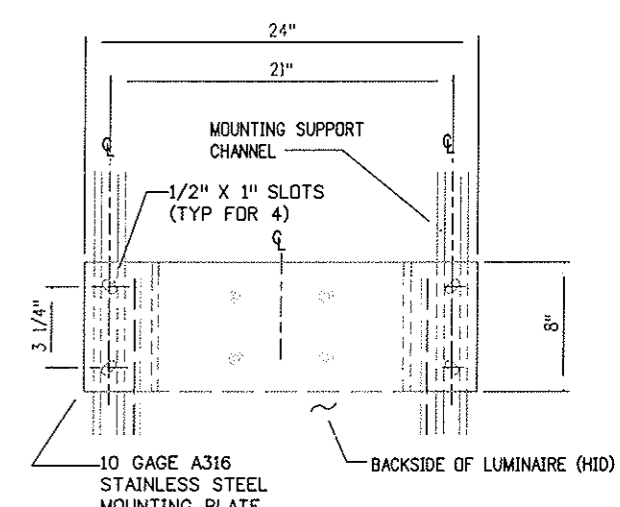


LUMINAIRE HID MOUNTING PLATE DETAIL

PHOTOMETRIC KEY
..... 45°


LUMINAIRE HID (TYPES M1, M2 & M3 TUNNEL) A

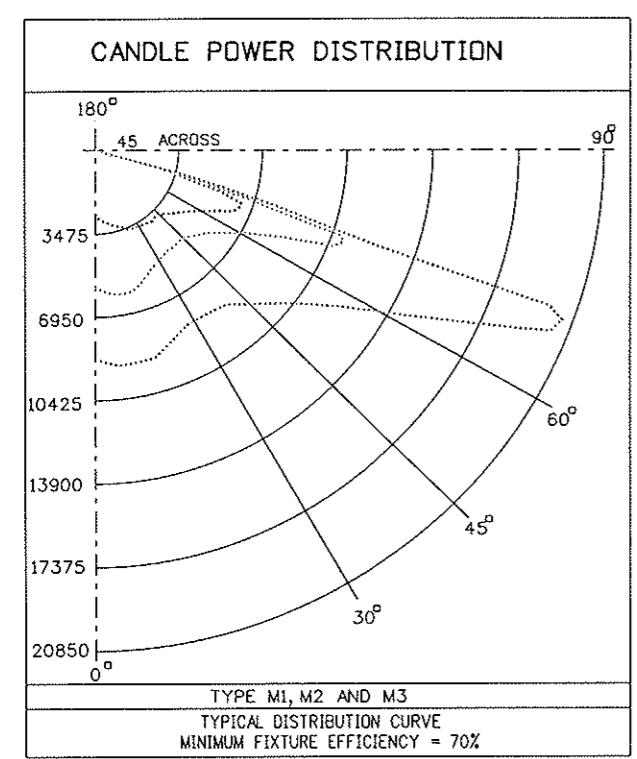


PHOTOMETRIC DATA

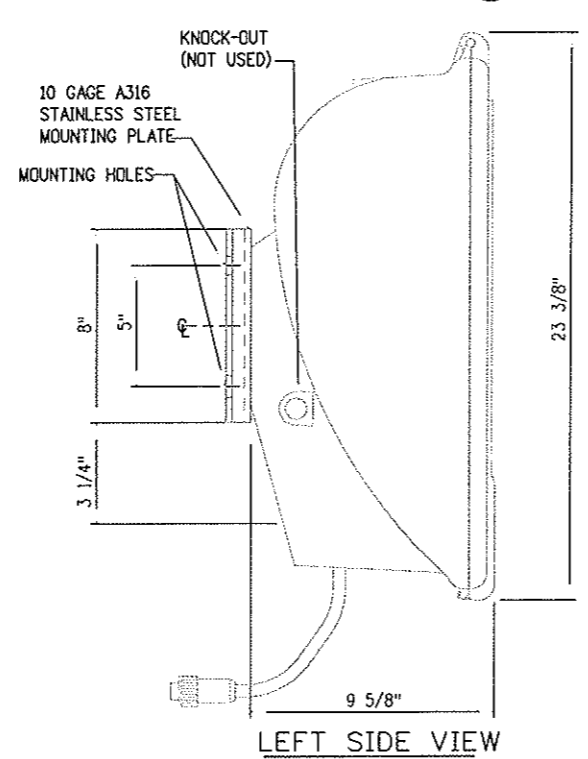

LEFT SIDE VIEW

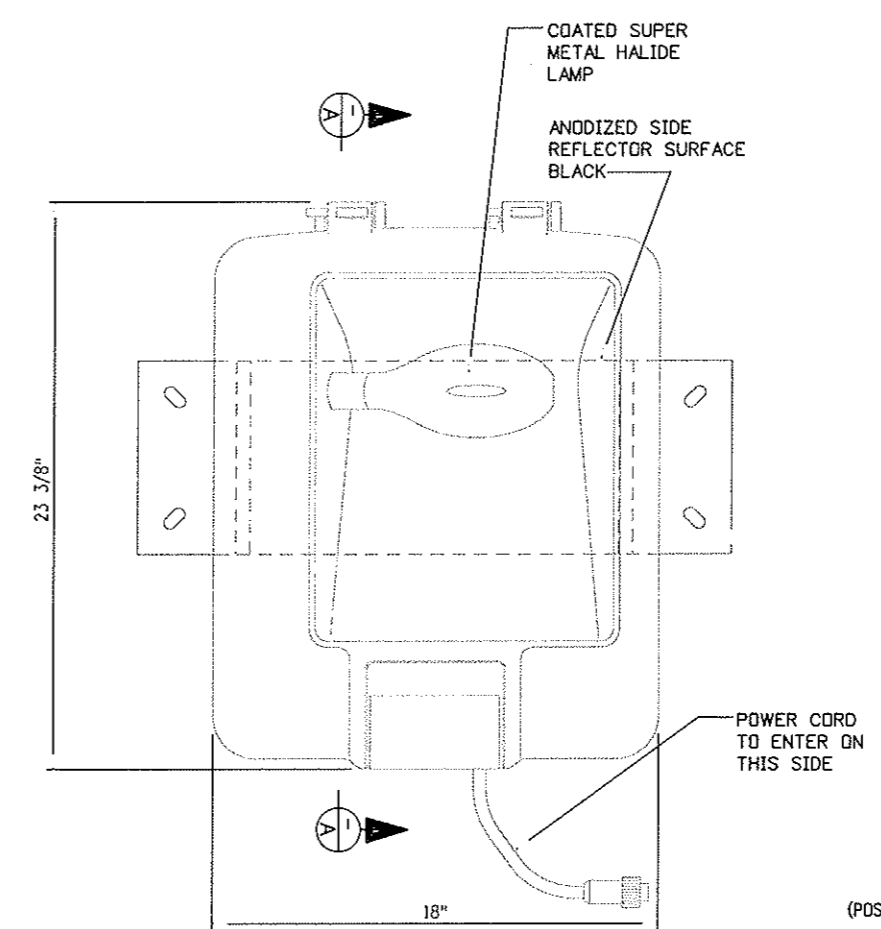

FRONT VIEW

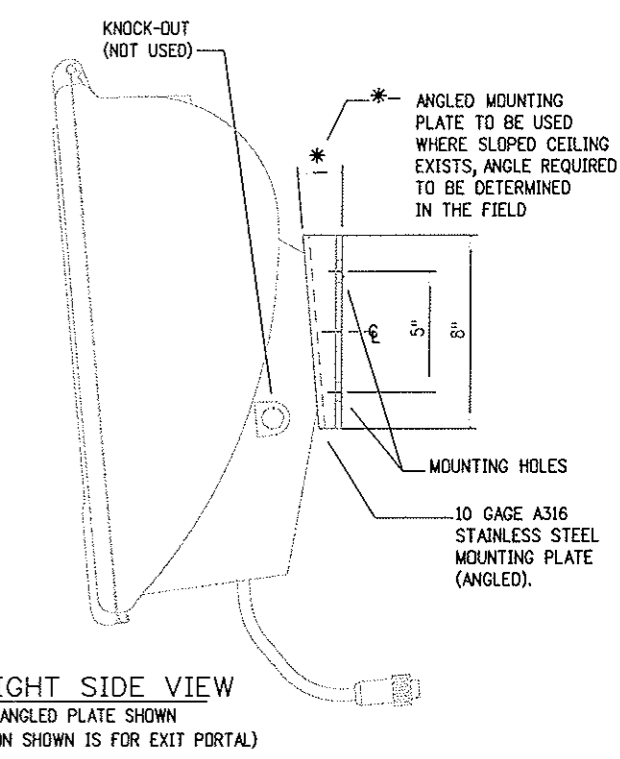


RIGHT SIDE VIEW
ANGLED PLATE SHOWN
(POSITION SHOWN IS FOR EXIT PORTAL)

Design File Name: DGN&SPEC*
Plot File Name: SPLDTFILE*
Date of Plot: \$\$\$DATE\$\$\$

Computer File Information	
Creation Date:	2/26/99 Initials: DJB
Last Modification Date:	11/27/00 Initials: DJB
Full Path:	014102\700cadd\703elec\
Drawing File Name:	ltd06n.dwg
Acad Ver. R14	Scale: NTS Units: ENGLISH

Sheet Revisions	
07/03/07	ASBUILT DJB

Colorado Department of Transportation




P.O. BOX 399
DUMONT, CO. 80436
Phone: 303-512-5750 FAX: 303-512-5775

Region 1 Mountain Residency I.N.Z.


As Constructed
No Revisions:
Revised:
Void:

TUNNEL LIGHTING DETAILS	
Designer: JPK/DJB	Structure Numbers
Detailer: D. BURROUGHS	
Sheet Subset: TLD	Subset Sheets: 8 of 13


Project No./Code	
IM 0703-269	
13166	
Sheet Number	52

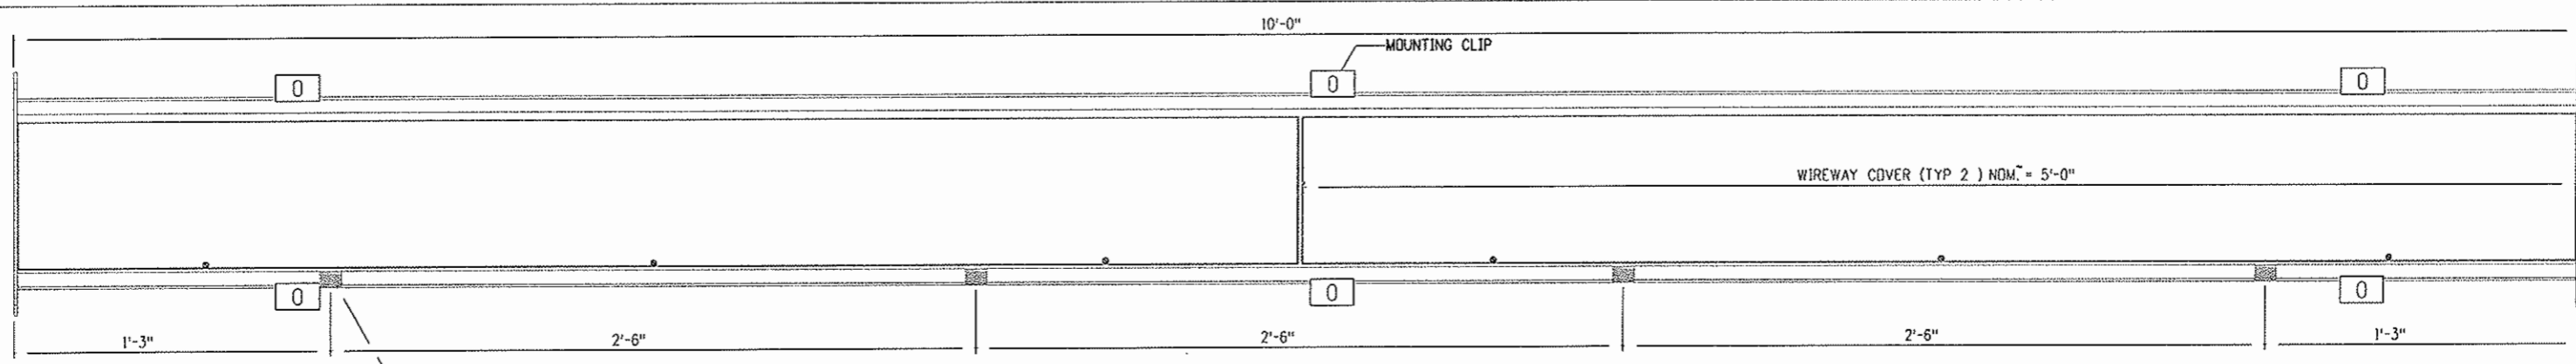

NON-FEED HID WIREWAY (SHOWN WITH COVER)

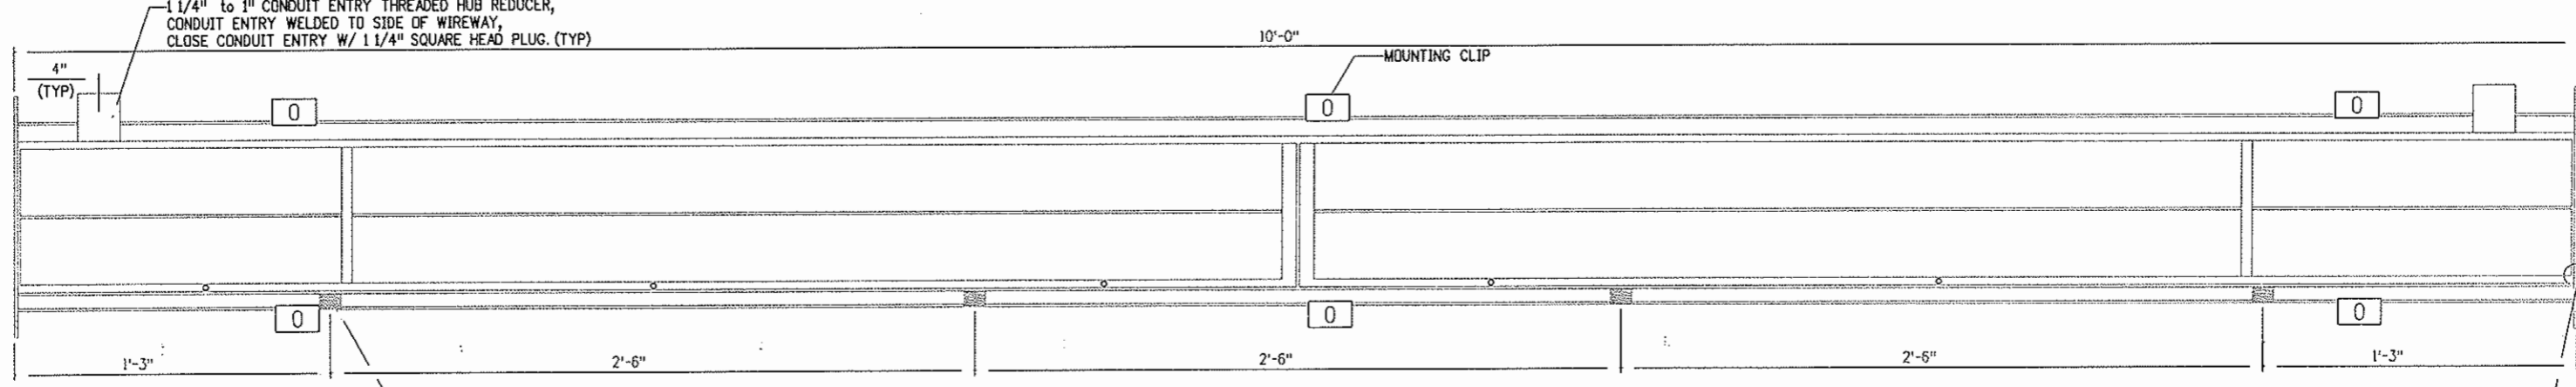


FEED HID WIREWAY (SHOWN WITHOUT COVER)

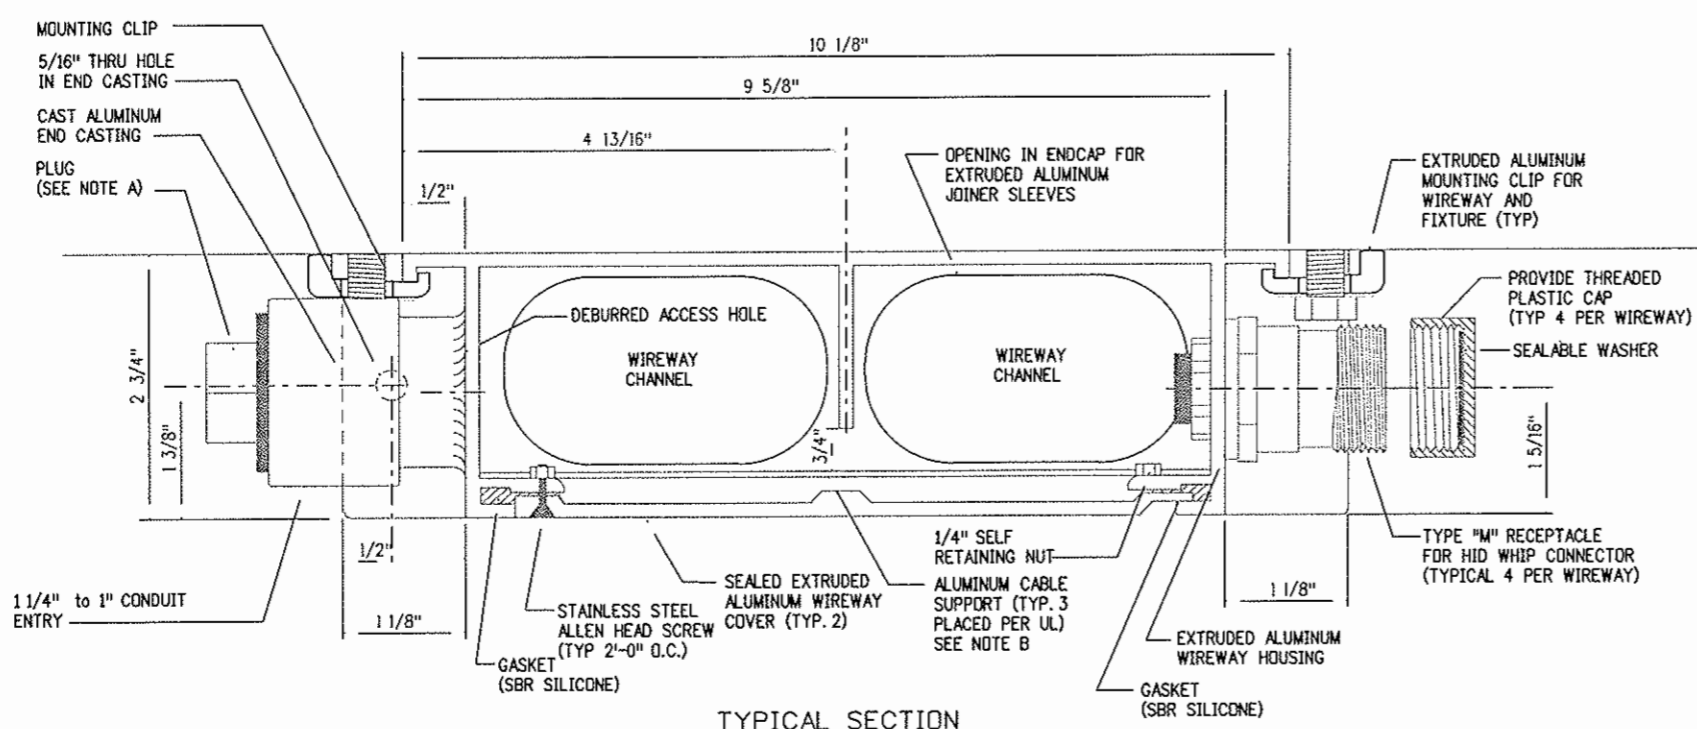

TYPICAL SECTION

PROVIDE SEALED CAST ALUMINUM END CAP (AS REQ'D AT END OF RUN)

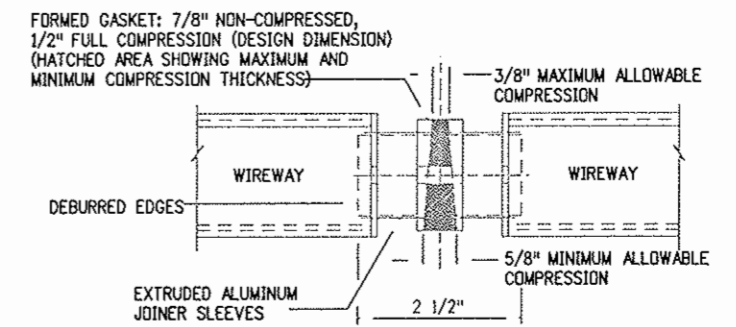

SIDE VIEW AT HID WIREWAY JOINT


NOTE:
 A. CONTRACTOR TO PROVIDE A PLUG TO CLOSE CONDUIT ENTRY WHEN NOT USED.
 B. CABLE SUPPORT STRAPS TO BE CONTINUOUSLY WELDED IN PLACE.

Design File Name: DGN5SPEC*
 Plot File Name: SPLDTFILE*
 Date of Plot: \$\$\$DATE\$\$\$

Computer File Information	
Creation Date:	04/21/99 Initials: DJB
Last Modification Date:	04/04/01 Initials: DJB
FullPath:	014102\700cadd\703elec\
Drawing File Name:	ltd12n.dwg
Acad Ver.	R14
Scale:	NTS
Units:	English

Sheet Revisions	
07/03/07	ASBUILT DJB

Colorado Department of Transportation




P.O. BOX 399
 DUMONT, CO. 80436
 Phone: 303-512-5750 FAX: 303-512-5775
 Region 1 Mountain Residency I.N.Z.


As Constructed
No Revisions:
Revised:
Void:

TUNNEL LIGHTING DETAILS		
Designer:	JPK/DJB	Structure Numbers
Detailer:	D. BURROUGHS	
Sheet Subset:	TL.D	Subset Sheets: 9 of 13

Project No./Code	IM 0703-269
	13166
Sheet Number	53

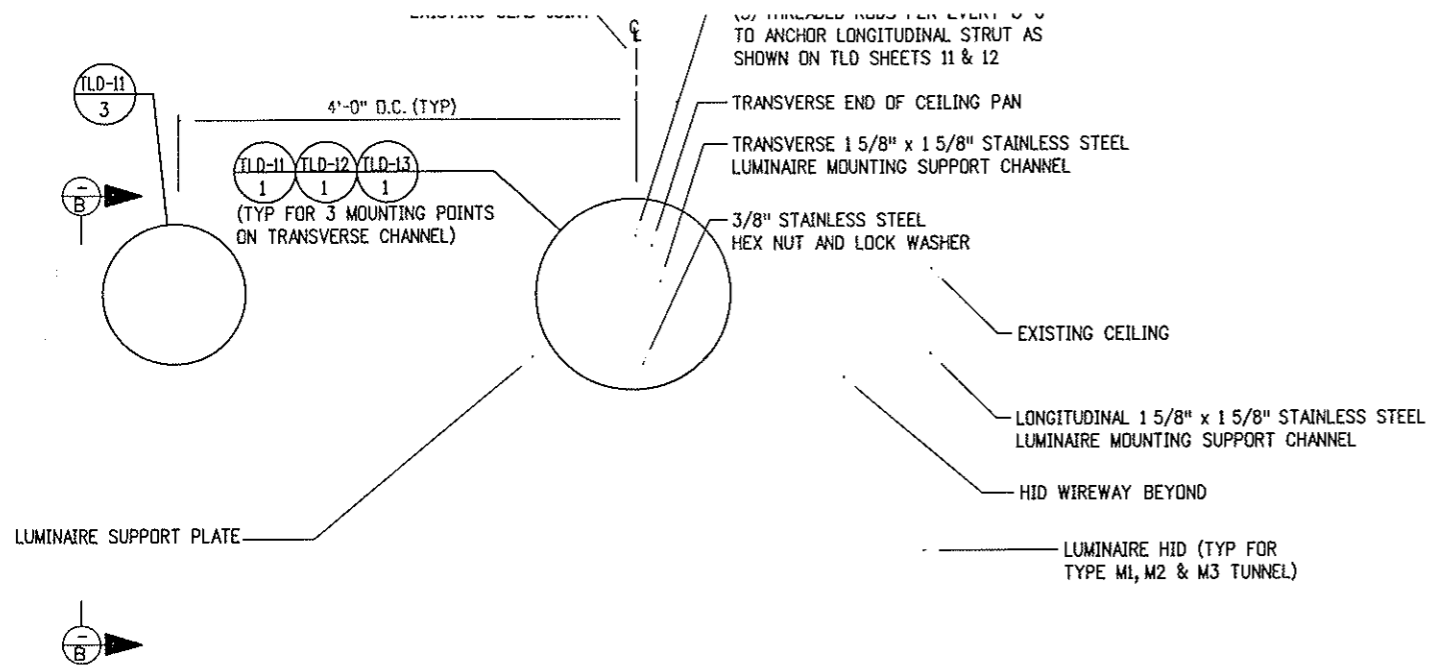


LONGITUDINAL SECTION TLD-11 A
LUMINAIRE HID TUNNEL (RACK MOUNTED)

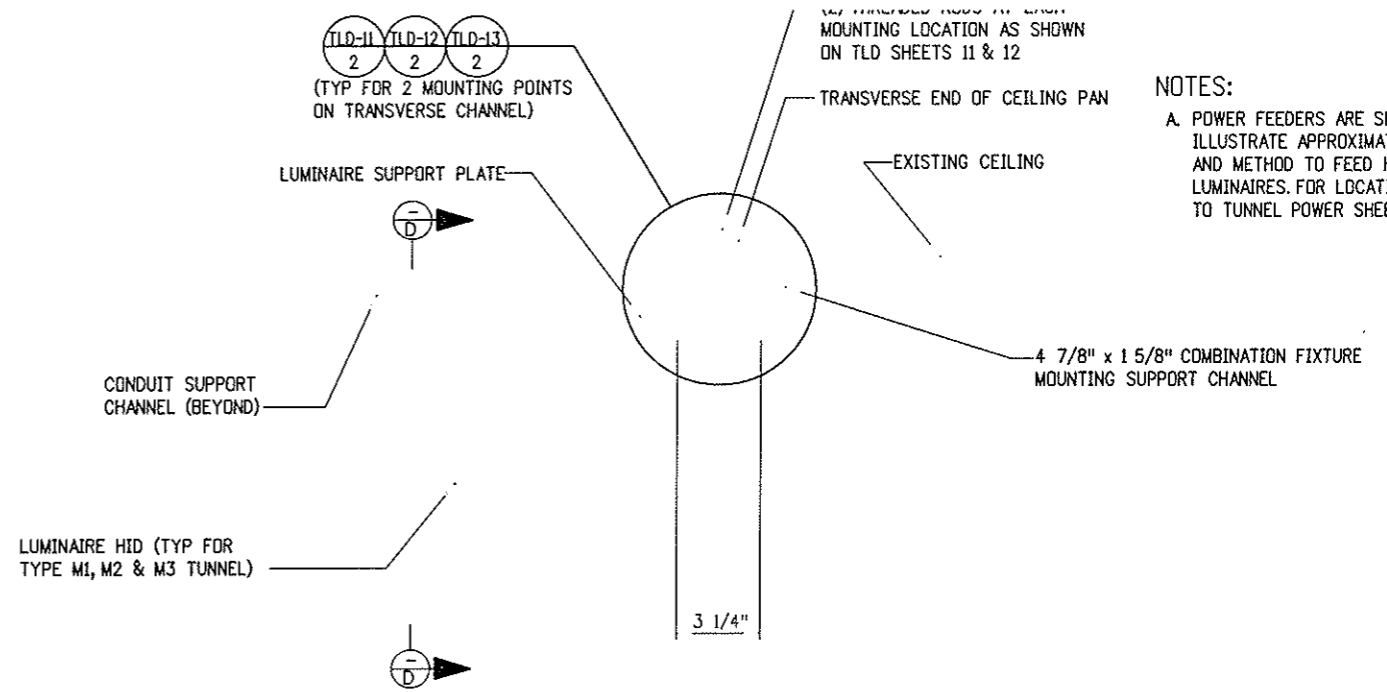


LONGITUDINAL SECTION TLD-11 C
LUMINAIRE HID TUNNEL (CEILING MOUNTED)


NOTES:
A. POWER FEEDERS ARE SHOWN TO ILLUSTRATE APPROXIMATE LOCATION AND METHOD TO FEED HID TUNNEL LUMINAIRES. FOR LOCATIONS REFER TO TUNNEL POWER SHEETS.

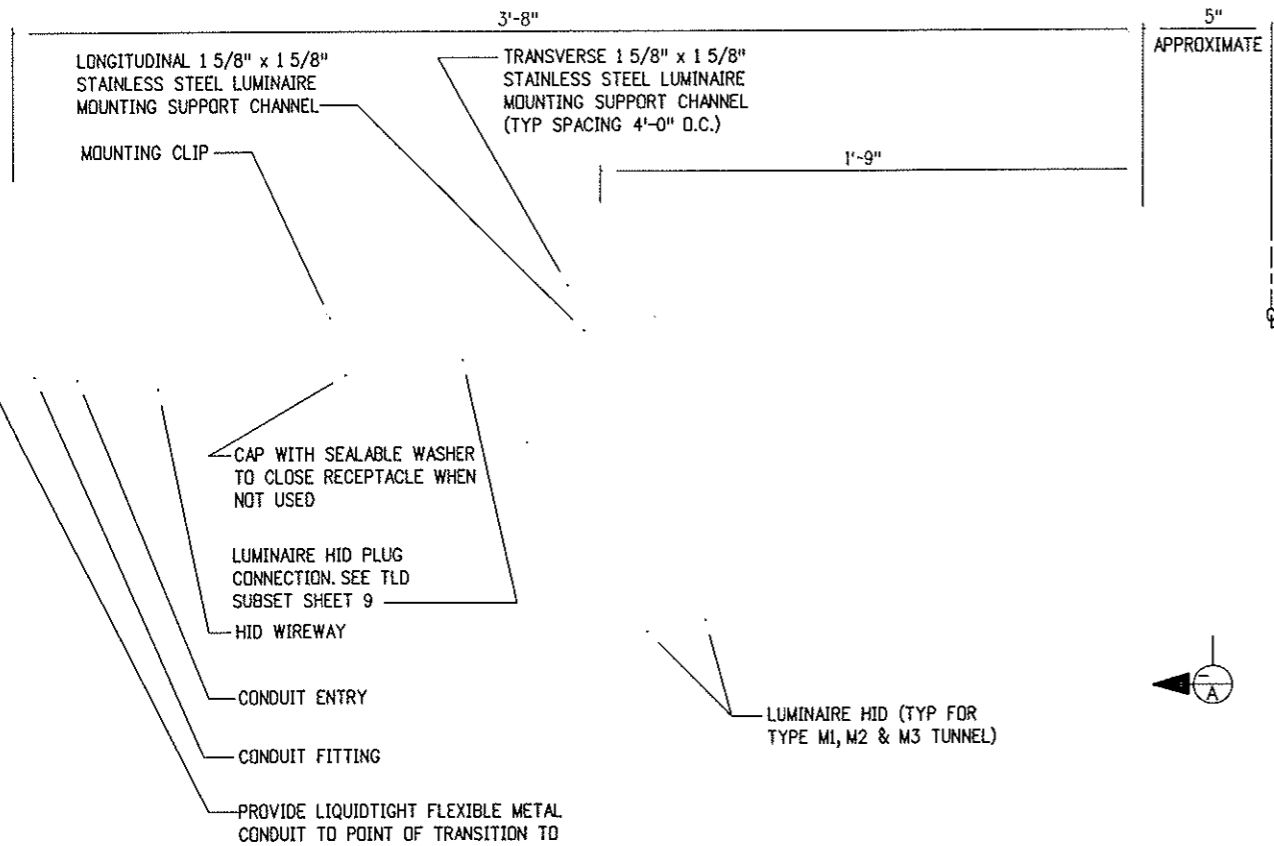

TRANSVERSE SECTION TLD-11 B
LUMINAIRE HID TUNNEL (RACK MOUNTED)

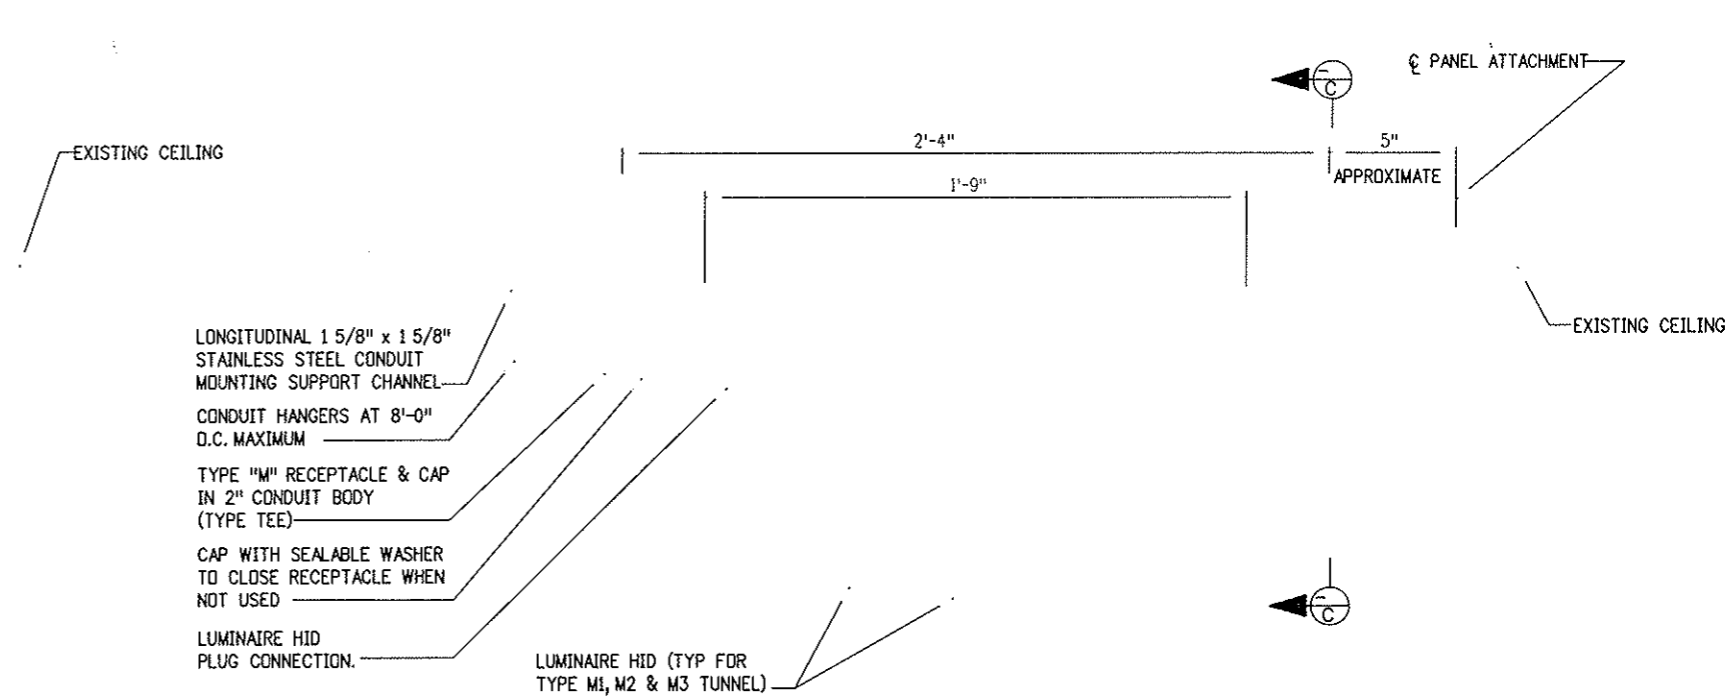


TRANSVERSE SECTION TLD-11 D
LUMINAIRE (HID) TUNNEL (CEILING MOUNTED)

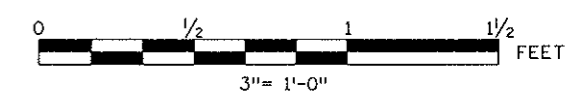

Design File Name: DGNSSPEC
Plot File Name: SLD01FILE
Date of Plot: 3/3/2004 8:55:55


Computer File Information		Sheet Revisions	
Creation Date:	02/26/99 Initials: DJB	07/03/07	ASBUILT DJB
Last Modification Date:	02/27/03 Initials: DJB		
Full Path:	14102\700CADD\703elec\		
Drawing File Name:	ltd17n.dwg		
Acad Ver.	R14 Scale: 3" = 1'-0" Units: English		

Colorado Department of Transportation



P.O. BOX 399
DUMONT, CO. 80436
Phone: 303-512-5750 FAX: 303-512-5775
Region 1 Mountain Residency I.N.Z.


As Constructed		TUNNEL LIGHTING DETAILS		Project No./Code	
No Revisions:				IM 0703-269	
Revised:		Designer: JPK/DJB	Structure Numbers:	13166	
Void:		Detailer: D. BURROUGHS		Sheet Number 54	
		Sheet Subset: TLD	Subset Sheets: 10 of 13		

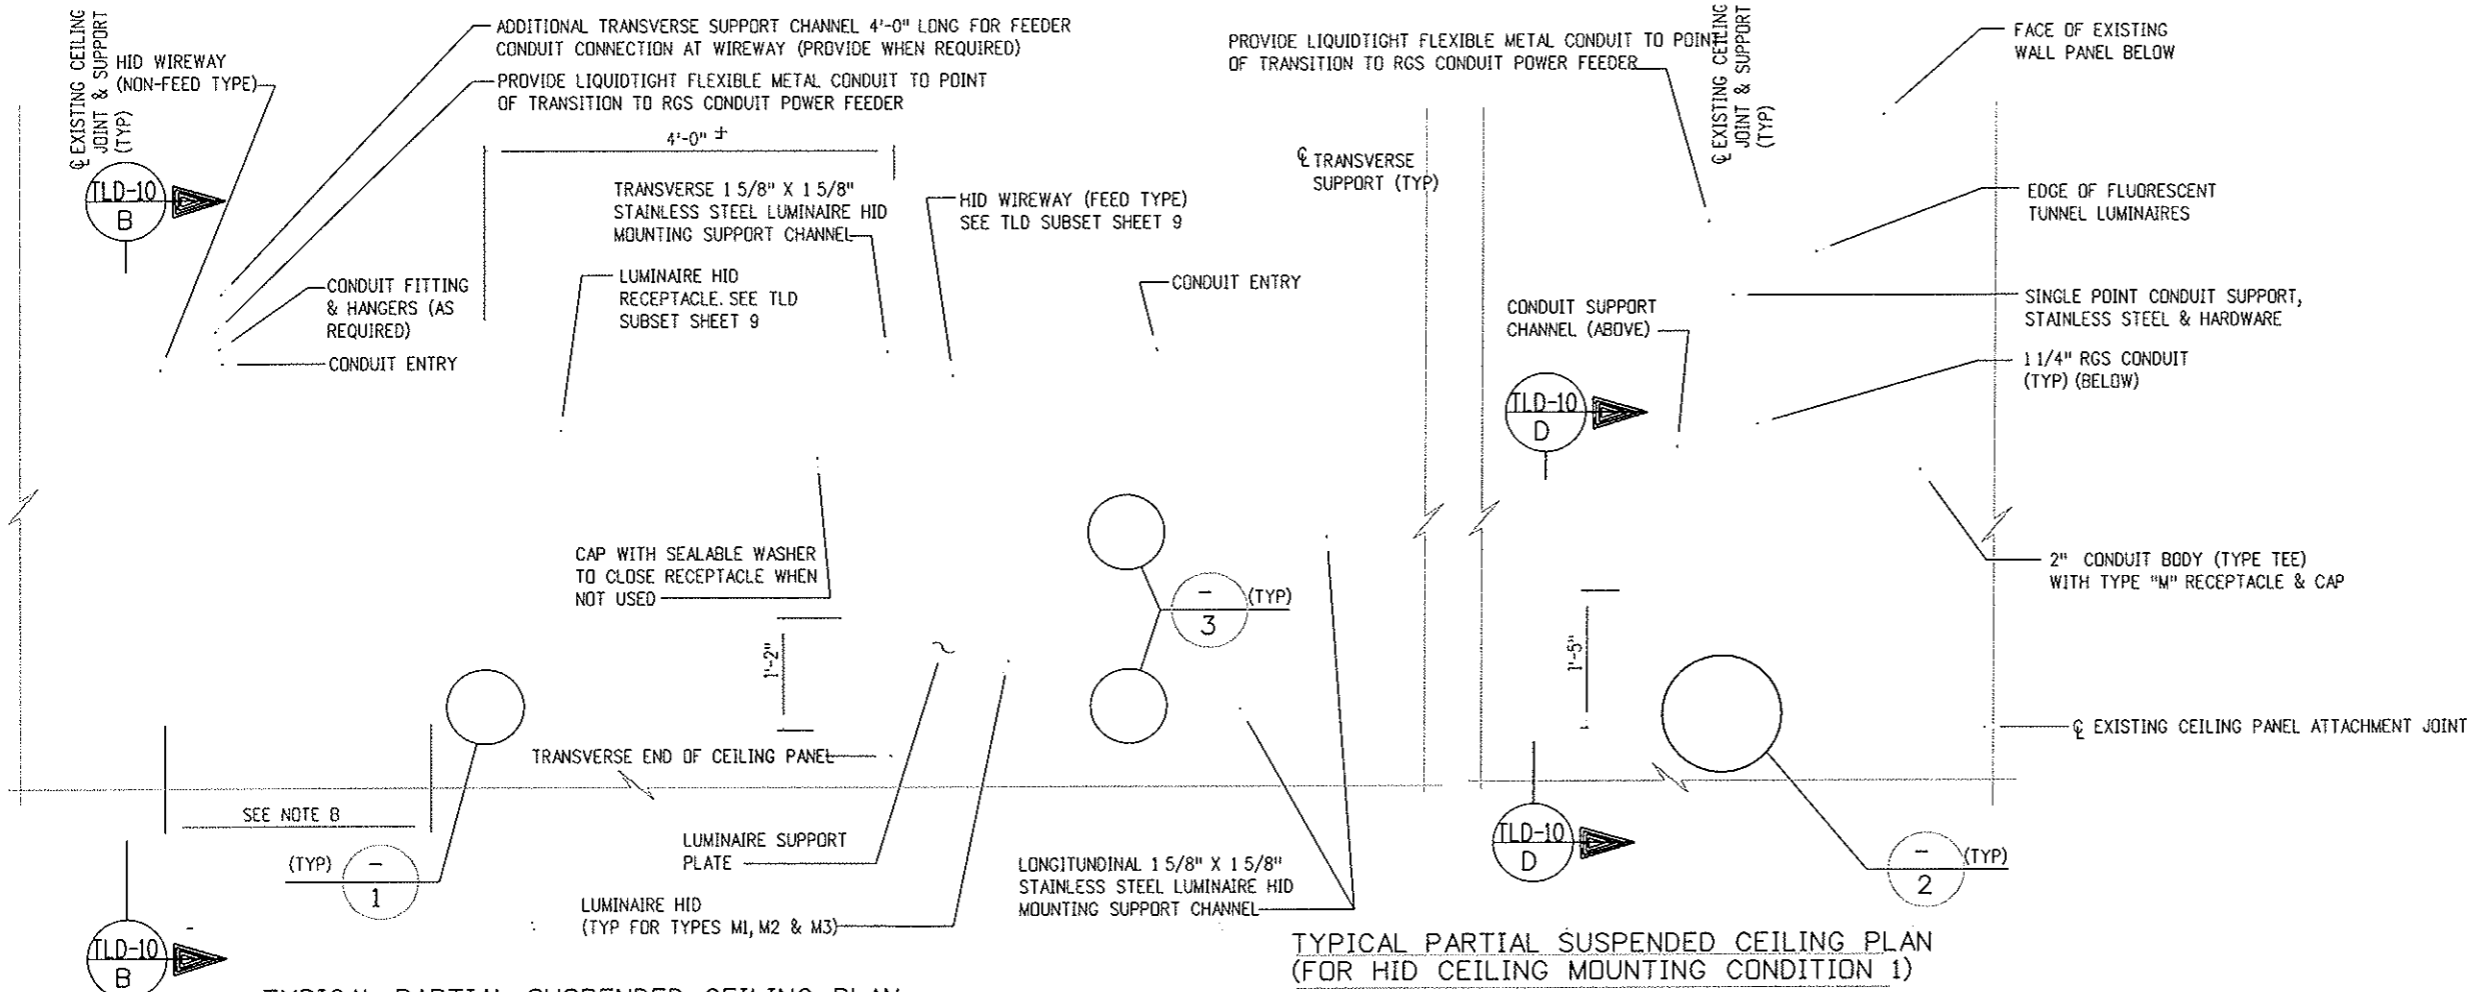


- NOTES:**
- A. POWER FEEDERS ARE SHOWN TO ILLUSTRATE APPROXIMATE LOCATION AND METHOD TO FEED LUMINAIRES HID - FOR LOCATIONS REFER TO TUNNEL POWER SHEETS.
 - B. FOR LUMINAIRE HID SPACING DIMENSIONS REFER TO NORTH TUNNEL LIGHTING PLANS, SHEETS 2, 18 & 19.
 - C. NEW 1 5/8" X 1 5/8" UNISTRUT CHANNEL SUPPORTED ON LONGITUDINAL 3 C 4.1 CHANNEL BY 1/2" DIA. ROD WITH LOCK NUTS AND WASHER. PROVIDE LENGTH REQUIRED TO SPAN FROM EDGE OF CEILING TO FIRST LONGITUDINAL CHANNEL. WHEN SPAN IS GREATER THAN 6'-0" PROVIDE ADDITIONAL SUPPORTING ROD SECURED TO CEILING BY MEANS OF AN EMBEDDED EPOXY ANCHOR.
 - D. MOUNTING OF HID SUPPORTS IS CONSTRAINED TO CEILING PANEL JOINT LOCATIONS AS INDICATED ON TUNNEL LIGHTING DETAILS FOR HID RACK MOUNTING SYSTEM. SEE SHEETS TLD-11, 12 & 13.

TYPICAL PARTIAL SUSPENDED CEILING PLAN (FOR HID RACK MOUNTING CONDITION 1)


TYPICAL PARTIAL SUSPENDED CEILING PLAN (FOR HID CEILING MOUNTING CONDITION 1)

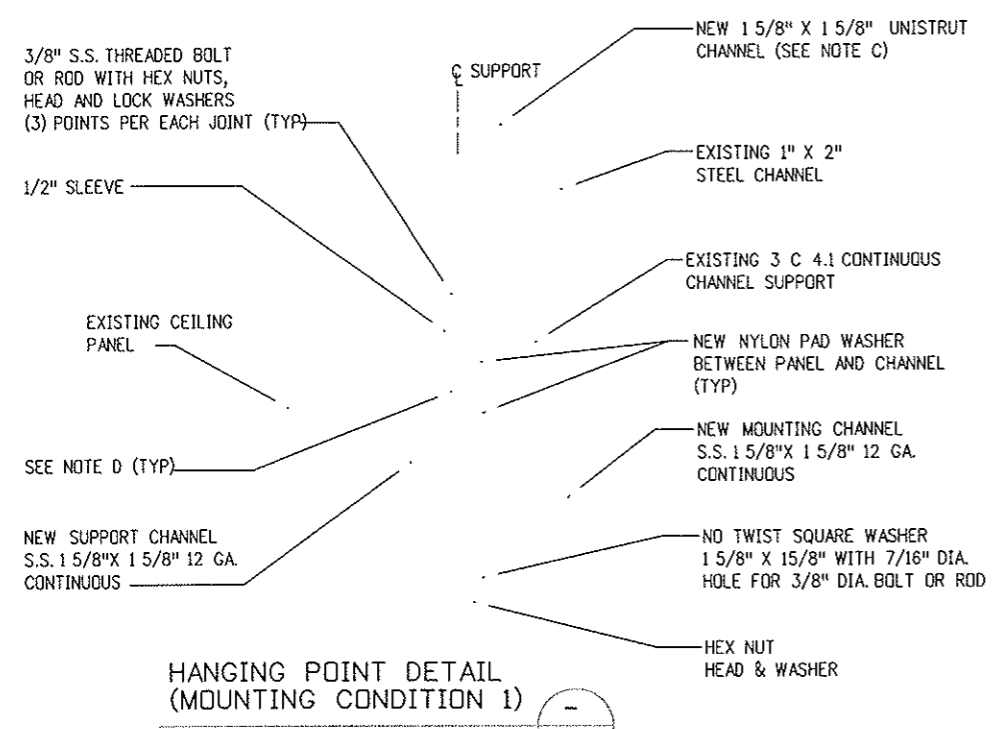

HANGING POINT DETAIL (MOUNTING CONDITION 1)

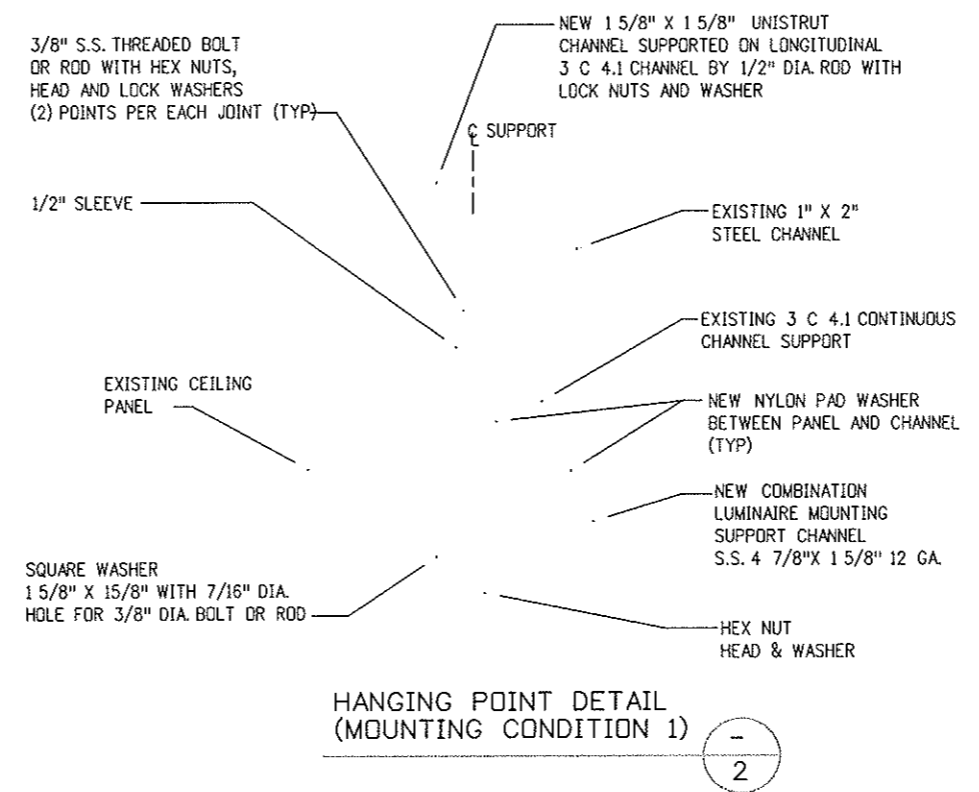

HANGING POINT DETAIL (MOUNTING CONDITION 1)

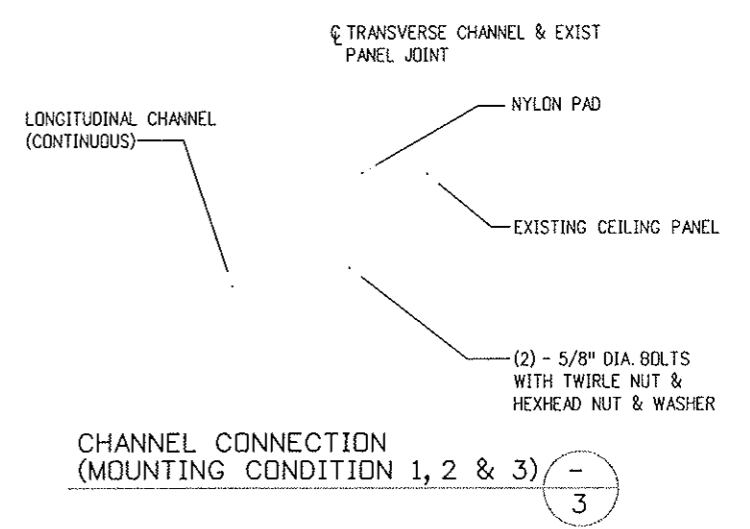


CHANNEL CONNECTION (MOUNTING CONDITION 1, 2 & 3)

Design File Name: DGN\$SPEC*
 Plot File Name: \$PLOTFILE*
 Date of Plot: \$\$\$DATE\$\$\$\$

Computer File Information	
Creation Date:	02/26/99 Initials: DJB
Last Modification Date:	02/25/05 Initials: DJB
Full Path:	14102\700CADD\703elec\
Drawing File Name:	ltd118n.dwg
Acad Ver.	R14 Scale: NTS Units: English

Sheet Revisions	
07/03/07	ASBUILT DJB

Colorado Department of Transportation




P.O. BOX 399
 DUMONT, CO. 80436
 Phone: 303-512-5750 FAX: 303-512-5775

Region 1 Mountain Residency I.N.Z.

As Constructed
No Revisions:
Revised:
Void:

TUNNEL LIGHTING DETAILS	
Designer:	JPK/DJB
Detailer:	D. BURROUGHS
Sheet Subset:	TLD
Subset Sheets:	11 of 13



Project No./Code	
IM 0703-269	
13166	
Sheet Number	55

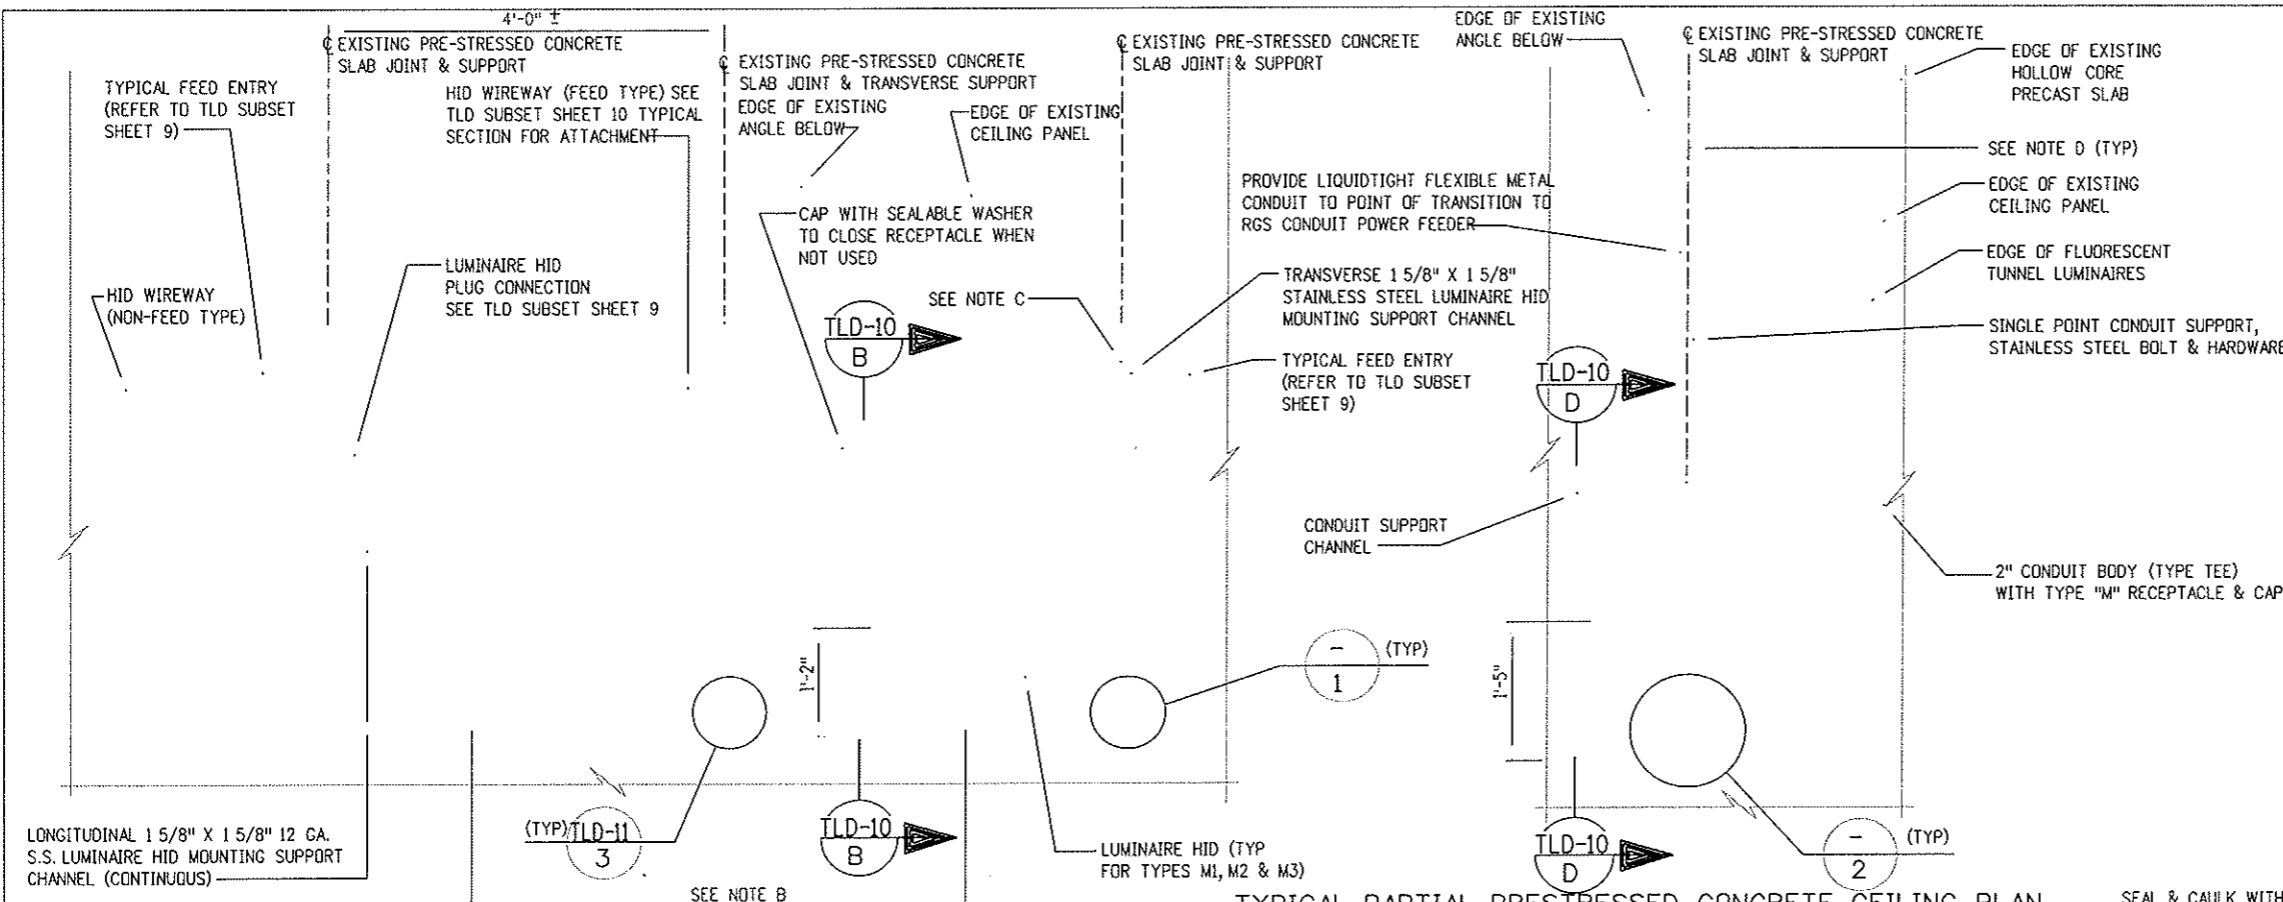

- NOTES:**
- A. POWER FEEDERS ARE SHOWN TO ILLUSTRATE APPROXIMATE LOCATION AND METHOD TO FEED LUMINAIRE HID - FOR LOCATIONS REFER TO TUNNEL POWER SHEETS.
 - B. FOR LIMINAIRE HID SPACING DIMENSIONS REFER TO NORTH TUNNEL LIGHTING PLANS, SHEETS 2, 18 & 19.
 - C. WHEN EXISTING CONDITION PROHIBITS USE OF CARRIAGE BOLT ANCHOR METHOD, A THREADED ROD SHALL BE SUBSTITUTED AND SHALL BE SECURED TO THE CEILING BY MEANS OF AN EMBEDDED EPOXY ANCHOR.
 - D. MOUNTING OF HID SUPPORTS IS CONSTRAINED TO CEILING PANEL JOINT LOCATIONS AS INDICATED ON TUNNEL LIGHTING DETAILS FOR HID RACK MOUNTING SYSTEM. SEE SHEETS TLD-11, 12 & 13.
 - E. MOUNTING CONDITION 2 SHOWN ON TLD-12, IS FOR NORTH SIDE (SUPPLY DUCT) OF TUNNEL CEILING. MOUNTING CONDITION 3 SHOWN ON TLD-13, IS FOR SOUTH SIDE (EXHAUST DUCT) OF TUNNEL CEILING.

TYPICAL PARTIAL PRESTRESSED CONCRETE CEILING PLAN (FOR HID RACK MOUNTING CONDITION 2 & 3)

TYPICAL PARTIAL PRESTRESSED CONCRETE CEILING PLAN (FOR HID CEILING MOUNTING CONDITION 2 & 3)

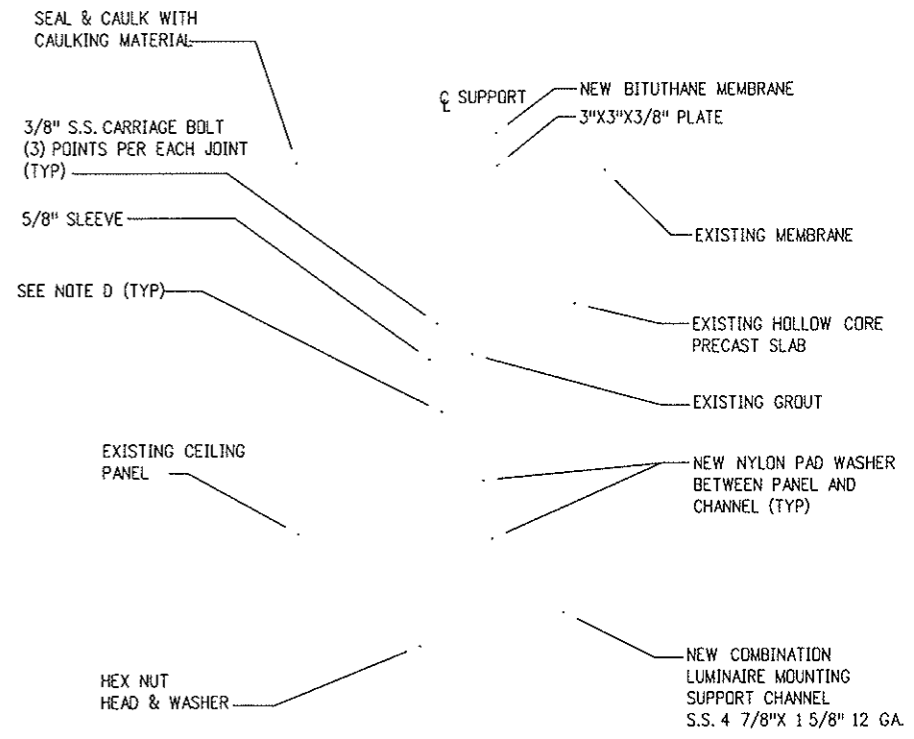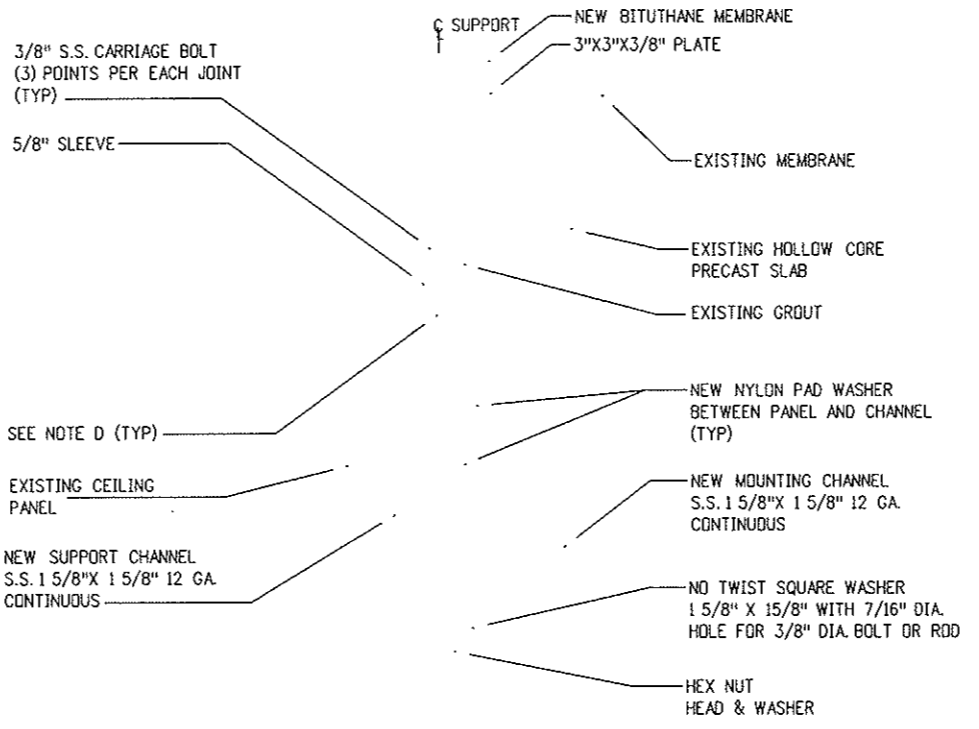

HANGING POINT DETAIL (MOUNTING CONDITION 2)

HANGING POINT DETAIL (MOUNTING CONDITION 2)

Design File Name: DONSPEC
 Plot File Name: TLD19n.dwg
 Date of Plot: 07/03/07

Computer File Information	
Creation Date:	02/26/99 Initials: DJB
Last Modification Date:	02/26/05 Initials: DJB
Full Path:	14102\700CADD\703elec\
Drawing File Name:	ltd19n.dwg
Acad Ver.	R14 Scale: NTS Units: English

Sheet Revisions	
07/03/07	ASBUILT DJB


Colorado Department of Transportation
 P.O. BOX 399
 DUMONT, CO. 80436
 Phone: 303-512-5750 FAX: 303-512-5775
 Region 1 Mountain Residency I.N.Z.

As Constructed
No Revisions:
Revised:
Void:

TUNNEL LIGHTING DETAILS	
Designer:	JPK/DJB
Detailer:	D. BURROUGHS
Sheet Subset:	TLD
Subset Sheets:	12 of 13


Project No./Code
IM 0703-269
13166
Sheet Number 56

TYPICAL EXHAUST SIDE CONCRETE CEILING DETAIL
(FOR HID RACK MOUNTING CONDITION 3) ODD AND EVEN SEGMENTS

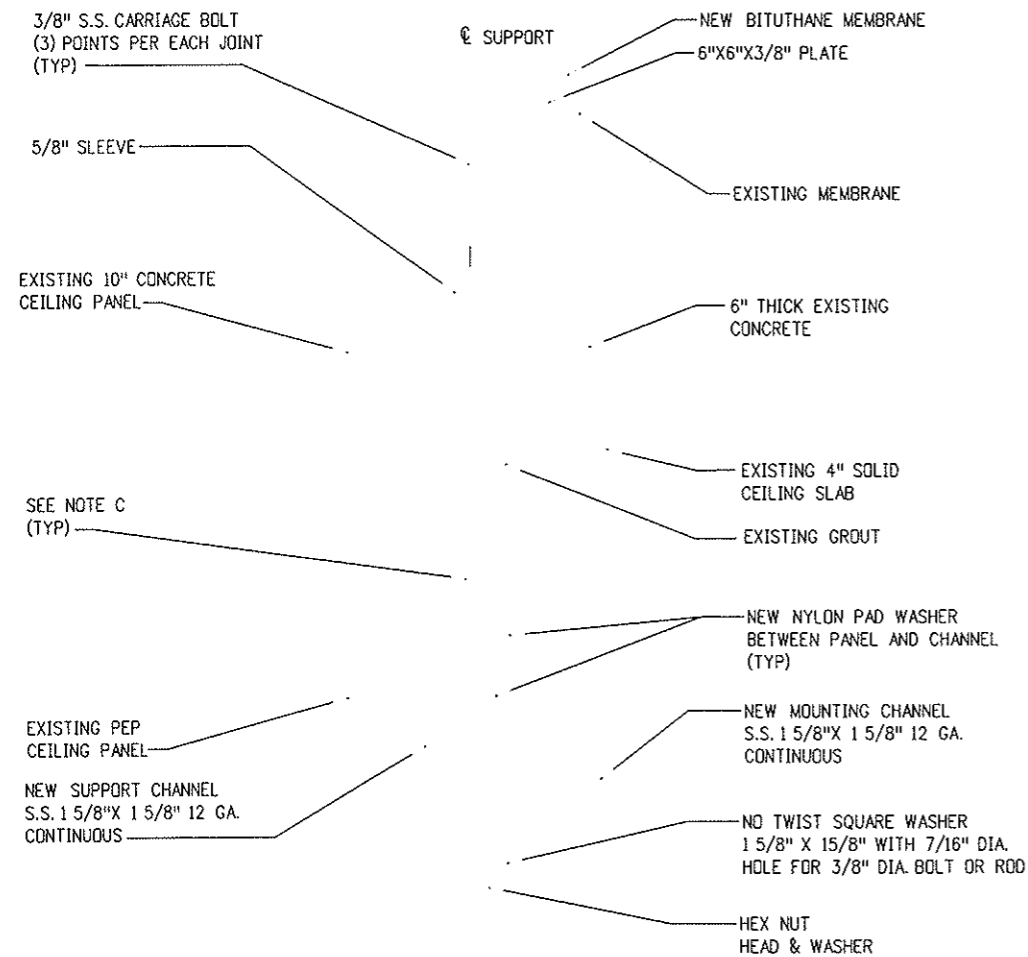

HANGING POINT DETAIL
(MOUNTING CONDITION 3)

1

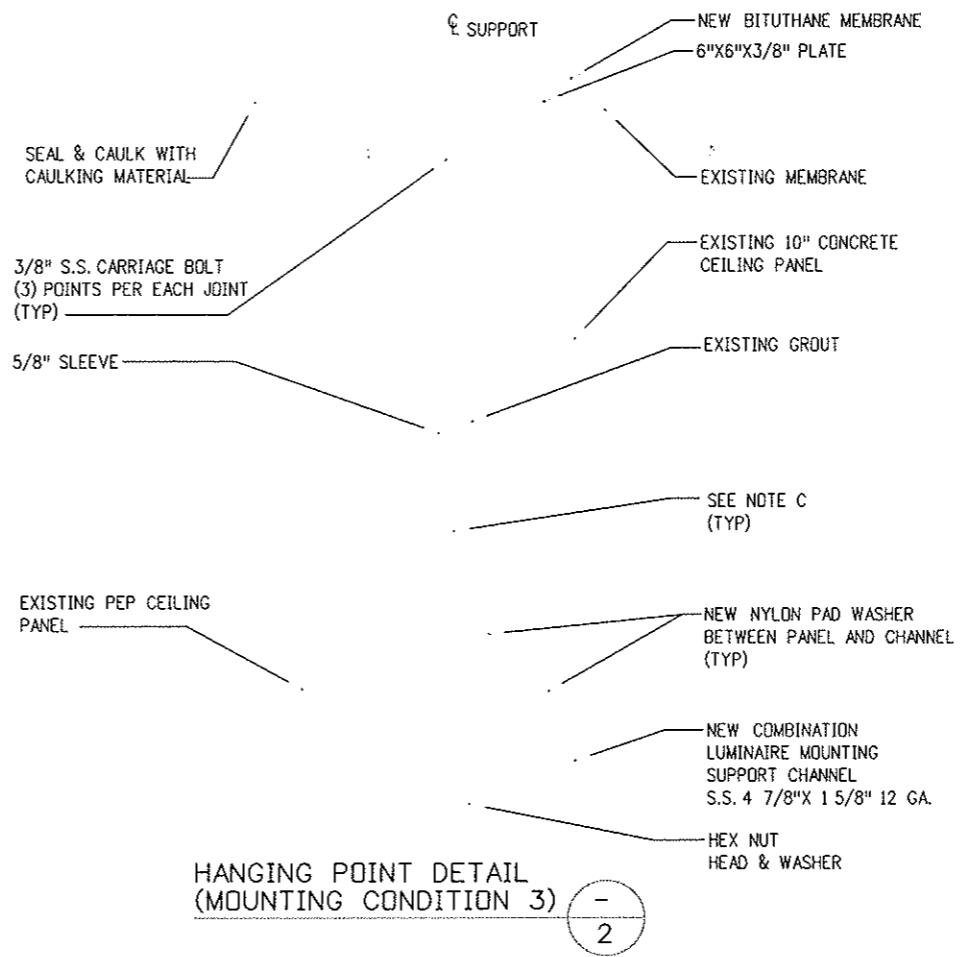

HANGING POINT DETAIL
(MOUNTING CONDITION 3)

2

NOTES:


- A. REFER TO TUNNEL LIGHTING DETAILS SHEETS TLD-10 & TLD-12 FOR TYPICAL HID SUPPORT REQUIREMENTS AND NOTES.
- B. THE 4'-0" WIDE CEILING PANELS IN MAIN TUNNEL OF THE NORTH BORE ARE ARRANGED IN SEGMENTS, INDICATED AS ODD OR EVEN WHICH ARE 50'-3" IN LENGTH CORRESPOND TO TUNNEL WALL SEGMENTS WHICH ARE NUMBERED FROM WEST TO EAST IN ASCENDING ORDER. THE ILLUSTRATION SHOWN PORTRAYS THE PATTERN WHICH IS REPEATED THROUGHOUT THE LENGTH OF THE MAIN TUNNEL CEILING. NOTE THAT THE TRANSVERSE HID MOUNTING SUPPORT CHANNELS ARE HUNG FROM THE CEILING SLAB JOINTS AT 4'-0" O.C. EXCEPT WHERE AN OBSTRUCTION (eg: DUCT, CONDUIT, etc) PREVENTS SUCH SPACING, AT WHICH THE 8'-0" O.C. DIMENSION WILL BE USED. SHOULD A CHANGE TO THE PATTERN SHOWN BE REQUIRED, IT MUST FIRST BE REVIEWED AND APPROVED BY THE RESIDENT ENGINEER.
- C. MOUNTING OF HID SUPPORTS IS CONSTRAINED TO CEILING PANEL JOINT LOCATIONS AS INDICATED ON TUNNEL LIGHTING DETAILS FOR HID RACK MOUNTING SYSTEM. SEE SHEETS TLD-11,12 & 13.

Design File Name: DGN\$SPEC*
 Plot File Name: \$PLOTFILE*
 Date of Plot: \$\$\$DATE\$\$\$

Computer File Information			
Creation Date:	02/26/99	Initials:	DJB
Last Modification Date:	02/08/01	Initials:	DJB
Full Path:	14102\700CADD\703elec\		
Drawing File Name:	ltdt20n.plt		
Acad Ver.	R14	Scale:	NTS
Units:	English		

Sheet Revisions			
07/03/07	ASBUILT		DJB

Colorado Department of Transportation



P.O. BOX 399
DUMONT, CO. 80436
Phone: 303-512-5750 FAX: 303-512-5775

Region 1 Mountain Residency I.N.Z.


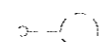
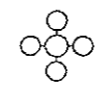





As Constructed		TUNNEL LIGHTING DETAILS	
No Revisions:		Designer:	DJB/JPK
Revised:		Detailer:	D. BURROUGHS
Void:		Sheet Subset:	TLD
		Structure Numbers:	
		Subset Sheets:	13 of 13

Project No./Code	
IM	0703-269
	13166
Sheet Number	57

APPROACH LIGHTING RULES

1. APPROACH LIGHTING POLE LOCATIONS ARE BASED ON A 10'-0" SET-BACK FROM THE EDGE OF THE PAVEMENT AT THE STATION INDICATED ON THE PLANS.
2. FOR HIGHMAST REFURBISHMENT SEE SPECIFICATIONS, APPROACH LIGHTING PLANS AND CDOT STANDARD PLANS.
3. STATIONS SHOWN FOR EXISTING POLES ARE APPROXIMATE.
4. LIGHT POLES AND LUMINAIRES TO BE REMOVED SHALL BECOME THE PROPERTY OF THE CONTRACTOR.
5. NO PHOTOCELLS ARE REQUIRED FOR APPROACH LIGHTING. THE TUNNEL LIGHTING CONTROL SYSTEM WILL CONTROL APPROACH LIGHTING FOR EACH APPROACH FROM THEIR RESPECTIVE PHOTOCELLS AT EACH VENTILATION BUILDING.

LEGEND

-  NEW LIGHTING POLE, LUMINAIRE AND FOUNDATION
-  REMOVE EXISTING LIGHTING POLE, LUMINAIRE AND FOUNDATION
-  EXISTING HIGHMAST POLE. INSTALL NEW LUMINAIRES AND LOWERING SYSTEM.
-  PROPOSED CONCRETE PULL BOX
-  EXISTING ELECTRICAL CONDUIT(S)/UNDERGROUND DUCTBANK (PVC)
-  PROPOSED DIRECT-BURIAL CABLE
-  PROPOSED ELECTRICAL CONDUITS ON STRUCTURE (METAL)
-  EXISTING MANHOLE/PULLBOX, TO REMAIN


POLE TYPE (A=NEW) (E=EXIST)		LAMP WATTAGE	
A	400		
M-S-III		DISTRIBUTION	
138	75	STATION	
AB		CIRCUIT / PHASE CONNECTION	


LIGHTING STANDARD / LUMINAIRE NOTATION

APPROXIMATE QUANTITIES - APPROACH LIGHTING



CONTRACT ITEM NUMBER	CONTRACT ITEM	UNIT	ROADWAY	
			PLAN	AS CONST.
CONSTRUCTION				
EAST APPROACH (WESTBOUND)				
202	REMOVAL OF LIGHT STANDARD	EA	13	
613	LIGHT STANDARD STEEL (40 FOOT)	EA	22	
613	CONCRETE FOUNDATION PAD	EA	22	
613	LOWERING DEVICE	EA	2	
613	PORTABLE POWER UNIT	EA	2	
613	LUMINAIRE HIGH PRESSURE SODIUM (400 WATT)	EA	22	
613	LUMINAIRE HIGH PRESSURE SODIUM (1000 WATT)	EA	8	
613	DIRECT-BURIAL CABLE	LF	5300	
WEST APPROACH (EASTBOUND)				
202	REMOVAL OF LIGHT STANDARD	EA	3	
613	LIGHT STANDARD STEEL (40 FOOT)	EA	11	
613	CONCRETE FOUNDATION PAD	EA	11	
613	LOWERING DEVICE	EA	2	
613	LUMINAIRE HIGH PRESSURE SODIUM (400 WATT)	EA	11	
613	LUMINAIRE HIGH PRESSURE SODIUM (1000 WATT)	EA	8	
613	DIRECT-BURIAL CABLE	LF	2900	
613	PULL BOX (24"x36"x36") DEEP	EA	2	

Computer File Information		Sheet Revisions		Colorado Department of Transportation		As Constructed		APPROACH POWER AND LIGHTING NOTES		Project No./Code	
Creation Date:	07/03/07	Initials:	DJB	07/03/07	ASBUILT			IM 0703-269			
Last Modification Date:		Initials:	DJB					13166			
Full Path:	14102\700CADD\703elec\							1 of 9		Sheet Number 58	
Drawing File Name:	ltx04.plt							Sheet Subset: APPROACH LTG			
Acad Ver. R14	Scale: NTS	Units: English						Subset Sheets: 1 of 9			


DOT
 P.O. BOX 399
 DUMONT, CO. 80436
 Phone: 303-512-5750 FAX: 303-512-5775
 Region 1 Mountain Residency I.N.Z.

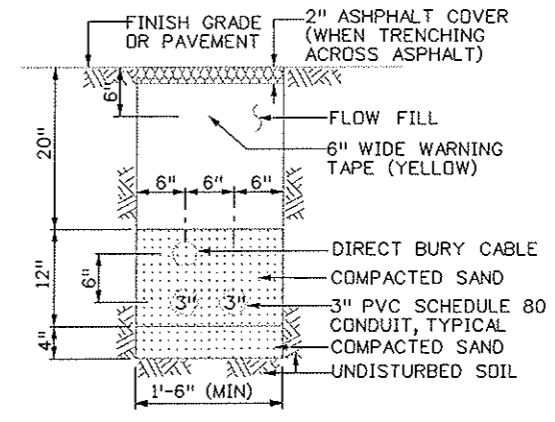


SECTION C
SCALE: NTS

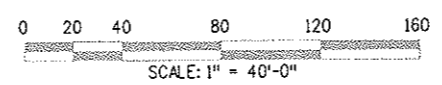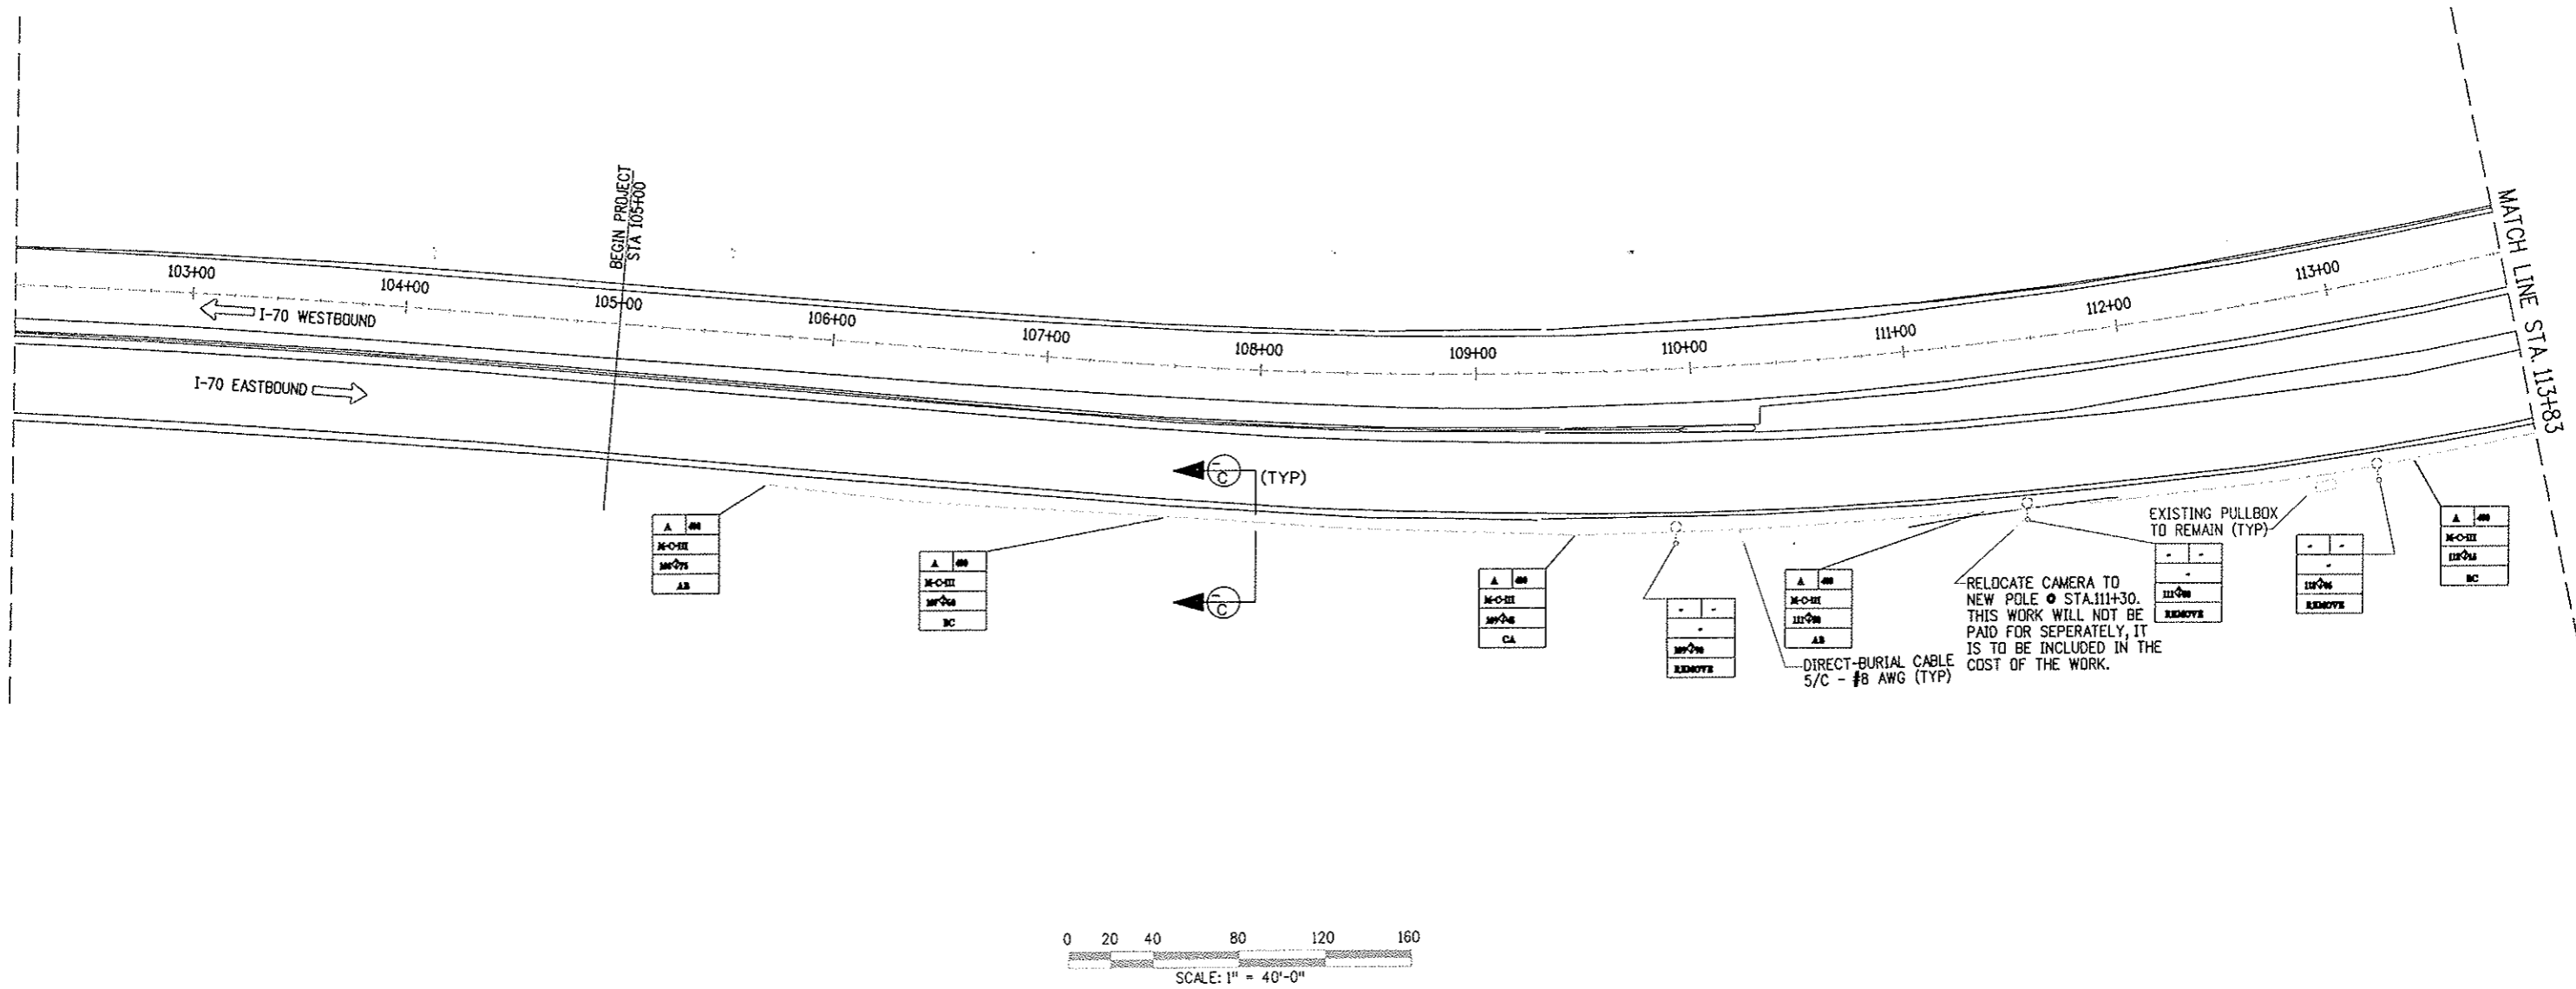

Design File Name: DONSSPEC*
 Plot File Name: \$PLOTFILE*
 Date of Plot: \$\$\$DATE\$\$\$

Computer File Information	
Creation Date:	Initials:
Last Modification Date: 02/19/07	Initials: DJB
Full Path:	
Drawing File Name: 14102\800Deliv\AsBuilt\Itap01	
Acad Ver. R14	Scale: 1" = 40'-0" Units:


Sheet Revisions		
<input type="checkbox"/>	07/03/07	ASBUILT DJB
<input type="checkbox"/>		
<input type="checkbox"/>		
<input type="checkbox"/>		

Colorado Department of Transportation

 P.O. BOX 399
 DUMONT, CO. 80436
 Phone: 303-512-5750 FAX: 303-512-5775
 Region 1 Mountain Residency I.N.Z.



As Constructed
No Revisions:
Revised:
Void:

WEST APPROACH POWER & LIGHTING PLAN	
Designer: J. WEAVER	Structure Numbers
Detailer: D. BURROUGHS	
Sheet Subset: APPROACH LTG	Subset Sheets: 2 OF 9

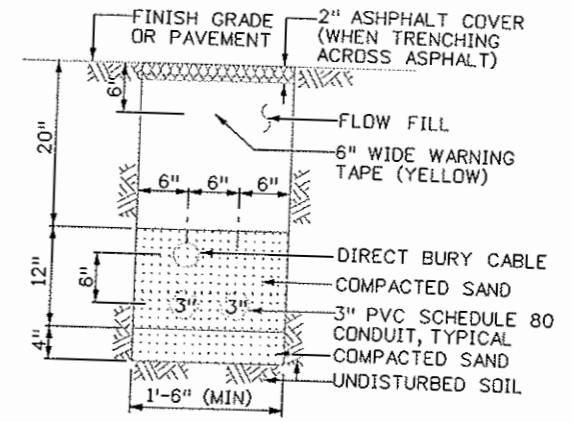Project No./Code
IM 0703-269
13166
Sheet Number 59




SECTION C
SCALE: NTS

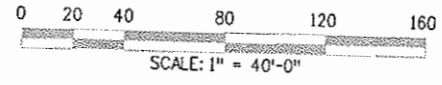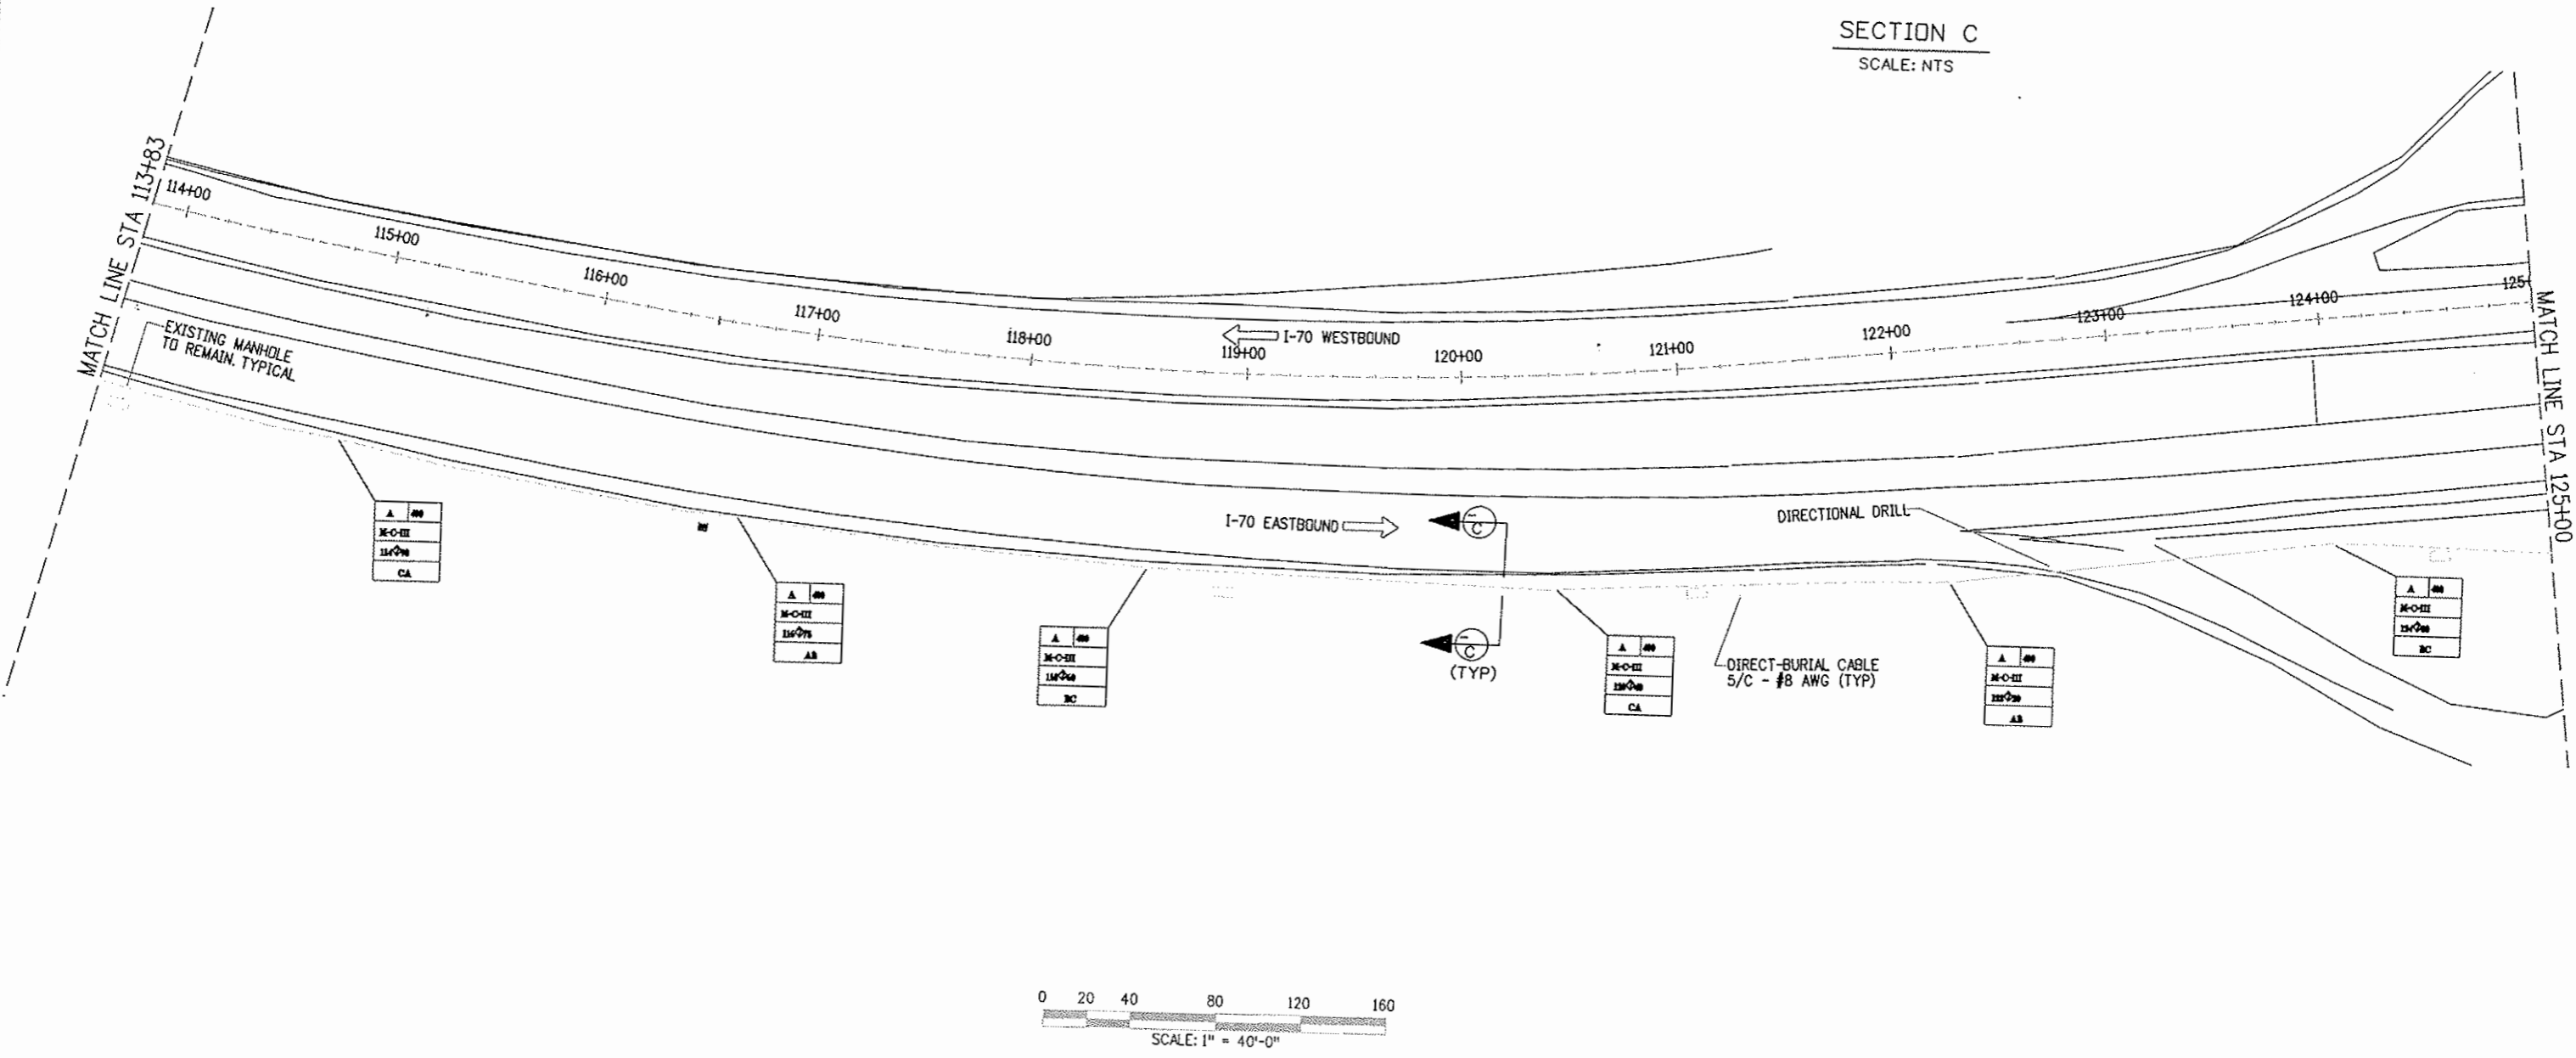


Design File Name: DGNSSPEC*
 Plot File Name: \$PLOTFILE*
 Date of Plot: \$\$\$DATE\$\$\$

Computer File Information		Sheet Revisions		As Constructed		WEST APPROACH POWER & LIGHTING PLAN		Project No./Code	
Creation Date:	Initials:	<input type="checkbox"/>	07/03/07	ASBUILT	DJB	No Revisions:			IM 0703-269
Last Modification Date:	Initials:	<input type="checkbox"/>				Revised:	Designer: J. WEAVER	Structure Numbers	13166
Full Path:		<input type="checkbox"/>				Void:	Detailer: D. BURROUGHS		
Drawing File Name:		<input type="checkbox"/>					Sheet Subset: APPROACH LTG	Subset Sheets: 3 OF 9	Sheet Number 60
Acad Ver. R14	Scale: 1" = 40'-0"	Units:							


Colorado Department of Transportation
 P.O. BOX 399
 DUMONT, CO. 80436
 Phone: 303-512-5750 FAX: 303-512-5775
 Region 1 Mountain Residency I.N.Z.

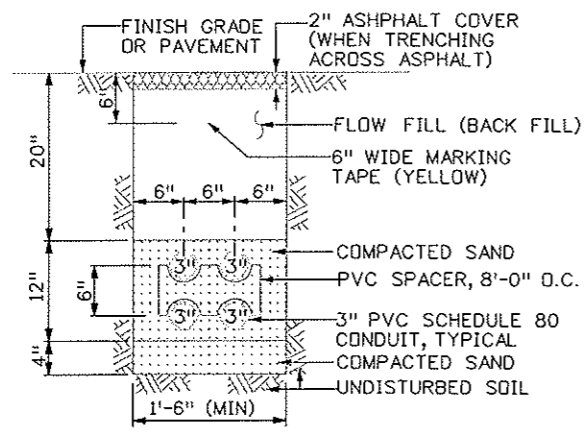


SECTION A (EXISTING)
SCALE: NTS

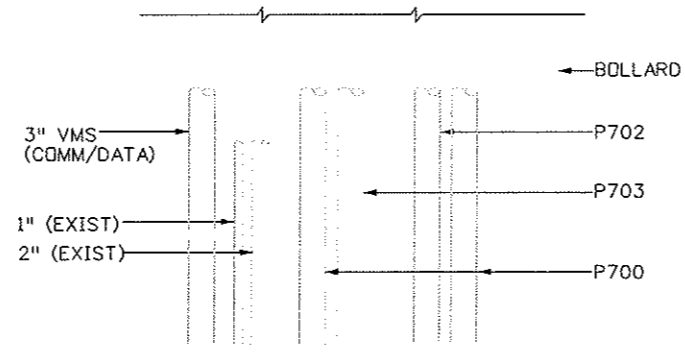

SECTION B
SCALE: NTS

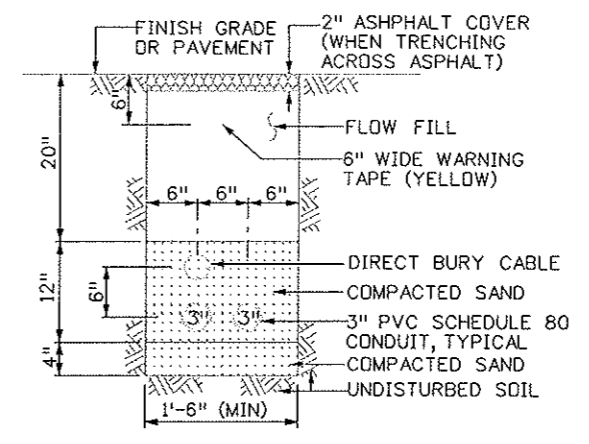


SECTION C
SCALE: NTS

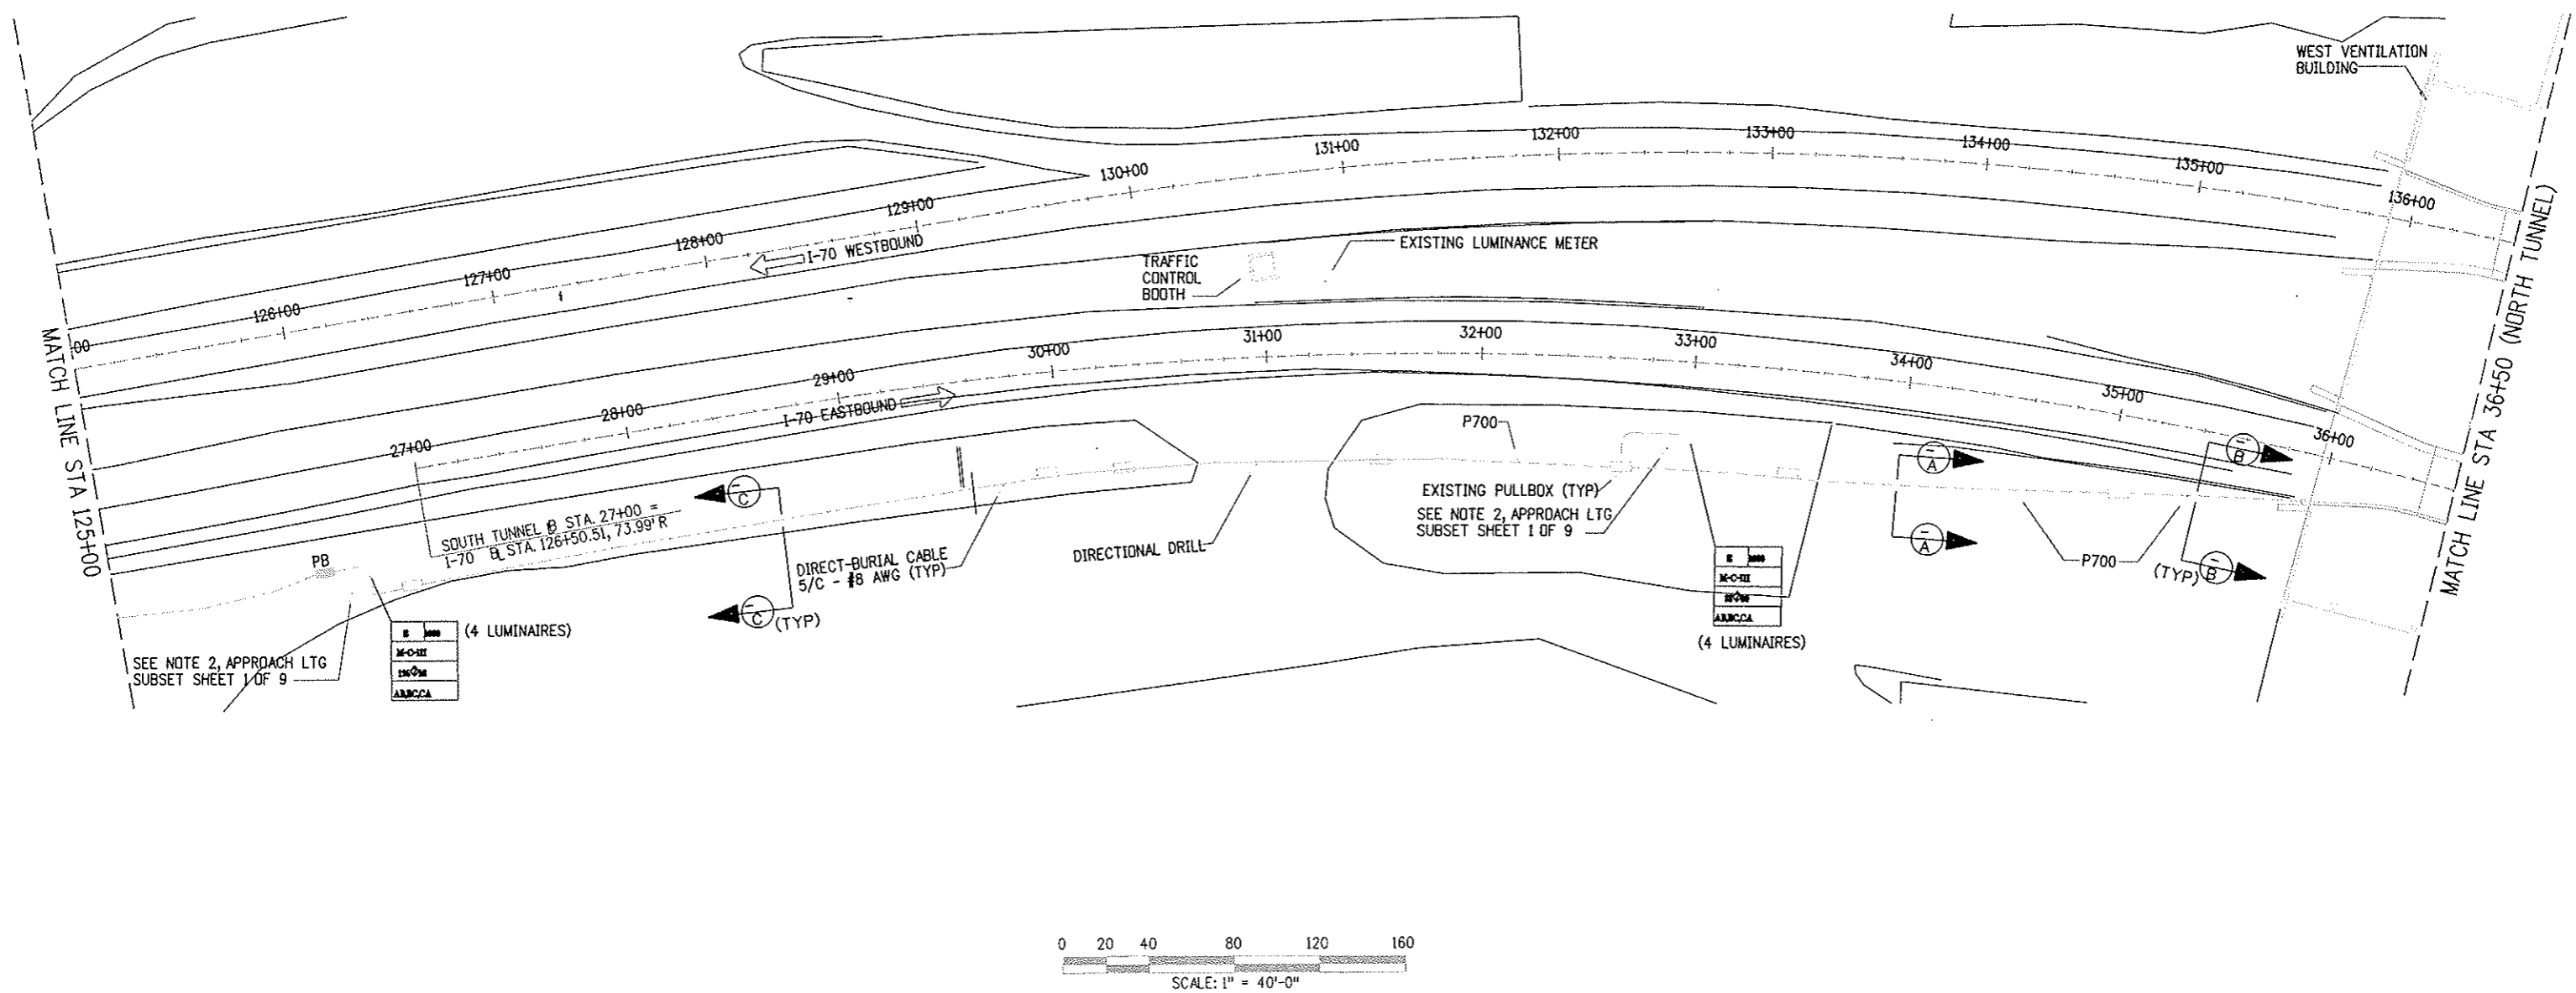

Computer File Information	
Creation Date:	07/03/07
Last Modification Date:	02/19/07
Full Path:	
Drawing File Name:	14102\800deliv\AsBuilt\ltap03
Acad Ver.	R14
Scale:	1" = 40'-0"
Units:	

Sheet Revisions		
07/03/07	ASBUILT	DJB

Colorado Department of Transportation



P.O. BOX 399
DUMONT, CO. 80436
Phone: 303-512-5750 FAX: 303-512-5775


Region 1 Mountain Residency I.N.Z.

As Constructed
No Revisions:
Revised:
Void:


WEST APPROACH POWER & LIGHTING PLAN	
Designer: J. WEAVER	Structure Numbers
Detailer: D. BURROUGHS	
Sheet Subset: APPROACH LTG	Subset Sheets: 4 OF 9

Project No./Code
IM 0703-269
13166
Sheet Number 61

NOTES:
 A. ROUTE CONDUIT BETWEEN EXISTING PULL BOX AND EXISTING MANHOLE TO PROVIDE LIGHTING CIRCUITS TO HIGHEST LUMINAIRES AT STA.228+30

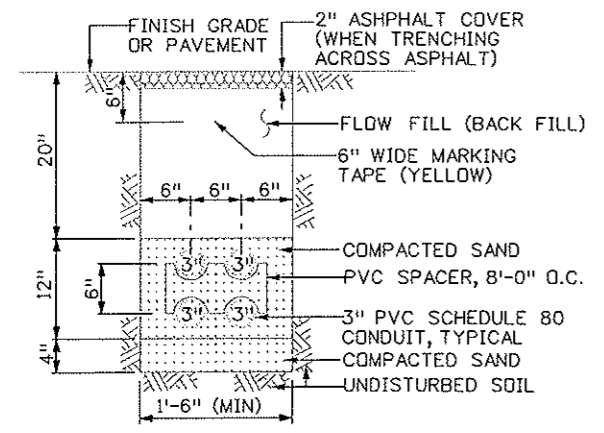


SECTION A (EXISTING)
 SCALE: NTS


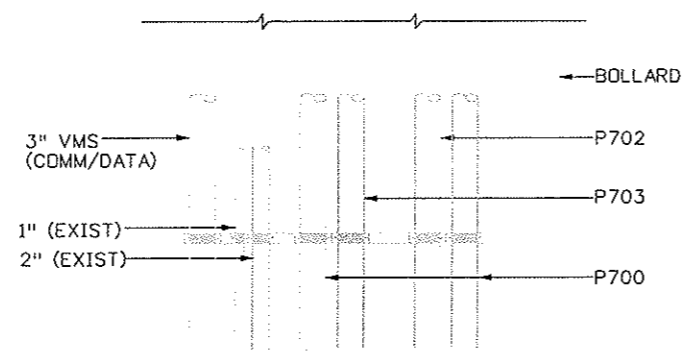


NOTE: RIGID GALVANIZED RISER CONDUITS.

SECTION B
 SCALE: NTS

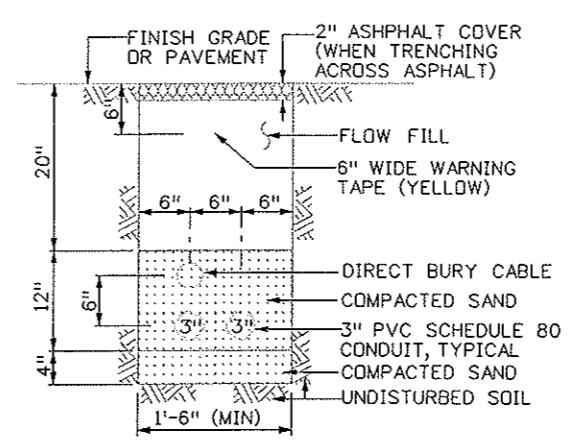

SECTION C
 SCALE: NTS

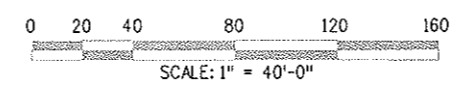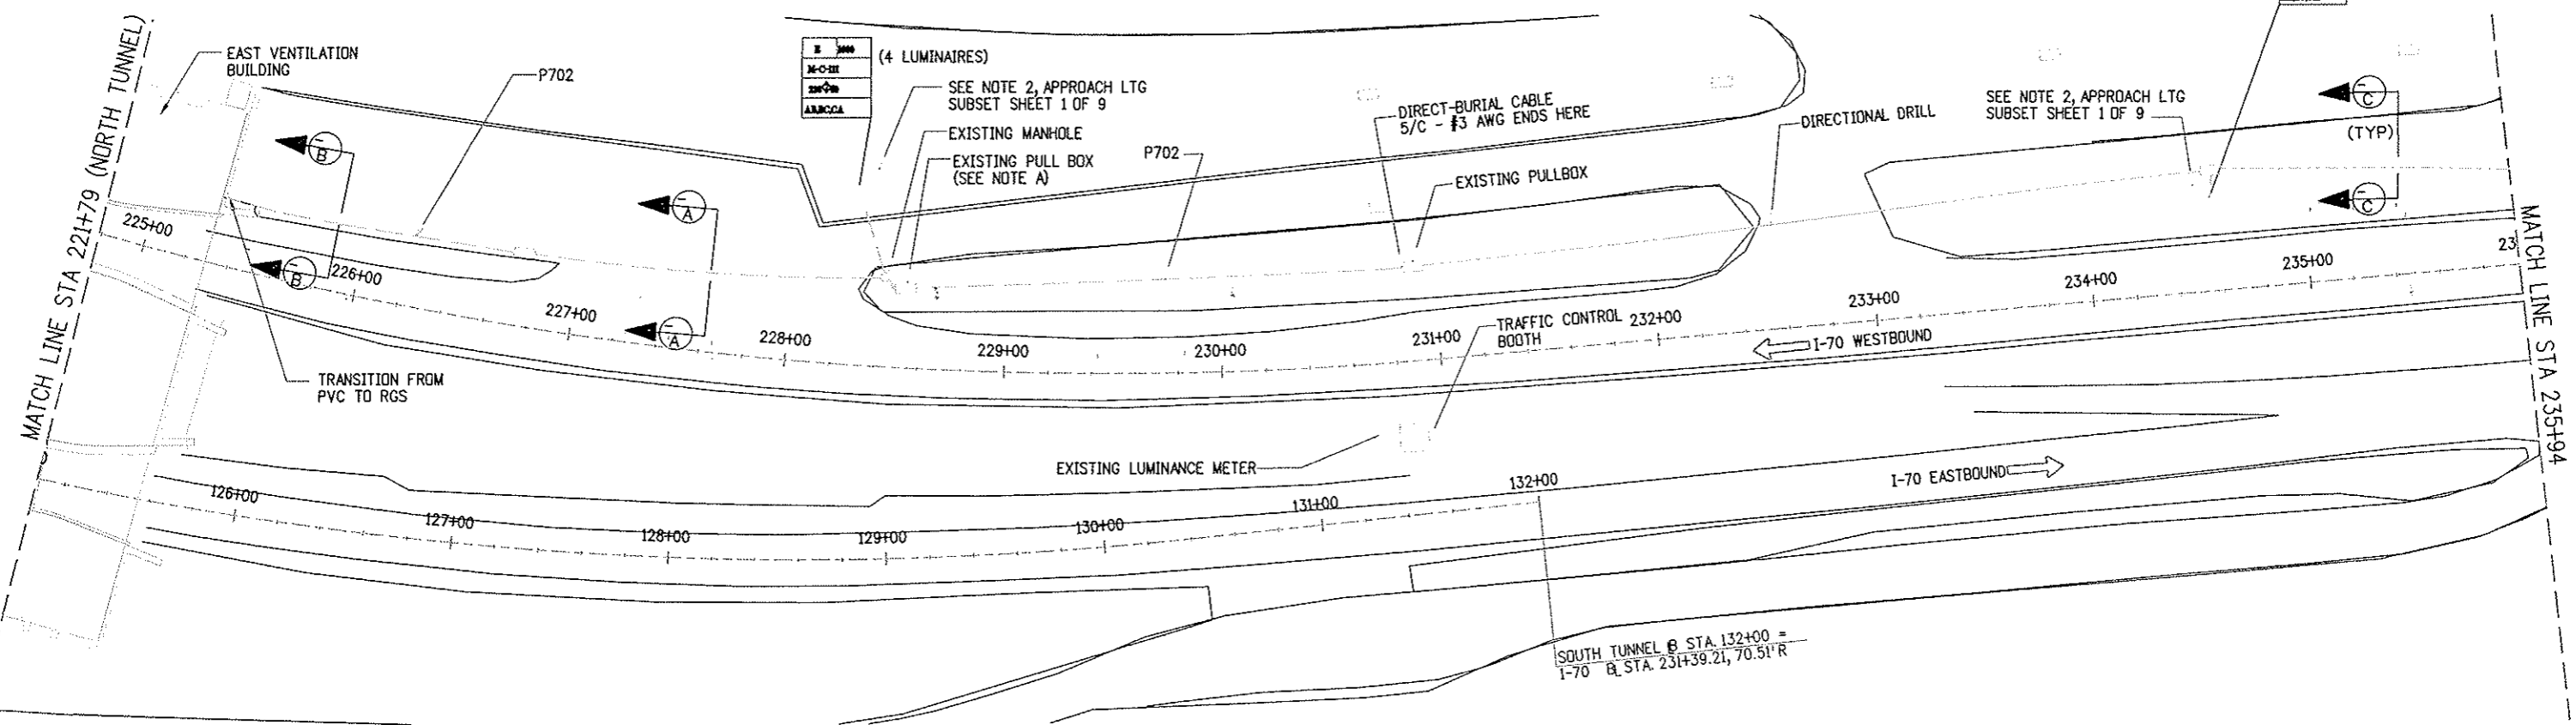


Plot File Name: S:\DOT\FILE*
 Date of Plot: \$\$\$DATE\$\$\$

Computer File Information	
Creation Date:	Initials:
Last Modification Date: 02/19/07	Initials: DJB
Full Path:	
Drawing File Name: 14102\800Deliv\AsBuilt\Itap04	
Acad Ver. R14	Scale: 1" = 40'-0" Units:

Sheet Revisions		
07/03/07	ASBUILT	DJB

Colorado Department of Transportation




P.O. BOX 399
 DUMONT, CO. 80436
 Phone: 303-512-5750 FAX: 303-512-5775

Region 1 Mountain Residency I.N.Z.



As Constructed
No Revisions:
Revised:
Void:

EAST APPROACH POWER & LIGHTING PLAN		
Designer: J. T. Weaver	Structure Numbers	
Detailer: D.J. Burroughs		
Sheet Subset: APPROACH LTG		Subset Sheets: 5 OF 9


Project No./Code
IM 0703-269
13166
Sheet Number 62

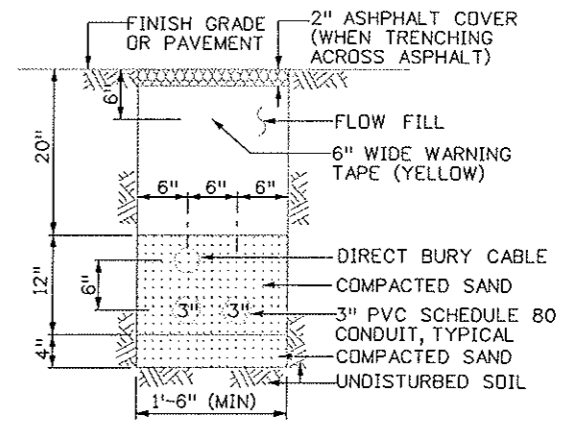


SECTION C
SCALE: NTS

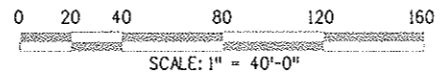
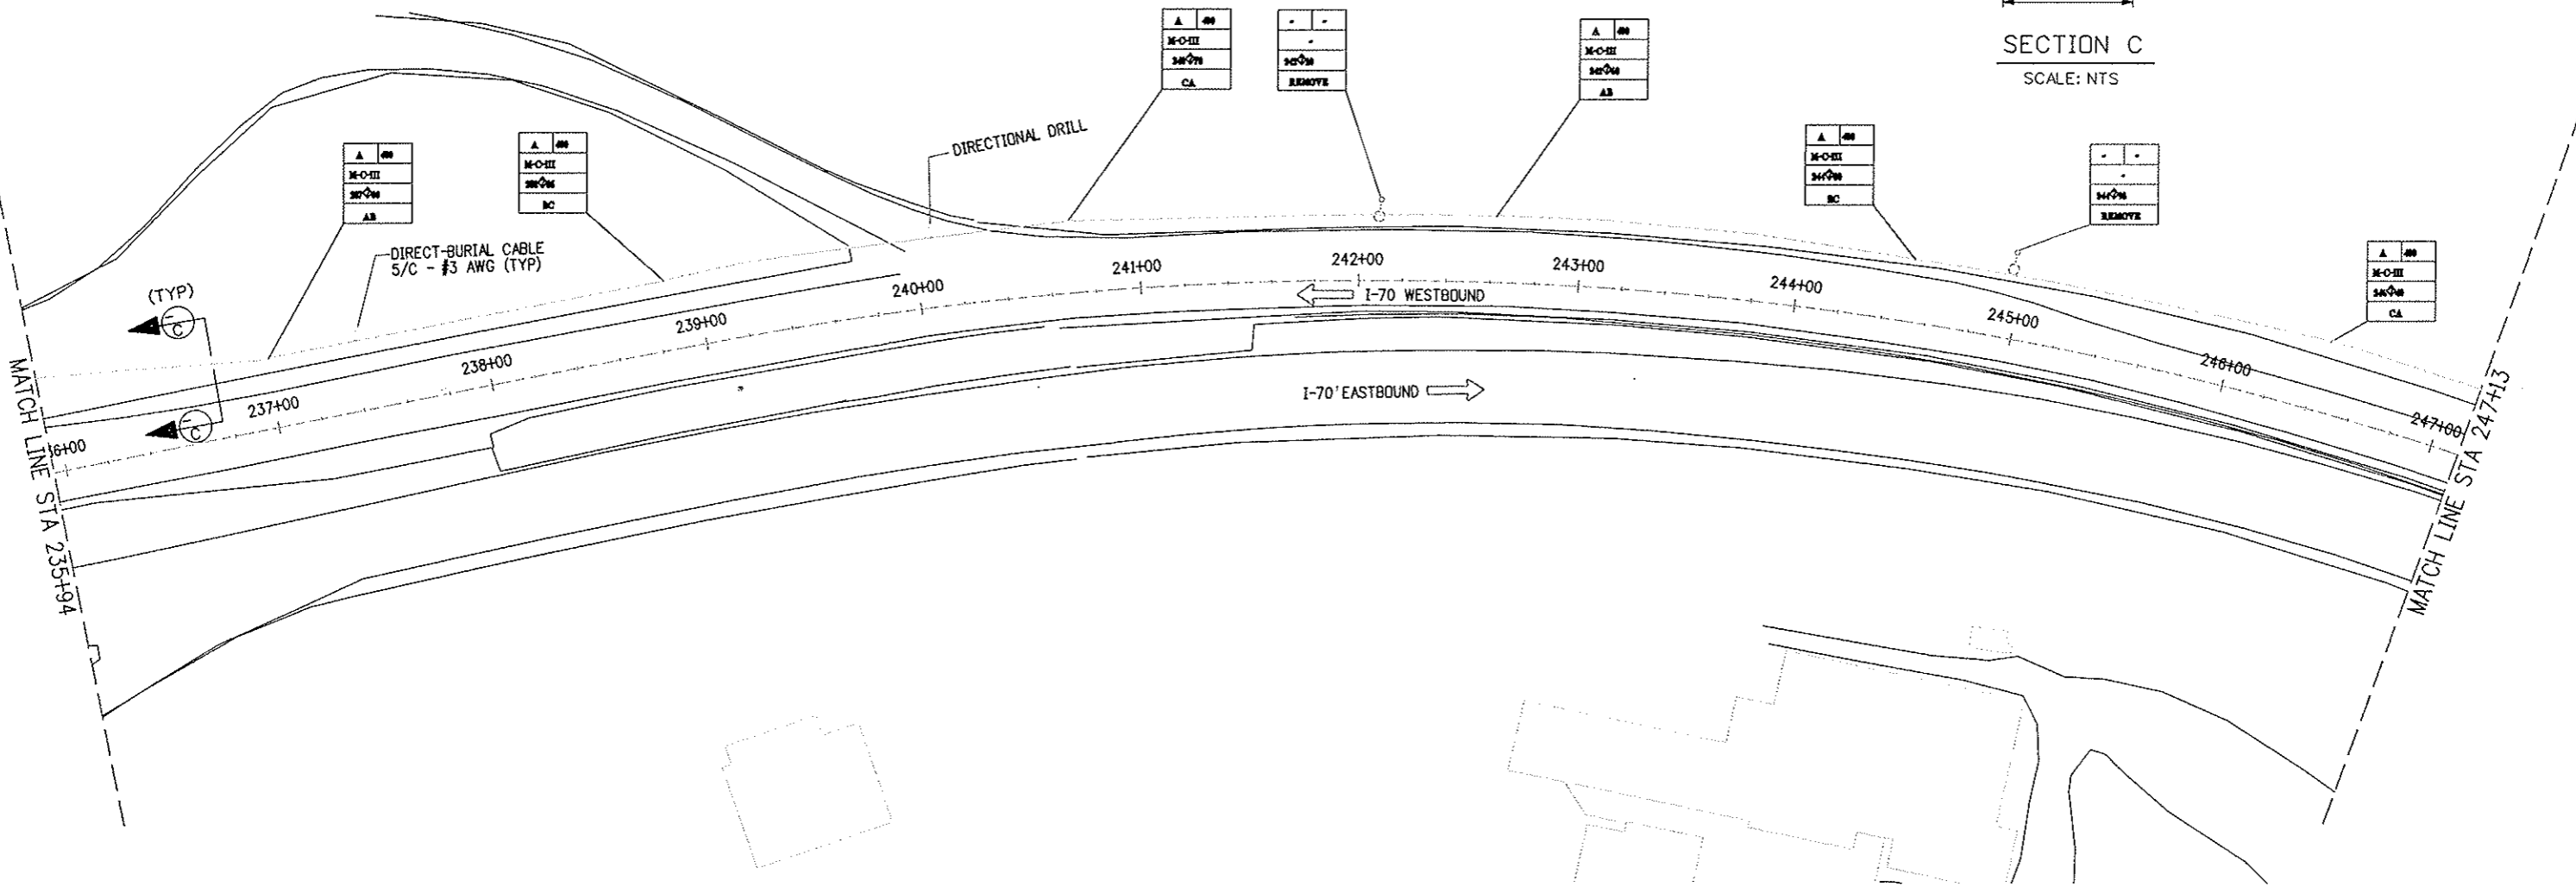


Plot File Name: \$PLOTFILE\$
Date of Plot: \$\$\$DATE\$\$\$\$

Computer File Information		Sheet Revisions		Colorado Department of Transportation		As Constructed		EAST APPROACH POWER & LIGHTING PLAN		Project No./Code	
Creation Date:	Initials:	07/03/07	ASBUILT					Designer: J. T. Weaver Structure Numbers		IM 0703-269	
Last Modification Date: 02/19/07	Initials: DJB									Detailer: D. J. Burroughs Numbers	
Full Path:				 P.O. BOX 399 DUMONT, CO. 80436 Phone: 303-512-5750 FAX: 303-512-5775 Region 1 Mountain Residency I.N.Z.		No Revisions:		Sheet Subset: APPROACH LTG		Subset Sheets: 6 OF 9	
Drawing File Name: 14102\800Deliv\AsBuilt\ltop05						Revised:					
Acad Ver. R14	Scale: 1" = 40'-0"	Units:						Void:			

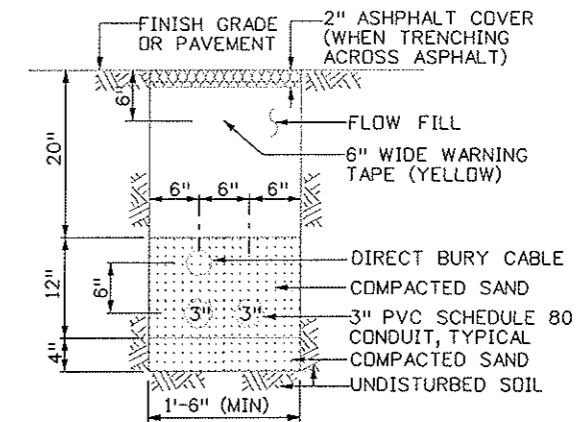


SECTION C
SCALE: NTS

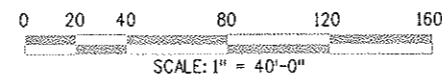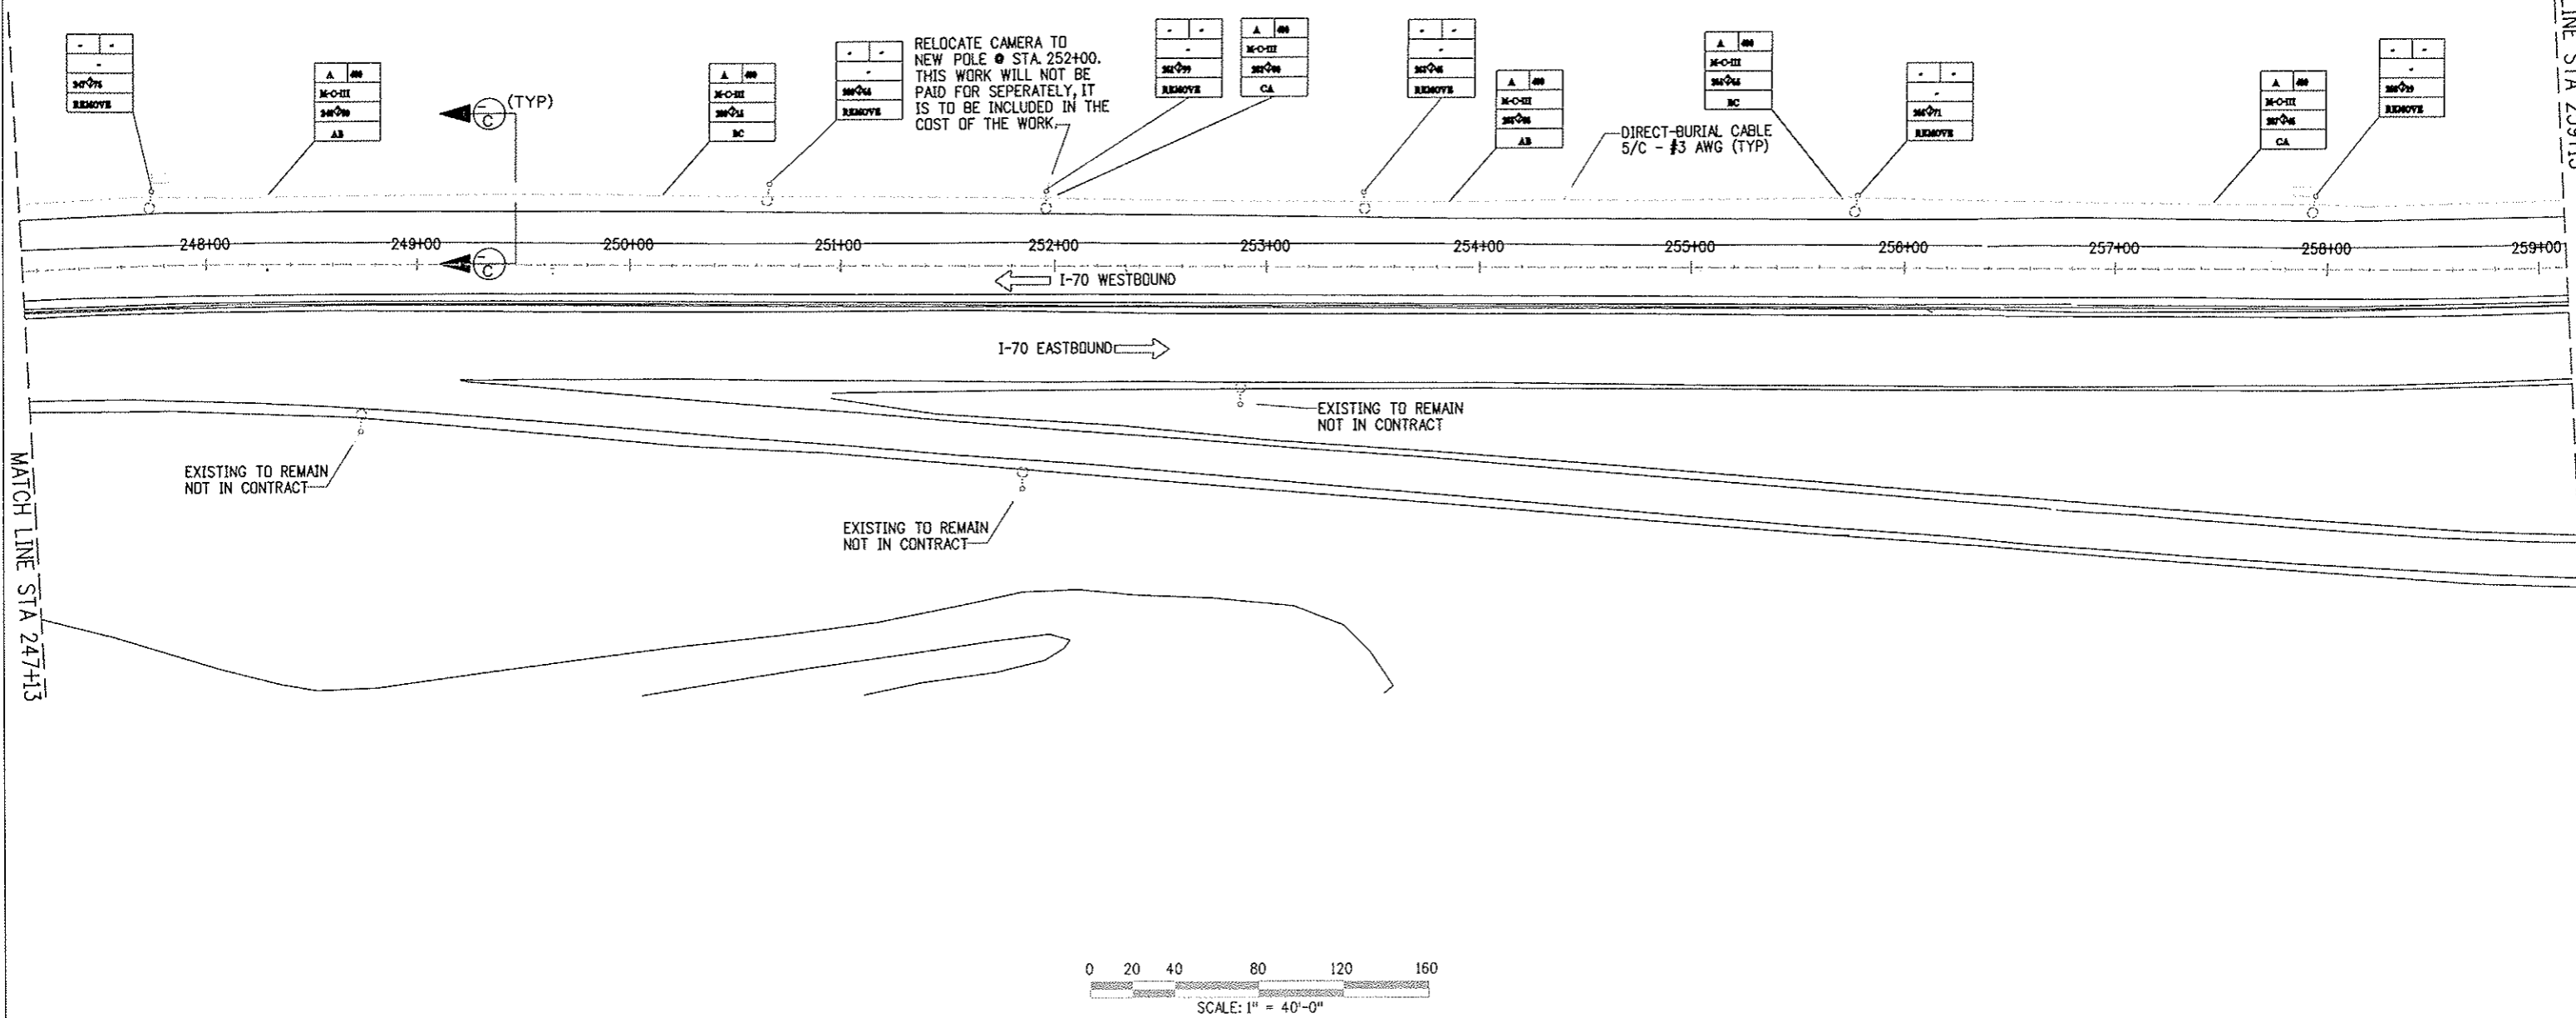

Design File Name: DGN\$SPEC*
Plot File Name: \$PLOTFILE*
Date of Plot: \$\$\$DATE\$\$\$

Computer File Information		Sheet Revisions	
Creation Date:	Initials:	07/03/07	ASBUILT
Last Modification Date: 02/31/07	Initials: DJB		
Full Path:			
Drawing File Name: 14102\800Deliv\AsBuilt\itap06			
Acad Ver. R14	Scale: 1" = 40'-0"		

Colorado Department of Transportation

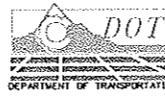




P.O. BOX 399
DUMONT, CO. 80436
Phone: 303-512-5750 FAX: 303-512-5775

Region 1 Mountain Residency I.N.Z.

As Constructed
No Revisions:
Revised:
Void:

EAST APPROACH POWER & LIGHTING PLAN	
Designer: J. T. Weaver	Structure Numbers
Detailer: D. J. Burroughs	
Sheet Subset: APPROACH LTG	
Subset Sheets: 7 OF 9	


Project No./Code
IM 0703-269
13166
Sheet Number 64

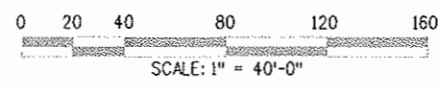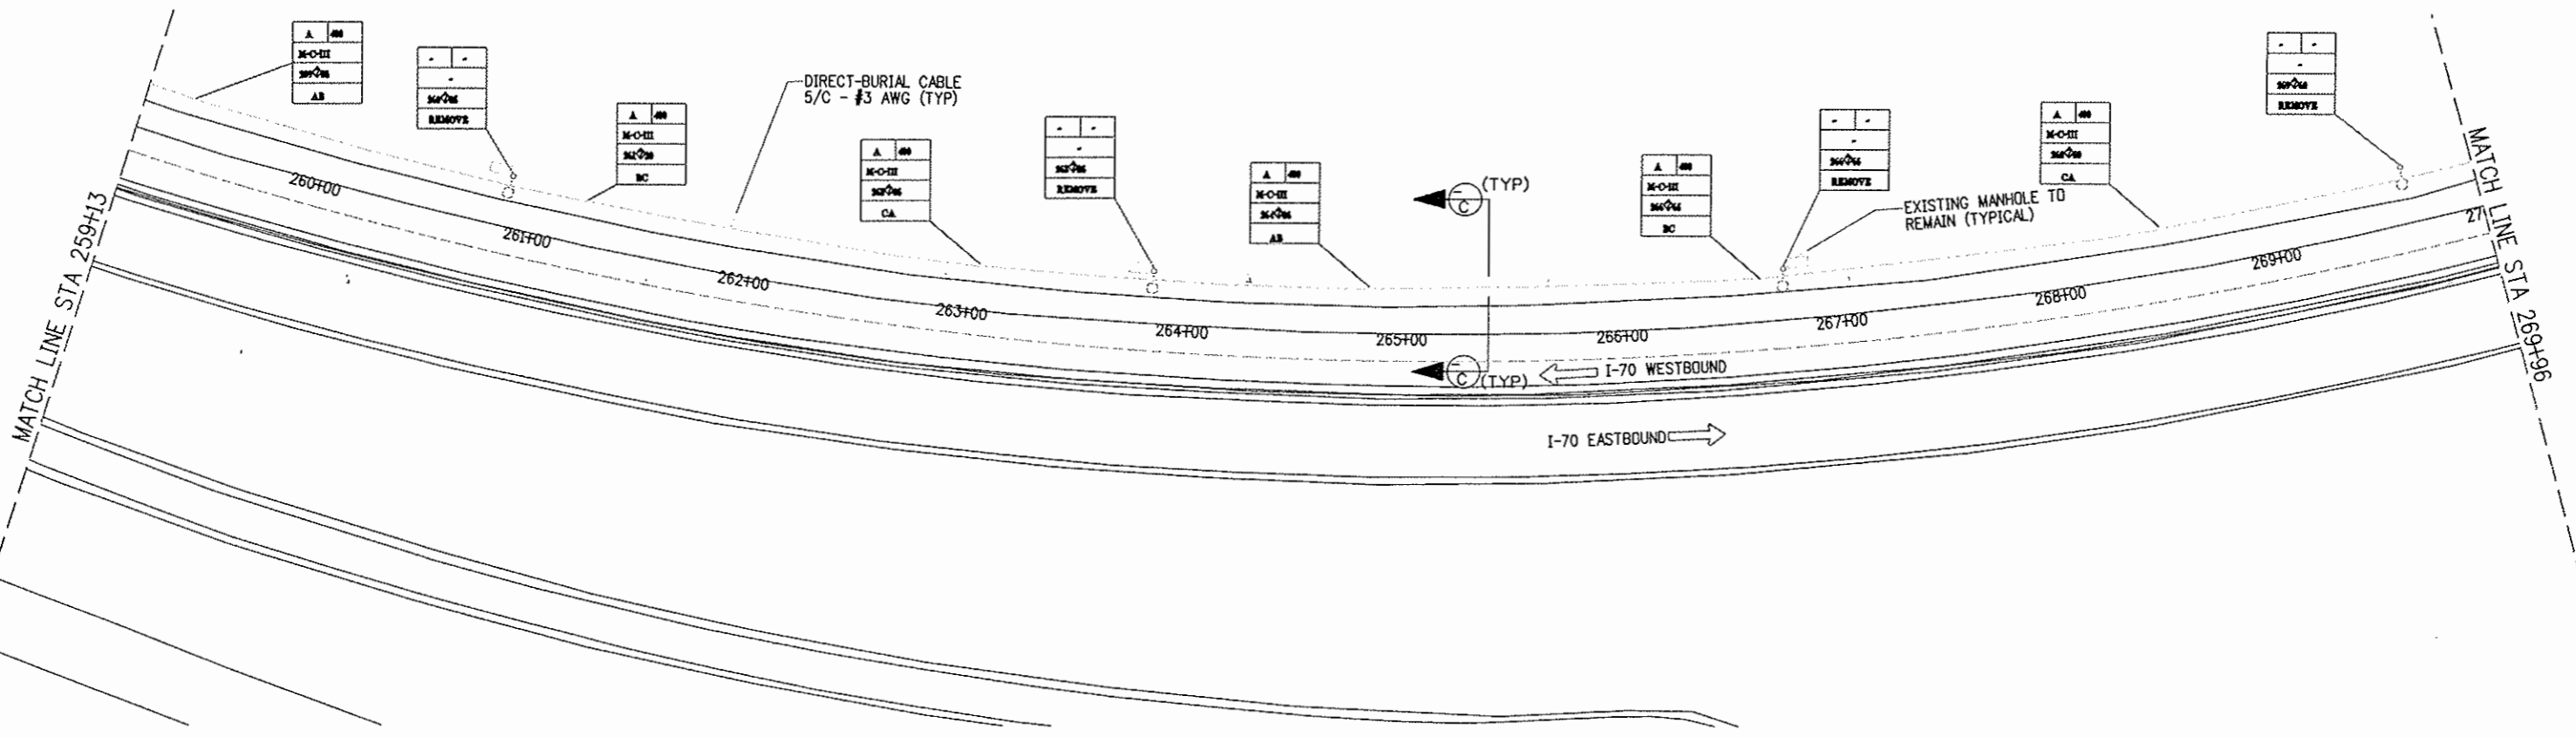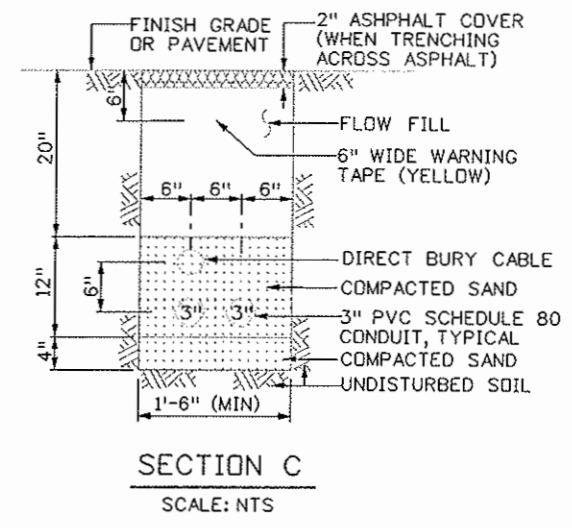

Computer File Information	
Creation Date:	Initials:
Last Modification Date: 02/19/07	Initials: DJB
Full Path:	
Drawing File Name: 14102\800Deliv\AsBuilt\ltop07	
Acad Ver. R14	Scale: 1" = 40'-0" Units:

Sheet Revisions		
<input type="checkbox"/>	07/03/07	ASBUILT DJB
<input type="checkbox"/>		
<input type="checkbox"/>		
<input type="checkbox"/>		

Colorado Department of Transportation



P.O. BOX 399
DUMONT, CO. 80436
Phone: 303-512-5750 FAX: 303-512-5775


Region 1 Mountain Residency I.N.Z.

As Constructed
No Revisions:
Revised:
Void:



EAST APPROACH POWER & LIGHTING PLAN		
Designer: J. T. Weaver	Structure Numbers	
Detailer: D. J. Burroughs		
Sheet Subset: APPROACH LTG		Subset Sheets: 8 OF 9

Project No./Code
IM 0703-269
13166
Sheet Number 65

Design File Name: DGN\$SPEC*
 Plot File Name: \$PLOTFILE*
 Date of Plot: \$\$\$DATE\$\$\$

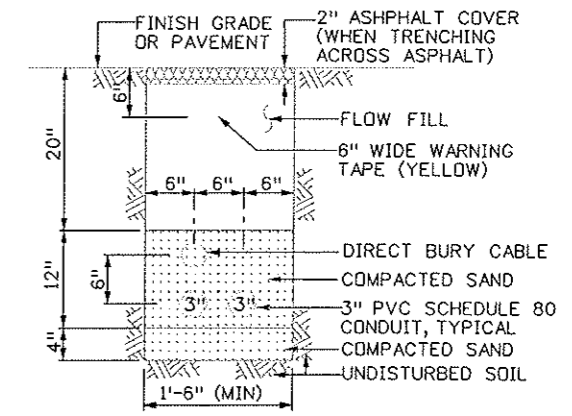

SECTION C
SCALE: NTS

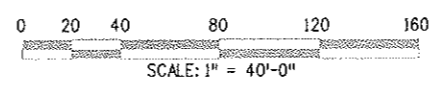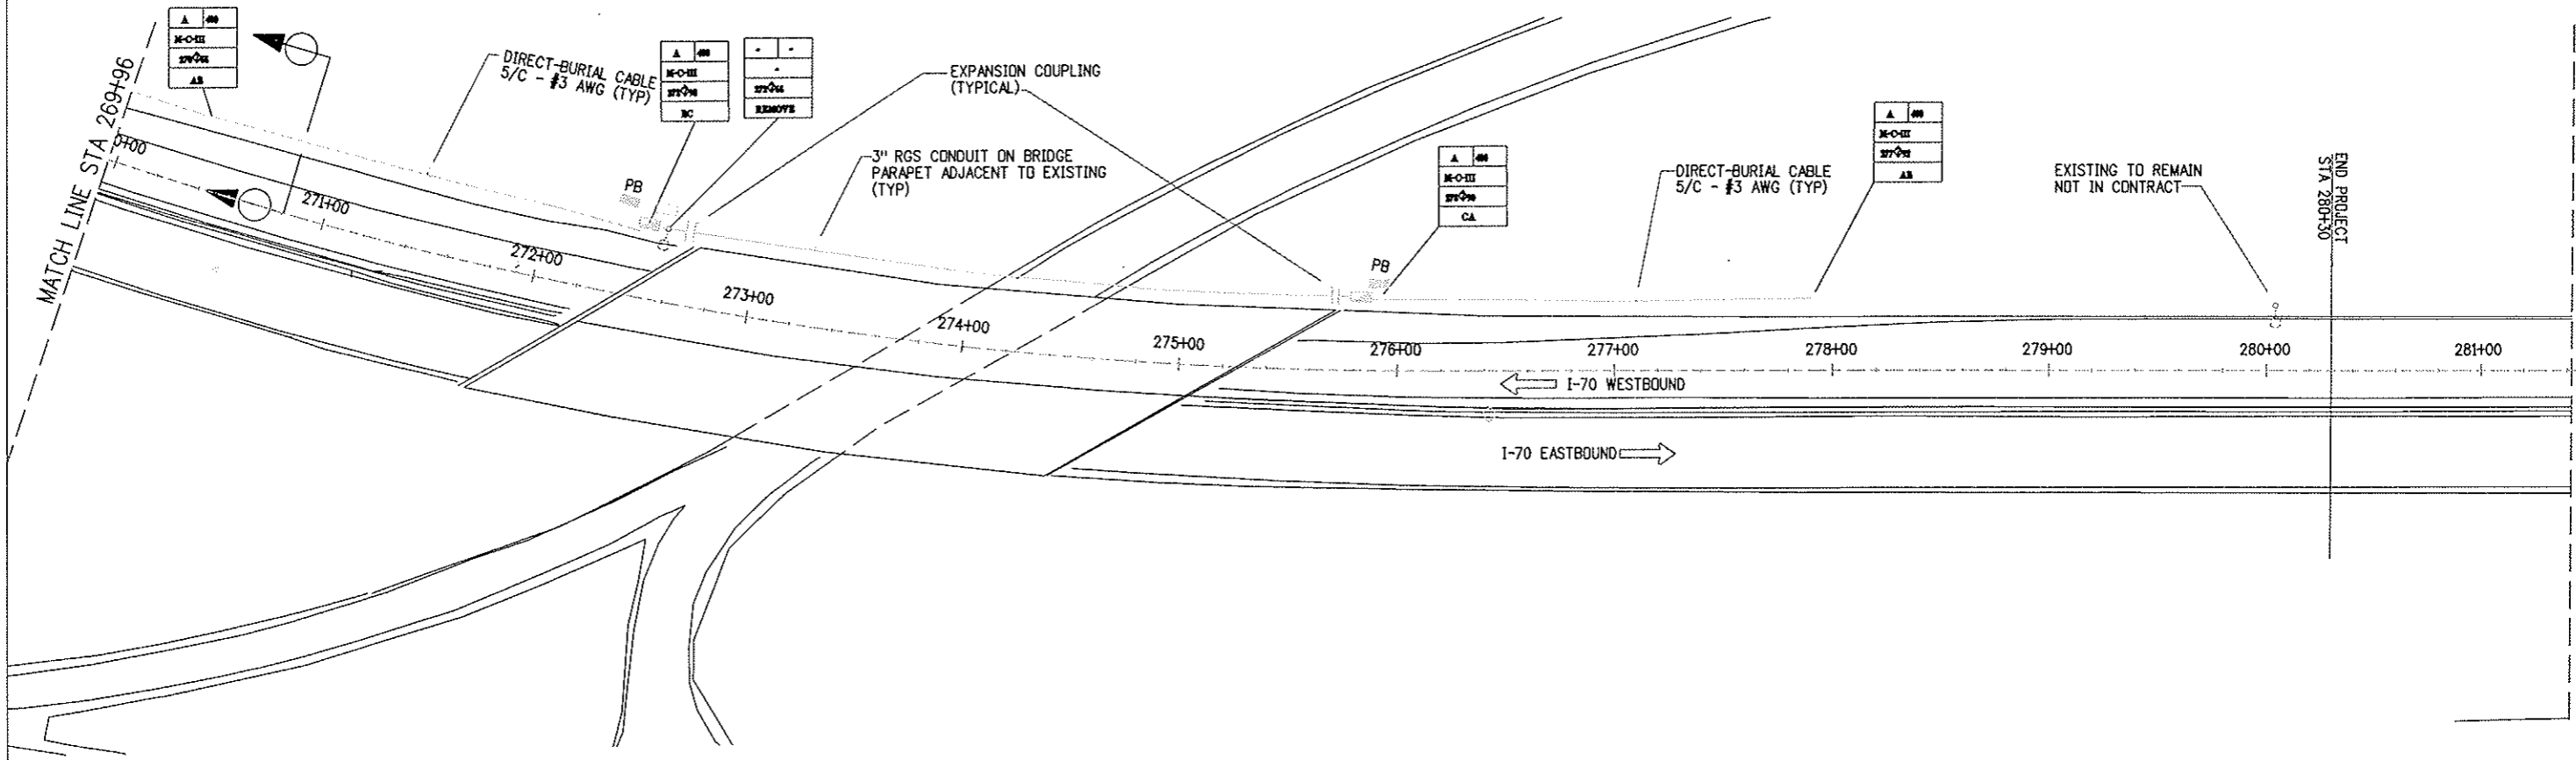


Design File Name: D:\NSPEC*
 Plot File Name: \$PLOTFILE*
 Date of Plot: \$\$\$DATE\$\$\$

Computer File Information	
Creation Date:	Initials:
Last Modification Date: 02/19/07	Initials: DJB
Full Path:	
Drawing File Name: 14102\8000Deliv\AsBuilt\ltop08	
Acad Ver. R14	Scale: 1" = 40'-0" Units:

Sheet Revisions		
<input type="checkbox"/>	07/03/07	ASBUILT DJB
<input type="checkbox"/>		
<input type="checkbox"/>		
<input type="checkbox"/>		

Colorado Department of Transportation

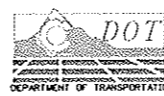

P.O. BOX 399
DUMONT, CO. 80436
Phone: 303-512-5750 FAX: 303-512-5775

Region 1 Mountain Residency I.N.Z.

As Constructed
No Revisions:
Revised:
Void:

EAST APPROACH POWER & LIGHTING PLAN	
Designer: J. T. Weaver	Structure Numbers
Detailer: D. J. Burroughs	
Sheet Subset: APPROACH LTG Subset Sheets: 9 OF 9	

Project No./Code	IM 0703-269
	13166
Sheet Number	66


TUNNEL POWER PLAN NOTES

- THE MAIN OBJECTIVE SHALL BE TO MAINTAIN A FULLY FUNCTIONAL TUNNEL DURING CONSTRUCTION. ALL LIGHTING, VMS, LUS OR ELECTRICAL DISTRIBUTION SYSTEMS OR MOBILIZATION THAT REQUIRES LANE CLOSURE SHALL BE PERFORMED DURING OFF-PEAK TRAFFIC PERIODS AND COORDINATED WITH THE ENGINEER. SEE CONTRACT DOCUMENTS AND SPECIAL PROVISIONS FOR OTHER RESTRICTIONS.
- PRIOR TO RE-OPENING OF A LANE TO TRAFFIC, ENSURE EQUIPMENT, DEVICES AND ANCHORAGE ARE SECURE AND MEET CLEARANCE REQUIREMENTS. CLEAN-UP SHALL BE PERFORMED CONTINUOUSLY AND SHALL REMOVE AND PROPERLY DISPOSE OF ALL DEBRIS.
- DRAWINGS REPRESENT DIAGRAMMATIC LOCATIONS AND APPROXIMATE QUANTITIES. THE CONTRACTOR SHALL VERIFY THE LOCATION OF EXISTING UTILITIES AND SHALL EXERCISE SUITABLE CARE TO AVOID DISRUPTION OR DAMAGE OF UTILITIES OR EQUIPMENT TO REMAIN IN SERVICE. REPAIR DAMAGE ACCORDING TO THE PROVISIONS.
- REFER TO ELECTRICAL DRAWINGS TO COORDINATE SUITABLE PHASING OF DEMOLITION AND NEW CONSTRUCTION. IMMEDIATELY NOTIFY THE ENGINEER IF CONCEALED UTILITIES, CONDUIT OR CONDITIONS ARE DISCOVERED THAT WILL INHIBIT NEW CONSTRUCTION INDICATED ON THE CONTRACT DOCUMENTS. ACT TO RESOLVE THESE ISSUES AS EXPEDITIOUSLY AS POSSIBLE.
- MAINTAIN EMERGENCY CIRCUITING UNTIL RAPID CHANGE-OVER TO NEW EMERGENCY CIRCUITING OCCURS. ALL TEMPORARY WIRING SHALL COMPLY WITH THE NATIONAL ELECTRICAL CODE AND BE PRE-APPROVED BY THE LOCAL AUTHORITY HAVING JURISDICTION. RE-LABEL ALL CIRCUIT BREAKERS WITH TEMPORARY OR PERMANENT REVISED LOAD DESCRIPTIONS AS REQUIRED.
- RE-UTILIZE EXISTING PULLBOXES, CONDUIT OR PENETRATIONS WHERE SUITABLE, SUCH AS WHERE THE ELECTRICAL ROOM CONDUIT INTERFACES WITH THE TUNNEL.
- INSTALL 3/4" RGS CONDUIT W/2#10 + 1 #10G DOWN FROM JB-P765 AND ACROSS SUPPLY AIR DUCT FLOOR. MOUNT FS TYPE BOX WITH COVER TO FLOOR WITH PROVISION TO EXTEND A FUTURE 3/4" RGS CONDUIT DOWN TO TUNNEL WALL. CORE DRILL (1"Ø) SUPPLY AIR DUCT FLOOR FOR FUTURE INSTALLATION OF A 3/4" RGS CONDUIT. CORE DRILL LOCATION TO BE DETERMINED BY ENGINEER.
- CONNECT CONDUIT TO FLUORESCENT LIGHTING WIREWAY WHERE INDICATED ON TUNNEL POWER PLANS. WIREWAY IS CONTINUOUS AS SHOWN ON LIGHTING PLANS EXCEPT AT VMS SIGNS OR EQUIPMENT INTERRUPTIONS. ROUTE CONDUIT THROUGH ELECTRICAL ROOM WALL AND SEAL WITH FIRESTOP AND CONDUIT SEAL FITTING. END RIGID METAL CONDUIT IN THE INTERSTITIAL SPACE TO ALLOW LIQUIDTIGHT FLEXIBLE METAL CONDUIT TO CONTINUE UNSUPPORTED, 3' MAX, TO THE BACK OF THE FLUORESCENT WIREWAY. SEE TUNNEL LIGHTING DETAILS.
- ROUTE CIRCUITS BETWEEN LUMINAIRES IN CONDUIT AT VMS SIGN LOCATIONS. PROVIDE 1 1/4" CONDUIT CONNECTING EACH OF THE CHANNELS OF THE WIREWAY, (2) 1 1/4" TOTAL, TRANSITION FROM RGS TO POWER FEED ENTRY USING 1 1/4" LIQUIDTIGHT FLEXIBLE METAL CONDUIT. (UNLESS NOTED OTHERWISE MAKE ALL NECESSARY CONNECTIONS & SUPPORTS AS REQUIRED PER CODE).
- ALL CONDUIT SHOWN ABOVE THE ROADWAY IN THE VENT BUILDING AREA SHALL BE ROUTED FROM THE TUNNEL CEILING, DROP AND TRAVEL IN NORTH-SOUTH DIRECTION IN THE INTERSTITIAL SPACE AND INTO THE VENT BUILDING.
- ALL CONDUITS AND PULLBOXES SHOWN ABOVE THE ROADWAY IN THE TUNNEL INTERIOR PAST THE PARTIAL INTERSTITIAL SPACE SHALL BE ROUTED WITHIN THE SUPPLY VENTILATION DUCT UNLESS SHOWN CROSSING INTO THE EXHAUST VENT DUCT (NORTH SIDE) OF THE NORTH TUNNEL.
- CONNECT CONDUIT TO HID LIGHTING WIREWAY MOUNTED TO TUNNEL CEILING. ROUTE CONDUIT THROUGH ELECTRICAL ROOM WALL AND SEAL WITH FIRESTOP AND CONDUIT SEAL FITTING. END RIGID METAL CONDUIT IN THE INTERSTITIAL SPACE TO ALLOW LIQUIDTIGHT FLEXIBLE METAL CONDUIT, (3' MAX), TO CONTINUE UNSUPPORTED TO THE SIDE OF THE METAL HALIDE POWER FEED TYPE WIREWAY. SEE TUNNEL LIGHTING DETAILS. ROUTE ALL CONDUCTORS FOR HID LIGHTING TO END OF THE WIREWAY CONTROL ZONE IDENTIFIED.
- ROUTE CONDUIT FROM SUPPLY VENTILATION DUCT TO CONDUIT AT TUNNEL CEILING FOR CIRCUITING HID LIGHTING. SEE TUNNEL LIGHTING DETAILS, SHEETS 3 AND 4.
- ROUTE CIRCUIT FOR THERMAL DETECTION IN CONDUIT ALONG WALL ABOVE FLUORESCENT LIGHTING TO THE SURFACE MOUNTED TRANSMITTER JUNCTION BOX. ROUTE LIQUID-TIGHT FLEXIBLE METAL CONDUIT FROM J-BOX TO FLUORESCENT RACEWAY. PROVIDE A NEMA 4X JUNCTION BOX, 6"x4"x4" STAINLESS STEEL WITH HINGED COVER, AND INSTALL TRANSMITTER WITHIN AS REQUIRED.
- ASBESTOS ABATEMENT PROCEDURES SHALL BE UTILIZED IN THE VENTILATION BUILDING FIRST FLOOR AREA & CONTROL ROOM CEILINGS. TEST OTHER AREAS THAT MAY BE SUSPECT AND PROVIDE A WRITTEN REPORT OF FINDINGS TO THE ENGINEER AND SHALL BE HANDLED IN ACCORDANCE TO SECTION 250 OF THE SPECIFICATIONS.
- LOW LEVEL LEAD CONTAMINATION MAY BE PRESENT IN VENTILATION DUCTS AND SHALL BE HANDLED IN ACCORDANCE TO SECTION 250 OF THE SPECIFICATIONS.
- CONNECT CONDUIT FROM POWER FEED TYPE WIREWAY AND ROUTE ON STRUT BETWEEN HID LUMINAIRES. SEE TUNNEL LIGHTING DETAILS.
- WHERE HID LUMINAIRES ARE SPACED AT 5'-0" ON CENTER, TERMINATE ONLY TO ALTERNATE WIREWAY TYPE W/RECEPTACLES WHERE LUMINAIRE IS INDICATED.
- TERMINATE LUS SIGN POWER AND CONTROL CONDUCTORS TO RECEPTACLES AS INDICATED ON SIGN CONNECTION DETAILS OF VMS SUBSET.
- CONDUIT PENETRATION THROUGH CONCRETE TUNNEL CEILING AND VENTILATION DUCT CENTER WALL SHALL BE SEALED WITH NON-SHRINK GROUT TO MAINTAIN CEILING OR WALL FIRE RATING.
- SUPPORTS FOR CONDUITS AND BOXES LOCATED IN THE VENTILATION DUCTS SHALL BE DESIGNED TO WITHSTAND 100 MILE-PER-HOUR WIND SPEEDS.

- REFERENCE VB ELECT SUBSET SHEET 19 "ELECT CIRCUIT SCHEDULES, SHEET 2" FOR SERIES 600 CONTROL CONDUIT AND WIRE (OR CABLE) DESCRIPTIONS AND ROUTING.
- REFERENCE TUN. POWER SUBSET SHEETS 5 (6,7, & 8) "TUNNEL CIRCUIT SCHEDULES, SHEET 1 (2,3 & 4)" FOR POWER CONDUIT AND WIRE (OR CABLE) DESCRIPTIONS AND ROUTING WITHIN TUNNEL.
- REFERENCE VB ELECT SUBSET SHEET 18 "ELECT CIRCUIT SCHEDULES, SHEET 1" FOR P670 THROUGH P712 CONDUIT AND WIRE (OR CABLE) DESCRIPTIONS AND ROUTING.

QUANTITIES - NORTH TUNNEL POWER

CONTRACT ITEM NUMBER	CONTRACT ITEM	UNIT	ROADWAY	
			PLAN	AS CONST.
613	3/4" ELECTRICAL CONDUIT	LF	500	
613	1" ELECTRICAL CONDUIT	LF	40,000	
613	1 1/4" ELECTRICAL CONDUIT (LIQUIDTIGHT FLEXIBLE METAL)	LF	400	
613	1 1/4" ELECTRICAL CONDUIT	LF	18,000	
613	1 1/2" ELECTRICAL CONDUIT	LF	17,500	
613	2" ELECTRICAL CONDUIT	LF	600	
613	3" ELECTRICAL CONDUIT	LF	46,600	
613	3" ELECTRICAL CONDUIT (LIQUIDTIGHT FLEXIBLE METAL)	LF	20	
613	2 1/2" ELECTRICAL CONDUIT (LIQUIDTIGHT FLEXIBLE METAL)	LF	50	
613	2" ELECTRICAL CONDUIT BODY (TYPE TEE)	EACH	84	
613	3" ELECTRICAL CONDUIT BODY (TYPE BUB)	EACH	8	
613	3" ELECTRICAL CONDUIT BODY (TYPE LB)	EACH	4	
613	PULL BOX (16"x24"x12") DEEP	EACH	38	
613	PULL BOX (24"x20"x12") DEEP	EACH	8	
613	PULL BOX (24"x24"x12") DEEP	EACH	8	
613	PULL BOX (24"x16"x24") DEEP	EACH	4	
613	PULL BOX (36"x16"x12") DEEP	EACH	4	
613	PULL BOX (28"x28"x12") DEEP	EACH	2	
613	PULL BOX (32"x24"x12") DEEP	EACH	14	
613	PULL BOX (37"x37"x12") DEEP	EACH	2	
613	POWER TRANSFORMER (150KVA, 2400-480V, 3 PHASE)	EACH	8	
613	PANELBOARD (5KVA MINI-LOAD CENTER)	EACH	11	
613	PANELBOARD (225A, 277/480V, 3-PHASE)	EACH	8	
613	EXHAUST FAN	EACH	4	
613	LUMINAIRE HIGH PRESSURE SODIUM (TYPE B)	EACH	352	

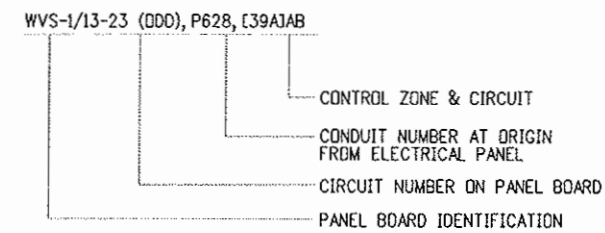

Computer File Information

Sheet Revisions

Colorado Department of Transportation

As Constructed

TUNNEL POWER PLAN NOTES & QUANTITIES

Project No./Code

Creation Date:	07/03/07	Initials:	SL
Last Modification Date:	12/01/05	Initials:	DJR
Full Path:	14102\700CADD\703ELECT\		
Drawing File Name:	pwr-02.dwg		
Acad Ver.	R14	Scale:	None
Units:			

07/03/07	ASBUILT	DJB



P.O. BOX 399
DUMONT, CO. 80436
Phone: 303-512-5750 FAX: 303-512-5775

No Revisions:
Revised:
Void:


Designer: J. WALSH
Detailer: R. RODDENBERRY
Structure Numbers
Sheet Subset: TUN POWER
Subset Sheets: 1 of 45

IM 0703-269
13166
Sheet Number 67

Region 1 Mountain Residency I.N.Z.

Design File Name: DONSPEC*
Plot File Name: SPLDTFILE*
Date of Plot: \$\$\$DATE\$\$\$\$

LIGHTING LEVEL CONTROL DIAGRAM - I-70 WESTBOUND

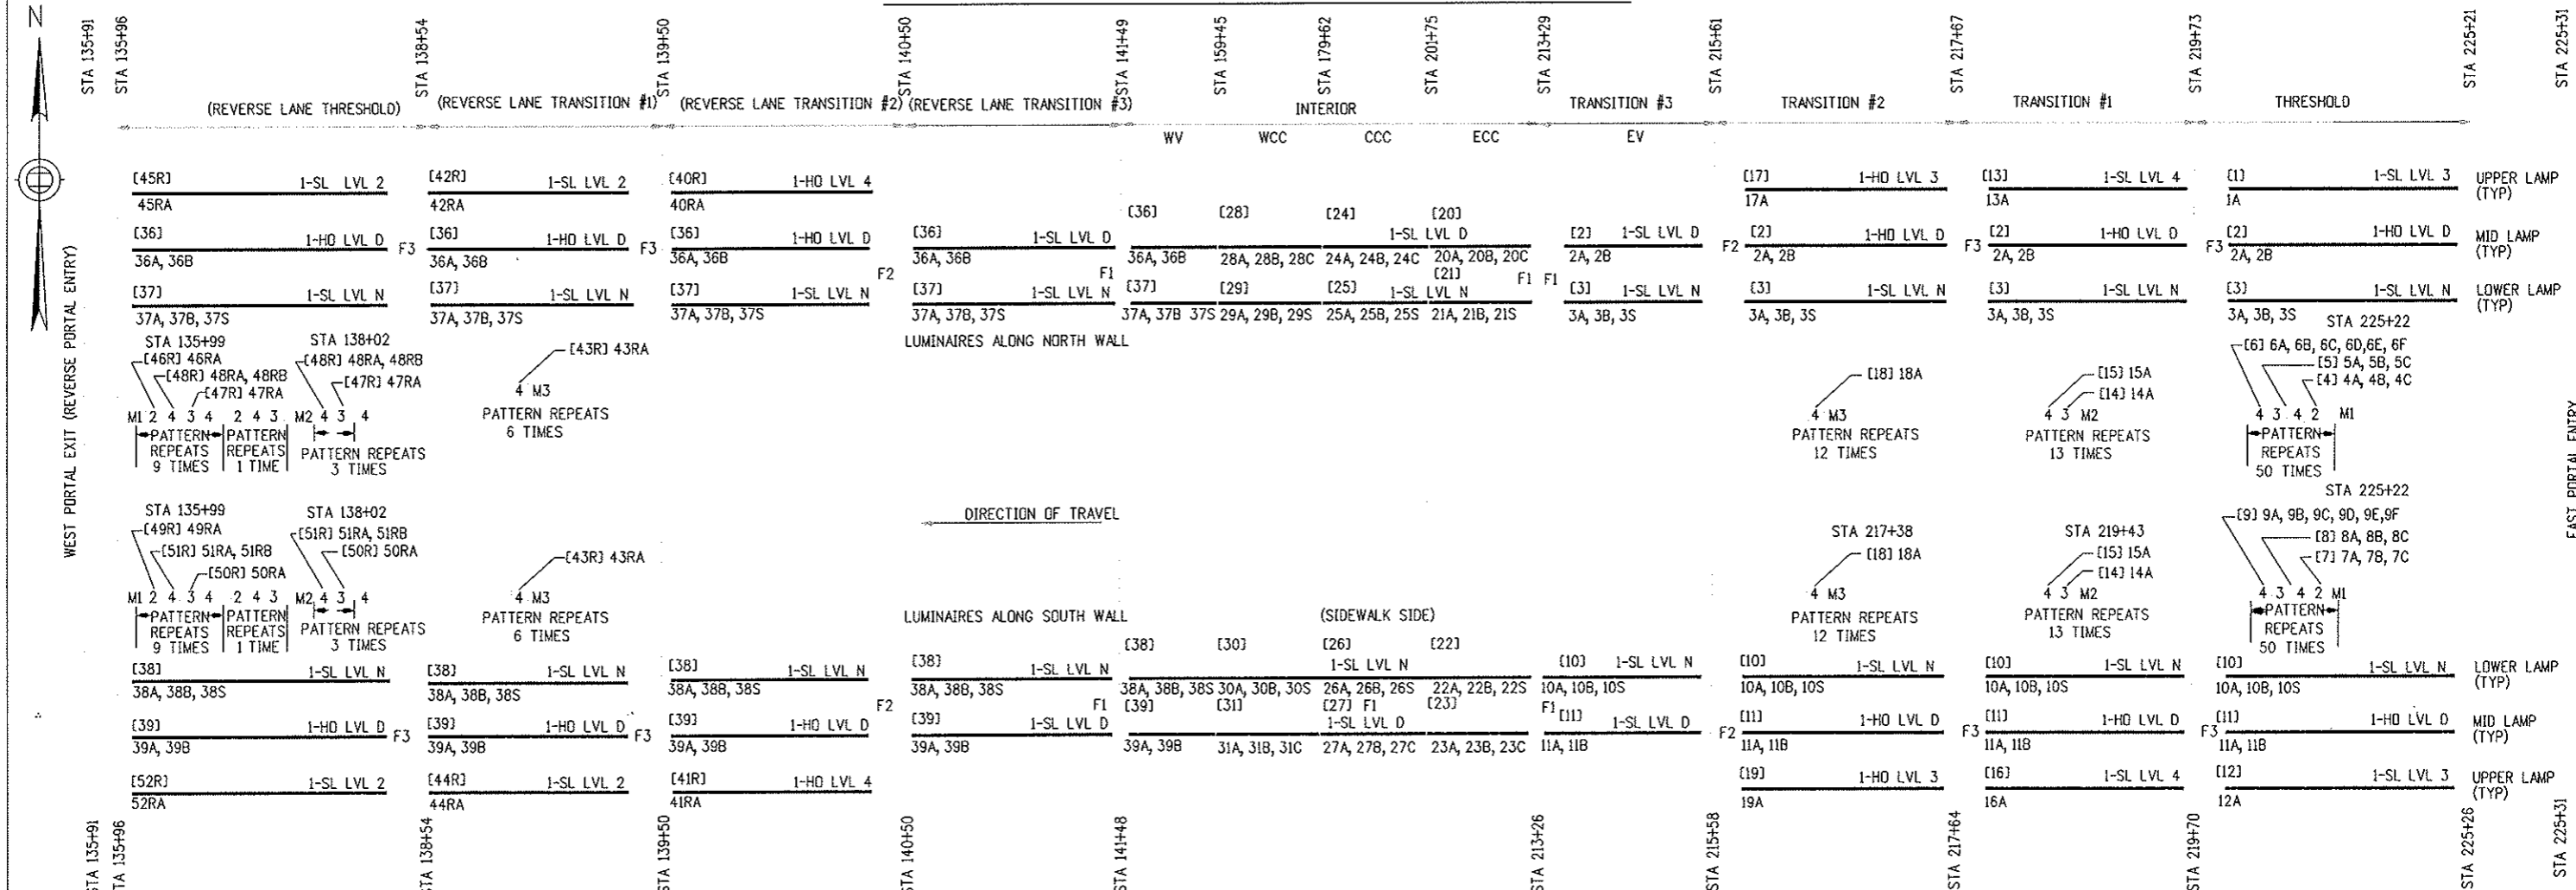


SENSOR SETTINGS (cd/m²) (I-70 W BD)

LEVEL	ON INCREASING DAYLIGHT	OFF DECREASING DAYLIGHT	%
4	4000	3800	100
3	800	700	40
2	200	180	22
D	50	35	5
NIGHT	0 TO 50		4

TUNNEL LIGHTING SWITCHING TABLE

CONTROL ZONE NOTE	LEVEL 4	LEVEL 3	LEVEL 2	LEVEL D	LEVEL N	CONTROL ZONE NOTE	LEVEL 4	LEVEL 3	LEVEL 2	LEVEL D	LEVEL N	CONTROL ZONE NOTE	LEVEL 4	LEVEL 3	LEVEL 2	LEVEL D	LEVEL N
1	ON	ON	OFF	OFF	OFF	22/a	ON	ON	ON	ON	ON	43/b	ON	OFF	OFF	OFF	OFF
2/a	ON	ON	ON	ON	OFF	23/a	ON	ON	ON	ON	OFF	44/b	ON	ON	ON	OFF	OFF
3/a	ON	ON	ON	ON	ON	24/a	ON	ON	ON	ON	OFF	45/b	ON	ON	ON	OFF	OFF
4	ON	ON	ON	OFF	OFF	25/a	ON	ON	ON	ON	ON	46/b	ON	ON	ON	OFF	OFF
5	ON	ON	OFF	OFF	OFF	26/a	ON	ON	ON	ON	ON	47/b	ON	ON	OFF	OFF	OFF
6	ON	OFF	OFF	OFF	OFF	27/a	ON	ON	ON	ON	OFF	48/b	ON	ON	OFF	OFF	OFF
7	ON	ON	ON	OFF	OFF	28/a	ON	ON	ON	ON	OFF	49/b	ON	ON	ON	OFF	OFF
8	ON	ON	OFF	OFF	OFF	29/a	ON	ON	ON	ON	ON	50/b	ON	ON	OFF	OFF	OFF
9	ON	OFF	OFF	OFF	OFF	30/a	ON	ON	ON	ON	ON	51/b	ON	OFF	OFF	OFF	OFF
10/a	ON	ON	ON	ON	ON	31/a	ON	ON	ON	ON	OFF	52/b	ON	ON	ON	OFF	OFF
11/a	ON	ON	ON	ON	OFF	32/c	-	-	-	-	-						
12	ON	ON	OFF	OFF	OFF	33/c	-	-	-	-	-						
13	ON	OFF	OFF	OFF	OFF	34/c	-	-	-	-	-						
14	ON	ON	OFF	OFF	OFF	35/c	-	-	-	-	-						
15	ON	OFF	OFF	OFF	OFF	36/a	ON	ON	ON	ON	OFF						
16	ON	OFF	OFF	OFF	OFF	37/a	ON	ON	ON	ON	ON						
17	ON	ON	OFF	OFF	OFF	38/a	ON	ON	ON	ON	ON						
18	ON	OFF	OFF	OFF	OFF	39/a	ON	ON	ON	ON	OFF						
19	ON	ON	OFF	OFF	OFF	40/b	ON	OFF	OFF	OFF	OFF						
20/a	ON	ON	ON	ON	OFF	41/b	ON	OFF	OFF	OFF	OFF						
21/a	ON	ON	ON	ON	ON	42/b	ON	ON	ON	OFF	OFF						

- SWITCHING TABLE NOTES:**
- A. CONTROL ZONES WITH AN "A" DESIGNATED WILL BE ALTERNATELY ENERGIZED AT NIGHT.
 - B. ALL LUMINAIRES WITH THE SAME SWITCH LEVEL DESIGNATED AS SHOWN ON THE DRAWING ARE ENERGIZED TOGETHER PART OF A SINGLE ZONE.
 - C. CONTROL ZONES WITH AN "R" DESIGNATED ARE ENERGIZED DURING REVERSE LANE OPERATION ONLY "R" OR "C".
 - D. INTERIOR ZONE POWER IS SERVED FROM 4 SEPERATE ELECTRICAL ROOM LOCATIONS.
 - E. CONTROL ZONES WITH AN "E" DESIGNATION ARE NOT USED.

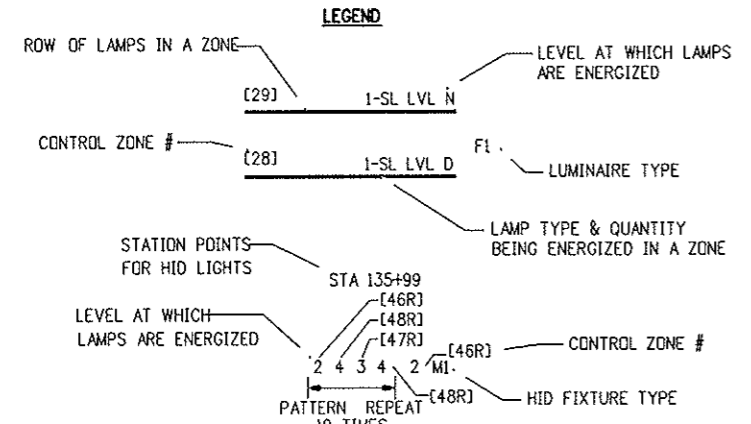


1 NORTH TUNNEL LIGHTING CONTROL
83


Design File Name: DGN5SPEC*
 Plot File Name: SLOTTFILE*
 Date of Plot: 8/30/99

Computer File Information		Sheet Revisions		As Constructed		NORTH TUNNEL LIGHTING CONTROL DIAGRAM		Project No./Code	
Creation Date:	02/26/99	Initials:	DJB	07/03/07	ASBUILT	No Revisions:		IM 0703-269	
Last Modification Date:	07/03/07	Initials:	DJB			Revised:		13166	
Full Path:	14102\800deliv\AsBuit\					Void:		Sheet Number 68	
Drawing File Name:	Its01n							Sheet Subset: TLCS	
Acad Ver.:	R14	Scale:	NTS					Subset Sheets: 1 of 12	
		Units:	English						

Colorado Department of Transportation
 P.O. BOX 399
 DUMONT, CO. 80436
 Phone: 303-512-5750 FAX: 303-512-5775
 Region 1 Mountain Residency I.N.Z.

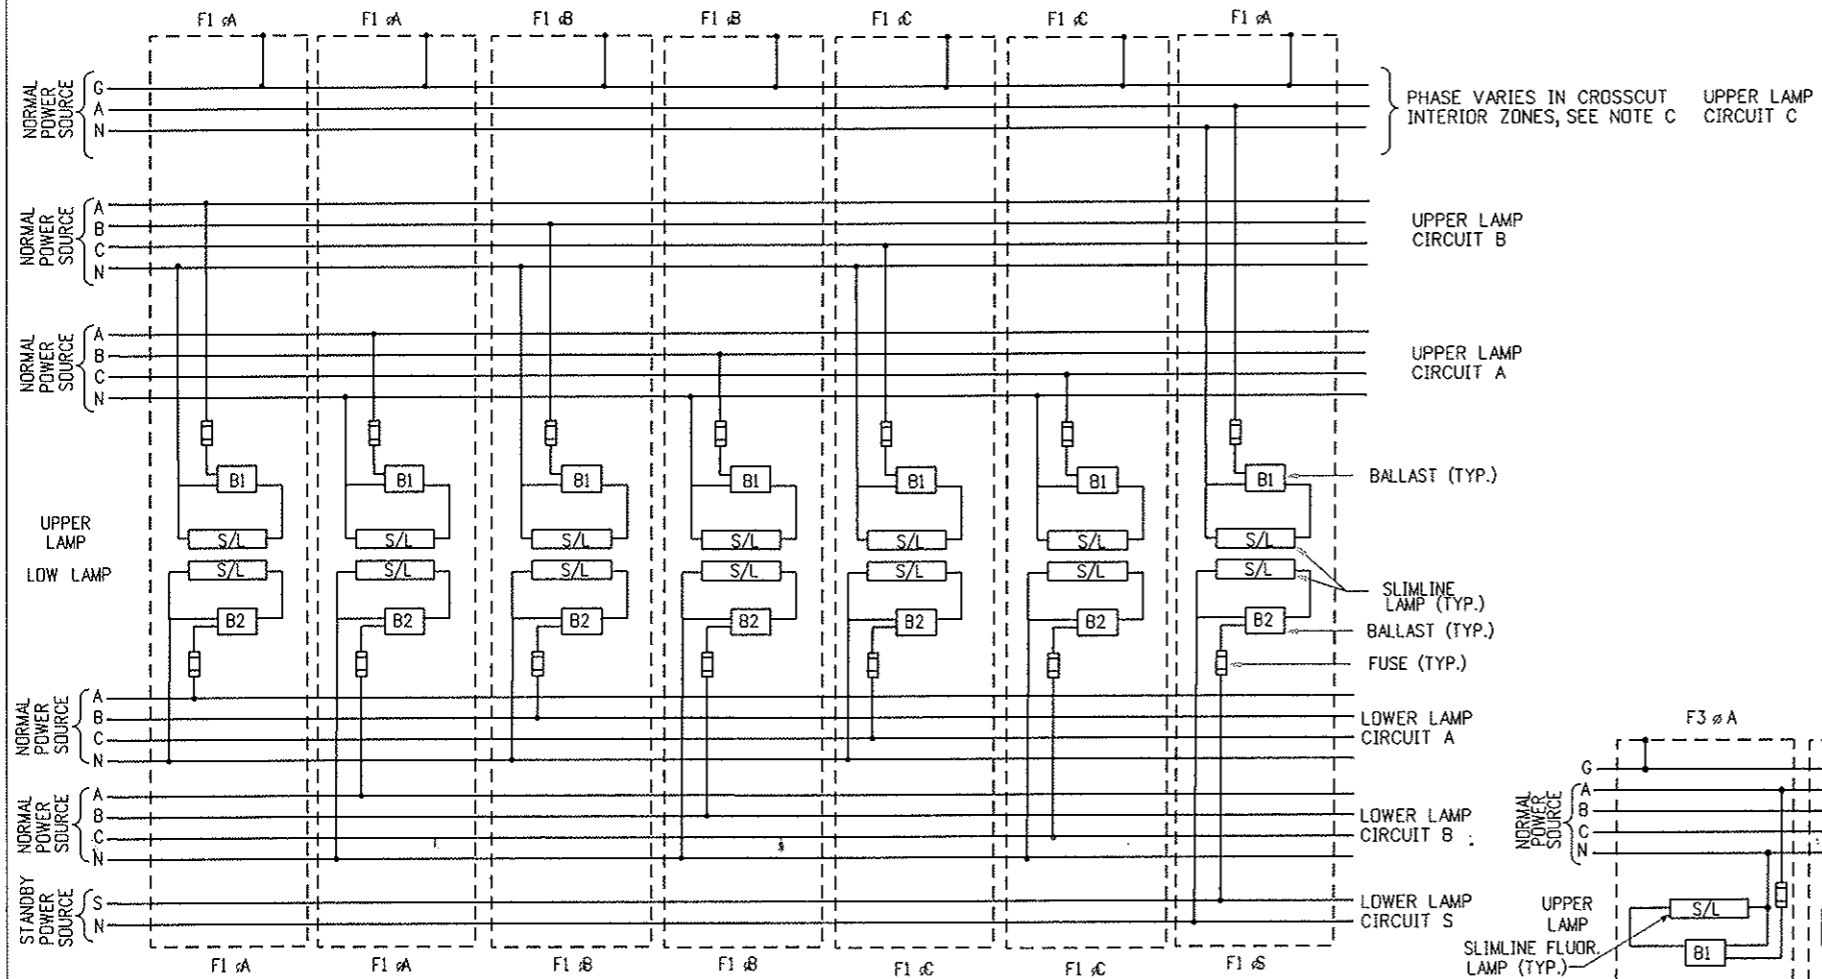

FIXTURE F1 WIRING DIAGRAM

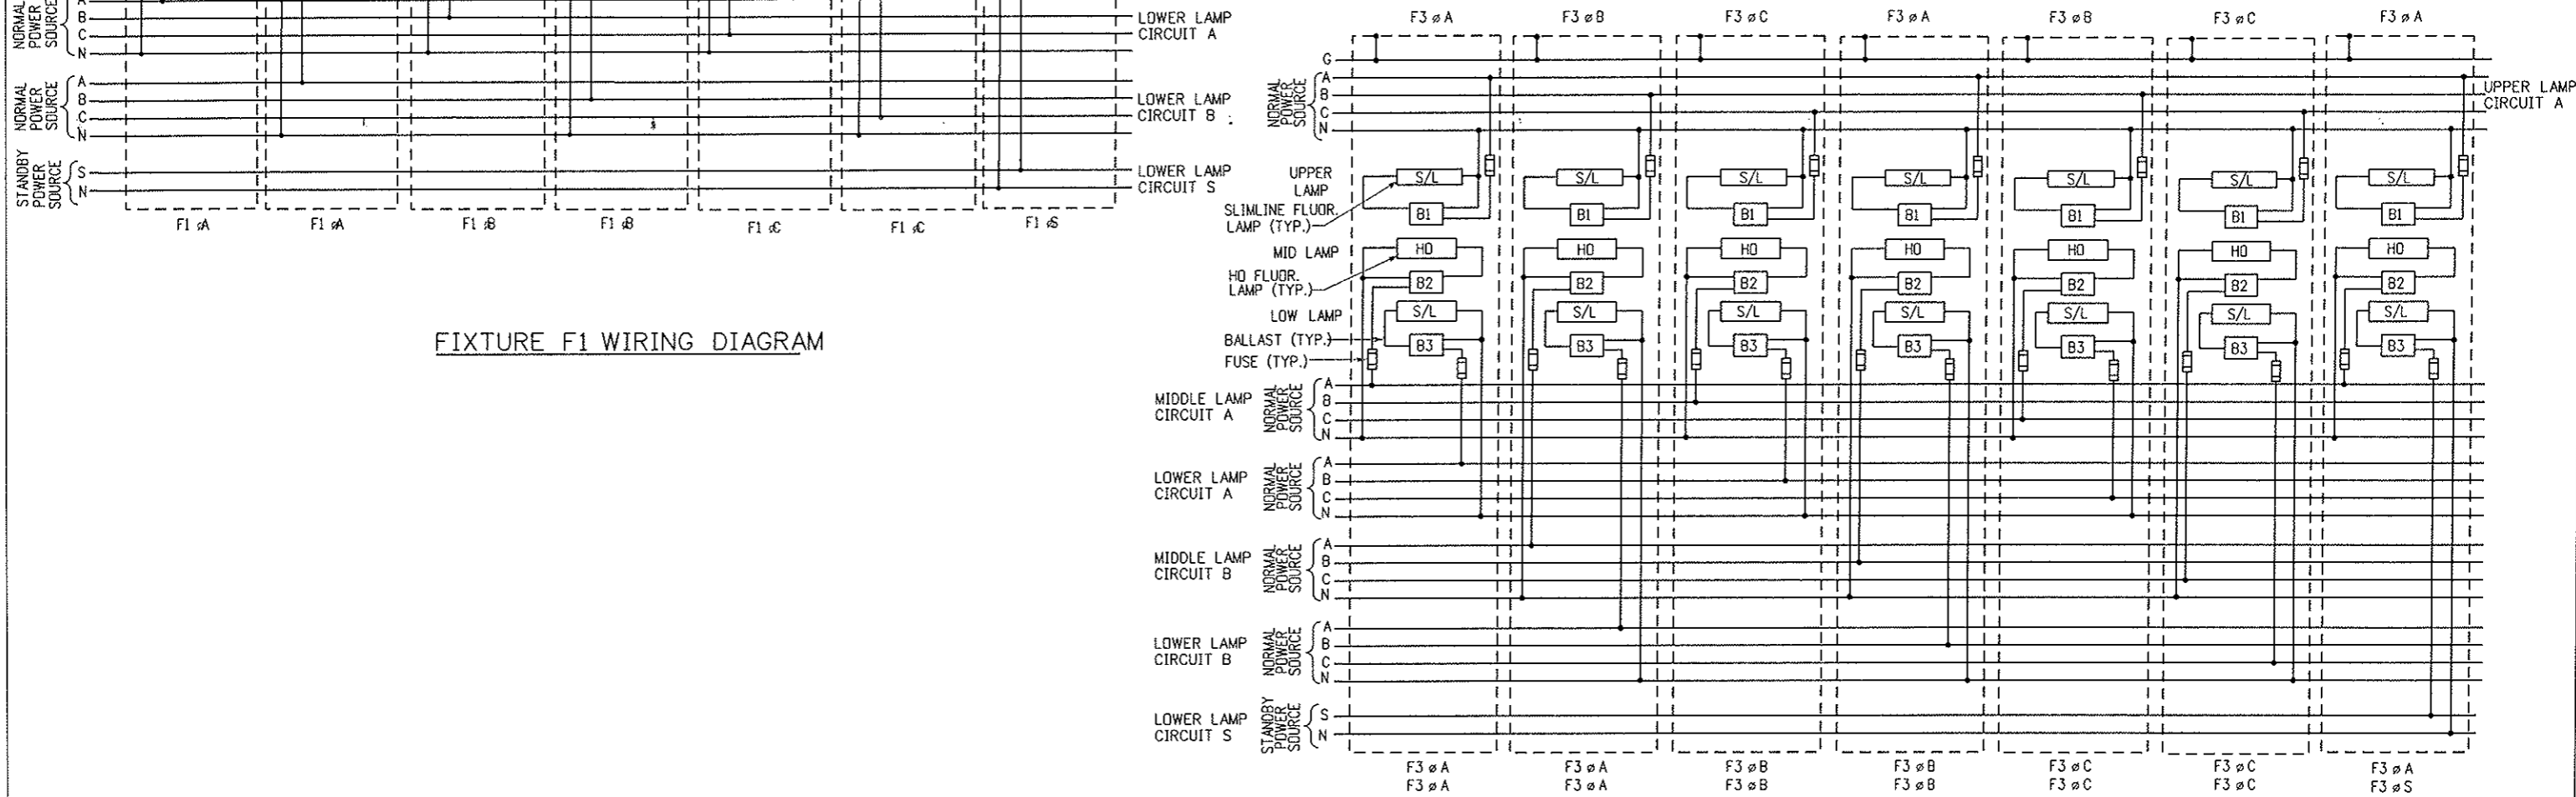

FIXTURE F3 WIRING DIAGRAM

(FIXTURE F2 WIRING DIAGRAM SAME EXCEPT UPPER LAMP TYPE IS "HO")

NOTES:


- A. THE LOWER FLUORESCENT LAMP IN EVERY SEVENTH FIXTURE SHALL BE ON THE STANDBY (S) CIRCUIT. CIRCUITING SEQUENCE SHALL BE AS SHOWN BELOW AND REPEATED.
- B. ON OPPOSITE WALL OF TUNNEL, STAGGER THE LOCATION OF THE LAMP CONNECTED TO THE STANDBY CIRCUIT.
- C. SEE CONDUIT SCHEDULES FOR THE CIRCUIT NUMBER AND PHASE FOR EACH INTERIOR ZONE. THIS SINGLE PHASE CIRCUIT IS NOT USED IN THE FIXTURE TYPE F1 FED FROM THE VENT BUILDINGS, BETWEEN STATIONS 140+50 TO 159+45 AND 213+26 TO 215+58. IN THOSE LOCATIONS, CONNECT THE UPPER LAMP TO THE NEXT 3-PHASE LEG IN SEQUENCE.

Design File Name: DONSPEC*
 Plot File Name: SFDOTFILE*
 Date of Plot: \$\$\$DATE\$\$\$

Computer File Information	
Creation Date:	02/26/99 Initials: DJB
Last Modification Date:	01/21/02 Initials: DJR
Full Path:	14102\700CADD\703ELECT\
Drawing File Name:	ltsd08n.dwg
Acad Ver.	R14 Scale: NONE Units: English

Sheet Revisions	
<input type="checkbox"/>	07/03/07 ASBUILT DJB
<input type="checkbox"/>	
<input type="checkbox"/>	
<input type="checkbox"/>	

Colorado Department of Transportation

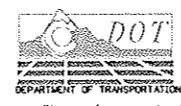

P.O. BOX 399
 DUMONT, CO. 80436
 Phone: 303-512-5750 FAX: 303-512-5775

Region 1 Mountain Residency I.N.Z.

As Constructed
No Revisions:
Revised:
Void:

TUNNEL LIGHTING FLUORESCENT TERMINATIONS DIAGRAM	
Designer:	J WALSH
Detailer:	D. BURROUGHS
Structure Numbers	
Sheet Subset:	TUN POWER
Subset Sheets:	3 of 45

Project No./Code
IM 0703-269
13166
Sheet Number 69


ZONE	CIRCUIT GROUP	NO.	SIZE (IN) & KIND	QTY.	SIZE & TYPE (AWG-kcmil)	FROM	TO
27	27A	P619A*	5/8" RGS	4	10-1/C 600	CONT. CAB. CNCW-1 No. 3	SOUTH WALL FLUOR WIREWAY
27	27B			4	10-1/C 600	CONT. CAB. CNCW-1 No. 4	SOUTH WALL FLUOR WIREWAY
27	27C			2	10-1/C 600	CONT. CAB. CNCW-1 No. 5	SOUTH WALL FLUOR WIREWAY
31	31A	P620	5/8" RGS	4	10-1/C 600	PNL NWS-1 CKT 1, 3, 5	CONT. CAB. CNW-1 No. 10
31	31B			4	10-1/C 600	PNL NWS-1 CKT 7, 9, 11	CONT. CAB. CNW-1 No. 11
31	31C			2	10-1/C 600	PNL NWS-1 CKT 13	CONT. CAB. CNW-1 No. 12
28	28A	P620A*	5/8" RGS	4	10-1/C 600	CONT. CAB. CNW-1 No. 1	NORTH WALL FLUOR WIREWAY
28	28B			4	10-1/C 600	CONT. CAB. CNW-1 No. 2	NORTH WALL FLUOR WIREWAY
28	28C			2	10-1/C 600	CONT. CAB. CNW-1 No. 3	NORTH WALL FLUOR WIREWAY
30	30A	P621	5/8" RGS	4	10-1/C 600	PNL NWS-1 CKT 19, 21, 23	CONT. CAB. CNW-1 No. 7
30	30B			4	10-1/C 600	PNL NWS-1 CKT 25, 27, 29	CONT. CAB. CNW-1 No. 8
29	29S			2	10-1/C 600	PNL NWS-1 CKT 15	CONT. CAB. CNW-1 No. 6
30	30S			2	10-1/C 600	PNL NWS-1 CKT 17	CONT. CAB. CNW-1 No. 9
29	29A	P621A*	5/8" RGS	4	10-1/C 600	CONT. CAB. CNW-1 No. 4	NORTH WALL FLUOR WIREWAY
29	29B			4	10-1/C 600	CONT. CAB. CNW-1 No. 5	NORTH WALL FLUOR WIREWAY
29	29S			2	10-1/C 600	CONT. CAB. CNW-1 No. 6	NORTH WALL FLUOR WIREWAY
29	29A	P622	5/8" RGS	4	10-1/C 600	PNL NWN-1 CKT 2, 4, 6	CONT. CAB. CNW-1 No. 4
29	29B			4	10-1/C 600	PNL NWN-1 CKT 8, 10, 12	CONT. CAB. CNW-1 No. 5
30	30A	P622A*	5/8" RGS	4	10-1/C 600	CONT. CAB. CNW-1 No. 7	SOUTH WALL FLUOR WIREWAY
30	30B			4	10-1/C 600	CONT. CAB. CNW-1 No. 8	SOUTH WALL FLUOR WIREWAY
-	-	P623	1" RGS	2	10-1/C 600	PNL NWN-1 SPARE	CONT. CAB. CNW-1 SPARE
30	30S	P623A*	1" RGS	2	10-1/C 600	CONT. CAB. CNW-1 No. 9	SOUTH WALL FLUOR WIREWAY
28	28A	P624	5/8" RGS	4	10-1/C 600	PNL NWN-1 CKT 14, 16, 18	CONT. CAB. CNW-1 No. 1
28	28B			4	10-1/C 600	PNL NWN-1 CKT 20, 22, 24	CONT. CAB. CNW-1 No. 2
28	28C			2	10-1/C 600	PNL NWN-1 CKT 26	CONT. CAB. CNW-1 No. 3
31	31A	P624A*	5/8" RGS	4	10-1/C 600	CONT. CAB. CNW-1 No. 10	SOUTH WALL FLUOR WIREWAY
31	31B			4	10-1/C 600	CONT. CAB. CNW-1 No. 11	SOUTH WALL FLUOR WIREWAY
31	31C			2	10-1/C 600	CONT. CAB. CNW-1 No. 12	SOUTH WALL FLUOR WIREWAY
36	36A	P625	5/8" RGS	4	10-1/C 600	PNL WVN-1 CKT 1, 3, 5	CONT. CAB. CWVN-1 No. 1
36	36B			4	10-1/C 600	PNL WVN-1 CKT 7, 9, 11	CONT. CAB. CWVN-1 No. 2
36	36A	P625A*	5/8" RGS	4	10-1/C 600	CONT. CAB. CWVN-1 No. 1	NORTH WALL FLUOR WIREWAY
36	36B			4	10-1/C 600	CONT. CAB. CWVN-1 No. 2	NORTH WALL FLUOR WIREWAY
37	37A	P626	5/8" RGS	4	10-1/C 600	PNL WVN-1 CKT 13, 15, 17	CONT. CAB. CWVN-1 No. 3
37	37B			4	10-1/C 600	PNL WVN-1 CKT 19, 21, 23	CONT. CAB. CWVN-1 No. 4
37	37S			2	10-1/C 600	PNL WVN-1 CKT 25	CONT. CAB. CWVN-1 No. 5
37	37A	P626A*	5/8" RGS	4	10-1/C 600	CONT. CAB. CWVN-1 No. 3	NORTH WALL FLUOR WIREWAY
37	37B			4	10-1/C 600	CONT. CAB. CWVN-1 No. 4	NORTH WALL FLUOR WIREWAY
37	37S			2	10-1/C 600	CONT. CAB. CWVN-1 No. 5	NORTH WALL FLUOR WIREWAY
38	38A	P627	5/8" RGS	4	10-1/C 600	PNL WVS-1 CKT 31, 33, 35	CONT. CAB. CWVN-1 No. 6
38	38B			4	10-1/C 600	PNL WVS-1 CKT 7, 9, 11	CONT. CAB. CWVN-1 No. 7
38	38S			2	10-1/C 600	PNL WVS-1 CKT 25	CONT. CAB. CWVN-1 No. 8
38	38A	P627A*	5/8" RGS	4	10-1/C 600	CONT. CAB. CWVN-1 No. 6	SOUTH WALL FLUOR WIREWAY

ZONE	CIRCUIT GROUP	NO.	SIZE (IN) & KIND	QTY.	SIZE & TYPE (AWG-kcmil)	FROM	TO
38	38B			4	10-1/C 600	CONT. CAB. CWVN-1 No. 7	SOUTH WALL FLUOR WIREWAY
38	38S			2	10-1/C 600	CONT. CAB. CWVN-1 No. 8	SOUTH WALL FLUOR WIREWAY
39	39A	P628	5/8" RGS	4	10-1/C 600	PNL WVS-1 CKT 13, 15, 17	CONT. CAB. CWVN-1 No. 9
39	39B			4	10-1/C 600	PNL WVS-1 CKT 19, 21, 23	CONT. CAB. CWVN-1 No. 10
39	39A	P628A*	5/8" RGS	4	10-1/C 600	CONT. CAB. CWVN-1 No. 9	SOUTH WALL FLUOR WIREWAY
39	39B			4	10-1/C 600	CONT. CAB. CWVN-1 No. 10	SOUTH WALL FLUOR WIREWAY
40R	40RA	P629	1" RGS	4	10-1/C 600	PNL WV-1 CKT 1, 3, 5	CONT. CAB. CWVN-1 No. 11
40R	40RA	P629A	1" RGS	4	10-1/C 600	CONT. CAB. CWVN-1 No. 11	JB-P629
40R	40RA	P629B*	1" RGS	4	10-1/C 600	JB-P629	NORTH WALL FLUOR WIREWAY
41R	41RA	P630	1" RGS	4	10-1/C 600	PNL WV-1 CKT 7, 9, 11	CONT. CAB. CWVN-1 No. 12
41R	41RA	P630A	1" RGS	4	10-1/C 600	CONT. CAB. CWVN-1 No. 12	JB-P630
41R	41RA	P630B*	1" RGS	4	10-1/C 600	JB-P630	SOUTH WALL FLUOR WIREWAY
42R	42RA	P631	1" RGS	4	10-1/C 600	PNL WV-1 CKT 13, 15, 17	CONT. CAB. CWVN-1 No. 13
42R	42RA	P631A	1" RGS	4	10-1/C 600	CONT. CAB. CWVN-1 No. 13	JB-P631
42R	42RA	P631B*	1" RGS	4	10-1/C 600	JB-P631	NORTH WALL FLUOR WIREWAY
44R	44RA	P632	1" RGS	4	10-1/C 600	PNL WV-1 CKT 19, 21, 23	CONT. CAB. CWVN-1 No. 14
44R	44RA	P632A	1" RGS	4	10-1/C 600	CONT. CAB. CWVN-1 No. 14	JB-P632
44R	44RA	P632B*	1" RGS	4	10-1/C 600	JB-P632	SOUTH WALL FLUOR WIREWAY
45R	45RA	P633	1" RGS	4	10-1/C 600	PNL WVN-1 CKT 2, 4, 6	CONT. CAB. CWVN-2 No. 2
45R	45RA	P633A*	1" RGS	4	10-1/C 600	CONT. CAB. CWVN-2 No. 2	NORTH WALL FLUOR WIREWAY
52R	52RA	P634	1" RGS	4	10-1/C 600	PNL WVS-1 CKT 2, 4, 6	CONT. CAB. CWVN-2 No. 11
52R	52RA	P634A*	1" RGS	4	10-1/C 600	CONT. CAB. CWVN-2 No. 11	SOUTH WALL FLUOR WIREWAY
43R	43RA	P635	5/8" RGS	4	10-1/C 600	WV-1 CKT 25, 27, 29	CONT. CAB. CWVN-2 No. 1
46R	46RA			4	10-1/C 600	WV-1 CKT 31, 33, 35	CONT. CAB. CWVN-2 No. 3
49R	49RA			4	10-1/C 600	WV-1 CKT 14, 16, 18	CONT. CAB. CWVN-2 No. 7
43R	43RA	P635A	5/8" RGS	4	10-1/C 600	CONT. CAB. CWVN-2 No. 1	JB-P635A
46R	46RA			4	10-1/C 600	CONT. CAB. CWVN-2 No. 3	JB-P635A
49R	49RA			4	10-1/C 600	CONT. CAB. CWVN-2 No. 7	JB-P635A
43R	43RA	P635B	1" RGS	4	10-1/C 600	JB-P635A	JB-635B
46R	46RA	P635C*	1" RGS	4	10-1/C 600	JB-P635A	NORTH CEILING MH WIREWAY
49R	49RA	P635D*	1" RGS	4	10-1/C 600	JB-P635A	SOUTH CEILING MH WIREWAY
43R	43RA	P635E*	1" RGS	4	10-1/C 600	JB-P635B	NORTH CEILING MH WIREWAY
43R	43RA	P635F*	1" RGS	4	10-1/C 600	JB-P635B	SOUTH CEILING MH WIREWAY
47R	47RA	P636	5/8" RGS	4	10-1/C 600	WV-1 CKT 37, 39, 41	CONT. CAB. CWVN-2 No. 4
48R	48RA			4	10-1/C 600	WV-1 CKT 2, 4, 6	CONT. CAB. CWVN-2 No. 5
48R	48RB			4	10-1/C 600	WV-1 CKT 8, 10, 12	CONT. CAB. CWVN-2 No. 6
47R	47RA	P636A*	5/8" RGS	4	10-1/C 600	CONT. CAB. CWVN-2 No. 4	NORTH CEILING MH WIREWAY
48R	48RA			4	10-1/C 600	CONT. CAB. CWVN-2 No. 5	NORTH CEILING MH WIREWAY
48R	48RB			4	10-1/C 600	CONT. CAB. CWVN-2 No. 6	NORTH CEILING MH WIREWAY
47R	47RA	P636B	1/4" RGS	4	10-1/C 600	NORTH CEILING MH WIREWAY	NORTH CEILING MH CONDUIT WIREWAY
48R	48RA			4	10-1/C 600	NORTH CEILING MH WIREWAY	NORTH CEILING MH CONDUIT WIREWAY

* SEE NOTE A, SUBSET SHEET 8 OF TUN POWER

Computer File Information	
Creation Date:	04/21/99 Initials: SPD
Last Modification Date:	02/20/07 Initials: DJB
Full Path:	14102\800deliv\AsBuilt
Drawing File Name:	102.CSM

Sheet Revisions	
07/03/07	ASBUILT DJB

Colorado Department of Transportation

 P.O. BOX 399
 DUMONT, CO. 80436
 Phone: 303-512-5750 FAX: 303-512-5775
 Region 1 Mountain Residency I.N.Z.

As Constructed	TUNNEL CIRCUIT SCHEDULES		Project No./Code
No Revisions:	SHEET 2		IM 0703-269
Revised:	Designer: J. WALSH	Structure Numbers	13166
Void:	Detailer: R. RODDENBERRY		Sheet Number 72

ZONE	CIRCUIT GROUP	NO.	SIZE (IN) & KIND	QTY.	SIZE & TYPE (AWG-kcmil)	FROM	TO
48R	48RB			4	10-1/C 600	NORTH CEILING MH WIREWAY	NORTH CEILING MH CONDUIT WIREWAY
50R	50RA	P637	1 5/64" RGS	4	10-1/C 600	WV-1 CKT 20, 22, 24	CONT. CAB. CWVN-2 No. 8
51R	51RA			4	10-1/C 600	WV-1 CKT 26, 28, 30	CONT. CAB. CWVN-2 No. 9
51R	51RB			4	10-1/C 600	WV-1 CKT 32, 34, 36	CONT. CAB. CWVN-2 No. 10
50R	50RA	P637A*	1 5/64" RGS	4	10-1/C 600	CONT. CAB. CWVN-2 No. 8	SOUTH CEILING MH WIREWAY
51R	51RA			4	10-1/C 600	CONT. CAB. CWVN-2 No. 9	SOUTH CEILING MH WIREWAY
51R	51RB			4	10-1/C 600	CONT. CAB. CWVN-2 No. 10	SOUTH CEILING MH WIREWAY
50R	50RA	P637B	1 1/4" RGS	4	10-1/C 600	SOUTH CEILING MH WIREWAY	SOUTH CEILING MH CONDUIT WIREWAY
51R	51RA			4	10-1/C 600	SOUTH CEILING MH WIREWAY	SOUTH CEILING MH CONDUIT WIREWAY
51R	51RB			4	10-1/C 600	SOUTH CEILING MH WIREWAY	SOUTH CEILING MH CONDUIT WIREWAY
4	4A	P638	1 5/64" RGS	4	10-1/C 600	EV-1 CKT 25, 27, 29	CONT. CAB. CEVN-2 No. 1
4	4B			4	10-1/C 600	EV-1 CKT 31, 33, 35	CONT. CAB. CEVN-2 No. 6
4	4C			4	10-1/C 600	EV-1 CKT 37, 39, 41	CONT. CAB. CEVN-2 No. 11
4	4A	P638A*	1 5/64" RGS	4	10-1/C 600	CONT. CAB. CEVN-2 No. 1	NORTH CEILING MH WIREWAY
4	4B			4	10-1/C 600	CONT. CAB. CEVN-2 No. 6	NORTH CEILING MH WIREWAY
4	4C			4	10-1/C 600	CONT. CAB. CEVN-2 No. 11	NORTH CEILING MH WIREWAY
5	5A	P639	1 5/64" RGS	4	10-1/C 600	EV-2 CKT 13, 15, 17	CONT. CAB. CEVN-2 No. 2
5	5B			4	10-1/C 600	EV-2 CKT 19, 21, 23	CONT. CAB. CEVN-2 No. 7
5	5C			4	10-1/C 600	EV-2 CKT 25, 27, 29	CONT. CAB. CEVN-2 No. 12
5	5A	P639A*	1 5/64" RGS	4	10-1/C 600	CONT. CAB. CEVN-2 No. 2	NORTH CEILING MH WIREWAY
5	5B			4	10-1/C 600	CONT. CAB. CEVN-2 No. 7	NORTH CEILING MH WIREWAY
5	5C			4	10-1/C 600	CONT. CAB. CEVN-2 No. 12	NORTH CEILING MH WIREWAY
6	6A	P640	1 5/64" RGS	4	10-1/C 600	EV-3 CKT 1, 3, 5	CONT. CAB. CEVN-2 No. 3
6	6B			4	10-1/C 600	EV-3 CKT 7, 9, 11	CONT. CAB. CEVN-2 No. 8
6	6C			4	10-1/C 600	EV-3 CKT 13, 15, 17	CONT. CAB. CEVN-2 No. 13
6	6A	P640A*	1 5/64" RGS	4	10-1/C 600	CONT. CAB. CEVN-2 No. 3	NORTH CEILING MH WIREWAY
6	6B			4	10-1/C 600	CONT. CAB. CEVN-2 No. 8	NORTH CEILING MH WIREWAY
6	6C			4	10-1/C 600	CONT. CAB. CEVN-2 No. 13	NORTH CEILING MH WIREWAY
6	6D	P641	1 5/64" RGS	4	10-1/C 600	EV-3 CKT 19, 21, 23	CONT. CAB. CEVN-2 No. 4
6	6E			4	10-1/C 600	EV-3 CKT 25, 27, 29	CONT. CAB. CEVN-2 No. 9
6	6F			4	10-1/C 600	EV-3 CKT 31, 33, 35	CONT. CAB. CEVN-2 No. 14
6	6D	P641A*	1 5/64" RGS	4	10-1/C 600	CONT. CAB. CEVN-2 No. 4	NORTH CEILING MH WIREWAY
6	6E			4	10-1/C 600	CONT. CAB. CEVN-2 No. 9	NORTH CEILING MH WIREWAY
6	6F			4	10-1/C 600	CONT. CAB. CEVN-2 No. 14	NORTH CEILING MH WIREWAY
7	7A	P642	1 5/64" RGS	4	10-1/C 600	EV-1 CKT 2, 4, 6	CONT. CAB. CEVN-2 No. 5
7	7B			4	10-1/C 600	EV-1 CKT 8, 10, 12	CONT. CAB. CEVN-2 No. 10
7	7C			4	10-1/C 600	EV-1 CKT 14, 16, 18	CONT. CAB. CEVN-2 No. 15
7	7A	P642A*	1 5/64" RGS	4	10-1/C 600	CONT. CAB. CEVN-2 No. 5	SOUTH CEILING MH WIREWAY
7	7B			4	10-1/C 600	CONT. CAB. CEVN-2 No. 10	SOUTH CEILING MH WIREWAY
7	7C			4	10-1/C 600	CONT. CAB. CEVN-2 No. 15	SOUTH CEILING MH WIREWAY
8	8A	P643	1 5/64" RGS	4	10-1/C 600	EV-2 CKT 31, 33, 35	CONT. CAB. CEVN-2 No. 16
8	8B			4	10-1/C 600	EV-2 CKT 37, 39, 41	CONT. CAB. CEVN-2 No. 21


ZONE	CIRCUIT GROUP	NO.	SIZE (IN) & KIND	QTY.	SIZE & TYPE (AWG-kcmil)	FROM	TO
8	8C			4	10-1/C 600	EV-2 CKT 2, 4, 6	CONT. CAB. CEVN-2 No. 26
8	8A	P643A*	1 5/64" RGS	4	10-1/C 600	CONT. CAB. CEVN-2 No. 16	SOUTH CEILING MH WIREWAY
8	8B			4	10-1/C 600	CONT. CAB. CEVN-2 No. 21	SOUTH CEILING MH WIREWAY
8	8C			4	10-1/C 600	CONT. CAB. CEVN-2 No. 26	SOUTH CEILING MH WIREWAY
9	9A	P644	1 5/64" RGS	4	10-1/C 600	EV-3 CKT 37, 39, 41	CONT. CAB. CEVN-2 No. 17
9	9B			4	10-1/C 600	EV-3 CKT 2, 4, 6	CONT. CAB. CEVN-2 No. 22
9	9C			4	10-1/C 600	EV-3 CKT 8, 10, 12	CONT. CAB. CEVN-2 No. 27
9	9A	P644A*	1 5/64" RGS	4	10-1/C 600	CONT. CAB. CEVN-2 No. 17	SOUTH CEILING MH WIREWAY
9	9B			4	10-1/C 600	CONT. CAB. CEVN-2 No. 22	SOUTH CEILING MH WIREWAY
9	9C			4	10-1/C 600	CONT. CAB. CEVN-2 No. 27	SOUTH CEILING MH WIREWAY
9	9D	P645	1 5/64" RGS	4	10-1/C 600	EV-3 CKT 14, 16, 18	CONT. CAB. CEVN-2 No. 18
9	9E			4	10-1/C 600	EV-3 CKT 20, 22, 24	CONT. CAB. CEVN-2 No. 23
9	9F			4	10-1/C 600	EV-3 CKT 26, 28, 30	CONT. CAB. CEVN-2 No. 28
9	9D	P645A*	1 5/64" RGS	4	10-1/C 600	CONT. CAB. CEVN-2 No. 18	SOUTH CEILING MH WIREWAY
9	9E			4	10-1/C 600	CONT. CAB. CEVN-2 No. 23	SOUTH CEILING MH WIREWAY
9	9F			4	10-1/C 600	CONT. CAB. CEVN-2 No. 28	SOUTH CEILING MH WIREWAY
14	14A	P646	1" RGS	4	10-1/C 600	EV-2 CKT 8, 10, 12	CONT. CAB. CEVN-2 No. 19
14	14A	P646A	1" RGS	4	10-1/C 600	CONT. CAB. CEVN-2 No. 19	JB-P646A
14	14A	P646B	1" RGS	4	10-1/C 600	JB-P646A	JB-P646B
14	14A	P646C*	1" RGS	4	10-1/C 600	JB-P646B	NORTH CEILING MH WIREWAY
14	14A	P646D*	1" RGS	4	10-1/C 600	JB-P646B	SOUTH CEILING MH WIREWAY
15	15A	P647	1 5/64" RGS	4	10-1/C 600	EV-1 CKT 20, 22, 24	CONT. CAB. CEVN-2 No. 24
18	18A			4	10-1/C 600	EV-1 CKT 26, 28, 30	CONT. CAB. CEVN-2 No. 29
15	15A	P647A	1 5/64" RGS	4	10-1/C 600	CONT. CAB. CEVN-2 No. 24	JB-P647A
18	18A			4	10-1/C 600	CONT. CAB. CEVN-2 No. 29	JB-P647A
15	15A	P647B	1 5/64" RGS	4	10-1/C 600	JB-P647A	JB-P647B
18	18A			4	10-1/C 600	JB-P647A	JB-P647B
18	18A	P647C	1" RGS	8	10-1/C 600	JB-P647B	JB-P647C
15	15A	P647D*	1" RGS	4	10-1/C 600	JB-P647B	NORTH CEILING MH WIREWAY
15	15A	P647E*	1" RGS	4	10-1/C 600	JB-P647B	SOUTH CEILING MH WIREWAY
18	18A	P647F*	1" RGS	8	10-1/C 600	JB-P647C	NORTH CEILING MH WIREWAY
18	18A	P647G*	1" RGS	8	10-1/C 600	JB-P647C	SOUTH CEILING MH WIREWAY
LUS	120 PWR	P648A	1" RGS	6	10-1/C 600	JB-P648 @ MINI-LOAD CENTER	JB-P648 @ LUS
120V		P648B	1" RGS	4	10-1/C 600	JB-P648 @ MINI-LOAD CENTER	MINI-LOAD CENTER
				5	6-1/C 600	JB-P648 @ MINI-LOAD CENTER	MINI-LOAD CENTER
MPC	480V	P648C	1" RGS	3	6-1/C 600	JB-P648 @ MINI-LOAD CENTER	MINI-LOAD CENTER
VMS/CONTROL. PWR		P648D	1" RGS	4	10-1/C 600	VMS MINI-LOAD CENTER IN SUPPLY DUCT	VMS/LUS CABINET IN TUNNEL
VMS	120V PWR	P648E	2-3/4" FLEX	5	10-1/C 600	VMS/LUS CABINET IN TUNNEL	TUNNEL VMS
LUS	120V PWR	P648F	3/4" RGS	5	10-1/C 600	JB-P648 @ LUS	LUS SIGN

* SEE NOTE A, SUBSET SHEET 8 OF TUN POWER

Computer File Information	
Creation Date:	04/21/99 Initials: SFD
Last Modification Date:	01/15/07 Initials: DJB
FullPath:	14102\800deliv\AsBuilt
Drawing File Name:	101.CSM

Sheet Revisions	
07/03/07	ASBUILT DJB

Colorado Department of Transportation



P.O. BOX 399
DUMONT, CO. 80436
Phone: 303-512-5750 FAX: 303-512-5775
Region 1 Mountain Residency I N 7

As Constructed
No Revisions:
Revised:
Void:

TUNNEL CIRCUIT SCHEDULES	
SHEET 3	
Designer:	J. WALSH
Detailer:	R. RODDENBERRY

Project No./Code	
IM 0703-269	
13166	
Sheet Number 73	

ZONE	CIRCUIT GROUP	NO.	SIZE (IN) & KIND	QTY.	SIZE & TYPE (AWG-kcmil)	FROM	TO
		P649	1" RGS	3	10-1/C 600	EXHAUST FAN	EXIST. 120/208V PANEL BOARD
		P700A	1" RGS	5	8 - I/C 600	PANEL WVN-1	CONTACTOR CABINET CWVN-2
		P702A	1/2" RGS	5	3 - I/C 600	PANEL EV-2	CONTACTOR CABINET CEVN-2
		P750	1" RGS	3	10 - I/C 600	CROSSCUT LIGHTING	LOCAL PANELBOARD
		P751	1" RGS	5	10 - I/C 600	CROSSCUT LTG W/SWITCH LEG	CROSSCUT LIGHTING FIXTURE
		P752	1" RGS	5	10 - I/C 600	CROSSCUT LTG W/3-WAY SWITCH LEGS	CROSSCUT LTG W/3-WAY SWITCH LEGS
		P753	1" RGS	4	10 - I/C 600	CROSSCUT LTG J-BOX	CROSSCUT LTG 3-WAY SWITCH
		P754	1" RGS	3	10 - I/C 600	CROSSCUT LIGHTING	CROSSCUT LIGHTING
		P755	1/4" RGS	4	10 - I/C 600	CNW-1 (W. CROSSCUT)	TERMINAL BOX P12W (HT. TAPE)
		P756	1/4" RGS	4	10 - I/C 600	CNE-1 (E. CROSSCUT)	TERMINAL BOX P12E (HT. TAPE)
		P757	1/4" RGS	4	10 - I/C 600	CNCW-1 (CTR. CROSSCUT W.)	TERMINAL BOX P12CW (HT. TAPE)
		P758	1/4" RGS	4	10 - I/C 600	CNCE-1 (CTR. CROSSCUT E.)	TERMINAL BOX P12CE (HT. TAPE)
		P759	1 1/2" RGS	5	6 - I/C 600	PNLBD NWS-1 (W. CROSSCUT)	JB-P759
		P759A	1 1/2" RGS	5	6 - I/C 600	JB-P759	JB-P648 @ VMS3 MINI-PWR CTR
		P759B	1 1/2" RGS	3	6 - I/C 600	JB-P648 @ VMS3 MINI-PWR CTR	JB-P648 @ VMS2 MINI-PWR CTR
		P760	1 1/2" RGS	5	6 - I/C 600	PNLBD NCS-2W (WEST CENTER CROSSCUT)	JB-P760
		P760A	1 1/2" RGS	5	6 - I/C 600	JB-P760	JB-P648 @ VMS5 MINI-PWR CTR
		P760B	1 1/2" RGS	3	6 - I/C 600	JB-P648 @ VMS5 MINI-PWR CTR	JB-P648 @ VMS4 MINI-PWR CTR
		P761	1 1/2" RGS	4	6 - I/C 600	PNLBD NCS-2E (EAST CENTER CROSSCUT)	JB-P761
		P761A	1 1/2" RGS	4	6 - I/C 600	JB-P761	JB-P648 @ VMS6 MINI-PWR CTR
		P761B	1 1/2" RGS	4	6 - I/C 600	JB-P648 @ VMS6 MINI-PWR CTR	JB-P648 @ VMS7 MINI-PWR CTR
		P761C	1 1/2" RGS	3	6 - I/C 600	JB-P648 @ VMS7 MINI-PWR CTR	JB-P648 @ VMS8 MINI-PWR CTR
		P762	1 1/2" RGS	5	6 - I/C 600	PNLBD NES-1 (EAST CROSSCUT)	JB-P762
		P762A	1 1/2" RGS	5	6 - I/C 600	JB-P762	JB-P648 @ VMS9 MINI-PWR CTR
		P762B	1 1/2" RGS	3	6 - I/C 600	JB-P648 @ VMS9 MINI-PWR CTR	JB-P648 @ VMS10 MINI-PWR CTR
		P763	1" RGS	3	6 - I/C 600	PNLBD WV-1	JB-P648 @ VMS1 MINI-PWR CTR
		P764	1" RGS	3	6 - I/C 600	PNLBD EVN-1	JB-P648 @ VMS11 MINI-PWR CTR
		P765	1/4" RGS	4	8 - I/C 600	CWVN-2	JB-P765 HEAT TRACE(FOR FUTURE USE)SEE NOTE B
		P765A	1/4" RGS	3	8 - I/C 600	JB-P765	JB-P765 HEAT TRACE (FOR FUTURE USE)
		P765B	1/4" RGS	4	8 - I/C 600	CNW-1	JB-P765 (FOR FUTURE USE) SEE NOTE B
		P765C	1/4" RGS	3	8 - I/C 600	JB-P765	JB-P765 HEAT TRACE (FOR FUTURE USE)
		P765D	1/4" RGS	4	8 - I/C 600	JB-765	JB-P765 (FOR FUTURE USE) SEE NOTE B
		P765E	1/4" RGS	5	8 - I/C 600	CNCW-1	JB-P765 HEAT TRACE (FOR FUTURE USE)
		P765F	1/4" RGS	4	8 - I/C 600	CNCE-1	JB-P765 (FOR FUTURE USE) SEE NOTE B
		P765G	1/4" RGS	3	8 - I/C 600	JB-P765	JB-P765 HEAT TRACE (FOR FUTURE USE)
		P765H	1/4" RGS	3	8 - I/C 600	JB-P765	JB-P765 HEAT TRACE (FOR FUTURE USE)
		P765I	1/4" RGS	4	8 - I/C 600	JB-P765	JB-P765 HEAT TRACE (FOR FUTURE USE)
		P765J	1/4" RGS	5	8 - I/C 600	CNE-1	JB-P765 HEAT TRACE(FOR FUTURE USE)SEE NOTE B
		P765K	1/4" RGS	3	6 - I/C 600	JB-P765	JB-P765 HEAT TRACE (FOR FUTURE USE)
		P765L	1/4" RGS	4	6 - I/C 600	JB-P765	JB-P765 HEAT TRACE (FOR FUTURE USE)

ZONE	CIRCUIT GROUP	NO.	SIZE (IN) & KIND	QTY.	SIZE & TYPE (AWG-kcmil)	FROM	TO
		P765M	1/4" RGS	5	6 - I/C 600	CEVN-2	JB-P765 HEAT TRACE(FOR FUTURE USE)SEE NOTE B
		P765Z	1/4" RGS	3	8 - I/C 600	JB-P765	JB-P765 HEAT TRACE (FOR FUTURE USE)
		P766	1" RGS	5	10 - I/C 600	PNLBD NWN-1	CNW-1 HEAT TRACE
		P767	1" RGS	5	10 - I/C 600	PNLBD NCS-1W	CNCW-1 HEAT TRACE
		P768	1" RGS	5	10 - I/C 600	PNLBD NCS-1E	CNCE-1 HEAT TRACE
		P769	1" RGS	5	10 - I/C 600	PNLBD NES-1	CNE-1 HEAT TRACE
		P770	1" RGS	4	10 - I/C 600	PNLBD WVN-1	CWVN-2 HEAT TRACE
		P771	1" RGS	5	10 - I/C 600	PNLBD EVN-1	CEVN-2 HEAT TRACE
		P772	1" RGS	4	10 - I/C 600	PNLBD NCS-1E CKT.13,15,17	CONTACTOR CABINET CNCE-1 NO. 4
				4	10 - I/C 600	PNLBD NCS-1E CKT.19,21,23	CONTACTOR CABINET CNCE-1 NO. 5

NOTE

A. * DENOTES A 3'-0" MAX LENGTH OF 1 1/4" FLEXIBLE METAL CONDUIT TO ACCOMMODATE TRANSITION FROM RGS CONDUIT TO DESIGNATED WIREWAY. USE REDUCERS WHERE NECESSARY.

B. CABLES FOR FUTURE HEAT TRACE SHALL ENTER EACH RESPECTIVE CONTACTOR CABINET AND SUFFICIENT SLACK SHALL BE PROVIDED FOR FUTURE CONNECTION TO HEAT TRACE CONTACTOR.

Computer File Information

Sheet Revisions

Colorado Department of Transportation

As Constructed

TUNNEL CIRCUIT SCHEDULES SHEET 4

Project No./Code

IM 0703-269

Creation Date:	04/21/99	Initials:	SPD
Last Modification Date:	02/21/07	Initials:	DJB
Full Path:	I4102\800deliv\AsBuilt		
Drawing File Name:	03LCS06		
Acad Ver.	R14	Scale:	NONE
Units:			

<input type="checkbox"/>	07/03/07	ASBUILT	DJB
<input type="checkbox"/>			
<input type="checkbox"/>			
<input type="checkbox"/>			



P.O. BOX 399
DUMONT, CO. 80436
Phone: 303-512-5750 FAX: 303-512-5775

Region 1 Mountain Residency I.N.Z.

No Revisions:	
Revised:	
Void:	

Designer:	J. WALSH	Structure Numbers	
Detailer:	R. RODDENBERRY		
Sheet Subset:	TUN POWER	Subset Sheets:	8 of 45

Sheet Number 74

PANEL WV-1 CIRCUIT SCHEDULE														
SERVICE VOLTAGE 480Y/277			BUS RATING 225A			LOCATION WEST VENTILATION BLDG								
MOUNTING SURFACE			BUS CONNECTION 3P 4W			DRAWING No.								
LOAD DESCRIPTION	VOLTAMPS			BREAKER POLE	RCKT No	BUS CONNECTION	CKT No	BREAKER AMP POLE			VOLTAMPS			LOAD DESCRIPTION
	A	B	C					A	B	C	A	B	C	
40RA/UPR	360			1			2				1855			48RA/M2
		360		3	20	3	4	20	3		1855			
			360				6				2040			
41RA/UPR	300			7			8				1855			48RB/M2
		300		3	20	9	10	20	3		1855			
			300				12				2040			
42RA/UPR	341			13			14				2040			49RA/M1
		341		3	20	15	16	20	3		2040			
			341				18				1530			
44RA/UPR	341			19			20				2365			50RA/M1
		341		3	20	21	22	20	3		1855			
			341				24				1855			
43RA/M3	528			25			26				1855			51RA/M2
		528		3	20	27	28	20	3		1855			
			528				30				2040			
46RA/M1	2040			31			32				1855			51RB/M2
		2040		3	20	33	34	20	3		1855			
			1530				36				2040			
47RA/M2	2365			37			38				2500			MINI PWR CTRS NORTH TUNNEL (VMS 1)
		1855		3	20	39	40				2500			
			1855				42							SPARE
TOTALS	6275	5765	5255			S/N					14325	13815	11545	
BUS A	20600		MAIN BREAKER		150 AMPS.		LINE AMPS		80.63					
BUS B	19580		LOCATION		TOP		PHASING		3 @ 480					
BUS C	16800		FEEDER SIZE		4#1/0, 1#4G, 1 1/2" C		KVA CONN		56.98					
TOTAL LOAD	56980		SOURCE		DP-WV		DATE		07/24/02					

PANEL WV-1 CIRCUIT SCHEDULE														
SERVICE VOLTAGE 480Y/277			BUS RATING 225A			LOCATION WEST VENTILATION BLDG								
MOUNTING SURFACE			BUS CONNECTION 3P 4W			DRAWING No.								
LOAD DESCRIPTION	VOLTAMPS			BREAKER POLE	RCKT No	BUS CONNECTION	CKT No	BREAKER AMP POLE			VOLTAMPS			LOAD DESCRIPTION
	A	B	C					A	B	C	A	B	C	
36A/MID	3512			1			2				719			45RA/UPR
		3423		3	20	3	4	20	3		719			
			3423				6				719			
36B/MID	3423			7			8				2375			TH-TR3 MID LAMP, 2A
		3423		3	20	9	10	20	3		2300			TH-TR3 MID LAMP, 2A
			3423				12				2300			TH-TR3 MID LAMP, 2A
37A/LOW	2829			13			14				2300			TH-TR3 MID LAMP, 2B
		2829		3	20	15	16	20	3		2300			TH-TR3 MID LAMP, 2B
			2760				18				2300			TH-TR3 MID LAMP, 2B
37B/LOW	2829			19			20				1575			TH-TR3 LOW LAMP, 3A
		2760		3	20	21	22	20	3		1575			TH-TR3 LOW LAMP, 3A
			2760				24				1500			TH-TR3 LOW LAMP, 3A
37S/LOW	2760			1	20	25	26				1575			TH-TR3 LOW LAMP, 3B
SPARE		0		1	20	27	28	20	3		1575			TH-TR3 LOW LAMP, 3B
SPARE			0	1	20	29	30				1500			TH-TR3 LOW LAMP, 3B
HEAT TRACE	4800			2	20	31	32	20	1		1500			TH-TR3 LOW LAMP, 3S
HEAT TRACE		4800		2	20	33	34				1000			LCP CWVN-2 CONTROL PWR
SPARE			0	1	20	35	36				1000			
SPARE			0	3	20	39	38				5402			APPROACH LIGHTING
			0				40	30	3		5402			
							42				5817			
TOTALS	20153	17235	12366			S/N					15446	14871	15136	
BUS A	35599		MAIN BREAKER		150 AMPS.		LINE AMPS		114.57					
BUS B	32106		LOCATION (TOP)		BOTTOM		PHASING		3 @ 480					
BUS C	27502		FEEDER SIZE		4#1/0, 1#6, 1 1/2" C		KVA CONN		95.21					
TOTAL LOAD	95207		SOURCE		DP-WV		DATE		2/25/03					

PANEL WVS-1 CIRCUIT SCHEDULE														
SERVICE VOLTAGE 480Y/277			BUS RATING 225A			LOCATION WEST VENTILATION BLDG								
MOUNTING SURFACE			BUS CONNECTION 3P 4W			DRAWING No.								
LOAD DESCRIPTION	VOLTAMPS			BREAKER POLE	RCKT No	BUS CONNECTION	CKT No	BREAKER AMP POLE			VOLTAMPS			LOAD DESCRIPTION
	A	B	C					A	B	C	A	B	C	
LCP CWVS-1 CONTROL PWR	750			1			2				719			52RA/UPR
		750		3	20	3	4	20	3		719			
			0				6				719			
38B/LOW	2829			7			8				2375			TH-TR3 MID LAMP, 11A
		2691		3	20	9	10	20	3		2300			TH-TR3 MID LAMP, 11A
			2760				12				2300			TH-TR3 MID LAMP, 11A
39A/MID	3423			13			14				2300			TH-TR3 MID LAMP, 11B
		3423		3	20	15	16	20	3		2300			TH-TR3 MID LAMP, 11B
			3354				18				2300			TH-TR3 MID LAMP, 11B
39B/MID	3334			19			20				1575			TH-TR3 LOW LAMP, 10A
		3423		3	20	21	22	20	3		1575			TH-TR3 LOW LAMP, 10A
			3354				24				1500			TH-TR3 LOW LAMP, 10A
38S/LOW	2829			1	20	25	26				1575			TH-TR3 LOW LAMP, 10B
SPARE				1	20	27	28	20	3		1575			TH-TR3 LOW LAMP, 10B
SPARE				1	20	29	30				1500			TH-TR3 LOW LAMP, 10B
38A/LOW	2829			31			32	20	1		1500			TH-TR3 LOW LAMP, 10S
		2760		3	20	33	34				1000			LCP CWVN-1 CONTROL PWR
			2851				36				1000			
SPARE				1	20	37	38				3565			VMS AND LUS SIGNS
DRAINAGE PIPE HT TRACING	4800			2	30	39	40	30	3		3565			FOR SOUTH
DRAINAGE PIPE HT TRACING		4800					42				3565			TUNNEL
TOTALS	15994	17897	17159			S/N					13609	13034	12884	
BUS A	29603		MAIN BREAKER		150 AMPS.		LINE AMPS		108.53					
BUS B	30881		LOCATION (TOP)		BOTTOM		PHASING		3 @ 480					
BUS C	30043		FEEDER SIZE		4#1/0, 1#6G, 1 1/2" C		KVA CONN		90.53					
TOTAL LOAD	90527		SOURCE		DP-WV		DATE		07/24/02					

Computer File Information		Sheet Revisions		Colorado Department of Transportation		As Constructed		ELECTRICAL PANEL SCHEDULES - SHEET 1		Project No./Code	
Creation Date:	04/26/99	Initials:	SPO	07/03/07	ASBUILT	P.O. BOX 399 DUMONT, CO. 80436		Designer: J. WALSH		IM 0703-269	
Last Modification Date:	02/20/07	Initials:	DJB			Phone: 303-512-5750 FAX: 303-512-5775		Detailer: R RODDENBERRY		13166	
Full Path:	14102\800Deliv\AsBuilt\					Region 1 Mountain Residency I.N.Z.		Structure Numbers		75	
Drawing File Name:	102.ppt							Sheet Subset: TUN POWER		Subset Sheets: 9 of 45	
Acad Ver. R14	Scale: N=	Units:								Sheet Number	

PANEL NWN-1												CIRCUIT SCHEDULE												
SERVICE VOLTAGE 480Y/277				BUS RATING 225A				LOCATION WEST CROSS CUT																
MOUNTING SURFACE				BUS CONNECTION 3 P 4 W				DRAWING No.																
LOAD DESCRIPTION	VOLTAMPS			BREAKER	CKT	BUS	VOLTAMPS			LOAD DESCRIPTION	VOLTAMPS			BREAKER	CKT	BUS	VOLTAMPS			LOAD DESCRIPTION				
	A	B	C	POLE/AMP	No	CONNECTION	No	AMP	A	B	C		A	B	C		No	AMP	A	B	C			
HEAT TRACE	4800				1		2		2410															
HEAT TRACE		4800		3	30	3	4	20	3		2410												29A/LOW	
HEAT TRACE			4800		5		6				2346													
SPACE	0				7		8		2410															
EXIST. 3 KVA TRANSFORMER		1500		2	20	9	10	20	3		2346												29B/LOW	
			1500		11		12				2346													
SPARE REMOVED BY CDDT	0				13		14		2410															
		0		3	30	15	16	20	3		2410												28A/MID	
			0		17		18				2346													
SPARE	0				19		20		2410															
		0		3	20	21	22	20	3		2346												28B/MID	
			0		23		24				2346													
SPARE	0				25		26	20	2	2346													28C/MID	
		0		3	20	27	28	20	1		1200												CROSSCUT LTG	
			0		29		30	20	1		0												SPARE	
SPARE	0			1	20	31	32			0														
SPACE		0			33		34			0													SPACE	
			0		35		36				0													
SPACE	0				37		38			0													SPACE	
		0			39		40			0														
			0		41		42				0													
TOTALS	4800	6300	6300			S/N					11986	10712	9384											
BUS A	16786			MAIN BREAKER			150 AMPS.			LINE AMPS 59.54														
BUS B	17012			LOCATION			TOP			PHASING 3 @ 480V														
BUS C	15684			FEEDER SIZE			4#4/0 1#4G, 2"C			KVA CONN. 49.48														
TOTAL LOAD	49482			SOURCE						DATE 07/25/02														

PANEL NWS-1												CIRCUIT SCHEDULE												
SERVICE VOLTAGE 480Y/277				BUS RATING 225A				LOCATION WEST CROSS CUT																
MOUNTING SURFACE				BUS CONNECTION 3 P 4 W				DRAWING No.																
LOAD DESCRIPTION	VOLTAMPS			BREAKER	CKT	BUS	VOLTAMPS			LOAD DESCRIPTION	VOLTAMPS			BREAKER	CKT	BUS	VOLTAMPS			LOAD DESCRIPTION				
	A	B	C	POLE/AMP	No	CONNECTION	No	AMP	A	B	C		A	B	C		No	AMP	A	B	C			
					1		2		85														TUNNEL TV CAMERAS	
31A/MID		2410		3	20	3	4	20	3		85													
			2410		5		6				85													
					7		8			3050													PULPET P5, P6, P7	
31B/MID		2410		3	20	9	10	20	3		3050													
			2410		11		12				3050													
31C/MID	2346			1	20	13	14	20	2		2500												MINI PWR CTRS NORTH TUNNEL (VMS 2)	
29S/LOW		2346		1	20	15	16	20	2		2500													
30S/LOW			2346	1	20	17	18	20	1		0												SPARE	
		2410			19		20			0														
30A/LOW		2410		3	20	21	22	30	3		0												SPARE	
			2410		23		24				0													
					25		26	20	2	2500													MINI PWR CTRS (VMS 3)	
30B/LOW		2410		3	20	27	28	20	2		2500													
			2410		29		30	20	1		0												SPARE	
	0				31		32			0														
SPARE		0		3	20	33	34			0													SPACE	
			0		35		36				0													
					37		38			0														
LCP CNW-1 CONTRL PWR	1000				39		40			0													SPACE	
		1000		3	20	39	40			0														
			0		41		42				0													
TOTALS	12986	12986	11986			S/N					8135	8135	3135											
BUS A	21121			MAIN BREAKER			150 AMPS.			LINE AMPS 69.03														
BUS B	21121			LOCATION			TOP			PHASING 3 @ 480V														
BUS C	15121			FEEDER SIZE			4#4/0 1#4G, 2"C			KVA CONN. 57.36														
TOTAL LOAD	57363			SOURCE						DATE 07/25/02														

PANEL NCS-1W												CIRCUIT SCHEDULE												
SERVICE VOLTAGE 480Y/277				BUS RATING 225A				LOCATION WEST CENTER CROSS CUT																
MOUNTING SURFACE				BUS CONNECTION 3 P 4 W				DRAWING No.																
LOAD DESCRIPTION	VOLTAMPS			BREAKER	CKT	BUS	VOLTAMPS			LOAD DESCRIPTION	VOLTAMPS			BREAKER	CKT	BUS	VOLTAMPS			LOAD DESCRIPTION				
	A	B	C	POLE/AMP	No	CONNECTION	No	AMP	A	B	C		A	B	C		No	AMP	A	B	C			
HEAT TRACE	4800				1		2																	
HEAT TRACE		4800		3	30	3	4	30	3		0												SPARE	
HEAT TRACE			4800		5		6				0													
SPACE	0				7		8	20	1	0													SPARE	
		0			9		10	20	1		0												SPARE	
SPARE			0		11		12	20	1		0												SPARE	
		0			13		14			0														
		0		3	20	15	16	30	3		0												SPARE	
SPARE			0		17		18			0														
	0				19		20			0														
		0		3	20	21	22	20	3		0												SPARE	
SPARE			0		23		24			0														
	0				25		26			0														
SPARE		0		3	20	27	28	20	3		0												SPARE	
			0		29		30			0														
SPARE	0			1	20	31	32			0														
SPACE		0			33		34			0													SPACE	
			0		35		36				0													
SPACE	0				37		38			0													SPACE	
		0			39		40			0													SPACE	
			0		41		42				0													
TOTALS	4800	4800	4800			S/N					0	0	0											
BUS A	4800			MAIN BREAKER			150 AMPS.			LINE AMPS 17.33														
BUS B	4800			LOCATION			TOP			PHASING 3 @ 480V														
BUS C	4800			FE																				

PANEL NCS-2W													CIRCUIT SCHEDULE												
SERVICE VOLTAGE 480Y/277				BUS RATING 225A				LOCATION WEST CENTER CROSS CUT					MOUNTING SURFACE				BUS CONNECTION 3 P 4 W				DRAWING No.				
LOAD DESCRIPTION	VOLTAMPS			BREAKER CKT No	BUS CONNECTION	CKT BREAKER No	VOLTAMPS			LOAD DESCRIPTION															
	A	B	C				A	B	C																
26A/LDW	2622			1		2	20	2	2500		MINI PWR CTRS NORTH TUNNEL (VMS 4)														
		2622		3	20	3			2500																
			2553	5		6	20	2	2500		MINI PWR CTRS NORTH TUNNEL (VMS 5)														
26B/LDW	2622			7		8			2500																
		2553		9		10	20	2	1000		LCP CNCW-1 CONTROL PWR														
			2553	11		12			1000																
27A/MID	2622			13		14			85		TUNNER TV CAMERAS														
		2622		15		16	20	3	85																
			2553	17		18			85																
27B/MID	2622			19		20	20	2	1525		PULPIT P4														
		2553		21		22			1525																
			2553	23		24	20	1	1500		CTR CROSSCUT LTG														
27C/MID	2553			25		26			0																
SPARE		0		27		28	30	3	0		SPARE														
SPARE			0	29		30			0																
SPACE		0		31		32			0																
		0		33		34	30	3	0		SPARE														
			0	35		36			0																
SPACE		0		37		38			0																
		0		39		40			0		SPACE														
			0	41		42			0																
TOTALS	13041	10350	10212		S/N				6610	5110	5085														
BUS A	19651	MAIN BREAKER		150	AMPS.	LINE AMPS		60.66																	
BUS B	15460	LOCATION		TOP	PHASING		3	480V																	
BUS C	15297	FEEDER SIZE		4#4/0 1#4G, 2"C	KVA CONN.		50.41																		
TOTAL LOAD	50408	SOURCE		TX-NCS-2W	DATE		07/25/02																		

PANEL NCS-2E													CIRCUIT SCHEDULE												
SERVICE VOLTAGE 480Y/277				BUS RATING 225A				LOCATION EAST CENTER CROSS CUT					MOUNTING SURFACE				BUS CONNECTION 3 P 4 W				DRAWING No.				
LOAD DESCRIPTION	VOLTAMPS			BREAKER CKT No	BUS CONNECTION	CKT BREAKER No	VOLTAMPS			LOAD DESCRIPTION															
	A	B	C				A	B	C																
SPARE		0		3	20	3			0		SPARE														
			0	5		6			0																
			0	7		8			0																
SPARE		0		9		10	20	3	0		SPARE														
			0	11		12			0																
SPARE			0	13		14			85		TUNNER TV CAMERAS														
25S/LDW		2644		15		16	20	3	85																
26S/LDW			2553	17		18			85																
		0		19		20	20	2	1000		LCP CNCE-1 CONTROL PWR														
SPARE		0		21		22			1000																
			0	23		24	20	1	0		SPARE														
		0		25		26			5000																
SPARE		0		27		28	30	3	5000		MINI-PWR CTRS FOR VMS 7,8 & 9 & LUS'S														
			0	29		30			5000																
		0		31		32			0																
SPACE		0		33		34	30	3	0		SPARE														
			0	35		36			0																
		0		37		38			0																
SPACE		0		39		40			0		SPACE														
			0	41		42			0																
TOTALS	0	2644	2553		S/N				6085	6085	5085														
BUS A	6085	MAIN BREAKER		150	AMPS.	LINE AMPS		27.02																	
BUS B	8729	LOCATION		TOP	PHASING		3	480V																	
BUS C	7638	FEEDER SIZE		4#4/0 1#4G, 2"C	KVA CONN.		22.45																		
TOTAL LOAD	22452	SOURCE		TX-NCS-2E	DATE		07/25/02																		

PANEL NCS-1E													CIRCUIT SCHEDULE												
SERVICE VOLTAGE 480Y/277				BUS RATING 225A				LOCATION EAST CENTER CROSS CUT					MOUNTING SURFACE				BUS CONNECTION 3 P 4 W				DRAWING No.				
LOAD DESCRIPTION	VOLTAMPS			BREAKER CKT No	BUS CONNECTION	CKT BREAKER No	VOLTAMPS			LOAD DESCRIPTION															
	A	B	C				A	B	C																
HEAT TRACE	4800			1		2			0																
HEAT TRACE		4800		3	30	3			0		SPARE														
HEAT TRACE			4800	5		6			0																
24C/MID	2644			7		8			2644																
EXIST 3 KVA TRANSFORMERS		1500		9		10	20	3	2644		24A/MID														
			1500	11		12			2644																
25A/LDW	2644			13		14			2644																
		2644		15		16	20	3	2644		24B/MID														
			2644	17		18			2644																
25B/LDW	2644			19		20			0																
		2644		21		22	20	3	0		SPARE														
			2644	23		24			0																
	0			25		26			0																
SPARE		0		27		28	20	3	0		SPARE														
			0	29		30			0																
	0			31		32			0																
SPACE		0		33		34			0		SPACE														
			0	35		36			0																
	0			37		38			0																
SPACE		0		39		40			0		SPACE														
			0	41		42			0																
TOTALS	12732	11588	11588		S/N				5288	5288	5288														
BUS A	18020	MAIN BREAKER		150	AMPS.	LINE AMPS		62.30																	
BUS B	16876	LOCATION		TOP	PHASING		3	480V																	
BUS C	16876	FEEDER SIZE		4#4/0 1#4G, 2"C	KVA CONN.		51.77																		
TOTAL LOAD	51772	SOURCE		TX-NCS-1E	DATE		05/10/01																		

Plot File Name: \$PLOTFILE*
 Date of Plot: \$\$\$DATE\$\$\$

Computer File Information		Sheet Revisions		Colorado Department of Transportation		As Constructed		ELECTRICAL PANEL SCHEDULES - SHEET 3		Project No./Code	
Creation Date:	04/26/99	Initials:	SPO	07/03/07	ASBUILT	P.O. BOX 399 DUMONT, CO. 80436 Phone: 303-512-5750 FAX: 303-512-5775		No Revisions:		IM 0703-269	
Last Modification Date:	02/20/07	Initials:	DJB			Region 1 Mountain Residency I.N.Z.		Revised:		13166	
Full Path:	14102\800Deliv\AsBuilt\							Void:		Sheet Number 77	
Drawing File Name:	102.p104							Designer: J. WALSH		Structure Numbers	
Acad Ver. R14	Scale: N=	Units:						Detailer: R. RODDENEERRY		Sheet Subst: TUN POWER	
								Subst Sheets: 11 of 45			

PANEL NES-1										CIRCUIT SCHEDULE									
SERVICE VOLTAGE 480Y/277					BUS RATING 225A					LOCATION EAST CROSS CUT									
MOUNTING SURFACE					BUS CONNECTION 3 P 4 W					DRAWING No.									
LOAD DESCRIPTION	VOLTAMPS			BREAKERCKT No	BUS CONNECTION	CKTBREAKER No	VOLTAMPS			LOAD DESCRIPTION									
	A	B	C				AMP	POLE	A		B	C							
22A/LOW	1379			1		2			85	TUNNEL TV									
		1379		3	20	3			85	CAMERAS									
			1311			6			85										
22B/LOW	1379			7		8			3050	PULPIT									
		1379		3	20	9			3050	P5, P6, P7									
			1311			11			3050										
23A/MID	1379			13		14			2500	MINI PWR CTRS NORTH TUNNEL (VMS 9)									
		1379		3	20	15			2500										
			1311			17			0										
23B/MID	1379			19		20	30	3	0	SPARE									
		1379		3	20	21			0										
			1311			23			0	SPACE									
23C/MID	1311			1	20	25			4800	HEAT TRACE									
22S/LOW		1311		1	20	27			4800	HEAT TRACE									
21S/LOW			1311	1	20	29			4800	HEAT TRACE									
SPARE	0			31		32	20	2	1500	EXIST. 3KVA TRANSFORMER									
		0		3	20	33			1500										
			0			35			0		SPARE								
LCP CNE-1 CONTROL PWR	1000			37		38			2500	MINI PWR CTRS NORTH TUNNEL (VMS 10)									
		1000		3	20	39			2500										
			0			41			0		SPARE								
TOTALS	7827	7827	6555			S/N			1443514435	7935									
BUS A	22262			MAIN BREAKER			150 AMPS.			LINE AMPS 71.00									
BUS B	22262			LOCATION			TOP			PHASING 3 • 480V									
BUS C	14490			FEEDER SIZE			4#4/0.1 #4G, 2" C			KVA CONN. 59.00									
TOTAL LOAD	59014			SOURCE			TX-NES-1			DATE 07/25/02									

PANEL NEN-1										CIRCUIT SCHEDULE									
SERVICE VOLTAGE 480Y/277					BUS RATING 225A					LOCATION EAST CROSS CUT									
MOUNTING SURFACE					BUS CONNECTION 3 P 4 W					DRAWING No.									
LOAD DESCRIPTION	VOLTAMPS			BREAKERCKT No	BUS CONNECTION	CKTBREAKER No	VOLTAMPS			LOAD DESCRIPTION									
	A	B	C				AMP	POLE	A		B	C							
SPARE	0			1		2			1379	20A/MID									
		0		3	30	3			1379										
			0			5			1379										
SPARE	0			7		8			1379	20B/MID									
		0		3	20	9			1379										
			0			11			1311										
SPARE	0			13		14	20	1	1311	20C/MID									
		0		3	20	15			1200		CROSS CUT LIGHTING								
			0			17			0			SPARE							
SPARE	0			19		20			1379	21A/LOW									
		0		3	20	21			1379										
			0			23			1379										
SPARE	0			25		26			1379	21B/LOW									
		0		3	20	27			1379										
			0			29			1311										
SPACE	0			31		32			0	SPACE									
		0		3	33	34			0										
			0			35			0										
SPACE	0			37		38			0	SPACE									
		0		3	39	40			0										
			0			41			0										
TOTALS	0	0	0			S/N			6827	6716	6691								
BUS A	6827			MAIN BREAKER			150 AMPS.			LINE AMPS 22.77									
BUS B	6716			LOCATION			TOP			PHASING 3 • 480V									
BUS C	5380			FEEDER SIZE			4#4/0.1 #4G, 2" C			KVA CONN. 18.92									
TOTAL LOAD	18923			SOURCE			TX-NEN-1			DATE 07/25/02									

NOTES:
A. REMOVE BRANCH CIRCUIT CONDUCTORS AND LEVEL THE CIRCUIT BREAKER "SPARE" AFTER THE NEWS VMS'S ARE OPERATIONAL.

Design File Name: DGN\$SPEC*
Plot File Name: \$PLOTFILE*
Date of Plot: \$\$\$DATE\$\$\$

Computer File Information		Sheet Revisions		Colorado Department of Transportation		As Constructed		ELECTRICAL PANEL SCHEDULES - SHEET 4		Project No./Code	
Creation Date:	07/03/07	Initials:	ASBUILT	P.O. BOX 399 DUMONT, CO. 80436 Phone: 303-512-5750 FAX: 303-512-5775		No Revisions:		Designer: J. WALSH		IM 0703-269	
Last Modification Date:	02/20/07	Initials:	DJB	Region 1 Mountain Residency I.N.Z.		Revised:		Detailer: R. RODDENBERRY		13166	
Full Path:	14102\800Deliv\AsBuilt					Void:		Sheet Subset: TUN POWER		78	
Drawing File Name:	102.V01							Structure Numbers		Sheet Number	
Acad Ver. R14	Scale: N**	Units:						Subset Sheets: 12 OF 45		Sheet Number 78	

PANEL		EVS-1		CIRCUIT SCHEDULE									
SERVICE VOLTAGE 480Y/277		BUS RATING 225A		LOCATION EAST VENTILATION BLDG.									
MOUNTING SURFACE		BUS CONNECTION 3 P 4 W		DRAWING No.									
LOAD DESCRIPTION	VOLTAMPS			BREAKER POLE	RCKT No	BUS CONNECTION	CKT No	BREAKER AMP POLE			VOLTAMPS	LOAD DESCRIPTION	
	A	B	C					A	B	C			
2A/MID	3064			3	20	3	2				2050	TH-INT MID LAMP, 36A	
		3064					4	20	3		2050	TH-INT MID LAMP, 36A	
			3064				6				2050	TH-INT MID LAMP, 36A	
2B/MID	3064			3	20	9	8				2050	TH-INT MID LAMP, 36B	
		3064					10	20	3		2050	TH-INT MID LAMP, 36B	
			3064				12				2050	TH-INT MID LAMP, 36B	
3A/LOW	1449			3	20	15	14	20	1	0		SPARE	
		1449					16	20	1		1575	TH-INT LOW LAMP, 37S	
			1380				18				1575	TH-INT LOW LAMP, 37A	
3B/LOW	1449			3	20	21	20	20	3		1575	TH-INT LOW LAMP, 37A	
		1449					22				1575	TH-INT LOW LAMP, 37A	
			1380				24				1575	TH-INT LOW LAMP, 37B	
3S/LOW	1380			1	20	25	26	20	3		1575	TH-INT LOW LAMP, 37B	
SPARE		0		1	20	27	28				1575	TH-INT LOW LAMP, 37B	
SPARE			0	1	20	29	30				750	TH UPPER LAMP, 45R	
HEAT TRACE	0					31	32	20	3		825	TH UPPER LAMP, 45R	
HEAT TRACE		0		3	20	33	34				825	TH UPPER LAMP, 45R	
HEAT TRACE			0			35	36	20	1		0	SPACE	
LCP CEVS CONTROL PWR	750			3	20	39	38	20	2		2500	MINI PWR CTRS NORTH TUNNEL (VMS 11)	
		750					40				2500		
			0			41	42	20	1		0	SPACE	
TOTALS	11156	9776	8888				S/N				10575	12625	8000
BUS A	21731			MAIN BREAKER		150 AMPS.			LINE AMPS			73.43	
BUS B	22401			LOCATION (TOP)		BOTTOM			PHASING			3 • 480	
BUS C	16888			FEEDER SIZE		4#2, 1#8G, 1-1/4" C			KVA CONN.			61.00	
TOTAL LOAD	61020			SOURCE		DP-EV			DATE			07/25/02	

PANEL		EVS-1		CIRCUIT SCHEDULE									
SERVICE VOLTAGE 480Y/277		BUS RATING 225A		LOCATION EAST VENTILATION BLDG.									
MOUNTING SURFACE		BUS CONNECTION 3 P 4 W		DRAWING No.									
LOAD DESCRIPTION	VOLTAMPS			BREAKER POLE	RCKT No	BUS CONNECTION	CKT No	BREAKER AMP POLE			VOLTAMPS	LOAD DESCRIPTION	
	A	B	C					A	B	C			
10A/LOW	1449			3	20	3	2				2050	TH-INT MID LAMP, 39A	
		1449					4	20	3		2050	TH-INT MID LAMP, 39A	
			1380				6				2050	TH-INT MID LAMP, 39A	
10B/LOW	1449			3	20	9	8				2050	TH-INT MID LAMPS, 39B	
		1449					10	20	3		2050	TH-INT MID LAMPS, 39B	
			1380				12				2050	TH-INT MID LAMPS, 39B	
11A/MID	3064			3	20	15	14	20	1	0		SPARE	
		3064					16	20	2		1575	TH-INT LOW LAMP, 38S	
			3064				18				1575	TH-INT LOW LAMP, 38A	
11B/MID	3064			3	20	21	20				1575	TH-INT LOW LAMP, 38A	
		3064					22	20	3		1575	TH-INT LOW LAMP, 38A	
			3064				24				1575	TH-INT LOW LAMP, 38B	
10S/LOW	1380			1	20	25	26				1575	TH-INT LOW LAMP, 38B	
SPARE		0		2	20	27	28	20	3		1575	TH-INT LOW LAMP, 38B	
			0			29	30				750	TH-INT UPPER LAMP, 52R	
LCP CEVN-1 CONTROL PWR	1000					31	32				825	TH-INT UPPER LAMP, 52R	
		1000		3	20	33	34	20	2		825	TH-INT UPPER LAMP, 52R	
			0			35	36	20	1		0	SPACE	
VMS AND LUS SIGNS FOR SOUTH TUNNEL	4398					37	38	30	1		2400	DRAINAGE PIPE HT TRACING	
		4398		3	30	39	40	30	1		4800	DRAINAGE PIPE HT TRACING	
			4398			41	42	30	1		5600	DRAINAGE PIPE HT TRACING	
TOTALS	5804	1442	413286				S/N				10475	14450	13600
BUS A	26279			MAIN BREAKER		150 AMPS.			LINE AMPS			98.72	
BUS B	28874			LOCATION (TOP)		BOTTOM			PHASING			3 • 480	
BUS C	26886			FEEDER SIZE		4#2, 1#8G, 1-1/4" C			KVA CONN.			82.04	
TOTAL LOAD	82039			SOURCE		DP-EV			DATE			07/25/02	

Plot File Name: \\SBS01\AT\ESSES
 Date of Plot: 02/20/07

Computer File Information		Sheet Revisions		Colorado Department of Transportation		As Constructed		ELECTRICAL PANEL SCHEDULES - SHEET 5		Project No./Code	
Creation Date:	Initials:	07/03/07	ASBUILT	DUMONT, CO. 80436		No Revisions:		IM 0703-269		IM 0703-269	
Last Modification Date:	Initials:			Phone: 303-512-5750 FAX: 303-512-5775		Revised:		Designer: J WALSH		Structure Numbers	
Full Path:				Region 1 Mountain Residency I.N.Z.		Void:		Detailer: R RODDENBERRY		Sheet Number	
Drawing File Name:	102.V02							Sheet Subset: TUN POWER		Subset Sheets: 13 of 45	
Acad Ver. R14	Scale: N=	Units:								Sheet Number 79	

PANEL EV-1 CIRCUIT SCHEDULE														
SERVICE VOLTAGE 480Y/277					BUS RATING 225A					LOCATION EAST VENTILATION BUILDING				
MOUNTING SURFACE					BUS CONNECTION 3.P 4.W					DRAWING No.				
LOAD DESCRIPTION	VOLTAMPS			BREAKER	CKT	BUS	CKT	VOLTAMPS			LOAD DESCRIPTION			
	A	B	C	POLE	NO	CONNECTION	NO	A	B	C				
1A/UPR	1528			1	2		2	3060						
		1528		3	20	3	4	3060			7A/M1			
			1528	5			6			2550				
12A/UPR	1528			7	8		8	3060						
		1528		9	10	20	10	3060			7B/M1			
			1528	11	12		12			2550				
17A/UPR	732			13	14		14	3060						
		732		15	16	20	16	3060			7C/M1			
			732	17	18		18			2550				
19A/UPR	732			19	20		20	3250						
		732		21	22	20	22	2600			15A/M2			
			732	23	24		24			2600				
4A/M1	3060			25	26		26	1056						
		3060		27	28	20	28	1056			18A/M3			
			2550	29	30		30			1056				
4B/M1	3060			31	32		32	0						
		3060		33	34	20	34	0			SPARE			
			2550	35	36		36			0				
4C/M1	3060			37	38		38	0						
		2550		39	40	20	40	0			SPARE			
			2550	41	42		42			0				
TOTALS	13700	13190	12170			S/N		13486	12836	11306				
BUS A	27186		MAIN BREAKER		150 AMPS.		LINE AMPS		92.24					
BUS B	26026		LOCATION (TOP)		NOTE A		PHASING		3 @ 480V					
BUS C	23476		FEEDER SIZE		4#500 1#2G, 3-1/2" C		KVA CONN.		75.69					
TOTAL LOAD	76688		SOURCE		EAST MCC NO. 2		DATE		07/25/02					


PANEL EV-2 CIRCUIT SCHEDULE														
SERVICE VOLTAGE 480Y/277					BUS RATING 225A					LOCATION EAST VENTILATION BUILDING				
MOUNTING SURFACE					BUS CONNECTION 3.P 4.W					DRAWING No.				
LOAD DESCRIPTION	VOLTAMPS			BREAKER	CKT	BUS	CKT	VOLTAMPS			LOAD DESCRIPTION			
	A	B	C	POLE	NO	CONNECTION	NO	A	B	C				
13A/UPR	552			1	2		2	3060						
		552		3	20	3	4	3060			8C/M1			
			552	5			6			2550				
16A/UPR	552			7	8		8	3250						
		552		9	10	20	10	2600			14A/M2			
			552	11	12		12			2600				
5A/M1	3060			13	14		14	0						
		3060		15	16	20	16	0			SPARE			
			2550	17	18		18			0				
5B/M1	3060			19	20		20	0						
		3060		21	22	20	22	0			SPARE			
			2550	23	24		24			0				
5C/M1	3060			25	26		26	0						
		2550		27	28	20	28	0			SPARE			
			2550	29	30		30			0				
8A/M1	3060			31	32		32	1000						
		3060		33	34	20	34	1000			LCP CEVN-2 CONTROL PWR			
			2550	35	36		36			0				
8B/M1	3060			37	38		38	4776						
		3060		39	40	50	40	4776			APPROACH LIGHTING			
			2550	41	42		42			4776				
TOTALS	16404	15894	13854			S/N		12086	11436	9926				
BUS A	28490		MAIN BREAKER		150 AMPS.		LINE AMPS		95.79					
BUS B	27330		LOCATION (TOP)		NOTE A		PHASING		3 @ 480V					
BUS C	23780		FEEDER SIZE		4#500 1#2G, 3-1/2" C		KVA CONN.		79.60					
TOTAL LOAD	79600		SOURCE		EAST MCC NO. 2		DATE		2/25/03					

PANEL EV-3 CIRCUIT SCHEDULE														
SERVICE VOLTAGE 480Y/277					BUS RATING 225A					LOCATION EAST VENTILATION BUILDING				
MOUNTING SURFACE					BUS CONNECTION 3.P 4.W					DRAWING No.				
LOAD DESCRIPTION	VOLTAMPS			BREAKER	CKT	BUS	CKT	VOLTAMPS			LOAD DESCRIPTION			
	A	B	C	POLE	NO	CONNECTION	NO	A	B	C				
6A/M1	3060			1	2		2	3060						
		3060		3	20	3	4	3060			9B/M1			
			2550	5			6			2550				
6B/M1	3060			7	8		8	3060						
		3060		9	10	20	10	3060			9C/M1			
			2550	11	12		12			2550				
6C/M1	3060			13	14		14	3060						
		3060		15	16	20	16	3060			9D/M1			
			2550	17	18		18			2550				
6D/M1	3060			19	20		20	3060						
		3060		21	22	20	22	3060			9E/M1			
			2550	23	24		24			2550				
6E/M1	3060			25	26		26	3060						
		2550		27	28	20	28	3060			9F/M1			
			2550	29	30		30			2550				
6F/M1	3060			31	32		32	0						
		2550		33	34	20	34	0			SPARE			
			2550	35	36		36			0				
9A/M1	3060			37	38		38	0						
		3060		39	40	20	40	0			SPARE			
			2550	41	42		42			0				
TOTALS	21420	20400	17850			S/N		15300	15300	12750				
BUS A	36720		MAIN BREAKER		200 AMPS.		LINE AMPS		123.99					
BUS B	35700		LOCATION (TOP)		NOTE A		PHASING		3 @ 480V					
BUS C	30600		FEEDER SIZE		4#500 1#2G, 3-1/2" C		KVA CONN.		103					
TOTAL LOAD	103020		SOURCE		EAST MCC NO. 2		DATE		07/25/02					

NOTES:
A. PROVIDE PANELS EV-1, EV-2 AND EV-3 WITH MAIN BREAKERS LEGS SIZED FOR 500 KCM PHASE CONDUCTORS. PANELS EV-1 AND EV-2 SHALL BE FURNISHED WITH DOUBLE LEGS PER PHASE ON THE MAIN BREAKER

Computer File Information		Sheet Revisions		Colorado Department of Transportation		As Constructed		ELECTRICAL PANEL SCHEDULES - SHEET 6		Project No./Code	
Creation Date: 04/29/01	Initials: SPD	07/03/07	ASBUILT	P.O. BOX 399 DUMONT, CO. 80436		No Revisions:		Designer: J. WALSH		IM 0703-269	
Last Modification Date: 02/21/07	Initials: DJB			Phone: 303-512-5750 FAX: 303-512-5775		Revised:		Detailer: R RODDENBERRY		13166	
Full Path: 14102\800Deliv\AsBuilt\				Region 1 Mountain Residency I.N.Z.		Void:		Sheet Subset: TUN POWER		103	
Drawing File Name: 102.V03.DGN								Structure Numbers		13166	
Acad Ver. R14	Scale: N=	Units:						Subset Sheets: 14 of 45		Sheet Number 80	

Design File Name: DGMSPC*
Plot File Name: S01.DWG*
Date of Plot: 08/04/03 08:55

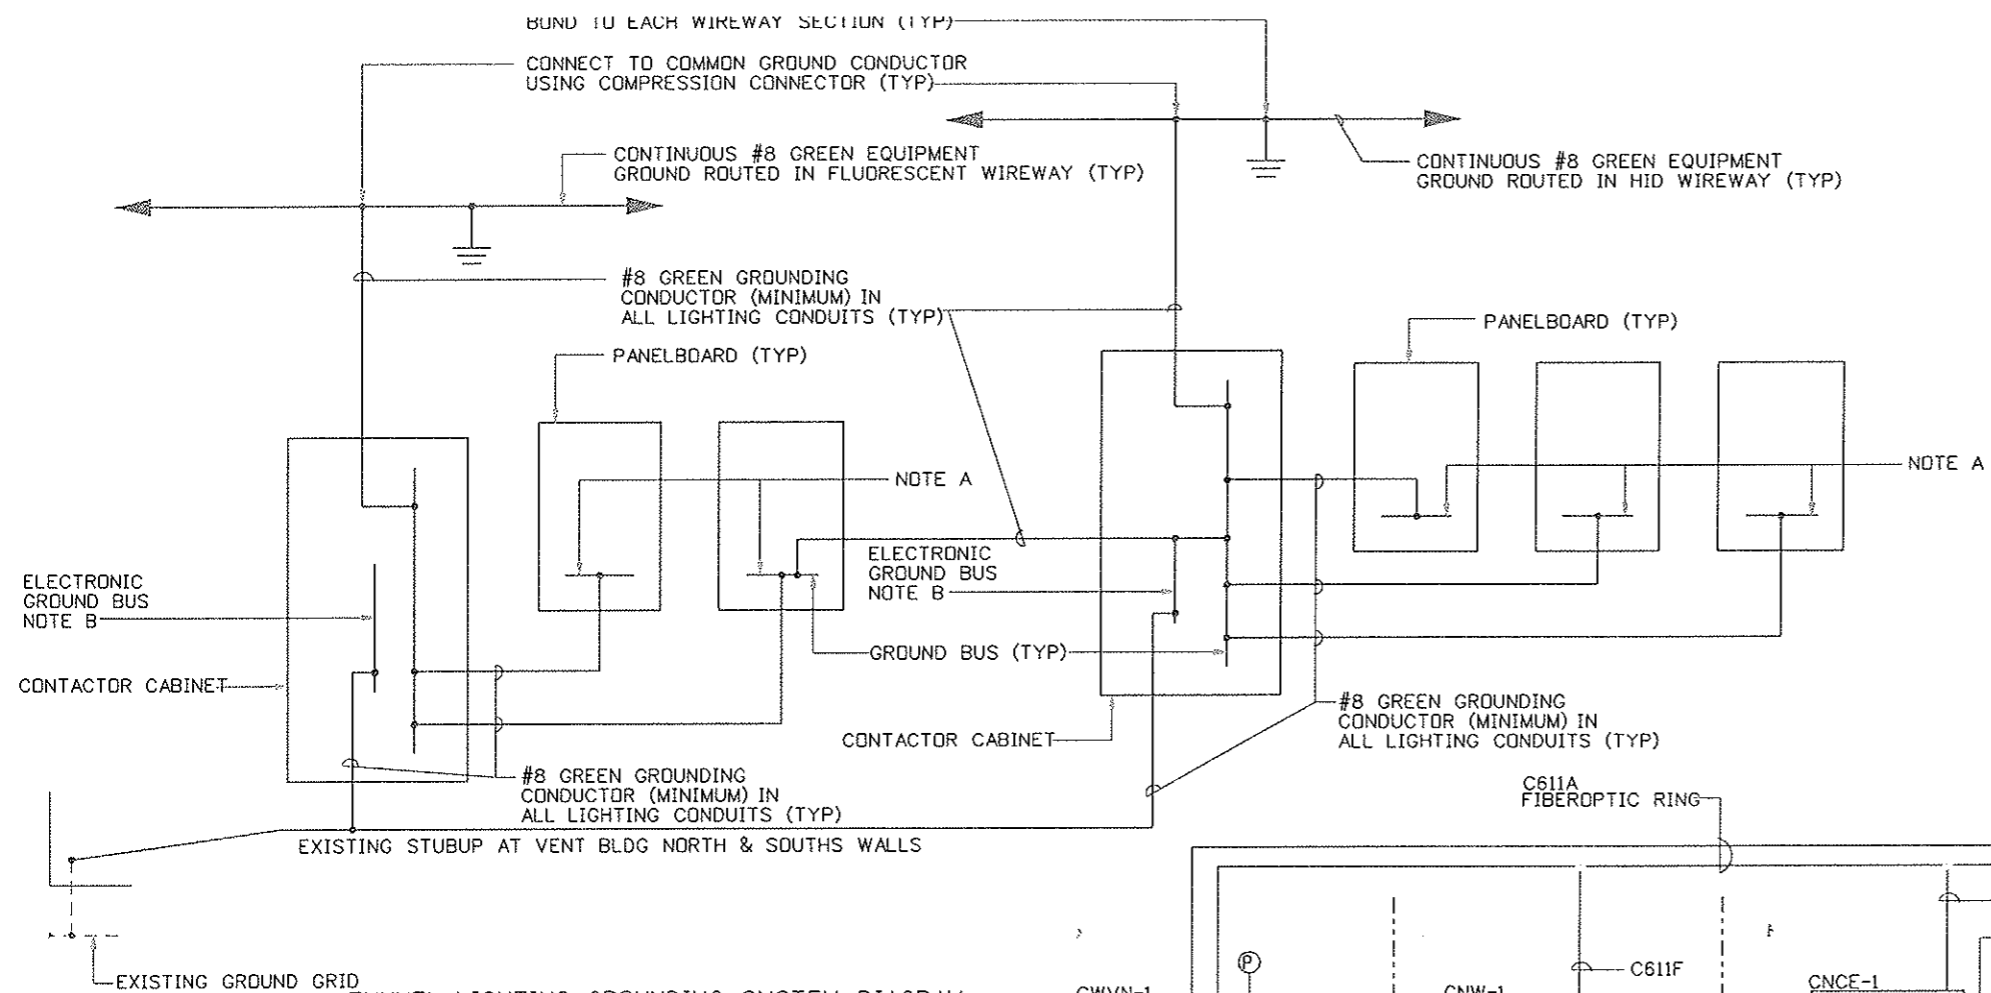


NOTES:

- A. NEUTRAL BUS (EACH PANELBOARD) SHALL NOT BE BONDED TO THE GROUND BUS OF THE PANELBOARD. CONNECTION SHALL BE MADE ONLY AT THE SOURCE. FOR A SEPARATELY DERIVED SYSTEM ("STEP DOWN" TRANSFORMER) IT SHALL BE BONDED WITH THE TRANSFORMER NEUTRAL GROUNDING PAD OR LUG.
- B. GROUNDING FOR ELECTRONIC, DATA LOGGING, TRANSMITTERS/RECEIVERS AND OTHER ELECTRONIC DEVICES SHALL BE SEPARATE FROM THE ELECTRICAL (A/C) SYSTEM GROUND. BONDING OF THESE SYSTEMS "GROUND" SHALL BE MADE AT THE SOURCE ONLY.

LEGEND

- (A) = SERIAL COMM.
- (B) = F.O. COMM.
- (C) = HOA SELECTOR SWITCHES
- (D) = PILOT LIGHT (LED HOA)
- (E) = OPERATOR TERMINAL
- (F) = ANALOG I/O
- (G) = DIGITAL I/O
- (H) = LIGHTING CONTACTORS (QTY)
- (I) = PC WORKSTATION (BY ITS)
- (J) = TEMPERATURE SENSOR
- (K) = RACK COMMUNICATION MODULE
- (L) = LUMINANCE SENSOR
- (M) = MODEM
- (P) = EXISTING PHOTOCELL (APPROACH LIGHTING)

TUNNEL LIGHTING GROUNDING SYSTEM DIAGRAM

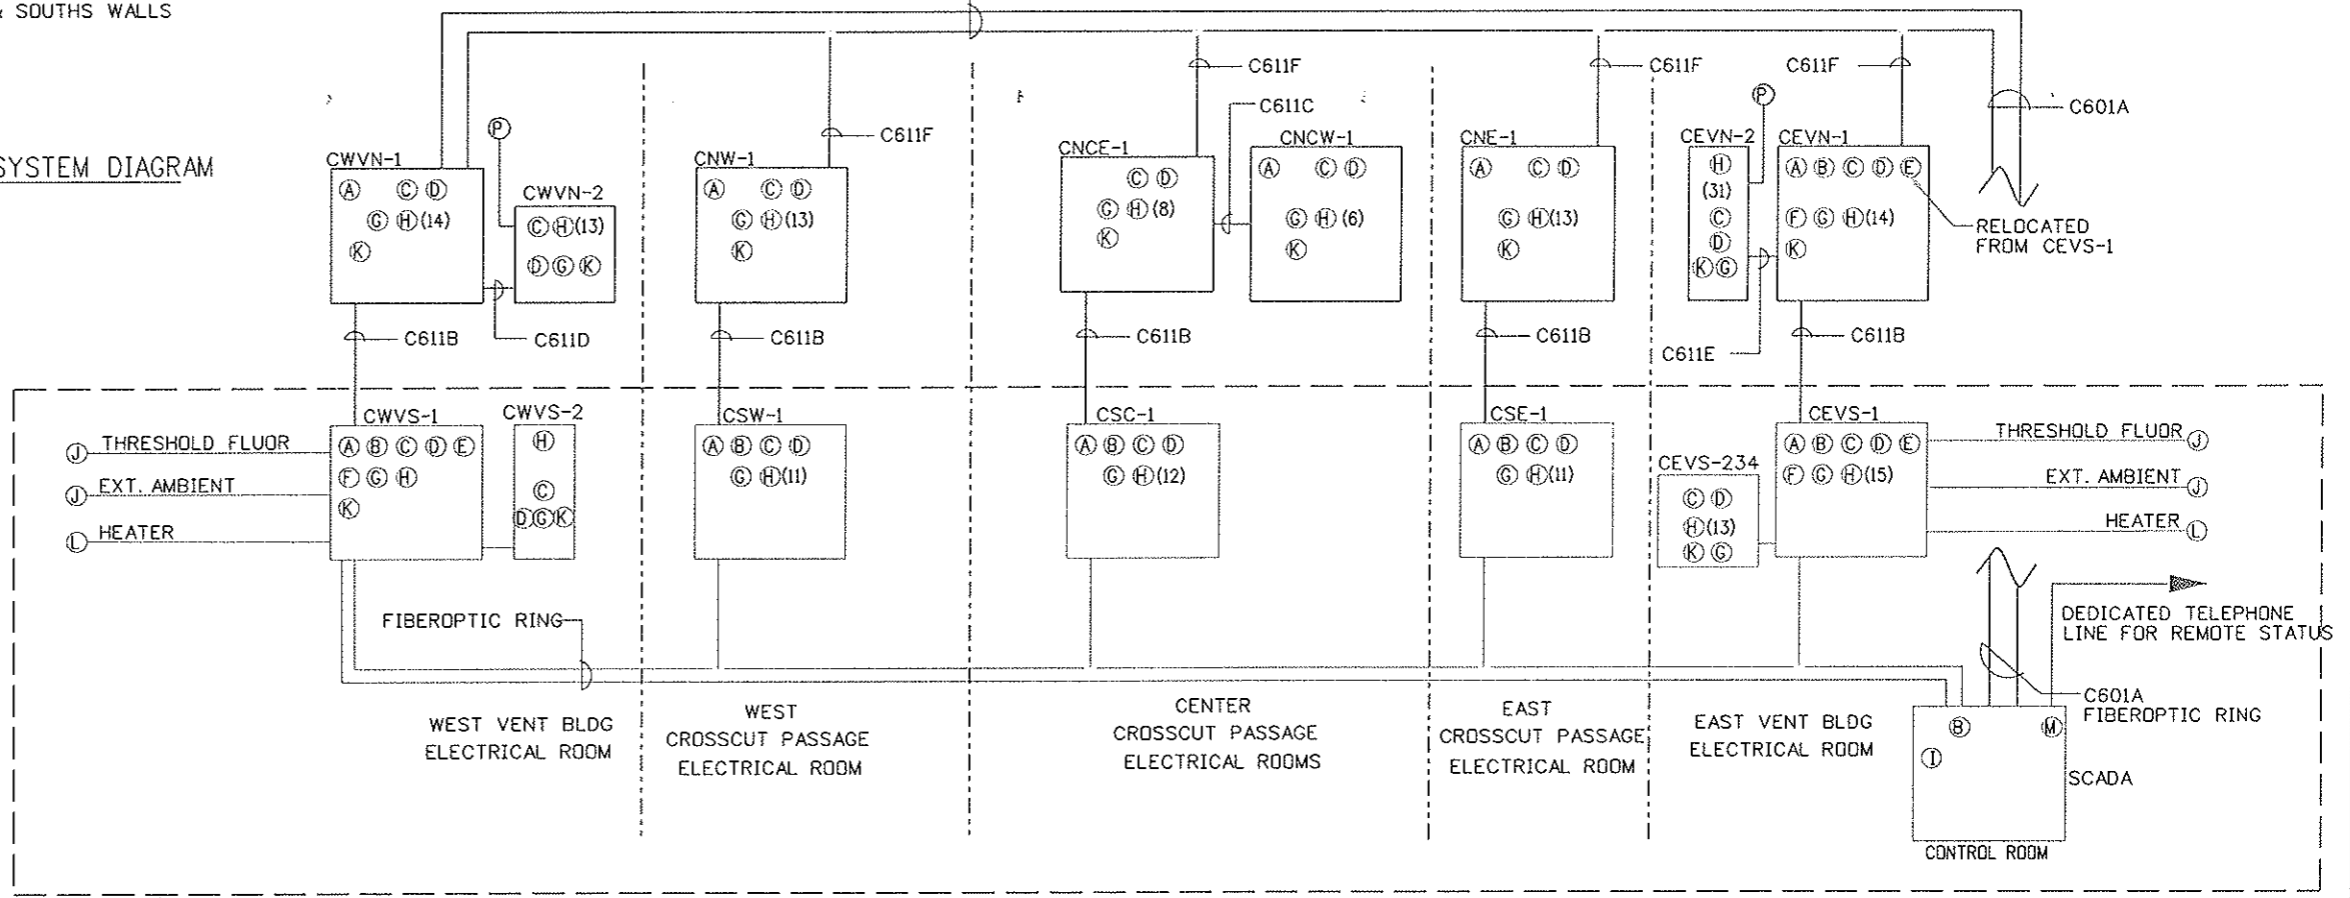

TUNNEL LIGHTING CONTROL BLOCK DIAGRAM

⌊ SOUTH TUNNEL (EXISTING) - SEE CONTRACT # IM0703-264 : 12982 ASBUILTS FOR FURTHER REFERENCE.


Computer File Information		Sheet Revisions		Colorado Department of Transportation		As Constructed		TUNNEL LIGHTING CONTROL SYSTEMS		Project No./Code	
Creation Date:	04/19/99	Initials:	SFO	07/03/07	ASBUILT					IM 0703-269	
Last Modification Date:	02/21/07	Initials:	DJB							13166	
Full Path:	14102\800Deliv\AsBUILT\									Sheet Number 81	
Drawing File Name:	14102_800_2.dwg									Sheet Subst: TUN POWER Subst Sheets: 15 of 45	
Acad Ver. R14	Scale: NONE	Units:								Sheet Number 81	

Region 1 Mountain Residency I.N.Z.


Colorado Department of Transportation

P.O. BOX 399
DUMONT, CO. 80436
Phone: 303-512-5750 FAX: 303-512-5775

Designer: J. WALSH
Detailer: RODDENBERRY
Structure Numbers: []
Sheet Subst: TUN POWER Subst Sheets: 15 of 45

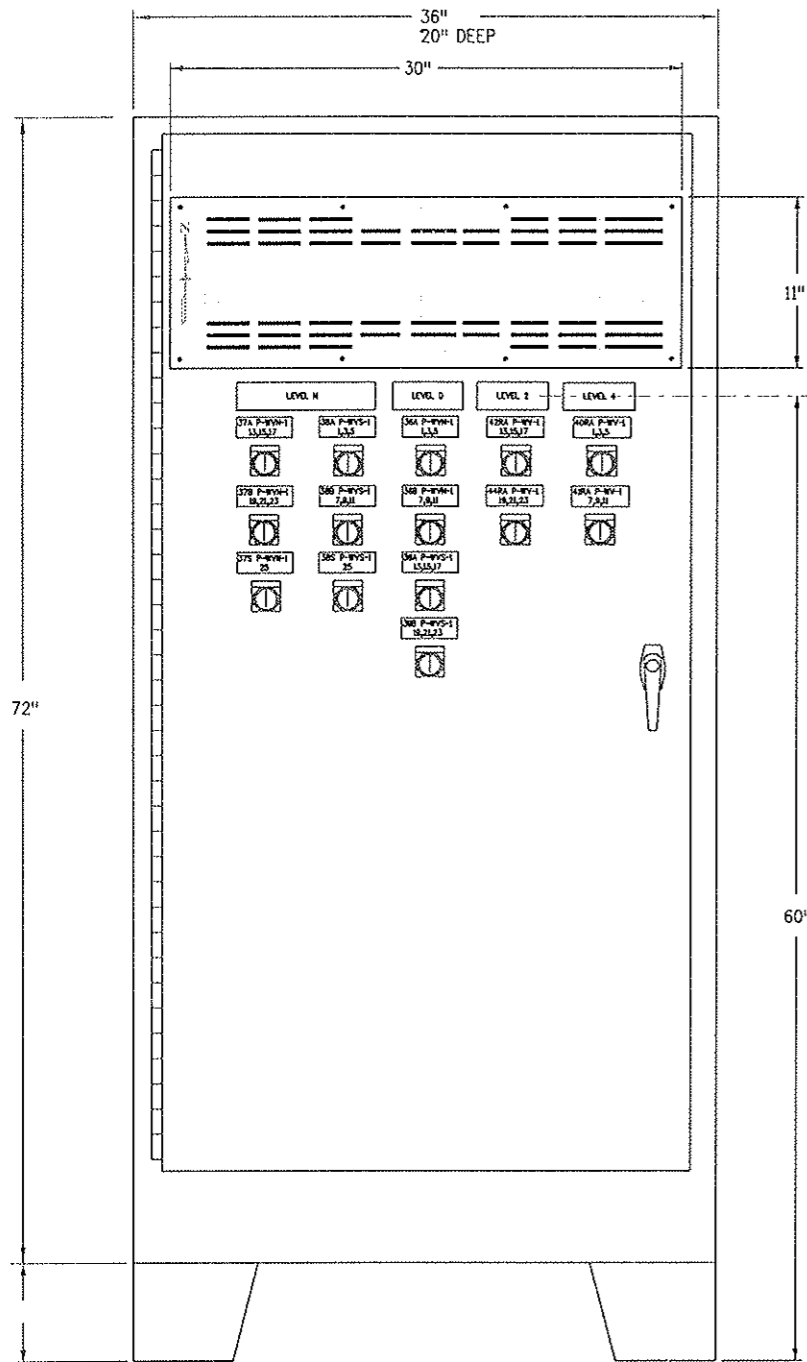



FRONT DOOR VIEW

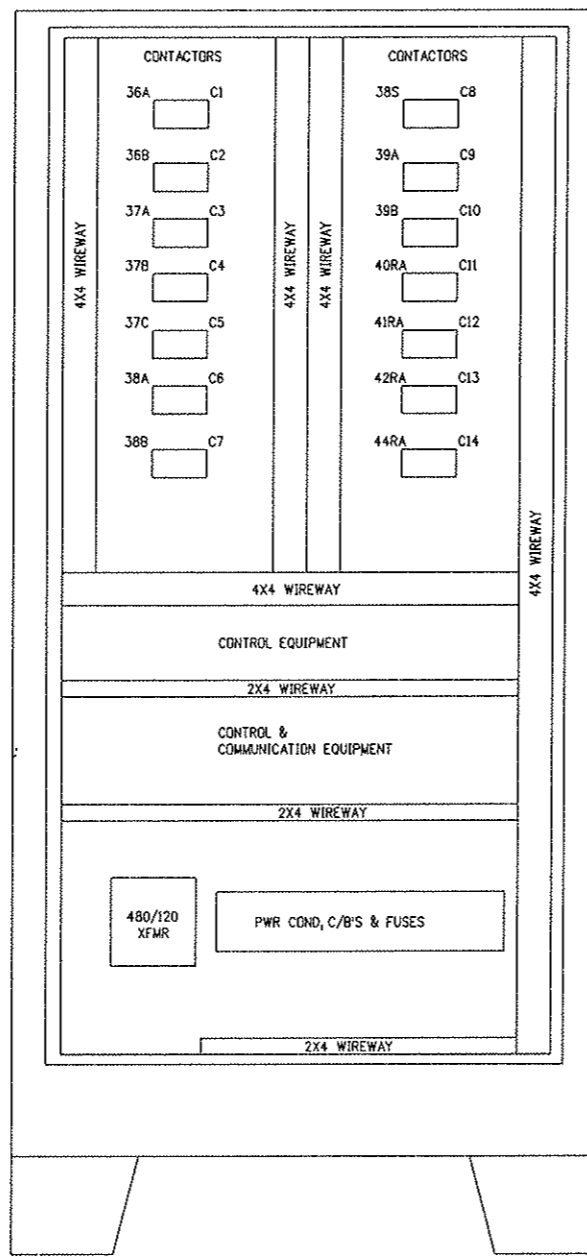

INTERIOR VIEW

1/4" CLEAR VIRGIN ACRYLIC SHEET WITH WEATHERSTRIP EDGES AND SECURED BY (8) 3/16" STAINLESS STEEL PAN HEAD MACHINE SCREWS WITH WASHERS AND NUTS

REPRODUCE THE "LIGHTING LEVEL CONTROL DIAGRAM - I-70 WESTBOUND" AS SHOWN ON THE NORTH TUNNEL LIGHTING CONTROL DIAGRAM DRAWING SHEET 2 OF THE SUBSET TUN POWER. SIZE THE REPRODUCTION TO FULLY FIT THE FRAME

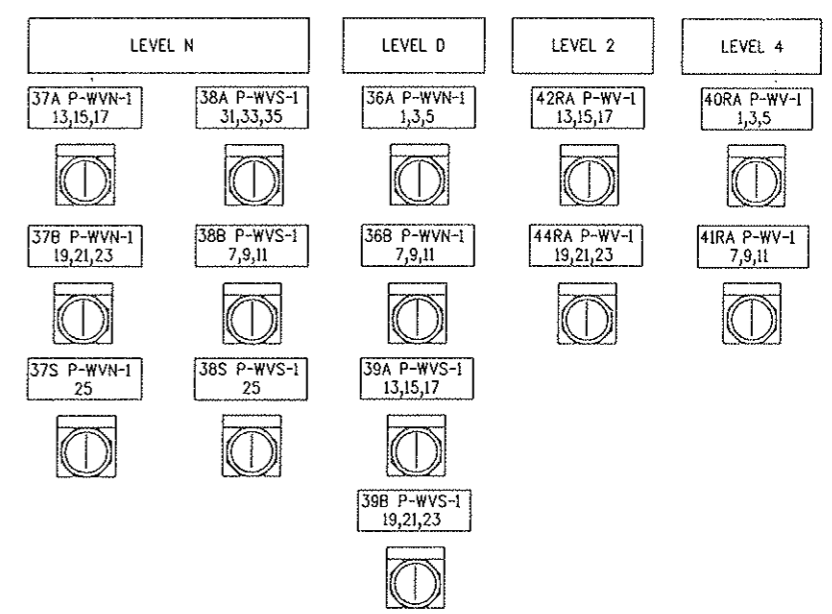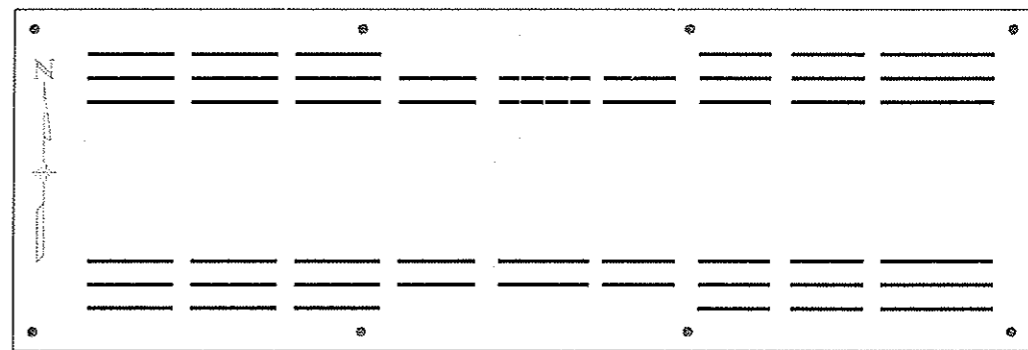


ENLARGED VIEW OF FRONT DOOR SWITCHES FOR CABINET CWVN-1

LIGHTING CONTROL AND CONTACTOR CABINET CWVN-1
PANEL ASSEMBLY IN WEST VENT. BLDG.

Design File Name: DGN\$SPEC*
Plot File Name: \$PLOTFILE*
Date of Plot: \$\$\$DATE\$\$\$\$

Computer File Information	
Creation Date:	04/19/99 Initials: SFO
Last Modification Date:	02/21/07 Initials: DJB
Full Path:	14102\800Deliv\AsBuilt\
Drawing File Name:	14102-01
Acad Ver. R14	Scale: N=1 Units:


Sheet Revisions	
07/03/07	ASBUILT DJB

Colorado Department of Transportation
 P.O. BOX 399
 DUMONT, CO. 80436
 Phone: 303-512-5750 FAX: 303-512-5775
 Region 1 Mountain Residency I.N.Z.

As Constructed
No Revisions:
Revised:
Void:


NORTH TUNNEL LIGHTING CONTROL 1	
Designer: J WALSH	Structure Numbers
Detailer: D. BURROUGHS	
Sheet Subset: TUN POWER	Subset Sheets: 16 of 45

Project No./Code
IM 0703-269
13166
Sheet Number 82

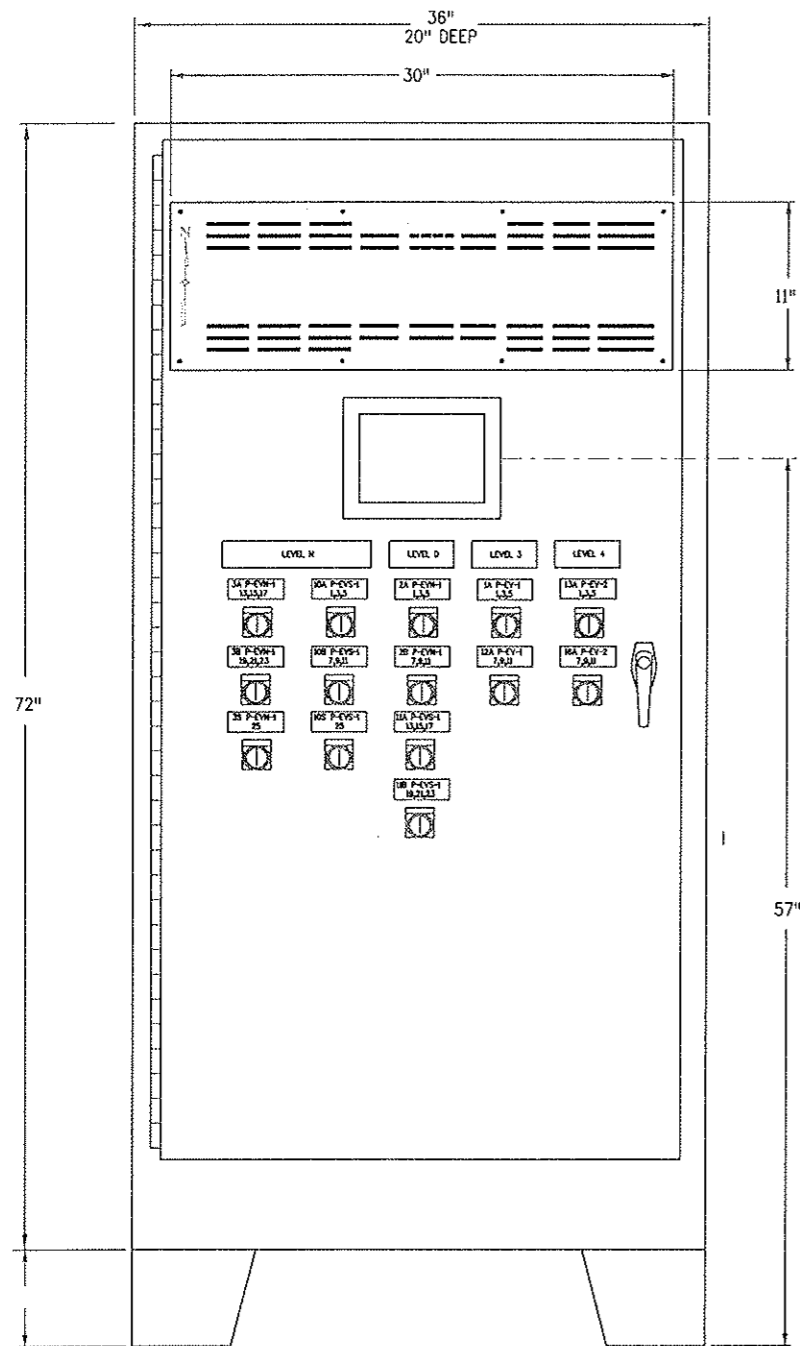

FRONT DOOR VIEW



FLOOR STAND

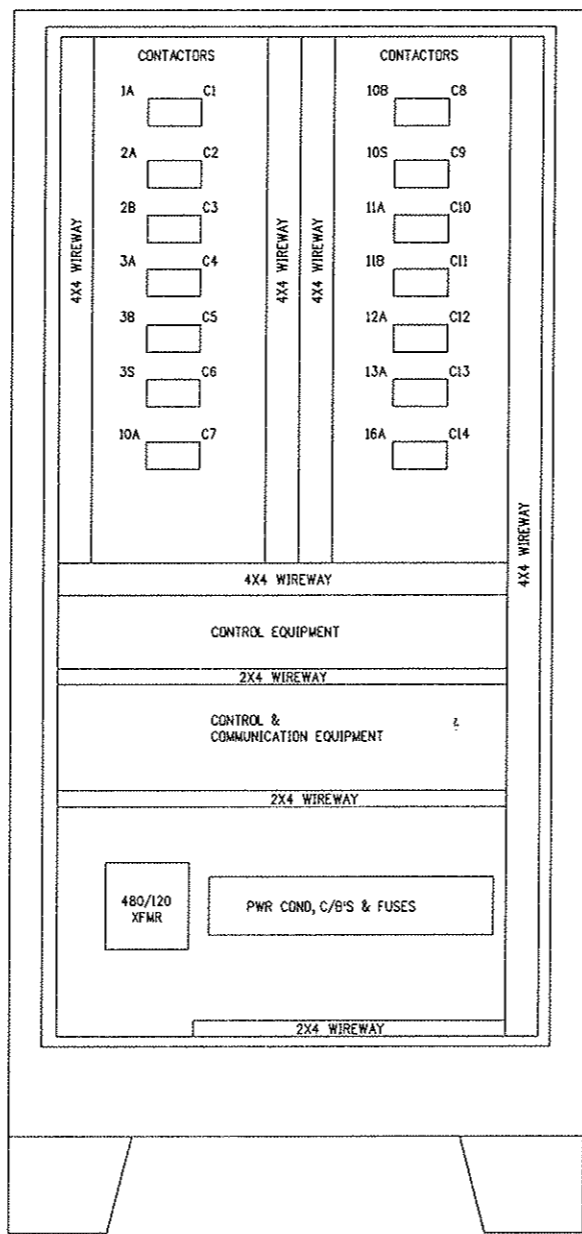

INTERIOR VIEW

1/4" CLEAR VIRGIN ACRYLIC SHEET WITH WEATHERSTRIP EDGES AND SECURED BY (8) 3/16" STAINLESS STEEL PAN HEAD MACHINE SCREWS WITH WASHERS AND NUTS

REPRODUCE THE "LIGHTING LEVEL CONTROL DIAGRAM - I-70 WESTBOUND" AS SHOWN ON THE NORTH TUNNEL LIGHTING CONTROL DIAGRAM DRAWING SHEET 2 OF THE SUBSET TUN POWER. SIZE THE REPRODUCTION TO FULLY FIT THE FRAME

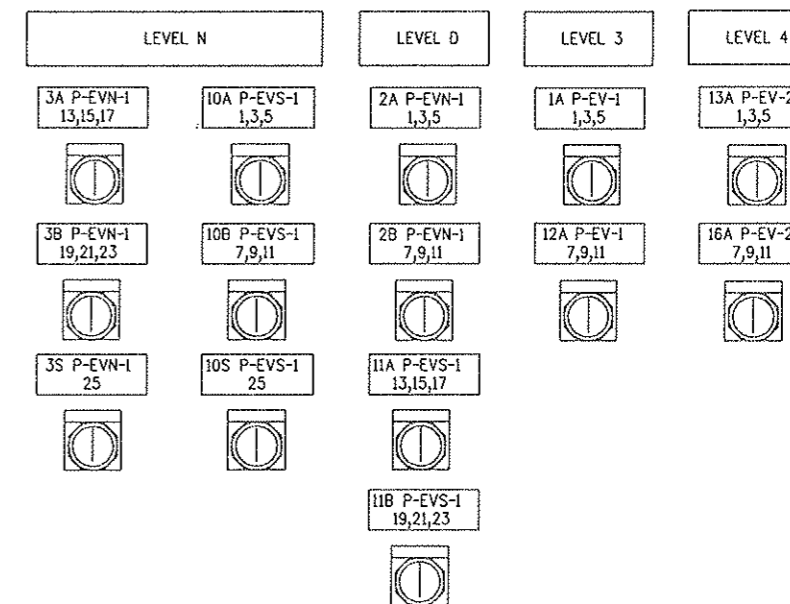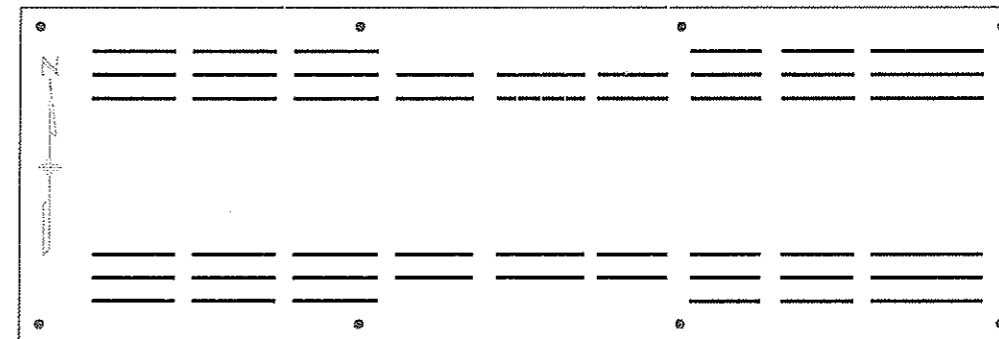


ENLARGED VIEW OF FRONT DOOR SWITCHES FOR CABINET CEVN-1

LIGHTING CONTROL AND CONTACTOR CABINET CEVN-1
PANEL ASSEMBLY IN EAST VENT BLDG

Design File Name: DGN\$SPEC*
Plot File Name: \$PLOT\$FILE*
Date of Plot: \$\$\$DATE\$\$\$\$

Computer File Information	
Creation Date:	04/19/99 Initials: SFO
Last Modification Date:	02/21/07 Initials: DJB
Full Path:	14102\800Deliv\AsBuilt\
Drawing File Name:	14121.dwg
Acad Ver. R14	Scale: N=1:1 Units:


Sheet Revisions	
07/03/07	ASBUILT DJB

Colorado Department of Transportation

 P.O. BOX 399
 DUMONT, CO. 80436
 Phone: 303-512-5750 FAX: 303-512-5775
 Region 1 Mountain Residency I.N.Z.


As Constructed
 No Revisions:
 Revised:
 Void:

NORTH TUNNEL
 LIGHTING CONTROL 2
 Designer: J WALSH
 Detailer: D. BURROUGHS
 Sheet Subset: TUN POWER
 Structure Numbers:
 Subset Sheets: 17 of 45

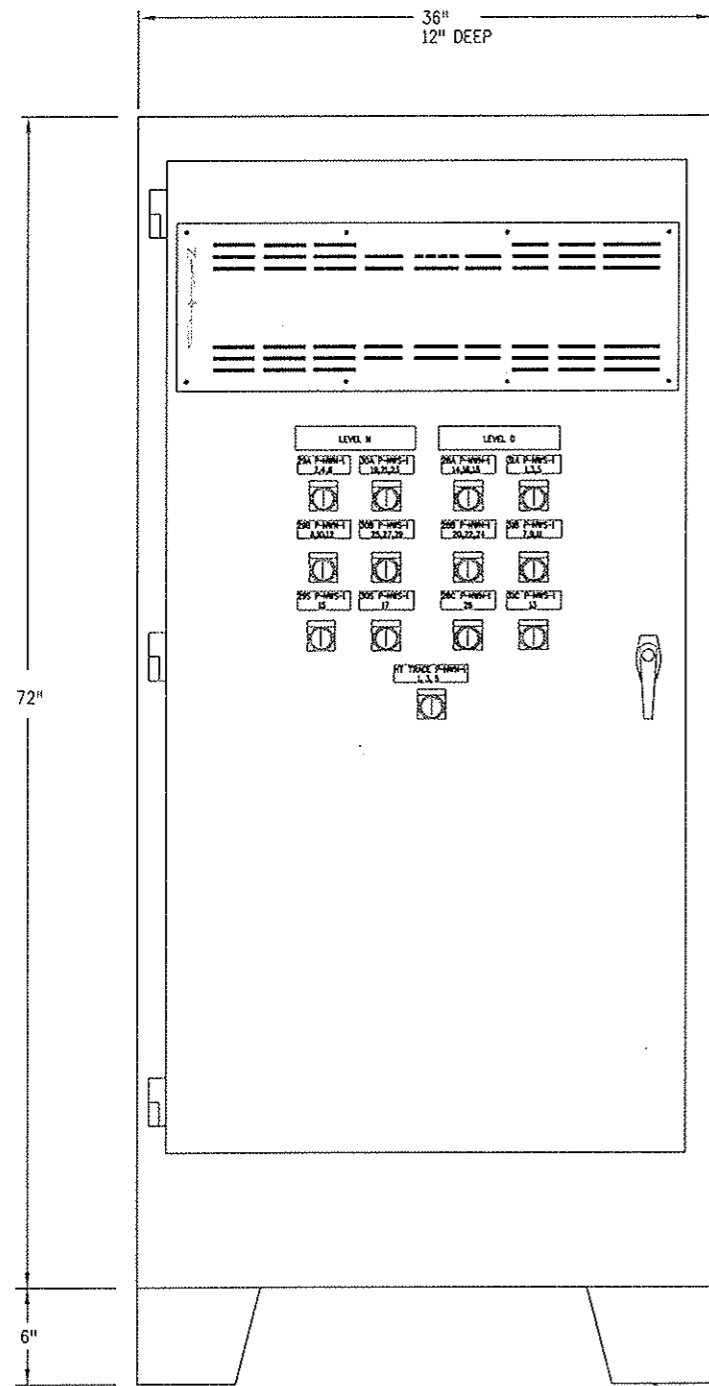Project No./Code
 IM 0703-269
 13166
 Sheet Number 83





FRONT DOOR VIEW

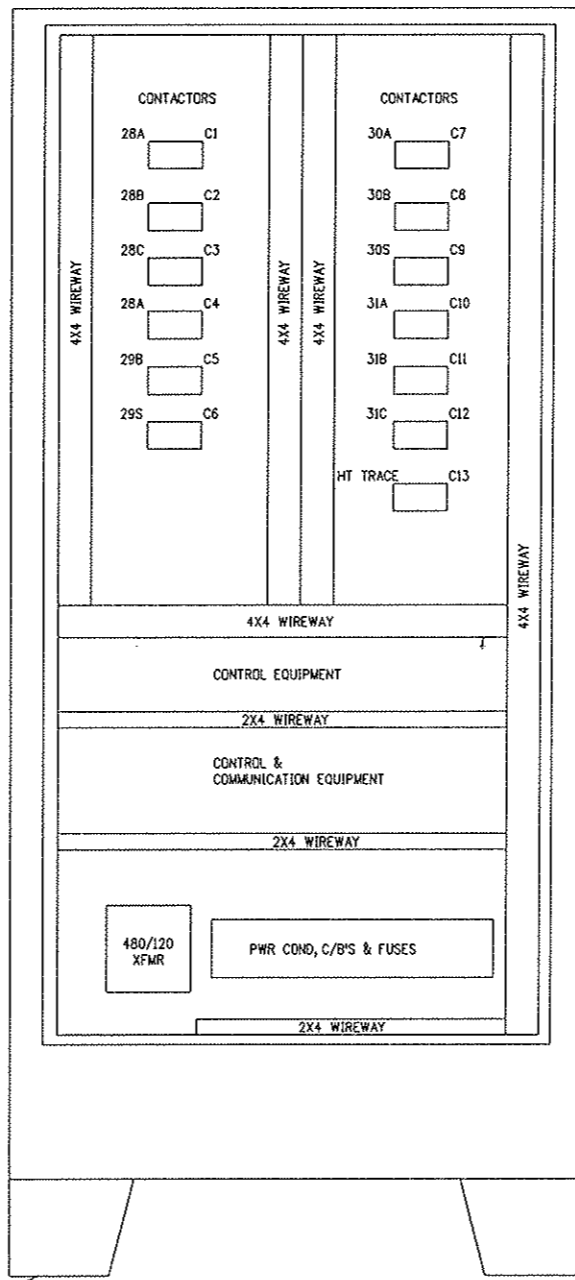

INTERIOR VIEW

1/4" CLEAR VIRGIN ACRYLIC SHEET WITH WEATHERSTRIP EDGES AND SECURED BY (8) 3/16" STAINLESS STEEL PAN HEAD MACHINE SCREWS WITH WASHERS AND NUTS

REPRODUCE THE "LIGHTING LEVEL CONTROL DIAGRAM - I-70 WESTBOUND" AS SHOWN ON THE NORTH TUNNEL LIGHTING CONTROL DIAGRAM DRAWING SHEET 2 OF THE SUBSET TUN POWER. SIZE THE REPRODUCTION TO FULLY FIT THE FRAME

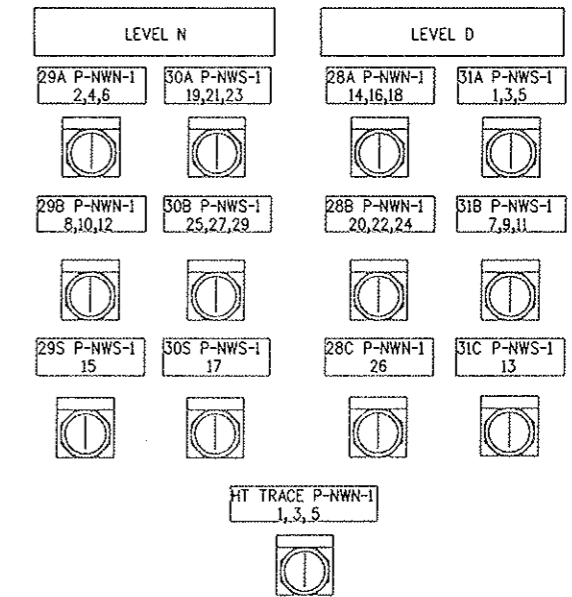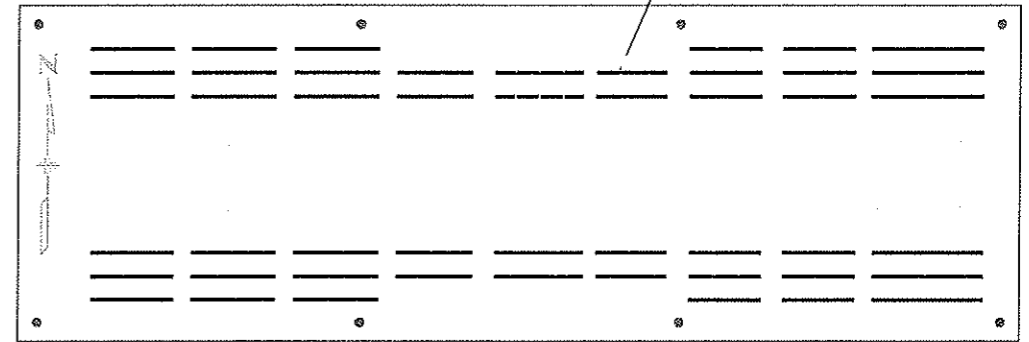

ENLARGED VIEW OF FRONT DOOR SWITCHES FOR CABINET CNW-1


LIGHTING CONTROL AND CONTACTOR CABINET CNW-1
PANEL ASSEMBLY IN NORTH TUNNEL WEST CROSSCUT PASSAGE ELECTRICAL ROOM

Design File Name: DONMSPEC*
 Plot File Name: SPLOTFILE*
 Date of Plot: \$\$\$DATE\$\$\$

Computer File Information	
Creation Date:	01/21/99 Initials: SFO
Last Modification Date:	02/21/07 Initials: DJB
Full Path:	14102\800Deliv\AsBuilt\
Drawing File Name:	14102
Acad Ver.	R14 Scale: NONE Units: English

Sheet Revisions	
07/03/07	ASBUILT DJB

Colorado Department of Transportation




P.O. BOX 399
 DUMONT, CO. 80436
 Phone: 303-512-5750 FAX: 303-512-5775

Region 1 Mountain Residency I.N.Z.

As Constructed
No Revisions:
Revised:
Void:



NORTH TUNNEL LIGHTING CONTROL 3	
Designer:	J. WALSH
Detailer:	RODDENBERRY
Structure Numbers:	
Sheet Subset:	TUN POWER
Subset Sheets:	18 of 45

Project No./Code
IM 0703-269
13166
Sheet Number 84

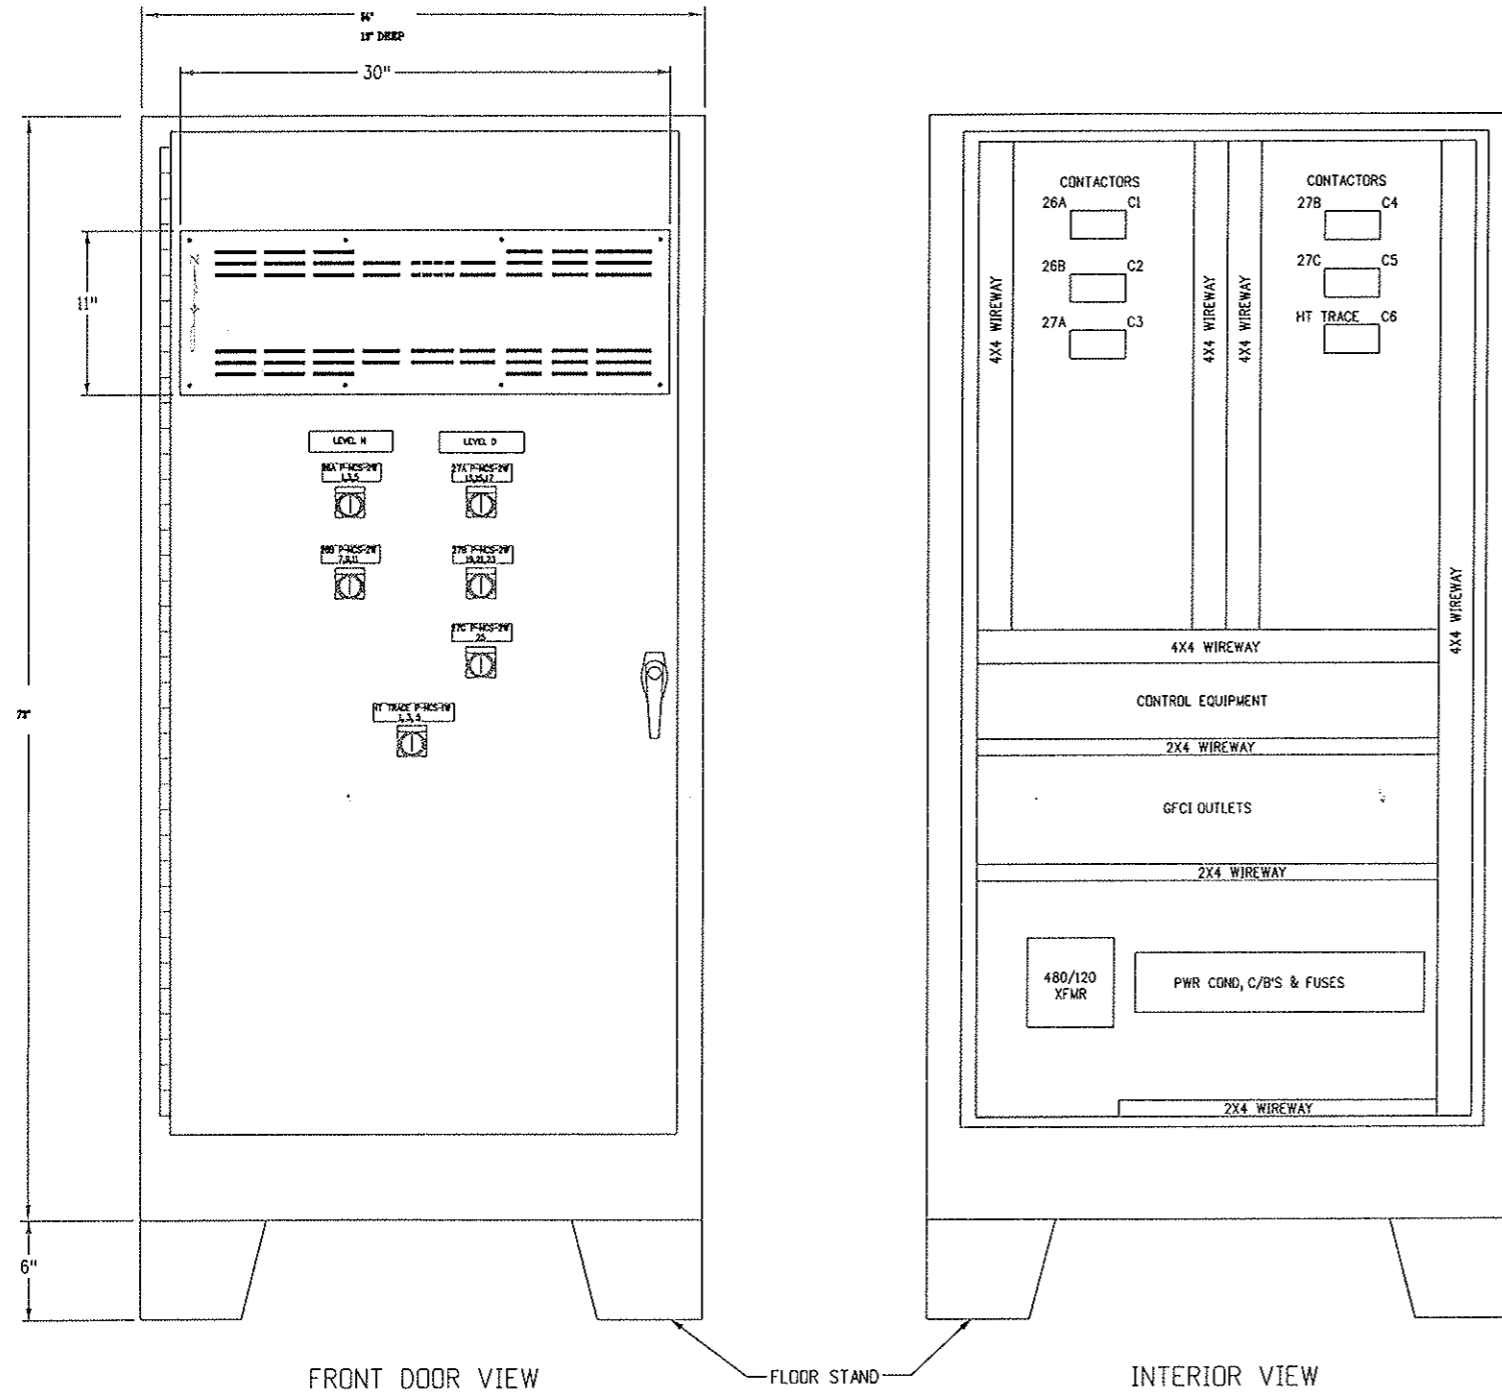

1/4" CLEAR VIRGIN ACRYLIC SHEET WITH WEATHERSTRIP EDGES AND SECURED BY (8) 3/16" STAINLESS STEEL PAN HEAD MACHINE SCREWS WITH WASHERS AND NUTS

REPRODUCE THE "LIGHTING LEVEL CONTROL DIAGRAM - I-70 WESTBOUND" AS SHOWN ON THE NORTH TUNNEL LIGHTING CONTROL DIAGRAM DRAWING SHEET 2 OF THE SUBSET TUN POWER. SIZE THE REPRODUCTION TO FULLY FIT THE FRAME.

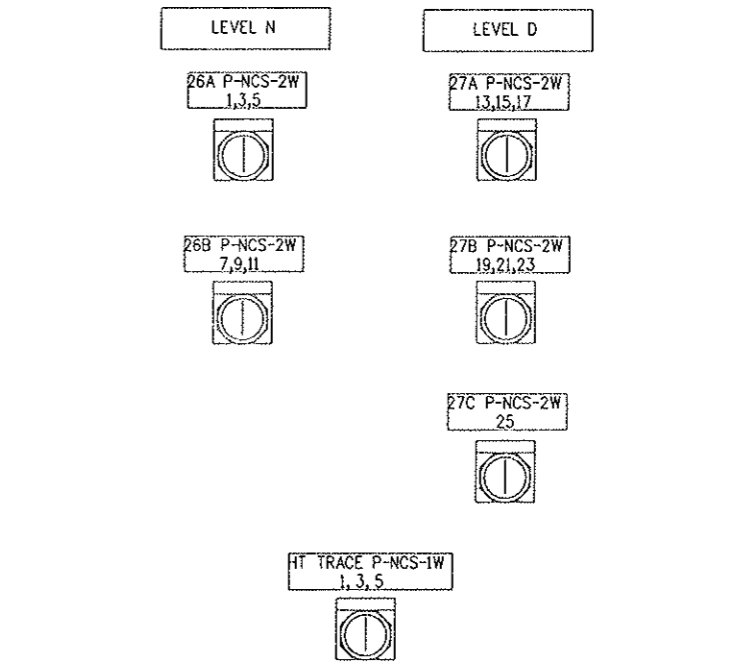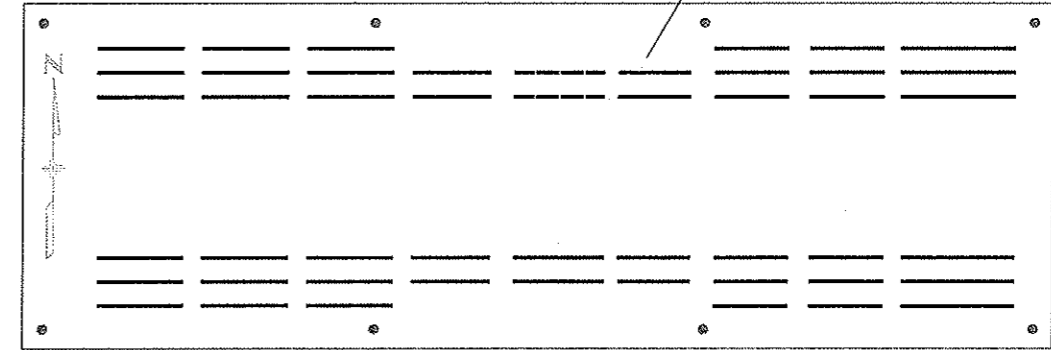

ENLARGED VIEW OF FRONT DOOR SWITCHES FOR CABINET CNCW-1


LIGHTING CONTROL AND CONTACTOR CABINET CNCW-1
 PANEL ASSEMBLY IN NORTH TUNNEL WEST CENTER CROSSCUT PASSAGE ELECTRICAL ROOM

Plot File Name: 3PLU1F.LL*
 Date of Plot: 03/03/07 08:33

Computer File Information		Sheet Revisions		Colorado Department of Transportation		As Constructed		NORTH TUNNEL LIGHTING CONTROL 4		Project No./Code	
Creation Date:	04/21/07	Initials:	SPO	07/03/07	ASBUILT	DJB	No Revisions:			IM 0703-269	
Last Modification Date:	02/21/07	Initials:	DJB				Revised:	Designer:	J. WALSH	Structure Numbers:	13166
Full Path:	14102\800Deliv\AsBuilt\						Void:	Detailer:	RODDENBERRY		Sheet Number
Drawing File Name:	14102-1							Sheet Subset:	TUN POWER	Subset Sheets:	19 of 45
Acad Ver.	R14	Scale:	NONE	Units:							85



P.O. BOX 399
 DUMONT, CO. 80436
 Phone: 303-512-5750 FAX: 303-512-5775
 Region 1 Mountain Residency I.N.Z.

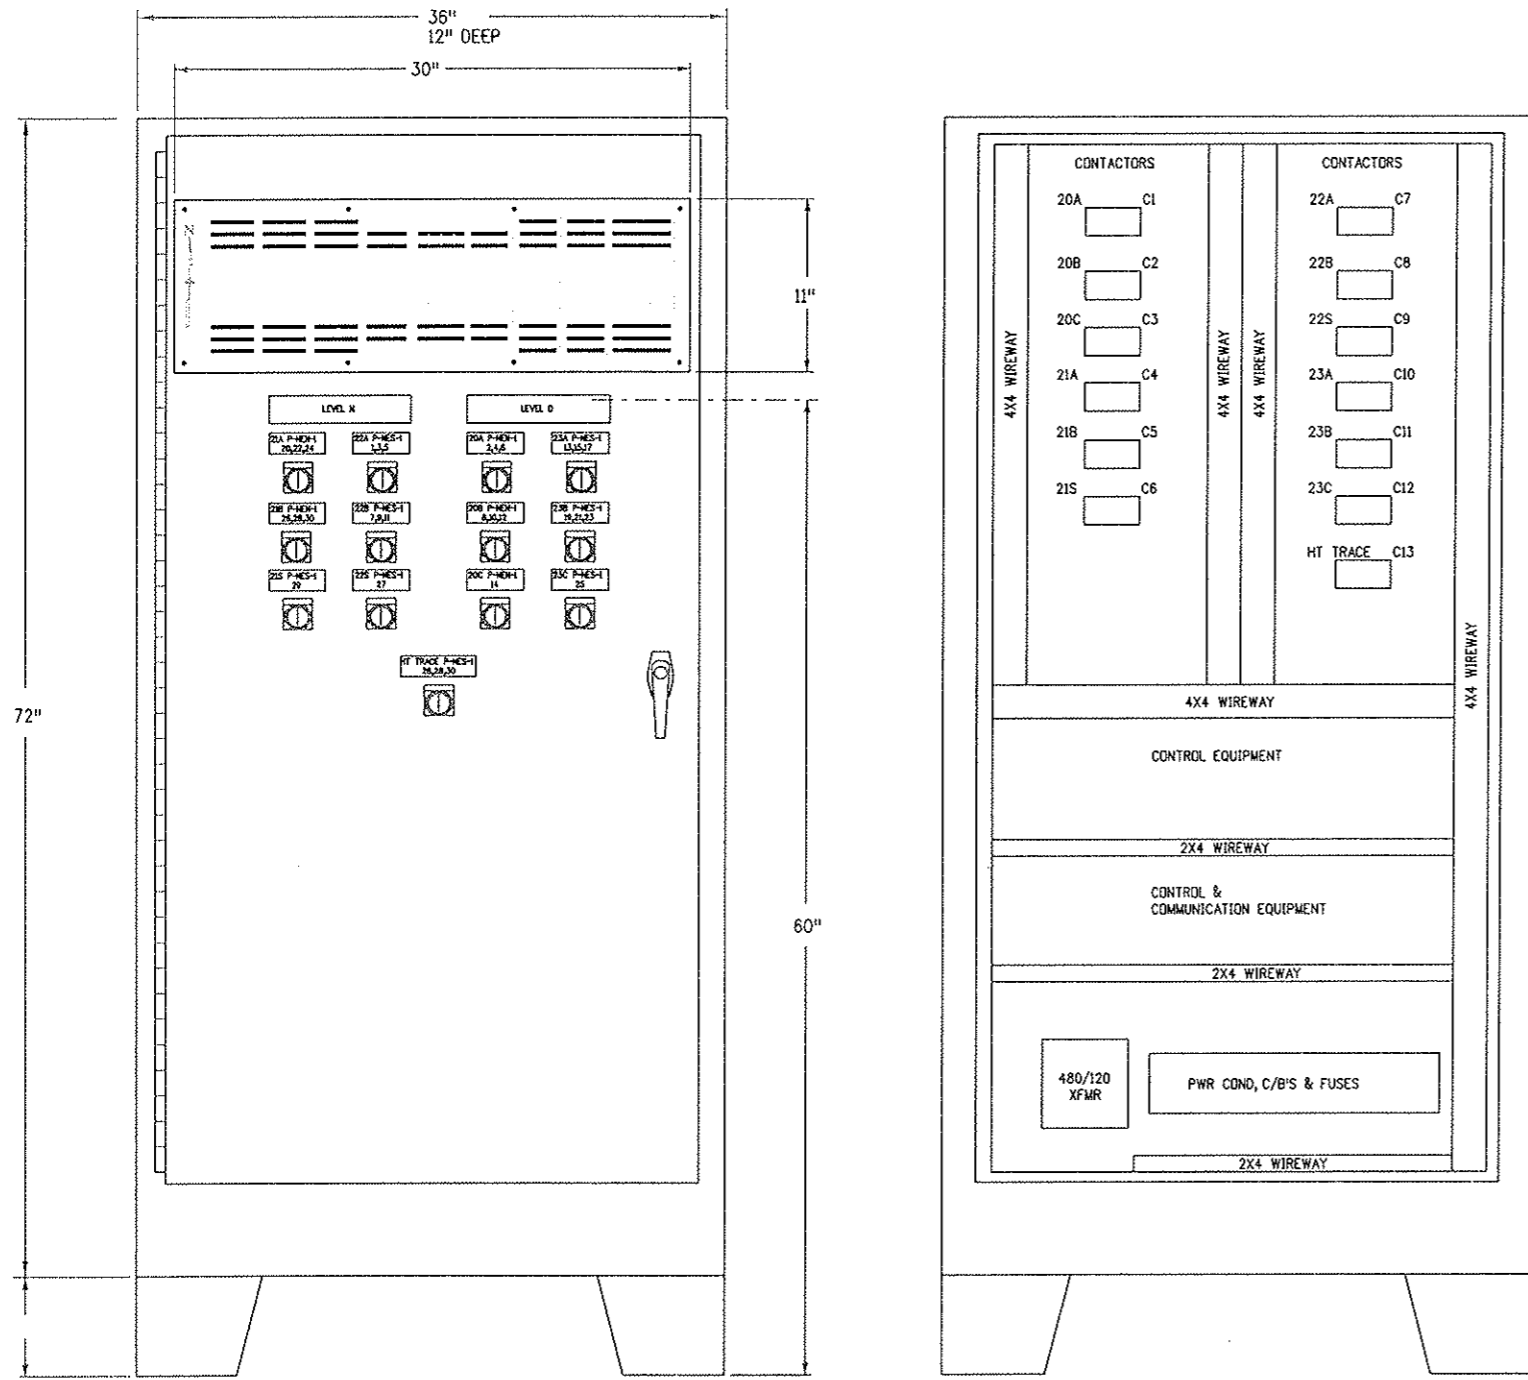



FRONT DOOR VIEW

FLOOR STAND

INTERIOR VIEW

1/4" CLEAR VIRGIN ACRYLIC SHEET WITH WEATHERSTRIP EDGES AND SECURED BY (8) 3/16" STAINLESS STEEL PAN HEAD MACHINE SCREWS WITH WASHERS AND NUTS

REPRODUCE THE "LIGHTING LEVEL CONTROL DIAGRAM - I-70 WESTBOUND" AS SHOWN ON THE NORTH TUNNEL LIGHTING CONTROL DIAGRAM DRAWING SHEET 2 OF THE SUBSET TUN POWER. SIZE THE REPRODUCTION TO FULLY FIT THE FRAME

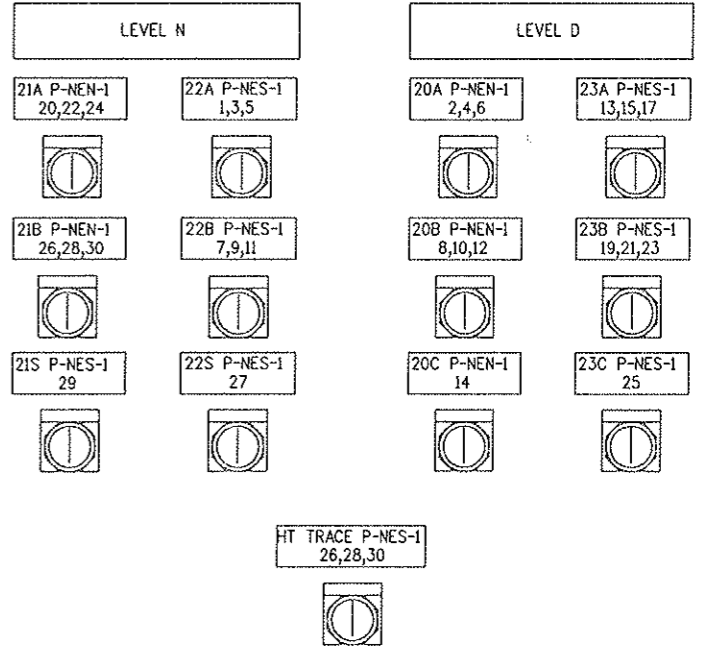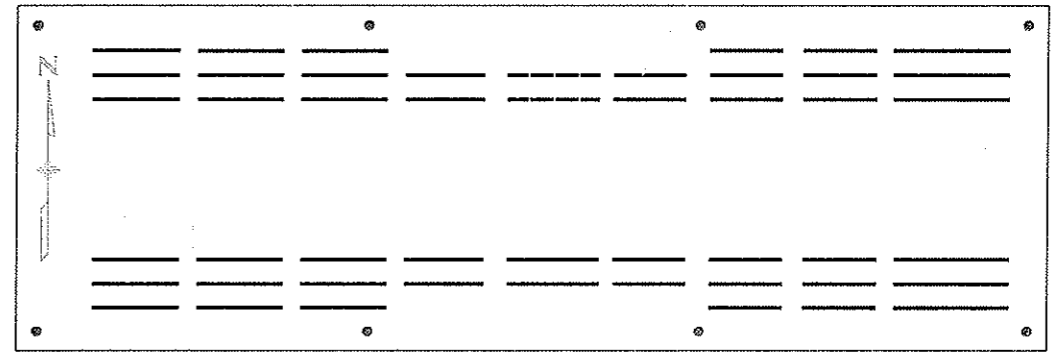

ENLARGED VIEW OF FRONT DOOR SWITCHES FOR CABINET CNE-1


LIGHTING CONTROL AND CONTACTOR CABINET CNE-1
 PANEL ASSEMBLY IN NORTH TUNNEL EAST CROSSCUT PASSAGE ELECTRICAL ROOM

Design File Name: DGN\$SPEC*
 Plot File Name: \$PLOTFILE*
 Date of Plot: \$\$\$DATE\$\$\$

Computer File Information			
Creation Date:	04/25/99	Initials:	SFO
Last Modification Date:	07/21/07	Initials:	DJB
Full Path:	14102\800Deliv\AsBuilt\		
Drawing File Name:	14102E.dwg		
Acad Ver.	R14	Scale:	N=
Units:			

Sheet Revisions			
<input type="checkbox"/>	07/03/07	ASBUILT	DJB
<input type="checkbox"/>			
<input type="checkbox"/>			
<input type="checkbox"/>			

Colorado Department of Transportation



P.O. BOX 399
 DUMONT, CO. 80436
 Phone: 303-512-5750 FAX: 303-512-5775

Region 1 Mountain Residency I.N.Z.


As Constructed	
No Revisions:	
Revised:	
Void:	

NORTH TUNNEL LIGHTING CONTROL 5			
Designer:	J. WALSH	Structure Numbers	
Detailer:	RODDENBERRY	Structure Numbers	
Sheet Subset:	TUN POWER	Subset Sheets:	20 of 45


Project No./Code	
IM 0703-269	
13166	
Sheet Number	86

1/4" CLEAR VIRGIN ACRYLIC SHEET WITH WEATHERSTRIP EDGES AND SECURED BY (8) 3/16" STAINLESS STEEL PAN HEAD MACHINE SCREWS WITH WASHERS AND NUTS


REPRODUCE THE "LIGHTING LEVEL CONTROL DIAGRAM - I-70 WESTBOUND" AS SHOWN ON THE NORTH TUNNEL LIGHTING CONTROL DIAGRAM DRAWING SHEET 2 OF THE SUBSET TUN POWER. SIZE THE REPRODUCTION TO FULLY FIT THE FRAME

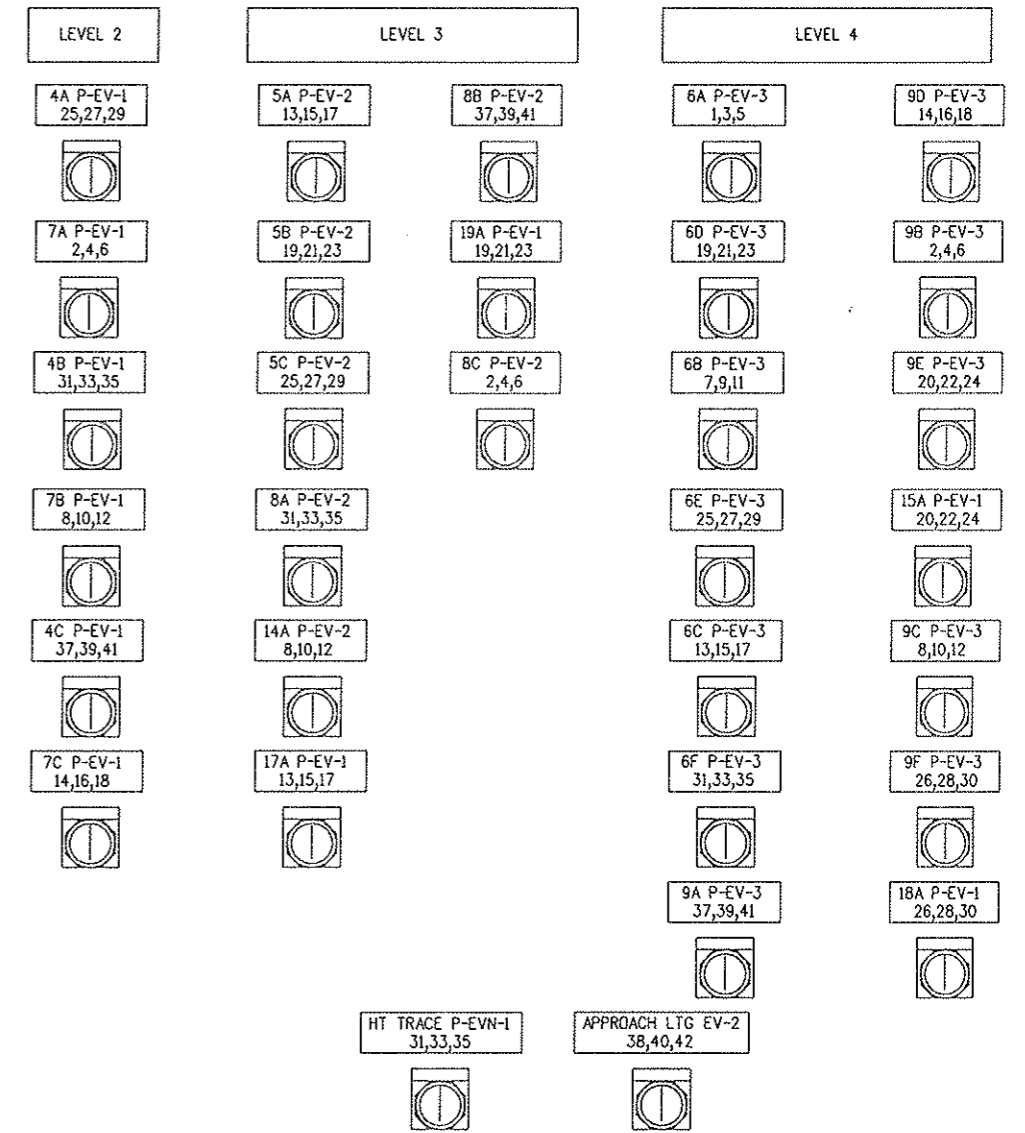

ENLARGED VIEW OF FRONT DOOR SWITCHES FOR CABINET CEVN-2

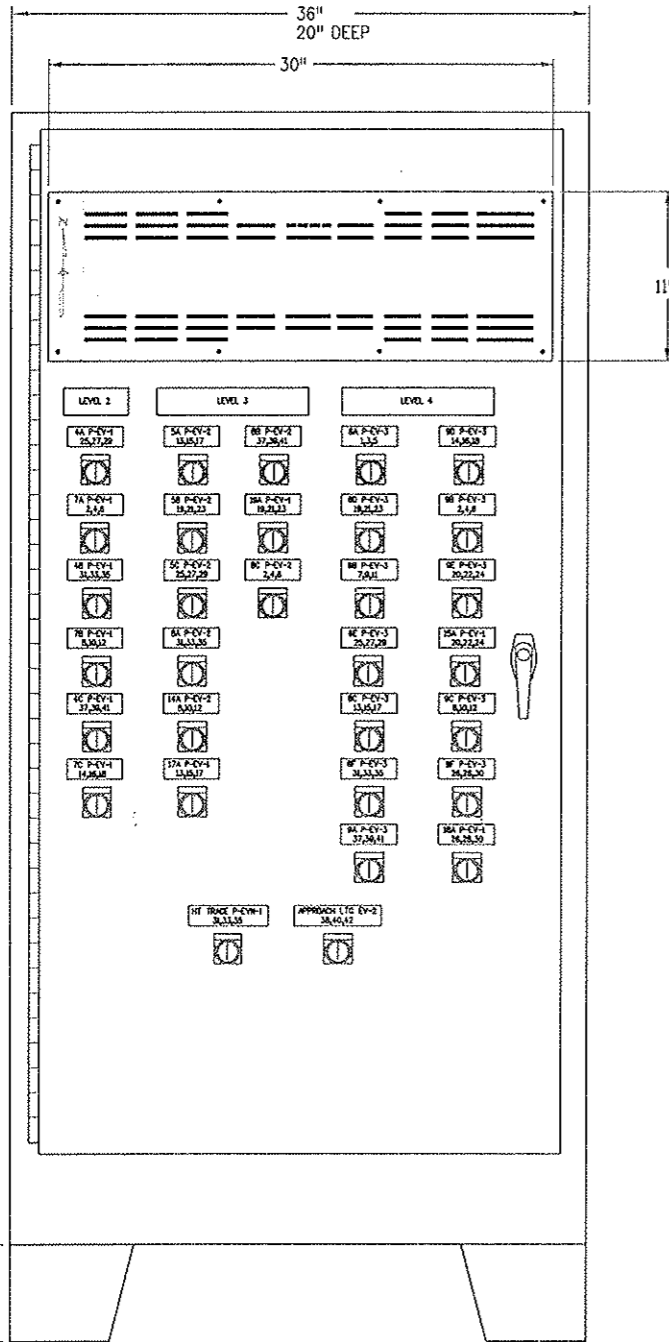

FRONT DOOR VIEW

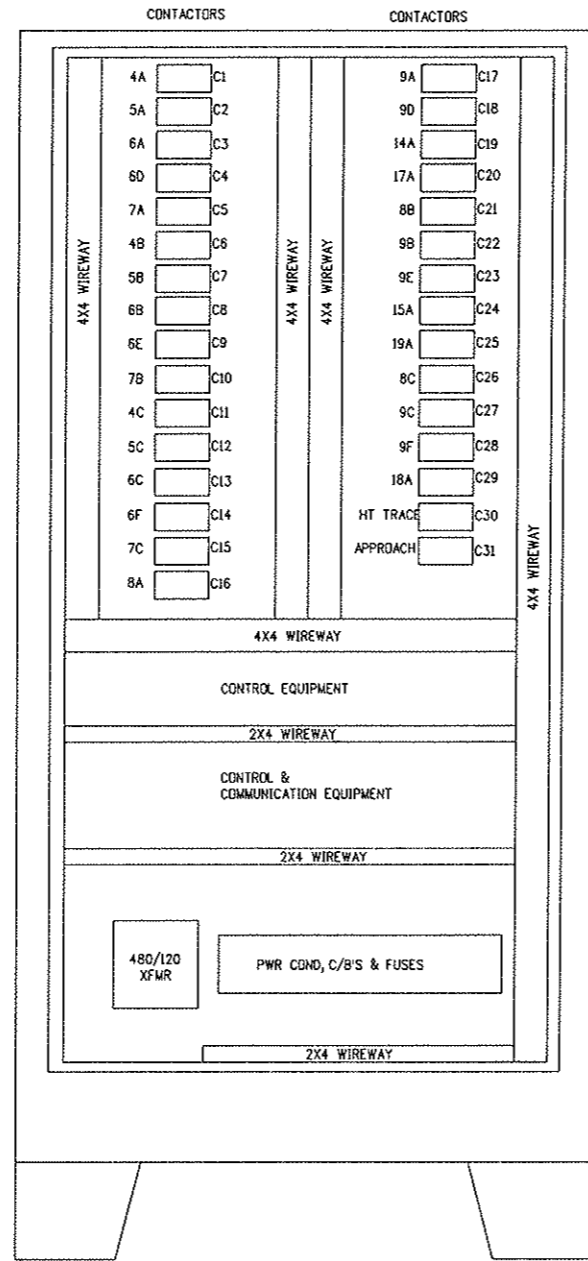

INTERIOR VIEW


FLOOR STAND

LIGHTING CONTROL AND CONTACTOR CABINET CEVN-2
PANEL ASSEMBLY IN EAST VENT. BLDG.

Design File Name: DGNSSPEC*
Plot File Name: \$PLOTFILE*
Date of Plot: \$\$\$DATE\$\$\$

Computer File Information	
Creation Date:	04/19/99 Initials: SPO
Last Modification Date:	05/31/07 Initials: DJB
Full Path:	14102\800Deliv\AsBuilt\
Drawing File Name:	14126--
Acad Ver.:	R14 Scale: N... Units:


Sheet Revisions	
07/03/07	ASBUILT DJB

Colorado Department of Transportation
 P.O. BOX 399
 DUMONT, CO. 80436
 Phone: 303-512-5750 FAX: 303-512-5775
 Region 1 Mountain Residency I.N.Z.


As Constructed
No Revisions:
Revised:
Void:

NORTH TUNNEL LIGHTING CONTROL 6	
Designer:	J WALSH
Detailer:	RODDENBERRY
Sheet Subset:	TUN POWER
Structure Numbers:	
Subset Sheets:	21 of 45

Project No./Code	
IM 0703-269	13166
Sheet Number	87

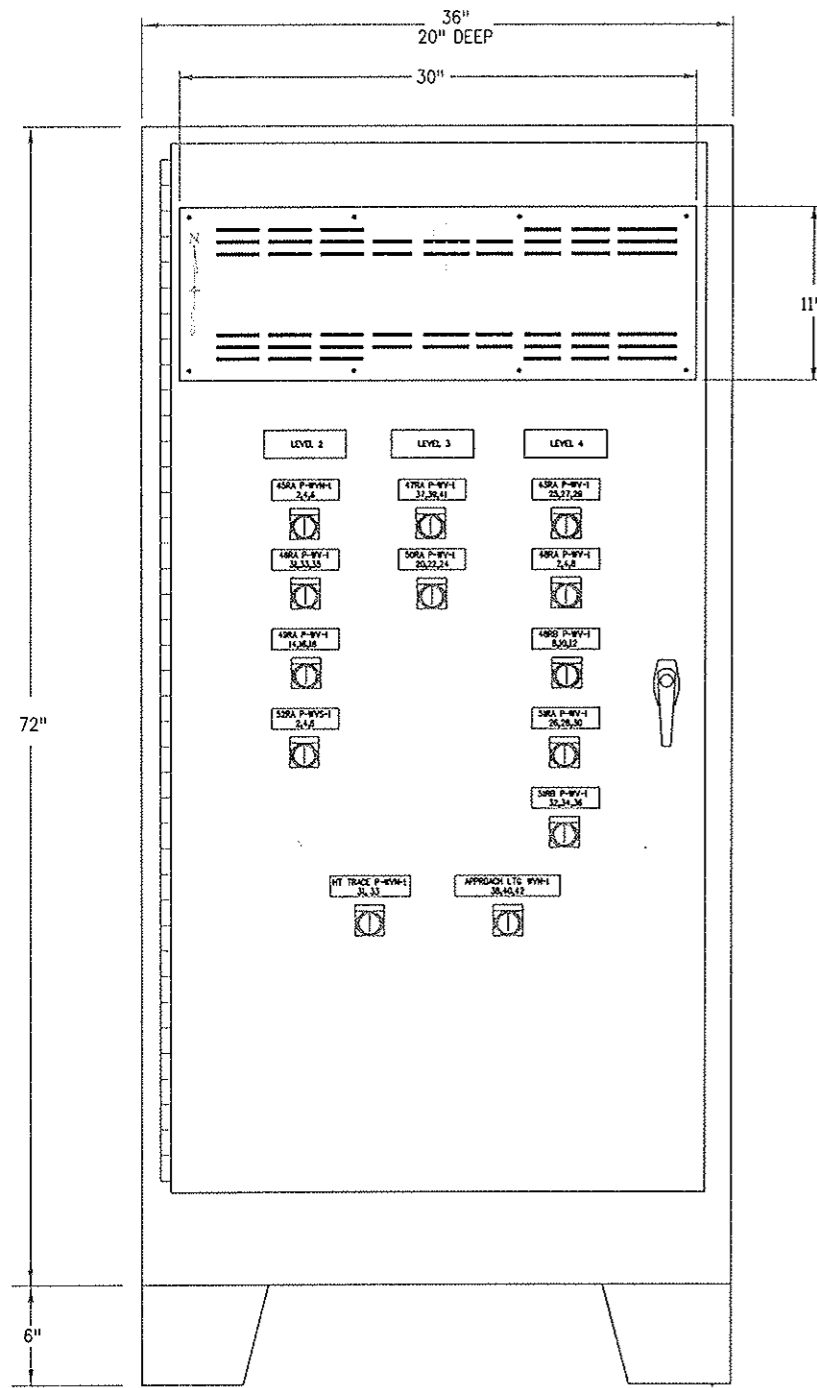

FRONT DOOR VIEW


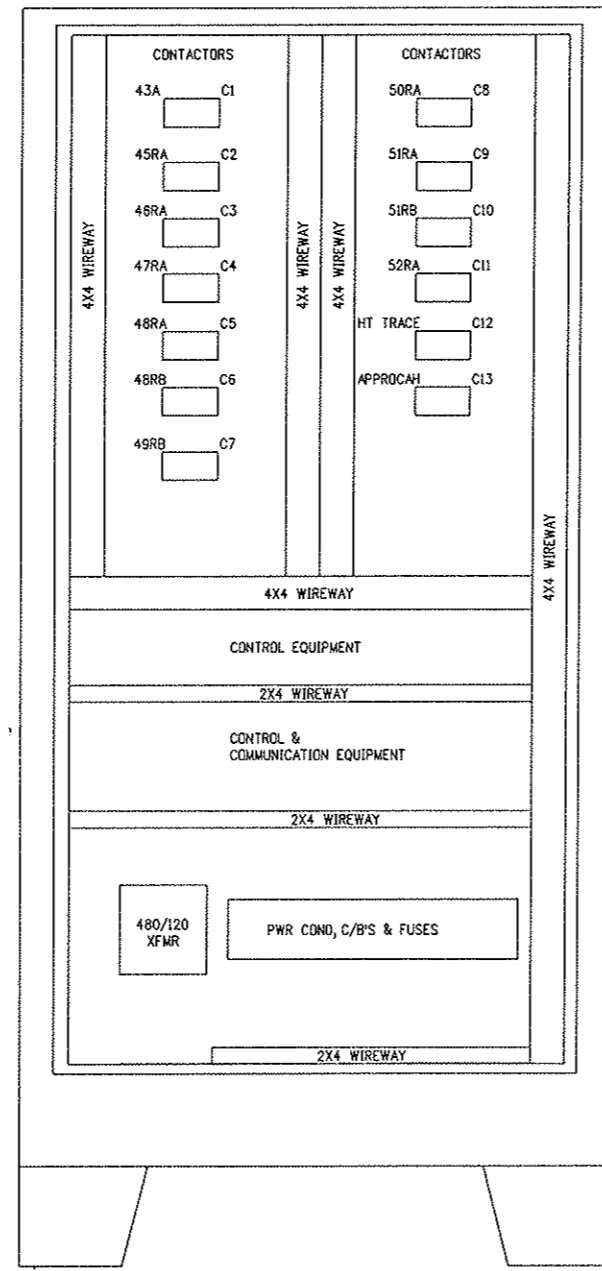


INTERIOR VIEW

LIGHTING CONTROL AND CONTACTOR CABINET CWVN-2
WALL PANEL ASSEMBLY IN WEST VENT BUILDING

1/4" CLEAR VIRGIN ACRYLIC SHEET WITH WEATHERSTRIP EDGES AND SECURED BY (8) 3/16" STAINLESS STEEL PAN HEAD MACHINE SCREWS WITH WASHERS AND NUTS

REPRODUCE THE "LIGHTING LEVEL CONTROL DIAGRAM - I-70 WESTBOUND" AS SHOWN ON THE NORTH TUNNEL LIGHTING CONTROL DIAGRAM DRAWING SHEET 2 OF THE SUBSET TUN POWER. SIZE THE REPRODUCTION TO FULLY FIT THE FRAME.

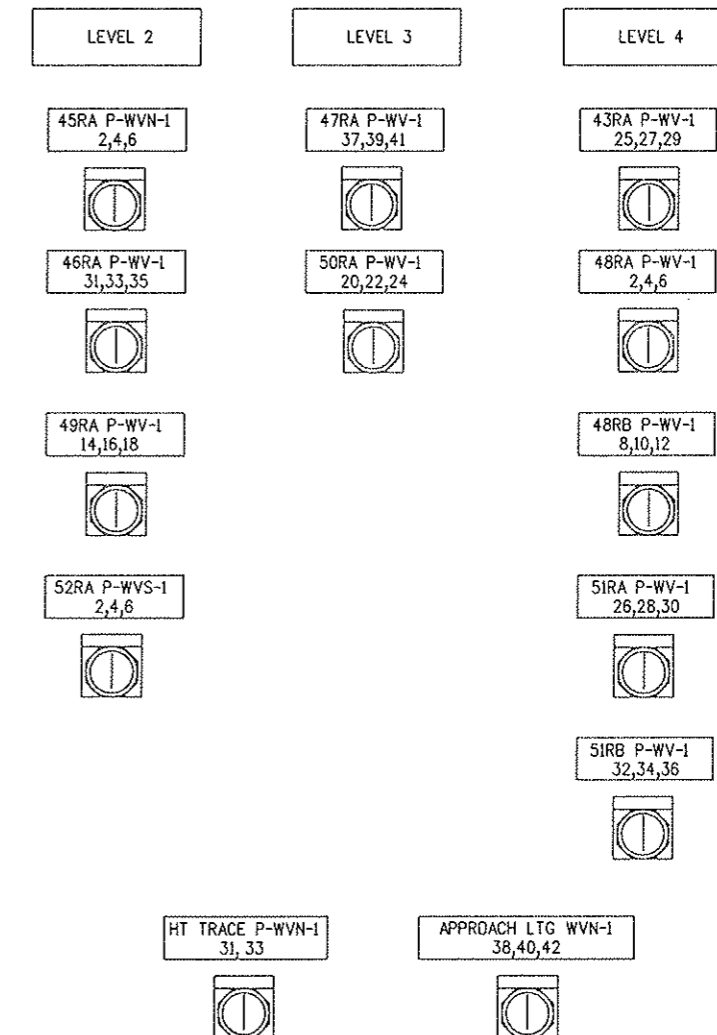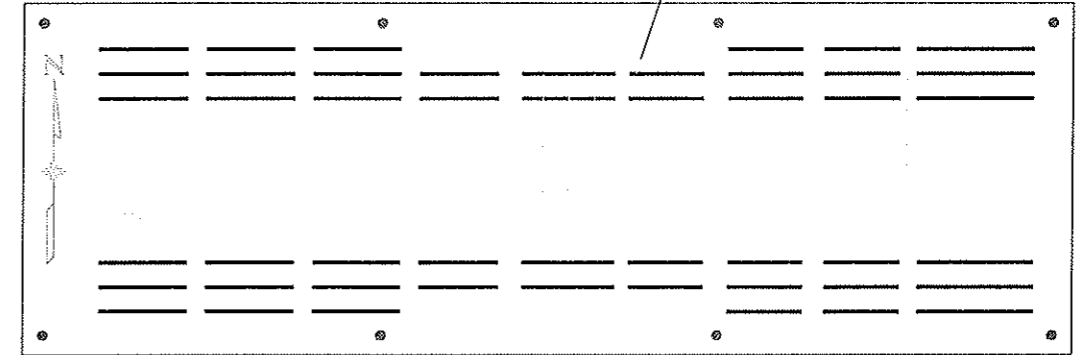

ENLARGED VIEW OF
FRONT DOOR SWITCHES FOR CABINET CWVN-2

FLOOR STAND

72"


11"

6"

Computer File Information	
Creation Date:	09/23/99 Initials: DMO
Last Modification Date:	01/21/02 Initials: DJR
Full Path:	14102\700CADD\703ELECT\
Drawing File Name:	14102-1-2
Acad Ver.	R14 Scale: NONE Units:

Sheet Revisions	
07/03/07	ASBUILT DJB

Colorado Department of Transportation




P.O. BOX 399
DUMONT, CO. 80436
Phone: 303-512-5750 FAX: 303-512-5775

Region 1 Mountain Residency I.N.Z.


As Constructed
No Revisions:
Revised:
Void:

NORTH TUNNEL LIGHTING CONTROL 7	
Designer: J WALSH	Structure Numbers
Detailer: RODDENBERRY	
Sheet Subset: TUN POWER	Subset Sheets: 22 of 45

Project No./Code
IM 0703-269
13166
Sheet Number 88

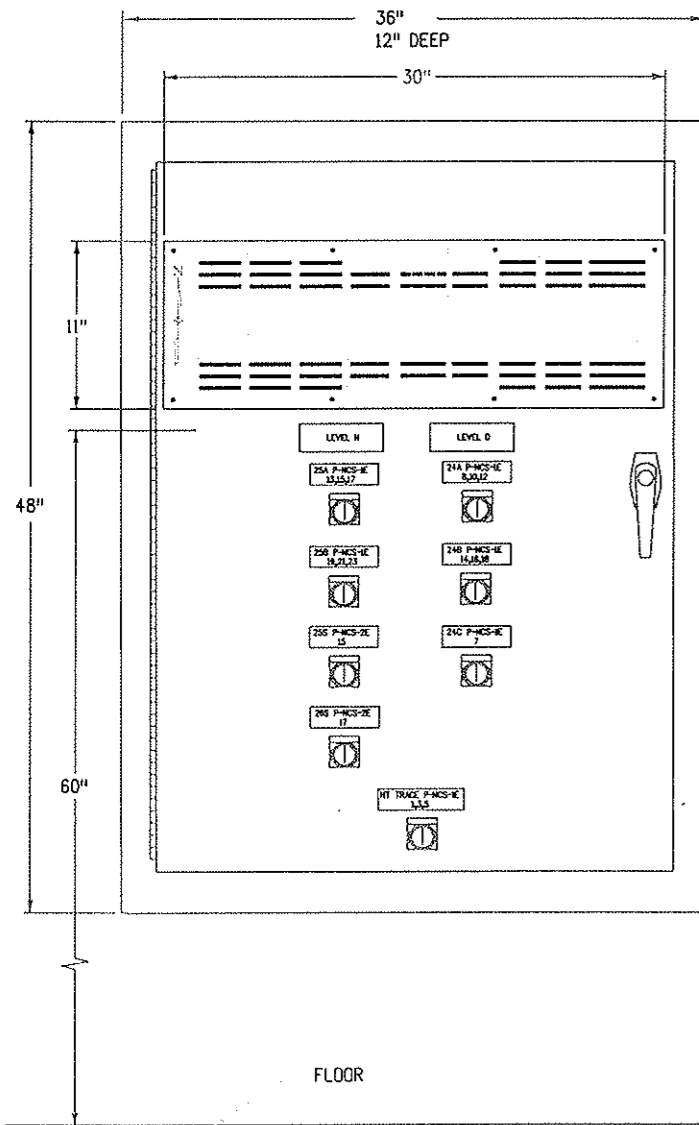


FRONT DOOR VIEW

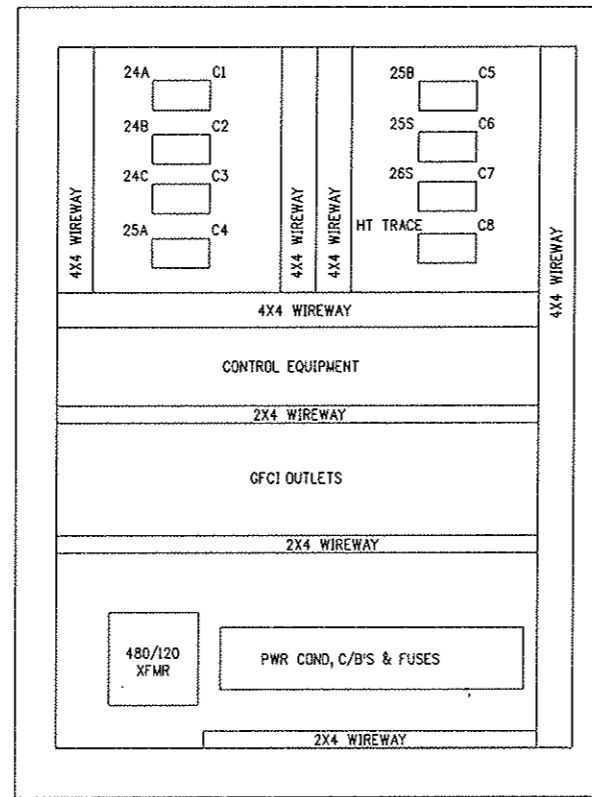

INTERIOR VIEW

1/4" CLEAR VIRGIN ACRYLIC SHEET WITH WEATHERSTRIP EDGES AND SECURED BY (8) 3/16" STAINLESS STEEL PAN HEAD MACHINE SCREWS WITH WASHERS AND NUTS


REPRODUCE THE "LIGHTING LEVEL CONTROL DIAGRAM - I-70 WESTBOUND" AS SHOWN ON THE NORTH TUNNEL LIGHTING CONTROL DIAGRAM DRAWING SHEET 2 OF THE SUBSET TUN POWER. SIZE THE REPRODUCTION TO FULLY FIT THE FRAME.

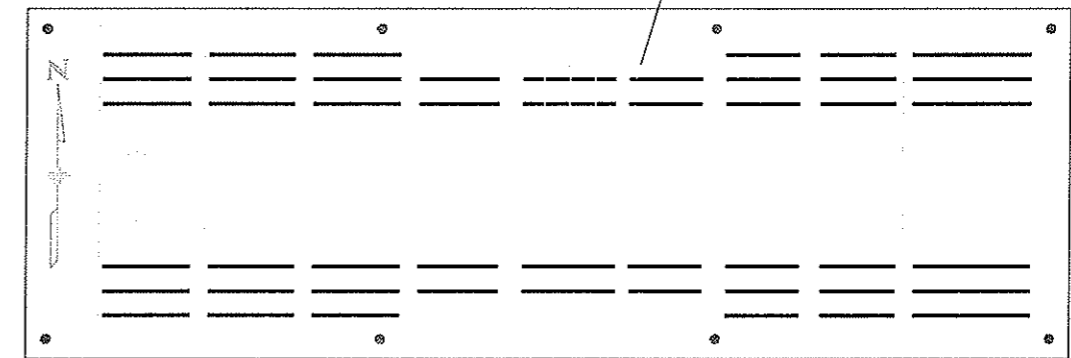

ENLARGED VIEW OF FRONT DOOR SWITCHES FOR CABINET CNCE-1

LIGHTING CONTROL AND CONTACTOR CABINET CNCE-1
WALL PANEL ASSEMBLY IN NORTH CENTER EAST CROSSCUT PASSAGE ELECTRICAL ROOM

Computer File Information		Sheet Revisions		Colorado Department of Transportation		As Constructed		NORTH TUNNEL LIGHTING CONTROL 8		Project No./Code	
Creation Date:	09/23/99	Initials:	DMO	07/03/07	ASBUILT						IM 0703-269
Last Modification Date:	02/21/07	Initials:	DJB								13166
Full Path:	14102\800Deliv\AsBuilt\										23 of 45
Drawing File Name:	14128a										Sheet Number
Acad Ver.	R14	Scale:	NONE								89

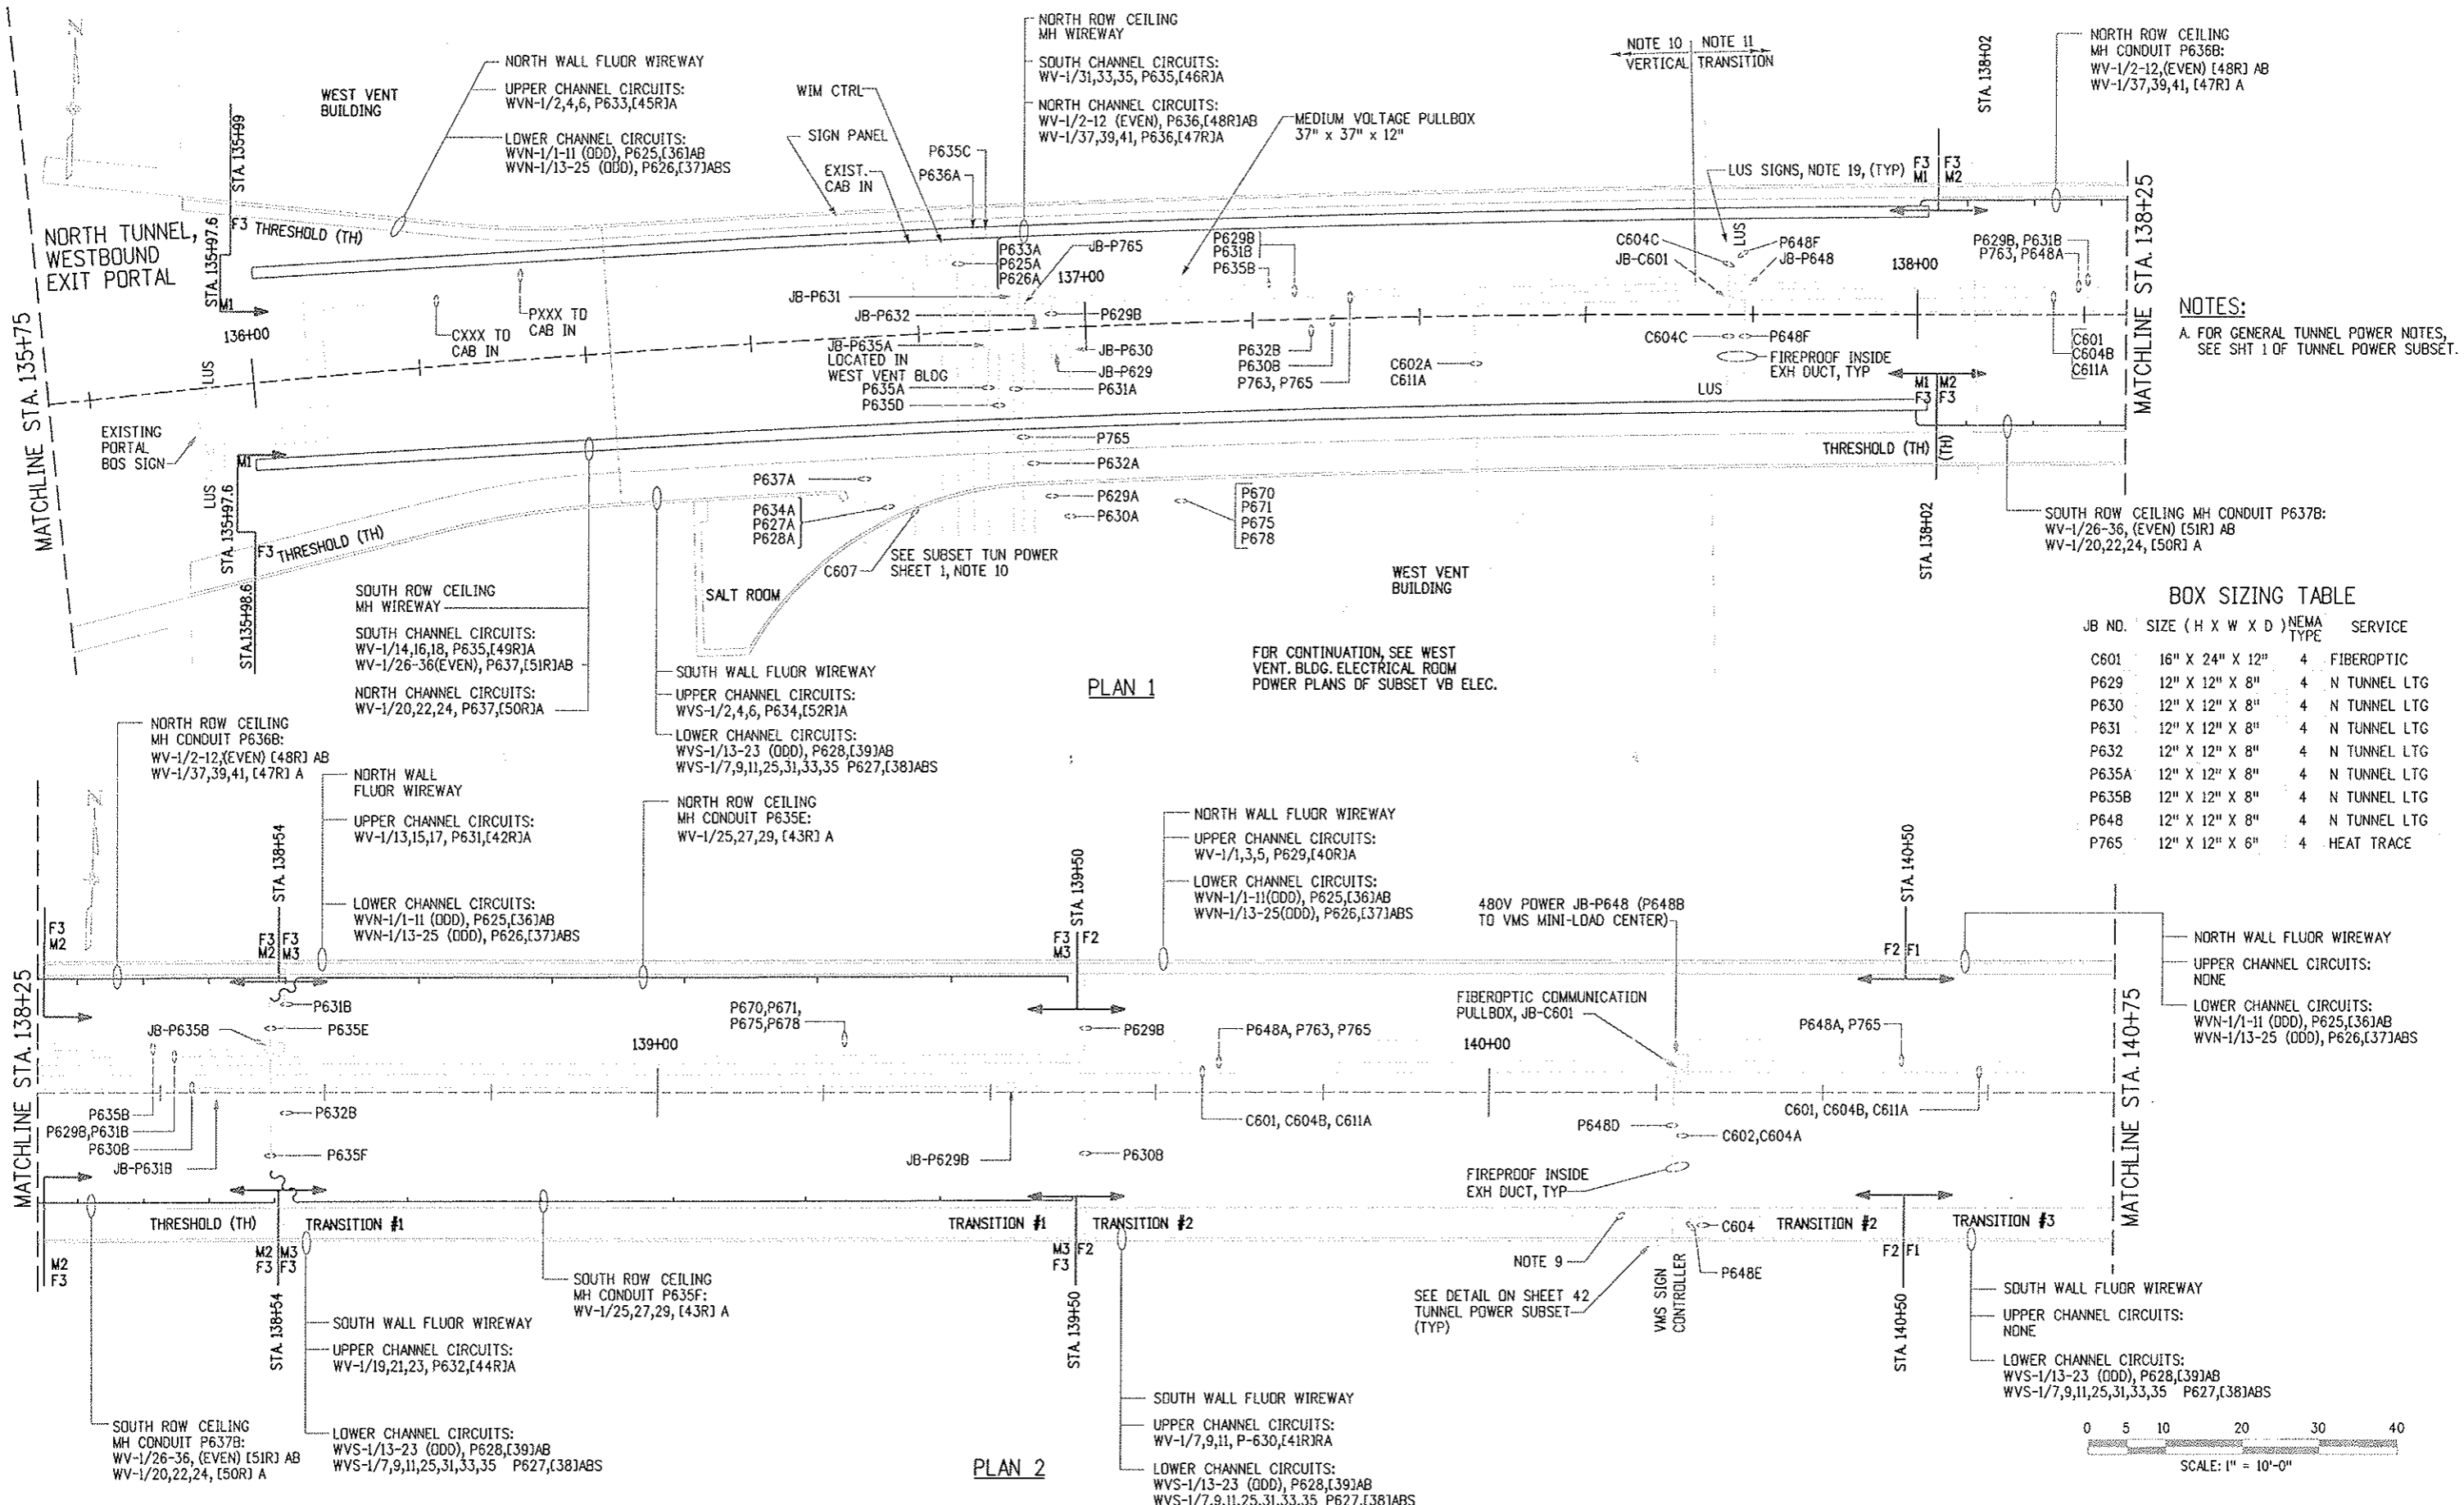

NOTES:
 A. FOR GENERAL TUNNEL POWER NOTES, SEE SHT 1 OF TUNNEL POWER SUBSET.

BOX SIZING TABLE

JB NO.	SIZE (H X W X D)	NEMA TYPE	SERVICE
C601	16" X 24" X 12"	4	FIBEROPTIC
P629	12" X 12" X 8"	4	N TUNNEL LTG
P630	12" X 12" X 8"	4	N TUNNEL LTG
P631	12" X 12" X 8"	4	N TUNNEL LTG
P632	12" X 12" X 8"	4	N TUNNEL LTG
P635A	12" X 12" X 8"	4	N TUNNEL LTG
P635B	12" X 12" X 8"	4	N TUNNEL LTG
P648	12" X 12" X 8"	4	N TUNNEL LTG
P765	12" X 12" X 6"	4	HEAT TRACE

FOR CONTINUATION, SEE WEST VENT BLDG. ELECTRICAL ROOM POWER PLANS OF SUBSET VB ELEC.

Design File Name: D:\NS\PLU*
 Plot File Name: S\PLUFILE*
 Date of Plot: 05/27/99


Computer File Information

Creation Date:	05/27/99	Initials:	SPD
Last Modification Date:	05/27/99	Initials:	DJB
Full Path:	14102\800deliv\AsBUILT		
Drawing File Name:	***101a		
Acad Ver.	R14	Scale:	1" = 10'-0"
Units:			

Sheet Revisions

Rev	Date	By	Description
01	07/03/07	ASBUILT	

Colorado Department of Transportation




P.O. BOX 399
 DUMONT, CO. 80436
 Phone: 303-512-5750 FAX: 303-512-5775


Region 1 Mountain Residency I.N.Z.

As Constructed	No Revisions:		NORTH TUNNEL POWER PLANS 1		Project No./Code	
	Revised:				IM 0703-269	
	Void:		Designer: J. WALSH	Structure Numbers:	13166	
			Detailer: RODDENBERRY	Sheet Subset: TUN POWER	Subst Sheets: 24 of 45	Sheet Number: 90

NOTES:
 A. FOR GENERAL TUNNEL POWER NOTES, SEE SHEET 1 OF TUNNEL POWER SUBSET.

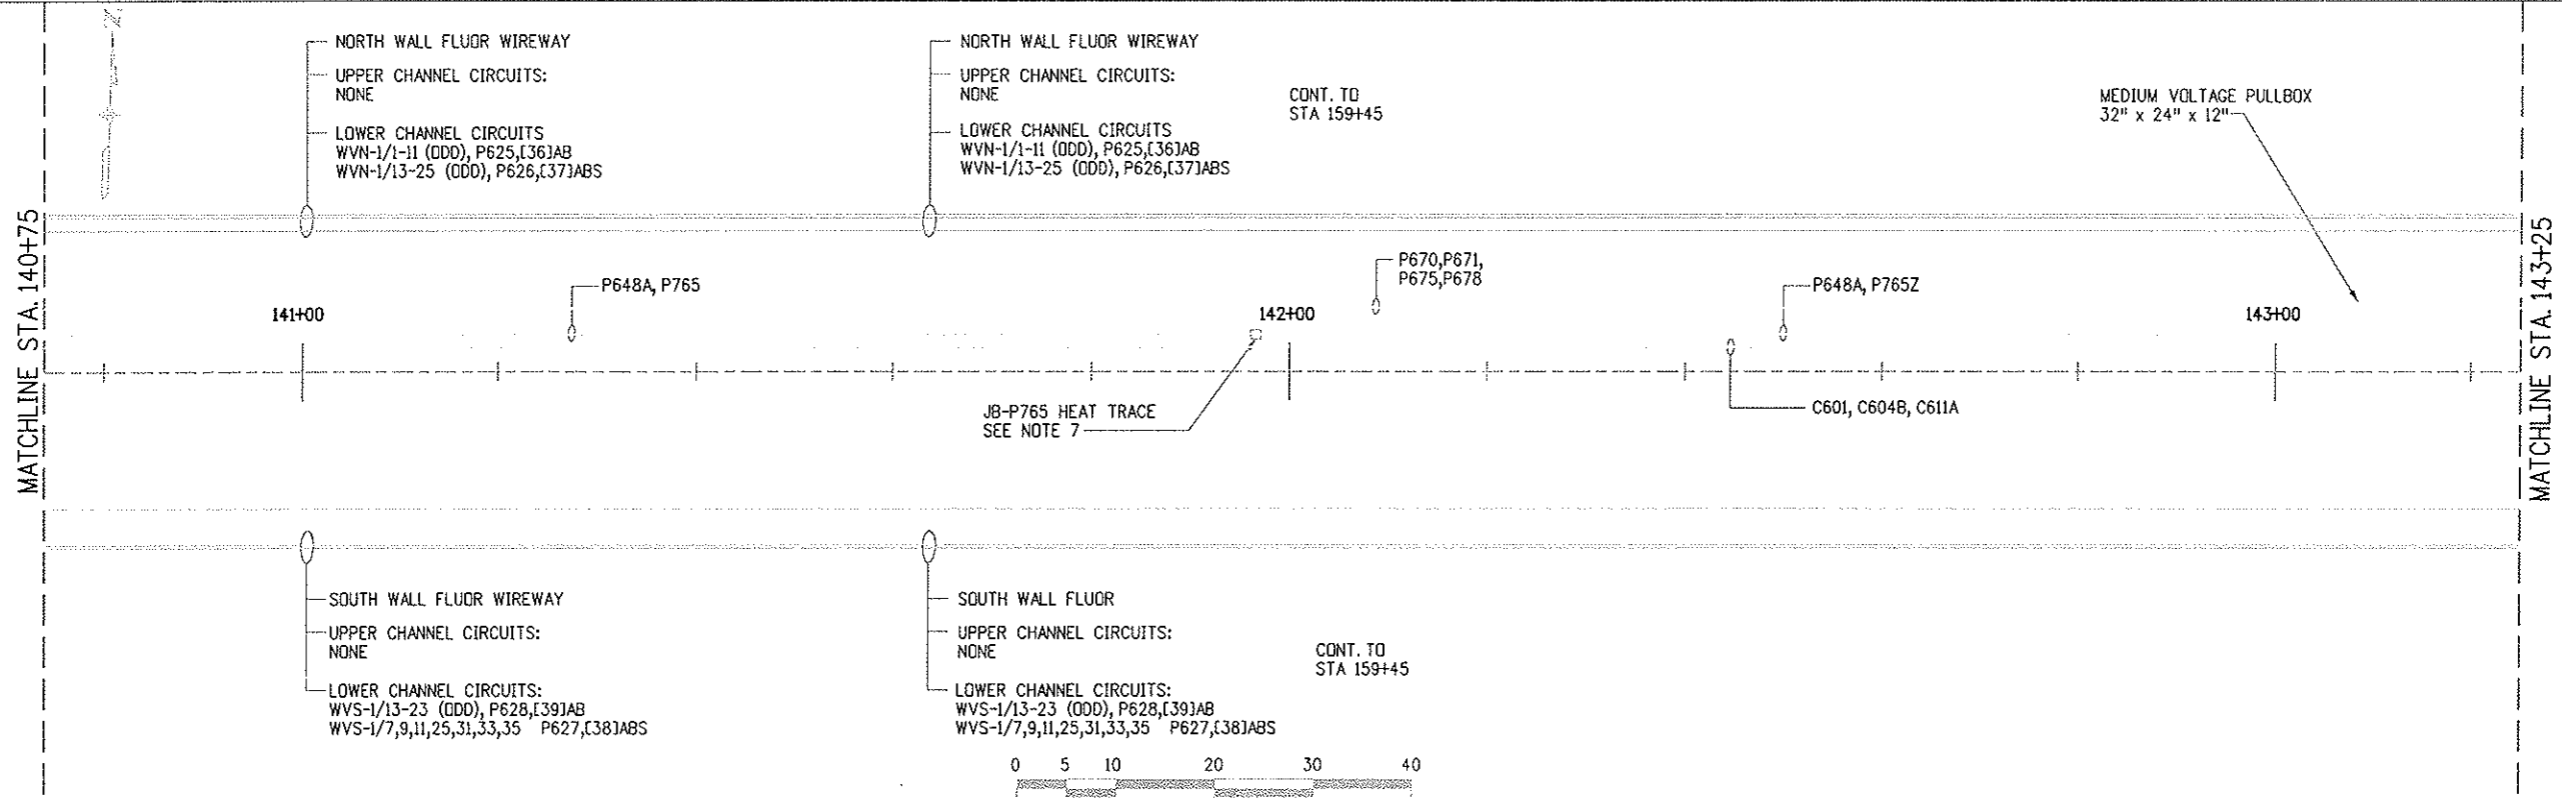

PLAN 1

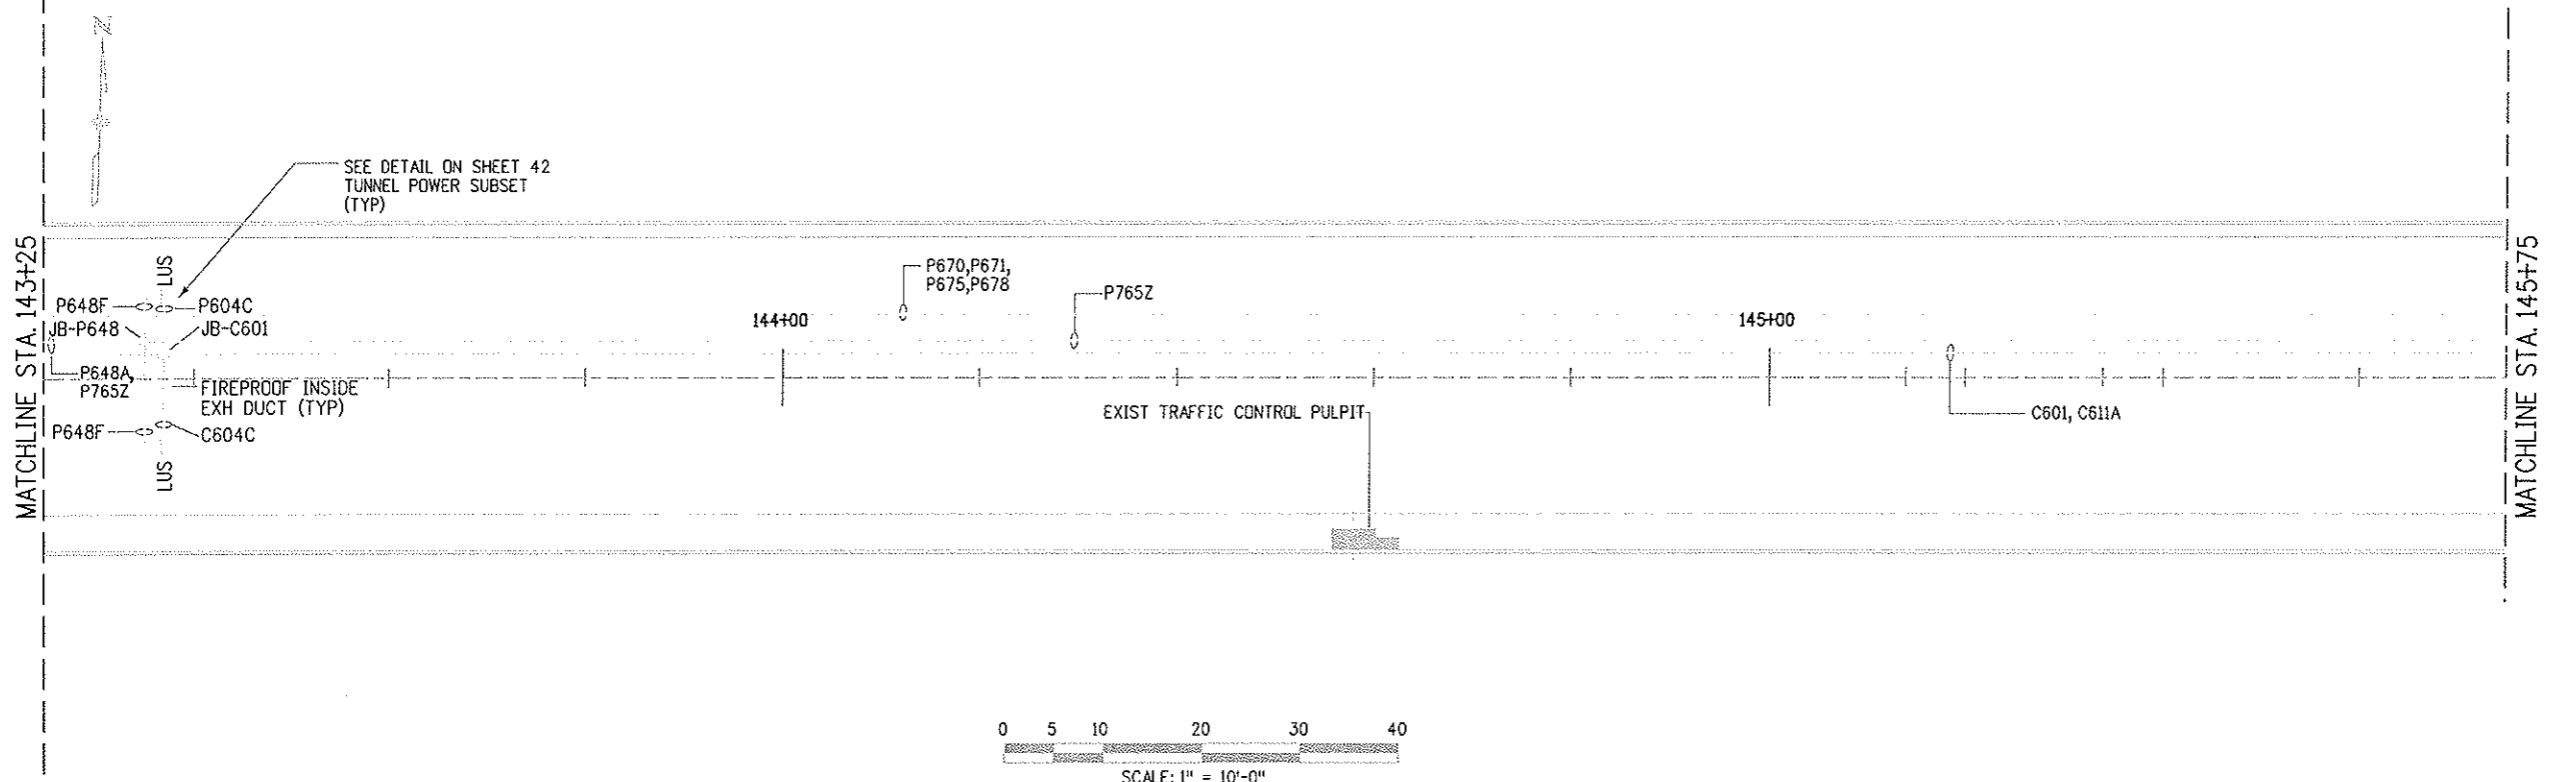


PLAN 2

Design File Name: DGN\$SPEC*
 Plot File Name: \$PLOTFILE*
 Date of Plot: \$\$\$DATE\$\$\$

Computer File Information	
Creation Date:	05/28/99 Initials: SFD
Last Modification Date:	02/27/07 Initials: DJR
Full Path:	14102\700CADD\ [Discipline] \ [Filename]
Drawing File Name:	***102*
Acad Ver.	R14 Scale: 1" = 10'-0" Units:

Sheet Revisions	
<input type="checkbox"/>	07/03/07 ASBUILT DJB
<input type="checkbox"/>	
<input type="checkbox"/>	
<input type="checkbox"/>	

Colorado Department of Transportation



P.O. BOX 399
 DUMONT, CO. 80436
 Phone: 303-512-5750 FAX: 303-512-5775
 Region 1 Mountain Residency I.N.Z.



As Constructed
No Revisions:
Revised:
Void:

NORTH TUNNEL POWER PLANS 2	
Designer:	J. WALSH
Detailer:	RODDENBERRY
Sheet Subset:	TUN. POWER
Structure Numbers	
Subset Sheets:	25 of 45



Project No./Code
IM 0703-269
13166
Sheet Number 91

NOTES

A. FOR GENERAL TUNNEL POWER NOTES, SEE SHEET 1 TUNNEL POWER SUBSET.

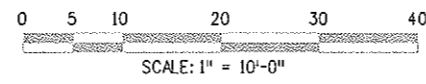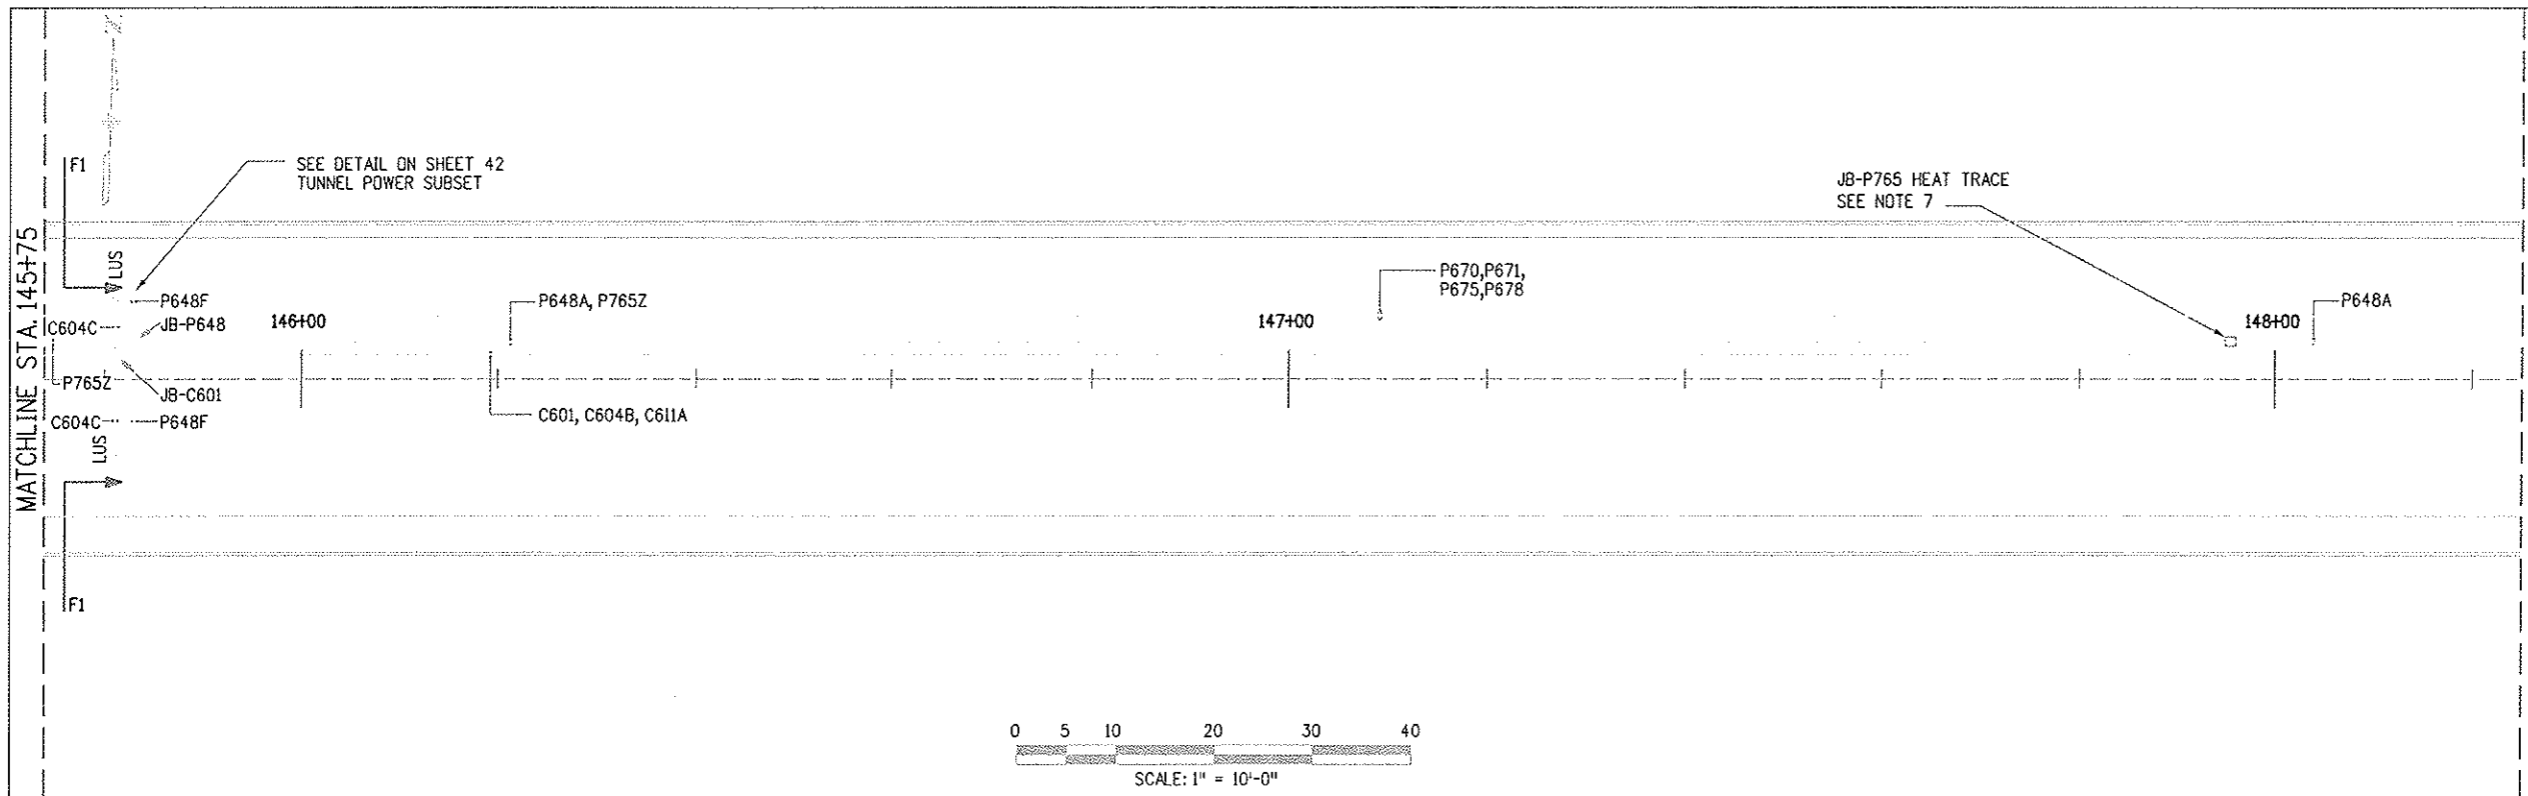

PLAN 1

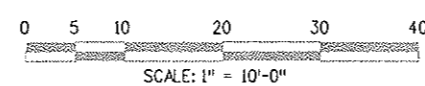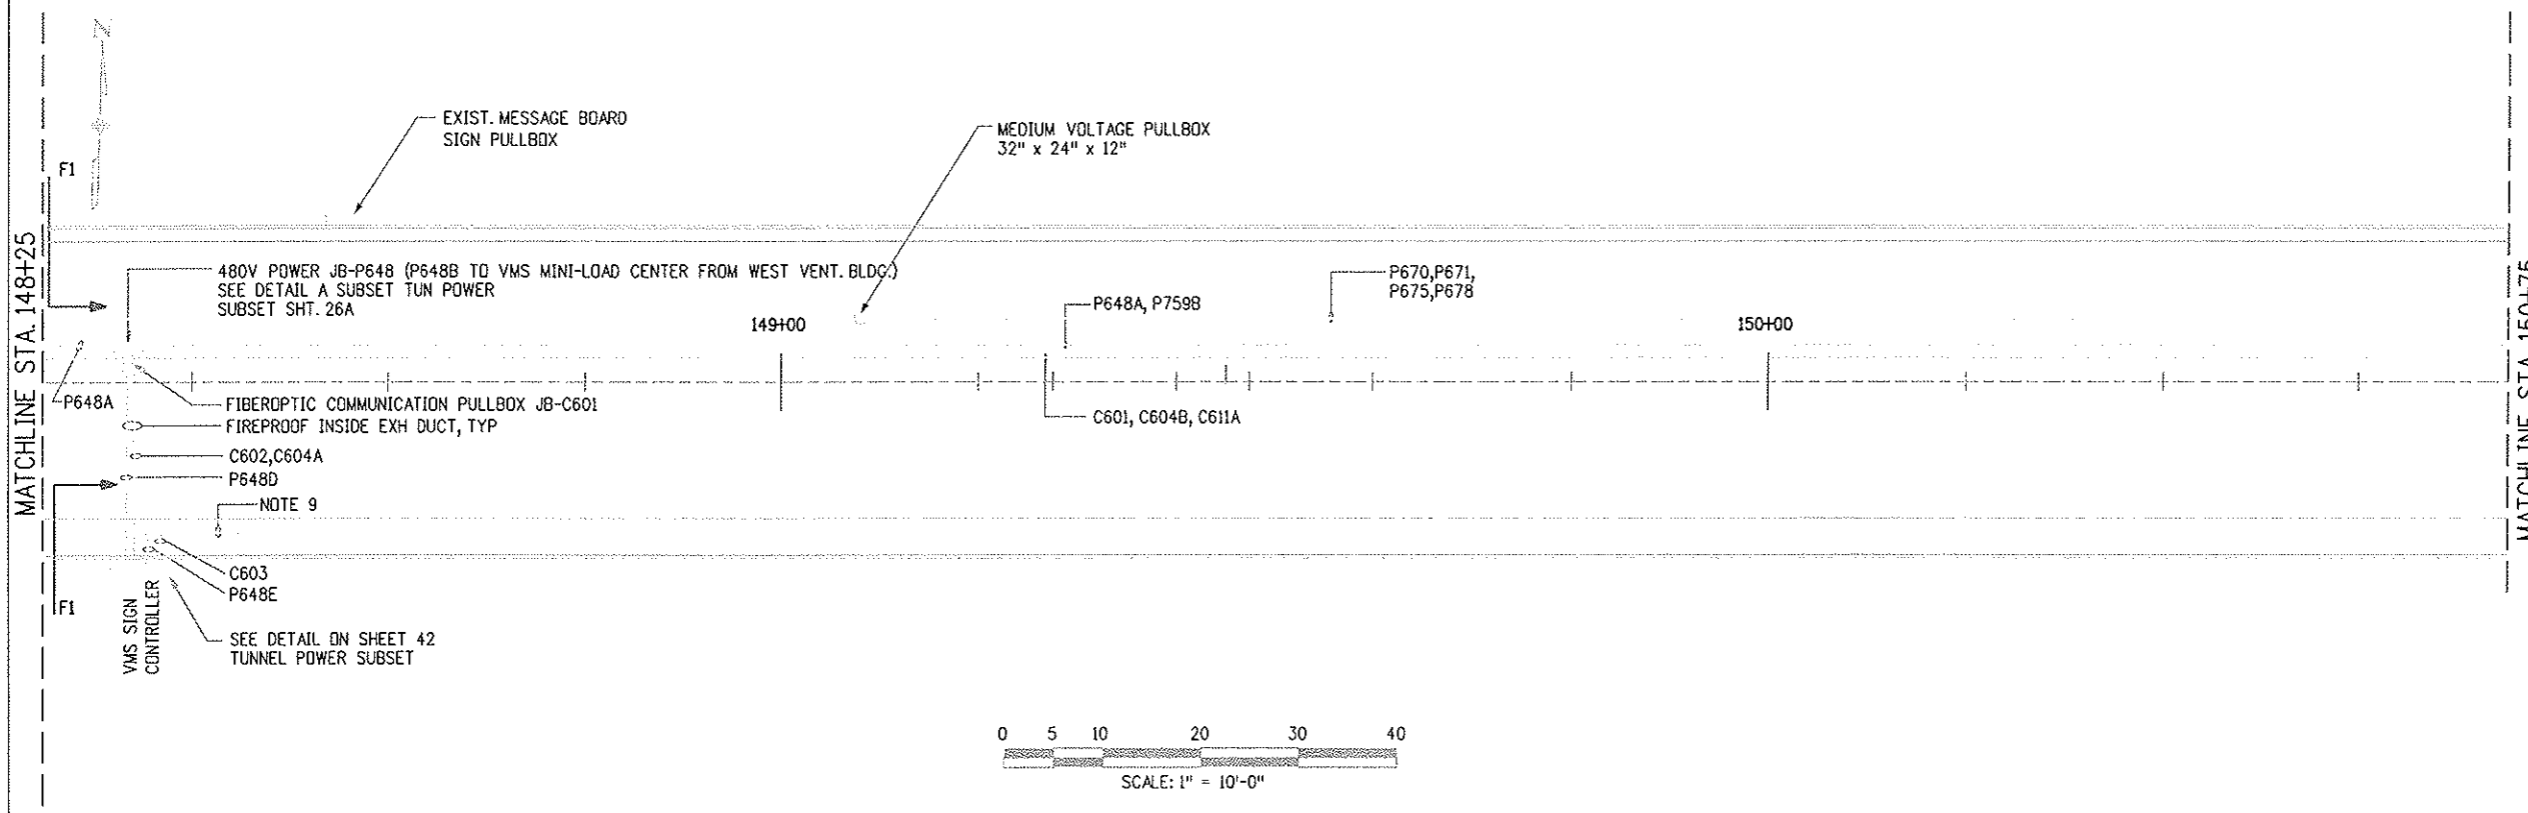


PLAN 2

Design File Name: DGNMSPEC*
 Plot File Name: \$PLOTFILE*
 Date of Plot: \$\$\$DATE\$\$\$

Computer File Information	
Creation Date:	04/26/99 Initials: SPD
Last Modification Date:	01/21/07 Initials: DJR
Full Path:	14102\800deliv\AsBuilt
Drawing File Name:	***105*
Acad Ver.	R14 Scale: 1" = 10'-0" Units:

Sheet Revisions	
<input type="checkbox"/>	07/03/07 ASBUILT DJB
<input type="checkbox"/>	
<input type="checkbox"/>	
<input type="checkbox"/>	



Colorado Department of Transportation

 P.O. BOX 399
 DUMONT, CO. 80436
 Phone: 303-512-5750 FAX: 303-512-5775
 Region 1 Mountain Residency I.N.Z.

As Constructed
No Revisions:
Revised:
Void:



NORTH TUNNEL POWER PLANS 3	
Designer:	J. WALSH
Detailer:	D. BURROUGHS
Structure Numbers	
Sheet Subset:	TUN. POWER
Subset Sheets:	26 of 45

Project No./Code
IM 0703-269
13166
Sheet Number 92

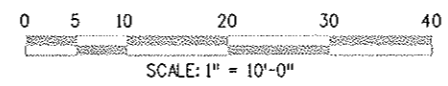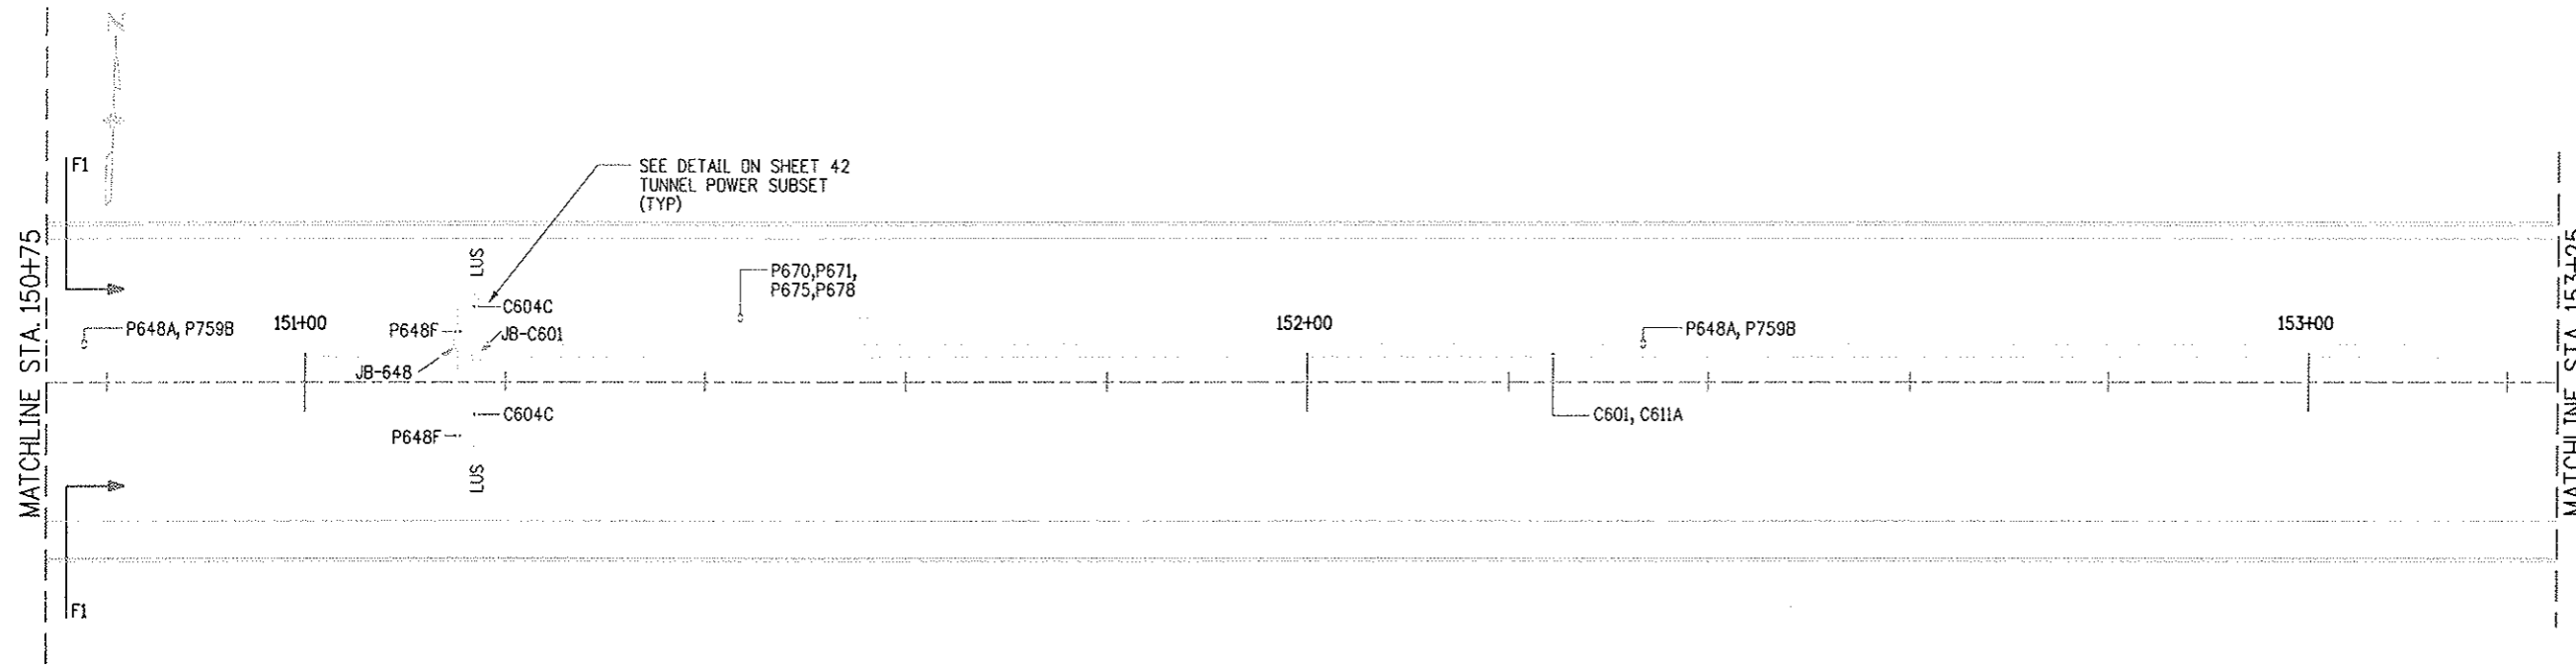NOTES:
 A. FOR GENERAL TUNNEL POWER NOTES, SEE SHEET 1 OF TUNNEL POWER SUBSET.



PLAN 1

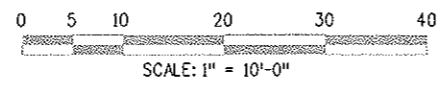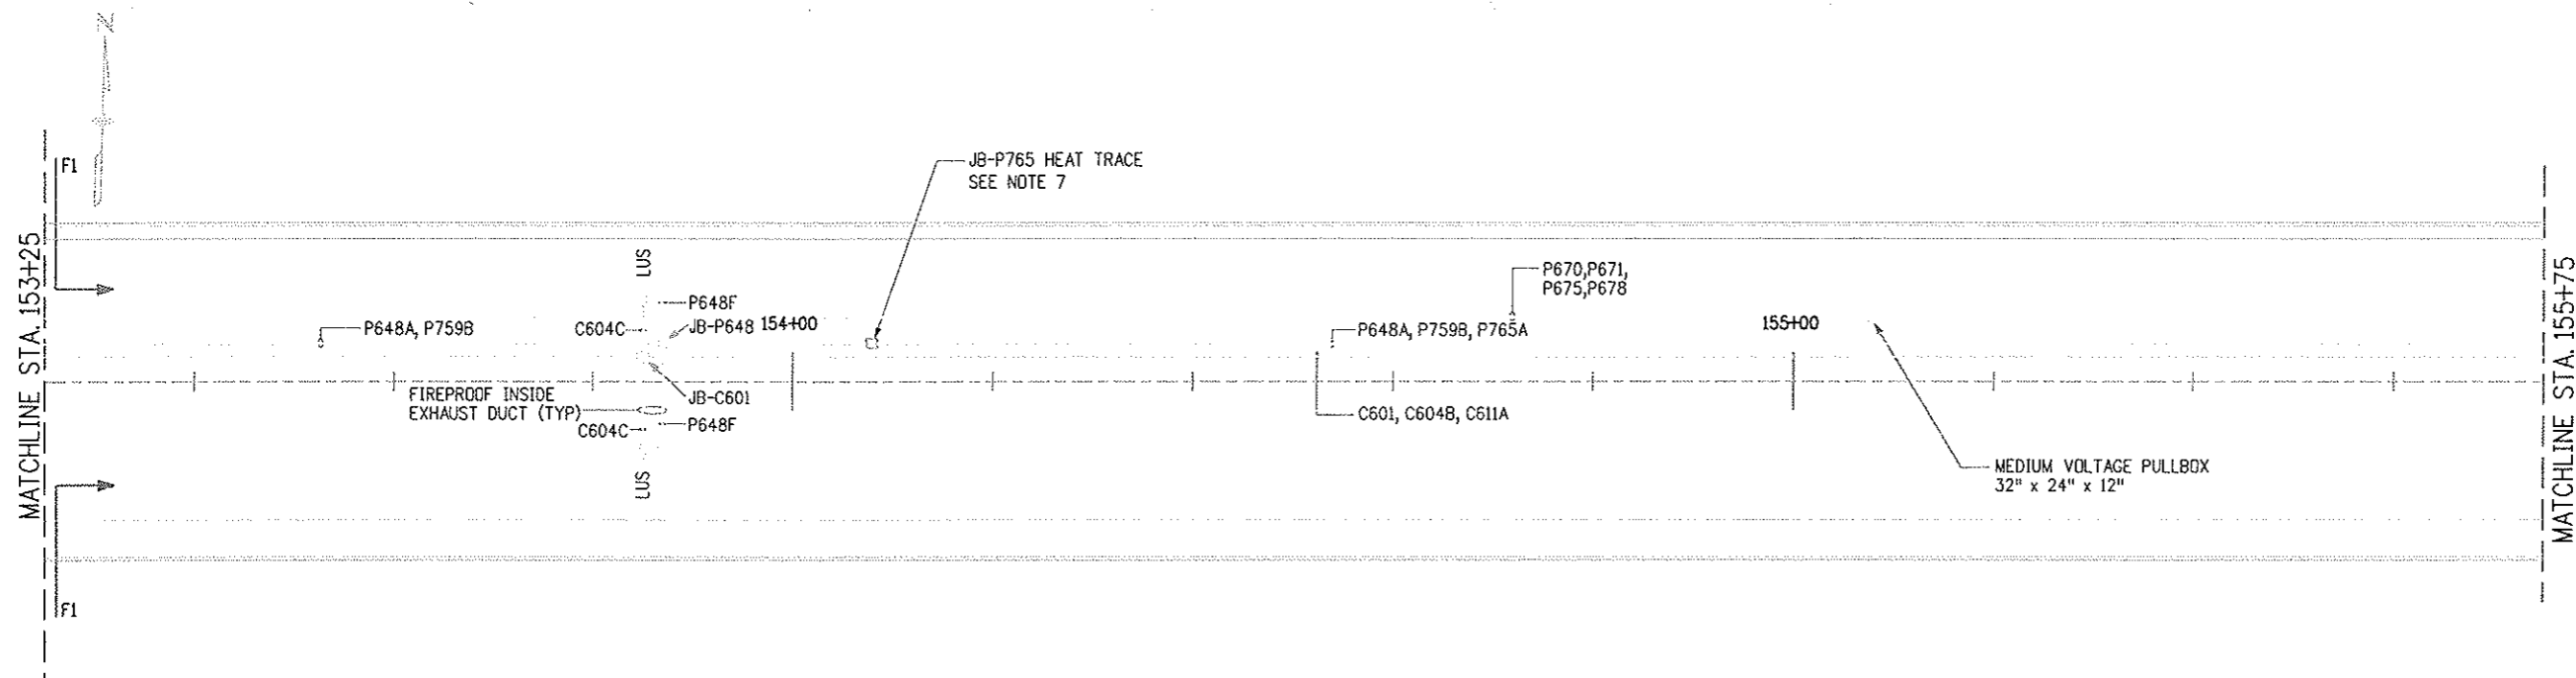


PLAN 2

Design File Name: DGN\$SPEC*
 Plot File Name: \$PLOTFILE*
 Date of Plot: \$\$\$DATE\$\$\$\$

Computer File Information	
Creation Date:	04/26/99 Initials: SFD
Last Modification Date:	03/27/07 Initials: DJB
Full Path:	14102\800deliv\AsBuilt
Drawing File Name:	***104a
Acad Ver.	R14 Scale: 1" = 10'-0" Units:

Sheet Revisions		
<input type="checkbox"/>	07/03/07	ASBUILT DJB
<input type="checkbox"/>		
<input type="checkbox"/>		
<input type="checkbox"/>		

Colorado Department of Transportation





P.O. BOX 399
 DUMONT, CO. 80436
 Phone: 303-512-5750 FAX: 303-512-5775

Region 1 Mountain Residency I.N.Z.

As Constructed
No Revisions:
Revised:
Void:

NORTH TUNNEL POWER PLANS 4		
Designer:	J. WALSH	Structure Numbers
Detailer:	RODDENBERRY	
Sheet Subset:	TUN. POWER	Subset Sheets: 27 of 45

Project No./Code
IM 0703-269
13166
Sheet Number 93

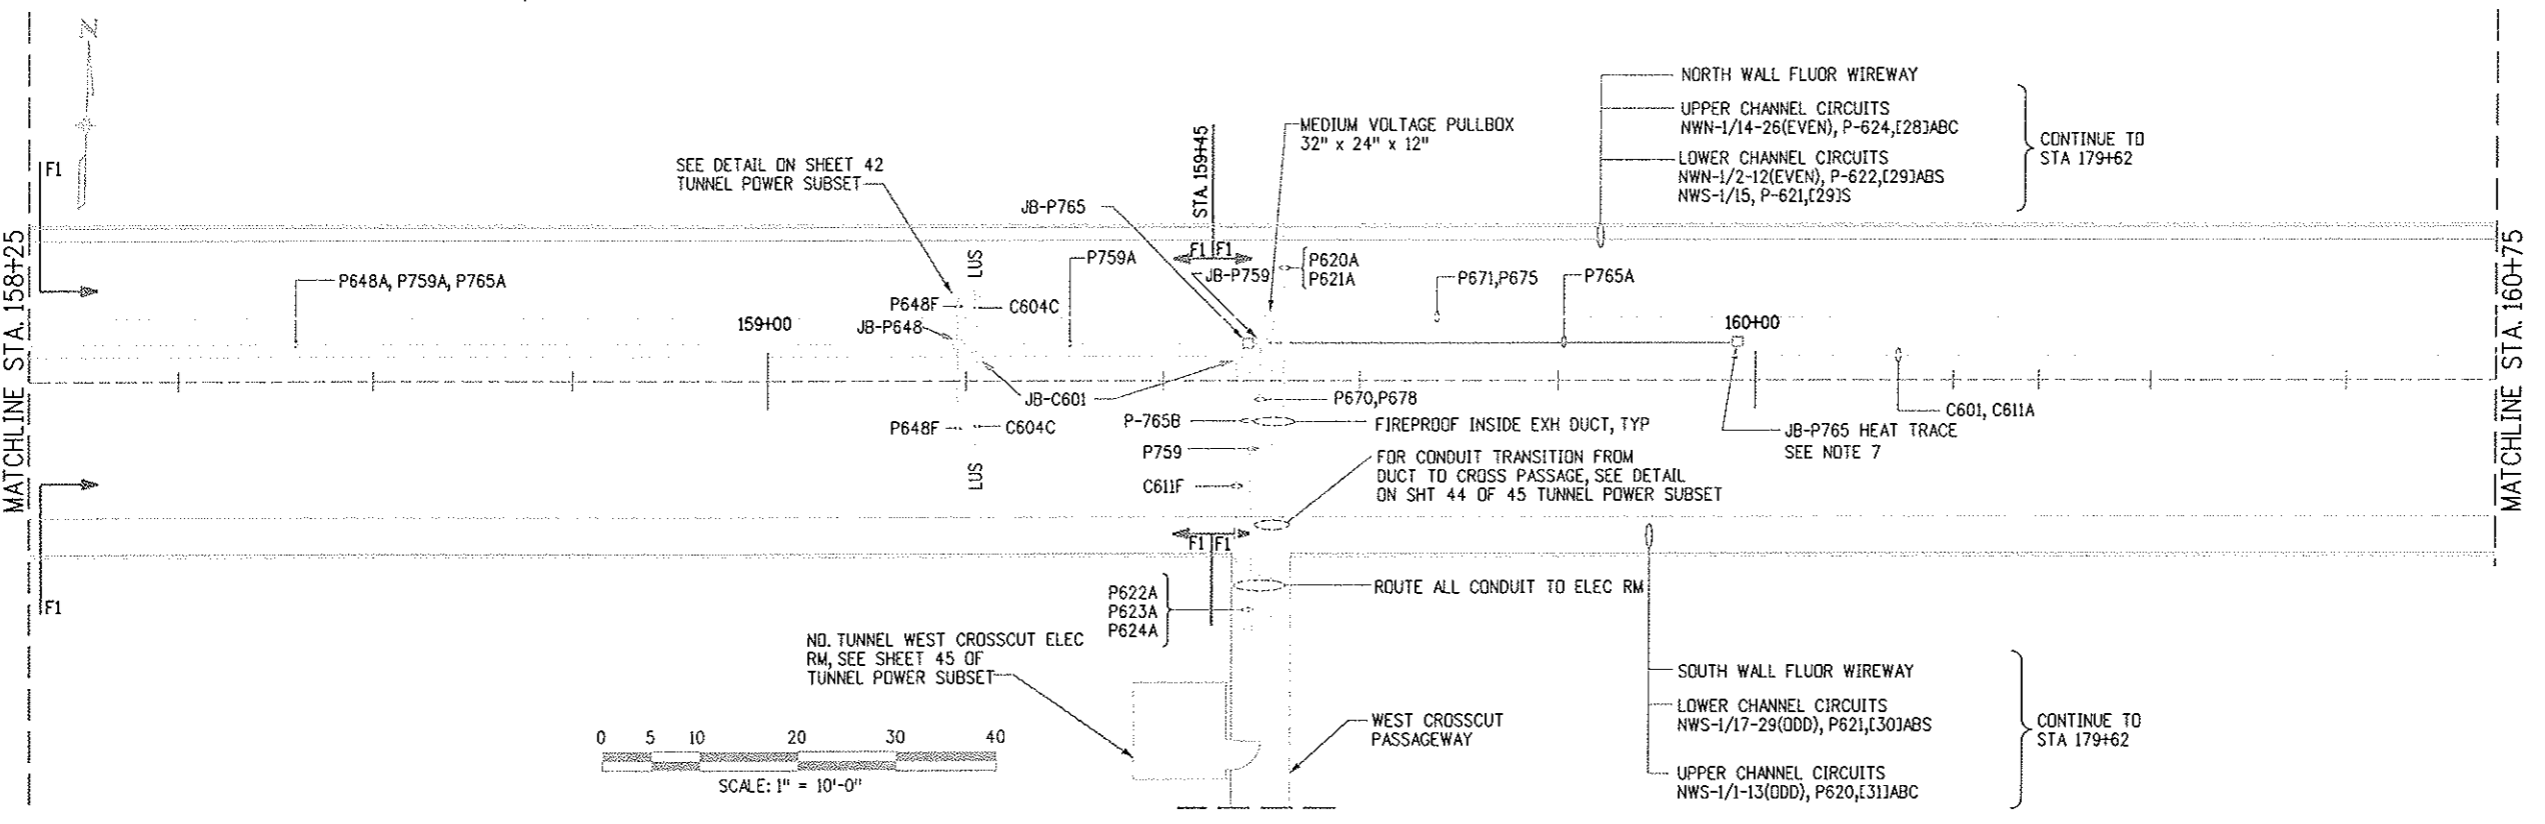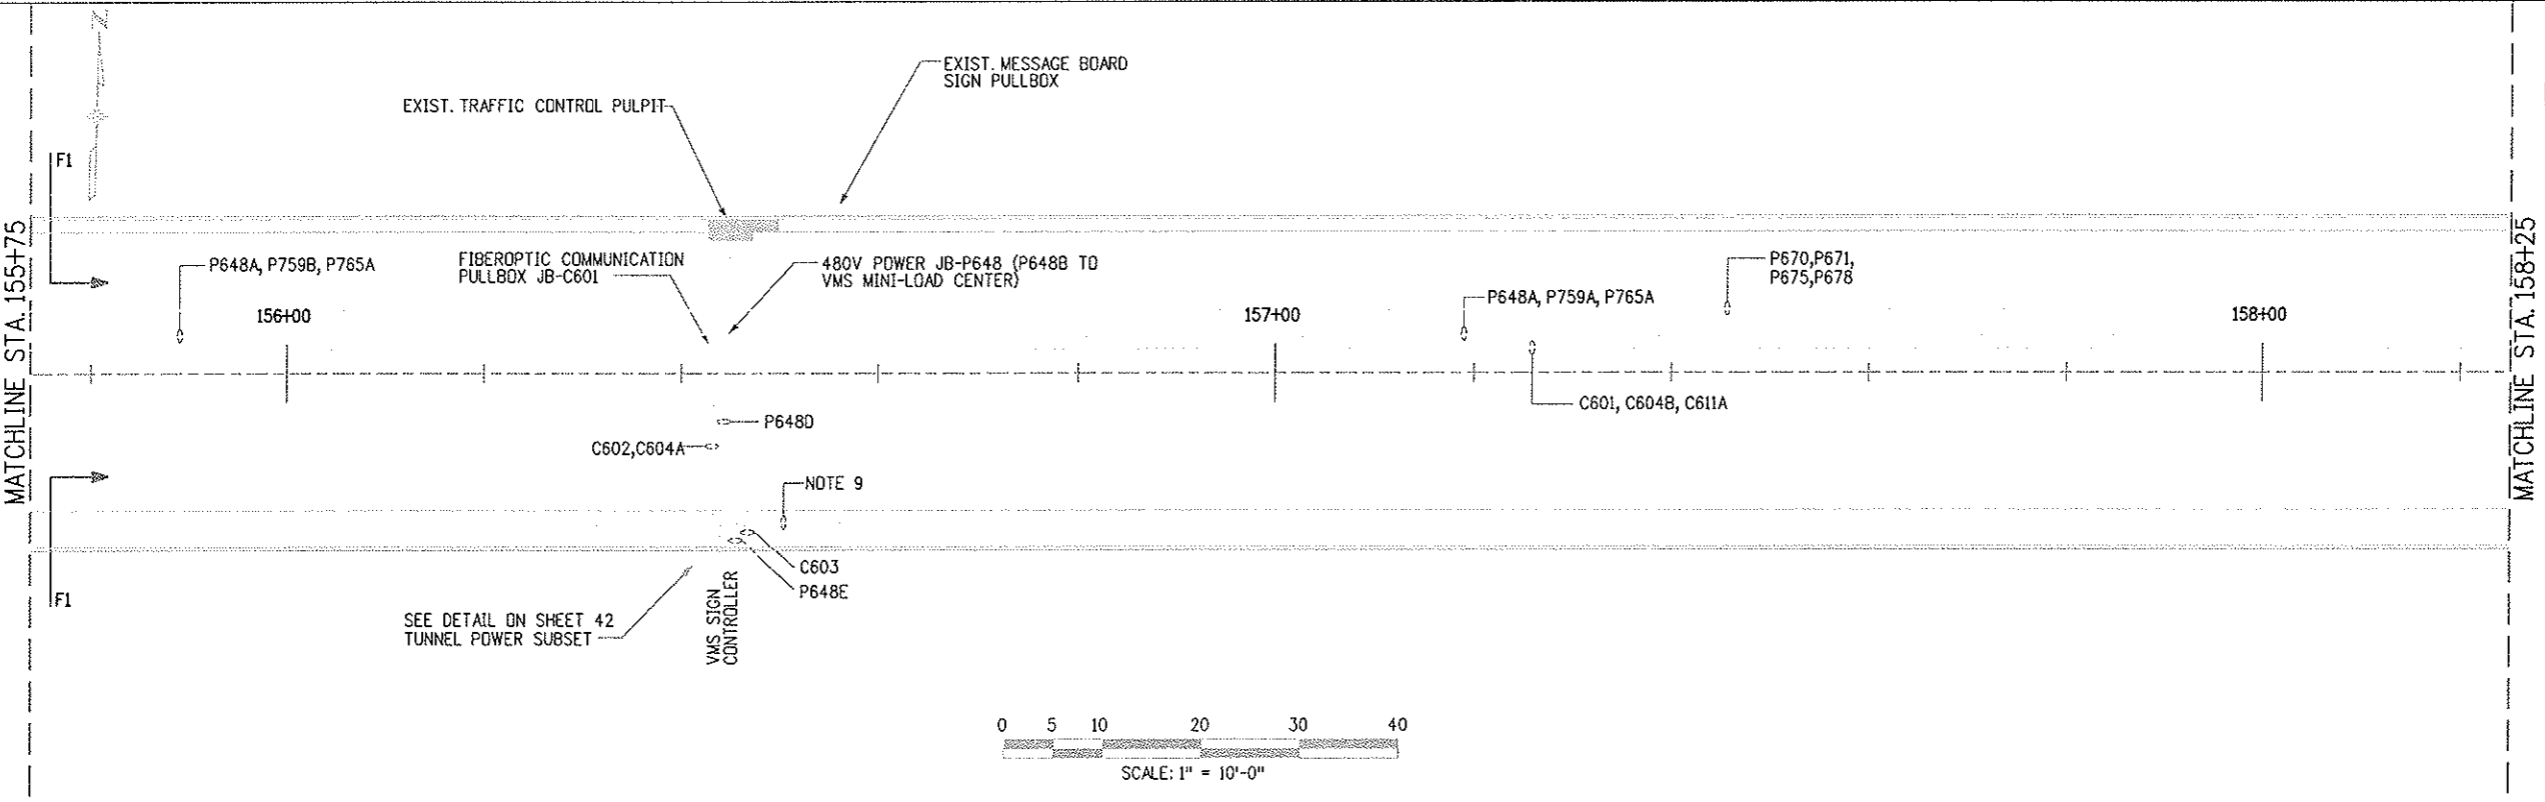


NOTES:
 A. FOR GENERAL TUNNEL POWER NOTES, SEE SHEET 1 OF TUNNEL POWER SUBSET.

Design File Name: DOWNSPEC*
 Plot File Name: SPLITFILE*
 Date of Plot: 03/03/99

Computer File Information	
Creation Date:	04/26/99 Initials: SFD
Last Modification Date:	05/27/99 Initials: DJB
Full Path:	14102\800deliv\AsBuilt
Drawing File Name:	app105a
Acad Ver.	R14 Scale: 1" = 10'-0" Units:

Sheet Revisions	
07/03/07	ASBUILT DJB

Colorado Department of Transportation



P.O. BOX 399
 DUMONT, CO. 80436
 Phone: 303-512-5750 FAX: 303-512-5775

Region 1 Mountain Residency I.N.Z.



As Constructed
No Revisions:
Revised:
Void:

NORTH TUNNEL POWER PLANS 5	
Designer:	J. WALSH
Detailer:	RODDENBERRY
Sheet Subset:	TUN. POWER
Subset Sheets:	28 of 45



Project No./Code	
IM 0703-269	
13166	
Sheet Number	94

NOTES:

A. FOR GENERAL TUNNEL POWER NOTES, SEE SHEET 1 OF TUNNEL POWER SUBSET.

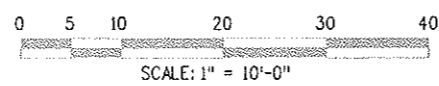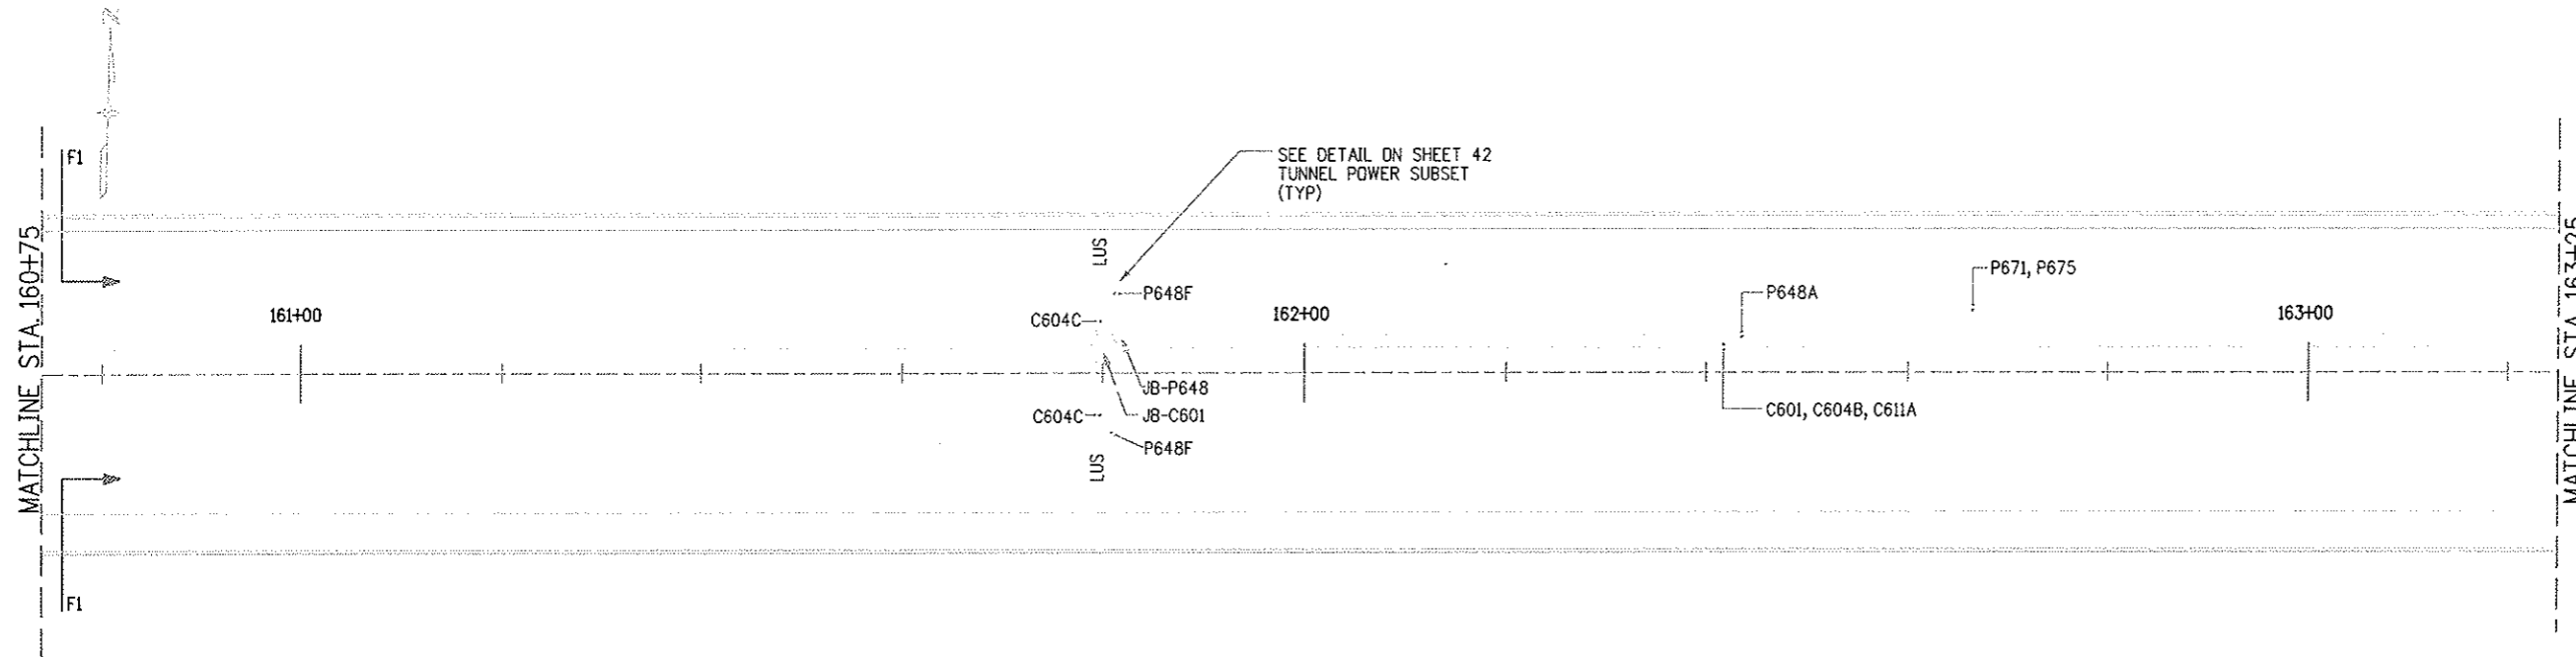

PLAN 1

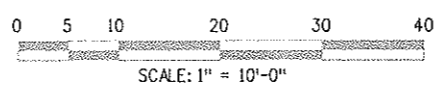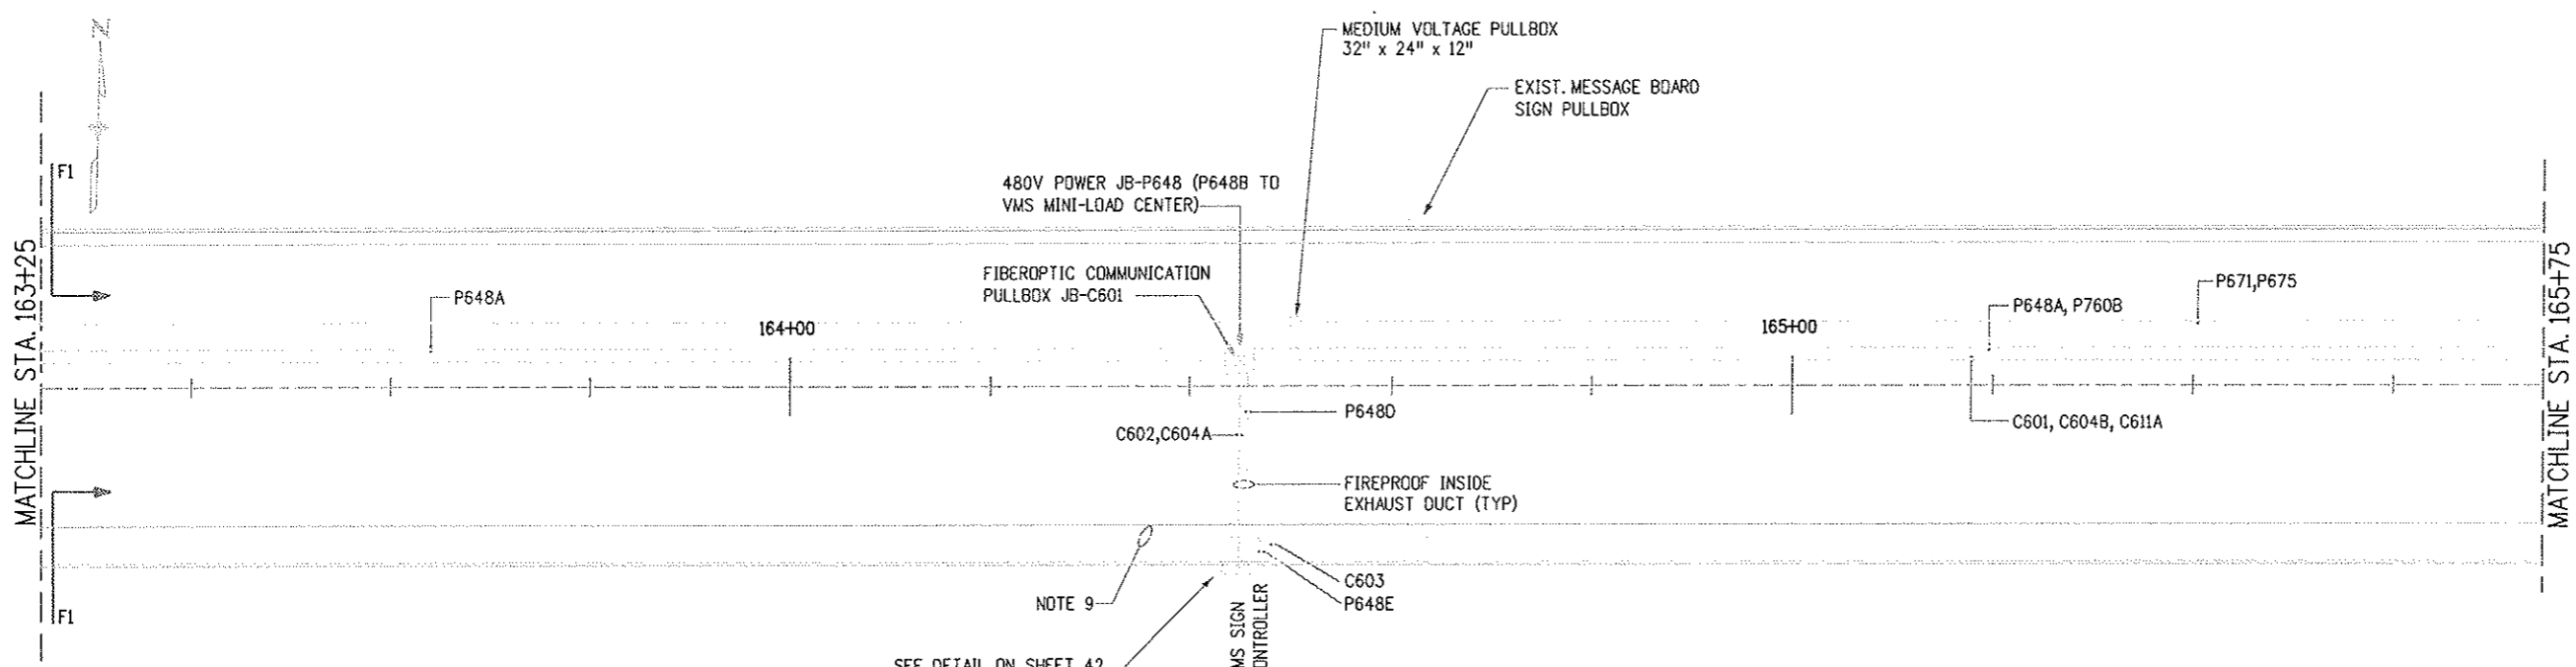


PLAN 2

Design File Name: DGN5SPEC*
 Plot File Name: \$PLOTFILE*
 Date of Plot: \$\$\$\$\$\$DATE\$\$\$\$\$

Computer File Information	
Creation Date:	04/26/99 Initials: SFD
Last Modification Date:	01/21/02 Initials: DJR
Full Path:	14102\700CADD\{Discipline}\{Filename}
Drawing File Name:	app106.dwg
Acad Ver.:	R14 Scale: 1" = 10'-0" Units:

Sheet Revisions		
<input type="checkbox"/>	07/03/07	ASBUILT DJB
<input type="checkbox"/>		
<input type="checkbox"/>		
<input type="checkbox"/>		

Colorado Department of Transportation



P.O. BOX 399
 DUMONT, CO. 80436
 Phone: 303-512-5750 FAX: 303-512-5775

Region 1 Mountain Residency I.N.Z.





As Constructed
No Revisions:
Revised:
Void:

NORTH TUNNEL POWER PLANS 6	
Designer:	J. WALSH
Detailer:	RODDENBERRY
Sheet Subset:	TUN. POWER
Structure Numbers	
Subset Sheets:	29 of 45

Project No./Code	
IM 0703-269	
13166	
Sheet Number	95

NOTES:

A. FOR GENERAL TUNNEL POWER NOTES, SEE SHEET 1 OF TUNNEL POWER SUBSET.

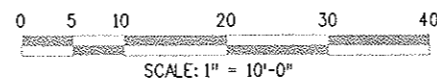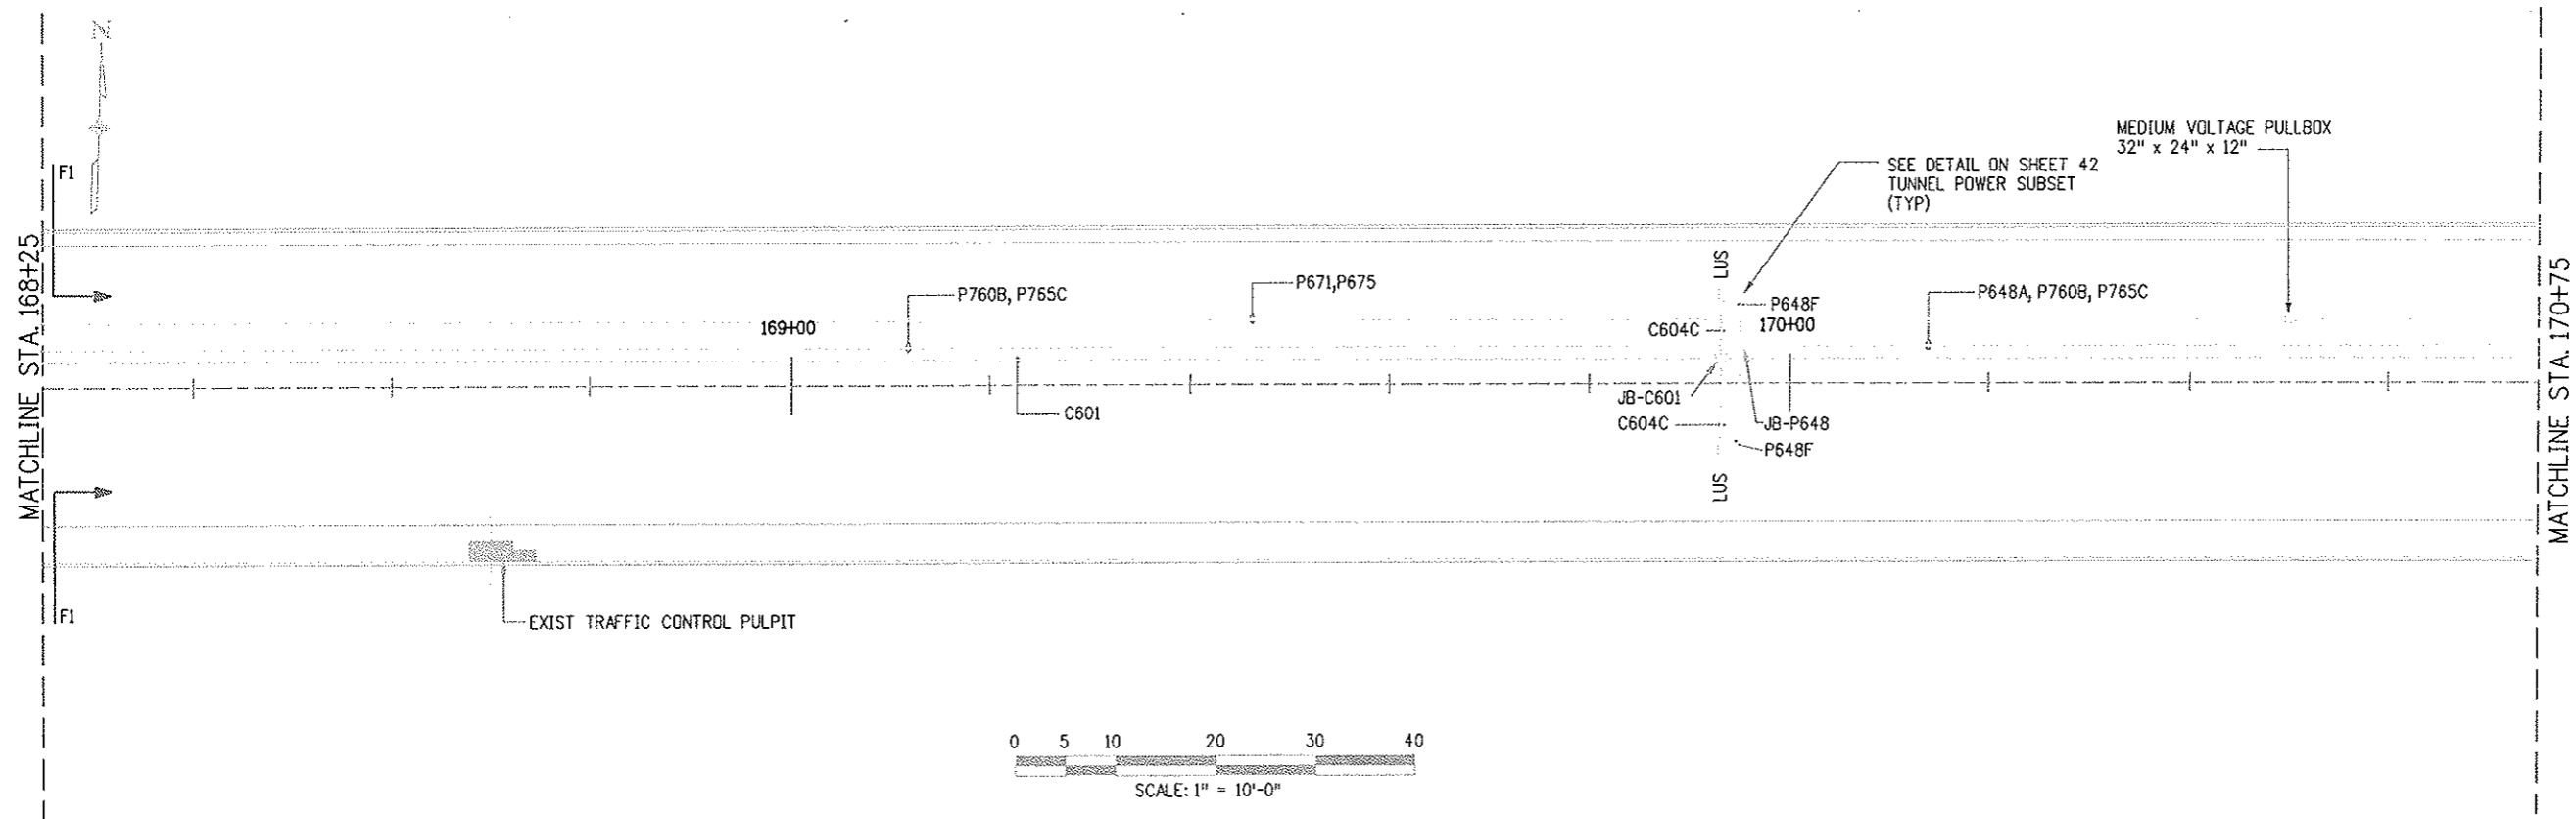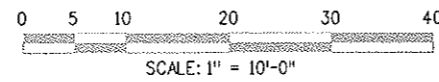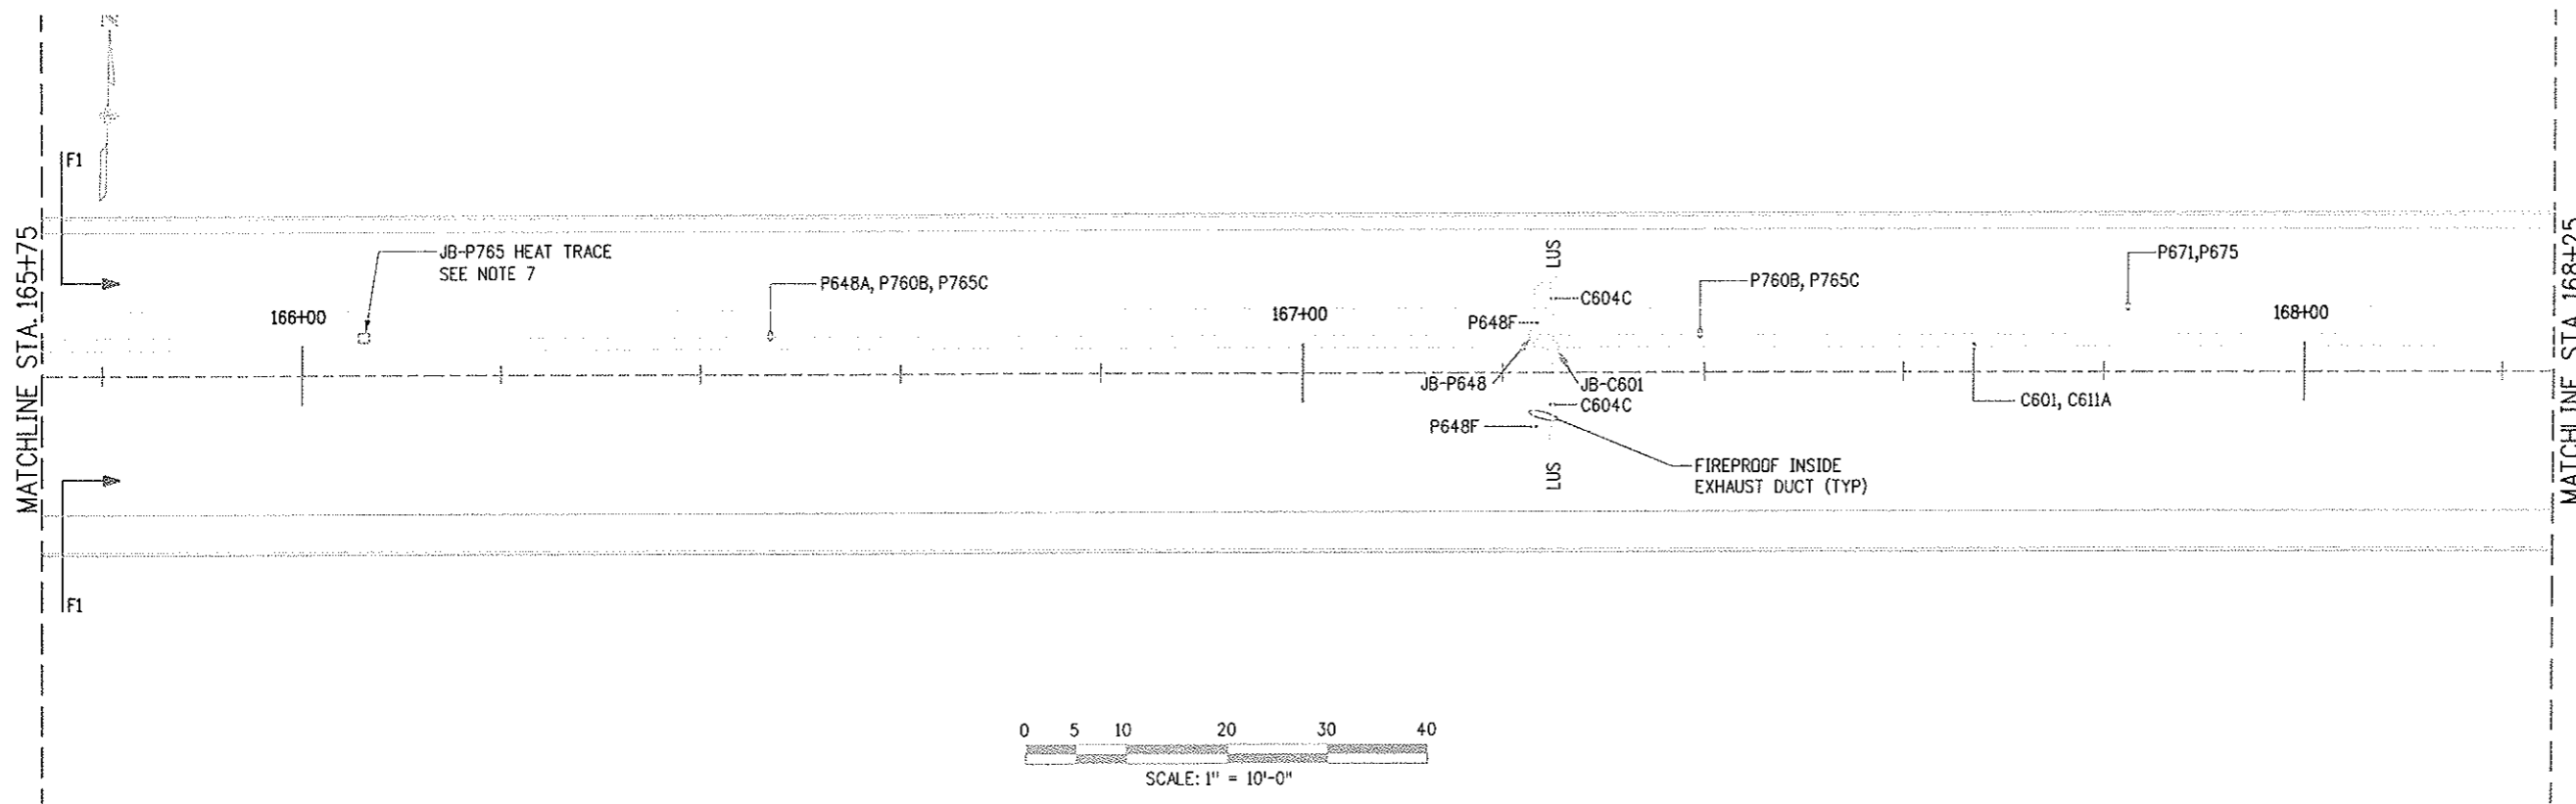

Design File Name: D:\nsr\c\c*
 Plot File Name: PLOTFILE*
 Date of Plot: 03/03/07

Computer File Information	
Creation Date:	04/26/99 Initials: SFD
Last Modification Date:	01/01/07 Initials: DJB
Full Path:	14102\800deliv\AsBUILT
Drawing File Name:	03/03/07
Acad Ver.:	R14 Scale: 1" = 10'-0" Units:

Sheet Revisions		
<input type="checkbox"/>	07/03/07	ASBUILT DJB
<input type="checkbox"/>		
<input type="checkbox"/>		
<input type="checkbox"/>		

Colorado Department of Transportation

As Constructed

No Revisions:

Revised:

Void:


P.O. BOX 399
DUMONT, CO. 80436
Phone: 303-512-5750 FAX: 303-512-5775

Region 1 Mountain Residency I.N.Z.


NORTH TUNNEL POWER PLANS 7		
Designer:	J. WALSH	Structure Numbers
Detailer:	RODENBERRY	
Sheet Subset:	TUN. POWER	Subset Sheets: 30 of 45

Project No./Code	
IM 0703-269	
13166	
Sheet Number	96

NOTES:
 A. FOR GENERAL TUNNEL POWER NOTES, SEE SHEET 1 TUNNEL POWER SUBSET.

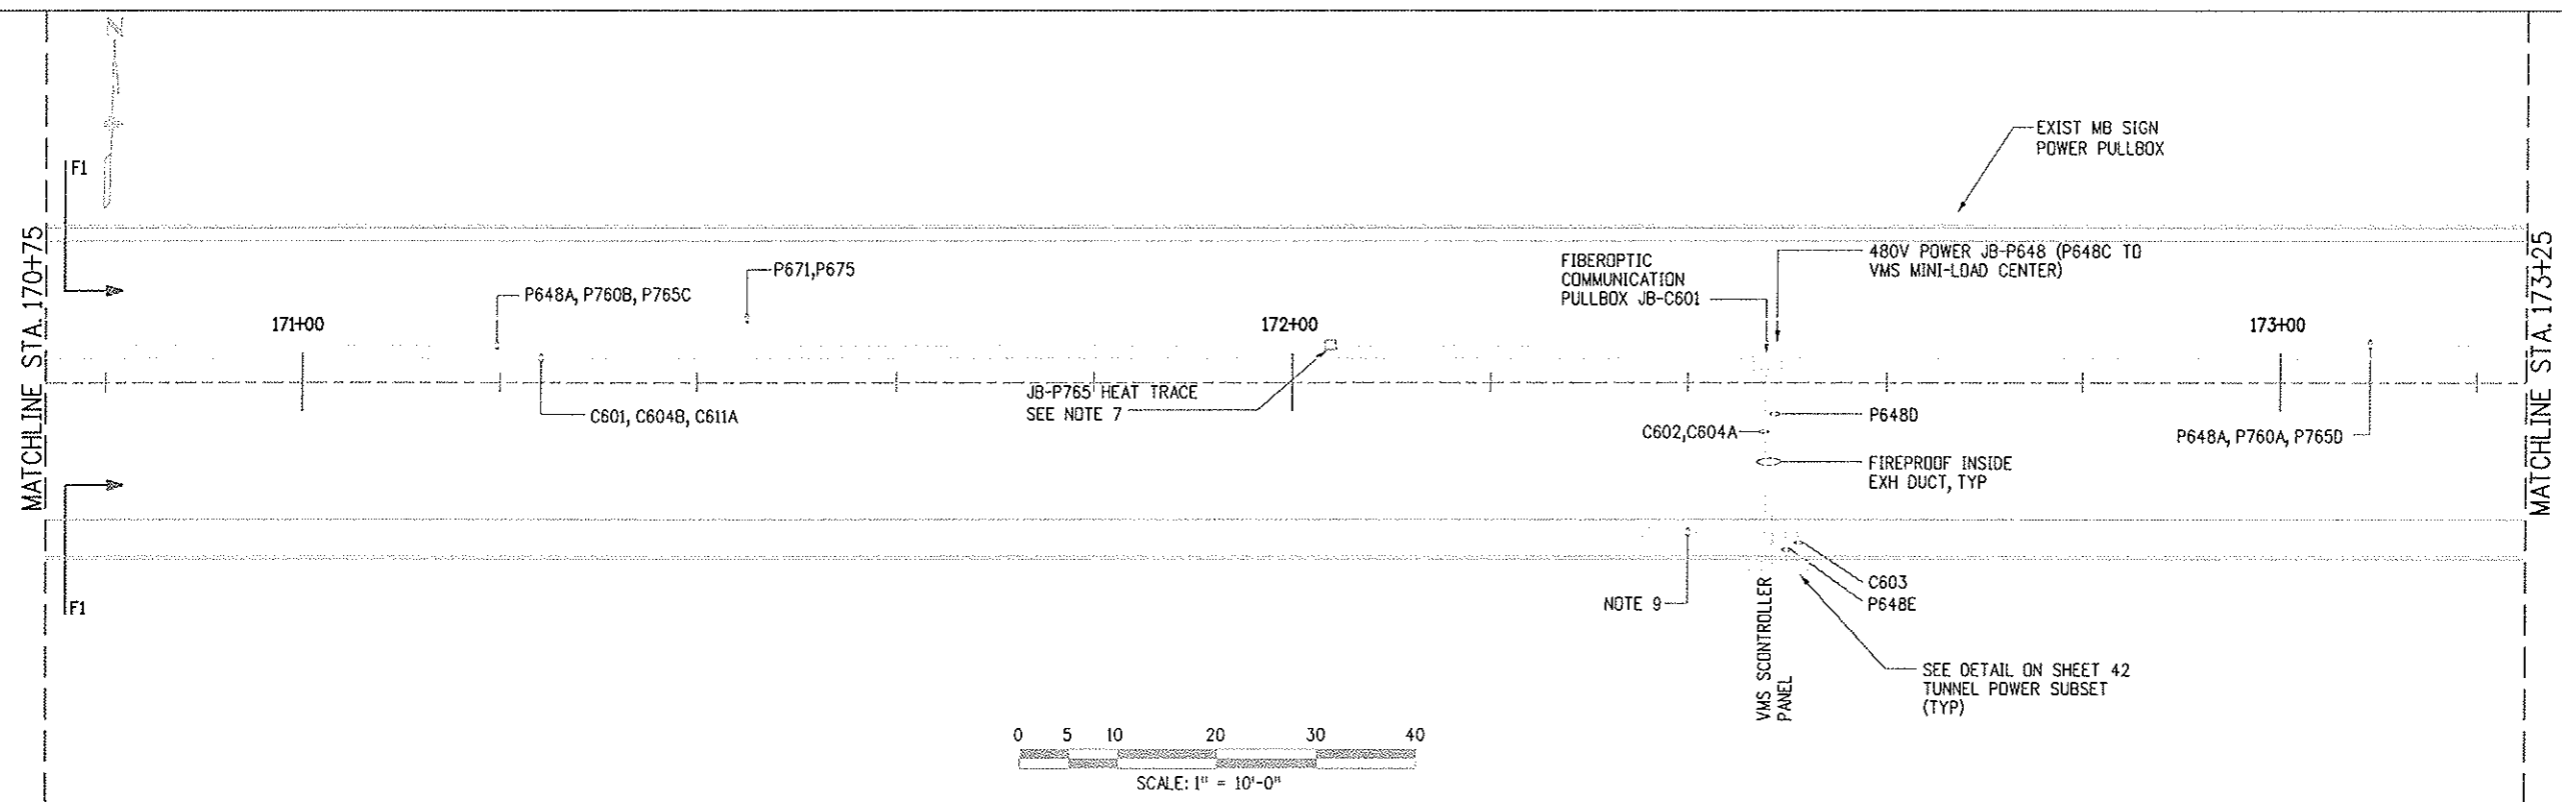

PLAN 1

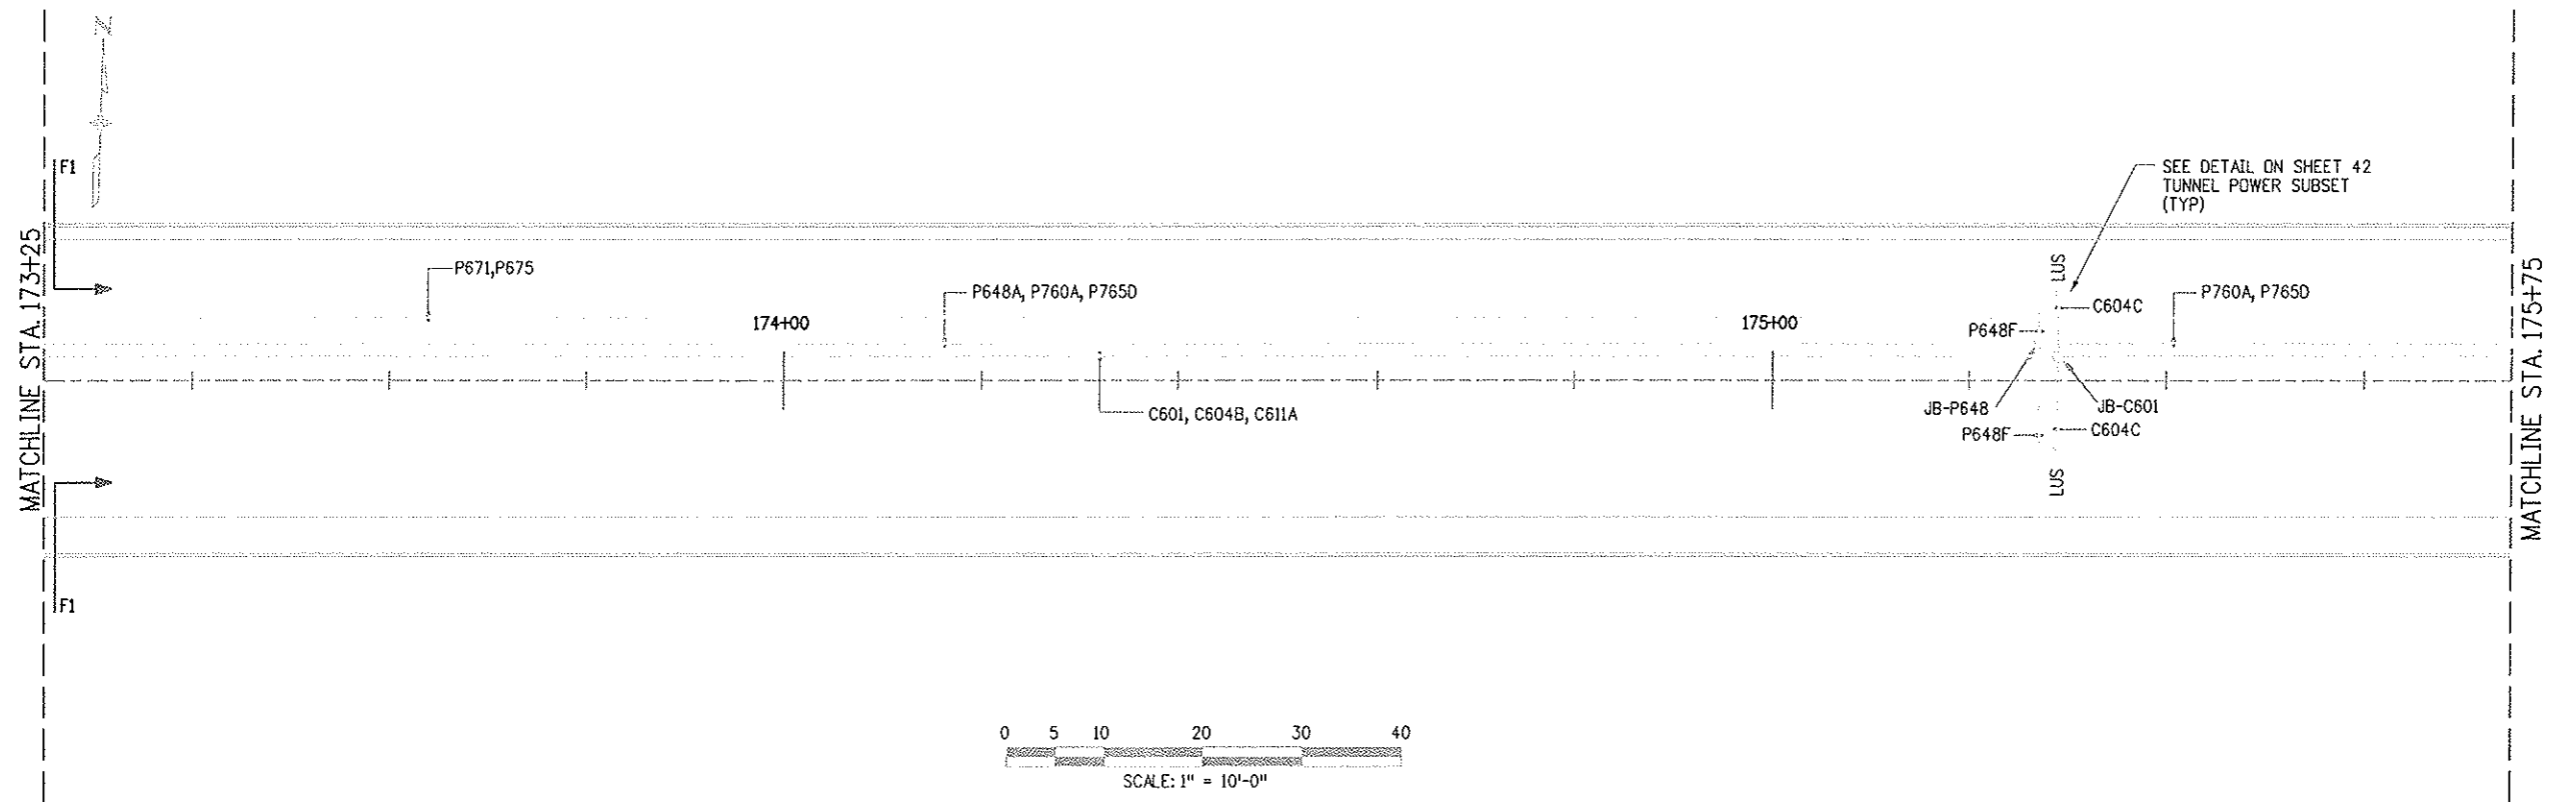


PLAN 2

Design File Name: D:\GSP\SPEC*
 Plot File Name: \$PLOTFILE*
 Date of Plot: \$\$\$\$\$DATE\$\$\$\$\$

Computer File Information	
Creation Date:	04/26/99 Initials: SFP
Last Modification Date:	01/21/07 Initials: DJB
Full Path:	14102\800deliv\AsBuilt
Drawing File Name:	app108a
Acad Ver.	R14 Scale: 1" = 10'-0" Units:



Sheet Revisions	
<input type="checkbox"/>	07/03/07 ASBUILT DJB
<input type="checkbox"/>	
<input type="checkbox"/>	
<input type="checkbox"/>	

Colorado Department of Transportation

 P.O. BOX 399
 DUMONT, CO. 80436
 Phone: 303-512-5750 FAX: 303-512-5775
 Region 1 Mountain Residency I.N.Z.



As Constructed
No Revisions:
Revised:
Void:

NORTH TUNNEL POWER PLANS 8	
Designer:	J. WALSH
Detailer:	RODDENBERRY
Structure Numbers	
Sheet Subset:	TUN. POWER
Subset Sheets:	31 of 45

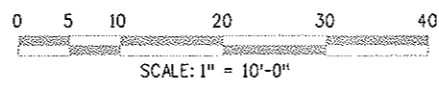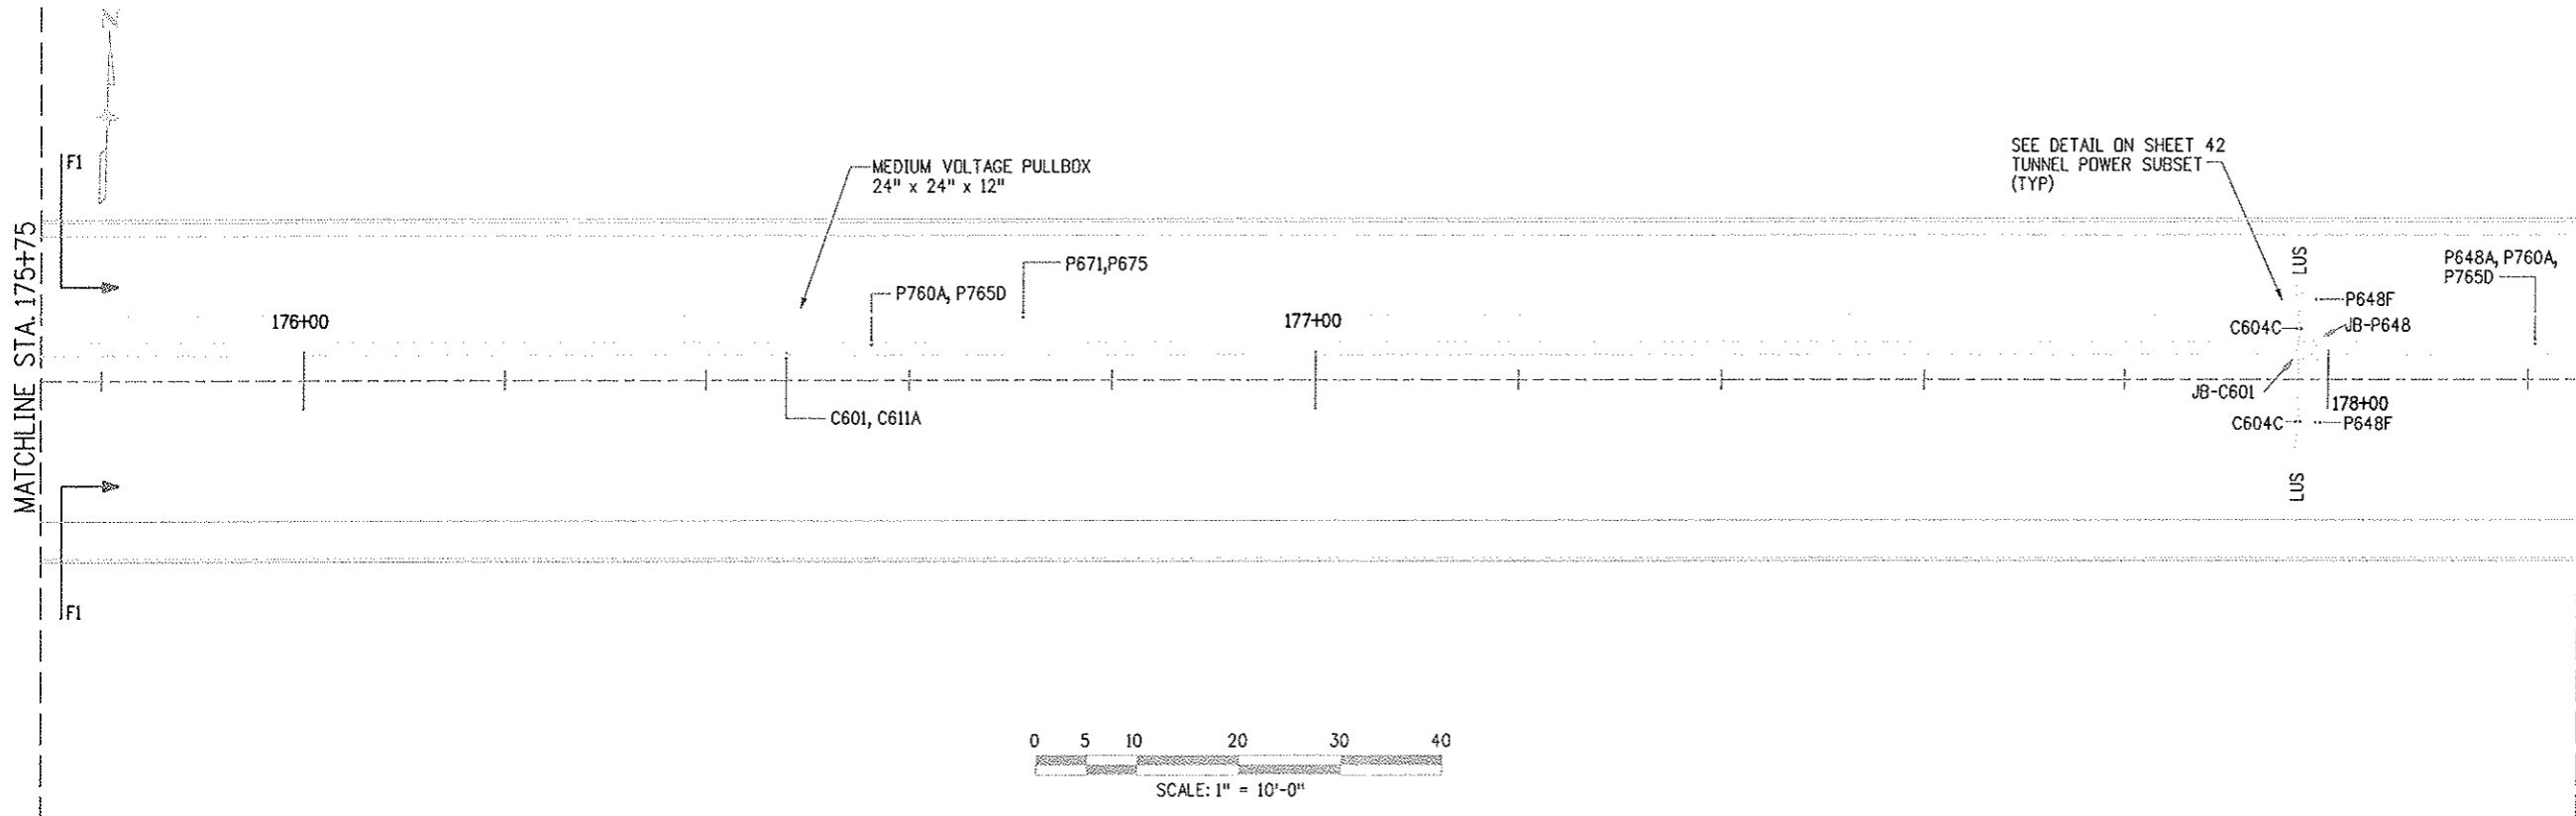Project No./Code
IM 0703-269
13166
Sheet Number 97



PLAN 1

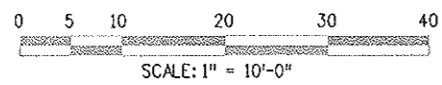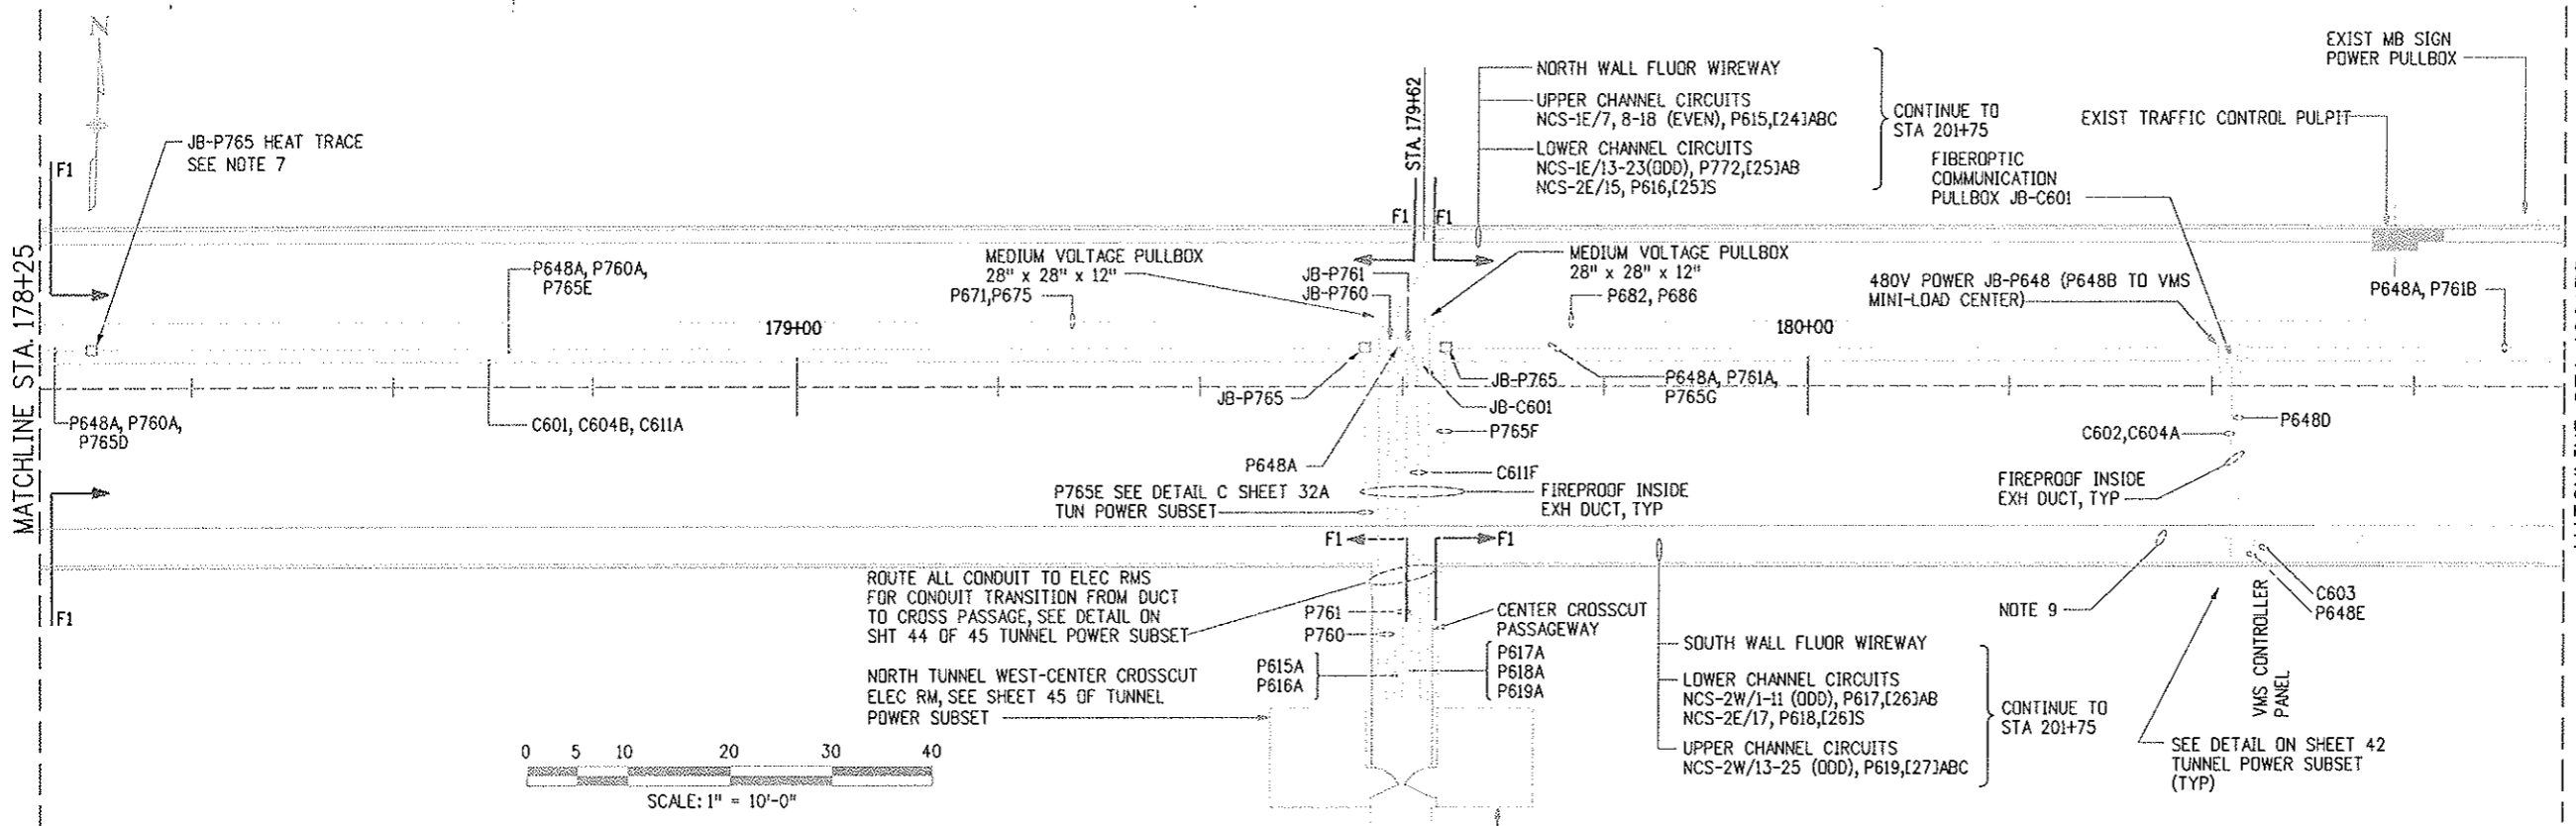

PLAN 2

NOTES:
A. FOR GENERAL TUNNEL POWER NOTES, SEE SHEET 1 OF TUNNEL POWER SUBSET.

SEE DETAIL ON SHEET 42
TUNNEL POWER SUBSET
(TYP)

ROUTE ALL CONDUIT TO ELEC RMS
FOR CONDUIT TRANSITION FROM DUCT
TO CROSS PASSAGE, SEE DETAIL ON
SHT 44 OF 45 TUNNEL POWER SUBSET


NORTH TUNNEL WEST-CENTER CROSSCUT
ELEC RM, SEE SHEET 45 OF TUNNEL
POWER SUBSET

NORTH TUNNEL EAST-CENTER CROSSCUT
ELEC RM, SEE SHEET 45 OF TUNNEL
POWER SUBSET

NOTE 9
SEE DETAIL ON SHEET 42
TUNNEL POWER SUBSET
(TYP)



Plot File Name: \$PLOTFILE\$
 Date of Plot: \$\$\$DATE\$\$\$

Computer File Information		Sheet Revisions		Colorado Department of Transportation		As Constructed		NORTH TUNNEL POWER PLANS 9		Project No./Code	
Creation Date:	04/26/99	Initials:	SPD	07/03/07	ASBUILT	DJB	No Revisions:	Designer: J. WALSH		IM 0703-269	
Last Modification Date:	05/28/07	Initials:	DJB				Revised:	Detailer: RODENBERRY		13166	
Full Path:	14102\700CADD\Discipline\[Filename]										
Drawing File Name:	eppl09n										
Acad Ver.	R14	Scale:	1" = 10'-0"	Units:			Void:	Sheet Subset: TUN POWER		Sheet Number 98	
								Structure Numbers		Subset Sheets: 32 of 45	
								VMS CONTROLLER PANEL		Sheet Number 98	


 P.O. BOX 399
 DUMONT, CO. 80436
 Phone: 303-512-5750 FAX: 303-512-5775
 Region 1 Mountain Residency I.N.Z.

NOTES:


A. FOR GENERAL TUNNEL POWER NOTES, SEE SHEET 1 OF TUNNEL POWER SUBSET.

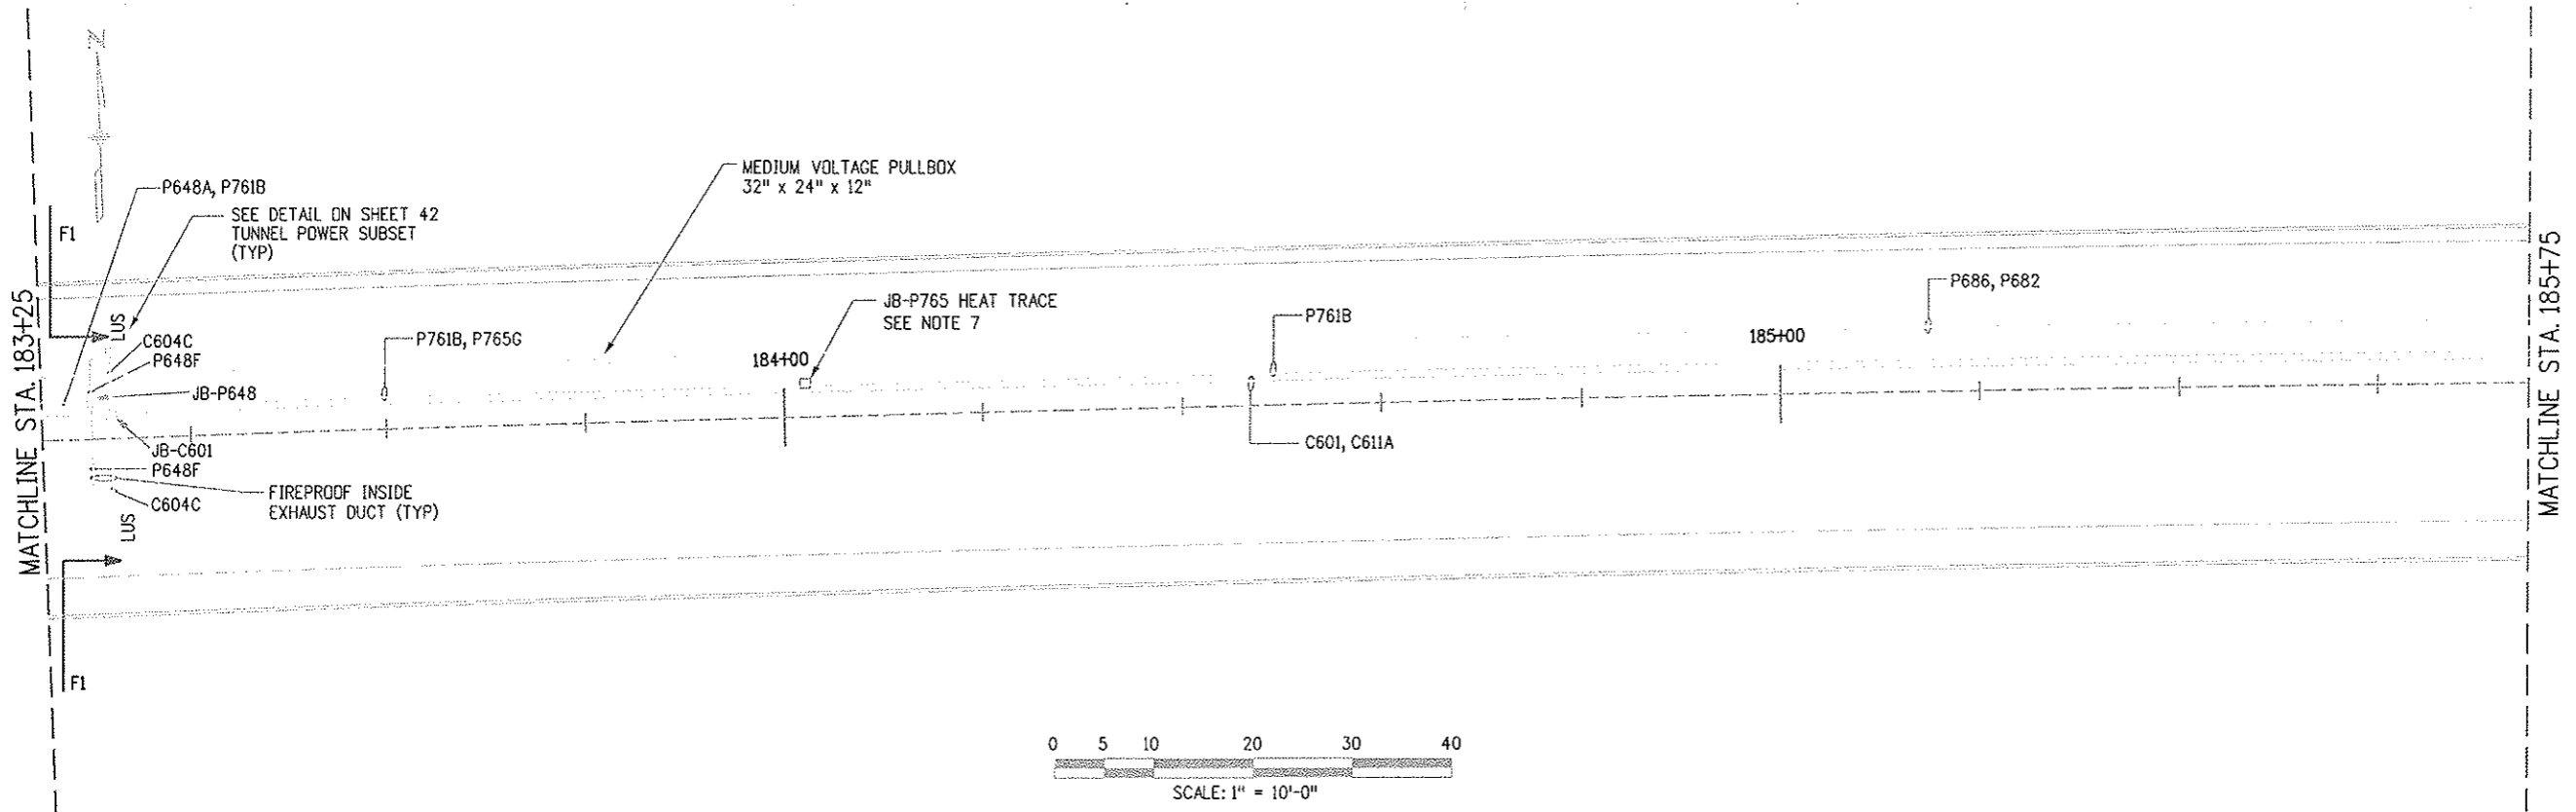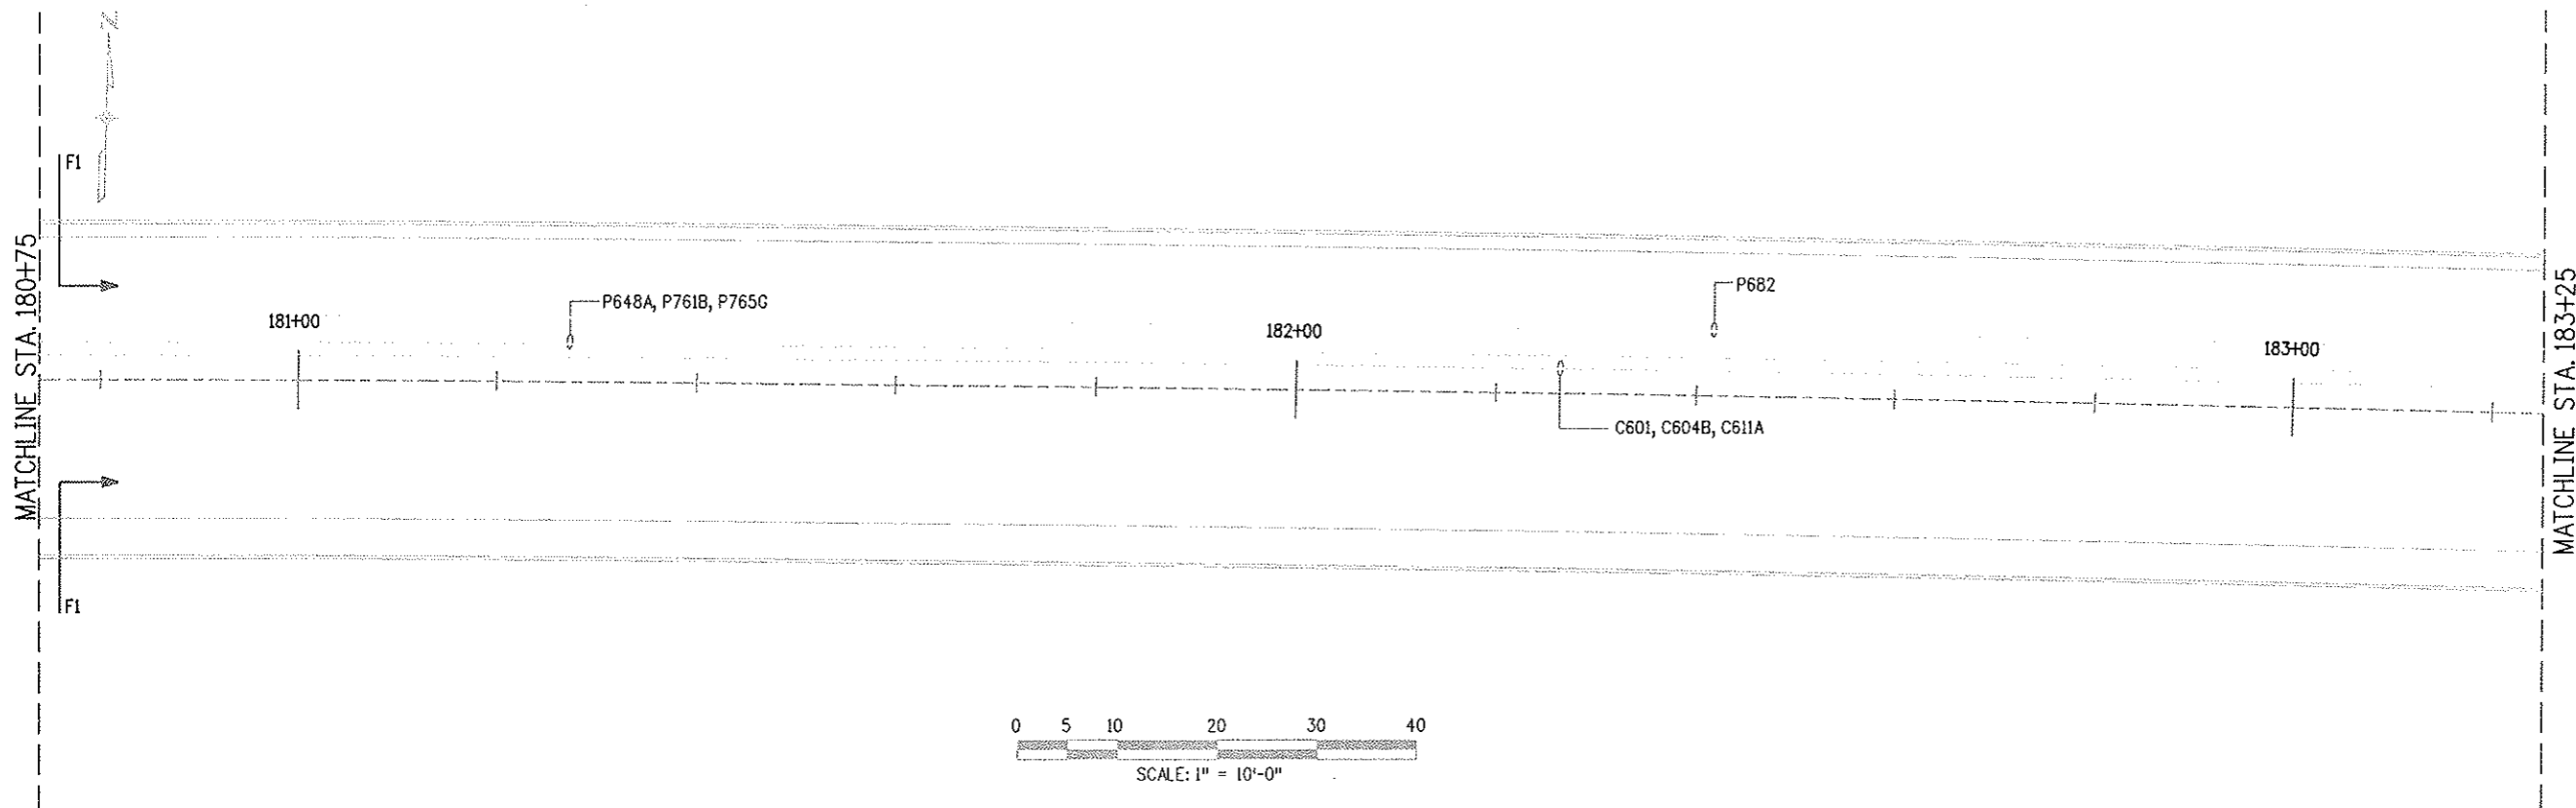

Design File Name: DGN\SPEC*
 Plot File Name: SPLD\FILE*
 Date of Plot: 05/01/07

Computer File Information		Sheet Revisions	
Creation Date:	04/26/99 Initials: SFD	07/03/07	ASBUILT DJB
Last Modification Date:	05/01/07 Initials: DJR		
Full Path:	14102\800Deliv\AsBuilt		
Drawing File Name:	eppl0n		
Acad Ver.	R14 Scale: 1" = 10'-0" Units: English		

Colorado Department of Transportation





P.O. BOX 399
 DUMONT, CO. 80436
 Phone: 303-512-5750 FAX: 303-512-5775

Region 1 Mountain Residency I.N.Z.



As Constructed		NORTH TUNNEL POWER PLANS 10		Project No./Code	
No Revisions:				IM 0703-269	
Revised:		Designer: J. WALSH	Structure Numbers	13166	
Void:		Detailer: RODDENBERRY			
		Sheet Subset: TUN POWER	Subset Sheets: 33 of 45	Sheet Number	99

NOTES:

A. FOR GENERAL TUNNEL POWER NOTES, SEE SHEET 1 OF TUNNEL POWER SUBSET.

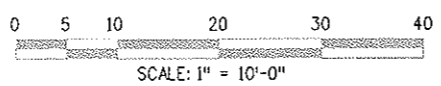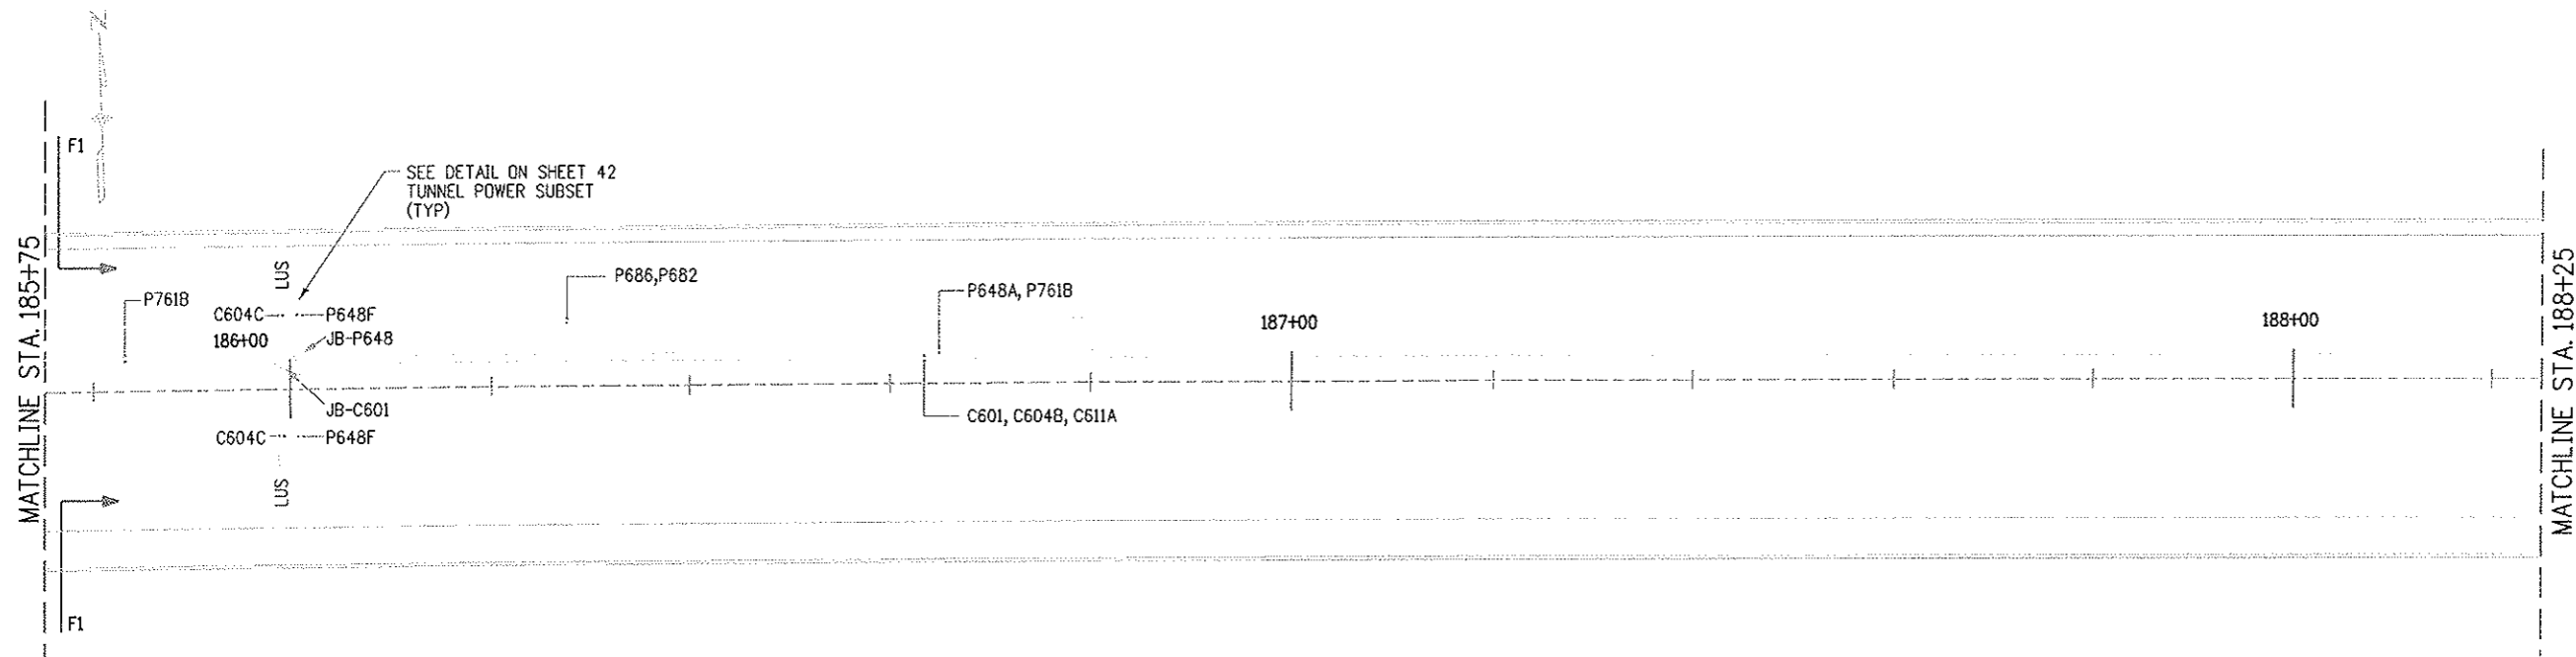

PLAN 1

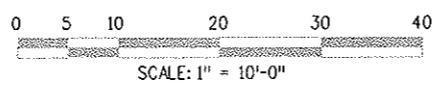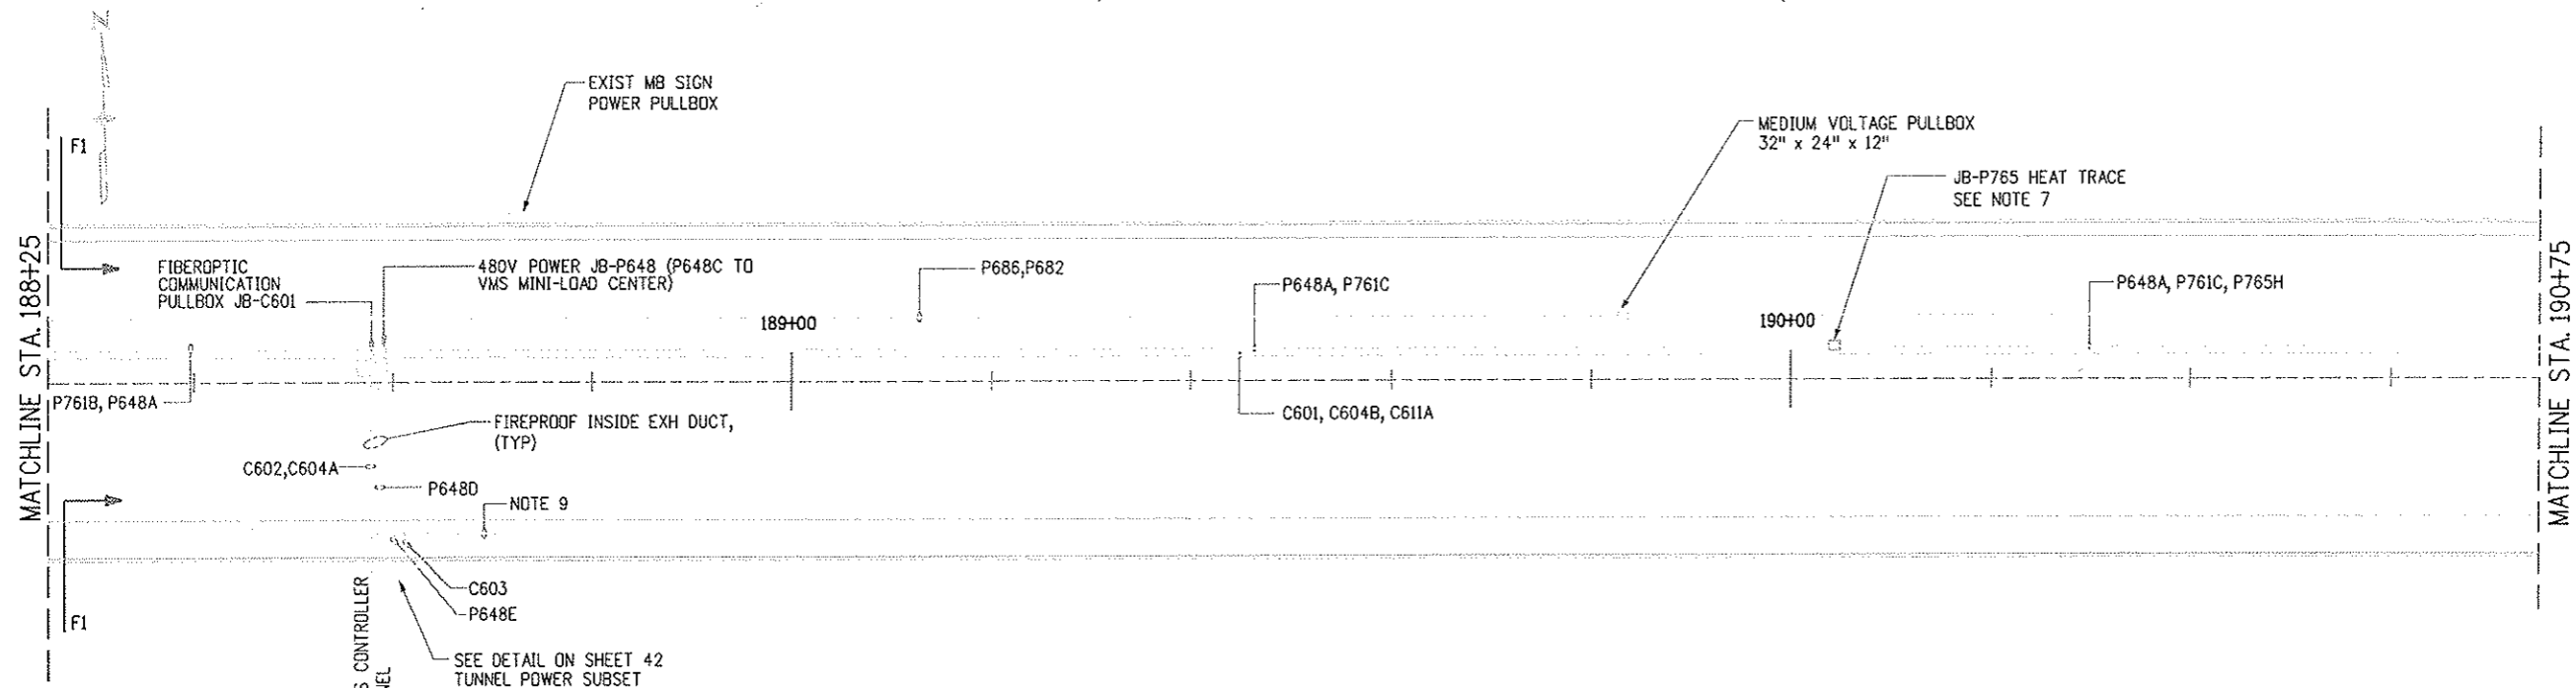


PLAN 2

Design File Name: D0N5P5E0*
 Plot File Name: 9PLOTFILE*
 Date of Plot: 03/16/07

Computer File Information	
Creation Date:	04/26/99 Initials: SFD
Last Modification Date:	03/16/07 Initials: DJR
Full Path:	14102\800Deliv\AsBuilt\
Drawing File Name:	epp11n
Acad Ver.	R14 Scale: 1" = 10'-0" Units: English

Sheet Revisions	
<input type="checkbox"/>	07/03/07 ASBUILT DJB
<input type="checkbox"/>	
<input type="checkbox"/>	
<input type="checkbox"/>	

Colorado Department of Transportation

 P.O. BOX 399
 DUMONT, CO. 80436
 Phone: 303-512-5750 FAX: 303-512-5775
 Region 1 Mountain Residency I.N.Z.



As Constructed
No Revisions:
Revised:
Void:

NORTH TUNNEL POWER PLANS 11	
Designer:	J. WALSH
Detailer:	RODDENBERRY
Sheet Subset:	TUN POWER
Structure Numbers	
Subset Sheets:	34 of 45



Project No./Code
IM 0703-269
13166
Sheet Number 100

NOTES:

A. FOR GENERAL TUNNEL POWER NOTES, SEE SHEET 1 OF TUNNEL POWER SUBSET.

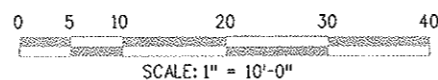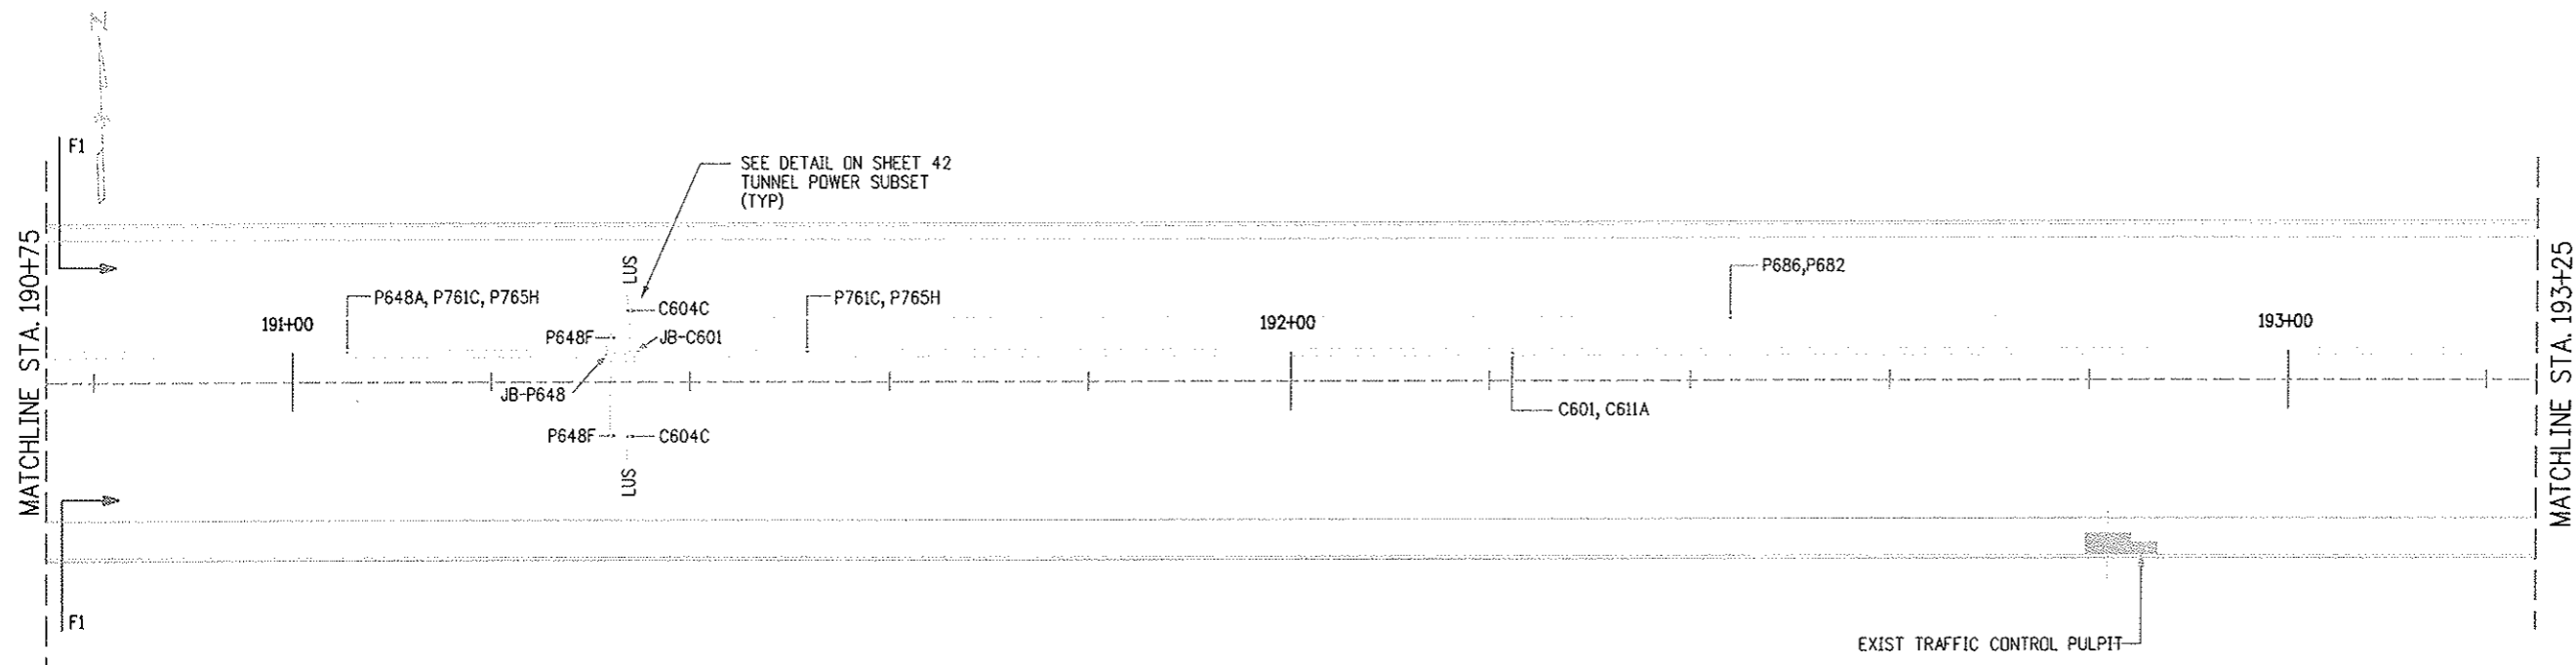

PLAN 1

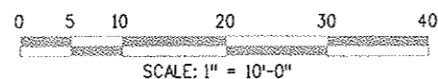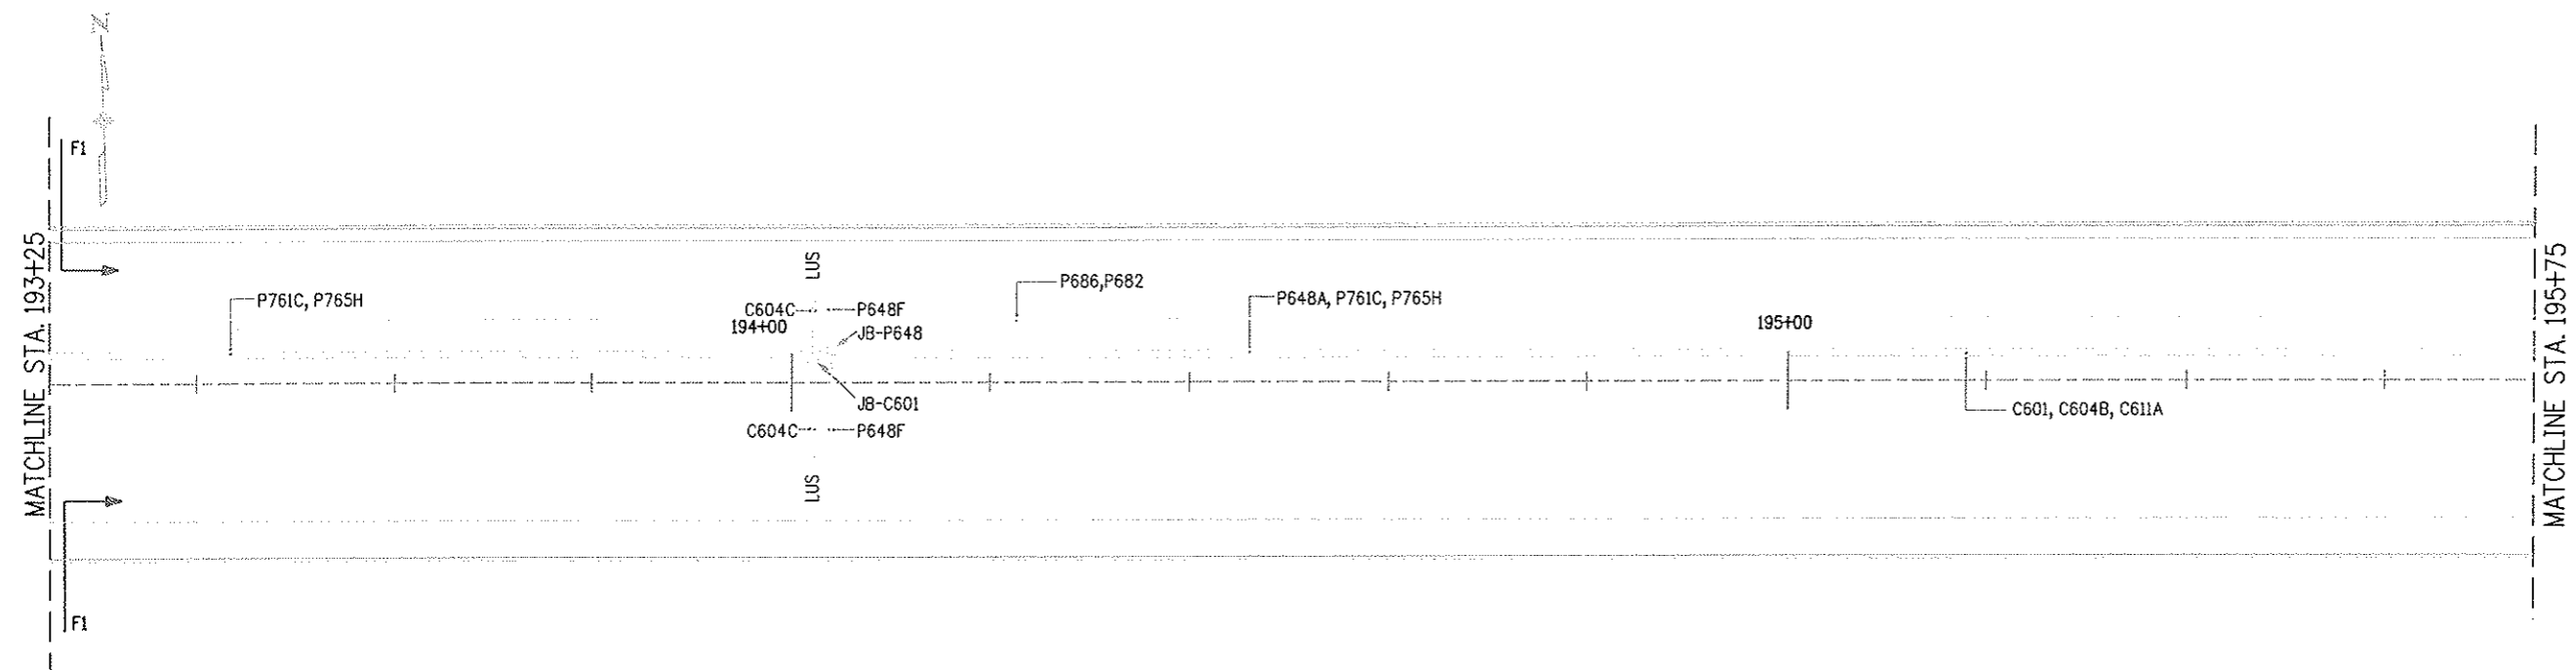


PLAN 2

DATE PLOTTED: 04/26/99 10:55 AM

Computer File Information	
Creation Date:	04/26/99 Initials: SPD
Last Modification Date:	01/21/02 Initials: DJR
Full Path:	14102\800Deliv\AsBuilt\
Drawing File Name:	epp112n
Acad Ver.:	R14 Scale: 1" = 10'-0" Units: English

Sheet Revisions	
07/03/07	ASBUILT DJB

Colorado Department of Transportation



P.O. BOX 399
DUMONT, CO. 80436
Phone: 303-512-5750 FAX: 303-512-5775

Region 1 Mountain Residency I.N.Z.


As Constructed
No Revisions:
Revised:
Void:

NORTH TUNNEL POWER PLANS 12	
Designer:	J WALSH
Detailer:	RODENBERRY
Sheet Subset:	TUN POWER
Structure Numbers:	
Subset Sheets:	35 of 45


Project No./Code
IM 0703-269
13166
Sheet Number 101

NOTES:


A. FOR GENERAL TUNNEL POWER NOTES, SEE SHEET 1 OF TUNNEL POWER SUBSET.

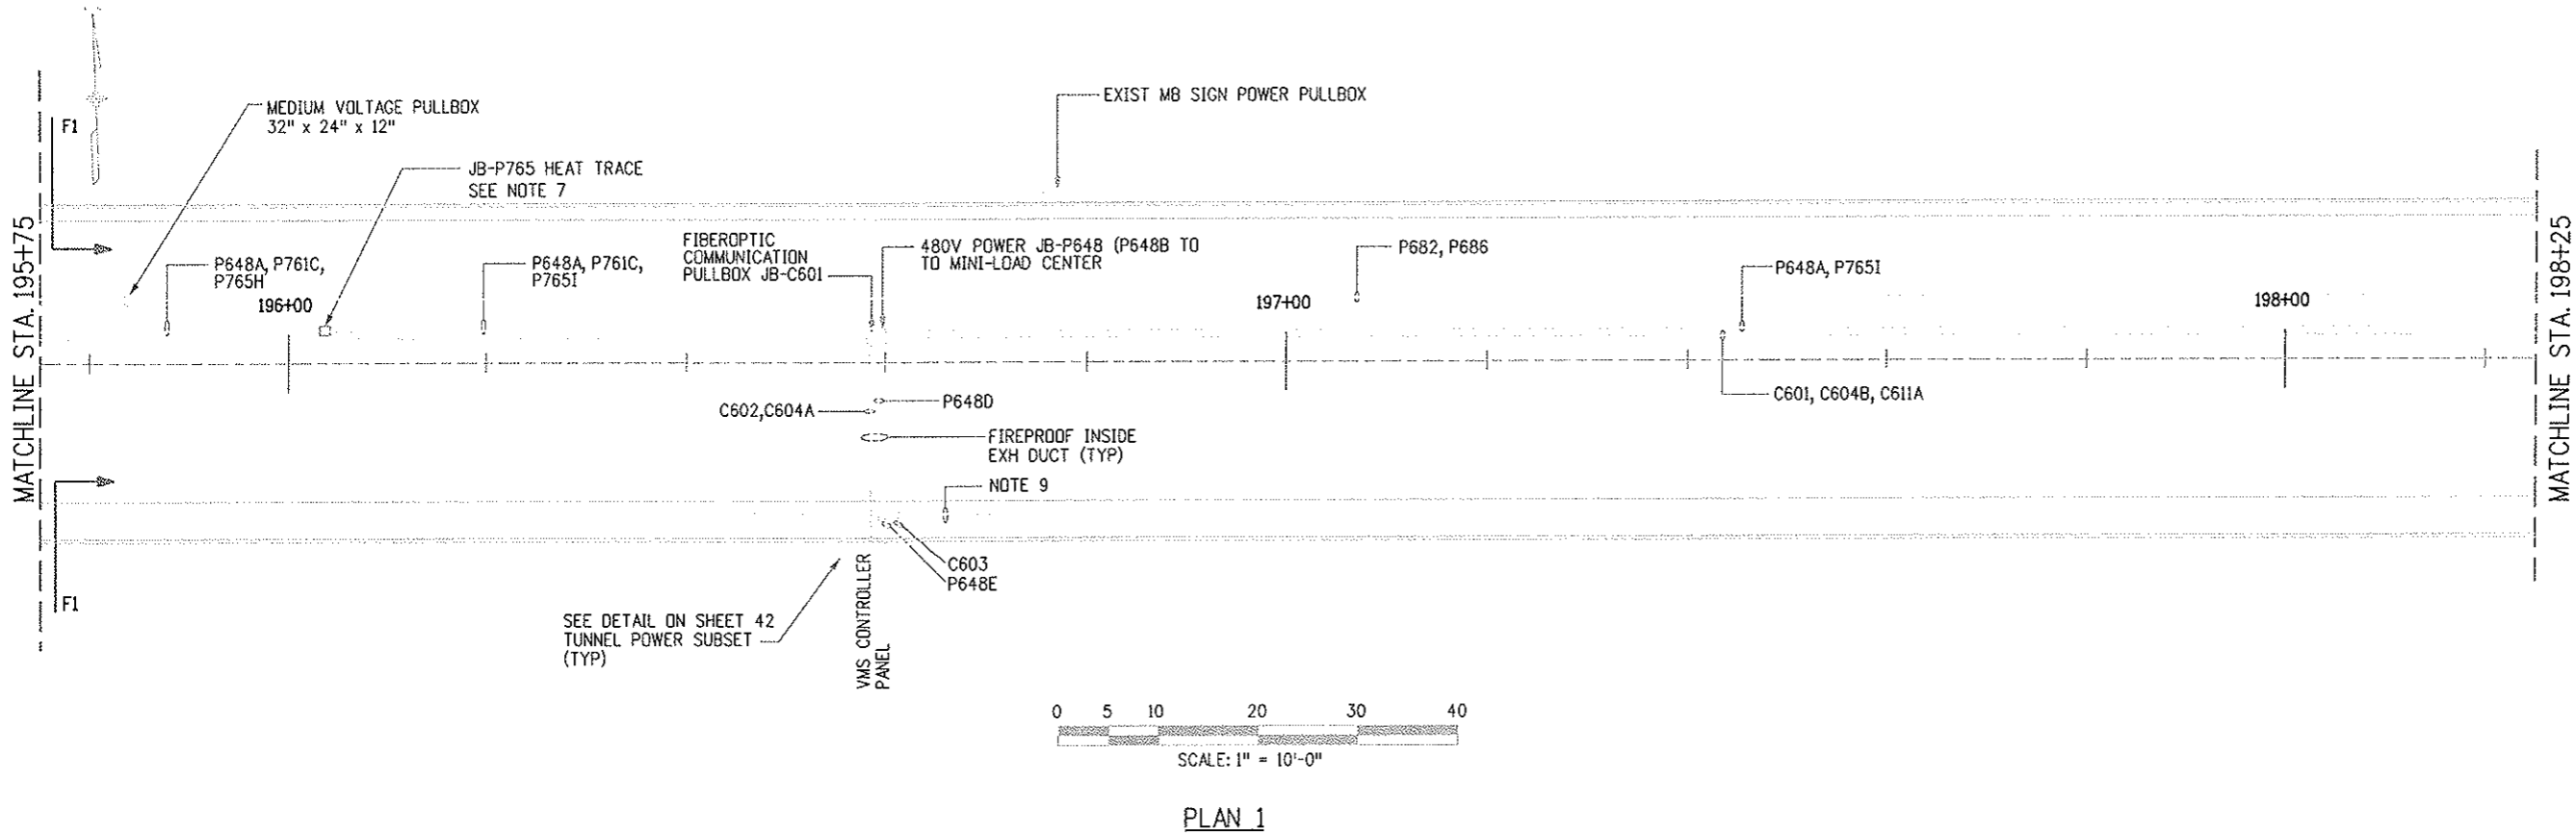


PLAN 1

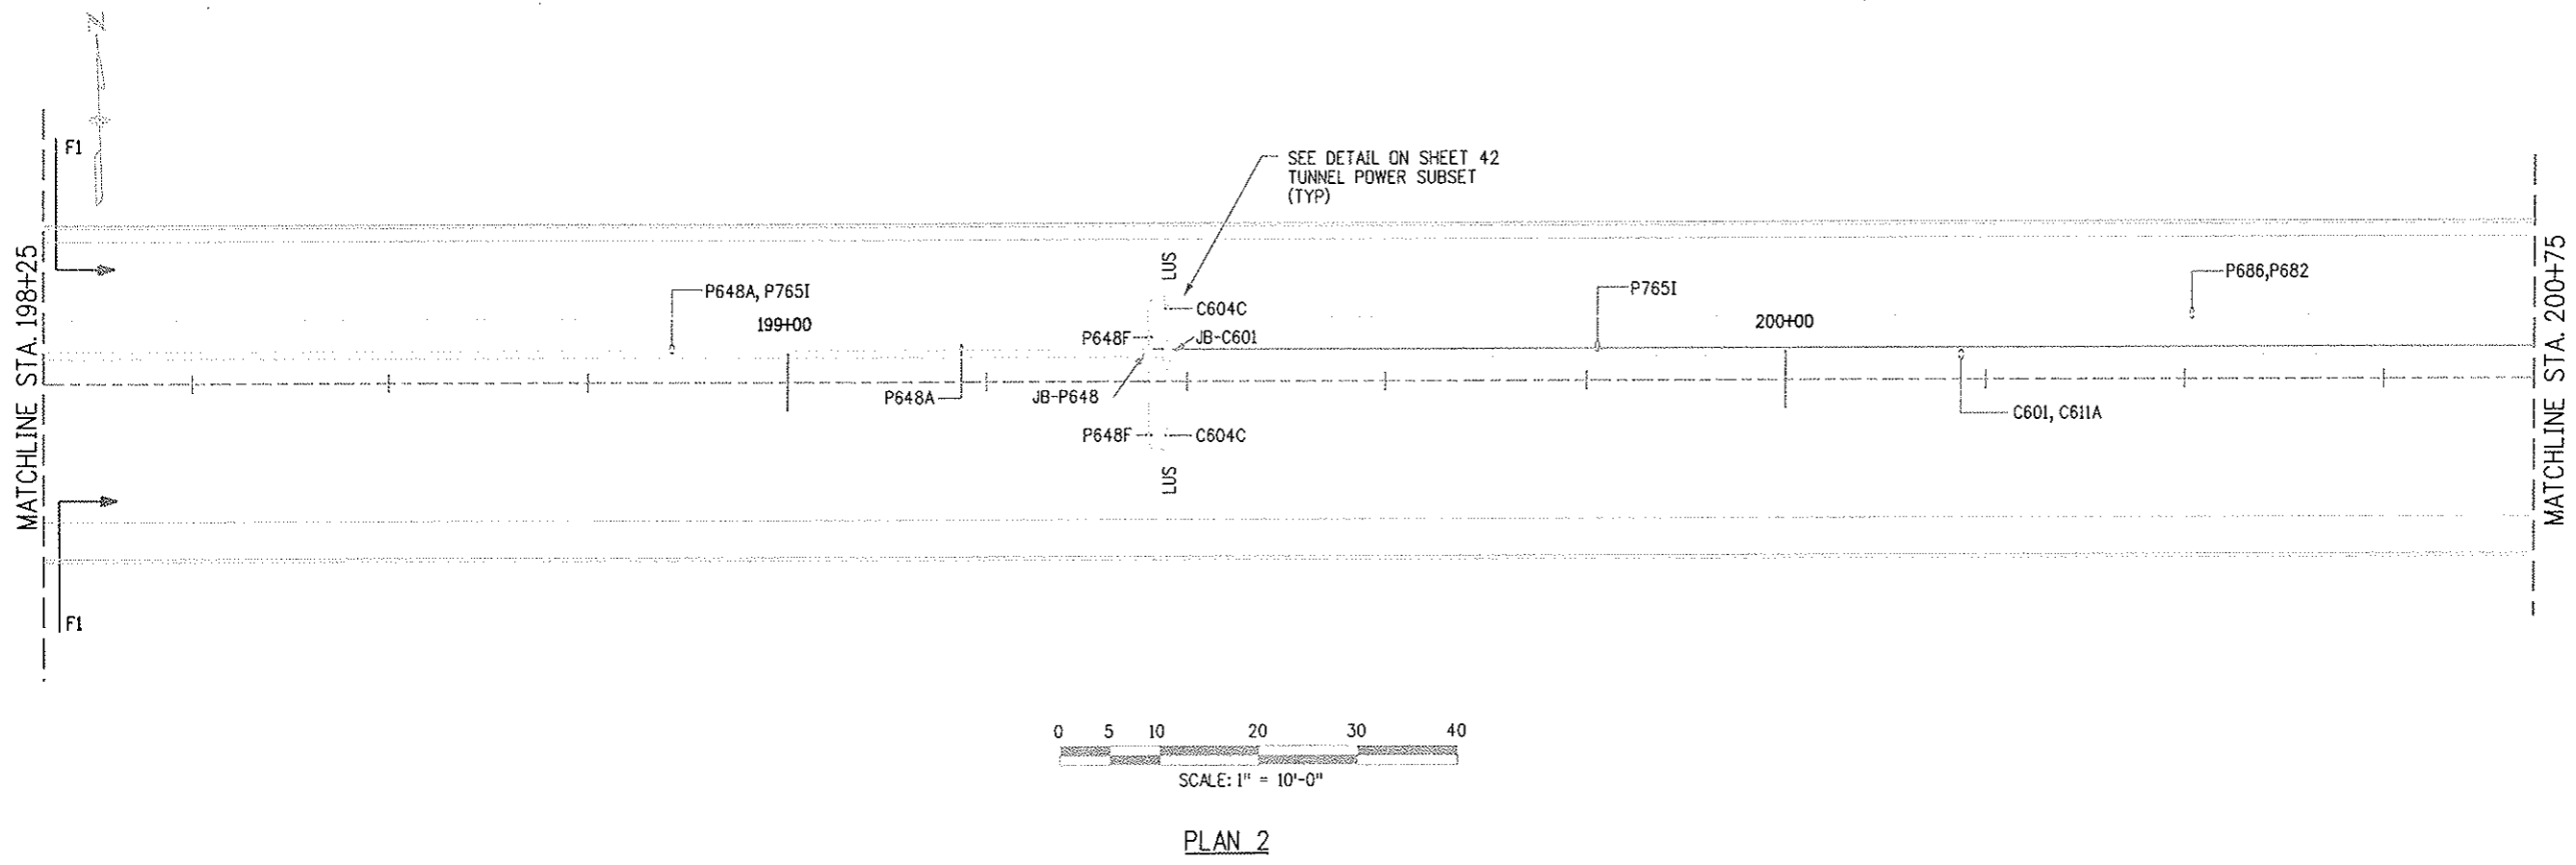


PLAN 2

Computer File Information		Sheet Revisions		Colorado Department of Transportation  P.O. 80X 399 DUMONT, CO. 80436 Phone: 303-512-5750 FAX: 303-512-5775 Region 1 Mountain Residency I.N.Z.	As Constructed	NORTH TUNNEL POWER PLANS 13		Project No./Code	
Creation Date: 04/26/99	Initials: SFD	07/03/07	ASBUILT		No Revisions:			IM 0703-269	
Last Modification Date: 01/25/02	Initials: DJR				Revised:	Designer: J. WALSH	Structure Numbers:	13166	
Full Path: 14102\800Deliv\AsBuilt\					Void:	Detailer: RODDENBERRY		Sheet Number 102	
Drawing File Name: eppl13n						Sheet Subset: TUN. POWER	Subset Sheets: 36 of 45		
Acad Ver. R14	Scale: 1" = 10'-0"	Units: English							

NOTES:
 A. FOR GENERAL TUNNEL POWER NOTES, SEE SHEET 1 OF TUNNEL POWER SUBSET.

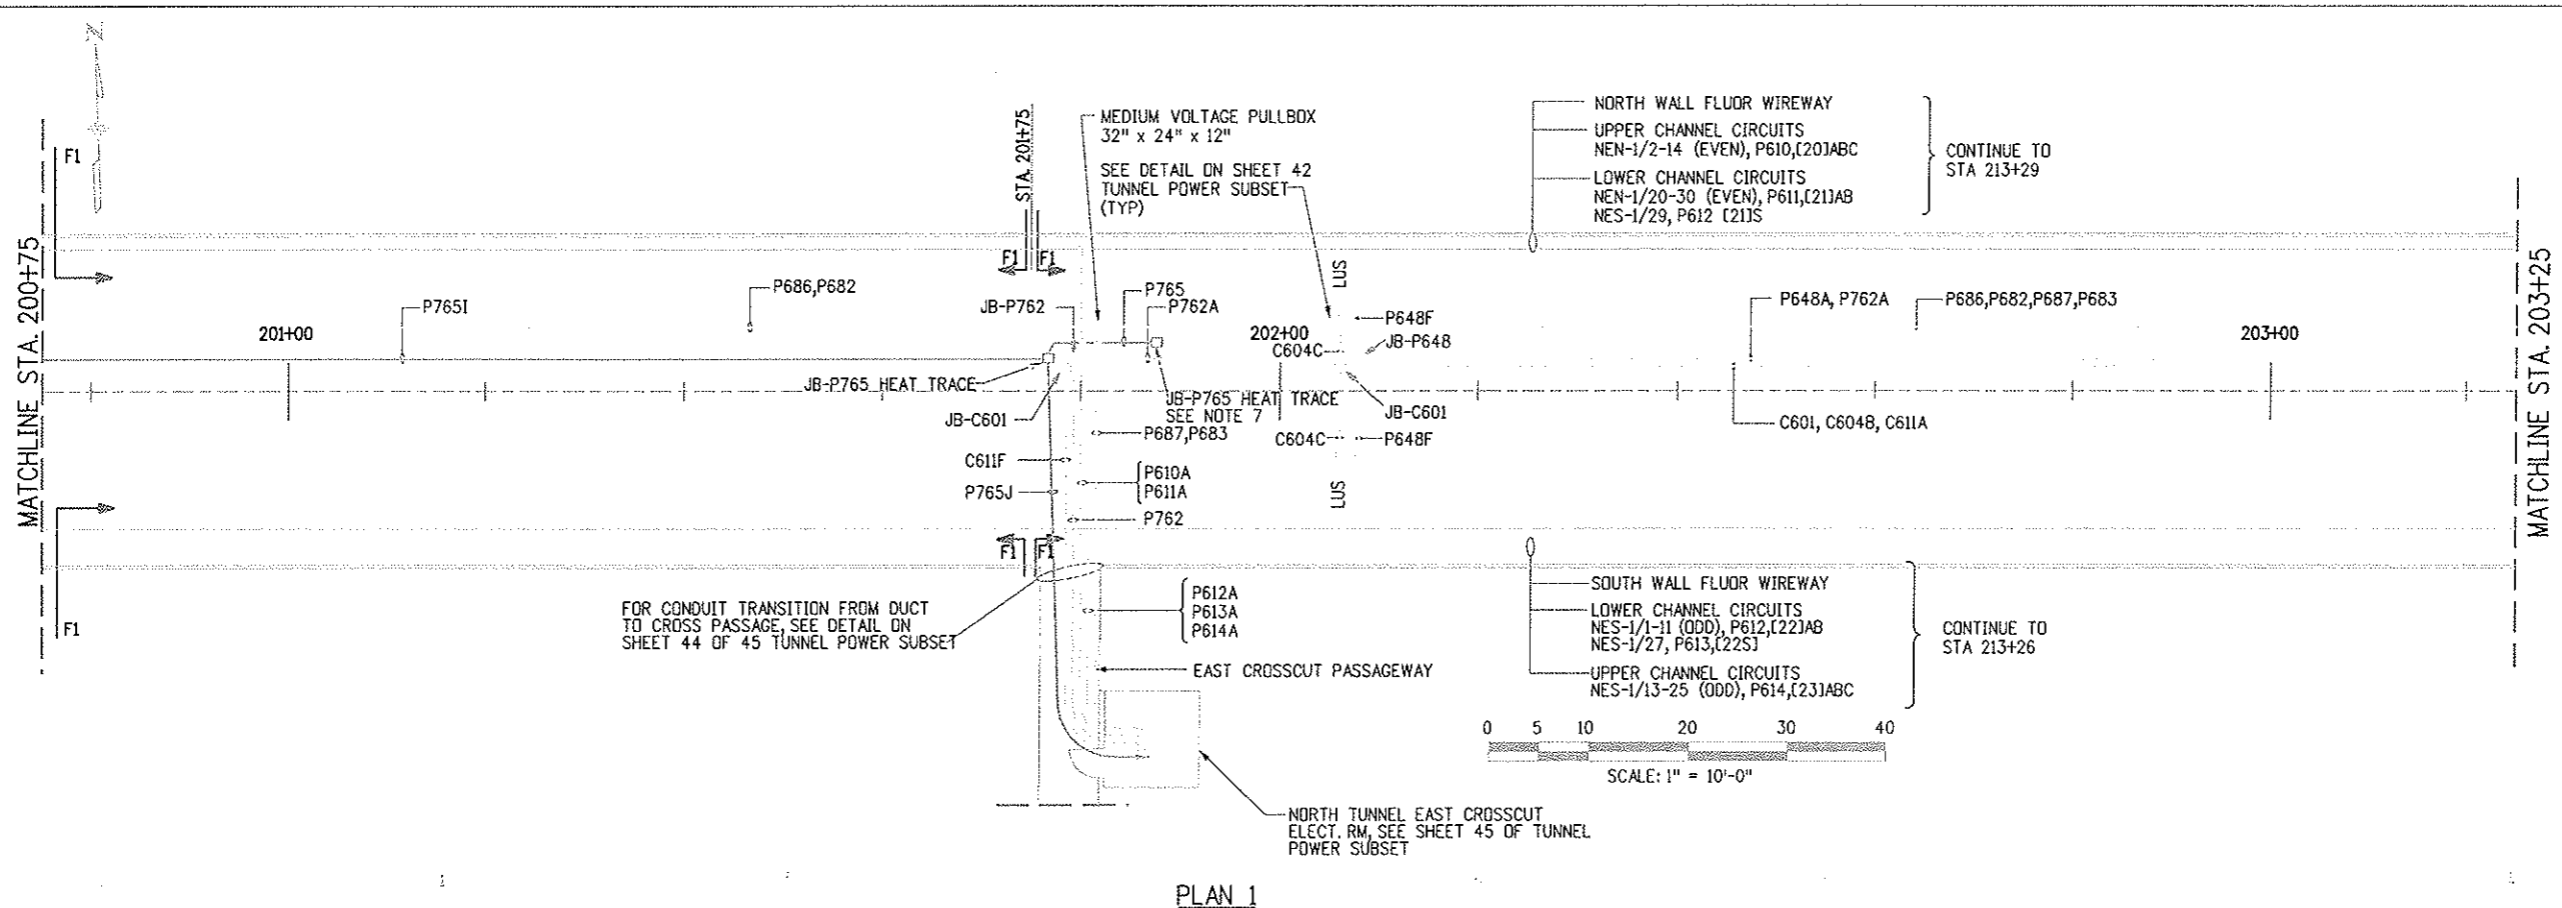

PLAN 1

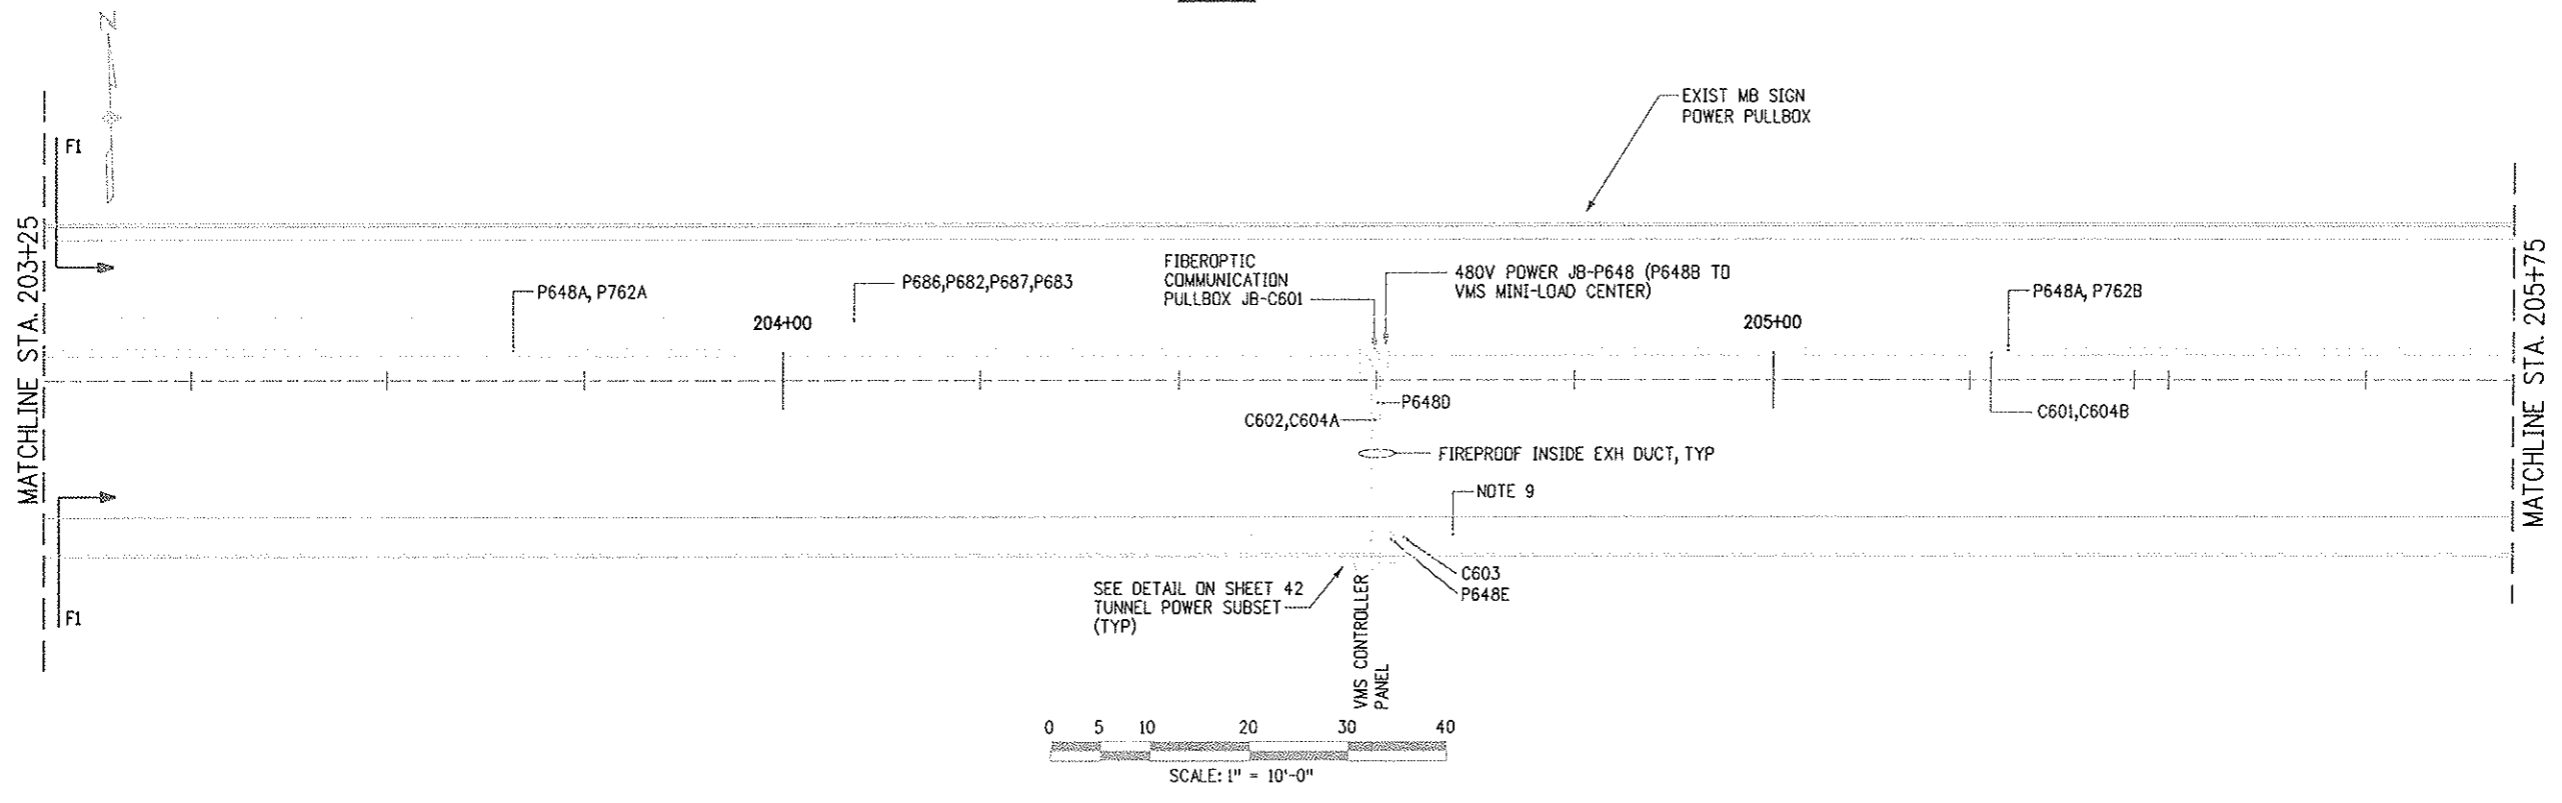


PLAN 2

Design File Name: DGNSSPEC*
 Plot File Name: SLDIFILE*
 Date of Plot: \$\$\$DATE\$\$\$

Computer File Information	
Creation Date:	04/26/99 Initials: SFD
Last Modification Date:	05/26/07 Initials: DJB
Full Path:	14102\800Deliv\AsBuilt\
Drawing File Name:	091114
Acad Ver.	R14 Scale: 1" = 10'-0" Units:

Sheet Revisions	
07/03/07	ASBUILT DJB

Colorado Department of Transportation




P.O. BOX 399
 DUMONT, CO. 80436
 Phone: 303-512-5750 FAX: 303-512-5775
 Region 1 Mountain Residency I.N.Z.


As Constructed	
No Revisions:	
Revised:	
Void:	

NORTH TUNNEL POWER PLANS 14		
Designer:	J. WALSH	Structure Numbers
Detailer:	RODDENBERRY	
Sheet Subset:	TUN. POWER	Subset Sheets: 37 of 45



Project No./Code	
IM 0703-269	
13166	
Sheet Number	103

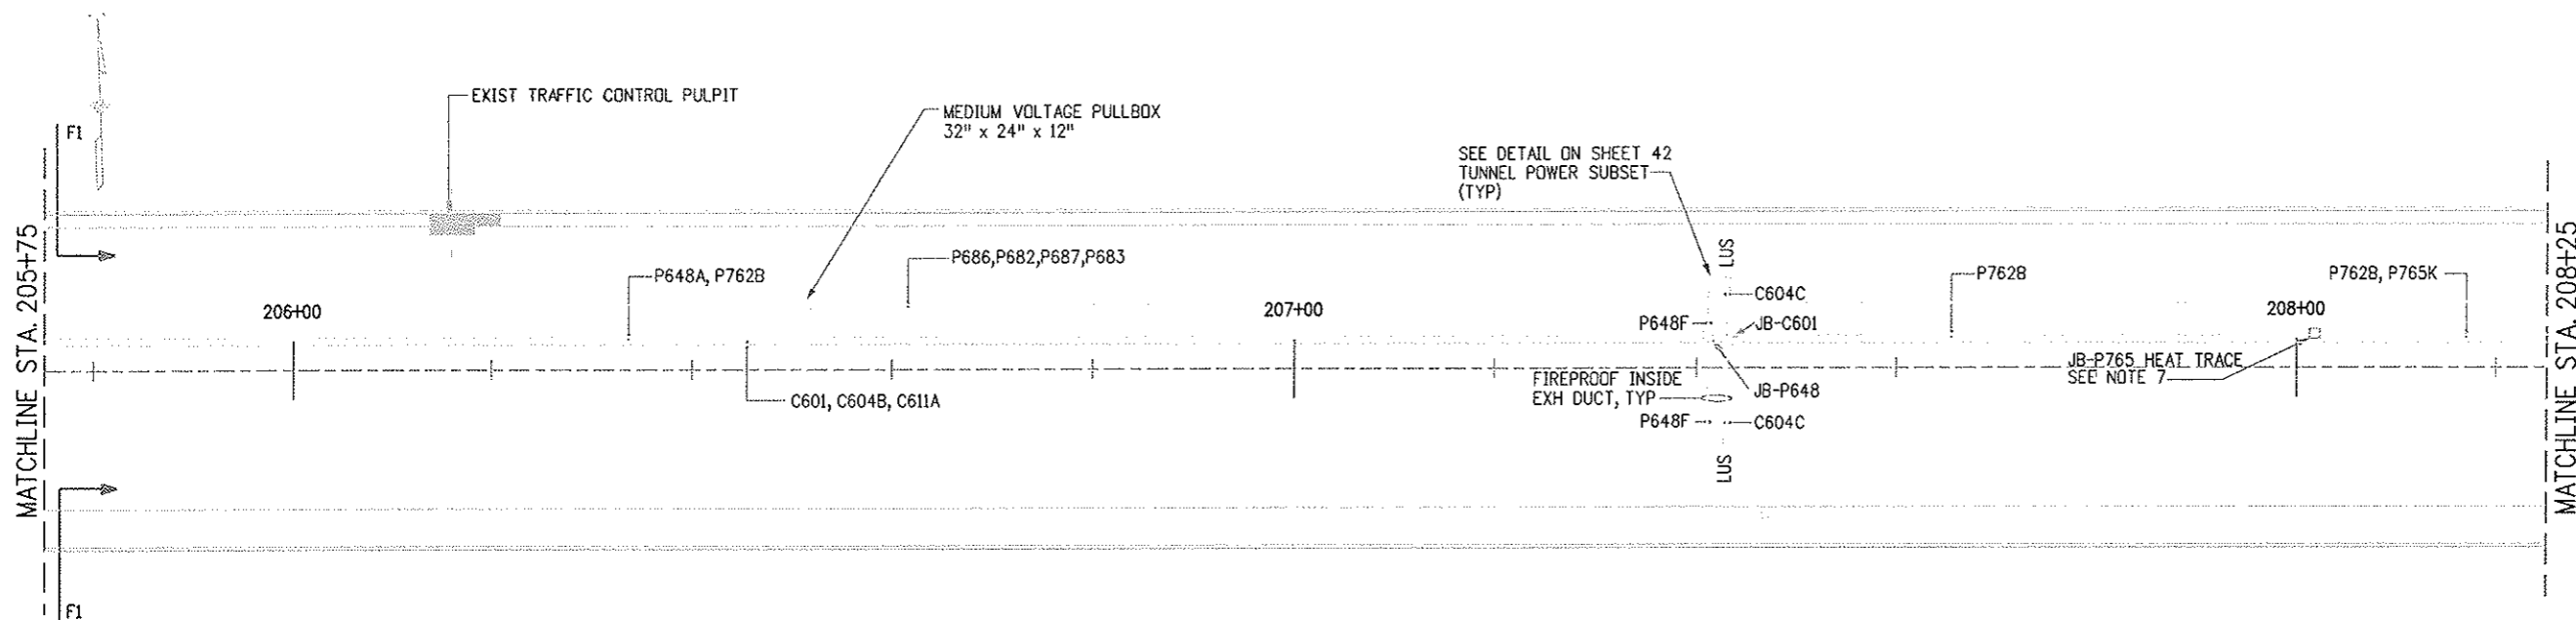

NOTES:
 A. FOR GENERAL TUNNEL POWER NOTES,
 SEE SHEET 1 OF TUNNEL POWER SUBSET.

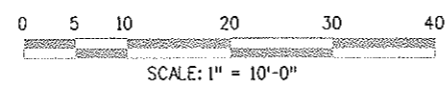


PLAN 1

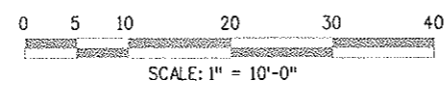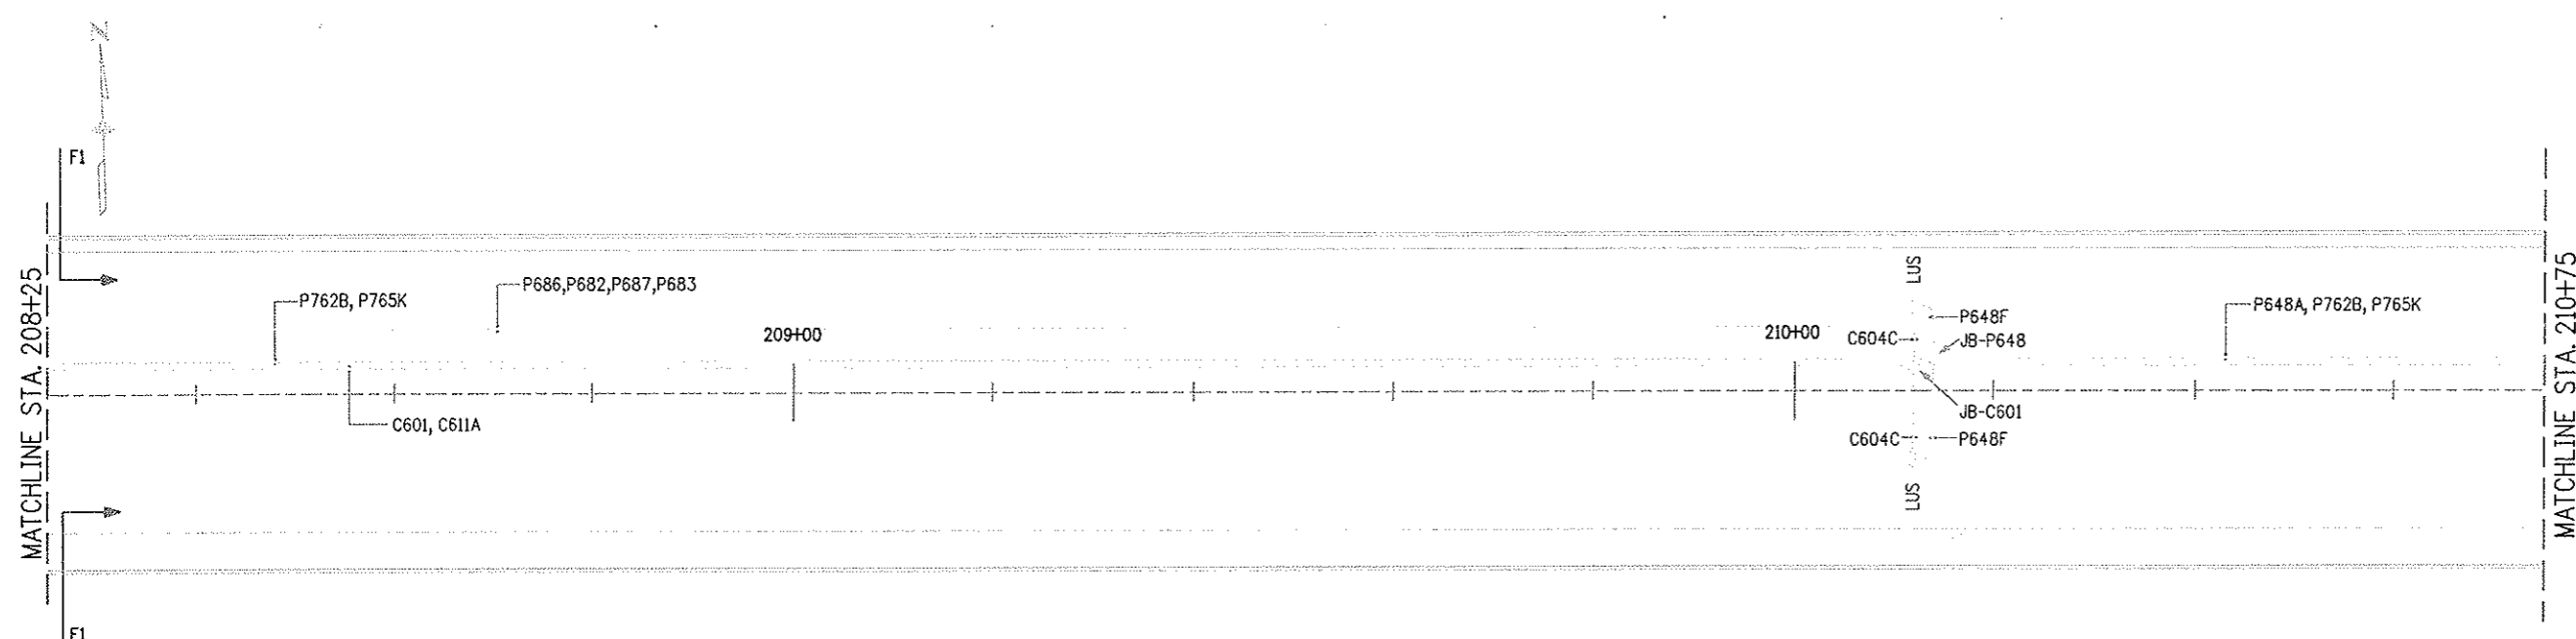

PLAN 2


Computer File Information		Sheet Revisions		Colorado Department of Transportation		As Constructed		NORTH TUNNEL POWER PLANS 15		Project No./Code	
Creation Date:	04/26/99	Initials:	SPD	07/03/07	ASBUILT			IM 0703-269		13166	
Last Modification Date:	01/21/02	Initials:	DJR								
Full Path:	14102\800Deliv\AsBuilt							Designer:	J. WALSH	Structure	
Drawing File Name:	pp15a							Detailer:	RODDENBERRY	Numbers	
Acad Ver.	R14	Scale:	1"=10'-0"	Units:				Sheet Subset:	TUN. POWER	Subset Sheets:	38 of 45
						Region 1 Mountain Residency I.N.Z.		Sheet Number		104	

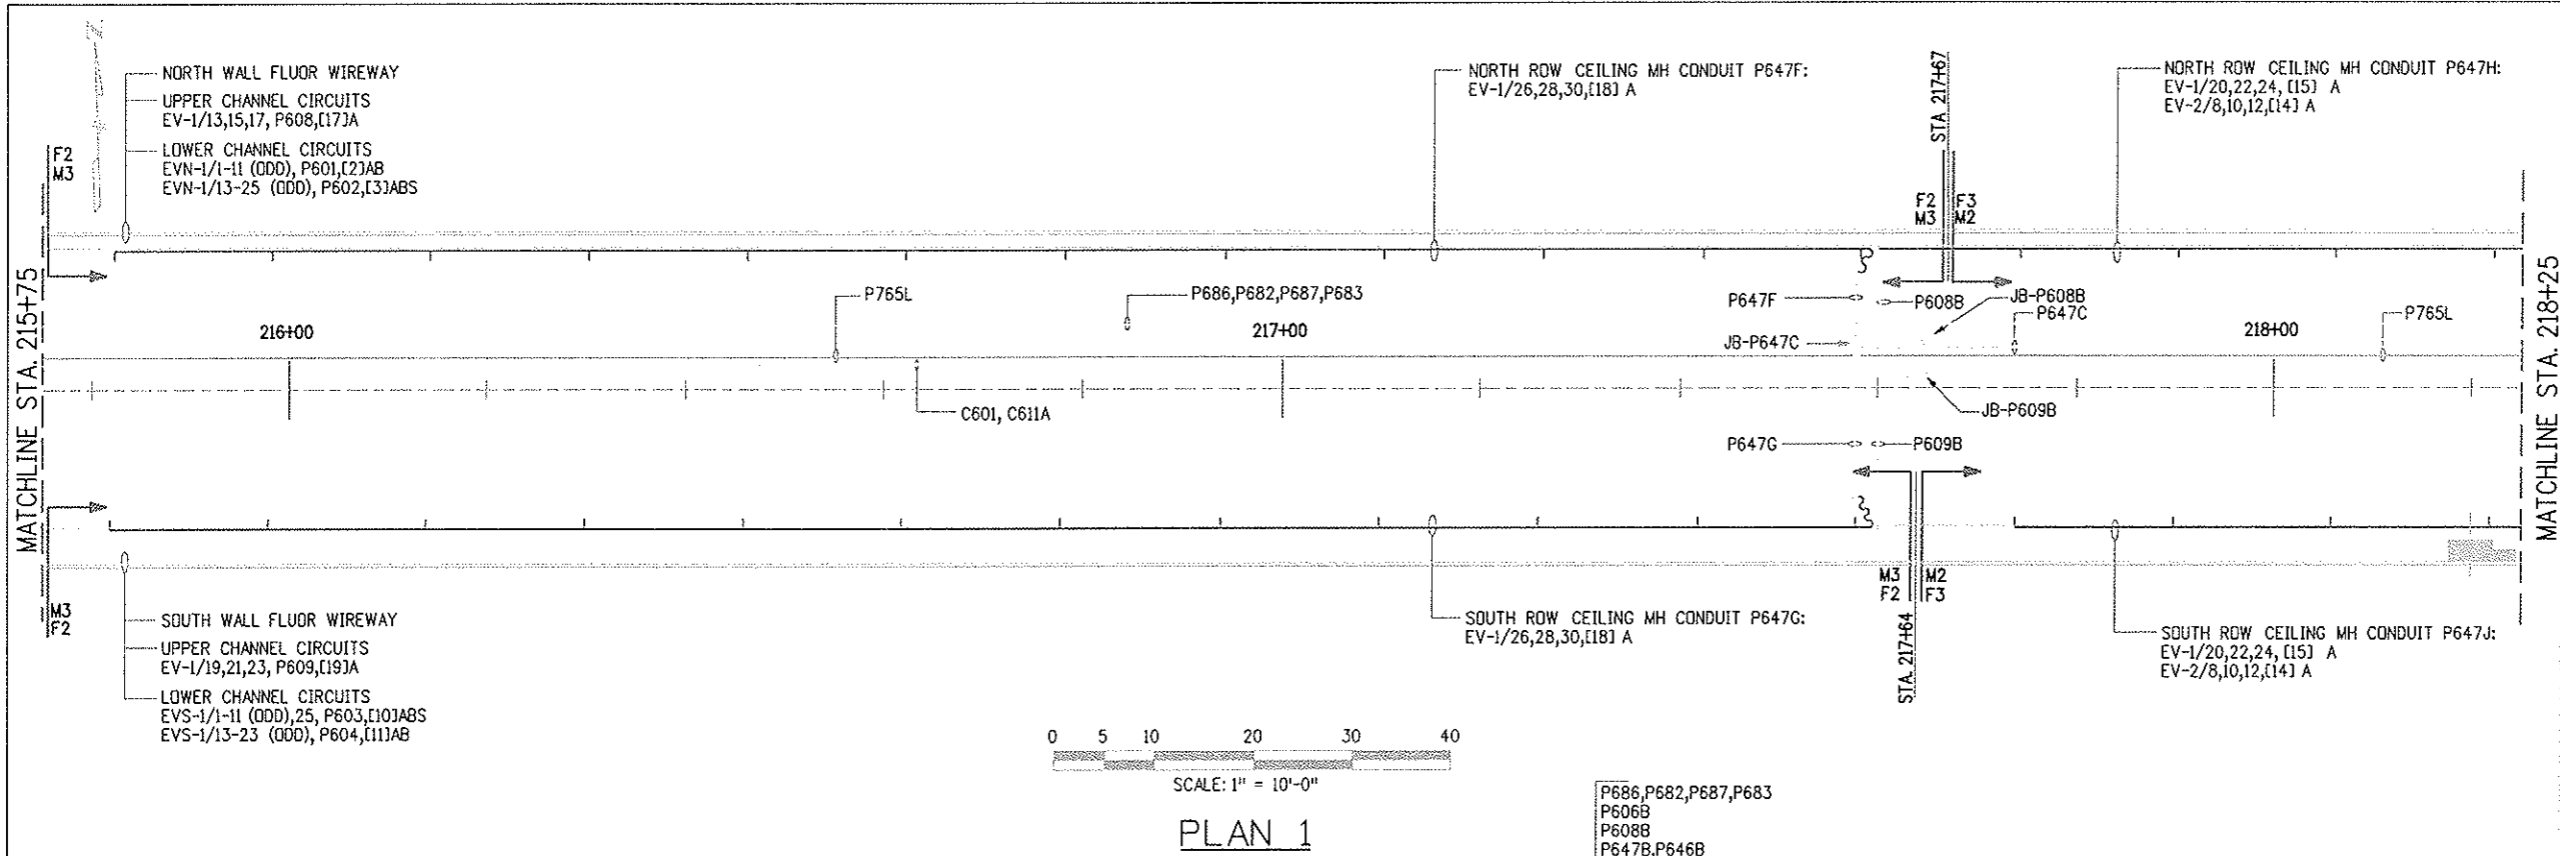

NOTES:
 A. FOR GENERAL TUNNEL POWER NOTES, SEE SHEET 1 OF TUNNEL POWER SUBSET.

BOX SIZING TABLE

JB NO.	SIZE (H X W X D)	NEMA TYPE	SERVICE
P647C	12" X 12" X 8"	4	N TUNNEL LTG
P647B	12" X 12" X 8"	4	N TUNNEL LTG
P646B	12" X 12" X 8"	4	N TUNNEL LTG
P765	12" X 12" X 6"	4	HEAT TRACE

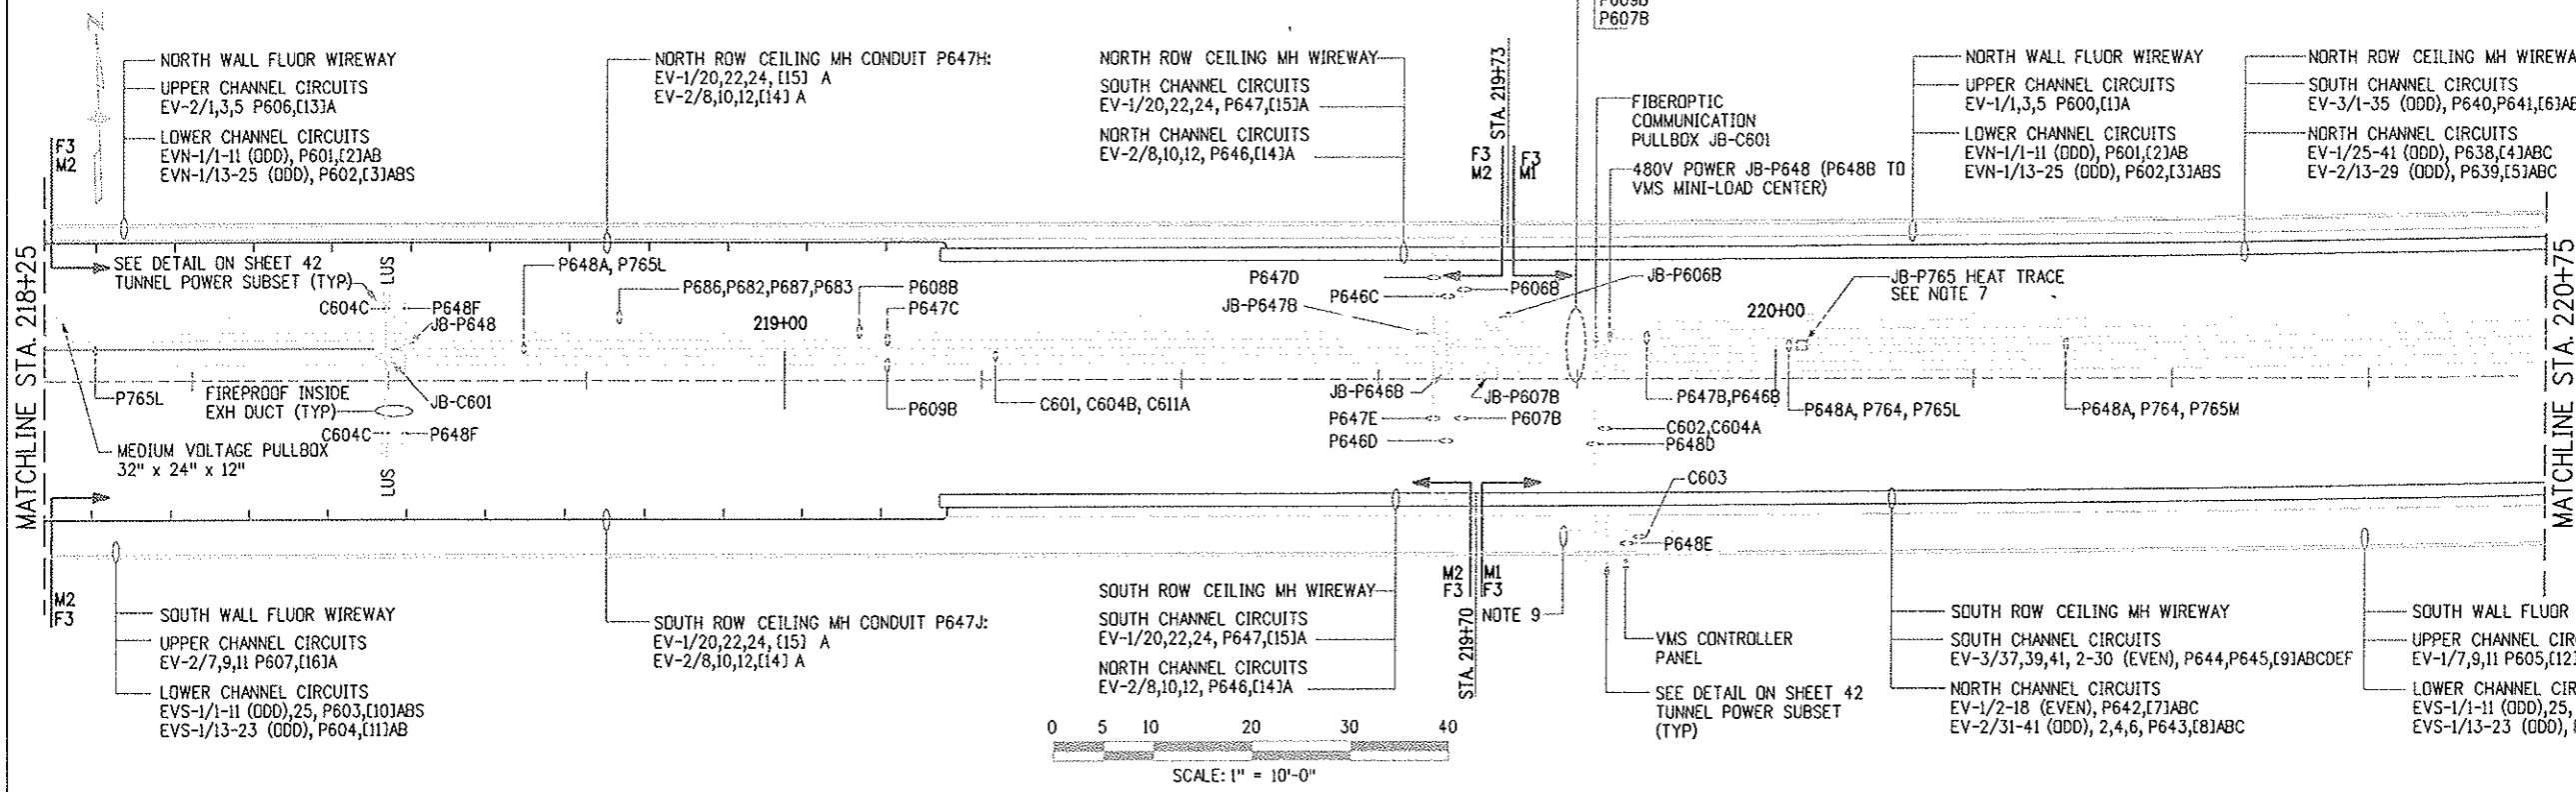

Design File Name: DGN\$SPEC*
 Plot File Name: \$PLOT\$FILE*
 Date of Plot: \$\$\$DATE\$\$\$

Computer File Information

Creation Date:	04/26/99	Initials:	SPD
Last Modification Date:	05/26/07	Initials:	DJR
Full Path:	14102\800Deliv\AsBuilt		
Drawing File Name:	***17*		
Acad Ver.	R14	Scale:	1"=10'-0"
Units:			

Sheet Revisions

07/03/07	ASBUILT	DJR

Colorado Department of Transportation
 Region 1 Mountain Residency I.N.Z.
 P.O. BOX 399
 DUMONT, CO. 80436
 Phone: 303-512-5750 FAX: 303-512-5775

As Constructed


No Revisions:	
Revised:	
Void:	

NORTH TUNNEL POWER PLANS 17

Designer:	J WALSH	Structure Numbers	
Detailer:	ROODENBERRY		
Sheet Subset:	TUN POWER	Subset Sheets:	40 of 45

Project No./Code


IM 0703-269
13166
Sheet Number 106

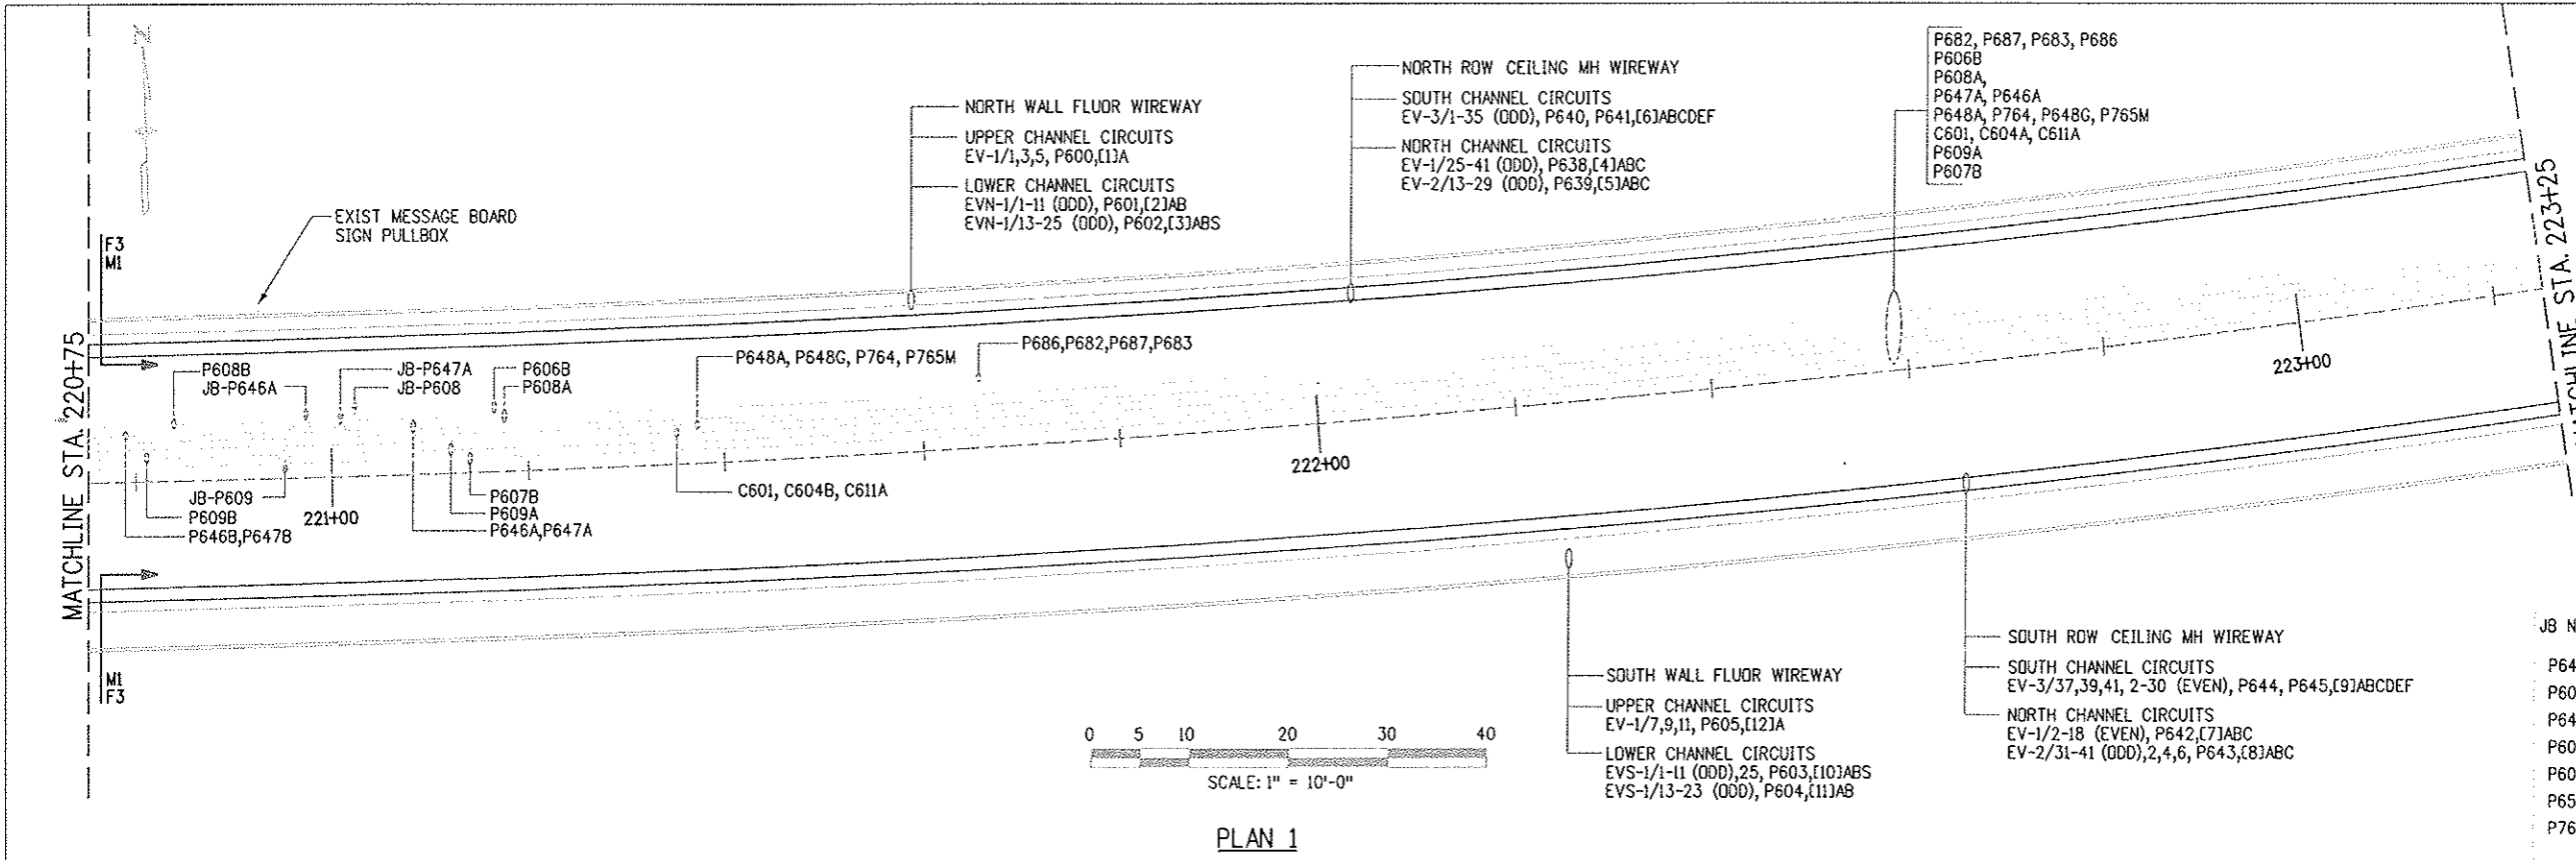

- NOTES:**
- A. FOR GENERAL TUNNEL POWER NOTES, SEE SHEET 10 OF TUNNEL POWER SUBSET.
 - B. ALL CONDUIT IN THIS TUNNEL PLAN AREA TO BE ROUTED INSIDE INTERSTITIAL SPACE BETWEEN TUNNEL CEILING AND VENTILATION DUCTS ABOVE.
 - C. ALL CONDUIT AND PULLBOXES IN THIS TUNNEL PLAN AREA TO BE ROUTED INSIDE THE SUPPLY VENTILATION DUCT, UNLESS NOTED OTHERWISE.

BOX SIZING TABLE

JB NO.	SIZE (H X W X D)	NEMA TYPE	SERVICE
P646A	12" X 12" X 8"	4	N TUNNEL LTG
P609	12" X 12" X 8"	4	N TUNNEL LTG
P647A	12" X 12" X 8"	4	N TUNNEL LTG
P608	12" X 12" X 8"	4	N TUNNEL LTG
P606	12" X 12" X 8"	4	N TUNNEL LTG
P651	12" X 12" X 8"	4	N TUNNEL LTG
P765	12" X 12" X 6"	4	HEAT TRACE

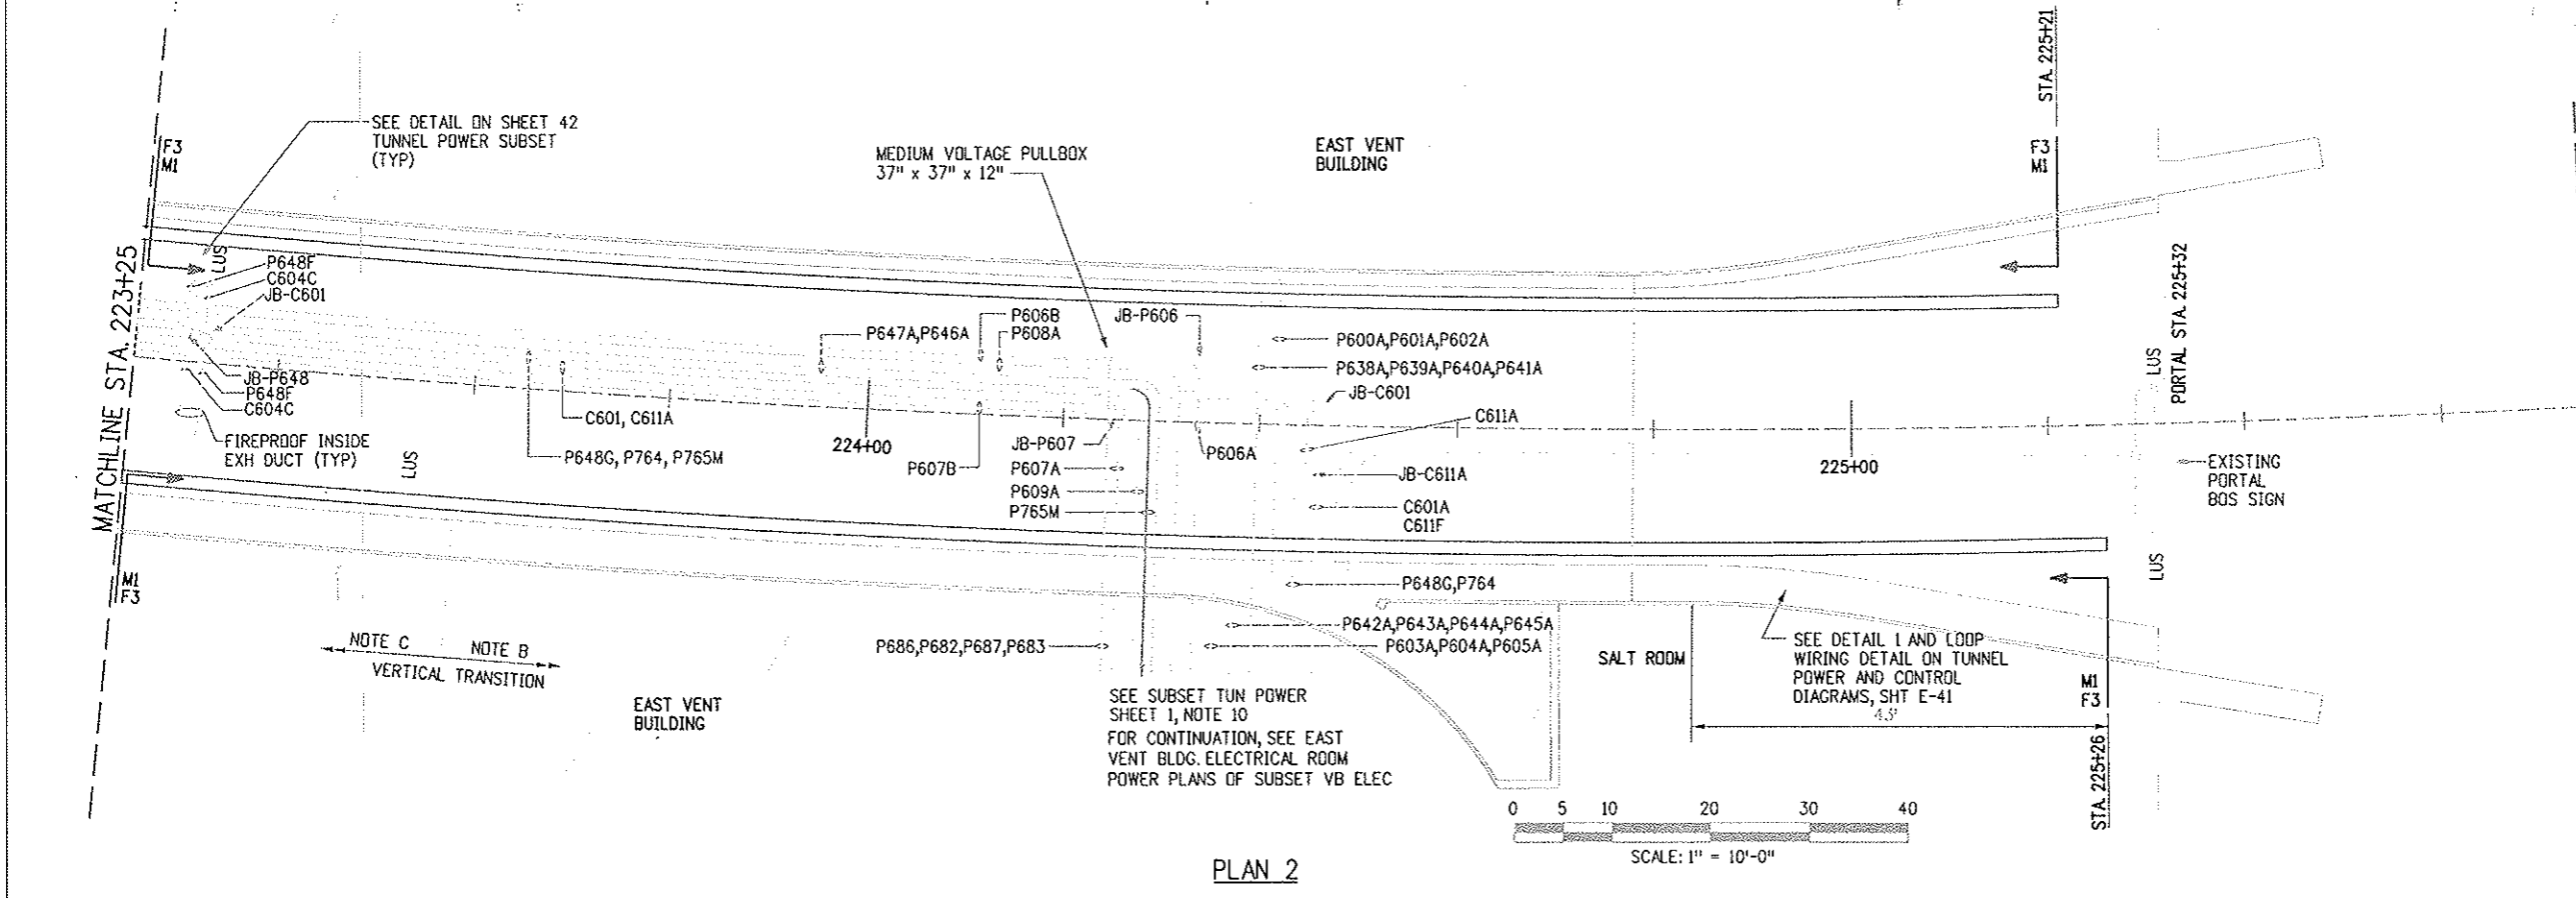

Design File Name: DGN\$SPEC*
 Plot File Name: \$PLOTFILE*
 Date of Plot: \$\$\$\$DATE\$\$\$\$

Computer File Information	
Creation Date:	04/26/99 Initials: SPD
Last Modification Date:	04/26/99 Initials: DJB
Full Path:	14102\800Deliv\AsBuilt
Drawing File Name:	14102.dwg
Acad Ver.	R14 Scale: 1"=10'-0" Units:


Sheet Revisions	
07/03/07	ASBUILT DJB

Colorado Department of Transportation
 P.O. BOX 399
 DUMONT, CO. 80436
 Phone: 303-512-5750 FAX: 303-512-5775
 Region 1 Mountain Residency I.N.Z.

As Constructed
 No Revisions:
 Revised:
 Void:

NORTH TUNNEL POWER PLANS 18
 Designer: J. WALSH
 Detailer: RODDENBERRY
 Sheet Subset: TUN POWER
 Subst Sheets: 41 of 45


Project No./Code
 IM 0703-269
 13166
 Sheet Number 107

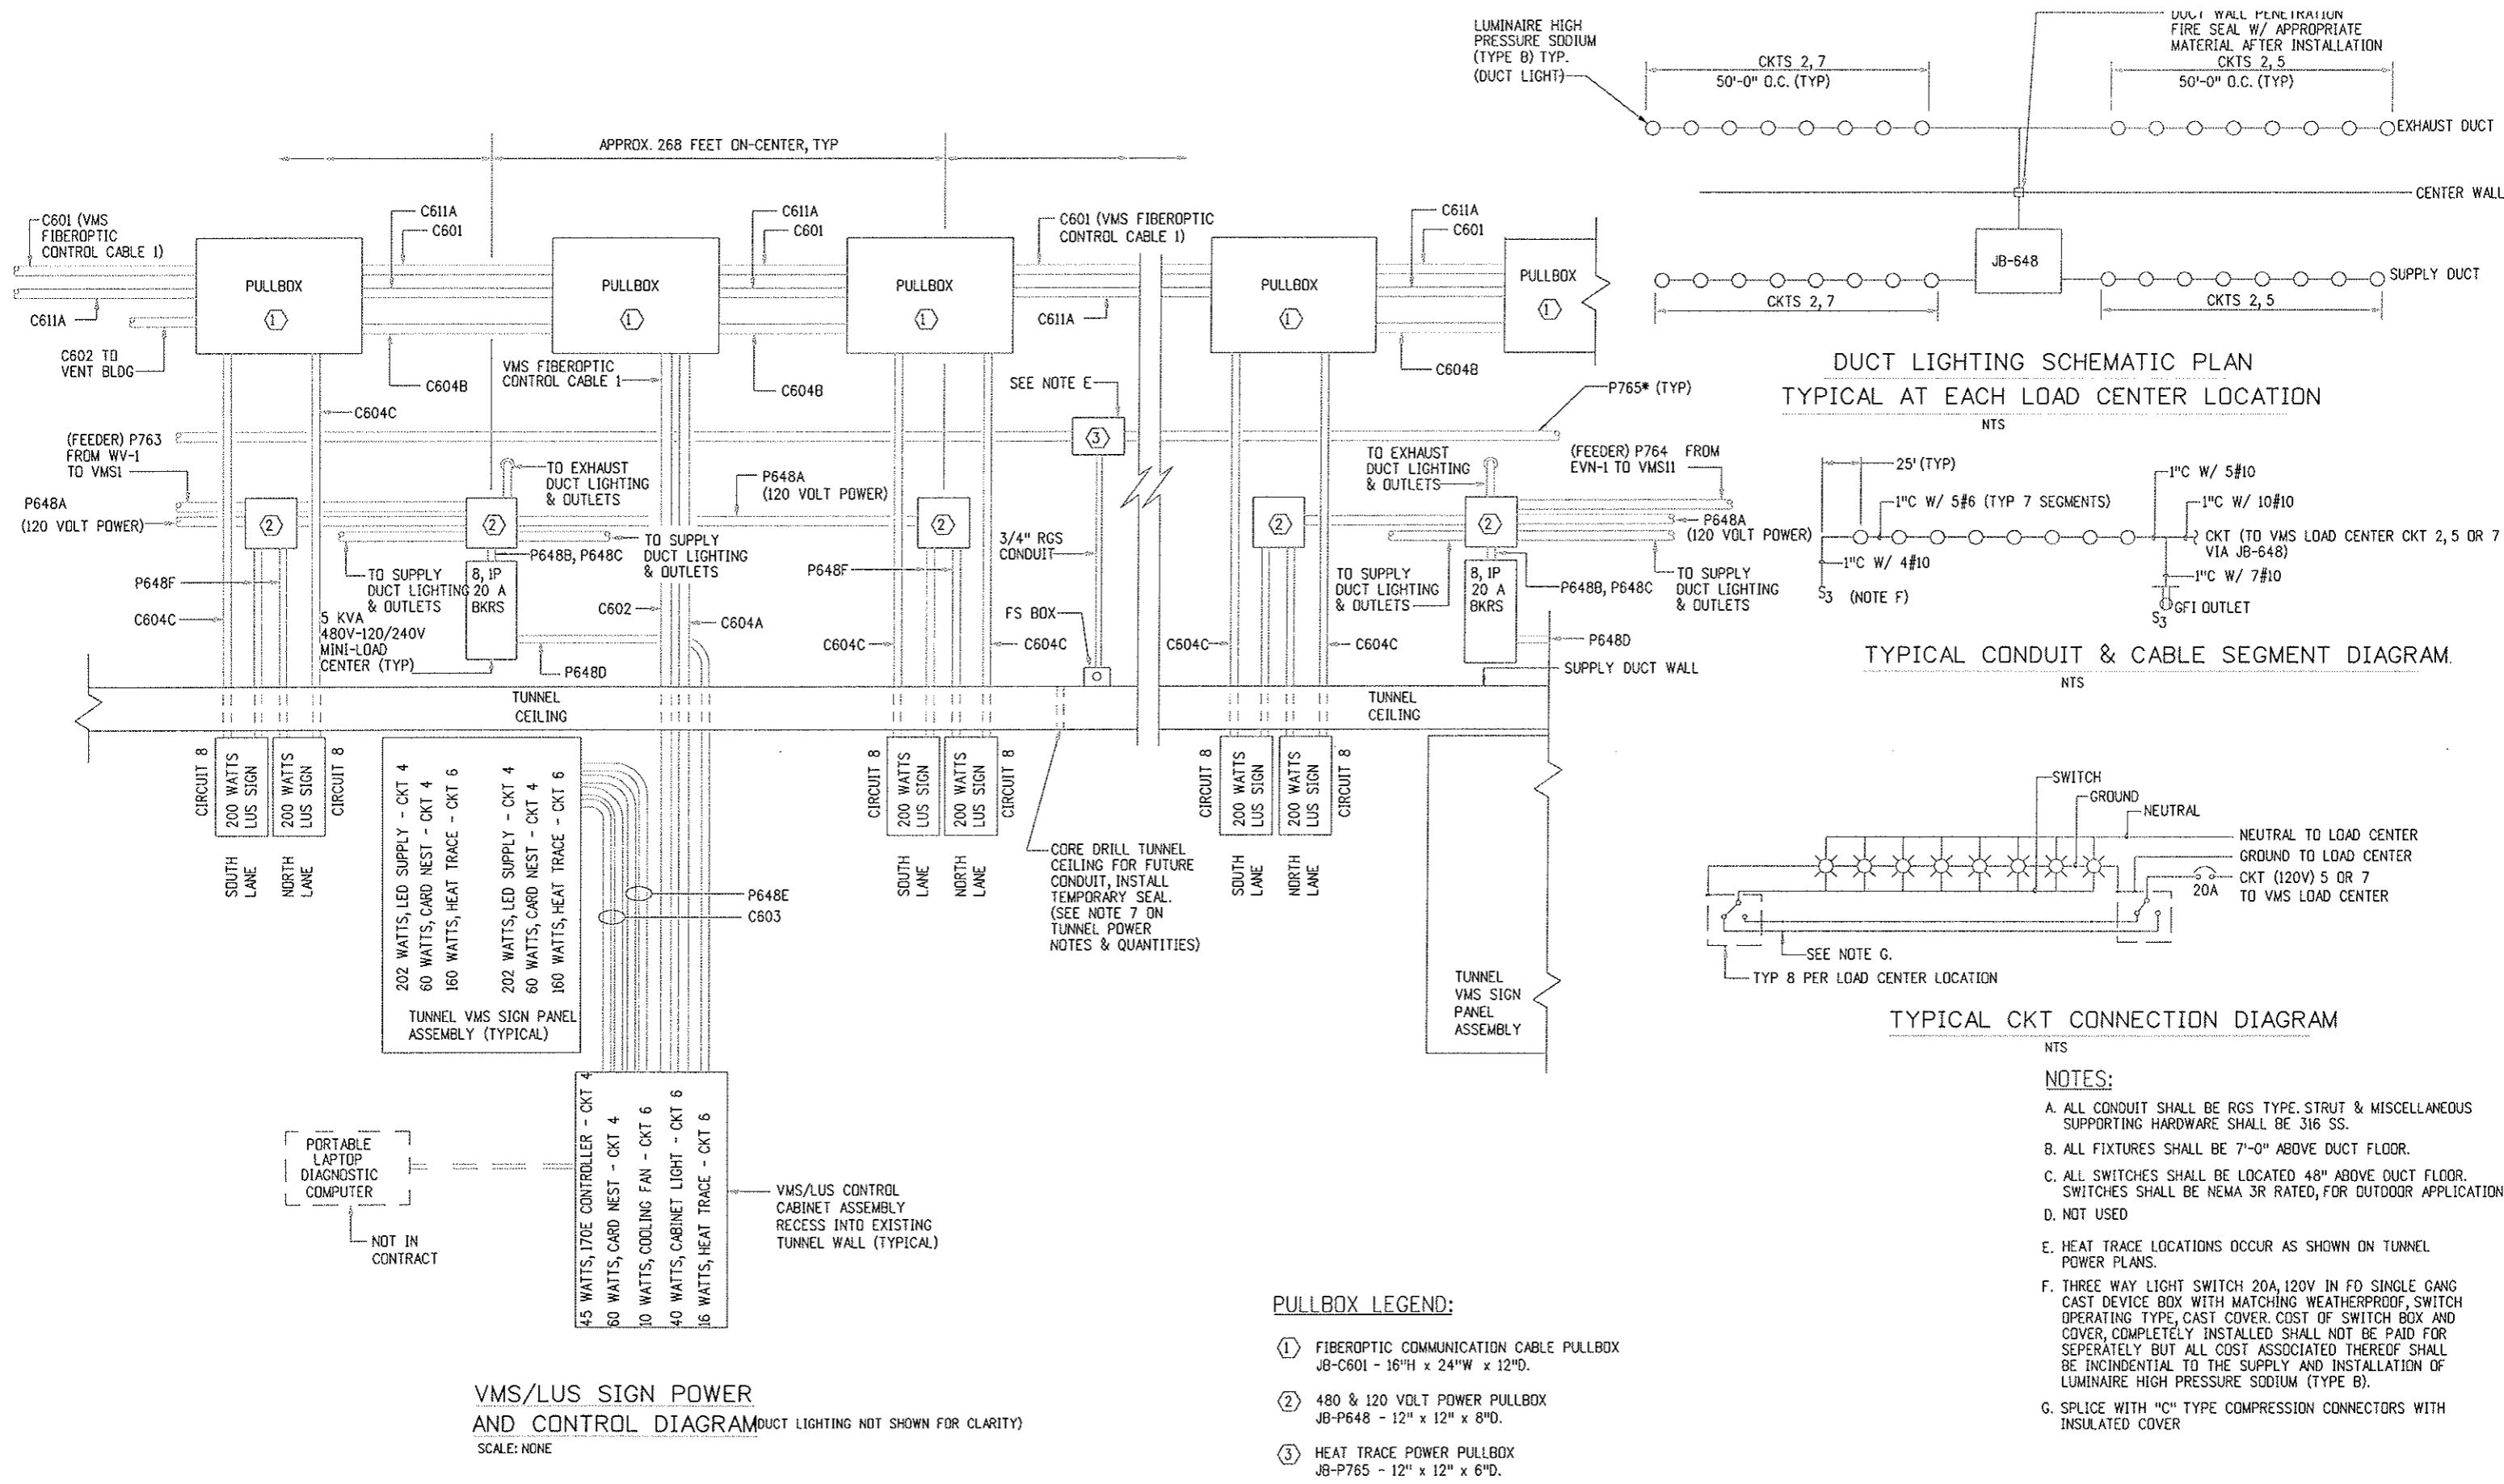

Computer File Information	
Creation Date: 07/03/07	Initials: ASB
Last Modification Date: 07/03/07	Initials: DJB
Full Path: 14102\800Defiv\AsBuilt\	
Drawing File Name: 102-101	
Acad Ver. R14	Scale: N= Units:

Sheet Revisions	
07/03/07	ASBUILT DJB

Colorado Department of Transportation




P.O. BOX 399
 DUMONT, CO. 80436
 Phone: 303-512-5750 FAX: 303-512-5775

Region 1 Mountain Residency I.N.Z.

As Constructed
No Revisions:
Revised:
Void:

TUNNEL POWER AND CONTROL DIAGRAMS	
Designer: J WALSH	Structure Numbers
Detailer: RODDENBERRY	
Sheet Subset: TUN POWER	Subset Sheets: 42 of 45

Project No./Code
IM 0703-269
13166
Sheet Number 108

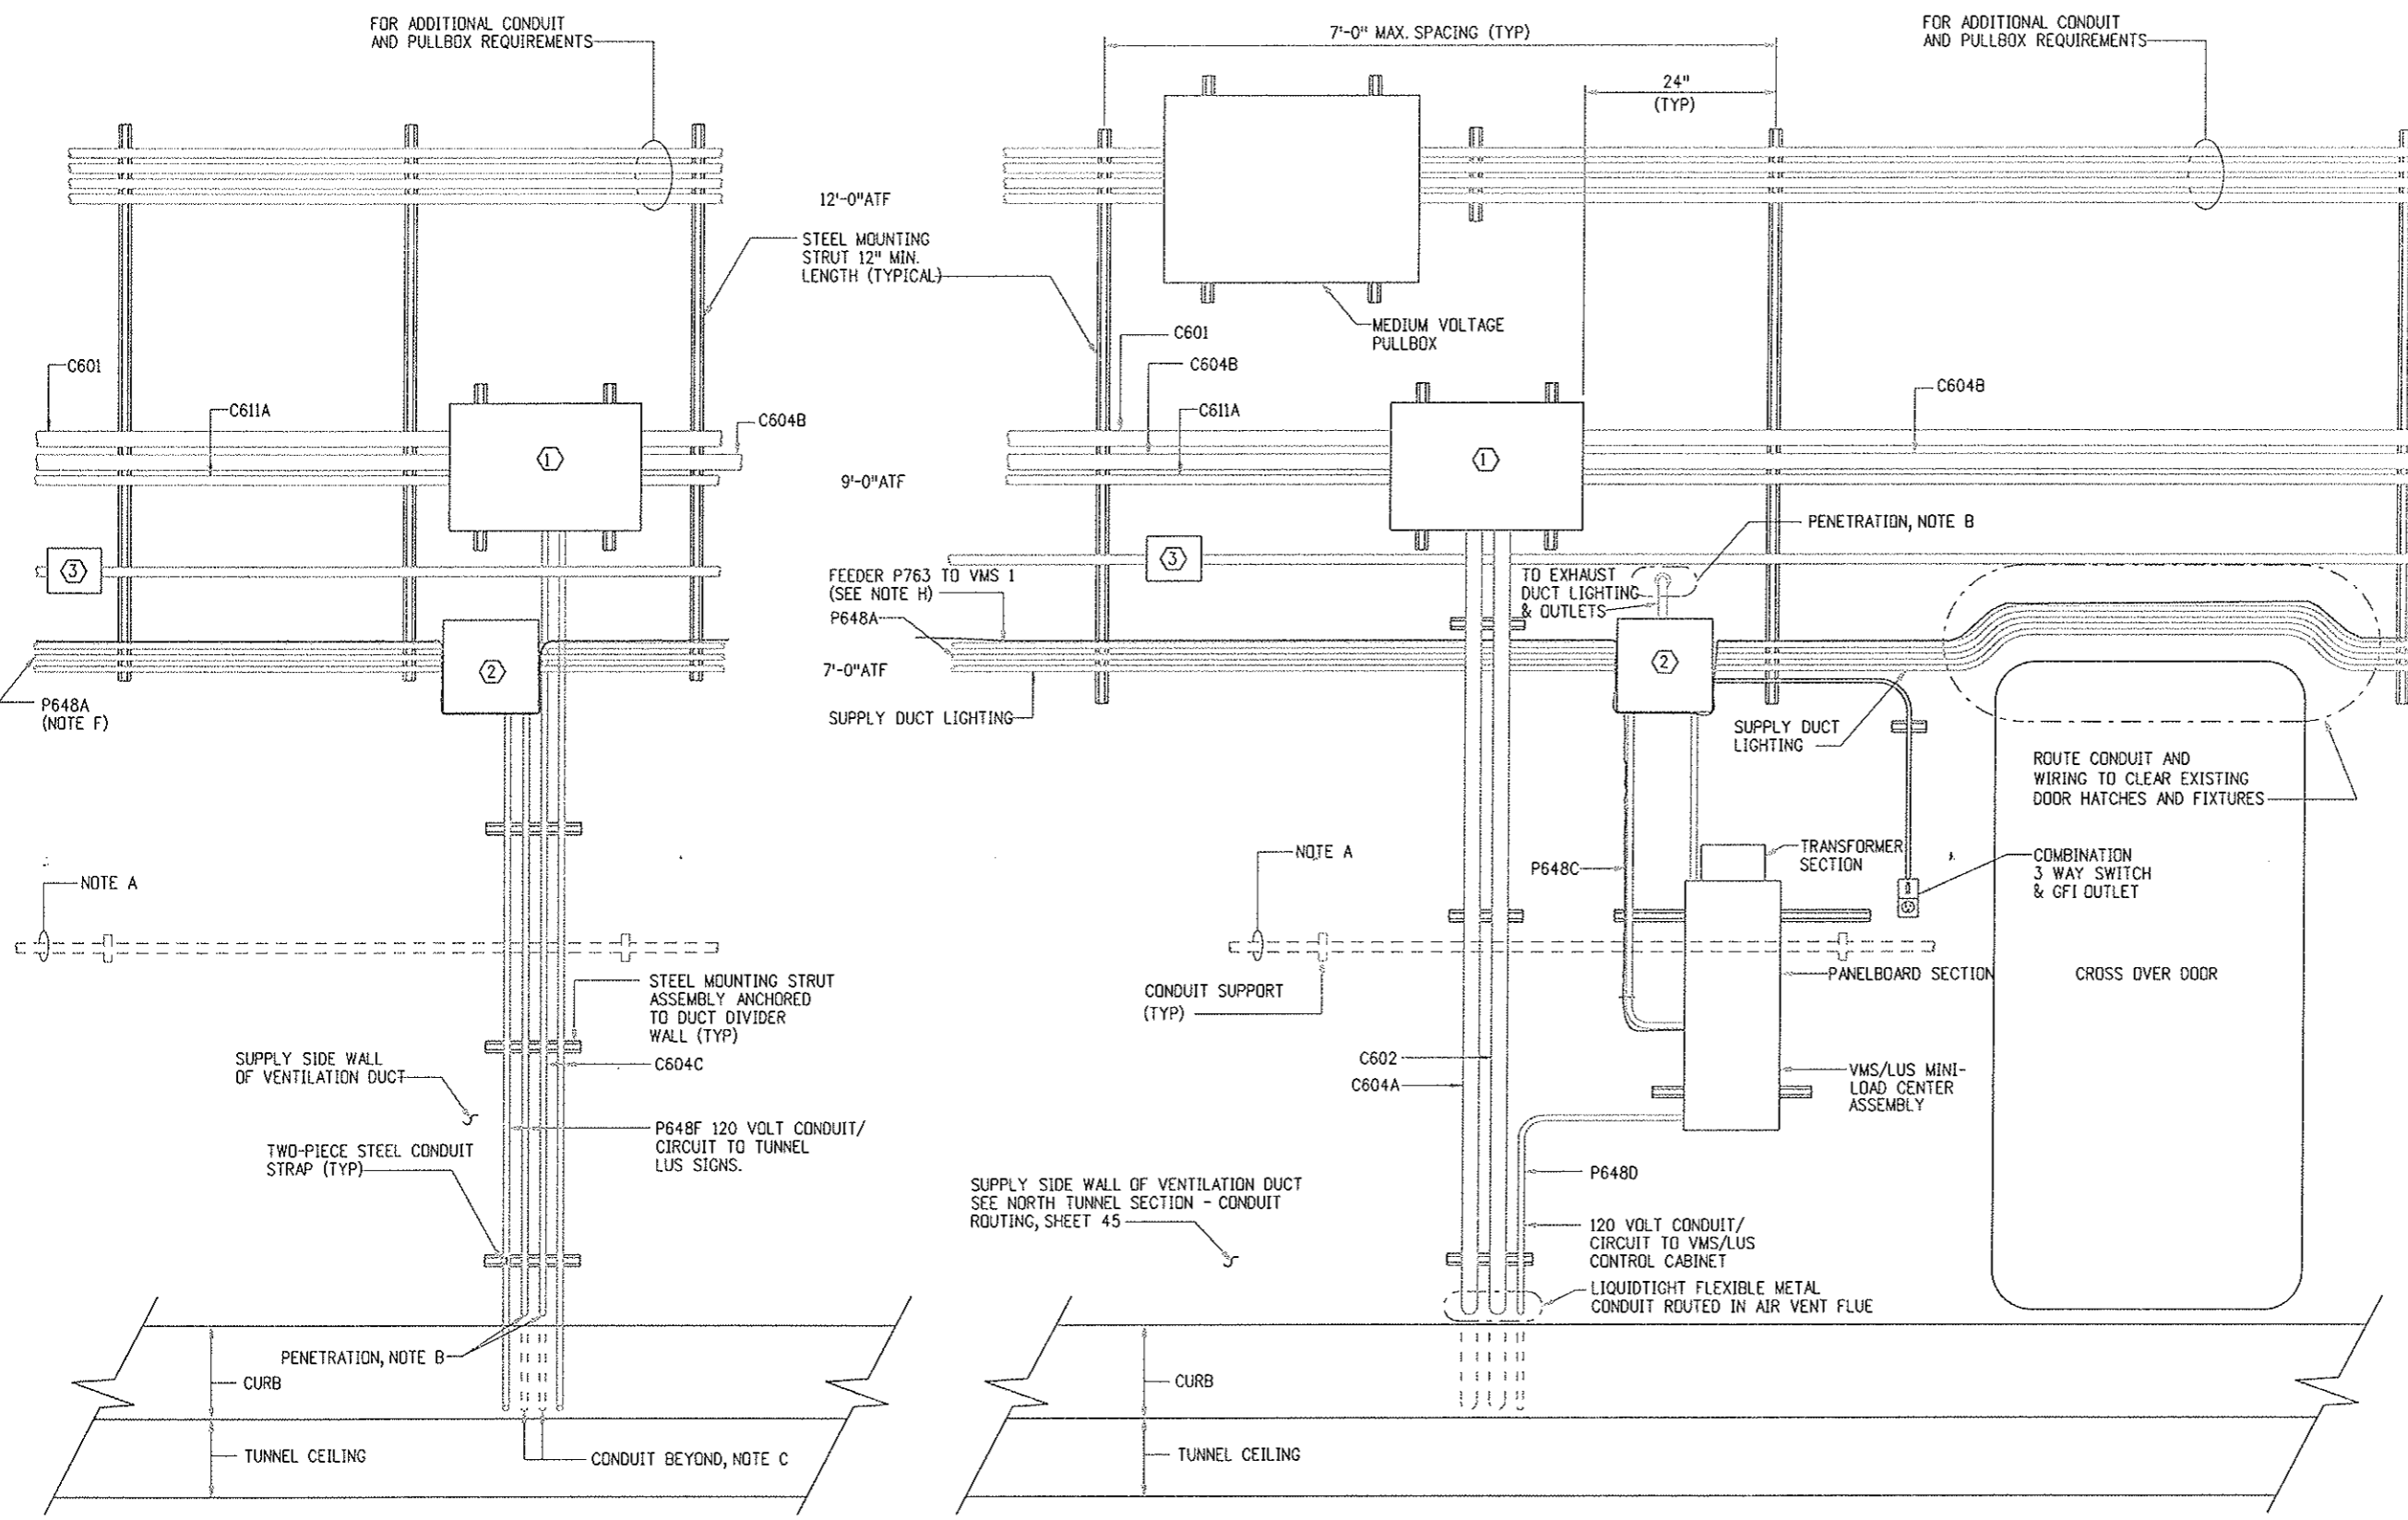

- NOTES::**
- A. REMOVE EXISTING EXPOSED (SUPPLY/EXHAUST VENTILATION DUCT) LIGHTING AND RECEPTACLE CONDUIT/ CONDUCTORS FROM STA 224+00 TO 180+50 (APPROX) REMOVE EXIST DISCONNECT, TRANSFORMER & PANELBOARDS LOCATED ON DUCT DIVIDER WALL (SUPPLY SIDE) AT APPROX STATIONS 190+50, 201+50, 212+50, & 223+50
 - B. CORE DRILL HOLE THROUGH CONCRETE DIVIDER WALL AND SEAL AROUND CONDUIT USING APPROVED FIRESTOP SEALANT. CONTROL CONDUITS SHALL HAVE 8 INCH MINIMUM BEND RADIUS.
 - C. ROUTE CONDUIT OVER WALL CURB AND ACROSS FLOOR OF EXHAUST VENTILATION DUCT. ALL CONDUIT AND PULLBOXES IN EXHAUST DUCT SHALL BE DUST-TIGHT WITH TWO-HOUR FIREPROOFING. PROVIDE PERMANENT RAMP OVER CONDUIT CROSSING ALL FLOORS TO FACILITATE WHEELING SUPPLIES AND EQUIPMENT FOR CONSTRUCTION AND MAINTENANCE.
 - D. ALL DUCT WALL PENETRATIONS SHALL AVOID EMBEDDED TENSION RODS SUPPORTING DUCT STRUCTURE.
 - E. DRILL INSERTS FOR CONDUIT IN DUCT WALL SHALL NOT PENETRATE DUCT WALL.
 - F. P648G ONLY AT JB-P648G FOR FEED FROM VENT BLDG.
 - G. FOR GENERAL TUNNEL POWER NOTES, SEE SHEET 1 OF TUNNEL POWER SUBSET.
 - H. SEE CONDUIT SHCHEDULES AND TUN POWER PLANS FOR SPECIFIC CONDUIT IDENTIFICATION FROM VMS 2 THROUGH VMS 11.

- PULLBOX LEGEND:**
- ① FIBEROPTIC COMMUNICATION CABLE PULLBOX JB-C601 - 16"H x 24"W x 12"D.
 - ② 480 & 120 VOLT POWER PULLBOX JB-P648 - 12"H x 12"W x 8"D
 - ③ HEAT TRACE PULLBOX JB-P765 - 12"H x 12"W x 6"D


VENTILATION SUPPLY DUCT PARTIAL ELEVATION
 AT LUS SIGNS (DUCT LIGHTING NOT SHOWN FOR CLARITY)
 SCALE: NONE

VENTILATION SUPPLY DUCT PARTIAL ELEVATION
 AT VMS/LUS MINI-LOAD CENTER (DUCT LIGHTING NOT SHOWN FOR CLARITY)
 SCALE: NONE


Computer File Information		Sheet Revisions		Colorado Department of Transportation		As Constructed		VENTILATION DUCT POWER SECTIONS / ELEVATIONS		Project No./Code	
Creation Date:	04/26/99	Initials:		07/03/07	ASBUILT			No Revisions:			IM 0703-269
Last Modification Date:	03/04/07	Initials:	DJB					Revised:		Designer: J. WALSH	Structure Numbers:
Full Path:	14102\800Deliv\AsBuilt\							Void:		Detailer: RODDENBERRY	
Drawing File Name:	102-J165									Sheet Subset: TUN POWER	Subset Sheets: 43 of 45
Acad Ver. R14	Scale: None	Units:									Sheet Number 109

Region 1 Mountain Residency I.N.Z.


P.O. BOX 399
 DUMONT, CO. 80436
 Phone: 303-512-5750 FAX: 303-512-5775

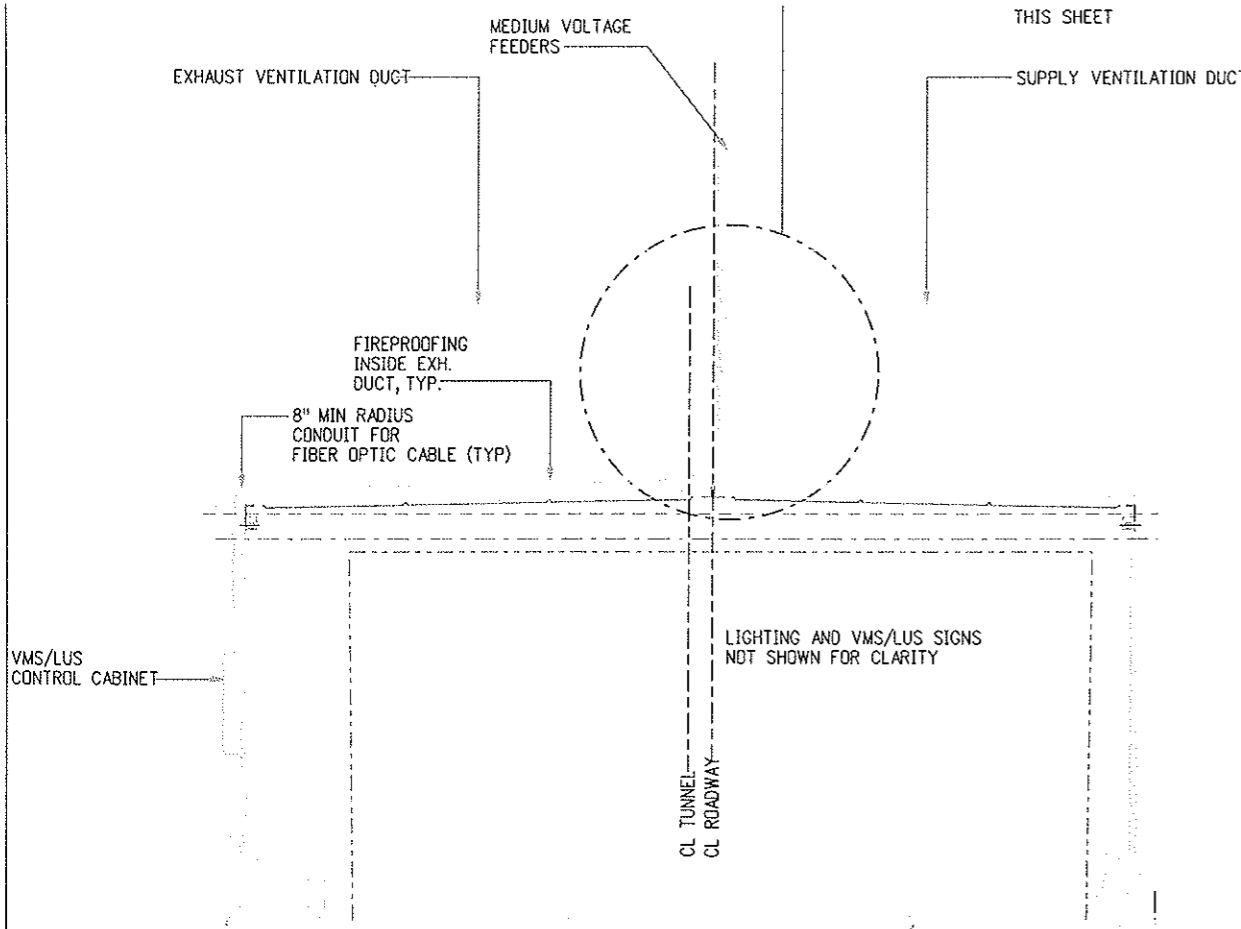

NORTH TUNNEL TYPICAL SECTION LOOKING WEST
AT VMS/LUS MINI-LOAD CENTER (DUCT LIGHTING NOT SHOWN FOR CLARITY)
SCALE: 1/4" = 1'-0"

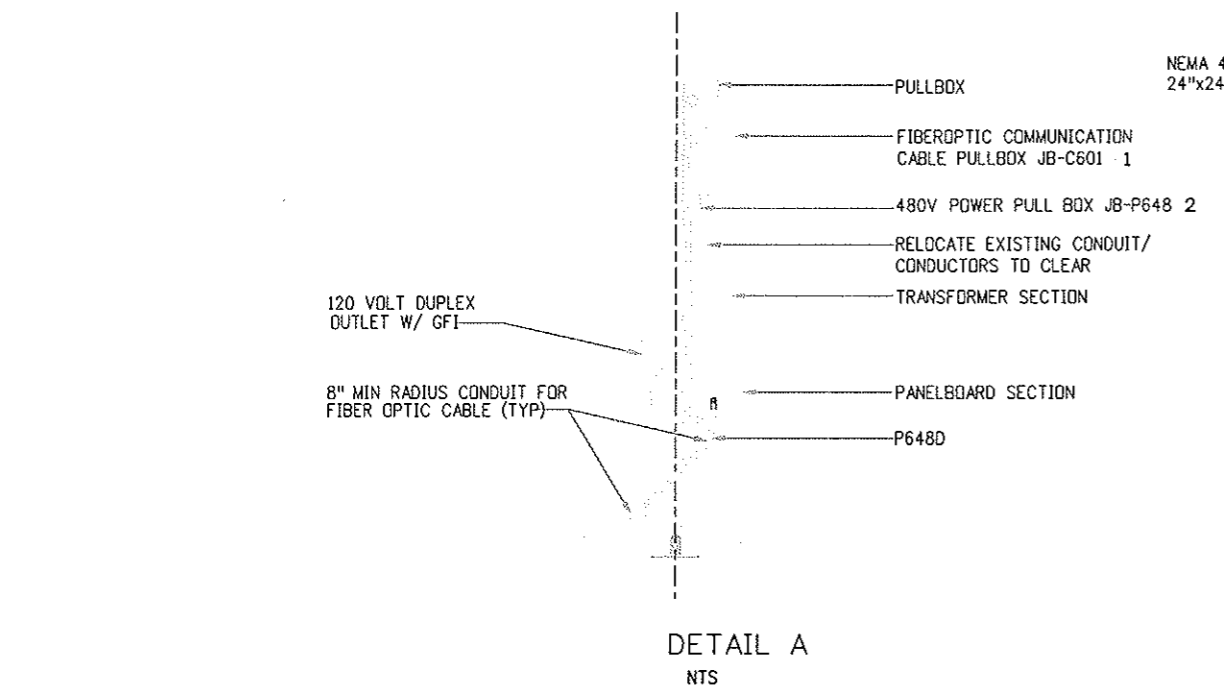

DETAIL A
NTS

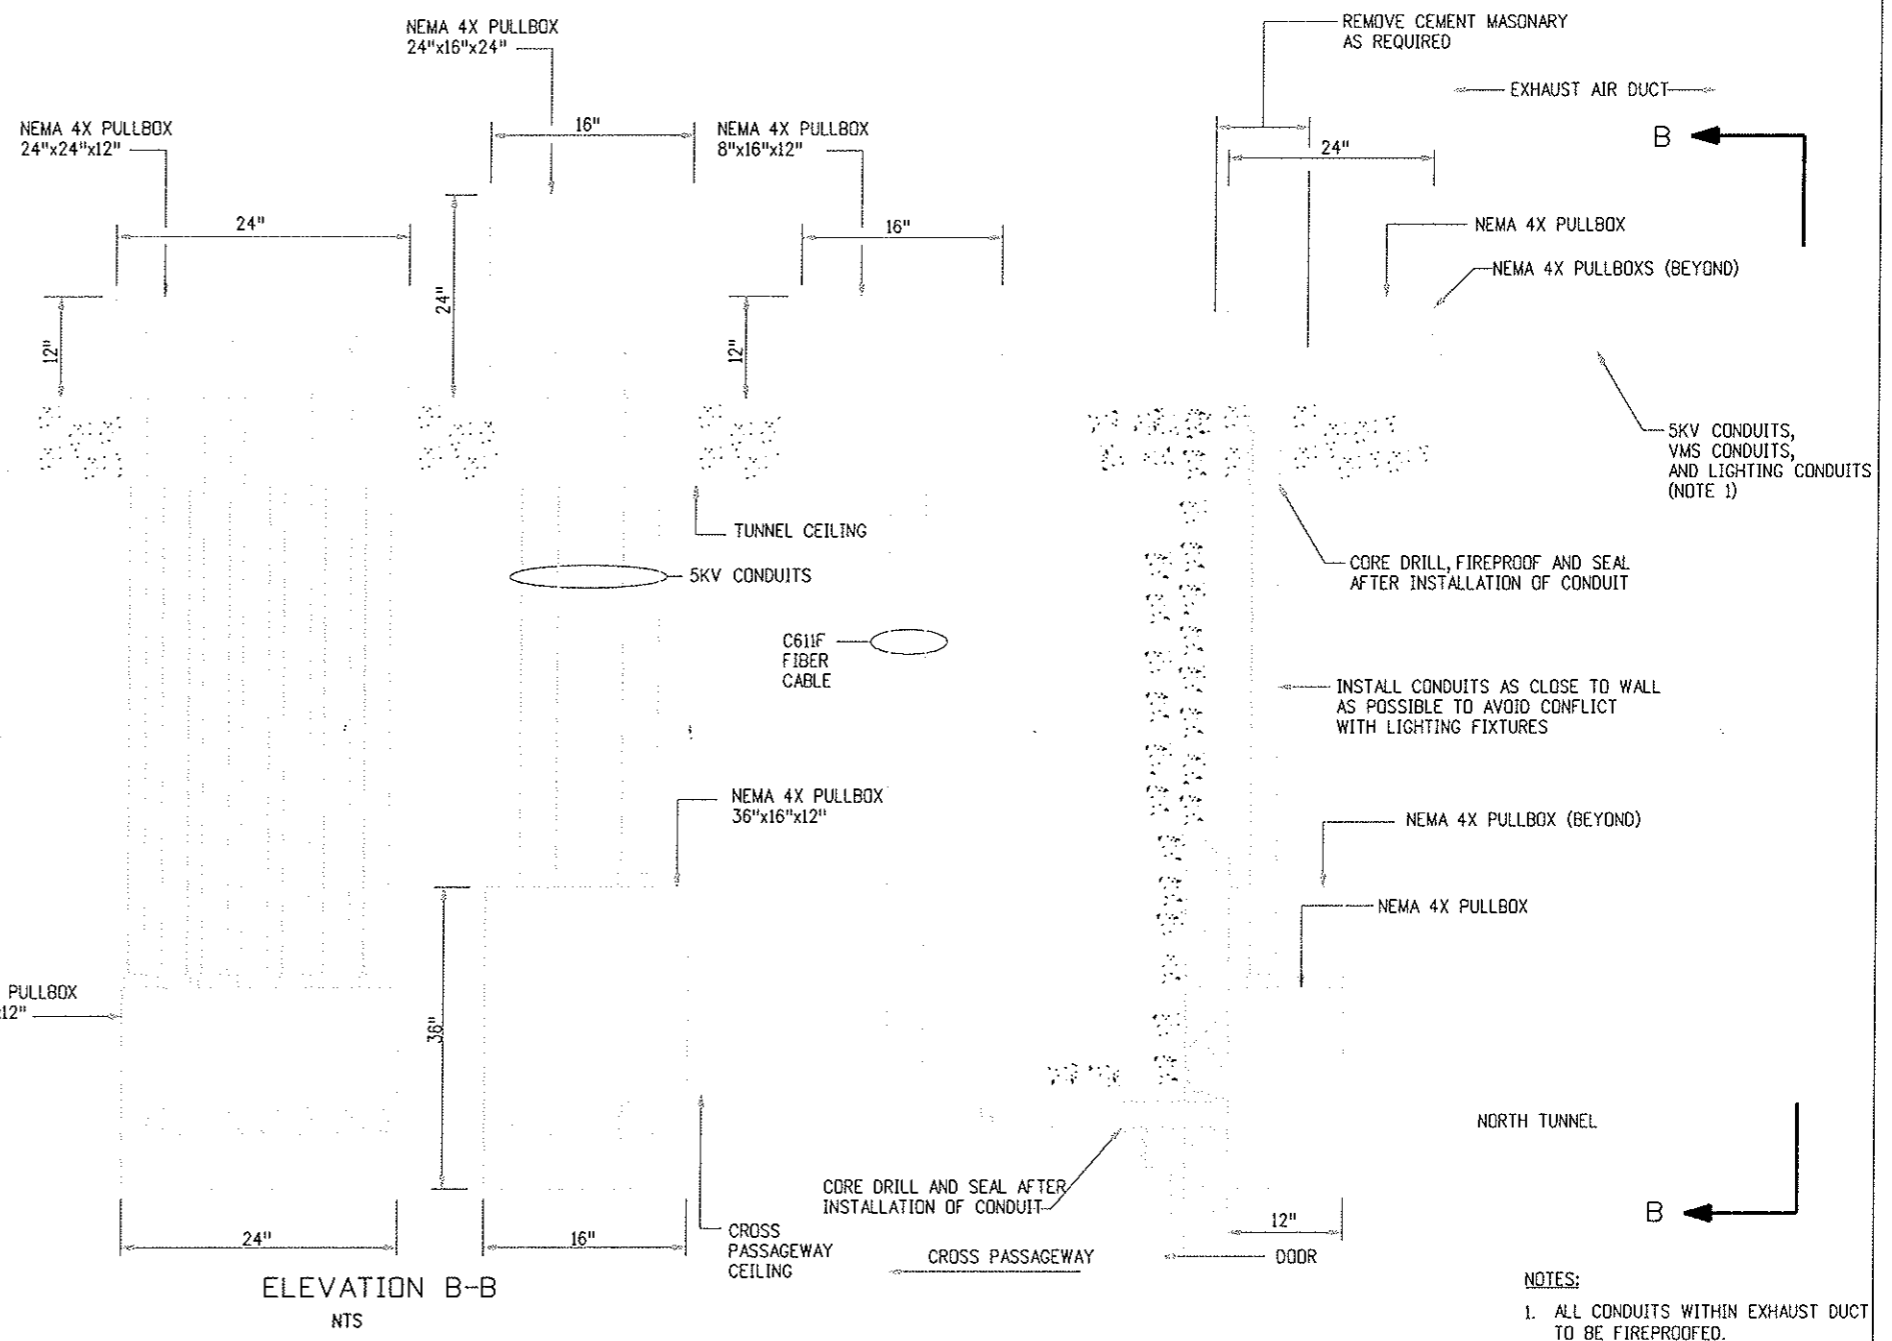


ELEVATION B-B
NTS


NORTH TUNNEL TRANSITION FROM
EXHAUST DUCT TO CROSS CUT ROOMS
SCALE: NTS

NOTES:
1. ALL CONDUITS WITHIN EXHAUST DUCT TO BE FIREPROOFED.


Computer File Information		Sheet Revisions		Colorado Department of Transportation		As Constructed		TUNNEL SECTION AND DETAILS		Project No./Code	
Creation Date:	08/26/99	Initials:		07/03/07	ASBUILT	DJB	No Revisions:	IM 0703-269		13166	
Last Modification Date:	02/28/07	Initials:	DJB				Revised:	Designer:	J. WALSH	Structure Numbers:	
Full Path:	14102\800Deliv\AsBuilt\										
Drawing File Name:	102BDT06										
Acad Ver.	R14	Scale:		Units:			Void:	Sheet Subset:	TUN POWER	Subset Sheets:	44 of 45
								Region 1 Mountain Residency		I.N.Z.	
								P.O. BOX 399		DUMONT, CO. 80436	
								Phone: 303-512-5750		FAX: 303-512-5775	
								DOT		DEPARTMENT OF TRANSPORTATION	
								Region 1 Mountain Residency		I.N.Z.	
								Sheet Number		110	

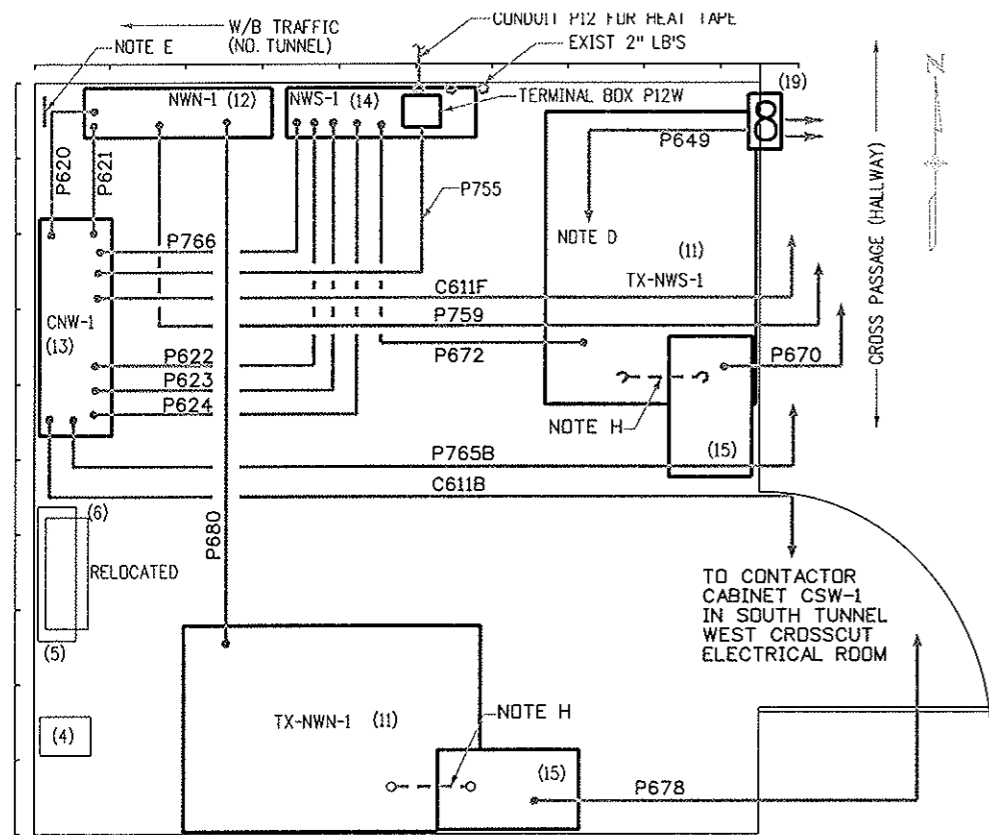


FINAL PLAN
CROSSCUT WEST

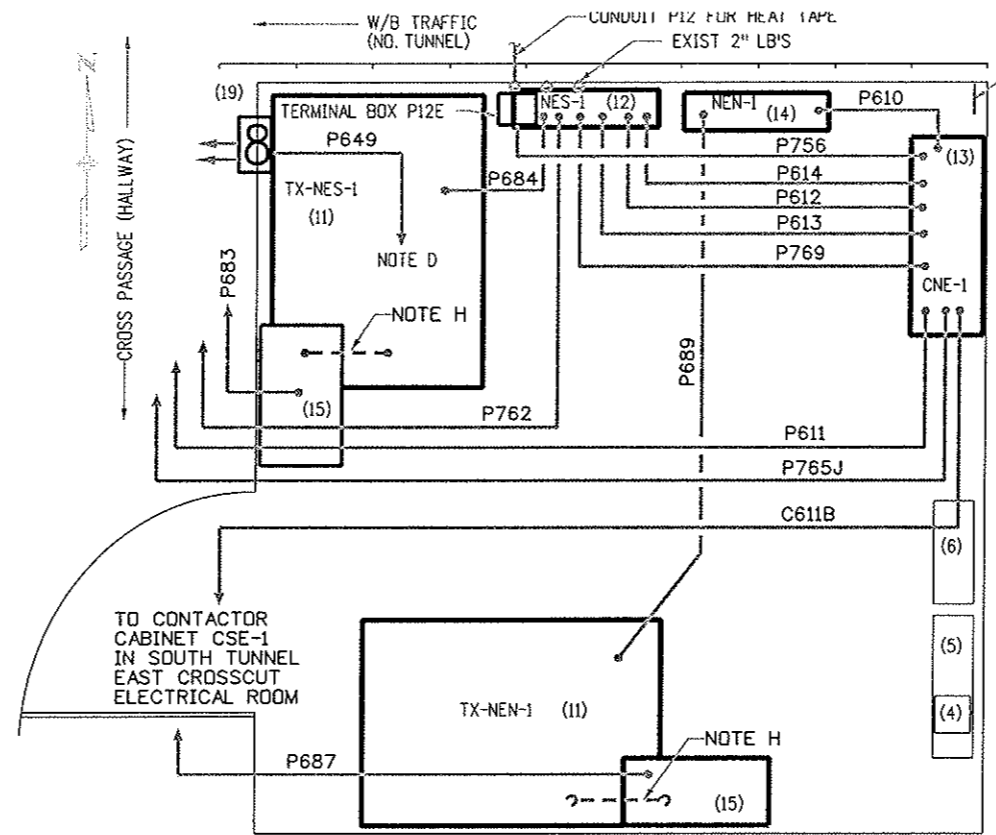

FINAL PLAN
CROSSCUT EAST

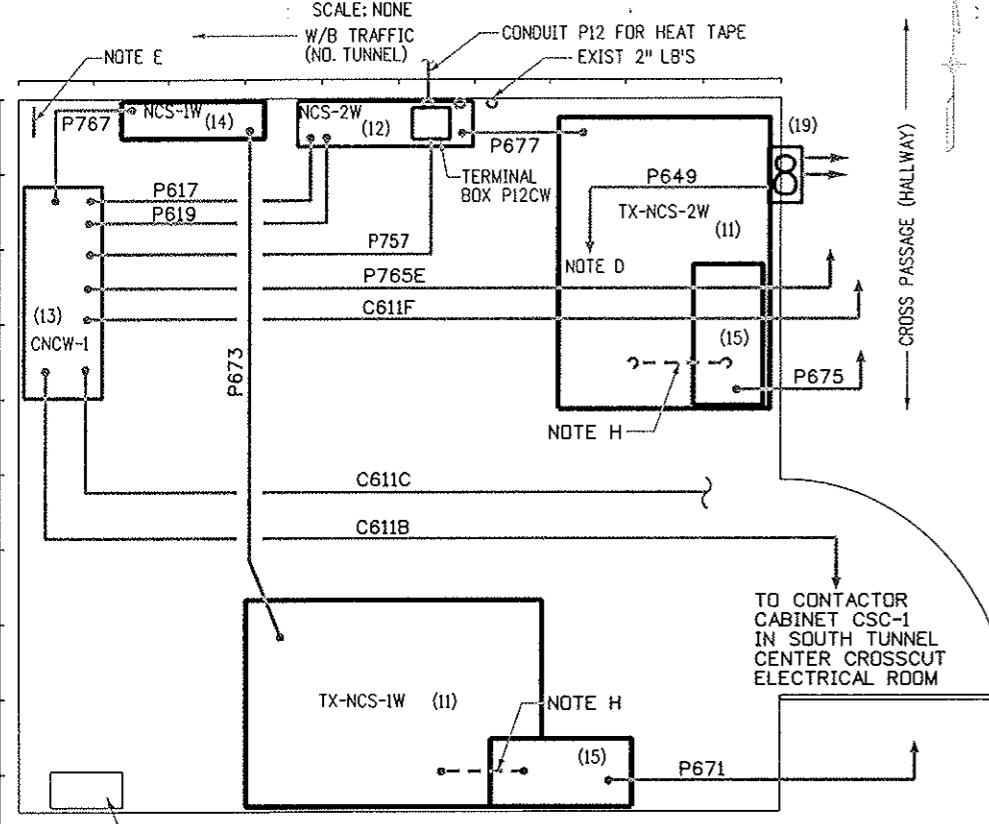

FINAL PLAN
CENTER CROSSCUT WEST

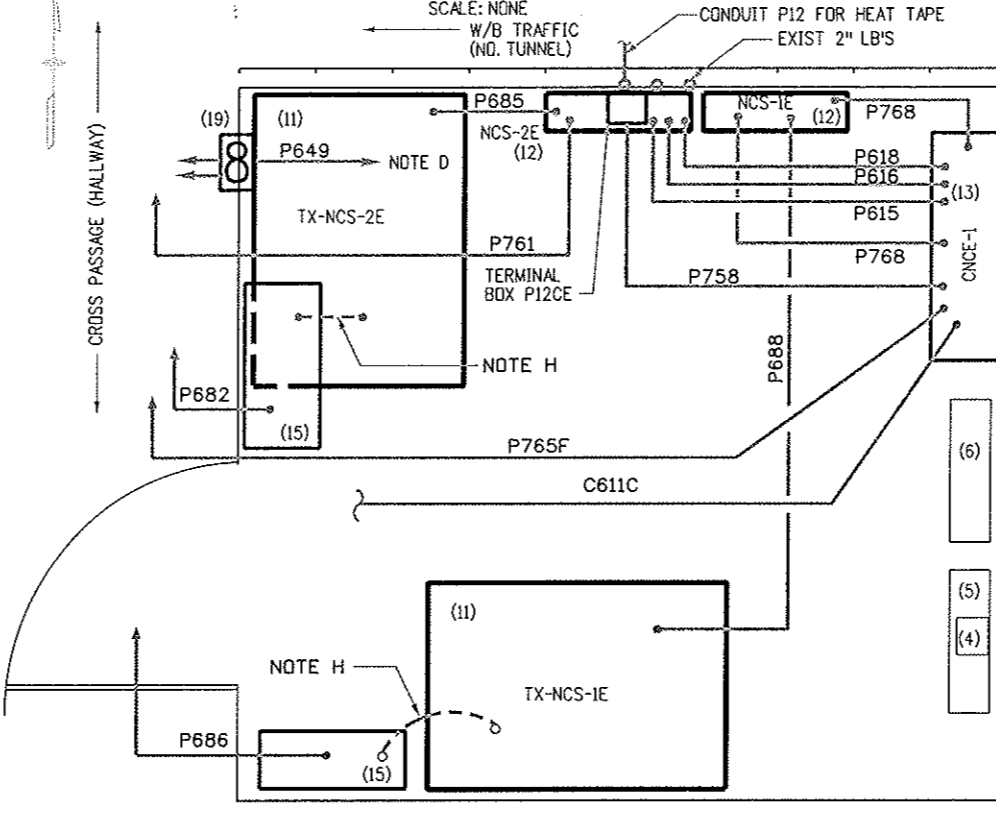

FINAL PLAN
CENTER CROSSCUT EAST

NOTES

- A. REFER TO THE ELEC DEMD SUBSET- SHEETS 6,7,8,9 & 10 FOR CONSTRUCTION STAGING REQUIREMENTS FOR WEST, WEST CENTER, EAST CENTER AND EAST CROSSCUT ELECTRICAL ROOMS
- B. REFER TO THE TUN. POWER- SUBSET SHEETS 28, 32 & 37 FOR TUNNEL CIRCUITS WHICH ROUTE TO CONTACTOR CABINETS (CNW-1, CNCW-1, CNE-1 & CNCE-1).
- C. REFERENCE TUN. POWER SUBSET-SHEET 15 "TUNNEL LIGHTING CONTROL SYSTEMS" FOR ROUTING OF C611B AND C611C.
- D. HOMERUN TO EXISTING 120/240V PANEL. TERMINATE ON EXISTING SPACE OR SPARE. PROVIDE 20A/1P BRANCH BREAKER WHERE REQUIRED.
- E. THREE EXISTING 1 1/2-INCH CONDUITS, P16 (MESSAGE BOARDS), P17 (TV CAMERA), P18 (PULPIT FEEDER) CONTAINING CONDUCTORS THAT ARE TO BE RECONNECTED TO CIRCUIT BREAKERS IN NEW PANELBOARD. A FOURTH EXISTING 1 1/2-INCH CONDUIT IS A SPARE. EXTEND EXISTING CONDUITS FROM NORTH WALL OF ELECTRICAL ROOM TO NEW PANELBOARD. REINSTALL TEMPORARILY REMOVED CONDUCTORS FROM NEAREST PULLBOX BACK INTO CONDUIT AND TO NEW PANELBOARD. SEE DEMO DRAWINGS ON SHEETS 15 THROUGH 18.
- F. REFERENCE VB ELECT SUBSET SHEETS 18 "ELECT CIRCUIT SCHEDULES, SHEET 1 FOR CONDUIT P670 -P712 AND WIRE (OR CABLE) DESCRIPTIONS AND ROUTING.
- G. REFERENCE TUN. POWER SUBSET SHEETS 5 (6,7, & 8) "TUNNEL CIRCUIT SCHEDULES, SHEET 1 (2,3, & 4)" FOR CONDUIT AND WIRE (OR CABLE) DESCRIPTIONS AND ROUTING, WITHIN TUNNEL.
- H. 3 INCH FLEXIBLE METAL CONDUIT WITH BUB FITTING FOR CONNECTION TO TRANSFORMER.

LEGEND:

- (4) 3 KVA, 480 V - 208Y / 120 V TRANSFORMER (EXIST)
- (5) 120 / 240 V PANEL - 16"W x 21"H x 6"D (EXIST)
- (6) 30A, 2P, 120/240 V ASCO SW. (ATS) (EXIST)
- (11) NEW 150 KVA, 2400 V - 480Y/277 V TRANSFORMER-48"W x 58"H x 32"D
- (12) NEW 480 / 277 V PANEL - 22"W x 65"H x 6"D
- (13) NEW CONTACTOR CABINET - (SEE SHEET 16 THRU 23 OF TUN PWR SUBSET)
- (14) NEW 480 / 277 V PANEL - 22"W x 50"H x 6"D
- (15) NEW - MV CABLE PULLBOX - 24"W x 20"H x 12"D
- (18) RELOCATED - F.O. CABINET
- (19) NEW THRU-WALL EXHAUST FAN (3000 CFM)

NOTE:

CONDUIT ROUTING IS DIAGRAMMATIC ON THIS SHEET..

Plot File Name: \\PLU\PLU\... Date of Plot: 02/26/99

Computer File Information		Sheet Revisions		Colorado Department of Transportation		As Constructed		NORTH TUNNEL ELEC. RM. CROSSCUT POWER PLANS		Project No./Code	
Creation Date:	02/26/99	Initials:	DJB	07/03/07	ASBUILT					IM 0703-269	
Last Modification Date:	02/28/07	Initials:	DJB							13166	
Full Path:	14102\800Deliv\AsBUILT\									Sheet Number 111	
Drawing File Name:	102_p160a										
Acad Ver.	R14	Scale:	NTS	Units:	ENGLISH						


VENTILATION BUILDING POWER NOTES:


1. THE MAIN OBJECTIVE SHALL BE TO MAINTAIN A FULLY FUNCTIONAL TUNNEL DURING CONSTRUCTION. ALL LIGHTING, VMS, LUS OR ELECTRICAL DISTRIBUTION SYSTEMS OR MOBILIZATION THAT REQUIRES LANE CLOSURE SHALL BE PERFORMED DURING OFF-PEAK TRAFFIC PERIODS AND COORDINATED WITH THE ENGINEER. SEE CONTRACT DOCUMENTS AND SPECIAL PROVISIONS FOR OTHER RESTRICTIONS.
2. NOT USED
3. DRAWINGS REPRESENT DIAGRAMATIC LOCATIONS AND APPROXIMATE QUANTITIES. THE CONTRACTOR SHALL VERIFY THE LOCATION OF EXISTING UTILITIES AND SHALL EXERCISE SUITABLE CARE TO AVOID DISRUPTION OR DAMAGE OF UTILITIES OR EQUIPMENT TO REMAIN IN SERVICE. REPAIR DAMAGE ACCORDING TO THE PROVISIONS.
4. REFER TO ELECTRICAL DRAWINGS TO COORDINATE SUITABLE PHASING OF DEMOLITION AND NEW CONSTRUCTION. IMMEDIATELY NOTIFY THE ENGINEER IF CONCEALED UTILITIES, CONDUIT OR CONDITIONS ARE DISCOVERED THAT WILL INHIBIT NEW CONSTRUCTION INDICATED ON THE CONTRACT DOCUMENTS. ACT TO RESOLVE THESE ISSUES AS EXPEDIENTLY AS POSSIBLE.
5. MAINTAIN EMERGENCY CIRCUITING UNTIL RAPID CHANGE-OVER TO NEW EMERGENCY CIRCUITING OCCURS. ALL TEMPORARY WIRING SHALL COMPLY WITH THE NATIONAL ELECTRICAL CODE AND BE PRE-APPROVED BY THE LOCAL AUTHORITY HAVING JURISDICTION. RE-LABEL ALL CIRCUIT BREAKERS WITH TEMPORARY OR PERMANENT REVISED LOAD DESCRIPTIONS AS REQUIRED.
6. RE-UTILIZE EXISTING PULLBOXES, CONDUIT OR PENETRATIONS WHERE SUITABLE, SUCH AS WHERE THE ELECTRICAL ROOM CONDUIT INTERFACES WITH THE TUNNEL.
7. REFERENCE VB ELECT SUBSET SHEET 19 "ELECT CIRCUIT SCHEDULES, SHEET 2" FOR SERIES 600 CONTROL CONDUIT AND WIRE (OR CABLE) DESCRIPTIONS AND ROUTING.
8. REFERENCE TUN. POWER SUBSET SHEETS 5 (6, 7 & 8) "TUNNEL CIRCUIT SCHEDULES, SHEET 1 (2, 3 & 4)" FOR POWER CONDUIT AND WIRE (OR CABLE) DESCRIPTIONS AND ROUTING WITHIN TUNNEL.
9. REFERENCE VB ELECT SUBSET SHEET 18 "ELECT CIRCUIT SCHEDULES, SHEET 1" FOR P670 THROUGH P712 CONDUIT AND WIRE (OR CABLE) DESCRIPTIONS AND ROUTING WITHIN TUNNEL.
10. INTERCEPT CONDUIT P-702 IN EAST VENTILATION BUILDING AND RE-ROUTE TO CONTRACTOR CABINET CEVN-2.
11. INTERCEPT CONDUIT P-700 IN WEST VENTILATION BUILDING AND RE-ROUTE TO CONTRACTOR CABINET CWNV-2.

QUANTITIES - TUNNEL POWER

CONTRACT ITEM NUMBER	CONTRACT ITEM	UNIT	ROADWAY	
			PLAN	AS CONST.
613	MEDIUM VOLTAGE LOAD INTERRUPTER SWITCH	EA	4	
613	3/4 INCH ELECTRICAL CONDUIT	LF	500	
613	1-1/4 INCH ELECTRICAL CONDUIT	LF	1000	
613	2 INCH ELECTRICAL BODY (TYPE LB)	EA	2	
613	2 INCH ELECTRICAL CONDUIT	LF	100	
613	3 INCH ELECTRICAL CONDUIT	LF	1400	
613	3-1/2 INCH ELECTRICAL CONDUIT	LF	200	
613	1 INCH ELECTRICAL CONDUIT	LF	1000	
613	2.4KV MOTOR CONTROL CENTER CUBICLE	EA	3	
613	CIRCUIT BREAKER (400A, 3 POLE)	EA	3	
613	PANELBOARD (225A, 277/480V, 3 PHASE)	EA	4	
613	PANELBOARD (5KVA, 480-120/240V MINI LOAD CENTER)	EA	2	
613	POWER TRANSFORMER (300KVA, 480-2400V, 3 PHASE)	EA	2	
613	TUNNEL LIGHTING CONTROL SYSTEM	LS	1	
613	1-1/2 INCH ELECTRICAL CONDUIT	LF	1500	
613	CIRCUIT BREAKER (150A, 3 POLE)	EA	1	

Design File Name: DGNSSPEC*
 Plot File Name: \$PLGFILE*
 Date of Plot: \$\$\$DATE\$\$\$

Computer File Information		Sheet Revisions		 Colorado Department of Transportation P.O. BOX 399 DUMONT, CO. 80436 Phone: 303-512-5750 FAX: 303-512-5775 Region 1 Mountain Residency I.N.Z.	As Constructed	VENT. BUILDING POWER NOTES & QUANTITIES		Project No./Code	
Creation Date:	02/26/99 Initials: SL	<input type="checkbox"/>	07/03/07 ASBUILT DJB		No Revisions:			IM 0703-269	
Last Modification Date:	02/07/02 Initials: DJR	<input type="checkbox"/>			Revised:	Designer: E.A. GAYAMAT	Structure Numbers:	13166	
Full Path:	14102\700cadd\703elect\	<input type="checkbox"/>			Void:	Detailer: R. MILLER	Sheet Subsets:	1 of 20	
Drawing File Name:	gesno03n.dgn	<input type="checkbox"/>			Sheet Subset: VB ELEC	Subset Sheets:	112		
Acad Ver. R14	Scale: NTS Units: ENGLISH	<input type="checkbox"/>							

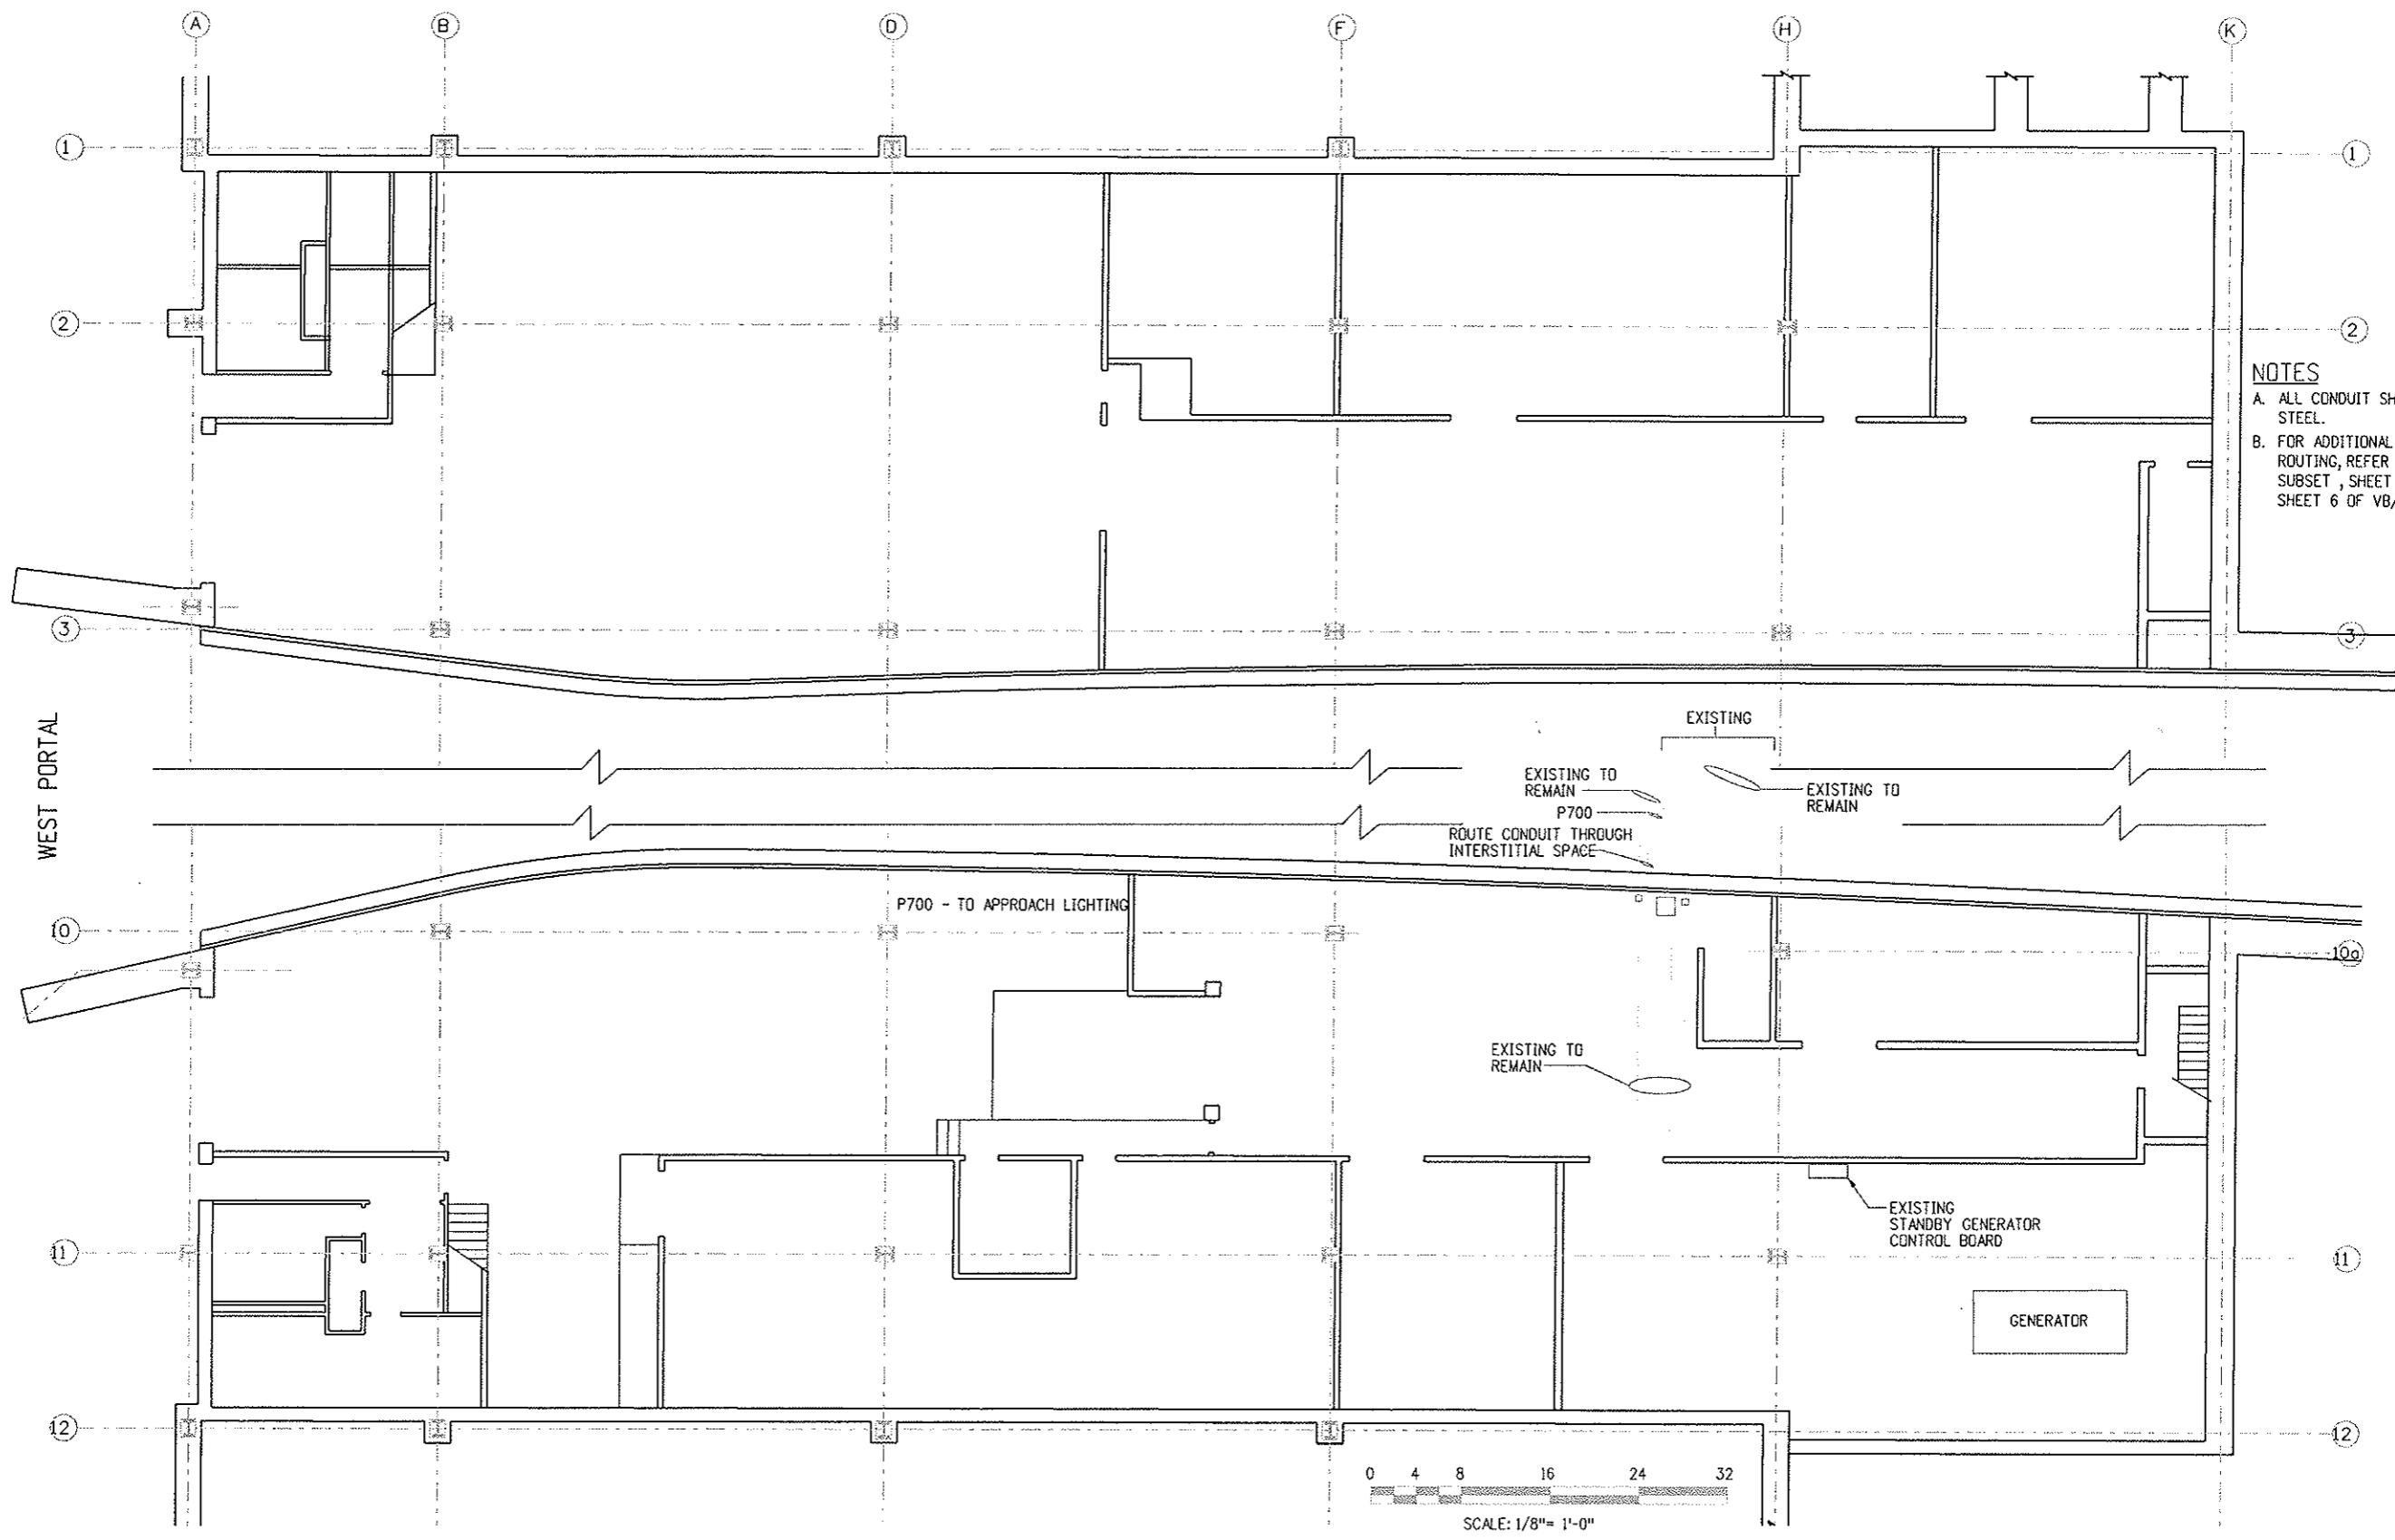


NOTES
 A. ALL CONDUIT SHALL BE RIGID GALVANIZED STEEL.
 B. FOR ADDITIONAL CONDUIT RUNS AND/OR ROUTING, REFER TO TUNNEL POWER SUBSET, SHEET 24 AND TO SUBSET SHEET 6 OF VB/ELEC.

Design File Name: D:\NSPEC*
 Plot File Name: \$PLOTFILE\$
 Date of Plot: \$\$\$DATE\$\$\$

Computer File Information	
Creation Date:	02/26/99 Initials: SL
Last Modification Date:	05/10/01 Initials: LK
Full Path:	14102\700cadd\703elect\
Drawing File Name:	eppl22wn.dgn
Acad Ver.	R14 Scale: 1/8" = 1'-0" Units: ENGLISH

Sheet Revisions	
07/03/07	ASBUILT DJB

Colorado Department of Transportation




P.O. BOX 399
 DUMONT, CO. 80436
 Phone: 303-512-5750 FAX: 303-512-5775

Region 1 Mountain Residency I.N.Z.


As Constructed
No Revisions:
Revised:
Void:

WEST VENT BUILDING PARTIAL POWER PLAN	
Designer: E.A. GAYAMAT	Structure Numbers
Detailer: R. MILLER	
Sheet Subset: VB ELEC	Subset Sheets: 2 of 20

Project No./Code
IM 0703-269
13166
Sheet Number 113

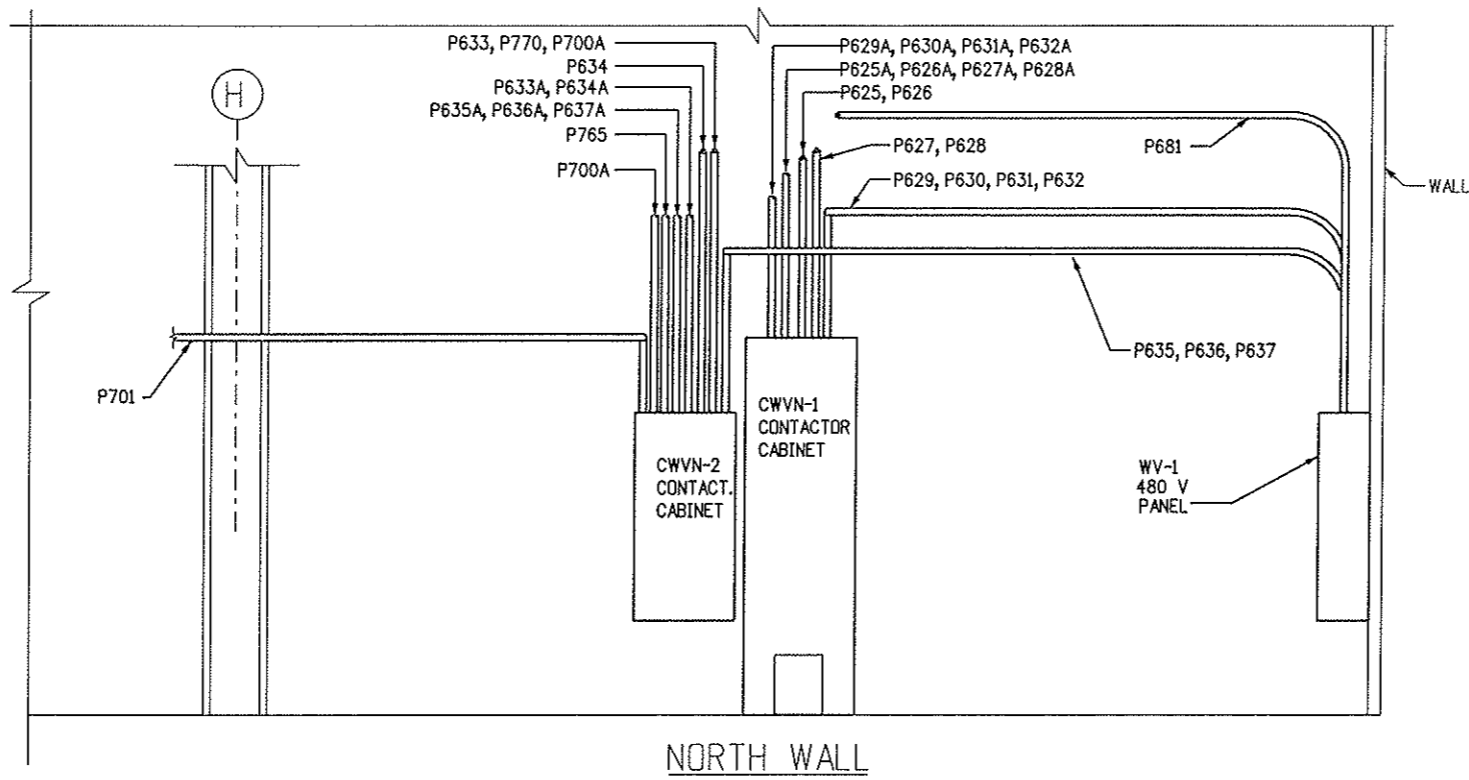


NOTES:
 1. NEW WORK IS INDICATED BY HEAVY LINES FOR WV-1, CWVN, AND CWVN-2, AND CONDUITS. ALSO SEE SHEET 18 OF VB/ELEC AND SHEET 6 OF TUNNEL POWER FOR CONDUIT REQUIREMENTS.

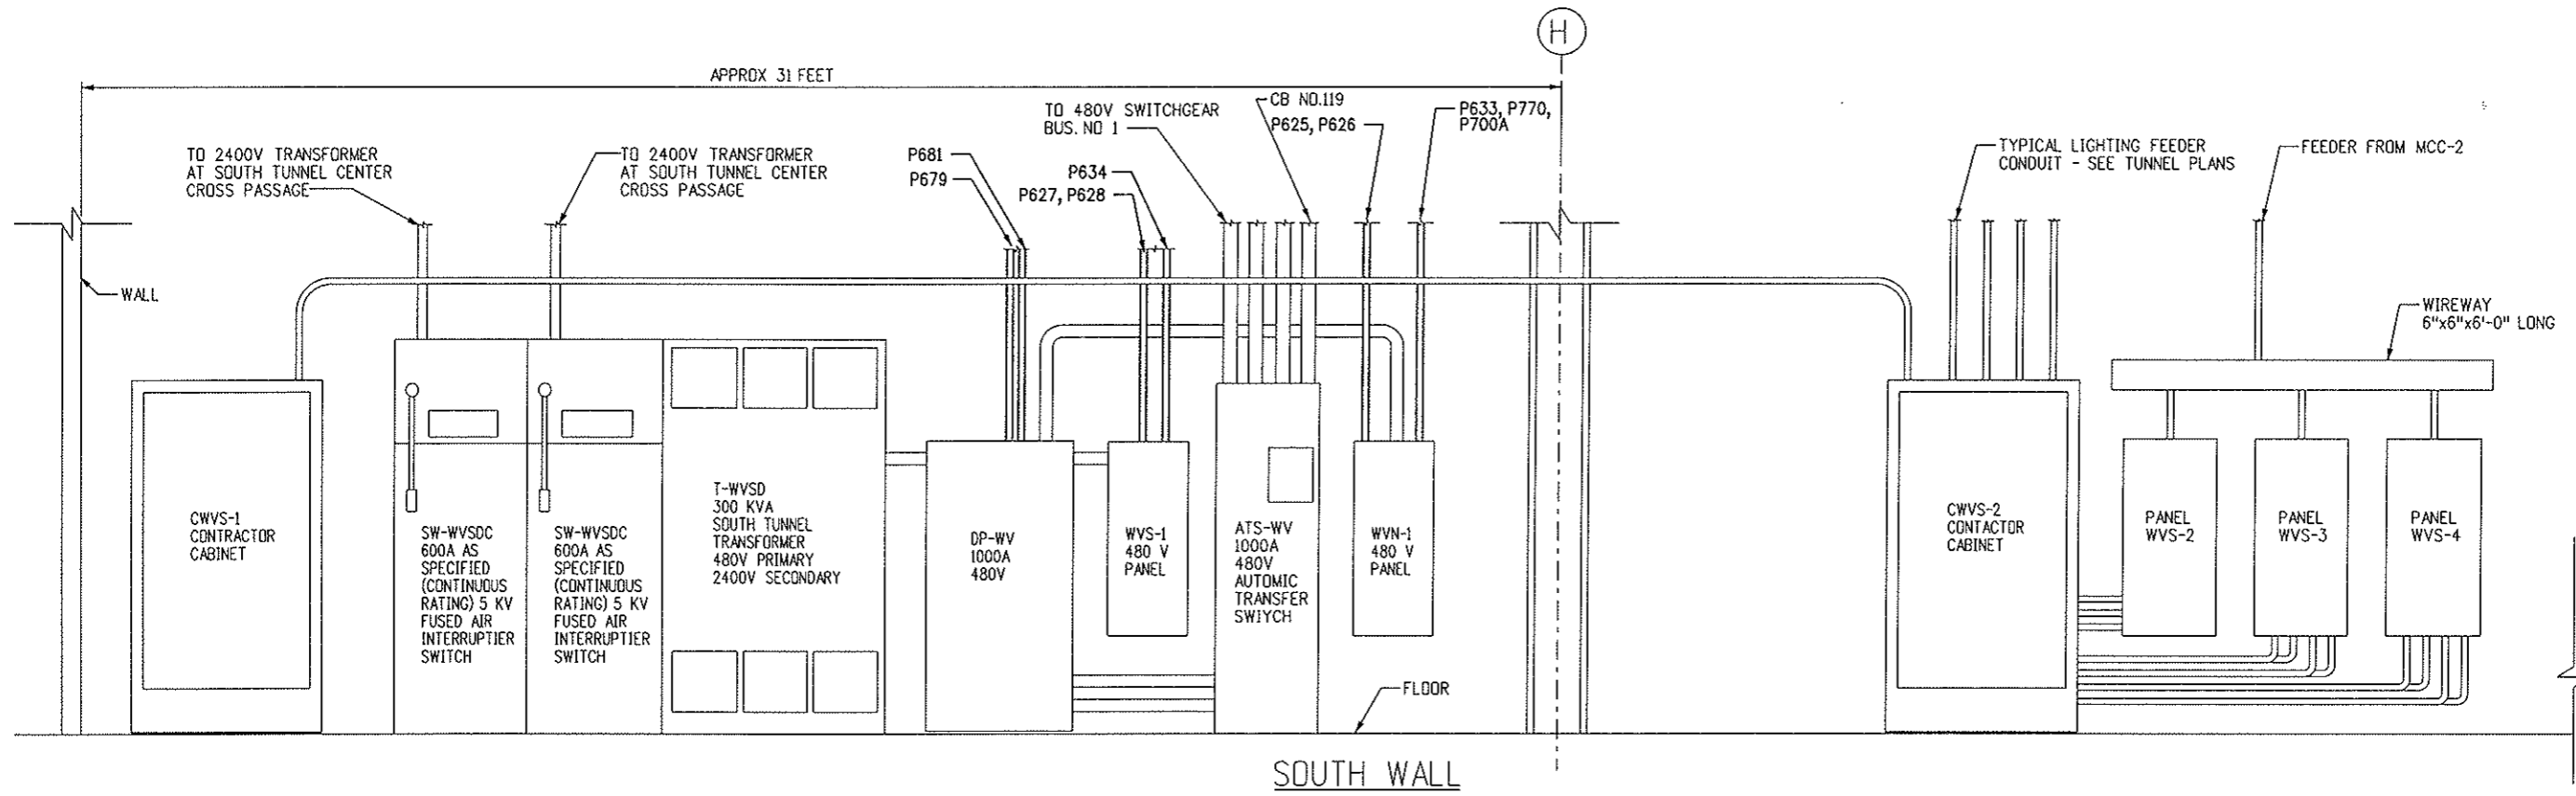


**PARTIAL ELEVATIONS MAIN ELECTRICAL ROOM EQUIPMENT
 WEST VENTILATION BUILDING**

SCALE: 1/2"=1'-0"

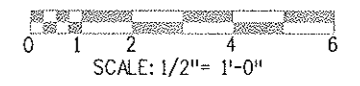


Computer File Information		Sheet Revisions		Colorado Department of Transportation		As Constructed		WEST VENT BUILDING ELECTRICAL ROOM DETAILS		Project No./Code	
Creation Date:	02/26/99	Initials:	SL	07/03/07	ASBUILT	DJB	No Revisions:			IM 0703-269	
Last Modification Date:	03/13/07	Initials:	DJB				Revised:	Designer:	E. A. GAYAMAT	Structure	
Full Path:	14102\800Deliv\AsBuilt						Void:	Detailer:	R. MILLER	Numbers	
Drawing File Name:	102eel02n							Sheet Subset:	VB ELEC	Subset Sheets:	3 OF 20
Acad Ver.	R14	Scale:	As Shown	Units:	ENGLISH					Sheet Number	114

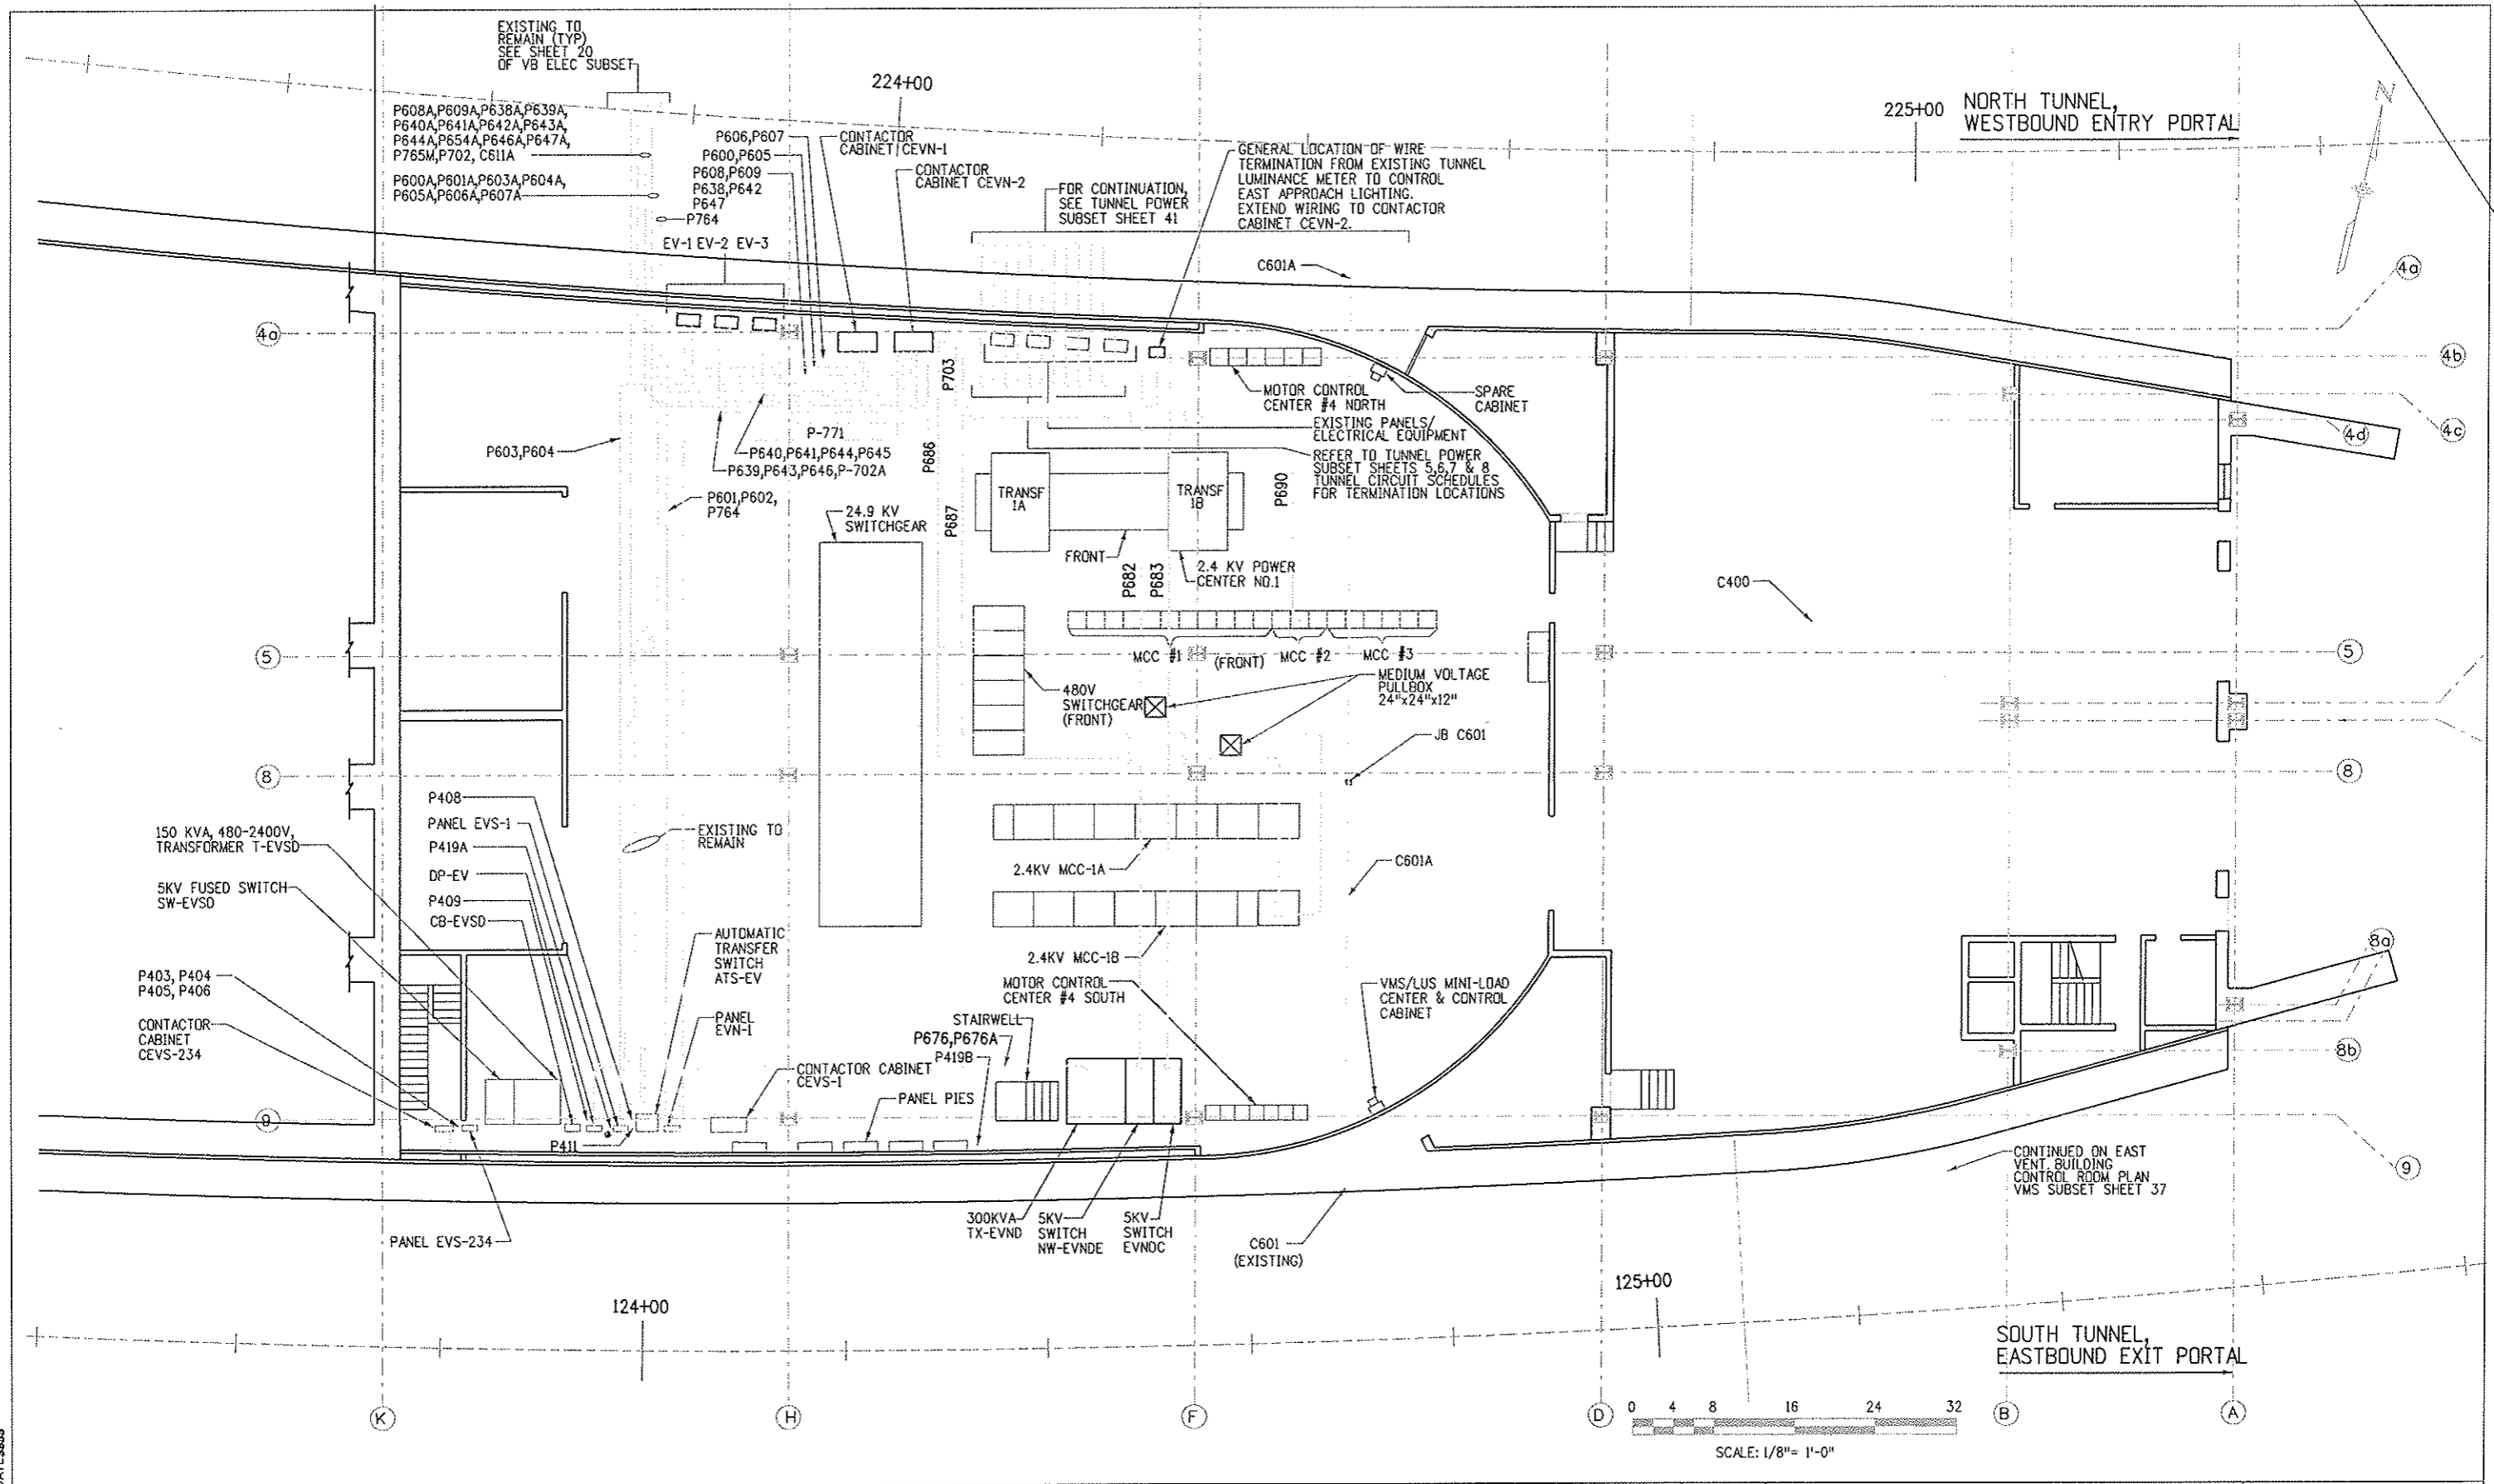

Design File Name: DGN&SPEC
 Plot File Name: \$PLOTFILE\$
 Date of Plot: \$\$\$DATE\$\$\$

Computer File Information	
Creation Date:	02/26/99 Initials: SL
Last Modification Date:	03/16/07 Initials: DJB
Full Path:	14102\800Deliv\AsBuil\
Drawing File Name:	epp121en
Acad Ver.	R14 Scale: 1/8"=1'-0" Units: ENGLISH

Sheet Revisions	
07/03/07	ASBUILT DJB

Colorado Department of Transportation

 P.O. BOX 399
 DUMONT, CO. 80436
 Phone: 303-512-5750 FAX: 303-512-5775
 Region 1 Mountain Residency I.N.Z.

As Constructed
No Revisions:
Revised:
Void:

EAST VENT BUILDING ELECTRICAL POWER PLAN	
Designer: E.A. GAYAMAT	Structure Numbers
Detailer: R. MILLER	
Sheet Subset: VB ELEC	Subset Sheets: 4 of 20





Project No./Code	
IM 0703-269	
13166	
Sheet Number	115



WEST VENTILATION BUILDING (MCC) NO. 3

100					
F1A	E1	D1	C1	B1	A1
F1B					
F2A	E2	D2	C2		A2
F2B					A3
F3A	E3	D3	C3		
F3B					
F4A					
F4B	E4	D4	C4		
F5A					
F5B					

MCC NO.3 ELEVATION
SCALE: NONE

LEGEND:

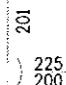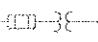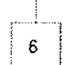-  201
225
200
MOLDED CASE AIR CIRCUIT BREAKER, THERMAL MAGNETIC, FRAME SIZE AS INDICATED (225) TRIP SETTING AS INDICATED (200) 3 POLE EXCEPT WHERE OTHERWISE INDICATED. "201" BREAKER DESIGNATION NUMBER.
-  FUSE AND CONTROL TRANSFORMER
-  6 LOCAL AND/OR REMOTE CONTROLS & INTERLOCKS (SEE ELEMENTARY DIAGRAMS)
-  1.5 MOTOR - HORSEPOWER AS INDICATED (1.5)

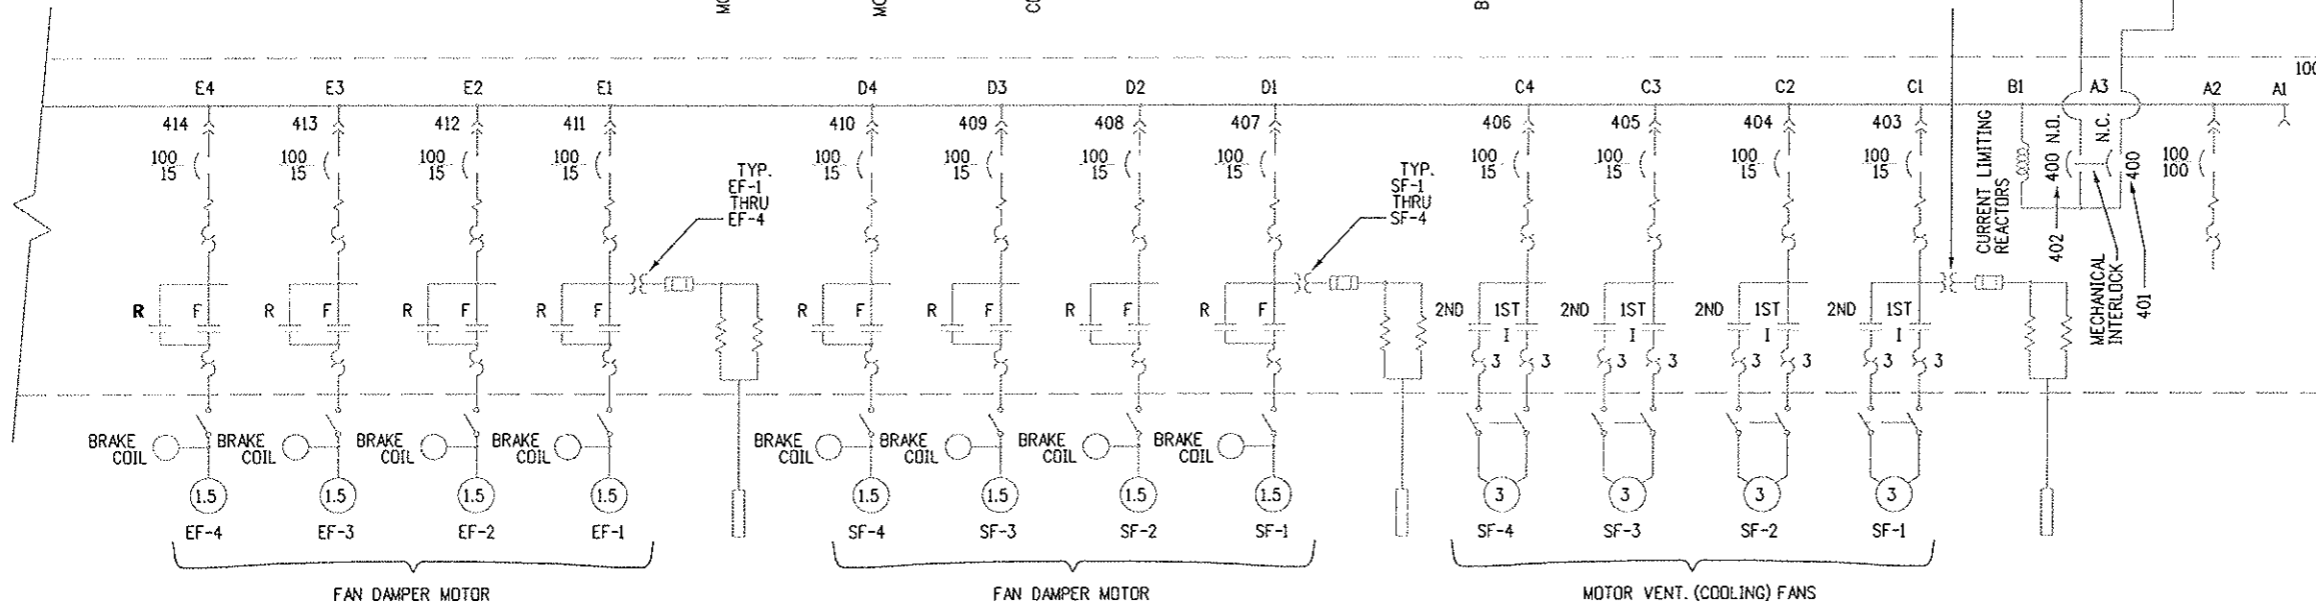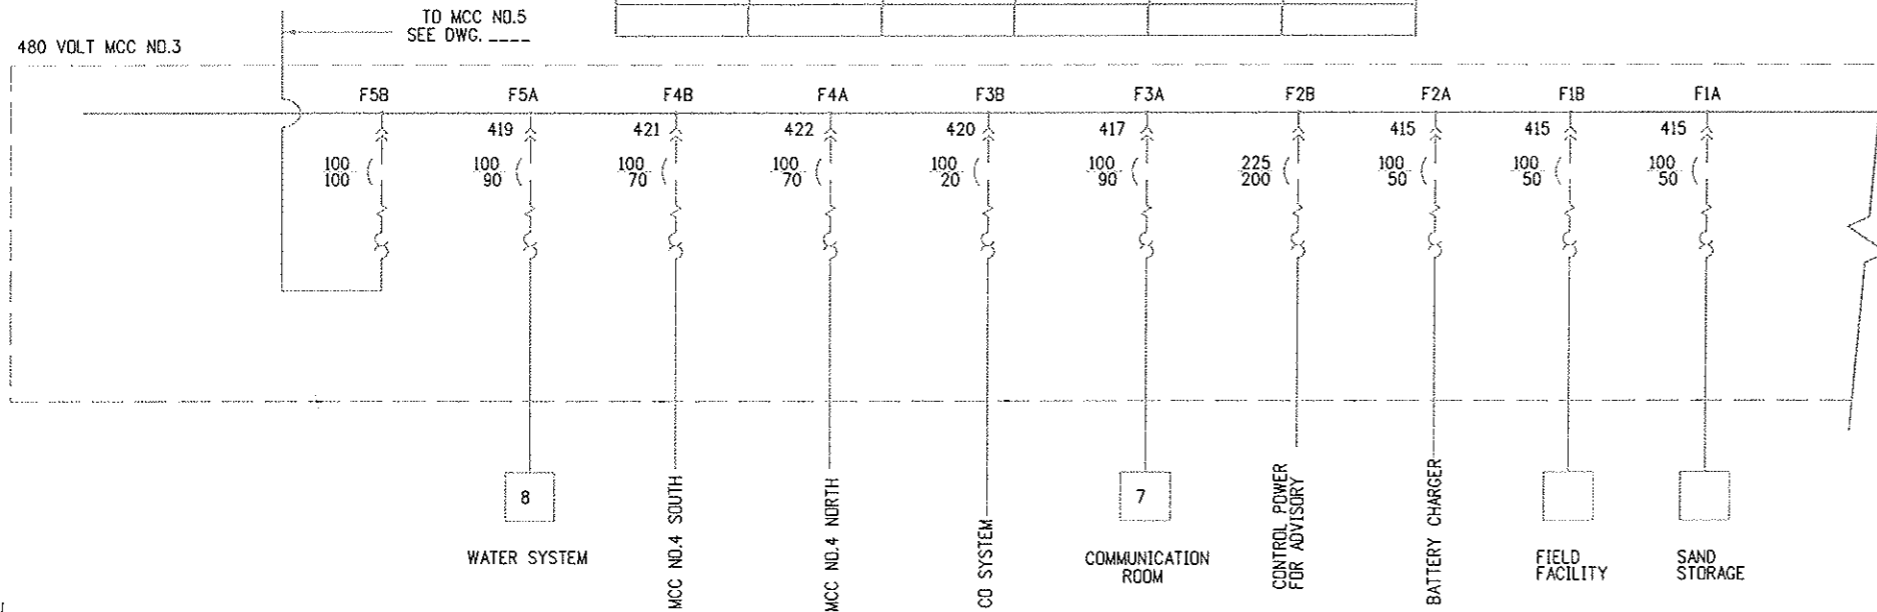

WEST VENTILATION BUILDING
MOTOR CONTROL CENTER NO.3
SCALE: NONE

FOR REFERENCE ONLY


NAMEPLATE SCHEDULE			
REF	FIRST LINE	SECOND LINE	THIRD LINE
100	480 VOLT	MCC NO. 3	SOUTH
A1	EQUIP. SPC.	FOR STARTER	SIZE 3
A2	SPARE	CIRCUIT BREAKER	
A3	INCOMING	FEEDER NO.1	FEEDER NO.2
B1	CURRENT LIMITING	REACTOR	
C1	VENT FAN	FOR	SF-1
C2	VENT FAN	FOR	SF-2
C3	VENT FAN	FOR	SF-3
C4	VENT FAN	FOR	SF-4
D1	DAMPER	FOR	SF-1
D2	DAMPER	FOR	SF-2
D3	DAMPER	FOR	SF-3
D4	DAMPER	FOR	SF-4
E1	DAMPER	FOR	EF-1
E2	DAMPER	FOR	EF-2
E3	DAMPER	FOR	EF-3
E4	DAMPER	FOR	EF-4
F1A	SAND	STORAGE	
F1B	FIELD	FACILITY	
F2A	BATTERY	CHARGER	
F2B	CONTROL	POWER FOR	SUPERVISORY
F3A	STATE	COMMUNICATION	
F3B	CO SYSTEM		
F4A	MOTOR CONTRL	CENTER NO. 4	NORTH
F4B	MOTOR CONTRL	CENTER NO. 4	SOUTH
F5A	WATER SYSTM	POWER DIST.	PANEL NO.8
F5B	MOTOR CONTRL	CENTER NO. 5	

Design File Name: DGN\$SPEC*
 Plot File Name: \$PLOTFILE*
 Date of Plot: \$\$\$DATE\$\$\$

Computer File Information	
Creation Date:	2/26/99 Initials: SL
Last Modification Date:	02/07/02 Initials: DJR
Full Path:	14102\700codd\703elec\
Drawing File Name:	102esd25n.dgn
Acad Ver. R14	Scale: NONE Units: ENGLISH

Sheet Revisions	
<input type="checkbox"/>	07/03/07 ASBUILT DJB
<input type="checkbox"/>	
<input type="checkbox"/>	
<input type="checkbox"/>	

Colorado Department of Transportation




P.O. BOX 399
DUMONT, CO. 80436
Phone: 303-512-5750 FAX: 303-512-5775

Region 1 Mountain Residency I.N.Z.

As Constructed
No Revisions:
Revised:
Void:

ONE LINE DIAGRAM WEST MCC NO.3	
Designer: E.A. GAYAMAT	Structure Numbers:
Detailer: R. MILLER	Subst Sheets: 5 of 20
Sheet Subset: VB ELEC	

Project No./Code	
IM 0703-269	
13166	
Sheet Number	116

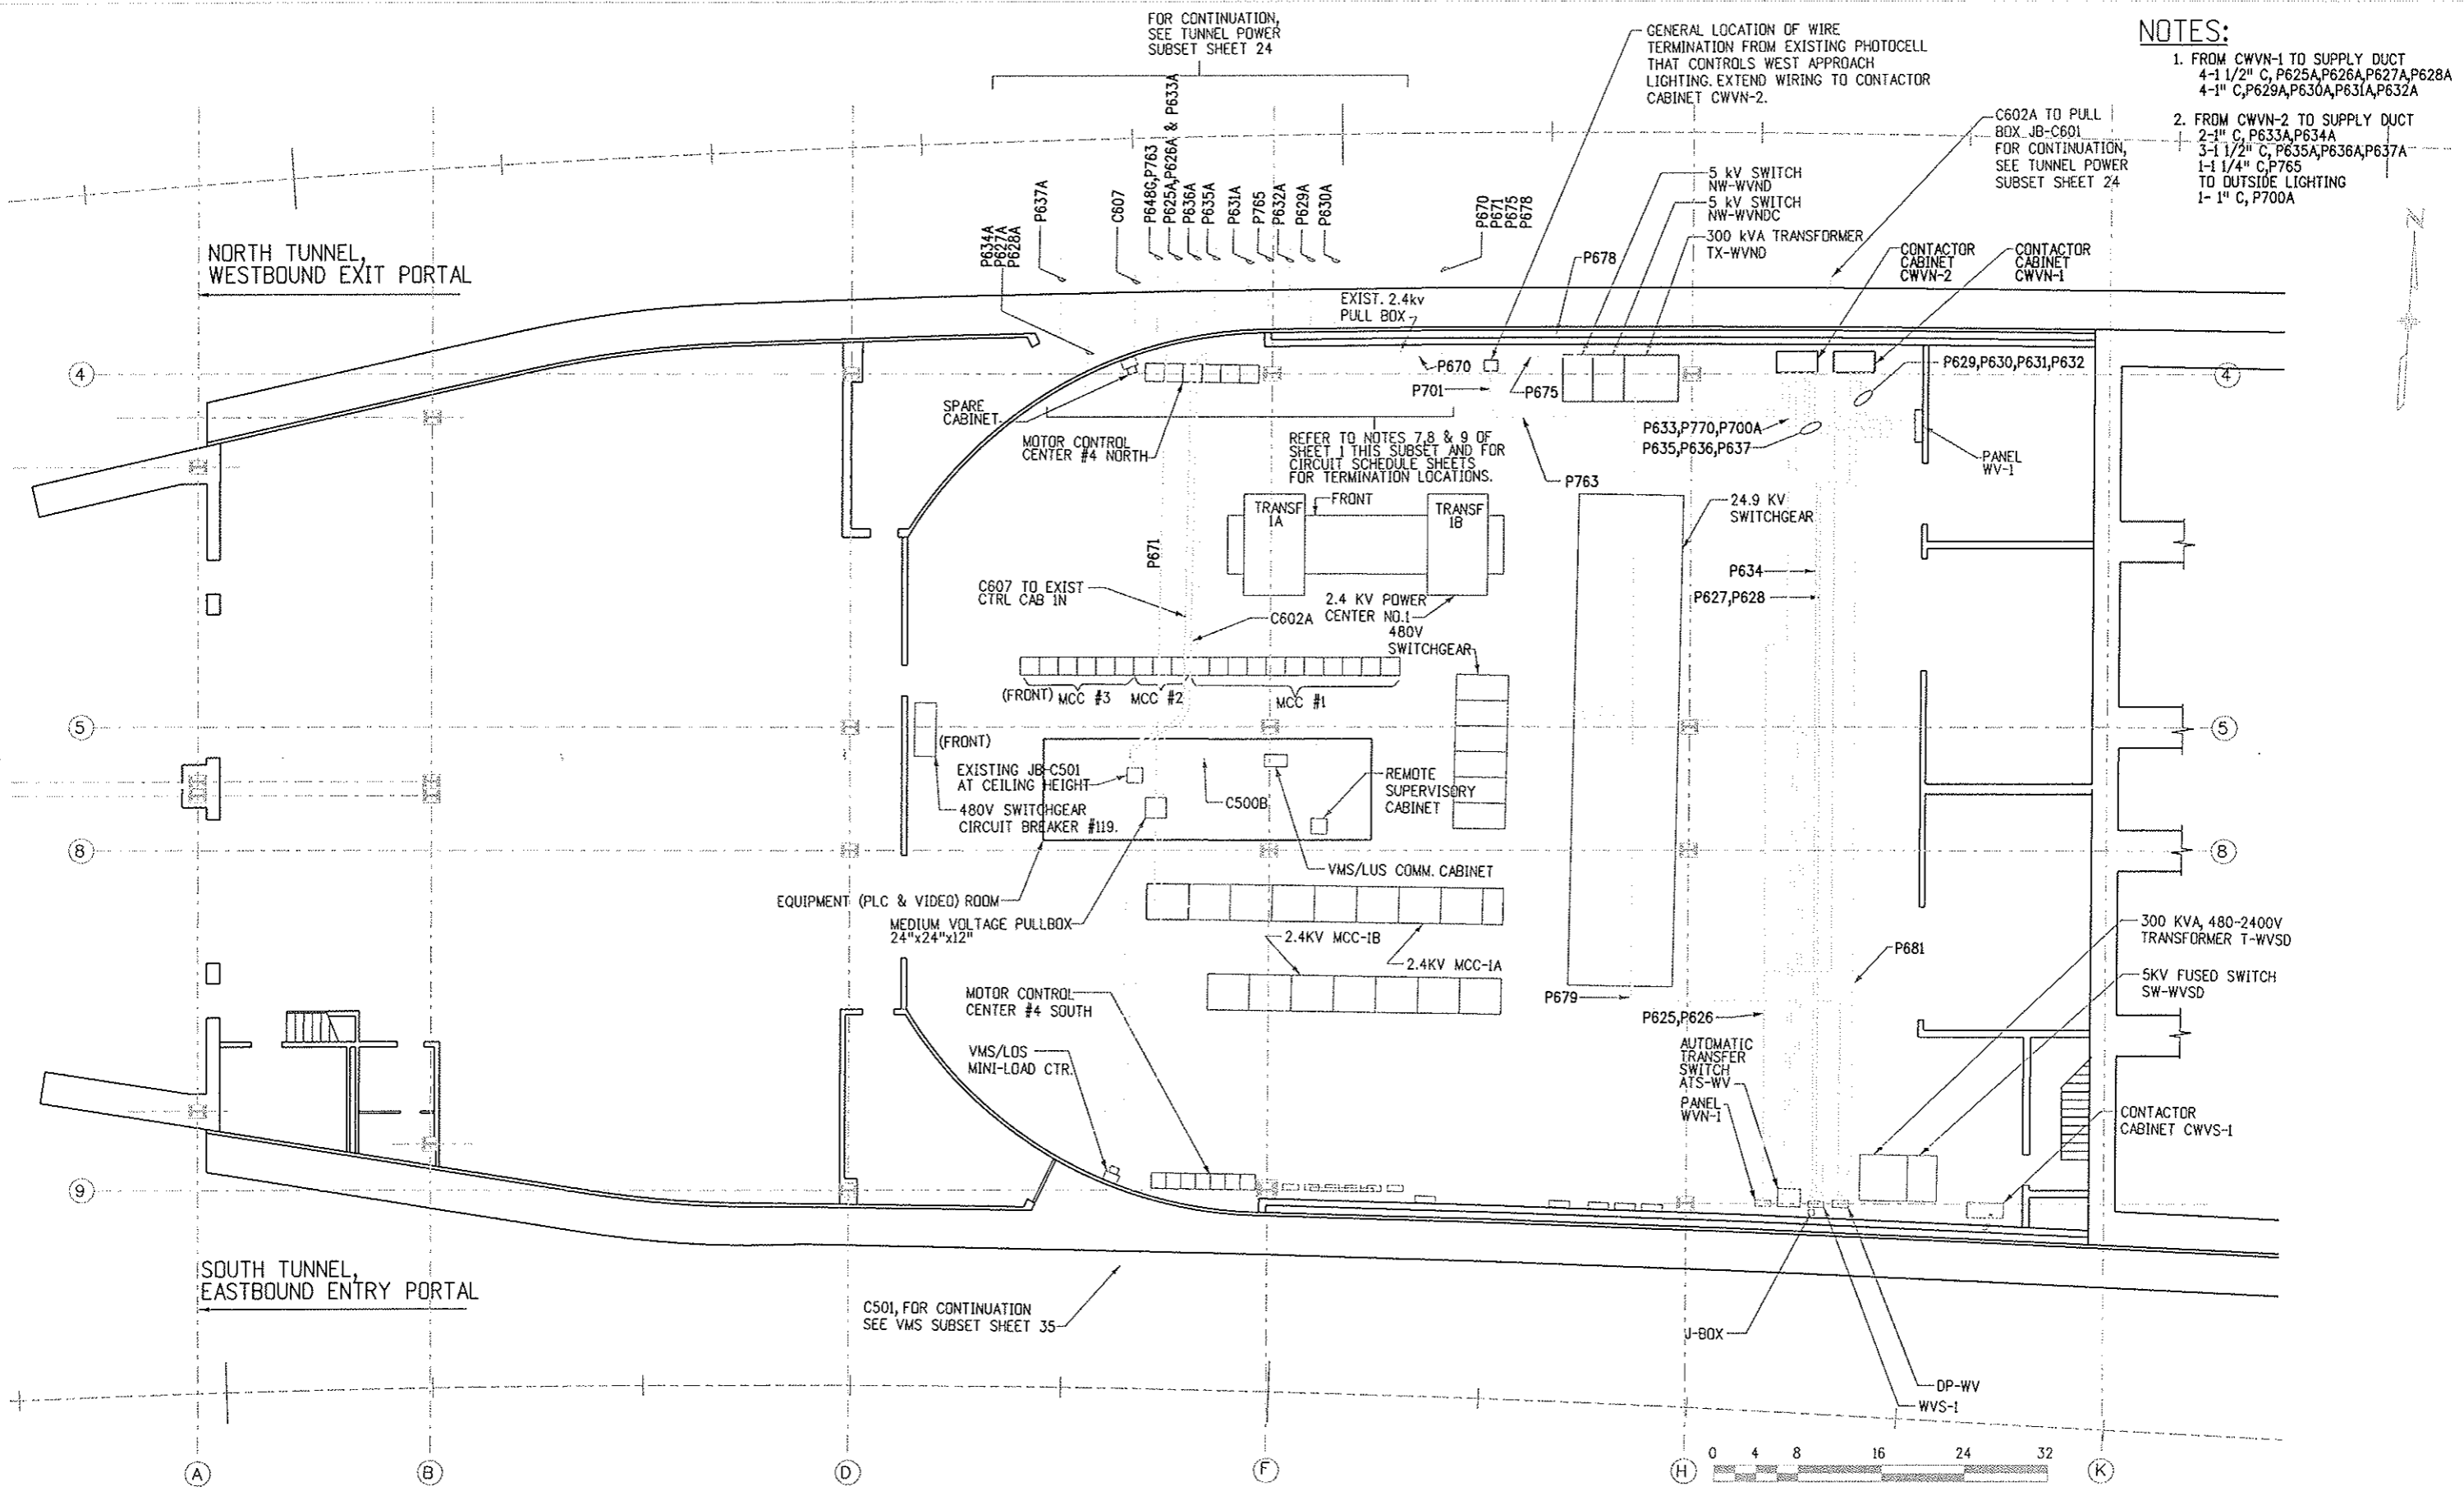


- NOTES:**
- FROM CWVN-1 TO SUPPLY DUCT
4-1 1/2" C, P625A, P626A, P627A, P628A
4-1" C, P629A, P630A, P631A, P632A
 - FROM CWVN-2 TO SUPPLY DUCT
2-1" C, P633A, P634A
3-1 1/2" C, P635A, P636A, P637A
1-1 1/4" C, P765
TO OUTSIDE LIGHTING
1-1" C, P700A

Design File Name: DGN\$SPEC*
 Plot File Name: \$PLOTFILE*
 Date of Plot: \$\$\$DATE\$\$\$\$

Computer File Information	
Creation Date:	05/26/99 Initials: SFD
Last Modification Date:	05/21/97 Initials: DJB
Full Path:	014102\800Deliv\AsBuilt\
Drawing File Name:	eppl20wn
Acad Ver.	R14 Scale: 1/8" = 1'-0" Units: ENGLISH

Sheet Revisions	
<input type="checkbox"/>	07/03/07 ASBUILT DJB
<input type="checkbox"/>	
<input type="checkbox"/>	
<input type="checkbox"/>	

Colorado Department of Transportation



P.O. BOX 399
DUMONT, CO. 80436
Phone: 303-512-5750 FAX: 303-512-5775

Region 1 Mountain Residency I.N.Z.


As Constructed
No Revisions:
Revised:
Void:

**WEST VENT BUILDING
ELECTRICAL POWER PLAN**


Designer: E.A. GAYAMAT
Detailer: R. MILLER

Structure Numbers: []
Subset Sheets: 6 OF 20

Project No./Code	
IM 0703-269	13166
Sheet Number	117

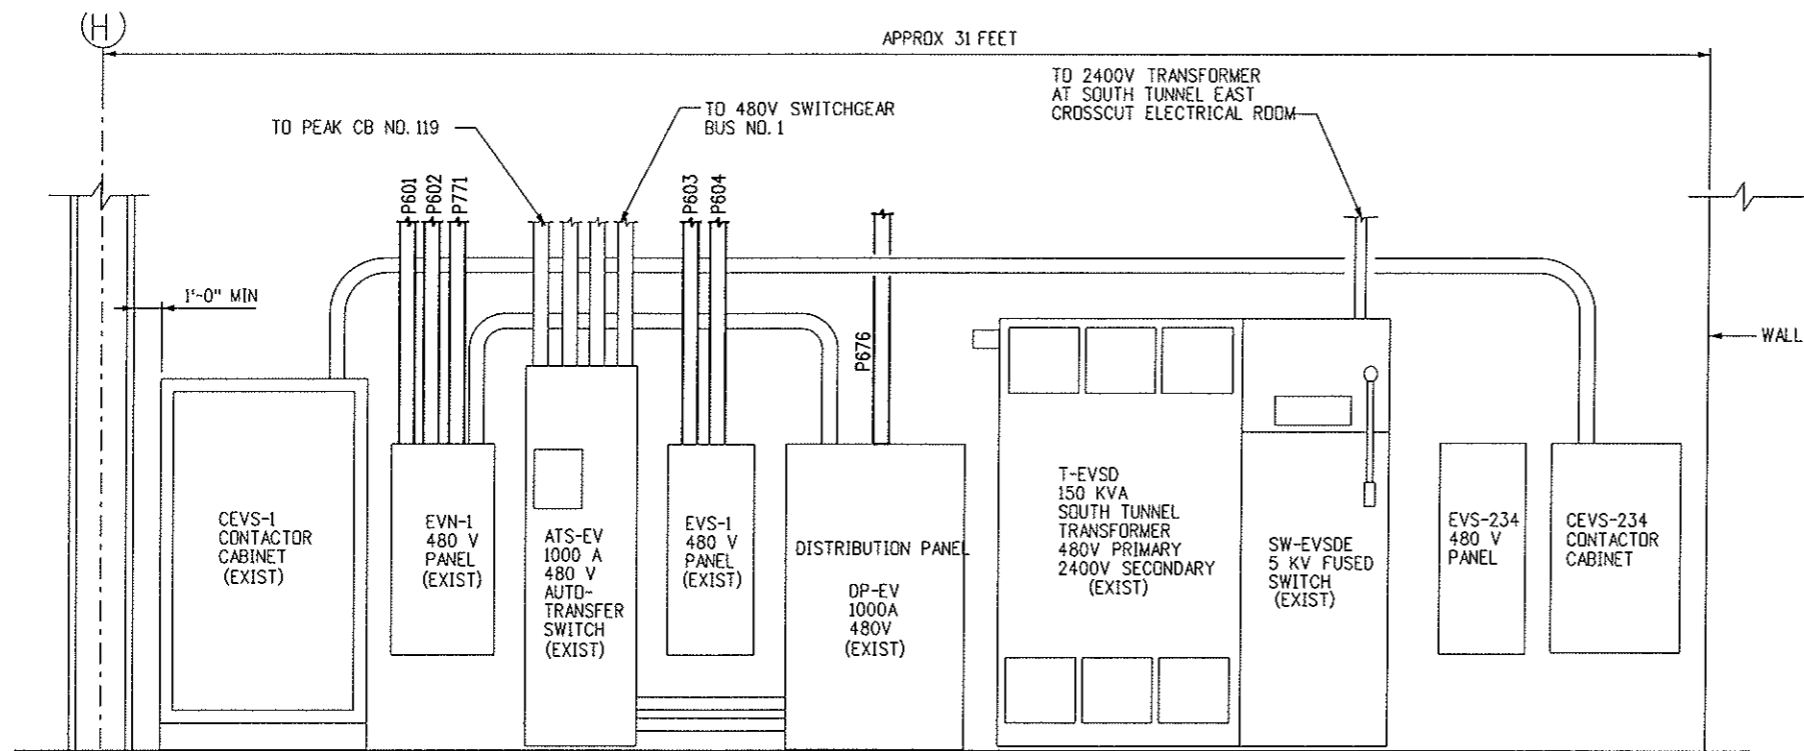


SOUTH WALL

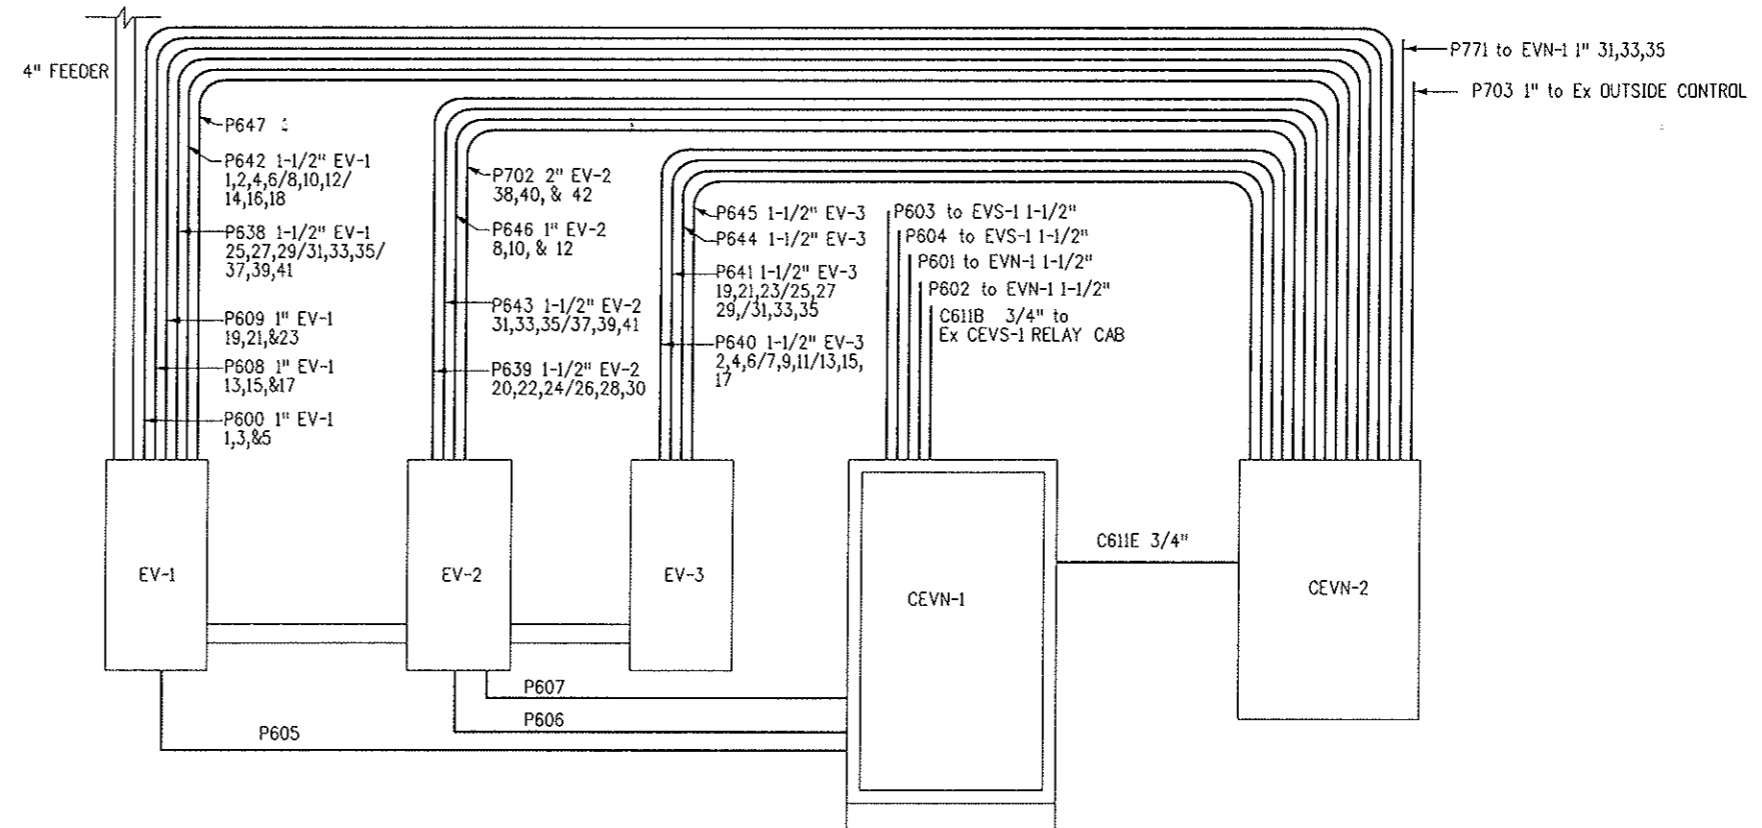

NORTH WALL

PARTIAL ELEVATIONS MAIN ELECTRICAL ROOM
EAST VENTILATION BUILDING
SCALE: 1/2" = 1'-0"

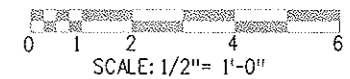

Computer File Information

Sheet Revisions

Colorado Department of Transportation

As Constructed

EAST VENT BUILDING
ELECTRICAL ROOM DETAILS

Project No./Code

Creation Date:	05/26/99	Initials:	SL
Last Modification Date:	03/05/07	Initials:	LK
Full Path:	I4102\800Deliv\AsBuilt\		
Drawing File Name:	102eel01n		
Acad Ver.	R14	Scale:	AS SHOWN
		Units:	ENGLISH

<input type="checkbox"/>	07/03/07	ASBUILT	DJB
<input type="checkbox"/>			
<input type="checkbox"/>			
<input type="checkbox"/>			



P.O. BOX 399
DUMONT, CO. 80436
Phone: 303-512-5750 FAX: 303-512-5775

Region 1 Mountain Residency I.N.Z.

No Revisions:

Revised:

Void:

Designer: E.A. GAYAMAT
Detailer: R. MILLER

Structure Numbers


Sheet Subset: VB ELEC

Subset Sheets: 7 OF 20

IM 0703-269

13166

Sheet Number 118

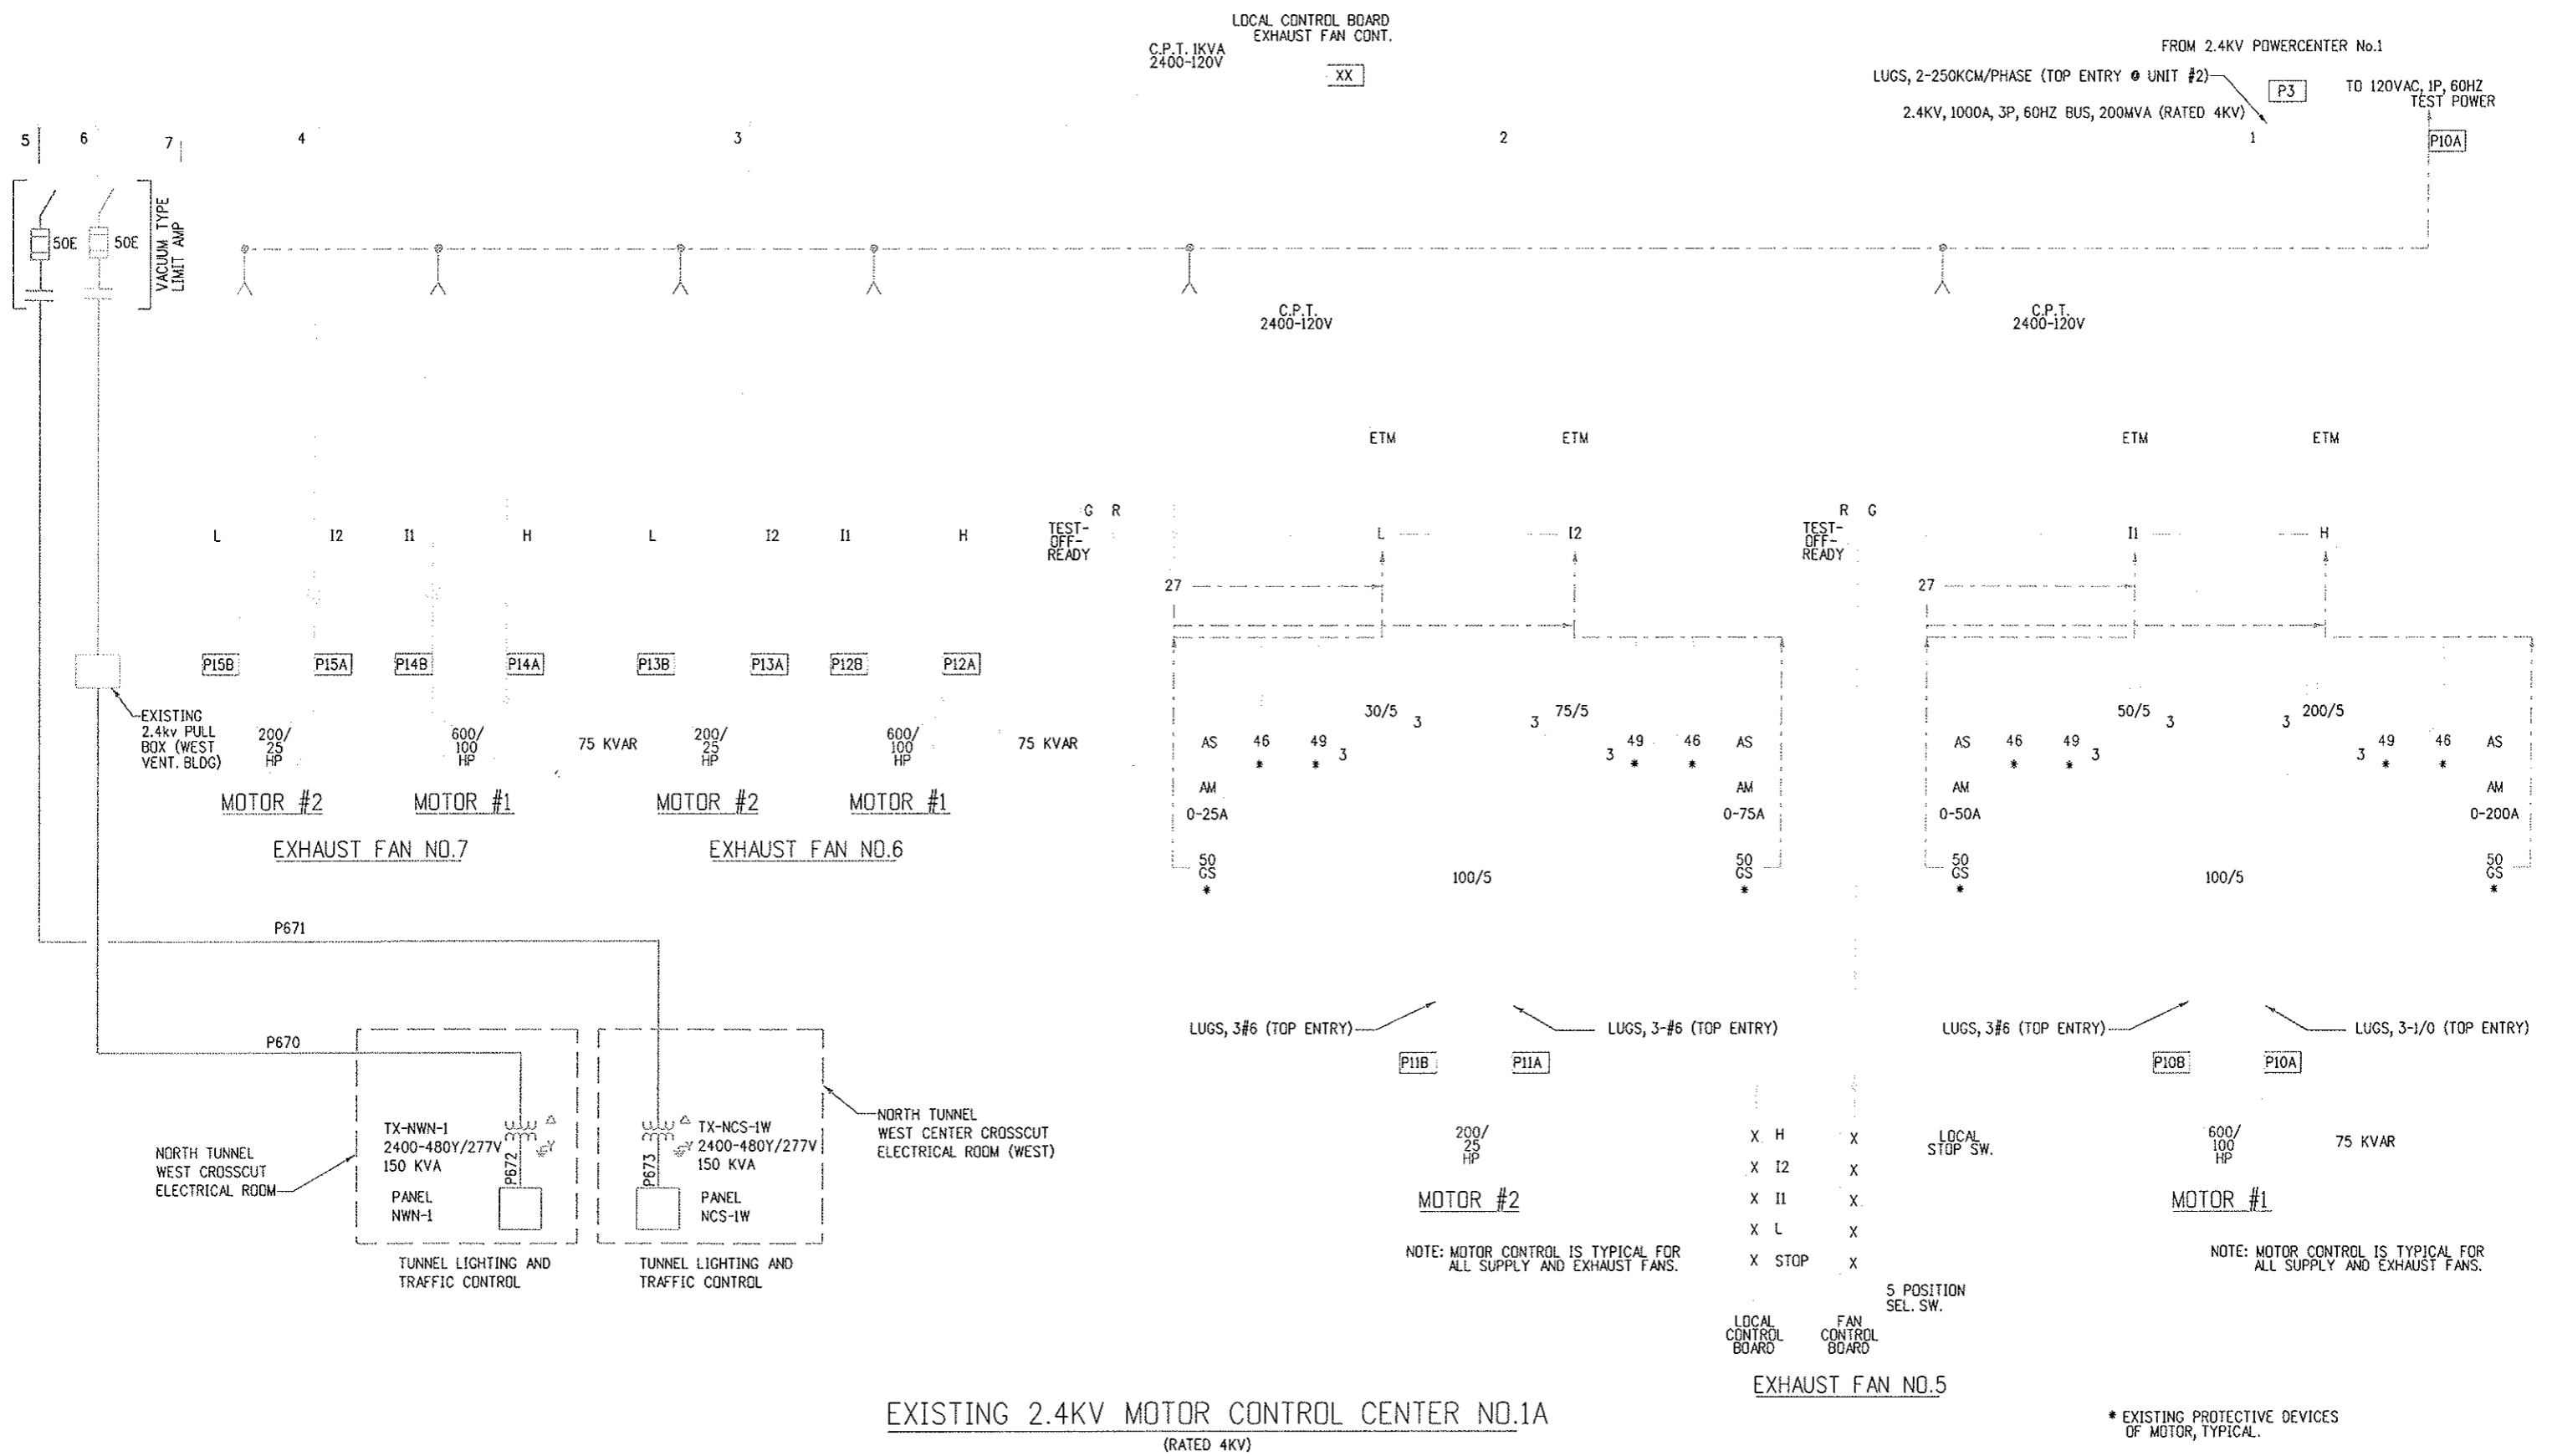

EXISTING 2.4KV MOTOR CONTROL CENTER NO.1A
(RATED 4KV)


* EXISTING PROTECTIVE DEVICES OF MOTOR, TYPICAL.

Design File Name: DGN\SPEC*
 Plot File Name: SPLITFILE*
 Date of Plot: 3/3/2000 10:30:33

Computer File Information	
Creation Date:	05/26/99 Initials: SL
Last Modification Date:	03/05/07 Initials: LK
Full Path:	14102\800Deliv\AsBuilt\
Drawing File Name:	102esd29n
Acad Ver.	R14 Scale: None Units: ENGLISH

Sheet Revisions		
07/03/07	ASBUILT	DJB

Colorado Department of Transportation



P.O. BOX 399
 DUMONT, CO. 80436
 Phone: 303-512-5750 FAX: 303-512-5775
 Region 1 Mountain Residency I.N.Z.

As Constructed
No Revisions:
Revised:
Void:


ONE LINE DIAGRAM WEST 2.4KV MCC NO.1A	
Designer: E.A. GAYAMAT	Structure Numbers
Detailer: R. MILLER	
Sheet Subset: VB ELEC	Subset Sheets: 8 of 20

Project No./Code
IM 0703-269
13166
Sheet Number 119

LUCAL CONTROL BOARD
SUPPLY FAN CONT. C.P.T. 1KVA
2400-120V

2.4KV, 1000A, 3P, 60HZ BUS, 200MVA (RATED 4KV)


FROM 2.4KV POWERCENTER NO.1
LUGS, 2-250MCM, 1P
(TOP ENTRY @ UNIT #2) P4 TO 120VAC, 1P, 60HZ
TEST POWER

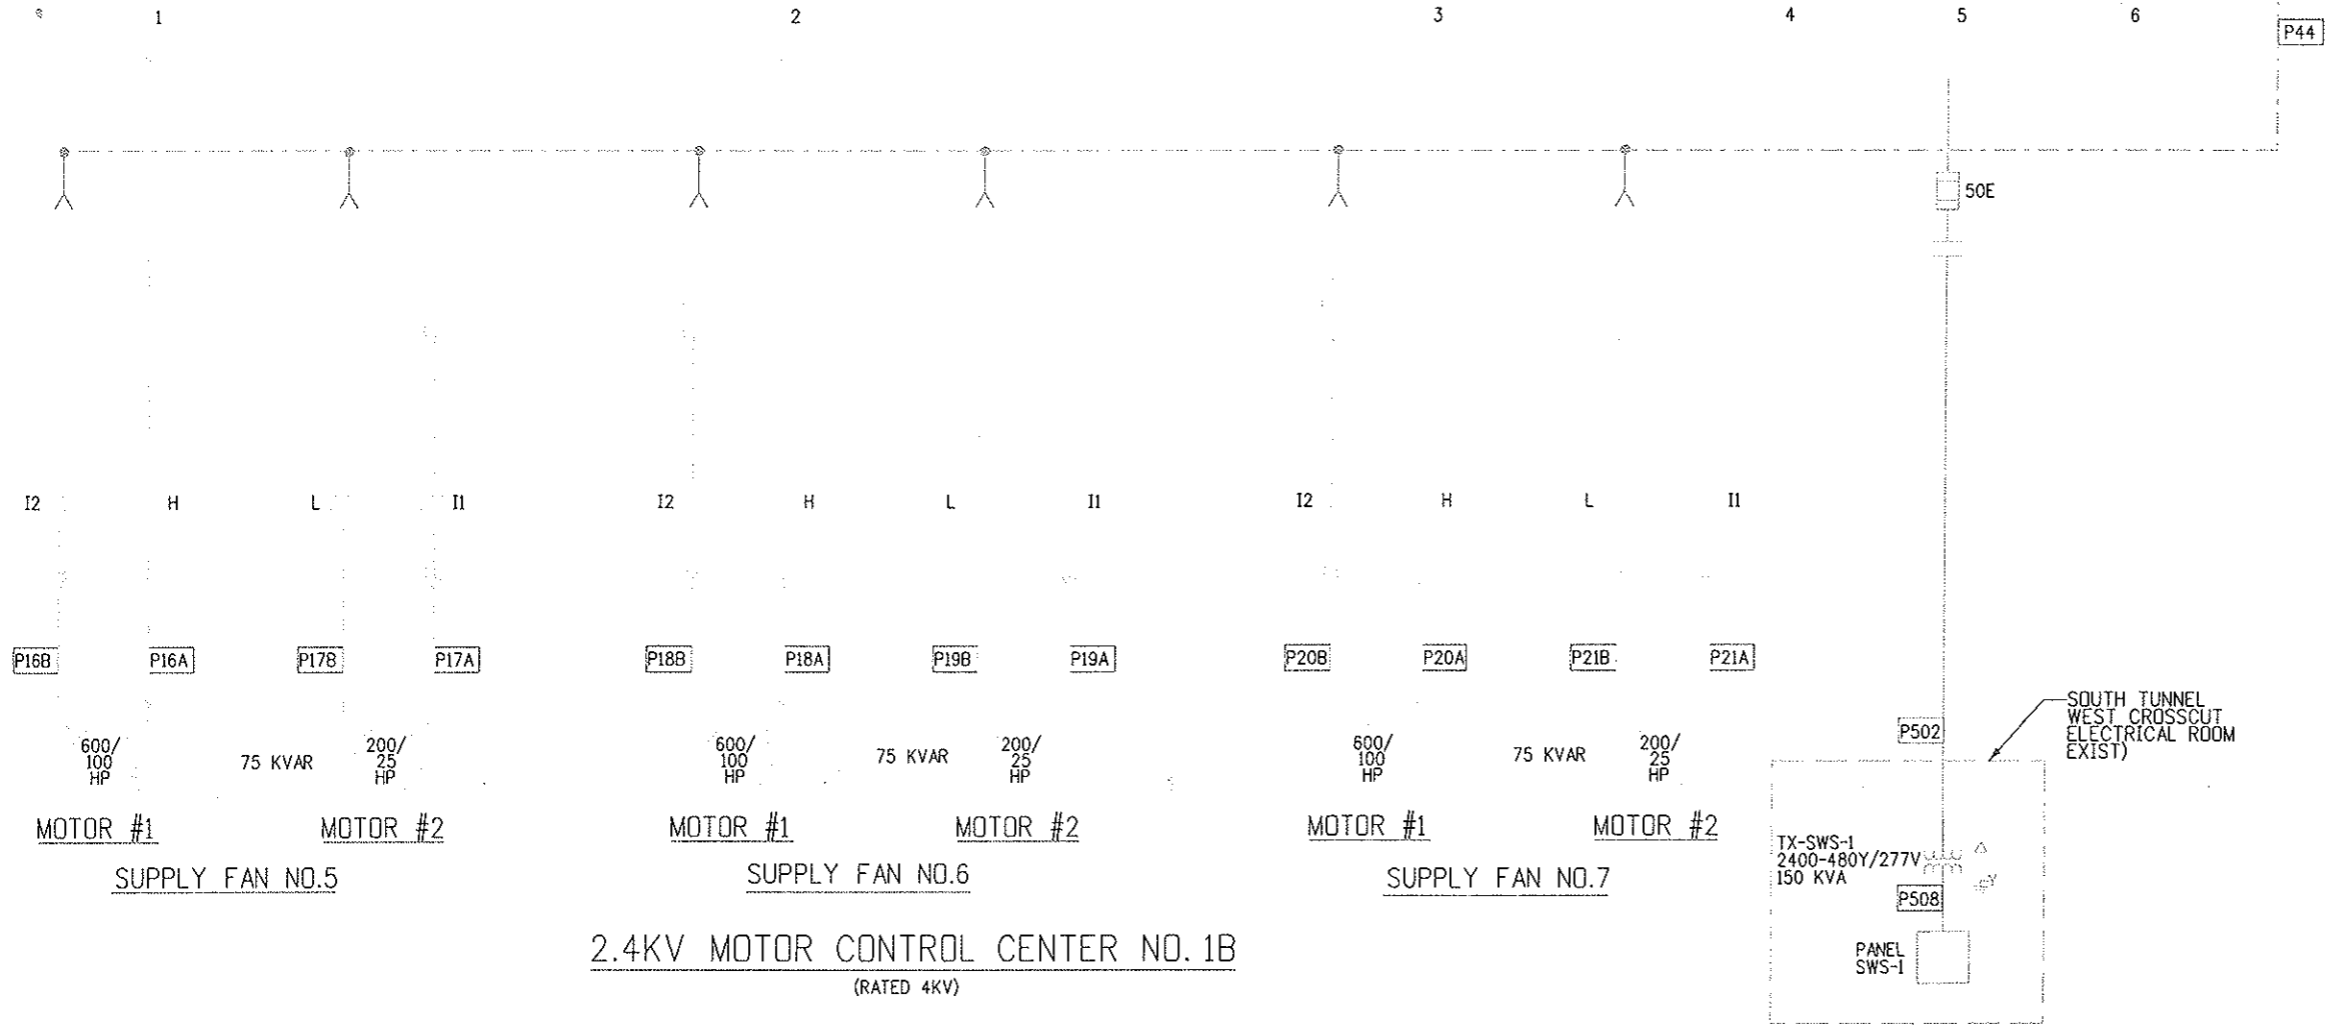

SOUTH TUNNEL
WEST CROSSCUT
ELECTRICAL ROOM
EXIST)


NP NO.	ENGRAVING
1	2.4KV M.C.C. NO.1A SOUTH TUNNEL
2	2.4KV M.C.C. NO.1B SOUTH TUNNEL
3	EXHAUST FAN EF-5 MOTOR NO.1
4	EXHAUST FAN EF-5 MOTOR NO.2
5	EXHAUST FAN EF-6 MOTOR NO.1
6	EXHAUST FAN EF-6 MOTOR NO.2
7	EXHAUST FAN EF-7 MOTOR NO.1
8	EXHAUST FAN EF-7 MOTOR NO.2
9	SUPPLY FAN SF-5 MOTOR NO.1
10	SUPPLY FAN SF-5 MOTOR NO.2
11	SUPPLY FAN SF-6 MOTOR NO.1
12	SUPPLY FAN SF-6 MOTOR NO.2
13	SUPPLY FAN SF-7 MOTOR NO.1
14	SUPPLY FAN SF-7 MOTOR NO.2
15	SOUTH TUNNEL TRANSFORMER FEEDER
16	NORTH TUNNEL WEST CENTER CROSSCUT TX-NCS-1W
17	NORTH TUNNEL WEST CROSSCUT TX-NWN-1

NAMEPLATE SCHEDULE

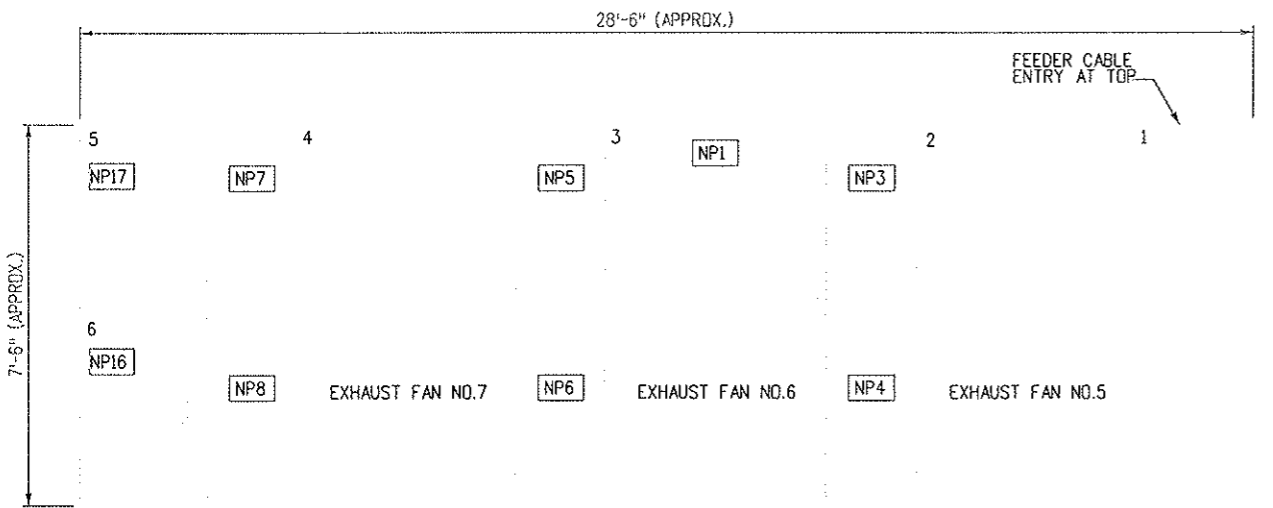

2.4KV MOTOR CONTROL CENTER NO. 1A - FRONT VIEW

N.T.S.
(EXISTING)

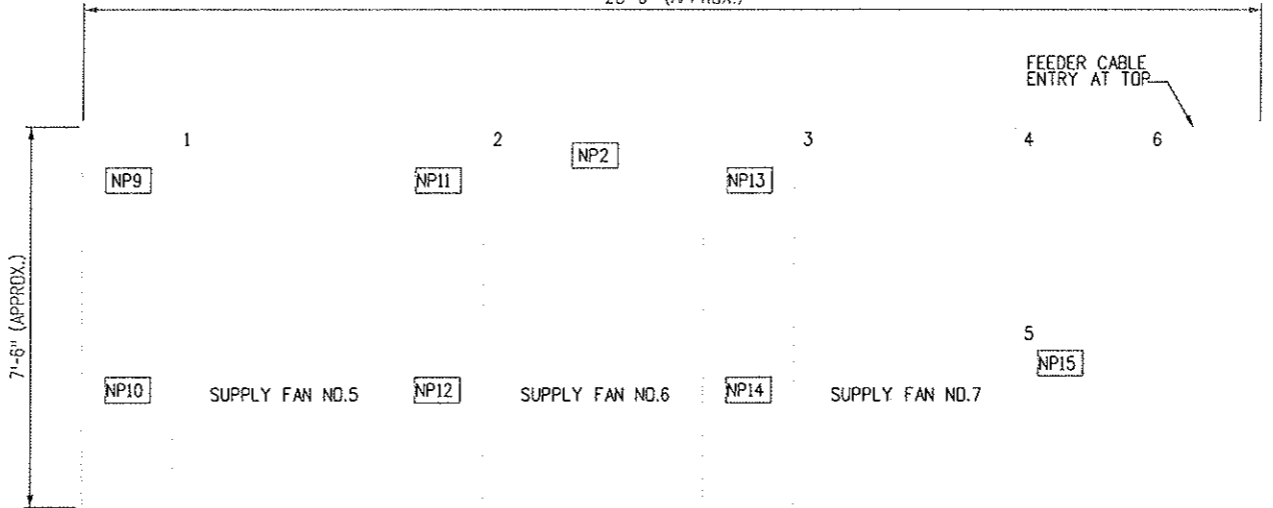


2.4KV MOTOR CONTROL CENTER NO. 1B - FRONT VIEW

N.T.S.
(EXISTING)

FOR REFERENCE ONLY

Computer File Information	
Creation Date:	05/27/99 Initials: SFD
Last Modification Date:	03/05/07 Initials: DJR
Full Path:	14102\800Deliv\AsBuilt\
Drawing File Name:	102esd30n
Acad Ver. R14	Scale: N=1:1 Units:

Sheet Revisions	
07/03/07	ASBUILT DJB


Colorado Department of Transportation
 P.O. BOX 399
 DUMONT, CO. 80436
 Phone: 303-512-5750 FAX: 303-512-5775
 Region 1 Mountain Residency I.N.Z.

As Constructed	
No Revisions:	
Revised:	
Void:	

ONE LINE DIAGRAM WEST 2.4KV MCC NO.1B	
Designer: E.A. GAYAMAT	Structure Numbers
Detailer: R. MILLER	
Sheet Subset: VB ELEC	Subset Sheets: 9 of 20


Project No./Code	
IM 0703-269	
13166	
Sheet Number	120

WEST VENTILATION BUILDING (MCC) NO. 2


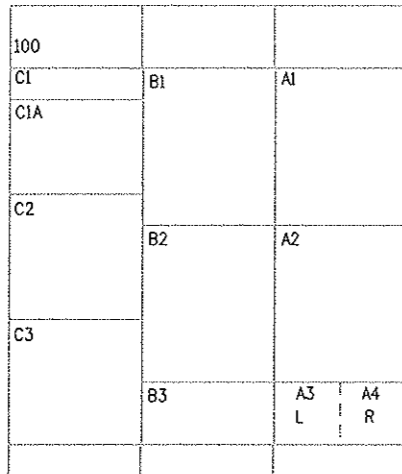


MCC NO.2 ELEVATION
SCALE: NONE

LEGEND:

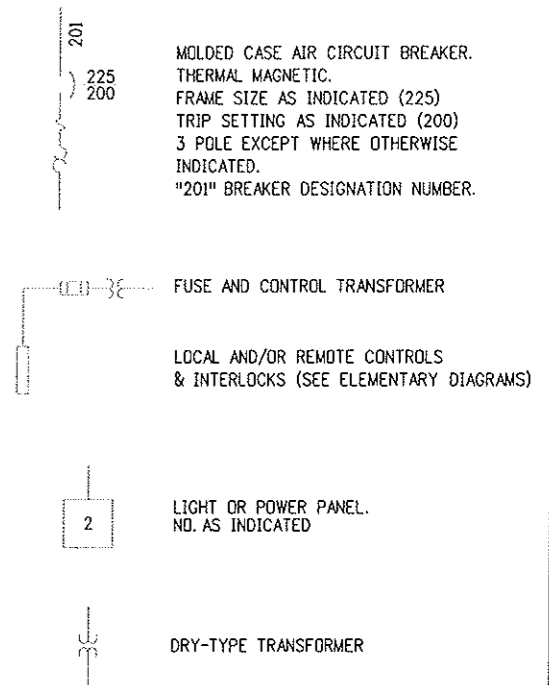

480 VOLT MCC NO.2 (1200A BUS)

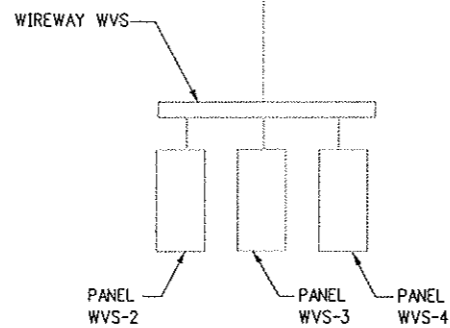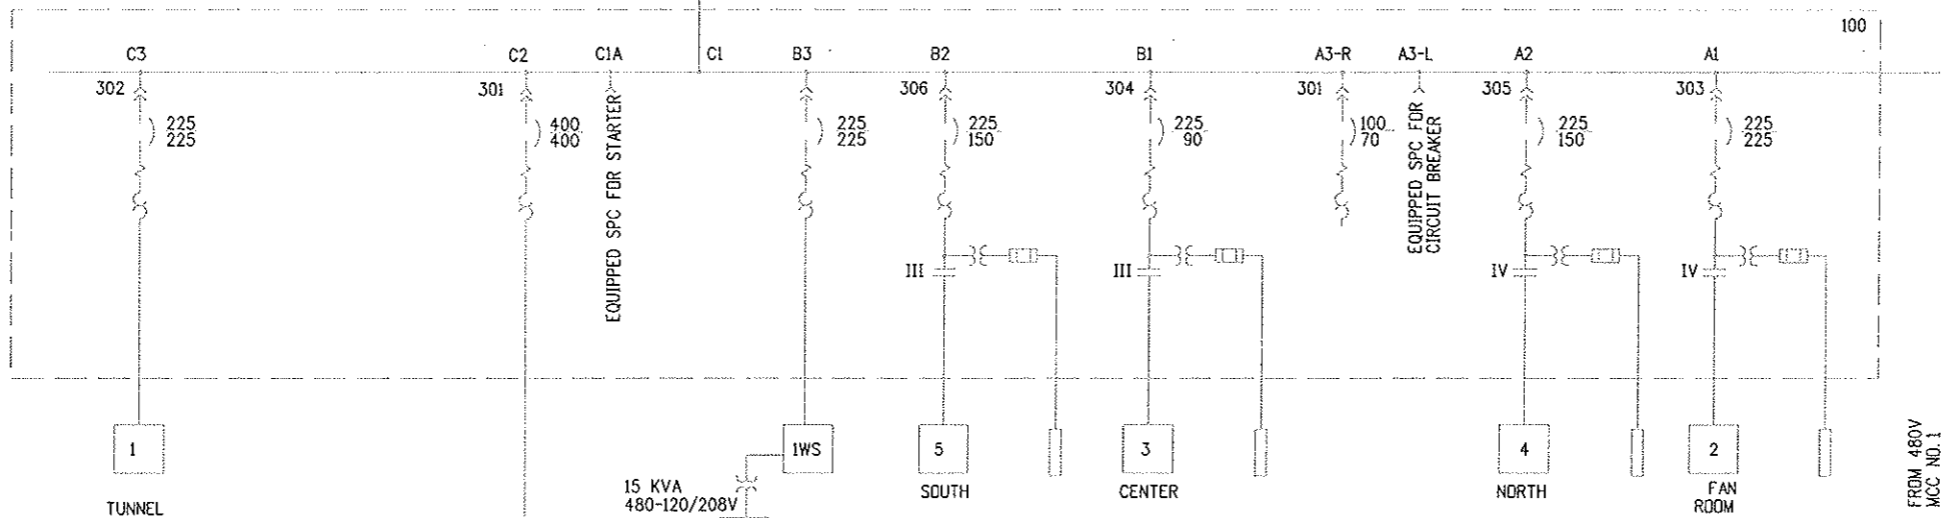

WEST VENTILATION BUILDING
MOTOR CONTROL CENTER NO.2

SCALE: NONE

NAMEPLATE SCHEDULE			
REF	FIRST LINE	SECOND LINE	THIRD LINE
100	480 VOLT	MCC NO. 2	SOUTH
A1	FAN ROOM	POWER DIST.	PANEL NO. 2
A2	NORTH BLDG.	POWER DIST.	PANEL NO. 4
A3-L	SPARE	CIRCUIT	BREAKER
A3-R	EQUIPD. SPC. FOR	CIRCUIT	BREAKER
B1	CENTER BLDG.	POWER DIST.	PANEL NO. 3
B2	SOUTH BLDG.	POWER DIST.	PANEL NO. 5
B3	PANEL	IWS	SOUTH TUNNEL
C1	INCOMING	FEEDER	BUS
C1A	EQUIPD. SPC. FOR	STARTER	SIZE 3
C2	WIREWAY WVS	FOR PANELS	WVS-2,-3,-4
C3	TUNNEL SUPPLY	POWER DIST.	PANEL NO. 1

FOR REFERENCE ONLY

Design File Name: DONSPEC*
 Plot File Name: \$PLTFILE*
 Date of Plot: \$\$\$DATE\$\$\$

Computer File Information	
Creation Date:	05/28/99 Initials: SFD
Last Modification Date:	02/07/02 Initials: DJR
Full Path:	14102\700cadd\703select\
Drawing File Name:	102esd24n.dgn
Acad Ver.	R14 Scale: NONE Units: ENGLISH

Sheet Revisions	
07/03/07	ASBUILT DJB

Colorado Department of Transportation


P.O. BOX 399
DUMONT, CO. 80436
Phone: 303-512-5750 FAX: 303-512-5775

Region 1 Mountain Residency I.N.Z.

As Constructed
No Revisions:
Revised:
Void:

ONE LINE DIAGRAM WEST MCC NO.2	
Designer: E.A. GAYAMAT	Structure Numbers
Detailer: R. MILLER	
Sheet Subset: VB ELEC	Subset Sheets: 10 of 20

Project No./Code	
IM 0703-269	
	13166
Sheet Number	121

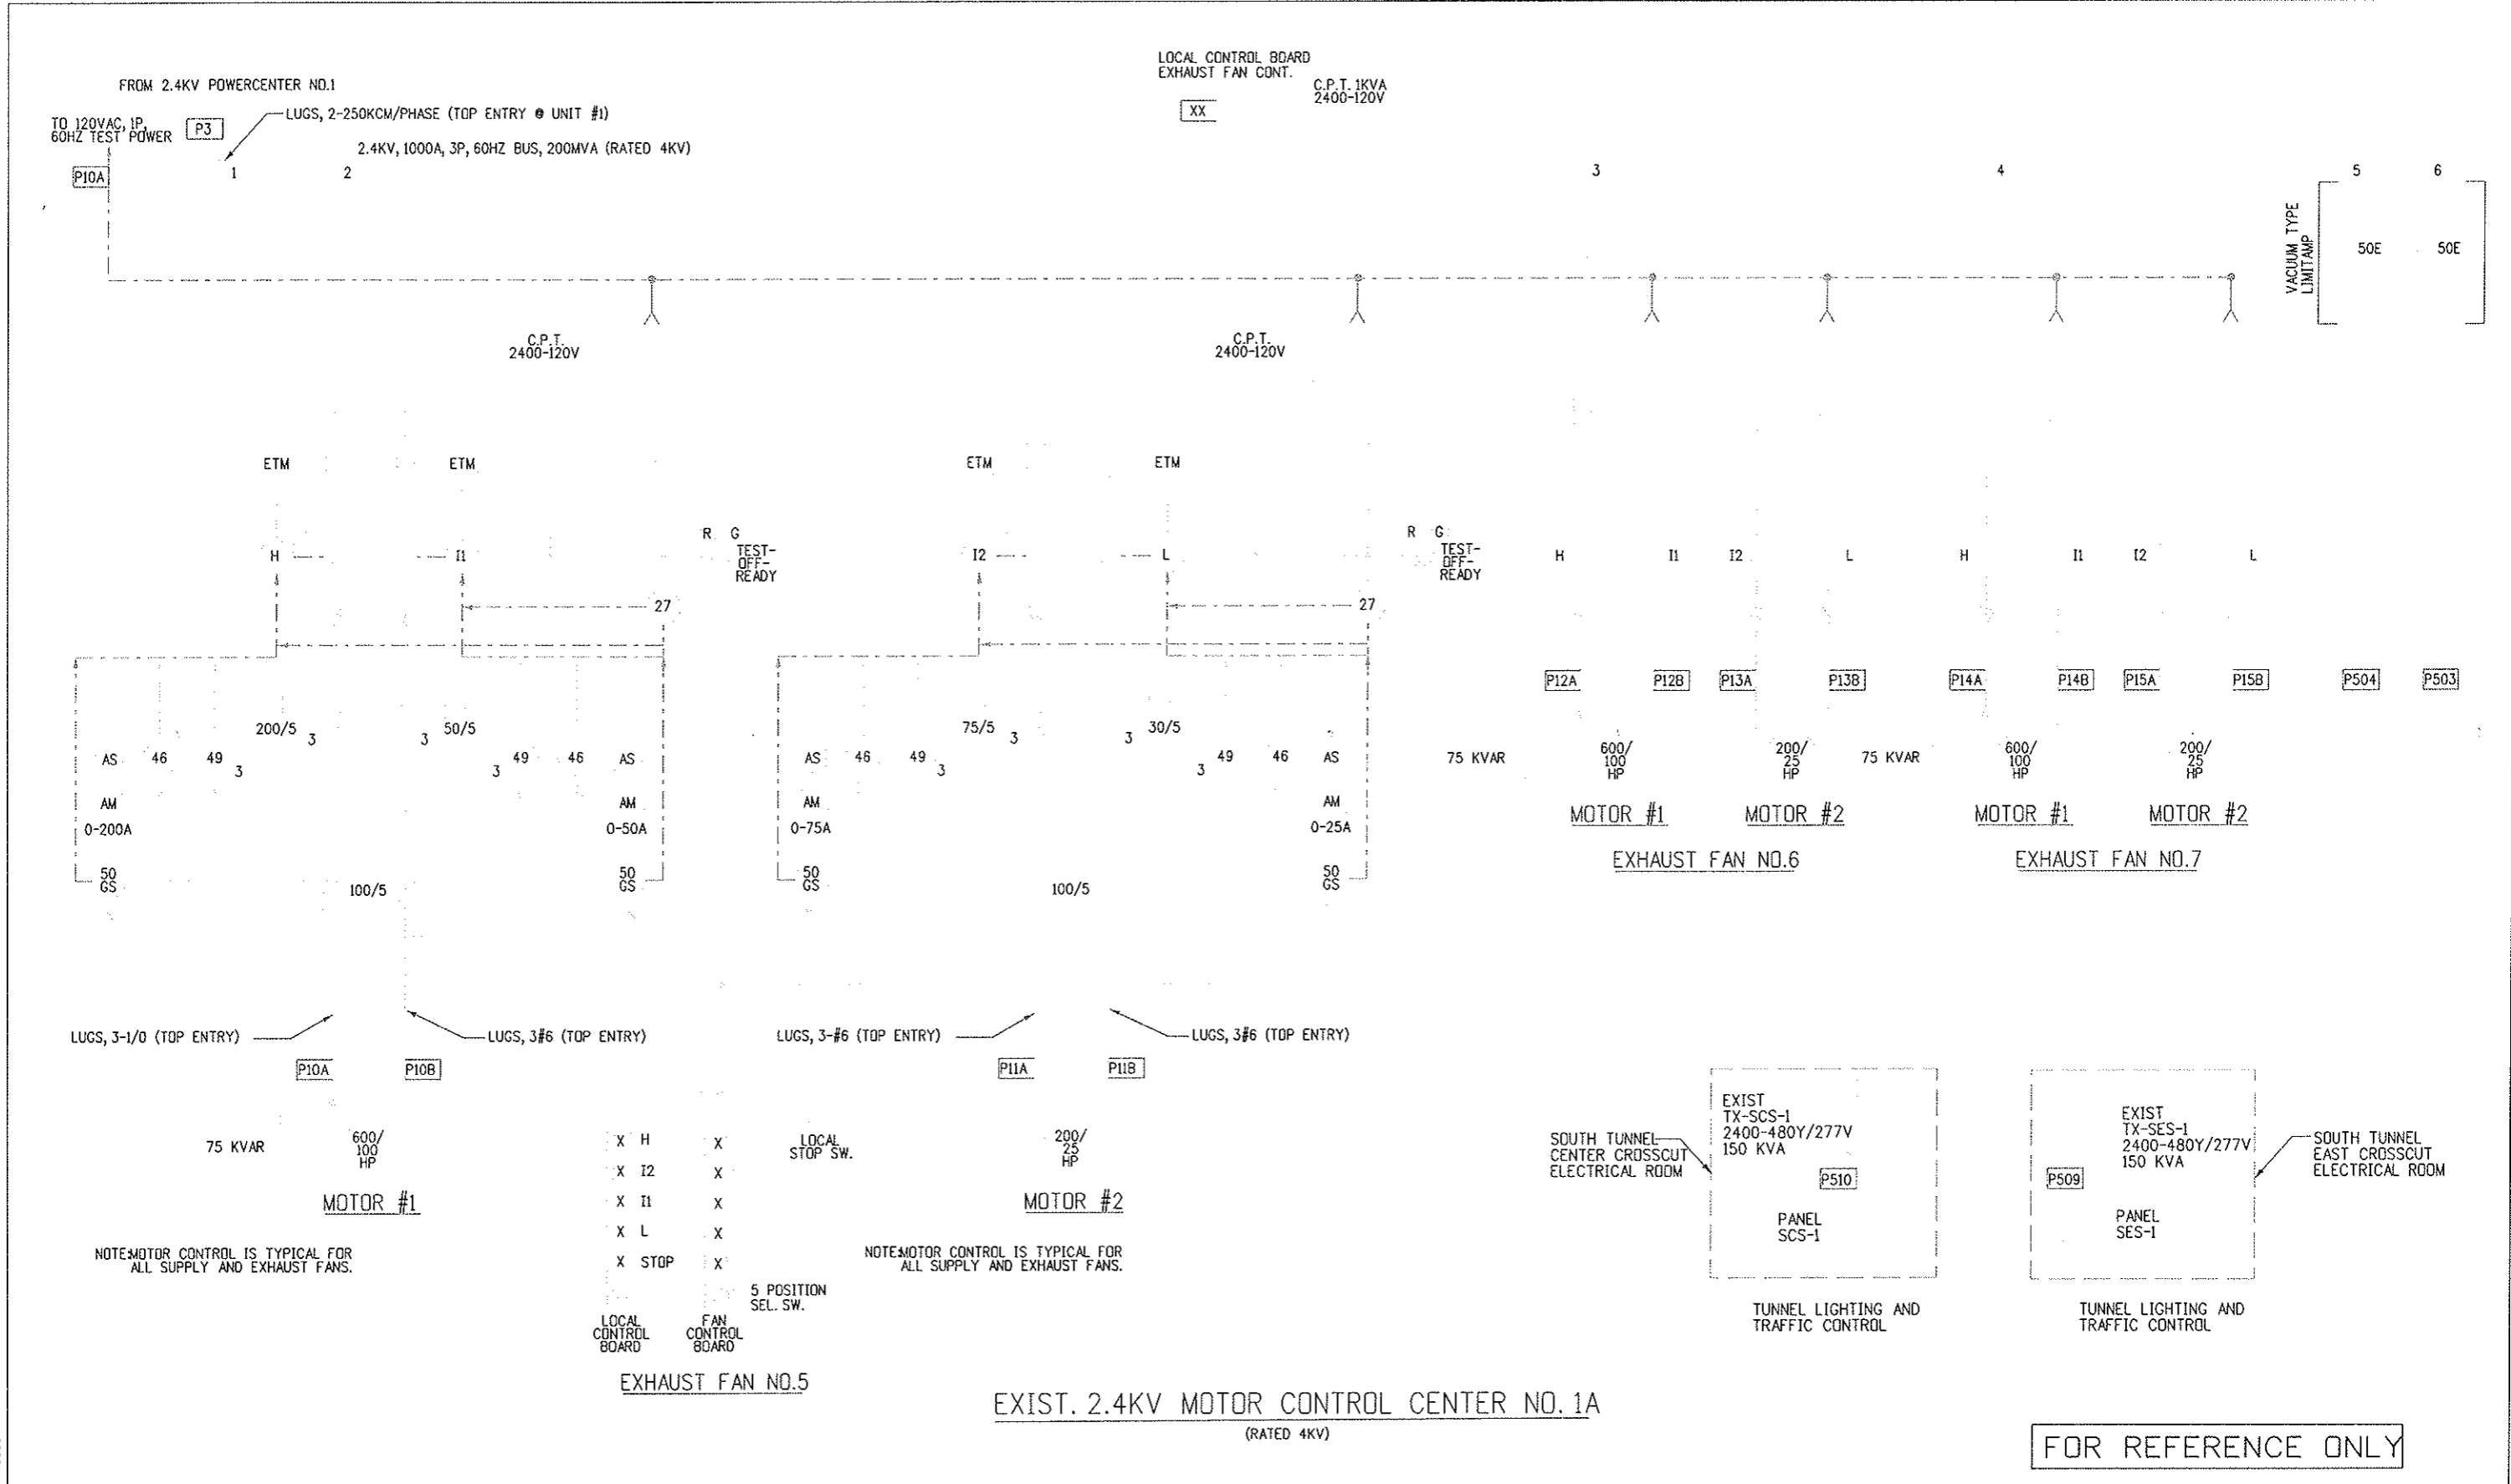

FOR REFERENCE ONLY


EXIST. 2.4KV MOTOR CONTROL CENTER NO.1A
(RATED 4KV)

Design File Name: DGN\$SPEC*
 Plot File Name: \$PLOTFILE*
 Date of Plot: \$\$\$DATE\$\$\$

Computer File Information	
Creation Date:	02/26/99 Initials: SFD
Last Modification Date:	02/07/02 Initials: DJR
Full Path:	14102\700cadd\703elect\
Drawing File Name:	102-JH-1.p
Acad Ver.	R14
Scale:	N=
Units:	ENGLISH

Sheet Revisions	
<input type="checkbox"/>	07/03/07 ASBUILT DJB
<input type="checkbox"/>	
<input type="checkbox"/>	
<input type="checkbox"/>	
<input type="checkbox"/>	

Colorado Department of Transportation




P.O. BOX 399
DUMONT, CO. 80436
Phone: 303-512-5750 FAX: 303-512-5775

Region 1 Mountain Residency I.N.Z.

As Constructed
No Revisions:
Revised:
Void:


ONE LINE DIAGRAM EAST 2.4 KV MCC NO. 1A	
Designer:	E.A. GAYAMAT
Detailer:	R. MILLER
Sheet Subset:	VB ELEC
Subset Sheets:	11 of 20

Project No./Code	
IM 0703-269	
13166	
Sheet Number	122

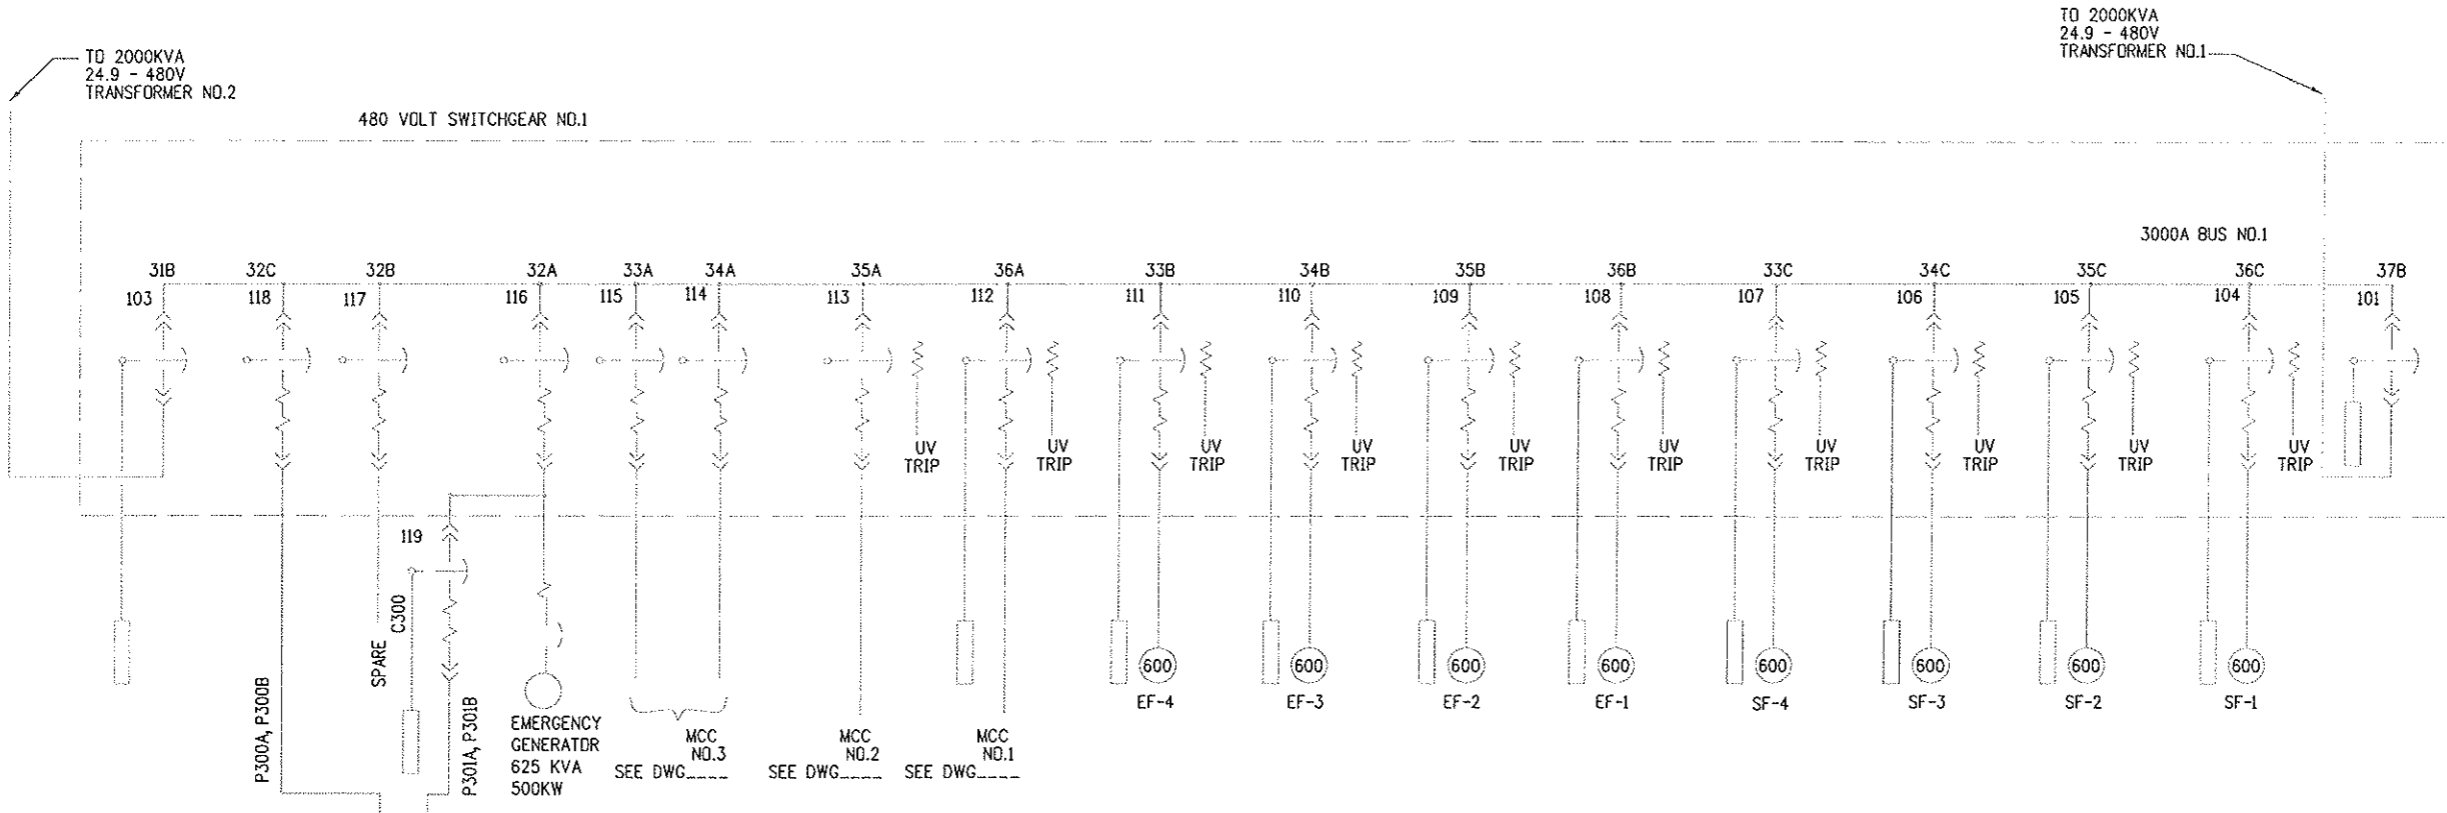

ATS-WV, 1000A, 4P

WEST VENTILATION BUILDING
480 VOLT SWITCHGEAR
 NO SCALE (EXISTING)

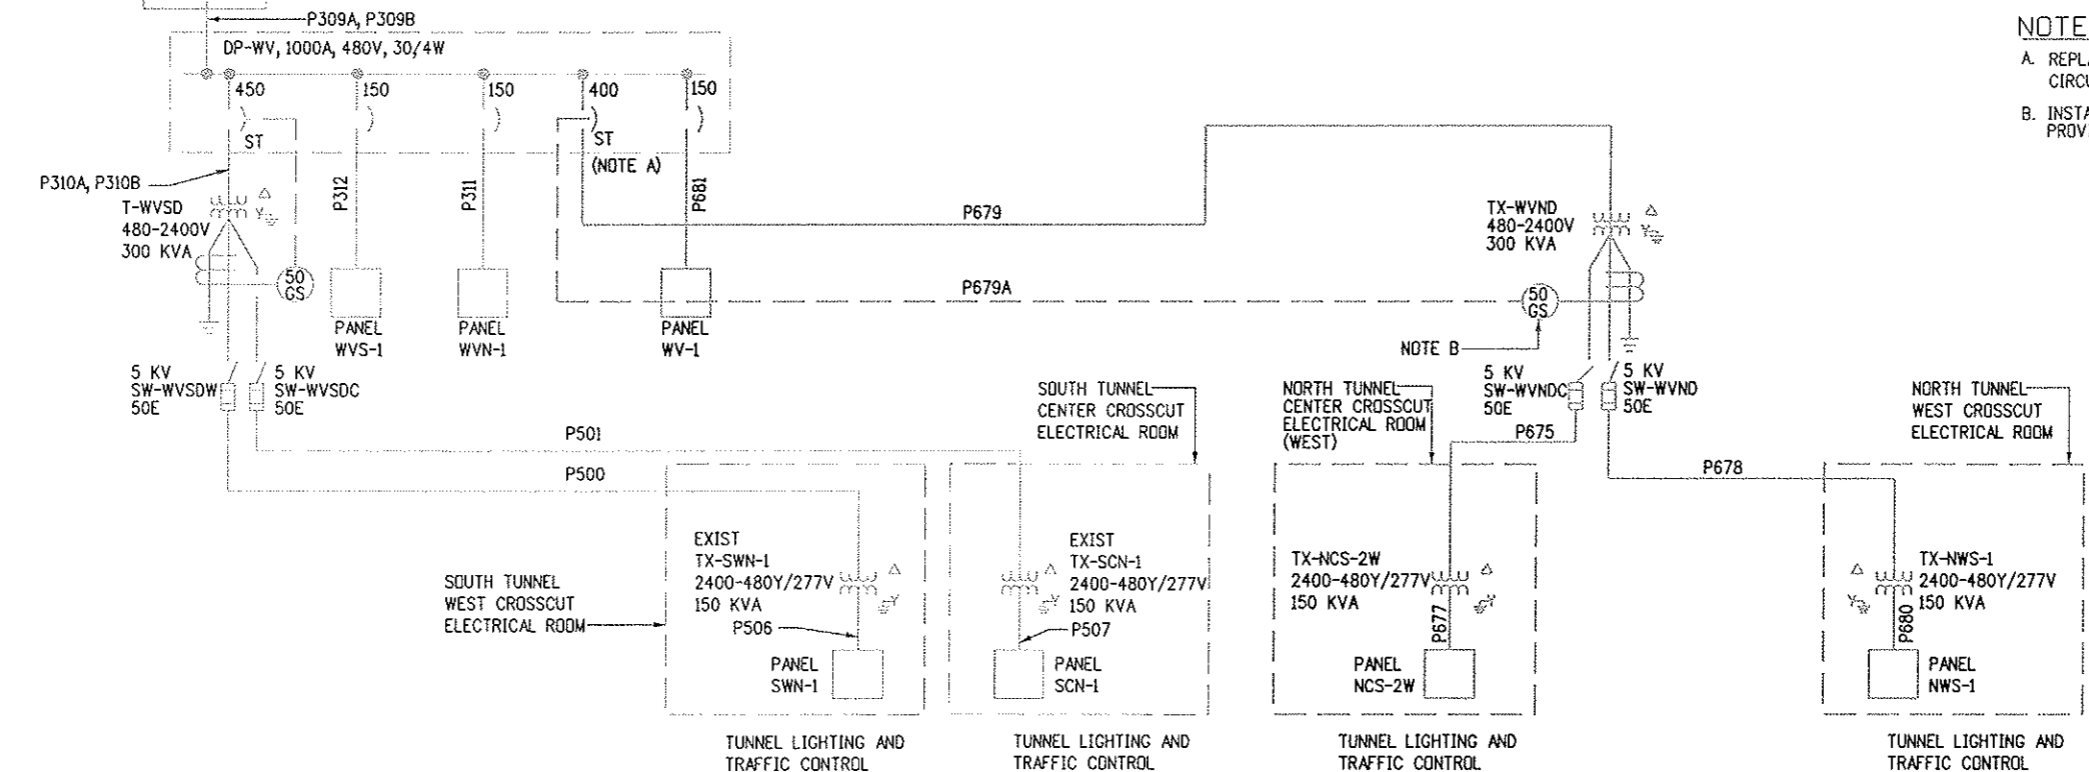


- NOTES:**
- A. REPLACE EXISTING SPARE CIRCUIT BREAKER AS REQUIRED. CIRCUIT BREAKER RATING/SIZE AS INDICATED.
 - B. INSTALL DEVICE IN SWITCH COMPARTMENT. SEE SPECIFICATIONS. PROVIDE CONTROL WIRING FOR SHUNT-TRIP DEVICE AS REQUIRED.

Design File Name: DONSPEC*
 Plot File Name: 94CLOTFILE*
 Date of Plot: 3/30/01E5555

Computer File Information	
Creation Date:	02/29/99 Initials: SL
Last Modification Date:	03/05/07 Initials: LK
Full Path:	14102\800Deliv\AsBuilt\
Drawing File Name:	102esd26n
Acad Ver.	R14 Scale: None Units: ENGLISH

Sheet Revisions	
07/03/07	ASBUILT DJB

Colorado Department of Transportation



P.O. BOX 399
 DUMONT, CO. 80436
 Phone: 303-512-5750 FAX: 303-512-5775


Region 1 Mountain Residency I.N.Z.

As Constructed
No Revisions:
Revised:
Void:

ONE LINE DIAGRAM
WEST 480V SWITCHGEAR


Designer: E.A. GAYAMAT
 Detailer: R. MILLER
 Sheet Subset: VB ELEC

Project No./Code	
IM 0703-269	
13166	
Sheet Number	123

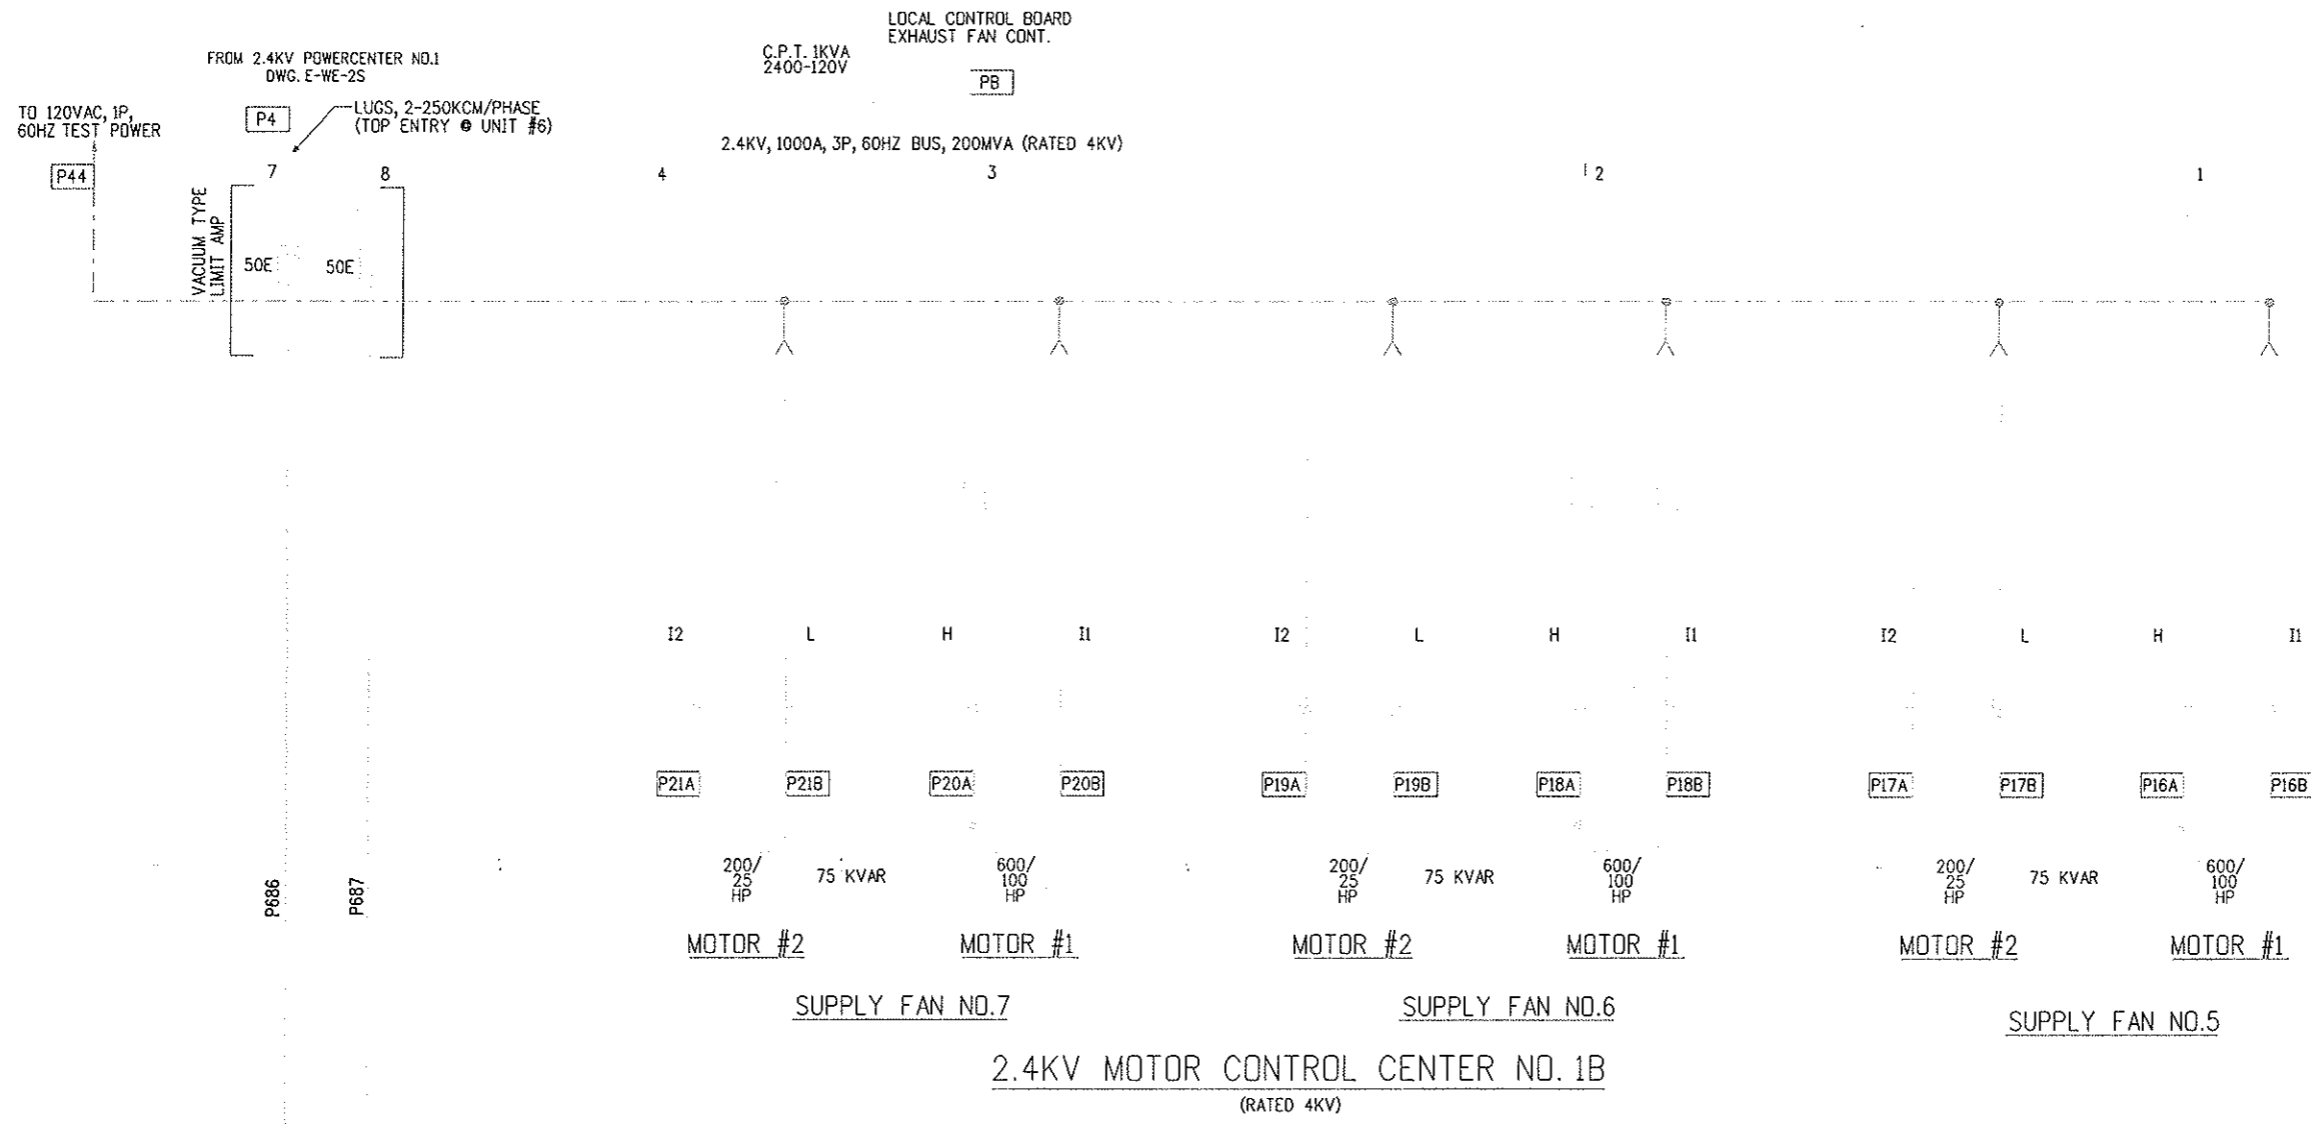

NP NO.	ENGRAVING
1	2.4KV M.C.C. NO.1A SOUTH TUNNEL
2	2.4KV M.C.C. NO.1B SOUTH TUNNEL
3	EXHAUST FAN EF-5 MOTOR NO.1
4	EXHAUST FAN EF-5 MOTOR NO.2
5	EXHAUST FAN EF-6 MOTOR NO.1
6	EXHAUST FAN EF-6 MOTOR NO.2
7	EXHAUST FAN EF-7 MOTOR NO.1
8	EXHAUST FAN EF-7 MOTOR NO.2
9	SUPPLY FAN SF-5 MOTOR NO.1
10	SUPPLY FAN SF-5 MOTOR NO.2
11	SUPPLY FAN SF-6 MOTOR NO.1
12	SUPPLY FAN SF-6 MOTOR NO.2
13	SUPPLY FAN SF-7 MOTOR NO.1
14	SUPPLY FAN SF-7 MOTOR NO.2
15	NORTH TUNNEL EAST CROSSCUT (EAST) TX-NCS-1E
16	NORTH TUNNEL EAST CROSSCUT TX-NEN-1

NAMEPLATE SCHEDULE

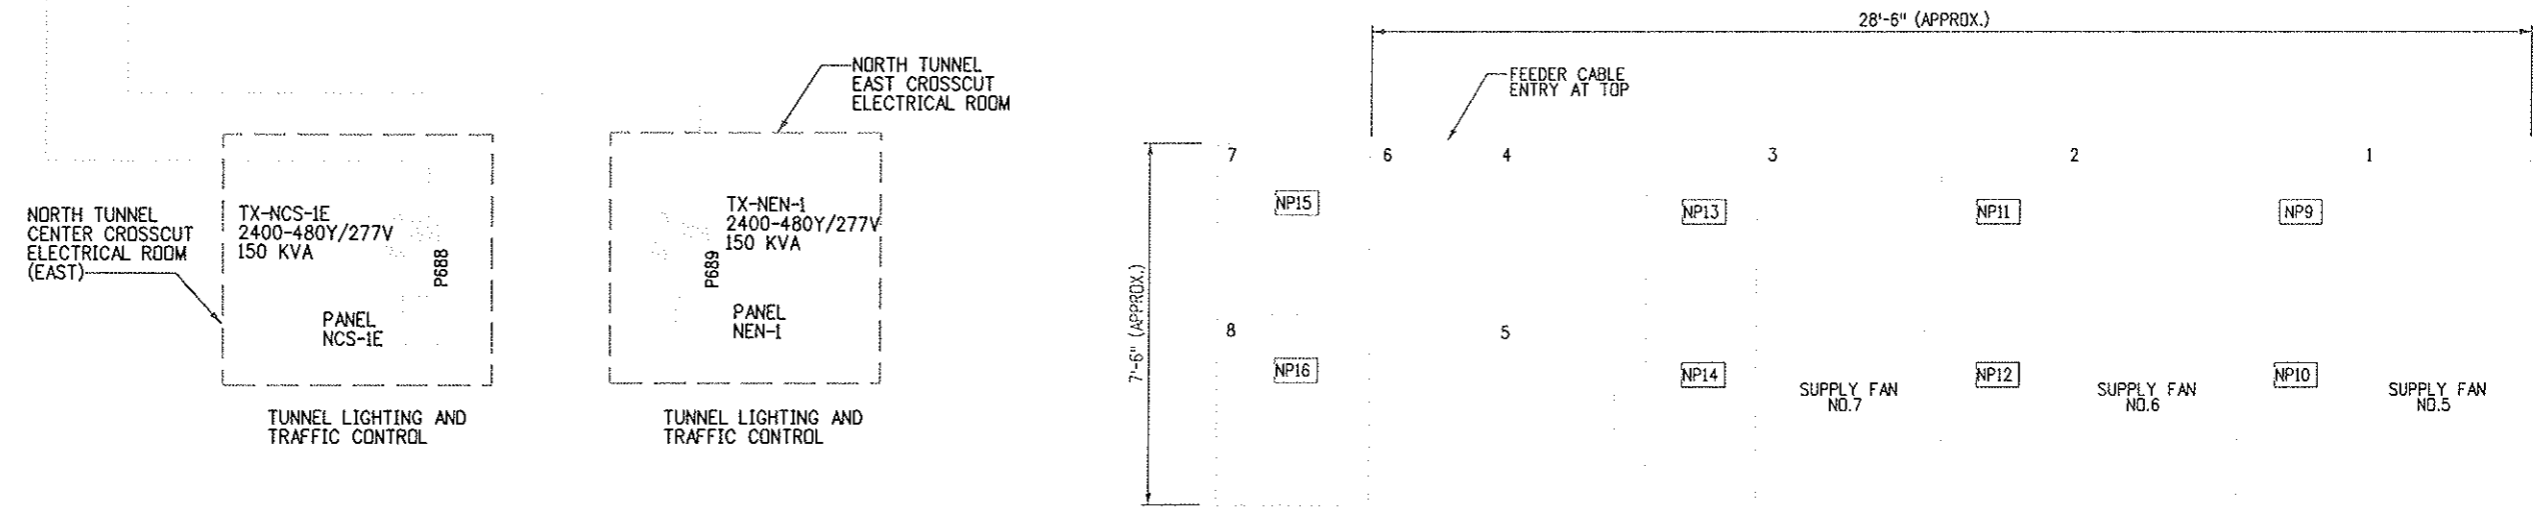

2.4KV MOTOR CONTROL CENTER NO. 1B - FRONT VIEW
N.T.S.

Design File Name: DONSPEC*
 Plot File Name: \$PLOTFILE*
 Date of Plot: \$\$\$DATE\$\$\$

Computer File Information	
Creation Date:	02/27/99 Initials: SL
Last Modification Date:	07/08/99 Initials: SL
Full Path:	14102\700cadd\703elect\
Drawing File Name:	103-1E1.dwg
Acad Ver.:	R14
Scale:	NONE
Units:	ENGLISH


Sheet Revisions	
07/03/07	ASBUILT DJB

Colorado Department of Transportation
 P.O. BOX 399
 DUMONT, CO. 80436
 Phone: 303-512-5750 FAX: 303-512-5775
 Region 1 Mountain Residency I.N.Z.

As Constructed
No Revisions:
Revised:
Void:


ONE LINE DIAGRAM EAST 2.4KV MCC NO.1B	
Designer: E.A. GAYAMAT	Structure Numbers
Detailer: R. MILLER	
Sheet Subset: VB ELEC	Subset Sheets: 13 of 20

Project No./Code	
IM 0703-269	
13166	
Sheet Number	124

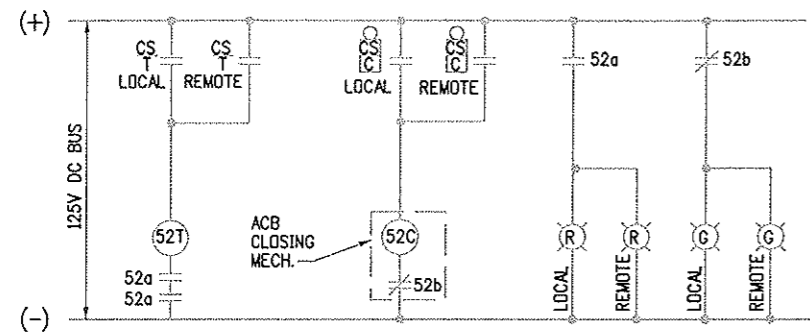

**AUTOMATIC TRANSFER SWITCH
460V BREAKER #118 CONTROL**

TYPICAL FOR BREAKER #118 IN WEST
(SERVING ATS-WV) AND EAST (SERVING ATS-EV)
VENTILATION BUILDING ELECTRICAL ROOMS.

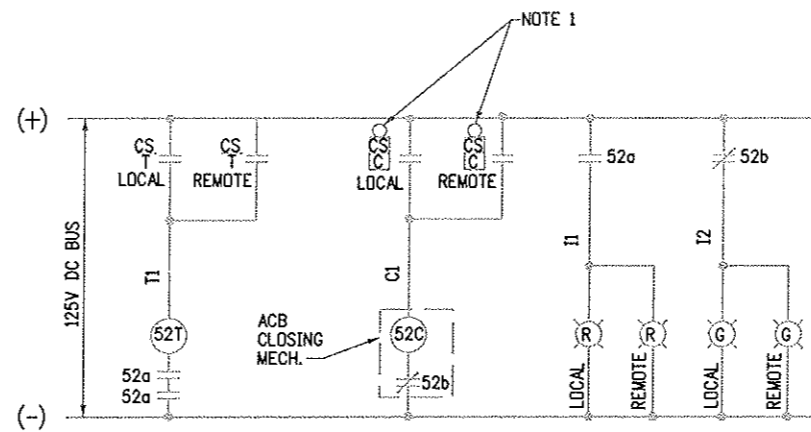

**STANDBY POWER (FORMER PEAK SHAVING)
460V BREAKER #119 CONTROL (EAST)**


○ KEY INTERLOCK SWITCHES

LEGEND:

- 52 AC CIRCUIT BREAKER
- 52a AUXILIARY SWITCH-OPEN WHEN BREAKER IS OPEN
- 52b AUXILIARY SWITCH-CLOSED WHEN BREAKER IS OPEN
- 52C BREAKER CLOSING RELAY
- 52T BREAKER TRIP COIL
- CS CONTROL SWITCH
- CS-C CONTROL SWITCH (CLOSING)
- CS-T CONTROL SWITCH (TRIPPING)
- CONTROL SWITCH WITH KEY INTERLOCK SWITCH
- LOCAL ON MCC OR ON THE BOARD CONTAINING THE EQUIPMENT
- PCB POWER CONTROL BOARD IN CONTROL ROOM
- REMOTE ON "POWER CONTROL BOARD" IN CONTROL ROOM


NOTES:

1. REMOVE KIRK-KEY INTERLOCK SWITCHES ASSOCIATED WITH THE CONTROL OF BREAKER #119 ON THE POWER CONTROL BOARD IN THE CONTROL ROOM AND ON BREAKER #119 ITSELF. INSTALL NEW CONTROL WIRING TO BYPASS THE PREVIOUS INTERLOCK FUNCTION OF THESE SWITCHES WHILE MAINTAINING ALL OTHER CONTROL FUNCTIONALITY.
2. MAKE MODIFICATIONS TO GENERATOR CONTROL BOARD WIRING AS REQUIRED TO INTERFACE NEW AUTOMATIC TRANSFER SWITCH START AND SHUTDOWN CONTACTS WHILE MAINTAINING ALL OTHER CONTROL FUNCTIONALITY.

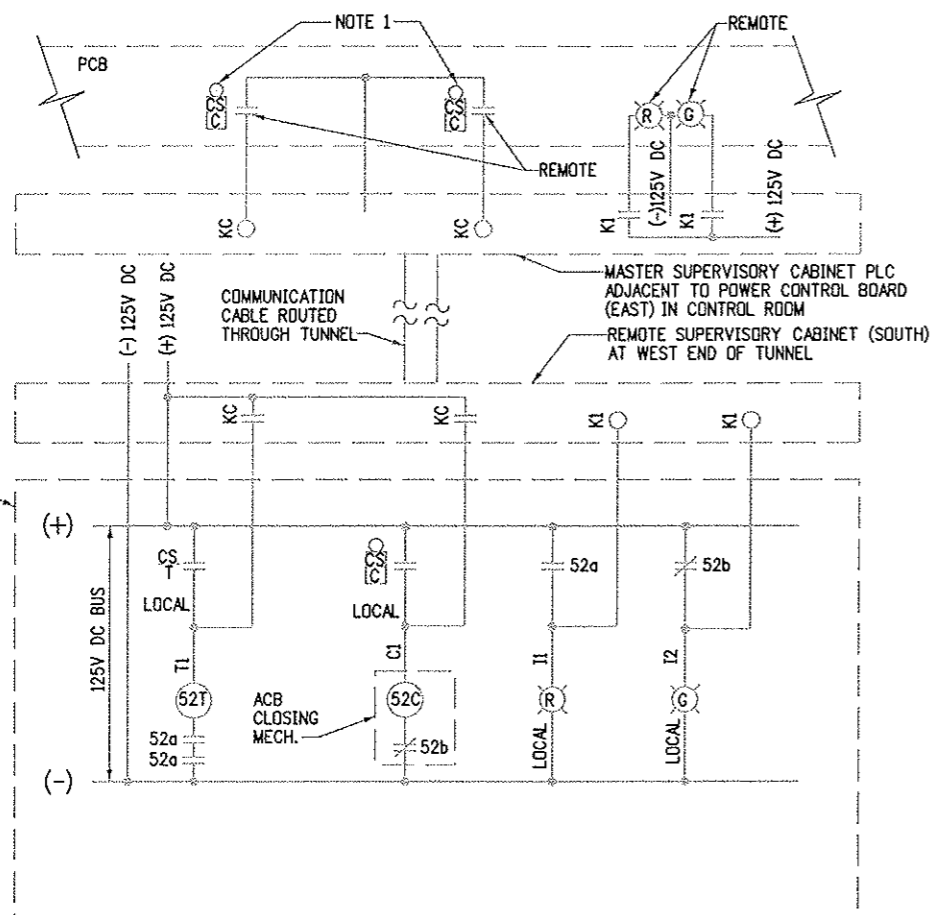

**STANDBY POWER (FORMER PEAK SHAVING)
460V BREAKER #119 CONTROL (WEST)**

○ KEY INTERLOCK SWITCHES

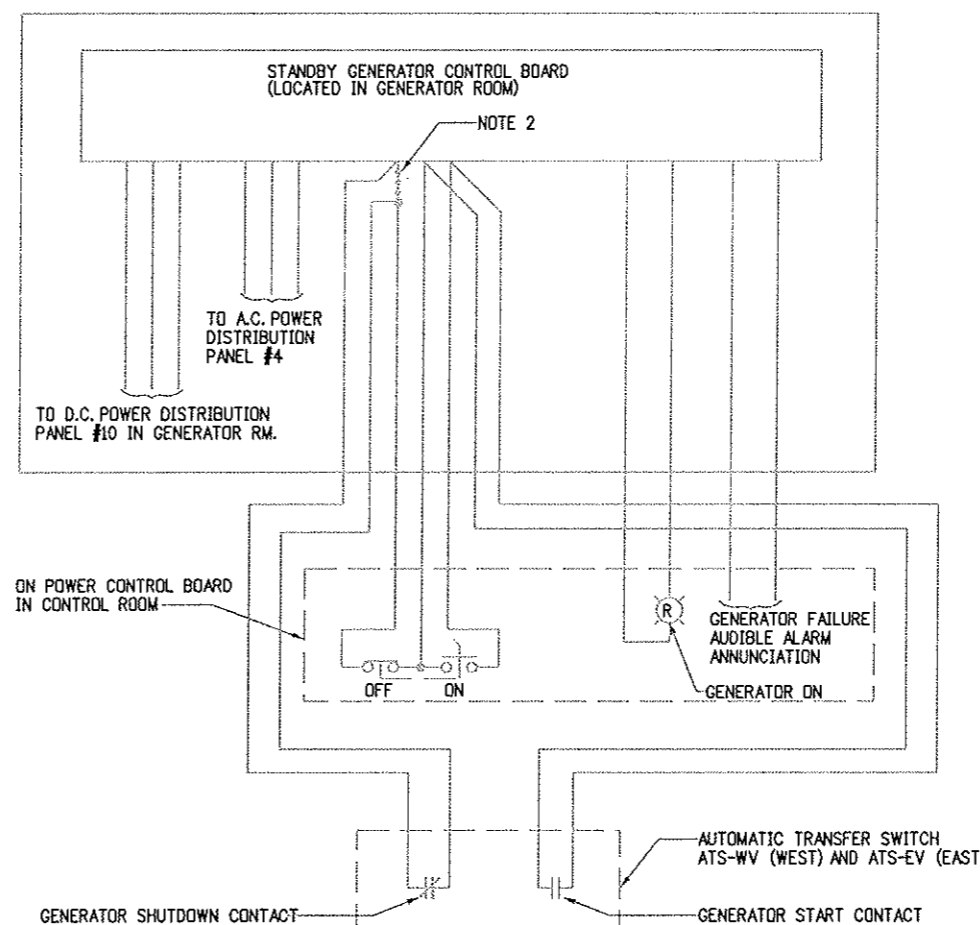

**STANDBY GENERATOR AC-DC POWER
SUPPLIES CONTROL AND INDICATION**


FOR REFERENCE ONLY

Design File Name: DGNSSPEC*
Plot File Name: \$PLOTFILE*
Date of Plot: \$\$\$DATE\$\$\$

Computer File Information	
Creation Date:	02/26/99 Initials: SL
Last Modification Date:	02/07/02 Initials: DJR
Full Path:	14102\700cadd\703elect\
Drawing File Name:	14102\700cadd\703elect\
Acad Ver.	R14 Scale: NONE Units: ENGLISH

Sheet Revisions	
07/03/07	ASBUILT DJB

Colorado Department of Transportation





P.O. BOX 399
DUMONT, CO. 80436
Phone: 303-512-5750 FAX: 303-512-5775
Region 1 Mountain Residency I.N.Z.

As Constructed
No Revisions:
Revised:
Void:

MISCELLANEOUS CONTROL AND ELEMENTARY DIAGRAMS	
Designer: E.A. GAYAMAT	Structure Numbers
Detailer: R. MILLER	
Sheet Subset: VB ELEC	Subset Sheets: 16 of 20

Project No./Code
IM 0703-269
13166
Sheet Number 127

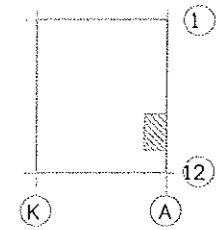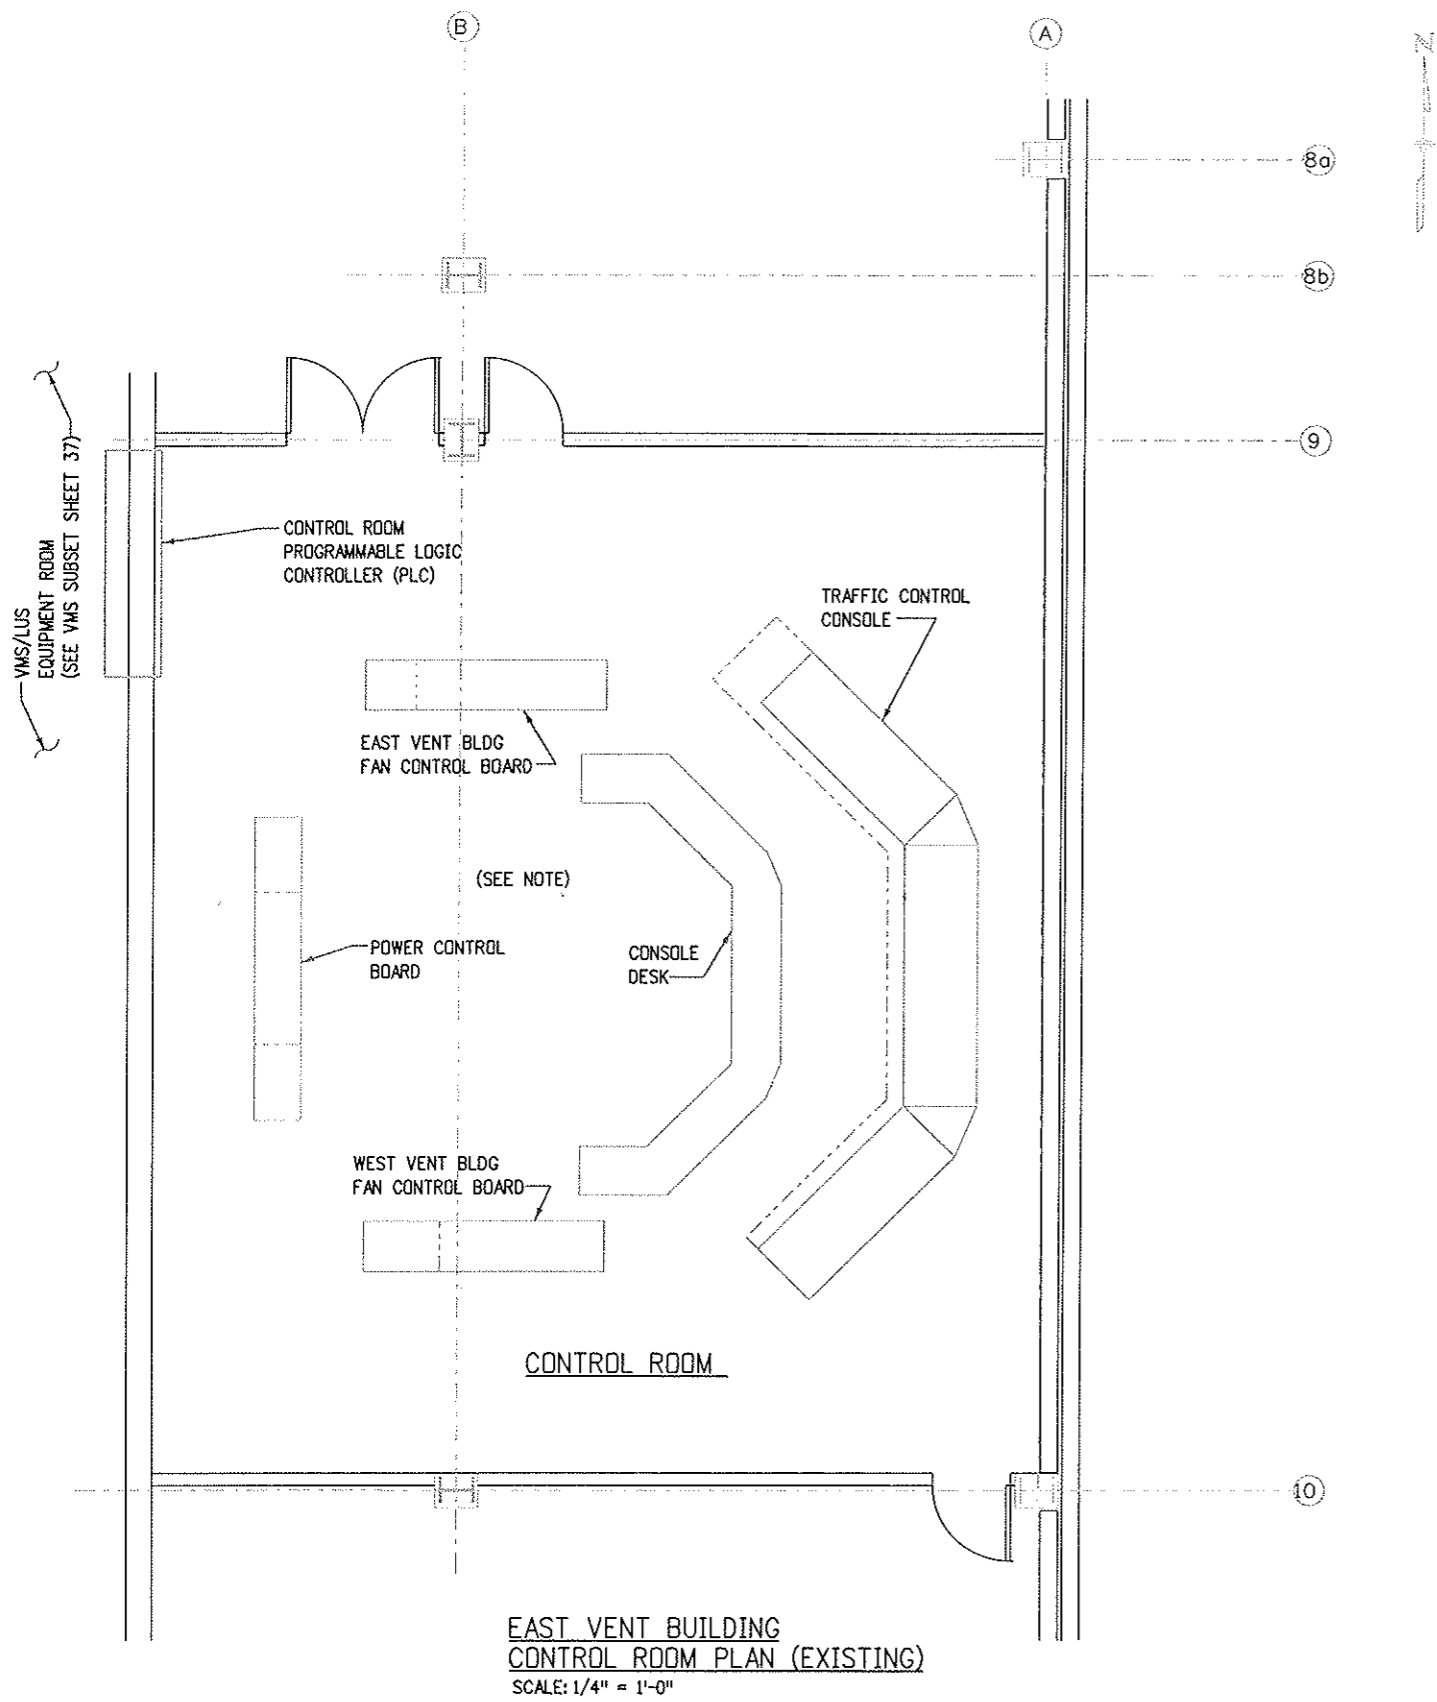

KEY PLAN

NOTE:

FOR VMS/LUS CONTROL CIRCUIT AND WIRING REFER TO VMS SUBSET.

**EAST VENT BUILDING
CONTROL ROOM PLAN (EXISTING)**
SCALE: 1/4" = 1'-0"

Computer File Information

Creation Date:	027/07/02	Initials:	SL
Last Modification Date:	027/07/02	Initials:	DJR
Full Path:	14102\700cadd\703elect\		
Drawing File Name:	102ep126n.dgn		
Acad Ver.	R14	Scale:	1/4" = 1'-0"
		Units:	ENGLISH

Sheet Revisions

<input type="checkbox"/>	07/03/07	ASBUILT	DJB
<input type="checkbox"/>			
<input type="checkbox"/>			
<input type="checkbox"/>			

Colorado Department of Transportation



P.O. BOX 399
DUMONT, CO. 80436
Phone: 303-512-5750 FAX: 303-512-5775

Region 1 Mountain Residency I.N.Z.

As Constructed

No Revisions:

Revised:

Void:

**EAST VENTILATION BUILDING
CONTROL ROOM PLAN**

Designer: E.A. GAYAMAT

Detailer: R. MILLER

Sheet Subset: VB ELEC

Structure
Numbers

Subset Sheets: 17 of 20

Project No./Code

IM 0703-269

13166

Sheet Number


128

CONDUIT				WIRE OR CABLE		ROUTING			CONDUIT				WIRE OR CABLE		ROUTING					
NO.	SIZE (IN) & KIND	QTY.	SIZE & TYPE (AWG-kcmil)	FROM	TO	FUNCTION	NO.	SIZE (IN) & KIND	QTY.	SIZE & TYPE (AWG-kcmil)	FROM	TO	FUNCTION	NO.	SIZE (IN) & KIND	QTY.	SIZE & TYPE (AWG-kcmil)	FROM	TO	FUNCTION
P670	3 RGS	3	2 1/c - 5kv	EXISTING PULL BOX, WEST VENT. BUILDING	WEST CROSSCUT ELECTRICAL ROOM	TX-NWN-1	P691													
		1	4 1/c-600V	EXISTING PULL BOX, WEST VENT. BUILDING	WEST CROSSCUT ELECTRICAL ROOM	GROUND WIRE														
P671	3 RGS	3	2 1/c - 5kv	2.4kv MOTOR CONTROL CENTER NO. 1A	WEST CENTER CROSSCUT ELECTRICAL ROOM	TX-NCS-1W	P692													
		1	4 1/c-600V	2.4kv MOTOR CONTROL CENTER NO. 1A	WEST CENTER CROSSCUT ELECTRICAL ROOM	GROUND WIRE														
P672	3 RGS	4	4/0 1/c - 600V	150KVA XFMR TX-NWN-1	PANELBOARD NWN-1, WEST CROSS CUT	SECONDARY FEEDER	P693													
		1	4 1/c-600V	150KVA XFMR TX-NWN-1	PANELBOARD NWN-1, WEST CROSS CUT	GROUND WIRE														
P673	3 RGS	4	4/0 1/c - 600V	150KVA XFMR TX-NCS-1W	PANELBOARD NCS-1W, CENTER CROSS CUT (WEST)	SECONDARY FEEDER	P694													
		1	4 1/c-600V	150KVA XFMR TX-NCS-1W	PANELBOARD NCS-1W, CENTER CROSS CUT (WEST)	GROUND WIRE														
P674							P695													
P675	3 RGS	3	2 1/c - 5KV	5.0KV SW-WVND IN WEST VENT BUILDING	WEST CENTER CROSSCUT ELECTRICAL ROOM	TX-NCS-2W	P696													
		1	4 1/c-600V	5.0KV SW-WVND IN WEST VENT BUILDING	WEST CENTER CROSSCUT ELECTRICAL ROOM	GROUND WIRE														
P676	4 RGS	3	500 1/c-600V	DISTRIBUTION PANEL DP-EV	300 KVA XFMR TX-EVND	FEEDER	P697													
		1	2 1/c - 600V	DISTRIBUTION PANEL DP-EV	300 KVA XFMR TX-EVND	GROUND WIRE														
P676A	3/4 RGS	1	2 #12	TX-EVND 50-GS	DISTRIBUTION PANEL DP-EV	GROUND FAULT	P698													
P677	3 RGS	4	4/0 1/c - 600V	150KVA XFMR TX-NCS-2W	PANELBOARD NCS-2W CENTER CROSSCUT (WEST)	SECONDARY FEEDER	P699													
		1	4 1/c-600V	150KVA XFMR TX-NCS-2W	PANELBOARD NCS-2W CENTER CROSSCUT (WEST)	GROUND WIRE														
P678	3 RGS	3	2 1/c - 5KV	5.0KV SW-WVND IN WEST VENT BUILDING	WEST CROSSCUT ELECTRICAL ROOM	TX-NWS-1														
		1	2 1/c-600V	5.0KV SW-WVND IN WEST VENT BUILDING	WEST CROSSCUT ELECTRICAL ROOM	GROUND WIRE	P700	2 RGS	4	4 1/c - 600V	CONTACTOR CABINET CWN-2	EXISTING CONDUIT AT PORTAL	EB APPROACH LIGHTING							
									1	10 1/c-600V			GROUND WIRE							
P679	4 RGS	3	500 1/c - 600V	DISTRIBUTION PANEL DP-WV	300KVA XFMR TX-WVND	FEEDER	P701	1 RGS	2	12 1/c - 600V	WIRE TERMINALS IN WEST VENT BLDG	CONTACTOR CABINET CWN-2	EB APPROACH LTG CONTROL							
		1	2 1/c-600V	DISTRIBUTION PANEL DP-WV	300KVA XFMR TX-WVND	GROUND WIRE				12 1/c - 600V	(FROM EXISTING EAST APPROACH LIGHTING PHOTOCCELL)		GROUND WIRE							
P679A	3/4 RGS	1	2 #12	TX-WVND 50-GS	DISTRIBUTION PANEL DP-WV	GROUND FAULT														
P680	3 RGS	4	4/0 1/c - 600V	150KVA XFMR TX-NWS-1	PANELBOARD NWS-1, WEST CROSSCUT	SECONDARY FEEDER	P702	2 RGS	4	4 1/c - 600V	CONTACTOR CABINET CEVN-2	EXISTING CONDUIT AT PORTAL	WB APPROACH LIGHTING							
		1	4 1/c-600V	150KVA XFMR TX-NWS-1	PANELBOARD NWS-1, WEST CROSSCUT	GROUND WIRE				1	10 1/c-600V		GROUND WIRE							
P681	1 1/2 RGS	4	1/0 1/c - 600V	DISTRIBUTION PANEL DP-WV	PANELBOARD WV-1	FEEDER	P703	1 RGS	2	12 1/c - 600V	WIRE TERMINALS IN EAST VENT BLDG	CONTACTOR CABINET CEVN-2	WB APPROACH LTG CONTROL							
		1	4 1/c-600V	DISTRIBUTION PANEL DP-WV	PANELBOARD WV-1	GROUND WIRE				12 1/c - 600V	(FROM EXISTING WEST APPROACH LIGHTING PHOTOCCELL)		GROUND WIRE							
P682	3 RGS	3	2 1/c - 5KV	5.0KV SW EVNDC. EAST VB	CENTER CROSSCUT ELECTRICAL ROOM (EAST)	TX-NCS-2E	P704													
		1	4 1/c-600V	5.0KV SW EVNDC. EAST VB	CENTER CROSSCUT ELECTRICAL ROOM (EAST)	GROUND WIRE														
P683	3 RGS	3	2 1/c - 5KV	5.0KV SW EVNDC. EAST VB	EAST CROSSCUT ELECTRICAL ROOM	TX-NES-1	P705													
		1	4 1/c -600V	5.0KV SW EVNDC. EAST VB	EAST CROSSCUT ELECTRICAL ROOM	GROUND WIRE														
P684	3 RGS	4	4/0 1/c - 600V	150KVA XFMR TX-NES-1	PANELBOARD NES-1, EAST CROSSCUT	FEEDER	P706													
		1	4 1/c - 600V	150KVA XFMR TX-NES-1	PANELBOARD NES-1, EAST CROSSCUT	GROUND WIRE														
P685	3 RGS	4	4/0 1/c - 600V	150KVA XFMR TX-NCS-2E	PANELBOARD NCS-2E, CENTER CROSSCUT (EAST)	FEEDER	P707													
		1	4 1/c - 600V	150KVA XFMR TX-NCS-2E	PANELBOARD NCS-2E, CENTER CROSSCUT (EAST)	GROUND WIRE														
P686	3 RGS	3	2 1/c - 5KV	EAST 2.4KV MOTOR CONTROL CENTER 1B	150KVA XFMR TX-NCS-1E	FEEDER	P708													
		1	4 1/c -600V	EAST 2.4KV MOTOR CONTROL CENTER 1B	150KVA XFMR TX-NCS-1E	GROUND WIRE														
P687	3 RGS	3	2 1/c - 5KV	EAST 2.4KV MOTOR CONTROL CENTER 1B	150KVA XFMR TX-NEN-1	FEEDER	P709													
		1	4 1/c -600V	EAST 2.4KV MOTOR CONTROL CENTER 1B	150KVA XFMR TX-NEN-1	GROUND WIRE														
P688	3 RGS	4	4/0 1/c - 600V	150KVA XFMR TX-NCS-1E	PANELBOARD NCS-1E, CENTER CROSSCUT (EAST)	FEEDER	P710													
		1	4 1/c - 600V	150KVA XFMR TX-NCS-1E	PANELBOARD NCS-1E, CENTER CROSSCUT (EAST)	GROUND WIRE														
P689	3 RGS	4	4/0 1/c - 600V	150KVA XFMR TX-NEN-1	PANELBOARD NEN-1, EAST CROSSCUT	FEEDER	P711													
		1	4 1/c - 600V	150KVA XFMR TX-NEN-1	PANELBOARD NEN-1, EAST CROSSCUT	GROUND WIRE														
P690	4 RGS	4	500 1/c - 600V	EAST MCC NO.2	PANELBOARDS EV-1, EV-2, EV-3	FEEDER	P712													
		1	2 1/c - 600V	EAST MCC NO.2	PANELBOARDS EV-1, EV-2, EV-3	GROUND WIRE														

Design File Name: DGN\$SPEC*
 Plot File Name: \$PLOTFILE*
 Date of Plot: \$\$\$\$\$DATE\$\$\$\$\$

Computer File Information			
Creation Date:	04/21/99	Initials:	SFD
Last Modification Date:	03/06/07	Initials:	DJB
Full Path:	14102\800Deliv\AsBuilt\		
Drawing File Name:	E-129		
Acad Ver.	R14	Scale:	NONE
		Units:	ENGLISH

Sheet Revisions			
07/03/07	ASBUILT		DJB

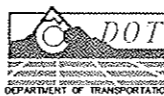Colorado Department of Transportation

 P.O. BOX 399
 DUMONT, CO. 80436
 Phone: 303-512-5750 FAX: 303-512-5775
 Region 1 Mountain Residency I.N.Z.

As Constructed
 No Revisions:
 Revised:
 Void:

ELECT CIRCUIT SCHEDULES
SHEET 1

Project No./Code
 IM 0703-269


Designer: E. GAYAMAT
 Detailer: L. KORSUNSKY
 Sheet Subset: VB ELEC


Structure Numbers
 13166
 Subset Sheets: 18 OF 20
 Sheet Number 129

CONDUIT		WIRE OR CABLE		ROUTING		FUNCTION
NO.	SIZE (IN) & KIND	QTY.	SIZE & TYPE (AWG-kcmil)	FROM	TO	
C601	3 RGS	4	F.O. CABLES	VMS/LUS COMM PULLBOX IN SUPPLY DUCT	FIBER TERMINATION CABINET	VMS/LUS CONTROL LOOP
C601A	3 RGS	4	F.O. CABLES	VMS/LUS COMM PULLBOX IN SUPPLY DUCT	PULL BOX PB-C5/6 IN EAST VB	VMS/LUS CONTROL LOOP
C602	1 1/2 RGS	2	F.O. CABLES	VMS/LUS COMM PULLBOX IN SUPPLY DUCT	VMS/LUS CTRL CABINETS IN TUNNEL	VMS/LUS CONTROL LOOP
C602A	3 RGS	4	F.O. CABLES	VMS/LUS COMM PULLBOX IN SUPPLY DUCT	PULL BOX JB-C501 IN WEST VB	VMS/LUS CONTROL LOOP
C603	3/4 FLEX	2	VMS DATA	VMS/LUS CTRL CABINET IN TUNNEL	TUNNEL VMS SIGN PANEL ASSEMBLY	VMS CONTROL
C604A	1 1/2 RGS	8	LUS DATA	VMS/LUS CTRL CABINET IN TUNNEL	JB - C601 PULL BOX	LUS CONTROL
C604B	1 1/4 RGS	4	LUS DATA	JB - C601 PULL BOX	JB-C601 PULL BOX	LUS CONTROL
C604C	3/4 RGS	2	BDS DATA	JB - C601 PULL BOX	TUNNEL LUS SIGNS, EACH	LUS CONTROL
C607	1* RGS	2	F.O. CABLES	WEST VENT. BLDG PULL BOX PB-C501	EXISTING CAB IN	VMS/LUS CONTROL LOOP
C608						
C609						
C610						
C611A	1 1/2 RGS	1	LTG FIBEROPTIC	TERMINATION PANEL IN CONTROL ROOM	NORTH TUNNEL	TUNNEL LTG CONTROL LOOP
C611B	3/4 RGS	1	LTG CABLE	CONT. CAB IN SOUTH ELEC ROOM CROSSCUT	CONT. CAB IN CROSSCUT NORTH ELEC RM	CONTROL COMMUNICATIONS
C611C	3/4 RGS	1	LTG CABLE	CONT. CAB CNCW-1 (NCCC-WEST)	CONT. CAB CNCE-1 (NCCC-EAST)	CONTROL COMMUNICATIONS
C611D	3/4 RGS	1	LTG CABLE	CONTACTOR CABINET CWVN-1	CONTACTOR CABINET CWVN-2	CONTROL COMMUNICATIONS
C611E	3/4 RGS	1	LTG CABLE	CONTACTOR CABINET CEVN-1	CONTACTOR CABINET CEVN-2	CONTROL COMMUNICATIONS
C611F	1 1/2 RGS	1	LTG FIBEROPTIC	LIGHTING CONTROLLER CONTINUOUS LOOP TEE	LIGHTING CONTACTOR CABINETS IN CROSS CUT ROOM	TUNNEL LTG CONTROL LOOP

CONDUIT		WIRE OR CABLE		ROUTING		FUNCTION
NO.	SIZE (IN) & KIND	QTY.	SIZE & TYPE (AWG-kcmil)	FROM	TO	
C500B	3 RGS	2	F.O. CABLES	VMS/LUS COMM CABINET IN VB EQUIPMENT RM	VMS/LUS COMM PULLBOX IN VB EQUIPMENT RM	VMS/LUS CONTROL LOOP
C501	3 EXIST	2	F.O. CABLES	W. VB EQUIPMENT RM VMS/LUS COMM PULLBOX	E. VB EQUIPMENT RM VMS/LUS COMM PULLBOX	VMS/LUS CONTROL LOOP

NOTES:
1. EXTEND EXISTING CAPPED CONDUIT AS REQUIRED AND
INSTALL NEW CABLES AS SCHEDULED AND SHOW ON
THE DRAWINGS.


Computer File Information Creation Date: 04/21/99 Initials: SPD Last Modification Date: 05/26/97 Initials: DJB Full Path: 14102\800Deliv\AsBuilt\ Drawing File Name: 102ecs06n Acad Ver. R14 Scale: NONE Units: ENGLISH		Sheet Revisions <input type="checkbox"/> 07/03/07 ASBUILT DJB		Colorado Department of Transportation  P.O. BOX 399 DUMONT, CO. 80436 Phone: 303-512-5750 FAX: 303-512-5775 Region 1 Mountain Residency I.N.Z.		As Constructed No Revisions: Revised: Void:		ELECT CIRCUIT SCHEDULES SHEET 2 Designer: E. GAYAMAT Detailer: L. KORSUNSKY Sheet Subset: VB ELEC		Project No./Code IM 0703-269 13166 Sheet Number 130	
---	--	---	--	--	--	---	--	---	--	---	--

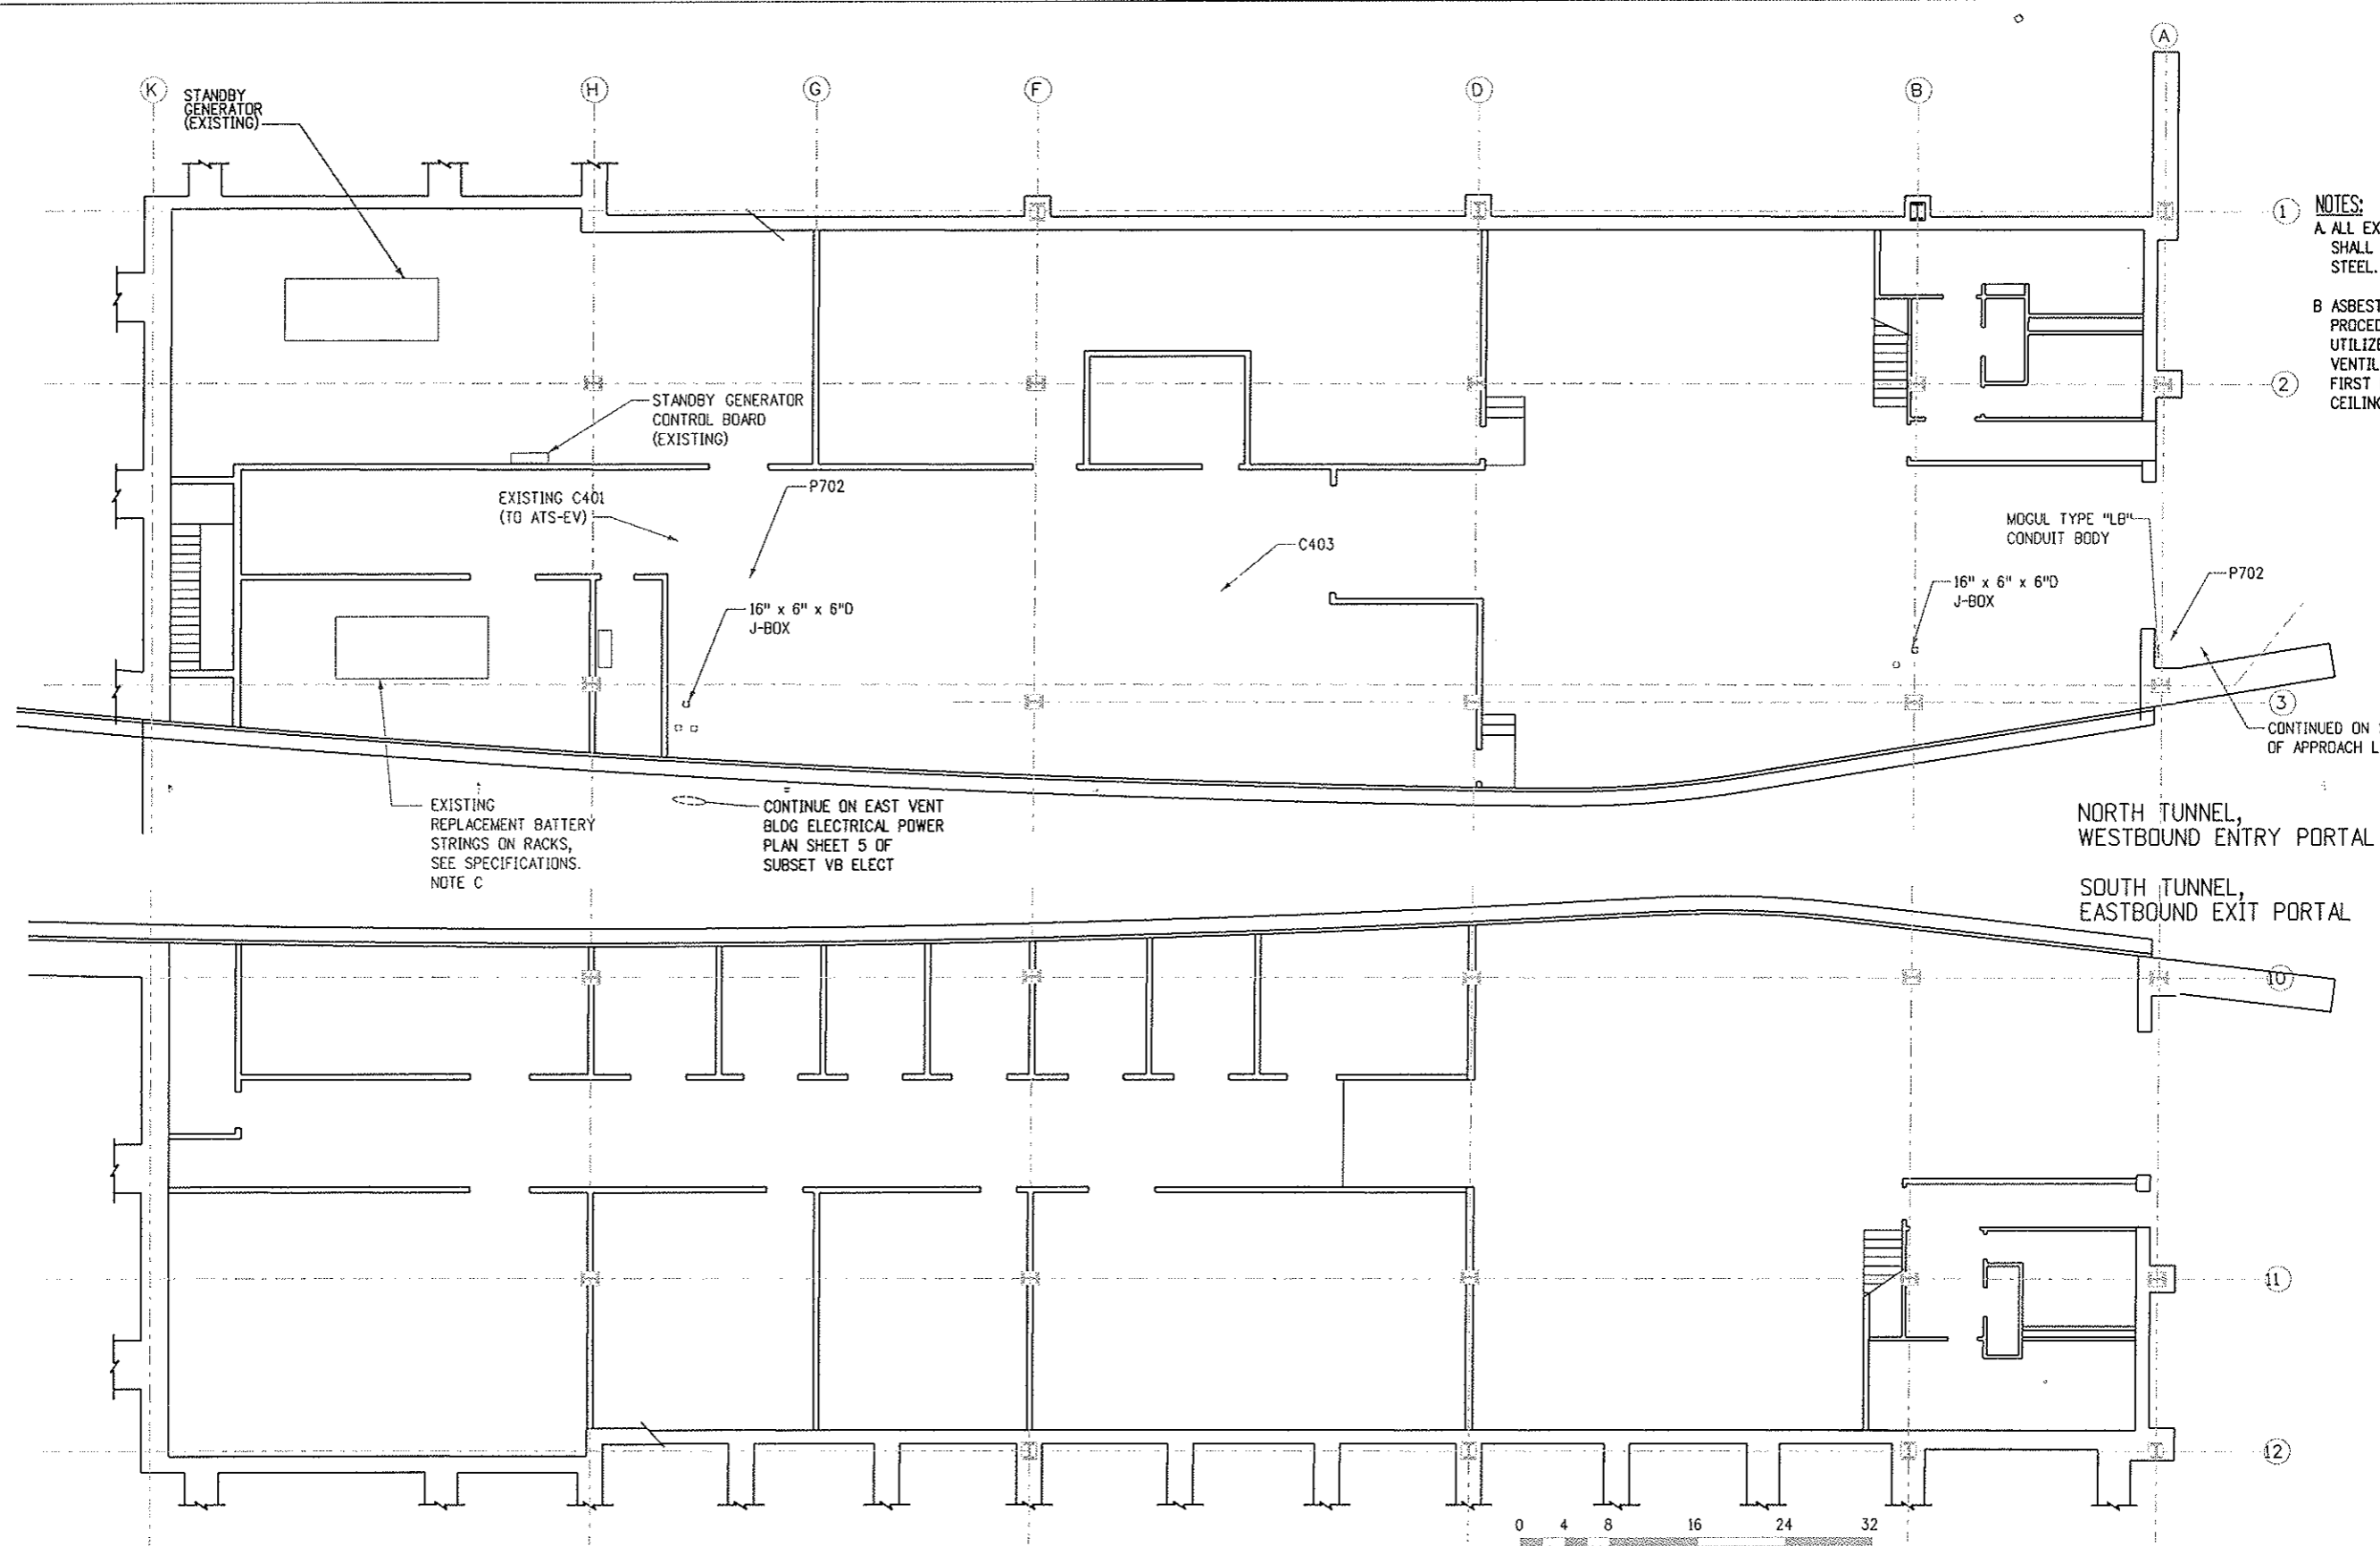

- NOTES:**
- ① ALL EXPOSED CONDUIT SHALL BE RIGID GALVANIZED STEEL.
 - ② ASBESTOS ABATEMENT PROCEDURES SHALL BE UTILIZED IN THE VENTILATION BUILDING FIRST FLOOR AREA CEILINGS.
 - ③ CONTINUED ON SHEET 5 OF APPROACH LTG SUBSET

NORTH TUNNEL,
WESTBOUND ENTRY PORTAL

SOUTH TUNNEL,
EASTBOUND EXIT PORTAL

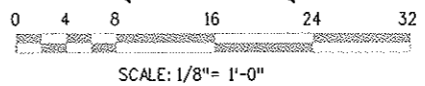

Design File Name: DGN\SPEC*
 Plot File Name: SPLOTFILE*
 Date of Plot: \$\$\$DATE\$\$\$\$

Computer File Information	
Creation Date:	04/22/03 Initials: SPD
Last Modification Date:	04/31/2003 Initials: SPD
Full Path:	14102\700CADD\703ELECT\
Drawing File Name:	epp123e.dwg
Acad Ver.	R14 Scale: 1/8"=1'-0" Units:

Sheet Revisions	
07/03/07	ASBUILT DJB

Colorado Department of Transportation

P.O. BOX 399
DUMONT, CO. 80436
Phone: 303-512-5750 FAX: 303-512-5775

Region 1 Mountain Residency I.N.Z.

As Constructed
No Revisions:
Revised:
Void:

EAST VENT BUILDING PARTIAL POWER PLANS	
Designer:	S. O'ROURKE
Detailer:	S. O'ROURKE
Sheet Subset:	VB ELECT
Structure Numbers	
Subset Sheets:	20 of 20

Project No./Code	
IM 0703-269	
13166	
Sheet Number	131

VMS NOTES

- UNLESS OTHERWISE NOTED, ALL VMS AND LUS ARE TO BE MOUNTED IN ACCORDANCE TO THE TYPICAL MOUNTING DETAILS SHOWN ON VMS AND LUS SIGN SUPPORT DETAILS, VMS SUBSET SHEETS 22 TO 30.
- PROPOSED SIGN AND RECESSED CONTROL CABINET LOCATIONS ARE APPROXIMATE. FINAL LOCATION SHALL BE FIELD SURVEY ADJUSTED AS PER FIELD CONDITION AND COORDINATED WITH THE TUNNEL LIGHTING FIXTURES AND APPROVED BY THE ENGINEER PRIOR TO DEVELOPING OF SHOP DRAWING. LOCATE THE LUS IN THE LEFT LANE FIRST AND MATCH THE OFFSET ON THE RIGHT TO ENSURE PROPER SPACING AND TO AVOID OVERHEAD AIR SUPPLY DUCTS.
- ALL SIGN INSTALLATIONS THAT REQUIRE A LANE CLOSURE SHALL BE PERFORMED DURING THE WORKING HOURS SPECIFIED.
- ALL EXISTING TRAFFIC SIGNS AND SIGNAL EQUIPMENT BEING REMOVED. AFTER REMOVAL THE WEIGH-IN-MOTION VMS SIGNS WILL REMAIN THE PROPERTY OF CDOT.
- EXISTING TUNNEL VMS AND LUS SHALL BE MAINTAINED IN OPERATIONAL CONDITION AT ALL TIMES DURING THE INSTALLATION OF THE PROPOSED VMS AND LUS. EXISTING VMS WILL BE REMOVED AFTER THE INSTALLATION OF THE PROPOSED VMS ARE COMPLETED, TESTED AND IN OPERATIONAL CONDITION.
- FOR PROPOSED TYPICAL TUNNEL VMS AND LUS CROSS SECTION, SEE VMS SUBSET SHEETS 15 THRU 17.
- FOR SIGN SUPPORT LOCATIONS, SIGNS CONTROLLERS, CONTROL CABINETS AND TRAFFIC SIGNS TO BE INSTALLED IN THIS CONTRACT, SEE TABULATION OF SIGNS VMS SUBSET SHEETS 2 AND 3.
- FOR VARIABLE MESSAGE SIGNS, THE MAXIMUM SIGN (CONTRACTOR DESIGNED) MOUNTING BRACKET SPACING ONTO THE FRAMING SUPPORT SYSTEM SHALL BE 2'-6" CENTER TO CENTER.
- FOR CONTROL CABINET MOUNTING DETAIL, SEE VMS SUBSET SHEETS 28 AND 29.
- FOR VMS/LUS MANAGEMENT SYSTEM, SEE VMS SUBSET SHEETS 31 THRU 47.
- FOR ADDITIONAL LEGEND AND ABBREVIATION, SEE VMS SUBSET SHEETS 22 AND 31.
- PROVIDE AND/OR EXTEND POWER SUPPLY, FIBER OPTIC CONTROL CABLE AND COPPER SIGNAL CIRCUIT WIRING TO EXISTING VMS/LUS BLANKOUT SIGN(S) TO BE RELOCATED AND PROPOSED AS REQUIRED.
- ALL ELECTRICAL SERVICES, TRAFFIC SIGNAL CONDUIT AND WIRING INSTALLATION SHALL CONFORM TO CDOT SPECIFICATION AND STANDARD PLAN NO. S-614-14 AND S-614-40.
- EXISTING OVERHEIGHT VEHICLE DETECTORS WILL REMAIN OPERATIONAL AT ALL TIMES UNTIL THE TIME OF RELOCATION. THE TIME AND METHOD OF RELOCATION WILL BE COORDINATED WITH THE TUNNEL OPERATIONS AND APPROVED BY THE ENGINEER.

LEGEND

- | | |
|---|--|
| CMS = CHANGEABLE MESSAGE SIGN | EXISTING TUNNEL VMS |
| VMS = VARIABLE MESSAGE SIGN | = EXISTING TUNNEL VMS |
| LUS = LANE USE SIGNAL | " = LUS |
| TSCS = TRAFFIC SIGNAL CONTROL SYSTEM | □ = EXISTING LUS |
| C = CONTROLLER | HP = HIGH POINT |
| CAB = CABINET | PGL = PAVING GRADE LEVEL |
| BOS = BLANKOUT SIGN | PEP = PORCELAIN ENAMEL PANEL |
| OHVD = OVERHEIGHT VEHICLE DETECTOR | CONST. = CONSTRUCTION LEVEL |
| MB-XX = EXISTING MESSAGE BOARD IDENTIFIER | LF = LINEAR FEET |
| VMS-XX = VMS IDENTIFIER | EA = EACH |
| LUS-XX = LANE USE SIGNAL (LUS) IDENTIFIER | LS = LUMP SUM |
| LUS-PXX = PORTAL LUS IDENTIFIER | STA. = STATION |
| C-XXN = CONTROLLER IDENTIFIER | = EXISTING TRAFFIC SIGNAL WITH MAST ARM |
| CAB-XXN = CABINET IDENTIFIER | = PROPOSED TRAFFIC SIGNAL WITH MAST ARM |
| BOS-NPX = PORTAL BLANKOUT SIGN IDENTIFIER | = EXISTING ELECTRICAL CONDUIT AND PULL BOX |
| S-X = SIGN IDENTIFIER | = PROPOSED ELECTRICAL CONDUIT AND PULL BOX |
| | = EXISTING TRAFFIC SIGNAL FACE |
| | = PROPOSED TRAFFIC SIGNAL FACE |

QUANTITIES - NORTH TUNNEL VMS

ITEM NUMBER	DESCRIPTION	UNIT	ROADWAY	
			PLAN	AS CONST.
CONSTRUCTION				
614	CABLE INNERDUCT (1 INCH)	LF	30,000	
614	OPTICAL TRANSCEIVER	EA	15	
614	BUFFER TUBE FAN OUT KIT	EA	34	
614	FIBER OPTIC CABLE (MULTI MDDE) (6 STRANDS)	LF	60,000	
614	FIBER OPTIC TERMINATION PANEL- 6 FIBER	EA	11	
614	FIBER OPTIC TERMINATION PANEL- 12 FIBER	EA	4	
614	MASTER COMPUTER AND SOFTWARE	LS	1	
614	WORKSTATIONS AND SOFTWARE	EA	2	
614	TMS MANAGEMENT SOFTWARE	LS	1	
614	SYSTEM INTEGRATION AND TESTING	LS	1	

QUANTITIES - NORTH TUNNEL VMS


ITEM NUMBER	DESCRIPTION	UNIT	ROADWAY	
			PLAN	AS CONST.
CONSTRUCTION				
202	REMOVAL OF TRAFFIC SIGNAL EQUIPMENT	LS	1	
606	GUARDRAIL TYPE 3 (6-3 POST SPACING)	LF	315	
606	END ANCHORAGE (FLARED)	EA	5	
606	END ANCHORAGE TYPE 3D	EA	5	
613	PULL BOX (24"x36"x36") DEEP	EA	13	
613	PULL BOX (24"x24"x8") DEEP	EA	2	
613	3 INCH ELECTRICAL CONDUIT (PLASTIC)	LF	2500	
614	VARIABLE MESSAGE SIGN LED (DOUBLE FACED)	EA	11	
614	WEIGH-IN-MOTION (LED) (SINGLE FACED)	EA	1	
614	LANE USE CONTROL SIGNAL LED (DOUBLE FACED)	EA	44	
614	CONTROLLER (TYPE 170E)	EA	13	
614	RECESSED CONTROL CABINET	EA	11	
614	SURFACE MOUNTED CONTROL CABINET	EA	4	
614	LUS MOUNTING SUPPORT AND WIRING (DOUBLE FACED)	EA	44	
614	VMS MOUNTING SUPPORT AND WIRING (DOUBLE FACED)	EA	11	
614	TRAFFIC SIGNAL (12-12-12) LED	EA	4	
614	TRAFFIC SIGNAL-LIGHT POLE STEEL (1 MAST ARM)	EA	2	
614	CONCRETE FOOTING (TYPE 3)	EA	4	
614	FLASHING BEACON	EA	4	
614	STEEL SIGN POST (W8x18)	LF	56	
614	TRAFFIC SIGNAL PEDESTAL POLE (INSTALL ONLY)	EA	4	
614	CONCRETE FOOTING (TRAFFIC SIGNAL POLE)	EA	4	
614	LANE USE CONTROL SIGNAL LED (DOUBLE FACED) (FURNISH ONLY)	EA	2	
614	VARIABLE MESSAGE SIGN LED (DOUBLE FACED) (FURNISH ONLY)	EA	1	
614	VMS MOUNTING SUPPORT AND WIRING (DOUBLE FACED) (FURNISH ONLY)	EA	1	

Design File Name: DONSPEC*
Plot File Name: SPLDIFILE*
Date of Plot: 03/03/07

Computer File Information	
Creation Date:	04/16/99 Initials: KJS
Last Modification Date:	03/27/03 Initials: KJS
FullPath:	14102\700CADD\713TRA\
Drawing File Name:	ttx01n.plt
Acad Ver.	R14 Scale: NTS Units: English

Sheet Revisions	
07/03/07	ASBUILT DJB

Colorado Department of Transportation



P.O. BOX 399
DUMONT, CO. 80436
Phone: 303-512-5750 FAX: 303-512-5775

Region 1 Mountain Residency I.N.Z.

As Constructed
No Revisions:
Revised:
Void:

VMS GENERAL NOTES	
Designer:	K HO
Detailer:	E. MCCHESENEY
Structure Numbers:	
Sheet Subset:	VMS
Subset Sheets:	1 OF 46

Project No./Code
IM 0703-269
13166
Sheet Number 132

SIGN SCHEDULE

LOCATION	LUS	VMS	MOUNTING & WIRING (BETWEEN SIGN & CONTROLLER)	VMS CONTROLLER 170E	CONTROL CABINET	CONTROL CABINET LOCATION	FIBEROPTIC TERMINATION PANEL	FIBEROPTIC TRANSCEIVER	FO PRIMARY RING OUT		FO PRIMARY RING IN		DISTANCE TO NEXT DEVICE	REMARKS
									CABLE	FIBERS	CABLE	FIBERS		
STA. 135+94	LUS-PIA, PIB	BDS-NP1	INCLUDED IN CONTRACT	C-1N	CAB-1N	WEST EXIT	INCLUDED IN CONTRACT	INCLUDED IN CONTRACT	1	1,2	1	1,2	178'	WEST EXIT
STA. 137+72	LUS-IA, IB	---	INCLUDED IN CONTRACT	---	---	PANEL #0027	---	---	---	---	---	---	242'	
STA. 140+20	---	VMS-1	INCLUDED IN CONTRACT	C-2N	CAB-2N	140+14 PANEL #0058	INCLUDED IN CONTRACT	INCLUDED IN CONTRACT	2	1,2	2	1,2	*8' 328'	MARKED OUT IN DUCT
STA. 143+48	LUS-2A, 2B	---	INCLUDED IN CONTRACT	---	---	PANEL #0098	---	---	---	---	---	---	239'	
STA. 145+87	LUS-3A, 3B	---	INCLUDED IN CONTRACT	---	---	PANEL #0127-#0128	---	---	---	---	---	---	242'	
STA. 148+37	---	VMS-2	INCLUDED IN CONTRACT	C-3N	CAB-3N	148+29 PANEL #0158	INCLUDED IN CONTRACT	INCLUDED IN CONTRACT	1	3,4	1	3,4	*8' 283'	MARKED OUT IN DUCT
STA. 151+20	LUS-4A, 4B	---	INCLUDED IN CONTRACT	---	---	PANEL #0194	---	---	---	---	---	---	266'	
STA. 153+86	LUS-5A, 5B	---	INCLUDED IN CONTRACT	---	---	PANEL #0227	---	---	---	---	---	---	245'	
STA. 159+15	---	VMS-3	INCLUDED IN CONTRACT	C-4N	CAB-4N	156+31 PANEL #0258	INCLUDED IN CONTRACT	INCLUDED IN CONTRACT	2	3,4	2	3,4	*284' 8'	MARKED OUT IN DUCT
STA. 159+23	LUS-6A, 6B	---	INCLUDED IN CONTRACT	---	---	PANEL #0294	---	---	---	---	---	---	274'	
WEST CROSSCUT ELECTRIC ROOM														
STA. 161+97	LUS-7A, 7B	---	INCLUDED IN CONTRACT	---	---	PANEL #0328	---	---	---	---	---	---	230'	
STA. 164+51	---	VMS-4	INCLUDED IN CONTRACT	C-5N	CAB-5N	164+27 PANEL #0357	INCLUDED IN CONTRACT	INCLUDED IN CONTRACT	1	1,2	1	1,2	*24' 280'	MARKED OUT IN DUCT
STA. 167+31	LUS-8A, 8B	---	INCLUDED IN CONTRACT	---	---	PANEL #0395	---	---	---	---	---	---	267'	
STA. 169+98	LUS-9A, 9B	---	INCLUDED IN CONTRACT	---	---	PANEL #0429	---	---	---	---	---	---	217'	
STA. 172+47	---	VMS-5	INCLUDED IN CONTRACT	C-6N	CAB-6N	172+15 PANEL #0456	INCLUDED IN CONTRACT	INCLUDED IN CONTRACT	2	1,2	2	1,2	*32' 284'	INSTALLED OVER DUCT
STA. 175+31	LUS-10A, 10B	---	INCLUDED IN CONTRACT	---	---	PANEL #0496	---	---	---	---	---	---	296'	
STA. 178+27	LUS-11A, 11B	---	INCLUDED IN CONTRACT	---	---	PANEL #0530	---	---	---	---	---	---	168'	168'+90'=258'
CENTER CROSSCUT WEST/EAST ELECTRIC ROOMS														
STA. 180+85	---	VMS-6	INCLUDED IN CONTRACT	C-7N	CAB-7N	181+17 PANEL #0560	INCLUDED IN CONTRACT	INCLUDED IN CONTRACT	1	3,4	1	3,4	**32' 242'	
STA. 183+59	LUS-12A, 12B	---	INCLUDED IN CONTRACT	---	---	PANEL #0596	---	---	---	---	---	---	267'	
STA. 186+26	LUS-13A, 13B	---	INCLUDED IN CONTRACT	---	---	PANEL #0630	---	---	---	---	---	---	254'	
STA. 188+88	---	VMS-7	INCLUDED IN CONTRACT	C-8N	CAB-8N	188+80 PANEL #0662	INCLUDED IN CONTRACT	INCLUDED IN CONTRACT	2	3,4	2	3,4	*8' 273'	BOXES WITHIN 5'
STA. 191+61	LUS-14A, 14B	---	INCLUDED IN CONTRACT	---	---	PANEL #0697	---	---	---	---	---	---	266'	
STA. 194+27	LUS-15A, 15B	---	INCLUDED IN CONTRACT	---	---	PANEL #0731	---	---	---	---	---	---	239'	
STA. 196+74	---	VMS-8	INCLUDED IN CONTRACT	C-9N	CAB-9N	196+66 PANEL #0761	INCLUDED IN CONTRACT	INCLUDED IN CONTRACT	1	1,2	1	1,2	*8' 285'	BOXES OVER DUCT
EAST CROSSCUT ELECTRIC ROOM														
STA. 199+59	LUS-16A, 16B	---	INCLUDED IN CONTRACT	---	---	PANEL #0798	---	---	---	---	---	---	272'	
STA. 202+31	LUS-17A, 17B	---	INCLUDED IN CONTRACT	---	---	PANEL #0832	---	---	---	---	---	---	259'	
STA. 204+90	---	VMS-9	INCLUDED IN CONTRACT	C-10N	CAB-10N	204+90 PANEL #0865	INCLUDED IN CONTRACT	INCLUDED IN CONTRACT	2	1,2	2	1,2	*0' 270'	CAMERA TO BE RELOCATED OVER DUCT OR 9' EAST
STA. 207+60	LUS-18A, 18B	---	INCLUDED IN CONTRACT	---	---	PANEL #0899	---	---	---	---	---	---	269'	
STA. 210+29	LUS-19A, 19B	---	INCLUDED IN CONTRACT	---	---	PANEL #0933	---	---	---	---	---	---	223'	
STA. 212+84	---	VMS-10	INCLUDED IN CONTRACT	C-11N	CAB-11N	212+52 PANEL #0961	INCLUDED IN CONTRACT	INCLUDED IN CONTRACT	1	3,4	1	3,4	*32' 253'	BOXES ARE 9' EAST OF DUCT
STA. 215+37	LUS-20A, 20B	---	INCLUDED IN CONTRACT	---	---	PANEL #0997	---	---	---	---	---	---	335'	
STA. 218+72	LUS-21A, 21B	---	INCLUDED IN CONTRACT	---	---	PANEL #1040	---	---	---	---	---	---	152'	
STA. 220+64	---	VMS-11	INCLUDED IN CONTRACT	C-12N	CAB-12N	220+24 PANEL #1059	INCLUDED IN CONTRACT	INCLUDED IN CONTRACT	2	3,4	2	3,4	*40' 280'	BOXES ARE 38' WEST OF DUCT
STA. 223+44	LUS-22A, 22B	---	INCLUDED IN CONTRACT	---	---	PANEL #1099	---	---	---	---	---	---	187'	BOXES ARE 16' WEST OF SIGN IN INTERSTESIAL SPACE
STA. 225+31	LUS-P2A, P2B	BDS-NP2	INCLUDED IN CONTRACT	C-13S	CAB-13S	LOCATED IN GROUND LEVEL VENT ROOM	INCLUDED IN CONTRACT	INCLUDED IN CONTRACT	1	1,2	1	1,2	TOTAL 8,939'	CONTROLLER HOUSED IN CONTROL CABINET CAB-13S

NOTE: * = DISTANCE FROM CONTROLLER TO VMS.
** = DISTANCE FROM VMS TO CONTROLLER.

Computer File Information

Creation Date:	11/21/00	Initials:	KLN
Last Modification Date:	03/06/07	Initials:	KLN
Full Path:	014102\800Deliv\AsBuilt		
Drawing File Name:	sgdt13n		
Acad Ver.	R14	Scale:	NTS
		Units:	ENGLISH

Sheet Revisions

<input type="checkbox"/>	07/03/07	ASBUILT	DJB
<input type="checkbox"/>			
<input type="checkbox"/>			
<input type="checkbox"/>			

Colorado Department of Transportation



P.O. BOX 399
DUMONT, CO. 80436
Phone: 303-512-5750 FAX: 303-512-5775

Region 1 Mountain Residency I.N.Z.

As Constructed

No Revisions:
Revised:
Void:

TABULATION OF SIGNS

Designer:	K. HO	Structure	
Detailer:	K.J.SINGH	Numbers	
Sheet Subset:	VMS	Subset Sheets:	2 OF 46

Project No./Code

IM 0703-269
13166
Sheet Number 133

GUARDRAIL TABULATION					
LOCATION STA TO STA	SIDE	END ANCHORAGE (FLARED)	END ANCHORAGE TYPE 3D	GUARDRAIL TYPE 3 6-3 POST SPACING	MISCELLANEOUS
		EACH	EACH	EACH	
105+70 TO 106+70	SHOULDER RIGHT	1	1	25	
105+90 TO 106+50	MEDIAN			120	ON BOTH FACES OF MEDIAN BARRIER: TERMINAL SECTION (CONNECTOR) FOR TYPE 3 W-BEAM ON TYPE 4 BARRIER FROM STA 105+90 TO 105+92.5 GUARDRAIL TYPE 3 W-BEAM ON TYPE 4 BARRIER FROM STA 105+92.5 TO 106+15 GUARDRAIL TYPE 3 W-BEAM (1-6 SPACING) FROM STA 106+15 TO 106+25 GUARDRAIL TYPE 3 W-BEAM ON TYPE 4 BARRIER FROM STA 106+25 TO 106+47.5 ON BOTH FACES OF MEDIAN BARRIER: TERMINAL SECTION (CONNECTOR) FOR TYPE 3 W-BEAM ON TYPE 4 BARRIER FROM STA 106+47.5 TO 106+50 SEE PLANS FOR DETAILS AND PAYMENT ITEMS-SEE NOTE 6
116+50 TO 117+50	SHOULDER RIGHT	1	1	25	
233+07.5 TO 233+82.5	SHOULDER LEFT	1	1	125	
245+50 TO 246+50	SHOULDER LEFT	1	1	25	
255+00 TO 256+00	SHOULDER LEFT	1	1	25	
255+20 TO 255+80	MEDIAN			120	ON BOTH FACES OF MEDIAN BARRIER: TERMINAL SECTION (CONNECTOR) FOR TYPE 3 W-BEAM ON TYPE 4 BARRIER FROM STA 255+20 TO 255+22.5 GUARDRAIL TYPE 3 W-BEAM ON TYPE 4 BARRIER FROM STA 255+22.5 TO 255+45 GUARDRAIL TYPE 3 W-BEAM (1-6 SPACING) FROM STA 255+45 TO 255+55 GUARDRAIL TYPE 3 W-BEAM ON TYPE 4 BARRIER FROM STA 255+55 TO 255+77.5 ON BOTH FACES OF MEDIAN BARRIER: TERMINAL SECTION (CONNECTOR) FOR TYPE 3 W-BEAM ON TYPE 4 BARRIER FROM STA 255+77.5 TO 255+80 SEE PLANS FOR DETAILS AND PAYMENT ITEMS-SEE NOTE 6
PROJECT TOTAL		5	5	315	

GUARDRAIL TABULATION NOTES:

1. LOCATIONS ARE APPROXIMATE ONLY. EXACT LOCATIONS WILL BE AS DIRECTED BY THE ENGINEER.
2. THE COST OF ADDITIONAL EMBANKMENT (APPROXIMATELY 65 CY EACH) AND PAVEMENT (APPROXIMATELY 60 SY EACH) REQUIRED FOR SRTS WILL BE INCIDENTAL TO THE COST OF SRT.
3. ALL GUARDRAIL TYPE 3 SHALL BE WEATHERED STEEL.
4. ALL GUARDRAIL TYPE 3 SHALL BE 10 GAUGE STEEL.
5. EACH END ANCHOR (SRT) SHALL INCLUDE ONE OM-BT SUPPLEMENTAL DELINEATOR. THE COST OF THESE DELINEATORS SHALL BE CONSIDERED SUBSIDIARY TO END ANCHOR (SRT) AND WILL NOT BE PAID FOR SEPARATELY BUT SHALL BE INCLUDED IN THE WORK.
6. TERMINAL SECTION CONNECTOR SHALL BE MEASURED PER LINEAR FOOT AND PAID FOR UNDER PAYMENT ITEM #606-00301: GUARDRAIL TYPE 3 (6-3 POST SPACING).









TABULATION OF SIGNS												
SIGN NO.	SIGN CODE	STATION	SIGN PANEL SIZE	BACK-GROUND COLOR	NUMBER OF POSTS (FOR INFORMATION ONLY)	STEEL SIGN POSTS (W8x18)	TRAFFIC SIGNAL PEDESTAL POLE (INSTALL ONLY)	LENGTH OF POST	CONC FOOTING (TYPE 3)	CONCRETE FOOTING (TRAFFIC SIGNAL POLE)	FLASHING BEACON	NOTES
						LF	EA	LF	EA	EA	EA	
D-1	OHVD	106+20			2		2			2		
S-1	OHVD BOS #1	117+00			2	28		14	2			
S-2		124+60	3'x3'	YELLOW	1						1	
S-3		124+60	3'x3'	YELLOW	1						1	
S-4		238+57	3'x3'	YELLOW	1						1	
S-5		238+57	3'x3'	YELLOW	1						1	
S-6	OHVD BOS #2	246+00			2	28		14	2			
D-2	OHVD	255+50			2		2			2		
PROJECT TOTALS						56	4		4	4	4	

TABULATION OF SIGNS NOTES:


1. FABRICATIONS OF REGULATORY SIGNS SHALL CONFORM TO CDDT STANDARD SPECIFICATIONS.
2. FOR TYPICAL GROUND SIGN PLACEMENT, SEE M&S STANDARD S-614-19.
3. FOR DETAILS OF SIGN SUPPORTS AND FOOTINGS FOR GROUND SIGNS, SEE M&S STANDARD S-614-5, S-614-6.
4. POST LENGTHS ARE APPROXIMATE ONLY. EXACT LENGTHS AS APPROVED BY THE ENGINEER.
5. OHVD BOS ELECTRONICS AND ATTACHED PULLBOXES WILL BE MOVED FROM EXISTING LOCATION TO PROPOSED LOCATION BY TUNNEL PERSONNEL ONLY.
6. TRAFFIC SIGNAL PEDESTAL POLE WILL BE STATE FURNISHED, CONTRACTOR INSTALLED.
7. GROUND MOUNTED TRAFFIC SIGNAL PEDESTAL POLES WILL REQUIRE CONCRETE FOOTING IN ACCORDANCE WITH M&S STANDARD S-614-40. BOLT PATTERN TO MATCH STATE FURNISHED POLES.
8. TRAFFIC SIGNAL PEDESTAL MOUNTING SYSTEM WILL BE PAID FOR AS CONCRETE FOOTING (TRAFFIC SIGNAL POLE), EACH.
9. WIRING AND FIBER OPTIC FOR OHVD WILL BE PAID FOR SEPARATELY.
10. FINAL TRAFFIC SIGNAL PEDESTAL POLE HEIGHT SHALL BE MINIMUM 16' ABOVE ROADWAY SURFACE.

Design File Name: DGNSSPEC*
 Plot File Name: \$PLOTFILE*
 Date of Plot: \$\$\$DATE\$\$\$



Computer File Information			Sheet Revisions			Colorado Department of Transportation			As Constructed		TABULATION OF SIGNS		Project No./Code	
Creation Date:	3/27/01	Initials: KLN	07/03/07	ASBUILT	DJB	P.O. BOX 399 DUMONT, CO. 80436 Phone: 303-512-5750 FAX: 303-512-5775			No Revisions:			IM 0703-269		
Last Modification Date:	03/06/07	Initials: DJR				Region 1 Mountain Residency I.N.Z.			Revised:	Designer: K. HO	Structure Numbers	13166		
Full Path:	014102\800Deliv\AsBuilt								Void:	Detailer: K.J.SINGH		Sheet Number 134		
Drawing File Name:	sgdt14n									Sheet Subset: VMS	Subset Sheets: 3 OF 46			
Acad Ver.	R14	Scale: NTS	Units: ENGLISH											

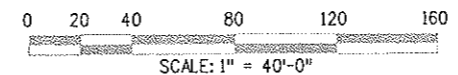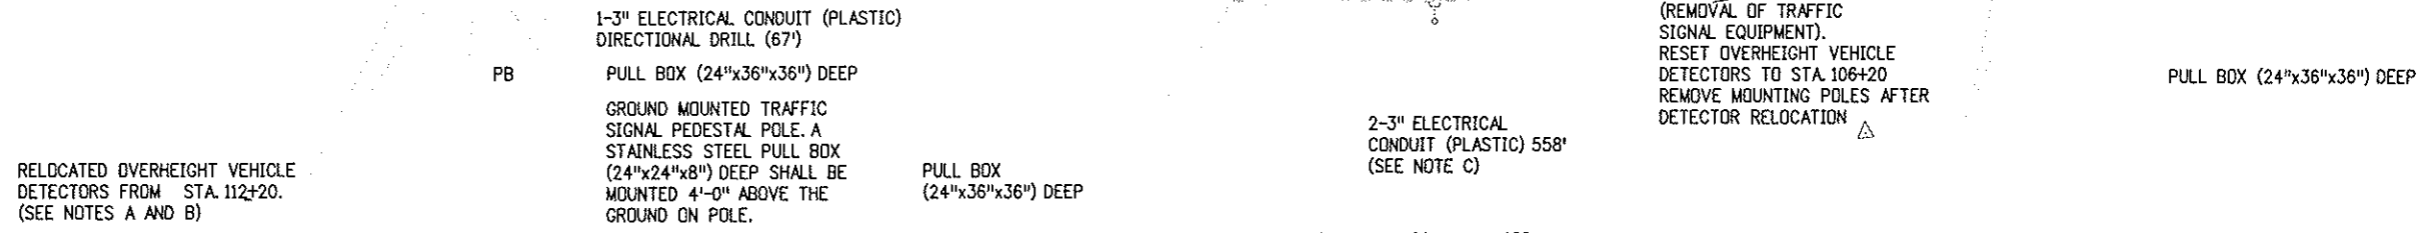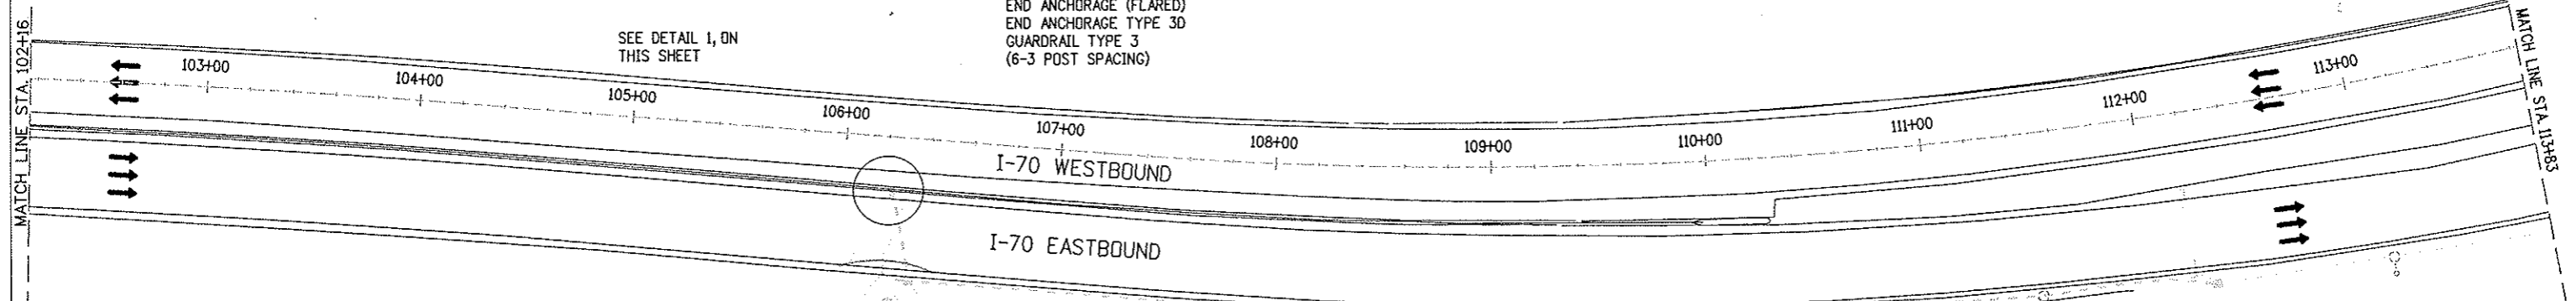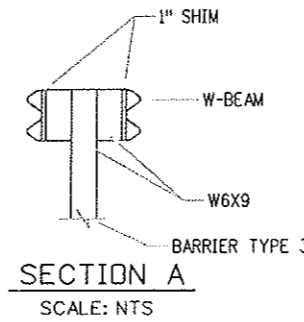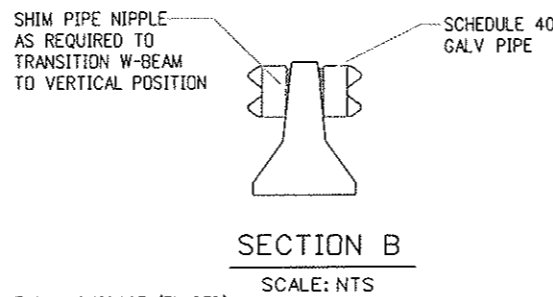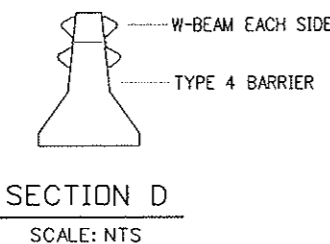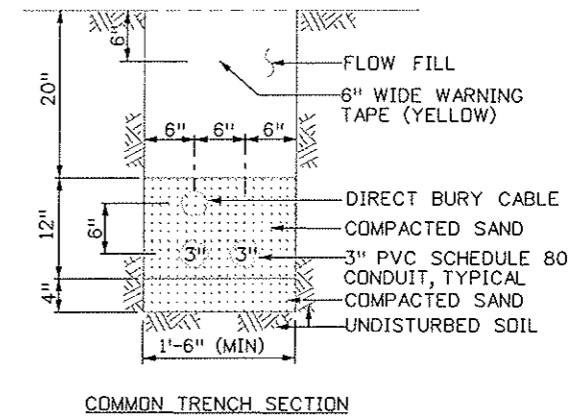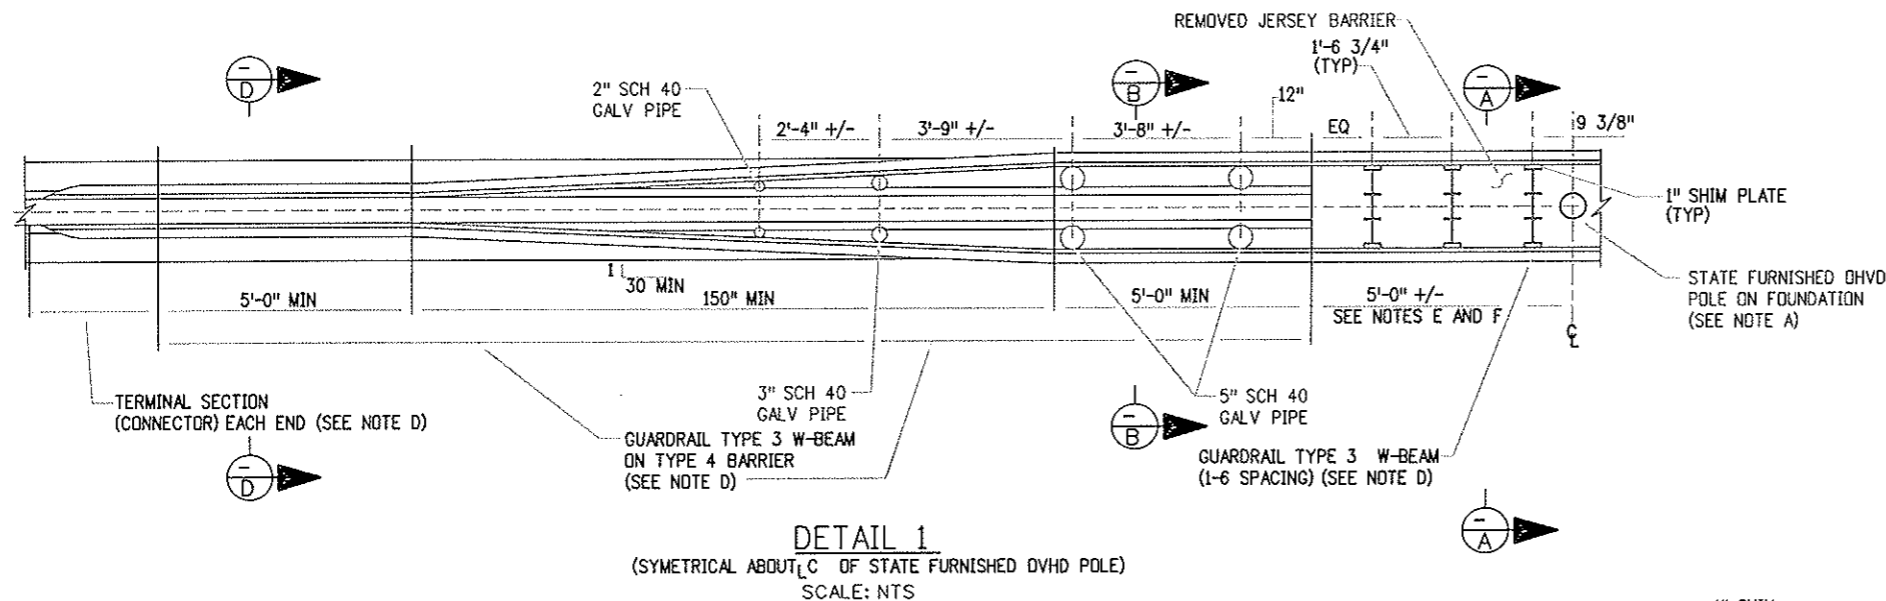

- NOTES:**
- A. CONTRACTOR SHALL PROVIDE FOUNDATION FOR RELOCATED OVERHEIGHT VEHICLE DETECTORS AND SHALL MOUNT THE STATE FURNISHED POLES
 - B. THE DETECTOR SYSTEM SHALL BE RELOCATED/TRANSFERRED FROM THE EXISTING LOCATION TO THE PROPOSED LOCATION BY TUNNEL PERSONNEL ONLY.
 - C. THE CONTRACTOR SHALL INSTALL 4-#3AWG AND 1 SIX-STRAND FIBER OPTIC CABLE IN THE INSTALLED CONDUITS
 - D. GUARD RAIL AND TERMINAL SECTION CONNECTOR COMPLETELY INSTALLED AS DETAILED, SHALL BE PAID FOR PER LINEAR FOOT EACH FACE UNDER PAYMENT ITEM #606-00301; GUARDRAIL TYPE 3 (6-3 POST SPACING).
 - E. COST FOR REMOVAL OF JERSEY BARRIER SHALL NOT BE PAID FOR SEPARATELY. IT SHALL BE INCLUDED IN THE LUMP SUM PRICE FOR PAYMENT ITEM #202-00828; REMOVAL OF TRAFFIC SIGNAL EQUIPMENT. REMOVED JERSEY BARRIER SHALL BECOME THE PROPERTY OF THE CONTRACTOR.
 - F. PATCH AREA UNDER REMOVED BARRIER WITH ASPHALT, TO BE LEVEL WITH ADJACENT ROADWAY. COST OF PATCHUP COMPLETE IN PLACE, SHALL NOT BE PAID FOR SEPARATELY BUT ALL COST ASSOCIATED THEREOF SHALL BE INCIDENTAL TO THE REMOVAL OF THE JERSEY BARRIER.

Computer File Information Creation Date: 11/28/00 Initials: KLN Last Modification Date: 03/06/07 Initials: KLN Full Path: 014102\800Deliv\AsBuilt Drawing File Name: sgap02n Acad Ver: R14 Scale: 1" = 40'-0" Units:		Sheet Revisions 07/03/07 ASBUILT DJB		Colorado Department of Transportation  P.O. BOX 399 DUMONT, CO. 80436 Phone: 303-512-5750 FAX: 303-512-5775 Region 1 Mountain Residency I.N.Z.		As Constructed No Revisions: Revised: Void:		I-70 EASTBOUND, POWER & APPROACH VMS Designer: K. Ho Detailer: E. McChesney Sheet Subset: VMS Structure Numbers: Subset Sheets: 4 OF 46		Project No./Code IM 0703-269 13166 Sheet Number 135	
--	--	--	--	--	--	---	--	---	--	---	--

Plot File Name: \\LURFILE\...
 Date of Plot: 03/06/07

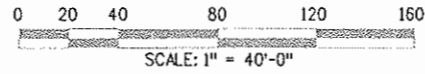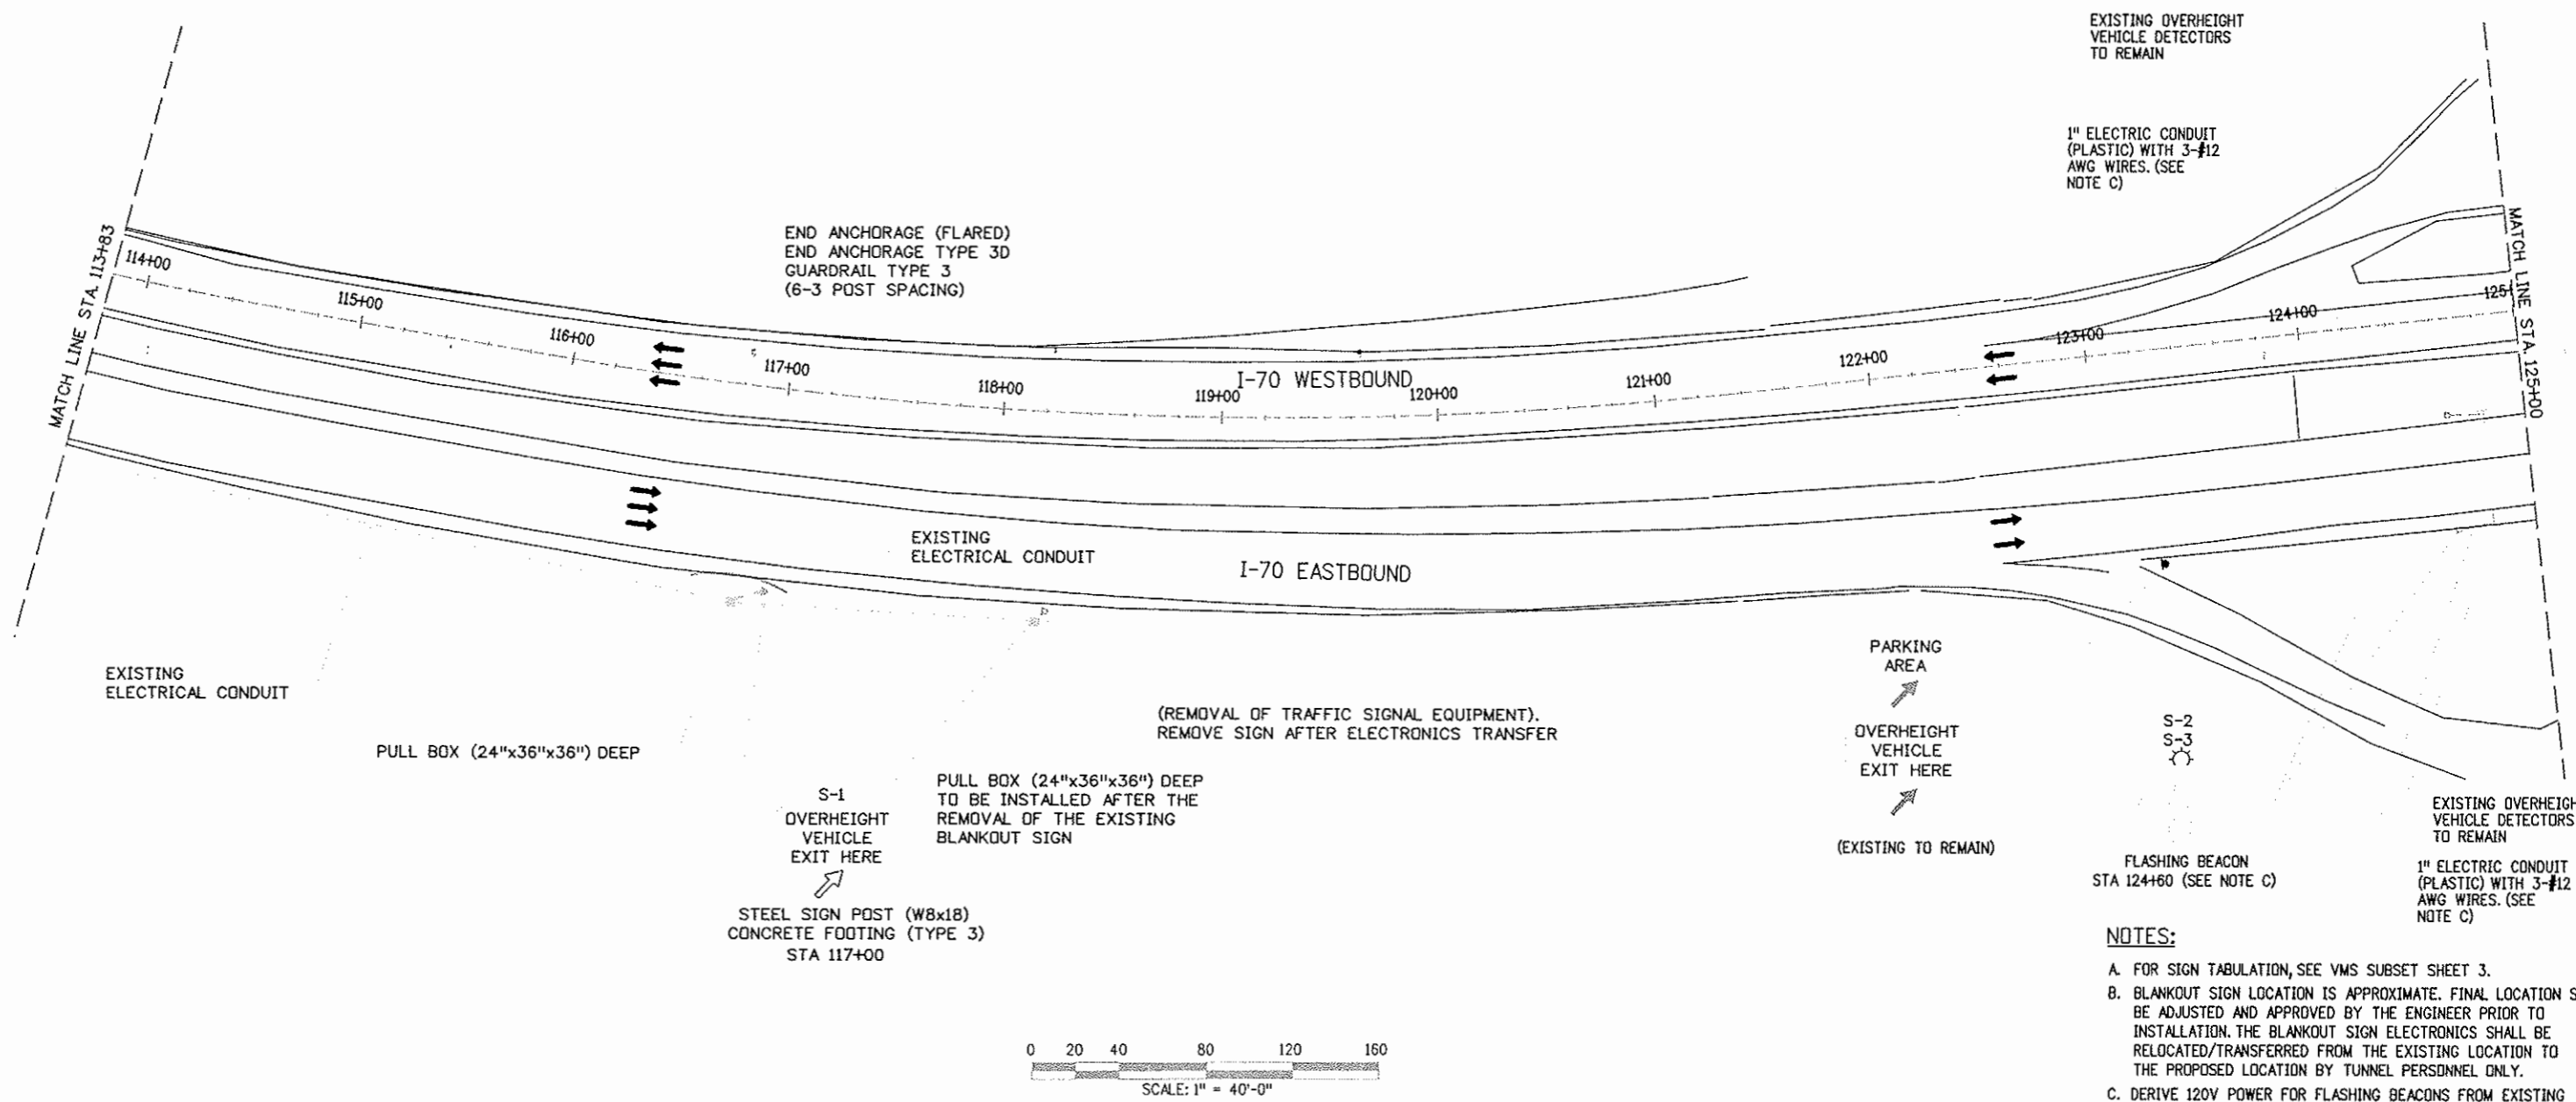

EXISTING OVERHEIGHT
VEHICLE DETECTORS
TO REMAIN

1" ELECTRIC CONDUIT
(PLASTIC) WITH 3-#12
AWG WIRES. (SEE
NOTE C)

END ANCHORAGE (FLARED)
END ANCHORAGE TYPE 3D
GUARDRAIL TYPE 3
(6-3 POST SPACING)

MATCH LINE STA. 125+00

MATCH LINE STA. 113+83

EXISTING
ELECTRICAL CONDUIT

PULL BOX (24"x36"x36") DEEP

(REMOVAL OF TRAFFIC SIGNAL EQUIPMENT).
REMOVE SIGN AFTER ELECTRONICS TRANSFER

PARKING
AREA
↑
OVERHEIGHT
VEHICLE
EXIT HERE
↑
(EXISTING TO REMAIN)

S-1
OVERHEIGHT
VEHICLE
EXIT HERE
↑
STEEL SIGN POST (W8x18)
CONCRETE FOOTING (TYPE 3)
STA 117+00

PULL BOX (24"x36"x36") DEEP
TO BE INSTALLED AFTER THE
REMOVAL OF THE EXISTING
BLANKOUT SIGN

S-2
S-3
FLASHING BEACON
STA 124+60 (SEE NOTE C)

EXISTING OVERHEIGHT
VEHICLE DETECTORS
TO REMAIN
1" ELECTRIC CONDUIT
(PLASTIC) WITH 3-#12
AWG WIRES. (SEE
NOTE C)


NOTES:

- A. FOR SIGN TABULATION, SEE VMS SUBSET SHEET 3.
- B. BLANKOUT SIGN LOCATION IS APPROXIMATE. FINAL LOCATION SHALL BE ADJUSTED AND APPROVED BY THE ENGINEER PRIOR TO INSTALLATION. THE BLANKOUT SIGN ELECTRONICS SHALL BE RELOCATED/TRANSFERRED FROM THE EXISTING LOCATION TO THE PROPOSED LOCATION BY TUNNEL PERSONNEL ONLY.
- C. DERIVE 120V POWER FOR FLASHING BEACONS FROM EXISTING OVERHEIGHT VEHICLE DETECTOR NEARBY. COST OF CONDUIT AND WIRE SHALL BE INCIDENTAL TO PAYMENT ITEM FOR FLASHING BEACON.

Design File Name: DGN\SPEC*
 Plot File Name: \$PLTFILE*
 Date of Plot: 3/3/2007 3:33

Computer File Information	
Creation Date:	11/28/00 Initials: KLN
Last Modification Date:	02/24/01 Initials: DJR
Full Path:	014102\700cadd\713tra\
Drawing File Name:	sgap03n.plt
Acad Ver.:	R14 Scale: 1" = 40'-0" Units:



Sheet Revisions	
07/03/07	ASBUILT DJB

Colorado Department of Transportation

 P.O. BOX 399
 DUMONT, CO. 80436
 Phone: 303-512-5750 FAX: 303-512-5775
 Region 1 Mountain Residency I.N.Z.

As Constructed
No Revisions:
Revised:
Void:

I-70 EASTBOUND POWER & APPROACH VMS	
Designer:	K. Ho
Detailer:	E. McChesney
Structure Numbers:	
Sheet Subset:	VMS
Subset Sheets:	5 OF 46

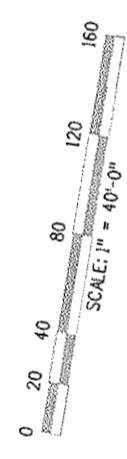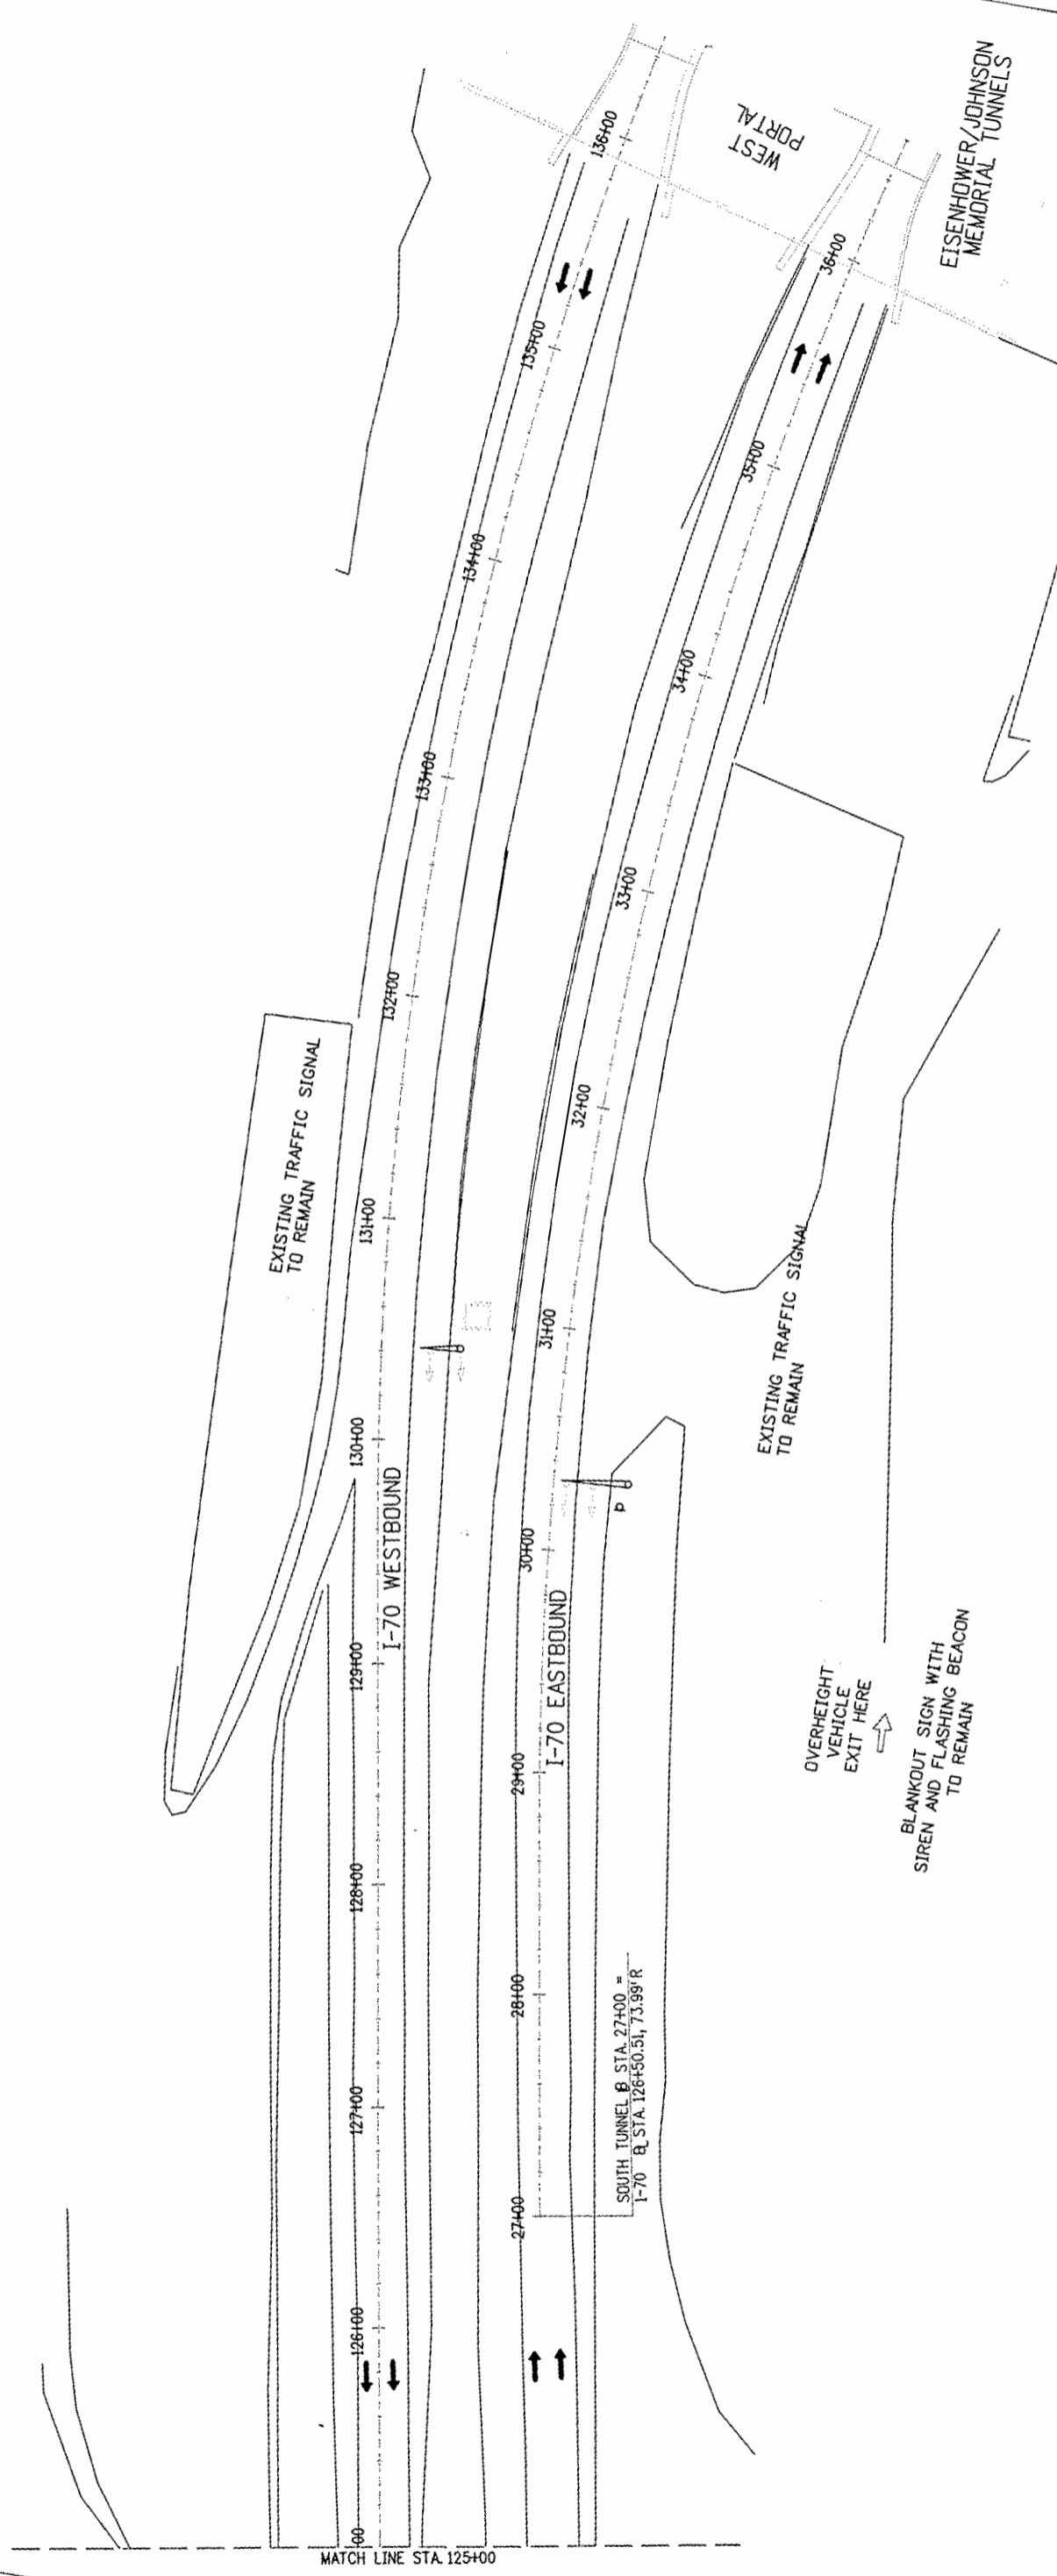Project No./Code
IM 0703-269
13166
Sheet Number 136



Computer File Information

Date: 11/21/00
 Initials: KLN
 Path: 014102\700cadd\7131ra\
 Initials: KLN
 Ver. R14
 Scale: 1" = 40'-0" Units:

Sheet Revisions

Date	By	Description
07/03/07	ASBUILT	
	DJB	

Colorado Department of Transportation



 P.O. BOX 399
 DUMONT, CO. 80436
 Phone: 303-512-5750 FAX: 303-512-5775
 Region 1 Mountain Residency I.N.Z.

As Constructed
 No Revisions:
 Revised:
 Void:

I-70 EASTBOUND POWER & APPROACH VMS
 Designer: K. Ho
 Detailer:



Project No. /

MATCH LINE STA. 125+00

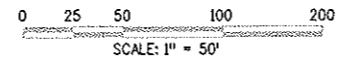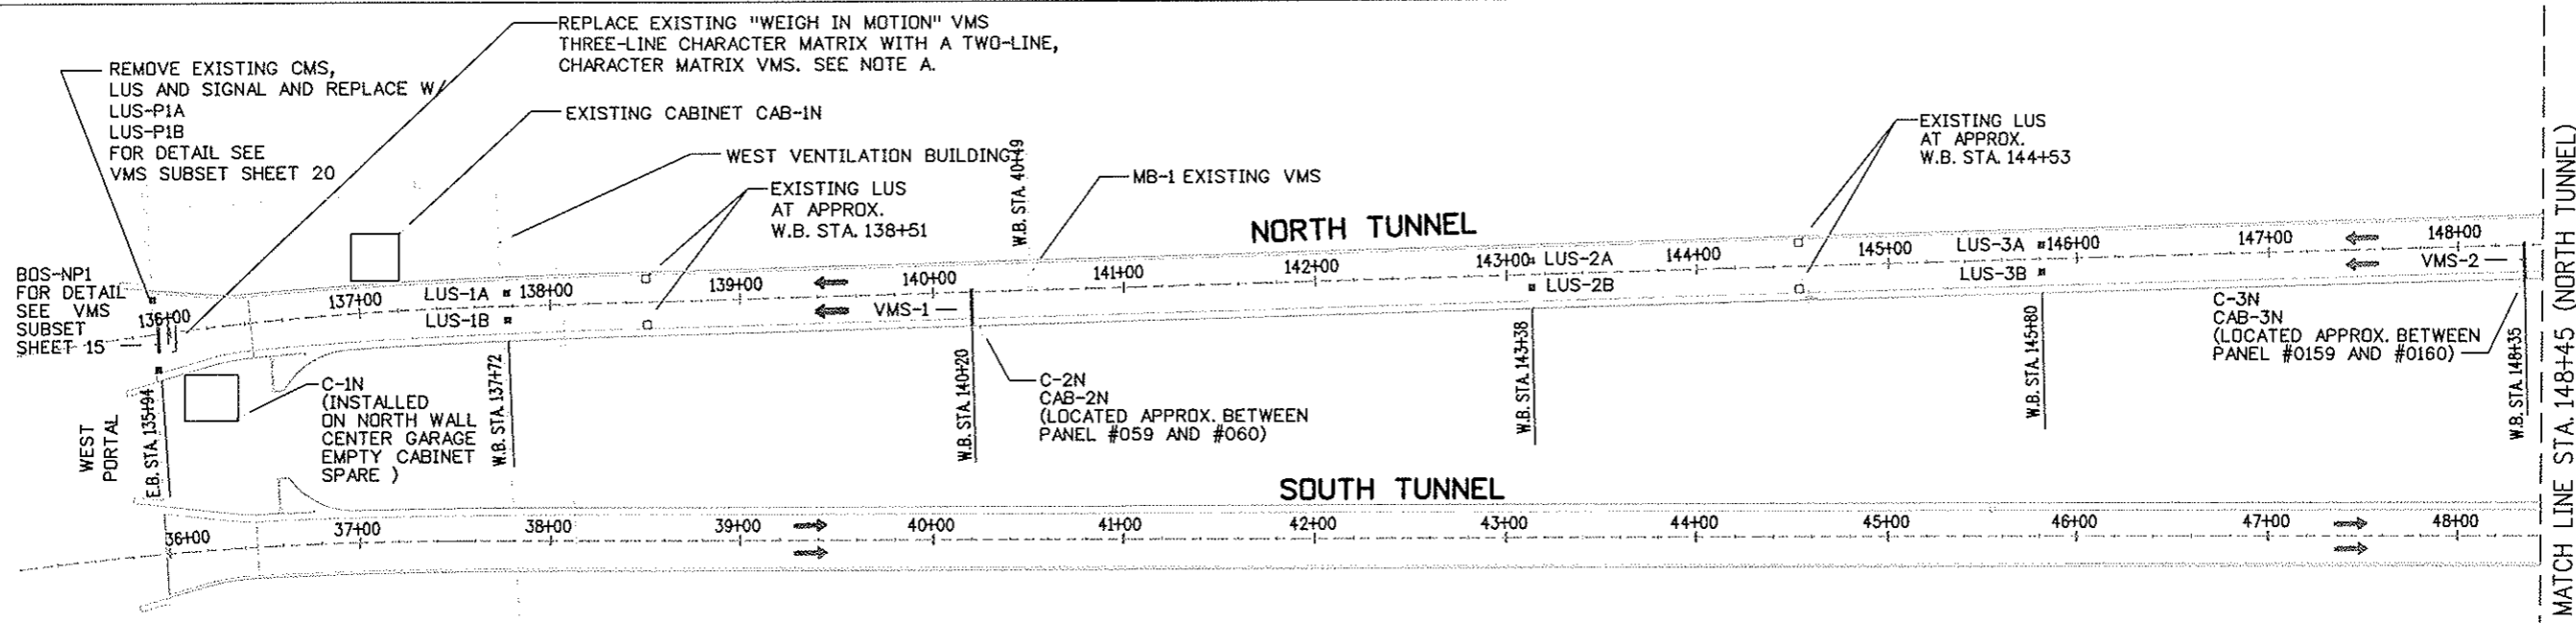

PLAN 1



NOTES:
 A. THE EXISTING 34 (12") CHARACTERS, CHARACTER MATRIX VMS, CONSISTS OF THREE LINES. THE TOP LINE PROVIDES FIXED MESSAGES AND THE BOTTOM TWO LINES PROVIDE VARIABLE MESSAGES. THE PROPOSED REPLACE-IN-KIND 34 (12") CHARACTERS, CHARACTER MATRIX VMS SHALL PROVIDE TWO LINES OF VARIABLE MESSAGE.

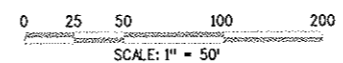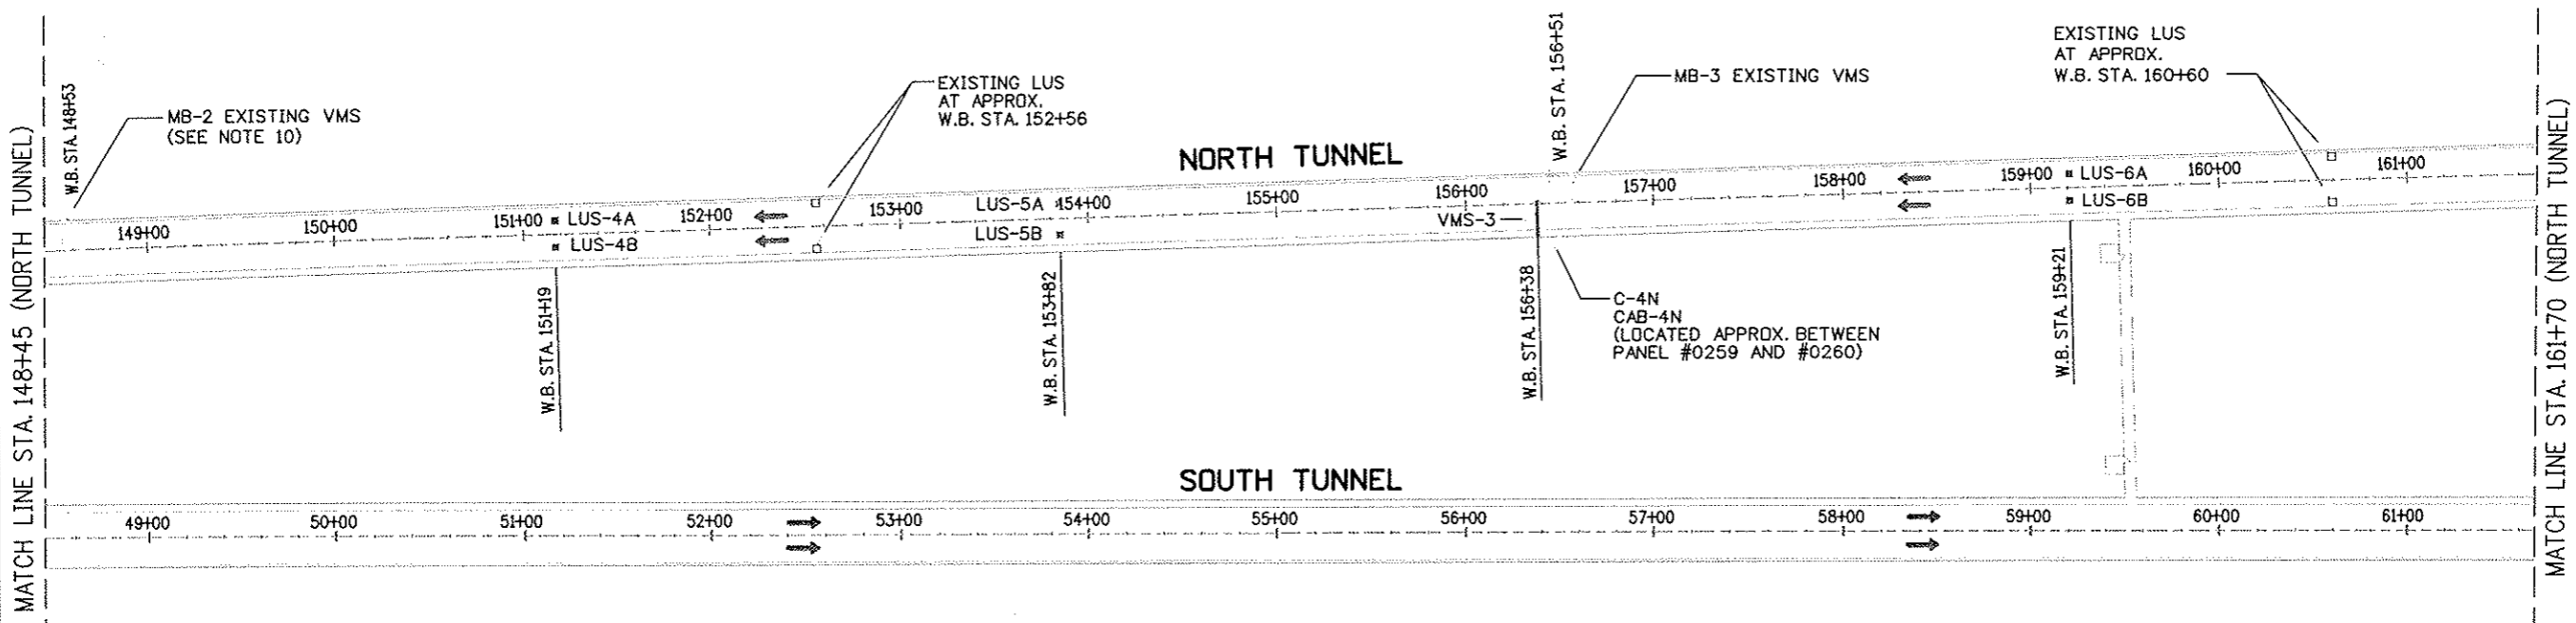



PLAN 2

Design File Name: DGN\$SPEC*
 Plot File Name: \$PLOTFILE*
 Date of Plot: \$\$\$DATE\$\$\$


Computer File Information		Sheet Revisions		Colorado Department of Transportation		As Constructed		NORTH TUNNEL VMS & LUS PLAN		Project No./Code	
Creation Date:	11/21/00	Initials:	KLN	07/03/07	ASBUILT	DUMONT, CO. 80436		No Revisions:		IM 0703-269	
Last Modification Date:	02/26/07	Initials:	DJR			Phone: 303-512-5750 FAX: 303-512-5775		Revised:		13166	
Full Path:	014102\800Deliv\AsBuilt\					Region 1 Mountain Residency I.N.Z.		Void:		Sheet Number 138	
Drawing File Name:	sgp101n							Designer: K. Ho		Structure Numbers	
Acad Ver.	R14	Scale:	1" = 50'-0"	Units:	ENGLISH			Detailer: E. McChesney		Subset Sheets: 7 OF 46	
								Sheet Subset: VMS		Subset Sheets: 7 OF 46	

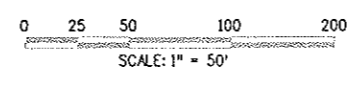
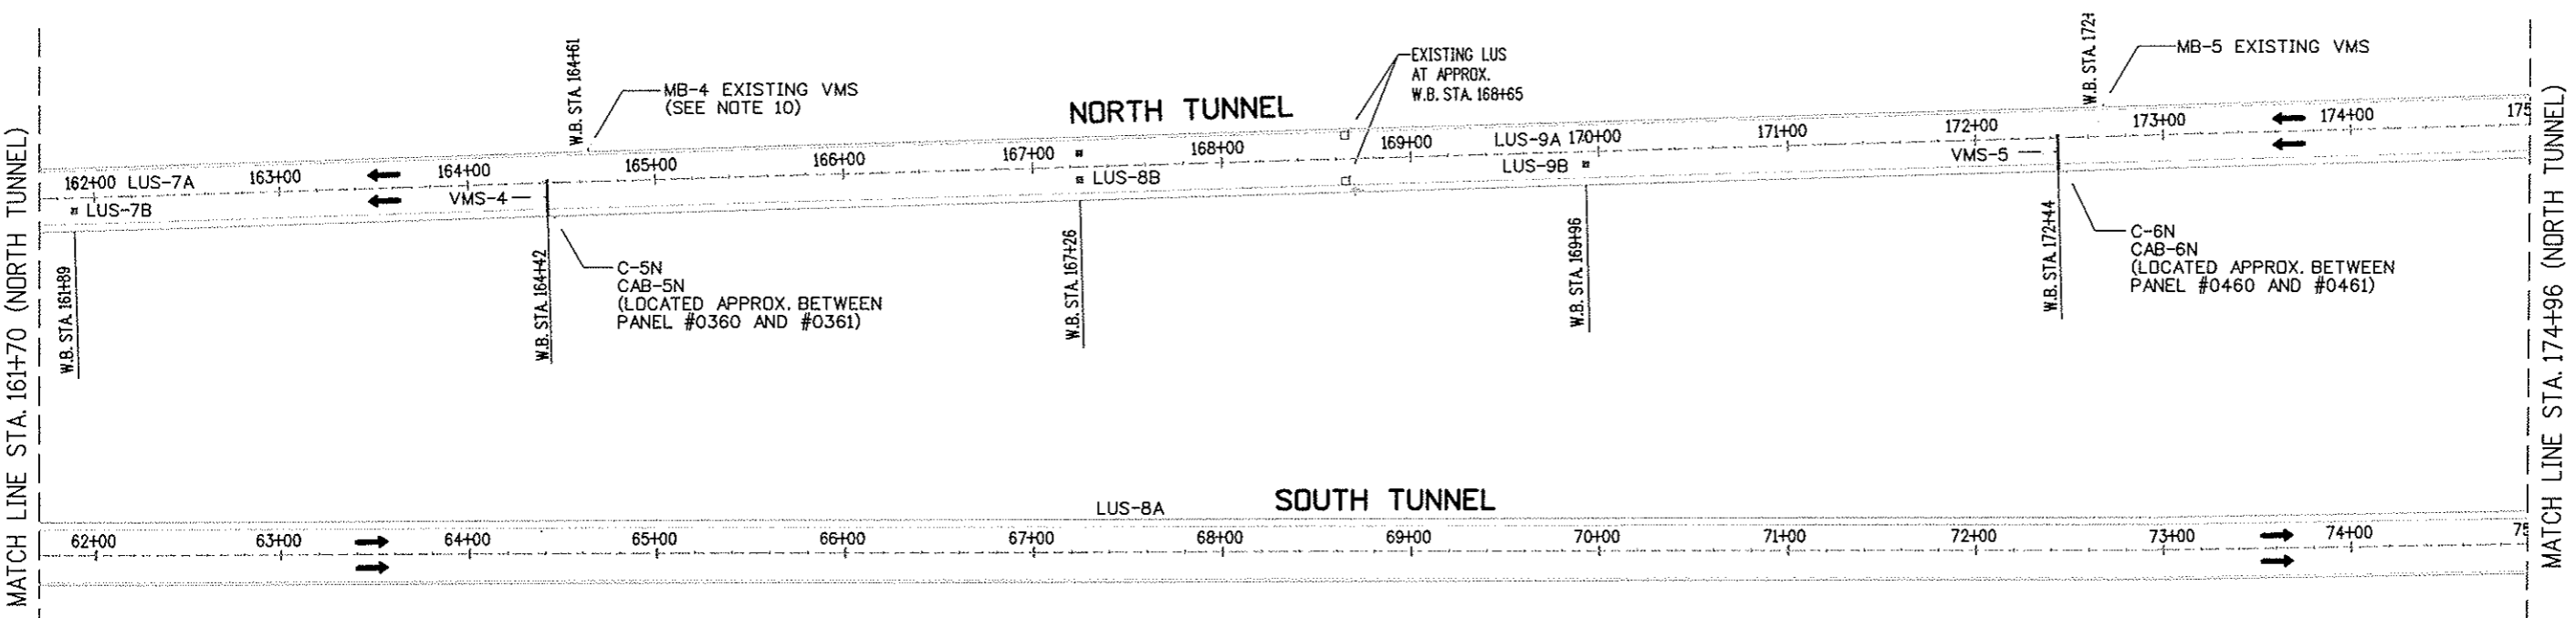


PLAN 1

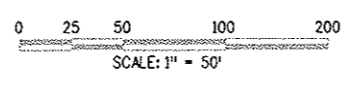
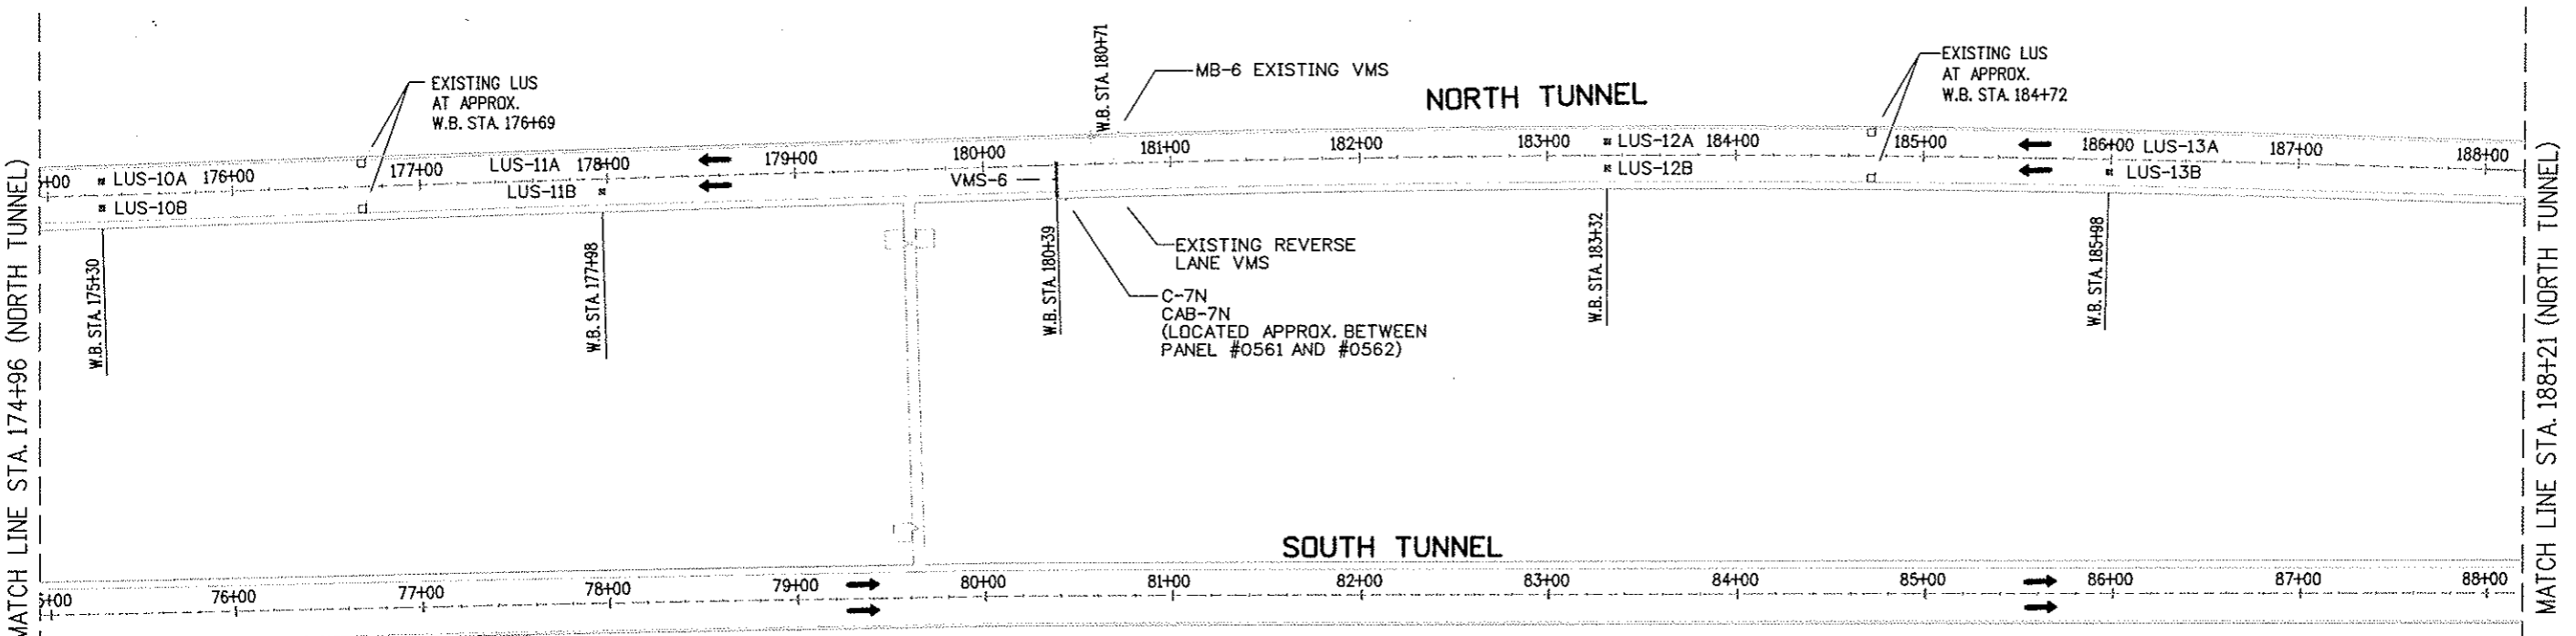


PLAN 2

Computer File Information		Sheet Revisions		Colorado Department of Transportation		As Constructed		NORTH TUNNEL VMS & LUS PLAN		Project No./Code			
Creation Date:	11/21/00	07/03/07	ASBUILT	 P.O. BOX 399 DUMONT, CO. 80436 Phone: 303-512-5750 FAX: 303-512-5775 Region 1 Mountain Residency I.N.Z.		No Revisions:		Designer: K. Ho Detailer: E. McChesney		IM 0703-269			
Last Modification Date:	02/08/01					Revised:				Structure Numbers		13166	
Full Path:	014102\700CADD\713TRA\					Void:		Sheet Subset: VMS		Subset Sheets: 8 OF 46		Sheet Number 139	
Drawing File Name:	sgpl02n.plt												
Acad Ver.	R14	Scale:	1" = 50'-0"	Units:	ENGLISH								

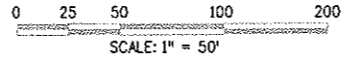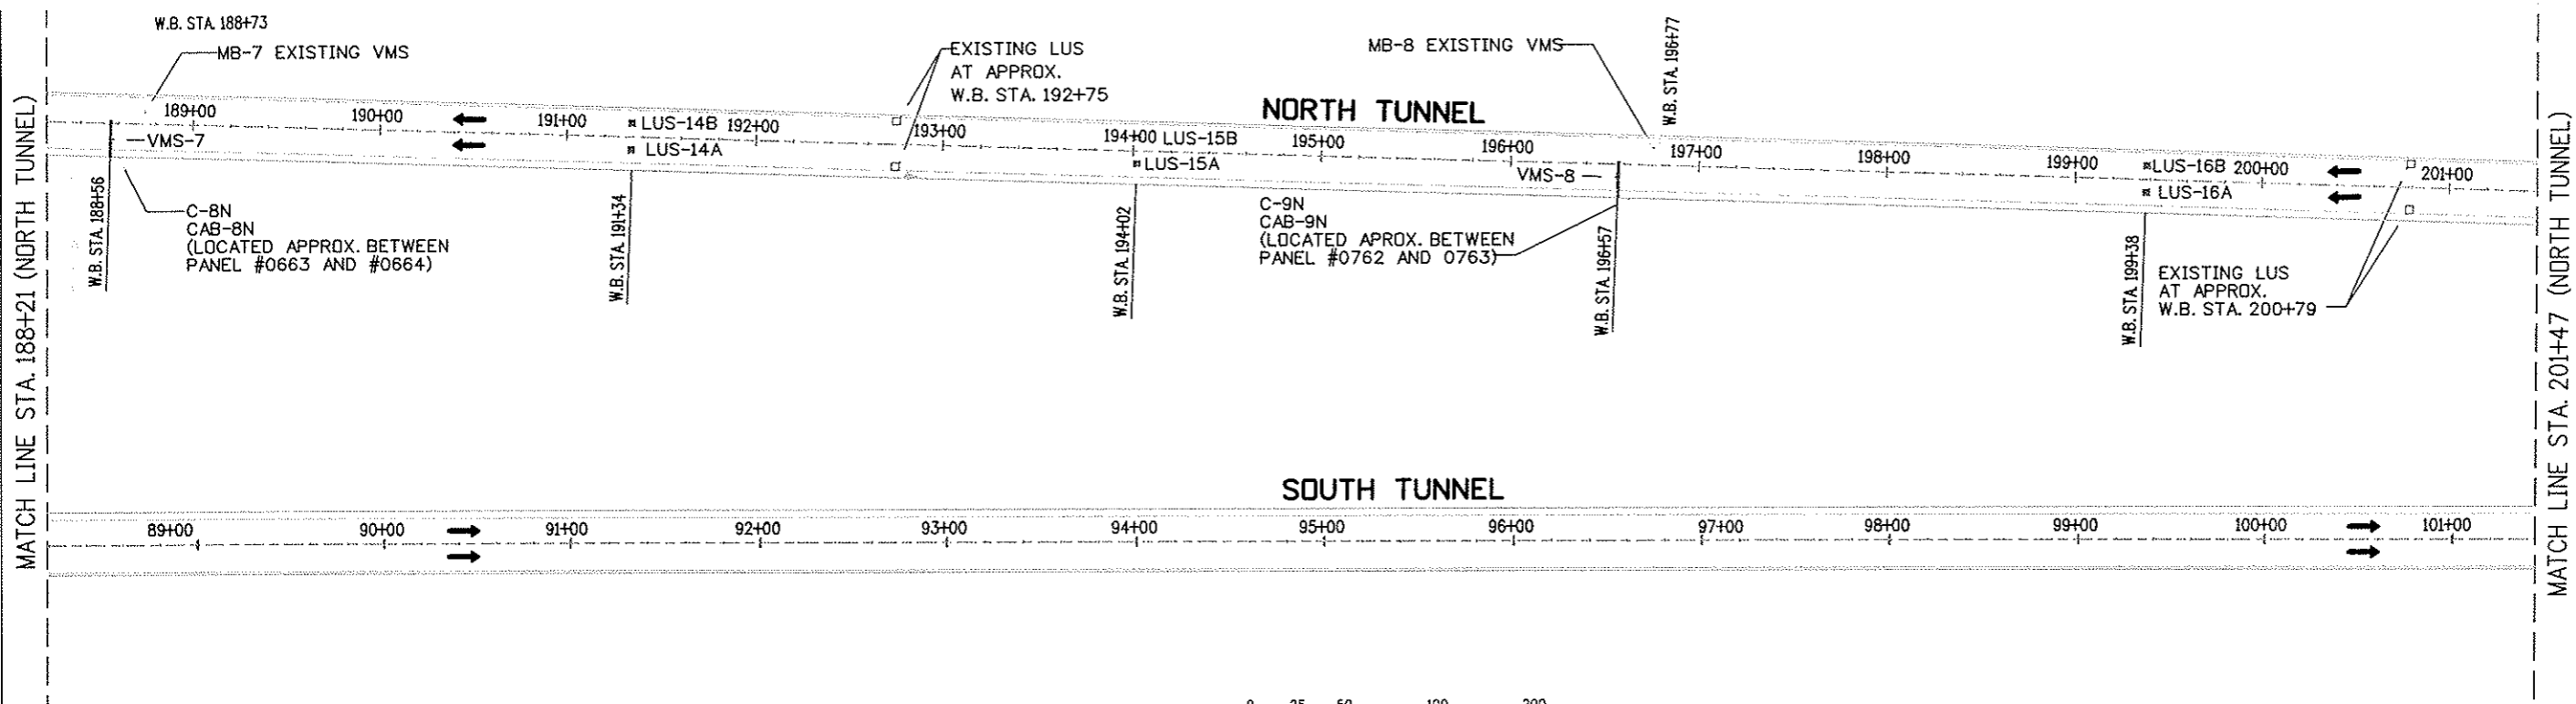

PLAN 1

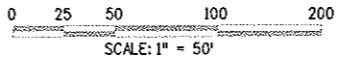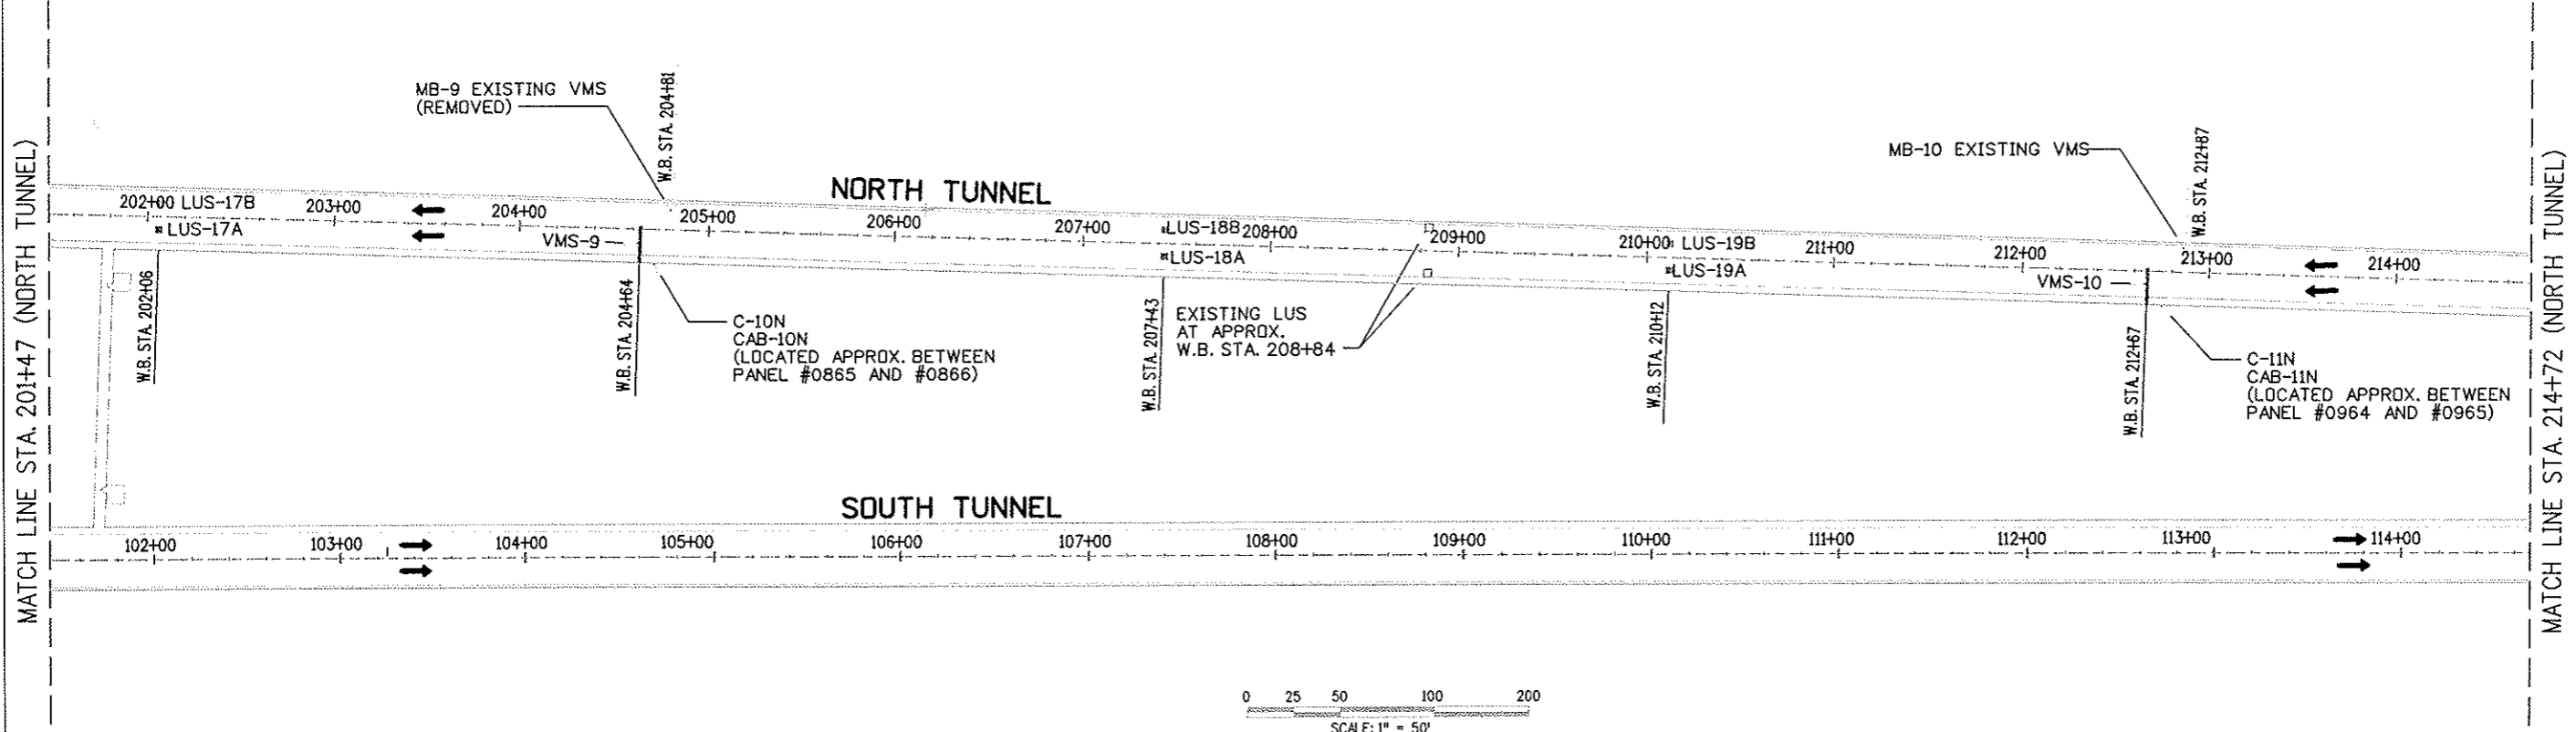


PLAN 2

Computer File Information	
Creation Date:	11/21/00 Initials: KLN
Last Modification Date:	02/08/01 Initials: KLN
Full Path:	014102\700CADD\713TRA\
Drawing File Name:	sgpl03n.plt
Acad Ver.	R14 Scale: 1" = 50'-0" Units: ENGLISH

Sheet Revisions	
07/03/07	ASBUILT DJB

Colorado Department of Transportation



P.O. BOX 399
DUMONT, CO. 80436
Phone: 303-512-5750 FAX: 303-512-5775

Region 1 Mountain Residency I.N.Z.



As Constructed
No Revisions:
Revised:
Void:

NORTH TUNNEL VMS & LUS PLAN	
Designer:	K. Ho
Detailer:	E. McChesney
Sheet Subset:	VMS
Structure Numbers	
Subset Sheets:	9 OF 46

Project No./Code
IM 0703-269
13166
Sheet Number 140

Plot File Name: S:\PLOTFILE*
 Date of Plot: 03/03/01

MATCH LINE STA. 214+72 (NORTH TUNNEL)

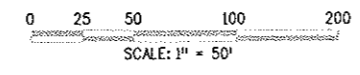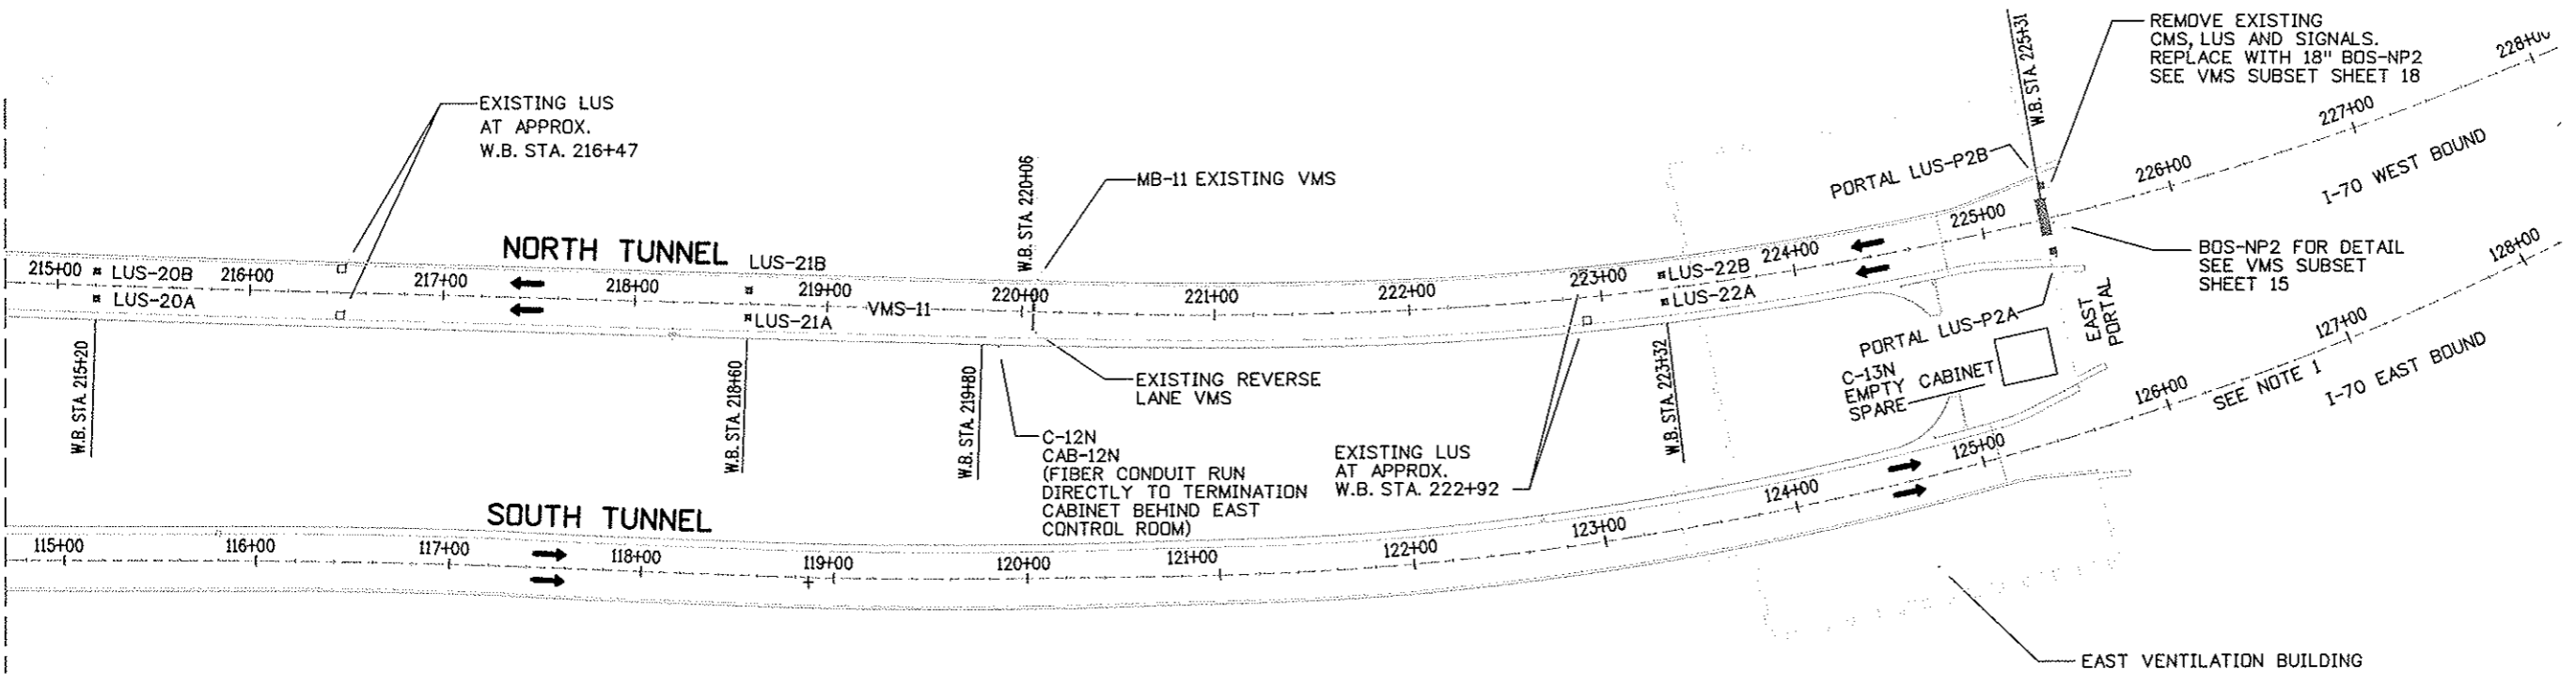


PLAN 1

Plot File Name: \$PLOTFILE*
Date of Plot: \$\$\$DATE\$\$\$

Computer File Information	
Creation Date:	11/21/00 Initials: KLN
Last Modification Date:	02/27/07 Initials: DJR
FullPath:	014102\800Deliv\AsBuilt\
Drawing File Name:	sgpl04n
Acad Ver.	R14 Scale: 1" = 50'-0" Units: ENGLISH

Sheet Revisions		
<input type="checkbox"/>	07/03/07	ASBUILT DJB
<input type="checkbox"/>		
<input type="checkbox"/>		
<input type="checkbox"/>		

Colorado Department of Transportation



P.O. BOX 399
DUMONT, CO. 80436
Phone: 303-512-5750 FAX: 303-512-5775
Region 1 Mountain Residency I.N.Z.


As Constructed
No Revisions:
Revised:
Void:

NORTH TUNNEL VMS & LUS PLAN		
Designer:	K. Ho	Structure Numbers
Detailer:	E. McChesney	
Sheet Subset:	VMS	Subset Sheets: 10 OF 46

Project No./Code
IM 0703-269
13166
Sheet Number 141



TRAFFIC CONTROL
BOOTH
GUARD HOUSE

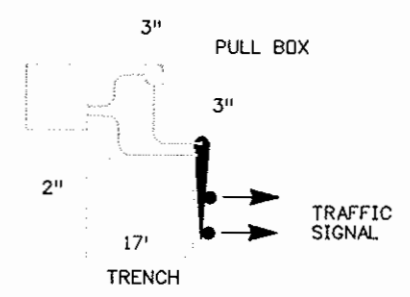

DRAWING 1

3' ELEC. CONDUIT (PLASTIC)

TRAFFIC SIGNAL-
LIGHT POLE STEEL
(1 MAST ARM) (45 FT)
SEE NOTE B




EXISTING BLANKOUT SIGN
TO REMAIN

3' ELEC. CONDUIT (PLASTIC)

PULL BOX
(24"x36"x36")
DEEP


REMOVAL OF TRAFFIC
SIGNAL EQUIPMENT
SEE NOTE A

PULL BOX
(24"x36"x36")
DEEP

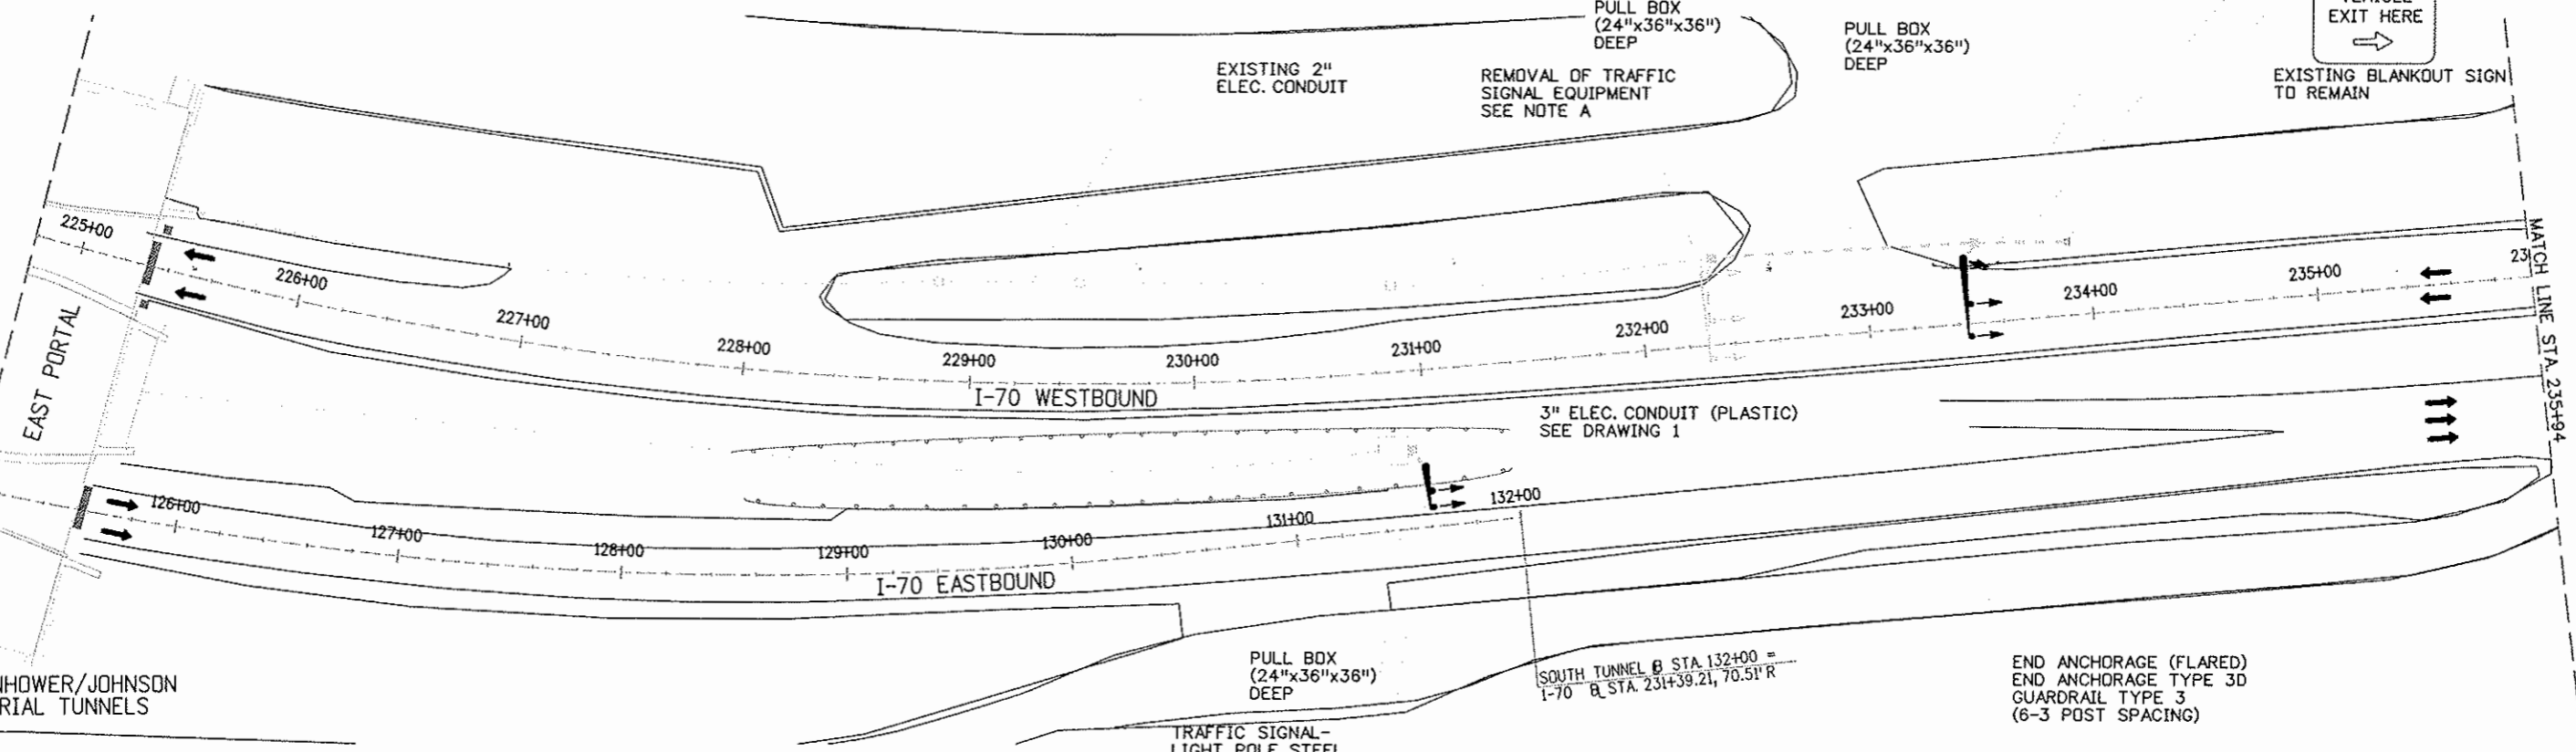

NOTES:

- A. REMOVE AND STACK MAST ARM (SIGNAL POLE). EXISTING SIGNAL POLES AND HEADS SHALL BE PROPERTY OF CDOT.
- B. FOR TRAFFIC SIGNAL DETAIL LAYOUT, SEE VMS SUBSET SHEET 14.

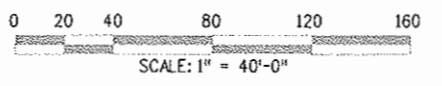


Design File Name: D085SPEC*
 Plot File Name: 9*LOTFILE*
 Date of Plot: 11/28/00

Computer File Information	
Creation Date:	11/28/00 Initials: KLN
Last Modification Date:	03/20/07 Initials: DJR
Full Path:	014102\8000deliv\AsBuilt
Drawing File Name:	sgap05n
Acad Ver.	R14 Scale: 1" = 40'-0" Units:

Sheet Revisions	
07/03/07	ASBUILT DJB

Colorado Department of Transportation



P.O. BOX 399
DUMONT, CO. 80436
Phone: 303-512-5750 FAX: 303-512-5775

Region 1 Mountain Residency I.N.Z.


As Constructed
No Revisions:
Revised:
Void:

I-70 WESTBOUND POWER & APPROACH VMS	
Designer:	K. Ho
Detailer:	E. McChesney
Sheet Subset:	VMS


Project No./Code	
IM 0703-269	13166
Sheet Number	142



1" ELEC CONDUIT (PLASTIC)
EXISTING OVERHEIGHT (SEE NOTE C)
VEHICLE DETECTORS TO REMAIN

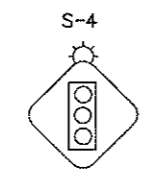

FLASHING BEACON
STA 238+57
NOTE A

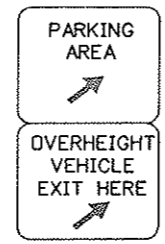


(EXISTING TO REMAIN)

(REMOVAL OF TRAFFIC SIGNAL EQUIPMENT).
REMOVE SIGN AFTER ELECTRONICS TRANSFER

PULL BOX
(24"x36"x36")
DEEP

1-3" CONDUIT 365'

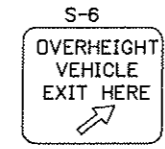


STEEL SIGN POST W8x18
CONCRETE FOOTING
NOTE B

END ANCHORAGE (FLARED)
END ANCHORAGE TYPE 3D
GUARDRAIL TYPE 3
(6-3 POST SPACING)

PULL BOX
(24"x36"x36")
DEEP


EXISTING CONDUIT

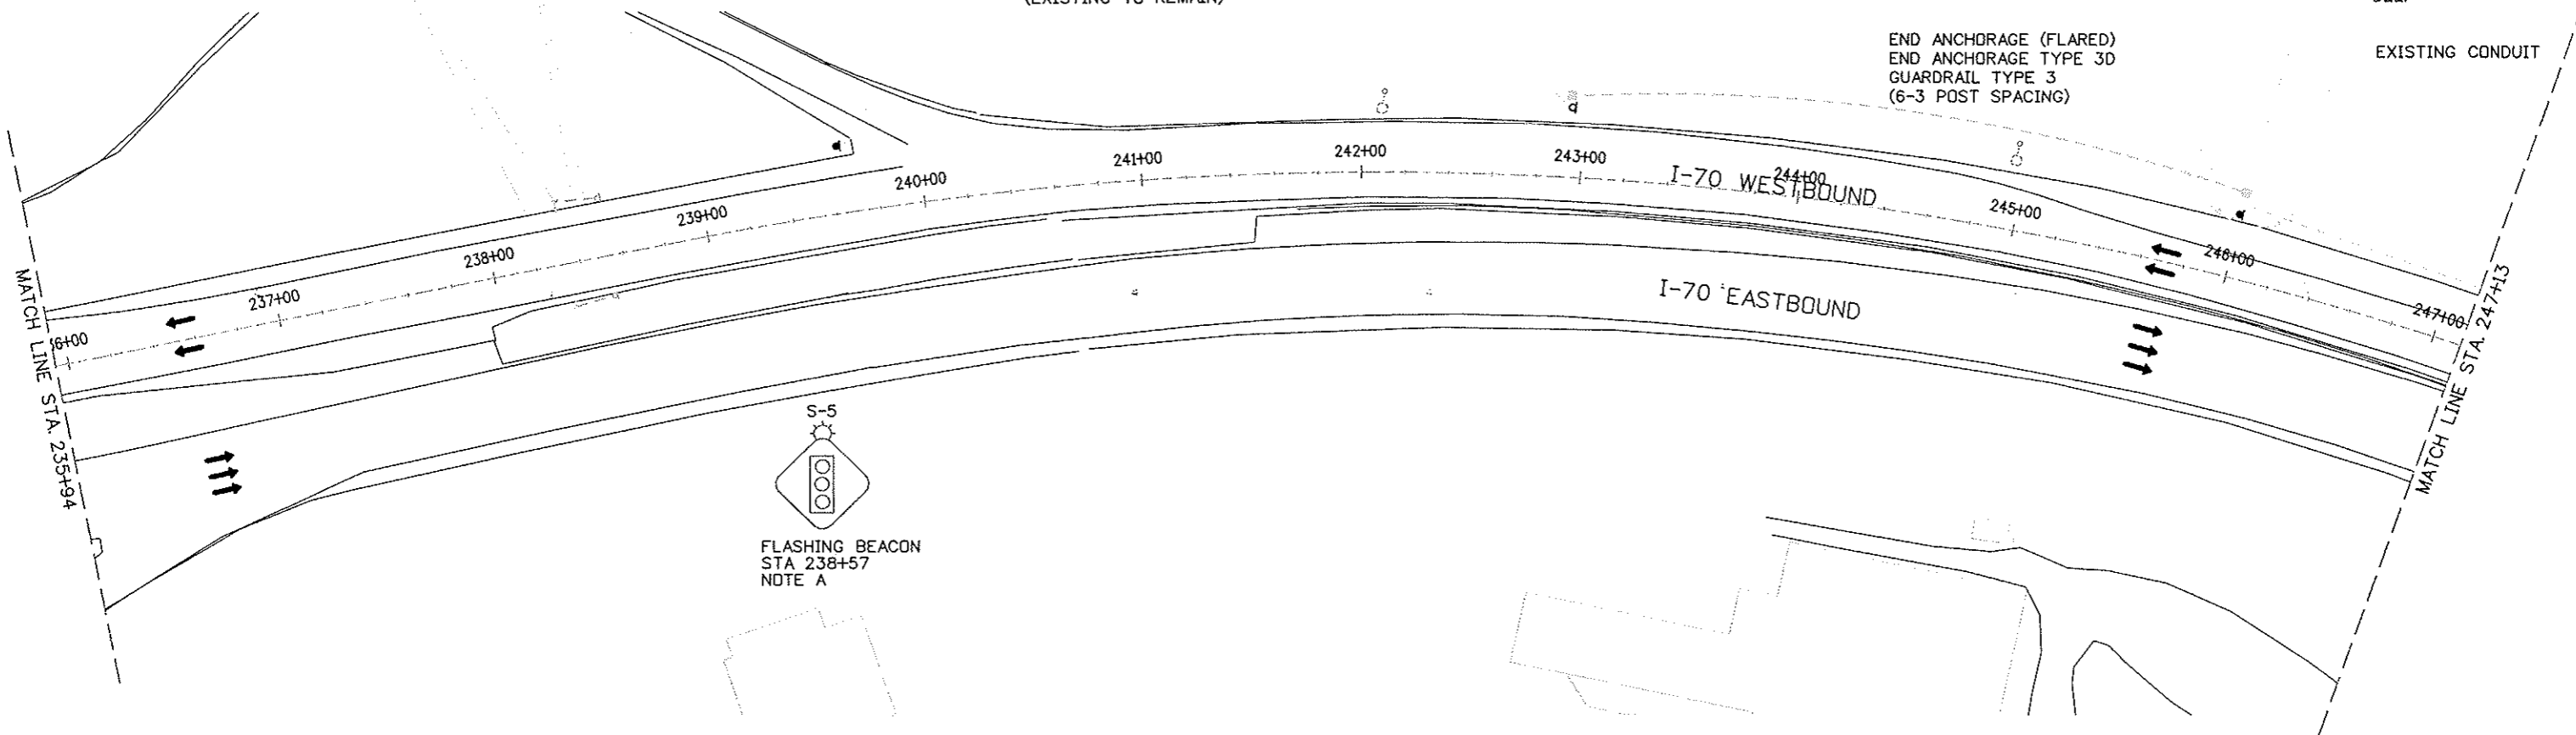

MATCH LINE STA. 235+94

MATCH LINE STA. 247+13

- A. CONNECT FLASHING BEACON TO SIGNAL CONTROL.
- B. BLANKOUT SIGN LOCATION IS APPROXIMATE. FINAL LOCATION SHALL BE ADJUSTED AND APPROVED BY THE ENGINEER PRIOR TO INSTALLATION. THE BLANKOUT SIGN ELECTRONICS SHALL BE RELOCATED/TRANSFERRED FROM THE EXISTING TO THE PROPOSED LOCATION BY THE TUNNEL PERSONNEL ONLY.
- C. DERIVE 120V POWER FOR FLASHING BEACONS FROM EXISTING OVERHEIGHT VEHICLE DETECTOR NEARBY. COST OF CONDUIT AND WIRE SHALL BE INCIDENTAL TO PAYMENT ITEM FOR FLASHING BEACON.

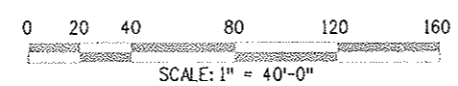



Computer File Information		Sheet Revisions		Colorado Department of Transportation		As Constructed		I-70 WESTBOUND POWER & APPROACH VMS		Project No./Code	
Creation Date:	11/28/00	Initials:	KLN	07/03/07	ASBUILT					IM 0703-269	
Last Modification Date:	05/20/07	Initials:	DJR							13166	
Full Path:	014102\800Deliv\AsBuilt									Sheet Number 143	
Drawing File Name:	sgap06n									Sheet Number 143	
Acad Ver.	R14	Scale:	1" = 40'-0"							Sheet Number 143	
		Units:								Sheet Number 143	




P.O. BOX 399
DUMONT, CO. 80436
Phone: 303-512-5750 FAX: 303-512-5775

Region 1 Mountain Residency I.N.Z.

Designer: K. Ho
Detailer: E. McChesney
Sheet Subset: VMS
Subset Sheets: 12 OF 46

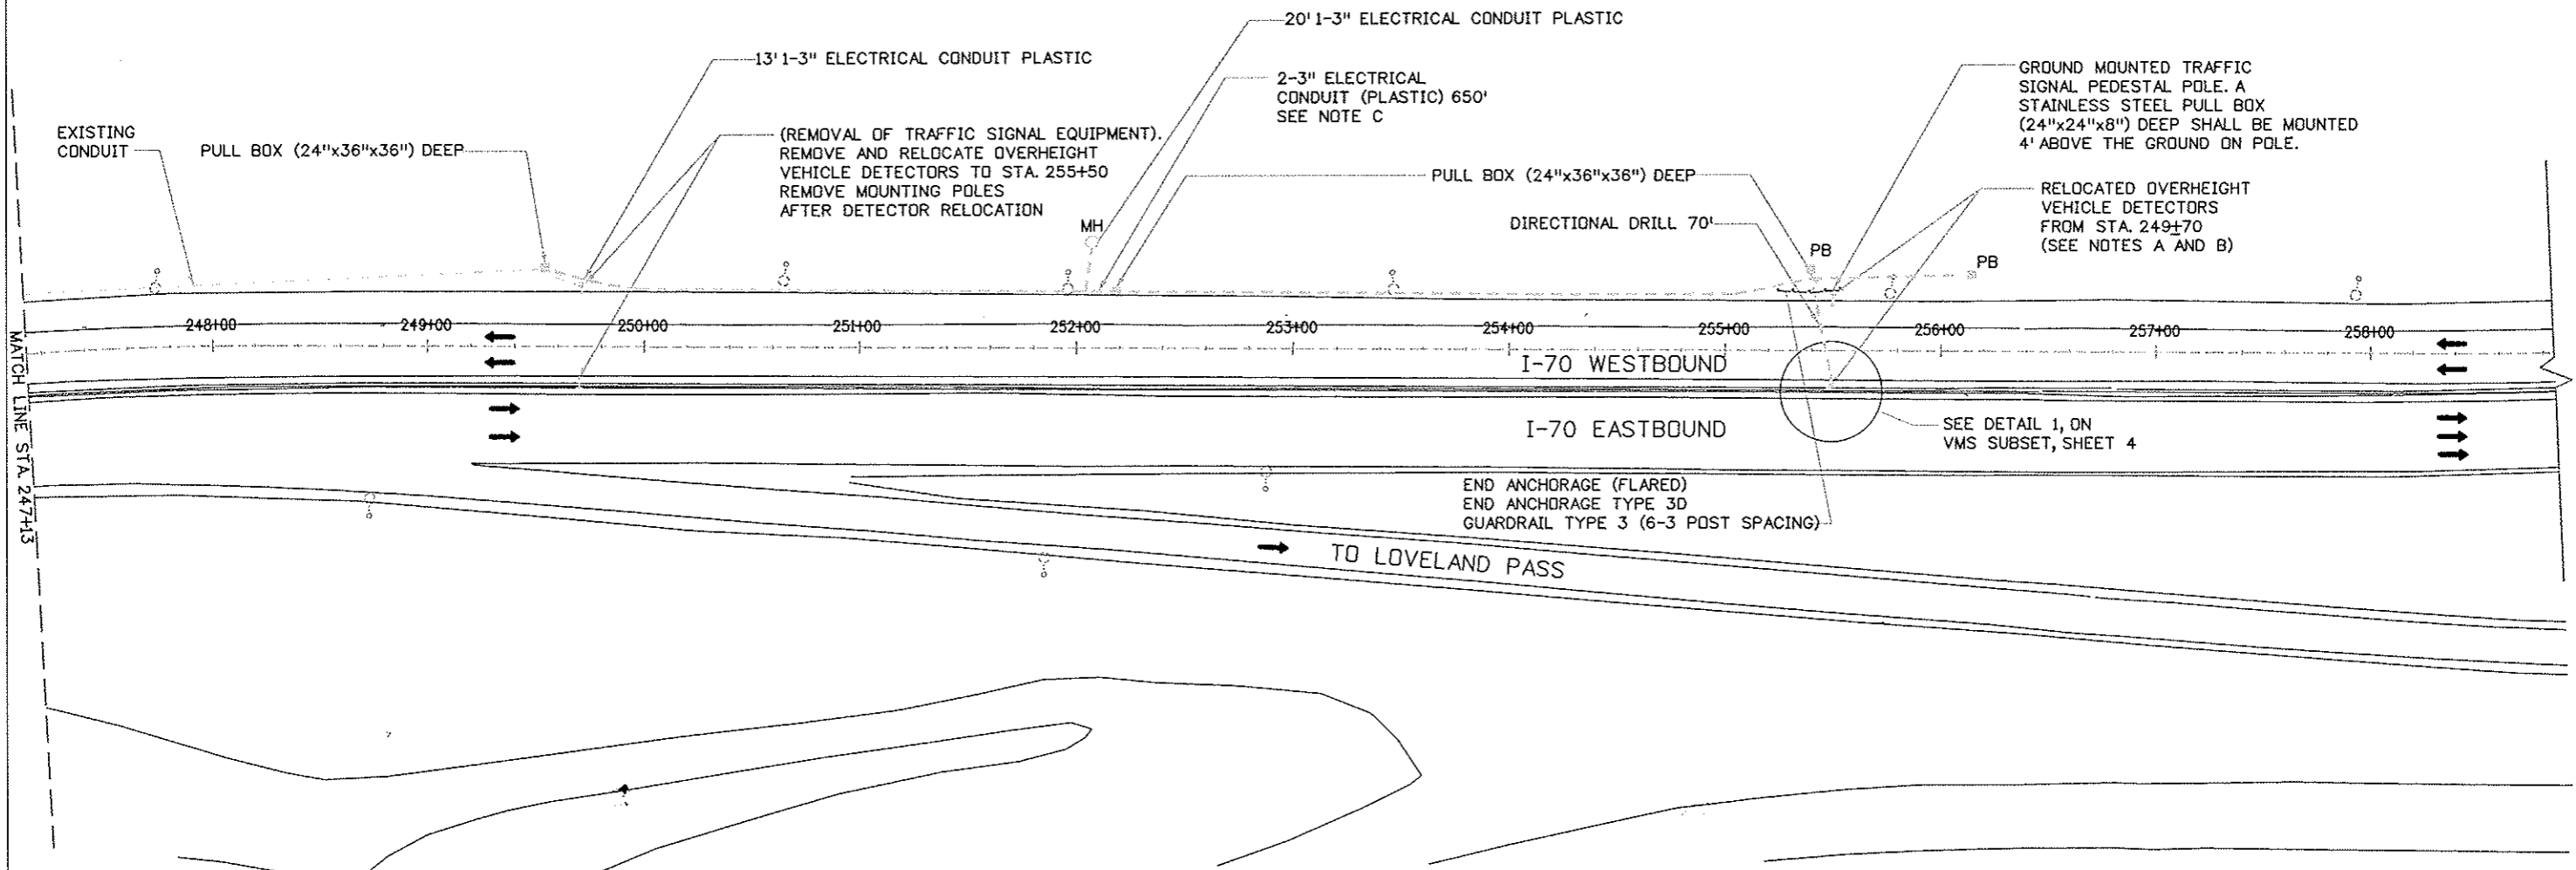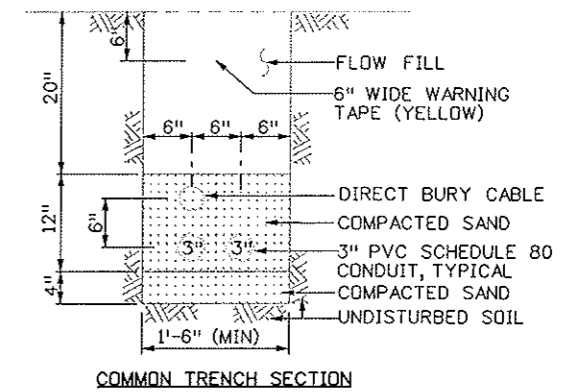


- NOTES:**
- A. CONTRACTOR SHALL PROVIDE FOUNDATION FOR RELOCATED OVERHEIGHT VEHICLE DETECTORS AND SHALL MOUNT THE STATE FURNISHED POLES
 - B. THE DETECTOR SYSTEM SHALL BE RELOCATED/TRANSFERRED FROM THE EXISTING LOCATION TO THE PROPOSED LOCATION BY TUNNEL PERSONNEL ONLY.
 - C. THE CONTRACTOR SHALL INSTALL 4-#3AWG AND 1 SIX-STRAND FIBER OPTIC CABLE IN THE INSTALLED CONDUITS

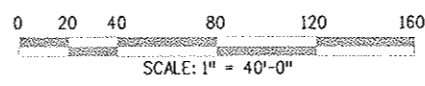

Design File Name: D088SPEC*
 Plot File Name: SPLITFILE*
 Date of Plot: \$\$\$DATE\$\$\$

Computer File Information	
Creation Date:	11/28/00 Initials: KLN
Last Modification Date:	05/06/07 Initials: DJR
Full Path:	014102\800Deliv\AsBuil\
Drawing File Name:	sgop07n
Acad Ver.	R14 Scale: 1" = 40'-0" Units:

Sheet Revisions	
07/03/07	ASBUILT DJB


Colorado Department of Transportation

 P.O. BOX 399
 DUMONT, CO. 80436
 Phone: 303-512-5750 FAX: 303-512-5775
 Region 1 Mountain Residency I.N.Z.

As Constructed	
No Revisions:	
Revised:	
Void:	

I-70 WESTBOUND POWER & APPROACH VMS	
Designer:	K. Ho
Detailer:	E. McChesney
Sheet Subset:	VMS
Structure Numbers:	
Subset Sheets:	13 OF 46

Project No./Code	
	IM 0703-269
	13166
Sheet Number	144

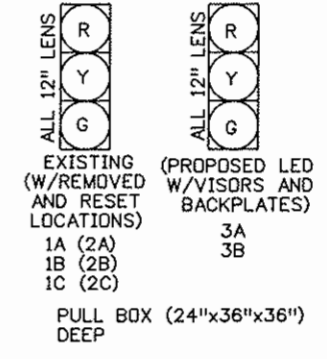SIGNAL IDENTIFICATION




EXISTING BLANKOUT SIGN W/ SIREN TO REMAIN.




PULL BOX (12"x12"x6") DEEP STAINLESS STEEL BOX TO BE MOUNTED ON THE BACK OF EXISTING OVERHEIGHT VEHICLE BOS. SUPPORT.

4'
SCHEMATIC - NTS

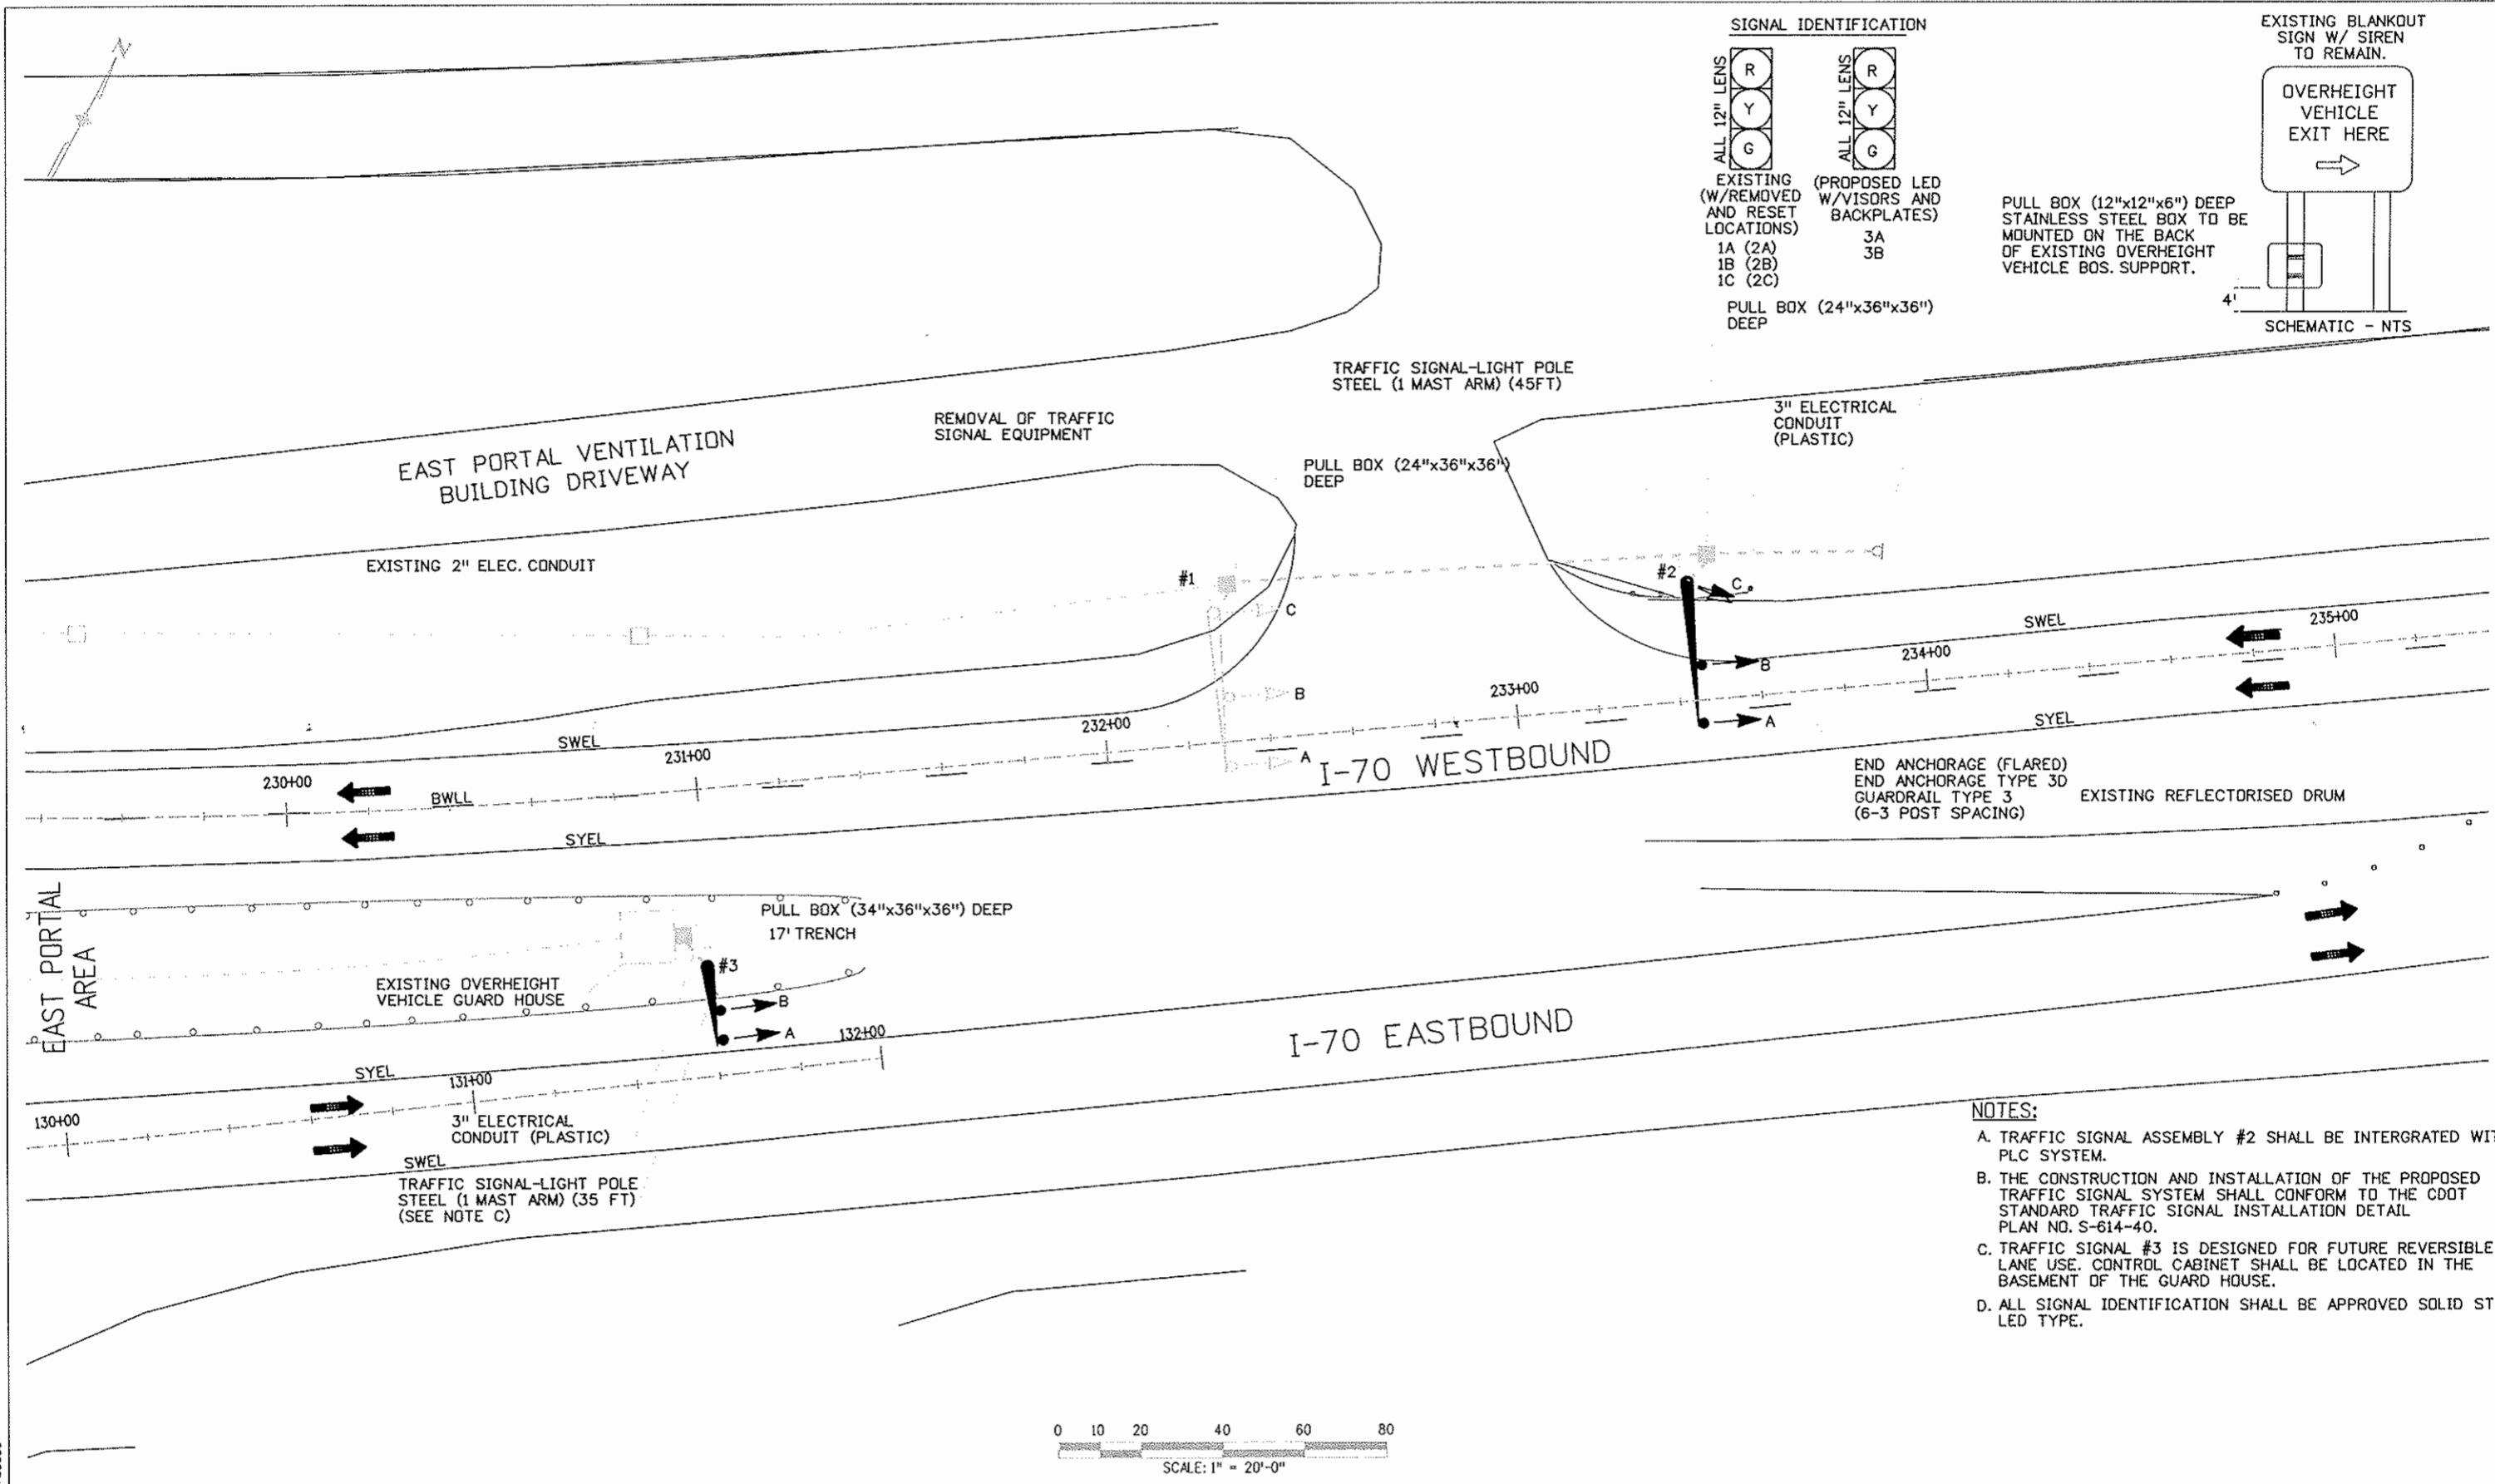

- NOTES:**
- A. TRAFFIC SIGNAL ASSEMBLY #2 SHALL BE INTERGRATED WITH PLC SYSTEM.
 - B. THE CONSTRUCTION AND INSTALLATION OF THE PROPOSED TRAFFIC SIGNAL SYSTEM SHALL CONFORM TO THE CDOT STANDARD TRAFFIC SIGNAL INSTALLATION DETAIL PLAN NO. S-614-40.
 - C. TRAFFIC SIGNAL #3 IS DESIGNED FOR FUTURE REVERSIBLE LANE USE. CONTROL CABINET SHALL BE LOCATED IN THE BASEMENT OF THE GUARD HOUSE.
 - D. ALL SIGNAL IDENTIFICATION SHALL BE APPROVED SOLID STATE LED TYPE.

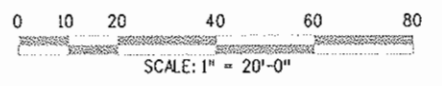

Design File Name: D0M5SPEC*
Plot File Name: SPLITFILE*
Date of Plot: \$\$\$DATE\$\$\$

Computer File Information	
Creation Date:	11/21/00 Initials: BAM
Last Modification Date:	05/06/07 Initials: DJR
Full Path:	014102\800Deliv\AsBuilt\
Drawing File Name:	trfsgin
Acad Ver.	R14 Scale: 1" = 20'-0" Units:

Sheet Revisions	
07/03/07	ASBUILT DJB

Colorado Department of Transportation

DOT

P.O. BOX 399
DUMONT, CO. 80436
Phone: 303-512-5750 FAX: 303-512-5775

Region 1 Mountain Residency I.N.Z.

As Constructed
No Revisions:
Revised:
Void:

I-70 WESTBOUND TRAFFIC SIGNAL PLAN	
Designer:	E. McChesney
Detailer:	E. McChesney
Sheet Subset:	VMS
Structure Numbers:	
Subset Sheets:	14 OF 46

Project No./Code
IM 0703-269
13166
Sheet Number 145


FOR REFERENCE ONLY

Design File Name: DONSPEC*
 Plot File Name: \$PLOTFILE*
 Date of Plot: \$\$\$DATE\$\$\$

Computer File Information			
Creation Date:	11/28/00	Initials:	KLN
Last Modification Date:	02/27/02	Initials:	DJR
Full Path:	014102\700CADD\713TRA\		
Drawing File Name:	sgdt11n.plt		
Acad Ver.	R14	Scale:	NTS
		Units:	ENGLISH

Sheet Revisions			
<input type="checkbox"/>	07/03/07	ASBUILT	DJB
<input type="checkbox"/>			
<input type="checkbox"/>			
<input type="checkbox"/>			
<input type="checkbox"/>			

Colorado Department of Transportation




P.O. BOX 399
 DUMONT, CO. 80436
 Phone: 303-512-5750 FAX: 303-512-5775

Region 1 Mountain Residency I.N.Z.

As Constructed
No Revisions:
Revised:
Void:

ELEVATION PORTAL FACE VMS & LUS	
Designer: K. Ho	Structure Numbers
Detailer: K. J. Singh	
Sheet Subset: VMS	Subset Sheets: 15 OF 46

Project No./Code
IM 0703-269
Sheet Number 146

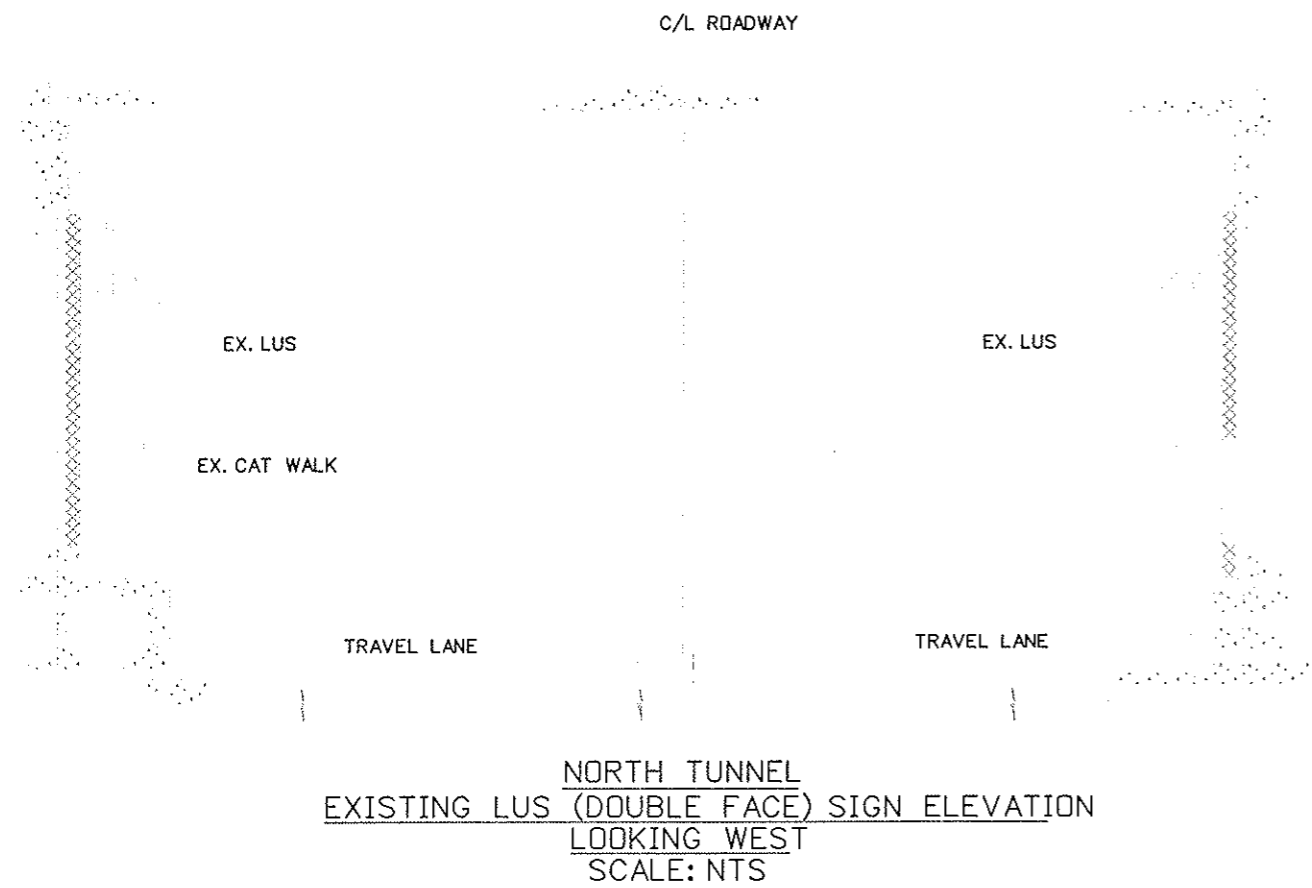


LOCATE LUS TO
AVOID AIRDUCTS
IN CEILING


NORTH TUNNEL
EXISTING LUS (DOUBLE FACE) SIGN ELEVATION
LOOKING WEST
SCALE: NTS

TRAVEL LANE TRAVEL LANE

NOTES:
A. FOR SIGN SUPPORT DETAIL, SEE VMS STRUCTURAL DRAWINGS.

Design File Name: 014102\700cadd\713tra*
 Plot File Name: \$\$\$\$\$DATE\$\$\$\$\$
 Date of Plot: \$\$\$\$\$DATE\$\$\$\$\$

Computer File Information				Sheet Revisions				Colorado Department of Transportation		As Constructed		TUNNEL LUS CROSS-SECTION		Project No./Code	
Creation Date:	4/29/99	Initials:	KLN	<input type="checkbox"/>	07/03/07	ASBUILT	DJB	 P.O. BOX 399 DUMONT, CO. 80436 Phone: 303-512-5750 FAX: 303-512-5775 Region 1 Mountain Residency I.N.Z.	No Revisions:	Designer: K. Ho		Structure	IM 0703-269		
Last Modification Date:	2/27/02	Initials:	DJR	<input type="checkbox"/>			Revised:		Detailer: E. McChesney		Numbers	13166			
Full Path:	014102\700cadd\713tra\			<input type="checkbox"/>			Void:		Sheet Subset: VMS		Subsets	16 OF 46			
Drawing File Name:	sgdt04n.plt			<input type="checkbox"/>							Sheet Number	147			
Acad Ver.	R14	Scale:	NTS	Units:											

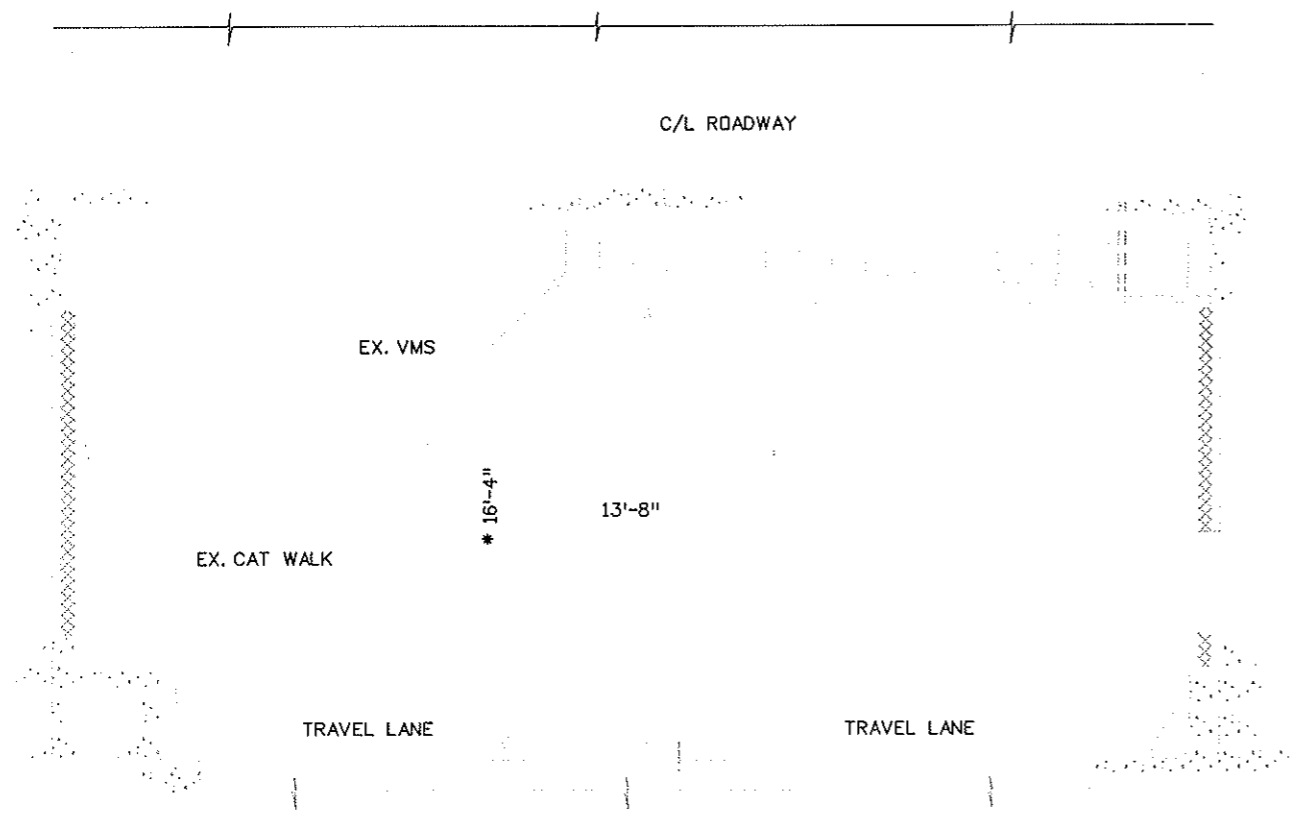


NORTH TUNNEL
 EXISTING VMS (SINGLE FACE) SIGN ELEVATION
LOOKING WEST
 SCALE: NTS

NOTE:
 A. FOR VMS SIGN SUPPORT #11 SEE
 VMS SUBSET SHEET 27.

Design File Name: DGN\$SPEC*
 Plot File Name: \$PLOTFILE*
 Date of Plot: \$\$\$BDATE\$\$\$

Computer File Information			
Creation Date:	11/28/00	Initials:	KLN
Last Modification Date:	02/27/02	Initials:	KLN
Full Path:	014102\700CADD\713TRA\		
Drawing File Name:	sgdt03n.plt		
Acad Ver.	R14	Scale:	NTS
		Units:	ENGLISH


Sheet Revisions			
<input type="checkbox"/>	07/03/07	ASBUILT	DJB
<input type="checkbox"/>			
<input type="checkbox"/>			
<input type="checkbox"/>			

Colorado Department of Transportation

 P.O. BOX 399
 DUMONT, CO. 80436
 Phone: 303-512-5750 FAX: 303-512-5775
 Region 1 Mountain Residency I.N.Z.

As Constructed
No Revisions:
Revised:
Void:

TUNNEL VMS ELEVATION		
Designer:	K. Ho	Structure Numbers
Detailer:	E. McChesney	
Sheet Subset:	VMS	Subset Sheets: 17 OF 46

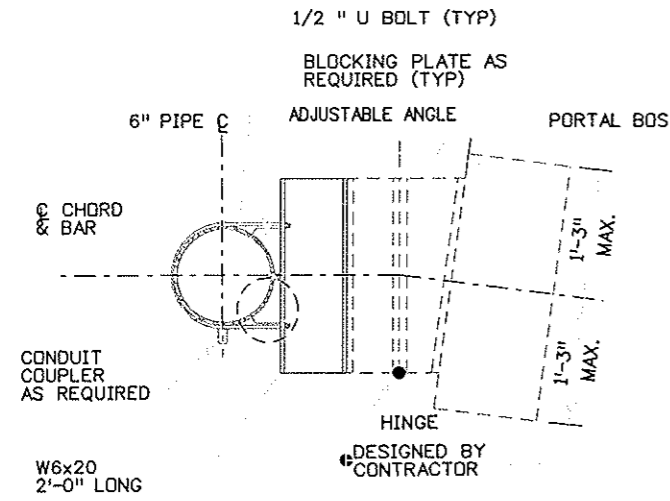Project No./Code	
IM	0703-269
Sheet Number	148



SIDE VIEW
SCALE: NTS

FOR SIGN SUPPORT
DETAIL, SEE VMS SUBSET
SHEET '24


SIDE VIEW
SCALE: NTS

Design File Name: DGN\SPEC*
 Plot File Name: \$PLTFILE*
 Date of Plot: \$\$\$DATE\$\$\$

Computer File Information			
Creation Date:	4/20/99	Initials:	KJS
Last Modification Date:	02/27/02	Initials:	DJR
Full Path:	014102\700CADD\713TRA\		
Drawing File Name:	sgdt09n.plt		
Acad Ver.	R14	Scale:	NTS
		Units:	ENGLISH

Sheet Revisions			
<input type="checkbox"/>	07/03/07	ASBUILT	DJB
<input type="checkbox"/>			
<input type="checkbox"/>			
<input type="checkbox"/>			

Colorado Department of Transportation



P.O. BOX 399
 DUMONT, CO. 80436
 Phone: 303-512-5750 FAX: 303-512-5775

Region 1 Mountain Residency I.N.Z.

As Constructed
No Revisions:
Revised:
Void:

VMS SIGN FACE LAYOUT DETAILS		
Designer:	Structure	
Detailer:	Numbers	
Sheet Subset: VMS	Subset Sheets: 18 OF 46	


Project No./Code
IM 0703-269
13166
Sheet Number 149

Design File Name: DGN\$SPEC*
 Plot File Name: \$PLOTFILE*
 Date of Plot: \$\$\$DATE\$\$\$\$

Computer File Information			
Creation Date:	11/28/00	Initials:	KLN
Last Modification Date:	02-07-02	Initials:	KLN
Full Path:	014102\700cadd\713tro		
Drawing File Name:	sgdt24n.plt		
Acad Ver.	R14	Scale:	Units:

Sheet Revisions			
<input type="checkbox"/>	07/03/07	ASBUILT	DJB
<input type="checkbox"/>			
<input type="checkbox"/>			
<input type="checkbox"/>			

Colorado Department of Transportation



P.O. BOX 399
 DUMONT, CO. 80436
 Phone: 303-512-5750 FAX: 303-512-5775

Region 1 Mountain Residency I.N.Z.

As Constructed	
No Revisions:	
Revised:	
Void:	


SIGN FACE LAYOUT DETAILS			
Designer:	K. HO	Structure Numbers	
Detailer:	E. MCCHESENEY	Sheet Subset:	VMS
Subset Sheets:		19 OF 46	

Project No./Code	
IM 0703-269	
Sheet Number	150

- NOTES:**
- A. THE WEIGH-IN-MOTION VMS WILL BE MOUNTED ON THE EXISTING MODIFIED SUPPORT STRUCTURE. THIS NEW WEIGH-IN-MOTION VMS SHALL BE CONNECTED AND FULLY INTEGRATED WITH THE EXISTING WEIGH-IN-MOTION SYSTEM.
 - B. FOR INFORMATION RELATED TO THE EXISTING WEIGH-IN-MOTION VMS SUPPORT SYSTEM AND CROSS SECTION, SEE VMS SUBSET SHEET 21.

NOTES:

A. FOR LUS LOCATIONS TO BE INSTALLED IN THIS CONTRACT, SEE SIGN TABULATION VMS SUBSET SHEET 2.

Computer File Information				Sheet Revisions			Colorado Department of Transportation		As Constructed		LUS SIGN FACE LAYOUT & POWER CONNECTION DETAILS		Project No./Code	
Creation Date:	4/21/99	Initials:	PTR	<input type="checkbox"/>	07/03/07	ASBUILT	DJB	 P.O. BOX 399 DUMONT, CO. 80436 Phone: 303-512-5750 FAX: 303-512-5775 Region 1 Mountain Residency I.N.Z.	No Revisions:	Designer:	K. Ho	Structure Numbers		IM 0703-269
Last Modification Date:	03/24/03	Initials:	CWB	<input type="checkbox"/>			Revised:		Detailer:	E. McChesney			13166	
Full Path:	014102\700CADD\713TRA\			<input type="checkbox"/>			Void:		Sheet Subset:	VMS	Subset Sheets:	20 OF 46	Sheet Number	151
Drawing File Name:	sgdt22n.plt			<input type="checkbox"/>										
Acad Ver.	R14	Scale:	NTS	Units:	ENGLISH									

Design File Name: D:\ASBUILT\...
 Plot File Name: S:\LOTFILE*
 Date of Plot: \$\$\$DATE\$\$\$\$

STRUCTURAL NOTES

SPECIFICATIONS AND CODES

SPECIFICATIONS:

- STRUCTURAL DESIGN: AASHTO "STANDARD SPECIFICATIONS FOR STRUCTURAL SUPPORTS FOR HIGHWAY SIGNS, LUMINAIRES AND TRAFFIC SIGNALS," 1985 AS REVISED BY INTERIM SPECIFICATIONS-BRIDGES 1986-1989, 1991, 1993 AND 1994.
- CONSTRUCTION: COLORADO DOT STANDARD SPECIFICATIONS FOR ROAD AND BRIDGE CONSTRUCTION 1999 SPECIFICATIONS, THE PROJECT CONSTRUCTION DRAWINGS, SPECIFICATIONS AND SPECIAL PROVISIONS.
- WELDING: 1. AWS D1.1-94 STRUCTURAL WELDING CODE.
2. ALL AREAS TO BE WELDED SHALL BE GROUND TO BRIGHT METAL. NO BUTT WELD SPLICES WILL BE PERMITTED.

STRUCTURAL DESIGN CRITERIA

1. THE DESIGN OF SIGN AND EQUIPMENT SUPPORTS ARE IN ACCORDANCE WITH THE WORKING STRESS METHOD.

2. DESIGN LOADS:

A. WIND LOADS:

60 MPH DESIGN BASIC WIND SPEED (TUNNEL INSIDE)
80 MPH DESIGN BASIC WIND SPEED (TUNNEL PORTAL)

B. DEAD LOADS:

IN ADDITION TO THE SELF-WEIGHT OF THE STRUCTURAL SUPPORT, THE FOLLOWING MAJOR DEAD LOAD HAS BEEN INCLUDED

DOUBLE FACED VMS SIGN AND HARDWARE (TUNNEL)	1,600 LBS
SINGLE FACED VMS SIGN AND HARDWARE (PORTAL)	550 LBS
DOUBLE FACED LUS SIGN AND HARDWARE (TUNNEL)	50 LBS
SINGLE FACED LUS SIGN AND HARDWARE (PORTAL)	80 LBS

C. EARTHQUAKE:

SEISMIC PERFORMANCE CATEGORY A REQUIREMENTS U.S.A. ACCORDING FOR BRIDGES - AASHTO STANDARD SPECIFICATIONS FOR BRIDGES-1996.

3. DESIGN STRENGTHS:

MATERIAL DESIGN STRENGTHS SHALL CONFORM TO THE FOLLOWING REQUIREMENTS:

A. STRUCTURAL STEEL:

PIPE (ROUND): ASTM A 53, EXTRA STRONG, WELDED AND SEAMLESS STEEL PIPE
TUBE: ASTM A 500, GRADE B OR C
BARS, PLATES AND SHAPES: AASHTO M270, ASTM DESIGNATION A 36
ANCHOR ROD: ASTM A 193, GRADE B7. STEEL.
PIN OR SHAFT: AASHTO M222, ASTM A 588
HIGH STRENGTH STEEL
BOLTS, NUTS AND WASHERS: ASTM A 325 SC SHALL CONFORM TO THE PROVISIONS OF COLORADO DOT SPECIFICATION SECTION 509.28.

B. ALL TUBE AND PIPE MEMBER SHALL BE HOT-DIP GALVANIZED AS PER ASTM A 123.

C. STRUCTURAL STEEL, NUTS, BOLTS AND WASHERS FOR SIGN STRUCTURES SHALL BE GALVANIZED AFTER FABRICATION AS PER ASTM A 123 OR ASTM A 153 AS APPROPRIATE, AND SHALL NOT BE PAINTED.

4. CLEARANCES: ALL SIGNS, EQUIPMENT AND SUPPORT STRUCTURES SHALL BE INSTALLED TO PROVIDE A MINIMUM VERTICAL CLEARANCE FROM THE ROADWAY AS SHOWN ON THE CONTRACT PLANS AND ELEVATIONS.

5. ALL MATERIAL, FABRICATIONS, AND ATTACHMENT OF FIXED ALUMINUM SHALL CONFORM TO CURRENT EDITION OF AASHTO STANDARD SPECIFICATIONS FOR STRUCTURAL SUPPORTS FOR COOT HIGHWAY SIGNS, LUMINAIRE AND TRAFFIC SIGNALS, UNLESS OTHERWISE SHOWN ON THESE CONTRACT DOCUMENTS.

6. FOR PAY ITEMS, QUANTITIES, AND GENERAL NOTES SEE NORTH TUNNEL VMS SUBSET SHEET 1.

7. CAULKING AND SEALER MATERIAL FOR TILE WALLS AND P.E.P. CEILING SHALL BE POLYURETHANE, ELASTOMERIC, NON-SAG SEALANT, CONFORM TO ASTM C 920, TYPE M, GRADE NS, CLASS 25, USE NT OR APPROVED EQUAL.

8. ALL GROUT SHALL BE EPOXY NON-SHRINK, NON-METALLIC GROUT UNLESS OTHERWISE NOTED.

9. ALL MEMBRANES SHALL CONSIST OF RUBBERIZED ASPHALT BONDED TO POLYETHYLENE SHEETING. SHEET MEMBRANE WILL BE SEALED WITH FILLET AND FLASHING MASTIC AROUND ENTIRE PERIMETER OF NEW SHEET.

ABBREVIATIONS

ASTM	AMERICAN SOCIETY FOR TESTING AND MATERIALS	GALV.	GALVANIZED	R	RADIUS
AWS	AMERICAN WELDING STANDARD	HEX	HEXAGON	REINF	REINFORCEMENT
&	AND	H.P.	HIGH POINT	RD.	ROAD
⊙	AT	HORIZ	HORIZONTAL	REQ'D	REQUIRED
B.C.	BOLT CIRCLE	LBS	POUNDS	SQ.	SQUARE
B.S.	BOTH SIDE	LS	LUMPSUM	S.S.	STAINLESS STEEL
CJP	COMPLETE JOINT PENETRATION	LG	LONG	STD	STANDARD
CL	CLEAR, CLEARANCE	LUS	LANE USAGE SIGNAL	STA	STATION
CONC.	CONCRETE	MAX	MAXIMUM	STIFF	STIFFNESS
CONT.	CONTINUOUS	MIN	MINIMUM	TS	TUBE STEEL
CY	CUBIC YARD	MANUF	MANUFACTURE	TYP	TYPICAL
⊕	CENTERLINE	MAT'L	MATERIAL	THK	THICK
C/C	CENTER TO CENTER	NTS	NOT TO SCALE	VMS	VARIABLE MESSAGE SIGN
DEG	DEGREE	NO. or #	NUMBER	WA	WEDGE ANCHOR
DWG	DRAWING	PL or R	PLATE	XS	EXTRA STRONG
DIA	DIAMETER	PCF	POUNDS PER CUBIC FOOT		
EA	EACH	PSF	POUNDS PER SQUARE FOOT		
EXIST	EXISTING	PSI	POUNDS PER SQUARE INCH		
FT	FEET	PEP	PORCELAIN ENAMELED PANEL		
FDN	FOUNDATION	PGL	PAVING GRADE LEVEL		
		PAV'T	PAVEMENT		

Computer File Information

Creation Date:	11/15/00	Initials:	HCM
Last Modification Date:	2/06/02	Initials:	DJR
Full Path:	14102\700CADD\713TRA\		
Drawing File Name:	SGP20.N.PLT		
Acad Ver.	R14	Scale:	NONE Units: ENGLISH

Sheet Revisions

<input type="checkbox"/>	07/03/07	ASBUILT	DJB
<input type="checkbox"/>			
<input type="checkbox"/>			
<input type="checkbox"/>			

Colorado Department of Transportation



P.O. BOX 399
DUMONT, CO. 80436
Phone: 303-512-5750 FAX: 303-512-5775

Region 1 Mountain Residency I.N.Z.

As Constructed


No Revisions:	
Revised:	
Void:	

NORTH TUNNEL VMS SUPPORT STRUCTURAL NOTES


Designer:	NHP	Structure Numbers:	
Detailer:	HCM		
Sheet Subset:	VMS	Subset Sheets:	22 of 47

Project No./Code

IM 0703-269
13166
Sheet Number 153

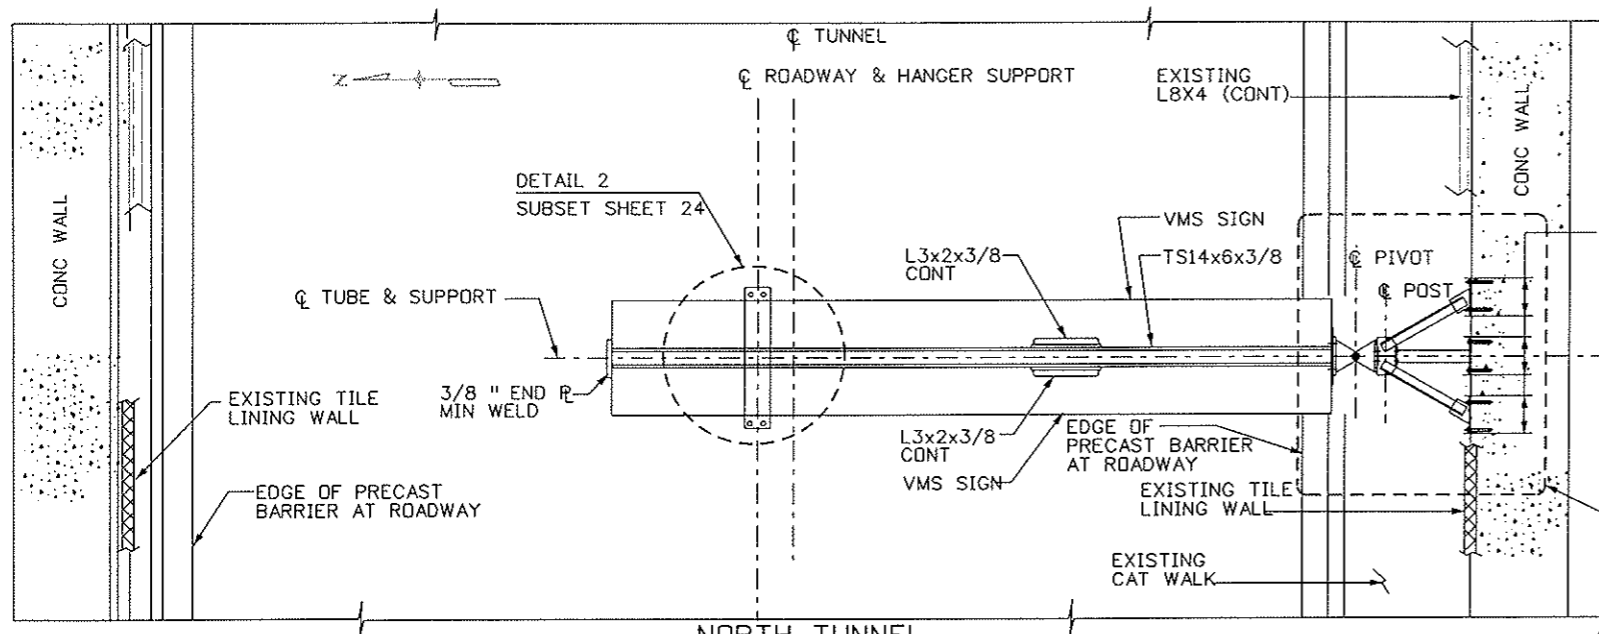


TYPICAL TUNNEL DOUBLE FACE VMS SIGN SUPPORT PLAN
(STRUCTURES 1 THRU 10)
SCALE: 3/8"=1'-0"


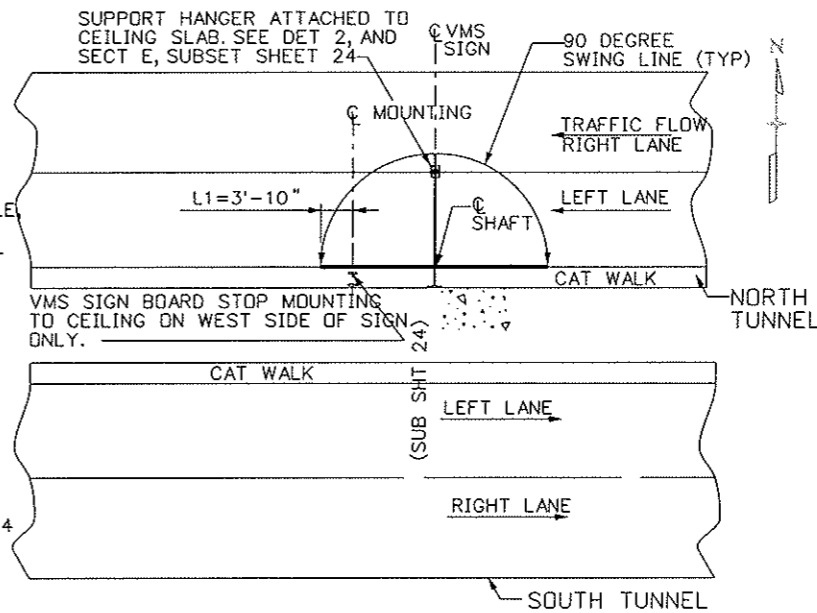


VMS SIGN SUPPORT ORIENTATION PLAN
(STRUCTURES 1 THRU 10)
SCALE: NTS

VMS SUPPORTS SCHEDULE (TUNNEL)	
NORTH TUNNEL	
SIGN SUPPORT STRUCTURE NO.	LOCATION STATION
1	STA. 140 + 20
2	STA. 148 + 35
3	STA. 156 + 38
4	STA. 164 + 42
5	STA. 172 + 44
6	STA. 180 + 39
7	STA. 188 + 56
8	STA. 196 + 57
9	STA. 204 + 64
10	STA. 212 + 67
11	STA. 219 + 80

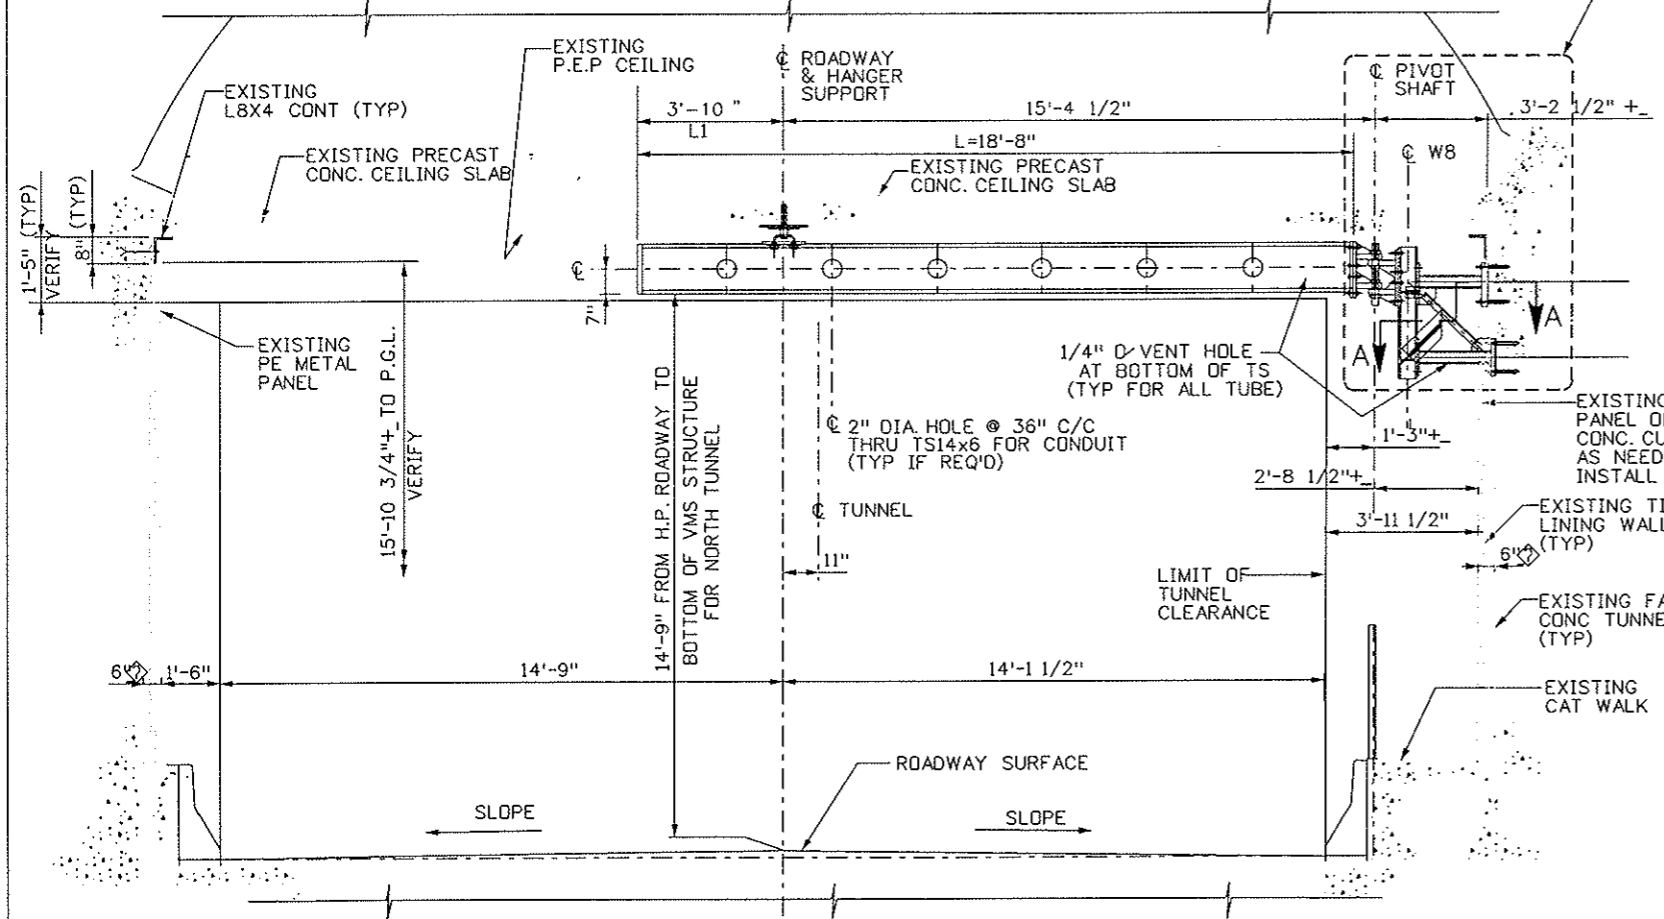

NORTH TUNNEL - LOOKING EAST
TYPICAL TUNNEL DOUBLE FACE VMS SIGN SUPPORT ELEVATION
(STRUCTURES 1 THRU 10)
SCALE: 3/8"=1'-0"

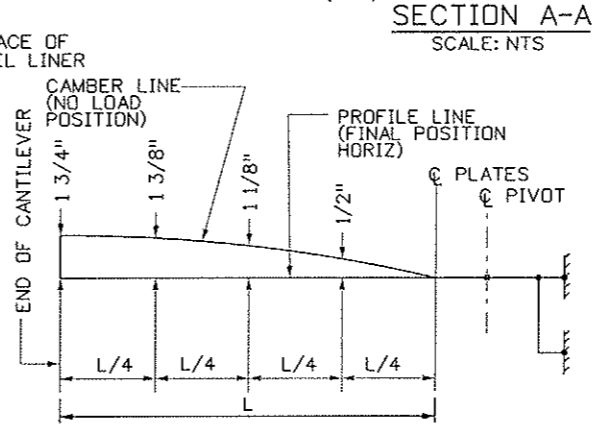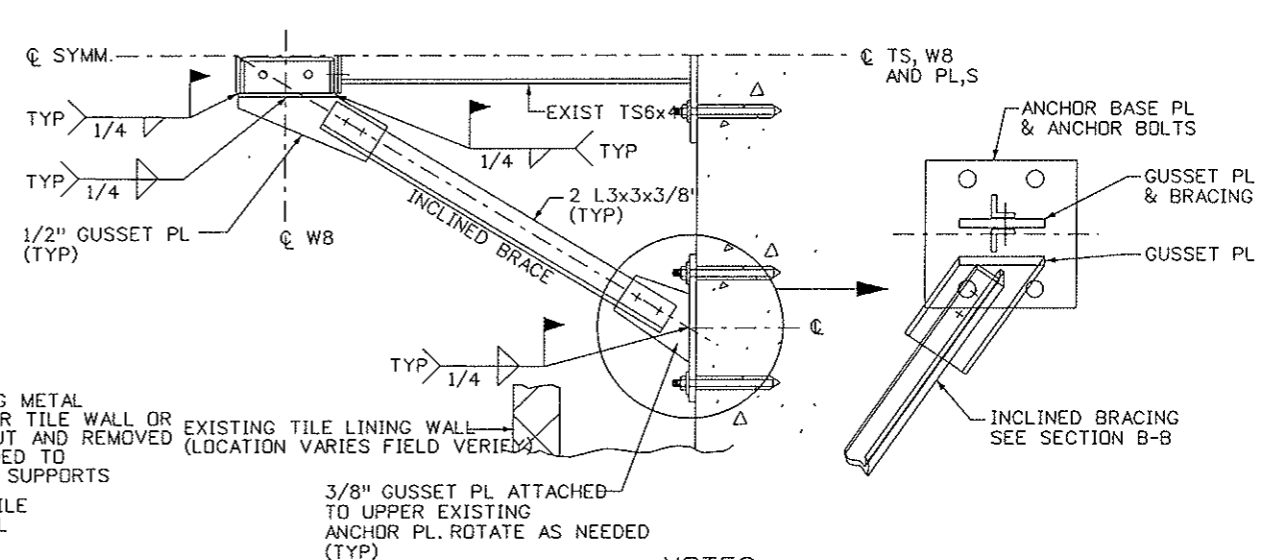

- NOTES:**
- FOR STRUCTURAL NOTES, SEE VMS SUBSET SHEET 22.
 - CONTRACTOR SHALL BE RESPONSIBLE FOR THE PROPER FIT OF SIGN STRUCTURES AT ANCHORAGES. CONTRACTOR SHALL TAKE FIELD MEASUREMENTS TO VERIFY ANCHORAGE LOCATIONS, ELEVATION CLEARANCES AND MEMBER SPANS PRIOR TO PREPARING SHOP DRAWINGS. STATION LOCATION SHOWN ON THIS SHEET ARE APPROXIMATE. CONTRACTOR SHALL ADJUST LOCATION PER FIELD CONDITION. REMOVE AND RELOCATE OBSTRUCTION WITH APPROVAL OF ENGINEER AT NO ADDITIONAL COST. CONTRACTOR SHALL FABRICATE/INSTALL ONE SIGN STRUCTURE TO ASSURE THE OPERATIONAL PERFORMANCE PRIOR TO SUBSEQUENT SUBMITTAL FOR SIGN STRUCTURES.
 - FOR VMS ELECTRONIC SIGN, SEE VMS SIGN ELEVATIONS SHEETS 15 THRU 21.
 - FOR VMS SUPPORT FRAMING DETAILS, SEE VMS SUBSET SHEET 24.
 - VMS MESSAGE BOARD SIGN LOCATION SEE SUBSET SHEET 2.
 - PROVIDE RECESS HOLE AND PIN INTO 2" DIA. SHAFT ROD TO HOLD IN PLACE AS REQUIRED. LUBRICATE WITH GREASE ALL PINS AND SHAFT ROD AS REQUIRED FOR EASY OPERATION.

Plot File Name: SPLITFILE* Date of Plot: \$\$\$DATE\$\$\$

Computer File Information			
Creation Date:	11/15/00	Initials:	HCM
Last Modification Date:	03/06/07	Initials:	DJB
Full Path:	14102\800Deliv\AsBuilt\		
Drawing File Name:	SGP21N		
Acad Ver.	R14	Scale:	AS NOTED
		Units:	ENGLISH

Sheet Revisions			
<input type="checkbox"/>	07/03/07	ASBUILT	DJB
<input type="checkbox"/>			
<input type="checkbox"/>			
<input type="checkbox"/>			

Colorado Department of Transportation

DOT






P.O. BOX 399
DUMONT, CO. 80436
Phone: 303-512-5750 FAX: 303-512-5775

Region 1 Mountain Residency I.N.Z.

As Constructed
No Revisions:
Revised:
Void:

NORTH TUNNEL VMS SUPPORT PLAN AND ELEVATION	
Designer:	NHP
Detailer:	HCM
Sheet Subset:	VMS
Structure Numbers:	
Subsets:	23 of 46

Project No./Code	
IM	0703-269
Sheet Number	154

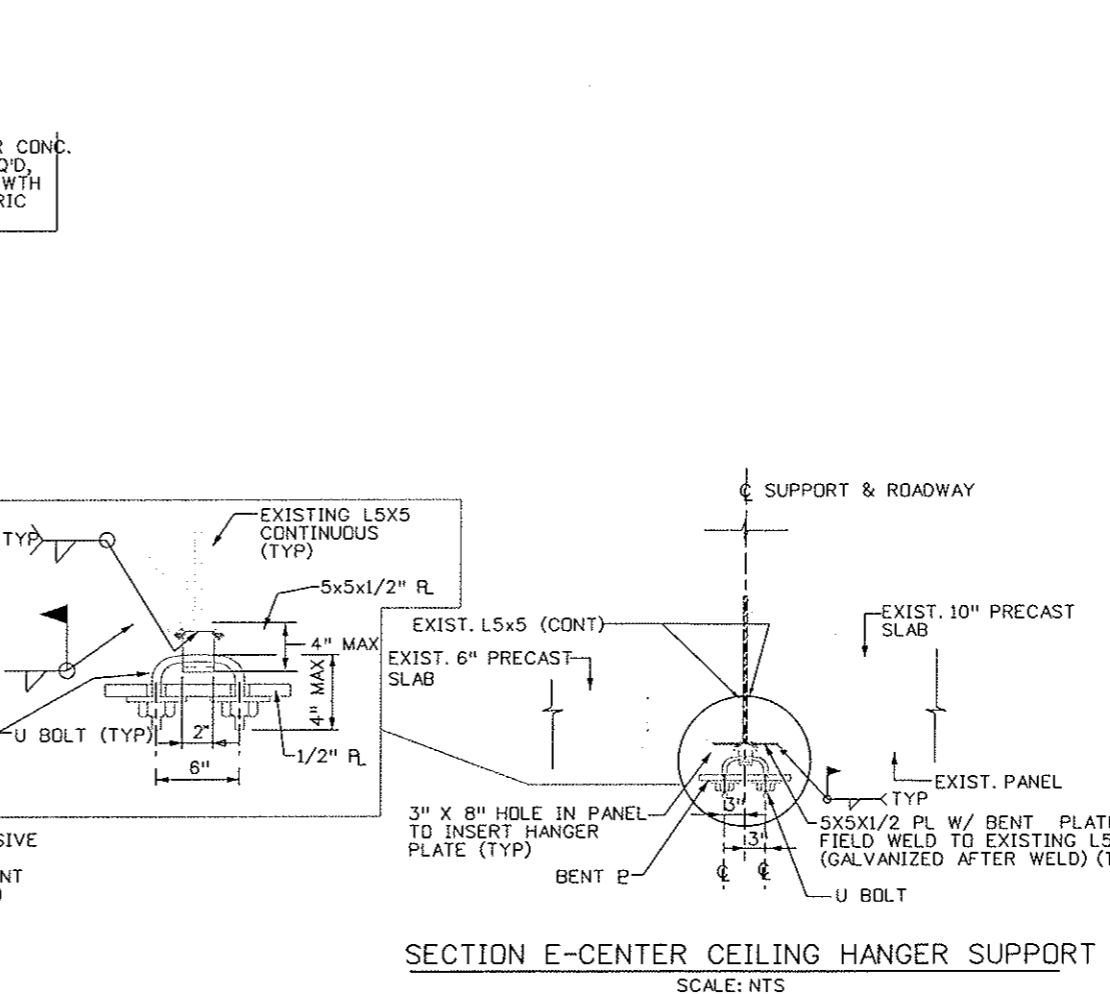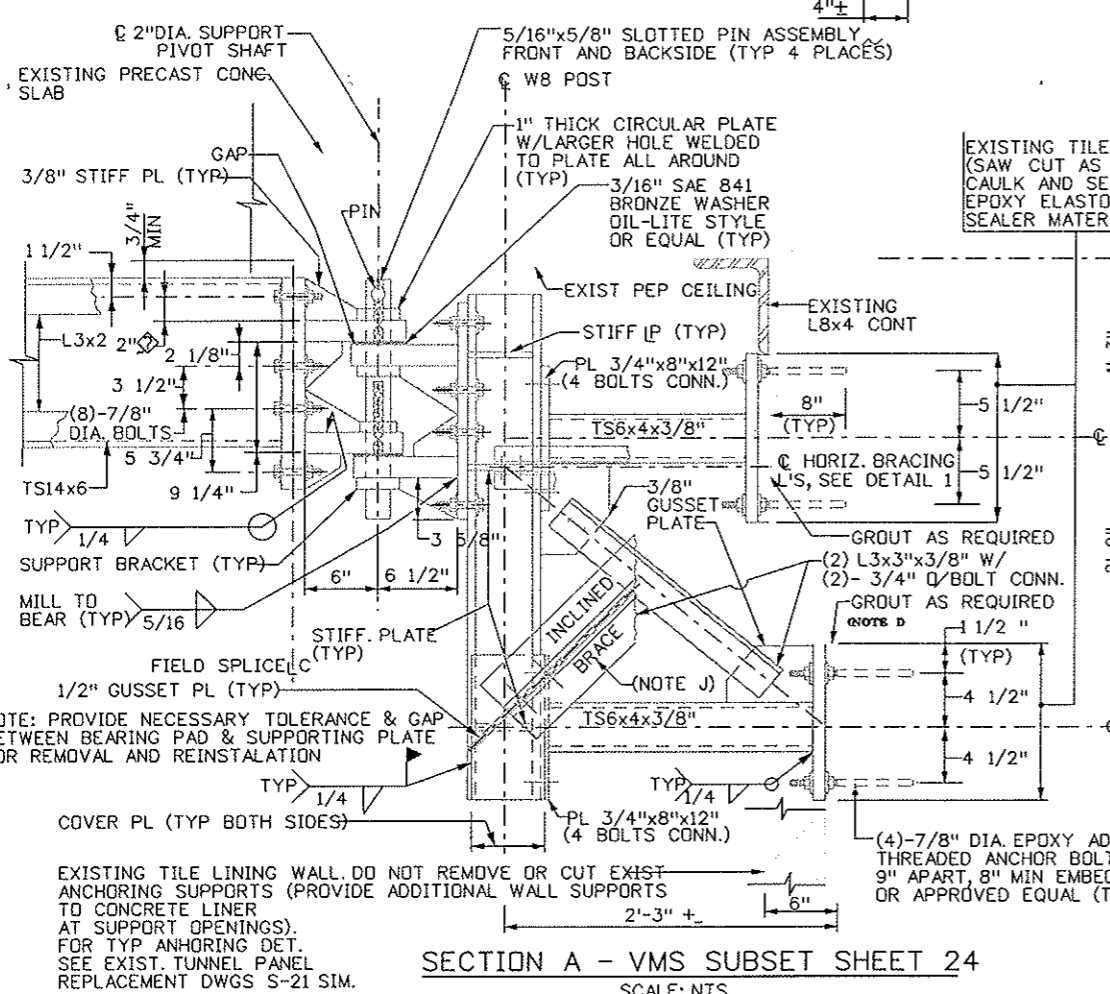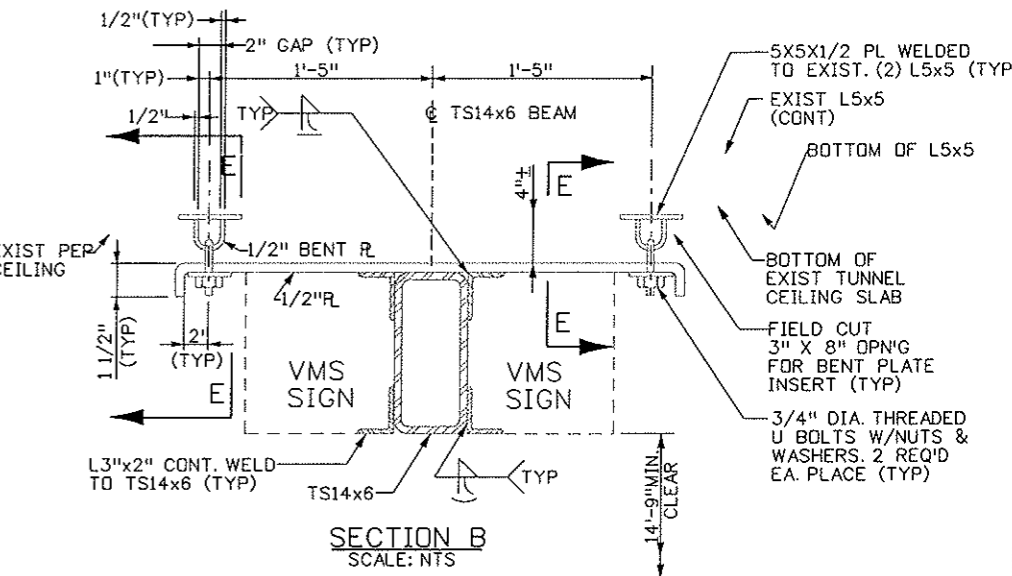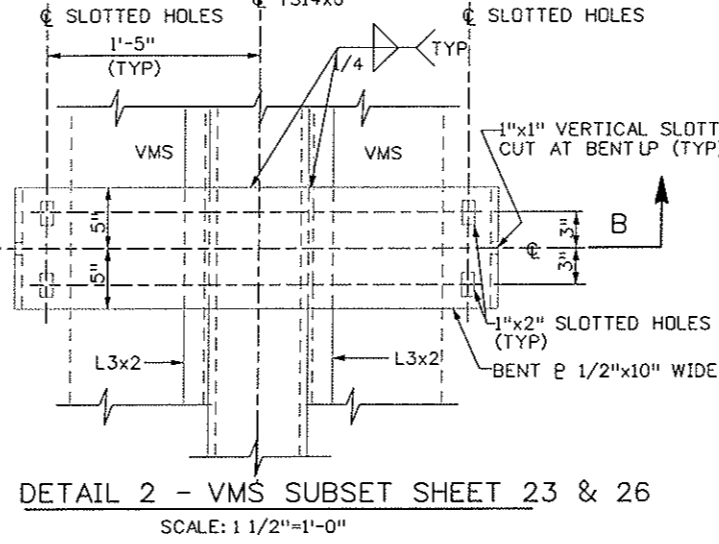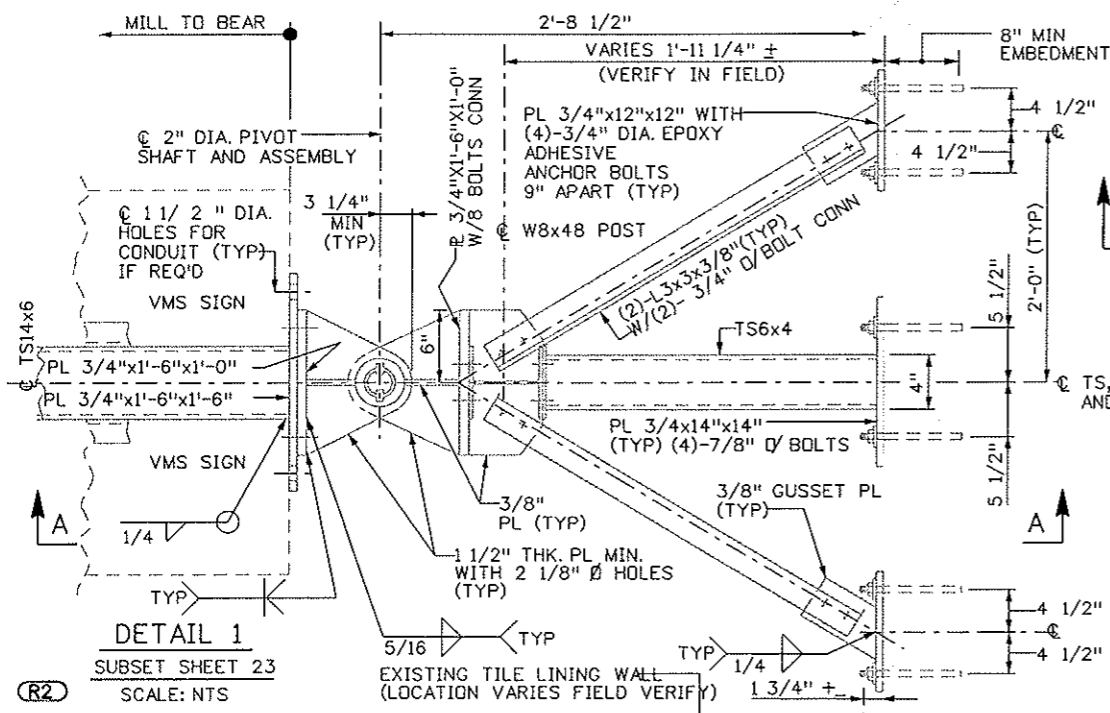


- NOTES:**
- A. VMS STEEL STRUCTURE, ATTACHMENT, CONNECTION, STEEL FRAMING, GROUT, CAULKING, SEALER, MEMBRANE, WIRING AND CUT PANEL, CONC. OR TILE ARE INCLUDED IN THE COST OF VMS STEEL SUPPORT STRUCTURE PAY ITEMS.
 - B. FOR ALL ANCHORING SYSTEMS TO EXISTING CONCRETE OR PRECAST CONCRETE SLAB, USE HILTI HSE 2411 EPOXY ADHESIVE, HAS SUPER THREADED ROD WITH LOCK NUTS OR APPROVED EQUAL.
 - C. CONTRACTOR SHALL BE RESPONSIBLE FOR PROPER AND EASY MANUAL SWING OPERATION OF BALL BEARING SUPPORT AND BRACKETS.
 - D. ALL CONNECTION BOLTS SHALL BE 7/8" DIA A 325 SC UNLESS NOTED OTHERWISE.
 - E. MINIMUM 3/8" THICK ELASTOMERIC PAD SHALL BE 100% VIRGIN CHLOROPRENE (NEOPRENE) 60+/- 5 DUROMETER (SHORE A). INTERNAL STEEL LAMINATE SHALL BE ASTM A570 GRADE 33.
 - F. NEW MEMBRANE SHALL BE MATCHED WITH EXISTING MEMBRANE TYPE AND THICKNESS.
 - G. CONTRACTOR SHALL DESIGN & PROVIDE NECESSARY PINS, LUGS, HOLES FOR LIFTING & REMOVAL OF PINS FROM SHAFT SLOTS AND FOR HOLDING SHAFT IN PLACE.
 - H. ALL DIMENSIONS SHOWN ON THIS DRAWING ARE SUGGESTED DIMENSIONS ONLY. IF NEEDED, ADJUST DIMENSIONS AND SUBMIT TO ENGINEER FOR APPROVAL.
 - I. PROVIDE GROUT AND LEVELING NUTS AS NEEDED TO PROVIDE UNIFORM BEARING OF SIGN SUPPORT AGAINST THE EXISTING TUNNEL STRUCTURE. GROUT BEHIND PLATE NOT SHOWN IN DETAIL I THIS SHEET.
 - J. INCLINED BRACE IS APPROXIMATELY 2'-11" LONG.

Design File Name: DGN5SPCC
 Plot File Name: \$PLOTFILE\$
 Date of Plot: \$\$\$DATE\$\$\$

Computer File Information		Sheet Revisions		Colorado Department of Transportation		As Constructed		NORTH TUNNEL VMS SUPPORT SECTIONS AND DETAILS		Project No./Code	
Creation Date:	11/15/00	Initials:	HCM	07/03/07	ASBUILT						IM 0703-269
Last Modification Date:	12/04/03	Initials:	DJB								13166
Full Path:	14102\700CADD\713TRA\										Sheet Number
Drawing File Name:	SCP22.N.PLT										155
Acad Ver.	R14	Scale:	AS NOTED	Units:	ENGLISH						Sheet Subset: VMS
											Subset Sheets: 24 of 46

NOTES:

- A. FOR STRUCTURAL NOTES, SEE VMS SUBSET SHEET 22.
- B. COST OF TUNNEL LUS SIGN SUPPORT FRAME, ATTACHMENT, WIRING, NEW MEMBRANE, MOUNTING, CUTTING PANEL, CAULKING, AND RELATED MISC. ITEMS ARE INCLUDED IN COST OF TUNNEL LUS SIGN SUPPORT PAY ITEM.

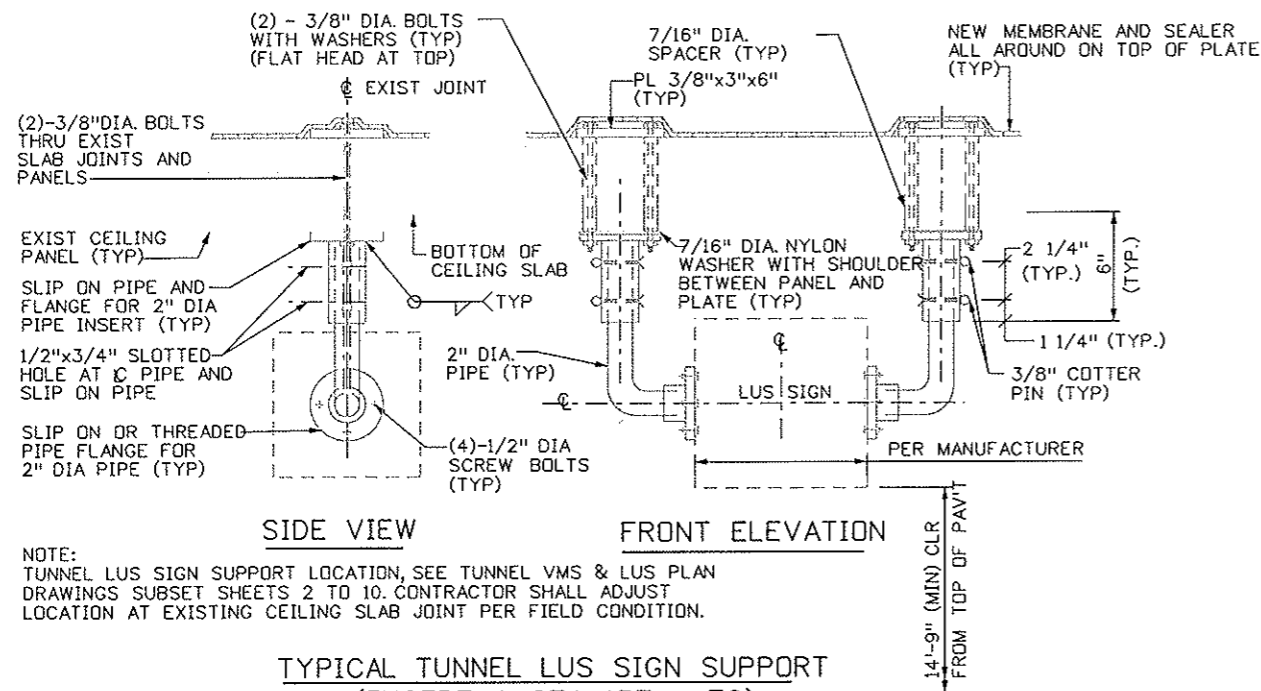

NOTE:
 TUNNEL LUS SIGN SUPPORT LOCATION, SEE TUNNEL VMS & LUS PLAN
 DRAWINGS SUBSET SHEETS 2 TO 10. CONTRACTOR SHALL ADJUST
 LOCATION AT EXISTING CEILING SLAB JOINT PER FIELD CONDITION.

TYPICAL TUNNEL LUS SIGN SUPPORT
 (EXCEPT @ STA. 137 + 72)


SCALE: NTS

Design File Name: DMSPEC*
 Plot File Name: SGPLOTFILE*
 Date of Plot: \$\$\$DATE\$\$\$

Computer File Information	
Creation Date:	11/15/00 Initials: HCM
Last Modification Date:	2/25/02 Initials: DJR
Full Path:	14102\700CADD\713TRA\
Drawing File Name:	SGP23.N.PLT
Acad Ver.	R14 Scale: AS NOTED Units: ENGLISH

Sheet Revisions	
<input type="checkbox"/>	07/03/07 ASBUILT DJB
<input type="checkbox"/>	
<input type="checkbox"/>	
<input type="checkbox"/>	

Colorado Department of Transportation






P.O. BOX 399
 DUMONT, CO. 80436
 Phone: 303-512-5750 FAX: 303-512-5775
 Region 1 Mountain Residency I.N.Z.

As Constructed
No Revisions:
Revised:
Void:

NORTH TUNNEL LUS SUPPORT MOUNTING BRACKET DETAILS	
Designer: NHP	Structure Numbers
Detailer: HCM	
Sheet Subset: VMS	Subset Sheets: 25 OF 46

Project No./Code
IM 0703-269
13166
Sheet Number 156

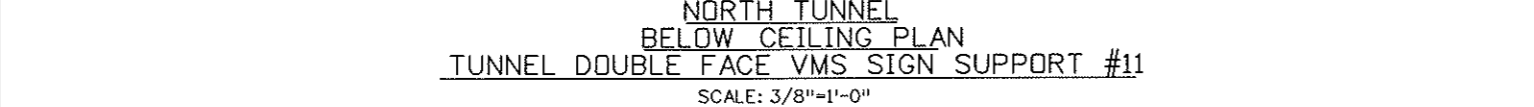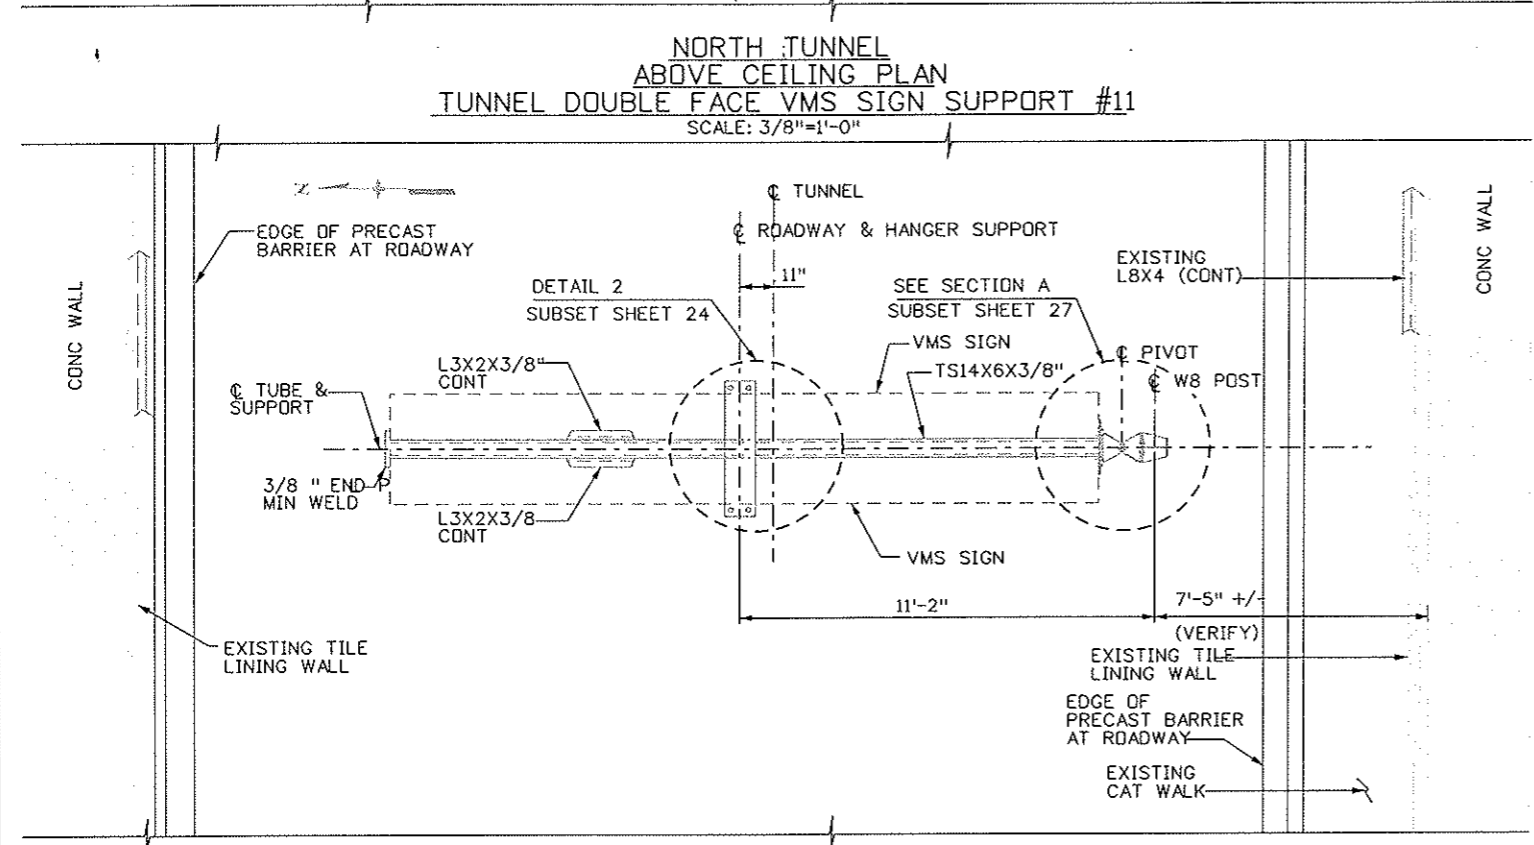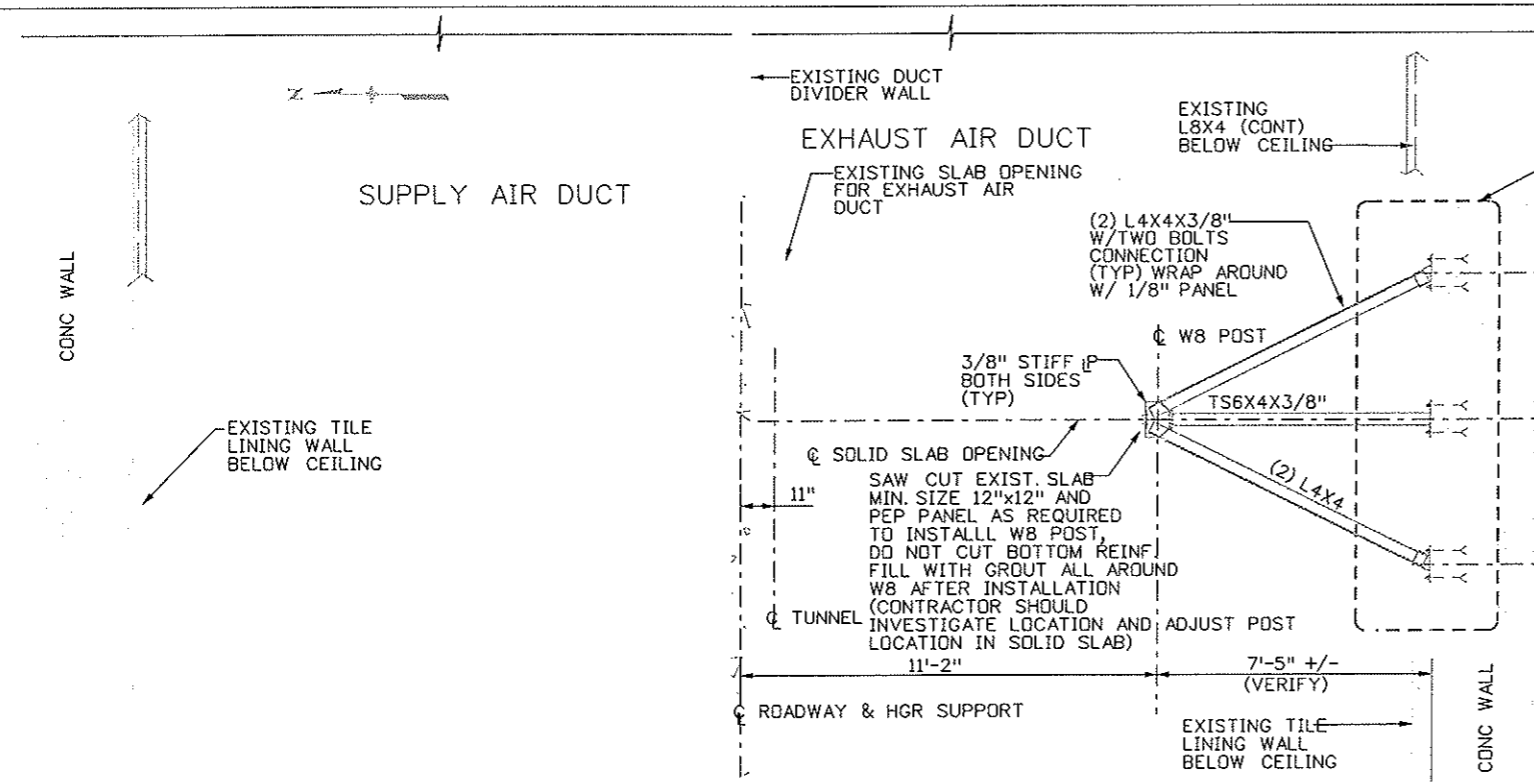

Computer File Information	
Creation Date:	11/15/00 Initials: HCM
Last Modification Date:	2/01/02 Initials: DJR
Full Path:	14102\700CADD\713TRA\
Drawing File Name:	SGP24.N.PLT
Acad Ver.	R14 Scale: AS NOTED Units: ENGLISH





Sheet Revisions	
07/03/07	ASBUILT DJB

Colorado Department of Transportation
 P.O. BOX 399
 DUMONT, CO. 80436
 Phone: 303-512-5750 FAX: 303-512-5775
 Region 1 Mountain Residency I.N.Z.

As Constructed
 No Revisions:
 Revised:
 Void:


NORTH TUNNEL VMS SUPPORT PLANS AND SECTIONS	
Designer:	NHP
Detailer:	HCM
Sheet Subset:	VMS
Structure Numbers:	
Subset Sheets:	26 OF 46

Project No./Code	
IM 0703-269	
13166	
Sheet Number	157

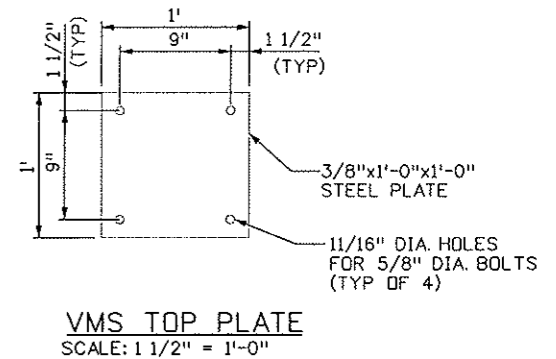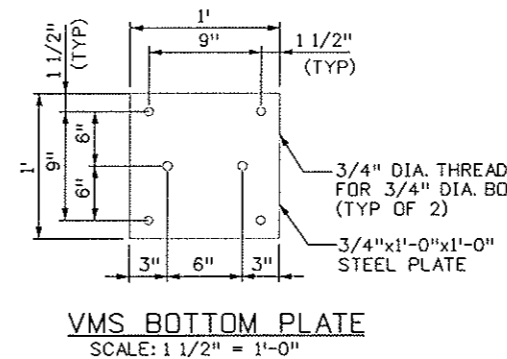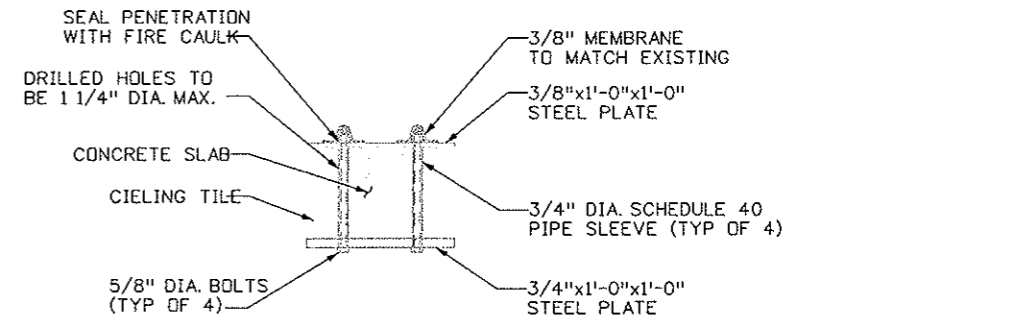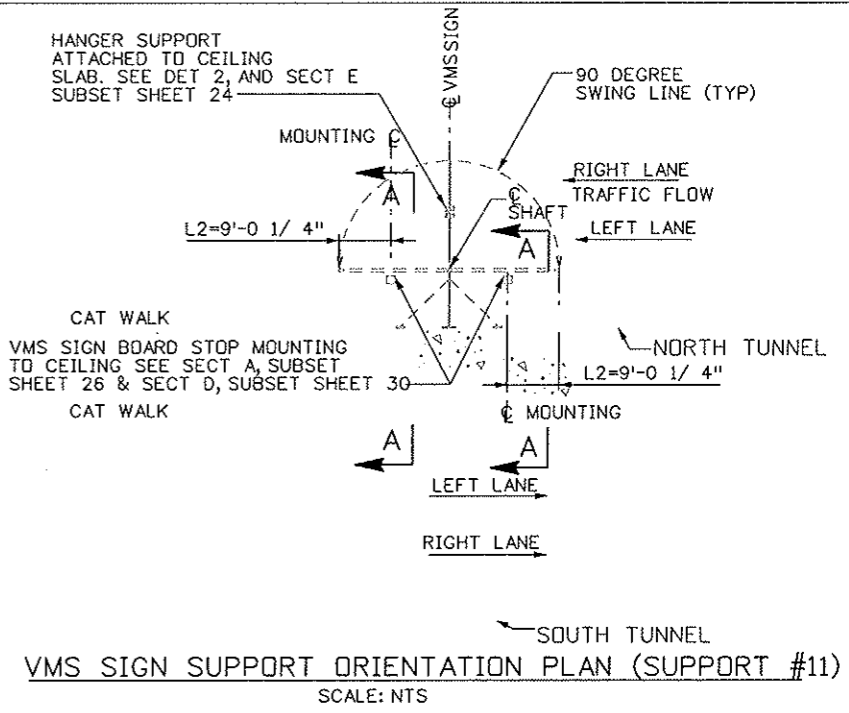


NOTES:
 A. FOR STRUCTURAL NOTES, SEE VMS SUBSET SHEET 22, 23 & 24.
 B. FOR TUNNEL DOUBLE FACE VMS SIGN SUPPORT ELEVATION AND MOUNTING DETAILS SEE SUBSET SHEET 27.


Design File Name: DGN\SPEC\...
 Plot File Name: SPC\PLTFILE\...
 Date of Plot: 3/30/01 13:33

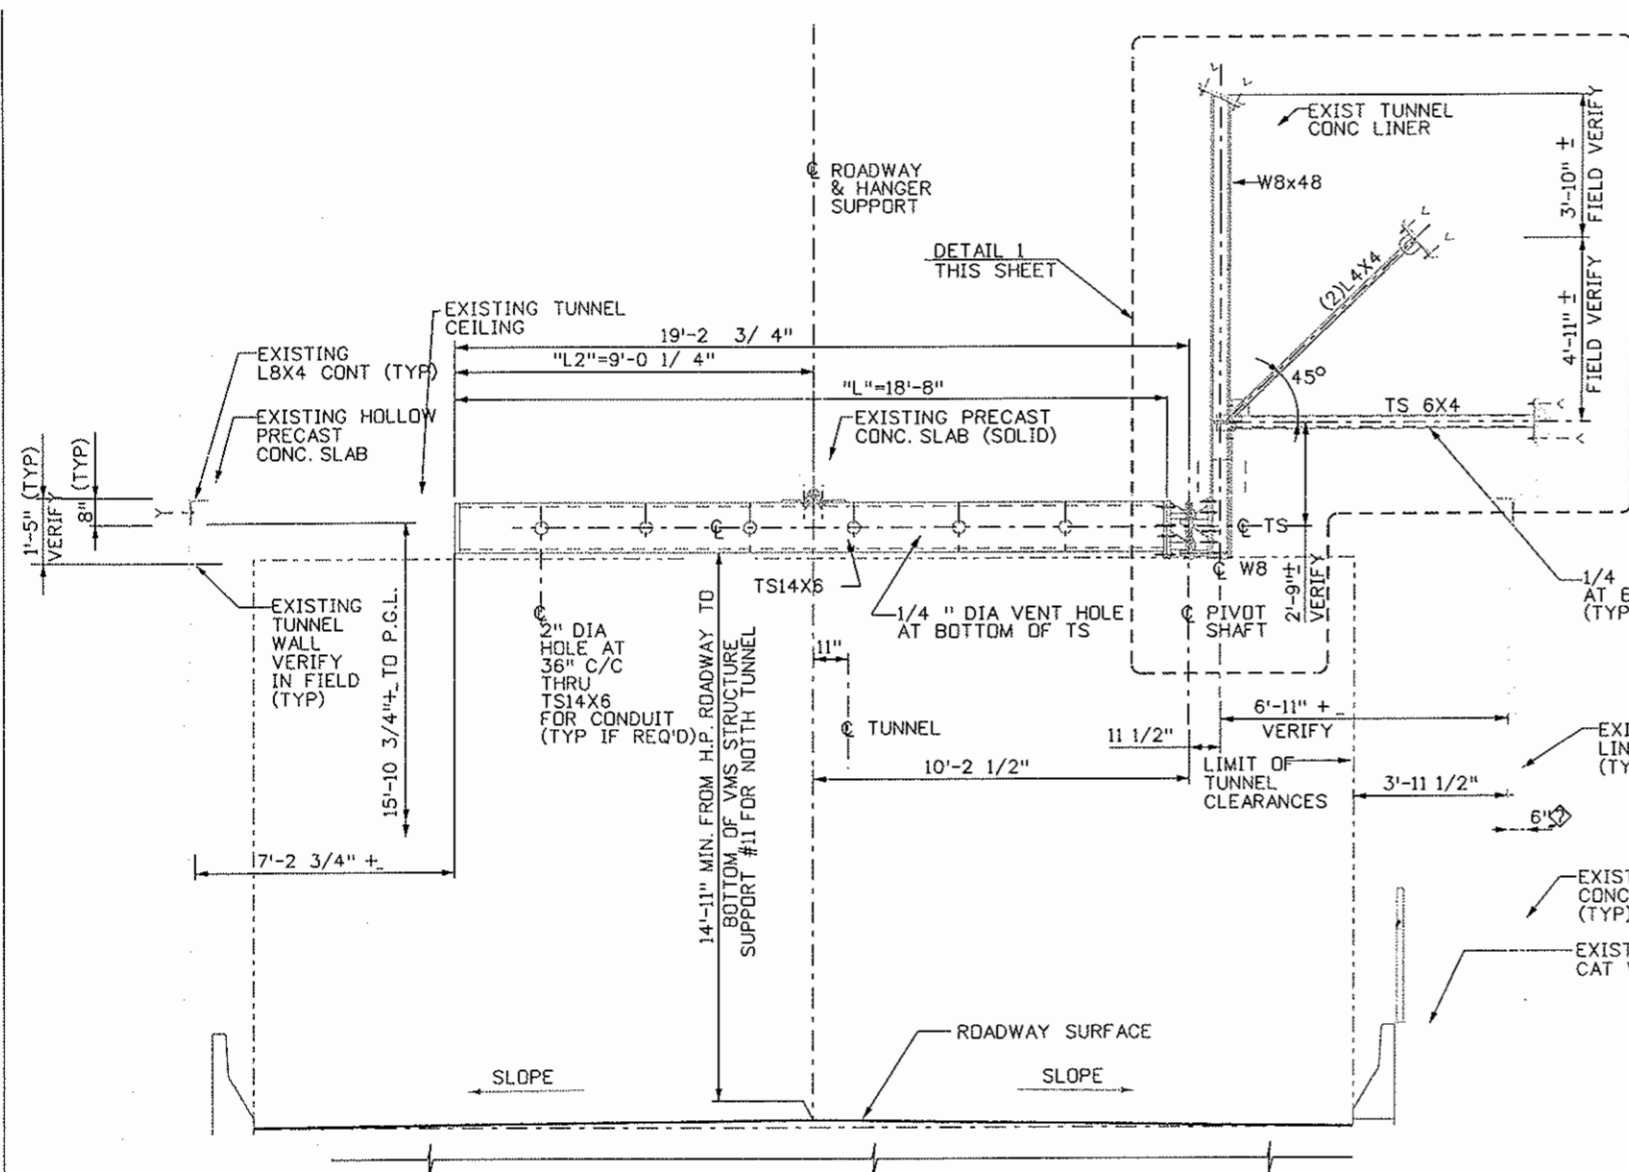


ELEVATION
TUNNEL DOUBLE FACE VMS SIGN SUPPORT #11
NORTH TUNNEL - LOOKING EAST
SCALE: 3/8"=1'-0"

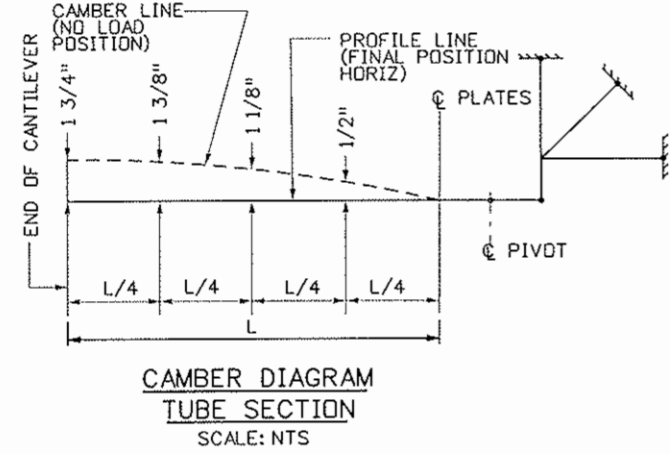

CAMBER DIAGRAM
TUBE SECTION
SCALE: NTS

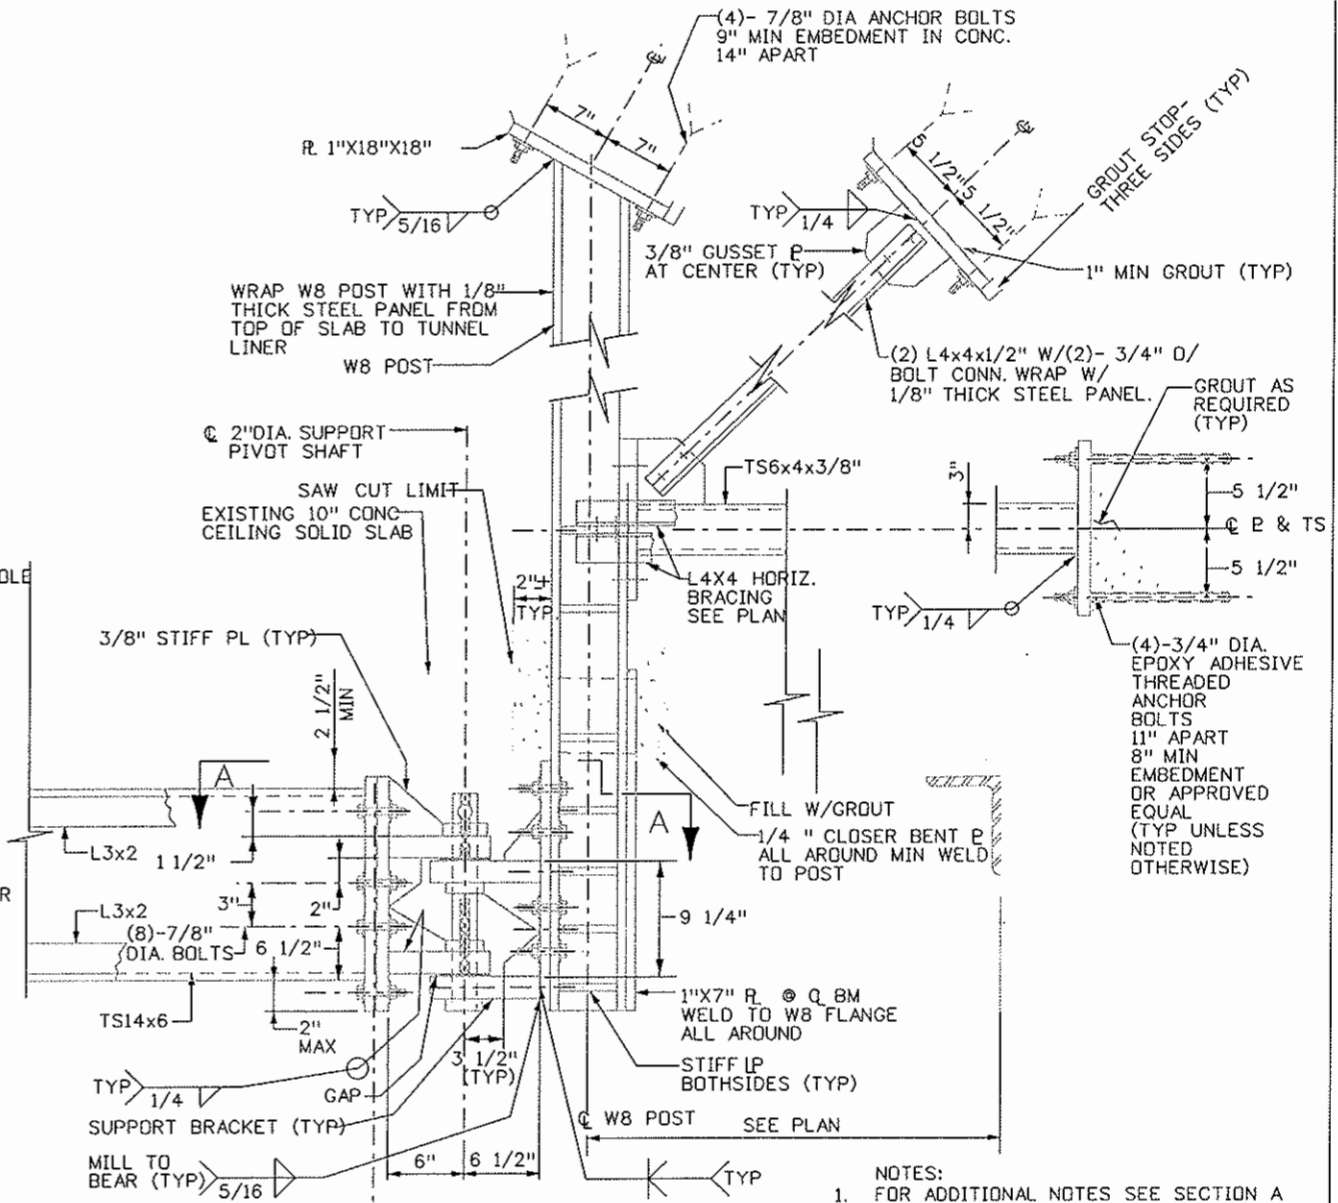

DETAIL 1
SCALE: NTS

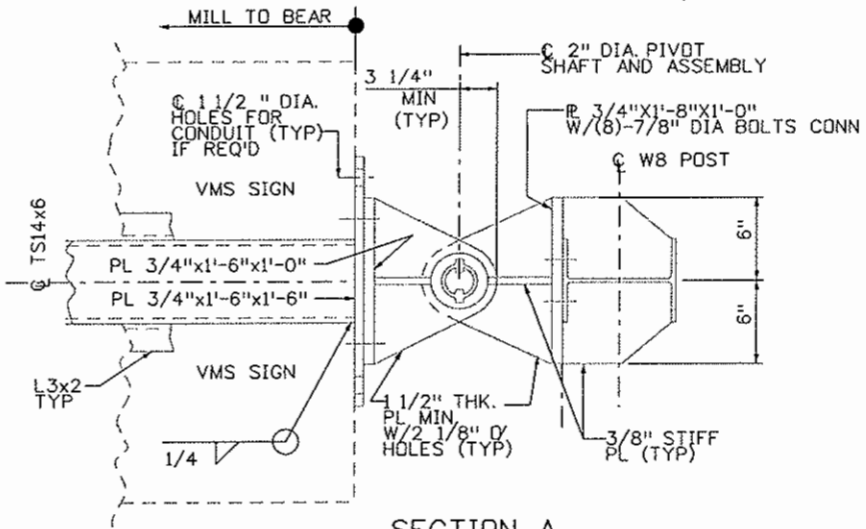

SECTION A
SCALE: NTS

- NOTES:
- FOR ADDITIONAL NOTES SEE SECTION A ON SUBSET SHEET 24.
 - THICKNESS OF TOP BEARING PAD SHALL BE 1/16" THICKER THAN BOTTOM PAD FOR OPERATIONAL GAP.
 - SEE NOTE # "H" ON SUBSET SHEET 24.
 - REMOVE AND RELOCATE ALL OBSTRUCTION WITH APPROVAL OF ENGINEER AT NO ADDITIONAL COST.


- NOTES:
- FOR STRUCTURAL NOTES, SEE VMS SUBSET SHEET 22, 23 & 24.
 - WORK THIS SHEET WITH SUBSET SHEET 26.

Design File Name: D0N5SPEC*
 Plot File Name: SGPLOTFILE*
 Date of Plot: \$\$\$SCATESSSS

Computer File Information	
Creation Date:	11/15/00 Initials: HCM
Last Modification Date:	2/04/02 Initials: DJR
Full Path:	14102\700CADD\713TRAN
Drawing File Name:	SGP25.N.PLT
Acad Ver.	R14 Scale: AS NOTED Units: ENGLISH

Sheet Revisions		
07/03/07	ASBUILT	DJB

Colorado Department of Transportation




P.O. BOX 399
DUMONT, CO. 80436
Phone: 303-512-5750 FAX: 303-512-5775

Region 1 Mountain Residency I.N.Z.

As Constructed
No Revisions:
Revised:
Void:

NORTH TUNNEL VMS SUPPORT ELEVATION AND DETAILS	
Designer:	NHP
Detailer:	HCM
Sheet Subset:	VMS
Structure Numbers:	
Subset Sheets:	27 of 46

Project No./Code
IM 0703-269
13166
Sheet Number 158

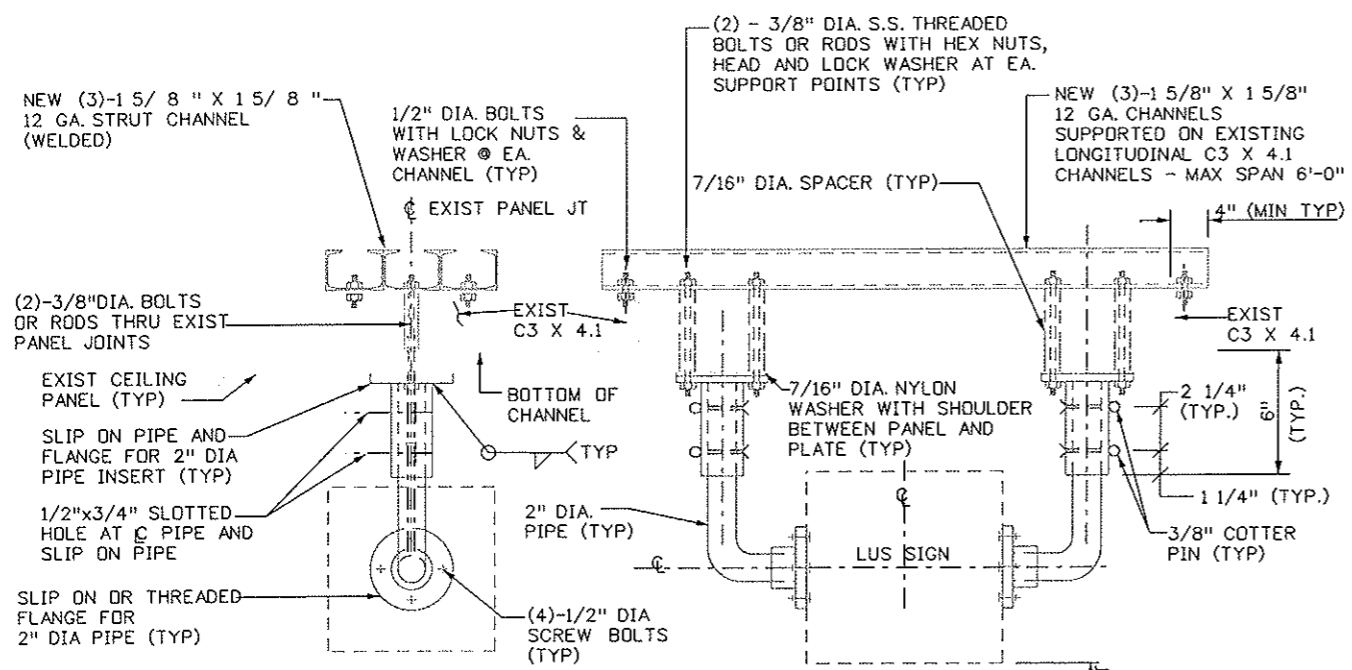


SIDE VIEW FRONT ELEVATION

- NOTES:
- A. TUNNEL LUS SIGN SUPPORT LOCATION, SEE TUNNEL VMS & LUS PLAN DRAWINGS SUBSET SHEETS 2 TO 10. CONTRACTOR SHALL ADJUST LOCATION AT EXISTING CEILING SLAB JOINT PER FIELD CONDITION.
 - B. FOR LUS POWER AND COMMUNICATION CONDUIT CONNECTION DETAILS, SEE LUS SIGN FACE LAYOUT & POWER CONNECTION DETAILS ON SUBSET SHEET 20.

TYPICAL TUNNEL LUS SIGN SUPPORT (AT STA. 137 +72) SCALE: NTS

- NOTES:
- A. REMOVAL OF CONCRETE AND CUTOUT PANELS FOR BLOCKOUT TO BE IN ACCORDANCE WITH CDOT SPEC. SECTION 202. THE PERIMETER OF THE BLOCKOUT SHALL BE SAWED TO A MINIMUM OF 3 INCHES BEFORE REMOVING CONCRETE. DO NOT CUT OR REMOVE EXISTING CONDUIT PIPES OR REINFORCEMENT. WATERPROOFING SEALANT SHALL BE APPLIED TO ALL CURED CONCRETE TUNNEL SURFACES AND TILE PANEL SURFACES/EDGES.
 - B. NOT USED.
 - C. WORK ASSOCIATED FOR THE CONTROLLER CABINET SHALL BE COORDINATED WITH SHEET # 29.
 - D. CONTRACTOR SHALL BE RESPONSIBLE TO DESIGN AND PROVIDE PROPER ANCHORING OF GLAZED TILE PANEL TO EXISTING CONCRETE TUNNEL LINER AFTER CUTOUT OF THE TILE PANEL. PROVIDE TEMPORARY SUPPORT TO GLAZED TILE PANEL AT THE TIME OF CUTOUT. FOR DESIGN PARAMETERS AND CONNECTION DETAILS (SIM.) SEE EXISTING PANEL REPLACEMENT PROJECT DRAWINGS FOR NORTH TUNNEL, PREPARED BY PARSONS DE LEUW, INC. 1993. ALL PANEL CUTOUT AND SUPPORT SHOP DRAWINGS SHALL BE SUBMITTED TO THE ENGINEER FOR APPROVAL.
 - E. FOR CONTROLLER CABINET LOCATION, SEE SHEET 2 THRU 10.
 - F. NOT USED.
 - G. COST OF REMOVAL OF CONCRETE, CUT OUT OF EXISTING GLAZED TILE PANELS, SECURING TILE PANELS WITH NEW ADDITIONAL ANCHORING, PLUGGING FLUES, SHELF, INSTALLATION OF COMPLETE CONTROL CABINET, WATER PROOFING, SEALING, MISC. STEEL, SHIMS, REINFORCEMENT, MORTAR JOINTS AND RELATED MISC. ITEMS ARE INCLUDED IN THE COST OF CONTROL CABINET PAY ITEMS.

FOR ENCLOSURE DETAILS SEE VMS SUBSET SHEET 29

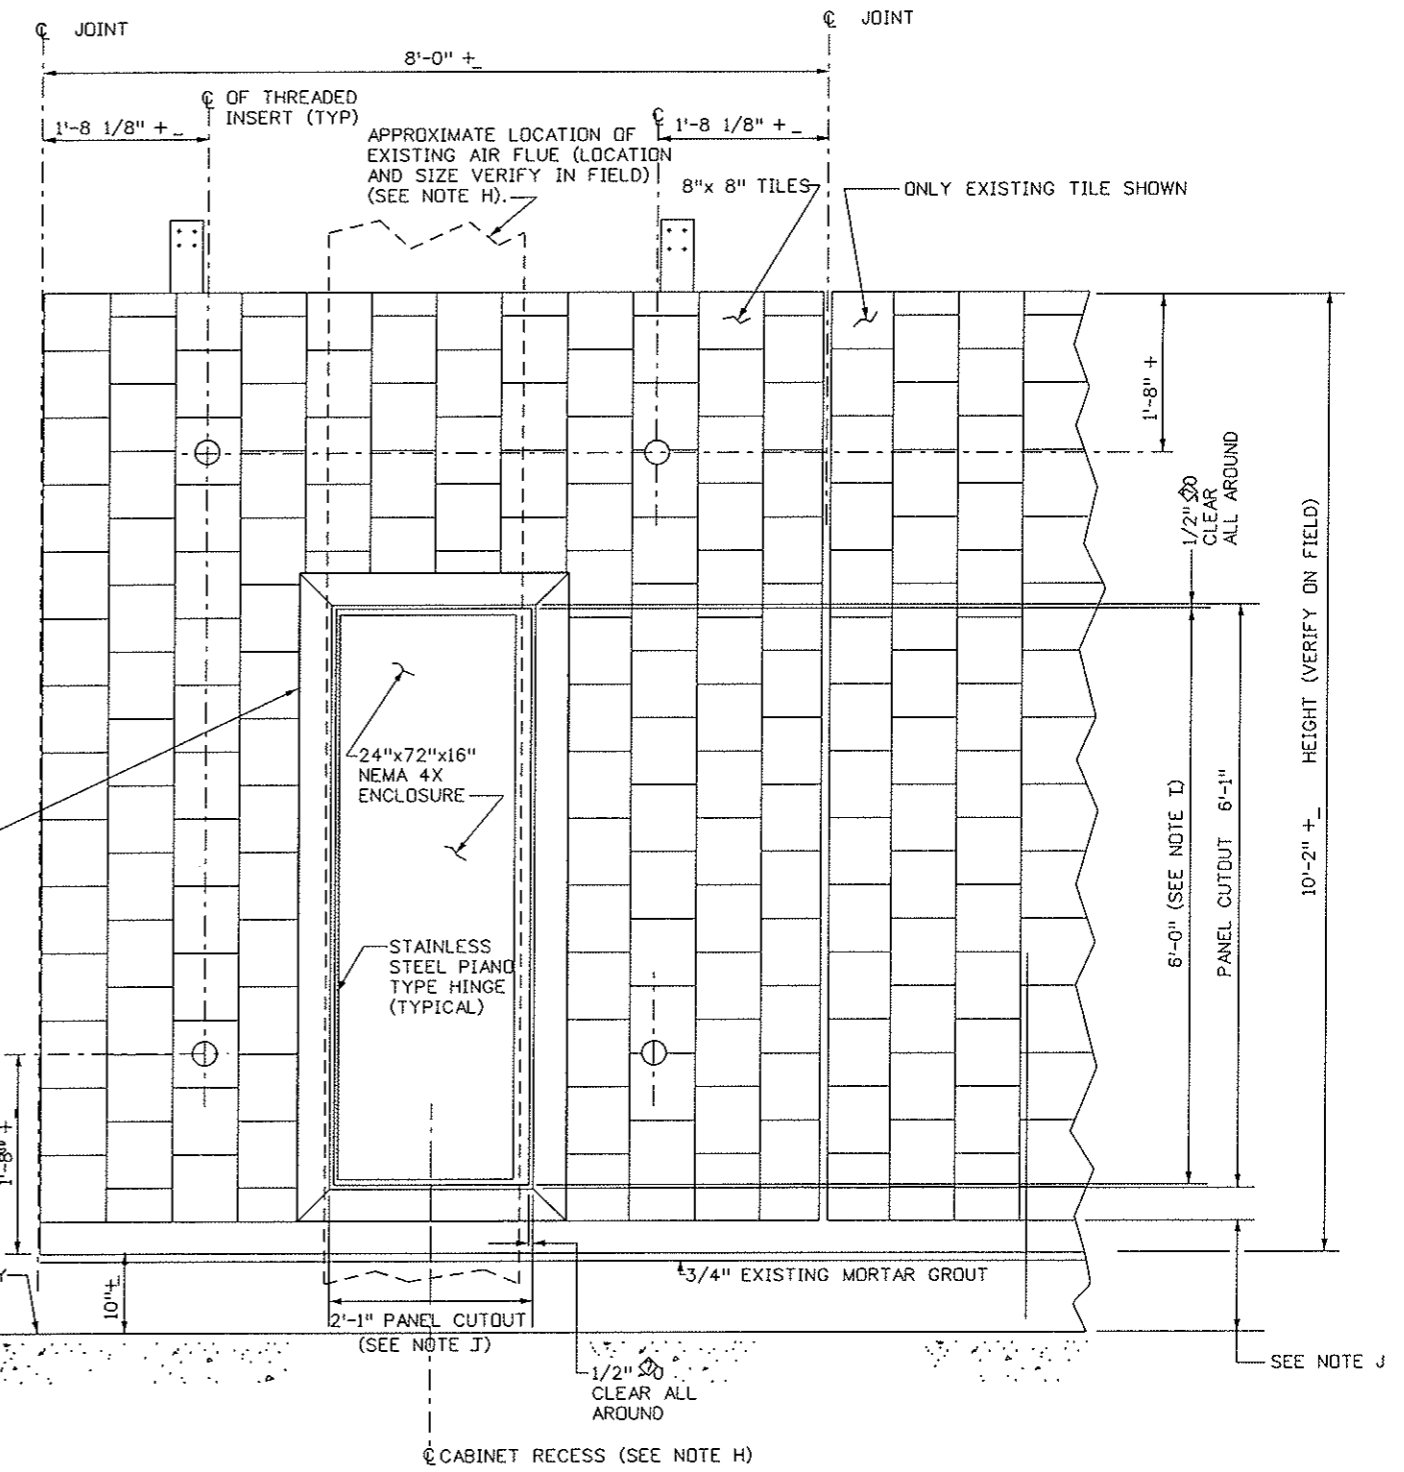


ELEVATION NORTH TUNNEL-SOUTH WALL CUTOUT GLAZED TILE PANELS FOR RECESS OF CONTROLLER CABINET SCALE: NTS

Design File Name: 00NSPEC*
 Plot File Name: 3PL01FILE*
 Date of Plot: 0000DATE3333

Computer File Information	
Creation Date:	11/15/00 Initials: HCM
Last Modification Date:	2/04/02 Initials: DJR
Full Path:	14102\700CADD\713TRA\
Drawing File Name:	SGP26.N.PLT
Acad Ver.	R14 Scale: AS NOTED Units: ENGLISH

Sheet Revisions		
07/03/07	ASBUILT	DJB

Colorado Department of Transportation






P.O. BOX 399
 DUMONT, CO. 80436
 Phone: 303-512-5750 FAX: 303-512-5775

Region 1 Mountain Residency I.N.Z.

As Constructed
No Revisions:
Revised:
Void:


NORTH TUNNEL CONTROLLER CABINET- ELEVATION	
Designer: NHP	Structure Numbers:
Detailer: HCM	
Sheet Subset: VMS	Subset Sheets: 28 OF 46

Project No./Code
IM 0703-269
13166
Sheet Number 159

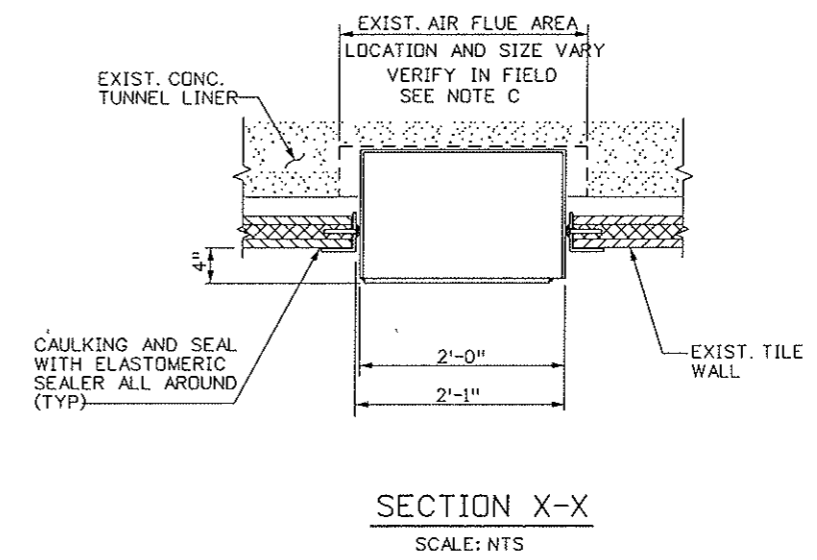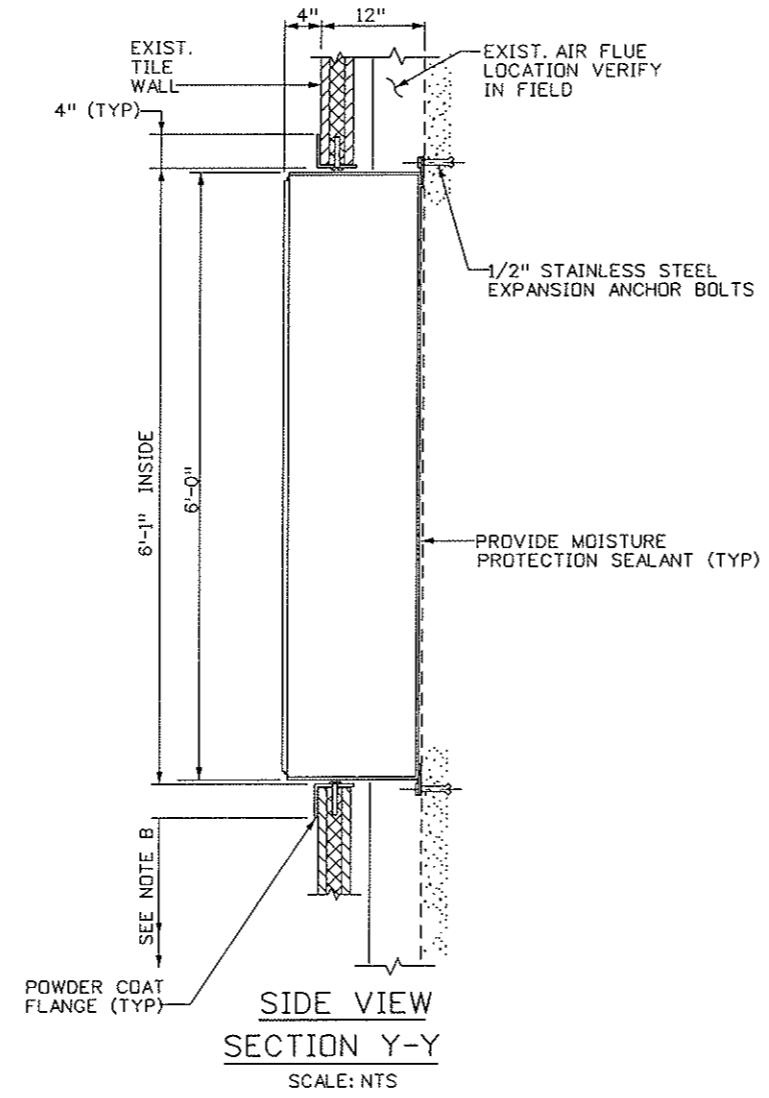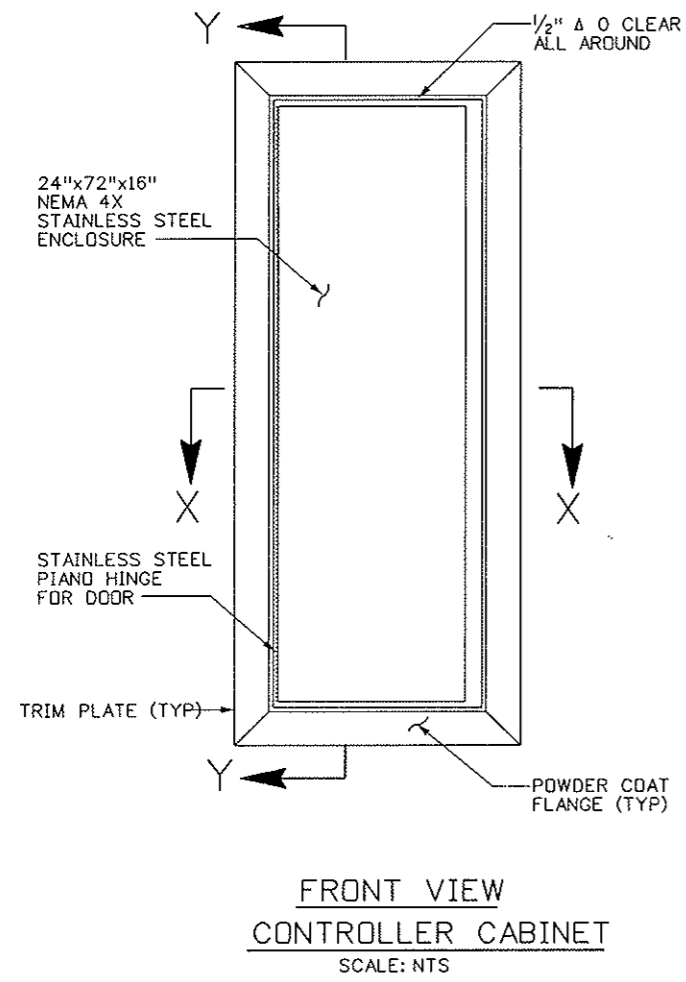

- NOTES:
- A. ALL AFFECTED AIR VENTILATION FLUES WILL BE PLUGGED WITH 4" THICK ELASTOMERIC COMPRESSION SEAL OR APPROVED EQUAL WATERTIGHT PLUG SEAL IN THE AIR FLUE AREA. ALL PLUGGED MATERIAL WILL BE SUPPORTED BY STEEL BENT PLATE OR ANGLE ATTACHED TO EXISTING CONCRETE SURFACE. PROVIDE PLUGGING DETAILS WITH LAYOUT PLAN TO THE ENGINEER FOR APPROVAL. PLUGGING FLUES WILL NOT BE PAID FOR SEPARATELY BUT IT WILL BE INCLUDED IN THE COST OF THE CONTROLLER CABINET WORK.
 - B. FOR MOUNTING HEIGHT ABOVE WALKWAY SEE SUBSET VMS SHEET NO. 28
 - C. CHIPPING OUT OF CONCRETE AT FLUE LOCATION IS REQUIRED AT LOCATIONS TO BE DETERMINED IN THE FIELD. SEE SPECIAL PROVISION 614.1530

Computer File Information		Sheet Revisions		Colorado Department of Transportation		As Constructed		NORTH TUNNEL CONTROLLER CABINET DETAILS		Project No./Code	
Creation Date:	11/15/00	Initials:	HCM	07/03/07	ASBUILT			IM 0703-269		13166	
Last Modification Date:	03/06/07	Initials:	DJR							Sheet Number	
Full Path:	14102\800Deliv\AsBuilt\							Designer: NHP		Structure Numbers	
Drawing File Name:	SGP27N							Detailer: HCM		Subset Sheets: 29 OF 46	
Acad Ver.	R14	Scale:	AS NOTED	Units:	ENGLISH			Sheet Subset: VMS		Sheet Number 160	

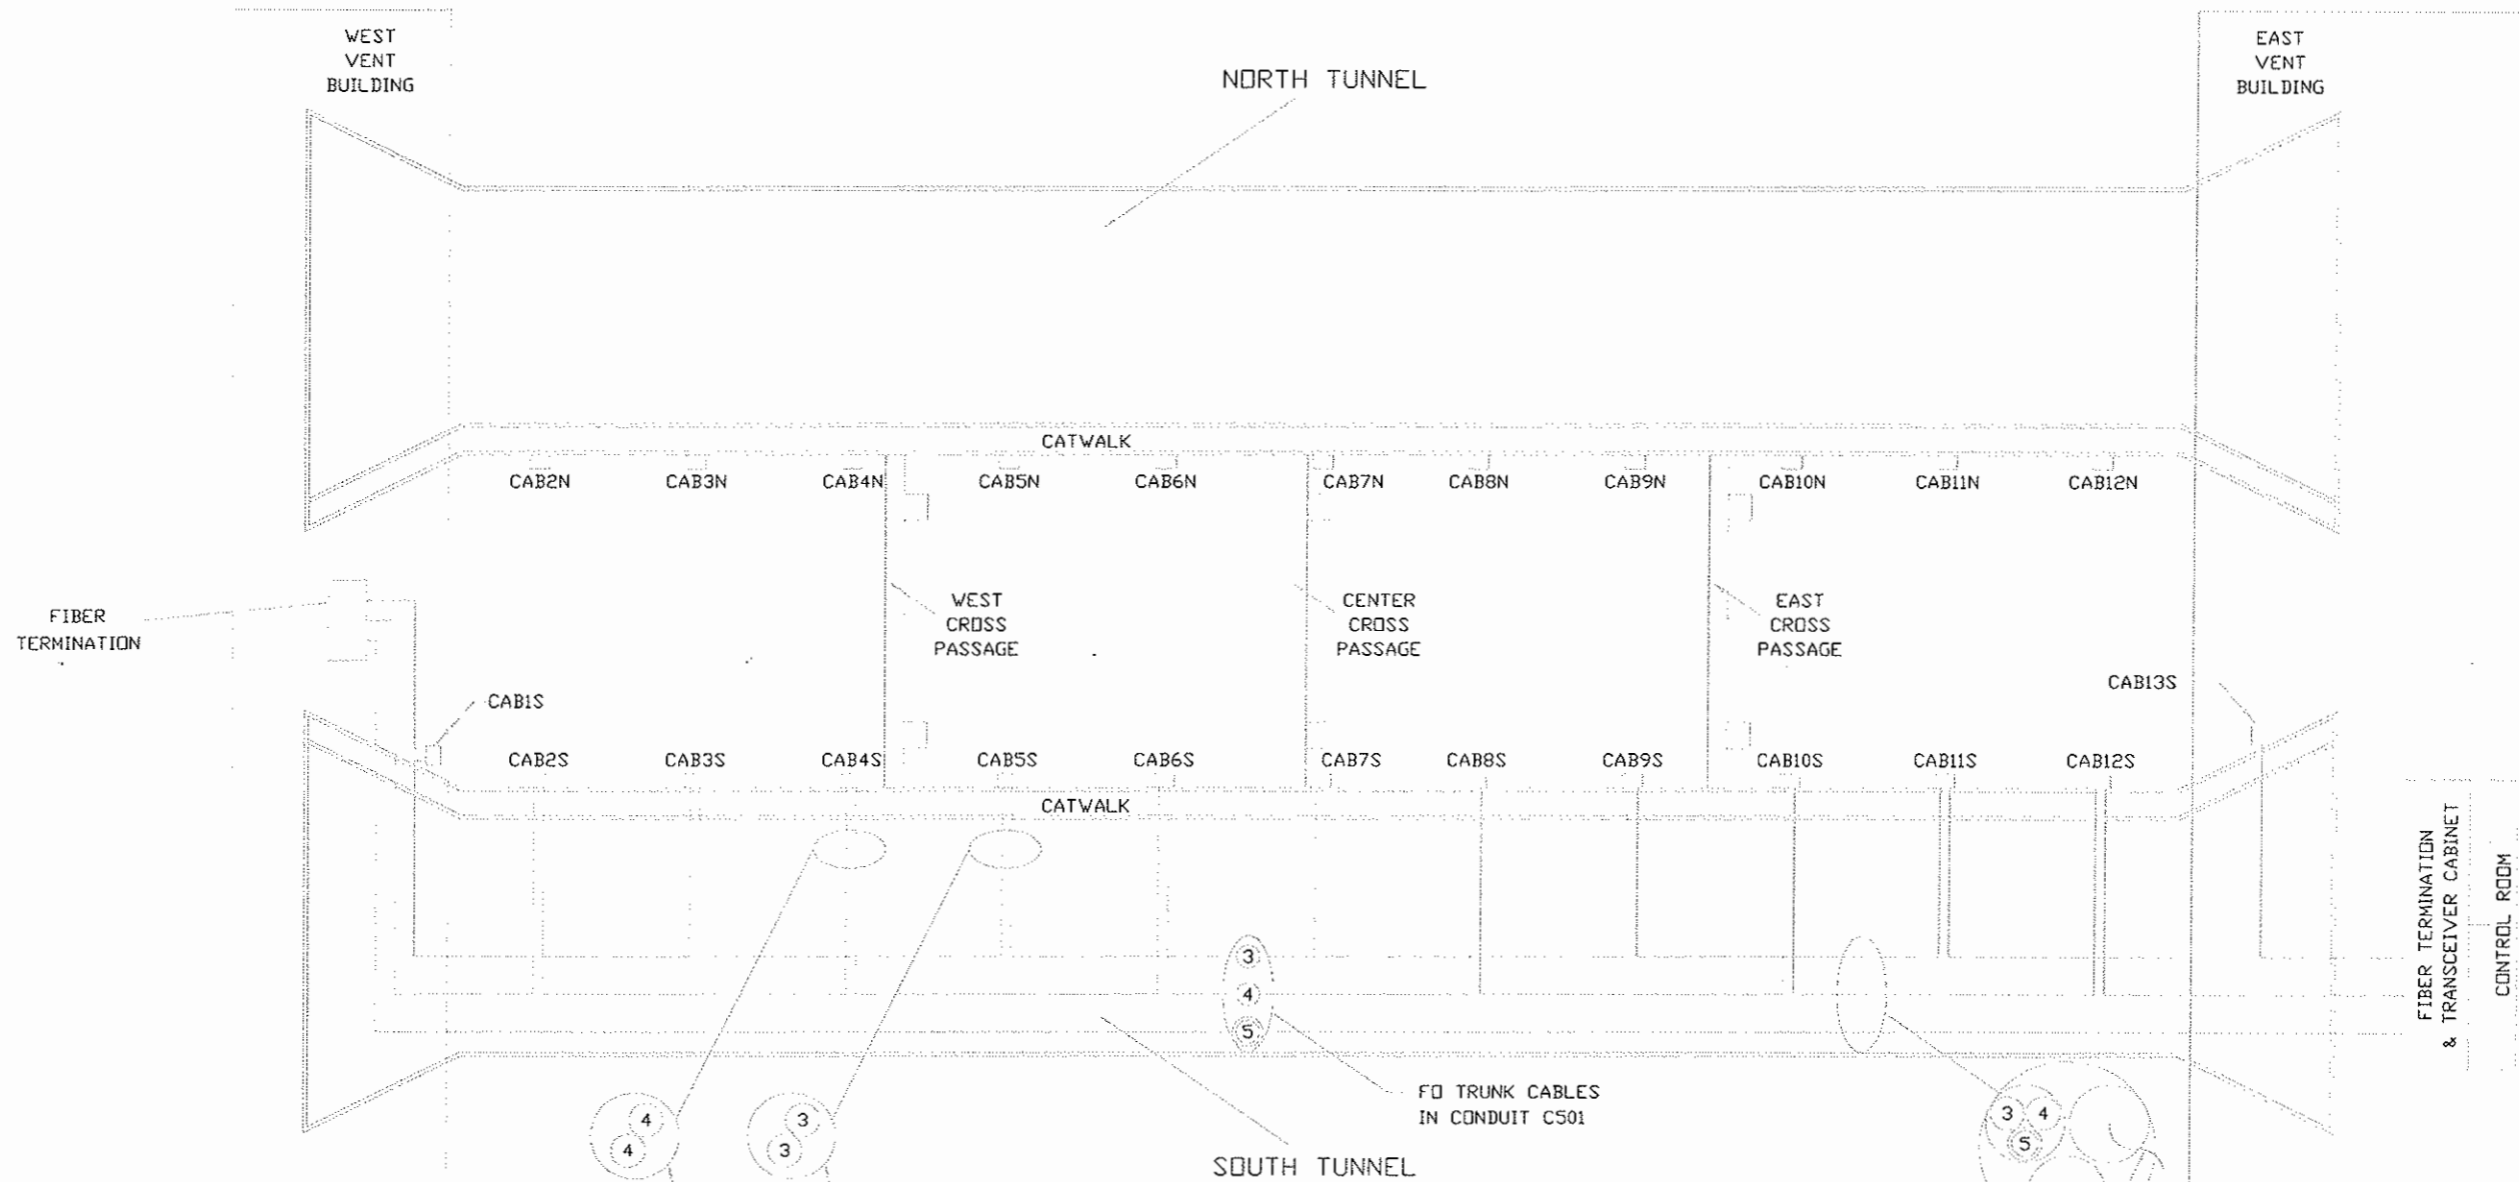

LEGEND:

- FD - FIBER OPTIC
- OR - TERMINATION PANELS
- ③ & ④ - 6-FIBER FD TRUNK CABLES
- ⑤ - 12-FIBER FD TRUNK CABLE
- CAB1S TO CAB13S, CAB1N TO CAB13N - CONTROLLER CABINETS
- C502 1-1 1/2' CONDUIT
- C501 1-3' CONDUIT

FOR REFERENCE ONLY

Design File Name: VMS-31.DWG
 Plot File Name: 2/6/02
 Date of Plot:

Computer File Information

Creation Date: 07/14/99 Initials: PWM
 Last Modification Date: 2/6/02 Initials: PWM
 Full Path: VMS-31.DWG
 Drawing File Name: VMS-31.DWG
 Acad Ver. R14 Scale: NTS Units: ENGLISH

Sheet Revisions

07/03/07	ASBUILT	DJB
----------	---------	-----

Colorado Department of Transportation



P.O. BOX 399
 DUMONT, CO. 80436
 Phone: 303-512-5750 FAX: 303-512-5775
 Region 1 Mountain Residency I.N.Z.

As Constructed


No Revisions:
 Revised:
 Void:

EXISTING VMS/LUS FIBER TRUNK

Designer: J. MANCINELLI
 Detailer: P. MEYDRECH
 Sheet Subset: VMS
 Structure Numbers
 Subset Sheets: 30 OF 46

Project No./Code

IM 0703-269
 13166
 Sheet Number 161

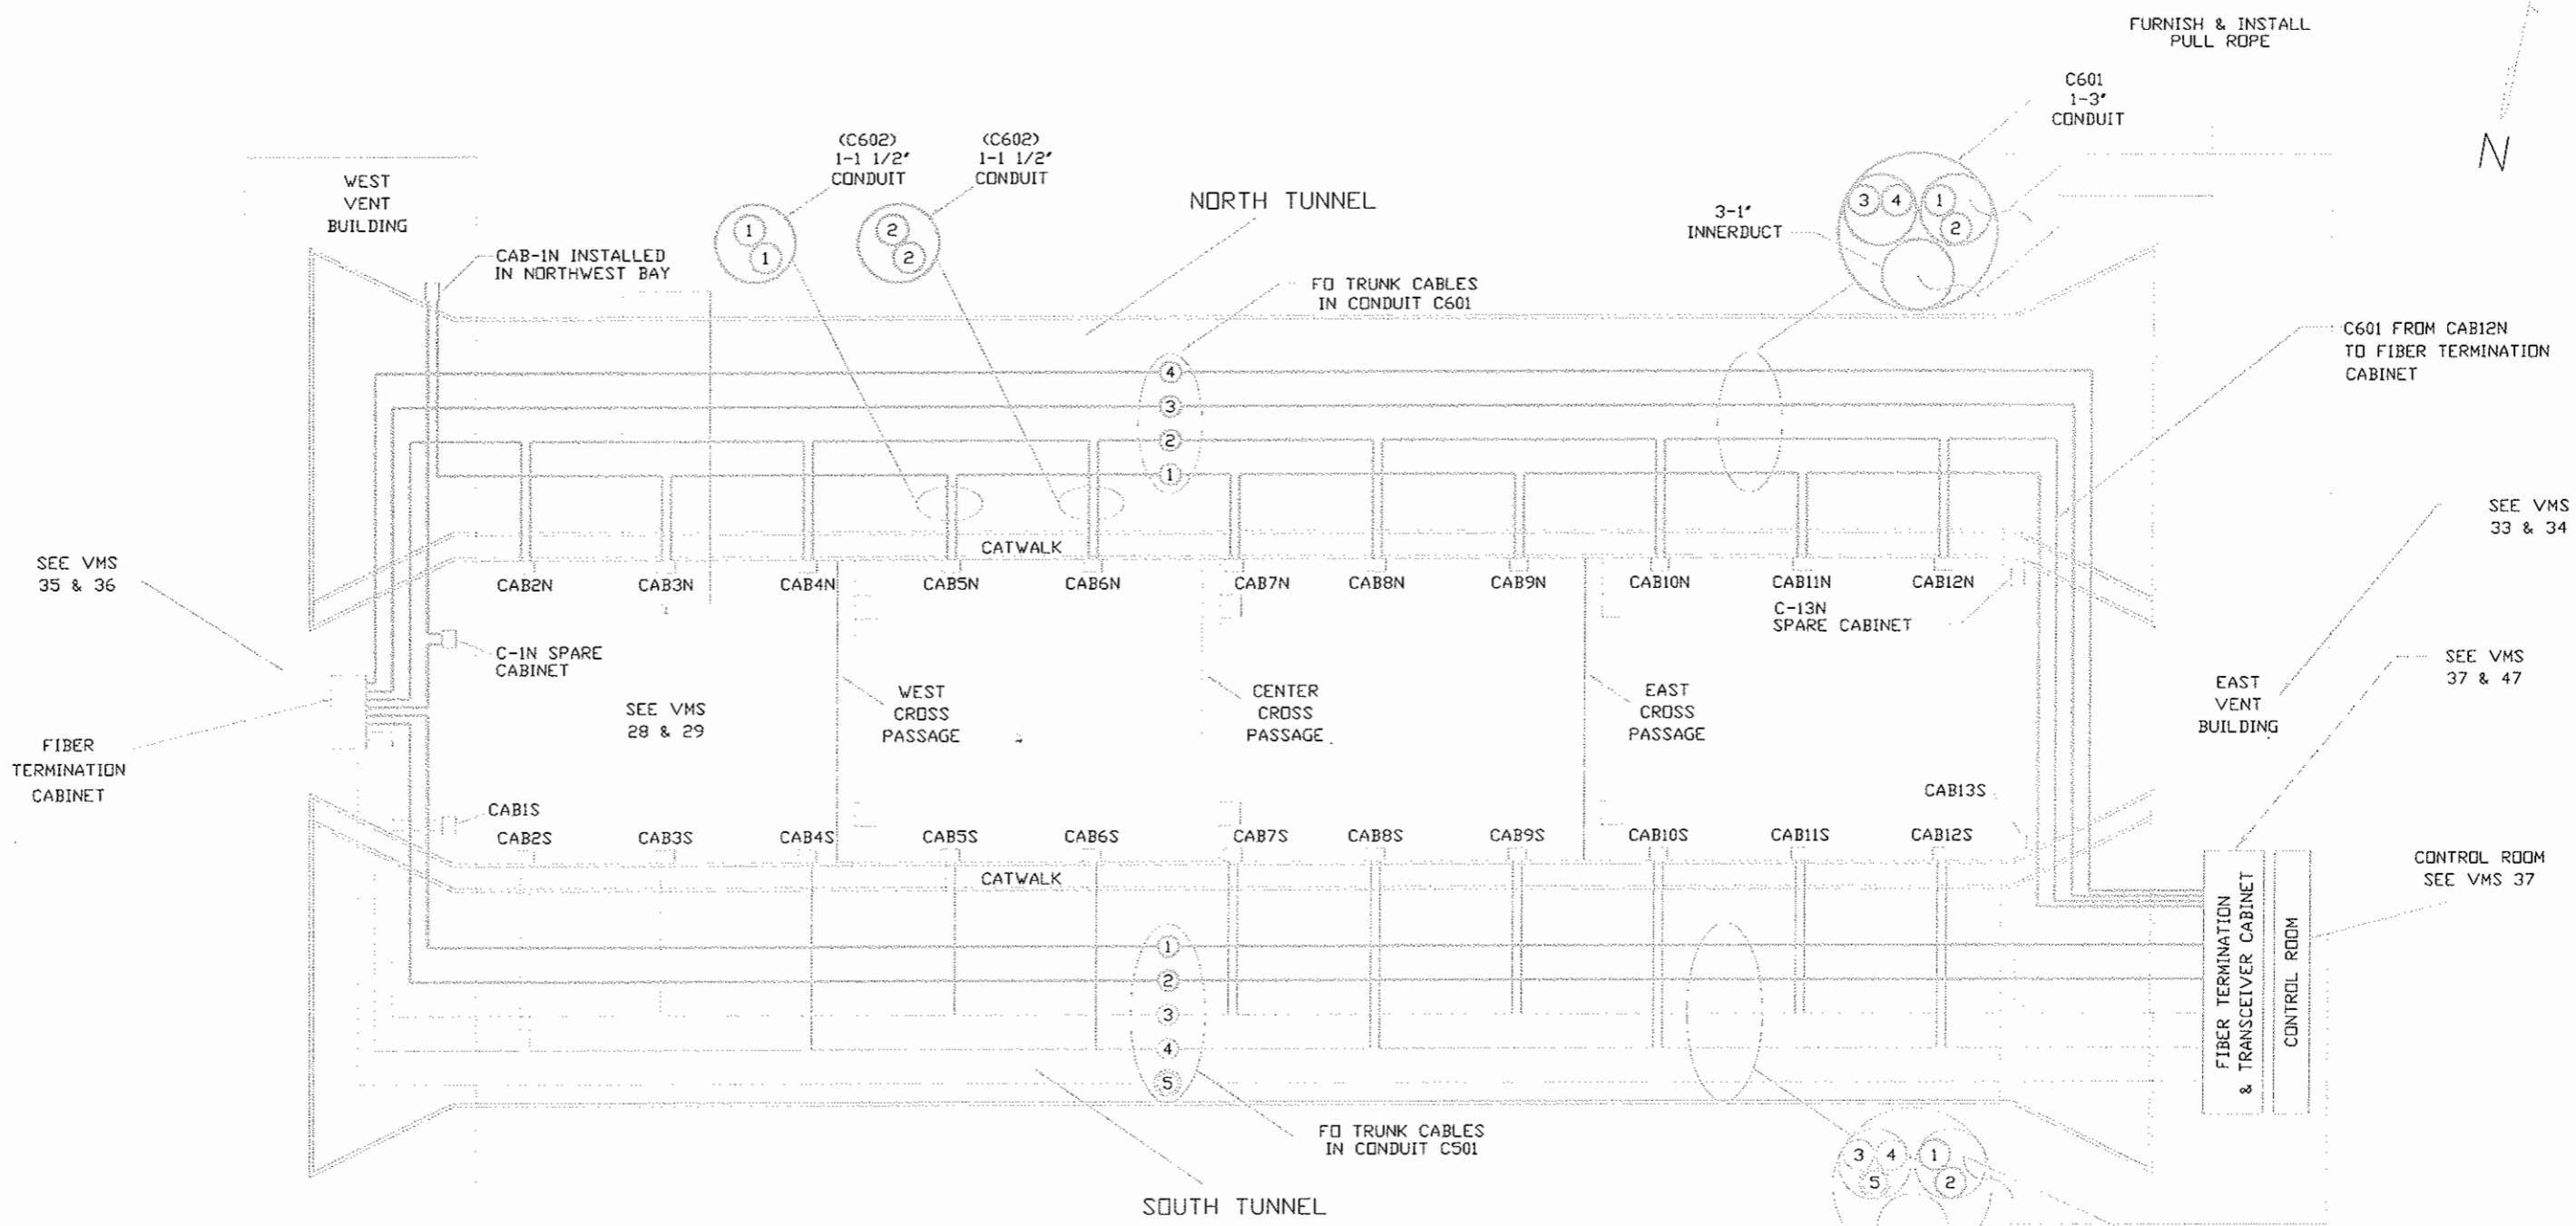

LEGEND:

- FD - FIBER OPTIC
- EXISTING FIBER RUNS
- - - NEW FIBER RUNS
- DR □ - TERMINATION PANELS
- ③ ④ - EXISTING 6-FIBER FD TRUNK CABLES
- ⑤ - EXISTING 12-FIBER FD TRUNK CABLE
- ① ② ③ ④ - NEW 6-FIBER FD TRUNK CABLES

CAB1N TO CAB13N, CAB1S TO CAB13S - CONTROLLER CABINETS

Computer File Information

Creation Date: 07/14/99 Initials: PWM
 Last Modification Date: 02/27/07 Initials: PWM
 Full Path: VMS-32.DWG
 Drawing File Name: VMS-32.DWG
 Acad Ver. R14 Scale: NTS Units: ENGLISH

Sheet Revisions

07/03/07	ASBUILT	DJB

Colorado Department of Transportation



P.O. BOX 399
 DUMONT, CO. 80436
 Phone: 303-512-5750 FAX: 303-512-5775

Region 1 Mountain Residency I.N.Z.

As Constructed

No Revisions:
 Revised:
 Void:

**VMS/LUS
 FIBER TRUNK PLAN**


Designer: J. MANCINELLI
 Detailer: P. MEYDRECH
 Sheet Subset: VMS

Structure Numbers:
 Subset Sheets: 31 OF 46


Project No./Code

IM 0703-269
 13166
 Sheet Number 162

Design File Name: VMS-32.DWG
 Plot File Name: 2/16/02
 Date of Plot:

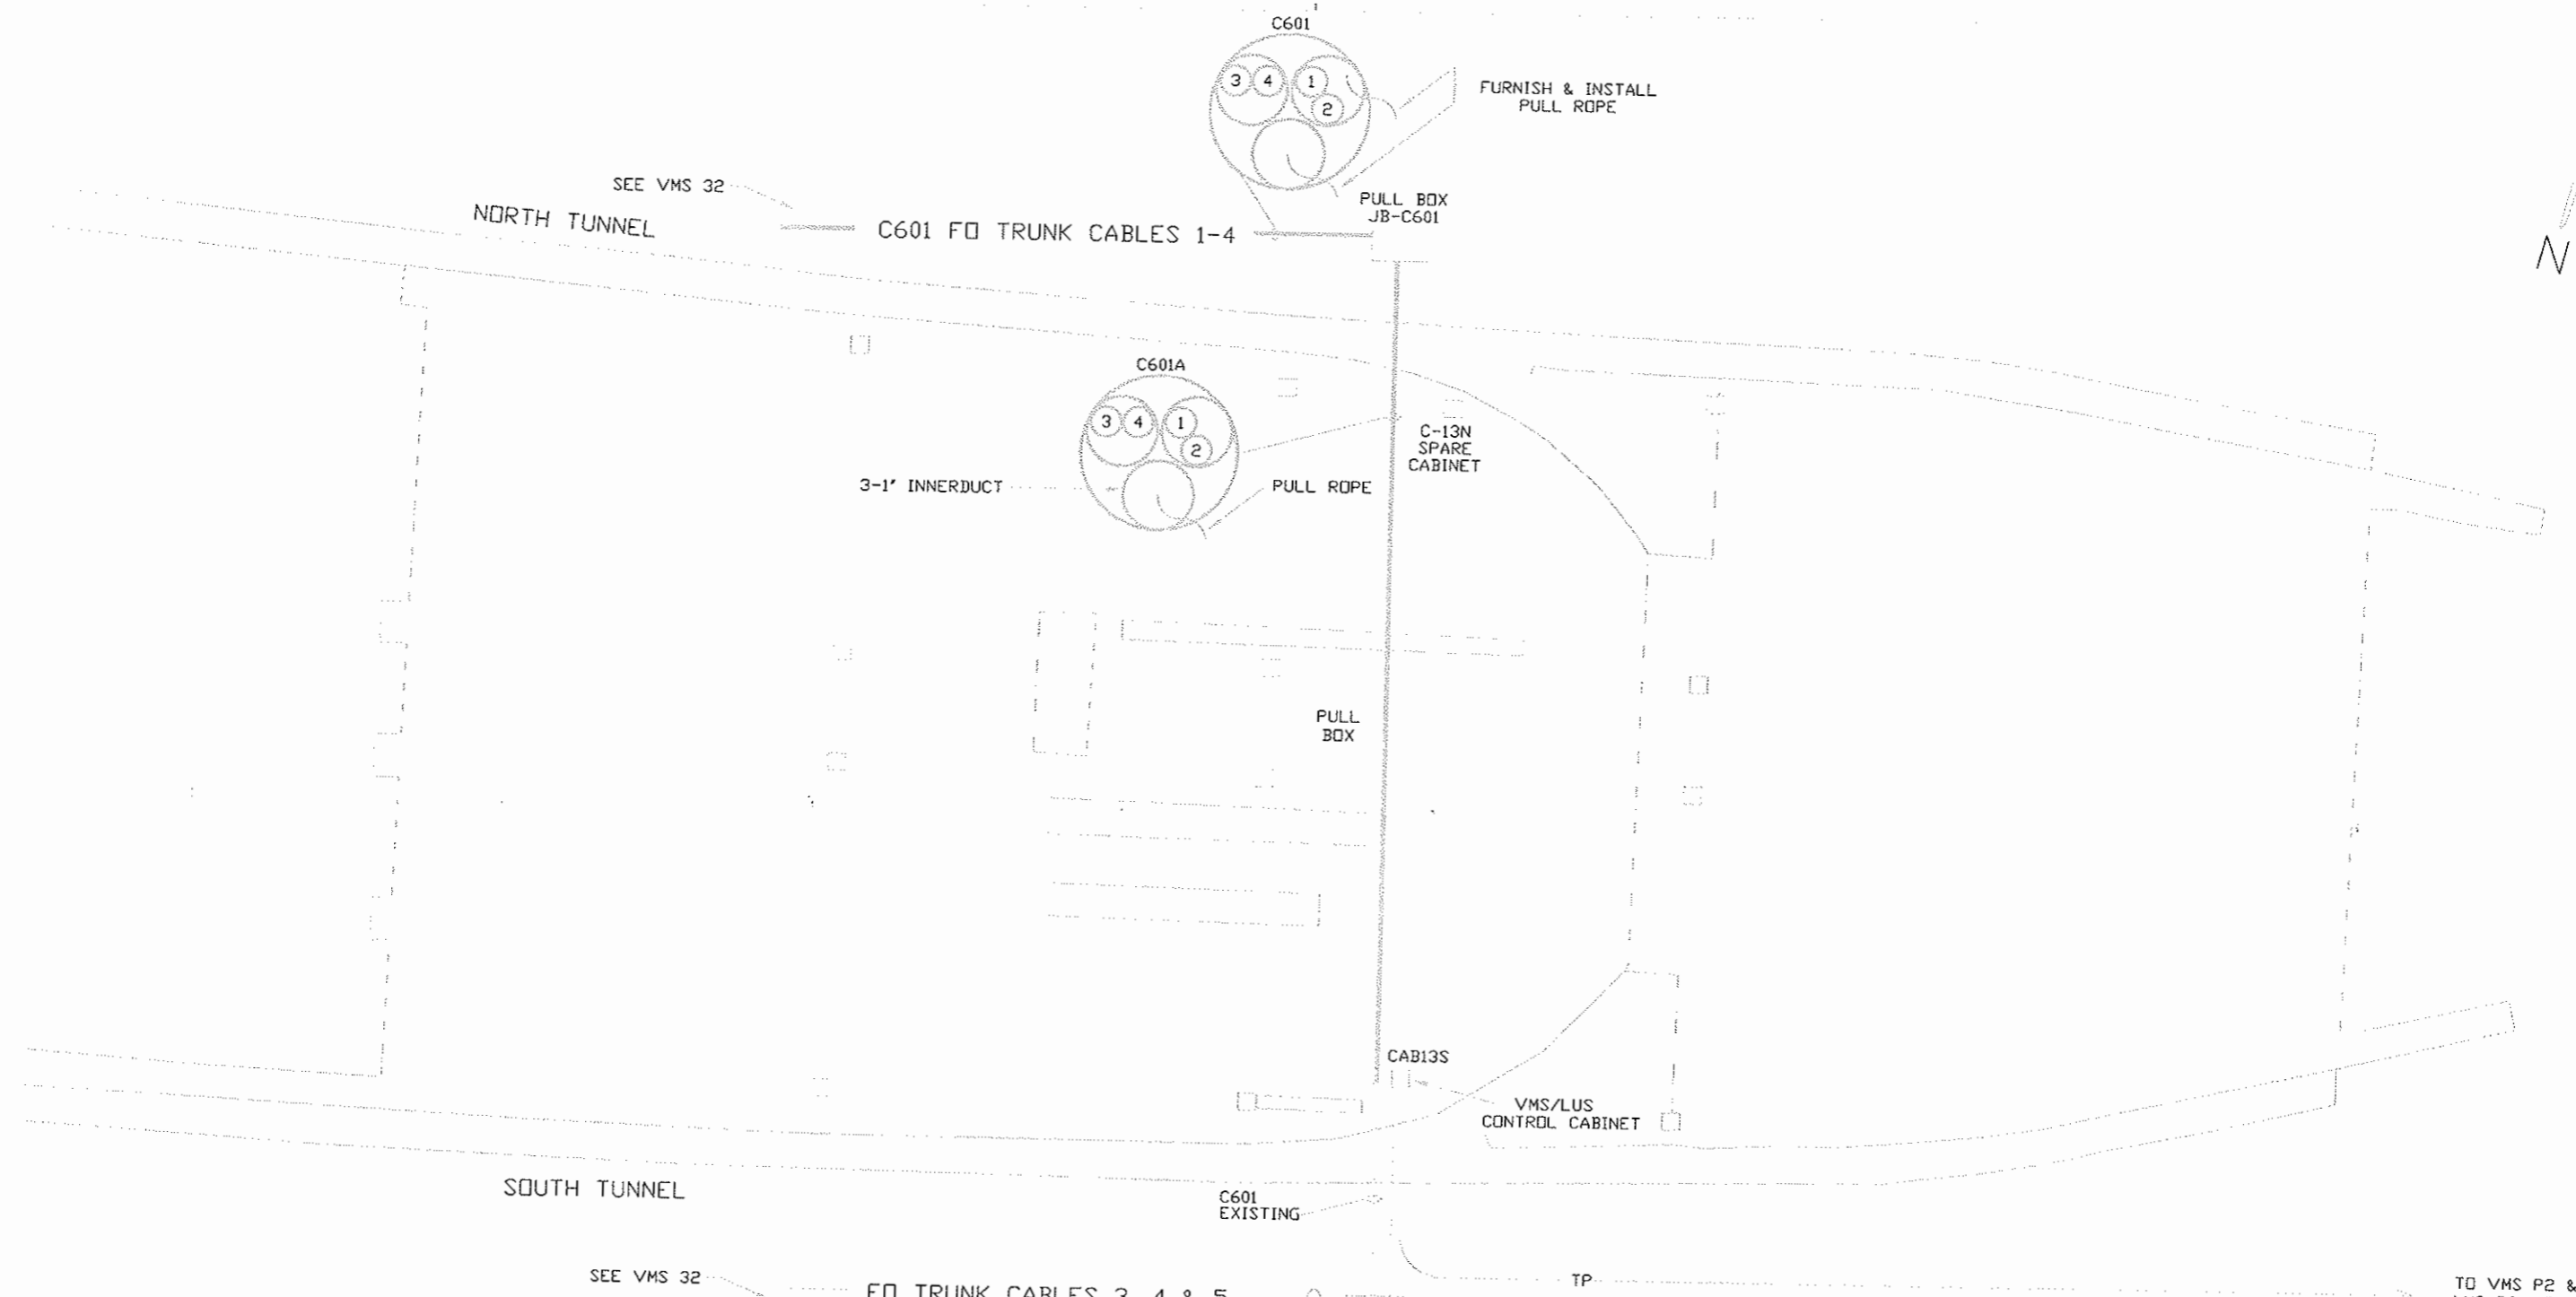

- LEGEND:**
- - - - - EXISTING FIBER RUNS IN CONDUIT
 - - - - - FIBER RUNS IN CONDUIT-(TO BE FURNISHED & INSTALLED)
 - - - - - TP - - - - - EXISTING COPPER WIRE RUNS IN CONDUIT
 - - - - - TP - - - - - COPPER WIRE RUNS IN CONDUIT-(TO BE FURNISHED & INSTALLED)
 - ① ② ③ ④ - 6-FIBER FO TRUNK CABLES
 - ⑤ - 12-FIBER FO TRUNK CABLE

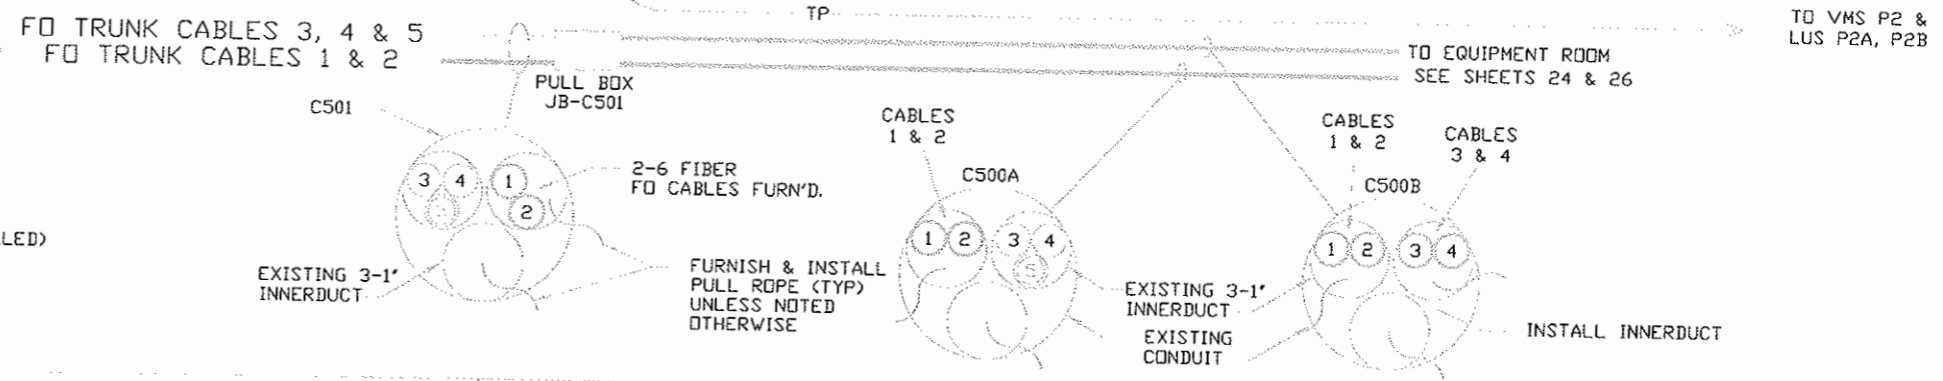


Design File Name: VMS-33.DWG
 Plot File Name: 2/6/02
 Date of Plot:

Computer File Information

Creation Date:	07/14/99	Initials:	PWM
Last Modification Date:	02/27/07	Initials:	PWM
Full Path:	VMS-33.DWG		
Drawing File Name:	VMS-33.DWG		
Acad Ver.	R14	Scale:	NTS
		Units:	ENGLISH

Sheet Revisions


07/03/07	ASBUILT	DJB
----------	---------	-----

Colorado Department of Transportation

 P.O. BOX 399
 DUMONT, CO. 80436
 Phone: 303-512-5750 FAX: 303-512-5775
 Region 1 Mountain Residency I.N.Z.

As Constructed
 No Revisions:
 Revised:
 Void:

**EAST VENT BUILDING
 VMS/LUS CABLE PLAN**
 Designer: J. MANCINELLI
 Detailer: P. MEYDRECH
 Sheet Subset: VMS
 Structure Numbers:
 Subset Sheets: 32 OF 46

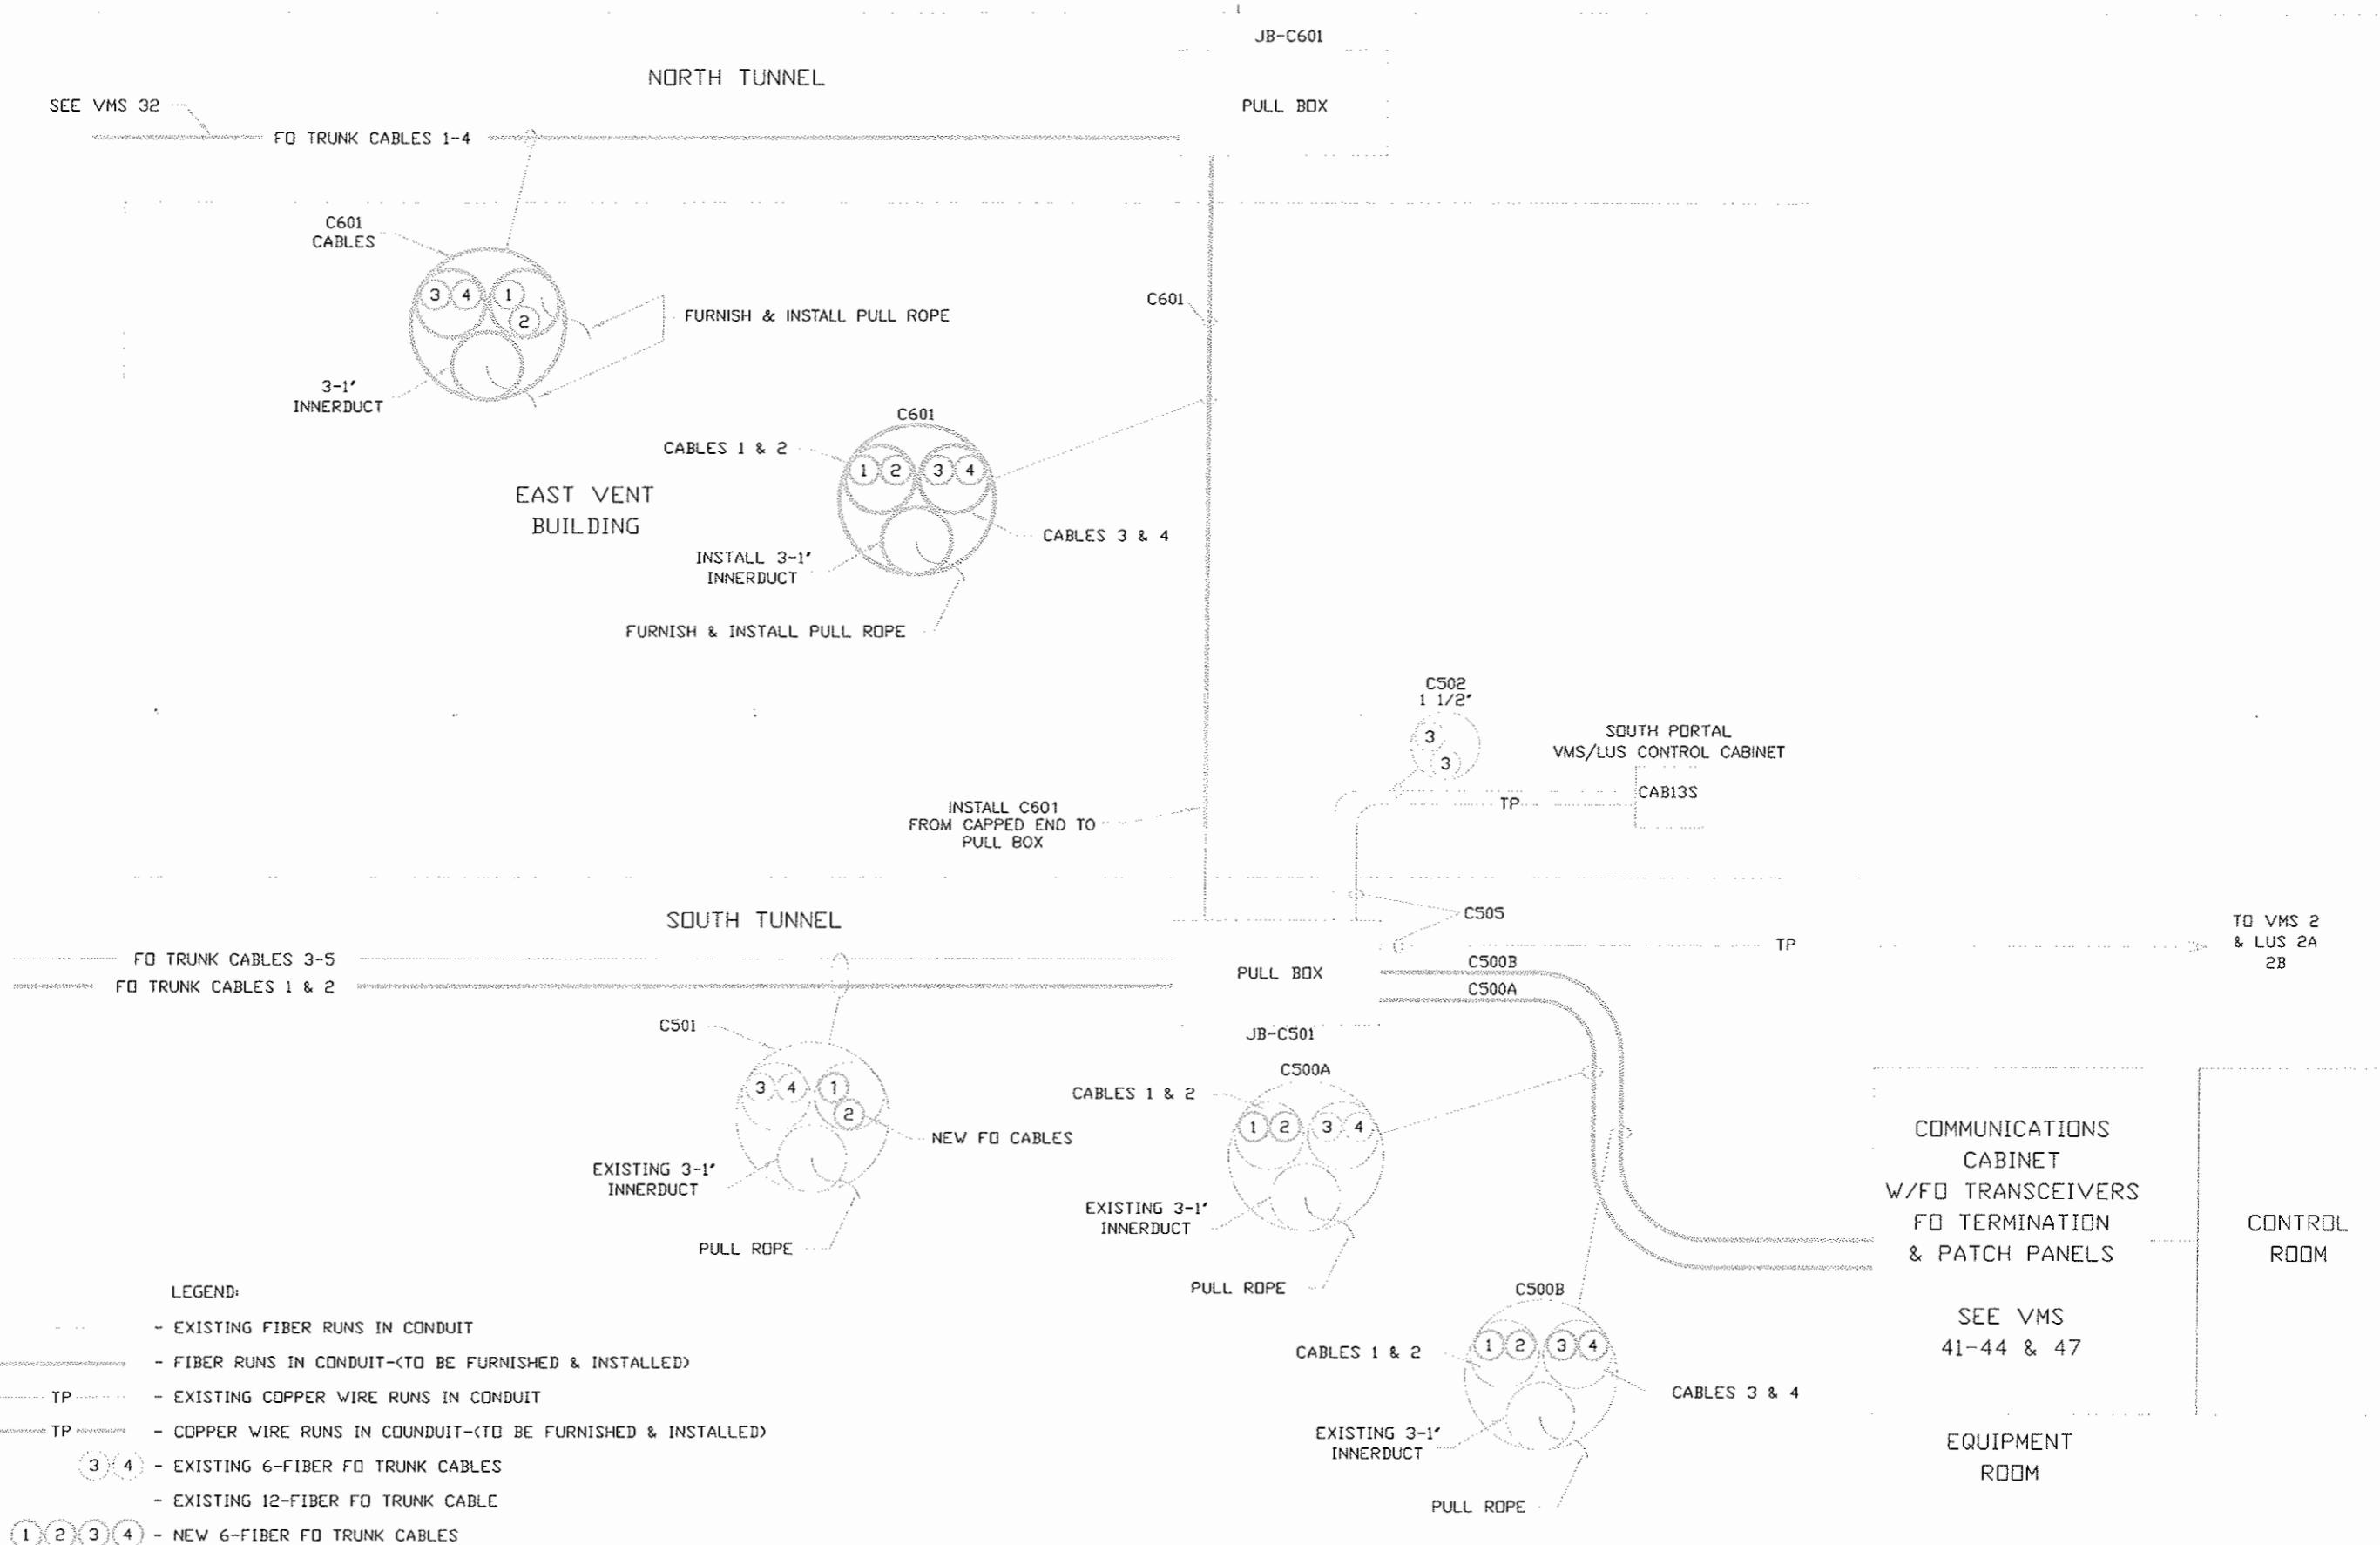Project No./Code
 IM 0703-269
 13166
 Sheet Number 163



LEGEND:

- - - - - EXISTING FIBER RUNS IN CONDUIT
- FIBER RUNS IN CONDUIT-(TO BE FURNISHED & INSTALLED)
- TP ----- EXISTING COPPER WIRE RUNS IN CONDUIT
- TP ----- COPPER WIRE RUNS IN CONDUIT-(TO BE FURNISHED & INSTALLED)
- (3) (4) - EXISTING 6-FIBER FO TRUNK CABLES
- EXISTING 12-FIBER FO TRUNK CABLE
- (1) (2) (3) (4) - NEW 6-FIBER FO TRUNK CABLES

Computer File Information

Creation Date: 07/14/99 Initials: PWM
 Last Modification Date: 02/27/07 Initials: PWM
 Full Path: VMS-34.DWG
 Drawing File Name: VMS-34.DWG

Sheet Revisions

07/03/07	ASBUILT	DJB
----------	---------	-----



Colorado Department of Transportation
 P.O. BOX 399
 DUMONT, CO. 80436
 Phone: 303-512-5750 FAX: 303-512-5775

As Constructed
 No Revisions:
 Revised:

**EAST VENT BUILDING
 VMS/LUS CABLING DETAIL**
 Designer: J. MANCINELLI
 Detailer: P. MEYDRECH

Project No. IM 0703-13166
 Structure Numbers
Sheet 164

gn File Name: VMS-34.DWG
 lot File Name:
 Date of Plot: 2/6/02

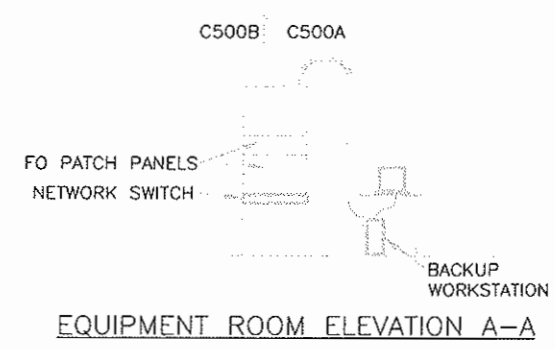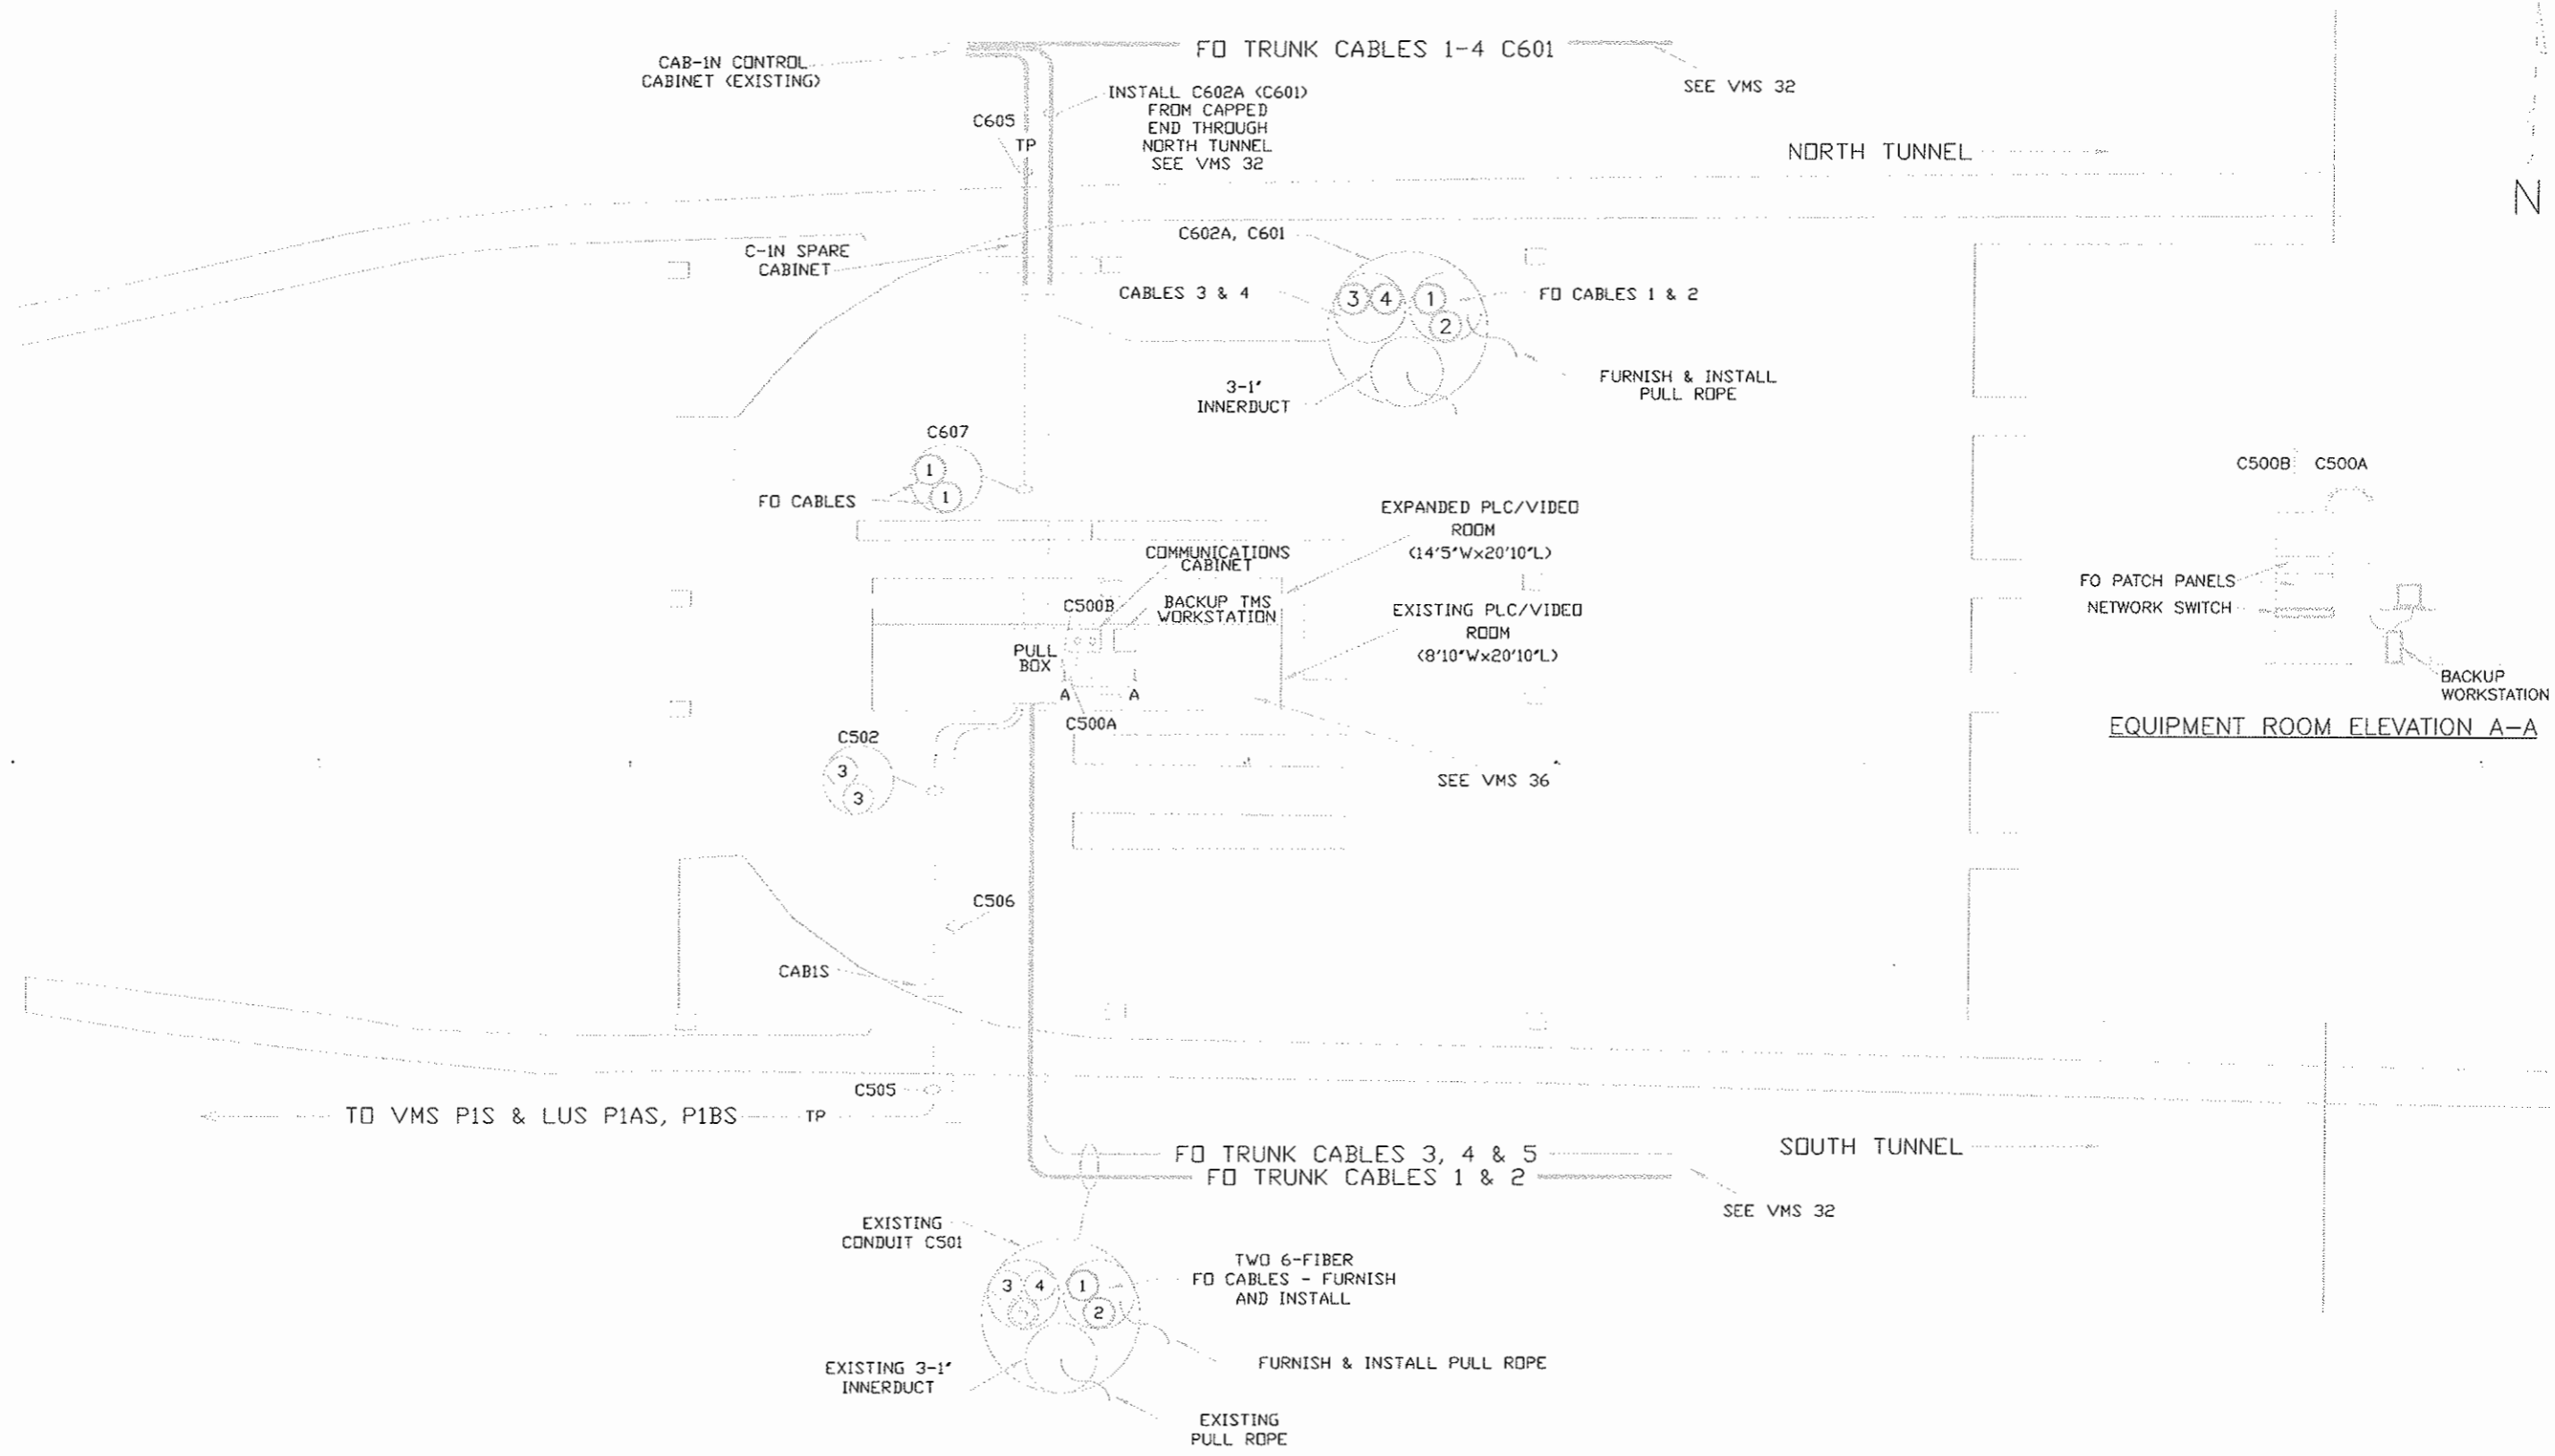

Design File Name: VMS-35.DWG
 Plot File Name: 2/6/02
 Date of Plot: 2/6/02

Computer File Information			
Creation Date:	07/14/99	Initials:	PWM
Last Modification Date:	2/6/02	Initials:	PWM
Full Path:	VMS-35.DWG		
Drawing File Name:	VMS-35.DWG		
Acad Ver.	R14	Scale:	NTS
		Units:	ENGLISH


Sheet Revisions	
07/03/07	ASBUILT DJB

Colorado Department of Transportation
 P.O. BOX 399
 DUMONT, CO. 80436
 Phone: 303-512-5750 FAX: 303-512-5775
 Region 1 Mountain Residency I.N.Z.

As Constructed
 No Revisions:
 Revised:
 Void:

WEST VENT BUILDING
 VMS/LUS CABLE RUNS
 Designer: J. MANCINELLI
 Detailer: P. MEYDRECH
 Sheet Subset: VMS
 Structure Numbers
 Subset Sheets: 34 OF 46

Project No./Code
 IM 0703-269
 13166
 Sheet Number 165

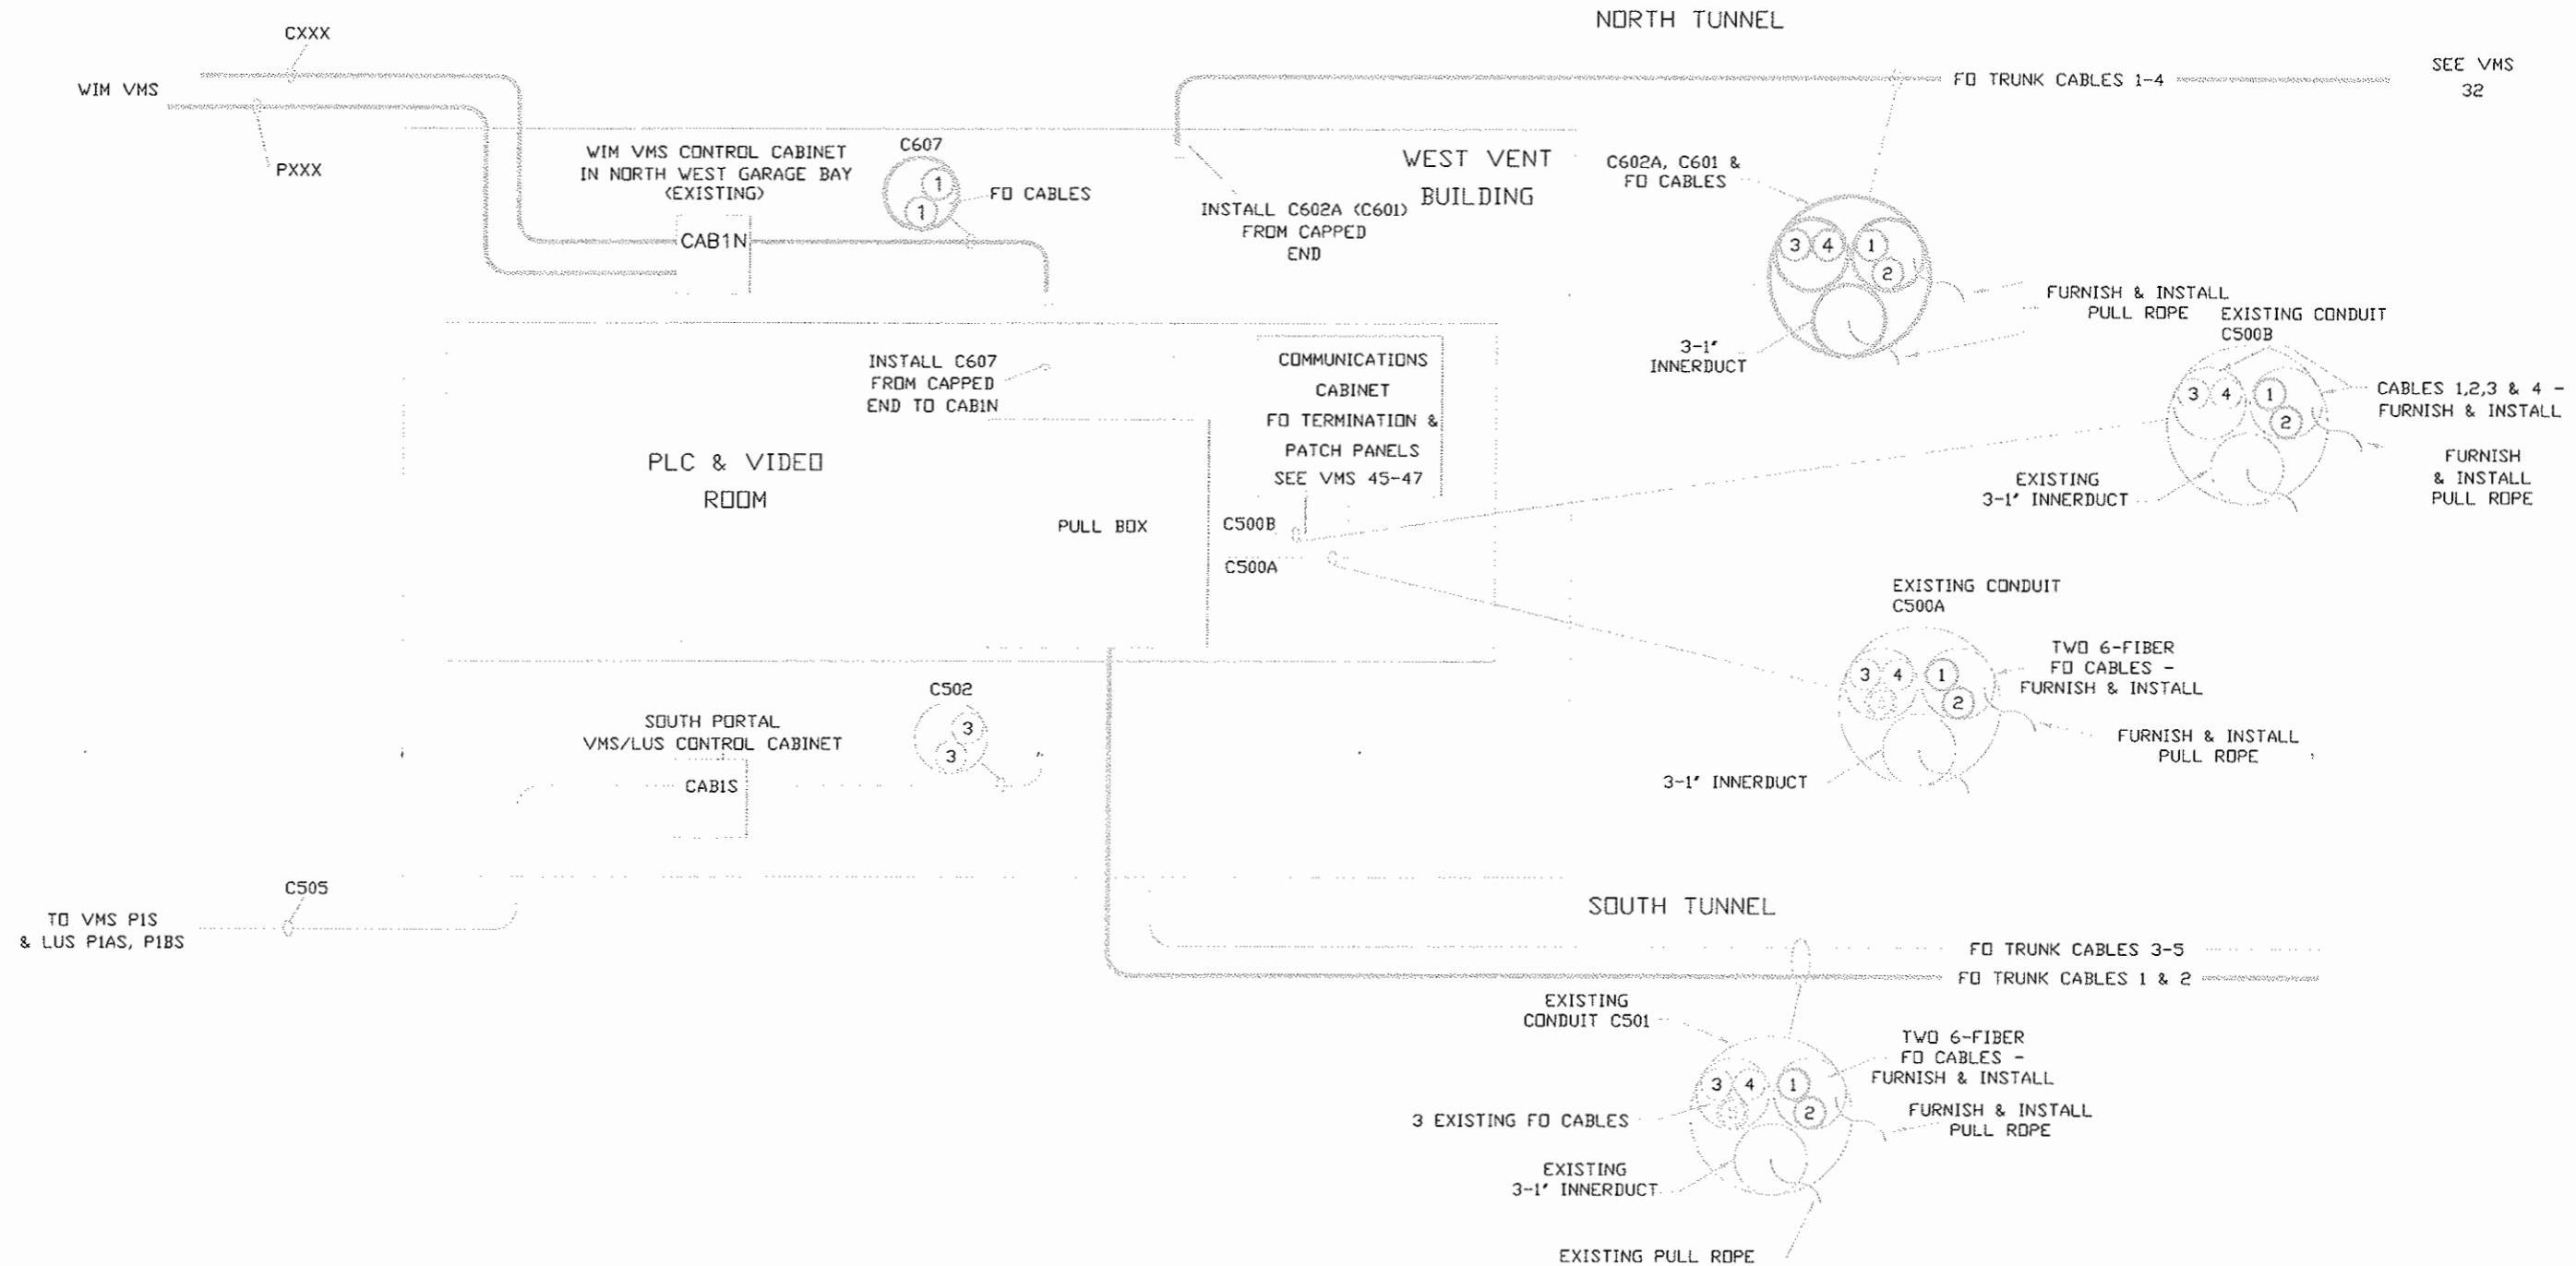

SEE VMS 32

- LEGEND
- - - - - EXISTING FIBER RUNS IN CONDUIT
 - ===== FIBER RUNS IN CONDUIT TO BE FURNISHED & INSTALLED
 - EXISTING COPPER WIRE RUNS IN CONDUIT
 - TO BE INSTALLED COPPER WIRE RUNS IN CONDUIT TO BE FURNISHED & INSTALLED
 - ③④ EXISTING 6-FIBER FD TRUNK CABLES
 - ①②③④ EXISTING 12-FIBER FD TRUNK CABLES
 - ①②③④ NEW 6-FIBER FD TRUNK CABLES

Design File Name: VMS-36.DWG
Plot File Name: VMS-36.DWG
Date of Plot: 2/6/02

Computer File Information

Creation Date:	07/14/99	Initials:	PWM
Last Modification Date:	02/27/07	Initials:	PWM
Full Path:	VMS-36.DWG		
Drawing File Name:	VMS-36.DWG		
Acad Ver.	R14	Scale:	NTS
		Units:	ENGLISH

Sheet Revisions



07/03/07	ASBUILT	DJB
----------	---------	-----

Colorado Department of Transportation
 P.O. BOX 399
 DUMONT, CO. 80436
 Phone: 303-512-5750 FAX: 303-512-5775
 Region 1 Mountain Residency I.N.Z.

As Constructed
 No Revisions:
 Revised:
 Void:

**WEST VENT BUILDING
 VMS/LUS CABLING DETAILS**
 Designer: J. MANCINELLI
 Detailer: P. MEYDRECH
 Sheet Subset: VMS
 Structure Numbers
 Subset Sheets: 35 OF 46


Project No./Code
 IM 0703-269
 13166
 Sheet Number 166

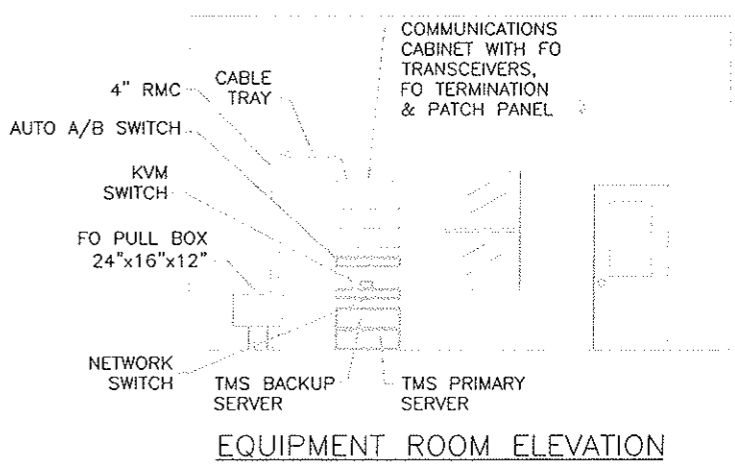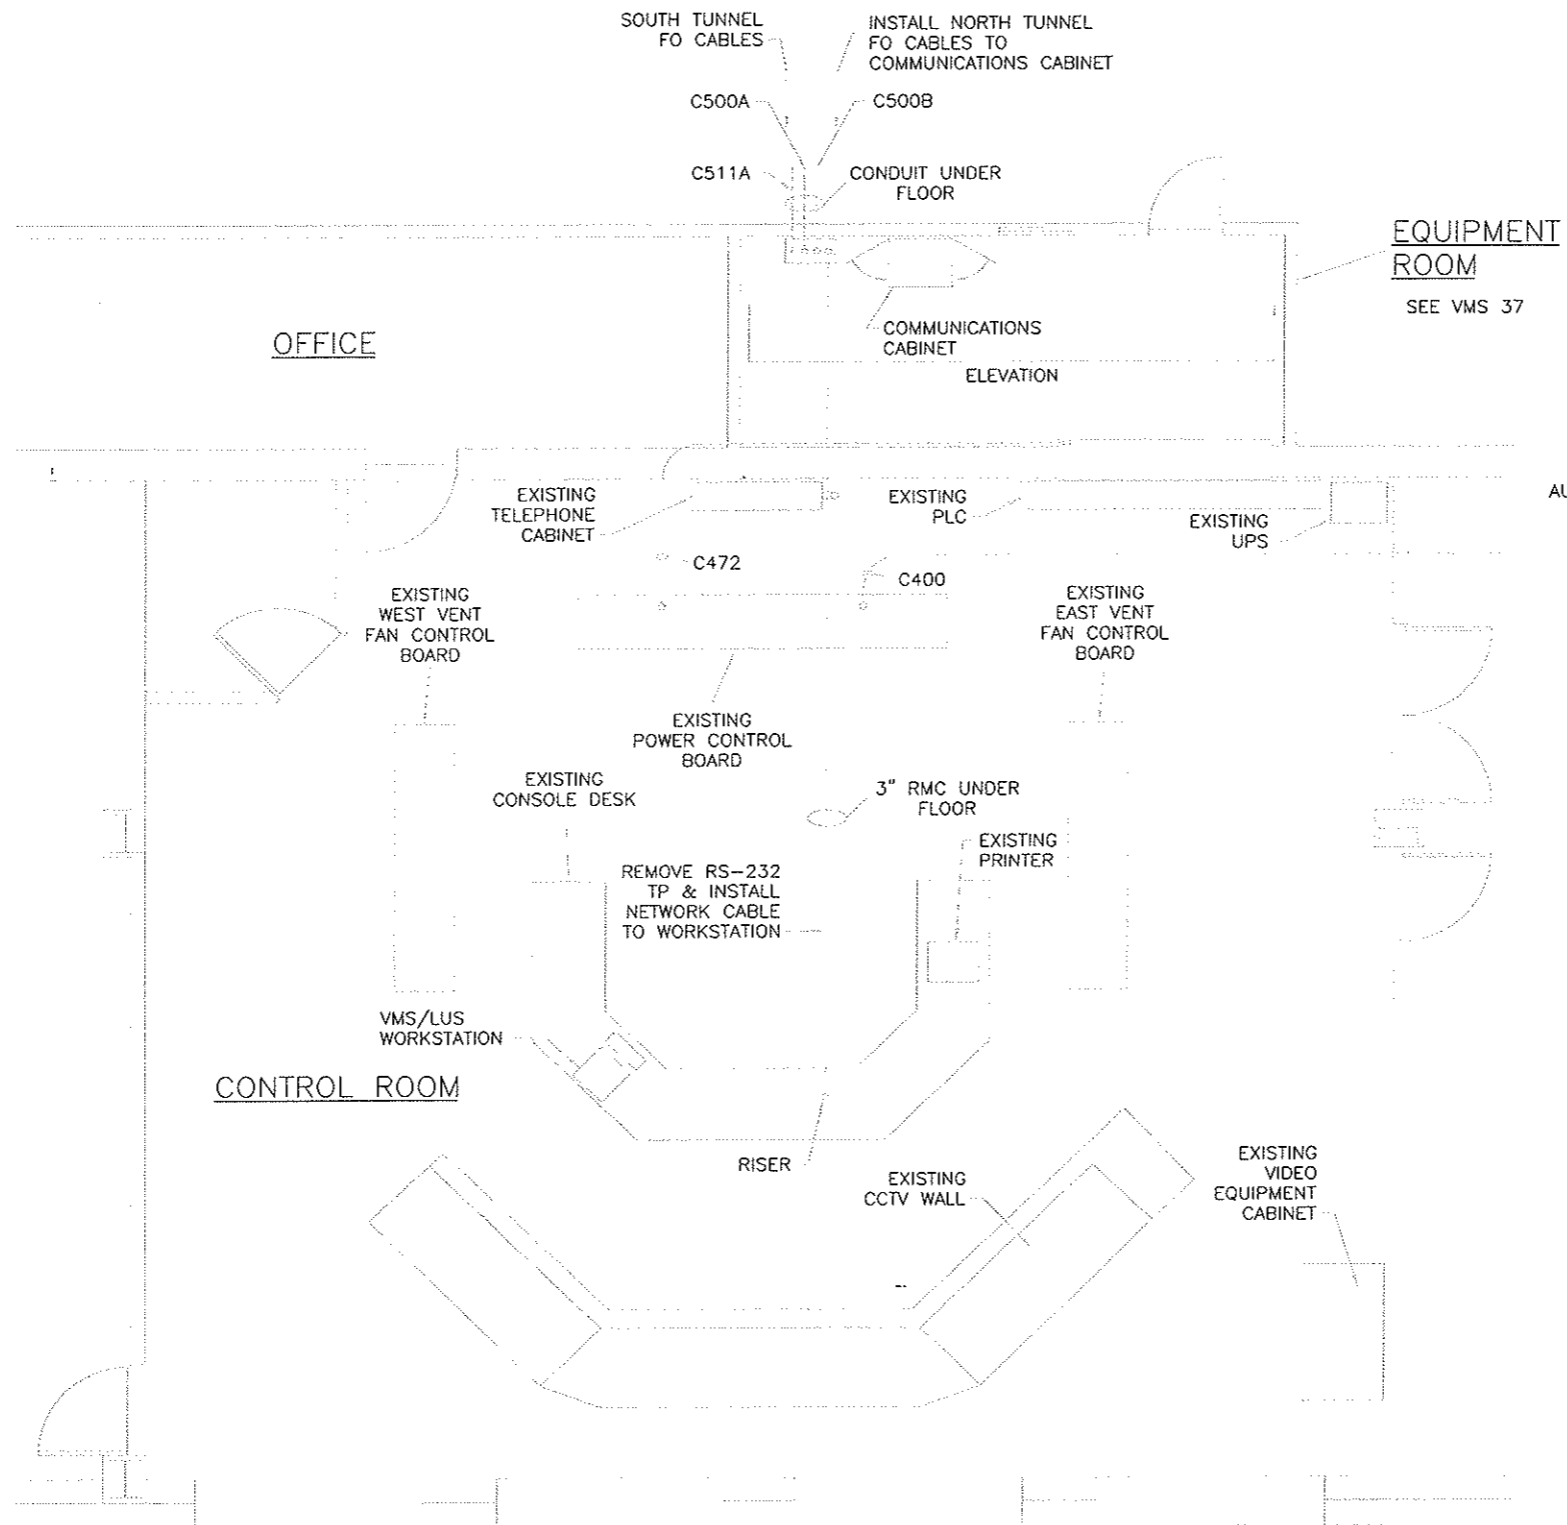


NOTE:
 1. SEE VB ELECT SUBSET SHEET 17 FOR RELATED ELECTRICAL MODIFICATIONS IN EAST VENT BUILDING CONTROL ROOM.
 2. ALL EQUIPMENT SHALL BE RACK MOUNTED.

SEE VMS 32-34

Sheet 167

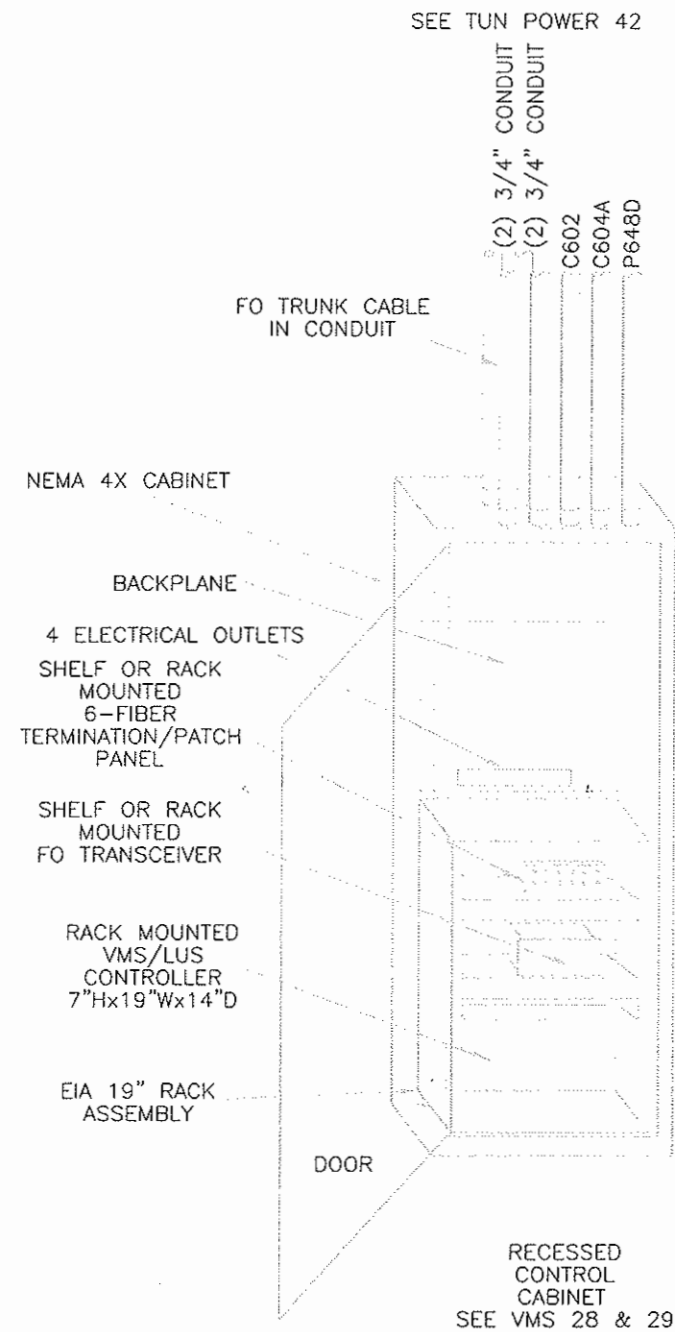

LEGEND:
FD - FIBER OPTIC

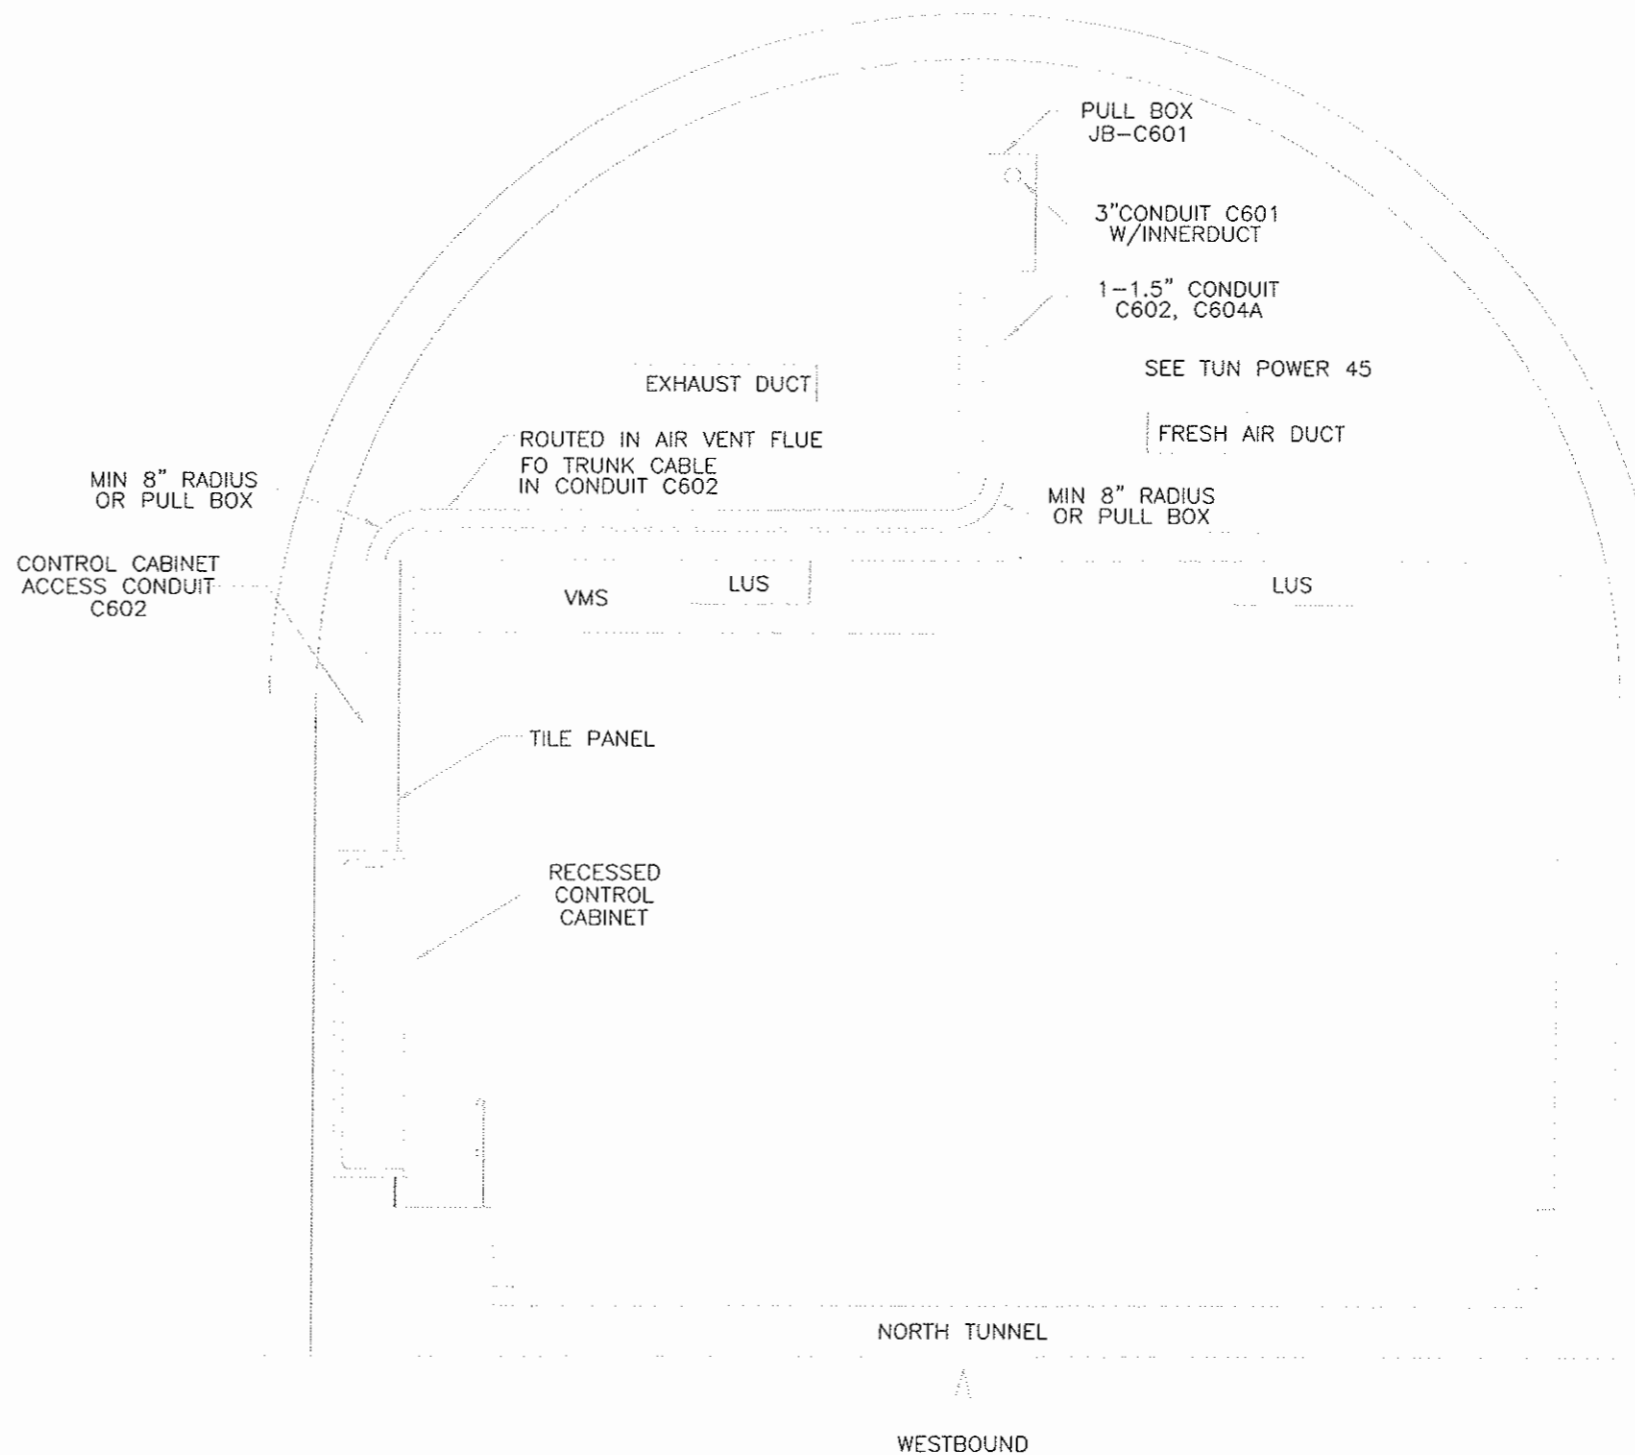

Design File Name: VMS-38.DWG
Plot File Name: 2/6/02

Computer File Information

Creation Date: 07/14/99 Initials: PWM
Last Modification Date: 03/06/07 Initials: PWM
Full Path: VMS-38.DWG
Drawing File Name: VMS-38
Acad Ver. R14 Scale: NTS Units: ENGLISH

Sheet Revisions

07/03/07 ASBUILT DJE



Colorado Department of Transportation
P.O. BOX 399
DUMONT, CO. 80436
Phone: 303-512-5750 FAX: 303-512-5775
Region 1 Mountain Residency I.N.Z.

As Constructed

No Revisions:
Revised:
Void:

VMS/LUS CONTROL CABINET LAYOUT


Designer: J. MANCINELLI Structure Numbers
Detailer: P. MEYDRECH
Sheet Subset: VMS Subset Sheets: 37 OF 46

Project No./Code

IM 0703-269

13166

Sheet Number 168

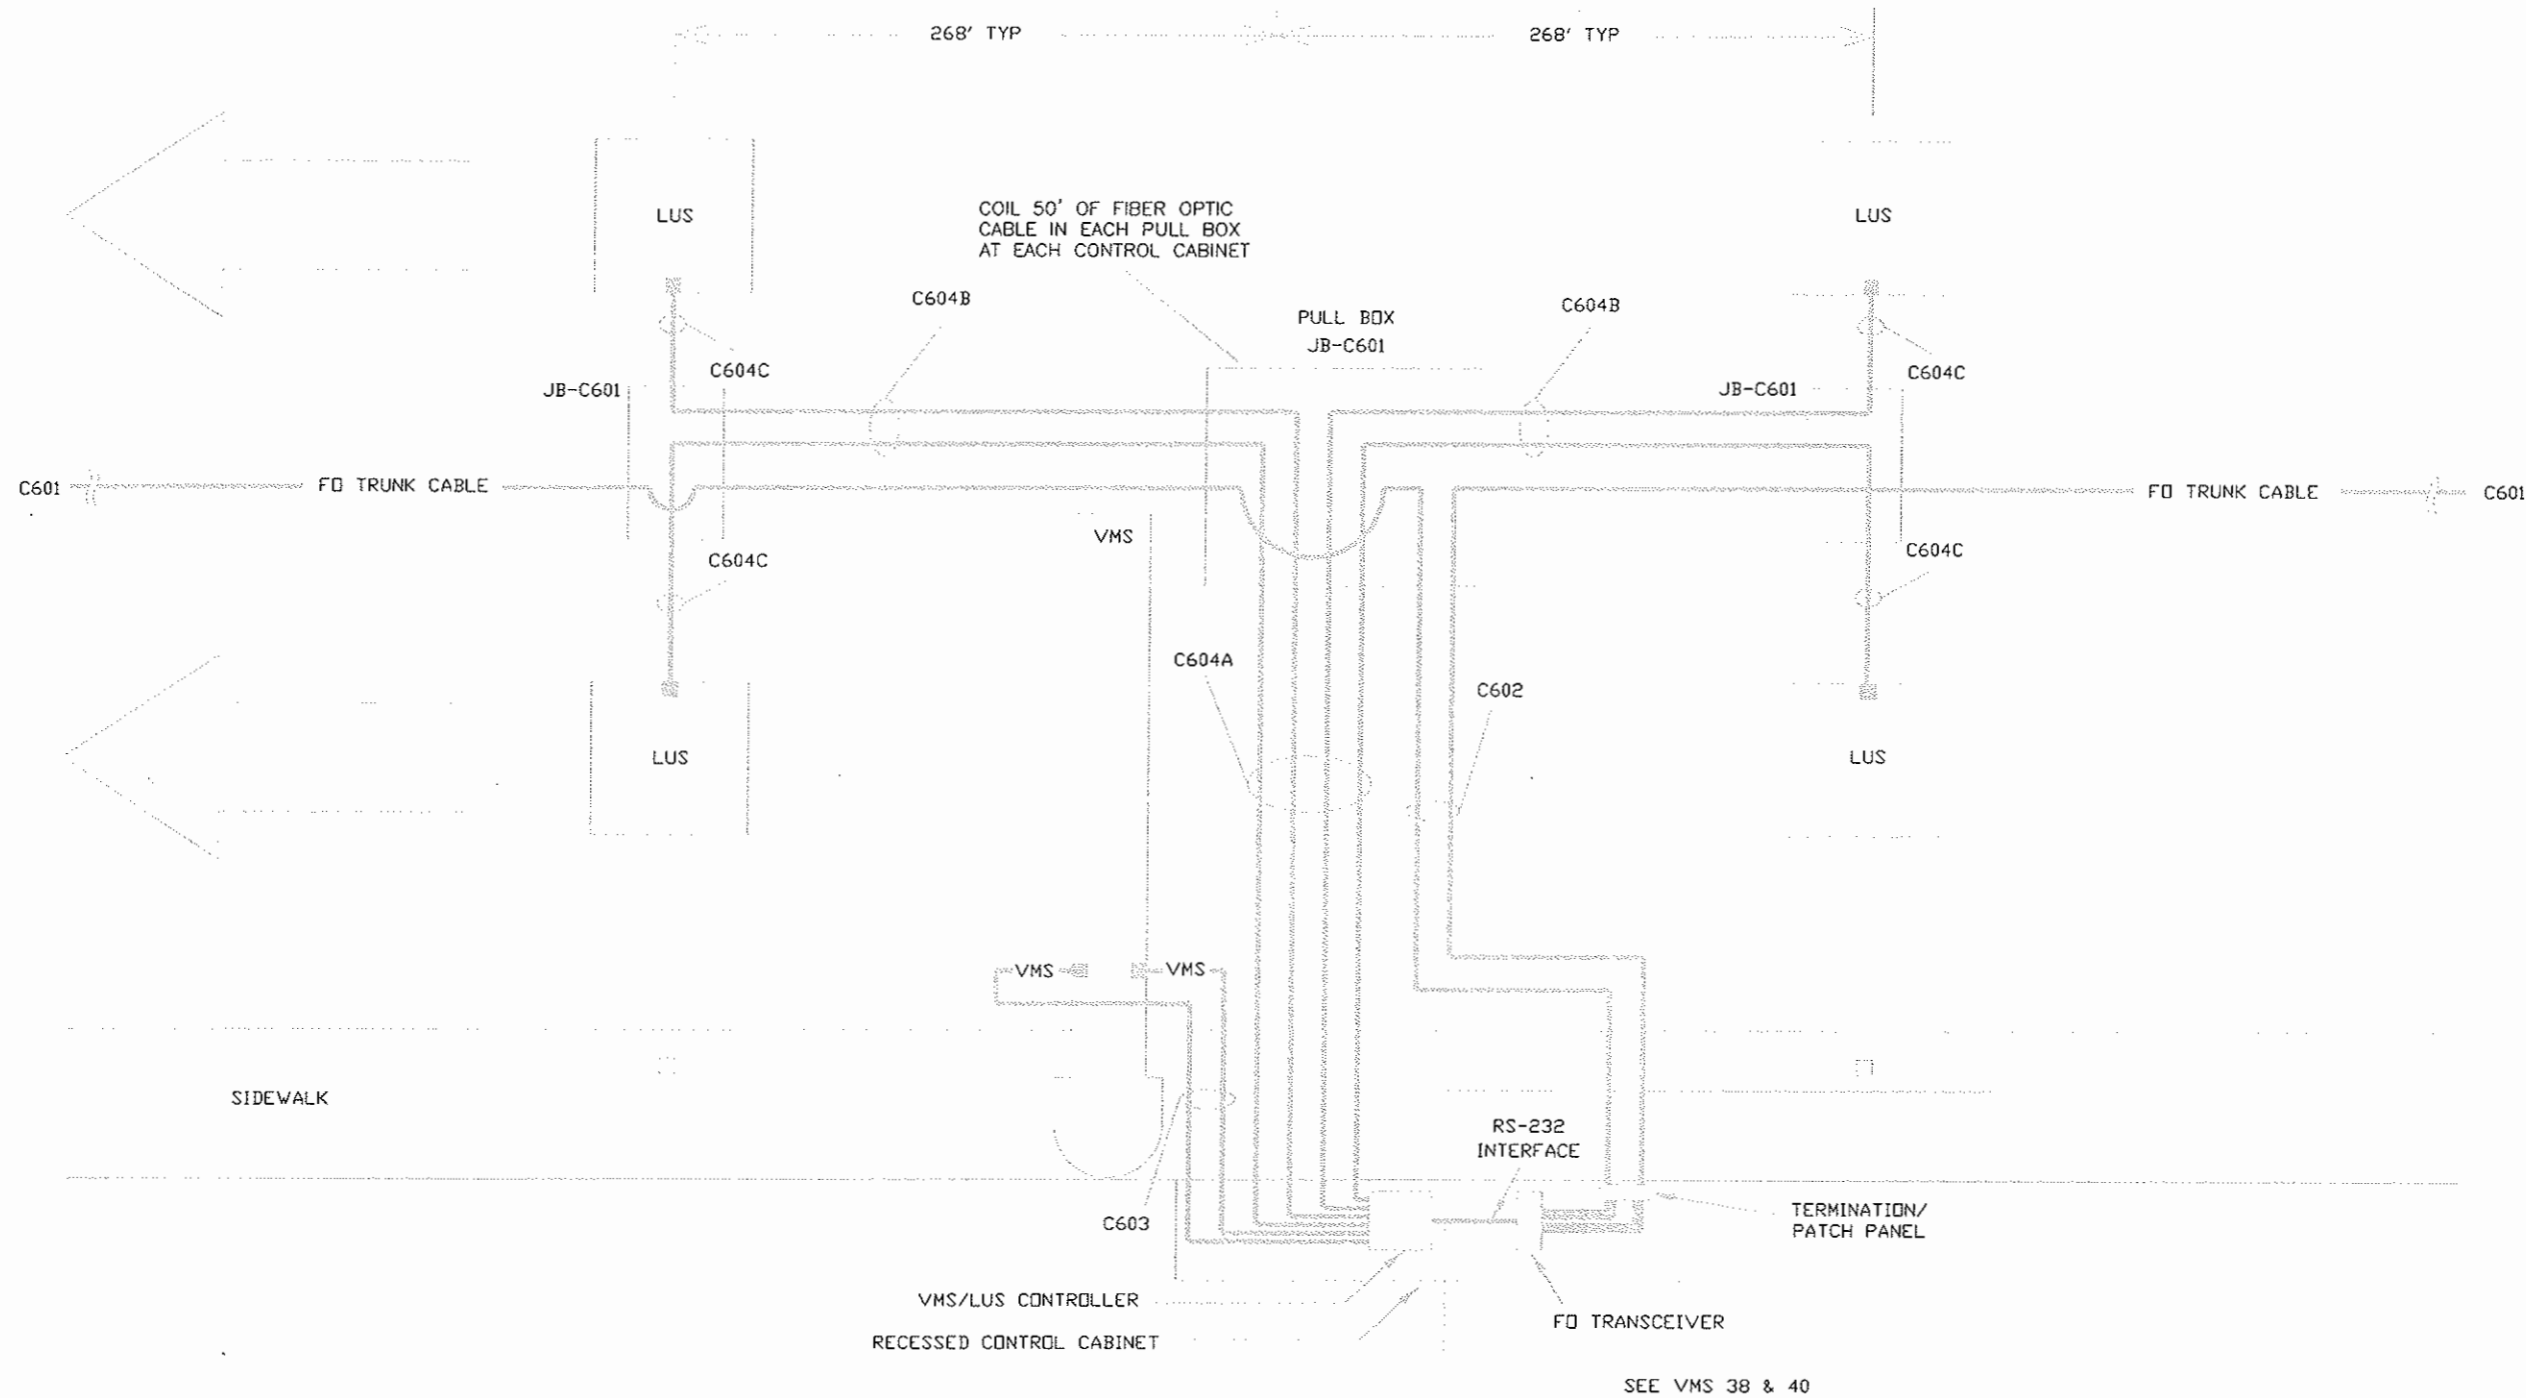

TYPICAL TUNNEL POWER AND CONTROL DIAGRAMS
SEE TUN POWER 42

LEGEND:

- FD - FIBER OPTIC
- ☒ - DEVICE INTERFACE

Design File Name: VMS-39.DWG
 Plot File Name: VMS-39.DWG
 Date of Plot: 2/6/02

Computer File Information

Creation Date: 07/14/99 Initials: PWM
 Last Modification Date: 2/6/02 Initials: PWM
 Full Path: VMS-39.DWG
 Drawing File Name: VMS-39.DWG
 Acad Ver. R14 Scale: NTS Units: ENGLISH

Sheet Revisions

07/03/07 ASBUILT DJB




Colorado Department of Transportation
 P.O. BOX 399
 DUMONT, CO. 80436
 Phone: 303-512-5750 FAX: 303-512-5775
 Region 1 Mountain Residency I.N.Z.

As Constructed
 No Revisions:
 Revised:
 Void:

NORTH TUNNEL VMS/LUS
 CONTROL CIRCUIT
 Designer: J. MANCINELLI
 Detailer: P. MEYDRECH
 Sheet Subset: VMS

Project No./Code
 IM 0703-269
 Structure Numbers
 13166
 Subst Sheets: 38 OF 46
 Sheet Number 169

- NOTES:
- A. INSTALL BUFFERS AND ST CONNECTORS ON ALL FIBERS PER MANUFACTURER'S INSTALLATION PROCEDURE
 - B. D1, D2 DENOTES OPTICAL DETECTOR
 - C. E1, E2 DENOTES LIGHT EMITTER

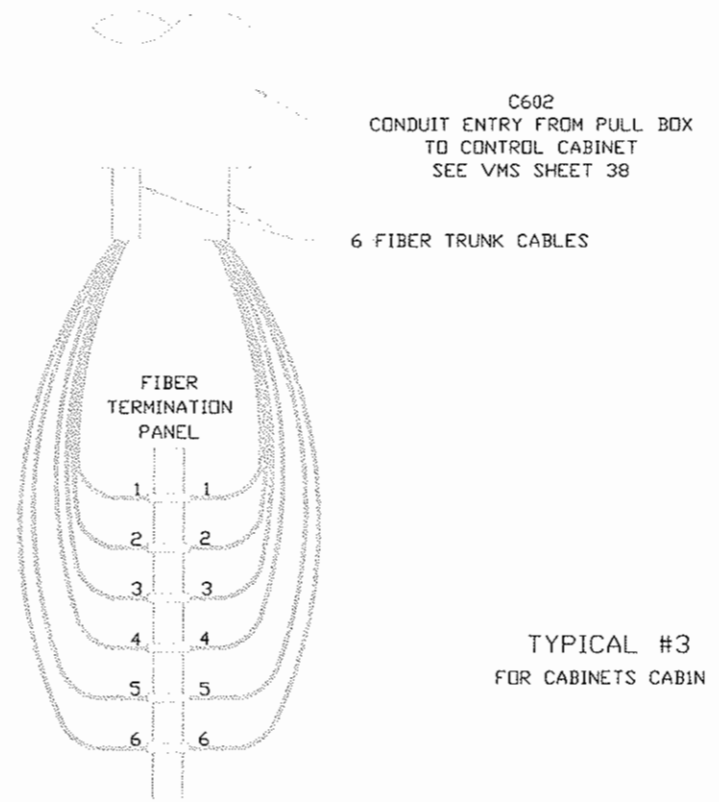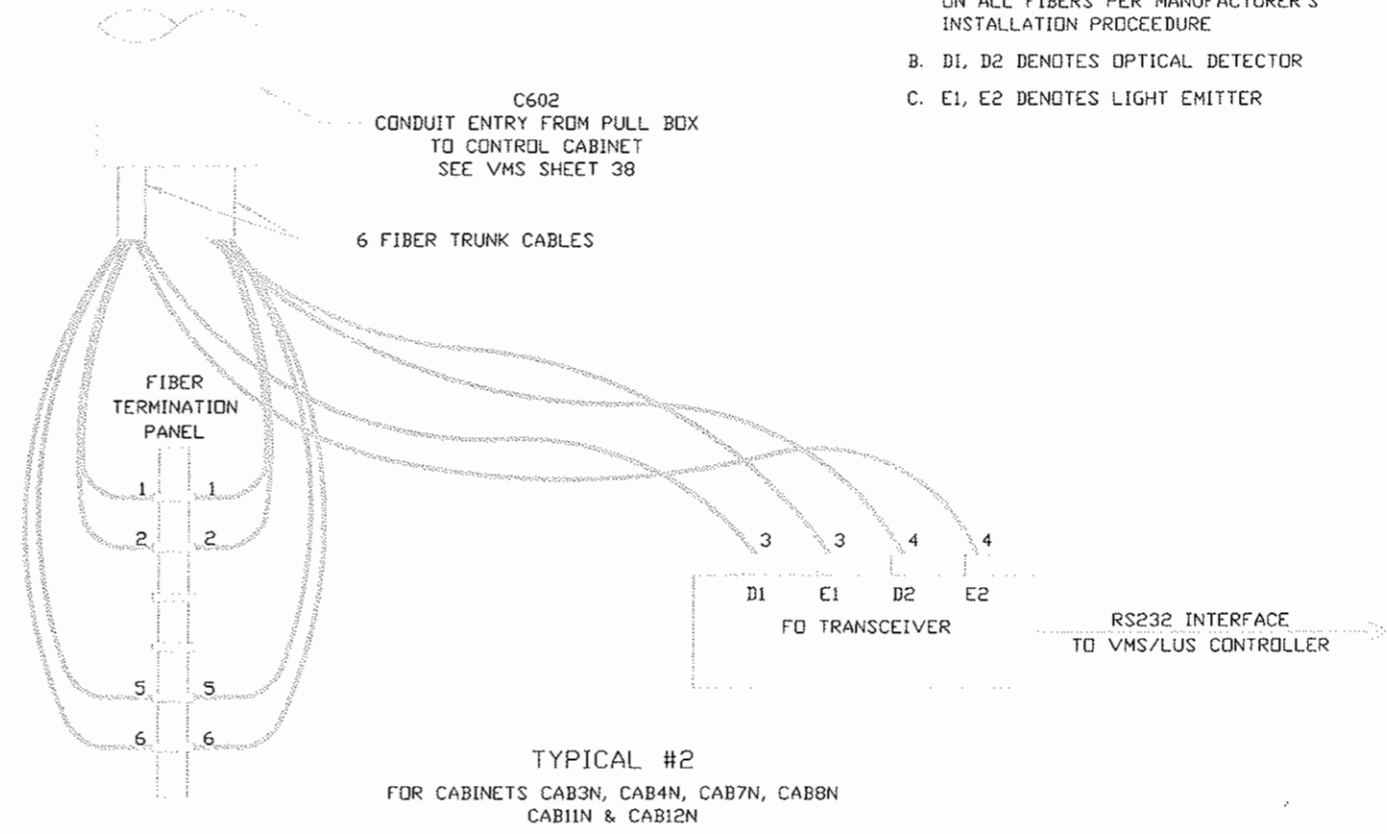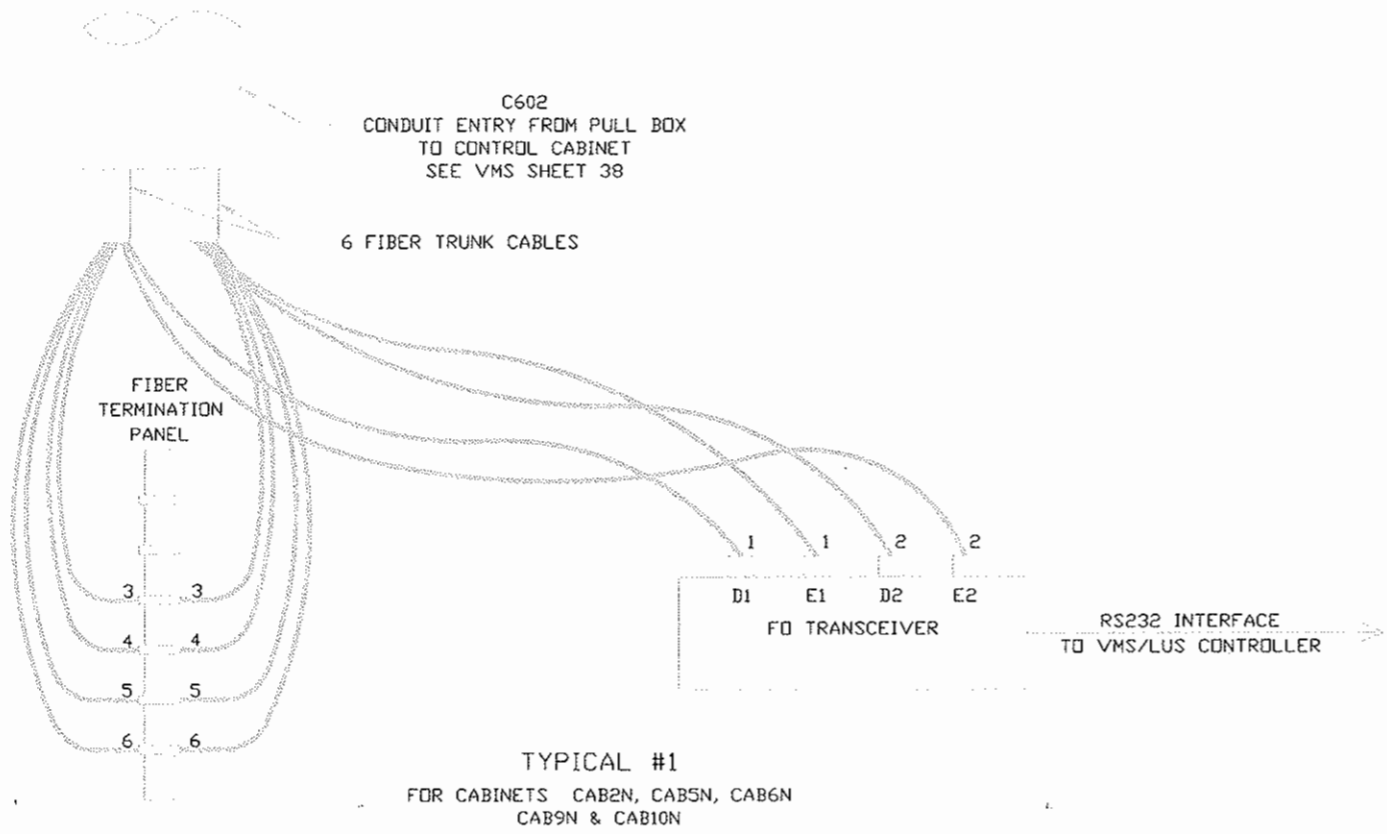

LEGEND:
FO - FIBER OPTIC

SEE VMS 39

Design File Name: VMS-40.DWG
Plot File Name: 2/6/02

Computer File Information

Creation Date: 07/14/99 Initials: PWM
Last Modification Date: 02/27/07 Initials: PWM
Full Path: VMS-40.DWG
Drawing File Name: VMS-40.DWG
Acad Ver. R14 Scale: NTS Units: ENGLISH

Sheet Revisions

07/03/07 ASBUILT DJB




Colorado Department of Transportation
P.O. BOX 399
DUMONT, CO. 80436
Phone: 303-512-5750 FAX: 303-512-5775
Region 1 Mountain Residency I.N.Z.

As Constructed
No Revisions:
Revised:
Void:

NORTH TUNNEL VMS/LUS
FIBER TERMINATION DETAILS

Designer: D. EWAN Structure Numbers
Detailer: P. MEYDRECH
Sheet Subset: VMS Subset Sheets: 39 OF 46

Project No./Code
IM 0703-269
13166
Sheet Number 170

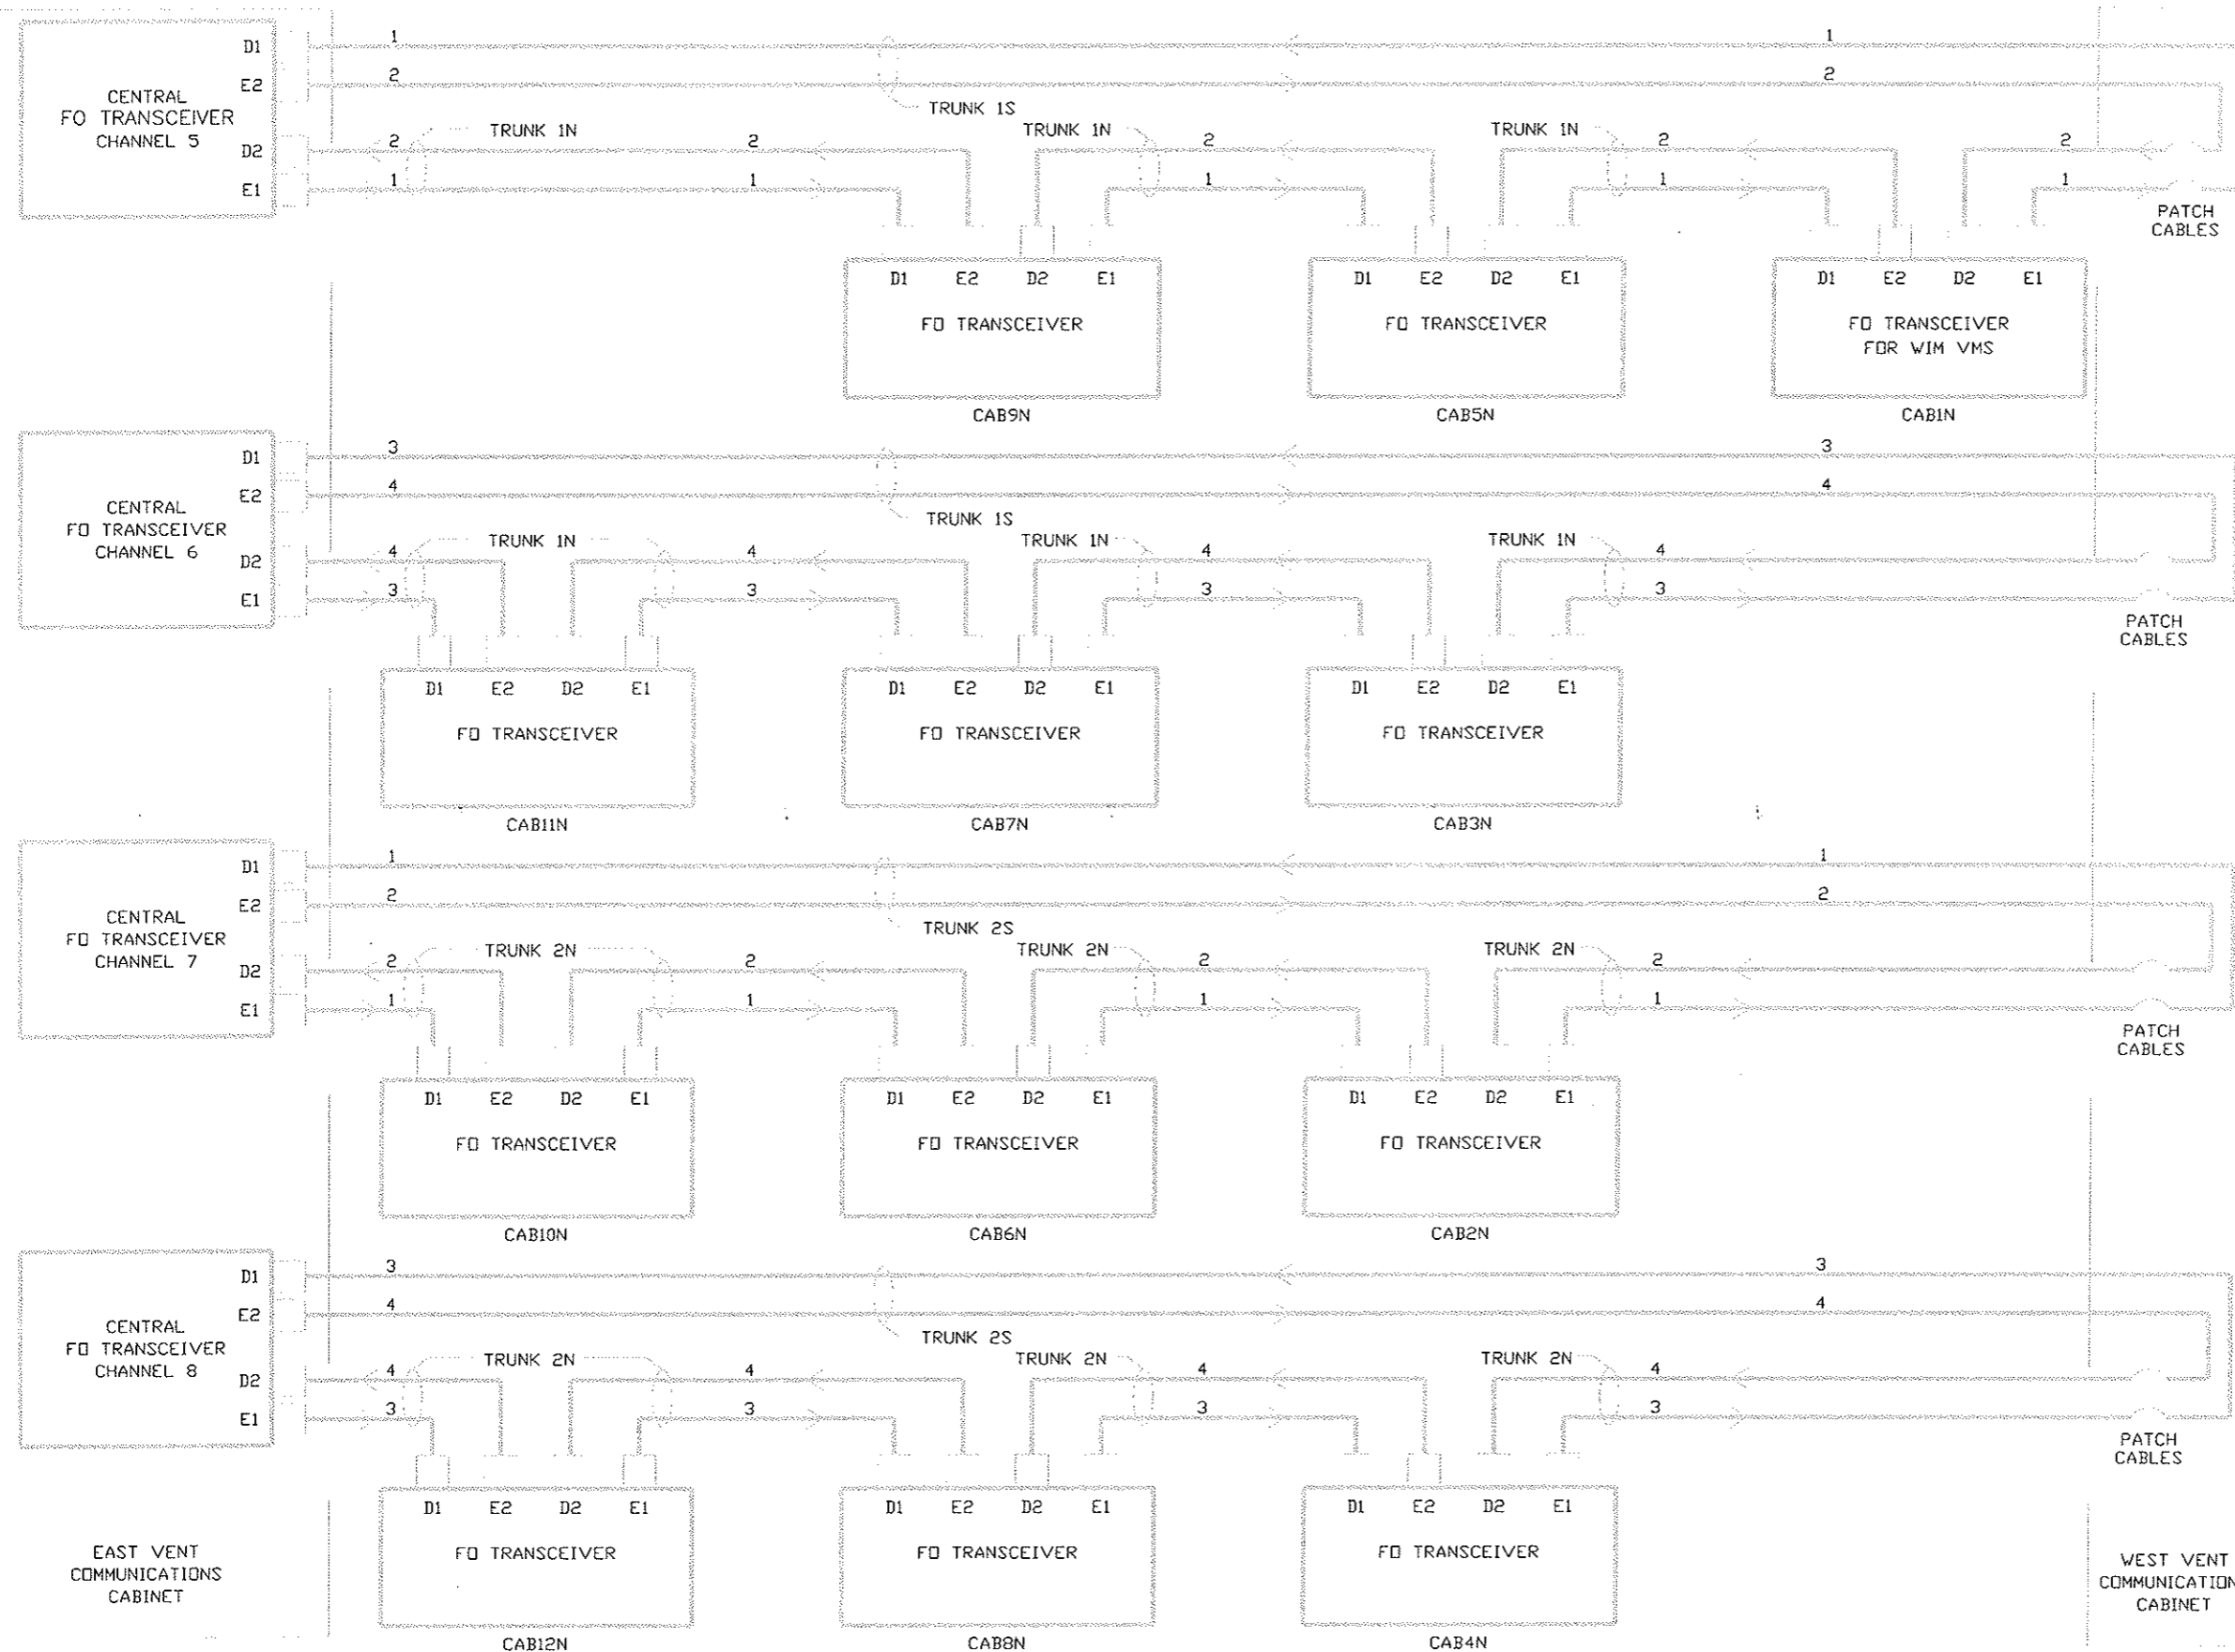

- NOTES:
1. DIRECTIONAL ARROWS DENOTE SIGNAL FLOW.
 2. EACH TRUNK IS LABELED TO INDICATE THE SPECIFIC FIBERS FOR THE DESIGNATED CHANNEL.
 3. SEE SHEETS 43 & 45 FOR COMMUNICATIONS CABINET WIRING.
 4. ON ALL FO TRANSCEIVERS, D1 & E1 DENOTE-RING 1 AND D2 & E2 DENOTE-RING 2.

LEGEND:
FO - FIBER OPTIC

Design File Name: VMS-41.DWG
 Plot File Name: 2/6/02
 Date of Plot:

Computer File Information

Creation Date:	09/24/99	Initials:	PWM
Last Modification Date:	02/27/07	Initials:	PWM
Full Path:	VMS-41.DWG		
Drawing File Name:	VMS-41.DWG		
Acad Ver.	R14	Scale:	NTS
		Units:	ENGLISH

Sheet Revisions


07/03/07	ASBUILT	DJB
----------	---------	-----

Colorado Department of Transportation
 P.O. BOX 399
 DUMONT, CO. 80436
 Phone: 303-512-5750 FAX: 303-512-5775
 Region 1 Mountain Residency I.N.Z.

As Constructed
 No Revisions:
 Revised:
 Void:

NORTH TUNNEL FO INTERCONNECT DETAIL
 Designer: D.EWAN
 Detailer: P. MEYDRECH
 Sheet Subset: VMS
 Structure Numbers
 Subset Sheets: 40 OF 46

Project No./Code
 IM 0703-269
 13166
 Sheet Number 171

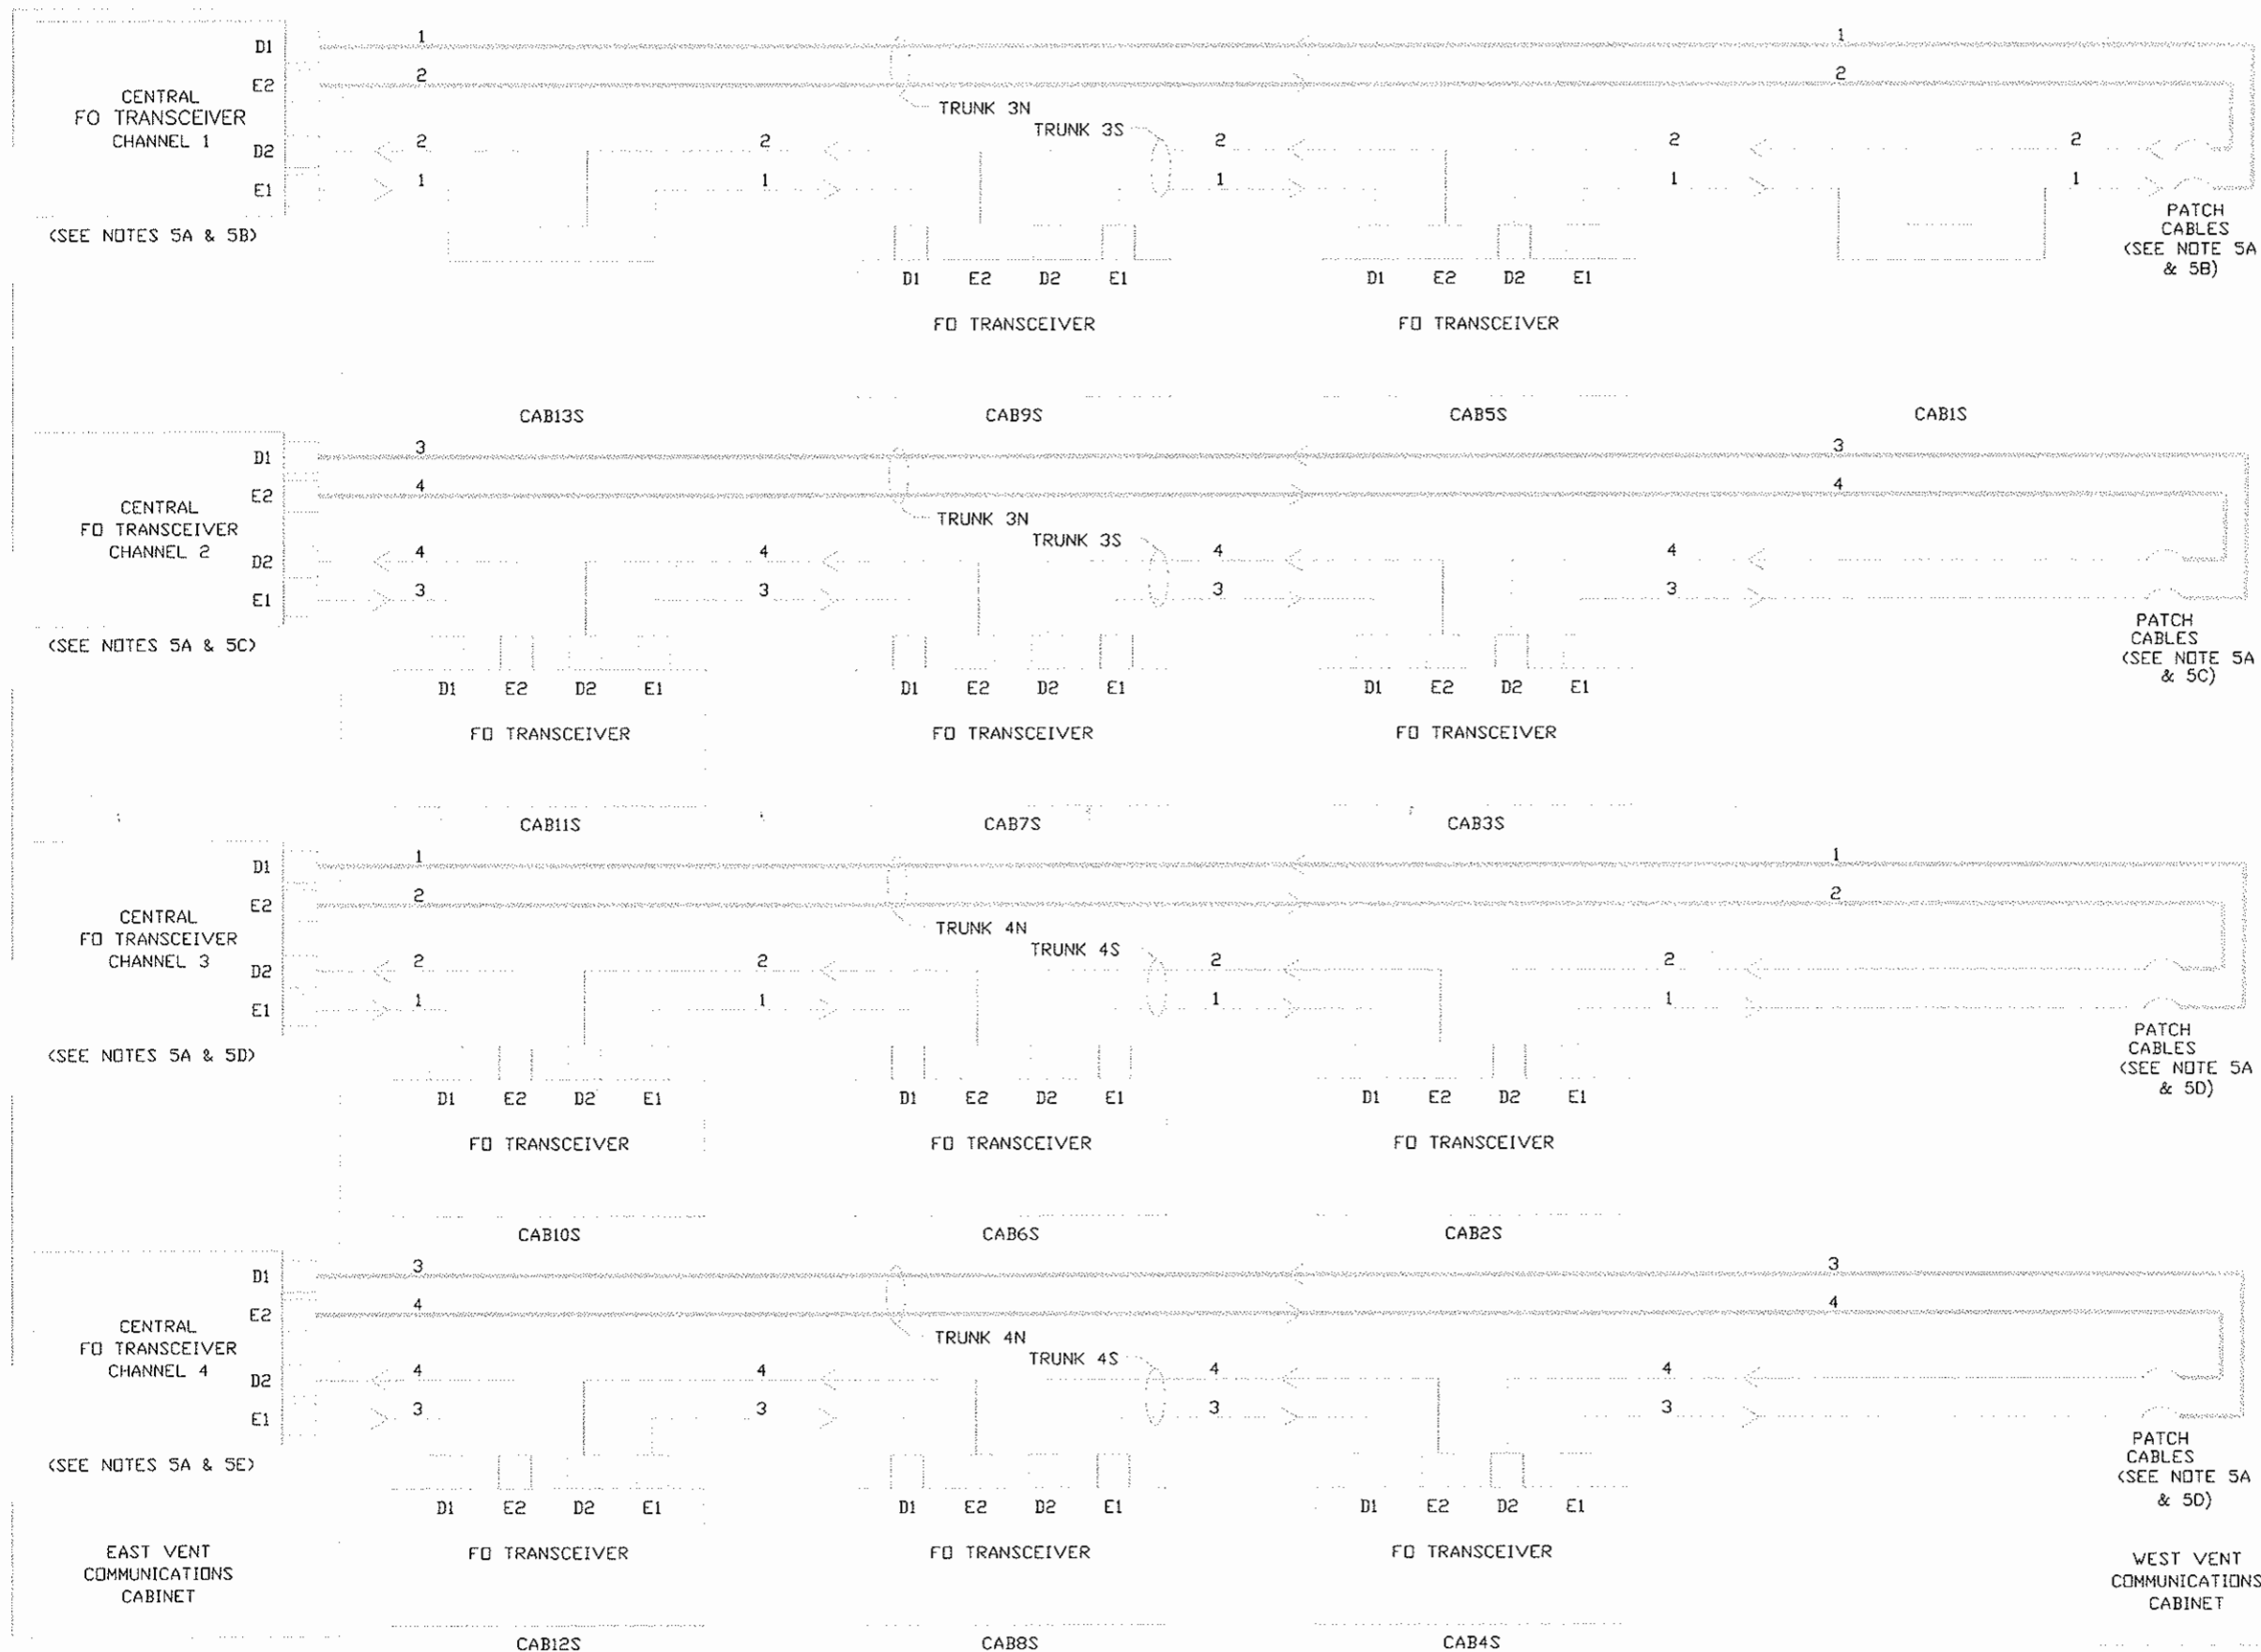

- NOTES:
1. DIRECTIONAL ARROWS DENOTE SIGNAL FLOW.
 2. EACH TRUNK IS LABELED TO INDICATE THE SPECIFIC FIBERS TO BE USED FOR THE DESIGNATED CHANNEL.
 3. SEE SHEETS 44 & 46 FOR COMMUNICATIONS CABINET WIRING.
 4. ON ALL FD TRANSCEIVERS, D1 & E1 DENOTE-RING 1 AND D2 & E2 DENOTE-RING 2.
 5. IN THE EAST & WEST VENT COMMUNICATIONS CABINETS.
 - A. DISCONNECT TRUNK 5 FROM CHANNELS 1-4
 - B. CONNECT TRUNK 3 FIBERS 1 & 2 FROM THE NORTH TUNNEL TO TRUNK 3 FIBERS 1 & 2 OF THE SOUTH TUNNEL.
 - C. CONNECT TRUNK 3 FIBERS 3 & 4 FROM THE NORTH TUNNEL TO TRUNK 3 FIBERS 3 & 4 OF THE SOUTH TUNNEL.
 - D. CONNECT TRUNK 4 FIBER 1 & 2 FROM THE NORTH TUNNEL TO TRUNK 4 FIBERS 1 & 2 OF THE SOUTH TUNNEL.
 - E. CONNECT TRUNK 4 FIBERS 3 & 4 FROM THE NORTH TUNNEL TO TRUNK 4 FIBERS 3 & 4 OF THE SOUTH TUNNEL.

LEGEND:
 FO - FIBER OPTIC

Design File Name: VMS-42.DWG
 Plot File Name: 2/6/02
 Date of Plot:

Computer File Information
 Creation Date: 09/24/99 Initials: PWM
 Last Modification Date: 2/6/02 Initials: PWM
 Full Path: VMS-42.DWG
 Drawing File Name: VMS-42.DWG
 Acad Ver. R14 Scale: NTS Units: ENGLISH

Sheet Revisions

07/03/07	ASBUILT	DJB
----------	---------	-----

Colorado Department of Transportation
 P.O. BOX 399
 DUMONT, CO. 80436
 Phone: 303-512-5750 FAX: 303-512-5775
 Region 1 Mountain Residency I.N.Z.

As Constructed
 No Revisions:
 Revised:
 Void:


SOUTH TUNNEL FO INTERCONNECT DETAIL
 Designer: D.EWAN
 Detailer: P. MEYDRECH
 Sheet Subset: VMS
 Structure Numbers:
 Subset Sheets: 41 OF 46

Project No./Code
 IM 0703-269
 13166
 Sheet Number 172

RS232 TO VMS/LUS CONTROLLER

NORTH TUNNEL

EQUIPMENT ROOM EAST VENT BUILDING

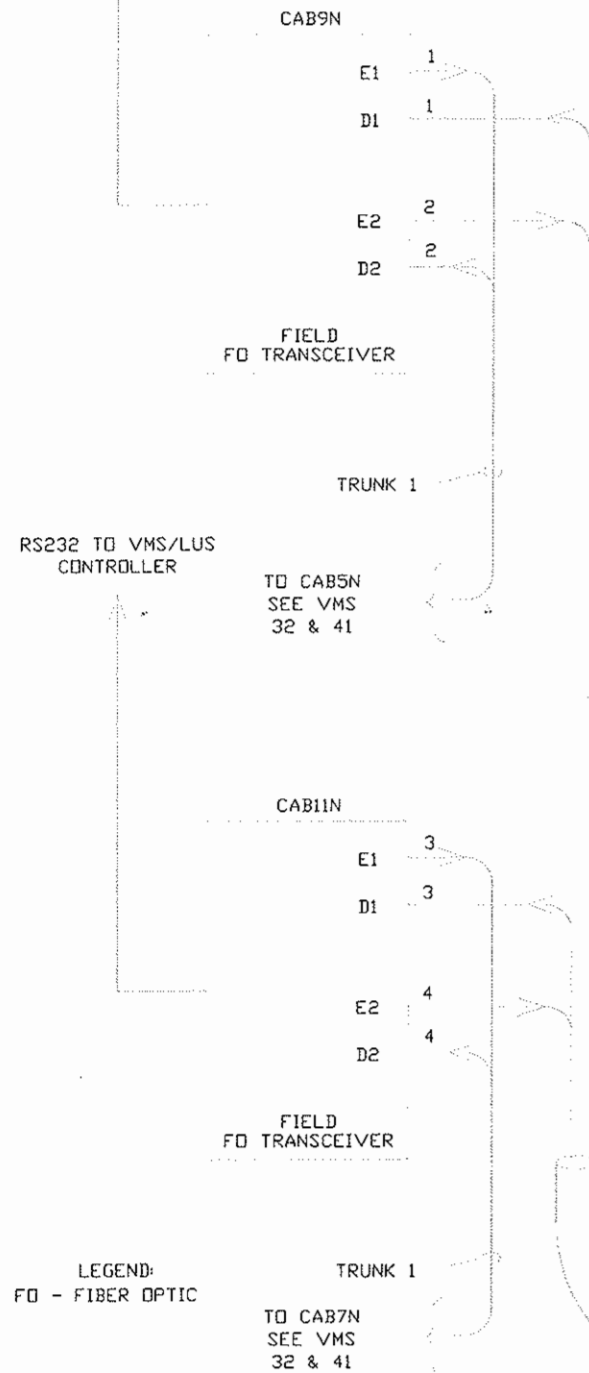

LEGEND: FO - FIBER OPTIC


TO CAB7N SEE VMS 32 & 41

PATCH PANEL & TRANSCEIVER INTERCONNECT FOR TRUNK 1

RS232 TO VMS/LUS CONTROLLER

NORTH TUNNEL

EQUIPMENT ROOM EAST VENT BUILDING

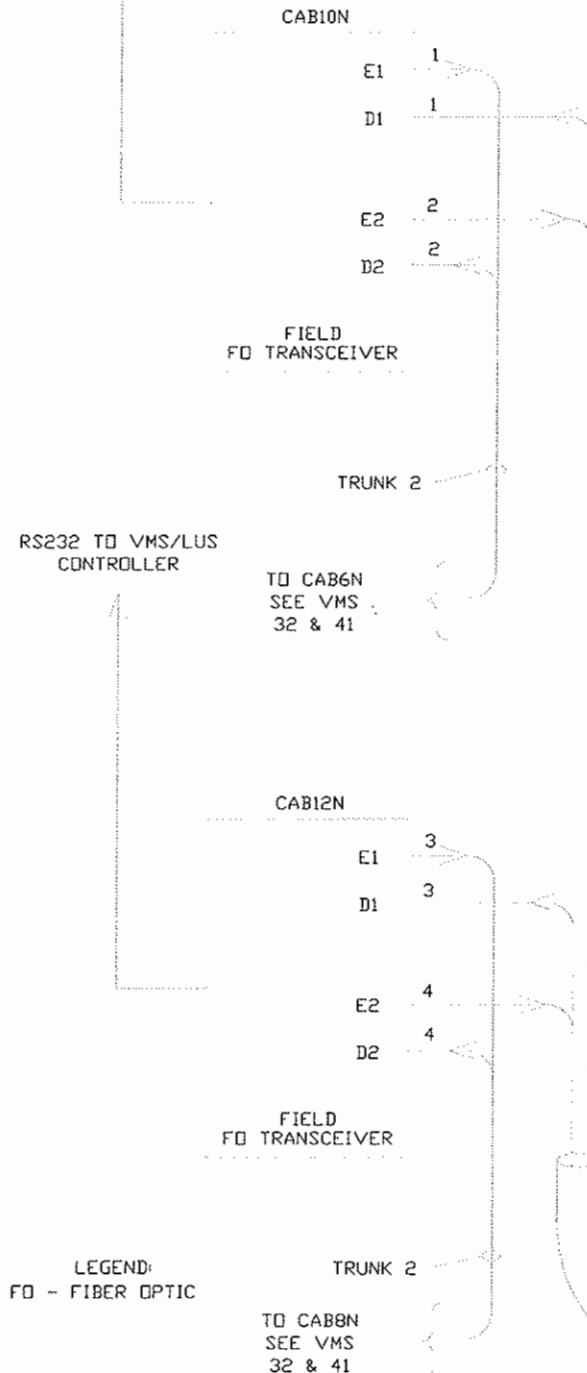

LEGEND: FO - FIBER OPTIC

TO CAB8N SEE VMS 32 & 41

PATCH PANEL & TRANSCEIVER INTERCONNECT FOR TRUNK 2

Design File Name: VMS-43.DWG
Plot File Name: 2/6/02

Computer File Information

Creation Date: 08/21/99 Initials: DE
 Last Modification Date: 2/6/02 Initials: JLM
 Full Path: VMS-43.DWG
 Drawing File Name: VMS-43.DWG
 Acad Ver. R14 Scale: NTS Units: ENGLISH

Sheet Revisions

07/03/07 ASBUILT DJB

Colorado Department of Transportation



P.O. BOX 399
 DUMONT, CO. 80436
 Phone: 303-512-5750 FAX: 303-512-5775

Region 1 Mountain Residency I.N.Z.

As Constructed

No Revisions:

Revised:

Void:

PATCH PANEL TO FO TRANSCEIVER INTERCONNECT

Designer: D. EWAN
 Detailer: P. MEYDRECH
 Sheet Subset: VMS



Structure Numbers:
 Subset Sheets: 42 OF 46

Project No./Code

IM 0703-269

13166

Sheet Number 173

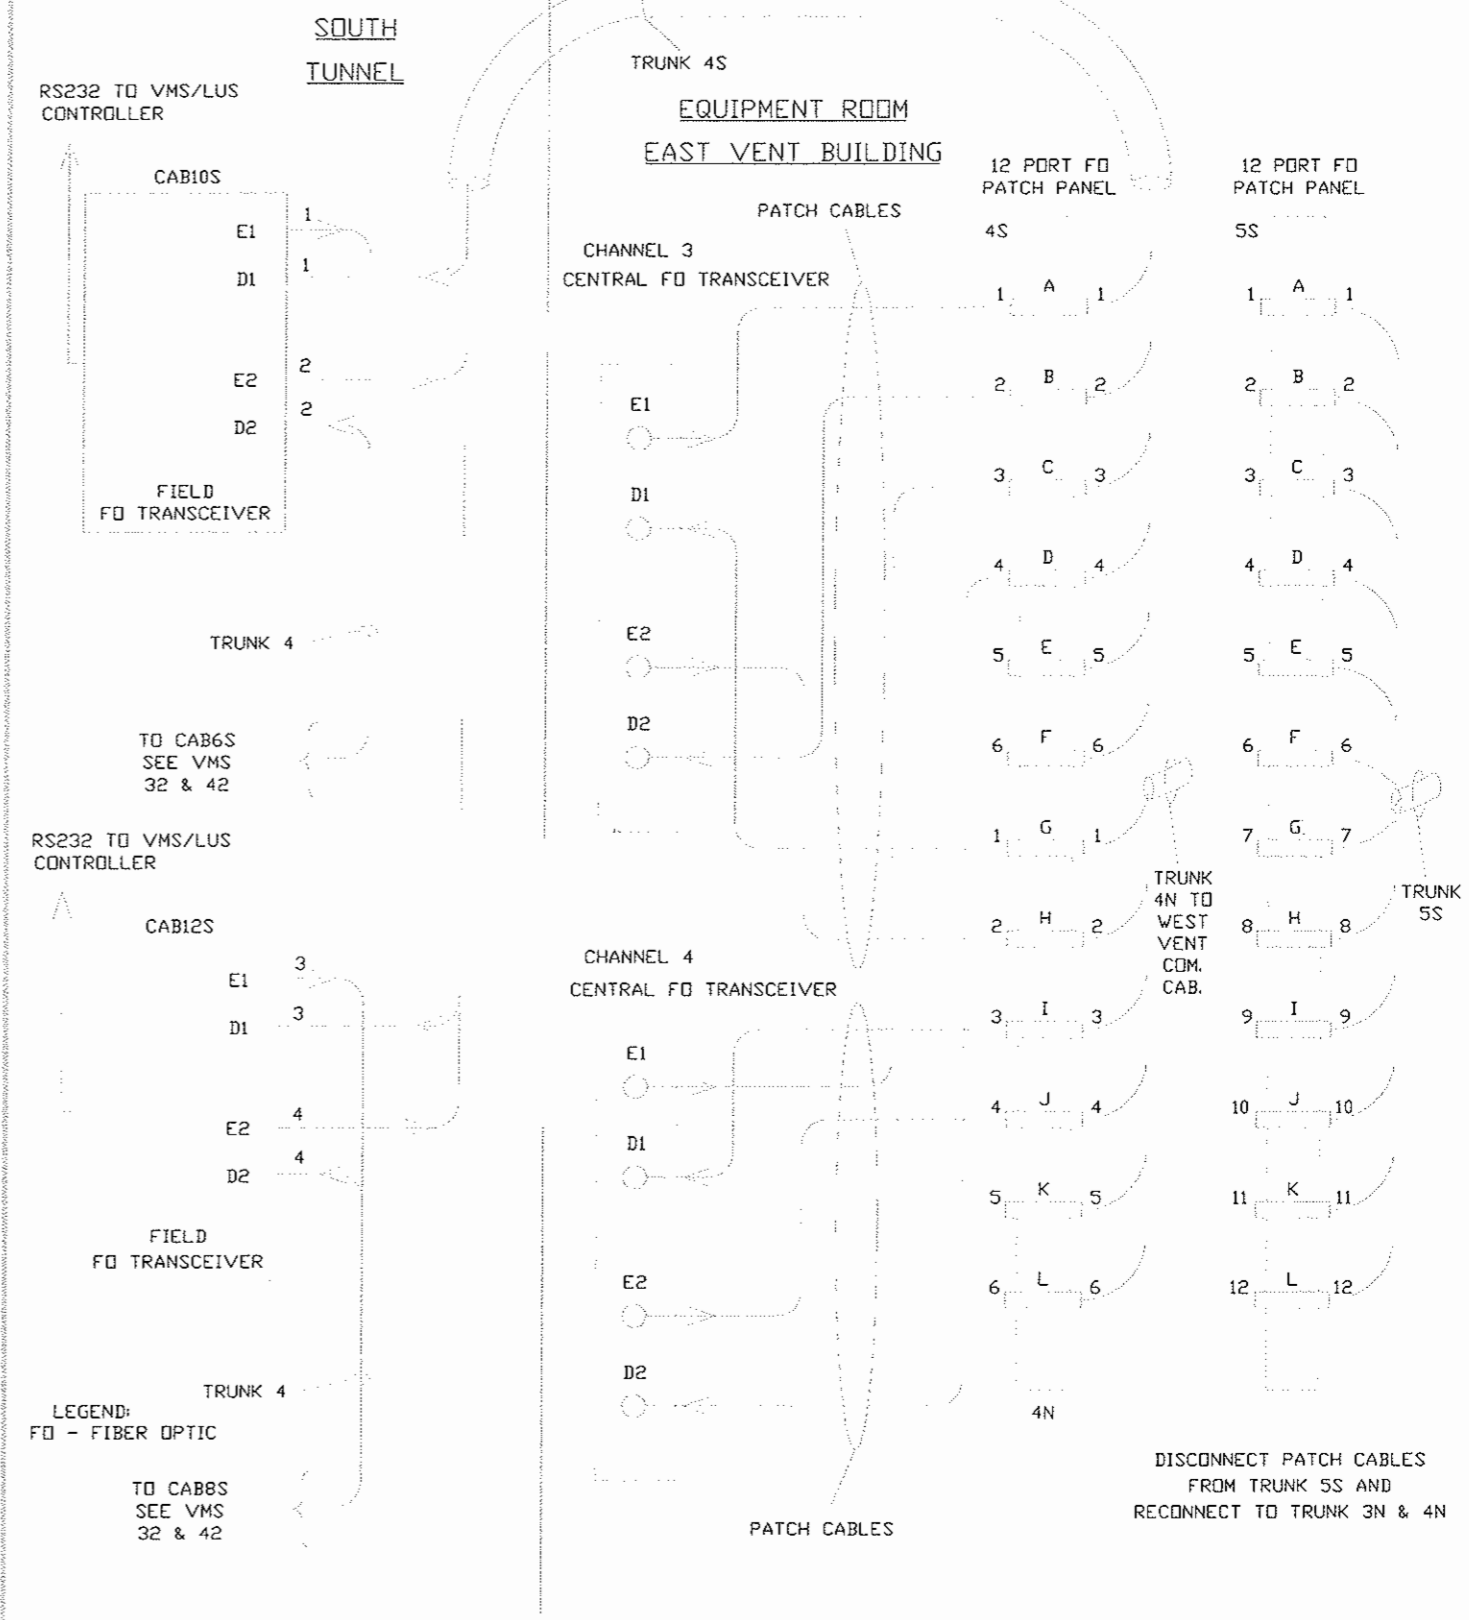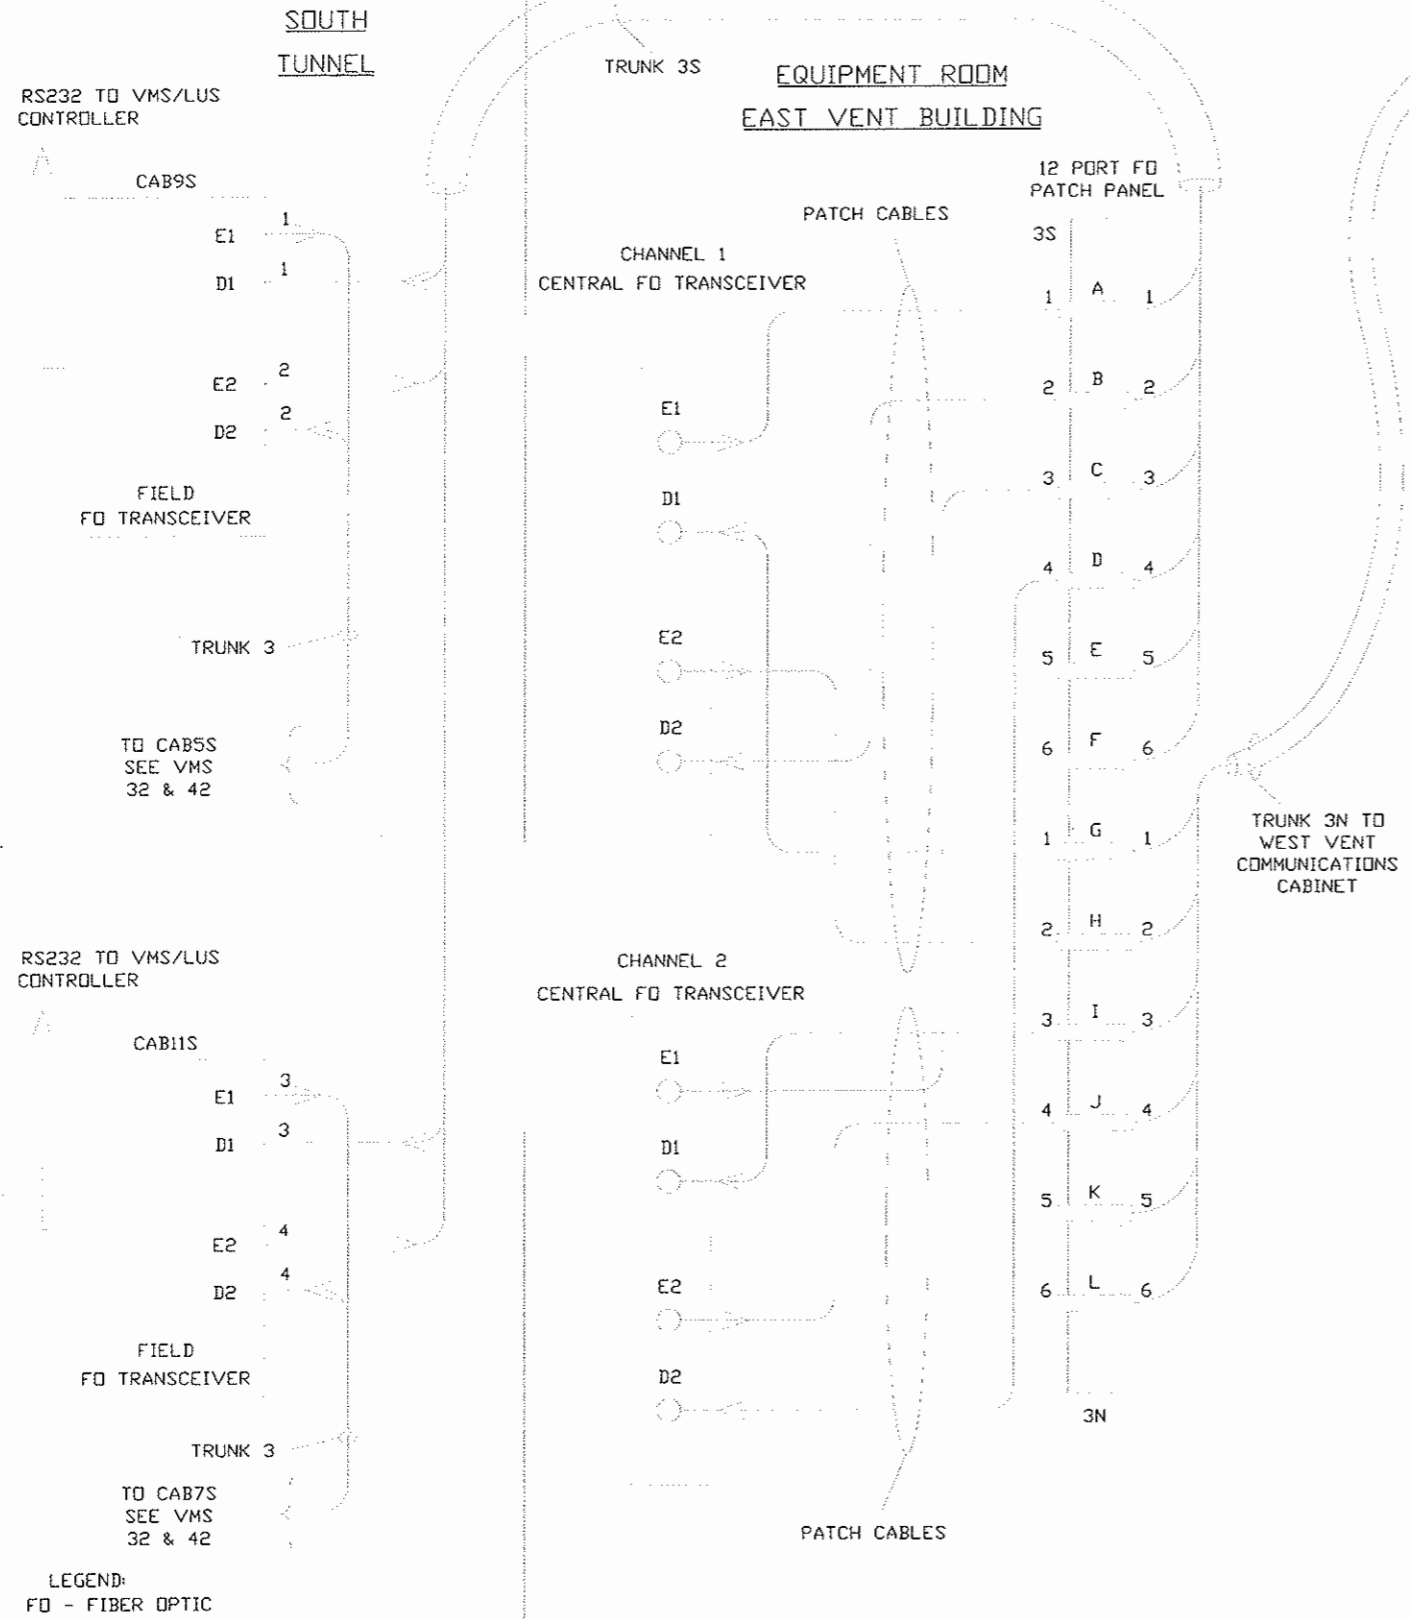


PATCH PANEL & TRANSCEIVER INTERCONNECT
MODIFICATION FOR TRUNK 3

PATCH PANEL & TRANSCEIVER INTERCONNECT
MODIFICATION FOR TRUNK 4

Design File Name: VMS-44.DWG
Plot File Name: 2/6/02
Date of Plot: 2/6/02

Computer File Information
Creation Date: 08/21/99 Initials: DE
Last Modification Date: 2/6/02 Initials: JLM
Full Path: VMS-44.DWG
Drawing File Name: VMS-44.DWG
Acad Ver. R14 Scale: NTS Units: ENGLISH

Sheet Revisions
07/03/07 ASBUILT DJB

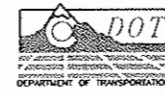


Colorado Department of Transportation
P.O. BOX 399
DUMONT, CO. 80436
Phone: 303-512-5750 FAX: 303-512-5775
Region 1 Mountain Residency I.N.Z.

As Constructed
No Revisions:
Revised:
Void:


PATCH PANEL TO FO
TRANSCEIVER INTERCONNECT
Designer: D. EWAN
Detailer: P. MEYDRECH
Sheet Subset: VMS

Project No./Code
IM 0703-269
Structure Numbers
13166
Subset Sheets: 43 OF 46
Sheet Number 174


DISCONNECT PATCH CABLES
FROM TRUNK 5S AND
RECONNECT TO TRUNK 3N & 4N

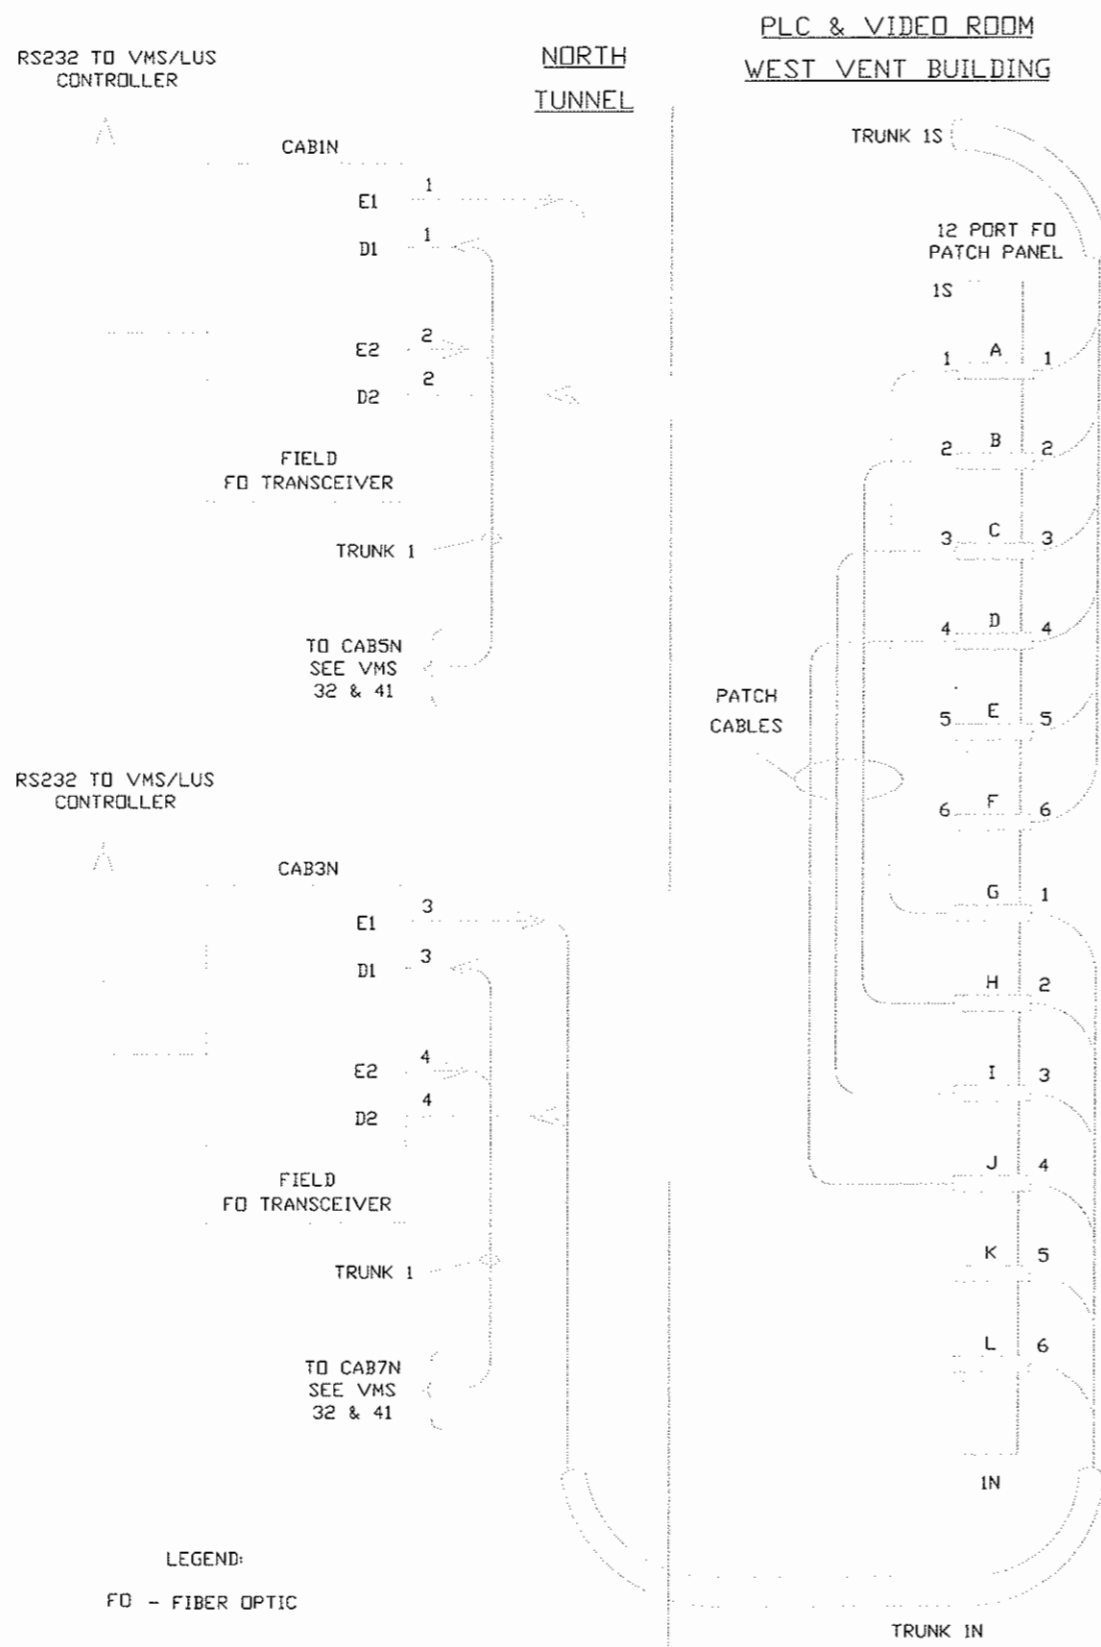

PATCH PANEL & TRANSCEIVER INTERCONNECT
FOR TRUNK 1

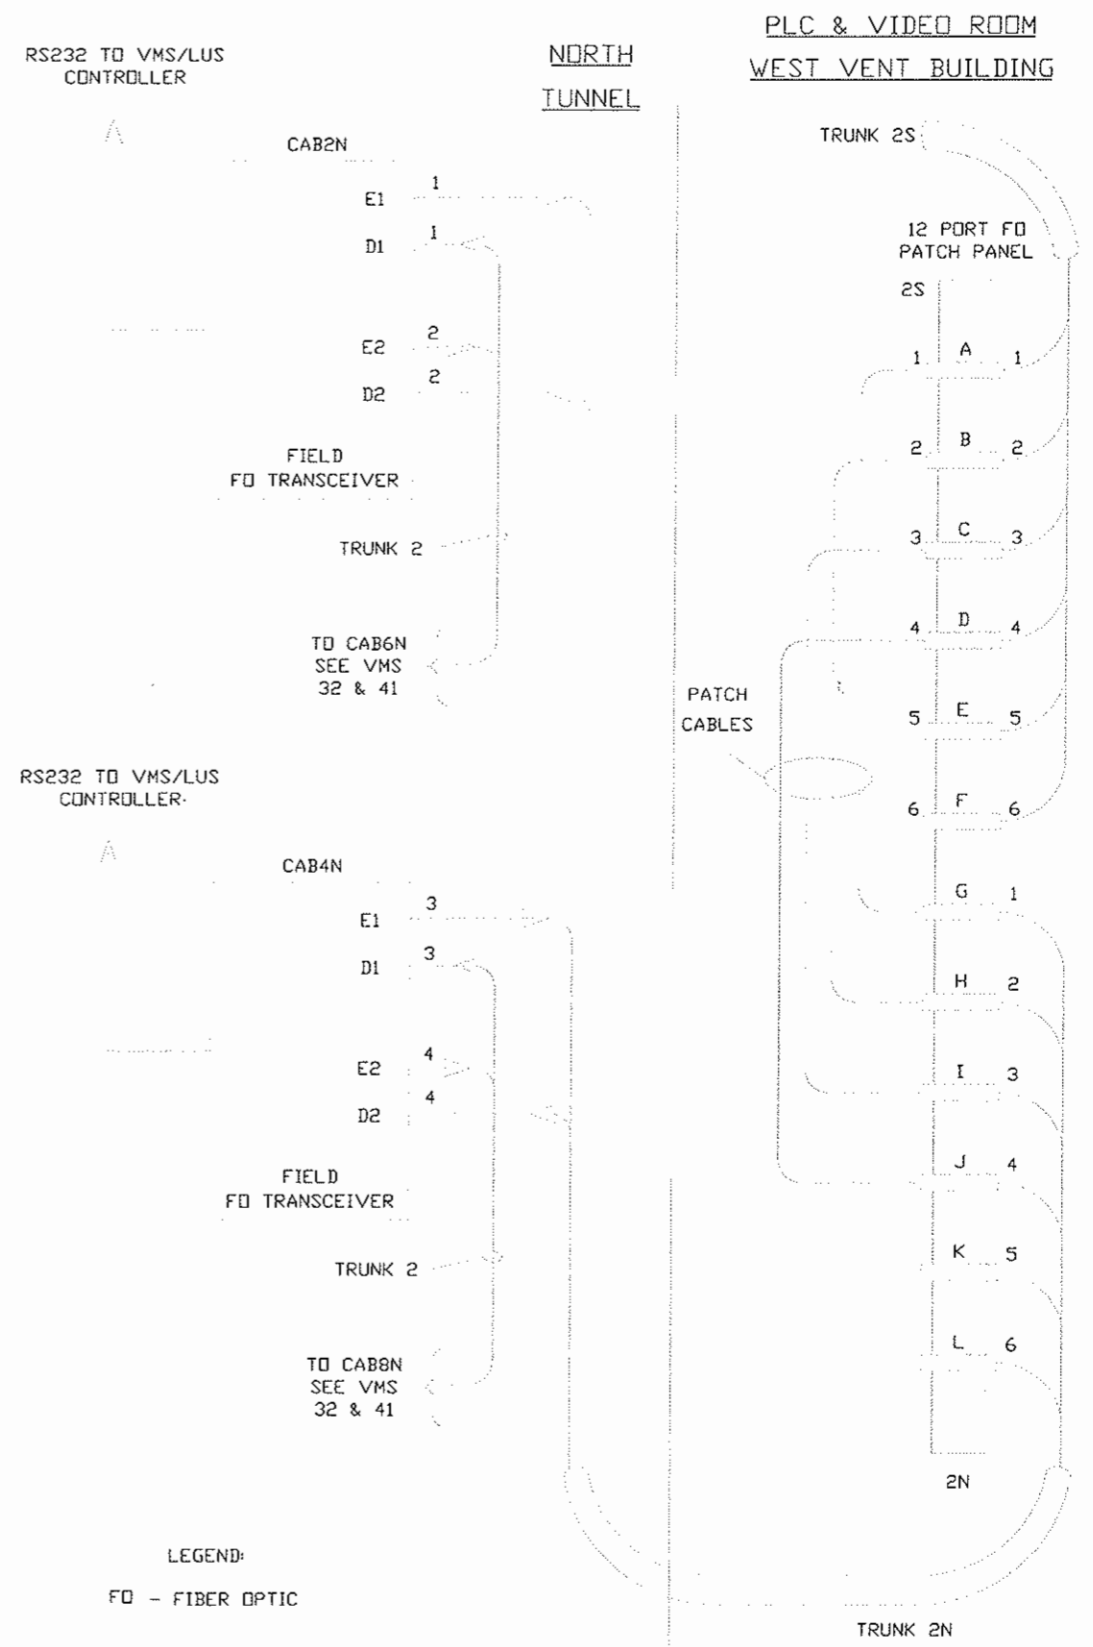


PATCH PANEL & TRANSCEIVER INTERCONNECT
FOR TRUNK 2

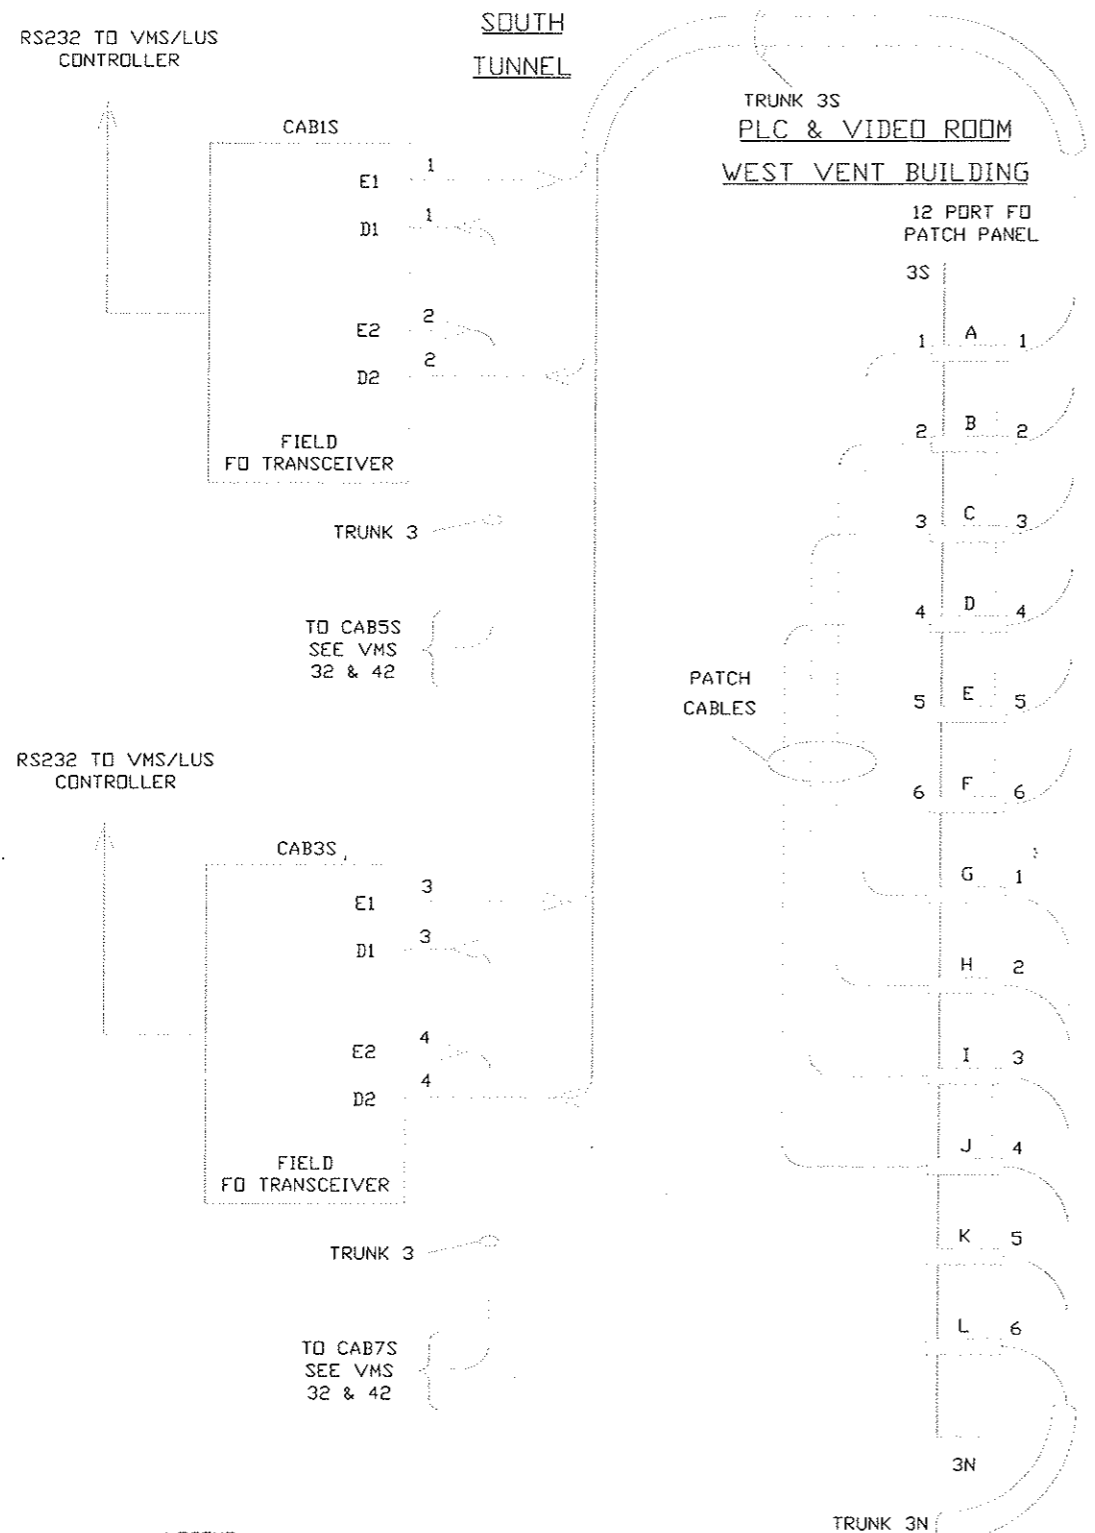

LEGEND:
FD - FIBER OPTIC

DISCONNECT PATCH CABLES FROM TRUNK 5S AND CONNECT TO TRUNK 3N

PATCH PANEL & TRANSCEIVER INTERCONNECT
MODIFICATION FOR TRUNK 3

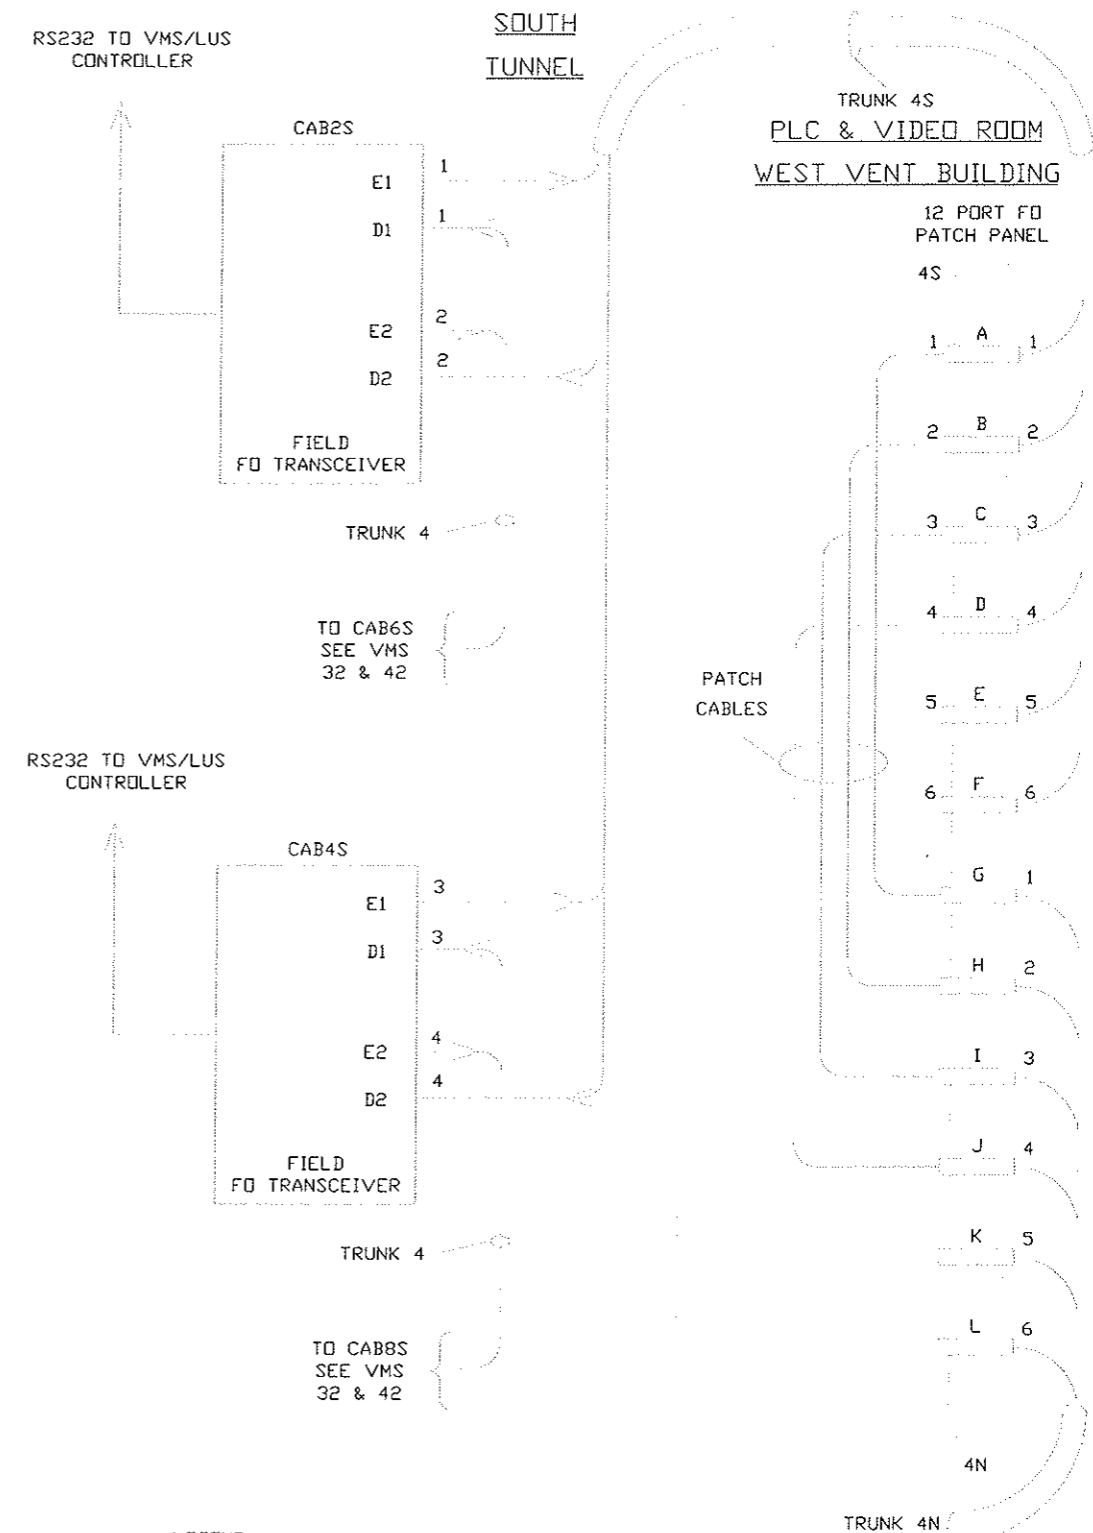

LEGEND:
FD - FIBER OPTIC


DISCONNECT PATCH CABLES FROM TRUNK 5S AND CONNECT TO TRUNK 4N

PATCH PANEL & TRANSCEIVER INTERCONNECT
MODIFICATION FOR TRUNK 4

Design File Name: VMS-46.DWG
Plot File Name: 2/6/02
Date of Plot:

Computer File Information			
Creation Date:	08/21/99	Initials:	DE
Last Modification Date:	2/6/02	Initials:	JLM
Full Path:	VMS-46.DWG		
Drawing File Name:	VMS-46.DWG		
Acad Ver.	R14	Scale:	NTS
		Units:	ENGLISH

Sheet Revisions	
07/03/07	ASBUILT DJB

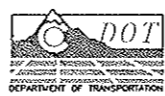

Colorado Department of Transportation
P.O. BOX 399
DUMONT, CO. 80436
Phone: 303-512-5751 FAX: 303-512-5775
Region 1 Mountain Residency I.N.Z.

As Constructed
No Revisions:
Revised:
Void:


WEST VENT TERMINATION
AND INTERCONNECT DETAIL
Designer: D. EWAN
Detailer: P. MEYDRECH
Sheet Subset: VMS

Structure Numbers
Subset Sheets: 45 of 46

Project No./Code
IM 0703-269
13166
Sheet Number 176

EQUIPMENT ROOM
EAST VENT BUILDING

PLC & VIDEO ROOM
WEST VENT BUILDING

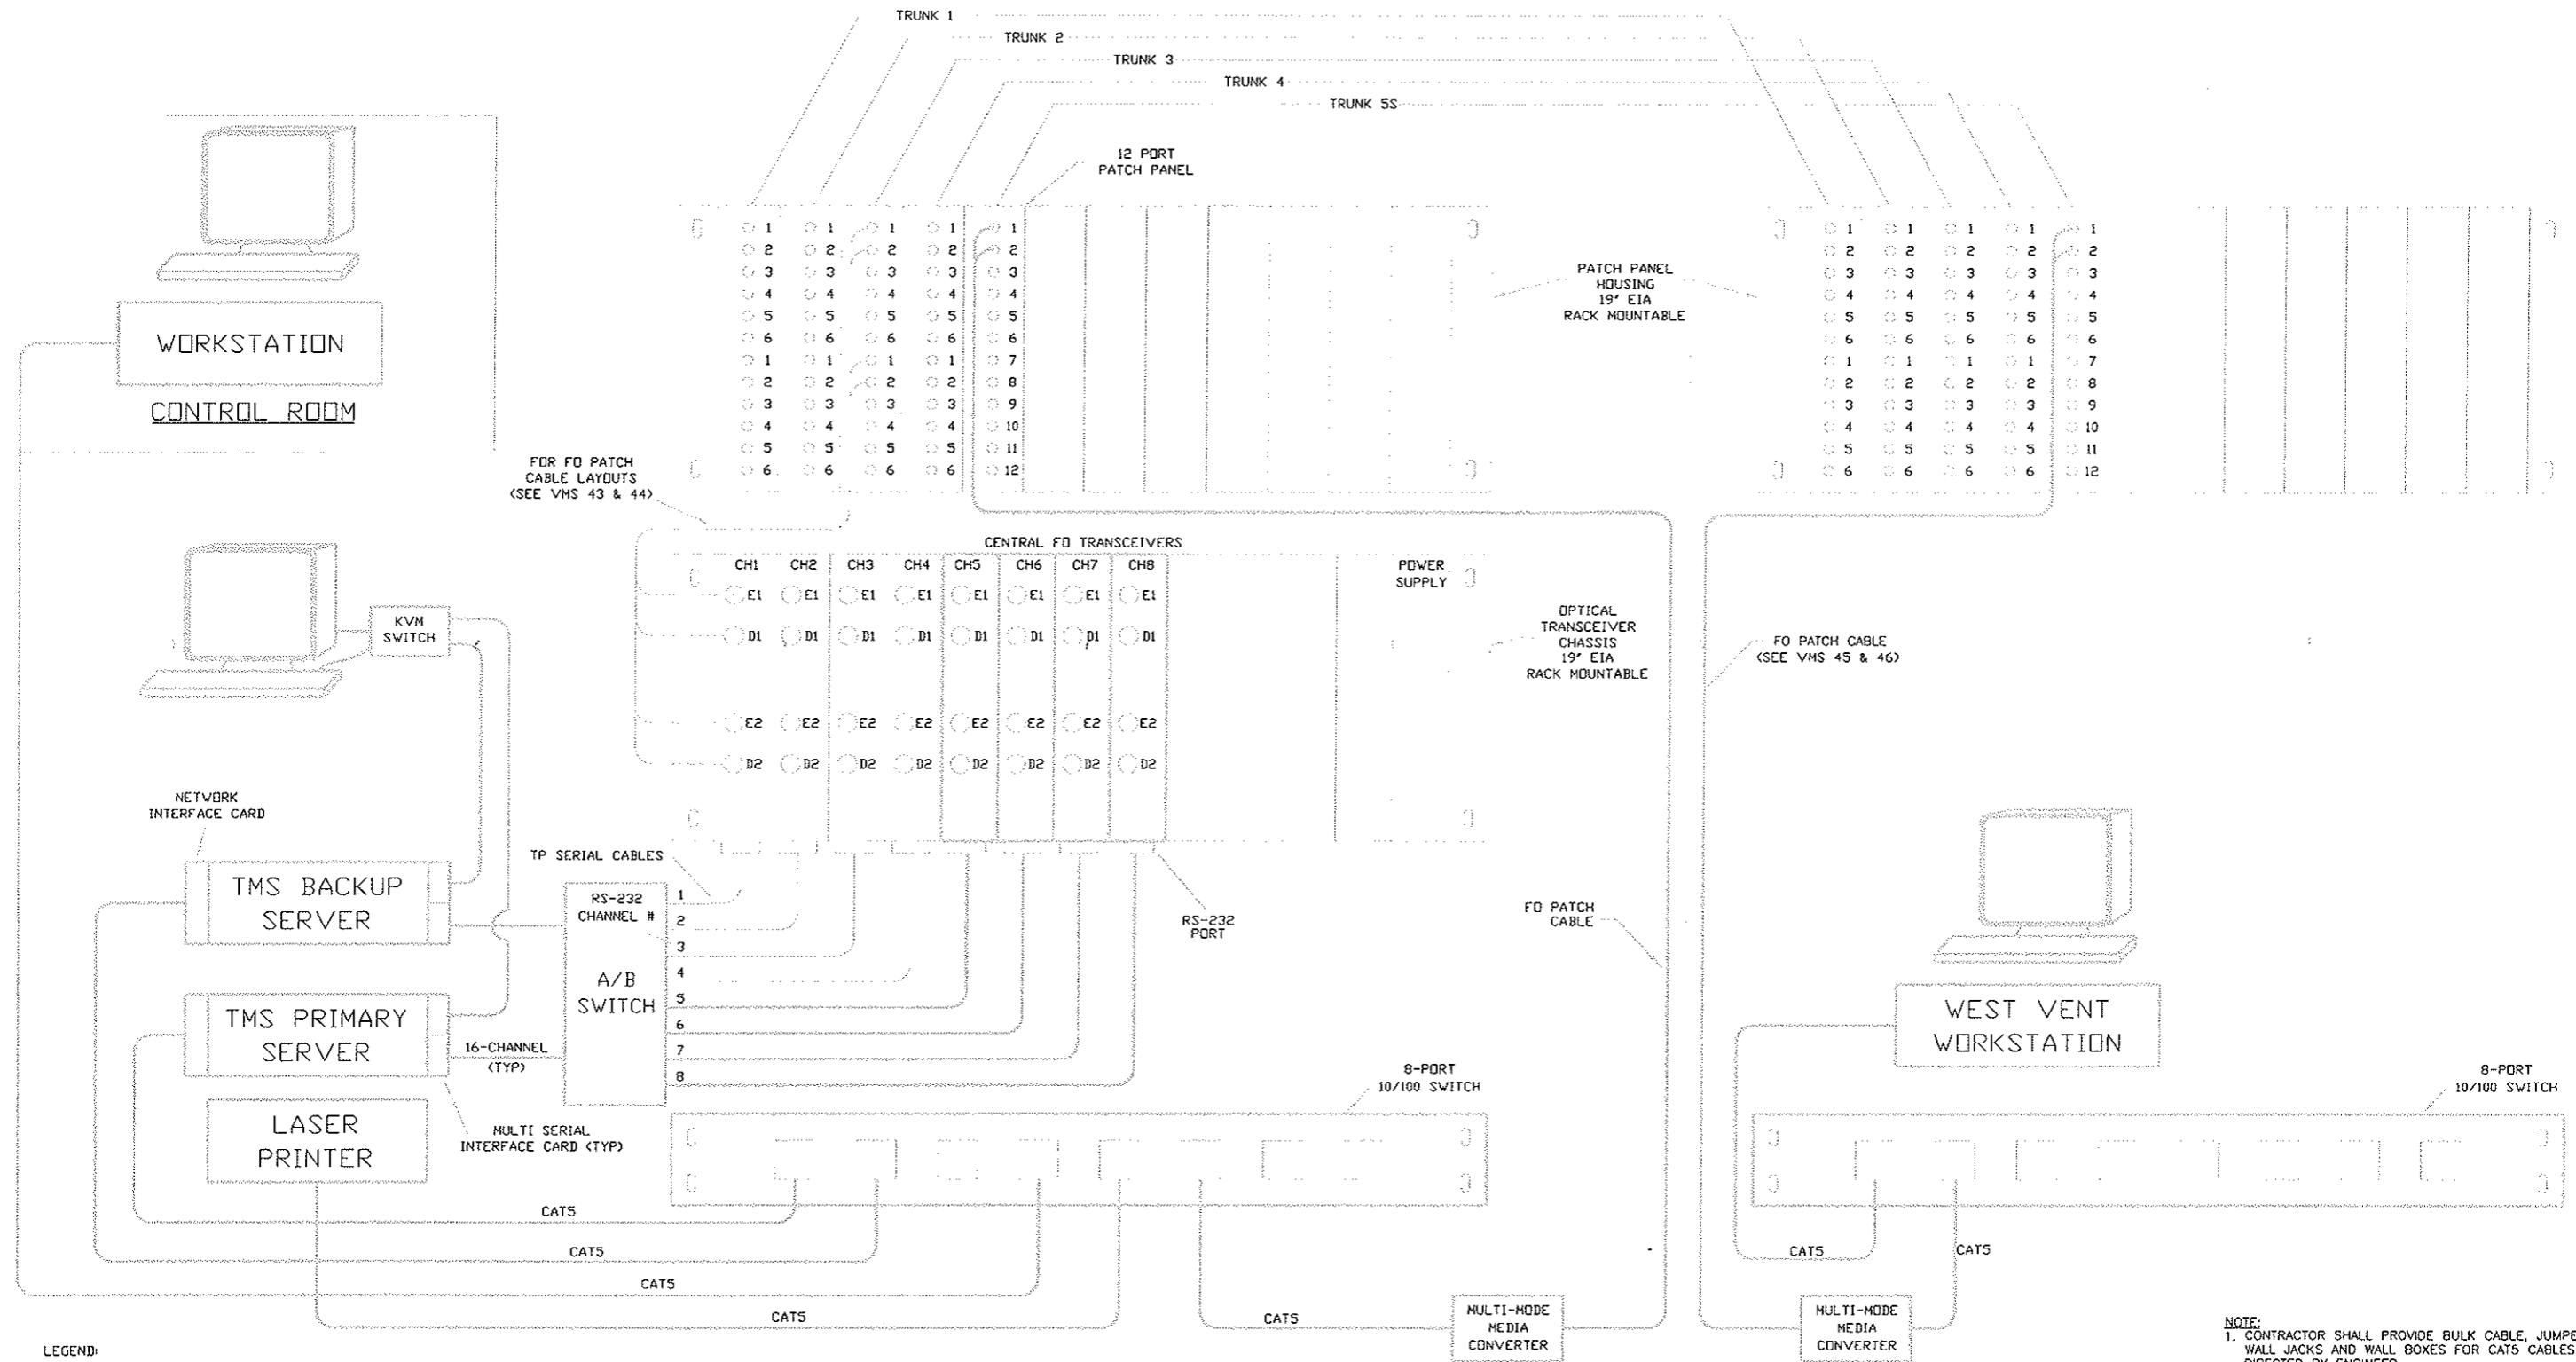

FOR FO PATCH
CABLE LAYOUTS
(SEE VMS 43 & 44)

PATCH PANEL
HOUSING
19" EIA
RACK MOUNTABLE

FO PATCH CABLE
(SEE VMS 45 & 46)

FO PATCH
CABLE

LEGEND:
FO - FIBER OPTIC CABLE
TP - TWISTED PAIR, COPPER
CAT5 - TWISTED PAIR, CATEGORY 5

FOR ROOM LAYOUT
SEE SHEET 37

NOTE:
1. CONTRACTOR SHALL PROVIDE BULK CABLE, JUMPERS,
WALL JACKS AND WALL BOXES FOR CAT5 CABLES, AS
DIRECTED BY ENGINEER.
2. ALL EQUIPMENT SHALL BE RACK MOUNTED.

Design File Name: VMS-47.DWG
Plot File Name: 2/6/02

Computer File Information
Creation Date: 08/21/99 Initials: DE
Last Modification Date: 2/6/02 Initials: JLM
Full Path: VMS-47.DWG
Drawing File Name: VMS-47.DWG
Acad Ver. R14 Scale: NTS Units: ENGLISH

Sheet Revisions
07/03/07 ASBUILT DJB

Colorado Department of Transportation
Region 1 Mountain Residency I.N.Z.
P.O. BOX 399
DUMONT, CO. 80436
Phone: 303-512-5750 FAX: 303-512-5775

As Constructed
No Revisions:
Revised:
Void:

**CENTRAL FIBER TERMINATION
AND TRANSCEIVER LAYOUT**
Project No./Code IM 0703-269
Designer: D. EWAN Structure Numbers 13166
Detailer: P. MEYDRECH
Sheet Subset: VMS Subset Sheets: 46 OF 46 Sheet Number 177