

LEFT END table with columns: BENT LINE, STATION, OFFSET, ELEVATION, ELEV+DL, X, Y, NORTHING, EASTING, BENT LNTH, SKEW, GIRDER LNTH, CRS-SLP. Includes data for WF and W1 sections.

Table with columns: BENT LINE, STATION, OFFSET, ELEVATION, ELEV+DL, X, Y, NORTHING, EASTING, BENT LNTH, SKEW, GIRDER LNTH, CRS-SLP. Includes data for WF and W1 sections.

Table with columns: BENT LINE, STATION, OFFSET, ELEVATION, ELEV+DL, X, Y, NORTHING, EASTING, BENT LNTH, SKEW, GIRDER LNTH, CRS-SLP. Includes data for WF and W1 sections.

HCL table with columns: BENT LINE, STATION, OFFSET, ELEVATION, ELEV+DL, X, Y, NORTHING, EASTING, BENT LNTH, SKEW, GIRDER LNTH, CRS-SLP. Includes data for WF and W1 sections.

RIGHT END table with columns: BENT LINE, STATION, OFFSET, ELEVATION, ELEV+DL, X, Y, NORTHING, EASTING, BENT LNTH, SKEW, GIRDER LNTH, CRS-SLP. Includes data for WF and W1 sections.

Table with columns: BENT LINE, STATION, OFFSET, ELEVATION, ELEV+DL, X, Y, NORTHING, EASTING, BENT LNTH, SKEW, GIRDER LNTH, CRS-SLP. Includes data for WF and W1 sections.

Vertical table with columns: Design, Detail, Quantities. Rows include initials, dates, and quantities for various items.

Print Date: 9/24/2010
File Name: 16042V_Brdg_Geometry_02.dgn
Horiz. Scale: 1:1
Unit Information 0221

Sheet Revisions table with columns: Date, Comments, Init.

Colorado Department of Transportation
3803 North Main Avenue
Suite 200
Durango, CO 81301
Phone: 970-385-1440 FAX: 970-385-8365
Region 5 EJA

As Constructed
No Revisions: 9/10

RAMP A OVER US 160 BRIDGE DECK ELEVATIONS (2 OF 2)
Designer: A. Leifheit
Detailer: R. Artman
Sheet Subset: Bridge

Project No./Code
NH 1602-114
16042
Sheet Number 266

GENERAL NOTES

EXCEPT AS SHOWN IN THE PLANS, STRUCTURE EXCAVATION AND BACKFILL SHALL BE IN ACCORDANCE WITH M-206-2 BRIDGES.

EXPANSION JOINT MATERIAL SHALL MEET AASHTO SPECIFICATION M213.

A COLORED STRUCTURAL CONCRETE STAIN FINISH WILL BE REQUIRED, AS SHOWN ON THE PLANS, ON EXPOSED CONCRETE SURFACES. THE COLORED STRUCTURAL CONCRETE STAIN IS TO BE SELECTED FROM TEST PANELS PROVIDED BY THE CONTRACTOR. A CLASS 2 FINISH SHALL BE PROVIDED FOR ALL CONCRETE SURFACES TO RECEIVE CONCRETE STAIN. A CLASS 1 FINISH SHALL BE PROVIDED FOR ALL OTHER SURFACES TO 1 FOOT BELOW THE GROUND LINE.

ALL BOLTS SHALL BE 3/8" DIAMETER, HIGH STRENGTH, UNLESS OTHERWISE NOTED.

GRADE 60 REINFORCING STEEL IS REQUIRED.

ALL REINFORCING STEEL SHALL BE EPOXY COATED UNLESS OTHERWISE NOTED.

(N) DENOTES NON COATED REINFORCING STEEL.

ALL THE PROVISIONS FOR BRIDGE DECK CONCRETE SHALL ALSO APPLY TO APPROACH SLAB CONCRETE.

AN EMERGENCY DECK CONSTRUCTION JOINT MAY BE LOCATED AT THE ONE QUARTER SPAN POINT BACK FROM A PIER OR ABUTMENT WITH RESPECT TO THE DIRECTION OF THE DECK PLACEMENT.

ALL CONCRETE SHALL BE LEVEL II SULFATE RESISTANT.

UNLESS NOTED OTHERWISE, THE FOLLOWING STRUCTURAL STEEL SHALL BE AASHTO M270 GRADE 36 (ASTM A-36): BEARING PLATES, BEARING DEVICES, BRIDGE RAILING.

THE FOLLOWING STRUCTURAL STEEL SHALL BE AASHTO M-222 (ASTM A-588) GRADE 50: BRIDGE RAILING.

DESIGN DATA

DESIGN CODE: AASHTO LRFD, 4TH EDITION WITH 2008 INTERIMS

DESIGN METHOD: LOAD AND RESISTANCE FACTOR DESIGN

LIVE LOAD: HL-93 (DESIGN TRUCK OR TANDEM, AND DESIGN LANE LOAD)

DEAD LOAD: ASSUMES 36 LBS. PER SQ. FT. FOR BRIDGE DECK OVERLAY.

ASSUMES 5 LBS. PER SQ. FT. FOR LOST DECK FORMS

SEISMIC: ZONE 1, SITE CLASS D, As=0.098g, SD1=0.098g

REINFORCED CONCRETE:

CLASS D CONCRETE: f'c = 4,500 psi

REINFORCING STEEL: fy = 60,000 psi

CAISSON CONCRETE:

CLASS BZ CONCRETE: f'c = 4,000 psi

REINFORCING STEEL: fy = 60,000 psi

THE FOLLOWING TABLE GIVES THE MINIMUM LAP SPLICE LENGTH FOR EPOXY COATED REINFORCING BARS PLACED IN ACCORDANCE WITH SUBSECTION 602.06. THESE SPLICE LENGTHS SHALL BE INCREASED BY 25% FOR BARS SPACED AT LESS THAN 6" ON CENTER.

BAR SIZE	#4	#5	#6	#7	#8	#9	#10	#11
----------	----	----	----	----	----	----	-----	-----

SPLICE LENGTH FOR CLASS D CONCRETE	1'-3"	1'-7"	2'-5"	2'-10"	3'-8"	4'-8"	5'-11"	7'-3"
------------------------------------	-------	-------	-------	--------	-------	-------	--------	-------

WHEN THE CONTRACTOR ELECTS TO SUBSTITUTE EPOXY COATED REINFORCEMENT FOR BLACK REINFORCING BARS, THE MINIMUM LAP SPLICE SHALL BE AS DESCRIBED ABOVE.

THE FOLLOWING TABLE GIVES THE MINIMUM LAP SPLICE LENGTH FOR BLACK REINFORCING BARS PLACED IN ACCORDANCE WITH SUBSECTION 602.06. THESE SPLICE LENGTHS SHALL BE INCREASED BY 25% FOR BARS SPACED AT LESS THAN 6" ON CENTER.

BAR SIZE	#4	#5	#6	#7	#8	#9	#10	#11
----------	----	----	----	----	----	----	-----	-----

SPLICE LENGTH FOR CLASS D CONCRETE	1'-1"	1'-4"	1'-7"	1'-11"	2'-6"	3'-1"	3'-11"	4'-10"
------------------------------------	-------	-------	-------	--------	-------	-------	--------	--------

THE ABOVE SPLICE LENGTHS MAY BE REDUCED BY 20% WHEN 3" OF CLEAR COVER EXISTS AND BAR SPACING IS 6" OR GREATER ON CENTER.

THE CONTRACTOR SHALL BE RESPONSIBLE FOR THE STABILITY OF THE STRUCTURE DURING CONSTRUCTION.

FOR STRUCTURE NUMBER INSTALLATION, SEE STANDARD S-614-12.

STATIONS, ELEVATIONS, AND DIMENSIONS CONTAINED IN THESE PLANS ARE CALCULATED FROM A RECENT FIELD SURVEY. THE CONTRACTOR SHALL VERIFY ALL DEPENDENT DIMENSIONS IN THE FIELD BEFORE ORDERING OR FABRICATING ANY MATERIAL.



THE INFORMATION SHOWN ON THESE PLANS CONCERNING THE TYPE AND LOCATION OF UNDERGROUND UTILITIES IS NOT GUARANTEED TO BE ACCURATE OR ALL INCLUSIVE. THE CONTRACTOR IS RESPONSIBLE FOR MAKING HIS OWN DETERMINATION AS TO THE TYPE AND LOCATION OF UNDERGROUND UTILITIES AS MAY BE NECESSARY TO AVOID DAMAGE THERETO.

INDEX OF DRAWINGS

Sheet No.	Title
B1	General Notes
B2	Summary of Quantities
B3	General Layout
B4	Typical Section
B5	Construction Constraints
B6	Engineering Geology
B7	Bridge Hydraulic Information (1 of 2)
B8	Bridge Hydraulic Information (2 of 2)
B9	Construction Layout (1 of 2)
B10	Construction Layout (2 of 2)
B11	Foundation Layout
B12	Drilled Caisson Details
B13	Abutment 1 Details
B14	Abutment 1 Reinforcing Details
B15	Abutment 3 Details
B16	Wingwall Details
B17	Pier 2 Details (1 of 2)
B18	Pier 2 Details (2 of 2)
B19	Superstructure Details
B20	Deck Reinforcing Plan
B21	Cast-In-Place Box Girder Details (1 of 4)
B22	Cast-In-Place Box Girder Details (2 of 4)
B23	Cast-In-Place Box Girder Details (3 of 4)
B24	Cast-In-Place Box Girder Details (4 of 4)
B25	Bearing Device Type III (1 of 2)
B26	Bearing Device Type III (2 of 2)
B27	Bridge Rail Type 10M (Special) (1 of 2)
B28	Bridge Rail Type 10M (Special) (2 of 2)
B29	Abut. 1 Mechanically Stabilized Backfill
B30	Abut. 3 Mechanically Stabilized Backfill
B31	Slope Paving Details
B32	Architectural Details
B33	Bridge Deck Elevations (1 of 2)
B34	Bridge Deck Elevations (2 of 2)

BRIDGE DESCRIPTION

2 SPAN (162'-6", 136'-6")
CONTINUOUS PRESTRESSED CONCRETE HAUNCHED BOX GIRDER OVER WILSON GULCH.
26'-0" ROADWAY CURB TO CURB,
NO SKEW. (2) 1'-6" TYPE 10M (SPECIAL) BRIDGE RAIL.

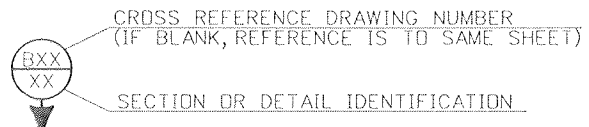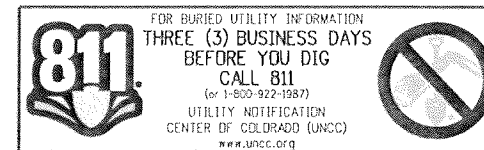


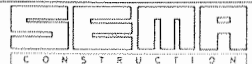

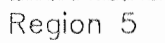
Design	INITIAL	DATE	Checked By	DATE	Checked By
	AML	10/08			
Detail	INITIAL	DATE	Checked By	DATE	Checked By
	AML	10/08			
Quantities	INITIAL	DATE	Checked By	DATE	Checked By
	AML	10/08			


Print Date: 9/22/2010	Sheet Revisions			Colorado Department of Transportation 3803 North Main Avenue Suite 200 Durango, CO 81301 Phone: 970-385-1440 FAX: 970-385-8365 Region 5 EJA	As Constructed	RAMP C OVER WILSON GULCH		Project No./Code
File Name: 16042W_GenNotes_01.dgn	Date:	Comments	Init.		No Revisions: 9/10	GENERAL NOTES		NH 1602-114
Horiz. Scale: 1:1 Vert. Scale: As Noted				Revised:	Designer: A. Leifheit	Structure: P-05-W	16042	
Unit Information 0221 Unit Leader STW				Void:	Detailer: D. Anderson	Sheet Subset: Bridge	Sheet Number 267	
SEMA CONSTRUCTION	WILSON & COMPANY					Subset Sheets: B1 of B34		

SUMMARY OF APPROXIMATE QUANTITIES


Item No.	Description	Units	Superstructure	Abut. 1	Pier 2	Abut. 3	Total
206	Structure Excavation	CY	-	13	174	96	283
206	Structure Backfill (Class 1)	CY	-	239	156	204	599
206	Mechanical Reinforcement of Soil	CY	-	163	-	153	316
403	Hot Mix Asphalt	TON	143	-	-	-	143
503	Drilled Caisson (36")	LF	-	275	-	223	498
503	Drilled Caisson (48")	LF	-	-	87	-	87
507	Concrete Slope and Ditch Paving (Reinforced)	CY	-	13	-	-	13
512	Bridge Bearing Device (Type III)	EA	-	2	-	-	2
515	Waterproofing Membrane	SY	880	-	-	-	880
518	Waterstop	LF	279	-	-	-	279
601	Concrete Class D (Bridge)	CY	589	72	67	52	780
601	Structural Concrete Coating	SY	1483	74	109	66	1732
602	Reinforcing Steel	LBS	46643	-	-	-	46643
602	Reinforcing Steel (Epoxy Coated)	LBS	89813	9223	18038	5134	122208
606	Bridge Rail Type 10M (Special)	LF	589	-	-	-	589
613	1" Conduit (Anti-Icing System)	LF	56	-	-	-	56
613	1.5" Conduit (Anti-Icing System)	LF	448	-	-	-	448
613	2" Conduit (Anti-Icing System)	LF	548	-	-	-	548
613	2" Electrical Conduit	LF	597	-	-	-	597
613	6" Electrical Conduit	LF	609	-	-	-	609
618	Prestressing Steel Strand	MKFT	1770	-	-	-	1770

Design		Detail		Quantities	
Designed By	Checked By	INITIAL	DATE	INITIAL	DATE
AWL	SEVA	AWL	10/08	AWL	10/08
Checked By	Checked By	Quantities By	Checked By	Quantities By	Checked By
SEVA	SEVA	AWL	10/08	LW	10/08

Print Date: 9/22/2010	Sheet Revisions			Colorado Department of Transportation 3803 North Main Avenue Suite 200 Durango, CO 81301 Phone: 970-385-1440 FAX: 970-385-8365 	As Constructed	RAMP C OVER WILSON GULCH		Project No./Code
File Name: 16042W_SumApproxQuant_01.dgn	Date:	Comments	Init.		No Revisions: 9/10	SUMMARY OF QUANTITIES		NH 1602-114
Horiz. Scale: 1:1 Vert. Scale: As Noted				Revised:	Designer: A. Leifheit	Structure	P-05-W	16042
Unit Information 0221 Unit Leader STW				Void:	Detailer: R. Artman	Numbers		Sheet Number 268
 	 Region 5			EJA	Sheet Subset: Bridge	Subset Sheets: B2 of B34		

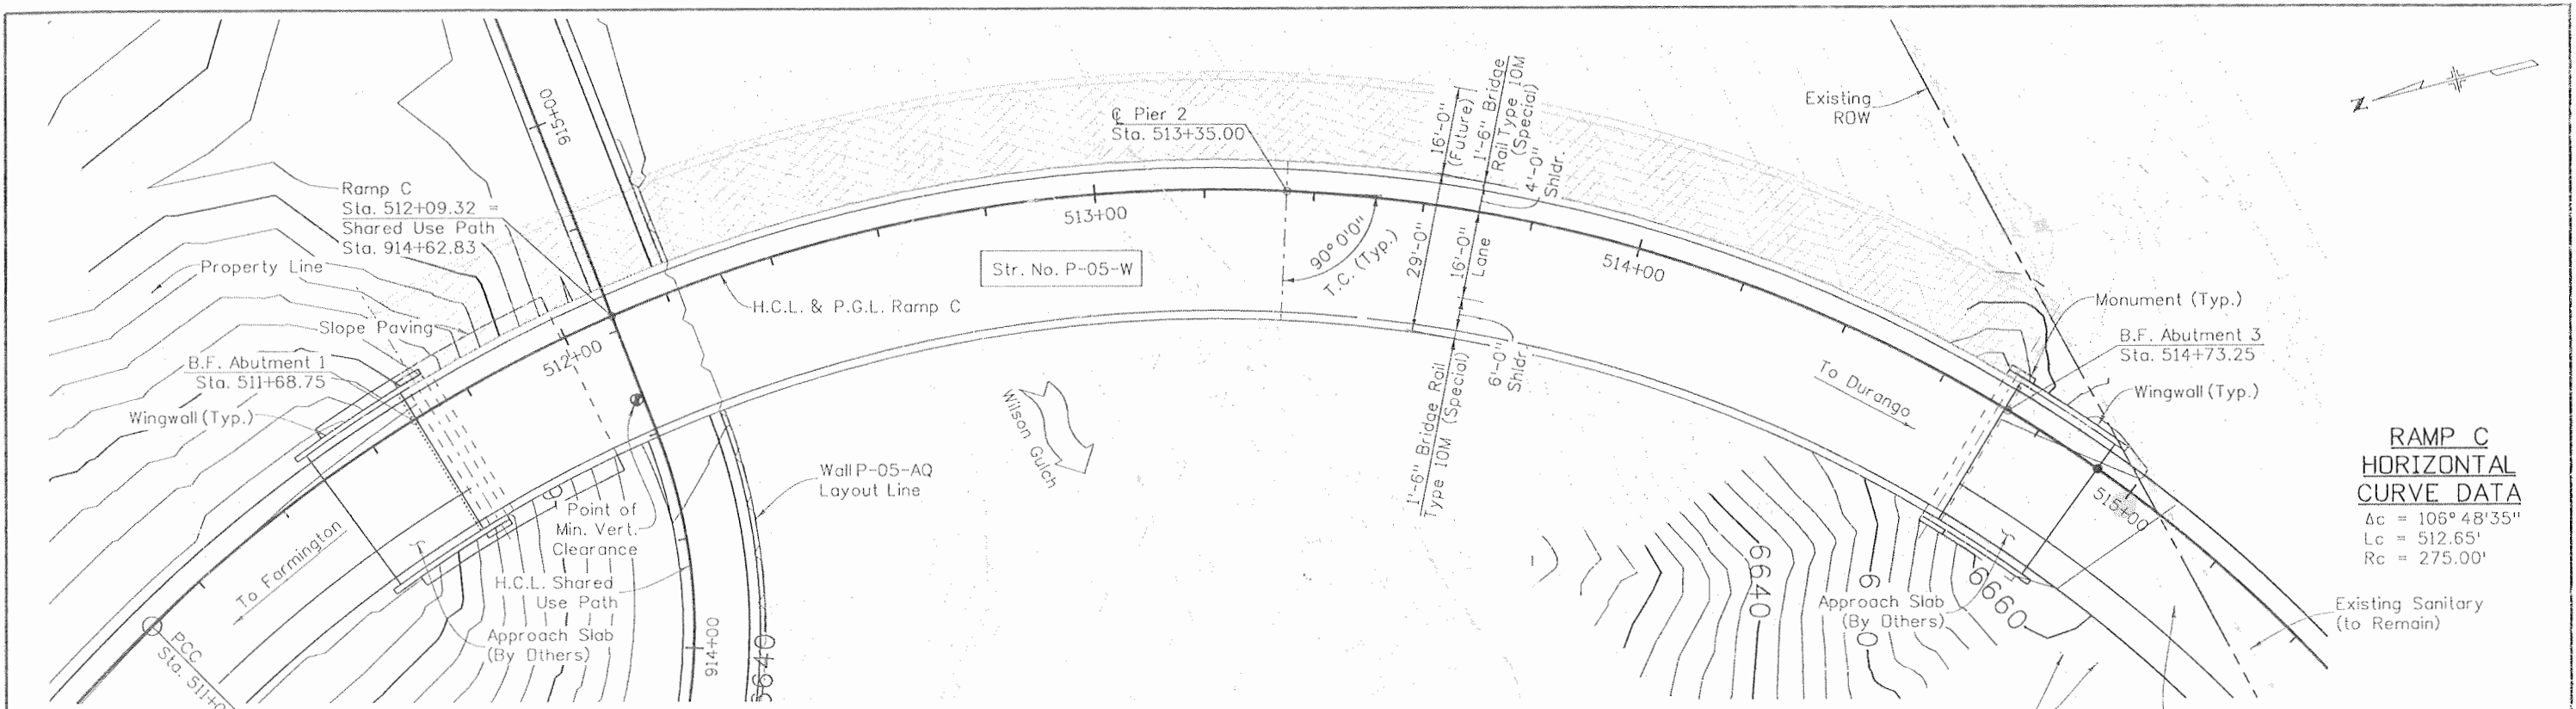

PLAN

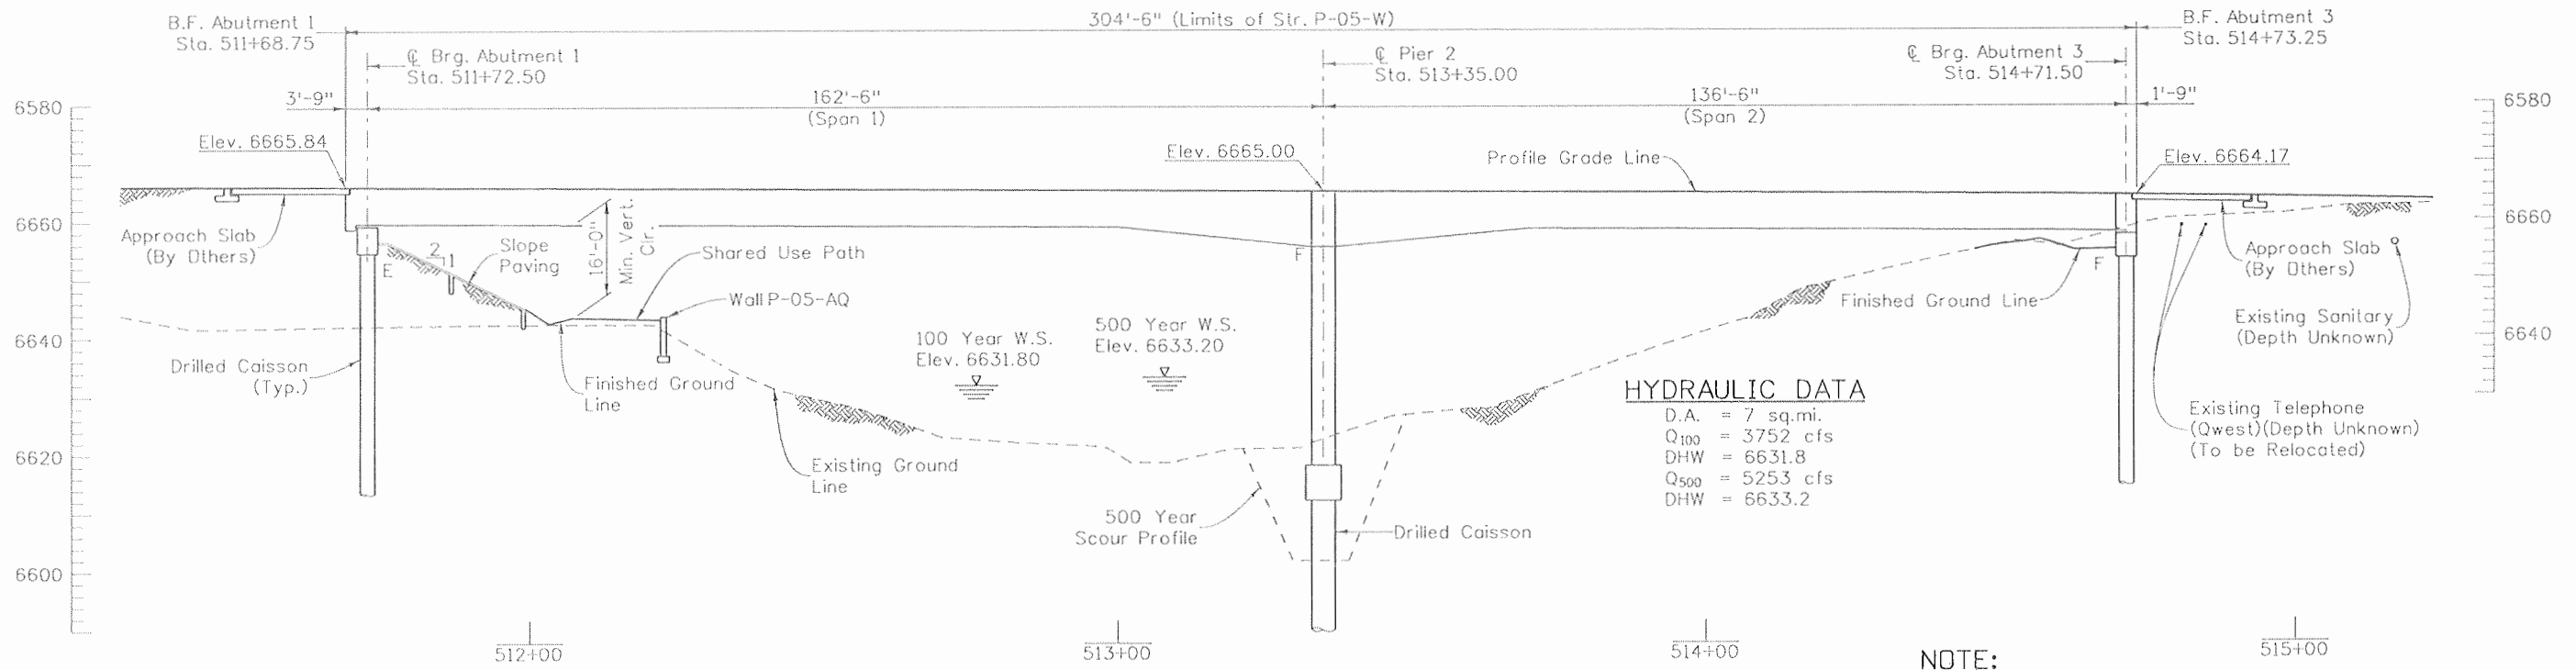



SECTION
(Taken Along P.G.L.)

NOTE:
 Elevations are taken at top of 3" HMA wearing surface.

Design		Detail		Quantities	
Designed By	Checked By	INITIAL	DATE	INITIAL	DATE
AML	MUN	AML	10/08	AML	10/08
Checked By	Checked By	MIN	10/08	LW	10/08

Print Date: 9/22/2010		Sheet Revisions		Colorado Department of Transportation		As Constructed		RAMP C OVER WILSON GULCH		Project No./Code		
File Name: 16042W_GenLayout_01.dgn		Date:	Comments	Init.	3803 North Main Avenue Suite 200 Durango, CO 81301 Phone: 970-385-1440 FAX: 970-385-8365		No Revisions: 9/10		GENERAL LAYOUT		NH 1602-114	
Horiz. Scale: 1:30					Region 5		Revised:		Designer: A. Leifheit		Structure Numbers	
Unit Information 0221					EJA		Void:		Detailer: D. Anderson		P-05-W	
Unit Leader STW									Sheet Subset: Bridge		Subset Sheets: B3 of B34	
SEMA CONSTRUCTION									Sheet Number		269	
WILSON & COMPANY												

Design		Detail		Quantities	
INITIAL	DATE	INITIAL	DATE	INITIAL	DATE
AML	10/08	DRA	10/08	AML	10/08
MUN	10/08	MAN	10/08	LW	10/08
Designed By	Checked By	Detached By	Checked By	Quantities By	Checked By

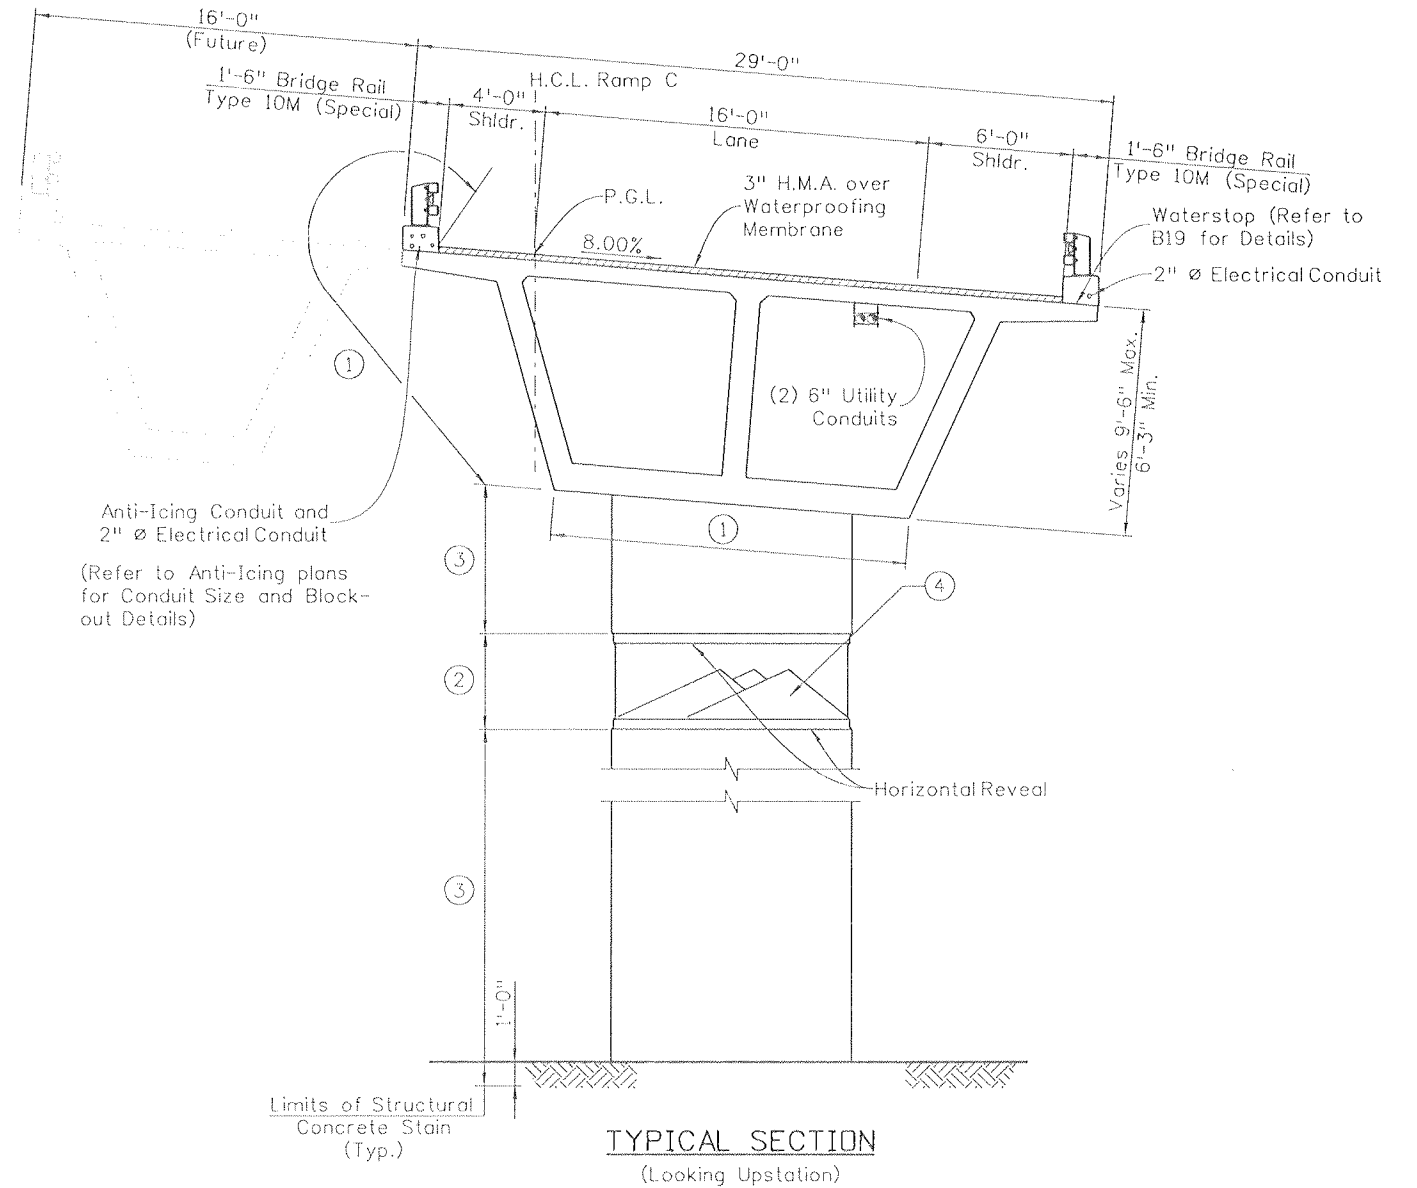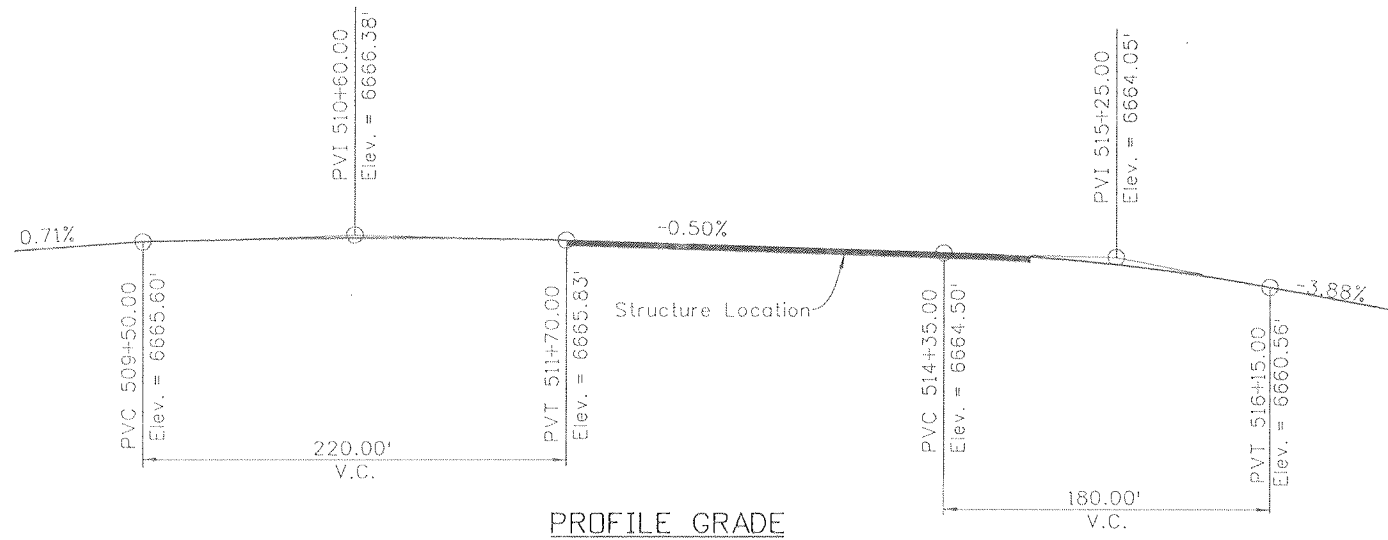


NOTE:

A colored structural concrete stain finish is required, as shown on the Plans, on all exposed concrete surfaces. Including piers, abutments, and wingwalls. Color numbers correspond to paint numbers as described by Diamond Vogel Paints.

- ① #8513 (Superstructure)
- ② #8515 (Banner Background)
- ③ #8513 (Column)
- ④ #8511 (Mountains)

Print Date: 9/22/2010	Sheet Revisions			Colorado Department of Transportation		As Constructed		RAMP C OVER WILSON GULCH		Project No./Code	
File Name: 16042W_TypSection_01.dgn	Date:	Comments	Init.	3803 North Main Avenue		No Revisions: 9/10		TYPICAL SECTION		NH 1602-114	
Horiz. Scale: 1:1				Suite 200		Revised:		Designer: A. Leifheit		Structure P-05-W	
Unit Information 0221				Durango, CO 81301		Void:		Detailer: D. Anderson		16042	
Unit Leader STW				Phone: 970-385-1440 FAX: 970-385-8365				Sheet Subset: Bridge		Subset Sheets: B4 of B34	
										Sheet Number 270	
				Region 5						EJA	

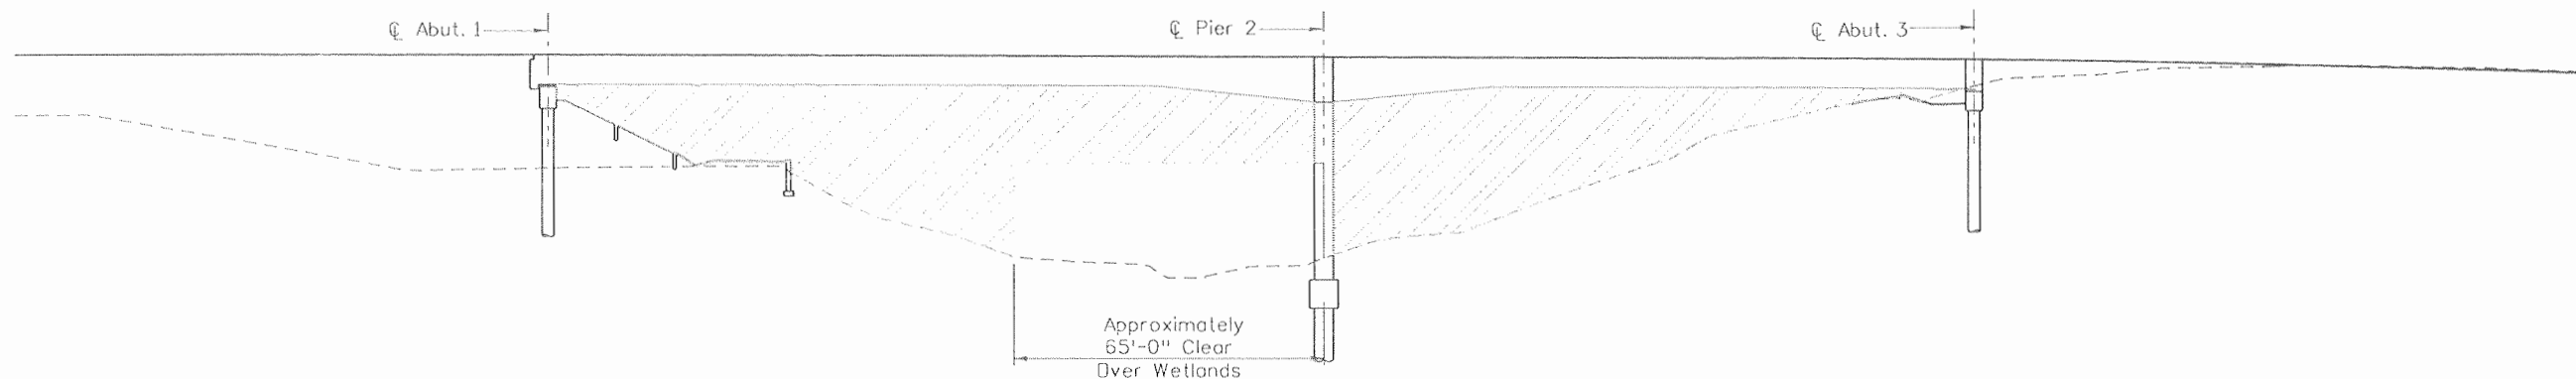


ELEVATION

NOTES:

1. Wetlands shall not be disturbed during Construction.
2. Refer to Erosion Control plans for work zone limitations and access limitations within Wilson Gulch.

Locations available for falsework.

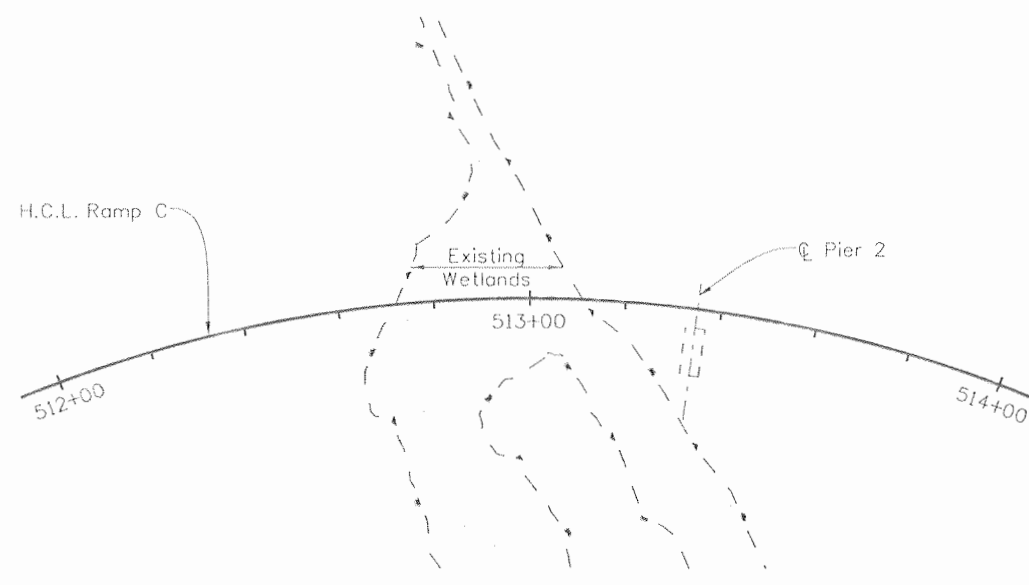

PARTIAL PLAN AT PIER 2

Design		Detail		Quantities	
INITIAL	DATE	INITIAL	DATE	INITIAL	DATE
AML	10/08	RCA	10/08	AML	10/08
MUN	10/08	MUN	10/08	LW	10/08
Designed By	Checked By	Detailed By	Checked By	Quantities By	Checked By

Print Date: 9/22/2010
 File Name: 16042W_ConstSeq_01.dgn
 Horiz. Scale: 1:40 Vert. Scale: As Noted
 Unit Information 0221 Unit Leader STW

Sheet Revisions		
Date:	Comments	Init.


Colorado Department of Transportation
 3803 North Main Avenue
 Suite 200
 Durango, CO 81301
 Phone: 970-385-1440 FAX: 970-385-8365

Region 5 EJA


As Constructed
No Revisions: 9/10
Revised:
Void:

RAMP C OVER WILSON GULCH CONSTRUCTION CONSTRAINTS			
Designer:	A. Leifheit	Structure	P-05-W
Detailer:	R. Artman	Numbers	
Sheet Subset:	Bridge	Subset Sheets:	B5 of B34

Project No./Code
NH 1602-114
16042
Sheet Number 271

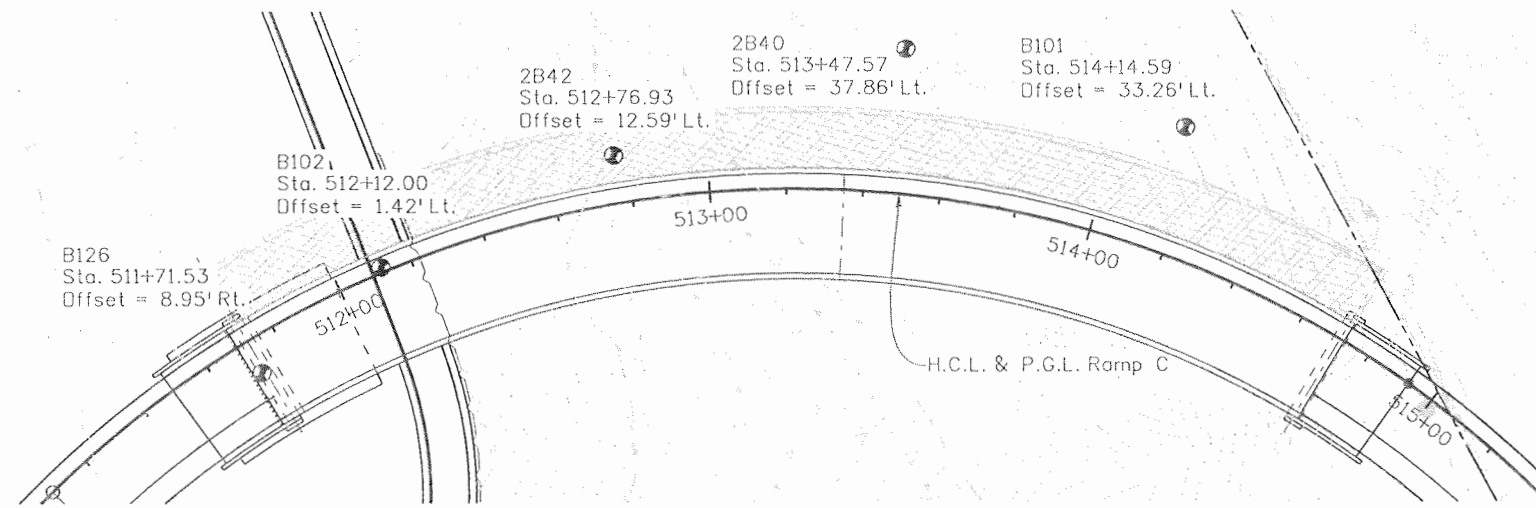

PLAN

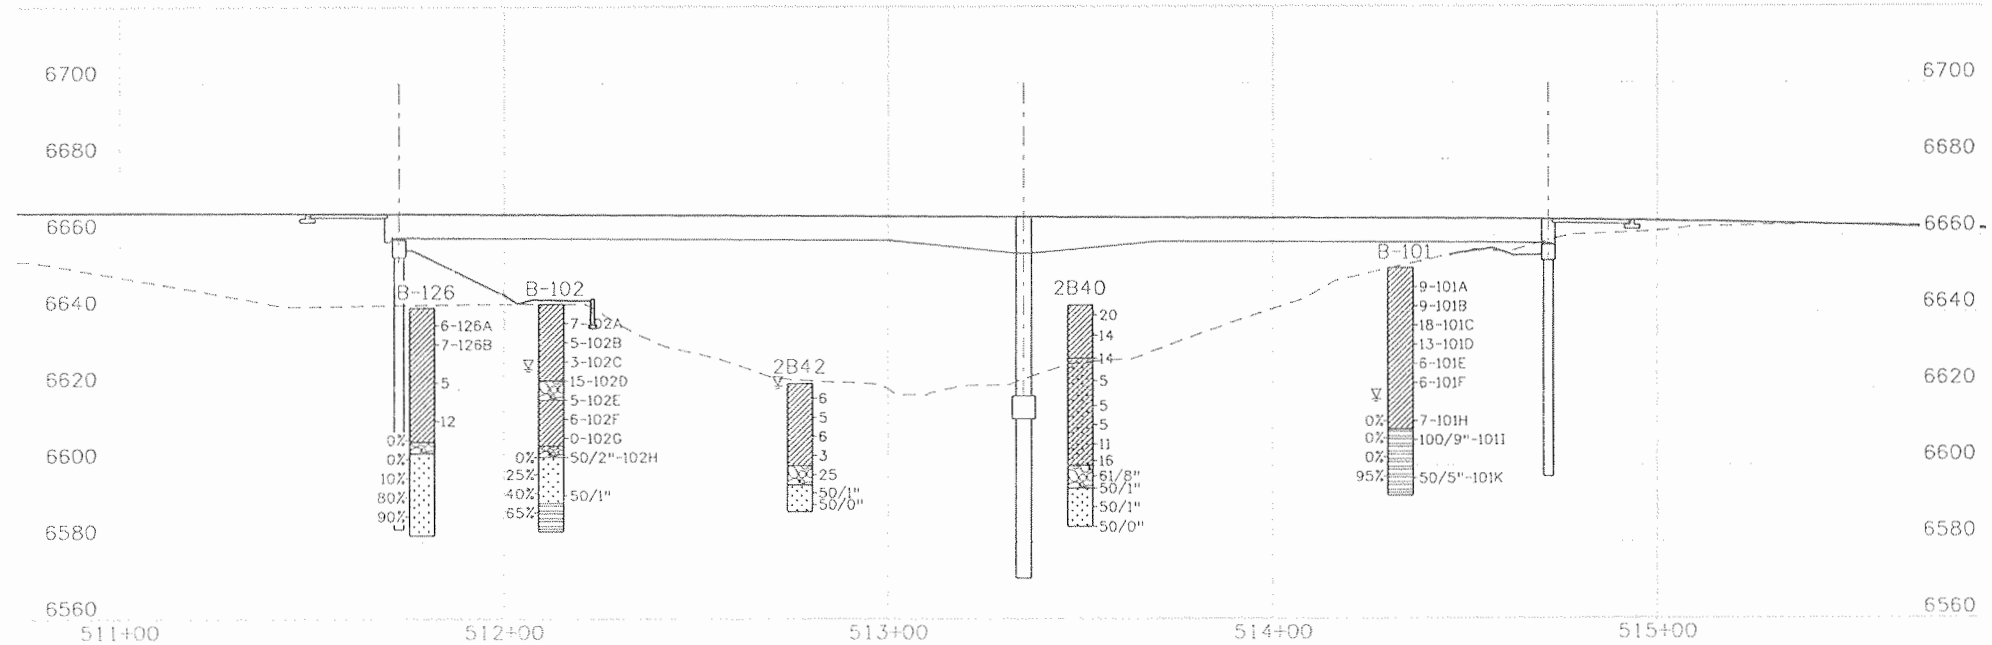

Design	INITIAL	DATE	10/08	10/08
	MCH	10/08	10/08	10/08
Detail	INITIAL	DATE	10/08	10/08
	MCH	10/08	10/08	10/08
Quantities	By	Checked By	Checked By	Checked By
	MCH	LW	LW	LW

Sample No.	Depth	Classification	Grading Analysis (AASHTO)				Atterberg Limits			Water Content %	Dry Unit Weight p.c.f.
			Coarse Sand	Fine Sand	Silt and Clay	Liquid Limit %	Plastic Limit %	Plasticity Index			
101-D	19.6-21.1	SANDY CLAY	4.8	7.3	13.1	74.8	34	22	12	20.7	153.7
101-2	57.5-58.3										
102-A	5-6.5	SANDY CLAY	0.6	4.5	18.0	76.9	38	21	17	25.0	
102-G	35-36.5	SANDY CLAY	0.3	2.0	12.5	85.2	44	22	22	33.1	
102-2	52.5-53.3										160.2

TYPE OF MATERIAL	
[Symbol]	Sandy Clay
[Symbol]	Shale
[Symbol]	Sandstone
[Symbol]	Clayey Sand
[Symbol]	Fill
[Symbol]	Coarse Sand - Clay
[Symbol]	Gravel and Cobbles

Note: Boulders may be encountered at any depth

LEGEND	
[Symbol]	Boring Designation
[Symbol]	Partial Blowcount 50 blows per 5 inches
[Symbol]	Sample Designation
[Symbol]	Standard Penetration Test Blows per Foot
[Symbol]	Location of Boring
[Symbol]	Groundwater Depth
[Symbol]	R.O.D.

Print Date: 9/22/2010
 File Name: 16042W_EngGeology_01.dgn
 Horiz. Scale: 1:30 Vert. Scale: As Noted
 Unit Information 0221 Unit Leader STW

Sheet Revisions		
Date:	Comments	Init.


Colorado Department of Transportation
 3803 North Main Avenue
 Suite 200
 Durango, CO 81301
 Phone: 970-385-1440 FAX: 970-385-8365
 Region 5 EJA

As Constructed
 No Revisions: 9/10
 Revised:
 Void:


RAMP C OVER WILSON GULCH
 ENGINEERING GEOLOGY
 Designer: M. Hallman Structure P-05-W
 Detailer: R. Artman Numbers
 Sheet Subset: Bridge Subset Sheets: B6 of B34

Project No./Code
 NH 1602-114
 16042
 Sheet Number 272



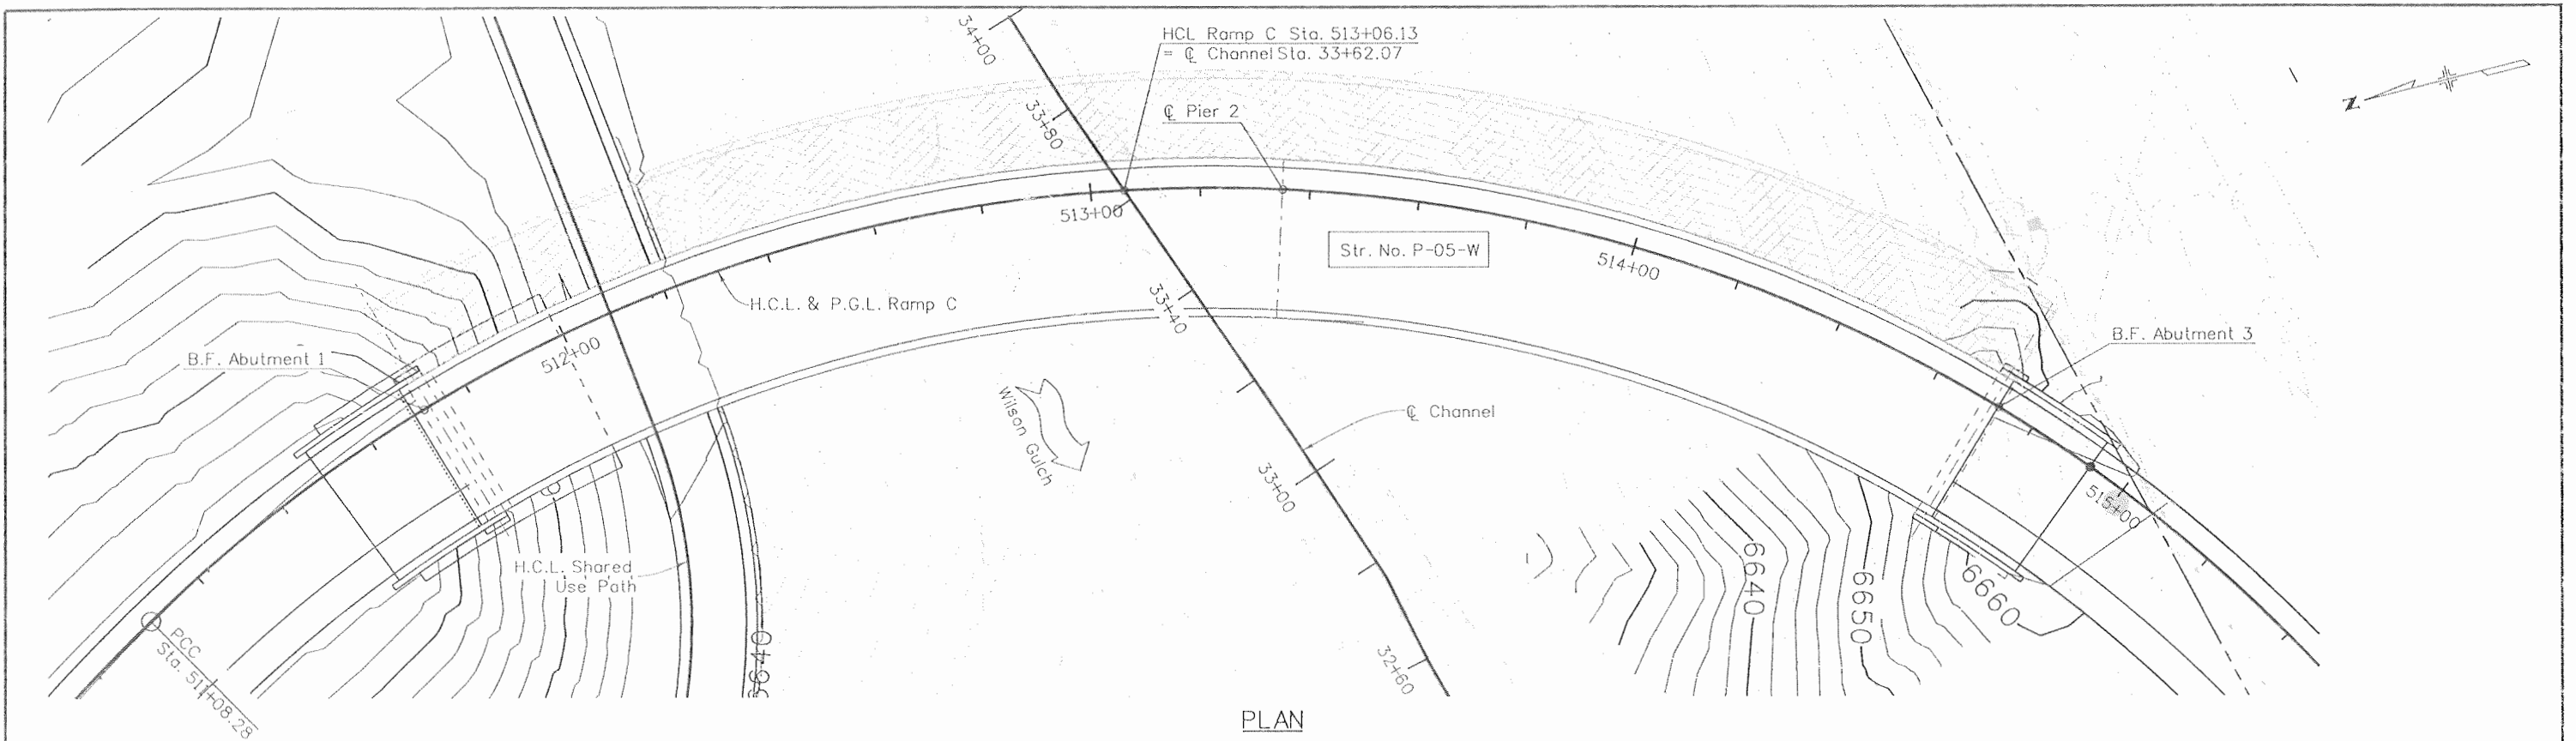

PLAN

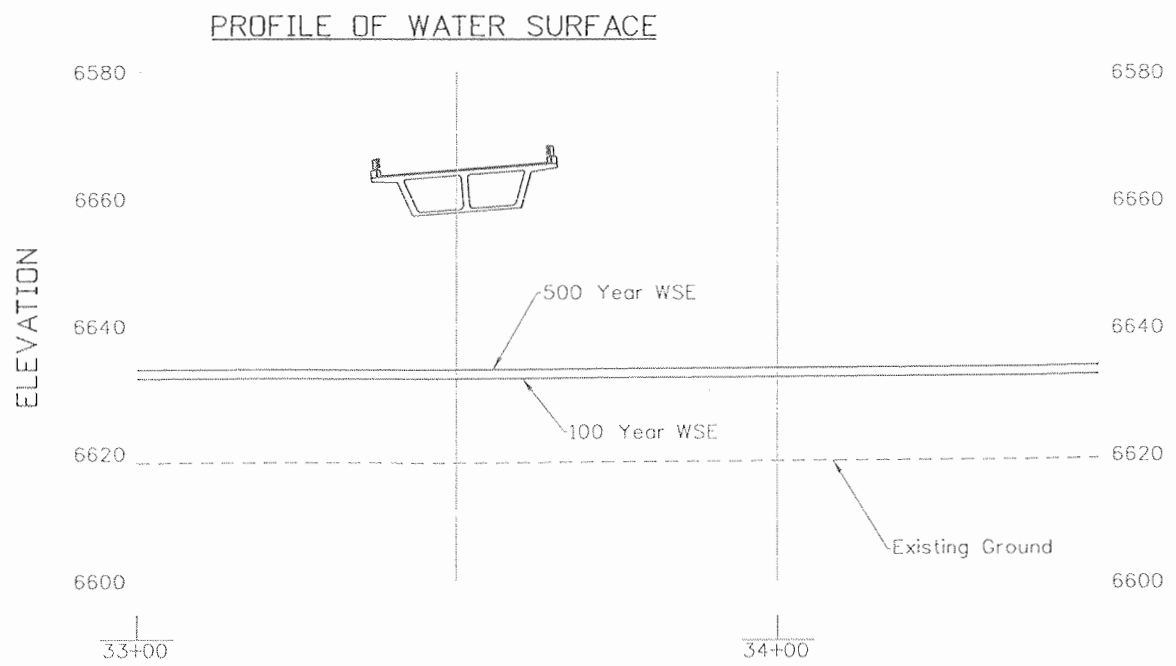

STATIONS ARE ALONG CHANNEL CENTERLINE IN FEET

Design		Detail		Quantities	
INITIAL	DATE	INITIAL	DATE	INITIAL	DATE
VSF	10/08	DRA	10/08	VSF	10/08
TAH	10/08	TAH	10/08	LW	10/08
Designed By	Checked By	Designed By	Checked By	Quantities By	Checked By

Print Date: 9/22/2010
 File Name: 16042W_BHR_01.dgn
 Horiz. Scale: 1:30 Vert. Scale: As Noted
 Unit Information 0221 Unit Leader STW

SEMA CONSTRUCTION **WILSON & COMPANY**

Sheet Revisions		
Date:	Comments	Init.

Colorado Department of Transportation
 3803 North Main Avenue
 Suite 200
 Durango, CO 81301
 Phone: 970-385-1440 FAX: 970-385-8365

DOT
 DEPARTMENT OF TRANSPORTATION

Region 5 EJA

As Constructed	
No Revisions:	9/10
Revised:	
Void:	

**RAMP C OVER WILSON GULCH
 BRIDGE HYDRAULIC INFORMATION
 (1 OF 2)**

Designer:	V. Fossinger	Structure	P-05-W
Detailer:	D. Anderson	Numbers	
Sheet Subset:	Bridge	Subset Sheets:	B7 of B34

Project No./Code	
NH	1602-114
	16042
Sheet Number	273

DRAINAGE AREA 7 SQUARE MILES

CHANNEL DESCRIPTION

BOTTOM MATERIAL: COHESIVE NON-COHESIVE
 BOTTOM MATERIAL SIZE: CLAY SILT SAND GRAVEL
 COBBLES OTHER
 STREAM FORM: STRAIGHT MEANDERING BRAIDED
 MANNINGS "n" FOR DESIGN: CHANNEL = 0.068 OVERBANK = 0.104
 DEBRIS: BRUSH TREES/LOGS ICE OTHER


COMPARISON OF HYDRAULICS Δ

	VELOCITY	FREEBOARD	MAX. BACKWATER
	fps.	ft.	ft.
NATURAL CHANNEL	N/A	N/A	N/A
EXISTING CHANNEL	5.1	N/A	N/A
PROPOSED CHANNEL	5.1	23.6	0.1


Δ AT PROPOSED BRIDGE LOCATION DURING DESIGN DISCHARGE (Q100)

THE SCOUR LIMITS AND RIVER FLOW RATES MAY BE FOUND IN THE REPORT BY WILSON & COMPANY, DATED JULY 2008, ENTITLED "FINAL DRAINAGE REPORT FOR US 550 AND US-160 INTERCHANGE".


DISCHARGE-FREQUENCY

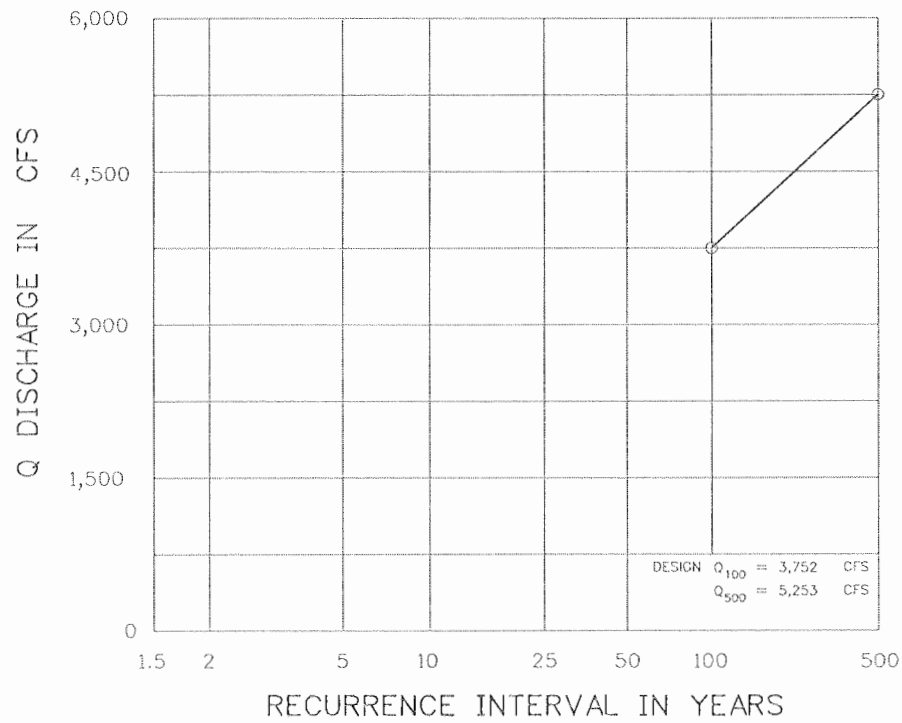


STAGE-DISCHARGE

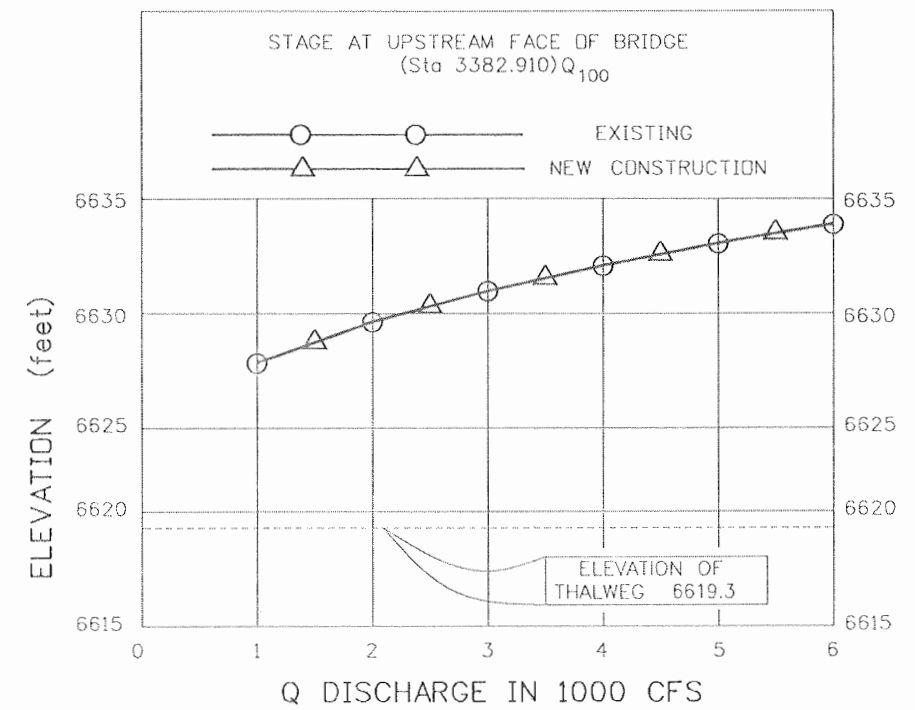


Design	INITIAL	DATE	Detail		Quantities	
			VSF	TAH	VSF	LW
Designed By	VSF	10/08	DR	10/08	Quantities By	VSF
Checked By	TAH	10/08	TAH	10/08	Checked By	LW

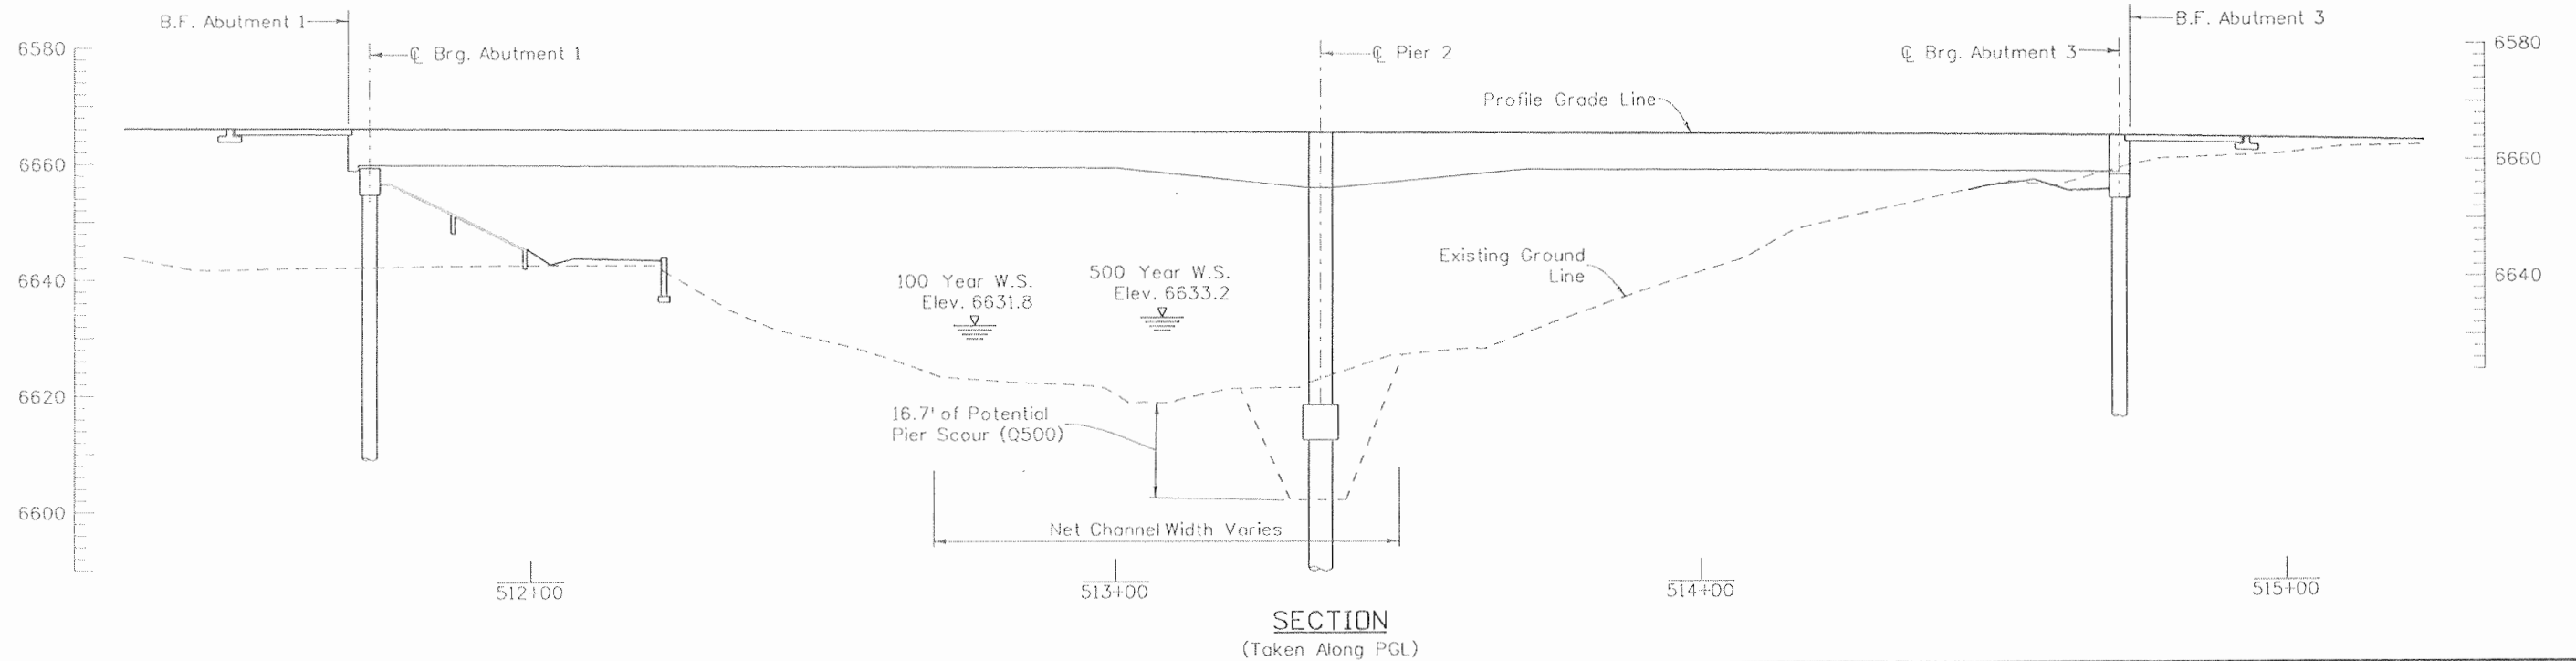

Print Date: 9/22/2010	Sheet Revisions			Colorado Department of Transportation	As Constructed	RAMP C OVER WILSON GULCH BRIDGE HYDRAULIC INFORMATION (2 OF 2)		Project No./Code
File Name: 16042W_BHR_02.dgn	Date:	Comments:	Init.			No Revisions: 9/10	NH 1602-114	
Horiz. Scale: 1:30				3803 North Main Avenue Suite 200 Durango, CO 81301 Phone: 970-385-1440 FAX: 970-385-8365	Revised:	Designer: V. Fossinger	Structure: P-05-W	16042
Unit Information 0221					Void:	Detailer: D. Anderson	Subset Sheets: B8 of B34	
Unit Leader STW				Region 5	EJA		Sheet Number: 274	

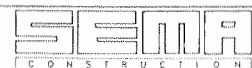

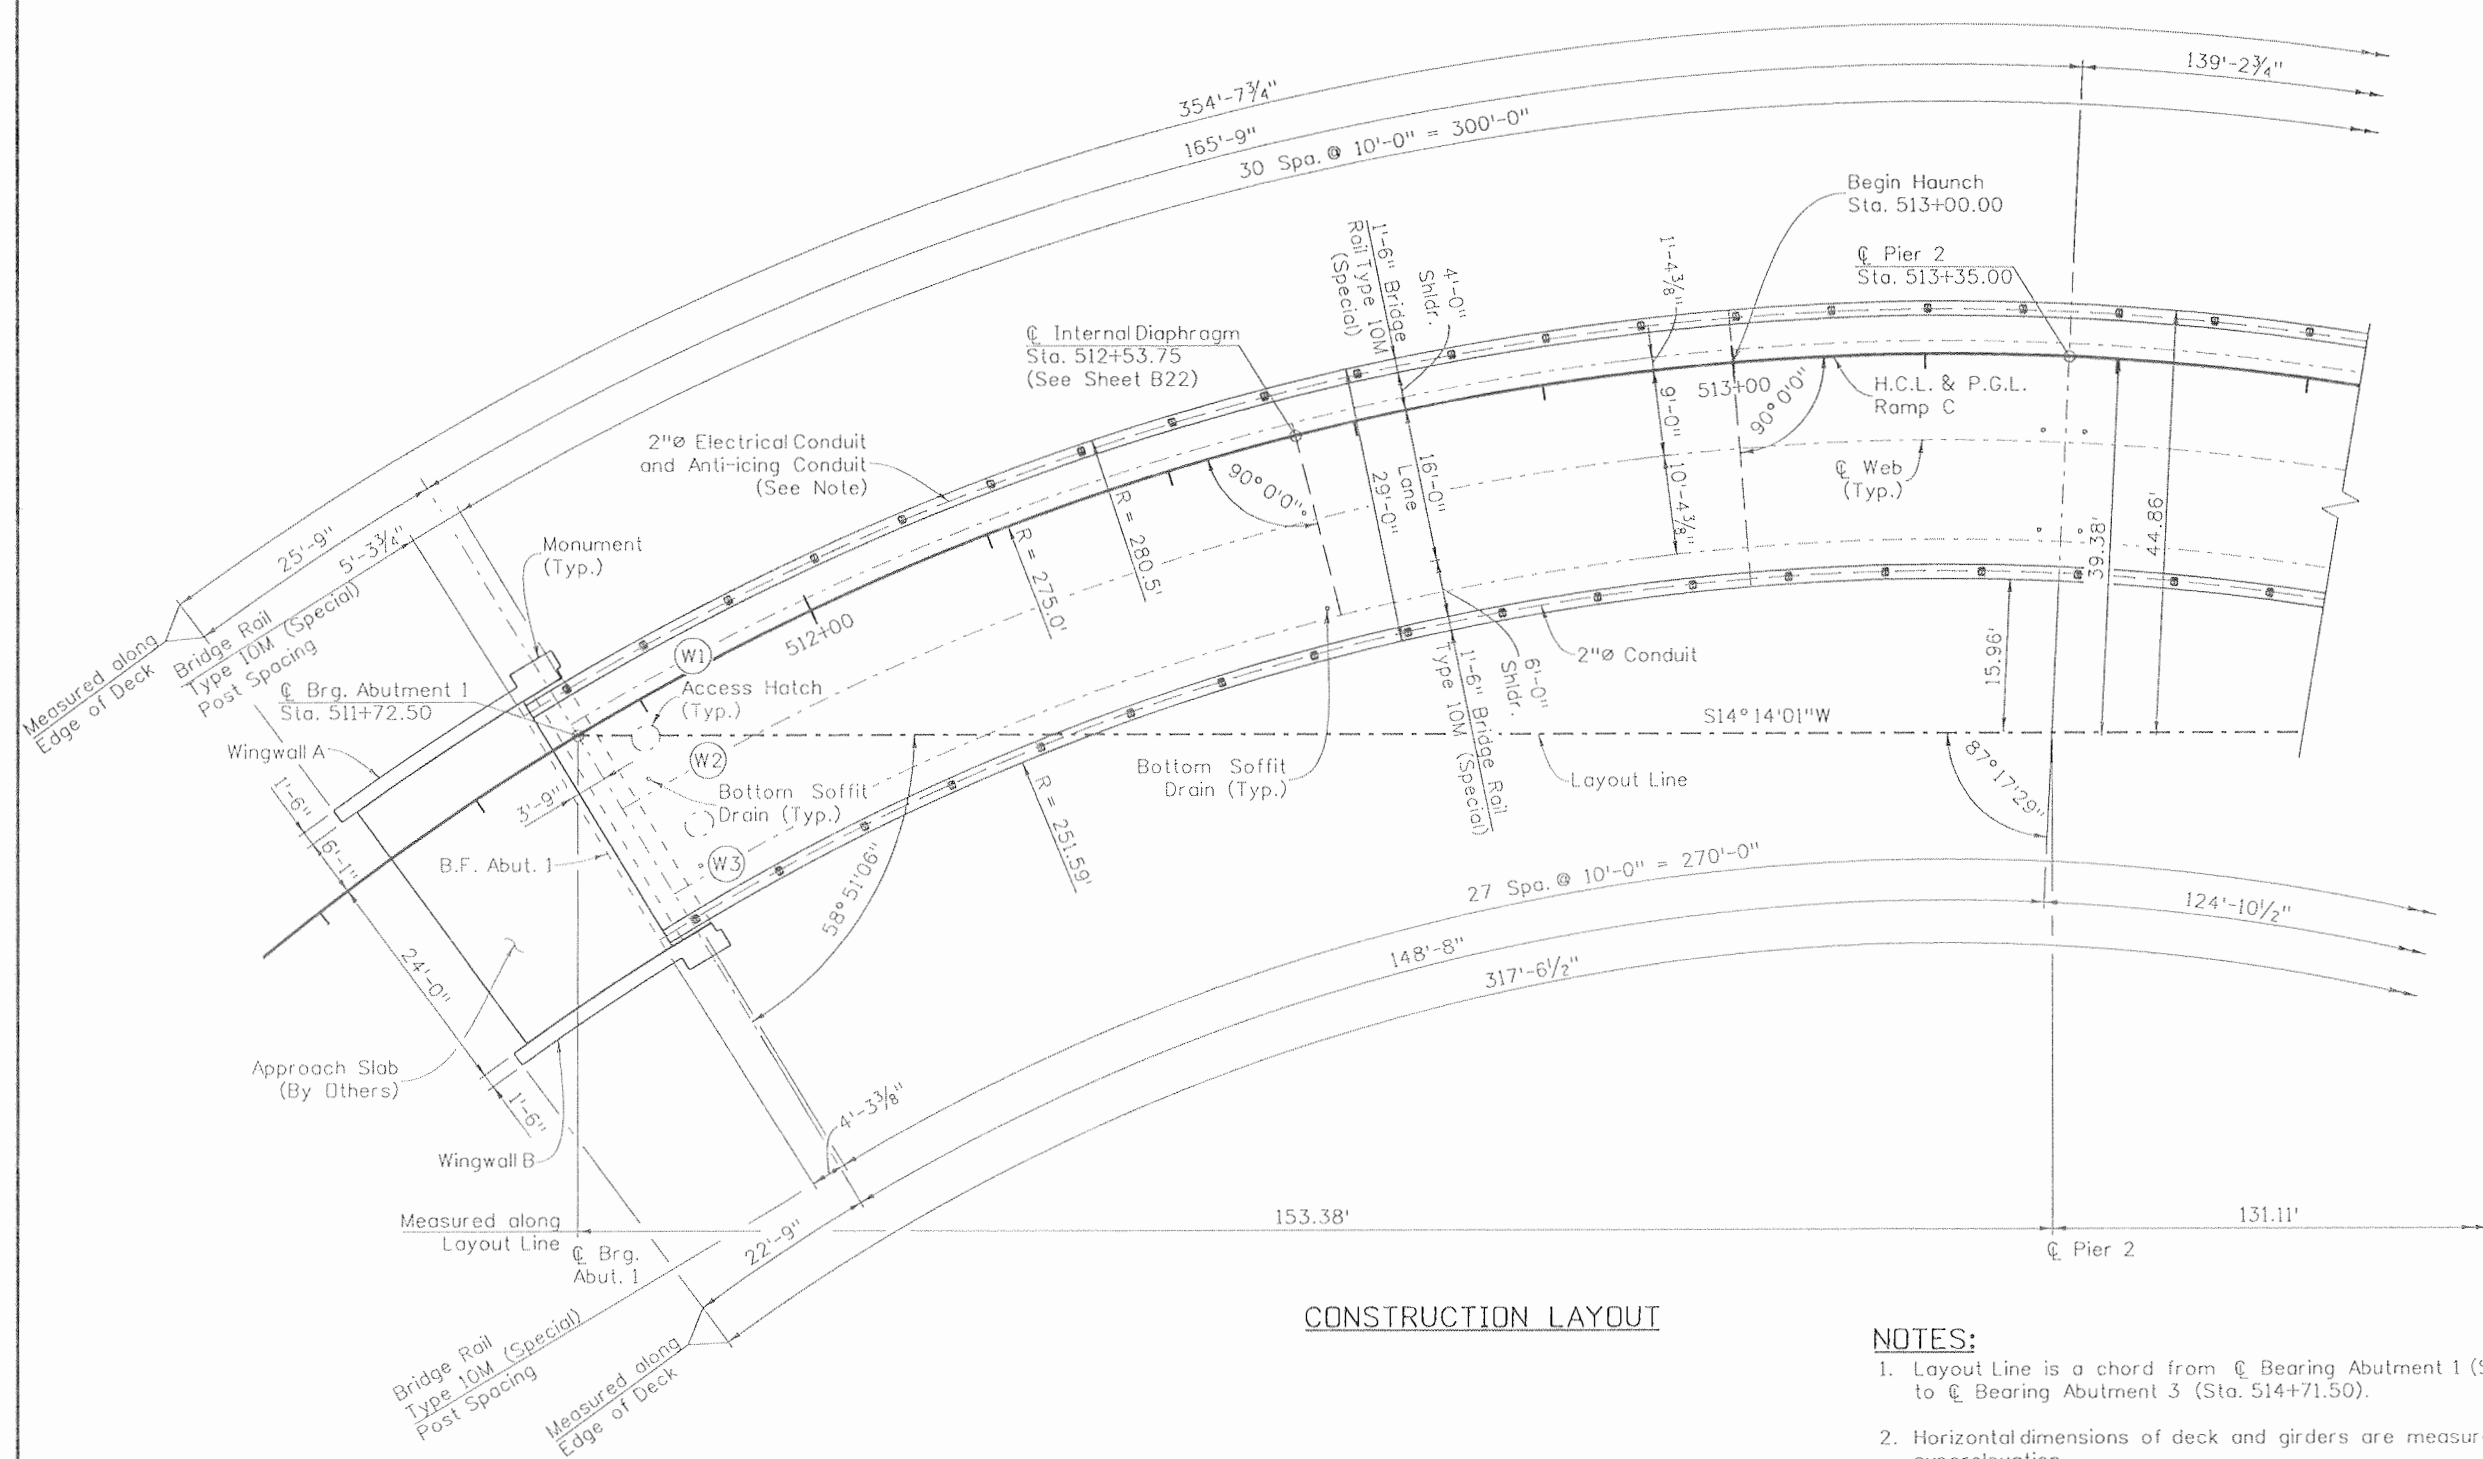

CONSTRUCTION LAYOUT

NOTES:

1. Layout Line is a chord from $\text{\textcircled{C}}$ Bearing Abutment 1 (Sta. 511+72.50) to $\text{\textcircled{C}}$ Bearing Abutment 3 (Sta. 514+71.50).
2. Horizontal dimensions of deck and girders are measured along the superelevation.
3. Girders are measured from $\text{\textcircled{C}}$ Web to $\text{\textcircled{C}}$ Web at top of concrete deck.
4. Refer to Anti-icing Plans for additional conduit size and location. A minimum of (1) 2" $\text{\textcircled{C}}$ conduit shall be placed in each curb. Project conduits a minimum of 2'-0" from curb ends.

Design		Detail		Quantities	
INITIAL	DATE	INITIAL	DATE	INITIAL	DATE
Designed By: AML	10/08	Detailed By: M.N.	10/08	Quantities By: AML	10/08
Checked By: M.N.	10/08	Checked By: M.N.	10/08	Checked By: LW	10/08

Print Date: 9/22/2010
 File Name: 16042W_ConstLay_01.dgn
 Horiz. Scale: 1:30 Vert. Scale: As Noted
 Unit Information 0221 Unit Leader STW

SEMA CONSTRUCTION **WILSON & COMPANY**

Sheet Revisions		
Date:	Comments	Init.


Colorado Department of Transportation
 3803 North Main Avenue
 Suite 200
 Durango, CO 81301
 Phone: 970-385-1440 FAX: 970-385-8365
Region 5 **EJA**

As Constructed	
No Revisions:	9/10
Revised:	
Void:	

RAMP C OVER WILSON GULCH CONSTRUCTION LAYOUT (1 OF 2)			
Designer:	A. Leifheit	Structure	P-05-W
Detailer:	R. Arltman	Numbers	
Sheet Subset:	Bridge	Subset Sheets:	B9 of 834

Project No./Code	
NH 1602-114	
16042	
Sheet Number	275

Design		Detail		Quantities	
INITIAL	DATE	INITIAL	DATE	INITIAL	DATE
AML	10/08	RCA	10/08	AML	10/08
MUN	10/08	MUN	10/08	LW	10/08

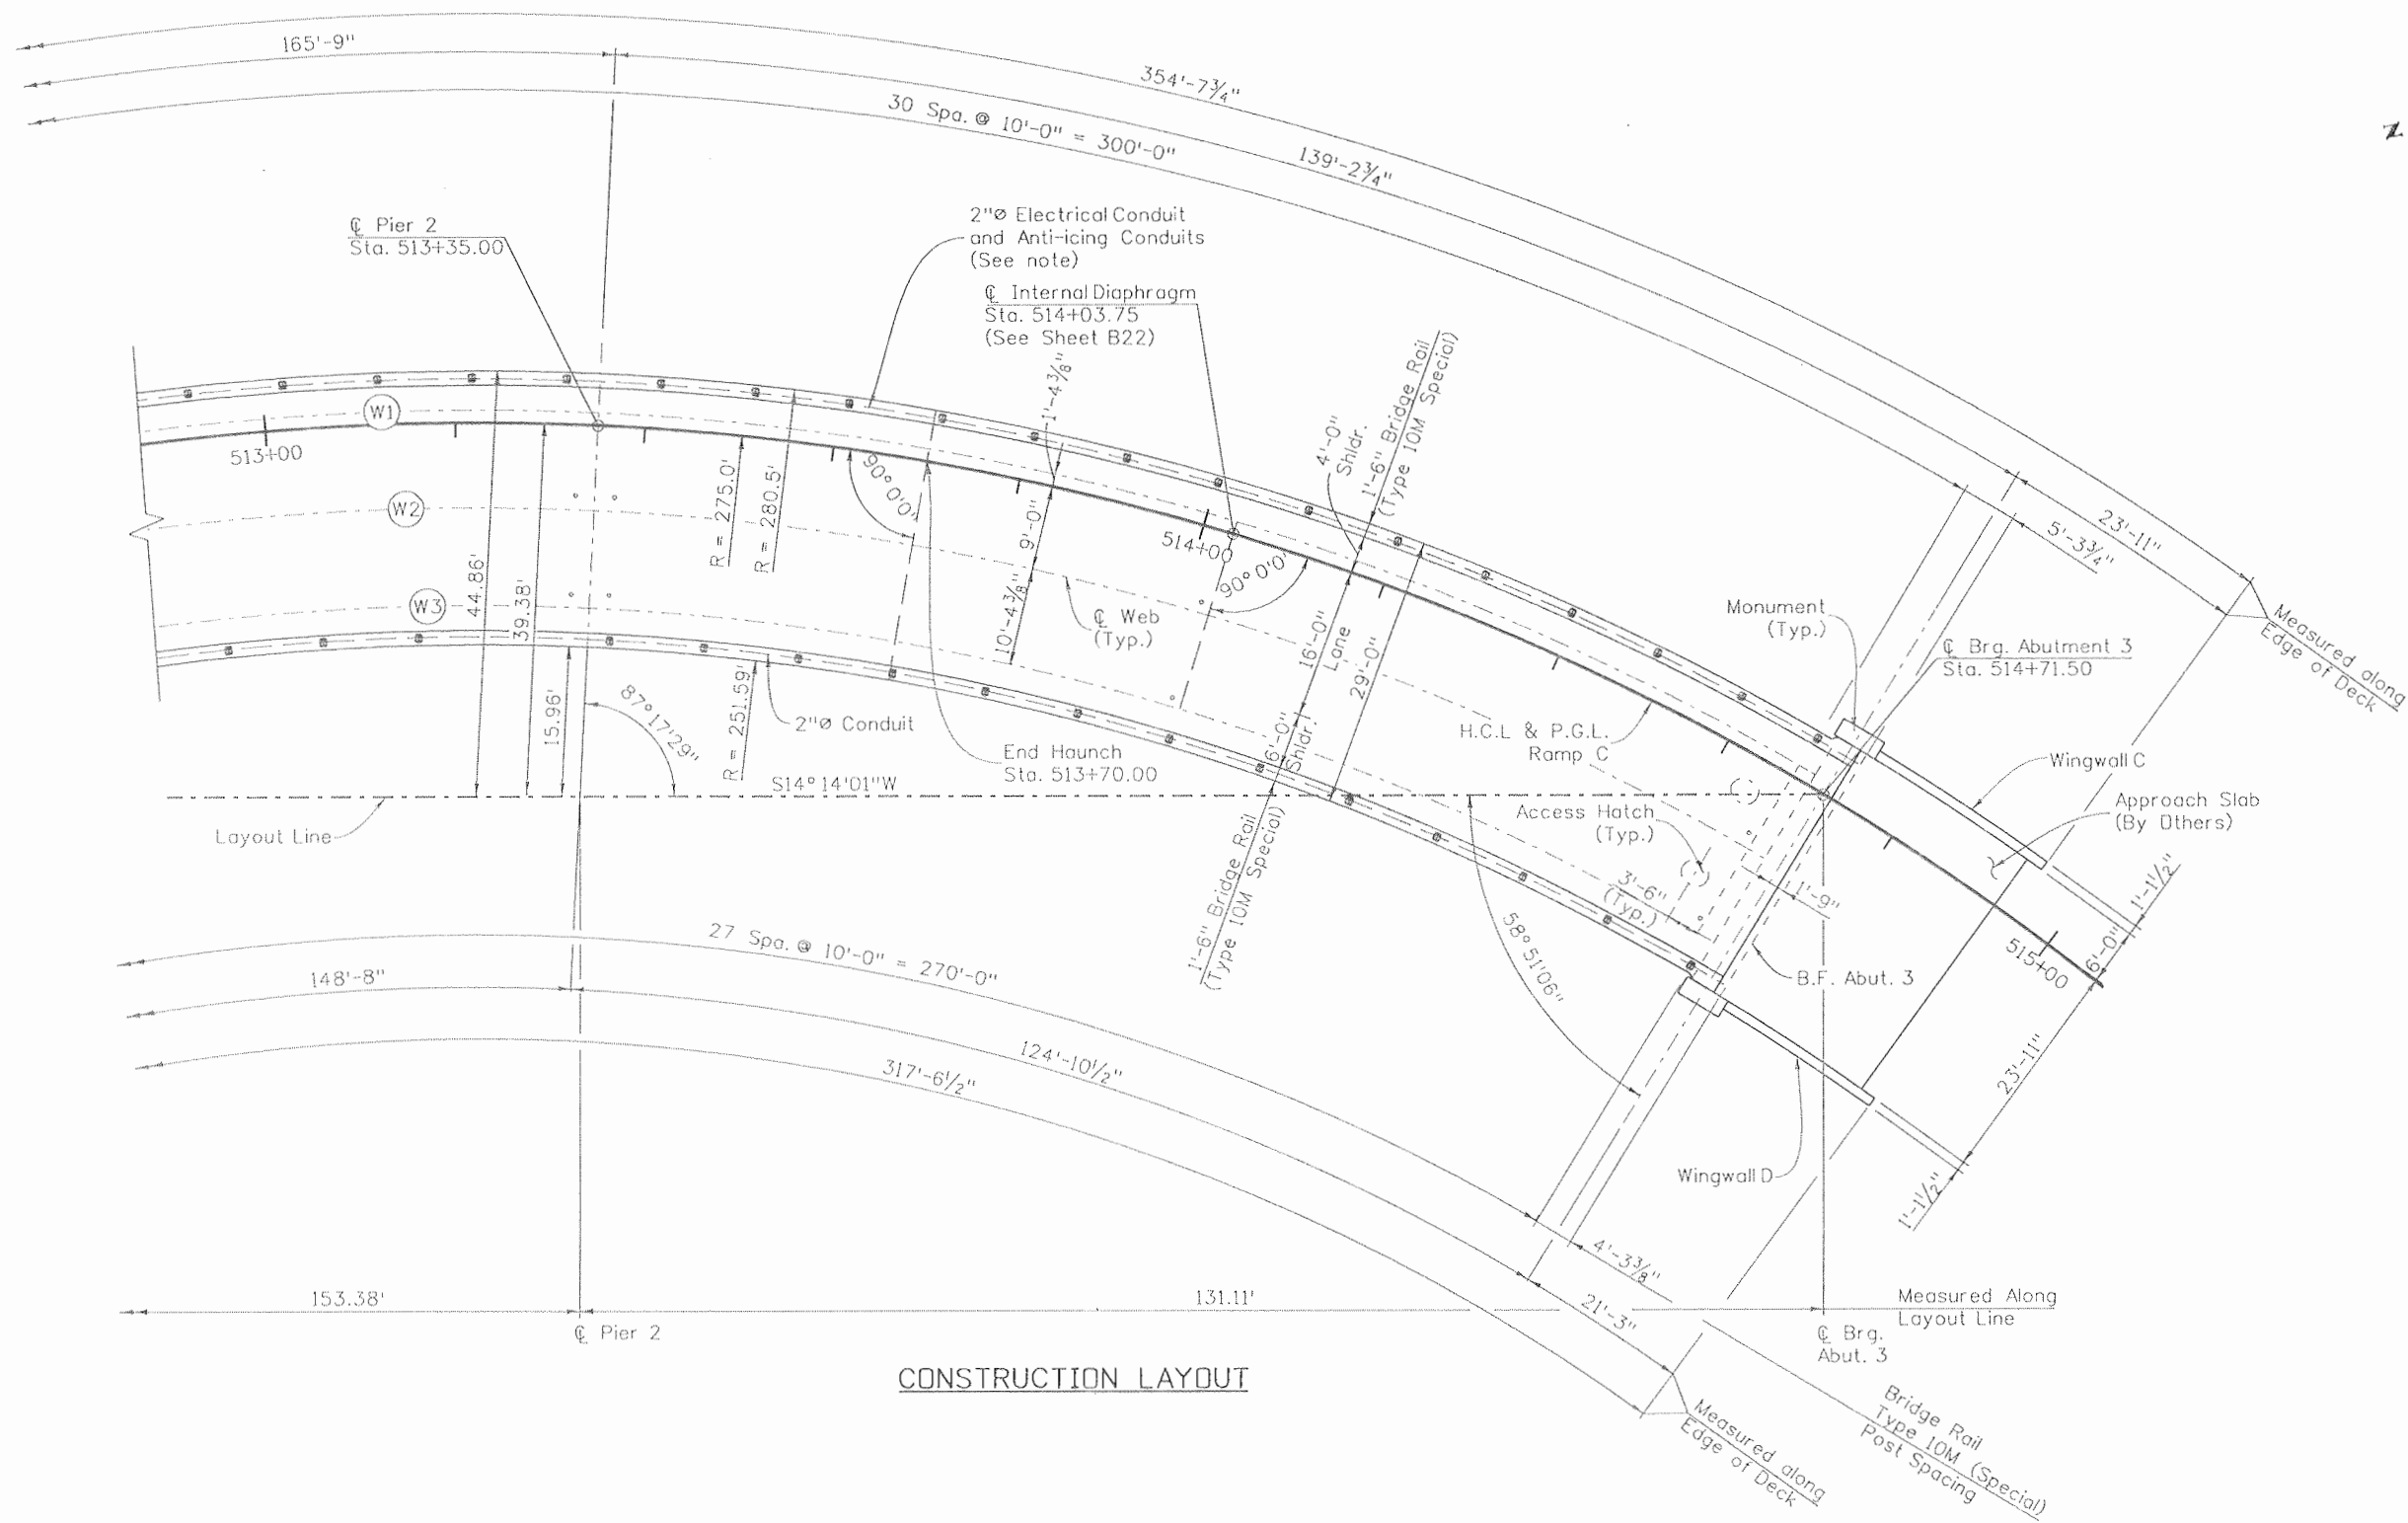

NOTE:
1. Refer to B9 for notes.

CONSTRUCTION LAYOUT

Print Date: 9/22/2010	
File Name: 16042W_ConstLay_02.dgn	
Horiz. Scale: 1:30 Vert. Scale: As Noted	
Unit Information 0221 Unit Leader STW	

Sheet Revisions		
Date:	Comments	Init.


Colorado Department of Transportation
 3803 North Main Avenue
 Suite 200
 Durango, CO 81301
 Phone: 970-385-1440 FAX: 970-385-8365
 Region 5 EJA

As Constructed
No Revisions: 9/10
Revised:
Void:

RAMP C OVER WILSON GULCH CONSTRUCTION LAYOUT (2 OF 2)			
Designer:	A. Leifheit	Structure	P-05-W
Detailer:	R. Artman	Numbers	
Sheet Subset:	Bridge	Subset Sheets:	B10 of B34


Project No./Code	NH 1602-114
	16042
Sheet Number	276

Design	INITIAL	DATE	Detail		Quantities	
			INITIAL	DATE	INITIAL	DATE
Designed By	AML	10/08	RCA	10/08	Quantities By	AML
Checked By	MUN	10/08	MUN	10/08	Checked By	LW

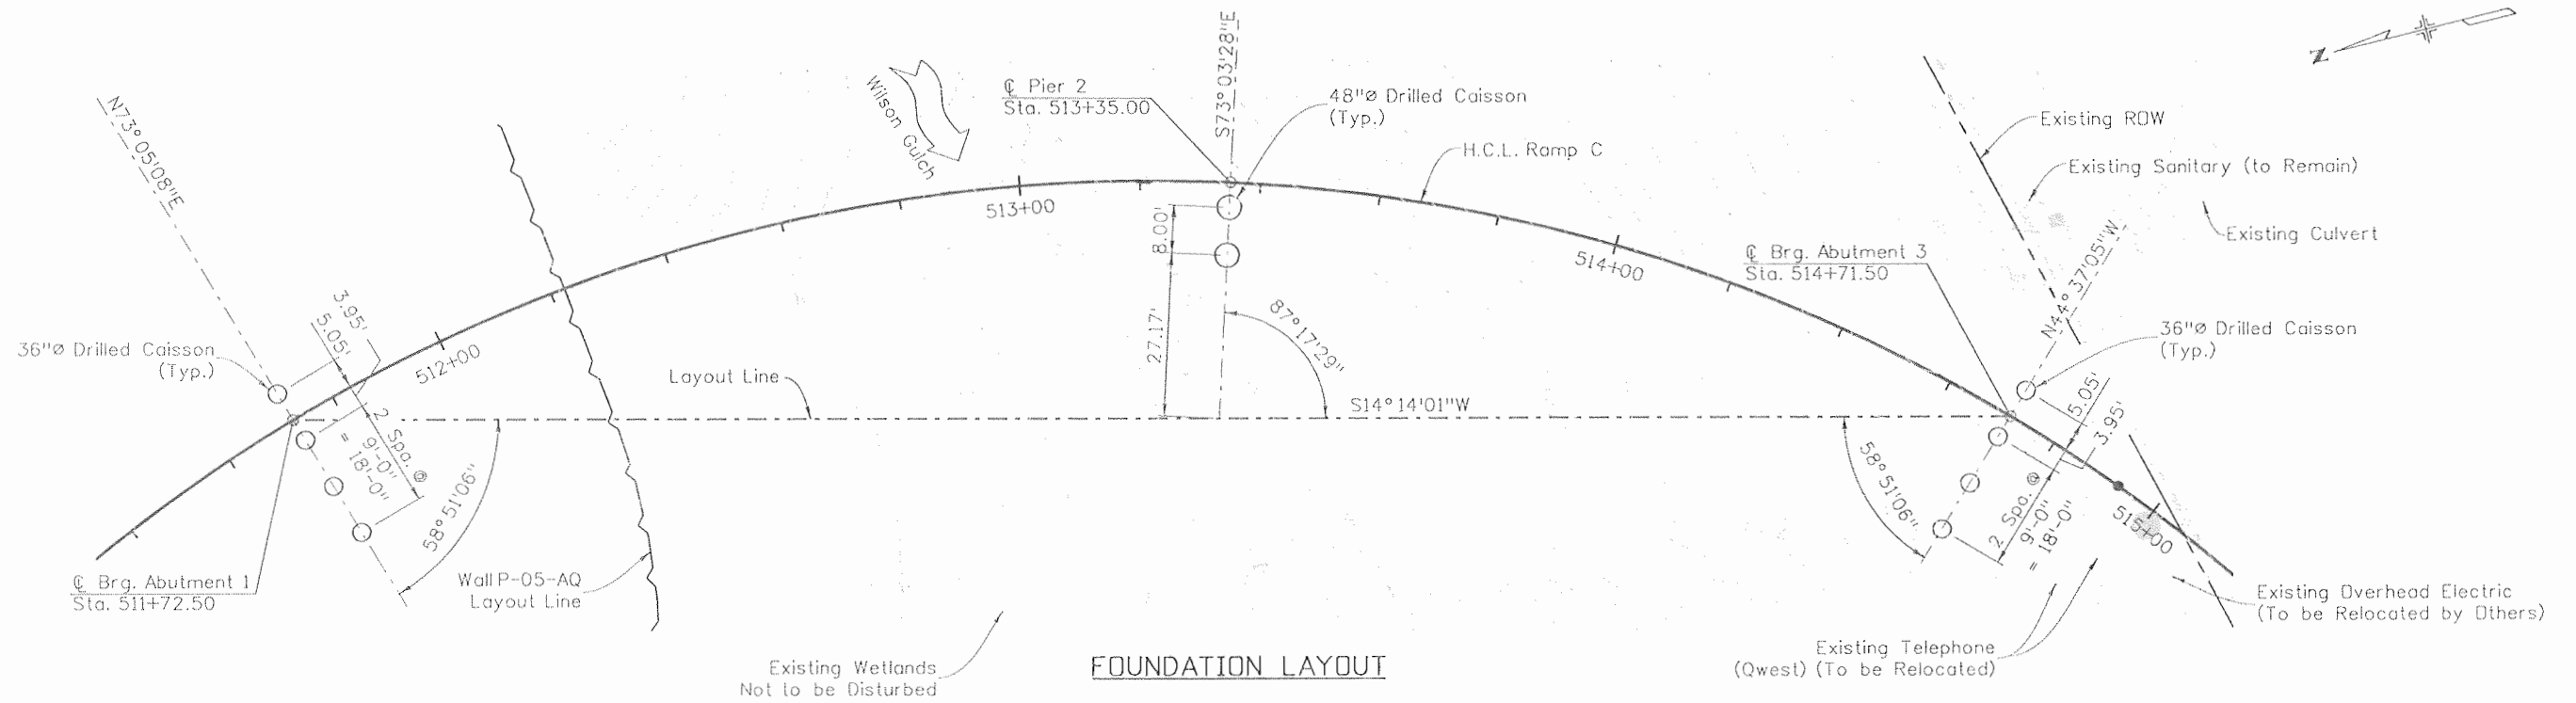

FOUNDATION LAYOUT

NOTE:
 Layout line is a chord from
 C Abutment 1 (Sta. 511+72.50) to
 C Abutment 3 (Sta. 514+71.50)

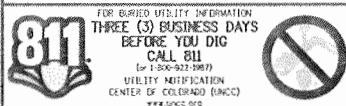

Print Date: 9/22/2010	
File Name: 16042W_FoundLay_01.dgn	
Horiz. Scale: 1:30 Vert. Scale: As Noted	
Unit Information 0221 Unit Leader STW	

Sheet Revisions		
Date:	Comments	Init.


Colorado Department of Transportation
 3803 North Main Avenue
 Suite 200
 Durango, CO 81301
 Phone: 970-385-1440 FAX: 970-385-8365
 Region 5 EJA

As Constructed
No Revisions: 9/10
Revised:
Void:


RAMP C OVER WILSON GULCH FOUNDATION LAYOUT			
Designer:	A. Leifheit	Structure	P-05-W
Detailer:	R. Artman	Numbers	
Sheet Subset:	Bridge	Subset Sheets:	B11 of B34

Project No./Code	NH 1602-114
	16042
Sheet Number	277


Design		Detail		Quantities	
INITIAL	DATE	INITIAL	DATE	INITIAL	DATE
AWL	10/08	DRA	10/08	AWL	10/08
MUN	10/08	MUN	10/08	LW	10/08
Designed By	Detailed By	Checked By	Checked By	Quantities By	Checked By

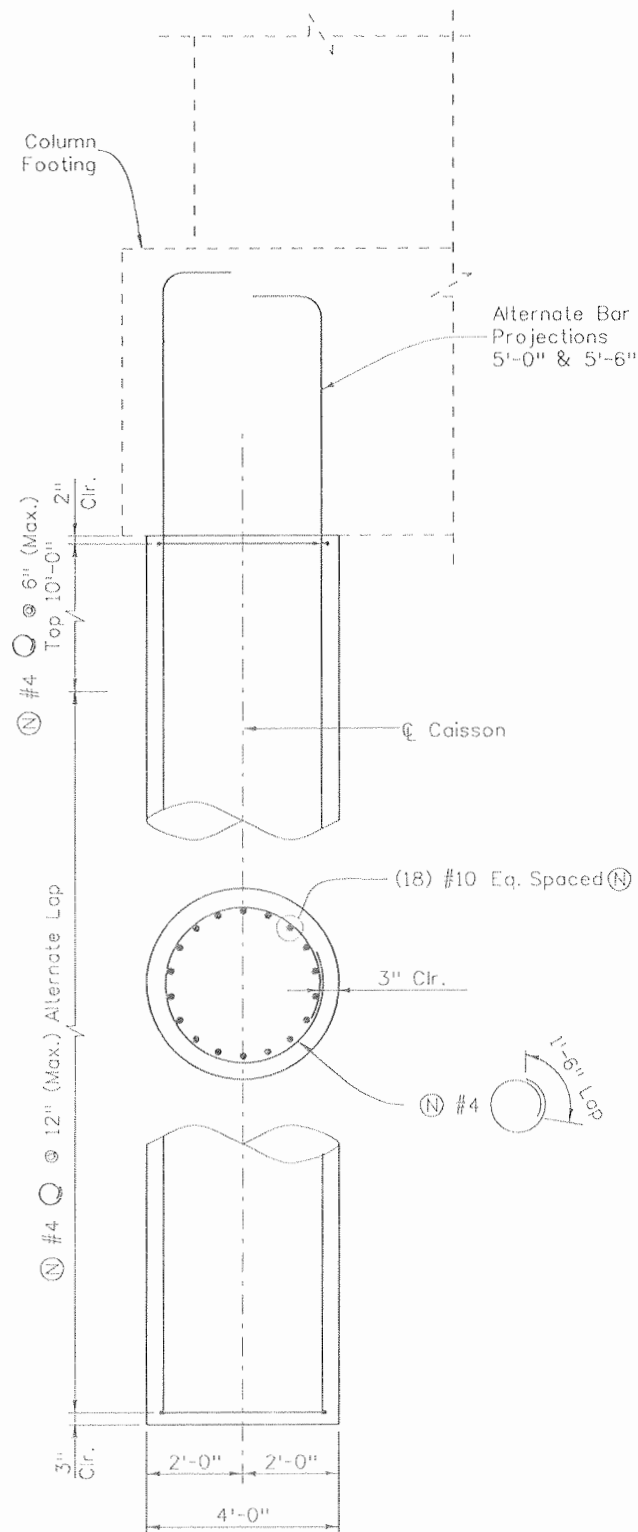


48" CAISSON DETAIL

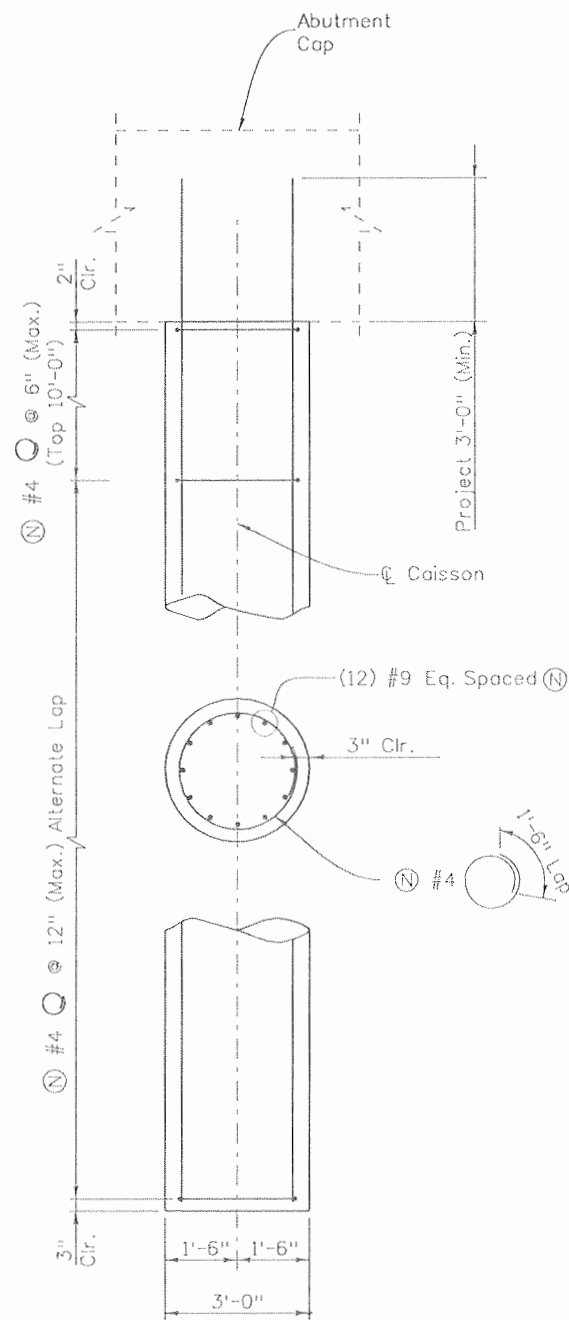

ABUTMENT 1
36" CAISSON DETAIL

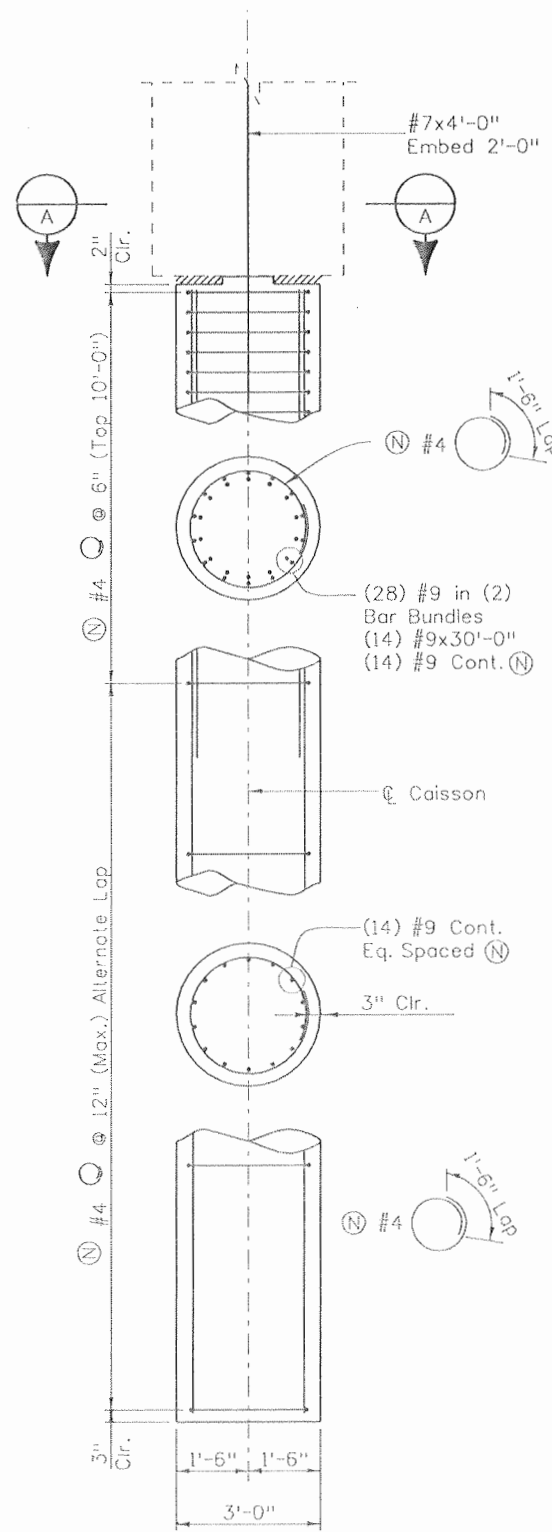

ABUTMENT 3
36" CAISSON DETAIL

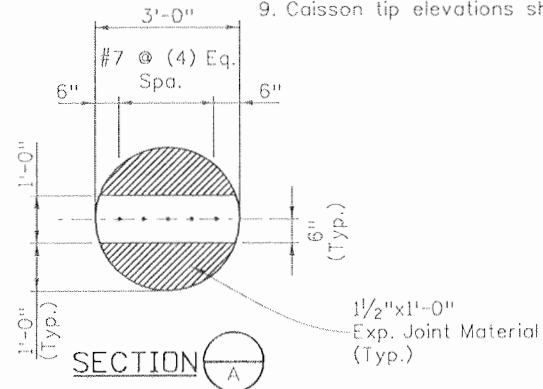

CAISSON DATA							
Location	Caisson Size	Top of Caisson Elevation	Minimum Tip Elevation	Min. Penetration Into. Bedrock	Max. Factored Load (kip)	Estimated Bedrock Elevation	Measured Bedrock Elevation
Abut. 1	36"	6651.35	6583.00	20'-0"	1328	6603.00	6600.35
Pier 2	48"	6613.50	6570.00	25'-0"	2255	6595.00	6595.00
Abut. 3	36"	6651.76	6596.00	19'-0"	460	6615.00	6615.00

NOTES:

- Caisson concrete shall be concrete Class BZ ($f'_c = 4000$ psi).
- Lap splices in caisson tie bar shall alternate 180°. Lap splices of longitudinal bars shall be staggered and shall be:
 - #10 5'-2"
 - #9 4'-1"
- Foundation design based upon recommendation provided by Shannon & Wilson, Inc.
 - Nominal End Bearing: 110 ksf
 - End Bearing Resistance Factor: 0.75
 - Nominal Side Shear: 9 ksf
 - Side Shear Resistance Factor: 0.75
- All caissons shall be Impact Echo tested per the Project Special Provisions.
- A factored downdrag force of 438 kips/caisson is included in the abutment 1 factored loads.
- Lateral reduction factors (ρ -multipliers) used in the lateral pile analysis include:

	Transverse	Longitudinal
Abutments	0.72	1.00
Pier	0.28	0.75
- If groundwater inflow is encountered, casing should be used to seal off local groundwater inflow. Casing should be pushed, rotated, vibrated, or driven into an impermeable, firm stratum below the seepage zone. If the casing is extended into bedrock, the minimum bedrock penetration shall be increased by a length equivalent to the casing protrusion into bedrock.
- If a wet hole is encountered and casing cannot be used, drilling slurry shall not be used and concrete shall be placed in accordance with Section 601.12(f) of the Standard Specifications.
- Caisson tip elevations shall not be reduced.

Print Date: 9/22/2010

File Name: 16042W_DrillShaftDet_01.dgn

Horiz. Scale: 1:1

Vert. Scale: As Noted

Unit Information 0221

Unit Leader STW



Sheet Revisions

Date:	Comments	Init.

Colorado Department of Transportation



3803 North Main Avenue
Suite 200
Durango, CO 81301
Phone: 970-385-1440 FAX: 970-385-8365

Region 5

EJA

As Constructed



No Revisions:	
Revised:	9/10
Void:	

**RAMP C OVER WILSON GULCH
DRILLED CAISSON DETAILS**


Designer:	A. Leifheit	Structure	P-05-W
Detailer:	D. Anderson	Numbers	
Sheet Subset:	Bridge	Subset Sheets:	B12 of B34

Project No./Code


NH 1602-114
16042
Sheet Number 278

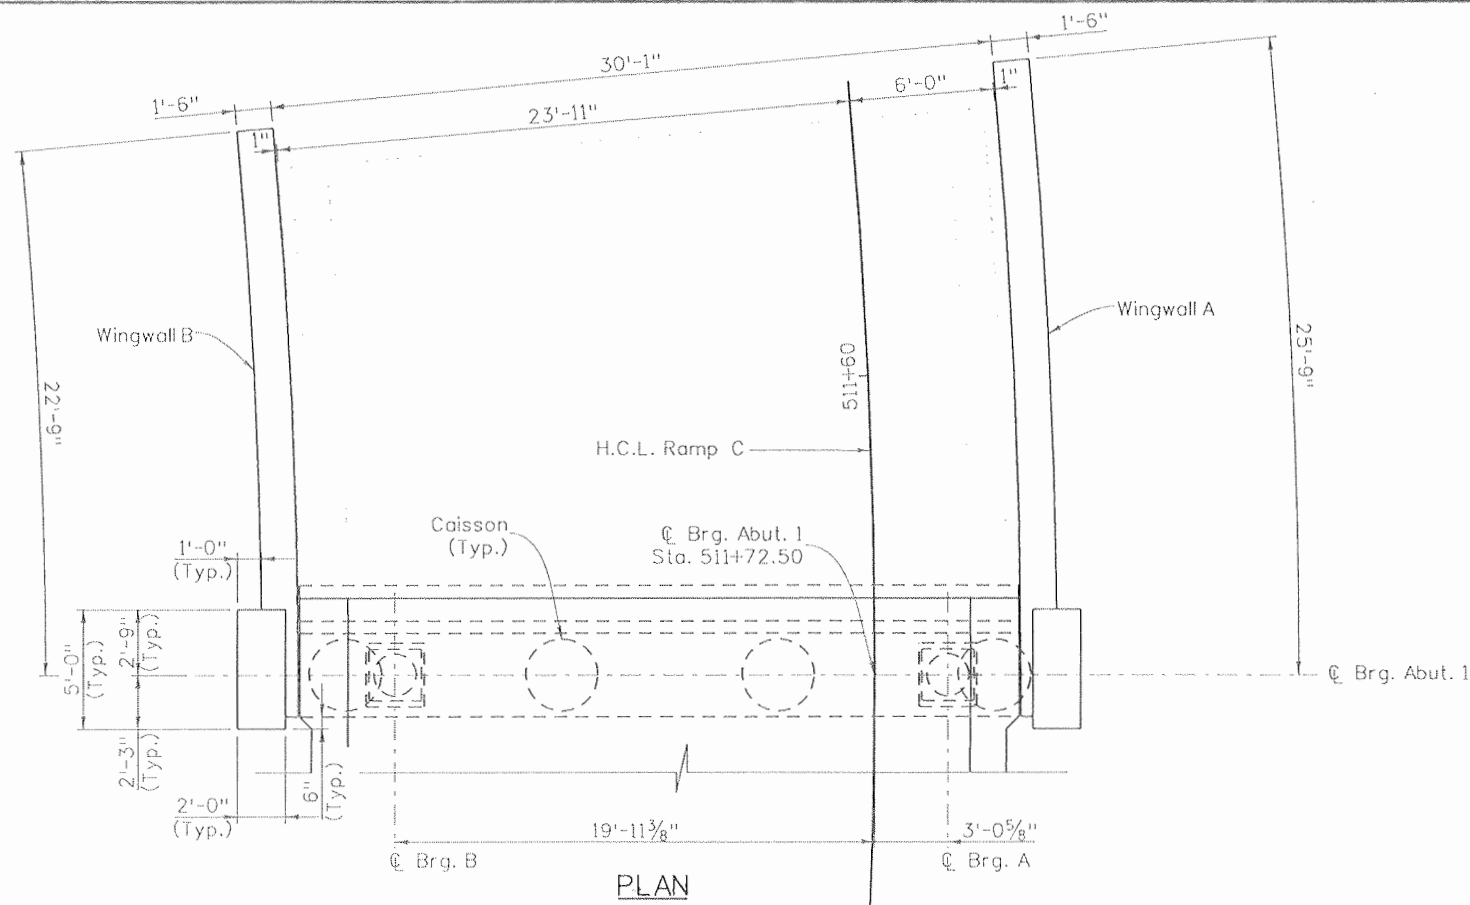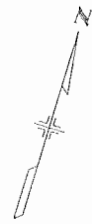


PLAN

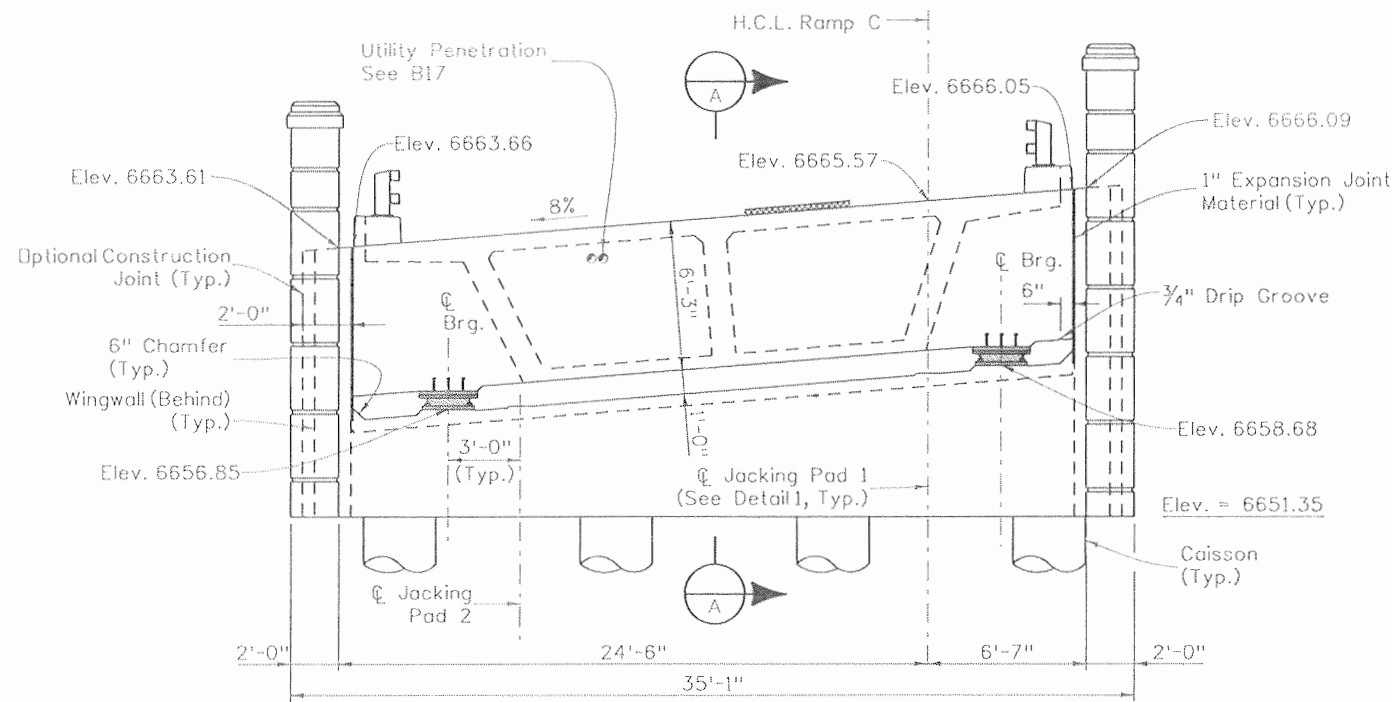

ELEVATION

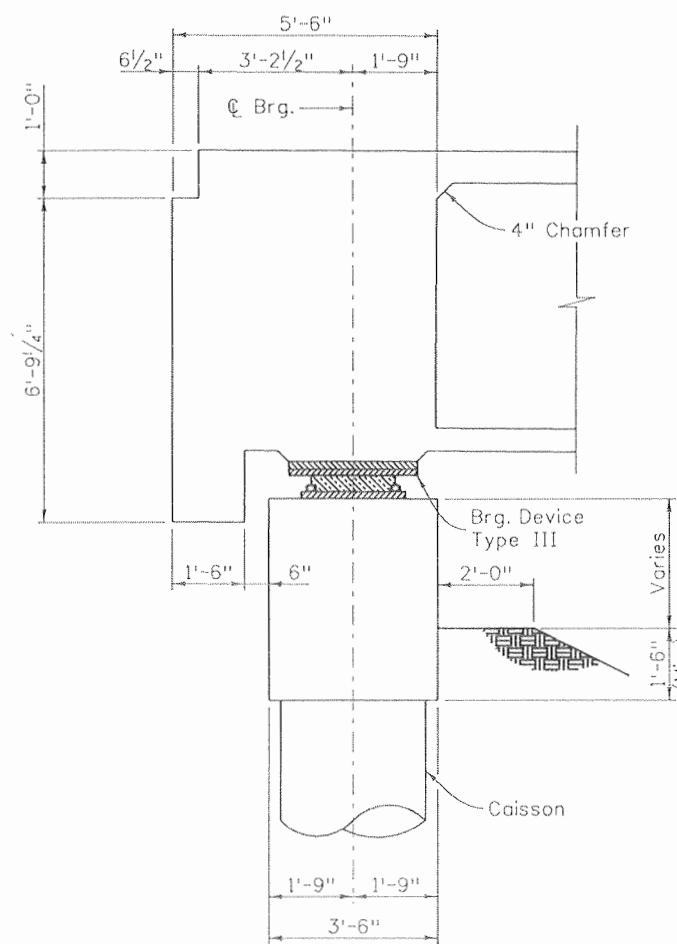

SECTION A-A

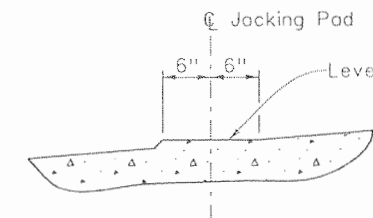

DETAIL 1

NOTE:

The estimated force required for jacking under DL is 439 Kips at pad 1 and 135 Kips at pad 2.

NOTES:

1. Abutments shall be concrete Class D (Bridge) ($f'c = 4,500$ psi).
2. Elevations are taken at C Brg. Abutment, top of concrete.
3. Elevations are based upon a total bearing thickness (H) of 9 inches. Elevations shall be adjusted by the contractor if required. Contractor shall notify engineer of any elevation adjustments.
4. See sheet B17 for utility penetration details.
5. See sheet B28 for curb modifications at abutments.

Design		Detail		Quantities	
INITIAL	DATE	INITIAL	DATE	INITIAL	DATE
AML	10/08	RCA	10/08	AML	10/08
MUN	10/08	MAN	10/08	LW	10/08

Print Date: 9/22/2010
 File Name: 16042W_Abutment1_01.dgn
 Horiz. Scale: 1:1 Vert. Scale: As Noted
 Unit Information 0221 Unit Leader STW


Sheet Revisions		
Date:	Comments	Init.

Colorado Department of Transportation
 3803 North Main Avenue
 Suite 200
 Durango, CD 81301
 Phone: 970-385-1440 FAX: 970-385-8365
 Region 5 EJA


As Constructed	
No Revisions:	9/10
Revised:	
Void:	

RAMP C OVER WILSON GULCH ABUTMENT 1 DETAILS			
Designer:	A. Leifheit	Structure	P-05-W
Detailer:	R. Artman	Numbers	
Sheet Subset:	Bridge	Subset Sheets:	B13 of B34


Project No./Code	
NH 1602-114	
16042	
Sheet Number	279

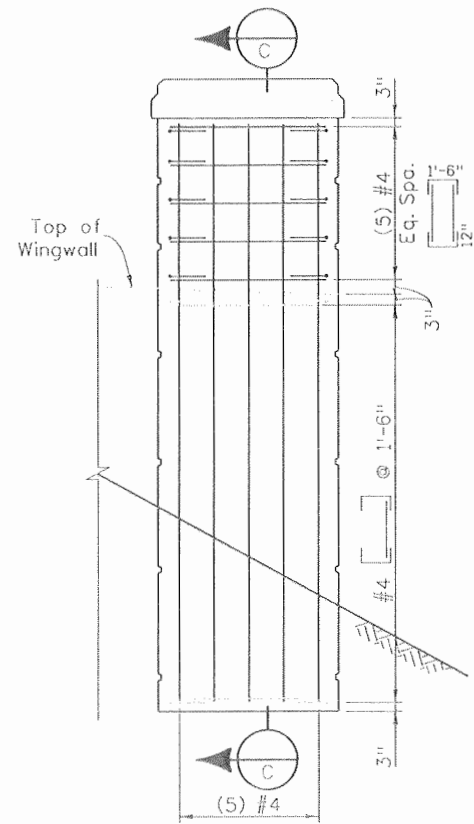


TYPICAL MONUMENT REINFORCING

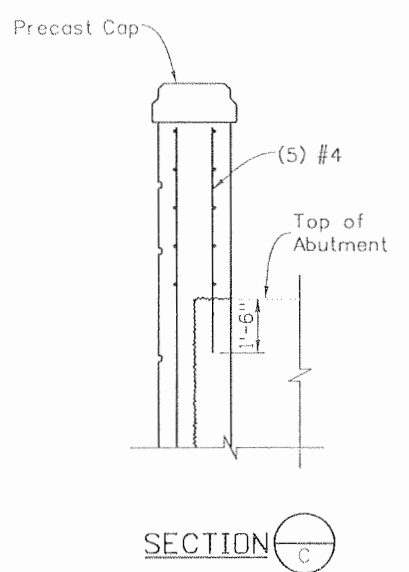


SECTION C

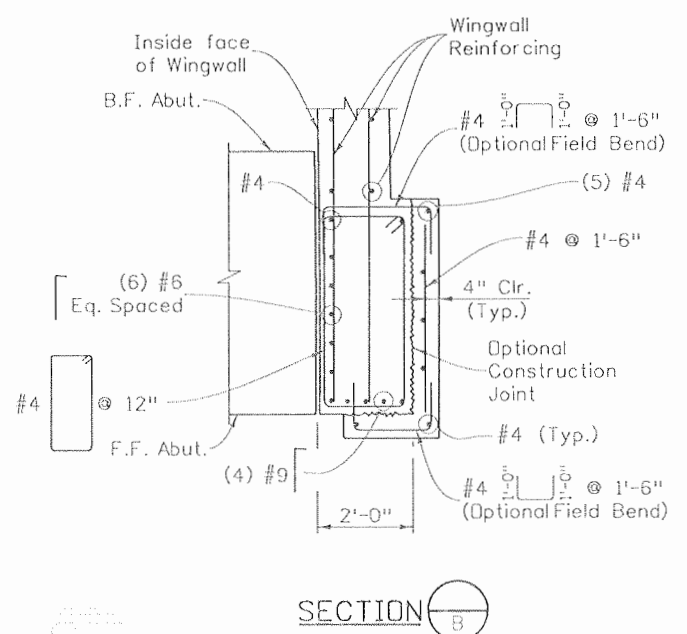

SECTION B

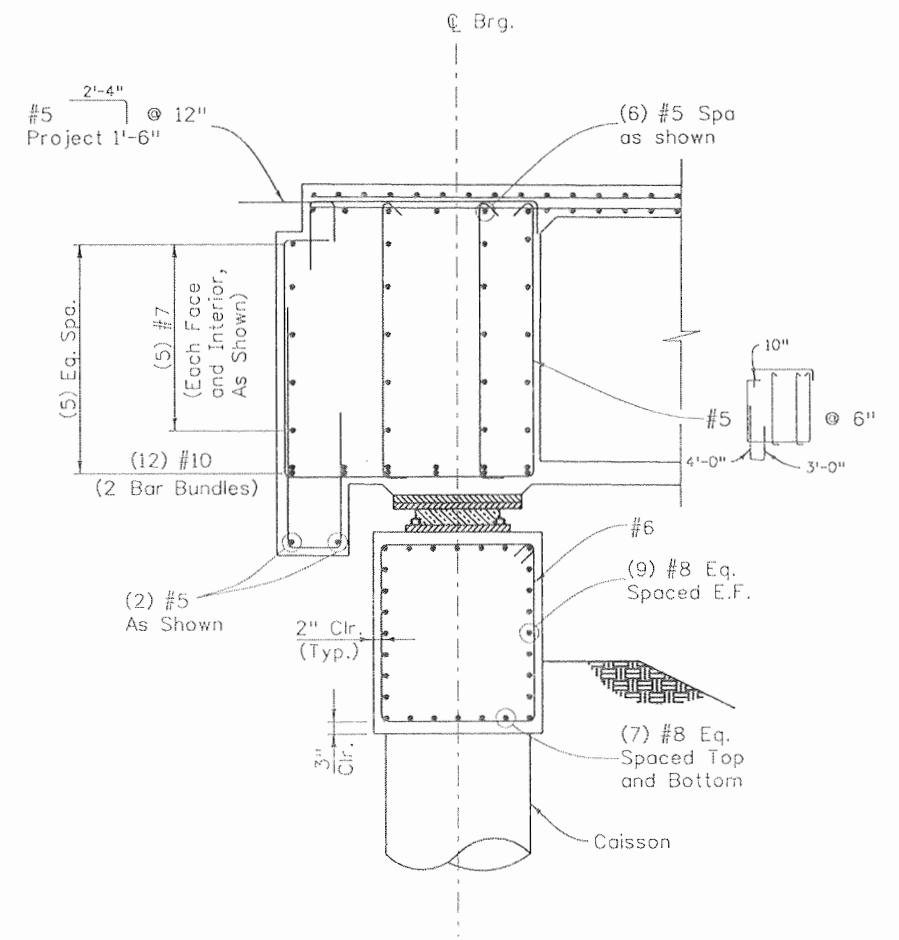

SECTION A

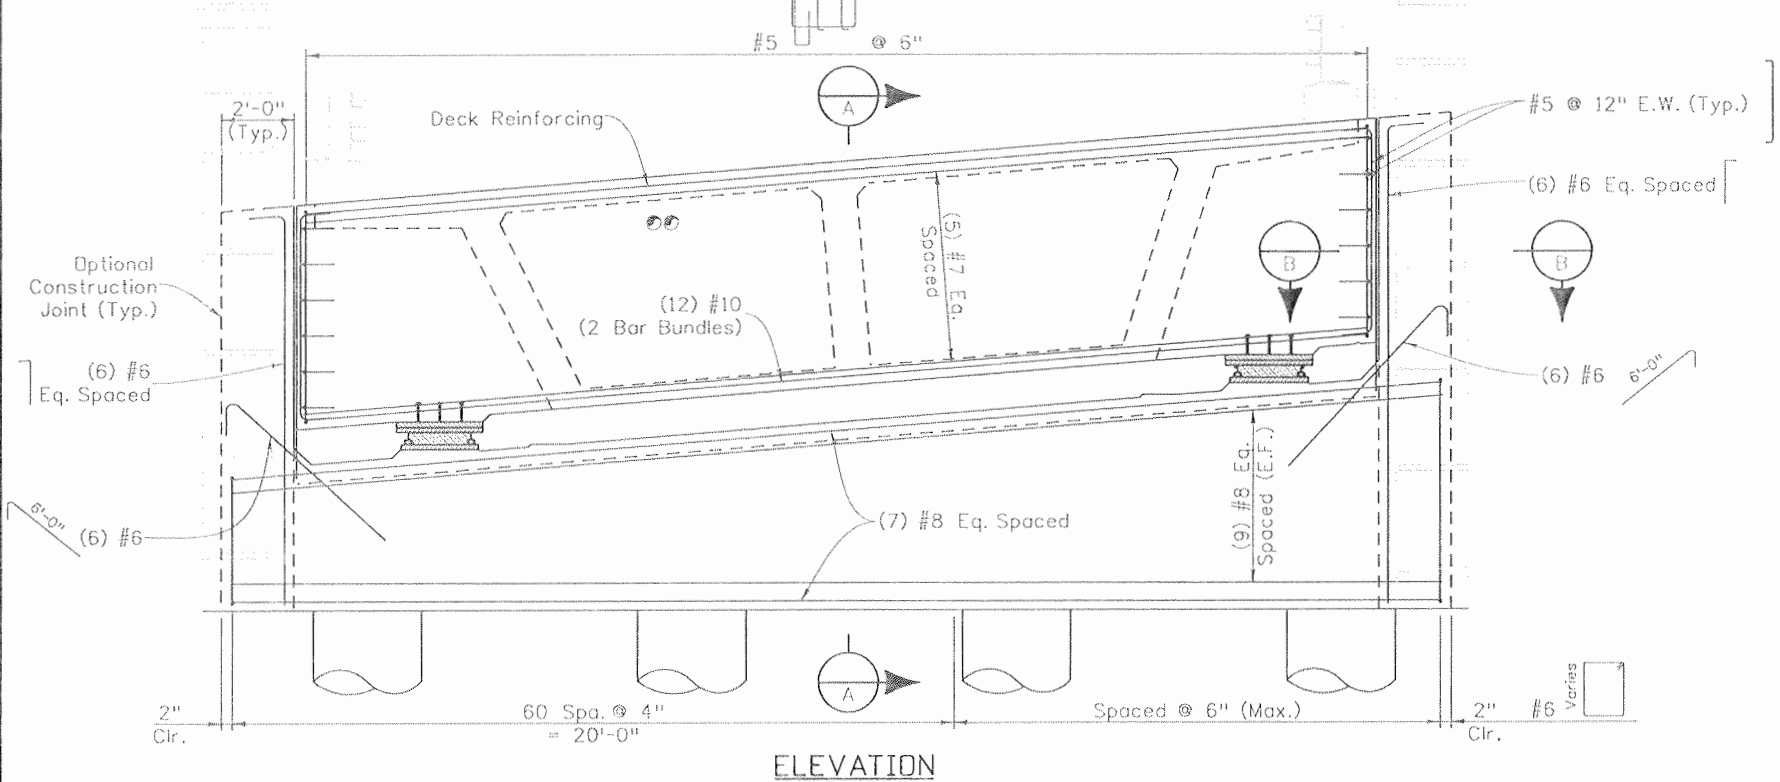

ELEVATION

NOTES:

1. Abutments shall be concrete Class D (Bridge) ($f'_c = 4,500$ psi).
2. Coordinate Utility Penetration to miss Reinforcing. See Sheet B17 for details.

Design		Detail		Quantities	
INITIAL	DATE	INITIAL	DATE	INITIAL	DATE
AML	10/08	RCA	10/08	AML	10/08
MUN	10/08	MUN	10/08	LW	10/08
Designed By	Detailed By	Checked By	Checked By	Checked By	Checked By

Print Date: 9/22/2010
 File Name: 16042W_Abutment1_Reinf_01.dgn
 Horiz. Scale: 1:1 Vert. Scale: As Noted
 Unit Information 0221 Unit Leader STW

SEMA CONSTRUCTION **WILSON & COMPANY**

Sheet Revisions		
Date:	Comments	Init.

Colorado Department of Transportation
 3803 North Main Avenue
 Suite 200
 Durango, CO 81301
 Phone: 970-385-1440 FAX: 970-385-8365





DOT
 DEPARTMENT OF TRANSPORTATION

Region 5 EJA

As Constructed	
No Revisions:	9/10
Revised:	
Void:	

RAMP C OVER WILSON GULCH ABUTMENT 1 REINFORCING DETAILS			
Designer:	A. Leifheit	Structure Numbers	P-05-W
Detailer:	R. Artman		
Sheet Subset:	Bridge	Subset Sheets:	B14 of B34

Project No./Code	
NH 1602-114	
16042	
Sheet Number	280

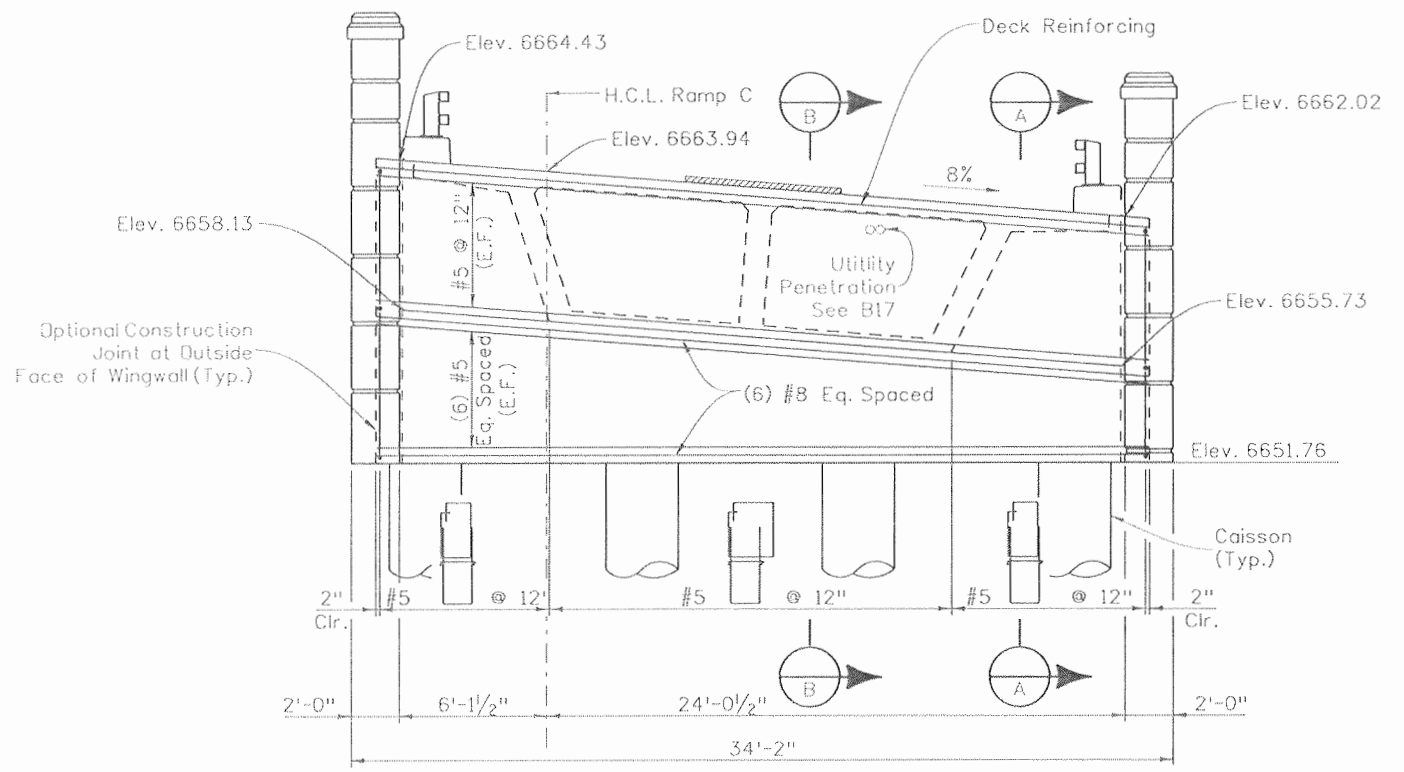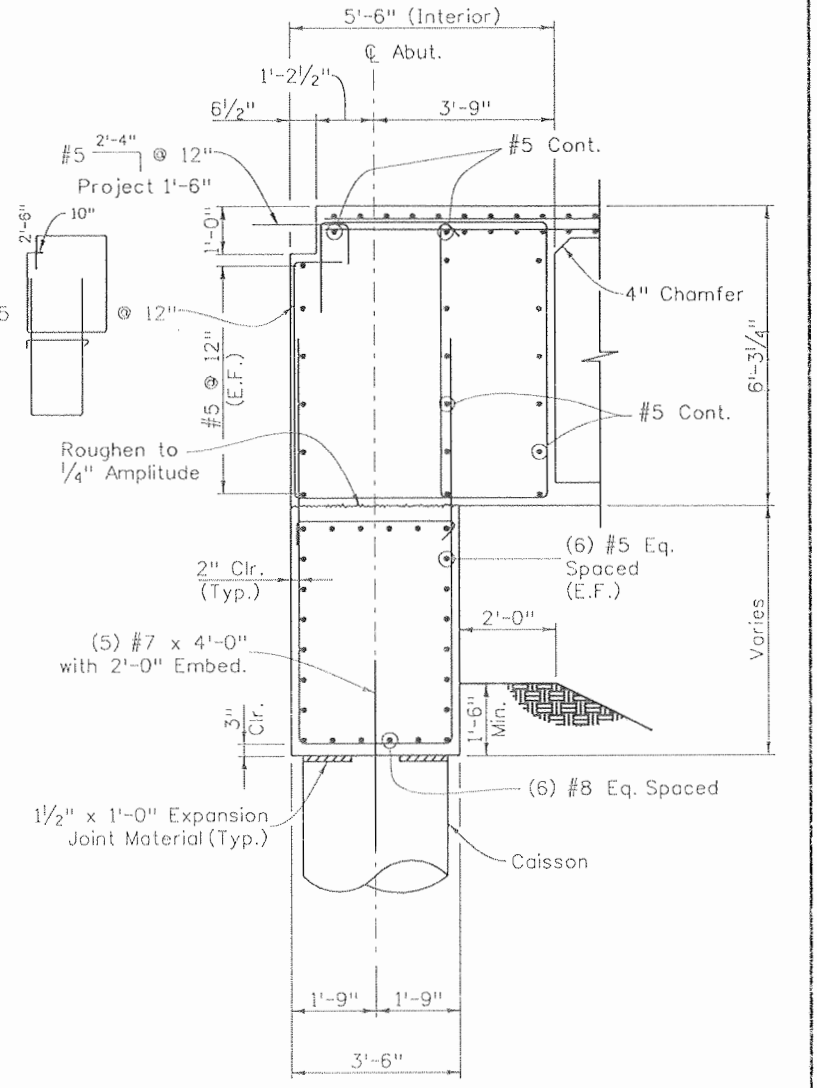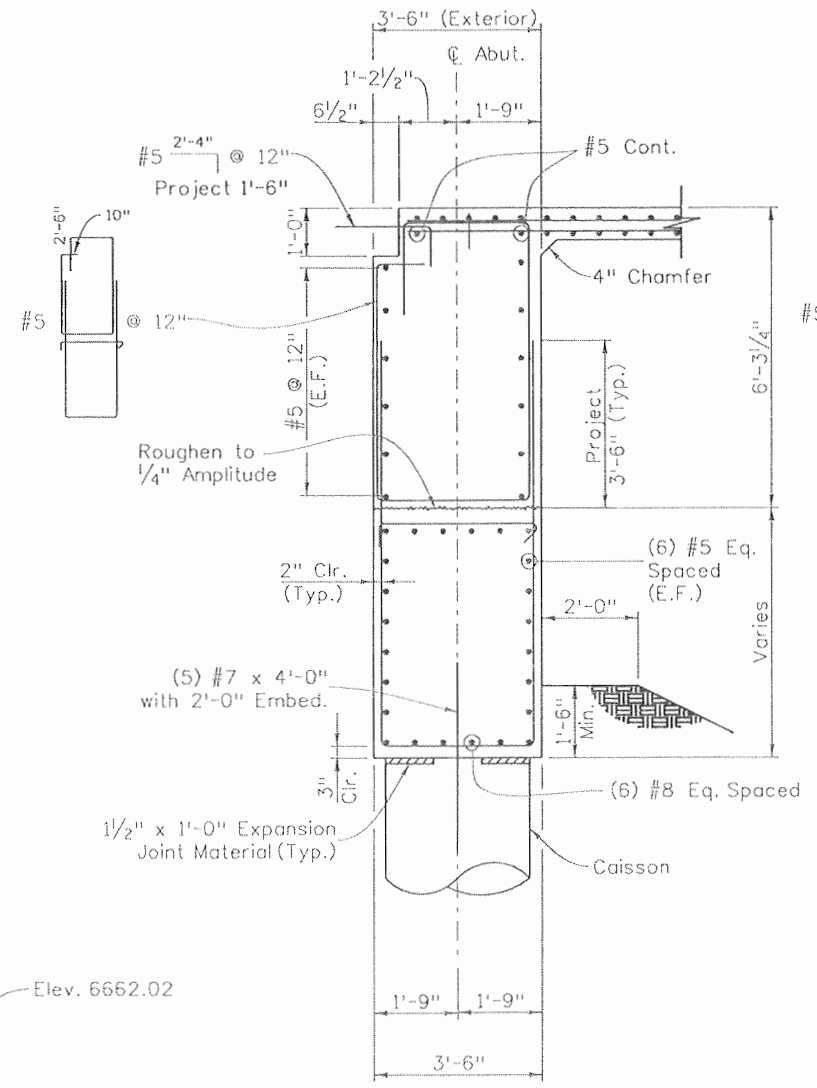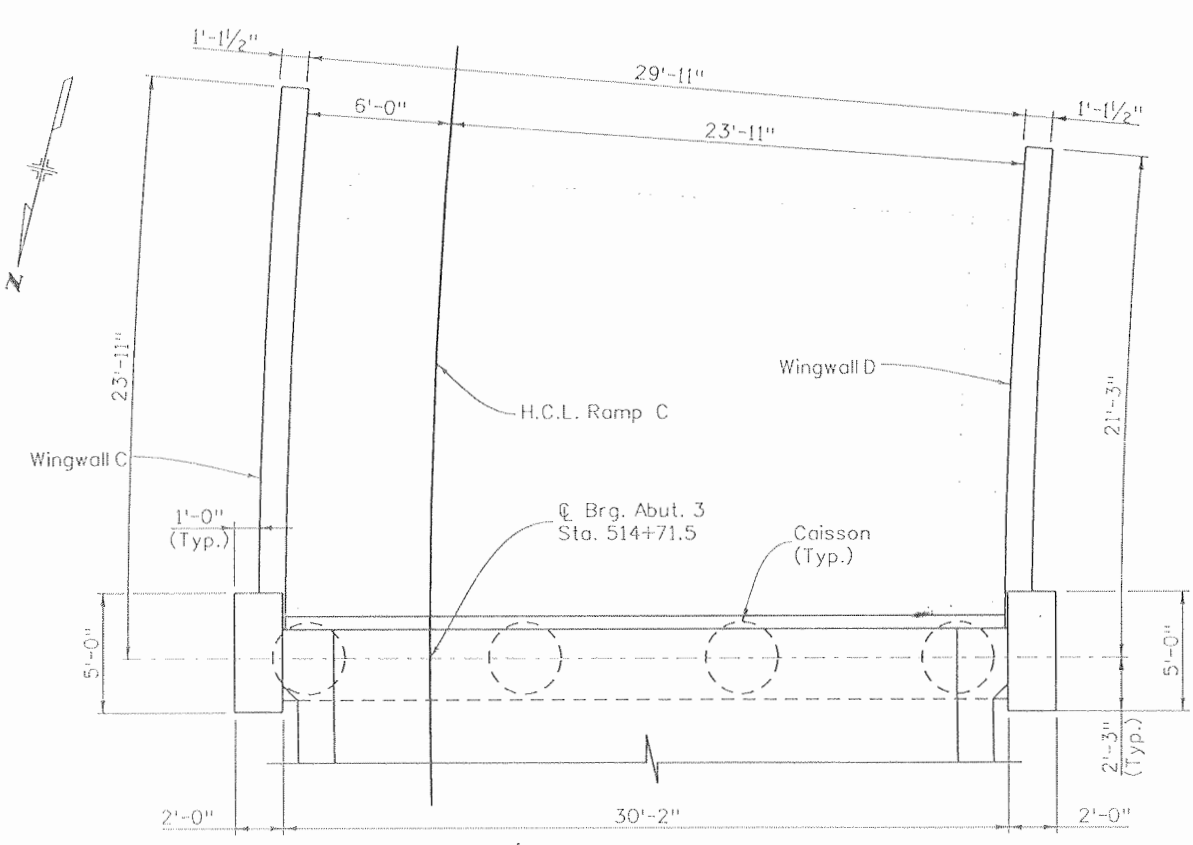

NOTES:

1. Abutments shall be concrete Class D (Bridge) (f'c = 4,500 psi).
2. Coordinate utility penetration to miss reinforcing. See sheet B17 for utility penetration details.
3. See sheet B16 for monument reinforcing at abutment 3.
4. See sheet B28 for curb modifications at abutments.
5. Elevations are taken at top of deck, centerline brg. abutment.

Design		Detail		Quantities	
INITIAL	DATE	INITIAL	DATE	INITIAL	DATE
AML	10/08	AML	10/08	AML	10/08
MUN	10/08	MUN	10/08	LW	10/08
Designed By	Checked By	Designed By	Checked By	Quantities By	Checked By

Print Date: 9/22/2010
 File Name: 16042W_Abutment3_01.dgn
 Horiz. Scale: 1:1 Vert. Scale: As Noted
 Unit Information 0221 Unit Leader STW

SEMA CONSTRUCTION **WILSON & COMPANY**

Sheet Revisions		
Date:	Comments	Init.



Colorado Department of Transportation
 3803 North Main Avenue
 Suite 200
 Durango, CO 81301
 Phone: 970-385-1440 FAX: 970-385-8365

Region 5 **EJA**

As Constructed	
No Revisions:	9/10
Revised:	
Void:	

RAMP C OVER WILSON GULCH ABUTMENT 3 DETAILS			
Designer:	A. Leifheit	Structure Numbers	P-05-W
Detailer:	R. Artman		
Sheet Subset:	Bridge	Subset Sheets:	B15 of B34

Project No./Code	
	NH 1602-114
	16042
Sheet Number	281

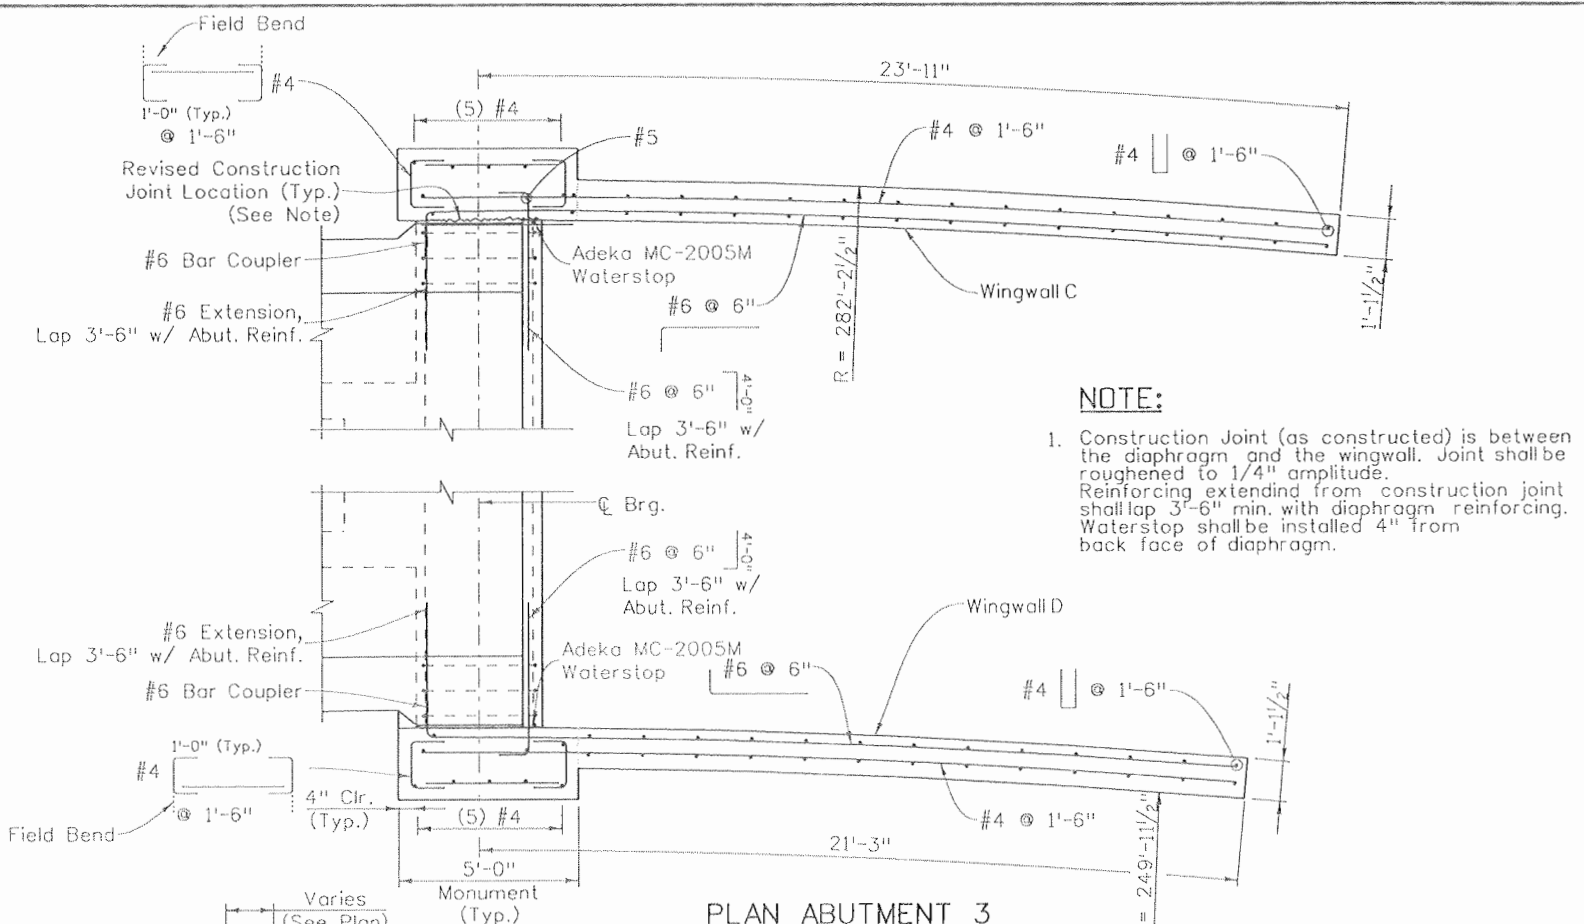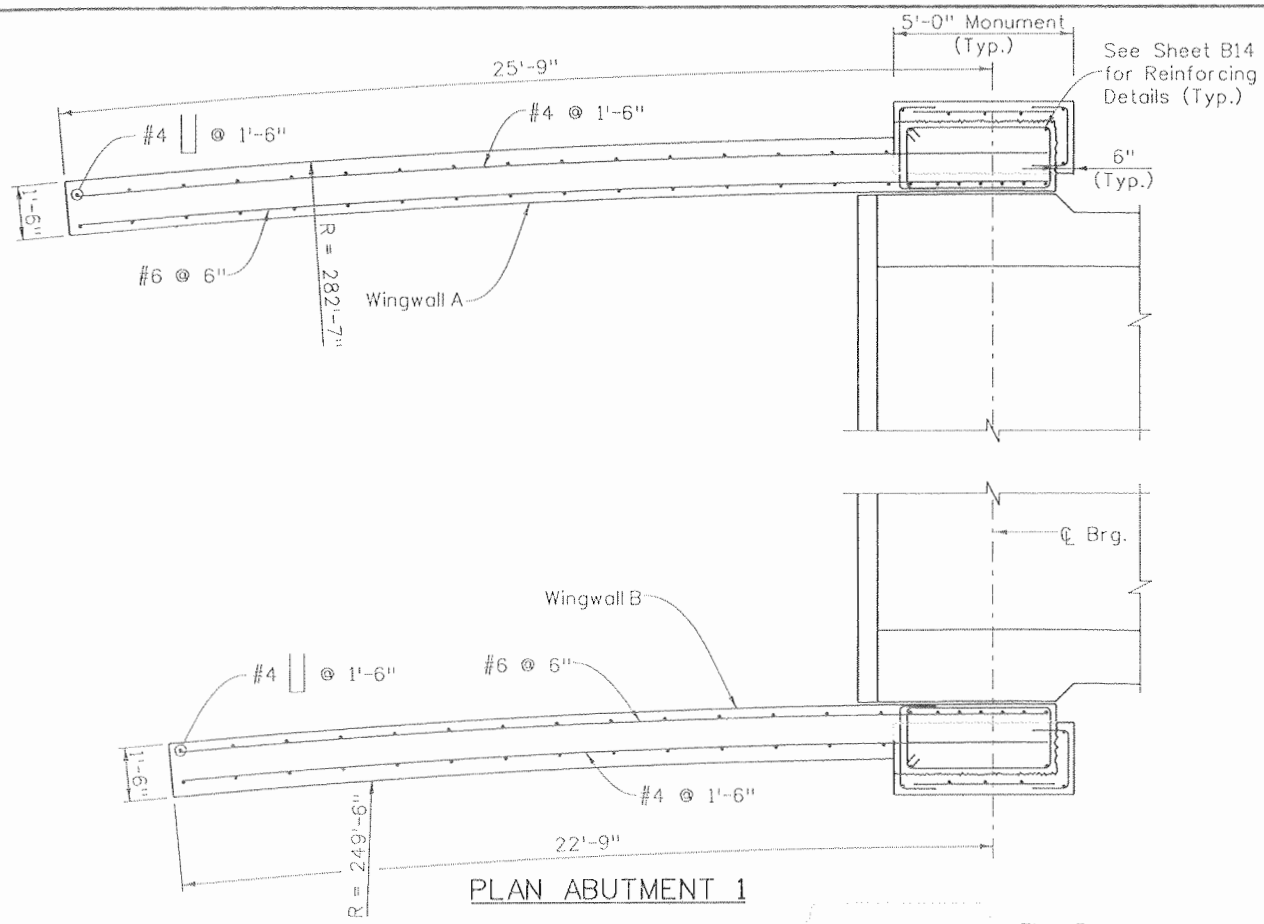

NOTE:

- Construction Joint (as constructed) is between the diaphragm and the wingwall. Joint shall be roughened to 1/4" amplitude. Reinforcing extending from construction joint shall lap 3'-6" min. with diaphragm reinforcing. Waterstop shall be installed 4" from back face of diaphragm.

PLAN ABUTMENT 1

PLAN ABUTMENT 3

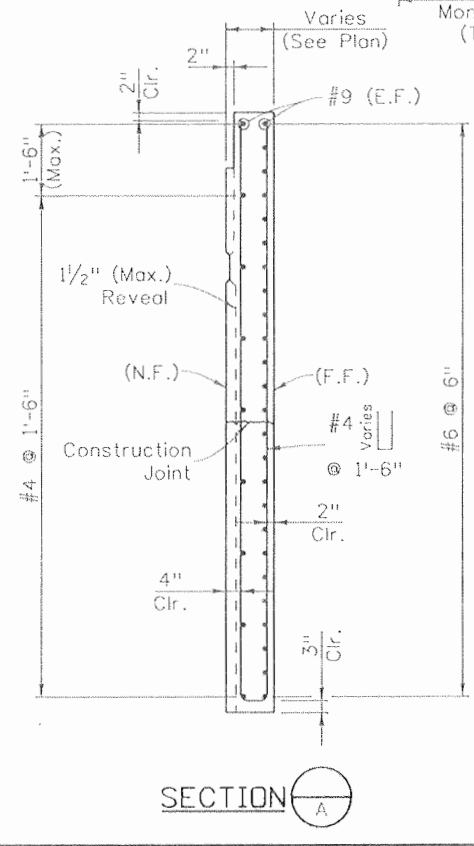
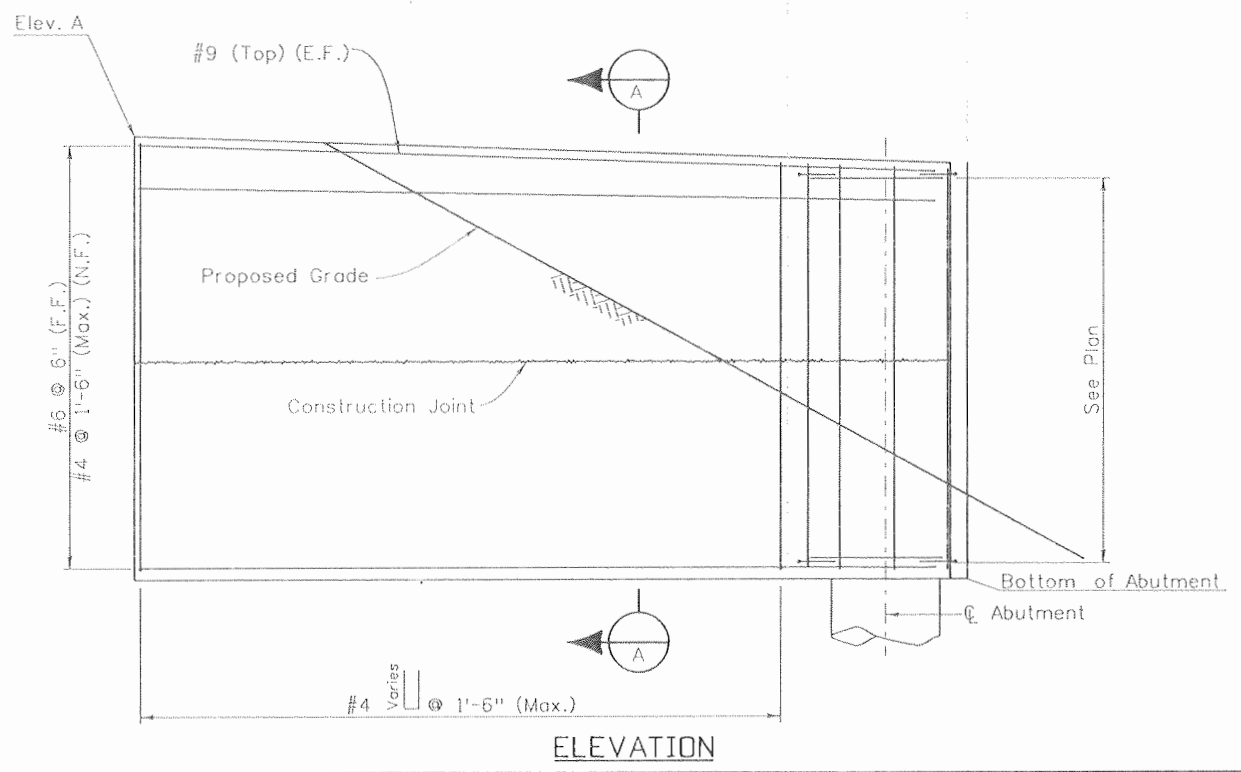


TABLE OF ELEVATIONS		
Wingwall	Elev. A	Elev. B
A	6666.16	6671.09
B	6663.76	6668.61
C	6664.10	6669.43
D	6661.70	6667.02

NOTE:

- All Wingwall and Monument concrete shall be Class D (Bridge), f'c = 4,500 psi at 28 days.
- For Monument Reinforcing Details above Wingwalls, see Sheet B14.
- The maximum depth of the form liner reveals shall not exceed 1/2".

Design		Detail		Quantities	
INITIAL	DATE	INITIAL	DATE	INITIAL	DATE
AML	10/08	AML	10/08	AML	10/08
MUN	10/08	MUN	10/08	LW	10/08

Print Date: 9/22/2010
 File Name: 16042W_WingwallDet_01-REV.dgn
 Horiz. Scale: 1:1 Vert. Scale: As Noted
 Unit Information 0221 Unit Leader STW

SEMA CONSTRUCTION **WILSON & COMPANY**

Sheet Revisions		
Date:	Comments	Init.

Colorado Department of Transportation
 3803 North Main Avenue
 Suite 200
 Durango, CO 81301
 Phone: 970-385-1440 FAX: 970-385-8365

DOT DEPARTMENT OF TRANSPORTATION



Region 5 EJA

As Constructed	
No Revisions:	
Revised:	9/10
Void:	


RAMP C OVER WILSON GULCH WINGWALL DETAILS			
Designer:	A. Leifheit	Structure	P-05-W
Detailer:	R. Artman	Numbers	
Sheet Subset:	Bridge	Subset Sheets:	B16 of B34

Project No./Code	
NH 1602-114	
16042	
Sheet Number	282


Design		Detail		Quantities	
INITIAL	DATE	INITIAL	DATE	INITIAL	DATE
Designed By: AML	10/08	Detailed By: M.N	10/08	Quantities By: AML	10/08
Checked By:		Checked By:		Checked By: LW	10/08

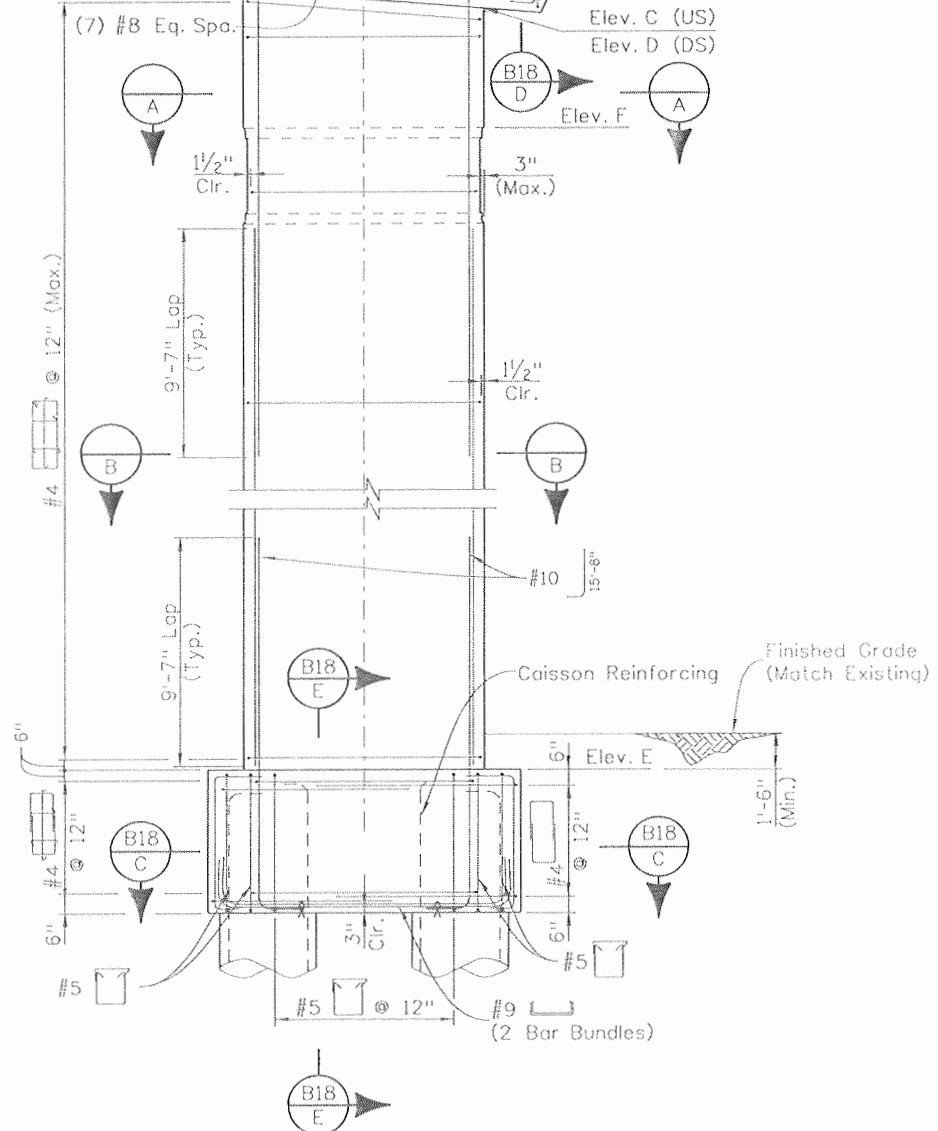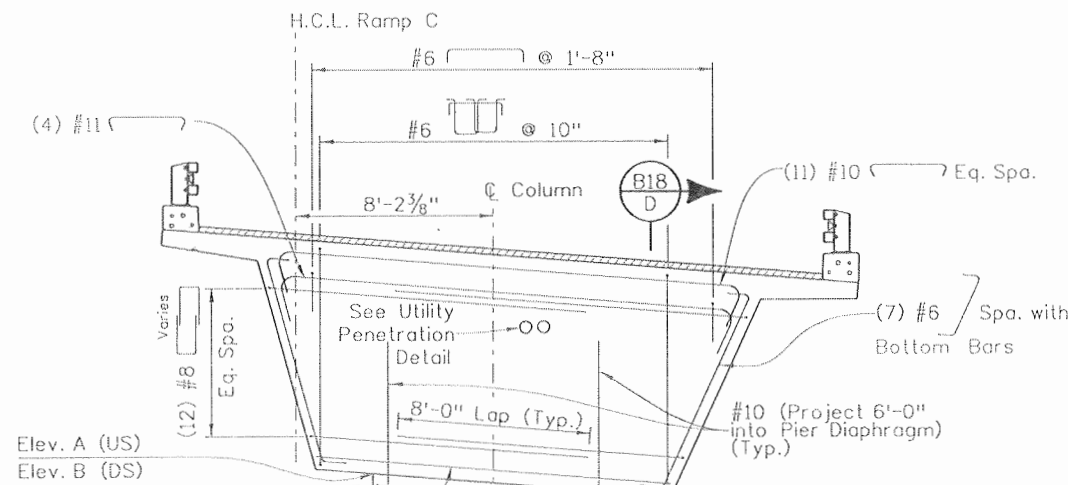


ELEVATION
(Deck Reinforcing Not Shown for Clarity)

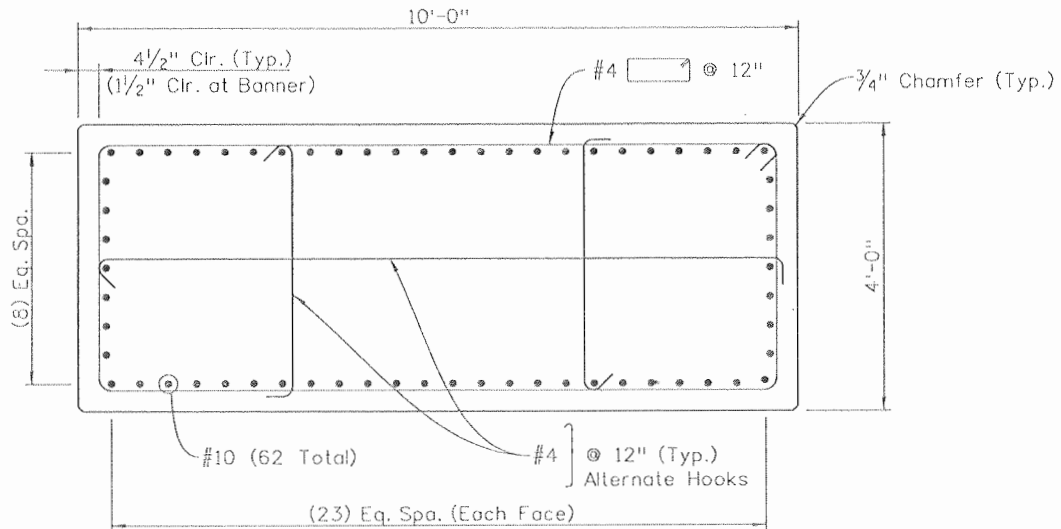

SECTION A-A

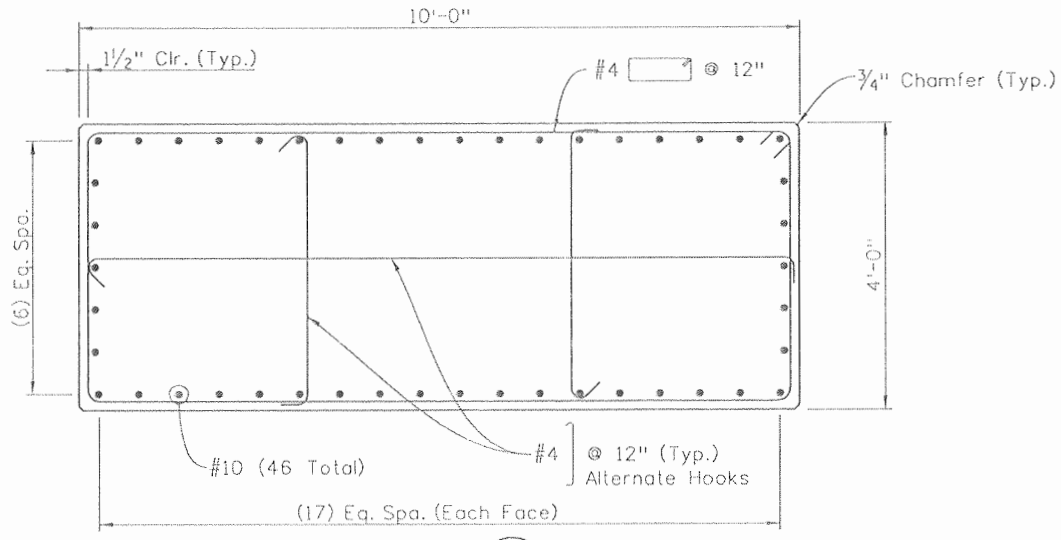

SECTION B-B

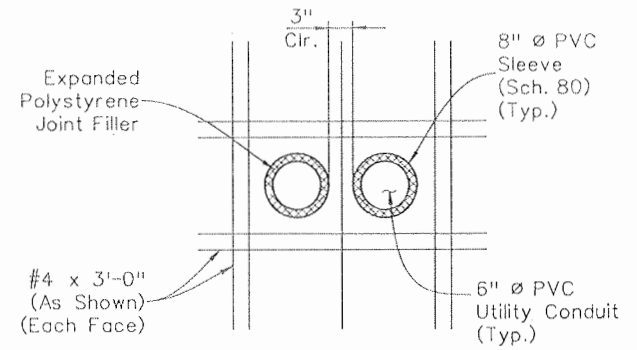

UTILITY PENETRATION

TABLE OF ELEVATIONS


Location	Pier 2
A	6654.96
B	6654.98
C	6654.16
D	6654.18
E	6619.50
F	6649.18

NOTES:


- Column concrete shall be Class D (Bridge), $f'_c = 4,500$ psi at 28 days.
- All reinforcing is 2" clear unless noted otherwise.
- Utility duct penetration shall be coordinated to miss reinforcing.
- A minimum of 1'-6" of earth cover shall be provided over the completed footing.
- The maximum reveal depth at the banner location shall not exceed 3".

Print Date: 9/22/2010 File Name: 16042W_Pier23Det_01.dgn Horiz. Scale: 1:1 Unit Information 0221		Sheet Revisions Date: Comments Init.		Colorado Department of Transportation 3803 North Main Avenue Suite 200 Durango, CO 81301 Phone: 970-385-1440 FAX: 970-385-8365 Region 5		As Constructed No Revisions: 9/10 Revised: Void:		RAMP C OVER WILSON GULCH PIER 2 DETAILS (1 OF 2) Designer: A. Leifheit Detailer: R. Artman Sheet Subset: Bridge		Project No./Code NH 1602-114 16042 Subset Sheets: B17 of B34 Sheet Number 283	
---	--	--	--	--	--	---	--	--	--	---	--




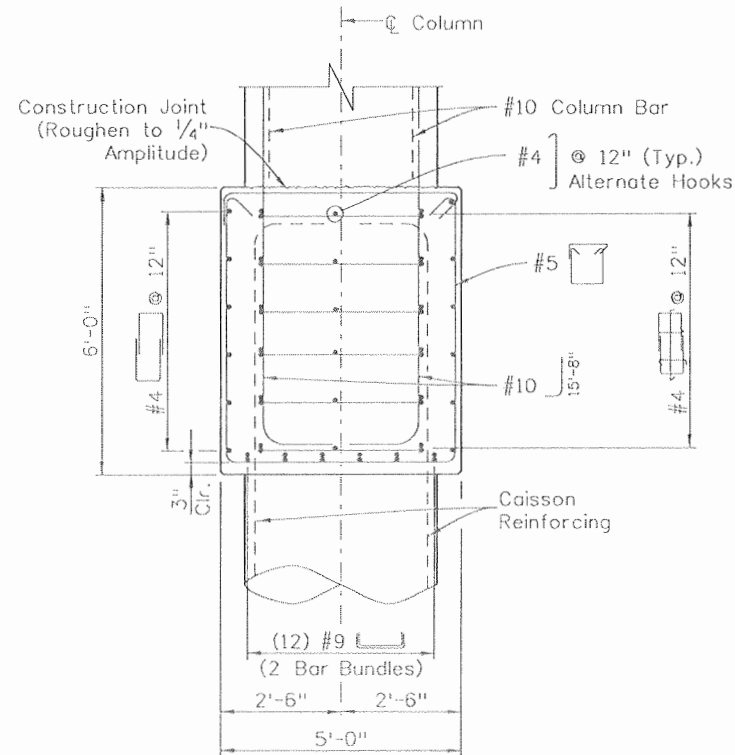

SECTION $\frac{B17}{E}$

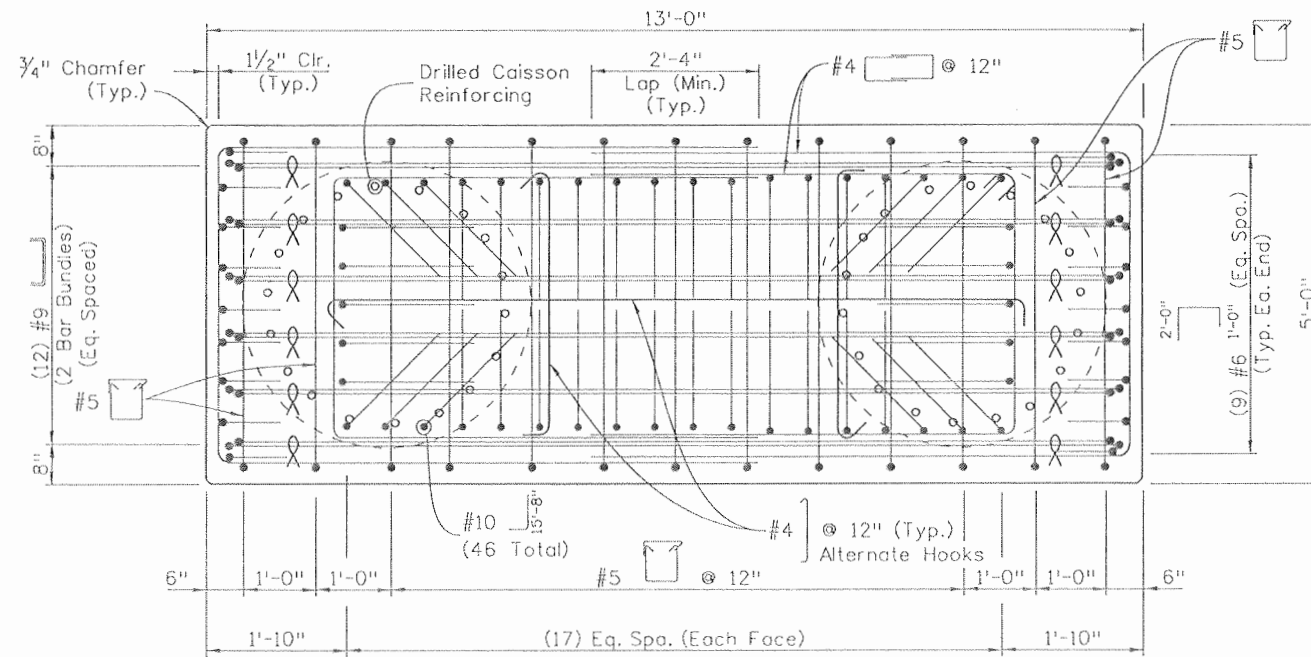

SECTION $\frac{B17}{C}$

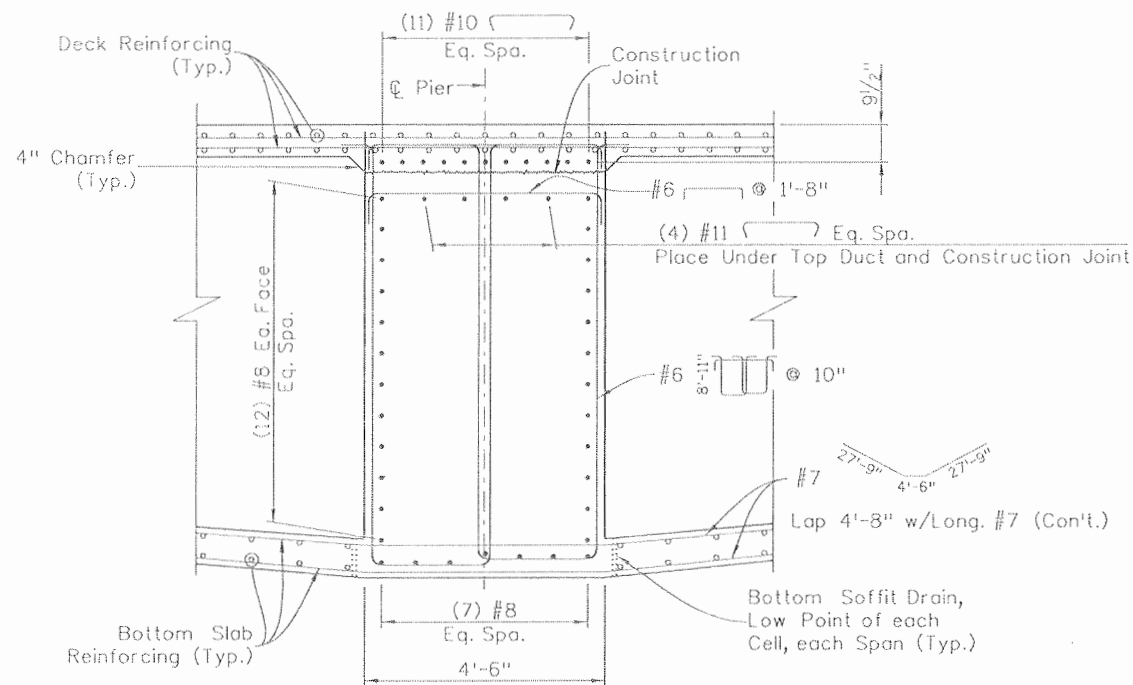


SECTION $\frac{B17}{D}$

NOTES:

1. Column concrete shall be Class D (Bridge), $f'_c = 4,500$ psi at 28 days.
2. All concrete cover is 2" clear unless noted otherwise.

Design		Detail		Quantities	
INITIAL	DATE	INITIAL	DATE	INITIAL	DATE
Designed By	10/08	DRA	10/08	Quantities By	AML
Checked By	10/08	M.N	10/08	Checked By	LW

Print Date: 9/22/2010
 File Name: 16042W_Pier23Det_02.dgn
 Horiz. Scale: 1:1 Vert. Scale: As Noted
 Unit Information 0221 Unit Leader STW

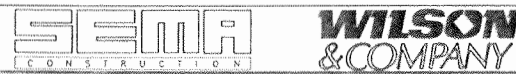


Sheet Revisions		
Date:	Comments	Init.

Colorado Department of Transportation
 3803 North Main Avenue
 Suite 200
 Durango, CO 81301
 Phone: 970-385-1440 FAX: 970-385-8365
 Region 5 EJA


As Constructed
 No Revisions: 9/10
 Revised:
 Void:

RAMP C OVER WILSON GULCH
 PIER 2 DETAILS
 (2 OF 2)
 Designer: A. Leifheit
 Detailer: D. Anderson
 Sheet Subset: Bridge
 Structure Numbers: P-05-W
 Subset Sheets: B18 of B34


Project No./Code
 NH 1602-114
 16042
 Sheet Number 284

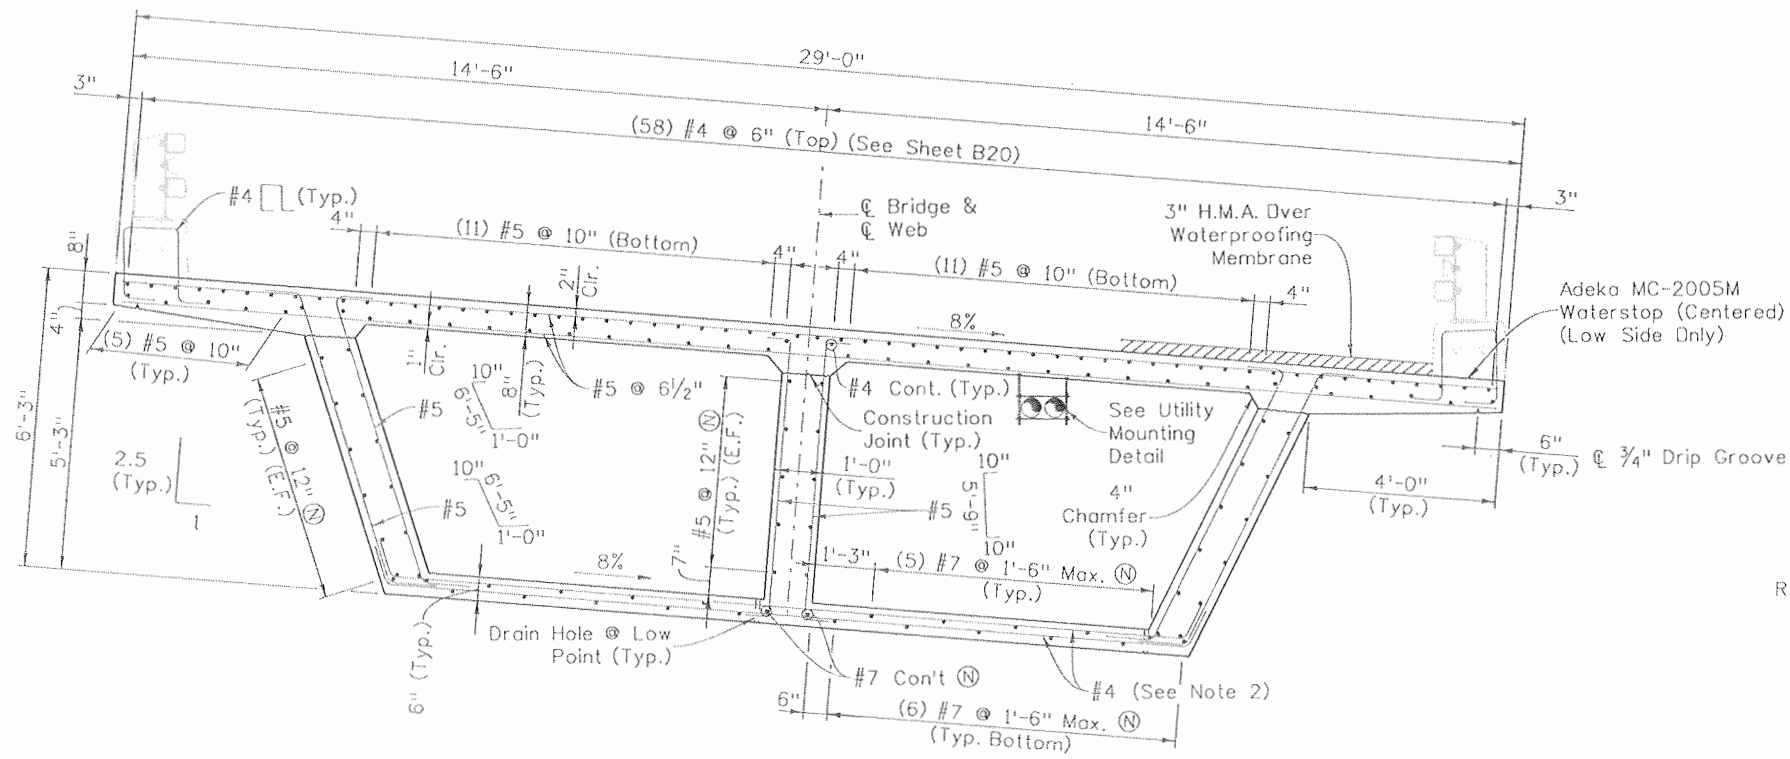

TYPICAL SECTION

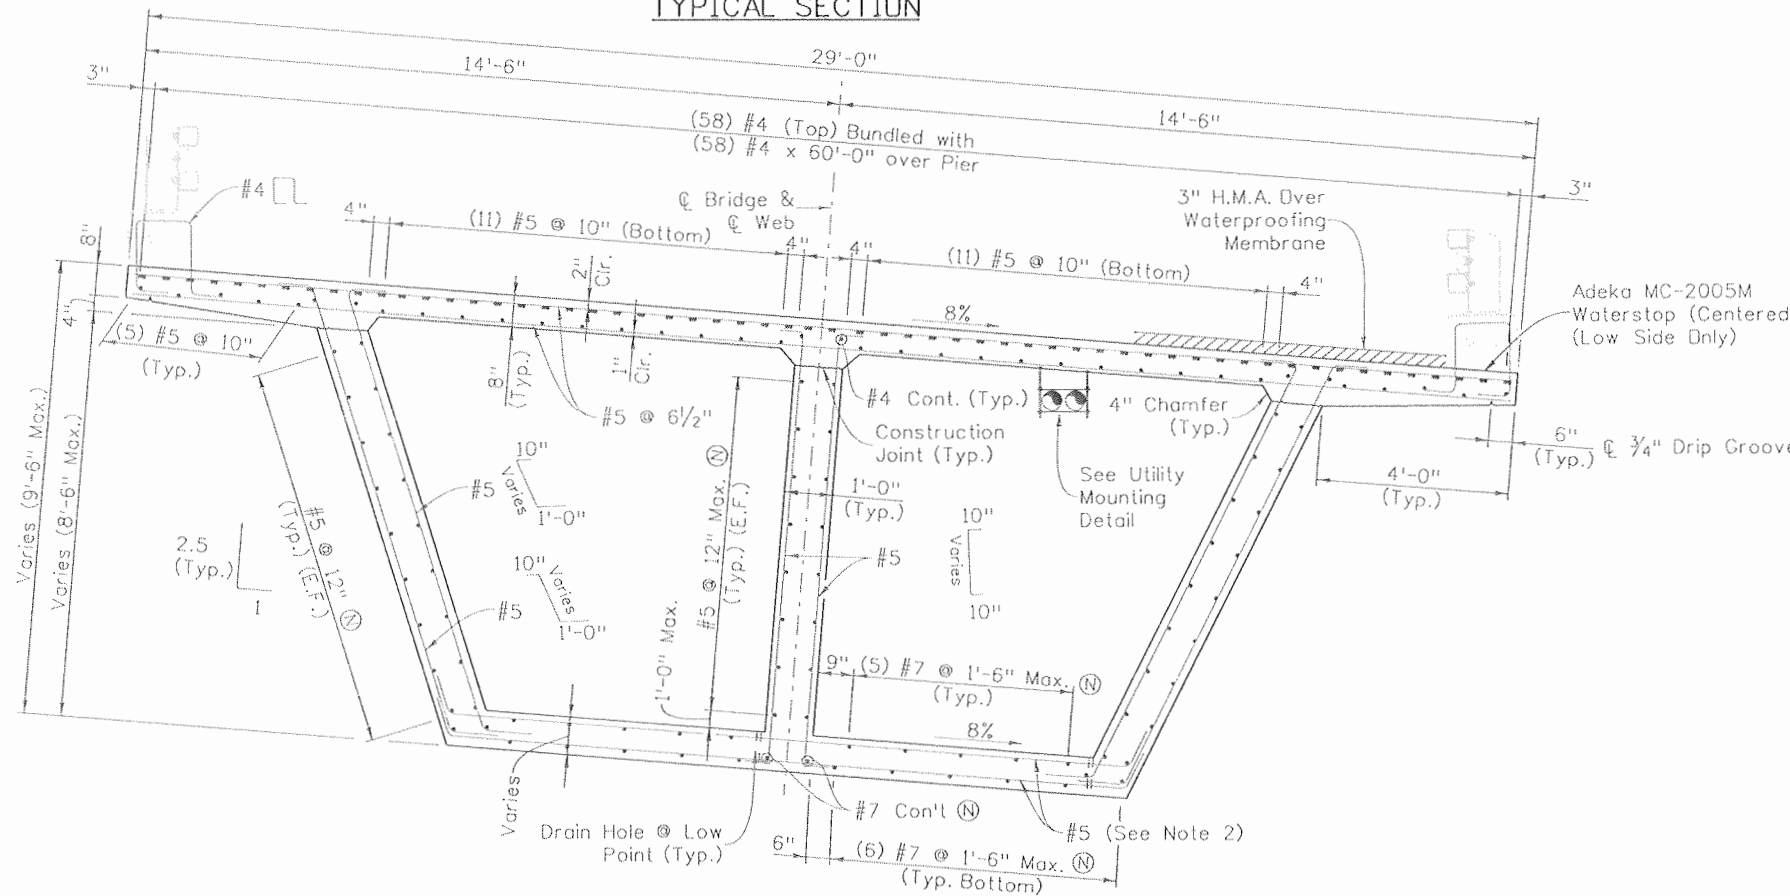

VARIABLE DEPTH SECTION

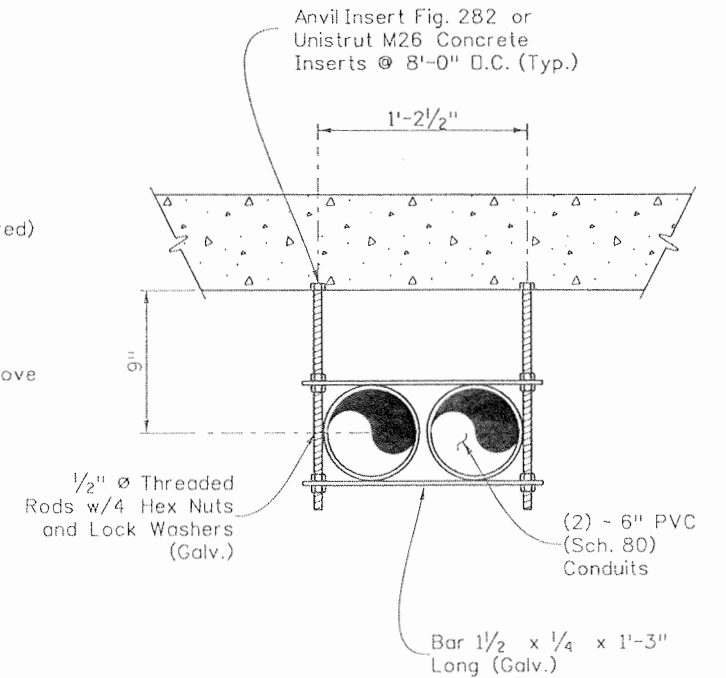

UTILITY MOUNTING DETAIL

NOTES:

1. Concrete cover is 1 1/2" clear unless noted otherwise.
2. See Cast-In-Place Box Girder Details sheets 1 thru 4 for stirrup size/spacing and additional information.
3. Superstructure shall be concrete Class D (Bridge), f' = 4,500 psi at 28 days.
4. Refer to Anti-icing Plans for locations of conduits, blockouts, and pavement monitoring device.

Design		Detail		Quantities	
INITIAL	DATE	INITIAL	DATE	INITIAL	DATE
AWL	10/08	AWL	10/08	AWL	10/08
Checked By	Checked By	Checked By	Checked By	Checked By	Checked By
GWK	10/08	GWK	10/08	LW	10/08

Print Date: 9/22/2010
 File Name: 16042W_SupStrSecs_01.dgn
 Horiz. Scale: 1:1 Vert. Scale: As Noted
 Unit Information 0221 Unit Leader STW

Sheet Revisions		
Date:	Comments	Init.


Colorado Department of Transportation
 3803 North Main Avenue
 Suite 200
 Durango, CD 81301
 Phone: 970-385-1440 FAX: 970-385-8365

Region 5 EJA

As Constructed	
No Revisions:	9/10
Revised:	
Void:	


RAMP C OVER WILSON GULCH SUPERSTRUCTURE DETAILS			
Designer:	A. Leifheit	Structure Numbers	P-05-W
Detailer:	R. Artman		
Sheet Subset:	Bridge	Subset Sheets:	B19 of B34

Project No./Code	
NH 1602-114	
16042	
Sheet Number	285

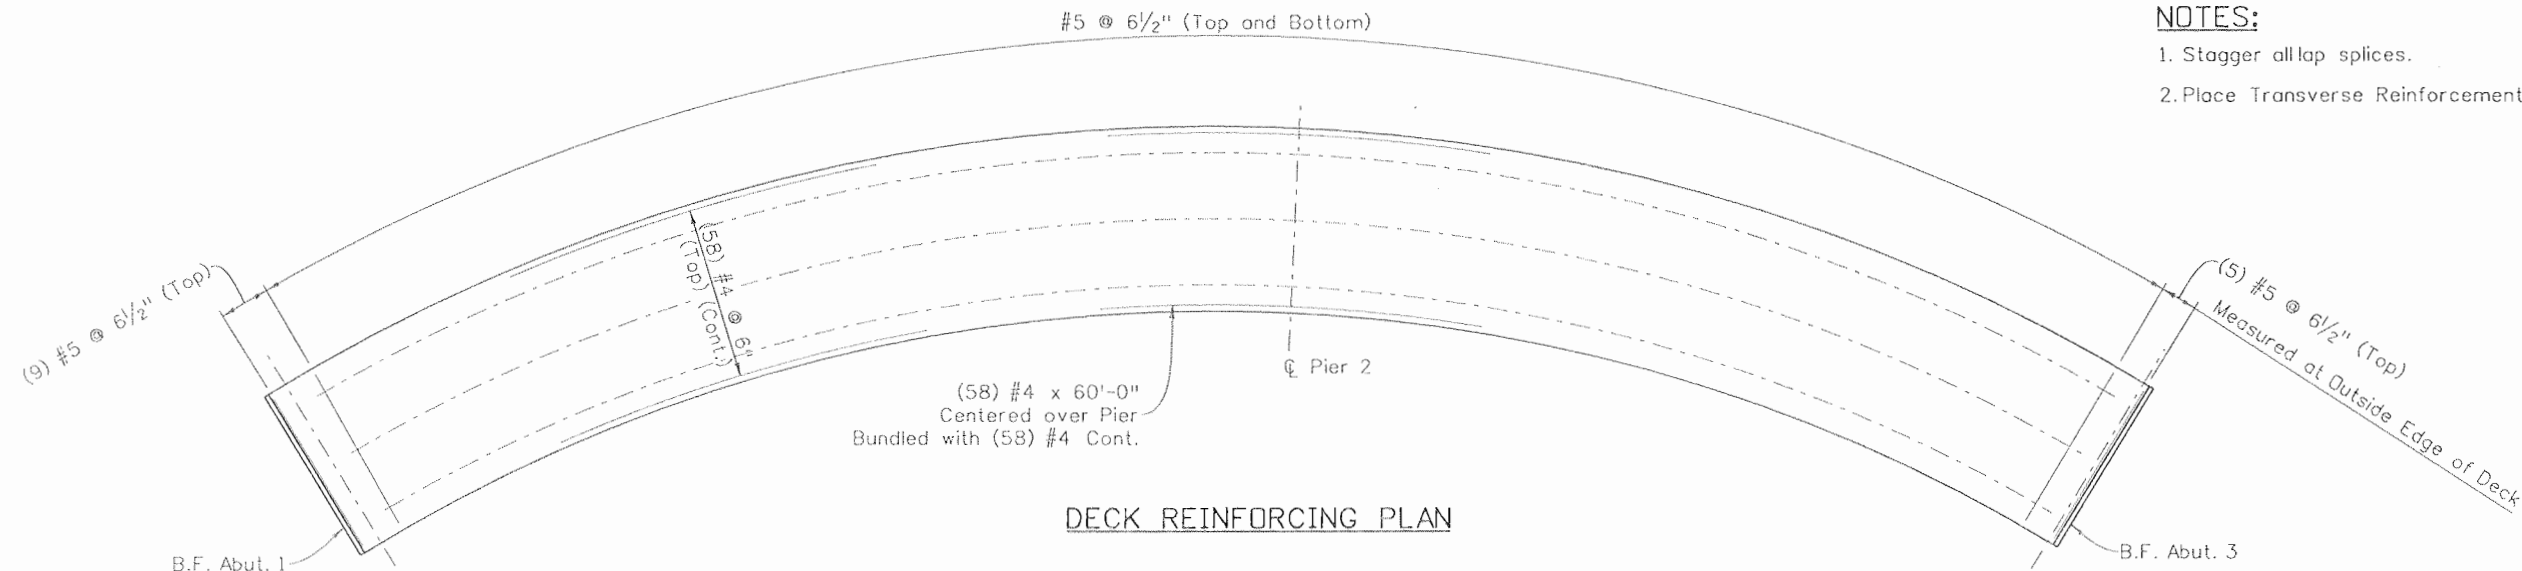

- NOTES:**
1. Stagger all lap splices.
 2. Place Transverse Reinforcement Radially.


DECK REINFORCING PLAN

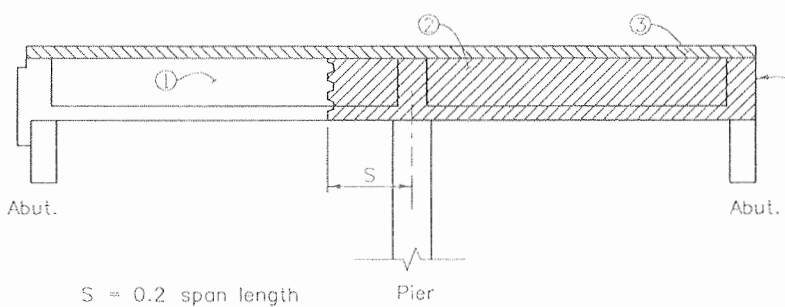


There shall be no construction joints through post-tensioning anchorage zone. Revise construction joints at abutments as necessary.

SUPERSTRUCTURE PLACING SCHEDULE

Numbers ① and ② indicate sequence of placing bottom slab and web concrete when each section constitutes a separate pour. ③ may be placed continuously or in parts, as indicated above and as approved by the Engineer. Contractor may submit an alternate placing schedule to the Engineer for approval.

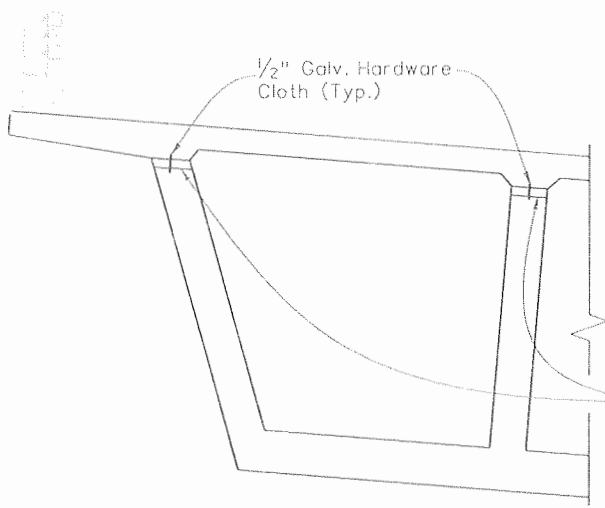

VENT HOLE DETAIL

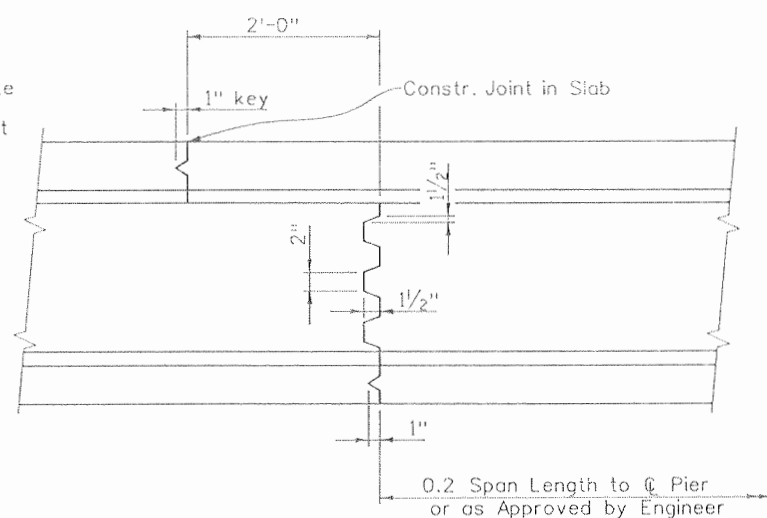

TRANSVERSE WEB CONSTRUCTION JOINT

Design		Detail		Quantities	
INITIAL	DATE	INITIAL	DATE	INITIAL	DATE
Designed By	10/08	Checked By	10/08	Checked By	10/08
Checked By	10/08	Checked By	10/08	Checked By	10/08

Print Date: 9/22/2010
 File Name: 16042W_SupStrReinfPlan_01.dgn
 Horiz. Scale: 1:30 Vert. Scale: As Noted
 Unit Information 0221 Unit Leader STW

SEMA CONSTRUCTION **WILSON & COMPANY**

Sheet Revisions		
Date:	Comments	Init.

Colorado Department of Transportation
 3803 North Main Avenue
 Suite 200
 Durango, CO 81301
 Phone: 970-385-1440 FAX: 970-385-8365


DOT
 DEPARTMENT OF TRANSPORTATION

Region 5 EJA

As Constructed	
No Revisions:	9/10
Revised:	
Void:	


RAMP C OVER WILSON GULCH DECK REINFORCING PLAN			
Designer:	A. Leifheit	Structure	P-05-W
Detailer:	R. Artman	Numbers	
Sheet Subset:	Bridge	Subset Sheets:	B20 of B34

Project No./Code	
NH 1602-114	
16042	
Sheet Number	285

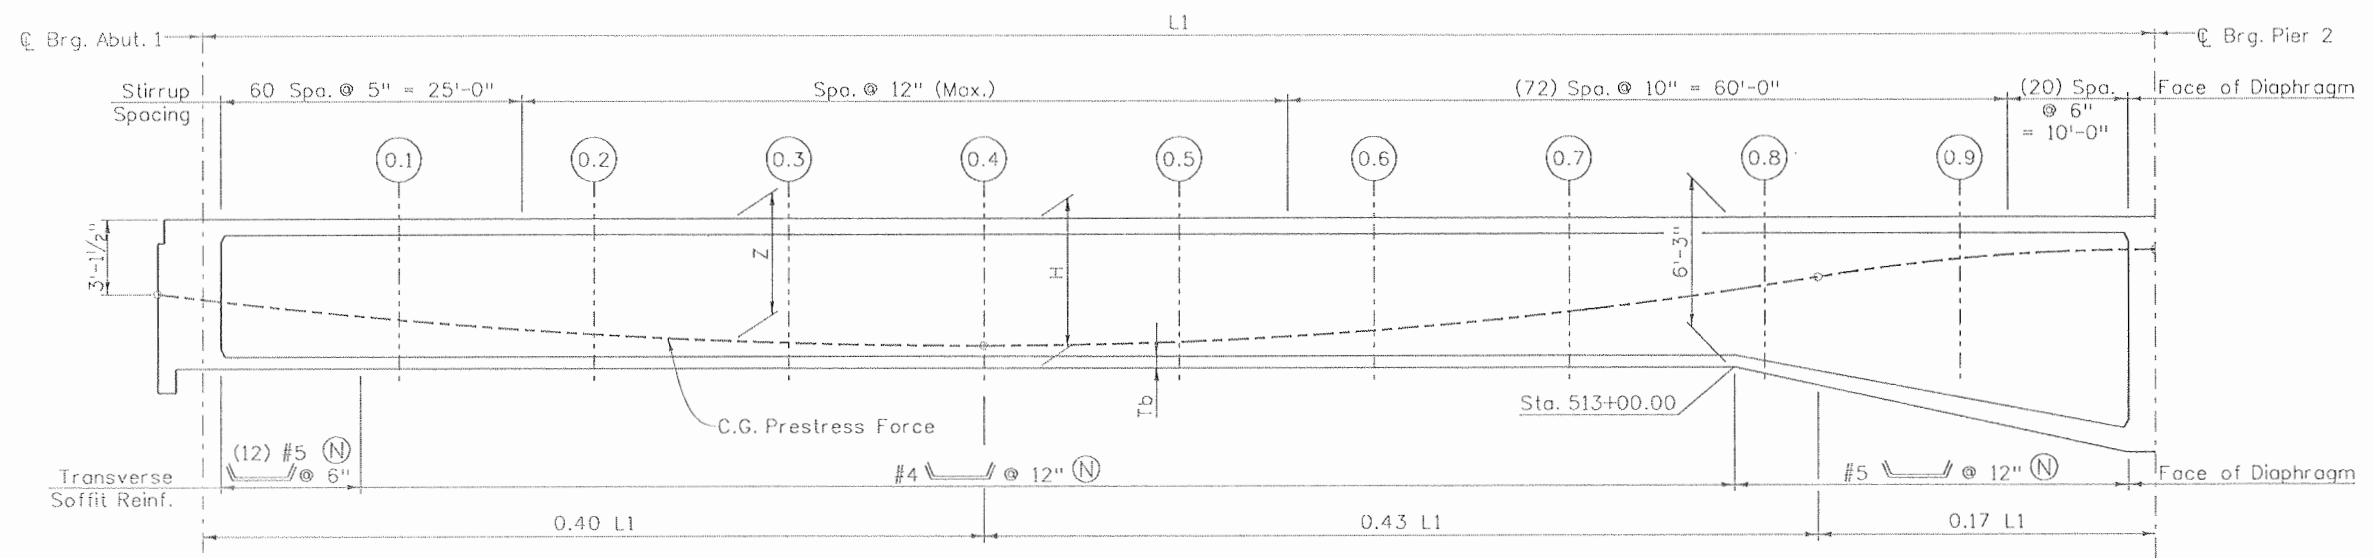

WEB ELEVATION

Item	End	Location									
		0.1	0.2	0.3	0.4	0.5	0.6	0.7	0.8	0.9	Pier 2
H (ft)	6.25	6.25	6.25	6.25	6.25	6.25	6.25	6.25	6.50	8.11	9.50
Tb (in)	6.00	6.00	6.00	6.00	6.00	6.00	6.00	6.00	6.15	7.17	8.00
Z (ft)	3.13	4.21	4.82	5.19	5.31	5.16	4.69	3.92	2.84	1.73	1.35
Deflection (in)	-0.08	0.39	0.83	1.19	1.39	1.38	1.17	0.83	0.48	0.21	0.00

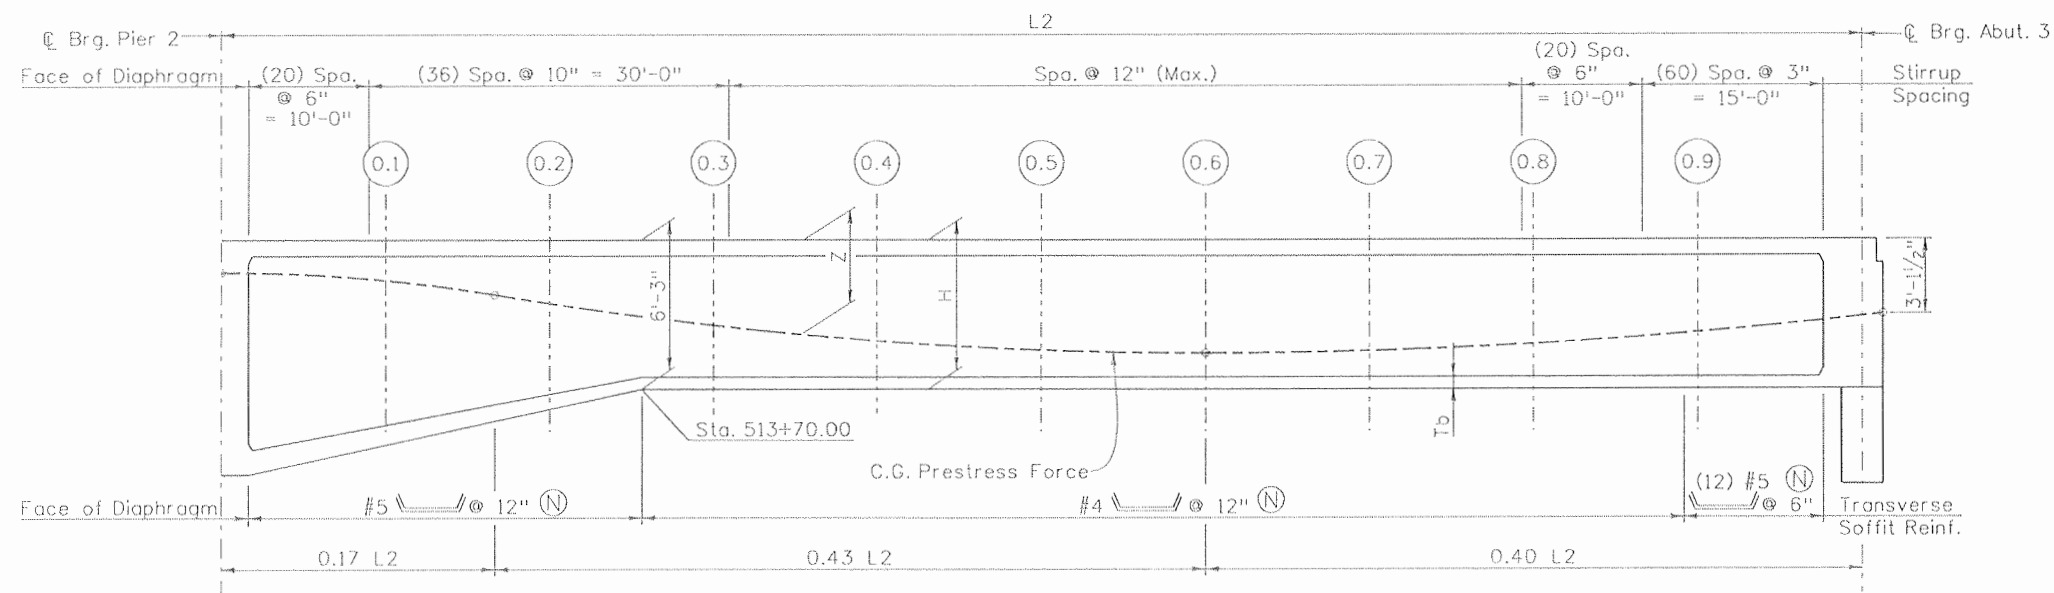

WEB ELEVATION

Item	Pier 2	Location									
		0.1	0.2	0.3	0.4	0.5	0.6	0.7	0.8	0.9	End
H (ft)	9.50	8.37	7.01	6.25	6.25	6.25	6.25	6.25	6.25	6.25	6.25
Tb (in)	8.00	7.30	6.47	6.00	6.00	6.00	6.00	6.00	6.00	6.00	6.00
Z (ft)	1.35	1.69	2.66	3.57	4.23	4.61	4.75	4.65	4.37	3.89	3.13
Deflection (in)	0.00	-0.07	-0.21	-0.37	-0.47	-0.53	-0.55	-0.52	-0.44	-0.26	0.00

NOTE:

See B22 for web length's L1 and L2.

Design	INITIAL	DATE	Detail		Quantities	
			INITIAL	DATE	INITIAL	DATE
Designed By	AML	10/08	DRA	10/08	Quantities By	AML
Checked By	GWK	10/08	GWK	10/08	Checked By	LW

Print Date: 9/22/2010
 File Name: 16042W_CIPPTBoxGirder_01.dgn
 Horiz. Scale: 1:1 Vert. Scale: As Noted
 Unit Information 0221 Unit Leader STW

Sheet Revisions		
Date:	Comments	Init.

Colorado Department of Transportation
 3803 North Main Avenue
 Suite 200
 Durango, CO 81301
 Phone: 970-385-1440 FAX: 970-385-8365
 Region 5 EJA

As Constructed	
No Revisions:	9/10
Revised:	
Void:	

RAMP C OVER WILSON GULCH
 CAST-IN-PLACE BOX GIRDER
 DETAILS (1 OF 4)


Designer:	A. Leifheit	Structure	P-05-W
Detailer:	D. Anderson	Numbers	
Sheet Subset:	Bridge	Subset Sheets:	B21 of B34

Project No./Code	
NH 1602-114	
16042	
Sheet Number	287

WEB LENGTHS

Web No.	L1 (ft)	L2 (ft)
1	163.31	137.18
2	157.18	132.03
3	151.06	126.89

Web Lengths are Measured from ϕ Brg. to ϕ Pier.

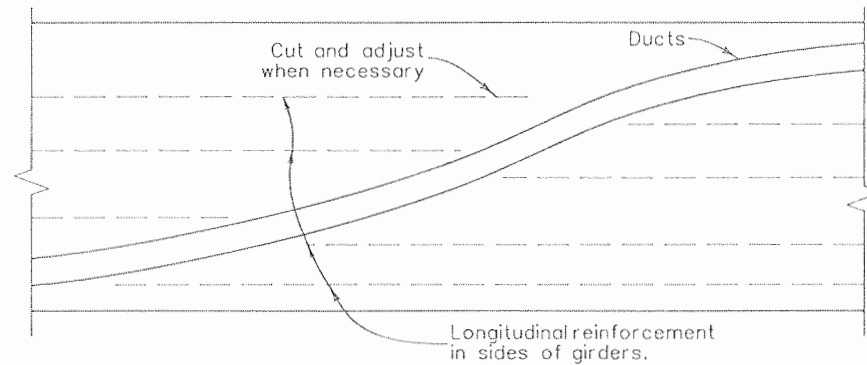

ADJUSTED GIRDER REINFORCING ELEVATION

NOTES:

Reinforcing that interferes with the prestressing tendon alignment shall be adjusted as approved by the Engineer.

Reinforcing shall be continuous through all construction joints.

Where dead end anchorage and tendons are accessible, the anchorage system and length of projecting prestressing steel shall permit jacking with the same jacking equipment that was used on the live end.

Deviations from the duct pattern, duct size, and strand size assumed in the design must be approved by the Engineer.

The deflection shown is positive downward. It includes the effects of dead load and prestressing, and the long term effects of creep. Formed web elevations must be adjusted upward for an indicated positive deflection.

Use low-relaxation strands meeting the requirements of ASTM A416 grade 270.

STRESSING SEQUENCE:

Tendons shall be jacked from both ends.

No more than 1/2 of the prestressing force in any web may be stressed before an equal force is stressed in the adjacent webs. At no time during the stressing operations will more than 1/6 of the total prestressing force be applied eccentrically about the centerline of the structure.

At the Contractors option, the prestressing force may vary $\pm 5\%$ from the theoretical force per web provided the total P(JACK) force is obtained and is distributed symmetrically about the centerline of the typical section. P(JACK) is the sum of the peak forces reached during jacking in each tendon.


DESIGN:

Design is based on $K=0.0002$ and $\mu=0.25$. P(JACK) at the jacking ends includes friction, anchor set of 0.375" at the jacking end, elastic shortening, and provisions for an additional 31 KSI long term loss in stress. Long term loss calculations based on ACI 209.


0.6" diameter low-relaxation strands with a "z" offset of 3/4" in 4 1/4" D.D. ducts was assumed in the design.

f'_s	= 270 ksi
f'_c	= 4,500 psi at 28 days field compressive strength
f_{ps}	= 4,000 psi at stressing
P(JACK)	= 5,537 kips
A_{ps} (min.)	= 27.342 in ²

The Contractor shall submit elongation and jacking calculations based on $KL + \mu\alpha$ (including anchor set if any) and initial stress (initial stress ratio times jacking stress before long term losses).

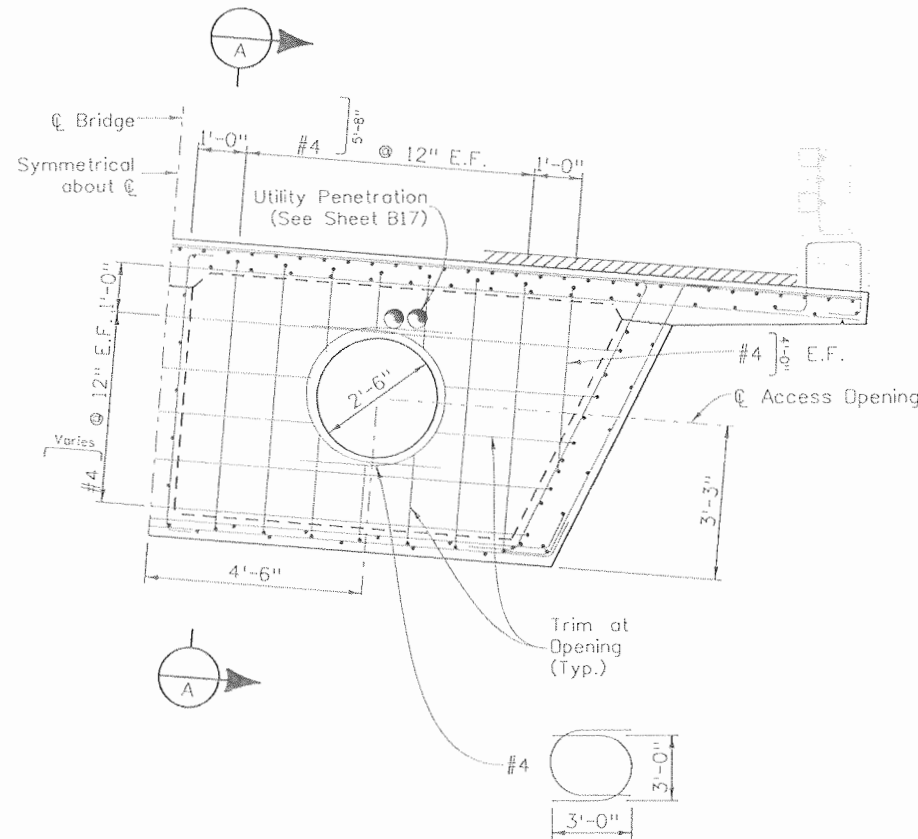



INTERNAL DIAPHRAGM DETAIL

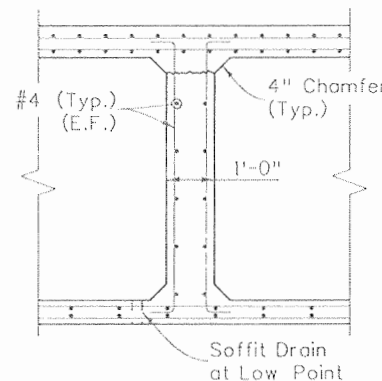




SECTION A-A

Design		Detail		Quantities	
INITIAL	DATE	INITIAL	DATE	INITIAL	DATE
AML	10/08	AML	10/08	AML	10/08
GWK	10/08	GWK	10/08	LW	10/08


Print Date: 9/22/2010	Sheet Revisions			Colorado Department of Transportation		As Constructed		RAMP C OVER WILSON GULCH CAST-IN-PLACE BOX GIRDER DETAILS (2 OF 4)		Project No./Code
File Name: 16042W_CIPPTBoxGirder_02.dgn	Date:	Comments:	Init.	3803 North Main Avenue Suite 200 Durango, CO 81301 Phone: 970-385-1440 FAX: 970-385-8365		No Revisions: 9/10		Designer: A. Leifheit Structure: P-05-W		NH 1602-114
Horiz. Scale: 1:1 Vert. Scale: As Noted				Region 5		Revised:		Detailer: D. Anderson Numbers:		16042
Unit Information Unit Leader Initials				EJA		Void:		Sheet Subset: Bridge Subset Sheets: B22 of B34		Sheet Number 288

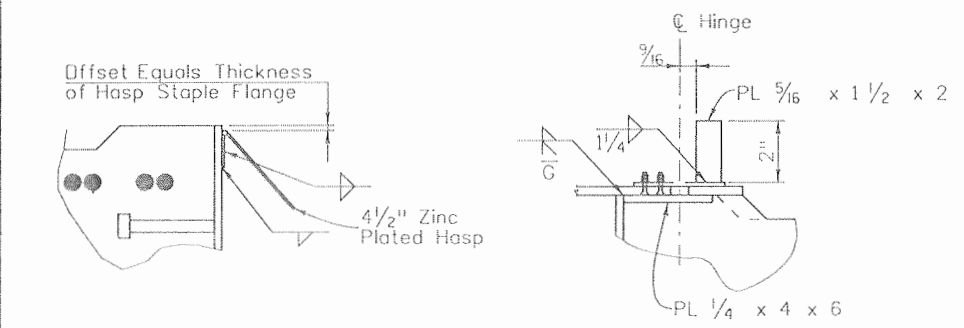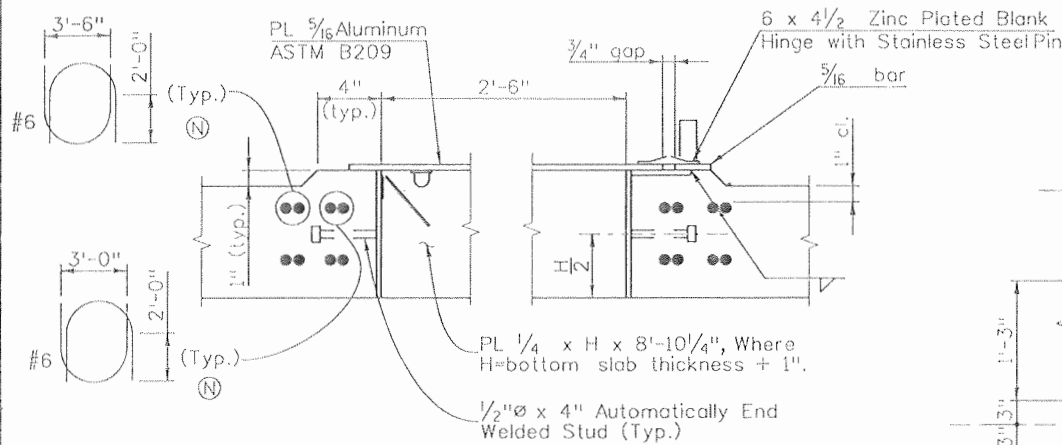


ACCESS DOOR DETAILS

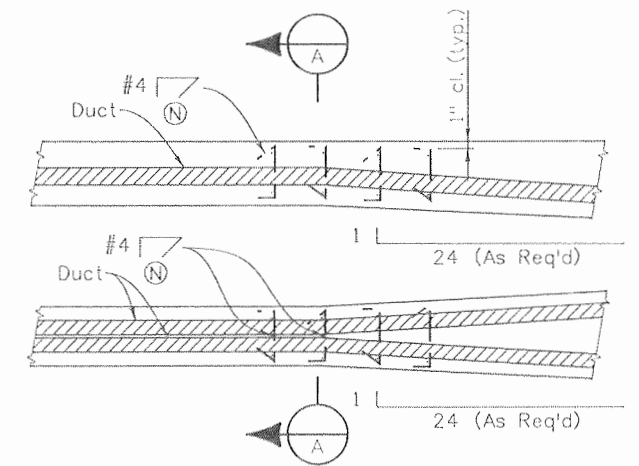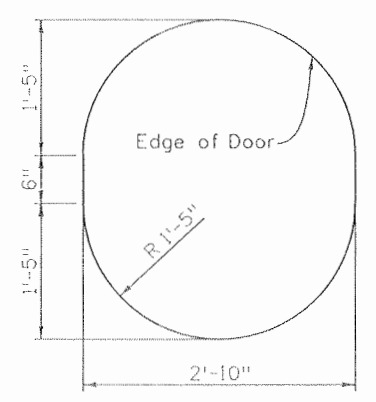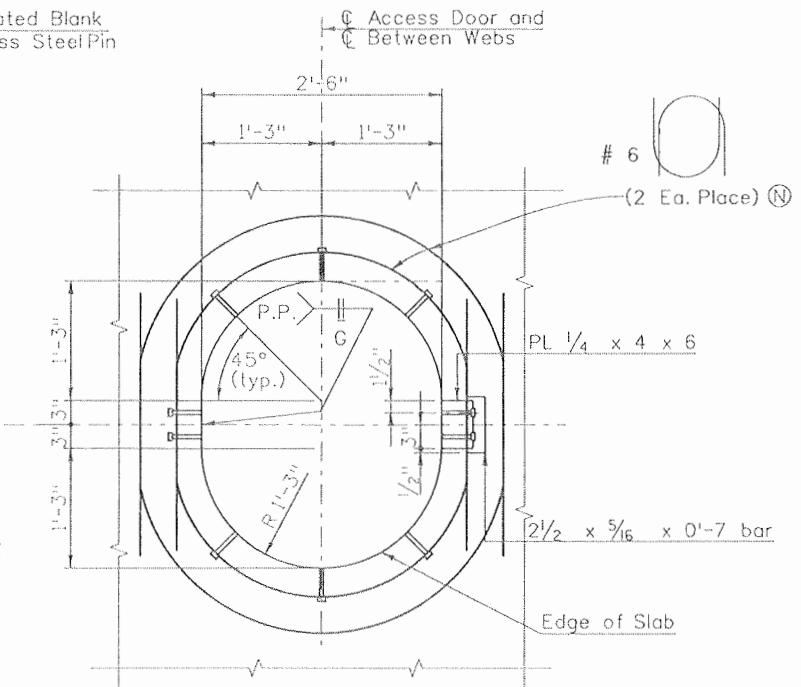


PLAN VIEW OF DUCTS AT GIRDER WEB FLARE

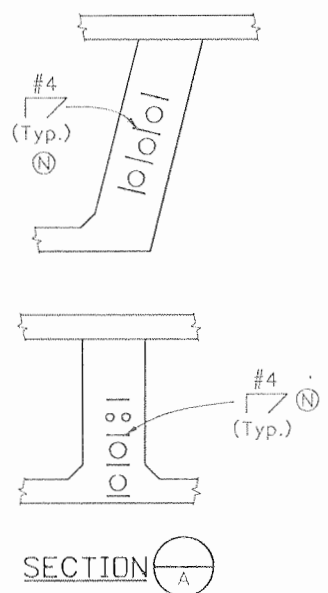


NOTES:
 See abutment details and superstructure details for dimensions and reinforcing not shown.
 Grind galvanizing from frame, where the hasp or hinge attaches, prior to welding. After welding, paint the weld and surrounding areas with zinc rich paint meeting Military Specifications DDD-P-21035A.
 Attach door with 4-1/4 inch zinc plated bolts with countersunk heads. Use double nuts; burr threads after tightening. Attach hasp staple in a similar manner. Leave door in the open position while pouring the bottom slab.
 Paint door after welding in accordance with section 509 of the specifications.

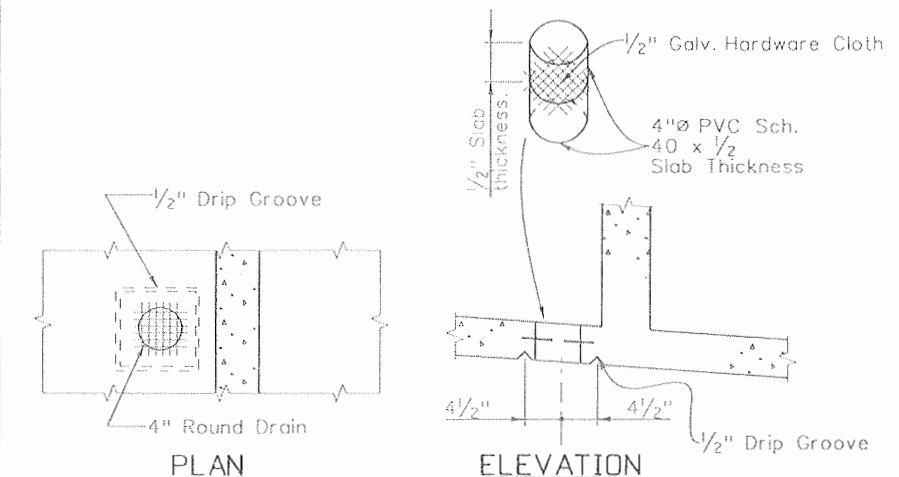

BOTTOM SLAB DRAIN DETAIL
 Locate at low point of each cell.

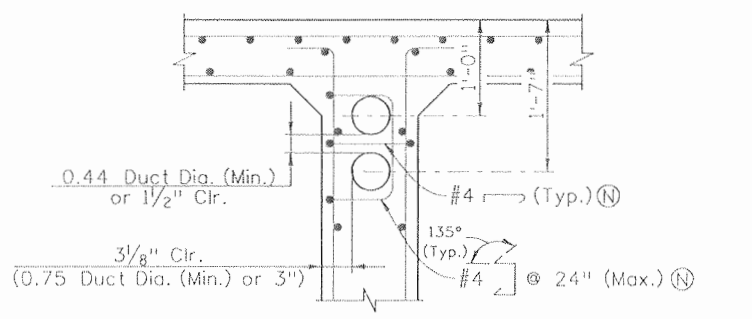

Typical Tendon High Point

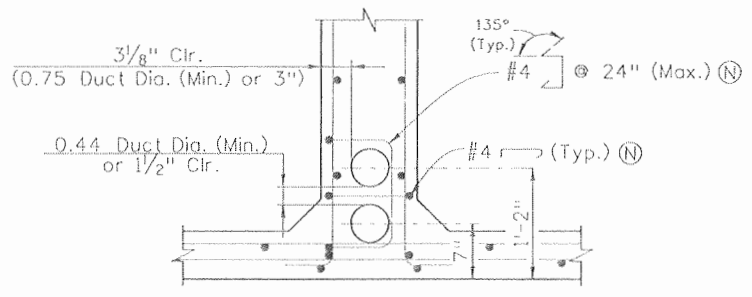

Span 1 Tendon Low Point
 Span 2 Varies


Hooks in #4 Duct Ties (↗) point Down Station.
 Hooks in #4 Duct Stirrups (↘) point Up Station.

CLEARANCE REQUIREMENTS FOR DUCTS


NOTES:
 1. Provide minimum side clearance at outside edge of curve.
 2. 4 1/4 inch O.D. duct has been assumed.
 3. The pattern shown is what was assumed in design. The duct pattern may be modified by the supplier, provided that the specified C.G. of prestressing, prestressing force, and duct clearances are maintained.

Design	INITIAL	DATE	DETAIL	INITIAL	DATE	QUANTITIES	INITIAL	DATE
Designed By	AML	10/08	Detailed By	DRA	10/08	Quantities By	AML	10/08
Checked By	GWK	10/08	Checked By	GWK	10/08	Checked By	LW	10/08

Print Date: 9/22/2010	Sheet Revisions			Colorado Department of Transportation		As Constructed		RAMP C OVER WILSON GULCH CAST-IN-PLACE BOX GIRDER DETAILS (3 OF 4)		Project No./Code	
File Name: 16042W_CIPPTBoxCirder_03.dgn	Date:	Comments:	Init.	3803 North Main Avenue Suite 200 Durango, CO 81301 Phone: 970-385-1440 FAX: 970-385-8365		No Revisions: 9/10		Designer: A. Leifheit Detailer: D. Anderson		NH 1602-114	
Horiz. Scale: 1:1 Unit Information 0221				Region 5		Revised:		Structure: P-05-W Numbers:		16042	
Unit Leader STW				EJA		Void:		Sheet Subset: Bridge Subset Sheets: B23 of B34		Sheet Number 289	
SEMA CONSTRUCTION	WILSON & COMPANY			DOT DEPARTMENT OF TRANSPORTATION							

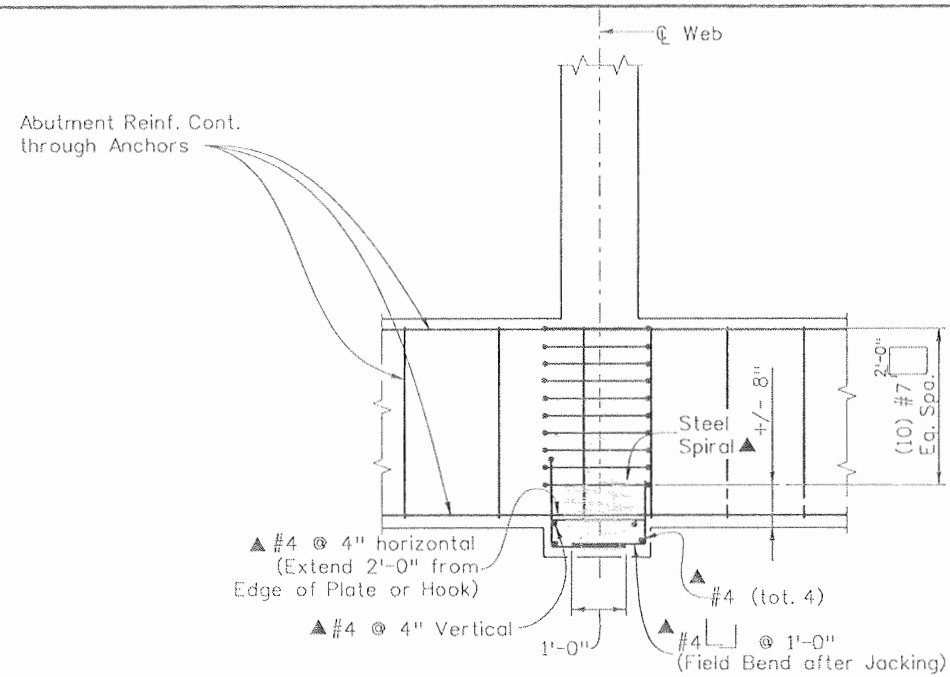

PLAN VIEW
SEAT FOR PRESTRESSED ANCHORAGE AT ABUTMENTS

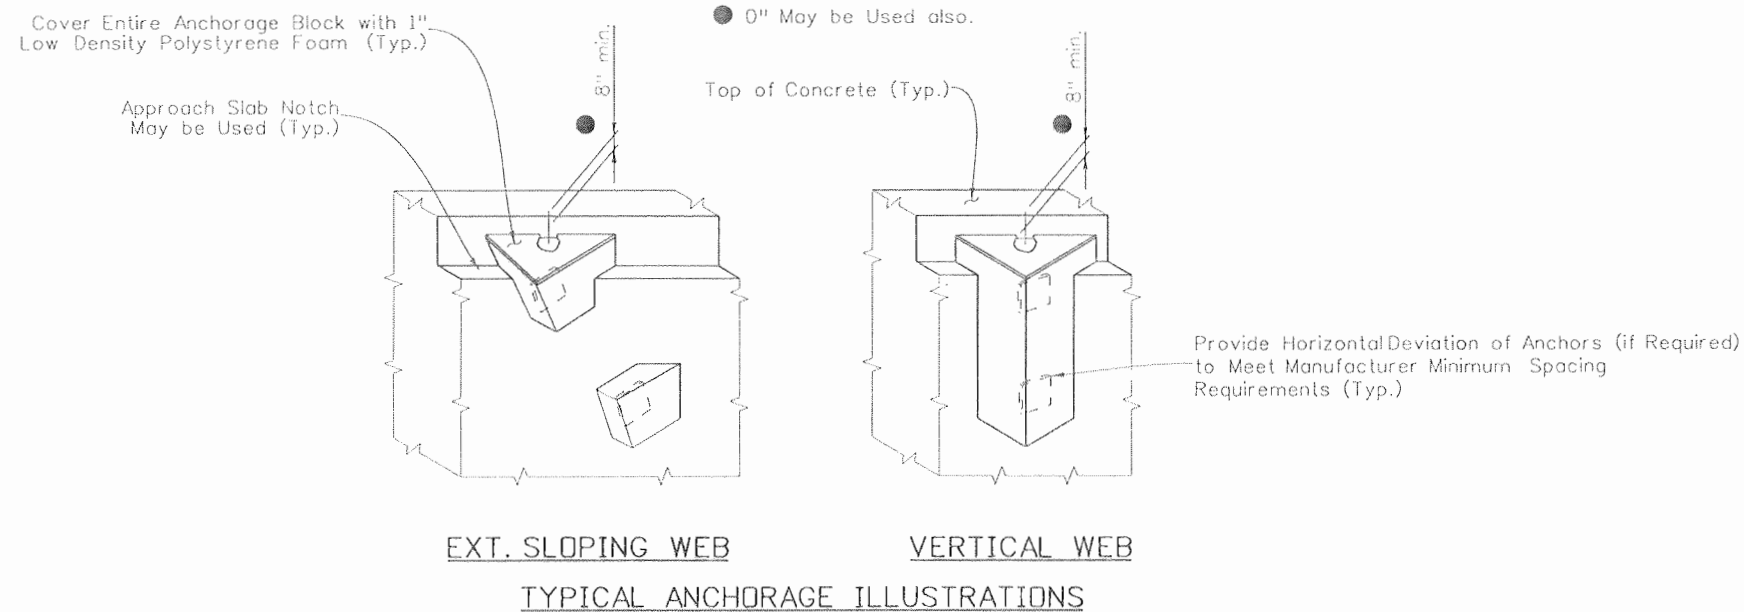

EXT. SLOPING WEB VERTICAL WEB
TYPICAL ANCHORAGE ILLUSTRATIONS

NOTES:

There shall be no construction joints under post-tensioning anchorages.

A tendon's jacking force shall not exceed 923 kips.

The following anchorages will be allowed:

1. DSI Multi-Plane MA Anchorages
2. SDI Type C Multistrand Anchorage
3. VSL Type E

P(Jack) = Tendon jacking force.

f'ci = Minimum concrete strength at stressing.

Composite (a combination of metal casting and mortar) anchorages shall not be allowed.

All Anchorages shall be of the same type and Manufacturer.

Each anchorage shall be confined within a reinforcing steel spiral and spalling reinforcement. Spalling reinforcement shall consist of #4 @ 4" vertically and horizontally placed in front of the bearing plate. Spiral and spalling reinforcement shall be Grade 60 conforming to the requirements of Section 602, and need not be epoxy coated. Lap splicing of spiral reinforcement is not allowed.

Anchorages and reinforcing steel spirals shall be covered with concrete to provide a minimum of 4 inches of concrete cover. All other reinforcing shall have a minimum of 2" concrete cover.

The minimum distance between the centerline of anchorages shall be as recommended by the manufacturer.

The distance from the edge of bearing plate/ spiral to edge/corner of concrete shall be a minimum of 4".

All reinforcing steel designated ▲, and additional concrete required in flares not included in explicit details will not be measured for separately but shall be included in Item 618.

See abutment and superstructure details for dimensions and reinforcing steel not shown.






Shop drawings shall be prepared under the supervision (and contain the seal) of a Professional Engineer registered in the State of Colorado and in accordance with the requirements of subsection 618.04 (a) and (c). Shop drawings shall provide:

1. Bearing plate and spiral steel sizes
2. Reinforcing steel bending diagrams for all rebar designated ▲
3. Coordination of anchorages and anchorage reinforcing with other superstructure rebar
4. All dimensions necessary to form concrete recesses or blisters, and all reinforcing steel designated ▲ in accordance with subsection 618.04(c)(6) and (7).
5. Horizontal and vertical dimensions to place anchorages and ducts.

Design		Detail		Quantity	
INITIAL	DATE	INITIAL	DATE	INITIAL	DATE
AWL	10/08	DRA	10/08	AML	10/08
GWK	10/08	GWK	10/08	LW	10/08

Print Date: 9/22/2010	Sheet Revisions			Colorado Department of Transportation 3803 North Main Avenue Suite 200 Durango, CO 81301 Phone: 970-385-1440 FAX: 970-385-8365 Region 5	As Constructed	RAMP C OVER WILSON GULCH CAST-IN-PLACE BOX GIRDER DETAILS (4 OF 4)		Project No./Code
File Name: 16042W_CIPPTBoxGirder_04.dgn	Date:	Comments:	Init.		No Revisions: 9/10			NH 1602-114
Horiz. Scale: 1:1 Vert. Scale: As Noted					Revised:	Designer: A. Leifheit	Structure: P-05-W	16042
Unit Information 0221 Unit Leader STW					Void:	Detailer: D. Anderson	Numbers:	Sheet Number 290
	EJA			Sheet Subset: Bridge Subset Sheets: B24 of B34				

Design		Detail		Quantities	
INITIAL	DATE	INITIAL	DATE	INITIAL	DATE
AML	10/08	KLT	10/08	AML	10/08
Checked By	MUN	Checked By	MUN	Checked By	LW
Checked By	MUN	Checked By	MUN	Checked By	LW

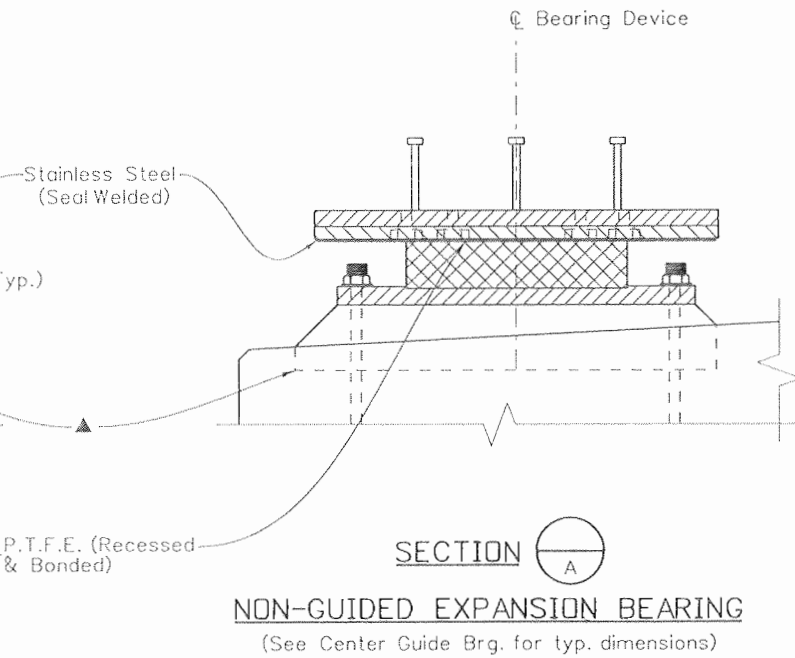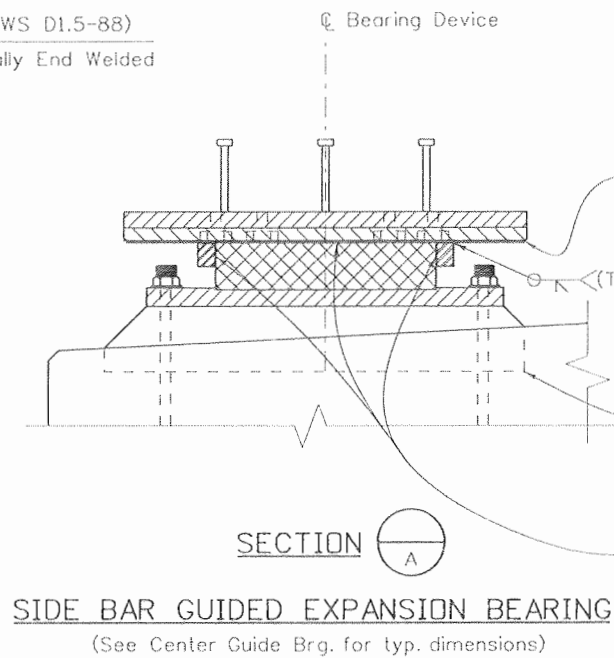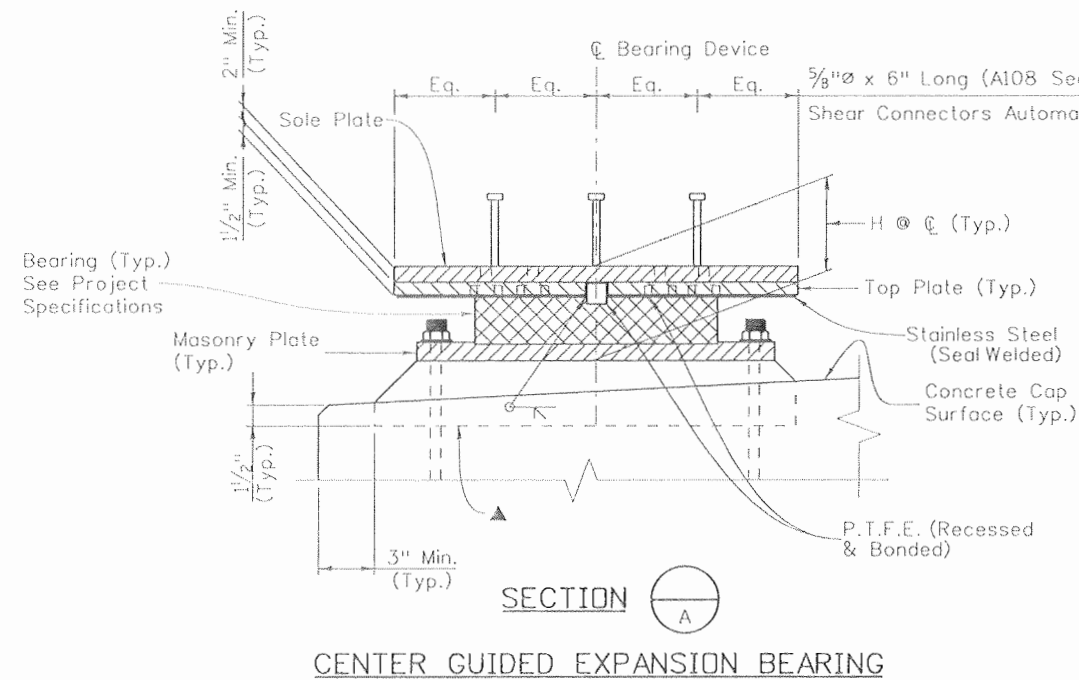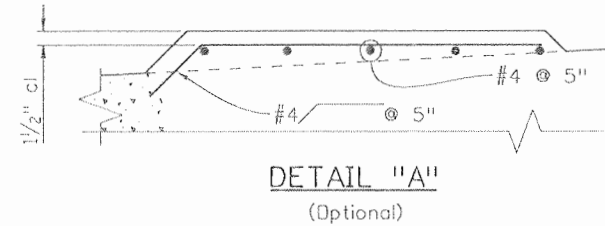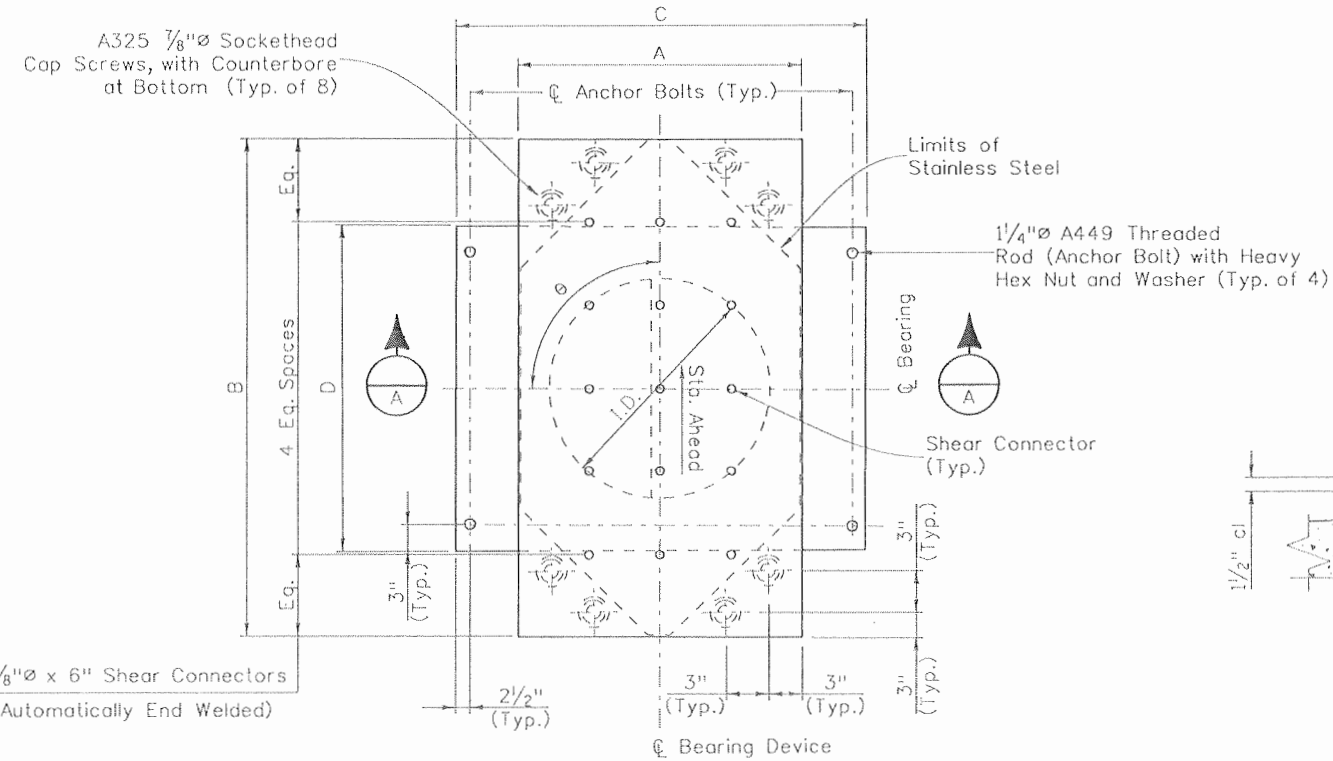

▲ Use non-shrink approved grout in formed cavity or see Detail "A" for alternate built-up monolithic cap seat.

Print Date: 9/22/2010	Unit Information 0221	Unit Leader STW
File Name: 16042W_BrdgBrgDeviceType3_01.dgn	Horiz. Scale: 1:1	Vert. Scale: As Noted

Sheet Revisions		
Date:	Comments	Init.

Colorado Department of Transportation

3803 North Main Avenue
Suite 200
Durango, CO 81301
Phone: 970-385-1440 FAX: 970-385-8365

Region 5 EJA

As Constructed	No Revisions: 9/10
Revised:	
Void:	

RAMP C OVER WILSON GULCH BEARING DEVICE TYPE III (1 OF 2)			
Designer:	A. Leifheit	Structure Numbers	P-05-W
Detailer:	K. Tucker		
Sheet Subset:	Bridge	Subset Sheets:	B25 of B34

Project No./Code	NH 1602-114
	16042
Sheet Number	291

NOTES:

All structural steel for the bearing devices, including sole plates, top plates, and masonry plates, shall be AASHTO M270 (ASTM A709) Grade 36 unless otherwise shown. Grade 50 may be substituted for Grade 36 at no additional cost to the project.

Bearing seat elevations at abutments and piers shall be checked and adjusted according to the final dimensions of bearing assemblies adopted.

Longitudinal structure movement due to temperature and shrinkage is based on a mid-range temperature of 50°F. If site temperature is not 50°, a longitudinal offset of top elements of the bearing (above sliding surface) shall be made in the field based on the 10° temperature increment in the table. In addition, longitudinal one way structure movement due to prestress shortening and creep shall be accommodated for all temperature ranges with the initial offset in the table away from Pier 2.

Anchor bolts may be set in wet concrete of bearing seat, or placed within a formed cylindrical void 4" in diameter and then grouted with high strength epoxy grout.

The internal surfaces of the pot cavity and the bottom surface of the piston shall be polished after zinc metalizing.

Rotations accounting for fabrication and construction tolerances have not been included in the charts. Additional rotations of 0.01 radians (pot bearings) or 0.005 radians (disk bearings) shall be provided in addition to the design rotations shown in the chart.

The longitudinal structure movement, is the total movement of the structure at the specified location.

The inside diameter of the pot (ID) was based on an average compression stress of 3 ksi at the Service Limit State. Pot or disk bearings shall be resized by the manufacturer per the AASHTO LRFD Bridge Design Specifications and the Project Specifications. Plates shall be resized to conform to the forces, deformations, and manufacturers ID.

Bearing plates (Gd, Exp) resized by the bearing manufacturer shall include a 2" construction tolerance for dimension B.


ACCEPTABLE ALTERNATES

D. S. Brown Company
North Baltimore, Ohio


Cosmec, Inc.
Walpole, MA

Con-Serv, Inc.
Georgetown, SC

R. J. Watson, Inc.
Amherst, NY
(Disk Bearing Alternate)

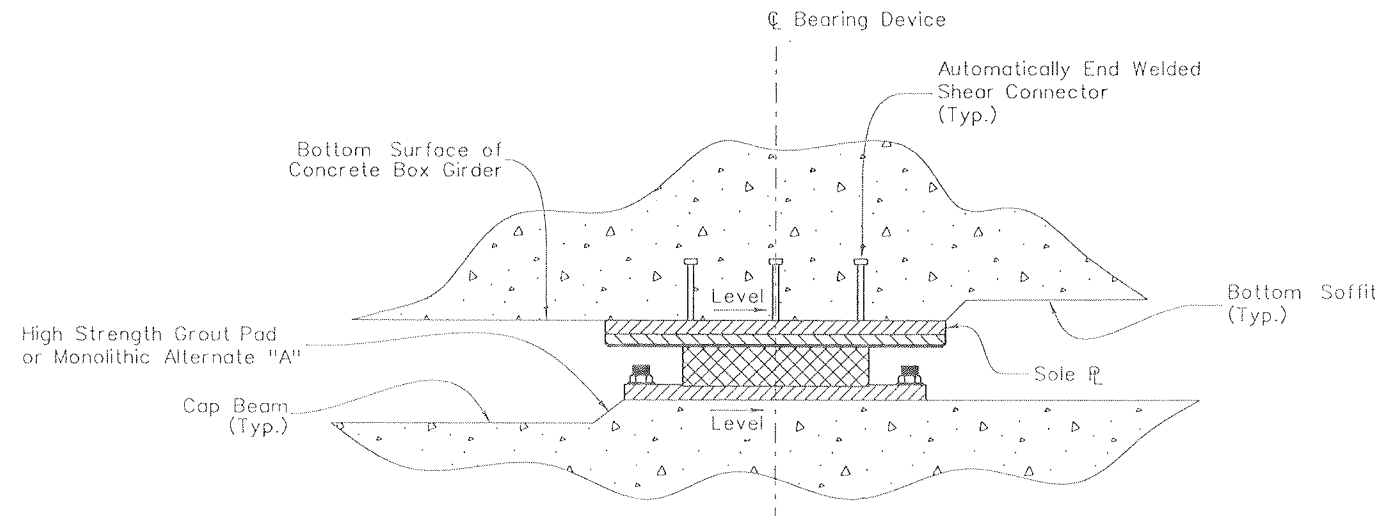

**BEARING DEVICE TYPE III
CONCRETE GIRDER CONNECTION**

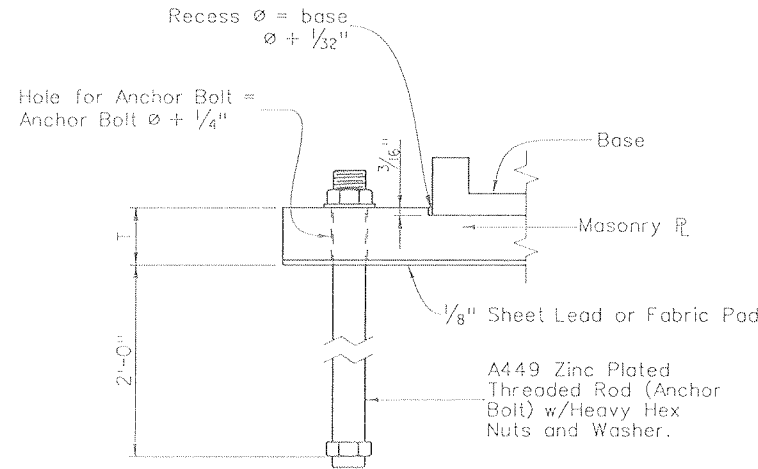

ANCHOR BOLT DETAIL


Design	INITIAL	DATE	INITIAL	DATE	INITIAL	DATE
	AML	10/08		AML		10/08
Detail	INITIAL	DATE	INITIAL	DATE	INITIAL	DATE
	AML	10/08		AML		10/08
Quantities	AML	10/08	AML	10/08	AML	10/08
	MUN	10/08		MUN		10/08

Location	Quant.	Type	Vertical Load Per Brg. (kips)		Horizontal Load Per Brg. (kips)				Longit. Range of Structure Movement (in)	Max. Rotation		Top Plate (Sole Plate Similar)		Bearing ID (in)	Masonry Plate			Top Connection (Anchor Studs)		A449 Anchor Bolts		Total Height (in)	Guide Angle (deg)	10° Temp. Incr. (in)	Initial Offset (in)	
			Service	Strength	Transv.	Longit	Transv.	Longit		Service	Strength	A (in)	B (in)		C (in)	D (in)	T (in)	No.	Size (in)	No.	Size (in)					
																										Service
Abut. 1	A	I	GD.	694	885	105	0	105	0	3.78	0.00341	0.0066	29	32	18	26	26	1.875	15	0.625	4	1.25	9	90	0.17	2.0
Abut. 1	B	I	EXP.	400	540	0	0	0	0	3.78	0.00328	0.0063	21	32	18	26	26	1.875	15	0.625	4	1.25	9	90	0.17	2.0

Fx = Fixed bearing
Gd = Guided expansion bearing
Exp = Non-guided (free floating) expansion bearing
PTFE = Polytetrafluoroethylene
ID = Inside Diameter of Pot

Print Date: 9/22/2010	Sheet Revisions			Colorado Department of Transportation 3803 North Main Avenue Suite 200 Durango, CO 81301 Phone: 970-385-1440 FAX: 970-385-8365 Region 5	As Constructed No Revisions: 9/10	RAMP C OVER WILSON GULCH BEARING DEVICE TYPE III (2 OF 2)			Project No./Code NH 1602-114
File Name: 16042W_BrdgBrgDeviceType3_02.dgn	Date:	Comments:	Init.			Revised:	Designer: A. Leifheit	Structure Numbers	
Horiz. Scale: 1:1				DOT DEPARTMENT OF TRANSPORTATION	Void:	Detailer: K. Tucker			16042
Unit Information 0221					Region 5	EJA	Sheet Subset: Bridge	Subset Sheets: B26 of B34	Sheet Number



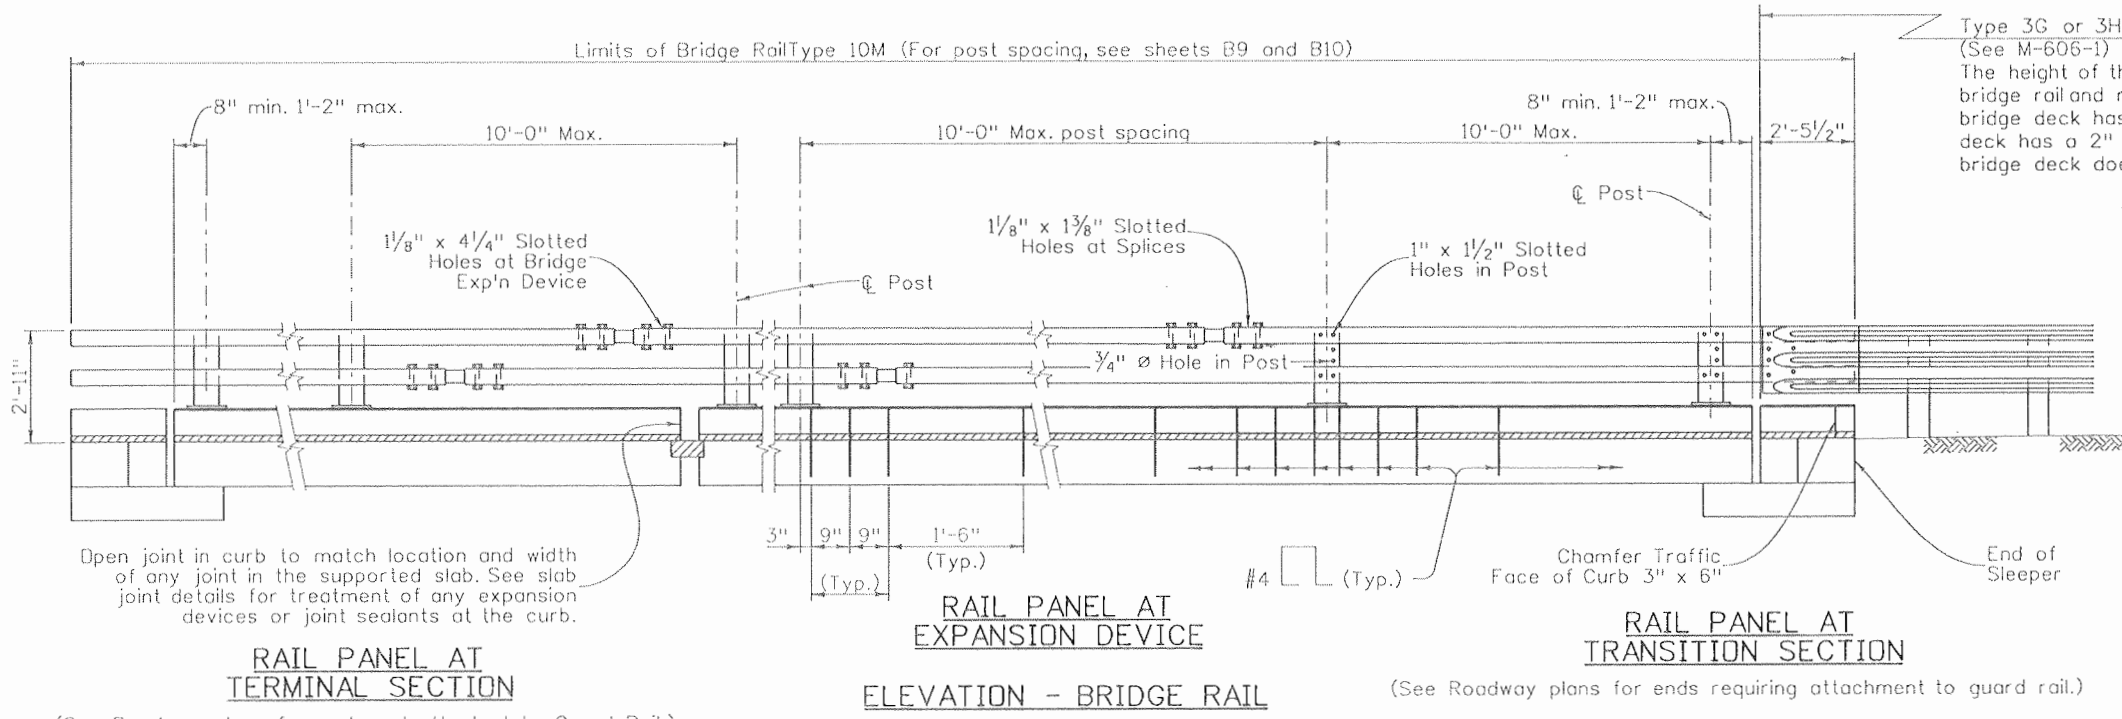

Type 3G or 3H transition (By Others)
(See M-606-1)
The height of the transition will vary to match bridge rail and roadway guardrail: 1" when bridge deck has a 3" overlay, 2" when bridge deck has a 2" silica fume overlay and 4" when bridge deck does not have an overlay.

NOTES:

- All tubes shall be ASTM A-847. (U.N.O.) All steel shall be ASTM A-588 Grade 50.
- All anchor bolts and miscellaneous bolts, nuts, and washers shall be galvanized after fabrication in accordance with Section 509. Concrete, reinforcing steel, and structural steel elements shall conform to the requirements of sections 601, 602 and 509, respectively.
- Post anchor, encased in concrete, shall be ASTM A-36 (AASHTO M-183) steel and need not be galvanized.
- The tubes shall be shop bent or fabricated to fit horizontal curve when radius is less than 1,500 feet.
- Tubes shall be continuous over not less than two posts. No welded butt splices will be allowed in the tube sections.
- The centerline of the tube splice shall be 1'-8" minimum and 2'-6" maximum from the centerline of the posts.
- All bolts that have lock washers shall be tightened to snug only.
- Posts shall be perpendicular to the longitudinal roadway grade.
- One or more 10'-0" post spacings may be reduced (6'-8" min.) in order to maintain dimensions from the end of the rail and expansion joints.
- Prior to fabrication of this item, three sets of working drawings which comply with the requirements of section 105, shall be submitted to the Engineer for information only.
- Structural Steel: AASHTO M-222 (ASTM A-588) GRADE 50 $f_y = 50,000$ psi
COLD FORMED ASTM A-847 $f_y = 46,000$ psi
- For additional details see next rail sheets.
- At bridge ends without Approach Slabs. Terminate tube at nearest splice. Continue post spacing to end of structure.
- Coordinate location of anti-icing equipment and conduits with bridge rail reinforcing and hardware. Move conduit or equipment if a conflict exists.
- Refer to Anti-Icing Drawings for additional reinforcing and concrete insert requirements.


Open joint in curb to match location and width of any joint in the supported slab. See slab joint details for treatment of any expansion devices or joint sealants at the curb.

RAIL PANEL AT TERMINAL SECTION
(See Roadway plans for ends not attached to Guard Rail.)


RAIL PANEL AT EXPANSION DEVICE

ELEVATION - BRIDGE RAIL
(See Roadway plans for ends requiring attachment to guard rail.)


RAIL PANEL AT TRANSITION SECTION
(See Roadway plans for ends requiring attachment to guard rail.)

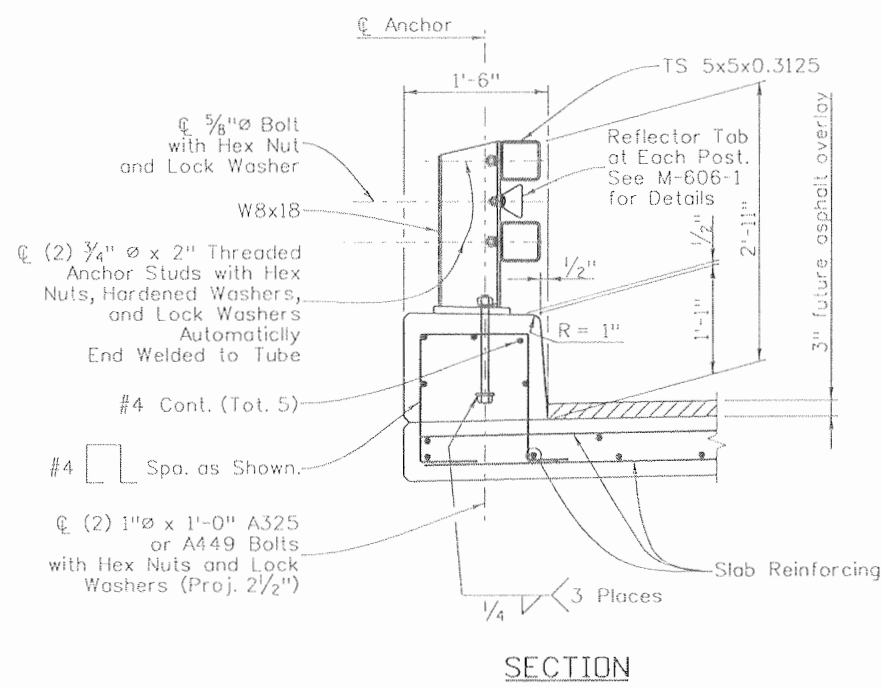


SECTION

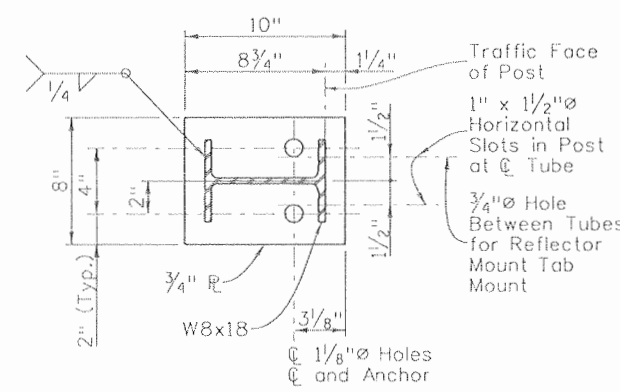


PLAN - POST DETAIL

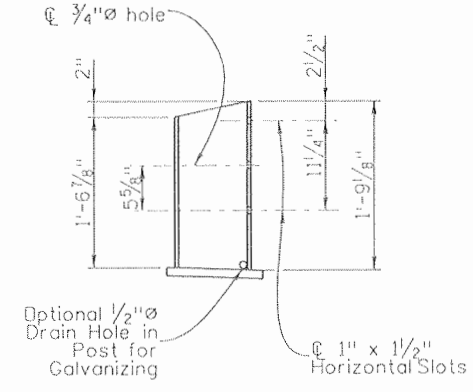

ELEVATION

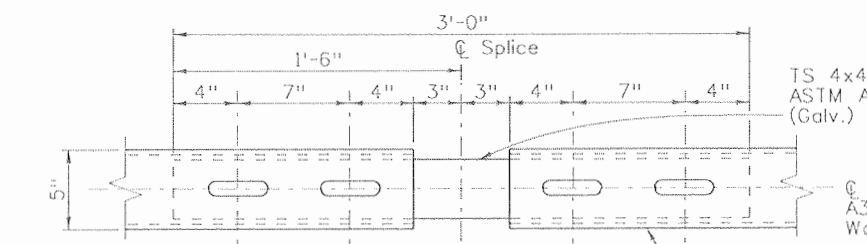

PLAN - TUBE SPLICE

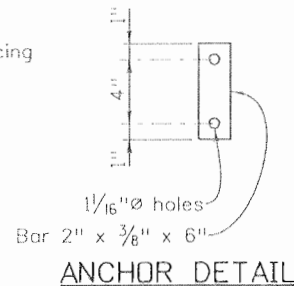

ANCHOR DETAIL


\varnothing 1/16" x 1 3/8" Slots at tube splice, and 1/8" x 4/4" slots at bridge exp'n device. Slot both inner and outer tubes. Stagger top and bottom splices into different post spacings except at expansion joint, place at opposite ends of same post space. (Range of motion = 1'-0" at bridge expansion device.)

INFORMATION ONLY


DESCRIPTION	UNIT	PER LIN. FT.
Structural Steel	LB.	45.1
Concrete Class D (Bridge)	CU.YD.	.06
Reinforcing Steel (Epoxy Coated)	LB.	6.6

Design	Initial		Date		Dist. By	Initial		Date		Dist. By	Initial		Date	
	By	Checked	By	Checked		By	Checked	By	Checked		By	Checked	By	Checked
Designed By	AML		10/08		AML	10/08		10/08		AML	10/08		10/08	
Checked By	GWK		10/08		GWK	10/08		10/08		GWK	10/08		10/08	

Print Date: 9/22/2010	Sheet Revisions			Colorado Department of Transportation		As Constructed		RAMP C OVER WILSON GULCH BRIDGE RAIL TYPE 10M (SPECIAL) (1 OF 2)		Project No./Code	
File Name: 16042W_BridgeRailType10M_01.dgn	Date:	Comments:	Init.	3803 North Main Avenue Suite 200 Durango, CO 81301 Phone: 970-385-1440 FAX: 970-385-8365		No Revisions: 9/10		Designer: A. Leifheit Detailer: D. Anderson		NH 1602-114	
Horiz. Scale: 1:1 Vert. Scale: As Noted				Region 5		Revised:		Structure: P-05-W Numbers:		16042	
Unit Information 0221 Unit Leader STW				EJA		Void:		Sheet Subset: Bridge Subset Sheets: B27 of B34		Sheet Number 293	

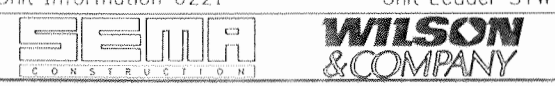


Design	INITIAL	DATE	INITIAL	DATE	INITIAL	DATE
Designed By	AML	10/09	DRA	10/09	AML	10/09
Checked By	GWK	10/09	GWK	10/09	LW	10/09
Detail	INITIAL	DATE	INITIAL	DATE	INITIAL	DATE
Detailled By	AML	10/09	AML	10/09	AML	10/09
Checked By	GWK	10/09	GWK	10/09	LW	10/09

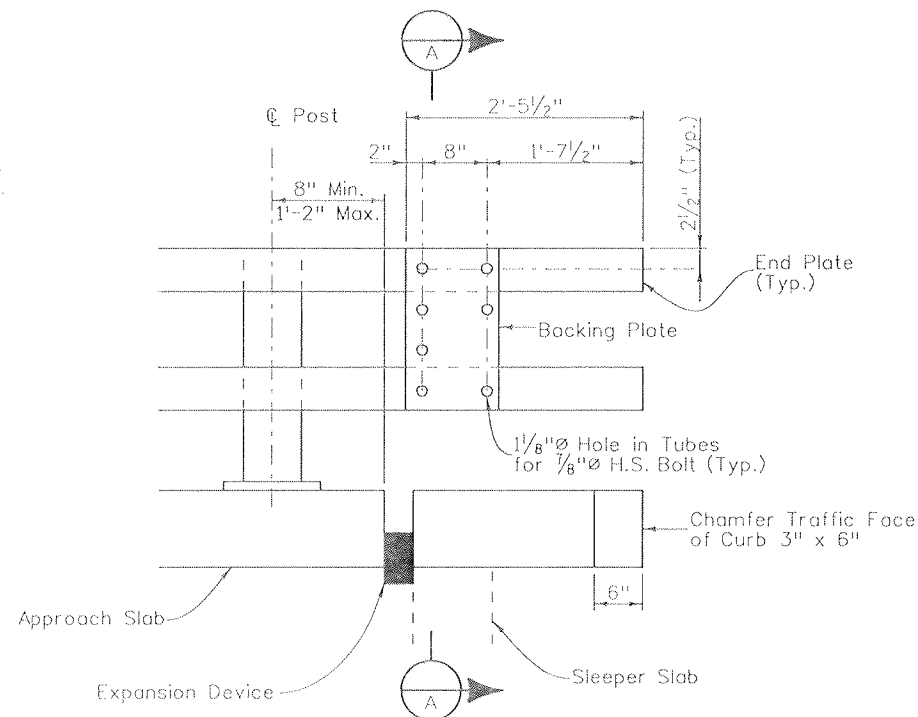


RAIL TUBE DETAILS

(Third beam not shown)
(Req'd at approach slab ends only)

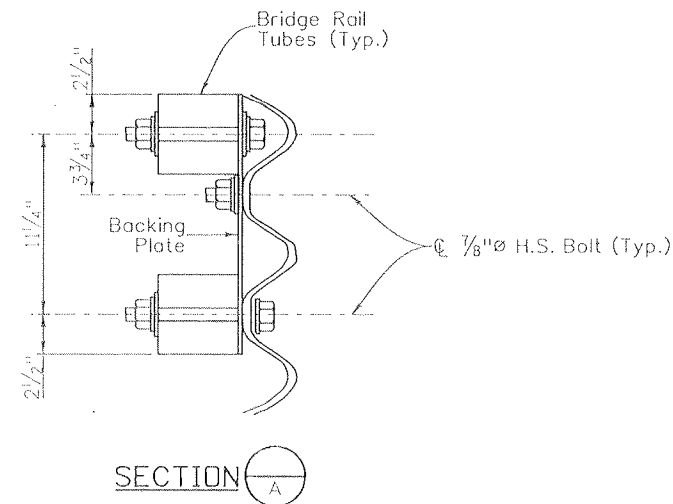


SECTION A

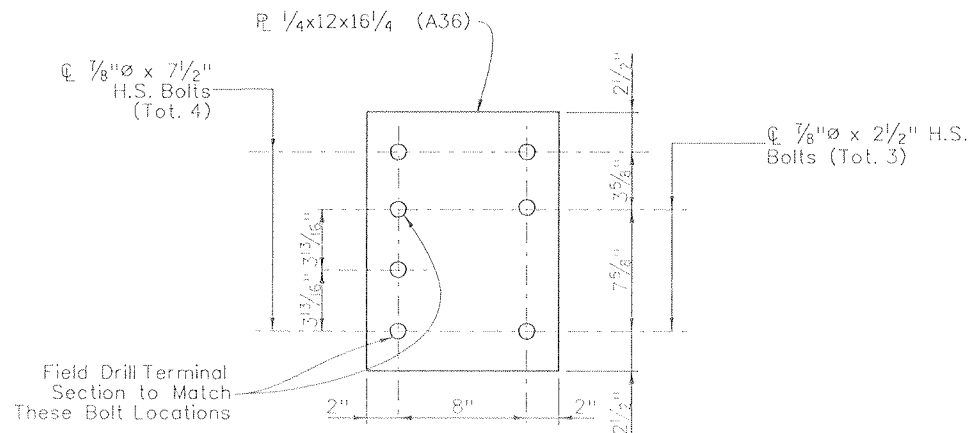


BACKING PLATE

Holes are 1/8" for 7/8" H. S. bolts with hex nuts, 2 PL washers, and 1 lock washer

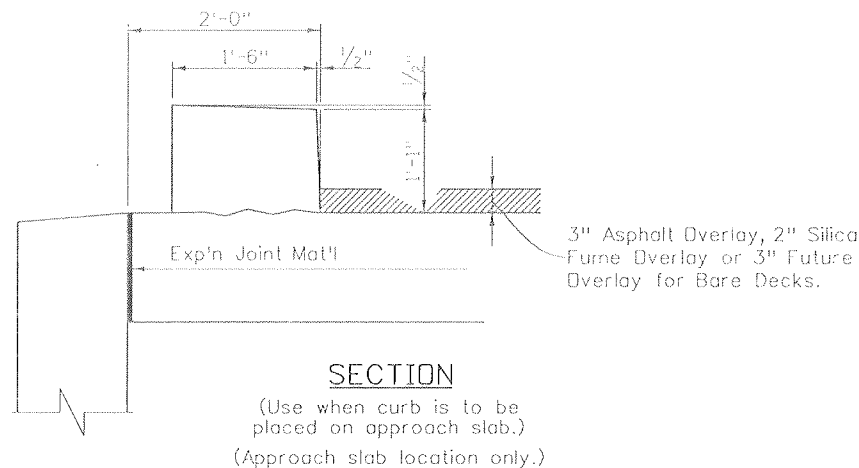

SECTION

(Use when curb is to be placed on approach slab.)
(Approach slab location only.)

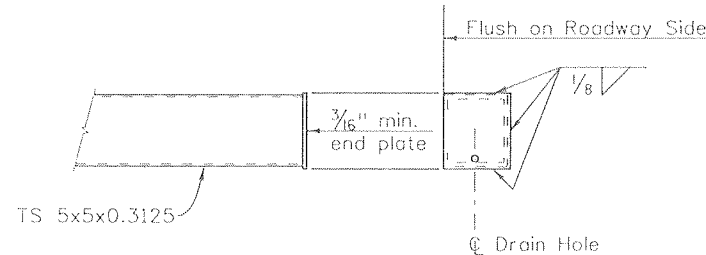


END PLATE DETAIL

NOTE


The information presented here is for information only. Approach slabs, Bridge Rail on the approach slabs, and expansion devices are not installed under this contract.

NOTE

Details applicable to this contract only.

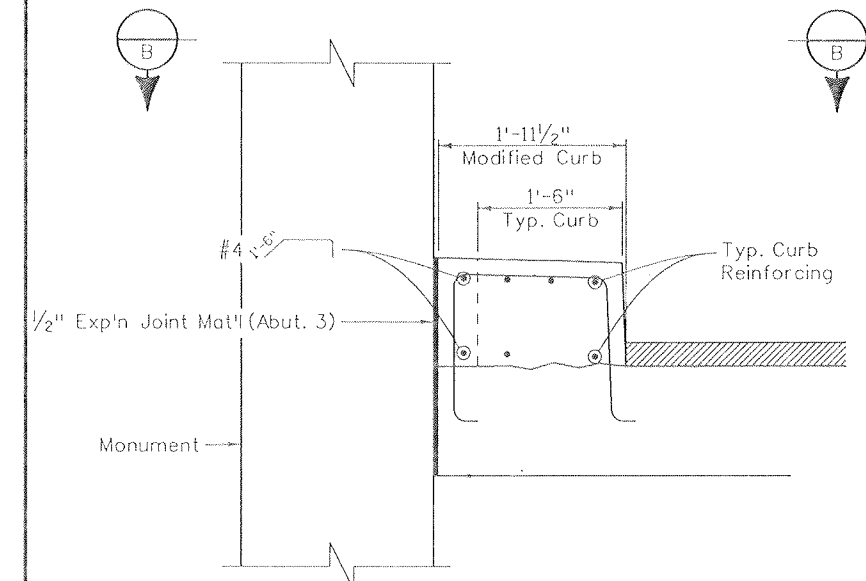


CURB MODIFICATION DETAIL

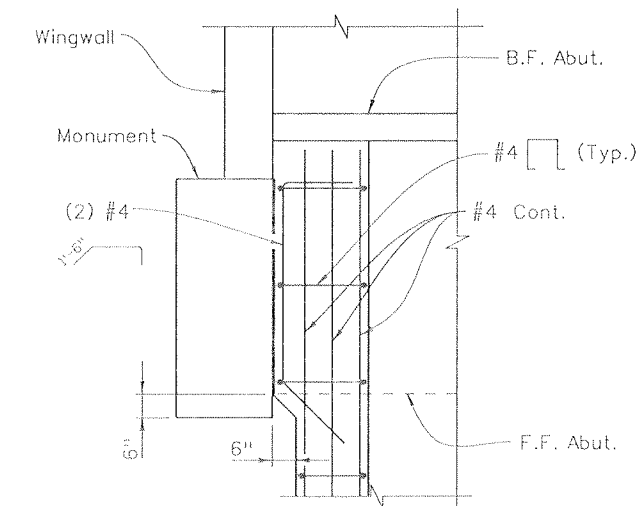

SECTION B

Print Date: 9/22/2010	Sheet Revisions			Colorado Department of Transportation 3803 North Main Avenue Suite 200 Durango, CO 81301 Phone: 970-385-1440 FAX: 970-385-8365 Region 5	As Constructed	RAMP C OVER WILSON GULCH BRIDGE RAIL TYPE 10M (SPECIAL) (2 OF 2)		Project No./Code
File Name: 16042W_BridgeRailType10M_02.dgn	Date:	Comments	Init.		No Revisions: 9/10			NH 1602-114
Horiz. Scale: 1:1				DOT DEPARTMENT OF TRANSPORTATION	Revised:	Designer: A. Leifheit	Structure Numbers	16042
Unit Information 0221					Void:	Detailer: D. Anderson		Sheet Number
Unit Leader STW				Region 5		Sheet Subset: Bridge	Subset Sheets: B28 of B34	294

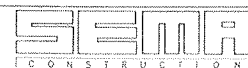

Region 5

EJA

As Constructed

No Revisions: 9/10

Revised:

Void:

RAMP C OVER WILSON GULCH
BRIDGE RAIL TYPE 10M (SPECIAL)
(2 OF 2)






Designer: A. Leifheit
Detailer: D. Anderson
Sheet Subset: Bridge
Subset Sheets: B28 of B34

Project No./Code



NH 1602-114

16042

Sheet Number 294

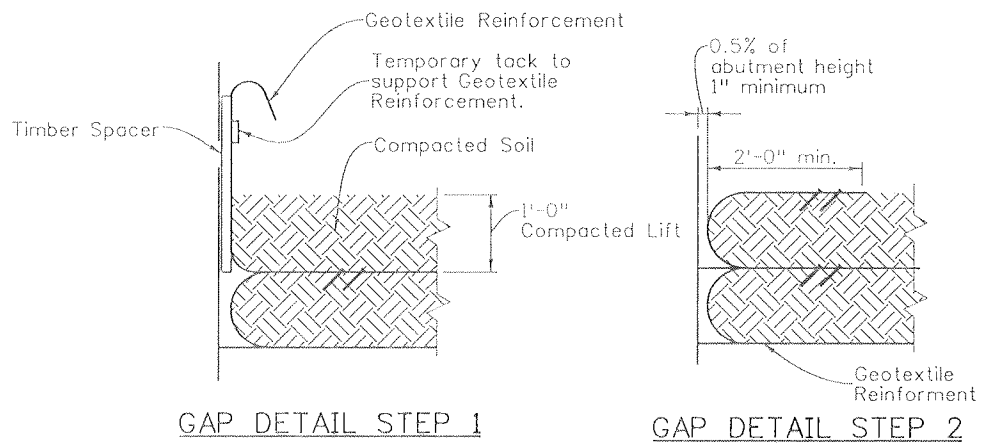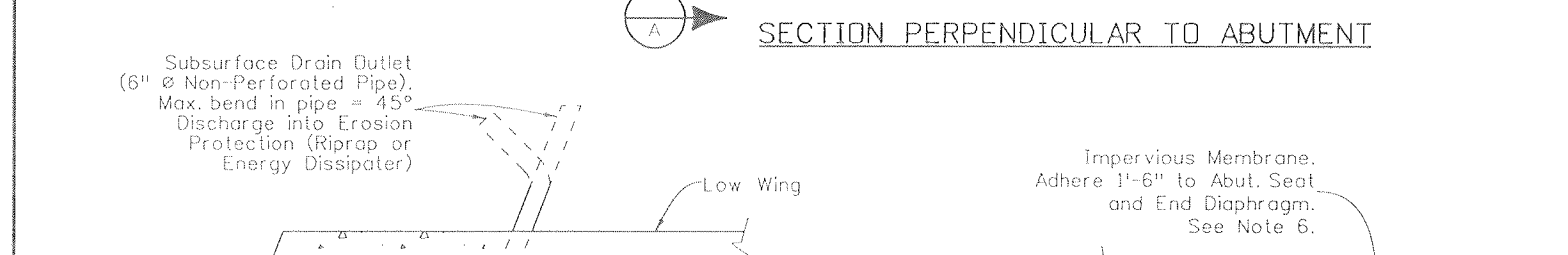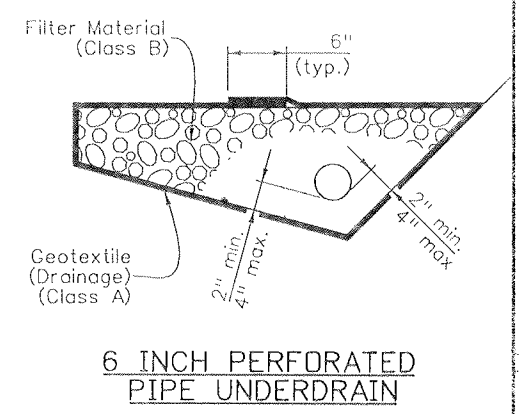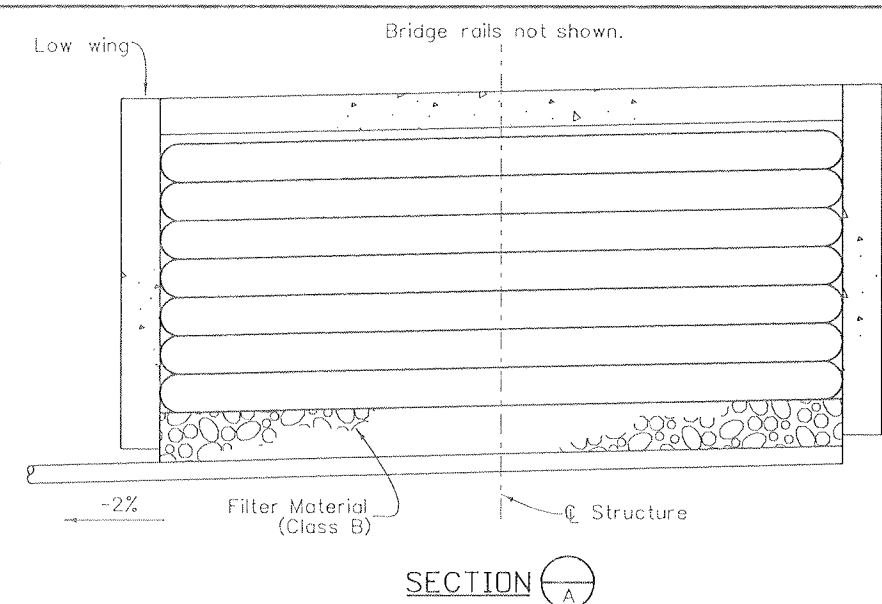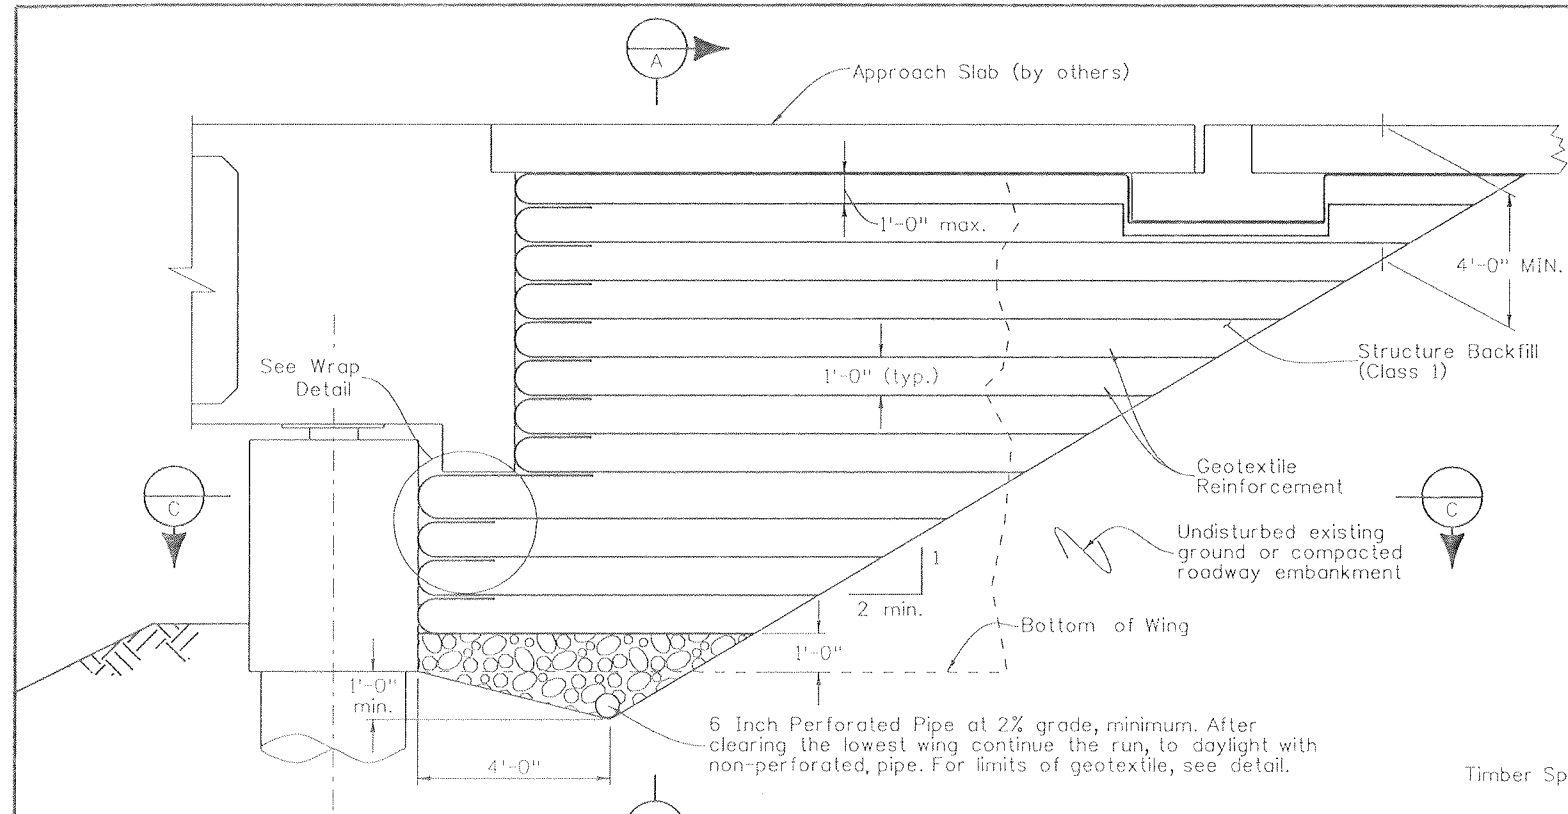

When required, the Geotextile Reinforcement wrap at Back Face of Abutment shall be temporarily hung with a spacer board and tack strip. After reaching a total of 1'-0" compacted lift, the tack strip shall be removed and Geotextile Reinforcement shall be pulled back slack free with its end anchored to soil underneath with staple or pins before the spacer board is pulled. Any alternate method to maintain the minimum gap between abutment concrete and Reinforced Soil may be proposed to the Engineer for approval.

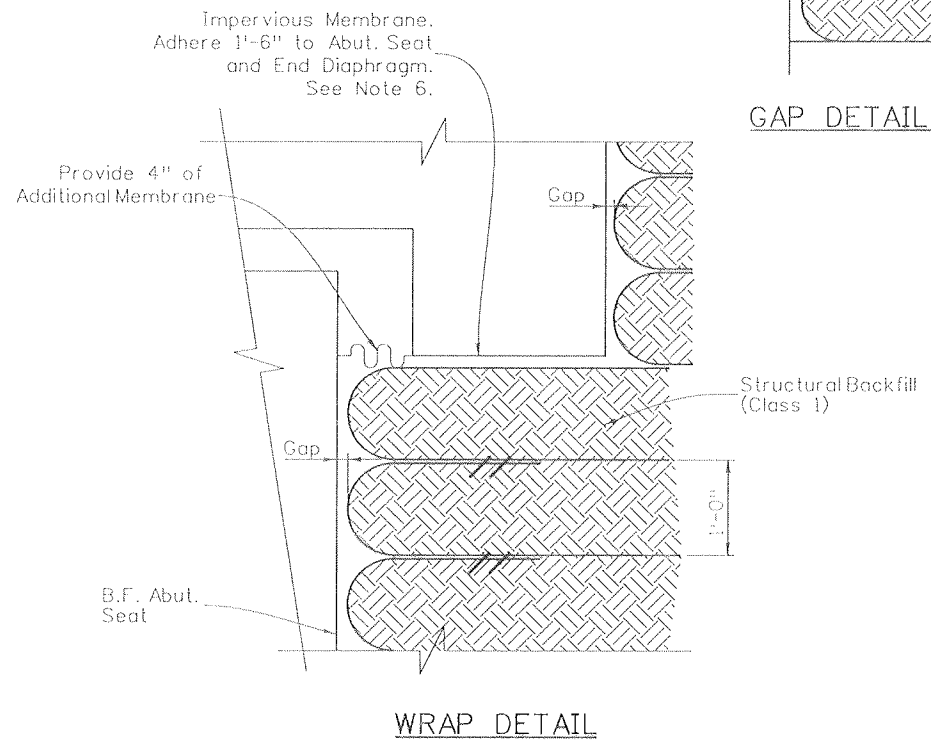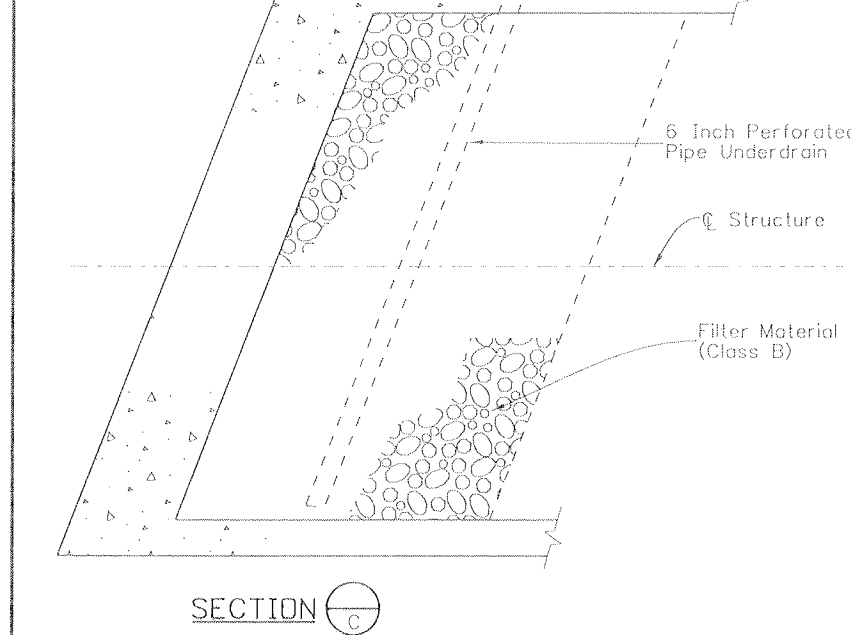

- NOTES:**
1. Geotextile reinforcement shall be woven fabric with a Minimum Average Roll Value of 4800 lb/ft for installations with a gap and 2400 lb/ft for installations without a gap based on ASTM D4595.
 2. Geotextile Reinforcement shall be placed by alternating Machine Direction (MD) with Cross Machine Direction (XD) from layer to layer.
 3. The Geotextile Reinforcement wrap at Back Face of Abutment shall be pulled back slack free with its end anchored to soil underneath with staples or pins.
 4. Minimum splice of all Geofabric shall consist of 6" of overlap.
 5. Installation of Pipe Underdrain and Subsurface Drain Outlet will conform to the Construction requirements of section 605.03 and 605.06, respectively.
 6. Impervious Membrane shall be Carlisle Sure-Seal EPDM. Contractor may submit alternate membrane for approval.

Design		Detail		Quantities	
INITIAL	DATE	INITIAL	DATE	INITIAL	DATE
AML	10/08	AML	10/08	AML	10/08
GWK	10/08	GWK	10/08	LW	10/08
Designed By	Checked By	Designed By	Checked By	Checked By	

Print Date: 9/22/2010
 File Name: 16042W_MSB_01.dgn
 Horiz. Scale: 1:1 Vert. Scale: As Noted
 Unit Information 0221 Unit Leader STW

SEMA CONSTRUCTION
WILSON & COMPANY

Sheet Revisions		
Date:	Comments	Init.

Colorado Department of Transportation
 3803 North Main Avenue
 Suite 200
 Durango, CO 81301
 Phone: 970-385-1440 FAX: 970-385-8365


DOT
 DEPARTMENT OF TRANSPORTATION

Region 5 EJA


As Constructed	
No Revisions:	9/10
Revised:	
Void:	

RAMP C OVER WILSON GULCH ABUT. 1 MECHANICALLY STABILIZED BACKFILL			
Designer:	A. Leifheit	Structure Numbers	P-05-AG
Detailer:	D. Anderson		
Sheet Subset:	Bridge	Subset Sheets:	B29 of B34


Project No./Code	
NH 1602-114	
16042	
Sheet Number	295

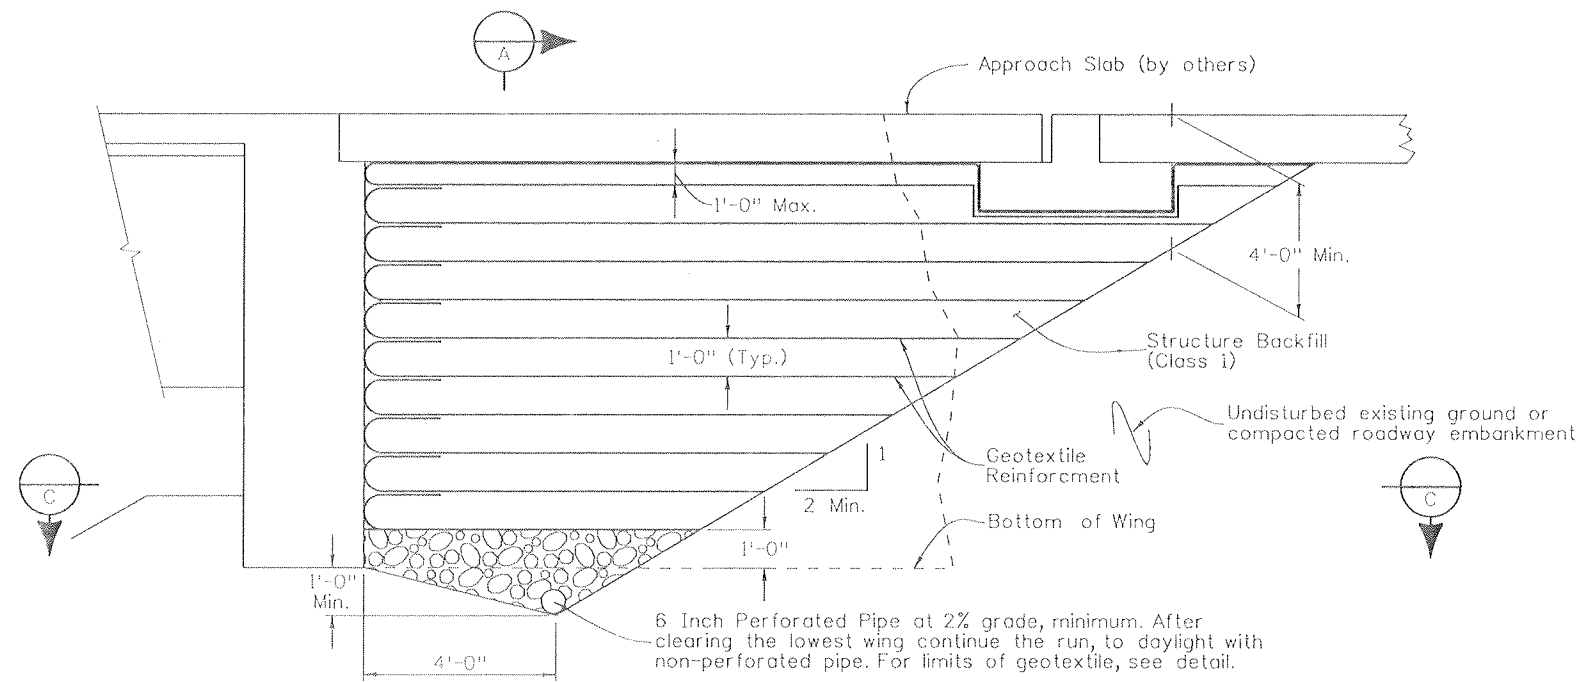


SECTION PERPENDICULAR TO ABUTMENT

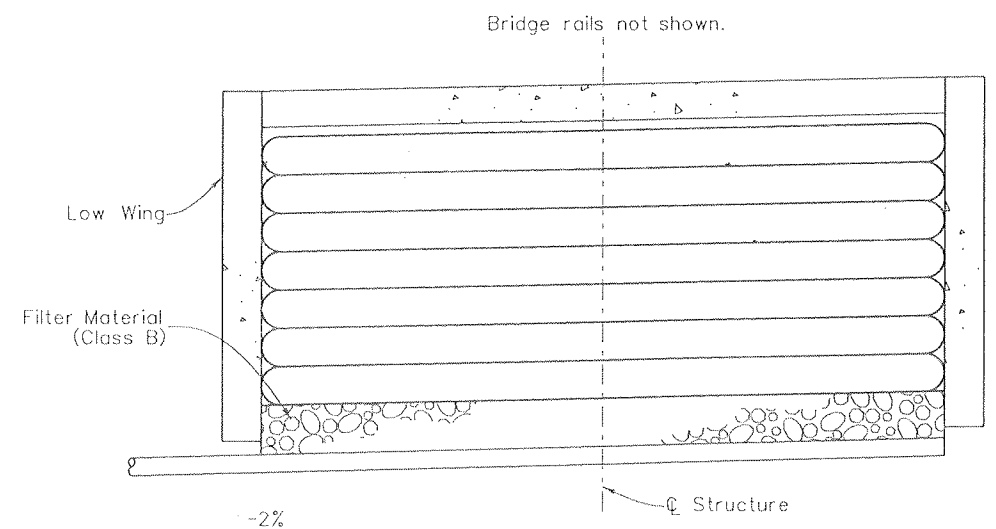

SECTION A-A

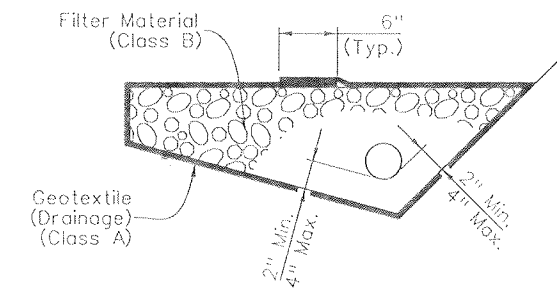

6 INCH PERFORATED PIPE UNDERDRAIN

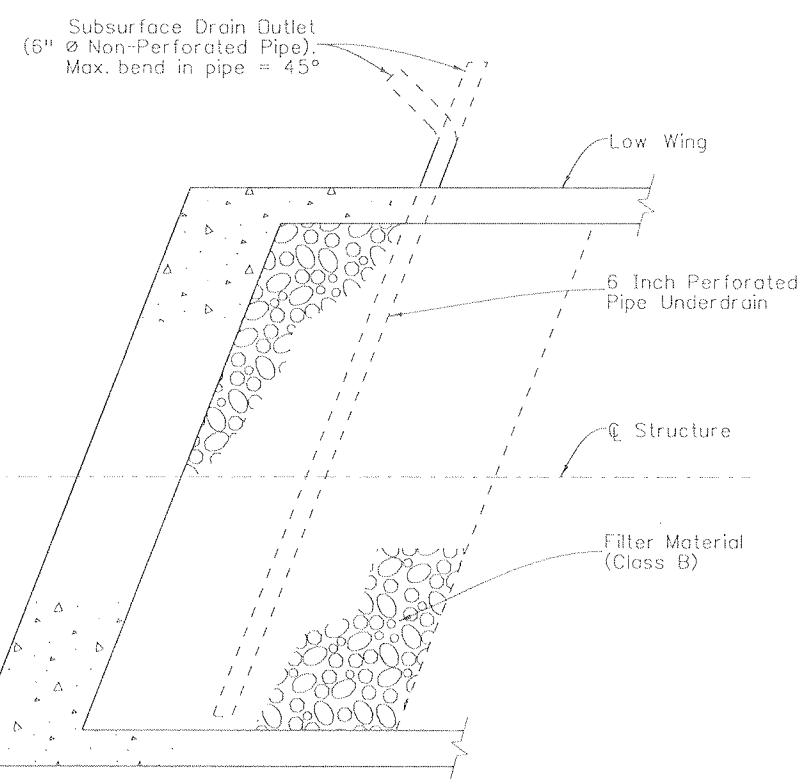

SECTION C-C

- NOTES:**
1. Geotextile reinforcement shall be woven fabric with a Minimum Average Roll Value of 4800 lb/ft for installations with a gap and 2400 lb/ft for installations without a gap based on ASTM D4595.
 2. Geotextile Reinforcement shall be placed by alternating Machine Direction (MD) with Cross Machine Direction (XD) from layer to layer.
 3. The Geotextile Reinforcement wrap at Back Face of Abutment shall be pulled back slack free with its end anchored to soil underneath with staples or pins.
 4. Minimum splice of all Geofabric shall consist of 6" of overlap.
 5. Installation of Pipe Underdrain and Subsurface Drain Outlet will conform to the Construction requirements of section 605.03 and 605.06, respectively.

Design		Detail		Quantities	
INITIAL	DATE	INITIAL	DATE	INITIAL	DATE
AML	10/08	RCA	10/08	AML	10/08
TAH	10/08	TAH	10/08	LW	10/08
Designed By	Checked By	Designed By	Checked By	Quantities By	Checked By

Print Date: 9/22/2010
 File Name: 16042W_MSB_02.dgn
 Horiz. Scale: 1:1 Vert. Scale: As Noted
 Unit Information 0221 Unit Leader STW

SEMA CONSTRUCTION **WILSON & COMPANY**

Sheet Revisions		
Date:	Comments	Init.

Colorado Department of Transportation
 3803 North Main Avenue
 Suite 200
 Durango, CO 81301
 Phone: 970-385-1440 FAX: 970-385-8365

DOT
 DEPARTMENT OF TRANSPORTATION


Region 5 EJA

As Constructed	
No Revisions:	9/10
Revised:	
Void:	

RAMP C OVER WILSON GULCH ABUT. 3 MECHANICALLY STABILIZED BACKFILL			
Designer:	A. Leifheit	Structure Numbers	P-05-W
Detailer:	R. Artman		
Sheet Subset:	Bridge	Subset Sheets:	B30 of B34

Project No./Code	
NH 1602-114	
16042	
Sheet Number	295


Design		Detail		Quantities	
INITIAL	DATE	INITIAL	DATE	INITIAL	DATE
AML	10/08	DRA	10/08	AML	10/08
Checked By	10/08	Detailed By	10/08	Quantities By	10/08
GWK		GWK		LW	

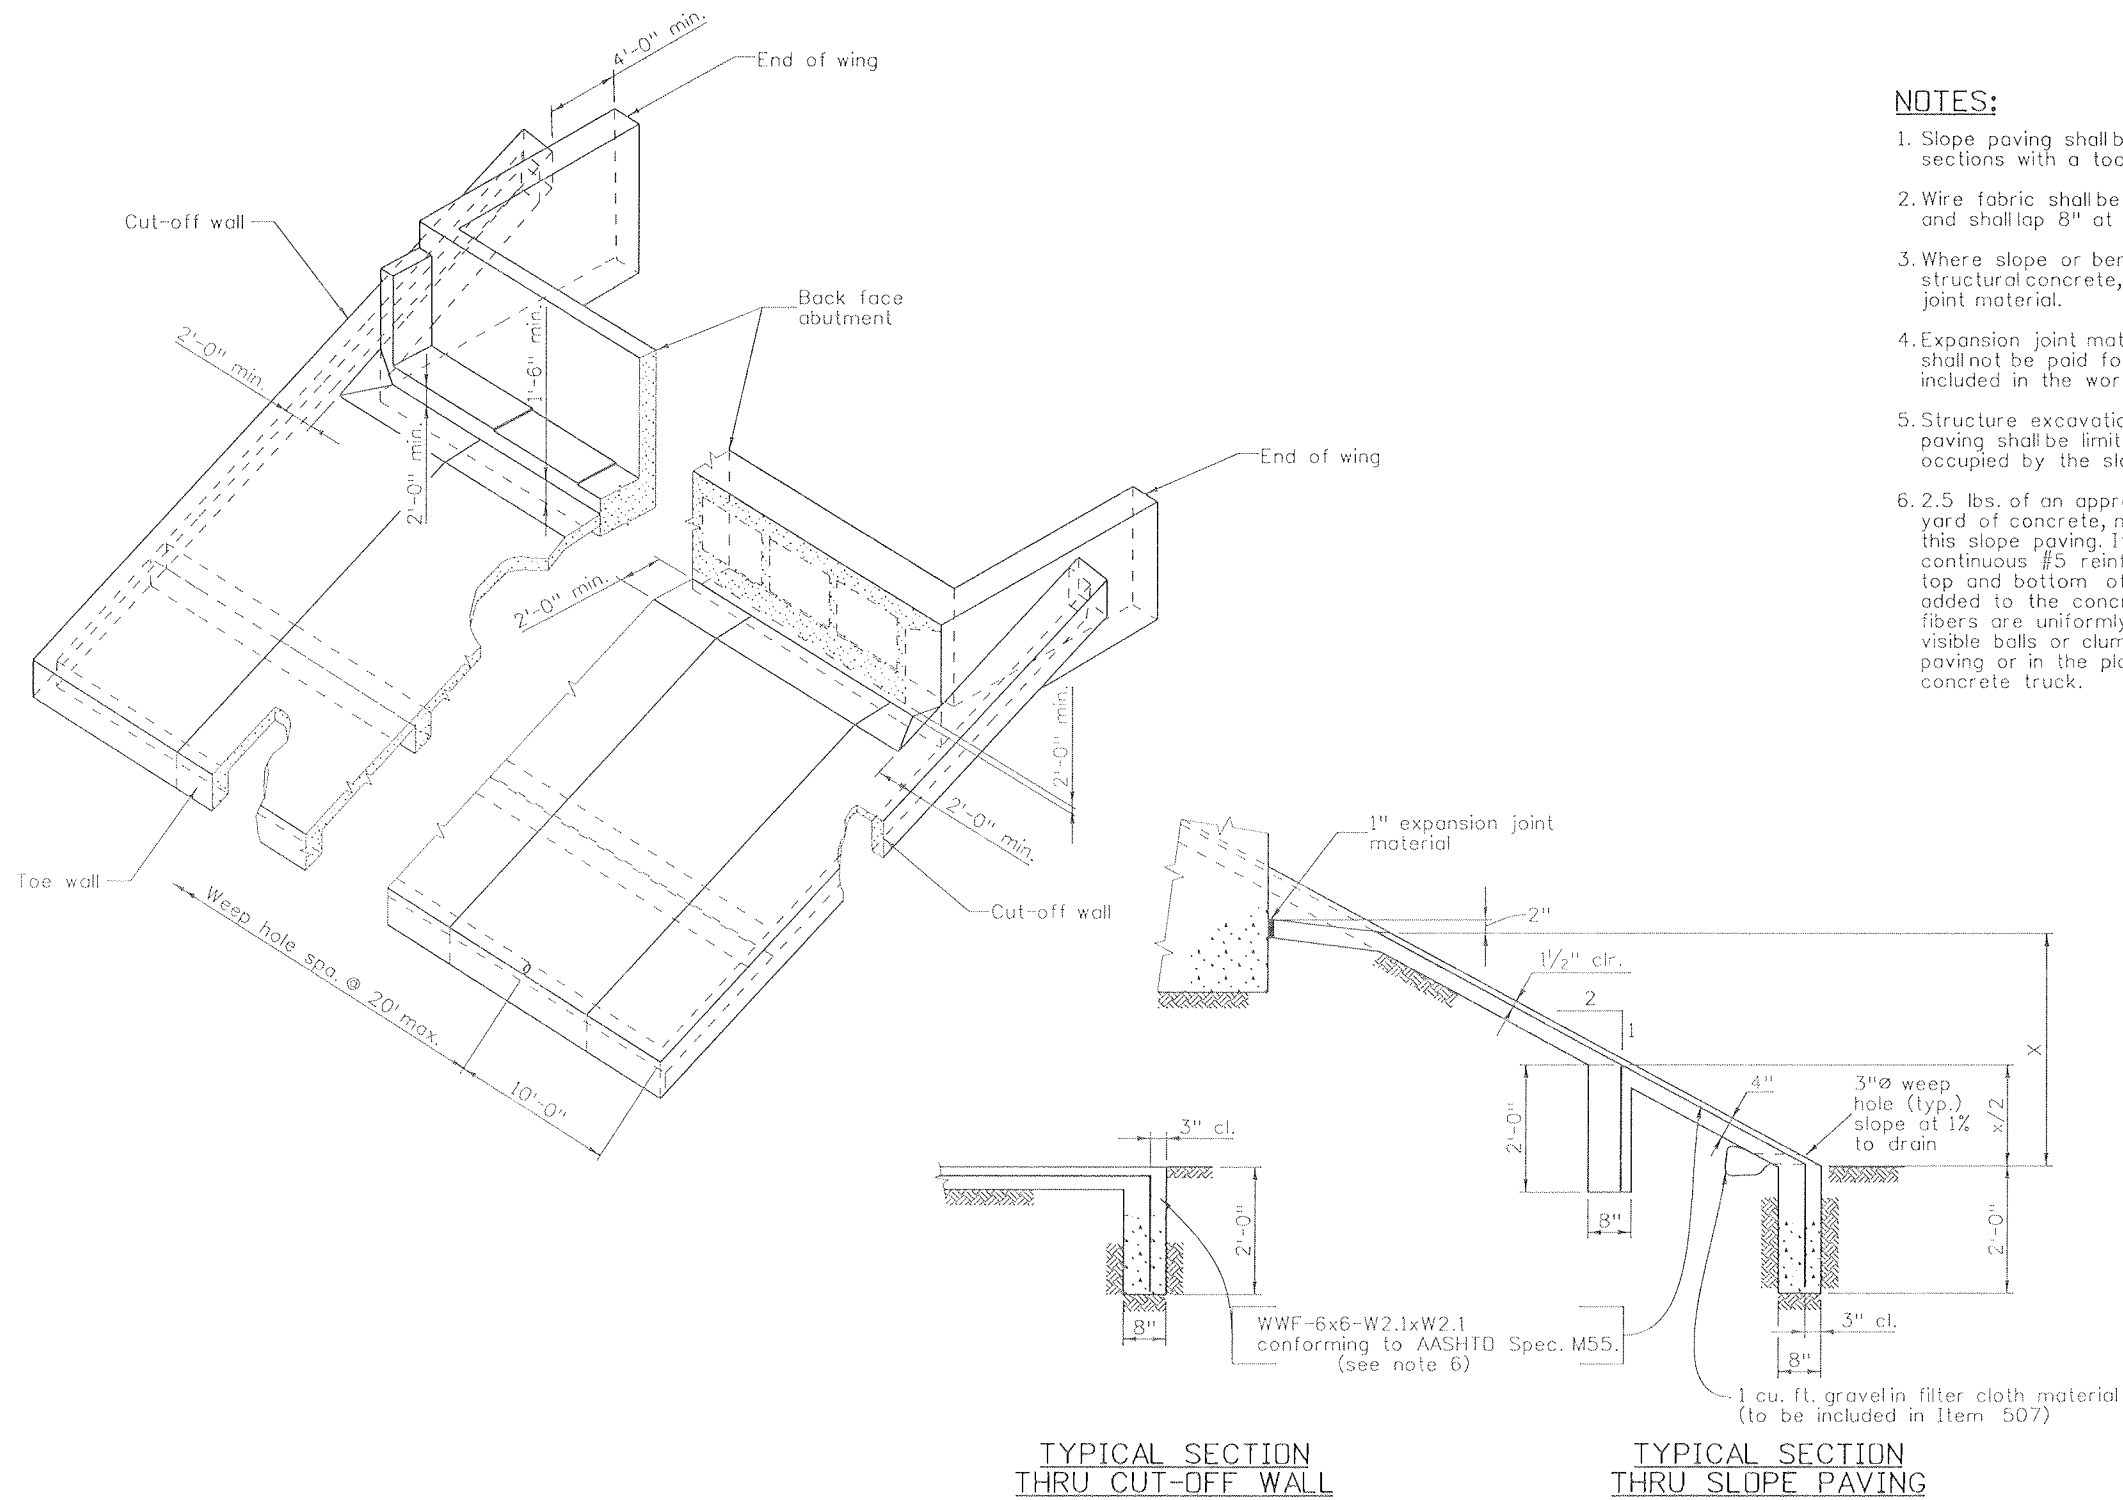


- NOTES:**
- Slope paving shall be poured in 10 ft. transverse sections with a tooled construction joint at each section.
 - Wire fabric shall be 2" from the end of joints and shall lap 8" at splices.
 - Where slope or berm paving butts against structural concrete, separate with 1" expansion joint material.
 - Expansion joint material and welded wire fabric shall not be paid for separately, but shall be included in the work.
 - Structure excavation for concrete slope and ditch paving shall be limited to the actual volume occupied by the slope paving concrete.
 - 2.5 lbs. of an approved polypropylene fiber, per cubic yard of concrete, may be substituted for the WWF in this slope paving. If this substitution is made, a continuous #5 reinforcing bar shall be added near the top and bottom of the cutoff wall. The fiber shall be added to the concrete mix in such a fashion that the fibers are uniformly dispersed in the concrete without visible balls or clumps in either the finished slope paving or in the plastic concrete delivered from the concrete truck.

Print Date: 9/22/2010	Sheet Revisions			Colorado Department of Transportation		As Constructed		RAMP C OVER WILSON GULCH		Project No./Code	
File Name: 16042W_SlopePavingDet_01.dgn	Date:	Comments	Init.	3803 North Main Avenue		No Revisions: 9/10		SLOPE PAVING DETAILS		NH 1602-114	
Horiz. Scale: 1:1				Suite 200		Revised:		Designer: A. Leifheit		Structure P-05-W	
Unit Information 0221				Durango, CO 81301		Void:		Detailer: D. Anderson		16042	
Unit Leader STW				Phone: 970-385-1440 FAX: 970-385-8365				Sheet Subset: Bridge		Sheet Number 297	
SEMA CONSTRUCTION	WILSON & COMPANY			DOT DEPARTMENT OF TRANSPORTATION		Region 5		Subset Sheets: B31 of B34			


Design		Detail		Quantities	
INITIAL	DATE	INITIAL	DATE	INITIAL	DATE
AML	10/08	RGA	10/08	AML	10/08
MUN	10/08	MUN	10/08	LW	10/08
Designed By	Checked By	Designed By	Checked By	Quantities By	Checked By

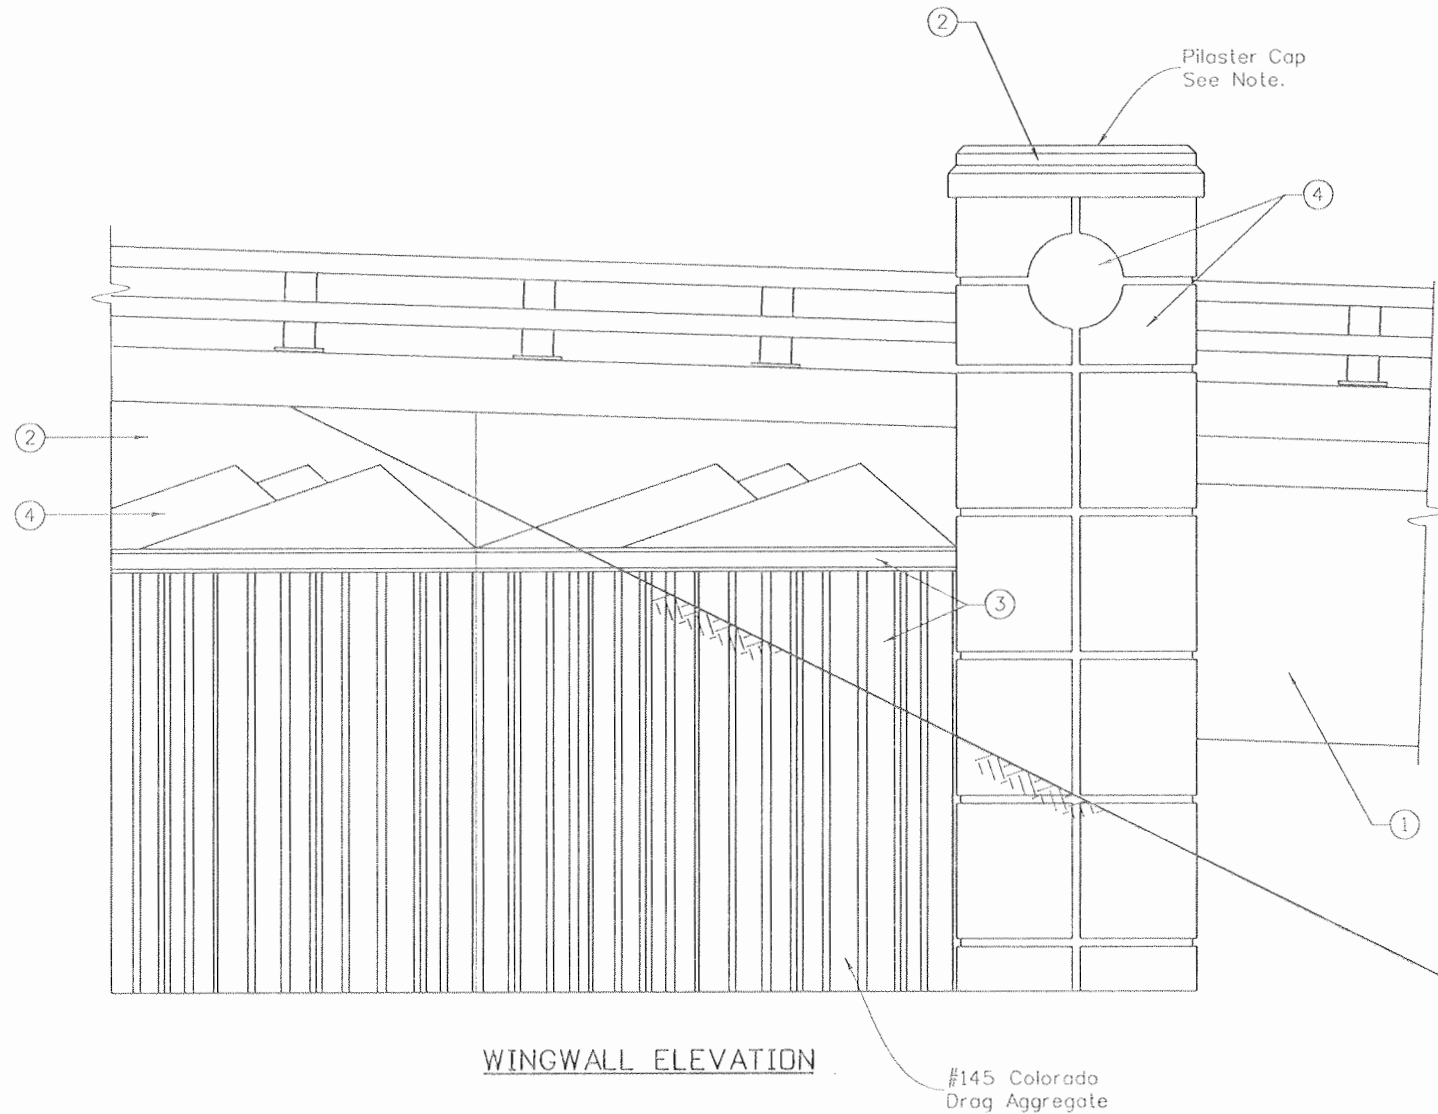

WINGWALL ELEVATION

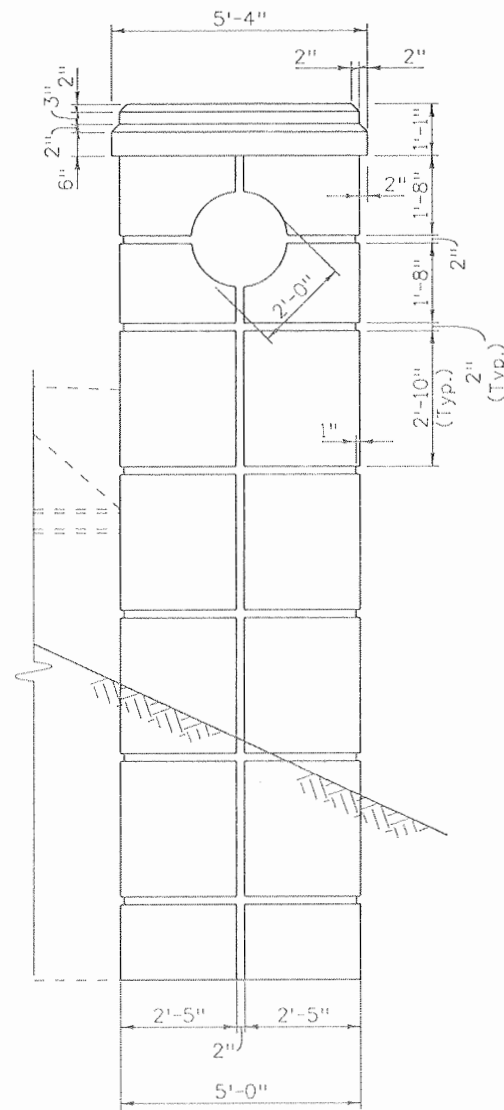

PILASTER DETAILS

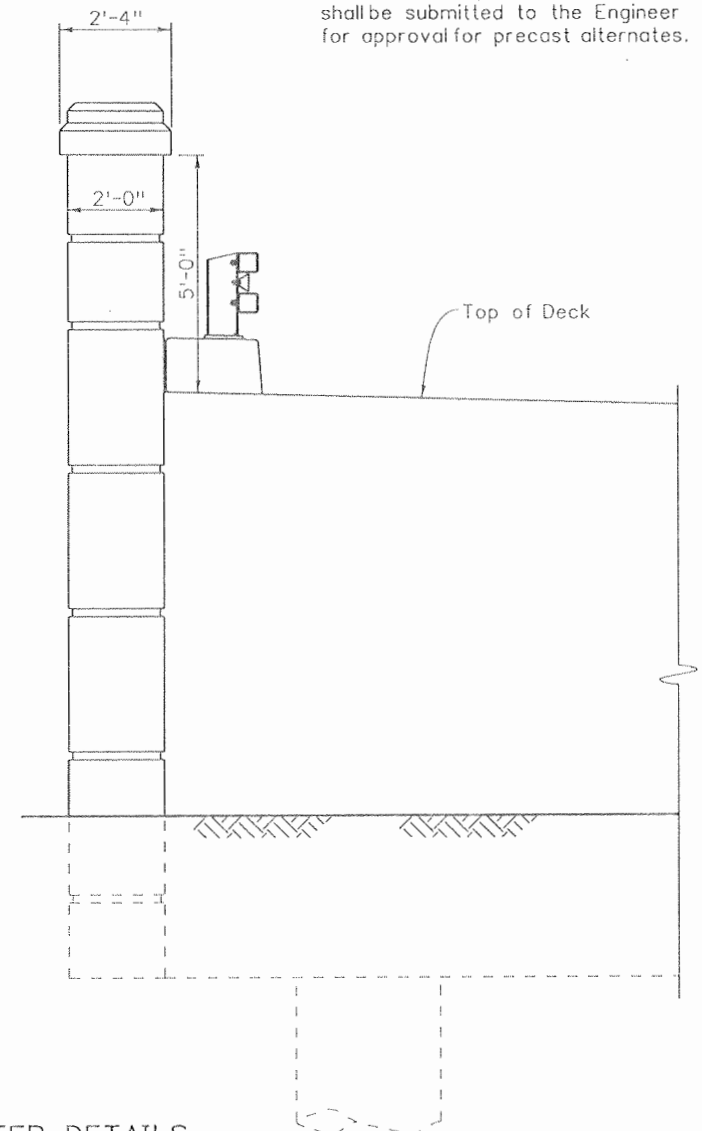

NOTE:
The Contractor may elect to precast the Pilaster Cap. Connection details shall be submitted to the Engineer for approval for precast alternates.

NOTES:

A colored structural concrete coating finish is required, as shown on the Plans, on all exposed concrete surfaces including piers, abutments, and wingwalls. Color numbers correspond to paint numbers as described by Diamond Vogel Paints. Coating shall extend to 1'-0" below ground surface.

- ① #8513
- ② #8515
- ③ #8513
- ④ #8511

Print Date: 9/22/2010

File Name: 16042W_ArchDet_01.dgn

Horiz. Scale: 1:1

Vert. Scale: As Noted

Unit Information 0221

Unit Leader STW



Sheet Revisions

Date:	Comments	Init.

Colorado Department of Transportation



3803 North Main Avenue
Suite 200
Durango, CO 81301
Phone: 970-385-1440 FAX: 970-385-8365

Region 5

EJA

As Constructed

No Revisions: 9/10

Revised:

Void:

RAMP C OVER WILSON GULCH
ARCHITECTURAL DETAILS

Designer:	A. Leifheit	Structure	P-05-AG
Detailer:	R. Artman	Numbers	
Sheet Subset:	Bridge	Subset Sheets:	B32 of B34

Project No./Code

NH 1602-114

16042

Sheet Number 298

State of Colorado
 Department of Transportation
 Staff Bridge Design
 Bridge Geometry Project Coordinate Converter
 Version 1.00

Run date & time = Tue Nov 11 06:20:44 2008

Input Northing Offset = 1213708.810000
 Input Easting Offset = 2320515.320000
 Input Bearing = S 14 14 1.0000 W

DESCRIPTION

Units: feet;
 Project: NH 1604-114; Subaccount: 16042;
 Designer: RML; Detailer: ;
 Location: Durango;
 2 Span CIP Box Girder
 Ramp C over Wilson Gulch

HORIZONTAL ALIGNMENT DATA

PC	511+06.2760	1	370.2540						
PI	514+78.6300	4c	512.6503	DELA 106 48 35.29 RT	Dc	20 50 05.28	RADIUS	275.000613	
PT	516+20.8263	1	370.3540						

VERTICAL ALIGNMENT DATA

ELEVATION AT PI	ELEVATION AT GRADE	STATION	ELEVATION AT GRADE	ELEVATION AT PI	PERCENT GRADE
					0.710000
509+50.0000	PC	511+06.2760	511+06.2760	511+06.2760	
510+50.0000	PI	514+78.6300	512.6503	512.6503	
511+70.0000	PT	516+20.8263	516+20.8263	516+20.8263	
					-0.501675
514+35.0000	PC	514+78.6300	514+78.6300	514+78.6300	
515+25.0000	PT	516+20.8263	516+20.8263	516+20.8263	
516+15.0000	PT	516+20.8263	516+20.8263	516+20.8263	-3.860000

TABLE OF ROADWAY CROSS-SLOPES (SUPERELEVATION: E=0.0)

STATION	SLOPE LEFT	SLOPE RIGHT	VC LENGTH
(ON TANGENT)	0.0000	0.0000	5.00 (MAX)

OFFSET PROFILE CONTROL TO PIVOT POINT = 0.0000 FEET

LIMITS OF VALID ELEVATION AND CROSS-SLOPE DATA

BEGIN * UNLIMITED *
 END * UNLIMITED *

LAYOUT LINE DATA

LAYOUT LINE DEFINED AS CHORD BETWEEN BENT LINES: CL BRG AB3
 AND: "REF LINE"

LAYOUT LINE DEFINED AS CHORD ON HORIZONTAL CONTROL LINE

A CHORD PARALLEL TO HORIZONTAL CONTROL AT OFFSET 94.5434
 IS TANGENT TO LAYOUT LINE AT STATION 513+22.0000
 Y FROM REF LINE 142.245170

LAYOUT LINE INTERSECTS HORIZONTAL CONTROL AT
 HCL STA 511+72.5000 SEW 31 06 53.04 X 0.00000000
 514+71.5000 -31 06 53.04 Y 284.489341

LAYOUT LINE INTERSECTS REF LINE AT
 HCL STA 511+72.5000 OFFSET 0.00000000 X 0.0000 Y 0.0000

TYPE 4 GIRDER LINE DATA
 (OFFSET VARIES WITH SUPER)

LINE OF CONSTANT OFFSET IS HORIZONTAL CONTROL

AVERAGE CROSS-SLOPE = -0.060000 FT/FT (RIGHT OF PROFILE CONTROL LINE)

DEAD LOAD DEFLECTION DATA

DEFLECTIONS AT TENTH POINTS FROM FITTED CURVE

	0.0	0.1	0.2	0.3	0.4	0.5	0.6	0.7	0.8	0.9	1.0
FOR BENT LINE: CL BRG AB1	97 CARD(S): 1 GIRDER LINES REFERENCED BY: (BLANK)										
INCH	0.0000	0.3908	0.8255	1.1933	1.3942	1.3790	1.1651	0.8301	0.4826	0.2094	0.0000
FOOT	0.0000	0.0326	0.0688	0.0994	0.1162	0.1149	0.0971	0.0692	0.0402	0.0174	0.0000
SLOPE	0.284115	-0.186769 SLOPE									

	0.0	0.1	0.2	0.3	0.4	0.5	0.6	0.7	0.8	0.9	1.0
FOR BENT LINE: CL Pier2	97 CARD(S): 1 GIRDER LINES REFERENCED BY: (BLANK)										
INCH	0.0000	-0.0686	-0.2180	-0.3615	-0.4678	-0.5314	-0.5525	-0.5250	-0.4340	-0.2612	0.0000
FOOT	0.0000	-0.0057	-0.0182	-0.0301	-0.0390	-0.0443	-0.0460	-0.0438	-0.0362	-0.0218	0.0000
SLOPE	0.018187	0.250199 SLOPE									

DEFLECTIONS SHOW SIGNIFICANT UPLIFT

BENT LINE :	INTERSECTION POINT :	FROM LAYOUT LINE :	PROJECT COORDINATES :	BENT LINE :	GIRDER LINE :	ROADWAY :
DESCRIPTION :	STATION :	OFFSET :	ORDINATE :	NORTHING :	EASTING :	LENGTH FROM :
:	STATION :	OFFSET :	ORDINATE :	NORTHING :	EASTING :	LENGTH FROM :

* HORIZONTAL CONTROL LINE * AT FINISHED GRADE

BENT LINE	STATION	OFFSET	ELEVATION	ELEV+DL	X	Y	NORTHING	EASTING	BENT LNTH	SHEW	GIRDER INTH	CRS-SLP
BP BR 1	511+48.7500	0.0000	6665.8350	1	1.9615	-3.1961	1213712.3903	2320514.2046	2.3112	0 00 00.00	-3.7500	+/- .080000
CL BRG AB1	511+72.5000	0.0000	6665.8163	10	0.0000	0.0000	1213708.8100	2320515.3200	0.0000	0 00 00.00	0.0000	+/- .080000
CL Pier2	513+35.0000	0.0000	6665.0020	10	-39.2736	155.2393	1213548.6629	2320515.2813	-39.3826	0 00 00.00	162.5000	+/- .080000
CL BRG AB3	514+71.5000	0.0000	6664.1930	1	0.0000	284.4883	1213433.0551	2320445.3711	0.0000	0 00 00.00	299.0000	+/- .080000
BP AB3	514+73.2500	0.0000	6664.1720	1	0.9099	285.9832	1213431.8298	2320444.1216	1.0674	0 00 00.00	300.7500	+/- .080000

* LAYOUT LINE * AT FINISHED GRADE


BENT LINE	STATION	OFFSET	ELEVATION	ELEV+DL	X	Y	NORTHING	EASTING	BENT LNTH	SHEW	GIRDER INTH	CRS-SLP
BP BR 1	511+48.7500	-2.3112	6665.8159	0.0000	-4.4184	1113713.0928	2320516.4064	0.0000	-31 55 45.74	-4.4184	+0.080000	
CL BRG AB1	511+72.5000	0.0000	6665.8163	0.0000	0.0000	1213708.8100	2320515.3200	0.0000	-31 09 53.04	0.0000	+/- .080000	
CL Pier2	513+35.0000	39.3826	6661.8514	0.0000	153.3783	1213546.1402	2320477.6080	0.0000	2 42 30.70	153.3783	-0.080000	
CL BRG AB3	514+71.5000	0.0000	6664.1930	0.0000	284.4883	1213433.0551	2320445.3711	0.0000	31 09 53.04	284.4883	+/- .080000	
BP AB3	514+73.2500	-1.0674	6664.2574	0.0000	286.5411	1213431.0653	2320444.8664	0.0000	31 30 45.64	286.5411	+0.080000	

WINGWALL ELEVATIONS

PARALLEL TO HORIZONTAL CONTROL

0.250000 FEET BELOW FINISHED GRADE

BENT LINE	STATION	OFFSET	ELEVATION	ELEV+DL	X	Y	NORTHING	EASTING	BENT LNTH	SHEW	GIRDER INTH	CRS-SLP
End WGA	511+47.4400	-6.0000	6666.1645	0.0000	9.6028	-24.4045	1213734.7129	2320512.5820	11.2055	0 00 00.00	-25.6143	+0.080000
End WWE	511+47.4400	24.0000	6663.7579	0.0000	23.2640	-6.5566	1213723.3775	2320484.7163	41.2885	0 00 00.00	-22.8729	-0.080000
End WWC	514+94.8100	-6.0000	6664.0955	0.0000	8.0339	307.4363	1213412.7929	2320431.9430	9.9310	0 00 00.00	329.3422	+0.080000
End WWD	514+94.8100	23.9167	6661.7122	0.0000	22.2356	289.6438	1213425.7900	2320412.8083	39.8477	0 00 00.00	294.2788	-0.080000

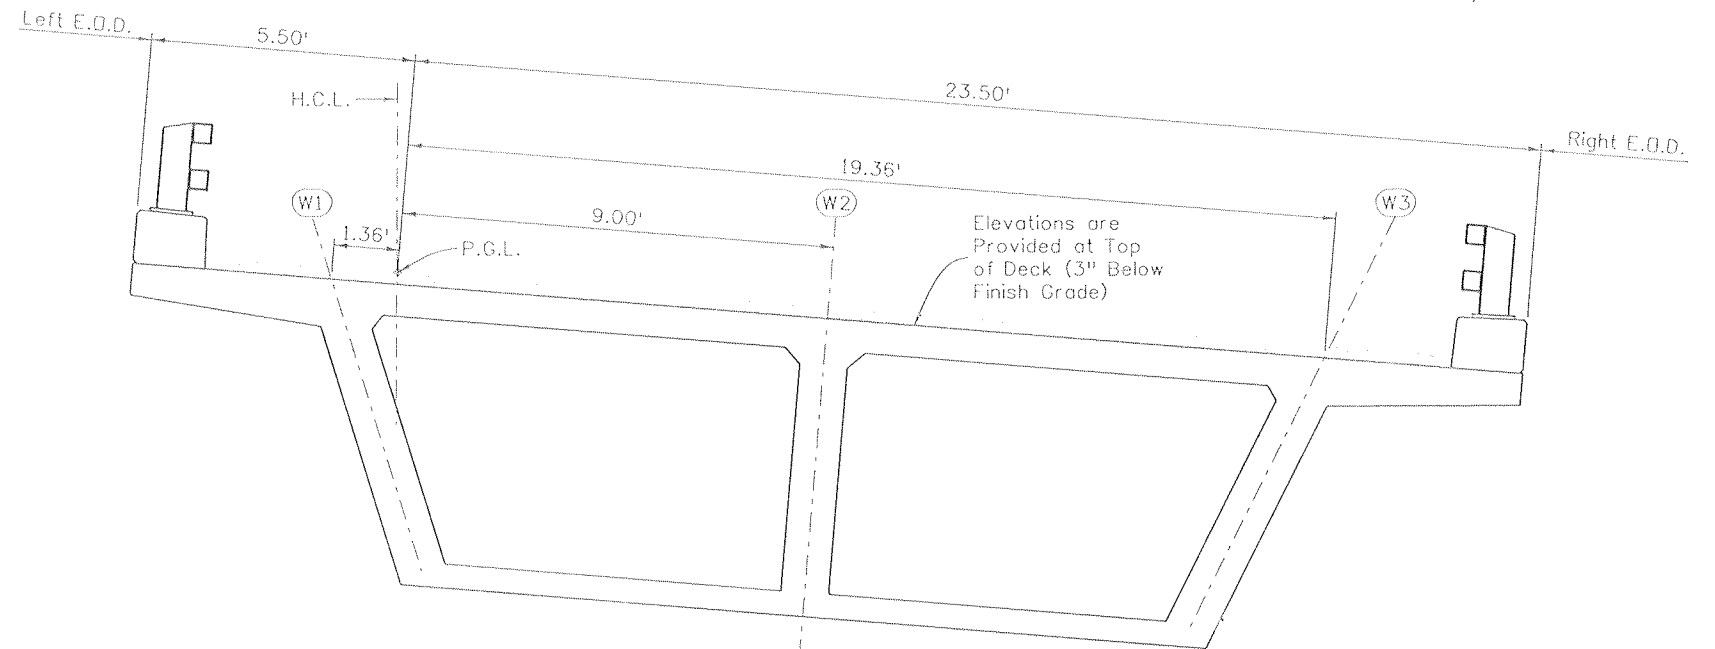

Design	Checked By	Date	Detail		Quantities	
			Checked By	Date	Checked By	Date

Print Date: 9/22/2010	Sheet Revisions			Colorado Department of Transportation 3803 North Main Avenue Suite 200 Durango, CO 81301 Phone: 970-385-1440 FAX: 970-385-8365 Region 5	As Constructed	RAMP C OVER WILSON GULCH BRIDGE DECK ELEVATIONS (1 OF 2)		Project No./Code
File Name: 16042W_Brdg_Geometry_01.dgn	Date:	Comments	Init.		No Revisions: 9/10			NH 1602-114
Horiz. Scale: 1:1				EJA	Revised:	Designer: A. Leifheit	Structure: P-05-W	16042
Unit Information 0221	Unit Leader STW				Void:	Detailer: R. Artman	Numbers:	Sheet Number 299
SEMA CONSTRUCTION		WILSON & COMPANY				Sheet Subset: Bridge	Subset Sheets: B33 of B34	

Design	INITIAL	DATE	RCA	DATE	INITIAL	DATE	AML	DATE	LW	DATE
	Checked By	10/08								
Detail	INITIAL	DATE	RCA	DATE	INITIAL	DATE	AML	DATE	LW	DATE
	Checked By	10/08								
Quantities	INITIAL	DATE	RCA	DATE	INITIAL	DATE	AML	DATE	LW	DATE
	Checked By	10/08								

Left End		VARIES WITH SUPER		NOMINAL OFFSET = -5.5024 FT		-0.2500 NORMAL FROM FINISHED GRADE						
BENT LINE	STATION	OFFSET	ELEVATION	ELEV+DL	X	Y	NORTHING	EASTING	BENT LNTH	SKEW	GIRDER LNTH	CRS-SLP
BF AB 1	511+68.7500	-5.5024	6666.0244		-2.7084	-0.1961	1213714.0627	2320519.4466	-3.1912	0 00 00.00	-3.8250	+0.080000
CL BRG AB1	511+72.5000	-5.5024	6666.0057	666.0057	-4.7092	-2.8461	1213710.4108	2320520.5844	-5.5024	0 00 00.00	0.0000	+0.080000
F-1	511+88.7500	-5.5024	6665.9243	665.9568	-12.8587	11.5844	1213694.4196	2320524.9356			16.5751	+0.080000
F-2	512+05.0000	-5.5024	6665.8428	665.9116	-20.1418	26.4710	1213678.1992	2320528.3349			33.2503	+0.080000
F-3	512+21.2500	-5.5024	6665.7614	665.8606	-26.5330	41.7618	1213661.8064	2320530.7702			49.7254	+0.080000
F-4	512+37.5000	-5.5024	6665.6800	665.7962	-32.0101	57.3033	1213645.2984	2320532.2333			66.3006	+0.080000
F-5	512+53.7500	-5.5024	6665.5986	665.7135	-36.5538	73.3410	1213628.7328	2320532.7189			82.8757	+0.080000
F-6	512+70.0000	-5.5024	6665.5171	665.6342	-40.1484	89.5192	1213612.1674	2320532.2253			99.4509	+0.080000
F-7	512+86.2500	-5.5024	6665.4357	665.5049	-42.7813	105.8815	1213595.6000	2320530.7542			116.0260	+0.080000
F-8	512+02.5000	-5.5024	6665.3543	665.3945	-44.4433	122.3707	1213579.2684	2320528.3105			132.6011	+0.080000
F-9	513+18.7500	-5.5024	6665.2729	665.2903	-45.1286	138.9292	1213563.0497	2320524.9038			149.1763	+0.080000
CL BRG AB2	513+35.0000	-5.5024	6665.1914	665.1914	-44.8349	155.4993	1213547.0605	2320520.5450	-44.8850	0 00 00.00	165.7514	+0.080000
F-1	513+48.6500	-5.5024	6665.1230	665.1173	-43.8221	169.3849	1213533.8477	2320516.1588			179.6746	+0.080000
F-2	513+62.3000	-5.5024	6665.0546	665.0365	-42.1416	183.2036	1213520.8689	2320511.1225			193.5977	+0.080000
F-3	513+75.9500	-5.5024	6664.9862	664.9561	-39.7676	196.9213	1213508.1560	2320505.4486			207.5208	+0.080000
F-4	513+89.6000	-5.5024	6664.9179	664.8789	-36.7159	210.5044	1213495.7403	2320499.1506			221.4439	+0.080000
F-5	514+03.2500	-5.5024	6664.8495	664.8052	-32.9940	223.9194	1213483.6522	2320492.2447			235.3670	+0.080000
F-6	514+16.9000	-5.5024	6664.7811	664.7350	-28.6111	237.1332	1213471.9217	2320484.7474			249.2902	+0.080000
F-7	514+30.5500	-5.5024	6664.7127	664.6689	-23.5780	250.1132	1213460.5777	2320476.6773			263.2133	+0.080000
F-8	514+44.2000	-5.5024	6664.6363	664.6052	-17.9071	262.8275	1213449.6480	2320468.0540			277.1364	+0.080000
F-9	514+57.8500	-5.5024	6664.5259	664.5051	-11.6123	275.2648	1213439.1597	2320458.8997			291.0595	+0.080000
CL BRG AB3	514+71.5000	-5.5024	6664.3824	664.3824	-4.7092	287.3345	1213429.1384	2320449.2360	-5.5024	0 00 00.00	304.9826	+0.080000
BF AB3	514+73.2500	-5.5024	6664.3814		-3.7810	285.8592	1213427.6888	2320447.9614	-4.4351	0 00 00.00	308.7676	+0.080000

W2		VARIES WITH SUPER		NOMINAL OFFSET = 8.9514 FT		-0.2500 NORMAL FROM FINISHED GRADE						
BENT LINE	STATION	OFFSET	ELEVATION	ELEV+DL	X	Y	NORTHING	EASTING	BENT LNTH	SKEW	GIRDER LNTH	CRS-SLP
BF AB 1	511+68.7500	8.9514	6664.8491		9.5586	1.5381	1213709.6693	2320505.6767	11.2626	0 00 00.00	-3.4279	-0.080000
CL BRG AB1	511+72.5000	8.9514	6664.8494	664.8494	7.6609	4.6301	1213706.2057	2320506.7558	8.9514	0 00 00.00	0.0000	-0.080000
F-1	511+88.7500	8.9514	6664.7680	664.8005	-0.0687	18.3171	1213691.0383	2320510.8829			15.7211	-0.080000
F-2	512+05.0000	8.9514	6664.6865	664.7553	-6.3765	32.4366	1213675.6198	2320514.1069			31.4421	-0.080000
F-3	512+21.2500	8.9514	6664.6051	664.7045	-13.0364	46.5395	1213660.1057	2320516.4168			47.1632	-0.080000
F-4	512+37.5000	8.9514	6664.5237	664.6399	-18.2332	61.7750	1213644.4483	2320517.8045			62.0842	-0.080000
F-5	512+53.7500	8.9514	6664.4423	664.5872	-22.5428	76.8215	1213628.7362	2320518.2650			78.0553	-0.080000
F-6	512+70.0000	8.9514	6664.3608	664.4579	-25.9522	92.2361	1213613.0244	2320517.7969			94.3263	-0.080000
F-7	512+86.2500	8.9514	6664.2794	664.3466	-28.4495	107.7552	1213597.3677	2320516.4017			110.0474	-0.080000
F-8	512+02.5000	8.9514	6664.1980	664.2382	-30.0258	123.3947	1213581.8207	2320514.9642			125.7684	-0.080000
F-9	513+18.7500	8.9514	6664.1166	664.1340	-30.6758	139.1000	1213566.2774	2320510.8527			141.4895	-0.080000
CL BRG AB2	513+35.0000	8.9514	6664.0351	664.0351	-30.3972	154.8163	1213551.4274	2320506.7164	-30.4312	0 00 00.00	157.2103	-0.080000
F-1	513+48.6500	8.9514	6663.9667	663.9610	-29.4461	167.9864	1213538.7405	2320502.5563			170.4162	-0.080000
F-2	513+62.3000	8.9514	6663.8983	663.8802	-27.8627	181.0930	1213526.4305	2320497.7815			183.6219	-0.080000
F-3	513+75.9500	8.9514	6663.8299	663.7998	-25.5911	194.1039	1213514.3726	2320492.4000			196.8276	-0.080000
F-4	513+89.6000	8.9514	6663.7615	663.7226	-22.6966	206.9871	1213502.5966	2320486.4267			210.0333	-0.080000
F-5	514+03.2500	8.9514	6663.6931	663.6469	-19.1645	219.7188	1213491.1315	2320479.8765			223.2390	-0.080000
F-6	514+16.9000	8.9514	6663.6248	663.5787	-15.0094	232.2437	1213480.0054	2320472.7655			236.4446	-0.080000
F-7	514+30.5500	8.9514	6663.5564	663.5126	-10.2357	244.5849	1213469.2459	2320465.1113			249.6503	-0.080000
F-8	514+44.2000	8.9514	6663.4880	663.4438	-4.8569	256.6140	1213458.8795	2320456.9326			262.8560	-0.080000
F-9	514+57.8500	8.9514	6663.3706	663.3488	1.1135	268.3915	1213448.9316	2320448.2496			276.0617	-0.080000
CL BRG AB3	514+71.5000	8.9514	6663.2261	663.2261	7.6609	279.8582	1213439.4267	2320439.0839	8.9514	0 00 00.00	289.2674	-0.080000
BF AB3	514+73.2500	8.9514	6663.2051		8.5412	281.3044	1213438.2414	2320437.8750	10.0168	0 00 00.00	290.9604	-0.080000

W3		VARIES WITH SUPER		NOMINAL OFFSET = 19.2794 FT		-0.2500 NORMAL FROM FINISHED GRADE						
BENT LINE	STATION	OFFSET	ELEVATION	ELEV+DL	X	Y	NORTHING	EASTING	BENT LNTH	SKEW	GIRDER LNTH	CRS-SLP
BF AB 1	511+68.7500	19.2794	6664.0419		18.3240	7.0003	1213706.5300	2320495.8373	21.5996	0 00 00.00	-3.4871	-0.080000
CL BRG AB1	511+72.5000	19.2794	6664.0231	664.0231	16.5000	9.9723	1213703.2008	2320496.8746	19.2794	0 00 00.00	0.0000	-0.080000
F-1	511+88.7500	19.2794	6663.9417	663.9743	9.0704	53.1279	1213688.6223	2320500.8415			15.1168	-0.080000
F-2	512+05.0000	19.2794	6663.8603	663.9291	2.4209	66.4954	1213673.8249	2320503.9403			30.2215	-0.080000
F-3	512+21.2500	19.2794	6663.7789	663.8783	-3.3958	80.8292	1213659.8904	2320506.1005			45.3323	-0.080000
F-4	512+37.5000	19.2794	6663.6974	663.8136	-8.3890	94.8989	1213645.8408	2320507.4374			60.4431	-0.080000
F-5	512+53.7500	19.2794	6663.6160	663.7309	-12.5213	74.4265	1213629.7387	2320507.9270			75.5538	-0.080000
F-6	512+70.0000	19.2794	6663.5346	663.6317	-15.0083	54.1774	1213613.6368	2320507.4870			90.6646	-0.080000
F-7	512+86.2500	19.2794	6663.4532	663.5223	-18.2066	369.0941	1213599.5879	2320506.1460			105.7753	-0.080000
F-8	513+02.5000	19.2794	6663.3717	663.4130	-19.7738	124.1264	1213583.6545	2320505.9186			120.8861	-0.080000
F-9	513+18.7500	19.2794	6663.2903	663.3078	-20.5485	139.1221	1213568.8556	2320508.8124			135.9969	-0.080000
CL BRG AB2	513+35.0000	19.2794	6663.2089	663.2089	-20.4907	154.3283	1213554.2820	2320498.8386	-20.1032	0 00 00.00	151.1076	-0.080000
F-1	513+48.6500	19.2794	6663.1274	663.1348	-19.1666	168.9871	1213542.2384	2320492.8401			163.8007	-0.080000
F-2	513+62.3000	19.2794	6663.0460	663.0539	-17.4254	179.5849	1213530.4045	2320488.2487			176.4937	-0.080000
F-3	513+75.9500	19.2794	6662.9646	662.9736	-15.4612	192.0907	1213518.8147	2320483.0761			189.1867	-0.080000
F-4	513+89.6000	19.2794	6662.8832	662.8826	-12.4791	204.4738	1213507.4958	2320477.3247			201.8798	-0.080000
F-5	514+03.2500	19.2794	6662.8018	662.8226	-9.2580	216.7035	1213496.4758	2320471.0587				

GENERAL NOTES

EXCEPT AS SHOWN IN THE PLANS, STRUCTURE EXCAVATION AND BACKFILL SHALL BE IN ACCORDANCE WITH M-206-2 FOR BRIDGES.

EXPANSION JOINT MATERIAL SHALL MEET AASHTO SPECIFICATION M213.

A COLORED STRUCTURAL CONCRETE COATING FINISH WILL BE REQUIRED, AS SHOWN ON THE PLANS, ON EXPOSED CONCRETE SURFACES. THE COLORED STRUCTURAL CONCRETE COATING IS TO BE SELECTED FROM TEST PANELS PROVIDED BY THE CONTRACTOR.

ALL BOLTS SHALL BE 1/8" DIAMETER, HIGH STRENGTH, UNLESS OTHERWISE NOTED.

LEVELING PADS ARE UNLAMINATED BEARINGS. THEY SHALL BE CUT OR MOLDED FROM AASHTO ELASTOMER GRADE 3, 4, OR 5 AS DESCRIBED IN TABLES 705-1 AND 705-2 WITH A DUROMETER (SHORE "A") HARDNESS OF 60.

GRADE 60 REINFORCING STEEL IS REQUIRED.

ALL REINFORCING STEEL SHALL BE EPOXY COATED UNLESS OTHERWISE NOTED.

Ⓝ DENOTES NON COATED REINFORCING STEEL.

ALL THE PROVISIONS FOR BRIDGE DECK CONCRETE SHALL ALSO APPLY TO APPROACH SLAB CONCRETE.

AN EMERGENCY DECK CONSTRUCTION JOINT MAY BE LOCATED AT THE ONE QUARTER SPAN POINT BACK FROM A PIER OR ABUTMENT WITH RESPECT TO THE DIRECTION OF THE DECK PLACEMENT.

ALL CONCRETE SHALL BE LEVEL II SULFATE RESISTANT.

DESIGN DATA

DESIGN CODE: AASHTO LRFD, 4TH EDITION WITH 2008 INTERIMS

DESIGN METHOD: LOAD AND RESISTANCE FACTOR DESIGN

LIVE LOAD: HL-93 (DESIGN TRUCK OR TANDEM, AND DESIGN LANE LOAD)
 DEAD LOAD: ASSUMES 36 LBS. PER SQ. FT. FOR BRIDGE DECK OVERLAY. ASSUMES 5 LBS. PER SQ. FT. FOR PERMANENT STEEL DECK FORMS
 SEISMIC: ZONE 1, SITE CLASS D, $A_s = 0.098g$, $SD1 = 0.098g$

REINFORCED CONCRETE:
 CLASS D/H CONCRETE: $f'_c = 4,500$ psi (FOR CLASS H CONCRETE, f'_c IS TAKEN AT 56 DAYS)
 REINFORCING STEEL: $f_y = 60,000$ psi

CAISSON CONCRETE:
 CLASS BZ CONCRETE: $f'_c = 4,000$ psi
 REINFORCING STEEL: $f_y = 60,000$ psi

PRECAST PRESTRESSED CONCRETE:
 CLASS PS CONCRETE $f'_c =$ (SEE DETAILS)
 $f'_s = 270,000$ psi

ALL GIRDERS SHALL BE 35 DAYS OLD (MIN.) AT TIME OF PIER AND ABUTMENT DIAPHRAGM PLACEMENT.

THE FOLLOWING TABLE GIVES THE MINIMUM LAP SPLICE LENGTH FOR EPOXY COATED REINFORCING BARS PLACED IN ACCORDANCE WITH SUBSECTION 602.06. THESE SPLICE LENGTHS SHALL BE INCREASED BY 25% FOR BARS SPACED AT LESS THAN 6" ON CENTER.

BAR SIZE	#4	#5	#6	#7	#8	#9	#10	#11
SPLICE LENGTH FOR CLASS D/H CONCRETE	1'-3"	1'-7"	2'-5"	2'-10"	3'-8"	4'-8"	5'-11"	7'-3"

WHEN THE CONTRACTOR ELECTS TO SUBSTITUTE EPOXY COATED REINFORCEMENT FOR BLACK REINFORCING BARS, THE MINIMUM LAP SPLICE SHALL BE AS DESCRIBED ABOVE.

THE FOLLOWING TABLE GIVES THE MINIMUM LAP SPLICE LENGTH FOR BLACK REINFORCING BARS PLACED IN ACCORDANCE WITH SUBSECTION 602.06. THESE SPLICE LENGTHS SHALL BE INCREASED BY 25% FOR BARS SPACED AT LESS THAN 6" ON CENTER.

BAR SIZE	#4	#5	#6	#7	#8	#9	#10	#11
SPLICE LENGTH FOR CLASS D/H CONCRETE	1'-1"	1'-4"	1'-7"	1'-11"	2'-6"	3'-1"	3'-11"	4'-10"

THE ABOVE SPLICE LENGTHS MAY BE REDUCED BY 20% WHEN 3" OF CLEAR COVER EXISTS AND BAR SPACING IS 6" OR GREATER ON CENTER.

THE CONTRACTOR SHALL BE RESPONSIBLE FOR THE STABILITY OF THE STRUCTURE DURING CONSTRUCTION.

PERMANENT DECK FORMS ARE REQUIRED. DECK FORMS MAY BE STEEL OR PRECAST CONCRETE.

FOR STRUCTURE NUMBER INSTALLATION, SEE STANDARD S-614-12.

STATIONS, ELEVATIONS, AND DIMENSIONS CONTAINED IN THESE PLANS ARE CALCULATED FROM A RECENT FIELD SURVEY. THE CONTRACTOR SHALL VERIFY ALL DEPENDENT DIMENSIONS IN THE FIELD BEFORE ORDERING OR FABRICATING ANY MATERIAL.

THE INFORMATION SHOWN ON THESE PLANS CONCERNING THE TYPE AND LOCATION OF UNDERGROUND UTILITIES IS NOT GUARANTEED TO BE ACCURATE OR ALL INCLUSIVE. THE CONTRACTOR IS RESPONSIBLE FOR MAKING HIS OWN DETERMINATION AS TO THE TYPE AND LOCATION OF UNDERGROUND UTILITIES AS MAY BE NECESSARY TO AVOID DAMAGE THERETO. THE CONTRACTOR SHALL CONTACT THE UTILITY NOTIFICATION CENTER OF COLORADO AT 1-800-922-1987 AT LEAST 2 DAYS (NOT INCLUDING THE DAY OF NOTIFICATION) PRIOR TO ANY EXCAVATION OR OTHER EARTHWORK.

INDEX OF DRAWINGS

SHEET NO.	TITLE
B1	GENERAL NOTES
B2	SUMMARY OF QUANTITIES
B3	GENERAL LAYOUT
B4	TYPICAL SECTION
B5	ENGINEERING GEOLOGY
B6	BRIDGE HYDRAULIC INFORMATION (1 OF 2)
B7	BRIDGE HYDRAULIC INFORMATION (2 OF 2)
B8	CONSTRUCTION & FOUNDATION LAYOUT
B9	DRILLED CAISSON AND PILE DETAILS
B10	ABUTMENT 1 DETAILS
B11	ABUTMENT 3 DETAILS
B12	WINGWALL DETAILS
B13	PIER 2 DETAILS (1 OF 2)
B14	PIER 2 DETAILS (2 OF 2)
B15	SUPERSTRUCTURE REINFORCING PLAN & TYPICAL SECTION
B16	BT 63 GIRDER DETAILS (1 OF 2)
B17	BT 63 GIRDER DETAILS (2 OF 2)
B18	PRECAST PANEL DECK FORM (1 OF 2)
B19	PRECAST PANEL DECK FORM (2 OF 2)
B20	BRIDGE RAIL TYPE 10M (SPECIAL) (1 OF 2)
B21	BRIDGE RAIL TYPE 10M (SPECIAL) (2 OF 2)
B22	SLOPE PAVING DETAILS
B23	MECHANICALLY STABILIZED BACKFILL
B24	ARCHITECTURAL DETAILS
B25	BRIDGE DECK ELEVATIONS (1 OF 2)
B26	BRIDGE DECK ELEVATIONS (2 OF 2)

BRIDGE DESCRIPTION

2 - SPAN (122'-9", 103'-9") BRIDGE
 CONCRETE PRESTRESSED GIRDER,
 CONTINUOUS (PRECAST) OVER WILSON
 GULCH.
 25'-0" ROADWAY CURB-TO-CURB, NO
 SKEW, (2) 1'-6" TYPE 10M (SPECIAL)
 BRIDGE RAILS

CROSS REFERENCE DRAWING NUMBER
 (IF BLANK, REFERENCE IS TO SAME SHEET)



SECTION OR DETAIL IDENTIFICATION

Design	INITIAL	DATE	Checked By
	BJA	08/08	
Detail	INITIAL	DATE	Checked By
	TAH	08/08	
Quantity	INITIAL	DATE	Checked By
	TAH	08/08	

FOR BURIED UTILITY INFORMATION
THREE (3) BUSINESS DAYS
BEFORE YOU DIG
CALL 811
 (or 1-800-922-1987)
 UTILITY NOTIFICATION
 CENTER OF COLORADO (UNCC)
 www.uncc.org



Print Date: 9/24/2010	Sheet Revisions			Colorado Department of Transportation 3803 North Main Avenue Suite 200 Durango, CO 81301 Phone: 970-385-1440 FAX: 970-385-8365 Region 5 EJA	As Constructed	RAMP D OVER WILSON GULCH		Project No./Code
File Name: 16042Y_GenNotes_01.dgn	Date:	Comments	Init.		No Revisions: 09/10	GENERAL NOTES		NH 1602-114
Horiz. Scale: 1:1 Vert. Scale: As Noted				Revised:	Designer: B. Allen	Structure: P-05-Y	16042	
Unit Information 0221 Unit Leader STW				Void:	Detailer: R. Artman	Subset Sheets: B1 of B26	Sheet Number 301	
SEMA CONSTRUCTION	WILSON & COMPANY							

SUMMARY OF QUANTITIES

Item No.	Description	Units	Superstructure	Abut. 1	Pier 2	Abut. 3	Total
206	Structure Excavation	CY	-	-	14	-	14
206	Structure Backfill (Class 1)	CY	-	175	11	193	379
206	Mechanical Reinforcement of Soil	CY	-	140	-	155	295
206	Driven Pile (HP 14x89)	LF	-	363	-	198	561
503	Drilled Caisson (36")	LF	-	-	49	-	49
507	Concrete Slope and Ditch Paving (Reinforced)	CY	-	57	-	88	145
518	Waterstop	LF	229	-	-	-	229
601	Concrete Class D (Bridge)	CY	-	32	56	34	122
602	Concrete Class H	CY	226	-	-	-	226
601	Structural Concrete Coating	SY	884	82	358	82	1,406
602	Reinforcing Steel (Epoxy Coated)	LBS	55,827	3,344	9,965	3,545	72,681
606	Bridge Rail Type 10M (Special)	LF	458	-	-	-	458
613	2" Electrical Conduit	LF	466	-	-	-	466
613	6" Electrical Conduit	LF	466	-	-	-	466
613	1" Conduit (Anti-Icing System)	LF	233	-	-	-	233
613	1 1/2" Conduit (Anti-Icing System)	LF	233	-	-	-	233
613	2" Conduit (Anti-Icing System)	LF	233	-	-	-	233
618	Prestressed Concrete I (BT 63)	LF	678	-	-	-	678


Design		Detail		Quantities	
INITIAL	DATE	INITIAL	DATE	INITIAL	DATE
Designed By: BJA	08/08	INITIAL: RGA	08/08	INITIAL: BJA	08/08
Checked By: TAH	08/08	Checked By: TAH	08/08	Checked By: TAH	08/08

Print Date: 9/24/2010	 	Sheet Revisions Date: Comments Init.			 Colorado Department of Transportation 3803 North Main Avenue Suite 200 Durango, CO 81301 Phone: 970-385-1440 FAX: 970-385-8365 Region 5 EJA	As Constructed No Revisions: 09/10		RAMP D OVER WILSON GULCH SUMMARY OF QUANTITIES		Project No./Code
File Name: 16042Y_SumApproxQuant_01.dgn		<input type="checkbox"/> <input type="checkbox"/> <input type="checkbox"/>					Designer: B. Allen Structure P-05-Y Detailer: R. Artman Numbers	NH 1602-114		16042
Horiz. Scale: 1:1 Vert. Scale: As Noted Unit Information 0221 Unit Leader STW							Sheet Subset: Bridge Subset Sheets: B2 of B26	Sheet Number		302

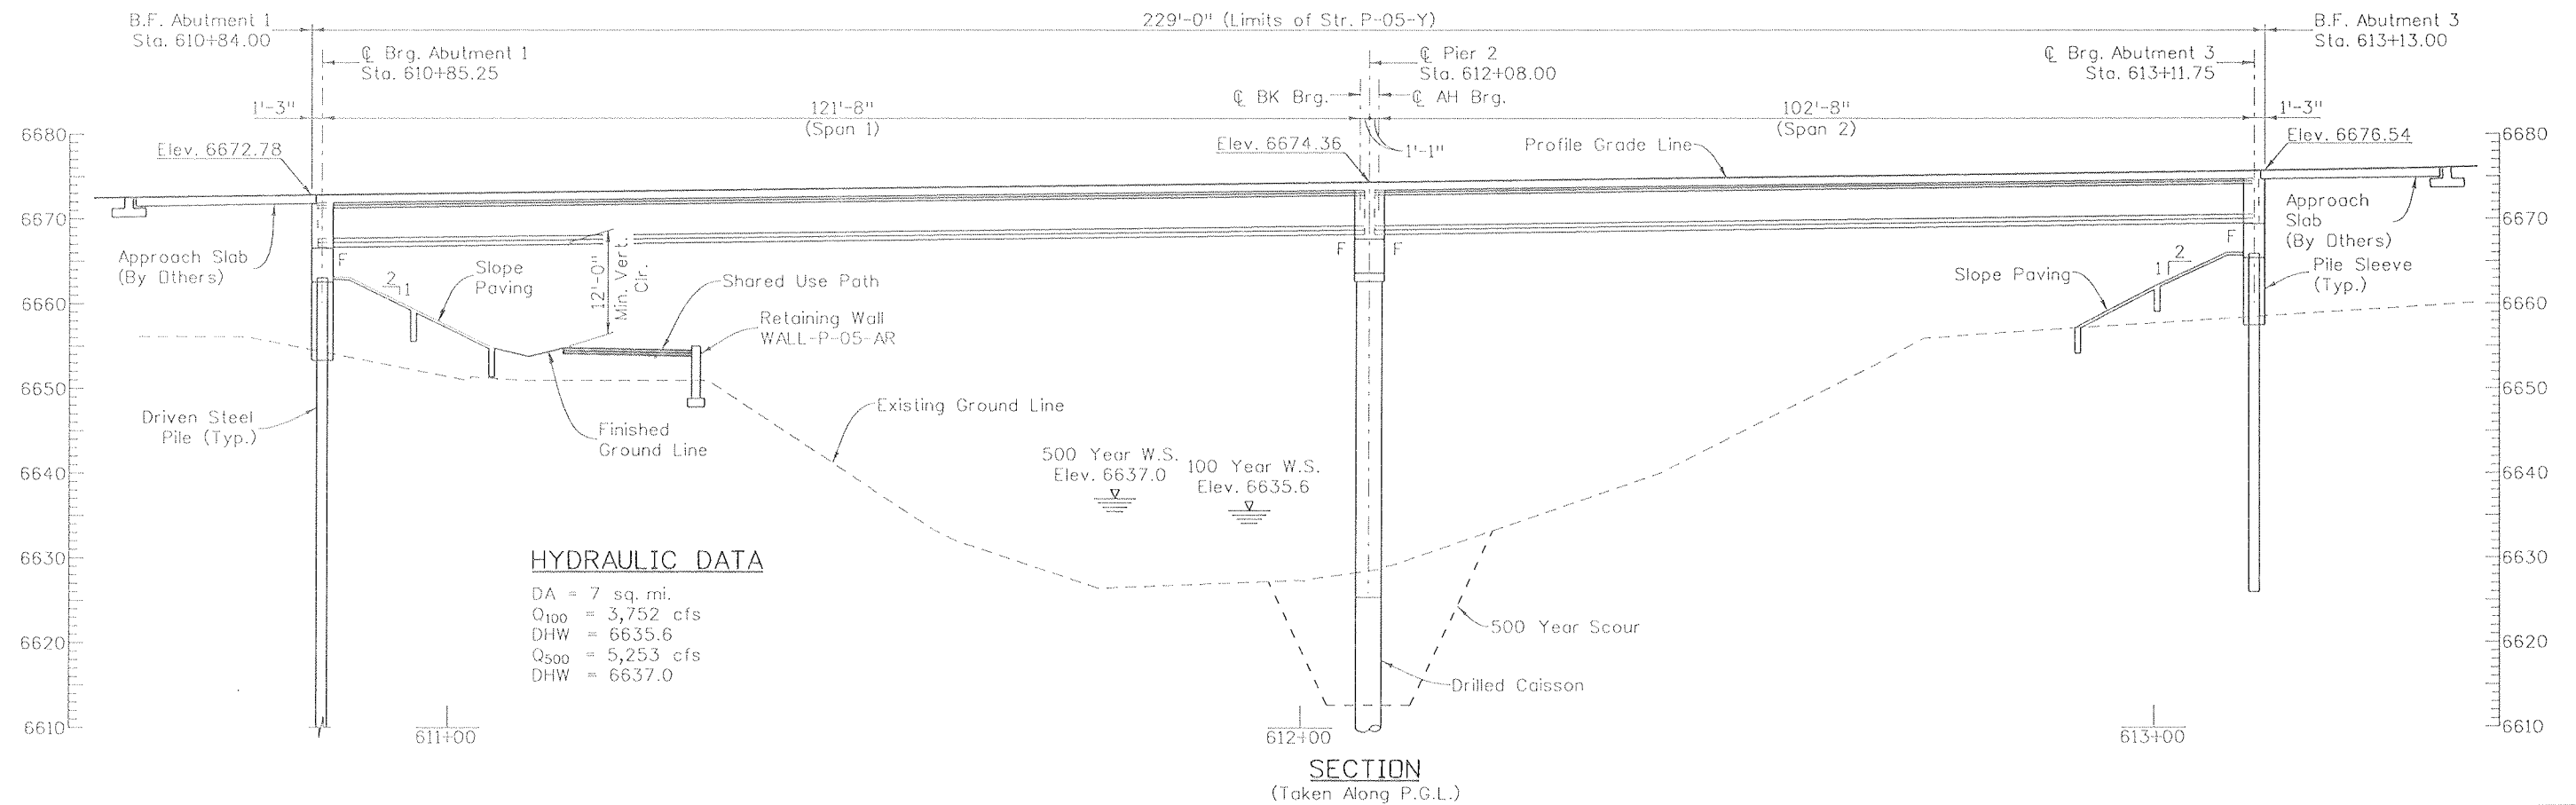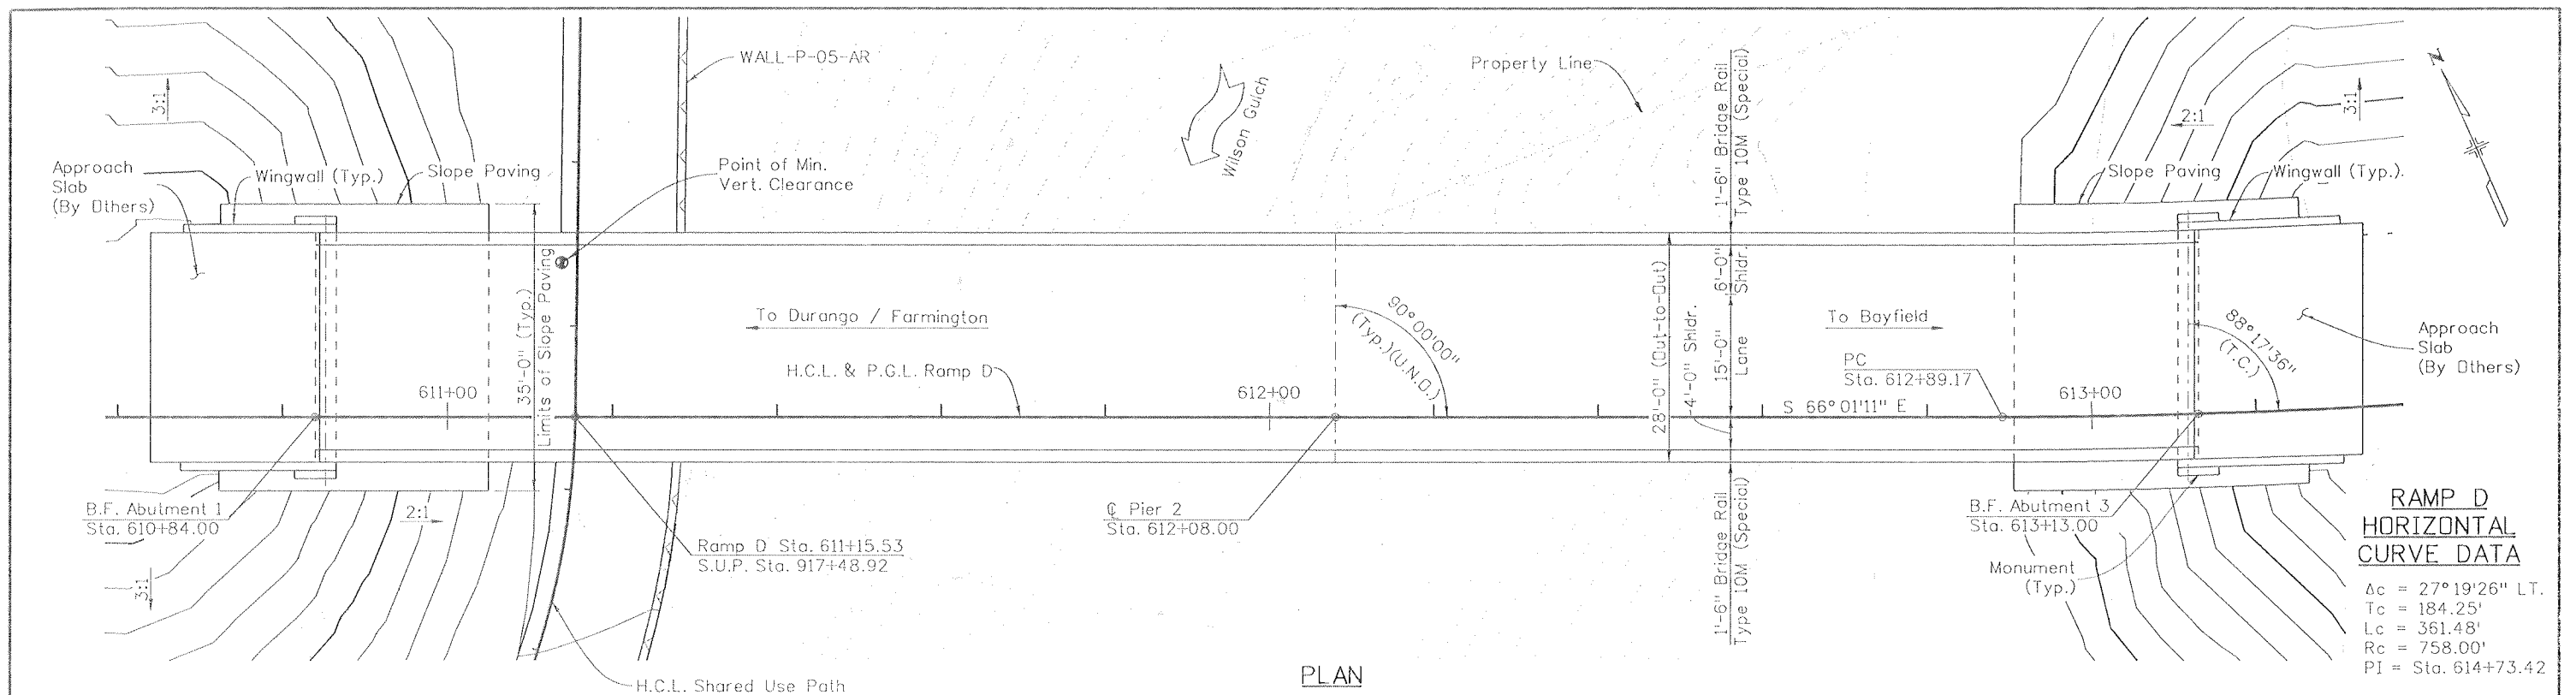


Design		Check		Quantity	
INITIAL	DATE	INITIAL	DATE	INITIAL	DATE
Designed By: BJA	08/08	Checked By: BJA	08/08	Checked By: BJA	08/08
Checked By: TAH	08/08	Checked By: TAH	08/08	Checked By: TAH	08/08


Print Date: 9/24/2010	Sheet Revisions			Colorado Department of Transportation 3803 North Main Avenue Suite 200 Durango, CO 81301 Phone: 970-385-1440 FAX: 970-385-8365	As Constructed		RAMP D OVER WILSON GULCH GENERAL LAYOUT		Project No./Code	
File Name: 16042Y_GenLayout_01.dgn	Date:	Comments:	Init.:		No Revisions: 09/10			NH 1602-114		
Horiz. Scale: 1:20				Region 5	Revised:	Designer: B. Allen	Structure Numbers: P-05-Y	16042		
Unit Information 0221					Void:	Detailer: D. Anderson	Subset Sheets: B3 of B26	Sheet Number 303		
SEMA CONSTRUCTION		WILSON & COMPANY		EJA						

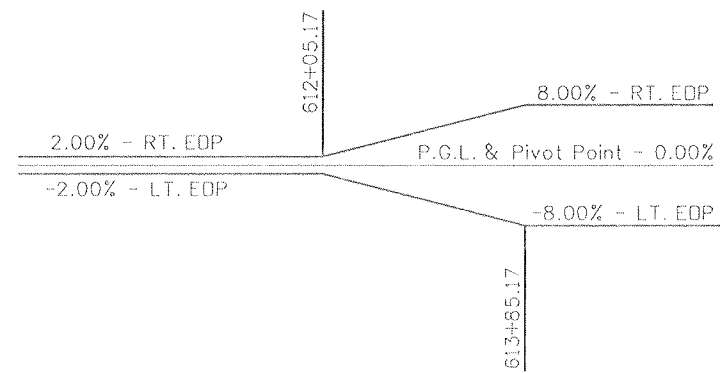

SUPERELEVATION DIAGRAM

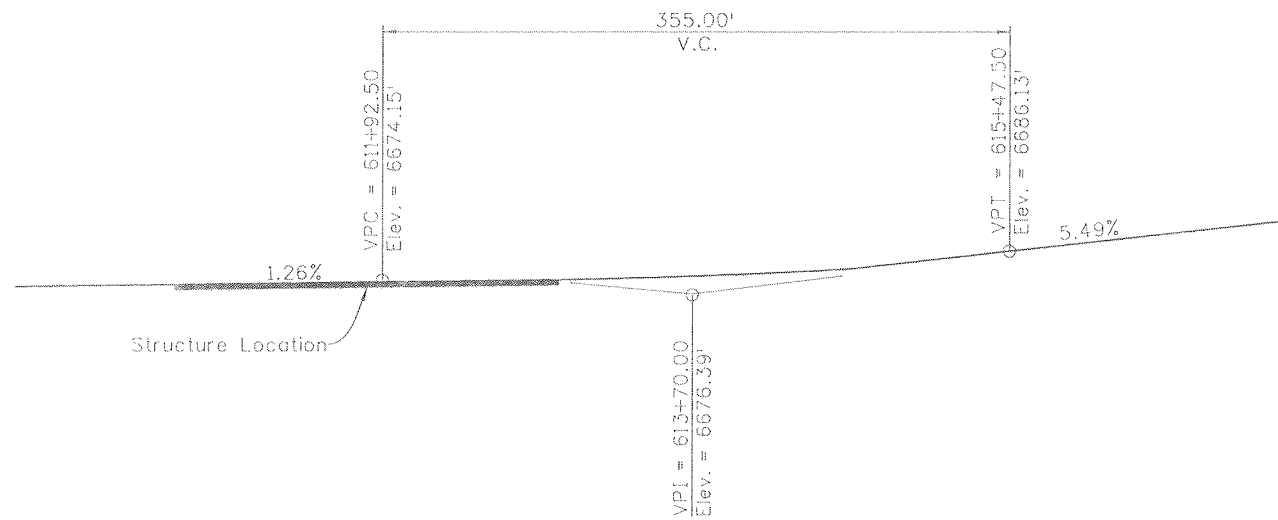

PROFILE GRADE

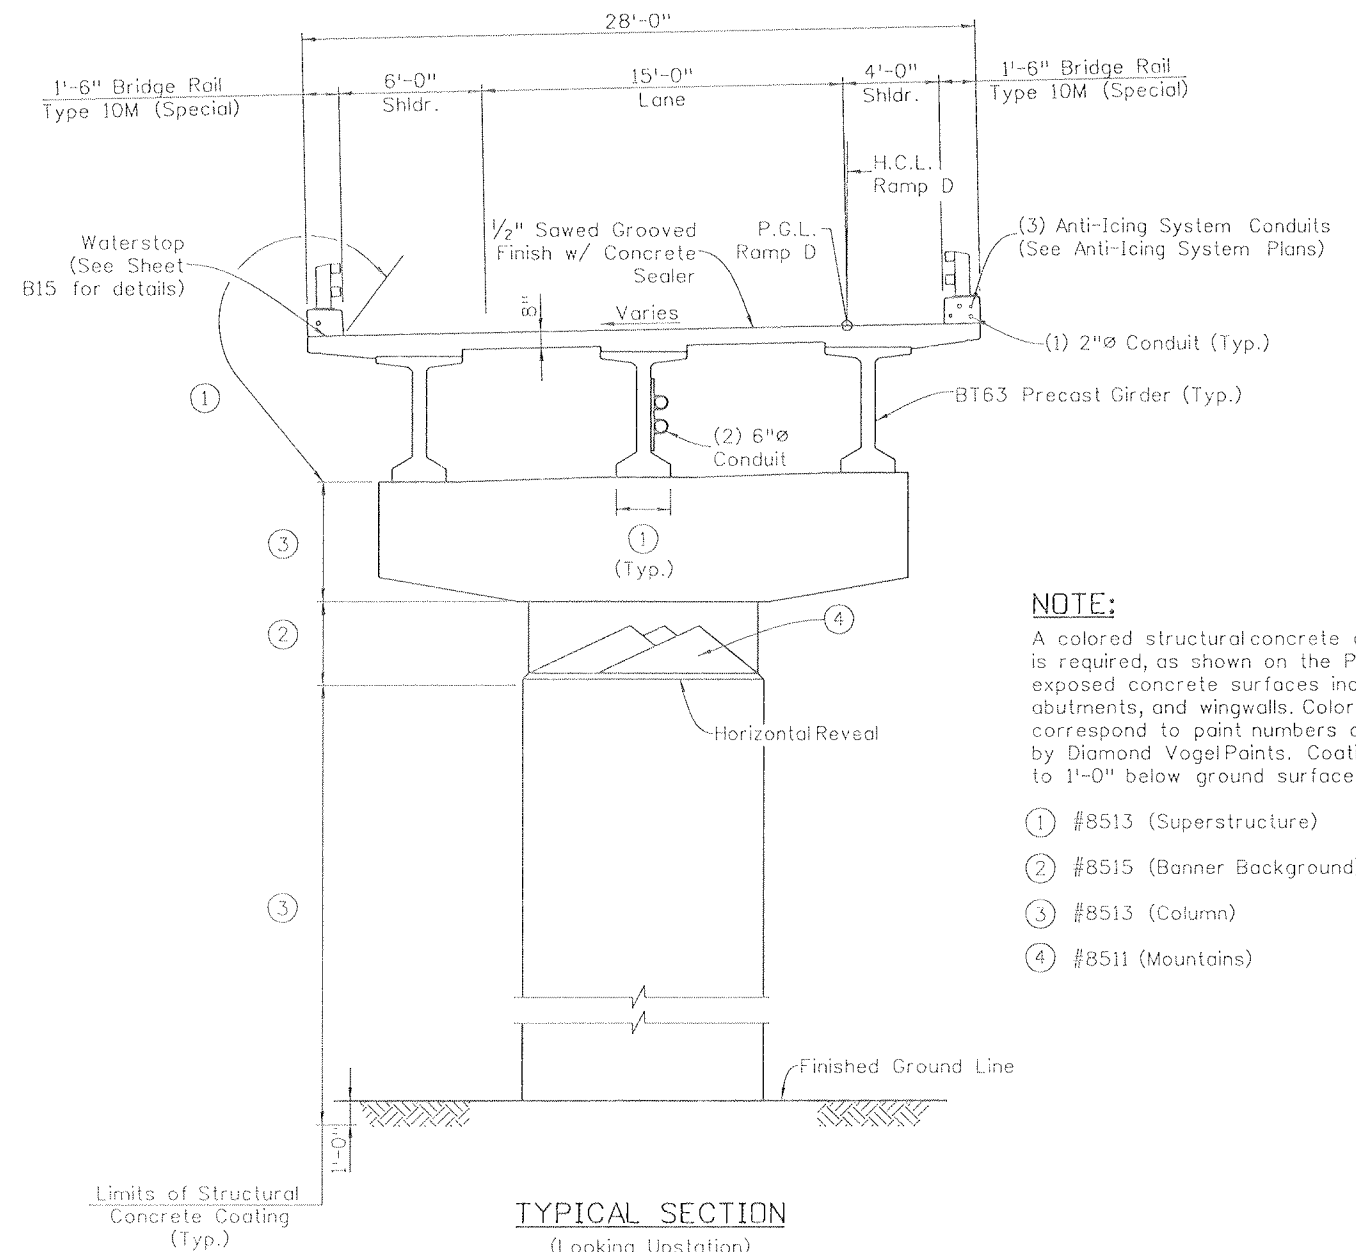

TYPICAL SECTION
(Looking Upstation)

NOTE:
A colored structural concrete coating finish is required, as shown on the Plans, on all exposed concrete surfaces including piers, abutments, and wingwalls. Color numbers correspond to paint numbers as described by Diamond Vogel Paints. Coating shall extend to 1'-0" below ground surface.

- ① #8513 (Superstructure)
- ② #8515 (Banner Background)
- ③ #8513 (Column)
- ④ #8511 (Mountains)

Design		Detail		Quantities	
INITIAL	DATE	INITIAL	DATE	INITIAL	DATE
Designed By BJA	08/08	Detailed By BJA	08/08	Quantity By BJA	08/08
Checked By TAH	08/08	Checked By TAH	08/08	Checked By TAH	08/08

Print Date: 9/24/2010
 File Name: 16042Y_TypSection_01.dgn
 Horiz. Scale: 1:1 Vert. Scale: As Noted
 Unit Information 0221 Unit Leader STW

SEMA CONSTRUCTION **WILSON & COMPANY**

Sheet Revisions		
Date:	Comments	Init.

Colorado Department of Transportation
 3803 North Main Avenue
 Suite 200
 Durango, CO 81301
 Phone: 970-385-1440 FAX: 970-385-8365



DOT
DEPARTMENT OF TRANSPORTATION

Region 5 EJA

As Constructed	
No Revisions:	09/10
Revised:	
Void:	

RAMP D OVER WILSON GULCH TYPICAL SECTION			
Designer:	B. Allen	Structure Numbers	P-05-Y
Detailer:	D. Anderson		
Sheet Subset:	Bridge	Subset Sheets:	B4 of B26

Project No./Code	
NH 1602-114	
16042	
Sheet Number	304

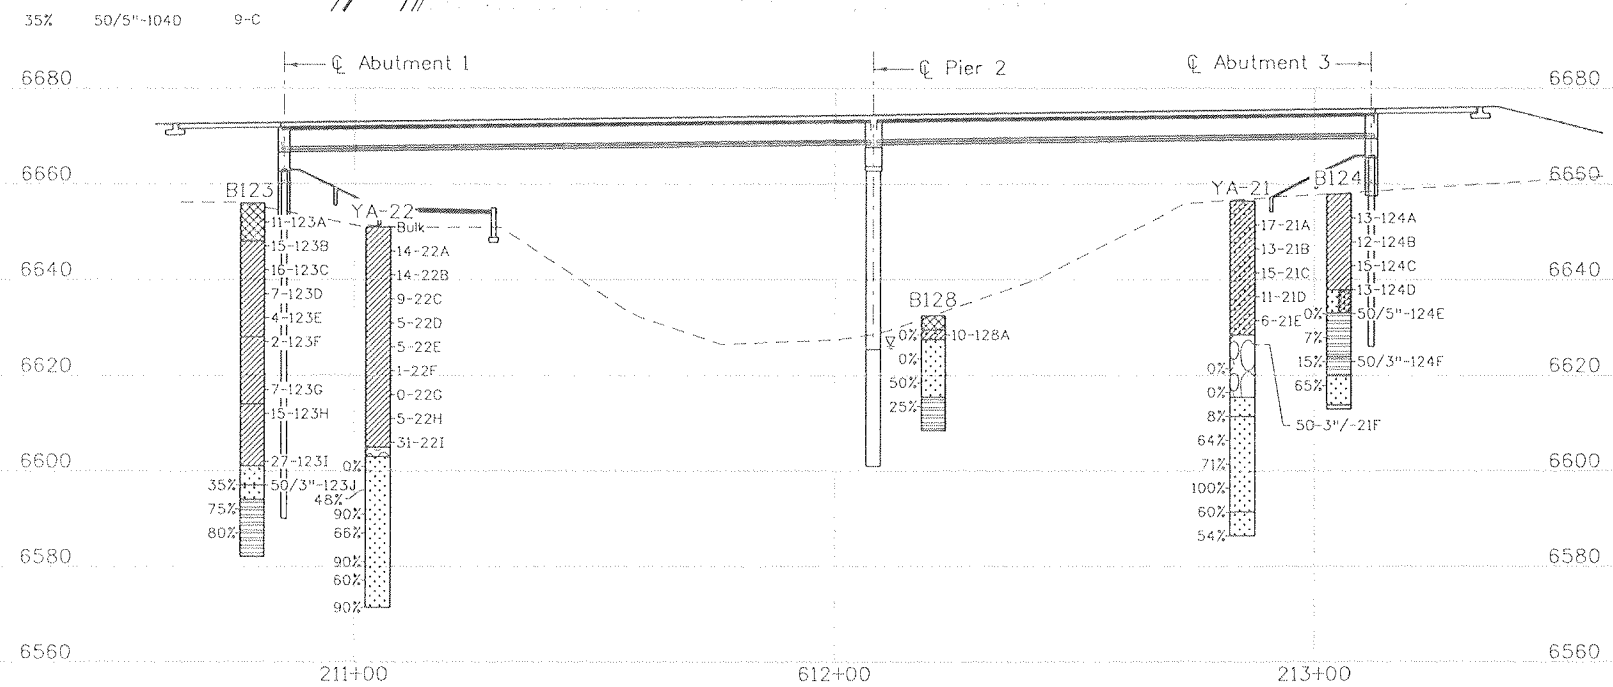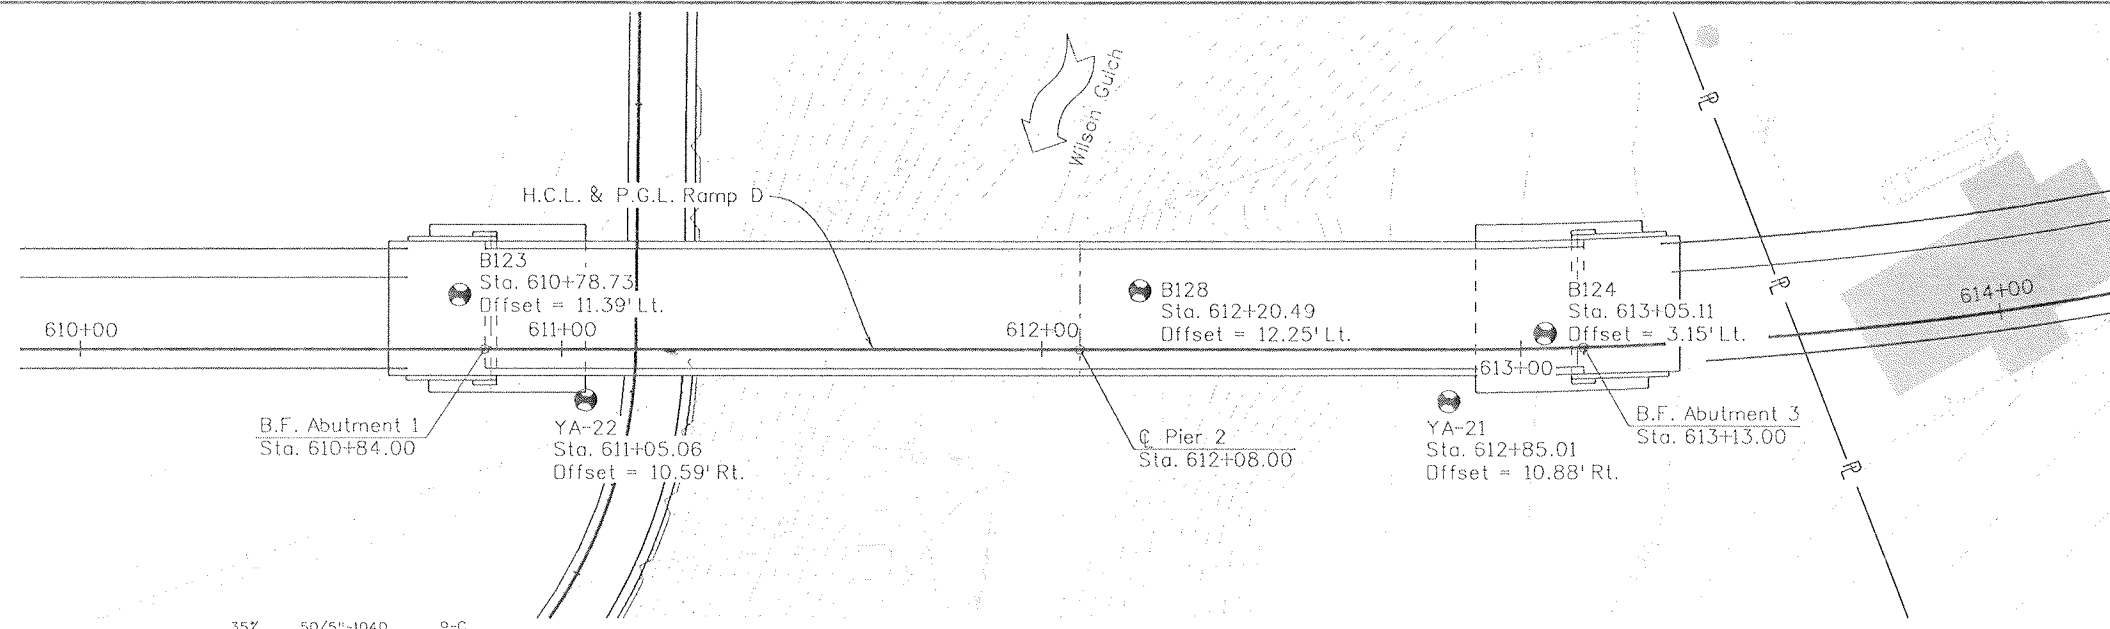

Design		Detail		Quantities	
INITIAL	DATE	INITIAL	DATE	INITIAL	DATE
KAK	08/08	RGA	08/08	KAK	08/08
Checked By	Checked By	Checked By	Checked By	Checked By	Checked By
TAH	08/08	TAH	08/08	TAH	08/08

Sample No.	Depth	Classification	Grading Analysis (MMD)				Atterberg Limits			Water Content %	Dry Unit Weight p.c.f.
			Gravel	Coarse Sand	Fine Sand	Silt and Clay	Liquid Limit %	Plastic Limit %	Plasticity Index %		
21A	5-6										
BULK	0-5	SANDY CLAY	2	10	21	67	52	23	29	10.7	
22A	5-6									19.8	
22B	10-11									85.4	

SUMMARY OF TEST RESULTS		TYPE OF MATERIAL	
	Sandy Clay		Shale
	Sandstone		Clayey Sand
	Fill		Coarse Sand - Clay
	Gravel and Cobbles		

Note: Boulders may be encountered at any depth

LEGEND	
	Boring Designation
	Partial Blowcount 50 blows per 5 inches
	Sample Designation
	Groundwater Depth
	R.Q.D.
	Standard Penetration Test Blows per Foot
	Location of Boring

Print Date: 9/24/2010
 File Name: 16042Y_EngGeology_01.dgn
 Horiz. Scale: 1:1 Vert. Scale: As Noted
 Unit Information 0221 Unit Leader STW

Sheet Revisions		
Date:	Comments	Init.

Colorado Department of Transportation
 3803 North Main Avenue
 Suite 200
 Durango, CO 81301
 Phone: 970-385-1440 FAX: 970-385-8365
 Region 5 EJA

As Constructed
 No Revisions: 09/10
 Revised:
 Void:


RAMP D OVER WILSON GULCH
 ENGINEERING GEOLOGY


Designer: K. Kershaw
 Detailer: R. Artman

Structure Numbers: P-05-Y

Sheet Subset: Bridge Subset Sheets: B5 of B26


Project No./Code
 NH 1602-114
 16042
 Sheet Number 305

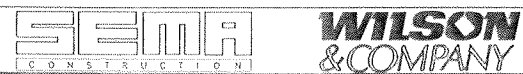

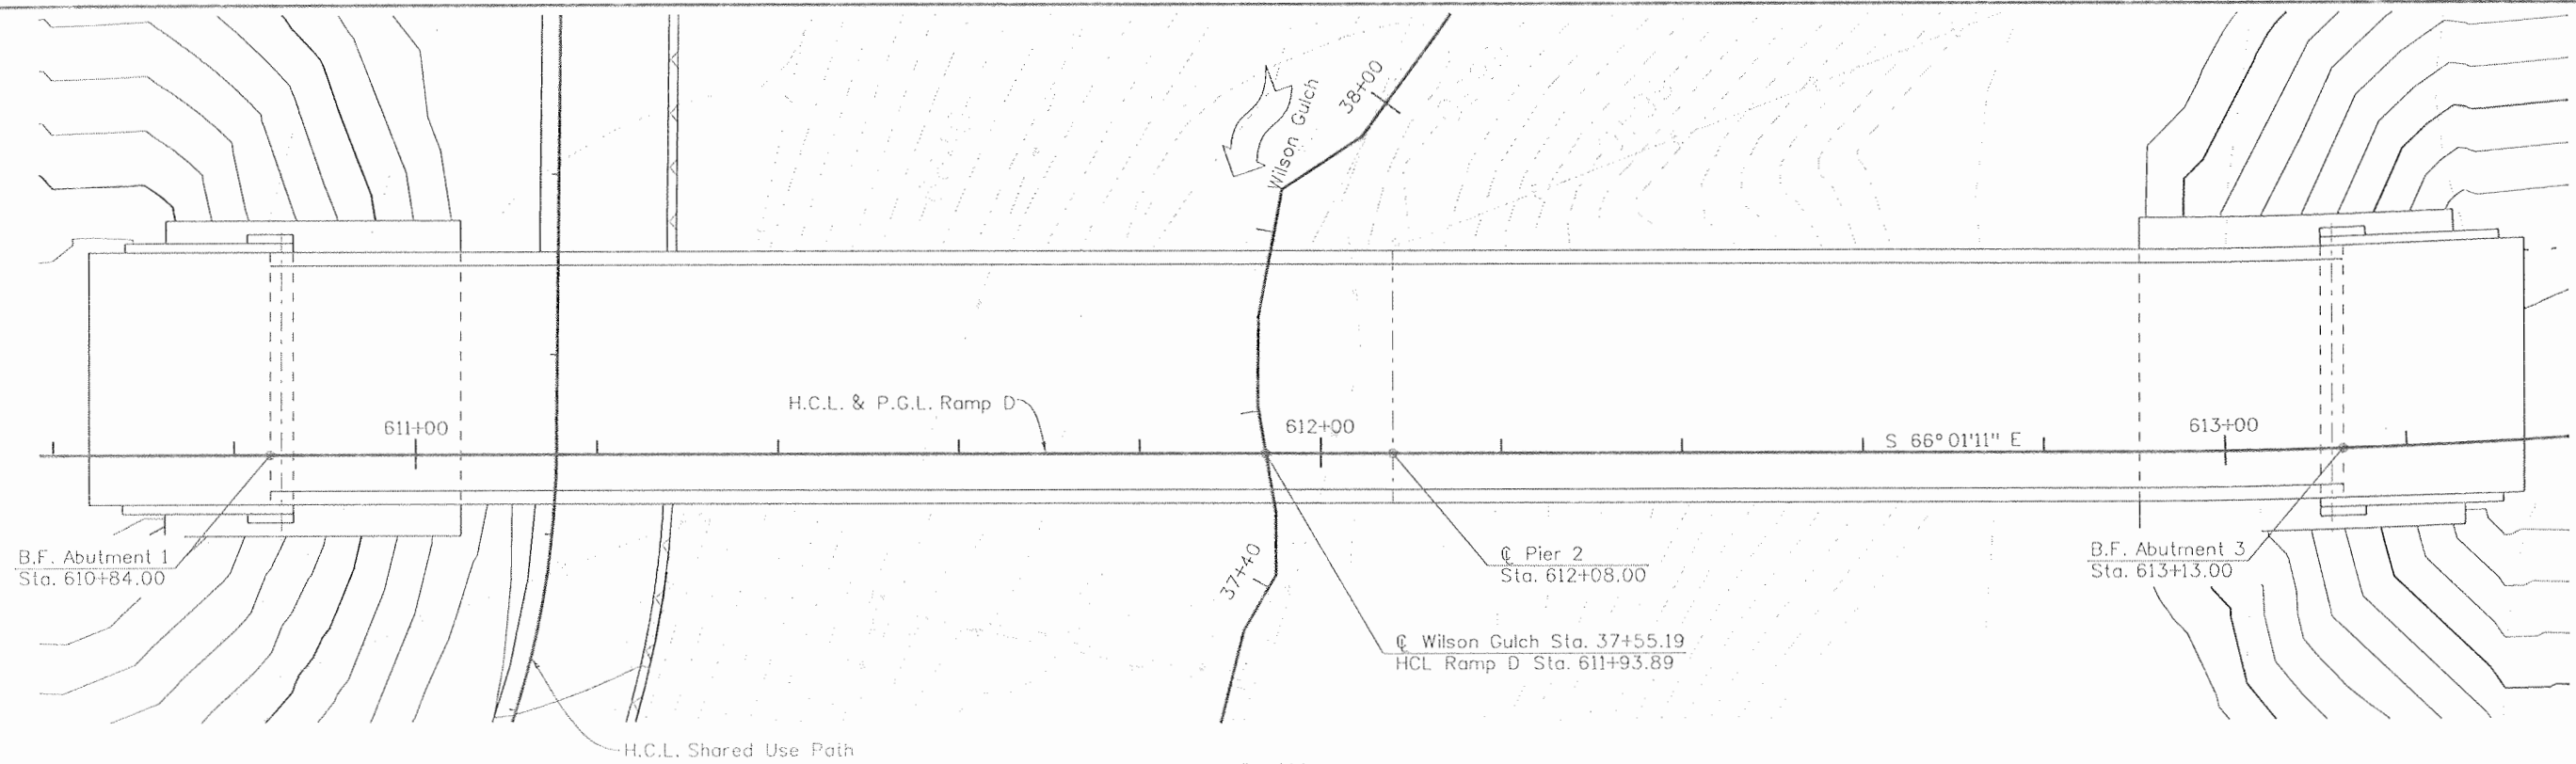

PLAN

PROFILE OF WATER SURFACE

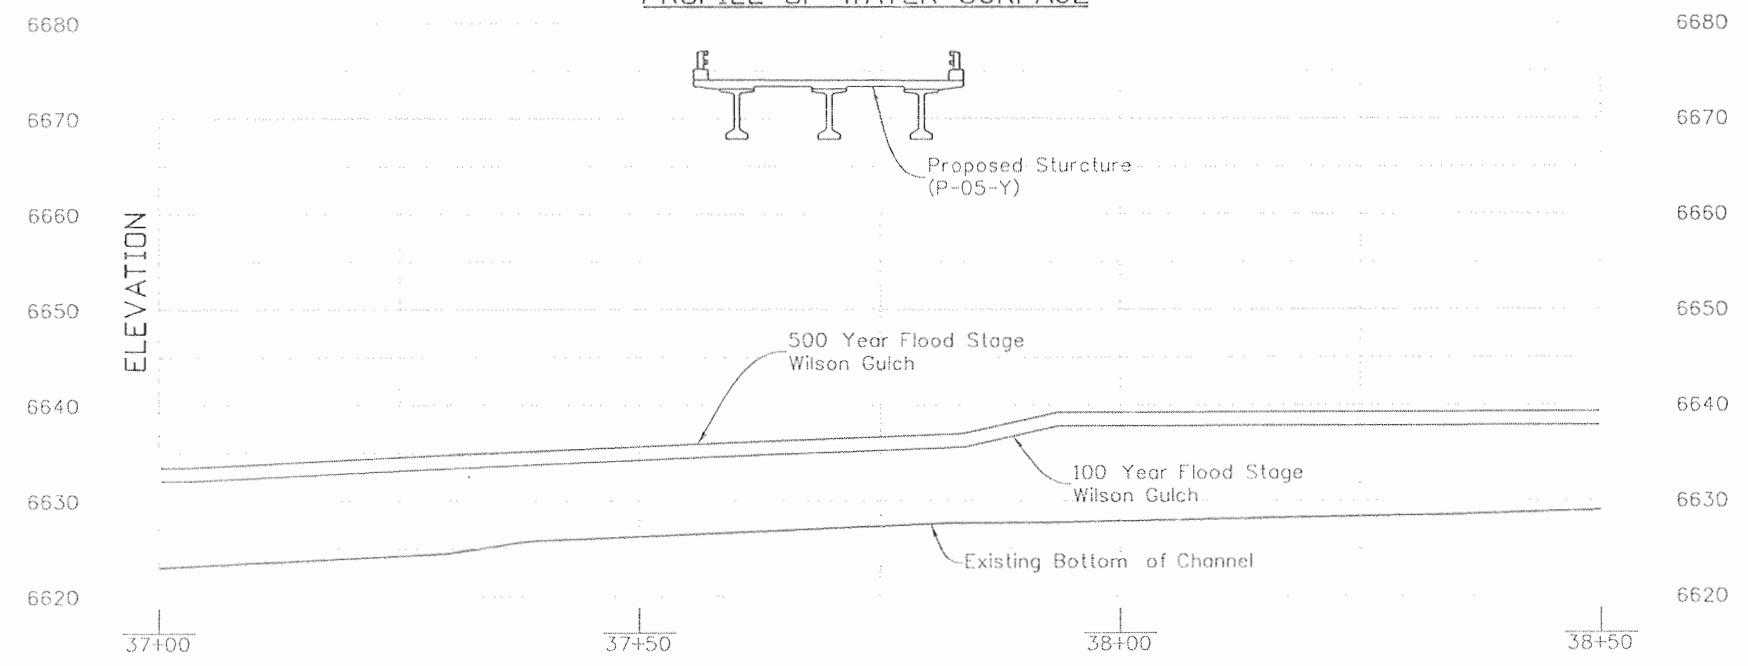

STATIONS ARE ALONG CHANNEL CENTERLINE IN FEET

NOTE:
See Stage Discharge Chart on Sheet B7.

Design		Detail		Quantities	
INITIAL	DATE	INITIAL	DATE	INITIAL	DATE
VSF	08/08	DFA	08/08	VSF	08/08
TAH	08/08	TAH	08/08	TAH	08/08
Designed By	Checked By	Designed By	Checked By	Quantities By	Checked By

Print Date: 9/27/2010	Sheet Revisions			Colorado Department of Transportation		As Constructed		RAMP D OVER WILSON GULCH BRIDGE HYDRAULIC INFORMATION (1 OF 2)		Project No./Code	
File Name: 16042Y_BHR_01.dgn	Date:	Comments	Init.	3803 North Main Avenue Suite 200 Durango, CO 81301 Phone: 970-385-1440 FAX: 970-385-8365		No Revisions: 09/10		Designer: E. Schmitz Structure P-05-Y		NH 1602-114	
Horiz. Scale: 1:20 Vert. Scale: As Noted				Region 5		Revised:		Detailer: D. Anderson Structure Numbers		16042	
Unit Information 0221 Unit Leader STW				EJA		Void:		Sheet Subset: Bridge Subset Sheets: B6 of B26		Sheet Number 306	

DRAINAGE AREA 7 SQUARE MILES

CHANNEL DESCRIPTION

BOTTOM MATERIAL: COHESIVE NON-COHESIVE
 BOTTOM MATERIAL SIZE: CLAY SILT SAND GRAVEL
 COBBLES OTHER
 STREAM FORM: STRAIGHT MEANDERING BRAIDED
 MANNINGS "n" FOR DESIGN: CHANNEL = 0.068 OVERBANK = 0.104
 DEBRIS: BRUSH TREES/LOGS ICE OTHER

COMPARISON OF HYDRAULICS Δ


	VELOCITY	FREEBOARD	MAX. BACKWATER
	fps	ft.	ft.
NATURAL CHANNEL	N/A	N/A	N/A
EXISTING CHANNEL	13.1	N/A	N/A
PROPOSED CHANNEL	13.3*	29.8	0.4*

Δ AT PROPOSED BRIDGE LOCATION DURING DESIGN DISCHARGE (Q100)


THE SCOUR LIMITS AND RIVER FLOW RATES MAY BE FOUND IN THE REPORT BY WILSON & COMPANY, DATED JULY 2008, ENTITLED "FINAL DRAINAGE REPORT FOR US 550 & US 160 INTERCHANGE".

*VELOCITY & BACKWATER DEPTHS CALCULATED BY HEC-RAS MODEL SIMULATING BRIDGE PIERS AS OBSTRUCTIONS IN OPEN CHANNEL.


DISCHARGE-FREQUENCY

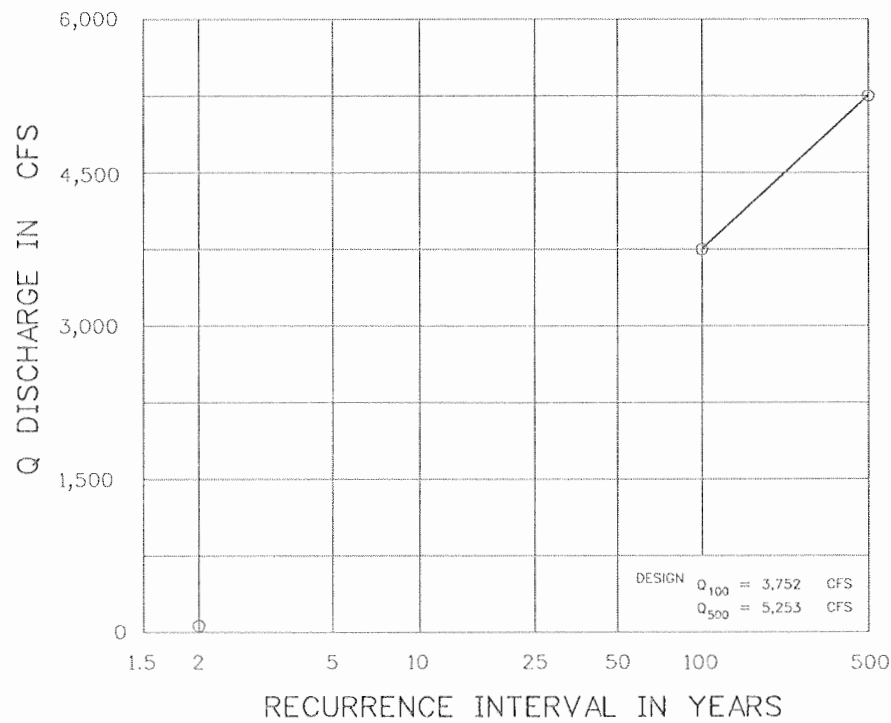


STAGE-DISCHARGE

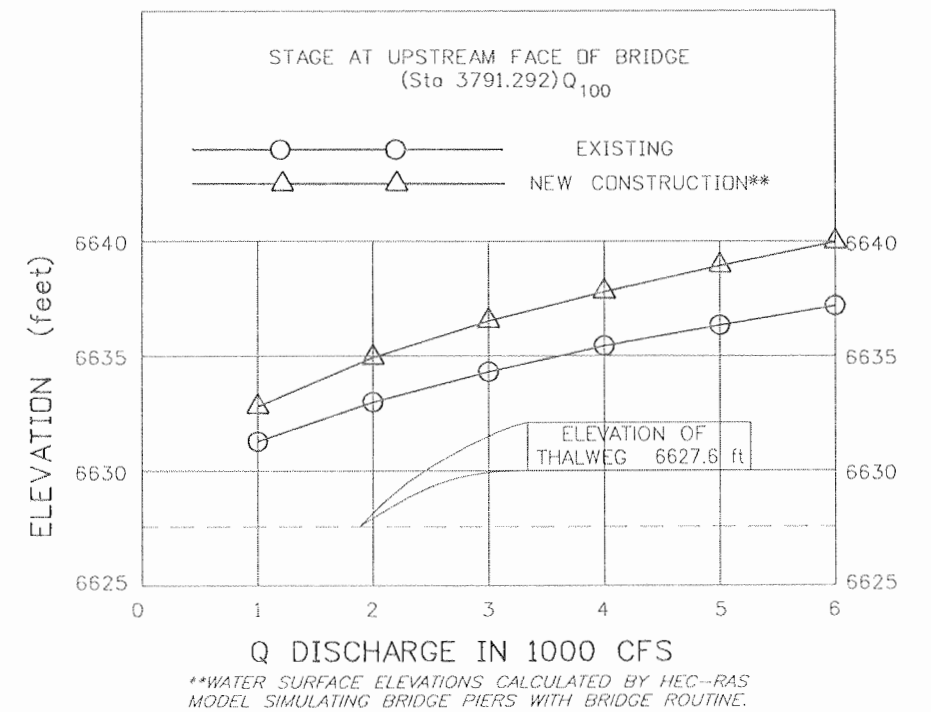


Design		Detail		Quantities	
INITIAL	DATE	INITIAL	DATE	INITIAL	DATE
VSF	05/08	TAH	08/08	VSF	08/08
Checked By	Checked By	Checked By	Checked By	Checked By	Checked By
TAH	TAH	TAH	TAH	TAH	TAH

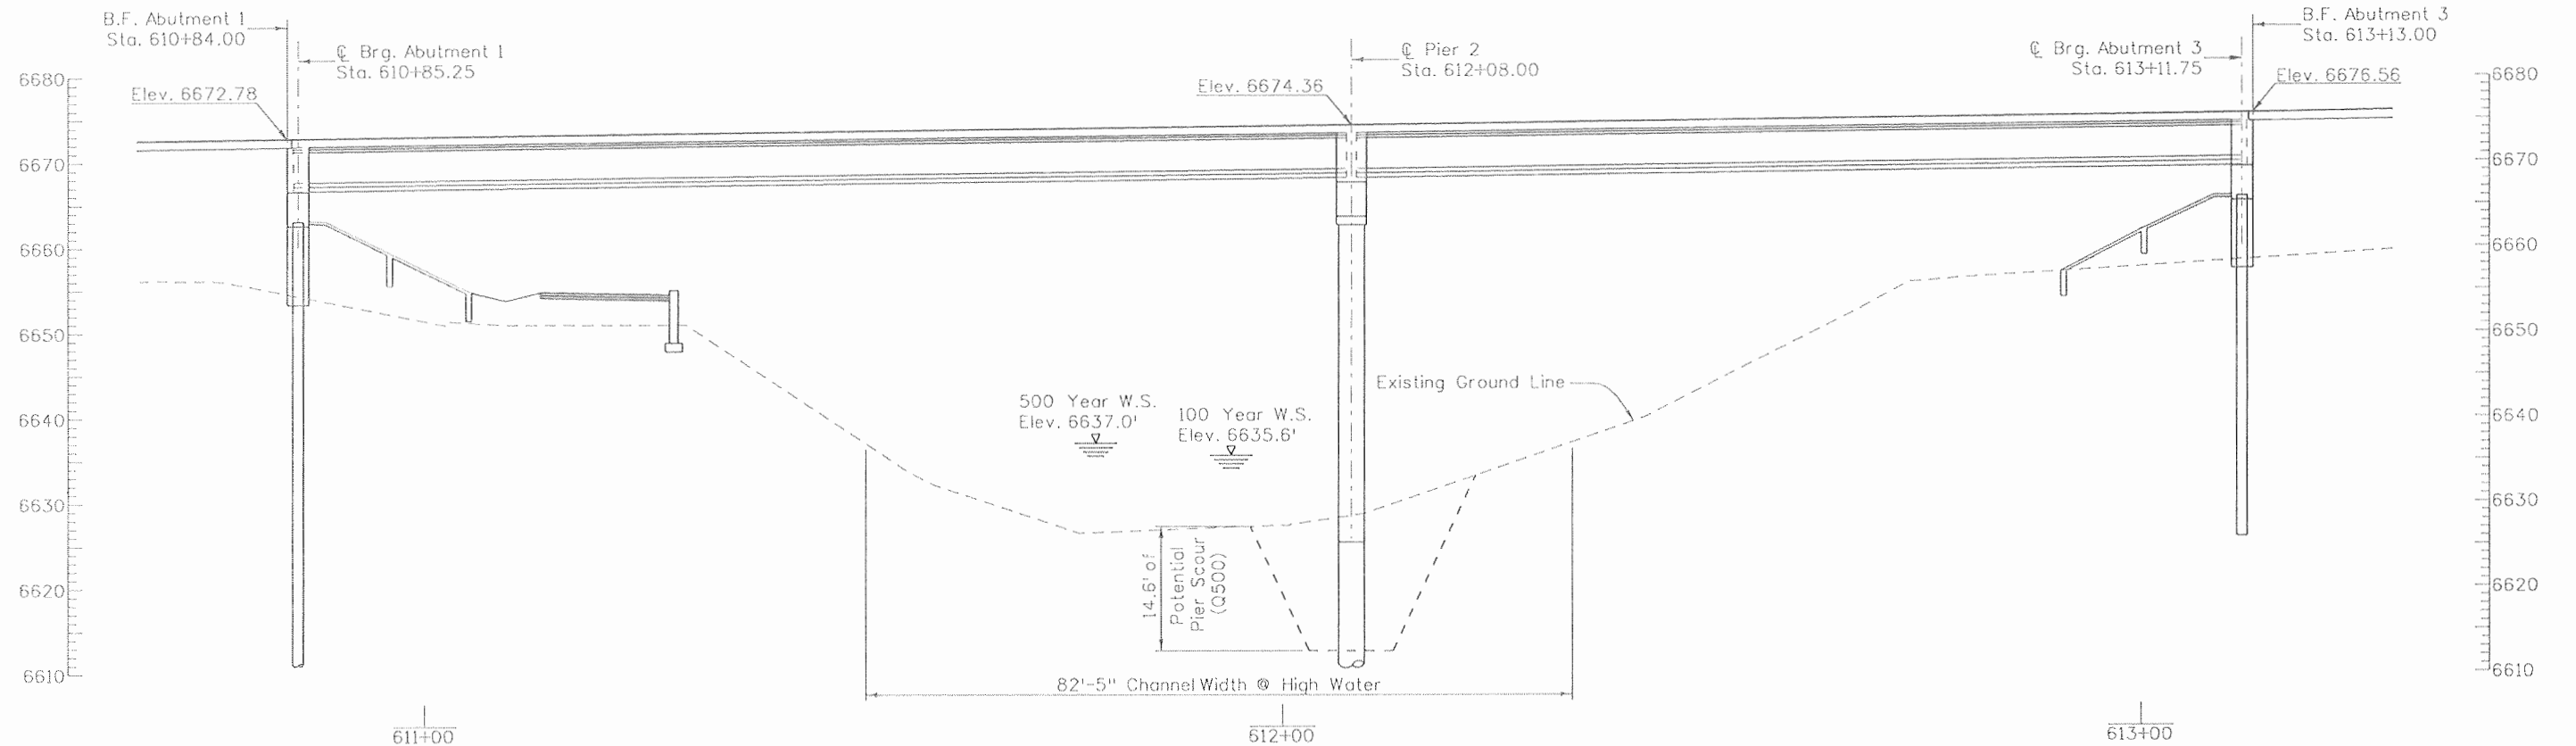


Print Date: 9/27/2010	Sheet Revisions			Colorado Department of Transportation		As Constructed	RAMP D OVER WILSON GULCH BRIDGE HYDRAULIC INFORMATION (2 OF 2)		Project No./Code
File Name: 16042Y_BHR_02.dgn	Date:	Comments:	Init.	3803 North Main Avenue Suite 200 Durango, CO 81301 Phone: 970-385-1440 FAX: 970-385-8365		No Revisions: 09/10	Designer: V. Fossinger Structure P-05-Y		NH 1602-114
Horiz. Scale: 1:1 Vert. Scale: As Noted				Region 5 EJA		Revised:	Detailer: D. Anderson Numbers		16042
Unit Information 0221 Unit Leader STW						Void:	Sheet Subset: Bridge Subset Sheets: B7 of B26		Sheet Number 307

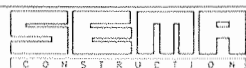


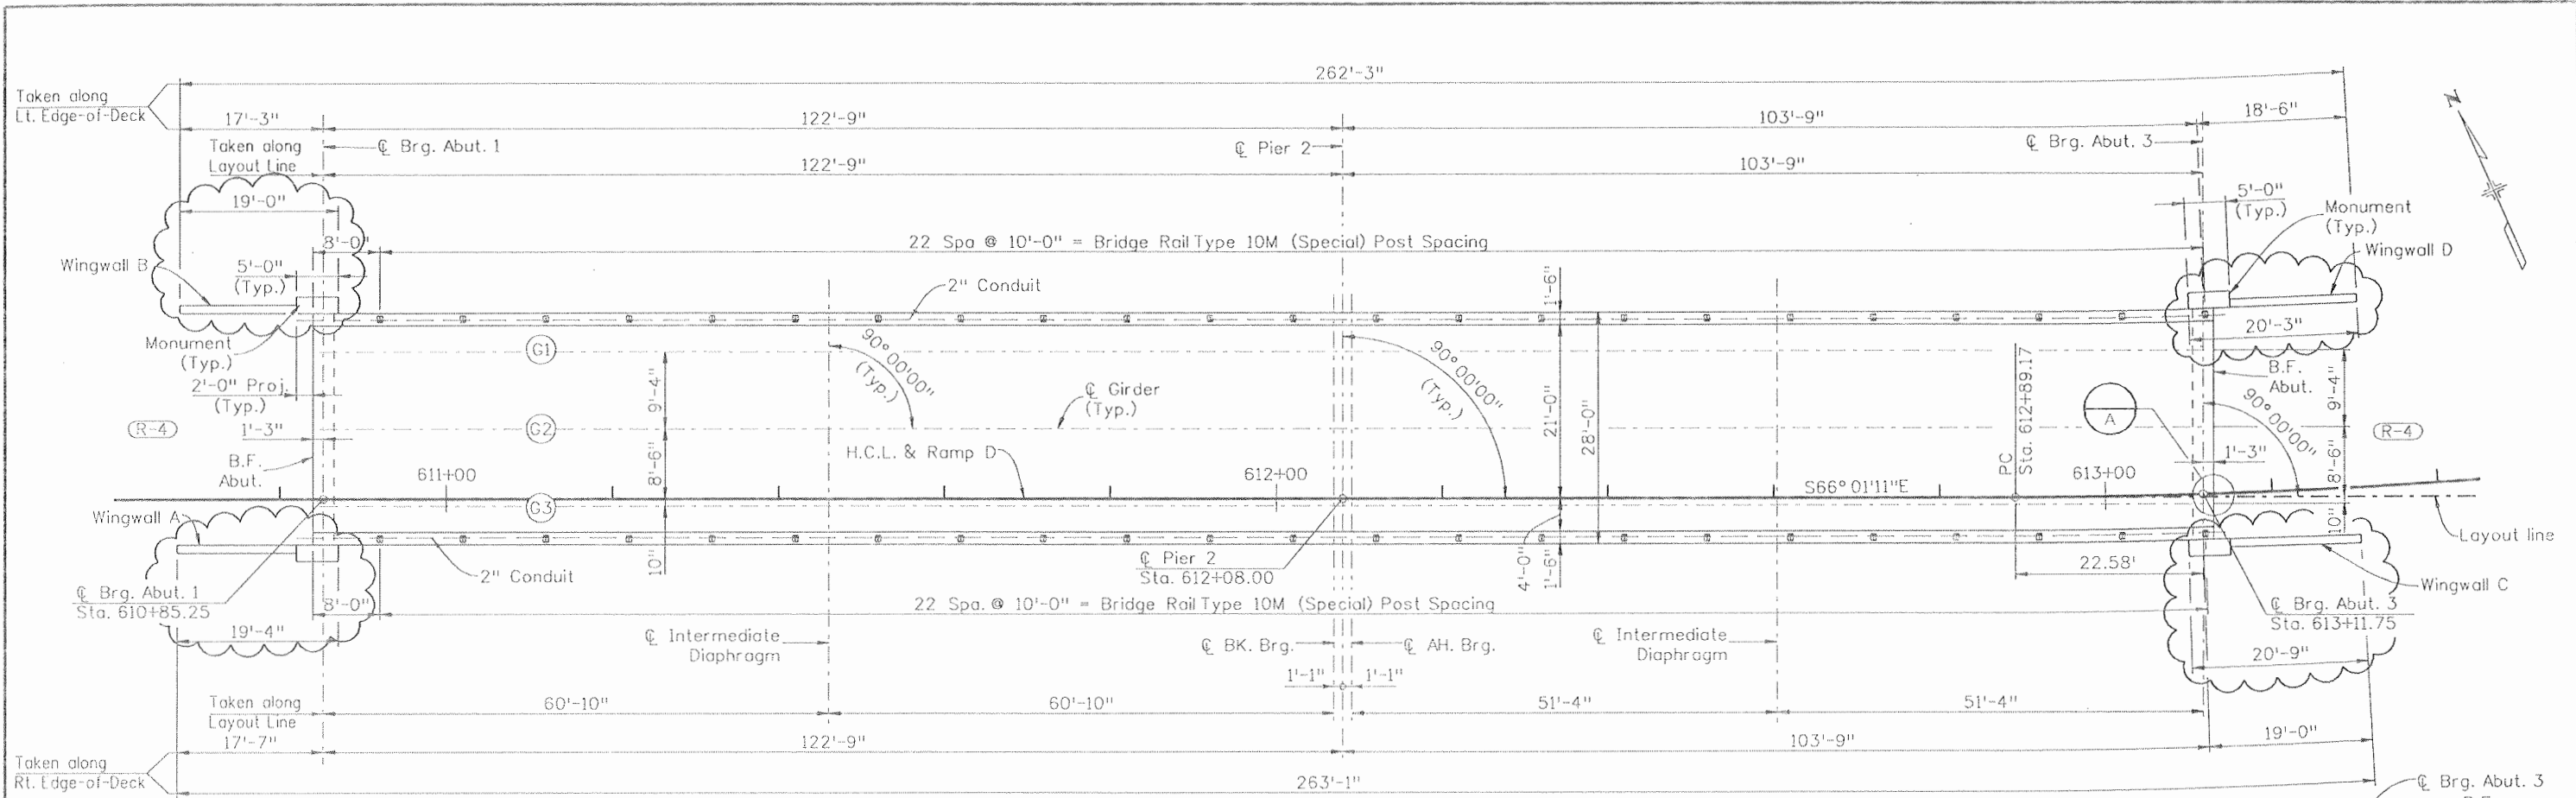

CONSTRUCTION LAYOUT

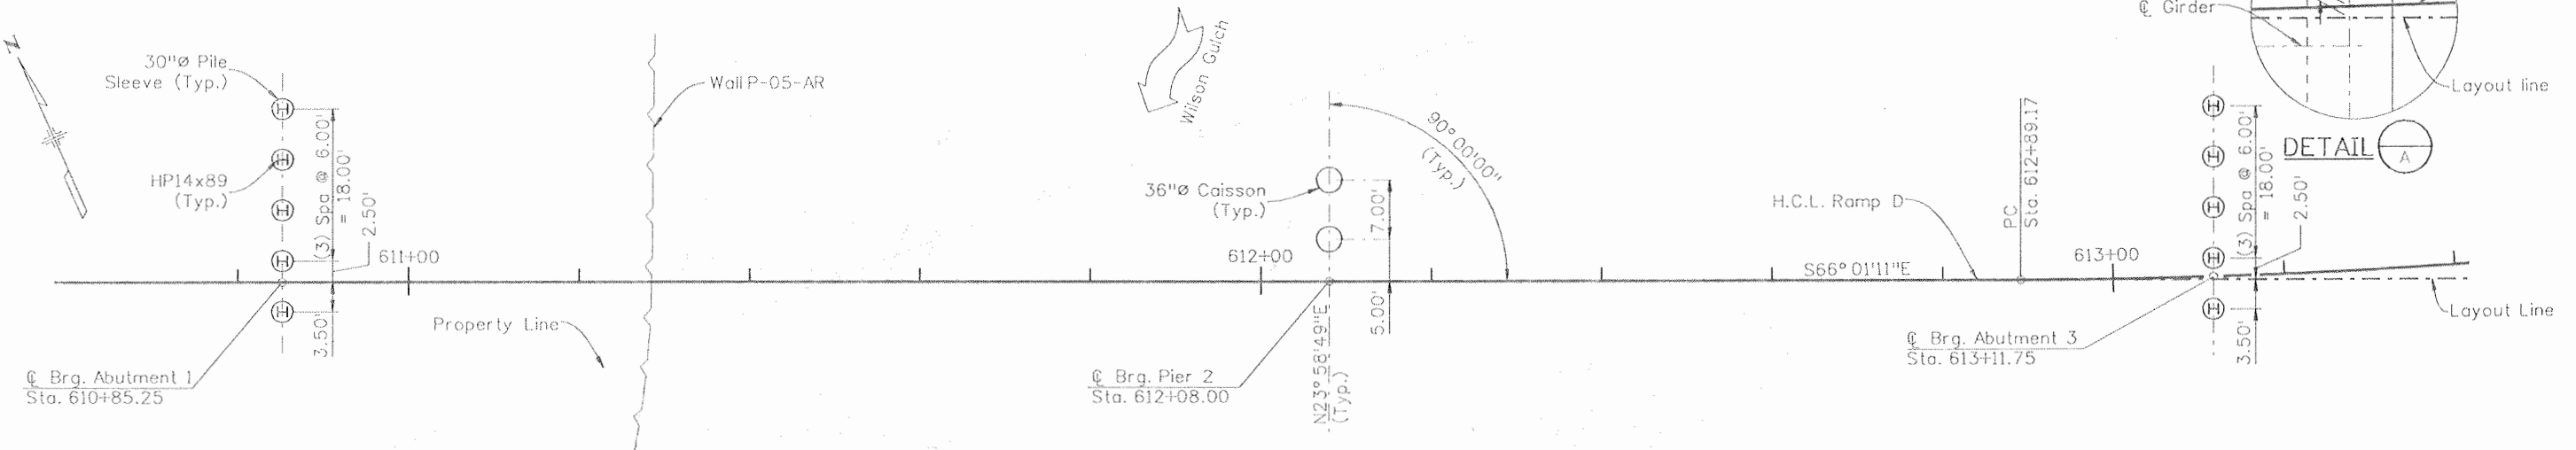

FOUNDATION LAYOUT

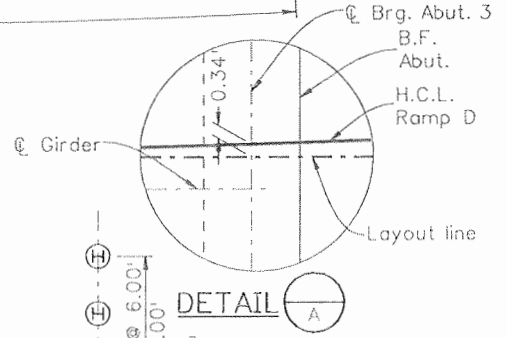

DETAIL A


- NOTE:**
1. Layout Line is back tangent from PC Sta. 612+89.17
 2. For Anti-icing System details, see Anti-icing System Plans.

Design		Detail		Quantities	
INITIAL	DATE	INITIAL	DATE	INITIAL	DATE
Designed By	08/08	Checked By	08/08	Checked By	08/08
Checked By	08/08	Checked By	08/08	Checked By	08/08


811
 FOR BURIED UTILITY INFORMATION
 THREE (3) BUSINESS DAYS
 BEFORE YOU DIG
 CALL 811
 (or 1-800-922-1987)
 UTILITY NOTIFICATION
 CENTER OF COLORADO (UNCC)
 www.uncc.org

Print Date: 9/27/2010	Sheet Revisions			Colorado Department of Transportation	As Constructed	RAMP D OVER WILSON GULCH CONSTRUCTION & FOUNDATION LAYOUT		Project No./Code
File Name: 16042Y_FoundLay_01.dgn	Date: 10/01/08	Comments: Monument Revisions	Init.: BJA			No Revisions: 09/10	NH 1602-114	
Horiz. Scale: 1:20	Vert. Scale: As Noted	Region 5			Revised:	Designer: B. Allen	Structure: P-05-Y	16042
Unit Information 0221	Unit Leader STW	EJA			Void:	Detailer: R. Artman	Subset Sheets: B8 of B26	Sheet Number 308

Design		Detail		Quantities	
Designed By	Checked By	INITIAL	DATE	INITIAL	DATE
TRJ	TAH	TRJ	08/08	TRJ	08/08
Checked By	Checked By	Checked By	Checked By	Checked By	Checked By
TAH	TAH	TAH	08/08	TAH	08/08

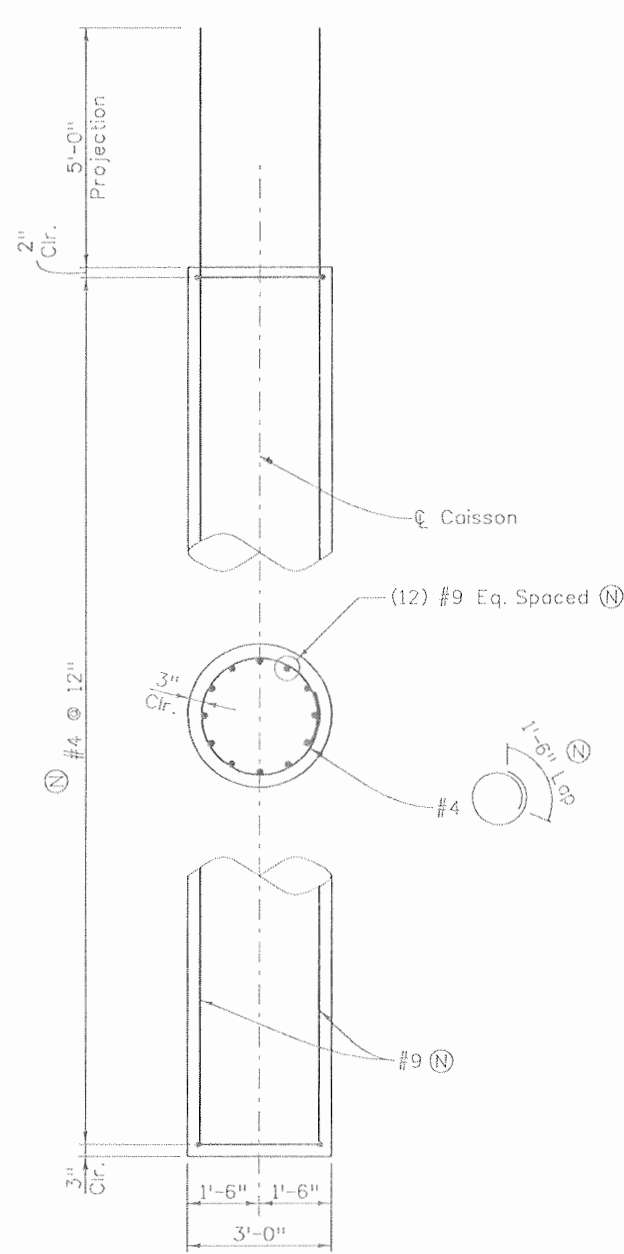


36" CAISSON ELEVATION

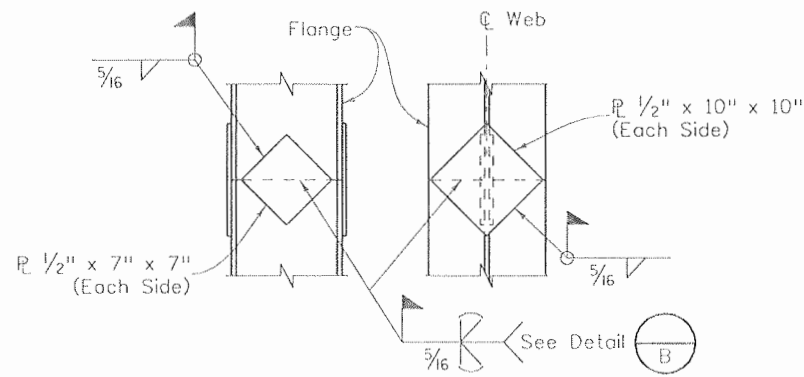

HP 14x89 SPLICE DETAIL

Reinforcing plates are required when pile splice is within 15 feet of the finished groundline. Reinforcing plates may be omitted only when pile splice is below 15 feet of the finished groundline. Before reinforcing plates are installed, grind the weld contours which will be covered by the reinforcing plates.

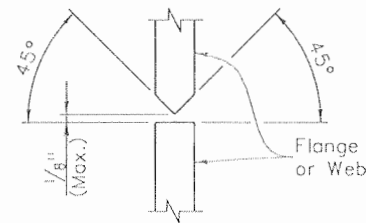

DETAIL B

CAISSON DATA


Location	Caisson Size	Top of Caisson Elevation	Estimated Tip Elevation	Min. Penetration Into Bedrock (ft)	Max. Factored Load (kip)	Estimated Bedrock Elevation	Measured Bedrock Elevation
Pier 2	36"	6625.22	6601	21	1783	6622	6620.26

CAISSON NOTES


- Caisson concrete shall be concrete Class BZ ($f'_c = 4000$ psi).
- Lap splices in caisson tie bar shall alternate 180°.
- Caisson design based upon recommendation provided by Shannon & Wilson, Inc.
Nominal End Bearing: 120 ksf
End Bearing Resistance Factor: 0.55
Nominal Side Shear: 9 ksf
Side Shear Resistance Factor: 0.75
- All caissons shall be tested using Impact Echo Method in accordance with contract requirements. All test data shall be submitted to the engineer.
- The Contractor shall roughen the side of the rock socket to an amplitude of 2" prior to placing caisson concrete.
- Lateral Reduction Factors (P-Multipliers) of 0.825 (longitudinal) and 0.427 (lateral) were used in the design.

TABLE 1

US Standard Sieve Size	% Passing by Weight
3/8"	100
No. 4	0-15
No. 200	0-1

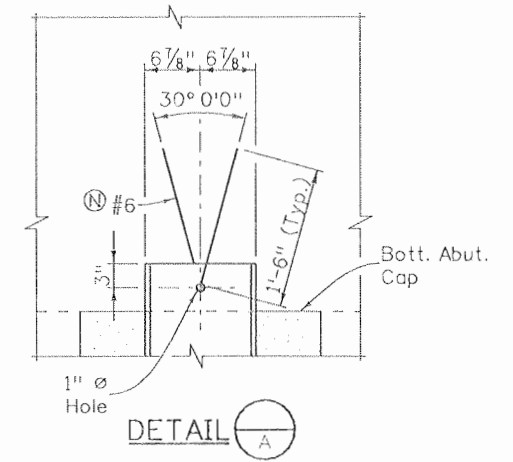

DETAIL A

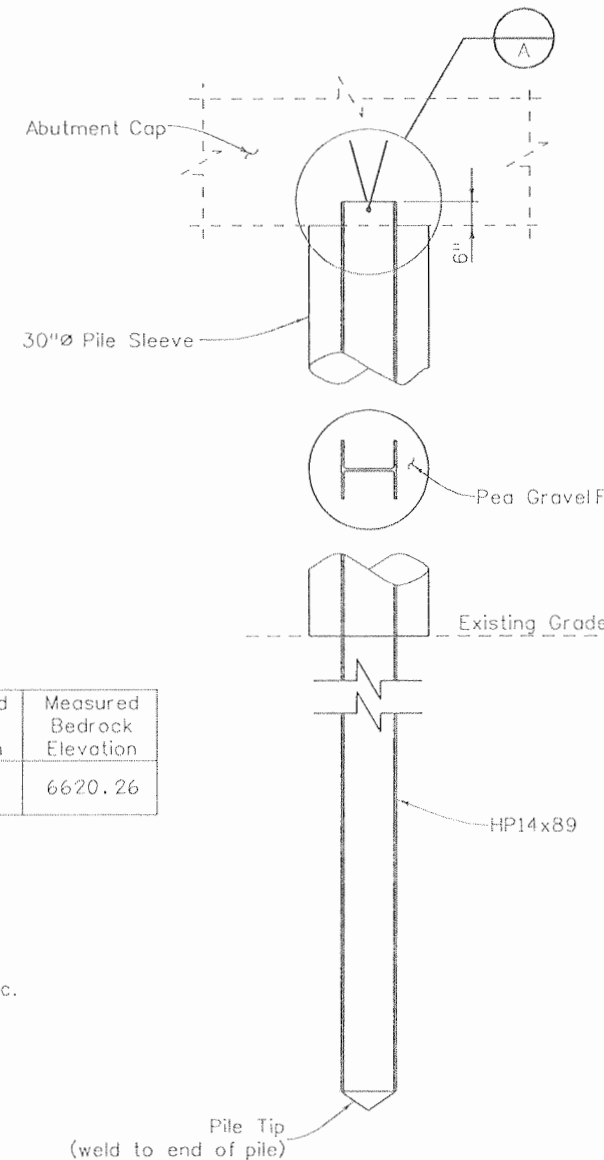

HP 14x89 ELEVATION

PILE DATA

Location	Pile Size	Top of Pile Elevation	Est. Tip Elevation	Max. Factored Load (kip)	Measured Bedrock Elevation
Abut 1	HP14x89	6662.44	6590.00	382.2	
Abut 3	HP14x89	6665.53	6626.00	365.5	

PILE NOTES

- Steel Piles shall be AASHTD M270, Grade 50 ($F_y = 50$ ksi).
- All piles shall be driven to practical refusal.
- A protective pile tip shall be used on all piles. Pile tip as manufactured by VersaSteel or approved equal.
- Pipe sleeve shall be smooth walled steel or PVC pipe. Corrugated pipe will not be allowed.
- Void space between pile sleeve and pile shall be filled with Pea Gravel prior to placing abutment cap. Pea Gravel shall conform to Table 1.
- Pile design based upon recommendation provided by Shannon & Wilson, Inc. Structural capacity of pile governs.

Strength Reduction Factors:

- End Bearing: 0.5
- Compression: 0.5
- Compression & Flexure: 0.7

- A minimum of one pile per abutment shall be dynamically monitored in accordance with contract requirements. All data shall be submitted to the engineer.

- A factored downdrag axial load of 161 kips per pile is included in the Max. Factored Load at Abutment 1 and a factored downdrag axial load of 168 kips per pile is included in the Max. Factored Load at Abutment 3.

Print Date: 9/27/2010


File Name: 16042Y_DrillShaftDet_01.dgn

Horiz. Scale: 1:1

Vert. Scale: As Noted

Unit Information 0221

Unit Leader STW

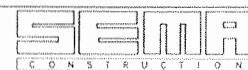

Sheet Revisions		
Date:	Comments	Init.

Colorado Department of Transportation



3803 North Main Avenue
Suite 200
Durango, CO 81301
Phone: 970-385-1440 FAX: 970-385-8365

Region 5

EJA

As Constructed

No Revisions:

Revised: 09/10

Void:

RAMP D OVER WILSON GULCH
DRILLED CAISSON & PILE DETAILS

Designer: T. Johnson

Detailer: R. Artman

Sheet Subset: Bridge

Structure Numbers

P-05-Y


Subset Sheets: B9 of B26

Project No./Code


NH 1602-114

16042


Sheet Number 309

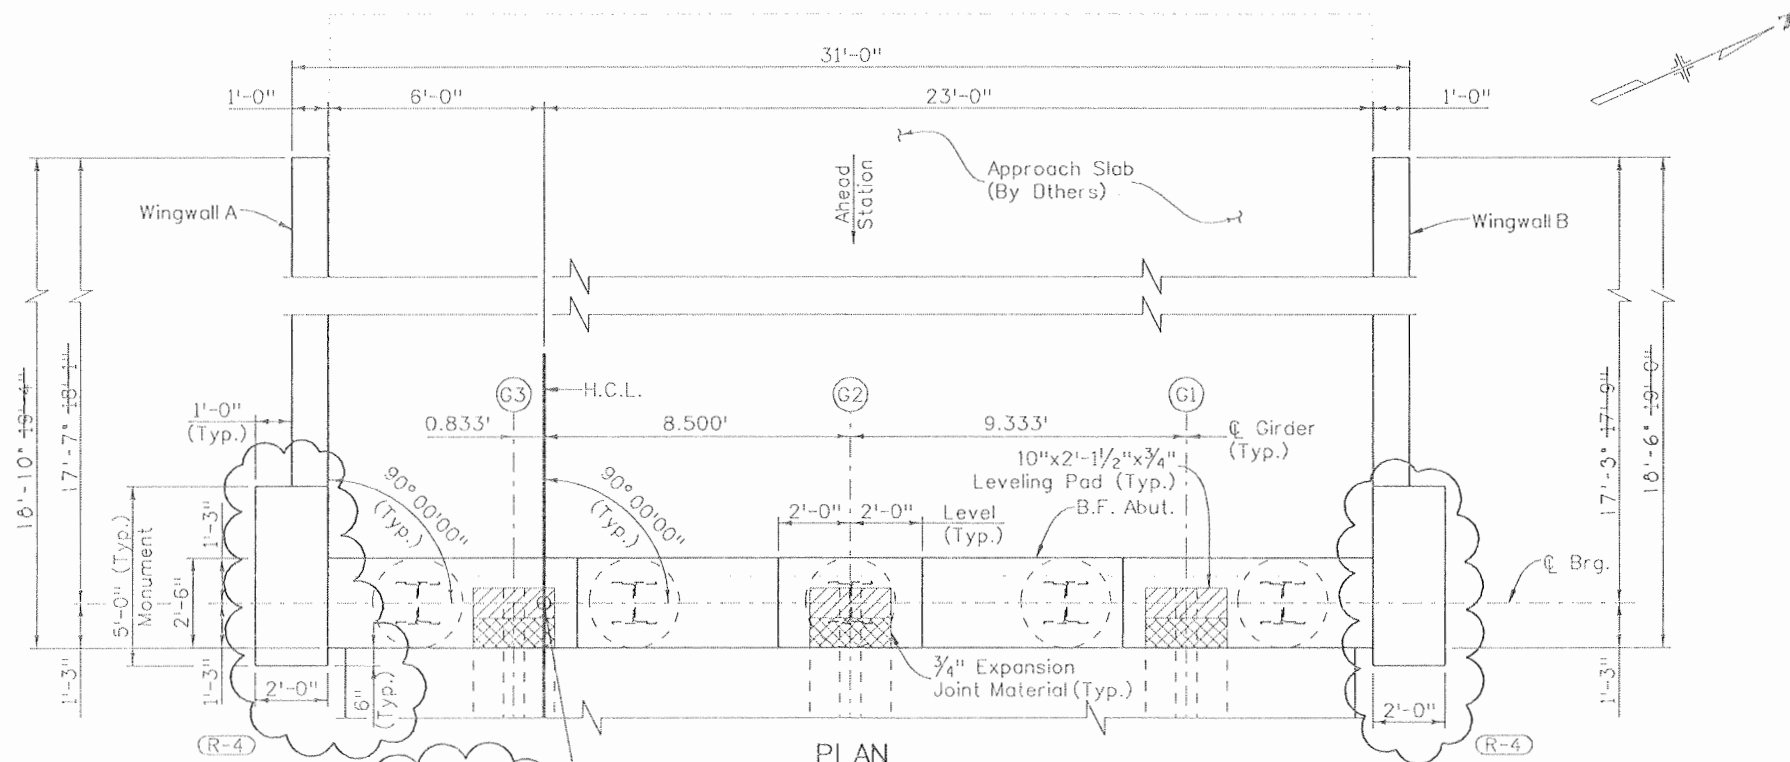

PLAN

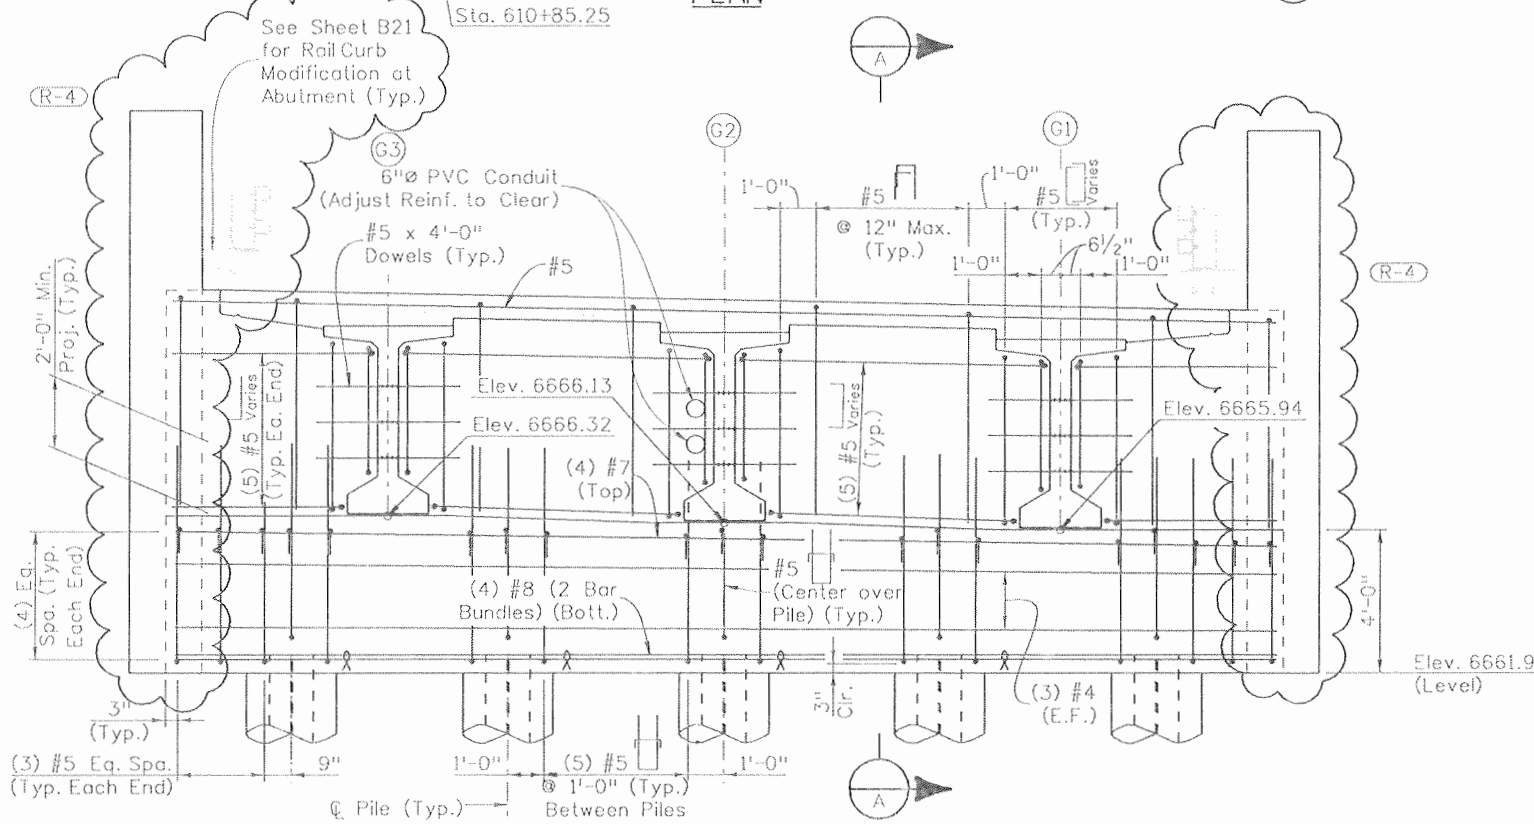

ELEVATION
(Looking Back Station)

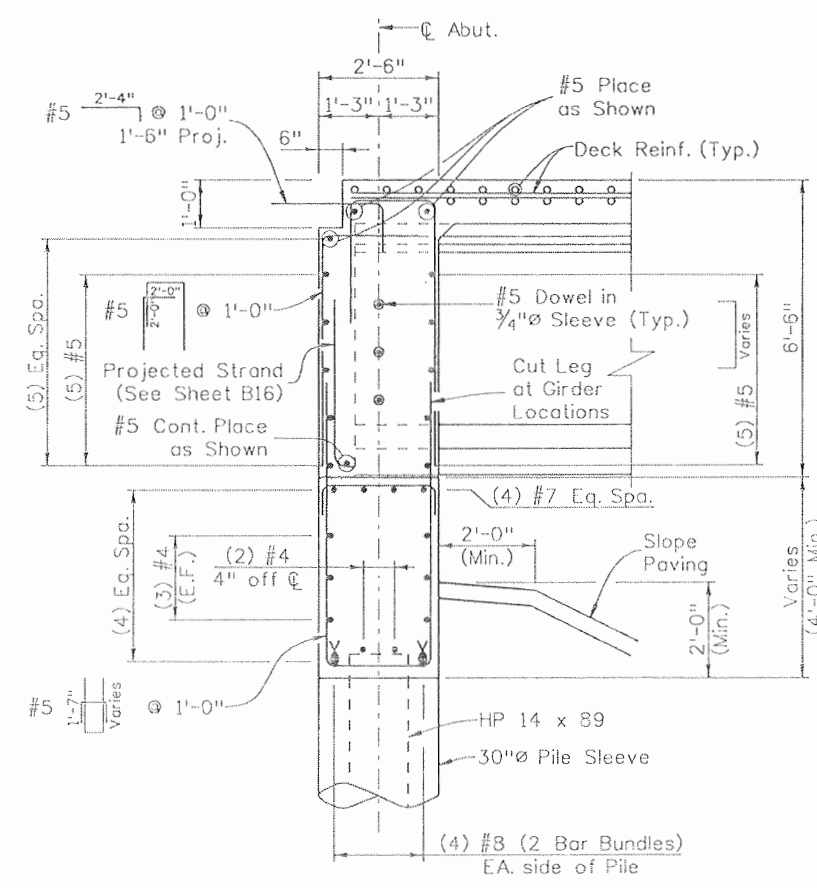

SECTION A-A

- NOTES:**
1. All cover is 2" unless noted otherwise.
 2. Abutment, Wingwall & Monument concrete shall be Class D (Bridge), f'c = 4,500 psi at 28 days.
 3. Elevations shown are taken at \bar{C} Abutment except as noted.

Design		Detail		Quantities	
INITIAL	DATE	INITIAL	DATE	INITIAL	DATE
TRJ	08/08	RGA	08/08	TRJ	08/08
TAH	08/08	TAH	08/08	TAH	08/08

Print Date: 9/27/2010	File Name: 16042Y_AbutmentDet_01.dgn
Horiz. Scale: 1:1	Vert. Scale: As Noted
Unit Information 0221	Unit Leader STW
SEMA CONSTRUCTION	WILSON & COMPANY

Sheet Revisions		
Date:	Comments	Init.
9/29/08	Monument Revisions	BJA




Colorado Department of Transportation
 3803 North Main Avenue
 Suite 200
 Durango, CO 81301
 Phone: 970-385-1440 FAX: 970-385-8365
Region 5 EJA

As Constructed	No Revisions:
Revised: 09/10	Void:

RAMP D OVER WILSON GULCH ABUTMENT 1 DETAILS			
Designer:	T. Johnson	Structure	P-05-Y
Detailer:	R. Artman	Numbers	
Sheet Subset:	Bridge	Subset Sheets:	B10 of B26


Project No./Code	NH 1602-114
Sheet Number	310

Design		Detail		Quantities	
INITIAL	DATE	INITIAL	DATE	INITIAL	DATE
TRJ	08/08	RGA	08/08	TRJ	08/08
TAH	08/08	TAH	08/08	TAH	08/08
Designed By	Checked By	Designed By	Checked By	Quantities By	Checked By
TRJ	TAH	RGA	TAH	TRJ	TAH

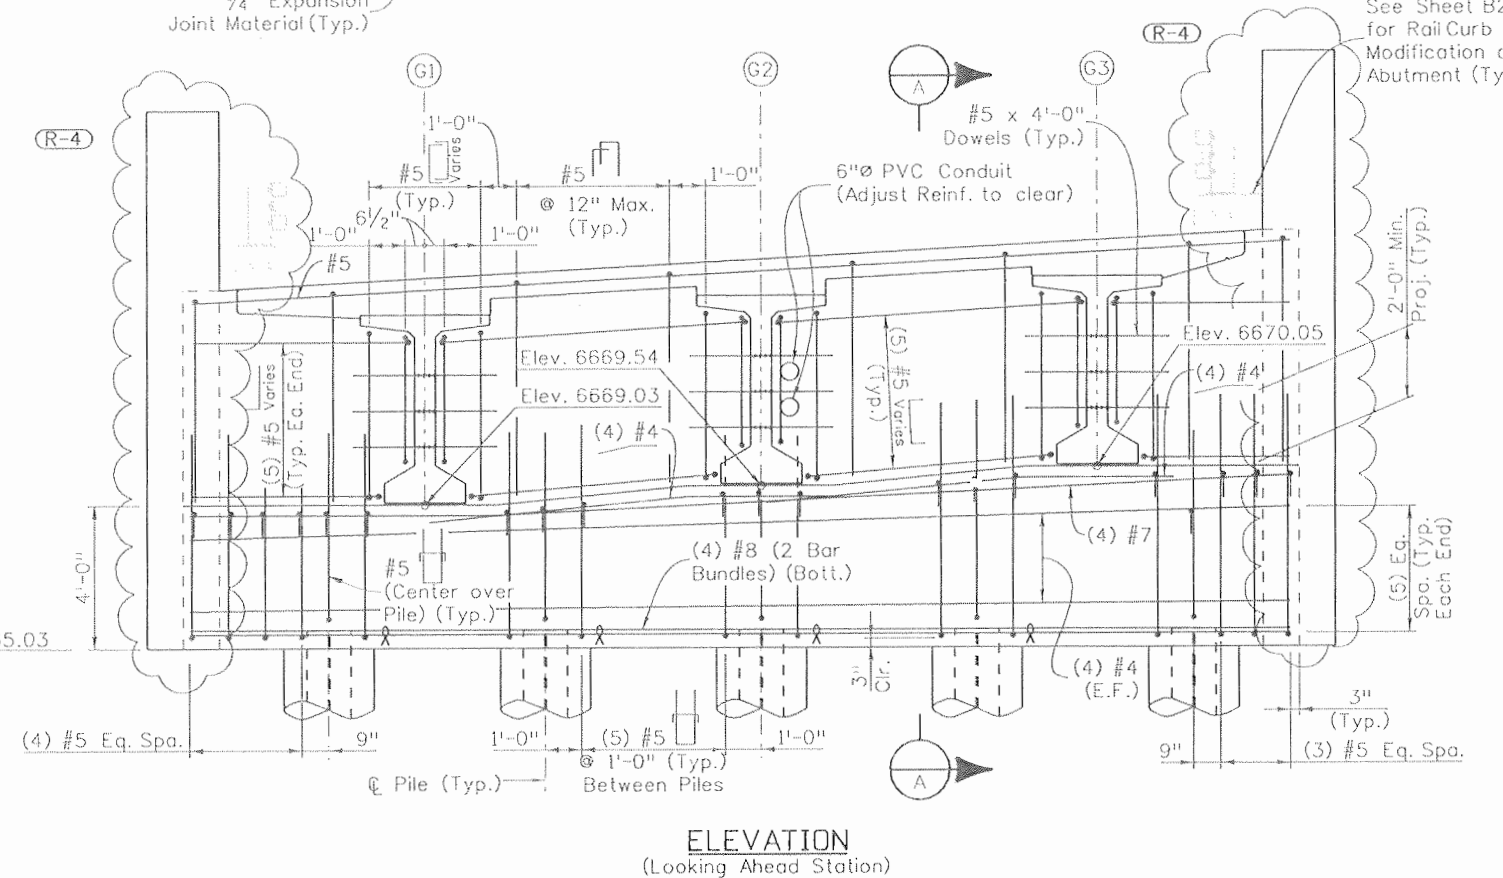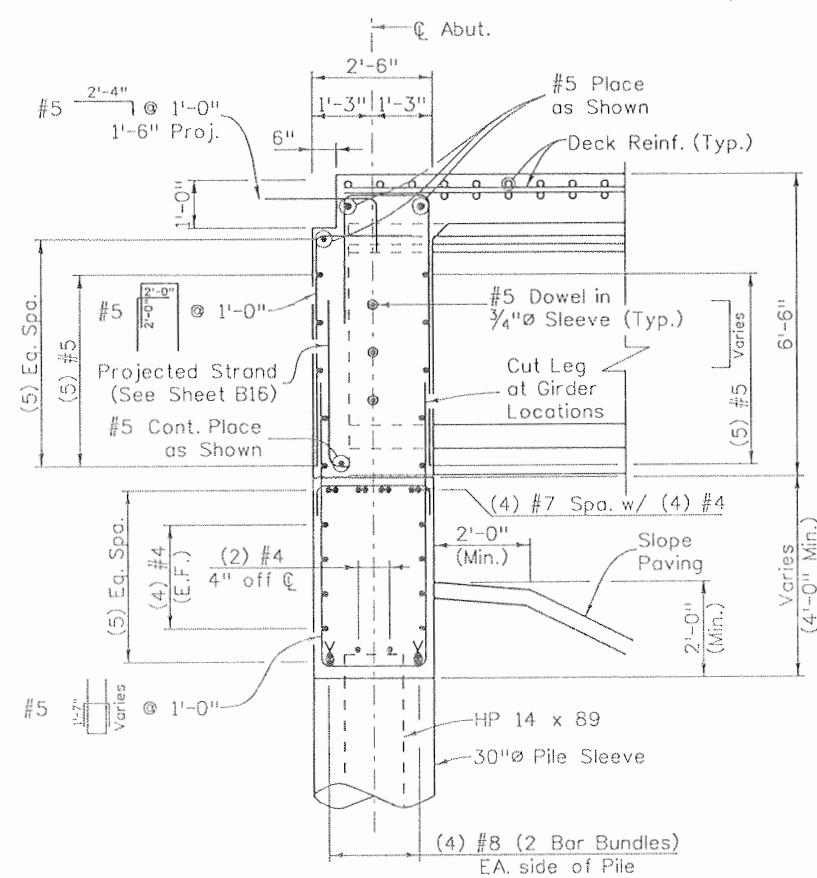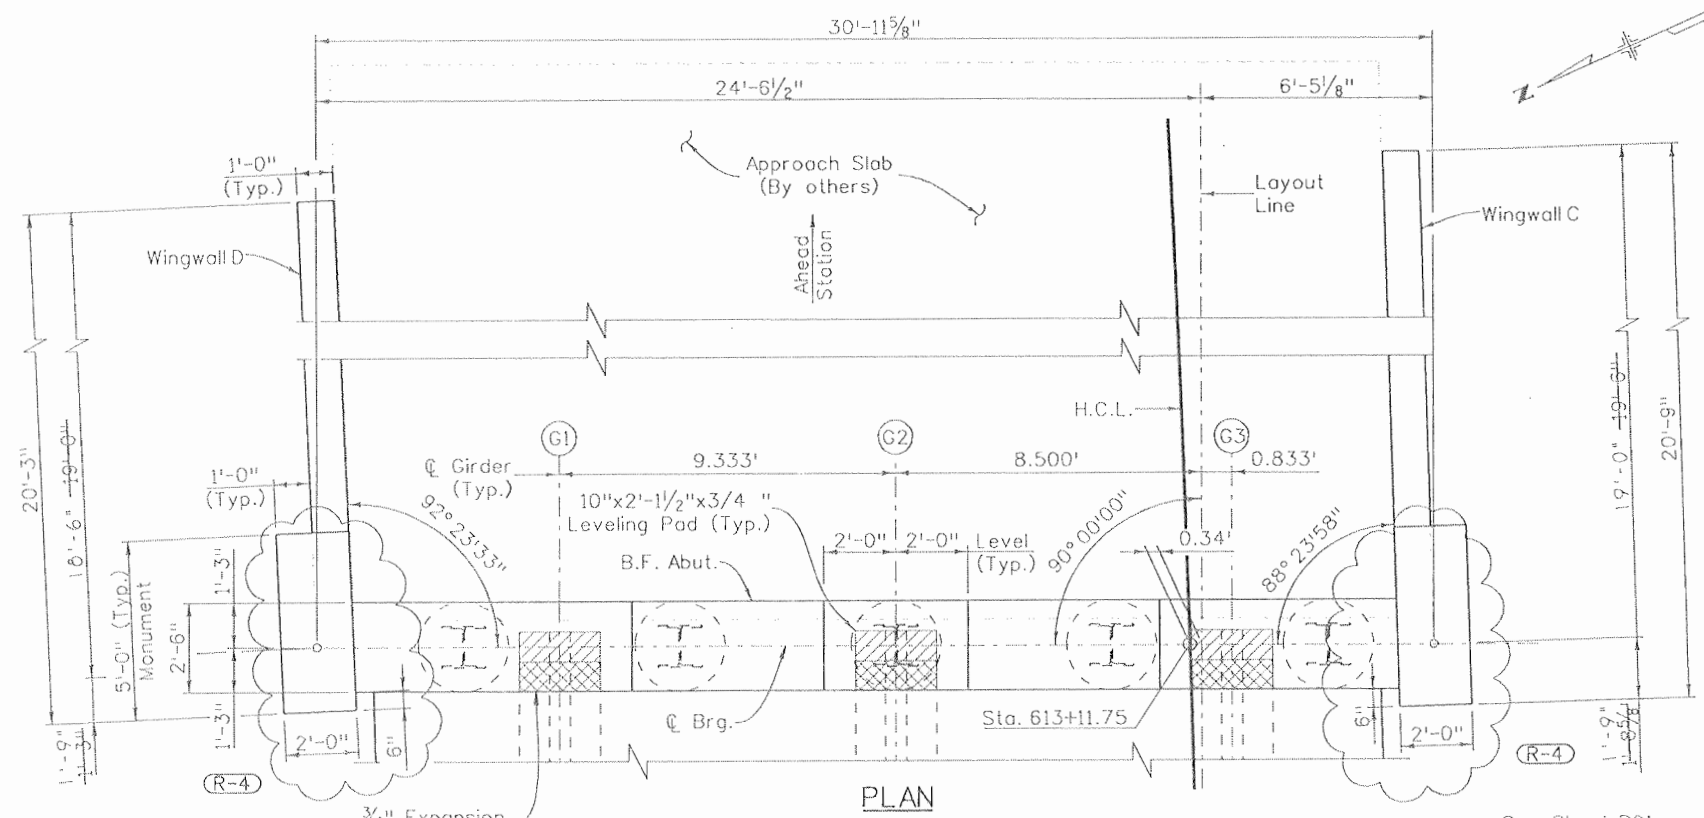


- NOTES:**
- All cover is 2" unless noted otherwise.
 - Abutment, Wingwall & Monument shall be Class D (Bridge), f'c = 4,500 psi at 28 days.
 - Elevations shown are taken at \bar{C} Abutment except as noted.

Print Date: 9/27/2010	Sheet Revisions			Colorado Department of Transportation		As Constructed		RAMP D OVER WILSON GULCH ABUTMENT 3 DETAILS		Project No./Code	
File Name: 16042Y_Abutment3Det_01.dgn	Date:	Comments	Init.	3803 North Main Avenue		No Revisions:		NH 1602-114		NH 1602-114	
Horiz. Scale: 1:1	9/29/08	Monument Revisions	BJA	Suite 200		Revised: 09/10		16042		16042	
Unit Information 0221				Durango, CO 81301		Void:		Designer: T. Johnson		Structure: P-05-Y	
Unit Leader STW				Phone: 970-385-1440 FAX: 970-385-8365				Detailer: R. Artman		Sheet Number: 311	
SEMA CONSTRUCTION				DOT DEPARTMENT OF TRANSPORTATION		Region 5		Sheet Subset: Bridge		Subset Sheets: B11 of B26	
WILSON & COMPANY						EJA		Sheet Number: 311			

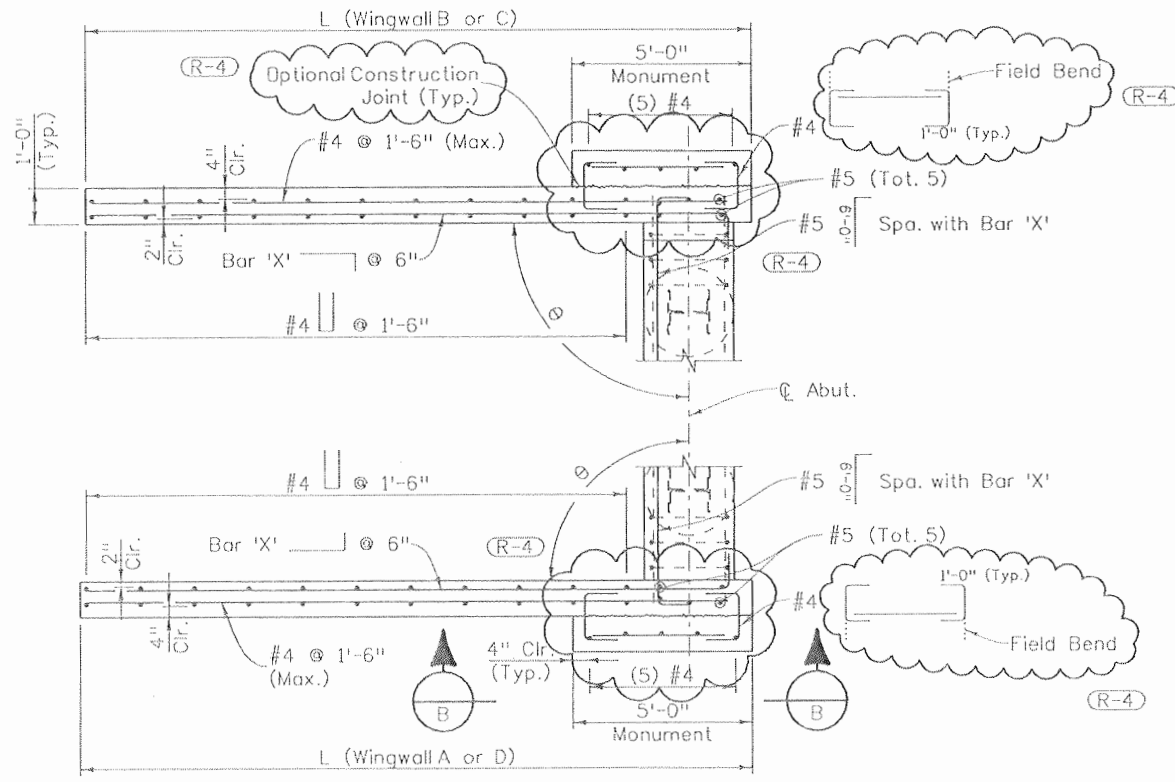


PLAN
(Wingwalls A & B Shown, C and D Similar)

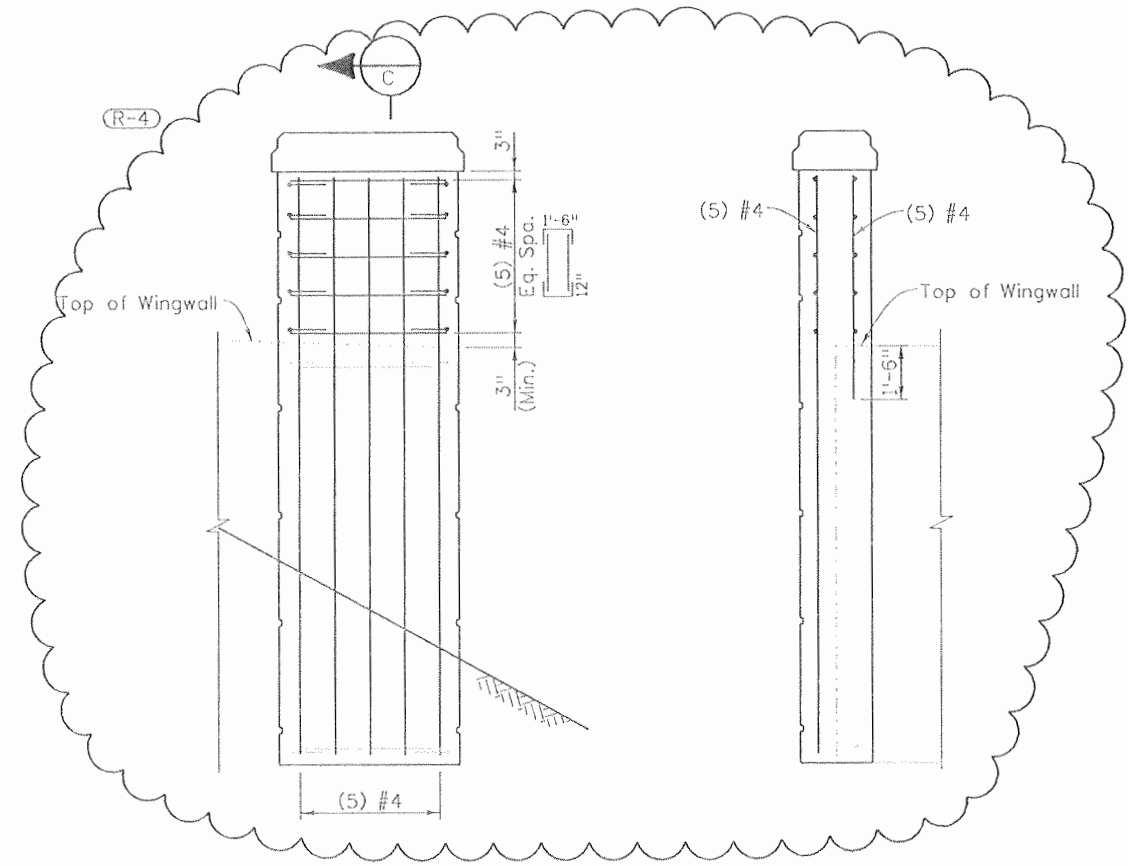


VIEW B

SECTION C

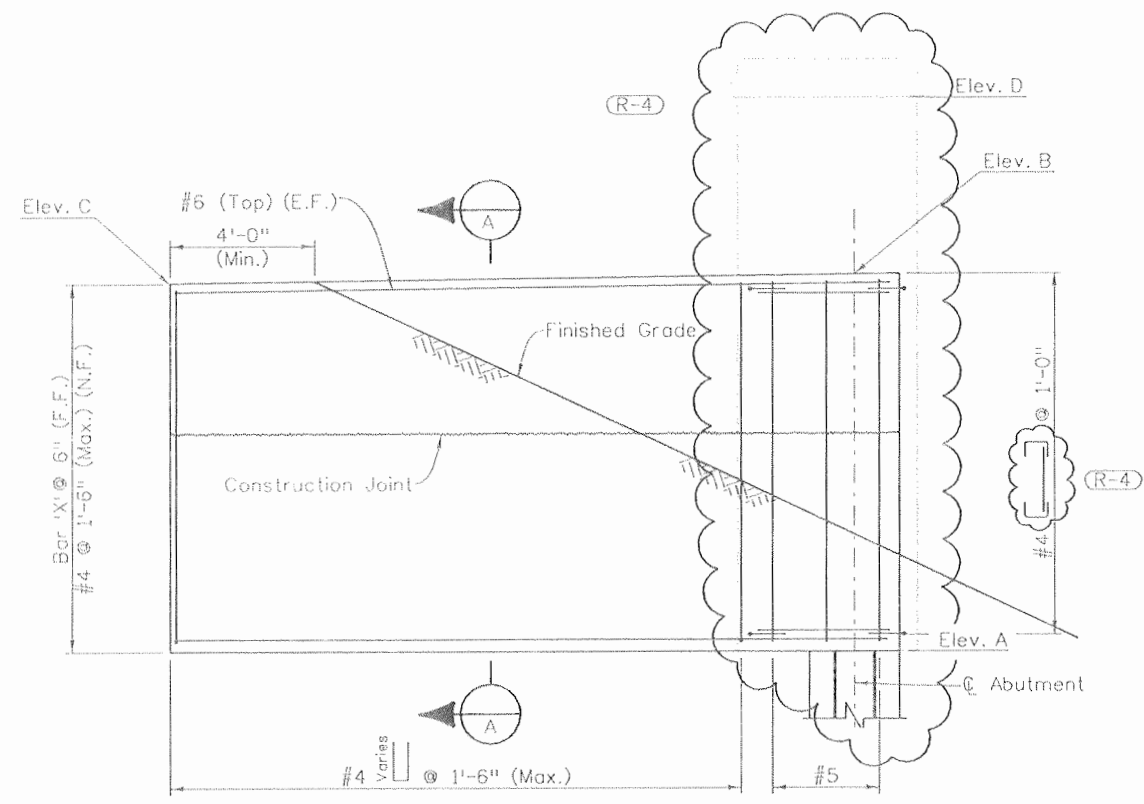

ELEVATION

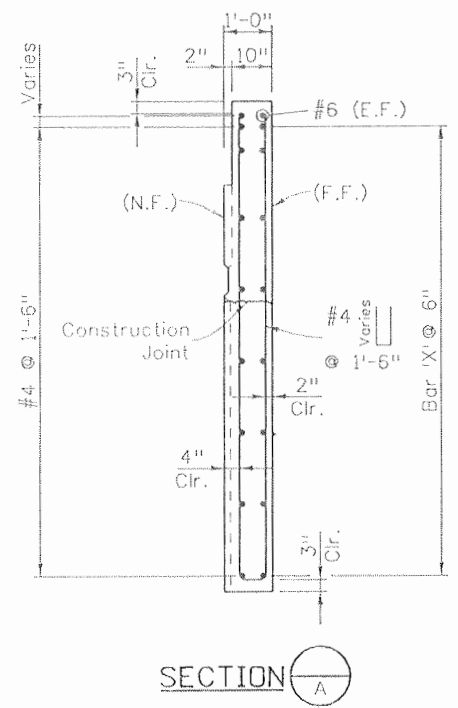

SECTION A

(R-4) TABLE OF VARIABLES

Wingwall	L	Bar 'X'	θ	Elev. A	Elev. B	Elev. C	Elev. D
A	19'-4"	#5	90° 00' 00"	6661.94	6672.92	6672.70	6677.92
B	19'-0"	#5	90° 00' 00"	6661.94	6672.34	6672.12	6677.34
C	20'-9"	#5	88° 23' 58"	6665.03	6676.86	6677.36	6681.86
D	20'-3"	#5	92° 23' 33"	6665.03	6675.21	6675.69	6680.21

Elevations taken at F.F. of wall.

Design		Detail		Quantities	
INITIAL	DATE	INITIAL	DATE	INITIAL	DATE
Designed By: BJA	08/08	Detailled By: BJA	08/08	Quantities By: BJA	08/08
Checked By: TAH	08/08	Checked By: TAH	08/08	Checked By: TAH	08/08

Print Date: 9/27/2010
 File Name: 16042Y_WingwallDet_01.dgn
 Horiz. Scale: 1:i Vert. Scale: As Noted
 Unit Information 0221 Unit Leader STW



Sheet Revisions		
Date:	Comments	Init.
9/29/08	Monument Revisions	BJA

Colorado Department of Transportation
 3803 North Main Avenue
 Suite 200
 Durango, CO 81301
 Phone: 970-385-1440 FAX: 970-385-8365
 Region 5 EJA


As Constructed	
No Revisions:	09/10
Revised:	
Void:	

RAMP D OVER WILSON GULCH WINGWALL DETAILS			
Designer:	T. Johnson	Structure Numbers	P-05-Y
Detailer:	R. Artman		
Sheet Subset:	Bridge	Subset Sheets:	B12 of B26


Project No./Code	
NH 1602-114	
16042	
Sheet Number	312

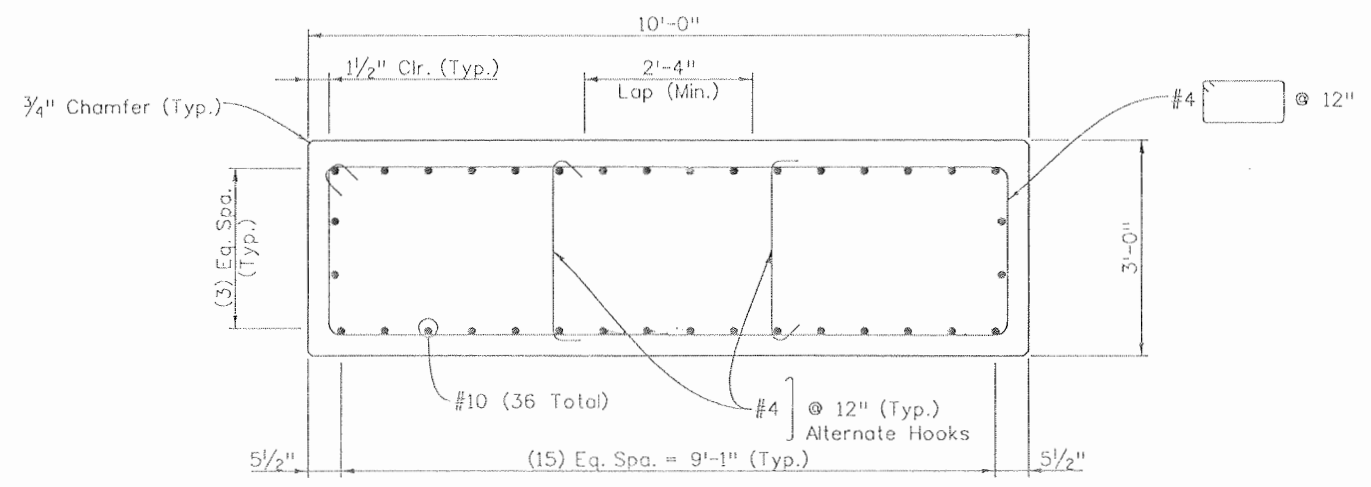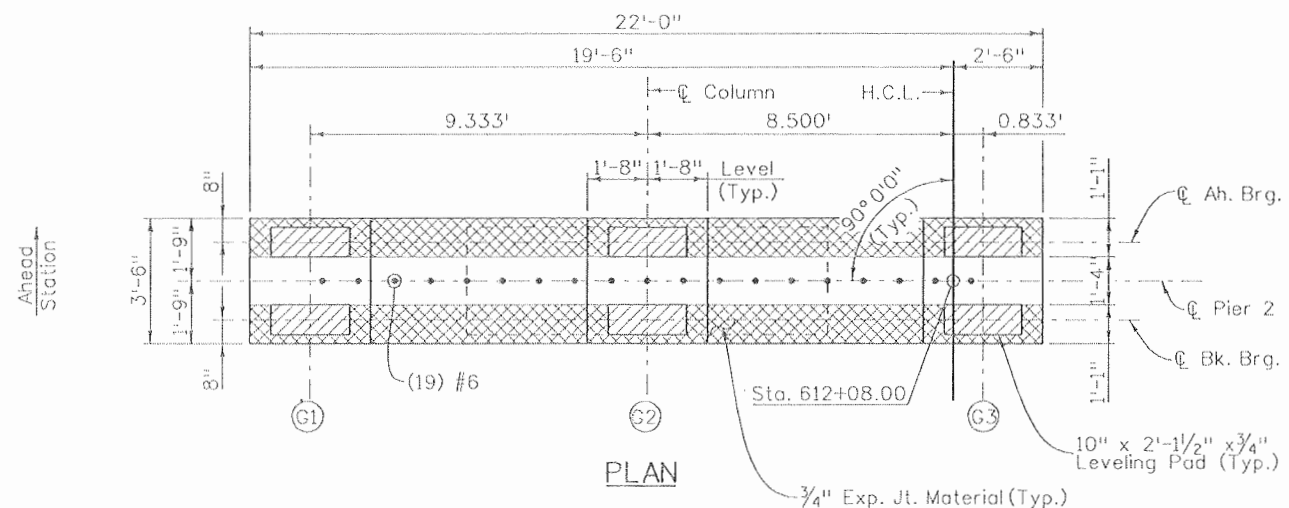


SECTION B

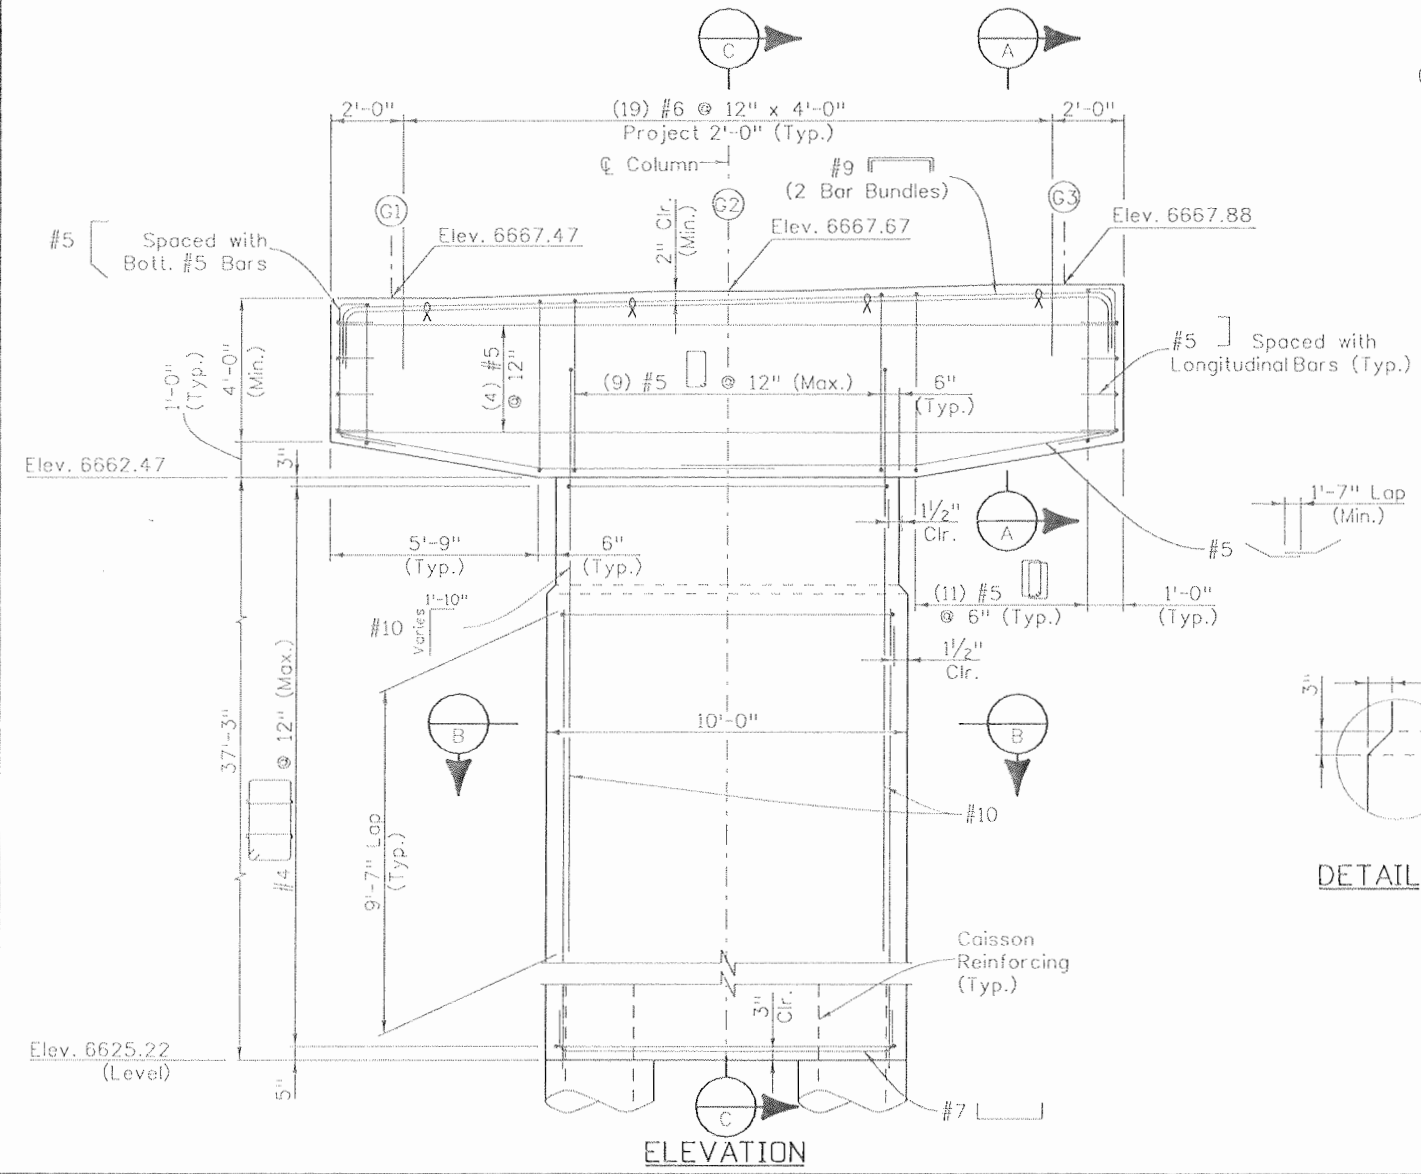


ELEVATION

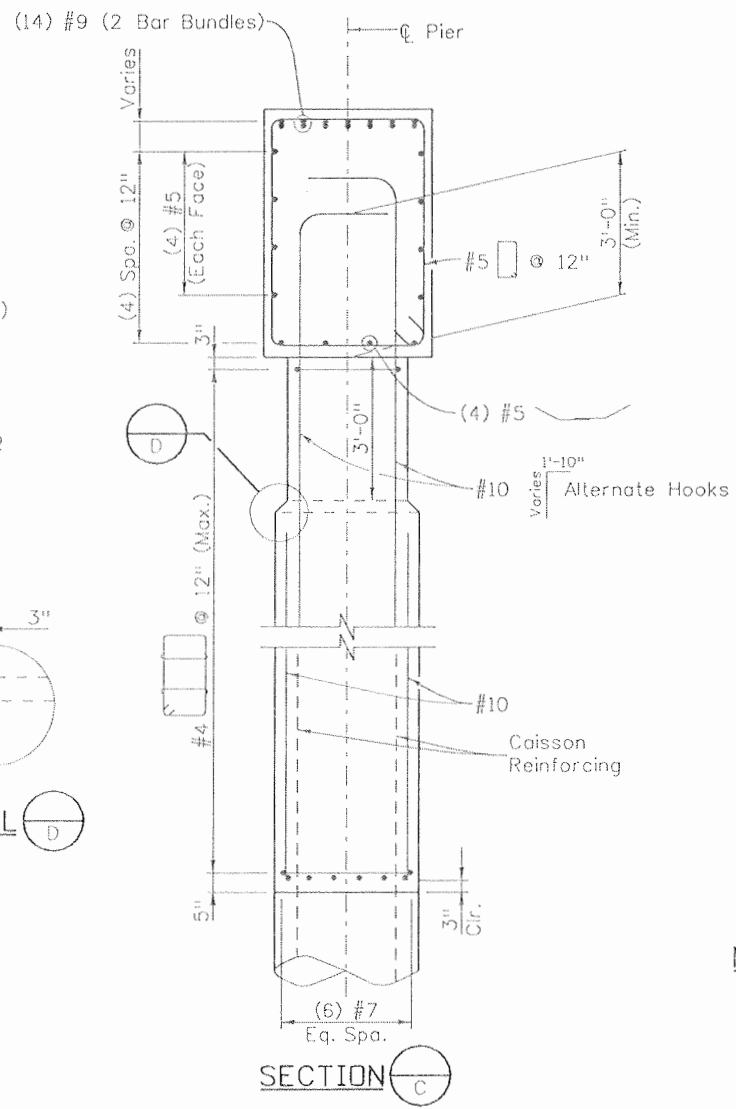

SECTION C

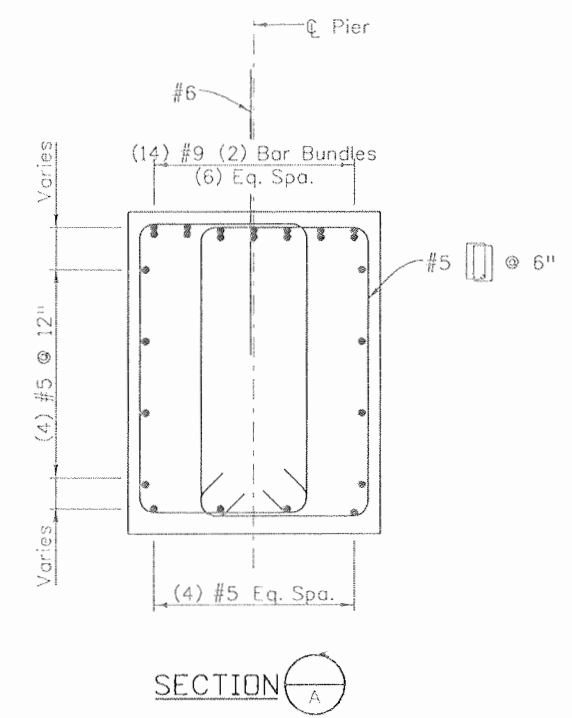

SECTION A

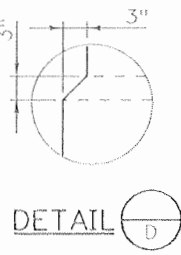

DETAIL D

NOTES:

1. All cover is 2" unless noted otherwise.
2. All concrete shall be Class D, $f'_c = 4,500$ psi at 28 days.
3. See B4 for Architectural details

Design		Detail		Quantities	
INITIAL	DATE	INITIAL	DATE	INITIAL	DATE
TRJ	05/08	RCA	08/08	TRJ	08/08
Checked By	Checked By	Checked By	Checked By	Checked By	Checked By
TAH	08/08	TAH	08/08	TAH	08/08

Print Date: 9/27/2010
 File Name: 16042Y_PierDet_01.dgn
 Horiz. Scale: 1:1 Vert. Scale: As Noted
 Unit Information 0221 Unit Leader STW

SEMA CONSTRUCTION **WILSON & COMPANY**

Sheet Revisions		
Date:	Comments	Init.

Colorado Department of Transportation
 3803 North Main Avenue
 Suite 200
 Durango, CO 81301
 Phone: 970-385-1440 FAX: 970-385-8365




DOT DEPARTMENT OF TRANSPORTATION
 Region 5 EJA

As Constructed	
No Revisions:	09/10
Revised:	
Void:	

RAMP D OVER WILSON GULCH PIER 2 DETAILS (1 OF 2)			
Designer:	T. Johnson	Structure	P-05-Y
Detailer:	R. Artman	Numbers	
Sheet Subset:	Bridge	Subset Sheets:	B13 of B26

Project No./Code	
NH 1602-114	
16042	
Sheet Number	313


Design		Detail		Quantities	
INITIAL	DATE	INITIAL	DATE	INITIAL	DATE
TRJ	08/08	TRJ	08/08	TRJ	08/08
Checked By	Checked By	Checked By	Checked By	Checked By	Checked By
TAH	08/08	TAH	08/08	TAH	08/08

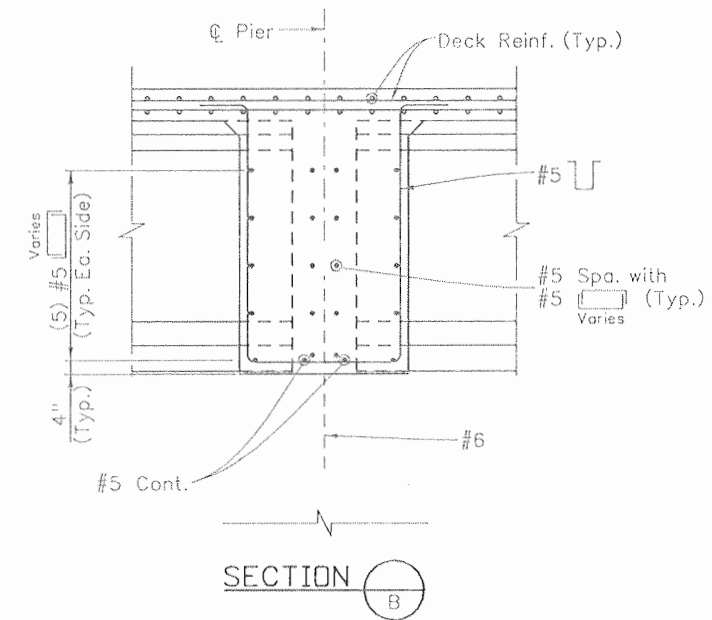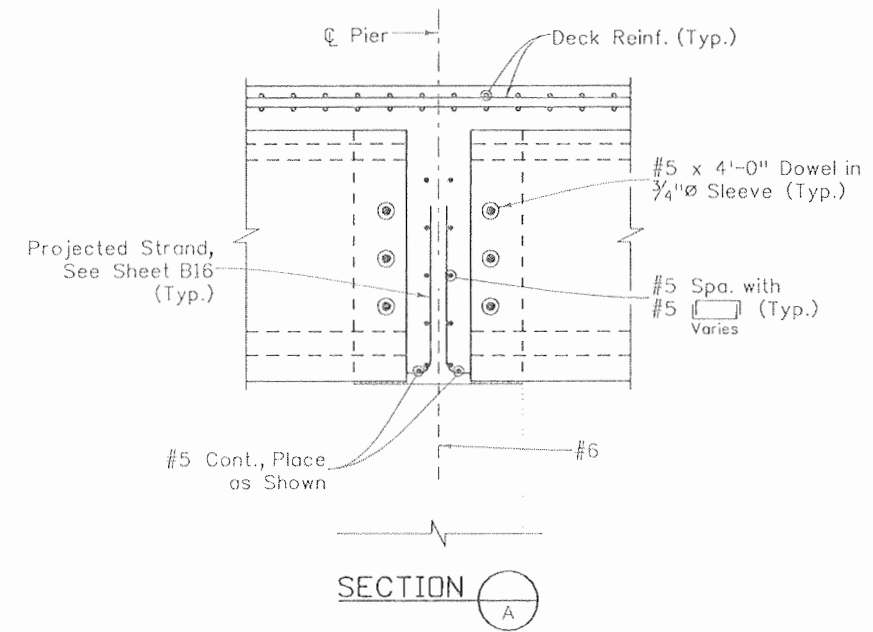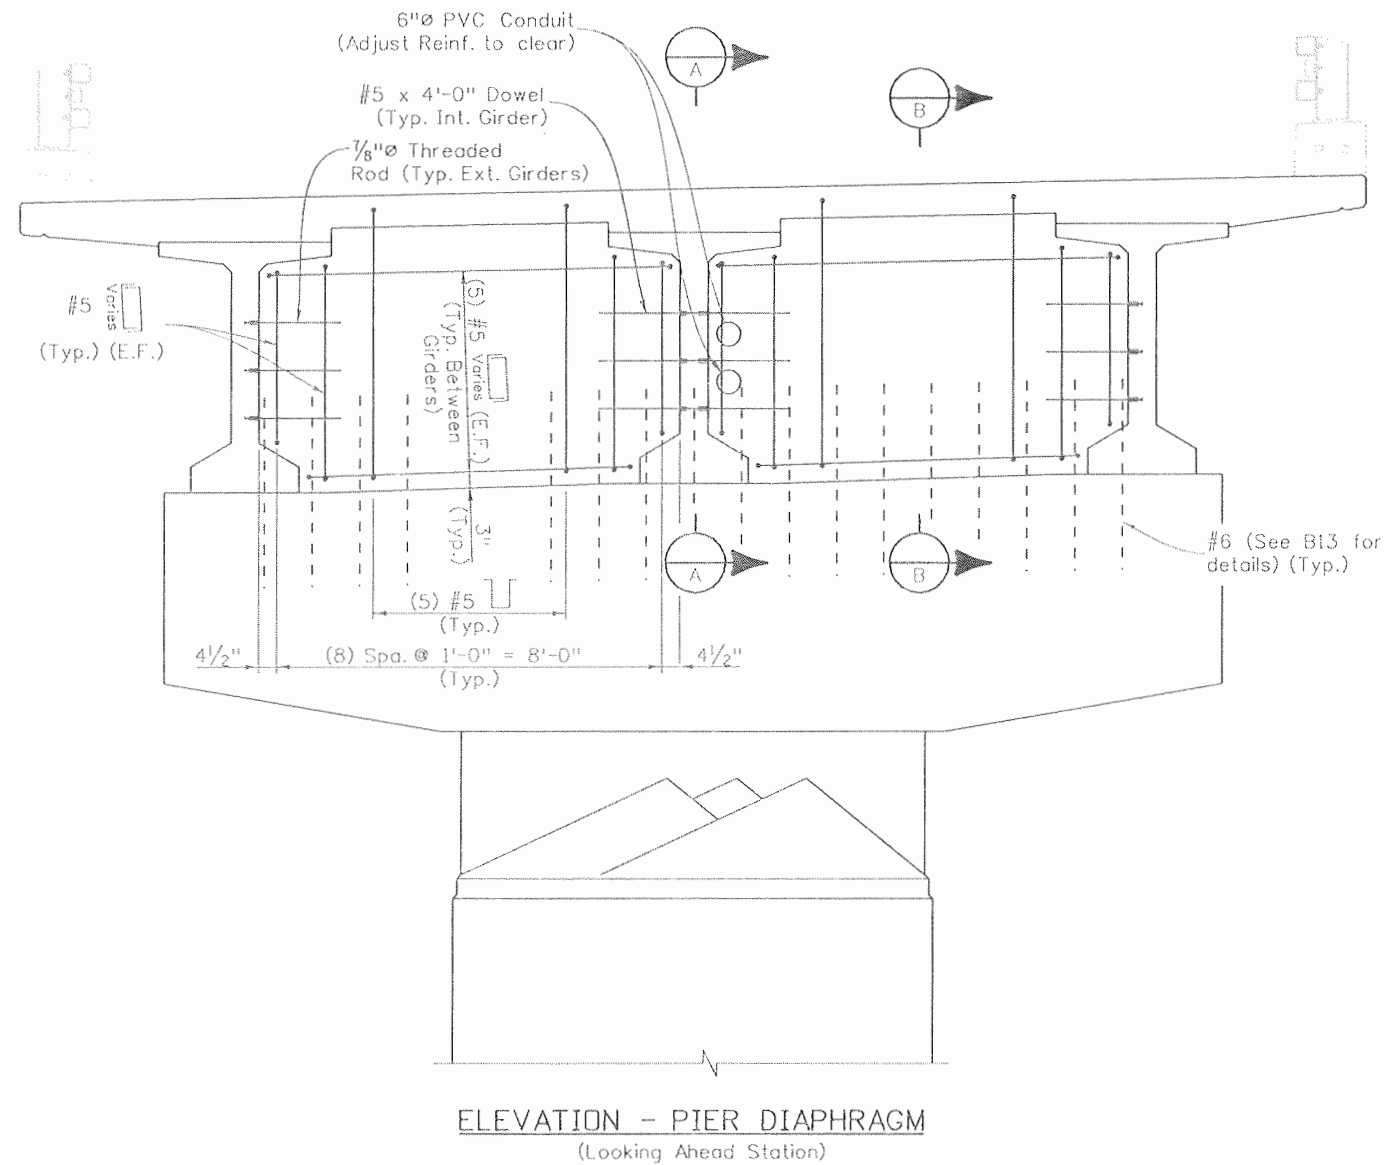

NOTES:

- All cover is 2" unless noted otherwise.
- Pier Diaphragm concrete shall be Class H (Bridge), f'c = 4,500 psi at 56 days.


Print Date: 9/27/2010	Sheet Revisions			Colorado Department of Transportation		As Constructed		RAMP D OVER WILSON GULCH		Project No./Code	
File Name: 16042Y_PierDet_02.dgn	Date:	Comments	Init.	3803 North Main Avenue		No Revisions: 09/10		PIER 2 DETAILS		NH 1602-114	
Horiz. Scale: 1:1				Suite 200		Revised:		(2 OF 2)		16042	
Unit Information 0221				Durango, CD 81301		Void:		Designer: T. Johnson		Structure P-05-Y	
Unit Leader STW				Phone: 970-385-1440 FAX: 970-385-8365				Detailer: R. Artman		Numbers	
SEMA CONSTRUCTION				Region 5				Sheet Subset: Bridge		Subset Sheets: B14 of B26	
WILSON & COMPANY				EJA				Sheet Number		314	

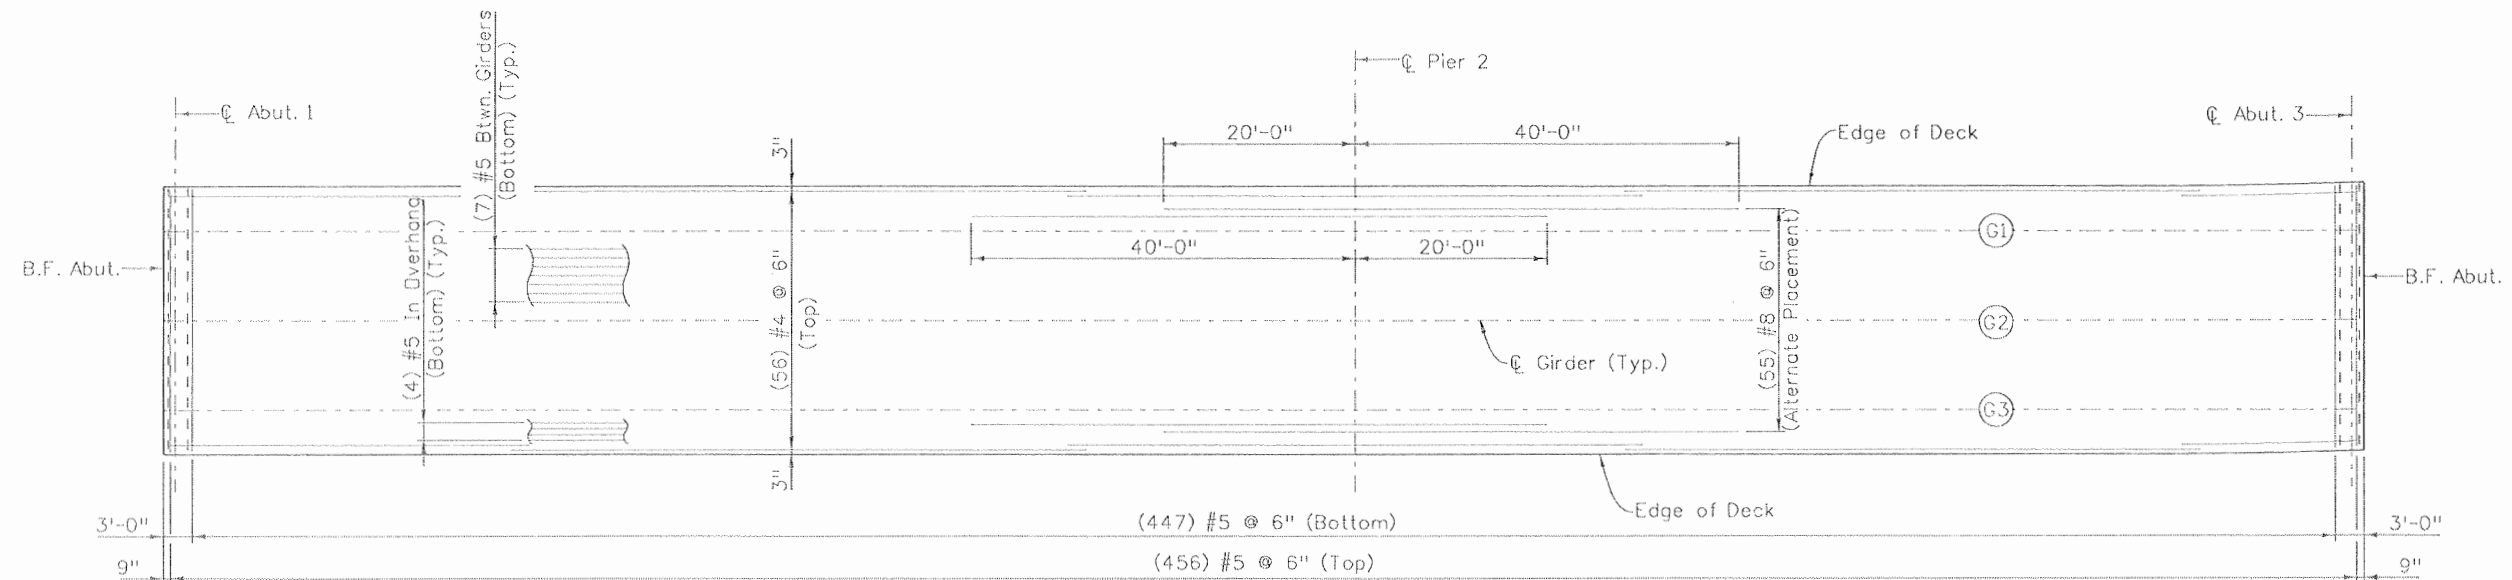


DECK REINFORCING PLAN

NOTES:

- Deck concrete shall be Class H, $f'c = 4,500$ psi at 56 days.
- Seal deck with CDDT approved deck sealer.
- For Anti-icing System details, see Anti-icing System Plans.
- Maximum permissible rebar relocation for anti-icing system is 2".

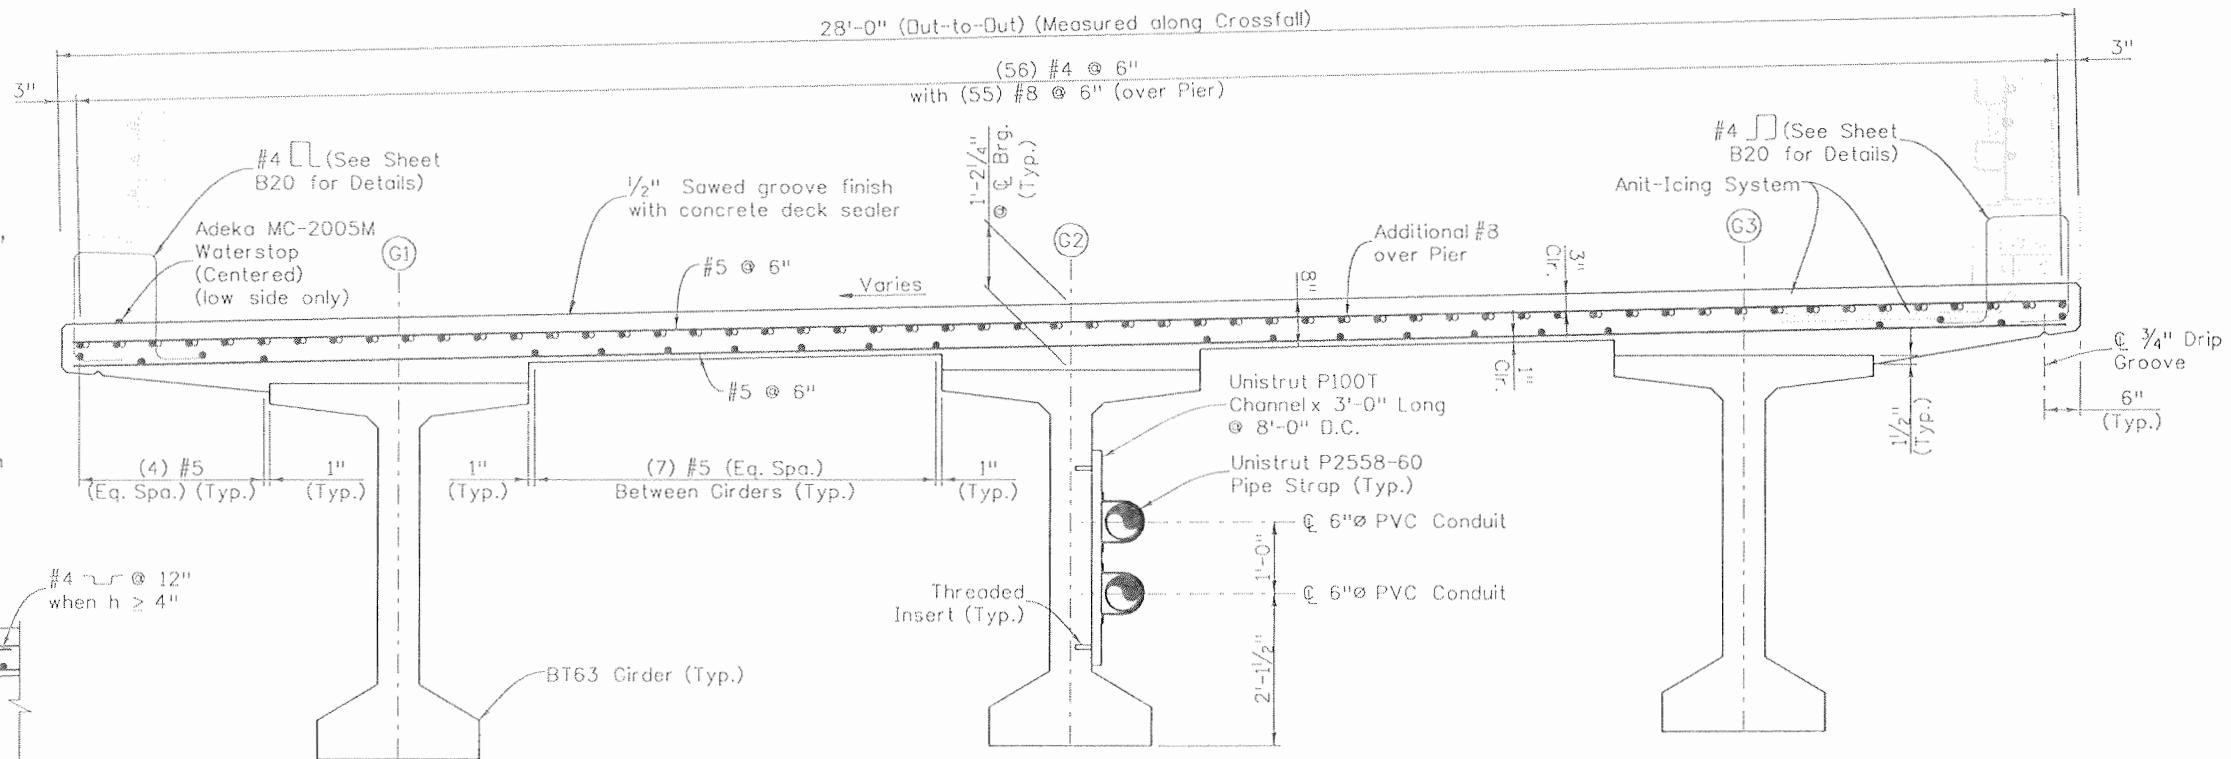

TYPICAL SECTION

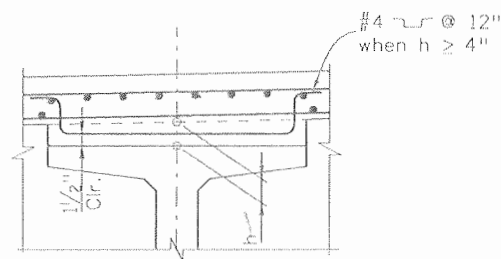


HAUNCH DETAIL


Design	INITIAL	DATE	INITIAL	DATE	INITIAL	DATE
	JSM	08/08	RCA	08/08	JSM	08/08
Checked By	TAH	08/08	TAH	08/08	TAH	08/08
	Checked By	Checked By	Checked By	Checked By	Checked By	Checked By

Print Date: 9/27/2010	Sheet Revisions			Colorado Department of Transportation 3803 North Main Avenue Suite 200 Durango, CO 81301 Phone: 970-385-1440 FAX: 970-385-8365 Region 5	As Constructed		RAMP D OVER WILSON GULCH SUPERSTRUCTURE REINFORCING PLAN & TYPICAL SECTION		Project No./Code
File Name: 16042Y_SupStrTypSect_01.dgn	Date:	Comments:	Init.		No Revisions: 09/10				
Horiz. Scale: 1:1				EJA	Revised:	Designer: J. Mills	Structure Numbers: P-05-Y	16042	
Unit Information 0221					Void:	Detailer: R. Artman	Sheet Subset: Bridge	Subset Sheets: B15 of B26	Sheet Number 315
Unit Leader STW									



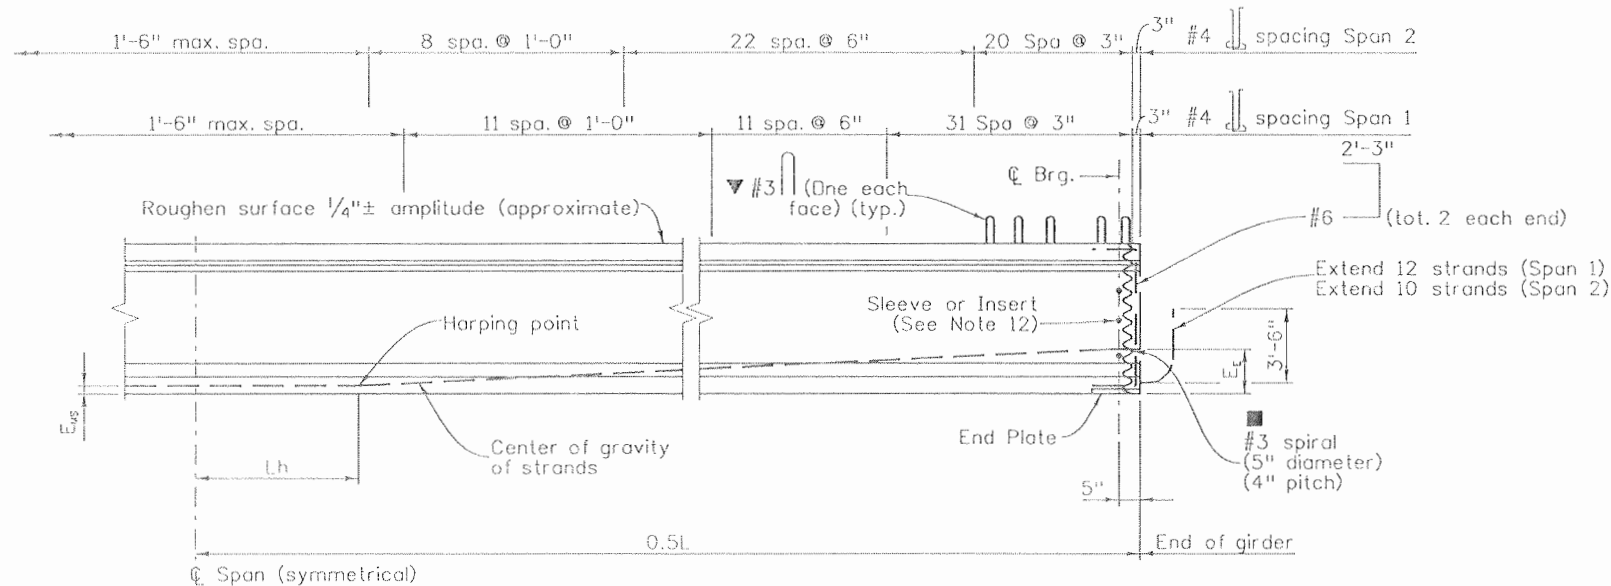

GIRDER ELEVATION

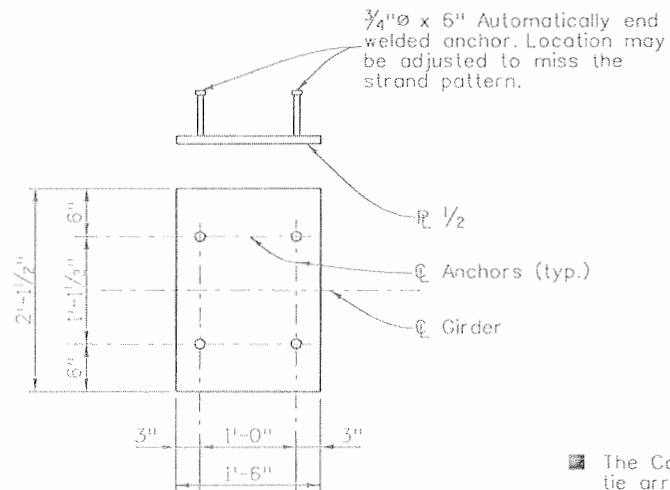


END PLATE DETAIL
Galvanize after fabrication.

- The Contractor may submit an alternate cross tie arrangement, at the end of the web, for approval by the Engineer.
- ▼ Space with #4 for stirrup spacings of 6" or more. Space at 1'-0" for stirrup spacings less than 6".

GIRDER SCHEDULE

Girder Type	Span No.	Girder No.	L (Feet)	Lh (Feet)	A _s * (Square Inch)	E _{MS} (Inch)	E _E (Inch)	F _J (KIPS)	F _F (KIPS)	Concrete Strength		Δ (Inch)	Predicted Camber (Inch)
										f' _{ci} (PSI)	f' _c (PSI)		
BT63	1	1-3	122.50	12.25	9.548	5.09	16.45	1933.5	1585.6	7250	8500	2.57	5.55
BT63	2	1-3	103.50	10.35	6.076	3.43	13.29	1230.4	1064.9	7250	8500	1.32	2.85

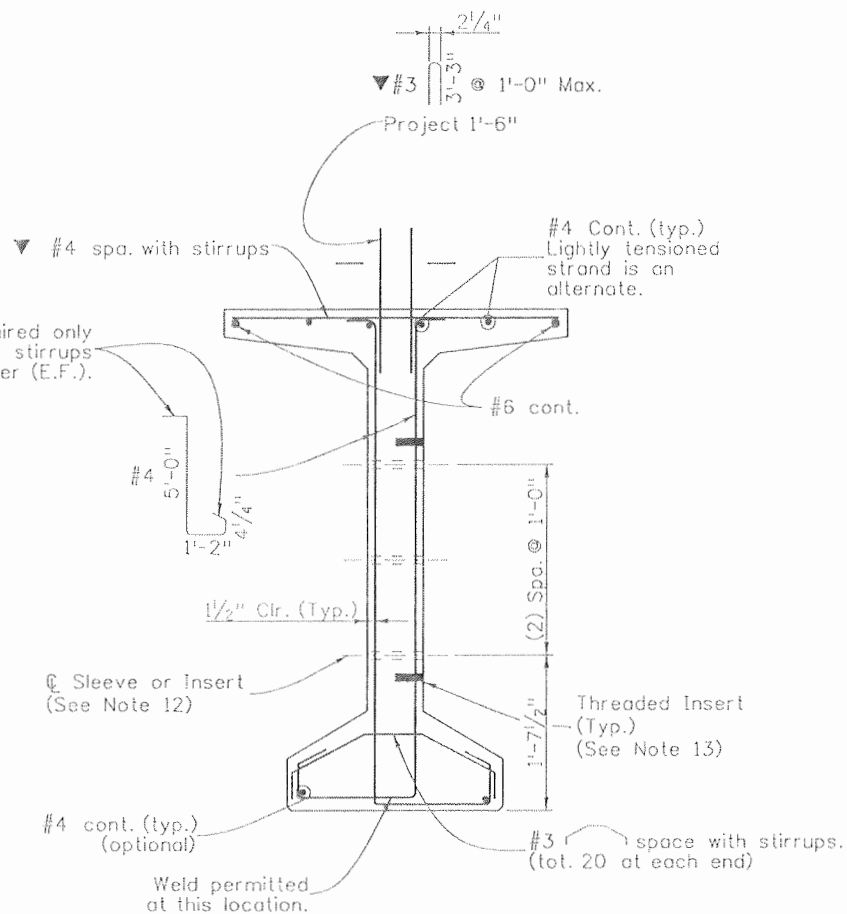

TYPICAL GIRDER SECTION

NOTES:

- When approved by the Engineer, a minimum of tack welding will be permitted on ASTM A706 uncoated reinforcing steel.
- Reinforcing projecting from the top of the girder shall be epoxy coated. Damaged coating on girder reinforcing need not be repaired. The minimum cover for reinforcing steel is 1".
- At girder ends embedded in concrete diaphragms, cut strands to project 3", except as shown. Do not make cosmetic repairs (damage less than 1/2" deep) to the parts of the girders embedded in concrete.
- Use low relaxation strands meeting the requirements of ASTM A-416 Grade 270. The minimum clear distance between groups or individual strands shall be 2.3(d_s) but not less than 1/4". The minimum cover for prestressing steels is 1/2".
- A minimum of two harping points shall be used per girder. Harped strands shall be well distributed at the girder ends, starting within 4" of the top of the girder and distributed such that there is no space between strands greater than 1'-0" at the end of the girder. As an alternate the Contractor may place #4 x 10'-0" in the sides of the end of the web parallel to the harped strands such that there is no space greater than 1'-0".
- A_s* = minimum area of the prestressing steel.
d_s = nominal strand diameter.
f'_s = ultimate strength of prestressing steel.
F_J = jacking force per girder.
F_F = final force per girder after all losses.
f'_{ci} = required concrete strength at release of prestress force.
f'_c = required concrete strength at 28 days of age.
L = length of girder along the grade of the girder.
Δ = deflection at centerline of span due to cast-in-place slab, diaphragms, asphalt, curbs, rails, and walks.
- Concrete shall be Class PS.
- Entrained air is not required for girder concrete.
- Use 1/2" chamfer on all corners.
- Predicted camber is the camber for the girder alone at 90 days. The Contractor shall limit the camber growth to a value not to exceed the predicted camber plus 1" prior to the deck pour by weighting, scheduling fabrication, post tensioning, or other means and must report to the Engineer values of camber which exceed the predicted camber plus 1". Remedial measures, as approved by the Engineer, shall be taken if the predicted camber plus 1" is exceeded. The approved remedial measures shall be free of any adverse impact. The costs associated with all remedial measures shall be borne by the Contractor.
- D20 wires may be used in lieu of #4.
2 - D20 wires may be used in lieu of #6.
D11 or W10.9 wires may be used in lieu of #3.
W5 wires may be used in lieu of #2.
- 3/4"Ø sleeves except use 7/8"Ø threaded inserts on interior face of exterior girders at Pier 2.
- Provide (2) 1/2"Ø threaded inserts at 8'-0" center as required for utility conduits. Adjust vertical locations of inserts as required to clear strand and rebar.


Design	INITIAL	DATE	INITIAL	DATE
	JSM	08/08	JSM	08/08
Checked By	TAH	08/08	TAH	08/08
	Checked By	Checked By	Checked By	Checked By
Detail	INITIAL	DATE	INITIAL	DATE
	JSM	08/08	JSM	08/08
Checked By	TAH	08/08	TAH	08/08
	Checked By	Checked By	Checked By	Checked By
Quantities	INITIAL	DATE	INITIAL	DATE
	JSM	08/08	JSM	08/08
Checked By	TAH	08/08	TAH	08/08
	Checked By	Checked By	Checked By	Checked By

Print Date: 9/27/2010	Sheet Revisions			Colorado Department of Transportation	As Constructed		RAMP D OVER WILSON GULCH		Project No./Code
File Name: 16042Y_Prestr_I_Girder_01.dgn	Date:	Comments	Init.		No Revisions: 09/10	BT63 GIRDER DETAILS		NH 1602-114	
Horiz. Scale: 1:1				3803 North Main Avenue Suite 200 Durango, CO 81301 Phone: 970-385-1440 FAX: 970-385-8365	Revised:	Designer: J. Mills Structure: P-05-Y		16042	
Unit Information 0221					Void:	Detailer: R. Artman Numbers:			
Unit Leader STW				Region 5	Sheet Subset: Bridge		Subset Sheets: B16 of B26	Sheet Number 316	





Region 5


EJA

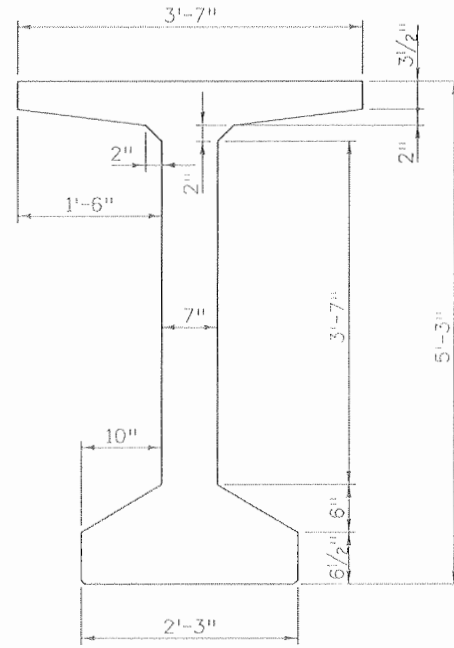


BT63 DETAIL

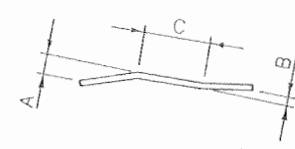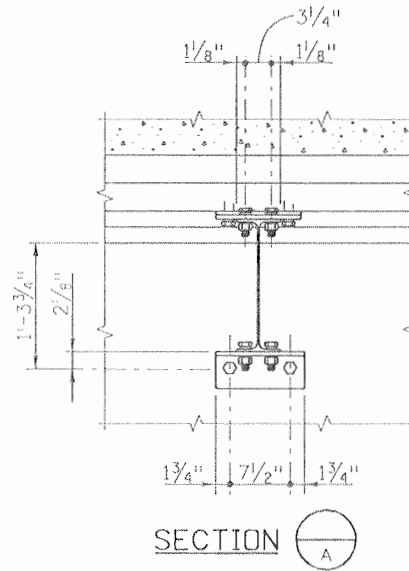


SECTION C
Dimensions A, B and C shall be shown on the shop drawings.

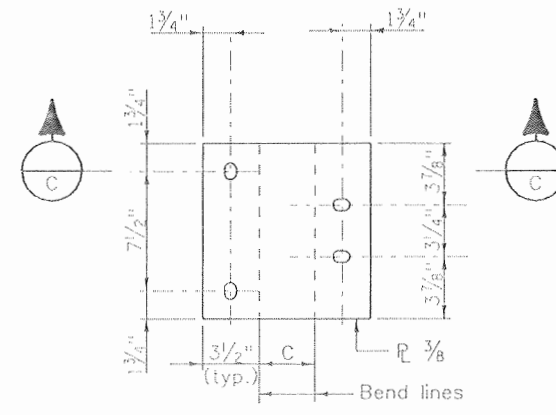

PLAN
(Before bending)
PLATE DETAIL

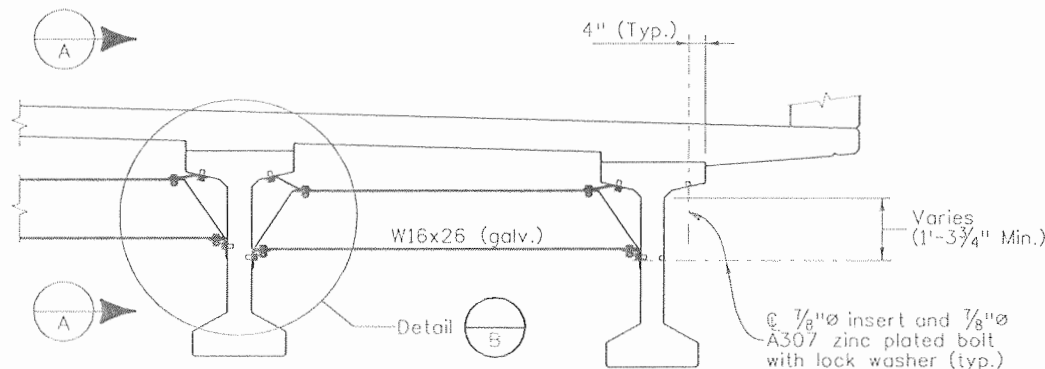

INTERMEDIATE DIAPHRAGM DETAILS

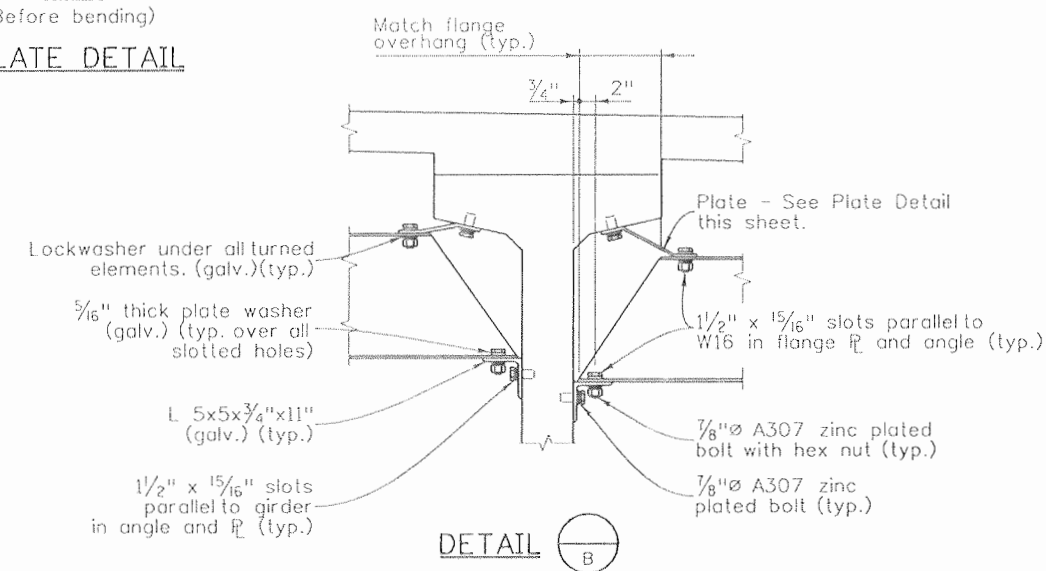

DETAIL B

NOTES:

1. All diaphragm materials, including bolts, nuts, and washers shall be galvanized. Galvanize after fabrication.
2. Bolts, nuts and lock washers may be zinc plated in lieu of being galvanized.
3. The diaphragms may be placed on a skew such that they are between 80° and 100° to the girders. Additionally, all diaphragms shall be installed level.
4. The Contractor is responsible for determining necessary bracing requirements and for providing adequate bracing for the specific wind and weather conditions to be encountered for each specific project.
5. When bracing or diaphragms are required, no girders shall be erected and left unbraced. The intermediate diaphragms (when used) shall be connected to the adjacent girders simultaneously with the erection of the girders.
6. Use and installation of the intermediate diaphragms shall not relieve the Contractor of full responsibility to construct the Work in a manner which provides all necessary rigidity, supports all loads imposed, and provides in the finished structure the lines and grades indicated on the plans.
7. For intermediate diaphragm location, see sheet B8.
8. All steel for diaphragms shall be AASHTO M270, Grade 36, minimum.

Design		Detail		Quantities	
INITIAL	DATE	INITIAL	DATE	INITIAL	DATE
JSM	08/08	JSM	08/08	JSM	08/08
TAH	08/08	TAH	08/08	TAH	08/08
Designed By	Checked By	Designed By	Checked By	Quantities By	Checked By

Print Date: 9/27/2010
 File Name: 16042Y_Prestr_I_Girder_02.dgn
 Horiz. Scale: 1:1 Vert. Scale: As Noted
 Unit Information 0221 Unit Leader STW

SEMA CONSTRUCTION
WILSON & COMPANY

Sheet Revisions		
Date:	Comments	Init.

Colorado Department of Transportation
 3803 North Main Avenue
 Suite 200
 Durango, CO 81301
 Phone: 970-385-1440 FAX: 970-385-8365



DOT
 DEPARTMENT OF TRANSPORTATION

Region 5 EJA

As Constructed	
No Revisions:	09/10
Revised:	
Void:	

RAMP D OVER WILSON GULCH BT63 GIRDER DETAILS (2 OF 2)			
Designer:	J. Mills	Structure Numbers	P-05-Y
Detailer:	R. Artman	Subset Sheets:	B17 of B26
Sheet Subset:	Bridge	Subset Sheets:	B17 of B26

Project No./Code	
NH 1602-114	16042
Sheet Number	317

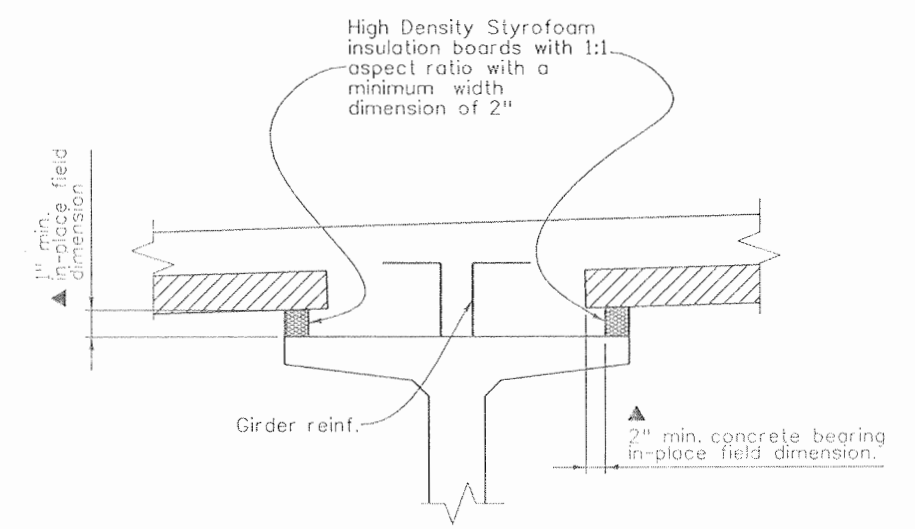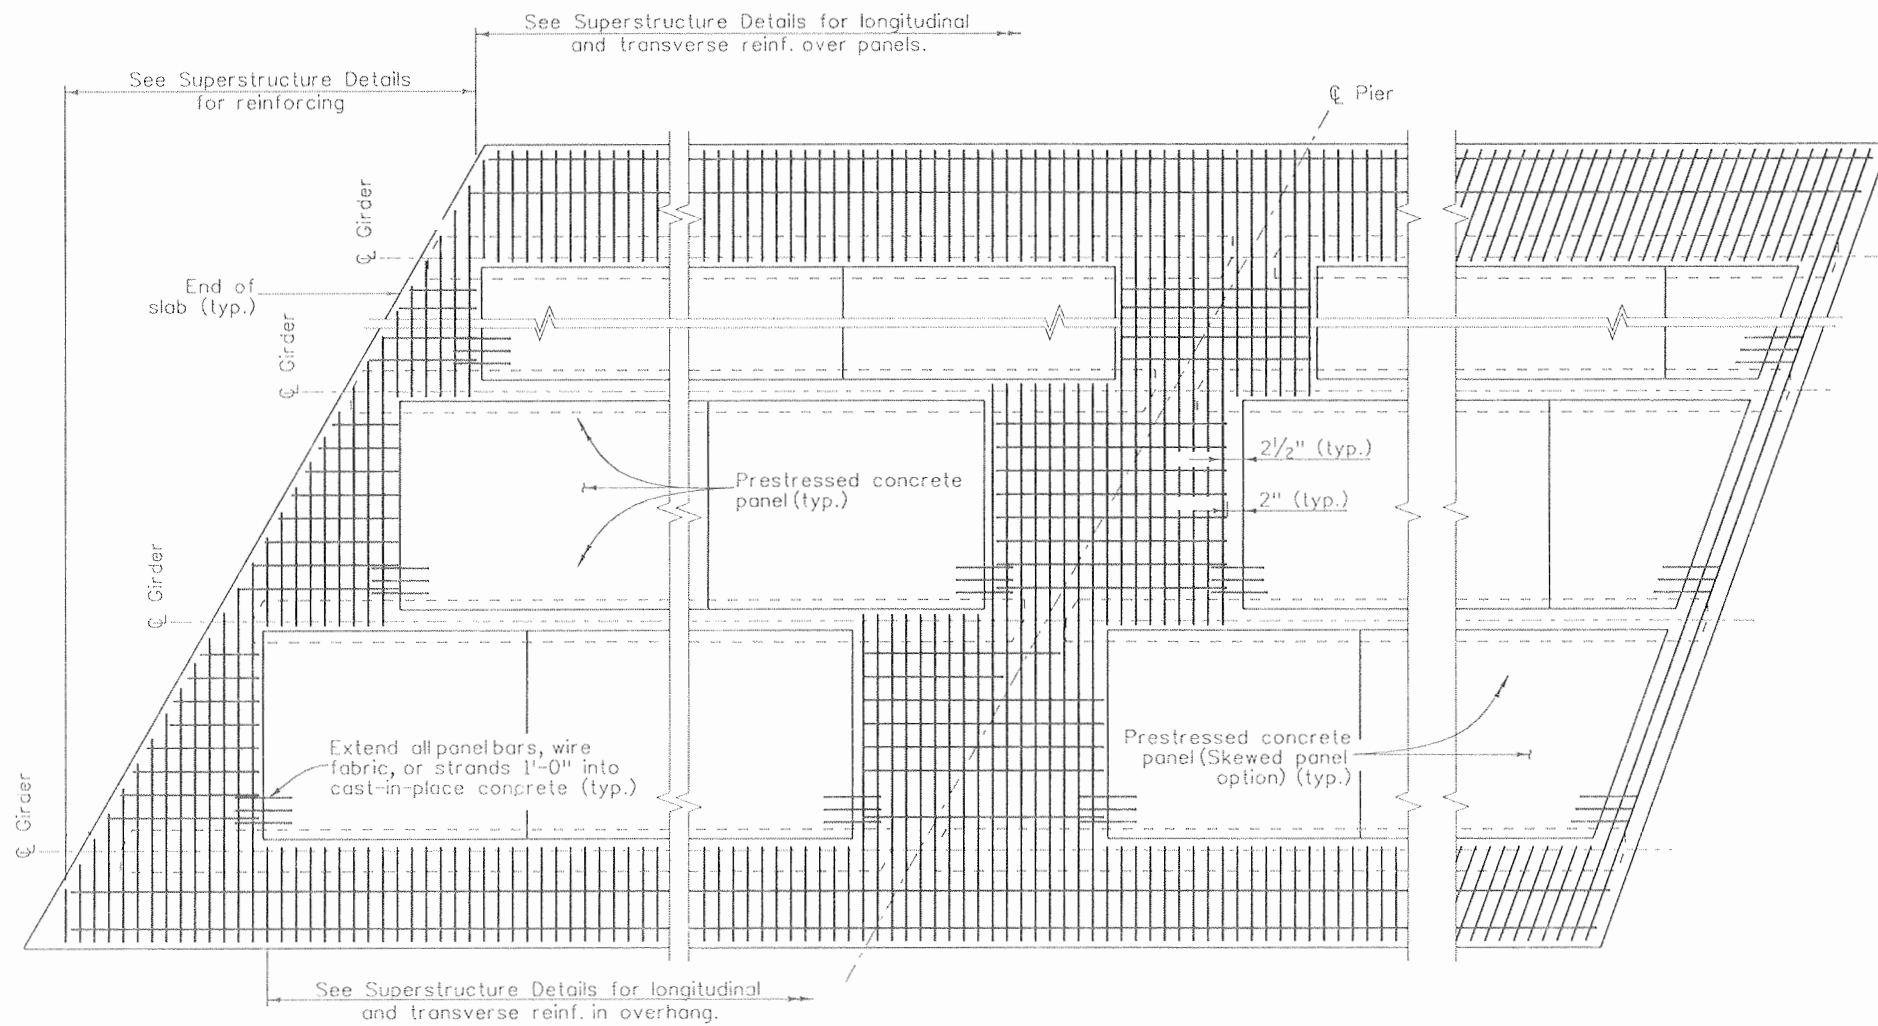

ALTERNATE SUPPORT DETAIL

END OF SLAB RECTANGULAR PANEL OPTION AND SKEWS LESS THAN 70°
CONTINUOUS SLAB OVER PIER
END OF SLAB SKEWED PANEL OPTION FOR SKEWS 70° to 90°
PART PLAN







Rectangular panel option shall be used for skews less than 70°.

NOTES:

1. Composite total slab designed for HS 25-44 and Alternate Military Loading.
2. All concrete shall be Class PS with release strength $f'_{ci} = 4500$ psi and minimum 28 day strength $f'_c = 6000$ psi. Entrained air is not required for precast panel deck form concrete. The strength shall be at least 5000 psi at the time of the deck pour.
3. Use $\frac{3}{8}$ " low relaxation strands meeting the requirements of ASTM A416 grade 270. Jacking force per strand (F_j) shall be at least 17.2 kips. Final force per strand (F_f) is estimated to be 14.2 kips.
4. Installation of Bar U (#3) is mandatory. All four Bar U (#3) loops shall be used simultaneously for lifting the panels.
5. Care must be taken to ensure proper cleaning of construction debris off the tops of the panels and consolidation of concrete mortar under the edges of the panels. Water, dirt or other debris on top of the panels will inhibit the bond of the cast-in-place concrete. It is also important that adequate space (▲ min. 1" x 2") is provided for the concrete to fill the space under the panels as the slab concrete is placed. Panel lengths and width shall be determined by the Contractor and shown on the shop plans.
6. The Contractor is responsible for the stability of the panels on the girders. Erected panels shall be uniformly supported along the length of the panel. The Contractor is responsible for meeting the total slab thickness shown on the Superstructure Details.
7. All planes of reinforcing steel shown in the superstructure details are required for areas not formed with precast panels.

Design		Detail		Quantities	
Designed By	JSM	INITIAL	FAH	INITIAL	JSM
Checked By	TAH	DATE	08/08	DATE	08/08
		Revised By		Revised By	
		Checked By		Checked By	

Print Date: 9/27/2010	Sheet Revisions			Colorado Department of Transportation		As Constructed		RAMP D OVER WILSON GULCH PRECAST PANEL DECK FORM (1 OF 2)		Project No./Code	
File Name: 16042Y_PrecastPanel_02.dgn	Date:	Comments:	Init.	3803 North Main Avenue Suite 200 Durango, CO 81301 Phone: 970-385-1440 FAX: 970-385-8365		No Revisions: 09/10		Designer: J. Mills Structure: P-05-Y		NH 1602-114	
Horiz. Scale: 1:1 Unit Information 0221				Region 5		Revised:		Detailer: R. Artman Numbers:		16042	
Vert. Scale: As Noted Unit Leader STW				EJA		Void:		Sheet Subset: Bridge Subset Sheets: B18 of B26		Sheet Number 318	
SEMA CONSTRUCTION	WILSON & COMPANY			DOT DEPARTMENT OF TRANSPORTATION							

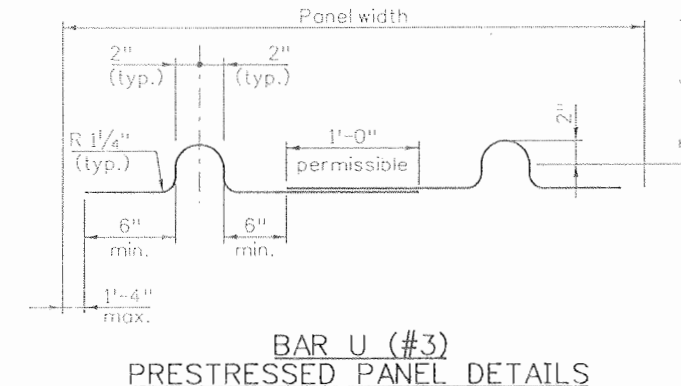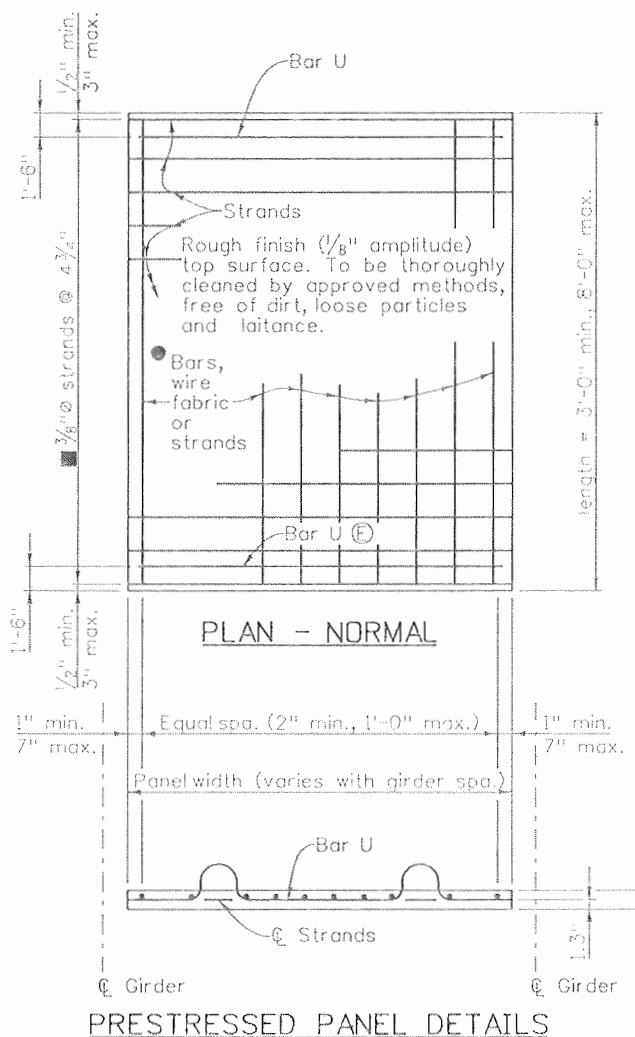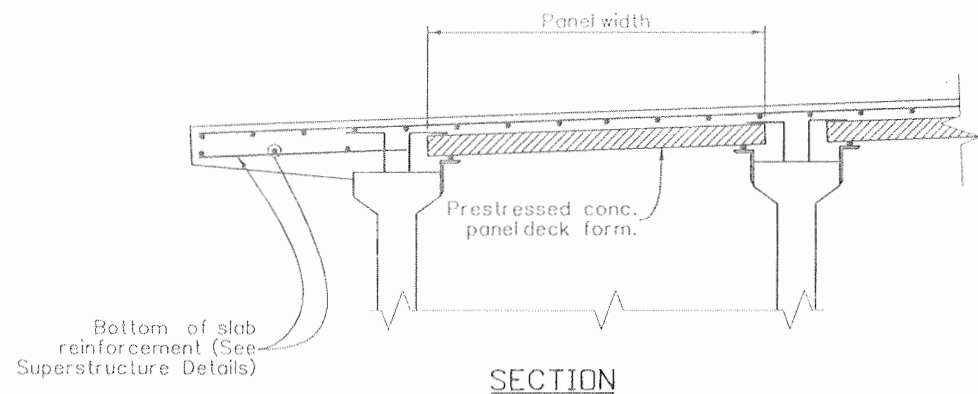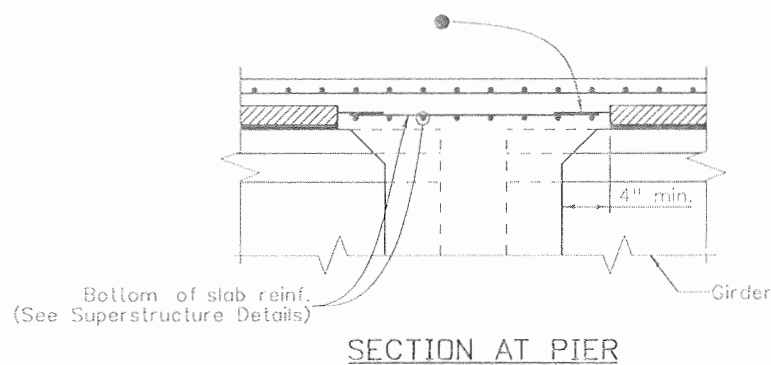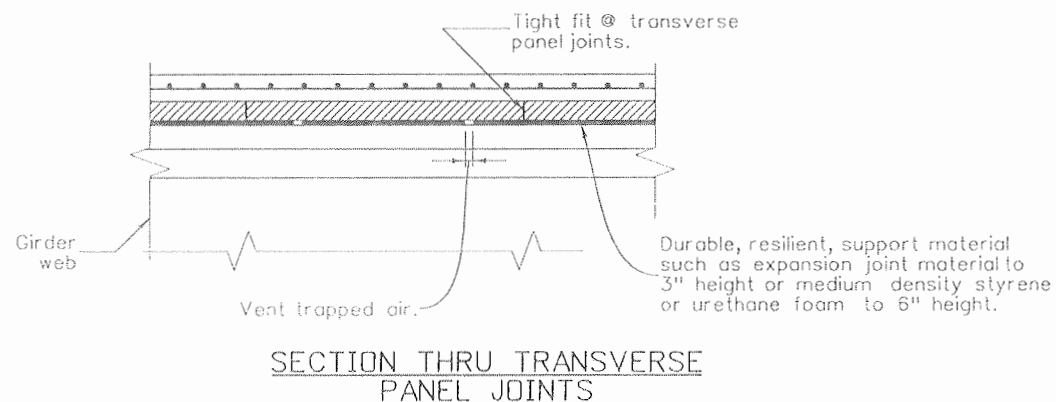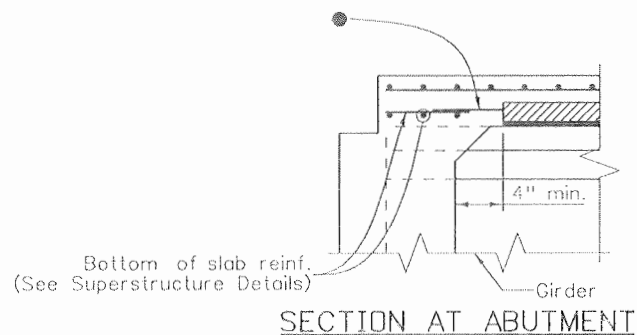


NOTES:

- Sawing of panels is acceptable in areas where projecting reinforcement is not required. It is desirable to have the prestressing strands project from the panels as long as the projecting strands do not interfere with other bridge components.
 - The longitudinal reinforcing steel in the cast-in-place portion of the deck may rest directly on the panels as necessary to obtain clearances at the top of deck, unless otherwise noted.
 - The tolerance on strand placement shall not exceed $\pm 1/4$ ".
 - The tolerance on panel thickness shall not exceed $\pm 1/4$ ".
 - Concentrated construction loads shall not exceed 500 lb for 3" panels, 700 lb for 3.5" panels, nor 1100 lb for 4" panels unless the load is distributed to less than 117 psf.
 - Total loads applied to any panel during construction shall not exceed 117 psf.
 - Bottom flexural cracks, sags greater than 0.5", or cambers greater than 0.5" will be considered evidence of mishandling, overloading, or exceeding allowable tolerances, and may be cause for rejecting panels at the Engineer's discretion.
- Reinforcing perpendicular to strands may be deformed reinf. bars, welded wire fabric, or welded deformed bar mats, and shall be placed directly above the strands. Minimum area of reinforcing perpendicular to strands shall be 0.11 sq. in. per ft. Tensioned or untensioned strands may also be used. These individual bars or wires shall be no larger than 0.375" diameter. For location of longitudinal bar extensions, see sheet 2 of 2.
 - May be reduced to 3/8" ϕ strands at 9/2" when the panel width is less than 5'-7" and the design span is less than 7'-7".

Design	INITIAL	DATE	Checked By	Checked By
	JSM	05/08		
Detail	INITIAL	DATE	Checked By	Checked By
	RGA	06/08		
Quantities	INITIAL	DATE	Checked By	Checked By
	JSM	06/08		

Print Date: 9/27/2010	Sheet Revisions			Colorado Department of Transportation 3803 North Main Avenue Suite 200 Durango, CO 81301 Phone: 970-385-1440 FAX: 970-385-8365	As Constructed	RAMP D OVER WILSON GULCH PRECAST PANEL DECK FORM (2 OF 2)		Project No./Code
File Name: 16042Y_PrecastPanel_01.dgn	Date:	Comments	Init.		No Revisions: 09/10	Designer: J. Mills Structure: P-05-Y		NH 1602-114
Horiz. Scale: 1:1 Unit Information 0221	Vert. Scale: As Noted	Unit Leader STW			Revised:	Detailer: R. Artman Structure Numbers:	16042	Sheet Number 319
		Region 5			Void:	Sheet Subset: Bridge Subset Sheets: B19 of B26	Sheet Number 319	

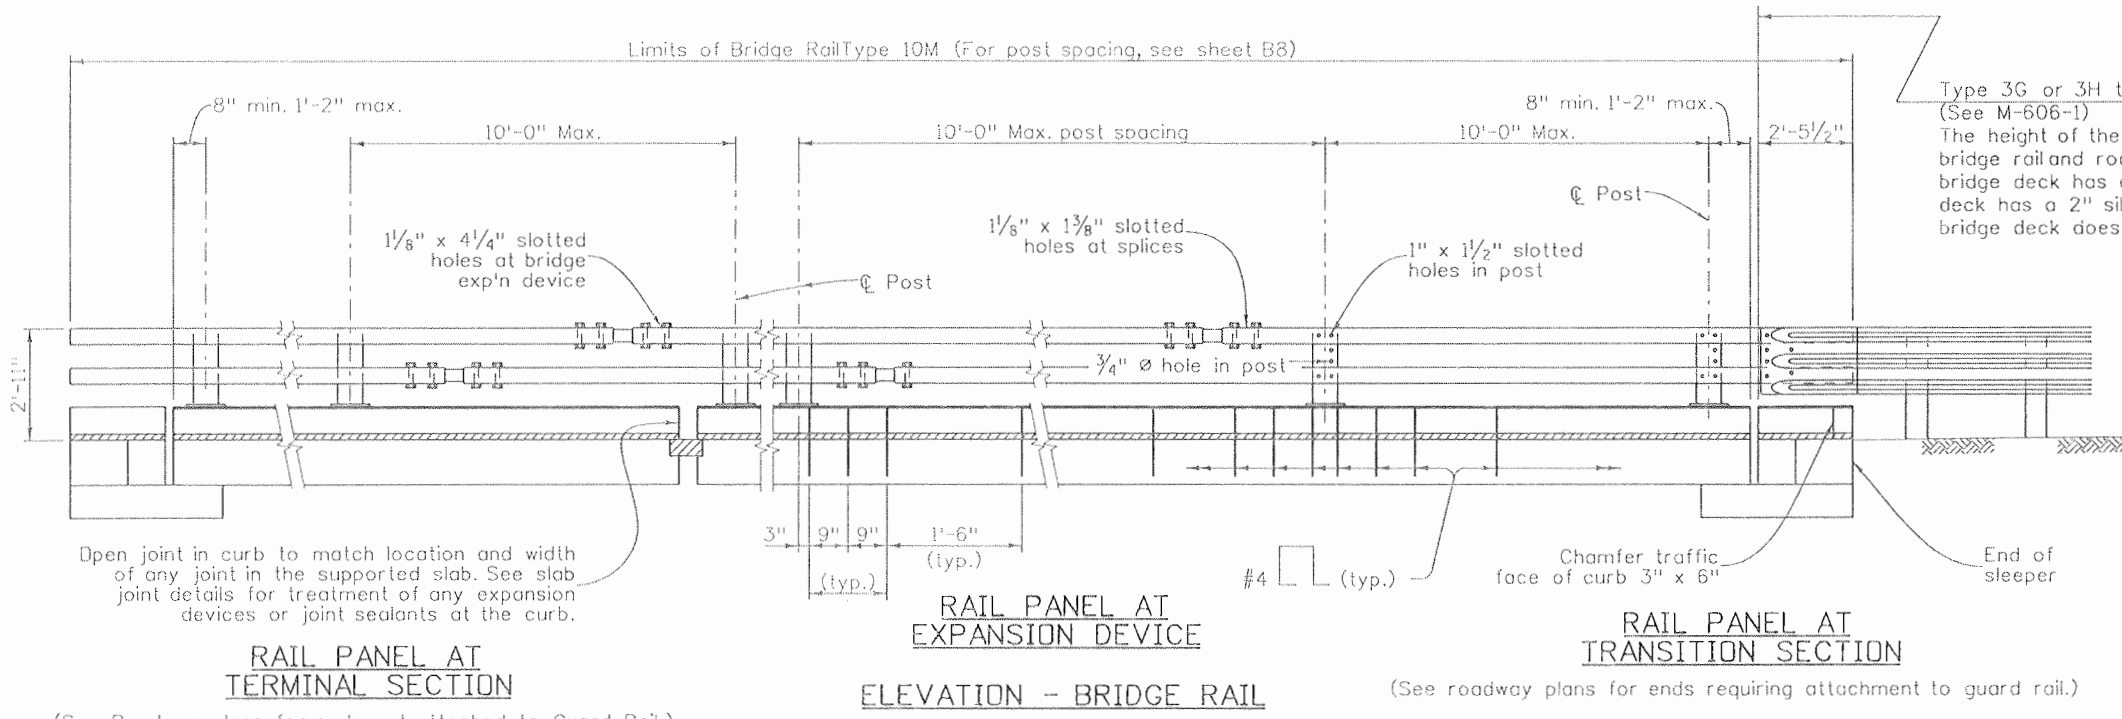

NOTES:

- All tubes shall be ASTM A-847. All other steel shall be ASTM A-588 Grade 50.
- Concrete, reinforcing steel, and structural steel elements shall conform to the requirements of sections 601, 602 and 509, respectively. Anchor bolts shall be galvanized in accordance with Section 509.
- Post anchor, encased in concrete, shall be ASTM A-36 (AASHTO M-183).
- The tubes shall be shop bent or fabricated to fit horizontal curve when radius is less than 1,500 feet.
- Tubes shall be continuous over not less than two posts. No welded butt splices will be allowed in the tube sections.
- The centerline of the tube splice shall be 1'-8" minimum and 2'-5" maximum from the centerline of the posts.
- All bolts that have lock washers shall be tightened to snug only.
- Posts shall be perpendicular to the longitudinal roadway grade.
- One or more 10'-0" post spacings may be reduced (6'-8" min.) in order to maintain dimensions from the end of the rail and expansion joints.
- Prior to fabrication of this item, three sets of working drawings which comply with the requirements of section 105, shall be submitted to the Engineer for information only.
Structural Steel:
ASTM A-36 $f_y = 36,000$ psi
ASTM A-588 Grade 50 $f_y = 50,000$ psi
A-847 Grade B $f_y = 46,000$ psi
- For additional details see next railsheets.
- At bridge ends without Approach Slabs. Terminate tube at nearest splice. Continue post spacing to end of structure.
- Coordinate location of de-icing equipment and conduits with bridge rail reinforcing and hardware. Move conduit or equipment if a conflict exists. Refer to de-icing plans for additional reinforcement required at sensor pole mounting location.


RAIL PANEL AT TERMINAL SECTION

(See Roadway plans for ends not attached to Guard Rail.)


RAIL PANEL AT EXPANSION DEVICE
ELEVATION - BRIDGE RAIL

(See roadway plans for ends requiring attachment to guard rail.)


RAIL PANEL AT TRANSITION SECTION

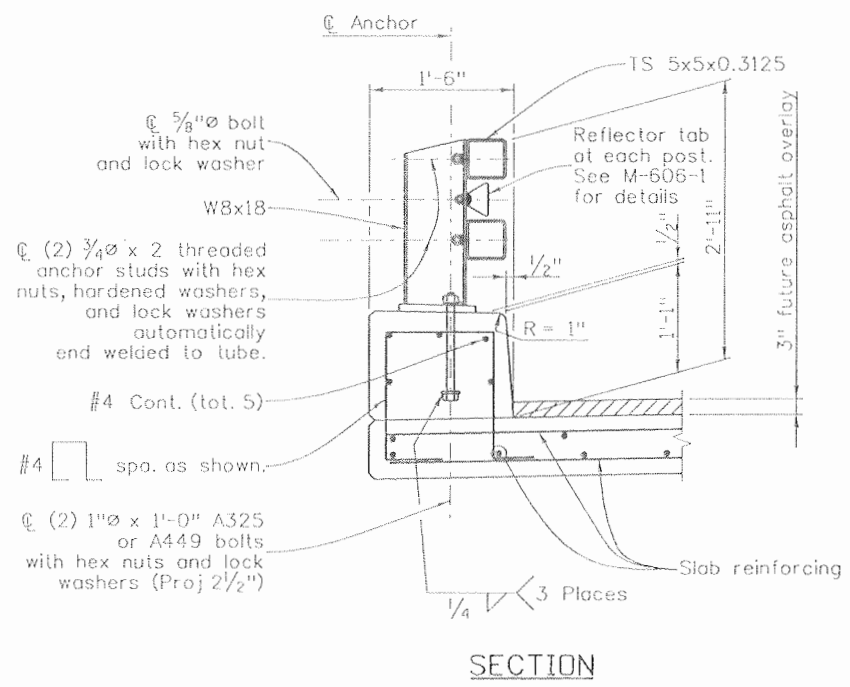


SECTION

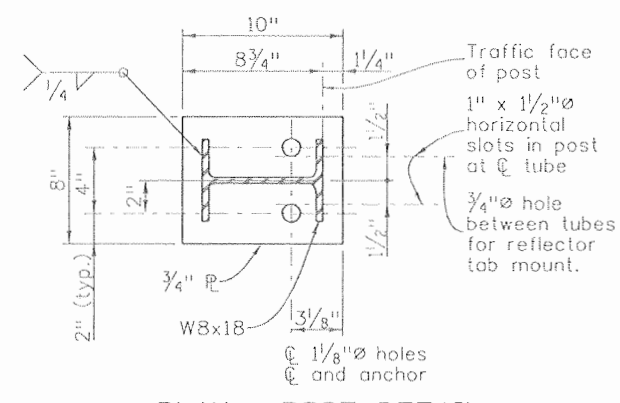


PLAN - POST DETAIL

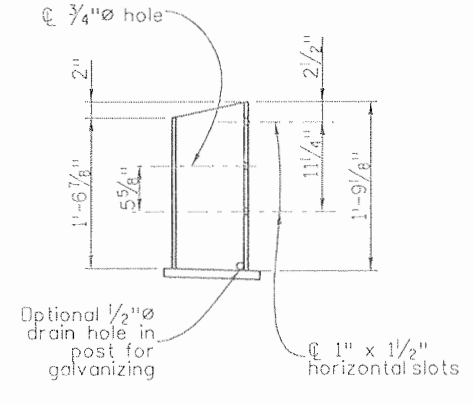

ELEVATION

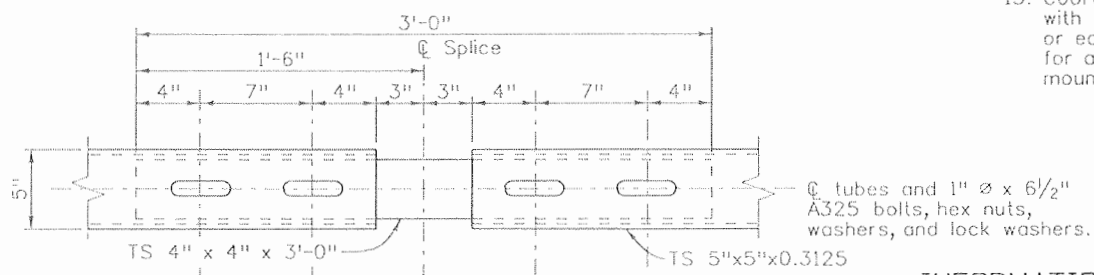

PLAN - TUBE SPLICE

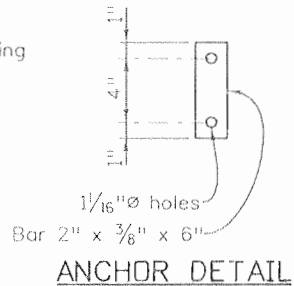

ANCHOR DETAIL

INFORMATION ONLY

DESCRIPTION	UNIT	PER LIN. FT.
Structural Steel	LB.	45.1
Concrete Class D (Bridge)	CU.YD.	.06
Reinforcing Steel (Epoxy Coated)	LB.	6.6


Design	INITIAL		DATE		Checked By	Checked By
	By	By	By	By		
Designed By	AML	AML	08/08	08/08	AML	08/08
Checked By	GWK	GWK	08/08	08/08	GWK	08/08

Print Date: 9/27/2010
 File Name: 16042Y_BridgeRailType10M_01.dgn
 Horiz. Scale: 1:1 Vert. Scale: As Noted
 Unit Information 0221 Unit Leader STW

Sheet Revisions			Colorado Department of Transportation	As Constructed	RAMP D OVER WILSON GULCH BRIDGE RAIL TYPE 10M (SPECIAL) (1 OF 2)			Project No./Code
Date:	Comments	Init.			No Revisions:	Designer:	Structure Numbers	
			3803 North Main Avenue Suite 200 Durango, CO 81301 Phone: 970-385-1440 FAX: 970-385-8365	09/10	A. Leifheit	P-05-Y	NH 1602-114	
				Revised:	D. Anderson			16042
			Region 5	Void:	Sheet Subset: Bridge	Subset Sheets: B20 of B26	Sheet Number 320	


SEMA CONSTRUCTION WILSON & COMPANY

Design		Detail		Quantities	
INITIAL	DATE	INITIAL	DATE	INITIAL	DATE
AWL	08/08	AWL	08/08	AWL	08/08
Checked By	Checked By	Checked By	Checked By	Checked By	Checked By
GWK	08/08	GWK	08/08	GWK	08/08

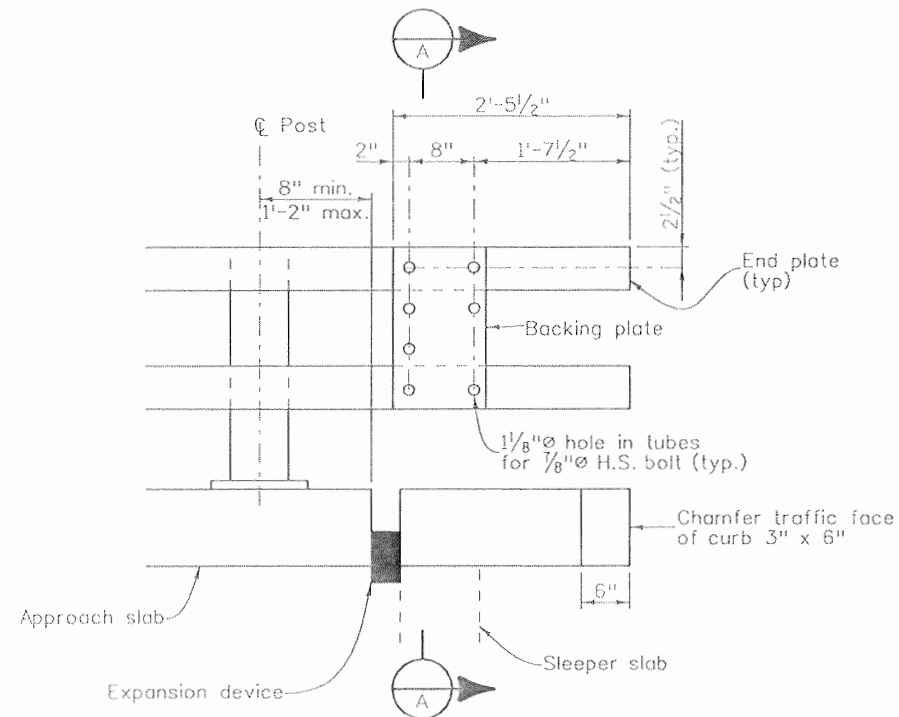


RAIL TUBE DETAILS

(Thrie beam not shown)
(Req'd at approach slab ends only)

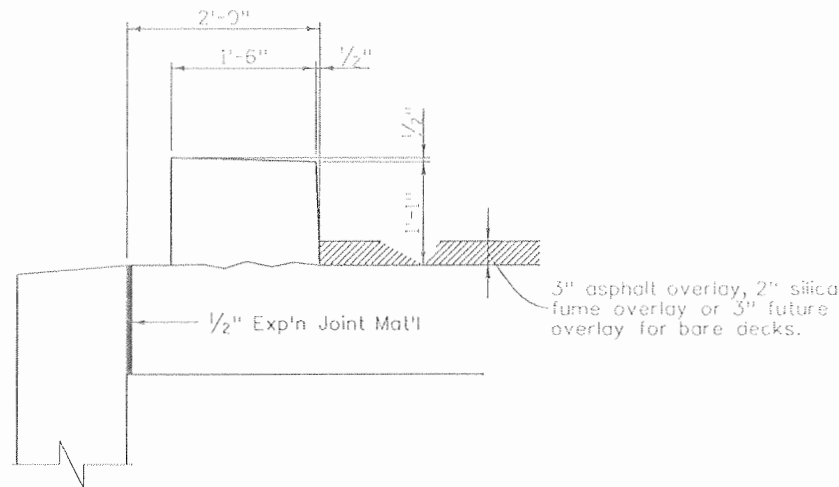


SECTION

(Use when curb is to be placed on approach slab.)
(Approach slab location only)

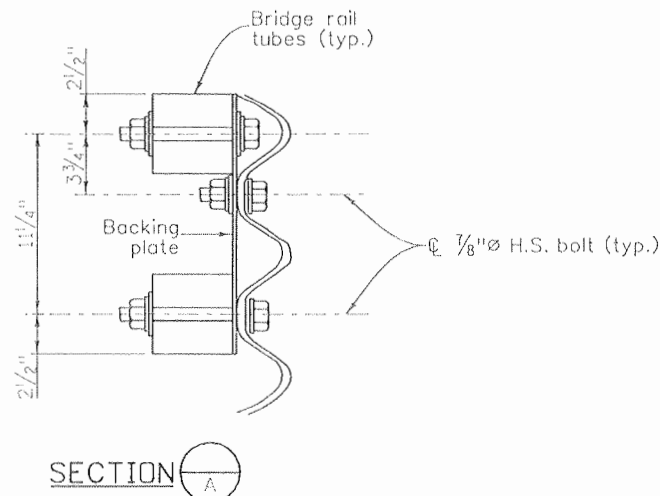


SECTION A

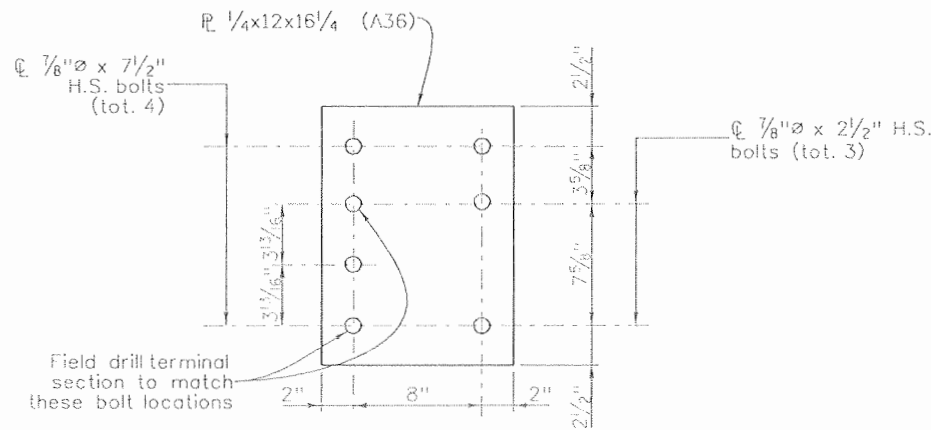


BACKING PLATE


Holes are 1 1/8" for 7/8" H. S. bolts with hex nuts, 2 PL washers, and 1 lock washer

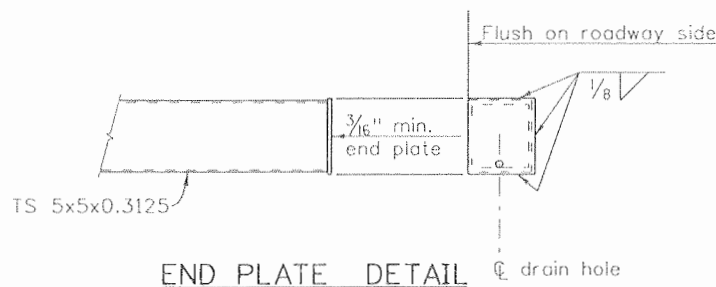

END PLATE DETAIL

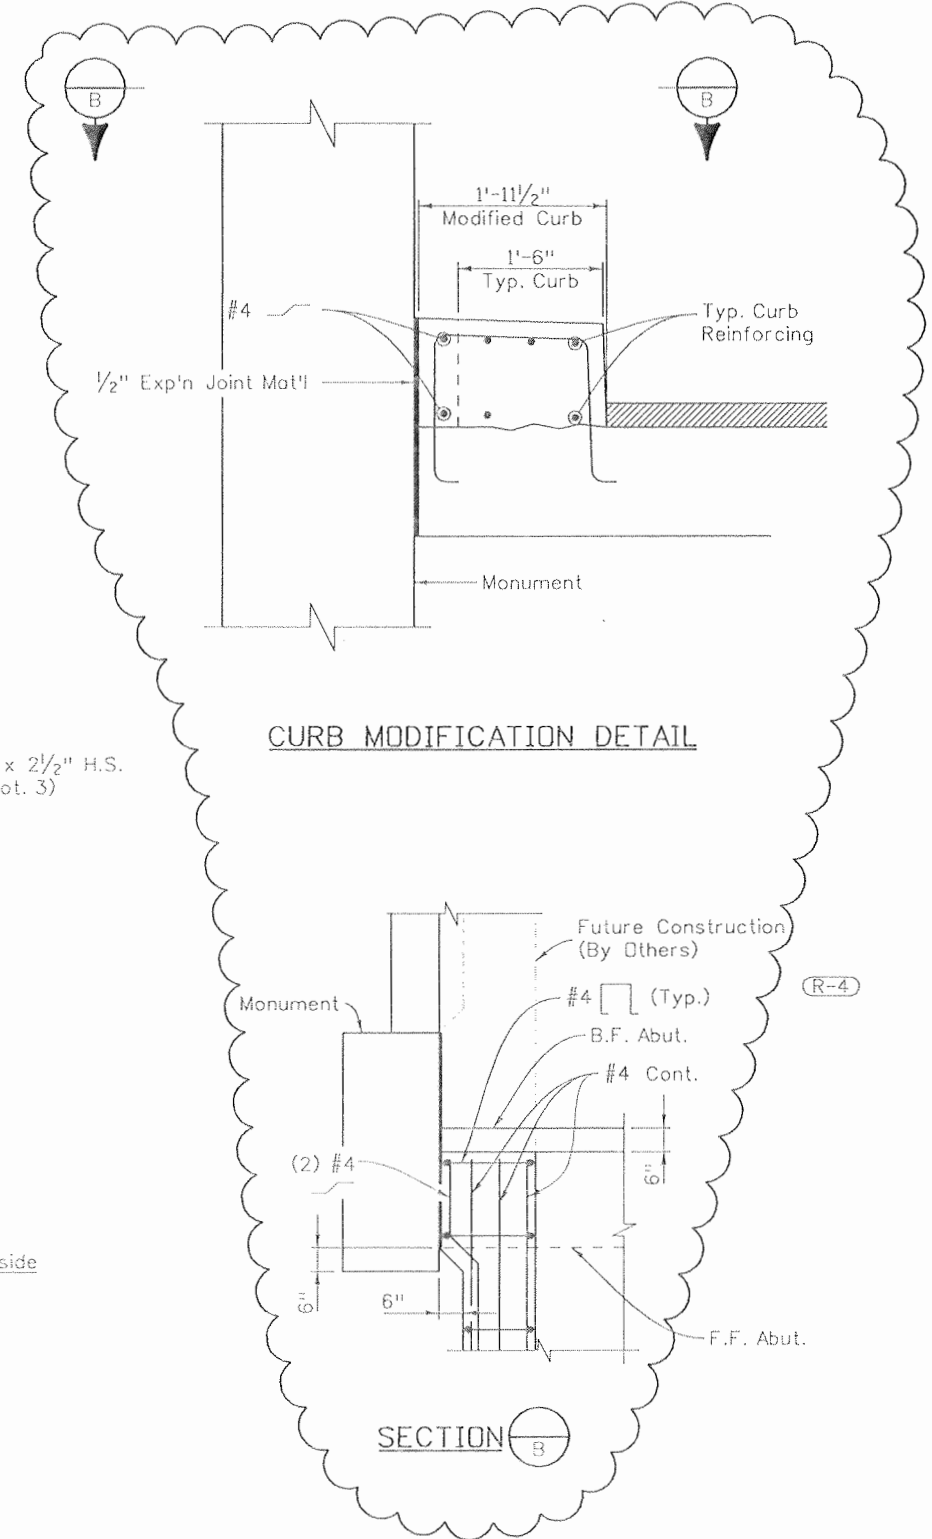


CURB MODIFICATION DETAIL

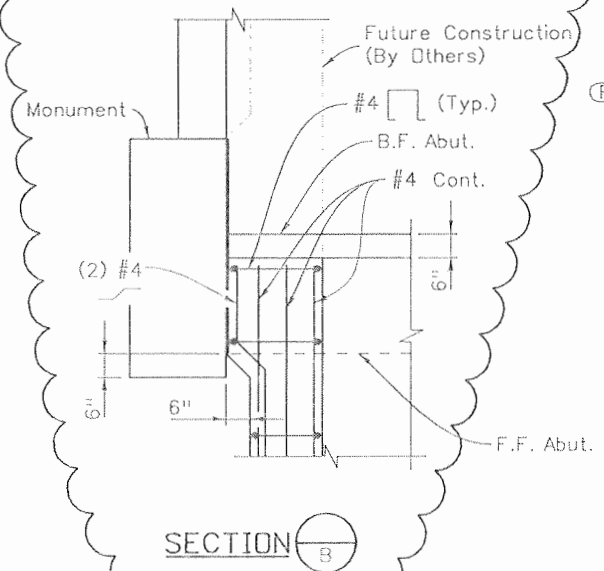

SECTION B

Print Date: 9/27/2010		Sheet Revisions			Colorado Department of Transportation		As Constructed		RAMP D OVER WILSON GULCH BRIDGE RAIL TYPE 10M (SPECIAL) (2 OF 2)		Project No./Code	
File Name: 16042Y_BridgeRailType10M_02.dgn		Date:	Comments	Init.	3803 North Main Avenue Suite 200 Durango, CO 81301 Phone: 970-385-1440 FAX: 970-385-8365		No Revisions: 09/10		Designer: A. Leifheit		NH 1602-114	
Horiz. Scale: 1:1		9/29/08	Added Rail Curb Modification	BJA	DOT DEPARTMENT OF TRANSPORTATION		Revised:		Structure: P-05-Y		16042	
Unit Information 0221					Region 5		Void:		Detailer: D. Anderson		Sheet Number 321	
Unit Leader STW					EJA				Sheet Subset: Bridge		Subset Sheets: B21 of B26	
SEMA CONSTRUCTION									Sheet Number		321	
WILSON & COMPANY												

Design		Detail		Quantities	
INITIAL	DATE	INITIAL	DATE	INITIAL	DATE
Designed By BJA	08/08	Detailed By TAH	08/08	Quantities By BJA	08/08
Checked By		Checked By		Checked By TAH	08/08

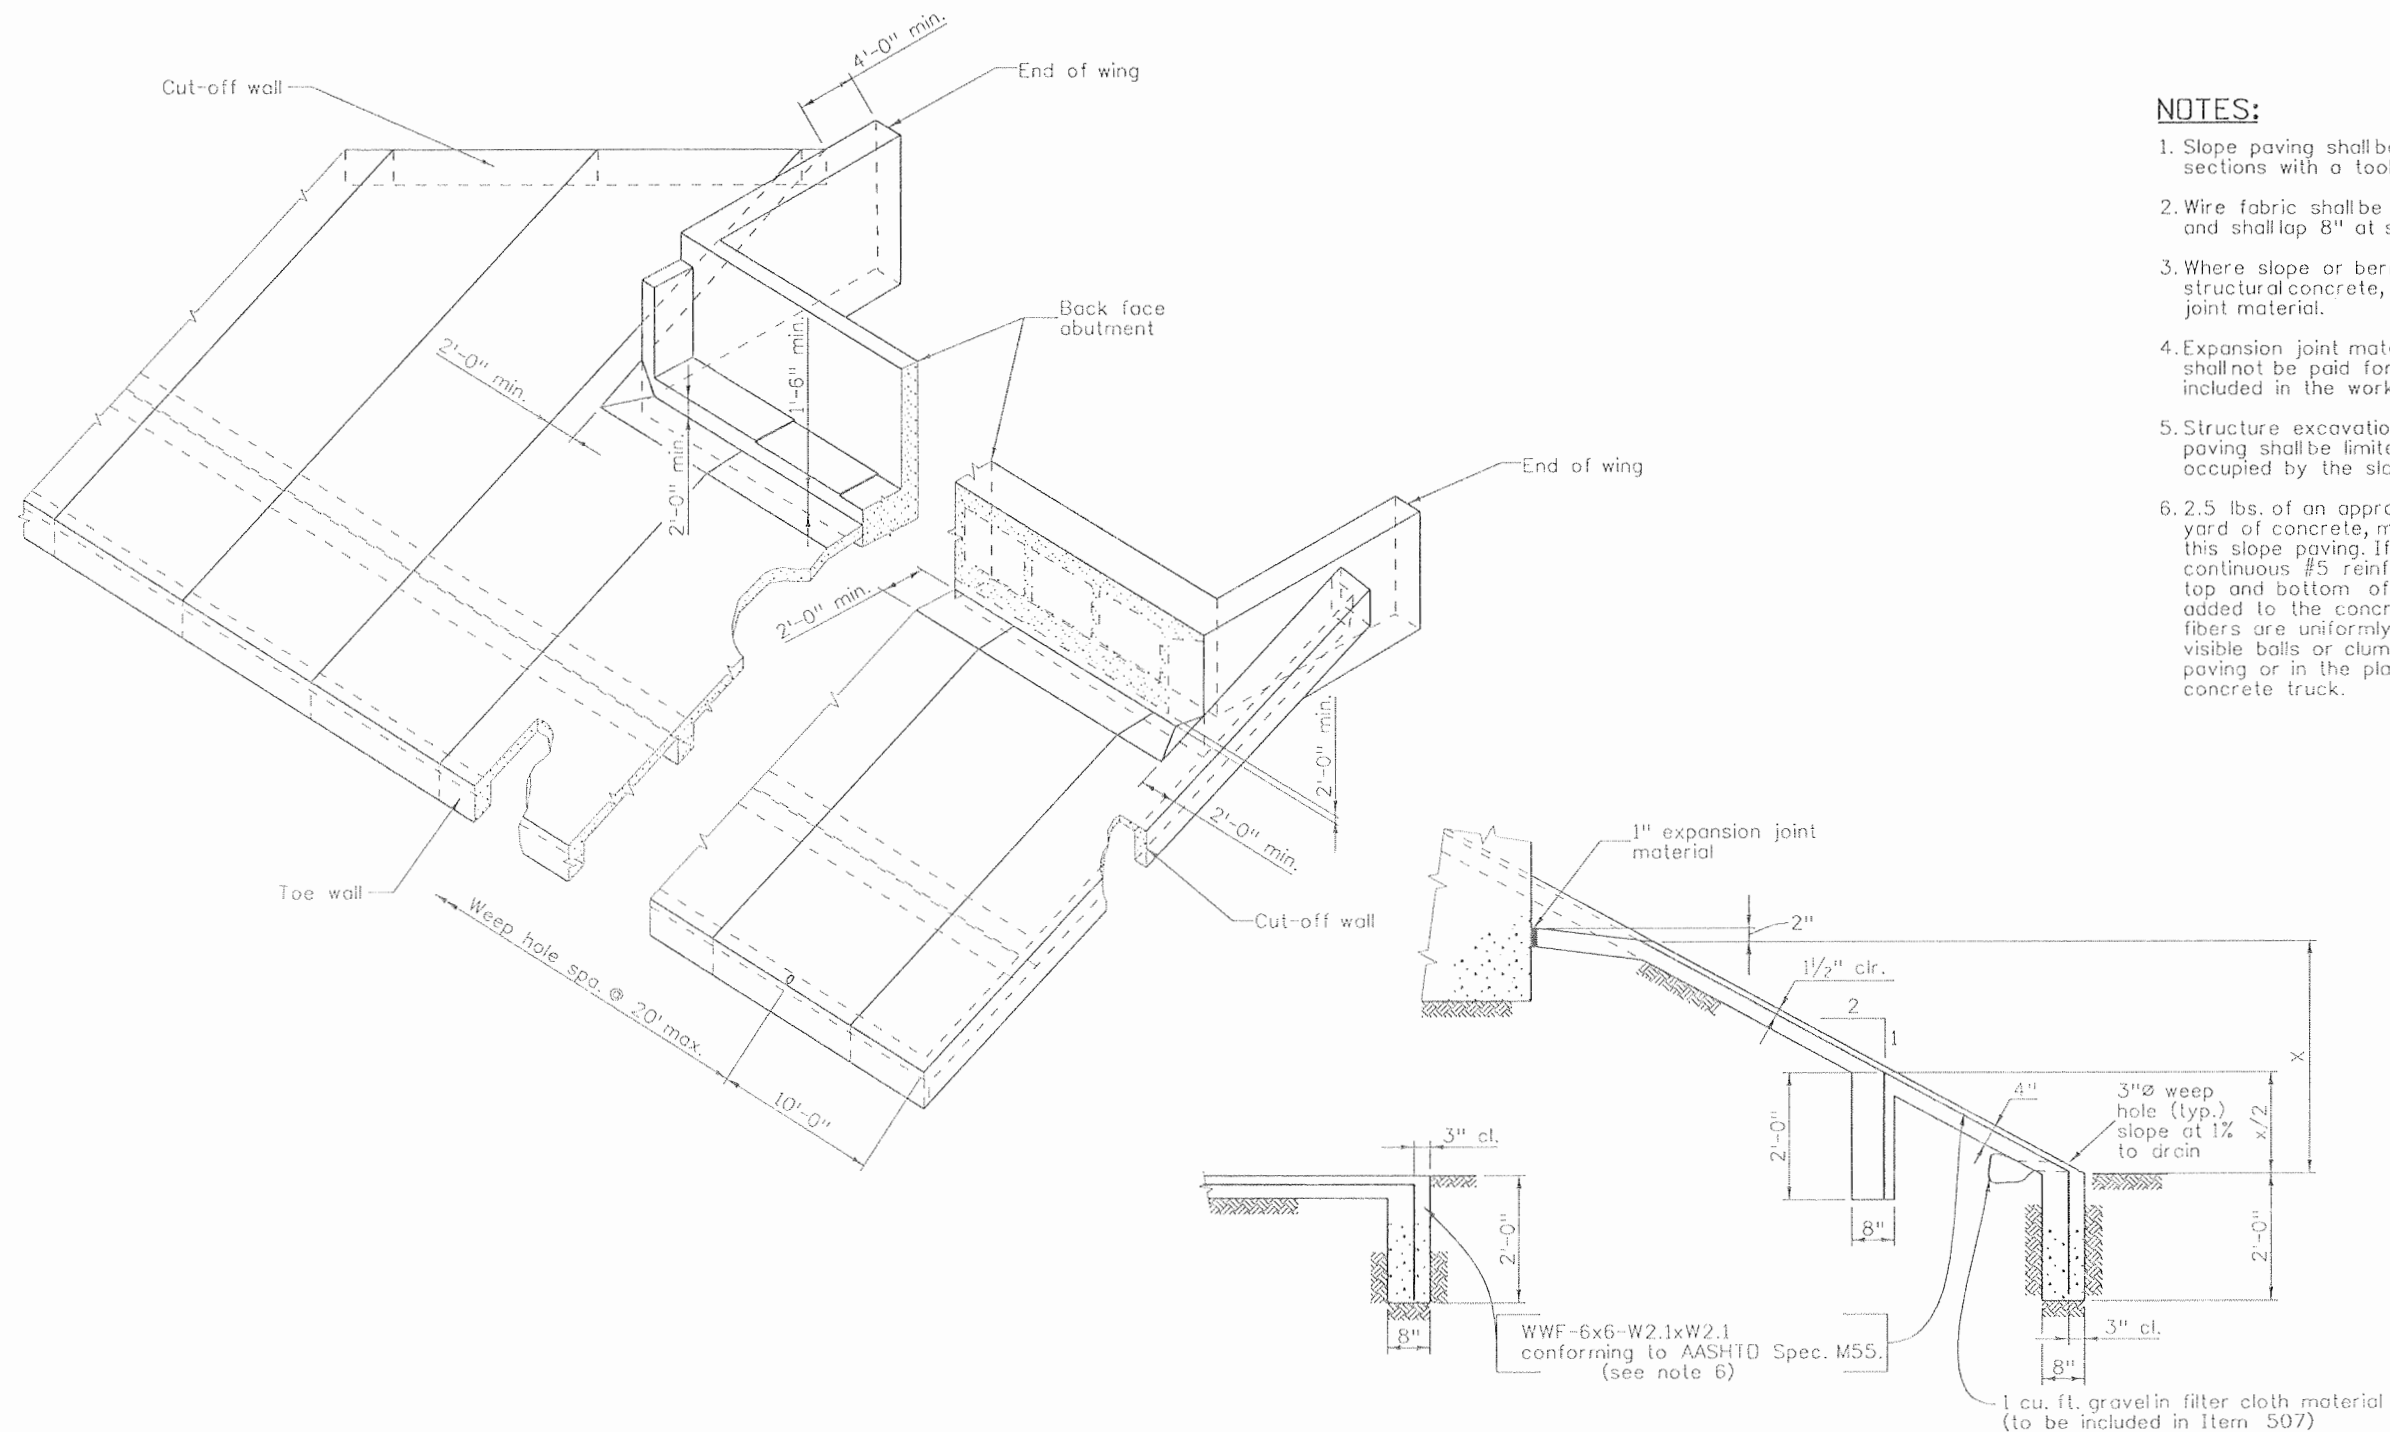


NOTES:

- Slope paving shall be poured in 10 ft. transverse sections with a tooled construction joint at each section.
- Wire fabric shall be 2" from the end of joints and shall lap 8" at splices.
- Where slope or berm paving butts against structural concrete, separate with 1" expansion joint material.
- Expansion joint material and welded wire fabric shall not be paid for separately, but shall be included in the work.
- Structure excavation for concrete slope and ditch paving shall be limited to the actual volume occupied by the slope paving concrete.
- 2.5 lbs. of an approved polypropylene fiber, per cubic yard of concrete, may be substituted for the WWF in this slope paving. If this substitution is made, a continuous #5 reinforcing bar shall be added near the top and bottom of the cutoff wall. The fiber shall be added to the concrete mix in such a fashion that the fibers are uniformly dispersed in the concrete without visible balls or clumps in either the finished slope paving or in the plastic concrete delivered from the concrete truck.


TYPICAL SECTION THRU CUT-OFF WALL

TYPICAL SECTION THRU SLOPE PAVING


Print Date: 9/27/2010	Sheet Revisions			Colorado Department of Transportation		As Constructed		RAMP D OVER WILSON GULCH		Project No./Code	
File Name: 16042Y_SlopePavingDet_01.dgn	Date:	Comments	Init.	3803 North Main Avenue		No Revisions: 09/10		SLOPE PAVING DETAILS		NH 1602-114	
Horiz. Scale: 1:1				Suite 200		Revised:		Designer: B. Allen		Structure P-05-Y	
Unit Information 0221				Durango, CO 81301		Void:		Detailer: R. Artman		Numbers	
Unit Leader STW				Phone: 970-385-1440 FAX: 970-385-8365				Sheet Subset: Bridge		Subset Sheets: B22 of B26	
SEMA CONSTRUCTION	WILSON & COMPANY			Region 5		EJA		Sheet Number		322	

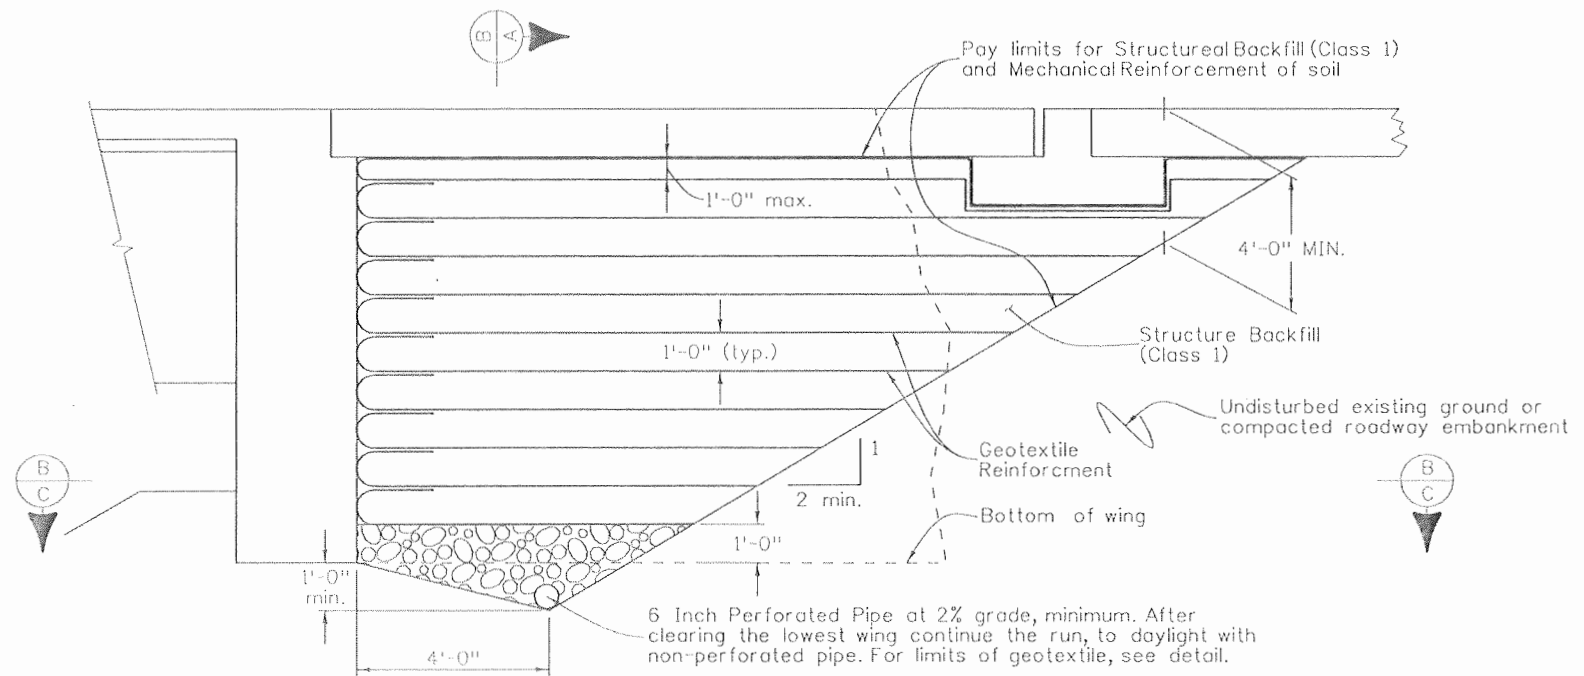

SECTION PERPENDICULAR TO ABUTMENT

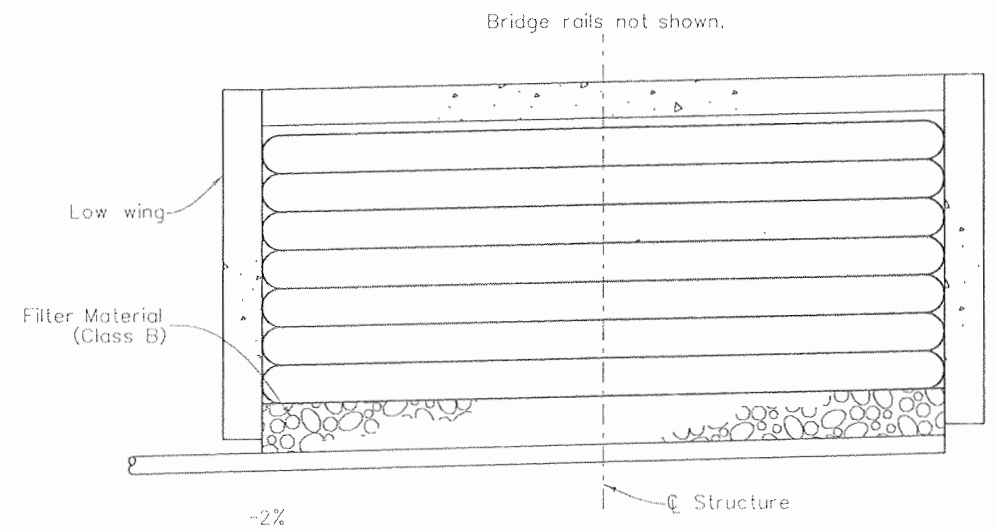


SECTION B/A

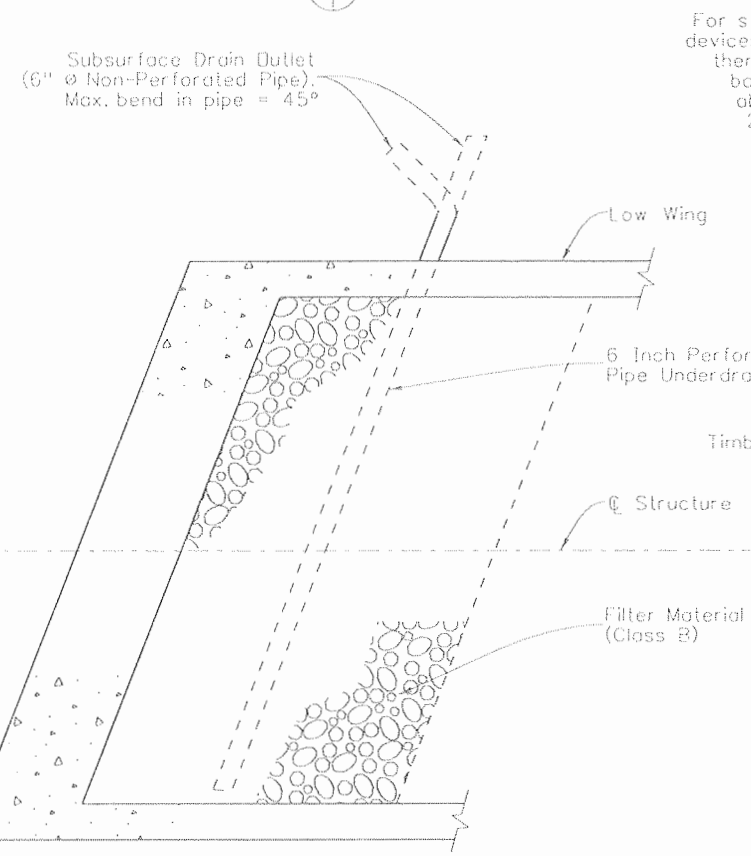


SECTION B/C

For steel structures longer than 300' without expansion devices between abutments and for abutments greater than 12' high, provide gap between the abutment and backfill. The gap width shall be at least 0.5% of the abutment height, 1" minimum. See Gap Detail 1 and 2. Do not provide this gap at bottom 2 nor the top 2 layers of Reinforced Soil.

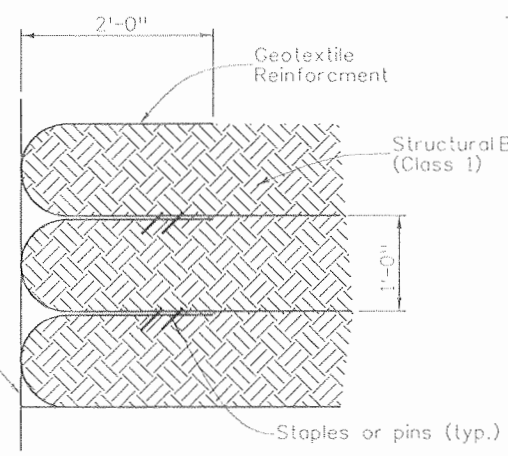


WRAP DETAIL

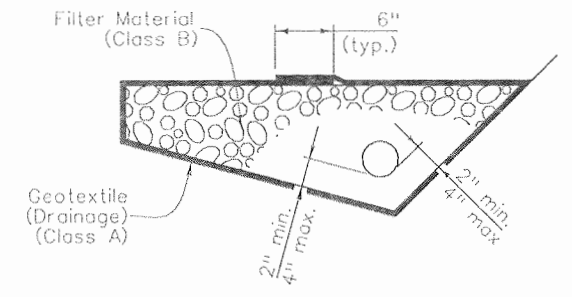

6 INCH PERFORATED PIPE UNDERDRAIN

6 Inch Perforated Pipe Underdrain includes all Filter Material (Class B) and Geotextile (Drainage) (Class A) surrounding the filter Material (Class B).

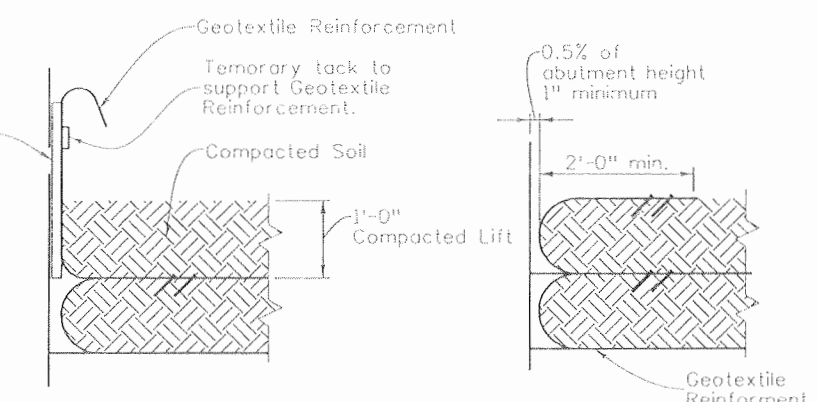

GAP DETAIL STEP 1

GAP DETAIL STEP 2


When required, the Geotextile Reinforcement wrap at Back Face of Abutment shall be temporarily hung with a spacer board and tack strip. After reaching a total of 1'-0" compacted lift, the tack strip shall be removed and Geotextile Reinforcement shall be pulled back slack free with its end anchored to soil underneath with staple or pins before the spacer board is pulled. Any alternate method to maintain the minimum gap between abutment concrete and Reinforced Soil may be proposed to the Engineer for approval.

NOTES:


- Geotextile reinforcement shall be woven fabric with a Minimum Average Roll Value of 4800 lb/ft for installations with a gap and 2400 lb/ft for installations without a gap based on ASTM D4595.
- Geotextile Reinforcement shall be placed by alternating Machine Direction (MD) with Cross Machine Direction (XD) from layer to layer.
- The Geotextile Reinforcement wrap at Back Face of Abutment shall be pulled back slack free with its end anchored to soil underneath with staples or pins.
- Minimum splice of all Geofabric shall consist of 6" of overlap.
- Payment will be made under item 206 Mechanical Reinforcement of Soil (cu.yd.) and item 206 Structure Backfill (Class 1) (cu.yd.) and shall include the cost for 6 inch Perforated Pipe underdrain and Subsurface Drain Outlet (6" diameter Non-Perforated Pipe).
- Installation of Pipe Underdrain and Subsurface Drain Outlet will conform to the Construction requirements of section 605.03 and 605.06, respectively.

Design	INITIAL		DATE		Checked By	Checked By	DATE	Checked By	Checked By	DATE
	By	By	By	By						
Designed By	TAH	TAH	08/08	08/08	TAH	TAH	08/08	08/08	TAH	08/08
Checked By	TAH	TAH	08/08	08/08	TAH	TAH	08/08	08/08	TAH	08/08

Print Date: 9/27/2010	Sheet Revisions			Colorado Department of Transportation		As Constructed		RAMP D OVER WILSON GULCH MECHANICALLY STABILIZED BACKFILL		Project No./Code	
File Name: 16042Y_MSB_01.dgn	Date:	Comments:	Init.	3803 North Main Avenue Suite 200 Durango, CO 81301 Phone: 970-385-1440 FAX: 970-385-8365		No Revisions: 09/10		Designer: B. Allen Detailer: R. Artman		NH 1602-114	
Horiz. Scale: 1:1 Unit Information 0221				Region 5		Revised:		Structure: P-05-Y Numbers:		16042	
Unit Leader STW				EJA		Void:		Sheet Subset: Bridge Subset Sheets: B23 of B26		Sheet Number 323	

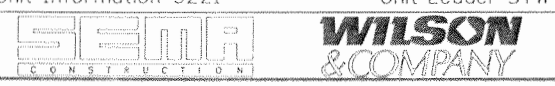

Design		Detail		Quantities	
Designed By	Checked By	INITIAL	DATE	INITIAL	DATE
BJA	TAH	BJA	08/08	BJA	08/08
Checked By	Checked By	RG	08/08	TAH	08/08
TAH	TAH	TAH	08/08	TAH	08/08

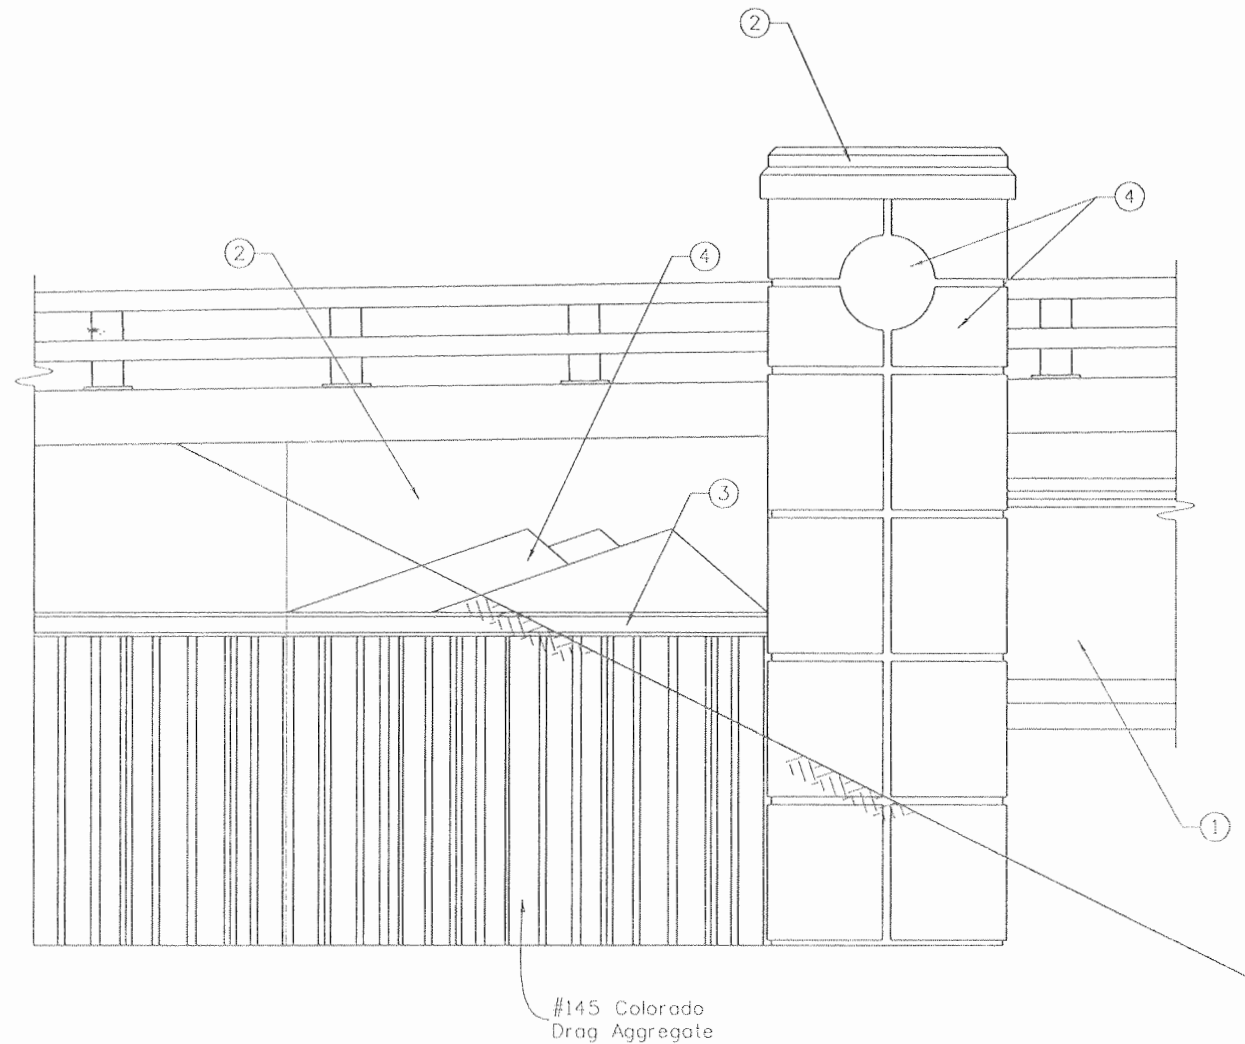


WINGWALL ELEVATION

NOTES:

A colored structural concrete coating finish is required, as shown on the Plans, on all exposed concrete surfaces including piers, abutments, and wingwalls. Color numbers correspond to paint numbers as described by Diamond Vogel Paints. Coating shall extend to 1'-0" below ground surface.

- ① #8513
- ② #8515
- ③ #8513
- ④ #8511

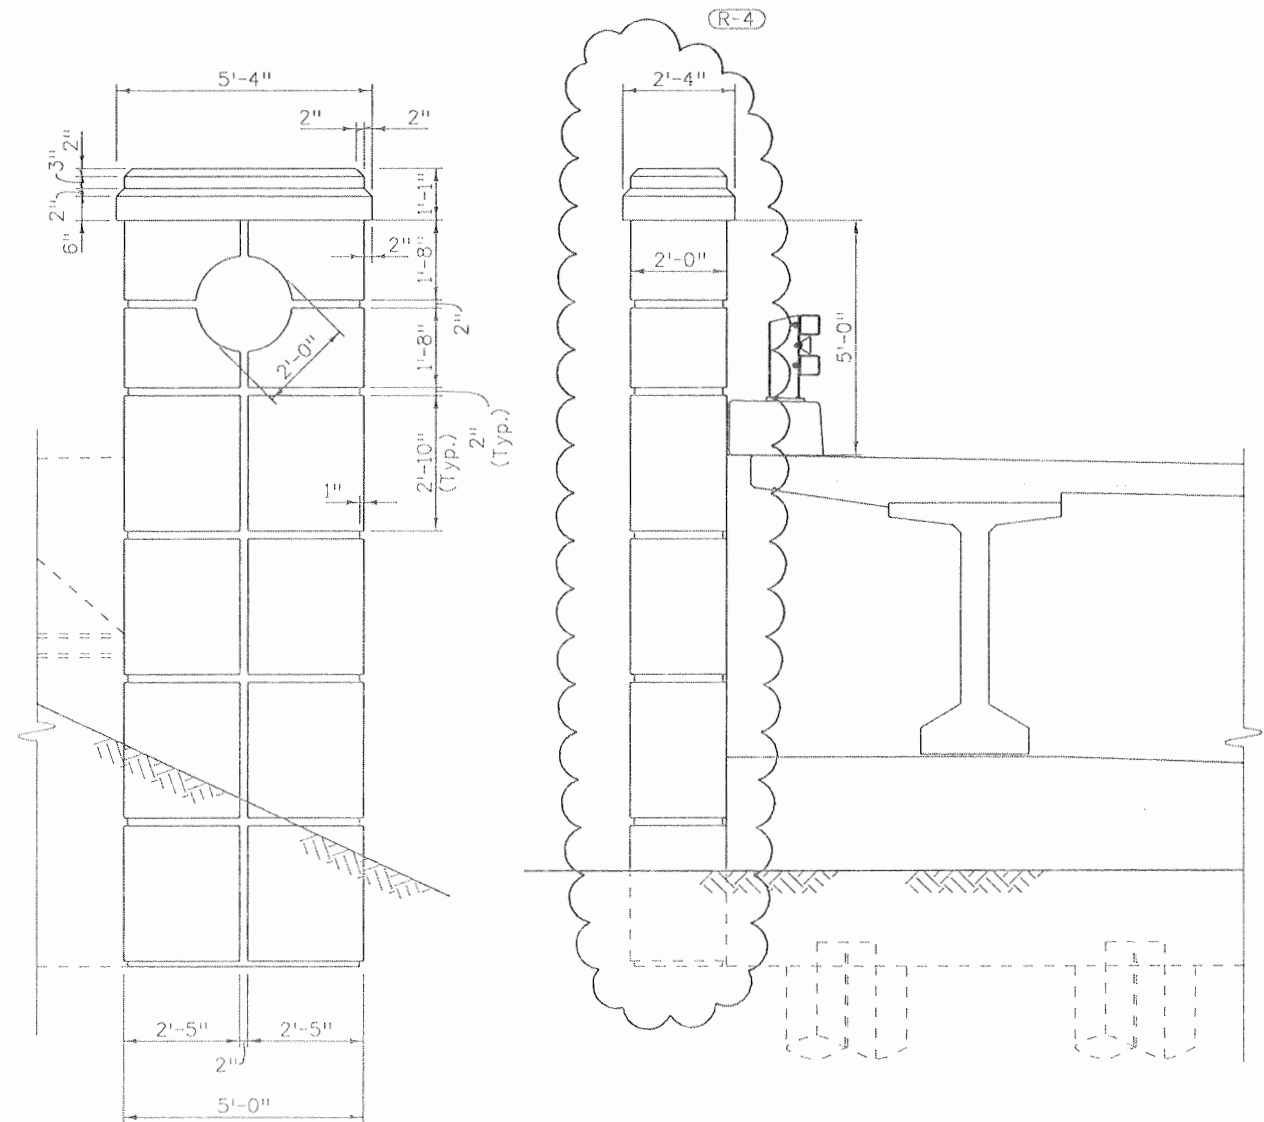

PILASTER DETAILS

Print Date: 9/27/2010		Sheet Revisions			Colorado Department of Transportation		As Constructed		RAMP D OVER WILSON GULCH		Project No./Code	
File Name: 16042Y_ArchDet_01.dgn		Date:	Comments	Init.	3803 North Main Avenue		No Revisions: 09/10		ARCHITECTURAL DETAILS		NH 1602-114	
Horiz. Scale: 1:1		9/29/08	Monument Revisions	BJA	Suite 200		Revised:		Designer: B. Allen		Structure P-05-Y	
Unit Information 0221					Durango, CO 81301		Void:		Detailer: R. Artman		Numbers	
Unit Leader STW					Phone: 970-385-1440 FAX: 970-385-8365				Sheet Subset: Bridge		Subset Sheets: B24 of B26	
SEMA CONSTRUCTION					Region 5		EJA		Sheet Number		324	
WILSON & COMPANY												

State of Colorado
 Department of Transportation
 Staff Bridge Design
 Bridge Geometry Project Coordinate Converter
 Version 1.00

Run date & time = Fri Aug 15 16:21:26 2008

Input Northing Offset = 1213765.030400
 Input Easting Offset = 2326757.585000
 Input Bearing = S 66 1 11.0000 E

DESCRIPTION

Units: feet;
 Project: NH 1602-114;
 Subaccount: 16042;
 Designer: RGA; Detailer: ;
 Location: Durango;
 Ramp D over Wilson Gulch

HORIZONTAL ALIGNMENT DATA

PC 612489.1728 T 184.2472
 PI 614473.4200 Lc 361.6841 DELTA 27 19 26.00 LT Dc 7 33 31.71 RADIUS 758.000143
 PT 616150.6569 T 184.2472

VERTICAL ALIGNMENT DATA

ELEVATION AT PT	ELEVATION AT GRADE	STATION	ELEVATION AT GRADE	ELEVATION AT PT	PERCENT GRADE
					1.260000
6674.3900	6674.1535	PC 612489.1728	6674.1535	6674.1535	
	6678.2671	PI 614473.4200	6678.2671	6678.2671	
	6686.1348	PT 616150.6569	6686.1348	6686.1348	
					5.490000

TABLE OF ROADWAY CROSS SLOPES (SUPERELEVATION: E= -NC)

STATION	SLOPE LEFT	SLOPE RIGHT	VC LENGTH
(ON TANGENT)	0.0000	0.0000	50.00 (MAX)
612489.1728	-0.0200	0.0200	50.00 -0-
612489.1728	-0.0200	0.0200	50.00 -0-
612489.1728	-0.0200	0.0200	50.00 -0-

OFFSET FROM CONTROL TO PIVOT POINT = 1.0000 FEET

LIMITS OF VALID ELEVATION AND CROSS-SLOPE DATA
 BEGIN 612489.1728 END 613480.1700
 SUPERELEVATION SUPERELEVATION

LAYOUT LINE DATA
 LAYOUT LINE DEFINED AS BACK TANGENT

DEAD LOAD DEFLECTION DATA
 DEFLECTIONS AT TENTH POINTS FROM FITTED CURVE


	0.0	0.1	0.2	0.3	0.4	0.5	0.6	0.7	0.8	0.9	1.0
FOR BENT LINE: CL Abut 1											
07 CARD(S): 1											
GIRDER LINES REFERENCED BY: (BLANK)											
INCH	0.0000	0.7979	1.5208	2.0919	2.4566	2.5817	2.4566	2.0919	1.5208	0.7979	0.0000
FOOT	0.0000	0.0665	0.1267	0.1743	0.2047	0.2151	0.2047	0.1743	0.1267	0.0665	0.0000
SLOPE 0.670261											

	0.0	0.1	0.2	0.3	0.4	0.5	0.6	0.7	0.8	0.9	1.0
FOR BENT LINE: CL Ab Beg											
07 CARD(S): 1											
GIRDER LINES REFERENCED BY: (BLANK)											
INCH	0.0000	0.3860	0.7437	1.0421	1.2417	1.3120	1.2417	1.0421	0.7437	0.3860	0.0000
FOOT	0.0000	0.0322	0.0620	0.0868	0.1035	0.1093	0.1035	0.0868	0.0620	0.0322	0.0000
SLOPE 0.330584											

BENT LINE DESCRIPTION	INTERSECTION POINT	FROM LAYOUT LINE	PROJECT COORDINATES	BENT LINE	GIRDER LINE	ROADWAY
	STATION	OFFSET	NORTHING EASTING	LENGTH FROM Y-AXIS	LENGTH FROM REF LINE	CROSS-SLOPE

* HORIZONTAL CONTROL LINE *	AT FINISHED GRADE	
SP Abut 1	610+84.0000	6672.7864
CL Abut 1	610+85.2500	6672.8022
CL Bk Beg	612+06.3167	6674.3475
CL Pter 2	612+08.0000	6674.3631
CL Ab Beg	612+09.0833	6674.3788
CL Abut 3	613+11.7500	6675.5033
SP Abut 3	613+13.0000	6676.5369

* LAYOUT LINE *	AT FINISHED GRADE	
SP Abut 1	610+84.0000	6672.7864
CL Abut 1	610+85.2500	6672.8022
CL Bk Beg	612+06.3167	6674.3475
CL Pter 2	612+08.0000	6674.3631
CL Ab Beg	612+09.0833	6674.3788
* TS OF PC *	612+89.1728	6675.9284
CL Abut 3	613+11.7500	6675.5033
SP Abut 3	613+13.0000	6676.5369

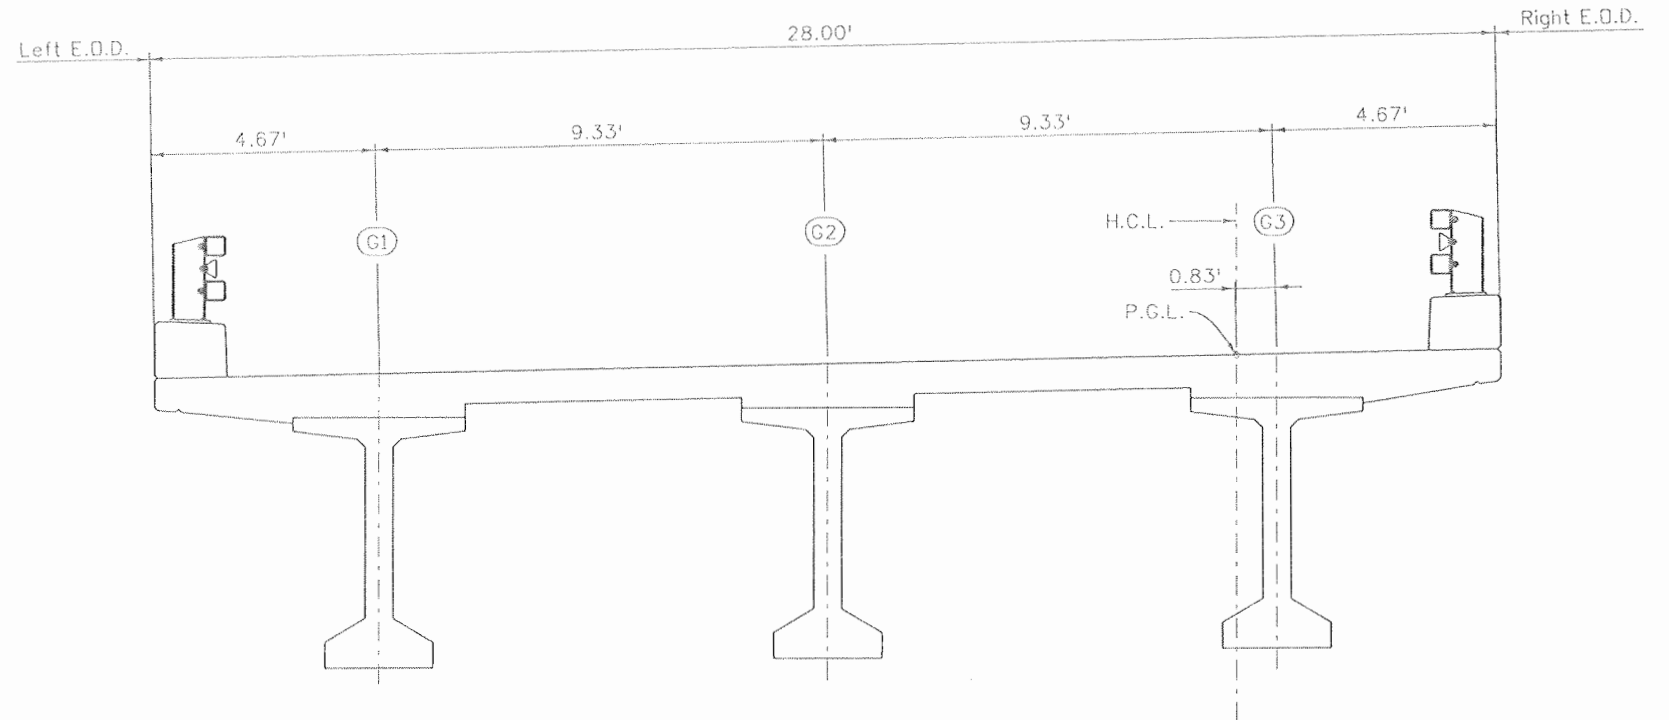

Design	Initial		Date		Checked By
	By	TAH	08/08	08/08	
Design	JSM	TAH	08/08	08/08	Checked By
Detail	JSM	TAH	08/08	08/08	Checked By
Quantity	JSM	TAH	08/08	08/08	Checked By

Print Date: 9/27/2010	Sheet Revisions			Colorado Department of Transportation 3803 North Main Avenue Suite 200 Durango, CO 81301 Phone: 970-385-1440 FAX: 970-385-8365	As Constructed	RAMP D OVER WILSON GULCH BRIDGE DECK ELEVATIONS (1 OF 2)		Project No./Code
File Name: 16042Y_Brdg_Geometry_01.dgn	Date:	Comments:	Init.		No Revisions: 09/10	Designer: J. Mills Structure: P-05-Y		NH 1602-114
Horiz. Scale: 1:1 Unit Information 0221	Vert. Scale: As Noted				Revised:	Detailer: R. Artman Numbers:	16042	
Unit Leader: STW					Void:	Sheet Subset: Bridge Subset Sheets: B25 of B26	Sheet Number: 325	



Region 5

EJA

* LT BOD *				PARALLEL TO HORIZONTAL CONTROL				AT FINISHED GRADE				
BENT LINE	STATION	OFFSET	ELEVATION	ELEV-DL	X	Y	NORTHING	EASTING	BENT LNTH	SKREW	GIRDER LNTH	CRS-SLP
BF Abut 1	610+84.0000	-22.5000	6672.3364	-22.5000	-1.2500	-1.2500	1213784.0963	2320765.5074	-22.5000	0 00 00.00	-1.2500	-0.020000
CL Abut 1	610+85.2500	-22.5000	6672.3522	672.3522	-22.5000	0.0000	1213785.5883	2320766.6495	-22.5000	0 00 00.00	0.0000	-0.020000
F-1	610+97.4167	-22.5000	6672.5055	672.5719	-22.5000	12.1667	1213780.4425	2320777.7660	12.1667	-0.020000	12.1667	-0.020000
F-2	611+09.5833	-22.5000	6672.6588	672.7855	-22.5000	24.3333	1213775.6987	2320788.8025	24.3333	-0.020000	24.3333	+0.020000
F-3	611+21.7500	-22.5000	6672.8121	673.0000	-22.5000	36.5000	1213770.7539	2320799.9990	36.5000	-0.020000	36.5000	+0.020000
F-4	611+33.9167	-22.5000	6672.9654	673.1701	-22.5000	48.6667	1213765.8091	2320811.1156	48.6667	-0.020000	48.6667	+0.020000
F-5	611+46.0834	-22.5000	6673.1187	673.3338	-22.5000	60.8334	1213760.8643	2320822.2321	60.8334	-0.020000	60.8334	+0.020000
F-6	611+58.2500	-22.5000	6673.2720	673.4767	-22.5000	73.0000	1213755.9195	2320833.3485	73.0000	-0.020000	73.0000	+0.020000
F-7	611+70.4167	-22.5000	6673.4253	673.5996	-22.5000	85.1667	1213750.9747	2320844.4651	85.1667	-0.020000	85.1667	+0.020000
F-8	611+82.5834	-22.5000	6673.5786	673.7048	-22.5000	97.3334	1213745.0299	2320855.5816	97.3334	-0.020019	97.3334	+0.020019
F-9	611+94.7500	-22.5000	6673.7319	673.7827	-22.5000	109.5000	1213740.0851	2320866.6981	109.5000	-0.022709	109.5000	+0.022709
CL Bk Brg	612+06.9167	-22.5000	6673.8852	673.8439	-22.5000	121.6667	1213735.1403	2320877.8146	-22.5000	0 00 00.00	121.6667	-0.022365
CL Pier 2	612+08.0000	-22.5000	6673.8550	-22.5000	-22.5000	122.7500	1213735.7000	2320878.8044	-22.5000	0 00 00.00	122.7500	-0.022582
CL Ab Brg	612+09.0833	-22.5000	6673.8661	673.8661	-22.5000	123.8333	1213735.2597	2320879.7942	-22.5000	0 00 00.00	123.8333	-0.022787
F-1	612+19.3500	-22.5000	6673.9696	674.0018	-22.5000	134.1000	1213730.3149	2320889.8800	134.1000	-0.025117	134.1000	-0.028150
F-2	612+29.6167	-22.5000	6674.0699	674.1328	-22.5000	144.3667	1213725.3697	2320899.9658	144.3667	-0.031571	144.3667	-0.034993
F-3	612+39.8834	-22.5000	6674.1739	674.2608	-22.5000	154.6334	1213720.4245	2320909.0516	154.6334	-0.038415	154.6334	-0.044837
F-4	612+50.1500	-22.5000	6674.2795	674.3940	-22.5000	164.9001	1213715.4793	2320919.1374	164.9001	-0.045259	164.9001	-0.052075
F-5	612+60.4167	-22.5000	6674.3835	674.5290	-22.5000	175.1668	1213710.5341	2320929.2233	175.1668	-0.052075	175.1668	-0.059569
F-6	612+70.6834	-22.5000	6674.4875	674.6649	-22.5000	185.4334	1213705.5889	2320939.3092	185.4334	-0.059569	185.4334	-0.067063
F-7	612+80.9501	-22.5000	6674.5915	674.8026	-22.5000	195.7001	1213700.6437	2320949.3951	195.7001	-0.064677	195.7001	-0.074551
F-8	612+91.2167	-22.5000	6674.6955	674.9456	-22.5000	205.9668	1213695.6985	2320959.4810	205.9668	-0.072062	205.9668	-0.082046
F-9	613+01.4834	-22.5000	6674.7995	675.1010	-22.5000	216.2335	1213690.7533	2320969.5669	216.2335	-0.082062	216.2335	-0.089534
CL Abut 3	613+12.7500	-22.5000	6675.2673	675.2673	-22.5000	226.4967	1213685.8081	2320979.6528	-22.5000	1 45 31.45	226.4967	-0.055757
BF Abut 3	613+13.7292	-22.5000	6675.2974	-22.8859	-22.8859	227.7461	1213693.3799	2320974.8946	-22.8859	1 51 22.31	227.7502	-0.056186

* G3 *				PARALLEL TO LAYOUT LINE				AT FINISHED GRADE				
BENT LINE	STATION	OFFSET	ELEVATION	ELEV-DL	X	Y	NORTHING	EASTING	BENT LNTH	SKREW	GIRDER LNTH	CRS-SLP
BF Abut 1	610+84.0000	0.8333	6672.8031	-0.8333	-1.2500	-1.2500	1213754.7771	2320756.0742	0.8333	0 00 00.00	-1.2500	+0.020000
CL Abut 1	610+85.2500	0.8333	6672.8198	672.8198	-22.5000	0.0000	1213755.2690	2320757.1663	0.8333	0 00 00.00	0.0000	+0.020000
F-1	610+97.4167	0.8333	6672.9721	673.0386	-22.5000	12.1667	1213750.3242	2320768.2629	12.1667	-0.020000	12.1667	+0.020000
F-2	611+09.5833	0.8333	6673.1254	673.2521	-22.5000	24.3333	1213745.3794	2320779.3993	24.3333	-0.020000	24.3333	+0.020000
F-3	611+21.7500	0.8333	6673.2787	673.4550	-22.5000	36.5000	1213740.4346	2320790.5357	36.5000	-0.020000	36.5000	+0.020000
F-4	611+33.9167	0.8333	6673.4320	673.6367	-22.5000	48.6667	1213735.4898	2320801.6721	48.6667	-0.020000	48.6667	+0.020000
F-5	611+46.0834	0.8333	6673.5853	673.8005	-22.5000	60.8334	1213730.5450	2320812.8085	60.8334	-0.020000	60.8334	+0.020000
F-6	611+58.2500	0.8333	6673.7386	673.9433	-22.5000	73.0000	1213725.6002	2320823.9449	73.0000	-0.020000	73.0000	+0.020000
F-7	611+70.4167	0.8333	6673.8919	674.0662	-22.5000	85.1667	1213720.6554	2320834.0813	85.1667	-0.020000	85.1667	+0.020000
F-8	611+82.5834	0.8333	6674.0452	674.1720	-22.5000	97.3334	1213715.7106	2320844.2177	97.3334	-0.020019	97.3334	+0.020019
F-9	611+94.7500	0.8333	6674.1985	674.2659	-22.5000	109.5000	1213710.7658	2320854.3541	109.5000	-0.022709	109.5000	+0.022709
CL Bk Brg	612+06.9167	0.8333	6674.3662	674.3662	-22.5000	121.6667	1213705.8210	2320864.4905	0.8333	0 00 00.00	121.6667	-0.022365
CL Pier 2	612+08.0000	0.8333	6674.3819	-22.5000	-22.5000	122.7500	1213705.3762	2320865.5827	0.8333	0 00 00.00	122.7500	-0.022582
CL Ab Brg	612+09.0833	0.8333	6674.3978	674.3978	-22.5000	123.8333	1213704.9314	2320866.6746	0.8333	0 00 00.00	123.8333	-0.022787
F-1	612+19.3500	0.8333	6674.5018	674.5018	-22.5000	134.1000	1213699.9866	2320876.7604	0.8333	0 00 00.00	134.1000	-0.025117
F-2	612+29.6167	0.8333	6674.6058	674.6058	-22.5000	144.3667	1213695.0418	2320886.8462	0.8333	0 00 00.00	144.3667	-0.031571
F-3	612+39.8834	0.8333	6674.7098	674.7098	-22.5000	154.6334	1213690.0970	2320896.9320	0.8333	0 00 00.00	154.6334	-0.038415
F-4	612+50.1500	0.8333	6674.8138	674.8138	-22.5000	164.9001	1213685.1522	2320907.0178	0.8333	0 00 00.00	164.9001	-0.045259
F-5	612+60.4167	0.8333	6674.9178	674.9178	-22.5000	175.1668	1213680.2074	2320917.1037	0.8333	0 00 00.00	175.1668	-0.052075
F-6	612+70.6834	0.8333	6675.0218	675.0218	-22.5000	185.4334	1213675.2626	2320927.1895	0.8333	0 00 00.00	185.4334	-0.059569
F-7	612+80.9501	0.8333	6675.1258	675.1258	-22.5000	195.7001	1213670.3178	2320937.2754	0.8333	0 00 00.00	195.7001	-0.067063
F-8	612+91.2167	0.8333	6675.2298	675.2298	-22.5000	205.9668	1213665.3730	2320947.3612	0.8333	0 00 00.00	205.9668	-0.074551
F-9	613+01.4834	0.8333	6675.3338	675.3338	-22.5000	216.2335	1213660.4282	2320957.4471	0.8333	0 00 00.00	216.2335	-0.082046
CL Abut 3	613+11.7152	1.1640	6676.5672	676.5672	-22.5000	226.4967	1213655.4834	2320967.5330	0.8333	0 00 00.00	226.4967	-0.055757
BF Abut 3	613+12.9621	1.2672	6676.6034	-22.5000	-22.5000	227.7461	1213660.5386	2320968.6188	0.8333	0 00 00.00	227.7461	+0.055931

* C1 *				PARALLEL TO LAYOUT LINE				AT FINISHED GRADE				
BENT LINE	STATION	OFFSET	ELEVATION	ELEV-DL	X	Y	NORTHING	EASTING	BENT LNTH	SKREW	GIRDER LNTH	CRS-SLP
BF Abut 1	610+84.0000	-17.8333	6672.4297	-17.8333	-1.2500	-1.2500	1213781.8325	2320763.4107	-17.8333	0 00 00.00	-1.2500	-0.020000
CL Abut 1	610+85.2500	-17.8333	6672.4455	672.4455	-17.8333	0.0000	1213781.3244	2320764.7528	-17.8333	0 00 00.00	0.0000	-0.020000
F-1	610+97.4167	-17.8333	6672.5988	672.6633	-17.8333	12.1667	1213776.3796	2320775.4694	12.1667	-0.020000	12.1667	-0.020000
F-2	611+09.5833	-17.8333	6672.7521	672.8788	-17.8333	24.3333	1213771.4348	2320786.9858	24.3333	-0.020000	24.3333	+0.020000
F-3	611+21.7500	-17.8333	6672.9054	673.0797	-17.8333	36.5000	1213766.4900	2320798.1024	36.5000	-0.020000	36.5000	+0.020000
F-4	611+33.9167	-17.8333	6673.0587	673.2634	-17.8333	48.6667	1213761.5452	2320819.2189	48.6667	-0.020000	48.6667	+0.020000
F-5	611+46.0834	-17.8333	6673.2120	673.4271	-17.8333	60.8334	1213756.6004	2320830.3354	60.8334	-0.020000	60.8334	+0.020000
F-6	611+58.2500	-17.8333	6673.3653	673.5706	-17.8333	73.0000	1213751.6556	2320841.4519	73.0000	-0.020000	73.0000	+0.020000
F-7	611+70.4167	-17.8333	6673.5186	673.6929	-17.8333	85.1667	1213746.7108	2320852.5684	85.1667	-0.020000	85.1667	+0.020000
F-8	611+82.5834	-17.8333	6673.6719	673.7983	-17.8333	97.3334	1213741.7660	2320863.6849	97.3334	-0.020019	97.3334	+0.020019
F-9	611+94.7500	-17.8333	6673.8252	673.8793	-17.8333	109.5000	1213736.8212	2320874.8014	109.5000	-0.022709	109.5000	+0.022709
CL Bk Brg	612+06.9167	-17.8333	6673.9785</									

ANTI-ICING SYSTEM PHASE I


INDEX OF DRAWINGS

AIS1 GENERAL NOTES
 AIS2 BRIDGE LAYOUT
 AIS3 BRIDGE CROSS SECTION
 AIS4 BRIDGE RAIL ELEVATION
 AIS5 SENSOR POLE ANCHORAGE

GENERAL NOTES



1. The Anti-Icing System Phase I construction drawings include information for the installation of the basic components and shall include conduits, junction boxes, and sensor anchorage to accommodate the future components of an operational system.
2. Conduit shall have a high point placed at the midpoint of the junction boxes to facilitate drainage of the conduits.
3. Spray nozzle and spray pattern on layout are for information only.
4. Unless otherwise indicated, junction boxes shall be placed on the upstream side of super elevation or normal cross slope.

Structure P-05-AG US 550 OVER US 160 RELEASED FOR CONSTRUCTION

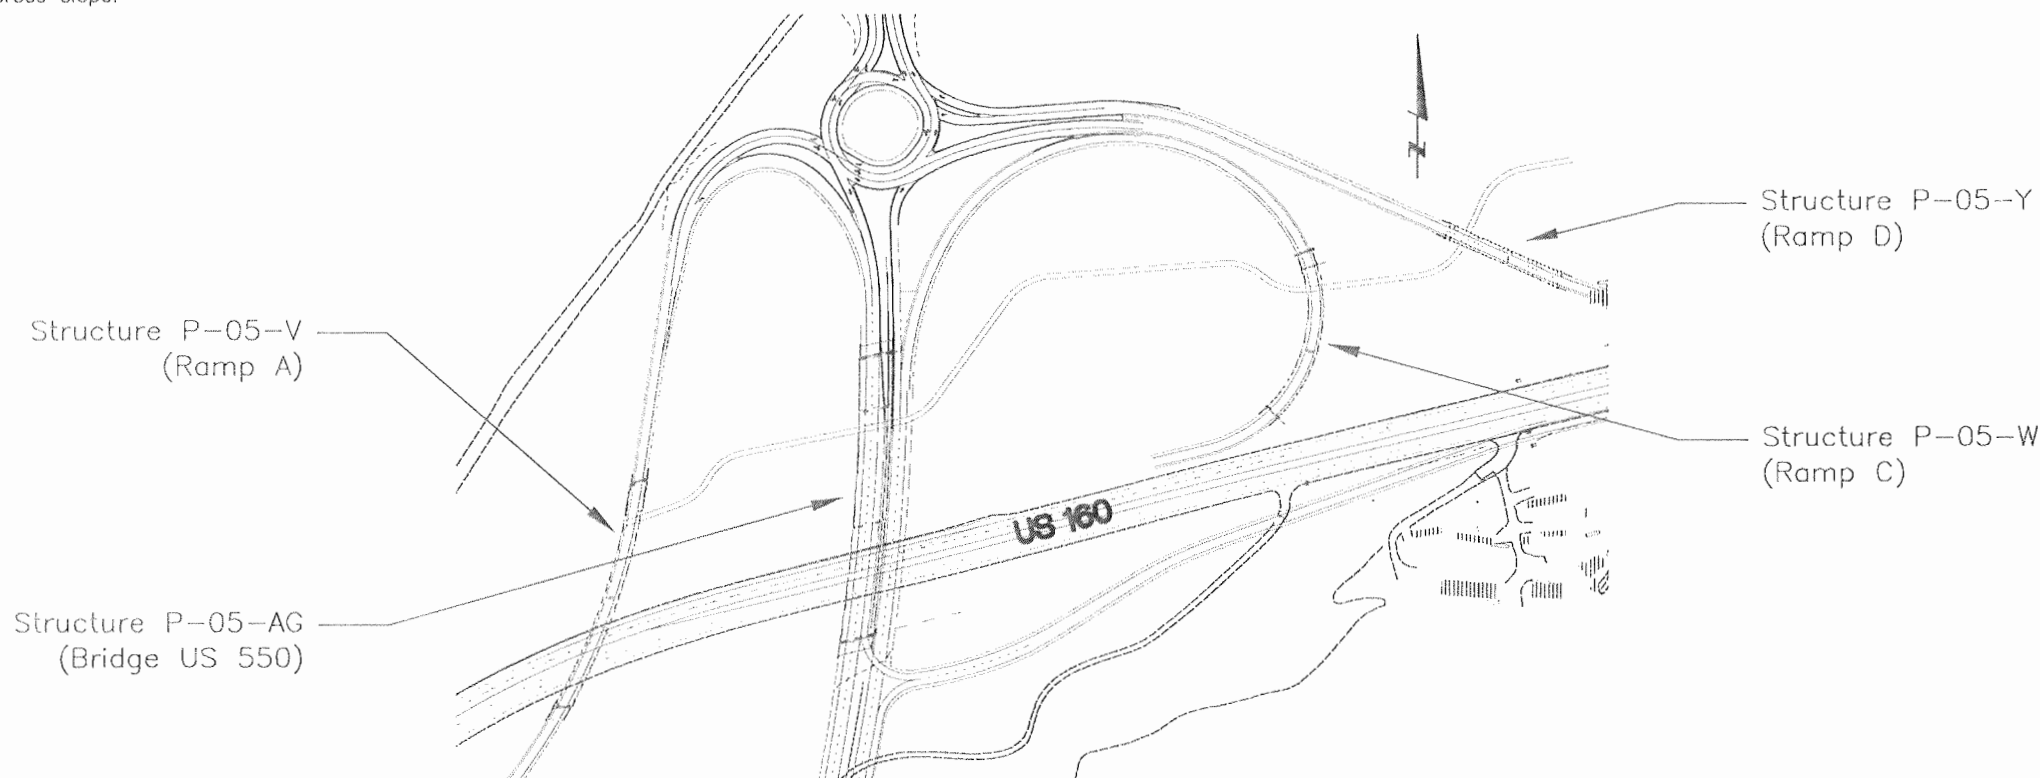

Design		Detail		Quantity	
INITIAL	DATE	INITIAL	DATE	INITIAL	DATE
Designed By: JNH	07/08	Detailled By: RJK	07/08	Quantity By: XXX	MM/YY
Checked By: DDH	07/25	Checked By: DDH	07/25	Checked By: XXX	MM/YY

Print Date: Wednesday, September 01, 2010		Sheet Revisions			As Constructed		GENERAL NOTES		Project No./Code	
File Name: 0208005.08P101-BRIDGE 550.DWG		Date:	Comments	Init.	No Revisions: 11/1/09				NH 1602-114	
Horiz. Scale: As Noted Vert. Scale: As Noted		(R-X)			Revised:		Designer: Daniel Hull	Structure	P-05-AG	
Unit Information Unit Leader Initials		()			Void:		Detailer: Rick Keller	Numbers	16042	
Lamy, Ryanman & Associates, Inc. 110 2nd Street, Suite 211, Durango, CO 81301		()			Region 5		EJA	Sheet Subset: Anti-Icing	Subset Sheets: AIS1 of AIS5	Sheet Number: 327
Colorado Department of Transportation 3803 North Main Avenue, Suite 200, Durango, CO 81301 Phone: 970-385-1440 FAX: 970-385-8365		()								

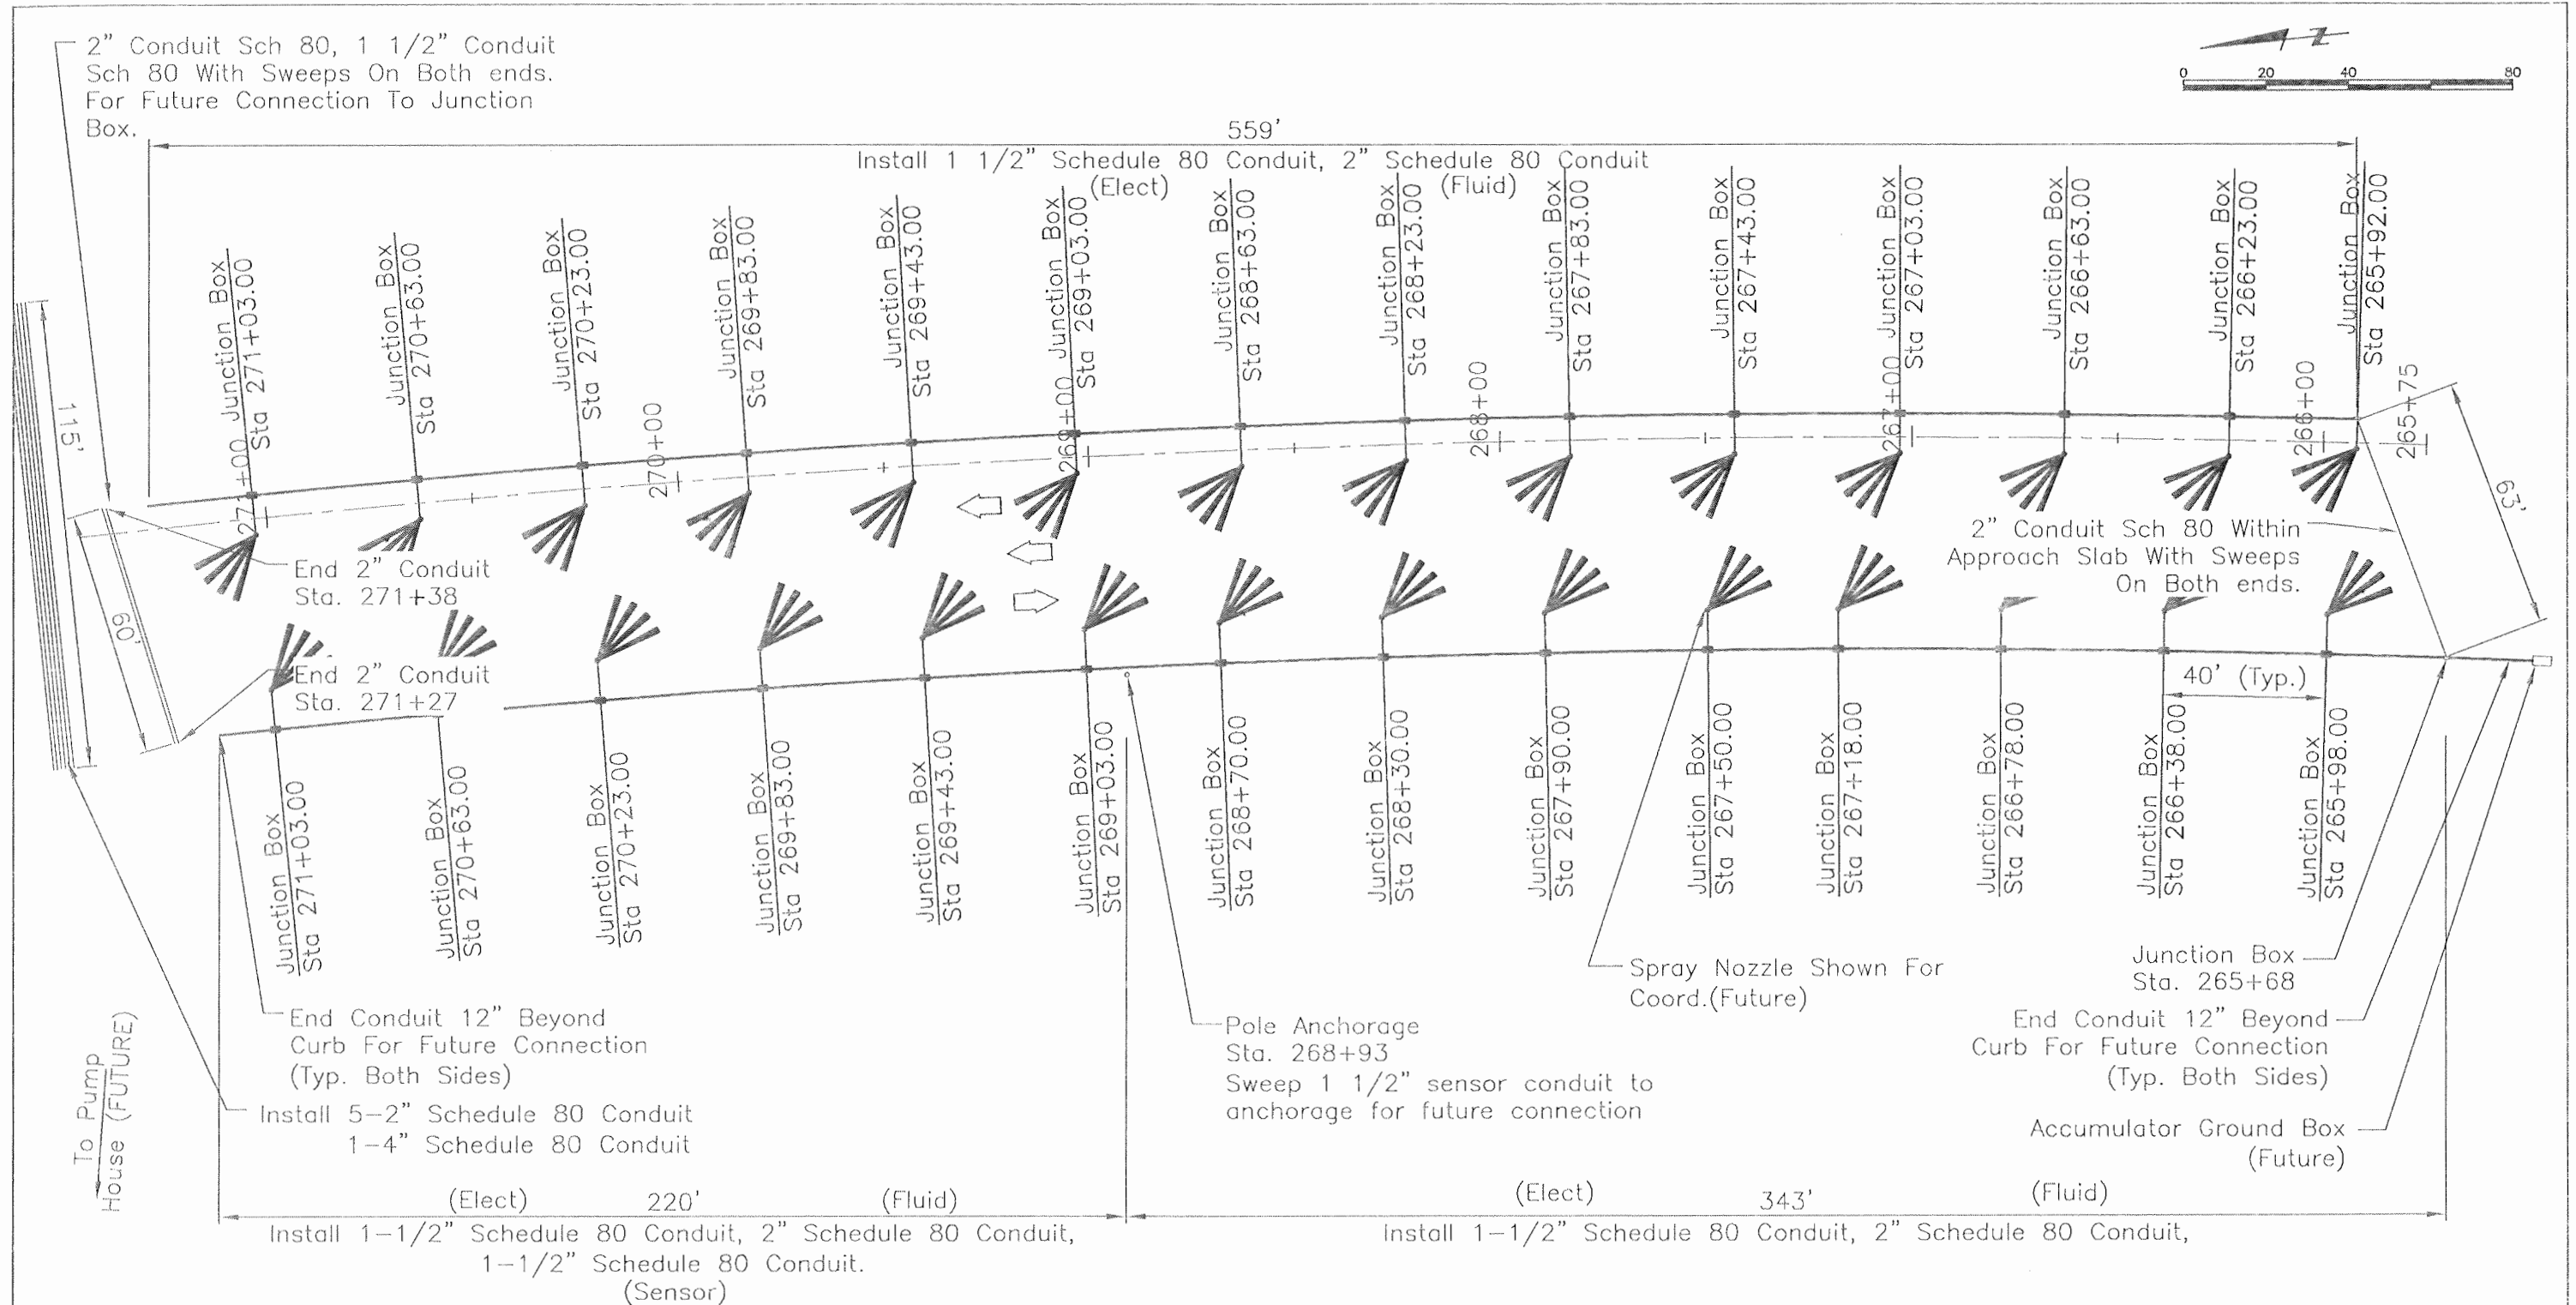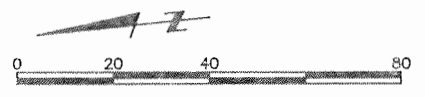


Design		Detail		Quantities	
INITIAL	DATE	INITIAL	DATE	INITIAL	DATE
Designed By: JMH	07/08	Detailed By: RJK	07/08	Quantities By: XXX	MM/YY
Checked By: DDH	07/23	Checked By: DDH	07/23	Checked By: XXX	MM/YY

NOTE: See Bridge Cross Section For Junction Box Installation.
 Rail And Curb On North End Of Bridge Approach Is Future.


Print Date: Wednesday, September 01, 2010		Sheet Revisions		Colorado Department of Transportation		As Constructed		BRIDGE LAYOUT		Project No./Code	
File Name: 0208005.08P101-BRIDGE 550.DWG		Date:	Comments	Init.	3803 North Main Avenue		No Revisions: 11/1/09		NH 1602-114		
Horiz. Scale: 1:40 Vert. Scale: As Noted		(R-X)			Suite 200		Revised:		Designer: Daniel Hull	Structure: P-05-AG	16042
Unit Information Unit Leader Initials					Durango, CO 81301		Void:		Detailer: Rick Keller	Subset Sheets: AIS2 of AIS5	Sheet Number: 328
					 Phone: 970-385-1440 FAX: 970-385-8365 Region 5 EJA						

Design	DATE	BY	Checked By
INITIAL	DATE	BY	Checked By
JRH	07/08	DDH	DDH
DDH	07/25	DDH	DDH

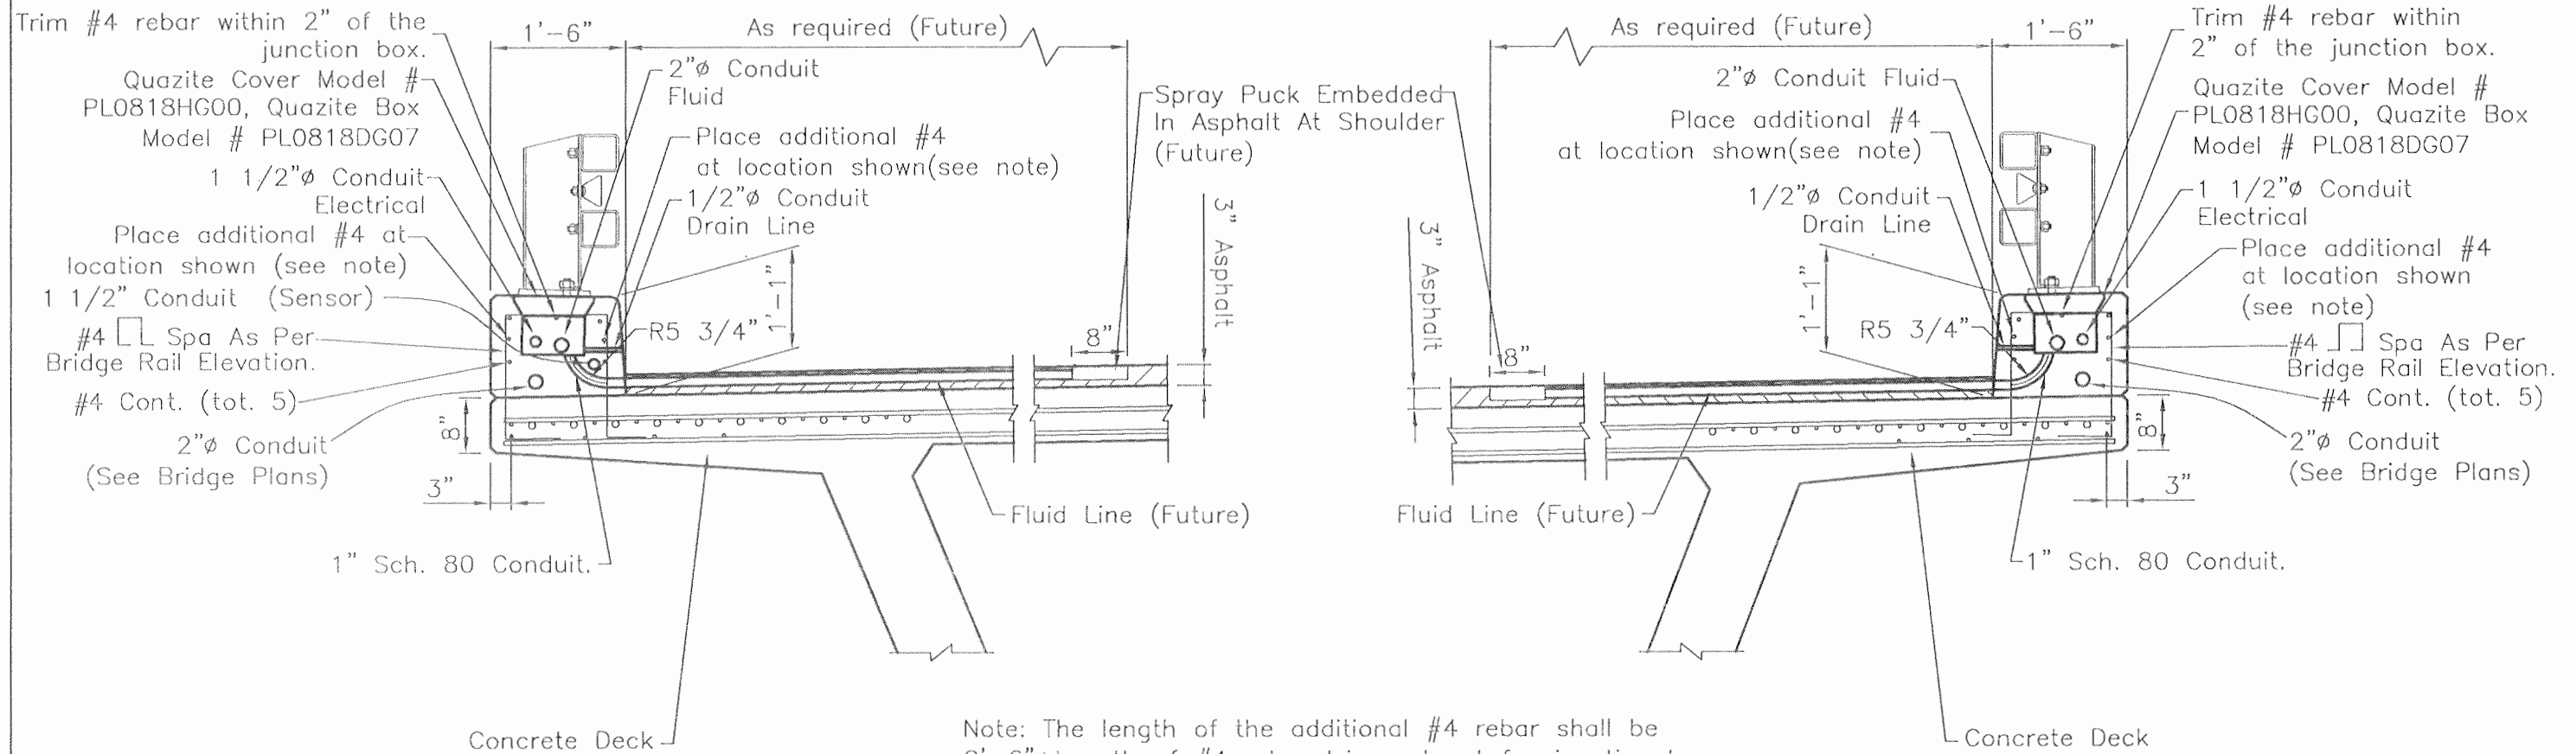

BRIDGE SECTION
Scale: 1/2" = 1'-0"

Print Date: Wednesday, September 01, 2010	Sheet Revisions			Colorado Department of Transportation		As Constructed		BRIDGE CROSS SECTION		Project No./Code	
File Name: 0208005.08P101-BRIDGE 550.DWG	Date:	Comments	Init.	3803 North Main Avenue Suite 200 Durango, CO 81301 Phone: 970-385-1440 FAX: 970-385-8365		No Revisions: 11/1/09		Designer: Daniel Hull Structure P-05-AG		NH 1602-114	
Horiz. Scale: As Noted Vert. Scale: As Noted	(R-X)			Region 5		Revised:		Detailer: Rick Keller Numbers		16042	
Unit Information Unit Leader Initials				EJA		Void:		Sheet Subset: Anti-Icing Subset Sheets: AIS3 of AIS5		Sheet Number 329	

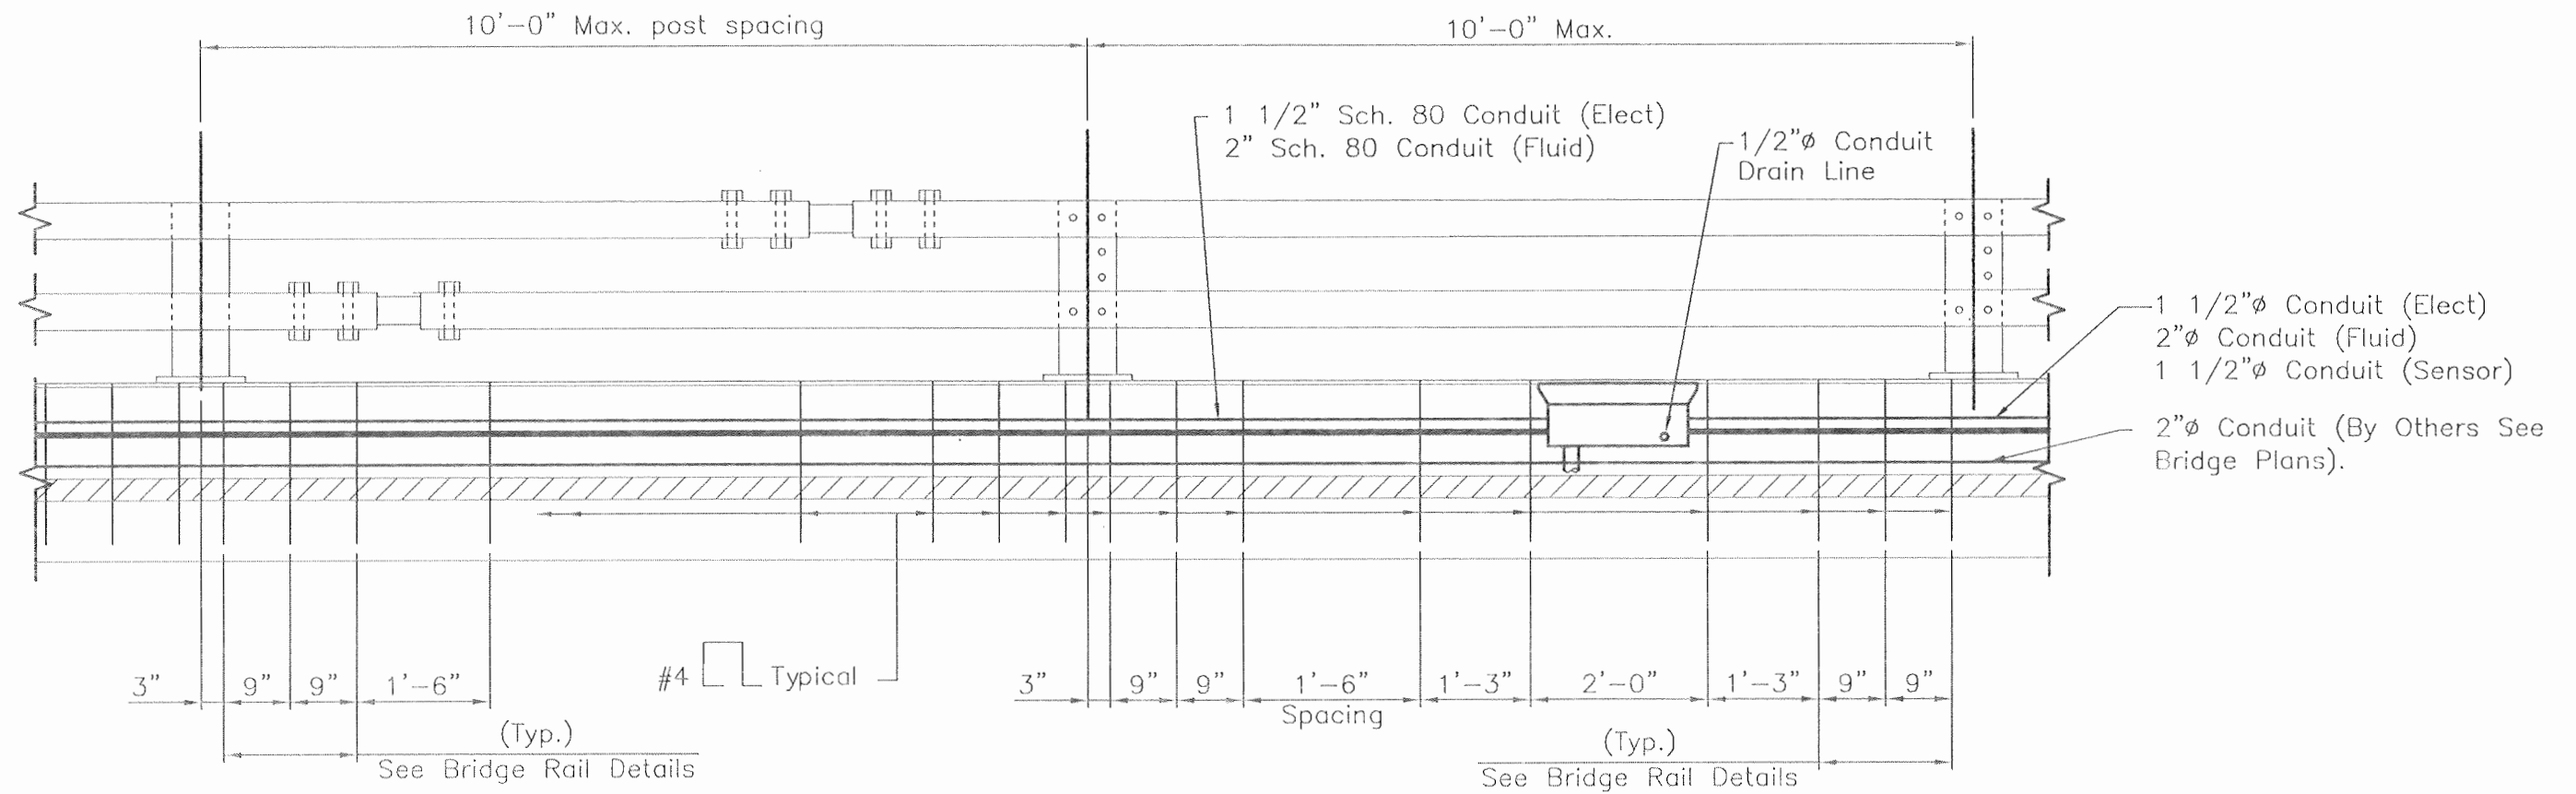

BRIDGE RAIL ELEVATION
Scale 1/2" = 1'-0"

Design		Detail		Quantity	
INITIAL	DATE	INITIAL	DATE	INITIAL	DATE
Designed By JMH	07/08	Detailled By RJK	07/08	Quantity By XXX	MM/YY
Checked By DDH	07/25	Checked By DDH	07/25	Checked By XXX	MM/YY

Print Date: Wednesday, September 01, 2010	File Name: 0208005.08P101-BRIDGE 550.DWG
Horiz. Scale: As Noted	Vert. Scale: As Noted
Unit Information	Unit Leader Initials

Sheet Revisions		
Date:	Comments	Init.
<input type="checkbox"/>		
<input type="checkbox"/>		
<input type="checkbox"/>		

Colorado Department of Transportation
3803 North Main Avenue
Suite 200
Durango, CO 81301
Phone: 970-385-1440 FAX: 970-385-8365


Region 5 EJA

As Constructed
No Revisions: 11/1/09
Revised:
Void:

BRIDGE RAIL ELEVATION			
Designer: Daniel Hull	Structure	P-05-AG	
Detailer: Rick Keller	Numbers		
Sheet Subset: Anti-Icing	Subset Sheets: AIS4 of AIS5		


Project No./Code	NH 1602-114
16042	
Sheet Number	330

Design	INITIAL	DATE	QUANTITY
	JMH	07/08	07/25
Detail	INITIAL	DATE	QUANTITY
	DDH	07/25	07/25
Checked By	Checked By	Checked By	Checked By
	DDH	DDH	DDH

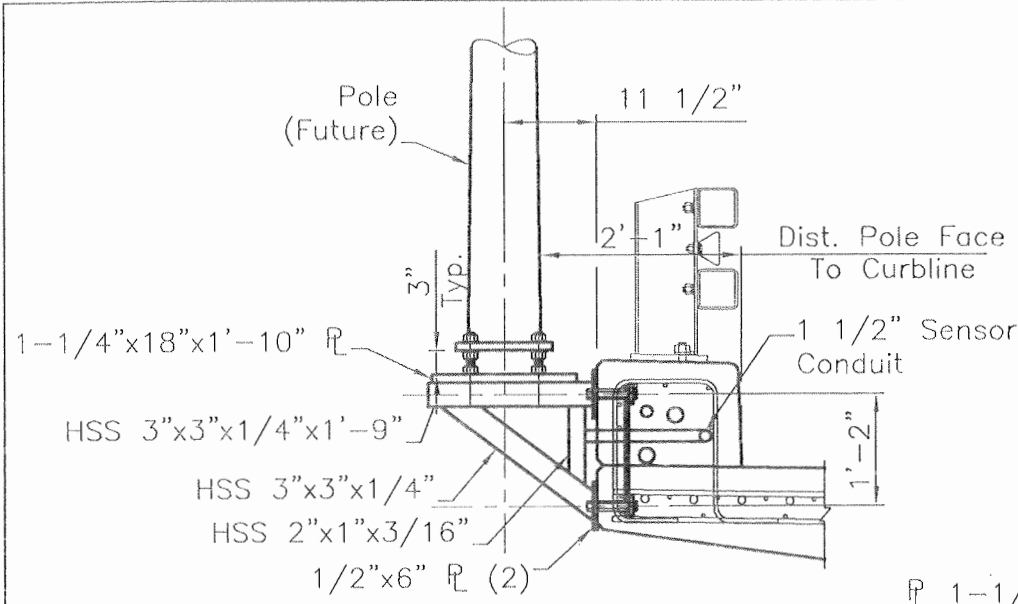


POST MOUNTING DETAIL

Scale: 1/2" = 1'-0"

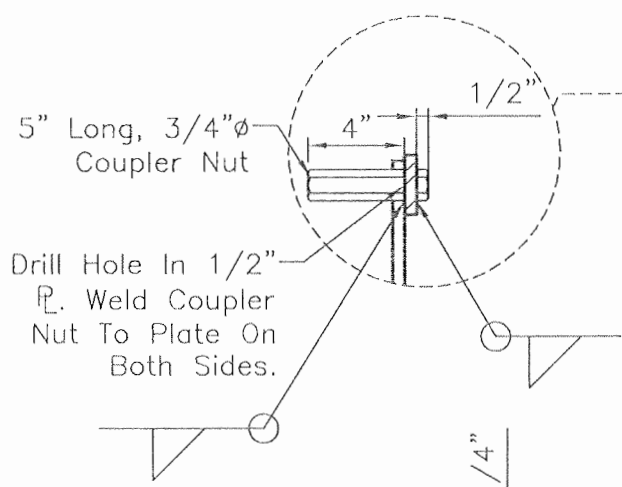


SIDE VIEW

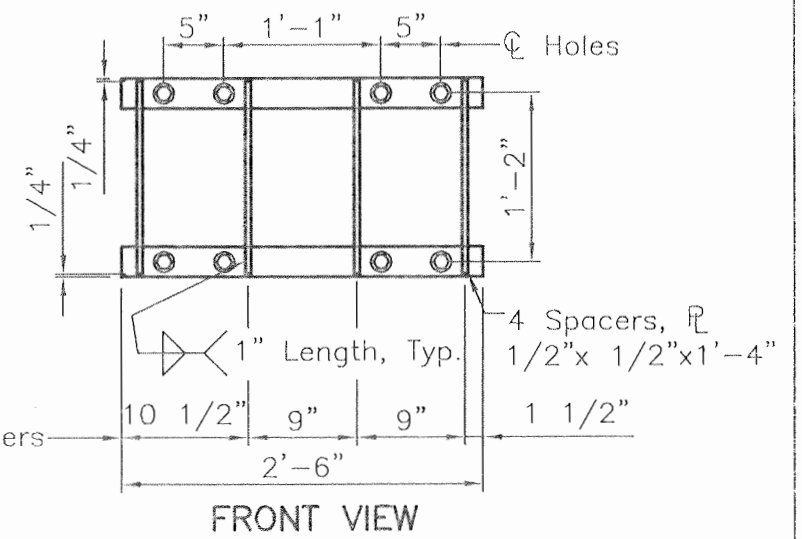

FRONT VIEW


BARRIER INSERT DETAIL

Scale: 3/4" = 1'-0"

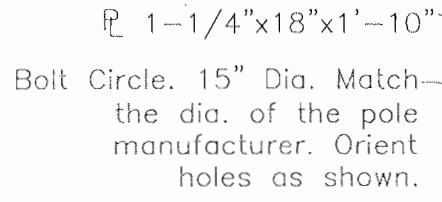


PLAN VIEW OF MOUNTING BRACKET

Scale: 1/2" = 1'-0"

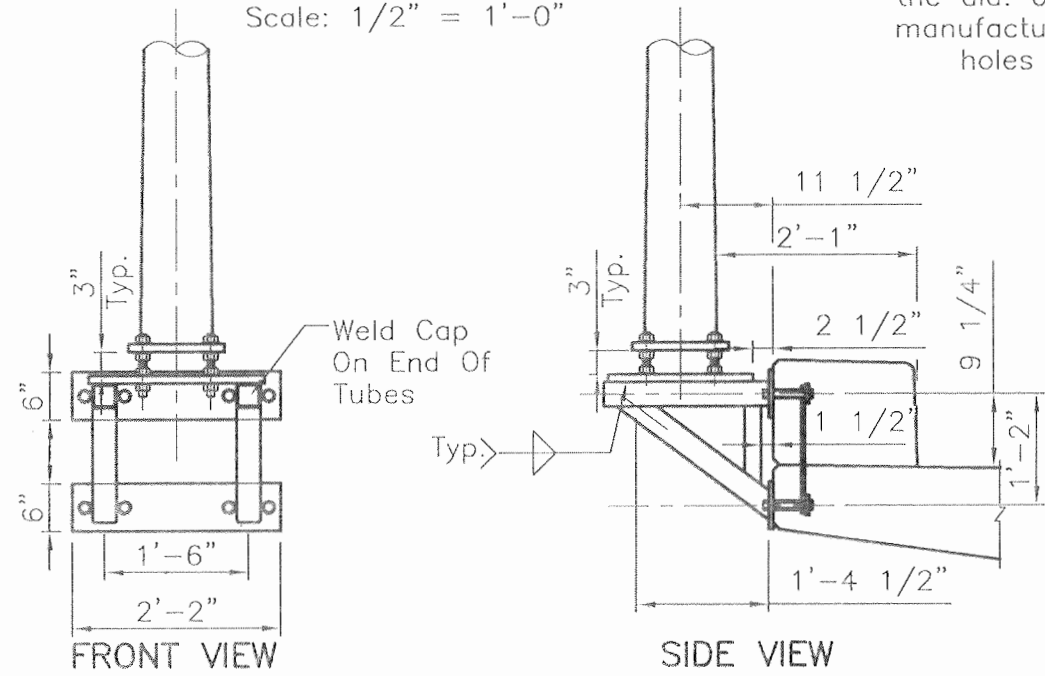

OUTSIDE MOUNTING BRACKET

Scale: 1/2" = 1'-0"

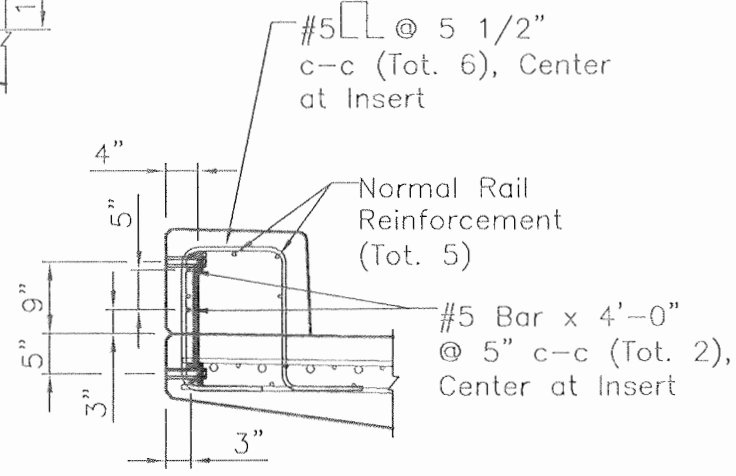

BARRIER WITH BRACKET INSERTS

Scale: 1/2" = 1'-0"

STRUCTURAL STEEL AND METAL EMBEDMENTS FOR CONCRETE STRUCTURES

- Miscellaneous steel items in the structures shall be fabricated from structural steel conforming to ASTM A36 or A572. Welding shall meet requirements of AWS D1.1. The finished fabrication shall be hot-dip galvanized in accordance with ASTM A123.
- All Bolts, Nuts and Washers shall be A325, and shall be galvanized.
- All HSS Round or Rectangular Sections shall conform to ASTM A500, Grade B or C structural tubing.
- All welds shall be 1/4" minimum effective throat welds, or to the thickness of the smaller material being welded, whichever is smaller, based on 70 ksi electrode strength. HSS members may require flare bevel welds.
- 3/4" Coupler Nuts shall be 5" minimum in length, and shall meet the requirements of A325.
- Bolts to connect the Bracket to the barrier shall be 3 1/2" in length with washers.
- Pole Mounting Bracket is designed for following conditions:
 - Maximum wind velocity of 100 mph.
 - Maximum height of pole not to exceed 30 feet from top of mounting bracket plate.
 - Top of pole shall not exceed 100 feet as measured above the local ground elevation.
 - Horizontal projected area of installed equipment shall not exceed 4.5 SF mounted at 27 Feet above the top of the mounting plate (or equivalent produced moment).
 - Base of the pole shall not exceed 8" diameter, Bolt circle shall not exceed 15".

Print Date: Wednesday, September 01, 2010	File Name: 0208005.08P101-BRIDGE 550.DWG
Horiz. Scale: As Noted	Vert. Scale: As Noted
Unit Information	Unit Leader Initials
Design: L&P, Ryznar & Associates, Inc.	Engineering: RYZNAR & ASSOCIATES, INC.

Sheet Revisions		
Date:	Comments	Init.

Colorado Department of Transportation
 3803 North Main Avenue
 Suite 200
 Durango, CO 81301
 Phone: 970-385-1440 FAX: 970-385-8365
 Region 5 EJA

As Constructed	No Revisions: 11/1/09
Revised:	
Void:	

SENSOR POLE ANCHORAGE			
Designer:	Daniel Hull	Structure Numbers:	P-05-AG
Detailer:	Rick Keller	Sheet Subset:	Anti-Icing
		Subset Sheets:	AIS5 of AIS5

Project No./Code	NH 1602-114
Sheet Number	331

ANTI-ICING SYSTEM PHASE I


INDEX OF DRAWINGS

- AIS1 GENERAL NOTES
- AIS2 BRIDGE LAYOUT
- AIS3 BRIDGE CROSS SECTION
- AIS4 BRIDGE RAIL ELEVATION
- AIS5 SENSOR POLE ANCHORAGE

GENERAL NOTES



1. The Anti-Icing System Phase I construction drawings include information for the installation of the basic components and shall include conduits, junction boxes, and sensor anchorage to accommodate the future components of an operational system.
2. Conduit shall have a high point placed at the midpoint of the junction boxes to facilitate drainage of the conduits.
3. Spray nozzle and spray pattern on layout are for information only.
4. Unless otherwise indicated, junction boxes shall be placed on the upstream side of super elevation or normal cross slope.

Structure P-05-V RAMP A OVER US 160 RELEASED FOR CONSTRUCTION

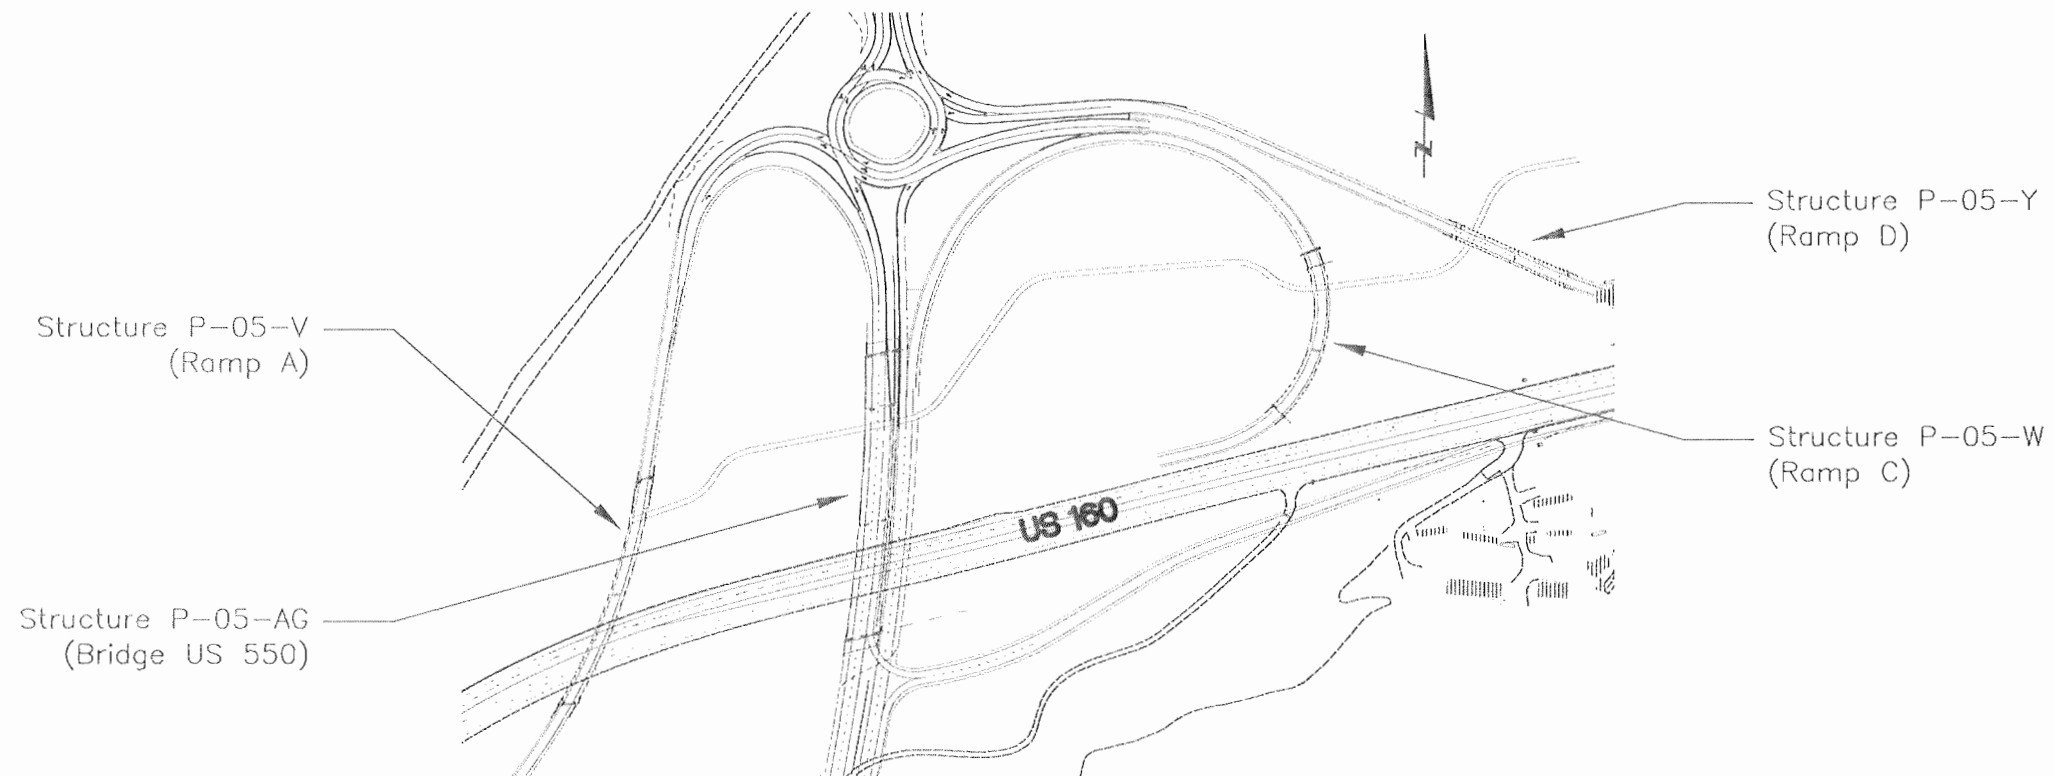

Design		Detail		Quantities	
INITIAL	DATE	INITIAL	DATE	INITIAL	DATE
JMH	07/08	RJK	07/08	XXX	MM/YY
DDH	07/25	DDH	07/25	XXX	MM/YY
Designed By	Detailed By	Checked By	Checked By	Checked By	Checked By

Print Date: Wednesday, September 01, 2010		Sheet Revisions			Colorado Department of Transportation		As Constructed		Project No./Code	
File Name: 0208005.08P101-RAMP A.DWG		Date:	Comments	Init.	3803 North Main Avenue Suite 200 Durango, CO 81301 Phone: 970-385-1440 FAX: 970-385-8365		No Revisions: 11/1/09		NH 1602-114	
Horiz. Scale: As Noted	Vert. Scale: As Noted	(R-X)			Region 5		Revised:		GENERAL NOTES	
Unit Information	Unit Leader Initials				EJA		Void:		Designer: Daniel Hull	
Lamp, Ryanovich & Associates, Inc. 1142 20th Avenue, Suite #1 Durango, CO 81301					DOT				Structure P-05-V	
LEVIWROTECH					Region 5				Detailer: Rick Keller	
									Sheet Subset: Anti-Icing	
									Subset Sheets: AIS1 of AIS5	
									Sheet Number 332	

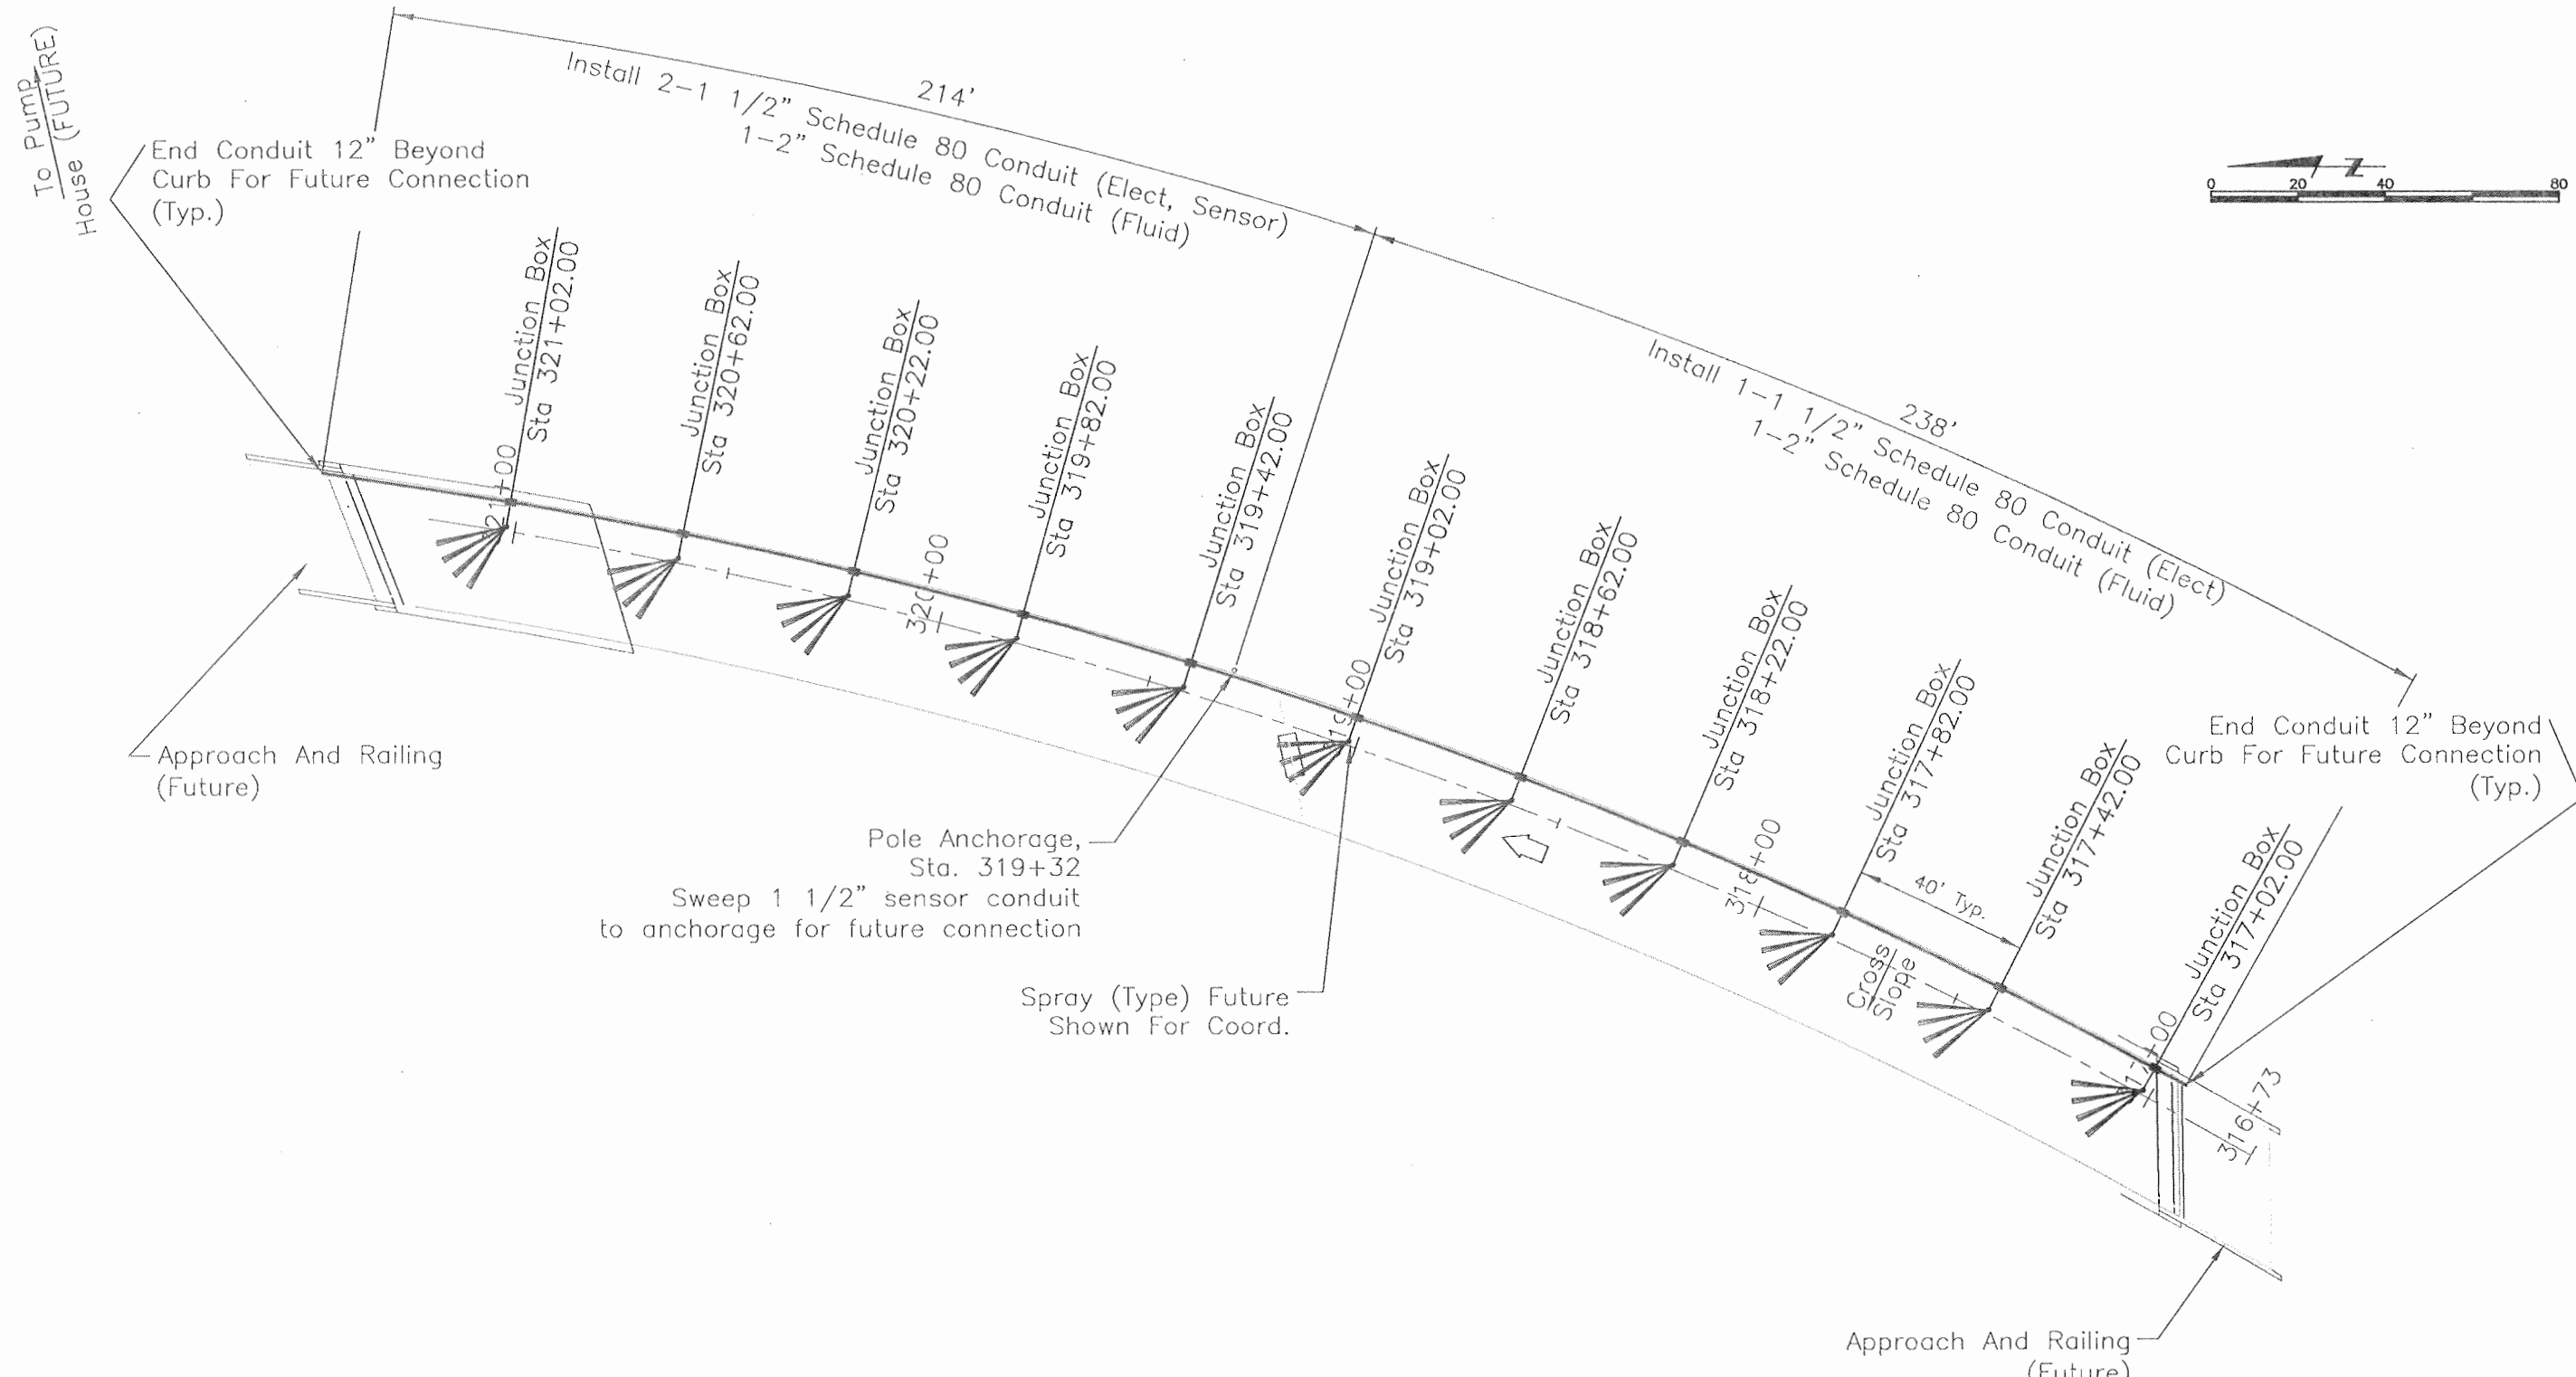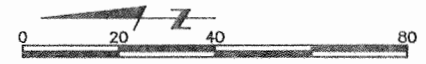


Design		Detail		Quantities	
INITIAL	DATE	INITIAL	DATE	INITIAL	DATE
JMH	07/08	RJK	07/08	XXX	MM/YY
DDH	07/25	DDH	07/25	XXX	MM/YY
Designed By	Checked By	Detailed By	Checked By	Quantities By	Checked By

NOTE: See Bridge Cross Section For Junction Box Installation.

Print Date: Wednesday, September 01, 2010		Sheet Revisions		Colorado Department of Transportation		As Constructed		BRIDGE LAYOUT		Project No./Code	
File Name: 0208005.08P101-RAMP A.DWG		Date:	Comments	Init.	3803 North Main Avenue Suite 200 Durango, CO 81301 Phone: 970-385-1440 FAX: 970-385-8365		No Revisions: 11/1/09		NH 1602-114		
Horiz. Scale: 1:40 Vert. Scale: As Noted		(R-X)			Region 5 EJA		Revised:		Designer: Daniel Hull	Structure: P-05-V	16042
Unit Information Unit Leader Initials							Void:		Detailer: Rick Keller	Subset Sheets: AIS2 of AIS5	Sheet Number 333


Design		Detail		Quantities	
INITIAL	DATE	INITIAL	DATE	INITIAL	DATE
AMH	07/08	RAK	07/08	XXX	MM/YY
DDH	07/25	DDH	07/25	XXX	MM/YY
Designed By	Detailed By	Quantities By	Checked By		
Checked By	Checked By				

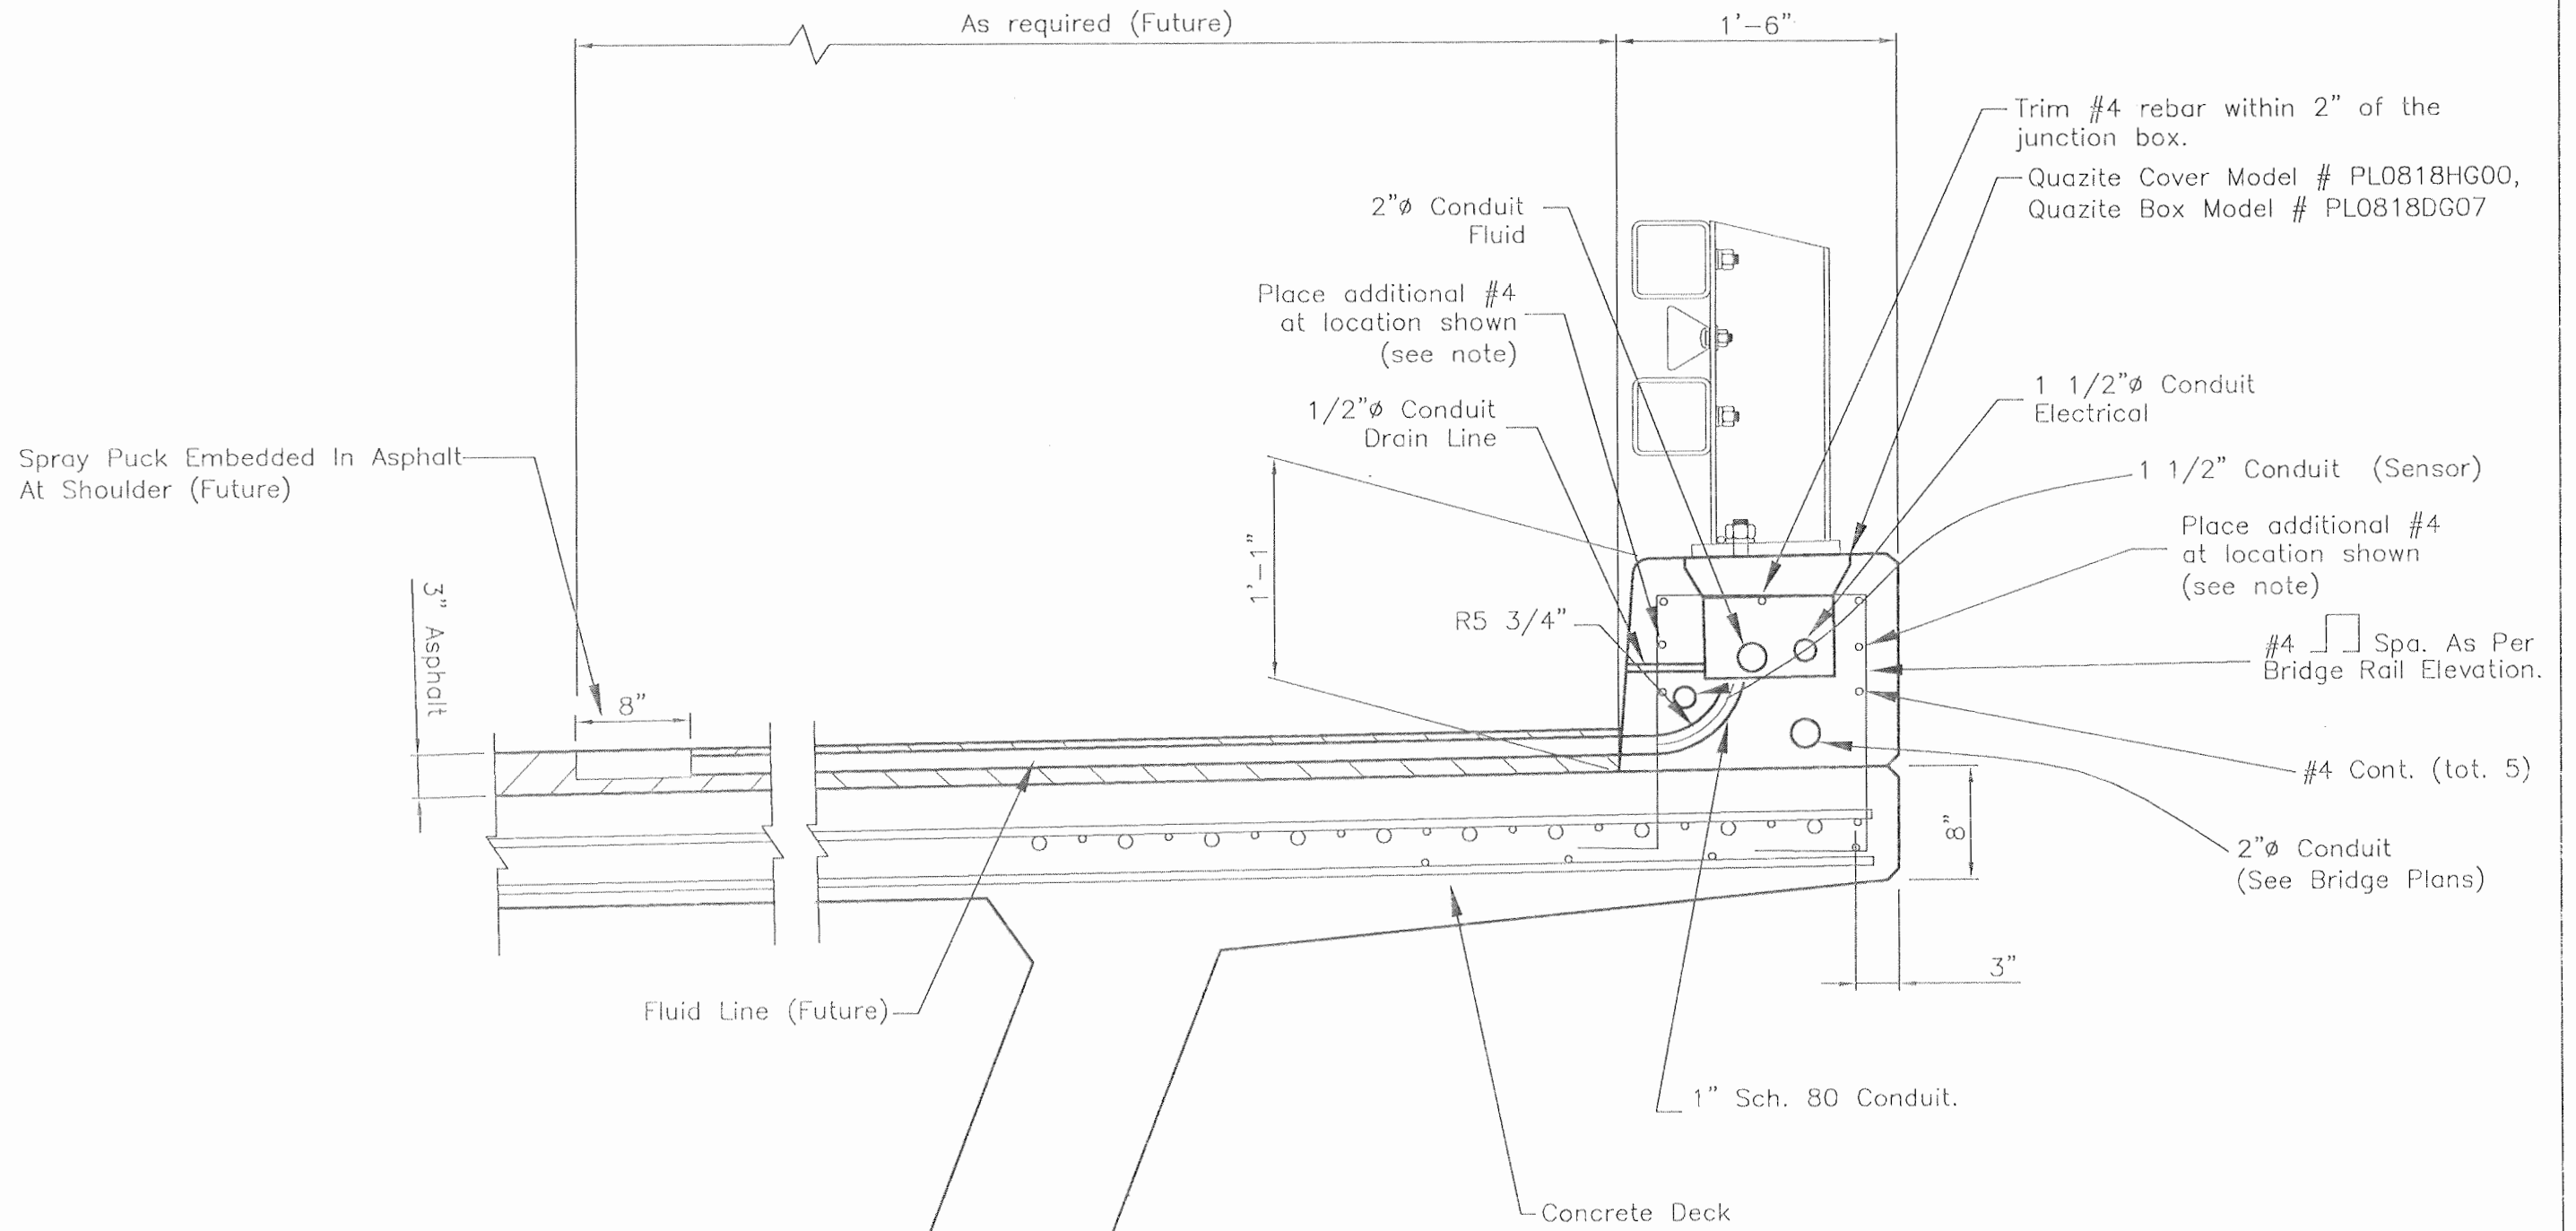

Note: The length of the additional #4 rebar shall be 2'-6" + Length of #4 rebar trimmed out for junction box.

BRIDGE SECTION
Scale: 1/2" = 1'-0"


Print Date: Wednesday, September 01, 2010		Sheet Revisions			Colorado Department of Transportation		As Constructed		BRIDGE CROSS SECTION		Project No./Code	
File Name: 0208005.08P101-RAMP A.DWG		Date:	Comments	Init.	3803 North Main Avenue Suite 200 Durango, CO 81301 Phone: 970-385-1440 FAX: 970-385-8365		No Revisions: 11/1/09		Designer: Daniel Hull Detailer: Rick Keller		NH 1602-114	
Horiz. Scale: As Noted Vert. Scale: As Noted					Region 5		Revised:		Structure P-05-V		16042	
Unit Information Unit Leader Initials					EJA		Void:		Sheet Subset: Anti-Icing		Subset Sheets: AIS3 of AIS5	
									Sheet Number		334	

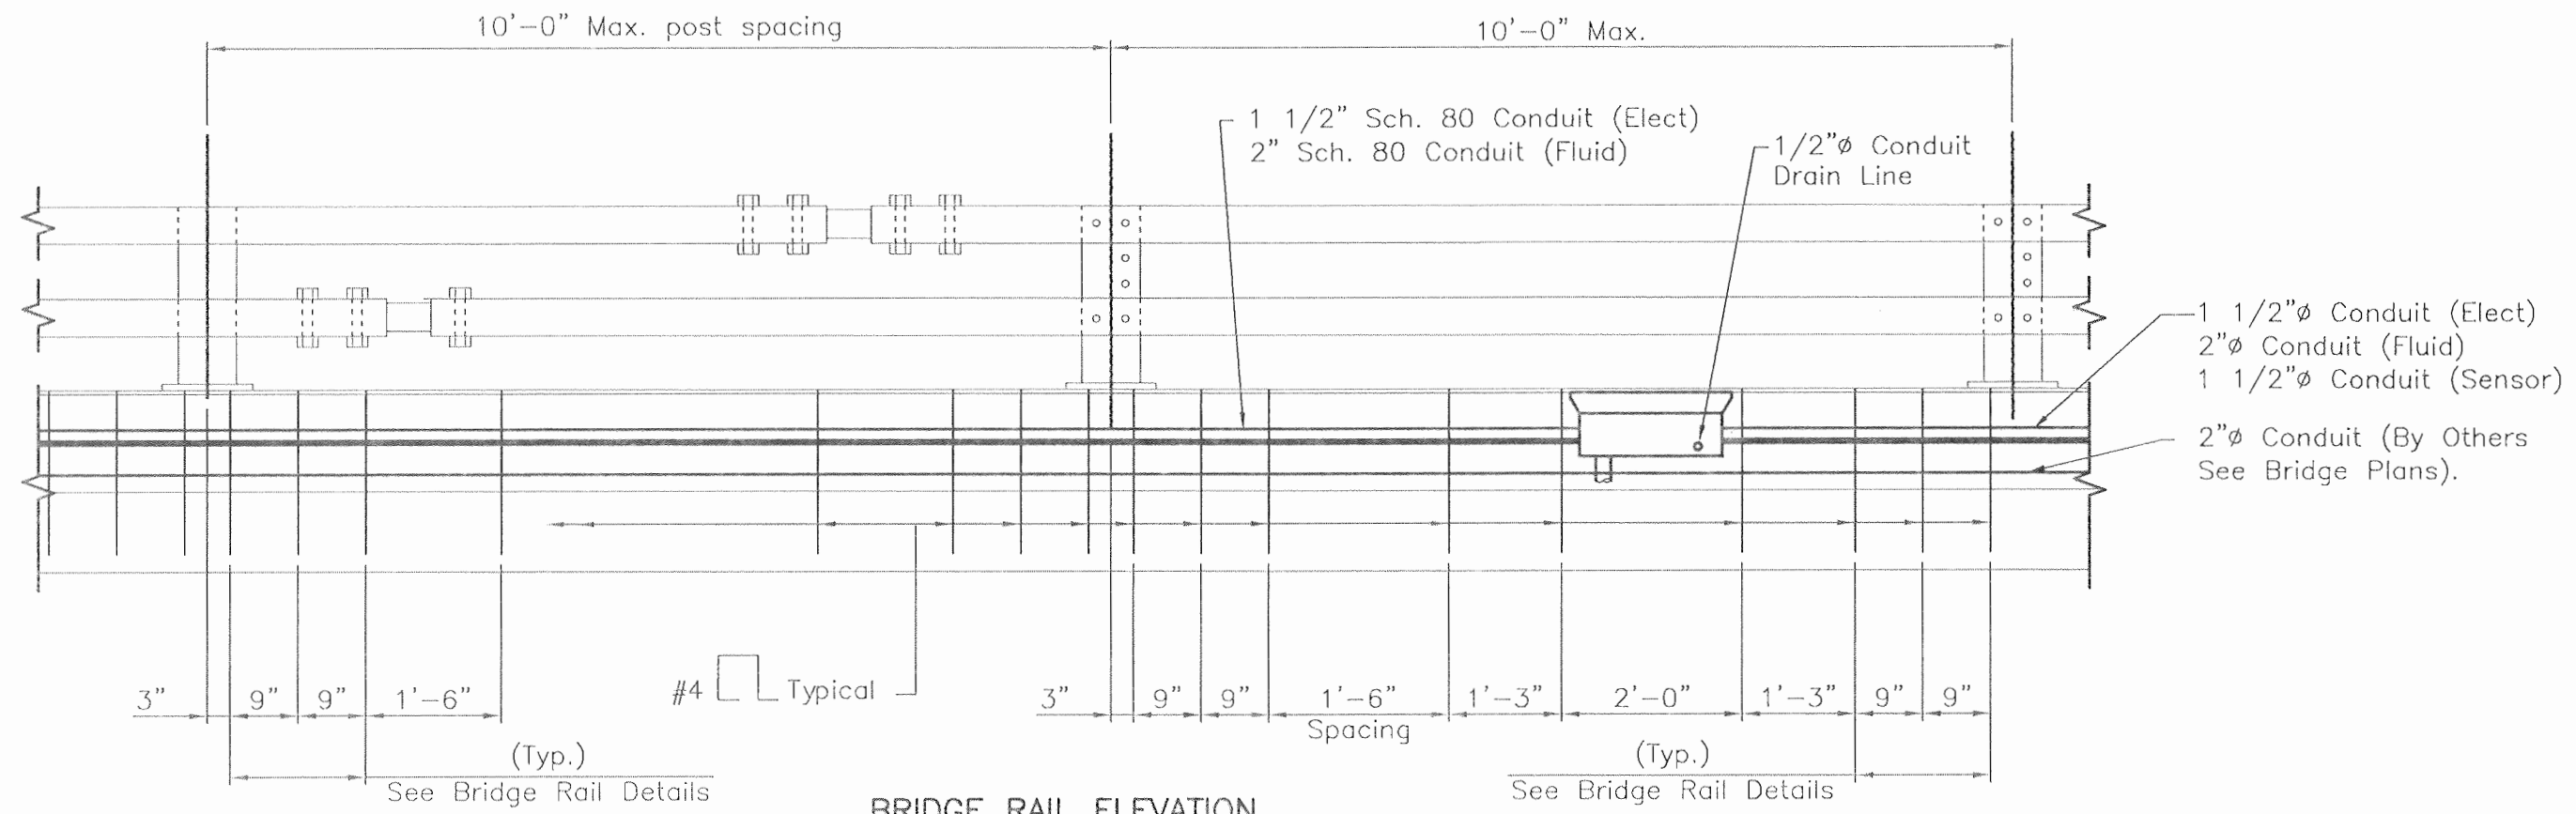


BRIDGE RAIL ELEVATION
Scale " 1/2" = 1'-0"

Design		Detail		Quantities	
INITIAL	DATE	INITIAL	DATE	INITIAL	DATE
JMH	07/08	RJK	07/08	XXX	MM/YY
DDH	07/25	DDH	07/25	XXX	MM/YY
Designed By	Detailed By	Checked By	Checked By	Quantity By	Checked By



Print Date: Wednesday, September 01, 2010	Sheet Revisions			Colorado Department of Transportation 3803 North Main Avenue Suite 200 Durango, CO 81301 Phone: 970-385-1440 FAX: 970-385-8365 Region 5	As Constructed	BRIDGE RAIL ELEVATION		Project No./Code
File Name: 0208005.08P101-RAMP A.DWG	Date:	Comments	Init.		No Revisions: 11/1/09			NH 1602-114
Horiz. Scale: As Noted	Vert. Scale: As Noted	(R-X)			Revised:	Designer: Daniel Hull	Structure P-05-V	16042
Unit Information	Unit Leader Initials				Void:	Detailer: Rick Keller	Numbers	Sheet Number 335
<small>Lasery, Ryan & Associates, Inc. www.lraa.com</small> 				<small>11-000-0000, 11-000-0000</small>		Sheet Subset: Anti-Icing Subset Sheets: AIS4 of AIS5		

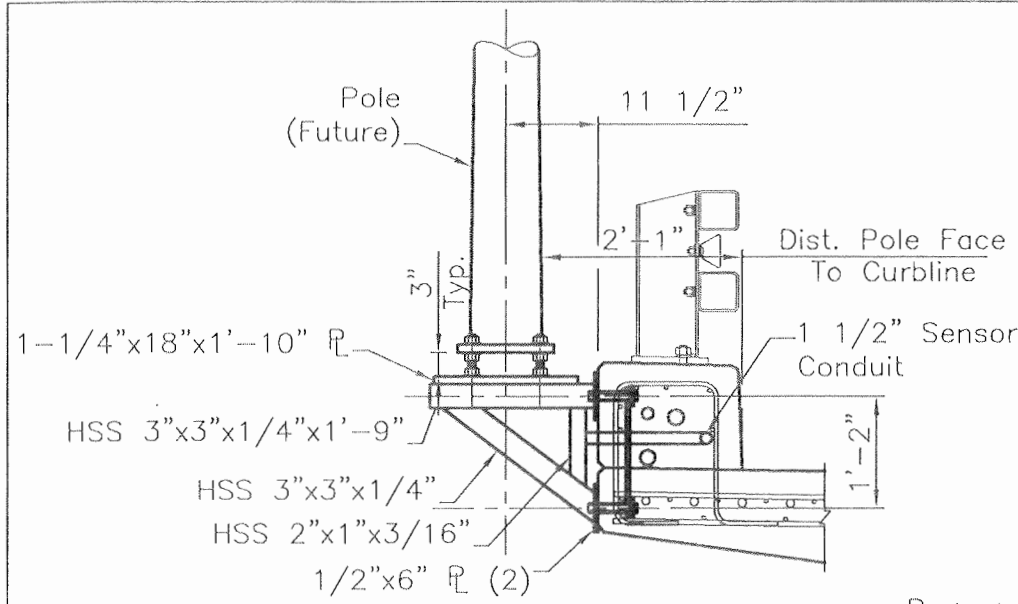


POST MOUNTING DETAIL
Scale: 1/2" = 1'-0"

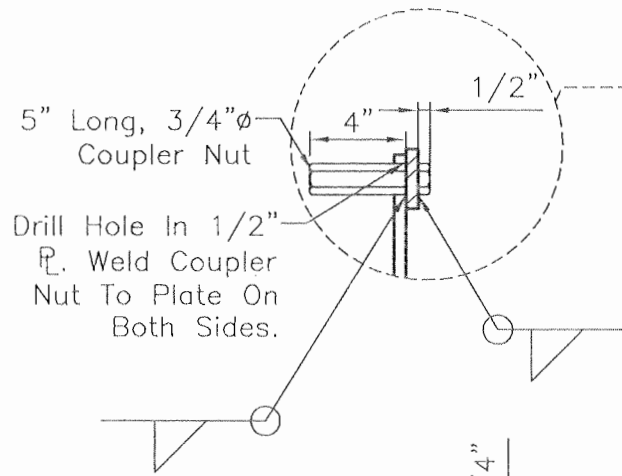


BARRIER INSERT DETAIL
Scale: 3/4" = 1'-0"

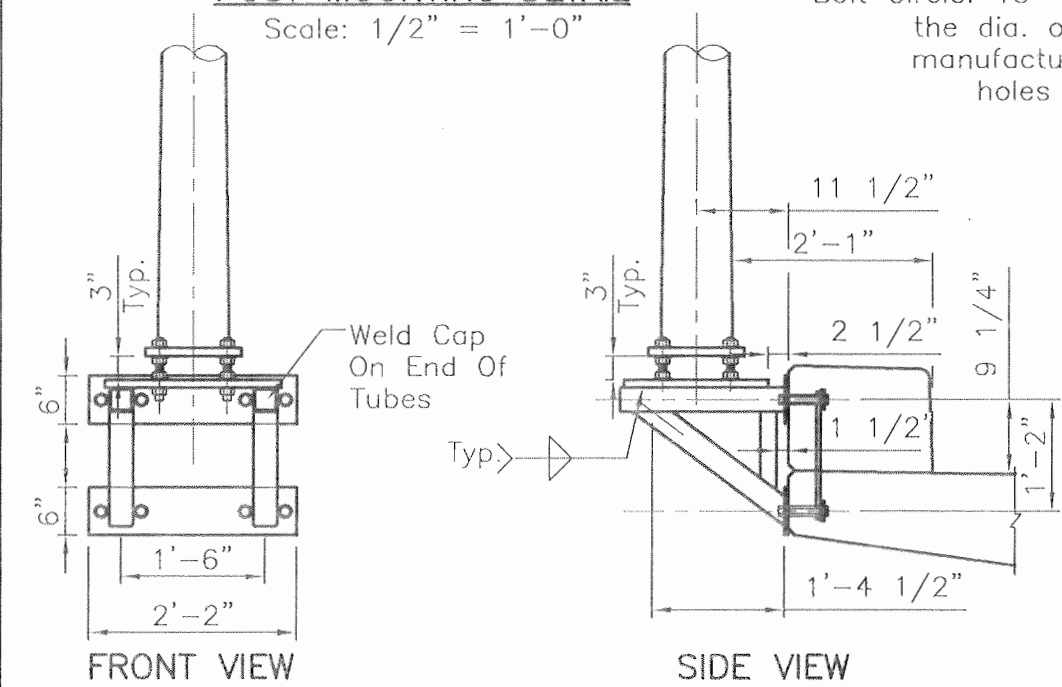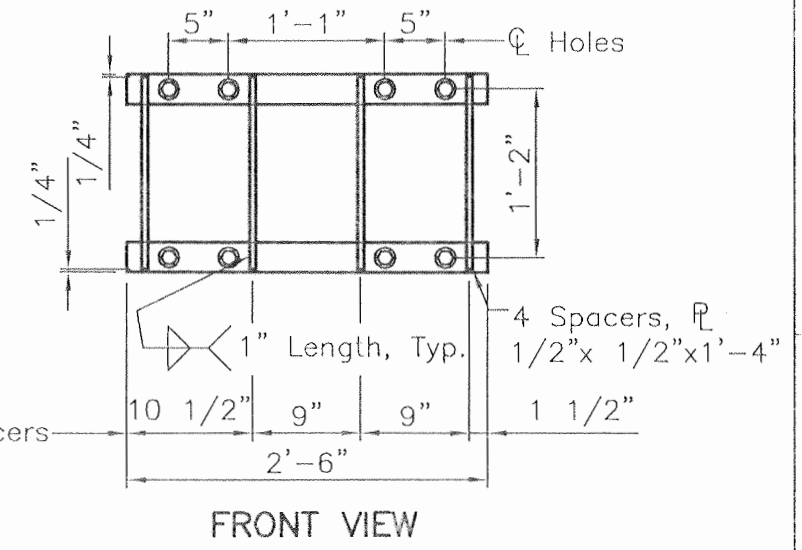

OUTSIDE MOUNTING BRACKET
Scale: 1/2" = 1'-0"

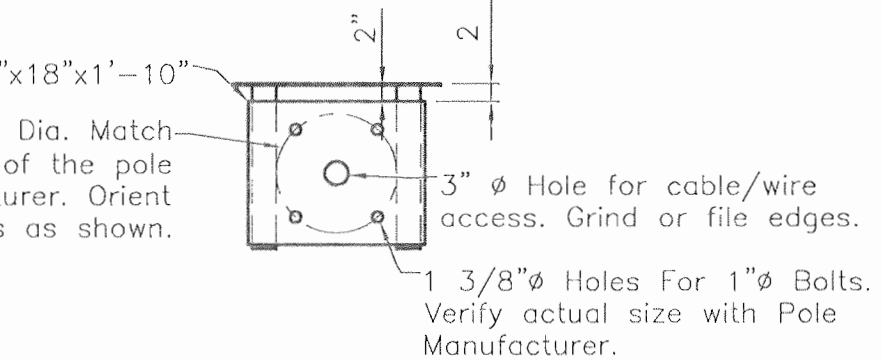

PLAN VIEW OF MOUNTING BRACKET
Scale: 1/2" = 1'-0"

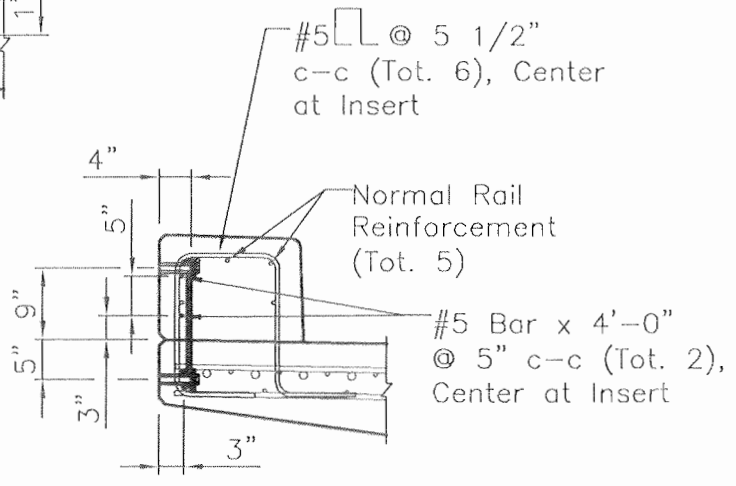

BARRIER WITH BRACKET INSERTS
Scale: 1/2" = 1'-0"

STRUCTURAL STEEL AND METAL EMBEDMENTS FOR CONCRETE STRUCTURES

- Miscellaneous steel items in the structures shall be fabricated from structural steel conforming to ASTM A36 or A572. Welding shall meet requirements of AWS D1.1. The finished fabrication shall be hot-dip galvanized in accordance with ASTM A123.
- All Bolts, Nuts and Washers shall be A325, and shall be galvanized.
- All HSS Round or Rectangular Sections shall conform to ASTM A500, Grade B or C structural tubing.
- All welds shall be 1/4" minimum effective throat welds, or to the thickness of the smaller material being welded, whichever is smaller, based on 70 ksi electrode strength. HSS members may require flare bevel welds.
- 3/4" Coupler Nuts shall be 5" minimum in length, and shall meet the requirements of A325.
- Bolts to connect the Bracket to the barrier shall be 3 1/2" in length with washers.
- Pole Mounting Bracket is designed for following conditions:
 - Maximum wind velocity of 100 mph.
 - Maximum height of pole not to exceed 30 feet from top of mounting bracket plate.
 - Top of pole shall not exceed 100 feet as measured above the local ground elevation.
 - Horizontal projected area of installed equipment shall not exceed 4.5 SF mounted at 27 Feet above the top of the mounting plate (or equivalent produced moment).
 - Base of the pole shall not exceed 8" diameter, Bolt circle shall not exceed 15".

Design	DATE	INITIAL	QUANTITIES
Checked By	07/08	JMH	By XXX
Designed By	07/25	DDH	Checked By XXX
Checked By	07/25	DDH	Checked By XXX

Print Date: Wednesday, September 01, 2010	Sheet Revisions			Colorado Department of Transportation	As Constructed		Project No./Code	
File Name: 0208005.08P101-RAMP A.DWG	Date:	Comments	Init.		No Revisions: 11/1/09		SENSOR POLE ANCHORAGE	
Horiz. Scale: As Noted	Vert. Scale: As Noted				Revised:		Designer: Daniel Hull	Structure: P-05-V
Unit Information	Unit Leader Initials				Void:		Detailer: Rick Keller	Numbers:
				Region 5	EJA		Sheet Subset: Anti-Icing	Subset Sheets: AIS6 of AIS5
								Sheet Number: 336

ANTI-ICING SYSTEM PHASE I


INDEX OF DRAWINGS

- AIS1 GENERAL NOTES
- AIS2 BRIDGE LAYOUT
- AIS3 BRIDGE CROSS SECTION
- AIS4 BRIDGE RAIL ELEVATION
- AIS5 SENSOR POLE ANCHORAGE

GENERAL NOTES



1. The Anti-Icing System Phase I construction drawings include information for the installation of the basic components and shall include conduits, junction boxes, and sensor anchorage to accommodate the future components of an operational system.
2. Conduit shall have a high point placed at the midpoint of the junction boxes to facilitate drainage of the conduits.
3. Spray nozzle and spray pattern on layout are for information only.
4. Unless otherwise indicated, junction boxes shall be placed on the upstream side of super elevation or normal cross slope.

Structure P-05-W RAMP C OVER WILSON GULCH RELEASED FOR CONSTRUCTION

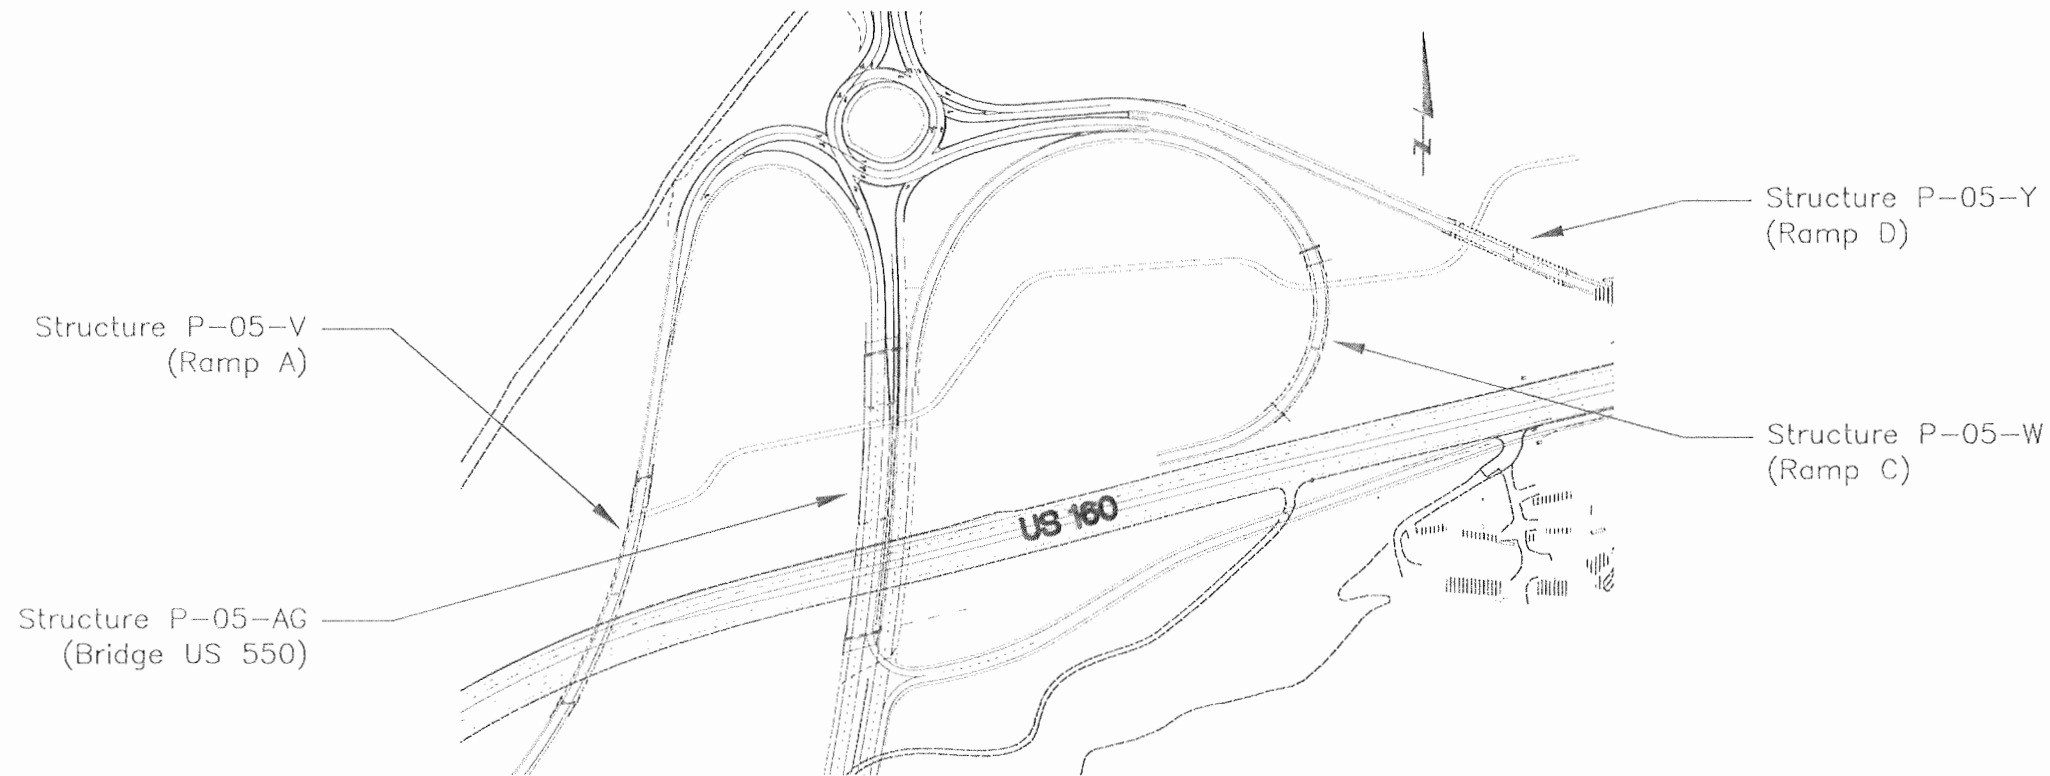

Design		Detail		Quantities	
INITIAL	DATE	INITIAL	DATE	INITIAL	DATE
JMH	07/08	RJK	07/08	XXX	MM/YY
DDH	07/25	DDH	07/25	XXX	MM/YY
Designed By	Checked By	Designed By	Checked By	Quantities By	Checked By

Print Date: Wednesday, September 01, 2010		Sheet Revisions			Colorado Department of Transportation		As Constructed		Project No./Code	
File Name: 0208005.08P101-RAMP C.DWG		Date:	Comments	Init.	3803 North Main Avenue Suite 200 Durango, CO 81301 Phone: 970-385-1440 FAX: 970-385-8365		No Revisions: 11/1/09		NH 1602-114	
Horiz. Scale: As Noted Vert. Scale: As Noted		(R-X)			Region 5 EJA		Revised:		GENERAL NOTES	
Unit Information Unit Leader Initials							Void:		Designer: Daniel Hull Structure P-05-W	
Lamp, Rysman & Associates, Inc. 1140 20th Street, Suite 200, Durango, CO 81301									Detailer: Rick Keller Numbers	
ENVIROTECH									Sheet Subset: Anti-Icing Subset Sheets: AIS1 of AIS5	
									Sheet Number 337	

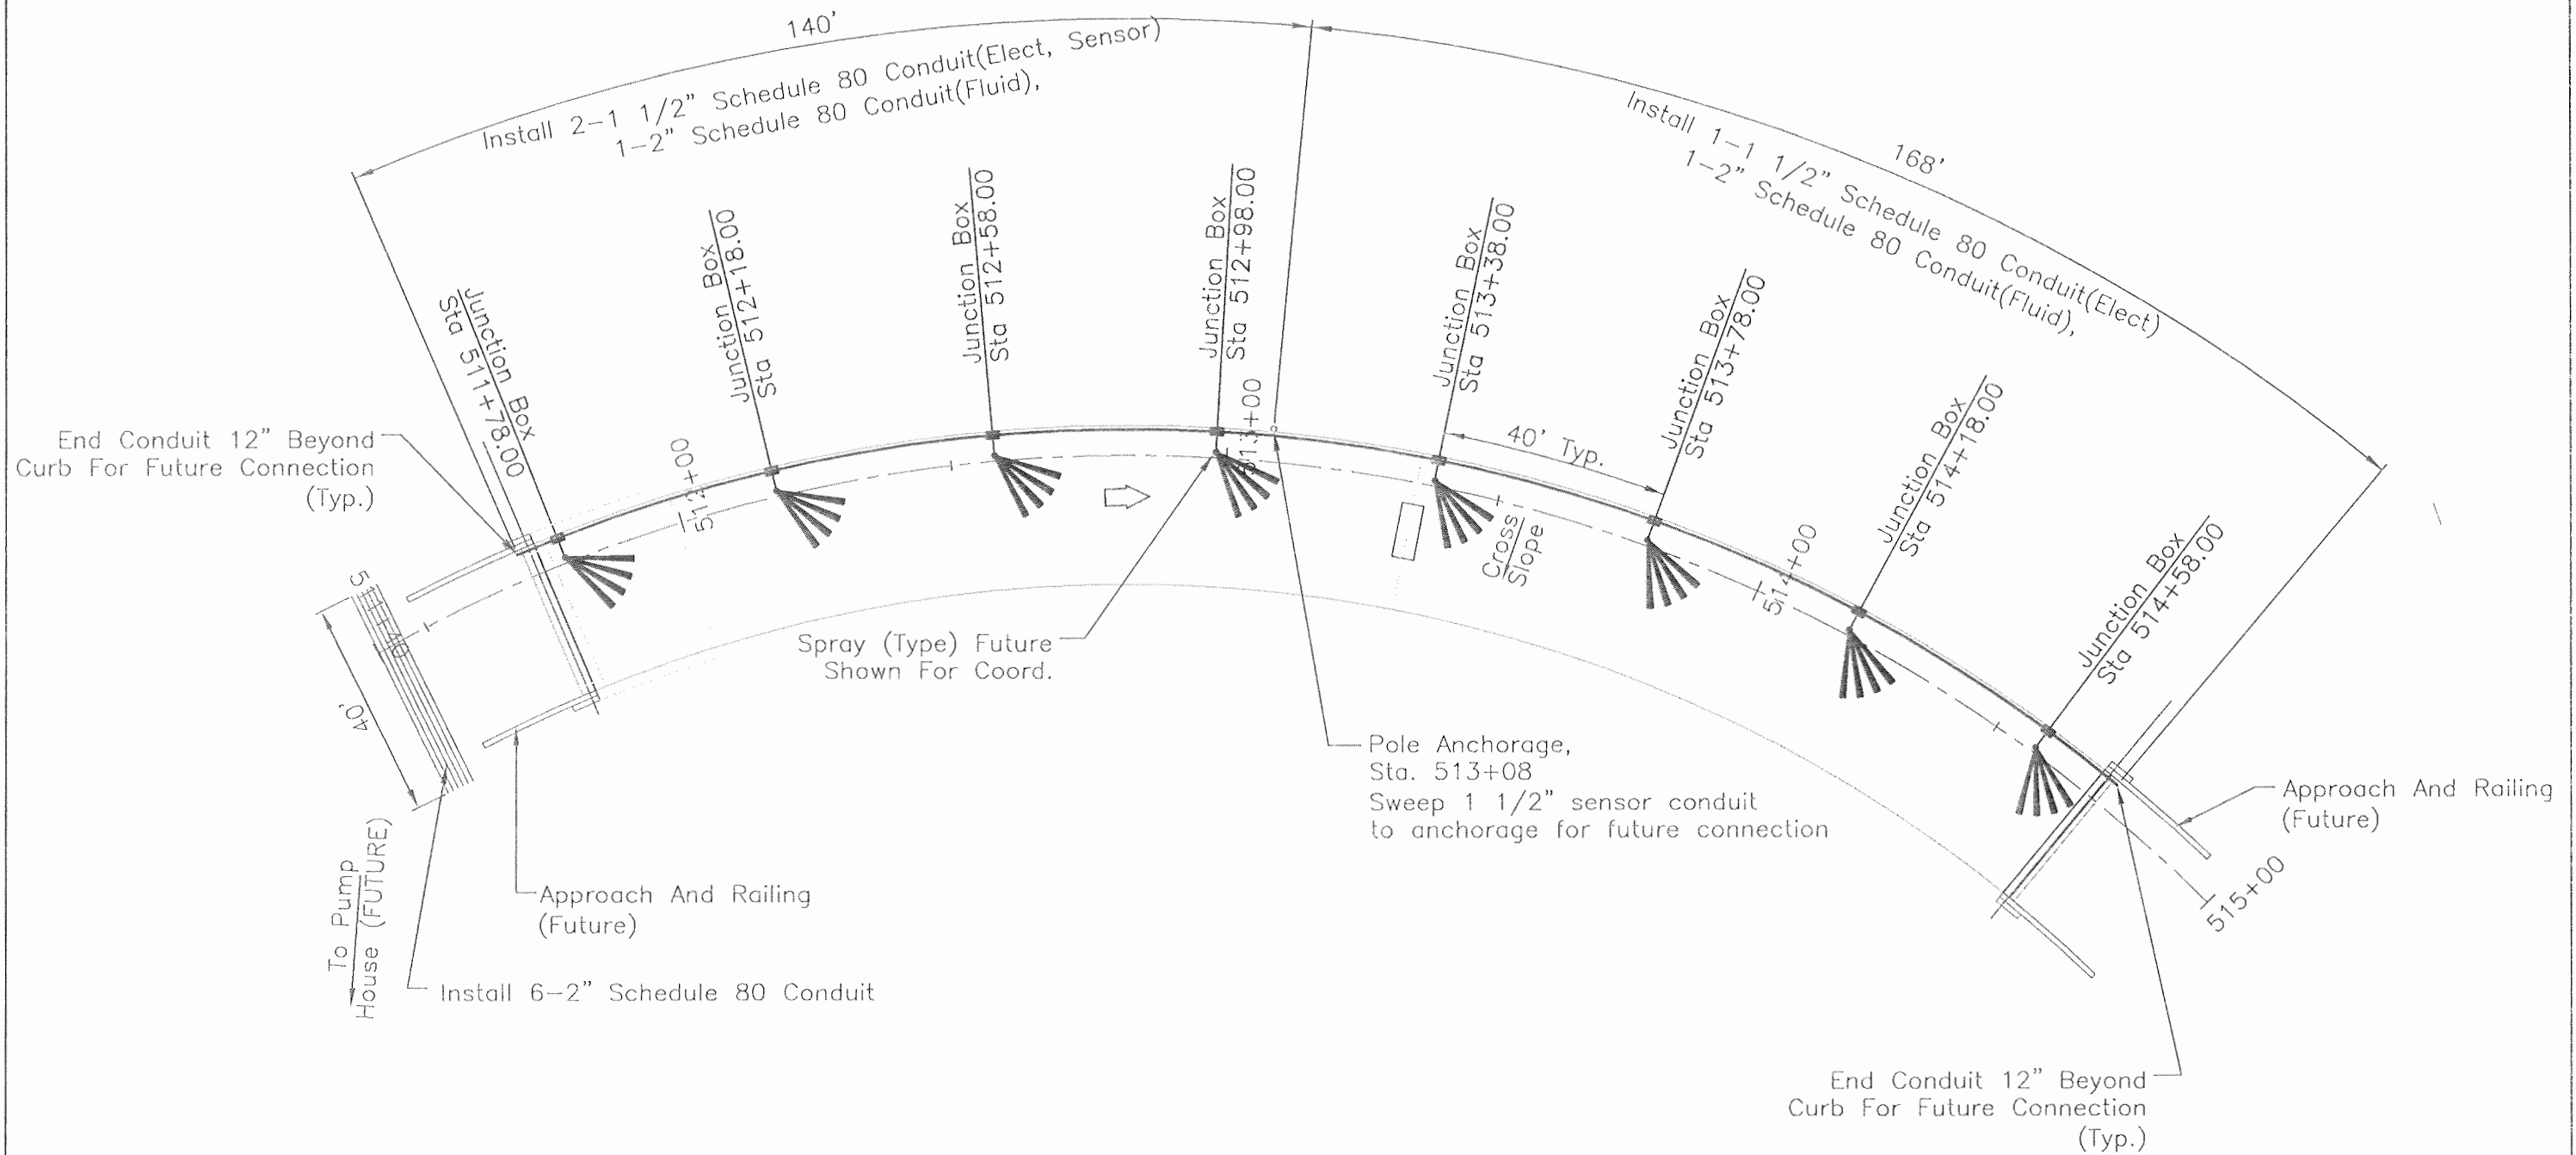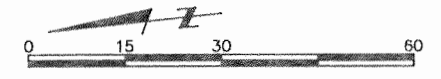

Design		Detail		Quantities	
INITIAL	DATE	INITIAL	DATE	INITIAL	DATE
JMH	07/06	RJK	07/06	XXX	MM/YY
DDH	07/25	DDH	07/25	XXX	MM/YY
Designed By	Detailed By	Checked By	Checked By	Quantity By	Quantity By
DDH	DDH	DDH	DDH	XXX	XXX


NOTE: See Bridge Cross Section For Junction Box Installation.

Print Date: Wednesday, September 01, 2010		Sheet Revisions			Colorado Department of Transportation		As Constructed		BRIDGE LAYOUT		Project No./Code	
File Name: 0208005.08P101-RAMP C.DWG		Date:	Comments	Init.	3803 North Main Avenue Suite 200 Durango, CO 81301 Phone: 970-385-1440 FAX: 970-385-8365		No Revisions: 11/1/09		Designer: Daniel Hull Detailer: Rick Keller		NH 1602-114	
Horiz. Scale: 1:30 Vert. Scale: As Noted					Region 5 EJA		Revised:		Structure P-05-W Numbers		16042	
Unit Information Unit Leader Initials							Void:		Sheet Subset: Anti-Icing Subset Sheets: AIS2 of AIS5		Sheet Number 338	

Lamp, Ryan & Associates, Inc. 4774 LMA BLDG
 1000 10th Avenue, Suite 200
 Durango, Colorado 81301

LEVIROTECH
 11-00 200 Avenue, Suite 200
 Durango, Colorado 81301


Design	INITIAL	DATE	Detail	INITIAL	DATE	Quantities	INITIAL	DATE
	Designed By	JMH		07/08	RJK		07/08	By
Checked By	Checked By	DDH	Checked By	DDH	Checked By	Checked By	XXX	MM/YY

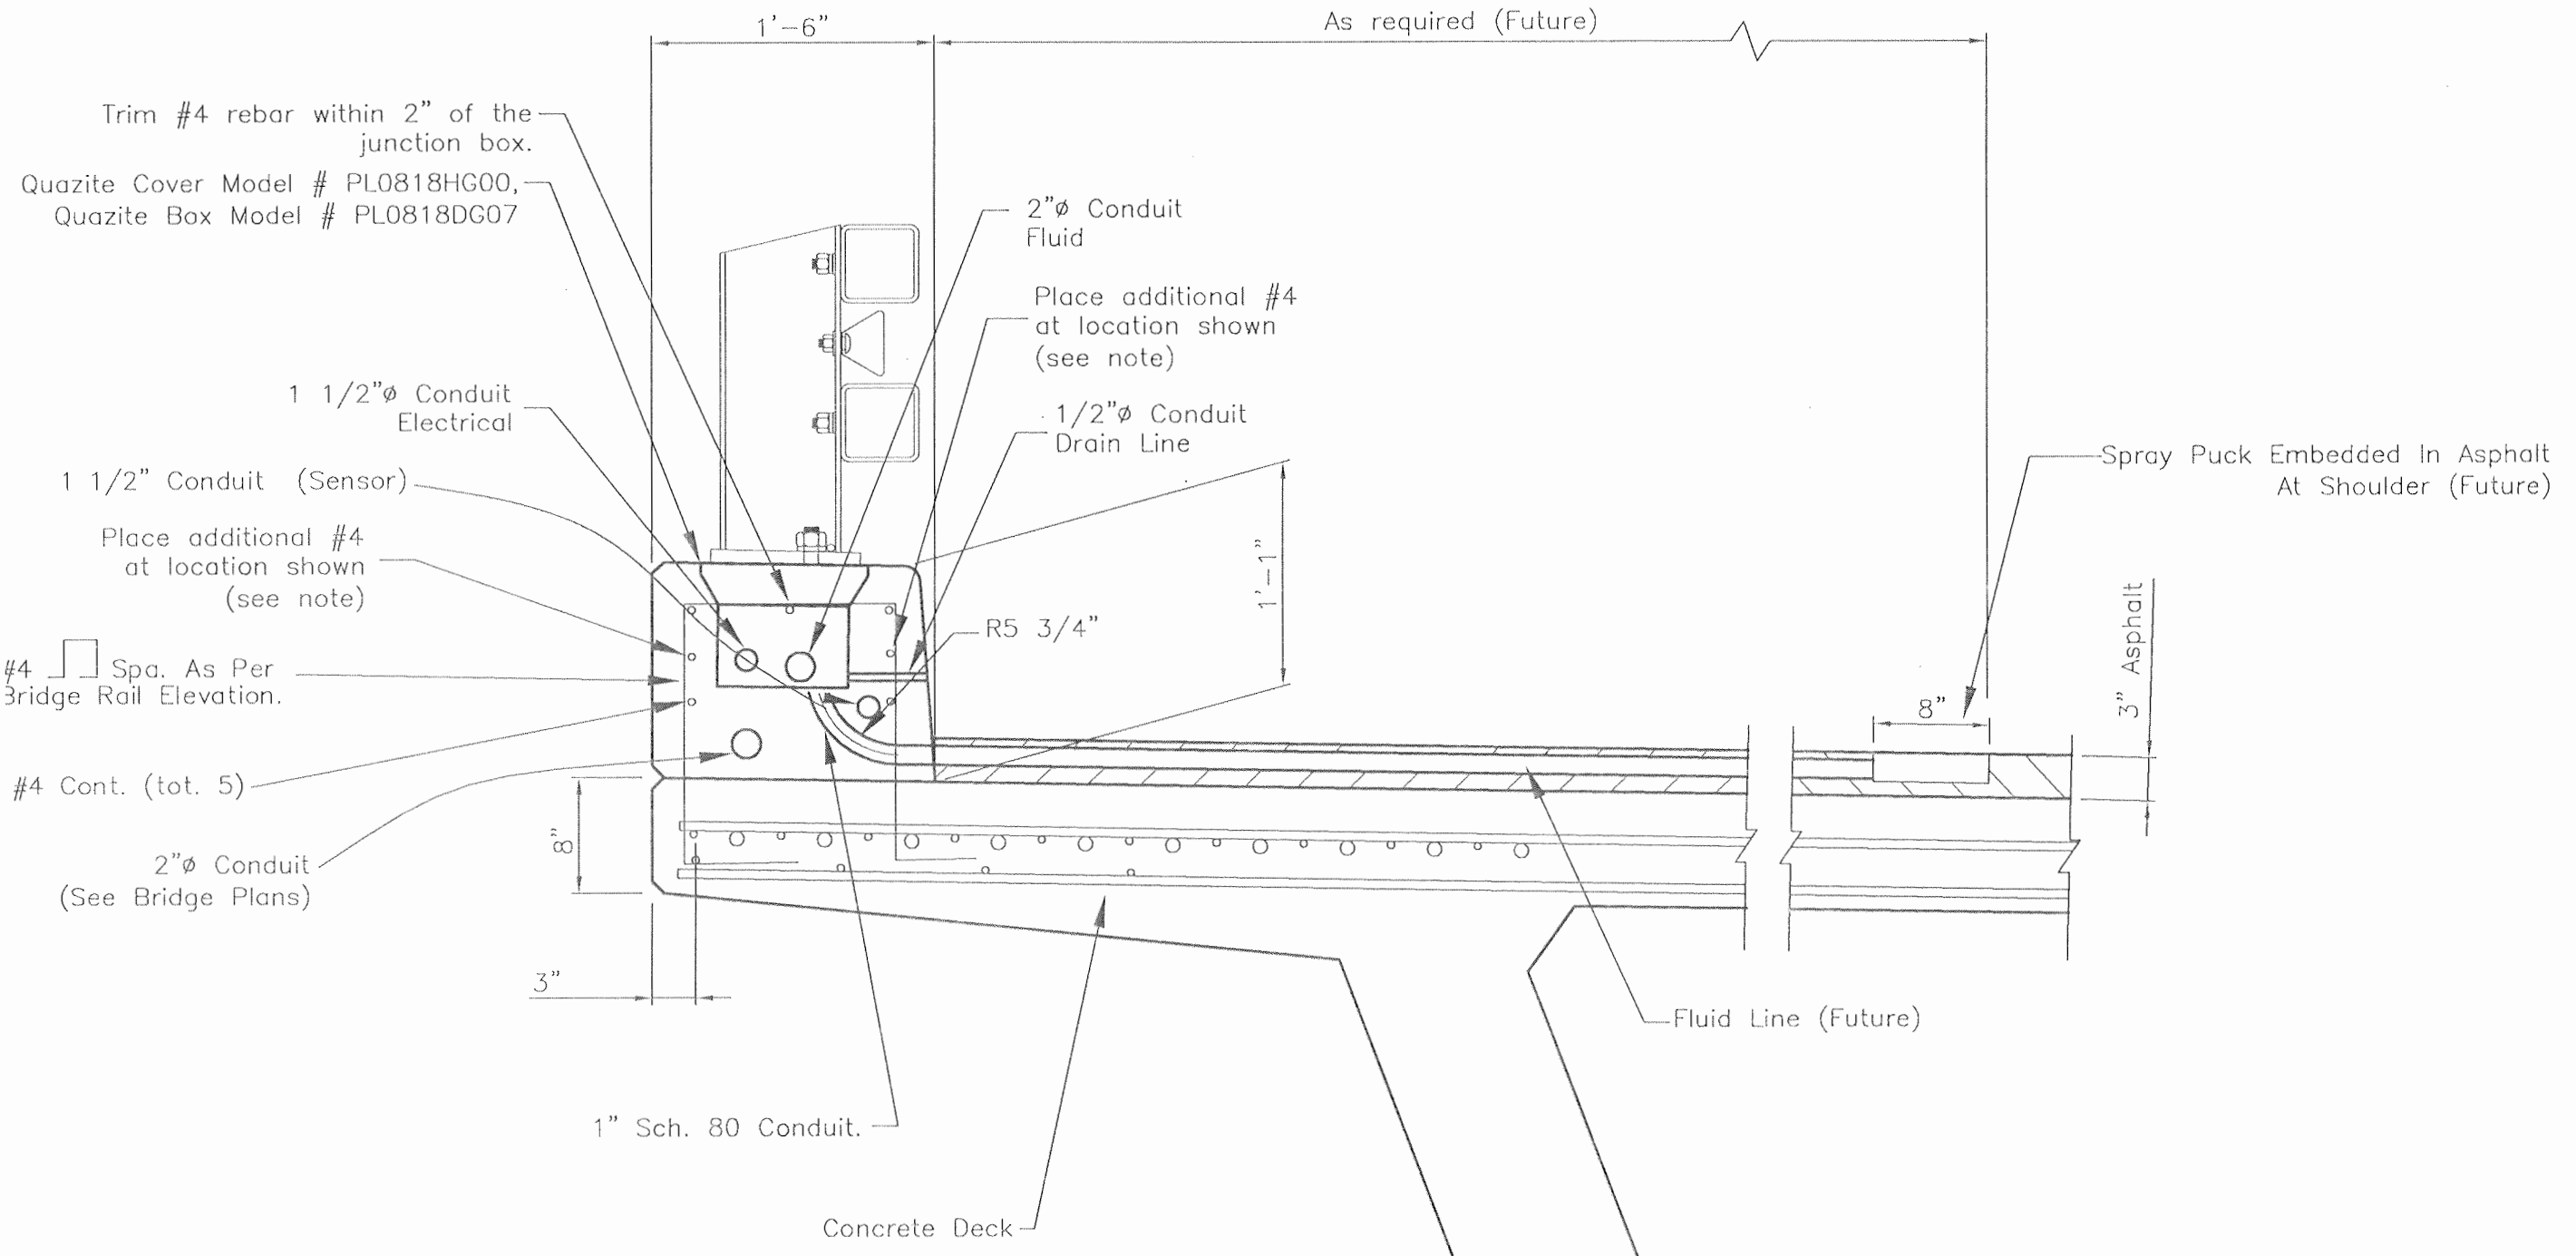

Note: The length of the additional #4 rebar shall be 2'-6" + Length of #4 rebar trimmed out for junction box.

BRIDGE SECTION
Scale: 1/2" = 1'-0"

Print Date: Wednesday, September 01, 2010	Sheet Revisions			Colorado Department of Transportation 3803 North Main Avenue Suite 200 Durango, CO 81301 Phone: 970-385-1440 FAX: 970-385-8365 Region 5 EJA	As Constructed	BRIDGE CROSS SECTION		Project No./Code
File Name: 0208005.08P101-RAMP C.DWG	Date:	Comments	Init.		No Revisions: 11/1/09			NH 1602-114
Horiz. Scale: As Noted Vert. Scale: As Noted					Revised:	Designer: Daniel Hull	Structure: P-05-W	16042
Unit Information Unit Leader Initials				Void:	Detailer: Rick Keller	Numbers:		
					Sheet Subset: Anti-Icing	Subset Sheets: AIS3 of AIS5	Sheet Number: 339	

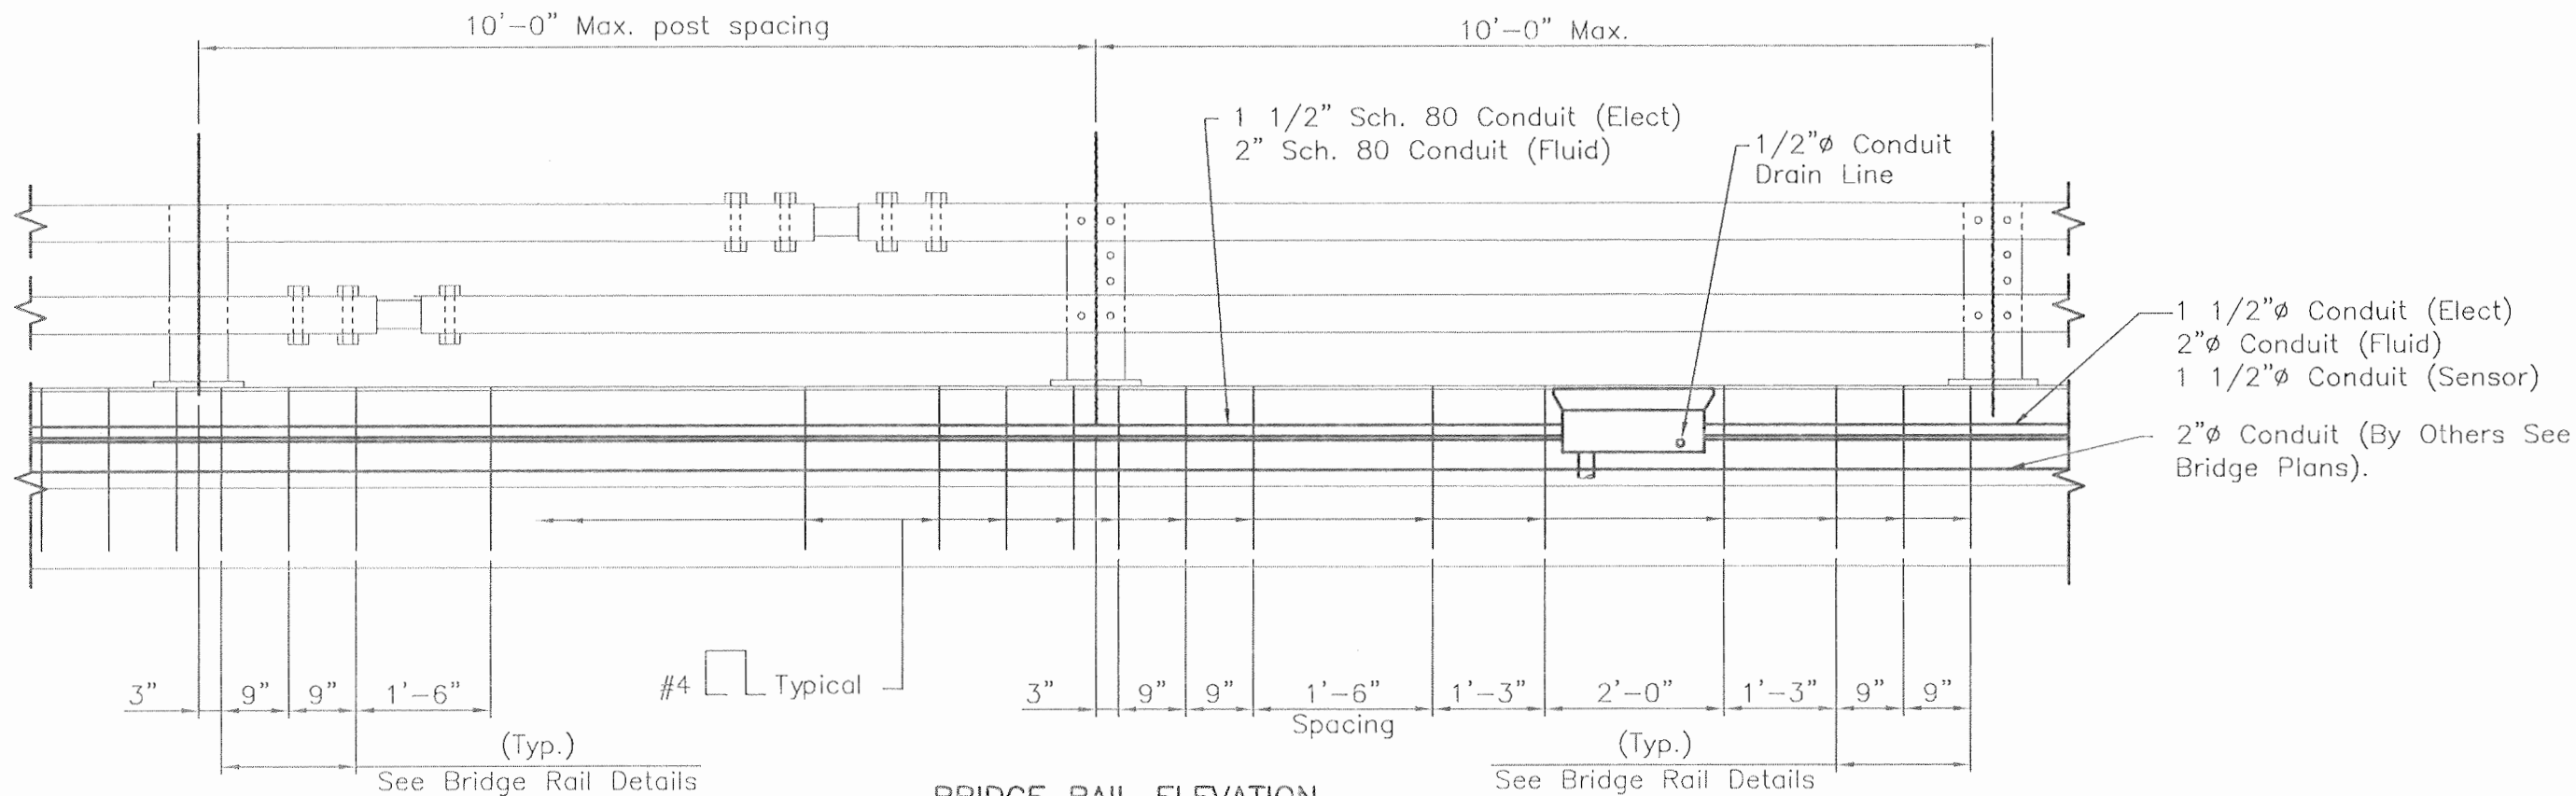

BRIDGE RAIL ELEVATION
Scale" 1/2" = 1'-0"

Design		Detail		Quantities	
INITIAL	DATE	INITIAL	DATE	INITIAL	DATE
Designed By JmH	07/08	RJK	07/08	Quantities By XXX	MM/YY
Checked By DDH	07/25	DDH	07/25	Checked By XXX	MM/YY

Print Date: Wednesday, September 01, 2010	
File Name: 0208005.08P101-RAMP C.DWG	
Horiz. Scale: As Noted	Vert. Scale: As Noted
Unit Information	Unit Leader Initials


Sheet Revisions		
Date:	Comments	Init.
<input type="checkbox"/>		
<input type="checkbox"/>		
<input type="checkbox"/>		

Colorado Department of Transportation
3803 North Main Avenue
Suite 200
Durango, CO 81301
Phone: 970-385-1440 FAX: 970-385-8365
Region 5 EJA

As Constructed
No Revisions: 11/1/09
Revised:
Void:


BRIDGE RAIL ELEVATION			
Designer: Daniel Hull	Structure	P-05-W	
Detailer: Rick Keller	Numbers		
Sheet Subset: Anti-Icing	Subset Sheets: AIS4 of AIS5		

Project No./Code	NH 1602-114
Sheet Number	340

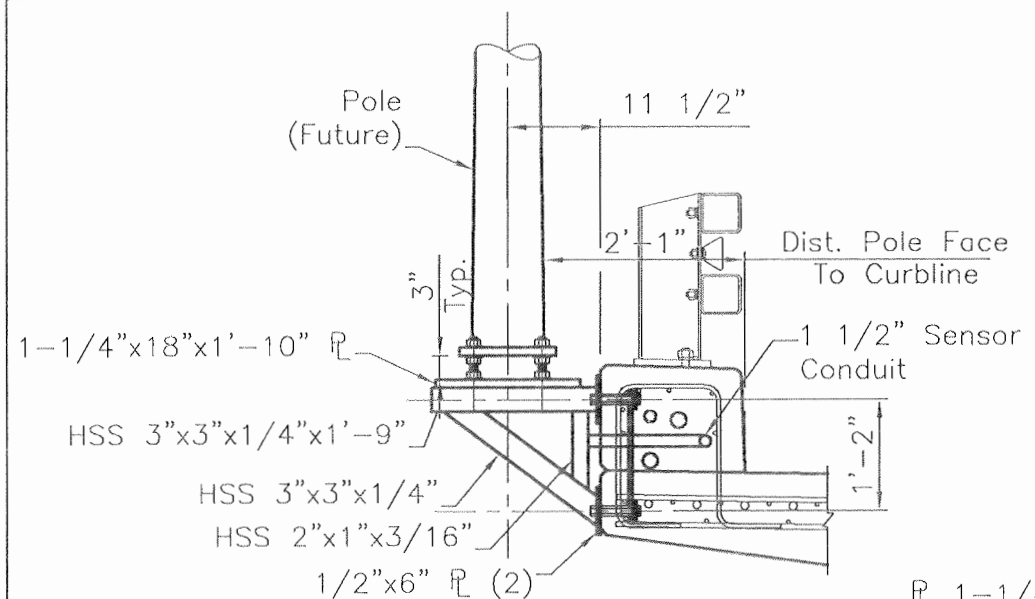


POST MOUNTING DETAIL

Scale: 1/2" = 1'-0"

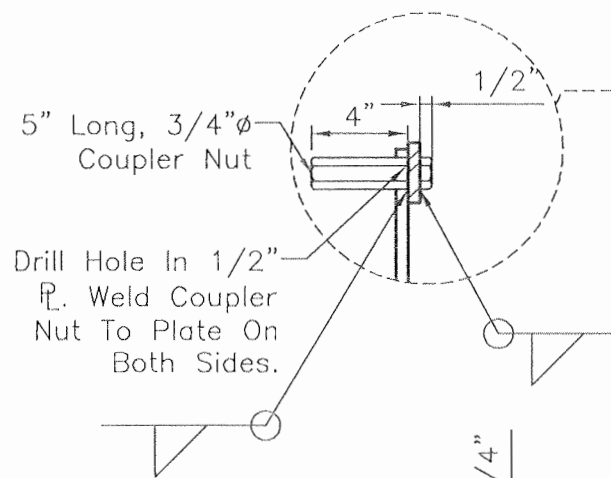

SIDE VIEW

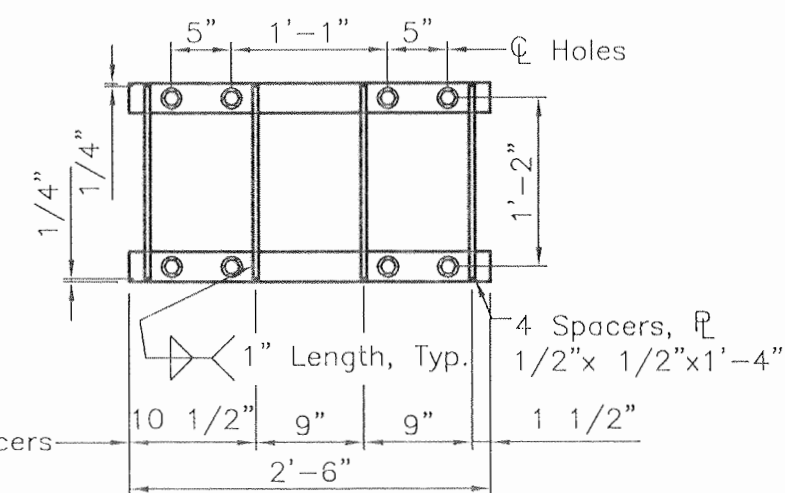

FRONT VIEW


BARRIER INSERT DETAIL

Scale: 3/4" = 1'-0"

Bolt Circle. 15" Dia. Match the dia. of the pole manufacturer. Orient holes as shown.


PLAN VIEW OF MOUNTING BRACKET

Scale: 1/2" = 1'-0"

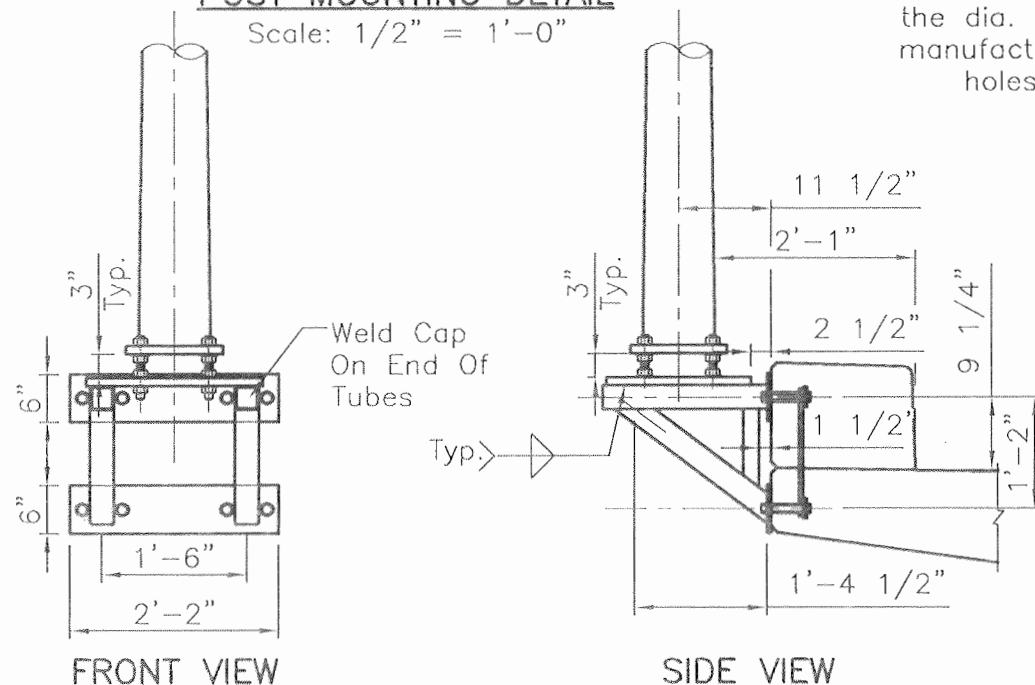

OUTSIDE MOUNTING BRACKET

Scale: 1/2" = 1'-0"

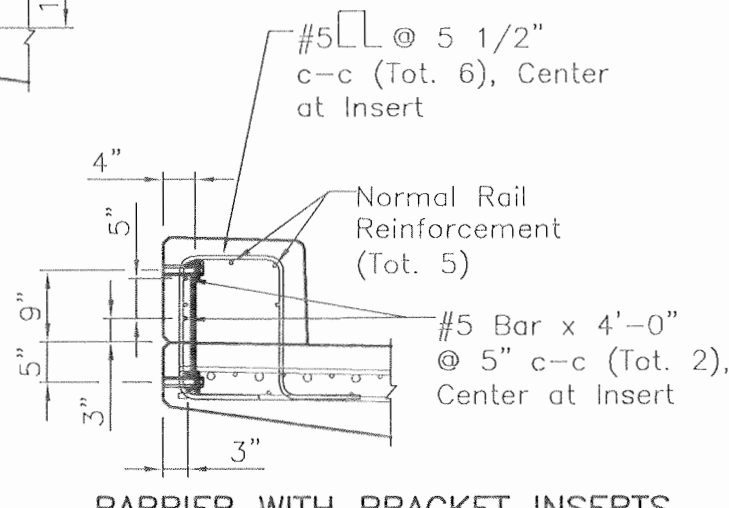

BARRIER WITH BRACKET INSERTS

Scale: 1/2" = 1'-0"

STRUCTURAL STEEL AND METAL EMBEDMENTS FOR CONCRETE STRUCTURES

- Miscellaneous steel items in the structures shall be fabricated from structural steel conforming to ASTM A36 or A572. Welding shall meet requirements of AWS D1.1. The finished fabrication shall be hot-dip galvanized in accordance with ASTM A123.
- All Bolts, Nuts and Washers shall be A325, and shall be galvanized.
- All HSS Round or Rectangular Sections shall conform to ASTM A500, Grade B or C structural tubing.
- All welds shall be 1/4" minimum effective throat welds, or to the thickness of the smaller material being welded, whichever is smaller, based on 70 ksi electrode strength. HSS members may require flare bevel welds.
- 3/4" Coupler Nuts shall be 5" minimum in length, and shall meet the requirements of A325.
- Bolts to connect the Bracket to the barrier shall be 3 1/2" in length with washers.
- Pole Mounting Bracket is designed for following conditions:
 - Maximum wind velocity of 100 mph.
 - Maximum height of pole not to exceed 30 feet from top of mounting bracket plate.
 - Top of pole shall not exceed 100 feet as measured above the local ground elevation.
 - Horizontal projected area of installed equipment shall not exceed 4.5 SF mounted at 27 Feet above the top of the mounting plate (or equivalent produced moment).
 - Base of the pole shall not exceed 8" diameter, Bolt circle shall not exceed 15".

Design	Detail		Quantity	
	INITIAL	DATE	INITIAL	DATE
Designed By	JNH	07/08	Quantities By	XXX
Checked By	DDH	07/25	Checked By	XXX

Print Date: Wednesday, September 01, 2010	File Name: 0208005.08P101-RAMP C.DWG
Horiz. Scale: As Noted	Vert. Scale: As Noted
Unit Information	Unit Leader Initials

Sheet Revisions		
Date:	Comments	Init.

Colorado Department of Transportation

3803 North Main Avenue
Suite 200
Durango, CO 81301
Phone: 970-385-1440 FAX: 970-385-8365



Region 5

EJA

As Constructed	No Revisions: 11/1/09
Revised:	
Void:	

SENSOR POLE ANCHORAGE			
Designer:	Daniel Hull	Structure	P-05-W
Detailer:	Rick Keller	Numbers	
Sheet Subset:	Anti-Icing	Subset Sheets:	AIS5 of AIS5

Project No./Code	NH 1602-114
Sheet Number	341

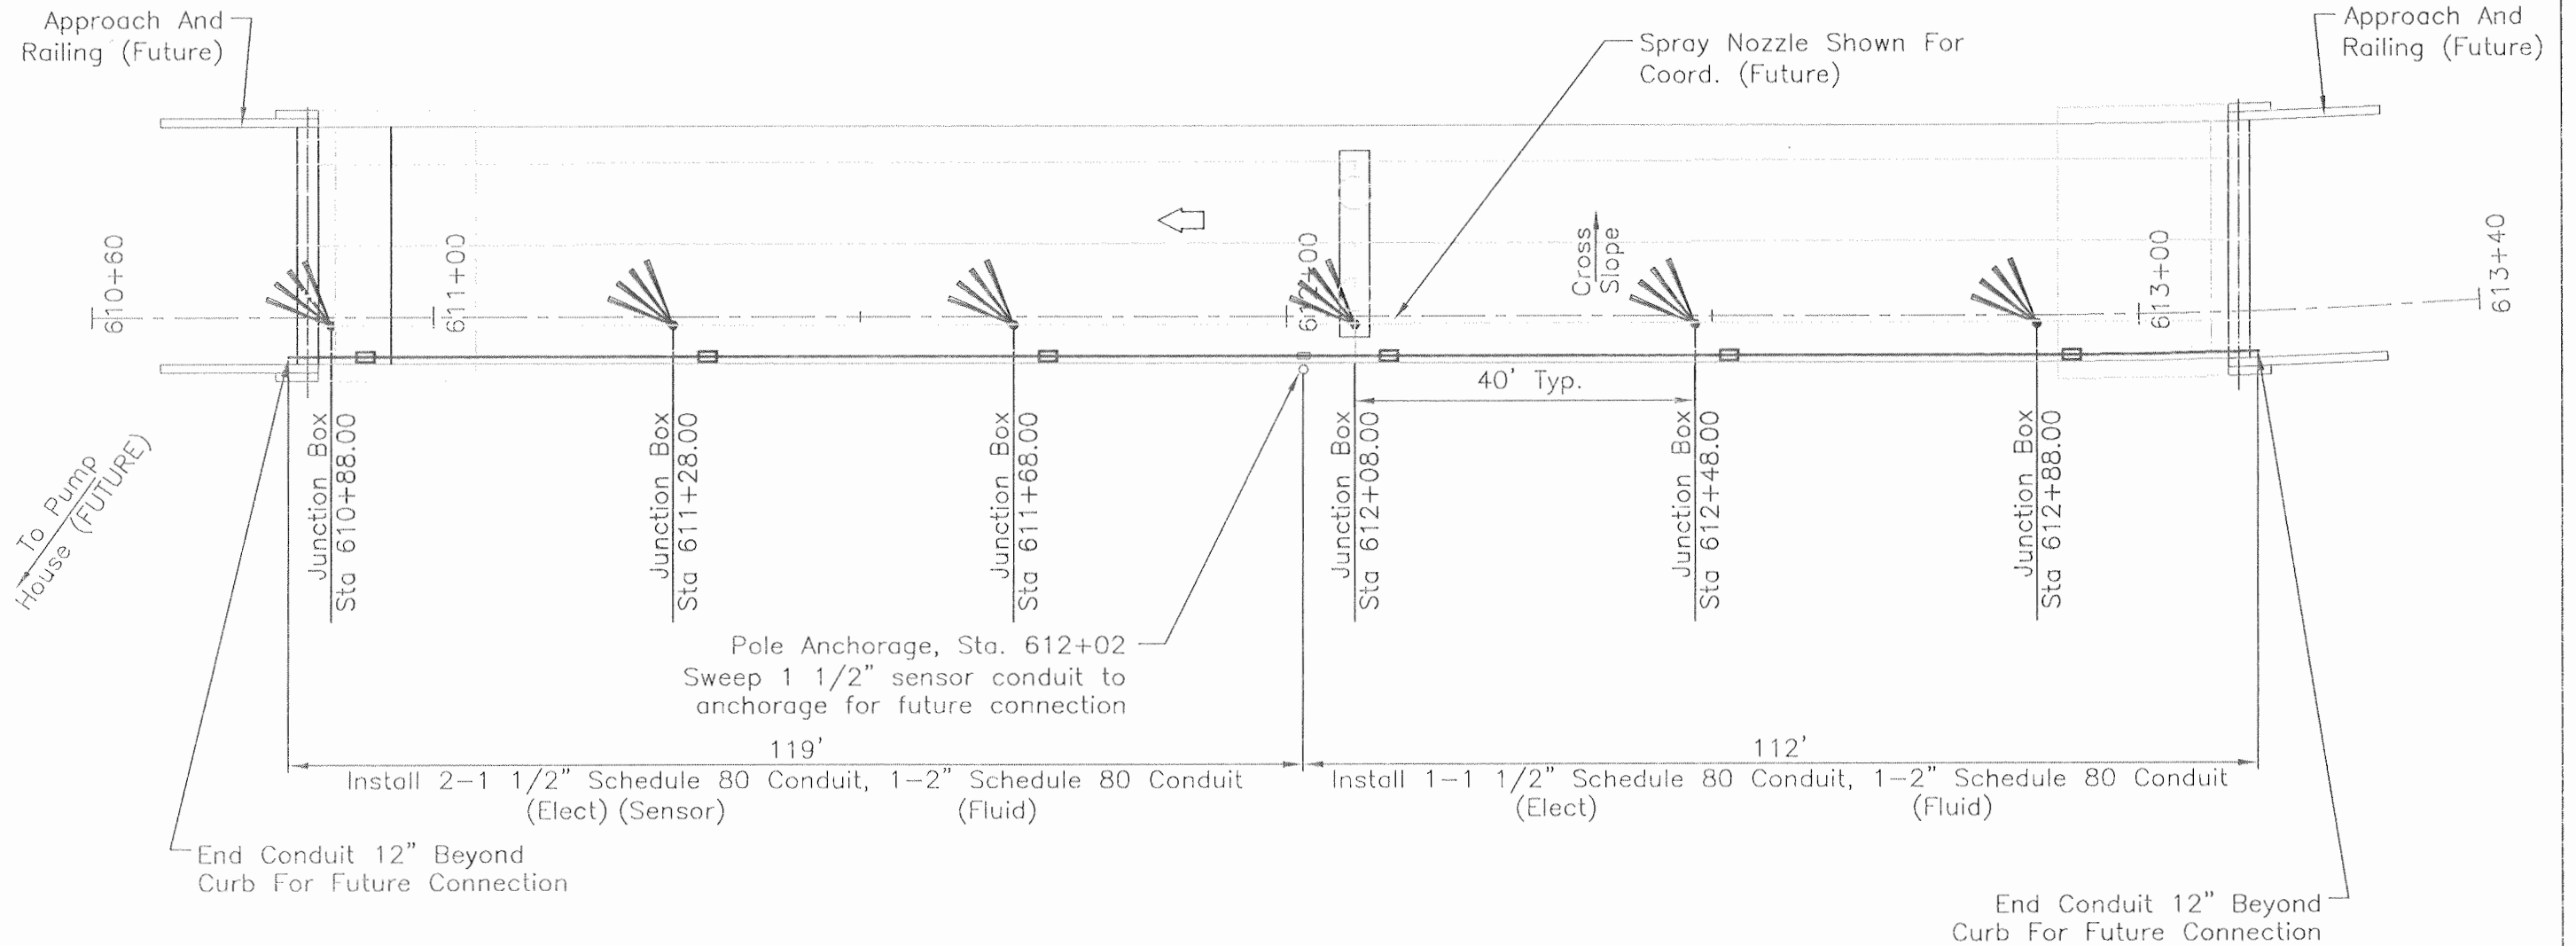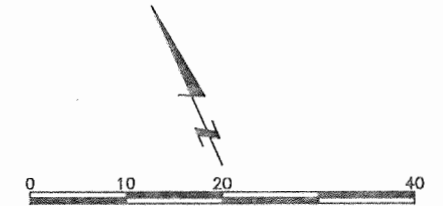

NOTE: See Bridge Cross Section For Junction Box Installation

Design		Detail		Quantities	
INITIAL	DATE	INITIAL	DATE	INITIAL	DATE
Designed By	JMH	07/08	RJK	Quantities By	XXX
Checked By	XXX	07/08	XXX	Checked By	XXX

Print Date: Wednesday, September 01, 2010	
File Name: 0208005.08P101-RAMP D.DWG	
Horiz. Scale: 1:20	Vert. Scale: As Noted
Unit Information	Unit Leader Initials

Sheet Revisions		
Date:	Comments	Init.

Colorado Department of Transportation

3803 North Main Avenue
Suite 200
Durango, CO 81301
Phone: 970-385-1440 FAX: 970-385-8365

Region 5 EJA

As Constructed
No Revisions: 11/1/09
Revised:
Void:


BRIDGE LAYOUT			
Designer:	Daniel Hull	Structure	P-05-Y
Detailer:	Rick Keller	Numbers	
Sheet Subset:	Anti-Icing	Subset Sheets:	AIS2 of AIS5

Project No./Code	NH 1602-114
16042	
Sheet Number	343

SPRAY NOZZLE KNOCKOUT NOTE:

The 4" opening width for the spray nozzle knockout is based on locations of deck reinforcing at 6" centers. The 4" opening at the pier location will require modification to the deck rebar placement. Changes to the rebar placement shall be approved by CDOT at the time of installation.

Note: The length of the additional #4 rebar shall be 2'-6" + Length of #4 rebar trimmed out for junction box.

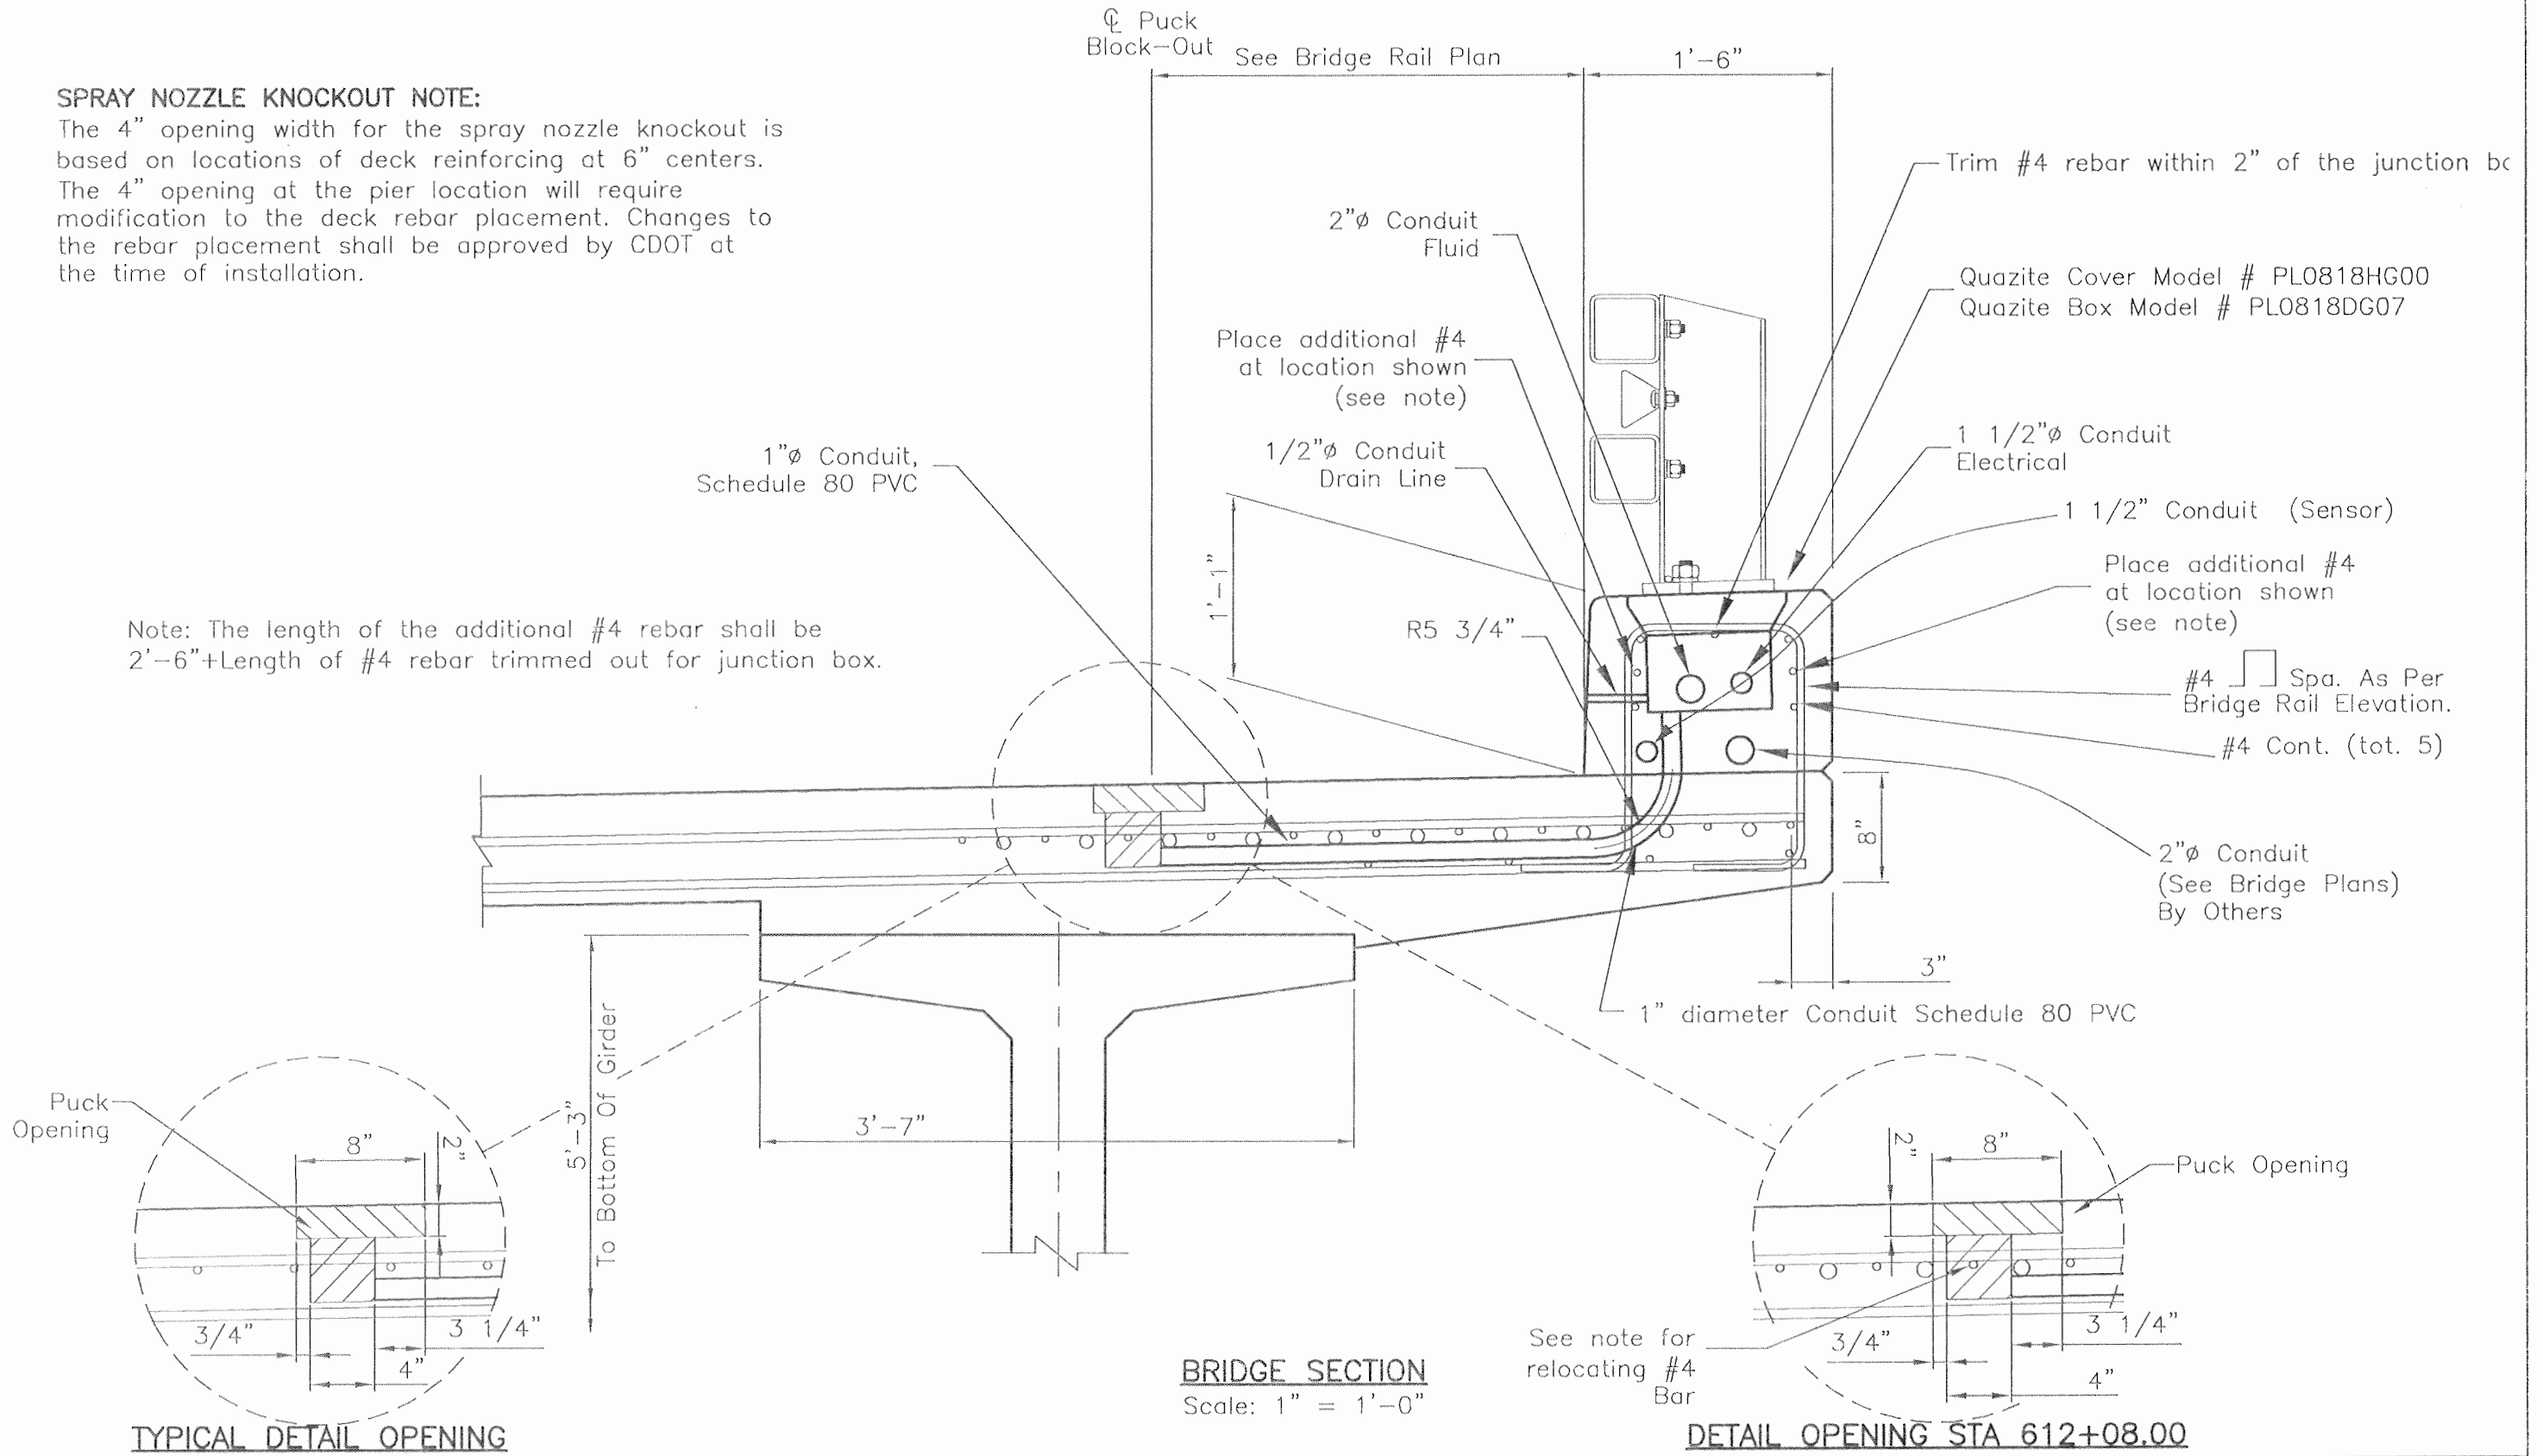

Design		Detail		Quantities	
INITIAL	DATE	INITIAL	DATE	INITIAL	DATE
JMH	07/08	RJK	07/08	XXX	MM/YY
XXX	MM/YY	XXX	MM/YY	XXX	MM/YY
Designed By	Detailed By	Checked By	Checked By	Quantities By	Checked By
XXX	XXX	XXX	XXX	XXX	XXX

Print Date: Wednesday, September 01, 2010	File Name: 0208005.08P101-RAMP D.DWG
Horiz. Scale: As Noted	Vert. Scale: As Noted
Unit Information	Unit Leader Initials


Sheet Revisions		
Date:	Comments	Init.

Colorado Department of Transportation
 3803 North Main Avenue
 Suite 200
 Durango, CO 81301
 Phone: 970-385-1440 FAX: 970-385-8365
 Region 5 EJA

As Constructed
No Revisions: 11/1/09
Revised:
Void:


BRIDGE CROSS SECTION			
Designer: Daniel Hull	Structure: P-05-Y		
Detailer: Rick Keller	Numbers:		
Sheet Subset: Anti-Icing	Subset Sheets: AIS3 of AIS5		

Project No./Code	NH 1602-114
	16042
Sheet Number	344

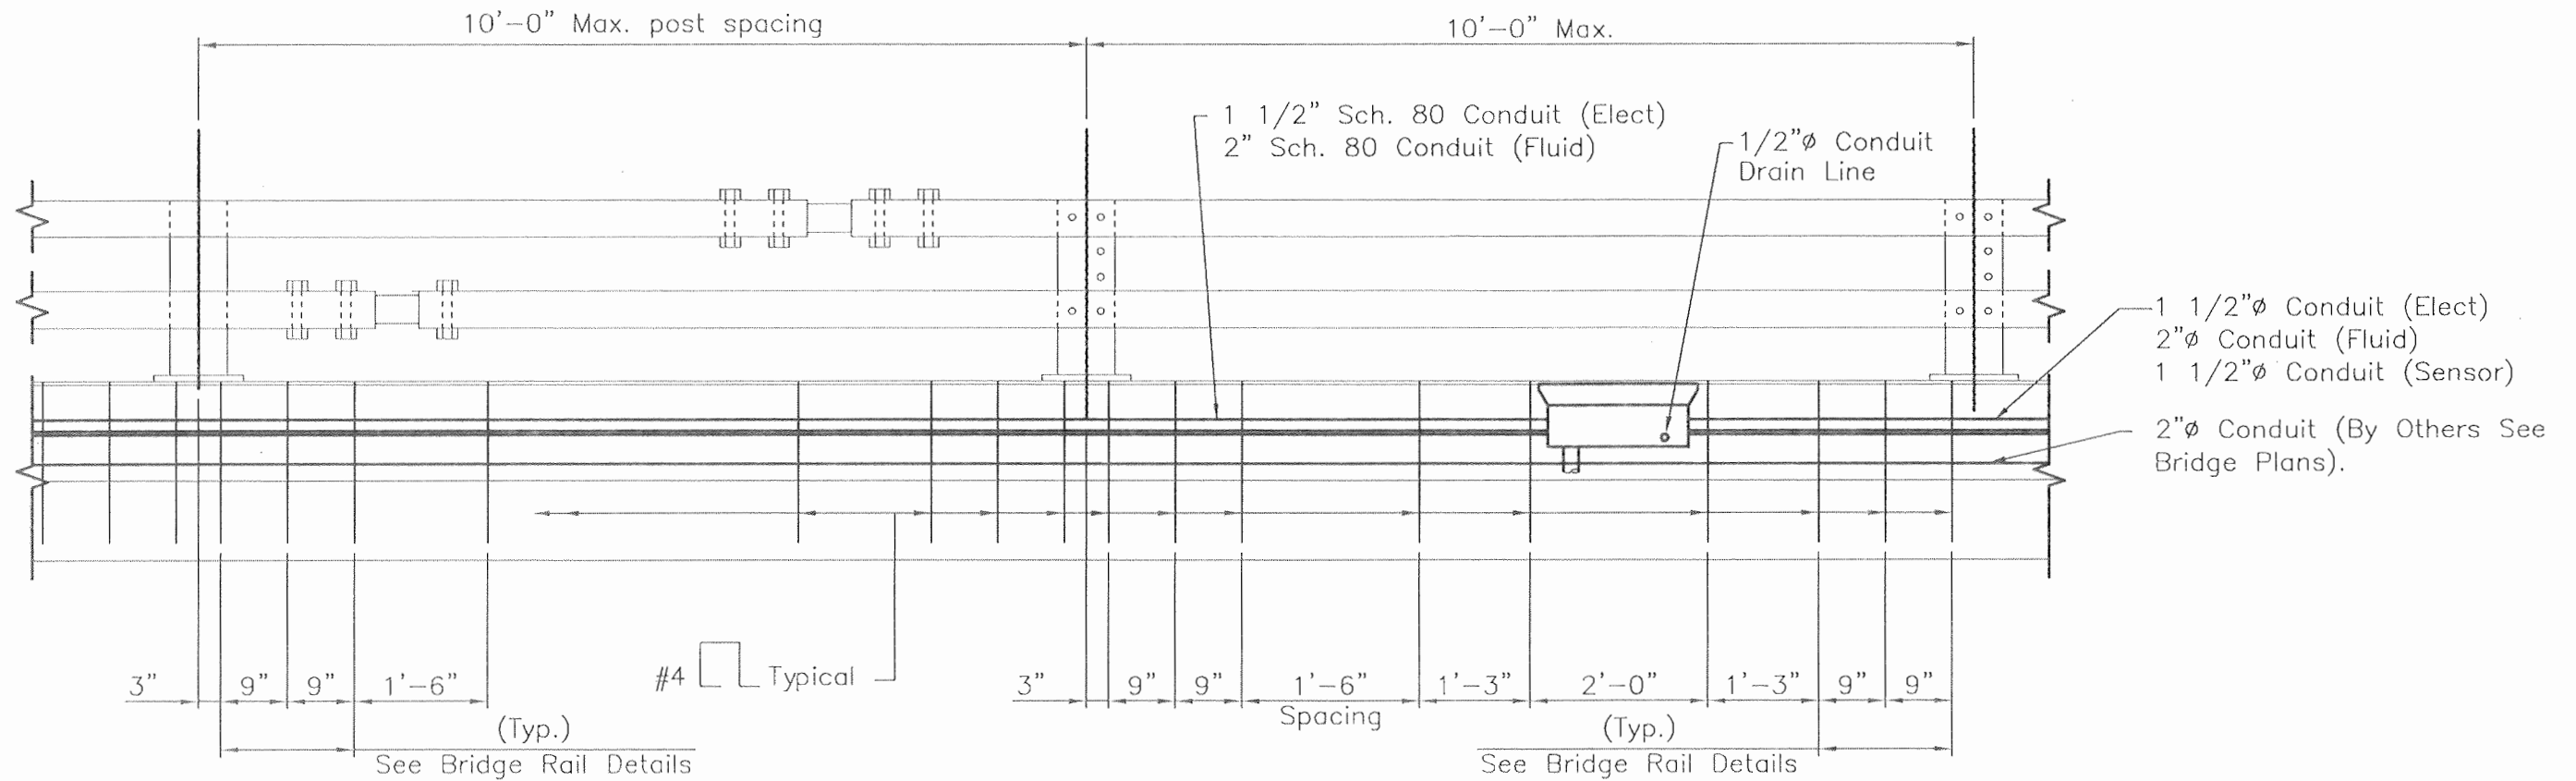


BRIDGE RAIL ELEVATION

Scale " 1/2" = 1'-0"

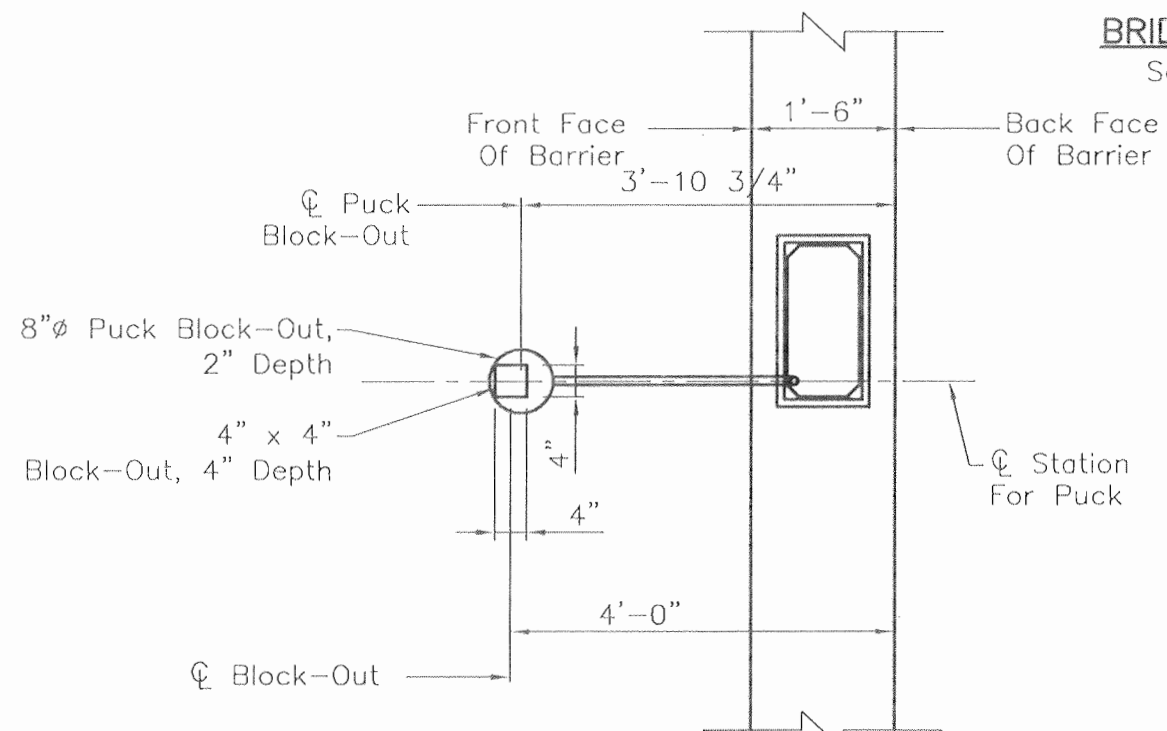

TYPICAL BRIDGE RAIL PLAN

Scale " 1/2" = 1'-0"

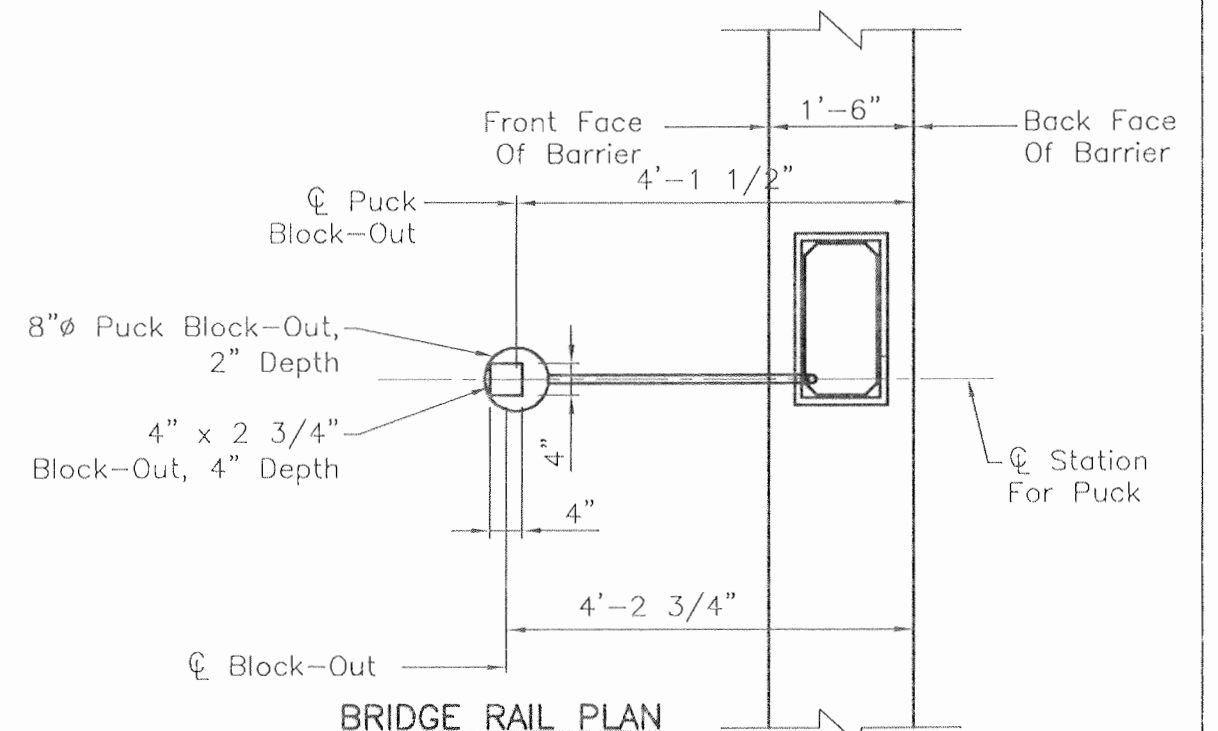

BRIDGE RAIL PLAN

STA 612+08.00

Scale " 1/2" = 1'-0"

Design	INITIAL	DATE	QUANTITIES	DATE	INITIAL
	Checked By	MM/YY	Checked By	MM/YY	Checked By
Detail	INITIAL	DATE	QUANTITIES	DATE	INITIAL
	Checked By	MM/YY	Checked By	MM/YY	Checked By

Print Date: Wednesday, September 01, 2010	File Name: 0208005.08P101-RAMP D.DWG	Horiz. Scale: As Noted	Vert. Scale: As Noted
Unit Information	Unit Leader Initials		

Sheet Revisions		
Date:	Comments	Init.

Colorado Department of Transportation

3803 North Main Avenue
Suite 200
Durango, CO 81301
Phone: 970-385-1440 FAX: 970-385-8365

Region 5 EJA

As Constructed	No Revisions: 11/1/09
Revised:	
Void:	

BRIDGE RAIL ELEVATION			
Designer:	Daniel Hull	Structure	P-05-Y
Detailer:	Rick Keller	Numbers	
Sheet Subset:	Anti-Icing	Subset Sheets:	AIS4 of AIS5

Project No./Code	NH 1602-114
Sheet Number	345