



BOOSTER PUMP EQUIPMENT


- 1.) CLOSE-COUPLED END SUCTION CENTRIFUGAL PUMP, CAST IRON BRONZE FITTED, BACK PULLOUT DESIGN, MECHANICAL SEAL, COP MOTOR. SIZE: 1 HP
- 2.) NEMA 4X SIMPLEX CONTROL PANEL, WITH VARIABLE FREQUENCY SPEED DRIVE AND COMPONENTS FOR AUTOMATIC OPERATION.
- 3.) PRESSURE GAUGE, LIQUID DAMPED.
- 4.) 3/4-INCH BRONZE 1/4 TURN BALL VALVE.
- 5.) 3/4-INCH BRONZE UNION ADAPTER.
- 6.) BRONZE, NON-ADJUSTABLE FLOW SWITCH.
- 7.) TYPE "L" COPPER, 3/4-INCH.
- 8.) BRASS 90 DEGREE ELBOW.
- 9.) STRUCTURAL ALUMINUM BASEPLATE.
- 10.) MARINE GRADE ALUMINUM ENCLOSURE, HINGED TOP, 48" X 30" X 30"H, SUPPLIED BY PUMP MANUFACTURER.
- 11.) MAIN POWER CONDUIT, 120V/SINGLE PHASE/60Hz .
- 12.) PIPE SLEEVE THROUGH CONCRETE FLOOR PENETRATION.
- 13.) 500 GALLON, 4' DIA. X 6' TALL WATER STORAGE TANK. TO BE SUPPLIED BY A LOCAL VENDOR TO THE FOLLOWING SPECIFICATIONS: TANK MUST BE FITTED FOR LEVEL SENSING EQUIPMENT, PROVIDE MOUNTED EQUIPMENT, PAINTED FOR CORROSION RESISTANCE.
- 14.) WARRICK CONTROLS SERIES 3N FITTING, MODEL NUMBER: 3H2C, CONTRACTOR SHALL MOUNT TO TANK IN ACCORDANCE WITH WARRICK SPECIFICATIONS.
- 15.) MAXIMUM REFILL WATER LEVEL SENSOR: WARRICK CONTROLS SERIES 3W WIRE SUSPENDED PROBE PART NUMBER: 3W2 WITH SUSPENSION WIRE (3Z1A) AND ADAPTER KIT 3Z1B.
- 16.) MINIMUM TANK/PUMP WATER LEVEL SENSOR: WARRICK CONTROLS SERIES 3W WIRE SUSPENDED PROBE PART NUMBER: 3W2 WITH SUSPENSION WIRE (3Z1A) AND ADAPTER KIT 3Z1B.
- 17.) CONTRACTOR SHALL INSTALL WARRICK CONTROL SERIES 16M LEVEL SENSING MODULE INSIDE PUMP CONTROL ENCLOSURE FOR CONTROL OF POTABLE TAP REFILL VALVE.
- 18.) WATER LEVEL SENSING CONTROL WIRE CONDUIT.
- 19.) 1-INCH SOLENOID CONTROL VALVE FOR WATER STORAGE TANK FILL.
- 20.) 120" X 54" 8-INCH REINFORCED CONCRETE SLAB INSTALLED ON COMPACTED SOIL. SOIL SHALL BE COMPACTED TO THE SAME DENSITY OF UNDISTURBED SURROUNDING SOIL. USE 4000 LB. STRENGTH CONCRETE WITH #4 REBAR ON 12-INCH CENTERS.

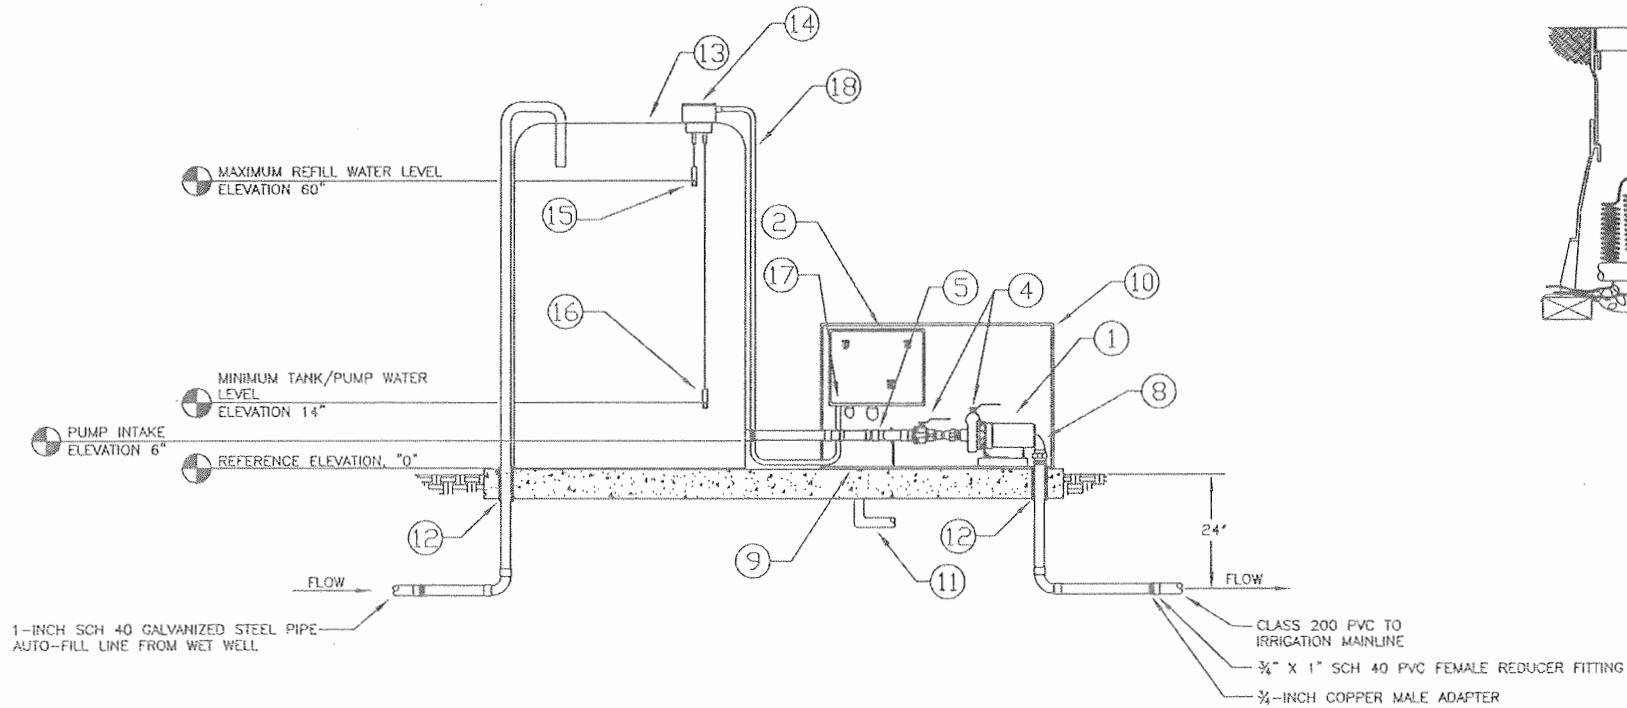

ELEVATION A-A
SCALE: 1"=1'

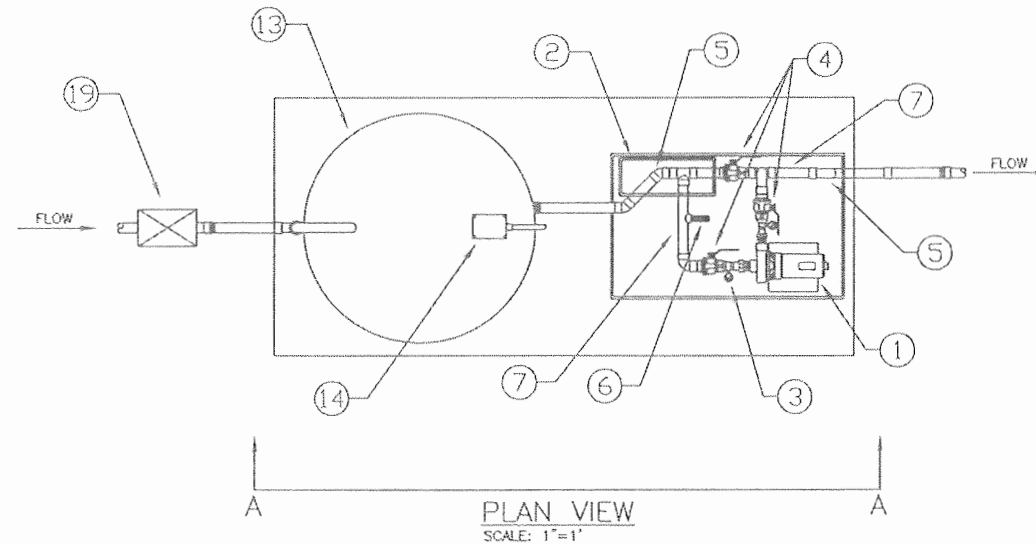

PLAN VIEW
SCALE: 1"=1'

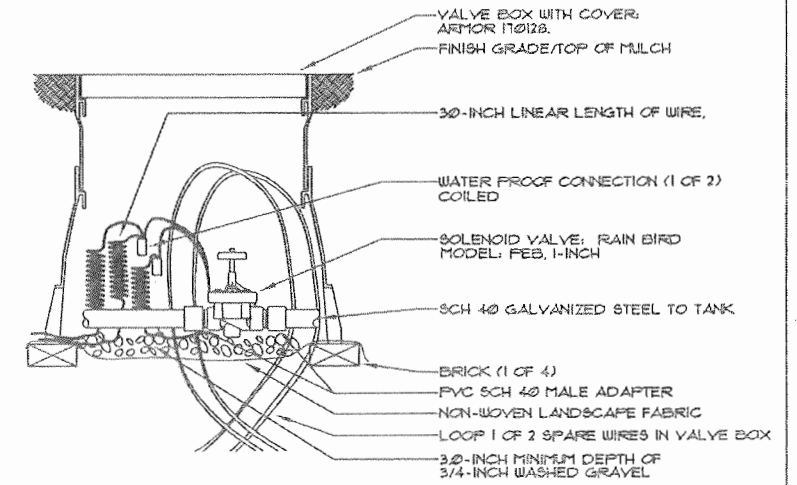

SOLENOID CONTROL VALVE
SCALE: N.T.S.

CONSTRUCTION NOTES

- 1.) CONTRACTOR SHALL CONFIRM PRESSURE AND FLOW REQUIREMENTS FROM WELL TO INSURE THAT PUMP WILL DELIVER 60 PSI AT 4 GPM TO MEET DESIGN SPECIFICATIONS PRIOR TO ORDERING PUMP.
- 2.) SKID MOUNTED BOOSTER PUMP SYSTEM IS TO BE SUPPLIED BY BARRETT PUMPS, 619.232.7867. SKID MOUNTED BOOSTER PUMP MODEL NUMBER: BEC615J-3/4-1-1/VFD, SUPPLIED WITH ENCLOSURE.
- 3.) BOOSTER PUMP AND ALL ASSOCIATED CONTROLS SHALL BE FULLY ENCLOSED IN MARINE GRADE ALUMINUM ENCLOSURE, HINGED TOP, PROVIDED BY THE PUMP MANUFACTURER.
- 4.) PUMP SHALL INCLUDE 3/4-INCH BUTTERFLY VALVES ON THE PUMP INTAKE, DISCHARGE AND BYPASS.
- 5.) VERIFY EXACT LOCATION FOR CONCRETE SLAB WITH OWNER'S REPRESENTATIVE PRIOR TO CONSTRUCTION.
- 6.) INSTALL BOOSTER PUMP, CONTROLS AND ASSOCIATED PIPES AS REQUIRED BY SINGLE BOOSTER PUMP MANUFACTURER.
- 7.) 4'6" X 10', 6-INCH REINFORCED CONCRETE SLAB INSTALLED ON COMPACTED SOIL. SOIL SHALL BE COMPACTED TO THE SAME DENSITY OF UNDISTURBED SURROUNDING SOIL. USE 2500 LB. STRENGTH CONCRETE WITH #4 REBAR ON 12-INCH CENTERS.
- 8.) MANUFACTURER SHALL SUPPLY ALL PUMP AND CONTROLS WITHIN ENCLOSURE. CONTRACTOR SHALL SUPPLY ALL BRASS, COPPER AND PVC PIPE OUTSIDE OF ENCLOSURE.
- 9.) CONTRACTOR SHALL COORDINATE AND PROVIDE 230VAC/SINGLE PHASE/60Hz POWER TO BOOSTER PUMP CONTROLS.

APPROVED FOR CONSTRUCTION

Date 8/5/09



Print Date: 02/19/2009	Sheet Revisions			Colorado Department of Transportation 3803 North Main Avenue Suite 200 Durango, CO 81301 Phone: 970-385-1440 FAX: 970-385-8365 Region 5	As Constructed	RAMP A		Project No./Code NH 1602-114
File Name:	Date:	Comments:	init.			No Revisions:	BOOSTER PUMP DETAIL	
Horiz. Scale: As Noted	Vert. Scale: As Noted				Revised:	Designer: EWP	Structure Numbers:	16042
Unit Information	Unit Leader Initials				Void:	Detailer: EDB		186
SEMA CONSTRUCTION	WILSON & COMPANY					Sheet Subset: IRRIGATION	Subset Sheets: 2 OF 7	Sheet Number BP-2

CONSTRUCTION DOCUMENTS - 100% PLANS - 02/19/2009

IRRIGATION LEGEND

⊠ (1)3" & (1)1.5" MAINLINE AND CONTROL WIRE SLEEVE: CLASS 200 PVC

— MAINLINE PIPE: CLASS 200 PVC
(1.25-INCH SIZE UNLESS OTHERWISE INDICATED)

∩ LATERAL PIPE TO EMITTERS: UV RADIATION RESISTANT
POLYETHYLENE (3/4-INCH SIZE, ROUTING IS DIAGRAMMATIC)

⊥ POINT-OF-CONNECTION (P.O.C)

⊠ WATER METER AND CURB STOP ASSEMBLY

⊠ STORAGE TANK AND BOOSTER PUMP ASSEMBLY (RE: PUMP PLANS)

⊠ GATE VALVE ASSEMBLY


⊠ QUICK COUPLER VALVE ASSEMBLY

⊠ DRAIN VALVE

⊠ DRIP ZONE CONTROL VALVE ASSEMBLY FOR DRIP LATERALS

∩ FLUSH UNIT ASSEMBLY

A/ IRRIGATION AUTOMATIC CONTROLLER:
CONTROLLER A: HUNTER PRO-C, PC-300: 3 STA. USED

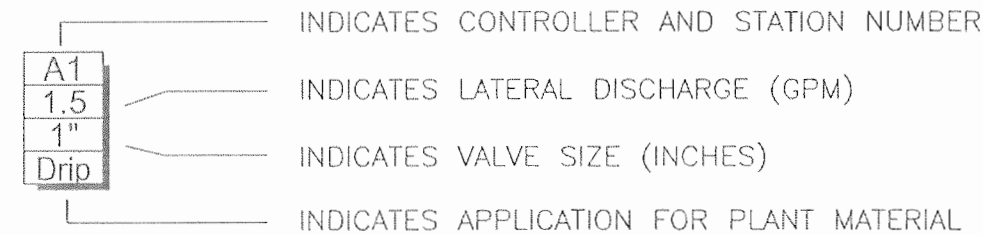

APPROVED FOR CONSTRUCTION

Date 8/5/09



CONSTRUCTION NOTES

- THE IRRIGATION SYSTEM POINT-OF-CONNECTION SHALL BE DOWNSTREAM OF THE EXISTING WELL PUMP. INSTALL NEW STORAGE TANK AND BOOSTER PUMP PER PLAN SHEETS BP1, BP2. VERIFY EXACT LOCATION OF POC WITH OWNER'S REPRESENTATIVE.
- PEDESTAL MOUNT THE IRRIGATION CONTROLLER AT THE APPROXIMATE LOCATION SHOWN. COORDINATE ELECTRICAL POWER TO THE CONTROLLER WITH THE OWNER'S REPRESENTATIVE. CARE SHOULD BE TAKEN TO INSTALL THE IRRIGATION CONTROLLER IN A LOCATION THAT IS ACCESSIBLE FOR MAINTENANCE, AND SCREENED FROM VIEW EITHER BEHIND ENTRY WALLS, NEXT TO BUILDINGS, OR BEHIND PLANT MATERIAL. FINAL LOCATION TO BE APPROVED BY OWNER'S REPRESENTATIVE.

Item Number	Description	Quantity	Units	Short Description
619-50100	1-1/4-inch Plastic Pipe	914	LF	includes mainline and fittings
619-50160	2-inch Plastic Pipe	30	LF	irrigation sleeves
619-50240	3-inch Plastic Pipe	30	LF	irrigation sleeves
622-05500	Storage Tank (500 Gal)	1	EA	Storage Tank
623-00162	Drip Emitter Tubing	1,554	LF	3/4-inch UV Radiation Resistant Polyethylene tubing to point source emitters and inline drip tubing to groundcover-includes all parts per shown in details
623-00164	Drip Emitter	600	EA	Point source drip emitters - includes all parts shown in details
623-00186	3/4-inch Flush Unit	9	EA	Drip Flush Cap for both inline and point source - includes all parts shown in details
623-02010	1-1/4-inch drain	1	EA	Includes manual drain valve and all parts shown in details
623-03004	3/4-inch Drip zone control valve	3	EA	remote control drip valve assembly - includes all parts shown in details
623-04000	Control Wire 24 Volt	4,500	LF	24 volt, 14awg, traditional wires - apprx.
623-04008	1-inch Quick-Coupler Valve	5	EA	includes all parts shown in details
623-05010	1-1/4-inch Gate Valve	1	EA	includes all parts shown in details
623-09000	Booster Pump	1	EA	Booster pump and all it's appertanences
623-07006	3/4-inch Water Meter	1	EA	includes all parts shown in details
623-08103	3 station Automatic Contoller	1	EA	Pedestal Mount Hunter Pro-C controller


Print Date: 02-17-09	Sheet Revisions			Colorado Department of Transportation	As Constructed	RAMP A		Project No./Code
File Name:	Date:	Comments	Init.			No Revisions:	IRRIGATION PLAN SHEET	
Horiz. Scale: 1"=50'	Vert. Scale: As Noted			3803 North Main Avenue Suite 200 Durango, CO 81301 Phone: 970-385-1440 FAX: 970-385-8365	Revised:	Designer: MLP	Structure Numbers	16042
Unit Information	Unit Leader Initials				Void:	Detailer: MLP	Sheet Subset: IRRIGATION	Subset Sheets: 3 OF 7
		Region 5		EJA				

CONSTRUCTION DOCUMENTS - 100% PLANS - 02-17-09



APPROVED FOR CONSTRUCTION

Date 8/5/09

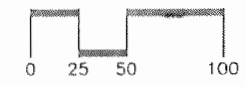

HINES IRRIGATION CONSULTANTS, INC.
 SYSTEM DESIGN AND WATER MANAGEMENT SERVICES
 313 N. GRAVE RD. SUITE 204
 FORT COLLINS, COLORADO 80526
 Telephone: 970.282.1800
 Fax: 970.229.4652

Print Date: 02-17-09	
File Name:	
Horiz. Scale: 1"=50'	Vert. Scale: As Noted
Unit Information	Unit Leader Initials


Sheet Revisions		
Date:	Comments	Init.

Colorado Department of Transportation
 3803 North Main Avenue
 Suite 200
 Durango, CO 81301
 Phone: 970-385-1440 FAX: 970-385-8365
 Region 5 EJA

As Constructed
 No Revisions:
 Revised:
 Void:

RAMP A
IRRIGATION PLAN SHEET
 Designer: MLP
 Detailer: MLP
 Sheet Subset: IRRIGATION
 Structure Numbers:
 Subset Sheets: 4 OF 7


Project No./Code
 NH 1602-114
 16042
 Sheet Number IR2

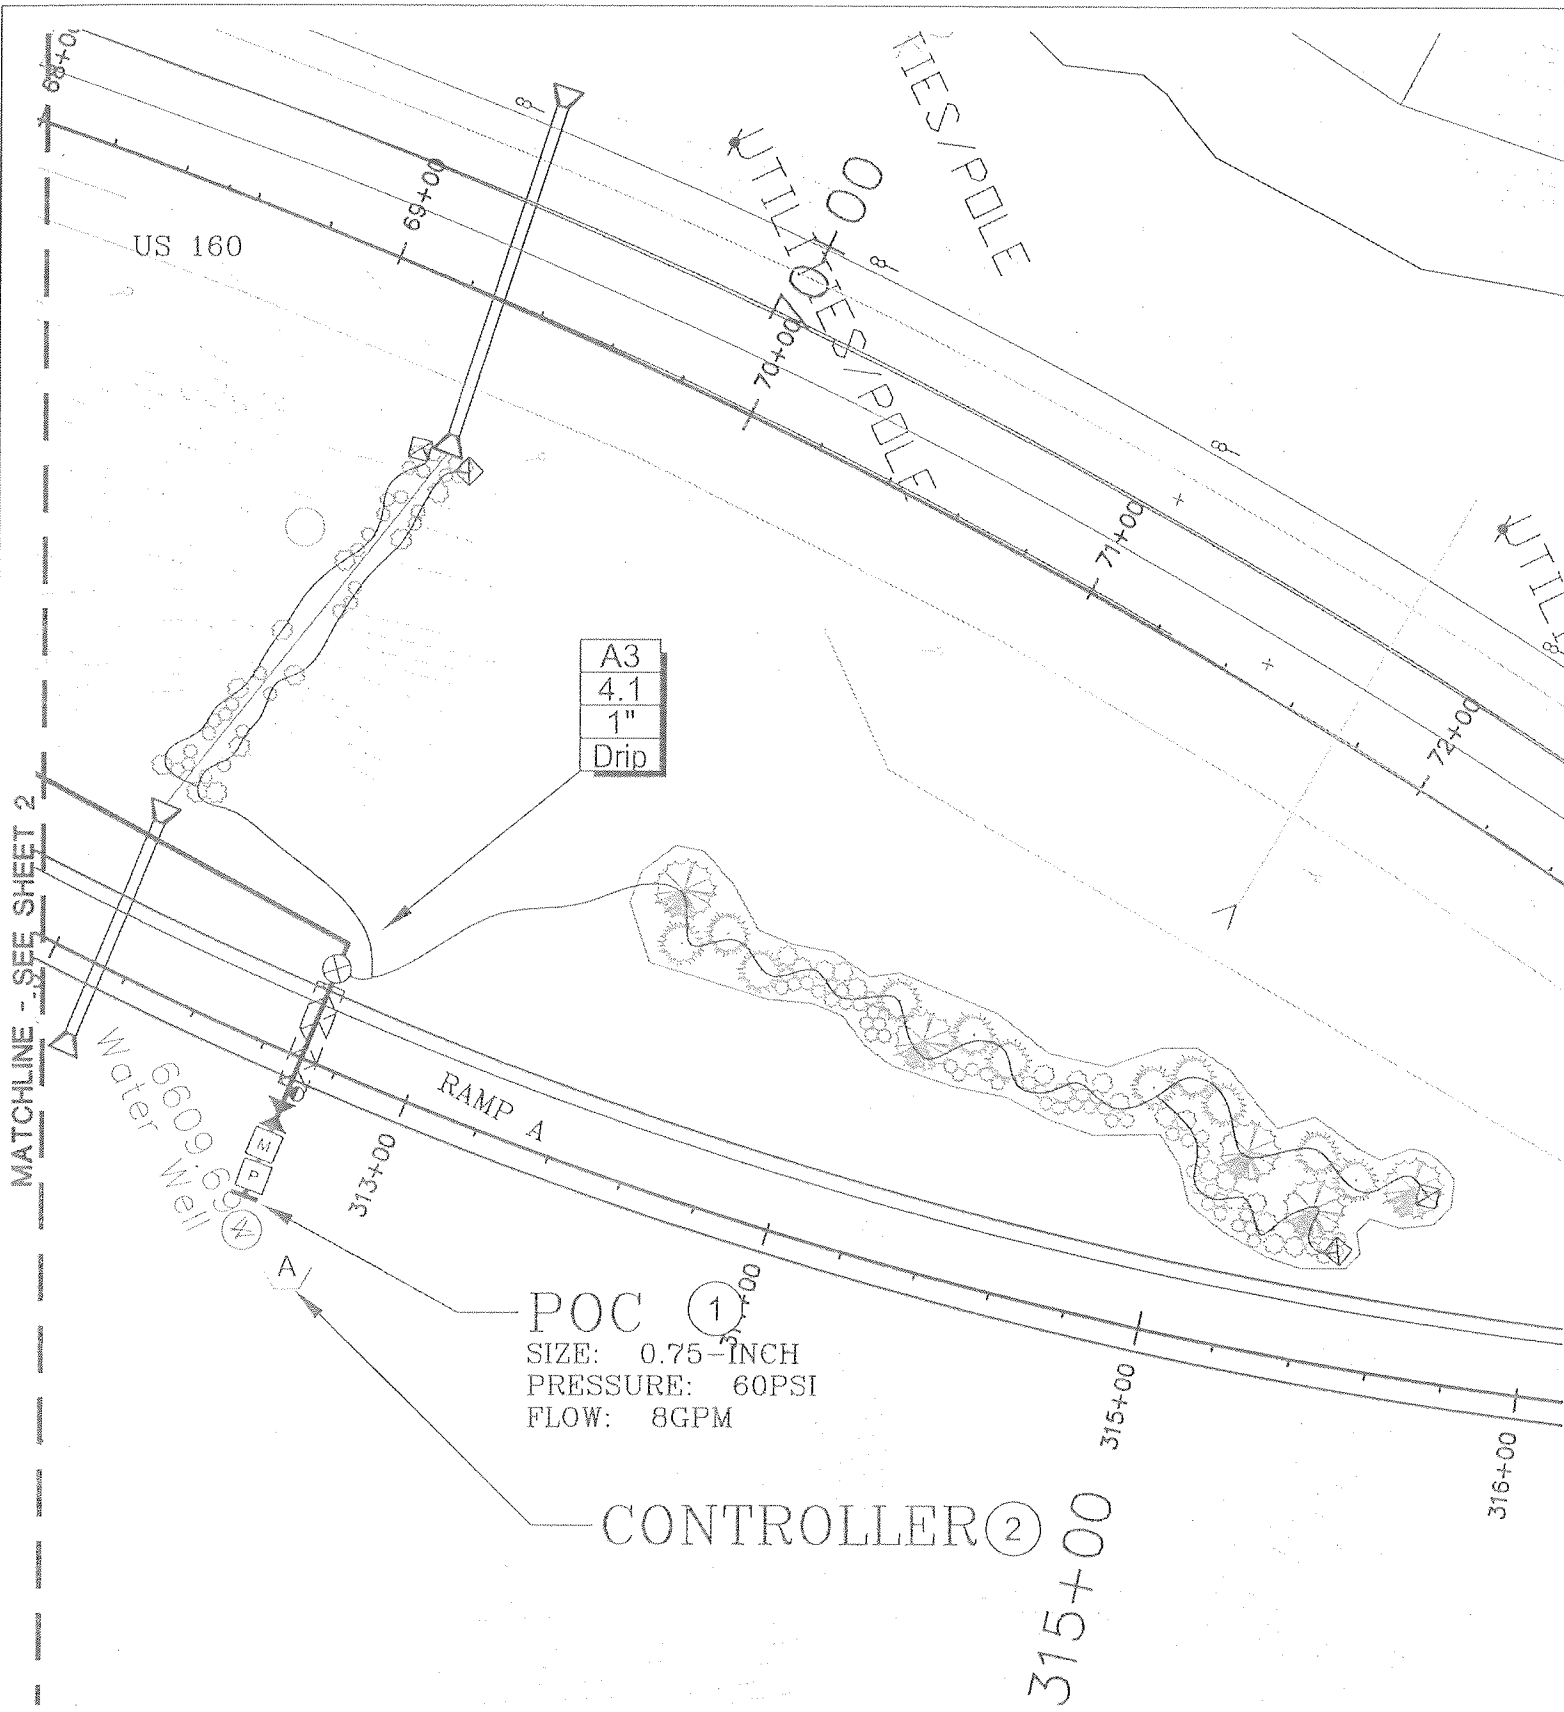

CONSTRUCTION NOTES

- ① THE IRRIGATION SYSTEM POINT-OF-CONNECTION SHALL BE DOWNSTREAM OF THE EXISTING WELL PUMP. INSTALL NEW STORAGE TANK AND BOOSTER PUMP PER PLAN SHEETS BP1, BP2. VERIFY EXACT LOCATION OF POC WITH OWNER'S REPRESENTATIVE.
- ② PEDESTAL MOUNT THE IRRIGATION CONTROLLER AT THE APPROXIMATE LOCATION SHOWN. COORDINATE ELECTRICAL POWER TO THE CONTROLLER WITH THE OWNER'S REPRESENTATIVE. CARE SHOULD BE TAKEN TO INSTALL THE IRRIGATION CONTROLLER IN A LOCATION THAT IS ACCESSIBLE FOR MAINTENANCE, AND SCREENED FROM VIEW EITHER BEHIND ENTRY WALLS, NEXT TO BUILDINGS, OR BEHIND PLANT MATERIAL. FINAL LOCATION TO BE APPROVED BY OWNER'S REPRESENTATIVE.


APPROVED FOR CONSTRUCTION
 Date 8/5/09

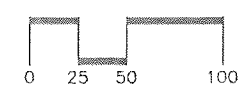

HINES IRRIGATION CONSULTANTS, INC.
 SYSTEM DESIGN AND WATER MANAGEMENT SERVICES
 323 W. GRAVE RD. SUITE 204
 FORT COLLINS, COLORADO 80526
 Telephone: 970.282.1600
 Fax: 970.224.6982


Print Date: 02-17-09		Sheet Revisions		Colorado Department of Transportation		As Constructed		RAMP A		Project No./Code	
File Name:		Date:	Comments	Init.	3803 North Main Avenue Suite 200 Durango, CO 81301 Phone: 970-385-1440 FAX: 970-385-8365		No Revisions:		IRRIGATION PLAN SHEET		NH 1602-114
Horiz. Scale: 1"=50'		Unit Information		Region 5		Revised:		Designer: MLP		16042	
Vert. Scale: As Noted		Unit Leader Initials		EJA		Void:		Detailer: MLP		Sheet Number IR3 189	
SEMA CONSTRUCTION		WILSON & COMPANY						Structure Numbers		Sheet Subset: IRRIGATION	
								Subset Sheets: 5 OF 7			

CONSTRUCTION DOCUMENTS - 100% PLANS - 02-17-09

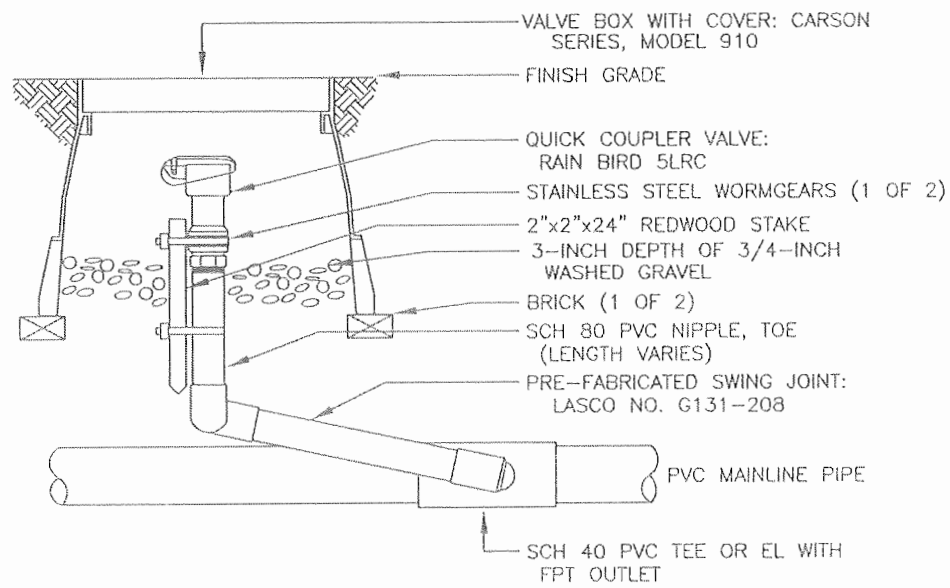


ALL PARTS DETAILED SHALL BE PAID FOR BY PAY ITEM 623-04008

1 QUICK COUPLER VALVE ASSEMBLY

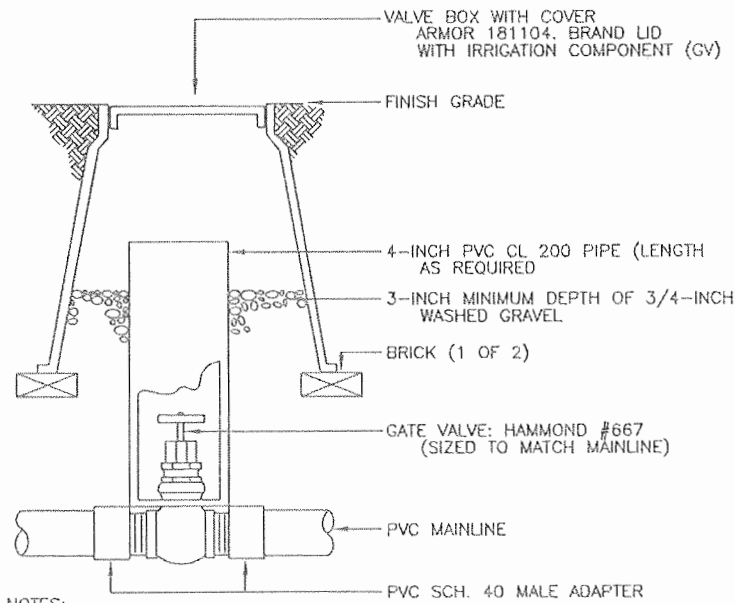


NOTES:
1. NOMINAL SIZE OF GATE VALVE TO MATCH NOMINAL MAINLINE SIZE.
ALL PARTS DETAILED SHALL BE PAID FOR BY PAY ITEM 623-05010

2 GATE VALVE ASSEMBLY

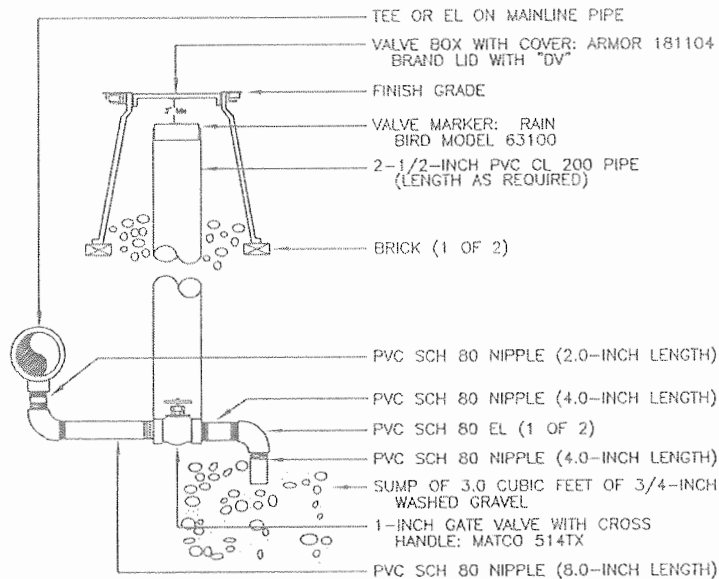

NOTE:
1. SLEEVE TO BE SET SQUARE OVER GATE VALVE TO ALLOW FOR OPERATION OF VALVE WITHOUT BINDING.
2. ALL PARTS DETAILED SHALL BE PAID FOR BY PAY ITEM 623-02010

3 DRAIN VALVE ASSEMBLY

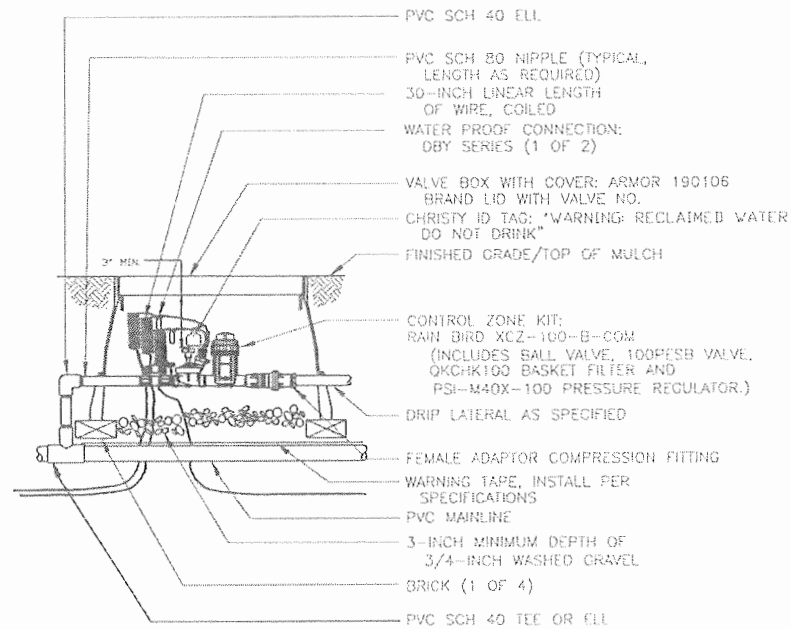

NOTES:
1. USE BARBED INSERT FITTINGS ON DRIP LATERAL PIPE WITH STAINLESS STEEL HOSE CLAMPS. PLACE CLAMPS ON DRIP TUBING DIRECTLY OVER BARBED AREA OF FITTING.
2. ALL PARTS DETAILED SHALL BE PAID FOR BY PAY ITEM 623-03004


4 DRIP ZONE CONTROL VALVE ASSEMBLY

APPROVED FOR CONSTRUCTION
Date 8/5/09

HINES IRRIGATION CONSULTANTS, INC.
SYSTEM DESIGN AND WATER MANAGEMENT SERVICES
223 W. DRIVE RD. SUITE 204
FORT COLLINS, COLORADO 80526
Telephone: 970.223.1000
Fax: 970.226.6662


Print Date: 02-17-09	Sheet Revisions			Colorado Department of Transportation	As Constructed	RAMP A		Project No./Code
File Name:	Date:	Comments:	Init.			IRRIGATION PLAN SHEET		
Horiz. Scale: 1"=50'	Vert. Scale: As Noted			3803 North Main Avenue Suite 200 Durango, CO 81301 Phone: 970-385-1440 FAX: 970-385-8365 Region 5 EJA	No Revisions:	Designer: MLP	Structure	16042
Unit Information	Unit Leader Initials				Revised:	Detailer: MLP	Numbers	
					Void:	Sheet Subset: IRRIGATION	Subset Sheets: 6 OF 7	Sheet Number IR4

CONSTRUCTION DOCUMENTS - 100% PLANS - 02-17-09

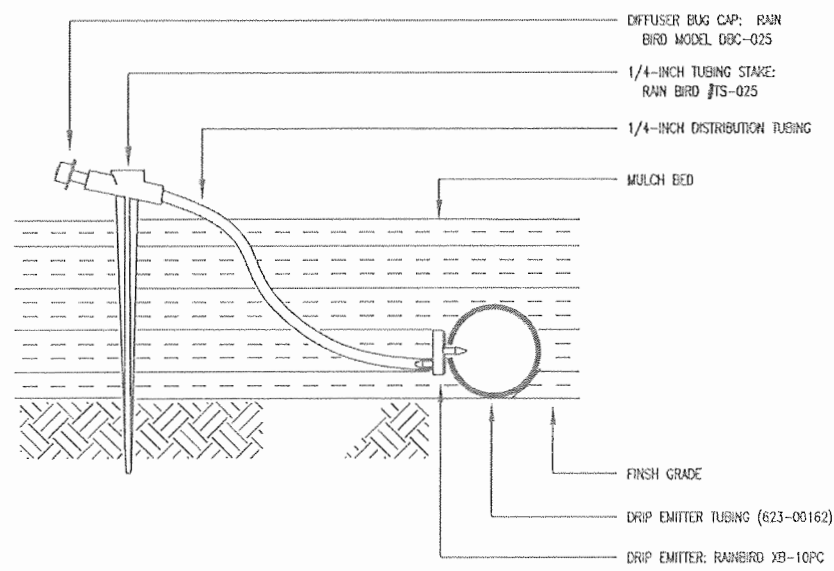


NOTE: ALL PARTS DETAILED SHALL BE PAID FOR BY PAY ITEM 623-00164.

5 DRIP EMITTER ASSEMBLY

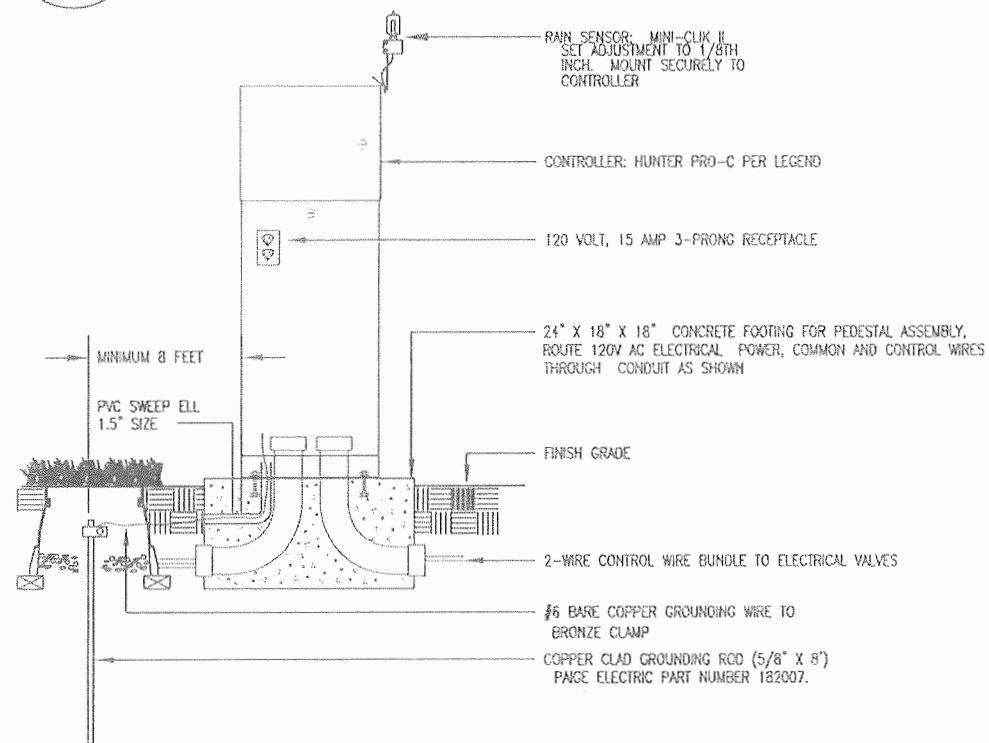


NOTE: ALL PARTS DETAILED SHALL BE PAID FOR BY PAY ITEM 623-08103

7 AUTOMATIC CONTROLLER ASSEMBLY

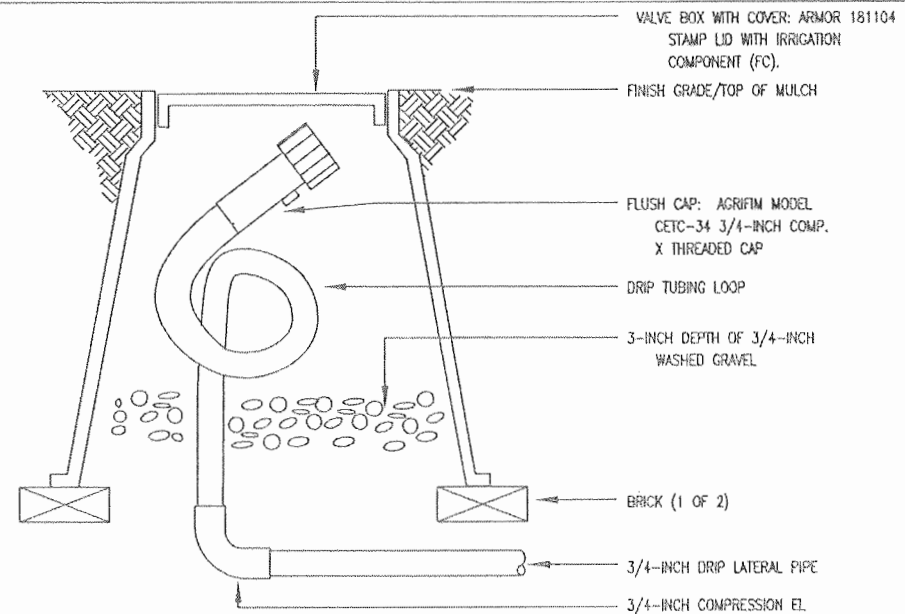

NOTE:
 1. LOOP IRRIGATION DRIP TUBING INSIDE VALVE BOX FOR EXTENSION OUTSIDE OF BOX DURING BLOWOUT.
 2. ALL PARTS DETAILED SHALL BE PAID FOR BY PAY ITEM 623-00186.

6 FLUSH UNIT ASSEMBLY

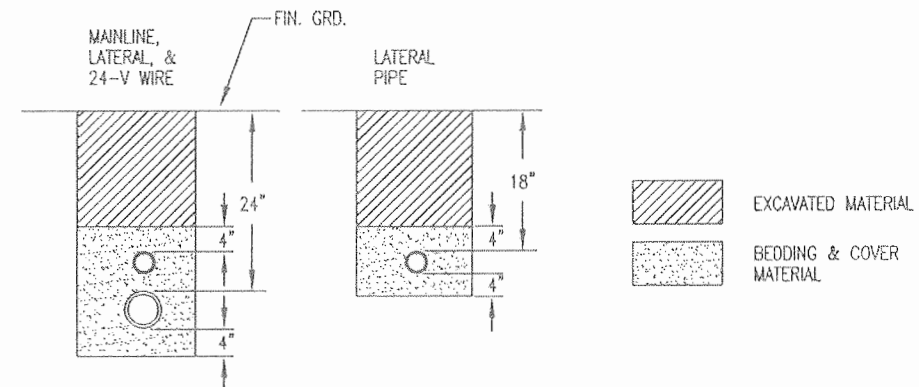

NOTES:
 1. MAINLINE AND 2-WIRE BUNDLE SHALL UTILIZE THE SAME SLEEVE. PLACE 2-WIRE BUNDLE IN A 1/2-INCH OR 3/4-INCH CONDUIT INSIDE SLEEVE.
 2. ALL PIPE TO BE INSTALLED PER MANUFACTURER'S SPECIFICATIONS. "SNAKE" UNSLEEVED PLASTIC PIPE IN TRENCH. PROVIDE A MIN. OF 2" CLEARANCE TO SIDE OF TRENCH AND BETWEEN PIPES.
 3. ALL 120-V WIRING SHALL BE INSTALLED IN ACCORDANCE WITH LOCAL CODE REQUIREMENTS. TAPE AND BUNDLE 24-V WIRE EVERY 10' AND PROVIDE LOOSE 20" LOOP AT ALL CHANGES OF DIRECTION OVER 30 DEGREES.

8 TYPICAL TRENCHING DETAIL

APPROVED FOR CONSTRUCTION
 Date 8/15/09

HINES IRRIGATION CONSULTANTS, INC.
 SYSTEM DESIGN AND WATER MANAGEMENT SERVICES
 123 N. GUNN RD, SUITE 204
 FORT COLLINS, COLORADO 80526
 Telephone: 970.282.1500
 Fax: 970.226.4882

Print Date: 02-17-09	Sheet Revisions			Colorado Department of Transportation 3803 North Main Avenue Suite 200 Durango, CO 81301 Phone: 970-385-1440 FAX: 970-385-8365 Region 5 EJA	As Constructed No Revisions: Revised: Void:	RAMP A IRRIGATION PLAN SHEET		Project No./Code
File Name:	Date:	Comments:	Init.			Designer: MLP	Structure Numbers	NH 1602-114
Horiz. Scale: 1"=50'	Vert. Scale: As Noted				Detailer: MLP		16042	
Unit Information	Unit Leader Initials				Sheet Subset: IRRIGATION	Subset Sheets: 7 OF 7	Sheet Number IR5	191



CONSTRUCTION DOCUMENTS - 100% PLANS - 02-17-09

GENERAL NOTES

EXCEPT AS SHOWN IN THE PLANS, STRUCTURE EXCAVATION AND BACKFILL SHALL BE IN ACCORDANCE WITH M-206-2 BRIDGES.

EXPANSION JOINT MATERIAL SHALL MEET AASHTO SPECIFICATION M213.

A COLORED STRUCTURAL CONCRETE COATING FINISH WILL BE REQUIRED, AS SHOWN ON THE PLANS, ON EXPOSED CONCRETE SURFACES. THE COLORED STRUCTURAL CONCRETE COATING IS TO BE SELECTED FROM TEST PANELS PROVIDED BY THE CONTRACTOR.

ALL BOLTS SHALL BE 7/8" DIAMETER, HIGH STRENGTH, UNLESS OTHERWISE NOTED.

GRADE 60 REINFORCING STEEL IS REQUIRED.

ALL REINFORCING STEEL SHALL BE EPOXY COATED UNLESS OTHERWISE NOTED.

(N) DENOTES NON COATED REINFORCING STEEL.

ALL THE PROVISIONS FOR BRIDGE DECK CONCRETE SHALL ALSO APPLY TO APPROACH SLAB CONCRETE.

AN EMERGENCY DECK CONSTRUCTION JOINT MAY BE LOCATED AT THE ONE QUARTER SPAN POINT BACK FROM A PIER OR ABUTMENT WITH RESPECT TO THE DIRECTION OF THE DECK PLACEMENT.

ALL CONCRETE SHALL BE LEVEL II SULFATE RESISTANT.

THE CURB PLATE AT THE EXPANSION DEVICE SHALL BE PAINTED IN ACCORDANCE WITH SECTION 509 OF THE STANDARD SPECIFICATIONS. REFER TO B4 FOR COLOR REQUIREMENTS.

THE FOLLOWING STRUCTURAL STEEL SHALL BE AASHTO M270 GRADE 36 (ASTM A-36): EXPANSION DEVICES, BEARING PLATES, BEARING DEVICES.

DESIGN DATA

DESIGN CODE: AASHTO LRFD, 4TH EDITION WITH 2008 INTERIMS

DESIGN METHOD: LOAD AND RESISTANCE FACTOR DESIGN

LIVE LOAD: HL-93 (DESIGN TRUCK OR TANDEM, AND DESIGN LANE LOAD)

DEAD LOAD: ASSUMES 36 LBS. PER SQ. FT. FOR BRIDGE DECK OVERLAY.

ASSUMES 5 LBS. PER SQ. FT. FOR PERMANENT STEEL DECK FORMS

SEISMIC: ZONE 1, SITE CLASS D, As=0.098g, SD1=0.098g

REINFORCED CONCRETE:

CLASS D CONCRETE: f'c = 4,500 psi

REINFORCING STEEL: fy = 60,000 psi

CAISSON CONCRETE:

CLASS BZ CONCRETE: f'c = 4,000 psi

REINFORCING STEEL: fy = 60,000 psi

THE FOLLOWING TABLE GIVES THE MINIMUM LAP SPLICE LENGTH FOR EPOXY COATED REINFORCING BARS PLACED IN ACCORDANCE WITH SUBSECTION 602.06. THESE SPLICE LENGTHS SHALL BE INCREASED BY 25% FOR BARS SPACED AT LESS THAN 6" ON CENTER.

BAR SIZE	#4	#5	#6	#7	#8	#9	#10	#11
----------	----	----	----	----	----	----	-----	-----

SPLICE LENGTH FOR CLASS D CONCRETE	1'-3"	1'-7"	2'-5"	2'-10"	3'-8"	4'-8"	5'-11"	7'-3"
------------------------------------	-------	-------	-------	--------	-------	-------	--------	-------

WHEN THE CONTRACTOR ELECTS TO SUBSTITUTE EPOXY COATED REINFORCEMENT FOR BLACK REINFORCING BARS, THE MINIMUM LAP SPLICE SHALL BE AS DESCRIBED ABOVE.

THE FOLLOWING TABLE GIVES THE MINIMUM LAP SPLICE LENGTH FOR BLACK REINFORCING BARS PLACED IN ACCORDANCE WITH SUBSECTION 602.06. THESE SPLICE LENGTHS SHALL BE INCREASED BY 25% FOR BARS SPACED AT LESS THAN 6" ON CENTER.

BAR SIZE	#4	#5	#6	#7	#8	#9	#10	#11
----------	----	----	----	----	----	----	-----	-----

SPLICE LENGTH FOR CLASS D CONCRETE	1'-1"	1'-4"	1'-7"	1'-11"	2'-6"	3'-1"	3'-11"	4'-10"
------------------------------------	-------	-------	-------	--------	-------	-------	--------	--------

THE ABOVE SPLICE LENGTHS MAY BE REDUCED BY 20% WHEN 3" OF CLEAR COVER EXISTS AND BAR SPACING IS 6" OR GREATER ON CENTER.

THE CONTRACTOR SHALL BE RESPONSIBLE FOR THE STABILITY OF THE STRUCTURE DURING CONSTRUCTION.

FOR STRUCTURE NUMBER INSTALLATION, SEE STANDARD S-614-12.

STATIONS, ELEVATIONS, AND DIMENSIONS CONTAINED IN THESE PLANS ARE CALCULATED FROM A RECENT FIELD SURVEY. THE CONTRACTOR SHALL VERIFY ALL DEPENDENT DIMENSIONS IN THE FIELD BEFORE ORDERING OR FABRICATING ANY MATERIAL.


THE INFORMATION SHOWN ON THESE PLANS CONCERNING THE TYPE AND LOCATION OF UNDERGROUND UTILITIES IS NOT GUARANTEED TO BE ACCURATE OR ALL INCLUSIVE. THE CONTRACTOR IS RESPONSIBLE FOR MAKING HIS OWN DETERMINATION AS TO THE TYPE AND LOCATION OF UNDERGROUND UTILITIES AS MAY BE NECESSARY TO AVOID DAMAGE THERETO.

INDEX OF DRAWINGS

SHEET NO.	TITLE
B1	GENERAL NOTES
B2	SUMMARY OF QUANTITIES
B3	GENERAL LAYOUT
B4	TYPICAL SECTION
B5	CONSTRUCTION CONSTRAINTS
B6	ENGINEERING GEOLOGY
B7	BRIDGE HYDRAULIC INFORMATION (1 of 2)
B8	BRIDGE HYDRAULIC INFORMATION (2 of 2)
B9	CONSTRUCTION AND FOUNDATION LAYOUT
B10	DRILLED CAISSON DETAILS
B11	ABUTMENT 1 DETAILS
B12	ABUTMENT 4 DETAILS
B13	ABUTMENT DETAILS
B14	ABUTMENT DIAPHRAGM DETAILS
B15	WINGWALL DETAILS
B16	PIER 2 AND 3 DETAILS (1 of 2)
B17	PIER 2 AND 3 DETAILS (2 of 2)
B18	SUPERSTRUCTURE DETAILS
B19	MISCELLANEDUS SUPERSTRUCTURE DETAILS
B20	DECK REINFORCING PLAN
B21	CAST-IN-PLACE POST TENSIONED BOX GIRDER (1 of 4)
B22	CAST-IN-PLACE POST TENSIONED BOX GIRDER (2 of 4)
B23	CAST-IN-PLACE POST TENSIONED BOX GIRDER (3 of 4)
B24	CAST-IN-PLACE POST TENSIONED BOX GIRDER (4 of 4)
B25	BEARING DEVICE (TYPE 1)
B26	GUIDE PLATE DETAILS
B27	BRIDGE RAIL TYPE 10M (SPECIAL) (1 of 2)
B28	BRIDGE RAIL TYPE 10M (SPECIAL) (2 of 2)
B29	APPROACH SLAB DETAILS
B30	BRIDGE EXPANSION DEVICE (0-4 inch) (1 of 2)
B31	BRIDGE EXPANSION DEVICE (0-4 inch) (2 of 2)
B32	MECHANICALLY STABILIZED BACKFILL
B33	SLOPE PAVING DETAILS
B34	ARCHITECTURAL DETAILS
B35	BRIDGE DECK ELEVATIONS (1 of 4)
B36	BRIDGE DECK ELEVATIONS (2 of 4)
B37	BRIDGE DECK ELEVATIONS (3 of 4)
B38	BRIDGE DECK ELEVATIONS (4 of 4)

BRIDGE DESCRIPTION

3 SPAN (211'-6", 211'-6", 99'-0") CONTINUOUS PRESTRESSED CONCRETE HAUNCHED BOX GIRDER OVER US 160 AND WILSON GULCH. 56'-0" ROADWAY CURB TO CURB, VARIABLE SKEW. (2) 1'-6" TYPE 10M (SPECIAL) BRIDGE RAIL.

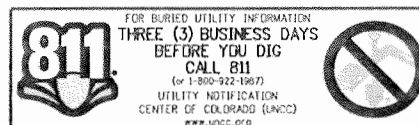

CROSS REFERENCE DRAWING NUMBER (IF BLANK, REFERENCE IS TO SAME SHEET)
SECTION OR DETAIL IDENTIFICATION

Design	INITIAL	DATE	Checked By	Date	Checked By
	AWL	08/08			
Detail	INITIAL	DATE	Checked By	Date	Checked By
	AWL	08/08			
Quantities	INITIAL	DATE	Checked By	Date	Checked By
	AWL	08/08			




Print Date: 9/22/2010	Sheet Revisions			Colorado Department of Transportation	As Constructed	US 550 OVER US 160		Project No./Code
File Name: 16042AG_GenNotes_01.dgn	Date:	Comments	Init.		No Revisions: 9/10	GENERAL NOTES		
Horiz. Scale: 1:1				3803 North Main Avenue Suite 200 Durango, CO 81301 Phone: 970-385-1440 FAX: 970-385-8365 Region 5	Revised:	Designer: A. Leifheit	Structure: P-05-AG	16042
Unit Information 0221					Void:	Detailer: D. Anderson	Numbers:	
				EJA	Sheet Subset: Bridge	Subset Sheets: B1 of B38		


SUMMARY OF APPROXIMATE QUANTITIES

Item No.	Description	Units	Superstructure	Approach Slab	Abut. 1	Pier 2	Pier 3	Abut. 4	Total
206	Structure Excavation	CY	-	-	901	120	113	590	1724
206	Structure Backfill (Class 1)	CY	-	-	527	-	-	428	955
206	Structure Backfill (Class 2)	CY	-	-	145	90	84	109	428
206	Mechanical Reinforcement of Soil	CY	-	-	527	-	-	428	955
403	Hot Mix Asphalt	TDN	554	-	-	-	-	-	554
503	Drilled Caisson (36")	LF	-	-	307	-	-	445	752
503	Drilled Caisson (48")	LF	-	-	-	200	180	-	380
507	Concrete Slope and Ditch Paving (Reinforced)	CY	-	-	57	-	-	-	57
507	Dry Rubble Slope and Ditch Paving (Special)	CY	-	-	-	-	-	296	296
512	Bridge Bearing Device (Type 1)	EA	-	-	6	-	-	6	12
512	Transverse Guide Plate	EA	-	-	2	-	-	2	4
515	Waterproofing Membrane	SY	3296	124	-	-	-	-	3420
518	Bridge Expansion Device (0-4 inch)	LF	-	-	67	-	-	-	67
518	Waterstop	LF	550	-	-	-	-	-	550
601	Concrete Class D (Bridge)	CY	2214	55	80	198	171	68	2786
601	Structural Concrete Coating	SY	4351	-	82	358	317	82	5190
602	Reinforcing Steel	LBS	120789	8233	-	-	-	-	129022
602	Reinforcing Steel (Epoxy Coated)	LBS	292643	-	8933	40465	36662	5810	384513
606	Bridge Rail Type 10M (Special)	LF	1096	-	-	-	-	-	1096
613	1" Conduit (Anti-Icing System)	LF	196	-	-	-	-	-	196
613	1.5" Conduit (Anti-Icing System)	LF	1402	-	-	-	-	-	1402
613	2" Conduit (Anti-Icing System)	LF	1820	-	-	-	-	-	1820
613	2" Electrical Conduit	LF	1066	-	-	-	-	-	1066
613	4" Electrical Conduit	LF	115	-	-	-	-	-	115
613	6" Electrical Conduit	LF	1066	-	-	-	-	-	1066
618	Prestressing Steel Strand	MKFT	10963	-	-	-	-	-	10963

(R-1)

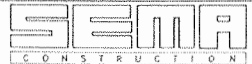
Design		Detail		Quantities	
Designed By	Checked By	INITIAL	DATE	INITIAL	DATE
AML	SEMA	AML	MM/YY	AML	MM/YY
Checked By	Checked By	Checked By	Checked By	Checked By	Checked By
AML	SEMA	AML	MM/YY	AML	MM/YY

Print Date: 9/22/2010	Sheet Revisions			Colorado Department of Transportation 3803 North Main Avenue Suite 200 Durango, CO 81301 Phone: 970-385-1440 FAX: 970-385-8365 Region 5	As Constructed	US 550 OVER US 160		Project No./Code
File Name: 16042AG_SumApproxQuant_01.dgn	Date:	Comments	Init.		No Revisions: 9/10	SUMMARY OF QUANTITIES		NH 1602-114
Horiz. Scale: 1:1 Vert. Scale: As Noted	9/30/08	Quantities	AML		Revised:	Designer: A. Leifheit	Structure Numbers	P-05-AG
Unit Information 0221 Unit Leader STW				Void:	Detailer: R. Artman			
 					Sheet Subset: Bridge	Subset Sheets: B2 of B38	Sheet Number 193	

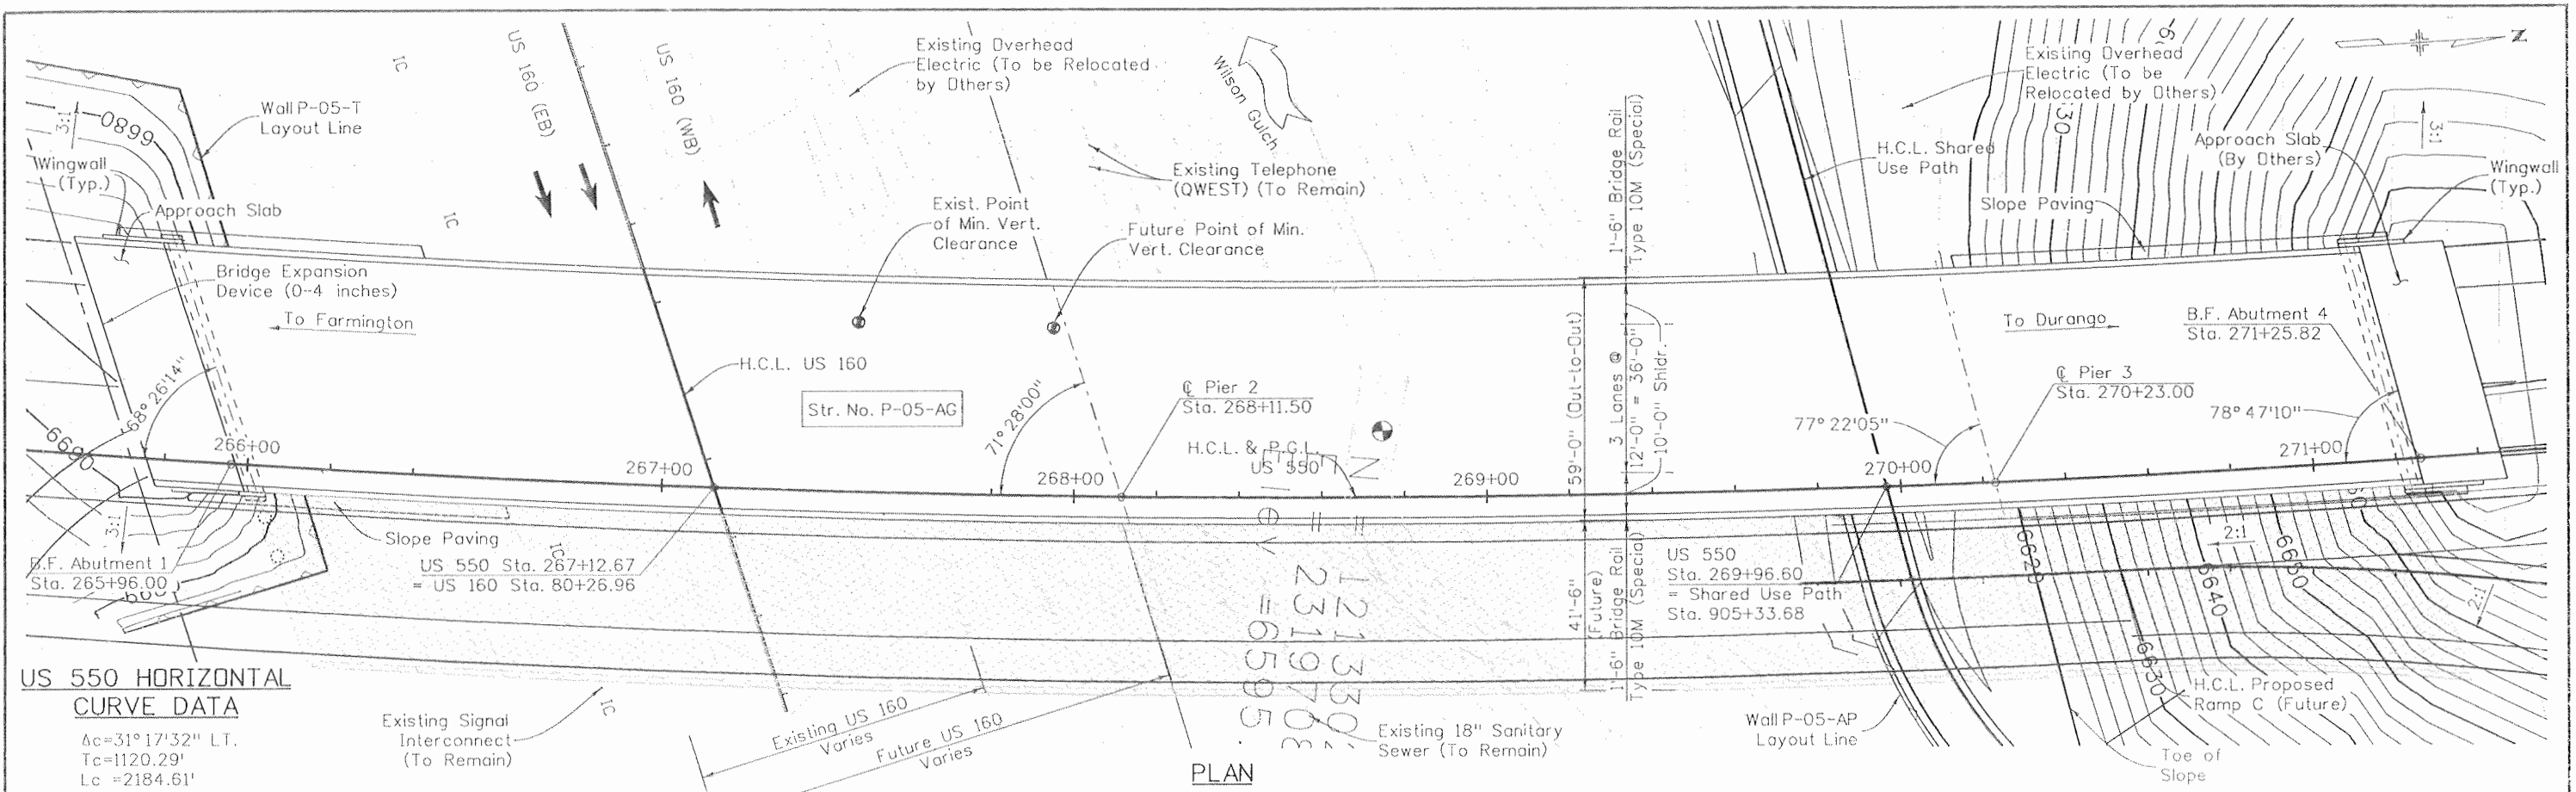

US 550 HORIZONTAL CURVE DATA
 $A_c = 31^\circ 17' 32''$ LT.
 $T_c = 1120.29'$
 $L_c = 2184.61'$
 $R_c = 4000.00'$
 $PI = \text{Sta. } 262+17.97$

PLAN

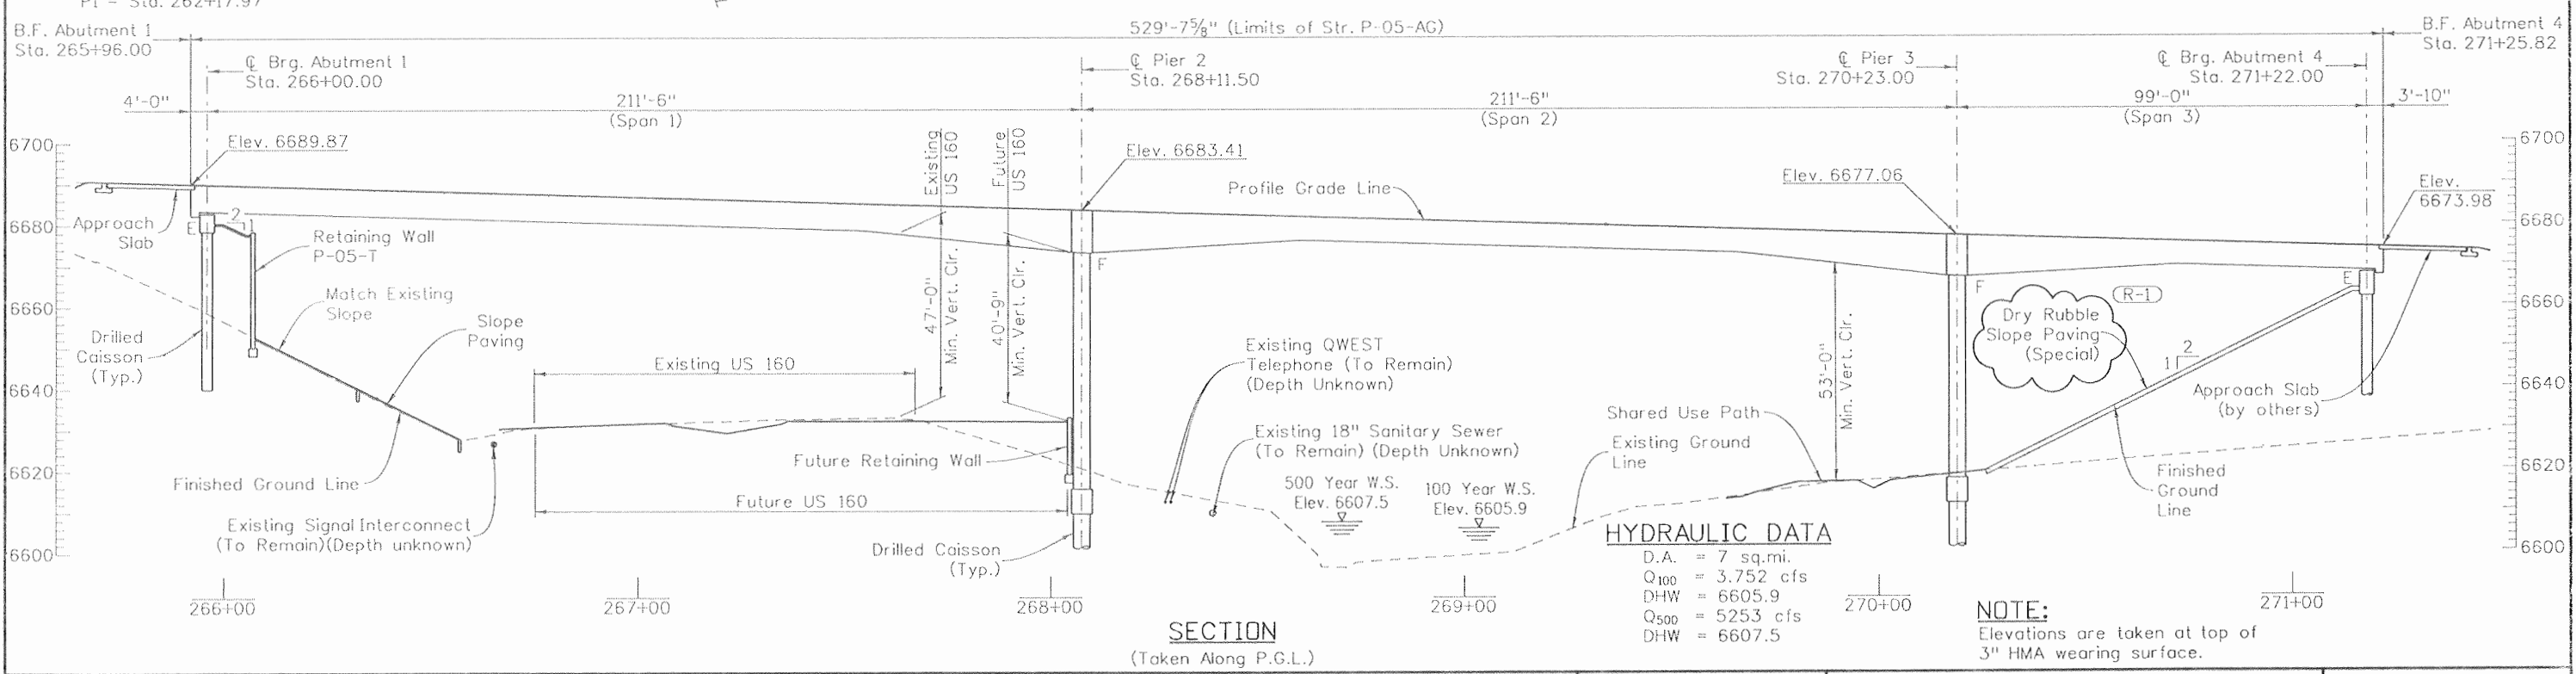

SECTION
(Taken Along P.G.L.)

HYDRAULIC DATA
 D.A. = 7 sq.mi.
 $Q_{100} = 3,752$ cfs
 $DHW = 6605.9$
 $Q_{500} = 5253$ cfs
 $DHW = 6607.5$

NOTE:
 Elevations are taken at top of 3" HMA wearing surface.

Design	Initial		Date		Checked By
	By	Checked By	By	Checked By	
Design	AML	MUN	08/08	08/08	
Checked By	MUN	MUN	08/08	08/08	

Print Date: 9/22/2010
 File Name: 16042AG_GenLayout_01.dgn
 Horiz. Scale: 1:40 Vert. Scale: As Noted
 Unit Information 0221 Unit Leader STW


Sheet Revisions		
Date:	Comments	Init.
9/30/08	Slope Paving	AML


Colorado Department of Transportation
 3803 North Main Avenue
 Suite 200
 Durango, CO 81301
 Phone: 970-385-1440 FAX: 970-385-8365
 Region 5 EJA

As Constructed
 No Revisions: 9/10
 Revised:
 Void:

US 550 OVER US 160 GENERAL LAYOUT
 Designer: A. Leifheit Structure Numbers: P-05-AG
 Detailer: D. Anderson
 Sheet Subset: Bridge Subset Sheets: B3 of B38

Project No./Code
 NH 1602-114
 16042
 Sheet Number 194

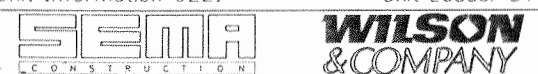

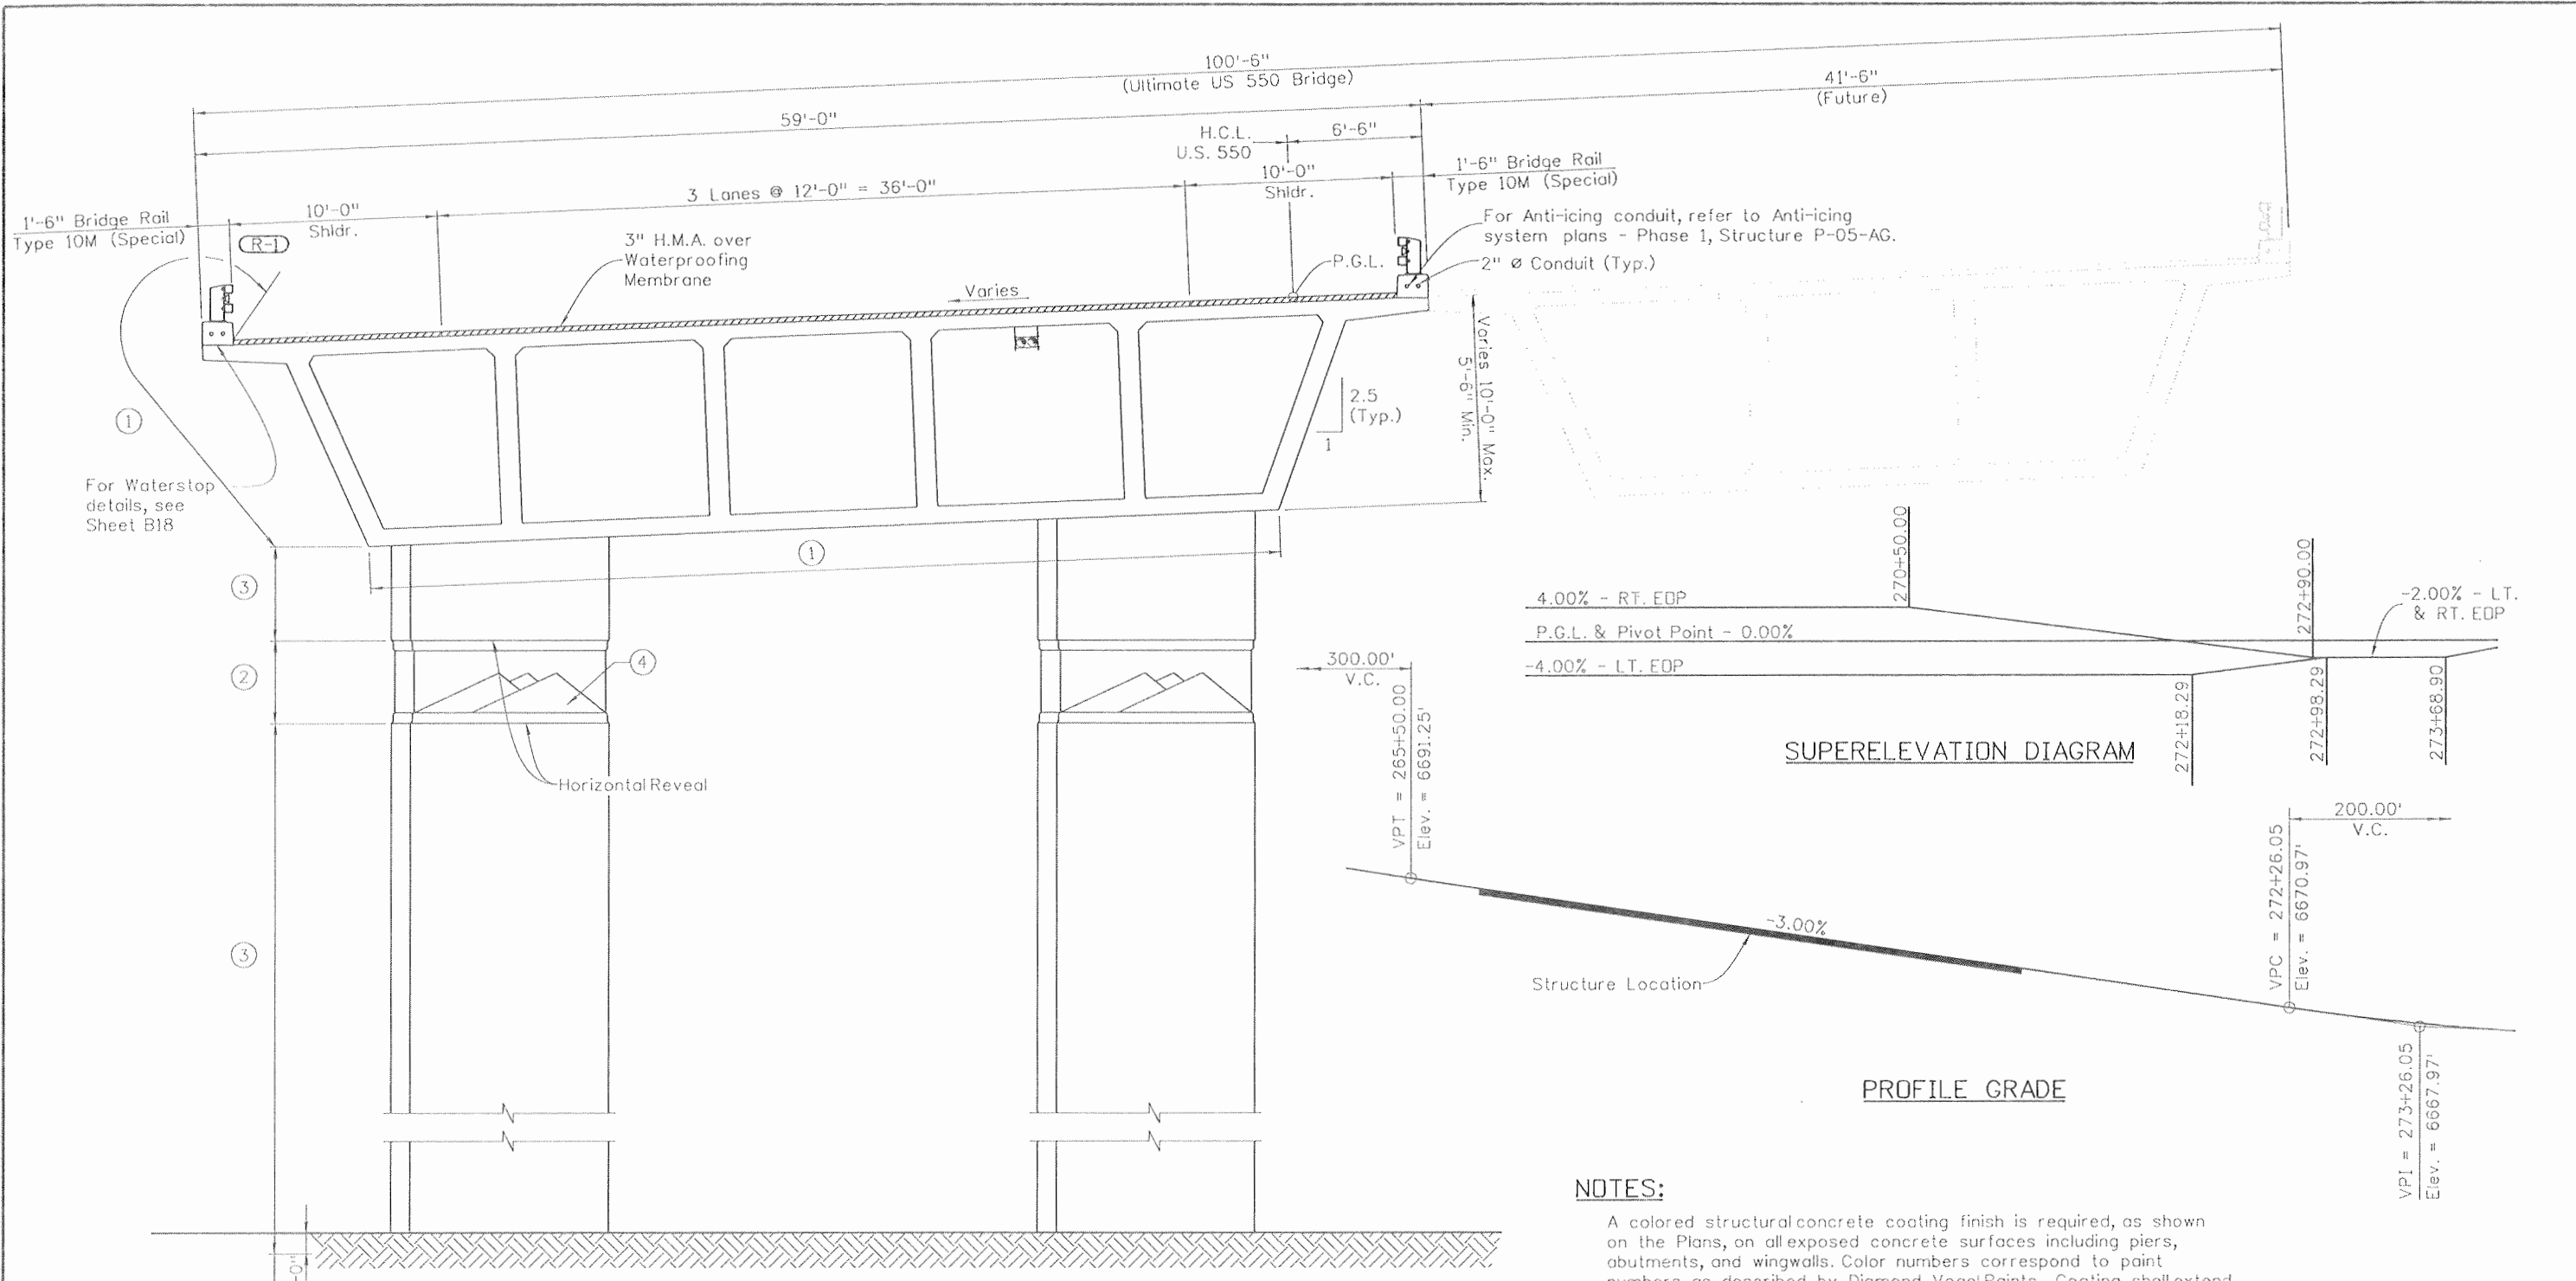

TYPICAL SECTION
(Looking Upstation)

SUPERELEVATION DIAGRAM

PROFILE GRADE

NOTES:

A colored structural concrete coating finish is required, as shown on the Plans, on all exposed concrete surfaces including piers, abutments, and wingwalls. Color numbers correspond to point numbers as described by Diamond Vogel Paints. Coating shall extend to 1'-0" below ground surface.

- ① #8513 (Superstructure)
- ② #8515 (Banner Background)
- ③ #8513 (Column)
- ④ #8511 (Mountains)

Design		Detail		Quantities	
INITIAL	DATE	INITIAL	DATE	INITIAL	DATE
AML	08/08	RCA	08/08	AML	08/08
GWK	08/08	GWK	08/08	GWK	08/08

Print Date: 9/22/2010
 File Name: 16042AG_TypSection_01.dgn
 Horiz. Scale: 1:1 Vert. Scale: As Noted
 Unit Information 0221 Unit Leader STW

SEMA CONSTRUCTION **WILSON & COMPANY**

Sheet Revisions		
Date:	Comments	Init.

Colorado Department of Transportation
 3803 North Main Avenue
 Suite 200
 Durango, CO 81301
 Phone: 970-385-1440 FAX: 970-385-8365


DOT
DEPARTMENT OF TRANSPORTATION

Region 5 EJA

As Constructed	
No Revisions:	9/10
Revised:	
Void:	

US 550 OVER US 160 TYPICAL SECTION			
Designer:	A. Leifheit	Structure Numbers	P-05-AG
Detailer:	R. Artman		
Sheet Subset:	Bridge	Subset Sheets:	B4 of B38

Project No./Code	
NH 1602-114	
	16042
Sheet Number	195

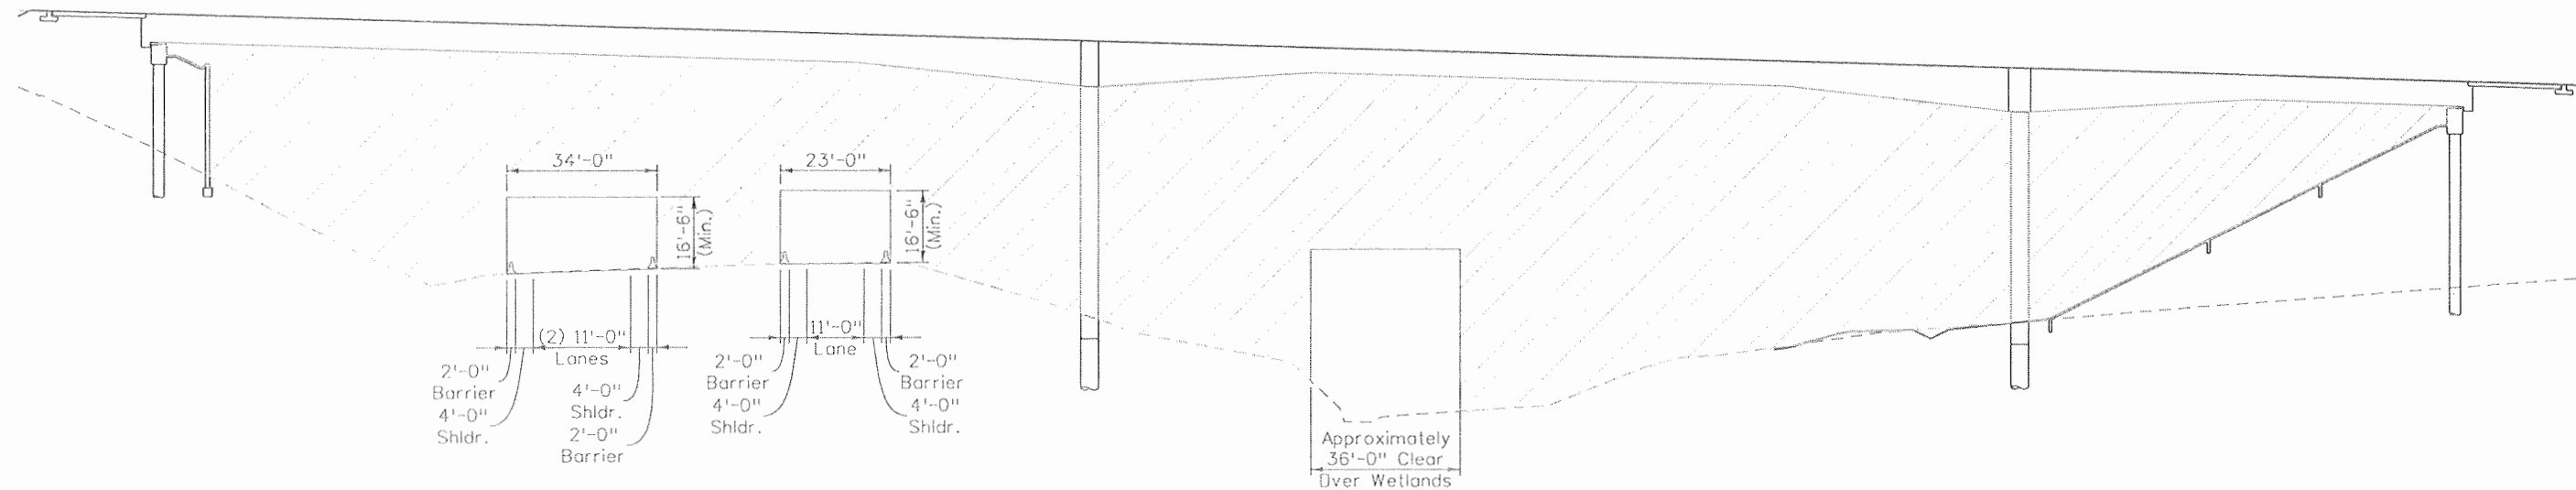

NOTES:

1. A minimum of two lanes eastbound, one lane westbound, shall be provided. A minimum of 4'-0" shall be provided from a lane line to any barrier or obstruction. This distance may be reduced to 3'-0" for lane width 12'-0" or greater.
2. Location of traffic openings are shown for general configuration only. Final locations shall be coordinated with the falsework design and the traffic control plans.
3. Wetlands shall not be disturbed during Construction.
4. Refer to Erosion Control Plans for work zone limitations and access limitations within Wilson Gulch.

☒ Locations available for falsework.

Design		Detail		Quantities	
INITIAL	DATE	INITIAL	DATE	INITIAL	DATE
Avl.	08/08	DRA	08/08	Avl.	08/08
GWK	08/08	GWK	08/08	GWK	08/08
Checked By		Checked By		Checked By	

Print Date: 9/22/2010
 File Name: 16042AG_ConstSeq_01.dgn
 Horiz. Scale: 1:40 Vert. Scale: As Noted
 Unit Information 0221 Unit Leader STW

Sheet Revisions		
Date:	Comments	Init.


Colorado Department of Transportation
 3803 North Main Avenue
 Suite 200
 Durango, CO 81301
 Phone: 970-385-1440 FAX: 970-385-8365

Region 5 EJA

As Constructed	
No Revisions:	9/10
Revised:	
Void:	

US 550 OVER US 160 CONSTRUCTION CONSTRAINTS			
Designer:	A. Leifheit	Structure Numbers	P-05-AG
Detailer:	D. Anderson	Sheet Subset:	Bridge
		Subset Sheets:	B5 of B38

Project No./Code	
NH 1602-114	
16042	
Sheet Number	196

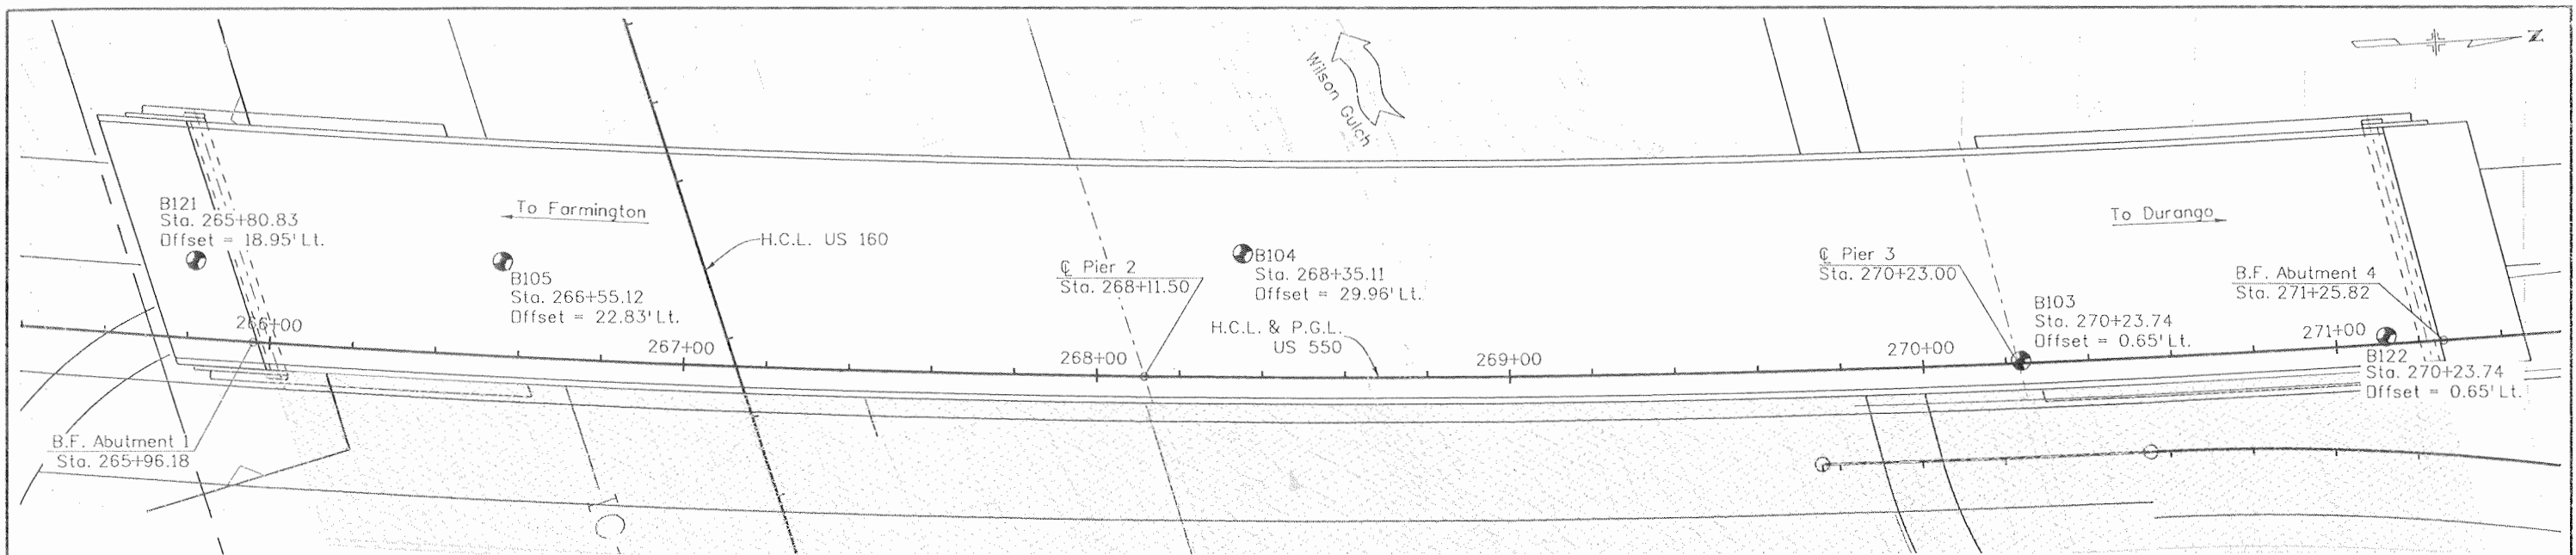

Design	INITIAL	DATE	DESIGNED BY	CHECKED BY
	KAK	08/08	KAK	GWK
Detail	INITIAL	DATE	DESIGNED BY	CHECKED BY
	KAK	08/08	KAK	GWK
Quantities	INITIAL	DATE	QUANTITIES BY	CHECKED BY
	KAK	08/08	KAK	GWK

SUMMARY OF TEST RESULTS

Sample No.	Depth	Classification	AASHTO	Grading Analysis (MSH10)				Atterberg Limits			Water Content %	Dry Unit Weight P.C.F.
				Gravel	Coarse Sand	Fine Sand	Silt and Clay	Liquid Limit %	Plastic Limit %	Plasticity Index PI		
103C	15-16.5	Sandy Clay	A-6(4)	2.1	13.9	23.7	60.3	31	20	11	18.3	156.8
103-1	44.2-45											
104A	4.5-6	Sandy Clay	A-6(10)	1.9	3.3	17.2	77.6	35	21	14	17.8	142.8
104-2	26.5-27.5											

TYPE OF MATERIAL

- Sandy Clay
- Gravel and Cobbles
- Bedrock - Shale
- Bedrock - Sandstone

Note: Boulders may be encountered at any depth

LEGEND

- Boring Designation
- Partial Blowcount - 50 blows per 5 inches
- Sample Designation
- Groundwater Depth
- R.O.D.
- Standard Penetration Test Blows per Foot
- Location of Boring

Print Date: 9/22/2010
 File Name: 16042AG_EngGeology_01.dgn
 Horiz. Scale: 1:1 Vert. Scale: As Noted
 Unit Information 0221 Unit Leader STW

Sheet Revisions		
Date:	Comments	Init.

Colorado Department of Transportation
 3803 North Main Avenue
 Suite 200
 Durango, CO 81301
 Phone: 970-385-1440 FAX: 970-385-8365
 Region 5 EJA


As Constructed	No Revisions: 9/10
Revised:	
Void:	

**US 550 OVER US 160
 ENGINEERING GEOLOGY**

Designer: K. Kershaw Structure: P-05-AG
 Detailer: D. Anderson Numbers:


Sheet Subset: Bridge Subset Sheets: B6 of B38

Project No./Code	NH 1602-114
	16042
Sheet Number	197

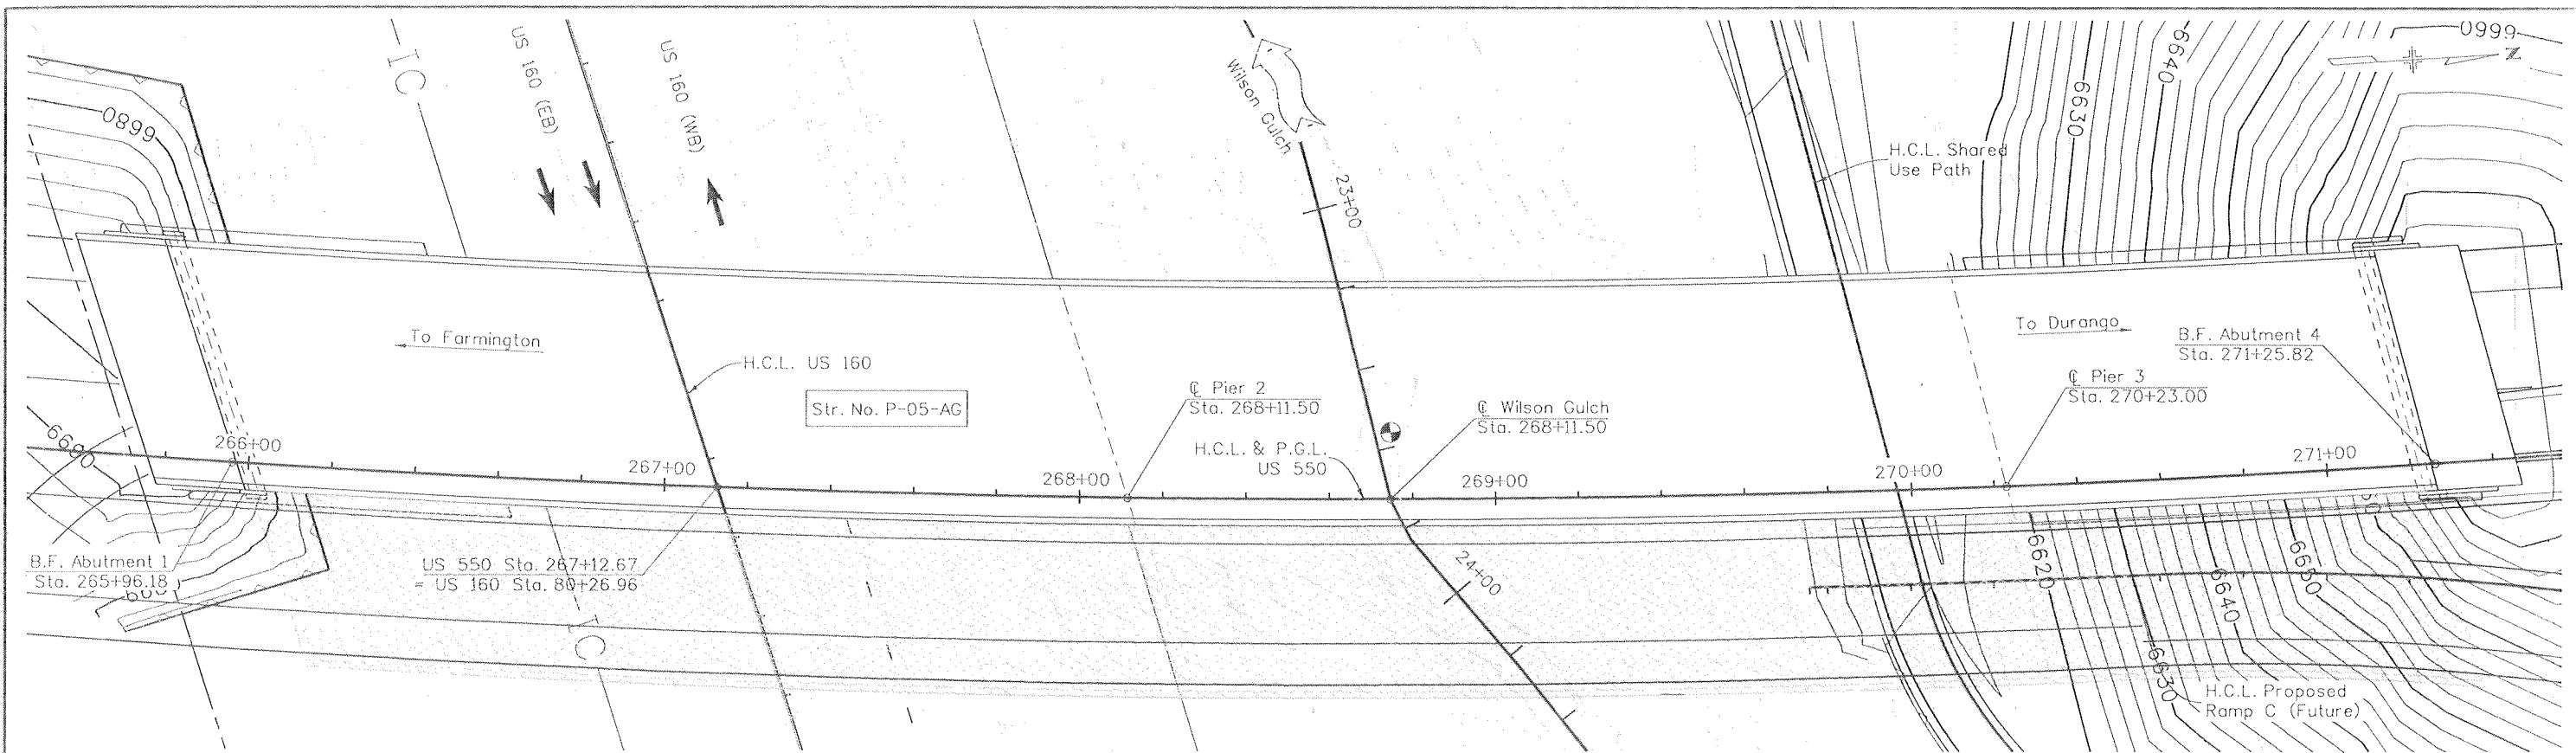

PLAN

PROFILE OF WATER SURFACE

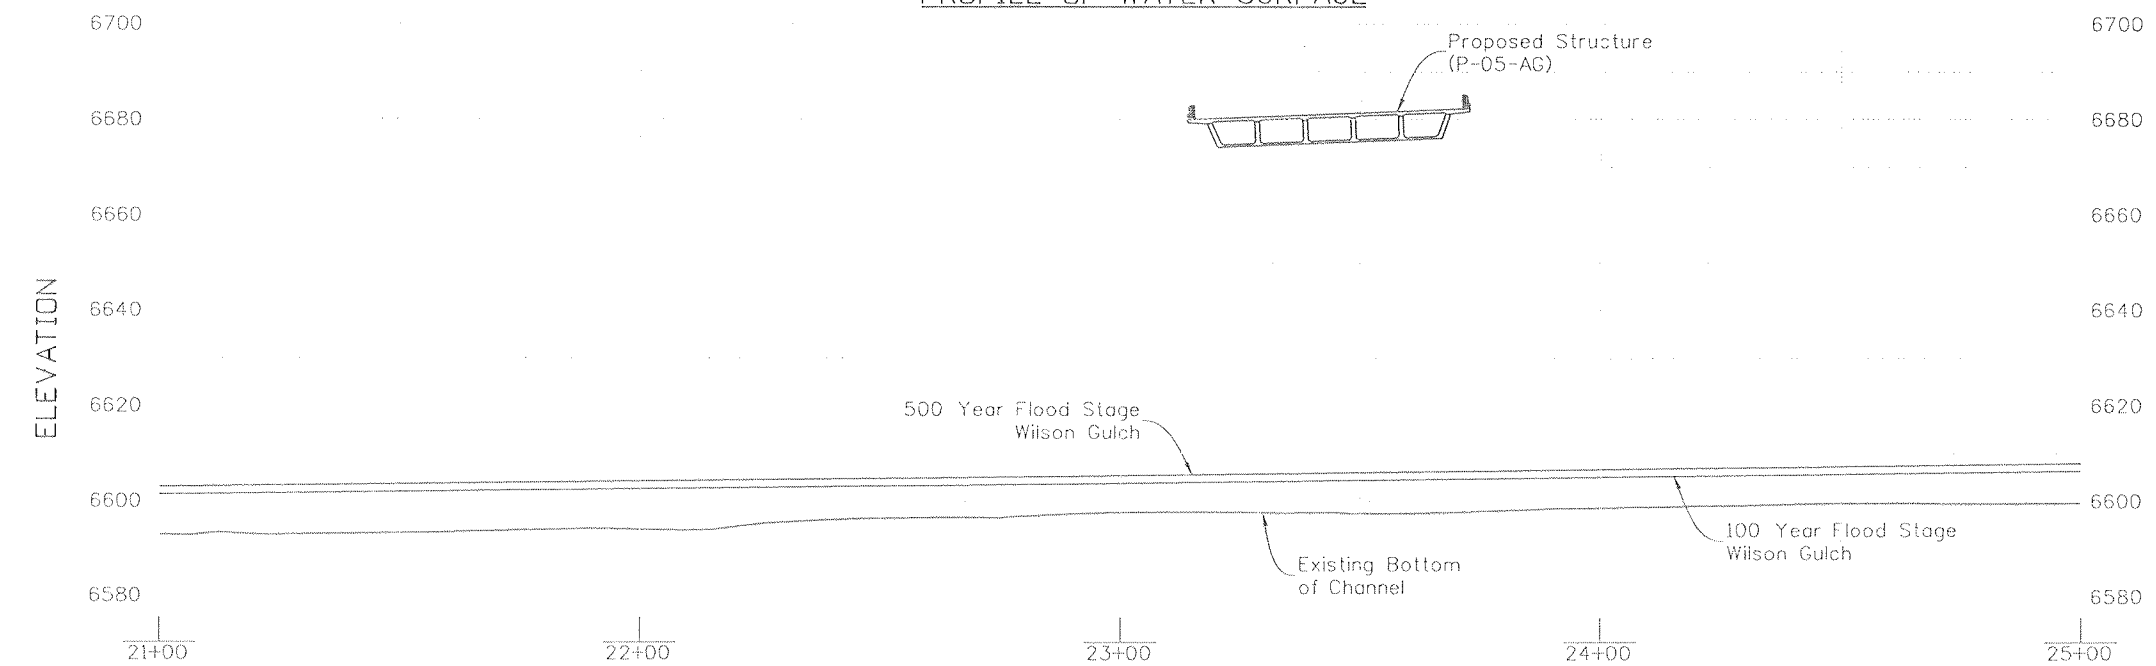

STATIONS ARE ALONG CHANNEL CENTERLINE IN FEET

Design		Detail		Quantities	
INITIAL	DATE	INITIAL	DATE	INITIAL	DATE
VSF	08/08	DRA	08/08	VSF	08/08
GWK	08/08	GWK	08/08	GWK	08/08
Designed By	Checked By	Designed By	Checked By	Quantities By	Checked By

Print Date: 9/22/2010
 File Name: 16042AG_BHR_01.dgn
 Horiz. Scale: 1:40 Vert. Scale: As Noted
 Unit Information 0221 Unit Leader STW

SEMA CONSTRUCTION **WILSON & COMPANY**

Sheet Revisions		
Date:	Comments	Init.

Colorado Department of Transportation
 3803 North Main Avenue
 Suite 200
 Durango, CO 81301
 Phone: 970-385-1440 FAX: 970-385-8365

DOT DEPARTMENT OF TRANSPORTATION
 Region 5 EJA

As Constructed	
No Revisions:	9/10
Revised:	
Void:	

US 550 OVER US 160 BRIDGE HYDRAULIC INFORMATION (1 OF 2)			
Designer:	V. Fossinger	Structure Numbers	P-05-AG
Detailer:	D. Anderson	Subset Sheets:	B7 of B38
Sheet Subset:	Bridge		

Project No./Code	
NH 1602-114	16042
Sheet Number	198

DRAINAGE AREA 7 SQUARE MILES

CHANNEL DESCRIPTION

BOTTOM MATERIAL: COHESIVE NON-COHESIVE
 BOTTOM MATERIAL SIZE: CLAY SILT SAND GRAVEL
 COBBLES OTHER
 STREAM FORM: STRAIGHT MEANDERING BRAIDED
 MANNINGS "n" FOR DESIGN: CHANNEL = 0.068 OVERBANK = 0.104
 DEBRIS: BRUSH TREES/LOGS ICE OTHER


COMPARISON OF HYDRAULICS Δ

	VELOCITY	FREEBOARD	MAX. BACKWATER
NATURAL CHANNEL	9.2 fps	N/A ft.	N/A ft.
EXISTING CHANNEL	9.2 fps	N/A ft.	N/A ft.
PROPOSED CHANNEL	9.2 fps	62 ft.	0.0 ft.


Δ AT PROPOSED BRIDGE LOCATION DURING DESIGN DISCHARGE (Q100)

THE SCOUR LIMITS AND RIVER FLOW RATES MAY BE FOUND IN THE REPORT BY WILSON & COMPANY, DATED JULY, 2008, ENTITLED "FINAL DRAINAGE REPORT FOR US 550 & US 160 INTERCHANGE".


DISCHARGE-FREQUENCY

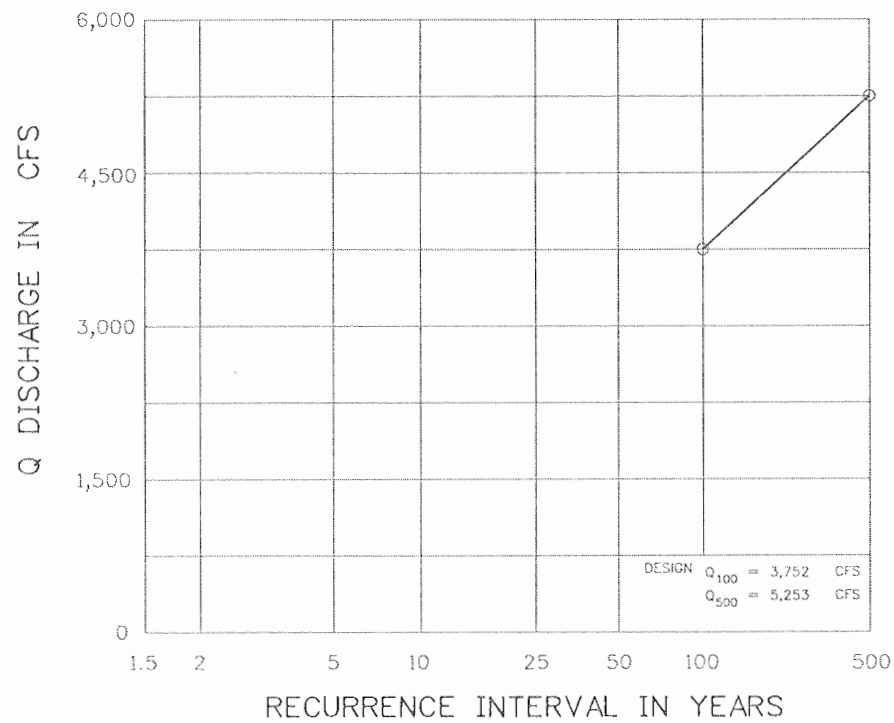


STAGE-DISCHARGE

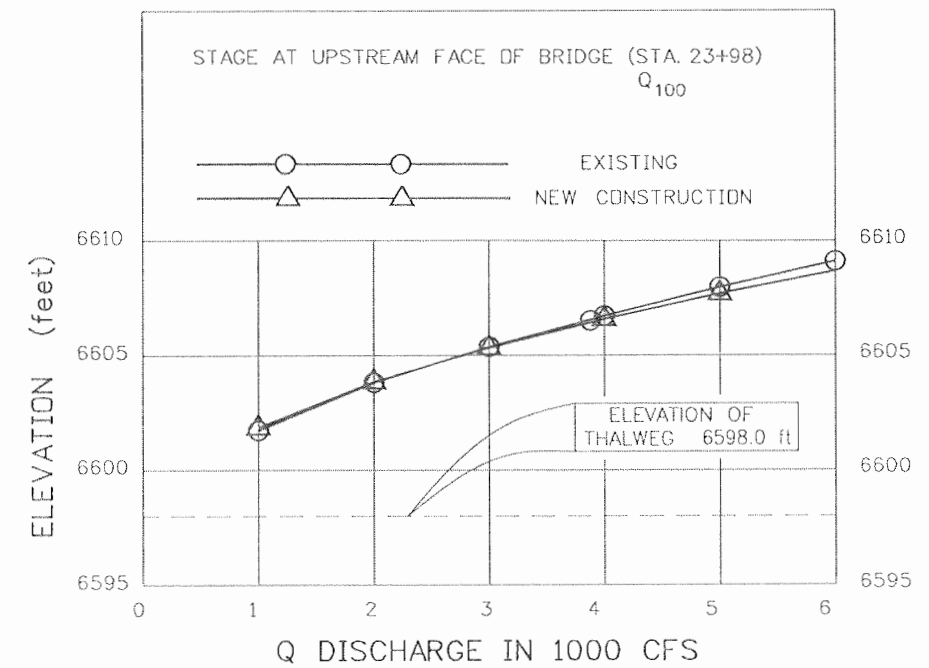

Design	INITIAL		DATE		Checked By
	By	Checked By	08/08	08/08	
Designed By	VSF	GWK	08/08	08/08	GWK
Checked By	GWK	GWK	08/08	08/08	GWK

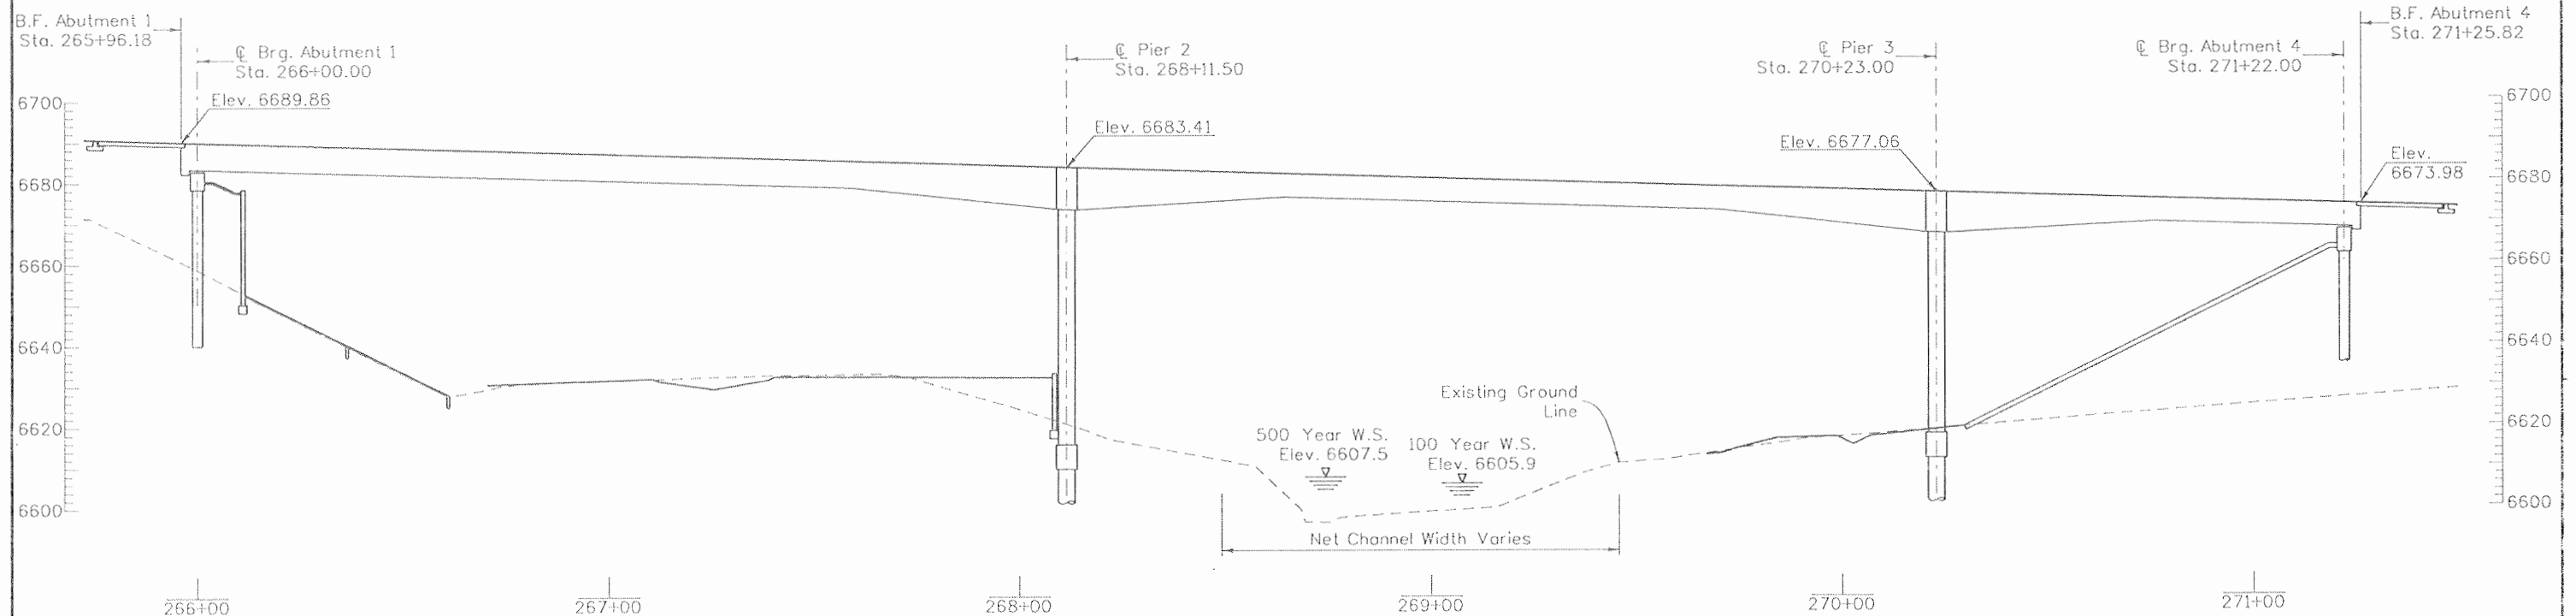


Print Date: 9/22/2010	Sheet Revisions			Colorado Department of Transportation 3803 North Main Avenue Suite 200 Durango, CO 81301 Phone: 970-385-1440 FAX: 970-385-8365 Region 5	As Constructed	US 550 OVER US 160 BRIDGE HYDRAULIC INFORMATION (2 OF 2)		Project No./Code
File Name: 16042AG_BHR_02.dgn	Date:	Comments:	Init.:		No Revisions: 9/10	Designer: V. Fossinger	Structure Numbers: P-05-AG	NH 1602-114
Horiz. Scale: 1:1				Revised:	Detailer: D. Anderson		16042	
Unit Information 0221				Void:	Sheet Subset: Bridge	Subset Sheets: B8 of 838	Sheet Number 199	

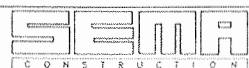


EJA

PILE DATA							
Location	Caisson Size	Top of Caisson Elevation	Estimated Tip Elevation	Min. Penetration Into Bedrock	Max. Factored Load (kip)	Estimated Bedrock Elevation	Measured Bedrock Elevation
Abut. 1	36"	6676.25	6632.00	14'-6"	1310	6646.50	
Pier 2	48"	6608.00	6558.00	32'-0"	3259	6590.00	
Pier 3	48"	6611.00	6566.00	25'-0"	2694	6591.00	
Abut. 4	36"	6661.97	6573.00	18'-0"	1679	6591.00	
Supplementary Caissons	36"	6676.25	6632.00	14'-6"	See Note 5	6646.50	


ABUTMENT 1 DETAIL

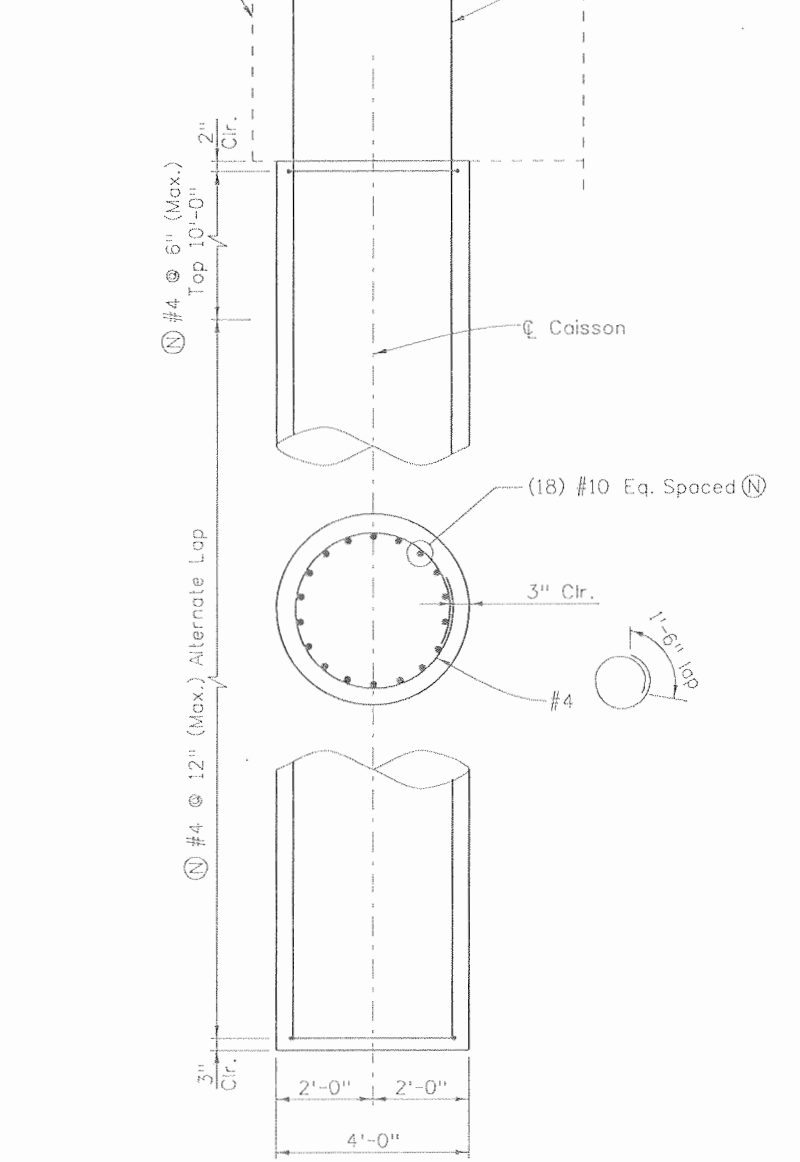

48" CAISSON DETAIL

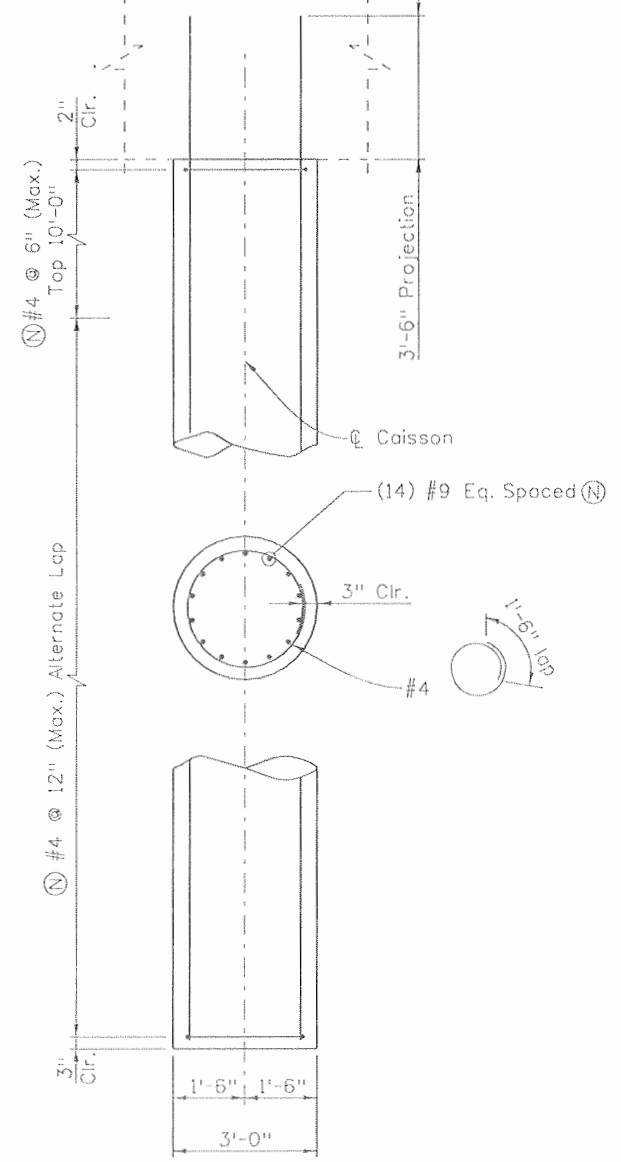

36" CAISSON DETAIL

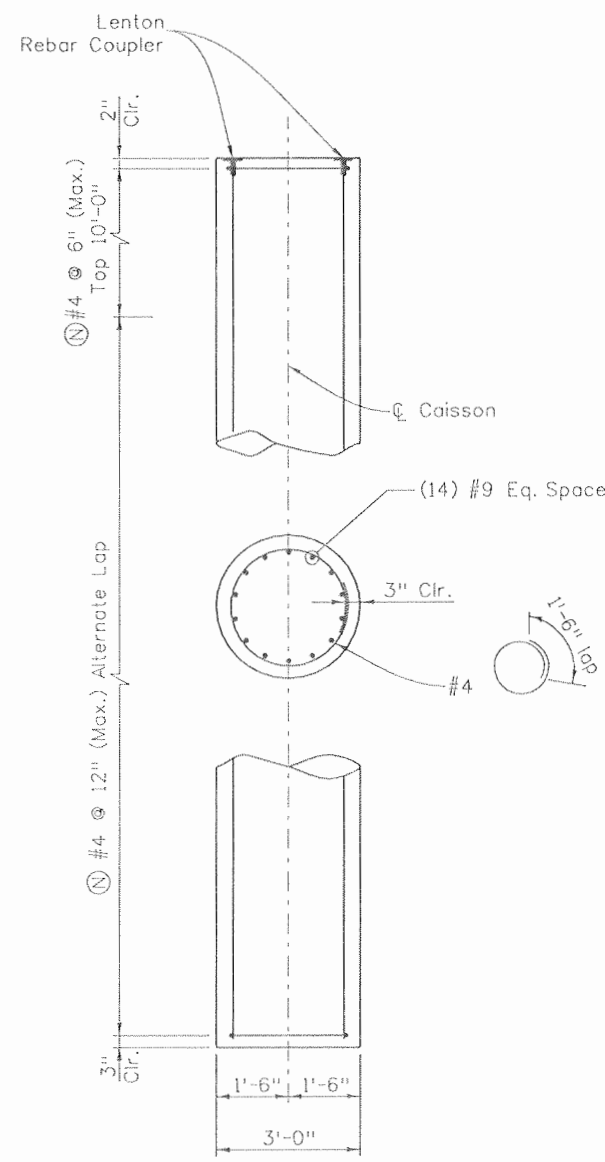

36" SUPPLEMENTARY CAISSON DETAIL


- NOTES:**
- Caisson concrete shall be concrete Class BZ ($f'_c = 4000$ psi).
 - Lap splices in caisson tie bar shall alternate 180°. Lap splices of longitudinal bars shall be:

	Staggered	Non-Staggered
#10	5'-2"	6'-9"
#9	4'-1"	5'-4"
 - Foundation design based upon recommendation provided by Shannon & Wilson, Inc. (Project # 23-1-01165-003)
 - Nominal End Bearing: 110 ksf
 - End Bearing Resistance Factor: 0.75
 - Nominal Side Shear: 9 ksf
 - Side Shear Resistance Factor: 0.75
 - Lateral reduction factors (p-multipliers) of 0.75 (longitudinal) and 0.28 (transverse) were used in the design.
 - A factored downdrag axial load of 875 kips is included in the Max. Factored Load at Abutment 4.
 - The Engineer of Record of the future widening shall be responsible for determining the applied loads and structural adequacy of the supplementary caissons.
 - The contractor shall roughen the sides of the rock socket to a depth of 2" prior to placing caisson concrete.
 - The minimum bedrock penetration at abutment 1 is measured from 6646.50 as a result of the required P-05-T wall excavation. Bedrock penetration shall be increased in the field should bedrock be encountered at a higher elevation.

Design		Detail		Quantities	
INITIAL	DATE	INITIAL	DATE	INITIAL	DATE
AML	08/08	MJN	08/08	AML	08/08
MJN	08/08	MJN	08/08	MJN	08/08


Print Date: 9/22/2010 File Name: 16042AG_DrillShaftDet_01.dgn Horiz. Scale: 1:1 Vert. Scale: As Noted Unit Information 0221 Unit Leader STW	Sheet Revisions <table border="1" style="width: 100%; border-collapse: collapse;"> <thead> <tr> <th>Date:</th> <th>Comments</th> <th>Init.</th> </tr> </thead> <tbody> <tr><td> </td><td> </td><td> </td></tr> <tr><td> </td><td> </td><td> </td></tr> <tr><td> </td><td> </td><td> </td></tr> </tbody> </table>	Date:	Comments	Init.										Colorado Department of Transportation 3803 North Main Avenue Suite 200 Durango, CO 81301 Phone: 970-385-1440 FAX: 970-385-8365 Region 5 EJA	As Constructed No Revisions: 9/10 Revised: Void:	US 550 OVER US 160 DRILLED CAISSON DETAILS Designer: A. Leifheit Structure: P-05-AG Detailer: D. Anderson Numbers: Sheet Subset: Bridge Subset Sheets: B10 of B38	Project No./Code NH 1602-114 16042 Sheet Number 201
Date:	Comments	Init.															



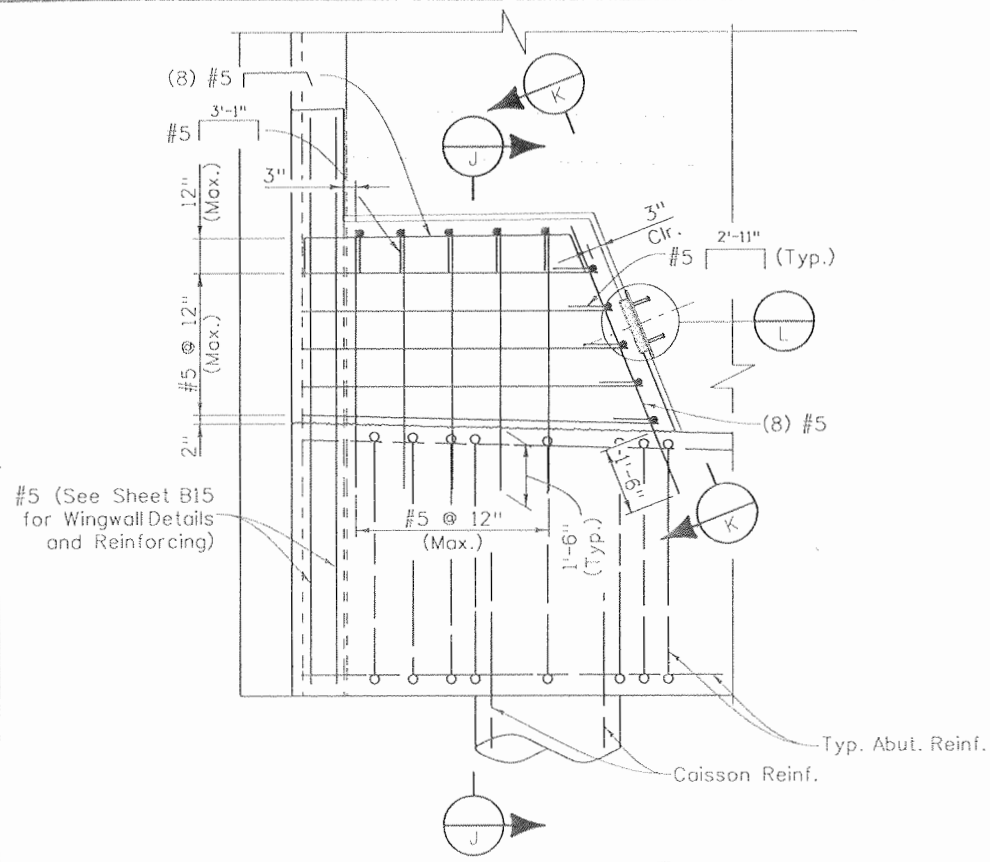


DETAIL B11 B12
D H


(Reinforcing Typ. both ends of Abutment)

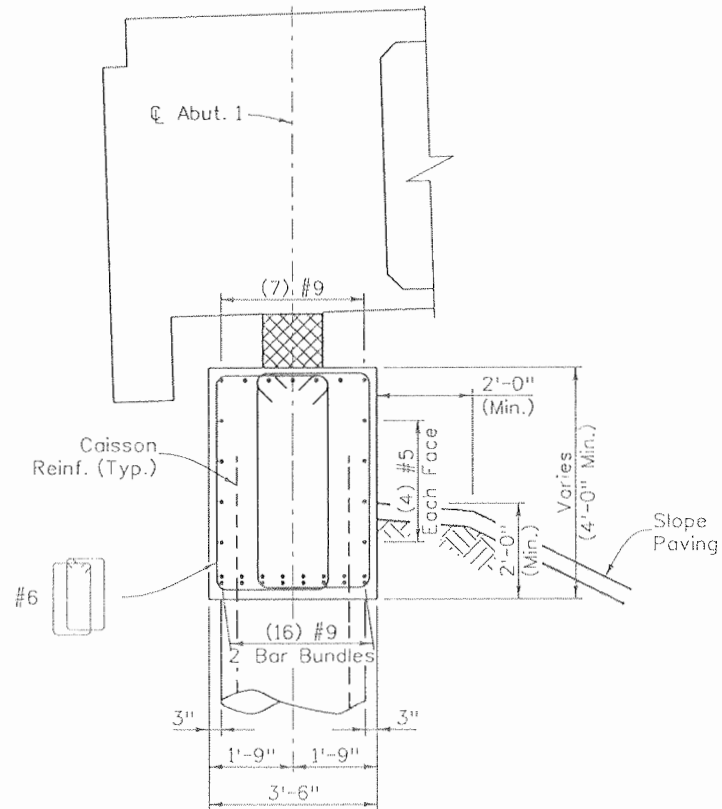


SECTION B11
C

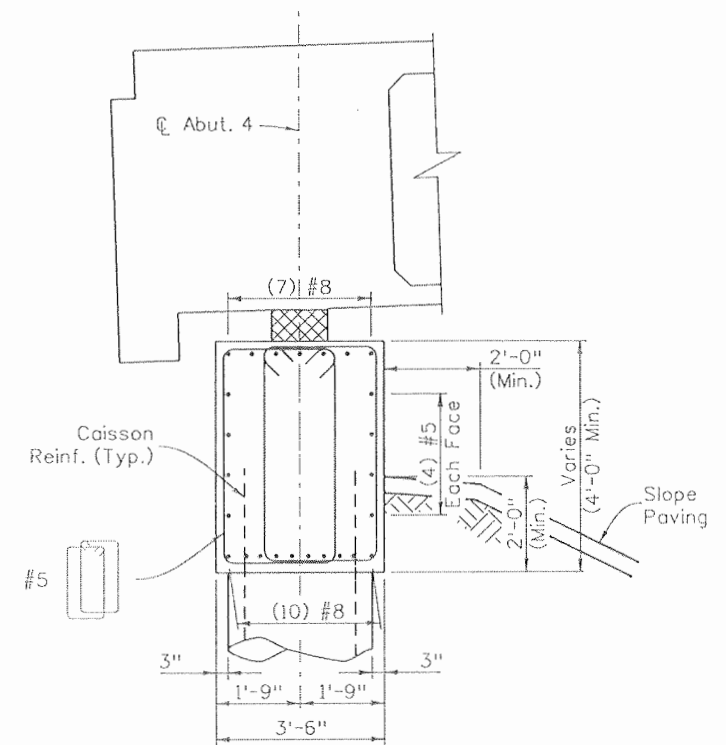


SECTION B12
G

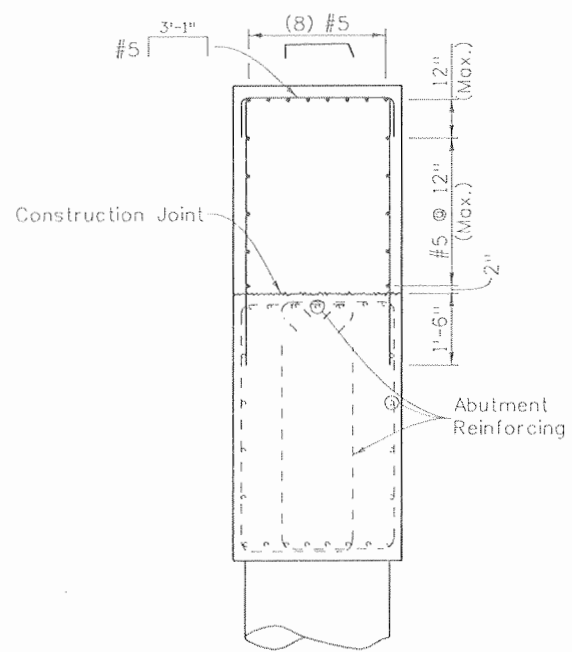

SECTION J

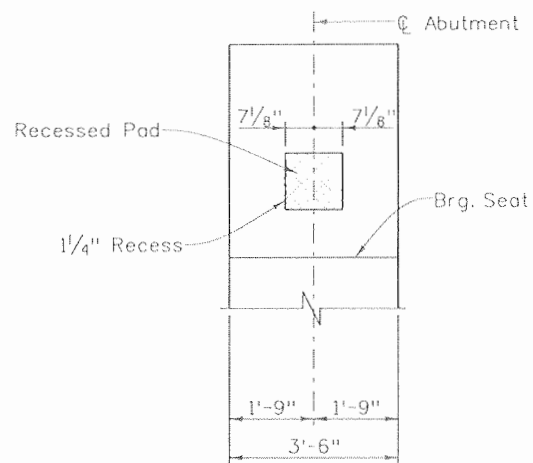

VIEW K

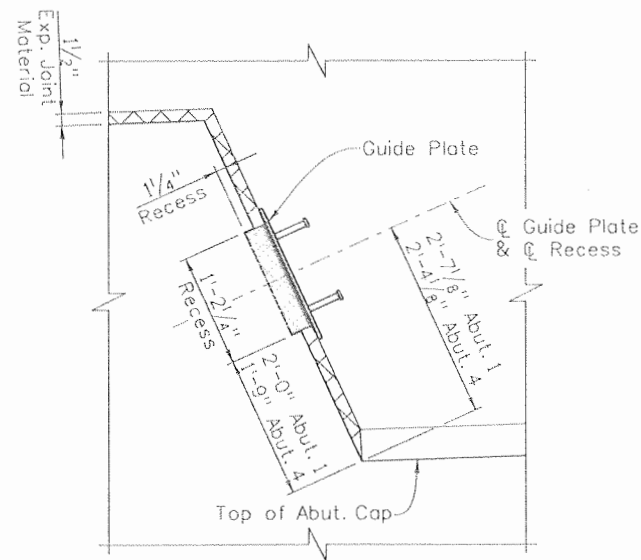

DETAIL L

NOTES:

- All cover is 2" unless noted otherwise.
- Abutment concrete shall be Class D, f'c = 4,500 psi at 28 days.

Design		Detail		Quantities	
INITIAL	DATE	INITIAL	DATE	INITIAL	DATE
Designed By	08/08	DRA	08/08	Quantities By	08/08
Checked By	08/08	M/JN	08/08	Checked By	08/08

Print Date: 9/22/2010	File Name: 16042AG_AbutmentDet_01.dgn
Horiz. Scale: 1:1	Vert. Scale: As Noted
Unit Information 0221	Unit Leader STW
SEMA CONSTRUCTION	WILSON & COMPANY


Sheet Revisions		
Date:	Comments	Init.

Colorado Department of Transportation
 3803 North Main Avenue
 Suite 200
 Durango, CO 81301
 Phone: 970-385-1440 FAX: 970-385-8365
 Region 5 EJA

As Constructed	No Revisions: 9/10
Revised:	
Void:	

US 550 OVER US 160 ABUTMENT DETAILS	
Designer: B. Allen	Structure: P-05-AG
Detailer: D. Anderson	Numbers:
Sheet Subset: Bridge	Subset Sheets: B13 of B38


Project No./Code	NH 1602-114
	16042
Sheet Number	204

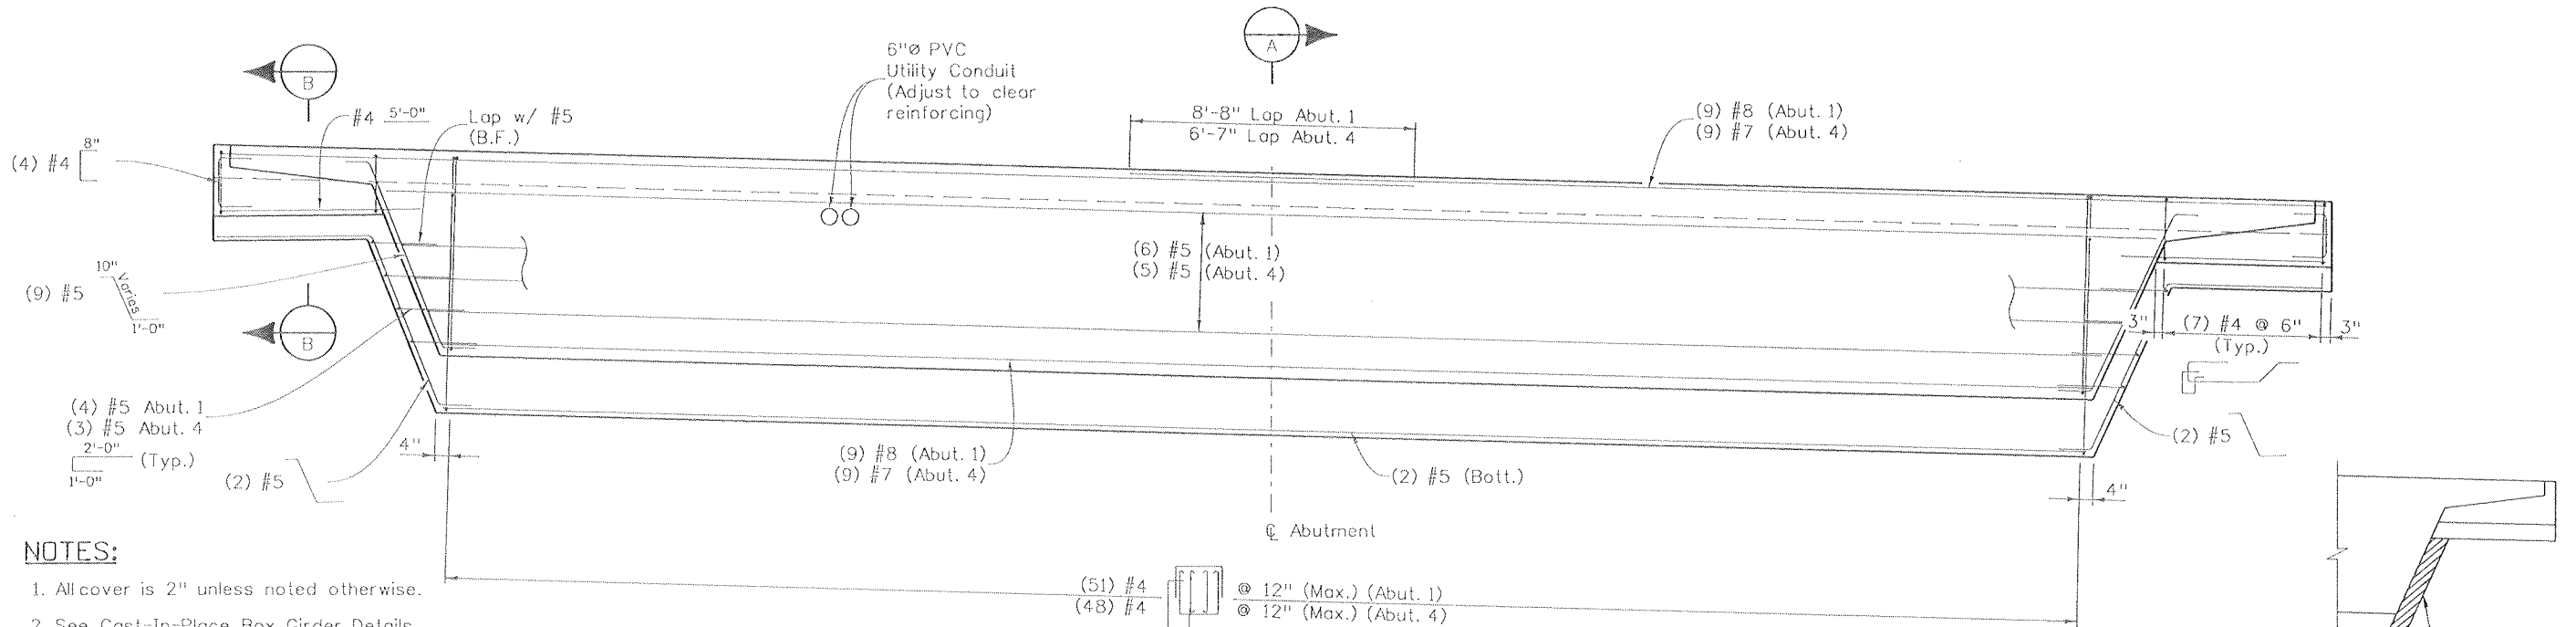


NOTES:

1. All cover is 2" unless noted otherwise.
2. See Cast-In-Place Box Girder Details sheets 1 thru 4 for additional information.
3. Abutment Diaphragm concrete shall be Class D (Bridge), $f'c = 4,500$ psi at 28 days.
4. Adjust diaphragm reinforcement as required to clear post-tensioning ducts, anchors, and anchor zone reinforcement.


DIAPHRAGM ELEVATION
Abut. 1 shown, Abut. 4 similar

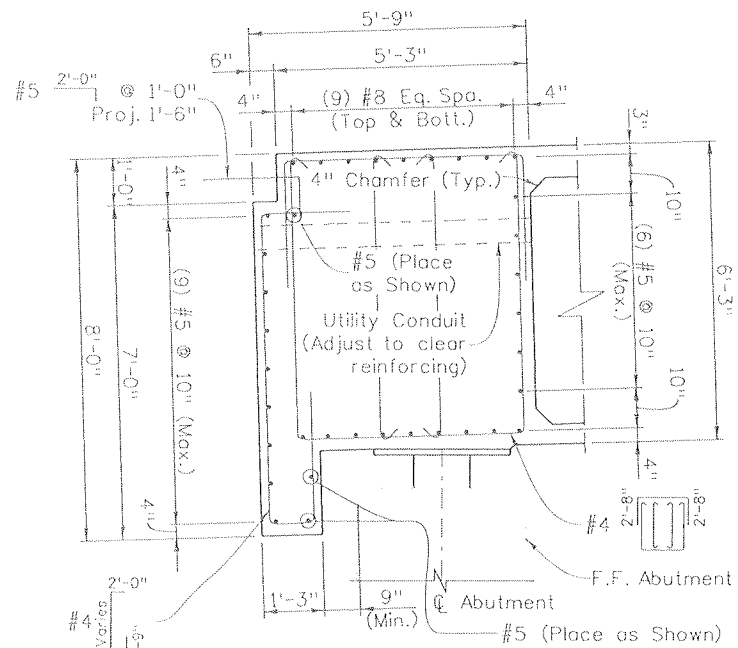

SECTION A-A
Abutment 1

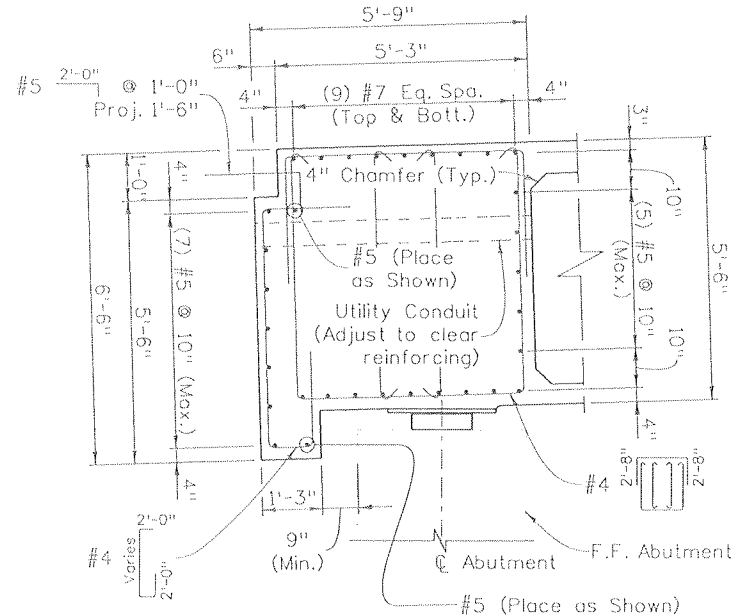

SECTION A-A
Abutment 4

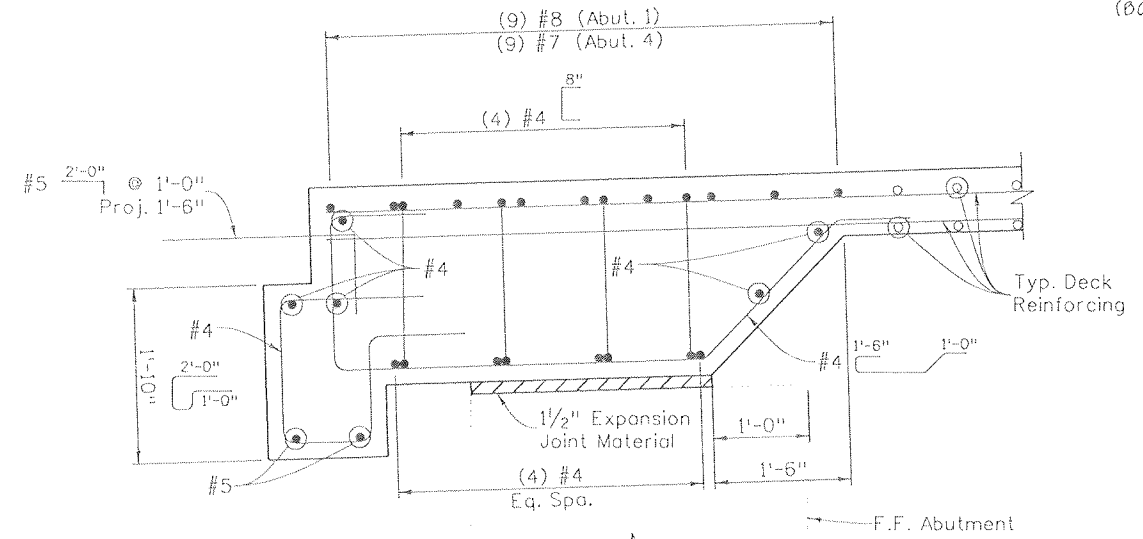

SECTION B-B

THIS SECTION NOT PLACED @ ABUT. 4 (BOTH SIDES)

Design		Detail		Quantities	
INITIAL	DATE	INITIAL	DATE	INITIAL	DATE
Designed By	08/08	Checked By	08/08	Checked By	08/08
Checked By	08/08	Checked By	08/08	Checked By	08/08

Print Date: 9/22/2010
 File Name: 16042AG_AbutDiaphragmDet_01.dgn
 Horiz. Scale: 1:1 Vert. Scale: As Noted
 Unit Information 0221 Unit Leader STW

SEMA CONSTRUCTION **WILSON & COMPANY**

Sheet Revisions		
Date:	Comments	Init.


Colorado Department of Transportation
 3803 North Main Avenue
 Suite 200
 Durango, CO 81301
 Phone: 970-385-1440 FAX: 970-385-8365

DOT DEPARTMENT OF TRANSPORTATION
 Region 5 EJA

As Constructed	
No Revisions:	
Revised:	9/10
Void:	


US 550 OVER US 160 ABUTMENT DIAPHRAGM DETAILS			
Designer:	B. Allen	Structure	P-05-AG
Detailer:	D. Anderson	Numbers	
Sheet Subset:	Bridge	Subset Sheets:	B14 of B38

Project No./Code	
NH 1602-114	
16042	
Sheet Number	205

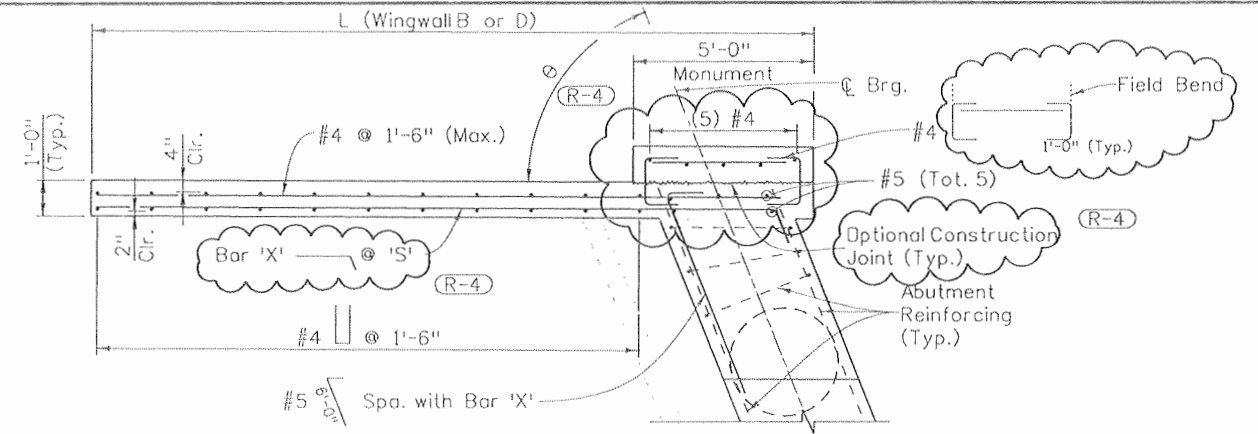


Wingwall	L	Bar 'X'	'S'	θ	Elev. A	Elev. B	Elev. C	Elev. D
A	22'-8"	#6	5"	68° 20' 43"	6676.84	6689.68	6690.32	6694.68
B	20'-0"	#5	6"	68° 01' 10"	6676.84	6688.02	6688.53	6693.02
C	16'-4"	#5	6"	78° 43' 26"	6661.97	6672.04	6672.47	6677.04
D	19'-10"	#5	6"	78° 55' 03"	6661.97	6673.94	6675.31	6678.94


NOTE:
All Wingwall and Monument concrete shall be Class D (Bridge), $f'c = 4,500$ psi at 28 days.

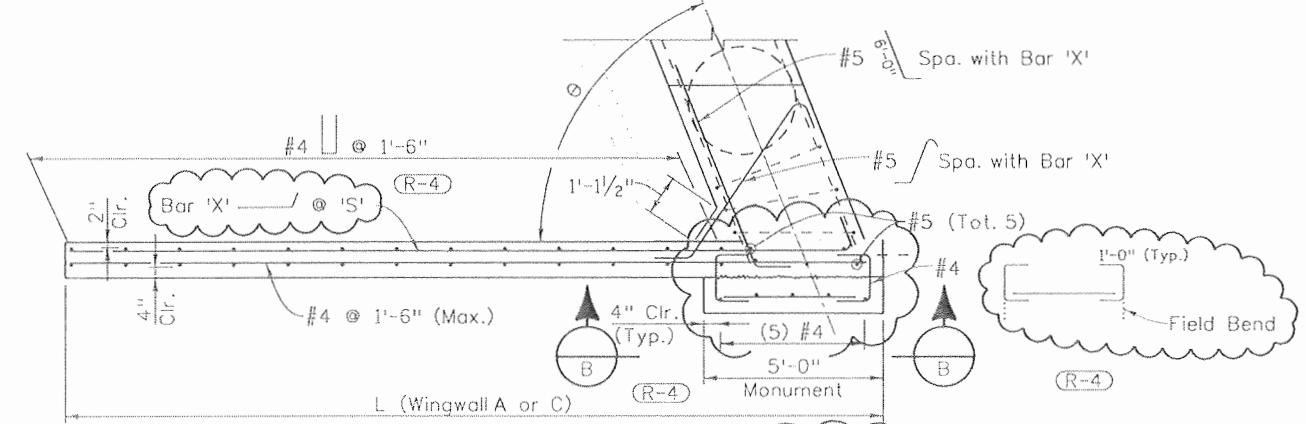


PLAN
(Wingwalls A & B Shown, C and D Similar)

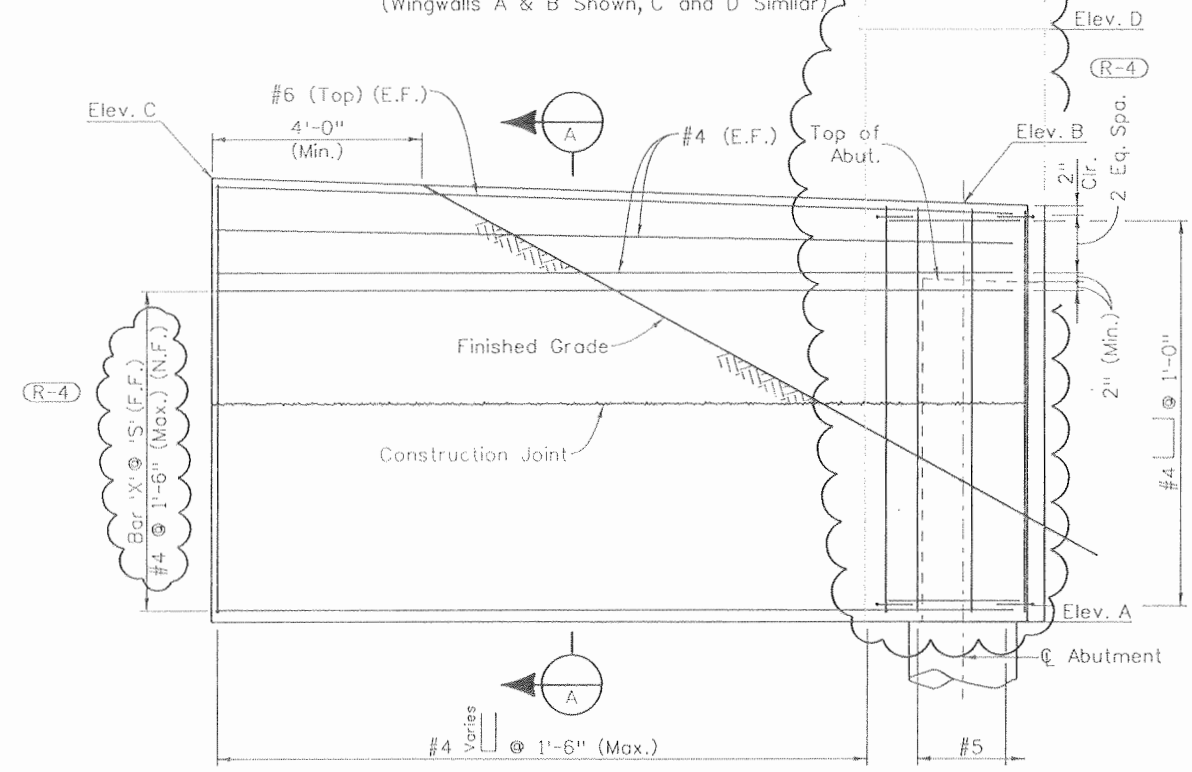

ELEVATION

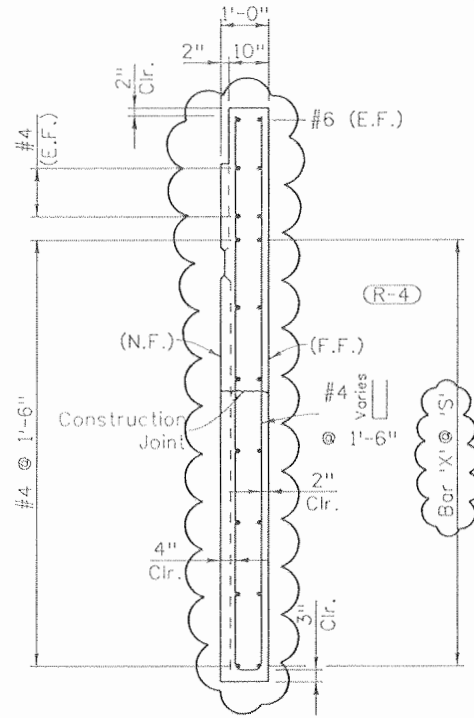

SECTION A

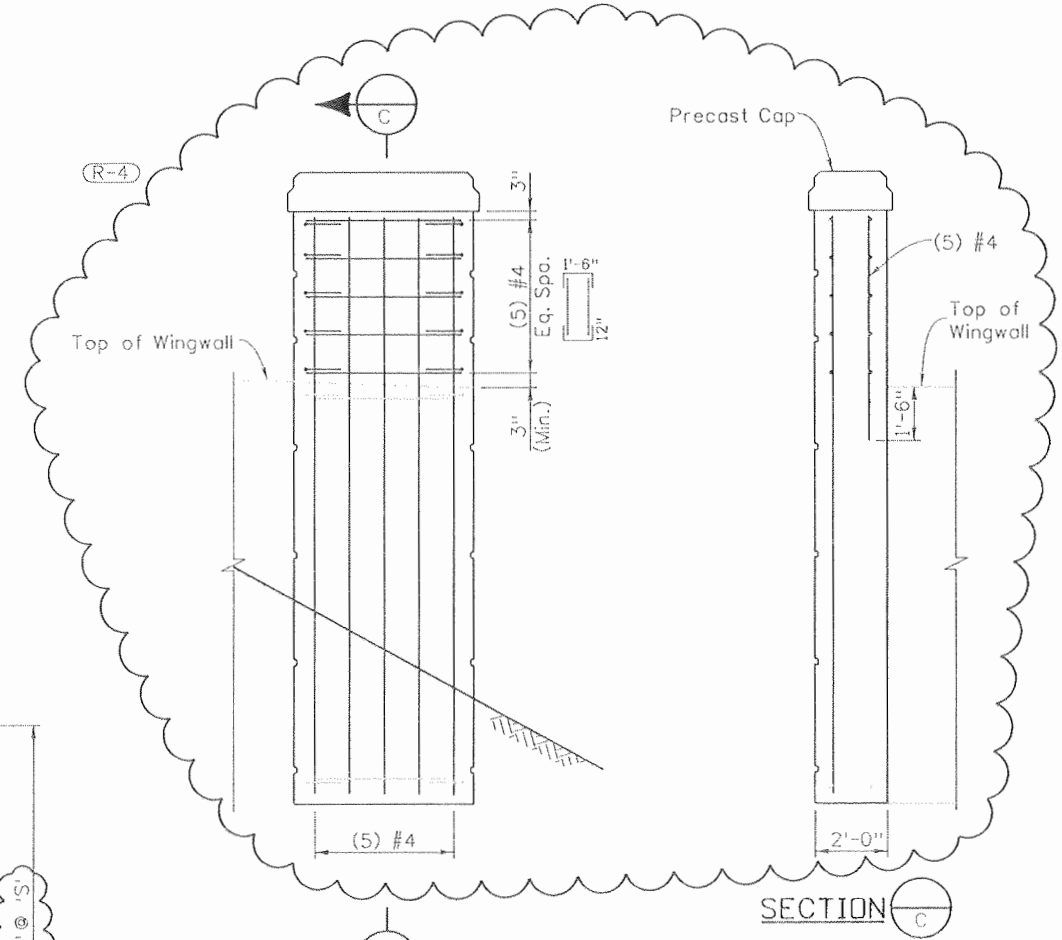

SECTION C

VIEW B

Design		Detail		Quantities	
INITIAL	DATE	INITIAL	DATE	INITIAL	DATE
Designed By	08/08	Detailed By	08/08	Quantities By	08/08
Checked By	08/08	Checked By	08/08	Checked By	08/08
MUN		MUN		MUN	

Print Date: 9/22/2010
File Name: 16042AG_WingwallDet_01.dgn
Horiz. Scale: 1:1 Vert. Scale: As Noted
Unit Information 0221 Unit Leader STW

SEMA CONSTRUCTION **WILSON & COMPANY**

Date:	Comments	Init.
9/29/08	Monument Revisions	BJA


Colorado Department of Transportation
3803 North Main Avenue
Suite 200
Durango, CO 81301
Phone: 970-385-1440 FAX: 970-385-8365

DOT DEPARTMENT OF TRANSPORTATION
Region 5 EJA

No Revisions:	9/10
Revised:	
Void:	

Designer:	B. Allen	Structure Numbers	P-05-AG
Detailer:	D. Anderson	Subset Sheets:	B15 of B38


NH 1602-114
16042
Sheet Number 206

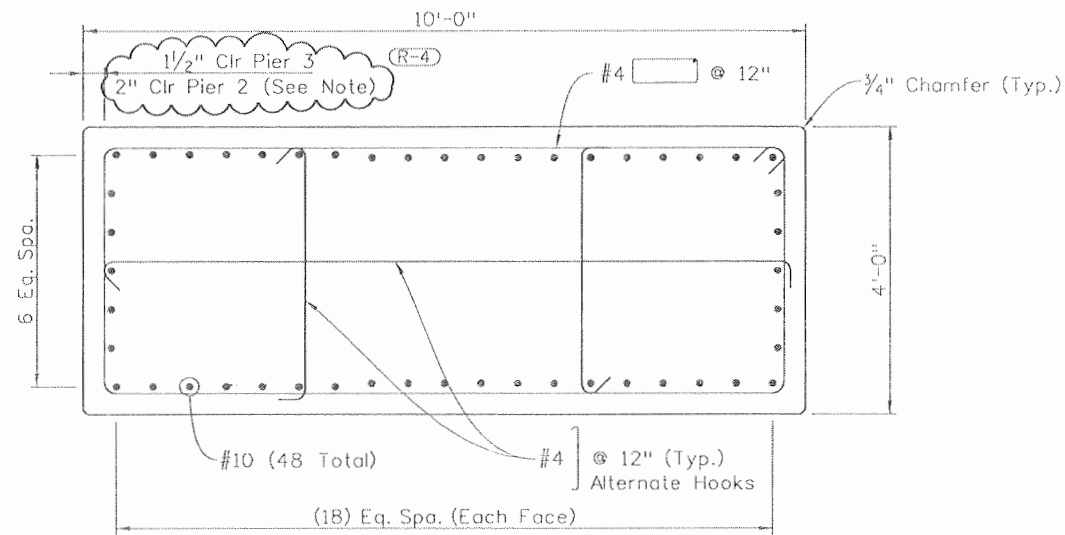


NOTE:

4 1/2" clear above Elevation J.


SECTION A

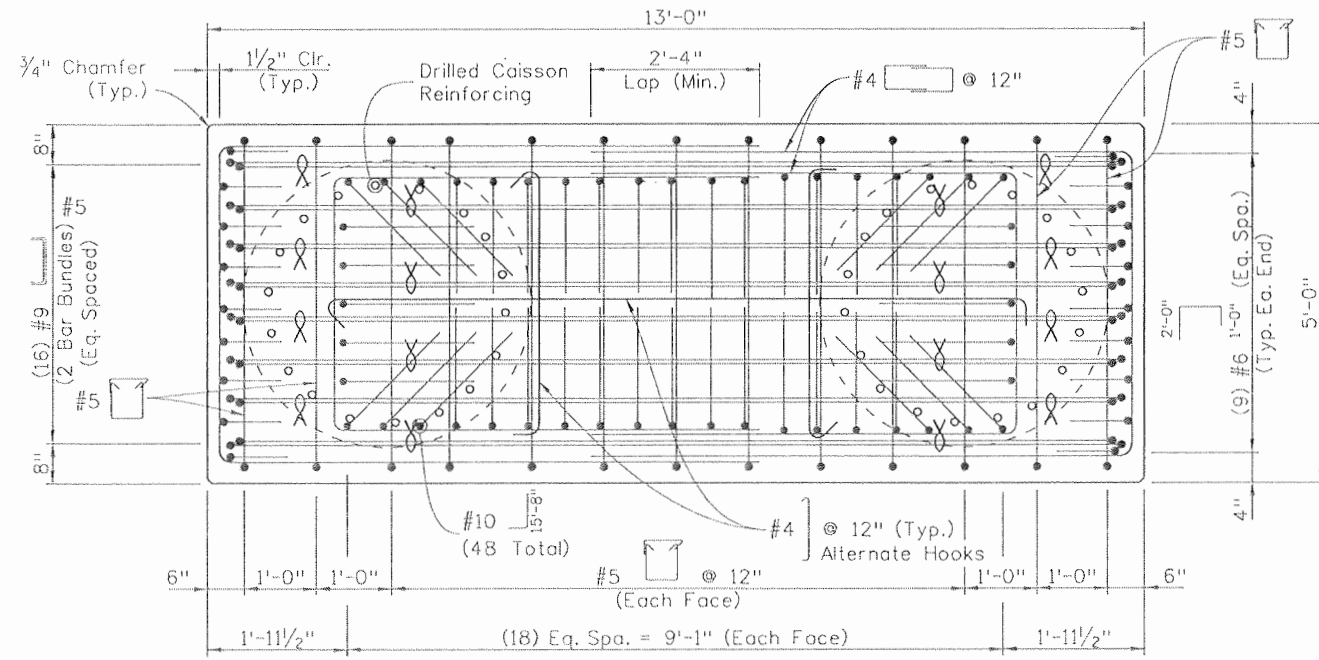


SECTION B

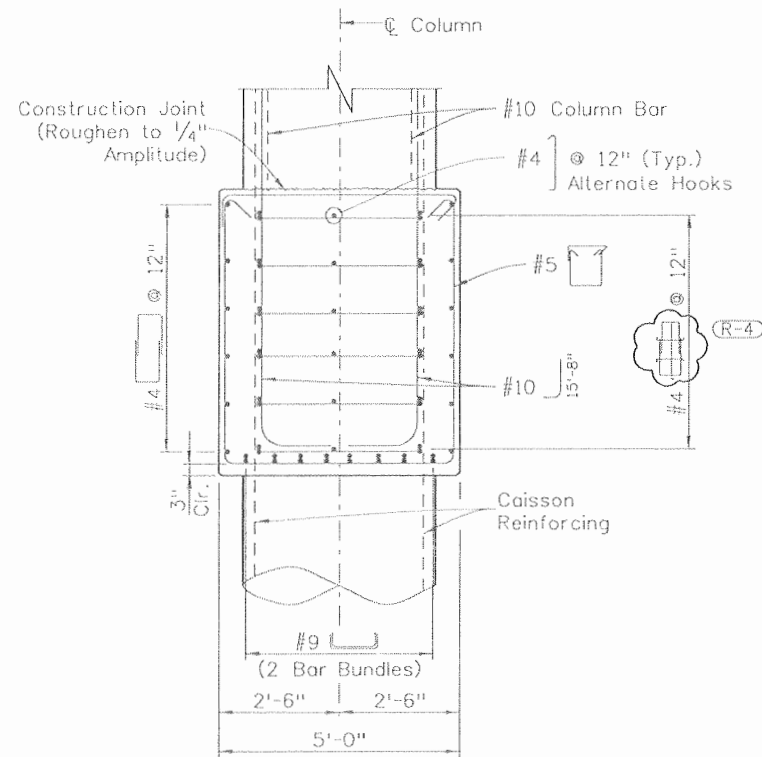

SECTION C

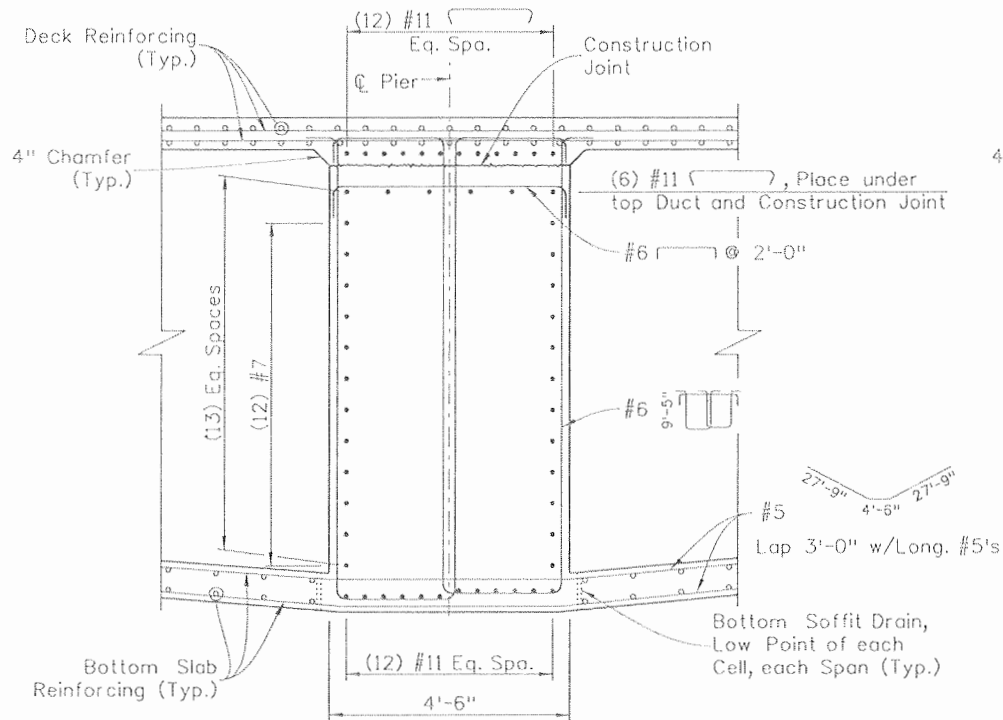

SECTION D

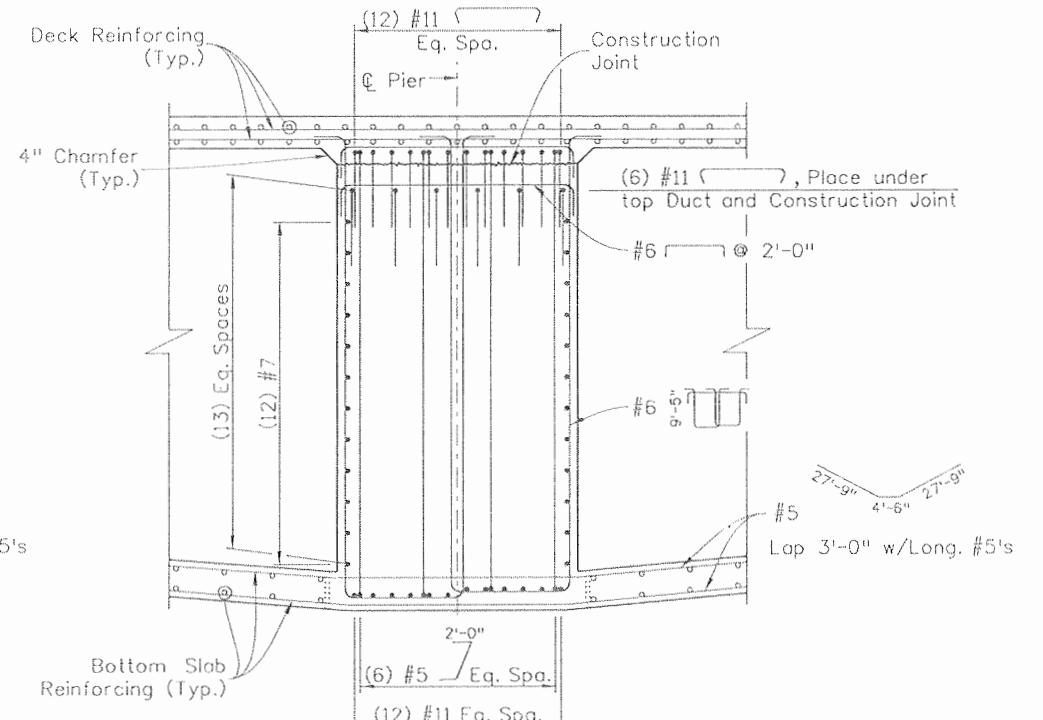

SECTION E

NOTES:

- Column concrete shall be Class D, (Bridge) $f'_c = 4,500$ psi at 28 days.
- All concrete cover is 2" clear unless noted otherwise.

Design		Detail		Quantities	
INITIAL	DATE	INITIAL	DATE	INITIAL	DATE
AML	08/08	DRA	08/08	AML	08/08
MUN	08/08	MUN	08/08	MUN	08/08

Print Date: 9/22/2010
 File Name: 16042AG_Pier23Det_02.dgn
 Horiz. Scale: 1:1 Vert. Scale: As Noted
 Unit Information 0221 Unit Leader STW

SEMA CONSTRUCTION **WILSON & COMPANY**

Sheet Revisions			
Date:	Comments	Init.	
9/30/08	Rebar clearance Pier 2	AML	

Colorado Department of Transportation
 3803 North Main Avenue
 Suite 200
 Durango, CO 81301
 Phone: 970-385-1440 FAX: 970-385-8365


DOT
 DEPARTMENT OF TRANSPORTATION

Region 5 EJA

As Constructed	
No Revisions:	9/10
Revised:	
Void:	

US 550 OVER US 160 PIER 2 AND 3 DETAILS (2 OF 2)			
Designer:	A. Leifheit	Structure Numbers	P-05-AG
Detailer:	D. Anderson	Sheet Subset:	Bridge
Sheet Subset:	Bridge	Subset Sheets:	B17 of B38


Project No./Code	
NH 1602-114	
16042	
Sheet Number	208

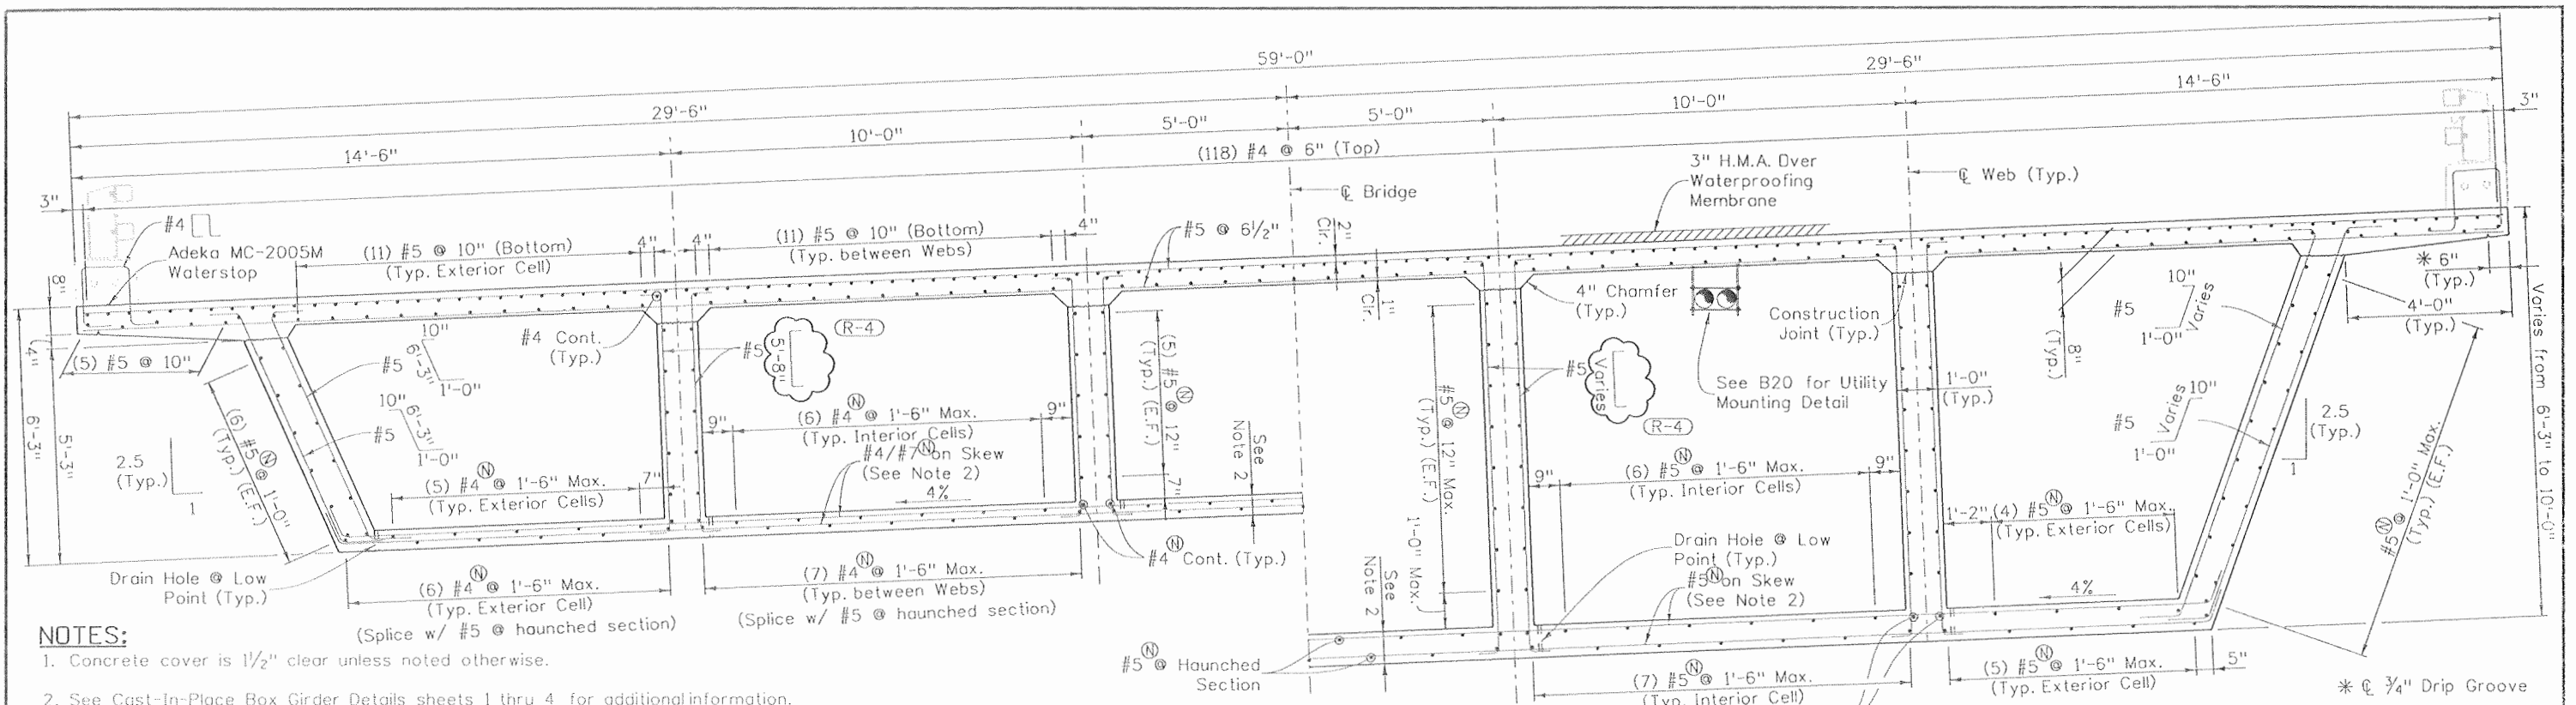

SPAN 1 - TYPICAL SECTION

NOTES:

1. Concrete cover is 1/2" clear unless noted otherwise.
2. See Cast-In-Place Box Girder Details sheets 1 thru 4 for additional information.
3. Superstructure shall be concrete Class D (Bridge), $f'_c = 4,500$ psi at 28 days.
4. Refer to De-icing Plans for locations of conduits, blockouts, and pavement monitoring device.

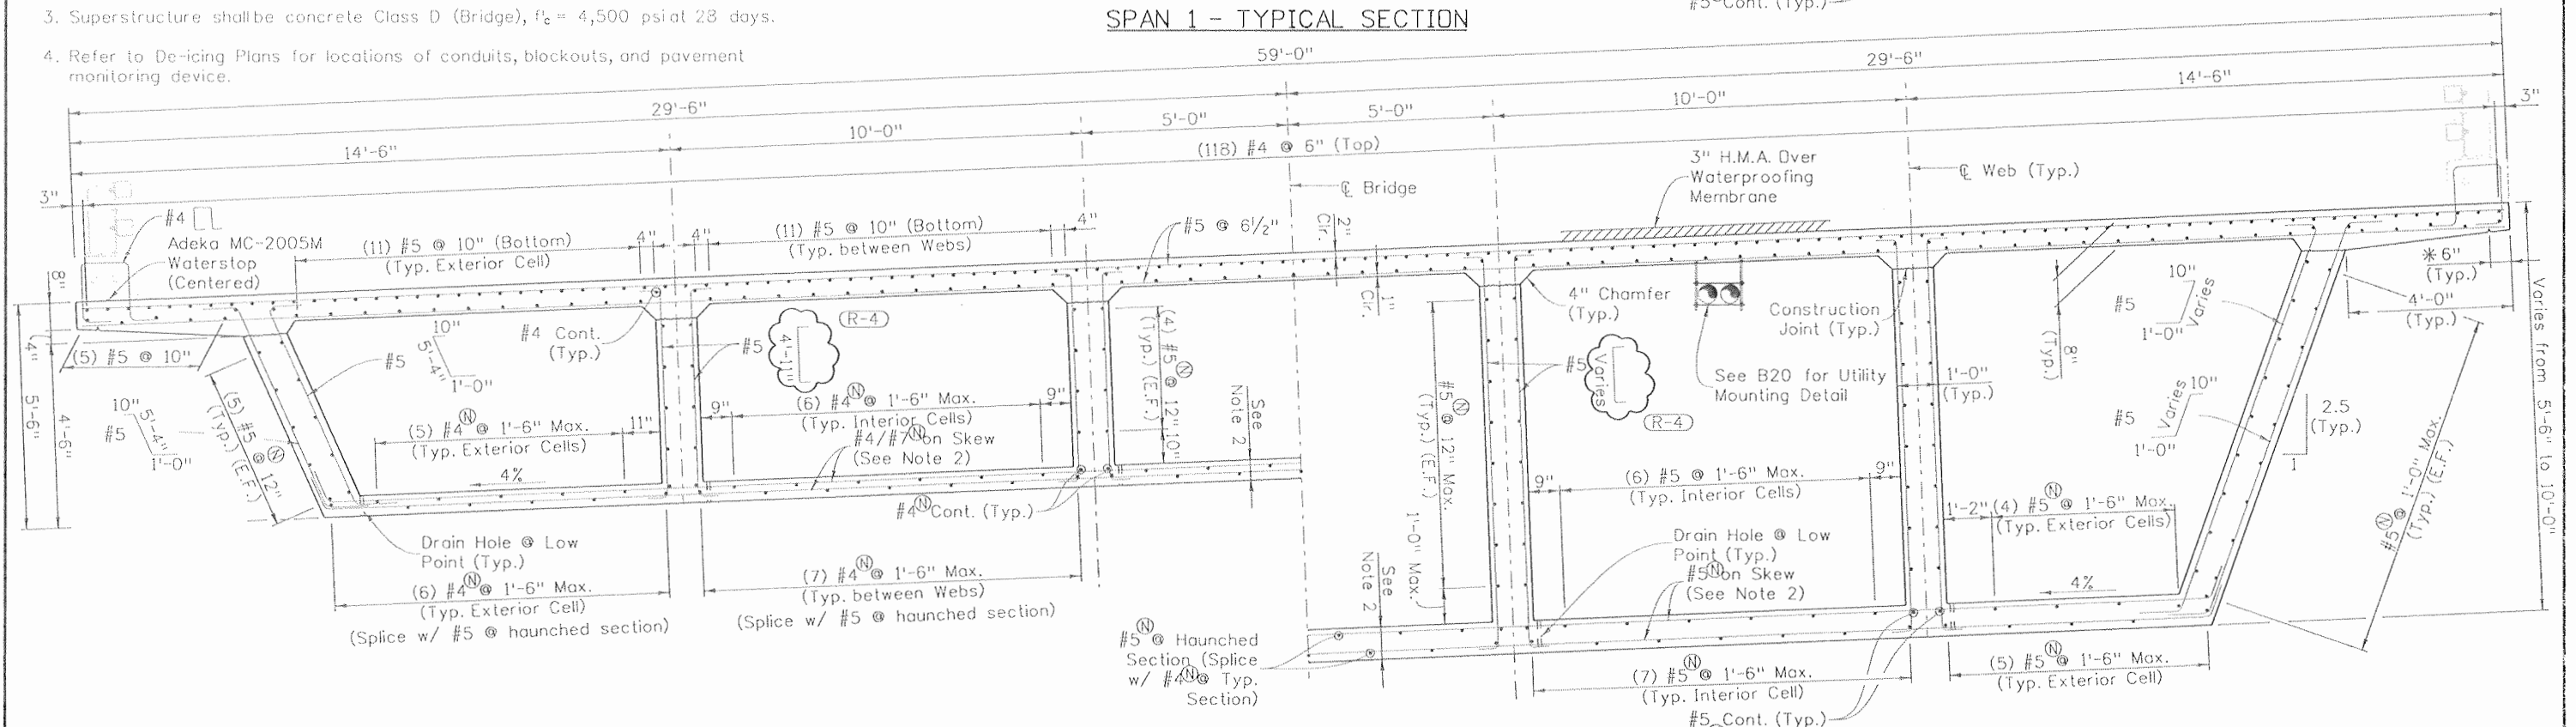

SPANS 2 & 3 - TYPICAL SECTION

Design	INITIAL	DATE	DESIGNED BY	CHECKED BY
	MJN	08/08	GWK	GWK
Detail	INITIAL	DATE	DESIGNED BY	CHECKED BY
	MJN	08/08	GWK	GWK
Quantities	INITIAL	DATE	QUANTITIES BY	CHECKED BY
	MJN	08/08	GWK	GWK

Print Date: 9/22/2010	
File Name: 16042AG_SupStrSecs_01.dgn	
Horiz. Scale: 1:1 Vert. Scale: As Noted	
Unit Information 0221 Unit Leader STW	

Sheet Revisions		
Date:	Comments	Init.
9/30/08	Standard hooks on stirrups	AML


Colorado Department of Transportation

3803 North Main Avenue
Suite 200
Durango, CO 81301
Phone: 970-385-1440 FAX: 970-385-8365


Region 5 EJA

As Constructed
No Revisions:
Revised: 9/10
Void:

US 550 OVER US 160 SUPERSTRUCTURE DETAILS			
Designer: M. Nork	Structure: P-05-AG	Project No./Code: NH 1602-114	
Detailer: D. Anderson	Numbers:	16042	
Sheet Subset: Bridge	Subset Sheets: B18 of B38	Sheet Number: 209	

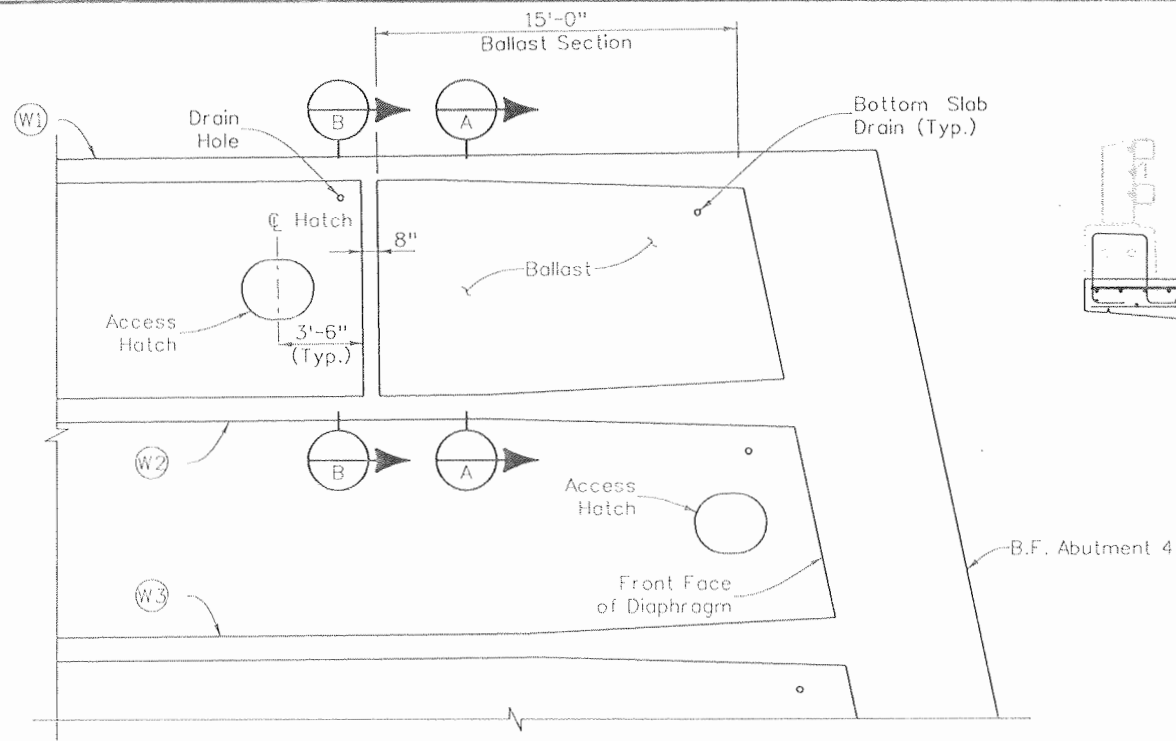


EXTERIOR CELL BALLAST DETAIL

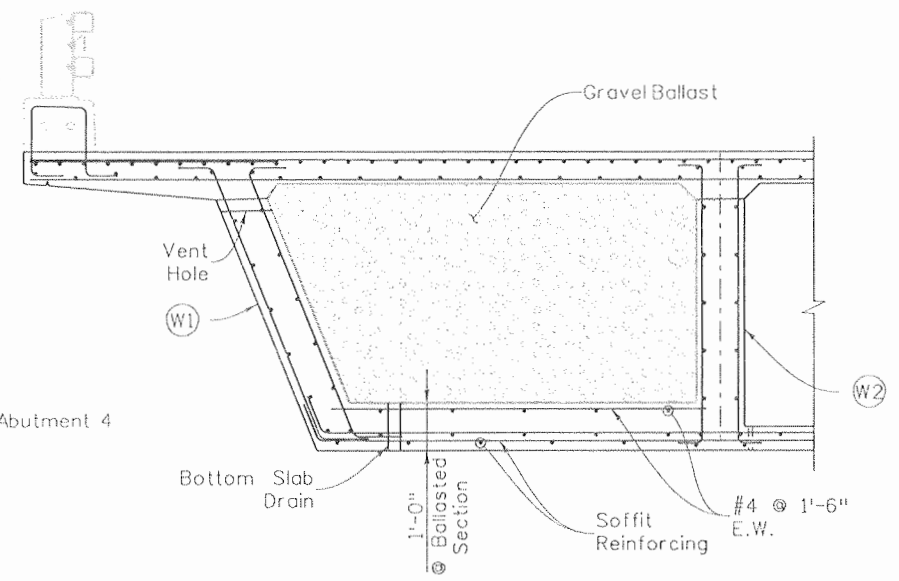


SECTION A

NOTE
Gravel ballast shall have a unit weight of 130 pcf or greater.

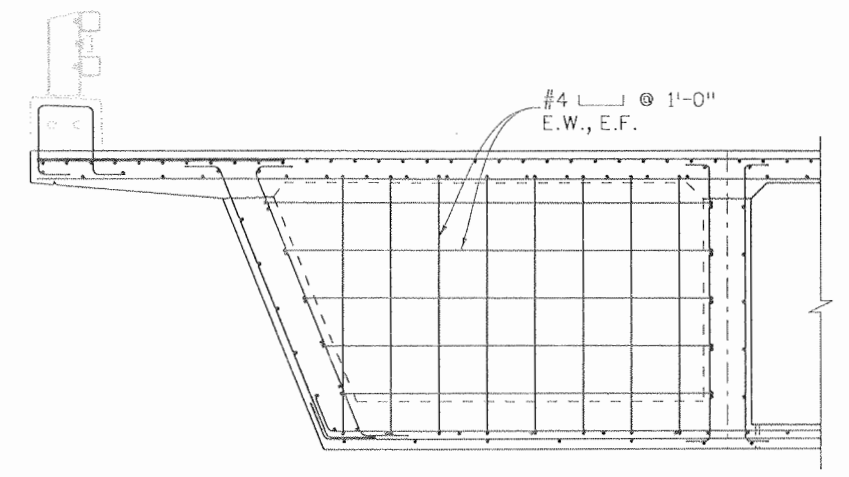


SECTION B

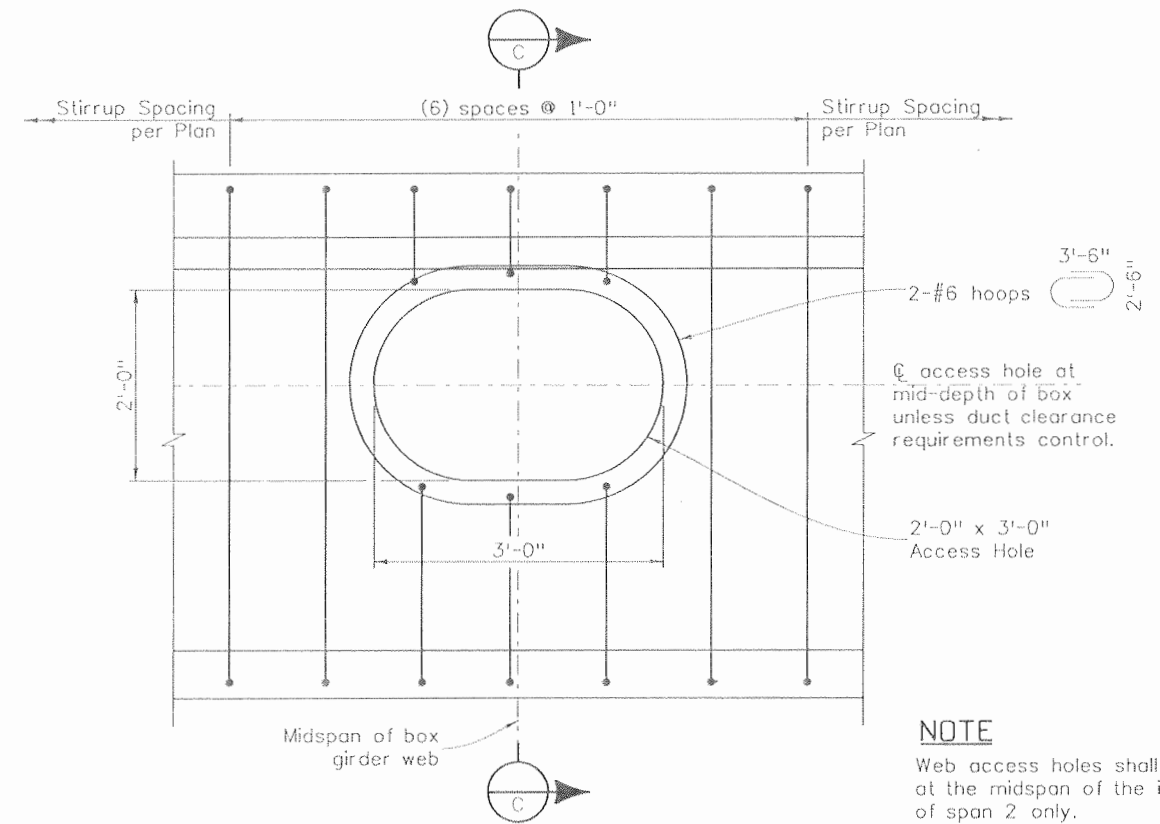


ELEVATION

Access Hole thru Interior Web at Midspan (Span 2)

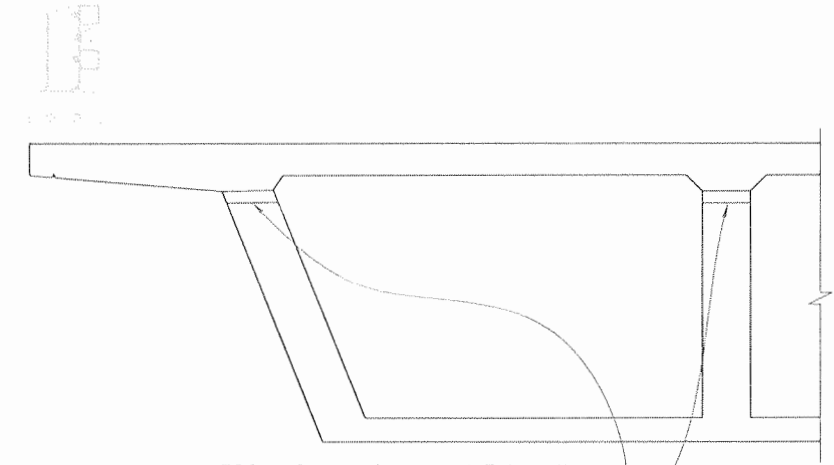

VENT HOLE DETAIL

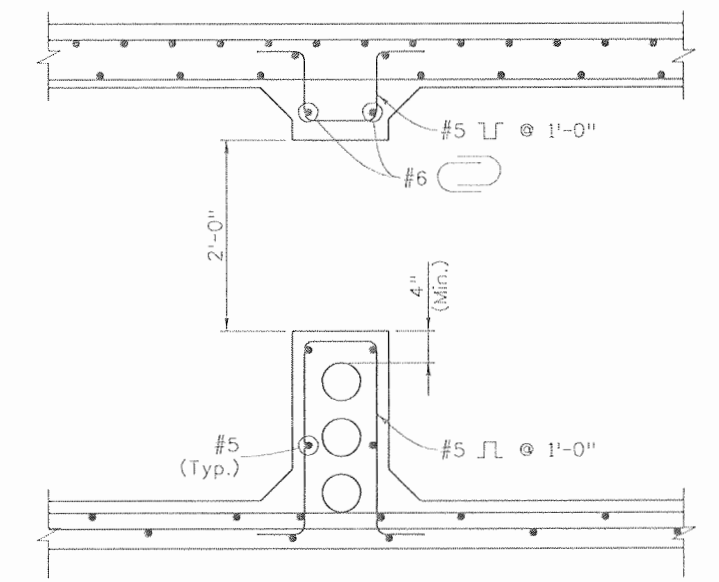

SECTION C

Design		Detail		Quantities	
INITIAL	DATE	INITIAL	DATE	INITIAL	DATE
AML	08/08	AML	08/08	AML	08/08
MUN	08/08	MUN	08/08	MUN	08/08

Print Date: 9/22/2010	File Name: 16042AG_MiscDetails_01.dgn
Horiz. Scale: 1:1	Vert. Scale: As Noted
Unit Information 0221	Unit Leader STW
SEMA CONSTRUCTION	WILSON & COMPANY


Sheet Revisions		
Date:	Comments	Init.

Colorado Department of Transportation
3803 North Main Avenue
Suite 200
Durango, CO 81301
Phone: 970-385-1440 FAX: 970-385-8365
Region 5 EJA

As Constructed	No Revisions: 9/10
Revised:	
Void:	

US 550 OVER US 160 MISCELLANEOUS SUPERSTRUCTURE DETAILS	
Designer: A. Leifheit	Structure: P-05-AG
Detailer: R. Artman	Numbers:
Sheet Subset: Bridge	Subset Sheets: B19 of B38

Project No./Code	NH 1602-114
	16042
Sheet Number	210

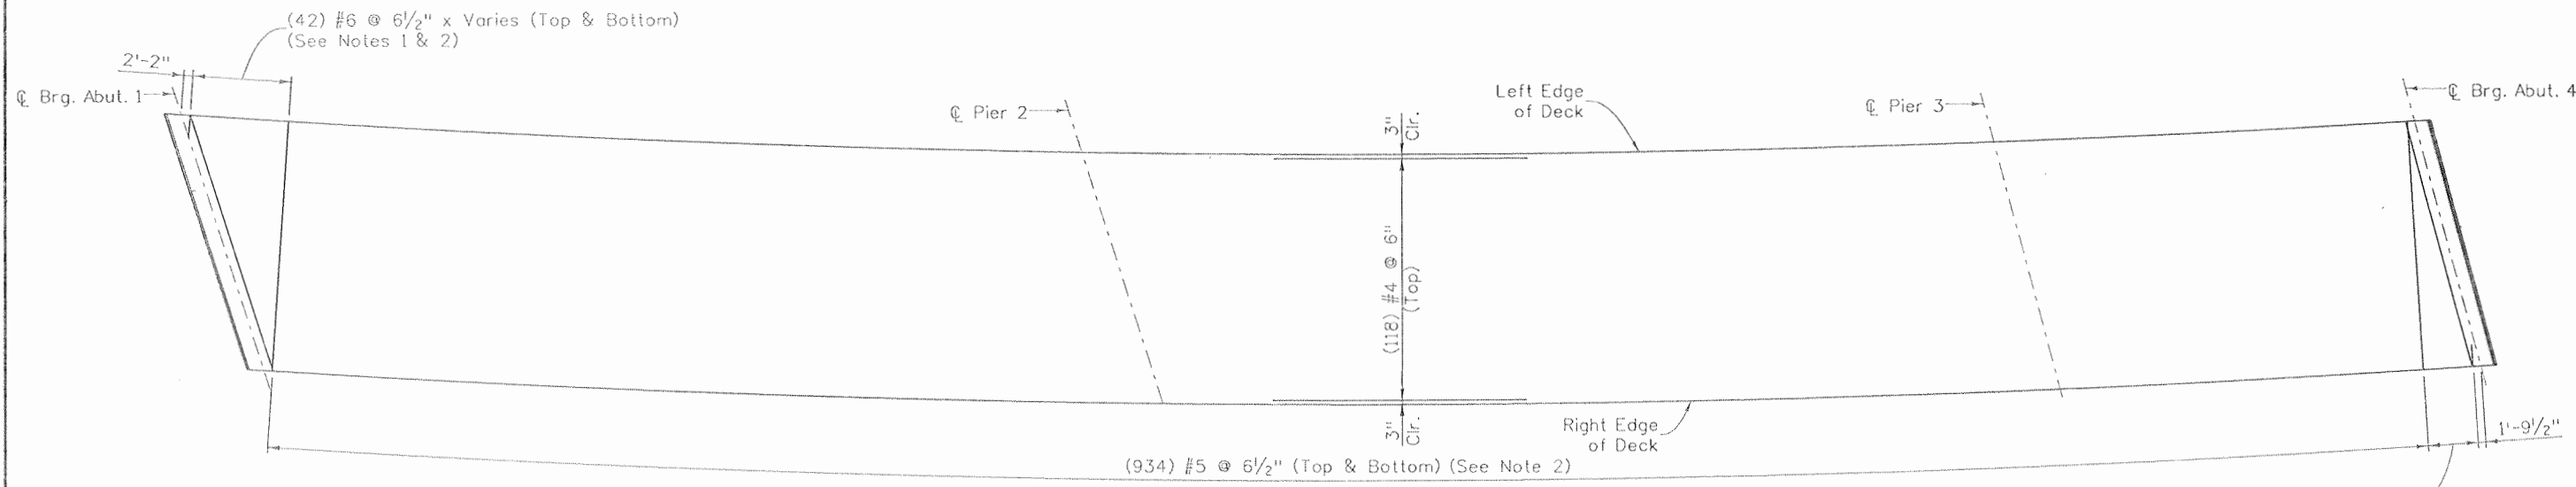


NOTES:


1. Project deck reinforcing 2'-0" minimum into abutment diaphragm.
2. Place transverse reinforcement radially, measuring spacing along centerline bridge.

DECK REINFORCING PLAN

Design	INITIAL	DATE	DESIGNED BY	CHECKED BY
	AWL	05/08	GWK	GWK
Detail	INITIAL	DATE	DESIGNED BY	CHECKED BY
	AWL	05/08	GWK	GWK
Quantities	INITIAL	DATE	DESIGNED BY	CHECKED BY
	AWL	05/08	GWK	GWK

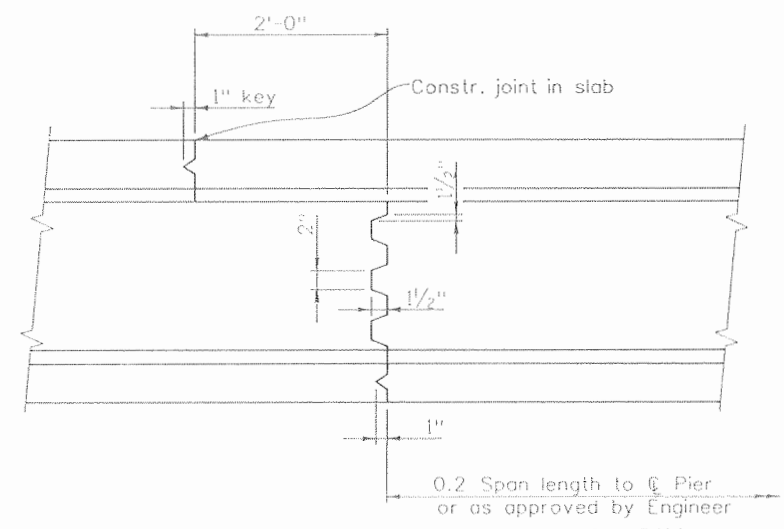

TRANSVERSE WEB CONSTRUCTION JOINT

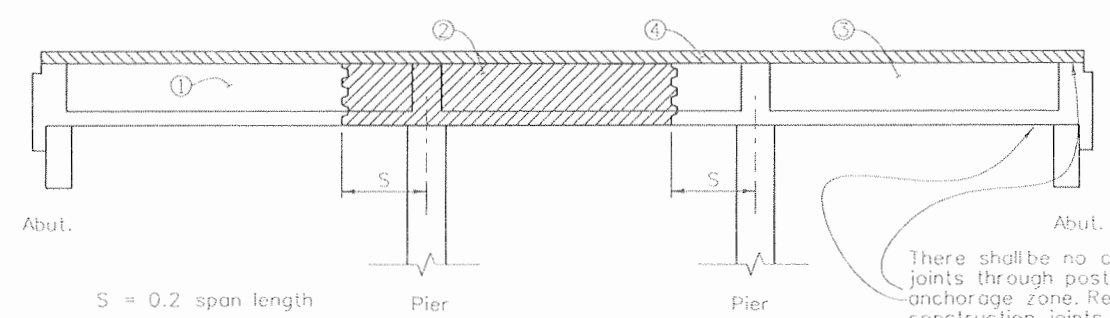


SUPERSTRUCTURE PLACING SCHEDULE


Numbers ①, ②, and ③ indicate sequence of placing bottom slab and web concrete when each section constitutes a separate pour. ④ may be placed continuously or in parts, as indicated above and as approved by the Engineer. Contractor may submit an alternate placing schedule to the Engineer for approval.

CONSTRUCTION JOINT LOCATIONS FOR WEBS AND SOFFIT


270+53.00
269+70.00
268+04.50
267+58.50
266+90.75

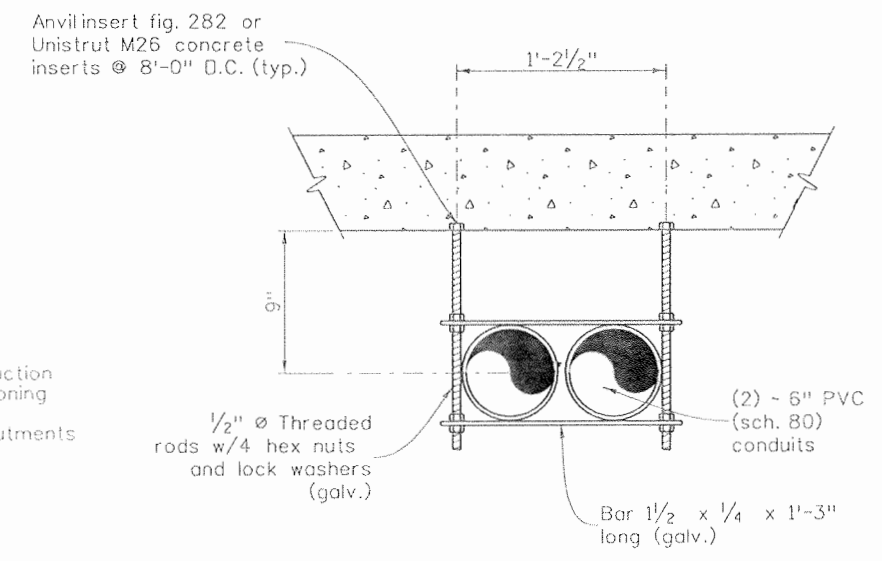

Print Date: 9/22/2010	<table border="1"> <tr><th colspan="3">Sheet Revisions</th></tr> <tr><th>Date:</th><th>Comments</th><th>Init.</th></tr> <tr><td> </td><td> </td><td> </td></tr> <tr><td> </td><td> </td><td> </td></tr> <tr><td> </td><td> </td><td> </td></tr> </table>	Sheet Revisions			Date:	Comments	Init.										Colorado Department of Transportation 3803 North Main Avenue Suite 200 Durango, CO 81301 Phone: 970-385-1440 FAX: 970-385-8365 Region 5	As Constructed No Revisions: 9/10 Revised: Void:	US 550 OVER US 160 DECK REINFORCING PLAN Designer: A. Leifheit Detailer: D. Anderson Sheet Subset: Bridge		Project No./Code NH 1602-114	
Sheet Revisions																						
Date:	Comments	Init.																				
File Name: 16042AG_SupStrReinfPlan_01.dgn Horiz. Scale: 1:40 Unit Information 0221 	Vert. Scale: As Noted Unit Leader STW 	3803 North Main Avenue Suite 200 Durango, CO 81301 Phone: 970-385-1440 FAX: 970-385-8365 EJA	Structure: P-05-AG Numbers: Subset Sheets: B20 of B38	16042 Sheet Number 211																		

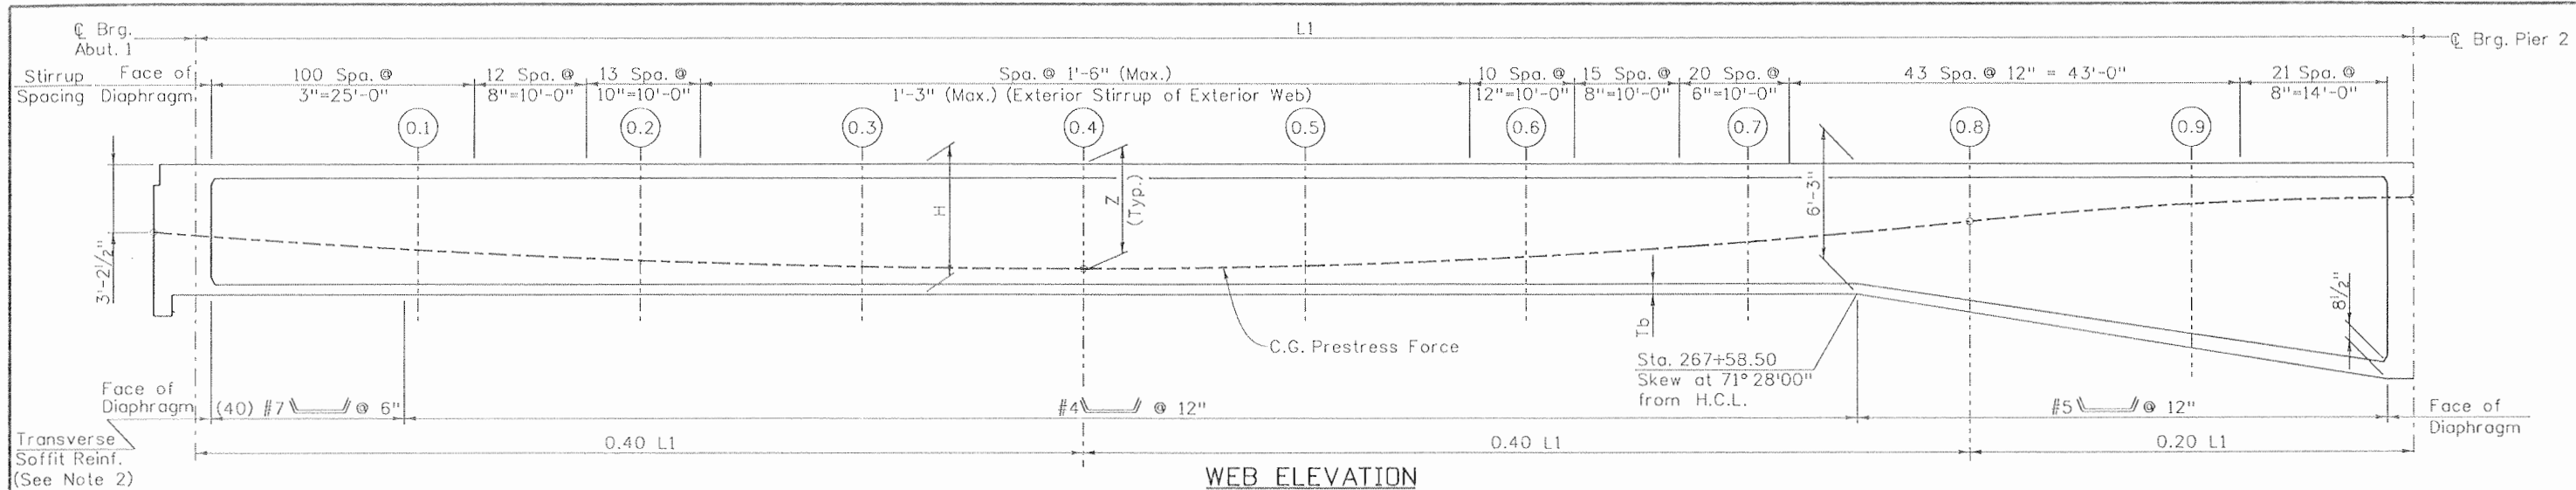

Item	End	Location									
		0.1	0.2	0.3	0.4	0.5	0.6	0.7	0.8	0.9	Pier 2
H (ft)	6.25	6.25	6.25	6.25	6.25	6.25	6.25	6.25	7.04	8.61	10.00
Tb (in)	6.00	6.00	6.00	6.00	6.00	6.00	6.00	6.00	6.53	7.57	8.50
Z (ft)	3.21	4.08	4.59	4.89	5.00	4.86	4.44	3.74	2.76	1.92	1.64
Deflection (in)	0.00	1.26	2.46	3.36	3.77	3.66	3.11	2.27	1.44	0.74	0.00

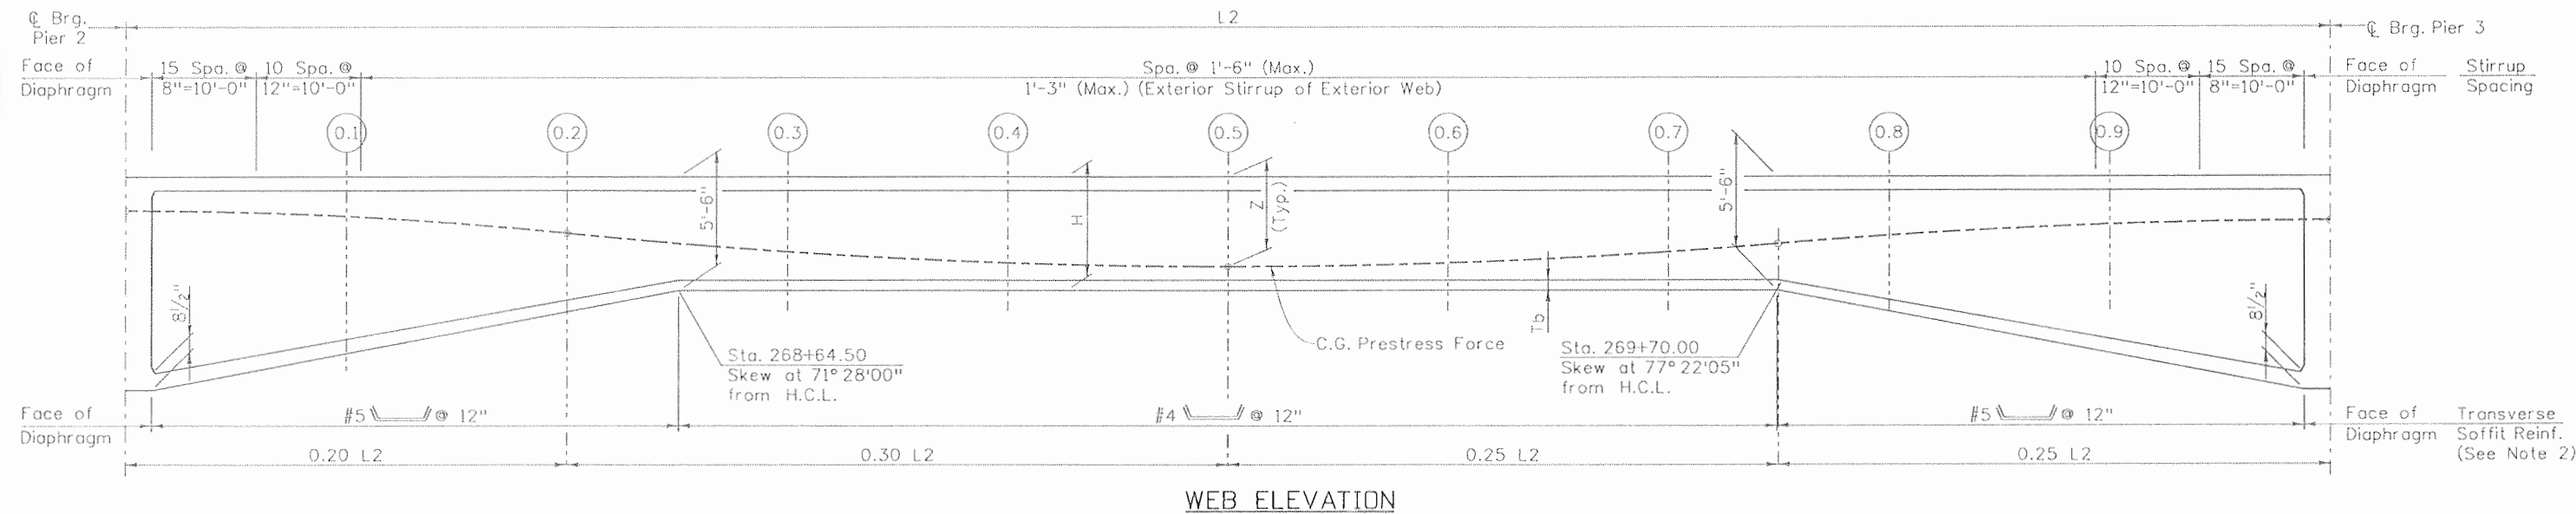

Item	Pier 2	Location									Pier 3
		0.1	0.2	0.3	0.4	0.5	0.6	0.7	0.8	0.9	
H (ft)	10.00	8.33	6.45	5.50	5.50	5.50	5.50	5.50	6.45	8.33	10.00
Tb (in)	8.50	7.57	6.53	6.00	6.00	6.00	6.00	6.00	6.53	7.57	8.50
Z (ft)	1.64	1.91	2.72	3.61	4.15	4.33	4.16	3.63	2.84	2.31	2.14
Deflection (in)	0.00	-0.30	-0.69	-0.73	-0.39	0.06	0.41	0.58	0.63	0.51	0.00

- NOTES:**
- See B22 for web length's L1, L2 and L3.
 - Place soffit reinforcing along skew.

Design	INITIAL	DATE	DESIGNED BY	CHECKED BY
	AML	08/08	AML	GWK
	AML	08/08	AML	GWK
	GWK	08/08	GWK	GWK
Detail	INITIAL	DATE	DESIGNED BY	CHECKED BY
	AML	08/08	AML	GWK
	AML	08/08	AML	GWK
	GWK	08/08	GWK	GWK
Quantities	INITIAL	DATE	DESIGNED BY	CHECKED BY
	AML	08/08	AML	GWK
	AML	08/08	AML	GWK
	GWK	08/08	GWK	GWK

Print Date: 9/22/2010
 File Name: 16042AG_CIPPTBoxGirder_01.dgn
 Horiz. Scale: 1:1 Vert. Scale: As Noted
 Unit Information 0221 Unit Leader STW

SEMA CONSTRUCTION
WILSON & COMPANY

Sheet Revisions		
Date:	Comments	Init.

Colorado Department of Transportation
 3803 North Main Avenue
 Suite 200
 Durango, CO 81301
 Phone: 970-385-1440 FAX: 970-385-8365

DOT
 DEPARTMENT OF TRANSPORTATION


Region 5 EJA

As Constructed	No Revisions: 9/10
Revised:	
Void:	

US 550 OVER US 160
 CAST-IN-PLACE POST-TENSIONED
 BOX GIRDER (1 OF 4)

Designer: A. Leifheit Structure: P-05-AG
 Detailer: D. Anderson Numbers:
 Sheet Subset: Bridge Subset Sheets: B21 of B38

Project No./Code	NH 1602-114
	16042
Sheet Number	212

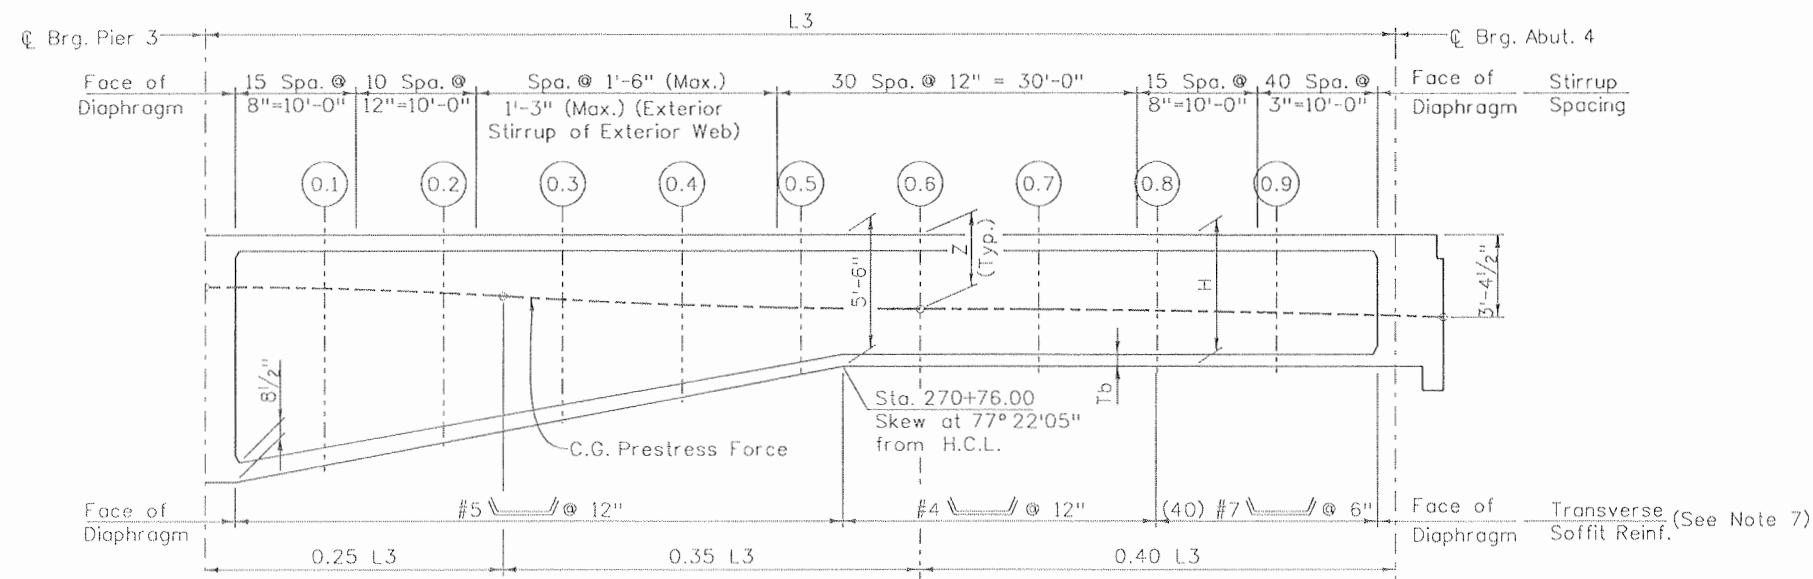


WEB ELEVATION

Item	Location										
	Pier 3	0.1	0.2	0.3	0.4	0.5	0.6	0.7	0.8	0.9	End
H (ft)	10.00	9.34	8.46	7.57	6.69	5.81	5.50	5.50	5.50	5.50	5.50
Tb (in)	8.50	8.13	7.64	7.15	6.63	6.17	6.00	6.00	6.00	6.00	6.00
Z (ft)	2.14	2.20	2.39	2.68	2.90	3.04	3.06	3.10	3.15	3.23	3.38
Deflection (in)	0.00	-0.13	-0.38	-0.63	-0.85	-1.03	-1.08	-1.00	-0.80	-0.48	0.00

Web Lengths

Web. No.	L1 (ft)	L2 (ft)	L3 (ft)
1	211.85	214.32	99.05
2	211.77	213.71	99.04
3	211.70	213.13	99.03
4	211.62	212.55	99.02
5	211.55	211.97	99.01
6	211.49	211.43	99.00

Web Lengths are Measured from C. Brg. to C. Pier and from C. Pier to C. Pier .

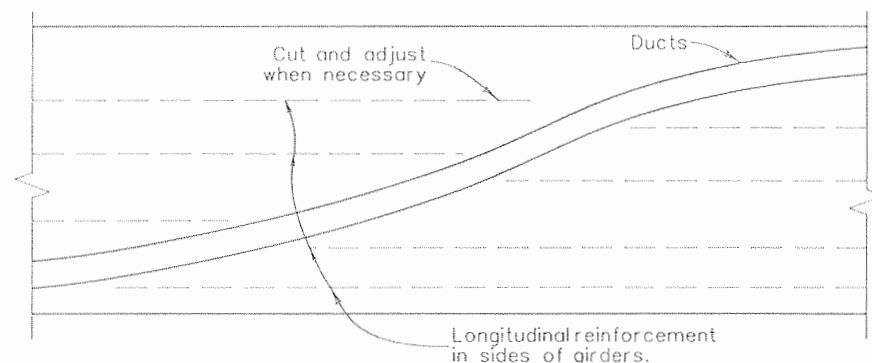

ADJUSTED GIRDER REINFORCING ELEVATION

NOTES:

1. Reinforcing that interferes with the prestressing tendon alignment shall be adjusted as approved by the Engineer.
2. Reinforcing shall be continuous through all construction joints.
3. Where dead end anchorage and tendons are accessible, the anchorage system and length of projecting prestressing steel shall permit jacking with the same jacking equipment that was used on the live end.
4. Deviations from the duct pattern, duct size, and strand size assumed in the design must be approved by the Engineer.
5. The deflection shown is positive downward. It includes the effects of dead load and prestressing, and the long term effects of creep. Formed web elevations must be adjusted upward for an indicated positive deflection.
6. Use low-relaxation strands meeting the requirements of ASTM A416 grade 270.
7. Place bottom soffit reinforcing along skew.

STRESSING SEQUENCE:

Tendons shall be jacked from both ends.

No more than $\frac{1}{2}$ of the prestressing force in any web may be stressed before an equal force is stressed in the adjacent webs. At no time during the stressing operations will more than $\frac{1}{6}$ of the total prestressing force be applied eccentrically about the centerline of the structure.

At the Contractors option, the prestressing force may vary $\pm 5\%$ from the theoretical force per web provided the total P(JACK) force is obtained and is distributed symmetrically about the centerline of the typical section. P(JACK) is the sum of the peak forces reached during jacking in each tendon.

DESIGN:

Design is based on $K=0.0002$ and $\mu=0.25$. P(JACK) at the jacking ends includes friction, anchor set of 0.375" at the jacking end, elastic shortening, and provisions for an additional 35 KSI long term loss in stress. Long term loss calculations based on ACI 209.


0.6" diameter low relaxation strands with a "z" offset of 1" in $4\frac{3}{4}$ " O.D. ducts was assumed in the design.


- f'_s = 270 ksi
- f'_c = 4,500 psi at 28 days field compressive strength
- f'_{ci} = 4,000 psi at stressing
- P(JACK) = 19,774 kips
- Aps (min.) = 97.65 in'

The Contractor shall submit elongation and jacking calculations based on $KL + \mu\alpha$ (including anchor set if any) and initial stress (initial stress ratio times jacking stress before long term losses).

Design	INITIAL	DATE	DESIGNED BY	CHECKED BY	DATE	INITIAL	DATE	Quantities	
								AML	GWK
		08/08			08/08				
		08/08			08/08				

Print Date: 9/22/2010	Sheet Revisions			Colorado Department of Transportation 3803 North Main Avenue Suite 200 Durango, CO 81301 Phone: 970-385-1440 FAX: 970-385-8365 Region 5	As Constructed	US 550 OVER US 160		Project No./Code
File Name: 16042AG_CIPPTBoxGirder_01a.dgn	Date:	Comments:	Init.		No Revisions: 9/10	CAST-IN-PLACE POST-TENSIONED BOX GIRDER (2 OF 4)		
Horiz. Scale: 1:1					Revised:	Designer: A. Leifheit	Structure: P-05-AG	16042
Unit Information 0221					Void:	Detailer: D. Anderson	Numbers:	Sheet Number 213
Unit Leader STW				EJA	Sheet Subset: Bridge	Subset Sheets: B22 of B38		

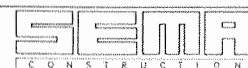

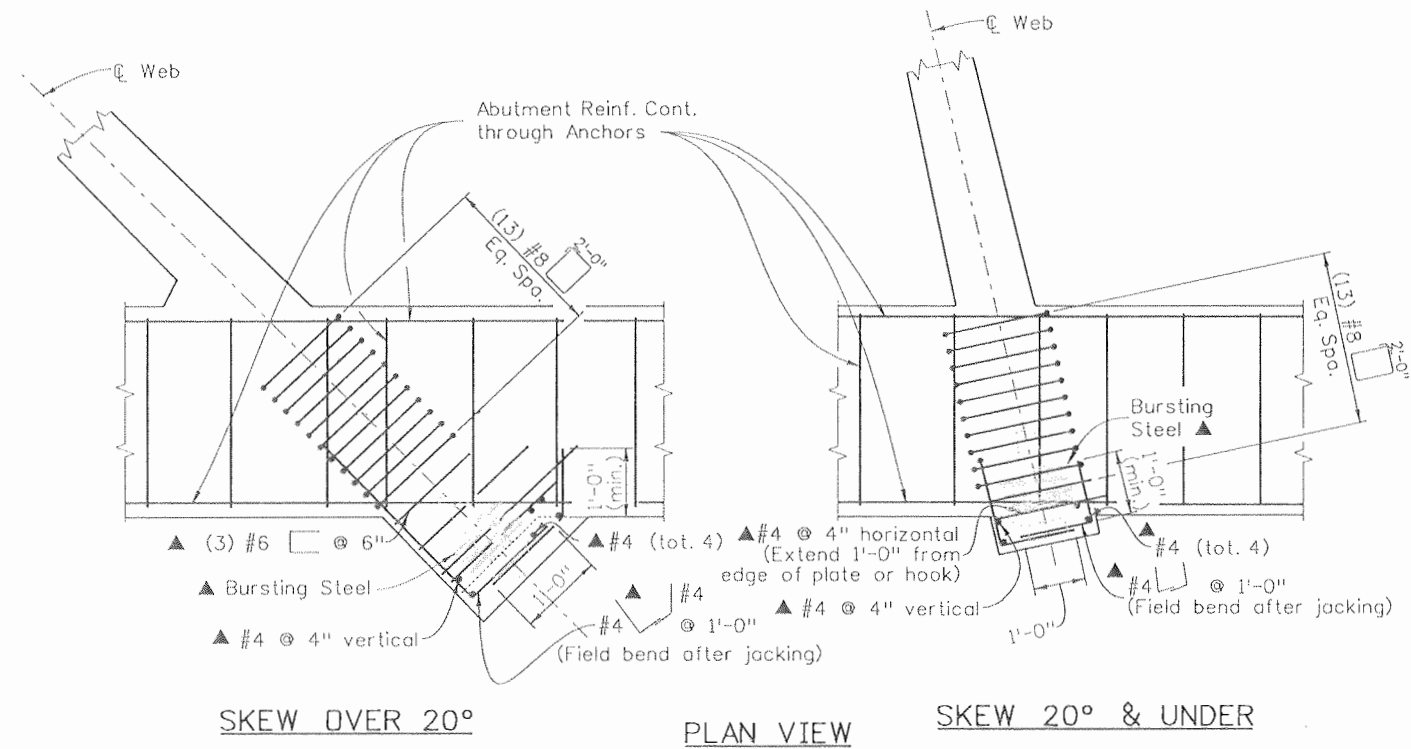

SKEW OVER 20°

PLAN VIEW

SKEW 20° & UNDER


SEAT FOR PRESTRESSED ANCHORAGE AT ABUTMENTS

Cover entire anchorage block with 1" low density polystyrene foam (typ.)

Approach slab notch may be used (typ.)

0" may be used also.

Top of concrete (typ.)

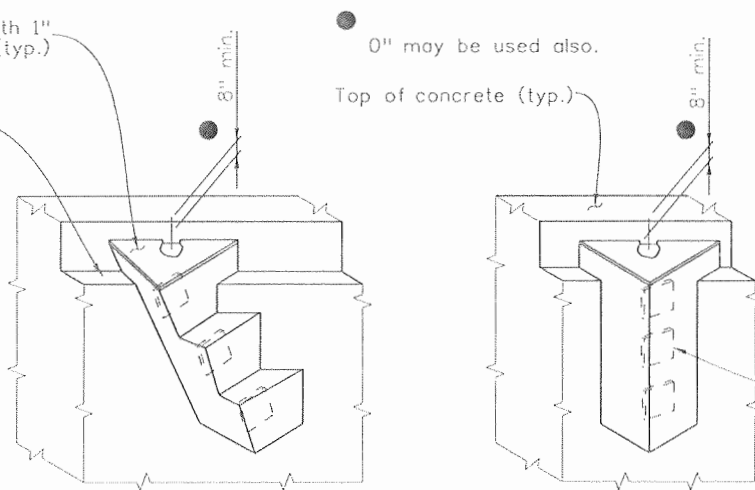

EXT. SLOPING WEB

VERTICAL WEB

TYPICAL ANCHORAGE ILLUSTRATIONS

NOTES:

There shall be no construction joints under post-tensioning anchorages.

A tendon's jacking force shall not exceed 1186 kips.

The following anchorages will be allowed:

1. DSI Multi-Plane MA Anchorages
2. SDI Multistrand Anchorage
3. VSL Type E

Composite (a combination of metal casting and mortar) anchorages shall not be allowed.

All Anchorages shall be of the same type and Manufacturer.

Each anchorage shall be confined within a reinforcing steelspiral and spalling reinforcement. Spalling reinforcement shall consist of #4 @ 4" vertically and horizontally placed in front of the bearing plate. Spiral and spalling reinforcement shall be Grade 60 conforming to the requirements of Section 602, and need not be epoxy coated. Lap splicing of spiral reinforcement is not allowed.

Anchorages and reinforcing steelspirals shall be covered with concrete to provide a minimum of 4 inches of concrete cover. All other reinforcing shall have a minimum of 2" concrete cover.

The minimum distance between the centerline of anchorages shall be as tested and recommended by the manufacturer.

The distance from the edge of bearing plate/ spiral to edge/corner of concrete shall be a minimum of 4", or as tested and recommended by the manufacturer.

All reinforcing steel designated ▲, and additional concrete required in flares not included in explicit details will not be measured and paid for separately but shall be included in Item 618.

See abutment and superstructure details for dimensions and reinforcing steel not shown.

Shop drawings shall be prepared under the supervision (and contain the seal) of a Professional Engineer registered in the State of Colorado and in accordance with the requirements of subsection 618.04 (a) and (c).

Shop drawings shall provide:

1. Bearing plate and spiral steel sizes
2. Reinforcing steel bending diagrams for all rebar designated ▲
3. Coordination of anchorages and anchorage reinforcing with other superstructure rebar
4. All dimensions necessary to form concrete recesses or blisters, and all reinforcing steel designated ▲ in accordance with subsection 618.04(c)(6) and (7).
5. Horizontal and vertical dimensions to place anchorages and ducts.

Design		Detail		Quantities	
INITIAL	DATE	INITIAL	DATE	INITIAL	DATE
AWL	05/08	DRA	05/08	AML	08/08
Checked By		Checked By		Checked By	
GWK	05/08	GWK	08/08	GWK	08/08

Print Date: 9/22/2010
 File Name: 16042AG_CIPPTBoxGirder_04.dgn
 Horiz. Scale: 1:1 Vert. Scale: As Noted
 Unit Information 0221 Unit Leader STW

SEMA CONSTRUCTION
WILSON & COMPANY

Sheet Revisions		
Date:	Comments	Init.

Colorado Department of Transportation
 3803 North Main Avenue
 Suite 200
 Durango, CO 81301
 Phone: 970-385-1440 FAX: 970-385-8365

DOT
 DEPARTMENT OF TRANSPORTATION


Region 5 EJA

As Constructed	
No Revisions:	9/10
Revised:	
Void:	


US 550 OVER US 160 CAST-IN-PLACE POST-TENSIONED BOX GIRDER (4 OF 4)			
Designer:	A. Leifheit	Structure	P-05-AG
Detailer:	D. Anderson	Numbers	
Sheet Subset:	Bridge	Subset Sheets:	B24 of B38

Project No./Code	
NH 1602-114	
16042	
Sheet Number	215

Ahead Station

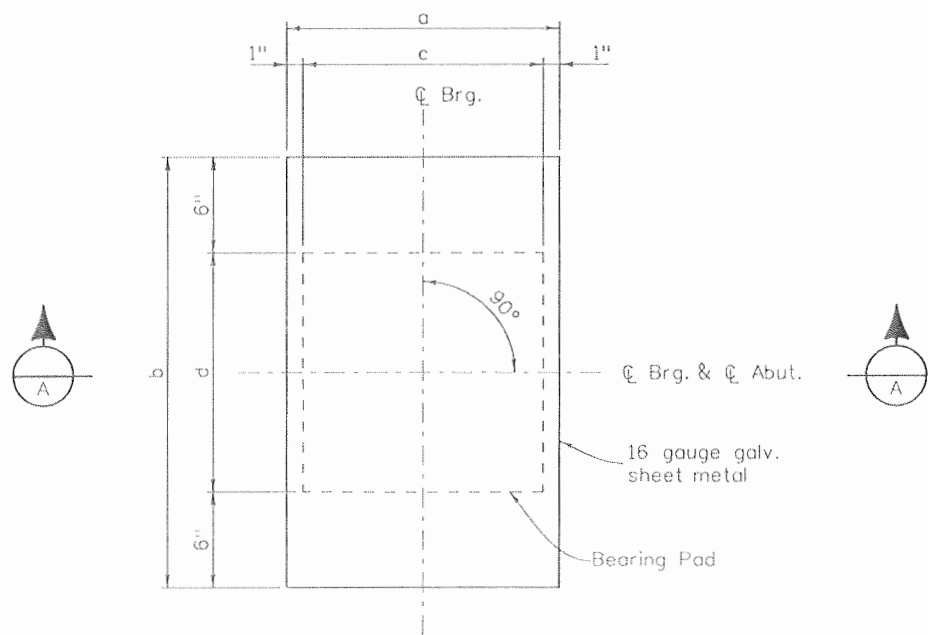


BEARING PLAN

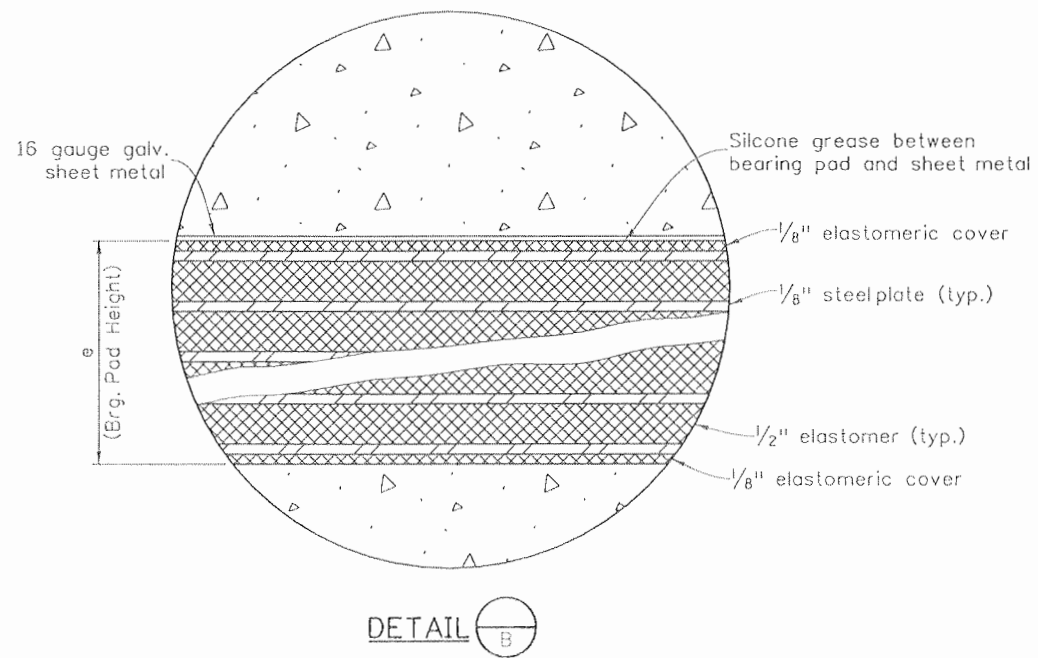

DETAIL B

NOTES

1. AASHTO design method B has been used.
2. Grade 3 elastomer shall be used. A higher grade elastomer may be substituted for Grade 3.
3. Elastomer shall conform to the requirements of AASHTO M251 and Section 18.2 of the AASHTO LRFD Bridge Construction Specifications.
4. The elastomer shear modulus, G, shall be 140 psi +/- 15% per AASHTO M251.
5. Apply a layer to grease to the top of the elastomeric pad immediately prior to placing sheet metal. All grease shall be silicone based.

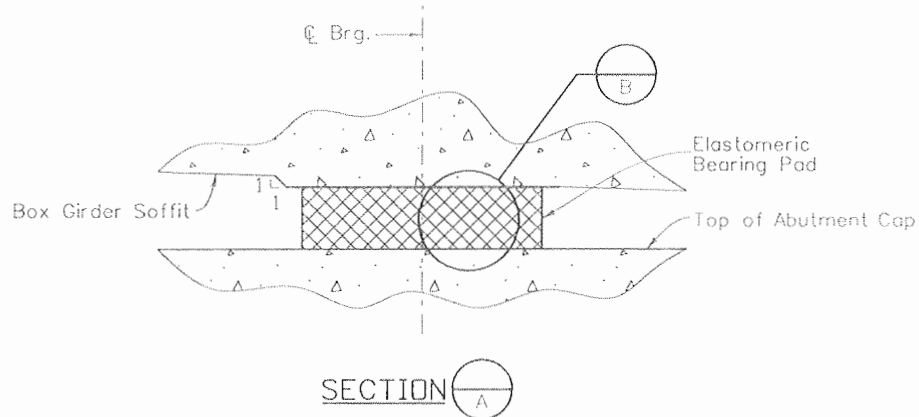

SECTION A

Abutment	Bearing No.	Number Required	Vertical Load per Bearing (kips)	a (in)	b (in)	c (in)	d (in)	e (in)
1	1	1	280	17.00	27.00	15.00	15.00	13.50
1	2-5	4	352	19.00	27.00	17.00	15.00	13.50
1	6	1	675	32.00	26.75	30.00	14.75	13.50
4	1-6	6	286	17.00	26.00	15.00	14.00	7.875

Design	INITIAL		DATE		Design	INITIAL		DATE	
	By	Checked By	08/08	08/08		By	Checked By	08/08	08/08
Designed By	BJA		08/08		Designed By	BJA		08/08	
Checked By	GWK		08/08		Checked By	GWK		08/08	

Print Date: 9/22/2010
 File Name: 16042AG_BrgDeviceType1_01.dgn
 Horiz. Scale: 1:1 Vert. Scale: As Noted
 Unit Information Unit Leader Initials

Sheet Revisions		
Date:	Comments	Init.

Colorado Department of Transportation
 3803 North Main Avenue
 Suite 200
 Durango, CO 81301
 Phone: 970-385-1440 FAX: 970-385-8365
 Region 5 EJA


As Constructed	
No Revisions:	9/10
Revised:	
Void:	

US 550 OVER US 160
 BEARING DEVICE (TYPE I)


Designer:	B. Allen	Structure	P-05-AG
Detailer:	B. Allen	Numbers	
Sheet Subset:	Bridge	Subset Sheets:	B25 of 838

Project No./Code	
NH 1602-114	
16042	
Sheet Number	216


Design		Detail		Quantities	
INITIAL	DATE	INITIAL	DATE	INITIAL	DATE
Designed By BJA	08/08	Detailled By RGA	08/08	Quantities By BJA	08/08
Checked By GWK	08/08	Checked By GWK	08/08	Checked By GWK	08/08

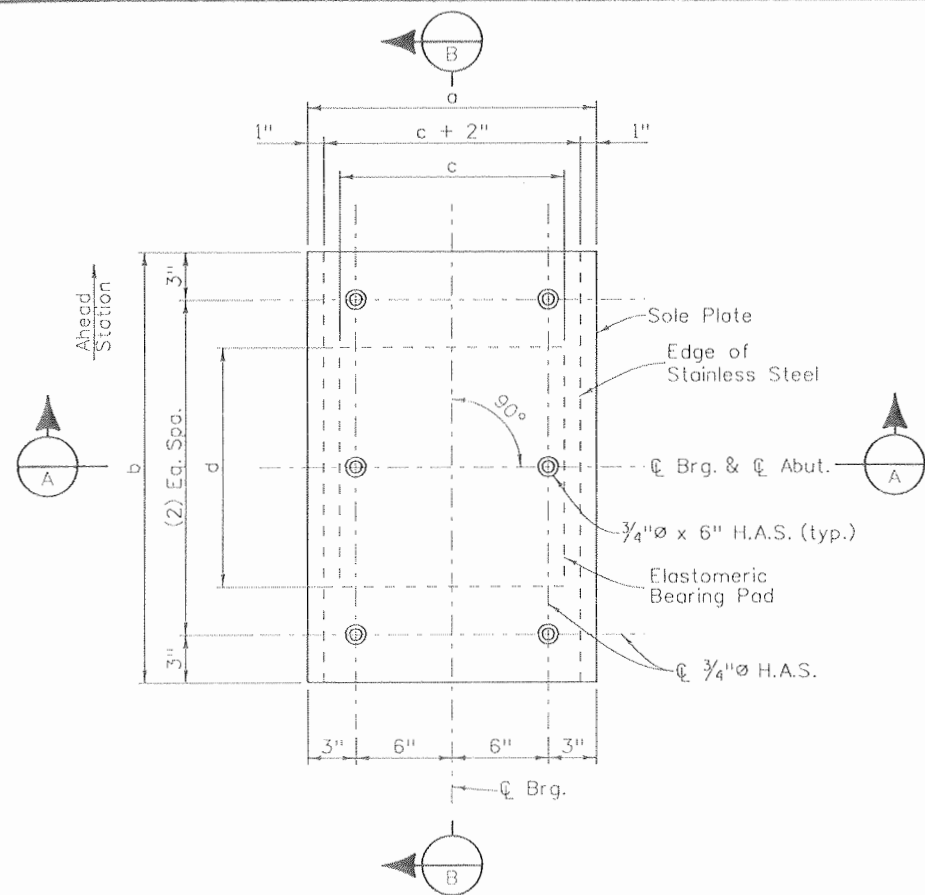


GUIDE PLATE PLAN

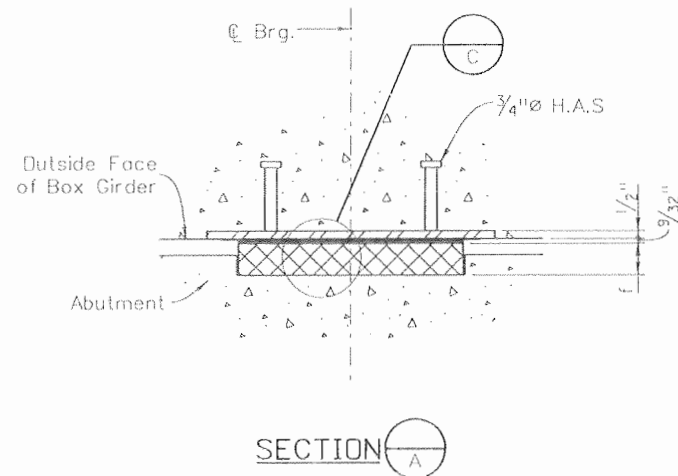

SECTION A

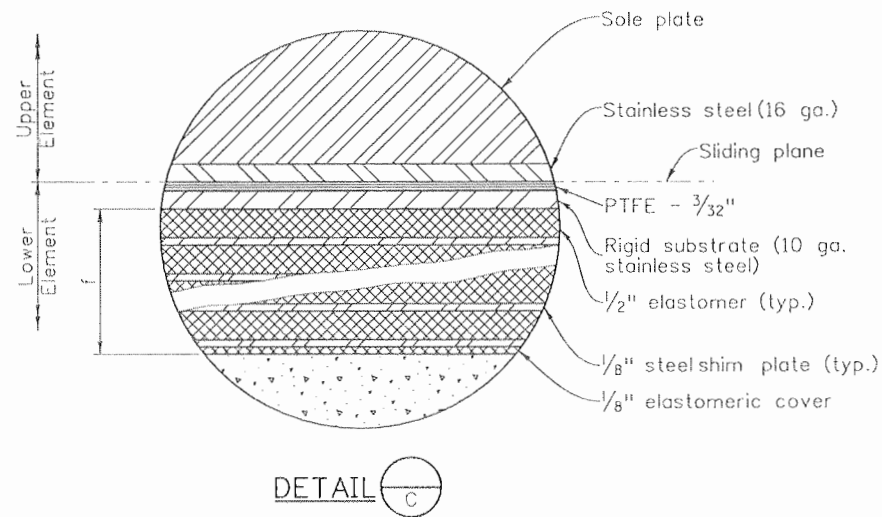

DETAIL C

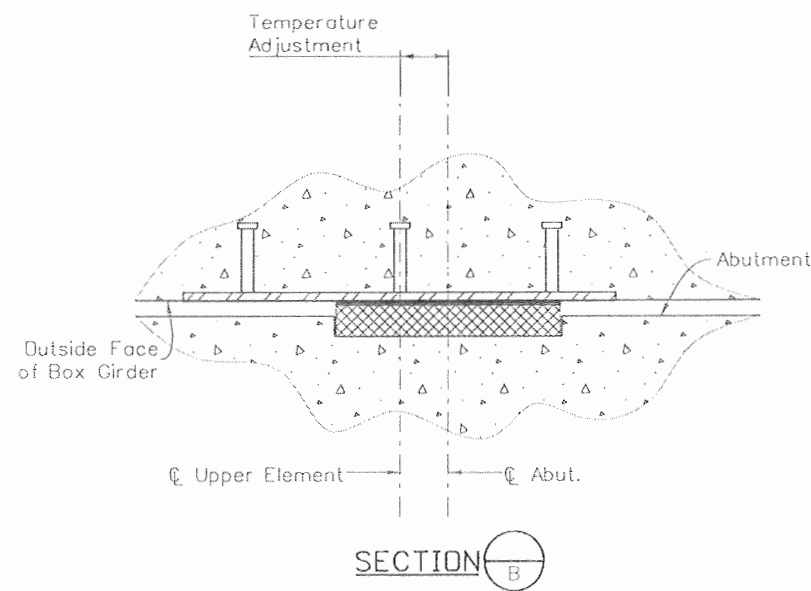


SECTION B

Abutment	Number Required	a	b	c	d	f	10° Temp Increment Dimensions
1	2	18.00	36.00	14.00	14.00	2.00	1/4"
4	2	18.00	36.00	14.00	14.00	2.00	1/4"

NOTES

1. AASHTO design method B has been used.
2. Grade 3 elastomer shall be used. A higher grade elastomer may be substituted for Grade 3.
3. Elastomer shall conform to the requirements of AASHTO M251 and Section 18.2 of the AASHTO LRFD Bridge Construction Specifications.
4. The elastomer shear modulus, G, shall be 140 psi +/- 15% per AASHTO M251.
5. PTFE = Polytetrafluoroethylene. PTFE sheets shall be unfilled.
6. PTFE and substrate to be vulcanized to the elastomeric pad.
7. Seal weld stainless steel to the sole plate
8. The stainless steel surface in contact with PTFE shall be polished to a brightness finish of less than 10 micro-inches root mean square.
9. The centerlines of the upper and lower elements of the guide plate shall be adjusted for temperature as shown in Section B. From the mid-point temperature of 40° the upper element shall be adjusted in relation to the Abutment for each 10° temperature change. Adjust away from the adjacent pier one 10° temperature increment for each 10° change above 40° and toward the fixed bearing for each 10° change below 40°.





Print Date: 9/22/2010	Sheet Revisions			Colorado Department of Transportation		As Constructed		US 550 OVER US 160		Project No./Code	
File Name: 16042AG_GuidePlate_01.dgn	Date:	Comments	Init.	3803 North Main Avenue		No Revisions: 9/10		GUIDE PLATE DETAILS		NH 1602-114	
Horiz. Scale: 1:1				Suite 200		Revised:		Designer: B. Allen		Structure: P-05-AG	
Unit Information				Durango, CO 81301		Void:		Detailer: R. Artman		16042	
Unit Leader Initials				Phone: 970-385-1440 FAX: 970-385-8365				Sheet Subset: Bridge		Subset Sheets: B26 of B38	
SEMA CONSTRUCTION				Region 5				EJA		Sheet Number 217	
WILSON & COMPANY											

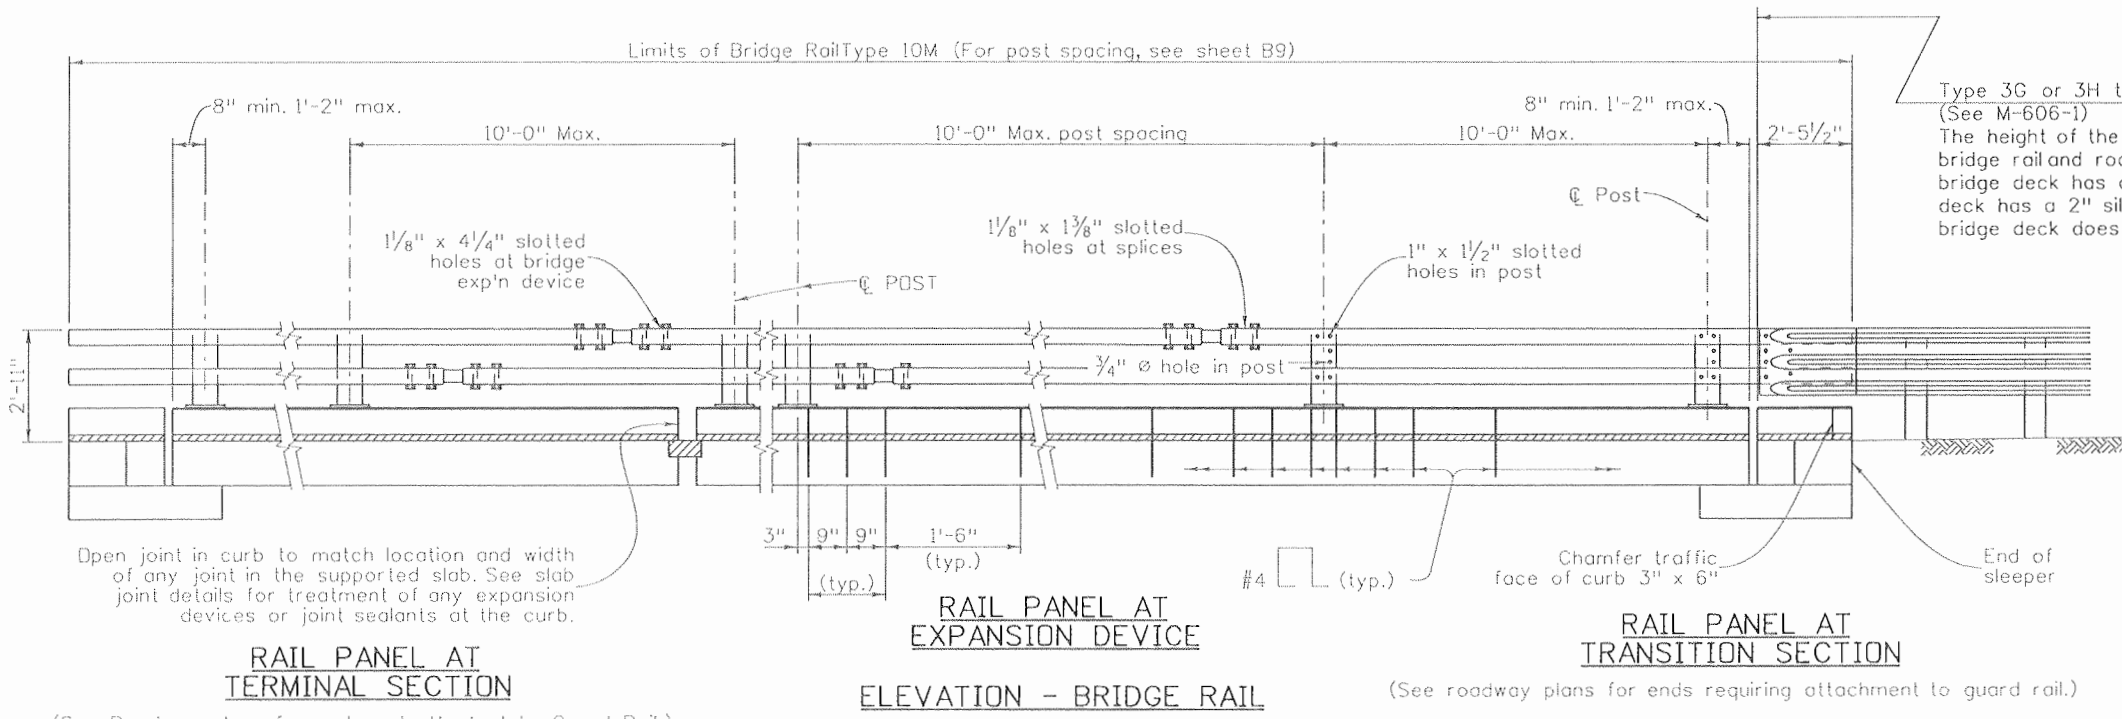

NOTES:

- All tubes shall be ASTM A-847. All other steel shall be ASTM A-588 Grade 50.
- Concrete, reinforcing steel, and structural steel elements shall conform to the requirements of sections 601, 602 and 509, respectively. Anchor bolts shall be galvanized in accordance with Section 509.
- Post anchor, encased in concrete, shall be ASTM A-36 (AASHTO M-183).
- The tubes shall be shop bent or fabricated to fit horizontal curve when radius is less than 1,500 feet.
- Tubes shall be continuous over not less than two posts. No welded butt splices will be allowed in the tube sections.
- The centerline of the tube splice shall be 1'-8" minimum and 2'-6" maximum from the centerline of the posts.
- All bolts that have lock washers shall be tightened to snug only.
- Posts shall be perpendicular to the longitudinal roadway grade.
- One or more 10'-0" post spacings may be reduced (6'-8" min.) in order to maintain dimensions from the end of the rail and expansion joints.
- Prior to fabrication of this item, three sets of working drawings which comply with the requirements of section 105, shall be submitted to the Engineer for information only.
Structural Steel:
ASTM A-36 $f_y = 36,000$ psi
ASTM A-588 Grade 50 $f_y = 50,000$ psi
A-847 Grade B $f_y = 46,000$ psi
- For additional details see next railsheets.
- At bridge ends without Approach Slabs. Terminate tube at nearest splice. Continue post spacing to end of structure.
- Coordinate location of de-icing equipment and conduits with bridge rail reinforcing and hardware. Move conduit or equipment if a conflict exists. Refer to de-icing plans for additional reinforcement required at sensor pole mounting location.

Design	INITIAL	DATE	Checked By		Checked By	
			AML	GWK	AML	GWK
Checked By						
Designed By						
Checked By						
Checked By						
Checked By						
Checked By						

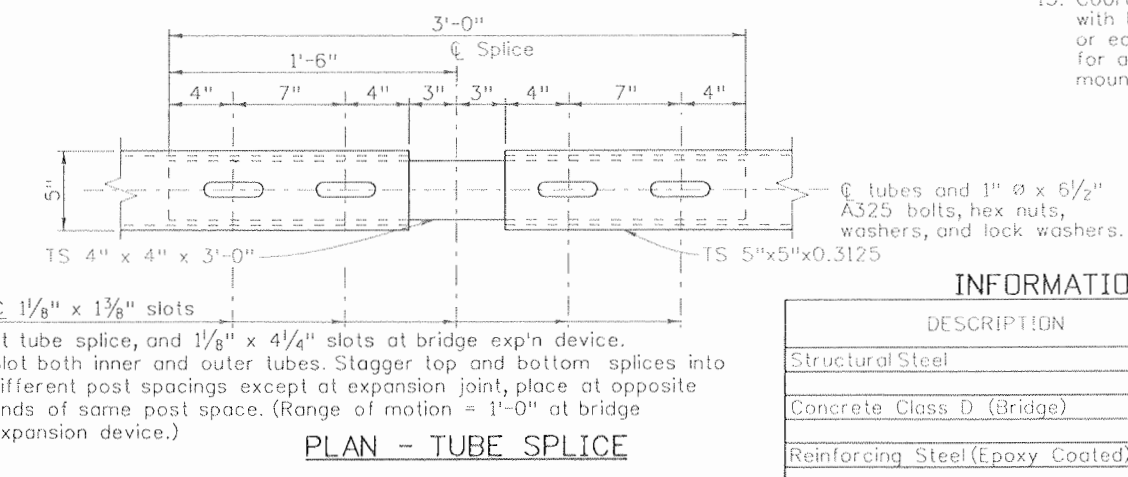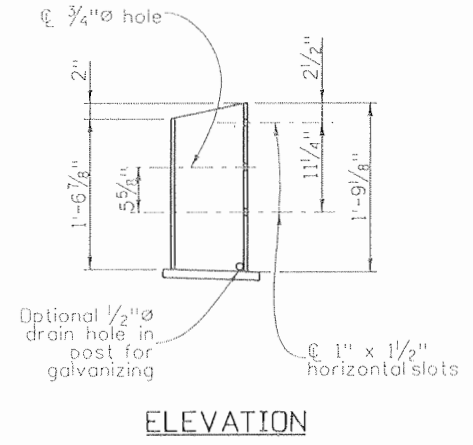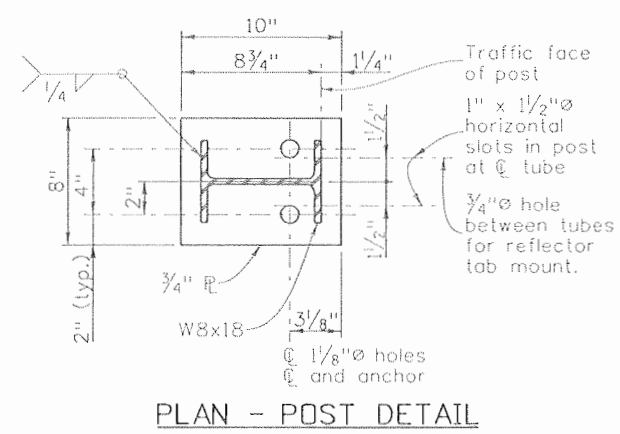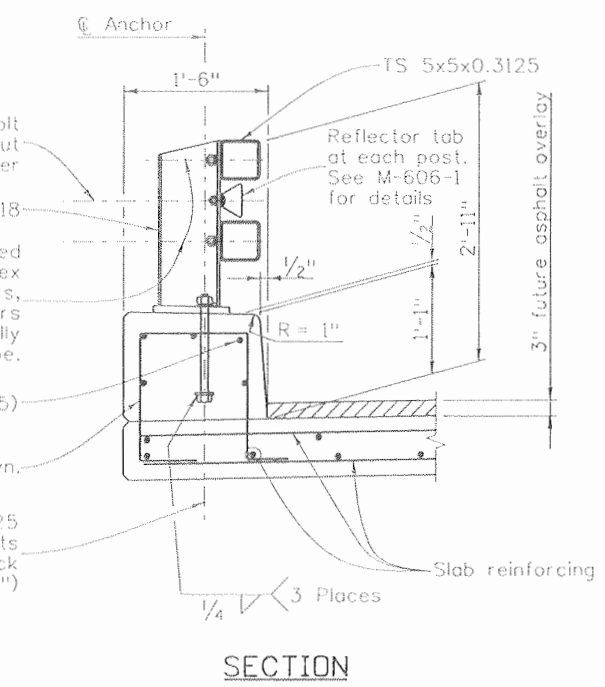

INFORMATION ONLY

DESCRIPTION	UNIT	PER LIN. FT.
Structural Steel	LB.	45.1
Concrete Class D (Bridge)	CU.YD.	.06
Reinforcing Steel (Epoxy Coated)	LB.	6.6

Print Date: 9/22/2010

File Name: 16042AG_BridgeRailType10M_01.dgn

Horiz. Scale: 1:1 Vert. Scale: As Noted

Unit Information 0221 Unit Leader STW

SEMA CONSTRUCTION

WILSON & COMPANY

Sheet Revisions		
Date:	Comments	Init.

Colorado Department of Transportation

3803 North Main Avenue
Suite 200
Durango, CO 81301
Phone: 970-385-1440 FAX: 970-385-8365

Region 5 EJA

As Constructed

No Revisions: 9/10

Revised:

Void:

US 550 OVER US 160 BRIDGE RAIL TYPE 10M (SPECIAL) (1 OF 2)

Project No./Code NH 1602-114


16042

Sheet Number 218

Designer: A. Leifheit Structure P-05-AG


Detailer: D. Anderson Numbers

Sheet Subset: Bridge Subset Sheets: B27 of B38

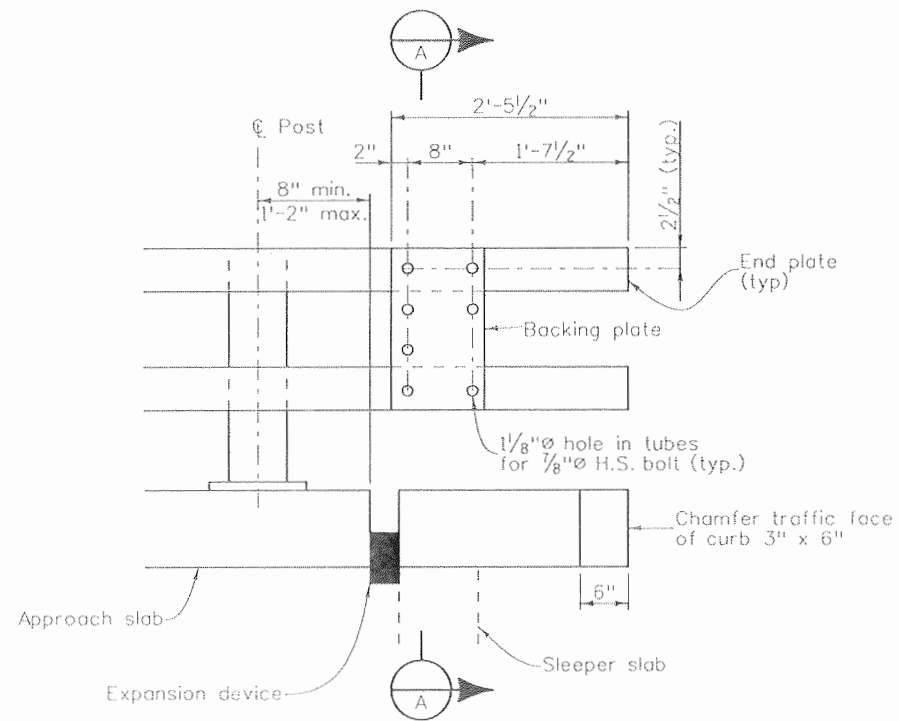


RAIL TUBE DETAILS

(Thrie beam not shown)
(Req'd at approach slab ends only)

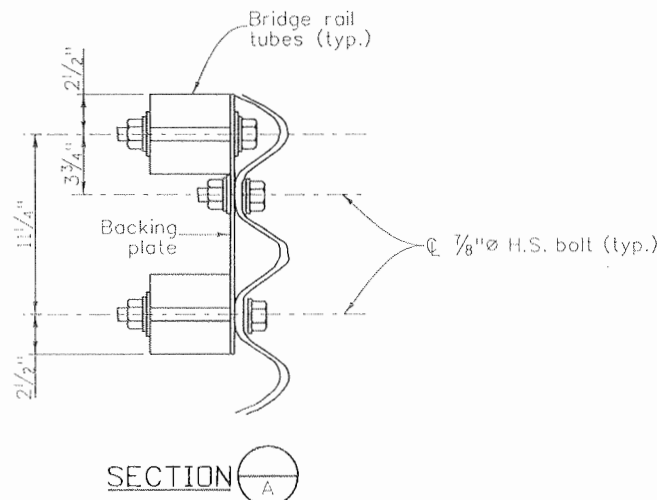


SECTION A

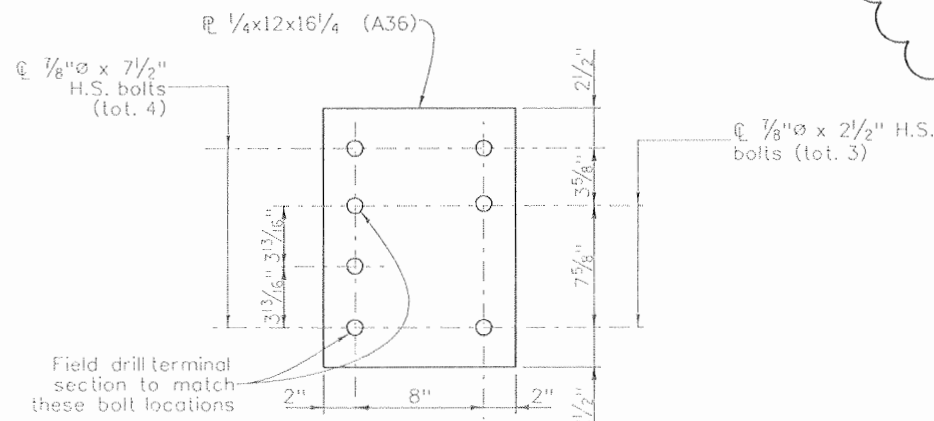


BACKING PLATE

Holes are 1/8" diameter for 1/8" H.S. bolts with hex nuts, 2 PL washers, and 1 lock washer

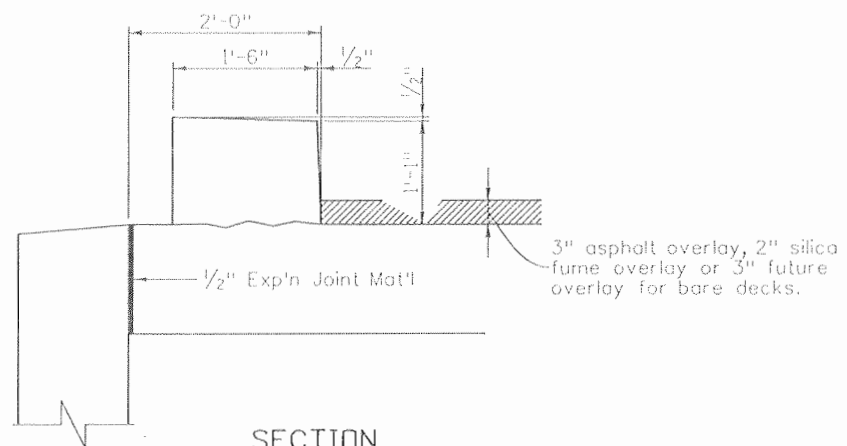


SECTION

(Use when curb is to be placed on approach slab.)
(Approach slab location only)

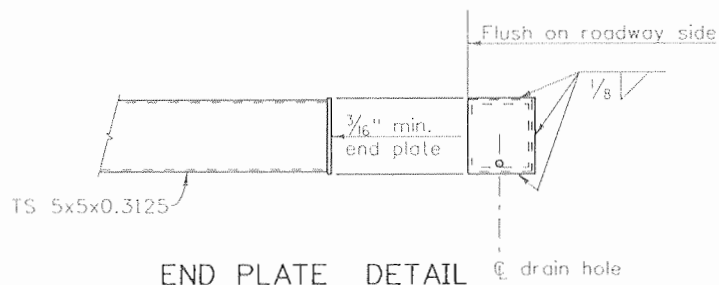

END PLATE DETAIL

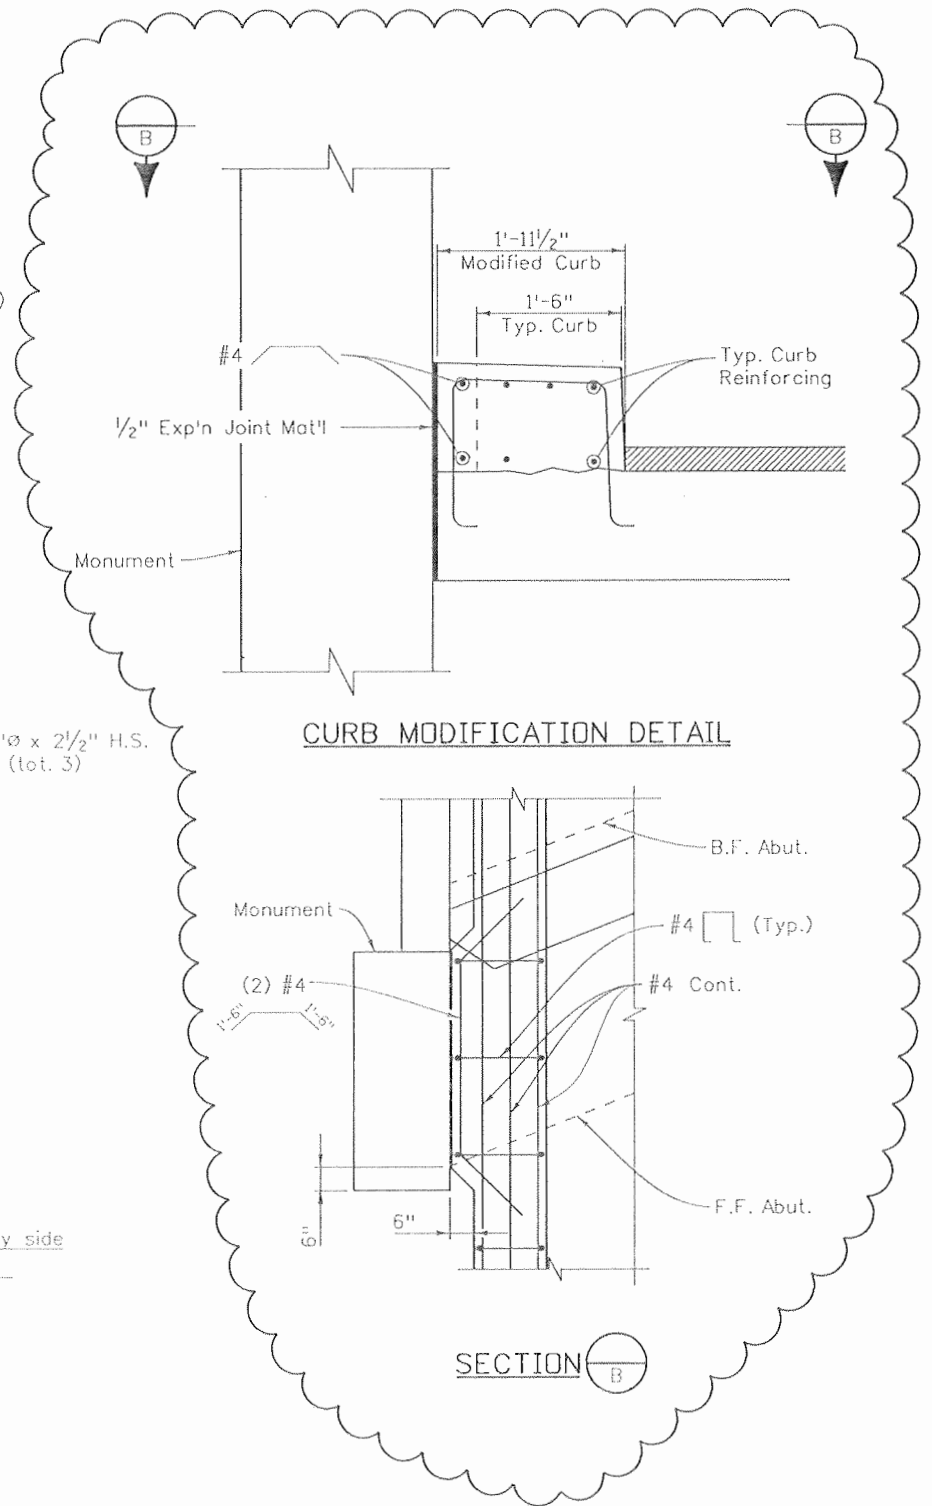

CURB MODIFICATION DETAIL


SECTION B

(R-4)


Design	Initial		Date		By		Checked	
	By	Date	By	Date	By	Date	By	Date
Designed By	AML	05/08	Detailed By	DRA	06/08	Quantities By	AML	08/08
Checked By	GWK	06/08	Checked By	GWK	06/08	Checked By	GWK	08/08

Print Date: 9/22/2010	Sheet Revisions			Colorado Department of Transportation		As Constructed		US 550 OVER US 160 BRIDGE RAIL TYPE 10M (SPECIAL) (2 OF 2)		Project No./Code	
File Name: 16042AG_BridgeRailType10M_02.dgn	Date:	Comments	Init.	3803 North Main Avenue Suite 200 Durango, CO 81301 Phone: 970-385-1440 FAX: 970-385-8365		No Revisions: 9/10		Designer: A. Leifheit Structure: P-05-AG		NH 1602-114	
Horiz. Scale: 1:1 Unit Information 0221	9/29/08	Added Rail Curb Modification	BJA	Region 5		Revised:		Detailer: D. Anderson Numbers:		16042	
Unit Leader: STW				EJA		Void:		Sheet Subset: Bridge Subset Sheets: B28 of B38		Sheet Number: 219	




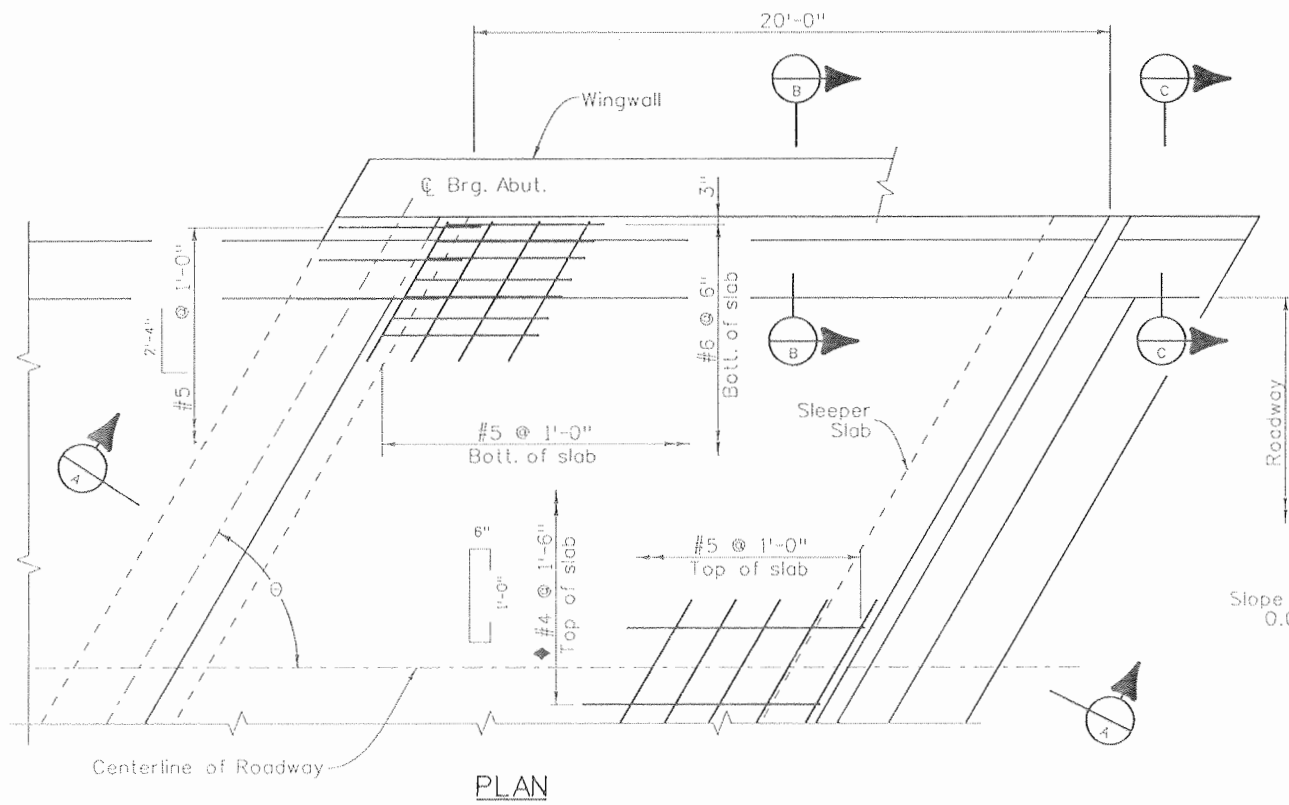


PLAN

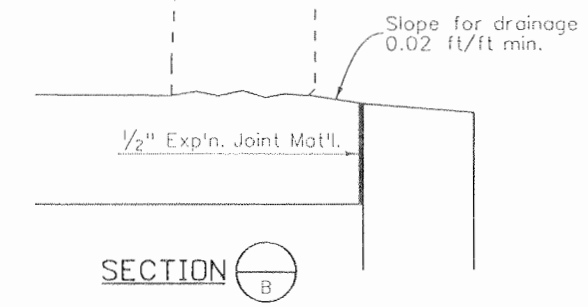


SECTION B

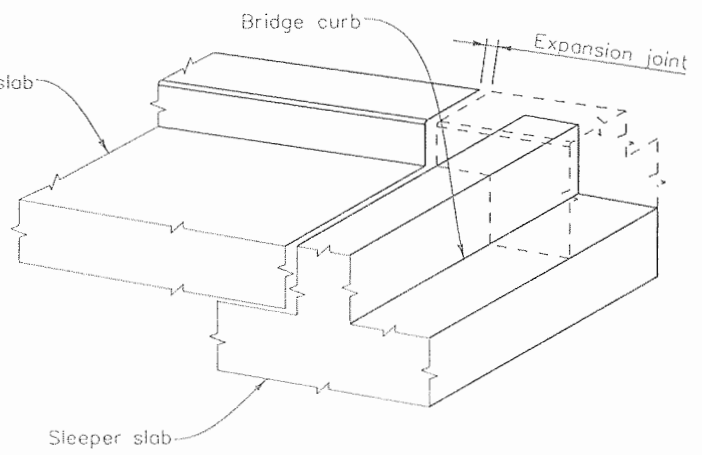


ISOMETRIC VIEW TYPE 10 RAILS

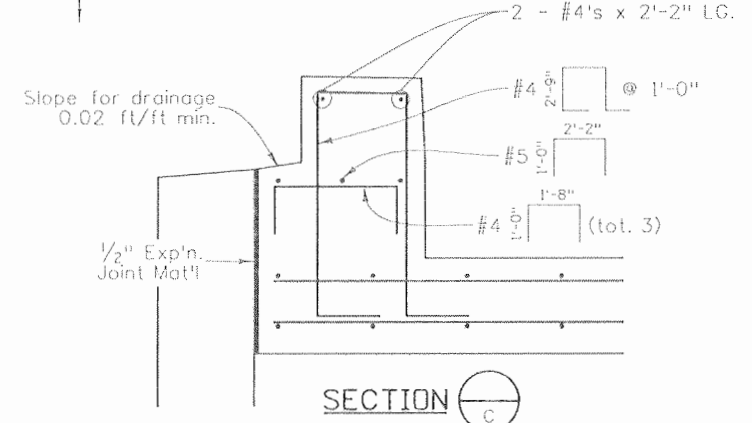


SECTION C

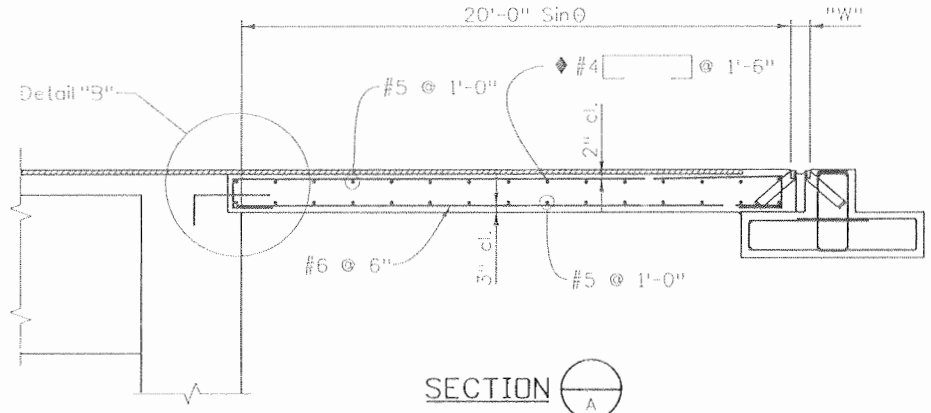

SECTION A

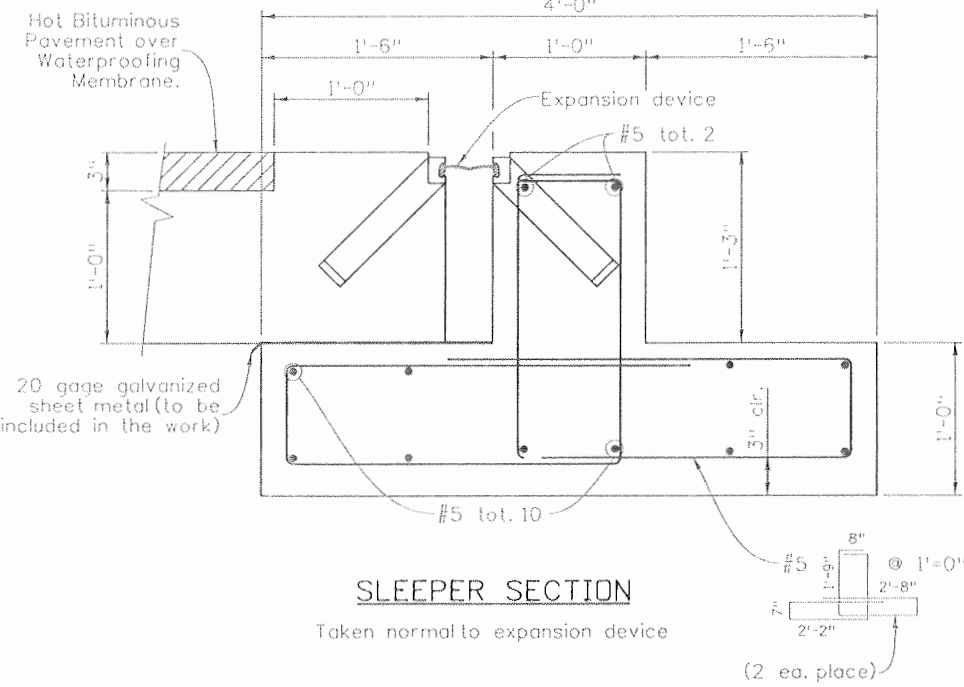

SLEEPER SECTION

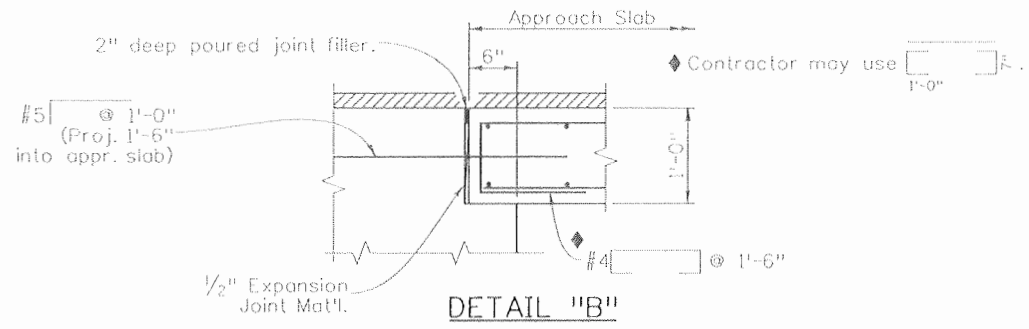

DETAIL "B"

NOTES:

- Concrete Class D (Bridge) shall be used for approach slabs.
- 1/2" expansion joint material shall meet AASHTO Spec. M213.
- For expansion device details, see sheet B30 and B31.
- For curb and rail details, see sheet B27 and B28.
- Approach slab concrete shall be cured in accordance with the Specifications for Bridge Deck Concrete in Subsection 601.
- The top surface of the post-tensioning block, if any, shall be covered with 1" of low density polystyrene foam. See sheet B24.
- Approach slab and sleeper slab are required at Abutment 1 only. Provisions for a future approach slab shall be made at Abutment 4.
- Approach slab reinforcing is non-epoxy coated.

Design	Checked By	GWK	08/08	Checked By	GWK	08/08	
Designed By	AML	08/08	Checked By	AML	08/08	Checked By	GWK
Detail	Checked By	GWK	08/08	Checked By	GWK	08/08	
Quantities	Checked By	GWK	08/08	Checked By	GWK	08/08	

Print Date: 9/22/2010	Sheet Revisions			Colorado Department of Transportation		As Constructed		US 550 OVER US 160		Project No./Code	
File Name: 16042AG_ApproachSlabDet_01.dgn	Date:	Comments:	Init.	3803 North Main Avenue		No Revisions: 9/10		APPROACH SLAB DETAILS		NH 1602-114	
Horiz. Scale: 1:1				Suite 200		Revised:		Designer: A. Leifheit		Structure: P-05-AG	
Unit Information 0221				Durango, CO 81301		Void:		Detailer: D. Anderson		Numbers:	
Unit Leader STW				Phone: 970-385-1440 FAX: 970-385-8365				Sheet Subset: Bridge		Subset Sheets: B29 of B38	
SEMA CONSTRUCTION				Region 5		EJA		Sheet Number		220	

NOTES:

The expansion device shall be installed on grade, parallel to the slope and grade of the deck, and no sooner than 90 days from Post-tensioning.

Dimension "A" at abutment 4 is provided for information only and does not include provisions for creep and shrinkage due to delayed installation.

After the concrete has attained initial set, the attachments used to hold the expansion device assembly in its proper position shall be removed.

Do not paint steel surfaces in contact with either concrete or seal.

"W" and "E" dimensions are dependent upon the particular expansion device supplied, and shall be shown on the working drawings.

See table for dimensions "A" and "W"; interpolate as needed. Do not install the gland until dimension "A" has opened up to at least 1 1/2". Use section 518.10(b) in the standard specifications to determine the structure temperature. Structure temperature shall be at least 20°F and less than 60°F for joint installation.


The neoprene gland shall be installed in one piece in accordance with section 518 of the standard specifications.

See section 518 in the standard specifications for water tight integrity testing requirements.

Set elevations at top of header and sleeper stem with the grade projection scheme.


ACCEPTABLE EXPANSION DEVICE ALTERNATES

D.S. Brown A2R400-SSA2
WABO SE400 Type A
E-poxy Engineered Materials S400-A Strip Seal

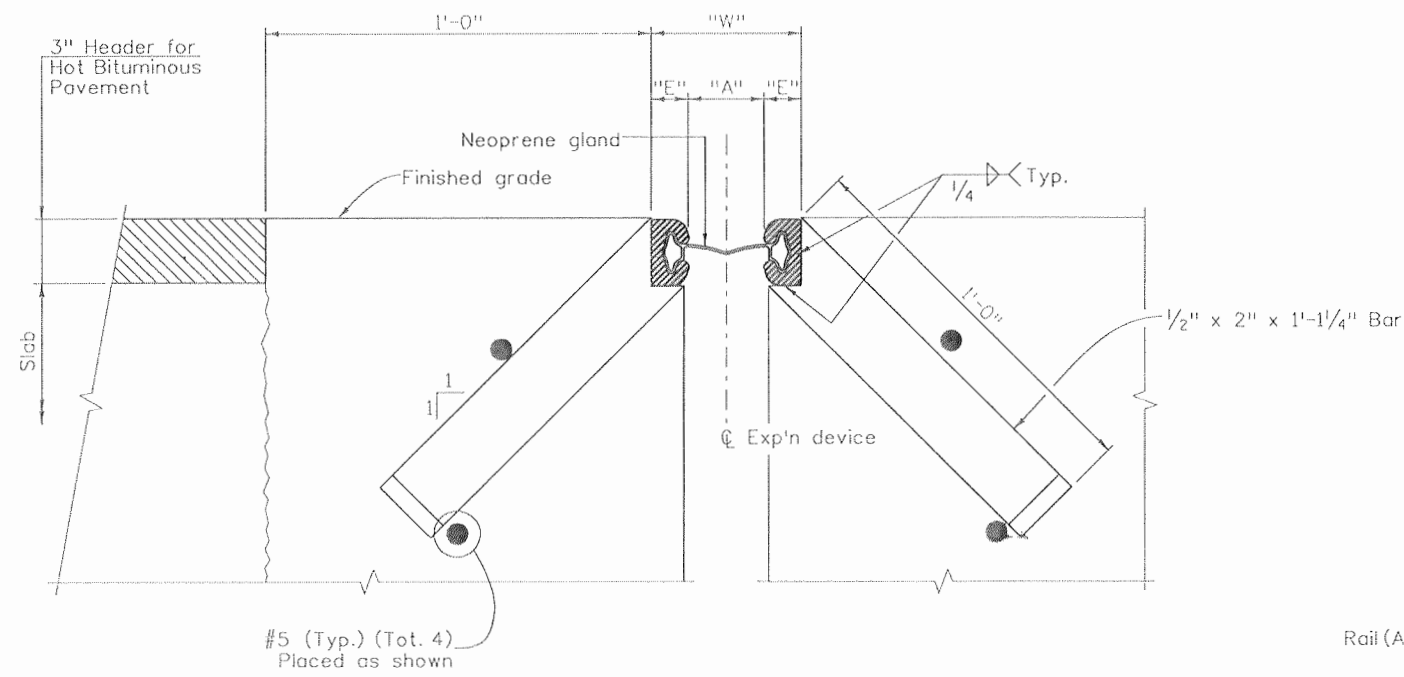


SECTION THRU STRIP SEAL BRIDGE EXPANSION DEVICE


Section taken perpendicular to ϕ exp'n device

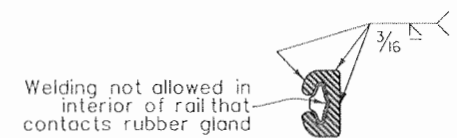

RAIL FIELD SPLICE DETAIL

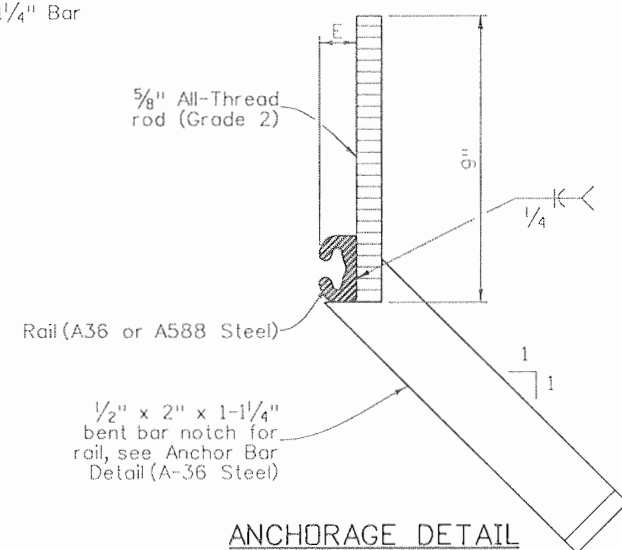


ANCHORAGE DETAIL

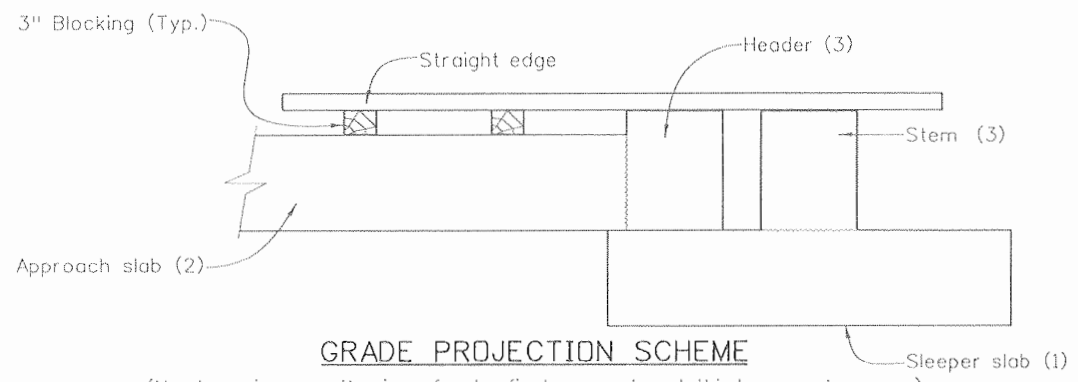


GRADE PROJECTION SCHEME


(Numbers in parenthesis refer to first, second and third concrete pours)

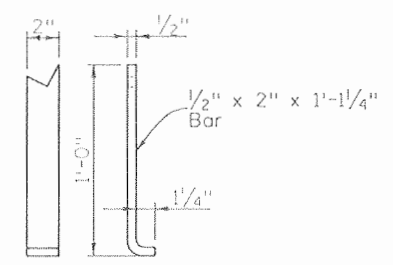

TYPICAL ANCHOR BAR DETAIL

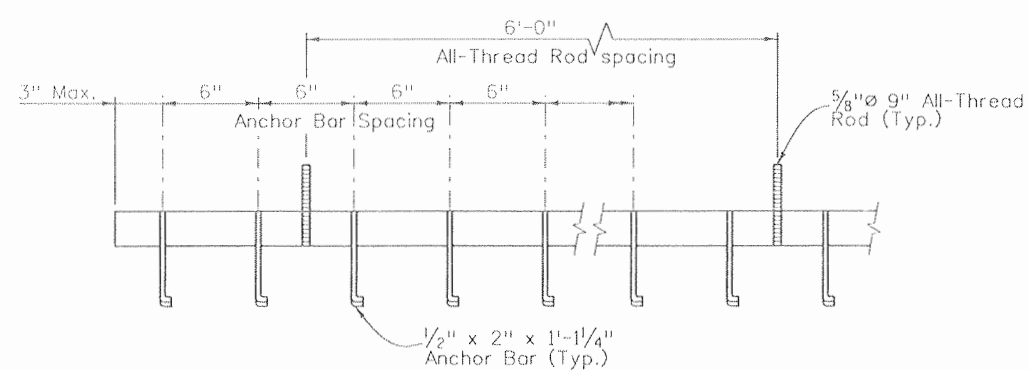

ANCHOR BAR SPACING

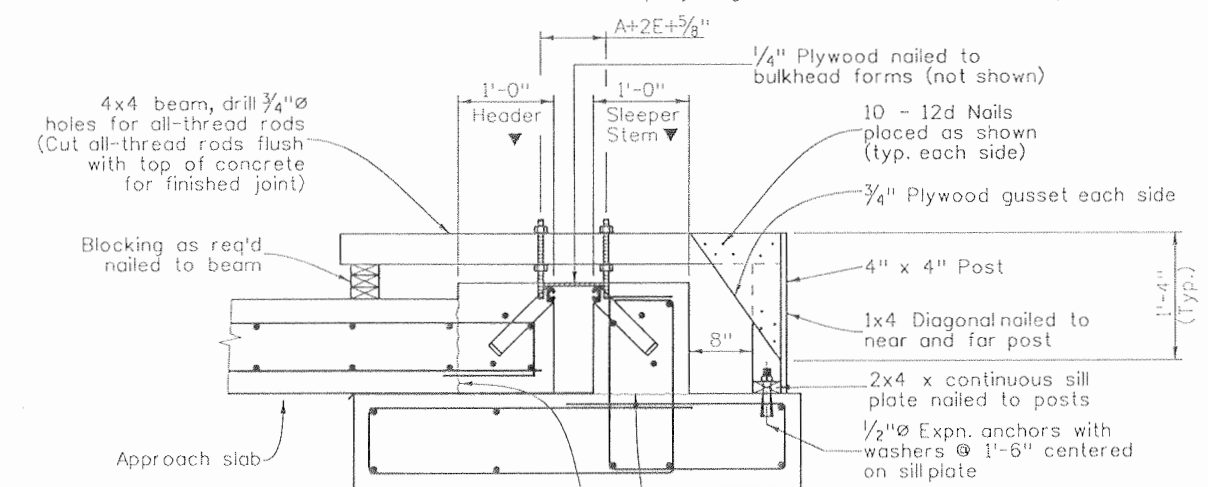

MINIMUM SUPPORT BRACKET REQUIREMENTS

NOTES:

1. Provide expansion device support as shown at 6'-0" intervals.
2. For reinforcing see approach slab details.

Concrete shall be placed after expansion device has been adjusted to proper grade and approved by the engineer using the Grade Projection Scheme.

Design	INITIAL	DATE	DESIGNED BY	CHECKED BY
	AML	08/08	GWK	GWK
Detail	INITIAL	DATE	QUANTITIES BY	CHECKED BY
	AML	08/08	GWK	GWK
Quantities	INITIAL	DATE	QUANTITIES BY	CHECKED BY
	AML	08/08	GWK	GWK

ABUTMENT 1

STR. TEMP	"A"	"W"*
20° F	2.00"	4.50"
30° F	1.75"	4.25"
40° F	1.50"	4.00"
50° F	1.25"	3.75"
60° F	1.00"	3.50"


ABUTMENT 4 (Information Only)

STR. TEMP	"A"	"W"*
20° F	2.50"	5.00"
30° F	2.25"	4.75"
40° F	2.00"	4.50"
50° F	1.75"	4.25"
60° F	1.50"	4.00"


* For E = 1/4" (Min.)

Print Date: 9/22/2010	Sheet Revisions			Colorado Department of Transportation 3803 North Main Avenue Suite 200 Durango, CO 81301 Phone: 970-385-1440 FAX: 970-385-8365	As Constructed No Revisions: 9/10	US 550 OVER US 160 BRIDGE EXPANSION DEVICE (0 - 4 INCH) (1 OF 2)		Project No./Code NH 1602-114
File Name: 16042AG_BrdgExpDevice_0-4_01.dgn	Date:	Comments:	Init.			Revised:	Designer: A. Leifheit	
Horiz. Scale: 1:1				DOT Region 5	Void:	Detailer: D. Anderson	Subst. Sheets: B30 of B38	Sheet Number: 221
Unit Information 0221						Sheet Subset: Bridge		






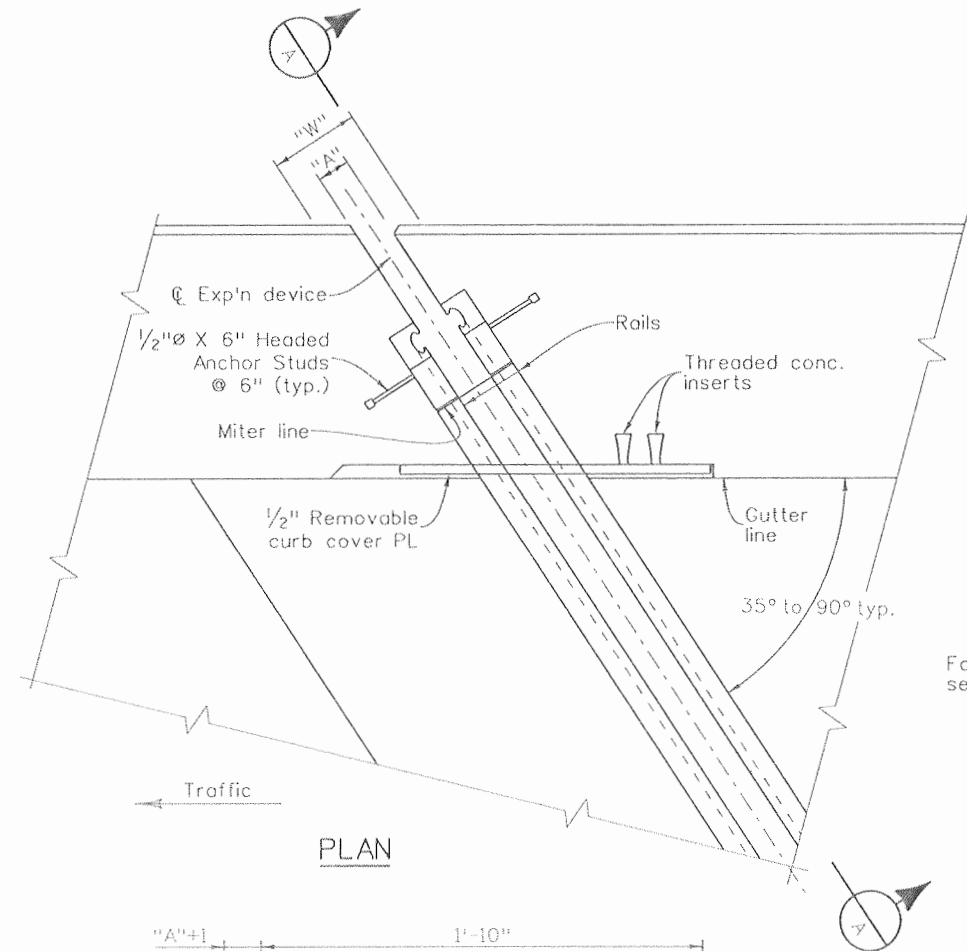

Provide 2" minimum cover between anchors and all concrete surfaces.

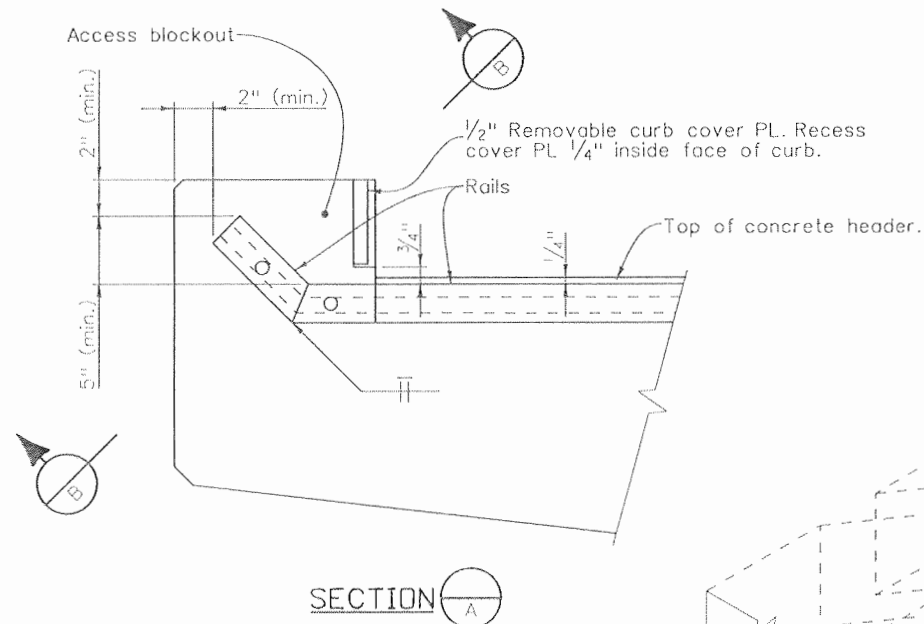

For actual skew direction, see bridge plans.

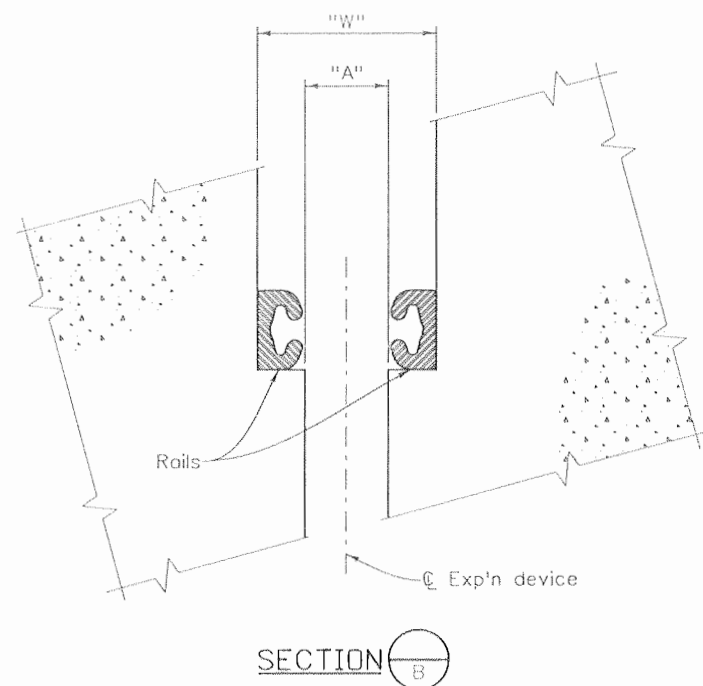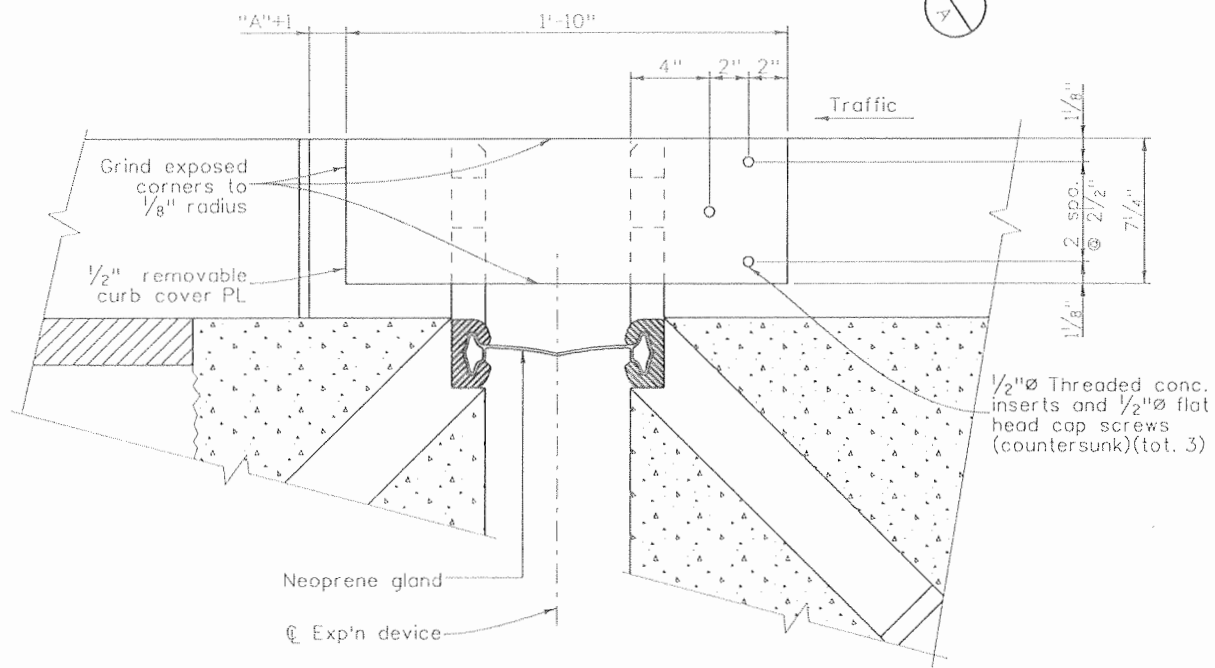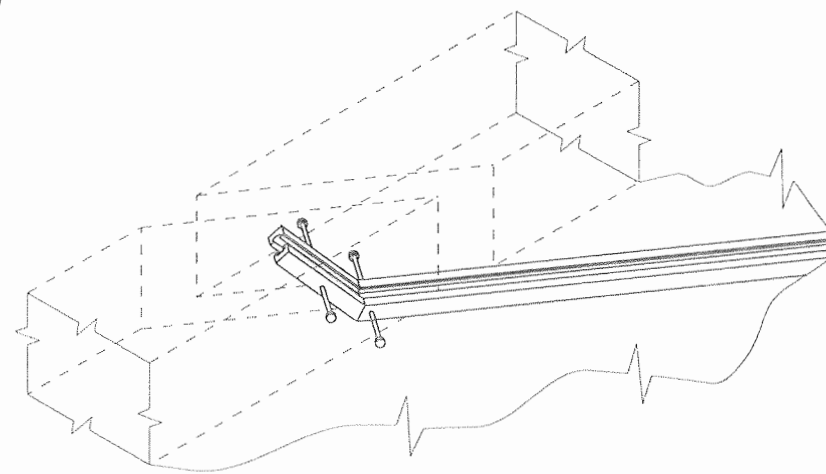

Design		Detail		Quantities	
INITIAL	DATE	INITIAL	DATE	INITIAL	DATE
AML	08/08	DRA	08/08	AML	08/08
GWK	08/08	GWK	08/08	GWK	08/08
Designed By	Checked By	Detailed By	Checked By	Quantities By	Checked By

Print Date: 9/22/2010
 File Name: 16042AG_BrdgExpDevice_0-4_02.dgn
 Horiz. Scale: 1:1
 Unit Information 0221
 Unit Leader STW


Sheet Revisions		
Date:	Comments	Init.


Colorado Department of Transportation
 3803 North Main Avenue
 Suite 200
 Durango, CO 81301
 Phone: 970-385-1440 FAX: 970-385-8365
 Region 5 EJA

As Constructed
 No Revisions: 9/10
 Revised:
 Void:


US 550 OVER US 160
 BRIDGE EXPANSION DEVICE
 (0 - 4 INCH) (2 OF 2)
 Designer: A. Leifheit
 Detailer: D. Anderson
 Sheet Subset: Bridge
 Structure Numbers
 Subset Sheets: B31 of B38

Project No./Code
 NH 1602-114
 16042
 Sheet Number 222

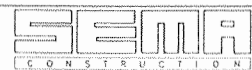


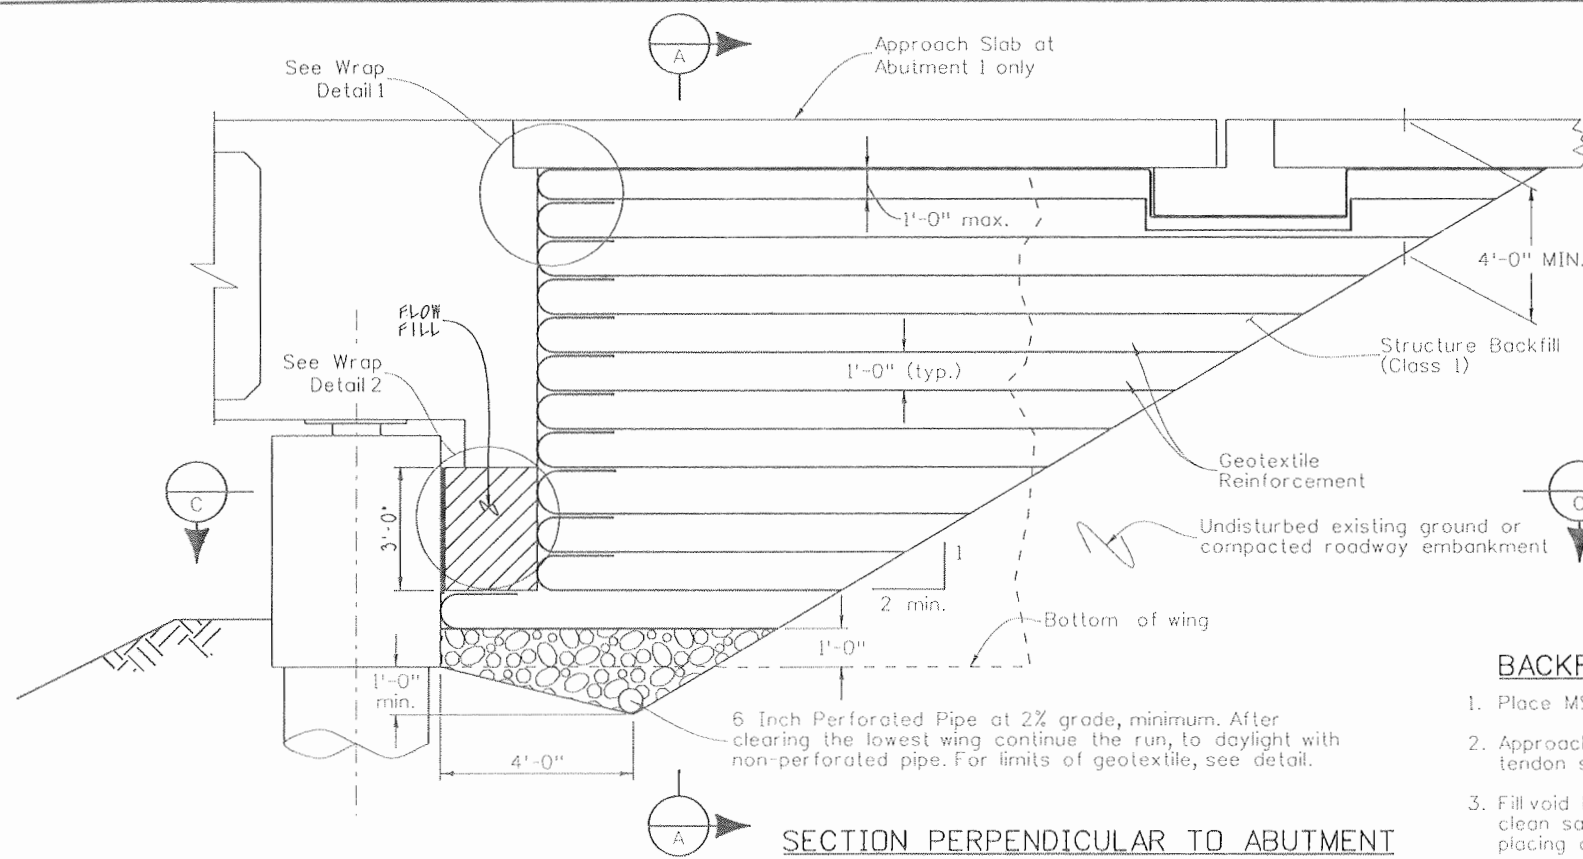

SECTION PERPENDICULAR TO ABUTMENT

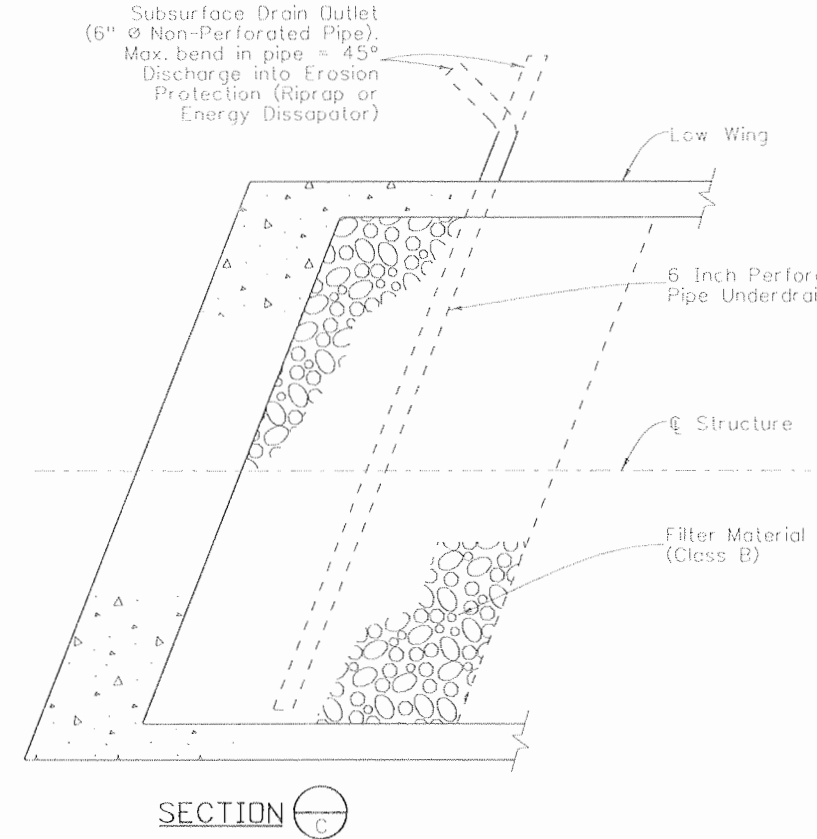


SECTION C-C

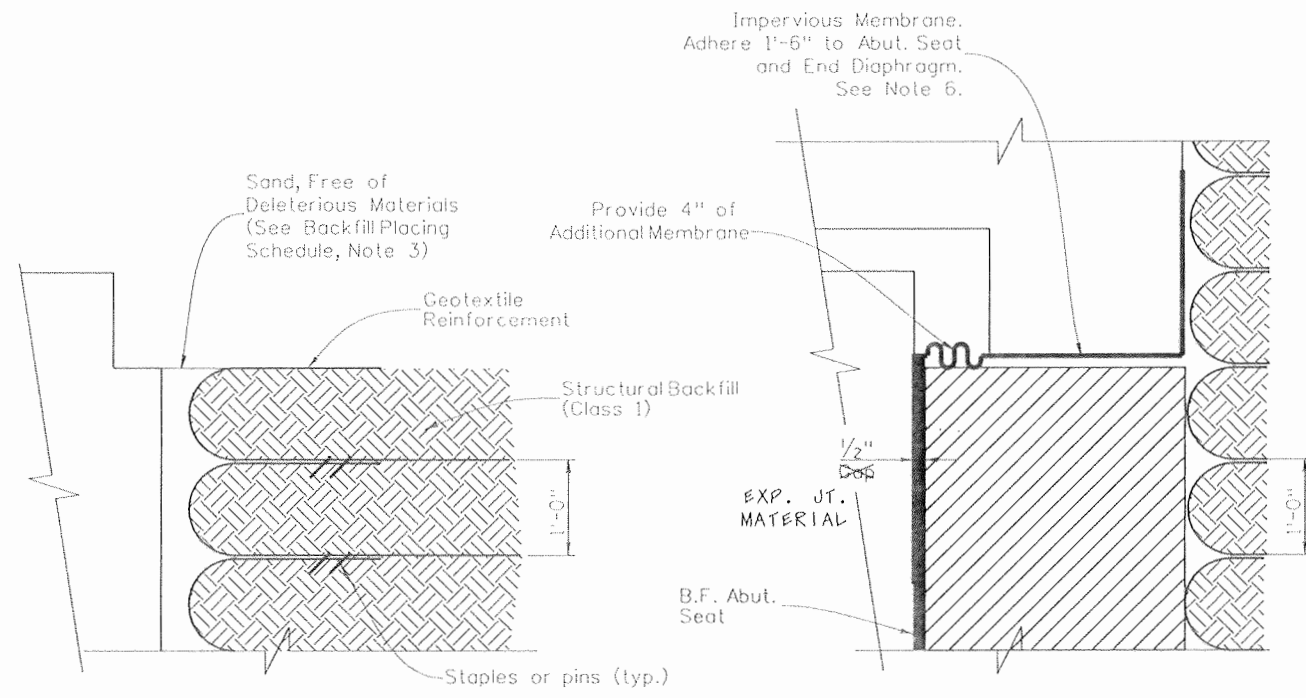


WRAP DETAIL 1

WRAP DETAIL 2

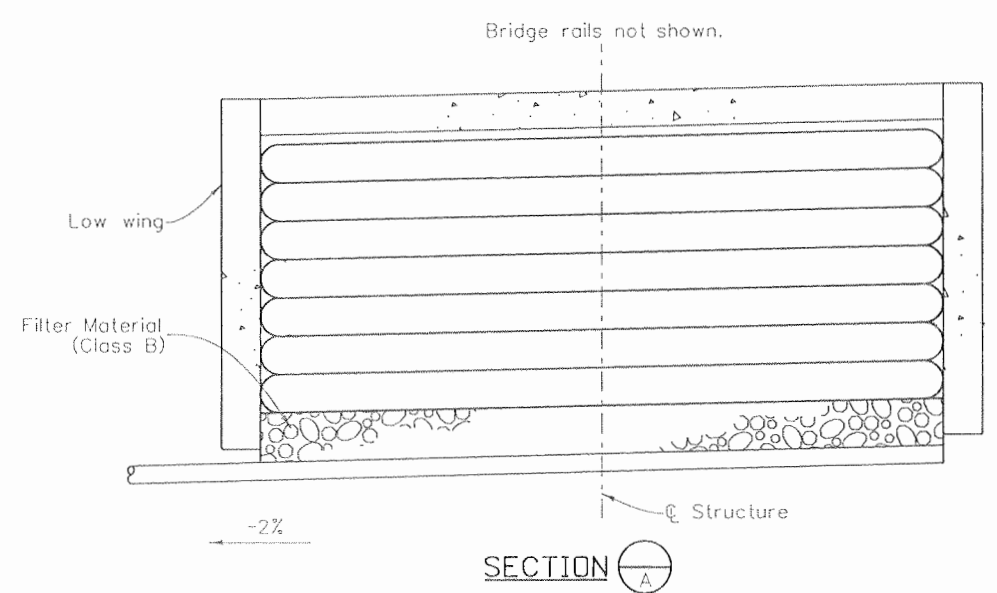

SECTION A-A

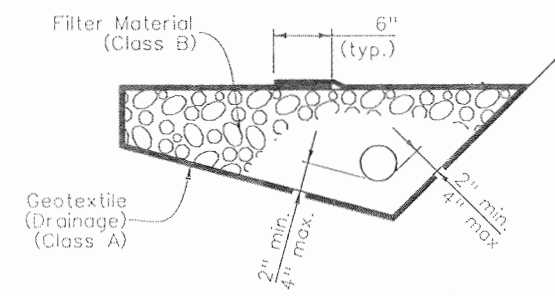

6 INCH PERFORATED PIPE UNDERDRAIN

BACKFILL PLACING SEQUENCE

1. Place MSB Backfill prior to removing falsework.
2. Approach slab shall not be placed within 90 days of tendon stressing.
3. Fill void between MSB and abutment diaphragm with clean sand, free of deleterious materials, prior to placing approach slab.


NOTES:

1. Geotextile reinforcement shall be woven fabric with a Minimum Average Roll Value of 4800 lb/ft for installations with a gap and 2400 lb/ft for installations without a gap based on ASTM D4595.
2. Geotextile Reinforcement shall be placed by alternating Machine Direction (MD) with Cross Machine Direction (XD) from layer to layer.
3. The Geotextile Reinforcement wrap at Back Face of Abutment shall be pulled back slack free with its end anchored to soil underneath with staples or pins.
4. Minimum splice of all Geofabric shall consist of 6" of overlap.
5. Installation of Pipe Underdrain and Subsurface Drain Outlet will conform to the Construction requirements of section 605.03 and 605.06, respectively.
6. Impervious Membrane shall be Carlisle Sure-Seal EPDM. Contractor may submit alternate membrane for approval.

Design	INITIAL		DATE		Del'ed	INITIAL		DATE		Quantities	INITIAL		DATE	
	By	Checked	By	By		By	Checked	By	Checked		By	Checked	By	Checked
Designed By	AML		08/08		DRA	GWK	08/08			AML	GWK	08/08		
Checked By	GWK		08/08		GWK		08/08			GWK		08/08		

Print Date: 9/22/2010	Sheet Revisions			Colorado Department of Transportation 3803 North Main Avenue Suite 200 Durango, CO 81301 Phone: 970-385-1440 FAX: 970-385-8365 Region 5	As Constructed		US 550 OVER US 160 MECHANICALLY STABILIZED BACKFILL		Project No./Code	
File Name: 16042AG_MSB_01.dgn	Date:	Comments:	Init.:		No Revisions:	NH 1602-114				
Horiz. Scale: 1:1					Revised: 9/10	Designer: A. Leifheit	Structure: P-05-AG	16042		
Unit Information 0221					Void:	Detailer: D. Anderson	Subset Sheets: B32 of B38	Sheet Number 223		
				EJA						

Design		Detail		Quantities	
INITIAL	DATE	INITIAL	DATE	INITIAL	DATE
Designed By	08/08	Detailed By	08/08	Quantities By	08/08
Checked By	GWK	Checked By	GWK	Checked By	GWK

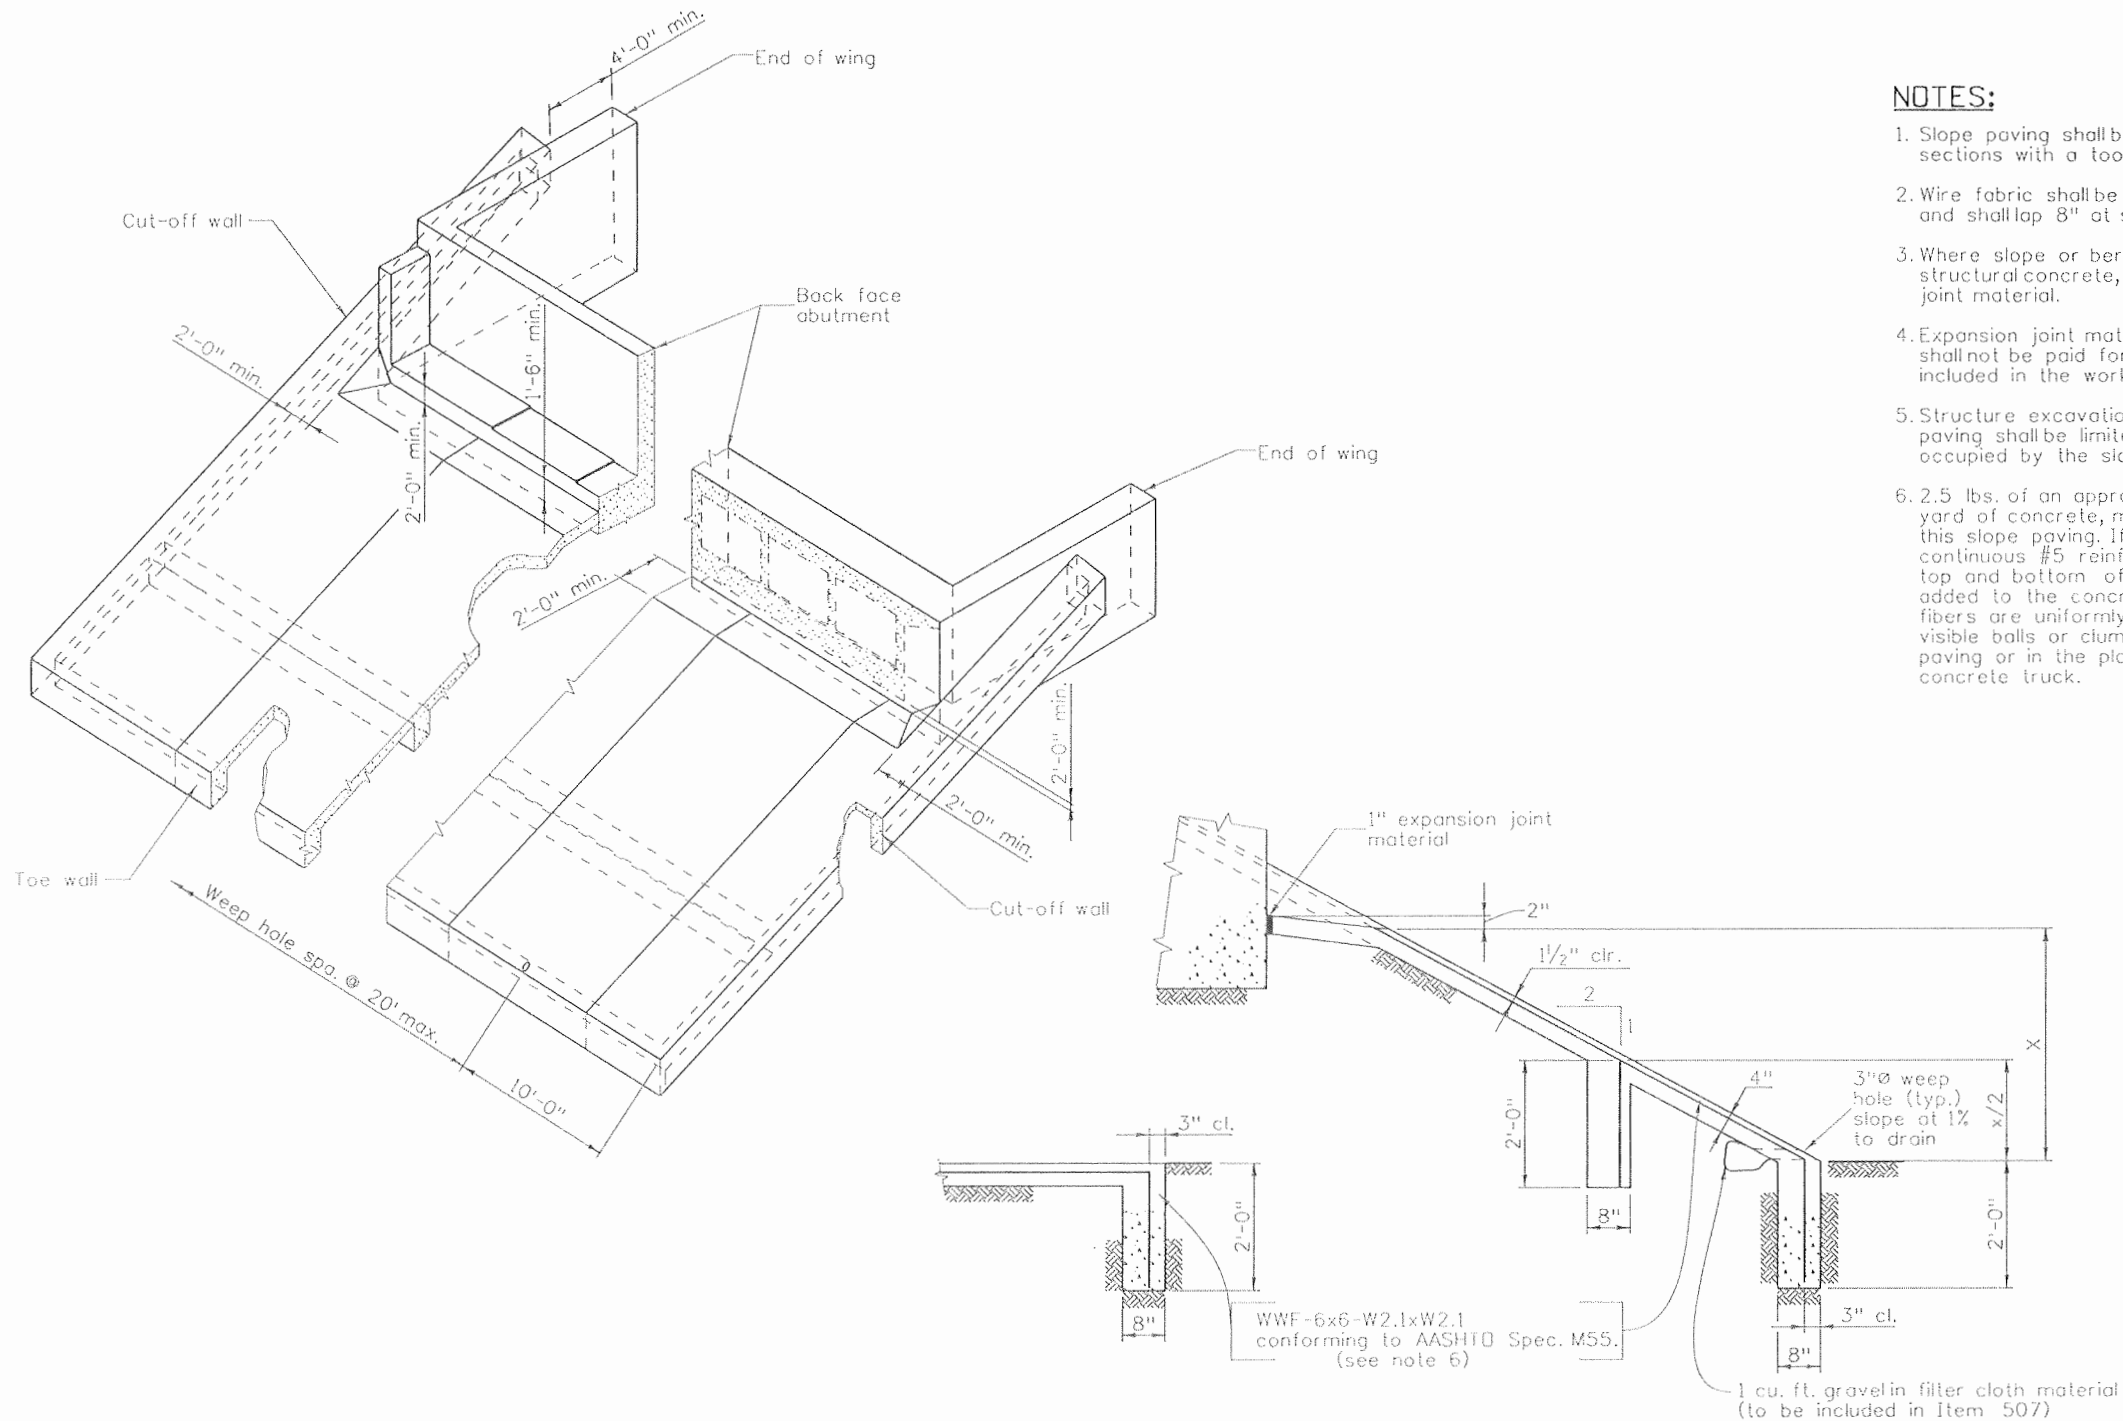

- NOTES:**
- Slope paving shall be poured in 10 ft. transverse sections with a tooled construction joint at each section.
 - Wire fabric shall be 2" from the end of joints and shall lap 8" at splices.
 - Where slope or berm paving butts against structural concrete, separate with 1" expansion joint material.
 - Expansion joint material and welded wire fabric shall not be paid for separately, but shall be included in the work.
 - Structure excavation for concrete slope and ditch paving shall be limited to the actual volume occupied by the slope paving concrete.
 - 2.5 lbs. of an approved polypropylene fiber, per cubic yard of concrete, may be substituted for the WWF in this slope paving. If this substitution is made, a continuous #5 reinforcing bar shall be added near the top and bottom of the cutoff wall. The fiber shall be added to the concrete mix in such a fashion that the fibers are uniformly dispersed in the concrete without visible balls or clumps in either the finished slope paving or in the plastic concrete delivered from the concrete truck.

TYPICAL SECTION THRU CUT-OFF WALL

TYPICAL SECTION THRU SLOPE PAVING

Print Date: 9/22/2010	Sheet Revisions			Colorado Department of Transportation		As Constructed		US 550 OVER US 160 SLOPE PAVING DETAILS		Project No./Code	
File Name: 16042AG_SlopePavingDet_01.dgn	Date:	Comments	Init.	3803 North Main Avenue		No Revisions: 9/10		NH 1602-114			
Horiz. Scale: 1:1				Suite 200		Revised:		Designer: A. Leifheit		Structure P-05-AG	
Unit Information 0221				Durango, CO 81301		Void:		Detailer: D. Anderson		16042	
Unit Leader STW				Phone: 970-385-1440 FAX: 970-385-8365				Sheet Subset: Bridge		Subset Sheets: B33 of B38	
SEMA CONSTRUCTION	WILSON & COMPANY			DOT DEPARTMENT OF TRANSPORTATION		Region 5		EJA		Sheet Number 224	

State of Colorado
 Department of Transportation
 Staff Bridge Design
 Bridge Geometry Project Coordinate Converter
 Version 1.00

Run date & time = Wed Aug 13 06:58:24 2008

Input Northing Offset = 1213028.060000
 Input Easting Offset = 2319698.110000
 Input Bearing = N 3 43 26.7600 E

DESCRIPTION

Units: feet;
 Project: NH 1604-114; Subaccount: 16042;
 Designer: AML; Detailer: ;
 Location: Durango;
 3 Span CIP Box Girder
 (211.5, 211.5, 99.9)
 US 550 over US160 and Wilson Gulch

HORIZONTAL ALIGNMENT DATA

PC 250+97.6790 T 1120.2910
 PI 262+17.9700 Lc 2184.6093 DELTA 31 17 32.00 LT Ds 1 25 56.42 RADIUS 4000.000121
 PT 272+82.2883 T 1120.2910

VERTICAL ALIGNMENT DATA

ELEVATION AT PT	ELEVATION AT GRADE	STATION	ELEVATION AT GRADE	ELEVATION AT PT	PERCENT GRADE
6695.7506	6695.7500	PI 244+00.0000			-3.000000
					-3.000000

TABLE OF ROADWAY CROSS-SLOPES (SUPERELEVATION: E= 0.0)

STATION	SLOPE LEFT	SLOPE RIGHT	VC LENGTH
(ON TANGENT)	0.0400	0.0400	9.00 (MAX)

OFFSET PROFILE CONTROL TO POINT = 0.0000 FEET

LIMITS OF VALID ELEVATION AND CROSS-SLOPE DATA
 BEGIN: UNLIMITED
 END: UNLIMITED

LAYOUT LINE DATA

LAYOUT LINE DEFINED AS CHORD BETWEEN BENT LINES: CL BNC AB4 AND: *RSP LINE*

LAYOUT LINE DEFINED AS CHORD ON HORIZONTAL CONTROL LINE

A CURVE PARALLEL TO HORIZONTAL CONTROL AT OFFSET -8.5121 IS TANGENT TO LAYOUT LINE AT STATION 268+61.0000 Y FROM REF LINE 268.616825

LAYOUT LINE INTERSECTS HORIZONTAL CONTROL AT	HCL STA	STEW	Y FROM REF LINE
	266+00.0000	-3.44 18.78	0.00000000
	271+22.0000	3.44 18.78	521.629671

LAYOUT LINE INTERSECTS RSP LINE AT	HCL STA	OFFSET	X	Y
	266+00.0000	0.00000000	0.0000	0.6000

TYPE 4 GIRDER LINE DATA
 (OFFSET VARIES WITH SUPER)

LINE OF CONSTANT OFFSET IS HORIZONTAL CONTROL

AVERAGE CROSS-SLOPE = 0.040000 FT/FT (RIGHT OF PROFILE CONTROL LINE)

DEAD LOAD DEFLECTION DATA

DEFLECTIONS AT TENTH POINTS FROM FITTED CURVE

FOR BENT LINE:	CL BNC AB1	07 CARD(S): 1	GIRDER LINES REFERENCED BY:	(BLANK)								
INCH	0.0000	1.2611	2.4847	3.4016	3.8199	3.6870	3.1008	2.2731	1.4425	0.7393	0.0000	INCH
FOOT	0.0000	0.1051	0.2071	0.2835	0.3183	0.3073	0.2584	0.1894	0.1202	0.0616	0.0000	FOOT
SLOPE	0.992617											-0.775350 SLOPE

A4=-68.4109
 A3= 85.2637
 A2= 6.38472
 A1=-22.6303
 A0=-11.9114

FOR BENT LINE:	CL Pier2	07 CARD(S): 1	GIRDER LINES REFERENCED BY:	(BLANK)								
INCH	0.0000	-0.2967	-0.4704	-0.6696	-0.3347	0.1135	0.4716	0.6483	0.6584	0.5116	0.0000	INCH
FOOT	0.0000	-0.0249	-0.0559	-0.0558	-0.0279	0.0095	0.0393	0.0540	0.0549	0.0426	0.0000	FOOT
SLOPE	0.070615											-0.731371 SLOPE

A4=-143.086
 A3= 323.126
 A2=-251.720
 A1= 63.7507
 A0=-.847381

FOR BENT LINE:	CL Pier 3	07 CARD(S): 1	GIRDER LINES REFERENCED BY:	(BLANK)								
INCH	0.0000	-0.1321	-0.3896	-0.6350	-0.8668	-1.0210	-1.0703	-1.0008	-0.8059	-0.4786	0.0000	INCH
FOOT	0.0000	-0.0110	-0.0308	-0.0529	-0.0722	-0.0851	-0.0892	-0.0834	-0.0672	-0.0399	0.0000	FOOT
SLOPE	-0.041810											0.471521 SLOPE

A4= 3.46308
 A3=-2.96488
 A2=-5.49383
 A1= 10.2321
 A0=0.501724

DEFLECTIONS SHOW SIGNIFICANT UPLIFT


BENT LINE :	INTERSECTION POINT :	FROM LAYOUT LINE :	PROJECT COORDINATES :	BENT LINE :	GIRDER LINE :	ROADWAY :
DESCRIPTION :	STATION :	OFFSET :	COORDINATE :	LENGTH FROM :	LENGTH FROM :	CROSS-
:	:	:	:	Y-AXIS :	D M S :	SLOPE :

* HORIZONTAL CONTROL LINE * AT FINISHED GRADE

BP AB 1	265+96.0000	0.0000	6689.8700	-0.2628	-3.9914	1213024.0941	2319697.5805	-0.2760	-21 36 45.31	-4.0000	+/- .040000
CL BNC AB1	266+00.0000	0.0000	6689.7500	0.0000	0.0000	1213028.0600	2319698.1100	0.0000	-21 33 19.05	0.0000	+/- .040000
CL Pier2	268+11.5000	0.0000	6683.4050	8.2058	211.3161	1213238.3969	2319720.0239	6.4192	-18 31 32.80	211.5000	+/- .040000
CL Pier 3	270+23.0000	0.0000	6677.0600	5.2321	422.7706	1213449.5990	2319730.7909	3.4154	-12 37 55.28	423.0000	+/- .040000
CL BNC AB4	271+22.0000	0.0000	6674.0900	0.0000	521.6297	1213548.5882	2319731.9909	0.0000	-11 12 58.22	522.0000	+/- .040000
BP AB 4	271+25.8200	0.0000	6673.9754	0.0000	525.4414	1213552.4082	2319731.9881	-6.2597	-11 09 33.24	525.8200	+/- .040000

* LAYOUT LINE * AT FINISHED GRADE

BP AB 1	265+96.1017	0.2566	6689.8772	0.0000	-3.9069	1213024.1613	2319697.8562	0.0000	-17 49 00.27	-3.9069	+0.040000
CL BNC AB1	266+00.0000	0.0000	6689.7500	0.0000	0.0000	1213028.0600	2319698.1100	0.0000	-17 49 00.27	0.0000	+/- .040000
CL Pier2	268+06.7558	-0.1714	6683.1605	0.0000	208.6789	1213236.2983	2319711.6641	0.0000	-17 49 00.27	208.6789	+0.040000
CL Pier 3	270+21.8141	-5.2842	6676.8842	0.0000	421.3733	1213448.5435	2319725.4791	0.0000	-14 57 09.00	421.3733	+0.040000
CL BNC AB4	271+22.0000	0.0000	6674.0900	0.0000	511.6297	1213548.5882	2319731.9909	0.0000	-14 57 09.00	521.6297	+/- .040000
BP AB 4	271+21.8703	0.2566	6673.9941	0.0000	525.5084	1213552.4087	2319732.2129	0.0000	-14 57 09.00	525.5084	+0.040000

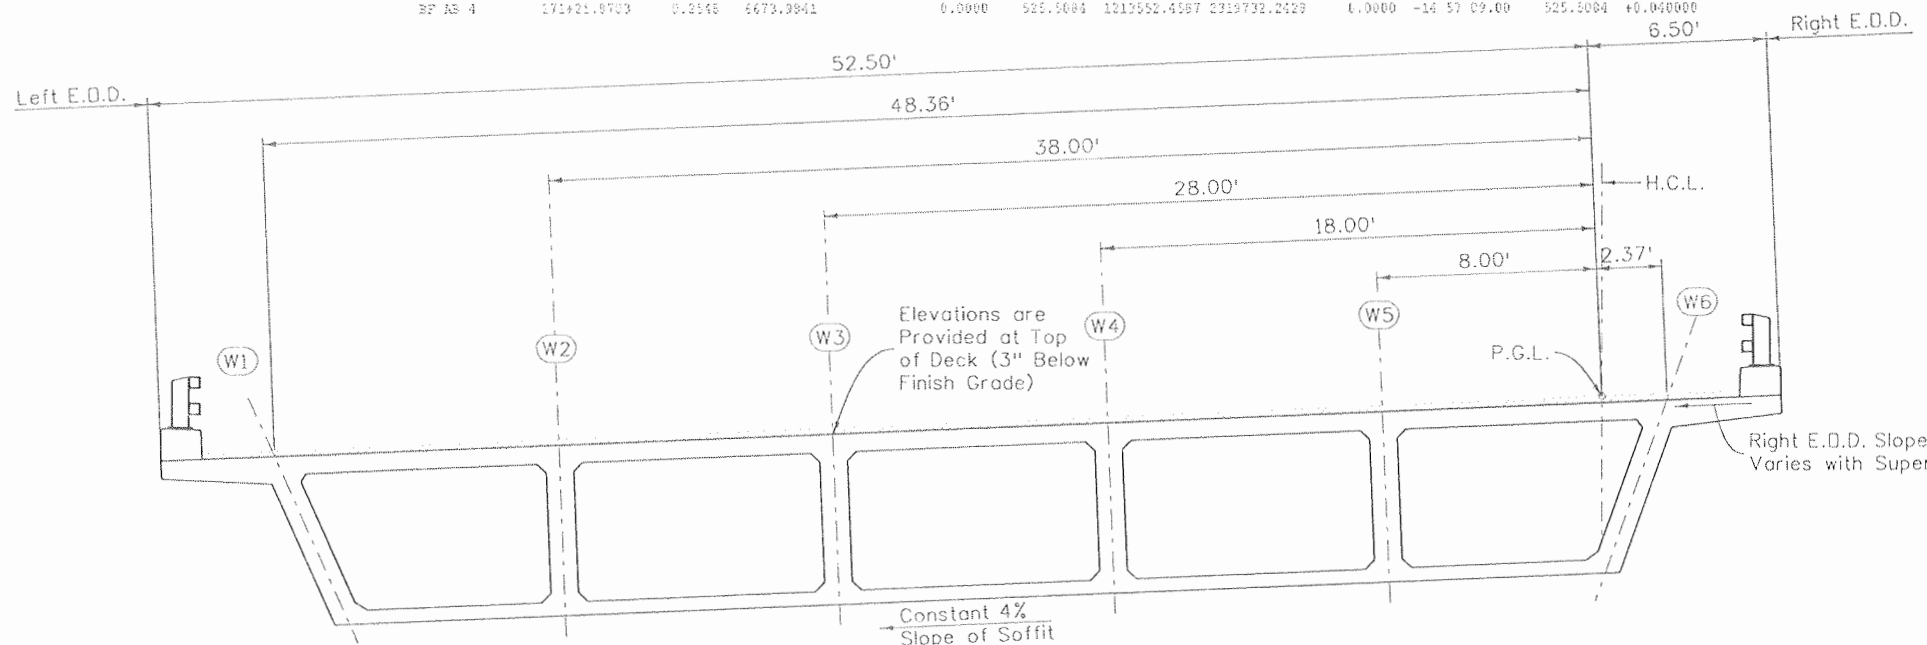

Design	Checked By	Date	Initial		Checked By	Date	Quantities	
			AML	GWK			AML	GWK

Print Date: 9/22/2010	Sheet Revisions			Colorado Department of Transportation 3803 North Main Avenue Suite 200 Durango, CO 81301 Phone: 970-385-1440 FAX: 970-385-8365 Region 5 EJA	As Constructed	US 550 OVER US 160 BRIDGE DECK ELEVATIONS (1 OF 4)		Project No./Code
File Name: 16042AG_Brdg_Geometry_01.dgn	Date:	Comments:	Init.		No Revisions: 9/10	NH 1602-114		
Horiz. Scale: 1:1				Revised:	Designer: A. Leifheit	Structure: P-05-AG	16042	
Unit Information 0221	Unit Leader STW			Void:	Detailer: K. Tucker	Sheet Subset: Bridge	Subset Sheets: B35 of B38	
SEMA CONSTRUCTION		WILSON & COMPANY				Sheet Number 226		

Design	INITIAL	DATE	Checked By	Checked By
	AML	08/08		
Detail	INITIAL	DATE	Checked By	Checked By
	AML	08/08		
Quantities	INITIAL	DATE	Checked By	Checked By
	AML	08/08		

LEFT END		VARIES WITH SUPER		NOMINAL OFFSET = -52.4481 FT		-0.2500 NORMAL FROM FINISHED GRADE						
BENT LINE	STATION	OFFSET	ELEVATION	ELEV+DL	X	Y	NORTHING	EASTING	BENT LNTH	SKEW	GIRDER LNTH	CRS-SLP
BF AB 1	265+74.9228	-52.4481	6688.1542	688.1458	-54.0275	-21.2707	1213010.3634	2319642.8150	-56.7492	-21 54 52.18	-4.0084	-0.040000
CL BRG AB1	265+78.9845	-52.4481	6688.0323	688.0323	-53.7431	-17.2724	1213014.3148	2319643.3585	-56.4505	-21 51 22.74	0.0000	-0.040000
F-1	266+00.9539	-52.4481	6687.3883	687.4934	-52.3073	3.8668	1213035.3161	2319646.1643	21.1878		-0.040000	
F-2	266+21.9232	-52.4481	6686.7442	686.9512	-50.9849	25.0133	1213056.3321	2319648.6574	42.3757		-0.040000	
F-3	266+43.3926	-52.4481	6686.1001	686.3836	-49.7760	46.1666	1213077.3622	2319651.4377	63.5635		-0.040000	
F-4	266+64.8619	-52.4481	6685.4560	685.7743	-48.6807	67.3261	1213098.4058	2319653.9051	84.7534		-0.040000	
F-5	266+86.3313	-52.4481	6684.8119	685.1192	-47.6390	88.4911	1213119.4624	2319656.2594	105.9392		-0.040000	
F-6	267+07.8006	-52.4481	6684.1679	684.4263	-46.8309	109.6612	1213140.5214	2319658.5007	127.1271		-0.040000	
F-7	267+29.2700	-52.4481	6683.5238	683.7132	-46.0764	130.8355	1213161.6120	2319660.8289	148.3149		-0.040000	
F-8	267+50.7393	-52.4481	6682.8797	682.9999	-45.4356	152.0137	1213182.7038	2319662.8439	169.5028		-0.040000	
F-9	267+72.2087	-52.4481	6682.2356	682.2972	-44.9085	173.1949	1213203.8061	2319664.5457	190.6906		-0.040000	
CL Pier 2	267+93.6780	-52.4481	6681.5915	681.5915	-44.4950	194.3787	1213224.9183	2319666.3343	211.8785	-46.7365	-18 66 51.81	-0.040000
F-1	268+15.4188	-52.4481	6680.9393	680.9144	-44.1523	215.8322	1213246.3068	2319668.0298	233.3341		-0.040000	
F-2	268+37.1595	-52.4481	6680.2871	680.2312	-44.0061	237.2874	1213267.7043	2319669.8091	254.7898		-0.040000	
F-3	268+58.9003	-52.4481	6679.6349	679.5791	-43.9365	258.7426	1213289.1100	2319671.0721	276.2455		-0.040000	
F-4	268+80.6410	-52.4481	6678.9826	678.9548	-43.9835	280.1982	1213310.5233	2319672.4188	297.7012		-0.040000	
F-5	269+02.3818	-52.4481	6678.3304	678.3399	-44.1472	301.6533	1213331.9430	2319673.6490	319.1569		-0.040000	
F-6	269+24.1225	-52.4481	6677.6782	677.7175	-44.4275	323.1071	1213353.3705	2319674.7628	340.6126		-0.040000	
F-7	269+45.8633	-52.4481	6677.0260	677.0800	-44.8243	344.5591	1213374.8030	2319675.7602	362.0683		-0.040000	
F-8	269+67.6040	-52.4481	6676.3738	676.4286	-45.3378	366.0056	1213396.2405	2319676.6409	383.5239		-0.040000	
F-9	269+89.3448	-52.4481	6675.7215	675.7642	-45.9678	387.4550	1213417.6825	2319677.4053	404.9796		-0.040000	
CL Pier 3	270+11.0855	-52.4481	6675.0693	675.0693	-46.7144	408.8977	1213439.1285	2319678.0530	426.4353	-48.3516	-12 48 09.66	-0.040000
F-1	270+21.1231	-52.4481	6674.4171	674.7572	-47.0584	418.7762	1213449.0310	2319678.3127	436.3412		-0.040000	
F-2	270+31.1606	-52.4481	6674.4671	674.4363	-47.5073	426.6936	1213458.9341	2319678.5675	446.2471		-0.040000	
F-3	270+41.1981	-52.4481	6674.1659	674.1130	-47.9410	438.5900	1213468.8377	2319678.7576	456.1531		-0.040000	
F-4	270+51.2356	-52.4481	6673.8648	673.7926	-48.3995	448.4853	1213478.7419	2319678.9427	466.0590		-0.040000	
F-5	270+61.2732	-52.4481	6673.5637	673.4786	-48.8828	458.3795	1213488.6466	2319679.1031	475.9649		-0.040000	
F-6	270+71.3107	-52.4481	6673.2626	673.1734	-49.3910	468.2729	1213498.5515	2319679.2385	485.8708		-0.040000	
F-7	270+81.3482	-52.4481	6672.9614	672.8780	-49.9240	478.1639	1213508.4569	2319679.3491	495.7767		-0.040000	
F-8	270+91.3858	-52.4481	6672.6603	672.5931	-50.4818	488.0541	1213518.3624	2319679.4349	505.6826		-0.040000	
F-9	271+01.4233	-52.4481	6672.3592	672.3193	-51.0645	497.9428	1213528.2681	2319679.4957	515.5884		-0.040000	
CL BRG AB4	271+11.4608	-52.4481	6672.0581	672.0581	-51.6719	507.8301	1213538.1740	2319679.5318	525.4945	-53.4829	-11 21 53.49	-0.040000
BF AB 4	271+15.3336	-52.4481	6671.9419	671.9502	-51.9129	511.6445	1213541.9960	2319679.5391	529.3165	-53.7323	-11 18 33.98	-0.040000

W2		VARIES WITH SUPER		NOMINAL OFFSET = -37.9596 FT		-0.2500 NORMAL FROM FINISHED GRADE						
BENT LINE	STATION	OFFSET	ELEVATION	ELEV+DL	X	Y	NORTHING	EASTING	BENT LNTH	SKEW	GIRDER LNTH	CRS-SLP
BF AB 1	265+80.8055	-37.9596	6688.5572	688.5489	-39.1641	-16.4937	1213014.1449	2319657.9573	-41.1370	-21 49 48.84	-4.0060	-0.040000
CL BRG AB1	265+84.8499	-37.9596	6688.4359	688.4359	-38.8857	-12.4974	1213018.1147	2319658.4947	-40.8446	-21 46 20.28	0.0000	-0.040000
F-1	266+06.2300	-37.9596	6687.7945	687.8996	-37.4813	8.6332	1213039.1095	2319661.2686	21.1772		-0.040000	
F-2	266+27.6102	-37.9596	6687.1531	687.3602	-36.1899	29.7710	1213060.1187	2319663.9302	42.3544		-0.040000	
F-3	266+48.9903	-37.9596	6686.5117	686.7952	-35.0114	50.9154	1213081.1419	2319666.4796	63.5317		-0.040000	
F-4	266+70.3704	-37.9596	6685.8703	686.1886	-33.9460	72.0658	1213102.1785	2319668.9165	84.7089		-0.040000	
F-5	266+91.7505	-37.9596	6685.2289	685.5369	-32.9937	93.2215	1213123.2271	2319671.2409	105.8861		-0.040000	
F-6	267+13.1306	-37.9596	6684.5875	684.8459	-32.1545	114.3821	1213144.2917	2319673.4527	127.0633		-0.040000	
F-7	267+34.5107	-37.9596	6683.9461	684.1355	-31.4283	135.5468	1213165.3619	2319675.5521	148.2405		-0.040000	
F-8	267+55.8909	-37.9596	6683.3047	683.4249	-30.8153	156.7151	1213186.4457	2319677.5387	169.4178		-0.040000	
F-9	267+77.2710	-37.9596	6682.6633	682.7249	-30.3155	177.8864	1213207.5398	2319679.4126	190.5950		-0.040000	
CL Pier 2	267+98.6511	-37.9596	6682.0219	682.0219	-29.9288	199.0601	1213228.6437	2319681.1738	211.7722	-31.4365	-18 42 35.37	-0.040000
F-1	268+20.2259	-37.9596	6681.3746	681.3497	-29.6534	220.4294	1213249.7500	2319682.8368	233.1433		-0.040000	
F-2	268+41.8027	-37.9596	6680.7273	680.6715	-29.4932	241.7998	1213270.8649	2319684.3845	254.5143		-0.040000	
F-3	268+63.3785	-37.9596	6680.0801	680.0243	-29.4482	263.1708	1213292.0288	2319685.8175	275.8854		-0.040000	
F-4	268+84.9543	-37.9596	6679.4328	679.4049	-29.5106	284.5417	1213313.2182	2319687.1353	297.2564		-0.040000	
F-5	269+06.5301	-37.9596	6678.7855	678.7950	-29.7042	305.9219	1213335.2553	2319688.3381	318.6275		-0.040000	
F-6	269+28.1059	-37.9596	6678.1382	678.1775	-30.0051	327.2808	1213356.5986	2319689.4258	339.9985		-0.040000	
F-7	269+49.6817	-37.9596	6677.4910	677.5450	-30.4218	348.6478	1213377.9475	2319690.3984	361.3696		-0.040000	
F-8	269+71.2575	-37.9596	6676.8437	676.8986	-30.9526	370.0122	1213399.3013	2319691.2558	382.7406		-0.040000	
F-9	269+92.8333	-37.9596	6676.1964	676.2390	-31.5992	391.3735	1213420.6595	2319691.9980	404.1117		-0.040000	
CL Pier 3	270+14.4092	-37.9596	6675.5491	675.5491	-32.3611	412.7389	1213442.0213	2319692.6250	425.4870	-33.4952	-12 45 18.27	-0.040000
F-1	270+24.4093	-37.9596	6675.3412	675.2382	-32.7532	432.6274	1213454.1263	2319692.8745	445.3827		-0.040000	
F-2	270+34.4075	-37.9596	6674.9492	674.9184	-33.1701	432.5229	1213461.8240	2319693.1032	445.2913		-0.040000	
F-3	270+44.4066	-37.9596	6674.6492	674.5963	-33.6173	432.4173	1213471.7262	2319693.3052	445.1955		-0.040000	
F-4	270+54.4058	-37.9596	6674.3492	674.2770	-34.0780	432.3105	1213481.6288	2319693.4825	445.0998		-0.040000	
F-5	270+64.4049	-37.9596	6674.0493	673.9642	-34.5691	432.2026	1213491.5319	2319693.6349	445.0040		-0.040000	
F-6	270+74.4040	-37.9596	6673.7493	673.6601	-35.0848	432.0934	1213501.4354	2319693.7627	444.9083		-0.040000	
F-7	270+84.4032	-37.9596	6673.4493	673.3659	-35.6294	432.0829	1213511.3391	2319693.8656	444.8125		-0.040000	
F-8	270+94.4023	-37.9596	6673.1493	673.0822	-36.1906	432.0710	1213521.2420	2319693.9439	444.7168		-0.040000	
F-9	271+04.4015	-37.9596	6672.8494	672.8095	-36.7805	432.0591	1213531.1452	2319693.9974	444.6211		-0.040000	
CL BRG AB4	271+14.4006	-37.9596	6672.5494	672.5494	-37.3952	432.0472	1213541.0484	2319694.0280	444.5253	-38.7058	-11 19 22.09	-0.040000

W4											HCL														
VARIES WITH SUPER											PARALLEL TO HORIZONTAL CONTROL														
NOMINAL OFFSET = -17.9756 FT											0.25000 FEET BELOW FINISHED GRADE														
-0.2500 NORMAL FROM FINISHED GRADE																									
BENT LINE	STATION	OFFSET	ELEVATION	ELEV+DL	X	Y	NORTHING	EASTING	BENT LNTH	SKW	GIRDER LNTH	CPS-SLP	BENT LINE	STATION	OFFSET	ELEVATION	ELEV+DL	X	Y	NORTHING	EASTING	BENT LNTH	SKW	GIRDER LNTH	CPS-SLP
BF AB 1	265+89.8437	-17.9756	6689.1155	688.1072	-18.6770	-9.8094	1213019.3866	2319678.8288	-19.6179	-21 42 54.34	-4.0028	-0.040000	BF AB 1	265+96.0000	0.0000	6689.6200	689.6117	-0.2628	-3.9914	1213024.0941	2319697.5885	-0.2740	-21 36 45.31	-4.0000	
CL BRG AB1	265+92.8646	-17.9756	6688.9948	688.9948	-18.4069	-5.9157	1213023.3524	2319679.3577	-19.3341	-21 39 26.99	0.0000	-0.040000	CL BRG AB1	266+00.0000	0.0000	6688.5000	689.5000	0.0000	0.0000	1213028.0600	2319698.1100	0.0000	-21 33 19.05	0.0000	
F-1	266+34.1229	-17.9756	6688.3571	688.4622	-17.0454	15.2032	1213044.3382	2319682.0681			21.1628	-0.040000	F-1	266+21.1500	0.0000	6688.8655	688.9706	1.3233	21.1085	1213049.0380	2319700.8015			21.1500	
F-2	266+35.3812	-17.9756	6687.7193	687.9264	-15.7962	36.3290	1213065.3383	2319684.7066			42.3256	-0.040000	F-2	266+42.3600	0.0000	6688.2310	688.4381	2.5349	42.2238	1213070.0300	2319703.3821			42.3000	
F-3	266+36.6395	-17.9756	6687.0816	687.3651	-14.5492	57.4612	1213086.3520	2319687.2139			63.4883	-0.040000	F-3	266+63.4500	0.0000	6687.5965	687.8800	3.6348	63.3451	1213091.0353	2319705.8515			63.4500	
F-4	266+37.8978	-17.9756	6686.4438	686.7622	-13.3046	78.5992	1213107.3786	2319689.6092			84.6231	-0.040000	F-4	266+84.6000	0.0000	6686.9620	687.2803	4.7231	84.4720	1213112.0533	2319708.2100			84.6000	
F-5	266+39.1562	-17.9756	6685.8061	686.1133	-12.0592	99.7423	1213128.4100	2319691.8928			105.8139	-0.040000	F-5	267+05.7500	0.0000	6686.3275	686.6348	5.8197	105.6038	1213133.0836	2319710.4573			105.7500	
F-6	267+20.4145	-17.9756	6685.1683	685.4267	-10.8138	120.8899	1213149.4490	2319694.0645			126.9767	-0.040000	F-6	267+26.9000	0.0000	6685.6930	685.9514	6.9165	126.7400	1213154.1255	2319712.5933			126.9000	
F-7	267+41.6728	-17.9756	6684.5306	684.7200	-9.5684	142.0415	1213170.5313	2319696.1243			148.1395	-0.040000	F-7	267+48.0500	0.0000	6685.0585	685.2479	8.0135	147.8798	1213175.1782	2319714.6180			148.0500	
F-8	267+62.9311	-17.9756	6683.8928	684.0130	-8.3230	163.1964	1213191.6042	2319698.0723			169.3022	-0.040000	F-8	267+69.2000	0.0000	6684.4240	684.5442	9.1004	169.0229	1213196.2415	2319716.5313			169.2000	
F-9	267+84.1894	-17.9756	6683.2551	683.3167	-7.0776	184.3541	1213212.6872	2319699.9080			190.4650	-0.040000	F-9	267+90.3500	0.0000	6683.7895	683.8511	10.1882	190.1685	1213217.3146	2319718.3334			190.3500	
CL Pier 2	268+05.4477	-17.9756	6682.6173	682.6173	-5.8320	205.5140	1213233.7796	2319701.6318	-10.3436	-18 36 44.89	211.6278	-0.040000	CL Pier 2	268+11.5000	0.0000	6683.1550	683.1550	11.2760	211.3161	1213238.3969	2319720.0239	8.6192	-18 31 32.80	211.5000	
F-1	268+26.7382	-17.9756	6681.9796	681.9519	-4.5866	226.7672	1213254.9725	2319703.2502			232.8824	-0.040000	F-1	268+32.6500	0.0000	6682.5205	682.4956	12.3648	232.4651	1213259.4679	2319721.6029			232.6500	
F-2	268+48.1487	-17.9756	6681.3363	681.2804	-3.3412	248.0212	1213276.1736	2319704.7594			254.1569	-0.040000	F-2	268+53.8000	0.0000	6681.8860	681.8301	13.4526	253.6148	1213280.5868	2319723.0704			253.8000	
F-3	268+69.5592	-17.9756	6680.6958	680.6400	-2.0958	269.2759	1213297.3826	2319706.1475			275.3915	-0.040000	F-3	268+74.9500	0.0000	6681.2515	681.1957	14.5404	274.7648	1213301.6933	2319724.4264			274.9500	
F-4	268+90.9697	-17.9756	6680.0553	680.0274	-0.8504	290.5302	1213318.5986	2319707.4263			296.6460	-0.040000	F-4	268+96.1000	0.0000	6680.6170	680.5891	15.6282	295.9144	1213322.8067	2319725.6707			296.1000	
F-5	269+12.2002	-17.9756	6679.4148	679.4242	0.0094	311.7836	1213339.8211	2319708.5920			317.9006	-0.040000	F-5	269+17.2500	0.0000	6679.9825	679.9920	16.7160	317.0630	1213343.9263	2319726.8034			317.2500	
F-6	269+33.5508	-17.9756	6678.7743	678.8135	0.0000	333.0356	1213361.0496	2319709.6442			339.1551	-0.040000	F-6	269+38.4000	0.0000	6679.3480	679.3873	17.8038	338.2100	1213365.0516	2319727.8243			338.4000	
F-7	269+54.9013	-17.9756	6678.1337	678.1878	0.0000	354.2855	1213382.2833	2319710.5832			360.4097	-0.040000	F-7	269+59.5500	0.0000	6678.7135	678.7675	18.8926	359.3549	1213386.1820	2319728.7336			359.5500	
F-8	269+76.2518	-17.9756	6677.4932	677.5481	0.0000	375.5328	1213403.5218	2319711.4088			381.6643	-0.040000	F-8	269+80.7000	0.0000	6678.0790	678.1339	19.9815	380.4970	1213407.3170	2319729.5311			380.7000	
F-9	269+97.6023	-17.9756	6676.8527	676.8953	0.0000	396.7766	1213424.7644	2319712.1211			402.9188	-0.040000	F-9	270+01.8500	0.0000	6677.4445	677.4871	21.0704	401.6357	1213428.4558	2319730.2168			401.8500	
CL Pier 3	270+18.9528	-17.9756	6676.2122	676.2122	-0.0000	418.0169	1213446.0105	2319712.7199	-13.0082	-12 41 23.98	424.1734	-0.040000	CL Pier 3	270+23.0000	0.0000	6676.8100	676.8100	22.1592	422.7706	1213449.5980	2319730.7909	5.4154	-12 37 55.28	423.0000	
F-1	270+28.6995	-17.9756	6675.5738	675.9028	-0.0000	439.2607	1213467.2607	2319713.2607			443.0754	-0.040000	F-1	270+32.0000	0.0000	6676.1755	676.1755	23.2480	432.6619	1213459.7363	2319731.0211			432.0000	
F-2	270+39.8462	-17.9756	6674.9353	675.3846	-0.0000	460.5038	1213488.5038	2319713.7577			466.9374	-0.040000	F-2	270+42.8000	0.0000	6675.5410	675.5410	24.3368	442.5523	1213469.8932	2319731.2268			442.8000	
F-3	270+48.7529	-17.9756	6674.2968	674.8641	-0.0000	481.7469	1213509.7469	2319713.2668			488.8794	-0.040000	F-3	270+52.7000	0.0000	6674.9065	674.9065	25.4262	452.4445	1213479.9915	2319731.4051			452.7000	
F-4	270+58.7396	-17.9756	6673.6583	674.3464	-0.0000	503.0000	1213531.0000	2319713.5332			510.8141	-0.040000	F-4	270+62.6000	0.0000	6674.2720	674.2720	26.5156	462.3369	1213489.1203	2319731.5649			462.6000	
F-5	270+68.6830	-17.9756	6673.0202	673.8281	-0.0000	524.2531	1213552.2531	2319713.8000			528.6834	-0.040000	F-5	270+72.5000	0.0000	6673.6375	673.6375	27.6050	472.2293	1213499.2484	2319731.7171			472.5000	
F-6	270+78.6363	-17.9756	6672.3821	673.3166	-0.0000	545.5062	1213573.5062	2319713.0666			547.5854	-0.040000	F-6	270+82.4000	0.0000	6673.0025	673.0025	28.6944	482.1218	1213509.3766	2319731.8049			482.4000	
F-7	270+88.5797	-17.9756	6671.7440	672.8051	-0.0000	566.7593	1213594.7593	2319712.3332			569.4874	-0.040000	F-7	270+92.3000	0.0000	6672.3675	672.3675	29.7838	492.0142	1213519.5046	2319731.8821			492.3000	
F-8	270+98.5264	-17.9756	6671.1059	672.2942	-0.0000	588.0124	1213616.0124	2319711.6000			592.2194	-0.040000	F-8	271+02.2000	0.0000	6671.7325	671.7325	30.8732	501.9067	1213529.6330	2319731.9449			502.2000	
F-9	271+08.4731	-17.9756	6670.4678	671.7833	-0.0000	609.2655	1213637.2655	2319710.8666			605.0394	-0.040000	F-9	271+12.1000	0.0000	6671.0975	671.0975	31.9676	511.7991	1213539.7614	2319731.9812			512.1000	
CL BRG AB4	271+18.4198	-17.9756	6670.8297	671.2722	-0.0000	630.5186	1213658.5186	2319710.1332			626.8134	-0.040000	CL BRG AB4	271+22.0000	0.0000	6670.4625	670.4625	33.0560	521.6927	1213549.8908	2319731.9909	0.0000	-11 12 50.22	522.0000	
BF AB 4	271+22.2577	-17.9756	6670.2130	670.7615	-0.0000	651.7717	1213679.7717	2319709.4000	-18.3271	-11 15 56.84	648.5682	-0.040000	BF AB 4	271+26.8000	0.0000	6670.8275	670.8275	34.1446	531.5854	1213560.0202	2319731.9881	-0.2597	-11 09 33.24	525.8200	

W5											WG														
VARIES WITH SUPER											PARALLEL TO HORIZONTAL CONTROL														
NOMINAL OFFSET = -7.9636 FT											0.25000 FEET BELOW FINISHED GRADE														
-0.2500 NORMAL FROM FINISHED GRADE																									
BENT LINE	STATION	OFFSET	ELEVATION	ELEV+DL	X	Y	NORTHING	EASTING	BENT LNTH	SKW	GIRDER LNTH	CPS-SLP	BENT LINE	STATION	OFFSET	ELEVATION	ELEV+DL	X	Y	NORTHING	EASTING	BENT LNTH	SKW	GIRDER LNTH	CPS-SLP
BF AB 1	265+92.8302	-7.9636	6689.2955	689.2955	-8.4396	-6.6193	1213022.0028	2319689.2583	-8.8647	-21 39 28.77	-4.0013	-0.040000	BF AB 1	265+96.3784	2.3700	6688.6866	689.6782	2.1640	-3.2114	1213024.7148	2319700.0688	2.2731	-21 35 56.93	-3.9996	-0.040000
CL BRG AB1	265+95.8395	-7.9636	6689.2753	689.2753	-8.1735	-2.6269	1213025.9675	2319689.7831	-8.5853	-21 38 02.02</															

Design		Detail		Quantities	
Designed By	Initial	Initial	Initial	Initial	Initial
Checked By	AML	KLT	AML	AML	AML
	GWK	GWK	GWK	GWK	GWK
	08/08	08/08	08/08	08/08	08/08
	08/08	08/08	08/08	08/08	08/08

Point Line	Station	Offset	Elevation	Elev/DL	X	Y	NORTHING	EASTING	BENT LNTH	SPEN	CHORD LNTH	CRS-SLP
RP AB 1	265+98.5707	6.5000	6689.8029	689.7946	6.3926	-1.8524	1213025.7943	2319704.3688	6.7146	-21 34 32.75	-3.9990	+0.040000
CL BRG AB1	266+02.5632	6.5000	6689.6831	689.6831	6.6527	2.1381	1213029.7615	2319704.8875	6.9879	-21 31 06.87	0.0000	+0.040000
P-1	266+23.6743	6.5000	6689.0498	689.1549	7.9623	33.2429	1213050.7367	2319707.5452			21.1454	+0.040000
P-2	266+44.7854	6.5000	6688.4164	688.6235	9.1604	44.3544	1213071.7258	2319710.1320			42.2909	+0.040000
P-3	266+65.8965	6.5000	6687.7831	688.0666	10.2471	65.4718	1213092.7280	2319712.5880			63.4363	+0.040000
P-4	266+87.0077	6.5000	6687.1498	687.4681	11.2224	86.5947	1213113.7429	2319714.9332			84.5817	+0.040000
P-5	267+08.1188	6.5000	6686.5164	686.8237	12.0861	107.7225	1213134.7700	2319717.1674			105.7271	+0.040000
P-6	267+29.2299	6.5000	6685.8831	686.1415	12.8384	128.8545	1213155.8085	2319719.2907			126.8726	+0.040000
P-7	267+50.3410	6.5000	6685.2498	685.4392	13.4790	149.9902	1213176.8580	2319721.3027			148.0180	+0.040000
P-8	267+71.4521	6.5000	6684.6164	684.7366	14.0082	171.1290	1213197.9178	2319723.2038			169.1634	+0.040000
P-9	267+92.5632	6.5000	6683.9831	684.0447	14.4257	192.2702	1213218.9872	2319724.9936			190.3088	+0.040000
CL Pier 2	268+13.6744	6.5000	6683.3498	683.3498	14.7317	213.4134	1213240.0659	2319726.6722	15.4738	-18 29 40.67	211.4543	+0.040000
P-1	268+34.7854	6.5000	6682.7174	682.6235	14.9258	234.5248	1213261.1201	2319728.2371			232.5665	+0.040000
P-2	268+55.8964	6.5000	6682.0851	682.0292	15.0088	255.6368	1213282.1821	2319729.6912			253.6788	+0.040000
P-3	268+76.9074	6.5000	6681.4527	681.3270	14.9804	276.7490	1213303.2516	2319731.0342			274.7910	+0.040000
P-4	268+97.9184	6.5000	6680.8204	680.7925	14.8408	297.8608	1213324.3219	2319732.2661			295.9032	+0.040000
P-5	269+19.0294	6.5000	6680.1881	680.1975	14.5900	318.9715	1213345.4103	2319733.3870			317.0155	+0.040000
P-6	269+40.1404	6.5000	6679.5557	679.5950	14.2279	340.0806	1213366.4993	2319734.3968			338.1277	+0.040000
P-7	269+61.2514	6.5000	6678.9234	678.9774	13.7536	361.1875	1213387.5914	2319735.2954			359.2400	+0.040000
P-8	269+82.3624	6.5000	6678.2911	678.3459	13.1701	382.2917	1213408.6899	2319736.0829			380.3522	+0.040000
P-9	270+03.4734	6.5000	6677.6587	677.7013	12.4744	403.3924	1213429.7904	2319736.7592			401.4645	+0.039999
CL Pier 3	270+24.5844	6.5000	6677.0222	677.0222	11.6675	424.4892	1213450.8950	2319737.3243	12.0764	-12 36 40.28	422.5767	+0.039366
P-1	270+45.6954	6.5000	6676.3898	676.3802	11.2509	444.5987	1213470.9917	2319737.5510			442.6890	+0.038666
P-2	270+66.8064	6.5000	6675.7574	675.7358	10.8098	464.7082	1213490.0884	2319737.5309			462.8013	+0.037710
P-3	270+87.9174	6.5000	6675.1250	675.1152	10.2443	484.8177	1213509.1851	2319737.2609			482.9136	+0.036496
P-4	271+09.0284	6.5000	6674.4926	674.4152	9.5844	504.9272	1213528.2818	2319736.8342			503.0259	+0.035025
P-5	271+30.1394	6.5000	6673.8602	673.8152	8.8400	525.0367	1213547.3785	2319736.2609			523.1382	+0.033298
P-6	271+51.2504	6.5000	6673.2278	673.2017	8.0012	545.1462	1213566.4752	2319735.5374			543.2505	+0.031313
P-7	271+72.3614	6.5000	6672.5954	672.5965	7.0780	565.2557	1213585.5719	2319734.5633			563.3628	+0.029071
P-8	271+93.4724	6.5000	6671.9630	671.9003	6.0804	585.3652	1213604.6686	2319733.3382			583.4751	+0.026620
P-9	272+14.5834	6.5000	6671.3306	671.3150	5.0384	605.4747	1213623.7653	2319731.9633			603.5874	+0.024169
CL BRG AB4	271+23.3645	6.5000	6673.9423	673.9423	6.4019	523.3394	1213549.8785	2319738.4803	6.4263	-11 11 43.88	521.5495	+0.021678
RP AB 4	271+27.1001	6.5000	6673.8217	673.8300	6.1496	527.1508	1213553.0982	2319738.4863	6.3654	-11 08 27.23	525.3893	+0.020725

Print Date: 9/22/2010	
File Name: 16042AG_Brdg_Geometry_04.dgn	
Horiz. Scale: 1:1	Vert. Scale: As Noted
Unit Information 0221	Unit Leader STW

Sheet Revisions		
Date:	Comments	Init.

Colorado Department of Transportation

3803 North Main Avenue
Suite 200
Durango, CO 81301
Phone: 970-385-1440 FAX: 970-385-8365



Region 5

EJA

As Constructed
No Revisions: 9/10
Revised:
Void:

US 550 OVER US 160 BRIDGE DECK ELEVATIONS (4 OF 4)	
Designer: A. Leifheit	Structure: P-05-AG
Detailer: K. Tucker	Numbers:
Sheet Subset: Bridge	Subset Sheets: B38 of B38

Project No./Code	NH 1602-114
16042	
Sheet Number	229

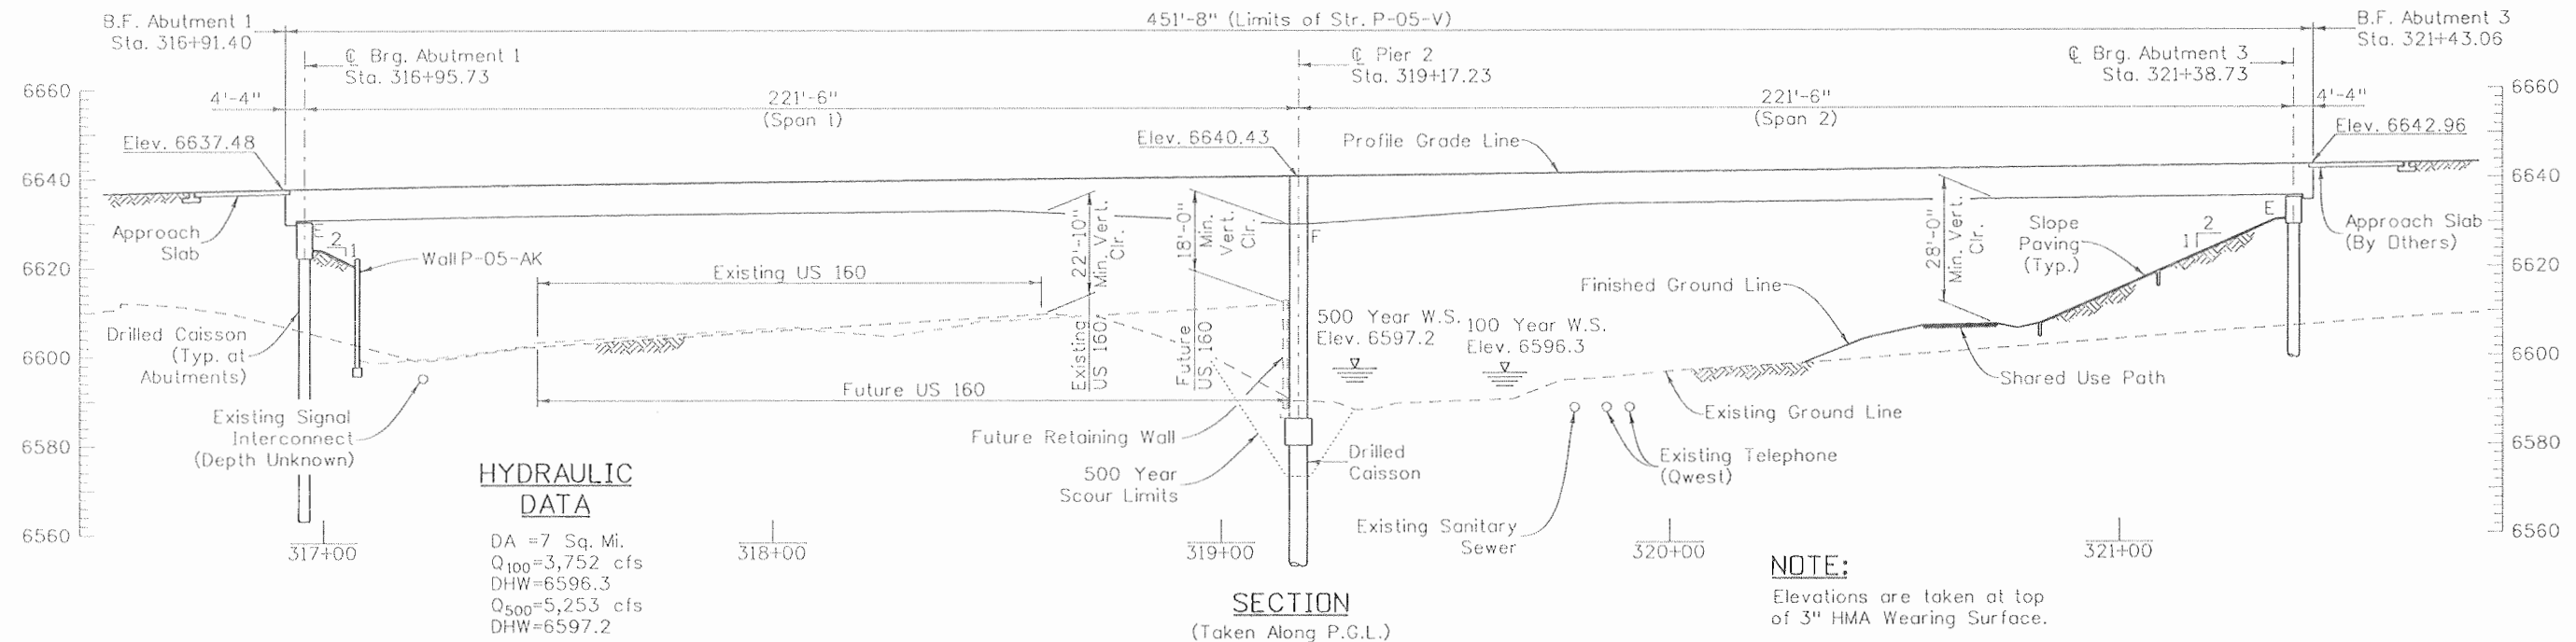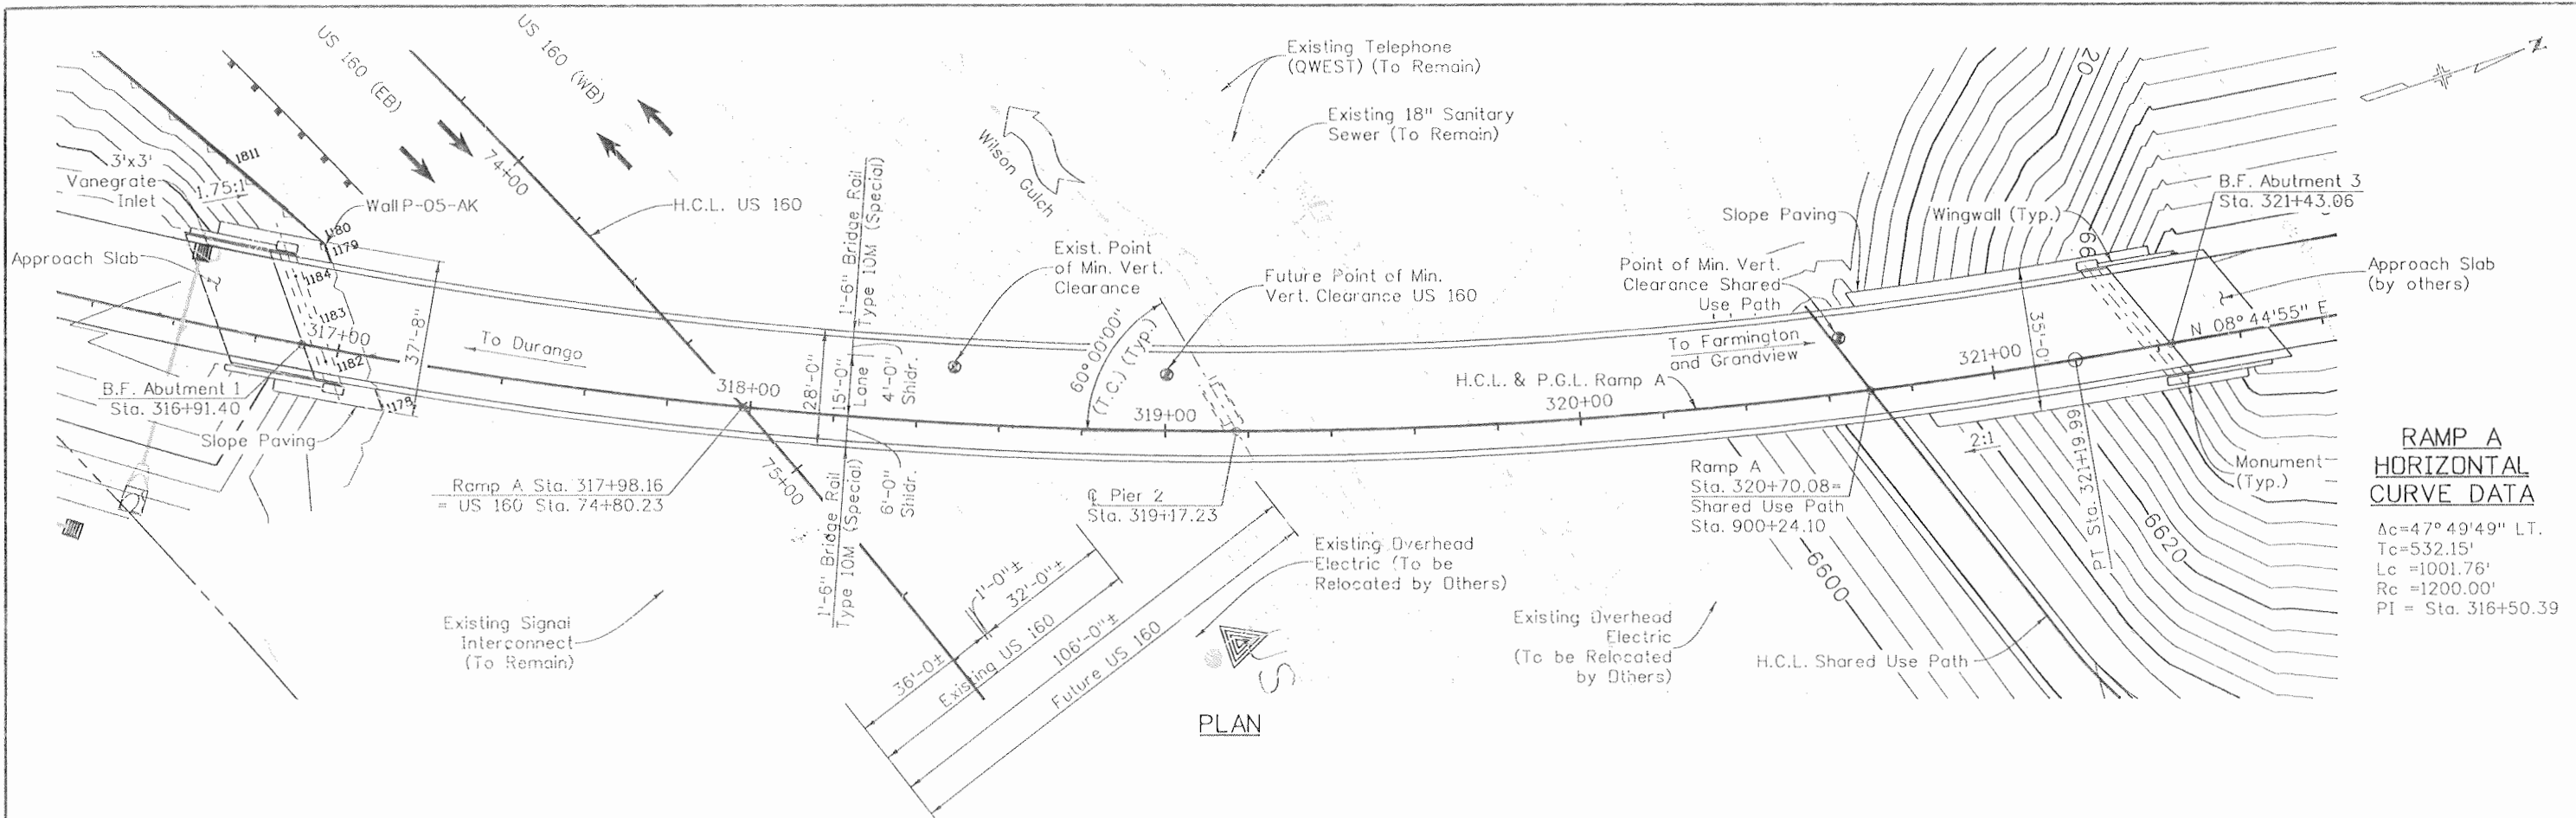


Design		Detail		Quantities	
INITIAL	DATE	INITIAL	DATE	INITIAL	DATE
Designed By	10/08	Checked By	10/08	Checked By	10/08
Checked By	10/08	Checked By	10/08	Checked By	10/08


Print Date: 9/24/2010	Sheet Revisions			Colorado Department of Transportation 3803 North Main Avenue Suite 200 Durango, CO 81301 Phone: 970-385-1440 FAX: 970-385-8365 Region 5	As Constructed No Revisions: Revised: Void:	RAMP A OVER US 160 GENERAL LAYOUT		Project No./Code
File Name: 16042V_GenLayout_01.dgn	Date:	Comments:	Init.			Designer: B. Allen Detailer: D. Anderson Sheet Subset: Bridge		Structure Numbers
Horiz. Scale: 1:40							16042	Sheet Number
Unit Information 0221							Subset Sheets: B3 of 37	232




Design		Detail		Quantities	
INITIAL	DATE	INITIAL	DATE	INITIAL	DATE
Designed By BJA	10/08	Detailed By DSD	10/08	Quantities By BJA	10/08
Checked By DSD	10/08	Checked By	10/08	Checked By LW	10/08

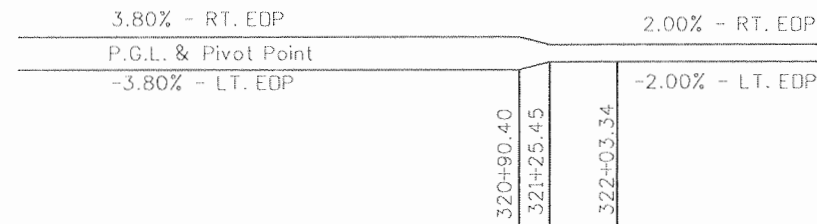

SUPERELEVATION DIAGRAM

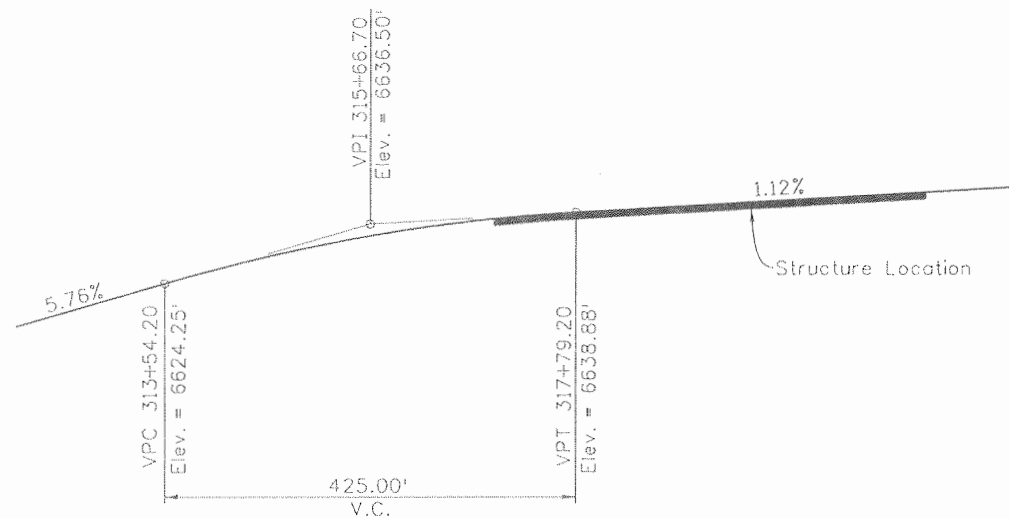

PROFILE GRADE

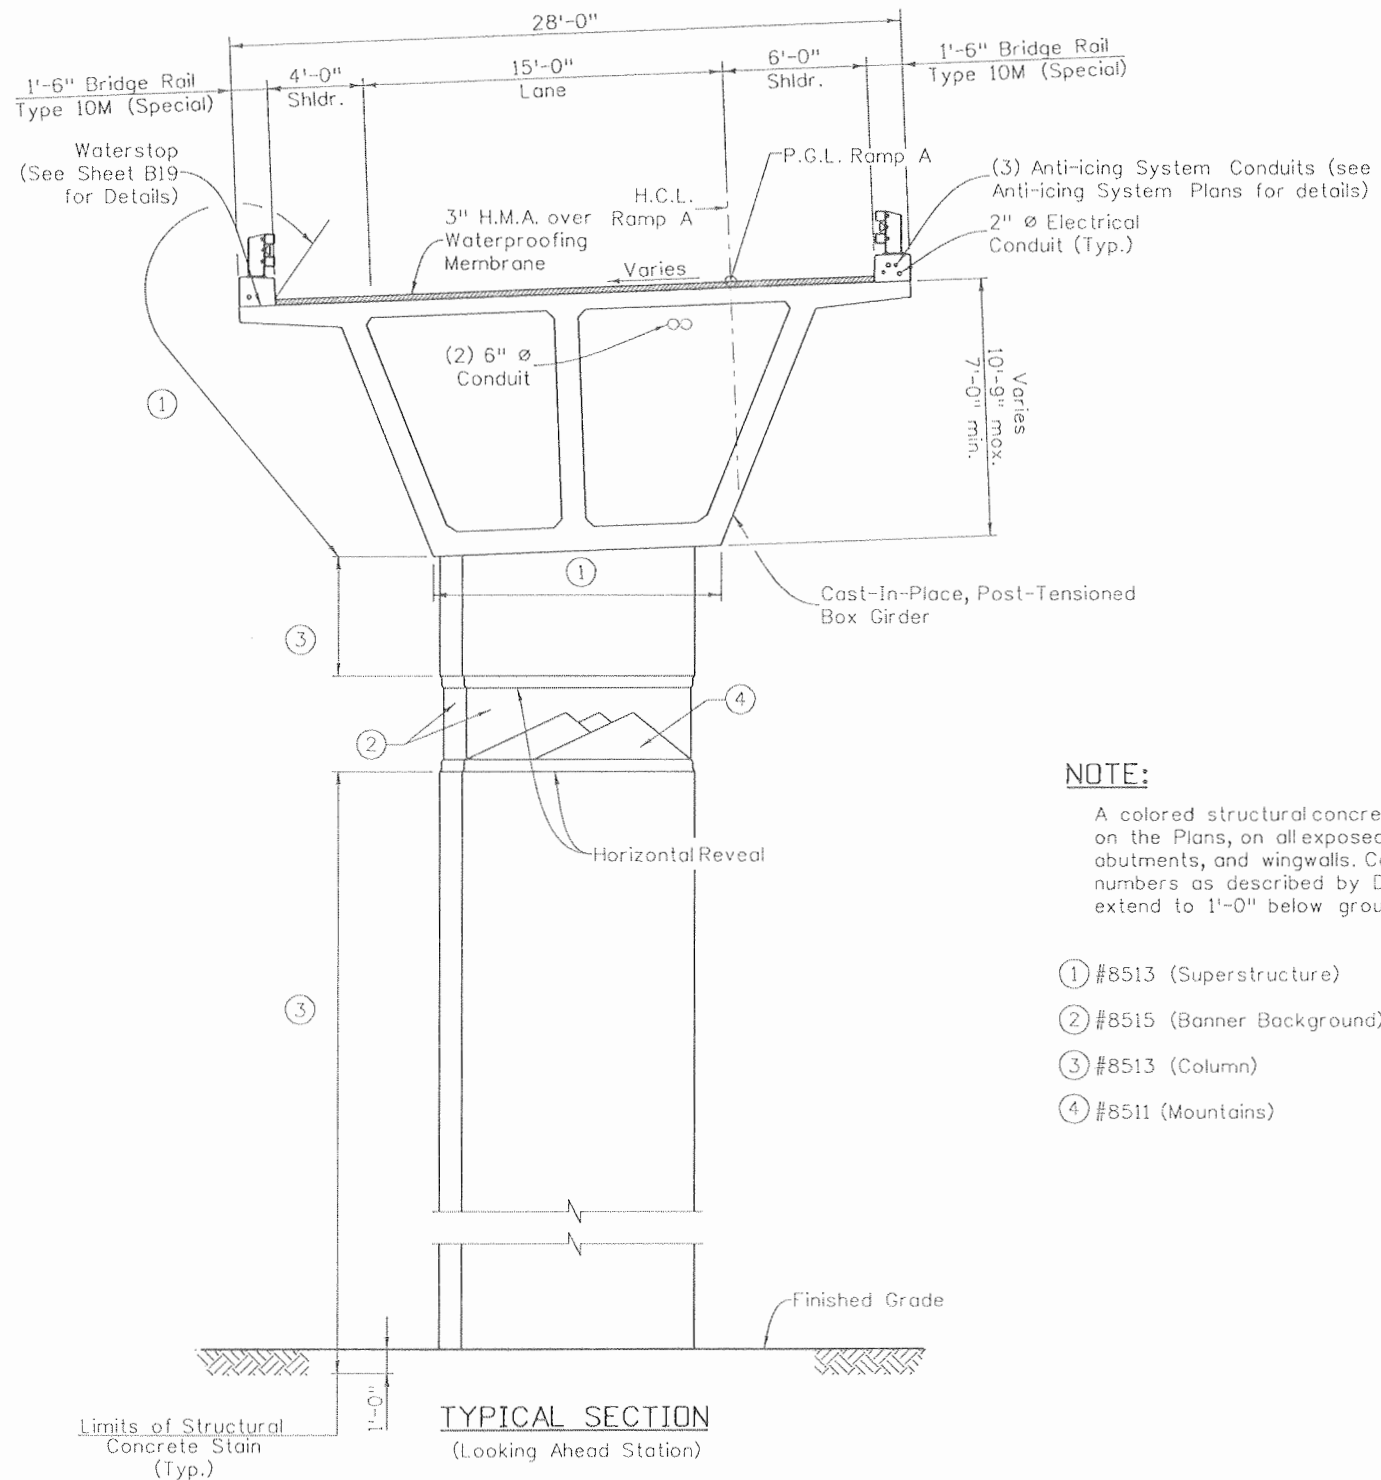

TYPICAL SECTION
(Looking Ahead Station)

NOTE:

A colored structural concrete coating stain is required, as shown on the Plans, on all exposed concrete surfaces. Including piers, abutments, and wingwalls. Color numbers correspond to paint numbers as described by Diamond Vogel Paints. Stain shall extend to 1'-0" below ground surface.

- ① #8513 (Superstructure)
- ② #8515 (Banner Background)
- ③ #8513 (Column)
- ④ #8511 (Mountains)

Print Date: 9/24/2010	
File Name: 16042V_TypSection_01.dgn	
Horiz. Scale: 1:1 Vert. Scale: As Noted	
Unit Information 0221 Unit Leader STW	


Sheet Revisions		
Date:	Comments	Init.

Colorado Department of Transportation
 3803 North Main Avenue
 Suite 200
 Durango, CO 81301
 Phone: 970-385-1440 FAX: 970-385-8365
 Region 5 EJA

As Constructed	
No Revisions:	9/10
Revised:	
Void:	

RAMP A OVER US 160 TYPICAL SECTION			
Designer:	B. Allen	Structure Numbers	P-05-V
Detailer:	R. Artman		
Sheet Subset:	Bridge	Subset Sheets:	B4 of 37


Project No./Code	
NH 1602-114	
16042	
Sheet Number	233

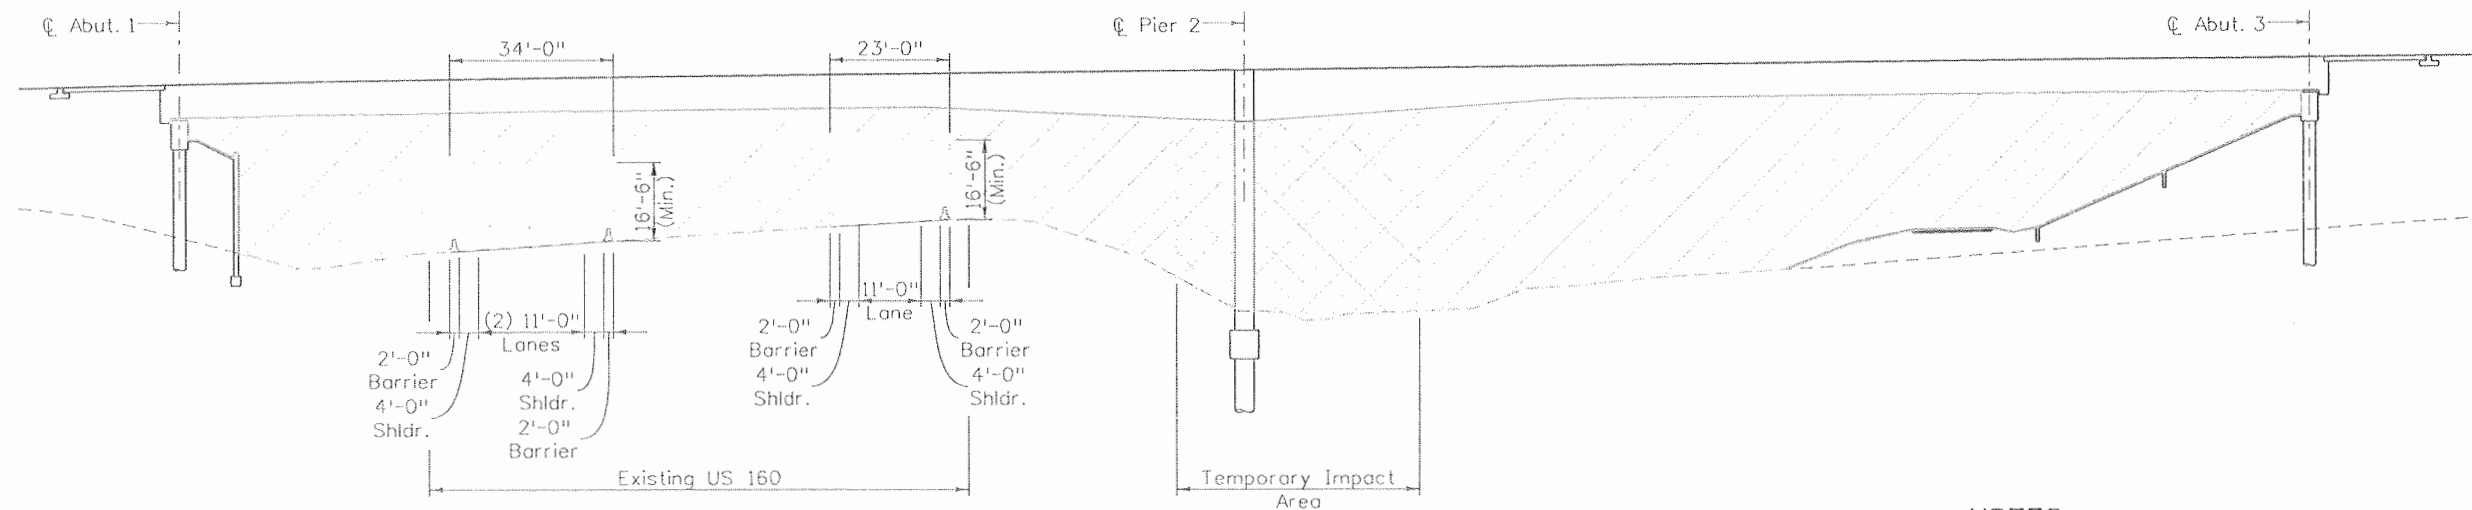

ELEVATION

NOTES:

1. A minimum of two lanes eastbound, one lane westbound, shall be provided. A minimum of 4'-0" shall be provided from a lane line to any barrier or obstruction. This distance may be reduced to 3'-0" for lane width 12'-0" or greater.
2. Clearing of native shrubs, trees, and vegetation adjacent to wetland areas should be minimized in order to limit vegetative buffer impacts, as shown in the Mitigation and Monitoring Proposal. Vegetation clearing shall be limited to cutting plants down to ground level rather than grubbing.

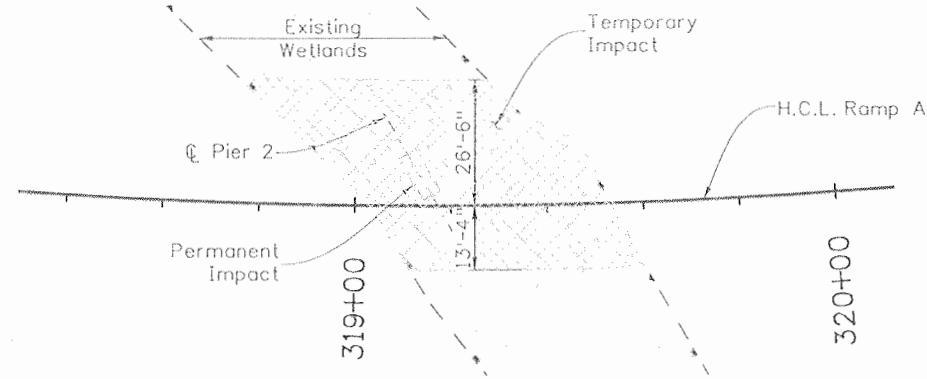

PARTIAL PLAN AT PIER 2

- Locations available for falsework.
- Temporary Wetland Impact Area = 0.05 Acre
- Permanent Wetland Impact Area < 0.006 Acre

Design		Detail		Quantities	
INITIAL	DATE	INITIAL	DATE	INITIAL	DATE
Designed By: BJA	10/08	RCG	10/08	Quantities By: BJA	10/08
Checked By: DSD	10/08	DSD	10/08	Checked By: LW	10/08

Print Date: 9/24/2010
 File Name: 16042V_ConstSeq_01.dgn
 Horiz. Scale: 1:40 Vert. Scale: As Noted
 Unit Information 0221 Unit Leader STW

SEMA CONSTRUCTION **WILSON & COMPANY**

Sheet Revisions		
Date:	Comments	Init.



Colorado Department of Transportation
 3803 North Main Avenue
 Suite 200
 Durango, CO 81301
 Phone: 970-385-1440 FAX: 970-385-8365

DOT DEPARTMENT OF TRANSPORTATION
 Region 5 EJA

As Constructed	
No Revisions:	9/10
Revised:	
Void:	

RAMP A OVER US 160 CONSTRUCTION CONSTRAINTS			
Designer:	B. Allen	Structure	P-05-V
Detailer:	R. Artman	Numbers	
Sheet Subset:	Bridge	Subset Sheets:	B5 of 37

Project No./Code	
NH 1602-114	
16042	
Sheet Number	234

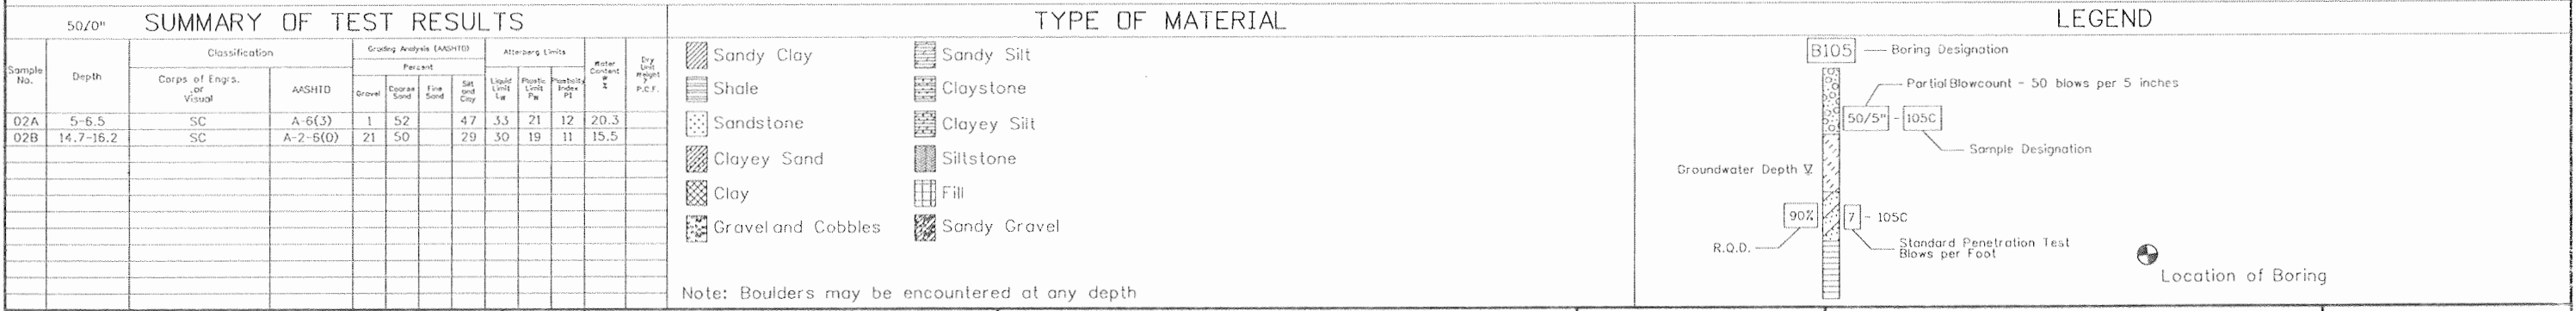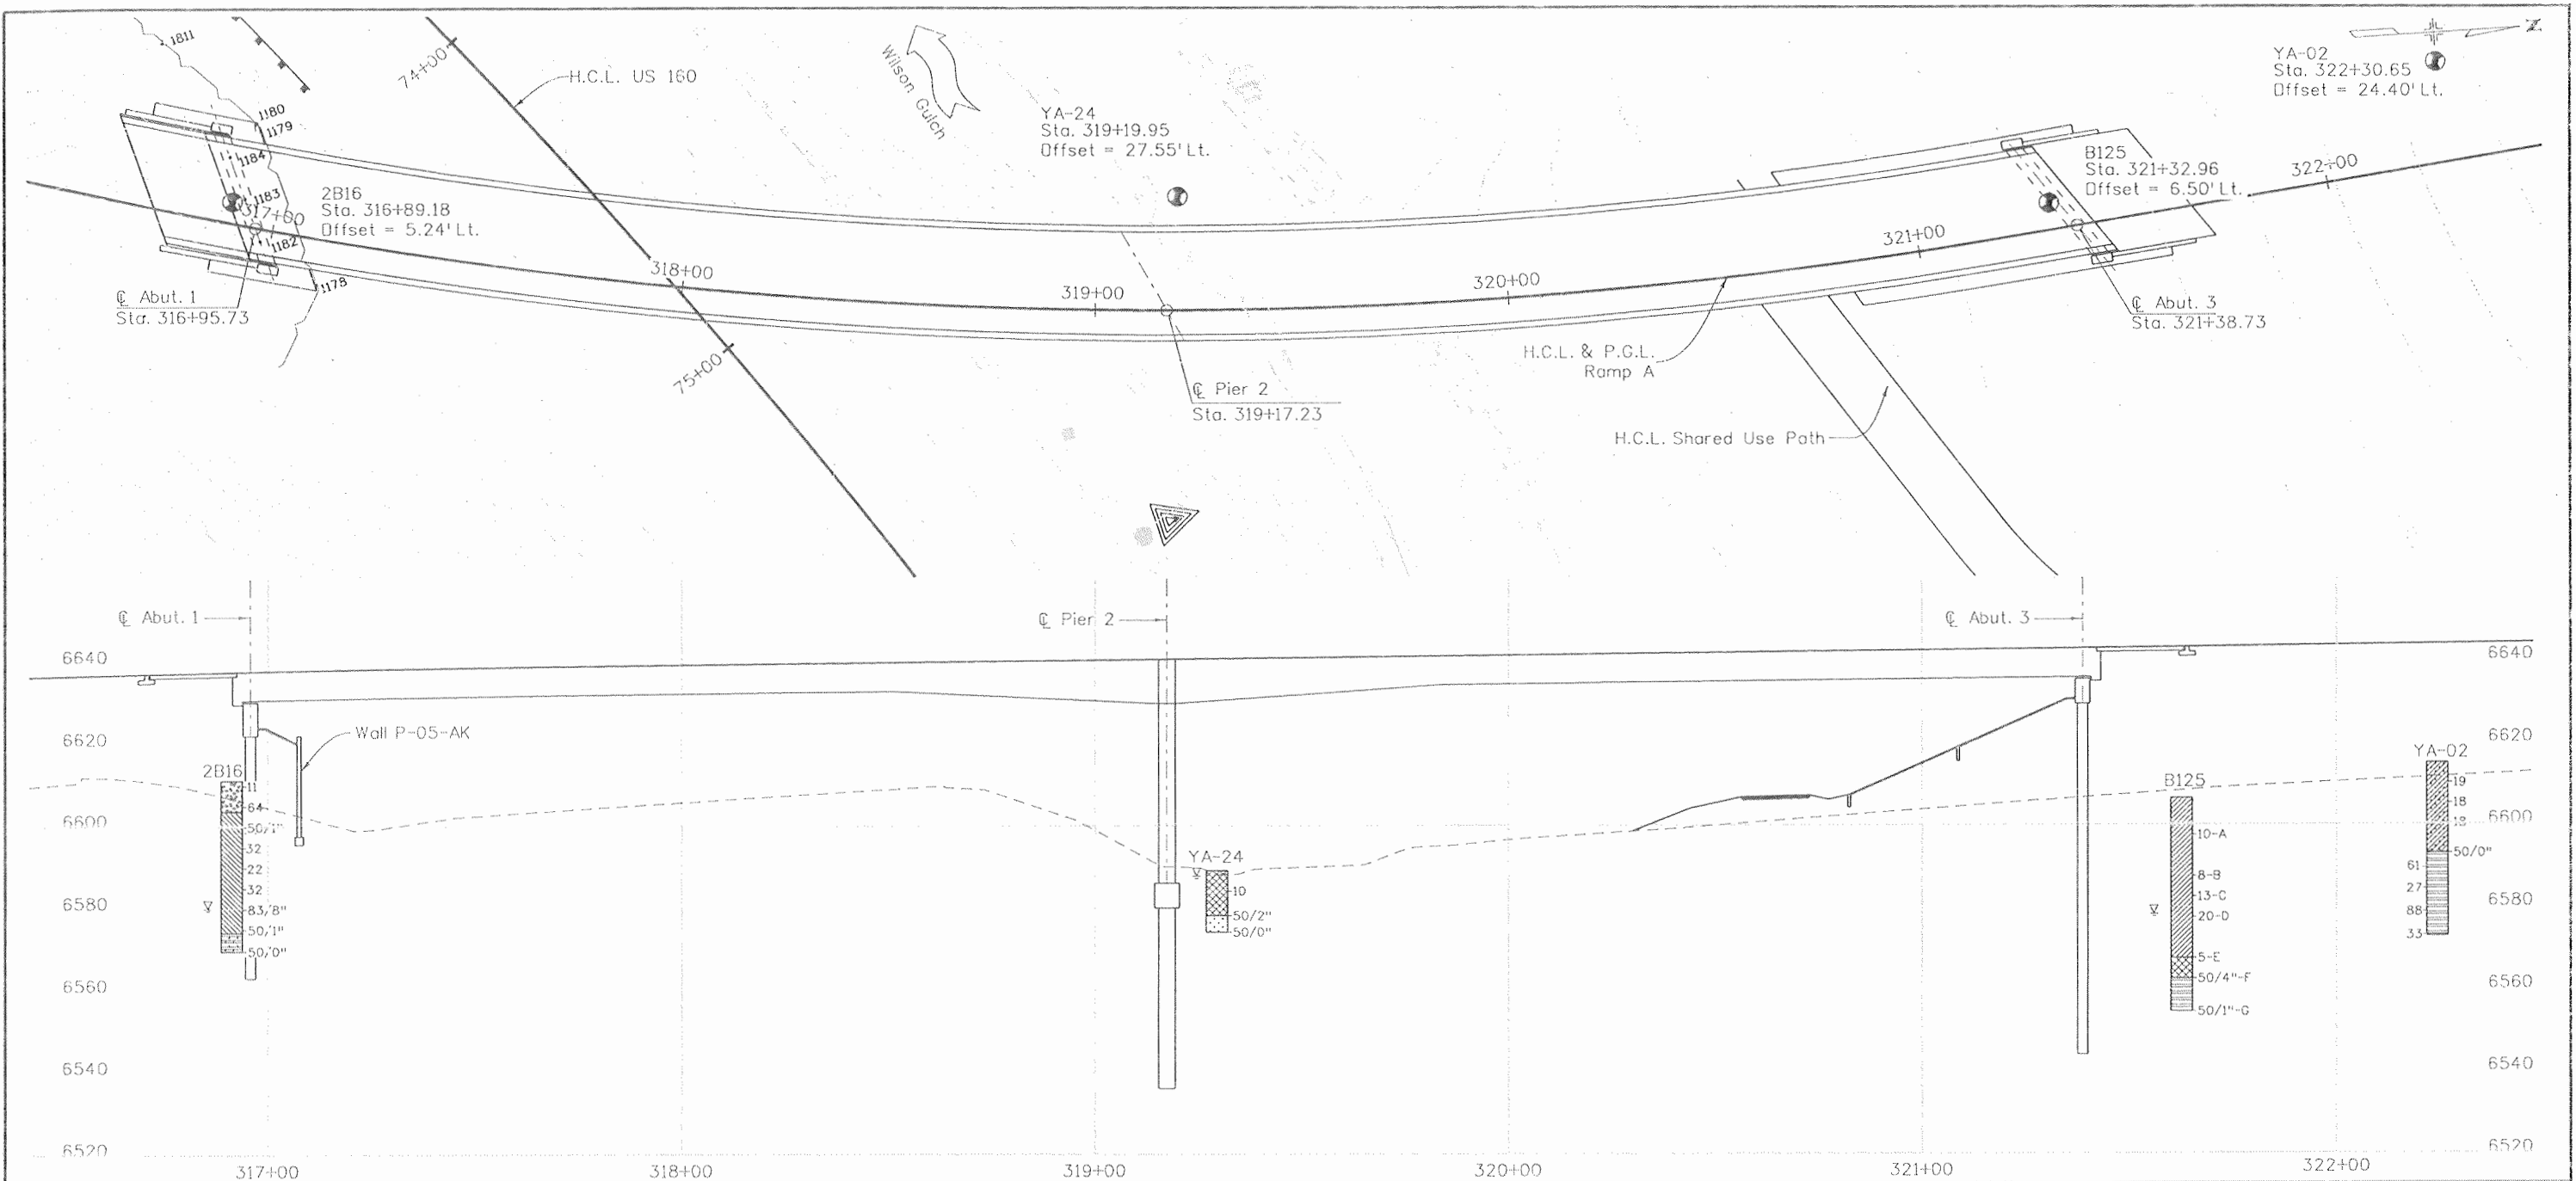


Design	INITIAL	DATE	INITIAL	DATE	INITIAL	DATE
	MCH	10/08	RG	10/08	MCH	10/08
	Checked By	SWI	Checked By	SWI	Checked By	LW
	Checked By	SWI	Checked By	SWI	Checked By	LW

Sample No.	Depth	Classification	Corps of Engrs. or Visual	AASHTO	Grading Analysis (ASHTO)				Atterberg Limits			Water Content %	Dry Unit Weight P.C.F.
					Gravel	Coarse Sand	Fine Sand	Silt and Clay	Liquid Limit %	Plastic Limit %	Plasticity Index PI		
02A	5-6.5	SC		A-6(5)	1	52	4.7	3.3	21	12	20.3		
02B	14.7-16.2	SC		A-2-6(0)	21	50	2.9	3.0	19	11	15.5		

Sandy Clay	Sandy Silt
Shale	Claystone
Sandstone	Clayey Silt
Clayey Sand	Siltstone
Clay	Fill
Gravel and Cobbles	Sandy Gravel

Note: Boulders may be encountered at any depth

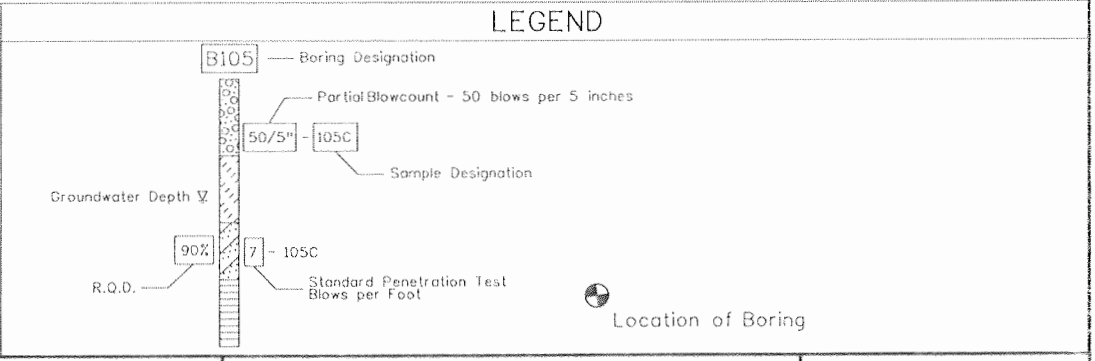

Print Date: 9/24/2010
 File Name: 16042V_EngGeology_01.dgn
 Horiz. Scale: 1:1 Vert. Scale: As Noted
 Unit Information: 0221 Unit Leader: STW

Date:	Comments	Init.


Colorado Department of Transportation
 3803 North Main Avenue
 Suite 200
 Durango, CO 81301
 Phone: 970-385-1440 FAX: 970-385-8365
 Region 5 EJA

As Constructed
 No Revisions: 9/10
 Revised:
 Void:

RAMP A OVER US 160
 ENGINEERING GEOLOGY
 Designer: M. Hallman
 Detailer: R. Artman
 Structure Numbers: P-05-V
 Sheet Subset: Bridge Subset Sheets: B6 of 37


Project No./Code
 NH 1602-114
 16042
 Sheet Number: 235



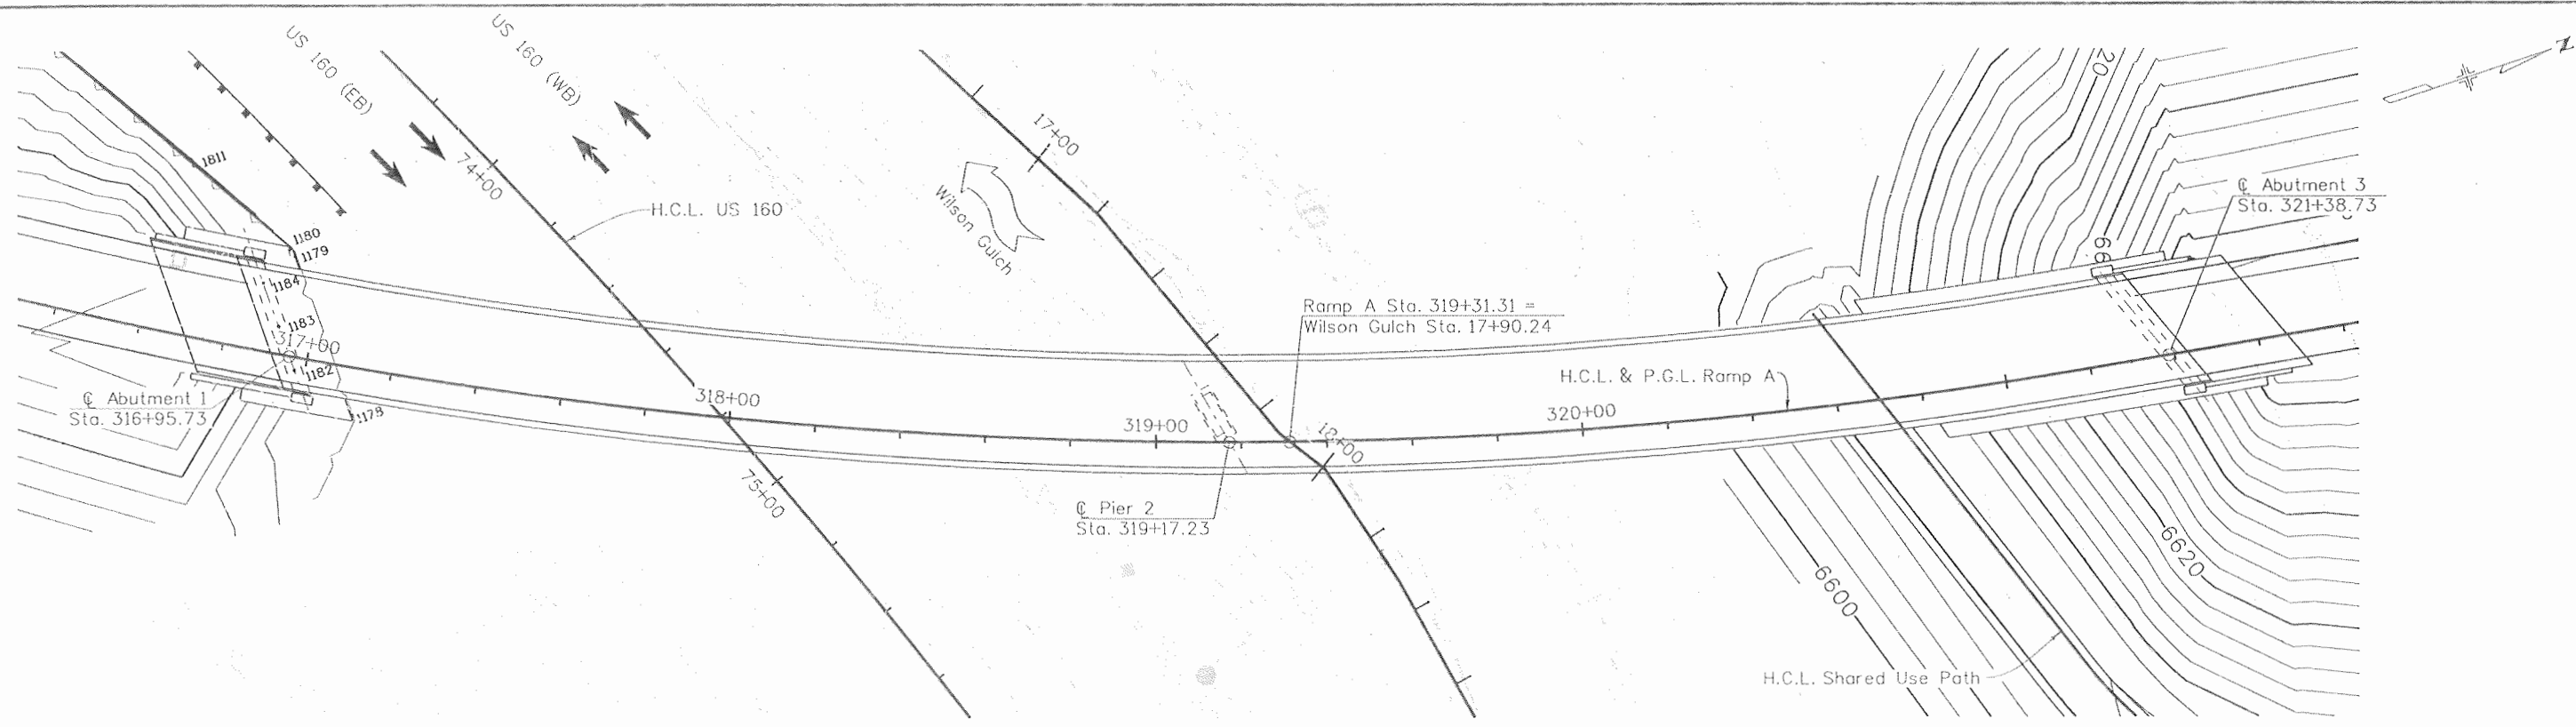

PLAN

PROFILE OF WATER SURFACE

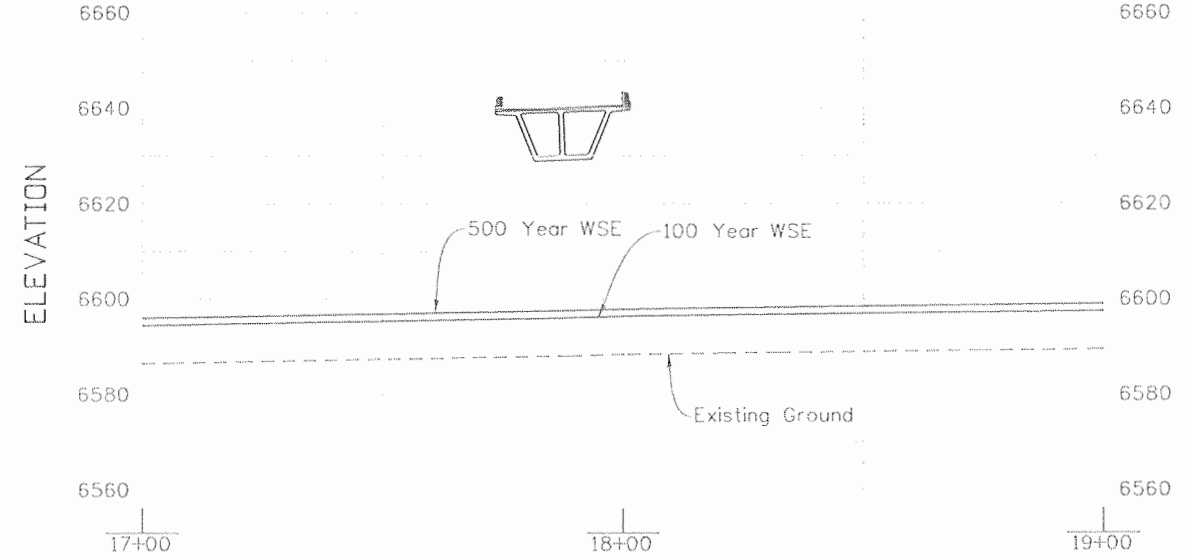

STATIONS ARE ALONG CHANNEL CENTERLINE IN FEET

Design		Detail		Quantities	
INITIAL	DATE	INITIAL	DATE	INITIAL	DATE
VSF	10/08	DRA	10/08	VSF	10/08
GWK	10/08	GWK	10/08	LW	10/08
Designed By	Checked By	Designed By	Checked By	Quantities By	Checked By

Print Date: 9/24/2010
 File Name: 16042V_BHR_01.dgn
 Horiz. Scale: 1:40 Vert. Scale: As Noted
 Unit Information 0221 Unit Leader STW

SEMA CONSTRUCTION **WILSON & COMPANY**

Sheet Revisions		
Date:	Comments	Init.

Colorado Department of Transportation
 3803 North Main Avenue
 Suite 200
 Durango, CO 81301
 Phone: 970-385-1440 FAX: 970-385-8365

DOT
 DEPARTMENT OF TRANSPORTATION

Region 5 EJA

As Constructed	No Revisions: 9/10
Revised:	
Void:	

RAMP A OVER US 160 BRIDGE HYDRAULIC INFORMATION (1 OF 2)	
Designer: V. Fossinger	Structure: P-05-V
Detailer: D. Anderson	Numbers:
Sheet Subset: Bridge	Subset Sheets: B7 of 37

Project No./Code	NH 1602-114
	16042
Sheet Number	236

DRAINAGE AREA 7 SQUARE MILES

CHANNEL DESCRIPTION

BOTTOM MATERIAL: COHESIVE NON-COHESIVE
 BOTTOM MATERIAL SIZE: CLAY SILT SAND GRAVEL
 COBBLES OTHER
 STREAM FORM: STRAIGHT MEANDERING BRAIDED
 MANNINGS "n" FOR DESIGN: CHANNEL = 0.068 OVERBANK = 0.104
 DEBRIS: BRUSH TREES/LOGS ICE OTHER


COMPARISON OF HYDRAULICS

	VELOCITY	FREEBOARD	MAX. BACKWATER
	fps.	ft.	ft.
NATURAL CHANNEL	N/A	N/A	N/A
EXISTING CHANNEL	11.3	N/A	N/A
PROPOSED CHANNEL	10.7	34.0	0.3


△ AT PROPOSED BRIDGE LOCATION DURING DESIGN DISCHARGE (Q100)

THE SCOUR LIMITS AND RIVER FLOW RATES MAY BE FOUND IN THE REPORT BY WILSON & CO., DATED JULY, 2008, ENTITLED "FINAL DRAINAGE REPORT FOR US 550 & US 160 INTERCHANGE".


DISCHARGE-FREQUENCY

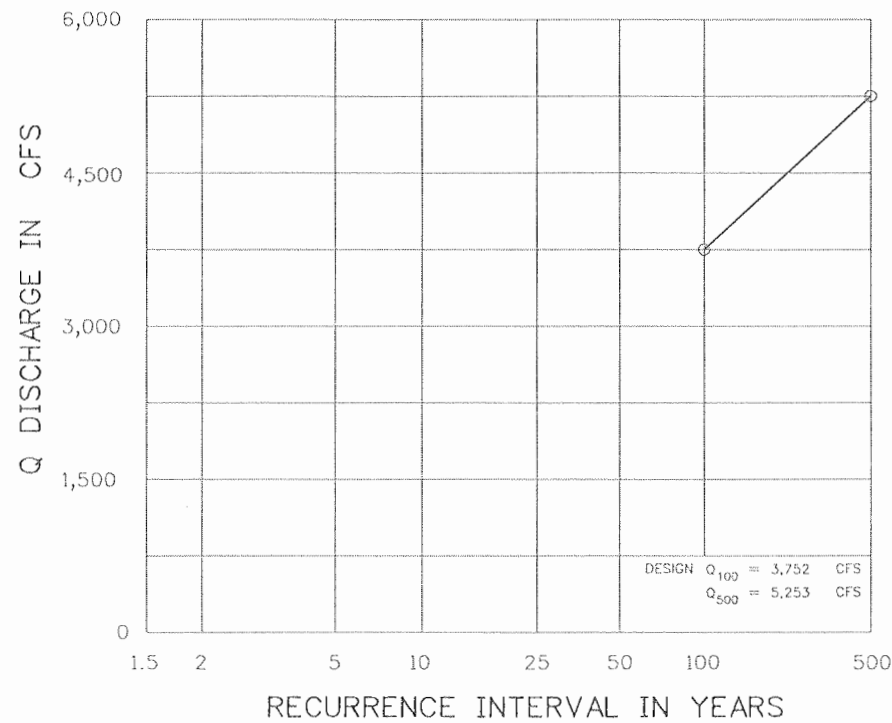


STAGE-DISCHARGE

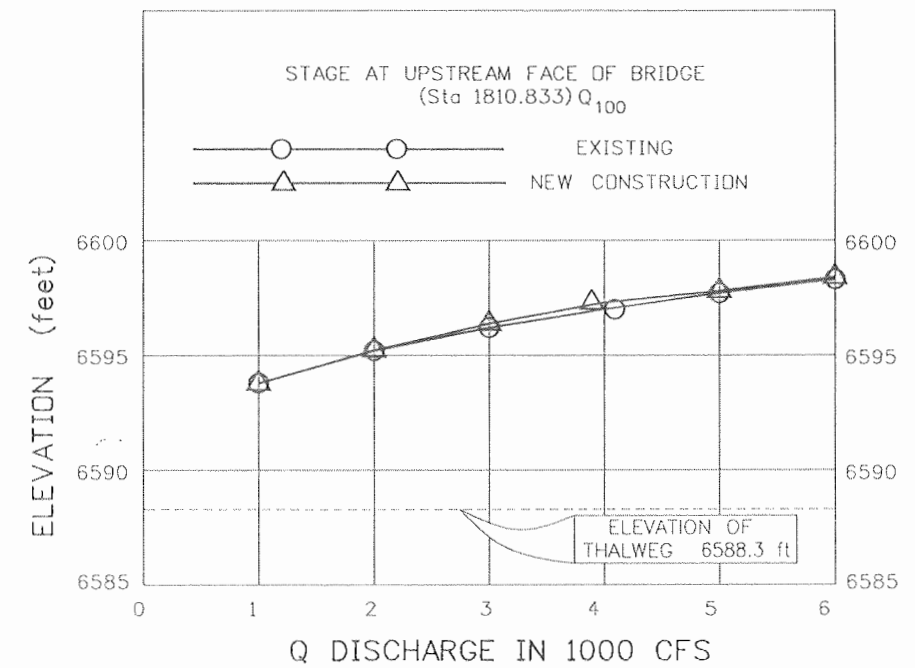


Design	INITIAL		DATE		Checked By	Checked By	DATE	Checked By	Checked By	DATE	Checked By	Checked By
	VSF	GWK	VSF	GWK								
Designed By												
Checked By												

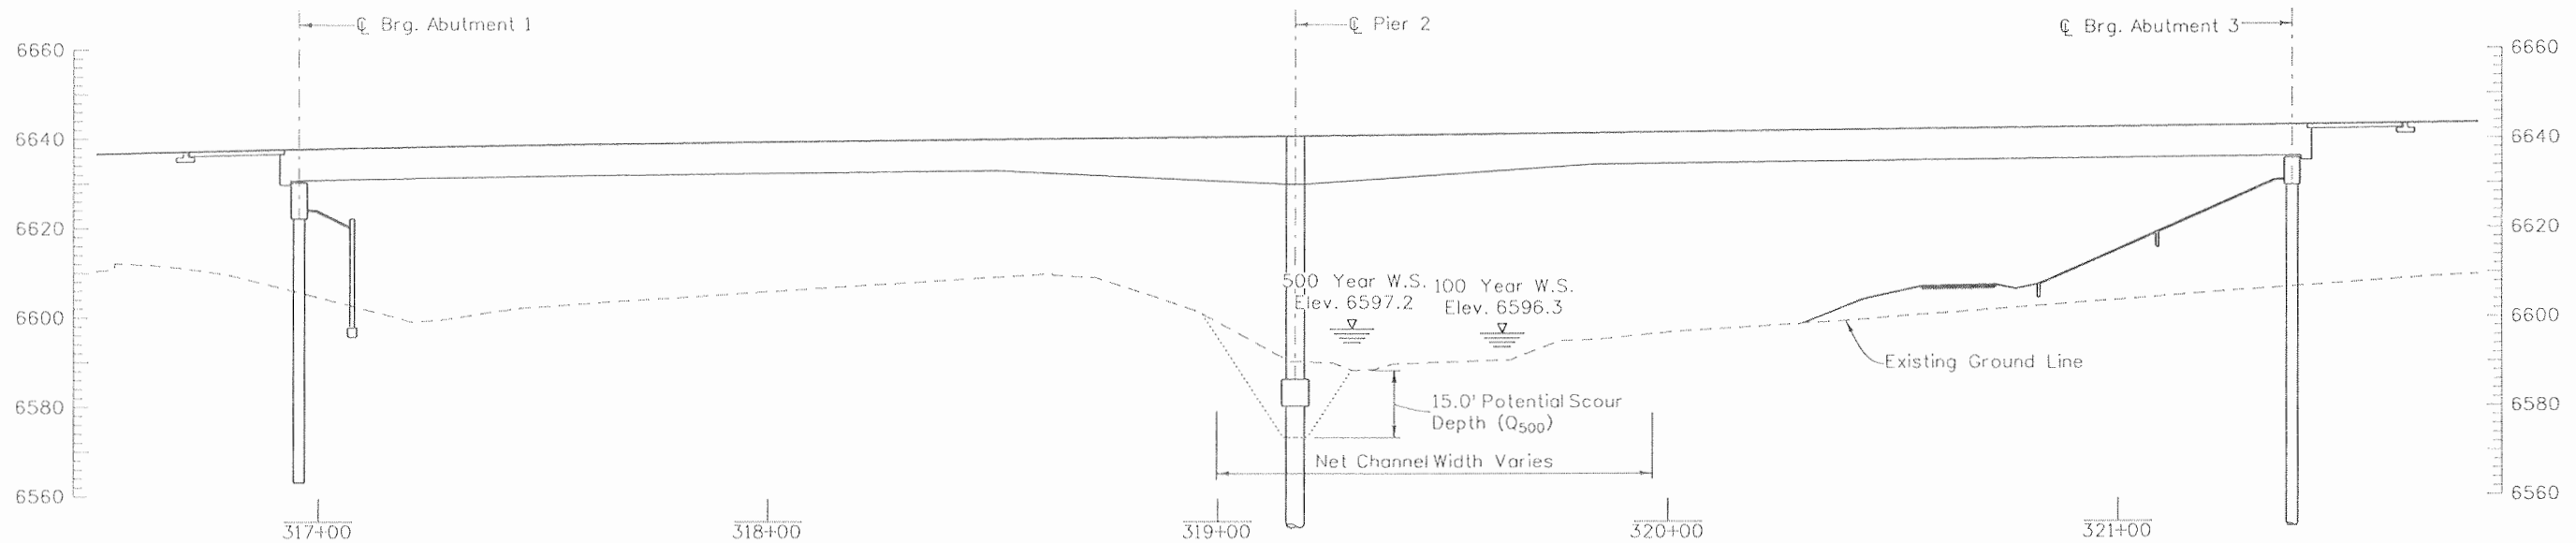

Print Date: 9/24/2010	Sheet Revisions			Colorado Department of Transportation 3803 North Main Avenue Suite 200 Durango, CO 81301 Phone: 970-385-1440 FAX: 970-385-8365 Region 5	As Constructed		RAMP A OVER US 160 BRIDGE HYDRAULIC INFORMATION (2 OF 2)		Project No./Code
File Name: 16042V_BHR_02.dgn	Date:	Comments:	Init.		No Revisions: 9/10	Structure Numbers		P-05-V	
Horiz. Scale: 1:40 Vert. Scale: As Noted				EJA	Revised:	Designer: V. Fossinger	Sheet Subset: Bridge		16042
Unit Information 0221 Unit Leader STW					Void:	Detailer: D. Anderson	Subset Sheets: BB of 37		Sheet Number 237

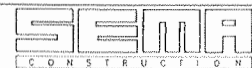


Design		Detail		Quantities	
DATE	INITIAL	DATE	INITIAL	DATE	INITIAL
10/08	BJA	10/08	RGA	10/08	BJA
10/08	DSO	10/08	DSO	10/08	LW
10/08		10/08		10/08	

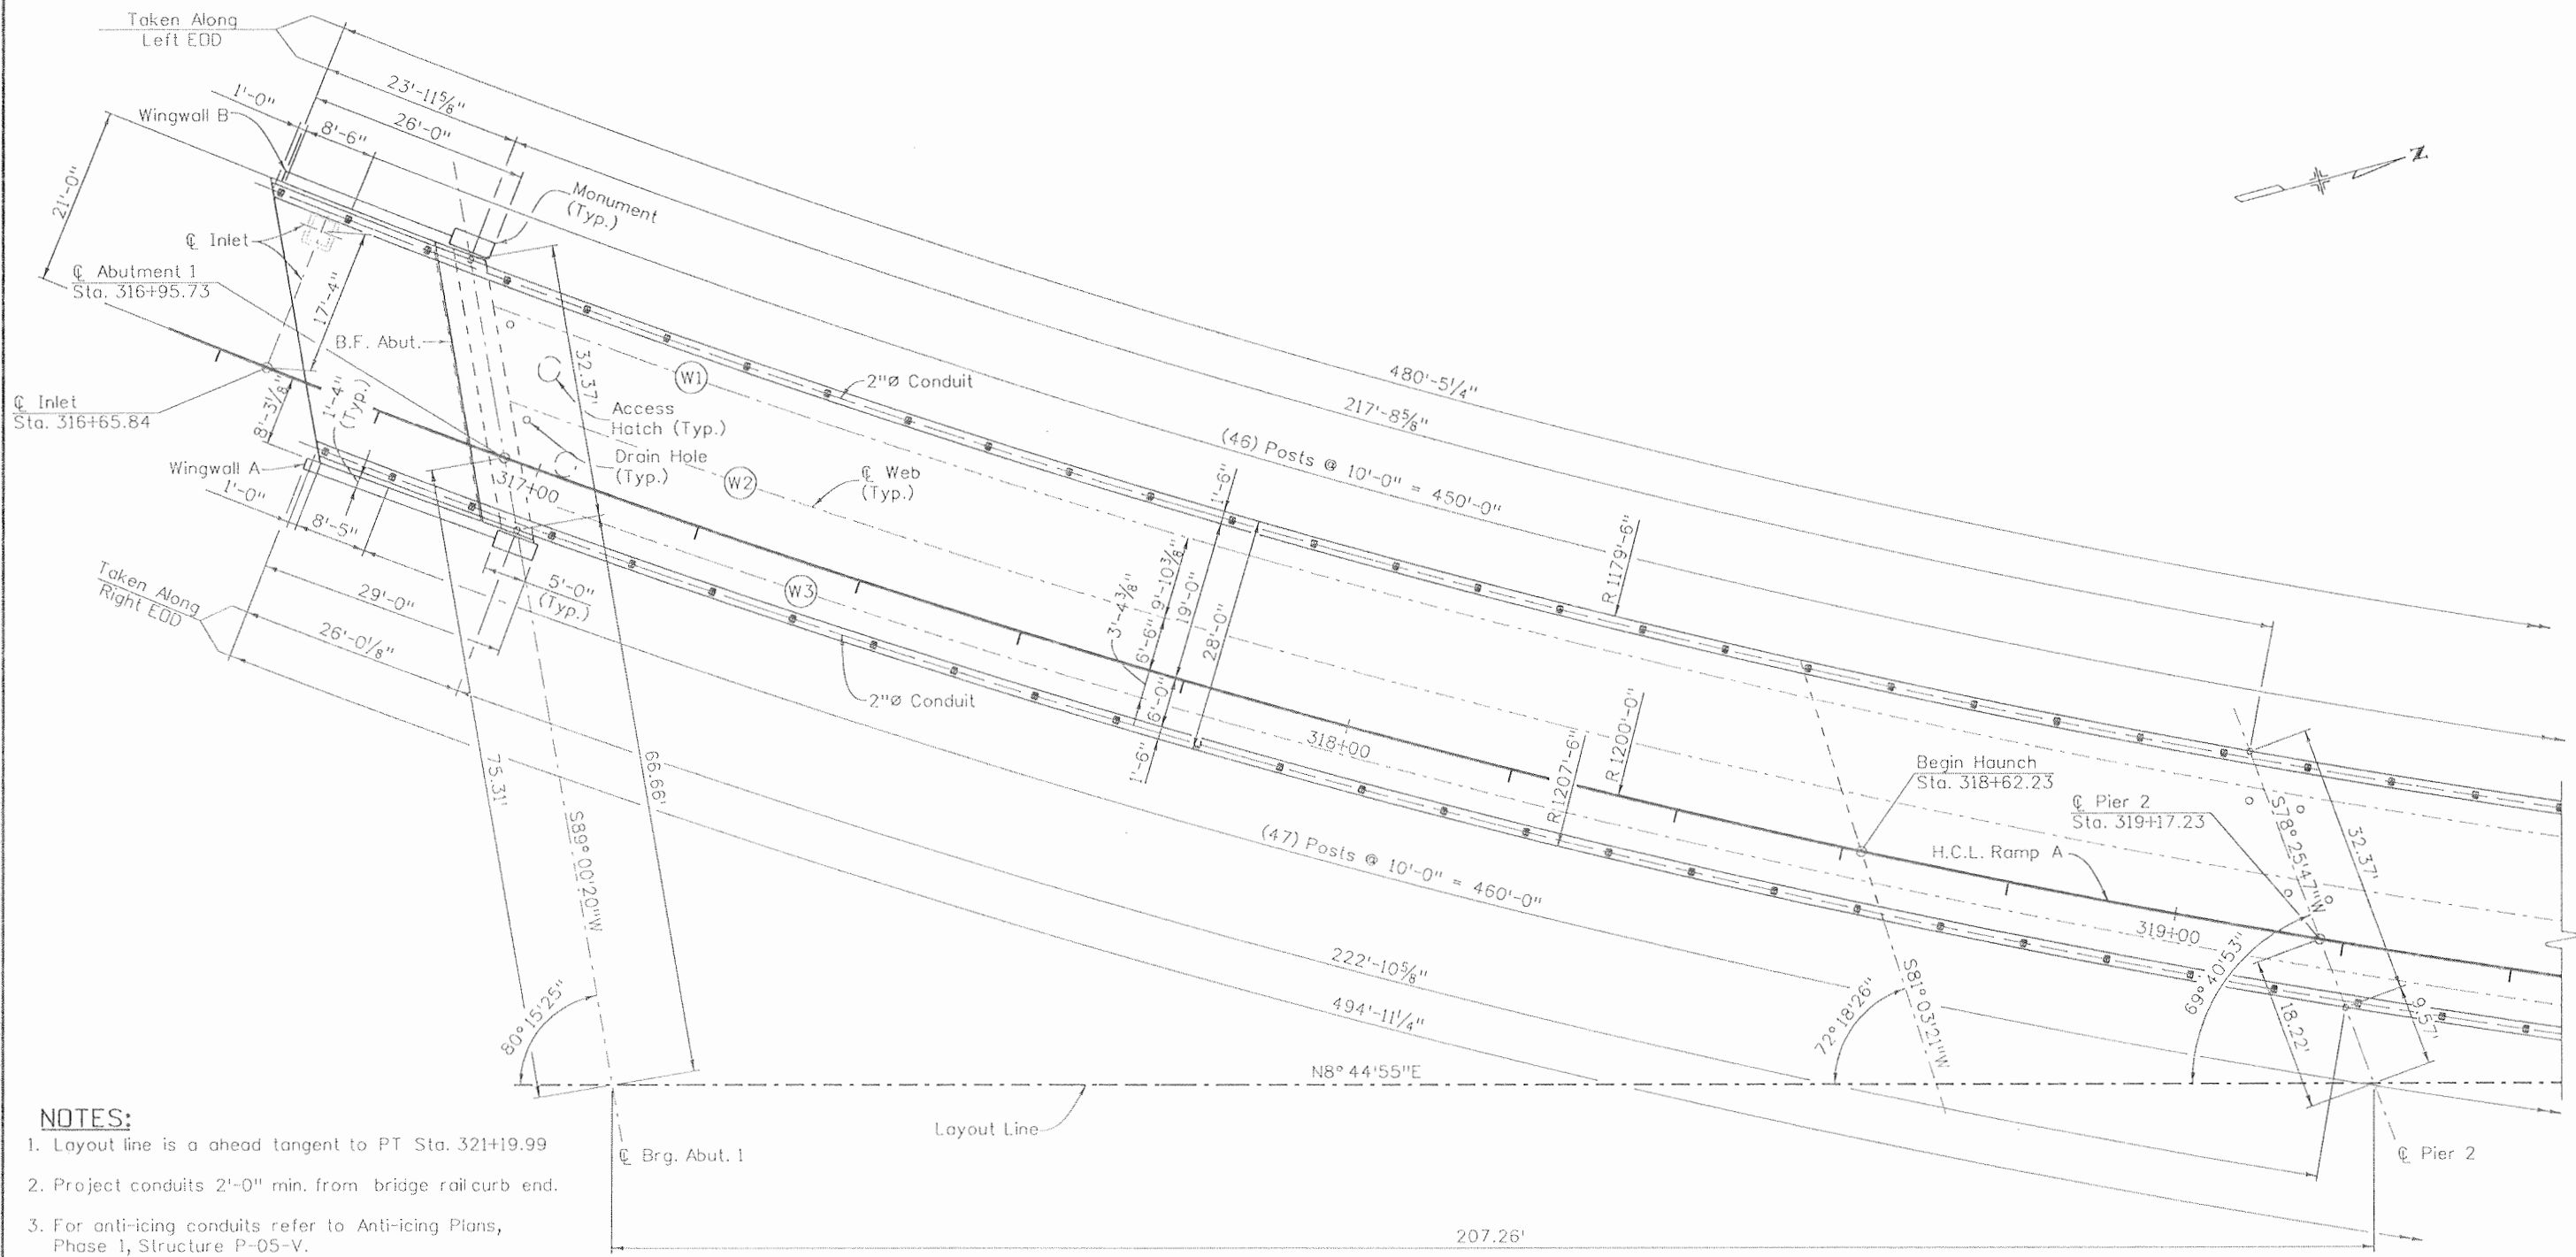

NOTES:

1. Layout line is a ahead tangent to PT Sta. 321+19.99
2. Project conduits 2'-0" min. from bridge rail curb end.
3. For anti-icing conduits refer to Anti-icing Plans, Phase 1, Structure P-05-V.
4. 6" conduits not shown for clarity. Refer to Sheet B19.
5. Web ventilation holes shall be placed at a maximum of 50'-0" intervals. Refer to Sheet B20.
6. Horizontal dimension of girders and deck are measured along the superelevation.
7. Centerline of Girders are measured at @ web at top of concrete deck.

CONSTRUCTION LAYOUT

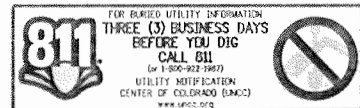

Print Date: 9/24/2010	Unit Information 0221	Unit Leader STW
File Name: 16042V_ConstLay_01.dgn	Horiz. Scale: 1:20 Vert. Scale: As Noted	

Sheet Revisions		
Date:	Comments	Init.

Colorado Department of Transportation


3803 North Main Avenue
Suite 200
Durango, CO 81301
Phone: 970-385-1440 FAX: 970-385-8365

Region 5 EJA

As Constructed	No Revisions: 9/10
Revised:	
Void:	

RAMP A OVER US 160 CONSTRUCTION LAYOUT (1 OF 2)			
Designer:	B. Allen	Structure Numbers	P-05-V
Detailer:	R. Artman		
Sheet Subset:	Bridge	Subset Sheets:	B9 of 37

Project No./Code	NH 1602-114
	16042
Sheet Number	238

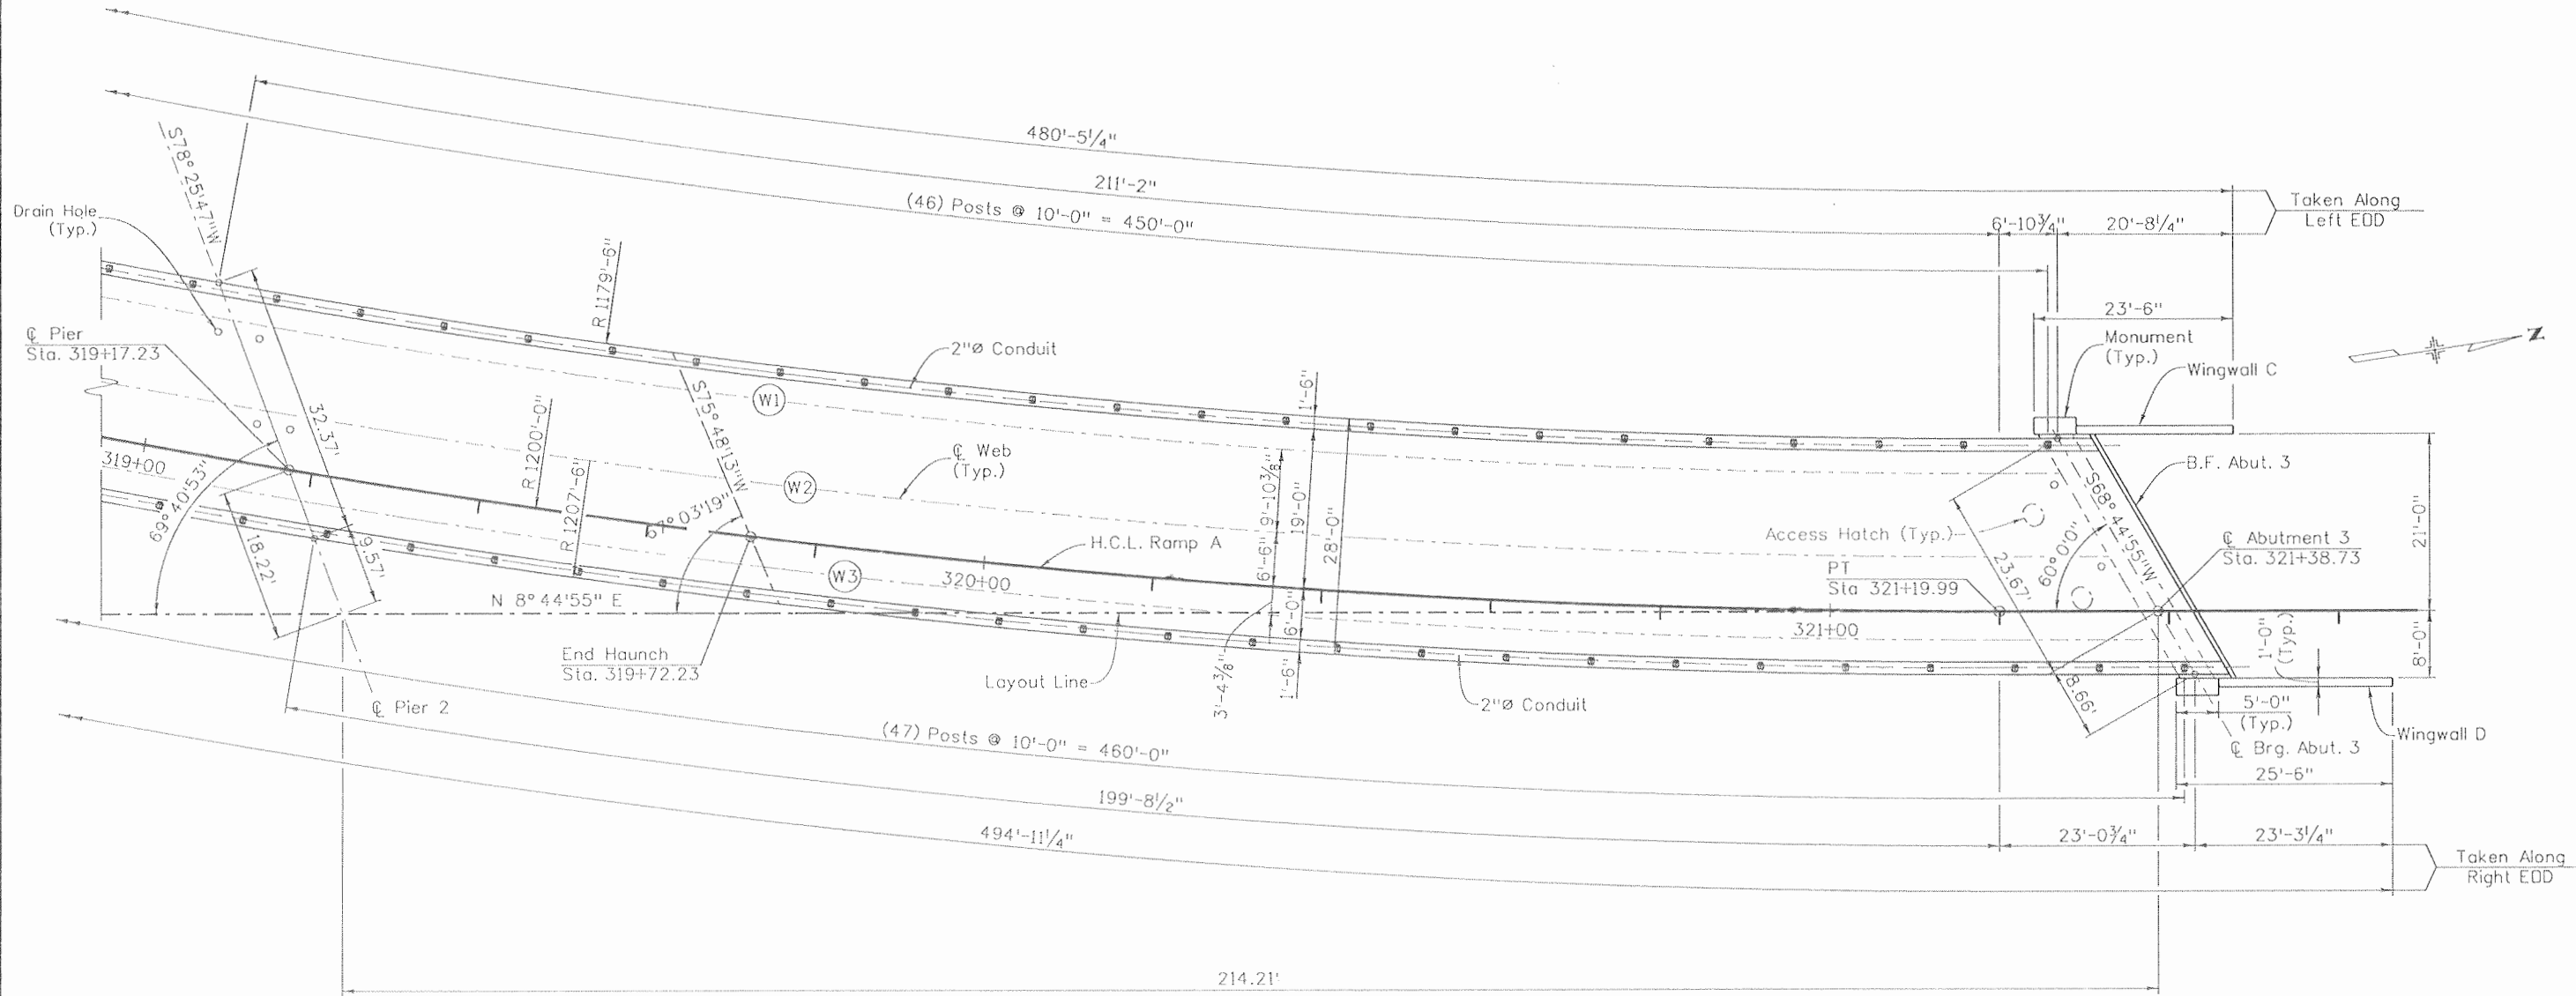

CONSTRUCTION LAYOUT

NOTES:

1. Layout line is a ahead tangent to PT Sta. 321+19.99
2. Project conduits 2'-0" min. from bridge railcurb end.
3. For anti-icing conduits refer to Anti-icing Plans, Phase 1, Structure P-05-V.
4. 6" conduits not shown for clarity. Refer to Sheet B19.
5. Web ventilation holes shall be placed at a maximum of 50'-0" intervals. Refer to Sheet B20.
6. Horizontal dimension of girders and deck are measured along the superelevation.
7. Centerline of Girders are measured at ϕ web at top of concrete deck.



Design		Detail		Quantities	
INITIAL	DATE	INITIAL	DATE	INITIAL	DATE
Designed By: BJA	10/08	Detail By: RGA	10/08	Quantities By: BJA	10/08
Checked By: DSD	10/08	Checked By: DSD	10/08	Checked By: LW	10/08

Print Date: 9/24/2010	File Name: 16042V_ConstLay_02.dgn
Horiz. Scale: 1:20	Vert. Scale: As Noted
Unit Information: 0221	Unit Leader: STW
SEMA CONSTRUCTION	WILSON & COMPANY

Sheet Revisions		
Date:	Comments	Init.

Colorado Department of Transportation

3803 North Main Avenue
Suite 200
Durango, CO 81301
Phone: 970-385-1440 FAX: 970-385-8365


DOT DEPARTMENT OF TRANSPORTATION

Region 5 EJA

As Constructed	No Revisions: 9/10
Revised:	
Void:	


RAMP A OVER US 160 CONSTRUCTION LAYOUT (2 OF 2)			
Designer: B. Allen	Structure: P-05-V		
Detailer: R. Artman	Numbers:		
Sheet Subset: Bridge	Subset Sheets: B10 of 37		

Project No./Code	NH 1602-114
	16042
Sheet Number	239

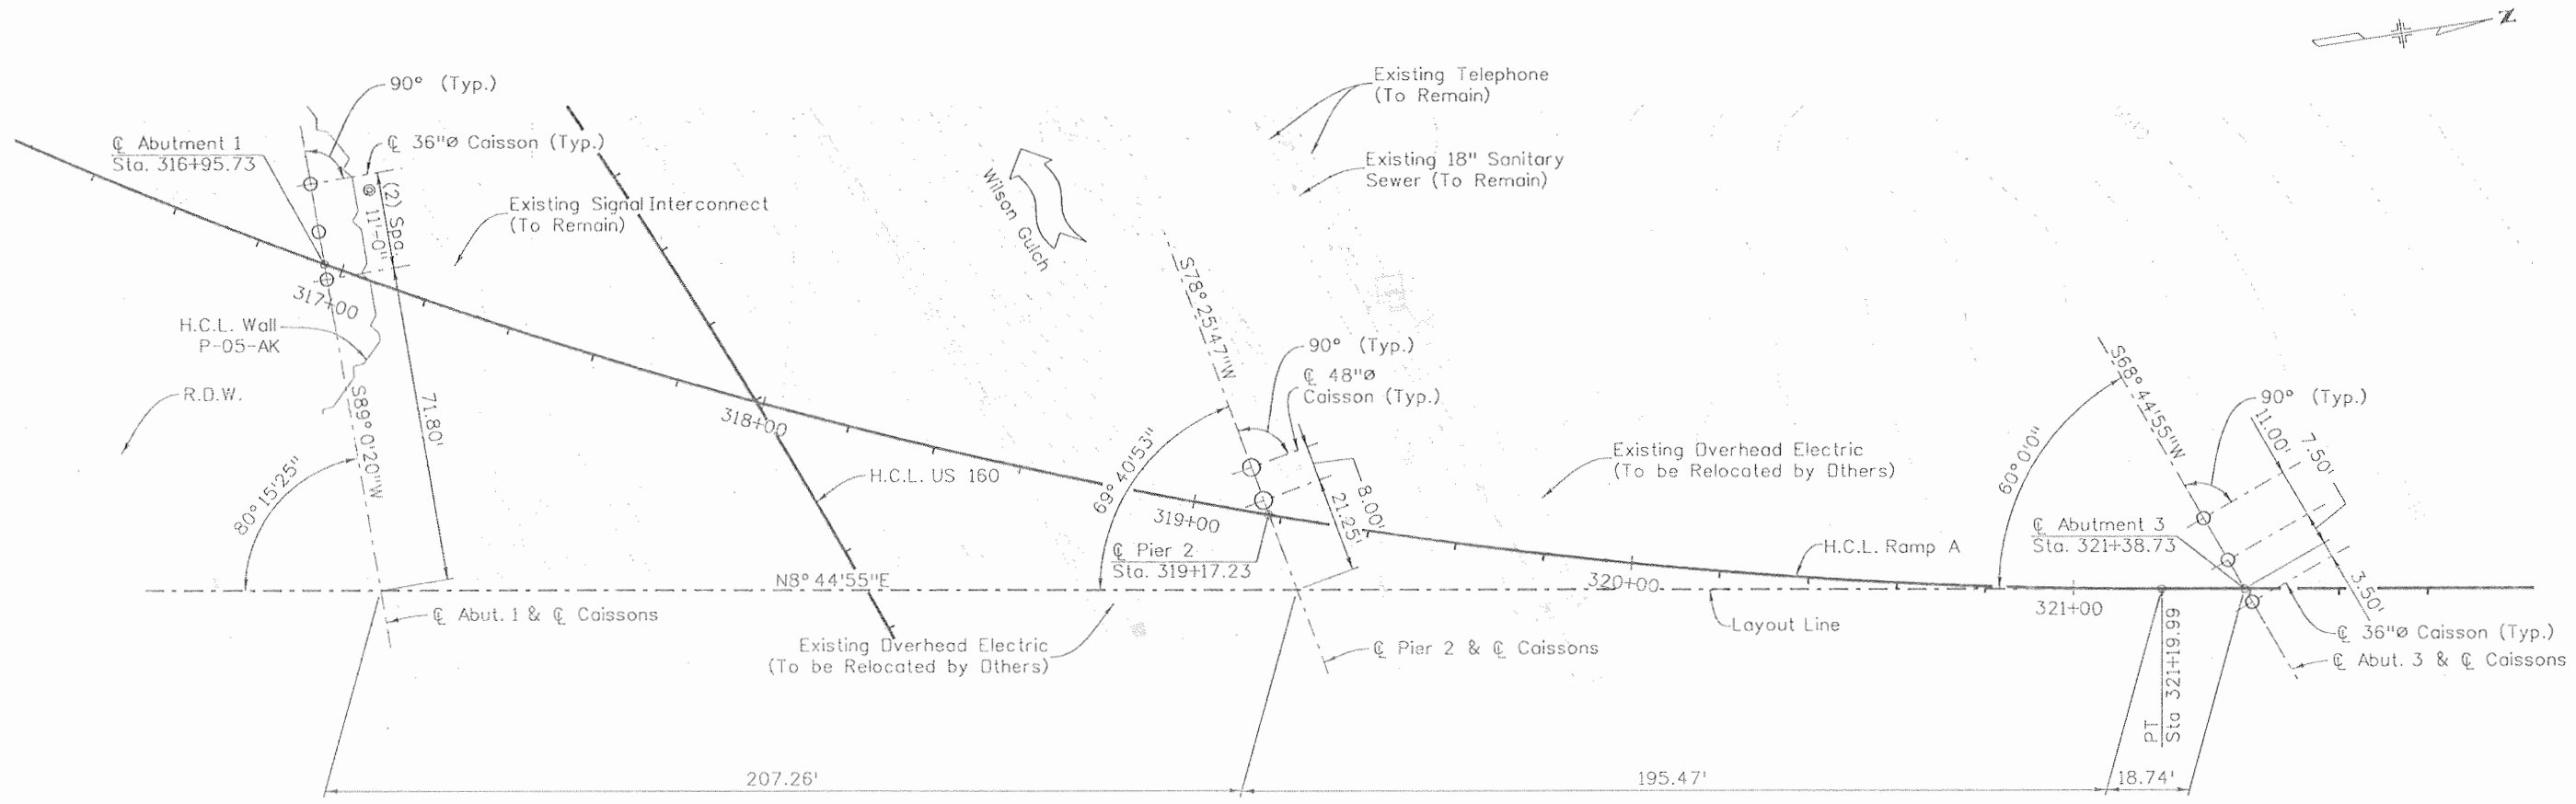

FOUNDATION LAYOUT

NOTE
Layout Line is an Ahead Tangent to PT Station 321+19.99

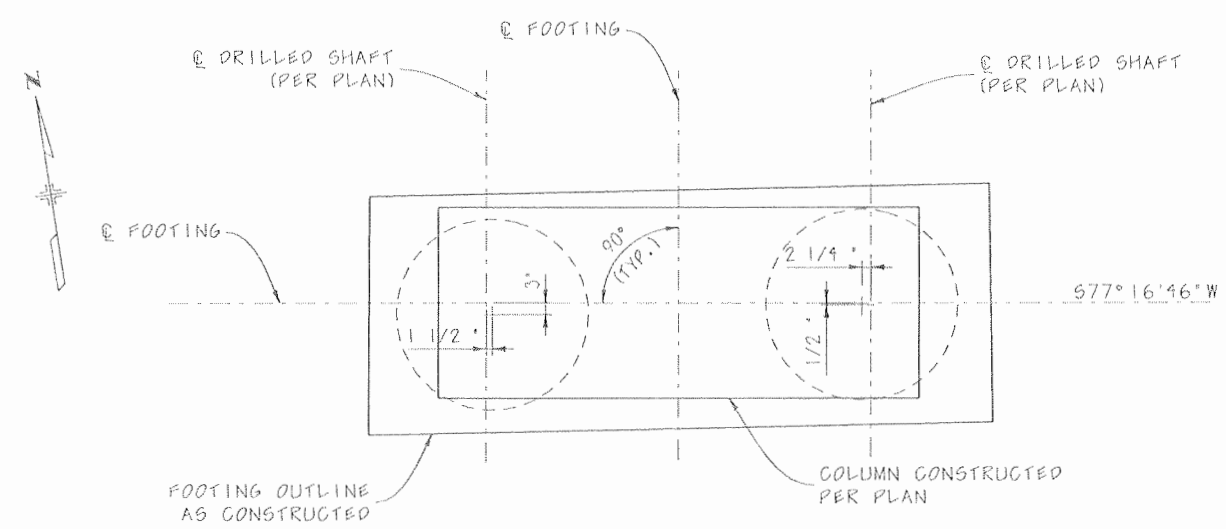

PIER LAYOUT AS CONSTRUCTED

Design		Detail		Quantities	
INITIAL	DATE	INITIAL	DATE	INITIAL	DATE
Designed By BJA	10/08	Detailled By BJA	10/08	Quantities By BJA	10/08
Checked By DSD	10/08	Checked By DSD	10/08	Checked By LW	10/08



Print Date: 9/27/2010
 File Name: 16042V_FoundLay_01.dgn
 Horiz. Scale: 1:40 Vert. Scale: As Noted
 Unit Information 0221 Unit Leader STW

SEMA CONSTRUCTION
WILSON & COMPANY

Sheet Revisions		
Date:	Comments	Init.


Colorado Department of Transportation
 3803 North Main Avenue
 Suite 200
 Durango, CO 81301
 Phone: 970-385-1440 FAX: 970-385-8365
 Region 5 EJA

As Constructed	
No Revisions:	
Revised:	9/10
Void:	


RAMP A OVER US 160 FOUNDATION LAYOUT			
Designer:	B. Allen	Structure	P-05-V
Detailer:	R. Artman	Numbers	
Sheet Subset:	Bridge	Subset Sheets:	B11 of 37

Project No./Code	
NH 1602-114	
16042	
Sheet Number	240


Design		Detail		Quantities	
INITIAL	DATE	INITIAL	DATE	INITIAL	DATE
Designed By	10/08	Detailed By	10/08	Quantities By	10/08
Checked By	10/08	Checked By	10/08	Checked By	10/08

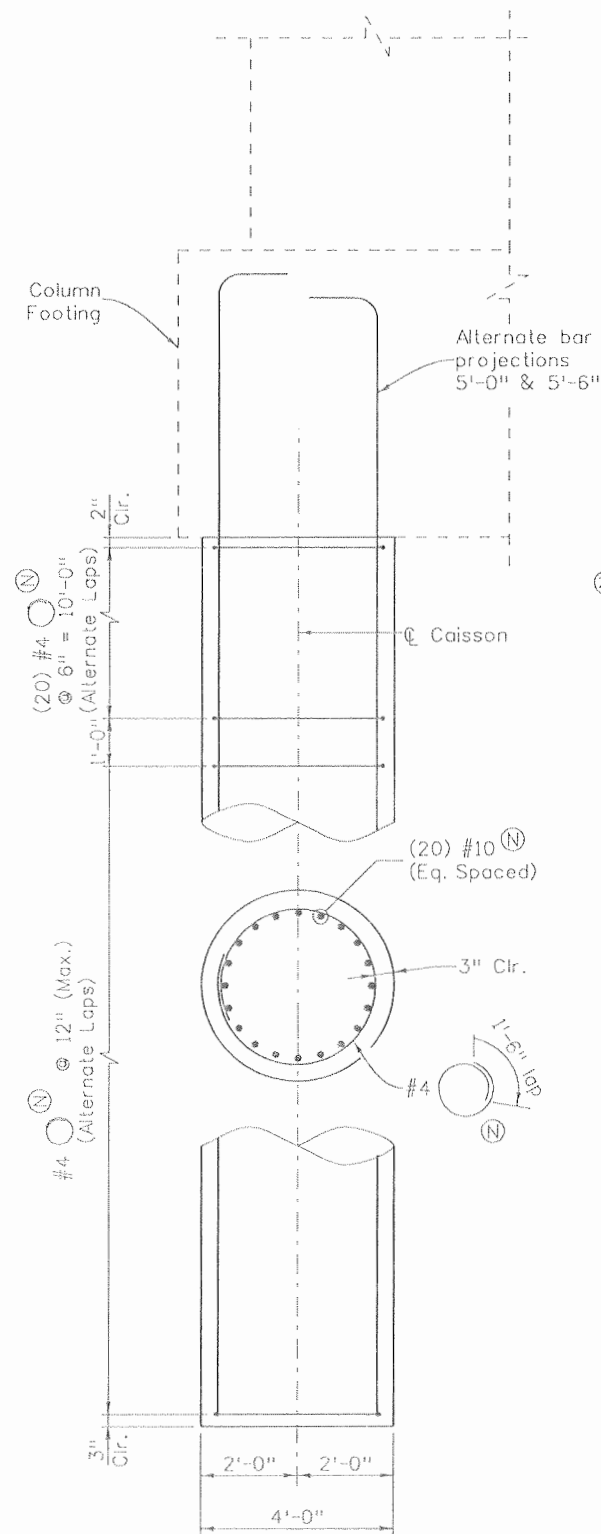

48" CAISSON DETAIL

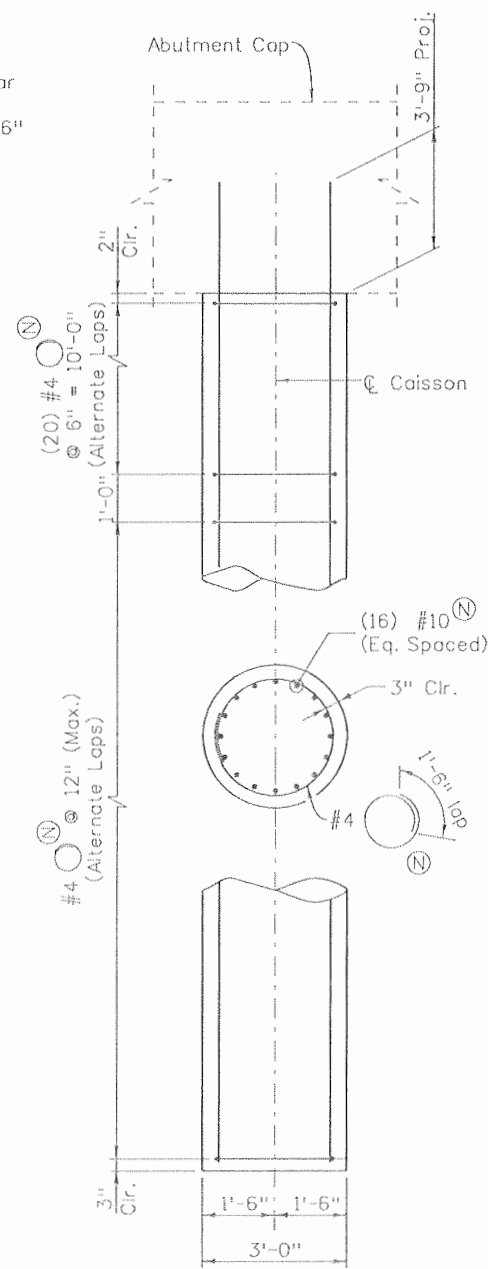

36" CAISSON DETAIL
ABUTMENT 1

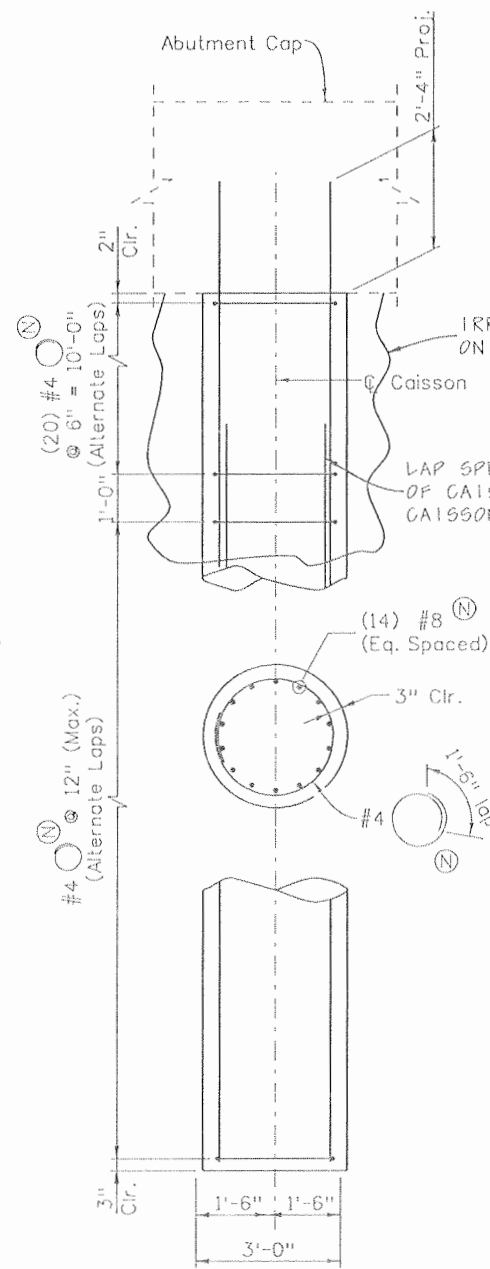

36" CAISSON DETAIL
ABUTMENT 3

CAISSON DATA

Location	Caisson Size	Top of Caisson Elevation	Estimated Tip Elevation	Min. Penetration Into Bedrock (ft.)	Max. Factored Load (kip)	Estimated Bedrock Elevation	Measured Bedrock Elevation
Abut. 1	36"	6622.00	6562.00	16	1334	6578.00	6578.00
Pier 2	48"	6582.50	6536.00	42	3785	6578.00	6576.94
Abut. 3	36"	6630.34	6543.00	20	1575	6563.00	6563.06

NOTES:

- Caisson concrete shall be concrete Class BZ ($f'_c = 4000$ psi).
- Lap splices in caisson tie bar shall alternate 180° .
Lap splices of longitudinal bars shall be staggered and shall be:

	Staggered	Non-Staggered
#8	3'-3"	4'-3"
#10	5'-3"	6'-10"

- Foundation design based upon recommendation provided by Shannon & Wilson, Inc.

Nominal End Bearing: 110 ksf
End Bearing Resistance Factor: 0.75

Nominal Side Shear: 9 ksf
Side Shear Resistance Factor: 0.75

Lateral reduction factors (ρ -multipliers):

36" \emptyset Caissons: 0.85 (transverse)
48" \emptyset Caissons: 0.28 (transverse), 0.75 (longitudinal)

- A factored downdrag axial load of 425 kips is included in the Max. Factored Load at Abutment 3.
- If groundwater inflow is encountered, casing should be used to seal off local groundwater inflow. Casing should be pushed, rotated, vibrated, or driven into an impermeable, firm stratum below the seepage zone. If the casing is extended into bedrock, the minimum bedrock penetration shall be increased by a length equivalent to the casing protrusion into bedrock.
- If a wet hole is encountered and casing cannot be used, drilling slurry shall not be used and concrete shall be placed in accordance with Section 601.12(f) of the Standard Specifications.
- The contractor shall roughen the sides of the rock socket to a depth of 2" prior to placing caisson concrete.

Print Date: 9/24/2010


File Name: 16042V_DrillShaftDet_01.dgn

Horiz. Scale: 1:1

Vert. Scale: As Noted

Unit Information 0221

Unit Leader STW

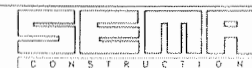

Sheet Revisions

Date:	Comments	Init.

Colorado Department of Transportation



3803 North Main Avenue
Suite 200
Durango, CO 81301
Phone: 970-385-1440 FAX: 970-385-8365

Region 5

EJA

As Constructed

No Revisions:

Revised: 9/10

Void:

RAMP A OVER US 160
DRILLED CAISSON DETAILS




Designer:	B. Allen	Structure	P-05-V
Detailer:	R. Artman	Numbers	
Sheet Subset:	Bridge	Subset Sheets:	B12 of 37

Project No./Code


NH 1602-114

16042

Sheet Number 241

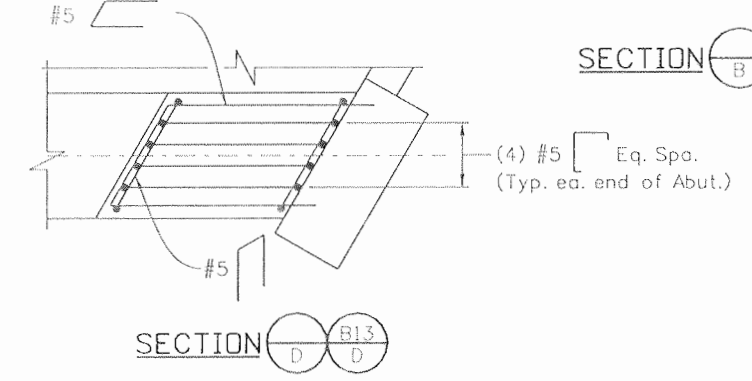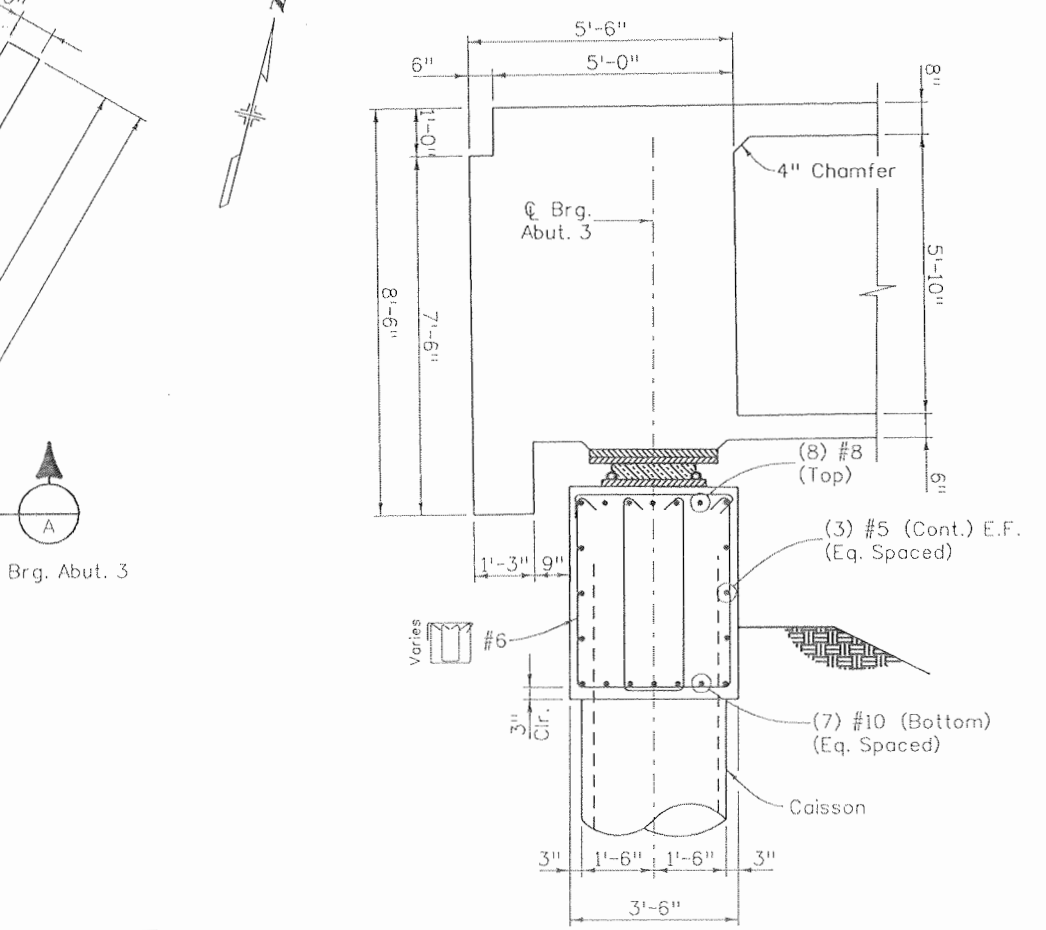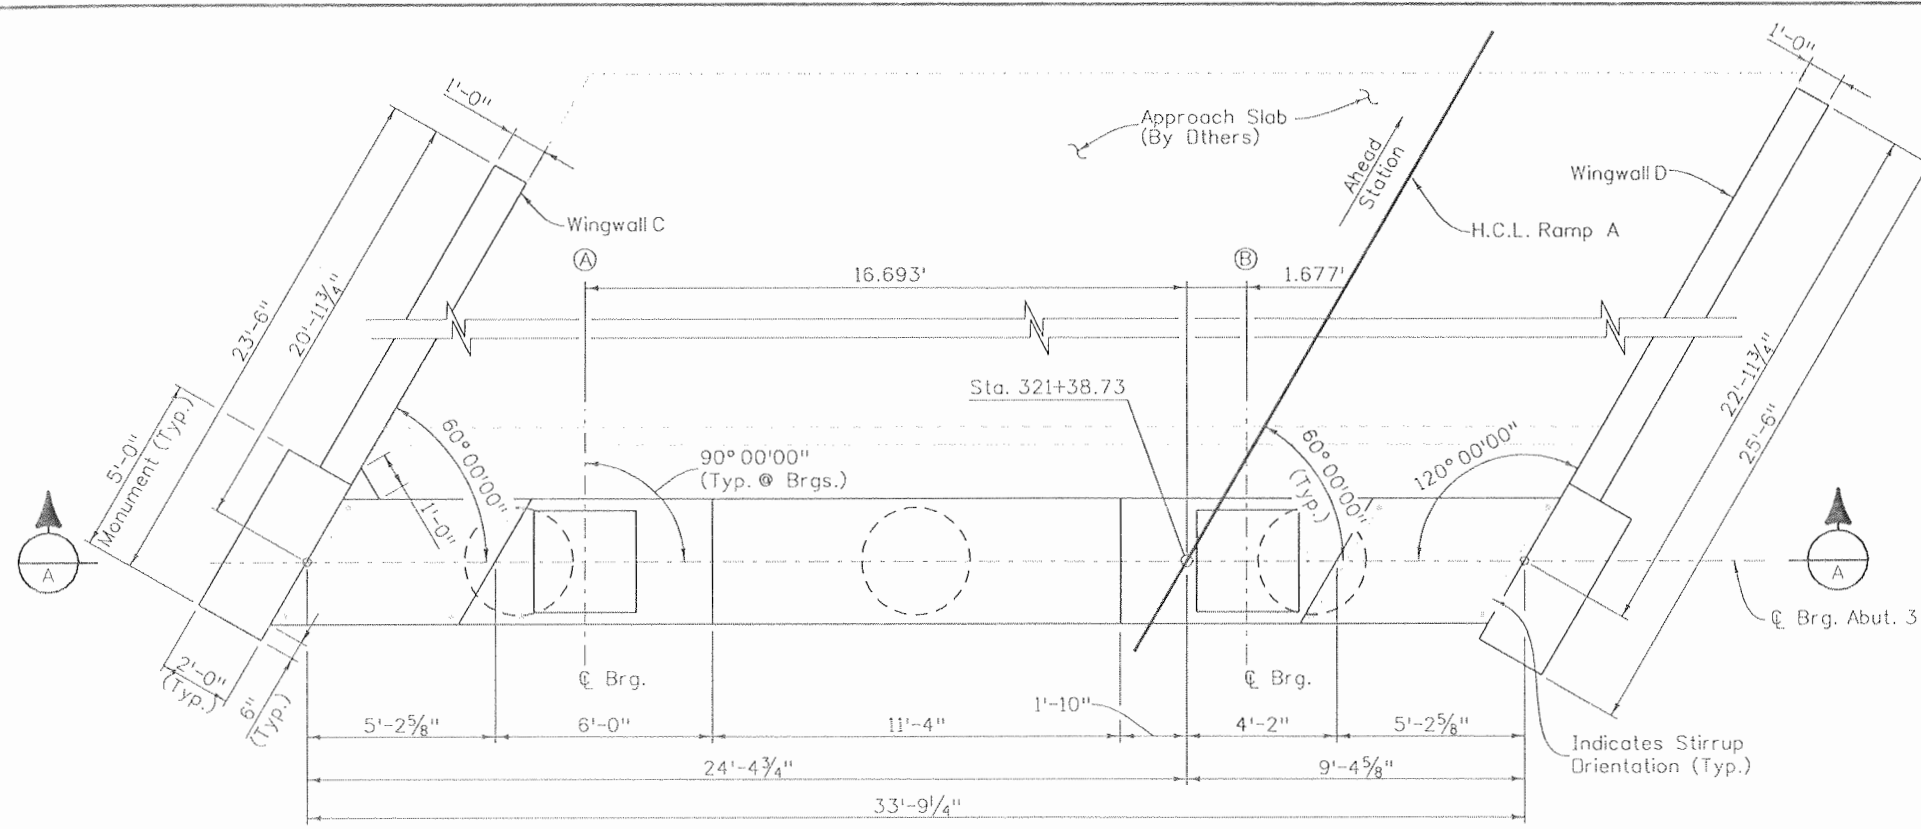

- NOTES:**
1. All cover is 2" unless noted otherwise.
 2. Abutment concrete shall be Class D (Bridge), $f'_c = 4,500$ psi at 28 days.
 3. Elevations shown are taken at \bar{C} Abutment except as noted.
 4. Elevations shall be adjusted as necessary after bearing devices are approved.
 5. The estimated force required for jacking under DL is 660 Kips at Pad 1 and 560 Kips at Pad 2.

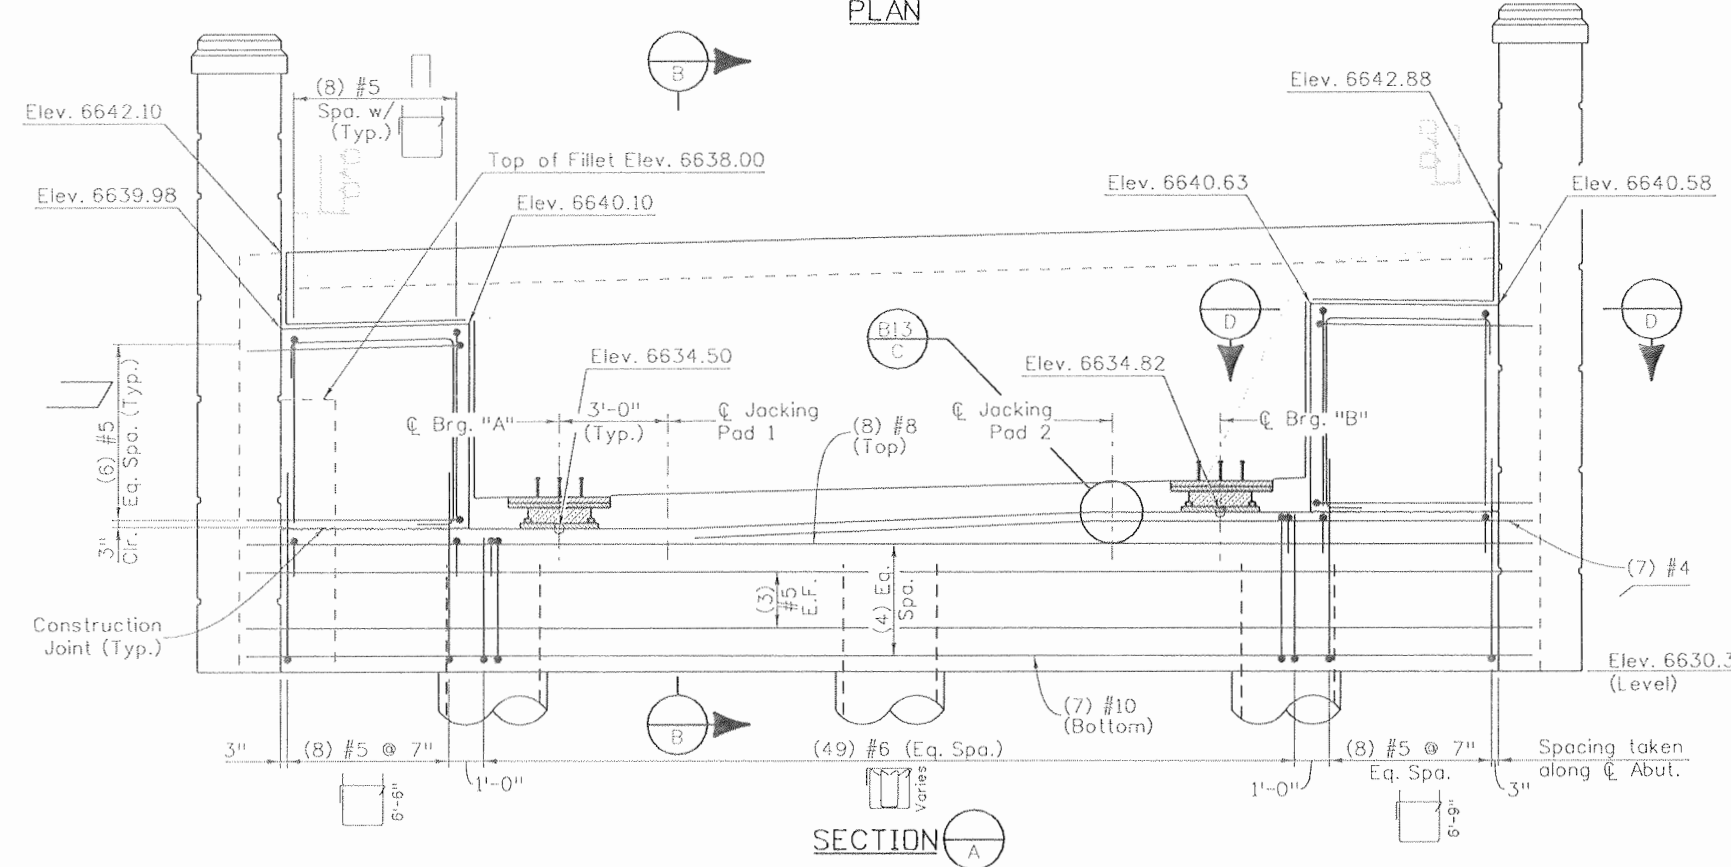

Design		Detail		Quantities	
INITIAL	DATE	INITIAL	DATE	INITIAL	DATE
Designed By: BJA	11/08	Detailled By: BJA	11/08	Quantities By: BJA	11/08
Checked By: DSO	11/08	Checked By: DSO	11/08	Checked By: LW	11/08

Print Date: 9/27/2010
 File Name: 16042V_Abutment3Det_01.dgn
 Horiz. Scale: 1:1 Vert. Scale: As Noted
 Unit Information: 0221 Unit Leader: STW


Sheet Revisions		
Date:	Comments	Init.

Colorado Department of Transportation
 3803 North Main Avenue
 Suite 200
 Durango, CO 81301
 Phone: 970-385-1440 FAX: 970-385-8365
 Region 5 EJA


As Constructed	
No Revisions:	9/10
Revised:	
Void:	

RAMP A OVER US 160 ABUTMENT 3 DETAILS			
Designer:	B. Allen	Structure Numbers:	P-05-V
Detailer:	R. Artman		
Sheet Subset:	Bridge	Subset Sheets:	B14 of 37

Project No./Code	
NH 1602-114	
16042	
Sheet Number	243

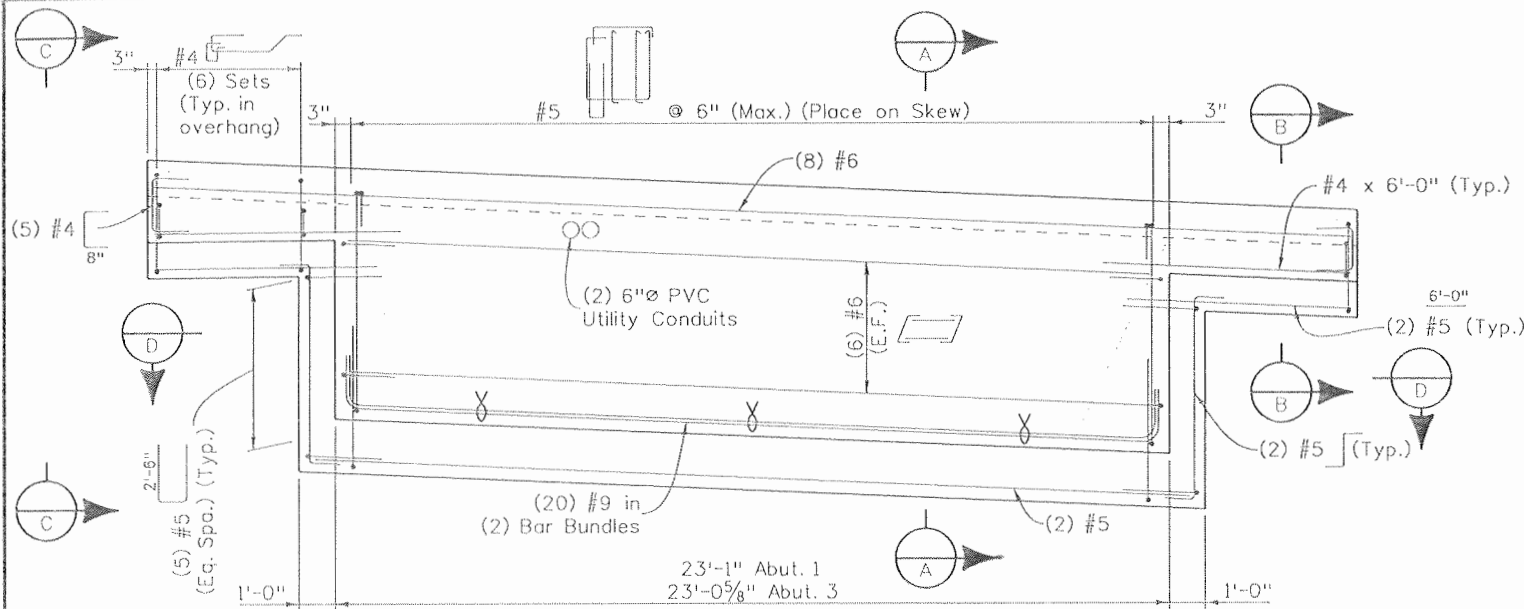


DIAPHRAGM ELEVATION
(Deck Reinforcing not shown)

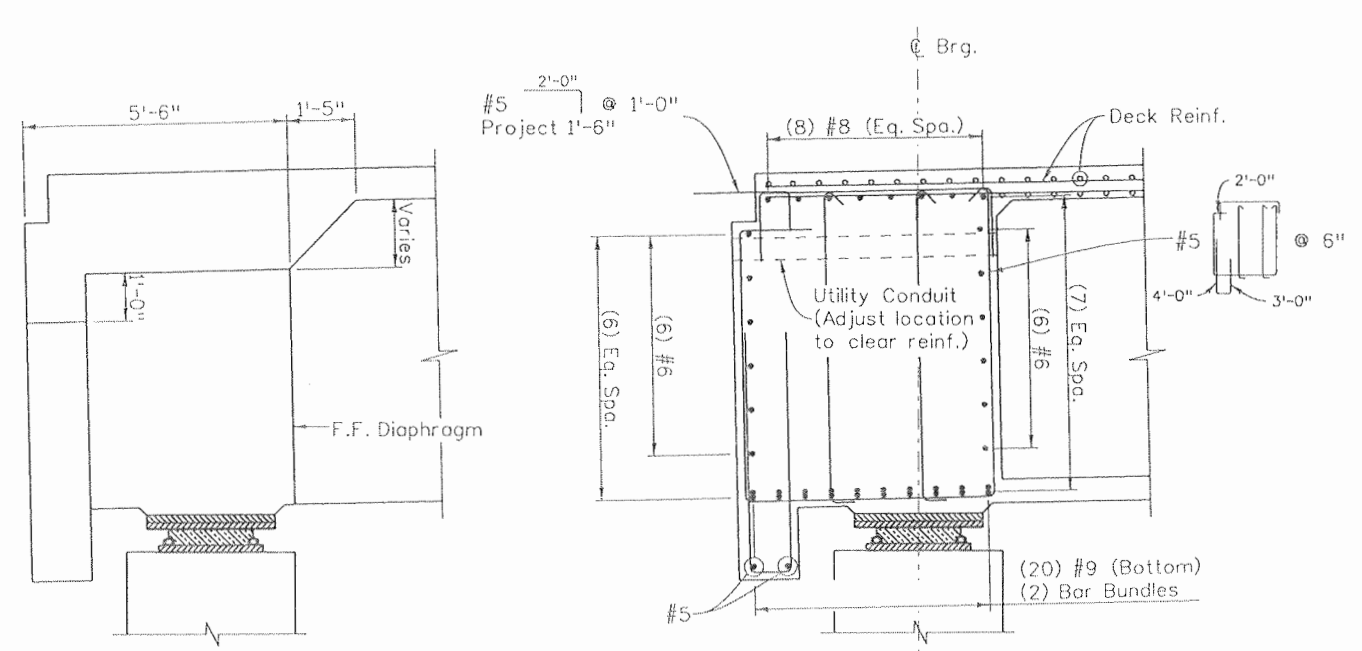


VIEW C


SECTION A

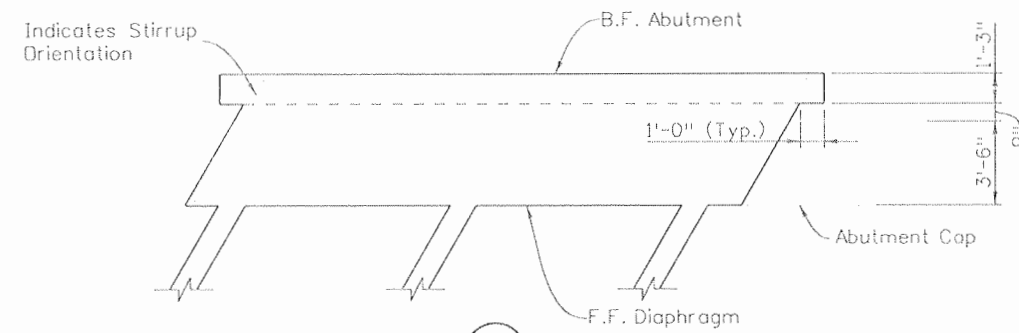


SECTION D

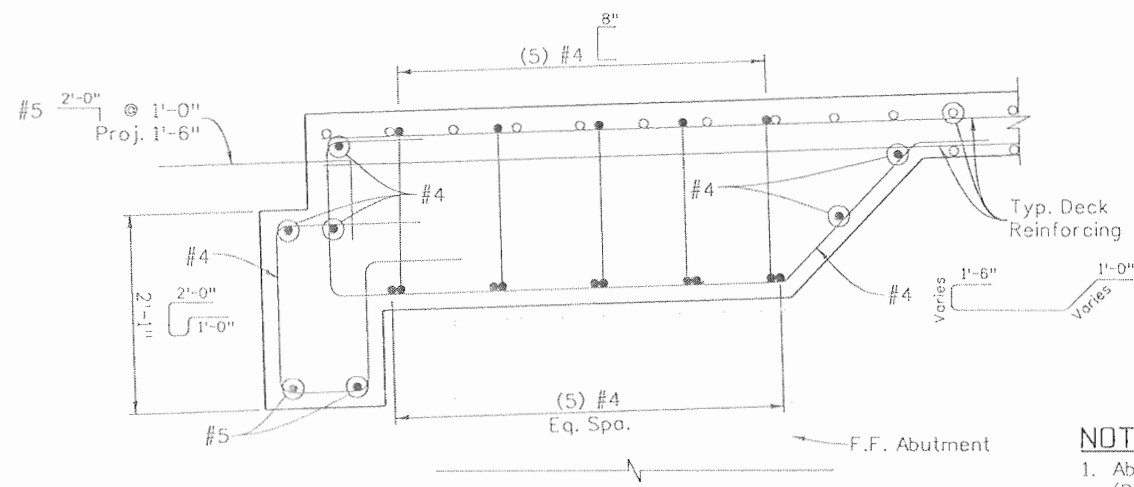

SECTION B

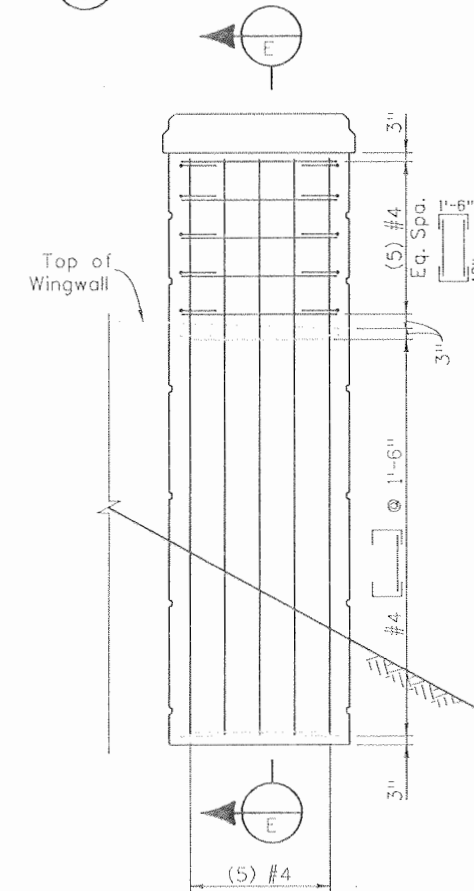

TYPICAL MONUMENT REINFORCING

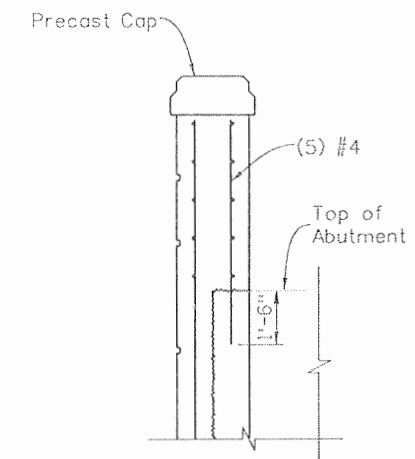

SECTION E

NOTES:

1. Abutments shall be concrete Class D (Bridge) ($f'_c = 4,500$ psi).
2. Coordinate Utility Penetration to miss Reinforcing. See Sheet B17 for details.

Design		Detail		Quantities	
INITIAL	DATE	INITIAL	DATE	INITIAL	DATE
Designed By: BJA	11/08	Detailed By: BJA	11/08	Quantities By: BJA	11/08
Checked By: DSO	11/08	Checked By: DSO	11/08	Checked By: LW	11/08

Print Date: 9/24/2010
 File Name: 16042V_Abutment_Det_01.dgn
 Horiz. Scale: 1:1 Vert. Scale: As Noted
 Unit Information 0221 Unit Leader STW

Sheet Revisions		
Date:	Comments	Init.


Colorado Department of Transportation
 3803 North Main Avenue
 Suite 200
 Durango, CO 81301
 Phone: 970-385-1440 FAX: 970-385-8365
 Region 5 EJA

As Constructed	
No Revisions:	9/10
Revised:	
Void:	


RAMP A OVER US 160 ABUTMENT DETAILS			
Designer:	B. Allen	Structure Numbers:	P-05-V
Detailer:	R. Artman		
Sheet Subset:	Bridge	Subset Sheets:	B15 of 37

Project No./Code	
NH 1602-114	
16042	
Sheet Number	244


Design	INITIAL	DATE	INITIAL	DATE	INITIAL	DATE
	TRJ	11/08	BJA	11/08	TRJ	11/08
Detail	QUANTITIES	DATE	INITIAL	DATE	INITIAL	DATE
	TRJ	11/08	BJA	11/08	TRJ	11/08
Checked By	Checked By	Checked By	Checked By	Checked By	Checked By	Checked By
	BJA	BJA	BJA	BJA	BJA	BJA

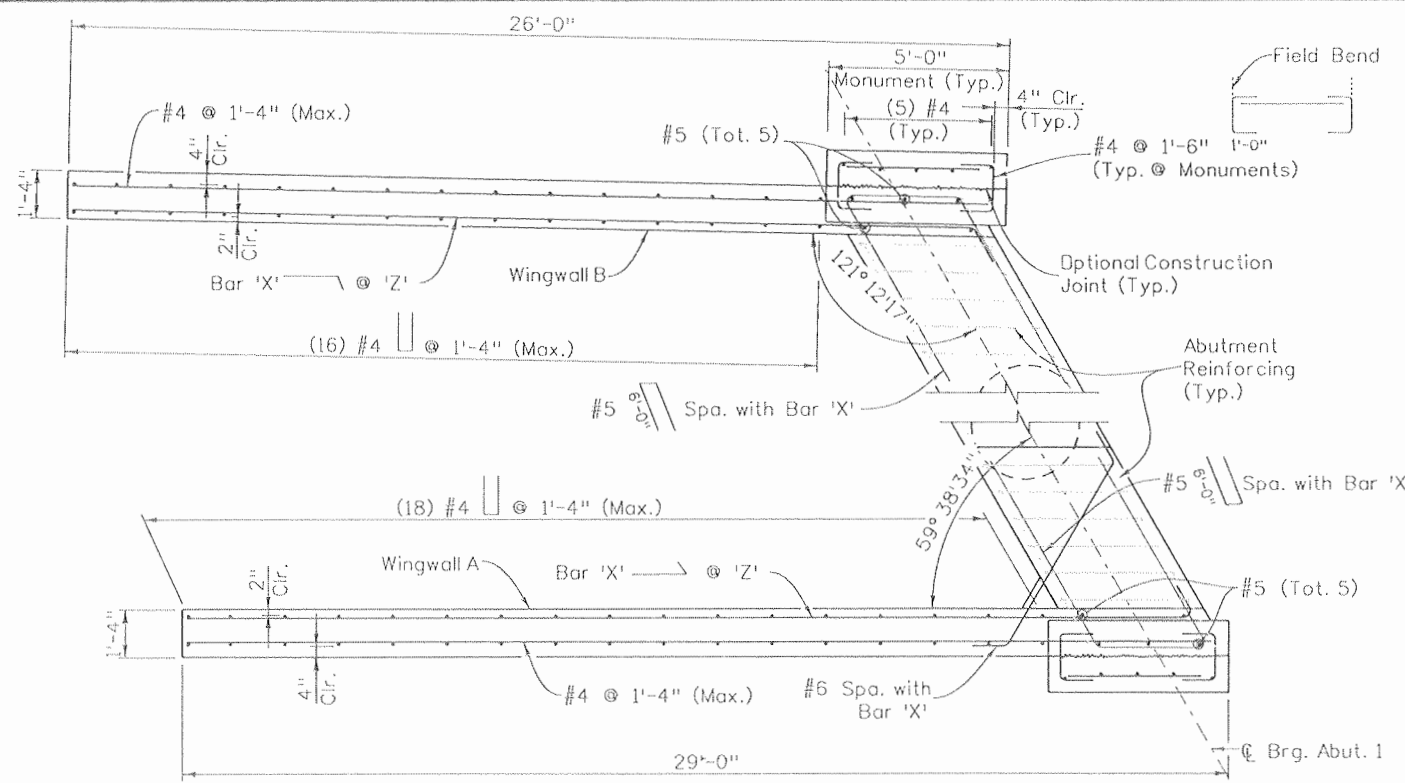


PLAN ABUTMENT 1

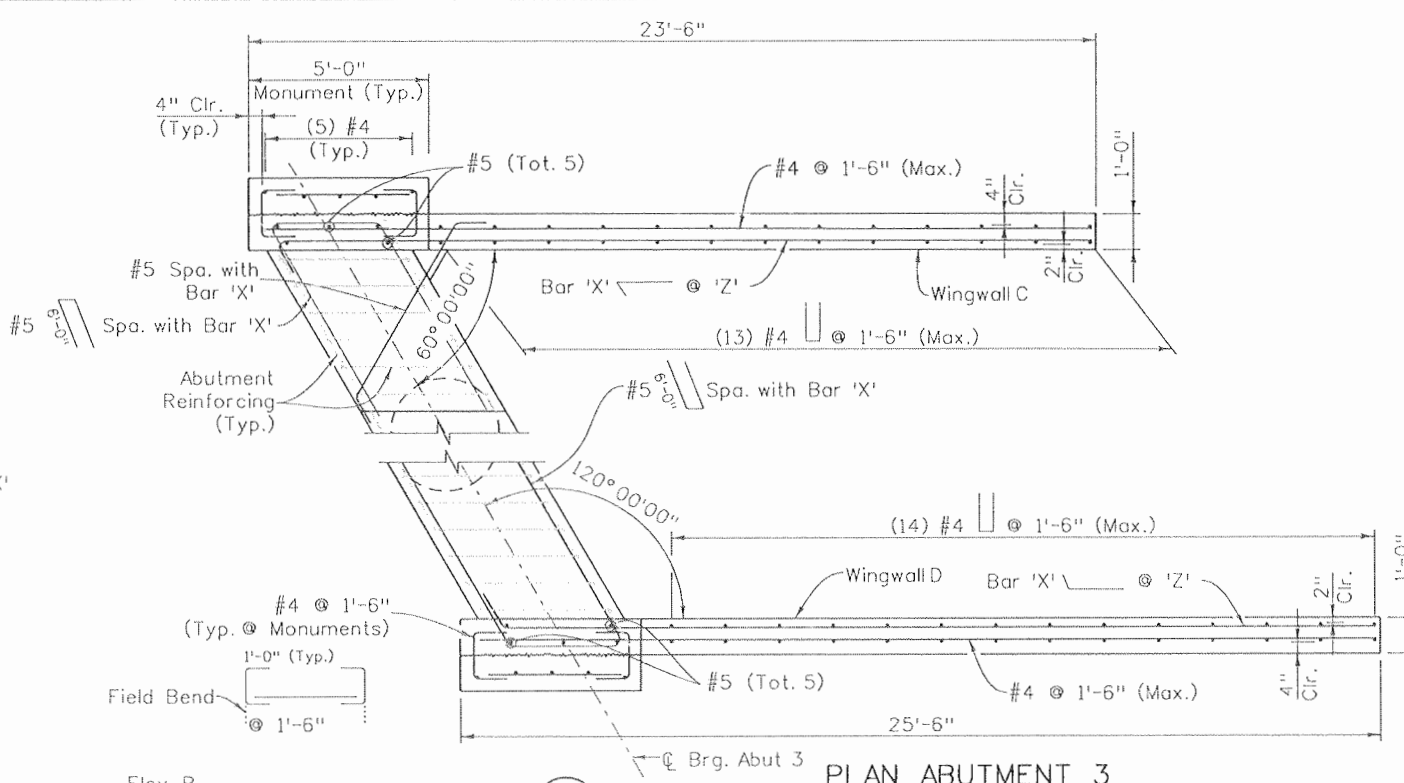


PLAN ABUTMENT 3

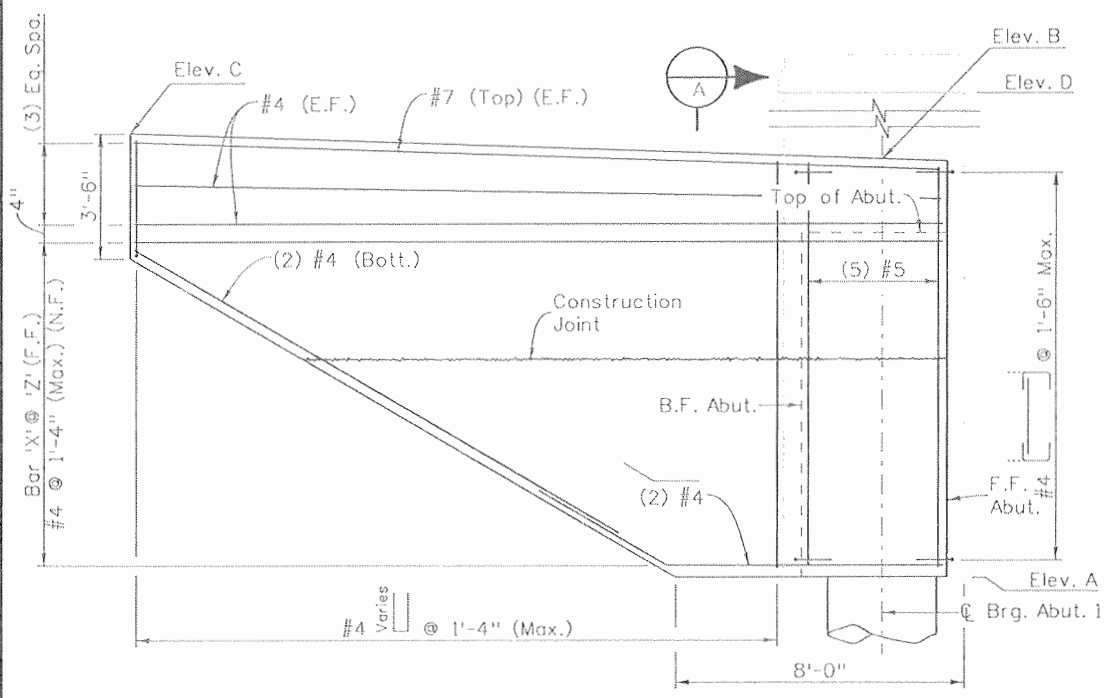

ELEVATION WALL A AND B

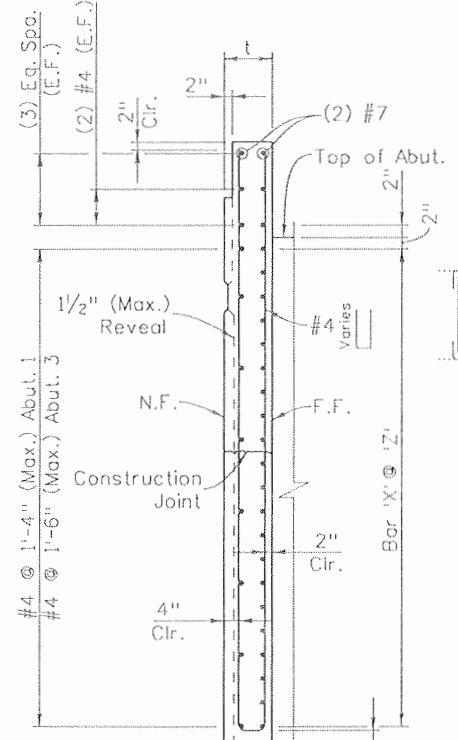

SECTION A-A

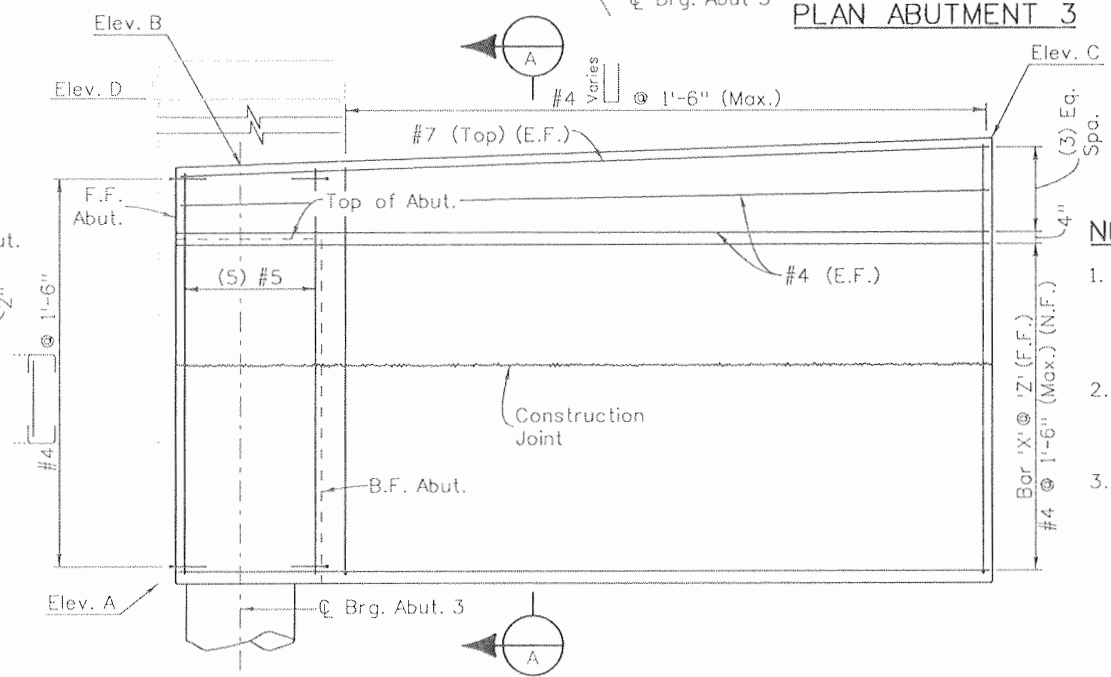


ELEVATION WALL C AND D


Wingwall	Bar 'X'	t	'Z'	Elev. A	Elev. B	Elev. C	Elev. D
A	#6	1'-4"	6"	6622.00	6637.71	6637.15	6642.71
B	#5	1'-4"	6"	6622.00	6636.26	6635.71	6641.26
C	#5	1'-0"	6"	6630.34	6642.07	6642.33	6647.07
D	#6	1'-0"	6"	6630.34	6642.88	6643.11	6647.88

- NOTES:**
1. All Wingwall and Monument concrete shall be Class D (Bridge), $f'_c = 4,500$ psi at 28 days.
 2. For additional Monument Reinforcing details, see Sheet B15.
 3. The maximum depth of the formliner reveals shall not exceed 1 1/2".

Print Date: 9/24/2010	Sheet Revisions			Colorado Department of Transportation				As Constructed		RAMP A OVER US 160 WINGWALL DETAILS		Project No./Code	
File Name: 16042V_WingwallDet_01.dgn	Date:	Comments:	Init.	3803 North Main Avenue Suite 200 Durango, CO 81301 Phone: 970-385-1440 FAX: 970-385-8365				No Revisions: 9/10		Designer: T. Johnson Structure P-05-V		NH 1602-114	
Horiz. Scale: 1:1				Region 5				Revised:		Detailer: R. Artman Numbers		16042	
Unit Information 0221				EJA				Void:		Sheet Subset: Bridge		Sheet Number 245	
SEMA CONSTRUCTION		WILSON & COMPANY								Subst Sheets: B16 of 37			

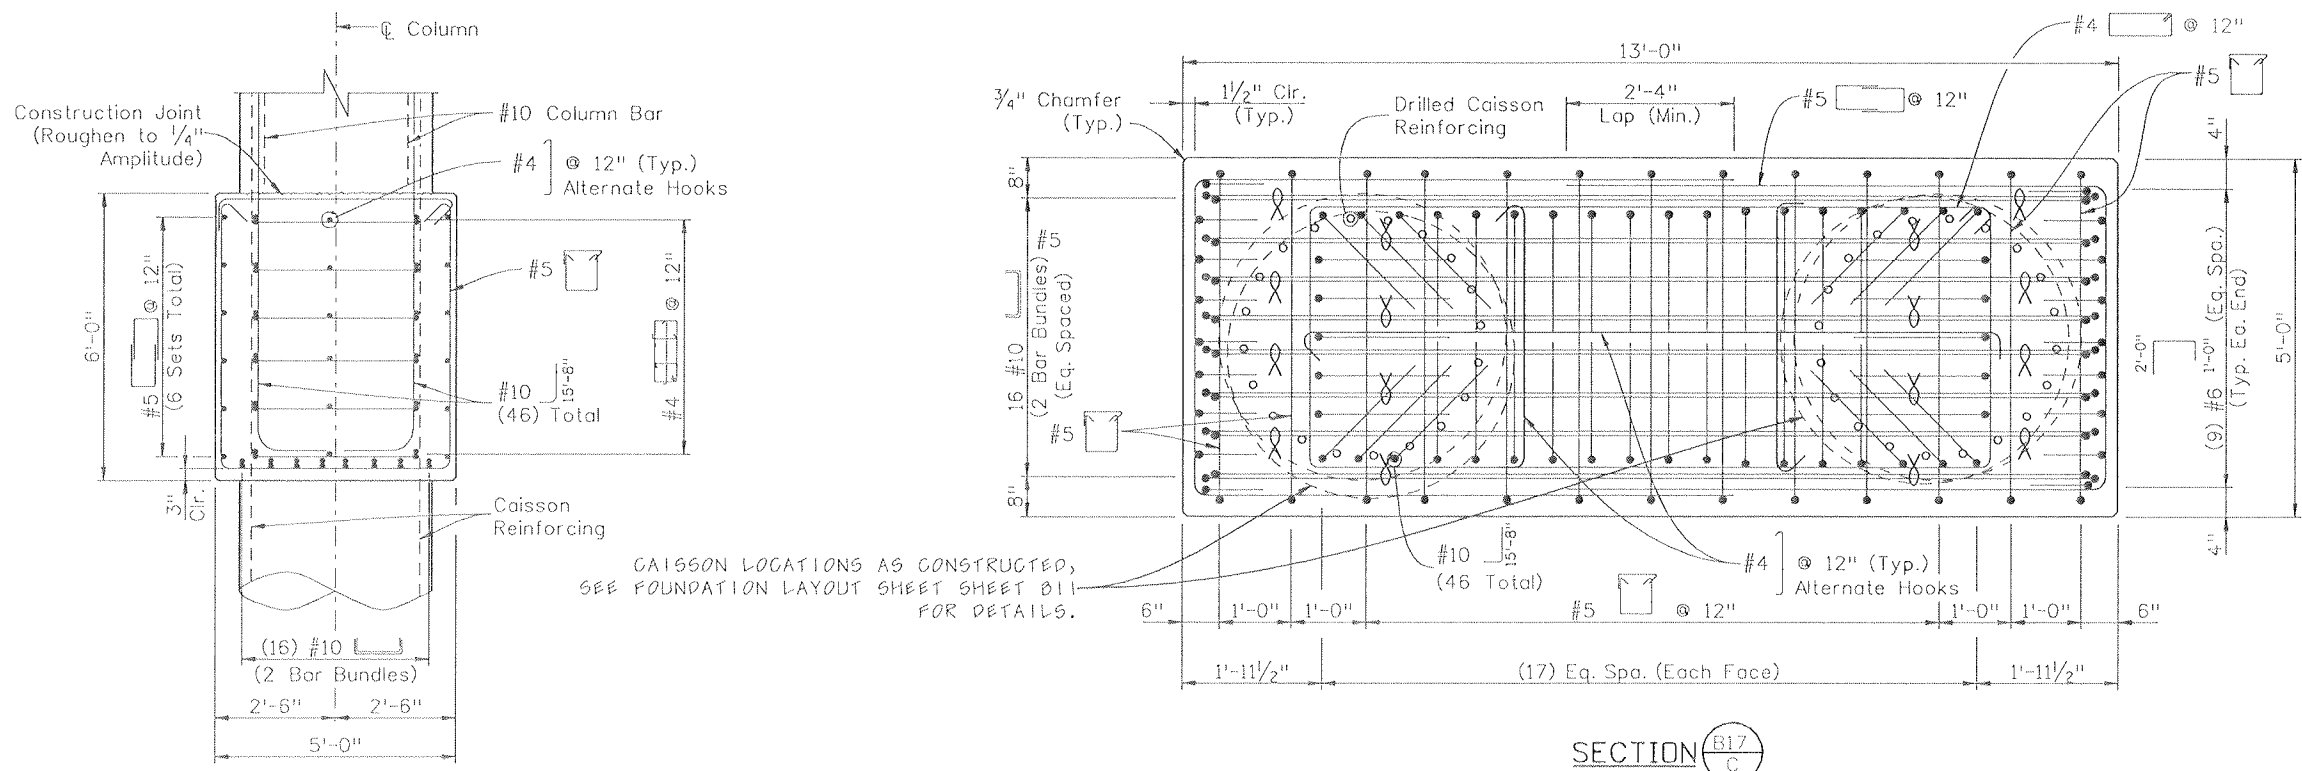

SECTION B17 E

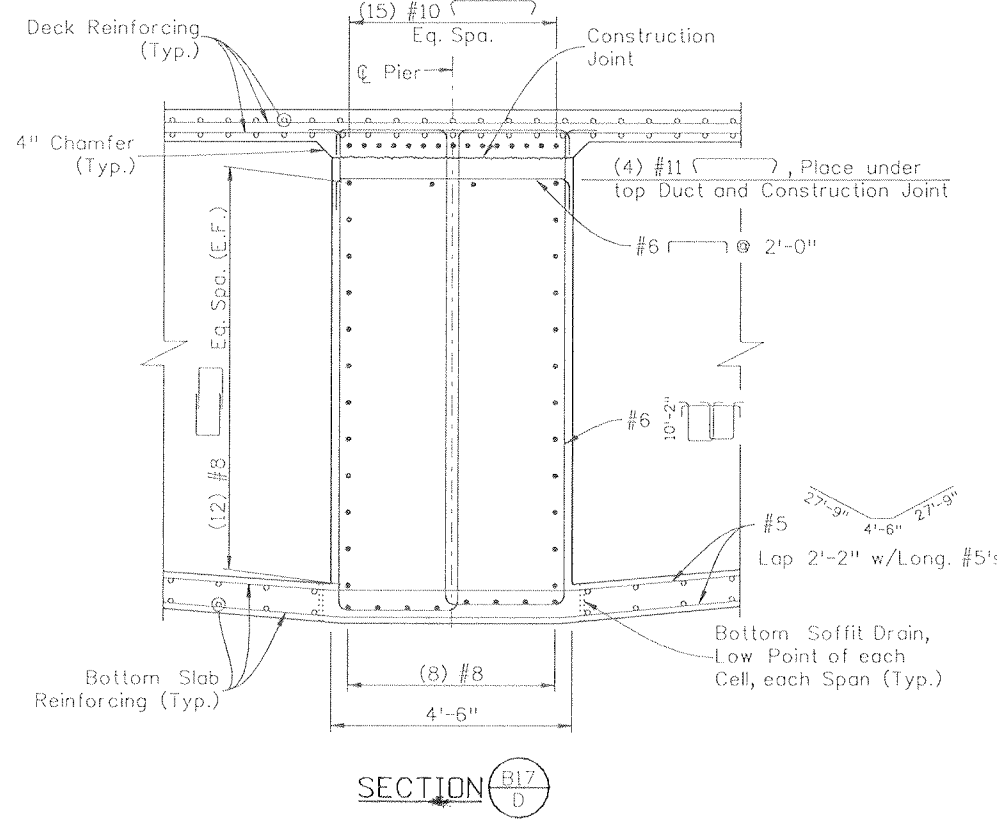


- NOTES:**
1. Column concrete shall be Class D, (Bridge) $f'_c = 4,500$ psi at 28 days.
 2. All concrete cover is 2" clear unless noted otherwise.


Design		Detail		Quantities	
INITIAL	DATE	INITIAL	DATE	INITIAL	DATE
Designed By: BJA	10/08	Detailled By: RGA	10/08	Quantities By: BJA	10/08
Checked By: DSO	10/08	Checked By: DSO	10/08	Checked By: LW	10/08

Print Date: 9/27/2010		Sheet Revisions			Colorado Department of Transportation		As Constructed		RAMP A OVER US 160 PIER 2 DETAILS (2 OF 2)		Project No./Code	
File Name: 16042V_PierDet_02.dgn		Date:	Comments	Init.	3803 North Main Avenue Suite 200 Durango, CO 81301 Phone: 970-385-1440 FAX: 970-385-8365		No Revisions:		Designer: B. Allen Structure P-05-V		NH 1602-114	
Horiz. Scale: 1:1 Vert. Scale: As Noted					Region 5 EJA		Revised: 9/10		Detailer: R. Artman Numbers		16042	
Unit Information 0221 Unit Leader STW							Void:		Sheet Subset: Bridge Subset Sheets: B18 of 37		Sheet Number 247	




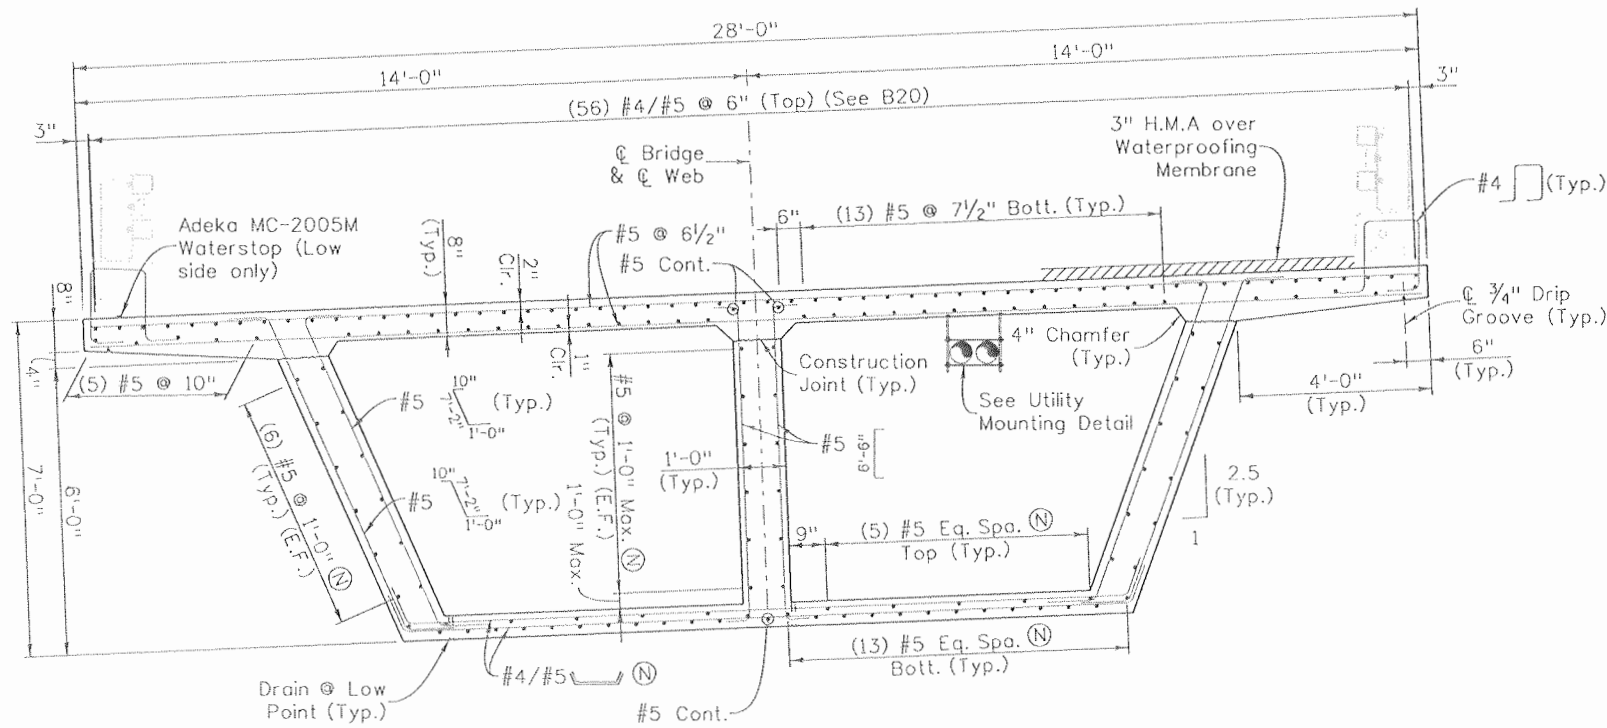

TYPICAL SECTION

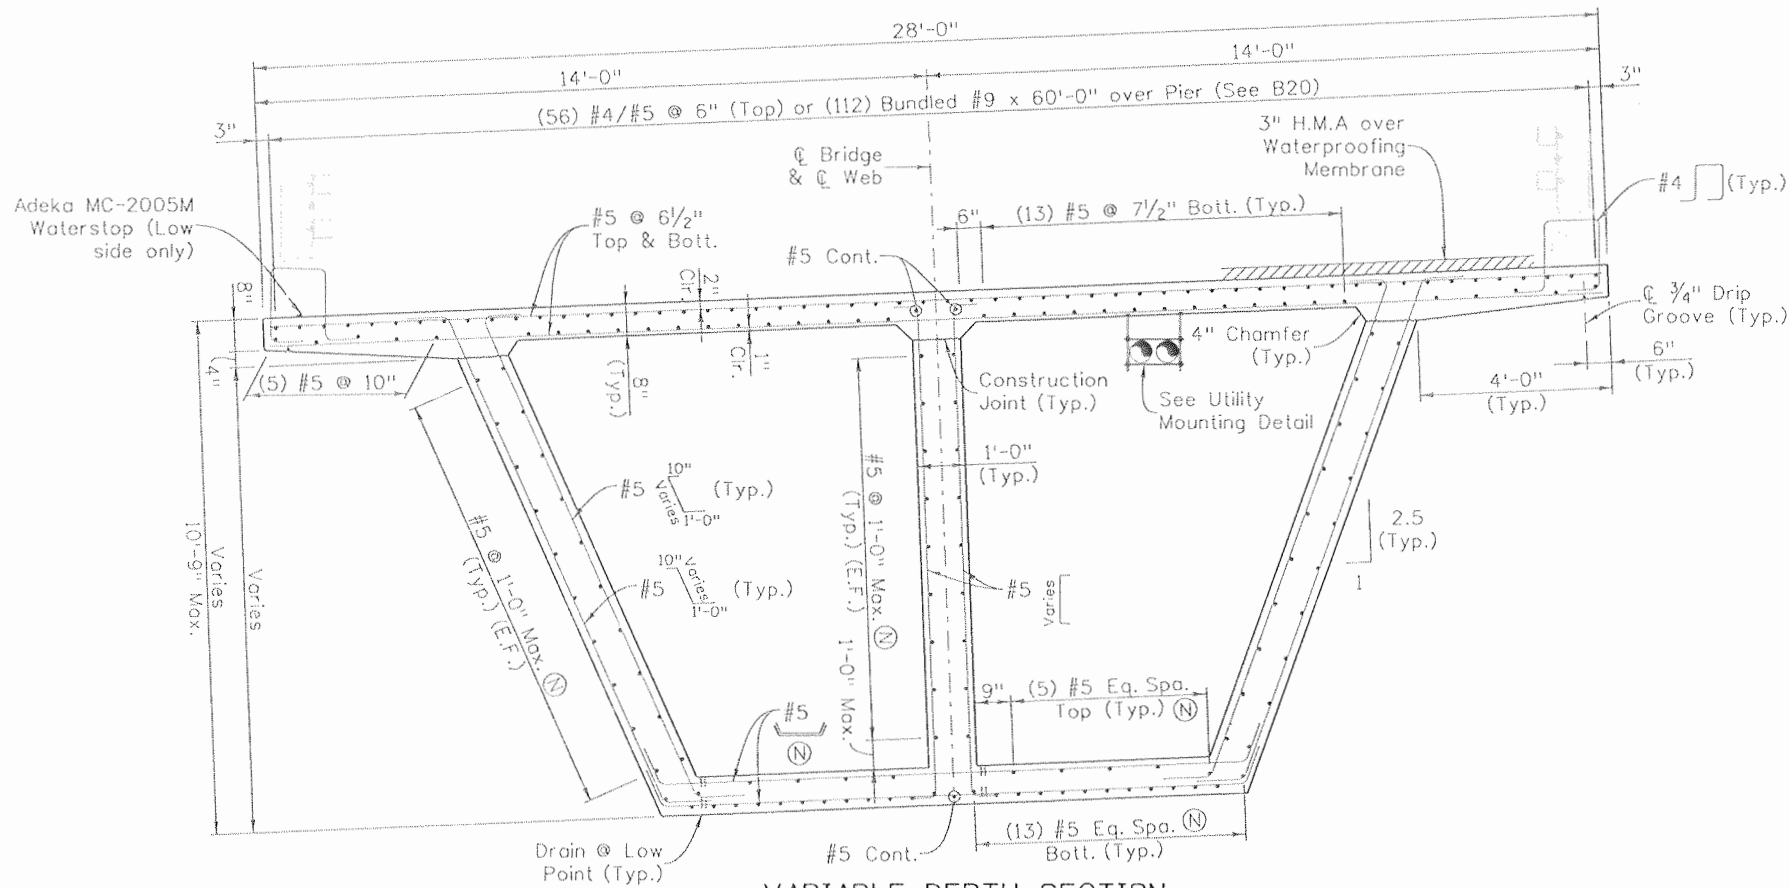

VARIABLE DEPTH SECTION

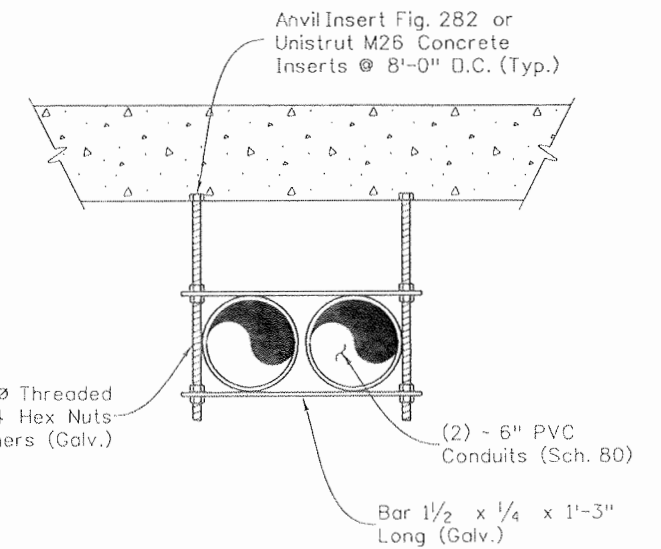

UTILITY MOUNTING DETAIL

NOTES:

1. Concrete cover is 1/2" clear unless noted otherwise.
2. See Cast-In-Place Box Girder Details sheets 1 thru 4 for additional information, including bottom soffit thickness.
3. Superstructure shall be concrete Class D (Bridge), f' = 4,500 psi at 28 days.
4. Refer to Anti-icing Plans for locations of conduits, blockouts, and pavement monitoring device.

Design	DATE		INITIAL		Detail	DATE		INITIAL		Quantities	DATE		INITIAL	
	By	Checked	By	Checked		By	Checked	By	Checked		By	Checked	By	Checked
Designed By			BJA		RGD			BJA		Quantities By				
Checked By			DSD		DSD			DSD		Checked By				

Print Date: 9/24/2010
 File Name: 16042V_SupStrSecs_01.dgn
 Horiz. Scale: 1:1 Vert. Scale: As Noted
 Unit Information 0221 Unit Leader STW

SEMA CONSTRUCTION
WILSON & COMPANY


Sheet Revisions		
Date:	Comments	Init.

Colorado Department of Transportation
 3803 North Main Avenue
 Suite 200
 Durango, CO 81301
 Phone: 970-385-1440 FAX: 970-385-8365
 Region 5 EJA

As Constructed	
No Revisions:	9/10
Revised:	
Void:	

RAMP A OVER US 160 SUPERSTRUCTURE DETAILS			
Designer:	A. Leifheit	Structure Numbers	P-05-V
Detailer:	R. Artman	Subset Sheets:	B19 of 37
Sheet Subset:	Bridge		

Project No./Code	
NH 1602-114	16042
Sheet Number	248

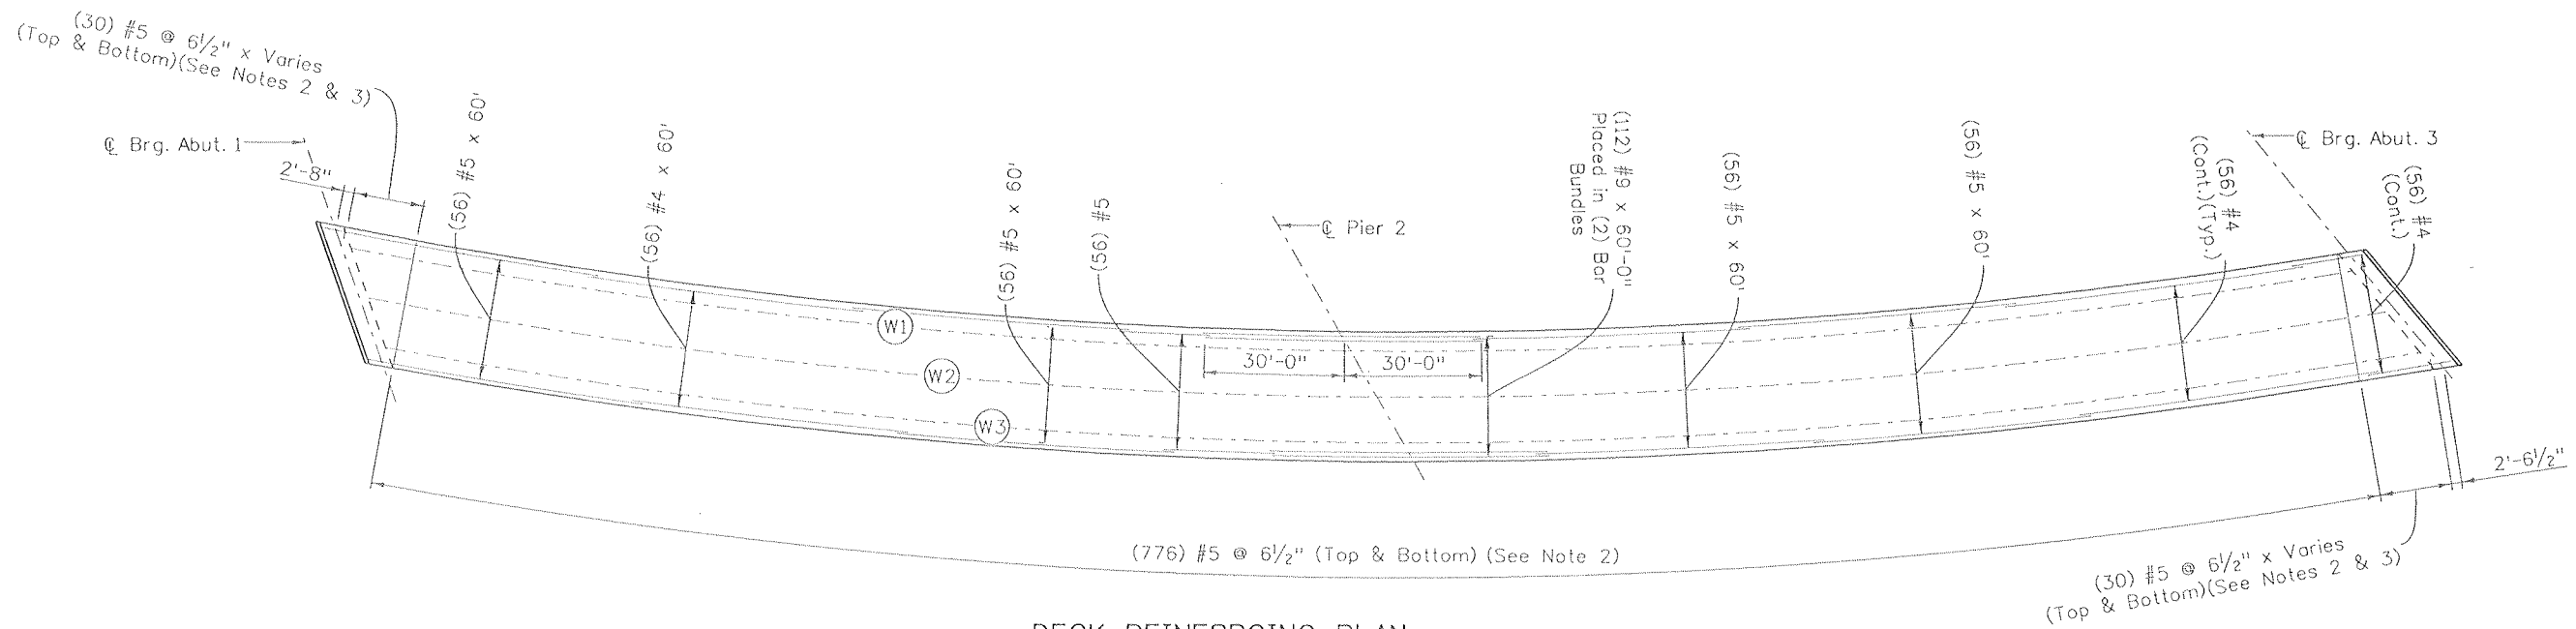

DECK REINFORCING PLAN

NOTES:


1. Stagger all lap splices, when possible

Non-staggered Lap Splices




2. Place transverse reinforcement radially, measuring spacing along bridge centerline.


3. Project transverse deck reinforcement 2'-0" minimum into abutment diaphragm.

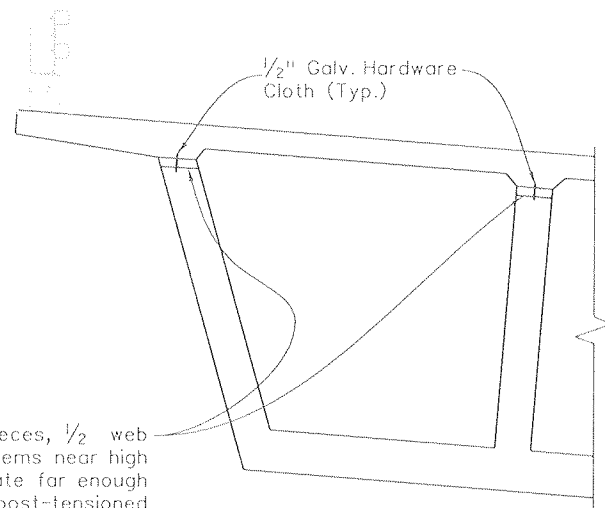

VENT HOLE DETAIL

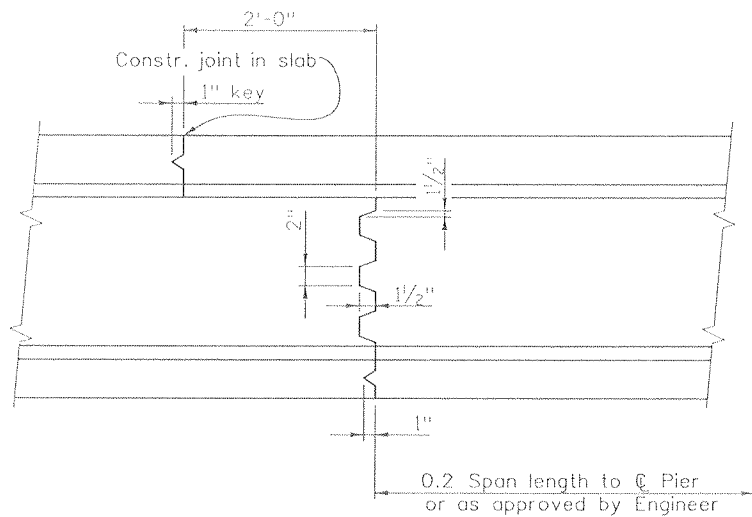

TRANSVERSE WEB CONSTRUCTION JOINT

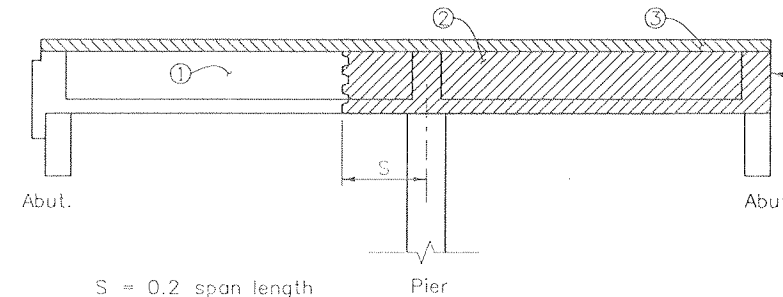

SUPERSTRUCTURE PLACING SCHEDULE

Numbers ① and ② indicate sequence of placing bottom slab and web concrete when each section constitutes a separate pour. ③ may be placed continuously or in parts, as indicated above and as approved by the Engineer. Contractor may submit an alternate placing schedule to the Engineer for approval.

There shall be no construction joints through post-tensioning anchorage zone. Revise construction joints at abutments as necessary.

S = 0.2 span length

0.2 Span length to C Pier or as approved by Engineer

Design	INITIAL	DATE	INITIAL	DATE	INITIAL	DATE
	BSA	10/08	BSA	10/08	BSA	10/08
Checked By	DSQ	10/08	DSQ	10/08	LW	10/08
	DSQ	10/08	DSQ	10/08	LW	10/08

Print Date: 9/24/2010
 File Name: 16042V_SupStrReinfPlan_01.dgn
 Horiz. Scale: 1:30 Vert. Scale: As Noted
 Unit Information 0221 Unit Leader STW


Sheet Revisions		
Date:	Comments	Init.

Colorado Department of Transportation
 3803 North Main Avenue
 Suite 200
 Durango, CO 81301
 Phone: 970-385-1440 FAX: 970-385-8365
 Region 5 EJA


As Constructed	No Revisions: 9/10
Revised:	
Void:	

RAMP A OVER US 160 DECK REINFORCING PLAN			
Designer:	B. Allen	Structure Numbers	P-05-V
Detailer:	R. Artman		
Sheet Subset:	Bridge	Subset Sheets:	B20 of 37

Project No./Code	NH 1602-114
	16042
Sheet Number	249

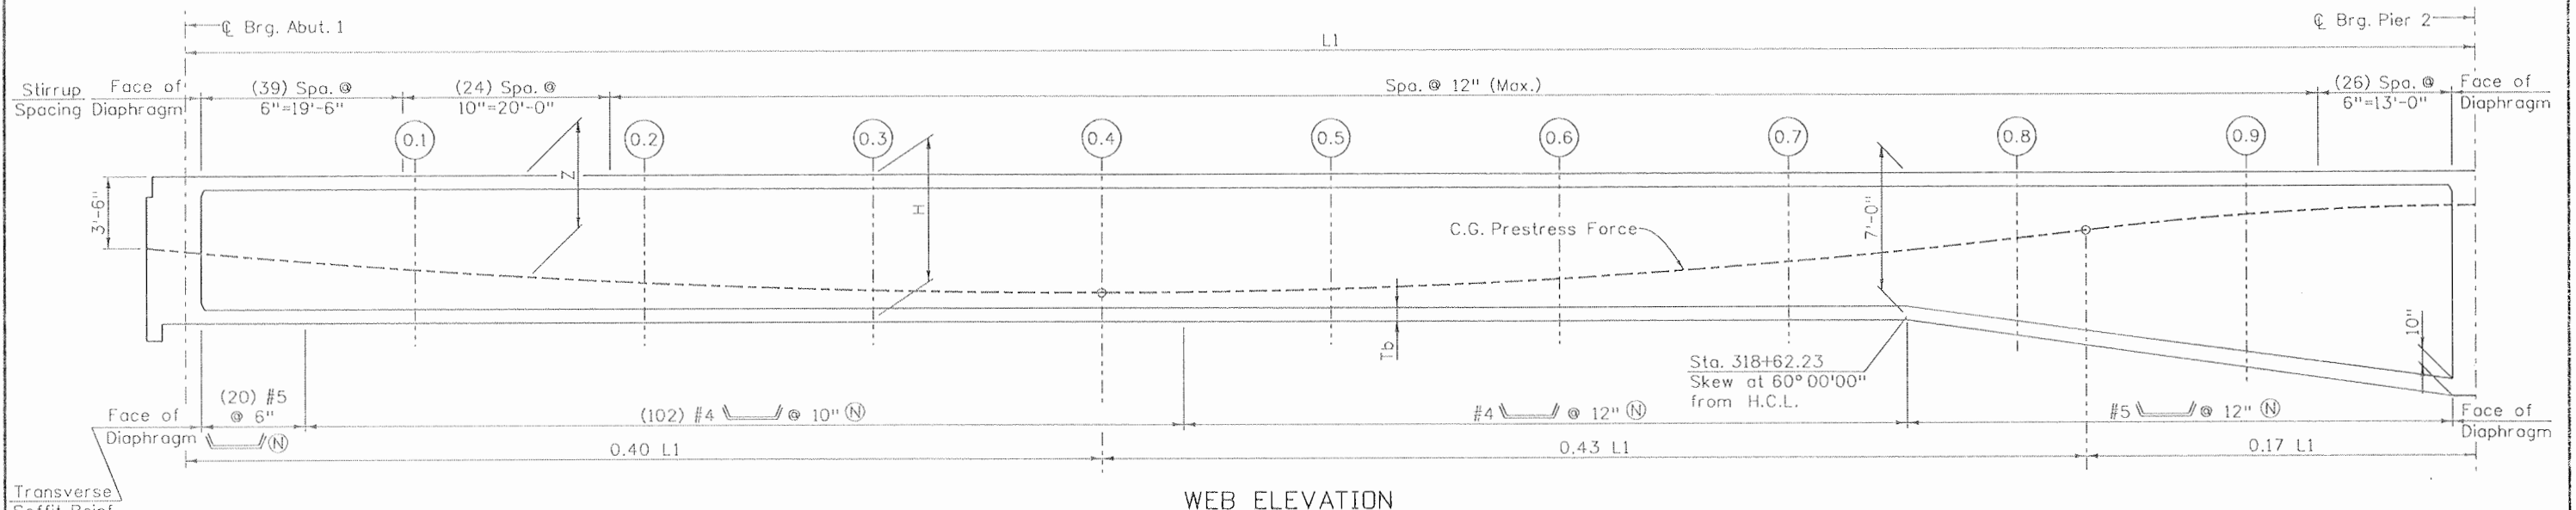

Item	End	Location									
		0.1	0.2	0.3	0.4	0.5	0.6	0.7	0.8	0.9	Pier 2
H (ft)	7.00	7.00	7.00	7.00	7.00	7.00	7.00	7.00	7.76	9.34	10.75
Tb (in)	6.00	6.00	6.00	6.00	6.00	6.00	6.00	6.00	6.81	8.50	10.00
Z (ft)	3.50	4.59	5.23	5.62	5.75	5.58	5.12	4.33	3.29	2.06	1.67
Deflection (in)	-0.10	0.66	1.57	2.34	2.74	2.65	2.13	1.36	0.69	0.23	0.00

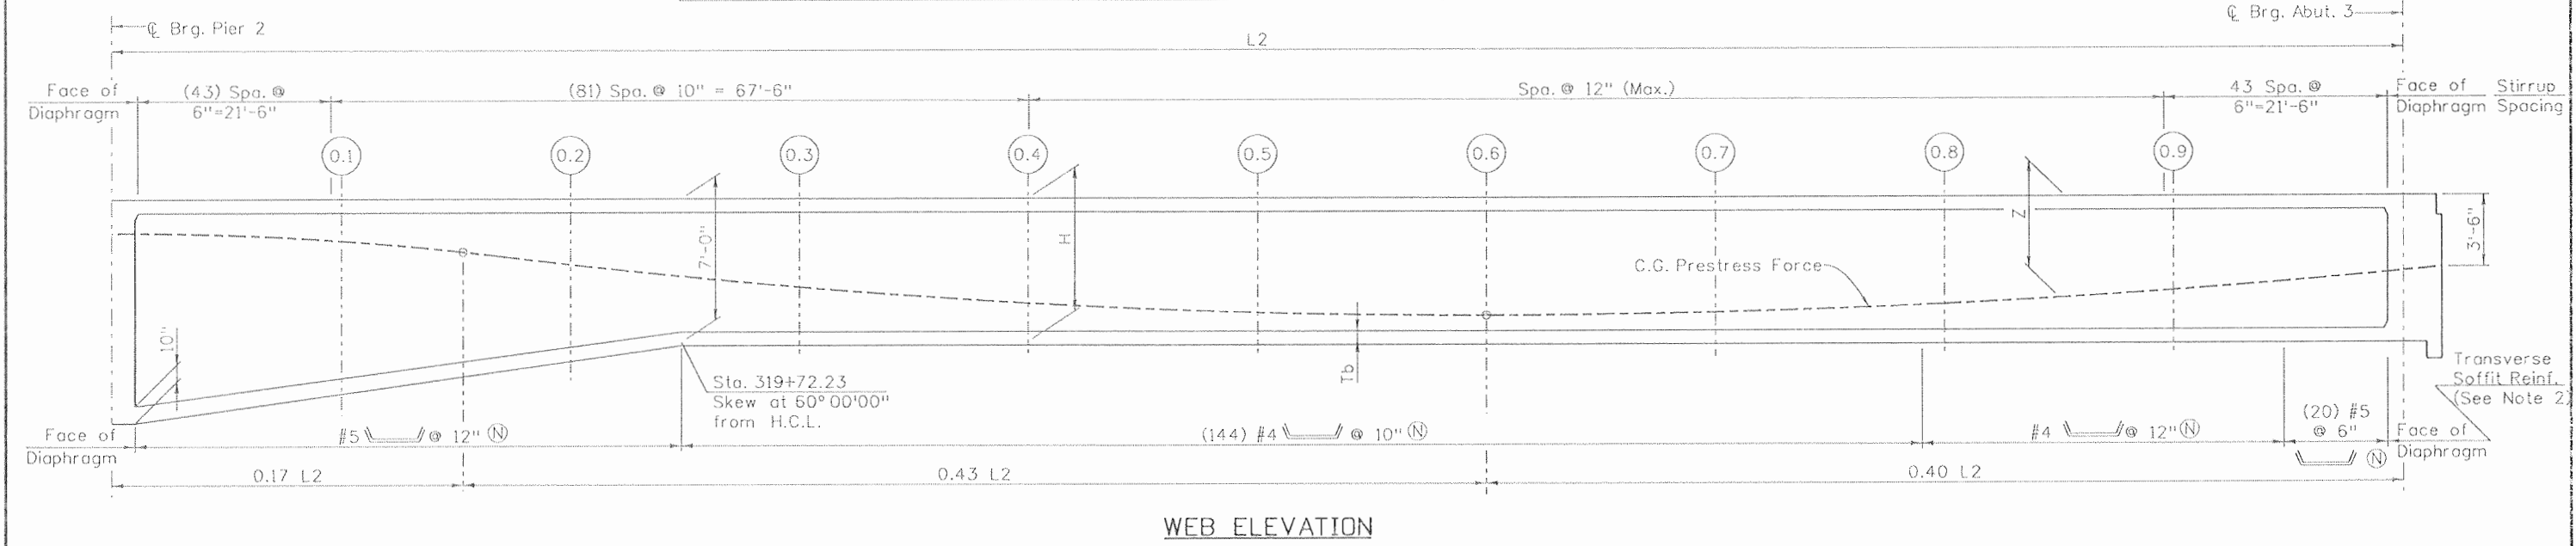


Item	Pier 2	Location									
		0.1	0.2	0.3	0.4	0.5	0.6	0.7	0.8	0.9	End
H (ft)	10.75	9.34	7.76	7.00	7.00	7.00	7.00	7.00	7.00	7.00	7.00
Tb (in)	10.00	8.50	6.81	6.00	6.00	6.00	6.00	6.00	6.00	6.00	6.00
Z (ft)	1.67	2.06	3.29	4.33	5.12	5.58	5.75	5.62	5.23	4.59	3.50
Deflection (in)	0.00	0.25	0.72	1.41	2.21	2.75	2.86	2.47	1.68	0.74	0.09

NOTE:
 1. See B23 for web lengths L1, L2 and L3.
 2. Place bottom soffit reinforcing radially, measured along centerline of bridge. Project bars 2'-0" into abutment and pier diaphragms.

Design	Initial		Date		Quantities	
	By	Checked	By	Checked	By	Checked
Designed By	AML	DSD	10/08	10/08	AML	LW
Checked By	DSD	DSD	10/08	10/08	LW	LW

Print Date: 9/24/2010	Sheet Revisions			Colorado Department of Transportation 3803 North Main Avenue Suite 200 Durango, CO 81301 Phone: 970-385-1440 FAX: 970-385-8365 Region 5	As Constructed	RAMP A OVER US 160 CAST-IN-PLACE BOX GIRDER DETAILS (1 OF 4)		Project No./Code
File Name: 16042V_CIPPTBoxGirder_01.dgn	Date:	Comments:	Init.		No Revisions: 9/10	Designer: A. Leifheit Structure P-05-V		NH 1602-114
Horiz. Scale: 1:1 Vert. Scale: As Noted					Revised:	Detailer: R. Artman Numbers		16042
Unit Information 0221 Unit Leader STW				Void:	Sheet Subset: Bridge	Subset Sheets: B21 of 37	Sheet Number 250	
 				EJA				

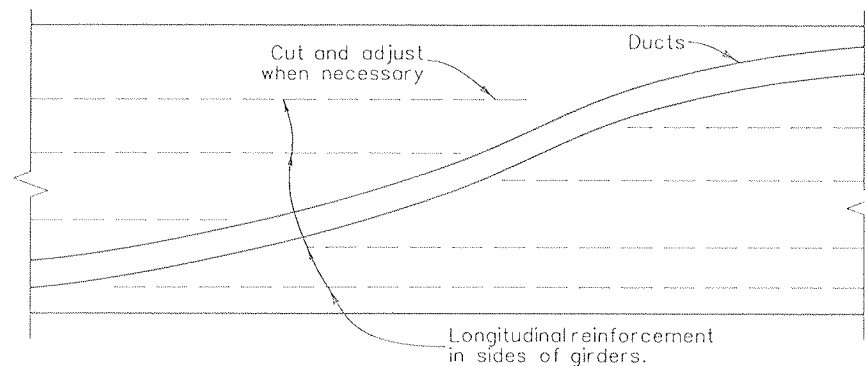

ADJUSTED GIRDER REINFORCING ELEVATION

Web Lengths

Web. No.	L1 (ft)	L2 (ft)
1	218.55	218.82
2	220.28	220.41
3	222.05	222.01

Web Lengths are Measured from ϕ Brg. to ϕ Pier.

NOTES:

Reinforcing that interferes with the prestressing tendon alignment shall be adjusted as approved by the Engineer.

Reinforcing shall be continuous through all construction joints.

Where dead end anchorage and tendons are accessible, the anchorage system and length of projecting prestressing steel shall permit jacking with the same jacking equipment that was used on the live end.

Deviations from the duct pattern, duct size, and strand size assumed in the design must be approved by the Engineer.

The deflection shown is positive downward. It includes the effects of dead load and prestressing, and the long term effects of creep. Formed web elevations must be adjusted upward for an indicated positive deflection.

Use stress relieved or low-relaxation strands meeting the requirements of ASTM A416 grade 270.

STRESSING SEQUENCE:

Tendons shall be jacked from both ends.

No more than $1/2$ of the prestressing force in any web may be stressed before an equal force is stressed in the adjacent webs. At no time during the stressing operations will more than $1/6$ of the total prestressing force be applied eccentrically about the centerline of the structure.

At the Contractors option, the prestressing force may vary $\pm 5\%$ from the theoretical force per web provided the total P(JACK) force is obtained and is distributed symmetrically about the centerline of the typical section. P(JACK) is the sum of the peak forces reached during jacking in each tendon.

DESIGN:


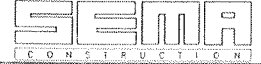

Design is based on $K=0.0002$ and $\mu=0.25$. P(JACK) at the jacking ends includes friction, anchor set of 0.375" at the jacking end, elastic shortening, and provisions for an additional 35 KSI long term loss in stress. Long term loss calculations based on ACI 209.



0.6" diameter low-relaxation strands with a "z" offset of 1" in $4\frac{3}{4}$ " O.D. ducts was assumed in the design.

- f'_s = 270 ksi
- f'_t = 4,500 psi at 28 days field compressive strength
- f'_{ci} = 4,250 psi at stressing
- P(JACK) = 10,282 kips
- Aps (min.) = 50.778 in²




The Contractor shall submit elongation and jacking calculations based on $KL + \mu\alpha$ (including anchor set if any) and initial stress (initial stress ratio times jacking stress before long term losses).

Design		Detail		Quantities	
INITIAL	DATE	INITIAL	DATE	INITIAL	DATE
AWL	10/08	RGA	10/08	AWL	10/08
DSD	10/08	DSD	10/08	SEMA	10/08
Designed By	Checked By	Detailed By	Checked By	Quantities By	Checked By


Print Date: 9/24/2010	Sheet Revisions			Colorado Department of Transportation  3803 North Main Avenue Suite 200 Durango, CO 81301 Phone: 970-385-1440 FAX: 970-385-8365 Region 5 EJA	As Constructed	RAMP A OVER US 160 CAST-IN-PLACE BOX GIRDER DETAILS (2 OF 4)		Project No./Code
File Name: 16042V_CIPPTBoxGirder_02.dgn	Date:	Comments:	Init.		No Revisions: 9/10			NH 1602-114
Horiz. Scale: 1:1 Vert. Scale: As Noted					Revised:	Designer: A. Leifheit	Structure: P-05-V	16042
Unit Information 0221 Unit Leader STW					Void:	Detailer: R. Artman	Sheet Subset: Bridge	Subset Sheets: B22 of 37
 								

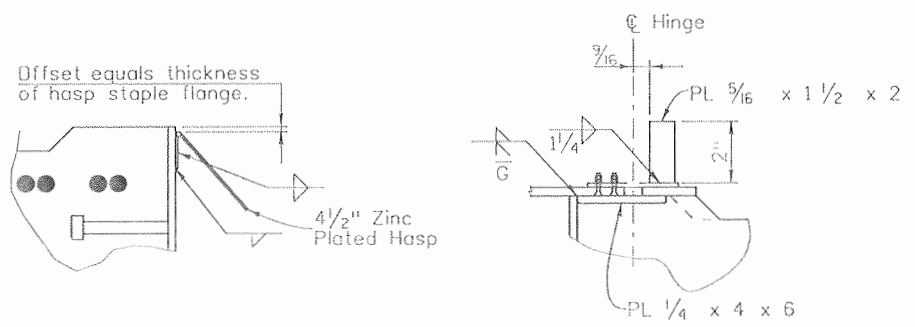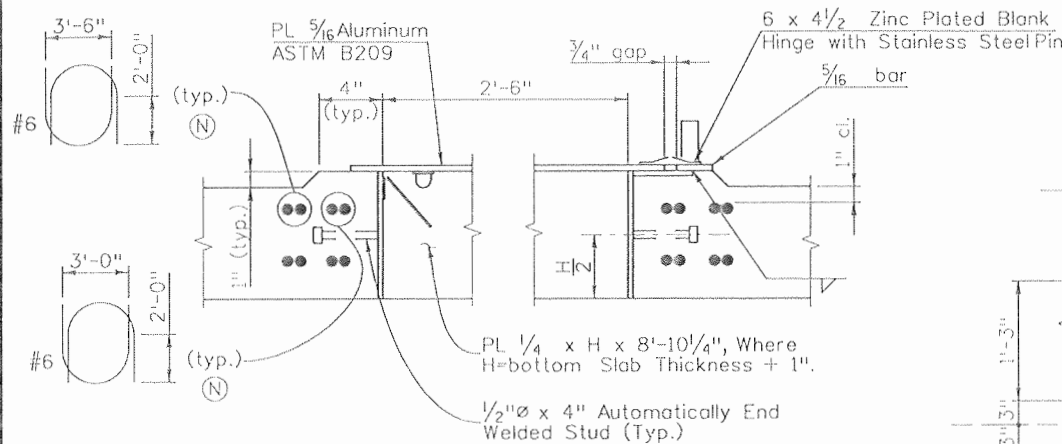

ACCESS DOOR DETAILS

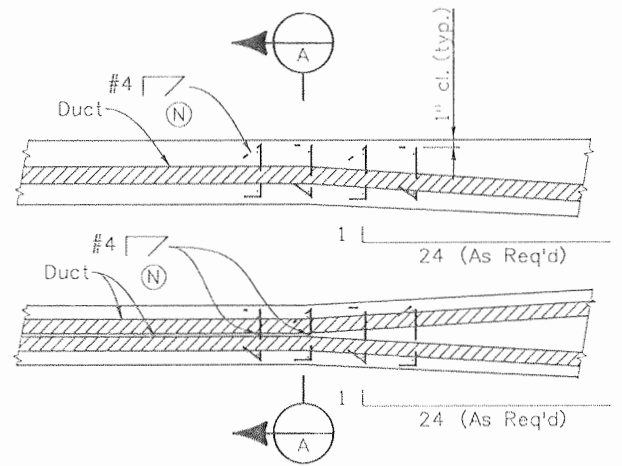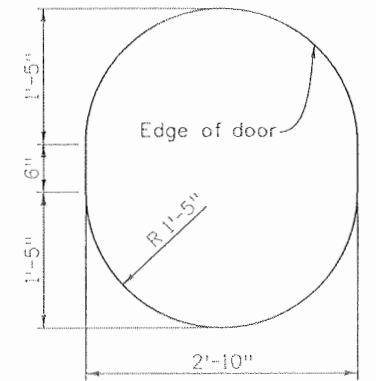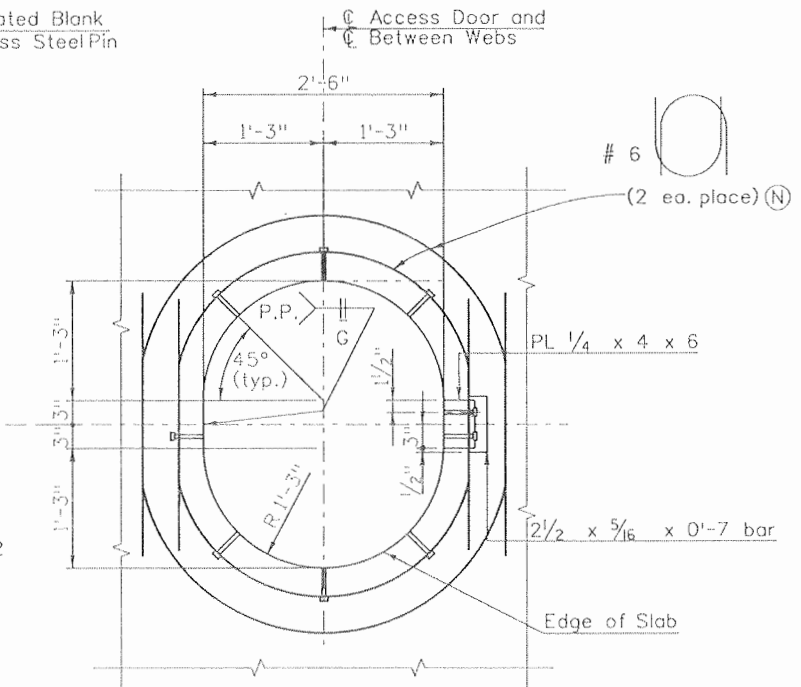

PLAN VIEW OF DUCTS AT GIRDER WEB FLARE

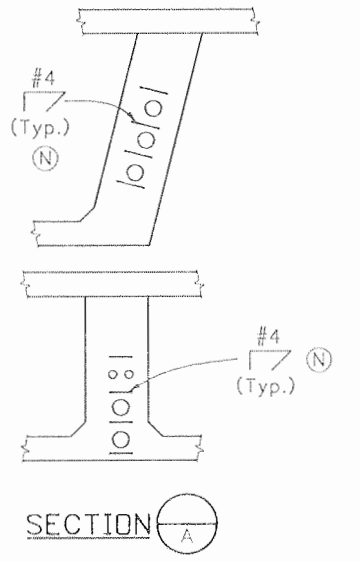


SECTION A-A


NOTES:

1. Provide minimum side clearance at outside edge of curve.
2. 4 3/4 inch O.D. duct has been assumed.
3. The pattern shown is what was assumed in design. The duct pattern may be modified by the supplier, provided that the specified C.G. of prestressing, prestressing force, and duct clearances are maintained.


Design	INITIAL	DATE	INITIAL	DATE	INITIAL	DATE
	AWL	10/08	DRA	10/08	AML	10/08
Checked By	DSD	10/08	DSG	10/08	LW	10/08
Quantities	By	Quantity	By	Quantity	By	Quantity

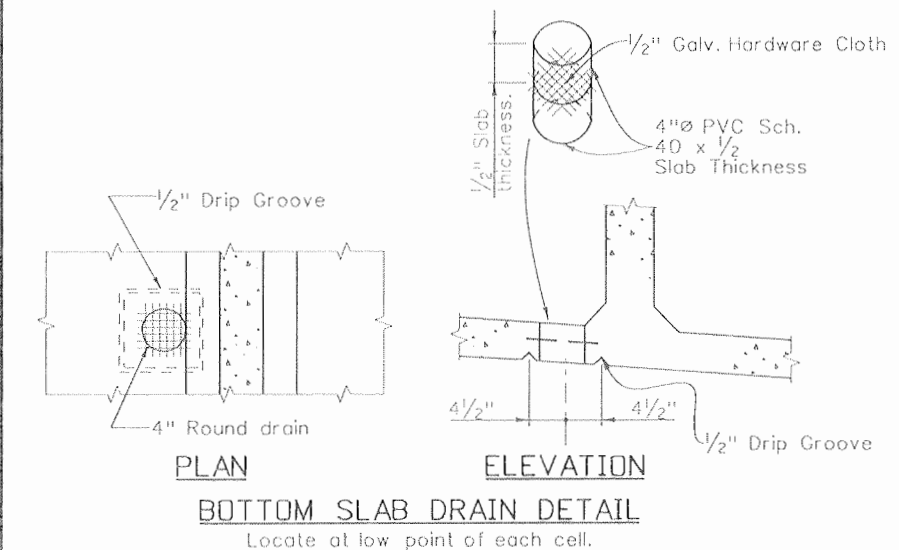

BOTTOM SLAB DRAIN DETAIL

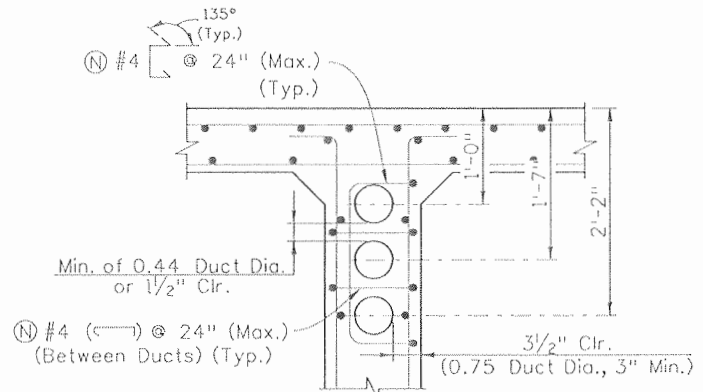

Typical Tendon High Point

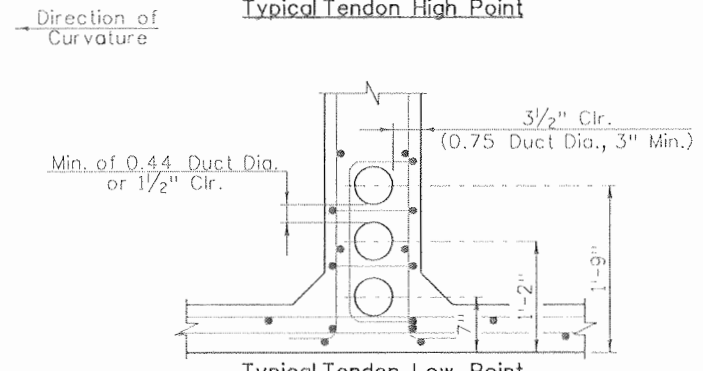

Typical Tendon Low Point

Hooks in #4 Duct Ties (r) point Down Station.
Hooks in #4 Duct Stirrups (r) point Up Station.

CLEARANCE REQUIREMENTS FOR DUCTS

Print Date: 9/24/2010	File Name: 16042V_CIPPTBoxGirder_03.dgn
Horiz. Scale: 1:1	Vert. Scale: As Noted
Unit Information: 0221	Unit Leader: STW
SEMA CONSTRUCTION	WILSON & COMPANY

Sheet Revisions		
Date:	Comments	Init.

Colorado Department of Transportation


3803 North Main Avenue
Suite 200
Durango, CO 81301
Phone: 970-385-1440 FAX: 970-385-8365

Region 5 EJA

As Constructed	No Revisions: 9/10
Revised:	
Void:	


RAMP A OVER US 160 CAST-IN-PLACE BOX GIRDER DETAILS (3 OF 4)	
Designer: A. Leifheit	Structure: P-05-V
Detailer: D. Anderson	Numbers:
Sheet Subset: Bridge	Subset Sheets: B23 of 37

Project No./Code	NH 1602-114
	16042
Sheet Number	252

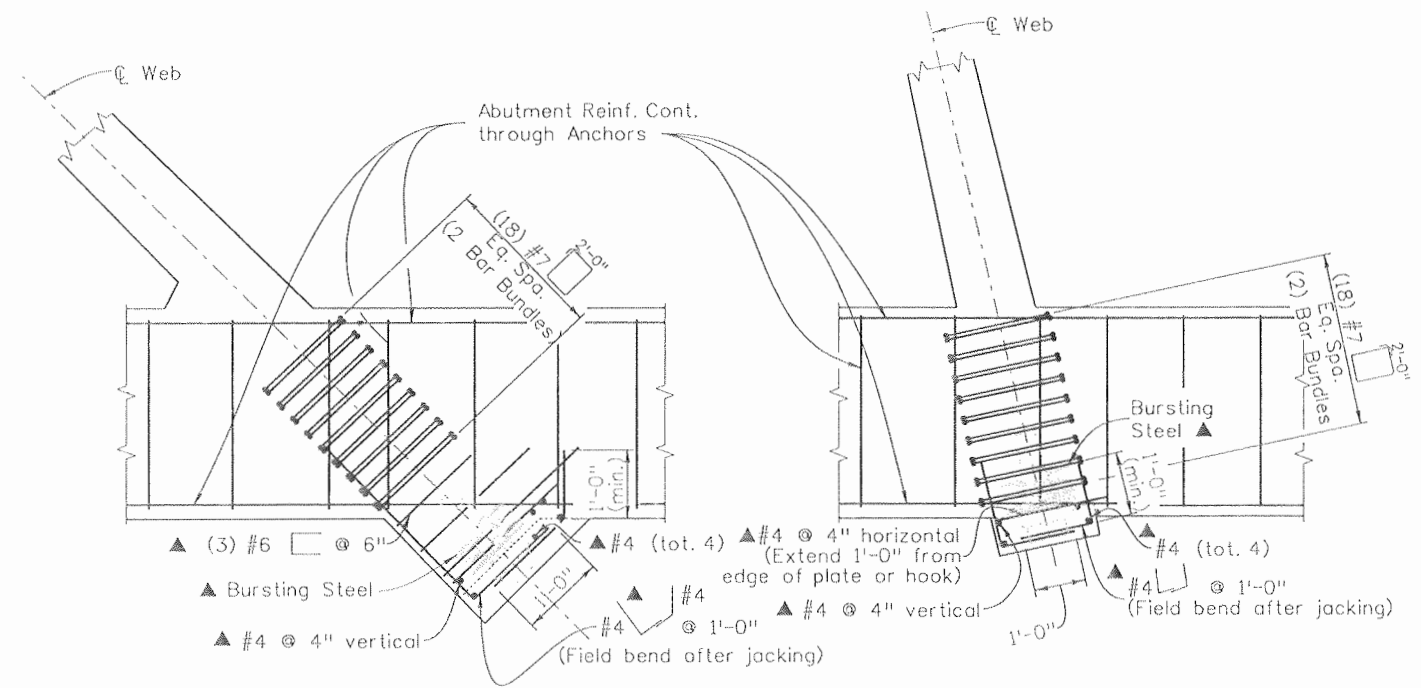

SKEW OVER 20° PLAN VIEW SKEW 20° & UNDER

SEAT FOR PRESTRESSED ANCHORAGE AT ABUTMENTS

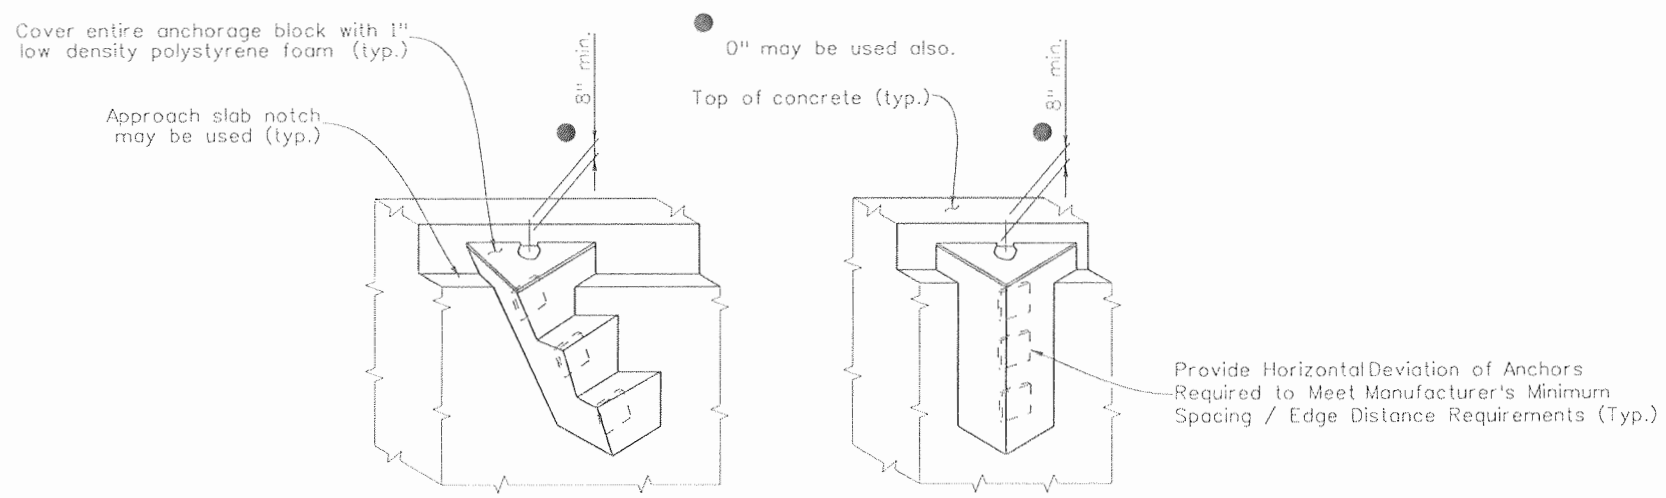

EXT. SLOPING WEB VERTICAL WEB TYPICAL ANCHORAGE ILLUSTRATIONS

NOTES:

There shall be no construction joints under post-tensioning anchorages.
 A tendon's jacking force shall not exceed 1186 kips.
 The following anchorages will be allowed:
 1. DSI Multi-Plane MA Anchorages
 2. SDI Multistrand Anchorage
 3. VSL Type E

Composite (a combination of metalcasting and mortar) anchorages shall not be allowed.
 All Anchorages shall be of the same type and Manufacturer.

Each anchorage shall be confined within a reinforcing steelspiral (bursting steel) and spalling reinforcement. Spalling reinforcement shall consist of #4 @ 4" vertically and horizontally placed in front of the bearing plate. Bursting and spalling reinforcement shall be Grade 60 conforming to the requirements of Section 602, and need not be epoxy coated. Lap splicing of spiral reinforcement is not allowed.

Anchorages and reinforcing steelspirals shall be covered with concrete to provide a minimum of 4 inches of concrete cover. All other reinforcing shall have a minimum of 2" concrete cover.

The minimum distance between the centerline of anchorages shall be as tested and recommended by the manufacturer.

The distance from the edge of bearing plate/ spiral to edge/corner of concrete shall be a minimum of 4", or as tested and recommended by the manufacturer.

All reinforcing steel designated ▲, and additional concrete required in flares not included in explicit details will not be measured and paid for separately but shall be included in Item 618.






See abutment and superstructure details for dimensions and reinforcing steel not shown.

Shop drawings shall be prepared under the supervision (and contain the seal) of a Professional Engineer registered in the State of Colorado and in accordance with the requirements of subsection 618.04 (a) and (c).
 Shop drawings shall provide:

1. Bearing plate and spiral steel sizes
2. Reinforcing steel bending diagrams for all rebar designated ▲
3. Coordination of anchorages and anchorage reinforcing with other superstructure rebar
4. All dimensions necessary to form concrete recesses or blisters, and all reinforcing steel designated ▲ in accordance with subsection 618.04(c)(6) and (7).
5. Horizontal and vertical dimensions to place anchorages and ducts.

Design	INITIAL	DATE	Checked By	Date	Checked By	Date	Checked By
	AWL	10/08					
Detail	INITIAL	DATE	Checked By	Date	Checked By	Date	Checked By
	DRA	10/08					
Quantities	INITIAL	DATE	Checked By	Date	Checked By	Date	Checked By
	AWL	10/08					

Print Date: 9/24/2010	Sheet Revisions			Colorado Department of Transportation 3803 North Main Avenue Suite 200 Durango, CO 81301 Phone: 970-385-1440 FAX: 970-385-8365 Region 5	As Constructed	RAMP A OVER US 160 CAST-IN-PLACE POST-TENSIONED BOX-GIRDER (4 OF 4)		Project No./Code
File Name: 16042V_CIPPTBoxGirder_04.dgn	Date:	Comments	Init.		No Revisions: 9/10	Designer: A. Leifheit	Structure Numbers	P-05-V
Horiz. Scale: 1:1				DOT DEPARTMENT OF TRANSPORTATION	Revised:	Detailer: D. Anderson		16042
Unit Information 0221					Void:	Sheet Subset: Bridge	Subset Sheets: B24 of 37	Sheet Number

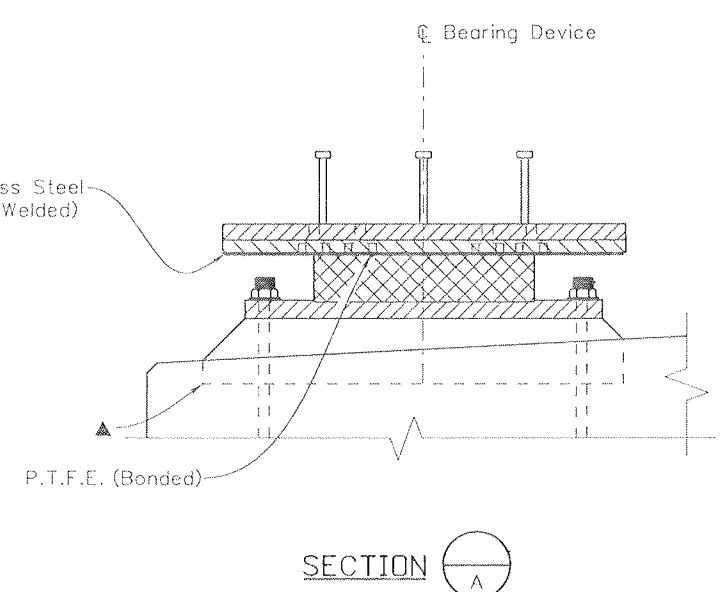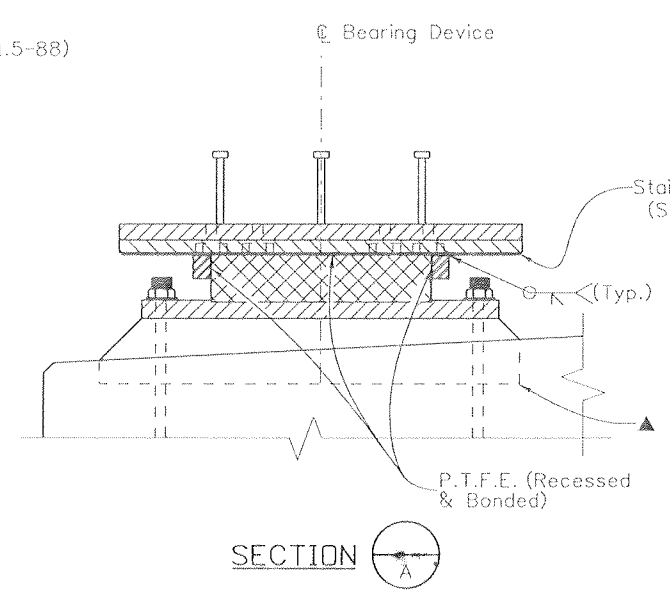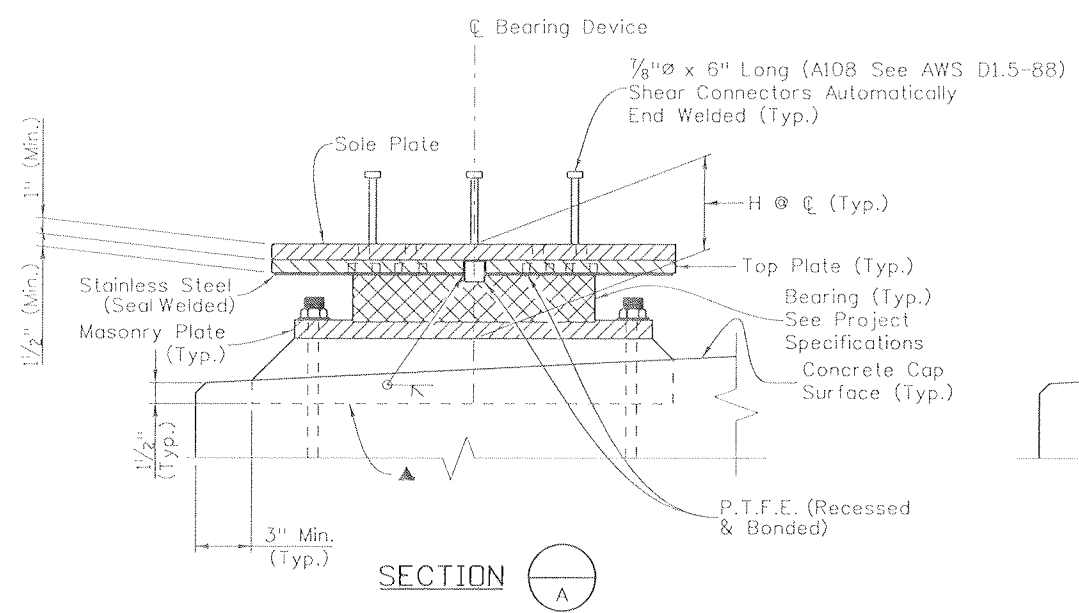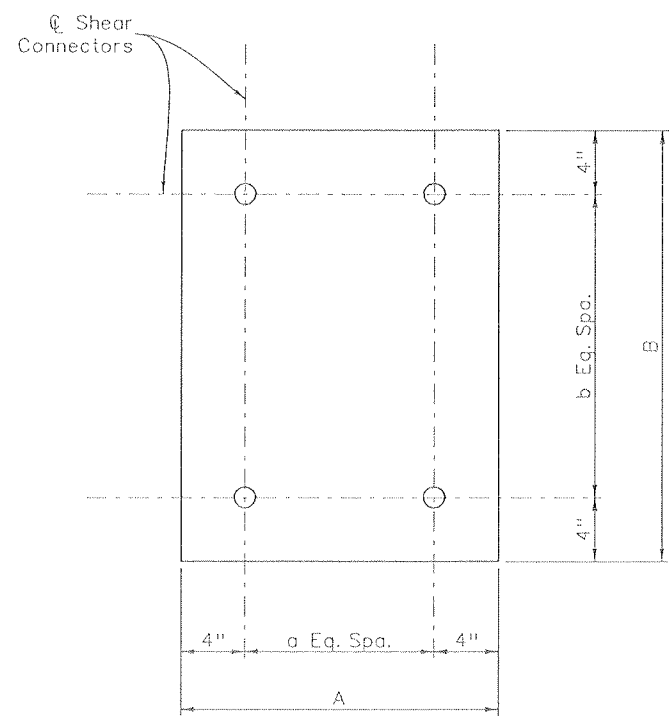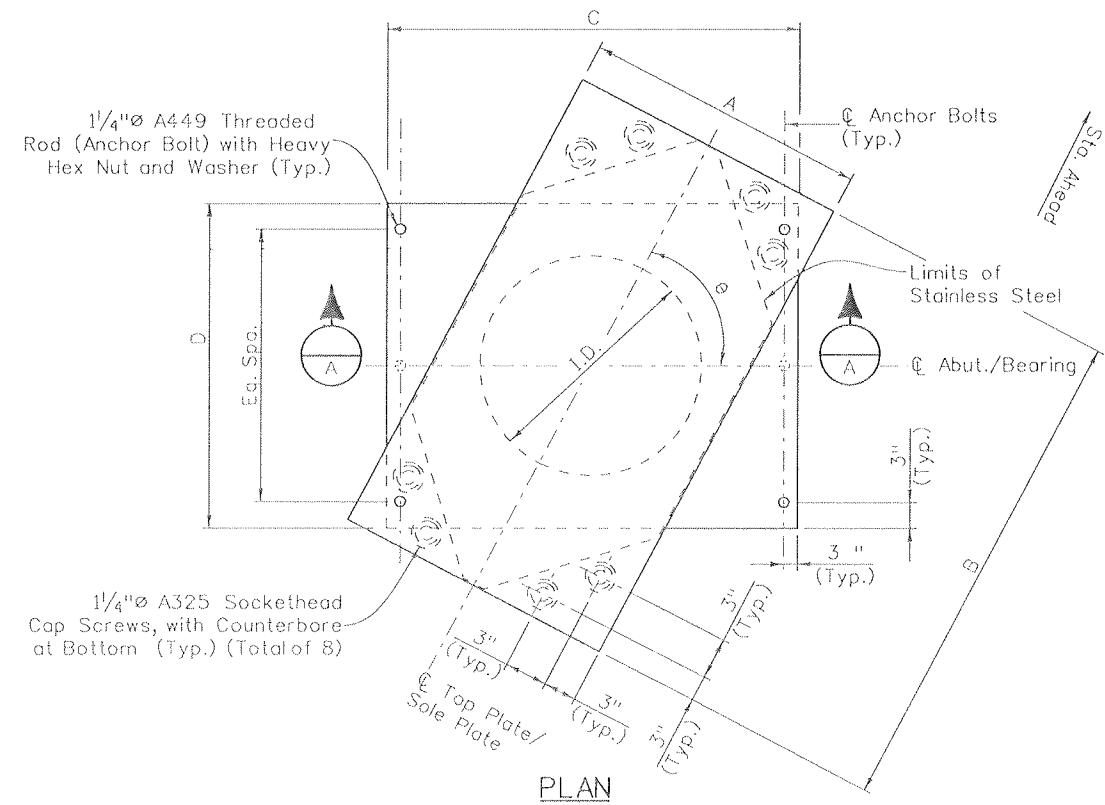

▲ Use non-shrink approved grout in formed cavity or see Detail "A" for alternate built-up monolithic cap seat.

Design		Detail		Quantities	
INITIAL	DATE	INITIAL	DATE	INITIAL	DATE
Designed By	12/08	KCT	12/08	Quantities By	BJA
Checked By	12/08	TWM	12/08	Checked By	LW

Print Date: 9/24/2010

File Name: 16042V_BrdgBrgDeviceType3_01.dgn

Horiz. Scale: 1:1 Vert. Scale: As Noted

Unit Information 0221 Unit Leader STW

SEMA CONSTRUCTION

WILSON & COMPANY

Sheet Revisions		
Date:	Comments	Init.

Colorado Department of Transportation

3803 North Main Avenue
Suite 200
Durango, CO 81301
Phone: 970-385-1440 FAX: 970-385-8365


DOT DEPARTMENT OF TRANSPORTATION

Region 5 EJA


As Constructed	
No Revisions:	9/10
Revised:	
Void:	

RAMP A OVER US 160 BEARING DEVICE TYPE III (1 OF 2)			
Designer:	B. Allen	Structure Numbers	P-05-V
Detailer:	K. Tucker		
Sheet Subset:	Bridge	Subset Sheets:	B25 of 37


Project No./Code	
NH 1602-114	
16042	
Sheet Number	254

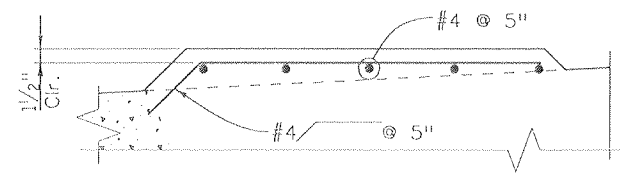


DETAIL "A"
(Optional)

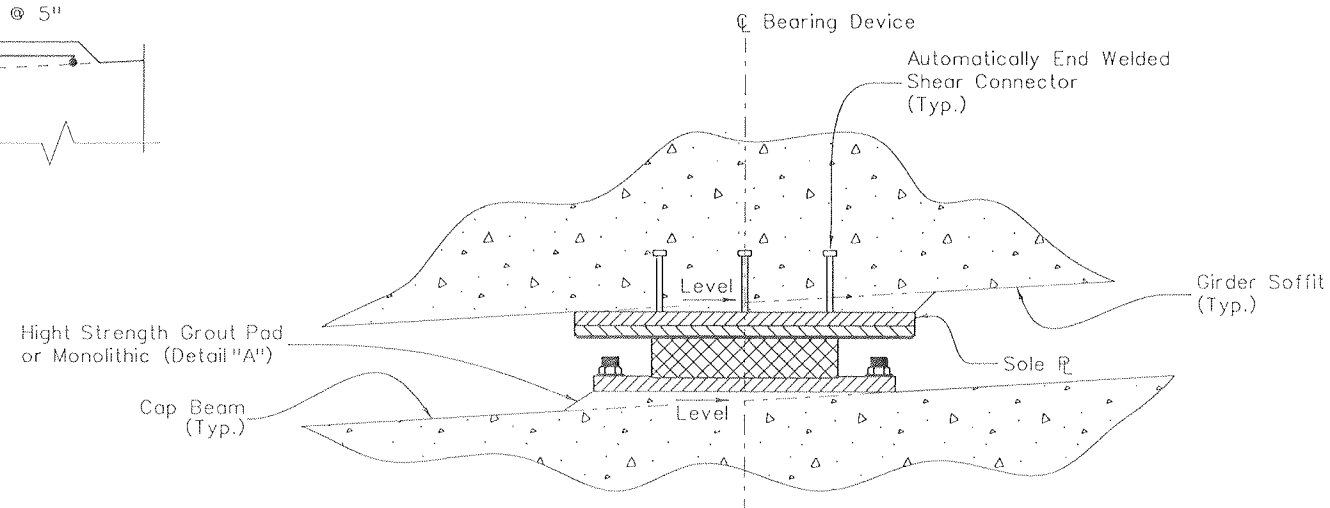

**BEARING DEVICE TYPE III
CONCRETE GIRDER CONNECTION**

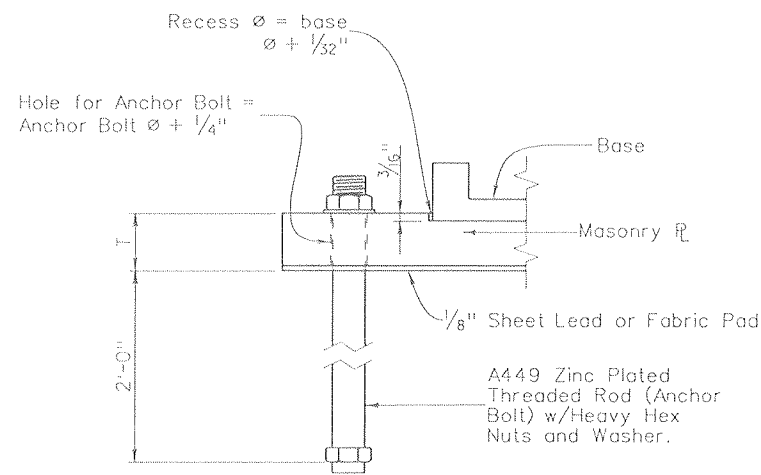

ANCHOR BOLT DETAIL

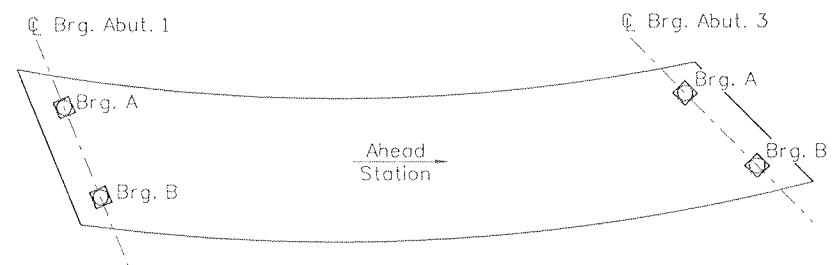

**BEARING
KEY PLAN**

NOTES:

All structure steel for the bearing devices, including sole plates, top plates, and masonry plates, shall be AASHTO M270 Grade 36 (ASTM A709 or A572) unless otherwise shown. Grade 50 may be substituted at no additional cost to the project.

Bearing seat elevations at abutments and piers shall be checked and adjusted according to the final dimensions of bearing assemblies adopted.

Longitudinal structure movement due to temperature and shrinkage is based on a mid-range temperature of 50°F. If site temperature is not 50°, a longitudinal offset of top elements of the bearing (above sliding surface) shall be made in the field based on the 10° temperature increment in the table. In addition, longitudinal one way structure movement due to prestress shortening and creep shall be accommodated for all temperature ranges with the initial offset in the table away from Pier 2.

Anchor bolts may be set in wet concrete of bearing seat, or placed within a formed cylindrical void 4" in diameter and then grouted with high strength epoxy grout.

Adjust diaphragm reinforcing 1/2" max. as required to clear shear connectors.

The internal surfaces of the pot cavity and the bottom surface of the piston shall be polished after zinc metalizing.

Rotations accounting for fabrication and construction tolerances have not been included in the charts. Additional rotations of 0.01 radians (pot bearings) or 0.005 radians (disk bearings) shall be provided in addition to the design rotations shown in the chart.

The longitudinal structure movement, is the total movement of the structure at that location.

Expansion bearing plates (Gd, Exp) resized by the bearing manufacturer shall include a 2" construction tolerance for dimension B.

The inside diameter of the pot (ID) was based on an average compression stress of 3 ksi at the Service Limit State. Pot or disk bearings shall be resized by the manufacturer per the AASHTO LRFD Bridge Design Specifications and the Project Specifications. Plates shall be resized to conform to the forces, deformations, and manufacturers ID.

Fx = Fixed bearing
Gd = Guided expansion bearing
Exp = Non-guided (free floating) expansion bearing
PTFE = Polytetrafluoroethylene

ACCEPTABLE ALTERNATIVES

D. S. Brown Company
North Baltimore, Ohio

Cosmec, Inc.
Walpole, MA


Con-Serv, Inc.
Georgetown, SC

R. J. Watson, Inc.
Amherst, NY
(Disk Bearing Alternate)

Location	Quant.	Type	Vertical Load Per Brg. (kips)		Horizontal Load Per Brg. (kips) (Strength)		Longit. Range of Structure Movement (in)	Max. Rotation		Top Plate (Sole Plate Similar)		Bearing ID (in)	Masonry Plate			Top Connection (Anchor Studs)		a No.	b No.	A449 Anchor Bolts		Total Height H (in)	Guide Angle Ø (deg)	10° Temp. Incr. (in)	Initial Offset (in)
			Service	Strength	Trans.	Long.		Service (rad)	Strength (rad)	A (in)	B (in)		C (in)	D (in)	T (in)	No.	Size (in)			No.	Size (in)				
Abut. 1	A	1	EXP.	540	690	0	0	3.25	0.0102	0.0145	17.5	26.0	15.375	24.0	24.0	1.5	8	1	3	4	1.50	8.50	49.0	0.16	1.75
Abut. 1	B	1	GD.	980	1350	295	0	3.25	0.0102	0.0145	30.5	33.5	20.625	35.0	27.0	2.0	18	2	5	6	1.50	11.25	49.0	0.16	1.75
Abut. 3	A	1	EXP.	740	1100	0	0	3.25	0.0140	0.0186	19.75	28.5	17.875	28.5	28.5	1.625	10	1	4	4	1.50	9.25	37.0	0.16	1.75
Abut. 3	B	1	GD.	760	920	295	0	3.25	0.0140	0.0186	25.75	31.5	18.5	33.0	25.0	1.875	18	2	5	6	1.50	10.50	37.0	0.16	1.75

Design	INITIAL	DATE	Checked By
	BJA	12/08	
	TWM	12/08	
	Checked By	Checked By	
Detail	INITIAL	DATE	Checked By
	KCT	12/08	
	TWM	12/08	
	Checked By	Checked By	
Quantities	INITIAL	DATE	Checked By
	BJA	12/08	
	TWM	12/08	
	Checked By	Checked By	

Print Date: 9/24/2010		Sheet Revisions Date: Comments Init.			Colorado Department of Transportation 3803 North Main Avenue Suite 200 Durango, CO 81301 Phone: 970-385-1440 FAX: 970-385-8365 Region 5 EJA	As Constructed No Revisions: 9/10		RAMP A OVER US 160 BEARING DEVICE TYPE III (2 OF 2)				Project No./Code NH 1602-114	
File Name: 16042V_BrdgBrgDeviceType3_02.dgn						Revised:	Designer: B. Allen	Structure	P-05-V	16042			
Horiz. Scale: 1:1 Vert. Scale: As Noted						Void:	Detailer: K. Tucker	Numbers					
Unit Information 0221 Unit Leader STW							Sheet Subset: Bridge	Subset Sheets: B26 of 37		Sheet Number 255			

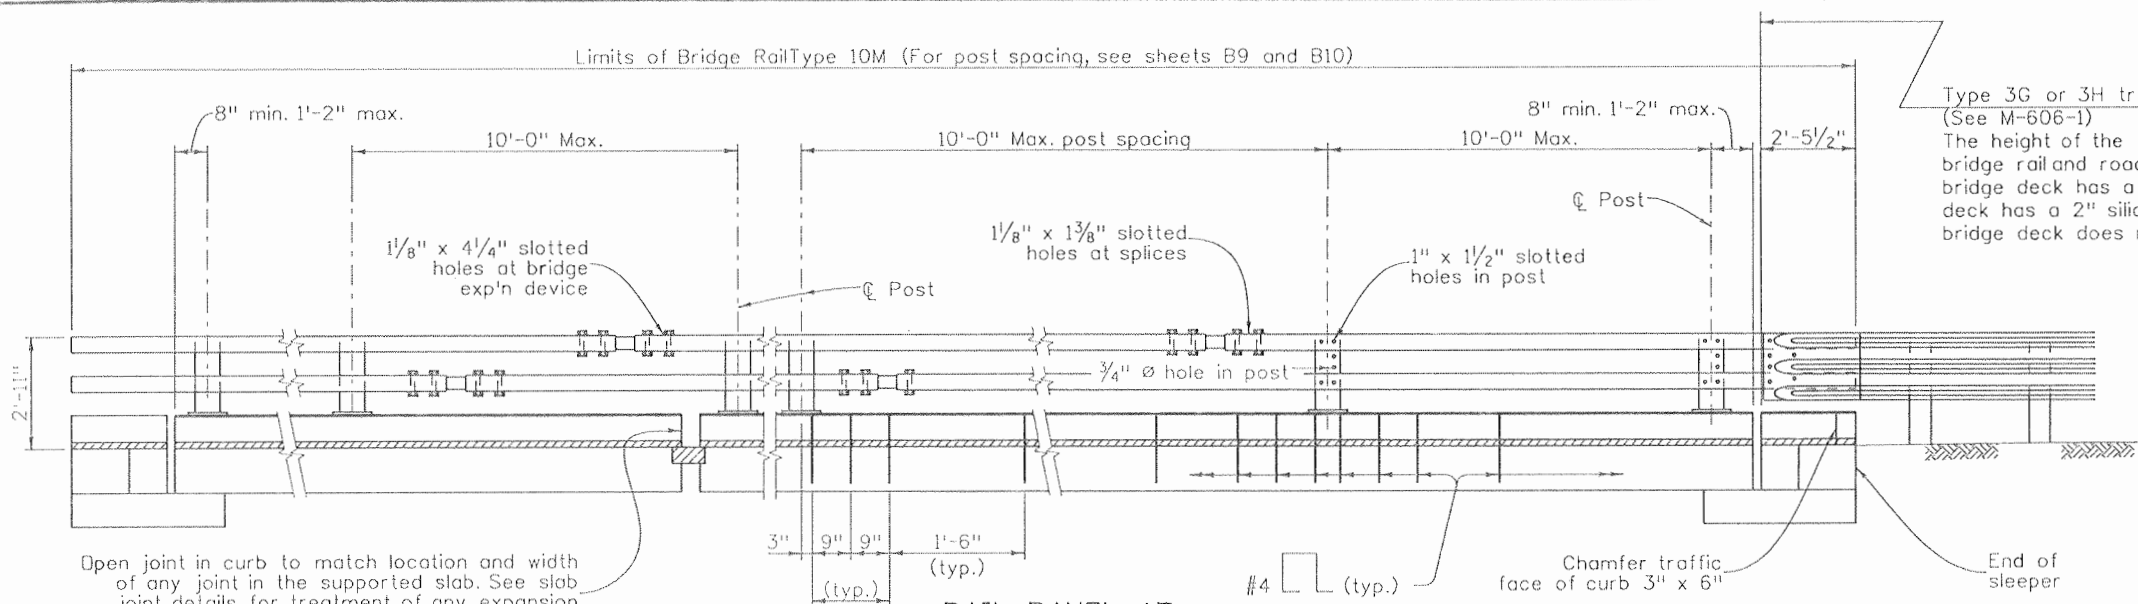

NOTES:

- All tubes shall be ASTM A-847. (U.N.D.)
All steel shall be ASTM A-588 Grade 50.
- All anchor bolts and miscellaneous bolts, nuts, and washers shall be galvanized after fabrication in accordance with Section 509. Concrete, reinforcing steel, and structural steel elements shall conform to the requirements of sections 601, 602 and 509, respectively.
- Post anchor, encased in concrete, shall be ASTM A-36 (AASHTO M-183) steel and need not be galvanized.
- The tubes shall be shop bent or fabricated to fit horizontal curve when radius is less than 1,500 feet.
- Tubes shall be continuous over not less than two posts. No welded butt splices will be allowed in the tube sections.
- The centerline of the tube splice shall be 1'-8" minimum and 2'-6" maximum from the centerline of the posts.
- All bolts that have lock washers shall be tightened to snug only.
- Posts shall be perpendicular to the longitudinal roadway grade.
- One or more 10'-0" post spacings may be reduced (6'-8" min.) in order to maintain dimensions from the end of the rail and expansion joints.
- Prior to fabrication of this item, three sets of working drawings which comply with the requirements of section 105, shall be submitted to the Engineer for information only.
- Structural Steel:
AASHTO M-222 (ASTM A-588) GRADE 50 $f_y = 50,000$ psi
COLD FORMED ASTM A-847 $f_y = 46,000$ psi
- For additional details see next rail sheets.
- At bridge ends without Approach Slabs, terminate tube at nearest splice. Continue post spacing to end of structure.
- Coordinate location of anti-icing equipment and conduits with bridge rail reinforcing and hardware. Move conduit or equipment if a conflict exists.
- Refer to Anti-Icing Drawings for additional reinforcing and concrete insert requirements.

RAIL PANEL AT TERMINAL SECTION


(See Roadway plans for ends not attached to Guard Rail.)

RAIL PANEL AT EXPANSION DEVICE


ELEVATION - BRIDGE RAIL

RAIL PANEL AT TRANSITION SECTION


(See roadway plans for ends requiring attachment to guard rail.)

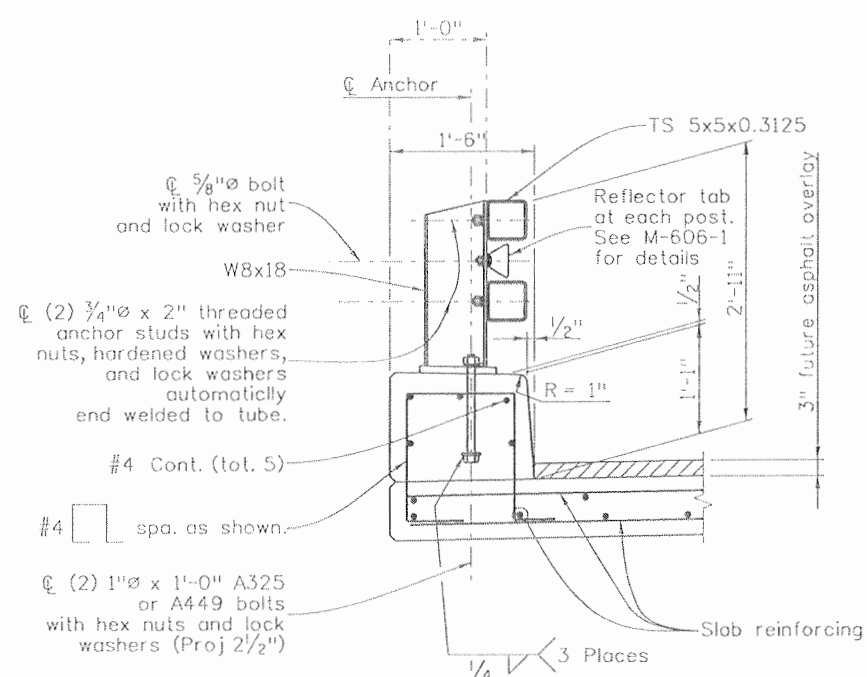


SECTION

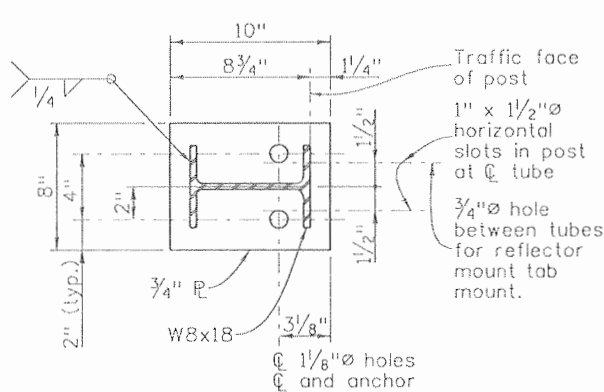


PLAN - POST DETAIL

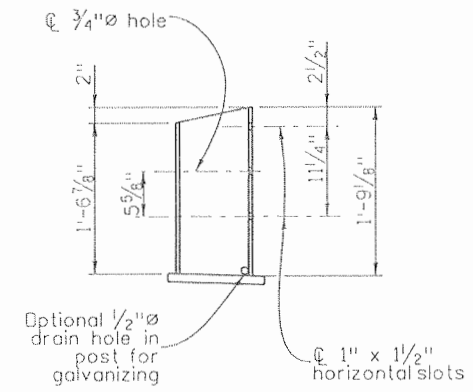

ELEVATION

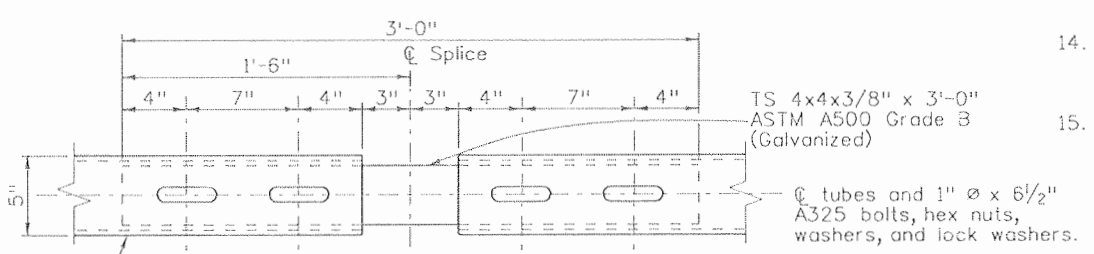

PLAN - TUBE SPLICE

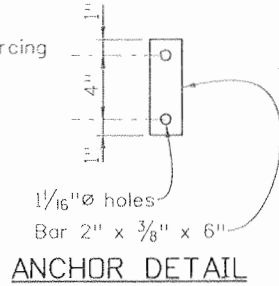


ANCHOR DETAIL


INFORMATION ONLY

DESCRIPTION	UNIT	PER LIN. FT.
Structural Steel	LB.	45.1
Concrete Class D (Bridge)	CU.YD.	0.06
Reinforcing Steel (Epoxy Coated)	LB.	6.6

Design	Initial		Date		Checked By		Checked By	
	BJA	DSD	11/08	11/08	BJA	DSD	LW	11/08
Designed By	BJA	DSD	11/08	11/08	BJA	DSD	LW	11/08
Checked By	BJA	DSD	11/08	11/08	BJA	DSD	LW	11/08


Print Date: 9/24/2010	Sheet Revisions			Colorado Department of Transportation 3803 North Main Avenue Suite 200 Durango, CO 81301 Phone: 970-385-1440 FAX: 970-385-8365	As Constructed		RAMP A OVER US 160 BRIDGE RAIL TYPE 10M (SPECIAL) (1 OF 2)		Project No./Code
File Name: 16042V_BridgeRailType10M_01.dgn	Date:	Comments:	Init.		No Revisions: 9/10			NH 1602-114	
Horiz. Scale: 1:1				Region 5	Revised:	Designer: B. Allen		Structure	P-05-V
Unit Information 0221					Void:	Detailer: D. Anderson		Numbers	
Unit Leader STW					Sheet Subset: Bridge		Subset Sheets: B27 of 37	Sheet Number 256	

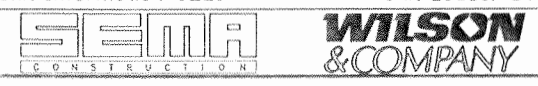

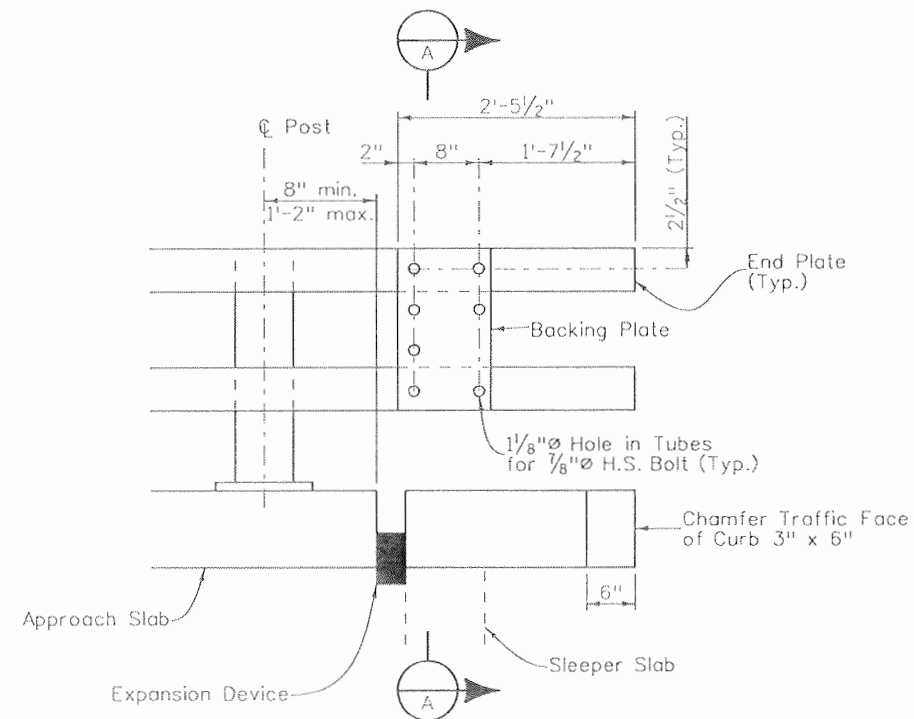


RAIL TUBE DETAILS

(Third beam not shown)
(Req'd at approach slab ends only)

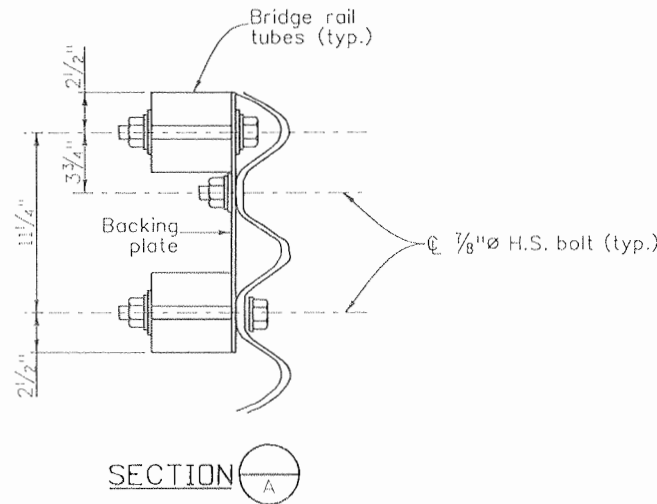


SECTION A

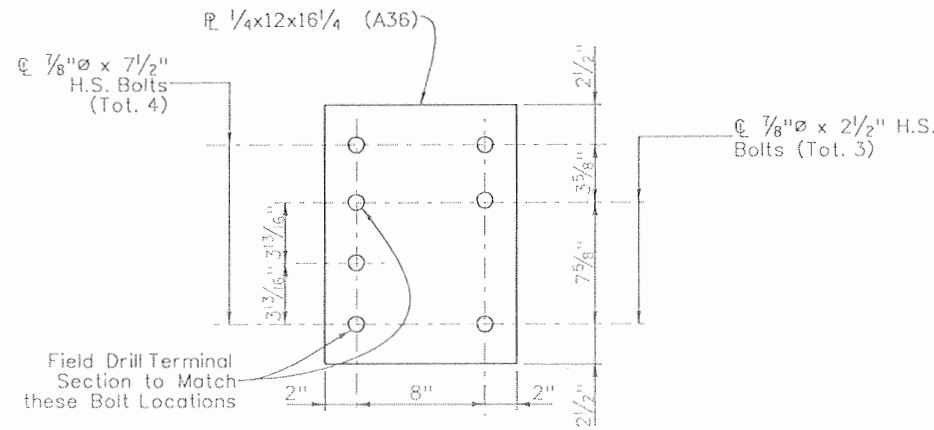


BACKING PLATE


Holes are 1/8" for 7/8" H. S. bolts with hex nuts, 2 PL washers, and 1 lock washer

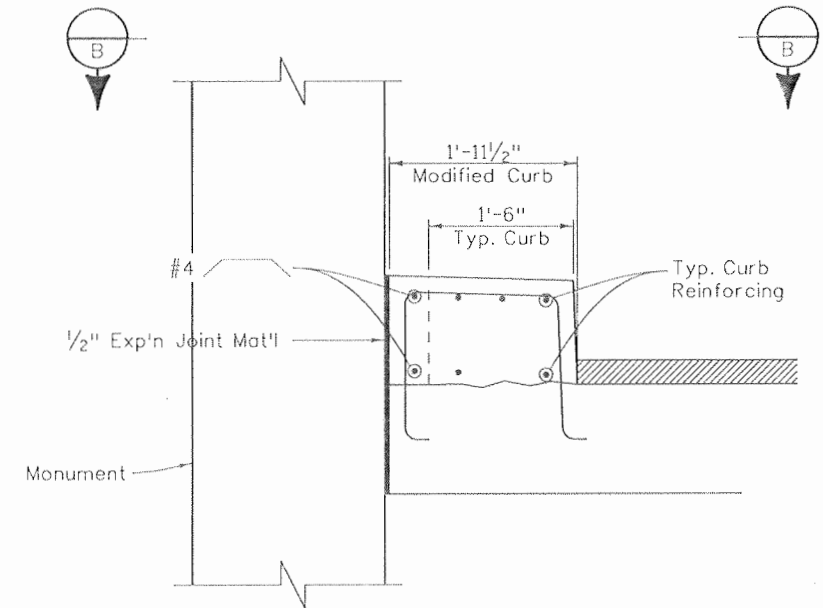

CURB MODIFICATION DETAIL

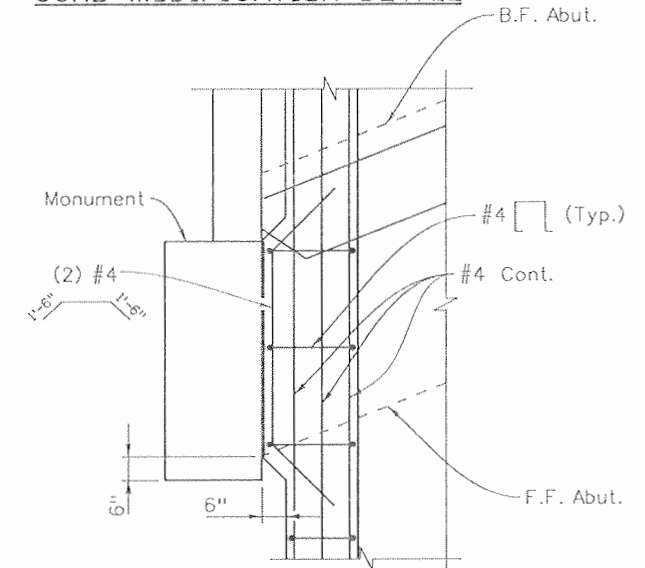


SECTION B

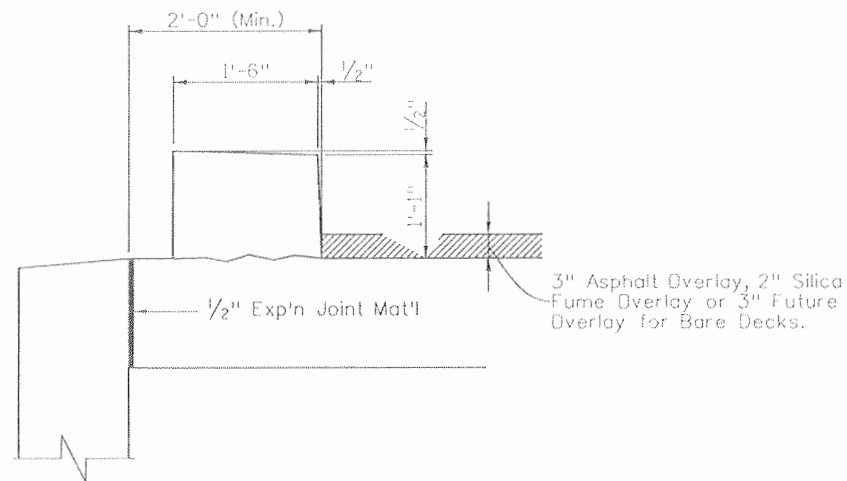

SECTION


(Use when curb is to be placed on approach slab.)
(Approach slab location only)

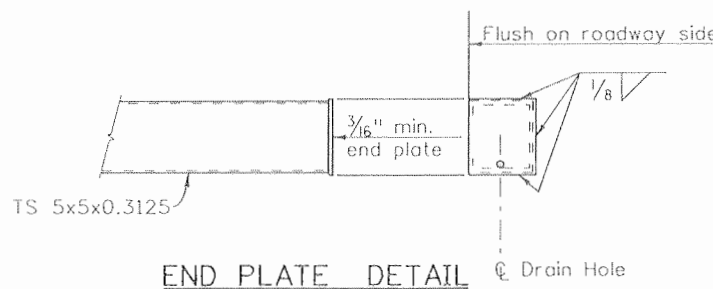

END PLATE DETAIL


Design	Initial		Date		Checked By		Quantity	
	By	By	By	By	By	By	By	By
Designed By	BJA	BJA	11/08	11/08	Checked By	BJA	Checked By	LW
Checked By	DSD	DSD	11/08	11/08	Checked By	DSD	Checked By	LW

Print Date: 9/24/2010	Sheet Revisions			Colorado Department of Transportation	As Constructed	RAMP A OVER US 160		Project No./Code
File Name: 16042V_BridgeRailType10M_02.dgn	Date:	Comments:	Init.:			No Revisions: 9/10	BRIDGE RAIL TYPE 10M (SPECIAL)	
Horiz. Scale: 1:1				3803 North Main Avenue Suite 200 Durango, CO 81301 Phone: 970-385-1440 FAX: 970-385-8365	Revised:	Designer: B. Allen	Structure: P-05-V	16042
Unit Information 0221					Void:	Detailer: D. Anderson	Numbers:	
Unit Leader STW				Region 5		Sheet Subset: Bridge	Subset Sheets: B28 of 37	Sheet Number 257

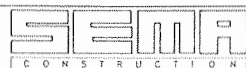


Region 5

EJA

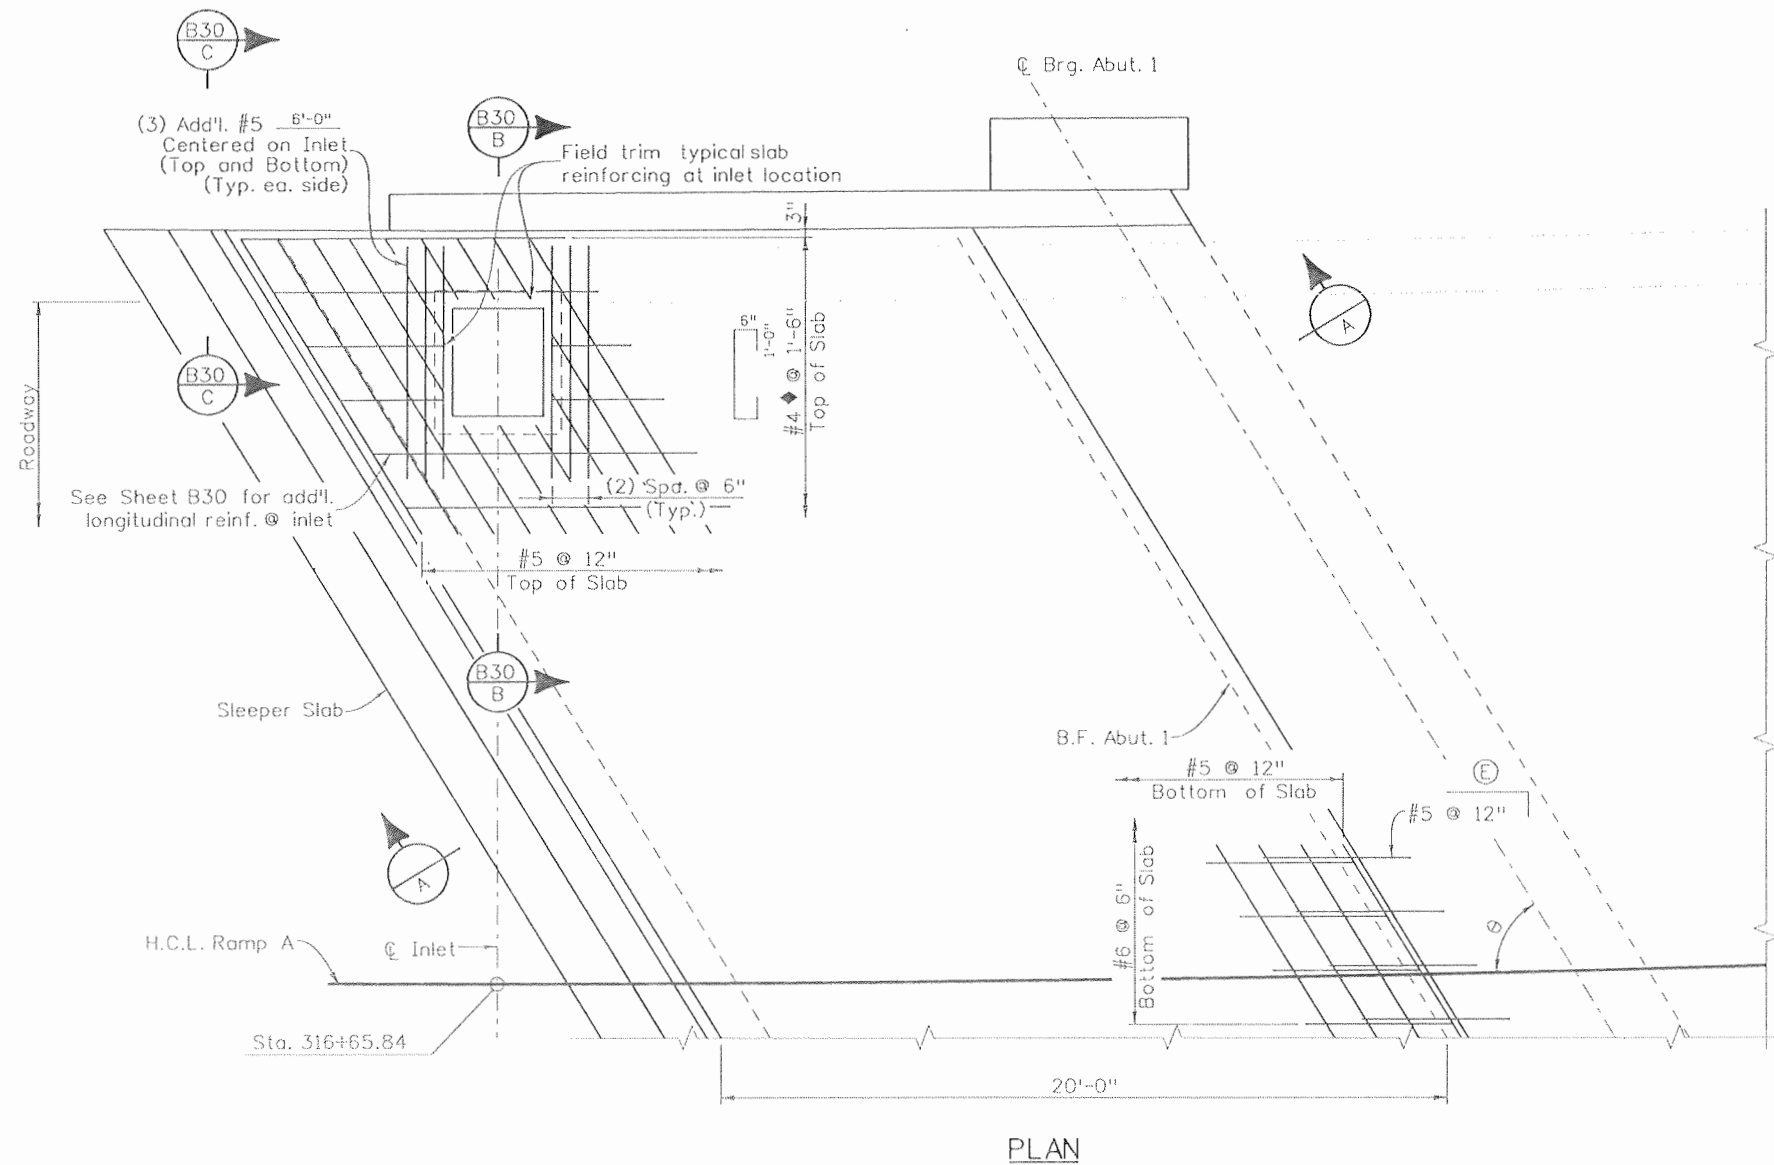


PLAN

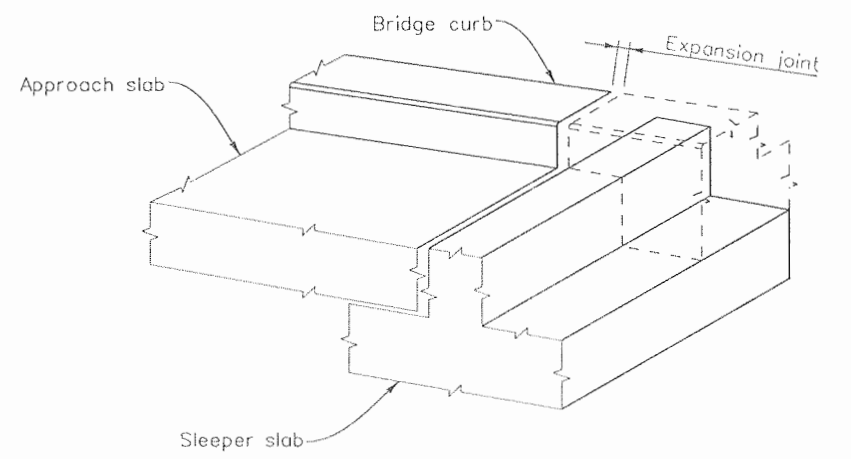


ISOMETRIC VIEW TYPE 10 RAILS

NOTES:

1. Concrete Class D (Bridge) shall be used for approach slabs.
2. Approach slab concrete shall be cured in accordance with the Specifications for Bridge Deck Concrete in Subsection 601.
3. 1/2" expansion joint material shall meet AASHTO Specification M213.
4. For expansion device details, see sheet B31 and B32.
5. For curb and rail details, see sheet B27 and B28.
6. The top surface of the post-tensioning block, if any, shall be covered with 1" of low density polystyrene foam. See sheet B24.
7. Approach slab and sleeper slab are required at Abutment 1 only. Provisions for a future approach slab shall be made at Abutment 3.
8. Approach slab reinforcing is non-epoxy coated unless noted otherwise.

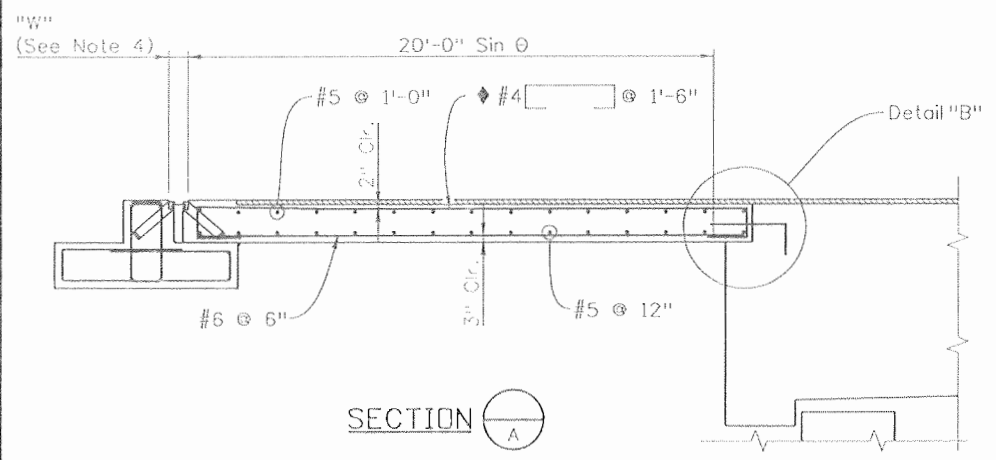

SECTION A-A

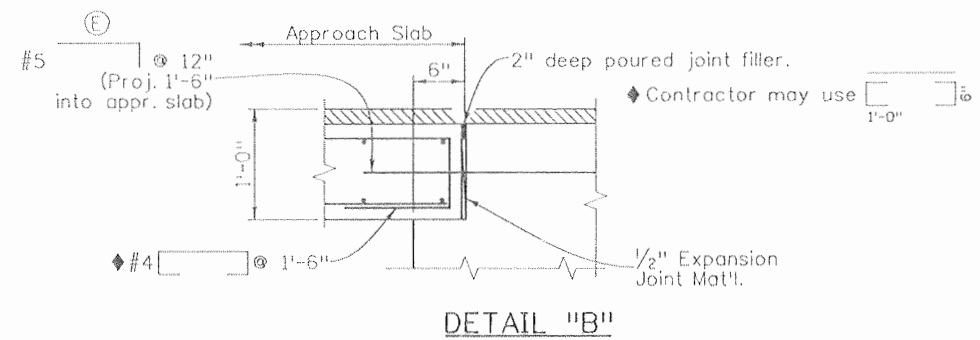


DETAIL "B"


Design		Detail		Quantities	
INITIAL	DATE	INITIAL	DATE	INITIAL	DATE
TRJ	11/08	TRJ	11/08	TRJ	11/08
Designed By		Detailled By		Quantities By	
Checked By	BJA	Checked By	BJA	Checked By	LW

Print Date: 9/24/2010	Sheet Revisions			Colorado Department of Transportation 3803 North Main Avenue Suite 200 Durango, CO 81301 Phone: 970-385-1440 FAX: 970-385-8365	As Constructed No Revisions: 9/10	RAMP A OVER US 160 APPROACH SLAB DETAILS (1 OF 2)		Project No./Code
File Name: 16042V_ApproachSlabDet_01.dgn	Date:	Comments:	Init.:			NH 1602-114		
Horiz. Scale: 1:1					Revised:	Designer: T. Johnson	Structure: P-05-V	16042
Unit Information: 0221						Region 5	EJA	Void:
Unit Leader: STW								Sheet Number: 258



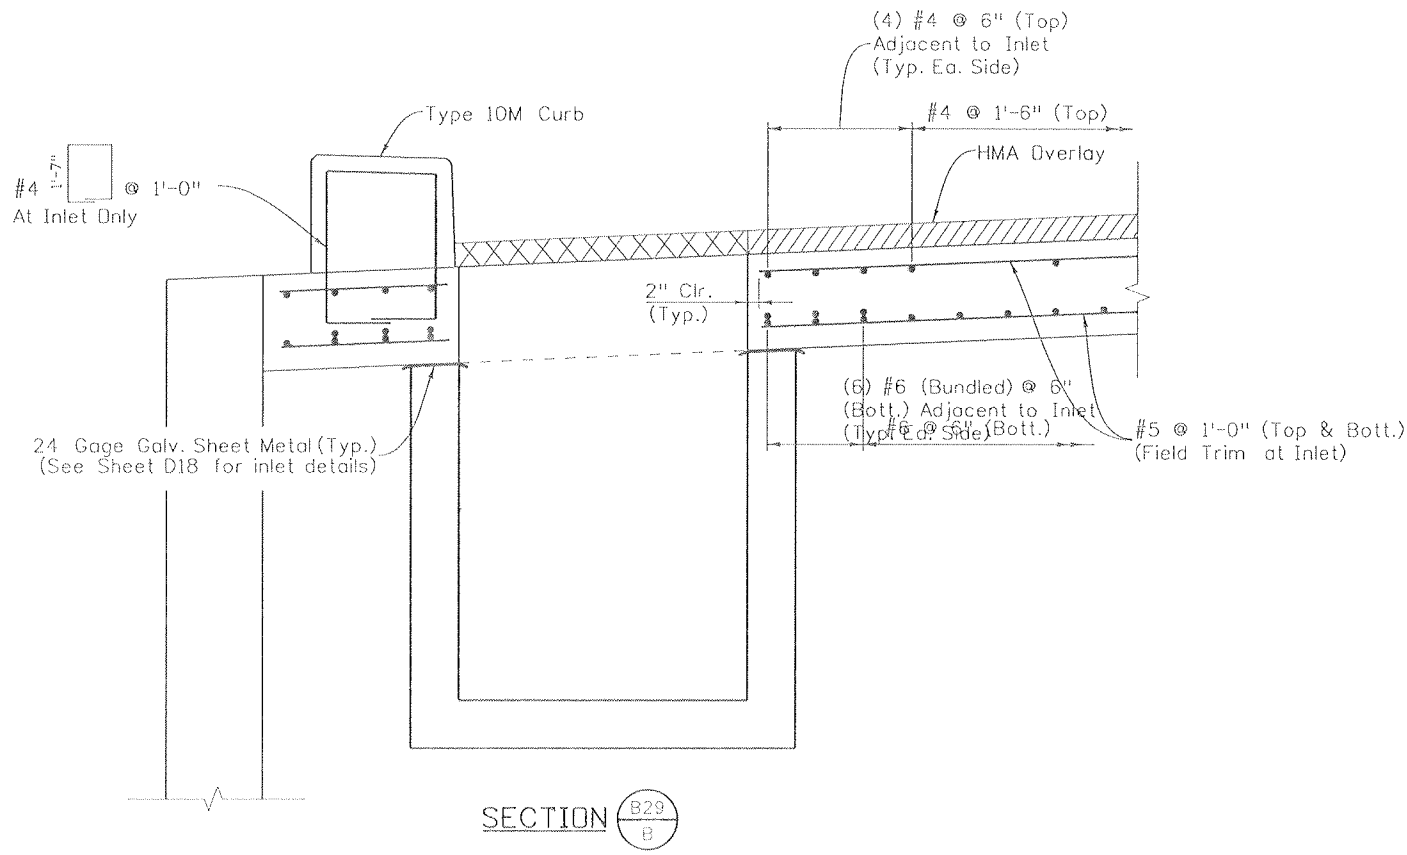


SECTION $\frac{B29}{B}$

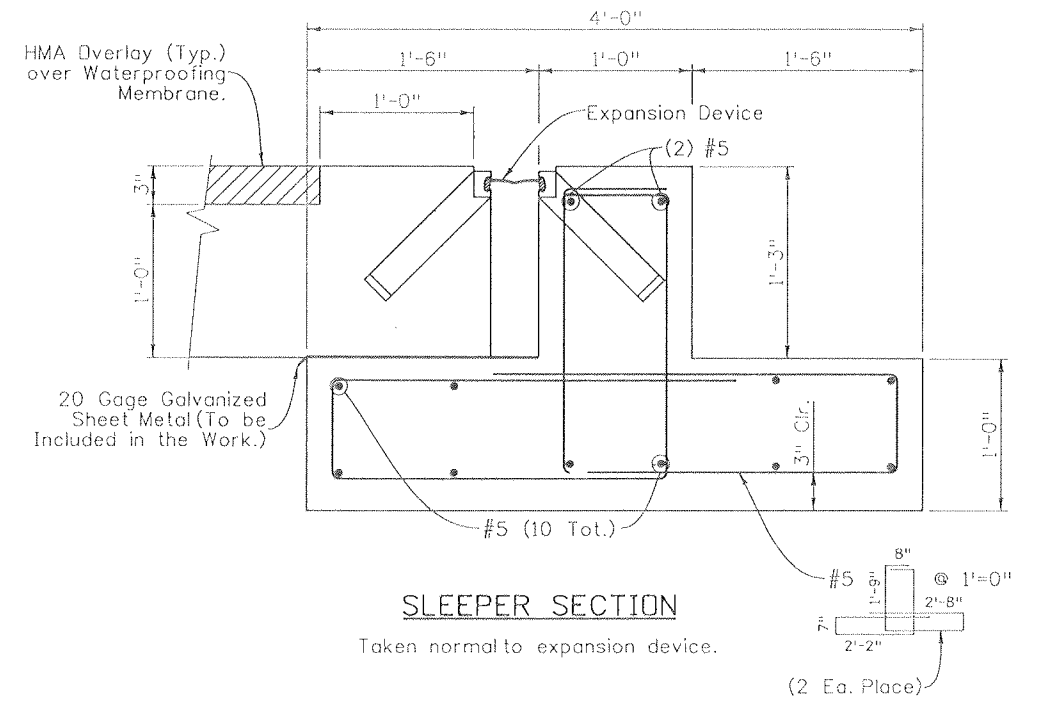

SLEEPER SECTION

Taken normal to expansion device.

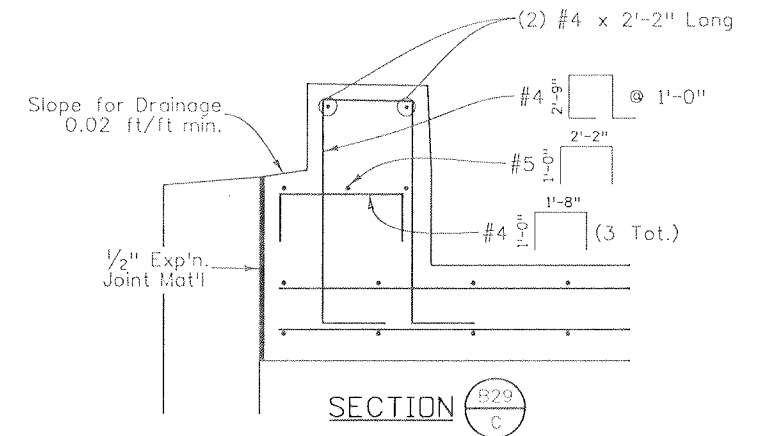

SECTION $\frac{B29}{C}$

Design		Detail		Quantities	
INITIAL	DATE	INITIAL	DATE	INITIAL	DATE
TRJ	11/08	KCT	11/08	TRJ	11/08
Checked By	BJA	Detalled By	BJA	Quantities By	LW
		Checked By		Checked By	

Print Date: 9/24/2010	Unit Information 0221	Unit Leader STW
File Name: 16042V_ApproachSlabDet_02.dgn	Horiz. Scale: 1:1	Vert. Scale: As Noted

Sheet Revisions		
Date:	Comments	Init.

Colorado Department of Transportation

3803 North Main Avenue
Suite 200
Durango, CO 81301
Phone: 970-385-1440 FAX: 970-385-8365

Region 5 EJA

As Constructed	No Revisions: 9/10
Revised:	
Void:	

RAMP A OVER US 160 APPROACH SLAB DETAILS (2 OF 2)		
Designer: T. Johnson	Structure Numbers	P-05-V
Detailer: K. Tucker	Sheet Subset: Bridge	Subset Sheets: B30 of 37

Project No./Code	NH 1602-114
Sheet Number	259

NOTES:

The expansion device shall be installed on grade, parallel to the slope and grade of the deck, and no sooner than 60 days from Post-tensioning.

After the concrete has attained initial set, the attachments used to hold the expansion device assembly in its proper position shall be removed.

Do not paint steel surfaces in contact with either concrete or seal.

"W" and "E" dimensions are dependent upon the particular expansion device supplied, and shall be shown on the working drawings.

See table for dimensions "A" and "W"; interpolate as needed. Do not install the gland until dimension "A" has opened up to at least 1/2". Use section 518.10(b) in the standard specifications to determine the structure temperature. Structure temperature shall be at least 20°F and less than 60°F for joint installation.


The neoprene gland shall be installed in one piece in accordance with section 518 of the standard specifications.

See section 518 in the standard specifications for water tight integrity testing requirements.

Set elevations at top of header and sleeper stem with the grade projection scheme.


ACCEPTABLE EXPANSION DEVICE ALTERNATES

D.S. Brown A2R400-SSA2
WABO SE400 Type A
E-poxy Engineered Materials S400-A Strip Seal

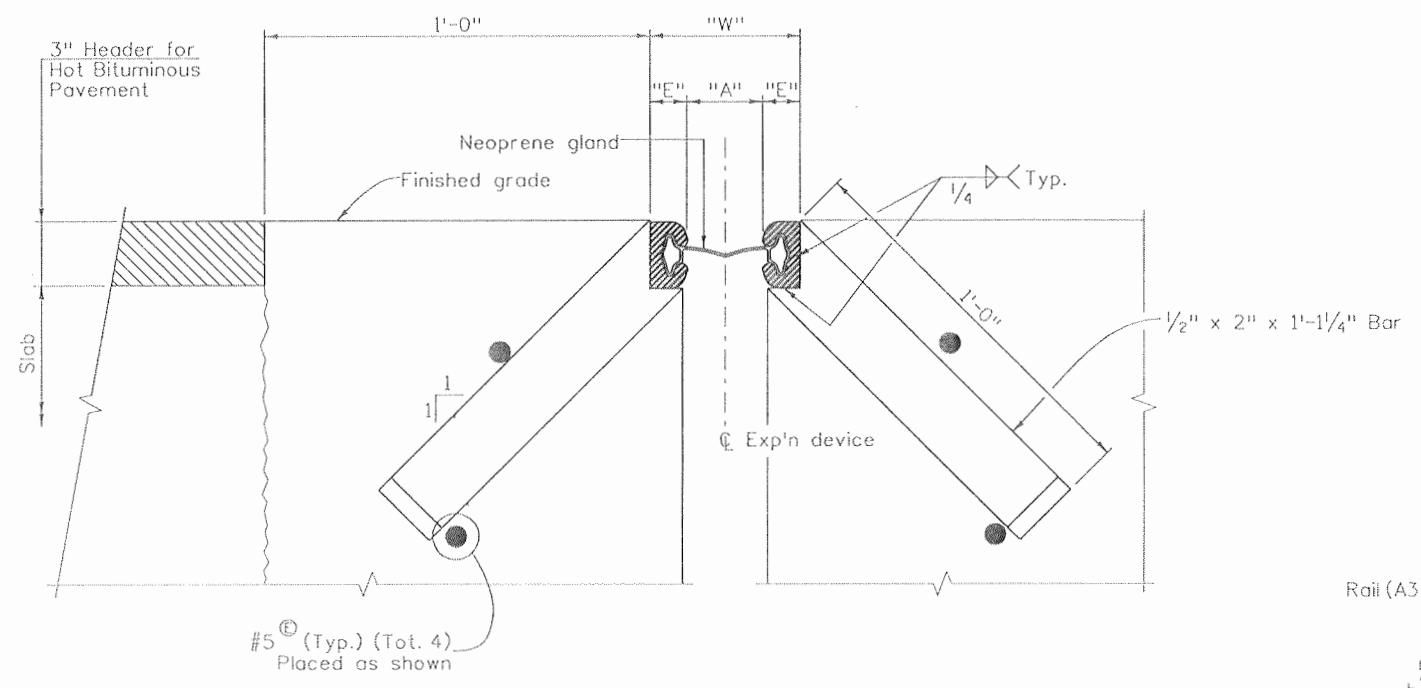


SECTION THRU STRIP SEAL BRIDGE EXPANSION DEVICE


Section taken perpendicular to ϕ exp'n device

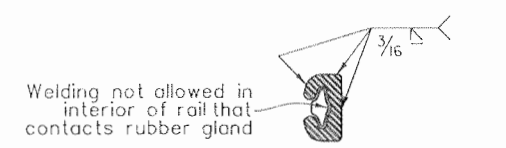

RAIL FIELD SPLICE DETAIL

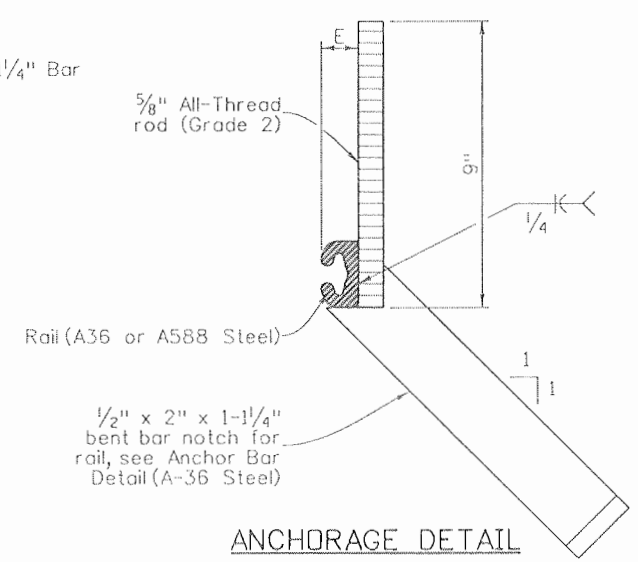


ANCHORAGE DETAIL

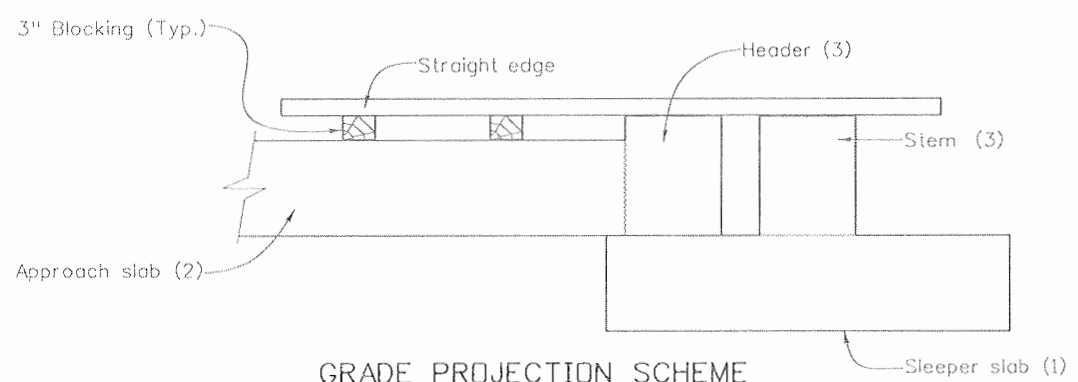


GRADE PROJECTION SCHEME

(Numbers in parenthesis refer to first, second and third concrete pours)

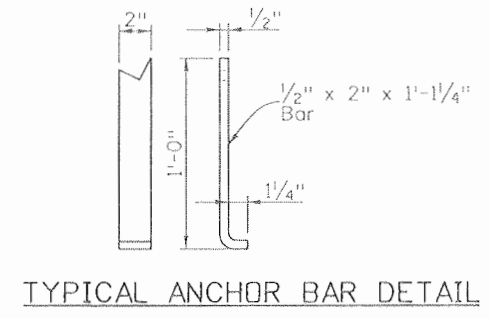

TYPICAL ANCHOR BAR DETAIL

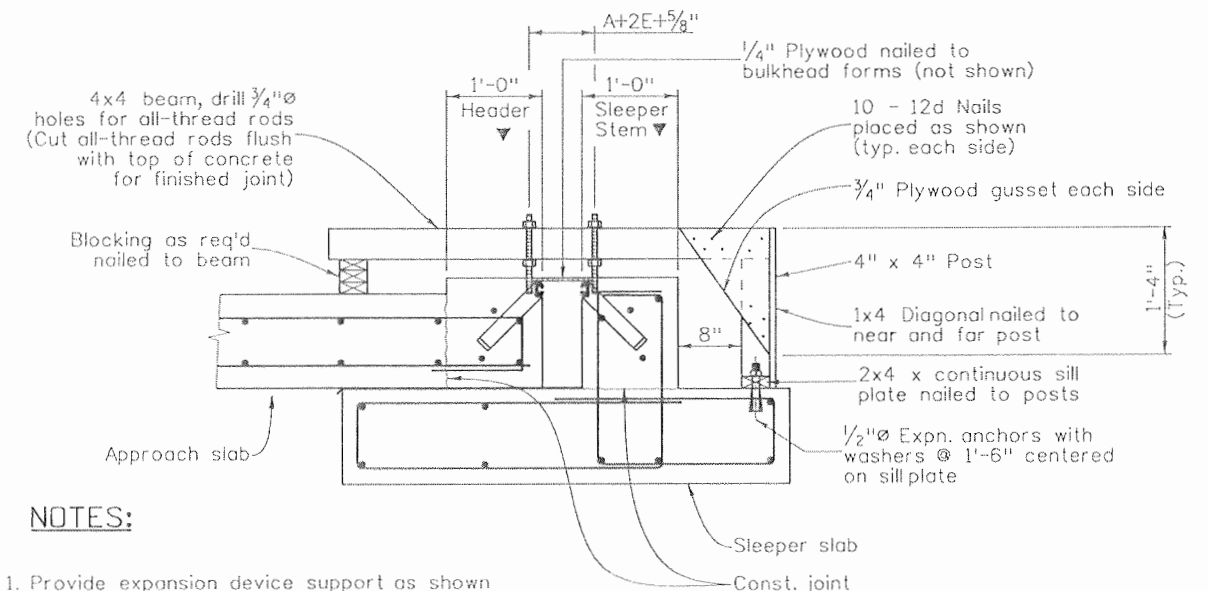

NOTES:


1. Provide expansion device support as shown at 6'-0" intervals.
 2. For reinforcing see approach slab details.
- ▼ Concrete shall be placed after expansion device has been adjusted to proper grade and approved by the engineer using the Grade Projection Scheme.

MINIMUM SUPPORT BRACKET REQUIREMENTS

Design	INITIAL	DATE	INITIAL	DATE	INITIAL	DATE
	BJA	11/08	RGA	11/08	BJA	11/08
Checked By	BJA	11/08	DSD	11/08	LW	11/08
	DSD	11/08	DSD	11/08	LW	11/08

STR. TEMP	"A"	"W"*
10° F	1 3/8"	3 7/8"
20° F	1 1/4"	3 3/4"
30° F	1 1/8"	3 5/8"
40° F	1"	3 1/2"
50° F	7/8"	3 3/8"
60° F	3/4"	3 1/4"
70° F	5/8"	3 1/8"
80° F	1/2"	3"

* For E = 1/4" (Min.)

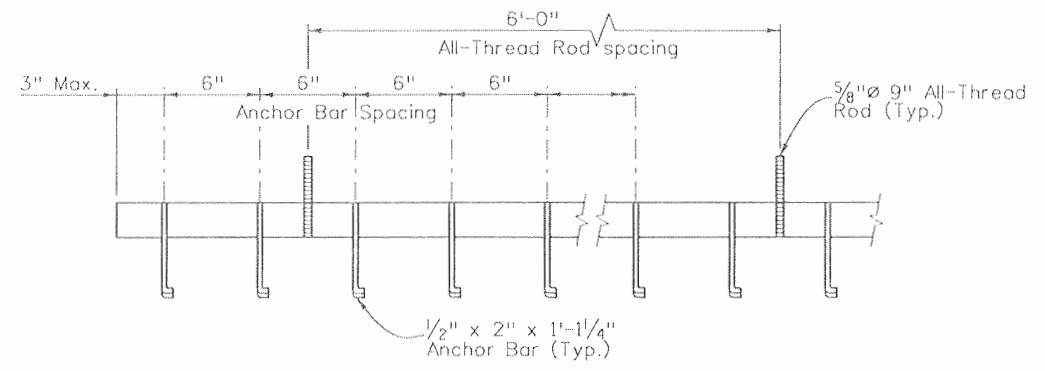

ANCHOR BAR SPACING

Print Date: 9/24/2010
File Name: 16042V_BrdgExpDevice_0-4_01.dgn
Horiz. Scale: 1:1 Vert. Scale: As Noted
Unit Information 0221 Unit Leader STW

SEMA CONSTRUCTION
WILSON & COMPANY

Sheet Revisions			
Date:	Comments	Init.	
8/10/09	Gap Table	RGA	(R-1)
8/24/09	Gap Table	BJA	(R-2)

Colorado Department of Transportation
3803 North Main Avenue
Suite 200
Durango, CO 81301
Phone: 970-385-1440 FAX: 970-385-8365


DOT
DEPARTMENT OF TRANSPORTATION

Region 5 EJA





As Constructed	No Revisions: 9/10
Revised:	
Void:	

RAMP A OVER US 160 BRIDGE EXPANSION DEVICE (0 - 4 INCH) (1 OF 2)			
Designer:	B. Allen	Structure	P-05-V
Detailer:	R. Arlman	Numbers	
Sheet Subset:	Bridge	Subset Sheets:	B31 of 37

Project No./Code	NH 1602-114
	16042
Sheet Number	260

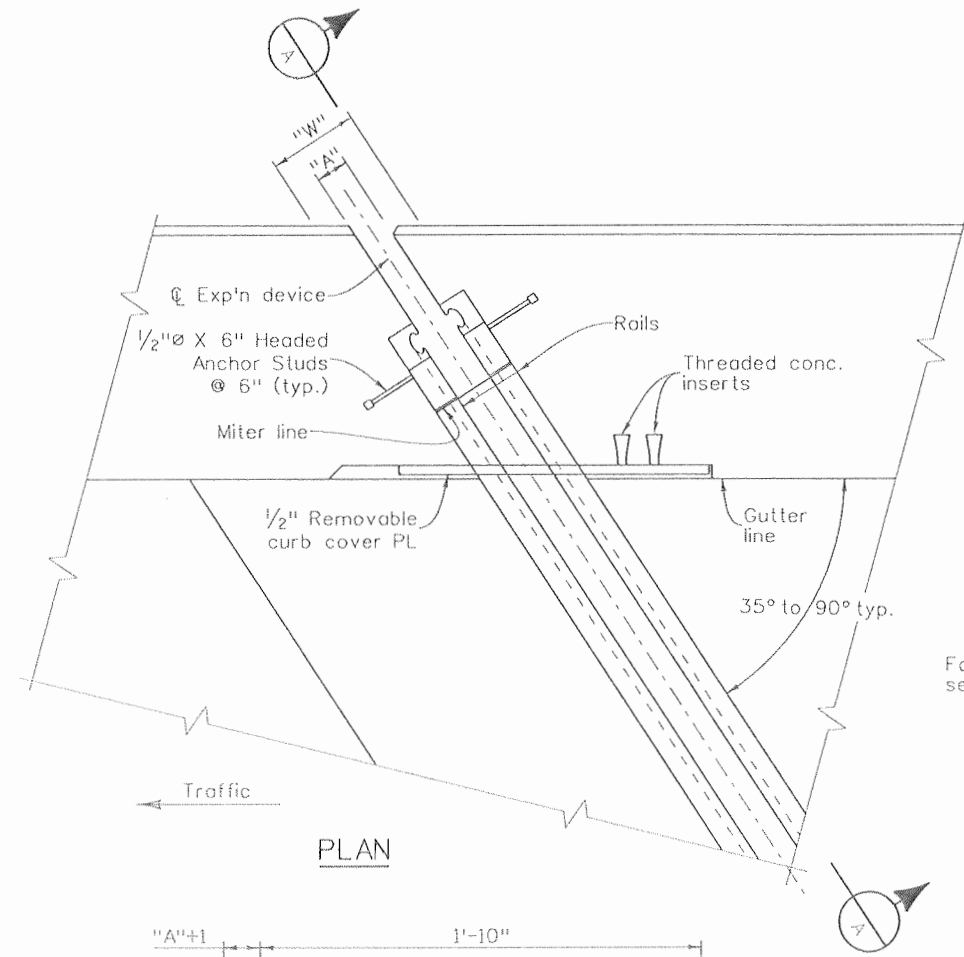

Provide 2" minimum cover between anchors and all concrete surfaces.

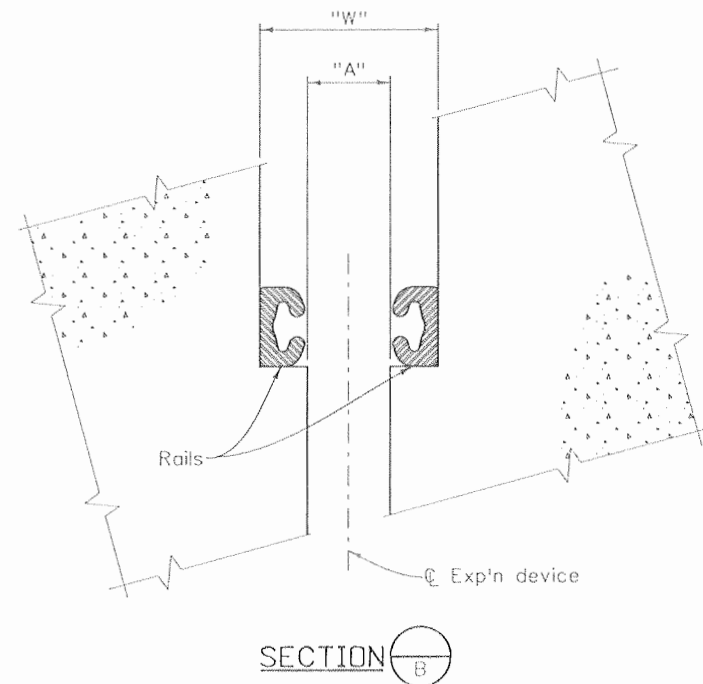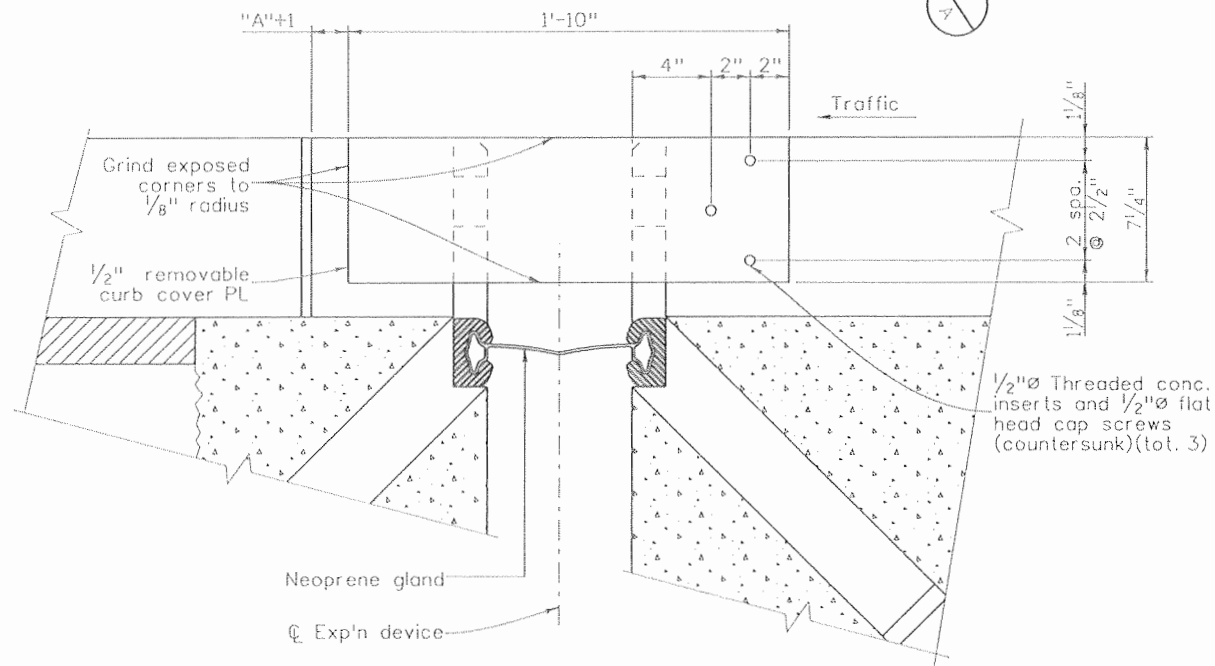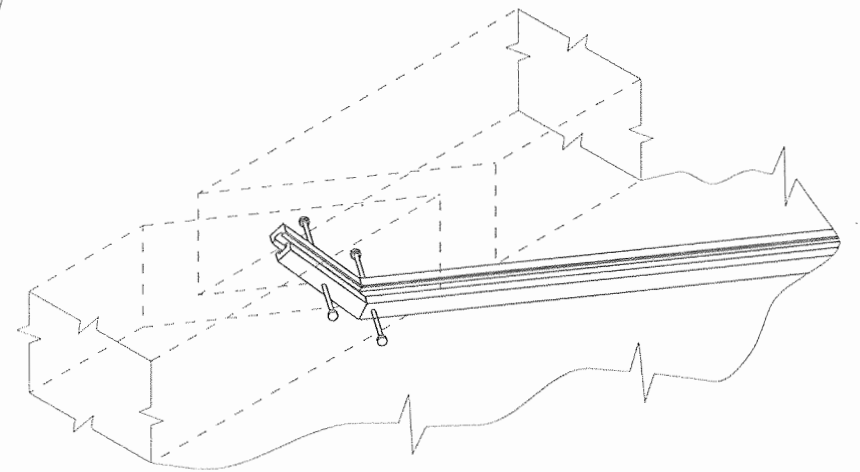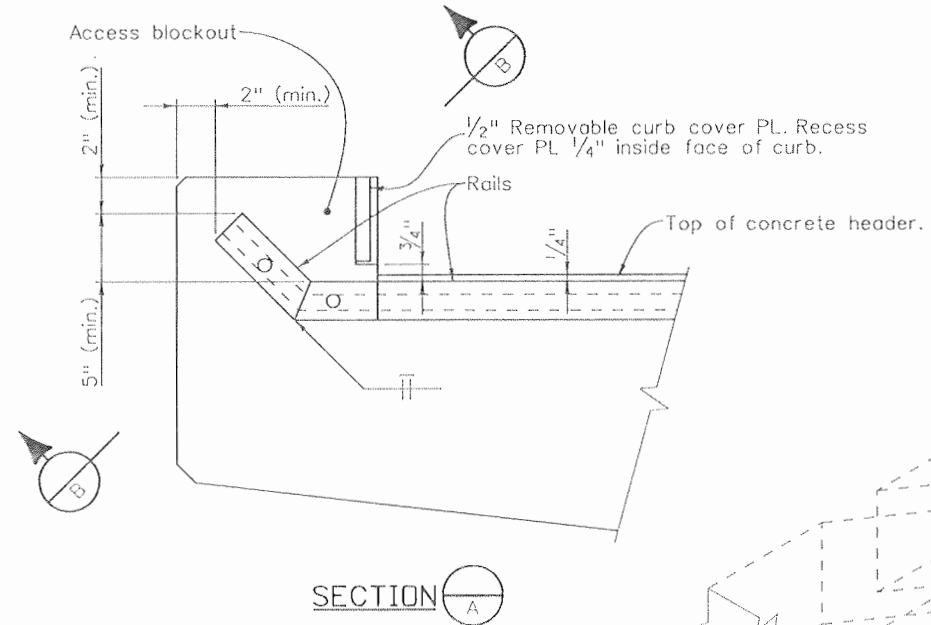

Design		Detail		Quantities	
INITIAL	DATE	INITIAL	DATE	INITIAL	DATE
Designed By	11/08	Checked By	11/08	Quantity By	11/08
BJA	DSD	DSD	DSD	BJA	LW
Checked By	11/08	Checked By	11/08		
DSD					

Print Date: 9/24/2010
 File Name: 16042V_BrdgExpDevice_0-4_02.dgn
 Horiz. Scale: 1:1
 Unit Information 0221
 Unit Leader STW

SEMA CONSTRUCTION
 WILSON & COMPANY

Sheet Revisions		
Date:	Comments	Init.



Colorado Department of Transportation
 3803 North Main Avenue
 Suite 200
 Durango, CO 81301
 Phone: 970-385-1440 FAX: 970-385-8365
 Region 5 EJA

As Constructed	
No Revisions:	9/10
Revised:	
Void:	

RAMP A OVER US 160
 BRIDGE EXPANSION DEVICE
 (0 - 4 INCH) (2 OF 2)


Designer:	B. Allen	Structure	P-05-V
Detailer:	R. Artman	Numbers	
Sheet Subset:	Bridge	Subset Sheets:	B32 of 37

Project No./Code	
NH 1602-114	16042
Sheet Number	261

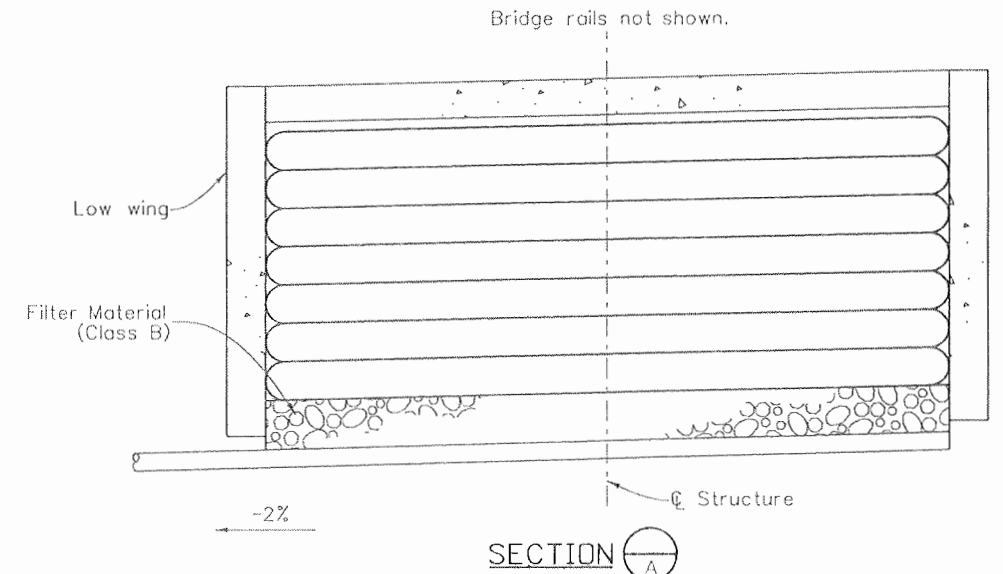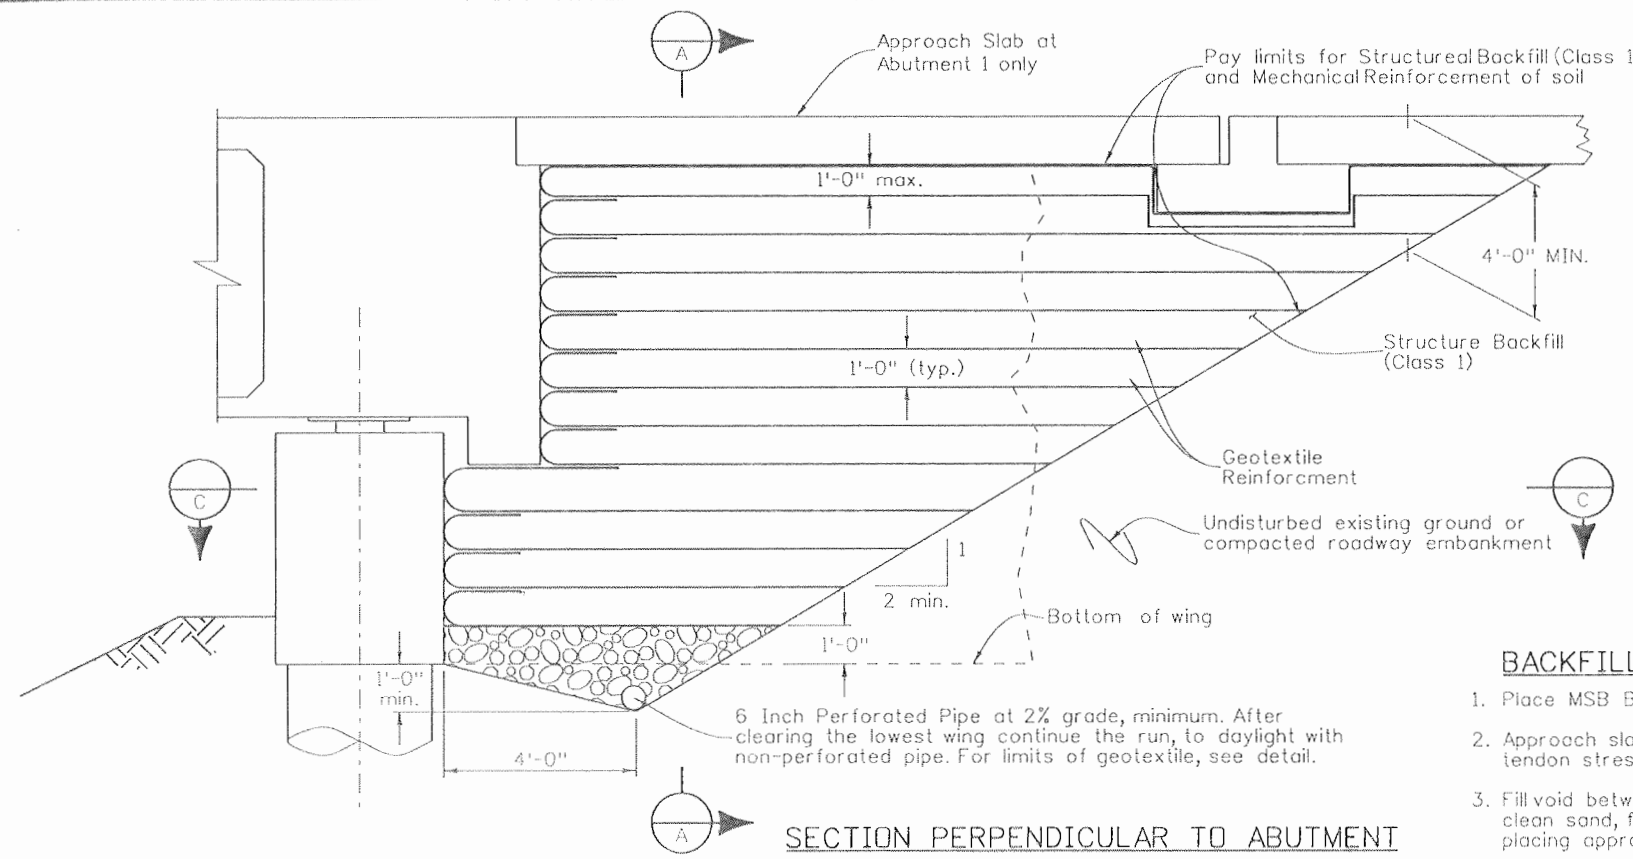

BACKFILL PLACING SEQUENCE

1. Place MSB Backfill prior to removing falsework.
2. Approach slab shall not be placed within 90 days of tendon stressing.
3. Fill void between MSB and abutment diaphragm with clean sand, free of deleterious materials, prior to placing approach slab.

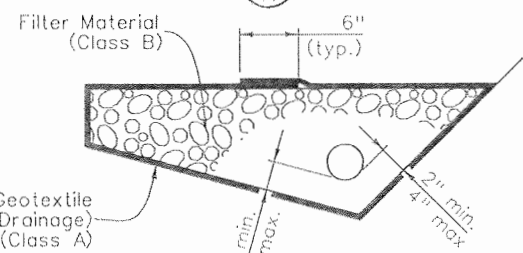



6 INCH PERFORATED PIPE UNDERDRAIN

NOTES:


1. Geotextile reinforcement shall be woven fabric with a Minimum Average Roll Value of 4800 lb/ft for installations with a gap and 2400 lb/ft for installations without a gap based on ASTM D4595.
2. Geotextile Reinforcement shall be placed by alternating Machine Direction (MD) with Cross Machine Direction (XD) from layer to layer.
3. The Geotextile Reinforcement wrap at Back Face of Abutment shall be pulled back slack free with its end anchored to soil underneath with staples or pins.
4. Minimum splice of all Geofabric shall consist of 6" of overlap.
5. Installation of Pipe Underdrain and Subsurface Drain Outlet will conform to the Construction requirements of section 605.03 and 605.06, respectively.
6. Impervious membrane shall be Carlisle Sure-Seal EPDM. Alternate membrane may be submitted for approval.

Subsurface Drain Outlet (6" ϕ Non-Perforated Pipe). Max. bend in pipe = 45°. Discharge into Erosion Protection (Riprap or Energy Dissipator)

SECTION PERPENDICULAR TO ABUTMENT

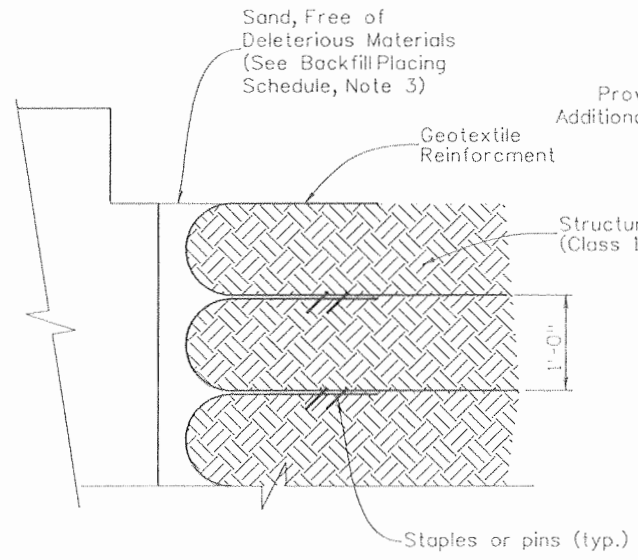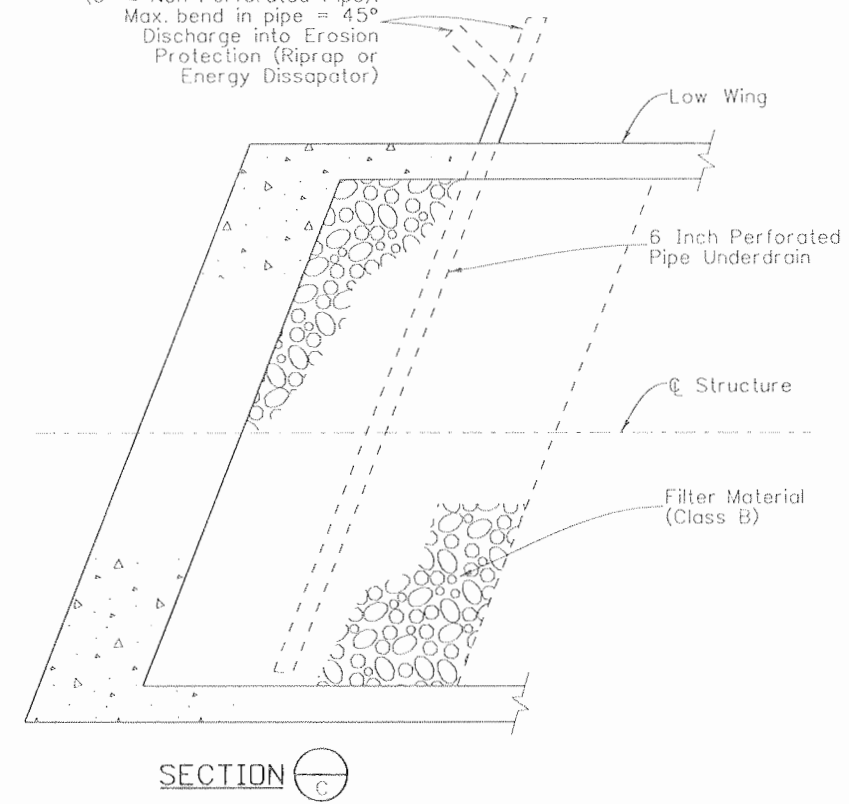

WRAP DETAIL 1

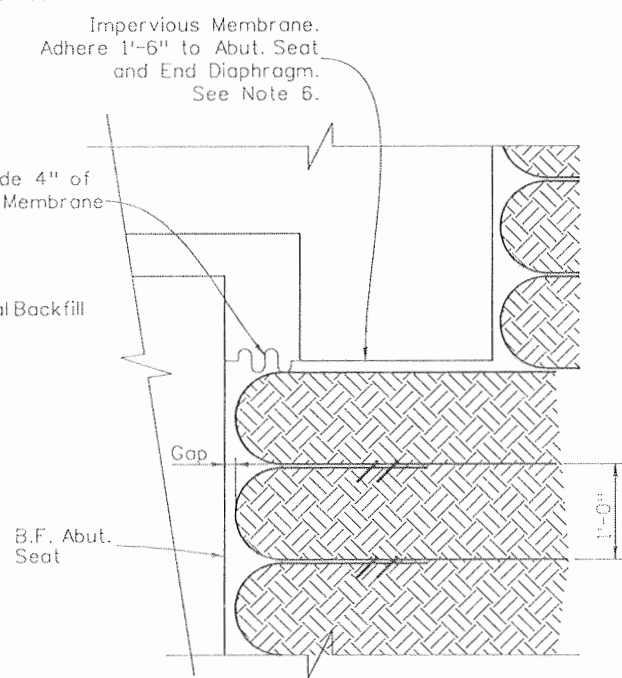

WRAP DETAIL 2

Design		Detail		Quantities	
INITIAL	DATE	INITIAL	DATE	INITIAL	DATE
BJA	11/08	RCA	11/08	BJA	11/08
DSD	11/08	DSD	11/08	LW	11/08
Designed By	Checked By	Detailed By	Checked By	Quantities By	Checked By

Print Date: 9/24/2010
 File Name: 16042V_MSB_01.dgn
 Horiz. Scale: 1:1 Vert. Scale: As Noted
 Unit Information 0221 Unit Leader STW

SEMA CONSTRUCTION
WILSON & COMPANY

Sheet Revisions		
Date:	Comments	Init.

Colorado Department of Transportation
 3803 North Main Avenue
 Suite 200
 Durango, CO 81301
 Phone: 970-385-1440 FAX: 970-385-8365

DOT
 DEPARTMENT OF TRANSPORTATION

Region 5 EJA


As Constructed	
No Revisions:	9/10
Revised:	
Void:	

**RAMP A OVER US 160
 MECHANICALLY STABILIZED
 BACKFILL**

Designer: B. Allen Structure P-05-V
 Detailer: R. Artman Numbers
 Sheet Subset: Bridge Subset Sheets: B33 of 37

Project No./Code	
NH 1602-114	
16042	
Sheet Number	262

Design		Detail		Quantities	
INITIAL	DATE	INITIAL	DATE	INITIAL	DATE
Designed By	11/08	Detalled By	11/08	Quantities By	11/08
Checked By	DSO	Checked By	DSO	Checked By	LW

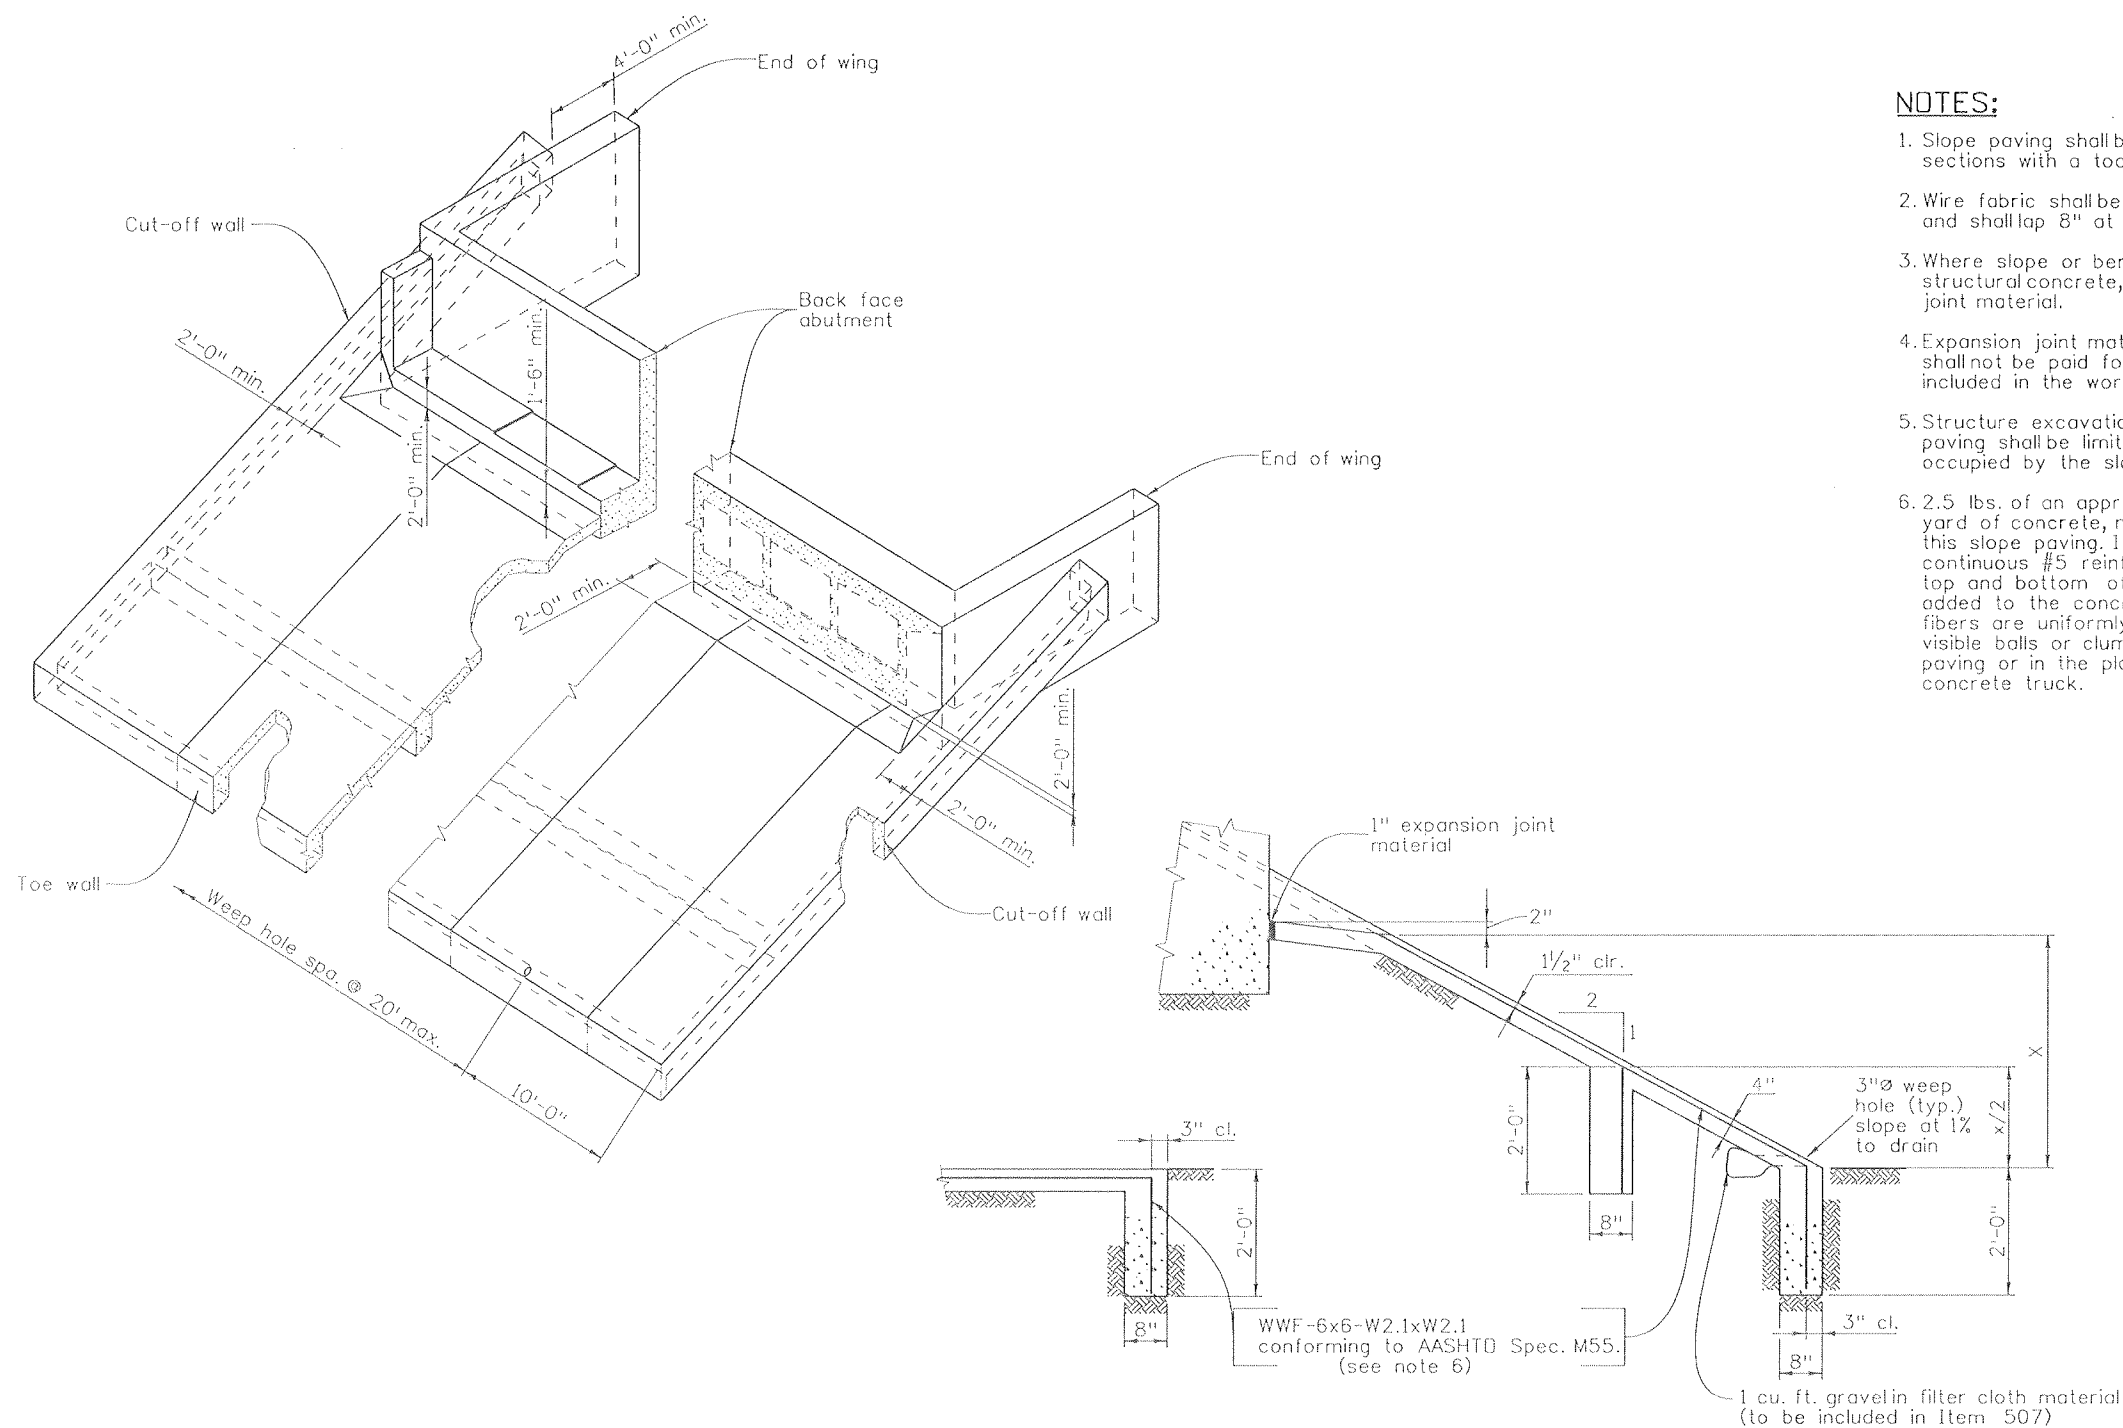

NOTES:


- Slope paving shall be poured in 10 ft. transverse sections with a tooled construction joint at each section.
- Wire fabric shall be 2" from the end of joints and shall lap 8" at splices.
- Where slope or berm paving butts against structural concrete, separate with 1" expansion joint material.
- Expansion joint material and welded wire fabric shall not be paid for separately, but shall be included in the work.
- Structure excavation for concrete slope and ditch paving shall be limited to the actual volume occupied by the slope paving concrete.
- 2.5 lbs. of an approved polypropylene fiber, per cubic yard of concrete, may be substituted for the WWF in this slope paving. If this substitution is made, a continuous #5 reinforcing bar shall be added near the top and bottom of the cutoff wall. The fiber shall be added to the concrete mix in such a fashion that the fibers are uniformly dispersed in the concrete without visible balls or clumps in either the finished slope paving or in the plastic concrete delivered from the concrete truck.

TYPICAL SECTION THRU CUT-OFF WALL

TYPICAL SECTION THRU SLOPE PAVING

Print Date: 9/24/2010	Sheet Revisions			Colorado Department of Transportation		As Constructed		RAMP A OVER US 160 SLOPE PAVING DETAILS		Project No./Code	
File Name: 16042V_SlopePavingDet_01.dgn	Date:	Comments	Init.	3803 North Main Avenue		No Revisions: 9/10		NH 1602-114			
Horiz. Scale: 1:1				Suite 200		Revised:		Designer: B. Allen		Structure: P-05-V	
Unit Information 0221				Durango, CO 81301		Void:		Detailer: R. Artman		16042	
Unit Leader STW				Phone: 970-385-1440 FAX: 970-385-8365				Sheet Subset: Bridge		Subset Sheets: B34 of 37	
SEMA CONSTRUCTION	WILSON & COMPANY			Region 5		EJA		Sheet Number		263	

Design		Detail		Quantities	
INITIAL	DATE	INITIAL	DATE	INITIAL	DATE
Designed By BJA	11/08	Detailled By DSD	11/08	Quantities By BJA	11/08
Checked By DSD	11/08	Checked By DSD	11/08	Checked By LW	11/08

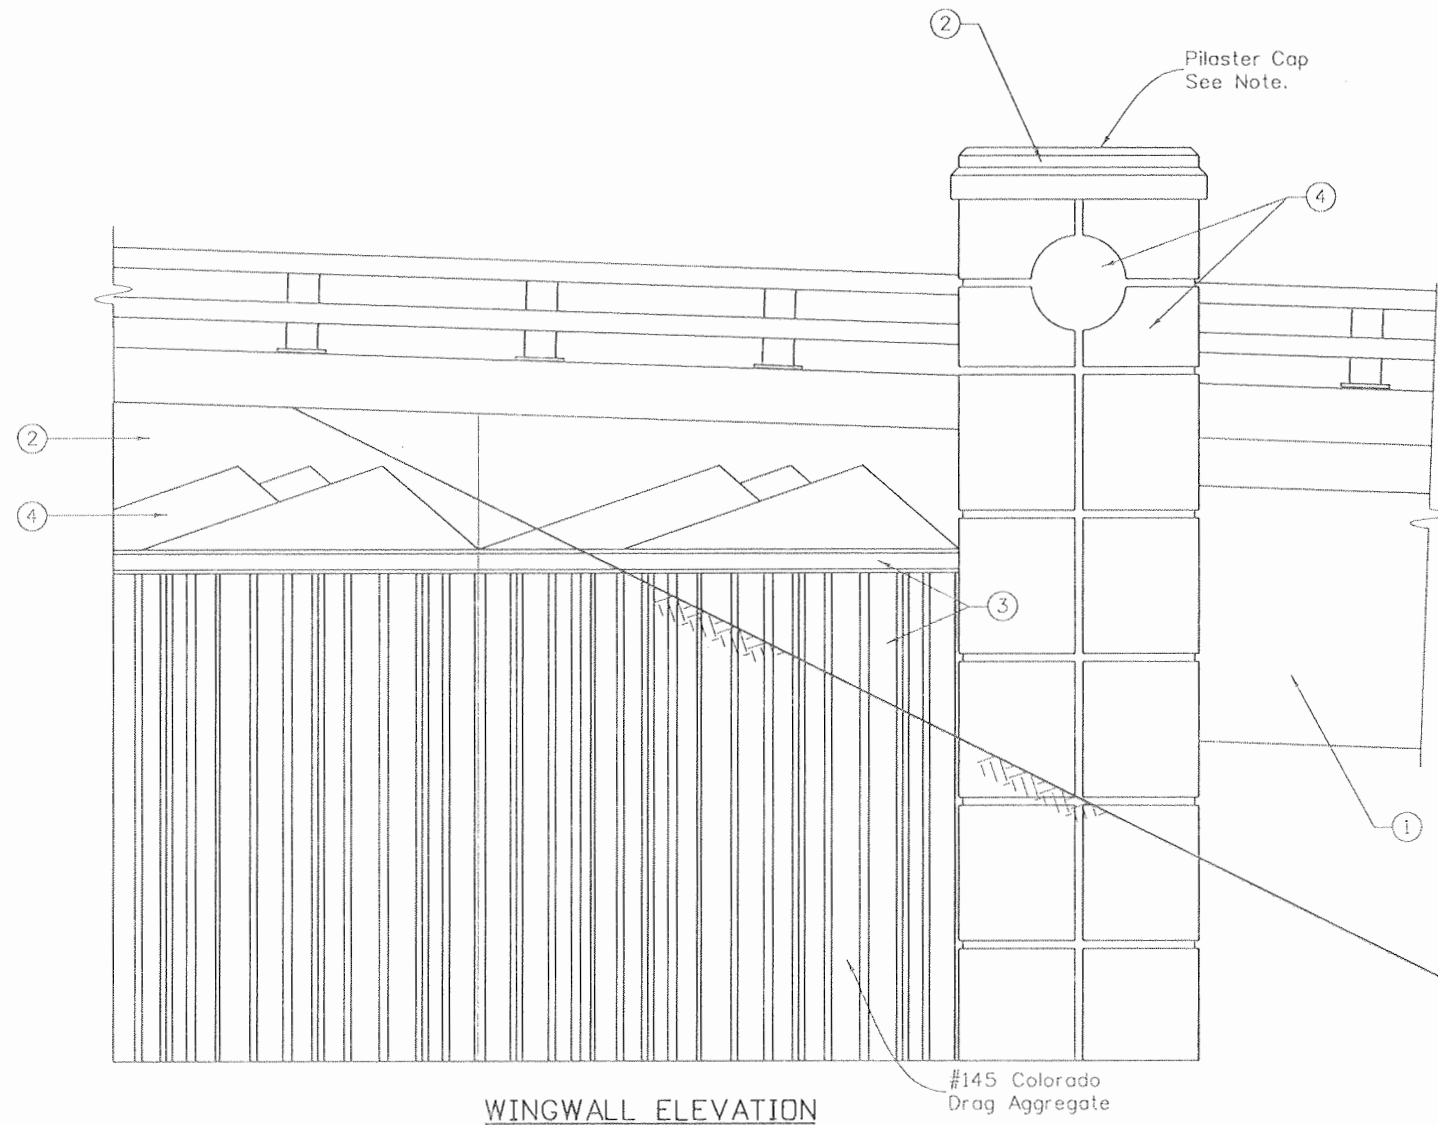


WINGWALL ELEVATION

NOTES:

A colored structural concrete coating finish is required, as shown on the Plans, on all exposed concrete surfaces including piers, abutments, and wingwalls. Color numbers correspond to paint numbers as described by Diamond Vogel Paints. Coating shall extend to 1'-0" below ground surface.

- ① #8513
- ② #8515
- ③ #8513
- ④ #8511

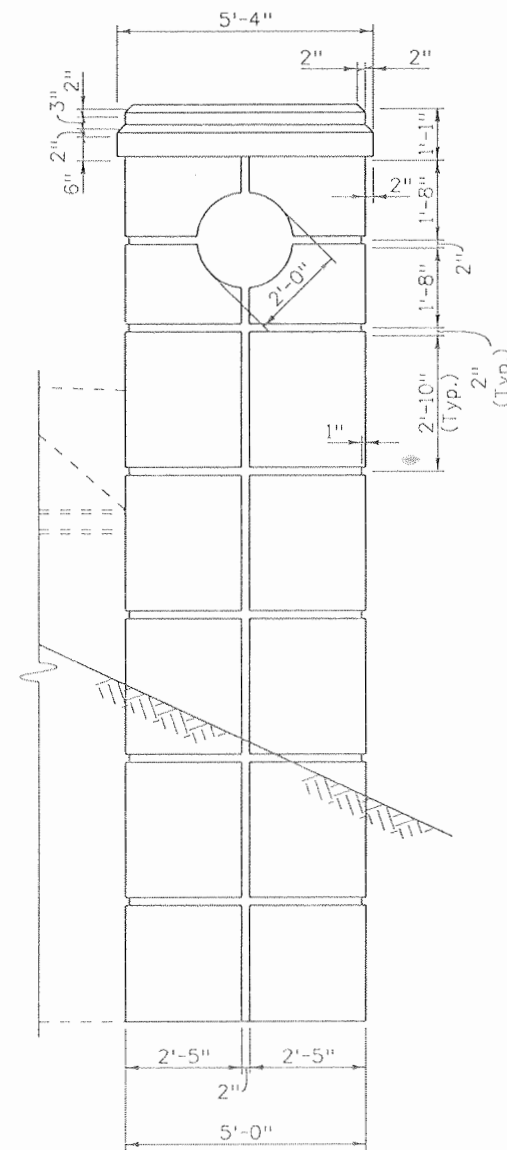

PILASTER DETAILS

NOTE:

The Contractor may elect to precast the Pilaster Cap. Connection details shall be submitted to the Engineer for approval for precast alternates.

Print Date: 9/24/2010	Sheet Revisions			Colorado Department of Transportation		As Constructed		RAMP A OVER US 160 ARCHITECTURAL DETAILS		Project No./Code	
File Name: 16042V_ArchDet_01.dgn	Date:	Comments:	Init.	3803 North Main Avenue		No Revisions: 9/10		Designer: B. Allen		NH 1602-114	
Horiz. Scale: 1:1	Unit Information 0221			Suite 200		Revised:		Detailer: R. Artman		16042	
Vert. Scale: As Noted	Unit Leader STW			Durango, CO 81301		Void:		Structure Numbers		P-05-V	
SEMA CONSTRUCTION	WILSON & COMPANY			Phone: 970-385-1440 FAX: 970-385-8365		Region 5		Sheet Subset: Bridge		Subset Sheets: B35 of 37	
				EJA				Sheet Number		264	

State of Colorado
 Department of Transportation
 Staff Bridge Design
 Bridge Geometry Project Coordinate Converter
 Version 1.00

Run date & time = Mon Nov 10 10:53:53 2008

Input Northing Offset = 1213314.630000
 Input Easting Offset = 2319280.130000
 Input Bearing = N 0 44 54.5100 E

DESCRIPTION

Units: Feet;
 Project: NH 1602-114; Subaccount: 16042;
 Designer: EJA; Detailer: RGA;
 Location: DURANGO;
 RAMP A OVER US 160 AND WILSON GULCH
 2 SPAN - 221.5, 221.5
 CAST-IN-PLACE BOX GIRDER

HORIZONTAL ALIGNMENT DATA

PC 311+18.2430 T 532.1470
 PI 316+50.3900 Lc 1601.7564
 PT 321+19.3994 T 532.1470
 DELTA 47 49 49.21 LT Ds 4 46 28.73 RADIUS 1200.000269

VERTICAL ALIGNMENT DATA

ELEVATION AT PI	ELEVATION AT GRADE	STATION	ELEVATION AT GRADE	ELEVATION AT PI	PERCENT GRADE
		313+54.2000	6624.2600		5.760000
		315+66.7000	6634.0250	6636.5000	
		317+79.2000	6639.8800		1.100000

TABLE OF ROADWAY CROSS-SLOPES (SUPERELEVATION: E= 0.0)

STATION	SLOPE LEFT	SLOPE RIGHT	VC LENGTH
(ON TANGENT)	0.0000	0.0000	50.00 (MAX)
315+00.0000	-0.0300	0.0300	50.00 -E-
320+50.4990	-0.0300	0.0300	50.00 -E-
321+25.4590	-0.0200	0.0200	50.00 -E-
322+00.0000	-0.0200	0.0200	50.00 -E-

OFFSET PROFILE CONTROL TO PIVOT POINT = 0.0000 FEET

LIMITS OF VALID ELEVATION AND CROSS-SLOPE DATA

BEGIN 313+25.0000
 END 321+75.0000
 SUPERELEVATION SUPERELEVATION

LAYOUT LINE DATA

LAYOUT LINE DEFINED AS AHEAD TANGENT

LAYOUT LINE INTERSECTS REF LINE AT HCL STA 321+38.7300 OFFSET 0.00000000 X 0.0000 Y 0.0000

TYPE 4 GIRDER LINE DATA (OFFSET VARIES WITH SURF)

LINE OF CONSTANT OFFSET IS HORIZONTAL CONTROL

AVERAGE CROSS SLOPE CALCULATED BETWEEN STATION 316+95.7300 AND STATION 321+38.7300

AVERAGE CROSS-SLOPE = 0.036748 FT/FT (RIGHT OF PROFILE CONTROL LINE)

DEAD LOAD DEFLECTION DATA

DEFLECTIONS AT TENTH POINTS FROM FITTED CURVE

	0.0	0.1	0.2	0.3	0.4	0.5	0.6	0.7	0.8	0.9	1.0	
FOR BENT LINE: CL ABUT 1												
INCH	0.0000	0.6406	1.5655	2.3472	2.7415	2.6436	2.1210	1.3783	0.6809	0.2312	0.0000	INCH
FOOT	0.0000	0.0550	0.1365	0.1956	0.2285	0.2203	0.1767	0.1149	0.0567	0.0193	0.0000	FOOT
SLOPE	0.340890											-0.192035 SLOPE

BENT LINE : INTERSECTION POINT : FROM LAYOUT LINE : PROJECT COORDINATES BENT LINE : GIRDER LINE ROADWAY
 DESCRIPTION : : OFFSET ORDINATE : NORTHING EASTING LENGTH FROM SFEW : LENGTH FROM CROSS-
 : STATION OFFSET ELEVATION : X Y : Y-AXIS D M S : REF LINE SLOPE

* HORIZONTAL CONTROL LINE * AT FINISHED GRADE


REF ABUT	STATION	OFFSET	ELEVATION	REF ABUT	STATION	OFFSET	ELEVATION	REF ABUT	STATION	OFFSET	ELEVATION
CL ABUT 1	316+91.4000	0.0000	6637.4758	CL ABUT 1	316+95.7300	0.0000	6637.5648	CL ABUT 1	316+95.7300	0.0000	6637.5648
CL PIER 2	319+17.2300	0.0000	6640.4259	CL PIER 2	319+17.2300	0.0000	6640.4259	CL PIER 2	319+17.2300	0.0000	6640.4259
CL ABUT 3	321+38.7300	0.0000	6642.9067	CL ABUT 3	321+38.7300	0.0000	6642.9067	CL ABUT 3	321+38.7300	0.0000	6642.9067
RF ABUT 3	321+43.0600	0.0000	6642.9552	RF ABUT 3	321+43.0600	0.0000	6642.9552	RF ABUT 3	321+43.0600	0.0000	6642.9552

* LAYOUT LINE * AT FINISHED GRADE

REF ABUT	STATION	OFFSET	ELEVATION	REF ABUT	STATION	OFFSET	ELEVATION	REF ABUT	STATION	OFFSET	ELEVATION
RF ABUT 1	317+27.7605	67.0852	6640.7088	RF ABUT 1	317+27.7605	67.0852	6640.7088	RF ABUT 1	317+27.7605	67.0852	6640.7088
CL ABUT 1	317+31.4334	65.7806	6640.7201	CL ABUT 1	317+31.4334	65.7806	6640.7201	CL ABUT 1	317+31.4334	65.7806	6640.7201
CL PIER 2	319+24.2239	15.8172	6641.1277	CL PIER 2	319+24.2239	15.8172	6641.1277	CL PIER 2	319+24.2239	15.8172	6641.1277
ST OR PT	321+19.9954	0.0000	6642.6970	*ST OR PT*	321+19.9954	0.0000	6642.6970	*ST OR PT*	321+19.9954	0.0000	6642.6970
CL ABUT 3	321+38.7300	0.0000	6642.9067	CL ABUT 3	321+38.7300	0.0000	6642.9067	CL ABUT 3	321+38.7300	0.0000	6642.9067
RF ABUT 3	321+43.0600	0.0000	6642.9552	RF ABUT 3	321+43.0600	0.0000	6642.9552	RF ABUT 3	321+43.0600	0.0000	6642.9552

WINDMILL ELEVATIONS

BENT LINE	STATION	OFFSET	ELEVATION	ELEV-DL	X	Y	NORTHING	EASTING	BENT LNTH	SFEW	GIRDER LNTH	CRS-SLP
W1	316+74.0900	6.1800	6637.1598		-74.2240	-457.4216	1212674.0103	2319137.1274	-79.7380	0 00 00.00	-472.2834	+0.038000
W2	316+53.4400	-21.0300	6638.7043		-206.8573	-460.1690	1212876.2675	2319104.5256	-115.2413	0 00 00.00	-659.0154	-0.038000
W3	321+47.5100	-21.1300	6642.8325		-21.1300	1.7800	1213326.7217	2319280.5512	-21.1300	0 00 00.00	-20.5794	-0.020000
W4	321+66.4000	6.1300	6643.1292		6.1300	27.0700	1213340.9415	2319292.2733	6.1300	0 00 00.00	22.9761	-0.020000

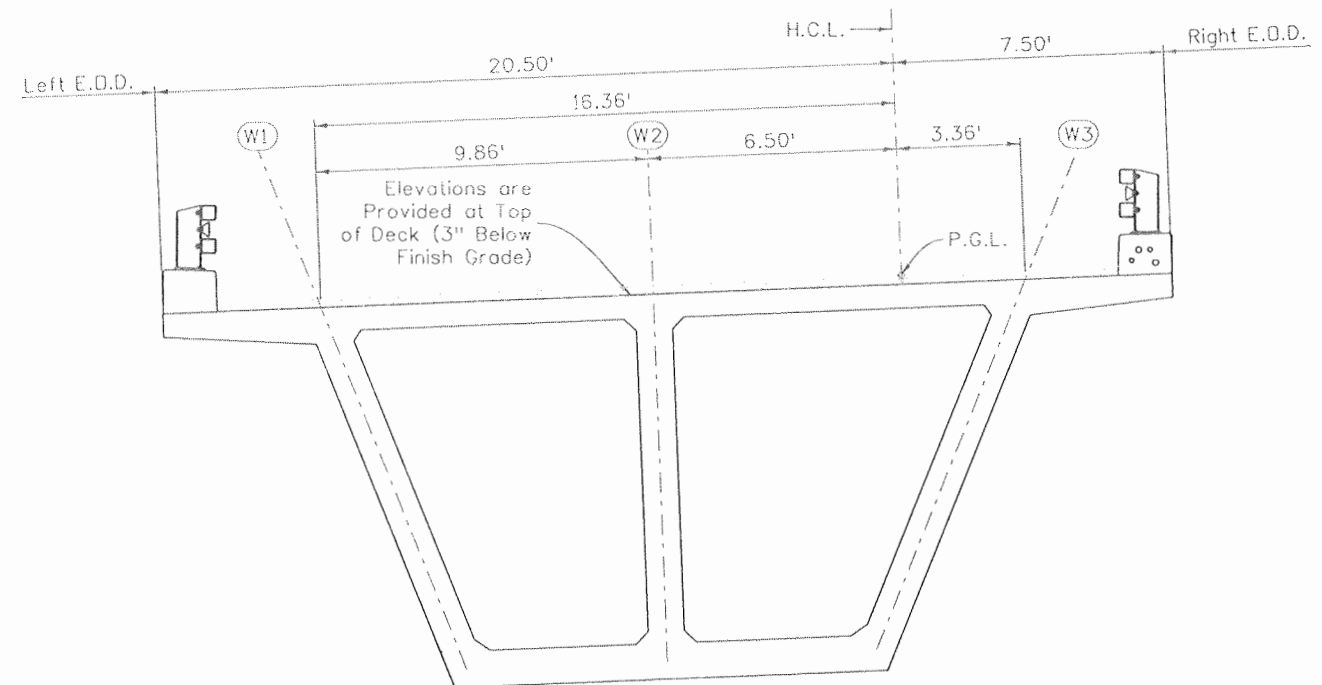

Design	Checked By	Date	Detail		Quantities	
			Checked By	Date	Checked By	Date

Print Date: 9/24/2010	Sheet Revisions			Colorado Department of Transportation				As Constructed		RAMP A OVER US 160 BRIDGE DECK ELEVATIONS (1 OF 2)			Project No./Code	
File Name: 16042V_Brdg_Geometry_01.dgn	Date:	Comments:	Init.	3803 North Main Avenue Suite 200 Durango, CO 81301 Phone: 970-385-1440 FAX: 970-385-8365				No Revisions: 9/10		Designer: A. Leifheit Detailer: R. Artman Sheet Subset: Bridge			NH 1602-114	
Horiz. Scale: 1:1 Unit Information 0221	Vert. Scale: As Noted	Unit Leader STW		Region 5				Revised:		Structure Numbers P-05-V			16042	
SEMA CONSTRUCTION		WILSON & COMPANY		EJA				Void:		Subset Sheets: B36 of 37			Sheet Number 265	