
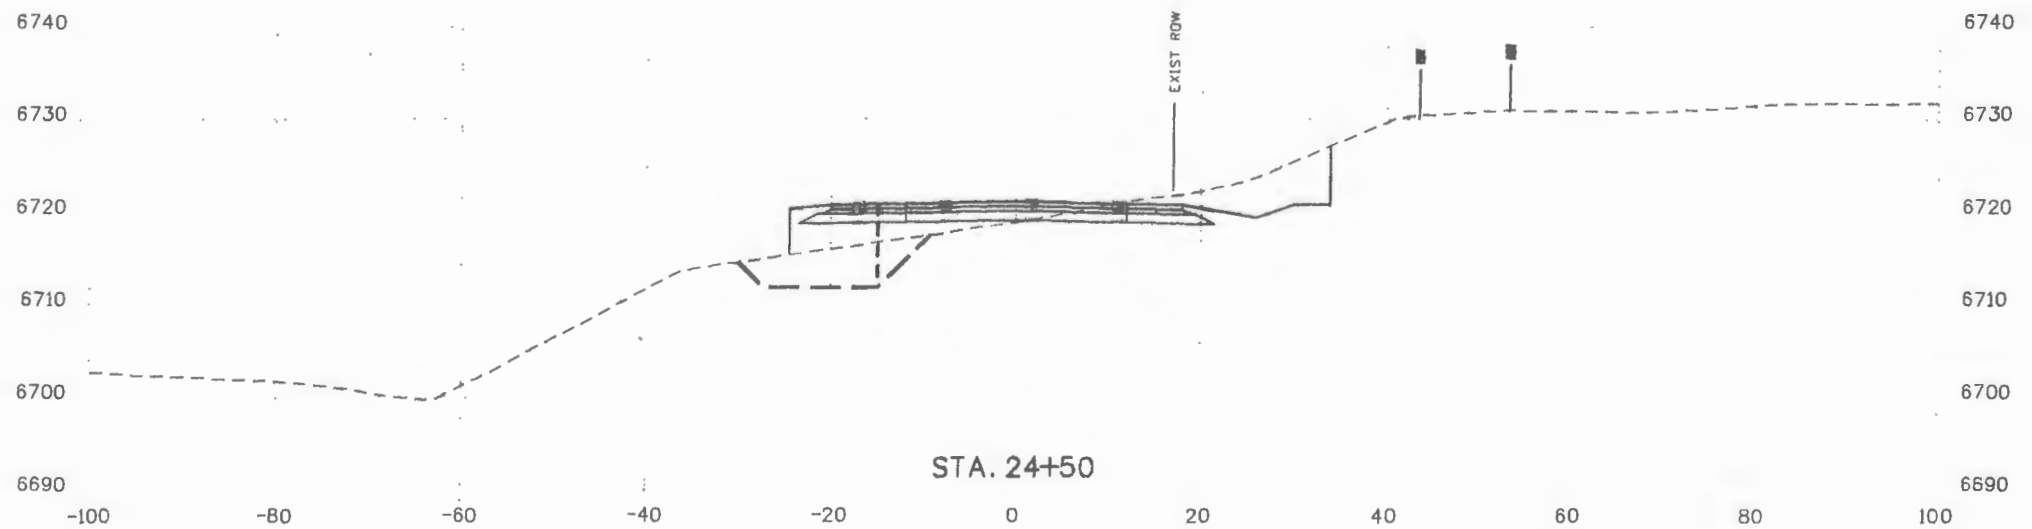


Allo by 15-73

Print Date: 2/25/2010	Sheet Revisions			Colorado Department of Transportation  3803 North Main Avenue Suite 200 Durango, CO 81301 Phone: 970-385-1440 FAX: 970-385-8365 Region 5	As Constructed		STR Wall P-05-BB CROSS SECTION		Project No./Code
File Name: 17269 Wall B Quantities.dgn	Date:	Comments	Init.		No Revisions:			ES5 160A-010	
Horiz. Scale: 1:20	Vert. Scale: As Noted			Revised: 8/27/10	Designer: SPC	Structure Numbers	P-05-BB		17269
Unit Information	Unit Leader Initials			Void:	Detaller: mn	Sheet Subset: Wall_Xsec	Subset Sheets: W3 of W6	Sheet Number 61	



n:\proj\10125157 AM C:\Project\17269\17269 Wall B Quantities.dgn

naranjan 10:25:58 AM C:\Project\Wise\FWZ_Working\mas0625\17269 WallB Quantities.dgn

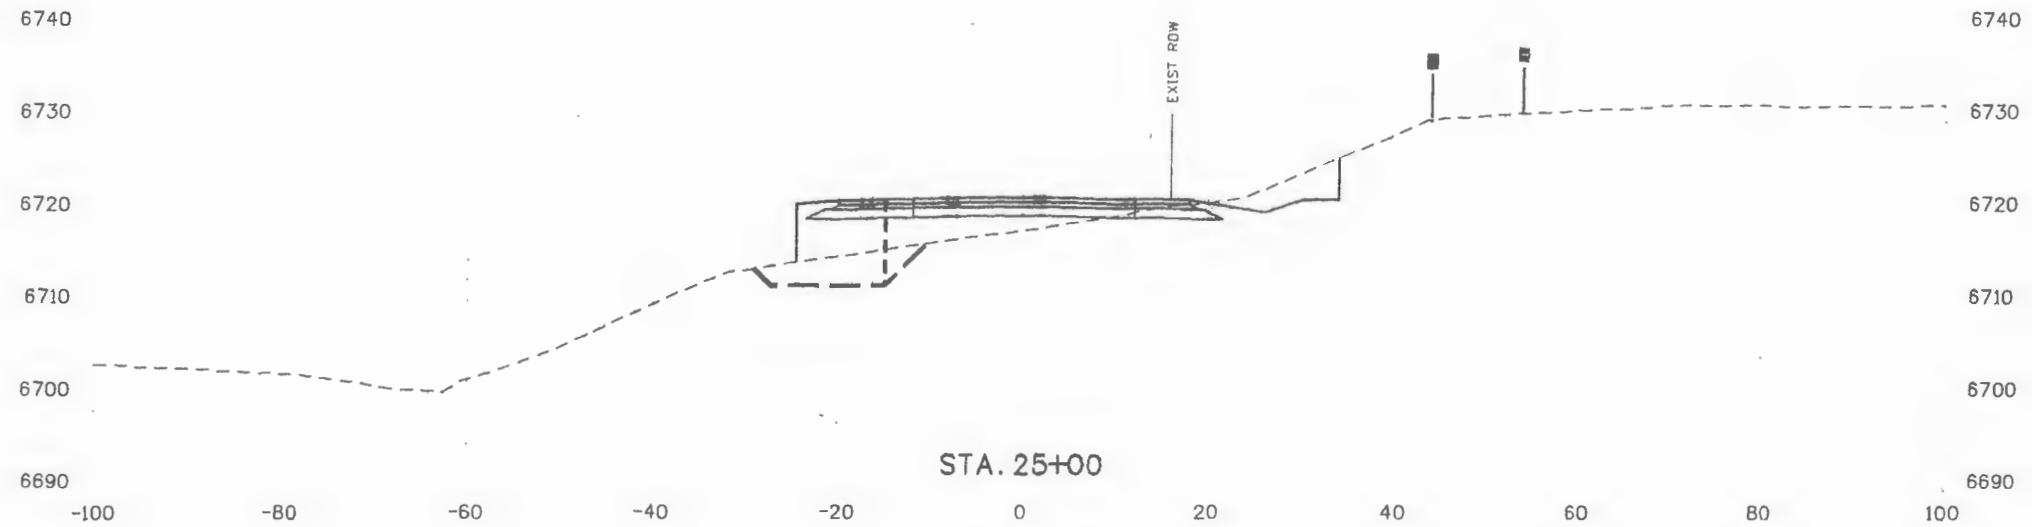

Added by 12-23

Print Date: 2/25/2010		Sheet Revisions Date: Comments Init. 			Colorado Department of Transportation 3803 North Main Avenue Suite 200 Durango, CO 81301 Phone: 970-385-1440 FAX: 970-385-8365 Region 5		As Constructed No Revisions:		STR Wall P-05-BB CROSS SECTION		Project No./Code ES5 190A-010	
File Name: 17269 WallB Quantities.dgn							Revised: <i>8/27/10</i> Void:				Designer: SPC Detailer: mn	
Horiz. Scale: 1:20 Vert. Scale: As Noted		<input checked="" type="checkbox"/> R-X <input type="checkbox"/> O <input type="checkbox"/> O <input type="checkbox"/> O				EJA						
Unit Information Unit Leader Initials												

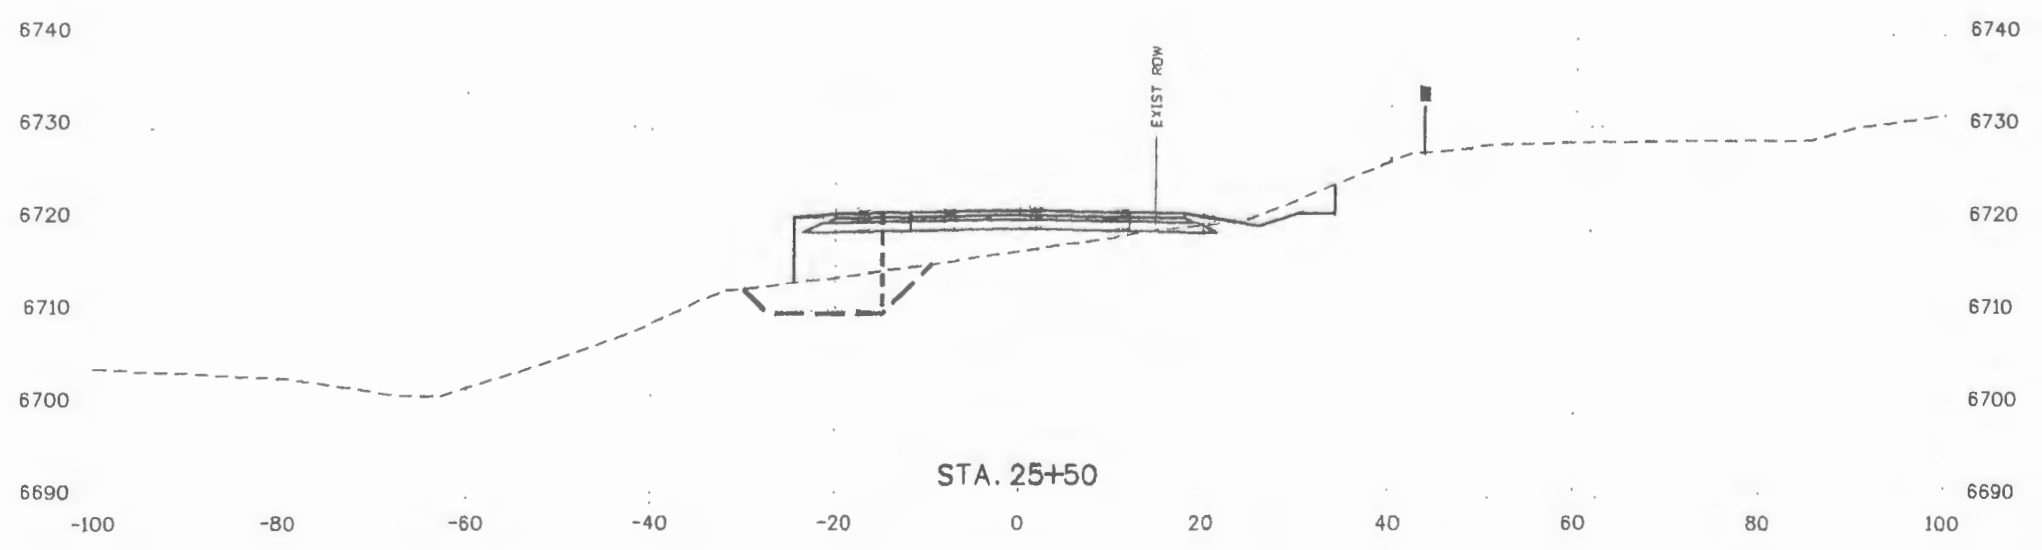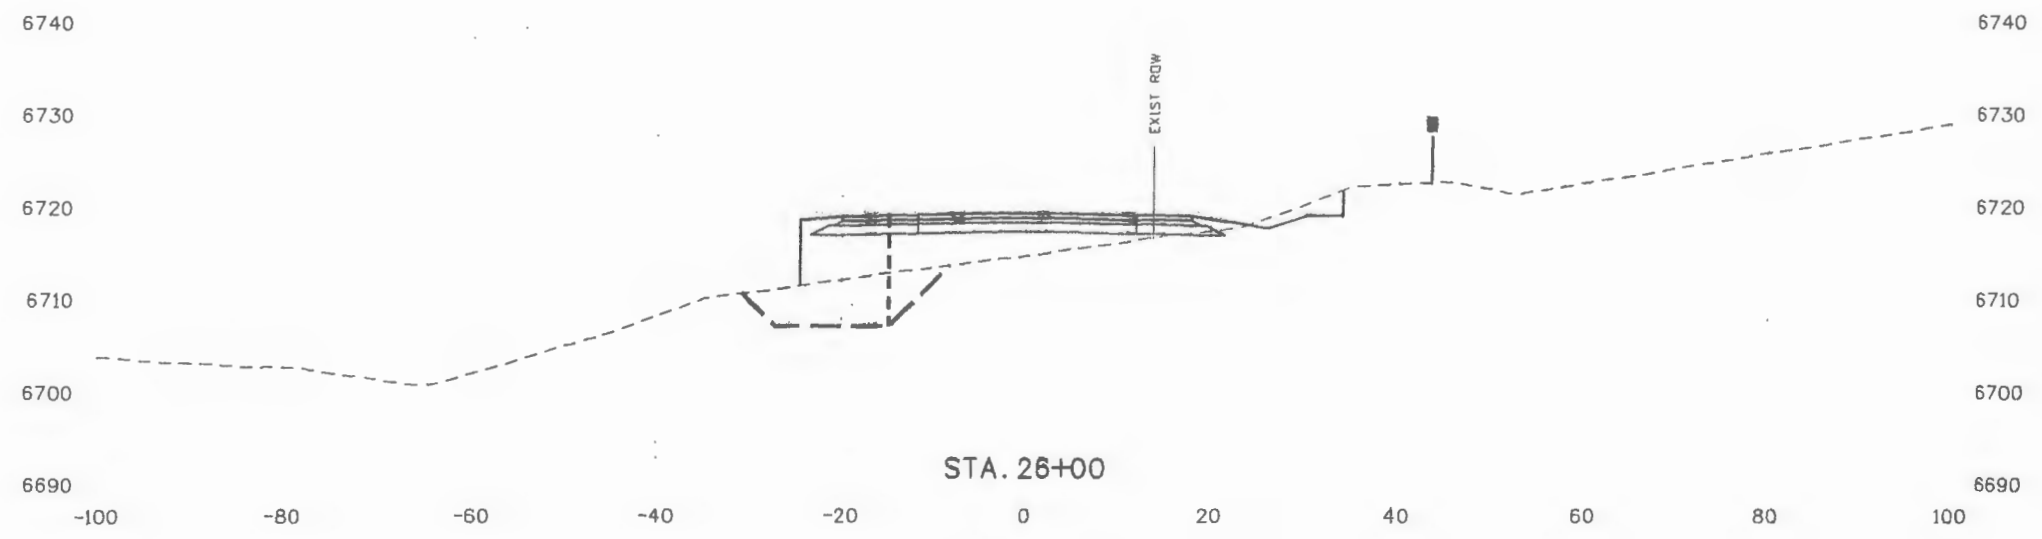


Added by 105-23

Print Date: 2/25/2010	Sheet Revisions			Colorado Department of Transportation 3803 North Main Avenue Suite 200 Durango, CO 81301 Phone: 970-385-1440 FAX: 970-385-8365 Region 5 EJA	As Constructed	STR Wall P-05-BB		Project No./Code
File Name: 17269 Wall B Quantities.dgn	Date:	Comments	Init.		No Revisions:	CROSS SECTION		ES5 160A-010
Horiz. Scale: 1:20					Revised: 8/27/10	Designer: SPC	Structure Numbers: P-05-BB	17269
Unit Information					Void:	Detailer: mn	Sheet Subset: Wall_Xsec	Subset Sheets: W5 of W6

nranjcm 10:26:00 AM C:\Project\17269\Working\17269\17269 Wall B Quantities.dgn

nrcan\jcm 10:26:02 AM C:\Project\wise\PWZ_Working\drms50628\17269 Wall B Quantities.dgn

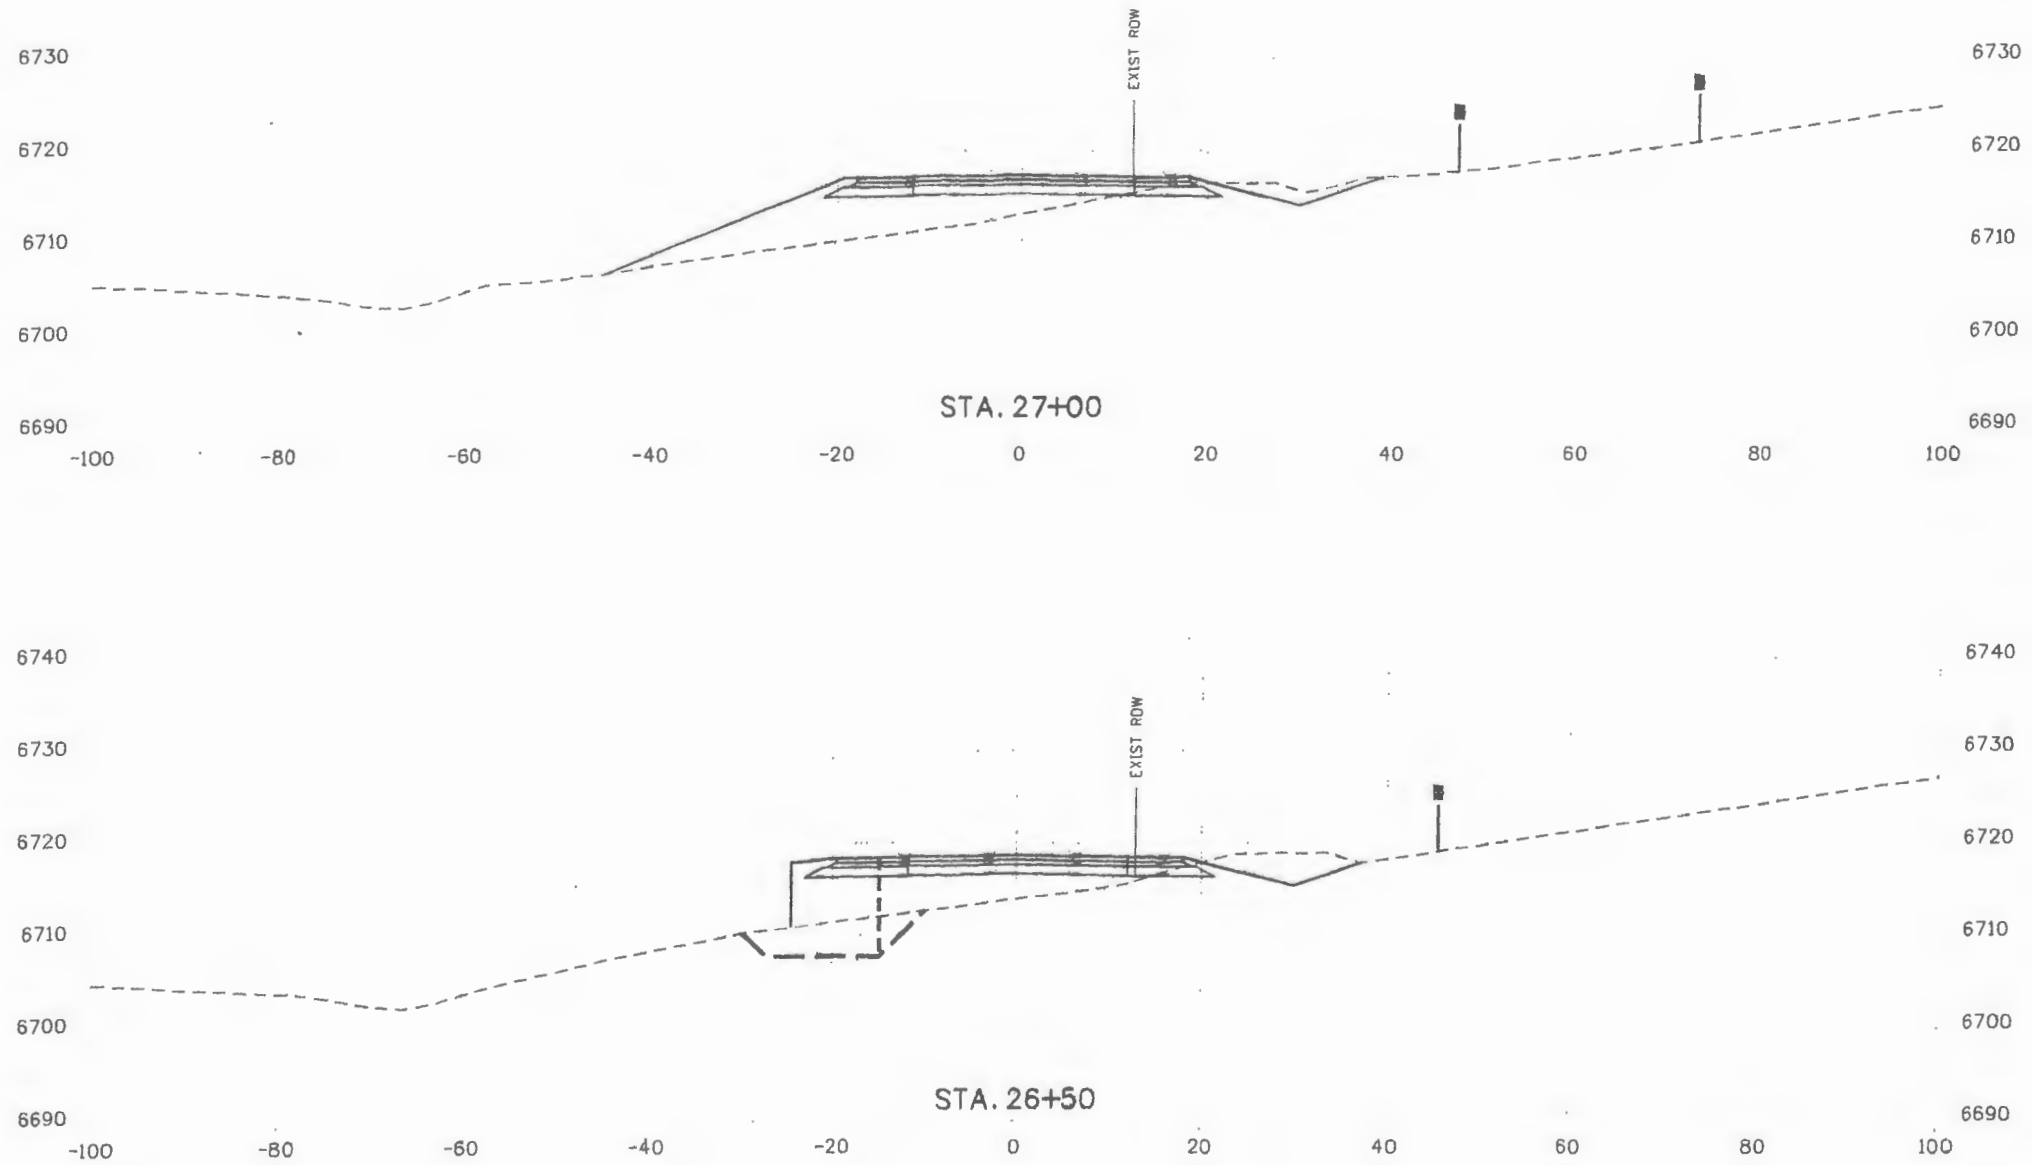

Added by 105-23

Print Date: 2/25/2010		Sheet Revisions			Colorado Department of Transportation		As Constructed		STR Wall P-05-BB		Project No./Code			
File Name: 17269 Wall B Quantities.dgn		Date:	Comments	Init.	 3803 North Main Avenue Suite 200 Durango, CO 81301 Phone: 970-385-1440 FAX: 970-385-8365		No Revisions:		CROSS SECTION		ES5 160A-010			
Horiz. Scale: 1:20	Vert. Scale: As Noted						Revised: <i>8/27/10</i>	Designer: SPC	Structure Numbers	P-05-BB		17269		
Unit Information							Void:	Detailer: mn		Sheet Subset: Wall_Xsec		Subset Sheets: W6 of W6	Sheet Number	64
	Unit Leader Initials													
					Region 5		EJA							