

*Stuka*

SEE STANDARD M-100-A FOR STANDARD SYMBOLS

### TABULATION OF LENGTH & DESIGN DATA

STATION	ROADWAY LIN. FT.	MAJOR STRUCTURES LIN. FT.
838+00.0 BEGIN I 70-2(42)197 = 838+00.0 ON I 70-2(45)194	4,197.00	
879+97.00		381.00
883+78.00 STR. NO. F-12-AL	517.90	
888+96.90 (PROJ.) Bk. = EQUATION	11,192.35	
889+03.64 (SURV.) Ab.		
1000+95.99 Bk. = EQUATION	1,068.06	
1004+90.08 Ab.		
1015+58.14		
1015+58.14 END I 70-2(42)197 = 1015+58.14 ON I 70-2(52)197		
<b>TOTALS</b>	<b>16,975.31</b>	<b>381.00</b>
<b>SUMMARY</b>		
	LIN. FT.	MILES
ROADWAY	16,975.31	3.215
MAJOR STRUCTURES	381.00	.072
<b>TOTAL (NET AND GROSS)</b>	<b>17,356.31</b>	<b>3.287</b>


## STATE DEPARTMENT OF HIGHWAYS DIVISION OF HIGHWAYS - STATE OF COLORADO

### PLAN AND PROFILE OF PROPOSED FEDERAL AID PROJECT NO. I 70-2(42)197 STATE HIGHWAY NO. 70 SUMMIT COUNTY

SCALES OF ORIGINAL DRAWINGS  
ON PLAN. 1 IN. = 100 FT.  
ON PROFILE. 1 IN. = 100 FT. HORIZONTAL  
1 IN. = 10 FT. VERTICAL  
GRADE LINE ON PROFILE IS SHOWN AS GRADE OF FINISHED ROAD

**DESIGN DATA**

MAXIMUM DEGREE OF CURVE	5°00'
MAXIMUM GRADE	5.8914
MINIMUM SSD HORIZONTAL	548'
MINIMUM SSD VERTICAL	466'
MAXIMUM DESIGN SPEED	60 MPH
1997 DESIGN TRAFFIC ADT	15,900
DHY	3,180

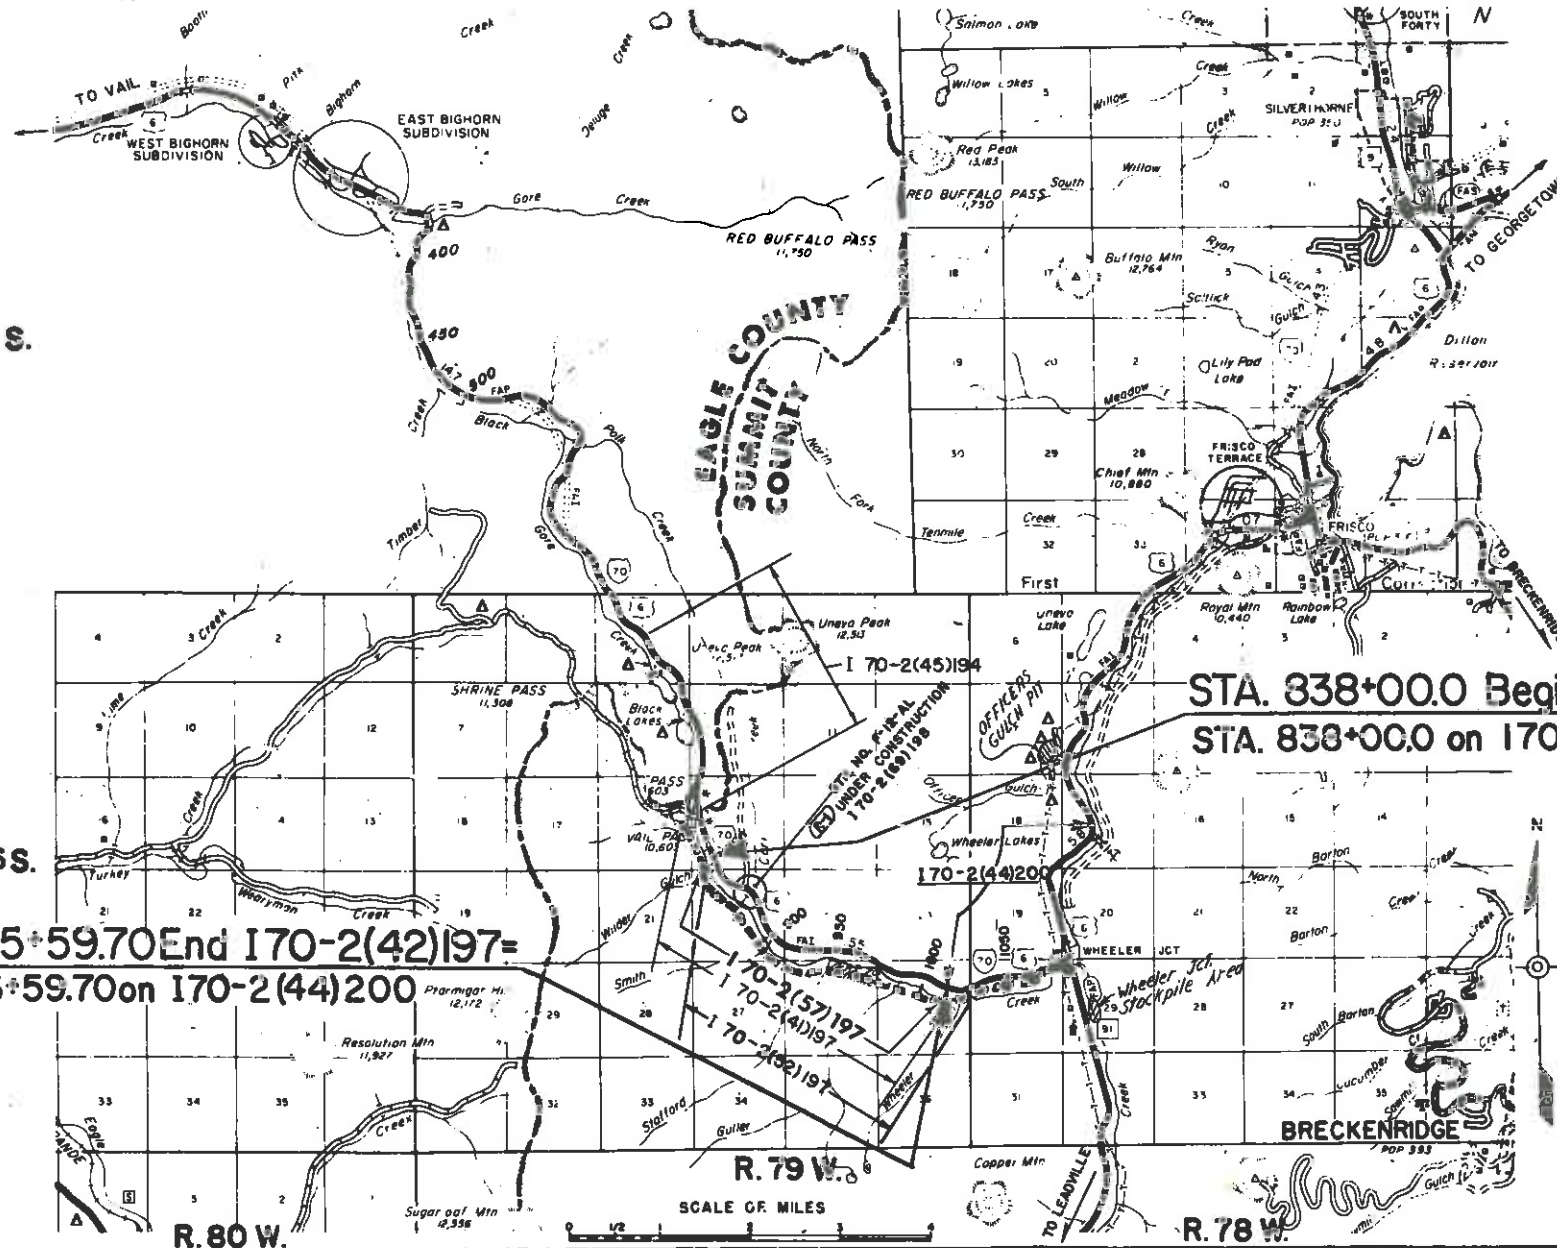

#### INDEX OF SHEETS

SHEET NO.	DESCRIPTION
1	TITLE SHEET
2	TYPICAL SECTIONS
3 - 7	SUMMARY OF APPROXIMATE QUANTITIES
8	GENERAL NOTES, SUMMARY OF EARTHWORK QUANTITIES AND TABULATION OF INTERCEPTING DITCHES
9 - 12	STRUCTURE QUANTITIES
13	SURFACING PLAN
14	WHEELER JUNCTION STOCKPILE AREA
15	DELINEATORS, SEAL COAT, AND DETAILS OF CONCRETE BARRIER DELINEATOR
16	MULCH NETTING, SOIL RETENTION BLANKET (JUTE) AND DETAILS OF MULCH NETTING
17	GUARD RAIL AND DETAILS OF DRY RUBBLE SLOPE AND DITCH PAVING
18	SILT FENCE AND DETAILS OF SILT FENCE
19	TIMBER CRIB WALL DETAILS
20 - 23	CORRAL CREEK: LANDSCAPE - EROSION CONTROL PLAN
24 - 42	ALIGNMENT PLAN AND PROFILE
43 - 64	SIGNING AND STRIPING PLANS

M-100-A	STANDARD SYMBOLS	"M" STANDARDS
M-107-A	TEMPORARY EROSION CONTROL	4-21-75
M-203-B	APPROACH ROADS, FLARING, CUT SLOPE TREATMENT, BRIDGE AND CREST WIDENING	12-11-72
M-203-C	DITCH TYPES	7-23-68
M-203-SD	SUPERELEVATION OF CURVES - DIVIDED HIGHWAYS	1-6-77
M-206-AB	EXCAVATION AND BACKFILL FOR STRUCTURES	(3 SHEETS) 5-8-78
M-214-A	PLANTING DETAILS	10-28-77
M-603-CA	CONCRETE AND METAL END SECTIONS	8-29-77
M-603-NA	METAL CULVERT PIPE - H-20 LOADING	8-20-75
M-604-DA	STEPS FOR MANHOLES AND INLETS	9-20-76
M-604-H	INLET, TYPE D	10-31-74
M-606-EA	GUARD RAIL, TYPE 4, CONCRETE BARRIER PRECAST - PORTABLE	10-28-77
M-707-CB	TYPICAL ALTERNATE COUPLING BANDS FOR CORRUGATED CULVERT PIPE	1-25-78

T.S.S.      T.S.S.

**STA. 1015+59.70 End I 70-2(42)197 =**  
**STA. 1015+59.70 on I 70-2(44)200**

**STA. 338+00.0 Begin I 70-2(42)197 =**  
**STA. 838+00.0 on I 70-2(45)194**

CONTINUED ON SHEET NO. 8

DIVISION OF HIGHWAYS

APPROVED: *W. J. Capron* 7-21-78  
FOR CHIEF ENGINEER DATE

DEPARTMENT OF TRANSPORTATION  
FEDERAL HIGHWAY ADMINISTRATION

APPROVED: \_\_\_\_\_ DATE \_\_\_\_\_

DIVISION ADMINISTRATOR

*M.C.B.*

AS CONSTRUCTED INFORMATION

CONTRACTOR: \_\_\_\_\_

ENGINEER (Project or Resident): \_\_\_\_\_

PROJECT STARTED: \_\_\_\_\_




PROJECT COMPLETED: \_\_\_\_\_

AS CONSTRUCTED PLANS APPROVED: \_\_\_\_\_

TITLE \_\_\_\_\_ DATE \_\_\_\_\_

AS CONSTRUCTED		FEDERAL ROAD REGION NO.	DIVISION	PROJ. NO.	SHEET NO.	TOTAL SHEETS
NO REVISIONS	REVISED	VOID	VIII	COLORADO	170-2(92)197	2


WIDENING FOR GUARD RAIL

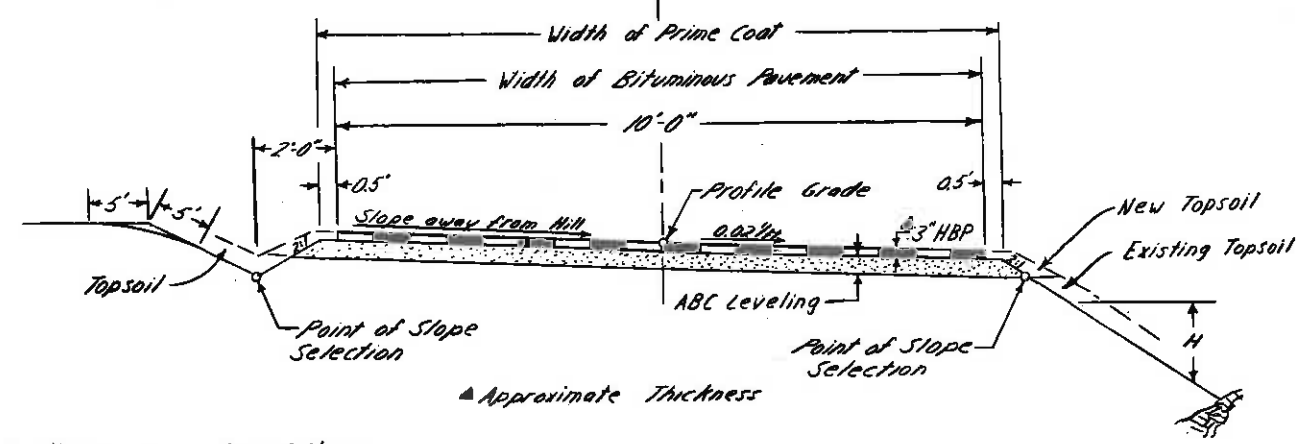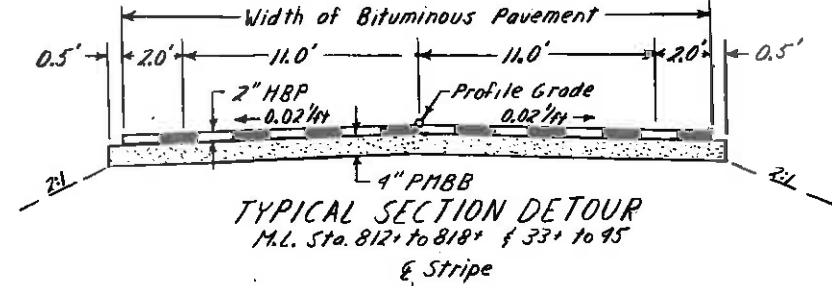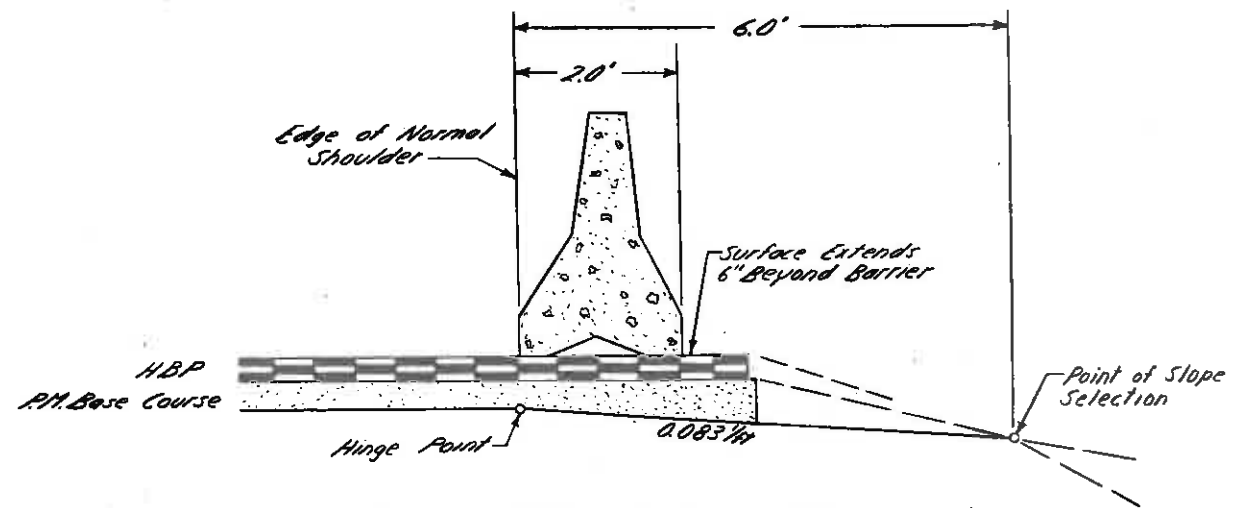

NOTE: Grading For Recreation Trail Was Completed on Previous Project, I70-2(68)197. Any additional grading shall be accomplished by Equipment Hours

Material shall be placed in separate courses at the following approximate rate per 100 lin. ft. of the Recreation Trail  
 Bituminous Pavement - Top Layer 19 Tons  
 ABC Leveling Course - Bottom Layer 7 Tons

TYPICAL SECTION (WEST BOUND ONLY)

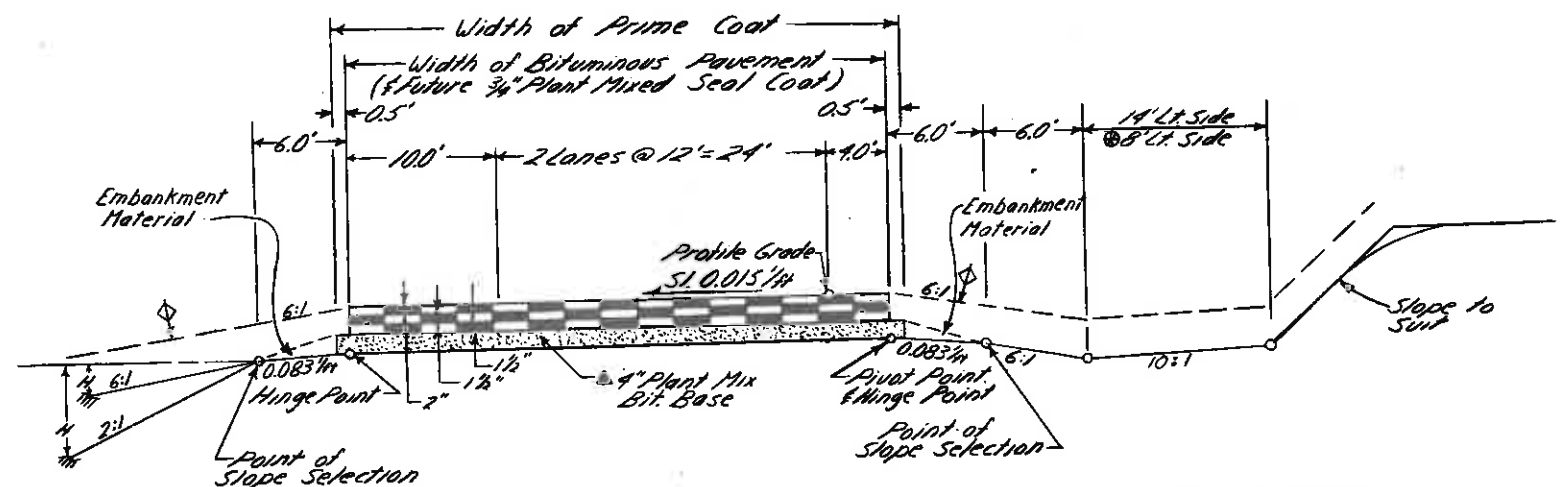

\* FILL SLOPE

H	Slope
0' to 10'	6:1
10' to 20'	4:1
20' to 30'	3:1
Over 30'	2:1

\* For information only, See Cross-Section

\* CUT SLOPE

H	Slope
0' to 6'	6:1
6' to 10'	4:1
10' to 15'	3:1
Over 15'	2:1


\* For information only, See Cross-Sections

Topsoil this Project  
 Sta. 996+00 to 996+50  
 Approximate Thickness

For Rock Cuts See Cross Sections For Slopes

Material shall be placed in separate courses at the following approximate rate per 100 lin. ft. of roadway:  
 Bituminous Pavement - Top Layer 47 Tons  
 Middle Layer 35 Tons  
 Bottom Layer 35 Tons  
 Plant Mix Bituminous Base 96 Tons

The rates shown have been determined from information available at the time of design. Rates should be adjusted during construction to obtain the required approximate thickness  
 Hot Bituminous Pavement may be placed in two lifts when approved by the Engineer.  
 Break points on slopes and in bottoms of ditches shall be rounded on construction for a pleasing appearance.  
 Slopes shall be varied as directed by the Engineer for aesthetics

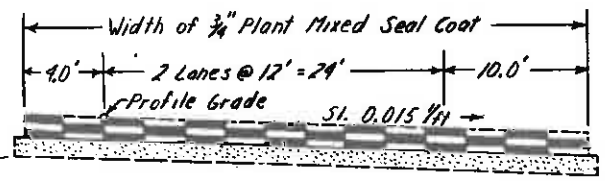

TYPICAL SECTION (EAST BOUND ONLY)

Seal Coat shall be placed at the following approximate rate - 18 Tons per 100 Lin. Ft. of Roadway

## SUMMARY OF APPROXIMATE QUANTITIES

AS CONSTRUCTED		
NO REVISIONS <input type="checkbox"/>	REVISED <input type="checkbox"/>	VOID <input type="checkbox"/>

FEDERAL ROAD DISTRICT NO.	DIVISION	PROJ. NO.	SHEET NO.	TOTAL SHEETS
XIII	COLORADO	170-2(42)197	3	

INDEX			CONTRACT ITEM NO.	CONTRACT ITEM	UNIT	STR. NO. F-12-AL	ROADWAY	PROJECT TOTALS
BOOK	PAGE	SHEET						
			201	Clearing and Grubbing	L.S.		1	1
			202	Removal of Structure	Each		35	35
			202	Removal of Pavement Marking	Sq. Ft.		21,193	21,193
			202	Removal of Bridge	Each		2	2
			202	Removal of Ground Sign	Each		7	7
			203	Unclassified Excavation	Cu. Yd.		360,898	360,898
			203	Compaction (AASHTO T 180)	Cu. Yd.		420,881	420,881
			203	Vibratory Rolling	Hour		100	100
			203	Blading	Hour		100	100
			203	Dozing	Hour		350	350
			203	Dozing (Landscaping)	Hour		200	200
			203	Truck (Dump)	Hour		150	150
			203	Front End Loader	Hour		300	300
			203	Combination Loader	Hour		400	400
			204	Haul	Yd. Mi.		334,706	334,706
			204	Haul	Ton Mi.		177,810	177,810
			206	Structure Excavation	Cu. Yd.		12,241	12,241
			206	Structure Backfill (Class 2)	Cu. Yd.		2,983	2,983
			206	Filter Material (Class A)	Cu. Yd.		6,972	6,972
			206	Bed Course Material	Cu. Yd.		61	61
			207	Topsoil (Haul)	Cu. Yd.		34,530	34,530
			209	Wetting	M. Gal.		10,559	10,559
			209	Water (Landscaping)	M. Gal.		1,100	1,100

(R-1) 8-9-78, Asphalt Cement, WCB

SUMMARY OF APPROXIMATE QUANTITIES

AS CONSTRUCTED  
 NO REVISIONS  REVISED  VOID

REGIONAL ROAD DISTRICT	DIVISION	PROJ. NO.	SHEET NO.	TOTAL SHEETS
XIII	COLORADO	170-2(12)/97	4	

INDEX			CONTRACT ITEM NO.	CONTRACT ITEM	UNIT	STR. NO. F-12-AL	ROADWAY	PROJECT TOTALS
BOOK	PAGE	SHEET						
			210	Reset End Section	Each		2	2
			210	Reset Ground Sign	Each		1	1
			212	Seeding (Native)	Lb		2,090	2,090
			212	Seeding (Forbs)	Ounce		18	18
			212	Fertilizer	Lb.		21,630	21,630
			212	Soil Preparation (Native)	Acre		44	44
			213	Mulching	Ton		50	50
			213	Mulching (Hydraulic)	Ton		19	19
			213	Mulch Netting (Paper)	Sq. Yd.		105,859	105,859
			213	Soil Retention Blanket (Jute)	Sq. Yd.		25,886	25,886
			301	Plant Mix Bituminous Base (Class 6)	Ton		18,467	18,467
			304	Aggregate Base Course (Class 6) (Haul)	Ton		2,114	2,114
			403	Hot Bituminous Pavement (Grading E)	Ton	180	20,551	20,731
			403	Hot Bituminous Pavement (Grading E) (Haul)	Ton		4,405	4,405
			410	Plant Mix Seal (Type B)	Ton		4,688	4,688
(R-1)			411	Asphalt Cement (AC-5)	Ton	11	1,766	1,777
(R-1)			411	Asphalt Cement (AC-5) (Fortified)	Ton		759	759
			411	Asphalt Cement (AC 20) (Rubberized)	Ton		305	305
			411	Emulsified Asphalt (CSS-1H)	Gal.		15,670	15,670
			411	Liquid Asphaltic Material (MC-70)	Gal.		40,714	40,714
			504	Place Timber Cribbing	Sq. Ft.		3,864	3,864
			506	Heavy Riprap	Cu. Yd.		100	100
			507	Dry Rubble Slope and Ditch Paving	Cu. Yd.		121	121
			515	Waterproofing (Membrane)	Sq. Yd.	1,624		1,624



## SUMMARY OF APPROXIMATE QUANTITIES

AS CONSTRUCTED			FEDERAL ROAD DISTRICT NO.	CITY/TOWN	PROJ. NO.	SHEET NO.	TOTAL SHEETS
NO REVISIONS	REVISED	VOID	XIII	COLORADO	170-2(42)197	5	

INDEX			CONTRACT ITEM NO.	CONTRACT ITEM	UNIT	STR. NO. F-12-AL	ROADWAY	PROJECT TOTALS
BOOK	PAGE	SHEET						
			603	18 Inch Corrugated Steel Pipe	Lin. Ft.		112	112
			603	24 Inch Corrugated Steel Pipe	Lin. Ft.		2,538	2,538
			603	30 Inch Corrugated Steel Pipe	Lin. Ft.		106	106
			603	36 Inch Corrugated Steel Pipe	Lin. Ft.		80	80
			603	42 Inch Corrugated Steel Pipe	Lin. Ft.		390	390
			603	18 Inch Steel End Section	Each		10	10
			603	24 Inch Steel End Section	Each		27	27
			603	30 Inch Steel End Section	Each		2	2
			603	36 Inch Steel End Section	Each		1	1
			603	42 Inch Steel End Section	Each		2	2
			604	Inlet Type D (5 Foot)	Each		17	17
			605	8 Inch Perforated Corrugated Steel Pipe	Lin. Ft.		14,164	14,164
			605	8 Inch Non Perforated Corrugated Steel Pipe	Lin. Ft.		120	120
			606	Guard Rail (Type 4) (Precast-Portable) (Colored)	Lin. Ft.		2,572	2,572
			607	Silt Fence	Lin. Ft.		1,200	1,200
			612	Delineator (Type 1)	Each		186	186
			612	Delineator (Type 1) (Barrier)	Each		14	14
			612	Reflector	Each		143	143
			614	Flagging	Hour		10,000	10,000

## SUMMARY OF APPROXIMATE QUANTITIES

AS CONSTRUCTED

NO REVISIONS  REVISED  VOID

FEDERAL ROAD DISTRICT NO.	DIVISION	PROJ. NO.	SHEET NO.	TOTAL SHEETS
333	COLORADO	170-2(42)197	6	

INDEX			CONTRACT ITEM NO.	CONTRACT ITEM	UNIT	STR. NO. F-12-AL	ROADWAY	PROJECT TOTALS
BOOK	PAGE	SUBJECT						
			614	Sign Panel (Class 1)	Sq. Ft		52	52
			614	Timber Sign Post (4x4) Inch	Lin. Ft		96	96
			614	Steel Sign Post (U-2)	Lin. Ft		33	33
			614	Concrete Footing (Type 4)	Each		2	2
			614	Modification of Sign Legend	L.S.		1	1
			614	Flashing Yellow Beacon (Portable)	Each		2	2
			614	Barricade (Type 3 M-A) (Temporary)	Each		21	21
			614	Barricade (Type 3 M-C) (Temporary)	Each		3	3
			614	Barricade (Type 3 M-D) (Temporary)	Each		1	1
			614	Construction Traffic Sign (Panel Size A)	Each		9	9
			614	Construction Traffic Sign (Panel Size B)	Each		37	37
			614	Construction Traffic Sign (Panel Size C)	Each		17	17
			614	Vertical Panel	Each		50	50
			614	Traffic Cone	Each		50	50



# GENERAL NOTES

FOR PRELIMINARY PLAN QUANTITIES OF BITUMINOUS MATERIALS AND COVER COAT MATERIALS, THE FOLLOWING RATES OF APPLICATION WERE USED:

PRIME COAT (MC-70) @ 0.40 GALS. PER SQ. YD.  
TACK COAT (CS-1H) @ 0.10 GALS. PER SQ. YD.

DILUTED EMULSIFIED ASPHALT FOR TACK COAT SHALL CONSIST OF 1 PART EMULSIFIED ASPHALT AND ONE PART WATER.

RATES OF APPLICATION SHALL BE AS DETERMINED BY THE ENGINEER AT THE TIME OF APPLICATION.

ANY LAYER OF BITUMINOUS PAVEMENT THAT IS TO HAVE A SUCCEEDING LAYER PLACED THEREON SHALL BE COMPLETED FULL WIDTH BEFORE SUCCEEDING LAYER IS PLACED.

DILUTED EMULSIFIED ASPHALT SHALL BE USED AS A DUST PALLIATIVE WHERE REQUIRED AND SHALL CONSIST OF A DILUTION OF CS-1H AND WATER, THE PORTIONS OF WHICH SHALL BE 9 PARTS WATER AND 1 PART CS-1H, BASED ON VOLUME MEASUREMENT. PLAIN WATER SHALL BE USED AS A DUST PALLIATIVE WHERE REQUIRED IN OTHER AREAS. LOCATIONS SHALL BE AS ORDERED.

THE FOLLOWING SHALL BE FURNISHED WITH EACH BITUMINOUS PAYER:

1. A SKI TYPE DEVICE AT LEAST 30 FEET IN LENGTH.
2. AT LEAST 5,000 FEET OF CONTROL LINE AND STAKES.

IT IS ESTIMATED THAT OLD ROAD IS TO BE OBLITERATED AT THE FOLLOWING LOCATIONS:

STATIONS 874+ TO 887+.

DEPTH OF MOISTURE-DENSITY CONTROL FOR THIS PROJECT SHALL BE AS FOLLOWS:

FULL DEPTH OF ALL EMBANKMENTS

BASES OF CUTS 1 FOOT

BASES OF FILLS 1 FOOT.

COMPACTION FOR THIS PROJECT SHALL BE AASHTO T 180.

EXCAVATION REQUIRED FOR COMPACTION OF BASES OF CUTS AND FILLS WILL BE CONSIDERED AS SUBSIDIARY TO THAT OPERATION AND WILL NOT BE PAID FOR SEPARATELY.

IT IS ESTIMATED THAT 10,000 HOURS OF FLAGGING FOR CONTROLLING TRAFFIC WILL BE REQUIRED FOR THIS PROJECT.

THE MINIMUM THICKNESS OF TOPSOIL SHALL BE 4 INCHES. IT IS ESTIMATED THAT 33,780 CU. YDS. WILL BE REQUIRED FOR ROADWAY AND 750 CU. YDS. FOR SHOULDER EDGE ON RECREATION TRAIL. APPROXIMATELY 34,530 WILL BE OBTAINED FROM STOCKPILES RIGHT OF STATION 948+, FROM ROADWAY STATION 880+ (N.B.) AND SURFACING STOCKPILE AREA

SEEDING, SOIL PREPARATION, FERTILIZING WITH COMMERCIAL FERTILIZER, AND MULCHING WILL BE REQUIRED FOR APPROXIMATELY 44 ACRES ON ALL DISTURBED AREAS NOT SURFACED.

ALL ROADWAY CUT SLOPE DITCHES SHALL HAVE SOIL RETENTION BLANKET (JUTE) APPLIED TO CONTROL EROSION.

SEEDING SHOWN BELOW WILL BE REQUIRED ON ALL ROADWAY DITCHES IN ADDITION TO NORMAL SEEDING.

COMMON NAME	BOTANICAL NAME	PERCENT PURITY	PERCENT GERMINATION	RATE PLS/ACRE
RED FESCUE V. DAWSON	FESTUCA RUBRA	80	77	35
FULTS	PUCCINELLIA DISTANS	85	80	35
LEMMONI	PUCCINELLIA DISTANS	85	80	20
KENTUCKY BLUEGRASS V. NUGGET	POA PRATENSIS	80	68	20
TOTAL PLS/ACRE SEEDING				110

CLASS "AX" CONCRETE WILL BE PERMITTED ON THIS PROJECT IN LIEU OF CLASS "A".

IT IS ESTIMATED THAT THE FOLLOWING WILL BE REQUIRED ON THIS PROJECT:

ITEM	HOURS
BLADING	100
DOZING	350
DOZING (LANDSCAPING)	200
TRUCK (DUMP)	150
FRONT END LOADER (RUBBER TIRE)	300
COMBINATION LOADER	400

IT IS ESTIMATED THAT 1,624 SQ. YDS. OF WATERPROOFING (MEMBRANE) WILL BE REQUIRED FOR CORRAL CREEK BRIDGE, STA. 880+.

ADDITIONAL LANDSCAPING MAY BE DONE ON FUTURE CONTRACT.

IT IS ESTIMATED THAT EXISTING HAUL ROAD IS TO BE OBLITERATED. WORK PAID FOR BY EQUIPMENT HOURS, TOPSOIL SEED AND MULCH.

COMMON NAME	BOTANICAL NAME	PERCENT PURITY	PERCENT GERMINATION	RATE PLS/ACRE
STREAMBANK WHEATGRASS	AGROPYRON RIPARIUM	97	92	7
WESTERN WHEATGRASS	AGROPYRON SMITHII	85	70	4
KENTUCKY BLUEGRASS	POA PRATENSIS	85	75	3
SMOOTH BROME (MANCHAR)	BRONUS INERMIS	85	80	5
TIMOTHY	PHLEUM PRATENSE	99	90	4
RED FESCUE	FESTUCA RUBRA	98	85	3
MEADOW FOXTAIL	ALOPECURUS PRATENSIS	95	80	4
SLENDER WHEATGRASS	AGROPYRON PAUCIFLORUM	90	85	5
WHITE DUTCH CLOVER	TRIFOLIUM REPENS	98-1/2	90	2
ALSIKE CLOVER	TRIFOLIUM HYBRIDUM	98-1/2	90	3
TOTAL PLS/ACRE SEEDING (NATIVE)				40

COMMERCIAL FERTILIZER (FOR SEEDING)	PERCENT AVAILABLE	LBS/ACRE AVAILABLE	LBS/ACRE AVAILABLE	RATE LBS/ACRE
NITROGEN (18-0-0)	18	50		278
POTASH (0-45-0)	45		100	222
TOTAL LBS/ACRE FERTILIZER				500

RATE OF APPLICATION WILL BE ADJUSTED BY THE ENGINEER TO MEET SOIL CONDITIONS. SEEDING (FORBS) WILL BE REQUIRED WHERE DESIGNATED. APPROXIMATELY 5 ACRES WILL BE SEEDED WITH FORBS. THE FOLLOWING TYPES AND RATES SHALL BE USED:

COMMON NAME	BOTANICAL NAME	OUNCES PLS/ACRE
PRIMROSE, YELLOW EVENING	DENOTHERA HOOKERI	1/2
PENSTEMON	PENSTEMON SPP. MIXED	1/2
GENTIAN, FRINGED	GENTIAMOPSIIS THERMALIS	1/4
IRIS, WILD BLUE	IRIS MISSOURIENSIS	1/2
FLAX, WILD BLUE	LINUM LEWISII	1/2
COLUMBINE	AQUILEGIA	1/4
DAISY, ASPEN, FLEABANE	ERIGERON SPECIOSUS	1/4
COMPOSITES		3/4
TOTAL OZ./ACRE FORBS		3-1/2

SEED TYPES THAT ARE NOT AVAILABLE AT TIME OF CONSTRUCTION MAY BE SUBSTITUTED FOR AFTER APPROVAL OF THE ENGINEER.

THE ACTUAL TYPE OF MULCH AND SEEDING METHOD SHALL BE DETERMINED BY THE ENGINEER AT THE TIME OF APPLICATION. NORMALLY THE FOLLOWING WILL BE USED:

FOR ALL SLOPES 3:1 OR FLATTER, SEEDING SHALL BE DONE BY DRILLING. HYDRAULIC MULCHING SHALL BE APPLIED AT A RATE OF 1 TON PER ACRE.

FOR ALL SLOPES STEEPER THAN 3:1, SEEDING SHALL BE DONE BY THE HYDRAULIC METHOD OR HANDBROADCAST WHERE PERMITTED. MULCHING SHALL BE NATIVE HAY APPLIED AT A RATE OF 2 TONS PER ACRE. THESE STEEPER SLOPES SHALL HAVE PAPER FIBER MULCH NETTING UNLESS OTHERWISE DIRECTED. CRITICALLY ERODIBLE SLOPES SHALL HAVE SOIL RETENTION BLANKETS APPLIED, AS DIRECTED BY THE ENGINEER.

## INTERCEPTING DITCHES

STATION TO	STATION	SIDE	CU. YDS.
838 + 00	to 839 + 50	Lt.	28
913 + 42	to 932 + 50	Lt.	380
940 + 00	to 968 + 00	Lt.	191
974 + 15	to 980 + 16	Lt.	113
984 + 67	to 988 + 23	Lt.	65
992 + 67	to 994 + 15	Lt.	29
996 + 18	to 1013 + 33	Lt.	306
TOTAL			1,112

## SEEDING SUMMARY

Seeding (Native) 2,090 lbs  
Fertilizer 21,630 lbs  
Soil Preparation (Native) 44 acres  
Mulching 50 tons  
Mulching (Hydraulic) 19 tons  
Seeding (Forbs) 18 ounces

## SUMMARY OF EARTHWORK QUANTITIES

INDEX	Book	Page	Sheet	QUANTITIES	UNIT
				<b>UNCLASSIFIED EXCAVATION</b>	
				Roadway (From Computer)	Cu. Yd.
				Structure Quantities as Embankment	349,591
				Estimate for Cut Slope Treatment	1,748
				Intercepting Ditches	1,112
				Topsoil - Remove	1,000
				Topsoil - Replace	1,000
				Shoulder Material	1,269
				TOTAL	360,898
				<b>COMPACTION (AASHTO T 180)</b>	
				Embankment (Net)	349,591
				Base of Cuts and Fills	66,112
				Structure Quantities as Emb. (Net)	5,178
				TOTAL	420,881
				<b>HAUL</b>	
				From Mass Diagram	Yd. Ft.
					334,706
				<b>ROADWAY QUANTITIES BALANCE</b>	
				(For Information Only)	
				EXCAVATION	
				Unclassified	349,591
				Total	
				EMBANKMENT, NET	
				Roadway (From Computer)	349,591
				* EMBANKMENT x FACTOR (1.0)	
				Roadway (From Computer)	349,591
				WETTING	M. Gal.
				Compaction	10,522
				Surfacing	37
				Total	10,559
				WATER (LANDSCAPING)	
				Seeding and Mulching	1,100
				Total	1,100

\* Includes 10,540 Cu. Yds. for Flattening Fill Slopes.

"S" STANDARDS

S-614-19B	TYPICAL GROUND SIGN PLACEMENT	11-17-71
S-614-20B	CLASS I GROUND SIGN INSTALLATIONS	11-02-73
S-614-21B	CLASS II GROUND SIGN INSTALLATIONS	12-02-69
S-614-26C	BREAK-AWAY SIGN SUPPORT DETAILS FOR GROUND SIGNS (2 SHEETS)	5-2-74
S-614-27C	CONCRETE, FOOTINGS AND SIGN ISLANDS FOR CLASS III SIGNS (2 SHEETS)	9-24-75
S-614-33D	MILEPOST SIGN AND INSTALLATION	10-28-77
S-614-39A	TRAFFIC SIGNING FOR HIGHWAY CONSTRUCTION (4 SHEETS)	5-8-78
S-614-52A	BARRICADES, DRUMS AND VERTICAL PANEL CHANNELIZING DEVICES	12-04-74
S-627-1A	TYPICAL PAVEMENT MARKINGS (2 SHEETS)	10-28-77







# STRUCTURE QUANTITIES

AS CONSTRUCTED  
NO REVISIONS  REVISED  VOID

FEDERAL ROAD DISTRICT NO.	DIVISION	PROJECT E.D.	SHEET NO.
VIII	COLORADO	170-2(42)197	11

INDEX BOOK PAGE SHEET	LOCATION	UNCLASSIFIED EXCAVATION CUBIC YARD			STRUCTURE EXCAVATION	STRUCTURE BACKFILL	REMOVAL OF STRUCTURE	AGGREGATE BASE COURSE SURFACING	HOT BITUMINOUS PAVEMENT	INLET TYPE D (8 FOOT)	FILTER MATERIAL (CLASS A)	8" NON-PERFORATED CSP	6" PERFORATED CSP	CORRUGATED STEEL PIPE LINEAR FEET						"H" OVER CULV.	DRY RUBBLE SLOPE AND DITCH FACING	STEEL END SECTION EACH					MISCELLANEOUS
		EXCAV.	EMB.	DITCH	CUBIC YARD	CUBIC YARD	EACH	TON	TON	EACH	"H"	CU. YD.	LINE FT.	LINE FT.	18"	24"	30"	36"	42"	FT.	CUBIC YARD	18"	24"	30"	42"	36"	
	936+																										
	938 + 938 + 50 939+ to 940+		25		52 100	42 300													68 40 8	8	3					2	1.5 Cu. Yd. - Bedding Course Material 600 Sq. Ft. - Timber Cribbing (Type A)
	940+ to 944+		70		257						187		380														
	944 + 50 945+ to 948+		19 65		43 239	29				1	3'-6"		173		350				68	4	3					1	1.5 Cu. Yd. - Bedding Course Material
	948+ 948 + 80 951 +		42		94	54				1	3'-6"								66 38 4	7	7					1	3.5 Cu. Yd. - Bedding Course Material
	953 + 50 958 +		40		87	44				1	3'-6"								64 28 8	5	4					1	2 Cu. Yd. - Bedding Course Material
	958 + 69 963+ to 968+ 963 + 10	10	38 92 13		90 333 43	48						246		500												2	
	970 + 40 970 + 972+ 973+ to 978+		186 78		350 283	168						207		420					88 110	25	8					1	4 Cu. Yd. - Bedding Course Material
	978 + 978 + 10 979+ to 982+ 982 + 60 985+		16 56 16		29 200 63	23 44				1	3'-6" 4'-6"		198		300					70	8 7	3 8				1	1.5 Cu. Yd. - Bedding Course Material 4 Cu. Yd. - Bedding Course Material
	985+55 986+ to 990+ 990+ to 991+		15 83		39 300	29				1	3'-6"		222		450				68	5	3					1	1.5 Cu. Yd. - Bedding Course Material 480 Sq. Ft. - Timber Cribbing (Type A)

# STRUCTURE QUANTITIES

AS CONSTRUCTED			FEDERAL ROAD REGION NO.	DIVISION	PROJECT NO.	SHEET NO.
NO REVISIONS	REVISED	VOID	VIII	COLORADO	170-2(42)197	12

INDEX BOOK PAGE SHEET	LOCATION	UNCLASSIFIED EXCAVATION CUBIC YARD			STRUCTURE EXCAVATION	STRUCTURE BACKFILL	REMOVAL OF STRUCTURE	AGGREGATE BASE COURSE SURFACING	HOT BITUMINOUS PAVEMENT	INLET TYPE D (5 FOOT)	FILTER MATERIAL (CLASS A)	6" NON-PERFORATED CSP	3" PERFORATED CSP	CORRUGATED STEEL PIPE LINEAR FEET						"H" OVER CULV.	DRY RUBBLE FLOVE AND DITCH PAVING	STEEL END SECTION EACH					MISCELLANEOUS
		EXCAV.	EMB.	DITCH	CUBIC YARD	CUBIC YARD	EACH	TON	TON	EACH	"H"	CU.YD.	LIN.FT.	LIN.FT.	18"	24"	30"	36"	42"	FT.	CUBIC YARD	18"	24"	30"	42"	36"	
	991+00		15		78	80													6	3						1.5 Cu. Yd. - Bedding Course Material	
	991+																										
	992+																										
	995+00		52		112	59													5	9				1		4.5 Cu. Yd. - Bedding Course Material	
	996+ to 999+		71		258						190		386														
	999+85		42		73	32				1	36"								5	3				1		1.5 Cu. Yd. - Bedding Course Material	
	1000+																										
	1005+ to 1011+		89		320						236		480														
	1007+																										
	1010+																										
	1011+00		65		106	95				1	36"								5					1			
	1011+ to 1014+		52		187						138		280														
	1014+																										
	1014+70		15		31	25				1	36"								8	6				1		3 Cu. Yd. - Bedding Course Material	
	33+ to 45+(E.B.)		1000	1000																							
	TOTALS		1560	5,178	12,241	2,485	35			17	6,972	120	14,164	112	2538	106	80	590			121	10	27	2	2	1	

△ Carried to Earthwork Summary  
● Carried to Surfacing Plan

① Requires 25" Elbows  
② Requires 15" Elbows  
③ Requires 5" Elbows  
④ Requires 25" and 30" Elbows

AS CONSTRUCTED			FEDERAL ROAD DISTRICT NO.	DIVISION	PROJ. NO.	SHEET NO.	TOTAL SHEETS
NO REVISIONS	REVISED	VOID	VIII	COLORADO	170-242/197	13	

### SURFACING PLAN

STATION	SOURCE	QUANTITY - TONS						HAUL - TON MILE						
		BASE COURSE		PMBB		SURFACE COURSE HOT BITUMINOUS PAVEMENT		BASE COURSE		PMBB		SURFACE COURSE HOT BITUMINOUS PAVEMENT		
		ABC CL6 (HAUL)	CL6	BOTTOM LAYER G.R.E.	MIDDLE LAYER G.R.E.	TOP LAYER G.R.E.	ABC CL6	CL6	BOTTOM LAYER G.R.E.	MIDDLE LAYER G.R.E.	TOP LAYER G.R.E.			
<u>MAINLINE</u> 838+00.00 to 879+97.00 STR. NO. F-12-A1			9,030		1,969	1,969	1,973			21,569		7,863	7,863	10,560
883+78.00 to 888+95.90(Prj) BA*			498		182	182	244			2,407		880	880	1,180
889+03.64 (Surv) Ah. to 1000+95.99 BA*			10,745		3,917	3,917	5,261			40,015		14,587	14,587	19,592
1004+90.08 Ah. to 1015+58.14			1,026		374	374	502			2,630		959	959	1,207
TEMPORARY DETOURS 812+ to 818+ (WB) 822+ 33+ to 45+ (EB) Guard Rail Widening		▲96 ▲50 ▲240	480		206	206	▲50 ▲30 ▲125 275			1,971		846	846	▲306 ▲189 ▲195 1,130
RECREATION TRAIL 200+00 to 206+25.01 BA*		▲44					▲119							▲733
0+00 Ah. to 29+08.5	Wheeler Flats Stockpiles	▲204					▲553							▲3,219
29+08.5 to 29+35.5 Str. F-12-A2							▲6							▲34
29+35.5 to 30+18.95 BA*		▲6					▲16			▲34				▲89
27+66.85 Ah. to 49+08.5	Wheeler Flats Stockpiles	▲150					▲407			▲799				▲2,166
49+08.5 to 49+35.5 Str. F-12-BA							▲6							▲31
49+35.5 to 94+75.5 94+75.5 to 95+14.5 Str. F-12-BB		▲318					▲863 ▲8			▲1,990				▲4,042 ▲34
95+14.5 to 98+26.29 BA*		▲22					▲60			▲93				▲253
99+88.34 Ah. to 116+93.5		▲120					▲324 ▲11			▲483				▲1,305 ▲43
116+93.5 to 117+50.5 Str. F-12-BC							▲173			▲242				▲657
117+50.5 to 126+57.5		▲64					▲9							▲34
126+57.5 to 127+02.5 Str. F-12-BD							▲109			▲149				▲395
127+02.5 to 132+74.87 BA*		▲41					▲1156 ▲380			▲1273 ▲313 ▲751				▲3,455 ▲848
133+74.87 Ah. to 194+57.80 194+57.80 to 214+57.80 Estimated for Irregularities		▲426 ▲140 ▲193	1,688							6,860				
<b>TOTALS</b>		▲2,114	18,967		6,148	6,148	8,935 ▲4,905			▲8,257	75,452	25,135	25,135	39,635 ▲17,968

Notes: Stabilization Based On  
 1. E.D.A. 18" Tip = 185  
 2. Regional Factor = 3.0  
 3. Serviceability Index = 2.5  
 4. Subgrade R Value = 47-82  
 Strength Coefficients  
 5. Hot Bituminous Pavement = 0.94  
 6. Plant Mix Bituminous Base = 0.39


\* Detour & Recreation Trail Quantities for Information Only  
 ▲ Detour & Recreation Trail Quantities

AS CONSTRUCTED		
NO REVISIONS	REVISED	VOID

PREPARED BY	DESIGNED	PROJECT NO.	SHEET NO.	TOTAL SHEETS
VAC	UNDESIGNED	170-2(42)197	19	

**WHEELER JUNCTION  
 STOCKPILE AREA**  
 SUMMIT COUNTY, COLO.  
 T. 6 S., R. 78 W., 6th P.M.  
 USE: ABC, AGGREGATE FOR PMBS,  
 HBP, PLANT MIX SEAL & TOPSOIL

WHEELER JUNCTION  
 STOCKPILE AREA

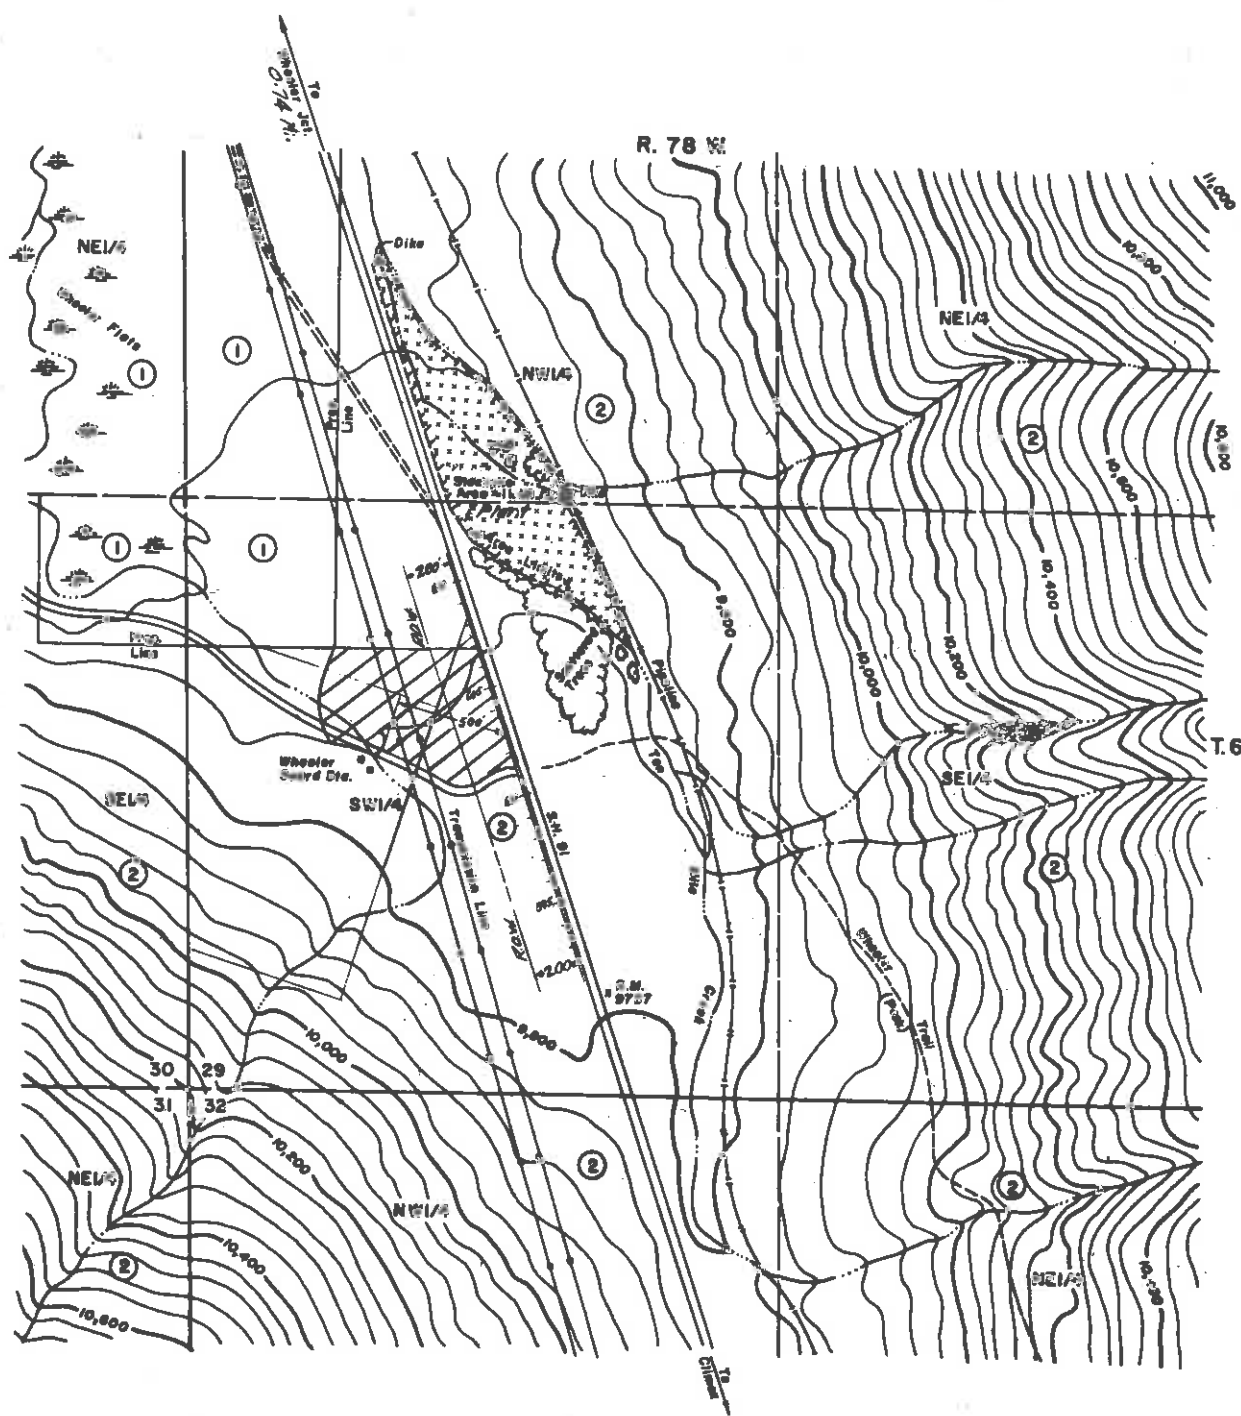

OWNERSHIP LEGEND	
PARCEL NO.	OWNER
1	Copper Mountain Inc.
2	Arapahoe National Forest

170-2(42)197 STOCKPILE AREA & PLANT AREA

NOTE



AS CONSTRUCTED		
NO REVISIONS	REVISED	VOID

FEDERAL ROAD DISTRICT NO.	DIVISION	PROJ. NO.	SHEET NO.	TOTAL SHEETS
VIII	COLORADO	170-2(42)/97	16	


### SEAL COAT

STATION (E.B. LANES)	SOURCE	QUANTITY-TONS		HAUL-TON MILE	
		SEAL COAT TYPE B TONS	SEAL COAT TYPE B TONS	SEAL COAT TYPE B TON-MILE	SEAL COAT TYPE B TON-MILE
823+00 to 878+22.62 Bk.	WHEELER JUNCTION STOCKPILE AREA	995		5,579	
878+34.33 Ah. to 942+63.44 Bk.		1,158		5,182	
942+72.35 Ah. to 965+94.76 Bk.		419		1,528	
966+07.10 Ah. to 1052+26.00		1,552		4,051	
7+27.00 to 39+00.00		564		1,113	
<b>TOTALS</b>		<b>4,688</b>		<b>17,453</b>	

### DELINEATORS

STATION	SIDE	SPACING	TYPE I		TYPE I BARRIER	
			EACH		EACH	
<b>TEMPORARY DETOUR (EB to WB)</b>						
312+72.91 to 318+99.05	Both	5°00'	14			
<b>MAINLINE</b>						
835+16.01 to 859+06.54	Both	0°30'	18			
859+06.54 to 876+19.87	Both	5°00'	16		2	
876+19.87 to 894+62.64	Both	3°00'	6		8	
894+62.64 to 905+61.91	Both	Tangent	8			
905+62.91 to 921+98.15	Both	5°00'	20			
921+98.15 to 937+28.55	Both	5°00'	18			
937+28.55 to 959+87.03	Both	2°00'	20			
959+87.03 to 975+78.87	Both	5°00'	12		4	
975+78.87 to 990+20.65	Both	4°00'	16			
990+20.65 to 1006+63.08	Both	4°00'	14			
1006+63.08 to 1015+58.14	Both	3°00'	10			
<b>TEMPORARY DETOUR (WB to EB)</b>						
138+00 to 143+19.72	Both	3°45'	14			
<b>TOTALS</b>			<b>*186</b>		<b>*14</b>	

### DETAIL OF CONCRETE BARRIER DELINEATOR

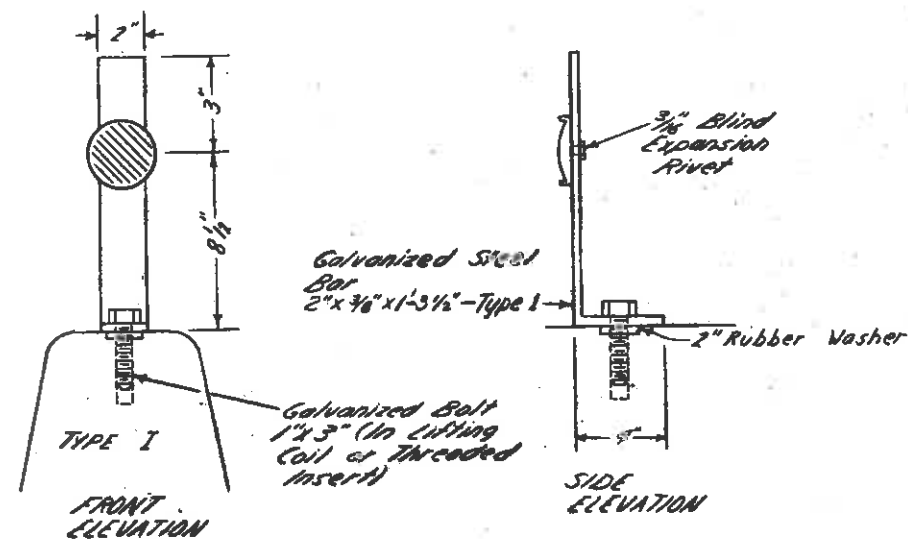

For further information see Standard S-612-51A and Guard Rail Details

Delineators to be placed 6' from shoulder



\*Includes 75 Yellow Type I for Median Side  
 \*Includes 11 Yellow Type I Barrier for Median Side

Note: Reflectors are to be placed on the back side of existing Median Side Delineators for facing westbound traffic while detouring over the East Bound lanes. It is estimated that: 130 Crystal Type I, 7 Crystal Type I Barrier, and 6 Crystal Type III reflectors will be required for this project.

MULCH NETTING

STATION TO STATION	SIDE	MULCH NETTING	
		SO. YDS.	
838+00 to 839+50	Lt.	1,517	
839+50 to 840+00	Lt.	128	
839+50 to 845+50	Rt.	3,400	
840+00 to 841+50	Lt.	150	
853+50 to 854+50	Rt.	312	
854+50 to 855+50	Rt.	212	
855+50 to 859+50	Rt.	3,778	
859+50 to 861+50	Rt.	712	
890+50 to 893+50	Rt.	2,900	
898+82.85 to 899+82.85	Rt.	389	
899+82.85 to 912+00	Rt.	8,384	
912+50 to 919+50	Lt.	534	
918+50 to 919+50	Rt.	923	
919+50 to 923+50	Rt.	7,556	
925+50 to 929+00	Rt.	389	
925+90 to 926+45	Lt.	868	
926+45 to 929+00	Lt.	3,635	
929+00 to 929+50	Lt.	245	
929+50 to 930+20	Lt.	109	
932+65 to 935+65	Lt.	1,500	
937+42 to 939+42	Rt.	1,423	
939+42 to 940+00	Rt.	129	
940+00 to 942+65	Lt.	1,178	
944+60 to 947+67	Lt.	2,027	
950+50 to 951+50	Rt.	834	
952+50 to 953+50	Rt.	823	
955+50 to 957+50	Rt.	312	
963+50 to 964+50	Lt.	1,078	
964+50 to 965+50	Lt.	3,400	
966+50 to 967+50	Lt.	829	
969+70 to 970+70	Rt.	1,411	
970+70 to 971+70	Rt.	1,834	
971+70 to 974+70	Rt.	6,800	
873+55 to 878+00	Lt.	8,604	
878+00 to 880+65	Lt.	3,887	
880+65 to 879+65	Lt.	234	
883+65 to 884+65	Lt.	632	
884+65 to 887+65	Lt.	2,400	
887+65 to 888+65	Lt.	356	
884+15 to 885+65	Rt.	100	
887+75 to 890+75	Rt.	2,834	
890+75 to 891+75	Rt.	1,489	
891+75 to 892+75	Rt.	900	
892+70 to 893+70	Lt.	1,389	
893+70 to 894+00	Lt.	321	
896+00 to 896+50	Lt.	435	
896+50 to 899+75	Lt.	5,817	
899+75 to 1005+50	Lt.	4,023	
1005+50 to 1007+75	Lt.	5950	
1008+20 to 1011+85	Lt.	5881	
1013+00 to 1014+80	Lt.	1,100	
1015+25 to 1015+75	Lt.	100	
<b>TOTAL</b>		<b>106,859</b>	

MULCH NETTING

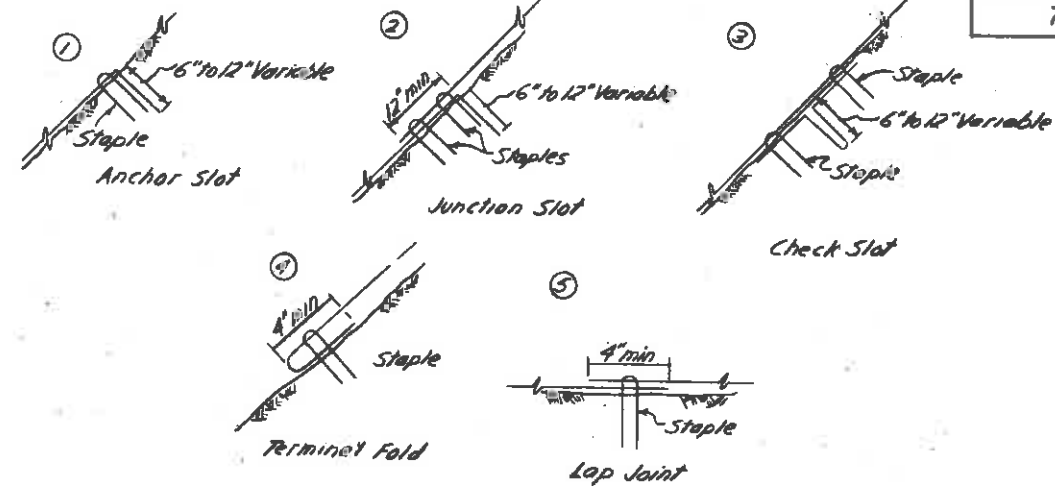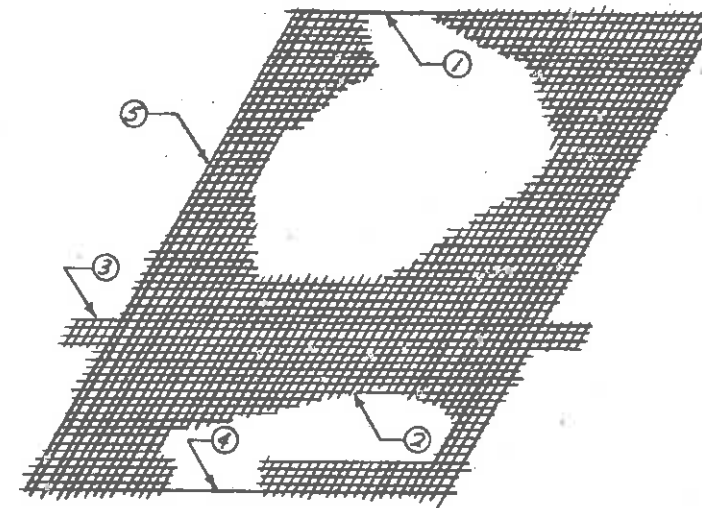

DESCRIPTION OF JOINTS AND SLOTS

- Anchor Slot** - Buried upper edge of blanket
- Junction Slot** - Joint between upper and lower pieces. Upper piece overlapping buried end of lower piece
- Check Slot** - Extra piece of blanket folded lengthwise and buried perpendicular to the slope. Continuous upper piece overlaying the unfolded portion remaining above ground. (To be used where directed)
- Terminal Fold** - Bottom edge of blanket, folded under and stapled
- Lap Joint** - Overlap joint between two rolls, running down the slope

SOIL RETENTION BLANKET (JUTE)

STATION	SIDE	JUTE	
		SO. YDS.	
<b>MAINLINE</b>			
872+50 to 874+50	Rt.	1,067	
874+50 to 878+50	Rt.	5,245	
885+50 to 890+50	Rt.	6,723	
From Ditch Tab. Above		12,851	
<b>TOTAL</b>		<b>25,886</b>	

FEDERAL ROAD DISTRICT NO.	DIVISION	PROJ. NO.	SHEET NO.	TOTAL SHEETS
VIII	COLORADO	170-24(2)/97	16	

AS CONSTRUCTED		
NO REVISIONS	REVISED	VOID



SOIL RETENTION BLANKET (JUTE)

STATION	SIDE	JUTE	
		SO. YDS.	
<b>ROADWAY DITCH</b>			
838+00 to 857+50	Lt.	2,167	
860+00 to 873+00	Lt.	1,445	
889+03 to 898+00	Lt.	997	
913+00 to 929+50	Lt.	1,834	
933+00 to 936+00	Lt.	332	
939+50 to 947+50	Lt.	889	
954+00 to 967+50	Lt.	1,500	
973+50 to 989+50	Lt.	1,778	
992+50 to 994+50	Lt.	223	
995+50 to 1000+56	Lt.	607	
1004+90 to 1011+50	Lt.	734	
1012+50 to 1015+58	Lt.	343	
<b>TOTAL</b>		<b>12,851</b>	

NOTE: All cut slope ditches shall have soil retention blanket (Jute) applied to control erosion.

FEDERAL ROAD DISTRICT NO.	DIVISION	PROJ. NO.	SHEET NO.	TOTAL SHEETS
VIII	COLORADO	129-221-17	17	
AS CONSTRUCTED				
NO REVISIONS		REVISED		VOID

DETAIL OF DRY RUBBLE  
SLOPE & DITCH PAVING

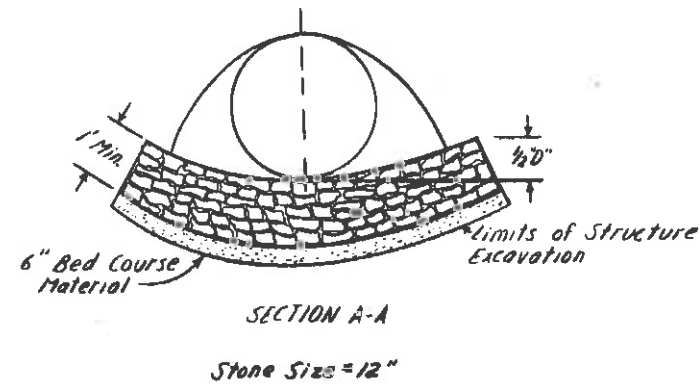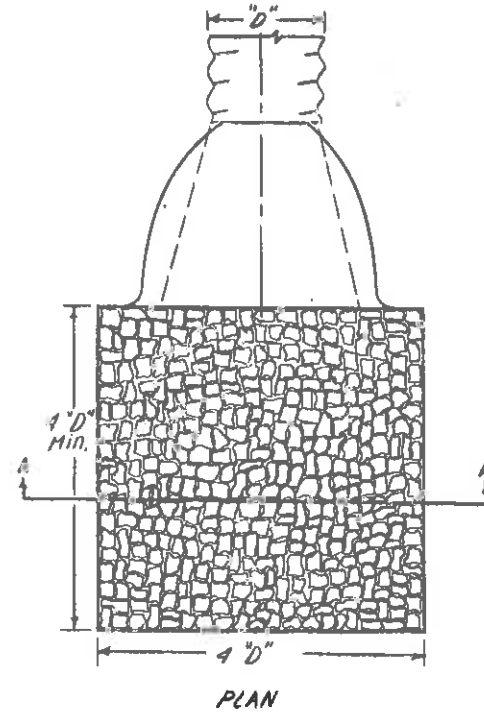

GUARD RAIL

STATION	SIDE	GUARD RAIL TYPE & LENGTH	LINEAL FEET
*838+48.0 to 845+52.0*	RT	704	4
*853+48.0 to 861+52.0*	RT	804	4
*872+45.0 to 879+97.0 <sup>Δ</sup>	RT	752	4
*878+49.0 to 879+97.0 <sup>Δ</sup>	LT	152	4
<sup>Δ</sup> 883+78.0 to 893+87.7*	RT	962	4
<sup>Δ</sup> 883+78.0 to 885+30.0*	LT	152	4
*898+53.0 to 912+97.0*	RT	1,394	4
*918+43.0 to 923+97.0*	RT	504	4
*937+43.0 to 941+27.0*	RT	384	4
*969+50.0 to 975+09.0*	RT	554	4
*987+68.0 to 992+62.0*	RT	494	4
<b>TOTAL</b>		2,572	

- \* Includes 12' Transition Section
- <sup>Δ</sup> Connect to Bridge Rail
- 72 Foot Flare on Approach End (Precast-Portable) (Colored)
- Future Guard Rail

PERSONAL HOME BUILDING NO.	DIVISION	PROJ. NO.	SHEET NO.	TOTAL SHEETS
YES	COLORADO	I 70-2 (42) 97	18	
IS CONSTRUCTED				
NO REVISIONS	<input type="checkbox"/>	REVISED	<input type="checkbox"/>	VOID


SILT FENCE

STATION	SIDE	SILT FENCE	
		LINE	FT.
* 846+ to 848+	Rt.		200
* 856+ to 857+	Rt.		180
* 864+ to 865+	Rt.		180
* 869+ to 870+	Rt.		100
* 875+ to 876+	Lt.		90
* 880+ to 881+	Lt.		130
* 882+ to 883+	Lt.		110
* 894+ to 895+	Rt.		120
901+ to 903+	Rt.		140
908+ to 909+	Rt.		120
911+ to 912+	Rt.		100
932+ to 933+	Rt.		140
937+ to 939+	Rt.		120
948+ to 949+	Rt.		100
953+ to 954+	Rt.		100
990+ to 992+	Rt.		140
999+ to 1000+	Rt.		100
1010+ to 1011+	Rt.		140
TOTAL			1,200

\* Placed by others, to be removed on this project as subsidiary item.

Note: See Alignment Sheets for Approximate Locations.


DETAIL OF SILT FENCE

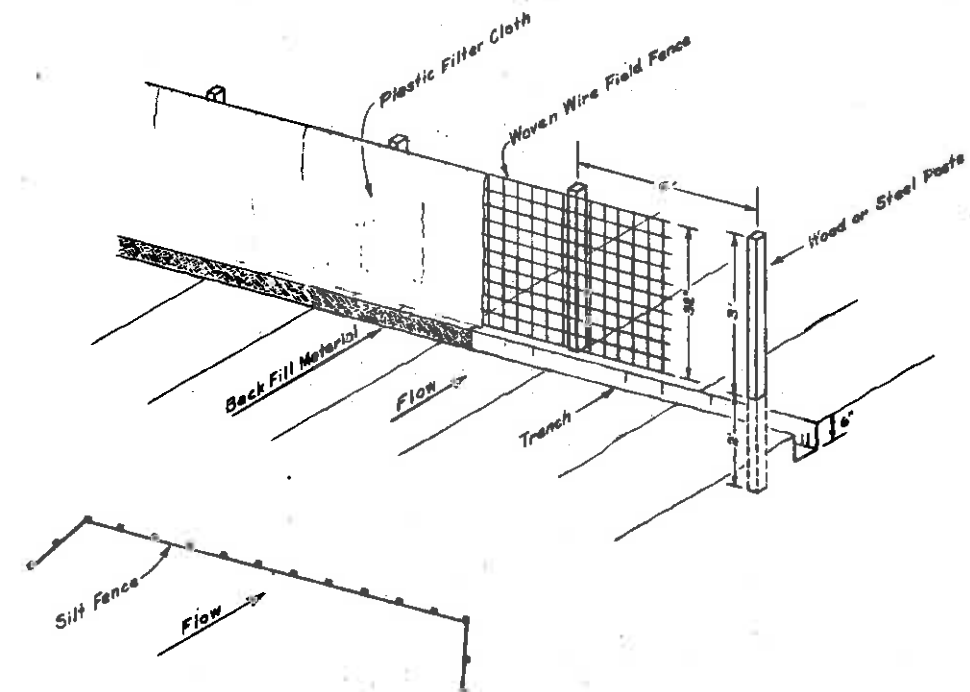


AS CONSTRUCTED			FEDERAL ROAD REGION NO.	DIVISION	PROJ. NO.	SHEET NO.	TOTAL SHEETS
NO REVISIONS	REVISED	VOID	VIII	COLORADO	I 70-2(42)197	19	

### TIMBER CRIB WALL DETAILS




- NOTES
- ALL WORK SHALL BE DONE IN ACCORDANCE WITH THE STANDARD SPECIFICATIONS.
  - ALL CRIBS TILT BACK TO FILL @ 2":12"
  - STABILITY COMPUTATIONS BASED ON 1-1/2:1 BACKSLOPE.
  - ALL TIMBER AND DRIFT PINS WILL BE STATE FURNISHED. TIMBER SHALL BE CUT AND REDRILLED TO FIT.
  - DRIFT PINS & HOLES TO BE 3/4" Ø.
  - ALL STRETCHERS TO BE LAID HORIZONTAL.
  - FILL WITHIN CRIBS & BEHIND CRIBS CONSISTS OF SAND, SAND & GRAVEL, OR OTHER FREE DRAINING GRANULAR MATERIAL PLACED IN 6" LAYERS AND COMPACTED WITH VIBRATORY COMPACTORS.
  - SOIL WEIGHT ASSUMED TO BE 125#/FT<sup>3</sup>.
  - EQUIVALENT SOIL FLUID PRESSURE 30#/FT<sup>3</sup>.
  - WELDED WIRE FABRIC SHALL HAVE A MAXIMUM GRID OPENING OF 2" X 1" AND SHALL BE FABRICATED WITH 14 GAUGE GALVANIZED WIRE. WIRE FABRIC SHALL BE FURNISHED BY CONTRACTOR. PAYMENT WILL BE INCLUDED IN "PLACE TIMBER CRIBBING."
  - THE WELDED WIRE FABRIC SHALL BE FASTENED TO THE TIMBER STRETCHERS BY STAPLING IN HORIZONTAL ROWS WITH A MINIMUM OF FIVE STAPLES PER ROW. STAPLES WILL BE 2" CEMENT COATED, BARBED. THE WELDED WIRE FABRIC SHALL BE STAPLED AT THE TOP AND BOTTOM STRETCHERS AND AT ALTERNATE INTERMEDIATE STRETCHERS. IF THE WIRE IS TO BE OVERLAPPED, THE MINIMUM OVERLAP SHALL BE FOUR INCHES.

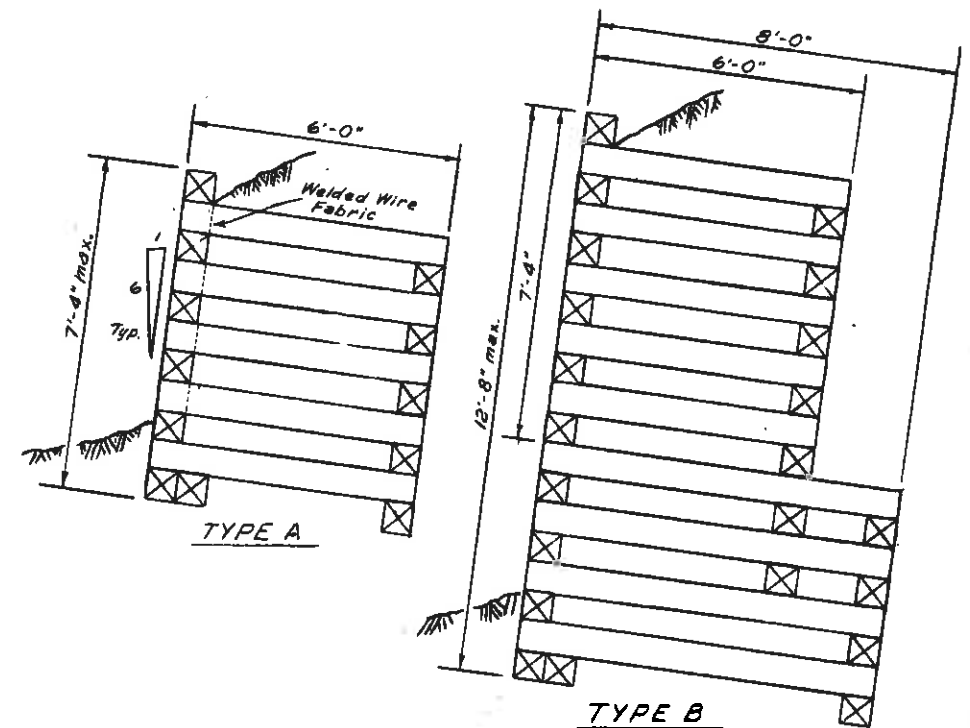

### ROCK WALL DETAILS

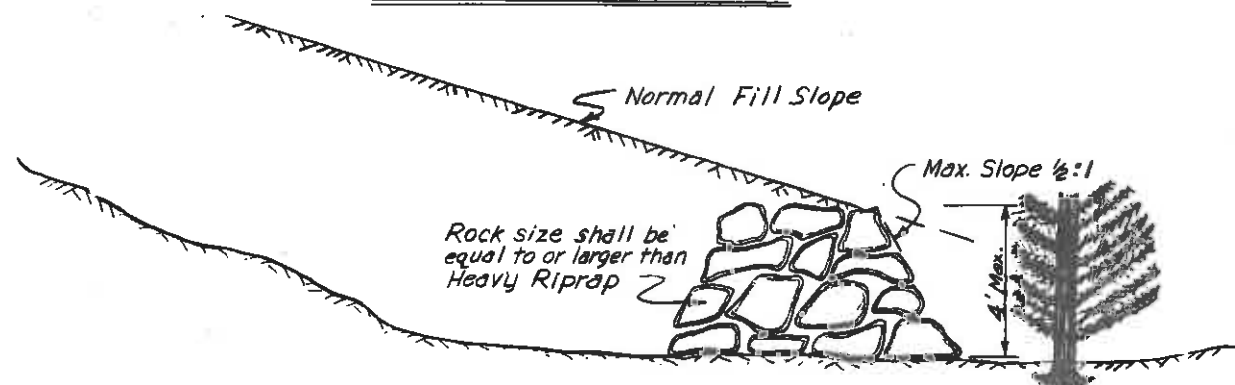

NOTE: Rock wall construction will be paid for under appropriate equipment hours where directed.

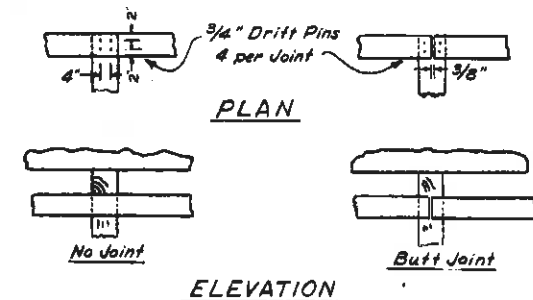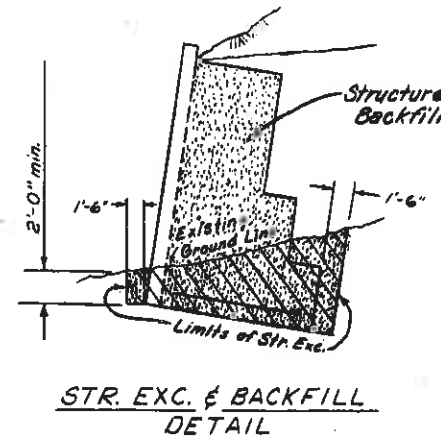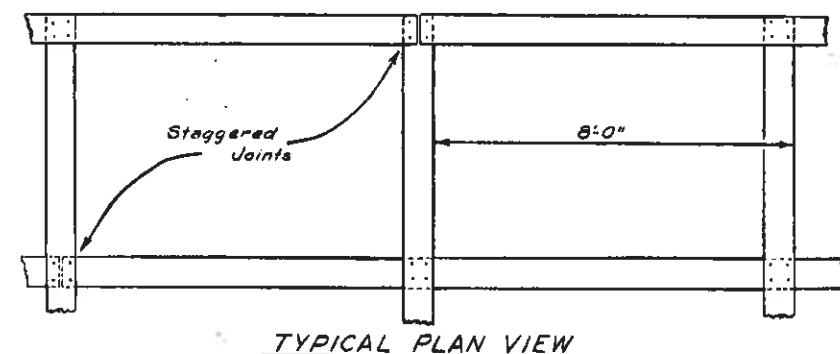




FEDERAL ROAD REGION NO.	DIVISION	PROJ. NO.	SHEET NO.	TOTAL SHEETS
VIII	COLORADO	I 70-2(42)197	20	
AS CONSTRUCTED				
NO REVISIONS		REVISED		VOID

**LEGEND**

- EXISTING CONTOURS
- PROPOSED CONTOURS
- RECREATION TRAIL
- SILT FENCE (Existing)
- HAY CHECK DAM (Existing)
- SEDIMENT TRAP
- WATER BAR
- TIMBER RETAINING WALL (Existing)

NOTE: SOIL RETENTION BLANKET IS REQUIRED IN DRAINAGE DITCHES AND ON SLOPES 3:1 AND STEEPER. (THIS SHEET ONLY)

NOTE: OBLITERATION OF OLD ROAD AND CONTOUR GRADING WILL BE ACCOMPLISHED ON THIS PROJECT

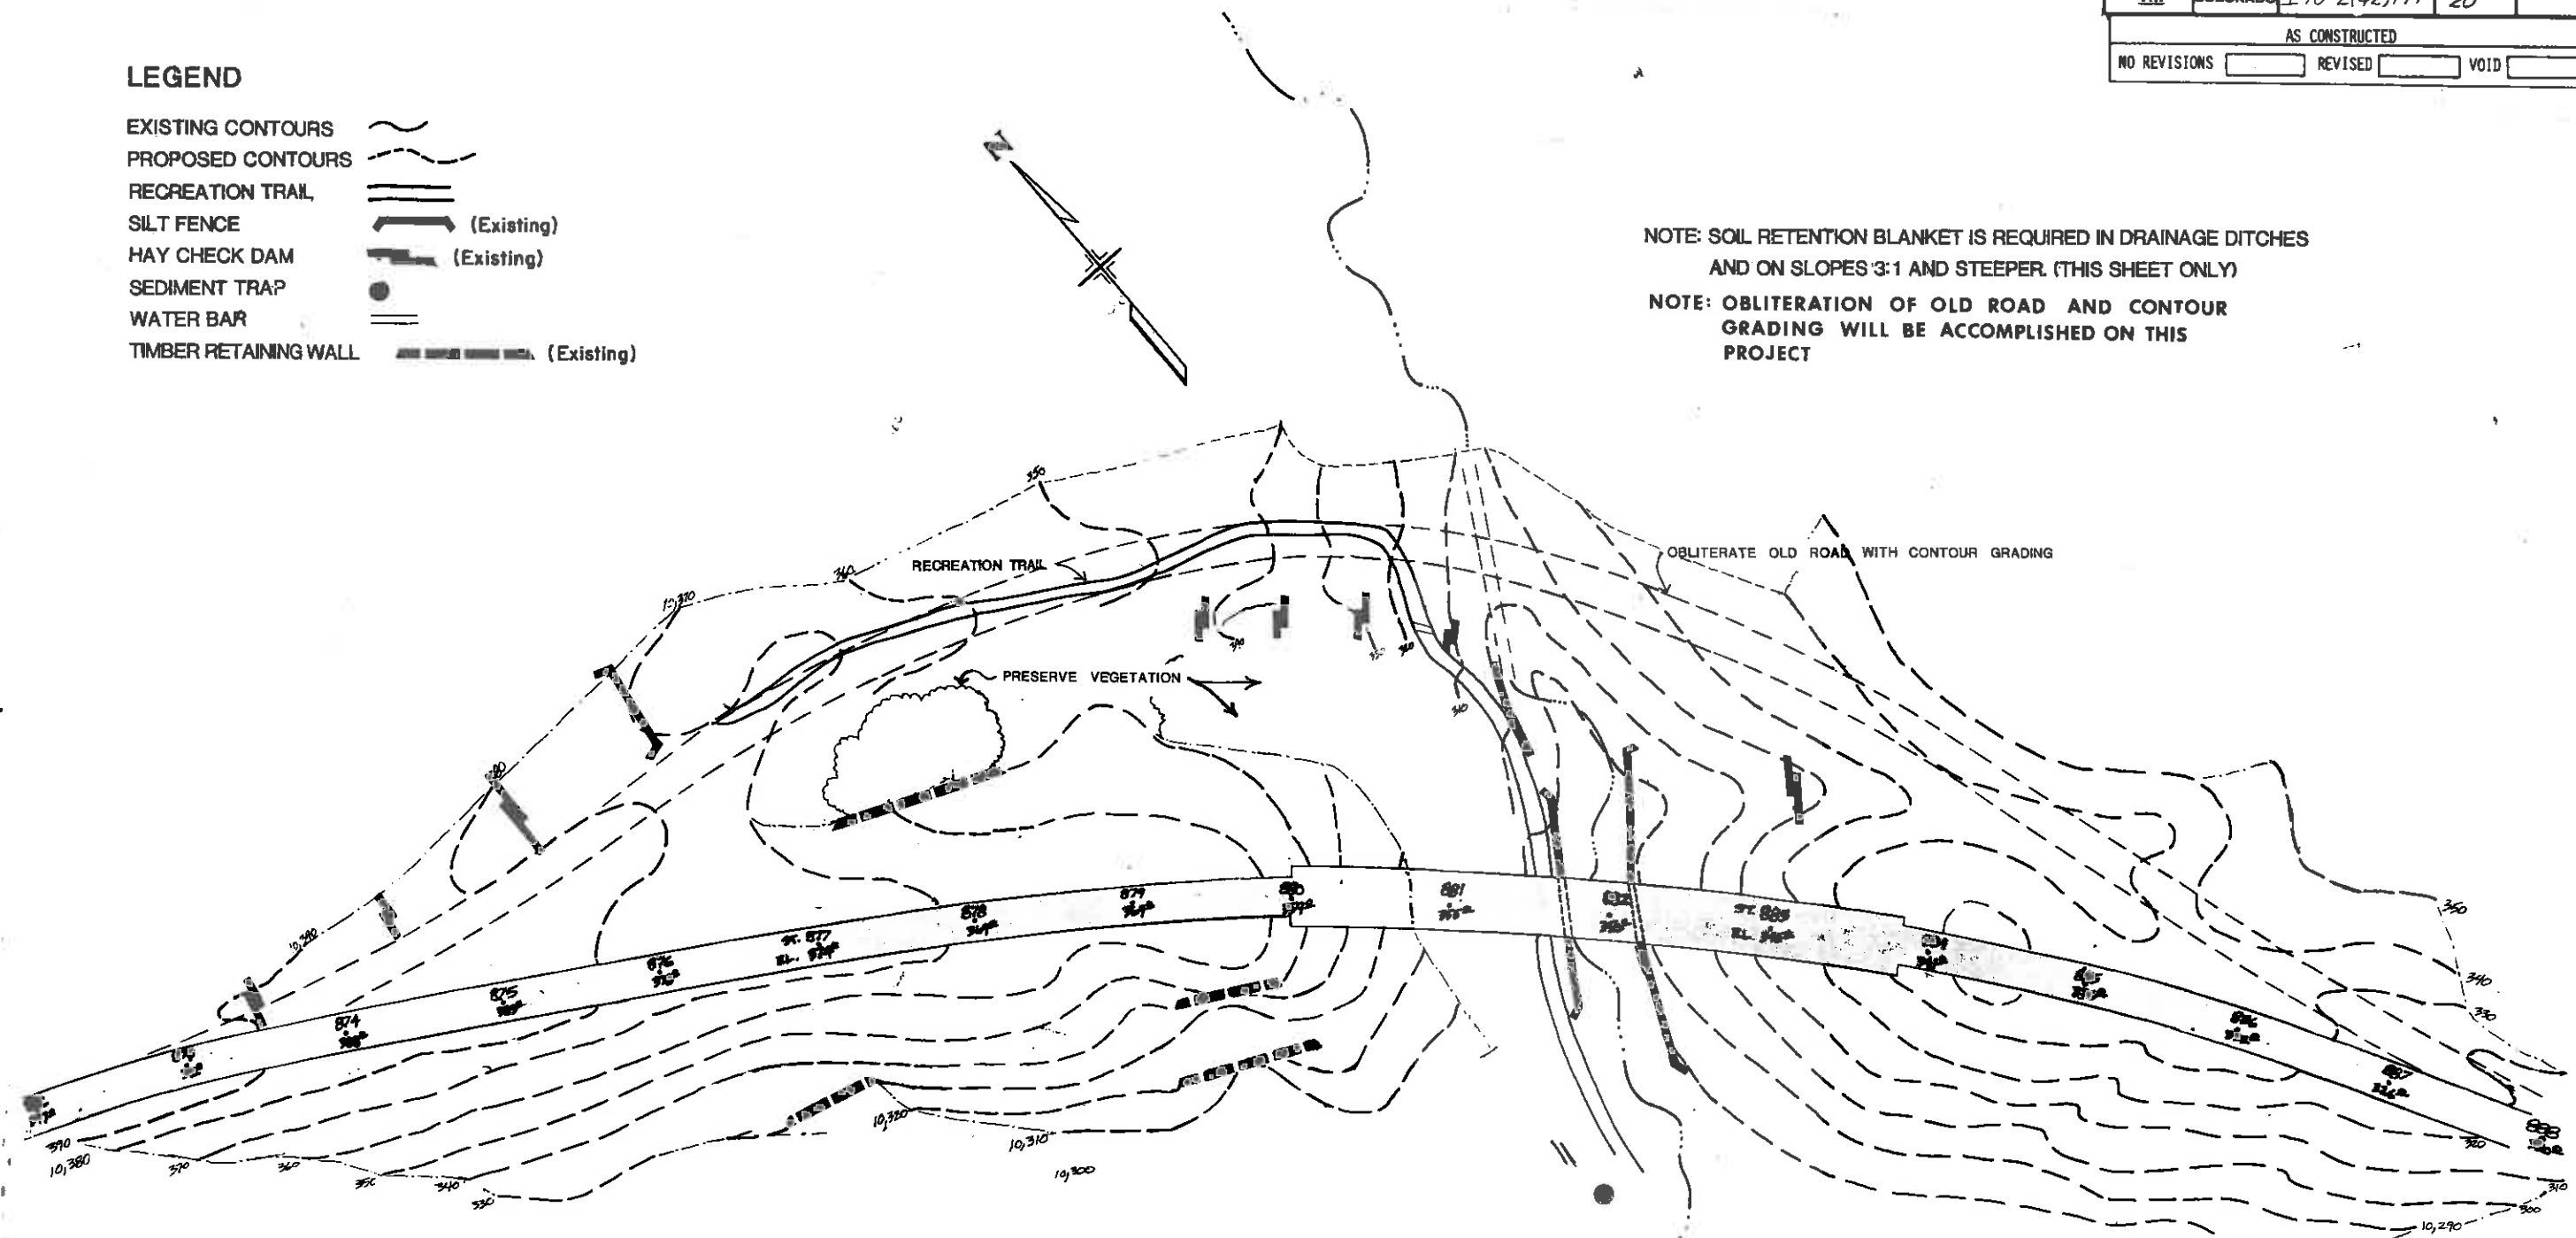


**CORRAL CREEK**  
**landscape · erosion control plan**



FEDERAL ROAD REGION NO.	DIVISION	PROJ. NO.	SHEET NO.	TOTAL SHEETS
VIII	COLORADO	I 70-2(42)197	21	
AS CONSTRUCTED				
NO REVISION	<input type="checkbox"/>	REVISED	<input type="checkbox"/>	VOID

# BENCHING, ROCK PLACEMENT AND ROUNDING



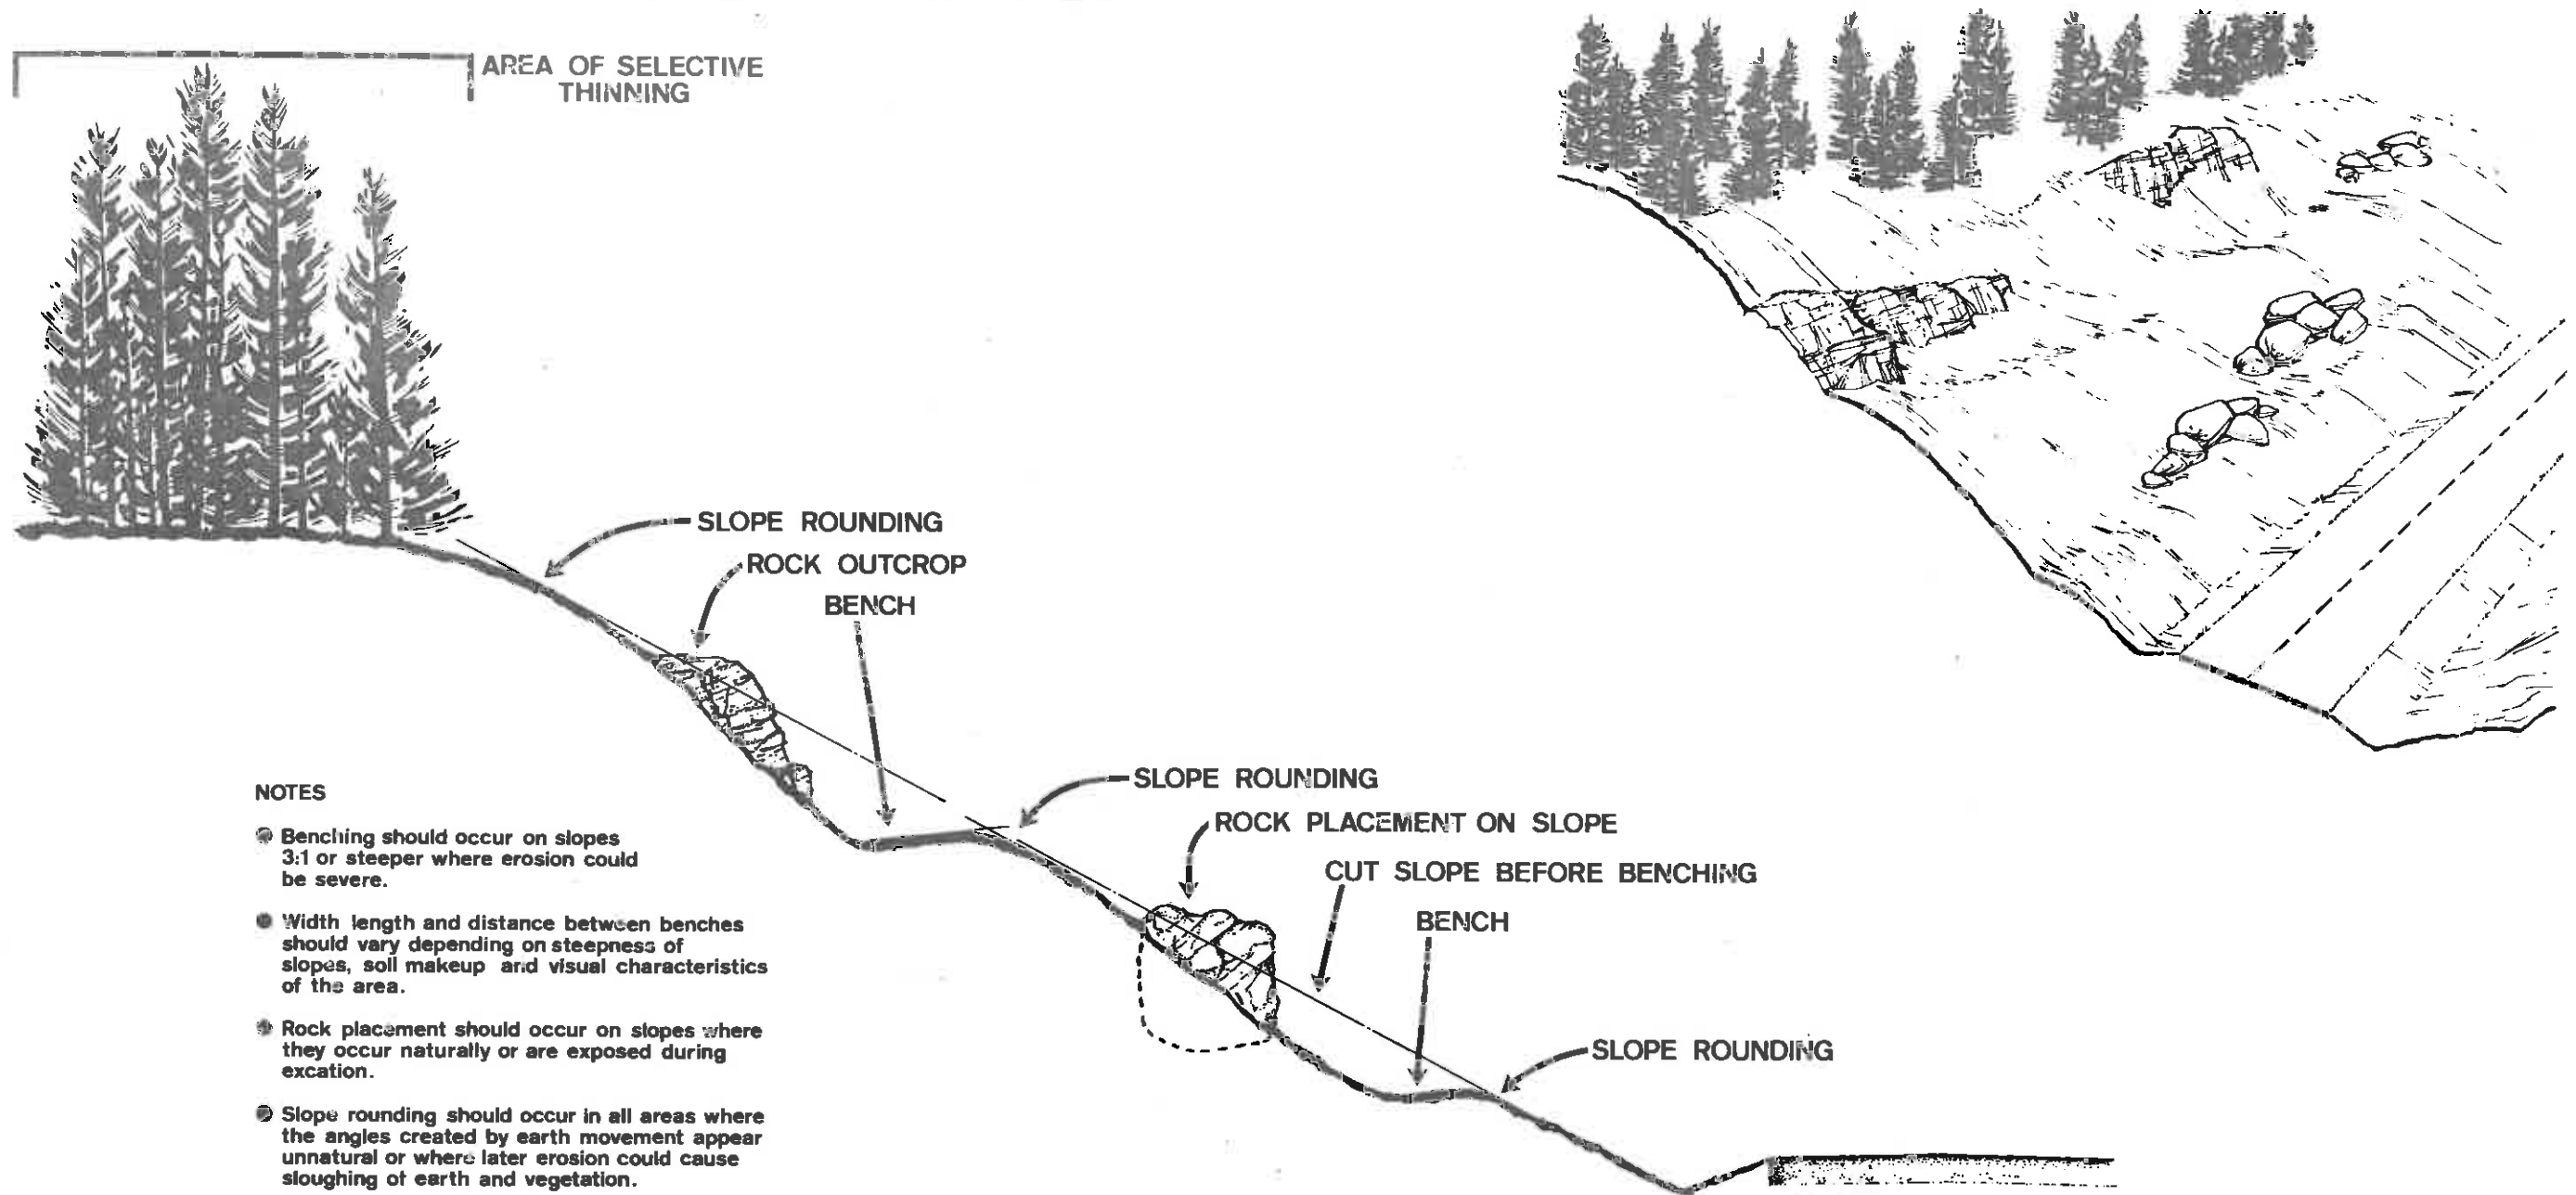


## NOTES

- Benching should occur on slopes 3:1 or steeper where erosion could be severe.
- Width length and distance between benches should vary depending on steepness of slopes, soil makeup and visual characteristics of the area.
- Rock placement should occur on slopes where they occur naturally or are exposed during excation.
- Slope rounding should occur in all areas where the angles created by earth movement appear unnatural or where later erosion could cause sloughing of earth and vegetation.
- Concepts shown on this sheet will be accomplished and paid for as part of earthwork operations except rock placement and selective thinning which will be paid for under Landscaping Special Effects (Force Account)

# LANDSCAPE SLOPE MOLDING

FEDERAL ROAD DISTRICT NO.	DIVISION	PROJ. NO.	SHEET NO.	TOTAL SHEETS
VII	COLORADO	I 70-2(42)197	22	
AS CONSTRUCTED				
NO REVISIONS	REVISED	WEB		

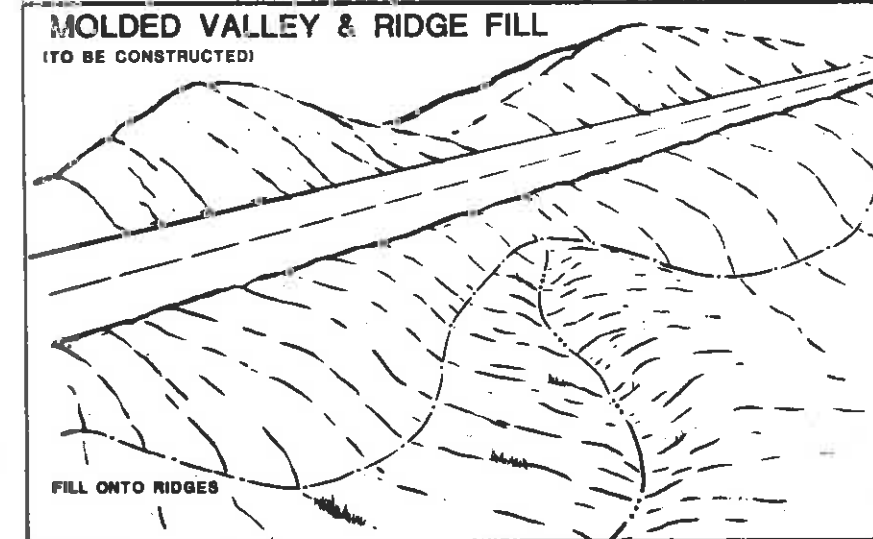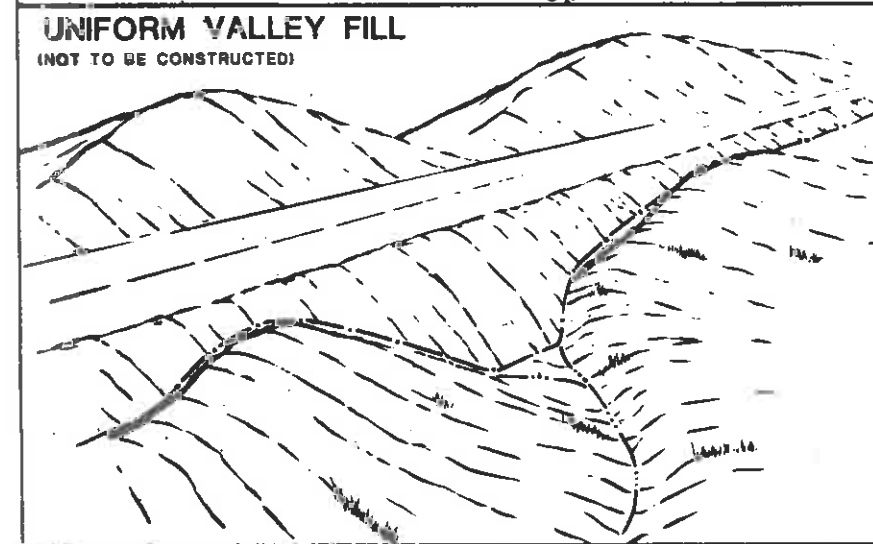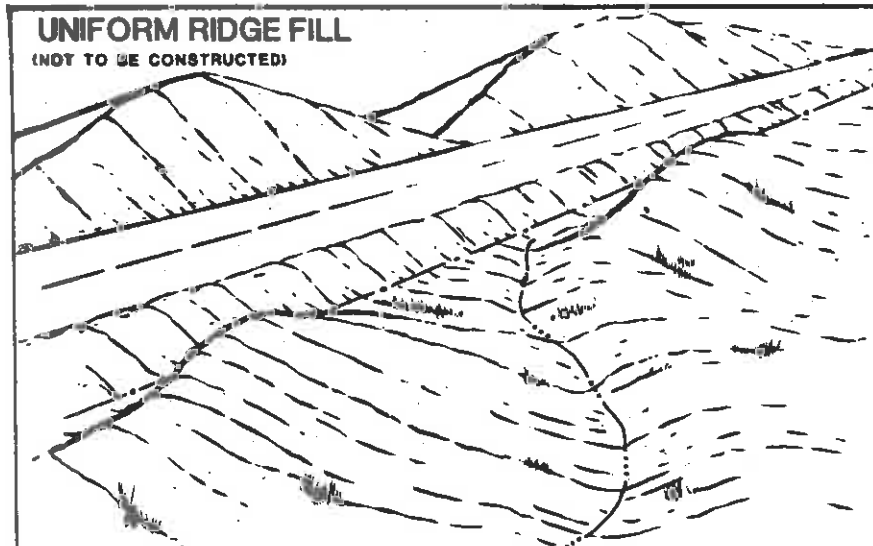





STATION	LANDFORM	RECOMMENDED SLOPE TREATMENT
---------	----------	-----------------------------

876-877, RT.	RIDGE	TIMBER CRIB WALL
880, 884, RT.	RIDGE	SEE DETAIL SHEET (CORRAL CREEK, LANDSCAPE-EROSION CONTROL PLAN)
886, RT.	RIDGE	SEE DETAIL SHEET (CORRAL CREEK, LANDSCAPE-EROSION CONTROL PLAN)
910+84-911+50, RT.	RIDGE	TIMBER CRIB WALL
913+90, LT.	RIDGE	ROCK BENCH (1)
914+42, LT.	VALLEY	ROCK BENCHES (2)
914+93, LT.	RIDGE	NO BENCH, ROUGHEN FACE
915+45, LT.	VALLEY	ROCK BENCHES (2)
915+96, LT.	RIDGE	ROCK BENCH (1)
916+99, LT.	VALLEY	ROCK BENCHES (2)
918+02, LT.	RIDGE	NO BENCH, ROUGHEN FACE
919+04, LT.	VALLEY	ROCK BENCHES (3)
920+06, LT.	RIDGE	NO BENCH, ROUGHEN FACE
921+07, LT.	RIDGE	ROCK BENCH (1)
922+07, LT.	RIDGE	NO BENCH, ROUGHEN FACE
923+07, LT.	VALLEY	ROCK BENCHES (2)
924+07, LT.	VALLEY	ROCK BENCHES (3)
924+32, LT.	RIDGE	NO BENCH, ROUGHEN FACE
924+57, LT.	VALLEY	ROCK BENCHES (3)
925+08, LT.	RIDGE	ROCK BENCH (1)
925+71, LT.	VALLEY	ROCK BENCHES (3)
926+09-926+80, LT.	RIDGE	SLOPE CONTOUR GRADING
927+10, LT.	VALLEY	VALLEY CUT
928+12-929+13, LT.	VALLEY	SLOPE CONTOUR GRADING
945+16-946+17, LT.	VALLEY CUT	VALLEY CUT
947+17, LT.	RIDGE	RIDGE CUT
964-967, LT.	RIDGE	CONTOUR GRADE SLIDE AREA
968+15-972+19, LT.	RIDGE	CONTOUR GRADE STOCKPILE AREA
971+ - 974+, RT.	RIDGE	TIMBER CRIB WALL
974+ - 980, LT.	RIDGES	RIDGE CUT, CONTOUR GRADING
980+15, LT.	VALLEY	VALLEY CUT
984+17, LT.	VALLEY	VALLEY CUT
984+67-985+17, LT.	RIDGE	RIDGE CUT
985+67, LT.	VALLEY	VALLEY CUT
986+23-988+23, LT.	RIDGE	RIDGE CUT
989+23, LT.	VALLEY	VALLEY CUT
993+17-994+17, LT.	RIDGE	RIDGE CUT
997+, LT.	VALLEY	VALLEY CUT
998+, LT.	RIDGE	RIDGE CUT
999-1001, LT.	RIDGE	REMOVE RIDGE, USE VALLEY CUT CONCEPT
1005-1006, LT.	RIDGE	RIDGE CUT
1006-1006+75, LT.	VALLEY	VALLEY CUT
1006+75-1008+75, LT.	RIDGE	RIDGE CUT, ROCK BENCH (1)
1009-1015	RIDGE	CONTOUR GRADING
1013-1014	RIDGE	RIDGE CUT

### GENERAL NOTES:

DRAINAGE TOE OF FILL TOP OF CUT


1. INFORMATION SHOWN ON THIS SHEET IS CONCEPTUAL, AND DOES NOT REPRESENT EXACT LINES, DIMENSIONS, OR LOCATIONS OF RESPONSIBILITY.
2. THESE DESIGN IDEAS WILL BE INCLUDED IN THE INITIAL PROJECT STAKING SO THAT THEY MAY BE IMPLEMENTED AS A PART OF NORMAL EXCAVATION PROCEDURES.
3. ADDITIONAL WORK PERFORMED FOR LANDSCAPING PURPOSES WILL BE PAID FOR UNDER APPLICABLE CONTRACT UNIT PRICE.

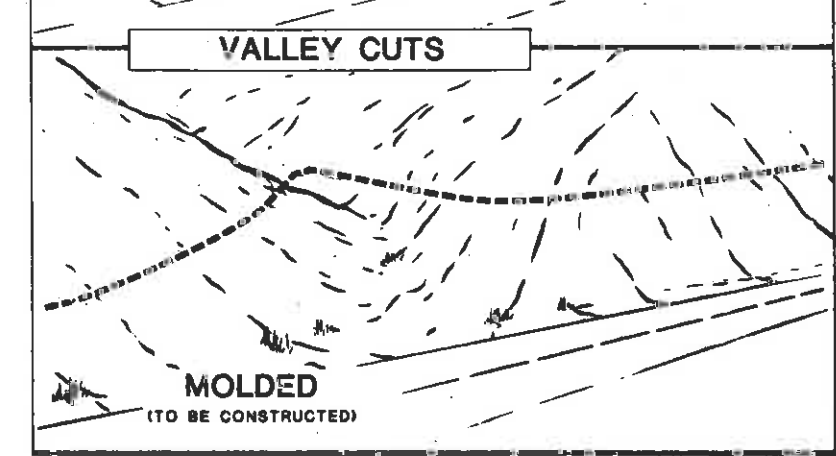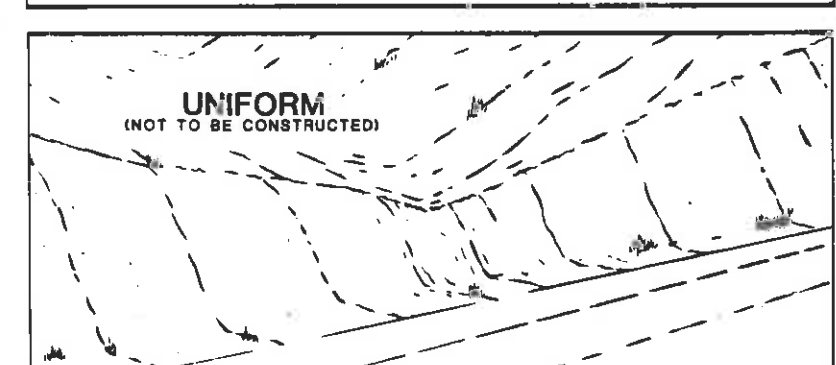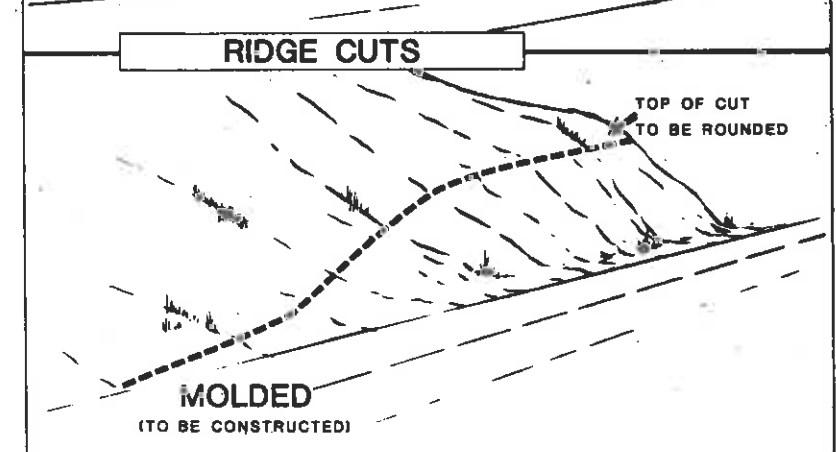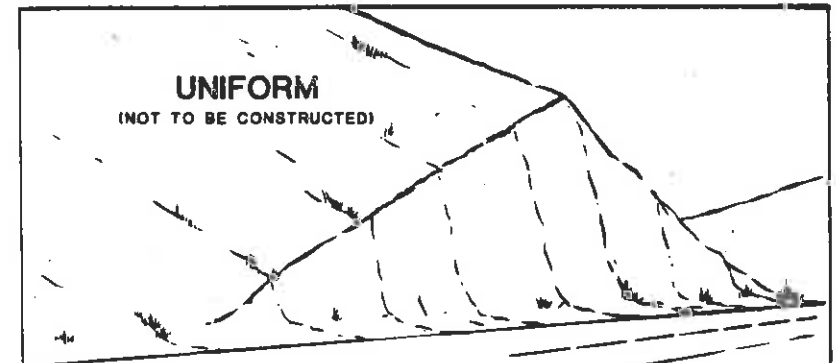

FEDERAL ROAD DISTRICT NO.	DIVISION	PROJ. NO.	COPY NO.	TOTAL SHEETS	
VII	COLORADO	I-70-2(42) 197	23		
AS CONSTRUCTED					
NO REVISIONS	<input type="checkbox"/>	REVISED	<input type="checkbox"/>	VOID	<input type="checkbox"/>

# TYPICAL ROCK SCULPTURE

SCALE 1"=20'  
0' 20' 40'

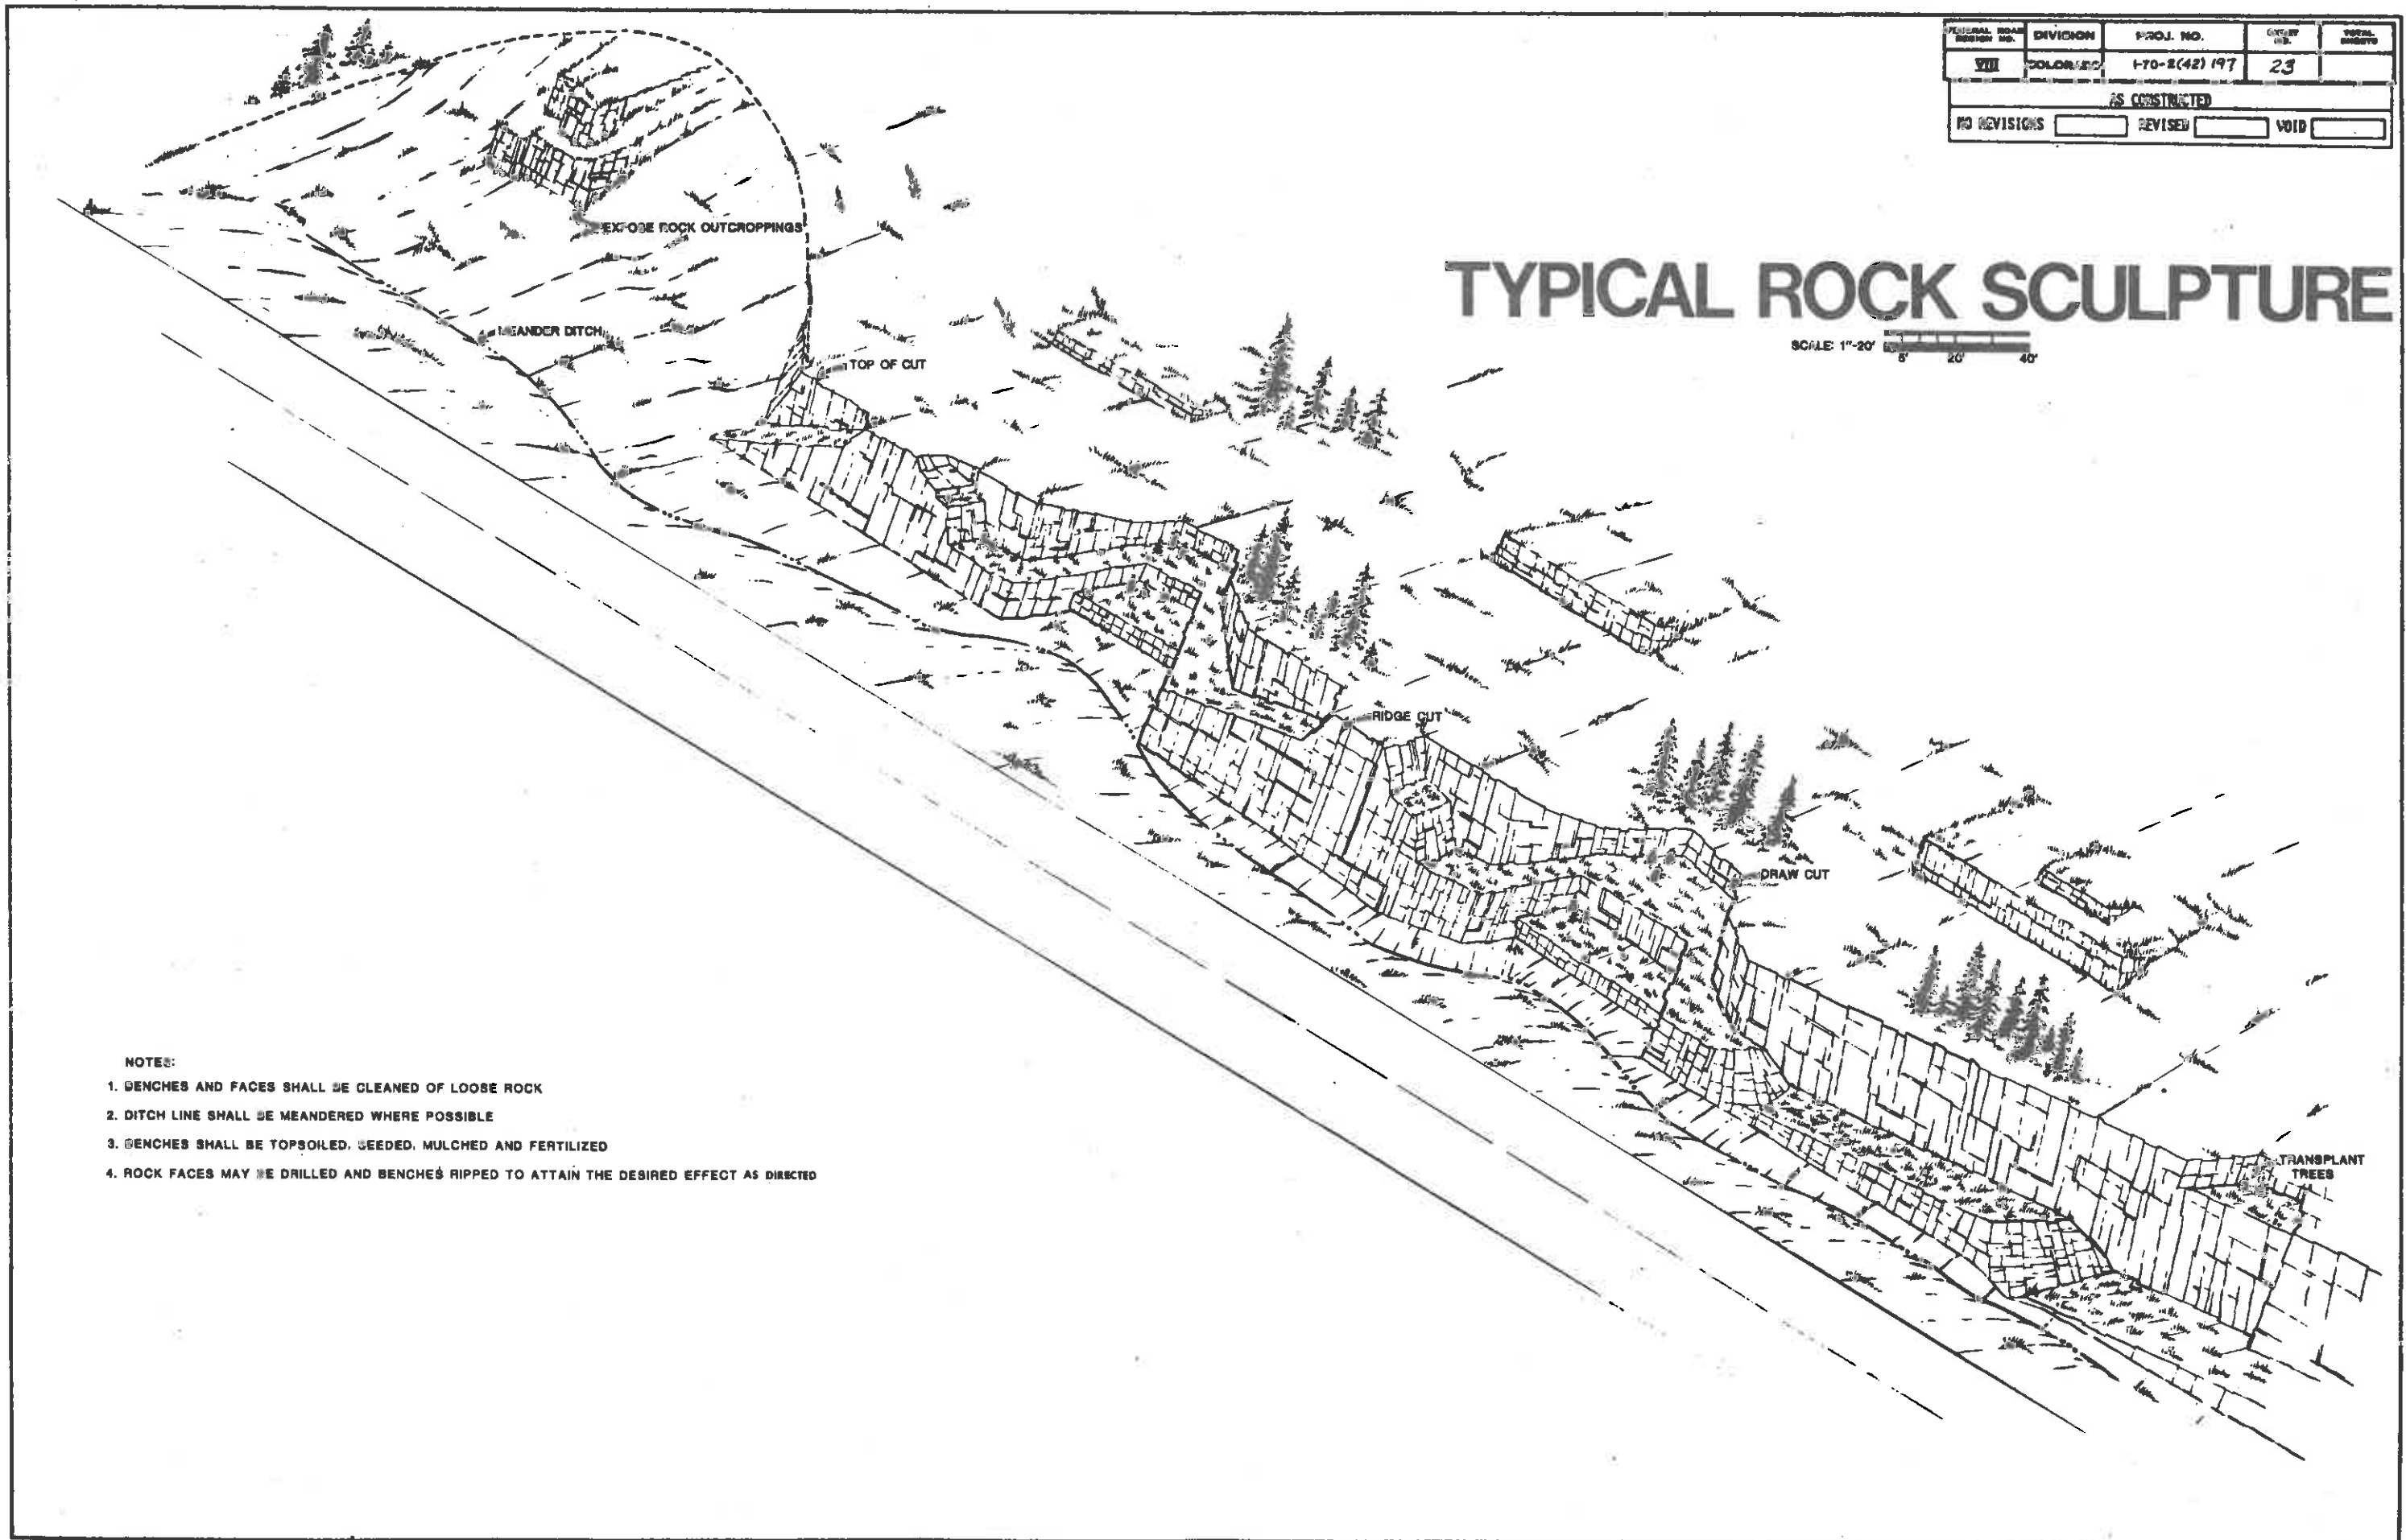

**NOTES:**

1. BENCHES AND FACES SHALL BE CLEANED OF LOOSE ROCK
2. DITCH LINE SHALL BE MEANDERED WHERE POSSIBLE
3. BENCHES SHALL BE TOPSOILED, SEEDED, MULCHED AND FERTILIZED
4. ROCK FACES MAY BE DRILLED AND BENCHES RIPPED TO ATTAIN THE DESIRED EFFECT AS DIRECTED



FEDERAL ROAD DISTRICT NO.	DIVISION	PROJ. NO.	SHEET NO.	TOTAL SHEETS
VIII	COLORADO	170-2(42)197	24	
AS CONSTRUCTED				
NO REVISIONS		REVISED	VOID	

STA. 838+00.0 Begin 170-2(42)197=  
STA. 838+00.0 on 170-2(45)199

**Curve Data**  
Detour - Both Curves  
 $\Delta = 13^\circ 52' 8.9''$   
 $T = 139.373'$   
 $D_c = 5^\circ 00'$   
 $L_c = 277.383'$   
 $R_c = 1145.916'$

**W.B.**  
 $\Delta_s 34^\circ 09' 00''$  Lt.  
 $T_s 833.22'$  Ts  
 $\Delta_c 21^\circ 24'$   
 $D_c 3^\circ 00'$   
 $T_c 360.87'$   
 $L_c 713.33'$   
 $R_c 1909.859'$   
 $S = 0.078'/ft.$   
 $MDS = 70 mph$   
 $SSD > 900'$

**E.B.**  
 $\Delta_s 28^\circ 59' 00''$  Lt.  
 $T_s 1334.91'$  Ts  
 $\Delta_c 25^\circ 14'$   
 $D_c 1^\circ 15'$   
 $T_c 1025.97'$   
 $L_c 2018.67'$   
 $R_c 4583.662'$   
 $S = 0.056'/ft.$   
 $MDS = 60 mph$   
 $SSD > 900'$

$\theta_s 5^\circ 15'$   
 $L_s 500'$   
 $L_t 333.63'$   
 $S.T. 166.94'$


$\theta_s 5^\circ 52' 30''$   
 $L_s 300'$   
 $L_t 200.01'$   
 $S.T. 100.01'$

812+ to 818+ (WB) in Reg'd  
Temporary Detour, Extend  
Existing 24' x 150' C.S.P.  
at Sta 814+42 (EB) 30' Lt  
and Reset End Section Lt

812+ to 818+ (WB) in Remove  
Temporary Detour, Remove  
Previously Placed 24' x 30'  
C.S.P. Extension at Sta 814+42  
(EB), Reset End Section to  
Original Position

833+ (EB) to 838+ (WB) in  
Reg'd Temporary Approach  
WB to EB and Remove

839+ to 842+ in Reg'd  
Timber Cribbing Rt.  
(Type A)

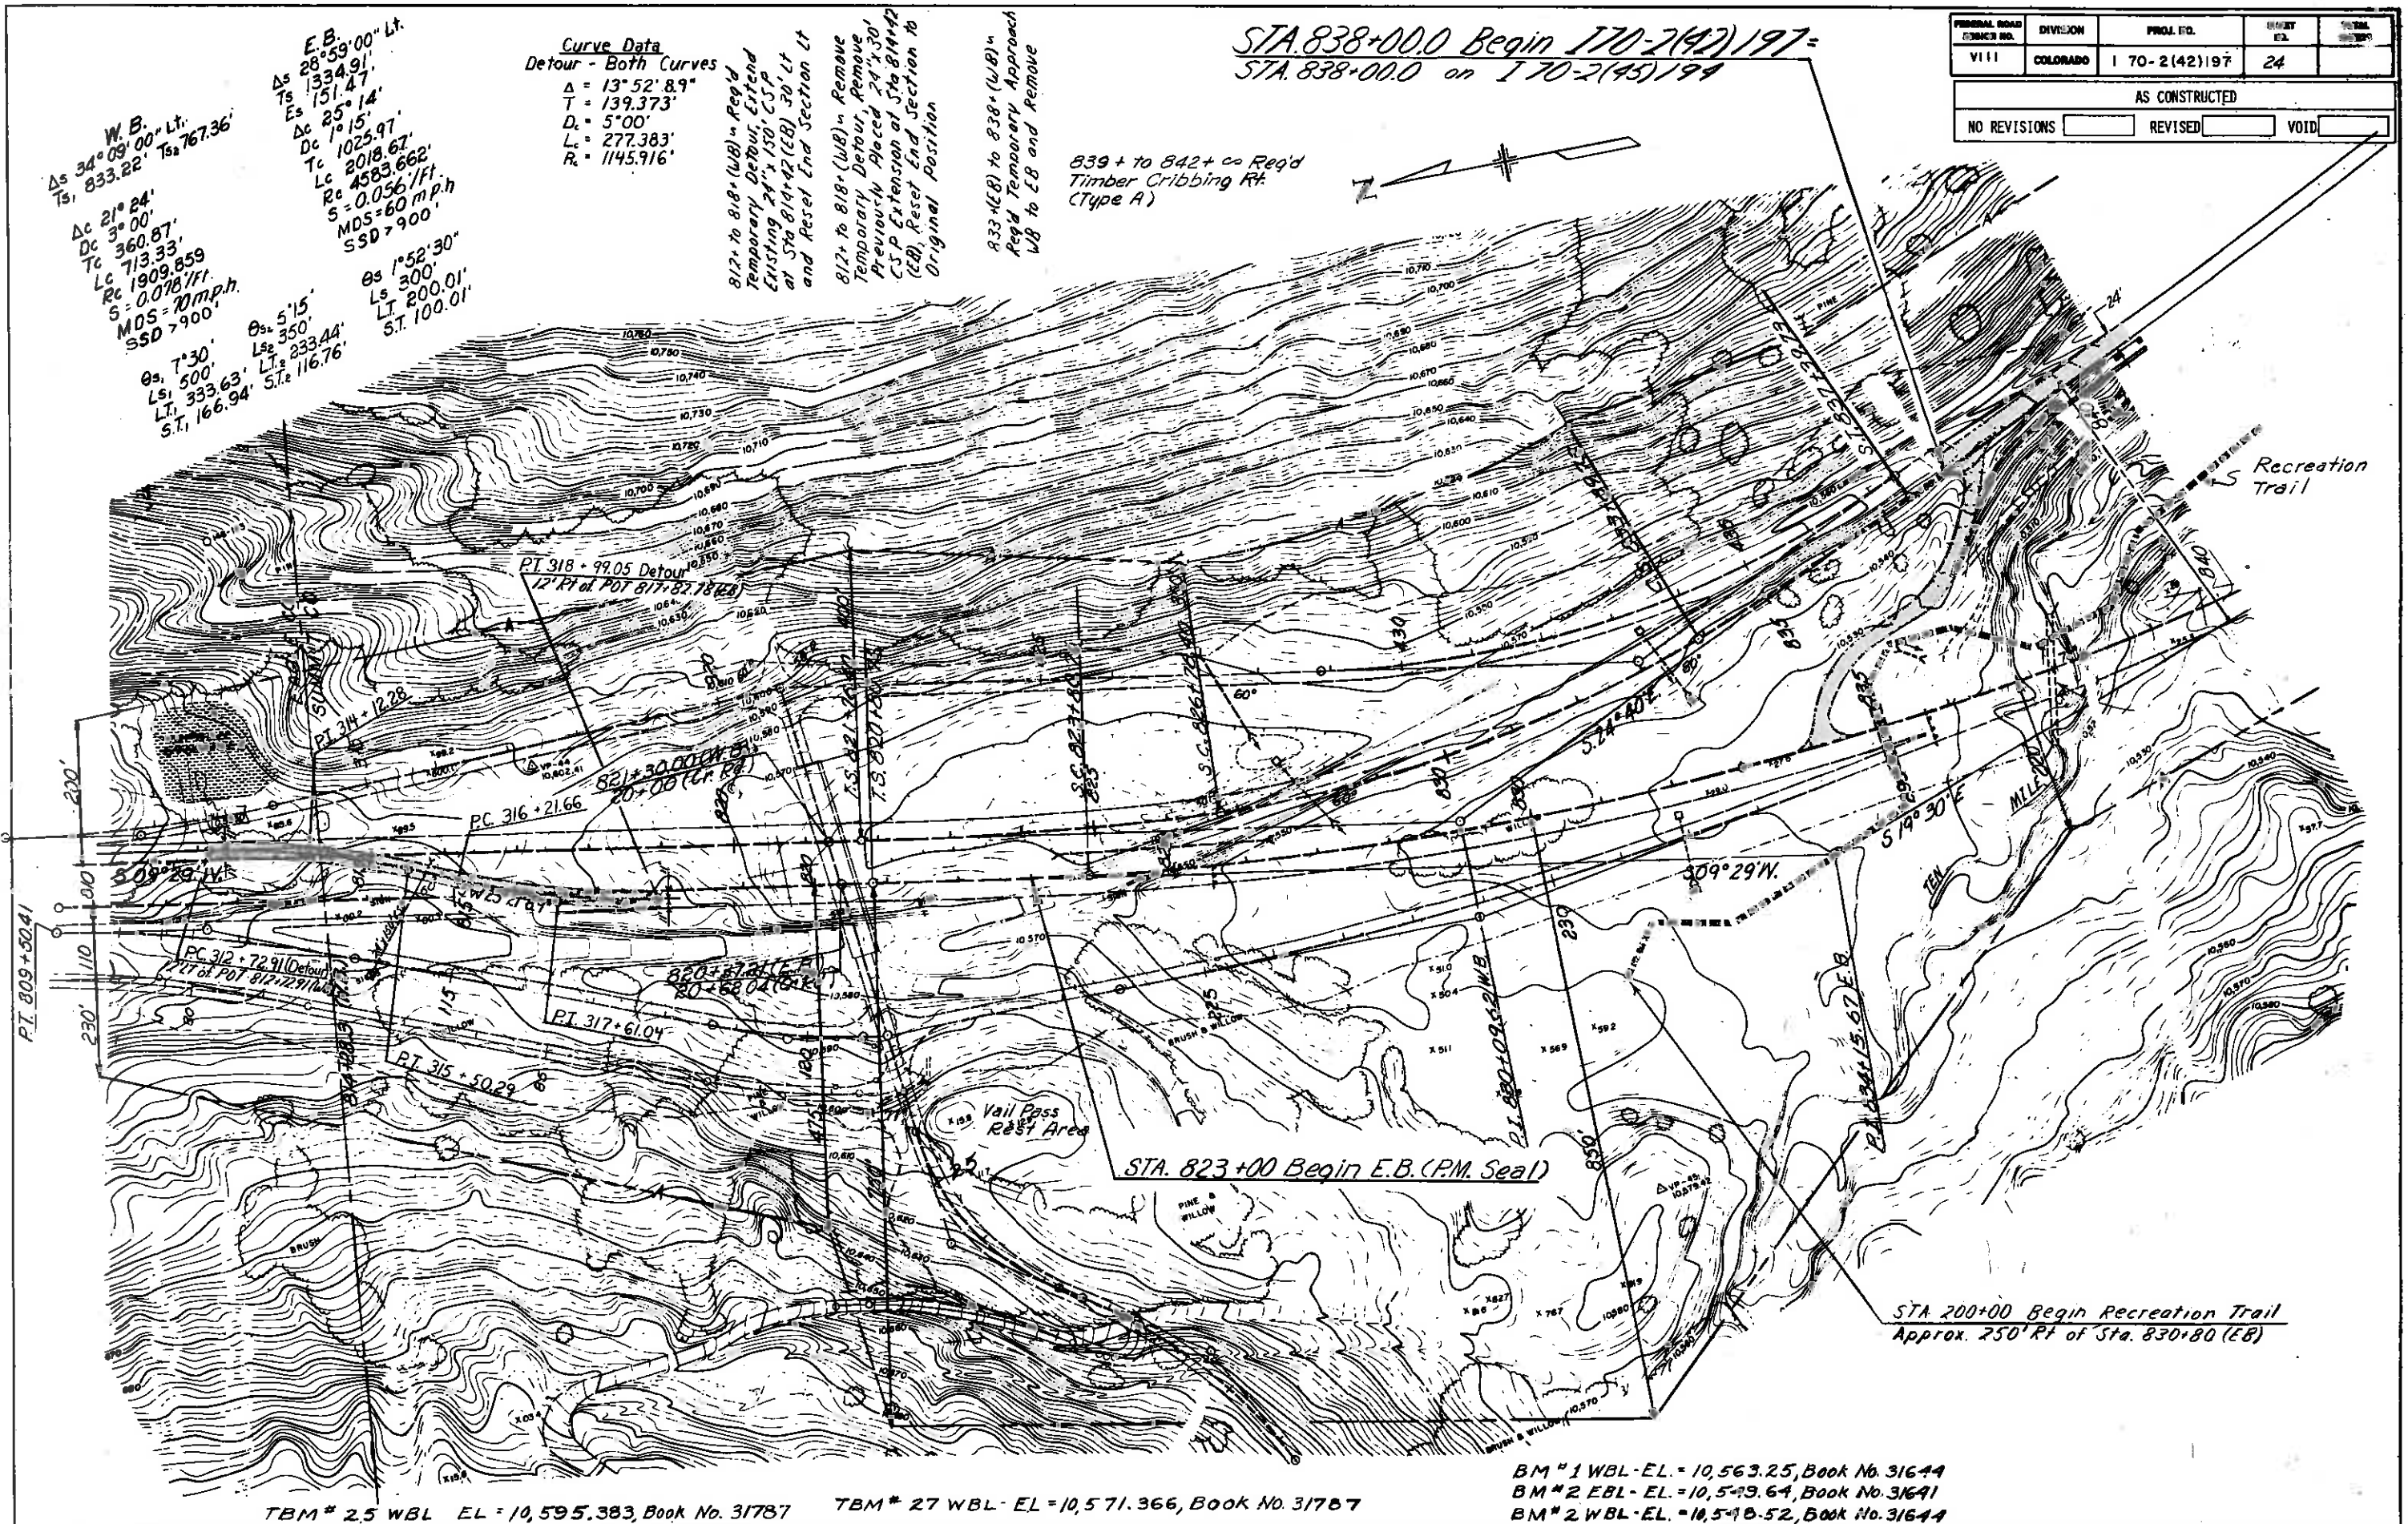

STA. 823+00 Begin E.B. (P.M. Seal)

STA 200+00 Begin Recreation Trail  
Approx. 250' Rt of Sta. 830+80 (EB)

TBM # 2.5 WBL EL = 10,595.383, Book No. 31787

TBM # 27 WBL EL = 10,571.366, Book No. 31787

BM # 1 WBL - EL = 10,563.25, Book No. 31644  
BM # 2 EBL - EL = 10,549.64, Book No. 31641  
BM # 2 WBL - EL = 10,548.52, Book No. 31644



AS CONSTRUCTED			FEDERAL ROAD REGION NO.	DIVISION	PROJECT NO.	SHEET NO.
NO REVISIONS	REVISED	VOID	VIII	COLORADO	170-2(42)197	25

100' 10-27  
 11-5-31  
 12-1-31  
 12-1-31  
 12-1-31  
 12-1-31


100' 10-27  
 11-5-31  
 12-1-31  
 12-1-31  
 12-1-31  
 12-1-31

DETOUR  
 FROM (L.B.) TO (W.B.)

STA 838+000 Begin 170-2(42)197-  
 STA 838+000 on 170-2(42)197

NOTE: BE CAREFUL  
 IN THE  
 AREAS  
 ORDERED

IN THE  
 AREAS  
 ORDERED

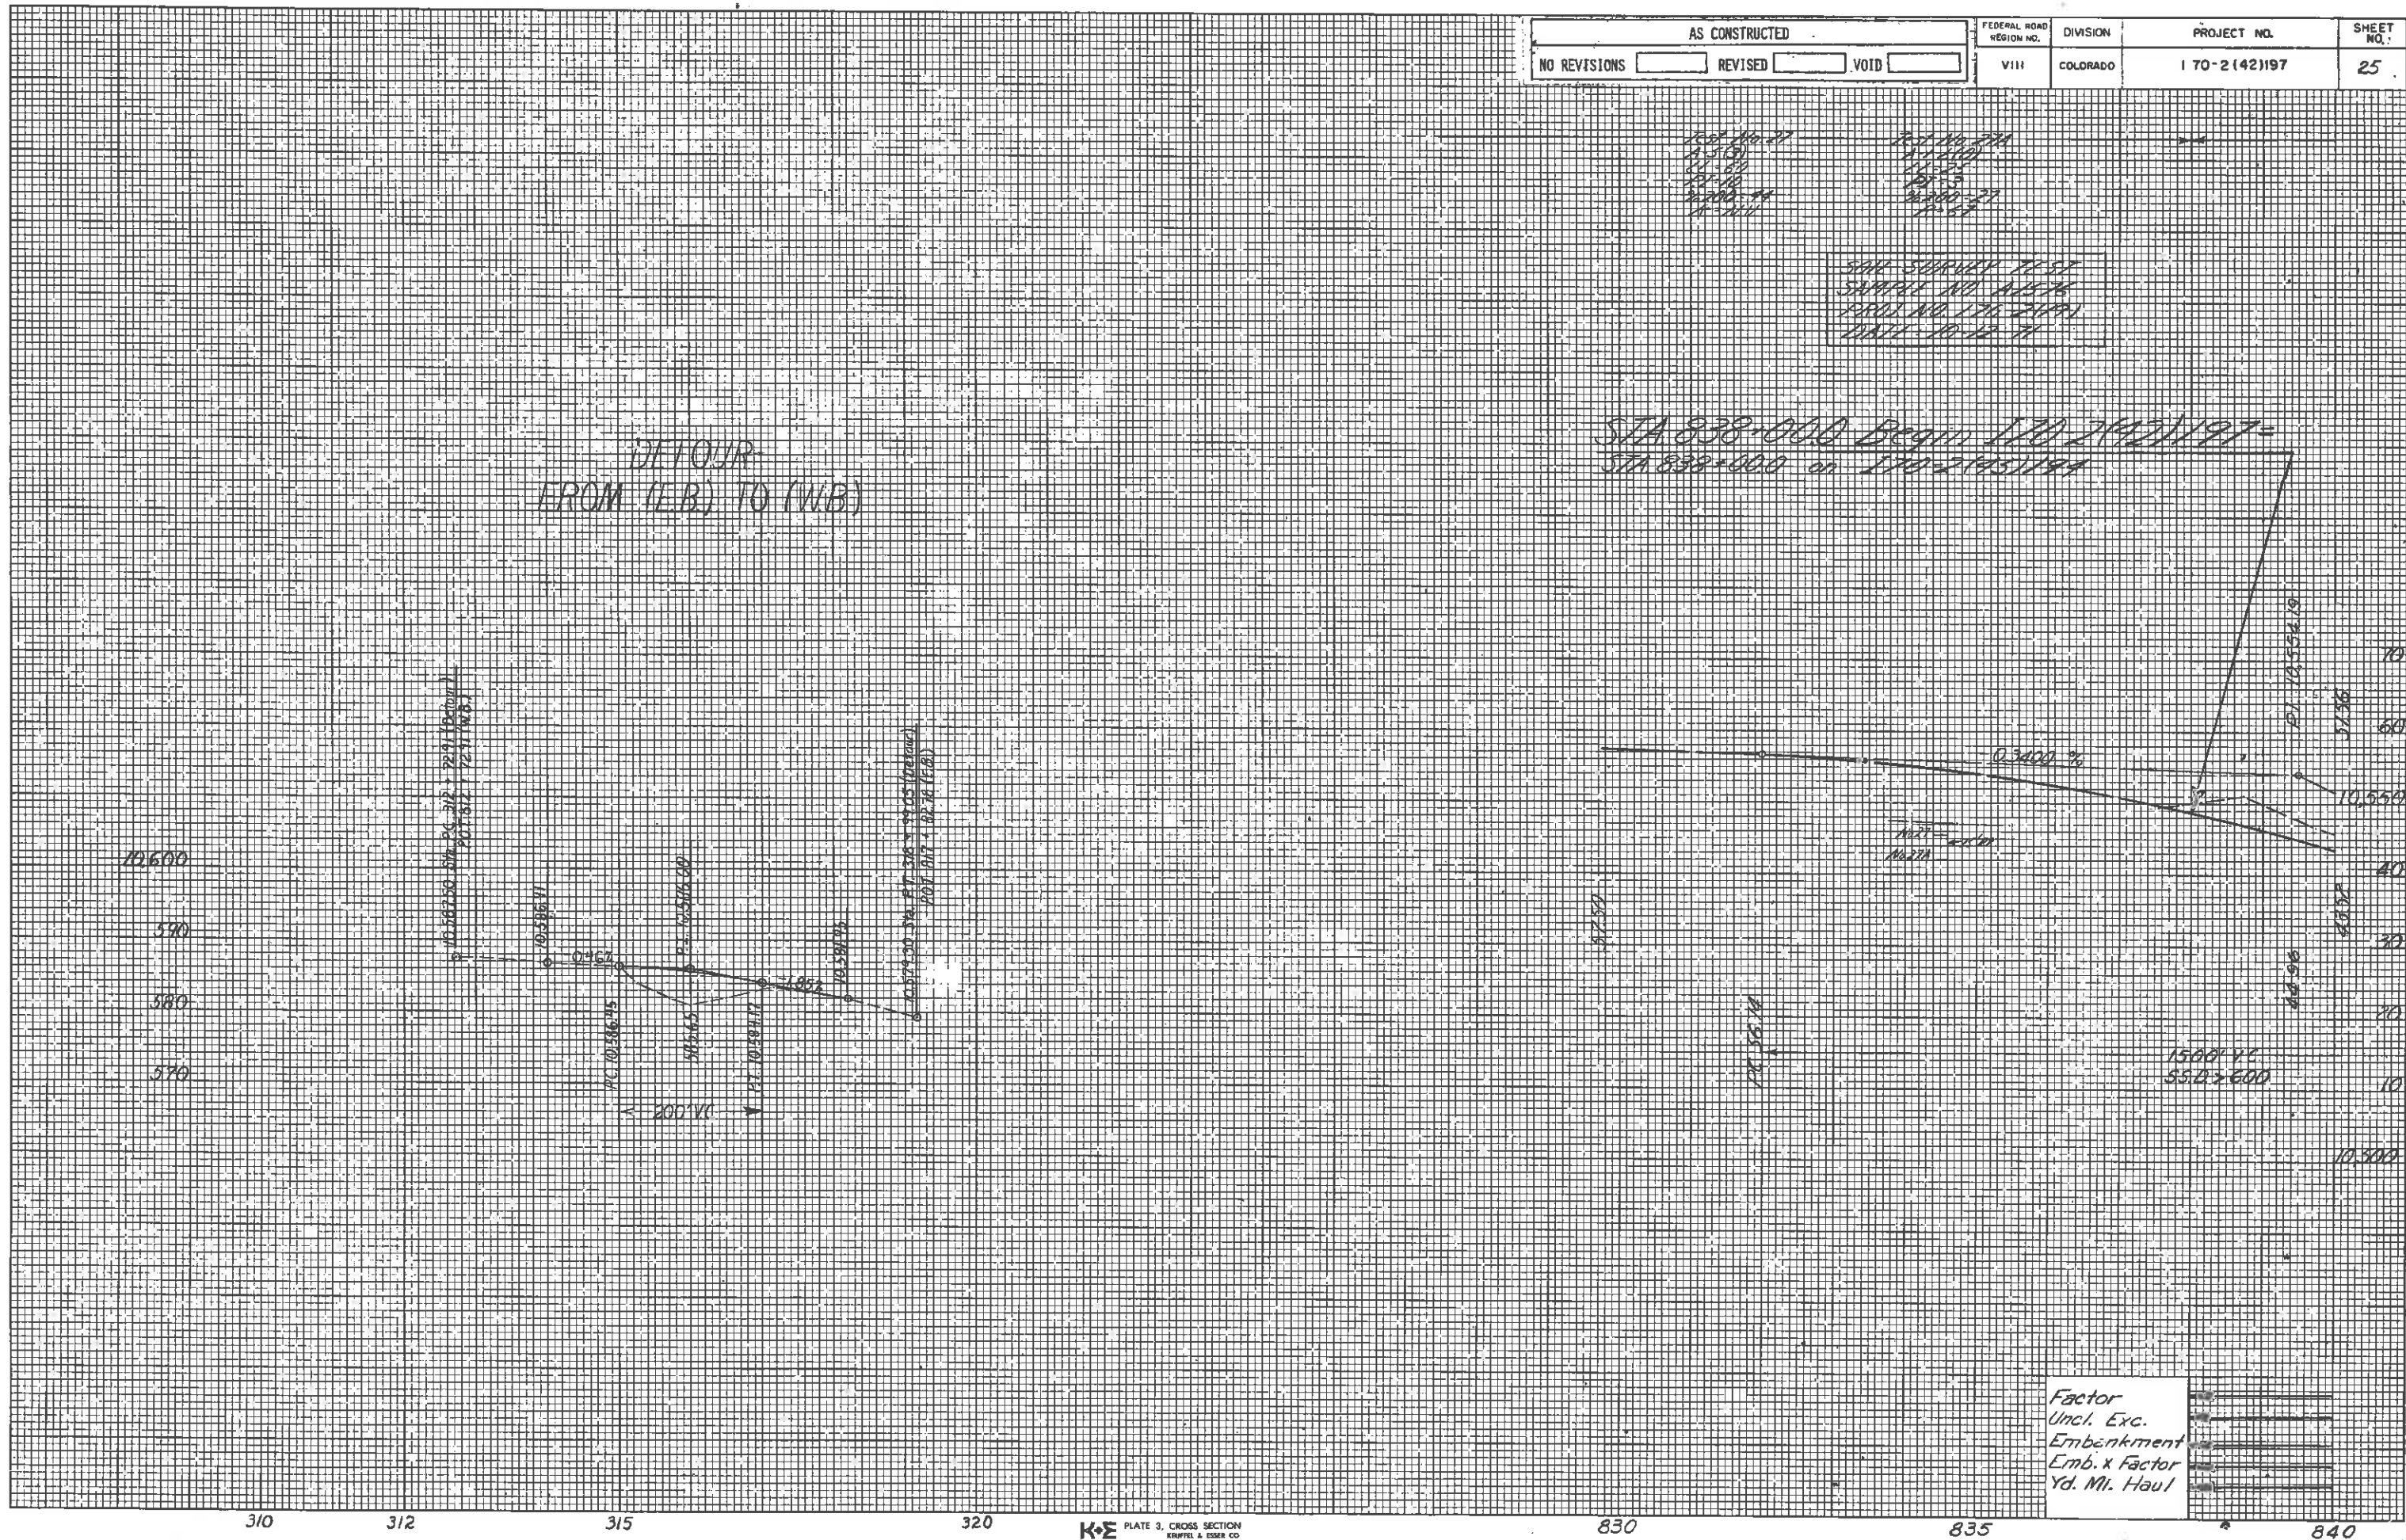






AS CONSTRUCTED  
 NO REVISIONS  REVISED  VOID

FEDERAL ROAD REGION NO.	DIVISION	PROJECT NO.	SHEET NO.
VIII	COLORADO	170-2(42)197	27

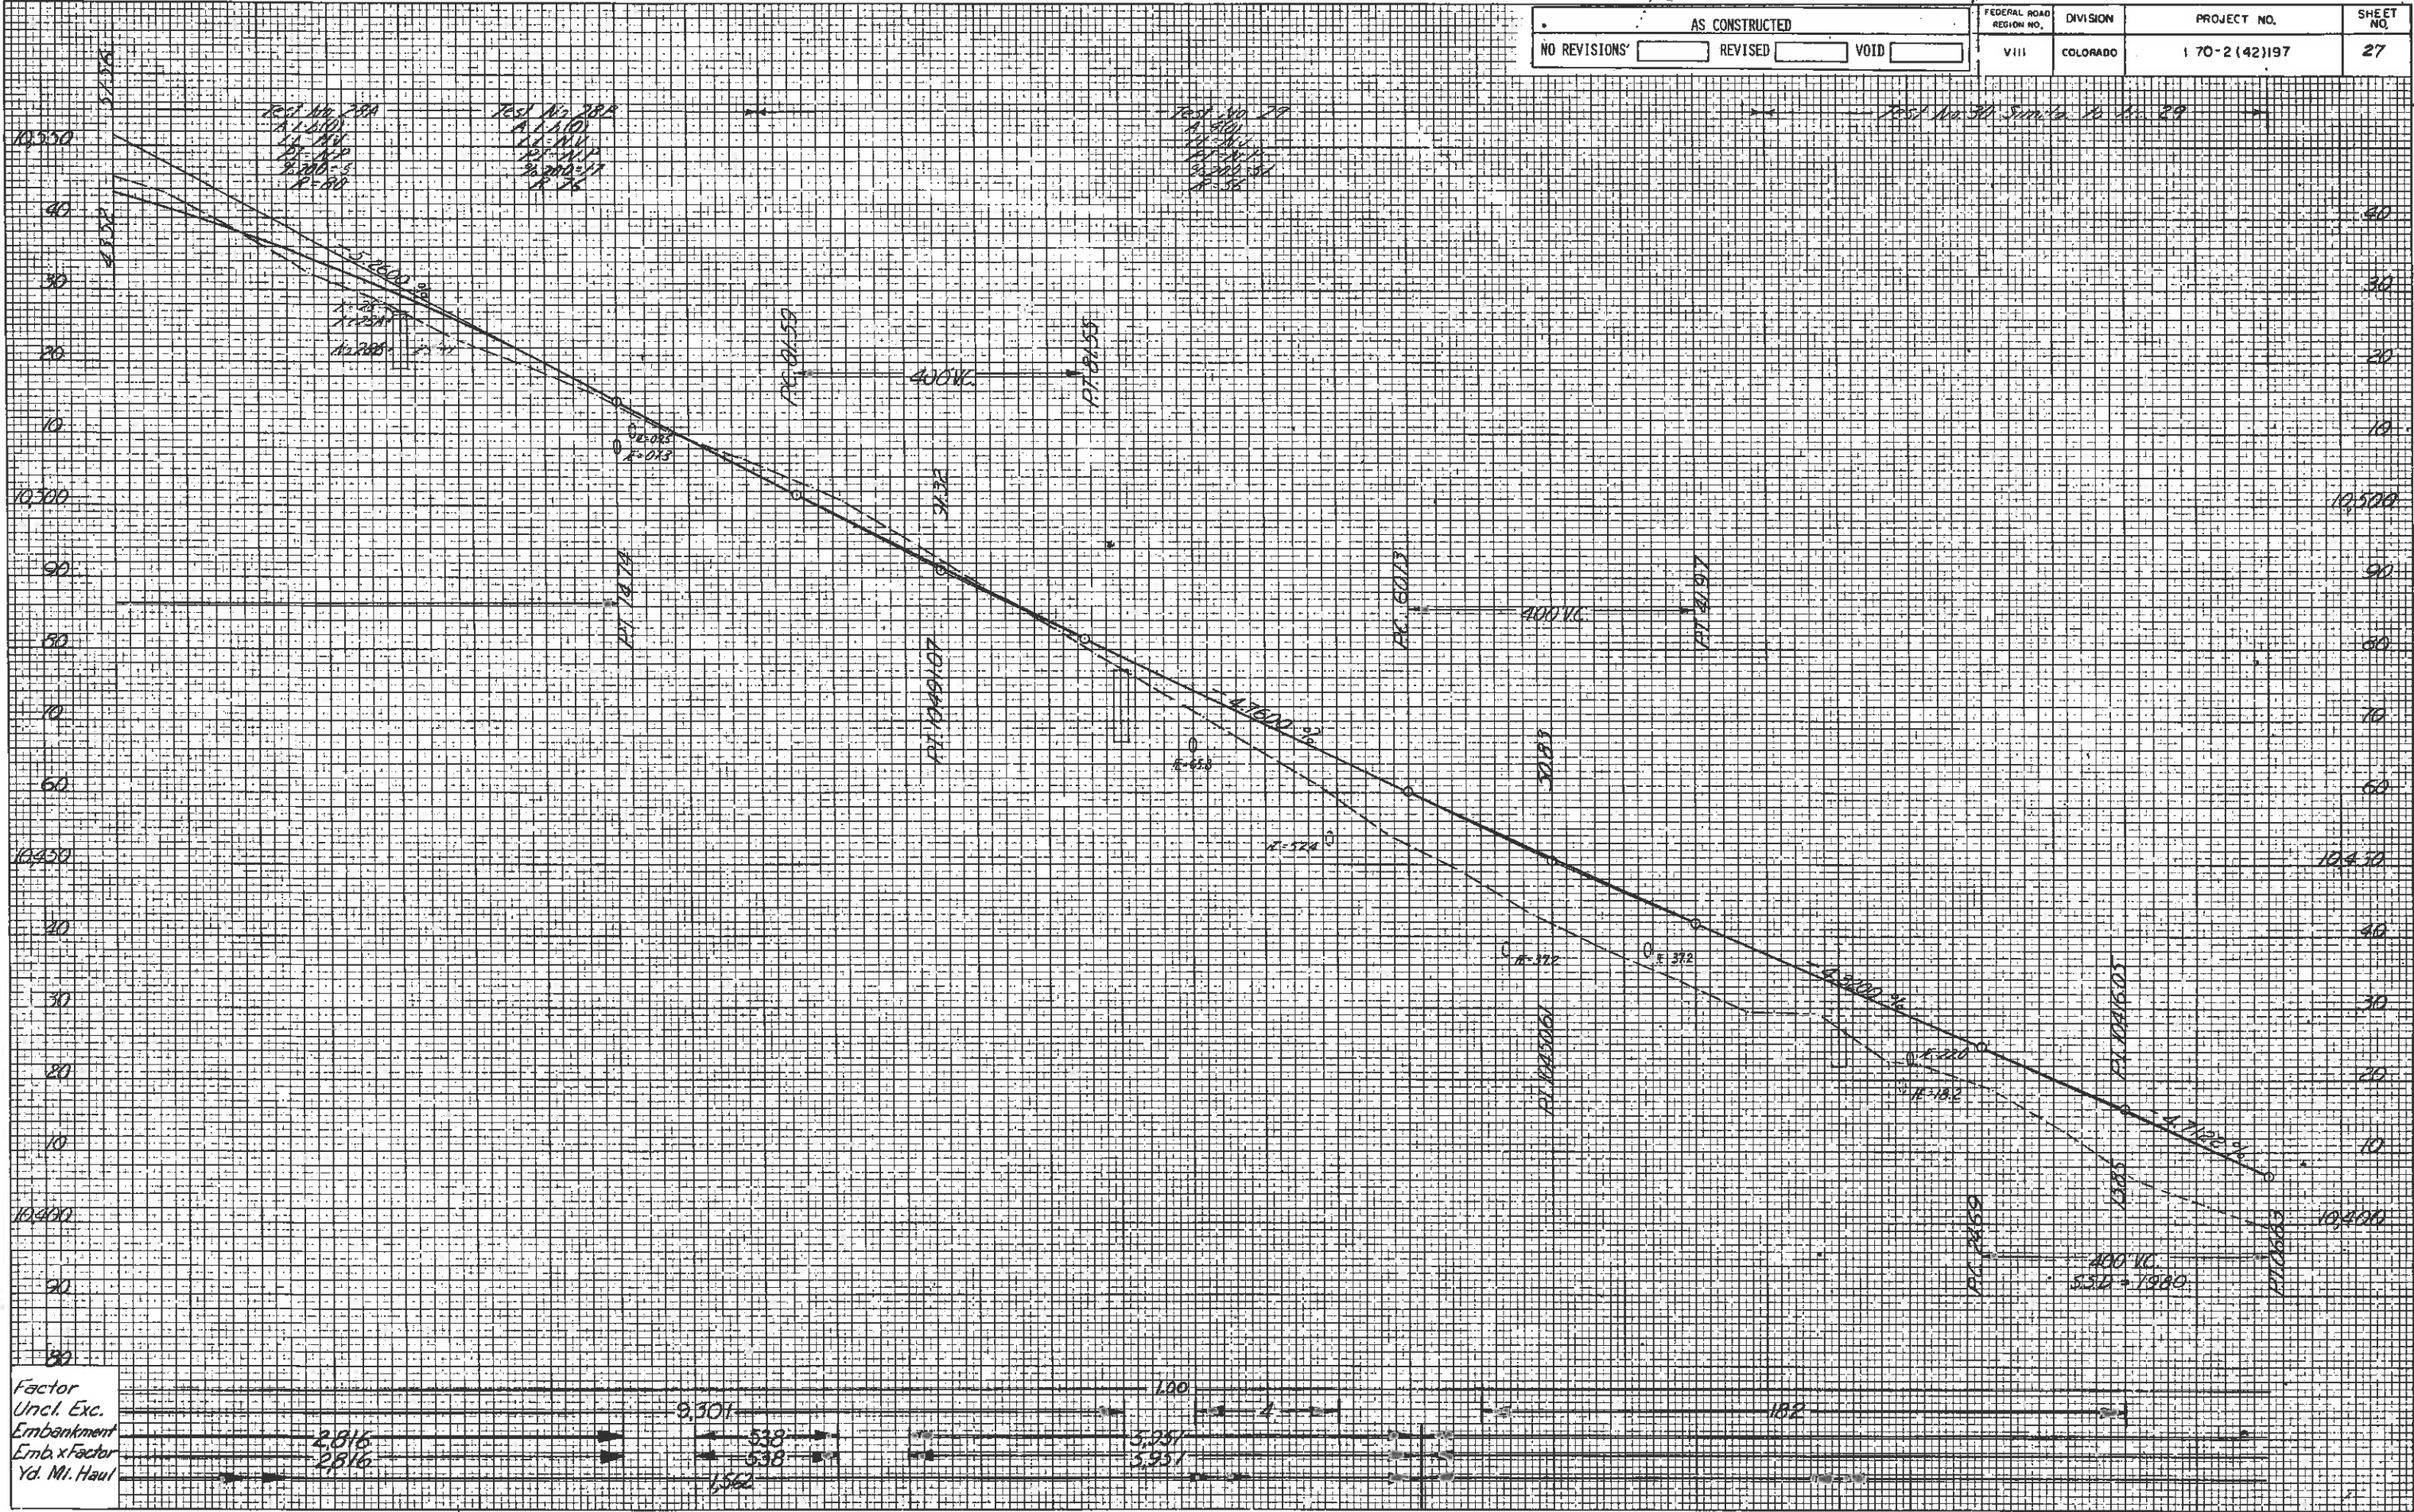

Factor  
 Uncl. Exc.  
 Embankment  
 Emb. x Factor  
 Yd. Mi. Haul

Factor	9.301	1.00	1.82
Uncl. Exc.	538	5,251	
Embankment	538		
Emb. x Factor	1,562	5,951	
Yd. Mi. Haul			

884+ to 890+ Reg'd 8" x 600' Perforated CSP  
 Lt. of Recreation Trail.

AS CONSTRUCTED		
NO REVISIONS	REVISED	VOID


FEDERAL ROAD REGION NO.	DIVISION	PROJ. NO.	SHEET NO.	TOTAL SHEETS
VIII	COLORADO	I 70-2(42)197	28	

(R-1) Str. No. F-12-AL Constructed  
 Under Proj. No. I 70-2(69)198

889+ to 895+ Reg'd 18" x 580' Perforated CSP Lt. f Connect  
 to Type "D" Inlet (Sta. 895+00 Lt)

(R-1) 8-4-78, Note f Bridge Stations, WCB

878+ to 907+ Reg'd 8" x 418'  
 Perforated CSP Lt.

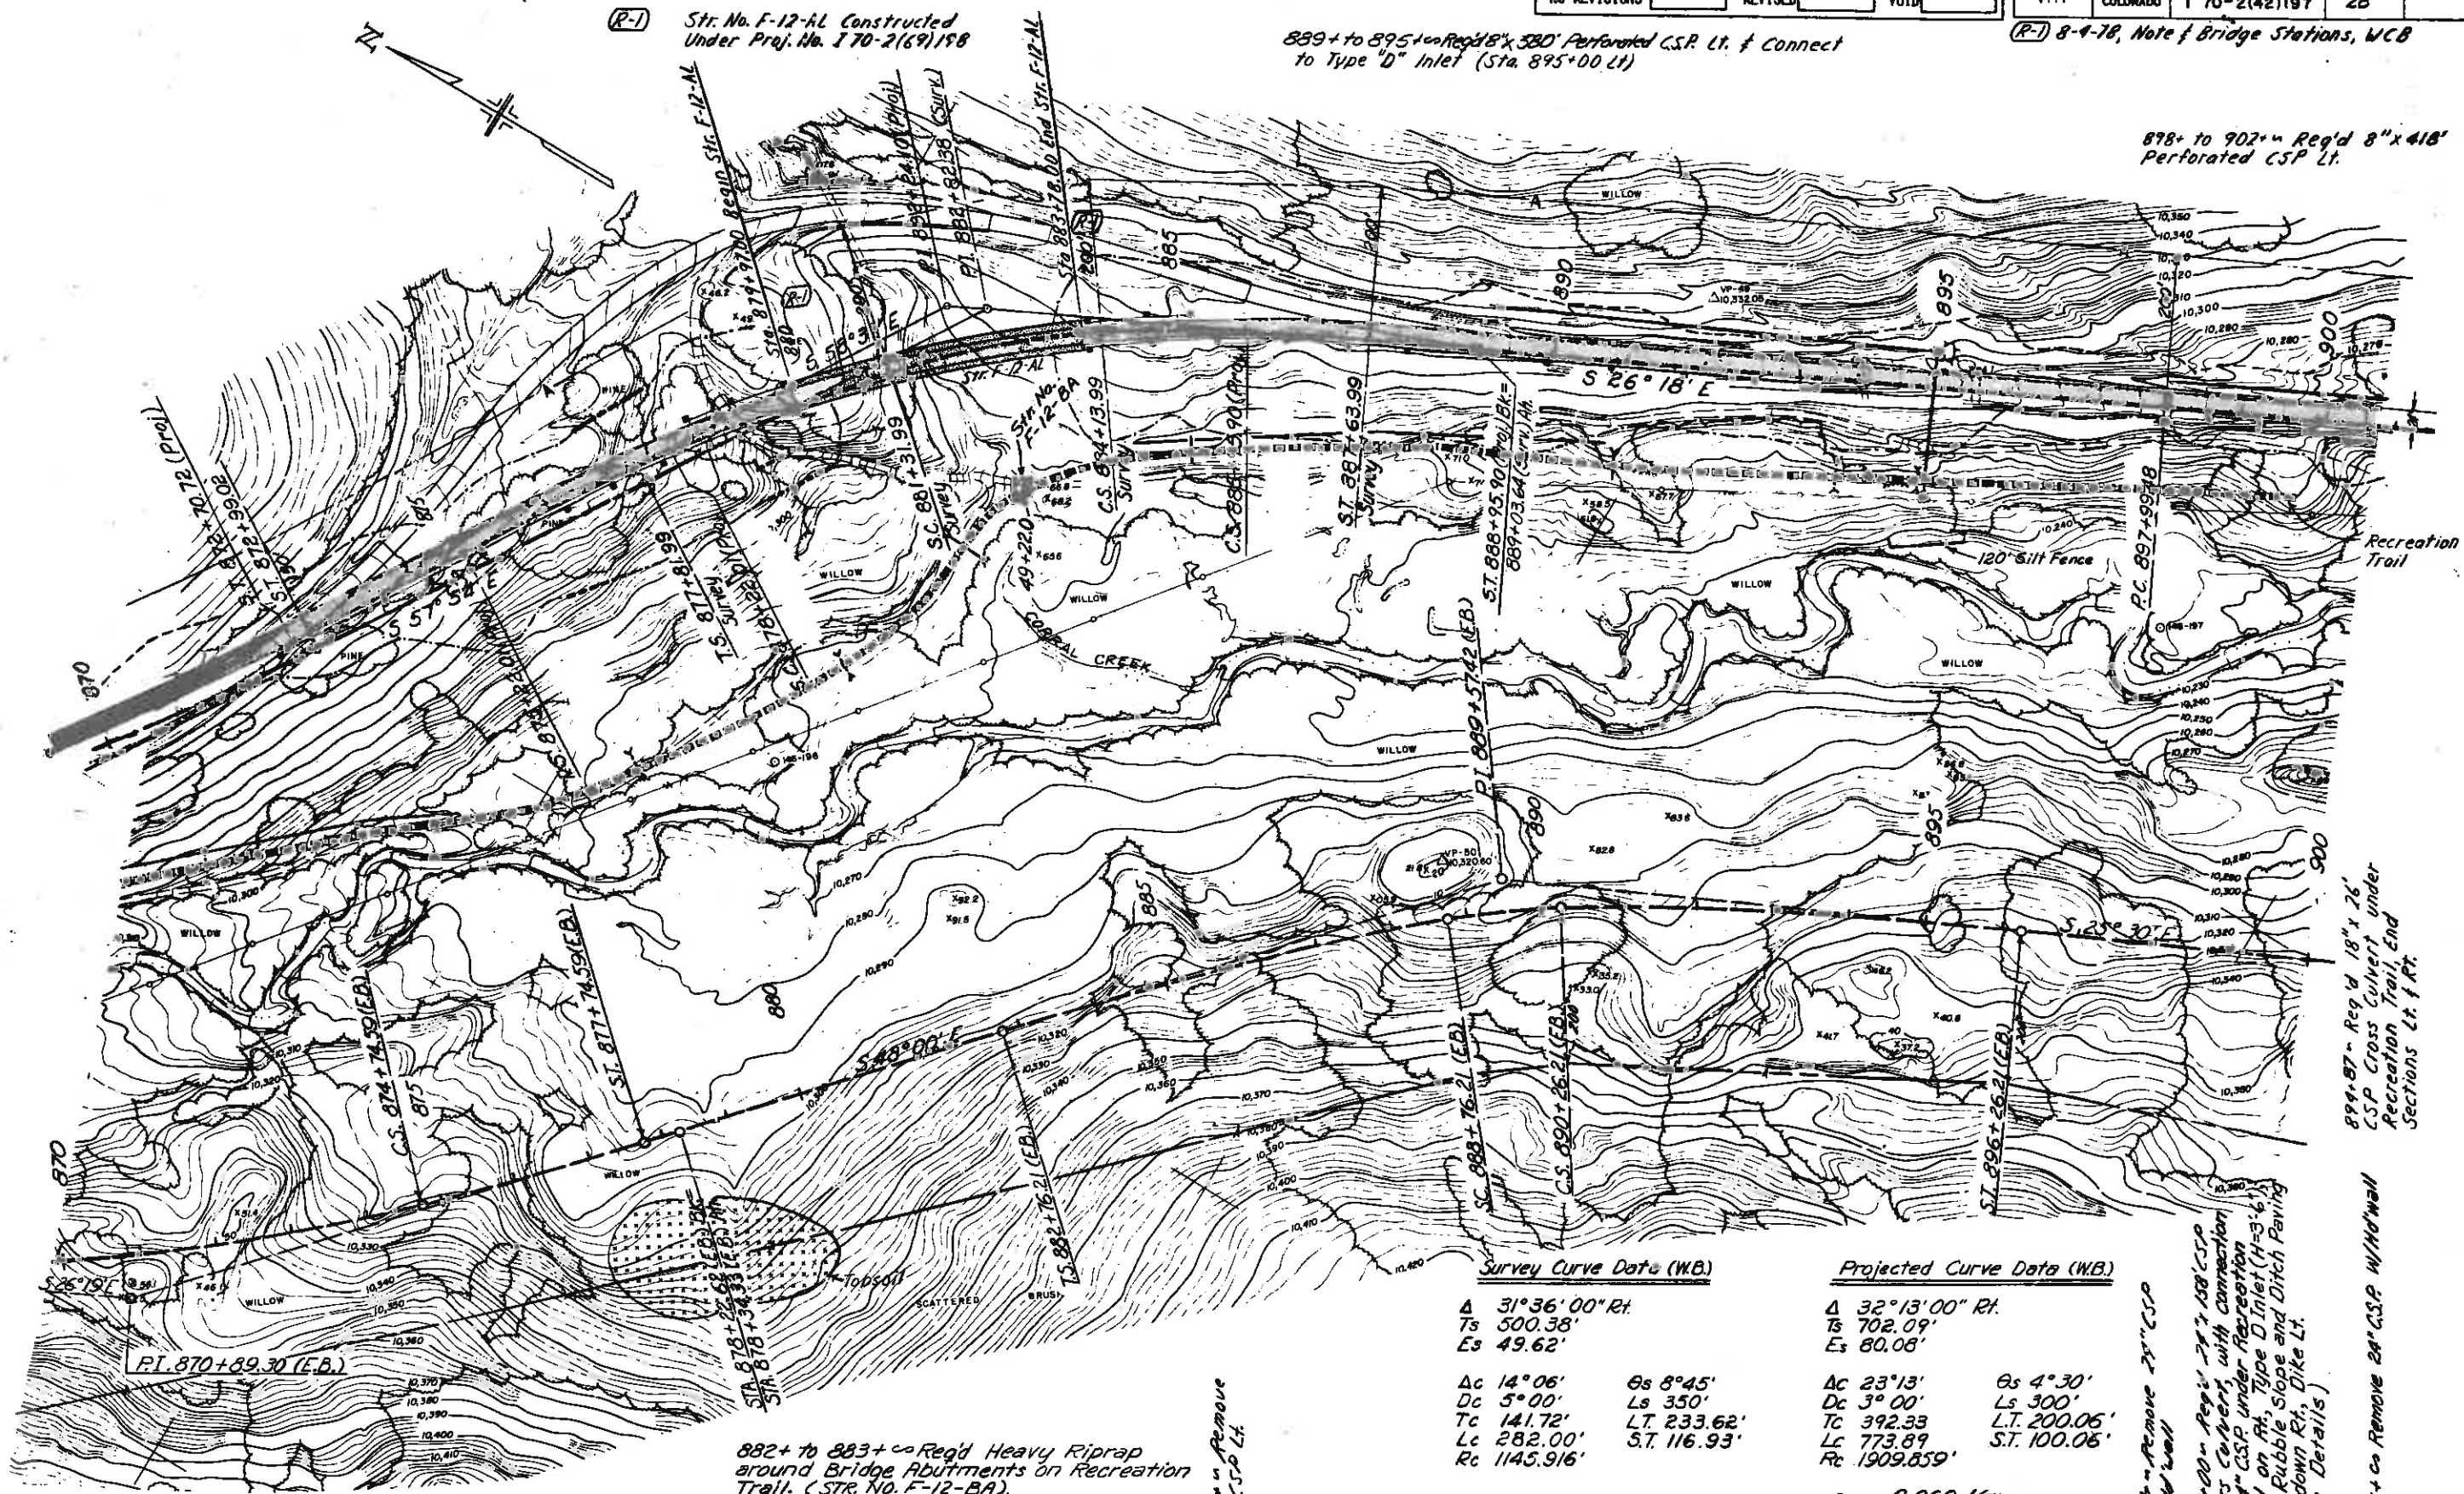

Survey Curve Data (W.B.)

Δ	31°36'00" Rt.
Ts	500.38'
Es	49.62'
Δc	14°06'
Dc	5°00'
Tc	141.72'
Lc	282.00'
Rc	1145.916'

Projected Curve Data (W.B.)

Δ	32°13'00" Rt.
Ts	702.09'
Es	80.08'
Δc	23°13'
Dc	3°00'
Tc	392.33'
Lc	773.89'
Rc	1909.859'

e = 0.060 1/Fx  
 M.D.S. = 70 mph  
 S.S.D. > 600'

882+ to 883+ Reg'd Heavy Riprap  
 around Bridge Abutments on Recreation  
 Trail. (STR. No. F-12-BA)

884+ Remove  
 24" CSP Lt.

894+ Remove 24" CSP  
 with well

895+ Reg'd 24" x 158' CSP  
 Cross Culvert, with connection  
 to 24" CSP under Recreation  
 Trail on Rt. Type D Inlet (H=5'-6")  
 Dry Rubble Slope and Ditch Paving  
 Rounddown Rt. Dike Lt.  
 (See Details)


894+ Reg'd 18" x 26'  
 CSP Cross Culvert under  
 Recreation Trail, End  
 Sections Lt. f Rt.

895+ Remove 24" CSP with well




AS CONSTRUCTED		
NO REVISION	REVISED	VOID

FEDERAL ROAD REGION NO	DIVISION	PROJECT NO	SHEET NO
VIII	COLORADO	170-2(42)197	29

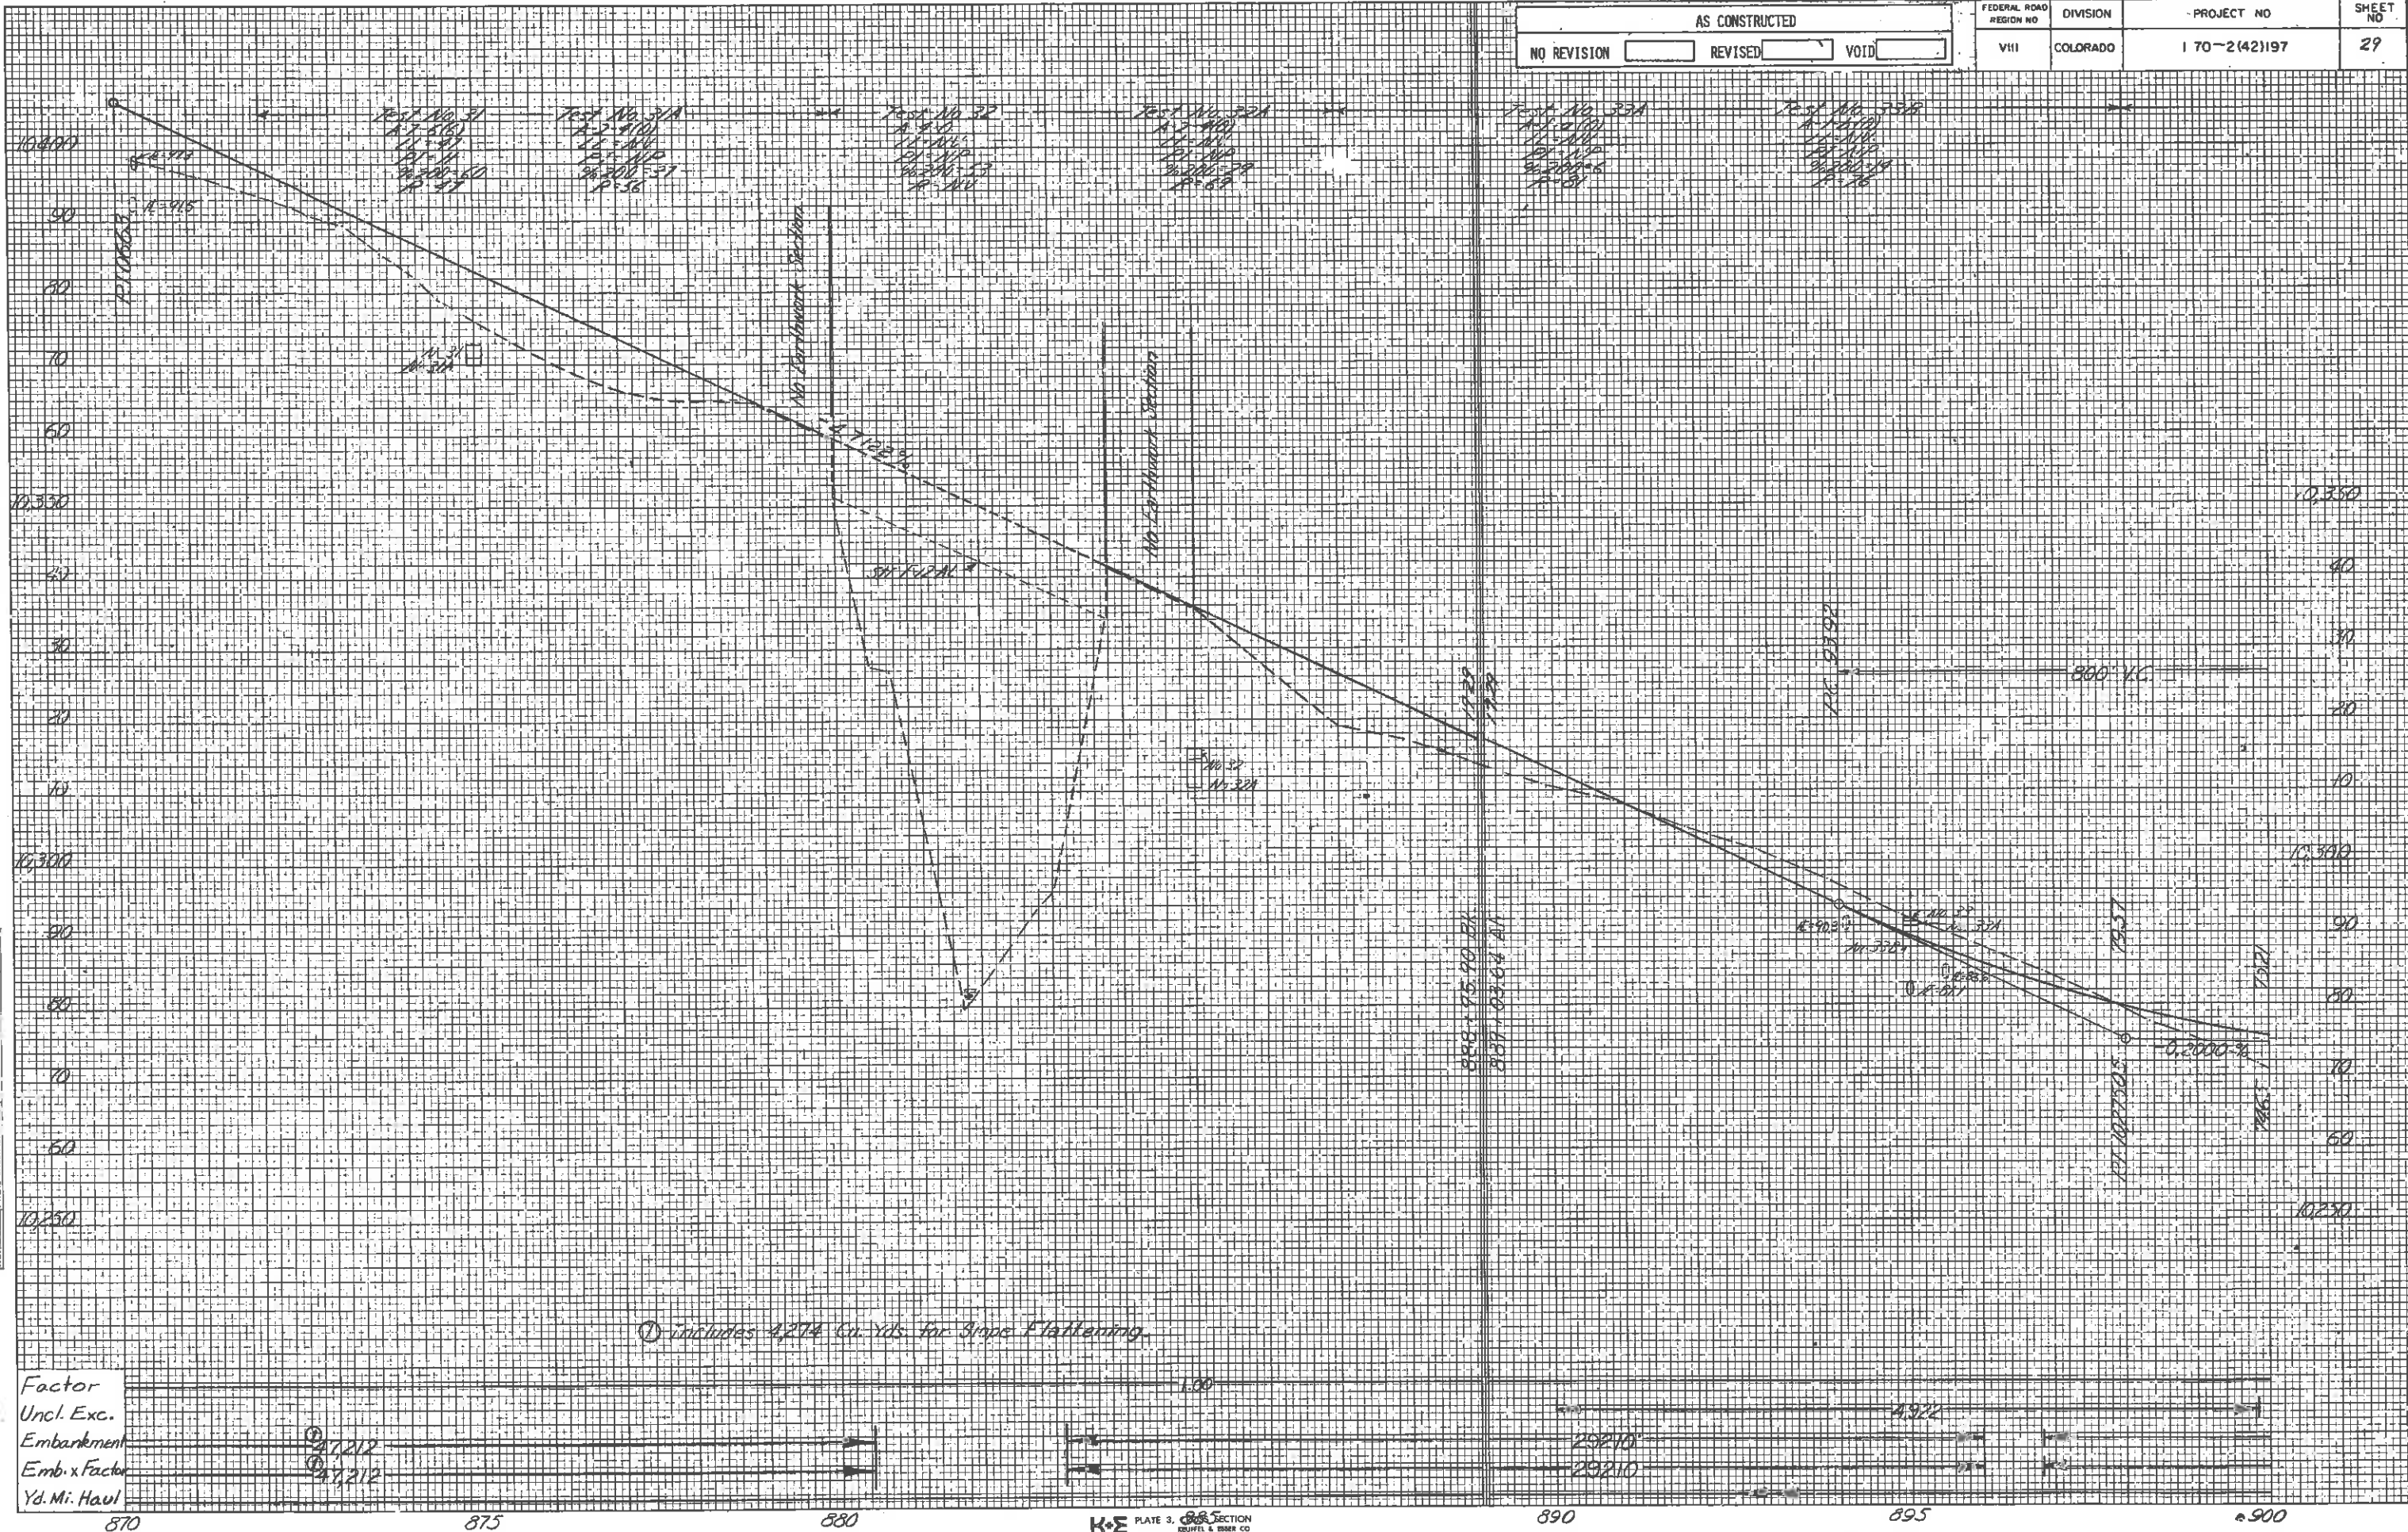



FEDERAL ROAD DISTRICT NO.	DIVISION	PROJ. E.D.	SHEET NO.	TOTAL SHEETS
VIII	COLORADO	70-2(42)197	30	
AS CONSTRUCTED				
NO REVISIONS	REVISED	VOID		

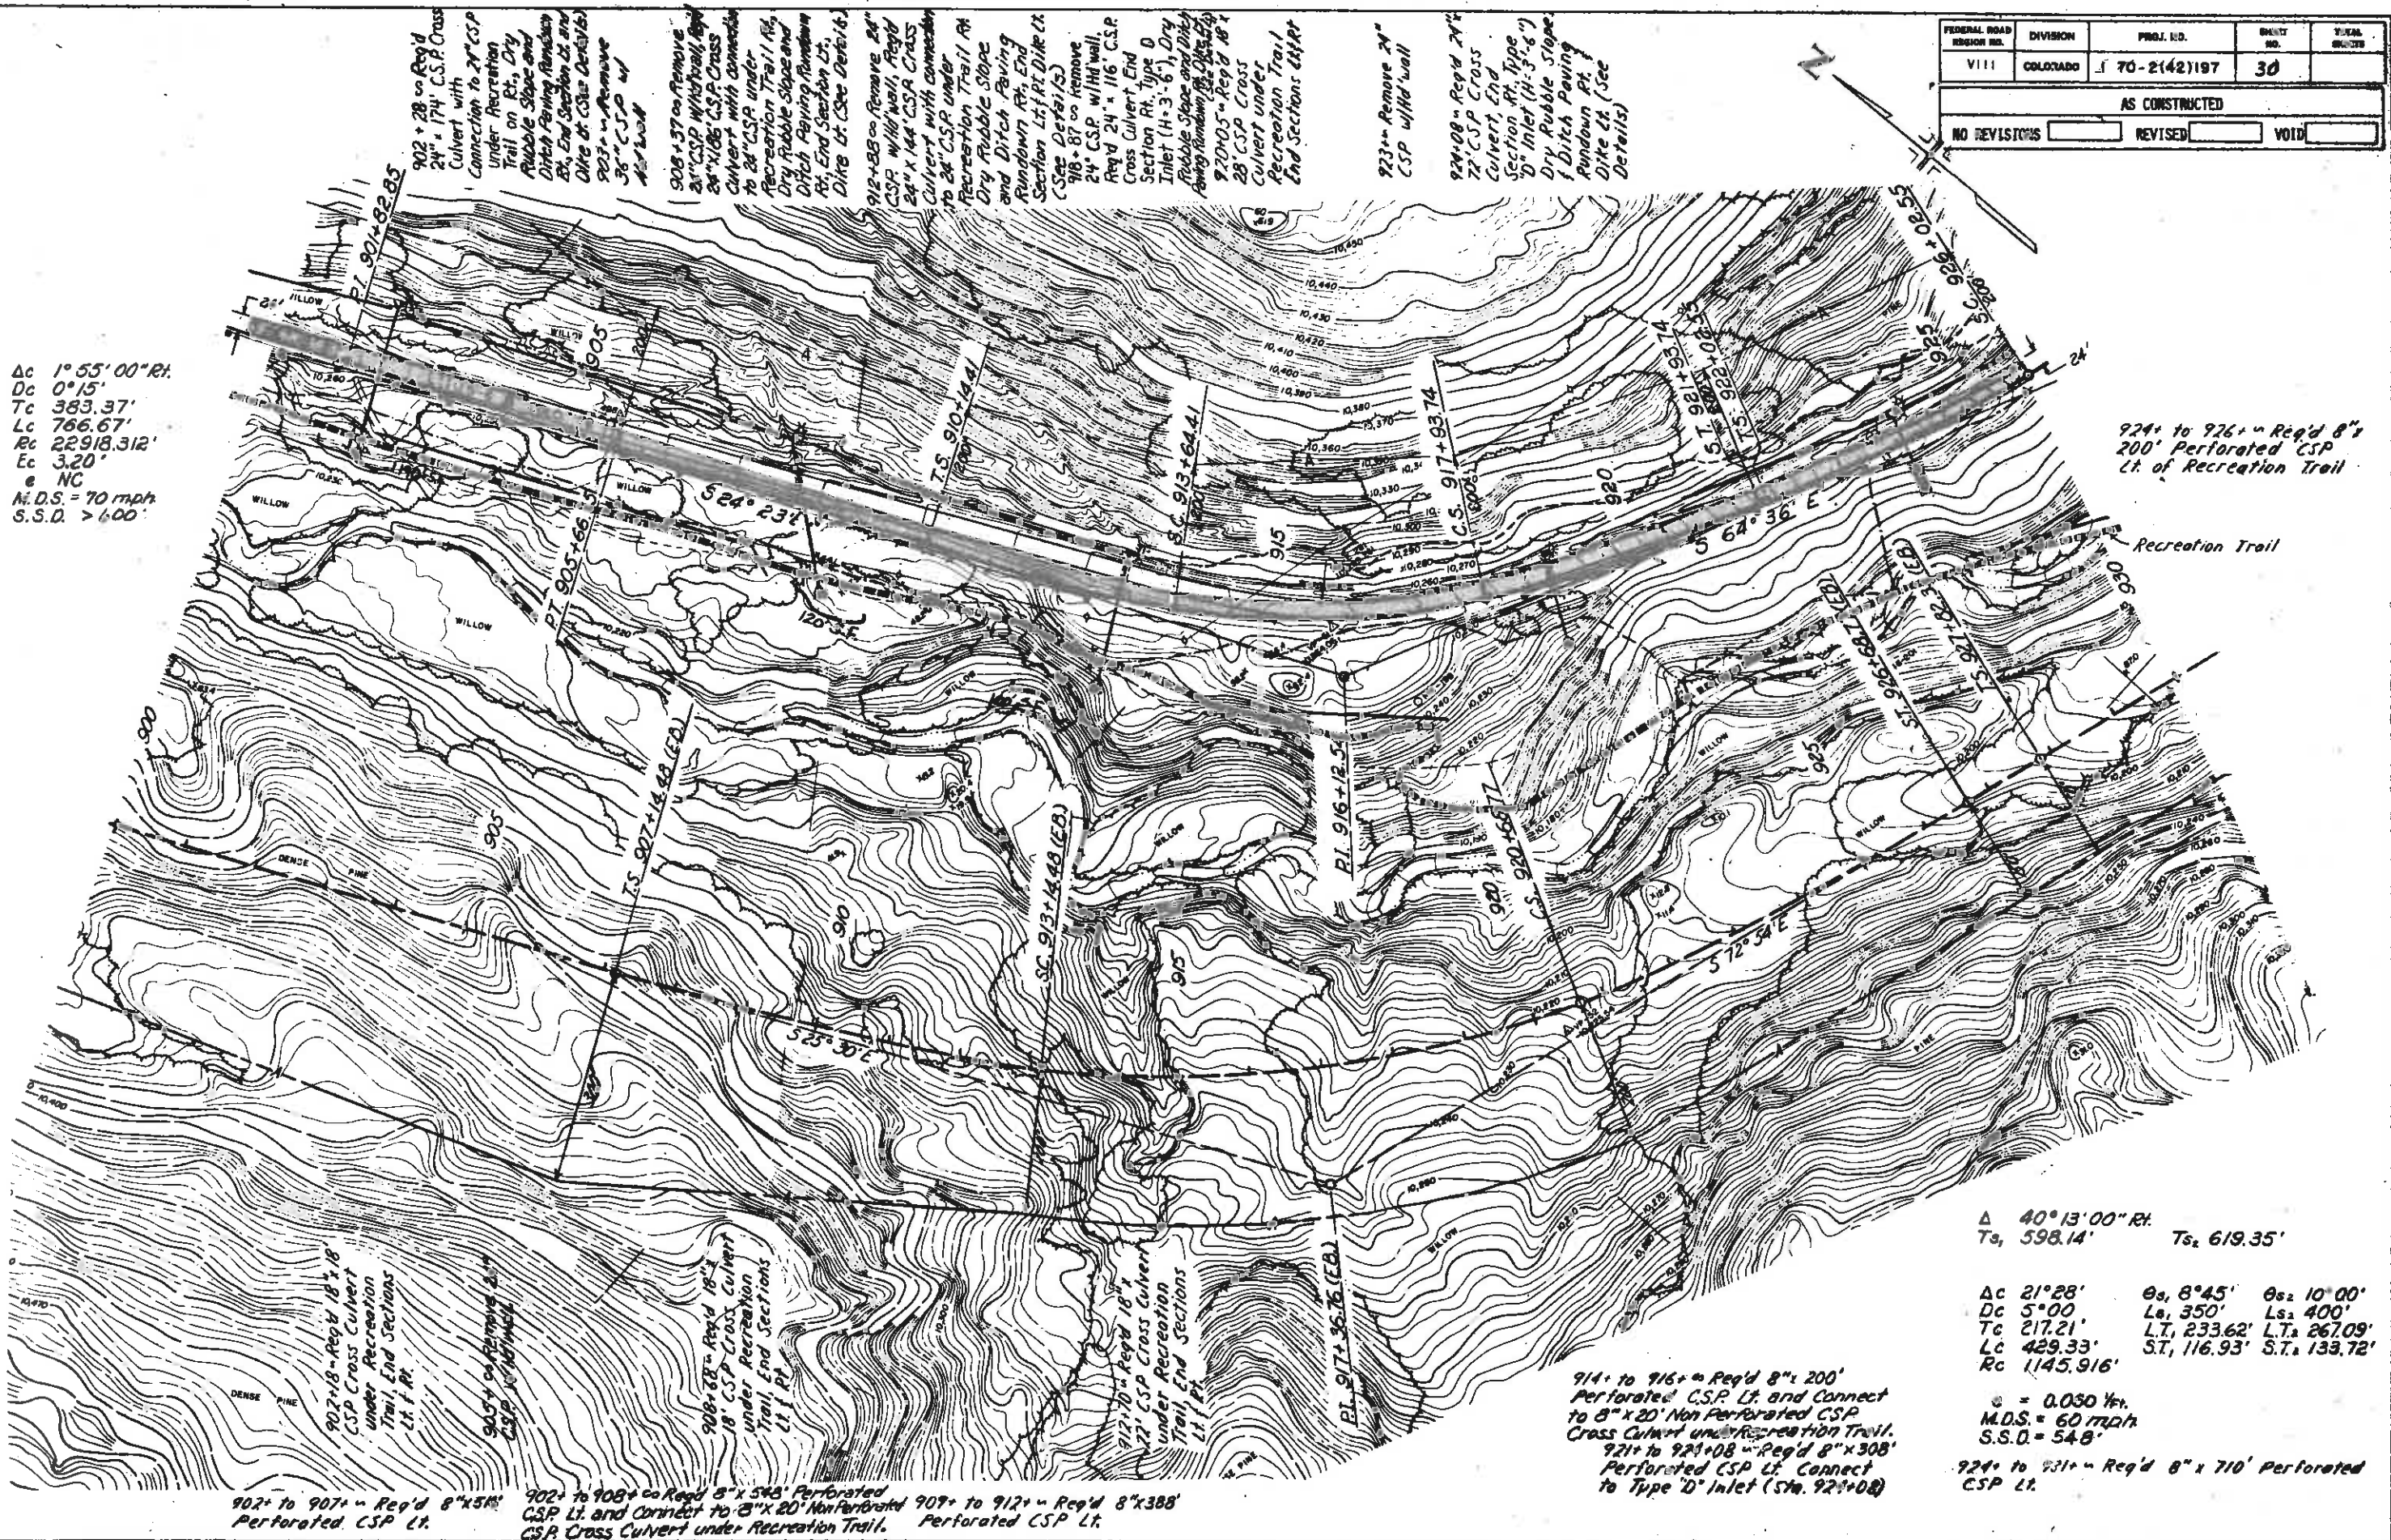

Δc 1° 55' 00" Rt.  
Dc 0° 15'  
Tc 383.37'  
Lc 766.67'  
Rc 22918.312'  
Ec 3.20'  
e NC  
M.D.S. = 70 mph  
S.S.D. > 600'

924+ to 926+ Reg'd 8" x 200' Perforated CSP Lt. of Recreation Trail

Δ 40° 13' 00" Rt.  
Ts, 598.14' Ts, 619.35'

Δc 21° 28' θs, 8° 45' θs, 10° 00'  
Dc 5° 00' Ls, 350' Ls, 400'  
Tc 217.21' LT, 233.62' LT, 267.09'  
Lc 429.33' ST, 116.93' S.T., 139.72'  
Rc 1145.916'

e = 0.050 ft.  
M.D.S. = 60 mph  
S.S.D. = 548'


924+ to 931+ Reg'd 8" x 710' Perforated CSP Lt.

914+ to 916+ Reg'd 8" x 200' Perforated CSP Lt. and Connect to 8" x 20' Non Perforated CSP Cross Culvert under Recreation Trail. 921+ to 921+08 Reg'd 8" x 308' Perforated CSP Lt. Connect to Type 'D' Inlet (Sta. 921+08)

902+ to 907+ Reg'd 8" x 358' Perforated CSP Lt.  
902+ to 908+ Reg'd 8" x 548' Perforated CSP Lt. and Connect to 8" x 20' Non Perforated CSP Cross Culvert under Recreation Trail.  
909+ to 912+ Reg'd 8" x 388' Perforated CSP Lt.

AS CONSTRUCTED  
 NO REVISIONS  REVISED  VOID

FEDERAL ROAD REGION NO.	DIVISION	PROJECT NO.	SHEET NO.
VIII	COLORADO	170-2(42)197	31

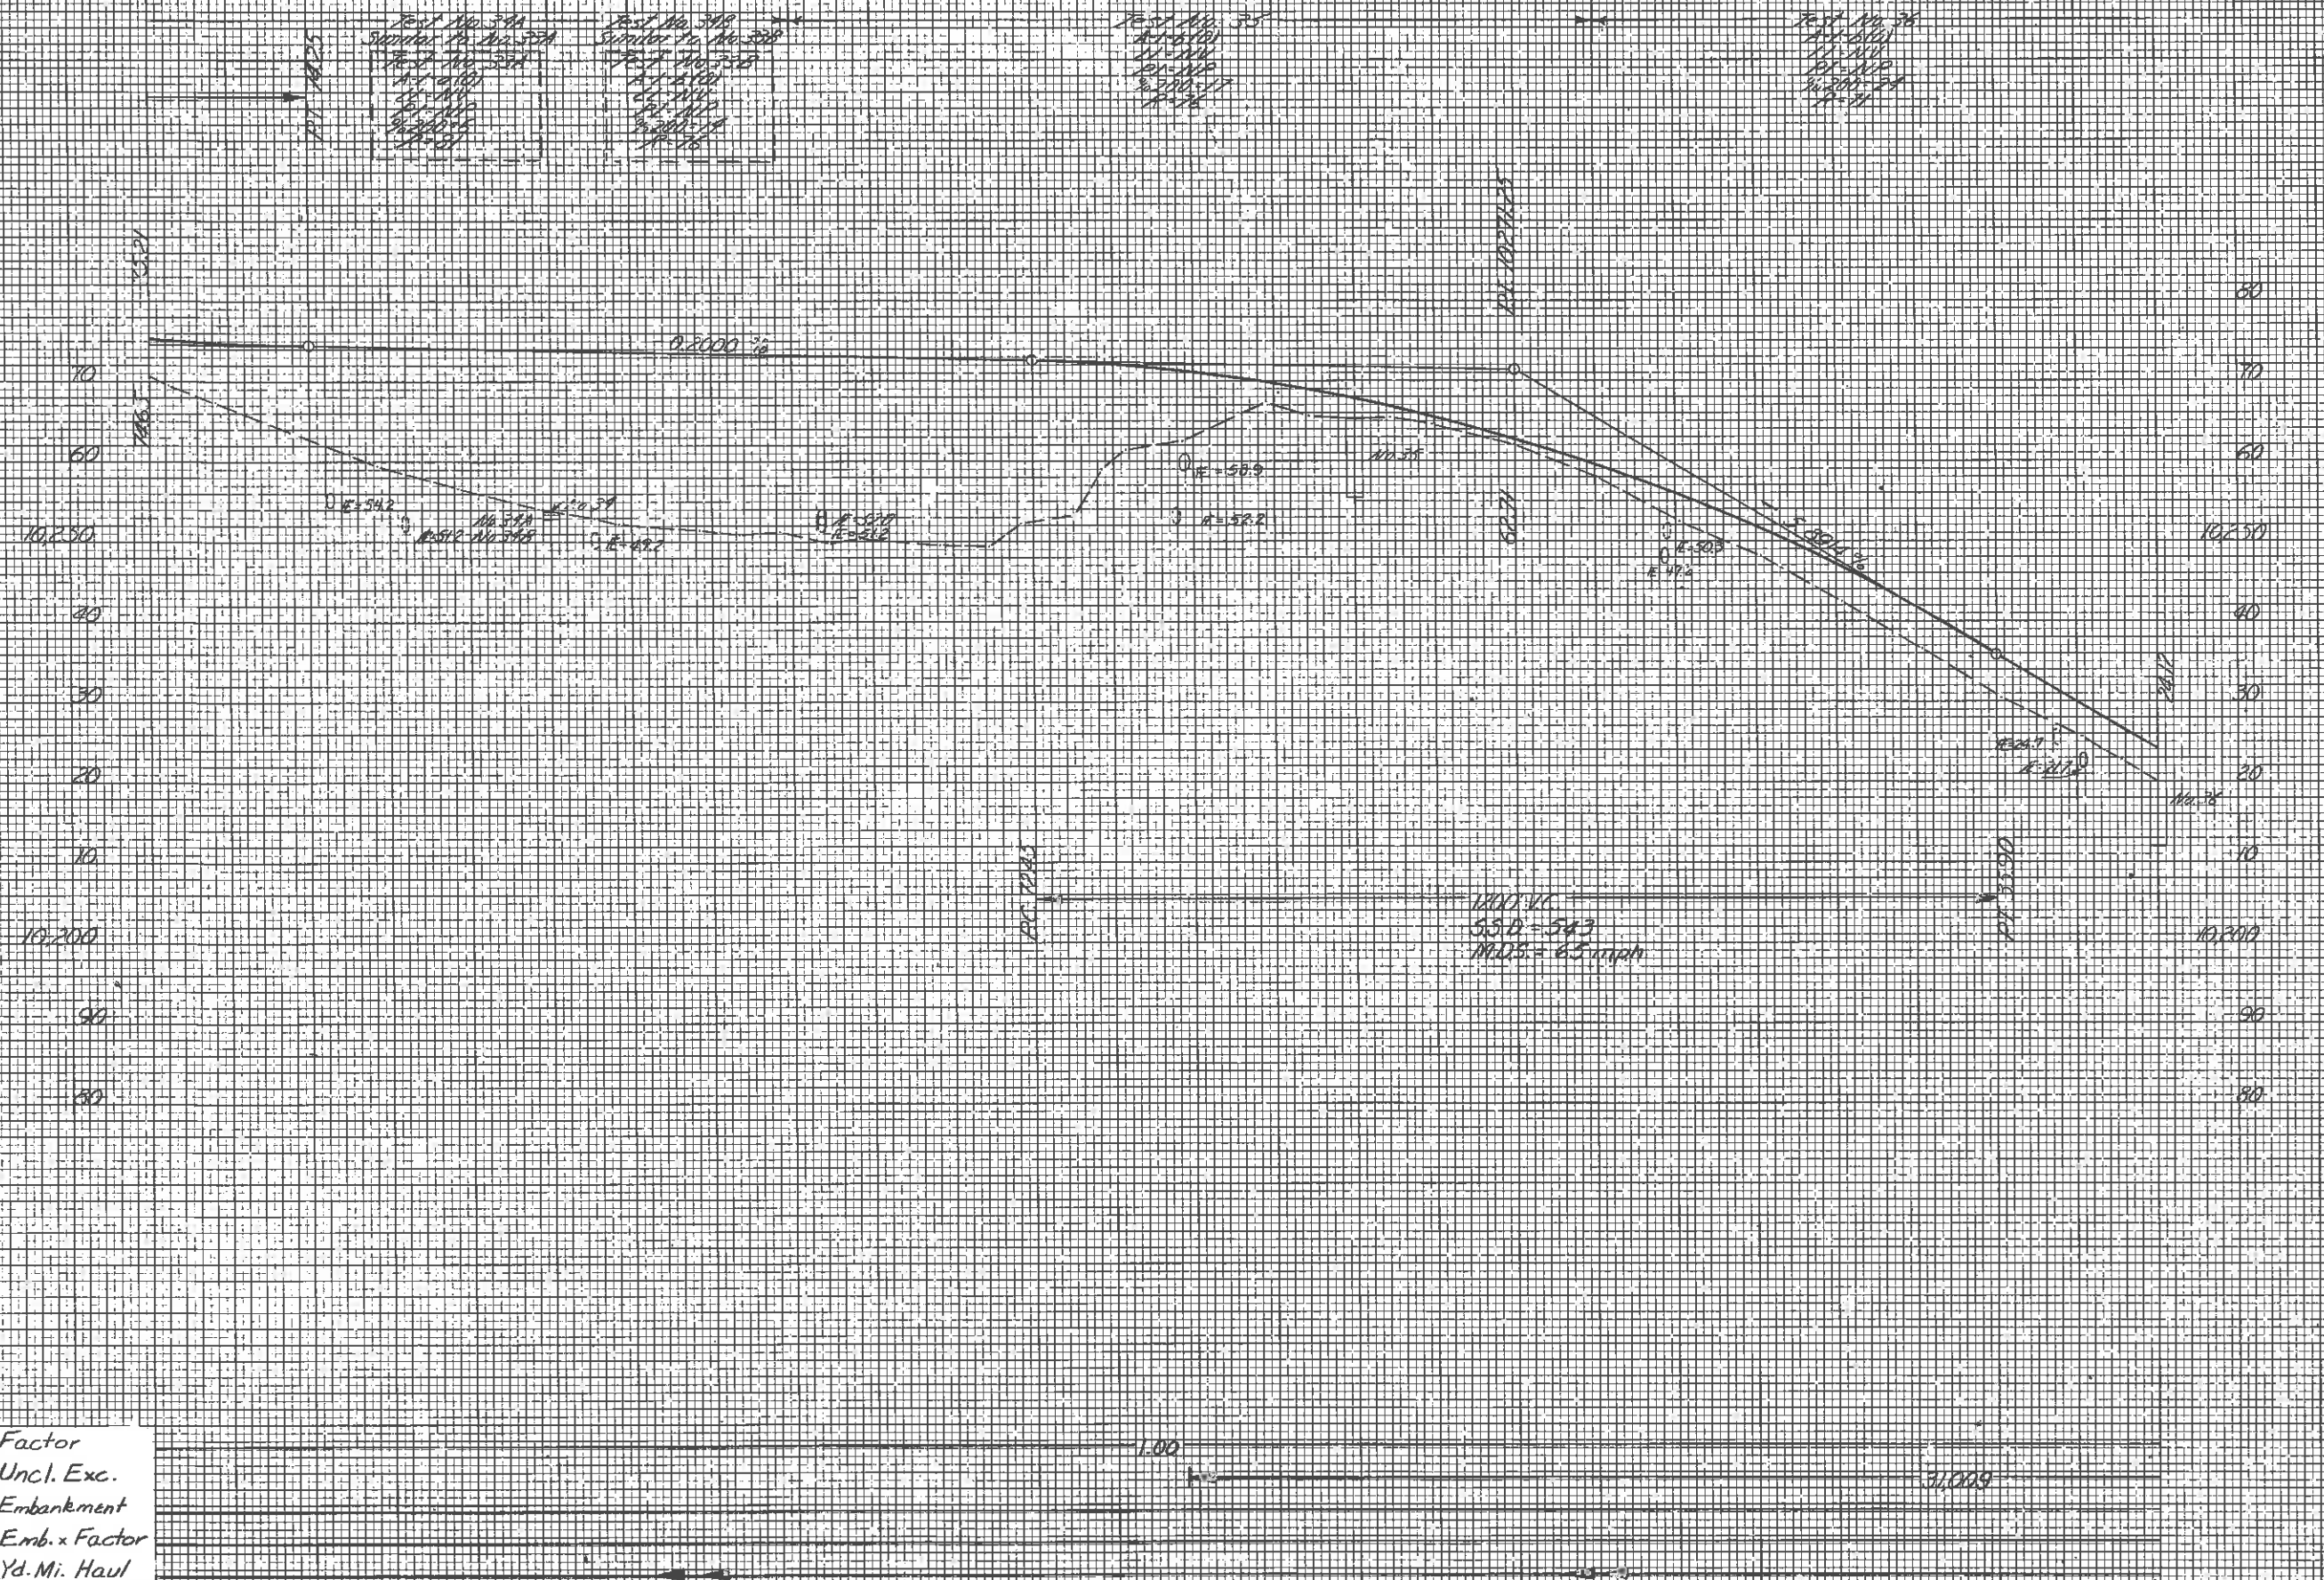

Factor  
 Uncl. Exc.  
 Embankment  
 Emb. x Factor  
 Yd. Mi. Haul



AS CONSTRUCTED			FEDERAL ROAD REGION NO.	DIVISION	PROJ. NO.	SHEET NO.	TOTAL SHEETS
NO REVISION	REVISED	VOID	VIII	COLORADO	170-2(42)197	32	

$\Delta$  34° 21' 00" Lt  
Ts, 553.35' Ts, 532.82'

Ac 15° 36'  
Dc 5° 00'  
Tc 156.97'  
Lc 312.00'  
Rc 1145.916

$\theta$ s, 10° 00'     $\theta$ s, 8° 45'  
Ls, 400'        Ls, 350'  
L.T., 267.09'    L.T., 233.62'  
S.T., 133.72    S.T., 116.93'

e 0.060 %  
M.D.S. = 60 mph  
S.S.D. > 600'

931+70 to Remove 24" CSP Willow Reg'd 24" x 120" CSP Cross Culvert End Section Lt. & Rt. Inlet Basin with Dike Lt.


938+ to Remove 24" CSP

938+ to Remove 24" CSP

938+50 to Reg'd 74" x 136" CSP Cross Culvert Dry Rubble Slope & Ditch Paving Rundown Rt. End Sections Lt. & Rt. Dike Lt.

944+50 to Remove 24" CSP w/ld wall, Reg'd 24" x 68" CSP Cross Culvert, End Section Rt., Type D Inlet (H-3'-6") Dry Rubble Slope & Ditch Paving Rundown Rt. of Dike Lt. (See Details)

939+ to 940+ Reg'd Timber Cribbing (Type A) Rt.

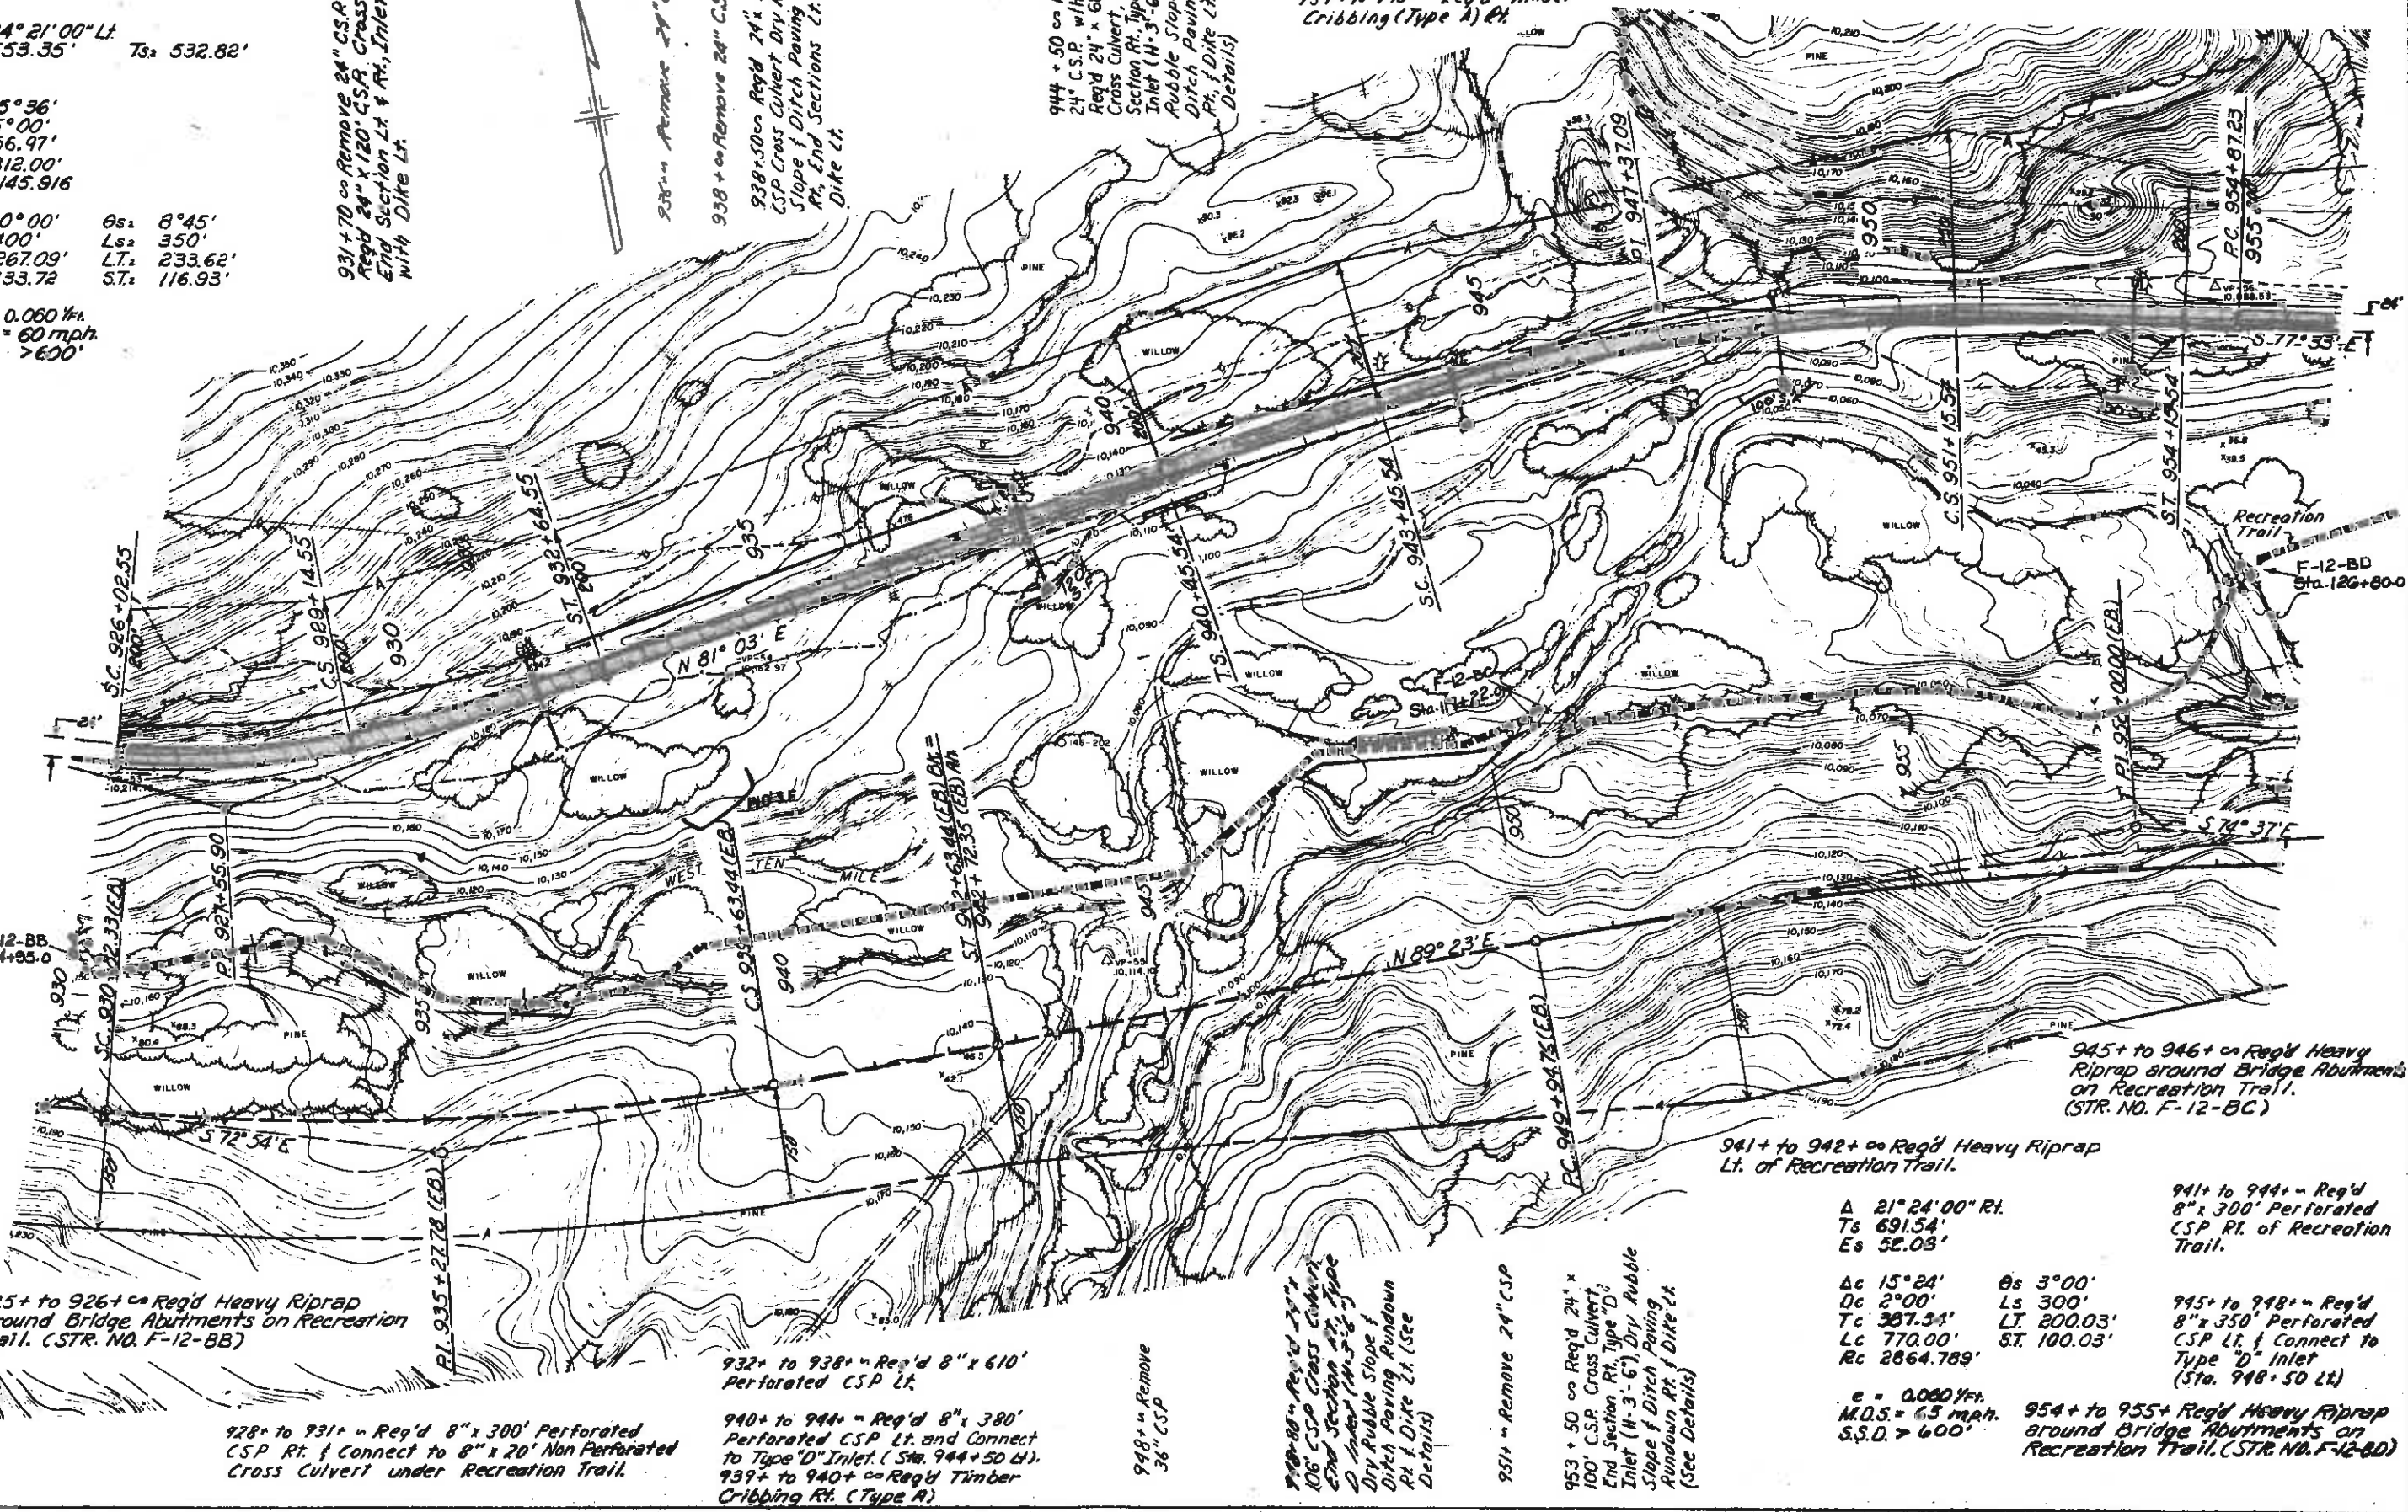

F-12-BB Sta. 94+95.0

925+ to 926+ Reg'd Heavy Riprap around Bridge Abutments on Recreation Trail. (STR. NO. F-12-BB)

928+ to 931+ Reg'd 8" x 300' Perforated CSP Rt. & Connect to 8" x 20' Non Perforated Cross Culvert under Recreation Trail.

932+ to 938+ Reg'd 8" x 610' Perforated CSP Lt.

940+ to 944+ Reg'd 8" x 380' Perforated CSP Lt. and Connect to Type "D" Inlet. (Sta. 944+50 Lt.)  
939+ to 940+ Reg'd Timber Cribbing Rt. (Type A)

948+ to Remove 36" CSP

948+ to Remove 24" CSP  
106' CSP Cross Culvert End Section Rt., Type D Inlet (H-3'-6") Dry Rubble Slope & Ditch Paving Rundown Rt. of Dike Lt. (See Details)

951+ to Remove 24" CSP

953+50 to Reg'd 24" x 100' CSP Cross Culvert, End Section Rt., Type "D" Inlet (H-3'-6") Dry Rubble Slope & Ditch Paving Rundown Rt. of Dike Lt. (See Details)

941+ to 942+ Reg'd Heavy Riprap Lt. of Recreation Trail.

$\Delta$  21° 24' 00" Rt  
Ts 691.54'  
Es 52.05'

Ac 15° 24'     $\theta$ s 3° 00'  
Dc 2° 00'    Ls 300'  
Tc 397.34'    LT 200.03'  
Lc 770.00'    ST 100.03'  
Rc 2864.789'

e = 0.060 %  
M.D.S. = 65 mph  
S.S.D. > 600'

941+ to 944+ Reg'd 8" x 300' Perforated CSP Rt. of Recreation Trail.

945+ to 948+ Reg'd 8" x 350' Perforated CSP Lt. & Connect to Type "D" Inlet (Sta. 948+50 Lt.)

954+ to 955+ Reg'd Heavy Riprap around Bridge Abutments on Recreation Trail. (STR. NO. F-12-BD)

945+ to 946+ Reg'd Heavy Riprap around Bridge Abutments on Recreation Trail. (STR. NO. F-12-BC)

F-12-BD Sta. 126+80.0





958 + on Remove  
 36" C.S.P. w/ Hd wall.  
 958 + 69 on Reg'd  
 30" x 106" C.S.P.  
 Cross Culvert, End  
 Sections Rt. & Lt.  
 D.A. = 0.20 Sq. Mi.  
 Q<sub>ave</sub> = 16 c.f.s.

963 + 10 on Remove  
 24" C.S.P. Reg'd 24" x  
 64" C.S.P. Cross Culvert  
 End Sections Lt. & Rt.

970 + 40 on Reg'd 42"  
 x 296" C.S.P. Cross  
 Culvert with connection  
 to 42" C.S.P. under  
 Recreation Trail on  
 Rt. Dry Rubble Slope  
 f Ditch Paving  
 Run-down Rt. f End  
 Section f Dike Lt.  
 (See Details)  
 D.A. = 0.87 Sq. Mi  
 Q<sub>ave</sub> = 98 c.f.s.  
 970 + on Remove  
 48" C.S.P. w/ Hd wall

972 + on Remove  
 24" C.S.P. w/ Hd wall.  
 978 + on Remove 24"  
 C.S.P. w/ Hd wall

978 + 10 on Reg'd 24" x 20"  
 C.S.P. Cross Culvert  
 End Section Rt. Type  
 "D" Inlet (H = 3'-6")  
 Dry Rubble Slope f  
 Ditch Paving Run-down  
 Rt. f Dike Lt.  
 (See Details)

AS CONSTRUCTED		
NO REVISIONS	REVISED	VOTE

FEDERAL ROAD DISTRICT NO.	DIVISION	PROJ. NO.	SHEET NO.	TOTAL SHEETS
VIII	COLORADO	170-2(42)197	34	

982 + 60 on Remove  
 36" C.S.P. Reg'd 36" x  
 80" C.S.P. Cross Culvert  
 End Section Rt. Type  
 "D" Inlet (H = 4'-6")  
 Dry Rubble Slope f  
 Ditch Paving Run-down  
 Rt. f Dike Lt.  
 (See Details)

985 + 55 on Reg'd  
 24" x 68" C.S.P.  
 Cross Culvert,  
 Type "D" Inlet  
 (H = 3'-6") Dry  
 Rubble Slope f  
 Ditch Paving Rt. f  
 Run-down Rt. f  
 Dike Lt. (See  
 Details)

985 + on Remove 48"  
 C.S.P. w/ Hd wall.  
 979 + to 982 + on Reg'd 8" x 300'  
 Perforated CSP Lt. Connect  
 to Type "D" Inlet (Sta. 982+10  
 Lt)



Δc 2°49'00" Lt.  
 Dc 0°15'  
 Tc 563.45'  
 Lc 1126.67'  
 Rc 22,918.312'  
 Es 6.92'

c MC  
 M.D.S. = 70 mph  
 S.S.D. > 600'

Δ 22°29'00" Rt.  
 Ts 378.33'  
 Es 25.77'  
 θs 7°30'  
 Ls 300'  
 LT 200.18'  
 S.T. 100.16'

Δc 7°29'  
 Dc 5°00'  
 Tc 74.94'  
 Lc 149.67'  
 Rc 1145.916'

e = 0.060 1/ft.  
 M.D.S. = 60 mph  
 S.S.D. > 600'

963 + to 968 + on Reg'd 8" x 500'  
 Perforated CSP Lt.  
 963 + to 966 + on Reg'd 8" x 300'  
 Perforated CSP Lt. f Connect  
 to 8" x 20" Non-Perforated CSP  
 Cross Culvert under  
 Recreation Trail.

θs 7°00'  
 Ls 350'  
 LT 233.52'  
 S.T. 116.83'

Δ 27°16'00" Lt.  
 Ts 523.19'  
 Es 45.25'

Δc 13°16'  
 Dc 5°00'  
 Tc 166.58'  
 Lc 331.67'  
 Rc 1132.394'

e 0.050 1/ft.  
 M.D.S. = 65 mph  
 S.S.D. > 600'

973 + to 978 + on Reg'd 8" x  
 420' Perforated CSP Lt.  
 Connect to Type "D"  
 Inlet (Sta. 978+10 Lt)

977 + to 980 + on Reg'd 8" x  
 250' Perforated CSP Lt.  
 f Connect to 8" x 20"  
 Non-Perforated CSP  
 Cross Culvert Under  
 Recreation Trail.





FEDERAL ROAD REGION NO.	DIVISION	PROJ. NO.	SHEET NO.	TOTAL SHEETS
VIII	COLORADO	170-2(42)197	36	
AS CONSTRUCTED				
NO REVISIONS	REVISED	VOID		

986+ to 990+ - Req'd 8" x 450' Perforated CSP Lt.


991+ to 998+ - Req'd 8" x 650' Perforated CSP Lt. of Recreation Trail

996+ to 999+ - Req'd 8" x 386' Perforated CSP Lt. & Connect to Type 'D' Inlet (Sta. 999+85 Lt.)

1005+ to 1011+ - Req'd 8" x 480' Perforated CSP Lt. & Connect to Type 'D' Inlet (Sta. 1011+00 Lt.)

STA. 1015+59.70 End 170-2(42)197 = STA. 1015+59.70 on 170-2(44)200

1011+ to 1014+ - Req'd 8" x 280' Perforated CSP Lt. & Connect to Type 'D' Inlet (Sta. 1014+20 Lt.)

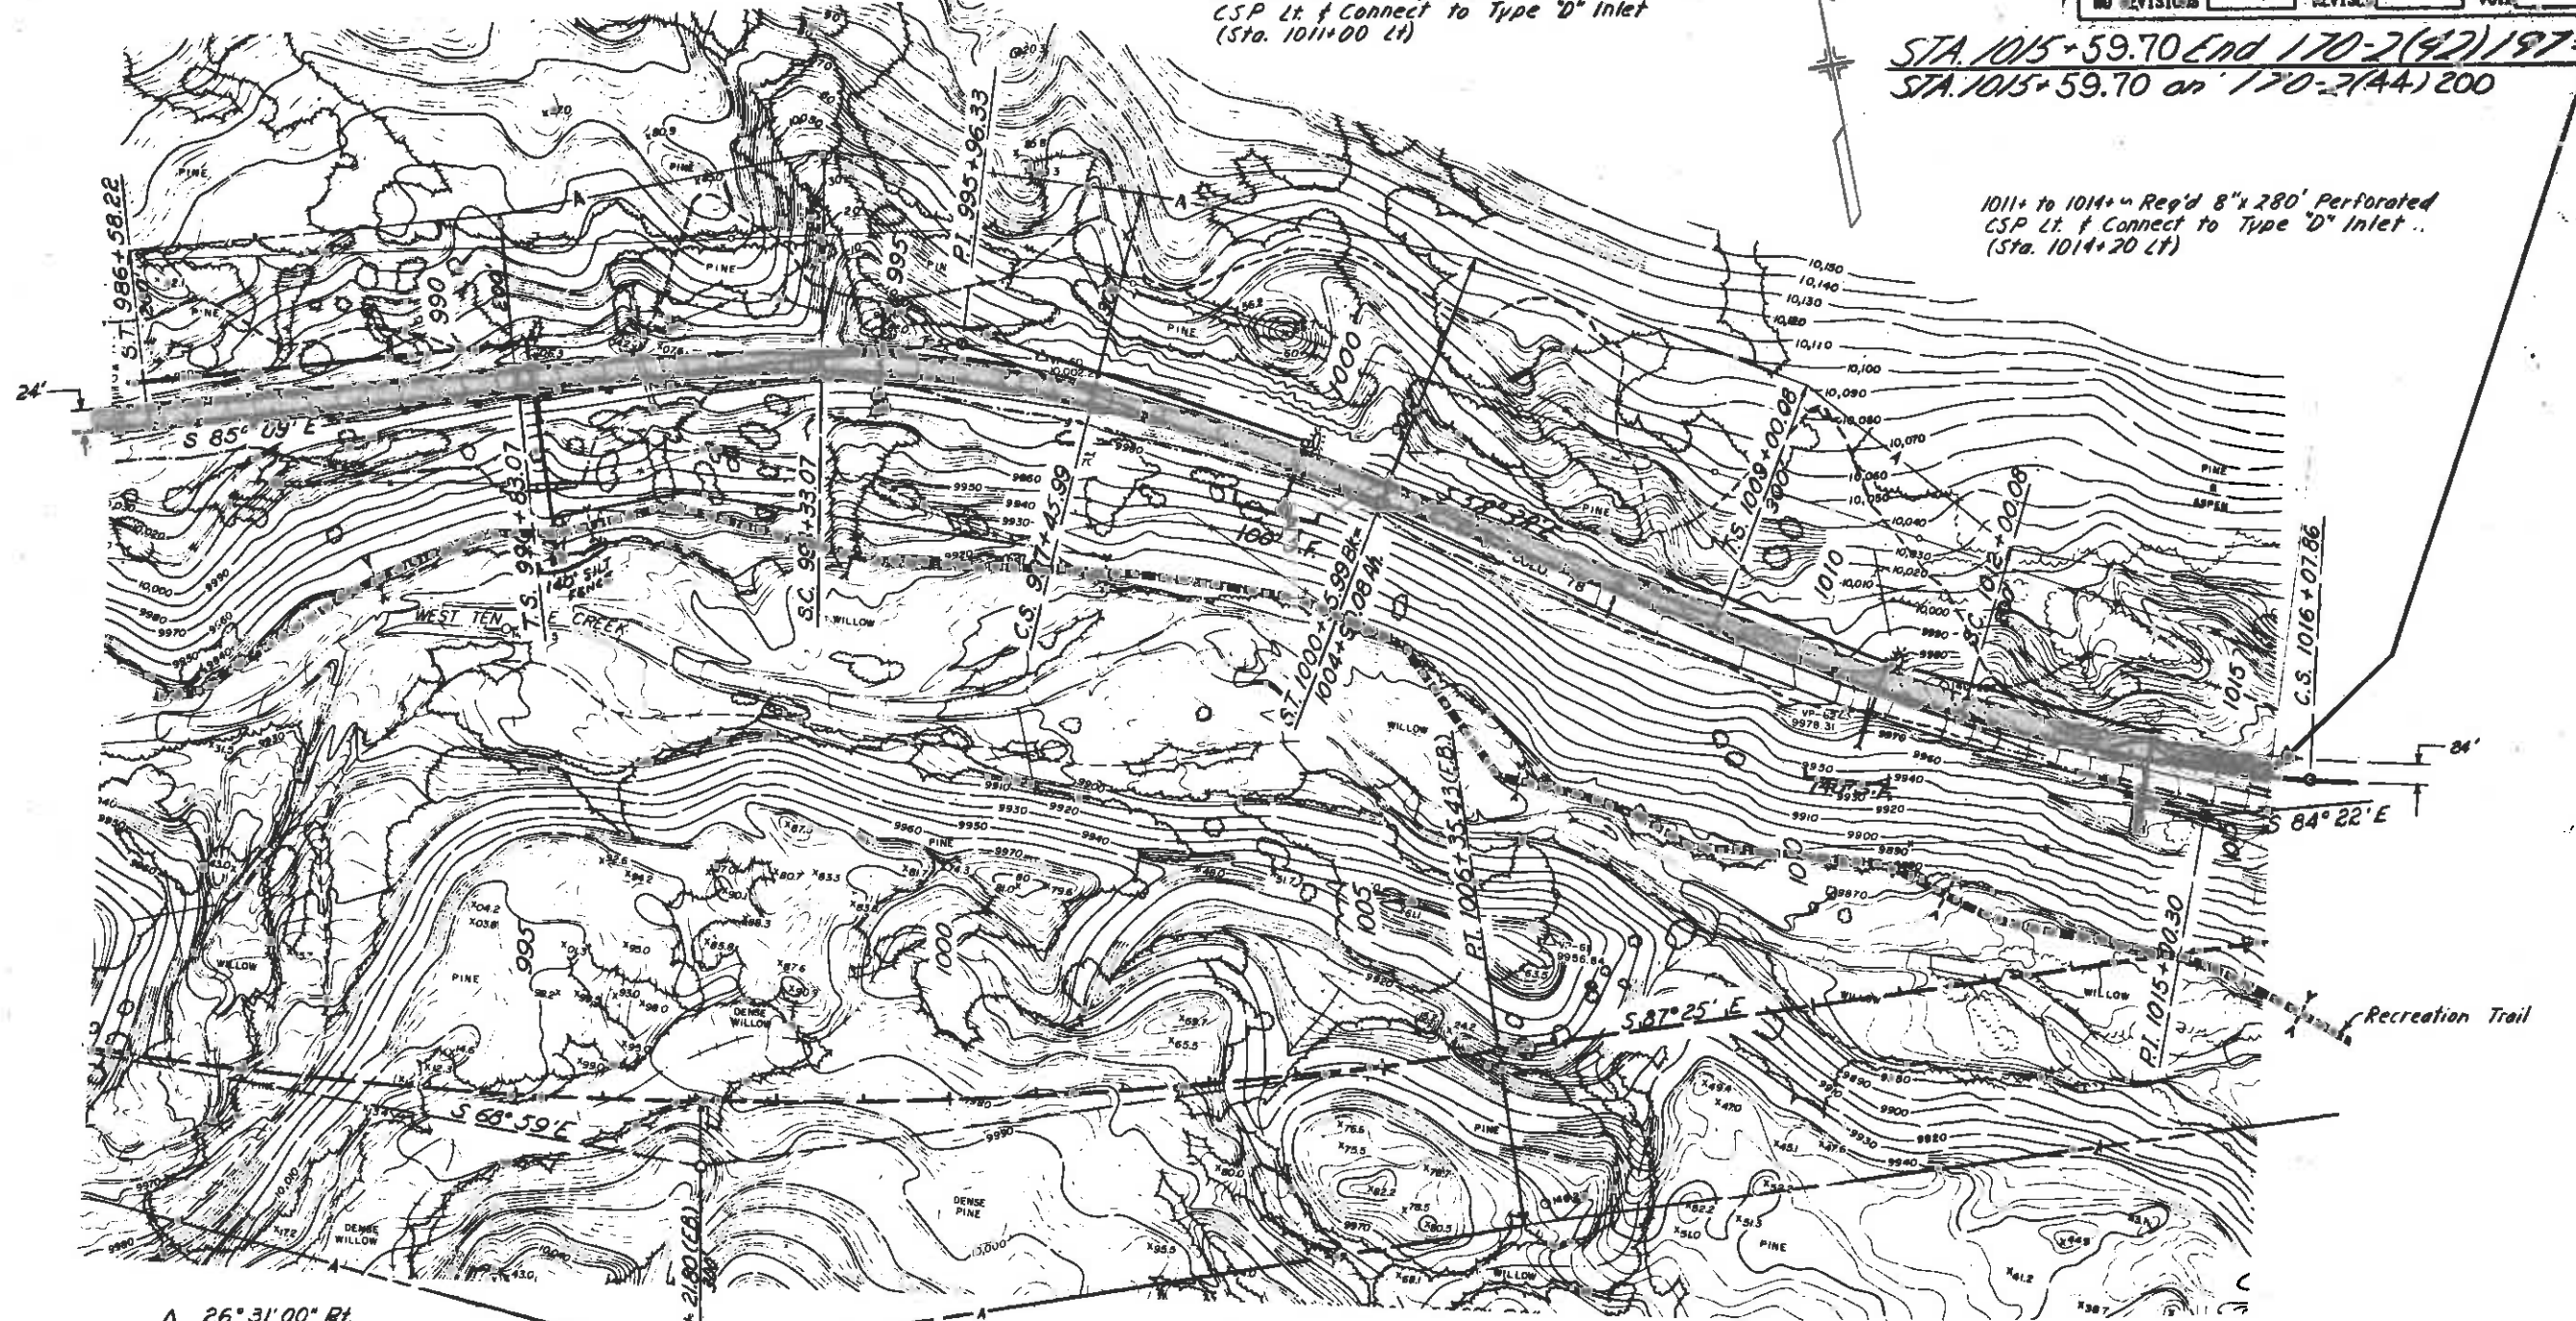

Δ 26° 31' 00" Rt.  
Ts 513.26'  
Es 42.88'

Δc 12° 31'      θs 7° 00'  
Dc 4° 00'      Ls 350'  
Tc 157.08'      LT 233.52'  
Lc 312.92      ST 116.83'  
Rc 1432.394

e 0.060 %  
M.D.S. = 65 mph.  
S.S.D. > 600'

990+ to 991+ - Req'd Timber Cribbing (Type A) Rt.

991+00 - Req'd 24" x 258' CSP Cross Culvert under Recreation Trail Rt. Dry Rubble Slope & Ditch Paving Rounddown Rt. End Sections Lt. & Rt. Dike Lt. (See Details)

991+ - Remove 24" CSP w/ Hd' wall.

992+ - Remove 60" CSP

995+00 - Remove 36" CSA w/ Hd' wall, Req'd 42" x 94' CSA Cross Culvert, Dry Rubble Slope & Ditch Paving Rounddown Rt. End Section & Ditch Lt. (See Details)  
DA = 0.79 Sp. Mi.  
Q100 = 43 cfs

999+85 - Req'd 24" x 68' CSP Cross Culvert, End Section Rt. Type 'D' Inlet (H: 3'-6") Dry Rubble Slope & Ditch Paving Rounddown Rt. with Dike Lt. (See Details)

1000+ - Remove 24" CSP w/ Hd' wall

1007+ - Remove 24" CSA w/ Hd' wall

1008+ - Remove 24" CSP w/ Hd' wall

1011+00 - Req'd 24" x 85' CSP Cross Culvert, End Section Rt. Type 'D' Inlet (H: 3'-6"), Dike Lt.

1014+ - Remove 24" CSP w/ Hd' wall

Δ 25° 44' 00" Lt.  
Ts 600.22'  
Ts 724.24'

Δc 12° 14'      θs 4° 30'  
Dc 3° 00'      θss 9° 00'  
Tc 204.67'      Ls 300'  
Lc 407.78'      Ls 600'  
Rc 1909.859'      LT 200.06'  
                      LT 400.52'  
                      ST 100.06'  
                      ST 200.47'

e 0.090 %  
M.D.S. 70 mph.  
S.S.D. > 600'



AS CONSTRUCTED  
 NO REVISIONS  REVISED  VOID

FEDERAL ROAD REGION NO.	DIVISION	PROJECT NO.	SHEET NO.
VII	COLORADO	170-2(42)197	37

Test No. 43A  
 Similar to No. 37A  
 Test No. 37A  
 1.5-100  
 1.5-100  
Test No. 43B  
 1.5-100  
 1.5-100  
Test No. 44A  
 1.5-100  
 1.5-100  
Test No. 44B  
 1.5-100  
 1.5-100  
Test No. 45  
 Similar to No. 44B

Test No. 46  
 1.5-100  
 1.5-100  
Test No. 46A  
 1.5-100  
 1.5-100  
AS CONSTRUCTED			FEDERAL ROAD DISTRICT NO.	DIVISION	PROJECT NO.	SHEET NO.	TOTAL SHEETS
NO REVISIONS	REVISED	VOID	VIII	COLORADO	I 70-2 (42) 177	38	

**W.B. PROJ.**  
 $\Delta s = 25^{\circ}44' Lt$   
 $Ts = 600.2'$   
 $Ts_2 = 724.2'$   
 $\Delta c = 12^{\circ}14'$   
 $Dc = 3^{\circ}00'$   
 $Tc = 204.7'$   
 $Lc = 407.8'$   
 $Rc = 1009.9'$   
 $e = 0.060 \frac{1}{ft}$   
 $SSD = 93.5'$   
 $MDS = 75 \text{ mph}$

**W.B. PROJ.**  
 $\Delta s = 3^{\circ}30' Lt$   
 $Ts_1 = 671.1$   
 $Ts_2 = 569.9'$   
 $\Delta c = 13^{\circ}30' Lt$   
 $Dc = 4^{\circ}00'$   
 $Tc = 169.5'$   
 $Lc = 337.5'$   
 $Rc = 1,432.4'$   
 $e = 0.060 \frac{1}{ft}$   
 $MDS = 65 \text{ mph}$   
 $SSD = 84.4'$

**E.B. PROJ.**  
 $\Delta s = 26^{\circ}51' Lt$   
 $Ts = 541.2'$   
 $Es = 48.4$   
 $\Delta c = 16^{\circ}21' Lt$   
 $Dc = 3^{\circ}30'$   
 $Tc = 235.2'$   
 $Lc = 467.1'$   
 $Rc = 1,637.0'$   
 $e = 0.073 \frac{1}{ft}$   
 $MDS = 70 \text{ mph}$   
 $SSD = 65.7'$

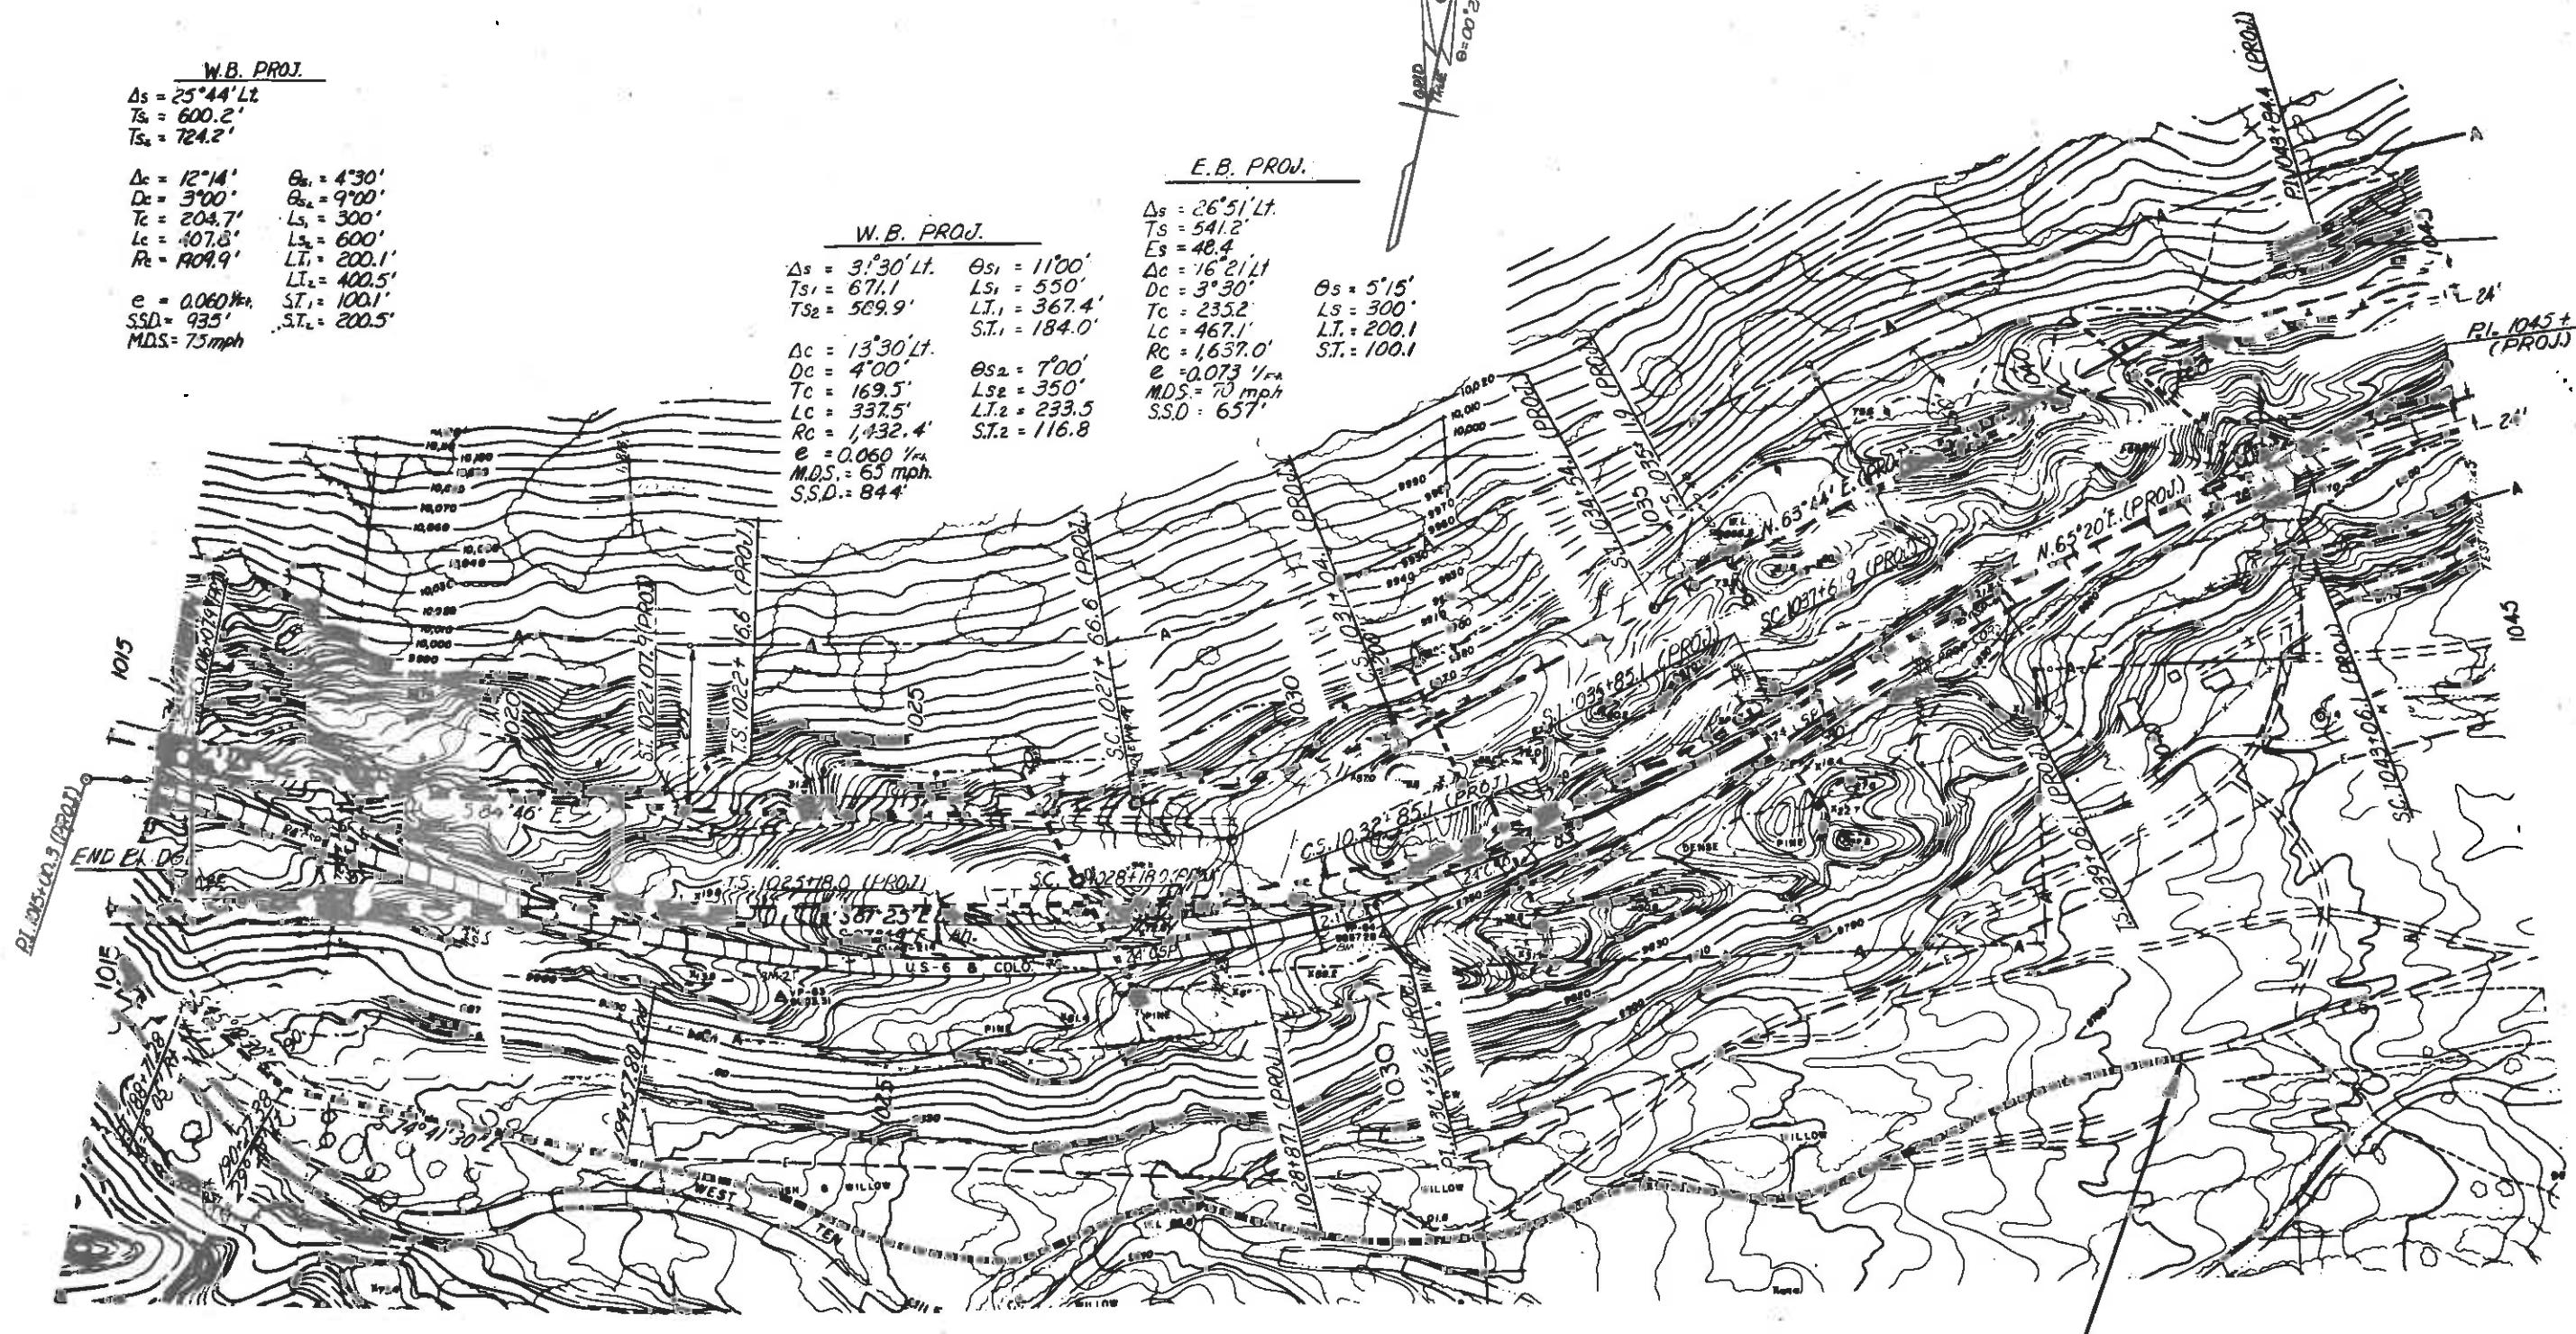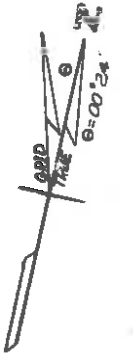


STA 194+57.80 End Recreation Trail  
 Approx. 310' Pt. of Sta. 1021+30 (EB)






FEDERAL ROAD DESIGN NO.	DIVISION	FED. NO.	SHEET NO.	TOTAL SHEETS
XIII	COLORADO	170-2(42)197	40	

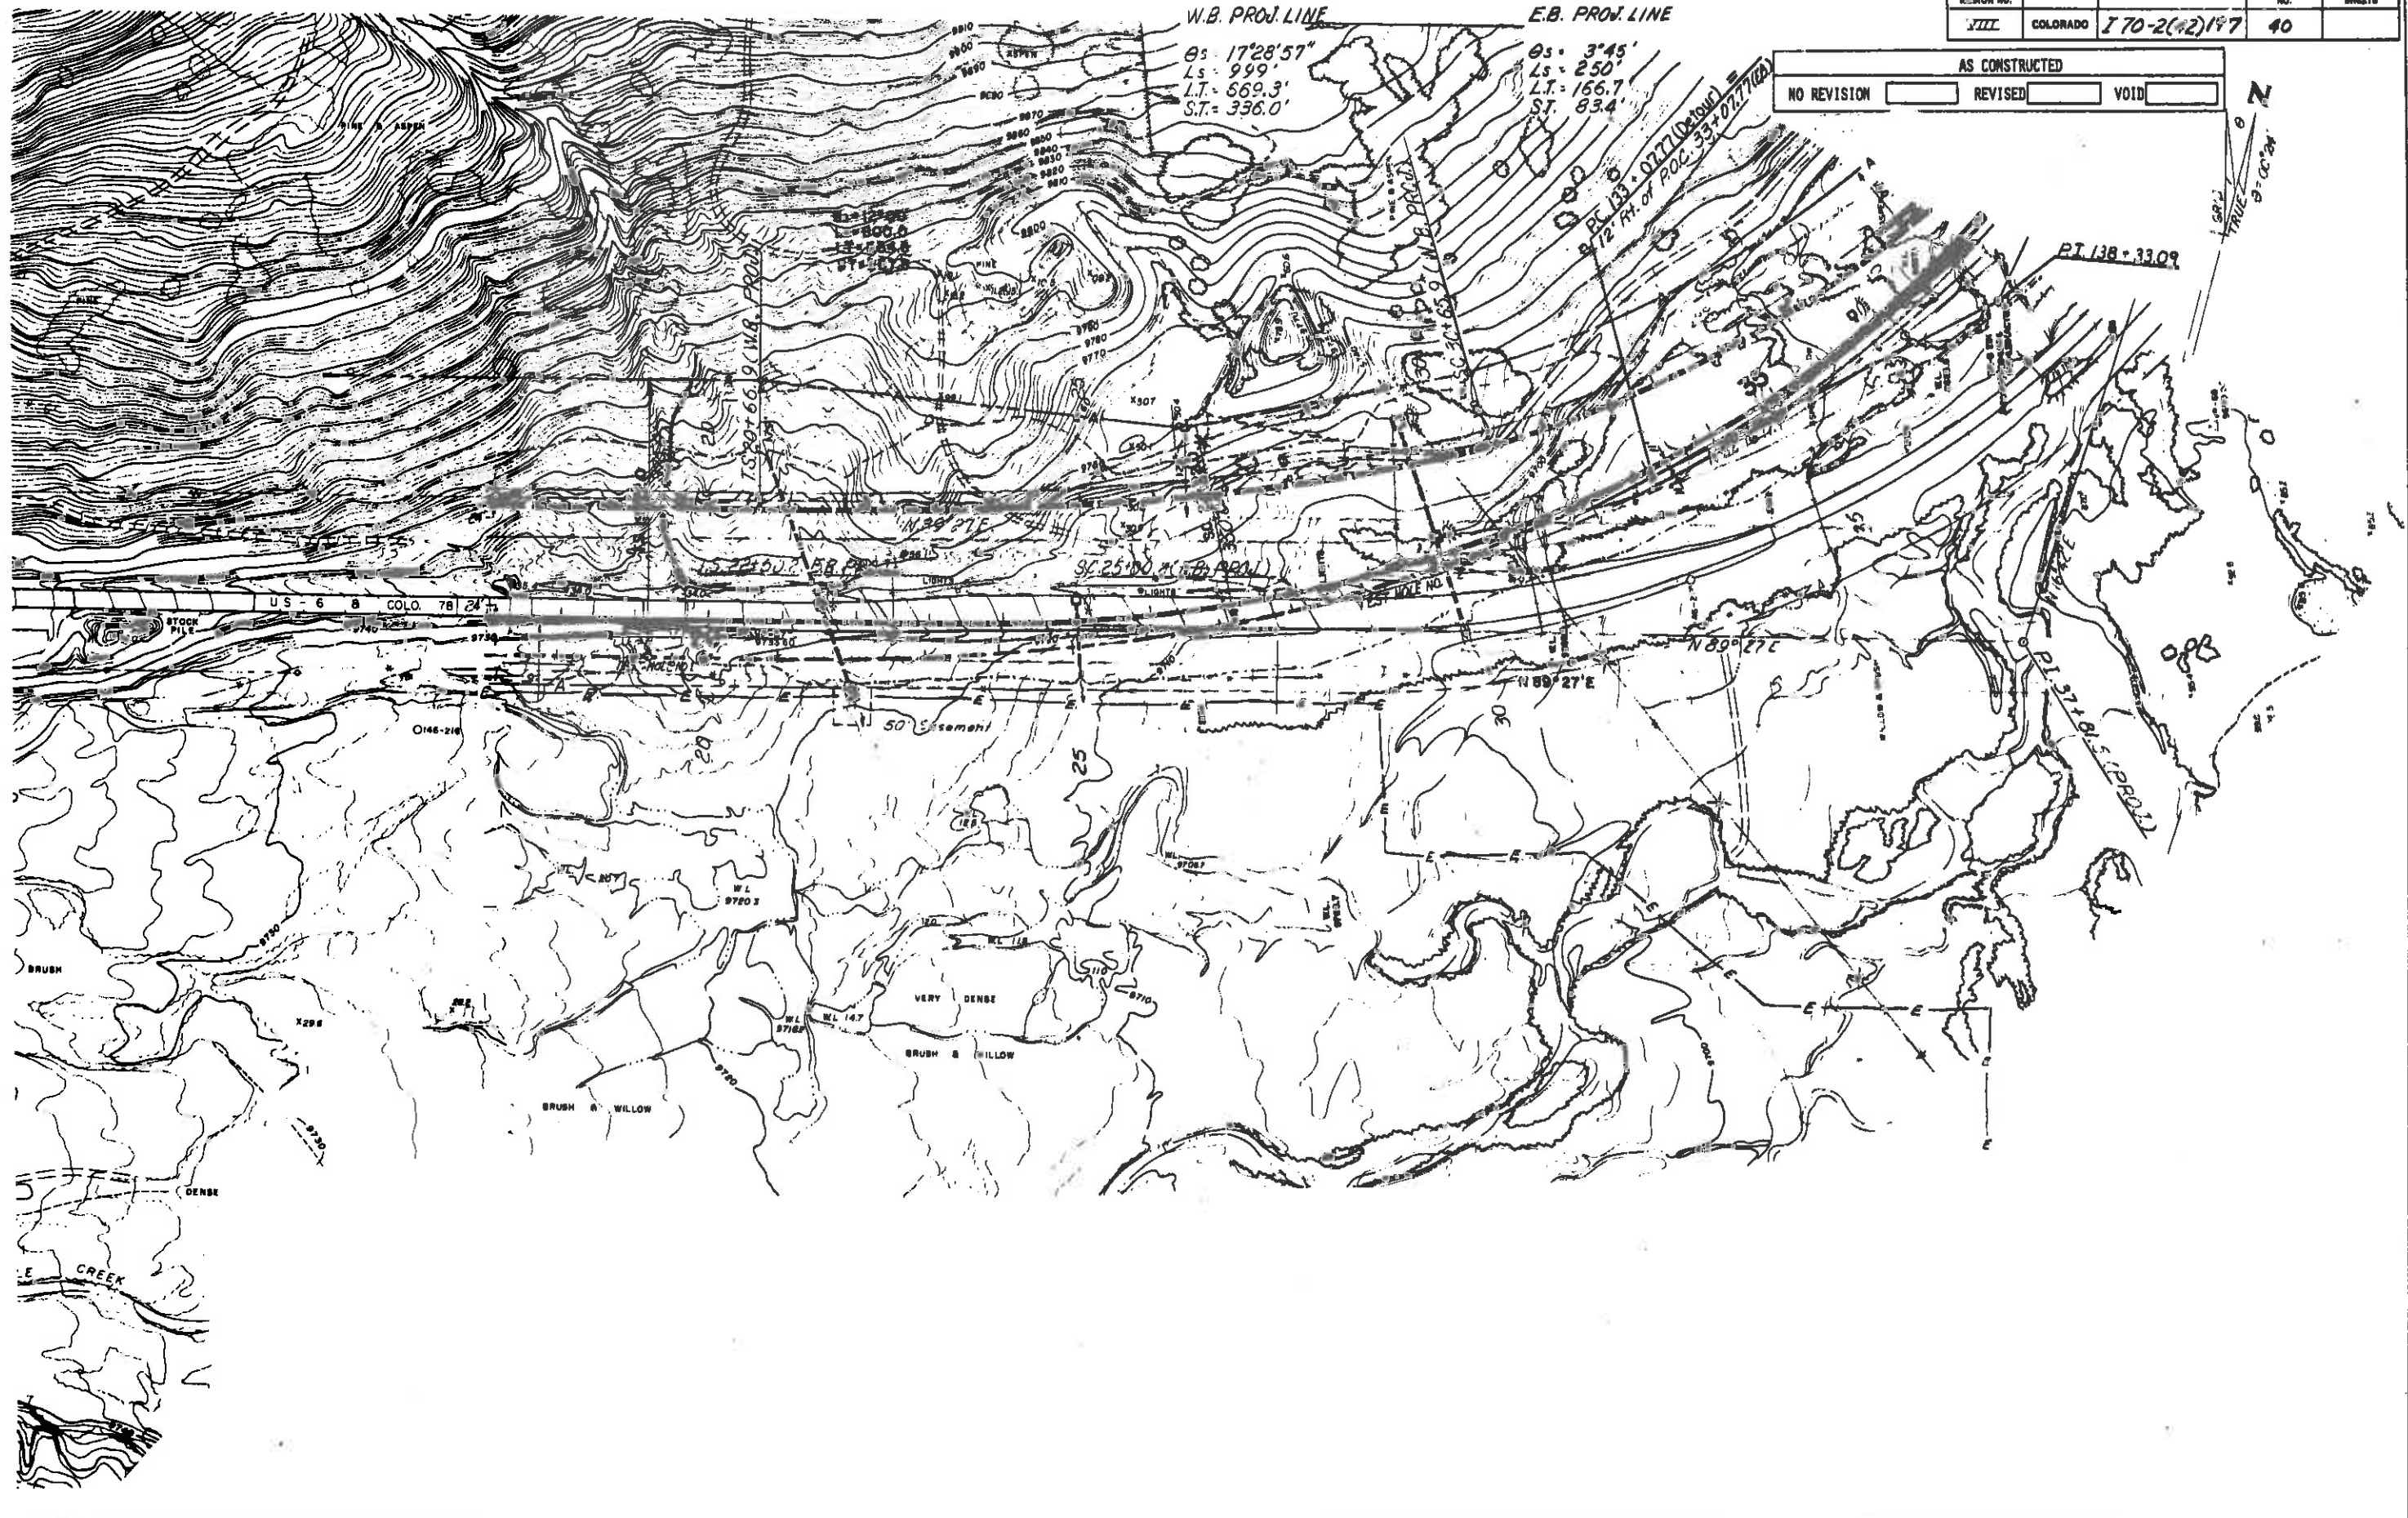

W.B. PROJ. LINE  
 $\theta_s = 17^\circ 28' 57''$   
Ls = 999'  
L.T. = 669.3'  
S.T. = 336.0'

E.B. PROJ. LINE  
 $\theta_s = 3^\circ 45'$   
Ls = 250'  
L.T. = 166.7'  
S.T. = 83.4'

AS CONSTRUCTED  
NO REVISION  REVISED  VOID

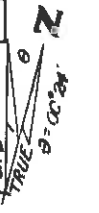

U.S. - 6 8 COLO. 78 24'

CREEK

BRUSH & WILLOW

BRUSH & WILLOW

VERY DENSE

DENSE

W.L. 9780.2

W.L. 9716.8

W.L. 14.7

W.L. 9710

PT. 138 = 33.09

PT. 137 = 15.00

SC 25100

SC 25100

RC 133 = 0771 (Detour)  
912 Ft. of POC 337077102

T.S. 201 = 66.9 (W.B. PROJ.)

W.L. 9716.8

W.L. 9716.8

FEDERAL ROAD DISTRICT NO.	DIVISION	PROJ. NO.	SHEET NO.	TOTAL SHEETS
VIII	COLORADO	170-2(42)197	41	
AS CONSTRUCTED				
NO REVISIONS	REVISED	VOID		

**Survey**

$\Delta s = 108^{\circ} 22' Lt.$   
 $Ts = 3065.2'$   
 $Es = 1577.7'$   
 $\Delta c = 84^{\circ} 22'$   
 $Dc = 3^{\circ} 00'$   
 $Tc = 1730.9'$   
 $Lc = 2812.2'$   
 $Rc = 1909.9'$

**(W.B. Proj.)**

$\Delta s = 102^{\circ} 45' 11" Lt.$   
 $Ts = 2578.6'$   
 $Es = 1026.1'$   
 $\Delta c = 67^{\circ} 47' 17"$   
 $Dc = 3^{\circ} 30'$   
 $Tc = 1099.8'$   
 $Lc = 1936.8'$   
 $Rc = 1637.0'$   
 $e = 0.080 \%$   
 $M.D.S. = 70 M.P.H.$   
 $S.S.D. > 1300'$

**(E.B. Proj.)**

$\Delta s = 72^{\circ} 45' Lt.$   
 $Ts = 1531.3'$   
 $Ts_2 = 1408.2'$   
 $\Delta c = 69^{\circ} 00'$   
 $Dc = 3^{\circ} 00'$   
 $Tc = 1312.6'$   
 $Lc = 2300.0'$   
 $Rc = 1909.9'$   
 $e = 0.080 \%$   
 $M.D.S. = 75 mph$   
 $S.S.D. > 1300'$

$\Delta s = 30^{\circ} 00' 11" Lt.$   
 $Ts = 463.1'$   
 $Ts_2 = 764.0'$   
 $\Delta c = 17^{\circ} 51' 29"$   
 $Dc = 3^{\circ} 30'$   
 $Tc = 257.2'$   
 $Lc = 510.2'$   
 $Rc = 1637.0'$   
 $e = 0.080 \%$   
 $M.D.S. = 70 mph$   
 $S.S.D. > 1300'$

$\theta s = 17^{\circ} 28' 57"$   
 $Ls = 999.0'$   
 $L.T. = 669.3'$   
 $S.T. = 336.0'$

$\theta s = 3^{\circ} 45'$   
 $Ls = 250.0'$   
 $L.T. = 166.7'$   
 $S.T. = 834'$


$\theta s = 12^{\circ} 08' 42"$   
 $Ls = 694.0'$   
 $L.T. = 463.8'$   
 $S.T. = 232.3'$

33+ to 45+ (E.B.) -> Reg'd Temporary Detour and Remove.



**Curve Data**


**Detour**  
 $\Delta = 37^{\circ} 56' 53.4"$   
 $T = 525.321'$   
 $D = 3^{\circ} 45' 00.0"$   
 $L = 1011.951'$   
 $R = 1527.887'$

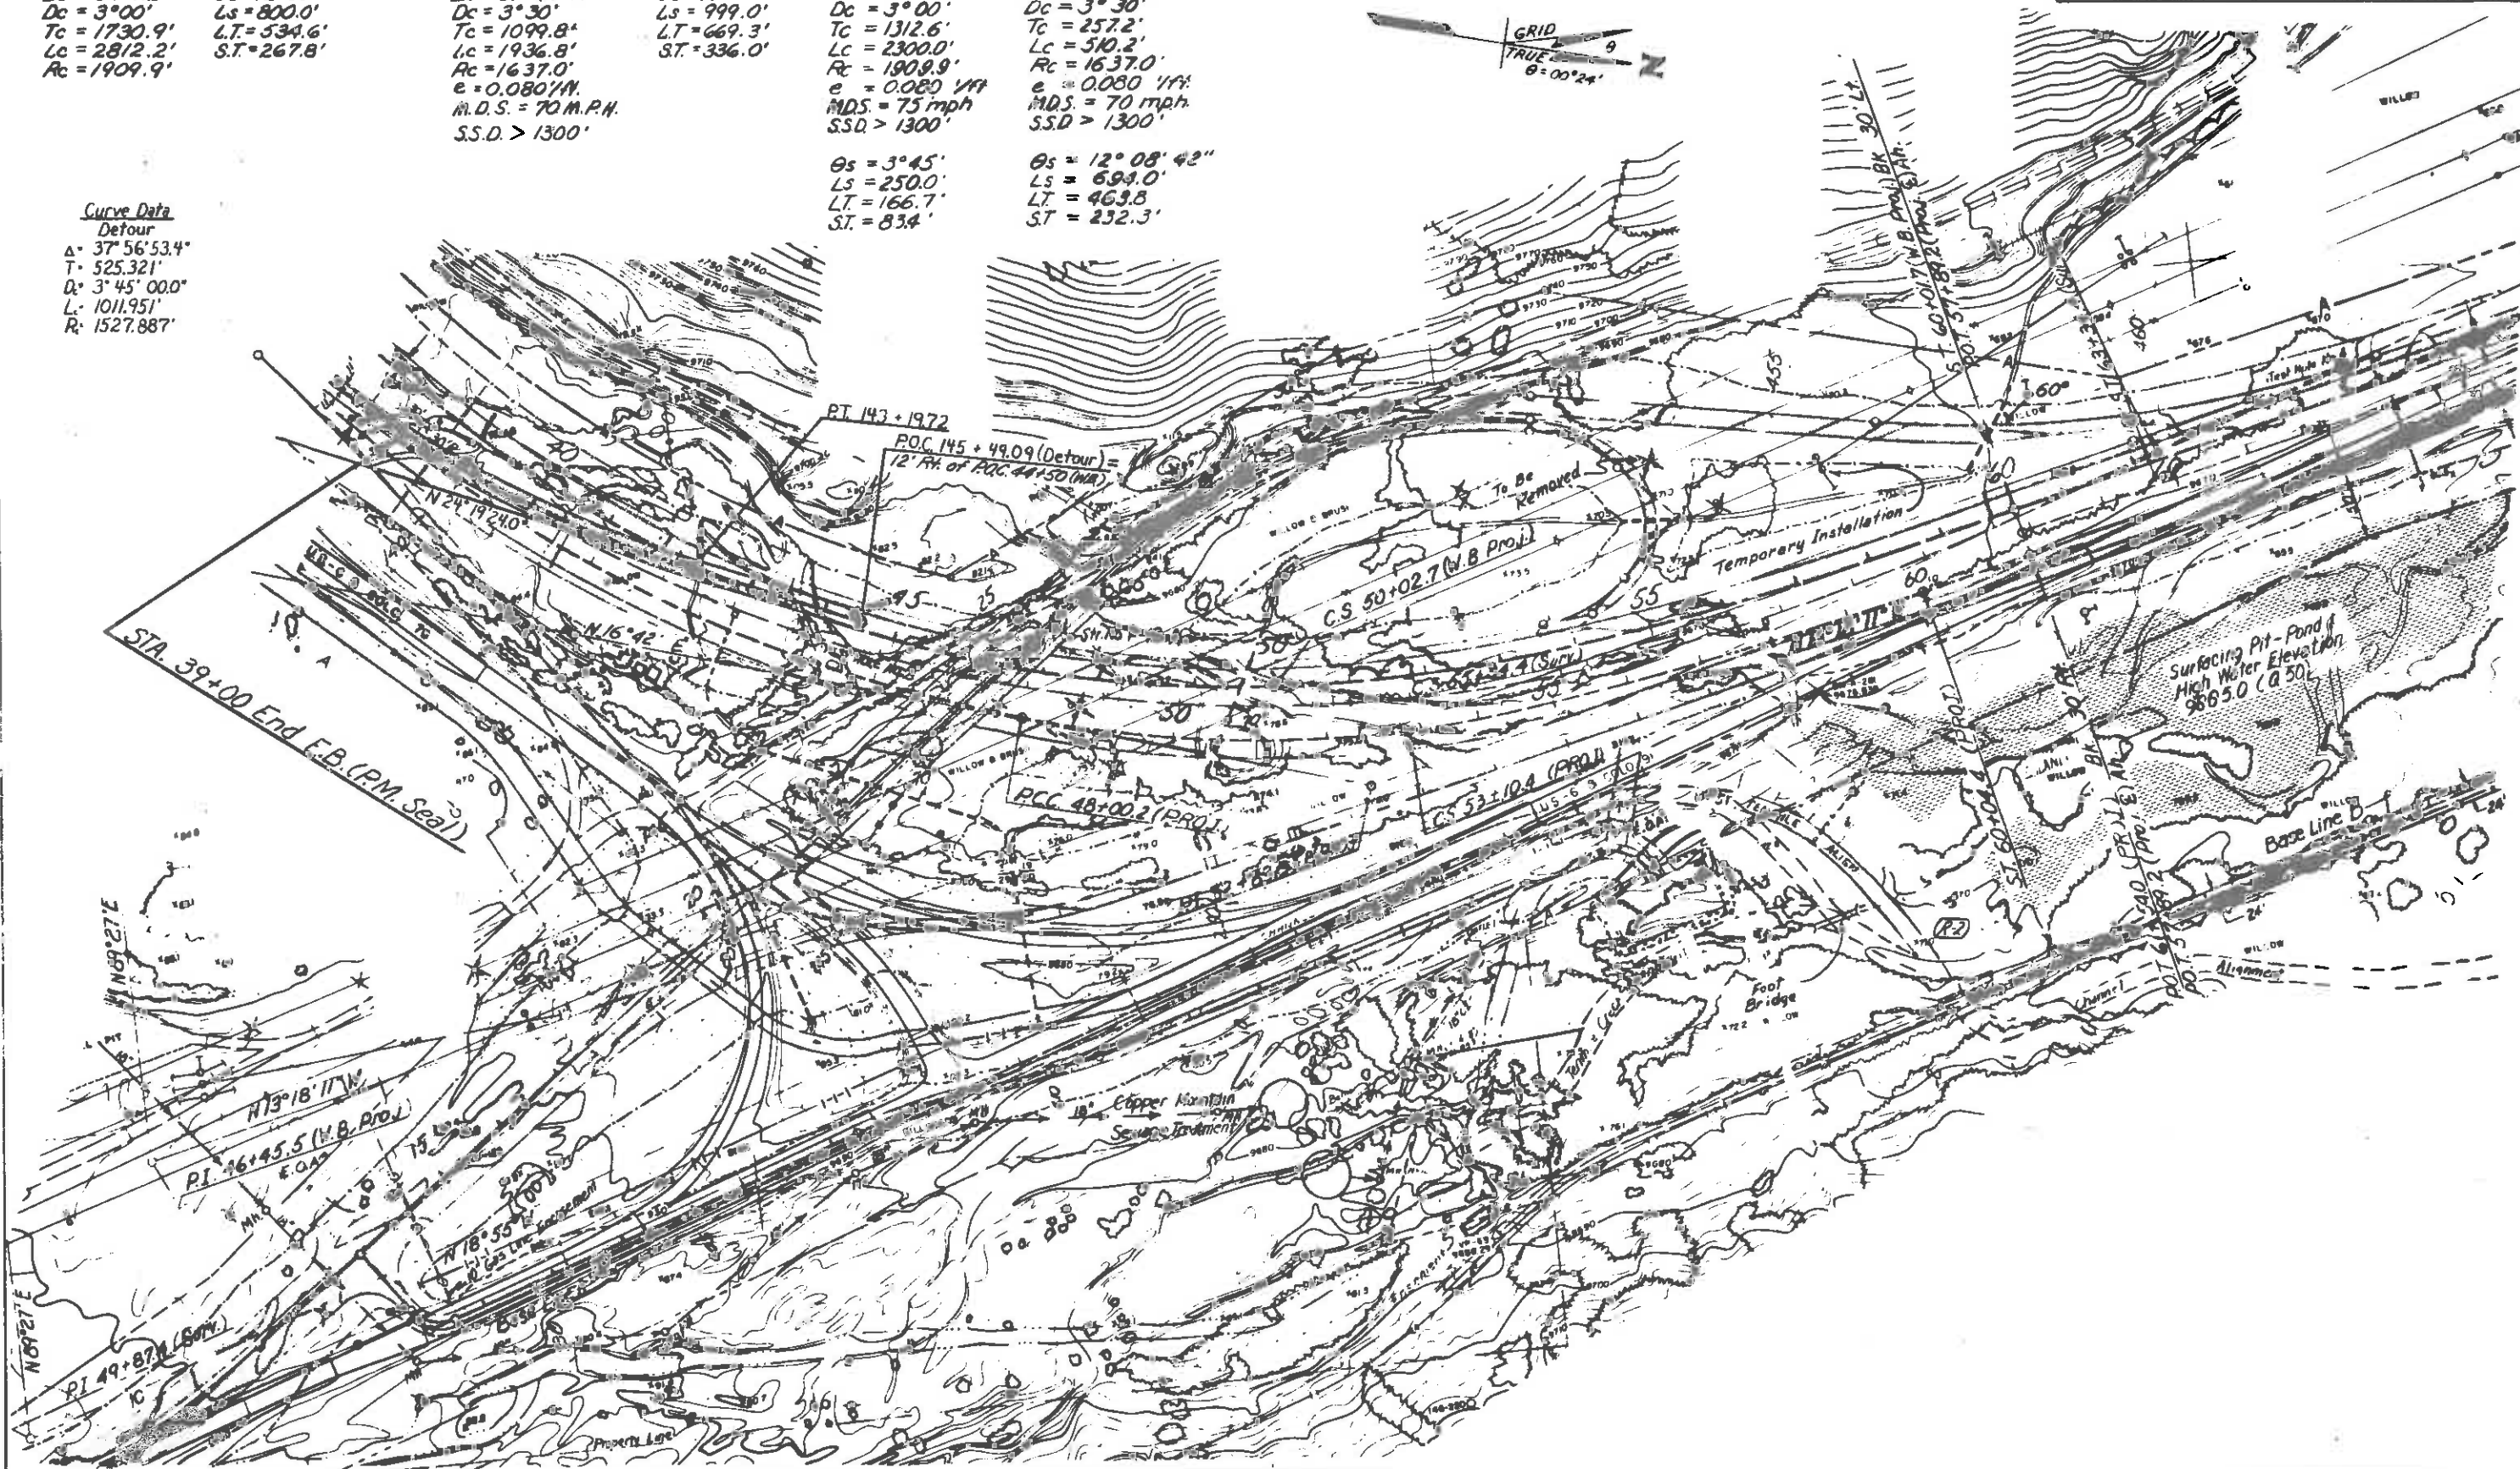

AS CONSTRUCTED		
NO REVISIONS	REVISED	VOID

FEDERAL ROAD REGION NO.	DIVISION	PROJ. NO.	SHEET NO.	TOTAL SHEETS
VIII	COLORADO	I 70-2(42)197	42	

DETOUR  
FROM (WB) TO (EB)

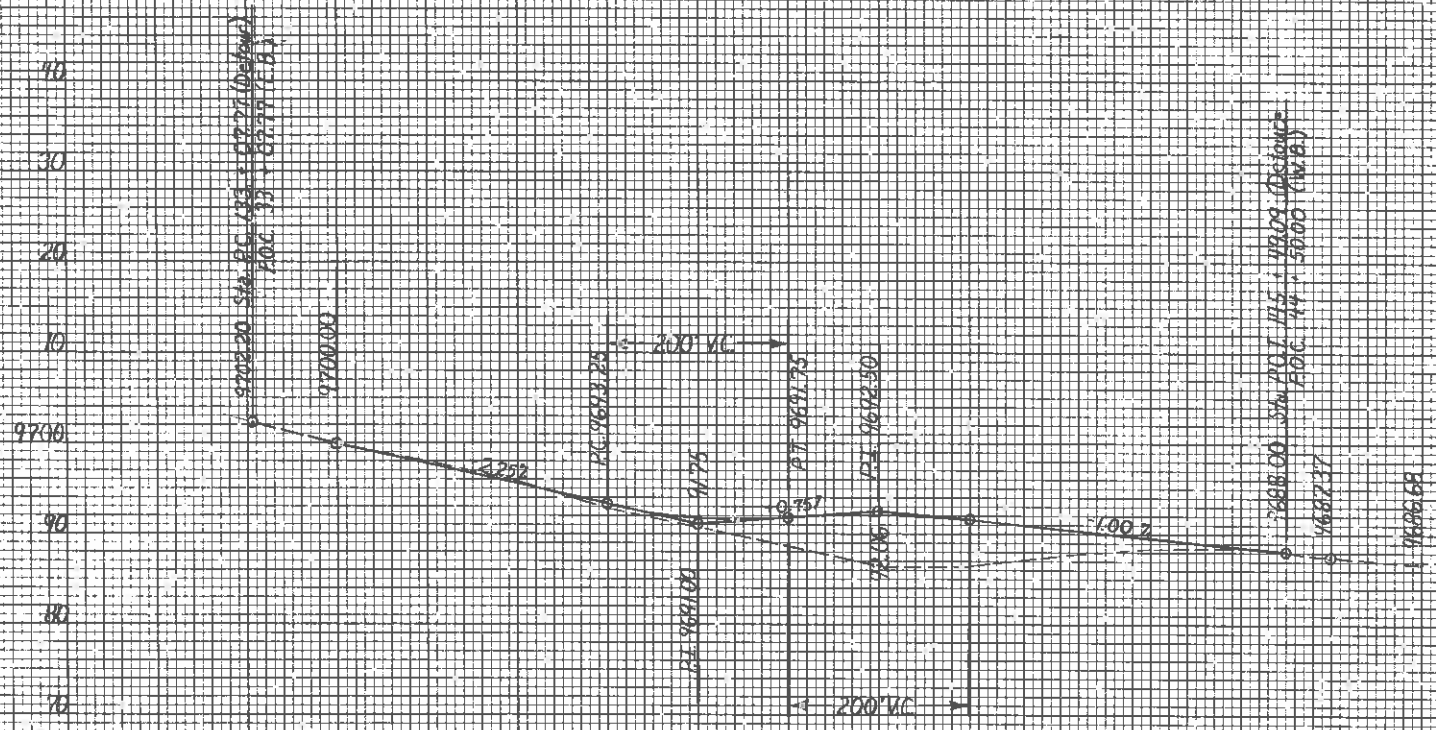


FEDERAL ROAD REGION NO.	DISTRICT	PROJ. NO.	SHEET NO.	TOTAL SHEETS
XXX	COLORADO	I70-2(42)	43	
AS CONSTRUCTED				
NO REVISIONS	REVISED	DATE		

### TABULATION OF SIGNING QUANTITIES

ITEM NO.	ITEM	UNIT	PROJECT TOTALS
202	REM. PVMT. MKG.	SQ. FT.	21,193
202	REM. GROUND SIGN	EACH	7
210	RES. GROUND SIGN	EACH	1
614	SIGN PANEL (CI. I)	SQ. FT.	52
614	TIMBER SIGN POST (4x4)	LIN. FT.	96
614	STEEL SIGN POST (U-2)	LIN. FT.	33
614	CONC. FOOTING (TY. 4)	EACH	2
614	MODIFICATION SIGN LEGEND	L.S.	1
614	FLASH. BEACON (PORT.)	EACH	2
614	BARRICADE (3-MA)(TEMP.)	EACH	21
614	BARRICADE (3-MC)(TEMP.)	EACH	3
614	BARRICADE (3-MD)(TEMP.)	EACH	1
614	CONST. TRAF. SIGN (A)	EACH	9
614	CONST. TRAF. SIGN (B)	EACH	37
614	CONST. TRAF. SIGN (C)	EACH	17
614	VERTICAL PANEL	EACH	50
614	TRAFFIC CONE (28 INCH)	EACH	50
527	PVMT. MKG. PAINT	GAL.	782

(R-1)  
TYPICAL DETOUR STRIPING LAYOUT

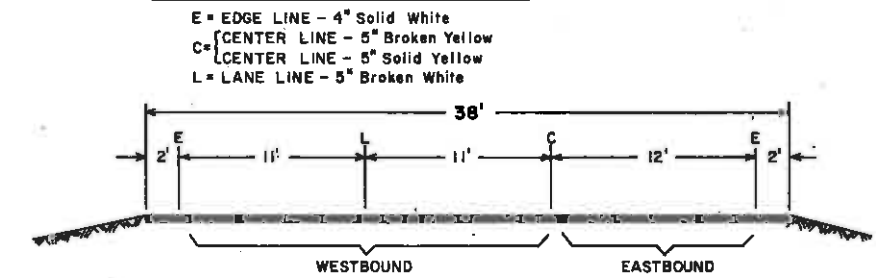

(R-1) 8-4-76, MARKING LAYOUT J.D.S.





AS CONSTRUCTED  
NO REVISIONS  REVISED  VOID

FEDERAL ROAD DISTRICT NO.	DIVISION	PROJ. NO.	SHEET NO.	TOTAL SHEETS
VIII	COLORADO	I 70-2(42)	45	

(R-1) 8-4-78, SIGN CODE J.D.S.

TABULATION OF CONSTRUCTION SIGNS

SIGN NO.	SIGN CODE	STATION	RESET GROUND SIGN (EACH)	CONCRETE BARRIER TEMPORARY (LIN. FT.)	BARRICADE TYPE (EACH)				CONSTRUCTION TRAFFIC SIGN PANEL SIZE (EACH)			VERTICAL PANEL (EACH)	TRAFFIC CONE 28 INCH (EACH)	FLASHING BEACON (PORTABLE) (EACH)	PORTABLE ELECTRONIC ADVANCE WARNING SIGN (EACH)
					3M-A	3M-B	3M-C	3M-D	A	B	C				
101	SG20-2	806+00													
102	XW20-1	170 E.B.													
103	XW20-1	170 E.B.													
104	XW20-1	170 E.B.													
105	XW20-1	170 E.B.													
106A	IW9-1(L)	793+50													
106B	SPECIAL														
107A	IW9-1(L)	793+75													
107B	SPECIAL														
108A	IW9-1(L)	796+25													
108B	SPECIAL														
109A	IW9-1(L)	796+75													
109B	SPECIAL														
110	IW6-2	800+50													
111	IW6-2	801+00													
112	IW4-2(L)	803+00													
113	IW4-2(L)	804+00													
114	IR4-1	807+75													
115	IR4-1	808+75													
116		812+00 TO 814+75			6										
117	SR11-2	815+00				1									
118A	SR11-2	838+70					1								
118B	SWI-6														
119	SWI-6	833+30						1							
120	DELETED														
121	DELETED														
122A	SR11-2	834+30					1								
122B	SWI-6														
123	IR5-9	813+00													
124	IR5-9	813+00													
125A	IW6-3	815+35													
125B	IR5-1														
126A	IR4-7	815+20													
126B	EIR4-7														
127	IW6-1	821+00													
128A	SR3-2	835+25													
128B	ESR3-2														

TABULATION OF CONSTRUCTION SIGNS

SIGN NO.	SIGN CODE	STATION	RESET GROUND SIGN (EACH)	CONCRETE BARRIER TEMPORARY (LIN. FT.)	BARRICADE TYPE (EACH)				CONSTRUCTION TRAFFIC SIGN PANEL SIZE (EACH)			VERTICAL PANEL (EACH)	TRAFFIC CONE 28 INCH (EACH)	FLASHING BEACON (PORTABLE) (EACH)	PORTABLE ELECTRONIC ADVANCE WARNING SIGN (EACH)
					3M-A	3M-B	3M-C	3M-D	A	B	C				
129	SPECIAL	835+10													
130	IW13-2(15)	835+75													
131	SR5-9	231+00 RAMP													
132	SR5-9	231+00 RAMP													
133	SPECIAL	845+00													
134A	IW6-3	233+50 RAMP													
134B	IR5-1														
135		835+00	MASK SIGN *												
136	IR4-2	845+50													
137		887+00	MASK SIGN *												
138	IW6-3	900+00													
139	IW6-3	900+00													
140		956+00	MASK SIGN *												
141	IW6-3	960+00													
142	IW6-3	960+00													
143	IW6-3	1020+00													
144	IW6-3	1020+00													
145	IR2-1(55)	26+50													
146	IR4-4	29+00													
147	IW6-3	31+50													
148	IW6-1	27+50													
149A	IR5-1	39+00													
149B	IW6-3														
150	IR5-9	40+50													
151	IR5-9	40+50													
152	SR11-2	40+60													
153		41+25 TO 49+75				15									
154	DELETED														
155	DELETED														
156	DELETED														
157	DELETED														
158	SRI-2	55+10													
159	DELETED														

NOTES

1. SEE APPROPRIATE PLAN SHEETS, STANDARDS AND SPECIFICATIONS FOR FABRICATION AND INSTALLATION DETAILS OF CONSTRUCTION SIGNS, BARRICADES, BARRIERS AND CHANNELIZING DEVICES.

2. LOCATIONS ARE APPROXIMATE ONLY. EXACT LOCATIONS TO BE DETERMINED BY THE ENGINEER.

\* TO BE PAID FOR AS "MODIFICATION SIGN LEGEND".

Δ LAYOUT WILL BE FURNISHED WITH THE SPECIAL SIGNS.




### TABULATION OF PAVEMENT MARKINGS

AS CONSTRUCTED  
NO REVISIONS  REVISED  VOID

FEDERAL ROAD DISTRICT NO.	DIVISION	PROJ. NO.	SHEET NO.	TOTAL SHEETS
VII	COLORADO	I 70-2(42)	47	

STATION	LOCATION	PAVEMENT MARKING LINES (Linear Feet)										
		EDGE		LANE	CENTER		CHANNELIZING		CROSSHATCH		CROSS WALK	STOP
		WHITE SOLID 4 INCH	YELLOW SOLID 4 INCH	WHITE BROKEN 5 INCH	YELLOW SOLID 5 INCH	YELLOW BROKEN 5 INCH	WHITE SOLID 10 INCH	YELLOW SOLID 10 INCH	WHITE SOLID 10 INCH	YELLOW SOLID 10 INCH	WHITE SOLID 12 INCH	WHITE SOLID 24 INCH
<b>TEMPORARY PAVEMENT MARKING</b>												
808+80 TO 810+00	TRANSITION (E.B. STA.)	400		400	400				1,420	315		
813+00 TO OPP. 816+40	TRANSITION (W.B. STA.)	340	340	340								
819+00 TO 845+50	2-WAY RD.	5,300		2,650	5,300							
834+80 TO 836+00	RT. TURN							150				
OPP. 833+10	MEDIAN CROSSOVER	800										
845+50 TO 850+50	2-WAY RD.	1,000		500	500	500						
850+50 TO 878+22.62BK	2-WAY RD.	5,546		2,773	2,773	2,773						
878+34.33 AH. TO 942+63.44BK	2-WAY RD.	12,859		6,430	6,430	6,430						
942+72.35 AH. TO 965+94.76BK	2-WAY RD.	6,646		2,323	2,323	2,323						
965+07.10 AH. TO 1052+26.0 BK	2-WAY RD.	17,238		8,619	8,619	8,619						
7+27.0 AH. TO 26+80	2-WAY RD.	3,648		1,923	1,923	1,923						
26+50 TO 29+00	2-WAY RD.	500		250	500							
29+00 TO 35+00	2-WAY RD.	1,200		600	1,200							
35+00 TO 39+30	TRANSITION (E.B. STA.)			450	450			900	215			
OPP. 38+36 TO 41+00	TRANSITION (W.B. STA.)	264	264	264								
41+00 TO 43+00	TRANSITION (W.B. STA.)		400	400								
41+00 TO 52+70	TRANSITION (W.B. STA.)							1,170				
<b>SUB-TOTAL (TEMP. PVMT. MKG.)</b>												
		53,958	1,004	27,922	30,418	22,568	1,320	2,320		530		
<b>FINAL PAVEMENT MARKING W.B. LANES</b>												
813+00 TO 1000+95.99BK	MAINLINE	18,796	18,796	18,796								
1000+90.03 AH. TO 1018+00	MAINLINE	1,310	1,310	1,310								
833+80 TO 837+40	DECEL. LANE						720					
40+00 TO 53+00	MAINLINE	1,300	1,300	1,300								
45+00 TO 53+00	ACCEL. LANE			500								
<b>SUB-TOTAL (FINAL PVMT. MKG. W.B. LANES)</b>												
		21,406	21,406	21,906			720					
<b>FINAL PAVEMENT MARKING E.B. LANES</b>												
805+00 TO 878+22.62BK	MAINLINE	7,323	7,323	7,323								
878+34.33 AH. TO 942+63.44BK	MAINLINE	6,430	6,430	6,430								
942+72.35 AH. TO 965+94.76BK	MAINLINE	2,323	2,323	2,323								
965+07.10 AH. TO 1052+26.0 BK	MAINLINE	8,619	8,619	8,619								
7+27.0 AH. TO 41+00	MAINLINE	3,373	3,373	3,373								
809+50 TO 813+00	DECEL. LANE						700					
833+30 TO 837+50	ACCEL. LANE	400					400					
35+00 TO 37+00	DECEL. LANE			200								
37+00 TO 40+00	DECEL. LANE						600					
<b>SUB-TOTAL (FINAL PVMT. MKG. E.B. LANES)</b>												
		28,468	28,068	28,268			1,700					
<b>PROJECT TOTALS</b>												
		103,812	50,478	78,096	30,418	22,568	3,740	2,320		530		

STATION	LOCATION	PAVEMENT MARKING LINES (Linear Feet)										
		EDGE		LANE	CENTER		CHANNELIZING		CROSSHATCH		CROSS WALK	STOP
		WHITE SOLID 4 INCH	YELLOW SOLID 4 INCH	WHITE BROKEN 5 INCH	YELLOW SOLID 5 INCH	YELLOW BROKEN 5 INCH	WHITE SOLID 10 INCH	YELLOW SOLID 10 INCH	WHITE SOLID 10 INCH	YELLOW SOLID 10 INCH	WHITE SOLID 12 INCH	WHITE SOLID 24 INCH
<b>PAVEMENT MARKING REMOVAL</b>												
806+25 TO 815+00	E.B.			975								
815+00 TO 878+22.62BK	E.B.	6,323	6,323	6,323								
878+34.33 AH. TO 942+63.44BK	E.B.	6,430	6,430	6,430								
942+72.35 AH. TO 965+94.76BK	E.B.	2,323	2,323	2,323								
965+07.10 AH. TO 1052+26.0 BK	E.B.	8,619	8,619	8,619								
7+27.0 AH. TO 39+50	E.B.	3,223	3,223	3,223								
812+75 TO 815+75	W.B.		300	300								
40+00 TO 45+00	W.B.		500	500								
48+00 TO 53+00	W.B.			500								
<b>PROJECT TOTAL (LINEAR FEET)</b>												
		26,918	27,718	29,193								
<b>PROJECT TOTAL (SQ. FEET)</b>												
		8,913	9,239	3,041								
			21,193	50. FT. REM. PVMT. MKG.								

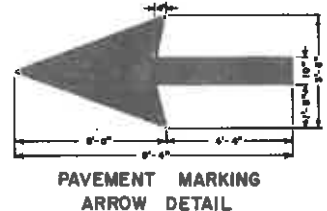

NOTE:  
FOR DETAILS OF PAVEMENT MARKING LINES AND LINE PLACEMENT, SEE STANDARD S-627-1A

IT IS ESTIMATED THAT THE RECREATION TRAIL (LENGTH 22,073 FT) WILL REQUIRE 18 GAL. OF YELLOW PAINT FOR A CENTER LINE (BROKEN YELLOW, 4 INCHES WIDE-3 FT. SEGMENTS WITH 9 FT. GAPS).




COLOR	PAINT (GAL.)	THERMOPLASTIC (SQ. FT.)
YELLOW	345	
WHITE	437	
TOTAL	782	

# UNIFORM STANDARD WARNING SIGNS

FEDERAL ROAD REGION NO.	DISTRICT	PROJ. NO.	SHEET NO.	TOTAL SHEETS
XIII	COLORADO	170-2(42)	48	
AS CONSTRUCTED				
NO REVISIONS		REVISED		VOID

**NOTES:**

- All Warning Signs shall have a Screen Processed Black Legend and Border on a Reflectorized Yellow Background.
- Galvanized Sheet Steel shall be hot dip Galvanized sheets of structural quality, 0.0598" min. thick, Grade A per ASTM Spec. A446-60T, 2 oz. coating class with a light Phosphate coating on surfaces that are to receive reflective sheeting per Federal Spec. TT-C-490 for Galvanized sheets.
- See applicable Standard for installation details: Class I or Class II as denoted in the Tabulation of Signs.

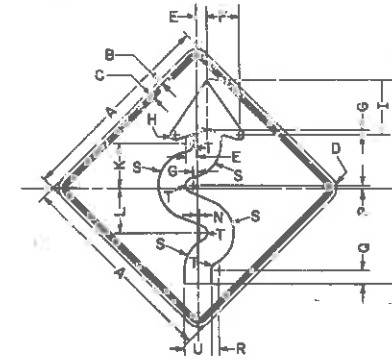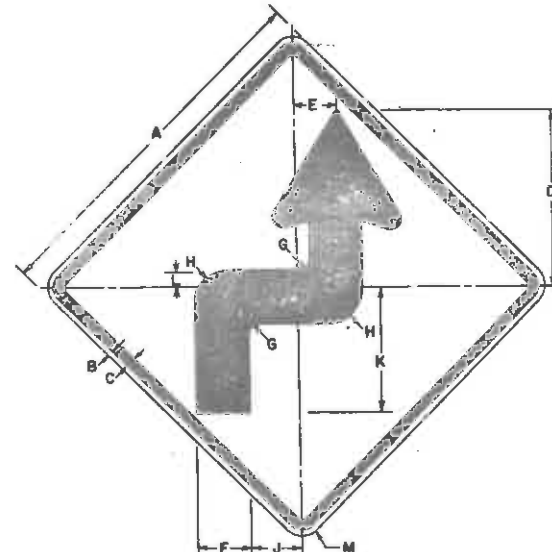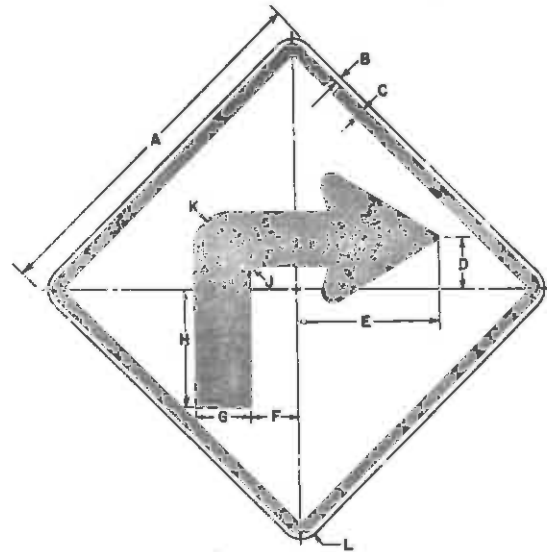


CODE	A	B	C	D	E	F	G	H	J	K	L
SWI-1(R)	24	8	8	3 1/2	9 1/2	3	3 1/2	7 1/2	13 1/2	2 1/2	1 1/2
SWI-1(R)	30	1 1/2	1 1/2	4 1/8	12	3 1/2	4 3/8	9 1/8	1	3	1 3/8
XWI-1(R)	36	3/8	3/8	4 7/8	14 1/2	4 1/2	5 1/2	11 1/2	1 1/2	3 1/2	2 1/2
IWI-1(R)	48	3/4	1 1/2	6 1/2	19 1/2	6	7	15 1/2	1 1/2	4 1/2	3

Legend - Black (Non-Ref)  
Background - Yellow (Ref)  
Reverse arrow design for left (L)

CODE	A	B	C	D	E	F	G	H	J	K	L	M
CWI-3(R)	24	8	7	11 1/2	2 1/2	3 1/2	1 1/2	2 1/2	3	8 1/2	1 1/2	1 1/2
SWI-3(R)	30	1 1/2	1 1/2	14 1/2	3 1/2	4 1/2	1	2	3 1/2	10 1/2	1 1/2	1 1/2
XWI-3(R)	36	3/8	3/8	17 1/2	4 1/2	5 1/2	1 1/2	3 1/2	4 1/2	12 1/2	1 1/2	2 1/2
IWI-3(R)	48	3/4	1 1/2	23 1/2	5 1/2	7	1 1/2	4 1/2	6	16 1/2	2 1/2	3

Legend - Black (Non-Ref)  
Background - Yellow (Ref)  
Reverse arrow design for left (L)

CODE NUMBER	PANEL DIMENSIONS				LEGEND DIMENSIONS															
	A	B	C	D	E	F	G	H	I	J	K	L	M	N	P	Q	R	S	T	U
CWI-5(RorL)	24	8	8	1 1/2	1 1/4	3 3/4	1 1/2	1 1/2	6 1/2	12 1/2	5 3/8	5 1/4	11 3/8	5 3/2	1 1/4	1 3/8	2 1/2	4 1/8	7 1/8	3 1/4
SWI-5(RorL)	30	1 1/2	1 1/2	1 7/8	1 9/16	4 1/16	1 1/8	1 1/8	8 1/8	15 1/8	6 1/4	6 9/16	14 7/8	3 1/16	1 1/16	2	3 1/8	5 3/16	1 3/16	4 1/16
XWI-5(RorL)	36	3/8	3/8	2 1/4	1 7/8	5 3/8	3/4	3/4	9 3/4	16 1/8	7 3/8	7 7/8	17 1/8	1/8	1/8	2 3/4	3 3/4	6 1/8	1 1/8	4 7/8
IWI-5(RorL)	48	3/4	1 1/4	3	2 1/2	7 1/2	1	1 1/2	13	25 1/2	10 3/8	10 1/2	22 1/4	5/16	1/2	3 5/8	5	6 1/4	1 1/4	6 1/2

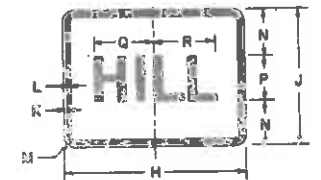

CODE	H	J	K	L	M	N	P	Q	R
ESW7-1	24	18	1 1/2	1 1/2	1 1/2	6	6D	7 1/2	8 1/2
EIW7-1	36	24	1 1/2	1 1/2	1 1/2	8	8D	10 1/2	10 1/2


Legend - Black (Non-Ref.)  
Background - Yellow (Ref.)



# UNIFORM STANDARD REGULATORY SIGNS


## ADDITIONAL CONSTRUCTION SIGNS

FEDERAL ROAD REGION NO.	DISTRICT	PROJ. NO.	SHEET NO.	TOTAL SHEETS
VIII	COLORADO	I 70-2(42)	49	
AS CONSTRUCTED				
NO REVISIONS		REVISED	VOID	

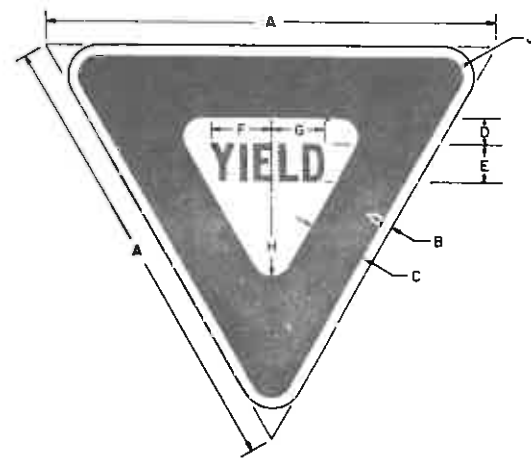


CODE	A	B	C	D	E	F	G	H	J
SR1-2	36	1/2	5	2	3C	4 1/8	4 1/4	1 1/2	2
XRI-2	48	1	6	2 1/2	4C	6 1/8	5 7/8	2	3
IRI-2	60	1 1/2	8	3 1/2	5C	7 3/8	7 1/4	2 1/2	4

Background - Reflectorized White  
Legend and Border - Reflectorized Red (Reverse screened on reflective sheeting).

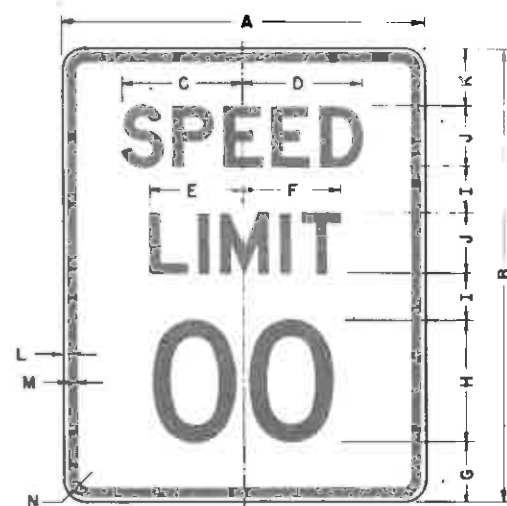


CODE	A	B	C	D	E	F	G	H	I	J	K	L	M	N
CR2-1(-)	18"	24"	7 3/8"	7 3/8"	5 7/8"	6"	2 3/8"	8" D"	1 1/2"	4" D"	2 3/8"	3 3/8"	1 1/2"	
SR2-1(-)	24"	30"	9 5/8"	9 5/8"	7 1/4"	7 1/4"	4"	10" E"	2"	4" E"	4"	3 3/8"	1 1/2"	1 1/2"
XR2-1(-)	36"	48"	14"	14 1/2"	10 3/4"	11 1/8"	7 1/2"	14" E"	4 1/2"	6" E"	5 1/2"	3 3/8"	2"	
IRZ-1(-)	48"	60"	19 3/8"	19 3/8"	12 5/8"	12 5/8"	8"	16" E"	6 1/2"	8" D"	7 1/2"	3 3/4"	3"	

Legend and border - Screen processed black.  
Background - Reflectorized white.

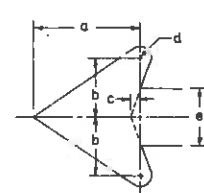


ARROW DETAILS	a	b	c	d	e
SR3-2	4 1/8"	2 3/8"	3 3/8"	1 1/2"	2 1/2"
XR3-2	7 1/2"	3 1/8"	3 3/8"	3 1/2"	3 3/4"

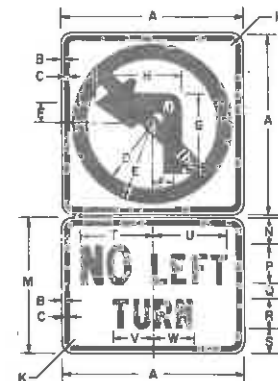

Background - Reflectorized White  
Circle and Diagonal - Reflectorized Red  
Legend and Border - Screen Processed Black

SYMBOL PANEL	A	B	C	D	E	F	G	H	J	K	L
SR3-2	24	3 3/8	3 3/8	8 1/2	10 1/2	2 3/8	10 1/2	11 1/2	2	1 1/2	2
XR3-2	36	3 3/8	7 1/8	12 3/8	15 3/8	4 1/8	15 3/8	17 1/4	3	2 1/4	3

WORD PANEL	M	N	P	Q	R	S	T	U	V	W
ESR3-2	18	3 1/2	5C	2	4C	3 1/2	9 1/2	9 3/8	5 1/2	5 3/8
EXR3-2	24	4	7C	3	6C	4	13 3/8	13 3/8	8 3/2	8

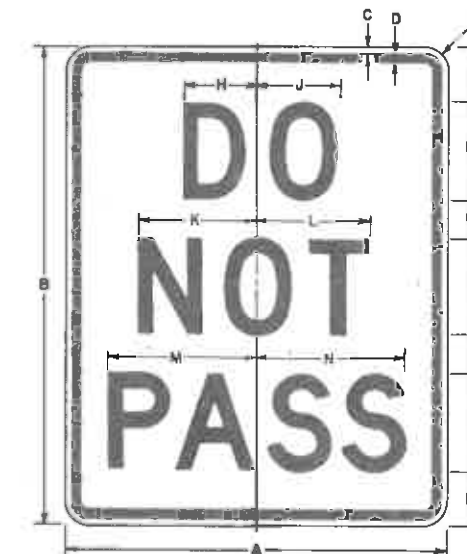


CODE	A	B	C	D	E	F	G	H	J	K	L	M	N	P
CR4-1	18	24	3 3/8	3 3/8	3 1/2	4D	2 1/2	3 1/2	3 3/8	4 1/2	4 1/2	6 1/2	6 1/2	1 1/2
SR4-1	24	30	3 3/8	3 3/8	3 1/2	6D	2 1/2	4 1/8	5	7 1/2	7 1/2	9 3/8	9 3/8	1 1/2
XR4-1	36	48	3 3/8	3 3/8	3 1/2	8D	5	6 1/4	6 1/4	9 1/2	9 1/2	12 1/2	13	2 1/2
IR4-1	48	60	3 3/8	3 3/8	3 1/2	10D	7	7 3/8	7 3/8	11 1/2	12 1/2	15 1/2	16 1/2	3

Legend - Black (Non-Ref.)  
Background - White (Ref.)



CODE	A	B	C	D	E	F	G	H	J	K	L	M	N	P
CR4-2	18	24	3 3/8	3 3/8	3 1/2	4C	2 1/2	3 1/2	3 3/8	4 1/2	4 1/2	6 1/2	6 1/2	1 1/2
SR4-2	24	30	3 3/8	3 3/8	3 1/2	6C	2 1/2	4 1/8	5	7 1/2	7 1/2	9 3/8	9 3/8	1 1/2
XR4-2	36	48	3 3/8	3 3/8	3 1/2	8C	5	10 1/4	10 1/4	12 1/2	12 1/2	15 1/2	16 1/2	2 1/2
IR4-2	48	60	3 3/8	3 3/8	3 1/2	10C	7	13 1/8	13 1/8	15 1/2	15 1/2	18 1/2	19 1/2	3


Legend - Black (Non-Ref.)  
Background - White (Ref.)

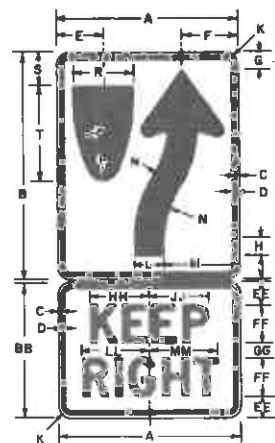

CODE	A	B	C	D	E	F	G	H	J	K	L	M	N	P	Q	R	S	T
CR4-7	18	24	3 3/8	3 3/8	4 1/8	5 1/8	1 1/2	2 1/2	1 1/2	3	7 1/2	5 1/2	1 1/2	22 1/2	6	3 3/8	9 3/8	
SR4-7	24	30	3 3/8	3 3/8	6 1/8	7 1/8	1 1/2	2 1/2	1 1/2	4	10	7	2	30	8	4 1/2	12 1/2	
XR4-7	36	48	3 3/8	3 3/8	9 1/8	11 1/8	1 1/2	2 1/2	1 1/2	6	15	10 1/2	3	45	12	6 3/4	18 1/2	
IR4-7	48	60	3 3/8	3 3/8	12 1/8	14 1/8	1 1/2	2 1/2	1 1/2	8	20	14	4	60	16	9	25	


CODE	A	BB	C	D	EE	FF	GG	HH	JJ	K	LL	MM
ECR4-7	18	12	3 3/8	1 1/2	4D	1	4 1/2	5 1/2	1 1/2	5 1/2	5 1/2	
ESR4-7	24	18	3 3/8	3	5D	2	7 1/2	8 1/2	1 1/2	9	9	
EXR4-7	36	24	3 3/8	3 1/2	7D	3	10 1/2	11 1/2	2 1/2	12	12	
EIR4-7	48	36	3 3/8	1 1/2	9D	5	13 1/2	14 1/2	3	15 1/2	16	

Legend - Black (Non-Ref.)  
Background - White (Ref.)

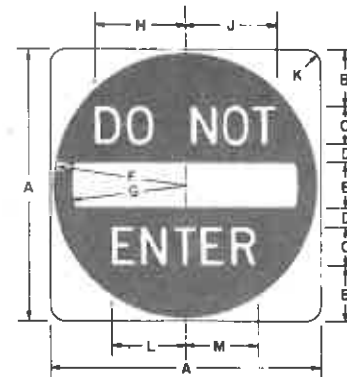

CODE	A	B	C	D	E	F	G	H	J	K	L	M
SR5-1	30	6 1/2	4D	2	5	14 1/2	12 1/2	9 1/2	9 1/2	1 1/2	7 3/4	7 3/4
XR5-1	36	7 1/2	5D	2 1/2	6	17 1/2	15	11 1/2	12 1/2	2 1/2	9 1/2	9 1/2
IR5-1	48	11	6D	3	8	23 1/2	20	14 1/2	14 1/2	3	11 1/2	11 1/2

Background and Legend - Reflectorized White.  
Circle - Reflectorized Red (Reverse screened on reflective sheeting)

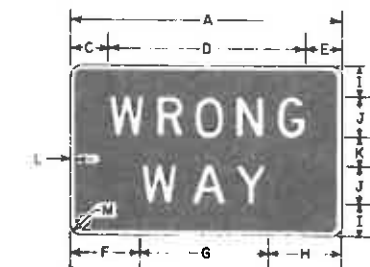

CODE	A	B	C	D	E	F	G	H	I	J	K	L	M
SR5-1A	24	1 1/2	3 1/2	2	3 1/2	4 1/2	3 1/2	4 1/2	3 1/2	4 1/2	4 1/2	6 1/2	6 1/2
SR5-9	36	2 1/2	5 1/2	3 1/2	5 1/2	6 1/2	5 1/2	6 1/2	5 1/2	6 1/2	6 1/2	8 1/2	8 1/2
IR5-9	48	3 1/2	7 1/2	5 1/2	7 1/2	8 1/2	7 1/2	8 1/2	7 1/2	8 1/2	8 1/2	10 1/2	10 1/2


Legend and border - Reflectorized white.  
Background - Reflectorized red (Reverse screened on reflective sheeting.)

# UNIFORM STANDARD WARNING SIGNS

## ADDITIONAL CONSTRUCTION SIGNS


NOTE: Background color for Construction Warning Signs shall be reflectorized orange.

FEDERAL ROAD REGION NO.	DISTRICT	PROJ NO	SHEET NO	TOTAL SHEETS
222	COLORADO	I 70-2 (42)	50	
AS CONSTRUCTED				
NO REVISIONS	REVISED	VOID		

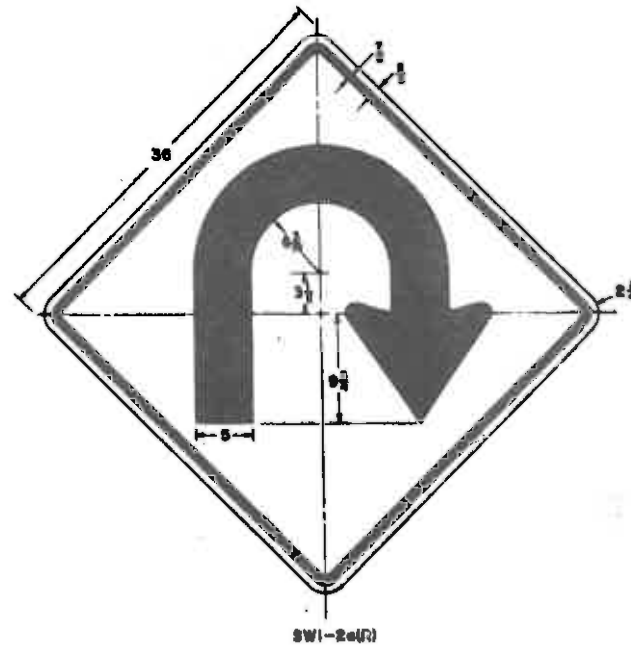



SW1-2a(R)

Legend - Black (Non-Ref)  
Background - Yellow (Ref)  
Reverse arrow design for left (L)

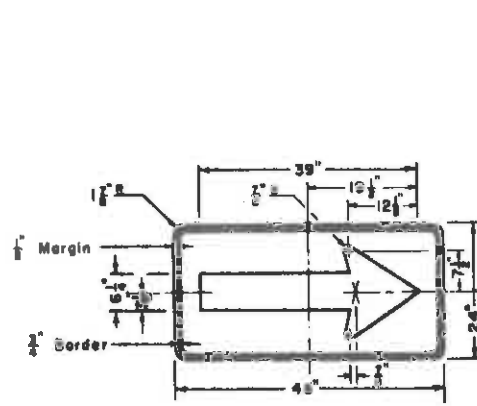

SW1-6

ARROW DETAILS	a	b	c	d
SW4-1	8 1/2	5	6	2 1/2
IW4-1	14	6	1	1 1/2

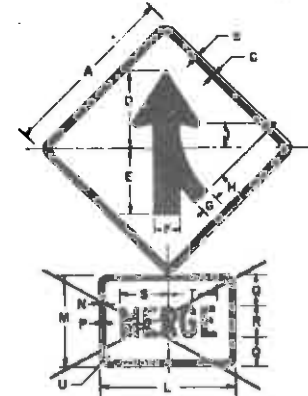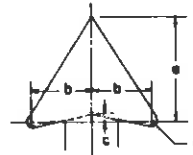


Reverse symbol design for left.

Background - Reflectorized Yellow.  
Legend and Border - Screen Processed Black.


SYMBOL PANEL	A	B	C	D	E	F	G	H	J	K
SW4-1	30	1/2	2 1/2	13	11	4 1/2	3	5 1/2	4 1/2	2
IW4-1	48	1/2	1 1/2	20 1/2	17 1/2	7	4 1/2	8 1/2	5 1/2	3

WORD PANEL	L	M	N	P	Q	R	S	T	U
ESW4-1	24	18	1/2	1/2	5C	10 1/2	10 1/2	1 1/2	
EIW4-1	36	24	1/2	1/2	8	5C	12 1/2	10 1/2	1 1/2

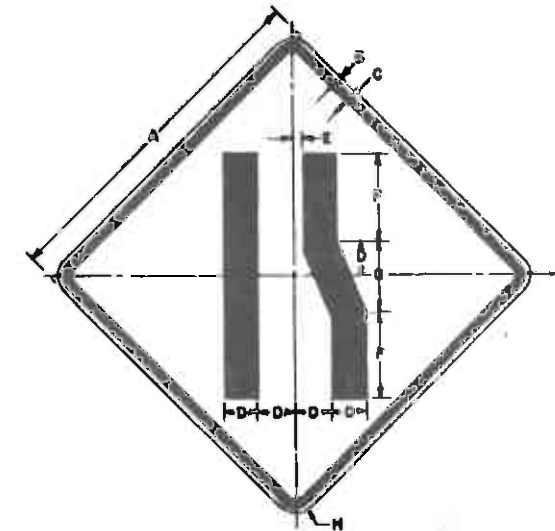


CODE	A	B	C	D	E	F	G	H
CW4-2(R)	30	1/2	1/2	3 1/2	10	10	5 1/2	1 1/2
SW4-2(R)	30	1/2	1/2	4	1	10	5	5 1/2
IW4-2(R)	40	1/2	1 1/2	8 1/2	1 1/2	15 1/2	10 1/2	5


Legend - Black (Non-Ref)  
Background - Yellow (Ref)  
Reverse symbol design for left (L)

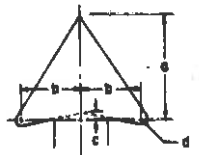


ARROW DETAILS	a	b	c	d
SW6-1	8 1/2	5	6	2 1/2
XW6-1	10 1/2	6	6	1 1/2

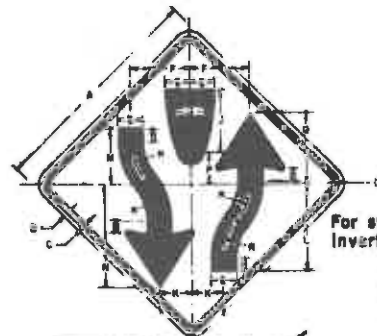

For symbol on W6-2 use inverted W6-1 panel.  
Background - Reflectorized Yellow.  
Legend and Border - Screen Processed Black.

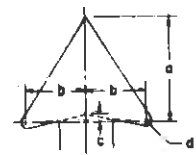


ARROW DETAILS	a	b	c	d
SW6-3	8 1/2	5	6	2 1/2
XW6-3	10 1/2	6	6	1 1/2
IW6-3	14	6	1	1 1/2

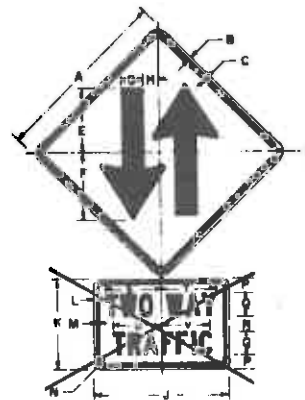

Background - Reflectorized Yellow.  
Legend and Border - Screen Processed Black.

SYMBOL PANEL	A	B	C	D	E	F	G	H
SW6-3	30	1/2	2 1/2	2	11 1/2	12 1/2	4	2 1/2
XW6-3	36	1/2	1 1/2	2 1/2	13	14	5	3
IW6-3	48	1/2	1 1/2	3	17	18	6	4

WORD PANEL	L	M	N	P	Q	R	S	T	U	V
ESW6-3	24	18	1/2	1/2	4C	3	9 1/2	9 1/2	8 1/2	8 1/2
EIW6-3	36	24	1/2	1 1/2	4	5C	4	14 1/2	14 1/2	12 1/2

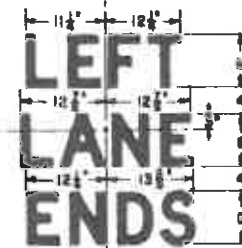


Series 'D' Letters  
(See IW4-1 for Plate Details)

IW9-1(L)



Series 'E' Letters  
(See IW4-1 for Plate Details)


IW9-1(R)

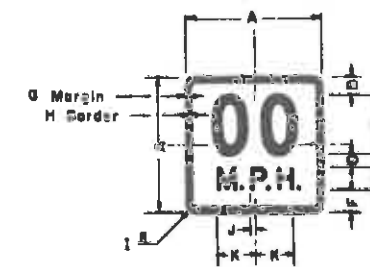

CODE	A	B	C	D	E	F	G	H	I	J	K
SW13-1(-)	15	2 1/2	2 1/2	2 1/2	2 1/2	2 1/2	2 1/2	2 1/2	2 1/2	2 1/2	2 1/2
XW13-1(-)	12	3 1/2	10	2 1/2	4	4	1 1/2	1 1/2	1 1/2	1 1/2	1 1/2

SYMBOL PANEL	A	B	C	D	E	F	G	H	J	K	L	M	N	P	Q	R
SW6-1	36	1/2	1/2	2 1/2	4	9 1/2	30	2	10	5	14	9	10 1/2	5	11 1/2	10
IW6-1	48	1/2	1 1/2	3	5 1/2	12 1/2	39 1/2	2 1/2	13 1/2	6 1/2	18 1/2	11 1/2	21 1/2	6 1/2	15 1/2	13 1/2

WORD PANEL	AA	BB	CC	DD	EE	FF	GG	HH	II	JJ	KK	LL	MM
ESW6-1	24	18	1/2	1/2	4C	2	8 1/2	8 1/2	9 1/2	9 1/2			
EIW6-1	36	24	1/2	1 1/2	4 1/2	6C	3	12 1/2	12 1/2	14 1/2	14 1/2		

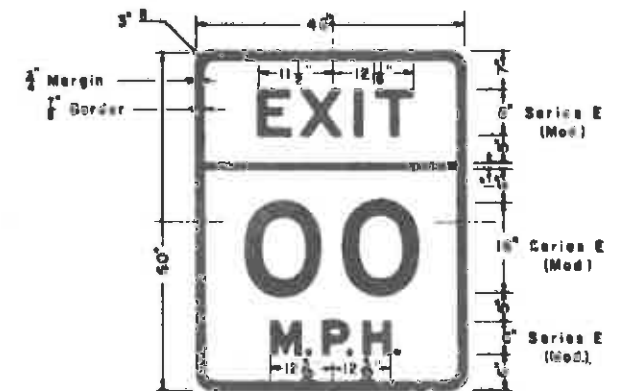


Stroke Width of Letters and Numerals is modified to 0.2" per inch of Letter Height.

IW13-2 (-)

# CROSS SECTION AT CLASS III SIGN LOCATION

PROJECT LEADER No. 1027 (1)	DIVISION	PROJ. NO.	SHEET NO.	TOTAL SHEETS
VIII	COLORADO	I 70-2(42)	51	
AS CONSTRUCTED				
NO REVISIONS	<input type="checkbox"/>	REVISED	<input type="checkbox"/>	VOID




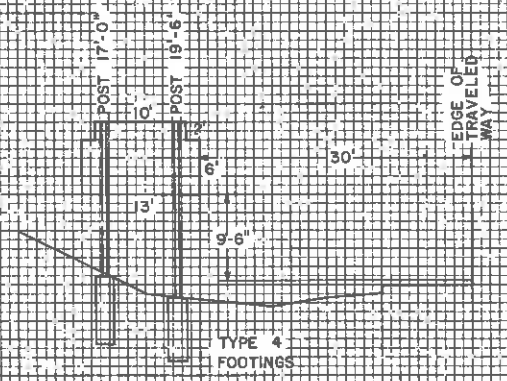


SIGN NO. 1  
STA. 860+00 W.B.

I 70 WESTBOUND

AS CONSTRUCTED		
NO REVISIONS	REVISED	VOID

FEDERAL ROAD REGION NO.	DIVISION	PROJ. NO.	SHEET NO.	TOTAL SHEETS
VIII	COLORADO	I 70-2 (42)	52	

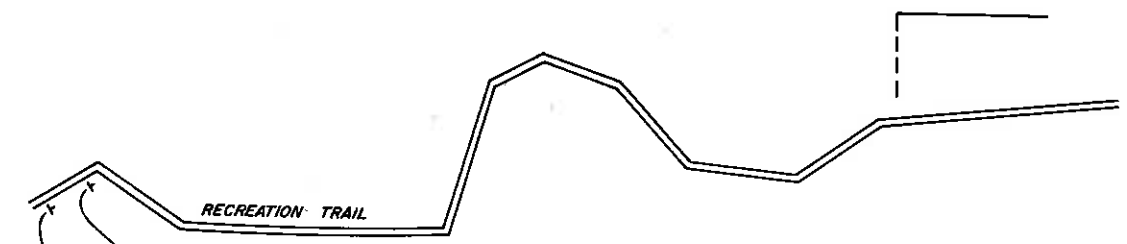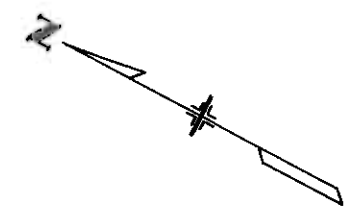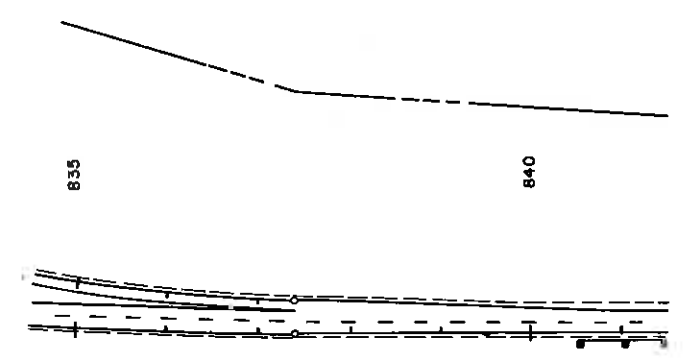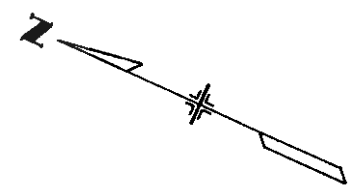


I 70 WESTBOUND

**EXIT 190**  
**REST AREA**  
**NEXT RIGHT**  
 TO REMAIN IN PLACE

10'  
**EXIT 190** 2' ← MODIFY LEGEND  
**Vail Pass**  
 1/2 MILE  
 RESET, NEW FOOTINGS REQUIRED.

12'  
 MILE  
 9 48"  
 2

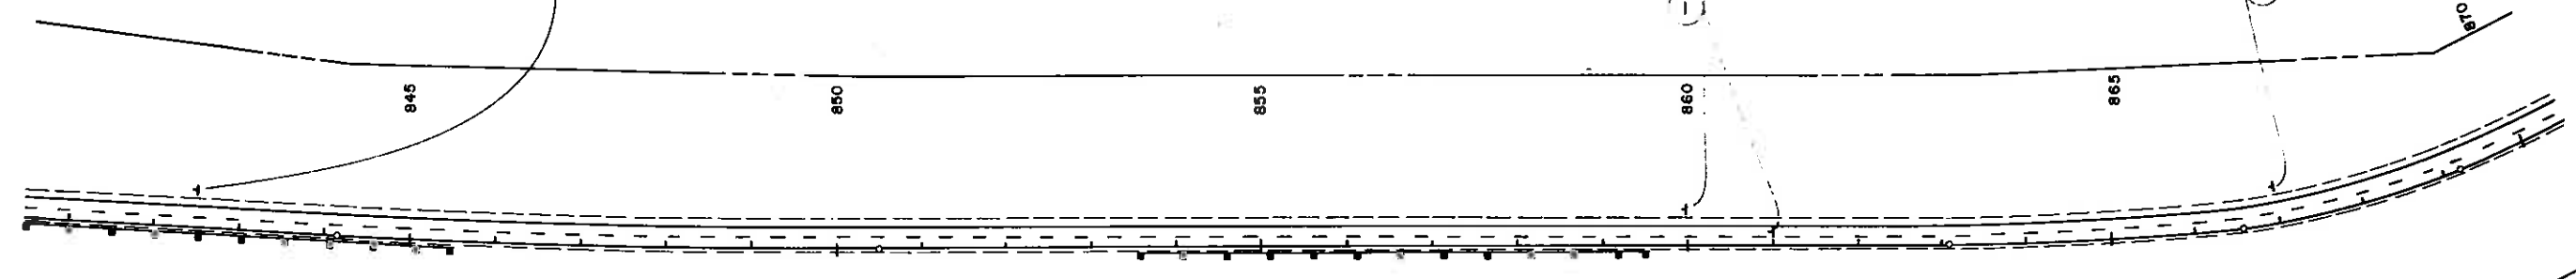

14  
 SPECIAL  
 ESW7-1

15  
 CWI-1(L)



CWI-5(L)  
 16

RECREATION TRAIL





I70 WESTBOUND

AS CONSTRUCTED		FEDERAL ROAD REGION NO.	DIVISION	PROJ. NO.	SHEET NO.	TOTAL SHEETS
NO REVISIONS	REVISED	VOID	VIII	COLORADO	I 70-2(42)	53

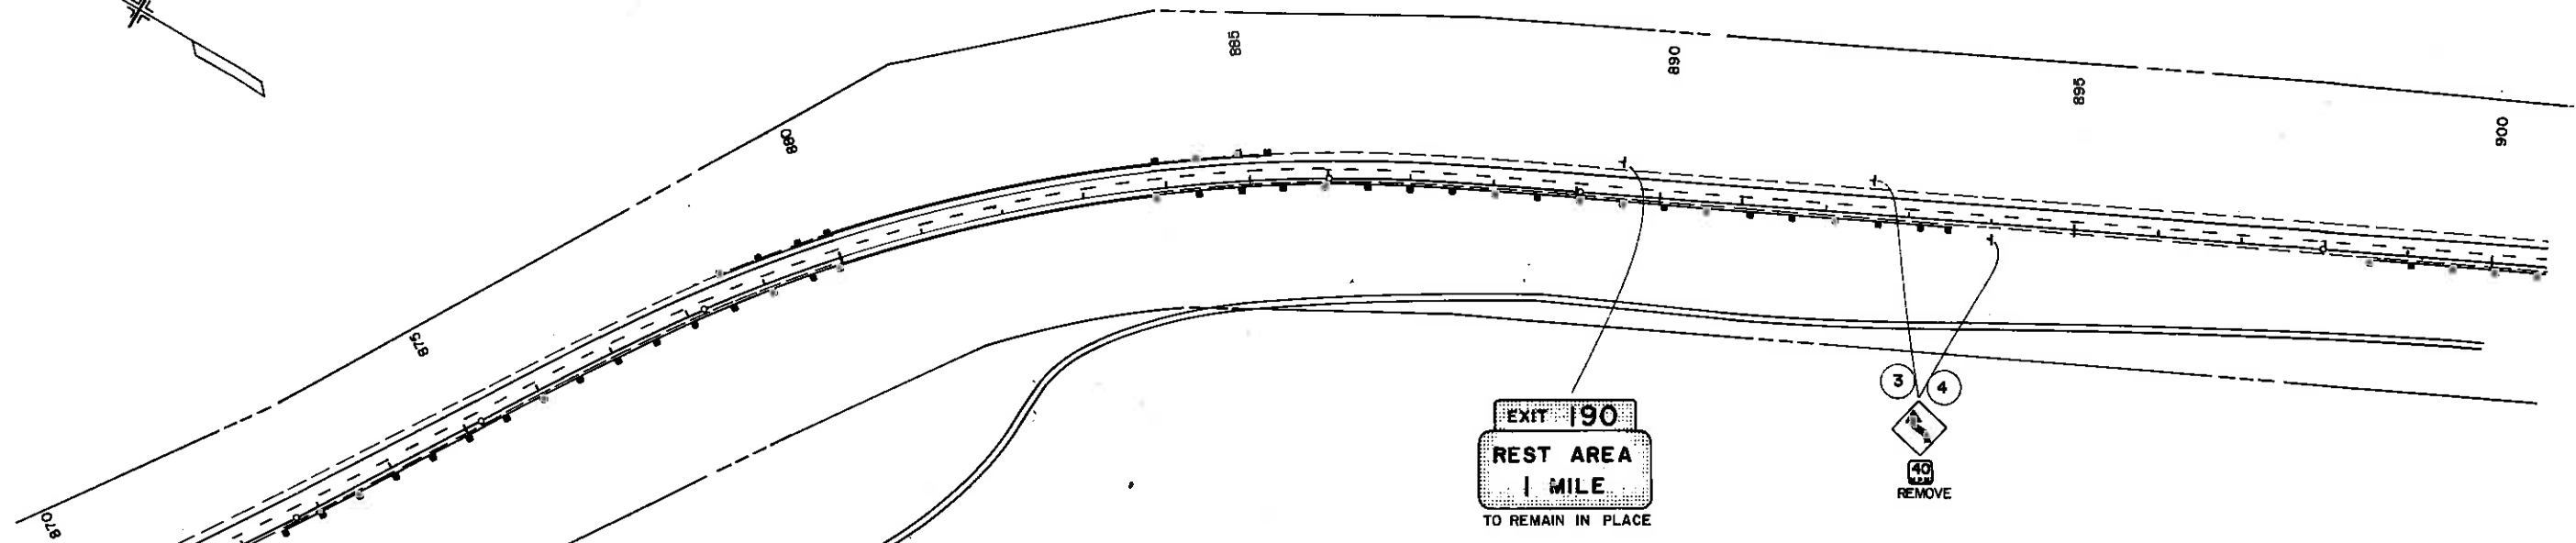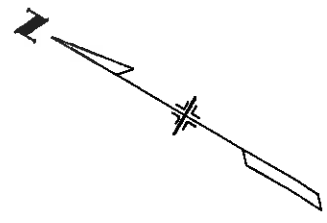

I70 WESTBOUND

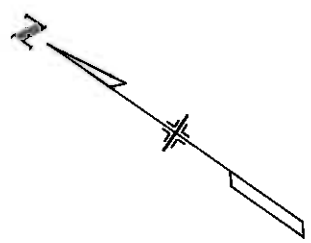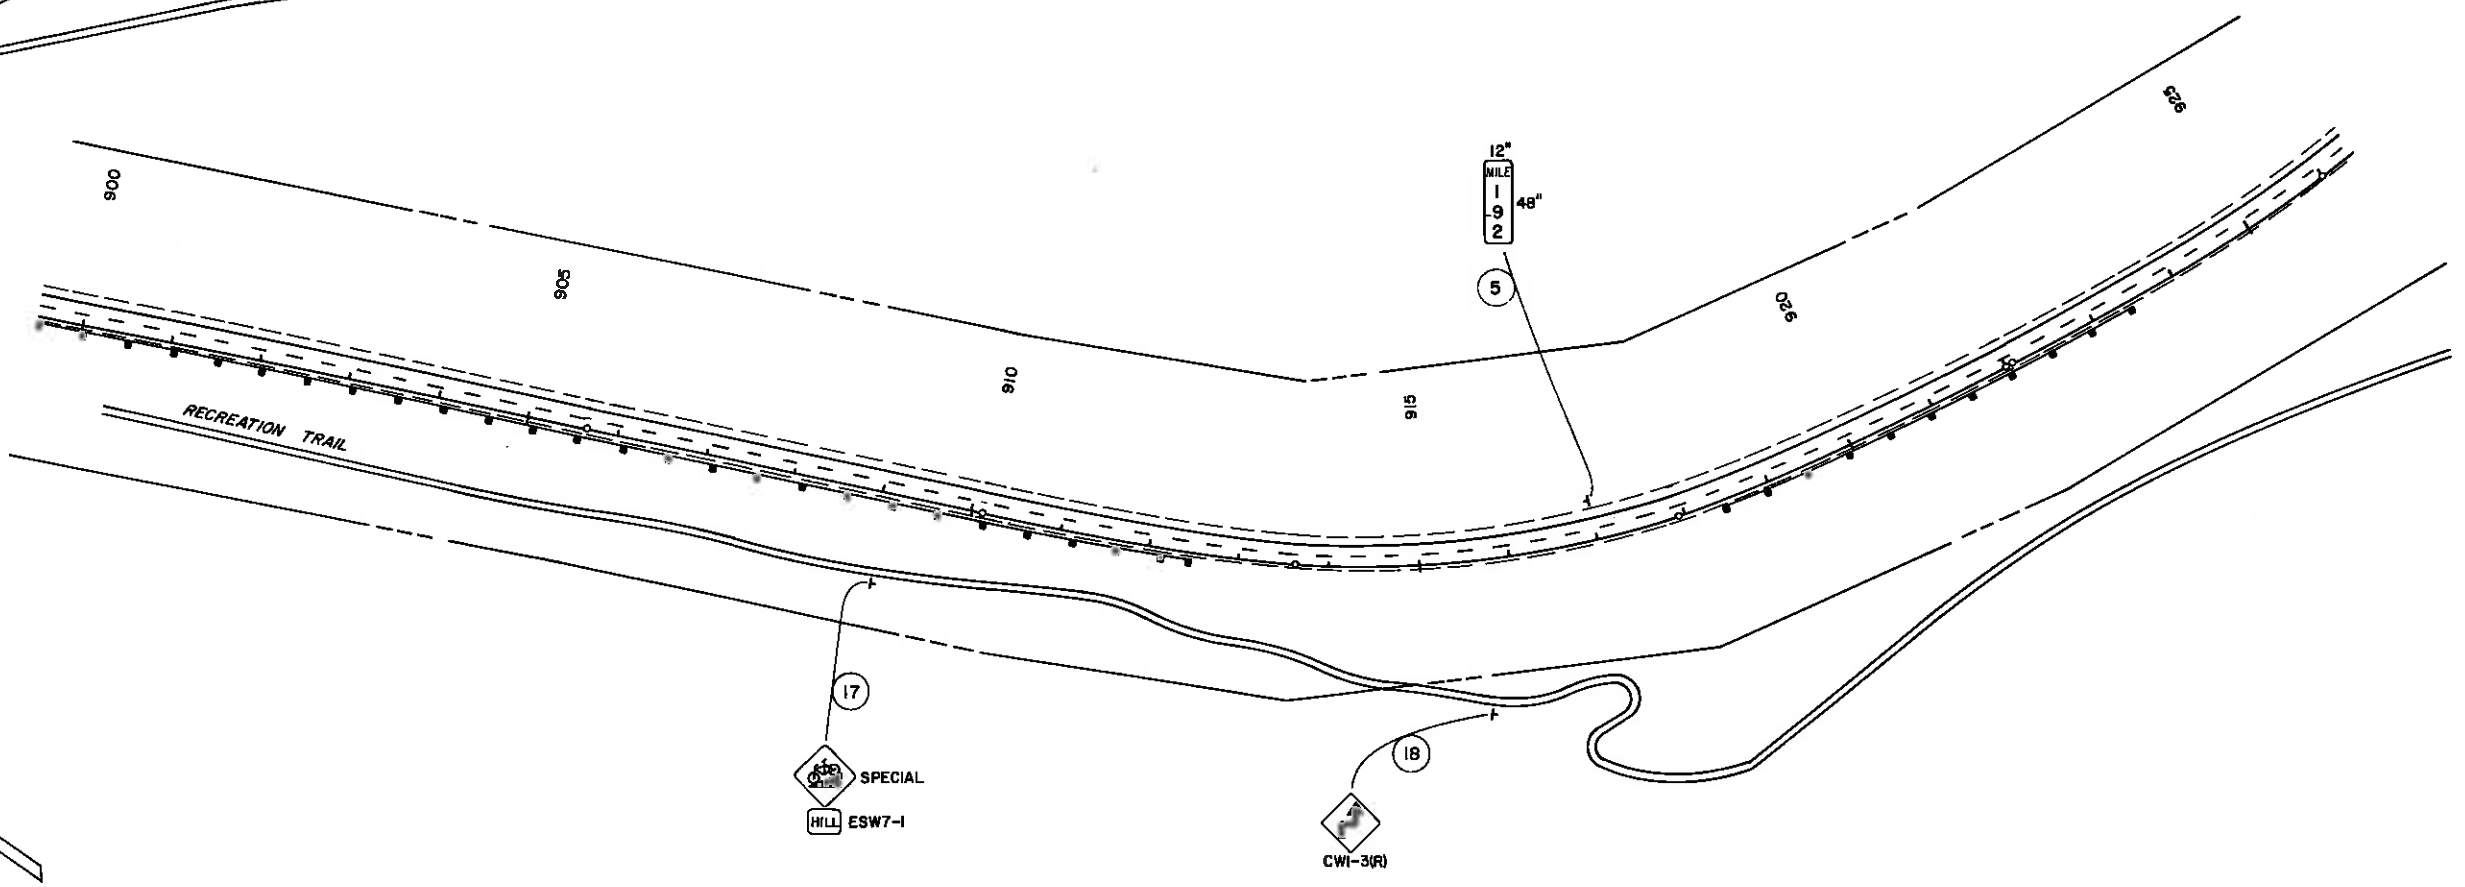

I70 WESTBOUND

AS CONSTRUCTED  
NO REVISIONS  REVISED  VOID

FEDERAL ROAD REGION NO.	DIVISION	PROJ. NO.	SHEET NO.	TOTAL SHEETS
VIII	COLORADO	I70-2(42)	54	



REMOVE  
6

930

935

940

945

950

955

I70 WESTBOUND

REMOVE  
7

960

965

970

975

980

985

8

12'  
M.I.D.  
-  
9  
3  
48'



RECREATION TRAIL

RECREATION TRAIL


AS CONSTRUCTED		
NO REVISIONS	REVISED	VOID

FEDERAL ROAD DISTRICT NO.	DIVISION	PROJ. NO.	SHEET NO.	TOTAL SHEETS
VIII	COLORADO	I 70-2(42)	55	

### I 70 WESTBOUND

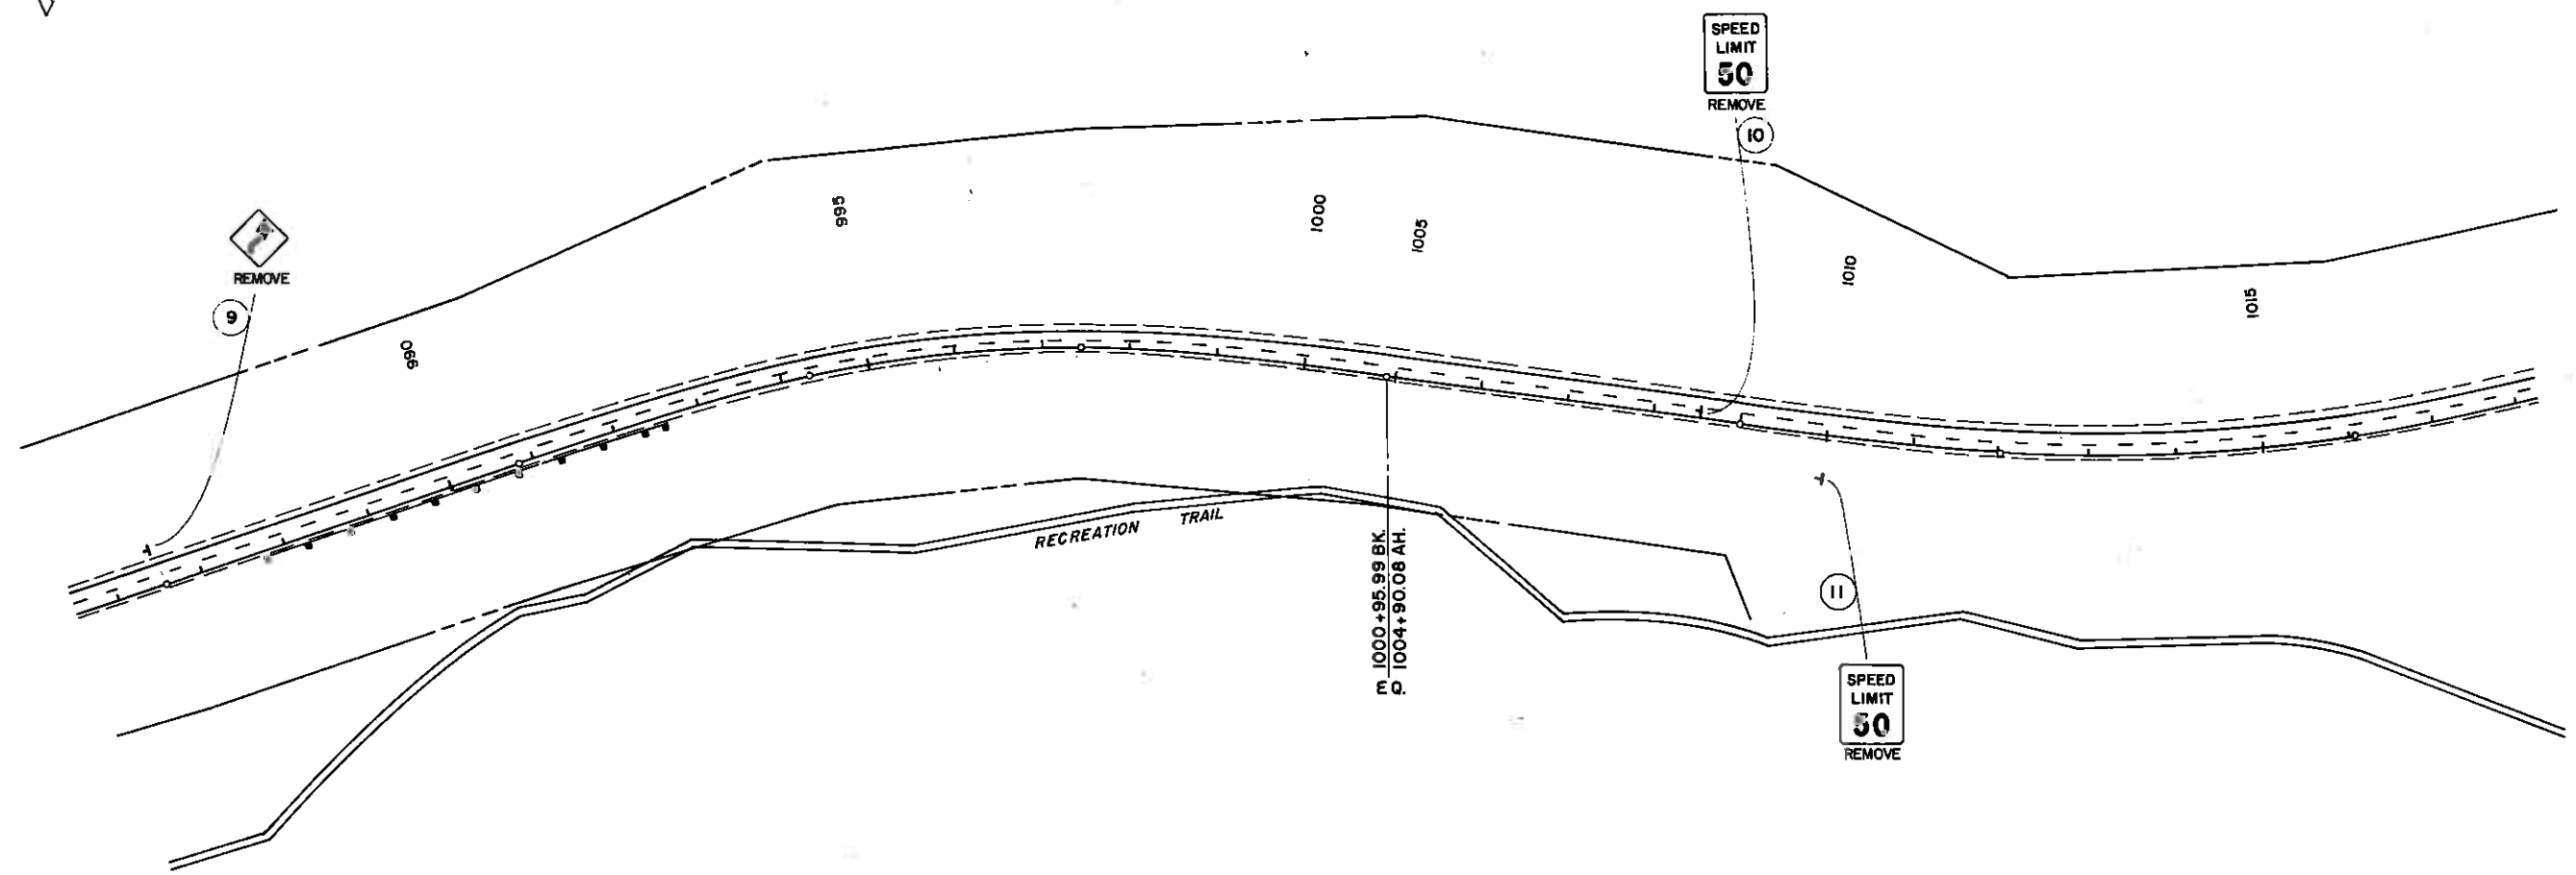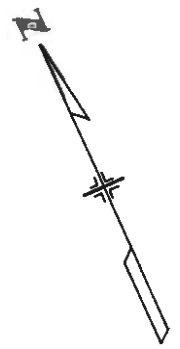




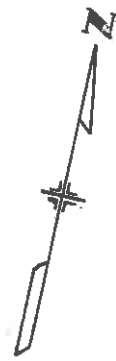


AS CONSTRUCTED		
NO REVISIONS	REVISED	VOID

FEDERAL ROAD DISTRICT NO.	DIVISION	PROJ. NO.	SHEET NO.	TOTAL SHEETS
VIII	COLORADO	I 70-2(42)	56	

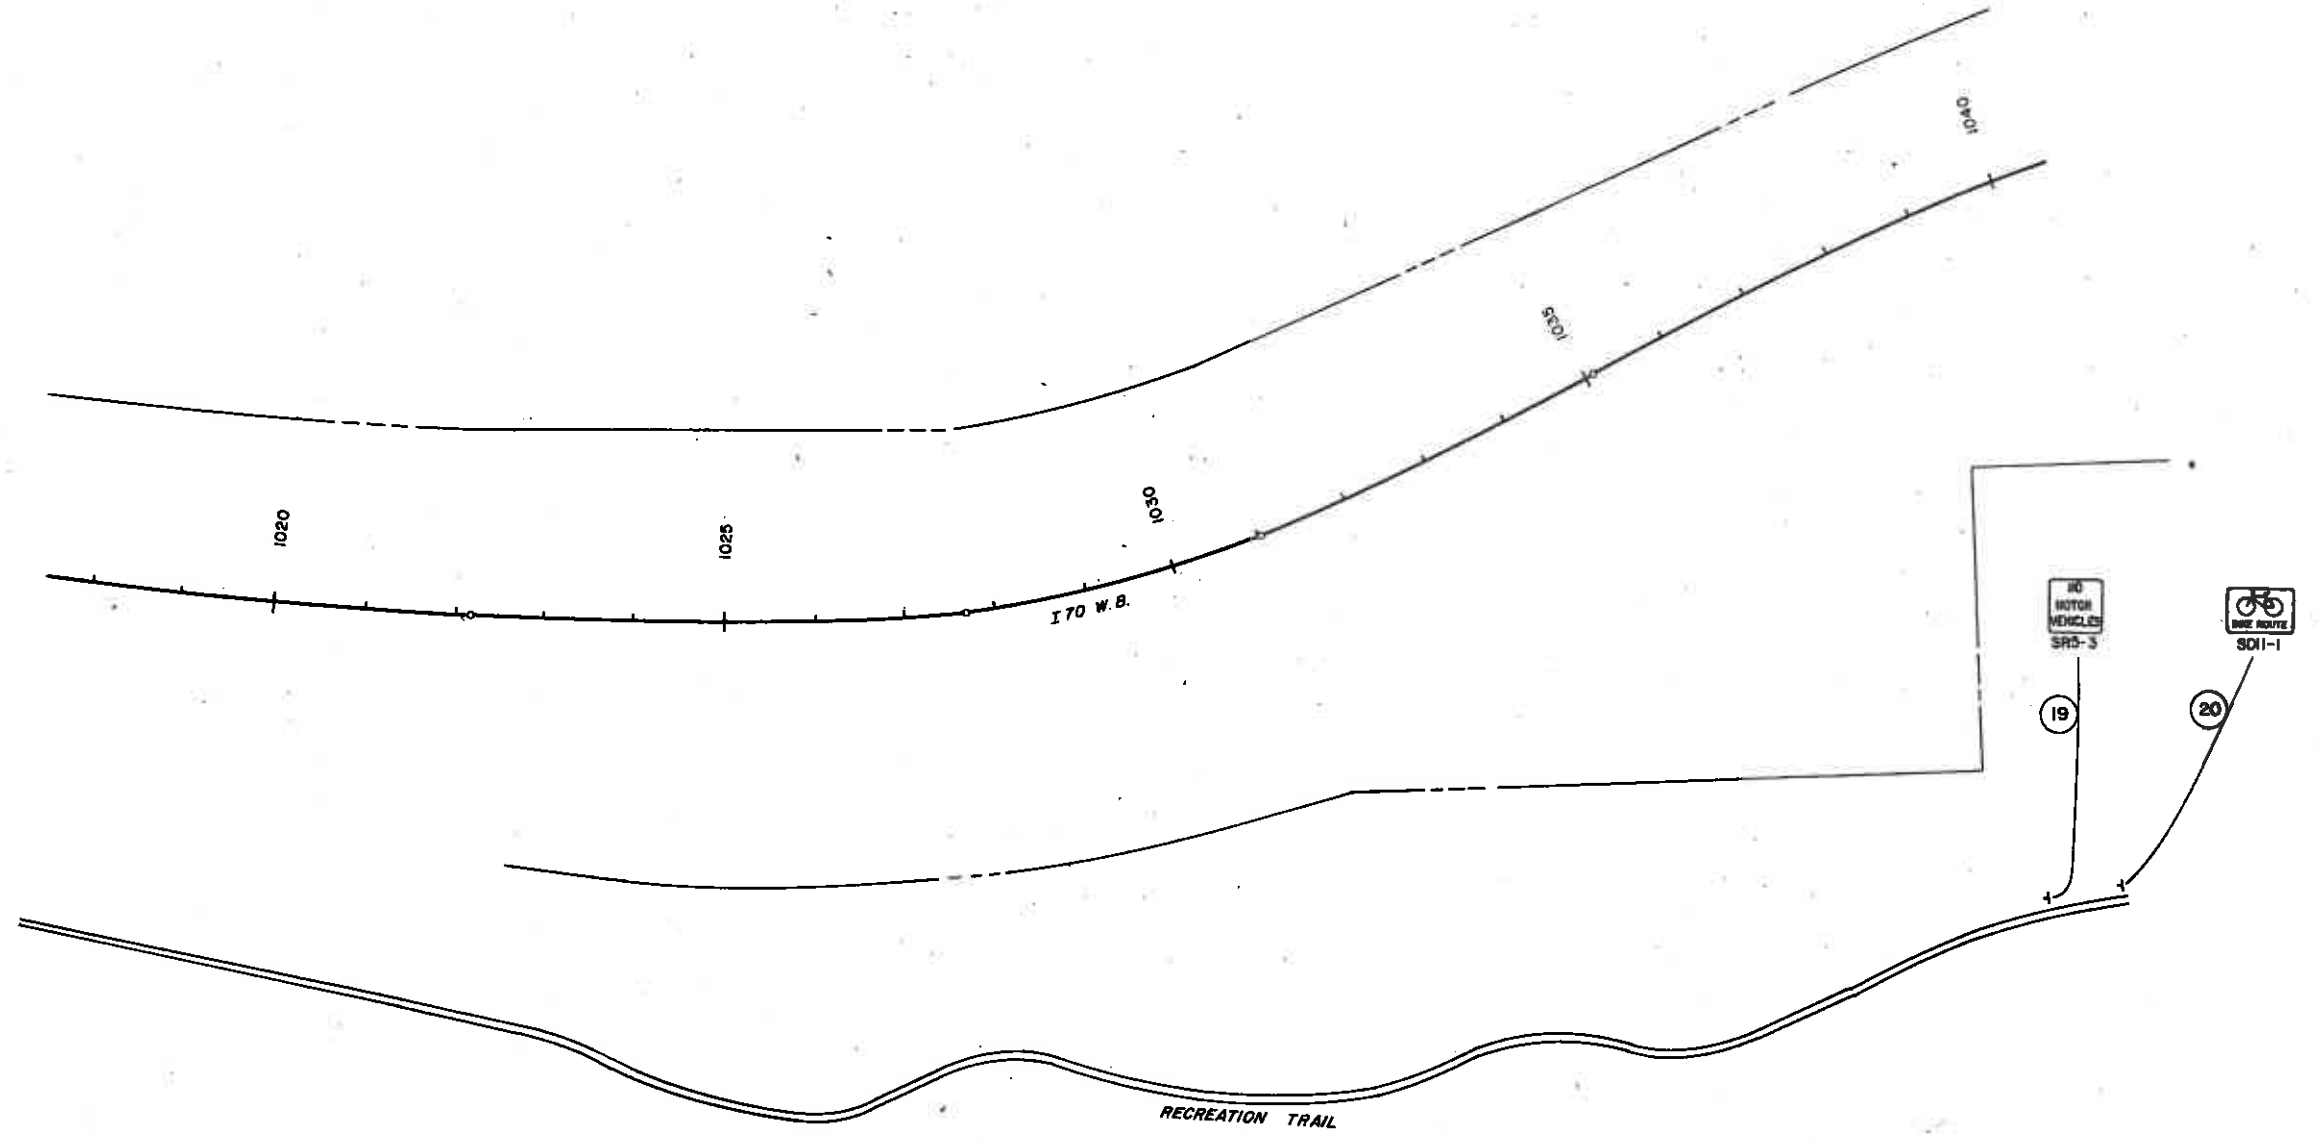

AS CONSTRUCTED  
 NO REVISIONS  REVISED  VOID


FEDERAL ROAD REGION NO.	DIVISION	PROJ. NO.	SHEET NO.	TOTAL SHEETS
VIII	COLORADO	I 70-2(42)	57	

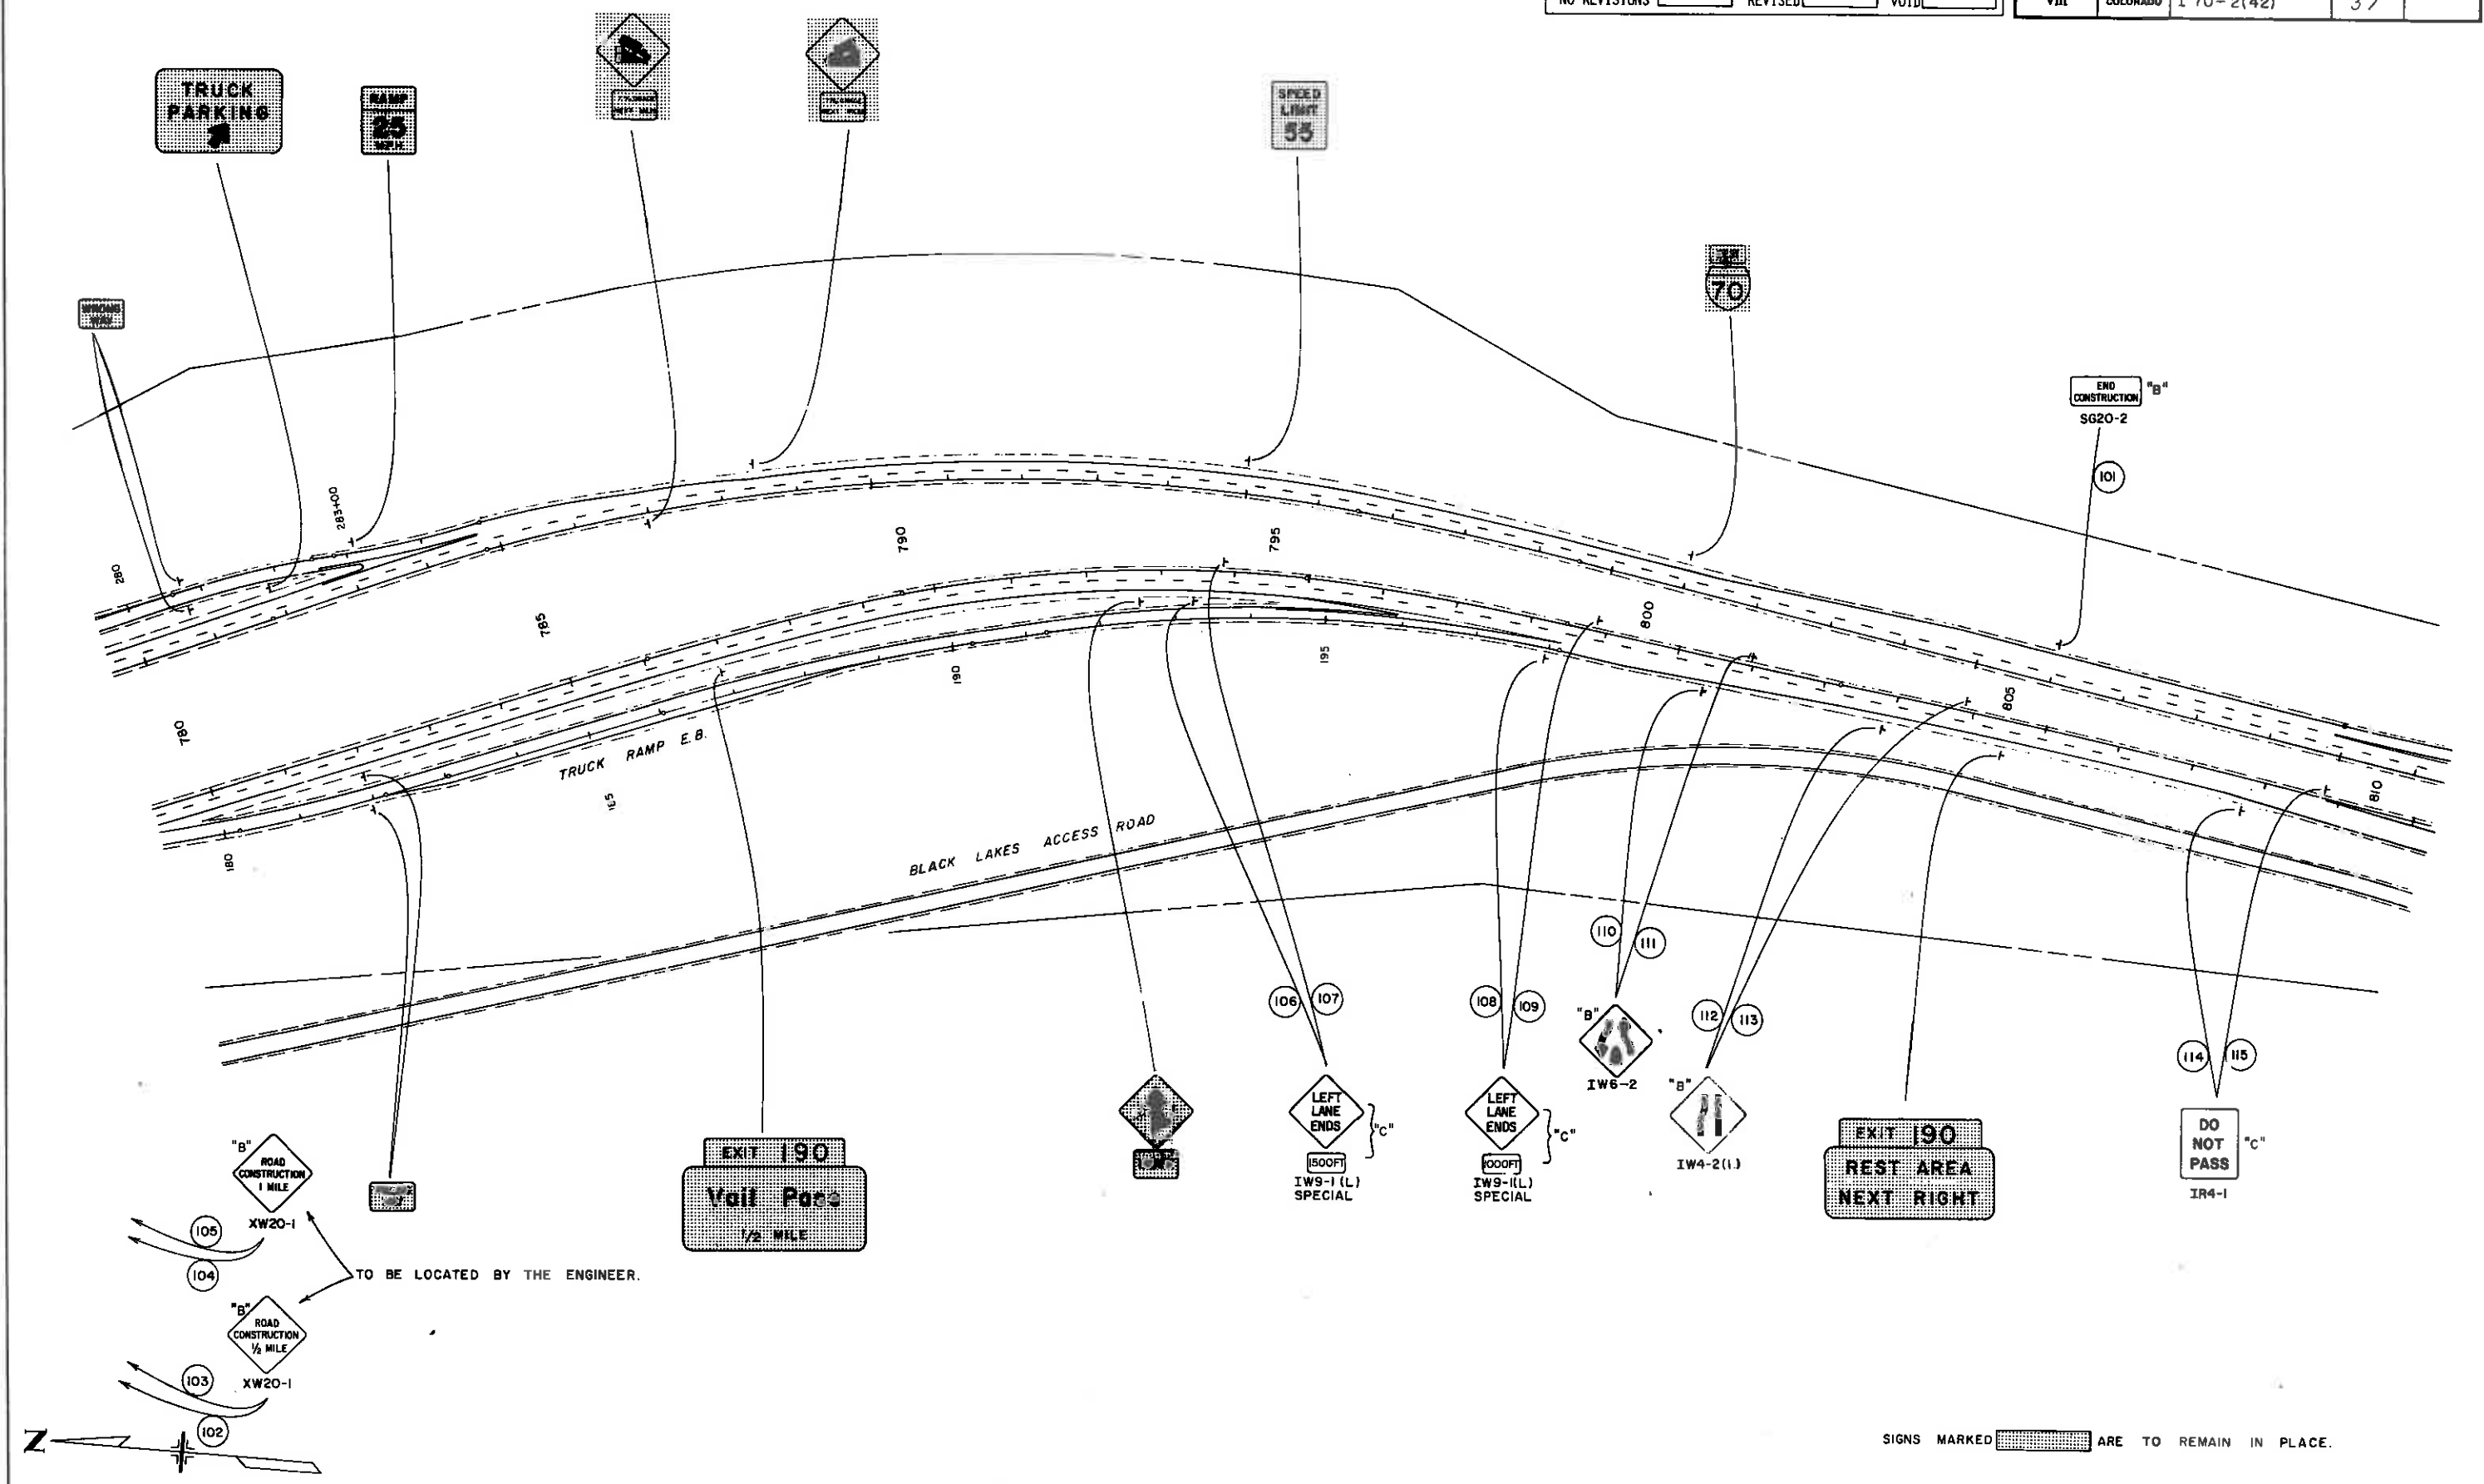

SIGNS MARKED  ARE TO REMAIN IN PLACE.

AS CONSTRUCTED  
NO REVISIONS [ ] REVISED [ ] VOID [ ]


FEDERAL ROAD DISTRICT NO.	DIVISION	PRBL. NO.	SHEET NO.	TOTAL SHEETS
VIII	COLORADO	I 70-1(42)	58	

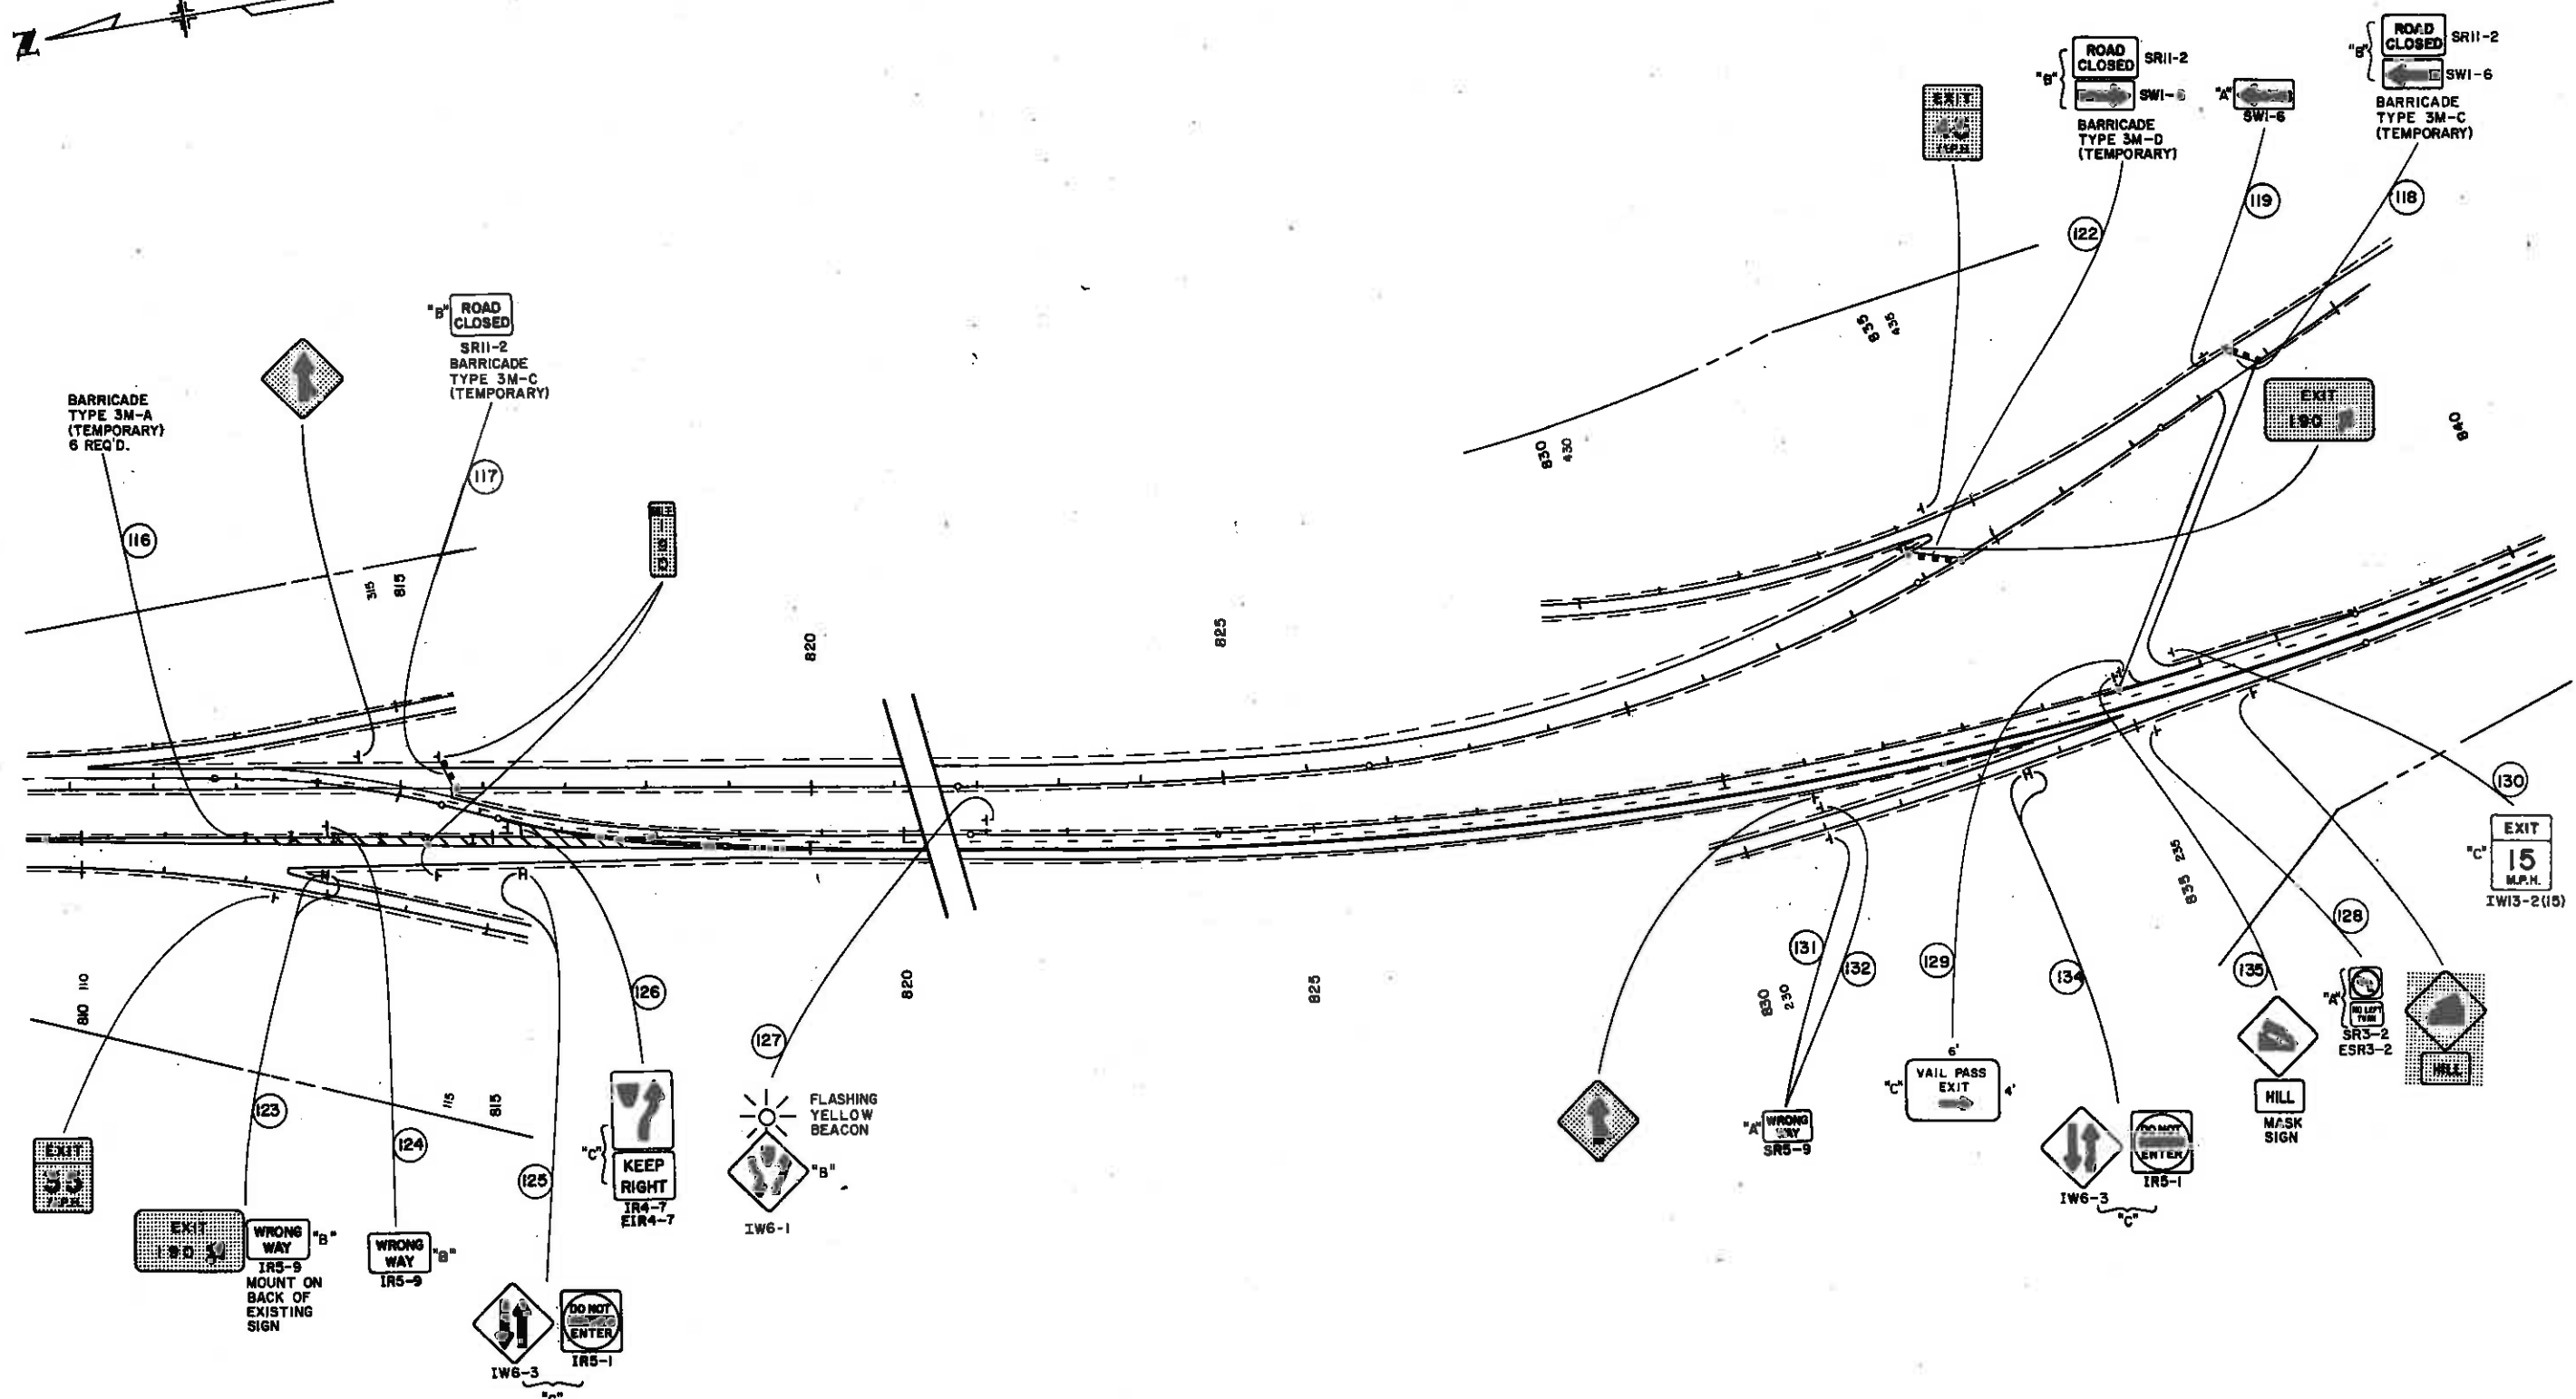

SIGNS MARKED [ ] ARE TO REMAIN IN PLACE.


AS CONSTRUCTED  
 NO REVISIONS  REVISED  VOID

FEDERAL ROAD DESIGN NO.	DIVISION	PROJ. NO.	SHEET NO.	TOTAL SHEETS
VIII	COLORADO	I 70-2(42)	59	

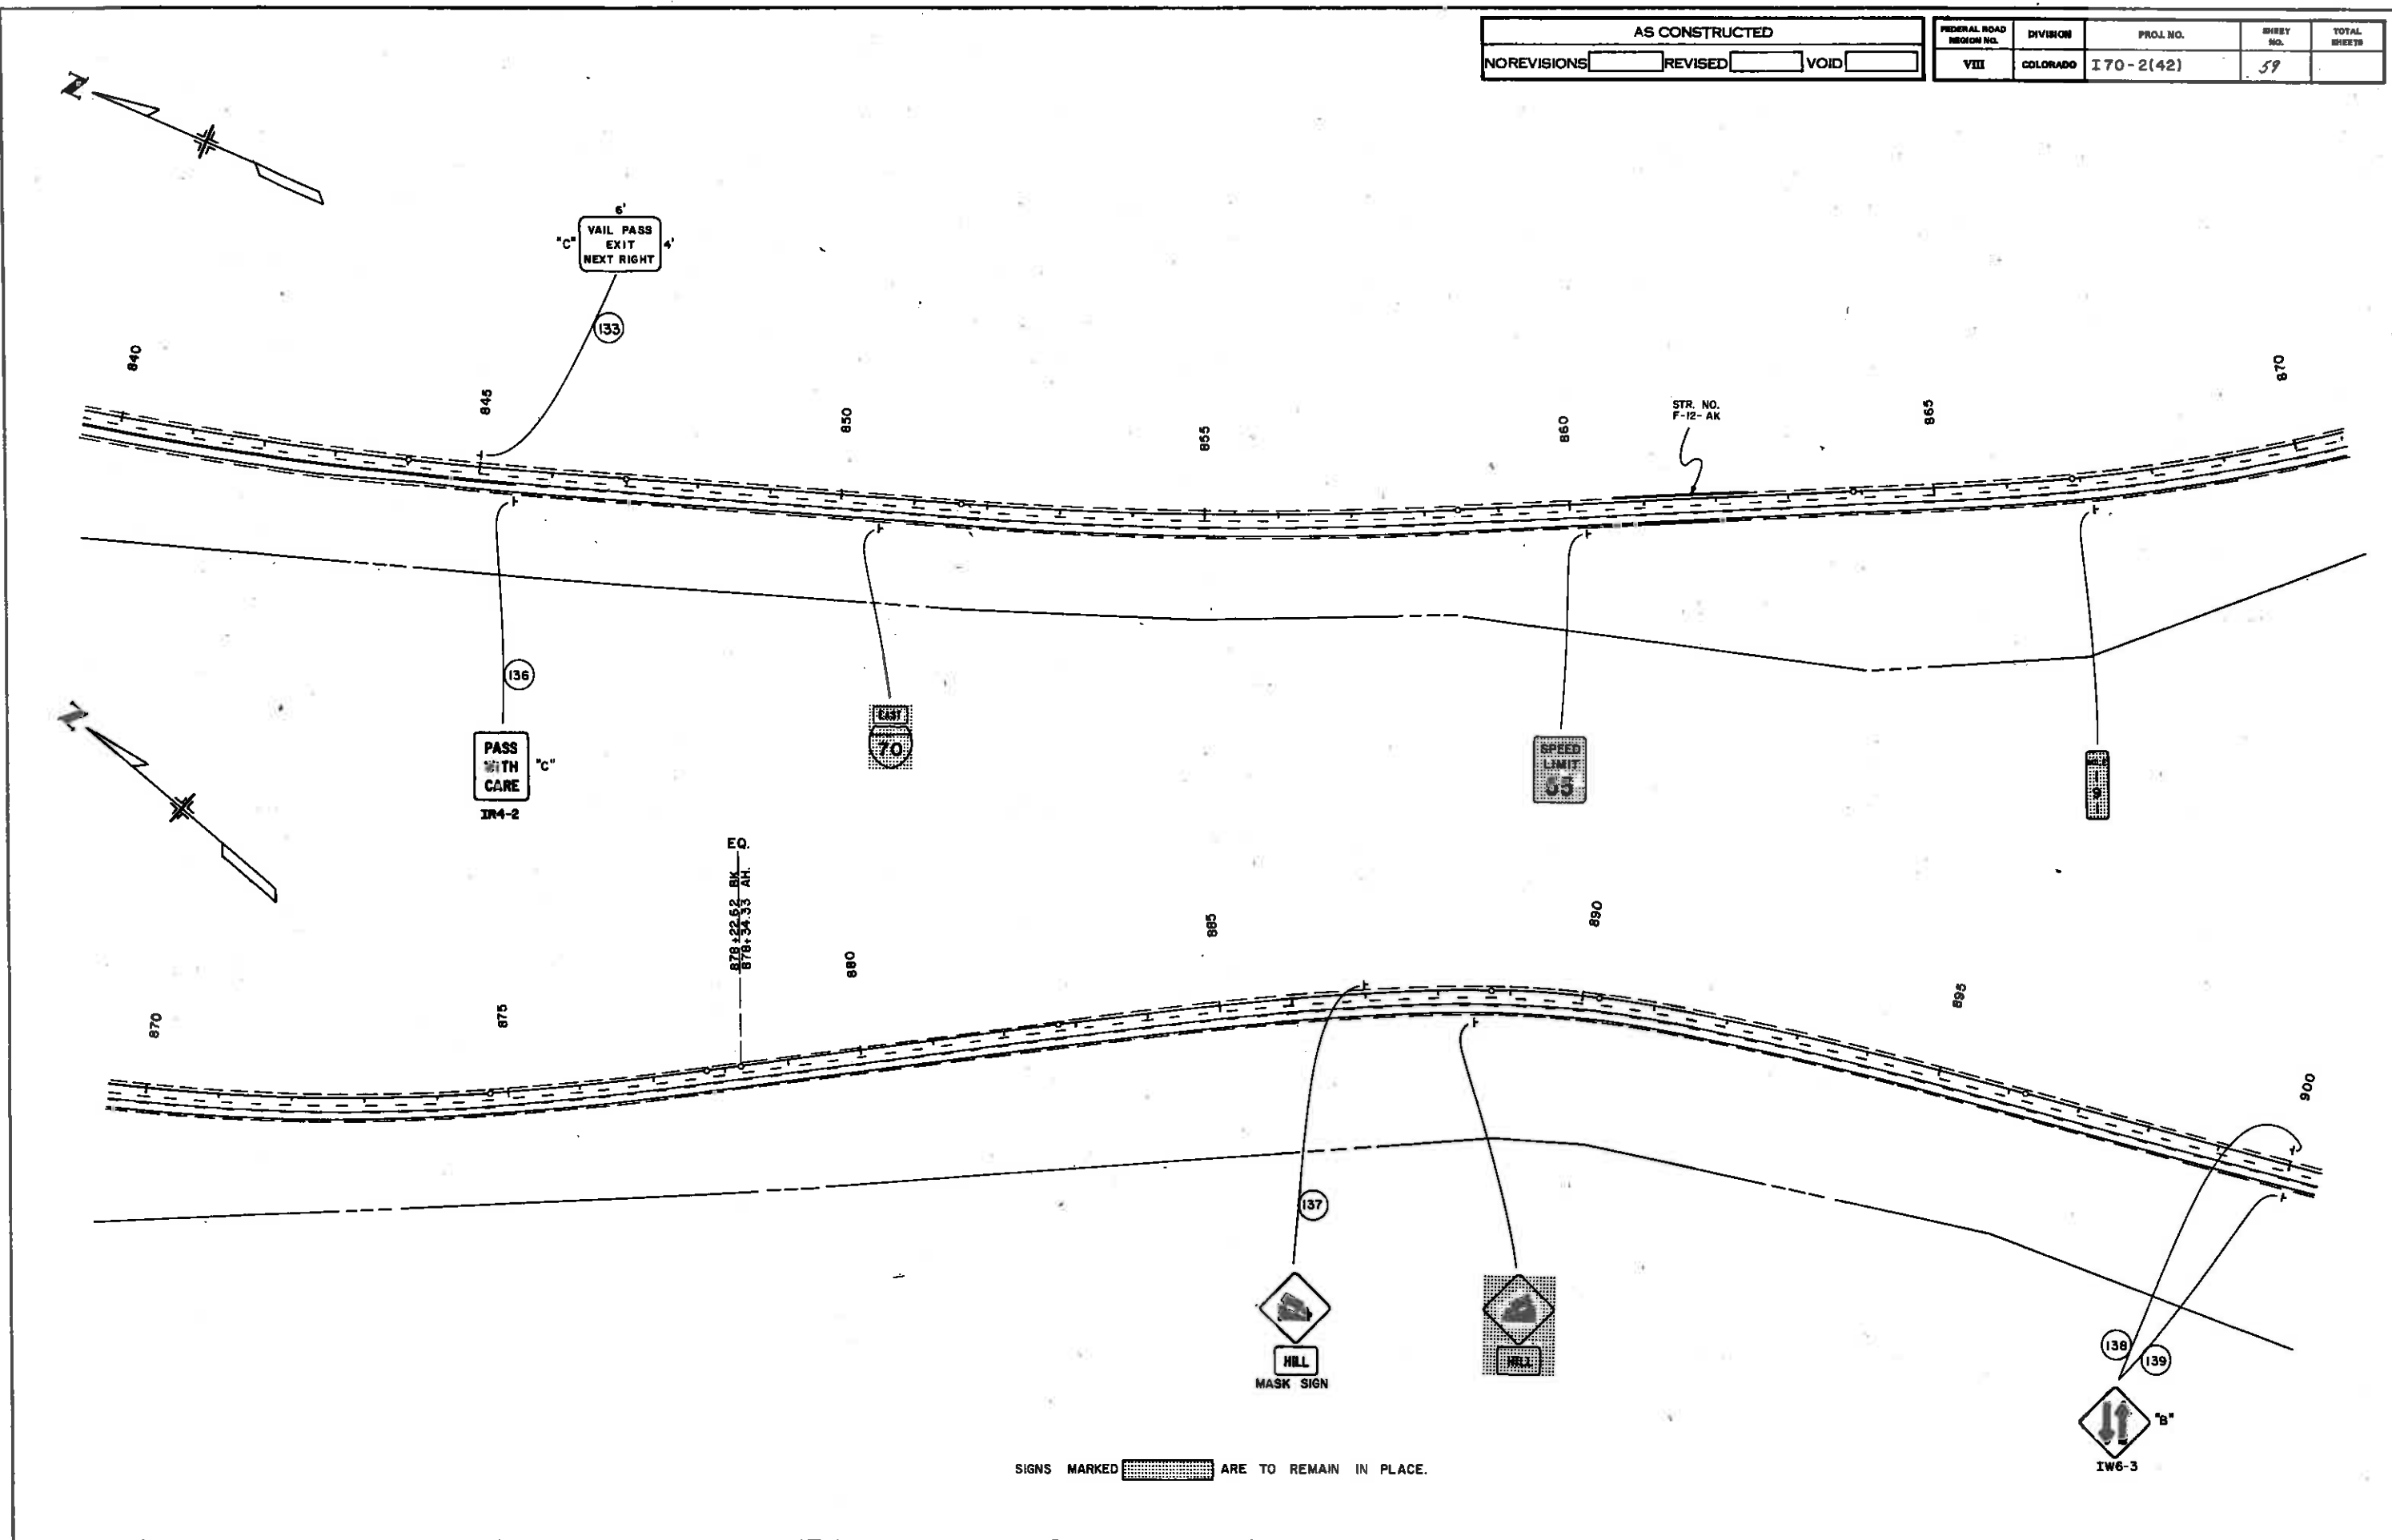


AS CONSTRUCTED  
 NO REVISIONS  REVISED  VOID

FEDERAL ROAD DISTRICT NO.	DIVISION	PROJ. NO.	SHEET NO.	TOTAL SHEETS
VIII	COLORADO	I 70-2(42)	60	

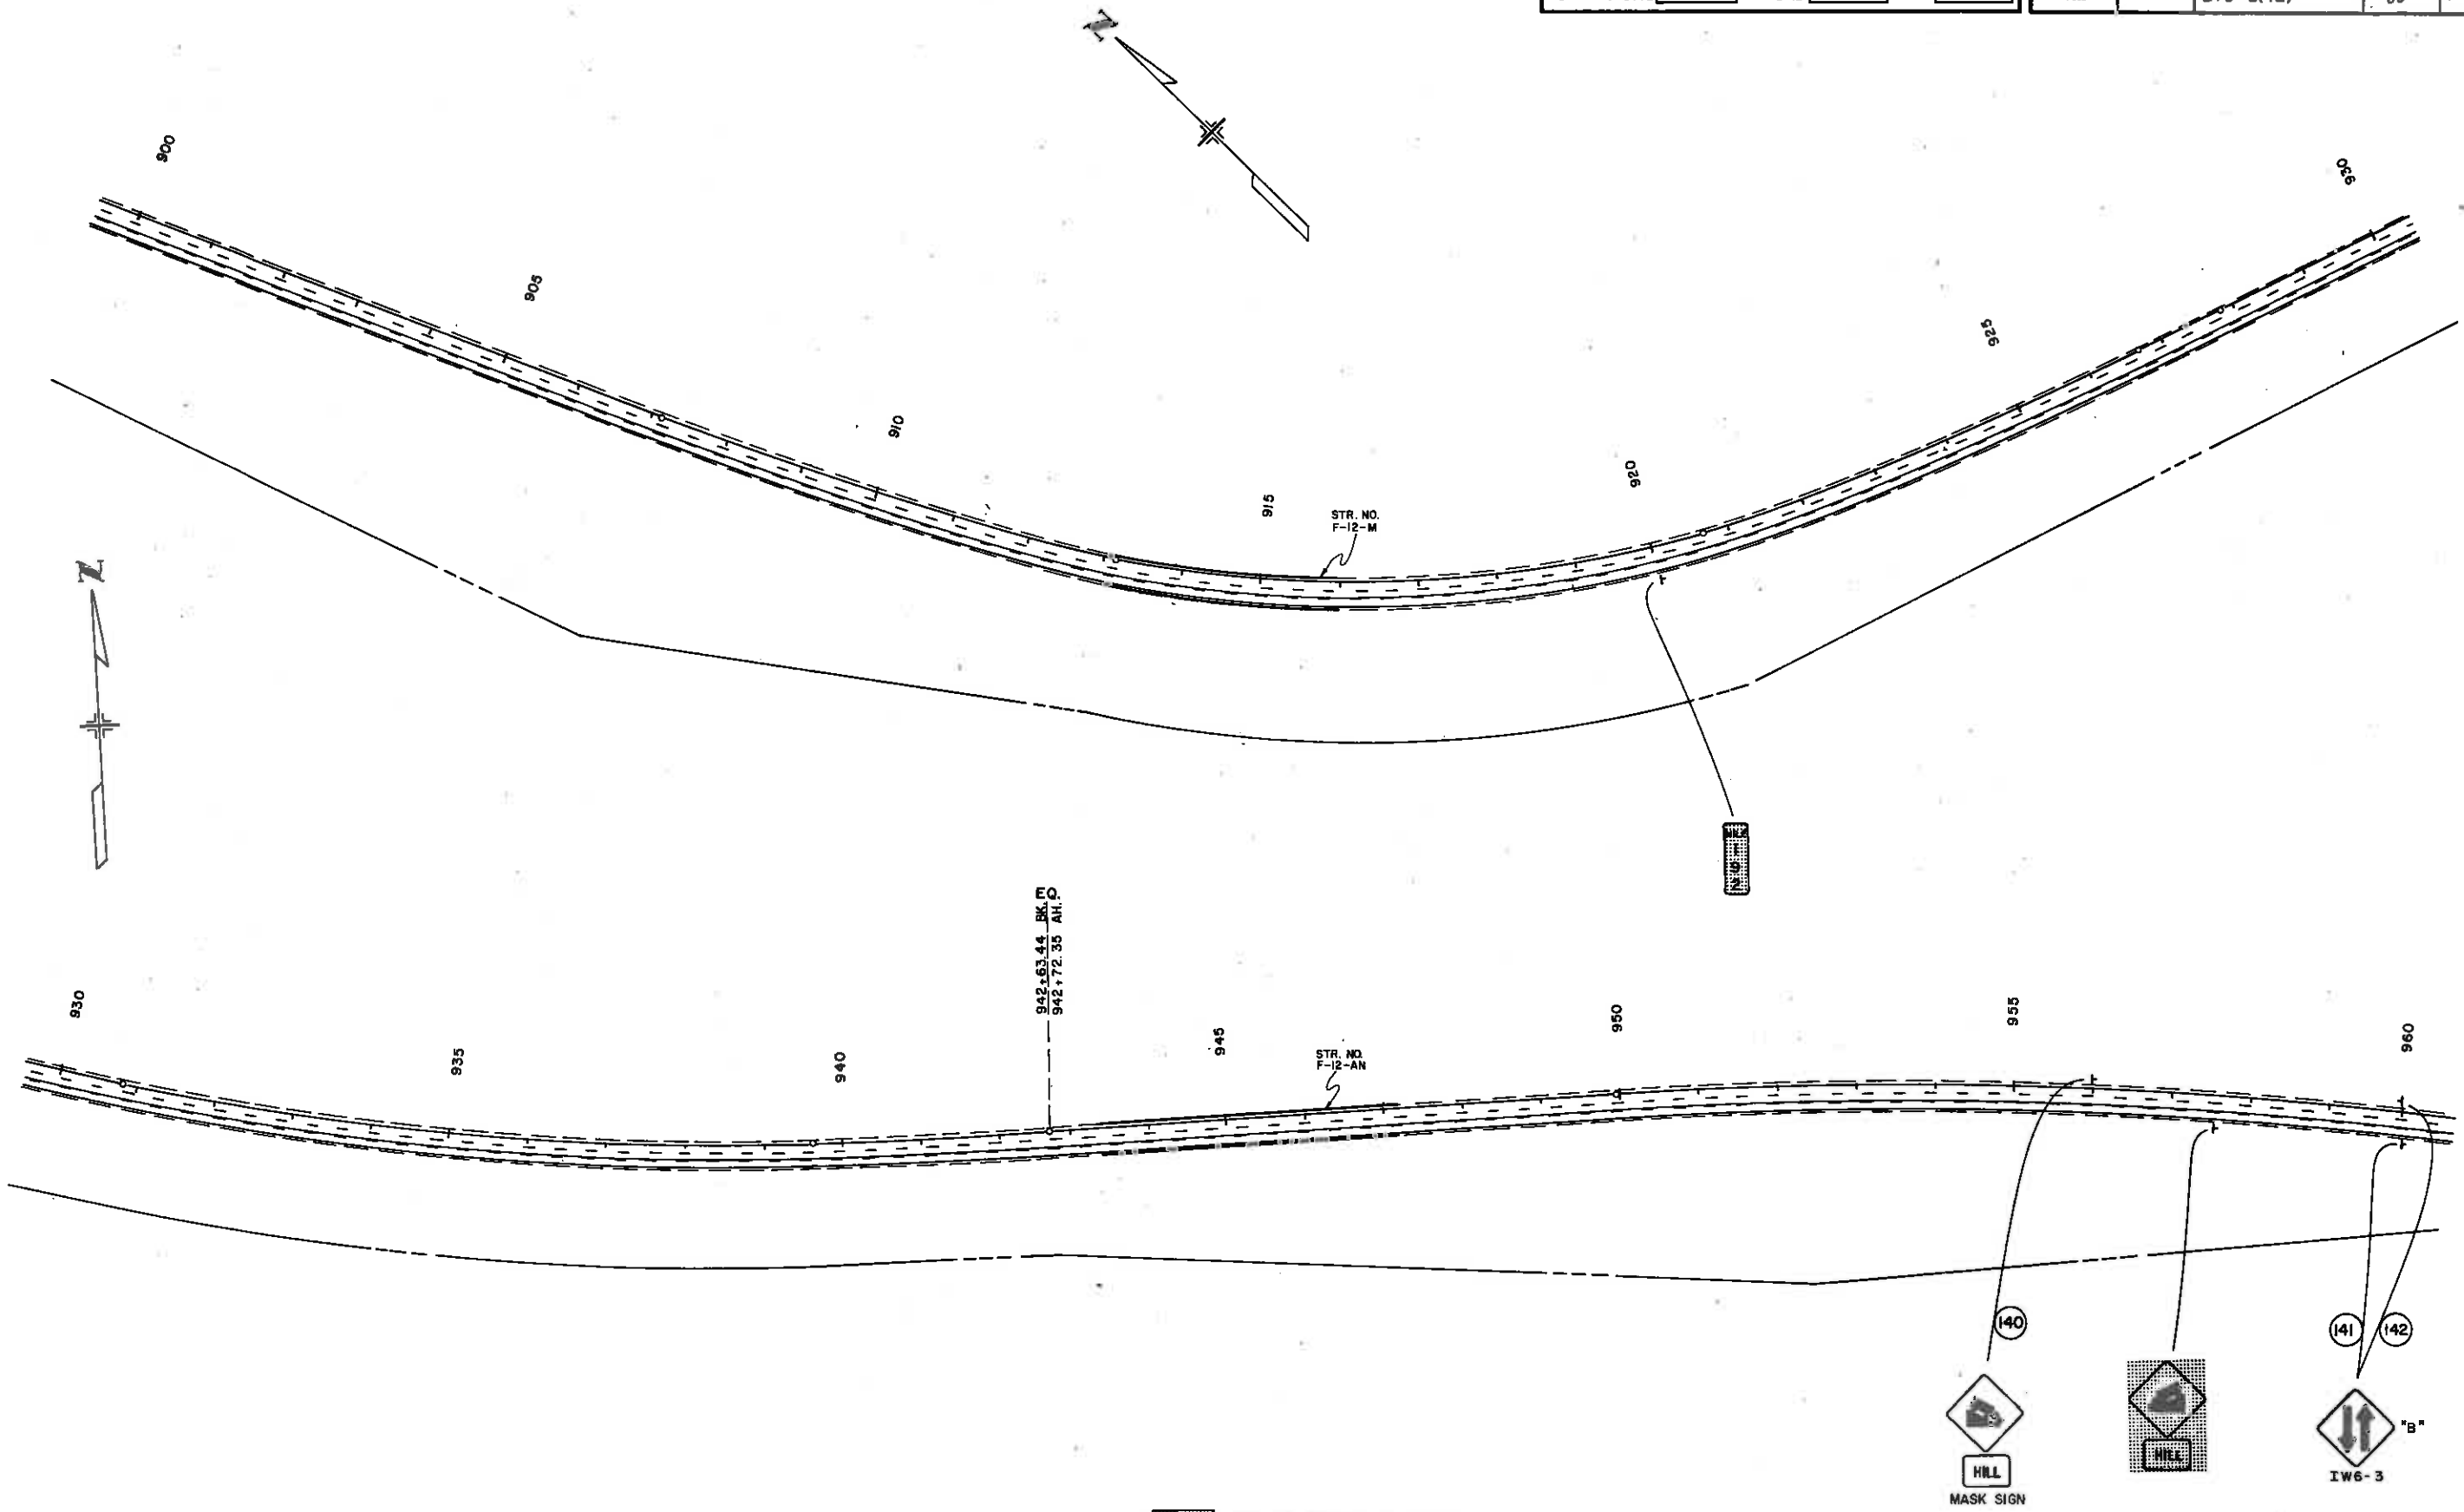

AS CONSTRUCTED  
 NO REVISIONS  REVISED  VOID

FEDERAL ROAD DISTRICT NO.	DIVISION	PROJ. NO.	SHEET NO.	TOTAL SHEETS
VIII	COLORADO	I70-2(42)	61	

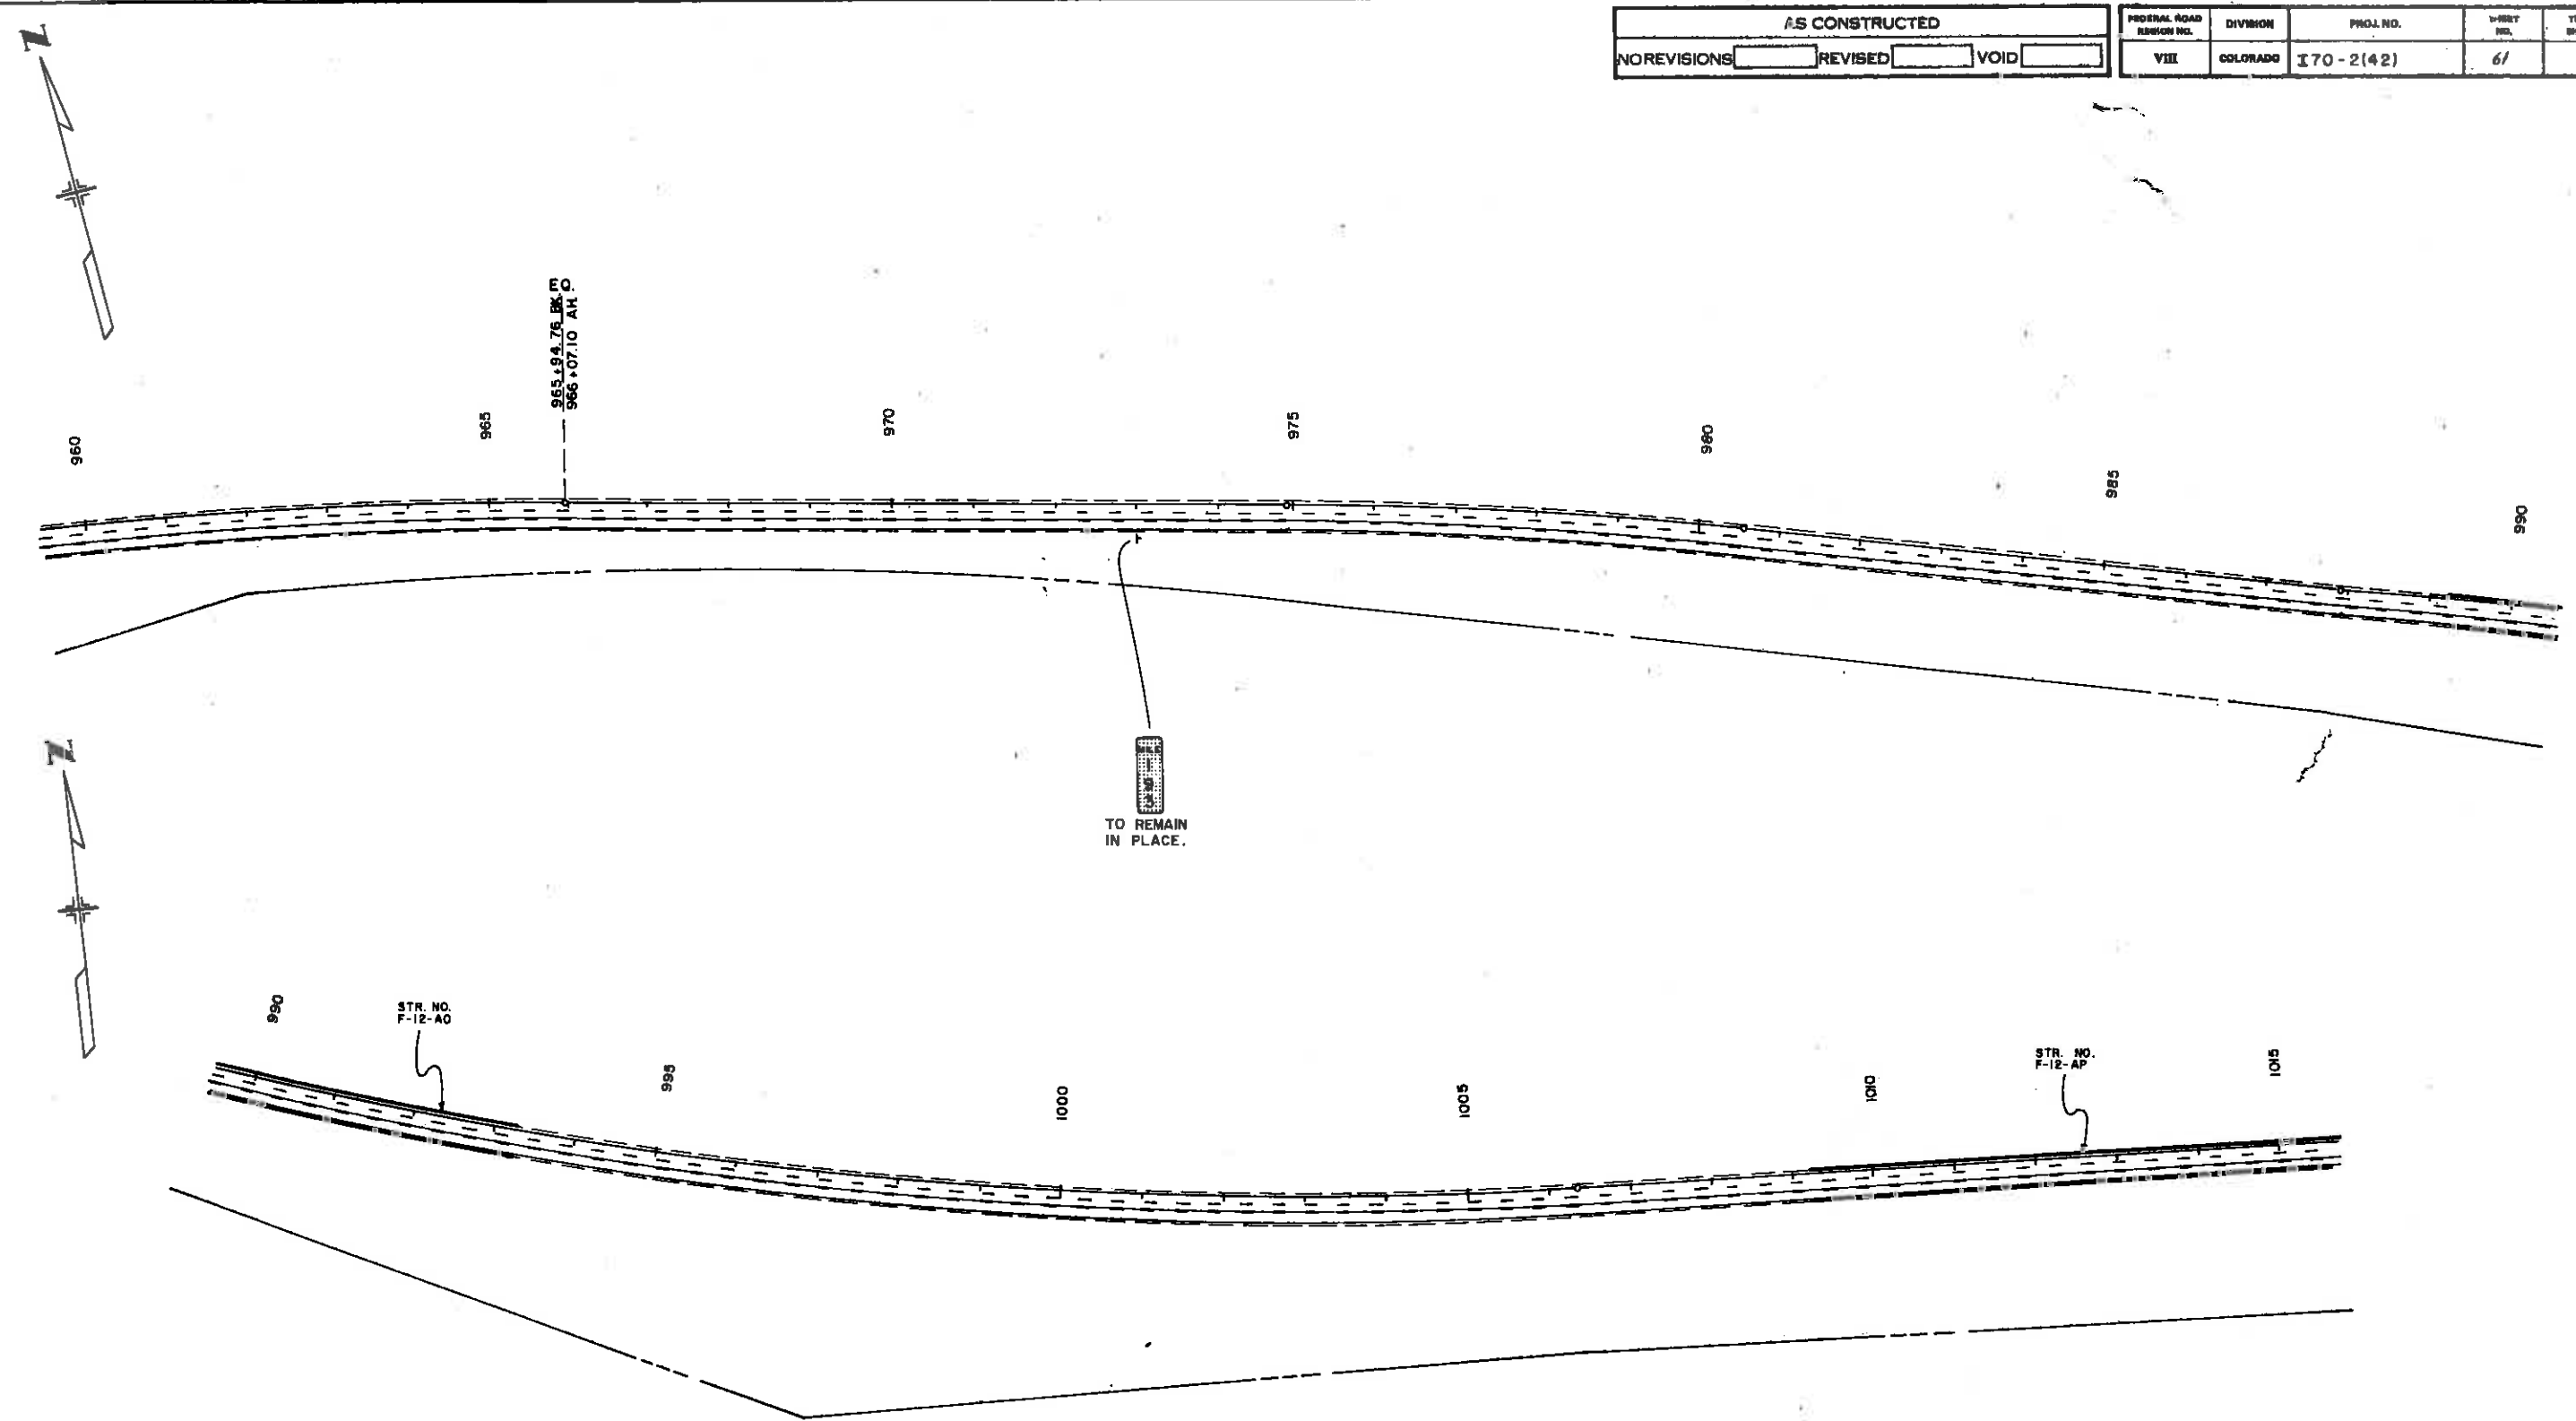

965+94.76 BK. P  
 966+07.10 AH. P

TO REMAIN  
 IN PLACE.

STR. NO.  
 F-12-A0

STR. NO.  
 F-12-AP

960

965

970

975

980

985

990

990

995

1000


1005

1010

1015

AS CONSTRUCTED  
 NO REVISIONS  REVISED  VOID

FEDERAL ROAD DISTRICT NO.	DIVISION	PROJ. NO.	SHEET NO.	TOTAL SHEETS
VII	COLORADO	I 70-2(42)	62	

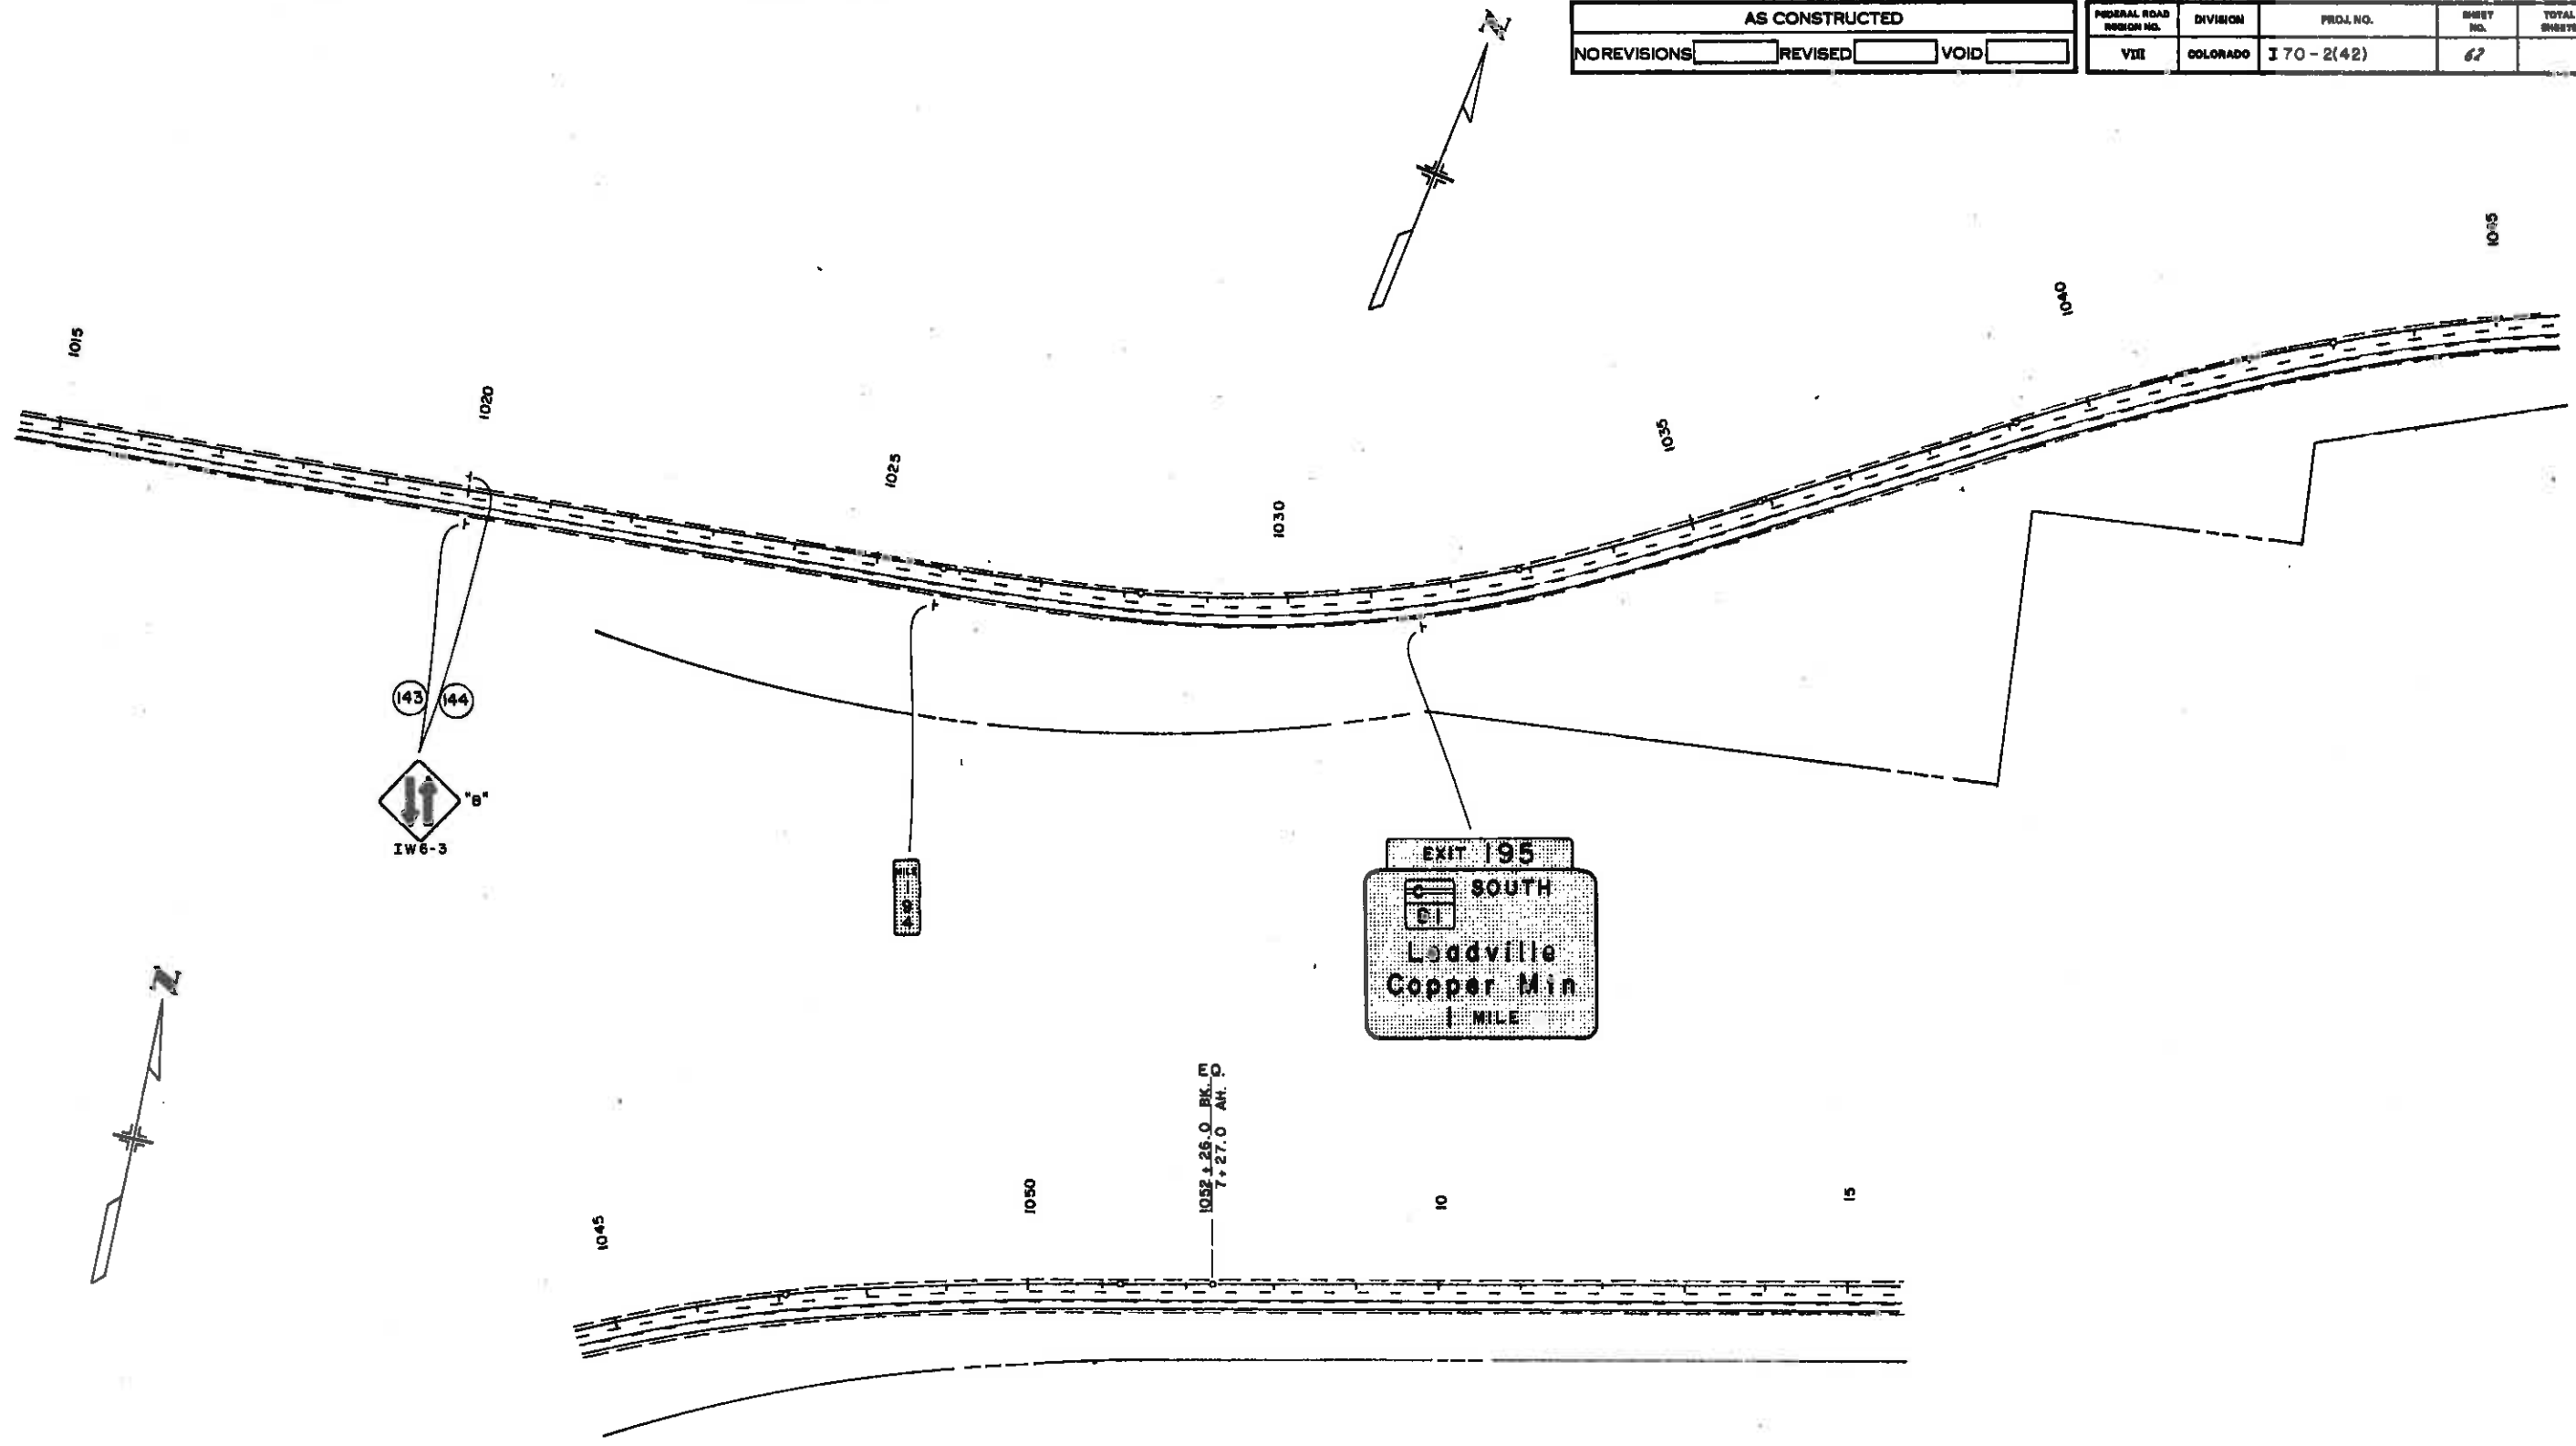



SIGNS MARKED  ARE TO REMAIN IN PLACE.



AS CONSTRUCTED  
 NO REVISIONS  REVISED  VOID

FEDERAL ROAD REGION NO.	DIVISION	PROJ. NO.	SHEET NO.	TOTAL SHEETS
VIII	COLORADO	I 70-2(42)	63	



(R-1) 8-4-78, SIGN J.D.S.

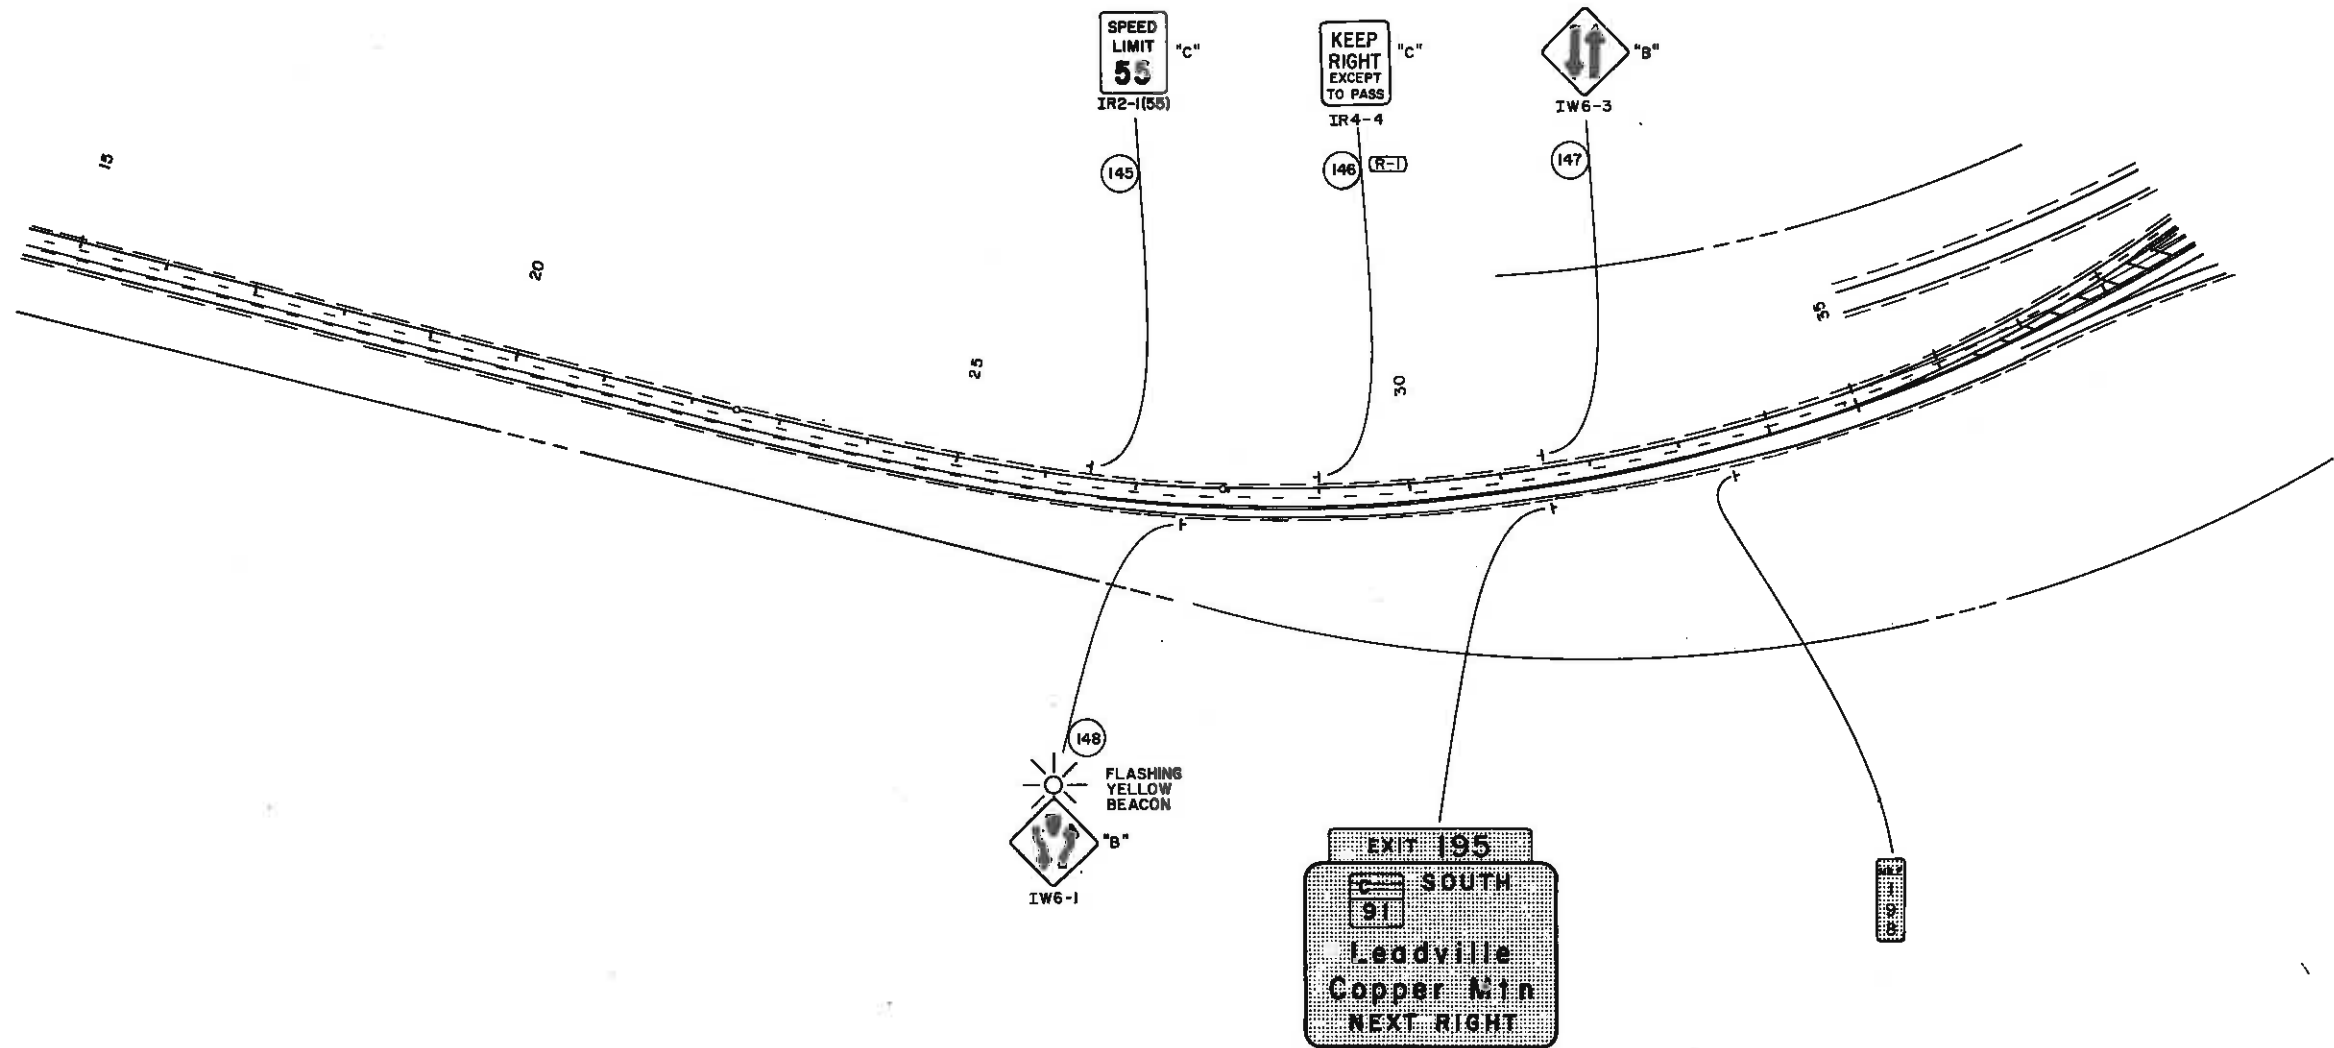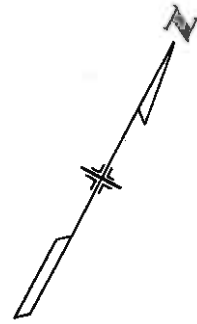

SIGNS MARKED ARE TO REMAIN IN PLACE.

AS CONSTRUCTED		
NO REVISIONS	REVISED	VOID

FEDERAL ROAD DISTRICT NO.	DIVISION	PROJ. NO.	SHEET NO.	TOTAL SHEETS
VIII	COLORADO	I 70-2(42)	64	

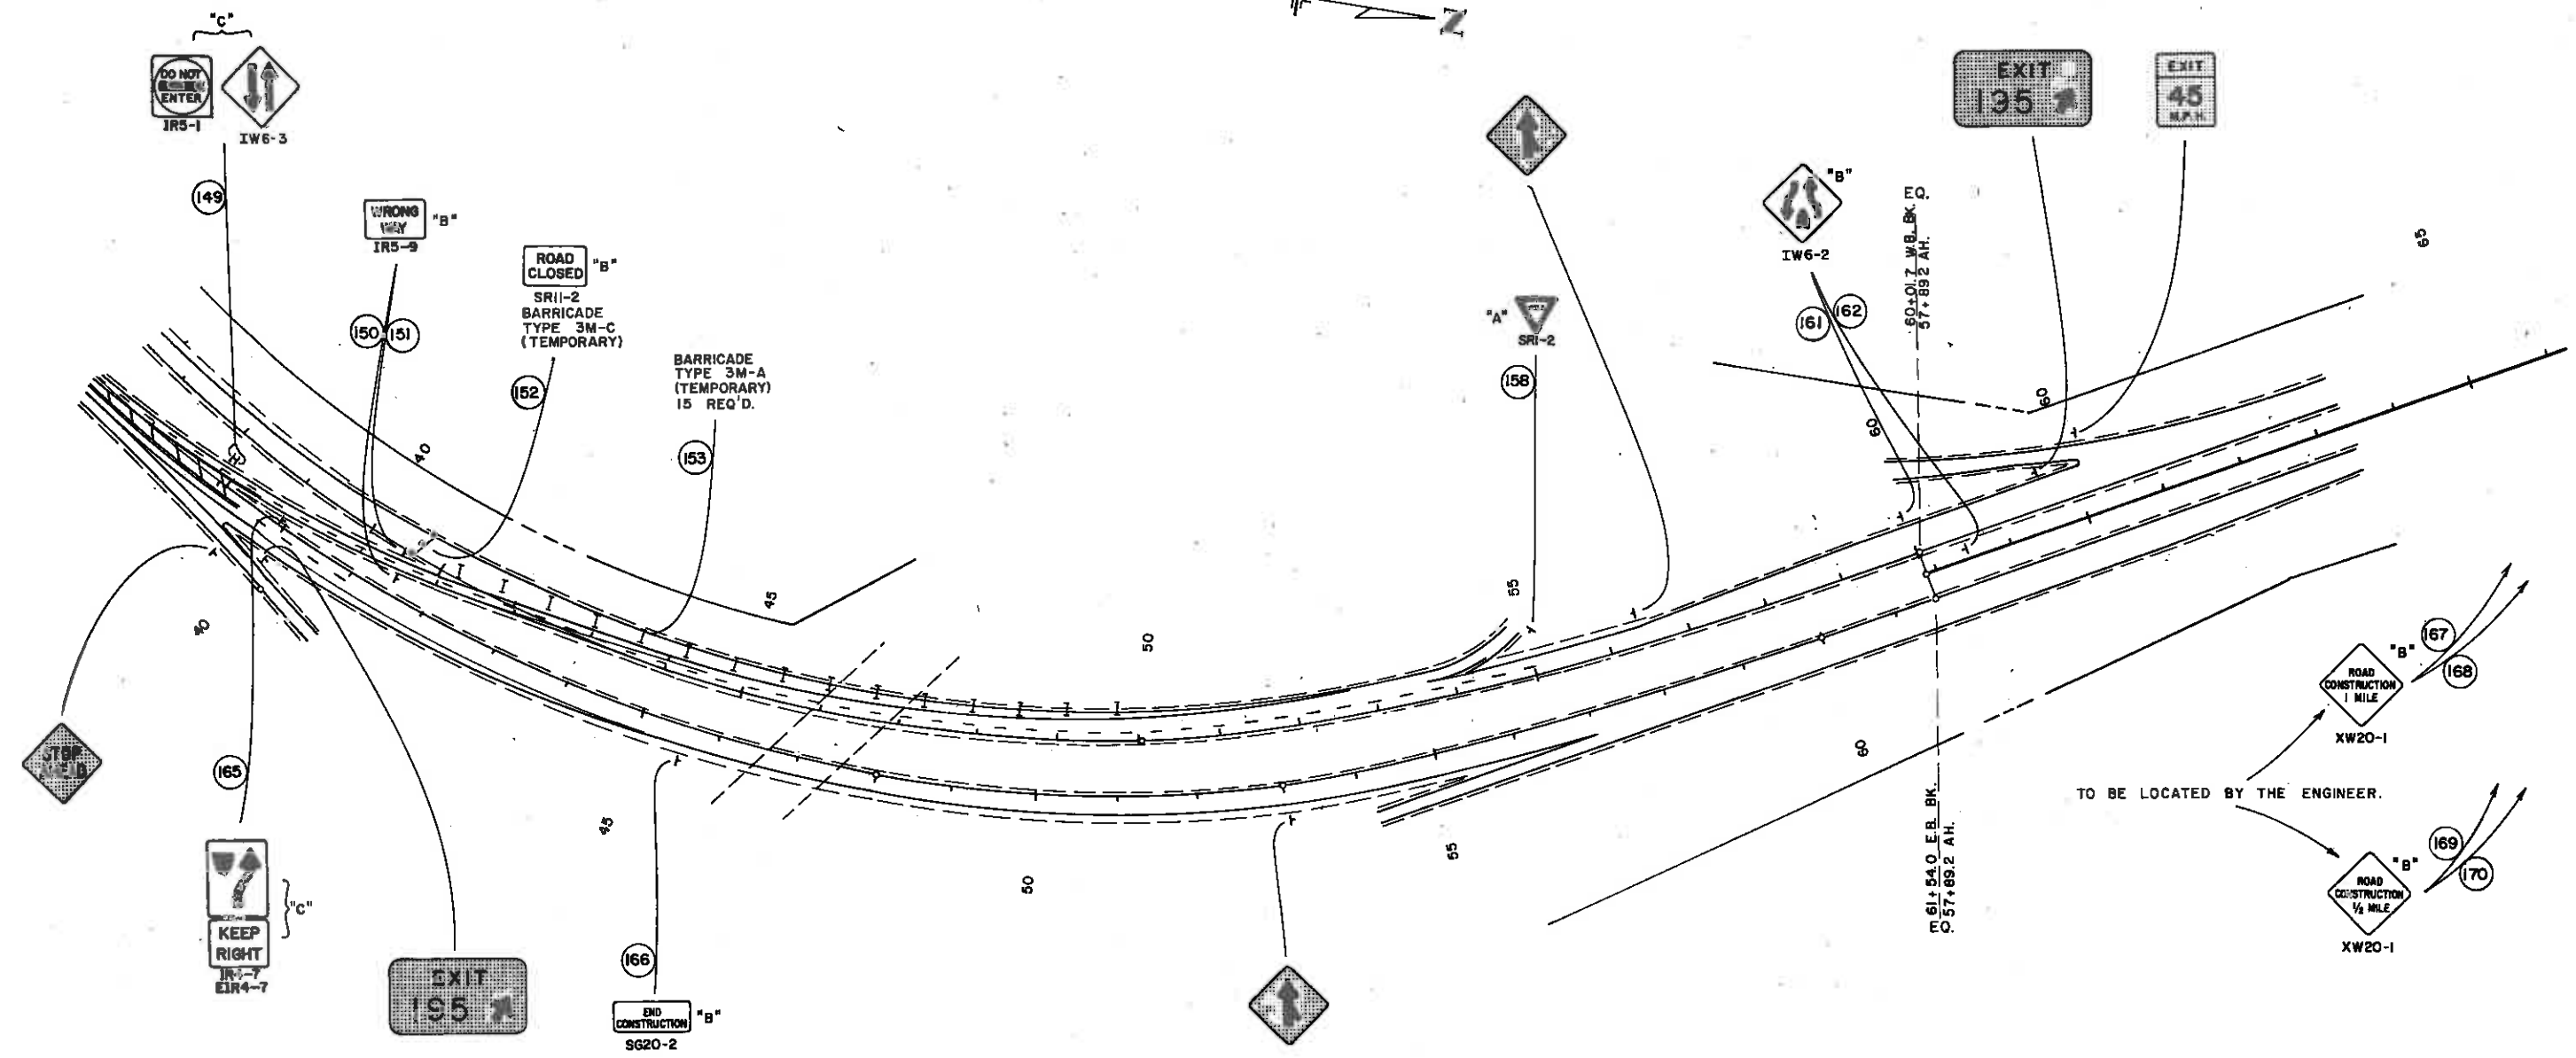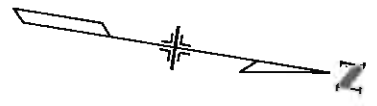

SIGNS MARKED  ARE TO REMAIN IN PLACE.

# STANDARD M-100-A

(MAY 11, 1973)

FEDERAL ROAD REGION NO.	DIVISION	PROJ. NO.	SHEET NO.	TOTAL SHEETS
VIII	COLORADO			

REVISIONS	

GENERAL NOTES

THESE SYMBOLS ARE INTENDED TO EXPLAIN THE VARIOUS TOPOGRAPHIC FEATURES INVOLVED ON THE ROADWAY PLAN SHEETS WHICH ARE PREPARED AT SCALES OF 1 INCH = 50 FEET OR 1 INCH = 100 FEET. NOTES ARE ADDED WHERE NECESSARY TO CLARIFY THE SYMBOL. IF THESE SYMBOLS ARE NOT APPROPRIATE FOR USE WITH OTHER SCALES, A LEGEND IS PROVIDED IN THE PLANS TO EXPLAIN THE SYMBOLS THAT ARE USED.







GUARD RAIL, CURB & GUTTER, ETC. ARE REPRESENTED BY A SYMBOL WITH TYPE GIVEN BY NOTE. SEE THE APPROPRIATE DIVISION M-STANDARD FOR EXPLANATION OF THE VARIOUS TYPES.

EXISTING BUILDINGS AND OTHER MAN MADE TOPOGRAPHICAL FEATURES NOT SYMBOLED HERE ARE SHOWN BY DASHED LINES WITH EXPLANATORY NOTES AS NECESSARY. NEW FEATURES TO BE CONSTRUCTED ARE SHOWN BY SOLID LINES.


LEGEND

- ++++ Topsoil
  - ||||| Overburden
  - ||||| Clay
  - ||||| Silt
  - ..... Sand
  - ..... Gravel
  - ||||| Shale
  - ||||| Limestone
  - ..... Sandstone
  - ..... Solid Rock (Igneous)
  - ..... Solid Rock (Metamorphic)
  - ..... Coal
- Composite materials are represented by combinations of the above symbols such as:
- ||||| Sandy Clay


TYPICAL LOG OF PIT

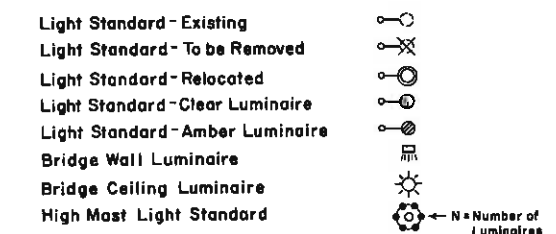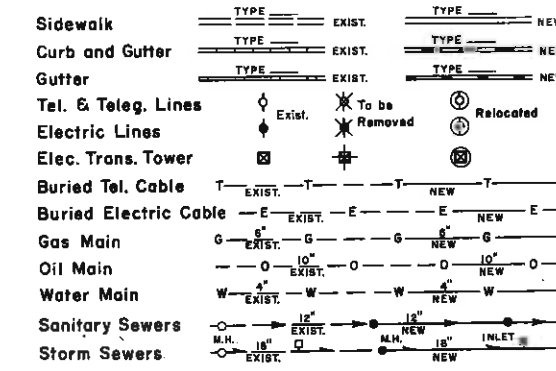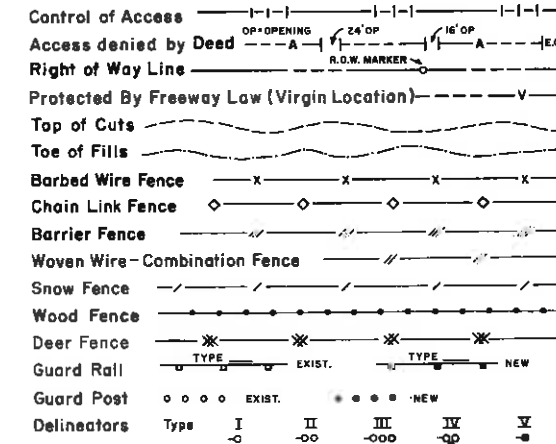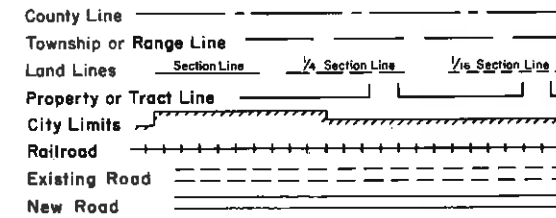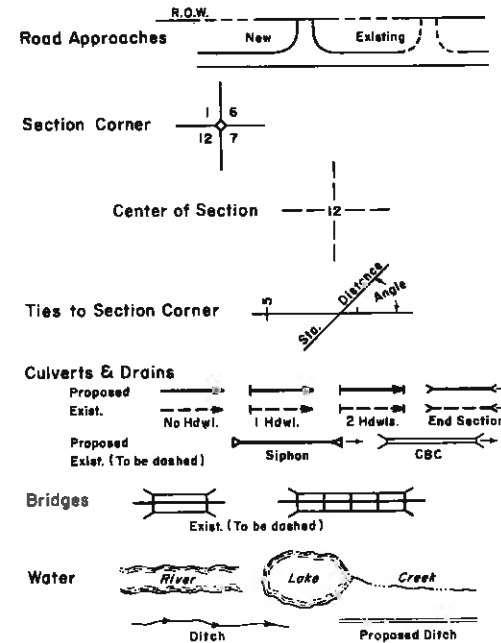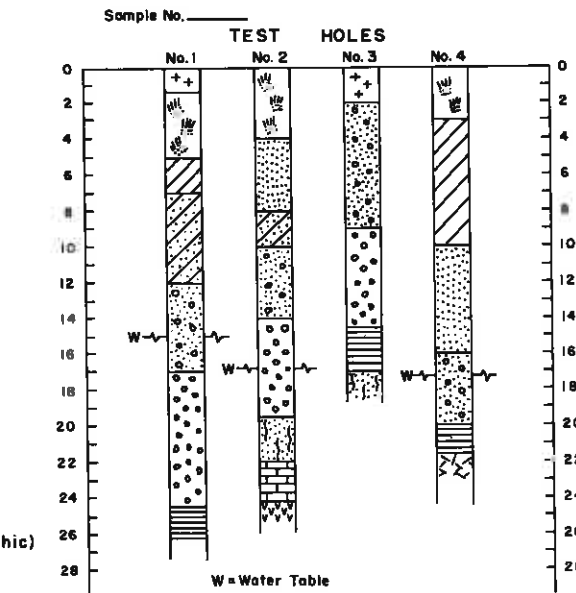


TYPICAL HORIZONTAL CURVE

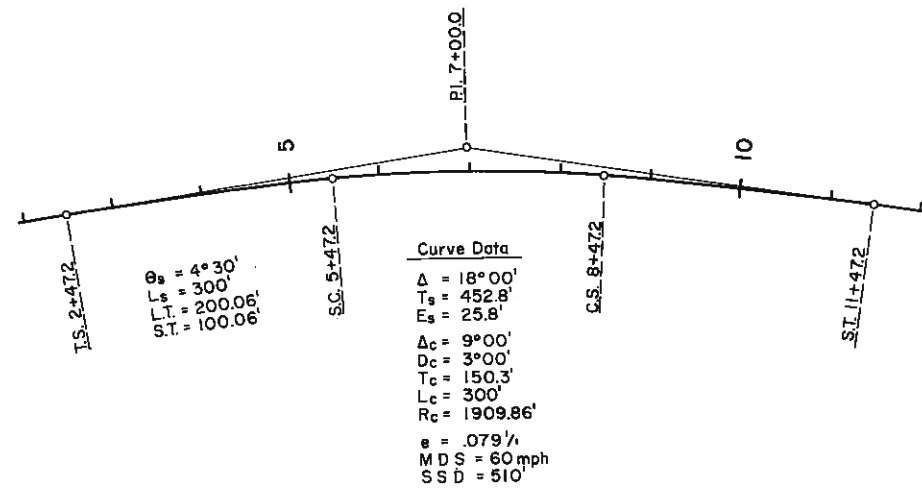

TYPICAL VERTICAL CURVE

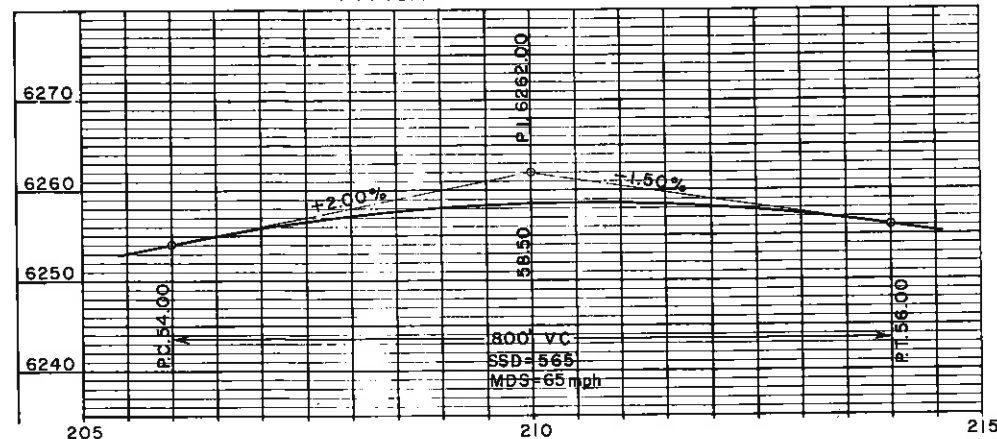

NORTH ARROWS

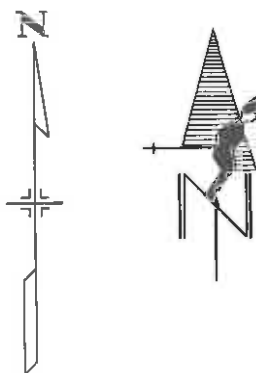

DEPARTMENT OF HIGHWAYS  
 STATE OF COLORADO  
 DIVISION OF HIGHWAYS

## STANDARD SYMBOLS

Designed by RLM  
 Made by HPS  
 Checked by DWD


Approved by *John M. Case*  
 Staff Design Eng.  
 Date: May 11, 1973

# STANDARD M-107-A


(APRIL 21, 1975)

FEDERAL ROAD REGION NO.	DIVISION	PROJ. NO.	SHEET NO.	TOTAL SHEETS
VIII	COLORADO			
REVISIONS				


## SLOPES

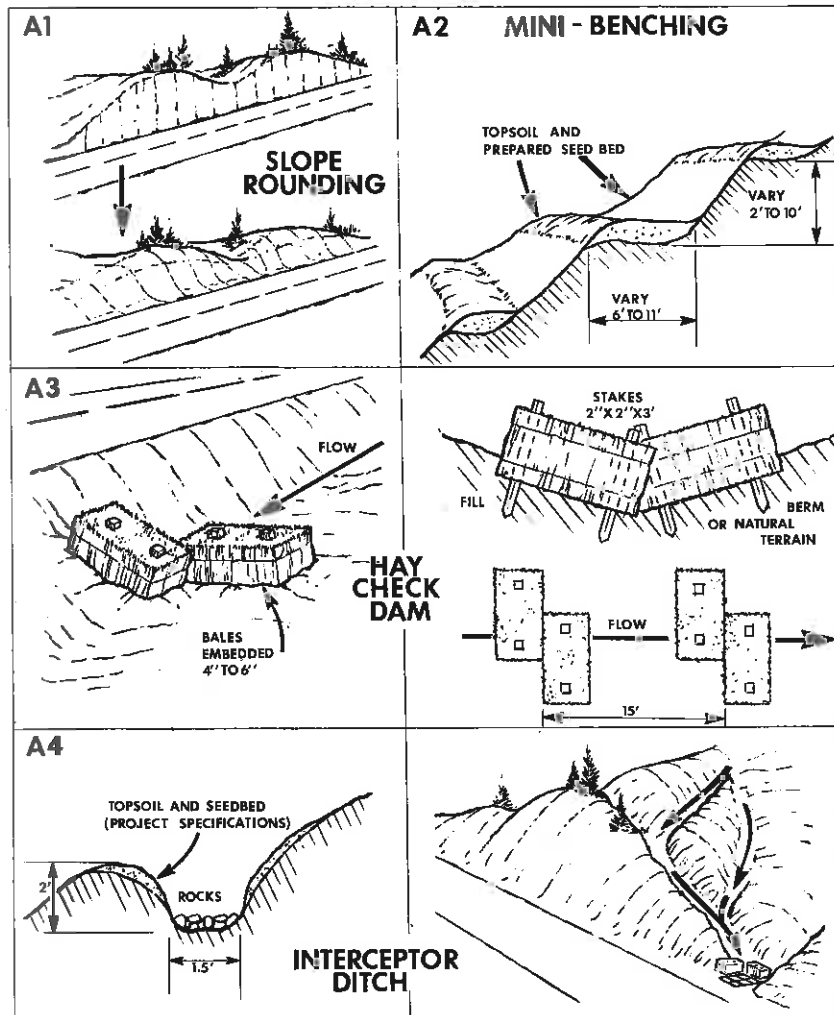


## TYPICAL PLAN CONCEPT

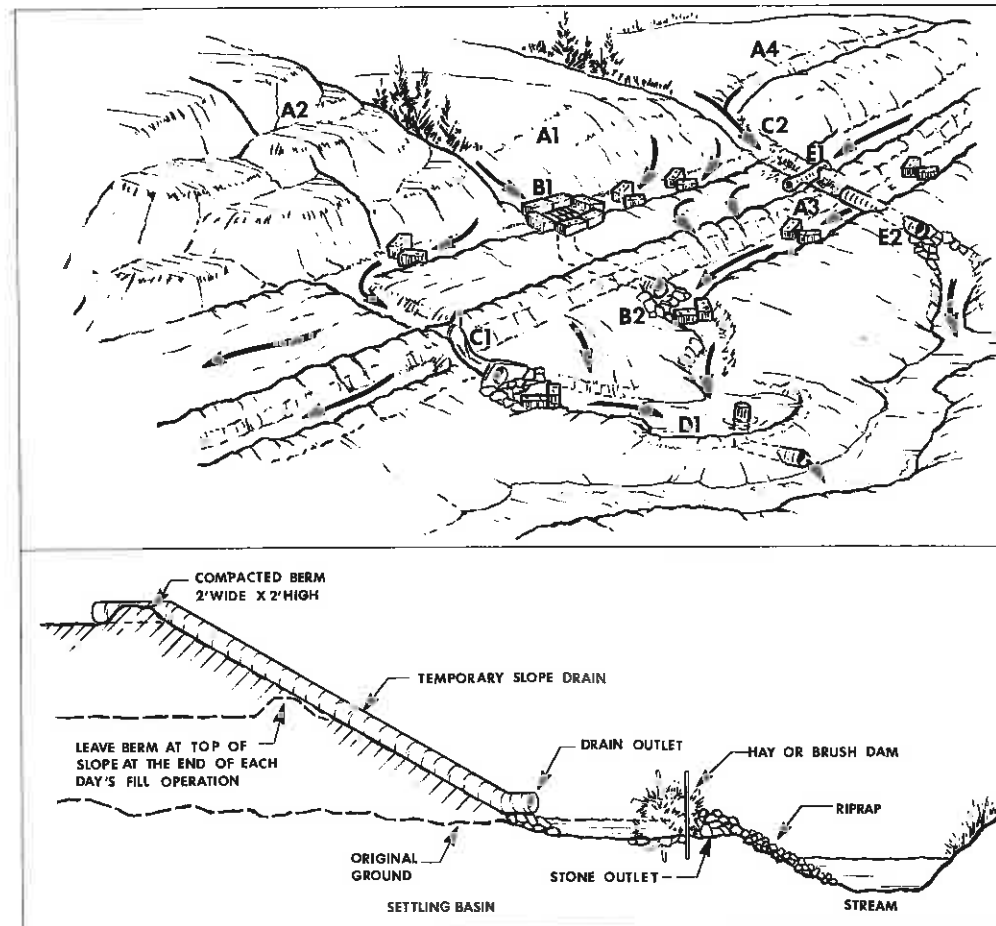


## SEDIMENTATION POND

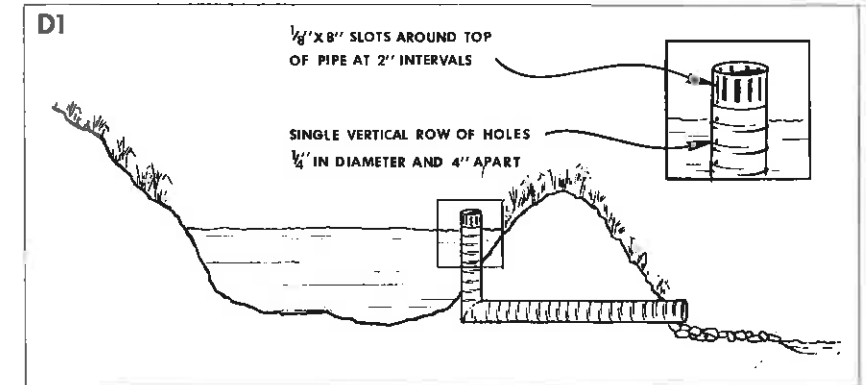


## CLEAR WATER DIVERSION

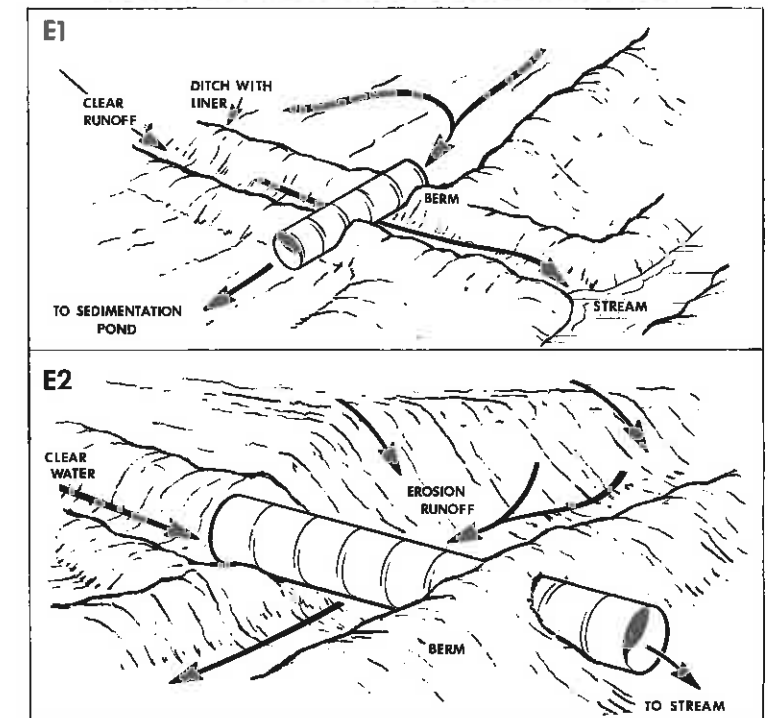

## RUNOFF CONTROL STRUCTURES

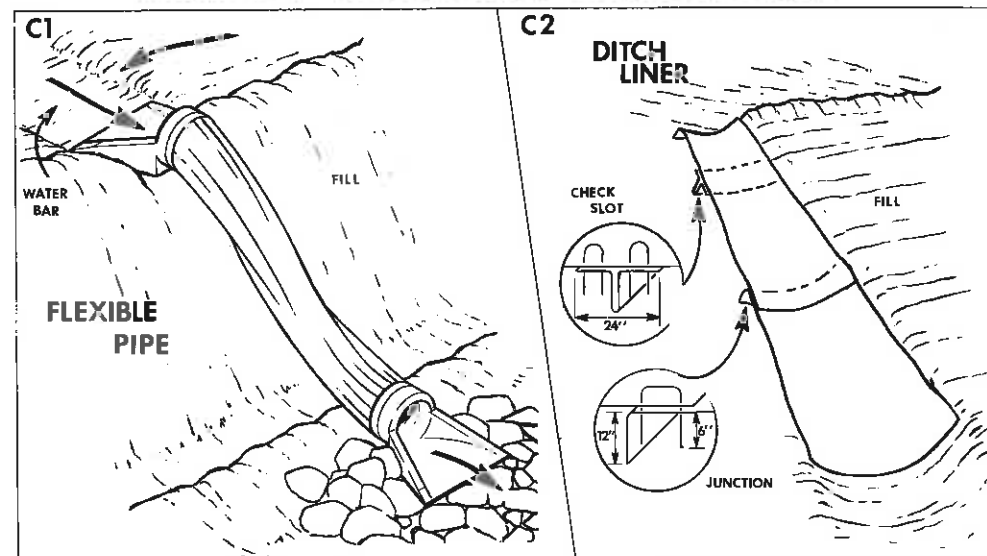

## DRAINAGE STRUCTURES

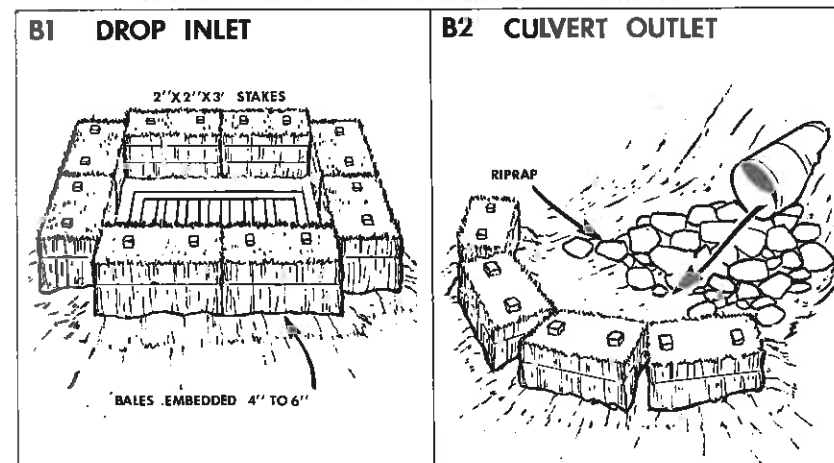

## GENERAL NOTES

ALL WORK SHALL BE DONE IN ACCORDANCE WITH THE SPECIFICATIONS APPLICABLE TO THE PROJECT.

EROSION CONTROL DETAILS ARE CONSIDERED TO BE TEMPORARY AND ARE TO SERVE ONLY DURING CONSTRUCTION, OR UNTIL THEY ARE INTEGRATED INTO A FINAL EROSION CONTROL SYSTEM.

AT THE END OF EACH DAY'S WORK THE APPROPRIATE COMBINATION OF TEMPORARY EROSION CONTROL MEASURES WILL BE PLACED FOR EACH DRAINAGE SECTION UNDER CONSTRUCTION, AS PER TYPICAL PLAN CONCEPT.

DEPARTMENT OF HIGHWAYS  
 STATE OF COLORADO  
 DIVISION OF HIGHWAYS

TEMPORARY  
 EROSION CONTROL

DESIGNED BY: RGM  
 MADE BY: RDL  
 CHECKED BY: MJT

APPROVED BY:  
*B. L. Johnson*  
 STAFF DESIGN ENGINEER  
 DATE: 4/21/75


# STANDARD SIDE APPROACH ROADS, FLARING, CUT SLOPE TREATMENT & WIDENING AT BRIDGES AND AT CREST OF GRADES

## STANDARD M-203-B (JULY 1, 1965)

FED. ROAD REG. NO.	DIVISION	PROJECT NO.	SHEET NO.
9	COLO.		




REVISIONS			
(R-1)	2-6-68	Median, Cross Over	MRH
(R-2)	7-30-68	Dept. Name	MRH
(R-3)	4-1-69	Widening for Guard Rail	MRH
(R-4)	4-27-70	Cut Slope and Note	MRH
(R-5)	12-11-72	Cut Slope Tr. Dimension	MRH

### GENERAL DETAILS FOR FLARING OF EARTH CUTS, CUT SLOPE TREATMENT & WIDENING AT BRIDGES

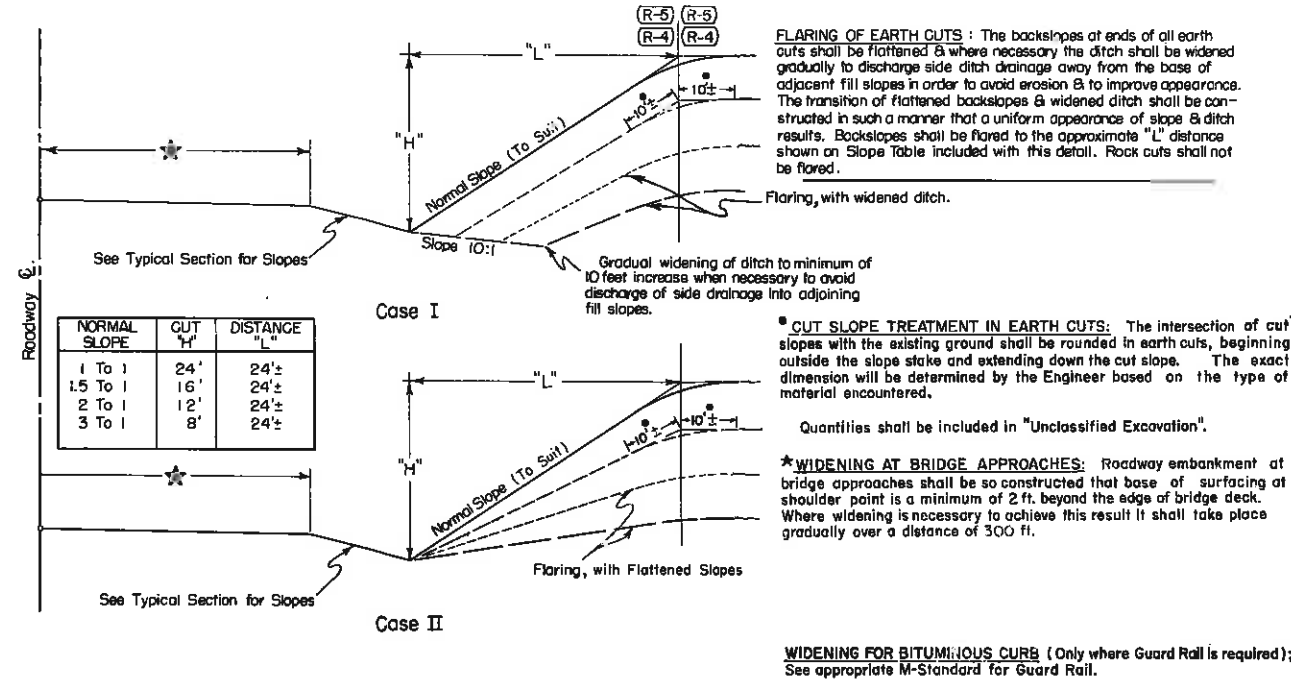



(R-4) **PLAN OF FLARING IN EARTH CUTS**

### TYPICAL PLANS FOR SIDE APPROACH ROADS AND EMERGENCY MEDIAN CROSS OVERS

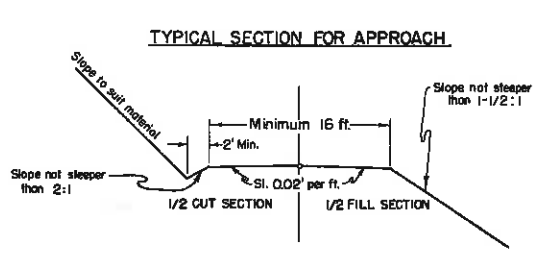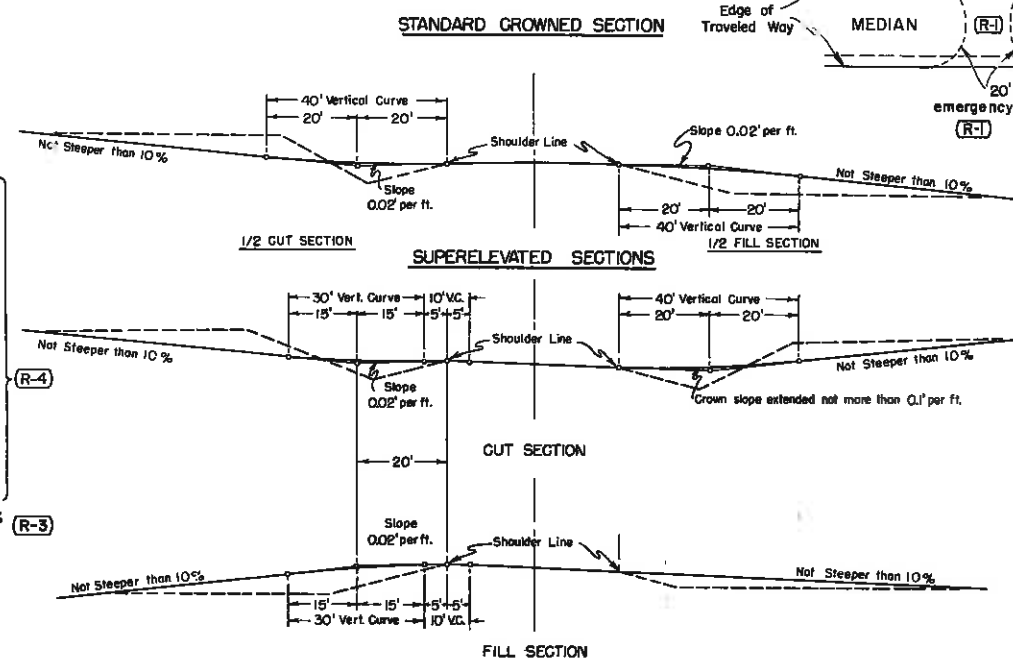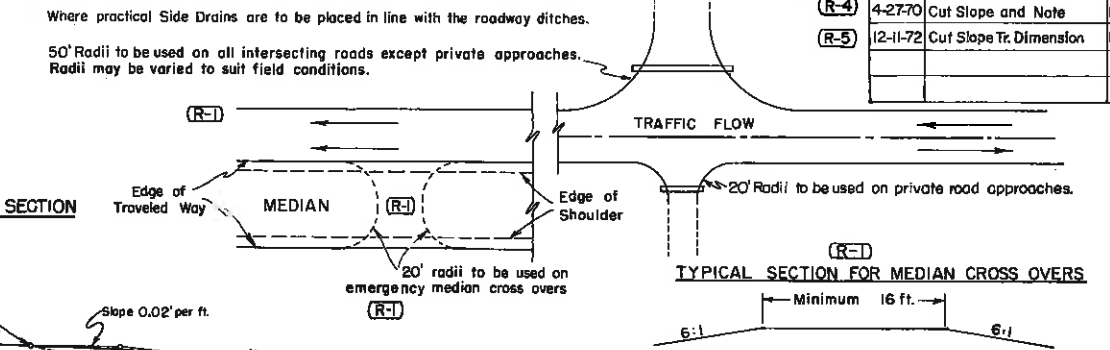

**NOTE:** Road Approaches shall conform to the above details unless otherwise indicated on plans. The width of the crowned section shall not be less than the width of the crowned section of the existing approach road and the new construction shall not be less than 16 feet in width.

### DETAILS FOR DITCH & WIDENED SHOULDERS AT CREST OF GRADES ( TO BE USED ONLY WHERE SIGHT DISTANCE AT CREST OF GRADE IS 600 FT. OR LESS )

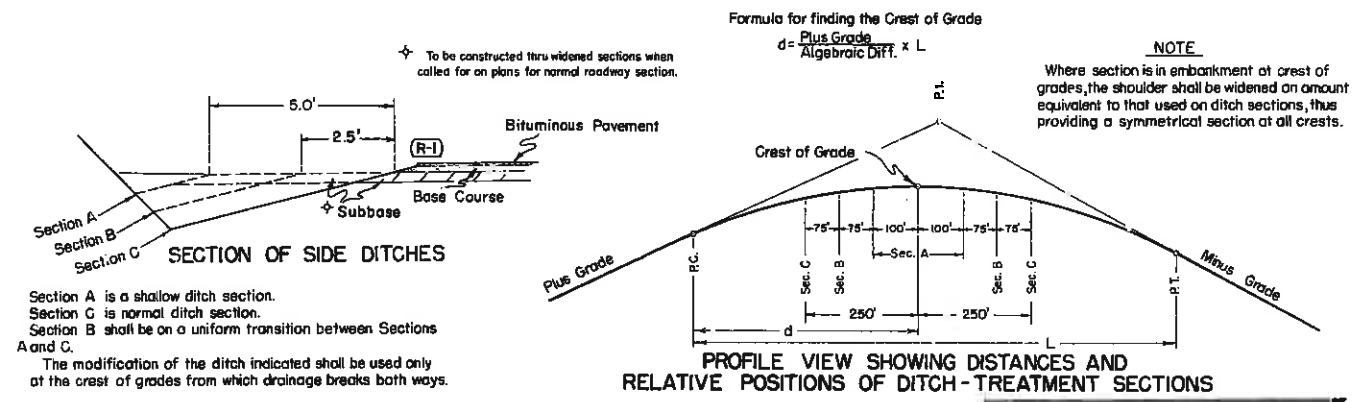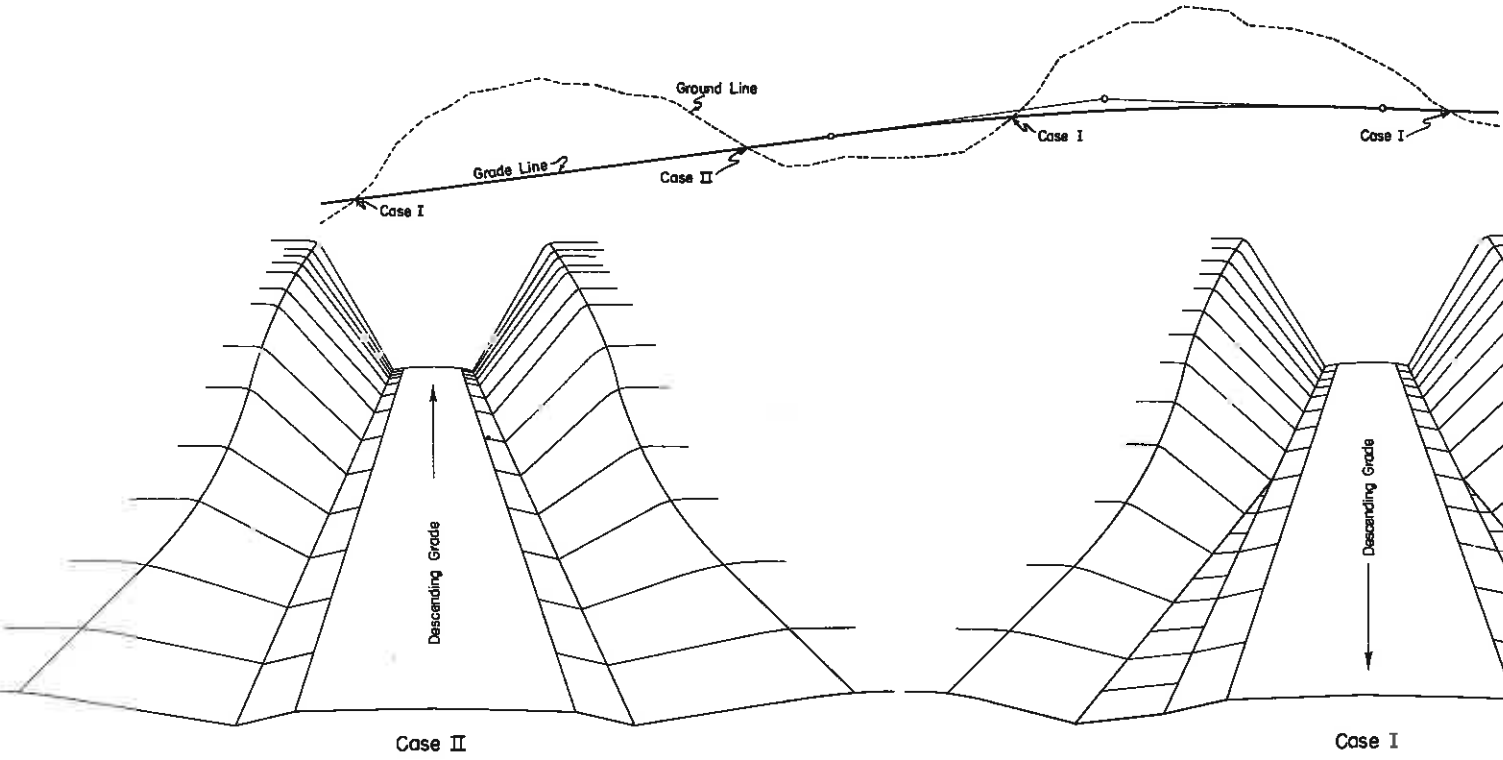

### GENERAL NOTES

All work shall be done in accordance with the Standard Specifications applicable to the Project.

All side approach roads to the Project shall be Gravel Surfaced with a 4 inch thickness of Aggregate Base Course extending approximately to the Right of Way Line. Estimated tonnage and class of material required for this operation are shown in the Aggregate Base Course Plan.

The maximum grades shown are to be the limiting grades for all road approaches. Modifications of grades will be permitted where adherence to the grades as shown would cause damage to property or create other unsatisfactory conditions. Grades flatter than the maximum shown are to be used wherever feasible.

**DEPARTMENT OF HIGHWAYS  
STATE OF COLORADO  
DIVISION OF HIGHWAYS**

**APPROACH ROADS,  
FLARING, CUT SLOPE TREATMENT,  
BRIDGE & CREST WIDENING**

Designed by A. Z. Made by S.J.M. & A.B. Checked by C.R.S. Approved by [Signature] Staff Design Engr. Date: July 1, 1965.


# STANDARD TYPES of DITCHES and CONSTRUCTION METHODS

STANDARD M-203-C  
(JULY 1, 1965)

FED. ROAD DIST. NO.	DIVISION	PROJECT NO.	SHEET NO.
3.	COLO.		

## DETAILS for CONTOUR INTERCEPTING DITCHES

Typical Section for Contour Intercepting Ditches

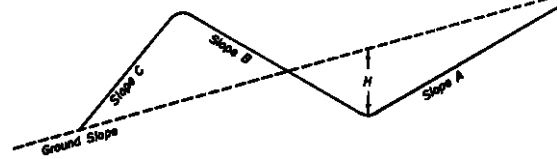


**PURPOSE & USE OF THE TABLE**  
The primary purpose of the information for Contour and Intercepting Ditches shown on this sheet is to serve as a guide in construction and to readily arrive at yardages of excavation involved. Foremost consideration in constructing these ditches is given first to the natural ground line slope contracted in construction, thence to the other values shown on the Typical Section. By properly arriving at the combination of values shown on the Typical Section and in the Table for a specified condition, the number of cubic yards of excavation per 100 lin. ft. of ditch may be read under the appropriate column for this item.

Table of Slopes and Yardages


Ground	SLOPES			H	Cubic Yards per 100 lin. ft. of Ditch		
	A	B	C				
5:1 Or Flatter	2:1	4:1	2:1	15"	16		
				18"	23		
				21"	32		
	1-1/2:1	3:1	2:1	15"	15		
				18"	22		
				21"	30		
		2:1	1-1/2:1	1-1/2:1	15"	14	
					18"	20	
					21"	27	
	4:1	1-1/2:1	4:1	1-1/2:1	15"	13	
					18"	19	
					21"	25	
2:1		3:1	2:1	15"	12		
				18"	18		
				21"	25		
3:1	2:1	4:1	2:1	15"	12		
				18"	17		
				21"	23		
	1-1/2:1	3:1	2:1	1-1/2:1	15"	10	
					18"	15	
					21"	20	
		2:1	1-1/2:1	4:1	1-1/2:1	15"	10
						18"	14
						21"	19
	2:1	1-1/2:1	3:1	2:1	15"	17	
					18"	25	
					21"	34	
1-1/2:1		2:1	1-1/2:1	1-1/2:1	15"	17	
					18"	24	
					21"	32	
		2:1	1-1/2:1	4:1	1-1/2:1	15"	15
						18"	22
						21"	30
3:1		1-1/2:1	4:1	1-1/2:1	15"	13	
					18"	18	
					21"	25	
	2:1	3:1	2:1	1-1/2:1	15"	12	
					18"	17	
					21"	23	
		1-1/2:1	2:1	1-1/2:1	1-1/2:1	15"	11
						18"	16
						21"	21
	2:1	1-1/2:1	3:1	2:1	15"	10	
					18"	14	
					21"	20	
1-1/2:1		2:1	1-1/2:1	1-1/2:1	15"	22	
					18"	31	
					21"	43	
		2:1	1-1/2:1	4:1	1-1/2:1	15"	21
						18"	30
						21"	41
1-1/2:1		1-1/2:1	3:1	1-1/2:1	15"	20	
					18"	29	
					21"	40	
	2:1	2:1	1-1/2:1	1-1/2:1	15"	13	
					18"	19	
					21"	26	
		1-1/2:1	2:1	1-1/2:1	1-1/2:1	15"	12
						18"	17
						21"	24
	2:1	1-1/2:1	2:1	1-1/2:1	15"	12	
					18"	17	
					21"	23	
1-1/2:1		2:1	1-1/2:1	1-1/2:1	15"	20	
					18"	29	
					21"	40	
		1:1	2:1	1:1	1:1	15"	9
						18"	13
						21"	17
1-1/2:1		1:1	1-1/2:1	1:1	15"	8	
					18"	12	
					21"	16	
	1:1	1-1/2:1	1:1	1:1	15"	11	
					18"	16	
					21"	21	

▲ Slopes are approximate and may be varied to suit conditions encountered during construction.

## TYPICAL SECTIONS for DRAINAGE, IRRIGATION DITCHES and CHANNEL CHANGES

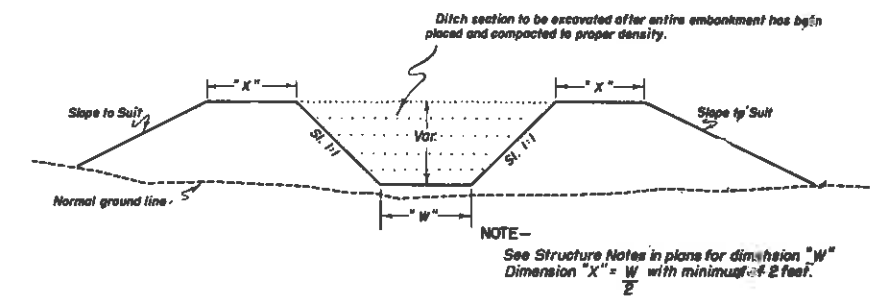

For Embankment Sections  
(Generally for use in Irrigation Ditches & Channel Changes)

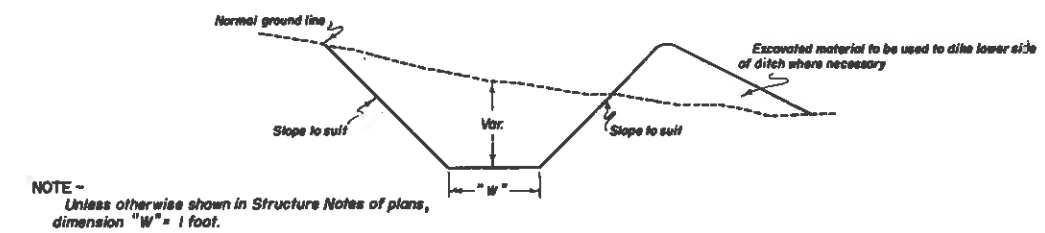

For Cut Sections

REVISIONS		
(R-1)	7-23-68 Dept. Name	M.R.H.

### GENERAL NOTES

All work shall be done in accordance with the Standard Specifications applicable to the Project.


All ditches are to be constructed to lines and grades as staked by the Engineer using the ditch section shown on plans or as ordered by the Engineer.

CONTOUR INTERCEPTING DITCHES: Ditches are to be laid out along the ground contour on a grade of not over 1% (Type of soil shall govern the grade). Ends of ditches are to be lined up so that concentration of flow from a higher contour ditch into one of lower contour is, as far as possible avoided. The use of a deeper ditch is recommended where this condition is encountered.

The following horizontal spacing of ditches is recommended:

4% to 6%	Approximately 70' Centers
8% to 10%	Approximately 60' Centers
20% to 4:1 Slope	Approximately 55' Centers
30% to 1-1/2:1 Slope	Approximately 50' Centers

Where ditch checks are required the intervening ditch between one set of ditch checks shall not exceed a grade of 1.0%. Details of checks will be shown on plans when required.

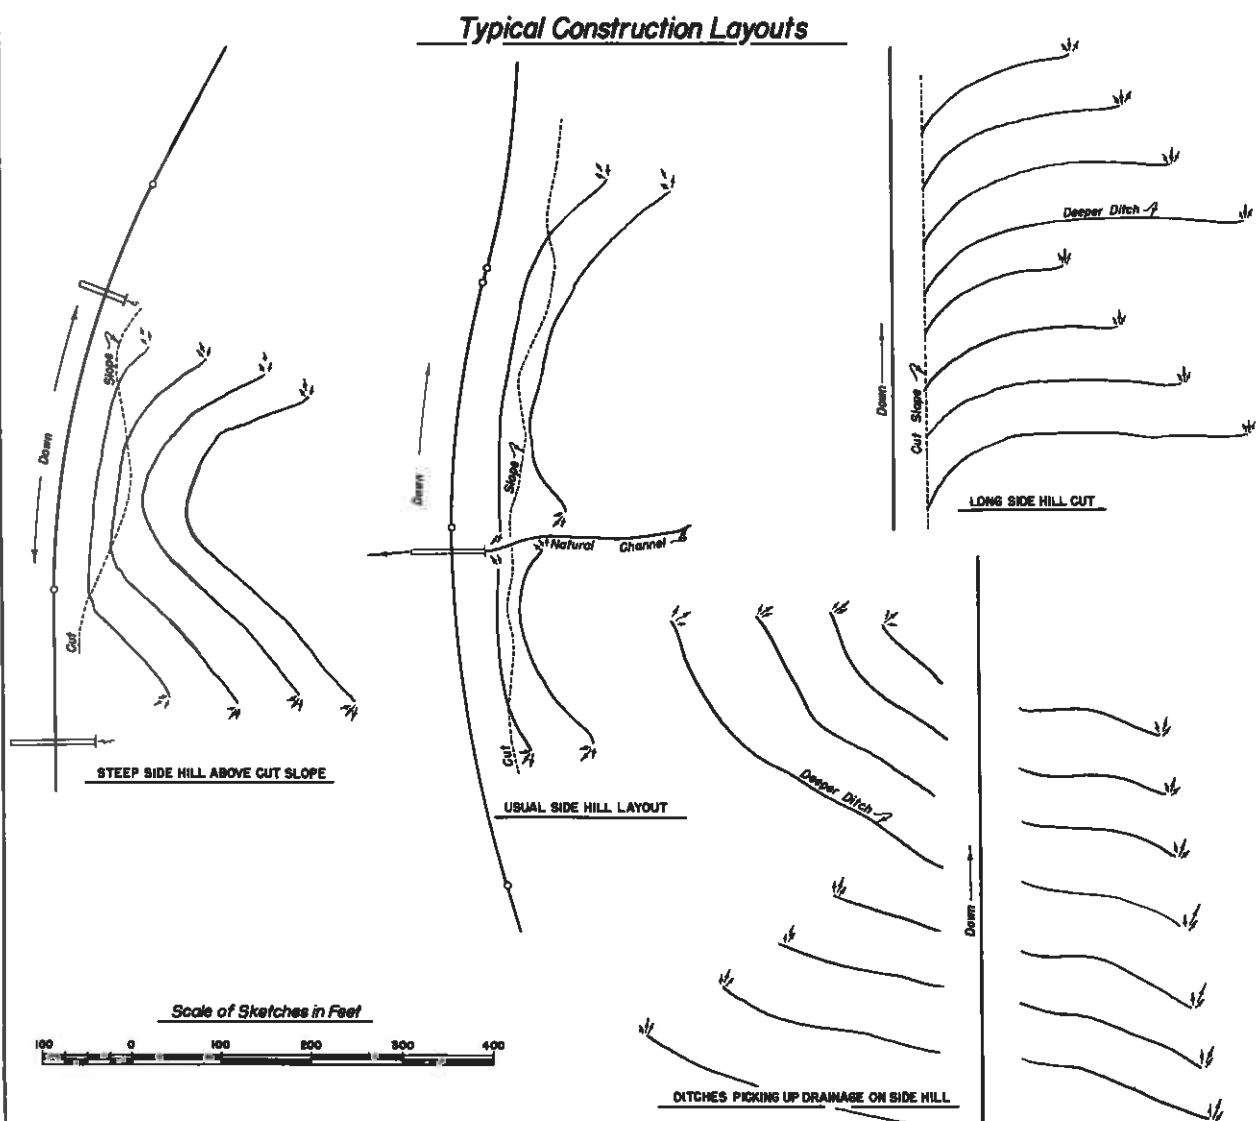

DEPARTMENT OF HIGHWAYS  
STATE OF COLORADO  
DIVISION OF HIGHWAYS

DITCH TYPES





Designed by G.G.M. Approved by G.G.M.  
Made by G.G.M. Staff Design Engr.  
Checked by Date: July 1, 1965



# STANDARD M-203-SD

(OCTOBER 22, 1971)

FEDERAL ROAD REGION NO.	DIVISION	PROJECT NO.	SHEET NO.
VIII	COLORADO		

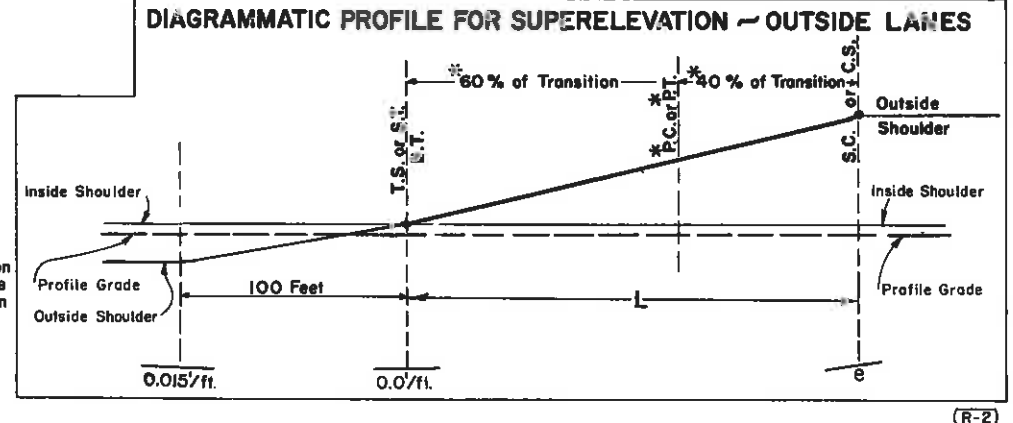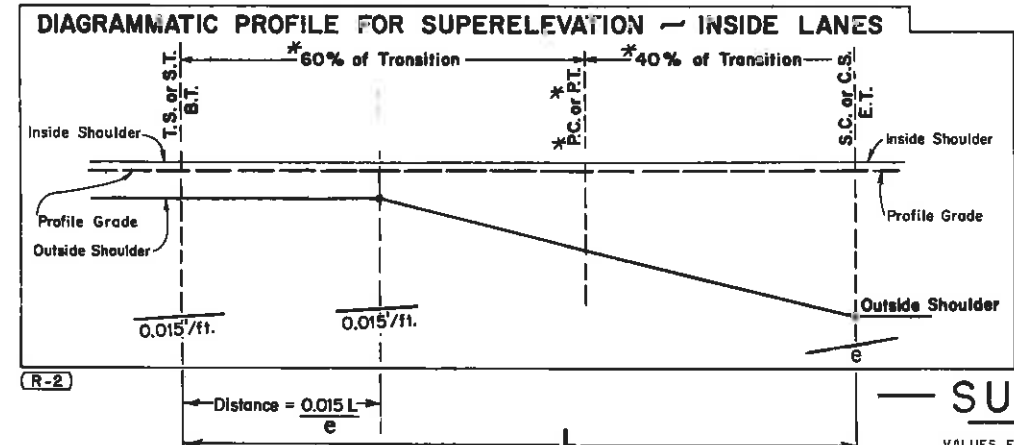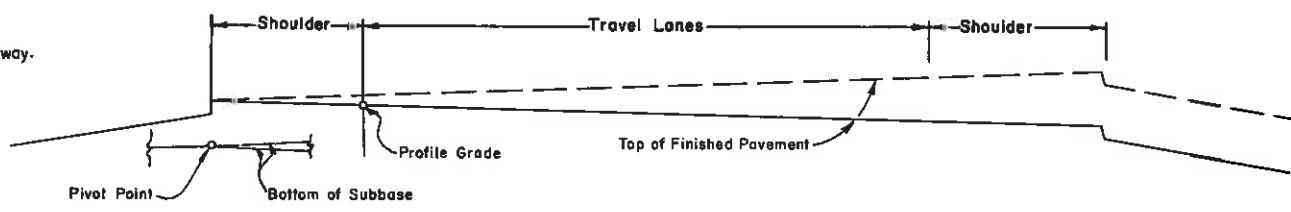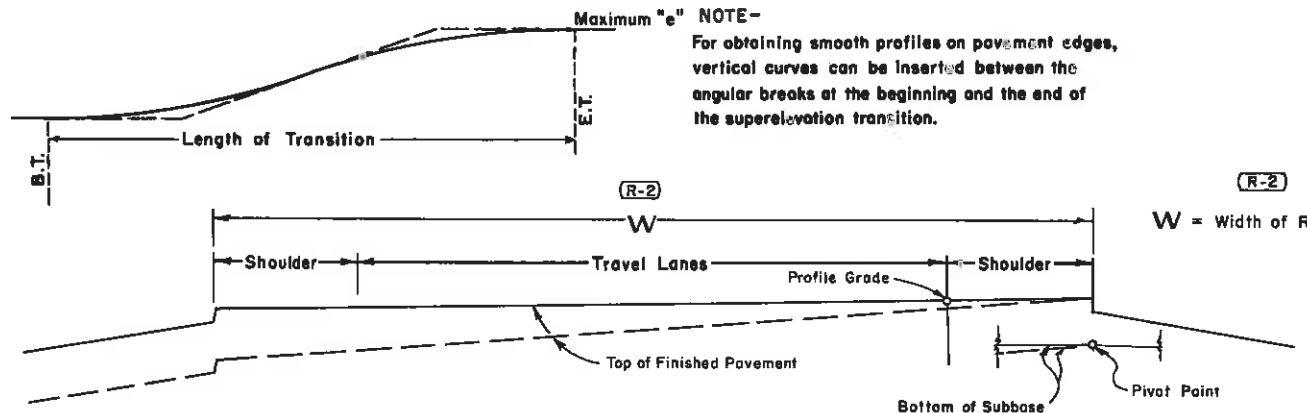

\* When Curve is Not Spiralled  
(R-2)  
e = Maximum rate of super-elevation in feet (per foot of width) for the given degree of curve and design speed.

REVISIONS		
(R-1)	3-24-75	Revise "L". M.R.H.
(R-2)	1-6-77	Clarify definitions. T.A.L.

## SUPERELEVATION RATES

VALUES FOR DESIGN ELEMENTS RELATED TO DESIGN SPEED AND HORIZONTAL CURVATURE

Use in Mountainous Areas and Areas where Icing Conditions Frequently Exist

D	R	V=30 MPH		V=40 MPH		V=50 MPH		V=60 MPH		V=65 MPH		V=70 MPH		V=75 MPH		V=80 MPH	
		e	L- FEET	e	L- FEET	e	L- FEET	e	L- FEET	e	L- FEET	e	L- FEET	e	L- FEET	e	L- FEET
0° 15'	23816'	NC	0	NC	0	NC	0	NC	0	NC	0	NC	0	NC	0	NC	0
0° 30'	11407'	NC	0	NC	0	NC	0	NC	0	NC	0	NC	0	NC	0	NC	0
0° 45'	7639'	NC	0	NC	0	NC	150	.022	175	.025	190	.029	200	.032	220	.036	240
1° 00'	5730'	NC	0	RC	125	.021	150	.029	175	.038	190	.043	200	.043	220	.047	240
1° 30'	3820'	RC	100	.021	125	.030	150	.040	175	.046	200	.053	240	.060	220	.065	320
2° 00'	2885'	RC	100	.027	125	.038	150	.051	210	.057	250	.061	280	.072	240	.078	360
2° 30'	2292'	.021	100	.033	125	.046	170	.060	240	.065	280	.073	330	.078	370	.080	400
3° 00'	1910'	.025	100	.038	125	.052	190	.067	270	.072	320	.073	370	.078	380	.080	400
3° 30'	1637'	.028	100	.043	140	.058	210	.073	300	.077	320	.088	360	.090	380	D max=2.5°	
4° 00'	1432'	.032	100	.047	150	.053	220	.077	310	.079	340	.080	360	D max=3.0°			
5° 00'	1146'	.038	100	.051	170	.071	260	.080	320	.080	320	D max=3.5°					
6° 00'	955'	.045	120	.061	190	.077	280	.080	320	D max=4.5°							
7° 00'	819'	.043	130	.067	210	.079	280	D max=5.0°									
8° 00'	716'	.052	140	.071	220	.080	290	D max=5.5°									
9° 00'	637'	.056	150	.075	240	D max=7.0°											
10° 00'	572'	.059	160	.077	240												
11° 00'	521'	.063	170	.078	250												
12° 00'	477'	.065	180	.080	250												
13° 00'	441'	.068	180	.080	230												
14° 00'	409'	.070	190	D max=12.5°													
16° 00'	358'	.074	200														
18° 00'	317'	.077	210														
20° 00'	286'	.079	210														
22° 00'	260'	.080	220														
		.080	220	D max=23.0°													

$e_{max} = 0.08$

Use in Rolling Areas and Areas where Icing Conditions Occasionally Exist

D	R	V=30 MPH		V=40 MPH		V=50 MPH		V=60 MPH		V=65 MPH		V=70 MPH		V=75 MPH		V=80 MPH	
		e	L- FEET	e	L- FEET	e	L- FEET	e	L- FEET	e	L- FEET	e	L- FEET	e	L- FEET	e	L- FEET
0° 15'	23816'	NC	0	NC	0	NC	0	NC	0	NC	0	NC	0	NC	0	NC	0
0° 30'	11407'	NC	0	NC	0	NC	0	NC	0	NC	0	NC	0	NC	0	NC	0
0° 45'	7639'	NC	0	NC	0	RC	150	.024	175	.027	190	.032	200	.033	220	.034	240
1° 00'	5730'	NC	0	RC	125	.023	150	.028	175	.031	190	.039	200	.044	220	.048	240
1° 30'	3820'	RC	100	.021	125	.038	150	.046	190	.052	220	.052	260	.055	310	.071	370
2° 00'	2885'	RC	100	.028	125	.048	150	.056	200	.056	230	.074	250	.072	290	.079	400
2° 30'	2292'	.021	100	.031	125	.051	180	.063	250	.077	320	.086	350	.094	430	.099	470
3° 00'	1910'	.025	100	.040	150	.057	210	.079	320	.087	380	.094	470	.100	490	.109	500
3° 30'	1637'	.028	100	.046	150	.067	240	.087	350	.093	400	.103	470	.100	480	.109	500
4° 00'	1432'	.032	100	.051	160	.073	260	.093	380	.098	420	.108	470	D max=3.0°		D max=3.0°	
5° 00'	1146'	.038	110	.061	190	.084	300	.099	400	.100	420	.100	450	D max=3.0°		D max=3.0°	
6° 00'	955'	.046	120	.070	220	.092	330	.100	410	D max=4.5°		D max=4.0°					
7° 00'	819'	.052	140	.077	240	.098	350	D max=5.5°									
8° 00'	716'	.059	160	.084	260	.100	360	D max=6.5°									
9° 00'	637'	.063	170	.089	280	.100	360										
10° 00'	572'	.068	180	.093	300	D max=8.5°											
11° 00'	521'	.072	200	.097	310												
12° 00'	477'	.077	210	.099	310												
13° 00'	441'	.080	220	.100	320												
14° 00'	409'	.083	220	.100	320												
16° 00'	358'	.089	240	D max=12.5°													
18° 00'	317'	.092	250														
20° 00'	286'	.097	260														
22° 00'	260'	.099	270														
24° 00'	231'	.100	270														
		.100	270	D max=21.0°													

$e_{max} = 0.10$

Use in Plains Areas and Areas where Icing Conditions Seldom Exist or Where Roadways are Well Sanded during Icing Conditions

D	R	V=30 MPH		V=40 MPH		V=50 MPH		V=60 MPH		V=65 MPH		V=70 MPH		V=75 MPH		V=80 MPH	
		e	L- FEET	e	L- FEET	e	L- FEET	e	L- FEET	e	L- FEET	e	L- FEET	e	L- FEET	e	L- FEET
0° 15'	23816'	NC	0	NC	0	NC	0	NC	0	NC	0	NC	0	NC	0	NC	0
0° 30'	11407'	NC	0	NC	0	NC	0	NC	0	NC	0	NC	0	NC	0	NC	0
0° 45'	7639'	NC	0	NC	0	RC	150	.024	175	.028	190	.032	200	.033	220	.034	240
1° 00'	5730'	NC	0	RC	125	.023	150	.028	175	.031	190	.039	200	.044	220	.048	240
1° 30'	3820'	RC	100	.021	125	.038	150	.046	190	.052	220	.052	260	.055	310	.071	370
2° 00'	2885'	RC	100	.027	125	.048	150	.056	200	.056	230	.074	250	.072	290	.079	400
2° 30'	2292'	.021	100	.031	125	.051	180	.063	250	.077	320	.086	350	.094	430	.099	470
3° 00'	1910'	.025	100	.040	150	.057	210	.079	320	.087	380	.094	470	.100	490	.109	500
3° 30'	1637'	.028	100	.046	150	.067	240	.087	350	.093	400	.103	470	.100	480	.109	500
4° 00'	1432'	.032	100	.051	160	.073	260	.093	380	.098	420	.108	470	D max=3.0°		D max=3.0°	
5° 00'	1146'	.038	110	.061	190	.084	300	.099	400	.100	420	.100	450	D max=3.0°		D max=3.0°	
6° 00'	955'	.046	120	.070	220	.092	330	.100	410	D max=4.5°		D max=4.0°					
7° 00'	819'	.052	140	.077	240	.098	350	D max=5.5°									
8° 00'	716'	.059	160	.084	260	.100	360	D max=6.5°									
9° 00'	637'	.063	170	.089	280	.100	360										
10° 00'	572'	.068	180	.093	300	D max=8.5°											
11° 00'	521'	.072	200	.097	310												
12° 00'	477'	.077	210	.099	310												
13° 00'	441'	.080	220	.100	320												
14° 00'	409'	.083	220	.100	320												
16° 00'	358'	.089	240	D max=12.5°													
18° 00'	317'	.092	250														
20° 00'	286'	.097	260														
22° 00'	260'	.099	270														
24° 00'	231'	.100	270														
		.100	270	D max=21.0°													

$e_{max} = 0.12$

- D - DEGREE OF CURVE
- R - RADIUS OF CURVATURE
- V - ASSUMED DESIGN SPEED
- (R-2) L - LENGTH OF SUPERELEVATION TRANSITION.
- NC - NORMAL CROWN SECTION
- RC - REMOVE ADVERSE CROWN, SUPERELEVATE AT NORMAL CROWN SLOPE

SPIRALS DESIRABLE BUT NOT AS ESSENTIAL ABOVE THE UPPERMOST HEAVY LINE. LENGTHS ROUNDED IN MULTIPLES OF 25 OR 50 FEET PERMIT SIMPLER CALCULATIONS.

DEPARTMENT OF HIGHWAYS  
STATE OF COLORADO  
DIVISION OF HIGHWAYS

**SUPERELEVATION OF CURVES DIVIDED HIGHWAYS**

Designed by J.W.K. Approved by R.M. Staff Design Engr.  
Made by R.L.M. Date: October 22, 1971  
Checked by D.L.V.


# STANDARD M-206-AB

(MARCH 4, 1976)  
(SHEET 1 OF 3)


FEDERAL ROAD REGION NO.	DIVISION	PROJ. NO.	SHEET NO.	TOTAL SHEETS
VIII	COLORADO			

REVISIONS				
(R-1)	3-26-76	Gen. Note, footing in rock.	T.A.L.	
(R-2)	4-16-76	Limit of Str. Excav. in Box Culv. detail.	T.A.L.	
(R-3)	5-8-78	Backfill for Wingwall.	T.A.L.	


## SIPHON OR CONDUIT IN TRENCH

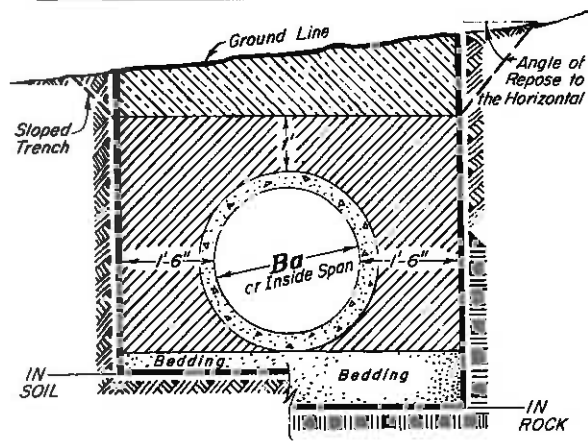

## CIRCULAR CONDUIT

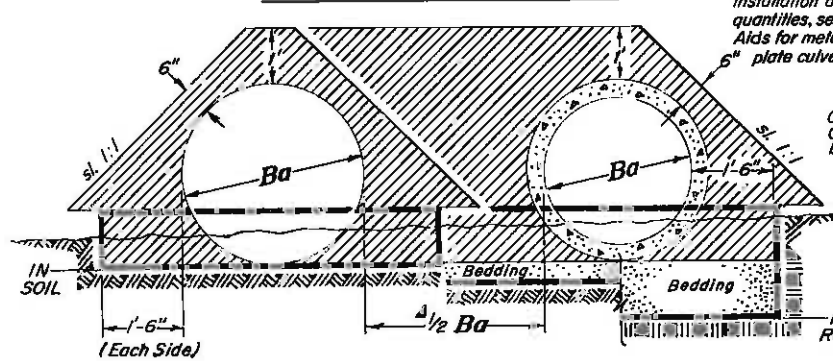

## ELLIPTICAL OR ARCH CONDUIT

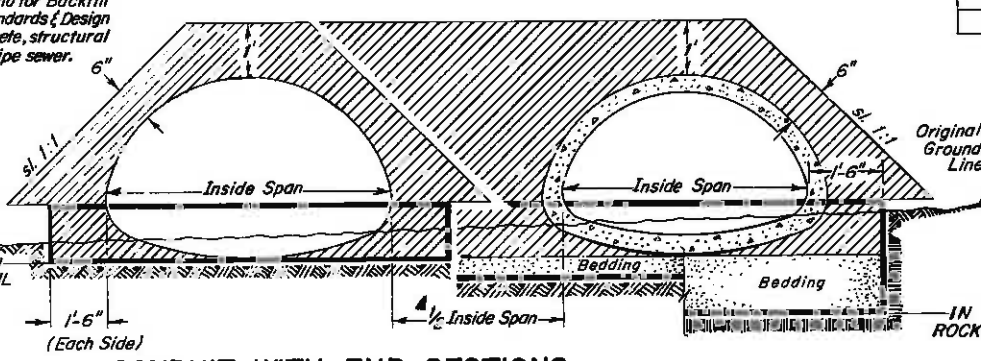


NOTE: For additional Culvert installation details and for Backfill quantities, see M Standards Design Aids for metal, concrete, structural plate culverts or pipe sewer.


## LEGEND

	STRUCTURE EXCAVATION
	STRUCTURE BACKFILL
	EARTH
	ROCK
	EMBAKMENT MATERIAL
	CONCRETE
$Ba$	INSIDE DIAMETER

## CAST IN PLACE CONDUIT

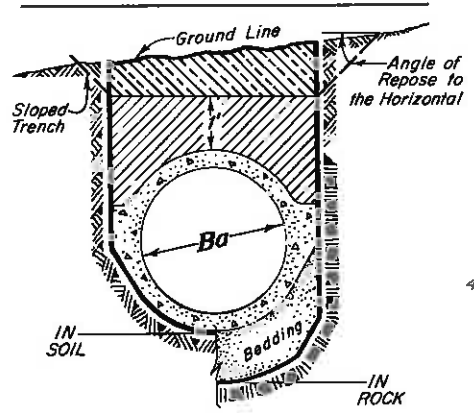


## TRENCH FOR PIPE UNDERDRAIN

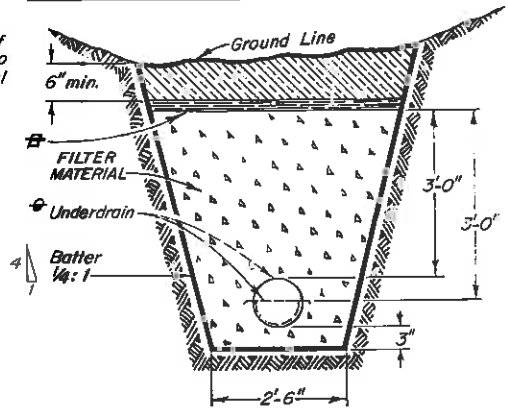


When 2 or more conduits are laid side by side they shall be placed so that the adjacent pipes will be  $\frac{1}{2}$  Inside Diameter or  $\frac{1}{2}$  Inside Span or 3 feet apart (including wall thickness) whichever is less. Minimum spacing shall be not less than one foot between outside walls of pipe or End Section.


## CONDUIT WITH END SECTIONS

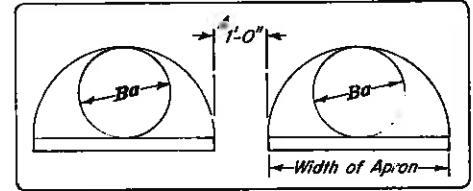

## RETAINING WALL IN CUT & IN PARTIAL CUT

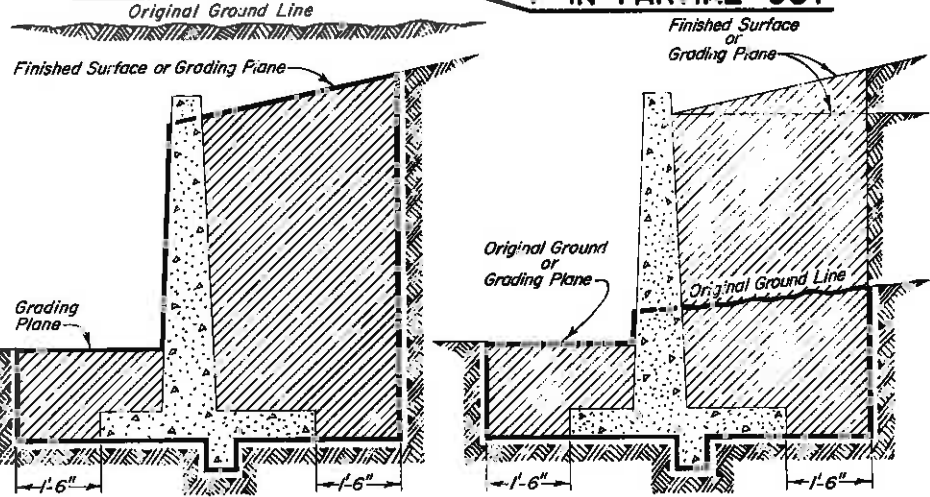


## HEAD WALL

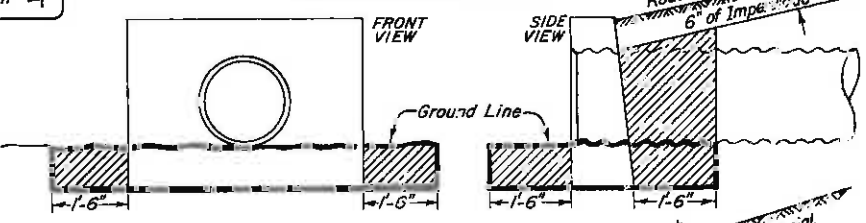

## END OF CULVERT




## CONCRETE BOX CULVERT

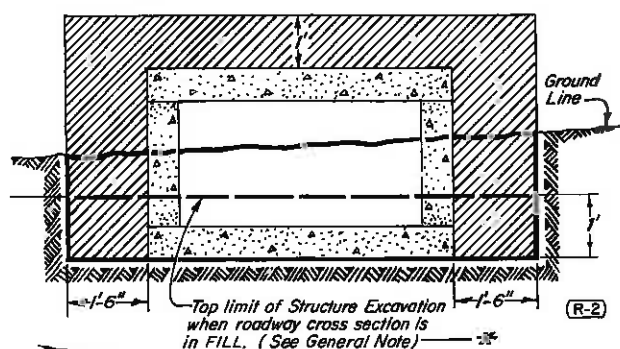


One thickness of Building Paper (30 weight) or Plastic Sheeting (10 mil.) or 4" layer of loose straw or acceptable equivalent.  
The lightest nominal thickness for Underdrain shall be:

TYPE III PIPE	CLASS I & II	CLASS III
STEEL	.052"	.054"
ALUMINUM	.048"	.050"


## DROP INLETS, DIVISION BOXES, INTERCEPTING HEADWALLS, ETC.

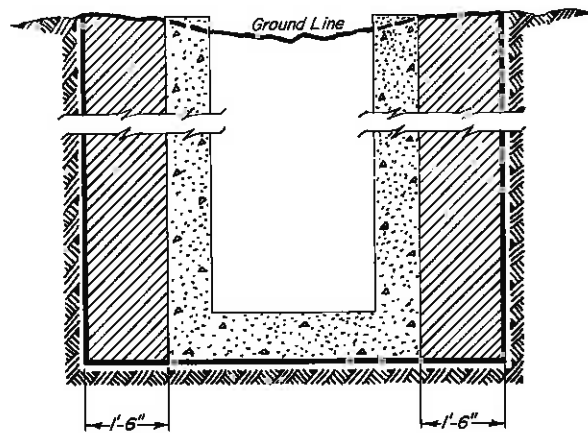

## RETAINING WALL IN FILL

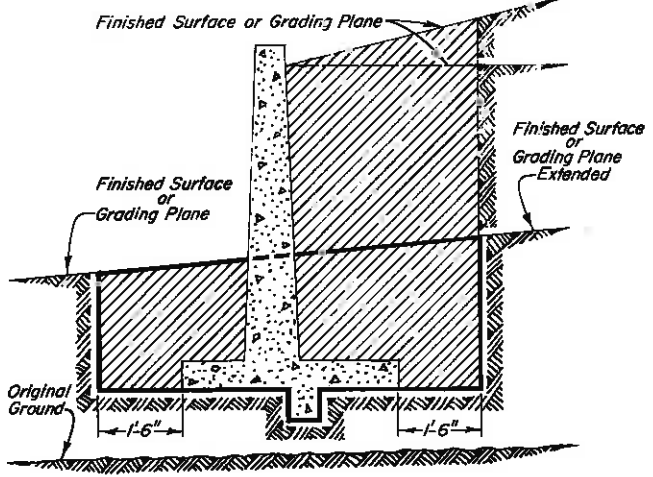

## WINGWALL

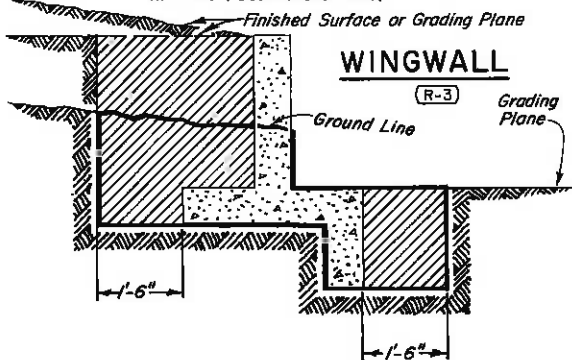

## GENERAL NOTES (R-1)

All work shall be done in accordance with the Standard Specifications applicable to the project.  
\* Where the roadway cross section is in FILL, excavation for box culverts shall be done as follows:  
1. Embankment shall be built up to one foot above the bottom of the box culvert.  
2. The trench shall then be excavated to accommodate construction of the box culvert. Excavation and Backfill patterns different from those indicated on these sheets will be shown elsewhere on the Plans.  
Excavation for structure installation shall be classified as "Structure Excavation" unless otherwise shown on the Plans.  
Structure footings which are located in rock shall be poured out to undisturbed rock without forming.

**DEPARTMENT OF HIGHWAYS  
STATE OF COLORADO  
DIVISION OF HIGHWAYS**

**EXCAVATION & BACKFILL  
FOR STRUCTURES**

Designed by M R H    Approved by B. J. Lamm  
Made by J R B        Staff Design Engineer  
Checked by O L S    Date: March 4, 1976


# STANDARD M-206-AB

(MARCH 4, 1976)  
(SHEET 2)


FEDERAL ROAD REGION NO.	DIVISION	PROJ. NO.	SHEET NO.	TOTAL SHEETS
VIII	COLORADO			

REVISIONS:				
(R-1)	3-25-76	Revision date only.		T.A.L.
(R-2)	4-16-76	" " "		T.A.L.
(R-3)	5-8-78	" " "		T.A.L.

## STRUCTURE EXCAVATION MEASUREMENT FOR PIPE CULVERTS

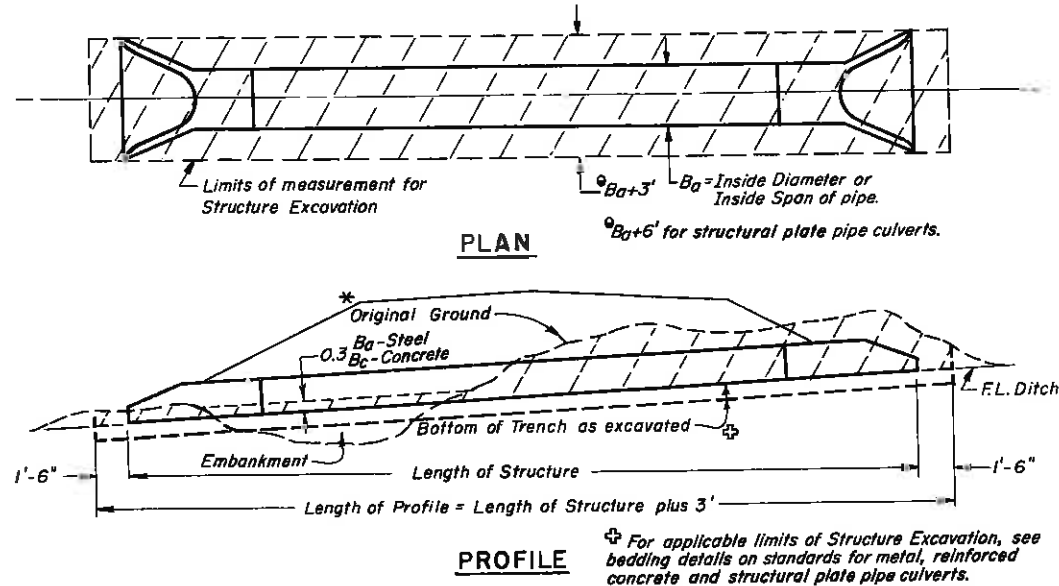

## STRUCTURE EXCAVATION MEASUREMENT FOR CONCRETE BOX CULVERTS

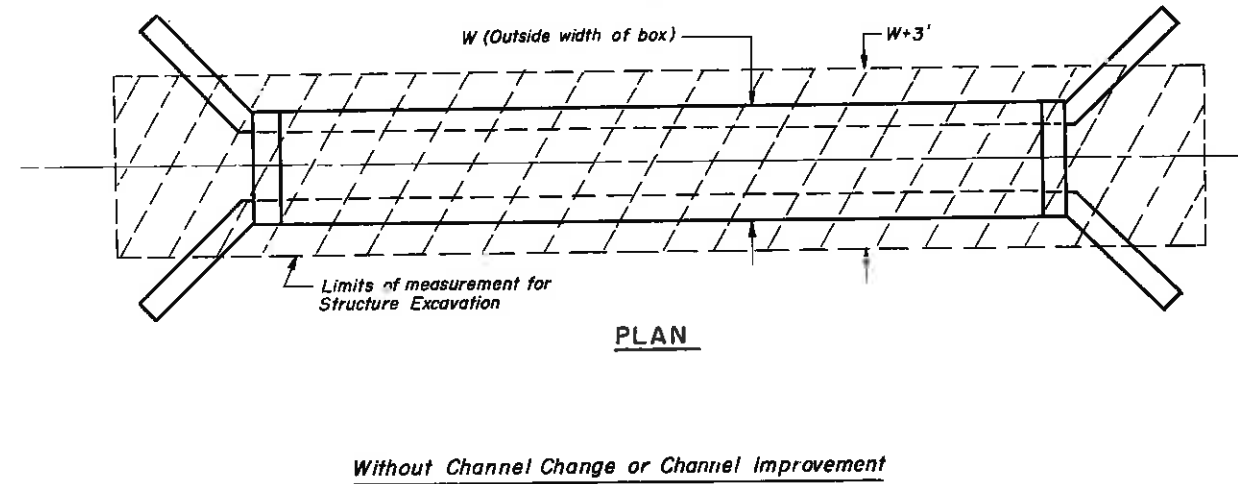



### GENERAL NOTES (Continued)

**TRENCH INSTALLATION:**  
Trenches over 5 feet in depth shall be either shored or the trench walls shall be sloped to the angle of repose. If sloped, the bottom of the slope shall be a minimum of 1 foot above the top of the pipe.


Shoring will be required when the bottom of the slope is more than 3 feet above the bottom of the trench. Shoring shall extend a minimum of one foot above the bottom of the slope.

Timber sheeting or shoring may be cut off 1 foot above the top of the pipe after backfilling is complete.

## STRUCTURE EXCAVATION MEASUREMENT FOR DIVERSION OR DIVISION BOXES

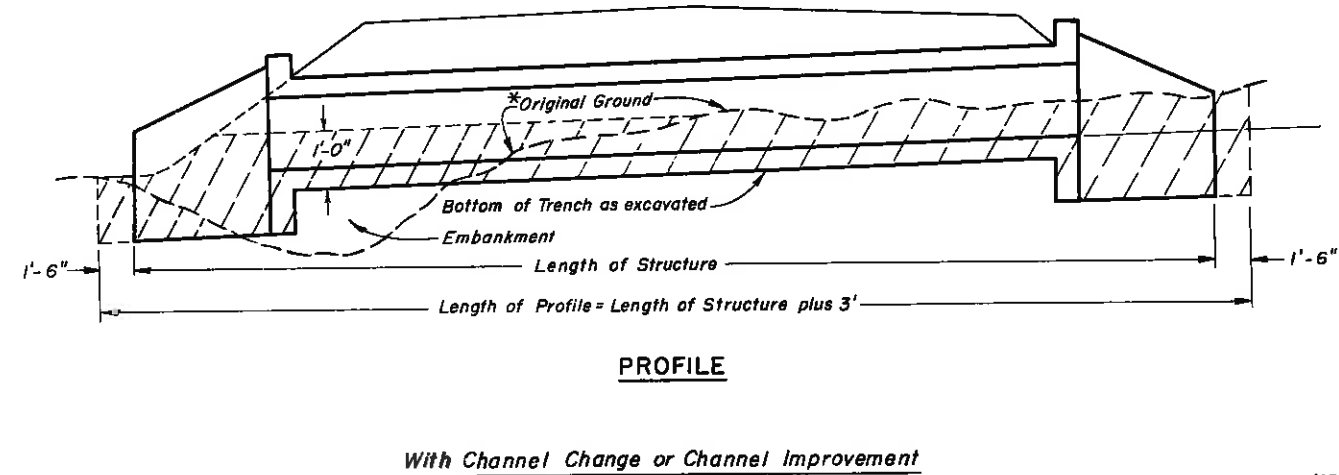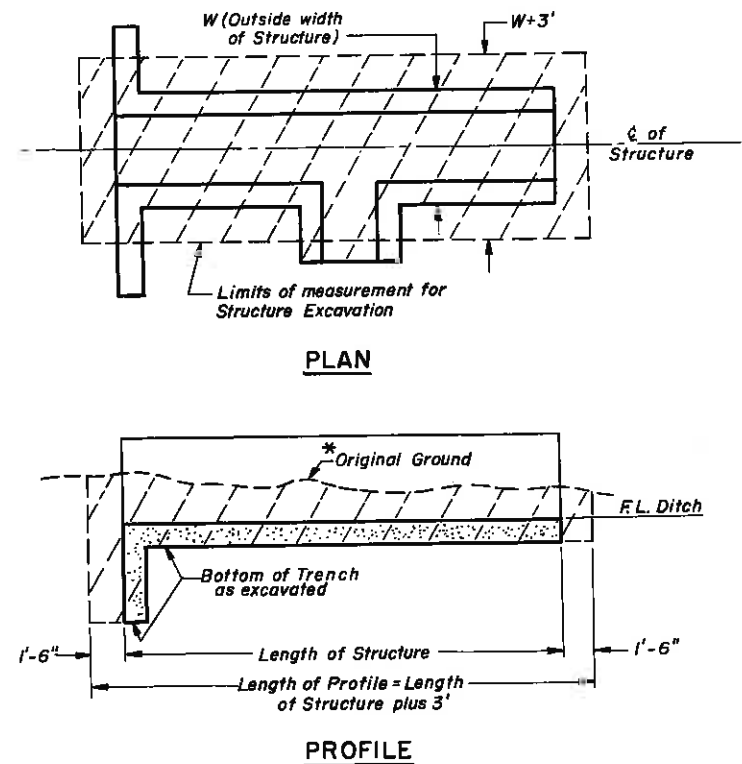

**NOTE:**  
See Sheet 1 for General Notes and Backfilling Details.

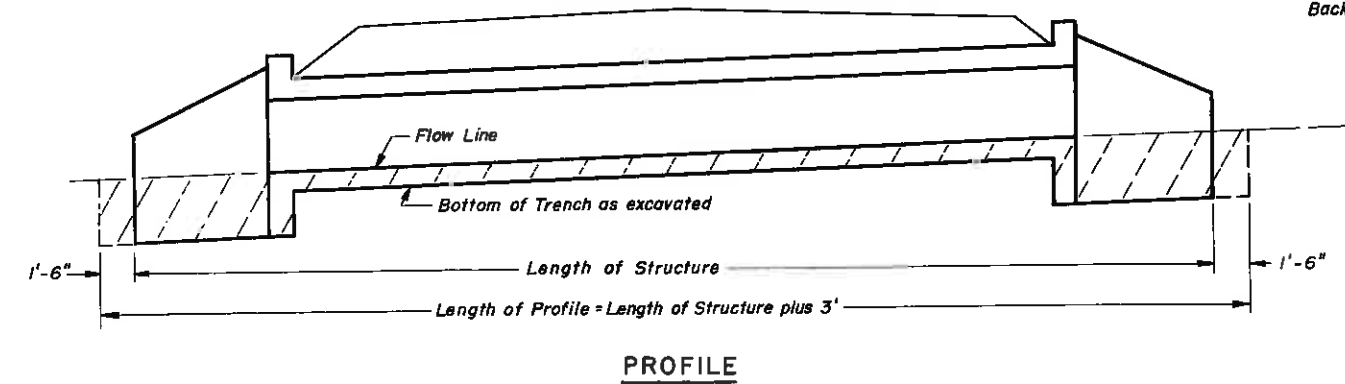

\* Along C of Structure  
Areas to be used for Structure Excavation computations.

DEPARTMENT OF HIGHWAYS  
STATE OF COLORADO  
DIVISION OF HIGHWAYS  
EXCAVATION AND  
BACKFILL  
FOR STRUCTURES

Designed by: M.R.H. Approved by: H.P.B.  
Made by: H.P.B. Staff Design Engr.  
Checked by: Date: March 4, 1976

# STANDARD M-206-AB


(MARCH 4, 1976)  
(SHEET 3)

FEDERAL ROAD REGION NO.	DIVISION	PROJ. NO.	SHEET NO.	TOTAL SHEETS
VIII	COLORADO			



REVISIONS				
R-1	3-26-76	Revision date only.		T.A.L.
R-2	4-16-76	" " "		T.A.L.
R-3	5-8-78	" " "		T.A.L.

## IN FILL


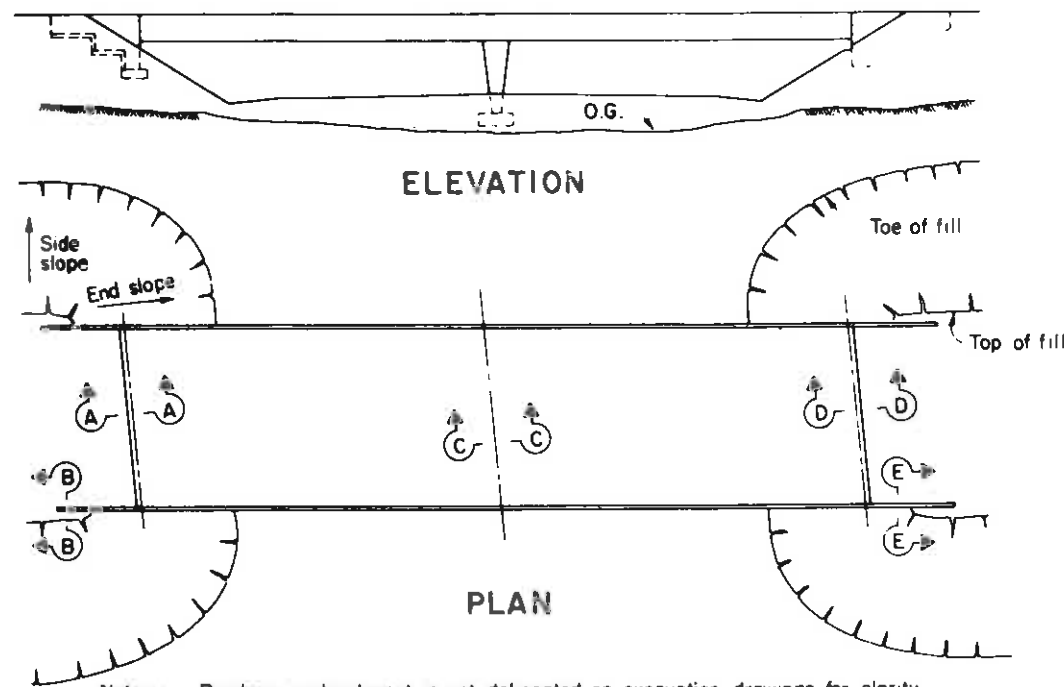


Notes: Roadway embankment is not delineated on excavation drawings for clarity. Embankment must be in place before structure excavation is made.


### EXCAVATION — BACKFILL

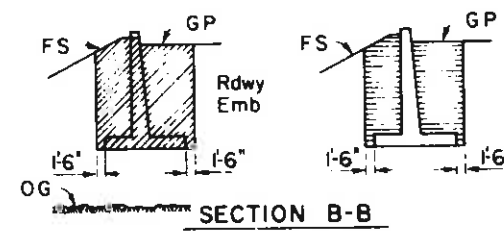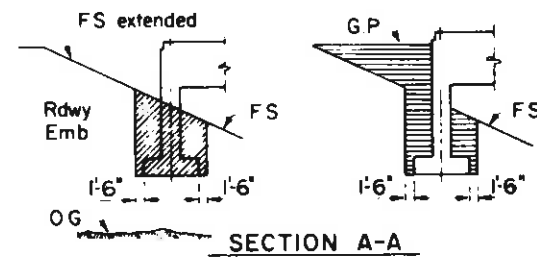


### EXCAVATION — BACKFILL

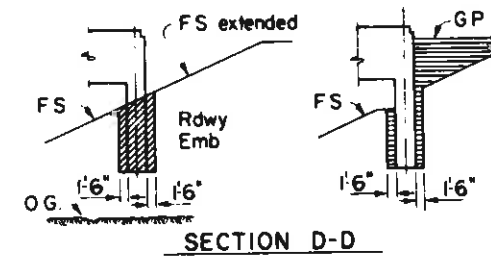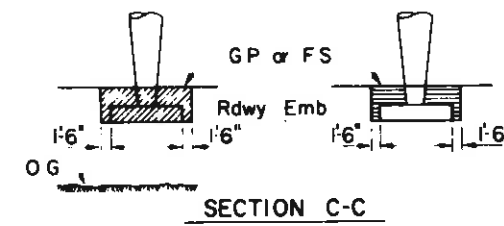

### EXCAVATION — BACKFILL



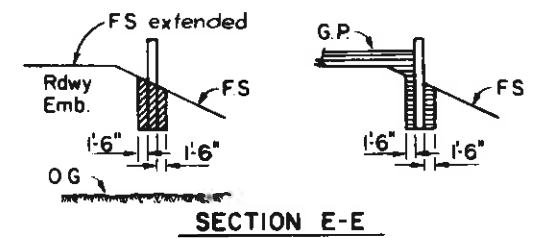


## IN CUT


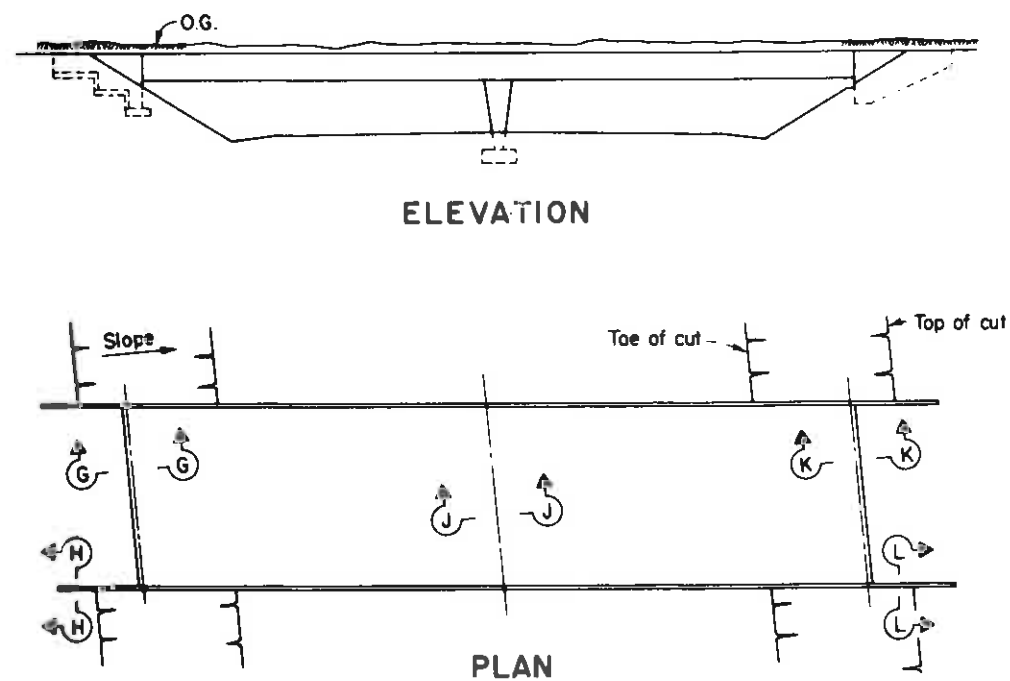


Note: If no roadway excavation is involved at bridge, structure excavation is measured from original ground.

### EXCAVATION — BACKFILL

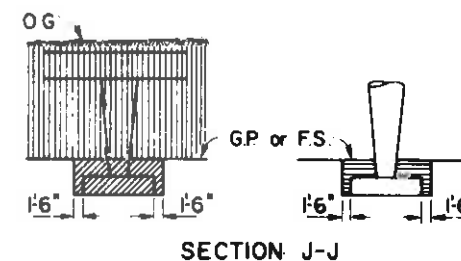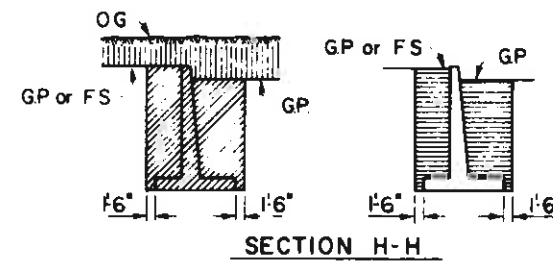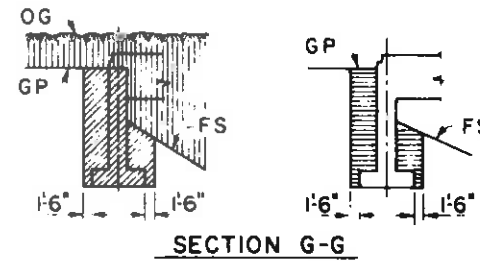

### EXCAVATION — BACKFILL

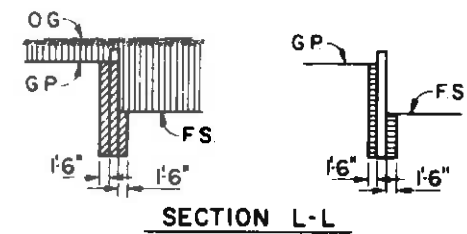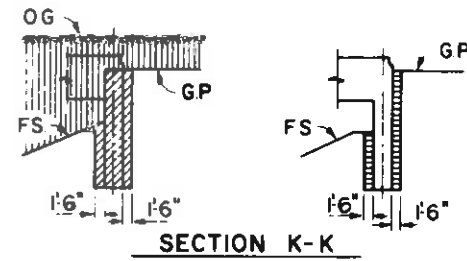

### ABBREVIATIONS

- O.G. Original Ground
- F.S. Planned Finished Surface
- G.P. Planned Grading Plane

### LEGEND

- Structure Excavation
- Structure Backfill
- Roadway Excavation

DEPARTMENT OF HIGHWAYS  
STATE OF COLORADO  
DIVISION OF HIGHWAYS

**EXCAVATION & BACKFILL  
FOR STRUCTURES  
(BRIDGE)**

Designed by *M R H* Accepted by *A. L. Vanman*  
Made by *J R B* Staff Design Engineer  
Checked by *O L S* Date: *March 4, 1976*



# STANDARD M-214-A


(JANUARY 21, 1975)

FEDERAL ROAD REGION NO.	DIVISION	PROJ. NO.	SHEET NO.	TOTAL SHEETS
VIII	COLORADO			

REVISIONS				
(R-1)	10-28-77	MULCH DETAILS		MJT

## SHRUBS ON SLOPE (R-1)

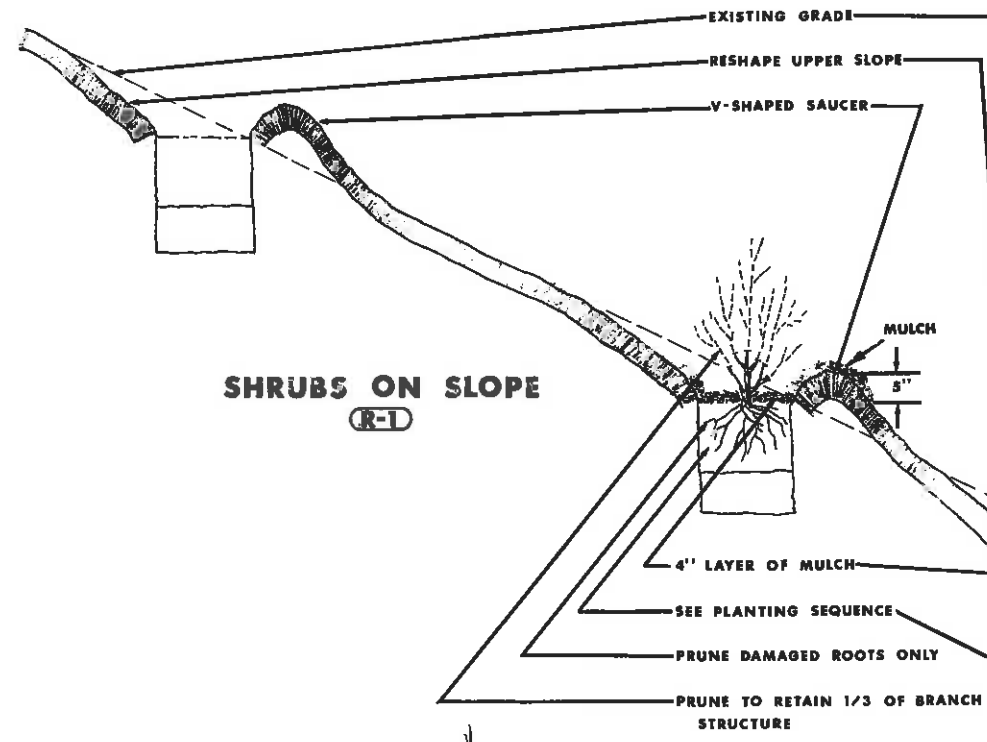

### GENERAL NOTES


ALL WORK SHALL BE DONE IN ACCORDANCE WITH THE STANDARD SPECIFICATIONS APPLICABLE TO THE PROJECT

DECIDUOUS TREES SHALL BE WRAPPED ACCORDING TO STANDARD SPECIFICATIONS

## TREES ON SLOPE (R-1)


MULCH SHALL COVER SAUCER BERM AS SHOWN.

(R-1)

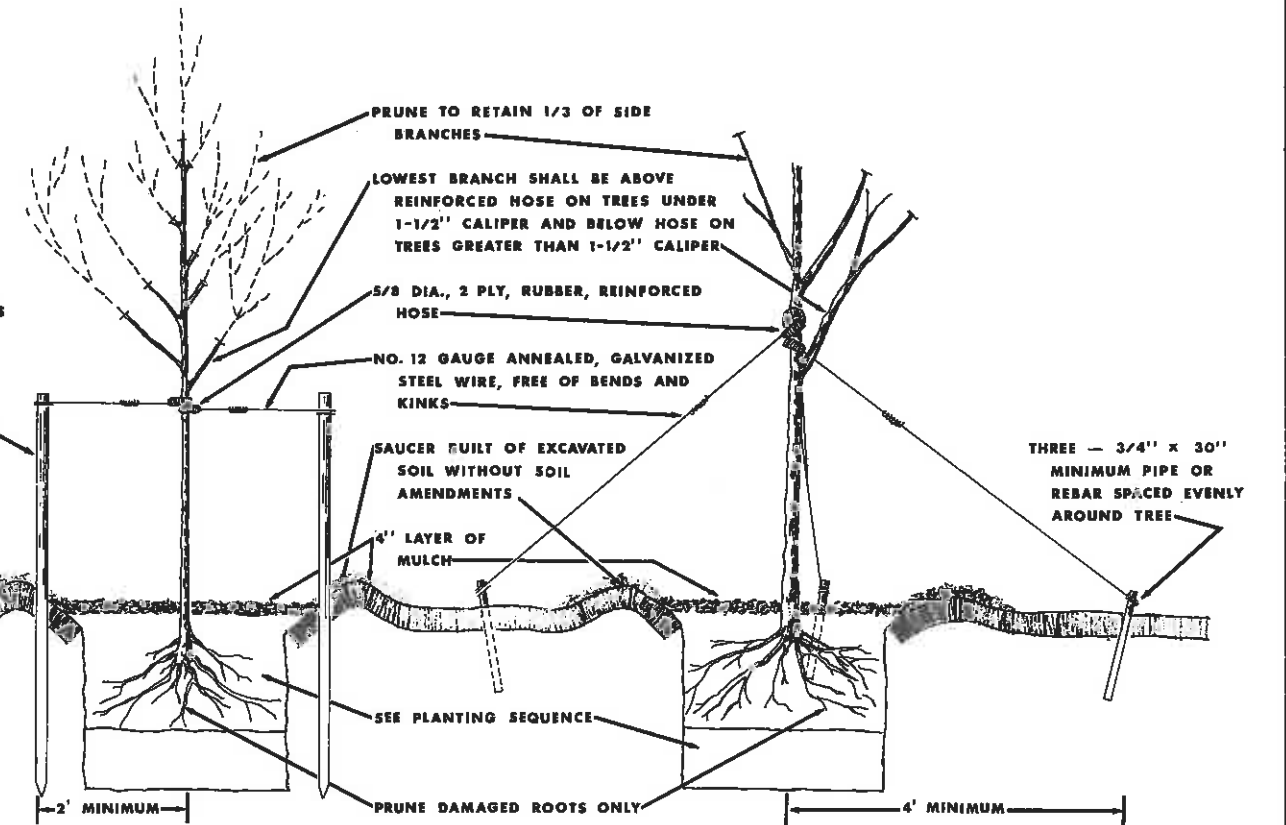

## DECIDUOUS TREES UNDER 1-1/2" CALIPER AND TREES OVER 1-1/2" CALIPER LEVEL PLANTING AREA

NOTE: V-SHAPED SAUCER REQUIRED WHERE GROUND SLOPES MORE THAN 4%

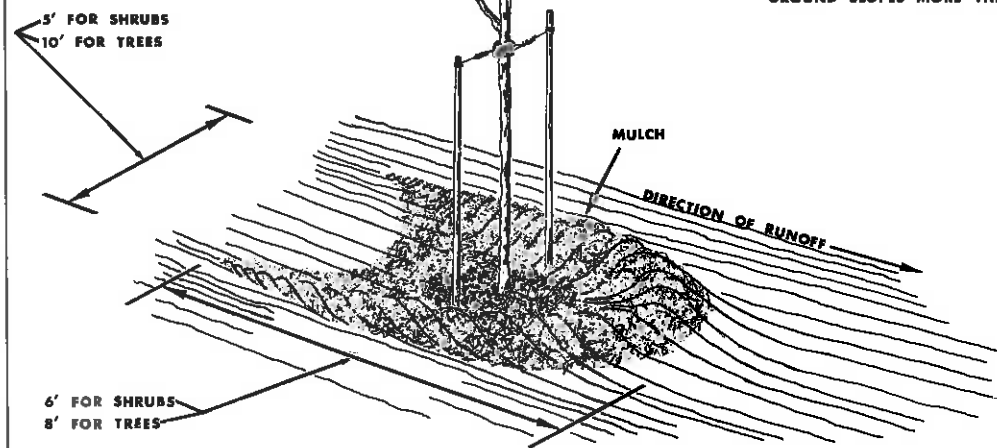


## V-SHAPED SAUCER FOR PLANTING ON SLOPES (R-1)

(R-1)

### PLANTING SEQUENCE

- 1) LOOSEN IN-PLACE MATERIAL TO A MINIMUM DEPTH OF 3"
- 2) ADD A MINIMUM OF 3" TOPSOIL AND MIX WITH IN-PLACE MATERIAL. COMPACT BY PUDDLING AND LET SETTLE FOR 24 HOURS
- 3) PLANT, ADD BACKFILL MIXTURE, COMPACT BY PUDDLING AND LET SETTLE FOR 24 HOURS
- 4) WATER BY STANDARD TECHNIQUE

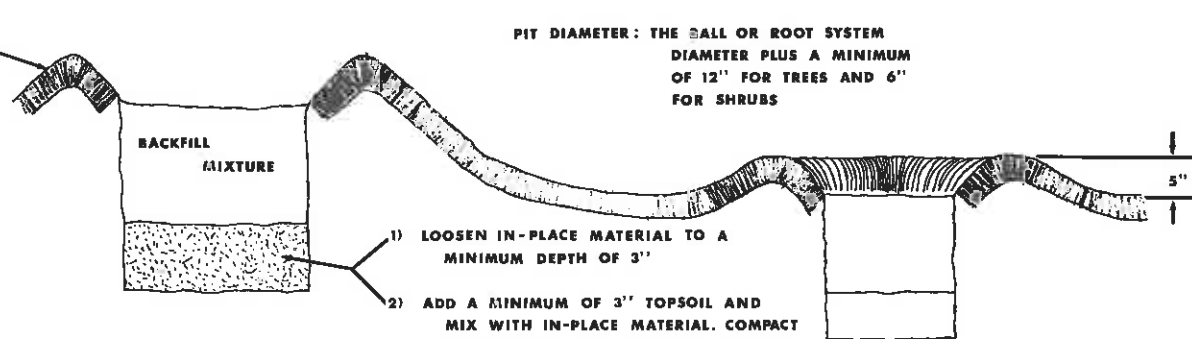

### SHRUBS IN LEVEL AREA

DEPARTMENT OF HIGHWAYS  
 STATE OF COLORADO  
 DIVISION OF HIGHWAYS  
**PLANTING  
 DETAILS**


DESIGNED BY: SPH Approved by: *E. J. Loman*  
 MADE BY: SPH Staff Design Engineer  
 CHECKED BY: MJT Date: January 21, 1975

# STANDARD M-603-CA


(NOVEMBER 10, 1967)

FEDERAL ROAD REGION NO.	DIVISION	PROJ. NO.	SHEET NO.	TOTAL SHEETS
VIII	COLORADO			









REVISIONS				
(R-1)	4-19-68	Welding - Conc. Arch, Ellipt. - Gen. Notes	M.R.H.	
(R-2)	7-23-68	Dept. Name.	M.R.H.	
(R-3)	3-10-71	Change all gage to thickness.	M.R.H.	
(R-4)	6-25-71	General Note for Joint Fasteners.	M.R.H.	
(R-5)	8-21-75	Gen'l. Note & CSPA Table.	M.R.H.	
(R-6)	8-29-77	Notes for Conc. St. End S. for RCP	T. A. L.	

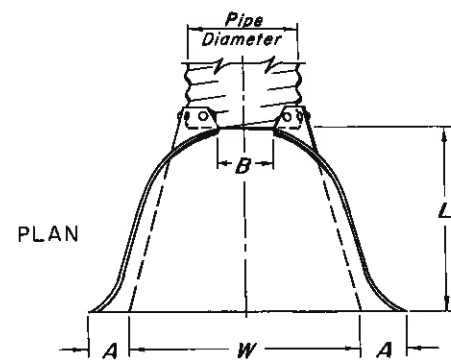

PIPE DIAM. in.	THICKNESS in.	DIMENSIONS					
		A (1"±) in.	B (Max.) in.	H (1"±) in.	L (1 1/2"±) in.	W (2"±) in.	T in.
12	.064	6	6	6	21	24	34
15	.064	7	8	6	26	30	40
18	.064	8	10	6	31	36	46
21	.064	9	12	6	36	42	52
24	.064	10	13	6	41	48	58
30	.079	12	16	8	51	60	70
36	.079	14	19	9	60	72	84
42	.109	16	22	11	69	84	106
48	.109	18	27	12	78	90	112
54	.109	18	30	12	84	102	124
60	.109	18	33	12	87	114	136
66	.109	18	36	12	87	120	142
72	.109	18	39	12	87	126	148
78	.109	18	42	12	87	132	154
84	.109	18	45	12	87	138	160

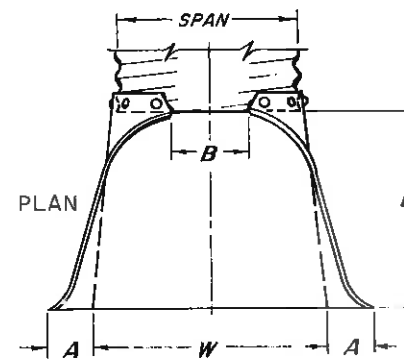


PIPE ARCH SPAN - RISE in. in.	THICKNESS in.	DIMENSIONS					
		A (1"±) in.	B (Max.) in.	H (1"±) in.	L (1 1/2"±) in.	W (2"±) in.	T in.
17 x 13	.064	7	9	6	19	30	40
21 x 15	.064	7	10	6	23	36	46
24 x 18	.064	8	12	6	28	42	52
28 x 20	.064	9	14	6	32	48	58
35 x 24	.079	10	16	6	39	60	70
42 x 29	.079	12	18	8	46	75	85
49 x 33	.109	13	21	9	53	85	103
57 x 38	.109	18	26	12	63	90	108
64 x 43	.109	18	30	12	70	102	120
71 x 47	.109	18	33	12	77	114	132

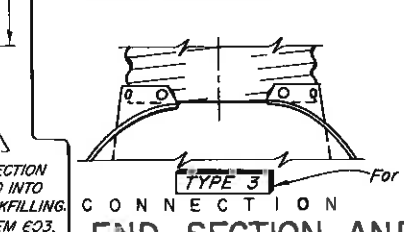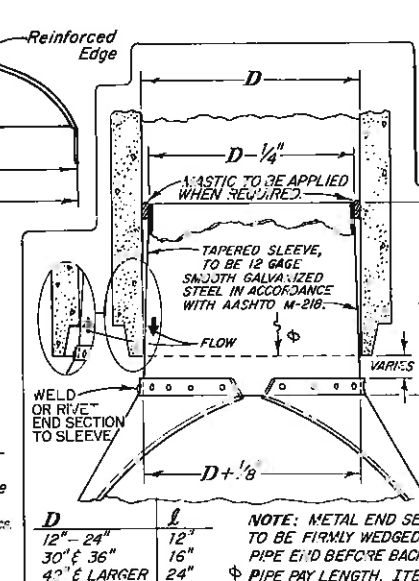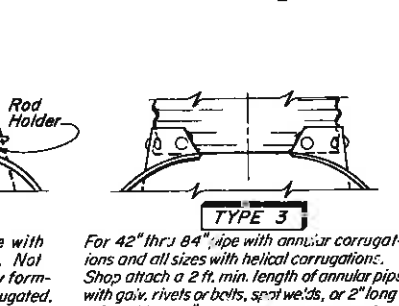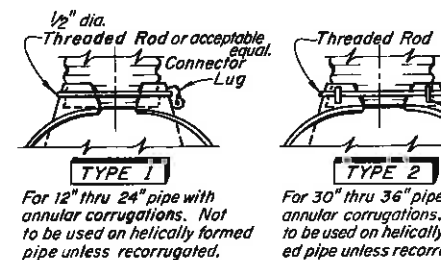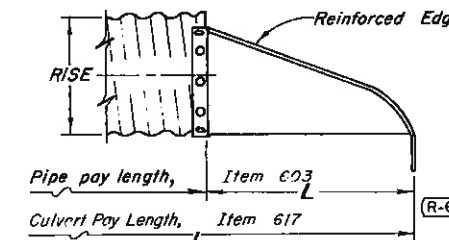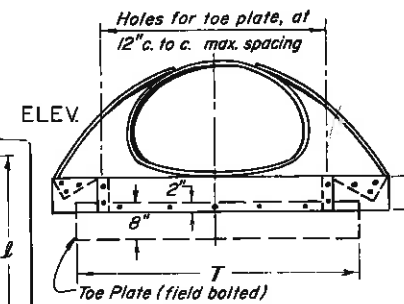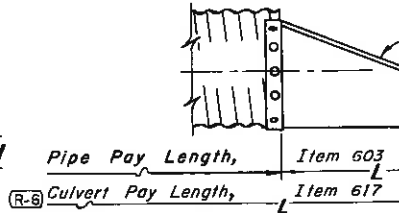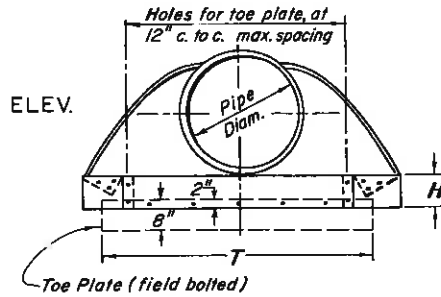



**TYPICAL CONNECTIONS**  
**END SECTION AND CONNECTION DETAILS FOR ROUND CORRUGATED STEEL PIPE CULVERTS**  
 (R-6)

**STEEL END SECTION FOR CONCRETE PIPE**  
 (Alternate for Concrete End Section)  
 (R-6)


**END SECTION AND CONNECTION DETAIL FOR CORRUGATED STEEL PIPE ARCH CULVERT**  
 (R-6)

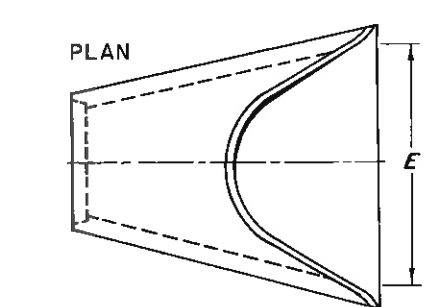


PIPE I. D. in.	DIMENSIONS				
	A in.	B in.	C in.	D in.	E in.
12	5 1/2	23	49	72	24
15	7	26	47	73	29
18	11 1/2	26	48	74	36
24	12	43	54	97	48
30	17	53	43	96	60
36	18	60	37	97	71
42	24	61	36	97	78
48	28	70	28	98	84
54	27	65	35	100	90
60	36	58	40	98	96
72	34 1/2	75	21	96	108

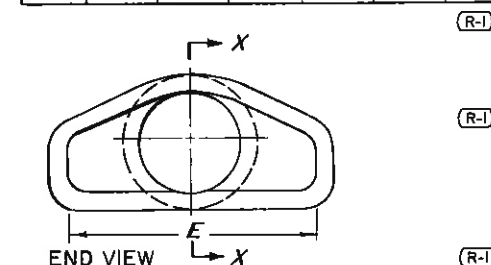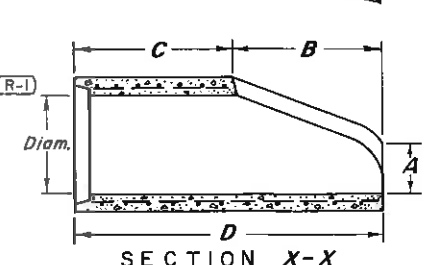

**END SECTION FOR REINFORCED CONCRETE CIRCULAR PIPE**  
 (R-1)

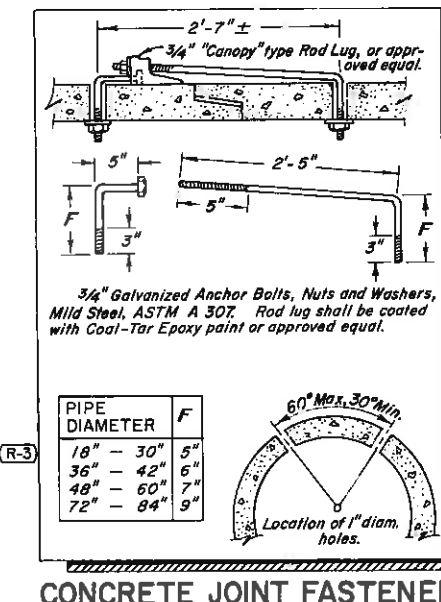


**CONCRETE JOINT FASTENER**  
 (R-4)

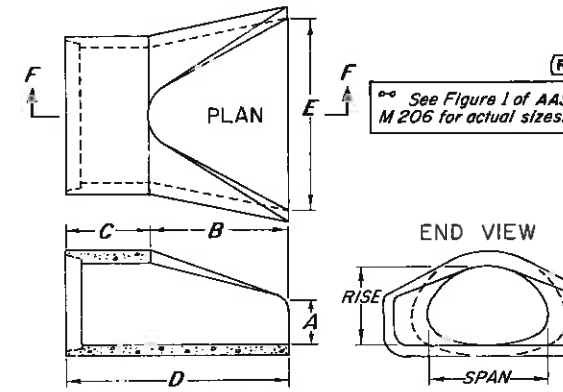

EQUIVALENT CIRCULAR DIAM. (Inches)	NOMINAL (in.)		DIMENSIONS (Inches)				
	SPAN	RISE	A	B	C	D	E
24	29	18	8 1/2	39	33	72	48
30	36	22	9 1/2	50	46	96	60
36	43	27	11 1/2	60	36	96	72
42	50	31	15 1/8	60	36	96	78
48	58	36	21	60	36	96	84
54	65	40	25 1/2	60	36	96	90
60	72	44	31	60	36	96	96
72	88	54	31	60	39	99	120

**END SECTION FOR REINFORCED CONCRETE ARCH PIPE**  
 (R-1)

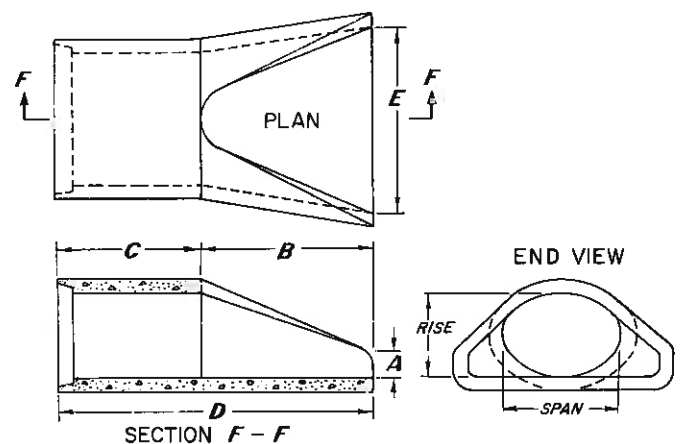

EQUIVALENT CIRCULAR DIAM. (Inches)	NOMINAL (in.)		DIMENSIONS (Inches)				
	SPAN	RISE	A	B	C	D	E
24	30	19	8 1/2	39	33	72	48
30	38	24	9 1/2	54	18	72	60
36	45	29	11 1/8	60	24	84	72
42	53	34	15 3/4	60	36	96	78
48	60	38	21	60	36	96	84
54	68	43	25 1/2	60	36	96	90
60	76	48	30	60	36	96	96

**END SECTION FOR REINFORCED CONCRETE ELLIPTICAL PIPE**  
 (R-1)

**DEPARTMENT OF HIGHWAYS**  
**STATE OF COLORADO**  
**DIVISION OF HIGHWAYS**  
**CONCRETE AND METAL**  
**END SECTIONS**

Designed by M.R.H. Approved by J.R.B.  
 Made by J.R.B. Staff Design Engineer (ASCE)  
 Checked by R.S.M. Date: November 10, 1967

# STANDARD M-603-MA

(JANUARY 11, 1974)

FEDERAL ROAD REGION NO.	DIVISION	PROJ. NO.	SHEET NO.	TOTAL SHEETS
VIII	COLORADO			

REVISIONS				
(R-1)	8-20-75	Gen'l. Notes & Table IV.		M.R.H.

## FILL HEIGHT & THICKNESS TABLES FOR METAL CULVERT PIPE


**TABLE I CORRUGATED STEEL PIPE**  
2<sup>2</sup>/<sub>3</sub>-inch by 1/2-inch Corrugations  
Riveted, Welded or Helical Fabrication

Pipe Diameter (inches)	Minimum Cover, Top of Pipe to Top of Subgrade (inches)	Maximum Fill Heights above Top of Pipe in Feet				
		Minimum Thickness Required (Decimal inches)				
		0.064	0.079	0.109	0.138	0.168
12	12	84	91	—	—	—
15	12	67	73	—	—	—
18	12	56	61	—	—	—
24	12	42	46	59	—	—
30	12	34	36	47	—	—
36	12	28	30	39	41	—
42	12	31	43	46 (67)	48 (70)	50 (73)
48	12	27	37	45 (58)	46 (61)	47 (64)
54	12	—	33	43 (52)	44 (54)	45 (57)
60	12	—	—	43 (47)	43 (49)	44 (51)
66	12	—	—	42	43	43 (47)
72	12	—	—	—	41	43
78	12	—	—	—	—	39
84	12	—	—	—	—	35

Values for elongated pipe are shown in parentheses.


**TABLE II CORRUGATED STEEL PIPE ARCH**  
2<sup>2</sup>/<sub>3</sub>-inch by 1/2-inch Corrugations  
Riveted, Welded or Helical Fabrication

Pipe Dimensions Span x Rise (inches)	Equiv. Diameter (inches)	Corner Radius (inches)	Minimum Cover, Top of Pipe to Top of Subgrade for 2 Tons per sq. ft. (inches)	Minimum Thickness Required (Decimal inches)	Maximum Fill Heights above Top of Pipe in Feet	
					Corner Bearing Pressure in Tons per Square Foot	
					*2 Tons	3 Tons*
17 x 13	15	3	18	0.064	13	15+
21 x 15	18	3	18	0.064	12	15+
24 x 18	21	3	18	0.064	10	15+
28 x 20	24	3	18	0.064	10	15
35 x 24	30	3	18	0.064	9	14
42 x 29	36	3 1/2	18	0.064	9	13
49 x 33	42	4	18	0.079	8	12
57 x 38	48	5	18	0.109	8	12
64 x 43	54	6	18	0.109	8	12
71 x 47	60	7	18	0.138	8	12
77 x 52	66	8	18	0.168	8	12
83 x 57	72	9	18	0.168	9	13

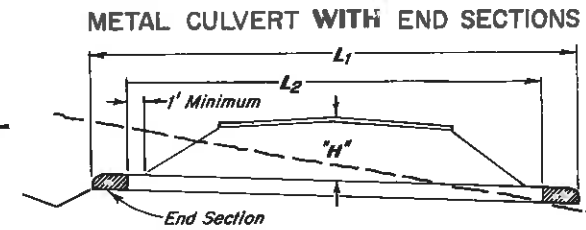

"H" = Maximum height of fill over top of Culvert, including pavement.  
 L<sub>1</sub> = Length of Culvert to be measured when placed in accordance with Section 617.  
 L<sub>2</sub> = Length of pipe to be measured when placed in accordance with Section 603.  
 Length of extension, when placed in accordance with Section 617, shall be the actual number of feet of new culvert required.

**METAL CULVERT WITHOUT END SECTIONS**

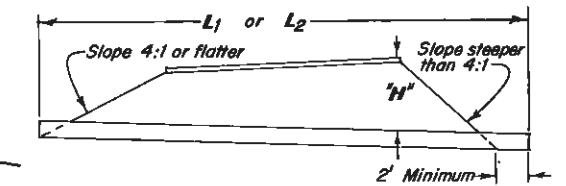

**TABLE III CORRUGATED STEEL PIPE**  
3-inch by 1-inch Corrugations  
Riveted, Welded, Helical or Bolted Fabrication

Pipe Diameter (inches)	Minimum Cover, Top of Pipe to Top of Subgrade (inches)	Maximum Fill Heights above Top of Pipe in Feet*				
		Minimum Thickness Required (Decimal inches)				
		0.064	0.079	0.109	0.138	0.168
36	12	48	60	78 (88)	89 (106)	101 (118)
42	12	41	51	64 (76)	71 (91)	79 (101)
48	12	36	45	57 (66)	61 (80)	66 (88)
54	12	32	40	52 (59)	55 (71)	59 (79)
60	12	29	36	49 (53)	51 (64)	54 (71)
66	12	26	33	47	49 (58)	51 (64)
72	12	24	30	44	47 (53)	49 (59)
78	12	22	28	41	46 (49)	47 (54)
84	12	21	26	38	45	46 (51)
90	12	19	24	35	43	45
96	12	18	22	33	40	44
102	24	17	21	31	38	42
108	24	—	20	30	35	39
114	24	—	19	28	34	37
120	24	—	—	27	32	35

\* Fill heights greater than 90' shall be used only after thorough investigation of foundation material.

**TABLE IV CORRUGATED STEEL PIPE ARCH**  
3-inch by 1-inch Corrugations  
Riveted, Welded or Helical Fabrication

Pipe Dimensions Span x Rise (inches)	Equiv. Diameter (inches)	Corner Radius (inches)	Minimum Cover, Top of Pipe to Top of Subgrade for 2 Tons per sq. ft. (inches)	Minimum Thickness Required (Decimal inches)	Maximum Fill Heights above Top of Pipe in Feet	
					Corner Bearing Pressure in Tons per Square Foot	
					*2 Tons	3 Tons*
43 x 27	36	5	18	0.064	12	15+
50 x 31	42	6	18	0.064	12	15+
58 x 36	48	7	18	0.064	12	15+
65 x 40	54	8	18	0.064	12	15+
72 x 44	60	9	18	0.064	12	15+
73 x 55	66	12	18	0.064	15+	—
81 x 59	72	14	18	0.079	15	—
87 x 63	78	14	18	0.079	14	15+
95 x 67	84	16	18	0.109	13	15+
103 x 71	90	16	24	0.109	12	15+
112 x 75	96	18	24	0.109	11	15+
117 x 79	102	18	24	0.109	10	15
128 x 83	108	18	24	0.138	9	14


(R-1)

**TABLE V CORRUGATED ALUMINUM PIPE ARCH**  
2<sup>2</sup>/<sub>3</sub>-inch by 1/2-inch Corrugations  
Riveted, Welded or Helical Fabrication

Pipe Dimensions Span x Rise (inches)	Equiv. Diameter (inches)	Corner Radius (inches)	Minimum Cover, Top of Pipe to Top of Subgrade for 2 Tons per sq. ft. (inches)	Minimum Thickness Required (Decimal inches)	Maximum Height of Fill above Top of Pipe in Feet	
					Corner Bearing Pressure in Tons per Square Foot	
					*2 Tons	3 Tons*
18 x 11	15	4	18	0.060	15	—
22 x 13	18	4	18	0.060	14	—
25 x 16	21	4 1/2	18	0.060	12	15+
29 x 18	24	4 1/2	18	0.060	10	15+
36 x 22	30	5	18	0.060	9	14
43 x 27	36	5 1/2	18	0.075	9	13
50 x 31	42	6	18	0.105	8	12
58 x 36	48	7	18	0.135	8	12
65 x 40	54	8	18	0.135	8	12
72 x 44	60	9	18	0.164	8	12

\* In the absence of a Bearing Pressure Report use fill heights listed under "2 Tons". Where bearing pressures exceeding 2 tons per square foot are required for given fill heights, the foundation material shall be investigated to determine its bearing capacity.

### INSTALLATION OF METAL CULVERT PIPE

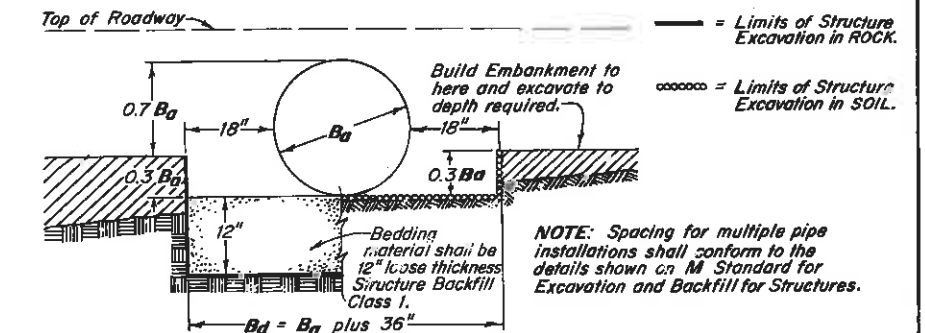

### GENERAL NOTES

- All work shall be done in accordance with the Standard Specifications applicable to the project.
- The tables on this sheet show minimum thickness for structural requirements only. They are intended for use only where corrosive and/or abrasive conditions are negligible. Heavier metal and/or protective coatings shall be used where site investigations indicate corrosive and/or abrasive conditions.
- Pipe arch with equal periphery and with span and rise dimensions approximately equal to those required by plans will be permitted.
- During construction, adequate cover shall be provided to protect the structure from damage.
- Pipe shall be placed with longitudinal seams at the sides or quarter points but not along top of vertical axis.
- When a culvert is to be extended with pipe of different material, the connection shall conform to the details on plans or be approved.
- Structural plate pipes of equal or larger diameter, conforming to Section 510 of the Standard Specifications, may be substituted for the pipes shown on this sheet at no additional cost to the State.
- Variations from corner radii shown will be acceptable provided the pipe is of sufficient strength to support its designated fill height.
- The minimum depth of fill excluding pavement over corrugated metal pipe culvert shall be as stated by the Engineer, but shall not be less than shown in the Fill Height Tables.
- Extensions for CSP Arch Culvert shall match the dimensions of the culvert shown on plans.
- Backfill and compaction shall be in accordance with Section 206.

**TRENCH INSTALLATION**  
 Installation and Maximum Fill Heights shall conform to the M Standard for "Pipe Sewer in Trench."

**TABLE VI CORRUGATED ALUMINUM PIPE**  
2<sup>2</sup>/<sub>3</sub>-inch by 1/2-inch Corrugations  
Riveted, Helical or Spot Welded Fabrication

Pipe Diameter (inches)	Minimum Cover, Top of Pipe to Top of Subgrade (inches)	Maximum Fill Heights above Top of Pipe in Feet						
		Riveted or Helical Fabrication				Spot Welded Fabrication		
		Minimum Thickness Required (Decimal inches)						
		0.060	0.075	0.105	0.135	0.164	0.060	0.075
12	12	45	45	78	81	84	26	33
18	12	30	30	52	54	56	18	22
24	12	22	22	39	41	42	14	16
30	12	18	18	31	32	34	11	13
36	12	15	15	26	27	28	9	11
42	12	—	26	43	43	44	—	—
48	12	—	—	40	41	43	—	—
54	12	—	—	35	37	38	—	—
60	12	—	—	—	33	34	—	—
66	12	—	—	—	30	31	—	—
72	12	—	—	—	—	29	—	—

DEPARTMENT OF HIGHWAYS  
 STATE OF COLORADO  
 DIVISION OF HIGHWAYS

**METAL CULVERT PIPE**  
 H-20 LOADING

Designed by M.R.H. Approved by J.M.M. Cox  
 Made by J.R.B. Staff Design Engineer  
 Checked by O.L.S. Date: January 11, 1974


# STANDARD M-604-DA

(SEPTEMBER 20, 1976)

FEDERAL ROAD REGION NO.	DIVISION	PROJ. NO.	SHEET NO.	TOTAL SHEETS
VII	COLORADO			
REVISIONS				


## TYPICAL CAST ALUMINUM STEP

This material shall conform to ASTM B26 for Aluminum Alloy 535.0-F.

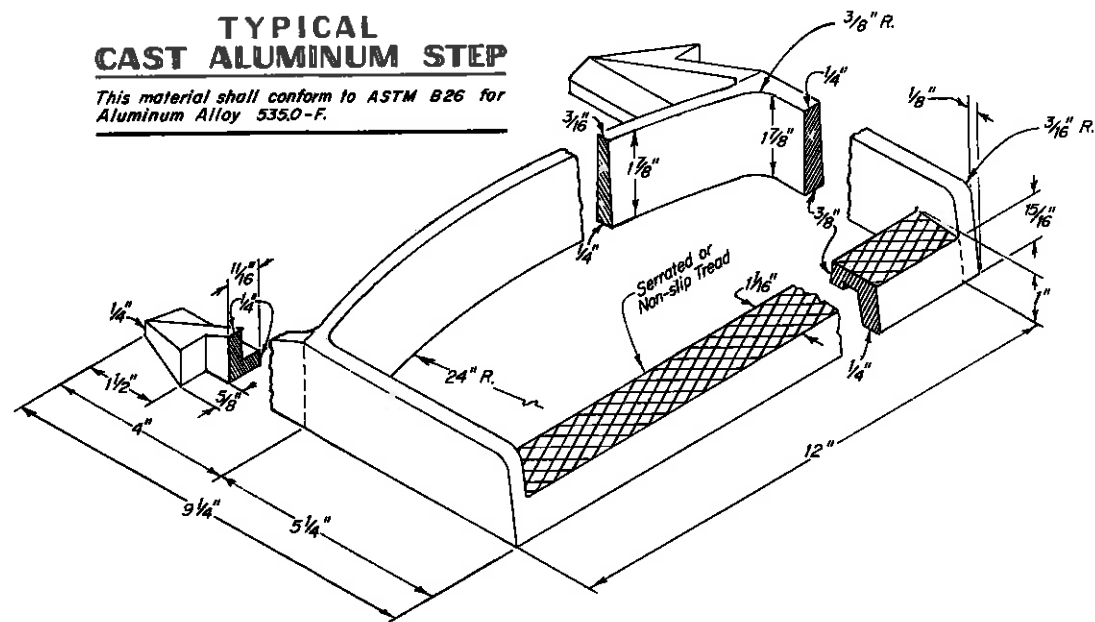


## TYPICAL EXTRUDED ALUMINUM STEP

This material shall conform to Federal Specification QQ-A-200/B for Aluminum Alloy 6061, T6510 or T6511.

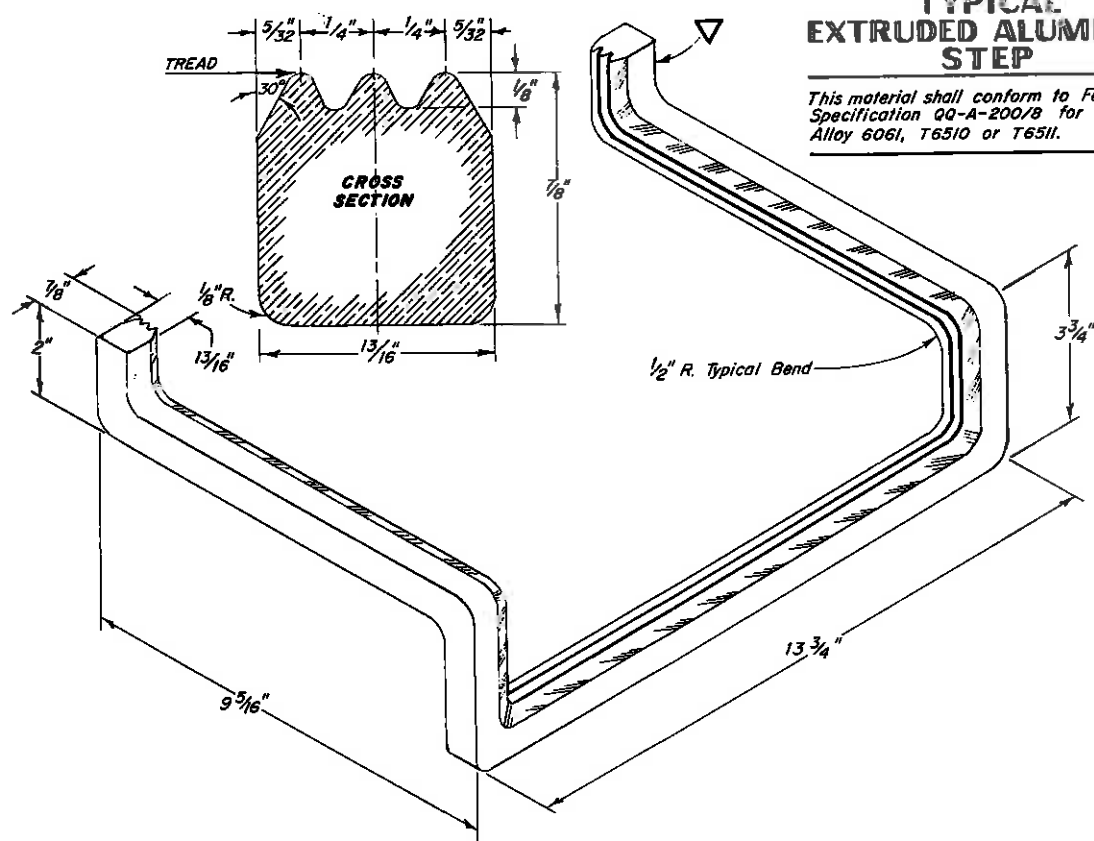


## TYPICAL DEFORMED REINFORCING BAR OR MILD STEEL STEP

Step shall be made from 3/4" diameter Deformed Reinforcing Steel Bar conforming to AASHTO M31, Grade 40 or made from Mild Steel conforming to ASTM A36. Steps shall be galvanized in accordance with AASHTO M111.

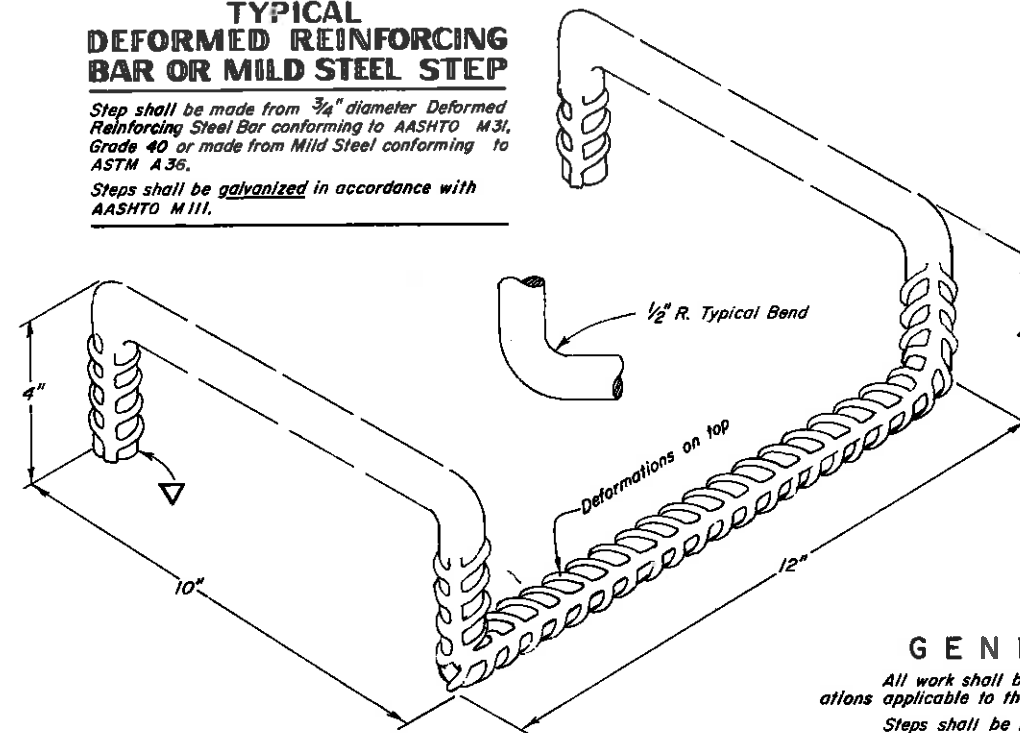

## GENERAL NOTES

All work shall be done in accordance with the Standard Specifications applicable to the project.  
 Steps shall be included in the cost of "Manholes" or "Inlets".  
 Cast Iron Steps will not be permitted.  
 All Steps shall conform to the requirements of AASHTO M199.

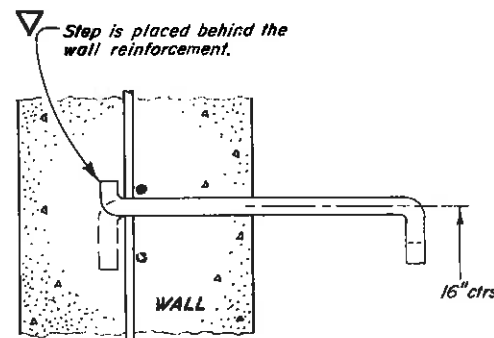

## TYPICAL STEP INSTALLATION FOR BAR STEPS

DEPARTMENT OF HIGHWAYS  
 STATE OF COLORADO  
 DIVISION OF HIGHWAYS

## STEPS FOR MANHOLES & INLETS

Designed by T.A.L. Approved by D.L. Vernon  
 Made by J.R.B. Staff Design Engineer  
 Checked by O.L.S. Date: September 20, 1976




# STANDARD M-604-H

(OCTOBER 31, 1974)


FEDERAL ROAD REGION NO.	DIVISION	PROJ. NO.	SHEET NO.	TOTAL SHEETS
XII	COLORADO			


REVISIONS	

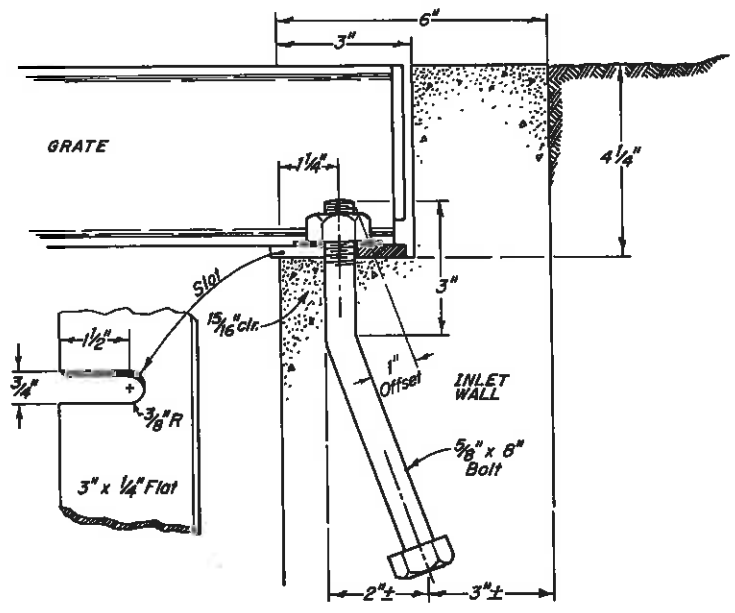

GRATE INSTALLATION DETAIL

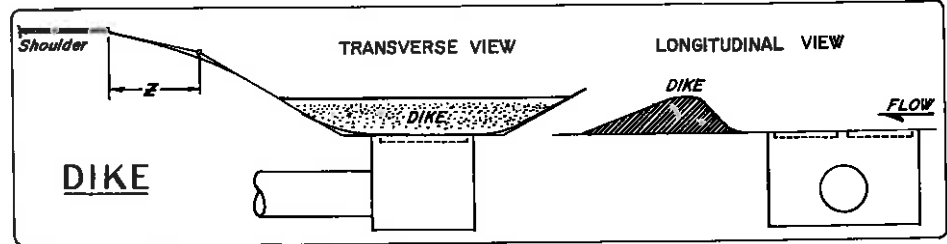

DIKE

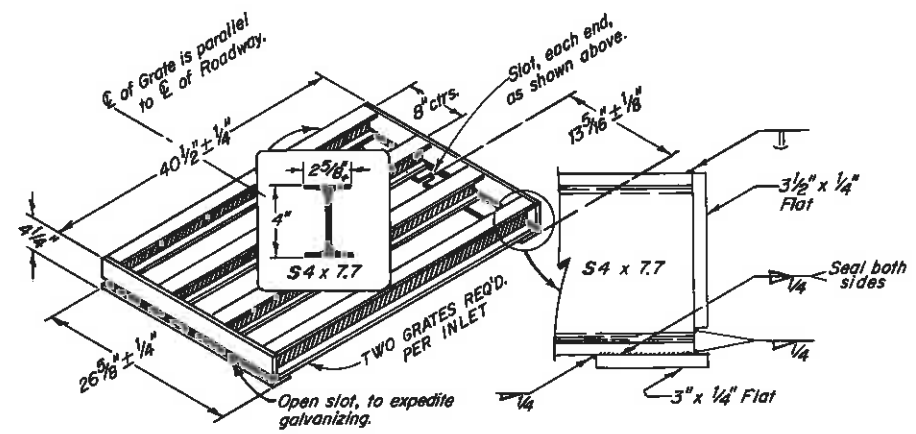


TYPE "C" INLET GRATE


QUANTITIES: 2 STEEL GRATES-ONE INLET

NO. PIECES	DESCRIPTION	LENGTH	Lb. per Ft.	WEIGHT (lbs.)
8	S4 x 7.7 Beam	40"	7.70	206
4	3 1/2 x 1/4 Flat	26 5/8"	2.98	26
4	3 x 1/4 Flat	26 5/8"	2.55	24
TOTAL				256 lbs.

## INLET, TYPE D

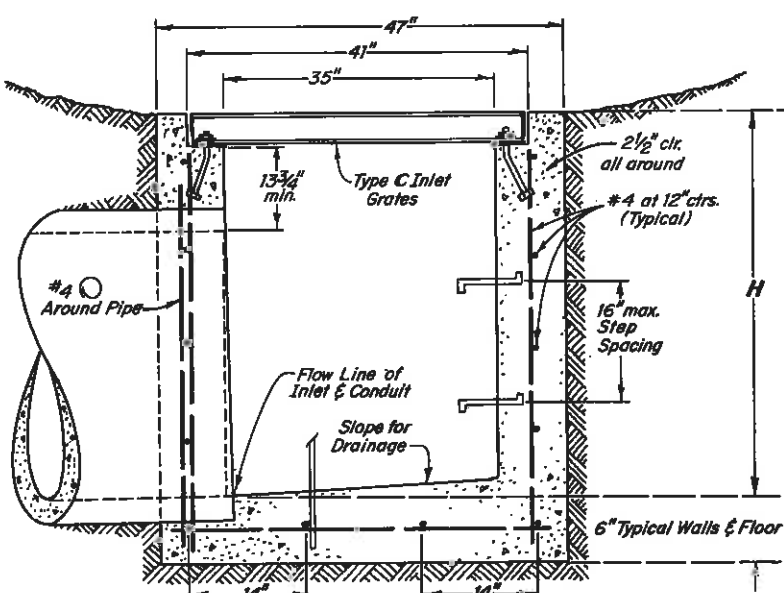

TRANSVERSE CROSS SECTION

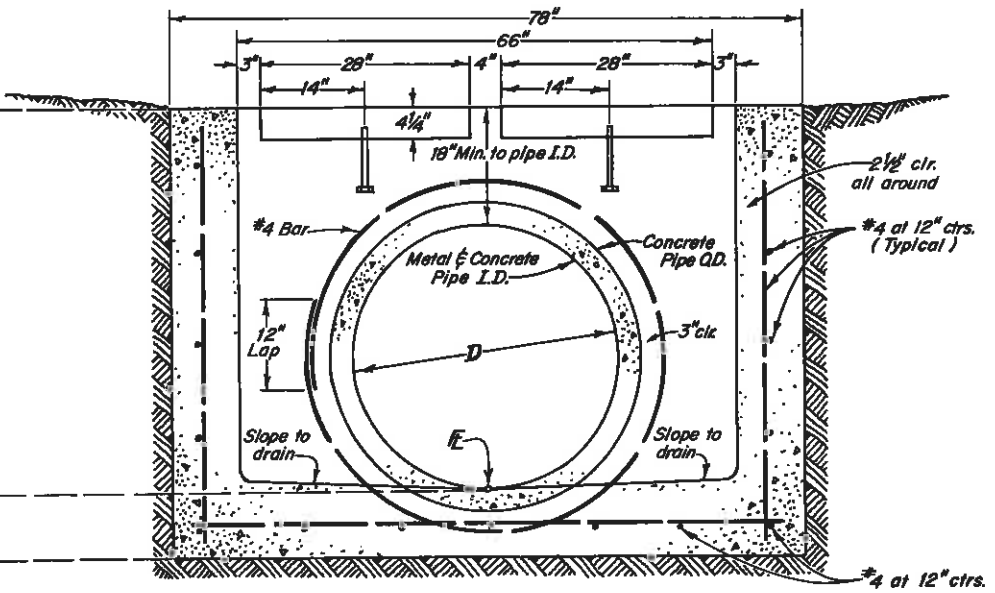

LONGITUDINAL CROSS SECTION

### GENERAL NOTES


- All work shall be done in accordance with the Standard Specifications applicable to the project.
- Concrete shall be Class A, B, or D.
- See plans for size and location of Conduit.
- Inlet Grating shall be galvanized as described for Frames, Grates, Covers & Steps in Section 712.
- All exposed concrete surfaces shall receive Class I finish.
- Footings in rock shall be poured out to rock and not formed.
- Inlet may be Cast-In-Place or Precast.
- Steps will be required when Inlet "H" exceeds 3'-6".
- For detail of Inlet Step, see Standard M-604-D.
- Steps shall be included in the cost for "Inlet, Type D".
- Grating shall conform to Section 604.

### QUANTITIES FOR ONE INLET

H ft.	CONCRETE cu. yd.	STEEL lb.	PIPE RANGE, D in.		STEEL RING		NO. STEPS REQ'D.
			CSP	RCP	CSP lb.	RCP lb.	
3.0	1.5	109	18	18	5	6	0
3.5	1.7	115	18-24	18-24	6	7	0
4.0	1.9	134	18-30	18-30	7	9	1
4.5	2.0	140	18-36	18-36	9	10	1
5.0	2.2	159	18-42	18-42	10	11	2
5.5	2.4	165	18-48	18-48	11	12	2
6.0	2.6	184	18-54	18-48	12	12	2
6.5	2.7	190	18-60	18-48	13	12	3
7.0	2.9	209	18-66	18-48	14	12	3
7.5	3.1	215	18-66	18-48	14	12	4
8.0	3.3	234	18-66	18-48	14	12	4
8.5	3.4	240	18-66	18-48	14	12	4
9.0	3.6	259	18-66	18-48	14	12	5
9.5	3.8	265	18-66	18-48	14	12	5
10.0	4.0	284	18-66	18-48	14	12	5

Concrete and Steel quantities are for ONE entire Inlet before deduction for volume occupied by pipe.

\* Steel Ring weights are for the maximum pipe D shown.

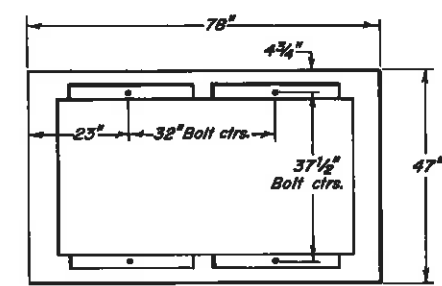

PLAN VIEW  
SHOWING ANCHOR BOLT LAYOUT

DEPARTMENT OF HIGHWAYS  
 STATE OF COLORADO  
 DIVISION OF HIGHWAYS

## INLET, TYPE D


Designed by M R H      Approved by D. J. Dorman  
 Made by J R B      Staff Design Engineer  
 Checked by O L S      Date: October 31, 1974




# STANDARD M-707-CB

(JANUARY 25, 1978)

FEDERAL ROAD REGION NO.	DIVISION	PROJ. NO.	SHEET NO.	TOTAL SHEETS
VIII	COLORADO			
REVISIONS				


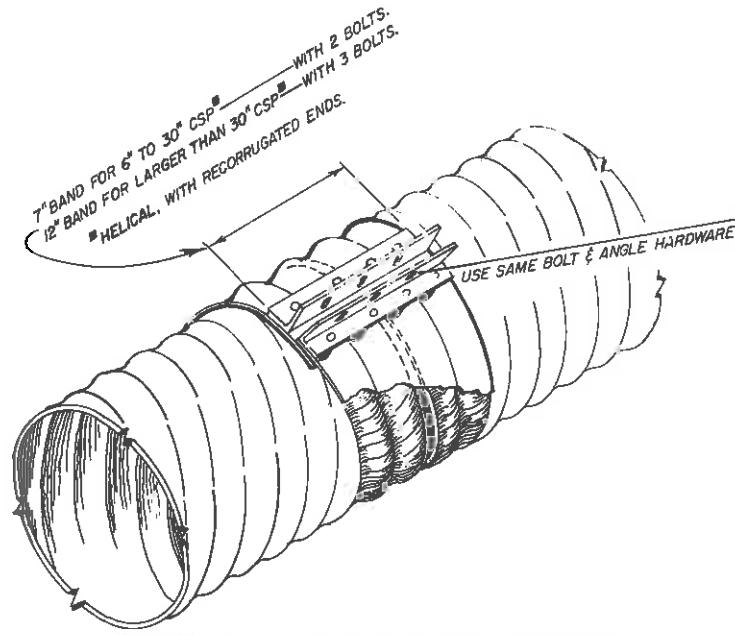


**TYPICAL ANNULAR BAND FOR HELICAL PIPE WITH RECORRUGATED ENDS**

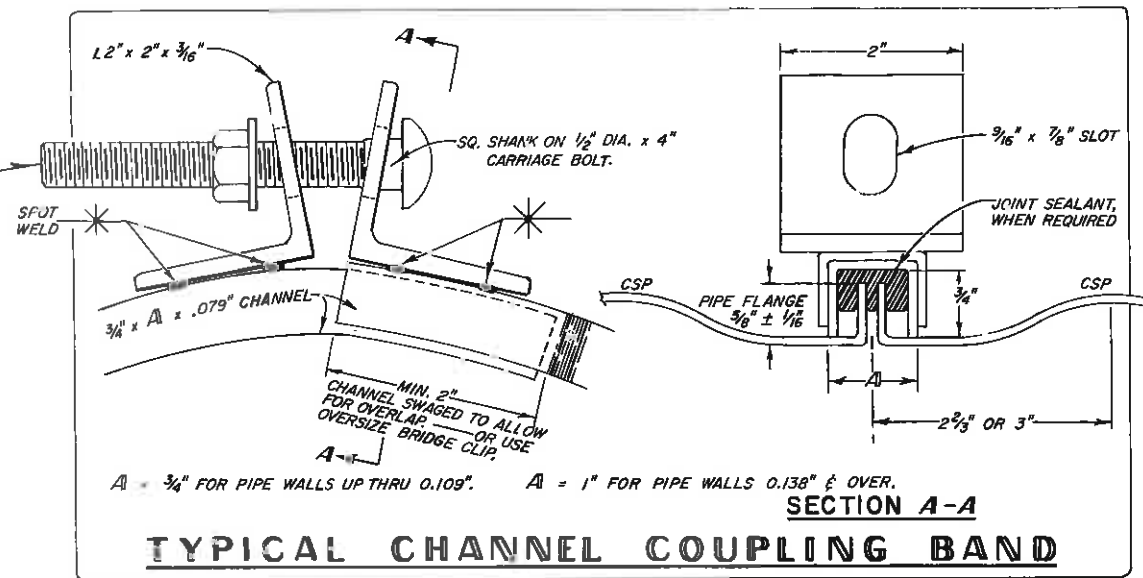

**TYPICAL CHANNEL COUPLING BAND**


PIPE DIAM.	CULVERT WALL	CORRUGATION	t
THRU 72"	.064" TO .168"	2 1/2" x 1 1/2"	.052"
78" THRU 84"	.168"	2 1/2" x 1 1/2"	.064"
48" THRU 84"	.064" TO .109"	3" x 1"	.052"
90" THRU 120"	.079" TO .109"	3" x 1"	.064"

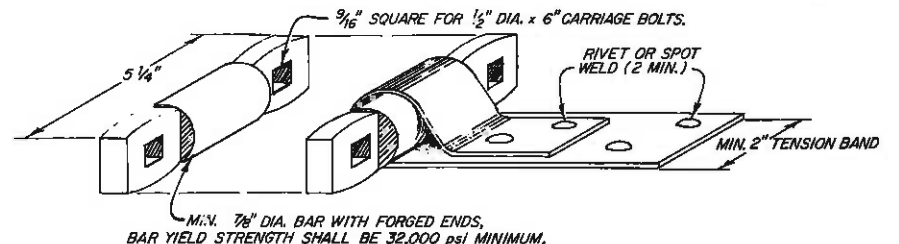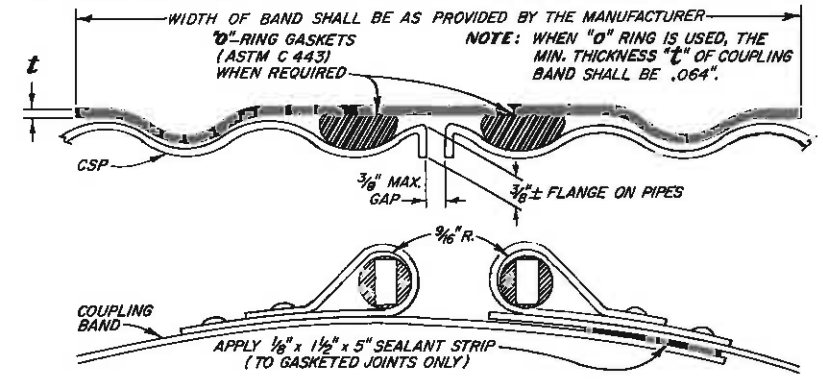


**TYPICAL ALTERNATIVE ANNULAR COUPLING BAND**

### GENERAL NOTES


- All work shall be done in accordance with the Standard Specifications & AASHTO M 36 except as shown hereon.
- All Coupling Band connection hardware shall be galvanized or electropated in accordance with the Standard Specifications.
- For Pipe Arches use the same width band as for round pipe of equal periphery. Dimensions and thicknesses are minimum.
- TOLERANCE:** Inside pipe diameters shall not vary more than 1/2" for all sizes of pipe. Spot welds shall develop minimum required strength of strap or angle.
- DISCLAIMER:** Infringement on patented couplings shall be the Contractor's responsibility in accordance with Subsection 107.03.

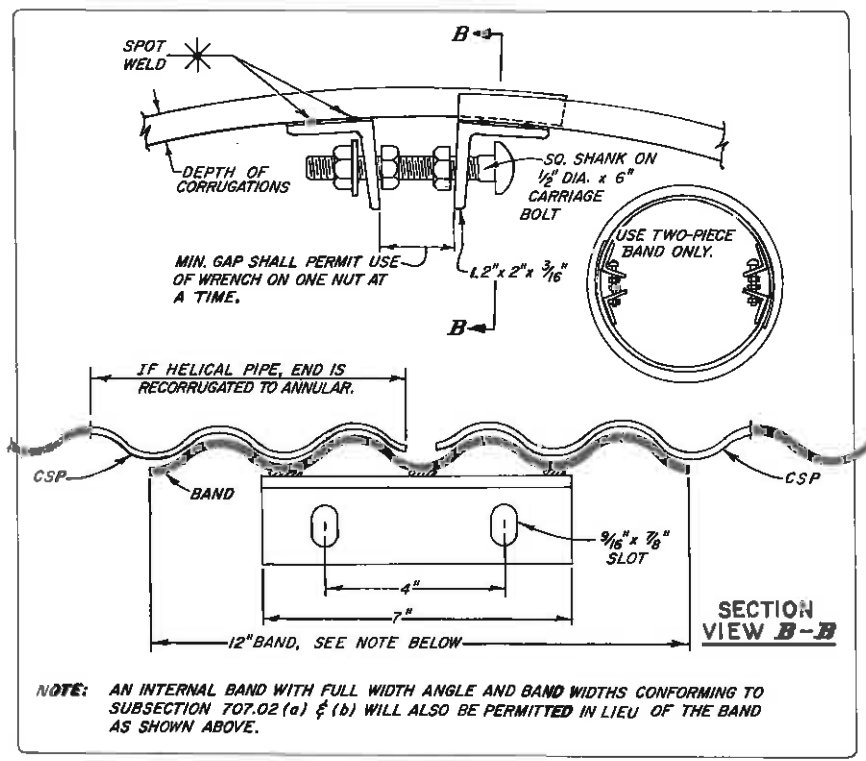

**TYPICAL INTERNAL ANNULAR COUPLING BAND**

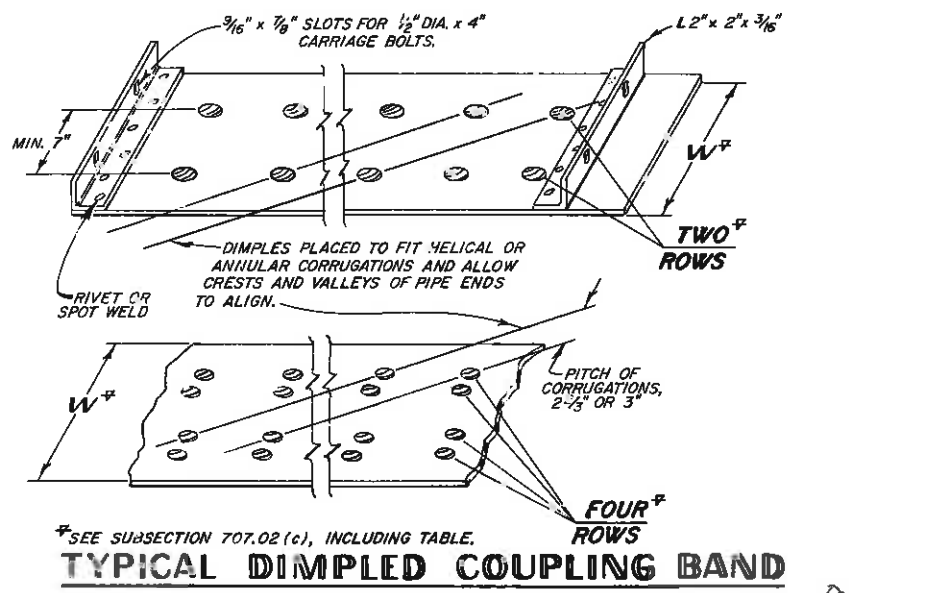

**TYPICAL DIMPLED COUPLING BAND**

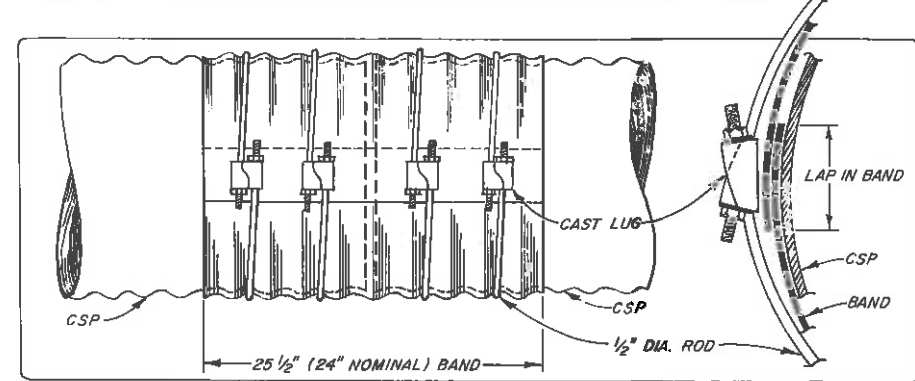

**TYPICAL SIPHON COUPLING BAND**

DEPARTMENT OF HIGHWAYS  
 STATE OF COLORADO  
 DIVISION OF HIGHWAYS

**TYPICAL ALTERNATE COUPLING BANDS FOR CORRUGATED CULVERT PIPE**

Designed by ABCR & OLS  
 Made by JRB  
 Checked by T A L

Approved by J. J. Johnson  
 Staff Design Engineer  
 Date: January 25, 1978


# STANDARD S - 614 - 19B

NOVEMBER 18, 1970

FEDERAL ROAD DISTRICT NO.	DESIGN NO.	PROJECT NO.	DATE

REVISIONS		
(R-1)	11-17-71	Table J.D.S.

## WARNING SIGN PLACEMENT

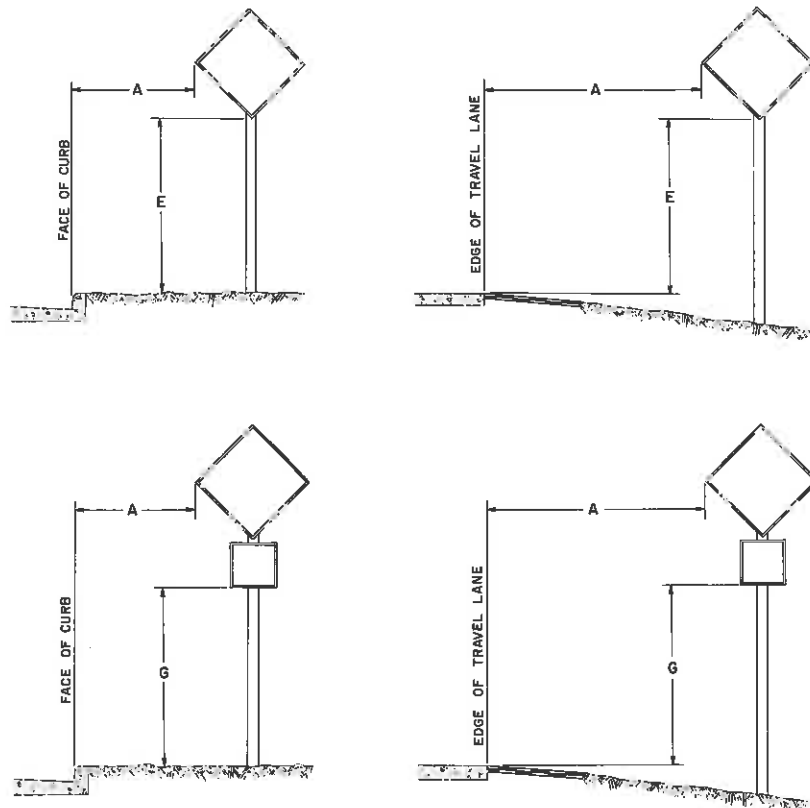


## CLASS III SIGN PLACEMENT




## GENERAL NOTES

1. All work shall be done in accordance with the Standard Specifications applicable to the project.
2. The Engineer shall establish grades and locations for all sign posts in accordance with details shown on the plans.
3. Special care shall be taken in sign location to ensure an unobstructed view of each sign.
4. Signs shall be set to provide as much lateral clearance as existing conditions permit but shall not exceed maximum clearances as shown in the LATERAL PLACEMENT TABLE.
5. The lateral placement for all signs may be reduced to a minimum of 2 ft. outside of the shoulder edge or face of curb where necessary to fit field conditions or improve sight distance.
6. Minimum post embedment shall be 3 ft. for U-2 posts and 4x4" timber posts, and 5 ft. for 6x6" timber posts. For footing depth see applicable Standard.


## CLASS III SIGNS PANEL GROUND CLEARANCE

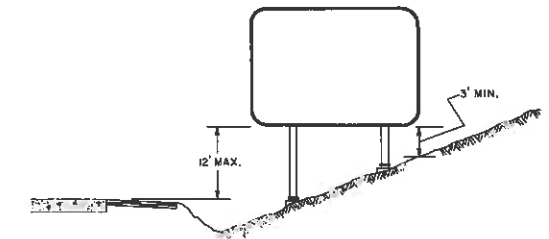

## REGULATORY SIGN PLACEMENT

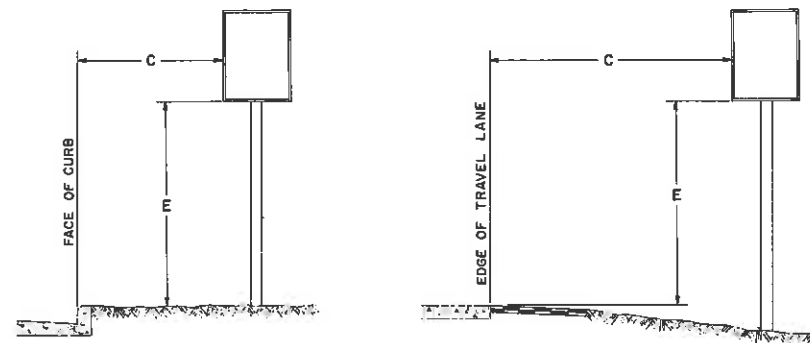

## TYPICAL LOCATIONS STOP SIGNS AND YIELD SIGNS

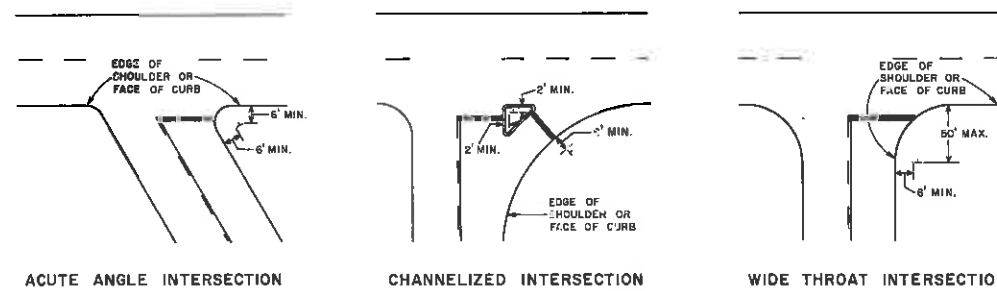



## PLACEMENT TABLES

KEY	LATERAL		(R-1) VERTICAL			
	MIN.	MAX.	INTERSTATE	EXPRESSWAY	NON-EXPRESSWAY	
			URBAN	RURAL	URBAN	RURAL
A	*	22'-0"	7'-0"	6'-0"	7'-0"	5'-0"
B	*	30'-0"	7'-0"	5'-0"	7'-0"	5'-0"
C	*	16'-0"	—	—	—	—
D	5'-0"	7'-0"	7'-0"	6'-0"	7'-0"	5'-0"
E	6'-0"	7'-0"	7'-0"	5'-0"	7'-0"	5'-0"
F	8'-0"	—	—	—	—	—
G	6'-0"	6'-0"	6'-0"	4'-0"	6'-0"	4'-0"
H	5'-0"	4'-0"	4'-0"	4'-0"	4'-0"	4'-0"


\* In no case shall any part of a sign be less than 2 ft. beyond any surface prepared for normal or emergency travel of vehicles.

\*\* When lateral placement is minimum, "D" shall be 7'-0".

## ROUTE MARKER ASSEMBLY PLACEMENT

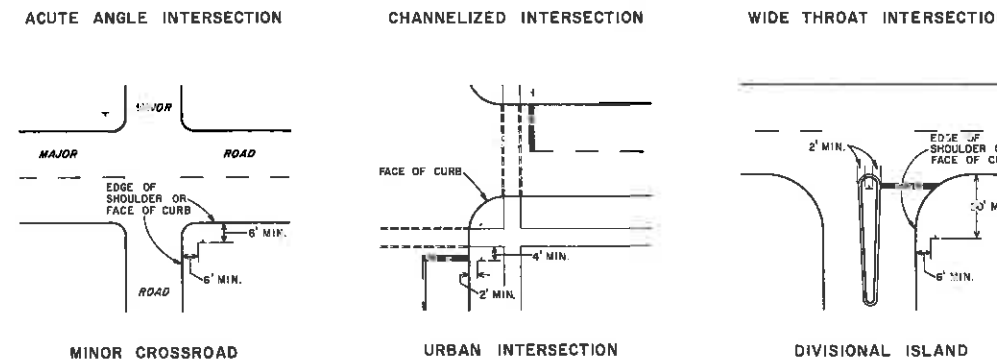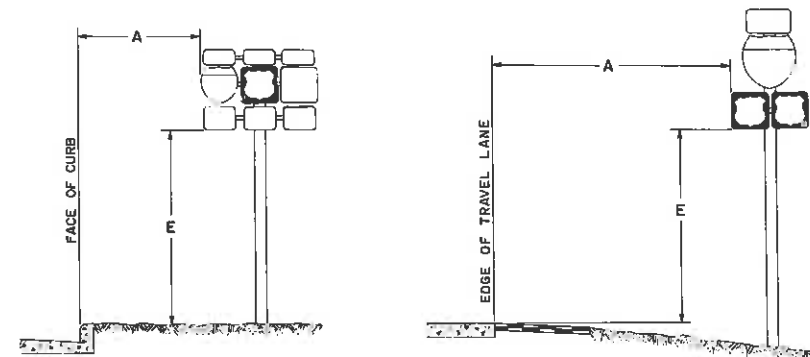

## ANGULAR PLACEMENT (ALL GROUND SIGNS)

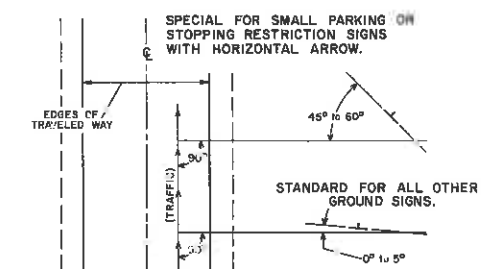

DEPARTMENT OF HIGHWAYS  
 STATE OF COLORADO  
 DIVISION OF HIGHWAYS

### TYPICAL GROUND SIGN PLACEMENT

Designed By: J. J. S. Approved By: *[Signature]*  
 Made By: J. E. M. Traffic Engineer  
 Checked By: J. J. B. Date: *Nov 18, 1970*


# STANDARD S-614-20B

JULY 1, 1968

FEDERAL ROAD REGION NO.	DIVISION	PROJ. NO.	SHEET NO.	TOTAL SHEETS
III	COLORADO			

REVISIONS		
(R-1)	11-17-71	Illustrations & Note J.D.S.
(R-2)	10-6-72	Rev post, Add note J.D.S.
(R-3)	11-2-73	Rev. Illustrations J.D.S.


## TYPICAL CLASS I GROUND SIGN INSTALLATIONS

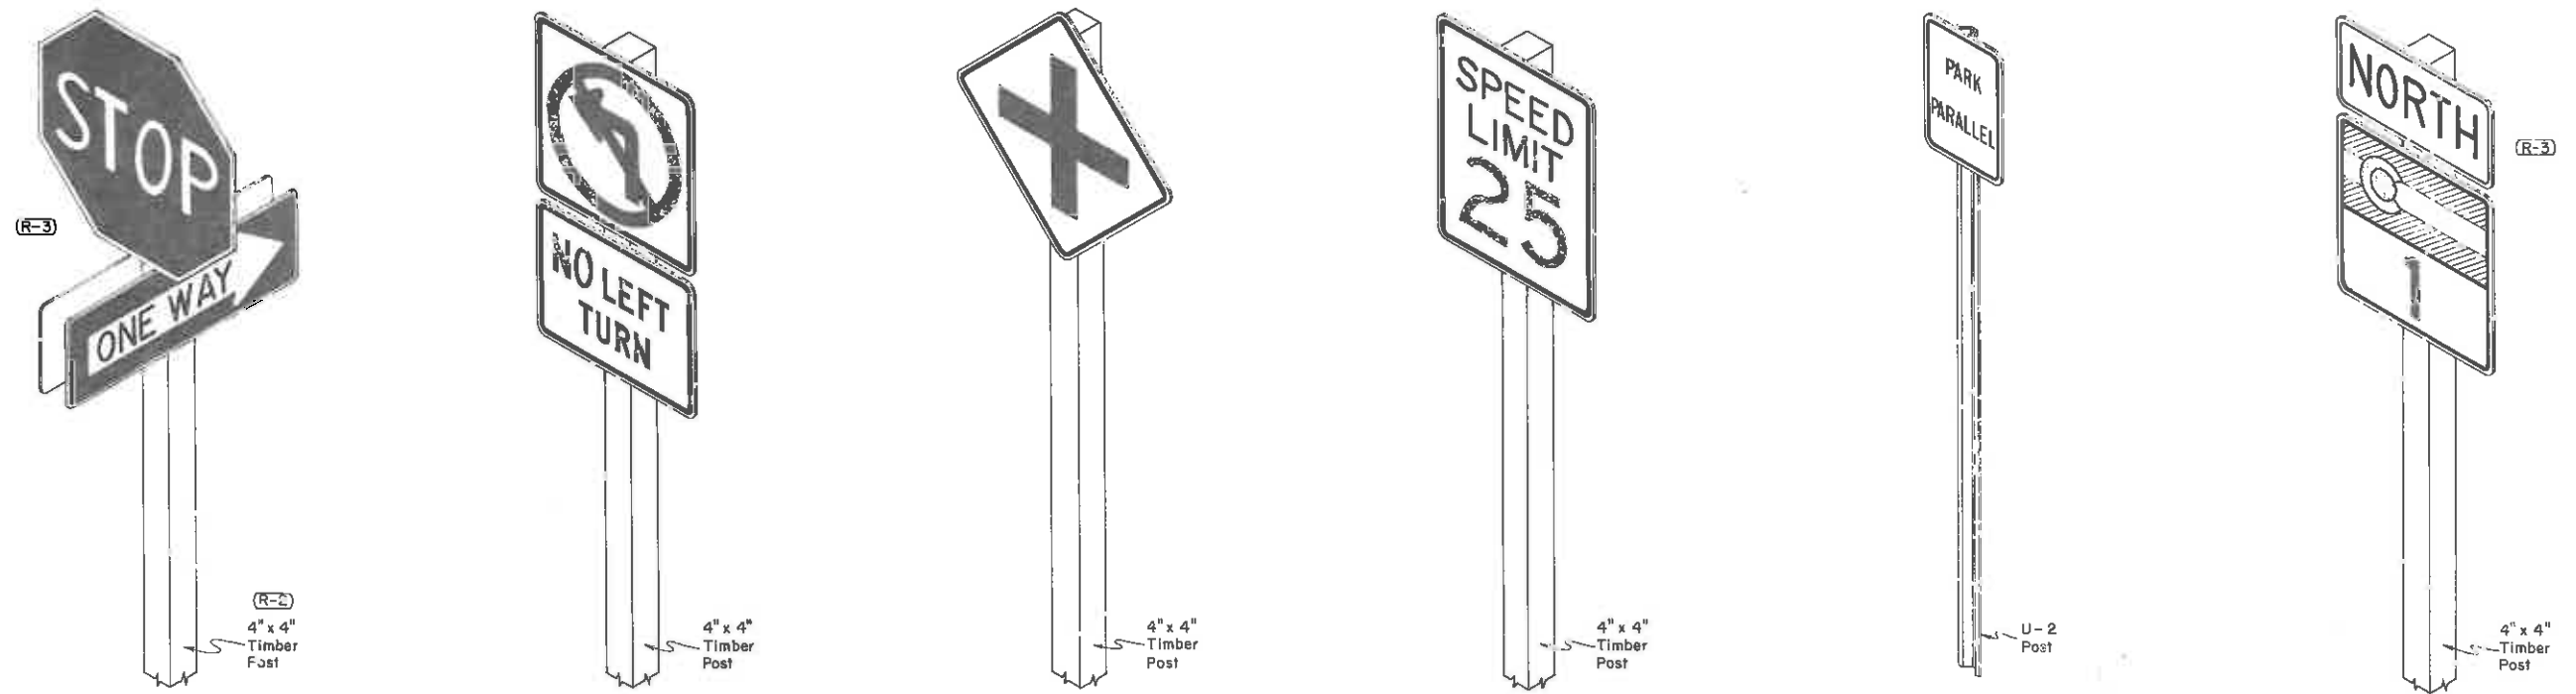


### GENERAL NOTES

- All work shall be done in accordance with the Standard Specifications applicable to the Project.
- All Class I sign panels shall be either sheet steel, 0.0598" minimum thickness, or sheet aluminum, 0.100" minimum thickness.
- Class I sign panels shall be fastened directly to the post. Fasten to U-2 post with 2 - 1/4" stove bolts and to timber posts with 2 - 3/8" machine bolts. See appropriate Standard for exceptions.
- A plastic fiber washer shall be placed between the bolt head and the face of the sign panel. Use a C.I.O.G. washer under the nut on the back of the timber post.
- Bolts, nuts and metal washers shall be galvanized or cadmium plated.
- Exposed bolt heads and fiber washers on the face of the sign panel shall be painted or reflectorized to match the surrounding color.
- (R-2) All reflective sheeting shall be of the Smooth Surface Type.
- For sign placement see appropriate Standard.
- (R-1) Steel posts shall meet requirements of Paragraph 4.5 U.S. Department of Commerce Commercial Standard 184-51. Re-rolled rails will not be permitted. U-2 post to weigh 2 lbs./ft. A mill tolerance of minus 1/2% of the weight of any one post will be allowed. Alternate post acceptable if section modulus is at least 0.200 in<sup>3</sup> about the X-X axis and at least 0.250 in<sup>3</sup> about the Y-Y axis.
- For additional information, refer to "TABULATION OF SIGNS". Timber posts shall be 4"x4" or 6"x6" as noted therein and shall conform to Standard Dressed (S4S) Sizes.
- (R-2) Vertical spacing between panels on the same post shall be 1" minimum to 1 1/2" maximum.

### TYPICAL TIMBER POST SECTION

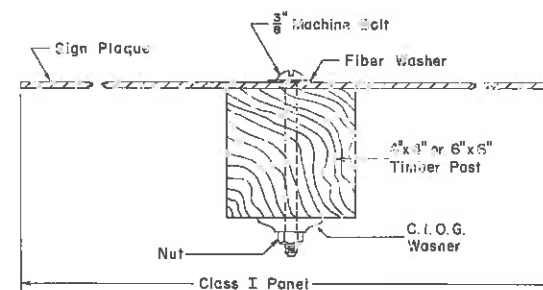

### TYPICAL U-2 POST SECTION

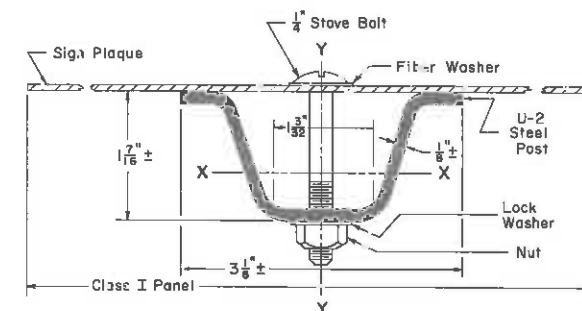

DEPARTMENT OF HIGHWAYS  
STATE OF COLORADO  
DIVISION OF HIGHWAYS  
**CLASS I  
GROUND SIGN  
INSTALLATIONS**

Designed By: F.J.B. Approved By: J.C.M. Traffic Engineer  
Made By: J.C.M. Traffic Engineer  
Checked By: J.D.S. Date: July 1, 1968









# STANDARD S-614-21B

JULY 1, 1968

FEDERAL ROAD REGION NO.	DIVISION	PROJ. NO.	SHEET NO.	TOTAL SHEETS
9	COLORADO			

REVISIONS				
(R-1)	4-22-69	REVISED TABLE		J. L. S.
(R-2)	12-2-69	REV. TABLE & ADD NOTE		J. J. B.

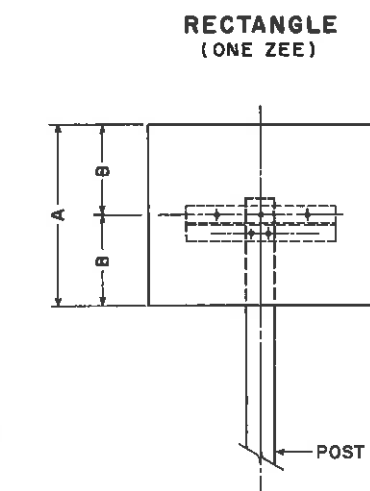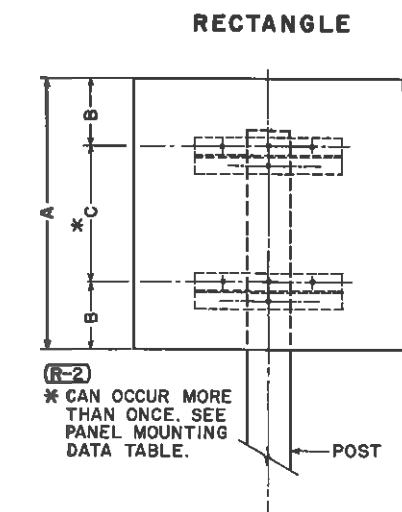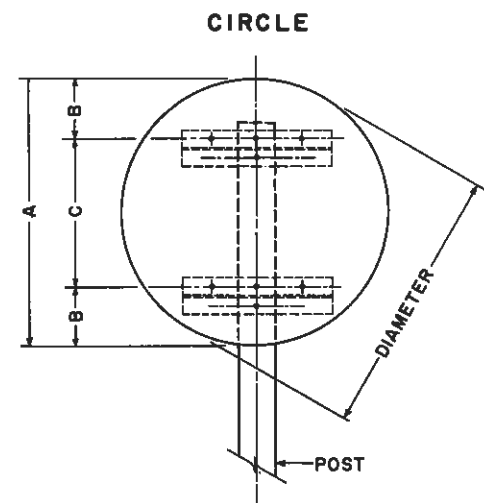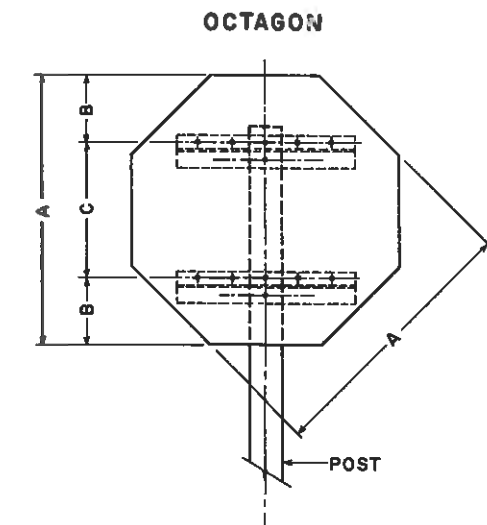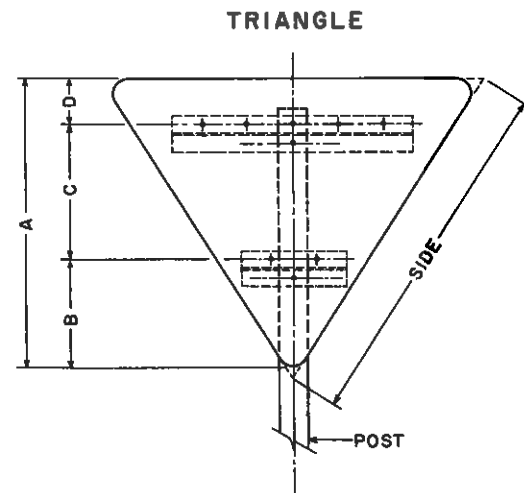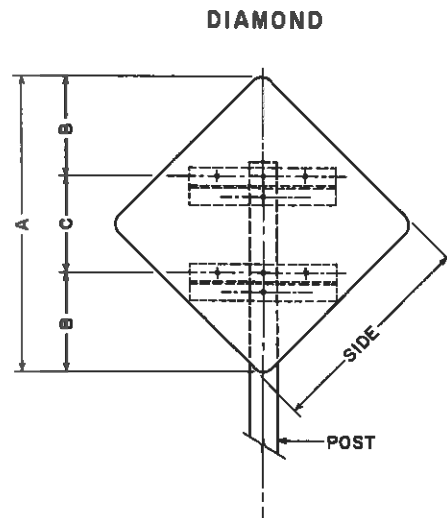


CLASS II PANEL MOUNTING DATA (R-1) (R-2)						
SIGN TYPE	A	B	C	D	POST SIZE	BACKING ZEE LENGTH
DIAMOND 30" SIDES	40 7/8"	14 7/16"	12"	—	4" x 4"	1'-8"
36" SIDES	49 1/16"	14 1/32"	21"	—	6" x 6"	1'-8"
48" SIDES	65 9/16"	20 3/16"	25"	—	6" x 6"	2'-8"
TRIANGLE 36" SIDES	29 3/16"	14 3/16"	9"	6"	4" x 4"	1'-8", 1'-2"
48" SIDES	38 9/16"	14 9/16"	18"	6"	4" x 4"	2'-8", 1'-2"
60" SIDES	48"	20"	22"	6"	6" x 6"	2'-8", 1'-8"
OCTAGON 30" x 30"	30"	9"	12"	—	4" x 4"	1'-8"
48" x 48"	48"	12"	24"	—	6" x 6"	2'-8"
CIRCLE 36" DIAMETER	36"	8"	20"	—	6" x 6"	1'-8"
RECTANGLE 40" x 20"	20"	10"	—	—	4" x 4"	2'-8"
30" x 24"	24"	12"	—	—	4" x 4"	1'-8"
36" x 24"	24"	12"	—	—	4" x 4"	2'-2"
40" x 24"	24"	12"	—	—	4" x 4"	2'-8"
48" x 24"	24"	12"	—	—	6" x 6"	3'-2"
30" x 30"	30"	9"	12"	—	6" x 6"	1'-8"
48" x 30"	30"	9"	12"	—	6" x 6"	3'-2"
60" x 30"	30"	9"	12"	—	6" x 6"	4'-2"
30" x 36"	36"	9"	18"	—	6" x 6"	1'-8"
36" x 36"	36"	9"	18"	—	6" x 6"	2'-2"
48" x 36"	36"	9"	18"	—	6" x 6"	3'-2"
40" x 40"	40"	9"	22"	—	6" x 6"	2'-8"
36" x 42"	42"	9"	24"	—	6" x 6"	2'-2"
36" x 48"	48"	12"	24"	—	6" x 6"	2'-2"
40" x 48"	48"	12"	24"	—	6" x 6"	2'-8"
42" x 48"	48"	12"	24"	—	6" x 6"	2'-8"
48" x 48"	48"	12"	24"	—	6" x 6"	3'-2"
60" x 48"	48"	12"	24"	—	6" x 6"	4'-2"
48" x 54"	54"	12"	30"	—	6" x 6"	3'-2"
48" x 60"	60"	12"	36"	—	6" x 6"	3'-2"
36" x 72"	72"	10"	26" (2)	—	6" x 6"	2'-2"
48" x 96"	96"	12"	24" (3)	—	6" x 6"	3'-2"

### GENERAL NOTES

- All work shall be done in accordance with the Standard Specifications applicable to the project.
- All Class II sign panels shall be either single sheet steel, 0.0598" minimum thickness, or single sheet aluminum, 0.100" minimum thickness, and shall be furnished with backing zees.
- Timber posts shall be 4"x4" or 6"x6" as noted in the "Tabulation of Signs" and shall conform to Standard Dressed (S4S) Sizes.
- Backing zees are 3"x2 3/4" x 1/4" at 6.7 lbs. per ft. for steel or 2.33 lbs. per ft. for 6061-T6 aluminum.
- Exposed bolt heads on the face of the sign shall be painted or reflectorized to match the surrounding color.
- For sign placement see "Typical Ground Sign Placement" Standard.
- All reflective sheeting shall be of the Non-Exposed Lens Type.
- Bolts, nuts and metal washers shall be galvanized or cadmium plated.


### SECONDARY PANEL MOUNTING

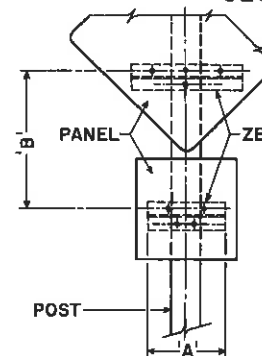

PANEL SIZE		'A' ZEE LENGTH	'B' ZEE SPACING	POST SIZE
PRIMARY	SECONDARY			
30" SIDES	18" SQUARE	1'-2"	24 7/16"	6" x 6"
36" SIDES	24" SQUARE	1'-8"	27 1/32"	6" x 6"
48" SIDES	24" SQUARE	1'-8"	33 3/16"	6" x 6"


NOTE: SEE CLASS II PANEL MOUNTING DATA AND TYPICAL BACKING ZEES FOR OTHER DIMENSIONS AND FASTENERS.

### TYPICAL BACKING ZEES

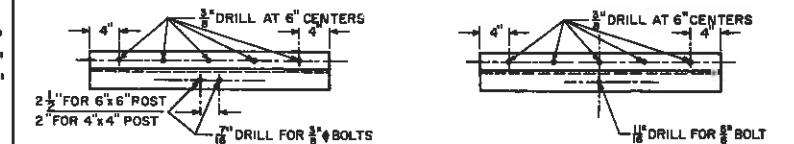


ONE POST-ONE ZEE

ONE POST-TWO ZEES

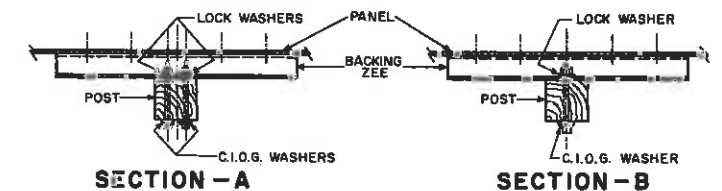


SECTION - A

SECTION - B

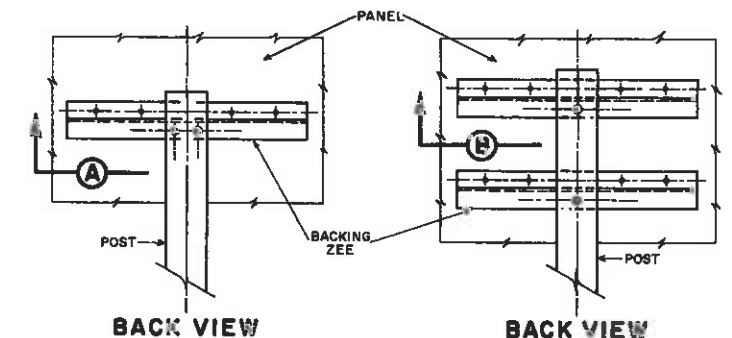

BACK VIEW

BACK VIEW

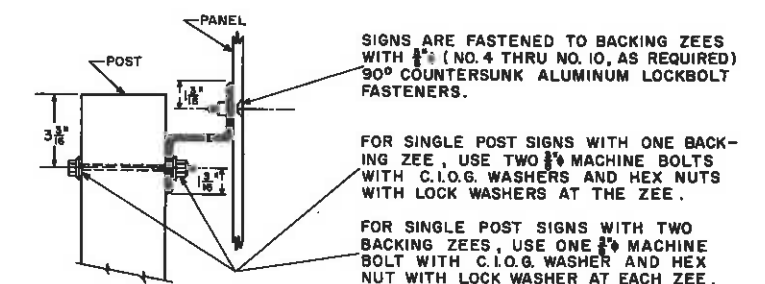

END VIEW

DEPARTMENT OF HIGHWAYS  
STATE OF COLORADO  
DIVISION OF HIGHWAYS  
CLASS II  
GROUND SIGN  
INSTALLATIONS

Designed By: J. L. S. Approved By: *[Signature]*  
Made By: F. J. B. Traffic Engineer  
Checked By: G. W. F. Date July 1, 1968

# STANDARD S-614-26 C


(SHEET 1 OF 2 SHEETS)

APRIL 11, 1973


FEDERAL ROAD REGION NO.	DIVISION	PROJ. NO.	SHEET NO.	TOTAL SHEETS
VIII	COLORADO			

REVISIONS			
(R-1)	5-2-74	Rev. Note	J.D.S.


## TYPICAL ELEVATION STEEL POST ASSEMBLY

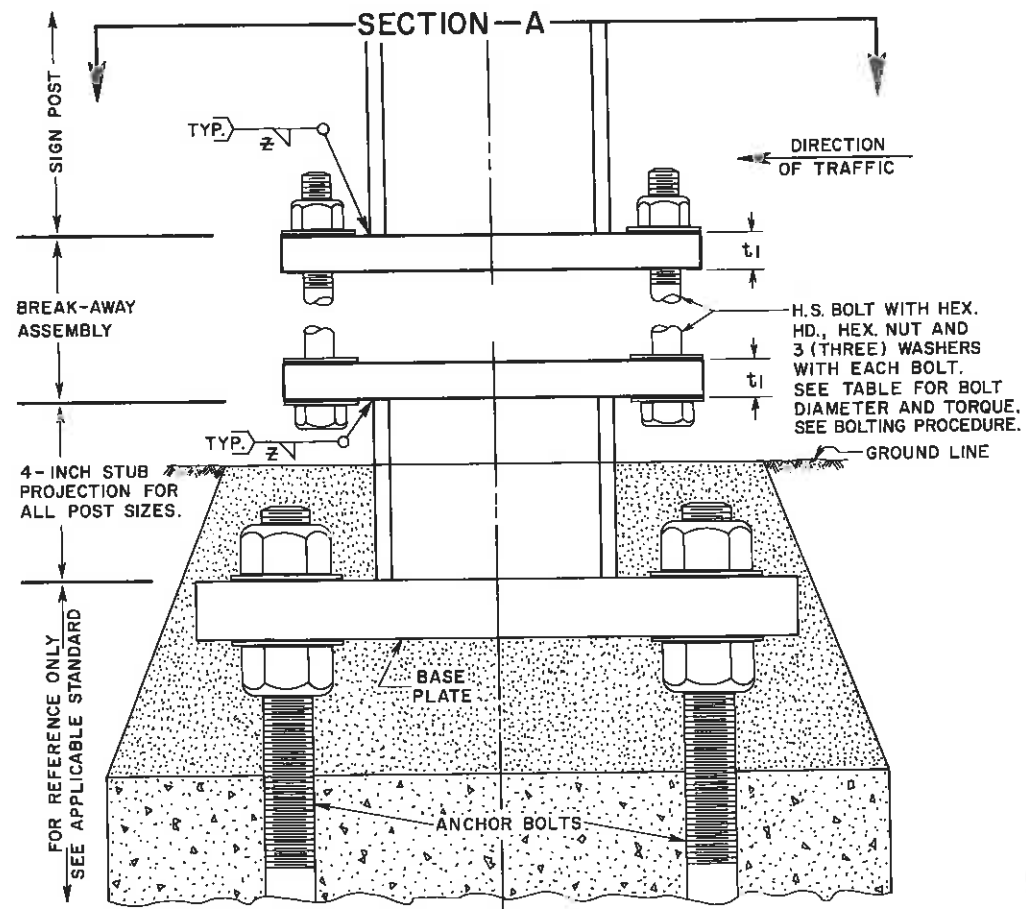


## TYPICAL BREAK-AWAY SIGN SUPPORT INSTALLATIONS

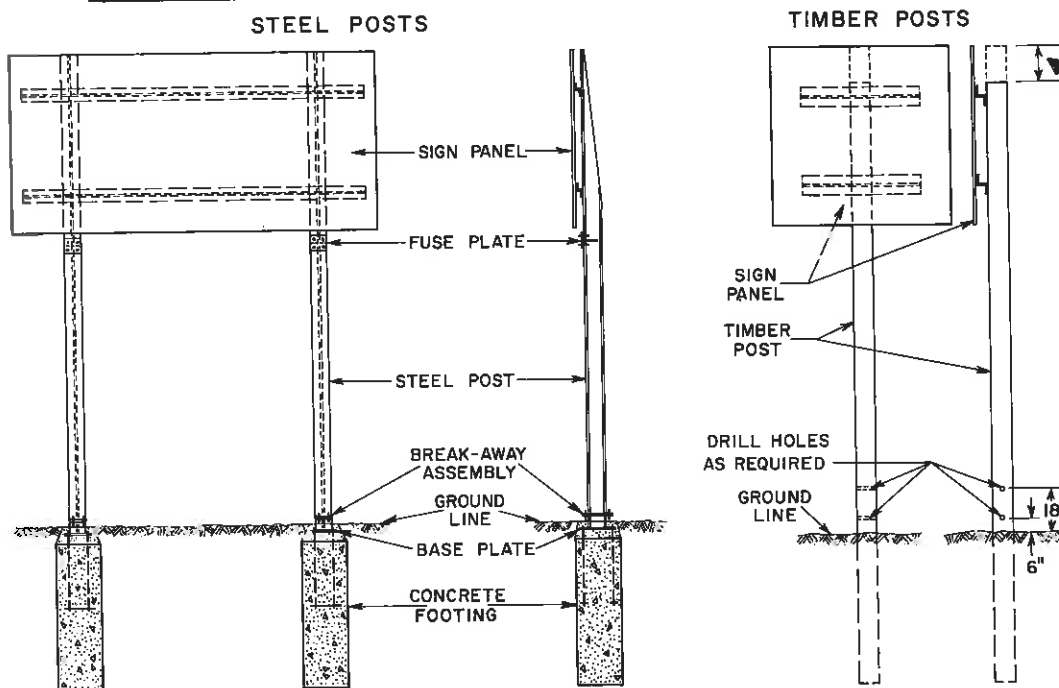

## TYPICAL PROJECTED VIEW STEEL POST ASSEMBLY

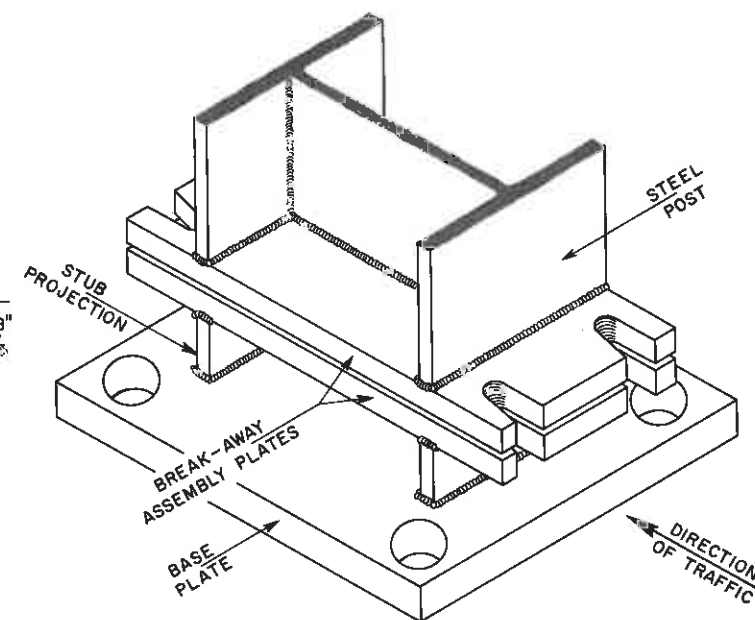

## TYPICAL SECTION -A-

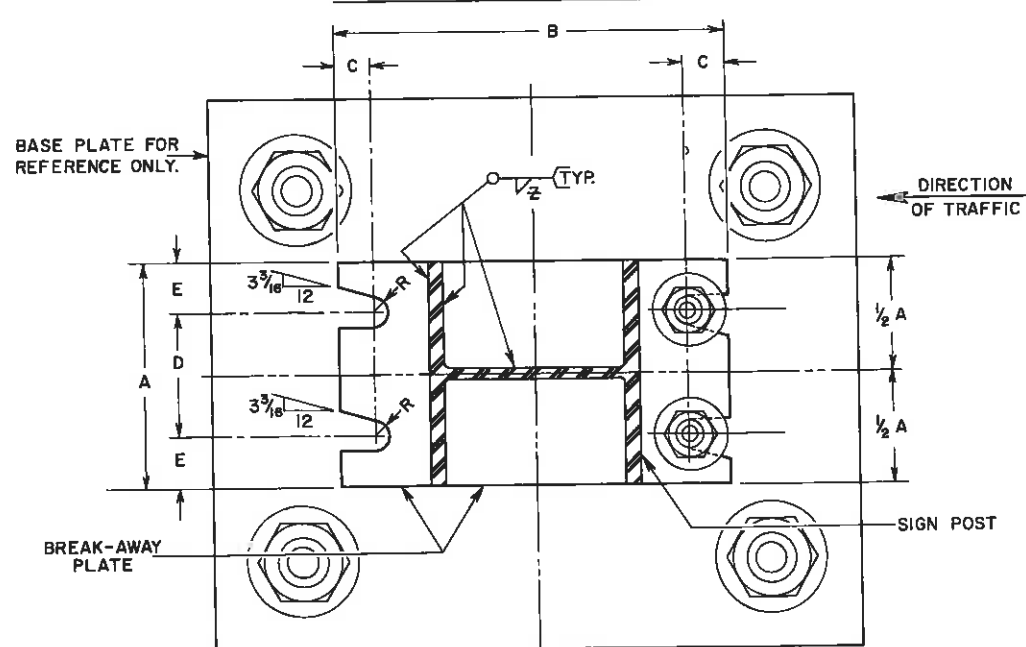

SECTION SHOWN IS FOR INSTALLATION ON RIGHT SHOULDER AND IN GORE. PLATE SLOT BEVELS ARE OPPOSITE HAND FROM THAT REQUIRED FOR INSTALLATION ON LEFT SHOULDER.

## GENERAL NOTES

- All work shall be done in accordance with the Standard Specifications applicable to the Project.
- Design conforms with AASHTO "Specifications for the Design and Construction of Structural Supports for Highway Signs".
- All structural steel shall conform to ASTM-A36 and Section 509 of the Standard Specifications.
- Notched steel fuse plates shall conform to the requirements of ASTM-A36.
- All high strength bolts, nuts and washers shall conform to ASTM-A325.
- All bolts other than high strength bolts shall conform to ASTM-A307.
- All bolts, nuts, and washers shall be galvanized as per ASTM-A153 or ASTM-A164.
- All holes shall be drilled.
- All steel cuts shall preferably be saw cuts; however, flame cutting will be permitted, provided all edges are ground. Remove all burrs. Metal shall not project beyond the plane of the plate face.
- High strength bolts in the break-away assembly shall be tightened only to the torque shown in the table. DO NOT OVERTIGHTEN.
- (R-1) The "STUB POST" and one "BREAK-AWAY PLATE" are considered part of the footing. The other "BREAK-AWAY PLATE" and all nuts, bolts and washers for fastening the break-away plates are considered a part of the post.
- Timber posts shall be in accordance with Section 614 of the Standard Specifications as to Size, Alternate Size, Grade, Species, Treatment, and Break-Away Holes.
- For all base plate and footing work see the applicable Standard included in the plans.
- For additional information, refer to "Tabulation of Signs" and "Cross Sections for Class III Signs" included in the plans.
- Timber post flush with top of sign panel for direct mount and 3 3/16" minimum above bolt for backing zee mount.

## BREAK-AWAY PLATE DATA TABLE

DIMENSION POST SIZE	BOLT SIZE AND TORQUE	A	B	C	D	E	t1	WELD Z	R	STUB POST LENGTH
W 12 x 40	7/8" ø x 3 3/4" 1,135 In. Lb.	8"	19 1/4"	1 5/8"	4"	2"	1 1/4"	3/8"	15 1/2"/32"	0'-4"
W 12 x 31		6 1/2"	16 5/8"	7/8"	3 1/2"	1 1/2"	1"	5/16"	15 1/2"/32"	0'-4"
W 10 x 25	3/4" ø x 3 1/2" 750 In. Lb.	5 3/4"	14 5/8"	7/8"	3 1/4"	1 1/4"	1"	5/16"	13 1/2"/32"	0'-4"
W 10 x 21		5 3/4"	14 3/8"	7/8"	3 1/4"	1 1/4"	1"	5/16"	13 1/2"/32"	0'-4"
W 8 x 20		5 1/4"	12 5/8"	7/8"	2 3/4"	1 1/4"	1"	5/16"	13 1/2"/32"	0'-4"
W 8 x 17		5 1/4"	12"	3/4"	3"	1 1/8"	3/4"	1/4"	11 1/2"/32"	0'-4"
W 6 x 15.5	5/8" ø x 2 3/4" 450 In. Lb.	6"	10"	3/4"	3 3/4"	1 1/8"	3/4"	1/4"	11 1/2"/32"	0'-4"
W 6 x 12		5"	10"	3/4"	2 3/4"	1 1/8"	3/4"	1/4"	11 1/2"/32"	0'-4"

## BOLTING PROCEDURE FOR BREAK-AWAY PLATE ASSEMBLY

- Assemble post to stub with bolts and with one flat washer on each bolt top, bottom, and between the break-away plates.
- Tighten all bolts to a "snug tight" condition with a 12" to 15" wrench to bed washers and to clean bolt threads, then loosen each bolt in turn and retighten in a systematic order to the prescribed torque. (See Break-Away Plate Data Table)
- Burr threads at junction with nut using a center punch to prevent nut loosening.

DEPARTMENT OF HIGHWAYS  
STATE OF COLORADO  
DIVISION OF HIGHWAYS  
BREAK-AWAY SIGN  
SUPPORT DETAILS  
FOR  
GROUND SIGNS

Designed By: G.W.F. Approved By: *[Signature]*  
Made By: F.J.B. Traffic Engineer  
Checked By: J.D.S. Date: April 11, 1973

# STANDARD S-614-26 C


(SHEET 2 OF 2 SHEETS)

APRIL 11, 1973


FEDERAL ROAD REGION NO.	DIVISION	PROJ. NO.	SHEET NO.	TOTAL SHEETS
VIII	COLORADO			

REVISIONS			
(R-1)	5-2-74	Rev. Note on Sheet No. 1	J.D.S.


TYPICAL SIDE VIEW  
FUSE PLATE AND POST COPE

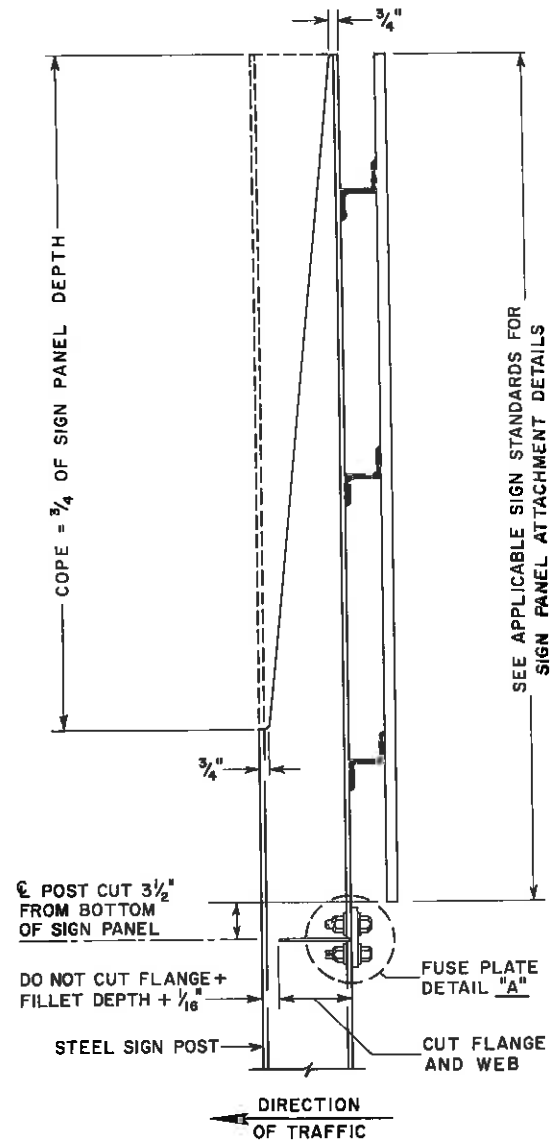

TYPICAL PROJECTED VIEW  
FUSE PLATE AND POST COPE

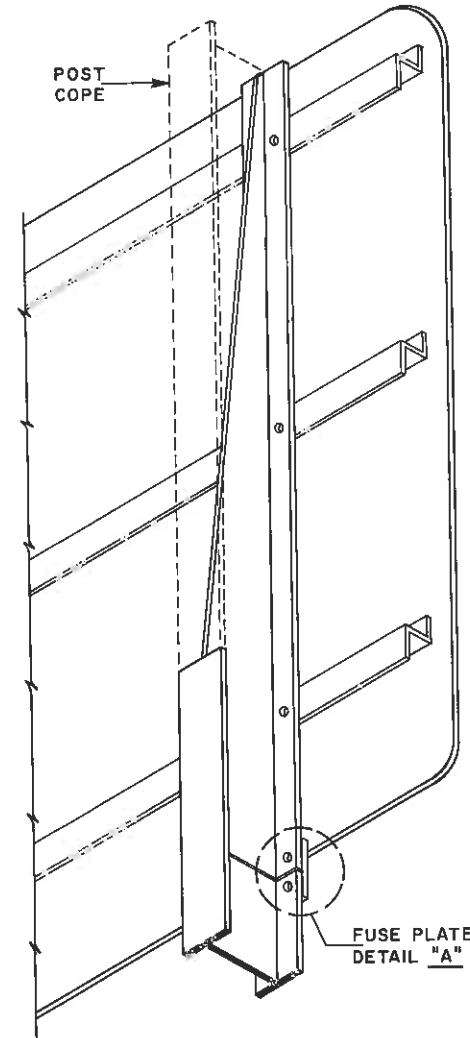

TYPICAL FUSE PLATE HINGE DETAILS

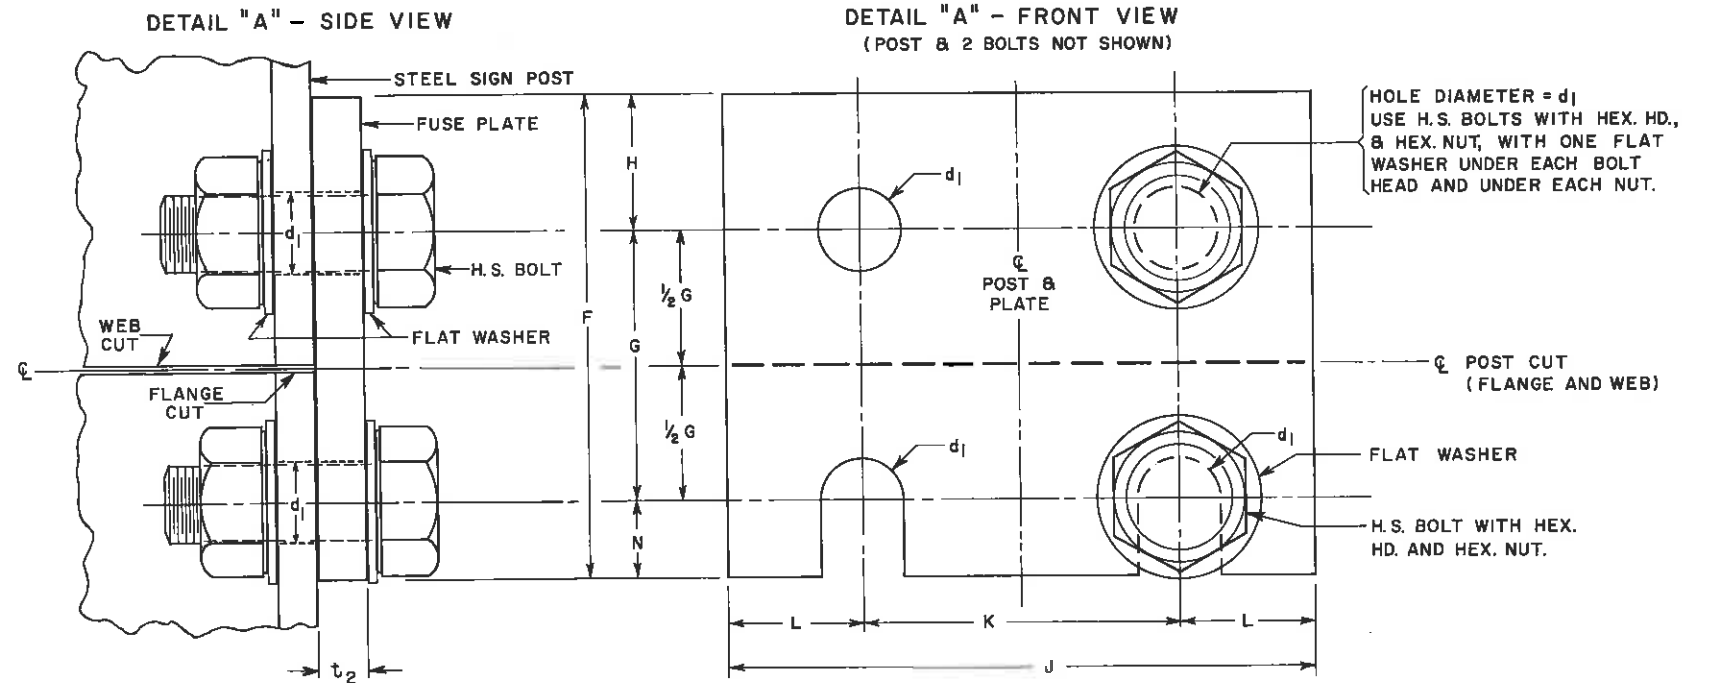

FUSE PLATE HINGE DATA TABLE

DIMENSION	F	G	H	J	K	L	N	d <sub>1</sub>	t <sub>2</sub>	BOLT SIZE	MINIMUM RESIDUAL BOLT TENSION	FABRICATION NOTES
POST SIZE												
W 12 x 40	6"	3 3/4"	1 3/4"	8"	4"	2"	1"	15/16"	5/8"	7/8" x 2 1/2"	36,050 LBS.	Fuse plate and post flange holes shall be drilled. Install fuse plate with the notches toward the base of the post. <b>IMPORTANT</b> —All fuse plate hinge bolts shall be tightened in the shop following a method approved by the Engineer. Tightening shall be to such a degree as to obtain the minimum residual tension in each of the bolts.
W 12 x 31	5 3/8"	3"	1 1/2"	6 1/2"	3 1/2"	1 1/2"	7/8"	15/16"	9/16"	7/8" x 2 1/2"	36,050 LBS.	
W 10 x 25	5 3/8"	3"	1 1/2"	5 3/4"	2 3/4"	1 1/2"	7/8"	15/16"	9/16"	7/8" x 2 1/2"	36,050 LBS.	
W 10 x 21	5 3/8"	3"	1 1/2"	5 3/4"	2 3/4"	1 1/2"	7/8"	15/16"	9/16"	7/8" x 2 1/2"	36,050 LBS.	
W 8 x 20	4 7/8"	2 1/2"	1 1/2"	5 1/4"	2 3/4"	1 1/4"	7/8"	15/16"	9/16"	7/8" x 2 1/2"	36,050 LBS.	
W 8 x 17	4 1/2"	2 1/2"	1 1/4"	5 1/4"	2 3/4"	1 1/4"	3/4"	13/16"	1/2"	3/4" x 2"	28,400 LBS.	
W 6 x 15.5	4 1/2"	2 1/2"	1 1/4"	6"	3 1/2"	1 1/4"	3/4"	13/16"	1/2"	3/4" x 2"	28,400 LBS.	
W 6 x 12	3 3/4"	2"	1 1/8"	4"	2 1/4"	7/8"	5/8"	1 1/16"	3/8"	5/8" x 2"	19,200 LBS.	

DEPARTMENT OF HIGHWAYS  
STATE OF COLORADO  
DIVISION OF HIGHWAYS  
BREAK-AWAY SIGN  
SUPPORT DETAILS  
FOR  
GROUND SIGNS

Designed By: G.W.F. Approved By: *[Signature]*  
Made By: F.J.B. Traffic Engineer  
Checked By: J.D.S. Date: April 11, 1973

# STANDARD S-614-27C

(SHEET 1 OF 2 SHEETS)


APRIL 11, 1973

FEDERAL ROAD DISTRICT NO.	DIVISION	PROJ. NO.	SHEET NO.	TOTAL SHEETS
VIII	COLORADO			


  

REVISIONS				
(R-1)	5-2-74	Add Note on Sheet No. 2	J.D.S.	
(R-2)	9-24-75	Rev. "D" for Ty. I Footing	J.D.S.	

## TYPICAL CONCRETE FOOTING ASSEMBLY

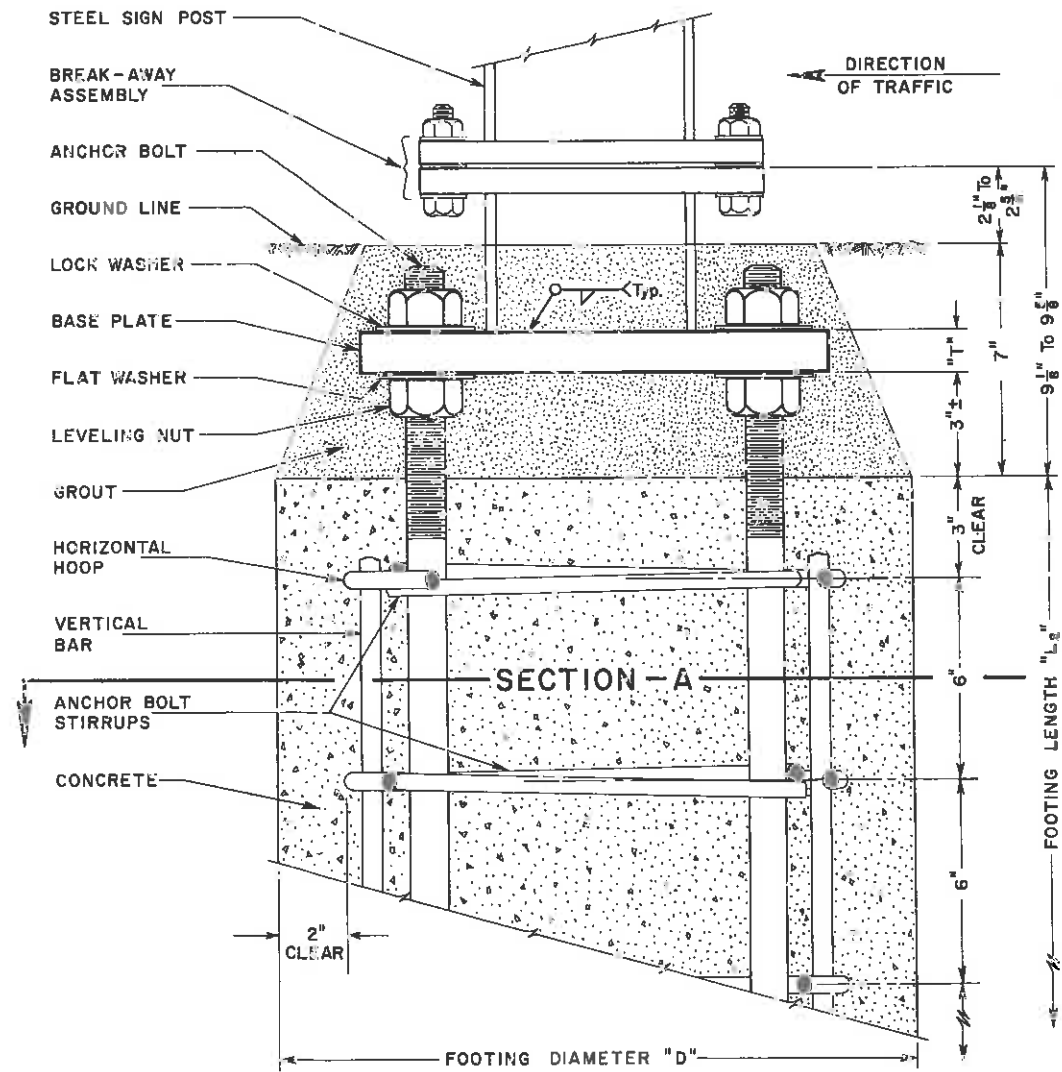


## TYPICAL SECTION -A-

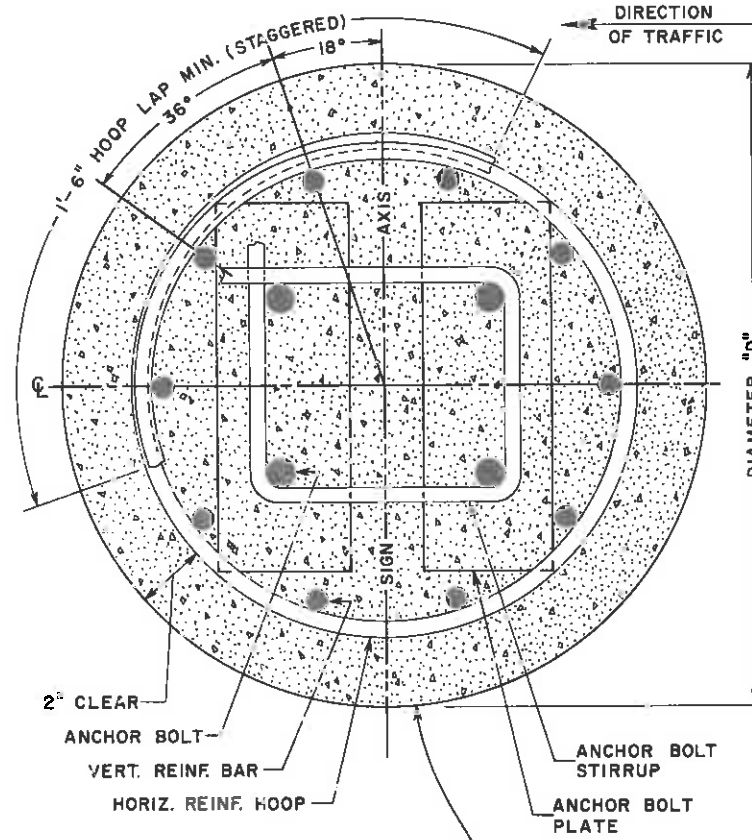


**EXCAVATION PROCEDURE**  
 DRILL TO O.D. OF FOOTING NEAT LINE AND TO DEPTH SHOWN, AND IN ACCORDANCE WITH THE STANDARD SPECIFICATIONS FOR DRILLED CAISSONS. (FOOTINGS SHALL BE CAST IN PLACE AGAINST UNDISTURBED MATERIAL.)


## TYPICAL FOOTING INSTALLATION

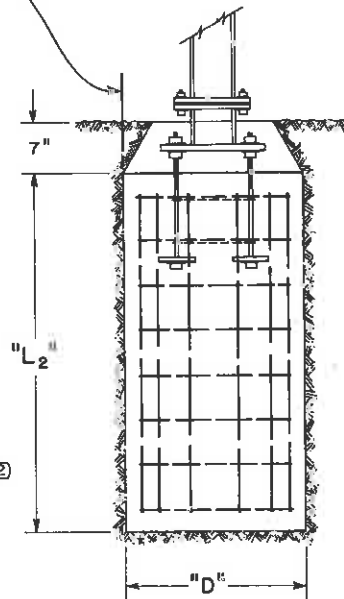

## BASE PLATE TYPICAL DETAILS

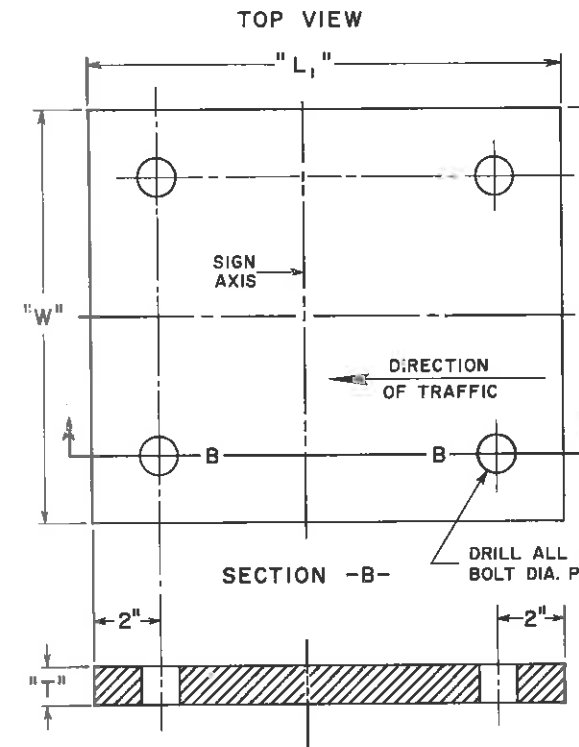

## BOLT PLATE TYPICAL DETAILS

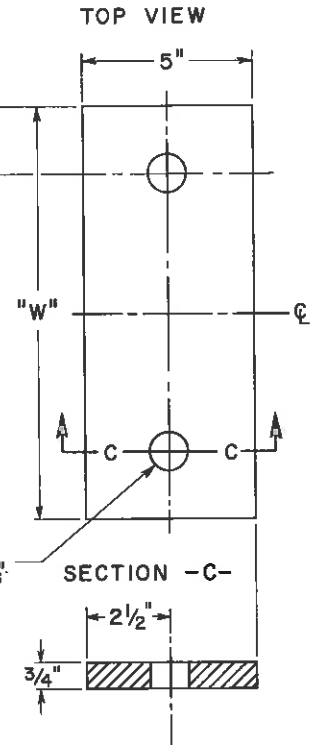

## CONCRETE FOOTING TABLE

POST BASE STRUCTURAL DATA					FOOTING STRUCTURAL DATA								
SIZE	MAXIMUM ALLOWABLE MOMENT	POST TO BASE WELD	BASE PLATE			ANCHOR COMPONENTS			TYPE	REINFORCING			
			"L1"	"W"	"T"	ANCHOR BOLTS	BOLT PLATES	STIRRUPS		"D"	"L2"	VERT. BAR	HORIZ. HOOP
W12x40	79.1 kip ft.	1/2" FILLET	21 1/2"	16"	1 3/4"	4-1 1/2" x 2'-6"	2-5" x 3/4" x 16"	2-1/2"	8	36"	11'	10-#10 x 10'-6"	22-#4 @ 6"
W12x31	57.6 kip ft.	3/8" FILLET	19 3/4"	14"	1 3/8"	4-1 1/2" x 2'-3"	2-5" x 3/4" x 14"	2-1/2"	7	36"	10'	10-#9 x 9'-6"	20-#4 @ 6"
W10x25	36.9 kip ft.	3/8" FILLET	16 1/2"	14"	1 1/4"	4-1 1/2" x 2'-6"	2-5" x 3/4" x 14"	2-1/2"	6	30"	9'	10-#9 x 8'-6"	18-#4 @ 6"
W10x21	29.3 kip ft.	3/8" FILLET	16 1/4"	14"	1 1/4"	4-1 1/2" x 2'-6"	2-5" x 3/4" x 14"	2-1/2"	5	30"	8'	10-#8 x 7'-6"	16-#4 @ 6"
W8x20	22.7 kip ft.	3/8" FILLET	14"	13 1/4"	1 1/8"	4-7/8" x 2'-0"	2-5" x 3/4" x 13 1/4"	2-1/2"	4	24"	7'	10-#8 x 6'-6"	14-#4 @ 6"
W8x17	18.3 kip ft.	3/8" FILLET	14"	13 1/4"	1 1/8"	4-7/8" x 2'-0"	2-5" x 3/4" x 13 1/4"	2-1/2"	3	24"	6'	10-#7 x 5'-6"	12-#4 @ 6"
W6x15.5	14.2 kip ft.	3/8" FILLET	14"	12 1/4"	1"	4-7/8" x 1'-6"	2-5" x 3/4" x 12 1/4"	2-1/2"	2	24"	5'	10-#6 x 4'-6"	10-#4 @ 6"
W6x12	8.3 kip ft.	1/4" FILLET	13"	12"	7/8"	4-3/4" x 1'-6"	2-5" x 3/4" x 12"	2-1/2"	1	24"	4'	10-#5 x 3'-6"	8-#4 @ 6"

TIMBER POST SHALL BE SET IN DRILLED OR EXCAVATED HOLES--DEPTH SHALL BE 5' FOR 6x6 POST (Unless otherwise noted on the tabulation in the plans) AND 3' FOR 4x4 POST. POSTS SHALL BE PLACED PLUMB, BACKFILLED WITH EXCAVATED MATERIALS, AND THOROUGHLY TAMPED INTO PLACE.

## GENERAL NOTES

- ALL WORK SHALL BE DONE IN ACCORDANCE WITH THE STANDARD SPECIFICATIONS APPLICABLE TO THE PROJECT.
- ALL CONCRETE IS TO BE CLASS "A" OR CLASS "B". GROUT SHALL CONFORM TO "JOINT MORTAR".
- ANCHOR BOLTS PROJECT ABOVE FOOTING 4" PLUS BASE PLATE THICKNESS, PLUS BOLT DIAMETER. THREAD UPPER PORTION--PROJECTION PLUS 2" ±. GALVANIZE UPPER PORTION--PROJECTION PLUS 4" ±.
- USE ASTM-A36 STEEL FOR BASE PLATES AND BOLT PLATES. USE ASTM-A307 STEEL FOR ANCHOR BOLTS.
- USE GRADE 40 FOR REINFORCING STEEL VERTICAL BARS, HORIZONTAL HOOPS, AND ANCHOR BOLT STIRRUPS.
- FOR ALL STEEL WORK ABOVE THE BASE PLATE, AND FOR ANGULAR PLACEMENT OF SIGNS, SEE APPLICABLE STANDARDS INCLUDED IN THE PLANS.
- FOR ADDITIONAL INFORMATION, REFER TO "TABULATION OF SIGNS" AND "CROSS SECTIONS FOR CLASS III SIGNS" INCLUDED IN THE PLANS.
- ALTERNATE FOOTING DESIGNS ARE AVAILABLE FROM THE TRAFFIC ENGINEER FOR FOOTINGS IN ROCK.

CONT D. SHEET 2.

DEPARTMENT OF HIGHWAYS  
 STATE OF COLORADO  
 DIVISION OF HIGHWAYS  
**CONCRETE FOOTINGS  
 AND  
 SIGN ISLANDS  
 FOR CLASS III SIGNS**

Designed By: J.E.S. Approved By: *[Signature]*  
 Made By: F.J.B. Traffic Engineer  
 Checked By: J.D.S. Date: April 11, 1973

# STANDARD S-614-27C


(SHEET 2 OF 2 SHEETS)

APRIL 11, 1973


## DETAILS OF SIGN PLACEMENT

FEDERAL ROAD REGION NO.	DIVISION	PROJ. NO.	SHEET NO.	TOTAL SHEETS
VIII	COLORADO			


REVISIONS				
(R-1)	5-2-74	Add Note		J.D.S.
(R-2)	9-24-75	Rev. Table on Sheet No. 1		J.D.S.

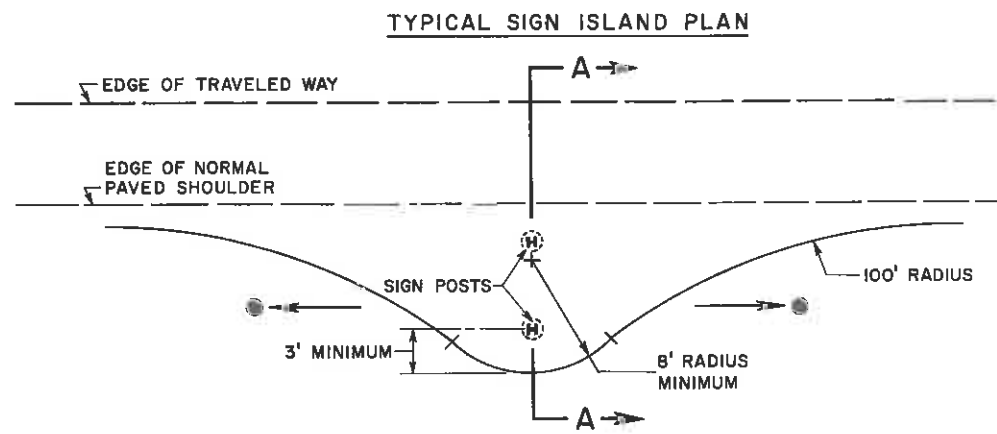



TYPICAL FILL SECTION : A-A

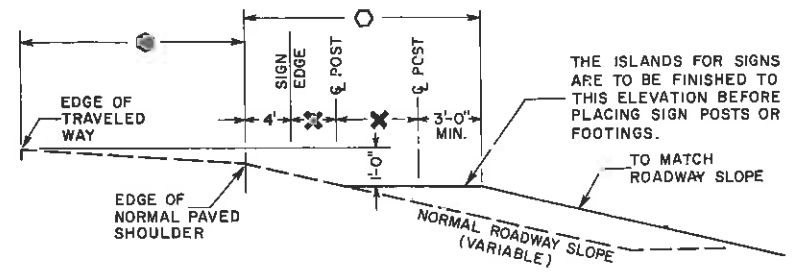


TYPICAL CUT SECTION : A-A

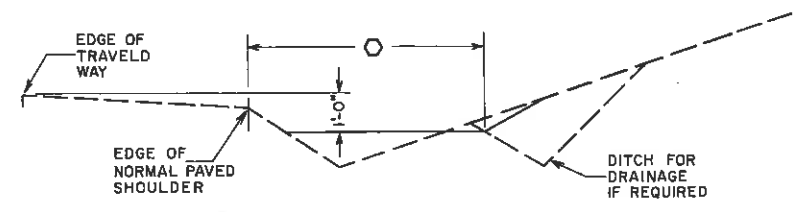


TYPICAL SIGN ISLAND ELEVATIONS

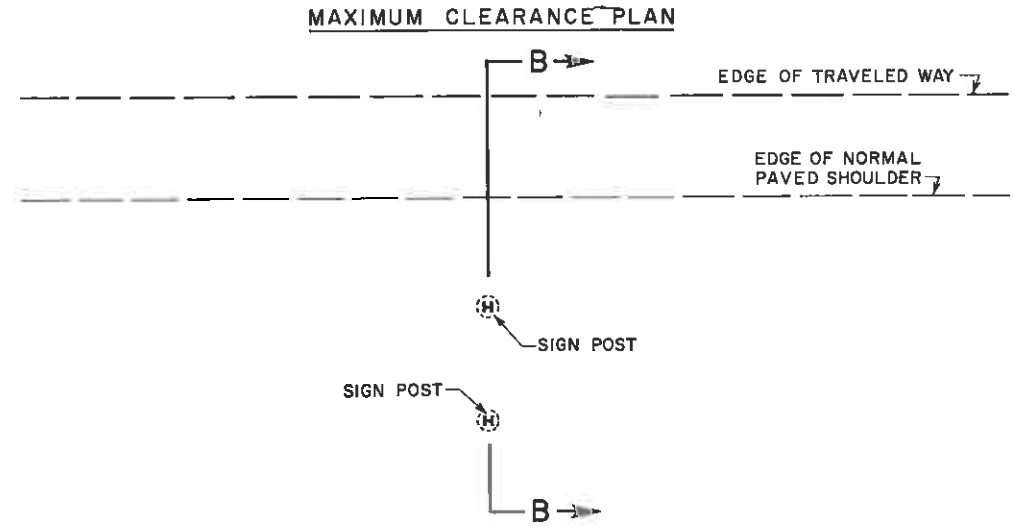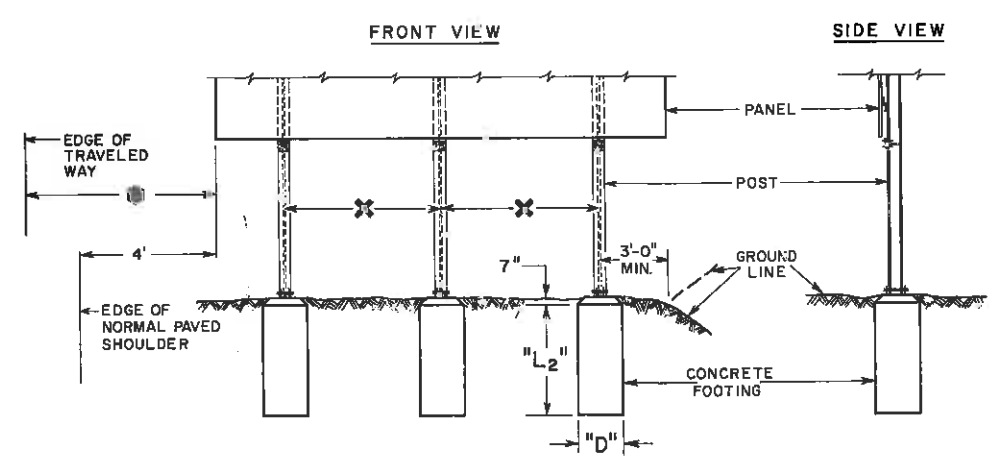


TYPICAL FILL SECTION : B-B

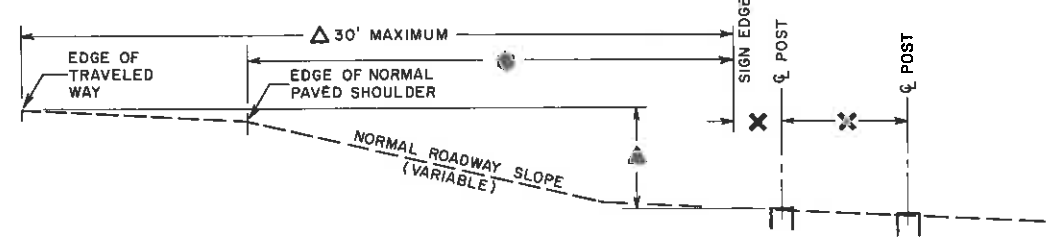

TYPICAL CUT SECTION : B-B

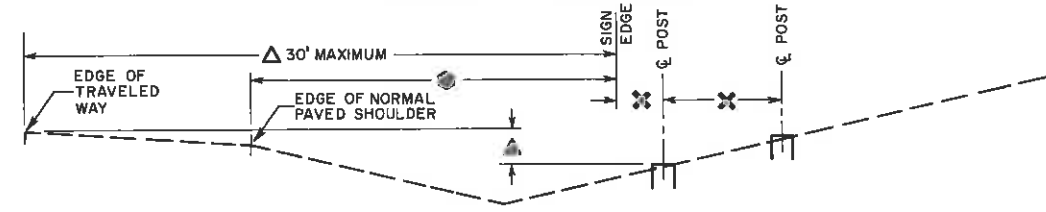

TYPICAL ELEVATIONS

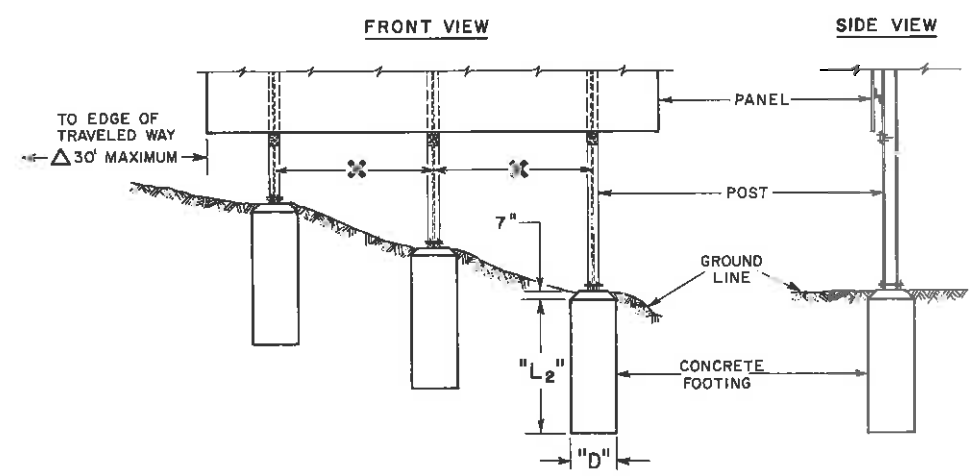

### GENERAL NOTES CONT'D.

9. ✕... FOR DIMENSIONS SEE APPLICABLE STANDARD INCLUDED IN THE PLANS.
10. ⊙... THE SIGN ISLAND SIDE SLOPE PARALLEL TO THE ROADWAY SHALL BE 4:1 OR FLATTER.
11. ○... VARIABLE, SEE SIGN ISLAND WIDTH COLUMN IN "TABULATION OF SIGNS" INCLUDED WITH THE PLANS, OR SEE APPLICABLE STANDARD.
12. ⊙... VARIABLE DIMENSION, SEE CROSS SECTIONS.
13. ▲... VARIABLE FOOTING ELEVATIONS, SEE CROSS SECTIONS FOR PLACEMENT.
14. Δ... THE LATERAL PLACEMENT MAY BE REDUCED TO A MINIMUM OF 4 FEET FROM THE EDGE OF NORMAL PAVED SHOULDER TO FIT FIELD CONDITIONS WHEN THE DESIRABLE 30 FOOT MAXIMUM PLACEMENT IS NOT FEASIBLE. SEE THE CROSS SECTIONS.
15. .... EMBANKMENT FOR SIGN ISLANDS IS TO BE COMPACTED AS REQUIRED UNDER ITEM 203 OF THE STANDARD SPECIFICATIONS.
16. .... FOR ANGULAR PLACEMENT OF SIGNS, SEE APPLICABLE STANDARD.
- (R-1) 17. THE "STUB POST" AND ONE "BREAK-AWAY PLATE" ARE CONSIDERED PART OF THE FOOTING. THE OTHER "BREAK-AWAY PLATE" AND ALL NUTS, BOLTS AND WASHERS FOR FASTENING THE BREAK-AWAY PLATES ARE CONSIDERED A PART OF THE POST.

DEPARTMENT OF HIGHWAYS  
STATE OF COLORADO  
DIVISION OF HIGHWAYS  
CONCRETE FOOTINGS  
AND  
SIGN ISLANDS  
FOR CLASS III SIGNS

Designed By: J. E. S.    Approved By: *[Signature]*  
 Made By: F. J. B.    Traffic Engineer  
 Checked By: J. D. S.    Date: April 11, 1973




# STANDARD S-614-33D

DECEMBER 16, 1976

REVISIONS		
(R-1)	10-28-77	Rev. Fastener J.D.S.

FEDERAL ROAD DISTRICT NO.	DIVISION	PROJECT NO.	SHEET NO.	TOTAL SHEETS
VIII	COLORADO			

## MILEPOST PANEL DETAILS

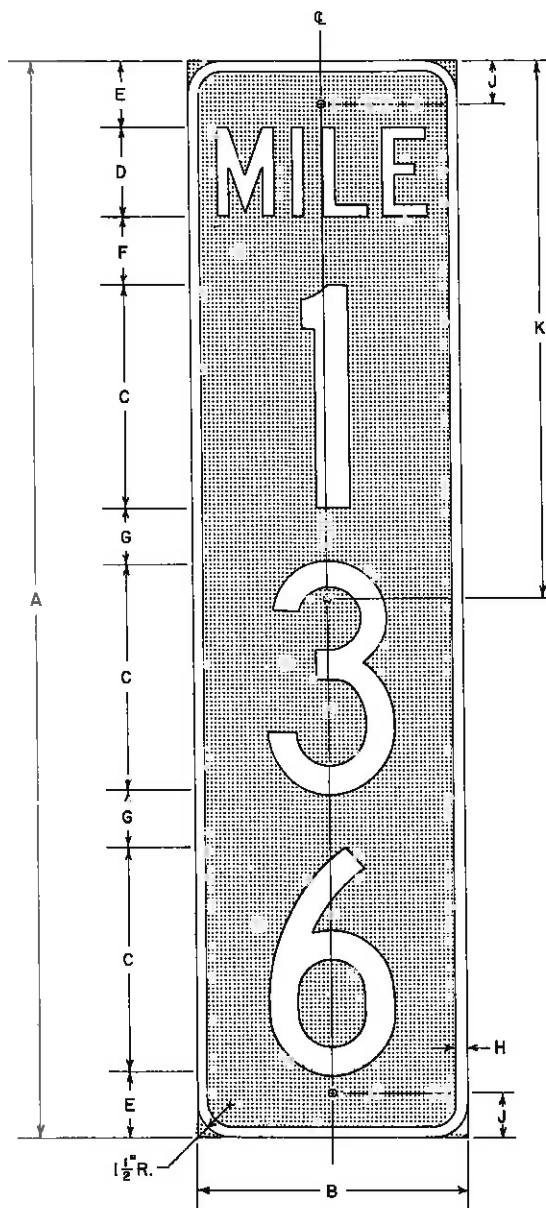

FREEWAYS & EXPRESSWAYS (dimensions in inches)


	A	B	C	D	E	F	G	H	J	K
1-Digit	24	12	10	4	3	4	-	1/2	2	-
2-Digit	36	12	10	4	3	3	3	1/2	2	18
3-Digit	48	12	10	4	3	3	2 1/2	1/2	2	24

OTHER (dimensions in inches)

	A	B	C	D	E	F	G	H	J	K
1-Digit	18	10	6	4	2 1/2	3	-	1/2	2	-
2-Digit	27	10	6	4	2 1/2	3	3	1/2	3	-
3-Digit	36	10	6	4	2 1/2	3	3	1/2	2	18

▲ Series "C" ● Series "B"


## LATERAL PLACEMENT DETAILS

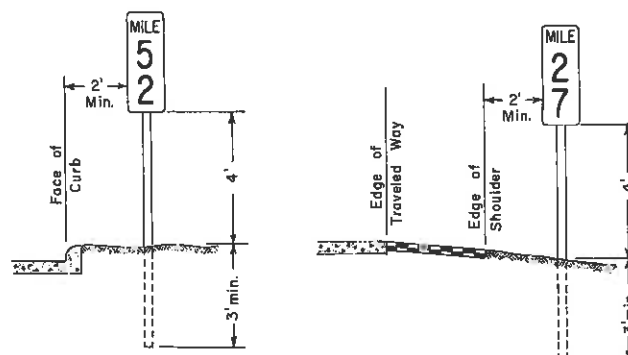


## GENERAL NOTES

- All work shall be done in accordance with the Standard Specifications applicable to the project.
- Posts shall meet requirements of Par. 4.5 U.S. Department of Commerce Commercial Standard 184-51. U-2 posts shall weigh 2 lbs./ft. except that a mill tolerance of minus 3 1/2 % of the weight of any one post will be allowed. Alternate posts will be acceptable if section modulus is at least 0.200 in.<sup>3</sup> about the X-X axis or at least 0.250 in.<sup>3</sup> about the Y-Y axis. Color of posts shall be interstate green. Posts shall be set in drilled or excavated holes, placed plumb and firmly tamped in place; or may be driven plumb. There shall be a minimum of 23 - 5/16" diameter mounting holes, drilled or punched on 2" centers with the first hole 1/2" from the top of the post.
- (R-1) Fasten the panel to the U-2 post with 1/4" Stove Bolts (Standard Fastener) as follows: Use a plastic fiber washer or nylon washer between the bolt head and the face of the panel and a lock washer under the nut on the back of the post. Bolts, nuts and metal washers shall be galvanized or cadmium plated. Jam bolt threads after tightening or use vandal-proof bolts.
- All panels shall be either sheet steel 0.0598" minimum thickness or sheet aluminum 0.100" minimum thickness. Mounting holes shall be 5/16" diameter. Background on sign panels shall be interstate green reflective sheeting (smooth surfaced type). Legend and border shall be cutout silver reflective sheeting.
- Mileposts shall be located in line with delineator posts.

## TYPICAL PLACEMENT DETAILS

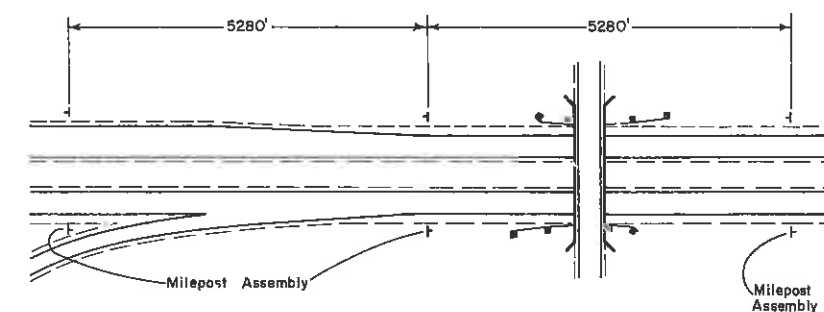

(R-1) STANDARD FASTENER DETAILS TYPICAL SECTION

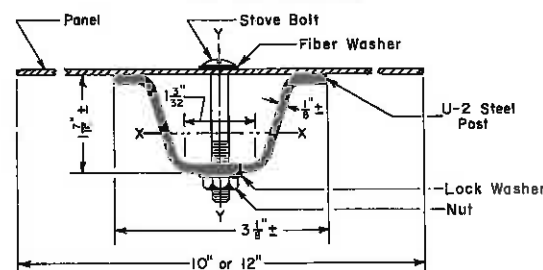

(R-1)

DEPARTMENT OF HIGHWAYS  
STATE OF COLORADO  
DIVISION OF HIGHWAYS  
MILEPOST SIGN  
AND  
INSTALLATION

Designed By: J.E.M. Approved By: *[Signature]*  
Made By: B.H.B. Staff Traffic Engineer  
Checked By: J.D.S. Date: Dec 16, 1976

# STANDARD S-614-39A

SHEET 1 OF 4 SHEETS  
MAY 17, 1977







SECTION NO.	DIVISION	PROJECT NO.	DATE	BY
VIII	COLORADO			

REVISIONS		
(R-1)	5-8-78	Rev. Date Only J.D.S.

NOTE: See sheet No. 4 for typical Construction Traffic Sign and Channelizing Device requirements for each Case.

LEGEND	
	Type 3 Barricade
	Type 1 or 2 Barricade
	Concrete Barrier (Temporary)
	Flagman
	Vertical Panel Channelizing Device
	Traffic Cone
	Drum Channelizing Device

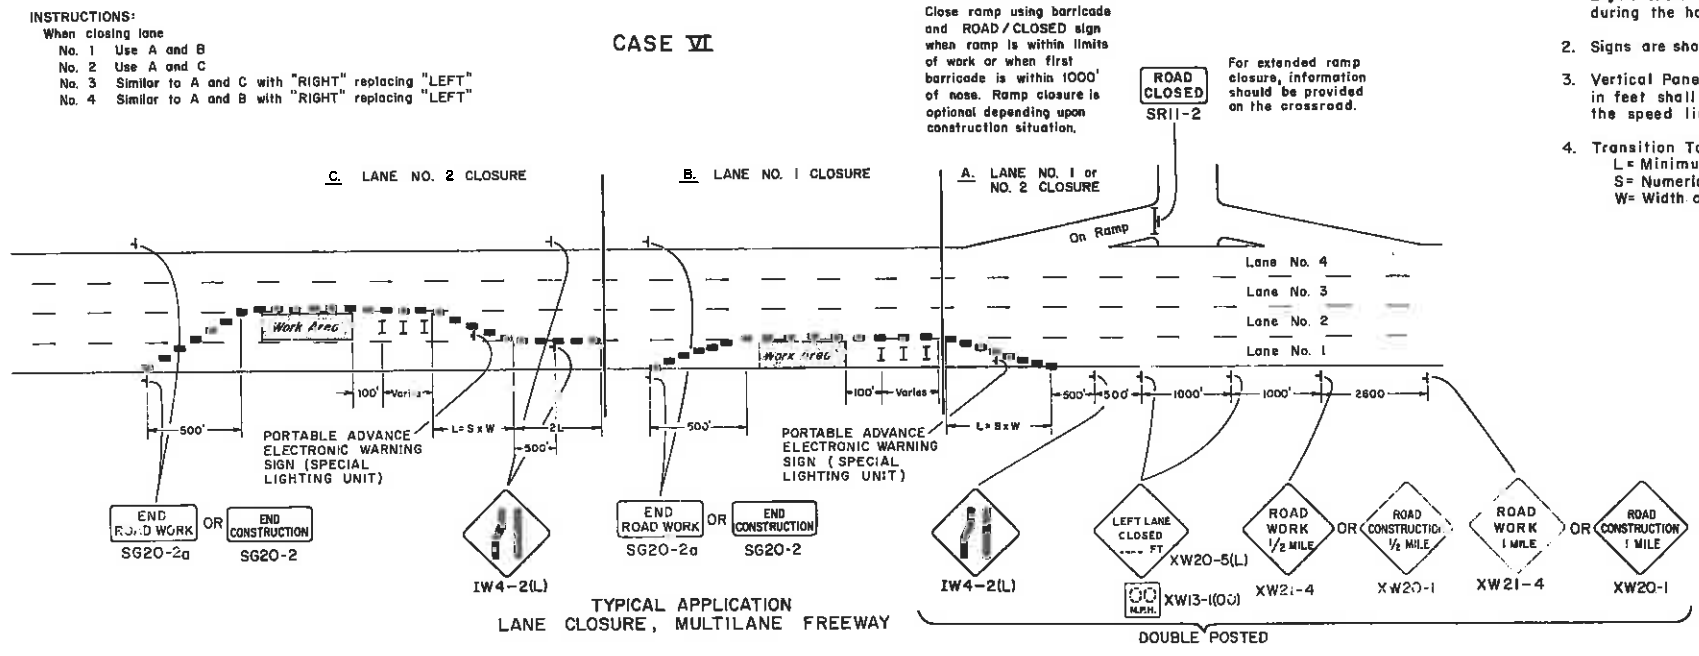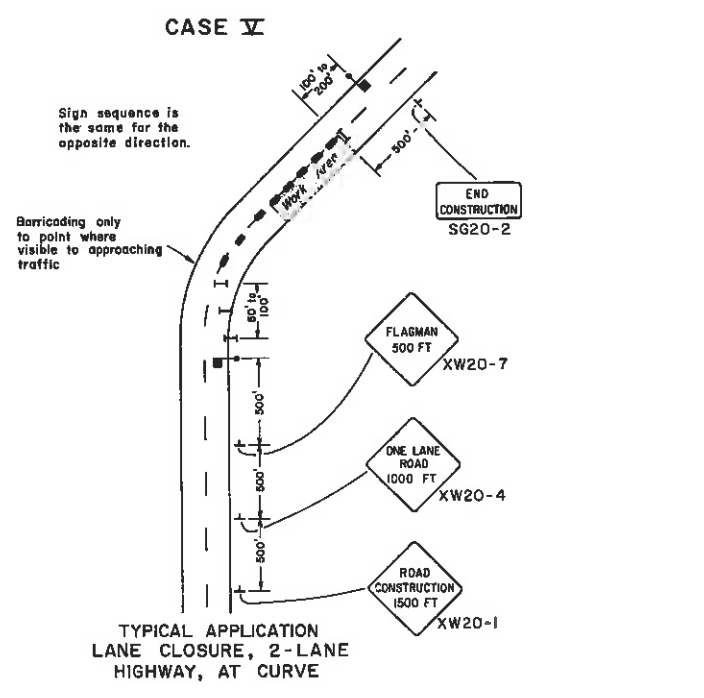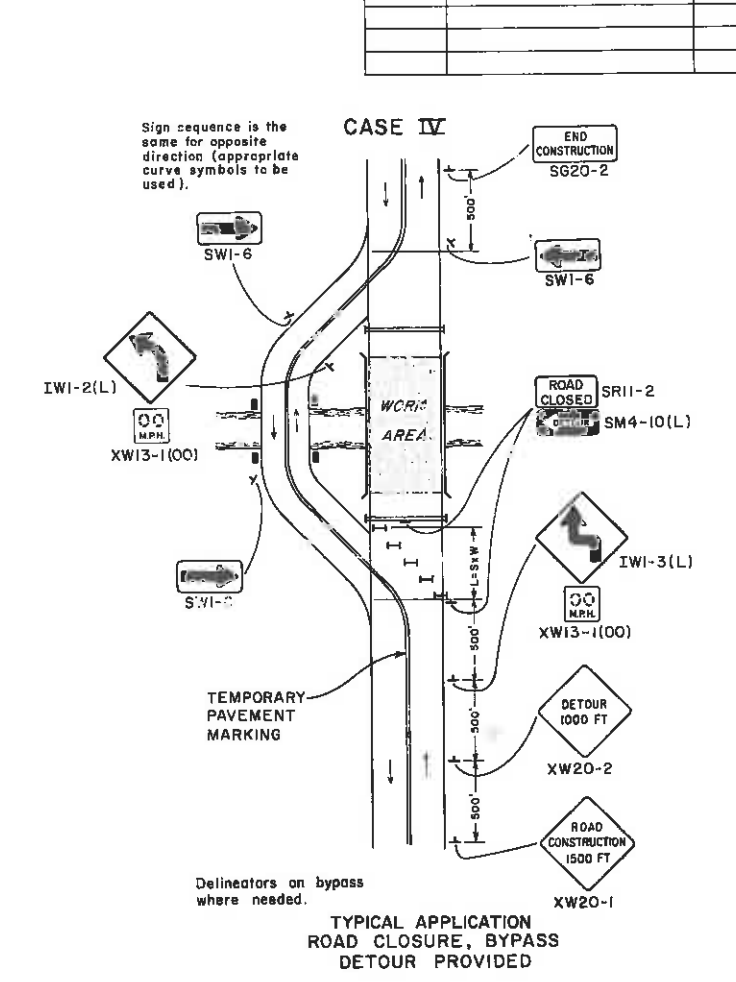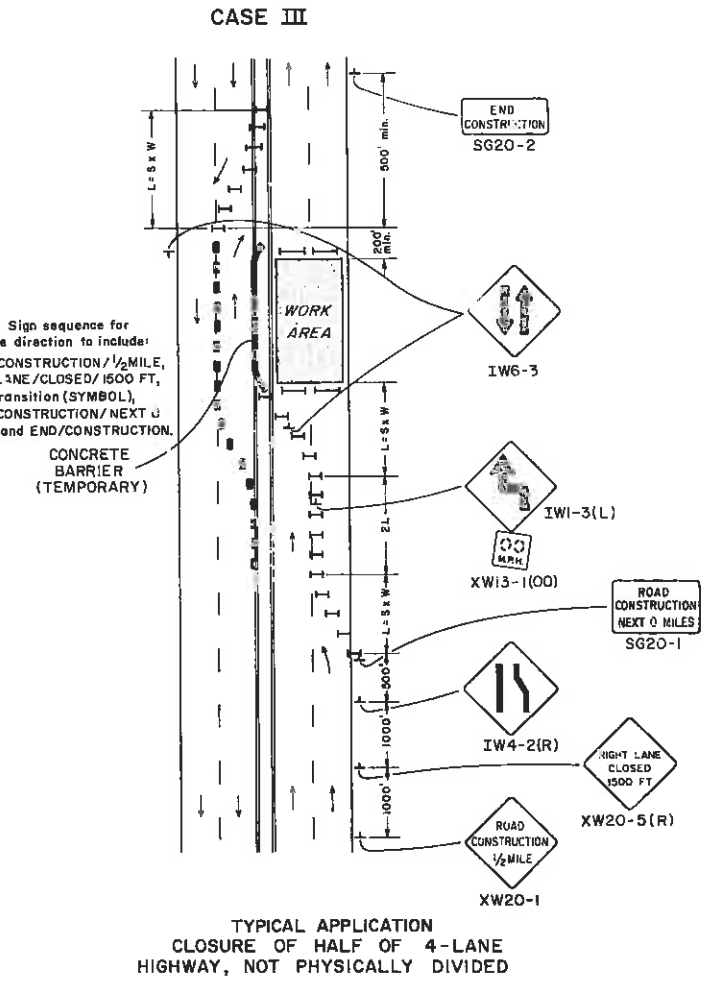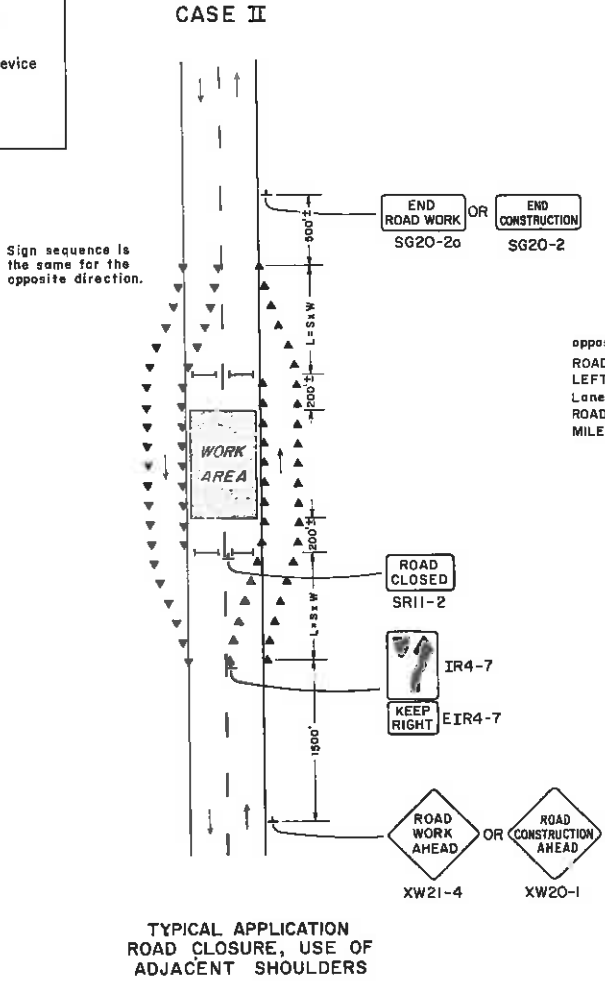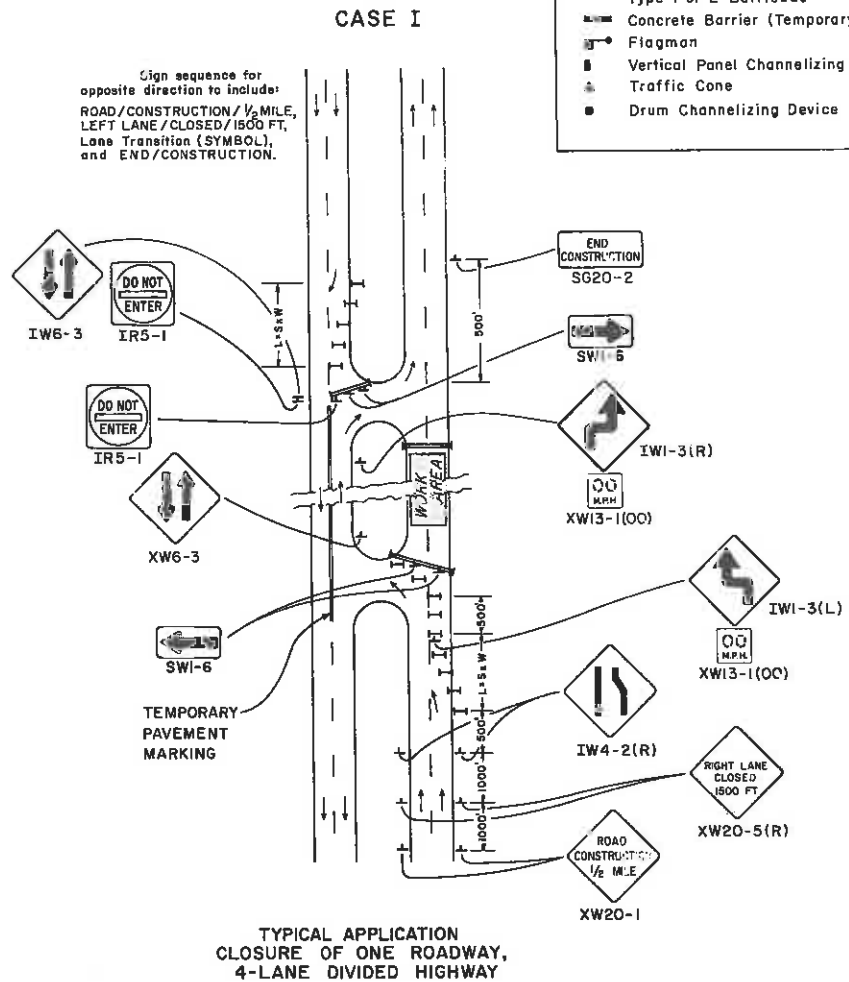

- ### NOTES
- Lights shall be used to mark flagman stations during the hours of darkness.
  - Signs are shown for one direction of travel only.
  - Vertical Panel, Traffic Cone, and Drum spacing in feet shall equal the numerical value of the speed limit (eg. 45mph = 45 ft. spacing).
  - Transition Taper:  $L = S \times W$   
L = Minimum length of taper.  
S = Numerical value of speed limit or 85 percentile speed.  
W = Width of offset

DEPARTMENT OF HIGHWAYS  
STATE OF COLORADO  
DIVISION OF HIGHWAYS

## TRAFFIC SIGNING FOR HIGHWAY CONSTRUCTION

Designed By: J.V.N. Approved By: J.E.M.  
Made By: J.E.M. Staff Traffic Engineer  
Checked By: J.D.S. Date: May 17, 1977

# STANDARD S-614-39A


SHEET 2 OF 4 SHEETS  
MAY 17, 1977

FEDERAL PROJECT NO.	DIVISION	PROJ. NO.	SHEET NO.	TOTAL SHEETS
	0101AD3			

REVISIONS			
(R-1)	5-8-78	Rev. Date Only	J.D.S.



## Typical Signing Where Traffic Is Prohibited Along Construction

(Advance signing not shown, see sheet No.1 for typical applications)

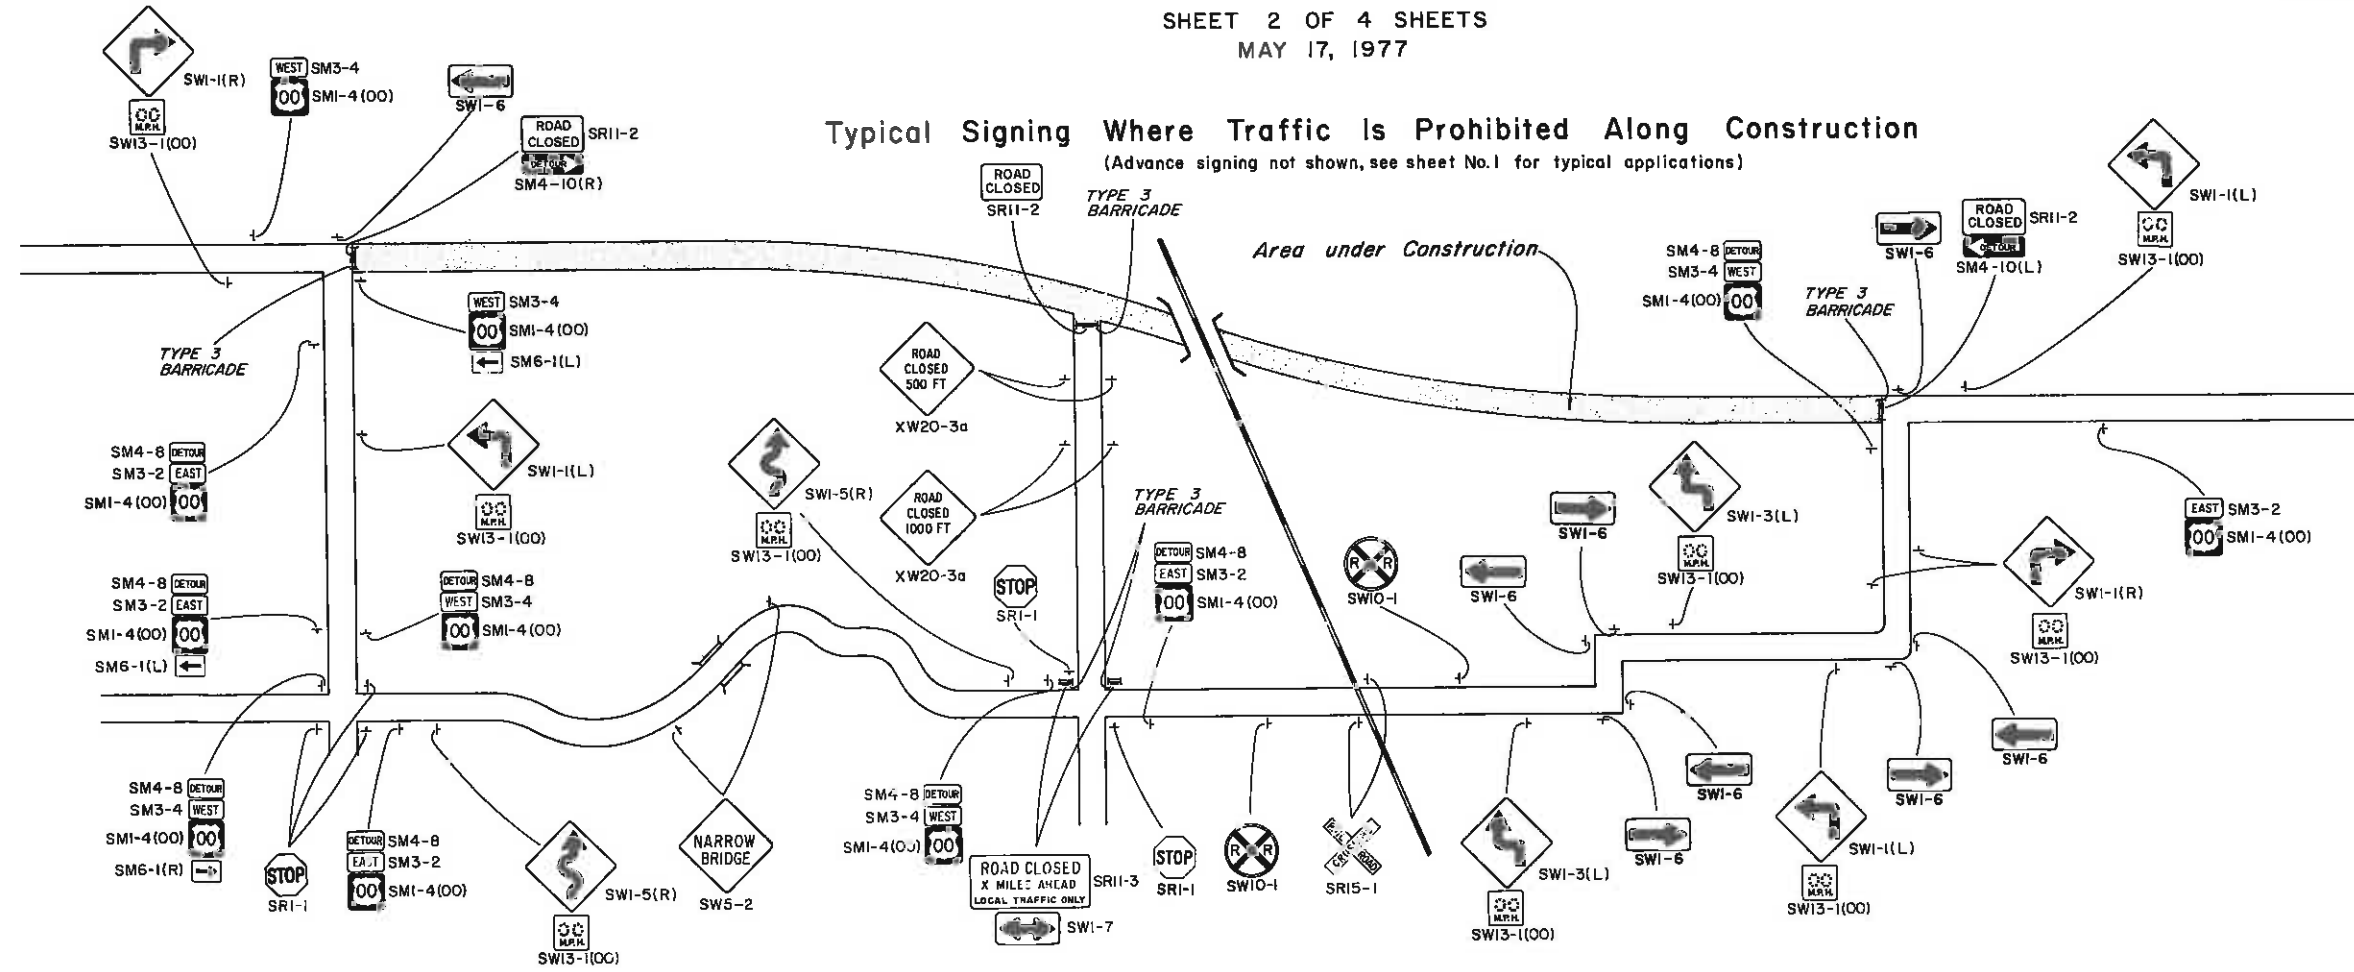

## Typical Signing Where Traffic Is Permitted Along Construction

(Advance signing not shown, see sheet No.1 for typical applications)

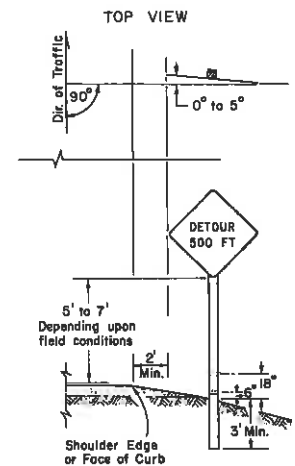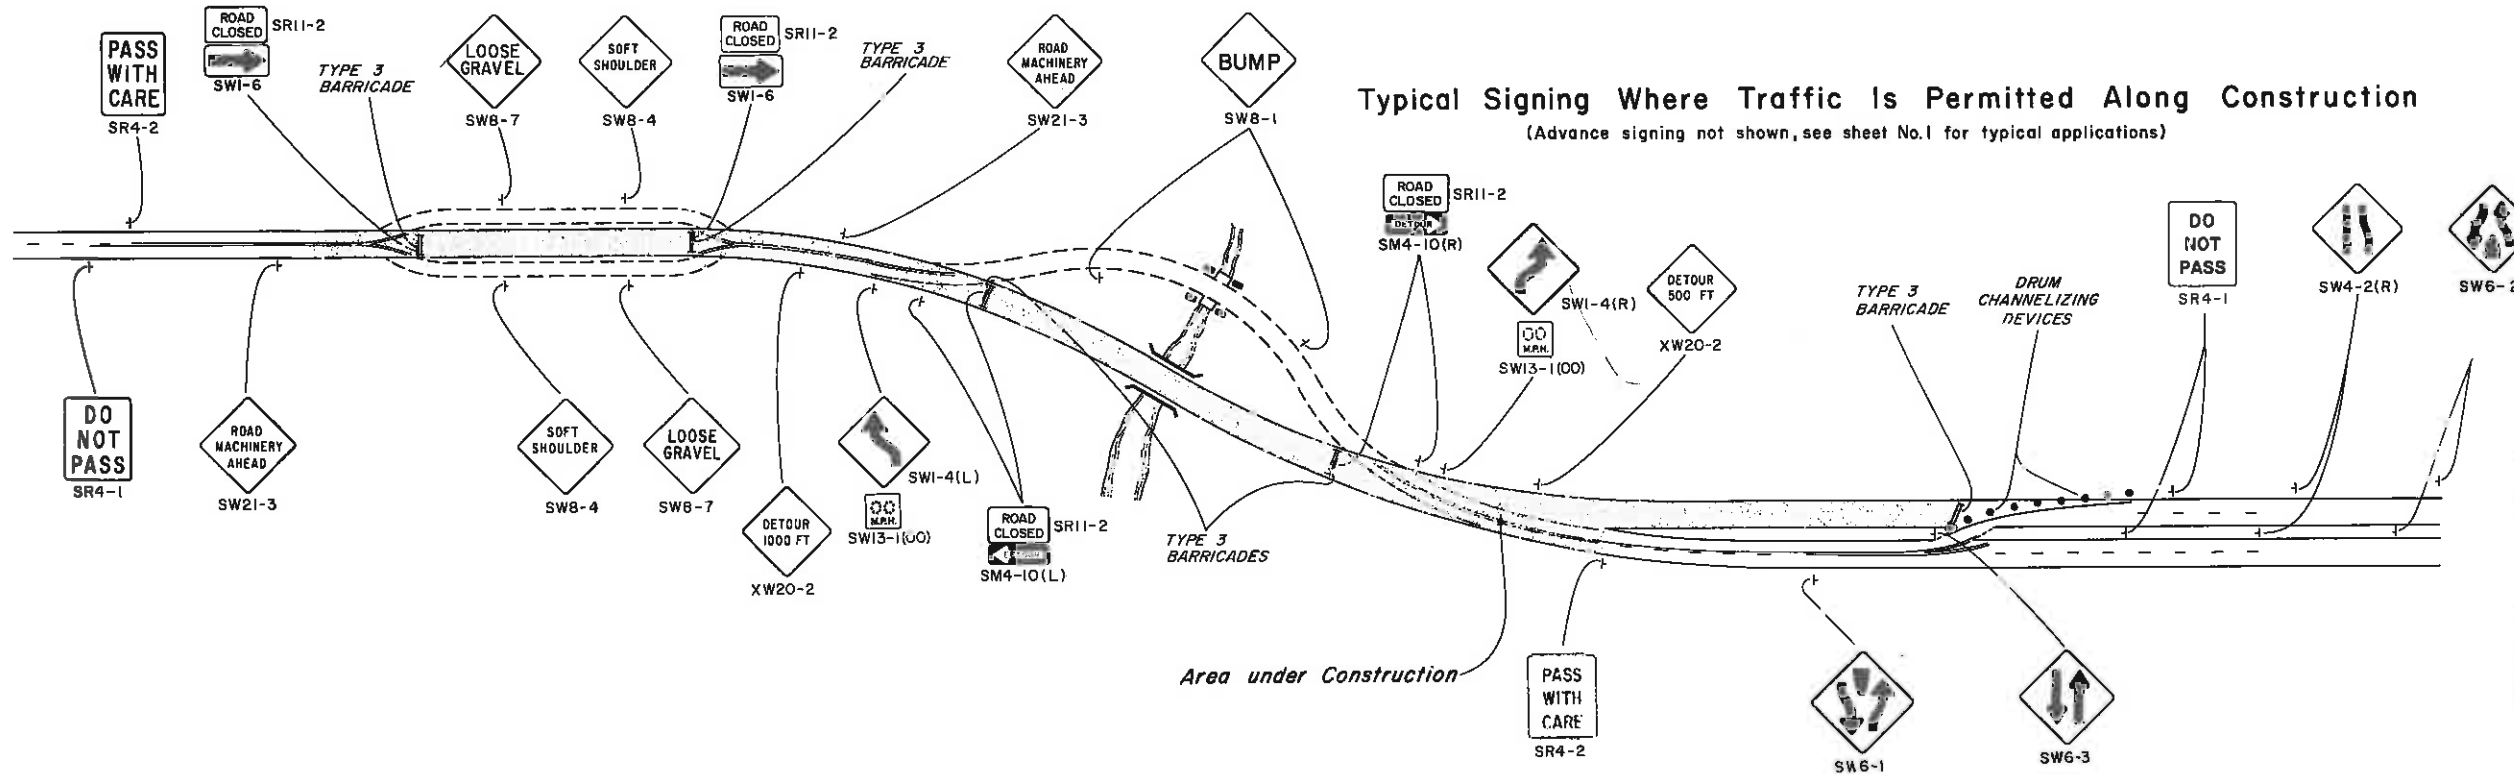

DEPARTMENT OF HIGHWAYS  
STATE OF COLORADO  
DIVISION OF HIGHWAYS  
TRAFFIC SIGNING  
FOR HIGHWAY  
CONSTRUCTION

Designed By: F.J.B.  
Made By: J.E.M.  
Checked By: J.D.S.

Approved By: *[Signature]*  
Staff Traffic Engineer  
Date: May 17, 1977

# STANDARD S-614-39A


FEDERAL ROAD REGION NO.	DIVISION	PROJ. NO.	SHEET NO.	TOTAL SHEETS
VIII	COLORADO			

SHEET 3 OF 4 SHEETS  
MAY 17, 1977

REVISIONS				
(R-1)	5-8-78	Rev. Date Only		J.D.S.


## REGULATORY SIGNS

See Note No. 9

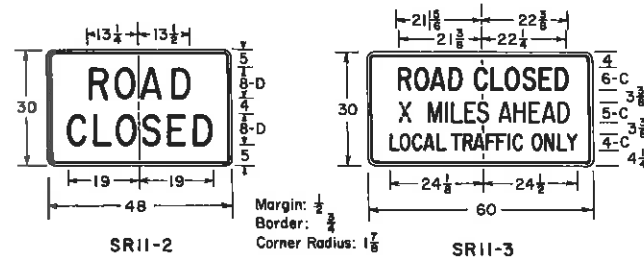




















## WARNING SIGNS

See Note No. 10

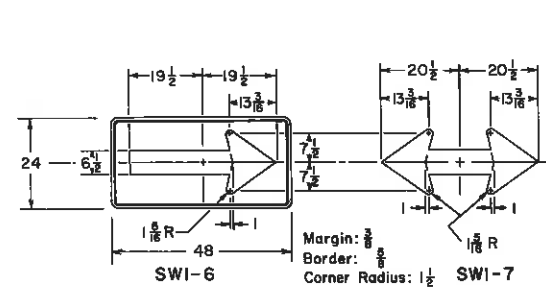

## PLATE DETAILS

S	M	B	R
30	1 1/2	1/4	1 1/2
36	2	7/8	2 1/4
48	3 1/4	1 1/4	3

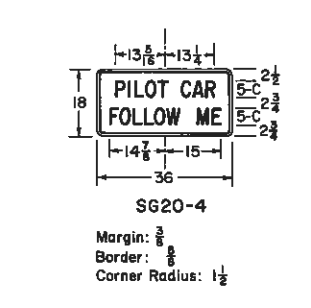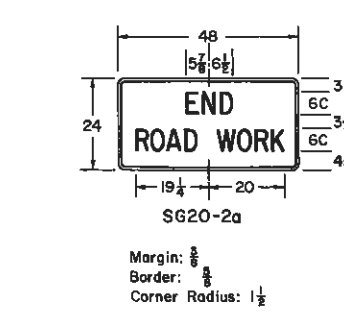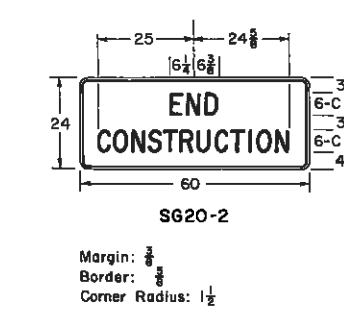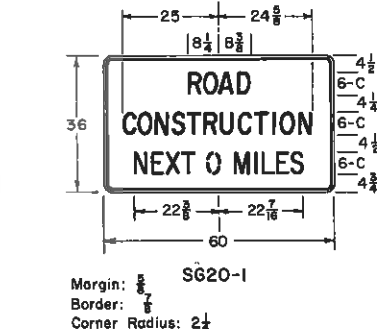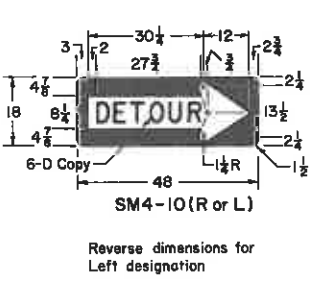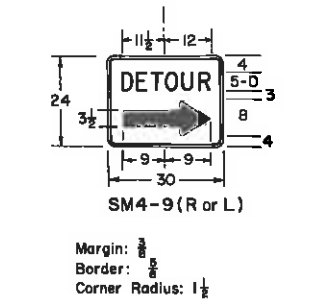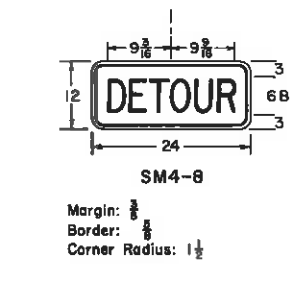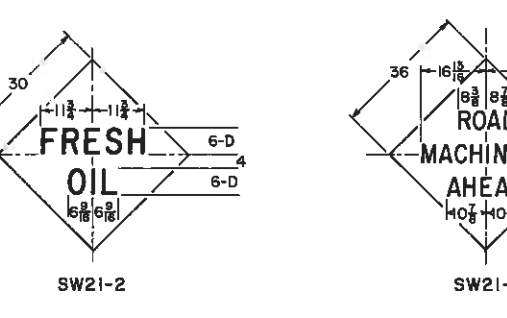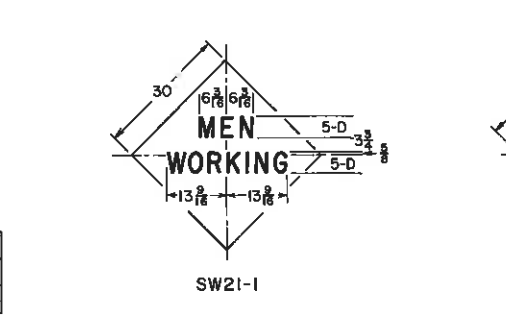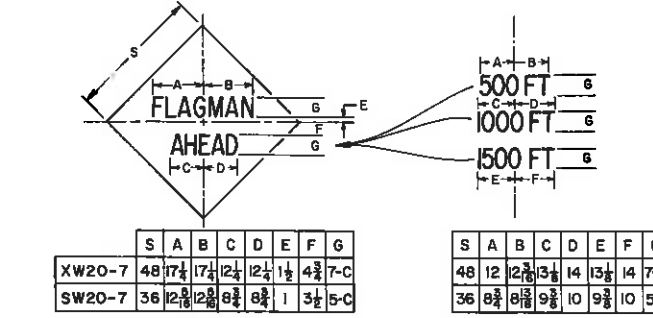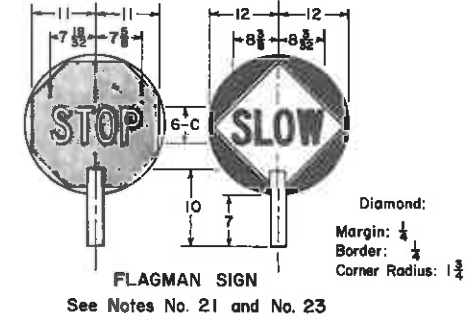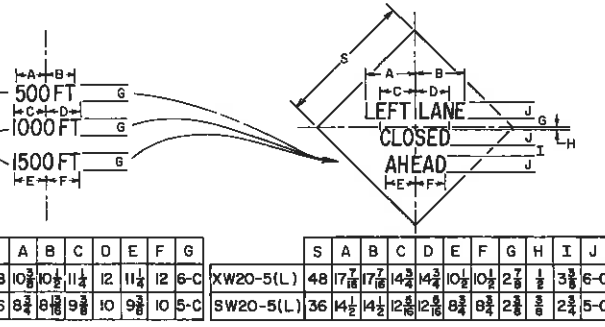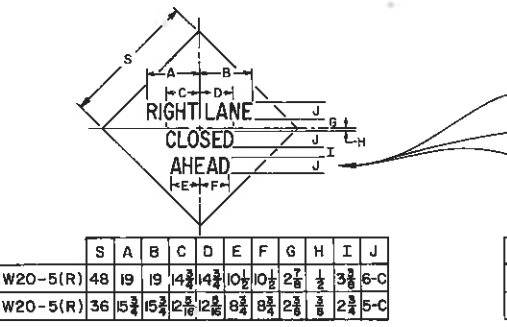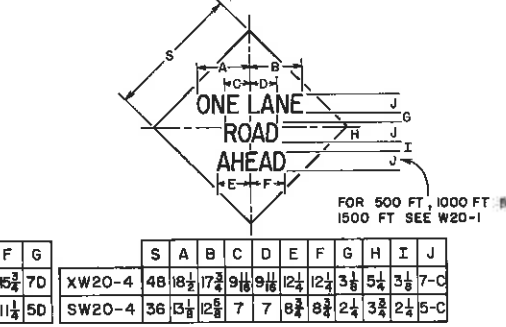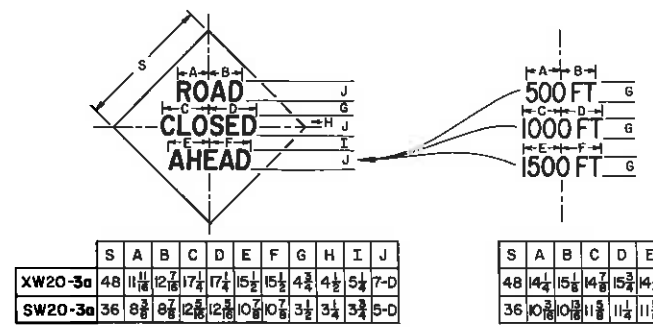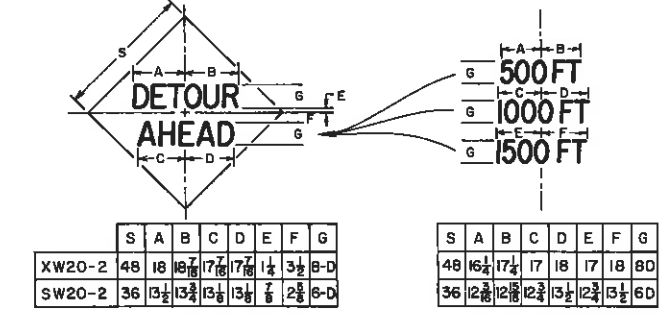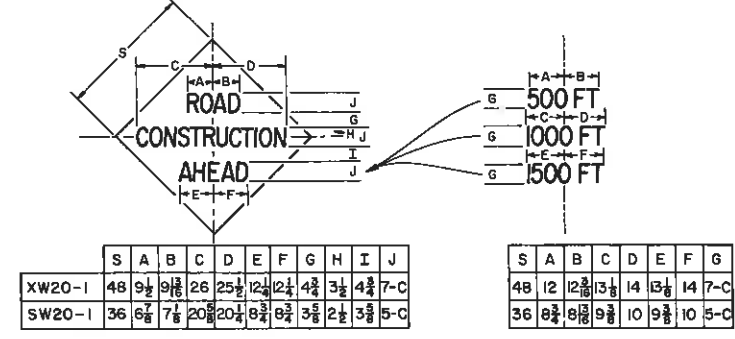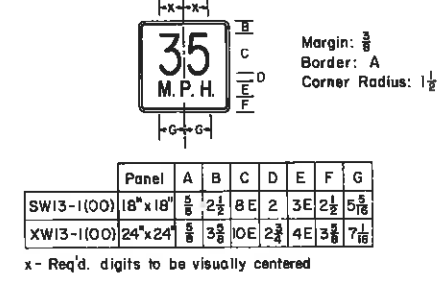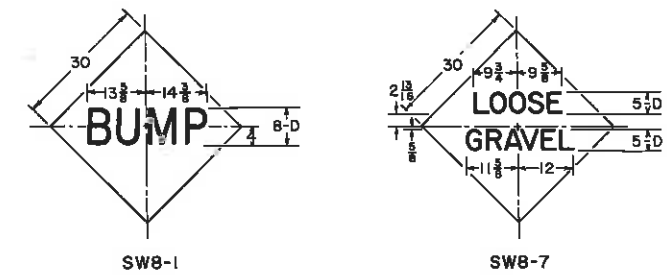

DEPARTMENT OF HIGHWAYS  
STATE OF COLORADO  
DIVISION OF HIGHWAYS  
TRAFFIC SIGNING  
FOR HIGHWAY  
CONSTRUCTION

Designed By: J.E.M. Approved By: *W.C. Tucker*  
Made By: J.E.M. Staff Traffic Engineer  
Checked By: J.D.S. Date: May 17, 1977

# STANDARD S-614-39A

SHEET 4 OF 4 SHEETS  
MAY 17, 1977

FEDERAL ROAD DISTRICT NO. <b>VIII</b>	DIVISION <b>COLORADO</b>	PROJ. NO.	SHEET NO.	TOTAL SHEETS
--	-----------------------------	-----------	-----------	--------------

REVISIONS		
(R-1)	5-8-78	Rev. Note No. 7

## GENERAL NOTES

- All work shall be done in accordance with the "Standard Specifications" applicable to the Project and the "Manual on Uniform Traffic Control Devices for Streets and Highways" (adopted by the Federal Highway Administration) and the related "Colorado Supplement".
- Where traffic is maintained through or over any part of the Project the Contractor will be required to mark all hazards within the limits of the Project (including connecting roads) with well-maintained Barricades, Warning, Regulatory, and Guide signs. All barricades and signs shall be moved, added to, changed or removed as required during the progress of construction and removed entirely when the Project is completed.
- Where traffic must be diverted from the Project by road closure, the Detour will be marked by the Division except that the Contractor shall provide, erect and maintain Barricades (when required) at the ends of the Project, ends of the Detour and connecting roads. All U.S. or State Route Markers required for the Project will be furnished and installed by the Division. The location and positioning of Barricades, Warning and Regulatory signs shall be as recommended by the Engineer.
- Work on the Project shall not be started until all required signs are in place and approved by the Engineer. Where speed limit reduction appears necessary such speed limit reduction shall be requested from the Engineer by the Contractor. Advisory Speed plates may be used in conjunction with Warning Signs (SW13-1 for use with 30" Diamond signs and XW13-1 for use with 36" and 48" Diamond signs), where the safe speed is lower than the imposed Regulatory speed limit.
- All Barricades and Signs shall be placed for best visibility and legibility, maintained in good condition, and kept clean and free of dirt at all times. Contractor's and Engineer's vehicles and equipment must be parked so that barricades and signs are visible to approaching traffic at all times.
- Where two identical signs are used for dual posting they are to be staggered on the two sides of the roadway for a minimum distance of 75' to avoid a tunneling effect.
- Examples for signing Projects, as illustrated on Sheets 1 and 2, are typical of signs required and are subject to alteration to fit actual conditions encountered in the field. In all cases Warning signs are to be placed well in advance of the hazard, the distance depending on topography and existing approach speeds.
- Desirable sizes for signs are shown on Sheets 1 and 2 of this Standard. Larger or smaller signs shall be used where warranted. Detailed dimensions for signs normally used in connection with construction are shown on Sheet 3 of this Standard. For information on standard roadway signs not detailed on this Standard see the "Manual on Uniform Traffic Control Devices for Streets and Highways" (adopted by the Federal Highway Administration) and the related "Colorado Supplement". Detailed layouts for these signs will be furnished in the plans or on request.
- Signs with the prefix "R" in the sign code are Regulatory signs, and as such they impose legal restrictions on drivers and shall only be used as authorized by the Engineer.
- Signs with the prefix "W" in the sign code are Warning signs, and are used to alert traffic to existing or potentially hazardous conditions.
- Signs with the prefix "D", "G" or "M" in the sign code are Guide signs. Those with the prefix "D" or "G" convey general information and those with the prefix "M" are used to mark the traffic route.
- All Warning and Regulatory signs shall be posted on both sides of the roadway on divided highways. Dual posting is required where warranted on two-lane, two-way highways.
- Guide sign SG20-1 shall be placed to mark the beginning of all Projects more than 2 miles in extent, where traffic is maintained through the project. It shall be placed singly and near the beginning of construction. Guide sign SG20-2 shall be placed to mark the end of the Project. It shall be placed singly and may be placed opposite barricade if desirable.
- Inapplicable pavement markings that could be confusing to motorists shall be removed by a method approved by the Engineer. Temporary markings shall be used as necessary to define vehicle paths. Refer to the appropriate Division Standard (Typical Pavement Markings) for marking details. Adhesive pavement marking tape and raised pavement markers may be used with the approval of the Engineer.
- Lanterns and Torches: Lanterns shall be used only in low speed urban areas and Open-Flame Torches shall not be used under any circumstances.
- Barricades, Flashing Beacons and Flashers: refer to appropriate Division Standard for details.
- Traffic Cones shall be orange, at least 18" in height, and not weighted to an extent that would be hazardous to traffic. They shall not be used during the hours of darkness.
- If closure is for extended period, including nighttime operations, barricade warning lights and temporary pavement markings are to be installed through-out the construction zone and inapplicable pavement markings are to be removed.
- Sign panels furnished by the Contractor for use only during construction may be fabricated from plywood, aluminum, steel or other suitable material but shall be stable and durable enough to meet other requirements of this Standard.
- All signs shall be reflectorized unless otherwise specified on plans. All reflective sheeting shall be non-exposed lens type.
- When Flags are used in lieu of the Flagman Sign, they shall be a minimum of 24"x24", made of a good grade of bright red material, and fastened securely to a staff of approximately 3 feet in length. The free edge should be weighted to insure that the flag will hang vertically, even in heavy winds.
- All material shall be sound and durable. Barricades, signs, symbols and lettering shall be of good workmanship. Uneven lettering will not be accepted.
- Flagman Sign: The background of the STOP face shall be reflectorized red with white reflectorized letters and border. The background of the SLOW face shall be reflectorized orange with black letters and border.
- Painting for all wood surfaces shall conform with the "Standard Specifications".
- Alternate methods of processing signs or the substitution of symbols or other reflecting elements for painted symbols will be permitted only after approval by the Division.
- Posts for regulatory, warning and guide signs shall conform with the "Standard Specifications" for Timber Sign Posts.
- Diamond warning signs shall have a standard size of 48"x48". Where speeds and volumes are relatively low, a minimum size of 36"x36" may be used for Construction Approach Warning Signs, provided that a minimum letter size of 5" can be accommodated on this size with the appropriate legend.

### TYPICAL CONSTRUCTION TRAFFIC SIGN AND CHANNELIZING DEVICE REQUIREMENTS

CASE	Construction Traffic Signs Each			Channelizing Devices per 100'			
	Panel Size <sup>▲</sup>			Barricades	Cones	Vertical Panels	Drums
I	11	11	*	2	3	2	2
II	6	4	*	2	3	2	2
III	4	9	*	2	3	2	2
IV	16	8	*	2	3	2	2
V	0	8	*	2	3	2	2
VI	6	11-13	*	2	3	2	2

\* As directed by the Engineer

▲ PANEL SIZE	A	0.01 to 9.00 sq. ft. including Type 1 and Type 2 Barricades.
	B	9.01 to 16.00 sq. ft.
	C	16.01 sq. ft. and over

DEPARTMENT OF HIGHWAYS  
STATE OF COLORADO  
DIVISION OF HIGHWAYS

**TRAFFIC SIGNING  
FOR HIGHWAY  
CONSTRUCTION**

Designed By: F.J.B.      Approved By: *[Signature]*  
Made By: F.J.B.          Staff Traffic Engineer  
Checked By: J.D.S.      Date: May 17, 1977




# STANDARD S-614-52A

(MARCH 1, 1972)

FEDERAL ROAD REGION NO.	DIVISION	PROJ. NO.	SHEET NO.	TOTAL SHEETS
VIII	COLORADO			


REVISIONS				
(R-1)	6-26-73	Notes		J.D.S.
(R-2)	11-1-73	Notes, Illustrations, & Title		J.D.S.
(R-3)	12-4-74	Notes, Illustrations, & Table		J.D.S.

## TYPE 1 BARRICADE (R-3)

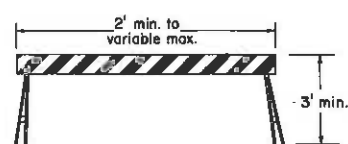


May be fabricated of lumber, aluminum or other suitable light weight materials of structural soundness. Stands may be detachable for mobility. Type 1 Barricade has 2 reflectorized rail faces (one each direction).

## TYPE 2 BARRICADE (R-3)

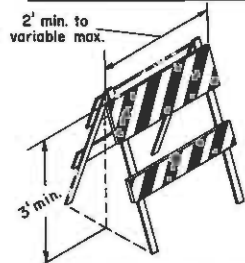


May be fabricated of lumber, aluminum or other suitable light weight materials of structural soundness. Type 2 Barricade has 4 reflectorized rail faces (two each direction).

## TYPICAL TYPE 3 BARRICADES (Timber) (R-3)

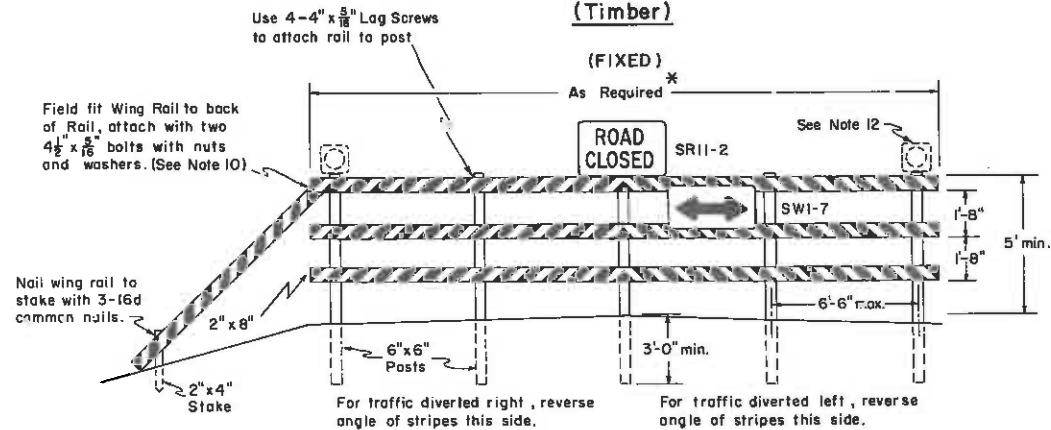


Type 3 Barricades have 3 reflectorized rail faces if facing traffic in one direction; 6 if facing traffic in two directions.


RIGID

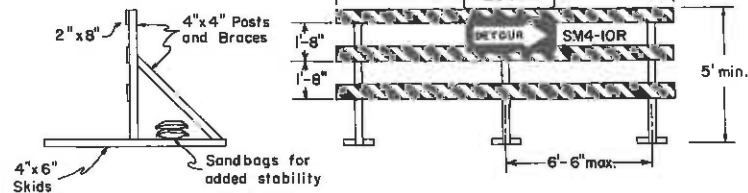


DEMOUNTABLE

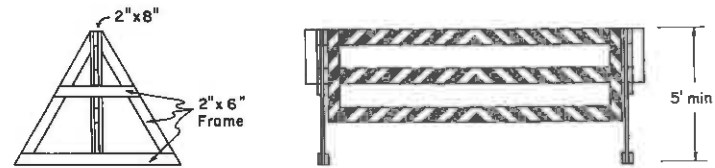

HINGED

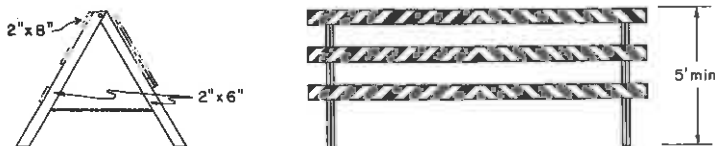


## (R-3) (R-2) TYPICAL DRUM CHANNELIZING DEVICE

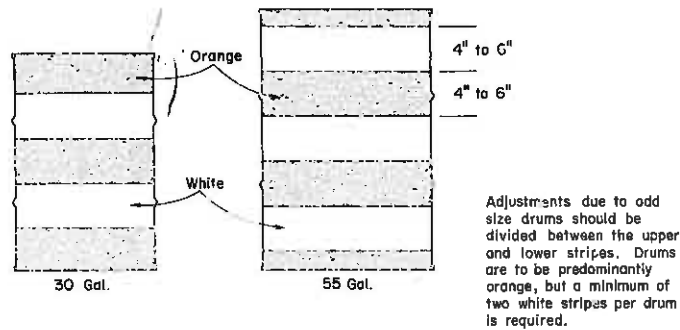


Adjustments due to odd size drums should be divided between the upper and lower stripes. Drums are to be predominantly orange, but a minimum of two white stripes per drum is required.

## (R-3) DETAIL OF BARRICADE RAIL STRIPING

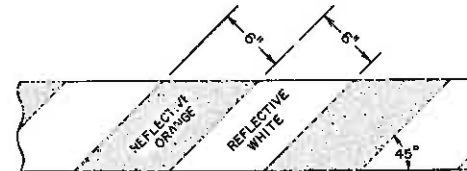

## (R-3) TYPICAL VERTICAL PANEL CHANNELIZING DEVICE

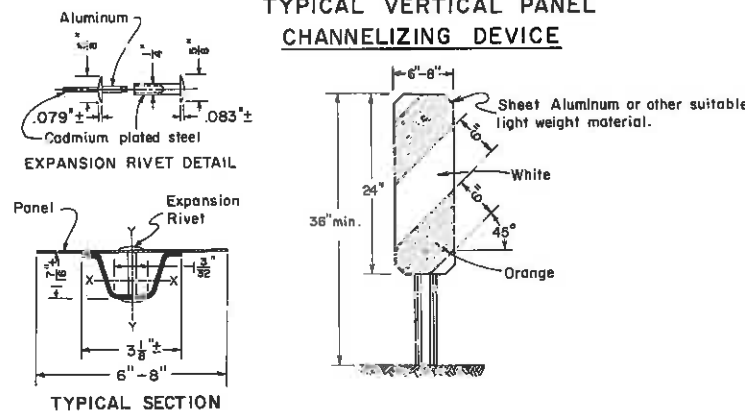

## GENERAL NOTES

- All work shall be done in accordance with the Standard Specifications applicable to the project.
- All signs, sign materials, beacons, and barricade warning lights shall conform to the standards set forth in the "Manual on Uniform Traffic Control Devices for Streets and Highways" published by the Federal Highway Administration, of current issue, and the Colorado Supplement thereto, and this standard.
- The various types and combinations of approved signs and beacons for barricades required for each project shall be governed by field conditions and subject to approval by the Engineer. Typical barricade applications are shown in Part 6 of the Manual on Uniform Traffic Control Devices for Streets and Highways.
- Painting shall conform with Subsections 508.08 and 614.07 of the Standard Specifications. All skids, braces and posts shall be painted with 2 coats of "Exterior White Paint". Horizontal and wing rails on all barricades shall have orange and white stripes. The entire area of orange and white stripes shall be reflectorized.
- Each barricade rail and vertical panel channelizing device shall be striped on the face side only with stripes slanting downward at a 45° angle toward the side to which traffic is to turn or pass. The backsides of rails and vertical panel channelizing devices shall be painted with "Exterior White Paint".
- When fixed barricades are designated on plans, the portion of the posts below ground line shall be dipped in hot creosote oil. The portion of the post above ground line shall be painted with 2 coats of "Exterior White Paint".
- Black and white barricade may be used to mark the end of a road, street or highway where there is no crossroad or outlet.
- All skids, braces, rails and posts shall be nailed together with No. 20d nails. All screws, bolts, nuts and washers shall be galvanized or cadmium plated. Skids (bases) of movable barricades shall be weighted where necessary to provide stability.
- All timber shall be Grade No. 2 or better, S 4 S, Douglas fir or Larch, as described in the current Standard Grading Rules published by the Western Wood Products Association, and shall conform to applicable paragraphs for the rails and posts.
- Detachable extension wing rails for bypassing of construction equipment are permitted when necessary. The length is variable and shall be adequate to provide closing of borrow pit and/or shoulder as required. May be used on Fixed or Movable Type 3 Barricades.
- Alternate materials or other reflective elements on traffic signs or barricades will be permitted only after approval of such material by the Division in writing.
- Flashing Beacons or Barricade Warning Lights shall be used in connection with barricades when called for by the Engineer. When used, they shall be positioned above the top rail of the barricades to produce the most effective results. When used, Barricade Warning Lights shall be of the type specified by the Engineer.
- All reflective surfaces shall be reflective sheeting of the smooth surface type.
- Barricades used as "Traffic Controls for Highway Construction" are not to be paid for separately.
- Barricades will be paid for separately when designated on plans as bid items.
- Drums shall be reflectorized for use at night and should never be placed in the roadway without advance warning signs.
- For wooden barricades, nominal lumber dimensions are satisfactory.
- For rails less than 3' long, 4" wide stripes are to be used.

	BARRICADE DESIGNATIONS		
	TYPE 1	TYPE 2	TYPE 3
Rail Width	8" min. - 12" max.	8" min. - 12" max.	8" min. - 12" max.
Rail Length	2' min. to variable max.	2' min. to variable max.	As required, see Table *
Height	3' min.	3' min.	5' min.
Stripes	See Detail of Barricade Striping		See Notes 4 & 7
Frame	Detachable or Heavy Duty Frame	Light "A" Frame	Posts, Skids or "A" Frame
Flexibility	Movable	Portable	Fixed or movable
Use	Temporary	Temporary	Temporary or Permanent

RAIL LENGTH TABLE *		
TYPE 3 BARRICADE		LENGTH
FIXED	MOVABLE	
F - A	M - A	8' - 14'
F - B	M - B	15' - 24'
F - C	M - C	25' - 35'
F - D	M - D	> 35'

DEPARTMENT OF HIGHWAYS  
STATE OF COLORADO  
DIVISION OF HIGHWAYS

**BARRICADES, DRUMS,  
& VERTICAL PANEL  
CHANNELIZING DEVICES**

Designed By: GWF  
Made By: JVN  
Checked By: GWF

Approved By: *[Signature]*  
Traffic Engineer  
Date: *March 1, 1972*

# STANDARD S-627-1A


( SHEET 1 OF 2 SHEETS )

AUGUST 3, 1976

FEDERAL ROAD REGION NO.	DIVISION	PROJ. NO.	SHEET NO.	TOTAL SHEETS
VIII	COLORADO			


REVISIONS				
(R-1)	12-10-76	Rev. Edge Lines		J.D.S.
(R-2)	5-25-77	Rev. Date Only		J.D.S.
(R-3)	10-28-77	Rev. Segment-Gap Ratio		J.D.S.

## TYPICAL ENTRANCE AND EXIT RAMP MARKINGS

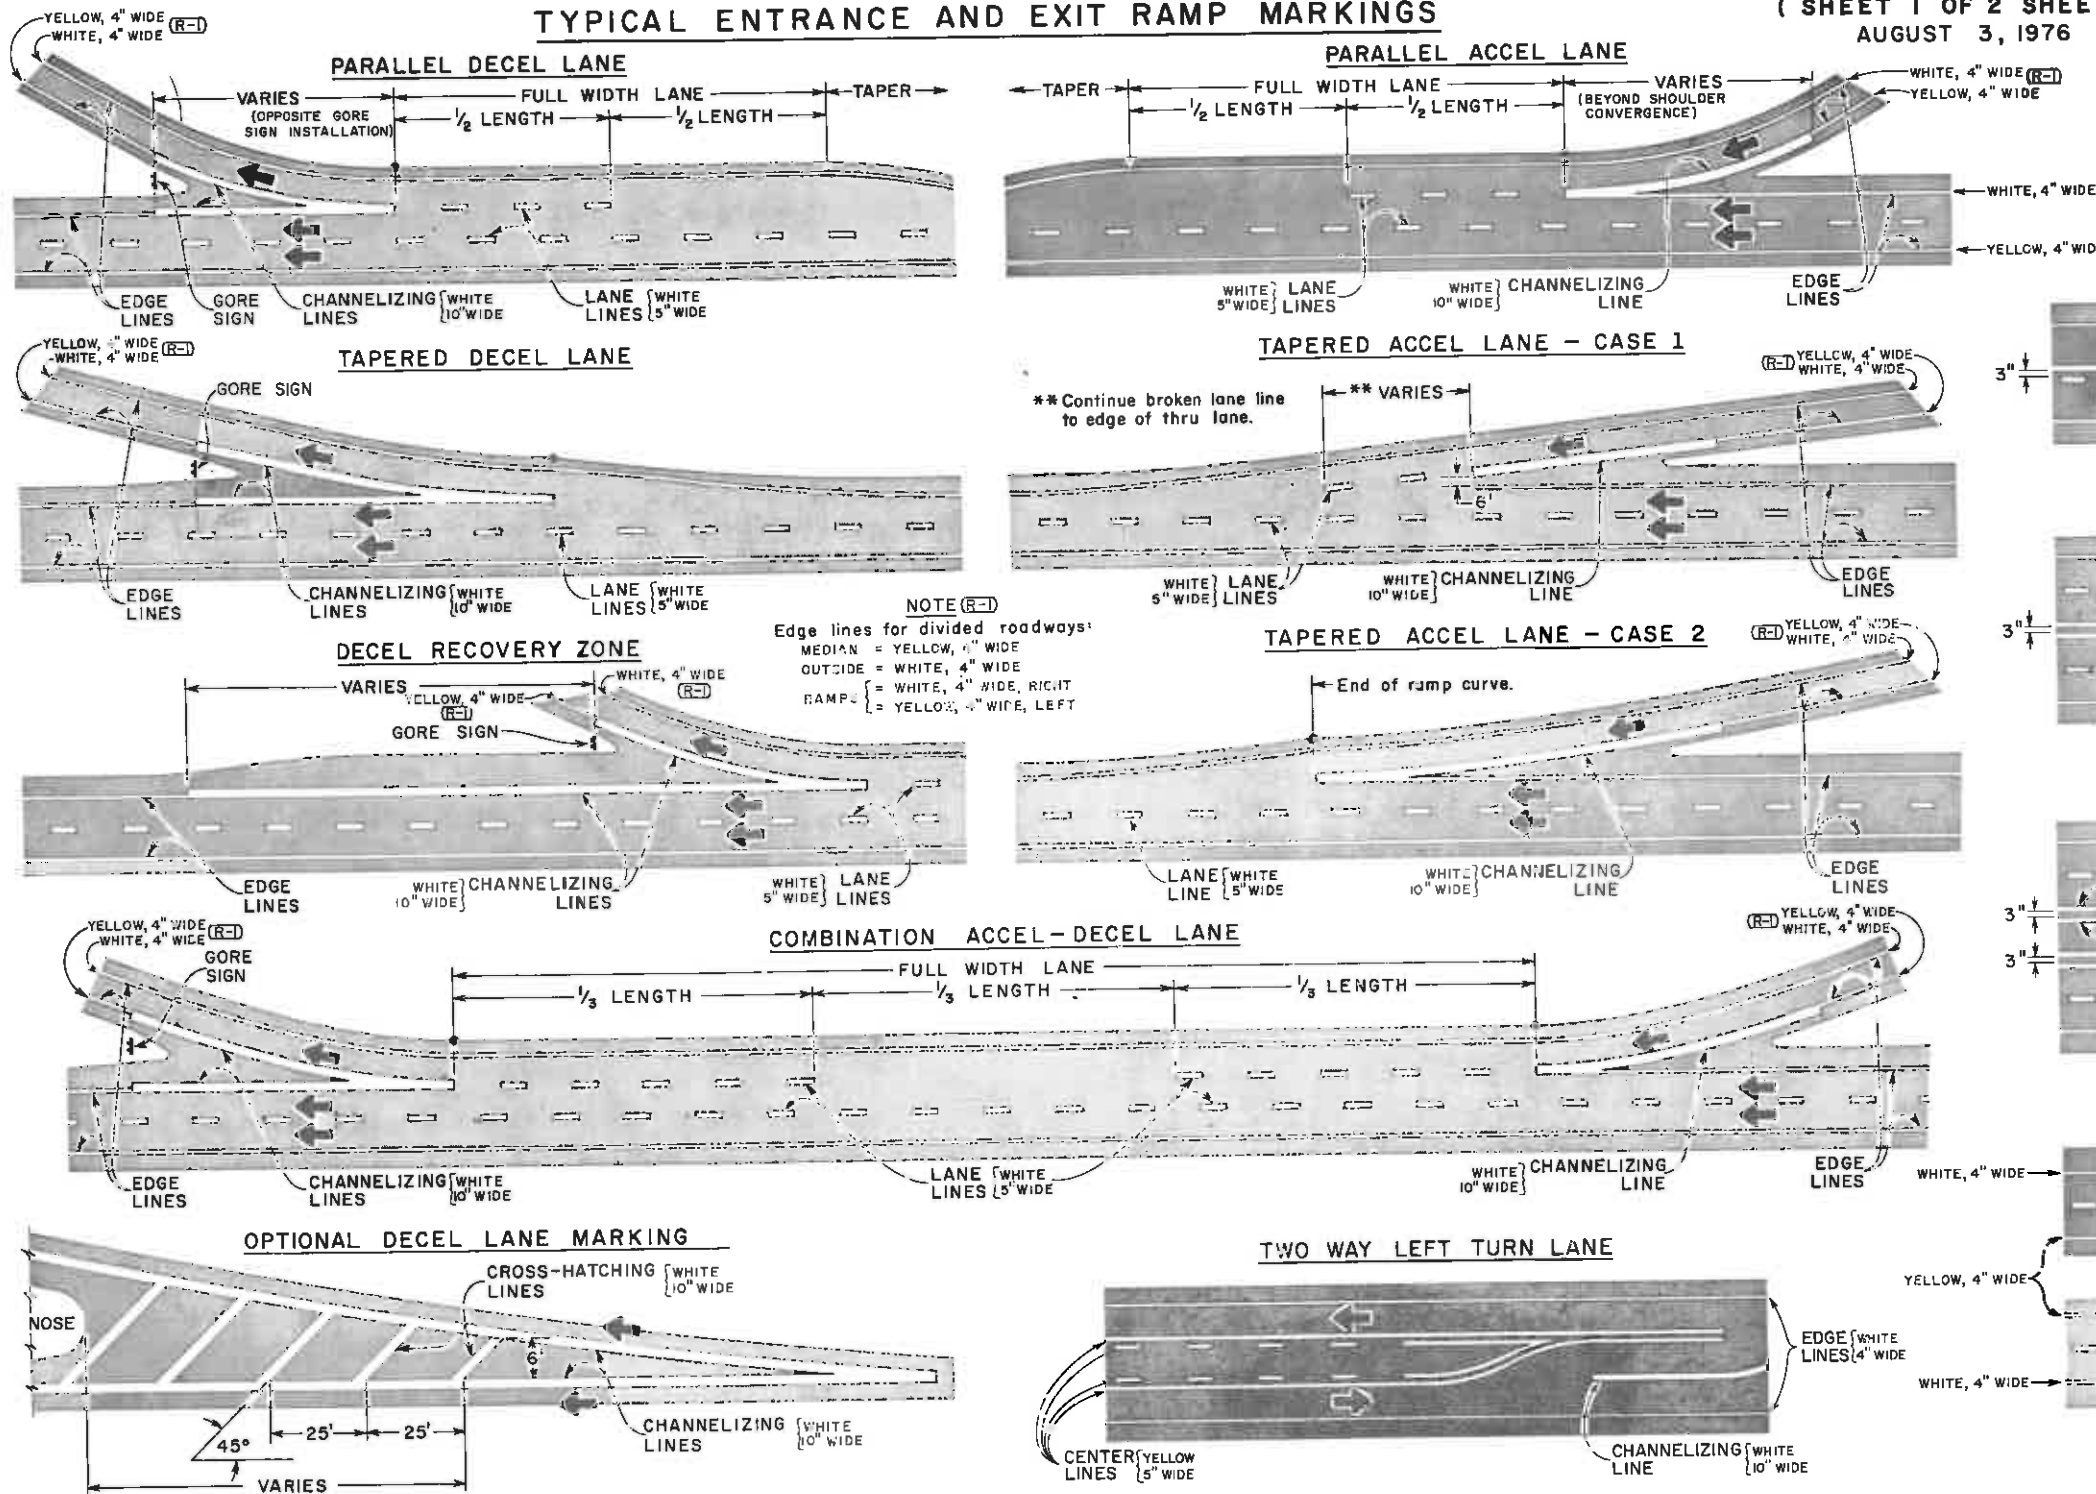

**NOTE (R-1)**  
Edge lines for divided roadways:  
MEDIAN = YELLOW, 4" WIDE  
OUTSIDE = WHITE, 4" WIDE  
RAMP = WHITE, 4" WIDE, RIGHT  
RAMP = YELLOW, 4" WIDE, LEFT

## TYPICAL HIGHWAY MARKINGS

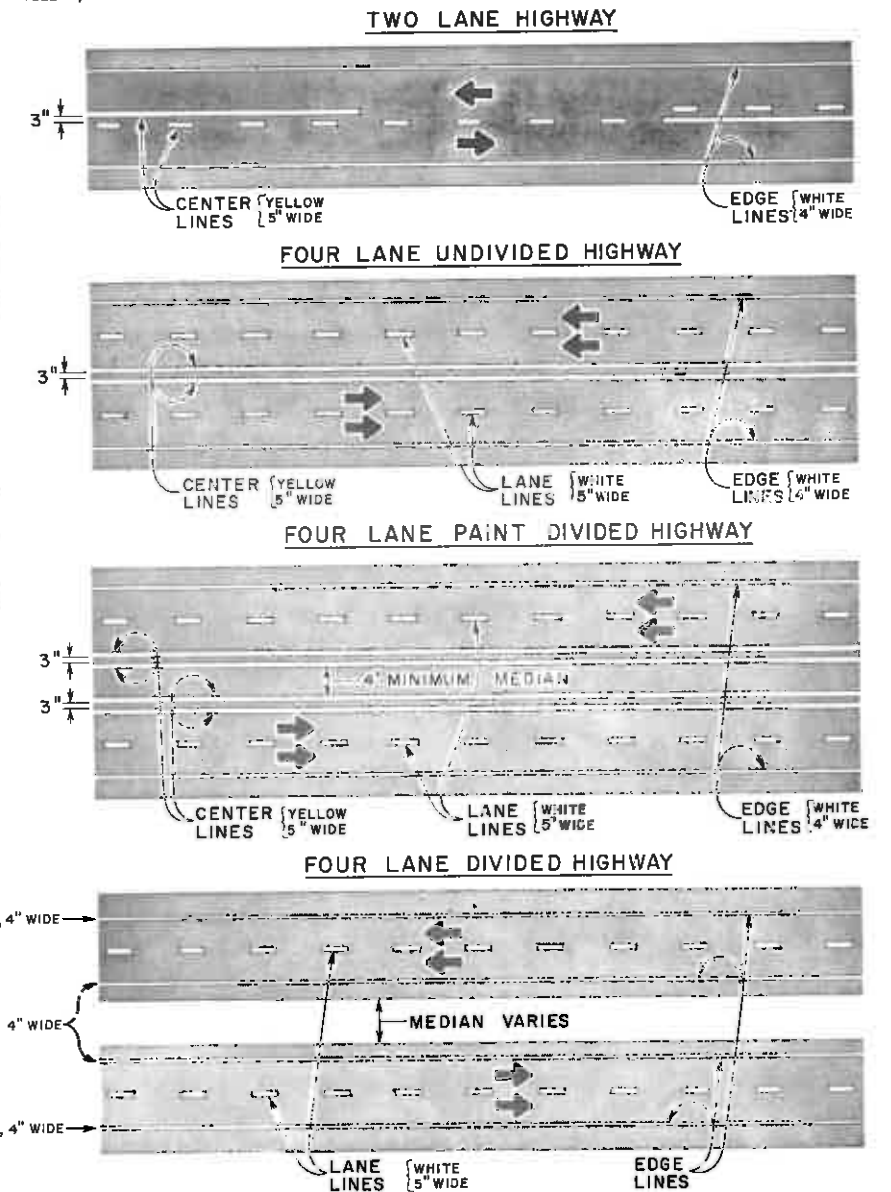

## GENERAL NOTES

ALL WORK SHALL BE DONE IN ACCORDANCE WITH THE STANDARD SPECIFICATIONS APPLICABLE TO THE PROJECT.

**(R-3) CENTER LINES**

1. Broken yellow, 5 inches wide - 10 foot segments with 30 foot gaps.
  2. Solid yellow, 5 inches wide.
- These lines separate adjacent-opposite direction traffic lanes. Double lines shall be spaced 3 inches apart.

**(R-3) LANE LINES**

1. Broken white, 5 inches wide - 10 foot segments with 30 foot gaps.
  2. Solid white, 5 inches wide.
- These lines separate adjacent-same direction traffic lanes. A solid line may be used to discourage lane changing.

**EDGE LINES**

1. Parallel - Solid white or yellow, 4 inches wide.
2. Diagonal - Solid white, 10 inches wide, spaced at intervals of 20 feet minimum to 100 feet maximum.

**(R-1) Yellow edge lines** shall be used only for the left edge, in the direction of travel, of divided streets and highways (separated by other than a painted median) and one-way roadways (including ramps).

Edge lines are not continued through intersections and are not broken for driveways. Care must be taken to avoid edge line appearing as lane line along roadways with wide shoulders and /or closely spaced driveways.

**CHANNELIZING LINES**

Solid white, 10 inches wide. These lines are used with acceleration-deceleration lanes, pavement width transitions, and left-right turn slots or islands.

**CROSS-HATCHING LINES**

Solid white or yellow, 10 inches wide - 45 degree Diagonal, spaced at 25 foot intervals. These lines are optional and may be placed at locations indicated on the plans or determined by the Engineer. Yellow shall be used for painted median-undivided road only.

**PARKING LINES**

Solid white, 3 inches wide - diagonal or parallel as shown on the plans.

**STOP LINES**

Solid white, 24 inches wide - extend parallel to intersected roadway across all approach lanes or as indicated at locations on the plans. Locate at the desired stopping point, not more than 30 feet nor less than 4 feet from the nearest edge of the intersected traffic lane.

**CROSSWALK LINES** ( see note on sheet 2 )

DEPARTMENT OF HIGHWAYS  
STATE OF COLORADO  
DIVISION OF HIGHWAYS

### TYPICAL PAVEMENT MARKINGS

Designed By: F.J.B. Approved By: J.F. Tolson  
Made By: F.J.B. Staff Traffic Engineer  
Checked By: J.E.M. Date: August 3, 1976

# STANDARD S-627-1A


( SHEET 2 OF 2 SHEETS )

AUGUST 3, 1976

FEDERAL ROAD REGION NO.	DIVISION	PROJ. NO.	SHEET NO.	TOTAL SHEETS
VIII	COLORADO			


REVISIONS			
(R-1)	12-10-76	Rev. Date Only	J.D.S.
(R-2)	5-25-77	Rev. Edge Lines	J.D.S.
(R-3)	10-28-77	Rev. Date Only	J.D.S.

## TYPICAL PAVEMENT WIDTH TRANSITION MARKINGS

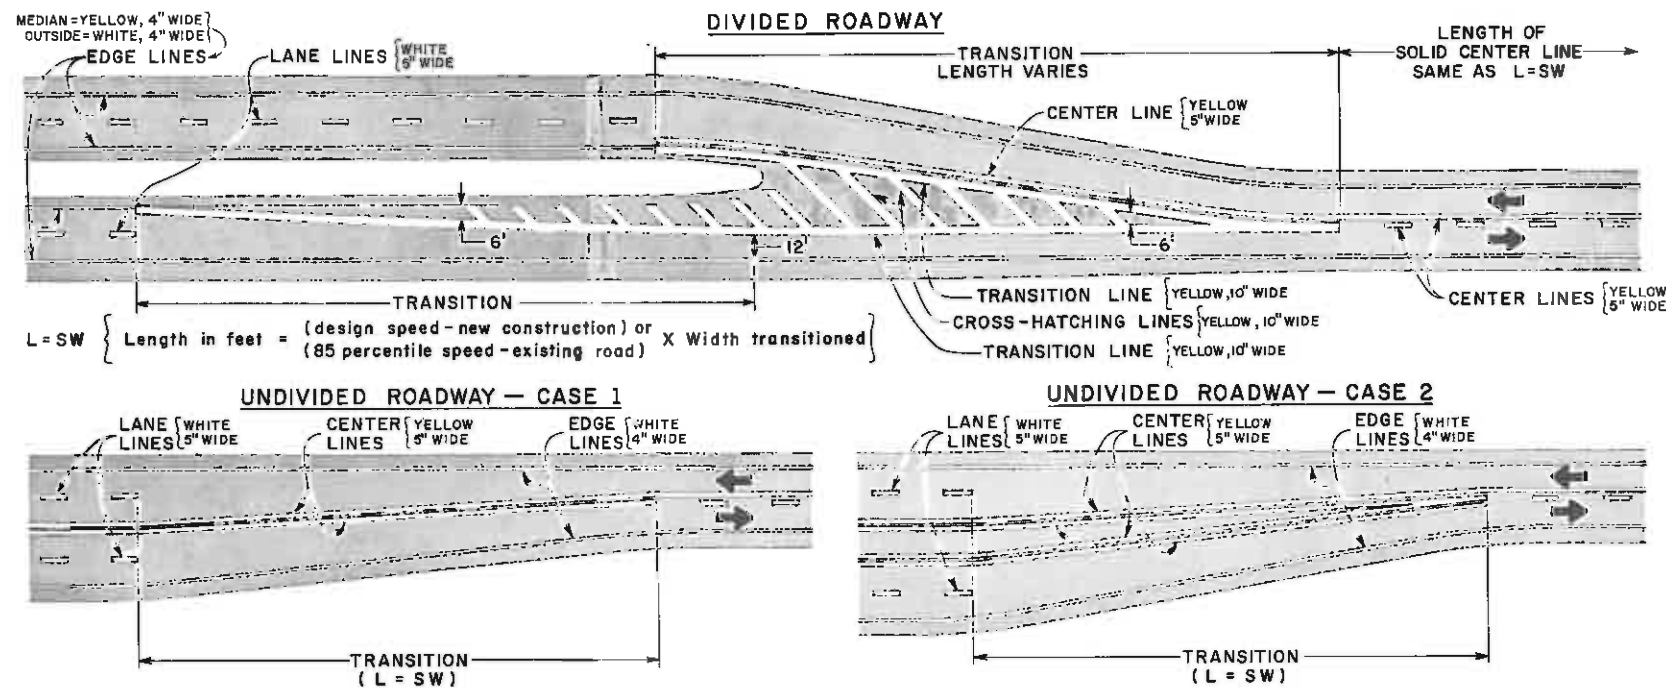


## TYPICAL PAVEMENT EDGE MARKINGS

NOTE: ▲ = SHOULDER WIDTH

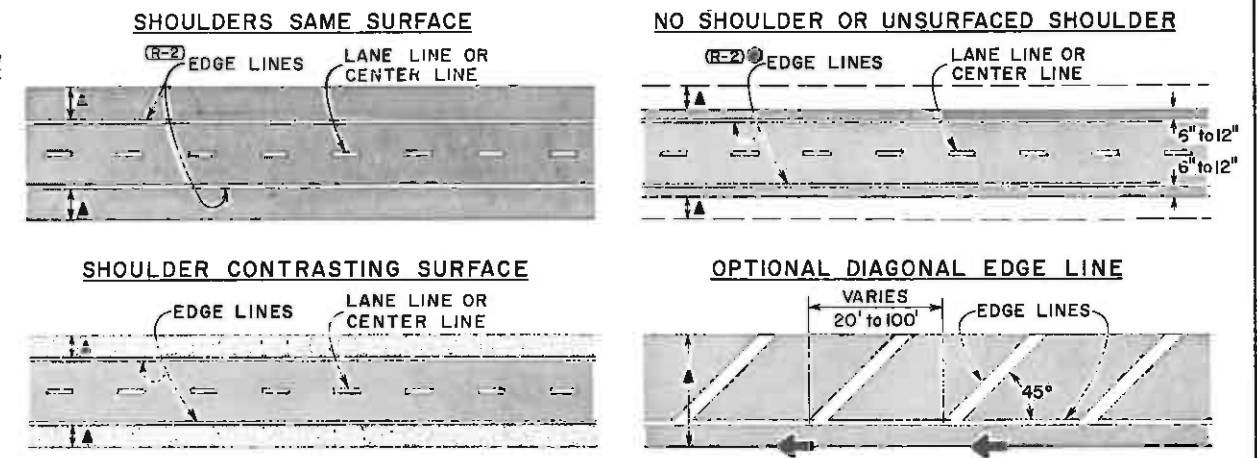


## TYPICAL INTERSECTION MARKINGS

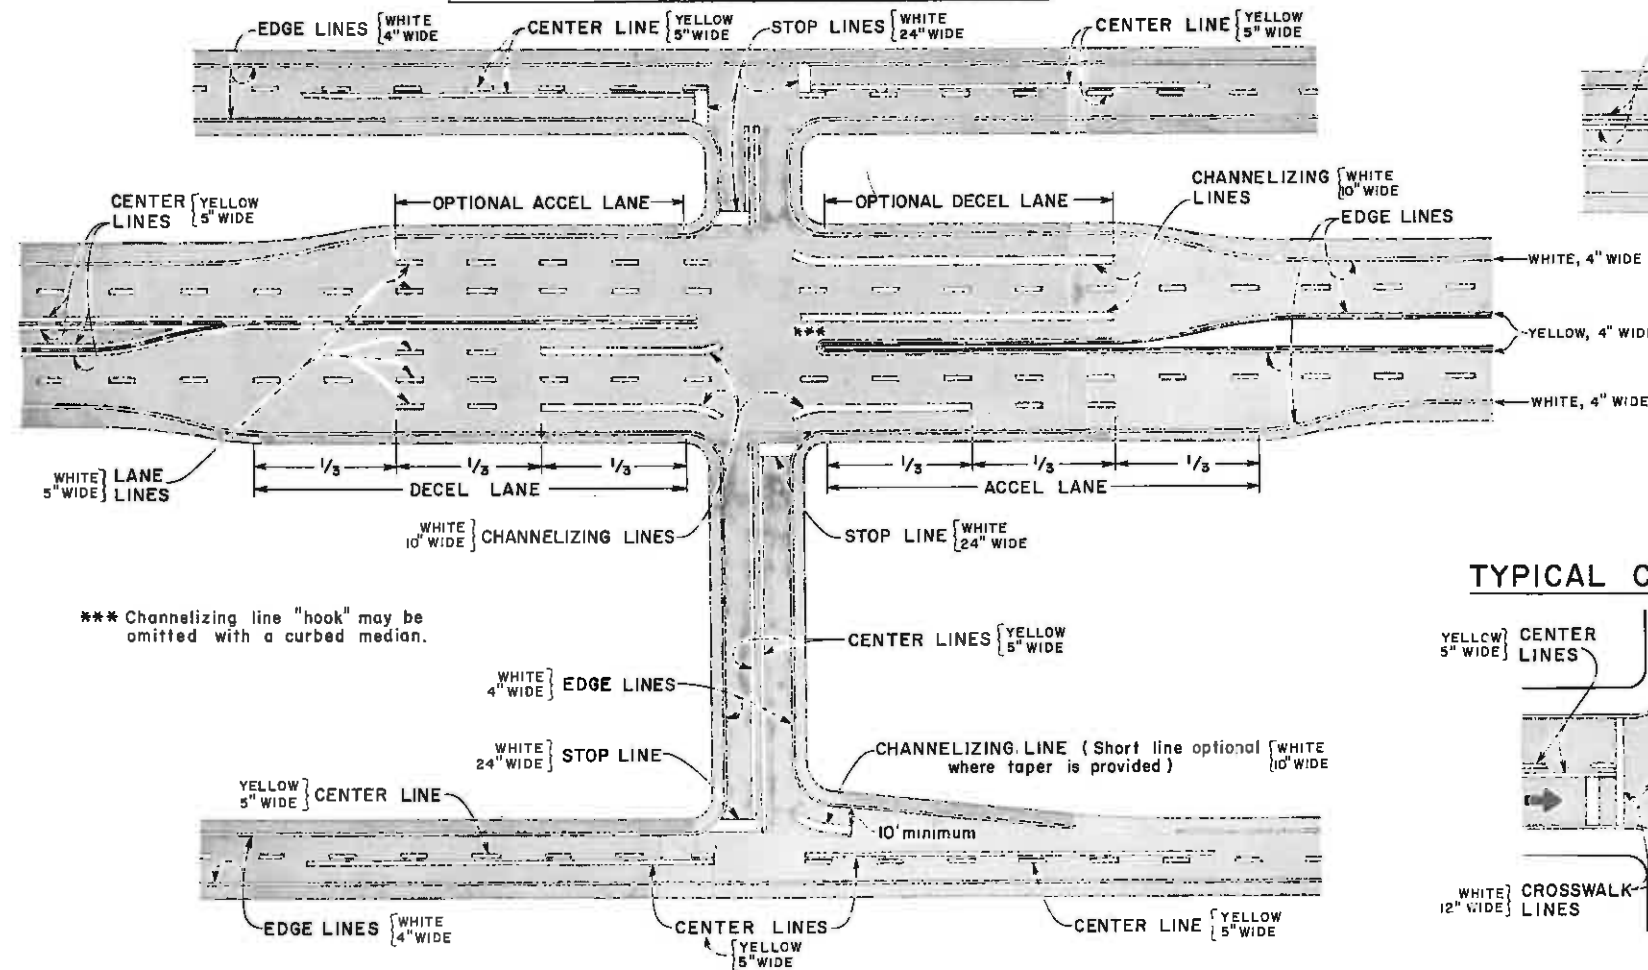


\*\*\* Channelizing line "hook" may be omitted with a curbed median.

## TYPICAL ISLAND MARKINGS

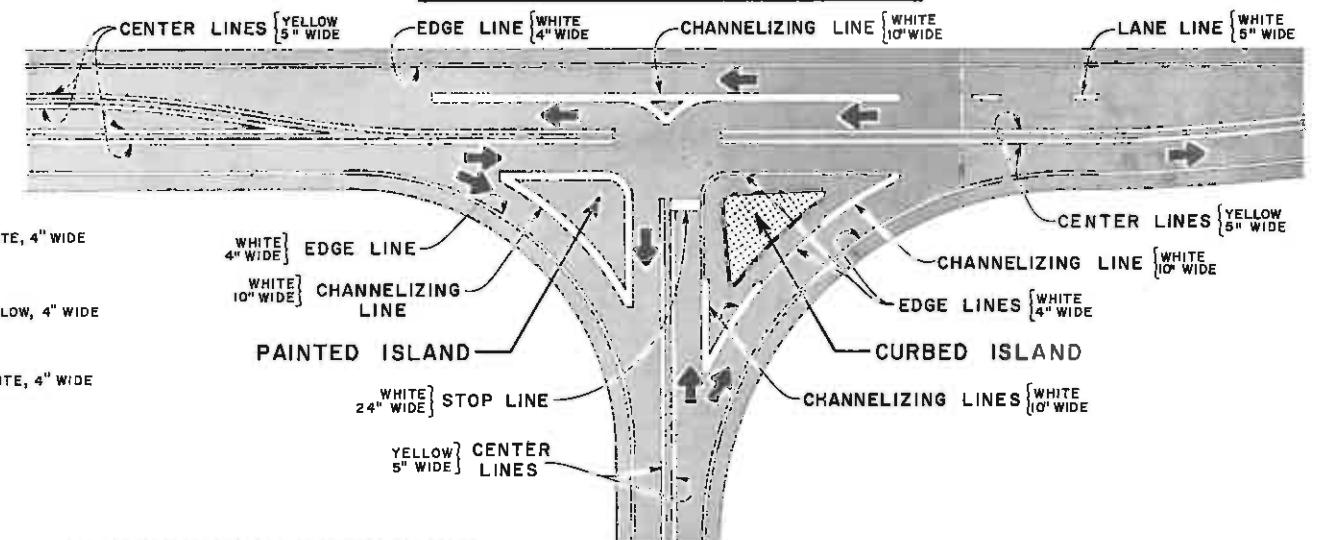

## TYPICAL CROSSWALK MARKINGS

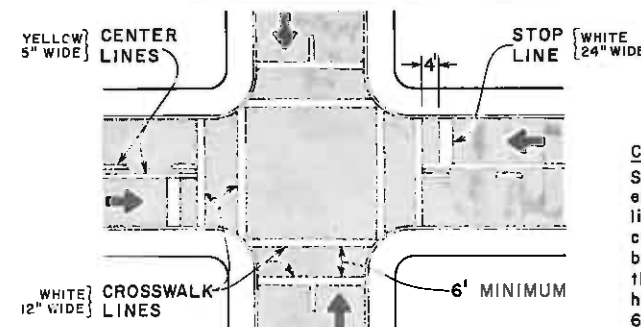

### CROSSWALK LINE APPLICATION

Solid white, 12 inches wide - extend across entire width of pavement. If no advance stop line is provided, increase the width of the crosswalk lines to 24 inches. The distance between the lines is usually determined by the width of the sidewalks so connected, however, in no case shall this be less than 6 feet. Complicated and/or channelized intersections and mid-block crosswalks shall be as detailed in the plans or as directed by the Engineer.

DEPARTMENT OF HIGHWAYS  
 STATE OF COLORADO  
 DIVISION OF HIGHWAYS

## TYPICAL PAVEMENT MARKINGS

Designed By: F.J.B.  
 Made By: F.J.B.  
 Checked By: J.J.S.

Approved By: *[Signature]*  
 Staff Traffic Engineer  
 Date: August 3, 1976