

FEDERAL ROAD DISTRICT	PROJ. NO.	SHEET NO.	TOTAL SHEETS
III	COLORADO	J-70-2 (52) 197	41

REVISIONS		
R-1	5-6-75	Note WCB

VOID
BY CONSTRUCTION DATE 6-27-77

INDEX OF DRAWINGS

DWG. NO.	TITLE
B-1	General Information Summary of Quantities
B-2	General Layout
B-3	Engineering Geology
B-4 & 5	Elevations
B-6	Construction Layout
B-7	Footings & Piling
B-8	Abutment No. 1 Details
B-9	Pier No. 2 Details
B-10	Abutment No. 3 Details
B-11	Deck Plan & Typical Deck Plan
B-12	90' Cantilever Construction Sequence
B-13	Prestressing Details
B-14	Diaphragm Details
B-15	Bridge Rail Type 4
B-16	Bridge Expansion Device - Premolded Armored
B-17	Structure Number Standard

Summary of Quantities

Item	Description	Unit	Super-Structure	Abut. 1	Pier 2	Abut. 3	Totals
206	Structure Excavation	Cu. Yd.		114	153	116	383
206	Structure Backfill (Class 2)	Cu. Yd.		52	84	54	190
④ A03	Hot Bituminous Pavement	Ton	122				122
④ A11	Asphalt Cement	Ton					
502	Steel Piling (HP 12 x 74)	Lin. Ft.		245		373	618
509	Structural Steel	Lbs.		123		123	246
① 512	Bearing Device (0 to 250 Ton Capacity)	Ea.		2		2	4
① 512	Bearing Device (501 to 750 Ton Capacity)	Ea.			2		2
④ 515	Waterproofing (Membrane)	Sq. Yd.	1128				1128
518	Bridge Expansion Device (Type 1)	Lin. Ft.	70				70
601	Conc. Class A (Bridge)	Cu. Yd.			50		50
601	Conc. Class A (Bridge) (Colored)	Cu. Yd.		24		23	47
601	Conc. Class D (Bridge) (Colored)	Cu. Yd.	(80)	62		60	202
602	Reinforcing Steel	Lbs.		10,006	2639	9656	22,301
② 618	Conc. Segmental Superstr. (F-12-AM)	L.S.	1				1
③ 618	Conc. Segmental Pier (F-12-AM)	L.S.					1
626	Mobilization	L.S.					0.2

- ① Masonry Plates to be Included. (R-1) ②+③ Approximate Quantities for Information only.
- ② Conc. Class S (Colored) (Precast) 589.24 Cu. Yd.
Reinforcing Steel 122,983 Lbs.
Conc. Class S
Prestressing Strands 26,800 Lbs.
- ③ Conc. Class S (Colored) (Precast) 60 Cu. Yd.
Reinforcing Steel 6053 Lbs.
Conc. Class S (Colored) (Cast-in-Place) 19 Cu. Yd.
Prestressing Strands for Pier 1560 Lbs.
- ④ Future Items

BRIDGE DESCRIPTION
Two Continuous Spans (120'-0", 120'-0")
Segmental Post-Tensioned Concrete box
Girder Bridge.
Over Smith Gulch, Sta. 914 +00 Near Vail Pass,
Curved, 1637.02' Radius, 3% Bridge Rail
Type 4.

GENERAL NOTES:

ALL WORK SHALL BE DONE ACCORDING TO THE STANDARD SPECIFICATIONS OF THE DIVISION OF HIGHWAYS, STATE OF COLORADO, APPLICABLE TO THE PROJECT.

ALL CONCRETE SURFACES AS REFERRED TO IN THE SPECIFICATIONS SHALL RECEIVE A CLASS 7 SURFACE FINISH.

ALL CONCRETE CHAMFERS SHALL BE 3/4 INCH UNLESS OTHERWISE NOTED.

EXPANSION JOINT MATERIAL SHALL MEET A.A.S.H.O. SPECIFICATION M 213-65 AND SHALL BE INCLUDED IN THE PAYMENT FOR ITEM NO. 601.

SOUNDINGS AND DEPTH OF FOOTINGS ARE IN ACCORDANCE WITH THE BEST AVAILABLE DATA. WHEN DIFFERENT CONDITIONS ARE ENCOUNTERED, THE BRIDGE ENGINEER WILL INSPECT AND DETERMINE IF REDESIGN IS NECESSARY.

WHEN EXCAVATING FOR FOOTINGS, THE FINAL SIX INCHES IN DEPTH SHALL BE DONE BY HAND LABOR METHODS.

FOOTINGS IN ROCK SHALL NOT BE FORMED BUT SHALL BE PLACED AGAINST UNDISTURBED ROCK.

FOR DETAILS OF STRUCTURE EXCAVATION AND STRUCTURE BACKFILL, SEE STANDARD M-205-AA.

ALL STRUCTURAL STEEL NOT OTHERWISE NOTED SHALL BE A.A.S.H.O. SPECIFICATION M-183. (ASTM A36)

ALL STRUCTURAL STEEL NOT OTHERWISE NOTED SHALL BE PAINTED IN ACCORDANCE WITH SECTION 509 FOR PAINT.

GRADE 60 REINFORCING STEEL REQUIRED FOR #5 BARS AND LARGER GRADE 40 OR GRADE 60 MAY BE FURNISHED FOR #4 BARS.

FORM, CONSTRUCTION EQUIPMENT, AND ADDITIONAL CONSTRUCTION LOADS WERE NOT CONSIDERED IN ANALYZING THIS STRUCTURE.

DESIGN PROVISIONS WERE MADE FOR A ONE SEGMENT UNBALANCED CANTILEVER MOMENT AT THE END OF THE CANTILEVER DURING CONSTRUCTION STAGES. FOR THE UNBALANCED MOMENT VALUES, SEE DWG. NO. B-9. THIS APPLIES TO THE FOOTINGS ONLY.

APPLIED WIND LOADS AND EARTHQUAKE LOADS WERE NOT CONSIDERED IN ANALYZING THE STRUCTURE FOR STABILITY DURING THE CONSTRUCTION STAGES.

THE SEQUENCE OF CONSTRUCTION SHALL BE AS SHOWN ON DWG. NO. B12. ANY CHANGE IN THIS CONSTRUCTION SEQUENCE SHALL BE WITH THE APPROVAL OF THE ENGINEER.

APPLY EPOXY JOINT SEALER TO ALL MATCHING SURFACES OF PRECAST SEGMENTS IN ACCORDANCE WITH THE SPECIFICATIONS.


GROUT ALL ANCHORAGE BLOCKOUTS AND MATCH EXPOSED SURFACES TO PRECAST SEGMENTS.

BEFORE ANY FORMS ARE REMOVED FROM THE PRECAST SEGMENTS, F_c SHALL OBTAIN A COMPRESSIVE STRENGTH OF 3000 P.S.I.

THE FOLLOWING TABLE SHOWS THE MINIMUM LAP FOR COMMON BAR SIZES.

BAR SIZE NUMBER	4	5	6	7	8	9	10	11
SPLICE GRADE 40	1'-0"	1'-3"	1'-6"	1'-9"	2'-2"	2'-8"	3'-5"	4'-3"
LENGTH GRADE 60	1'-6"	1'-11"	2'-3"	2'-8"	3'-0"	3'-5"	4'-2"	5'-0"

E, F. = EACH FACE
N, F. = NEAR FACE
F, F. = FAR FACE

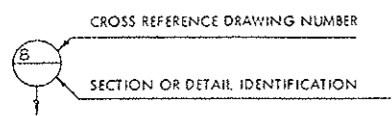

LOADING DATA

LIVELOAD: A.A.S.H.T.O. HS-20-44 OR INTERSTATE ALTERNATE
DEADLOAD: ASSUMES 25 LBS. PER SQ. FT. FOR BITUMINOUS PAVEMENT


DESIGN DATA:

A.A.S.H.T.O. 1973 UNIT STRESSES, AND 1974 INTERIM SPECIFICATIONS, EXCEPT AS NOTED.

REINFORCING STEEL: GRADE 60 - F_y = 60,000 LBS. PER SQ. IN.
FS = 24,000 LBS. PER SQ. IN.
GRADE 40 - F_y = 40,000 LBS. PER SQ. IN.
FS = 20,000 LBS. PER SQ. IN.

STRUCTURAL STEEL: A36, GRADE 36 - F_y = 36,000 LBS. PER SQ. IN.
A588, GRADE 50 - F_y = 50,000 LBS. PER SQ. IN.

CONCRETE: CLASS A & D - F_c = 3000 LBS. PER SQ. IN.
N = 9
CLASS S - F_c = 5000 LBS. PER SQ. IN.
(FOR LIMITS SEE PLANS.)
F_c = 6000 LBS. PER SQ. IN.

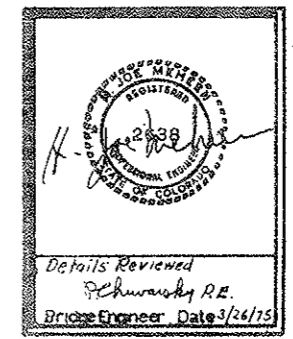


DIVISION OF HIGHWAYS	
GENERAL INFORMATION	
SUMMARY OF QUANTITIES	
Station 913 +10.00 to Station 915 + 80.00	
Near Vail Pass Sec. T. 6 S. R. 79 W.	
Designer A. Eriksen	Structure Numbers F-12-AM
Detailer R. Burns	of 17 Drawings
Drawing Number B-1	

FEDERAL ROAD DISTRICT	PROJ. NO.	SHEET NO.	TOTAL SHEETS
VIII	170-2(52)197	42	

REVISIONS	


VOID
 BY CONSTRUCTION DATE 6-24-77

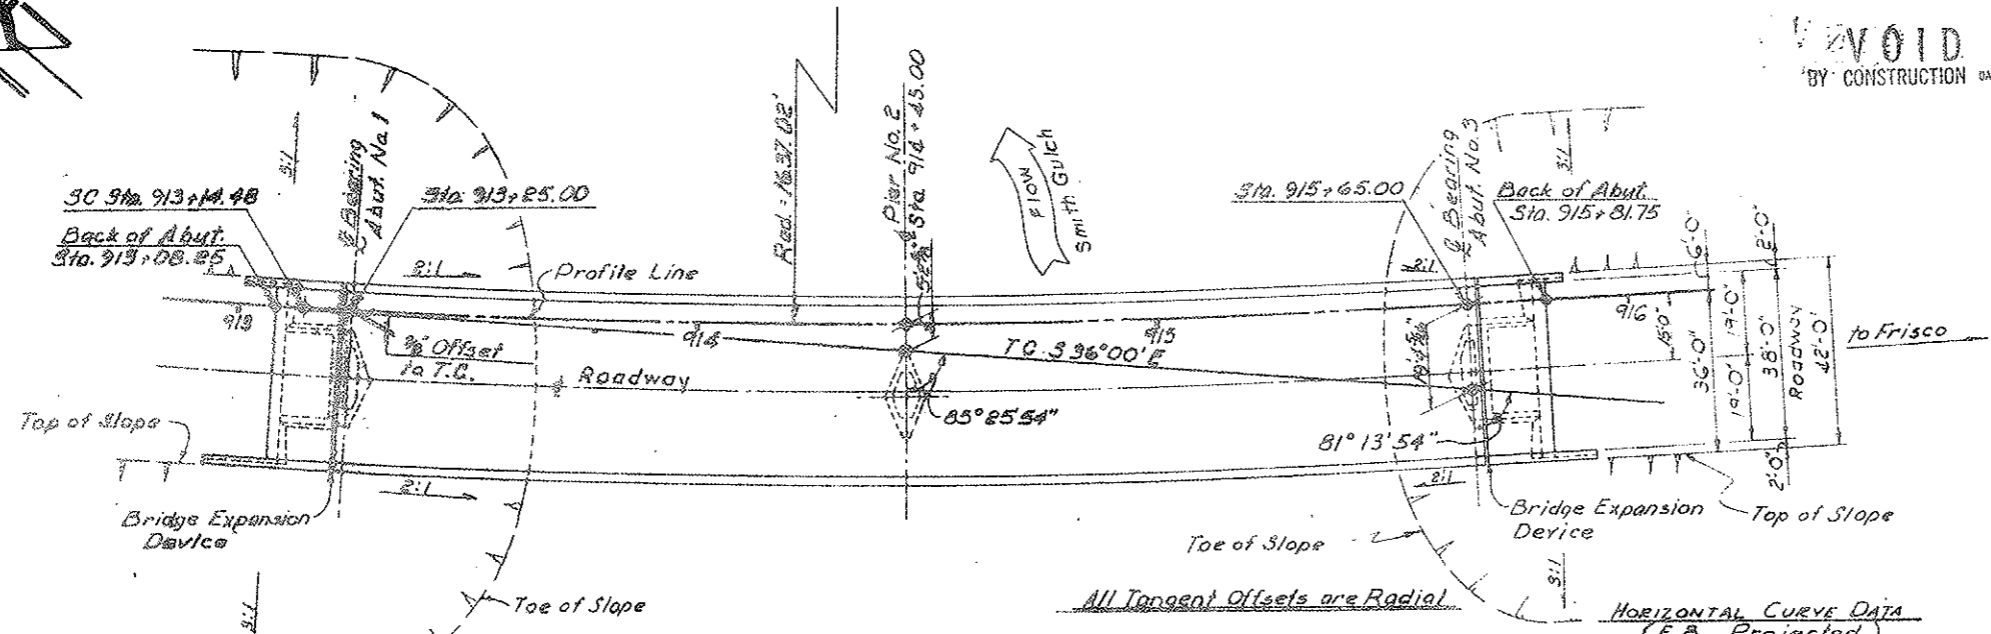


PLAN
 Orig. Scale: 1" = 20'

HORIZONTAL CURVE DATA
 (E.B. Projected)

TS = 907+14.48	ES = 10°30'
SC = 913+14.48	LS = 600'
Δs = 47°24' Lt.	LT = 400.71'
TS = 1022.28'	ST = 200.64'
ES = 160.80'	
Δc = 26°24' Lt.	S = 0.080'/ft
DC = 3°30'	MDS = 70 mph
TC = 383.96'	SSD > 600'
LC = 754.29'	
RC = 1637.02'	

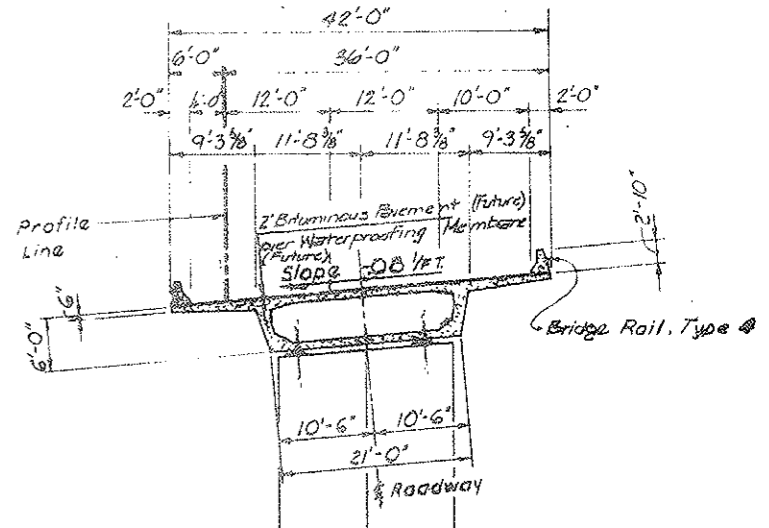

TYPICAL SECTION
 Orig. Scale: 1" = 10'

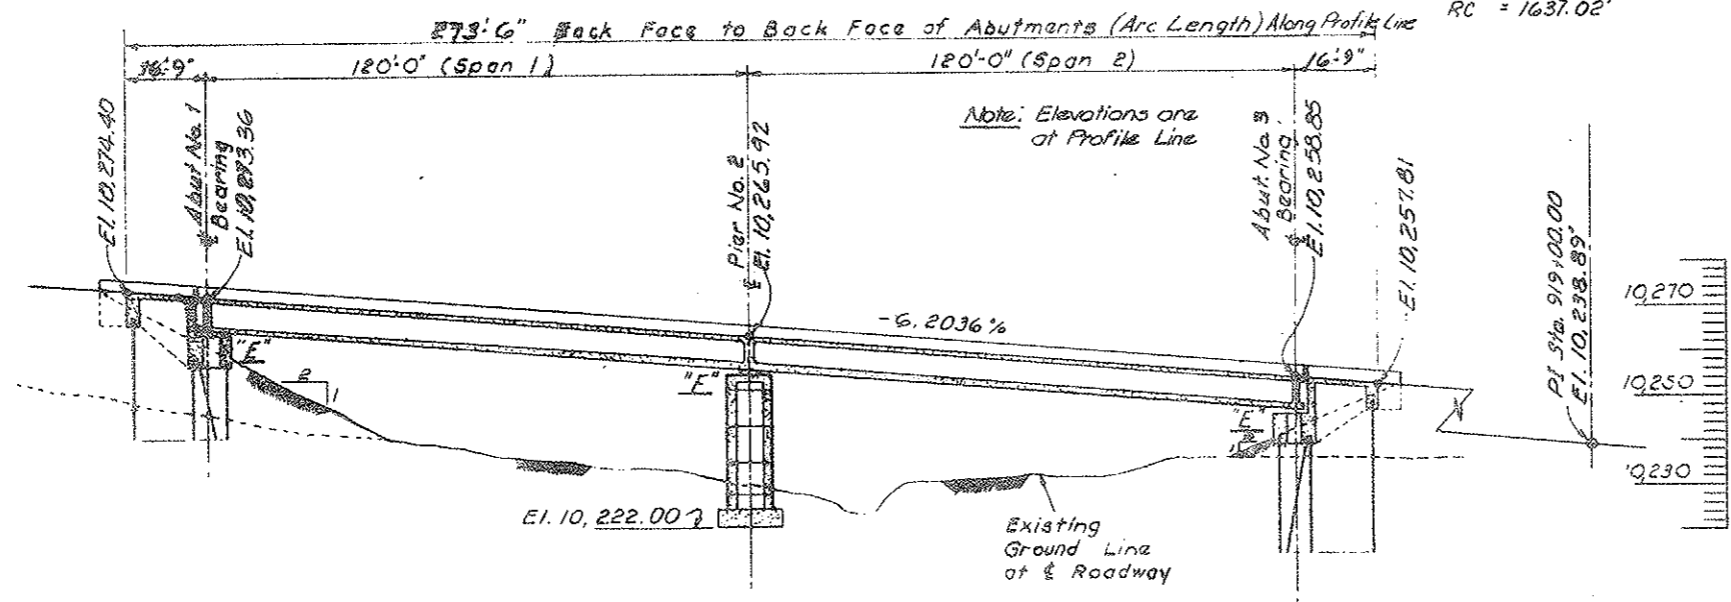

SECTION TAKEN AT CENTERLINE OF ROADWAY
 Orig. Scale: 1" = 20'

Indicates Expansion Bearing
 Indicates Fixed Bearing
 Elevations are to Finished Roadway

Piling Notes

Piling Size	Location	Est. Tip Elev.
HP 12x74	Abut. No. 1	10,242.00'
HP 12x74	Abut. No. 3	10,215.00'

DIVISION OF HIGHWAYS


GENERAL LAYOUT

Designer: A. Erikson	Structure: F-12-AM
Checker: L. McNamee	Number:
Drawing Number: B-2	of 17 Drawings

DESIGNED BY	
CHECKED BY	
DATE	

FED. ROAD REG. NO.	DIVISION	PROJECT NO.	SHEET NO.	TOTAL SHEETS
VIII	COLO.	177-2-17	43	

VOID
BY CONSTRUCTION DATE 6-24-77

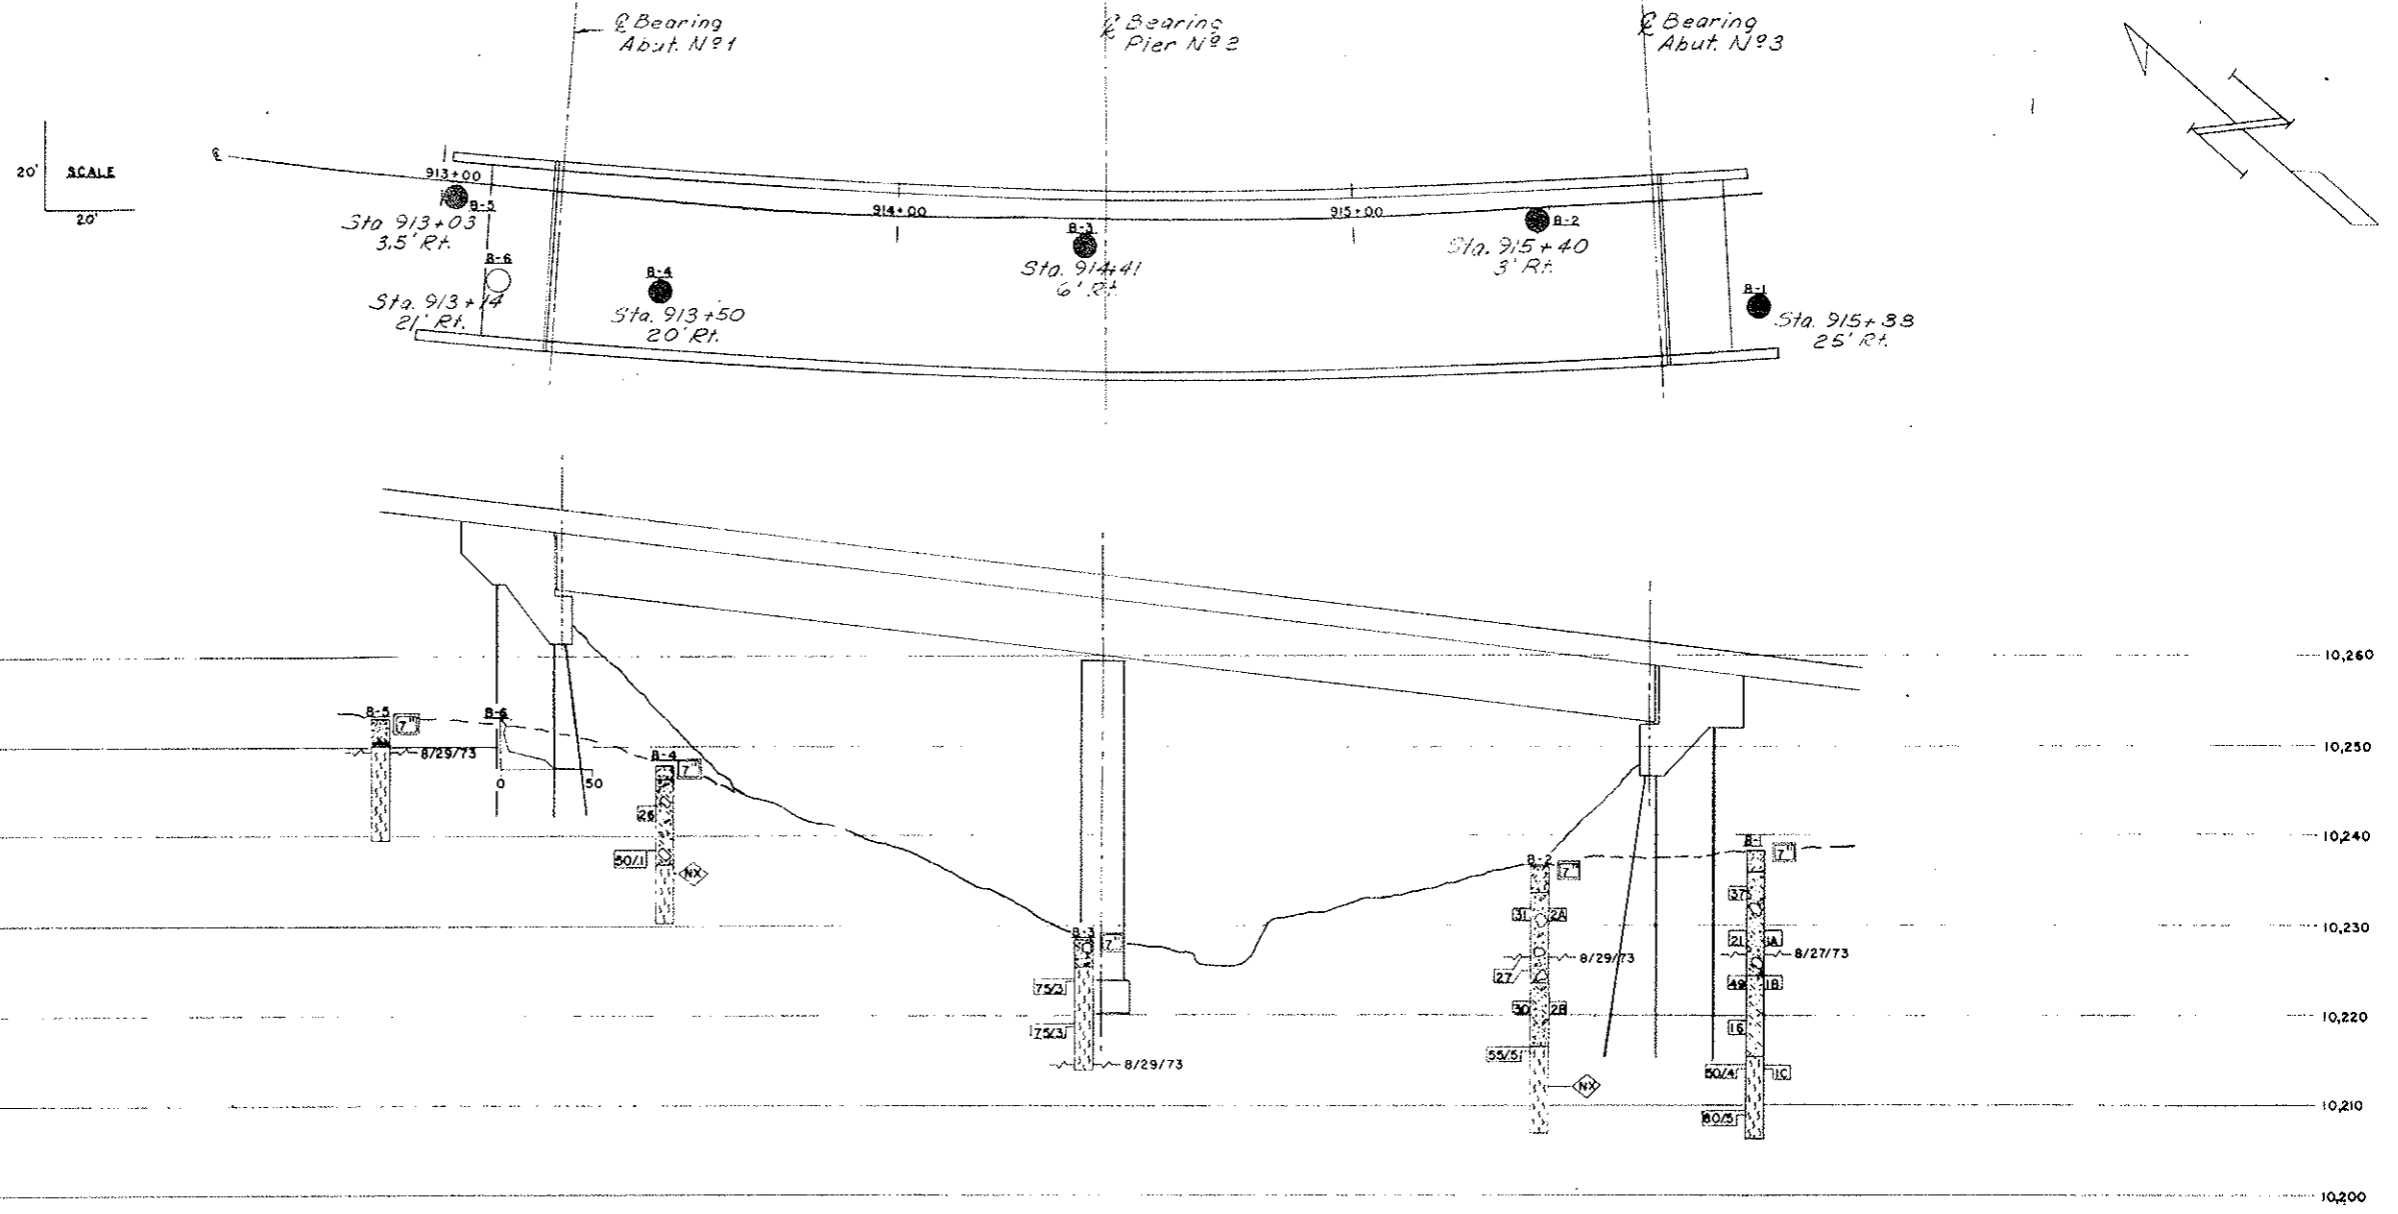

SUMMARY OF TEST RESULTS

Sample No.	Depth	Classification	AASHTO	Grading Analysis Percent				Atterberg Limits			Wet Cont. %	Wet Unit Weight	Unconfined Strength	Triaxial Shear Strength				Dis. of Sample
				Gravel	Coarse Sand	Fine Sand	Silt and Clay	Liquid Limit	Plastic Index	U _c				C	φ	U _c	C	
1A	9.0-10.5	GRAVELLY SAND	A-1-b(O)	40	31	19	10	NV	NP	NP	74							
1B	14.0-15.5	GRAVELLY SANDY SILT	A-4(O)	22	9	26	43	NV	NP	NP	20.2							
1C	24.0-24.4	SILTY SANDY GRAVEL	A-1-b(O)	51	11	16	22	19	19	Q	10.4							
2A	4.5-6.0	SILTY SANDY GRAVEL	A-1-a(O)	53	17	19	11	NV	NP	NP	6.4							
2B	15.0-16.5	SILTY SANDY GRAVEL	A-1-b(O)	41	17	23	19	NV	NP	NP	14.1							

TYPE OF MATERIAL

- SILT, GRAVELLY
- GRAVEL, SANDY W/COBBLES & BOULDERS
- GRAVEL & COBBLES
- GRAVEL, SANDY, SILTY
- SAND, GRAVELLY, SILTY W/COBBLES
- GRAVEL, SANDY, SILTY W/BOULDERS
- GRAVEL, SANDY, SILTY W/COBBLES & BOULDERS
- SILT, SANDY
- SANDSTONE
- SILT, SANDY, GRAVELLY

LEGEND

TEST BORING

Blows Per Foot (Standard Penetration Test)

Water Table

2 in. O.D. Split-Tube Sampler

140 Lb. Hammer

30 in. Free Fall

CONTINUOUS PENETRATION TEST

2 in. Dia. Drive Point

140 Lb. Hammer

30 in. Free Fall

Blows per Foot

- Location of Test Boring
- Location of Continuous Penetration Test
- Rotary Boring
- Auger Boring
- Core Boring

**DIVISION OF HIGHWAYS
STATE OF COLORADO**

ENGINEERING GEOLOGY

Across SMITH GULCH
Sta. 913+00 to 915+00

Near VAIL PASS Sec. 22, T. 6S, R. 19W

Geologist: A.C.E. Approved by: _____
Made by: D.L.S. Bridge Engineer
Checked by: G.C.P. Date: 19__

STRUCTURE NO. E-12-AM
DWG. NO. 1-3 OF 17

FEDERAL ROAD REGION NO.	DISTRICT	PROJ. NO.	SHEET NO.	TOTAL SHEETS
VIII	COLORADO	170-2 (52) 197	45	

REVISIONS	

VOID
BY CONSTRUCTION 6-24-77

***** BENT LINE INPUT ***** SKEW ANGLE
DISTANCE FROM REFERENCE LINE (TYPE) BENT LINE DESCRIPTION OF BENT LINE TO CHORD OF BENT LINE OR TANGENT BENT LINE ROADWAY ELEVATION AT INTERSECTION OF LINE AND BENT LINE

182.000000 7/ 20 PT.= 2 CONSTR. CL -3 34 12.0 915+47.000 10259.4248
ARC/REF B.T. LEFT SKEW

NE OUT CB 915+47.000 10258.9440
NE IN CB 915+47.000 10259.1095
PRO-CONTROL 915+47.000 10259.4245
CL BRIDGE 915+47.000 10260.0287
SW IN CB 915+47.000 10262.1350
SW OUT CB 915+47.000 10262.2953

228.000000 18/ 20 PT.= 2 CONSTR. CL -3 40 40.0 915+53.000 10259.0523
ARC/REF B.T. LEFT SKEW

NE OUT CB 915+53.000 10258.5730
NE IN CB 915+53.000 10258.7333
PRO-CONTROL 915+53.000 10259.0523
CL BRIDGE 915+53.000 10260.2484
SW IN CB 915+53.000 10261.7536
SW OUT CB 915+53.000 10261.9231

234.000000 19/ 20 PT.= 2 CONSTR. CL -3 59 24.0 915+59.000 10258.6001
ARC/REF B.T. LEFT SKEW

NE OUT CB 915+59.000 10258.2016
NE IN CB 915+59.000 10258.3611
PRO-CONTROL 915+59.000 10258.6001
CL BRIDGE 915+59.000 10259.0762
SW IN CB 915+59.000 10261.3914
SW OUT CB 915+59.000 10261.5509

240.000000 CL BRG ABUT 3 CONSTR. CL -4 12 .0 915+65.000 10258.3070
ARC/REF B.T. LEFT SKEW

NE OUT CB 915+65.000 10257.0294
NE IN CB 915+65.000 10257.9009
PRO-CONTROL 915+65.000 10258.3070
CL BRIDGE 915+65.000 10259.5040
SW IN CB 915+65.000 10261.0192
SW OUT CB 915+65.000 10261.1707

Front Face Abut. 3

N.E. Outside 915+67.007 10,257.7030
N.E. Inside 915+67.005 10,258.0297
Profile Line 915+67.000 10,258.3481
C.L. Roadway 915+66.982 10,259.4443
S.W. Inside 915+66.959 10,261.0590
S.W. Outside 915+66.957 10,261.0523

1/4 Pt.

N.E. Outside 915+70.706 10,257.4699
Profile Line 915+70.687 10,257.9483
C.L. Roadway 915+70.636 10,259.1445
S.W. Outside 915+70.565 10,260.8199

1/2 Pt.

N.E. Outside 915+74.410 10,257.2369
Profile Line 915+74.375 10,257.7153
C.L. Roadway 915+74.290 10,258.9115
S.W. Outside 915+74.173 10,260.0861

3/4 Pt.

N.E. Outside 915+78.110 10,257.0038
Profile Line 915+78.062 10,257.4822
C.L. Roadway 915+77.944 10,258.6794
S.W. Outside 915+77.781 10,260.3531

Back Face Abut. 3

N.E. Outside 915+81.811 10,256.7707
Profile Line 915+81.750 10,257.2491
C.L. Roadway 915+81.597 10,258.4453
S.W. Outside 915+81.389 10,260.1200

162.000000 7/ 20 PT.= 2 CONSTR. CL -1 28 12.0 914+87.000 10263.1466
ARC/REF B.T. LEFT SKEW

NE OUT CB 914+87.000 10262.6482
NE IN CB 914+87.000 10262.8277
PRO-CONTROL 914+87.000 10263.1466
CL BRIDGE 914+87.000 10264.3428
SW IN CB 914+87.000 10265.8500
SW OUT CB 914+87.000 10266.0175

168.000000 8/ 20 PT.= 2 CONSTR. CL -1 40 40.0 914+93.000 10262.7744
ARC/REF B.T. LEFT SKEW

NE OUT CB 914+93.000 10262.2960
NE IN CB 914+93.000 10262.4554
PRO-CONTROL 914+93.000 10262.7744
CL BRIDGE 914+93.000 10263.9706
SW IN CB 914+93.000 10265.4858
SW OUT CB 914+93.000 10265.6453

174.000000 9/ 20 PT.= 2 CONSTR. CL -1 53 24.0 914+99.000 10262.4022
ARC/REF B.T. LEFT SKEW

NE OUT CB 914+99.000 10261.9237
NE IN CB 914+99.000 10262.0832
PRO-CONTROL 914+99.000 10262.4022
CL BRIDGE 914+99.000 10263.5984
SW IN CB 914+99.000 10265.1135
SW OUT CB 914+99.000 10265.2730

180.000000 10/ 20 PT.= 2 CONSTR. CL -2 6 .0 915+ 5.000 10262.0300
ARC/REF B.T. LEFT SKEW

NE OUT CB 915+ 5.000 10261.5515
NE IN CB 915+ 5.000 10261.7110
PRO-CONTROL 915+ 5.000 10262.0300
CL BRIDGE 915+ 5.000 10263.2262
SW IN CB 915+ 5.000 10264.7413
SW OUT CB 915+ 5.000 10264.9008

186.000000 11/ 20 PT.= 2 CONSTR. CL -2 18 36.0 915+11.000 10261.6570
ARC/REF B.T. LEFT SKEW

NE OUT CB 915+11.000 10261.1793
NE IN CB 915+11.000 10261.3388
PRO-CONTROL 915+11.000 10261.6570
CL BRIDGE 915+11.000 10262.8540
SW IN CB 915+11.000 10264.3691
SW OUT CB 915+11.000 10264.5286

192.000000 12/ 20 PT.= 2 CONSTR. CL -2 31 12.0 915+17.000 10261.2056
ARC/REF B.T. LEFT SKEW

NE OUT CB 915+17.000 10260.8071
NE IN CB 915+17.000 10260.9666
PRO-CONTROL 915+17.000 10261.2056
CL BRIDGE 915+17.000 10262.4017
SW IN CB 915+17.000 10263.9969
SW OUT CB 915+17.000 10264.1564

198.000000 13/ 20 PT.= 2 CONSTR. CL -2 43 48.0 915+23.000 10260.9133
ARC/REF B.T. LEFT SKEW

NE OUT CB 915+23.000 10260.4349
NE IN CB 915+23.000 10260.5944
PRO-CONTROL 915+23.000 10260.9133
CL BRIDGE 915+23.000 10262.1095
SW IN CB 915+23.000 10263.6247
SW OUT CB 915+23.000 10263.7842

204.000000 14/ 20 PT.= 2 CONSTR. CL -2 56 24.0 915+29.000 10260.5411
ARC/REF B.T. LEFT SKEW

NE OUT CB 915+29.000 10260.0627
NE IN CB 915+29.000 10260.2221
PRO-CONTROL 915+29.000 10260.5411
CL BRIDGE 915+29.000 10261.7373
SW IN CB 915+29.000 10263.2529
SW OUT CB 915+29.000 10263.4120

210.000000 15/ 20 PT.= 2 CONSTR. CL -3 9 .0 915+35.000 10260.1689
ARC/REF B.T. LEFT SKEW

NE OUT CB 915+35.000 10259.6904
NE IN CB 915+35.000 10259.8499
PRO-CONTROL 915+35.000 10260.1689
CL BRIDGE 915+35.000 10261.3651
SW IN CB 915+35.000 10262.8803
SW OUT CB 915+35.000 10263.0397

216.000000 16/ 20 PT.= 2 CONSTR. CL -3 21 36.0 915+41.000 10259.7967
ARC/REF B.T. LEFT SKEW

NE OUT CB 915+41.000 10259.3182
NE IN CB 915+41.000 10259.4777
PRO-CONTROL 915+41.000 10259.7967
CL BRIDGE 915+41.000 10260.9929
SW IN CB 915+41.000 10262.5080
SW OUT CB 915+41.000 10262.6675

DIVISION OF HIGHWAYS

ELEVATIONS


Designer <i>A. Eriksen</i>	Structure Numbers	<i>F-12-AM</i>
Detailer <i>L. McNamee</i>		
Drawing Number <i>B-5</i>		of <i> </i> Drawings



FEDERAL ROAD REGION NO.	DISTRICT	PROJ. NO.	SHEET NO.	TOTAL SHEETS
XIII	COLORADO	170-2(52)197	46	

REVISIONS	

VOID
BY CONSTRUCTION DATE 6-24-77

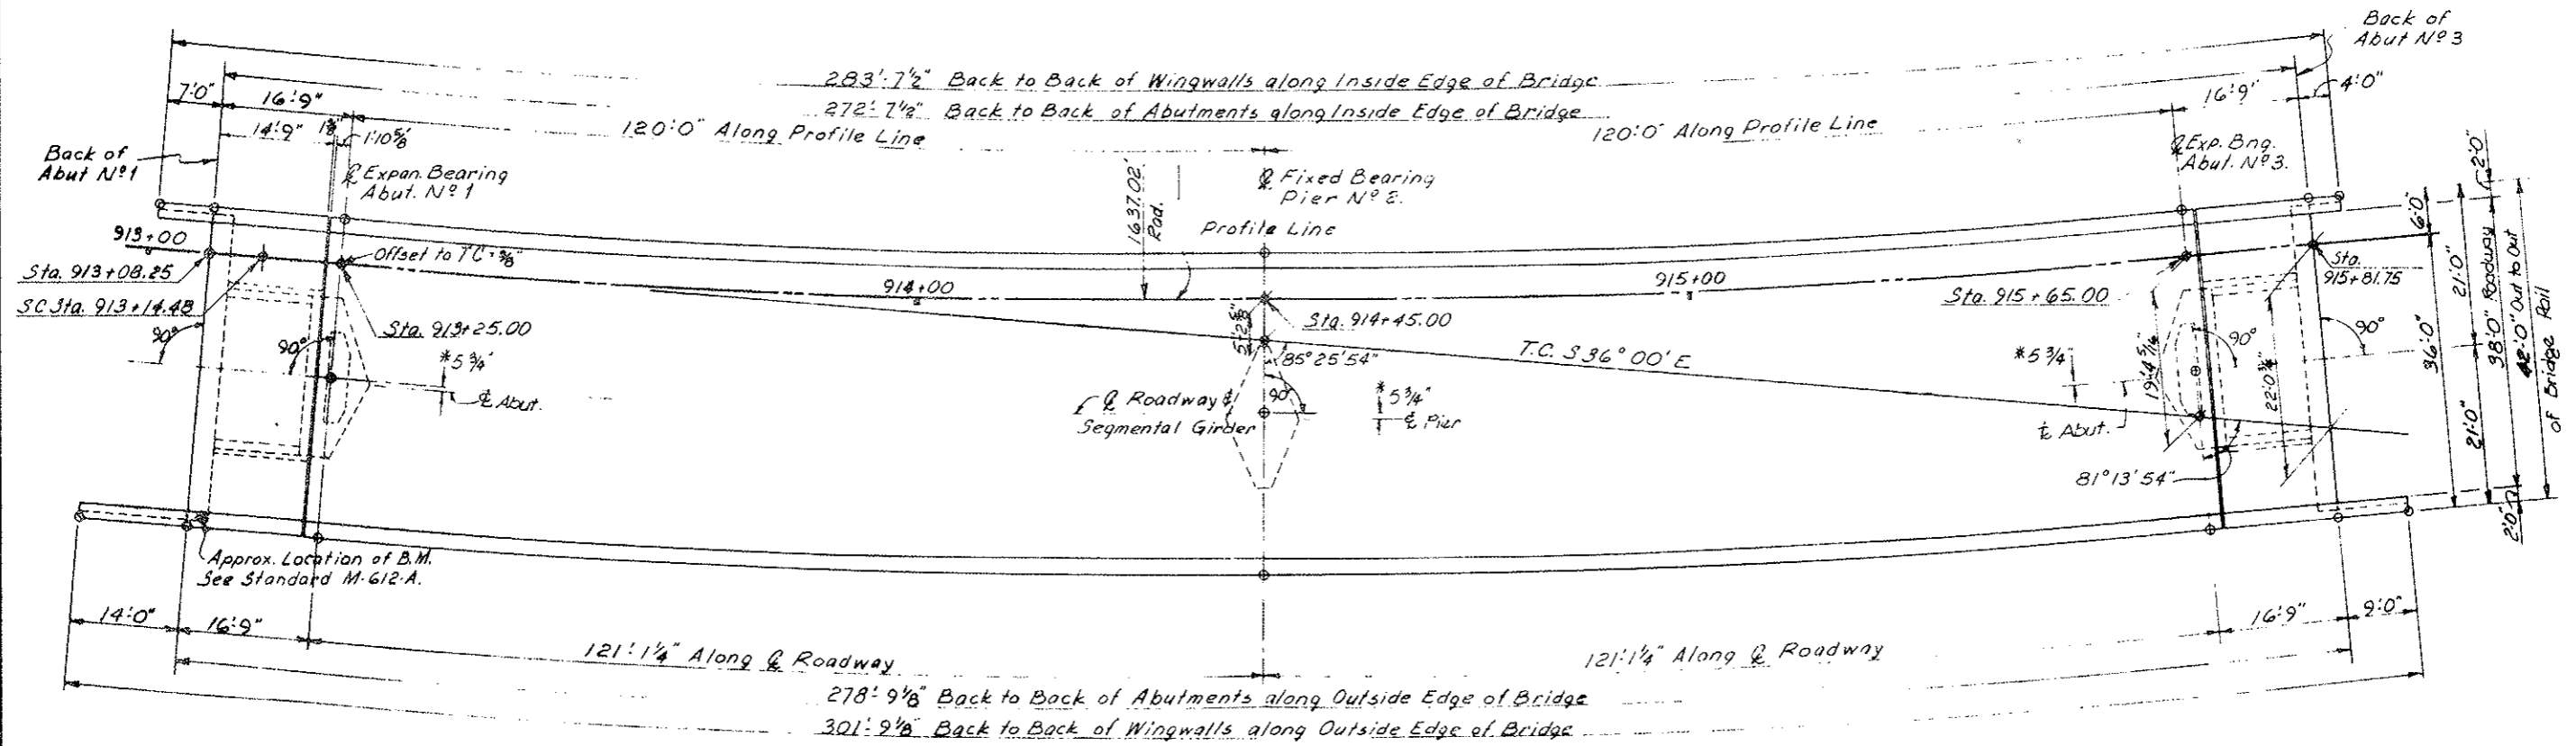

DESIGNED BY	DATE	CHECKED BY
A.E.	3-25	A.E.
CHECKED BY	DATE	QUANTITY BY
H.G.	3-75	L.M.
DETAILS BY	DATE	CHECKED BY
L.M.	3-75	A.E.

CONSTRUCTION LAYOUT
Orig. Scale: 3/32" = 1'-0"

Note:
Tangent Offsets are Radial.
* Location of Abutments and Pier Footing is offset by a Distance Equal to Rate of Super-elevation Times Depth of Superstructure (6'-0")


DIVISION OF HIGHWAYS	
CONSTRUCTION LAYOUT	
Designer A. Erikson	Structure F-12-AM
Detailer L. McNamee	Numbers
Drawing Number B-6 of 17 Drawings	

Revision Dates (Preliminary Stage Only)

FEDERAL ROAD REGION NO.	DISTRICT	PROJ. NO.	SHEET NO.	TOTAL SHEETS
XIII	COLORADO	170-2(52)197	47	

REVISIONS	

VOID
BY CONSTRUCTION DATE 6-24-77

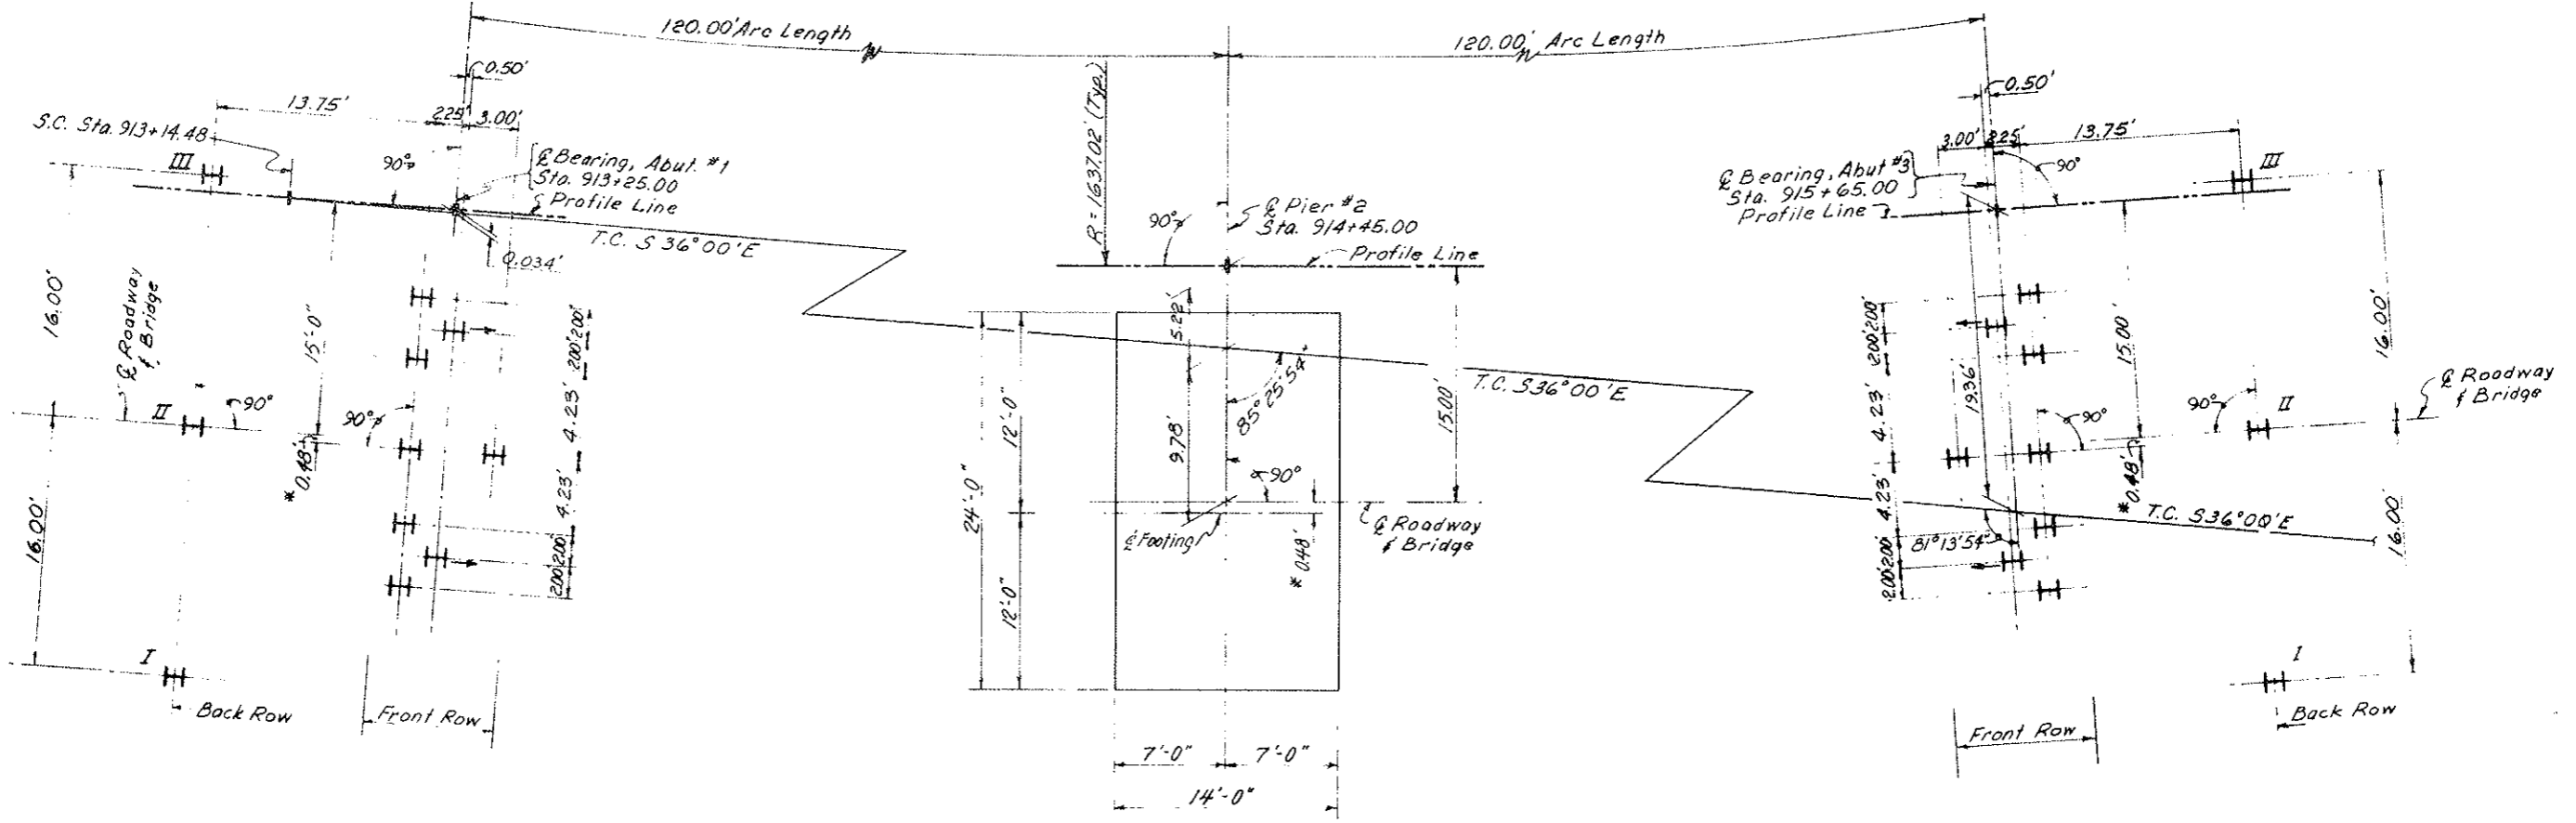

DESIGNED BY	DATE	CHECKED BY
CHECKED BY		QUANTITIES BY

FOOTING AND PILING LAYOUT

Orig. Scale: 1/4" = 1'-0"

*Location of Abutment and Pier Footings is offset by a distance equal to rate of Superlevation times depth of Superstructure (6'-0").

PILING ELEVATIONS				
Abut. N°	LOCATION	Pile N°	TOP ELEV.	*BOT. ELEV.
1	Back Row	I	10,271.52	10,242.00
1	" "	II	10,270.24	10,242.00
1	" "	III	10,268.96	10,242.00
1	Front Row	All	10,261.76	10,242.00
3	Front Row	All	10,246.87	10,215.00
3	Back Row	I	10,254.87	10,215.00
3	" "	II	10,253.59	10,215.00
3	" "	III	10,252.31	10,215.00

*Bottom Elevations to be Verified in Field.






- Notes:**
- All Dimensions are at bottom of concrete.
 - Piling shall be end bearing HP12x74 with max design pile load of 72 tons.
 - Indicates piling to be battered at 3:12 (2 per Abutment)
 - Max. Allowable Bearing Pressure @ Pier = 5 tons per Sq. Ft.
Max. Design Pressure = 4.75 Tons per sq. ft.

DIVISION OF HIGHWAYS	
FOOTING AND PILING LAYOUT	
Designer <i>A. Eriksen</i>	Structure <i>F-12-AM</i>
Detailer <i>L. McNamee</i>	Number <i>17</i>
Drawing Number <i>B-7</i>	of <i>17</i> Drawings

Revision	Date	(Preliminary Stage Only)

FEDERAL ROAD REGION NO.	DISTRICT	PROJ. NO.	SHEET NO.	TOTAL SHEETS
VIII	COLORADO	170-2(52)197	48	

REVISIONS				
4/1/75	REPRINT			WCB
1/11/77	Ground Movement specified			WCB

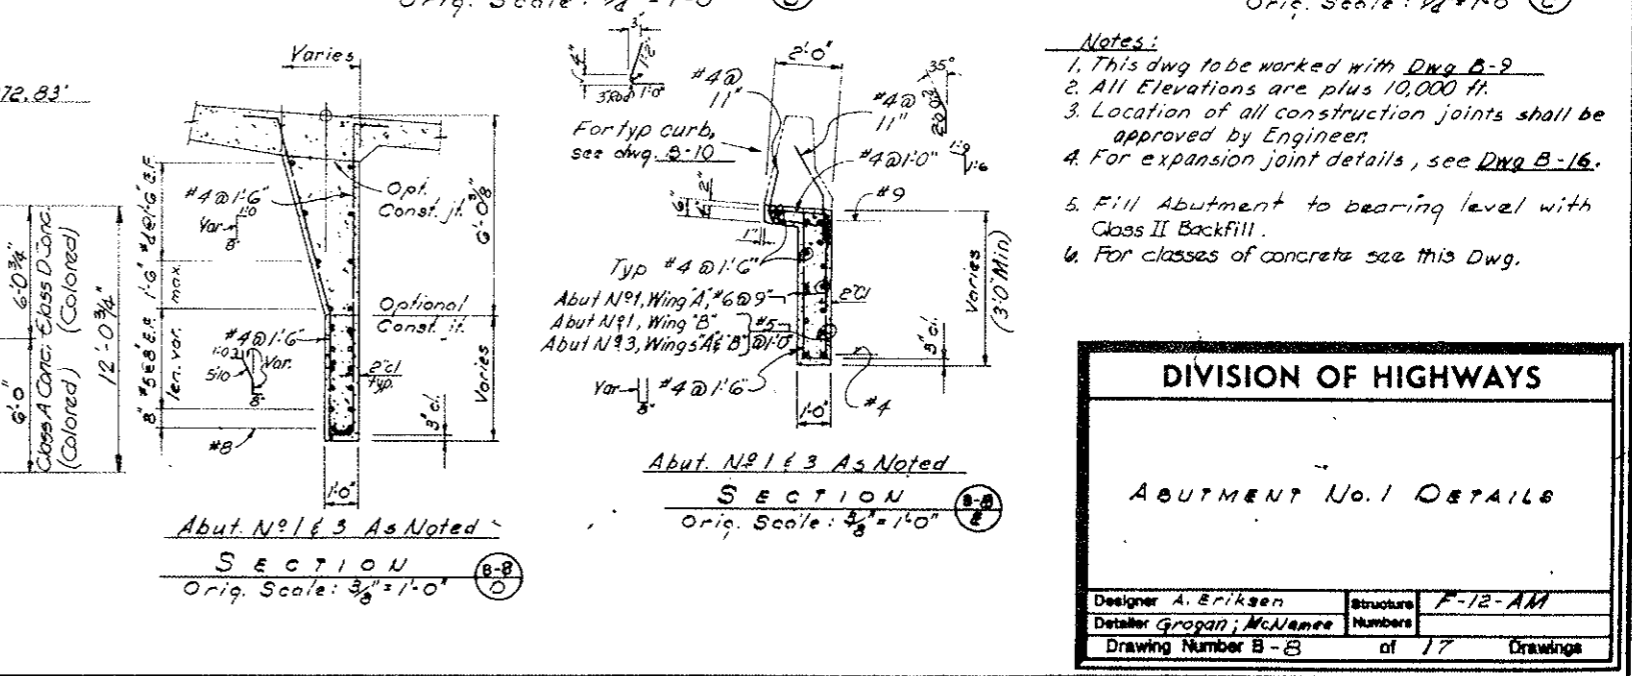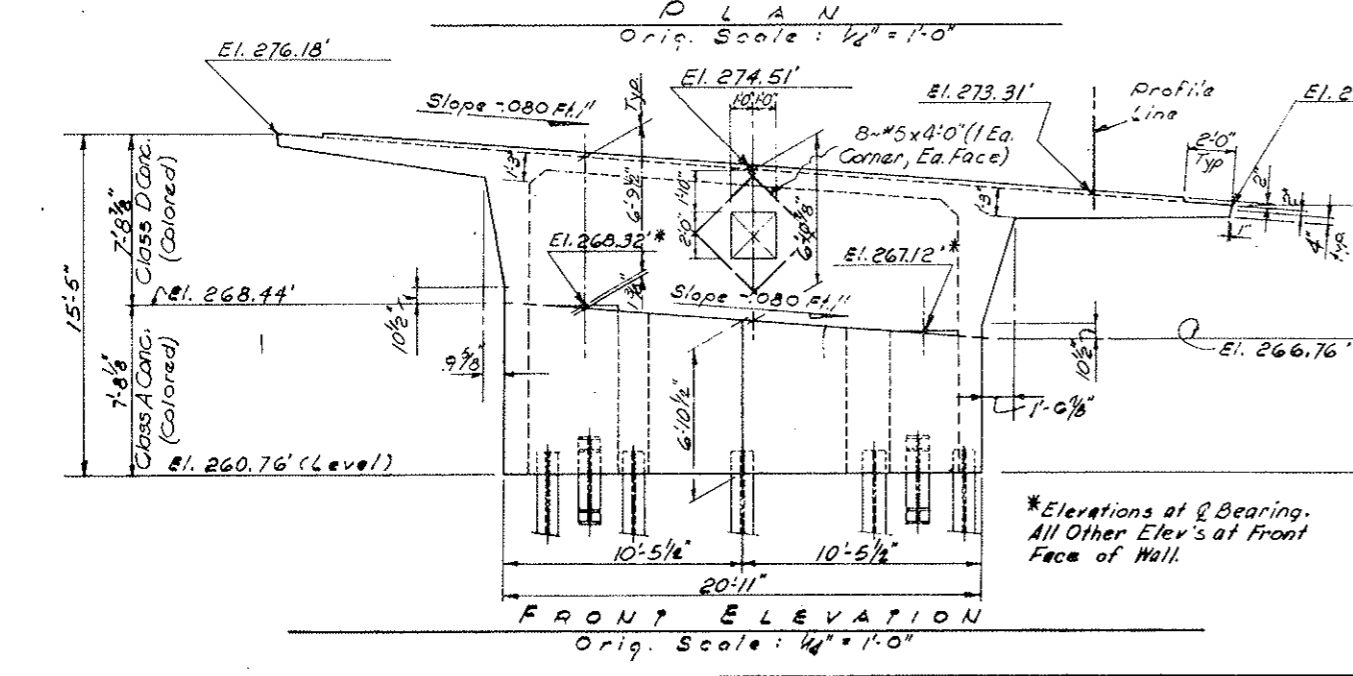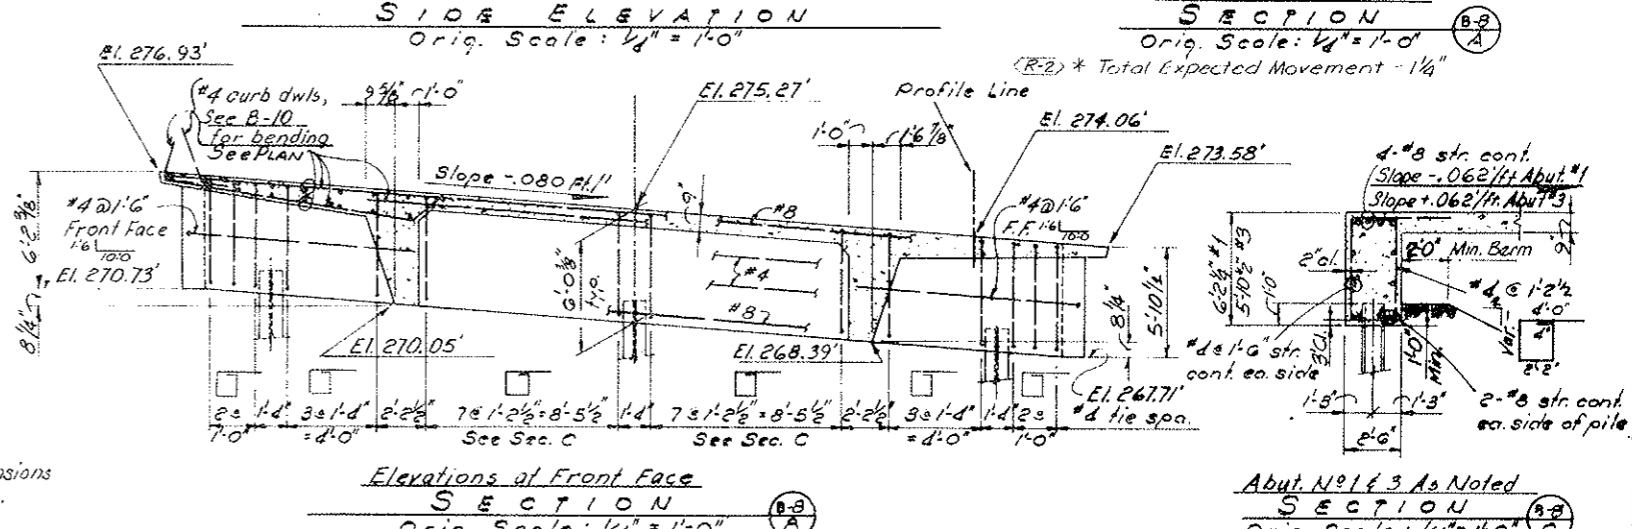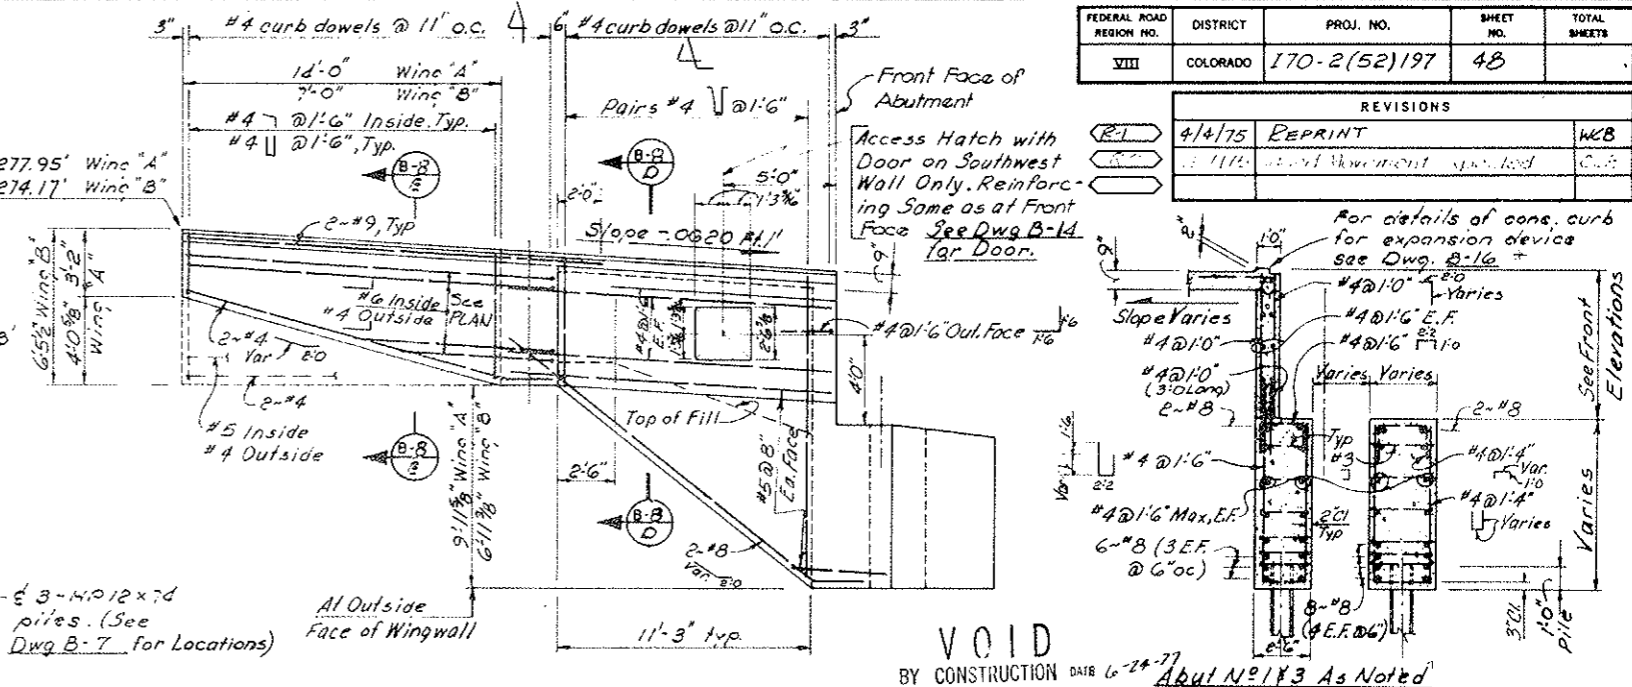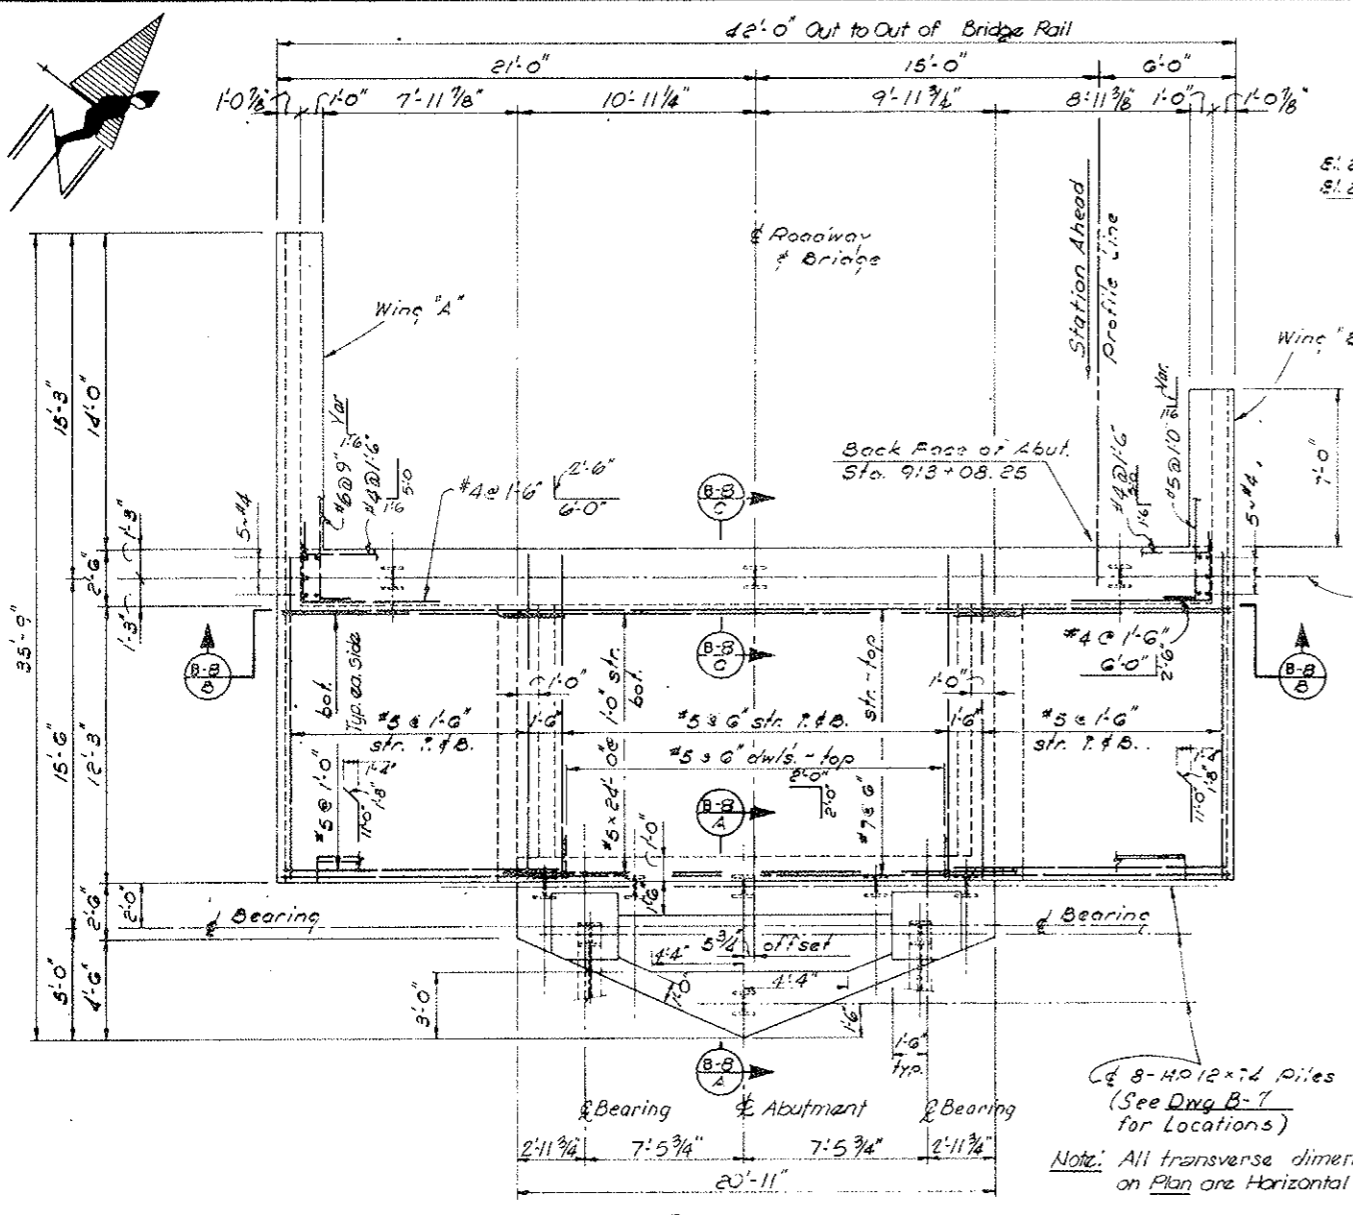

DESIGNED BY	CHECKED BY	DATE	QUANTITIES BY	CHECKED BY	DATE
AE	AE	3-7-75	LM	AE	3-7-75
AE	AE	3-7-75	AE	AE	3-7-75

- Notes:**
1. This dwg to be worked with Dwg B-9
 2. All Elevations are plus 10,000 ft.
 3. Location of all construction joints shall be approved by Engineer.
 4. For expansion joint details, see Dwg B-16.
 5. Fill Abutment to bearing level with Class II Backfill.
 6. For classes of concrete see this Dwg.

DIVISION OF HIGHWAYS

ABUTMENT No. 1 DETAILS

Designer A. Eriksen	Structure F-12-AM
Detailer Grogan, McNamee	Numbers
Drawing Number B-8	of 17 Drawings

Revision Dates (Preliminary Stage Only)

FEDERAL ROAD REGION NO.	DISTRICT	PROJ. NO.	SHEET NO.	TOTAL SHEETS
VIII	COLORADO	I-70-2(32)187	49	


BEARING DEVICES

ITEM	BEARING TYPE & CAPACITY TONS	HORIZ. CAPACITY		ACTUAL LOAD (KIPS)	ULTIMATE LOAD (KIPS)
		LONGITUDINAL (KIPS)	TRANSVERSE (KIPS)		
Pier 2	F-150	35	80	1405	2036


REVISIONS				
R1	4-17-75	Rev. Note # 3	Changed Anchorage	CLB
R2	4-29-75	Rev. Note # 4		JRE

Note: For additional notes on Bearing Device See Dwg. No. B-10
* Actual load shall be used to determine bearing capacity ≤ 21

Final Prestressing Force $F = 1600 K$ or $400 K$ Ea. Corner

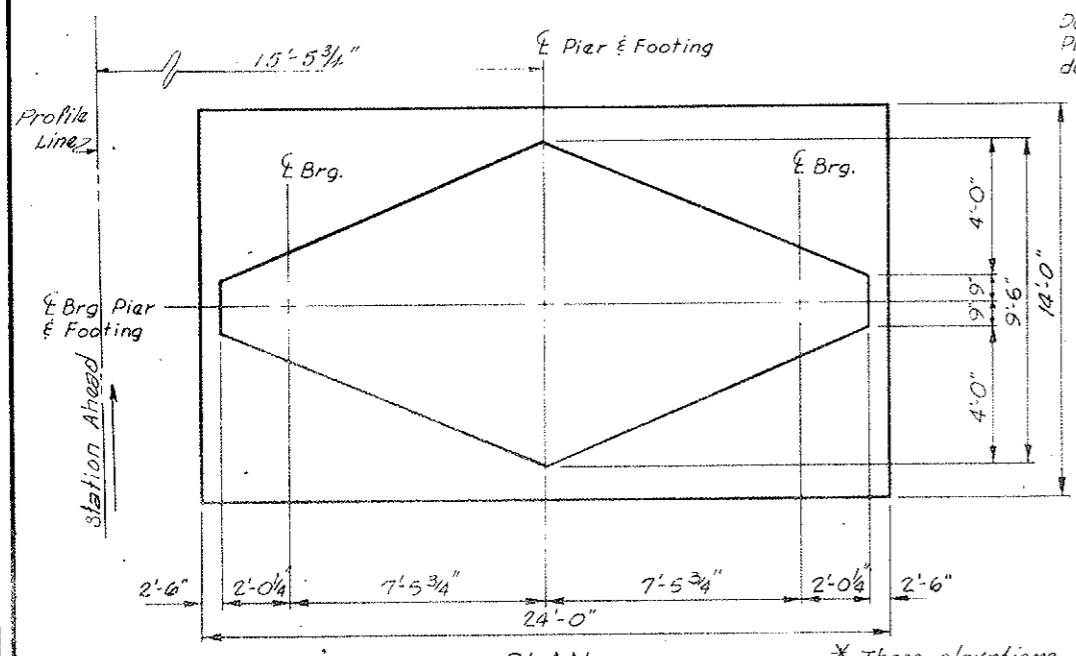


Ducts for prestressing tendons (typ) Place symmetrically with a minimum of one duct in each of the four corners.

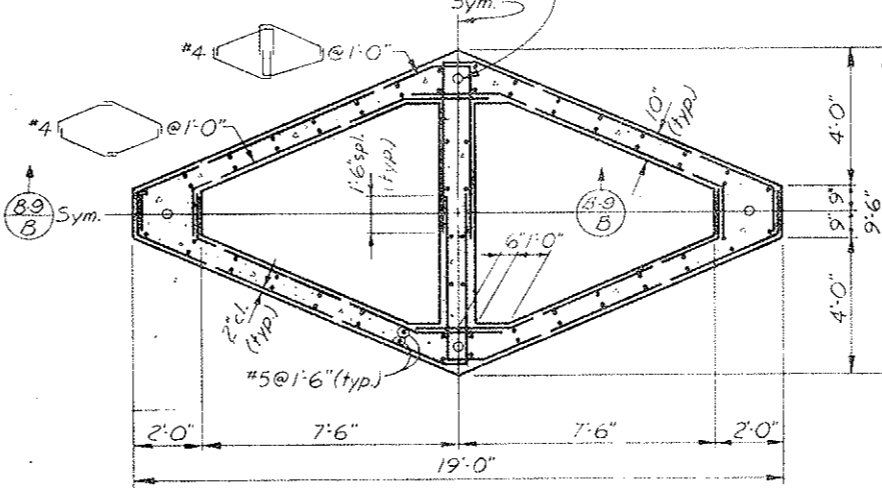

SECTION (B-9) A

Anchorage Note: Type of anchorage - both devices to be determined by bearing manufacturer and submitted on shop dwg's for approval.

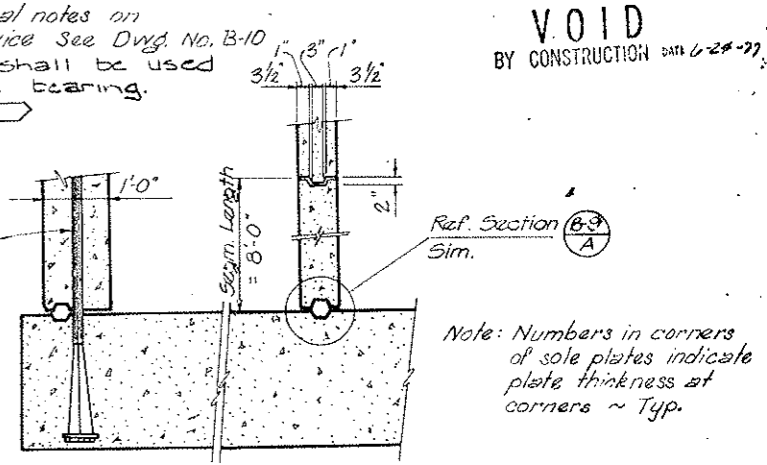


SECTION (B-9) B


VOID
BY CONSTRUCTION DATE 6-24-77

DESIGNED BY	CLB	DATE	8-24
CHECKED BY	CLB	DATE	8-24
QUANTITIES BY	CLB	DATE	8-24
DETAILED BY	CLB	DATE	8-24


For Allowable Ultimate Bearing Pressure on Concrete, See Dwg No B-11

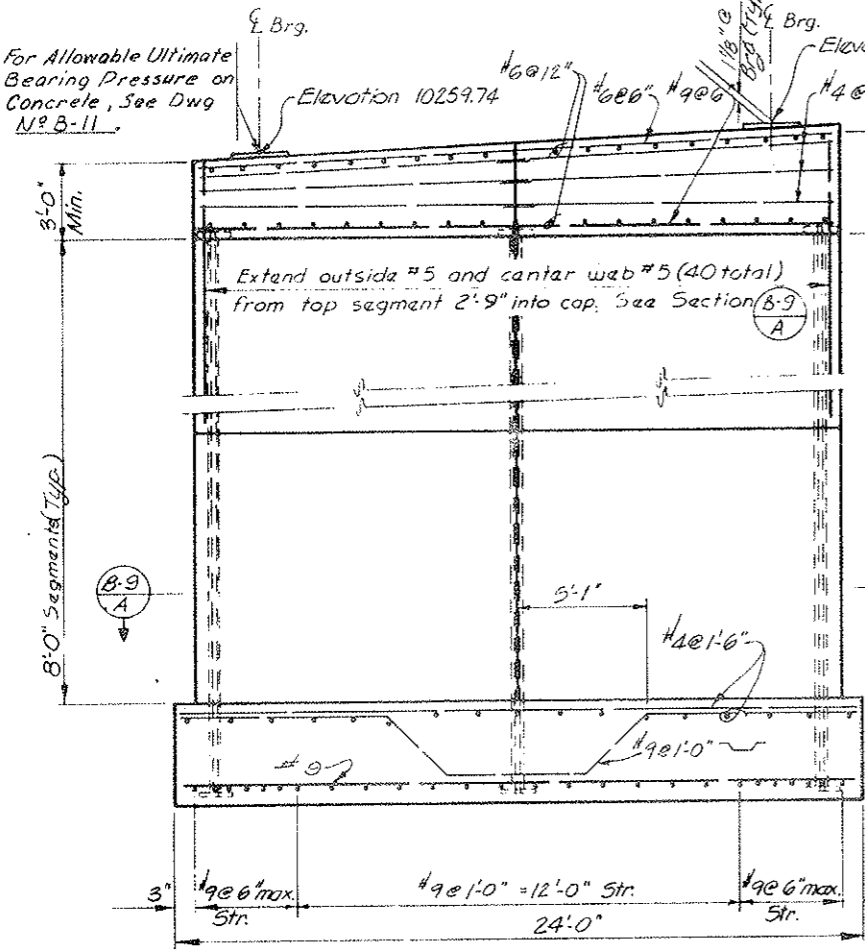

ELEVATION
Looking Ahead Station

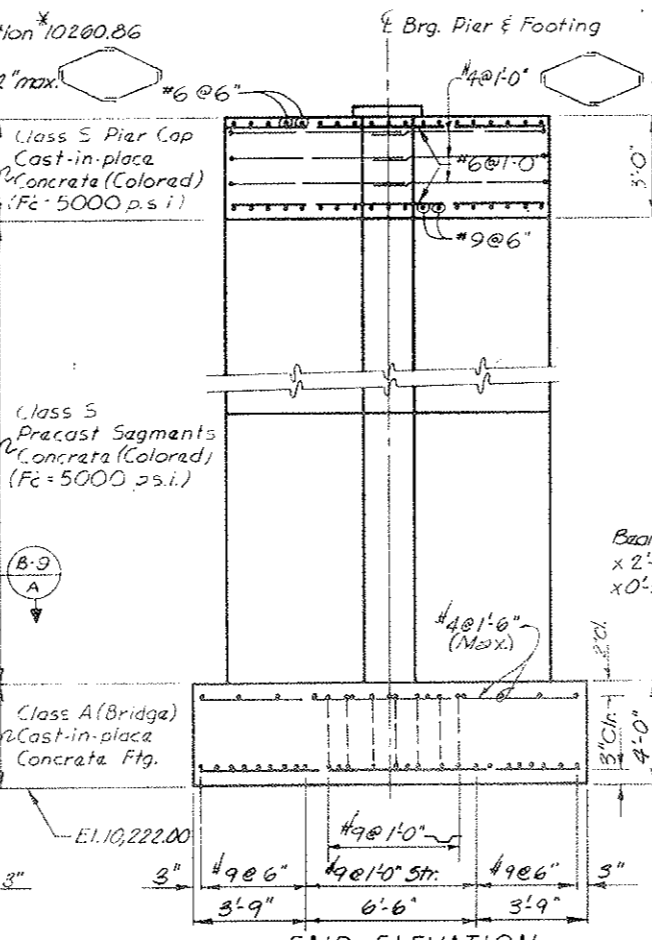


END ELEVATION

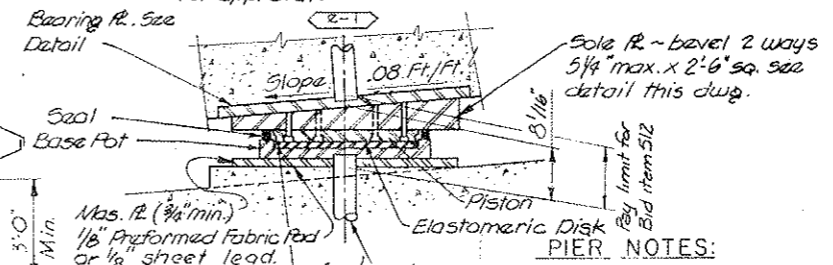


BEARING R. DETAIL
Orig. Scale: 1/2" = 1'-0"

FIXED FLOATING BEARING
Pier No. 2 - Cap. = 750 Tons (2 Req'd)
Capacity = D.L. + LL + I
orig. sale: none
O' Max Movement

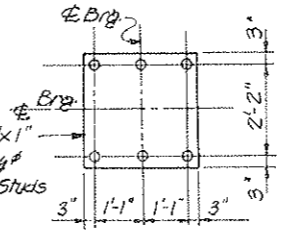

- PIER NOTES:**
- DESIGN PROVISIONS WERE MADE FOR A ONE SEGMENT, UNBALANCED CANTILEVER MOMENT AT THE END OF THE CANTILEVER DURING THE CONSTRUCTION STAGE. THE PIER COLUMN IS NOT DESIGNED FOR SUCH UNBALANCED MOMENT, BUT THE PIER FOOTING IS DESIGNED FOR AN UNBALANCED MOMENT OF 3,000 FOOT KIPS. THIS MOMENT IS BASED ON AN ALLOWABLE SOIL PRESSURE OF 5.0 TONS PER SQ. FOOT AND A VERTICAL LOAD OF 2190 KIPS (DEAD LOAD CANTILEVER AND PIER AND FOOTING.)
 - POST-TENSIONING TENDON ANCHORAGES IN PIER FOOTINGS AND PIER CAPS SHALL BE DETERMINED BY THE MANUFACTURER AND SUBMITTED FOR APPROVAL.
 - END BLOCKS SHALL BE USED TO DISTRIBUTE THE CONCENTRATED POST-TENSIONING FORCES AT THE ANCHORAGE. CLOSELY SPACED REINFORCEMENT SHALL BE PLACED BOTH VERTICALLY AND HORIZONTALLY THROUGHOUT THE LENGTH OF THE END BLOCK IN ACCORDANCE WITH ACCEPTED METHODS OF END BLOCK ANALYSIS.
 - ALL SEGMENTS SHALL BE MATCH-CAST TO ENSURE PROPER FIT DURING THE ERECTION STAGE. PRECAST SEGMENT HEIGHTS MAY BE REVISED IN ORDER TO MINIMIZE THE CAST IN PLACE PORTION. (R2)
 - CARE SHALL BE EXERCISED IN JOINING THE SEGMENTS WITH EPOXY TO ENSURE THAT COMPRESSION IS MAINTAINED OVER THE ENTIRE JOINT AREA UNTIL THE PERMANENT POST-TENSIONED TENDONS ARE STRESSED.
 - FOR CONCRETE CLASSES AND STRENGTHS, SEE DRAWINGS, THIS SHEET.

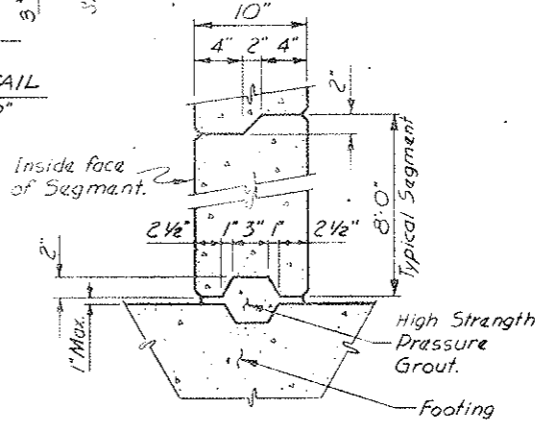

CONSTR. JOINT

(1) FORCE F IS THE POST-TENSIONING FORCE REQUIRED FOR SERVICE LOADS. IF THE PIER IS TO BE SUBJECT TO THE ONE SEGMENT, UNBALANCED MOMENT THAT THE FOOTINGS ARE DESIGNED FOR, CALCULATIONS MUST BE SUBMITTED FOR THE ADDITIONAL POST-TENSIONING FORCE NEEDED.

(1) FORCE F IS THE POST-TENSIONING FORCE REQUIRED IN THE PIERS AFTER ALL LOSSES INCLUDING CREEP, SHRINKAGE, FRICTION, AND ELASTIC SHORTENING FROM THE SUPERSTRUCTURE LOADS. POST-TENSIONING FORCE F IS TO BE THE SUM OF FOUR EQUAL FORCES, ONE AT EACH CORNER OF THE PIER AS SHOWN IN SECTION

IECO INTERNATIONAL ENGINEERING COMPANY, INC.
Bertha, Stoddard, Wilkinson and Higgins Division
1777 S. Ballou St. Denver, Colorado 80222




DIVISION OF HIGHWAYS

PIER DETAILS

Designer	A. Eriksen	Structure	F-12-AM
Detailer	D. Froman	Numbers	
Drawing Number	B-11	of	11
		Drawings	

FEDERAL ROAD REGION NO.	DISTRICT	PROJ. NO.	SHEET NO.	TOTAL SHEETS
XIII	COLORADO	170-2(52)197	50	

REVISIONS				
1	4-14-75	REPRINT		WLB
2	4-17-75	Added Note & Changed Anchorage		LEB

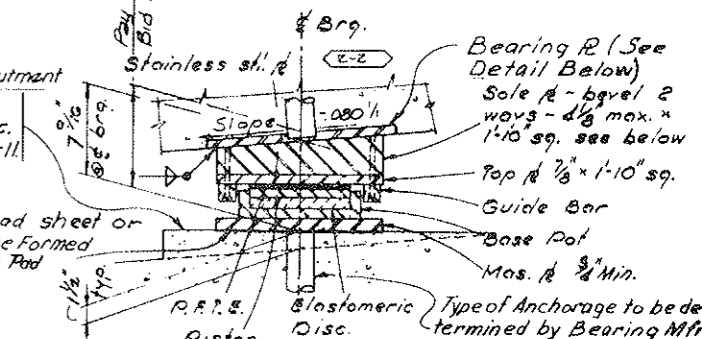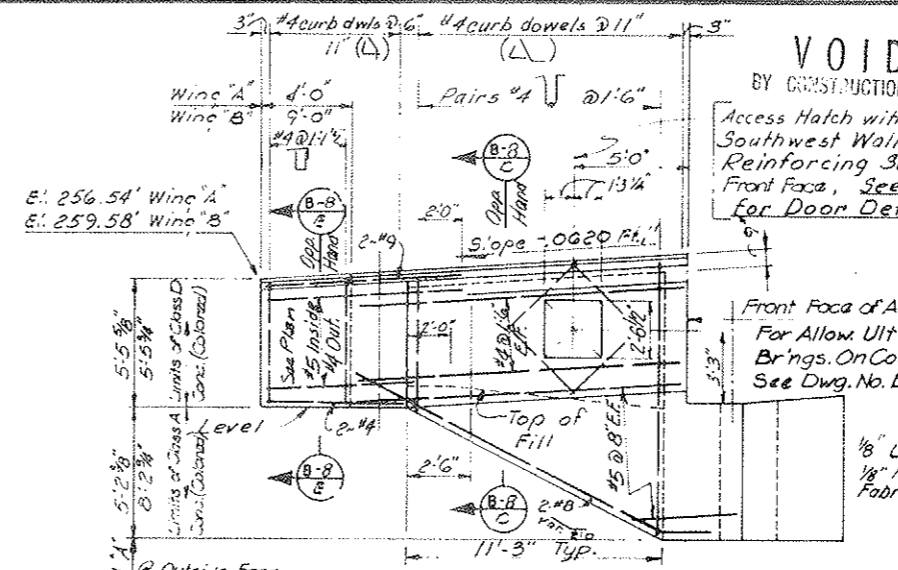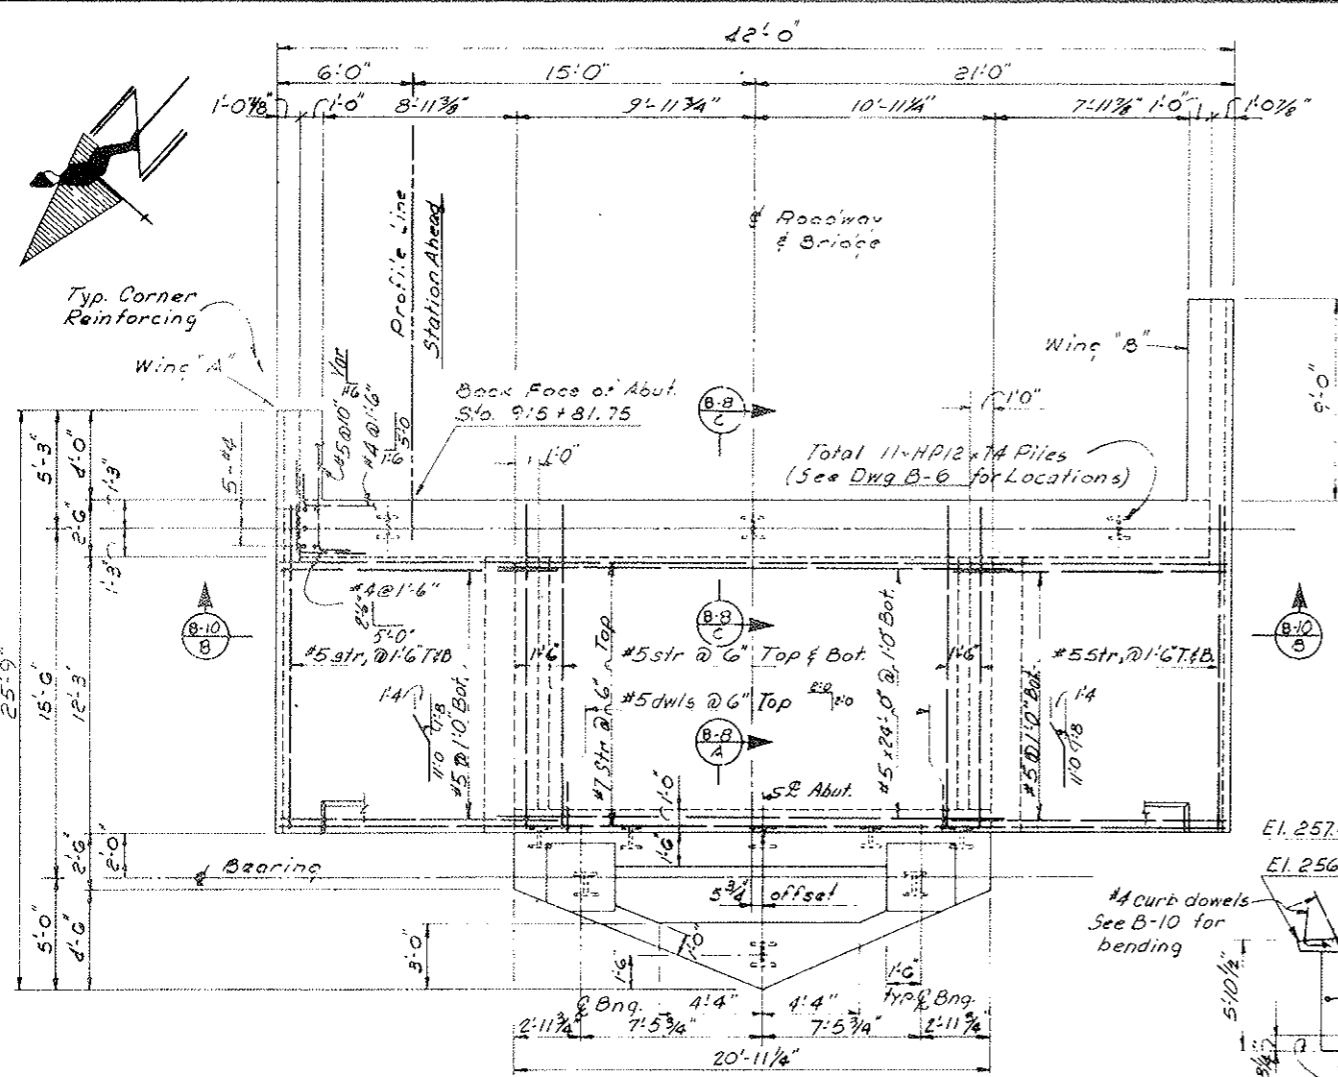

BEARING DEVICES


Item	Bearing Type & Capacity	Horz Capacity Longitudinal (Kips)	Transverse (Kips)	Actual* Load (Kips)	Ultimate Load (Kips)
Abut. 1	E-250	12	50	162	636
Abut. 3	E-250	12	50	162	636

* Actual load shall be used to determine bearing capacity.



GUIDED EXPANSION BEARING
 Cap. = 250 Tons - Lat. Cap. = 25% (d Req'd.)
 Capacity = D.L. + L.L. + I. Total Max. = 1/2
 Orig. Scale: None
 Abut. No. 3 - as shown (2 Req'd.)
 Abut. No. 1 - opp. hand (2 Req'd.)

INITIAL	DATE	CHECKED BY
AE	3-7-75	AE
AE	3-7-75	AE
AE	3-7-75	AE


PLAN
 Orig. Scale: 1/4" = 1'-0"

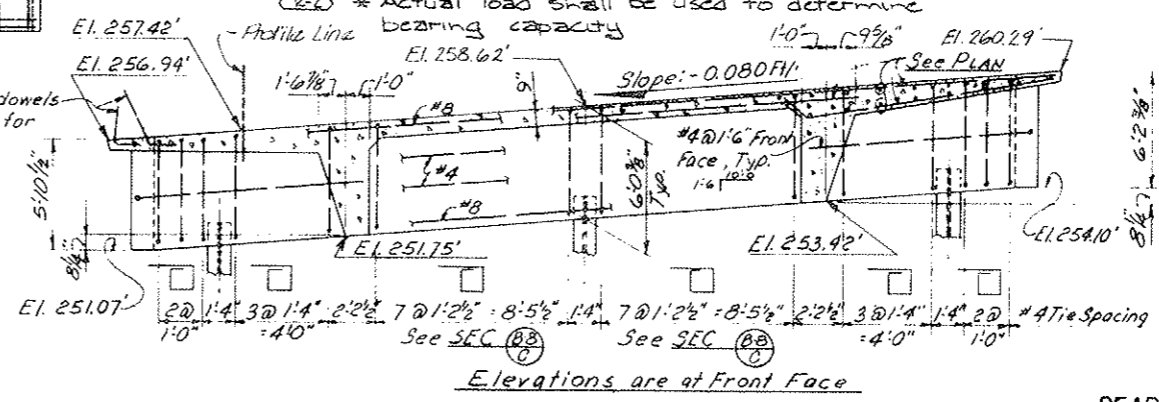


SECTION
 Orig. Scale: 1/4" = 1'-0"

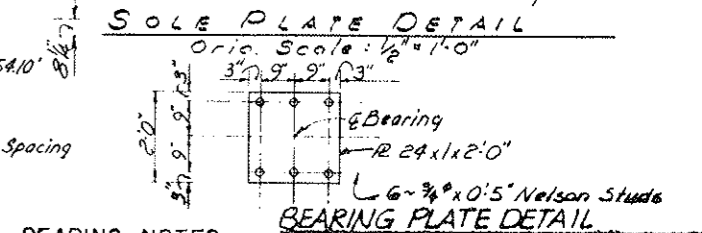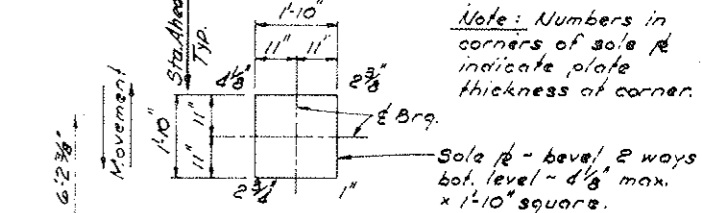

- BEARING NOTES:
- STEEL FOR THE BEARING DEVICES, MASONRY PLATES, AND SOLE PLATES SHALL BE A.A.S.H.T.O. SPECIFICATION M-183 (A.S.T.M. A36).
 - THE TYPE OF ANCHORAGE FOR BEARING DEVICES SHALL BE DETERMINED BY THE CONTRACTOR AND SUBMITTED ON SHOP DRAWINGS FOR APPROVAL.
 - FOR ALLOWABLE BEARING PRESSURE ON CONCRETE, SEE DRAWING B 11.
 - THE SOLE PLATES SHALL BE SUPPLIED WITH BEVELS AND CROSSFALLS AS REQUIRED FOR GRADE AND SUPERELEVATION.
 - THE SIZES OF MASONRY PLATES SHALL BE DETERMINED BY THE BEARING MANUFACTURER. THE ALLOWABLE ULTIMATE BEARING PRESSURES AND THE ULTIMATE LOADS SHALL BE USED TO DETERMINE THE MASONRY PLATE SIZES.
- ALL BEARING DETAILS, INCLUDING WELDS, ARE SHOWN FOR ILLUSTRATION PURPOSES ONLY. THE CONTRACTOR SHALL SUBMIT SHOP DRAWINGS SHOWING DETAILS OF THE SPECIFIC BEARING DEVICE TO BE USED.

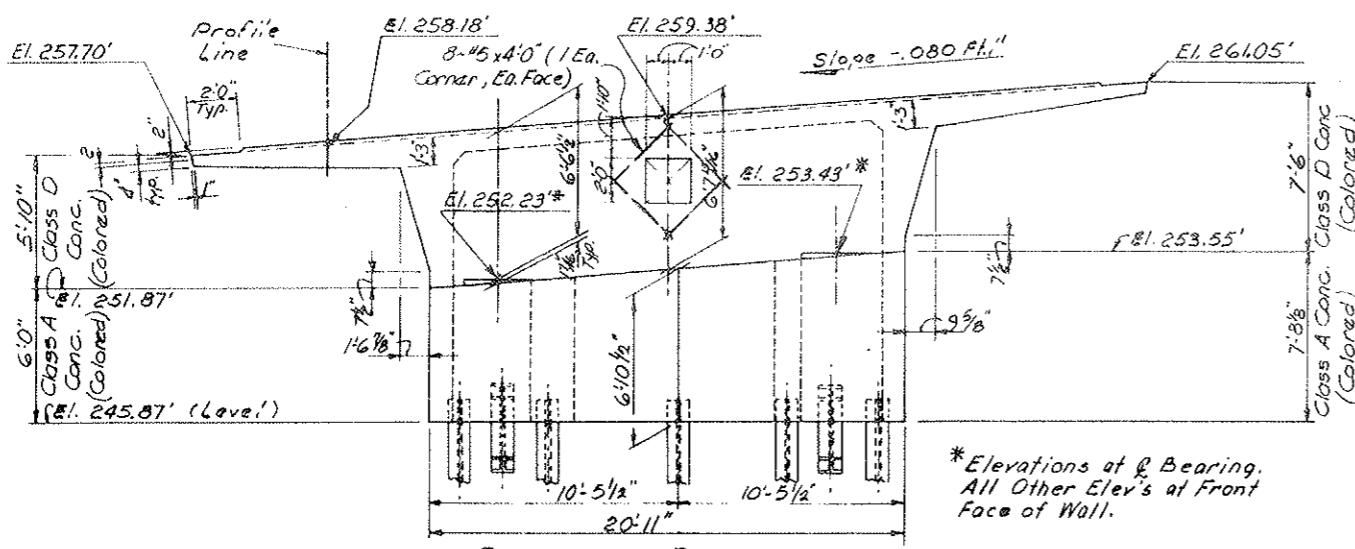

FRONT ELEVATION
 Orig. Scale: 1/4" = 1'-0"

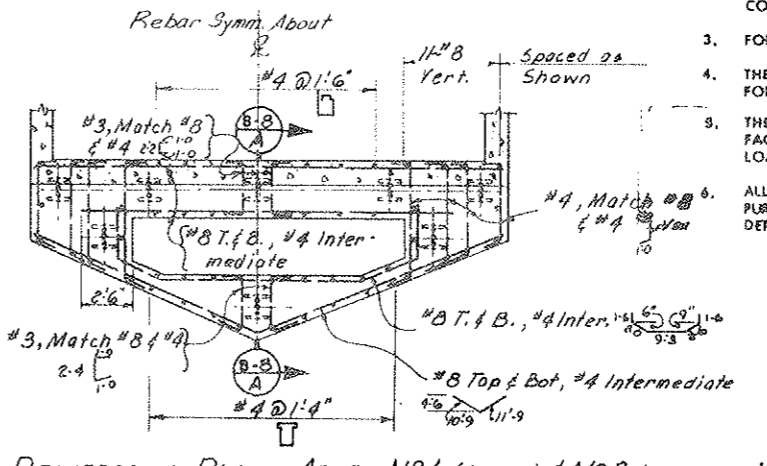

REINFORCING PLAN, ABUTS NO. 1 (SHOWN) & NO. 3 (OPP. HAND)
 Orig. Scale: 1/4" = 1'-0"

DIVISION OF HIGHWAYS

ABUTMENT No. 3 DETAILS


Designer: A. Erikson
 Detailer: Grogan, McNamara
 Drawing Number: B-10 of 17 Drawings

Registered Professional Engineer
 F-12-AM
 Members

FEDERAL ROAD DISTRICT NO.	DISTRICT	PROJ. NO.	SHEET NO.	TOTAL SHEETS
XIII	COLORADO	I 70-2(88)197	51	

REVISIONS				
1	4-14-75	REPRINT		MCB
2	4-17-75	REVISED BENDING MOMENTS & POS. PRESTRESS FORCES		CLB




VOID
BY CONSTRUCTION DATE 6-24-71

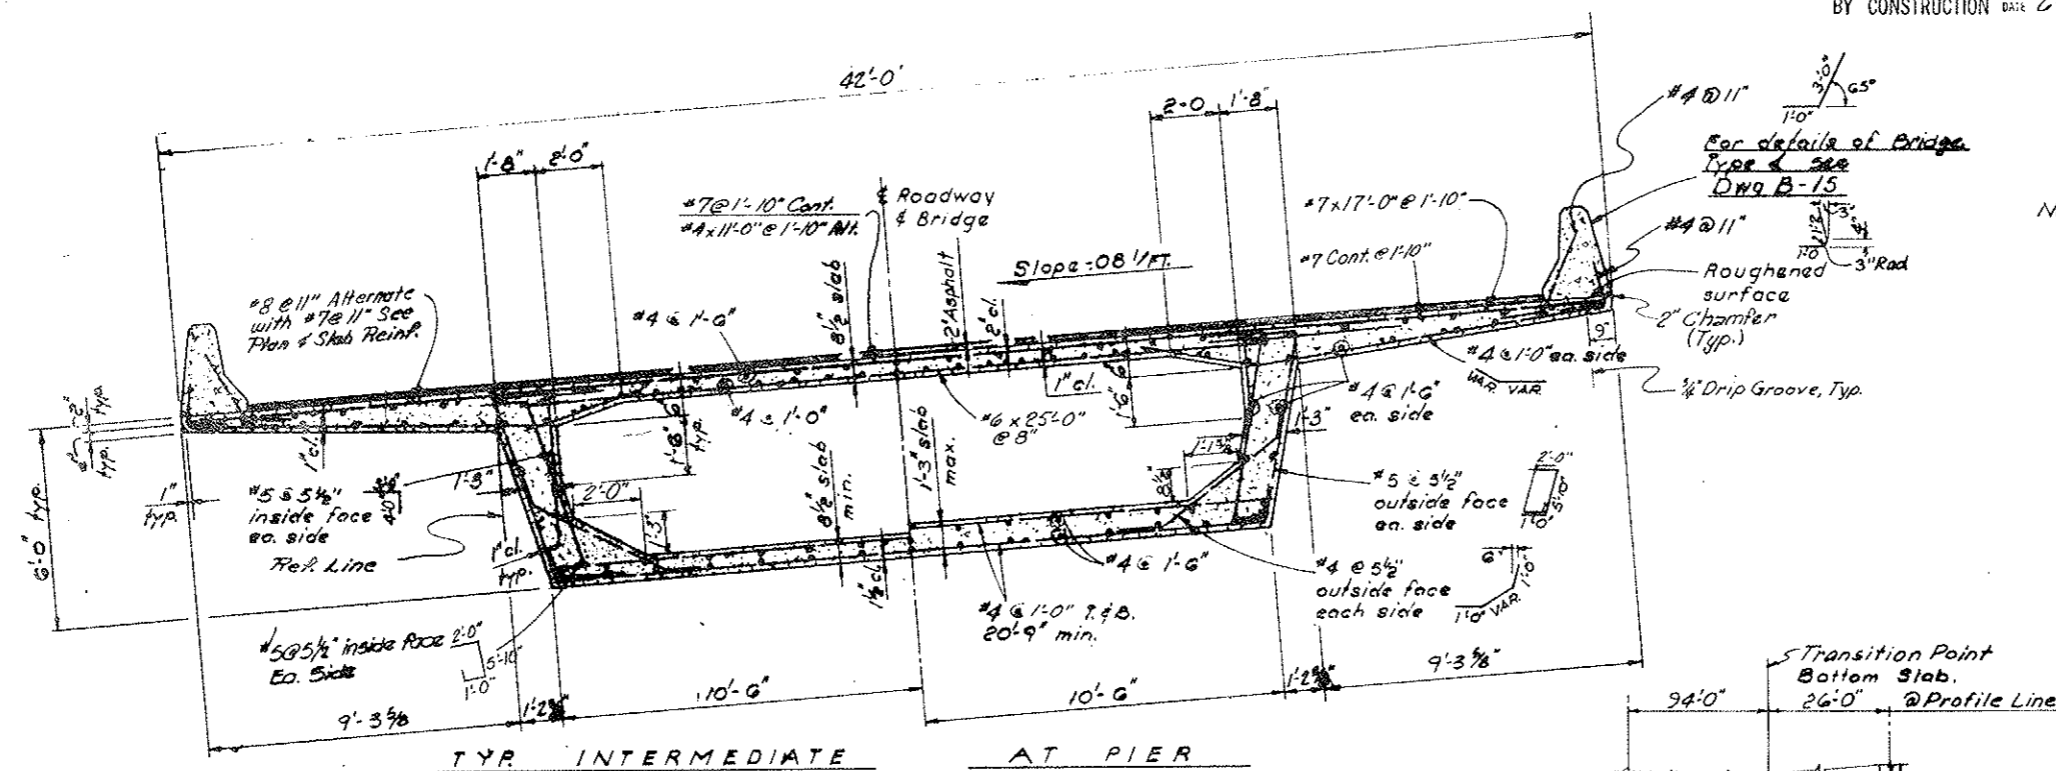

NOTE: Concrete shall be class 3 (Bridge) (colored) unless otherwise noted.
For Prestressing notes see Drawing No. B-13.

ALLOWABLE ULTIMATE BEARING PRESSURES:

At Abutments: ($f_c = 3000$ psi)	1785 psi
At Piers: ($f_c = 3000$ psi)	2975 psi
In Superstructure: ($f_c = 3000$ psi)	3075 psi

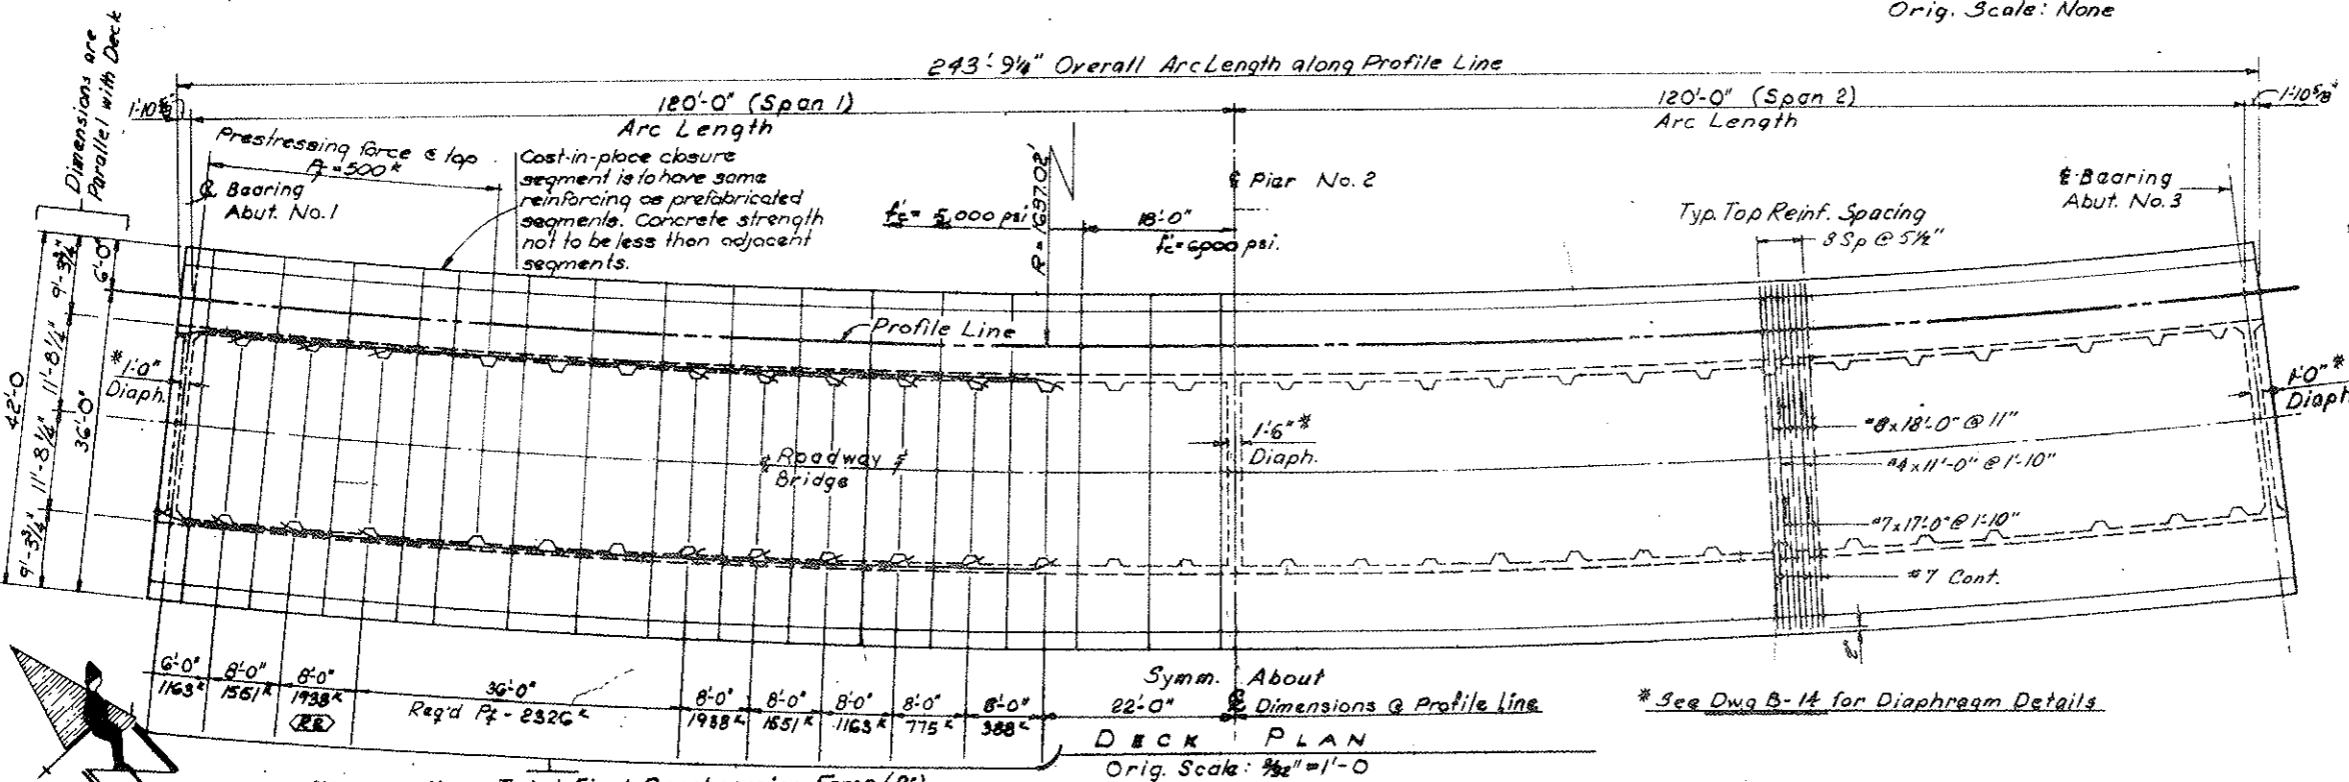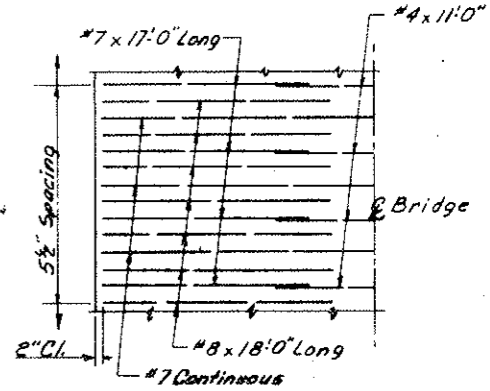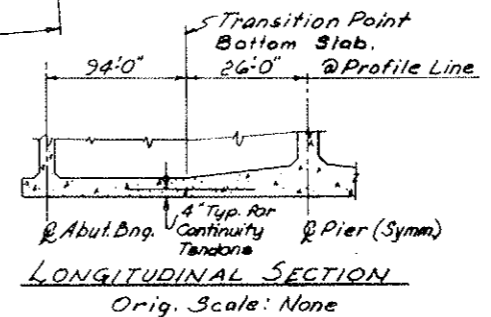

DESIGNED BY	CHECKED BY	DATE
AE	AE	5-7-75
H.G.	H.G.	5-7-75
SM	SM	5-7-75
AE	AE	5-7-75

DIVISION OF HIGHWAYS

DECK PLAN AND
TYPICAL DECK SECTION


Designer A. Eriksen	Structure F-12-AM
Detaler S. Martinez	Number
Drawing Number B-11	of 17 Drawings

Figures show Total Final Prestressing Force (Pf) for Both Webs, Bottom Tendons. See Dwg B-13 for Top Tendon Forces.



FEDERAL ROAD REGION NO.	DISTRICT	PROJ. NO.	SHEET NO.	TOTAL SHEETS
VIII	COLORADO	I-70-2(52)197	52	

VOID
BY CONSTRUCTION 6-24-77

REVISIONS	

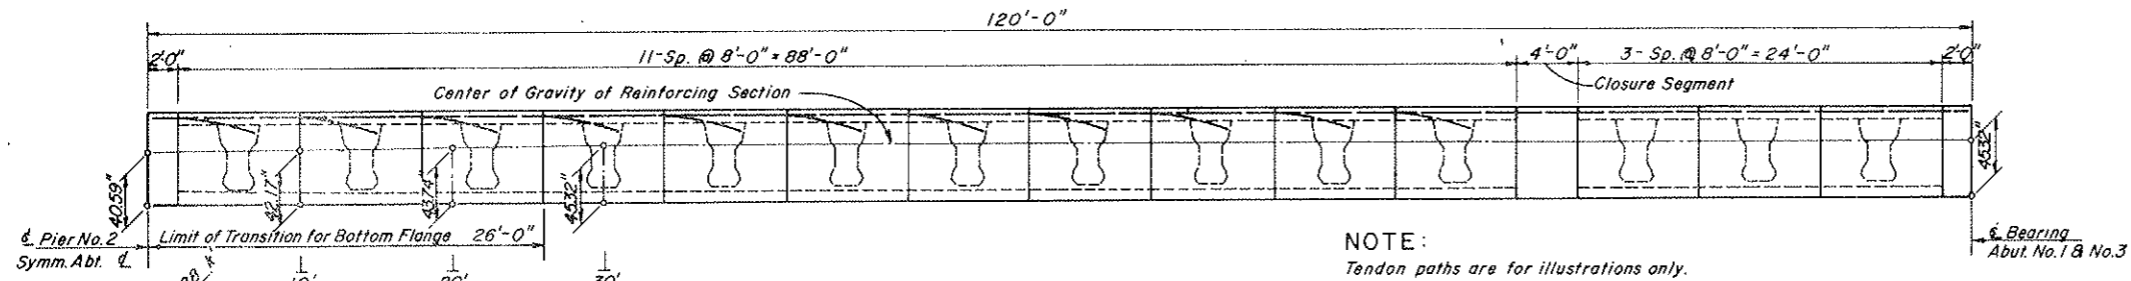

NOTE:
Tendon paths are for illustrations only.

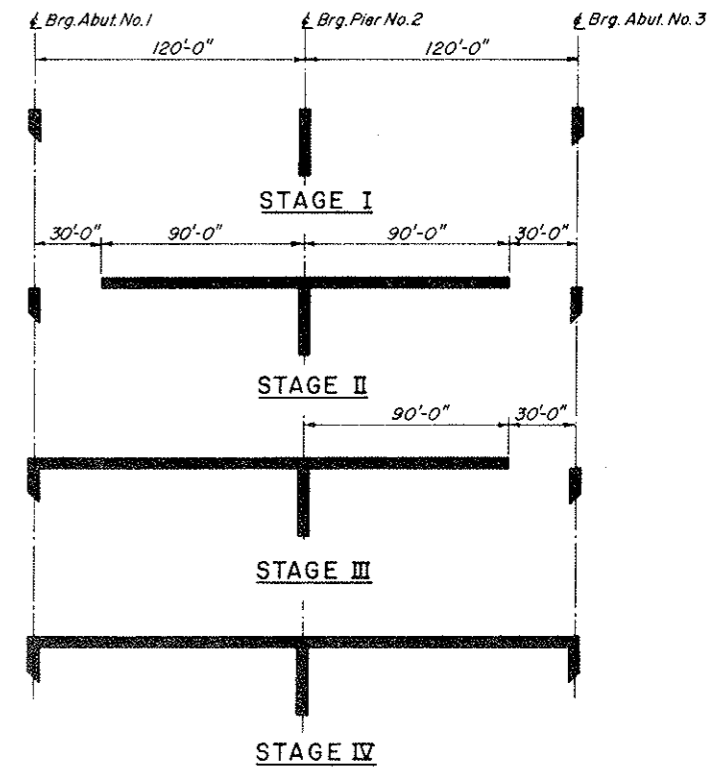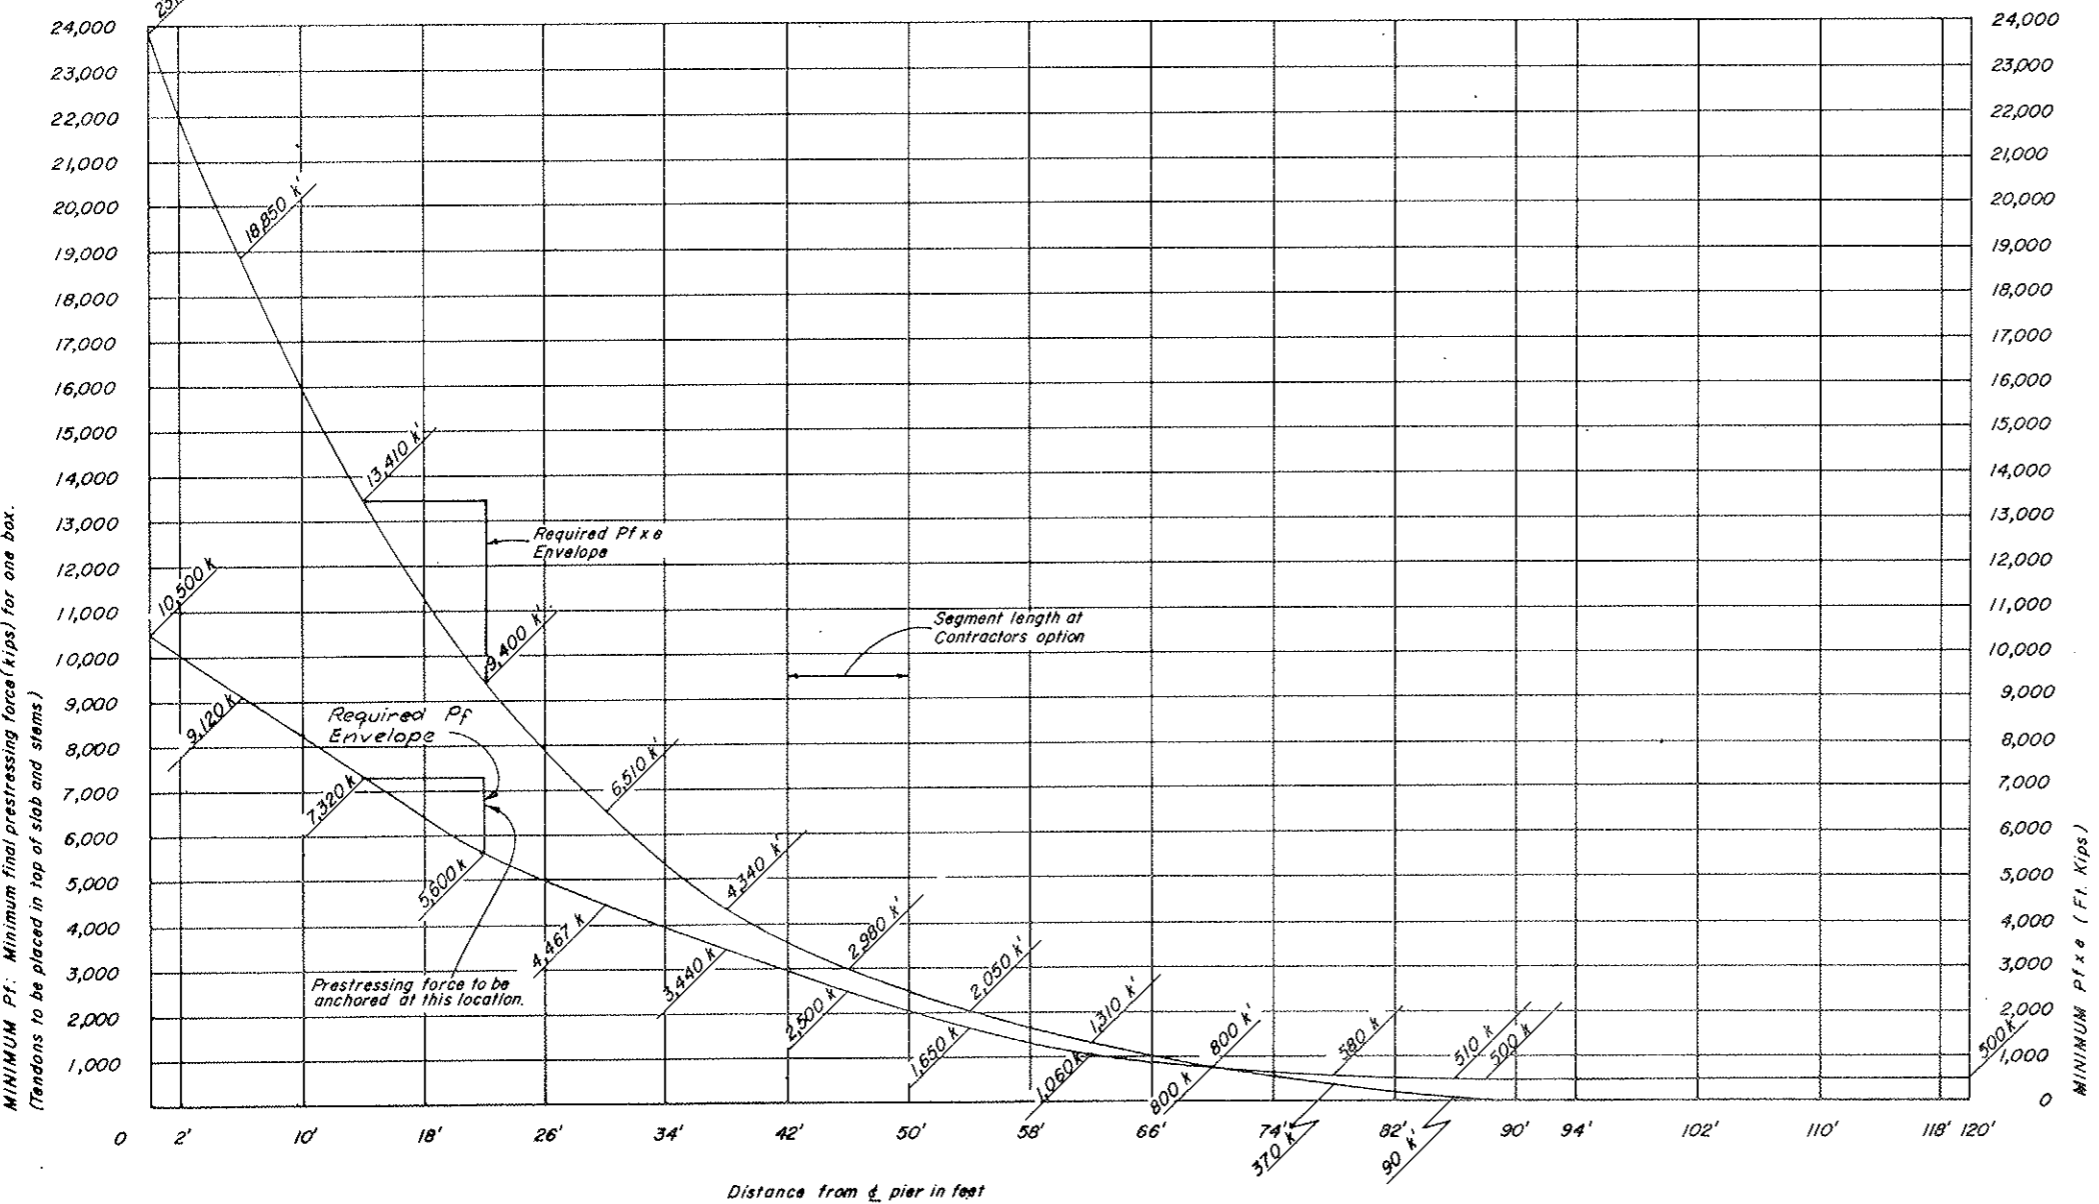

SEQUENCE OF CONSTRUCTION
(Assumed in Design)

DESIGNED BY	CHECKED BY	DATE	QUANTITIES BY	CHECKED BY	DATE
AE	AE	3-7-77	AE	AE	3-7-77
HS	HS	3-7-77	AE	AE	3-7-77

MINIMUM Pfx: Minimum final prestressing forces (kips) for one box.
(Tendons to be placed in top of slab and stems)

MINIMUM Pfx (Fl. Kips)

SPANS NO. 1 & NO. 2
Minimum Prestressing Forces & Prestressing Moments for Top (Negative) Tendons.

DIVISION OF HIGHWAYS


**90 FOOT CANTILEVER
CONSTRUCTION SEQUENCE**

Designer A. ERIKSEN	Structure F-12-AM
Detailer P. SCOFIELD	Number
Drawing Number B-12	of 17 Drawings


FEDERAL ROAD REGION NO.	DISTRICT	PROJ. NO.	SHEET NO.	TOTAL SHEETS
VIII	COLORADO	170 2(52)197	53	

REVISIONS				
R-1	5-14-75	Added Note		CLB


VOID
BY CONSTRUCTION DATE 6-28-77

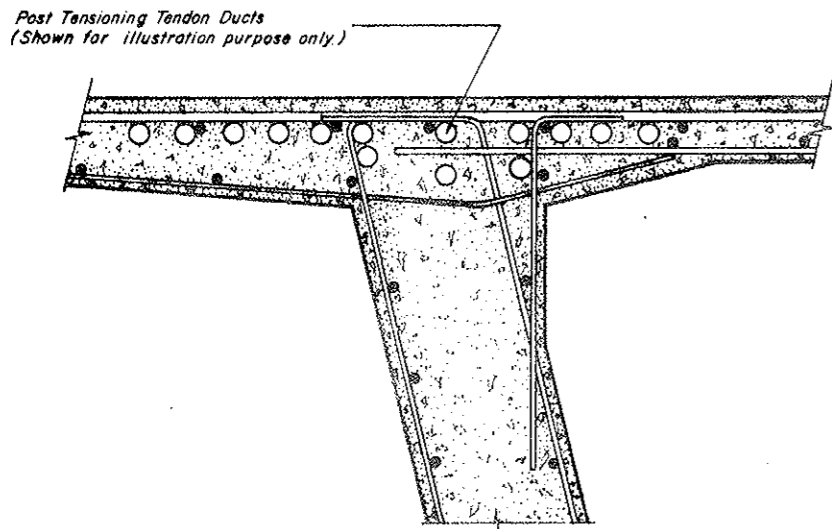


PART SECTION NEAR PIER
NO SCALE

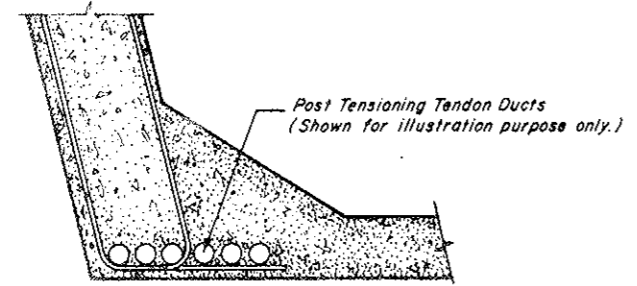


PART SECTION NEAR MID-SPAN
NO SCALE

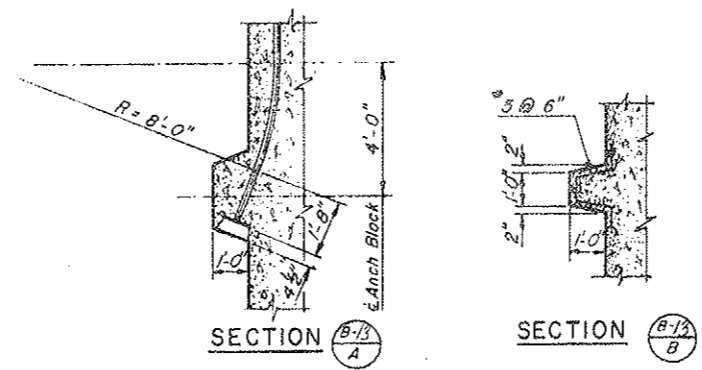


SECTION B-1/A **SECTION B-1/B**

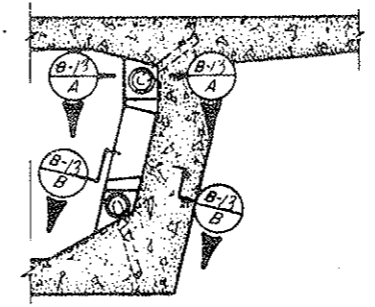

ANCHOR BLOCK DETAIL

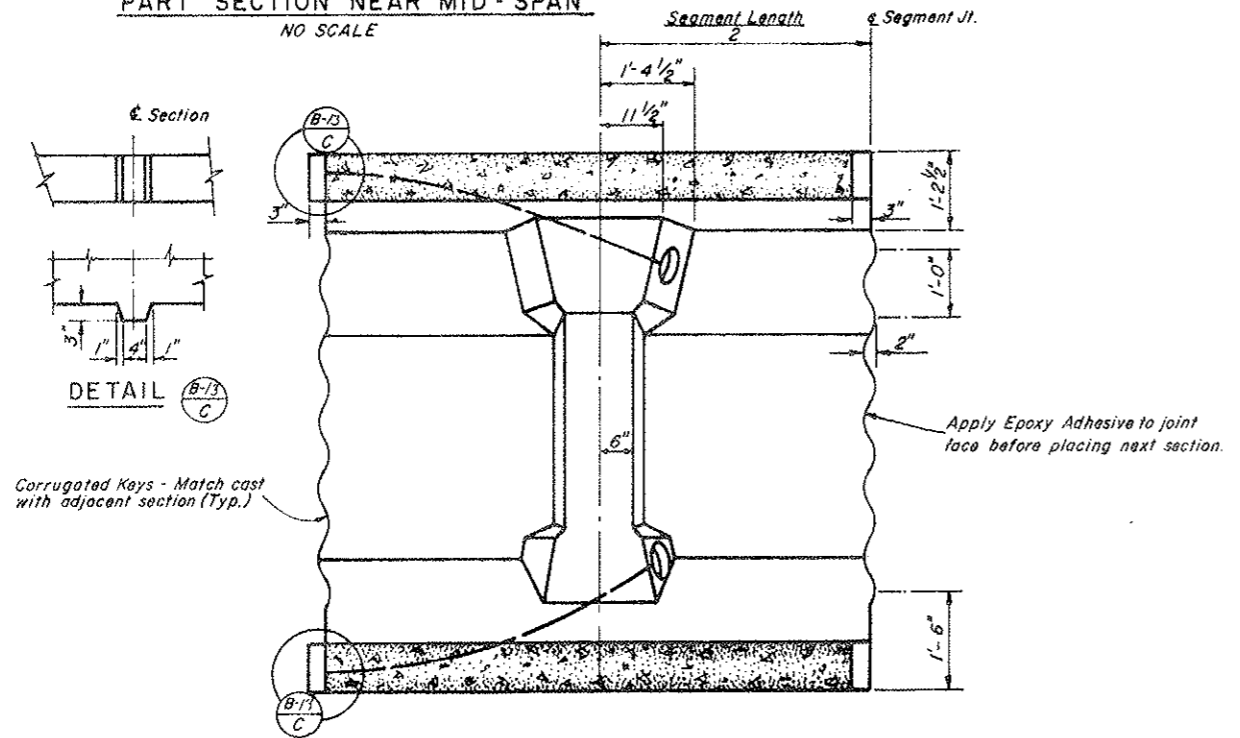

TYPICAL SEGMENT ELEVATION
NO SCALE

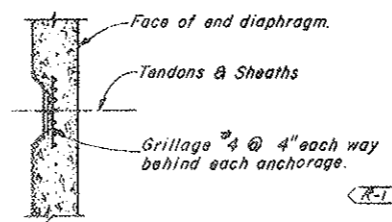

PART PLAN ANCHORAGE AT ABUTMENTS
NO SCALE

PRESTRESSING NOTES:


- "P_i" IS THE TOTAL PRESTRESSING FORCE REMAINING AT A SPECIFIC POINT AFTER ALL LOSSES INCLUDING CREEP, SHRINKAGE AND ELASTIC SHORTENING OF CONCRETE, CREEP AND ELONGATION OF STEEL TENDONS AND FRICTION.
- THE VALUE OF P_i SHALL BE FURNISHED AT THE MIDDLE OF LENGTH FOR WHICH IT IS GIVEN IN THE CASE OF BOTTOM PRESTRESSING THROUGH THE CLOSURE POURS. P_i FOR ALL OTHER BOTTOM PRESTRESSING SHALL BE FURNISHED AT THE END NEAREST MID-SPAN OF THE LENGTH FOR WHICH IT IS GIVEN. P_i FOR TOP PRESTRESSING SHALL BE FURNISHED AT END NEAREST THE SUPPORT OF THE LENGTH FOR WHICH IT IS GIVEN.
- "e" IS THE ECCENTRICITY OF THE PRESTRESSING FORCE ABOVE OR BELOW THE CENTER OF GRAVITY OF THE CONCRETE BOX CROSS-SECTION.
- PRESTRESSING OF THE STRUCTURES SHALL BE DONE IN A MANNER SUCH THAT NO TENSILE STRESSES ARE CREATED IN THE CONCRETE.
- ALL SEGMENTS SHALL BE MATCH CAST TO ENSURE PROPER FIT DURING THE ERECTION STAGES. DURING CASTING, SEGMENTS MUST BE ALIGNED TO ACHIEVE FINAL STRUCTURE GEOMETRY. AT THIS TIME, ALL CORRECTIONS FOR DEFLECTIONS, CAMBER, AND DEFORMATIONS DUE TO CREEP, ELASTIC SHORTENING, ETC. MUST BE COMPENSATED FOR IN THE FORM.
- PRESTRESSING STEEL PROPERTIES USED IN THE DESIGN CALCULATIONS ARE FOR TENDONS WITH AN ULTIMATE STRENGTH OF 270 K.S.I. CALCULATIONS MUST BE SUBMITTED FOR DEPARTMENT APPROVAL IF ANOTHER TYPE OF PRESTRESSING STEEL IS SUBSTITUTED. TENDONS SHALL BE SHIPPED IN MOISTURE-PROOF CONTAINERS THAT CAN BE STORED AT THE JOB SITE FOR AN EXTENDED PERIOD OF TIME WITHOUT CORRODING FROM ATMOSPHERIC CONDITIONS.
- REQUIRED PRESTRESSING FORCES (P_i) AND MOMENTS (P_i x e) ARE BASED ON A SEGMENT LENGTH OF 8' - 0" AND ON THE CONSTRUCTION SEQUENCE SHOWN ON DRAWING NUMBER B-12. DESIGN CALCULATIONS FOR ALTERNATIVE CONSTRUCTION SCHEMES MUST BE SUBMITTED TO THE ENGINEER FOR APPROVAL.
- PROVISIONAL PRESTRESSING USED DURING CONSTRUCTION MUST HAVE ENGINEERS APPROVAL.
- IF ONE END STRESSING IS USED, ALTERNATE TENDONS SHALL BE STRESSED FROM OPPOSITE ENDS. LONGITUDINAL TENDONS LOCATED IN BOTTOM SLAB SHALL BE STRESSED AFTER CLOSURE POUR IS MADE AND TOP SLAB TENDONS ARE STRESSED.
- RECTANGULAR ANCHOR PLATES SHALL BE USED TO MINIMIZE FLARES. ALTERNATE ANCHORAGE AND CONSTRUCTION JOINT DETAILS, TO FIT THE PRESTRESSING SYSTEM USED, SHALL BE SUBMITTED TO THE ENGINEER FOR APPROVAL.
- GIRDER STEMS SHALL BE FLARED AS NECESSARY NEAR ANCHORAGE TO PROVIDE A 2" MINIMUM OF CONCRETE COVERING THE DUCTS. THE FLARE SHALL BE ON INSIDE OF THE GIRDER ONLY.
- BAR REINFORCING INTERFERING WITH THE PRESTRESSING TENDON ALIGNMENT SHALL BE ADJUSTED AS DIRECTED BY ENGINEER.
- TENDON DUCTS MUST BE PRECISELY ALIGNED DURING PRODUCTION. INFLATABLE RUBBER OR SUITABLY RIGID MATERIAL SHALL BE USED TO PREVENT ANY INDENTATIONS OR COLLAPSE OF DUCTS.
- PROVIDE ADEQUATE SUPPORT FOR TENDON DUCTS TO PREVENT ALIGNMENT CHANGES DURING CONCRETE PLACEMENT.
- A MAXIMUM OF 3 DUCTS MAY BE BUNDLED INTO VERTICAL UNITS. MINIMUM HORIZONTAL CLEARANCE BETWEEN DUCT UNITS SHALL BE 2-1/2 IN. MINIMUM VERTICAL CLEARANCE BETWEEN DUCT UNITS SHALL BE 3 IN.
- GROUTING IS TO BE DONE AFTER PRESTRESSING IS COMPLETED IN ANY ONE SPAN IN SUCH A WAY THAT GROUTING CANNOT INTERFERE WITH THREADING AND STRESSING OF TENDONS.
- CARE SHALL BE EXERCISED IN JOINING THE SEGMENTS WITH EPOXY TO ENSURE THAT COMPRESSION IS MAINTAINED OVER THE ENTIRE JOINT AREA UNTIL THE PERMANENT POST-TENSIONED TENDONS ARE STRESSED.
- SEGMENT JOINTS SHALL HAVE A THOROUGH COATING OF EPOXY TO ELIMINATE VOIDS BETWEEN TENDON DUCTS.
- A COMPLETE SET OF DEFLECTION CALCULATIONS SHALL BE SUBMITTED TO ENGINEER FOR APPROVAL 60 DAYS PRIOR TO STARTING SUPERSTRUCTURE CONSTRUCTION.
- THE CAMBER TO BE USED WILL DEPEND ON SEGMENT LENGTH, STRENGTH, WEIGHT AND CREEP OF CONCRETE, PRESTRESSING, WEIGHT OF FALSE-WORK, AND INCIDENTAL CONSTRUCTION LOADS.
- CONTRACTOR WILL BE REQUIRED TO CHECK CAMBER AT INTERMEDIATE ERECTION STEPS AND PROVIDE CAMBER ADJUSTMENTS WITH SUPPORTING CALCULATIONS.
- FALSEWORK AT CLOSURE POURS SHALL BE SUPPORTED SUCH THAT APPLIED LOADS WILL RESULT IN EQUAL DEFLECTIONS OF EACH CANTILEVER.
- TYPICAL SECTION REINFORCING (SEE DWG. NO. B-11) SHALL EXTEND INTO CLOSURE POURS.
- A MINIMUM OF 30 P.S.I. COMPRESSION SHALL BE REQUIRED DURING AND AFTER INITIAL PRESTRESSING.
- SUPERSTRUCTURE CONCRETE FOR 2 SEGMENTS ADJACENT TO PIER EACH SIDE TO HAVE F_c = 6,000 P.S.I. ALL OTHER SUPERSTRUCTURE CONCRETE TO HAVE F_c = 5,000 P.S.I.
- WEB STIFFENERS AS SHOWN ON THE PLANS ARE FOR ILLUSTRATION ONLY. THE CONTRACTOR MUST SUBMIT CALCULATIONS FOR DEPARTMENT'S APPROVAL IF OTHER TYPES OF ANCHORAGE DETAILS ARE TO BE USED.
- WEB STIFFENER REINFORCING DETAILS SHALL BE SUBMITTED FOR THE ANCHORAGE SYSTEM USED.

DESIGNED BY	CHECKED BY	DATE	UNDESIGNED	QUANTITIES	CHECKED BY	DATE


DIVISION OF HIGHWAYS			
PRESTRESSING DETAILS			
Designer	J. Keller	Structure Numbers	F 12-AM
Detailer	PHS	of	17 Drawings
Drawing Number	B 13		

FEDERAL ROAD REGION NO.	DISTRICT	PROJ. NO.	SHEET NO.	TOTAL SHEETS
VIII	COLORADO	170-2(52)197	54	


REVISIONS	

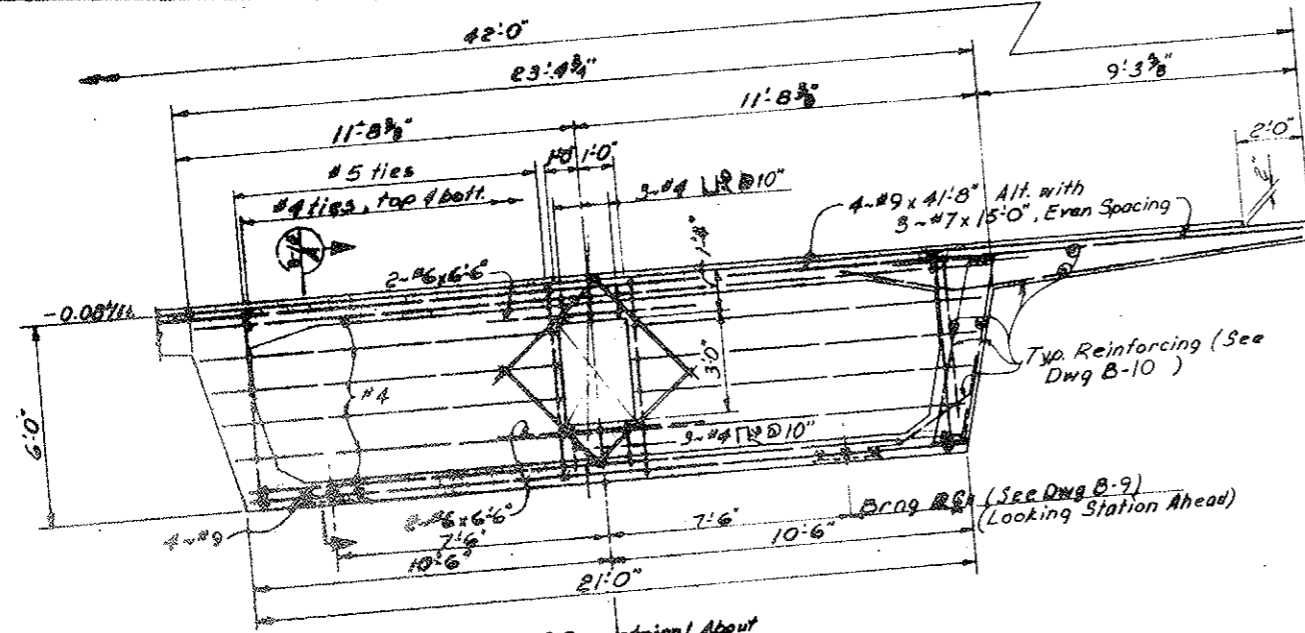


See Typ. Section Dwg B-10 for Add'l Dimensions
DIAPHRAGM ELEVATION AT ABUTMENTS NO 1 & NO 3
Orig. Scale: 1/8"=1'-0"

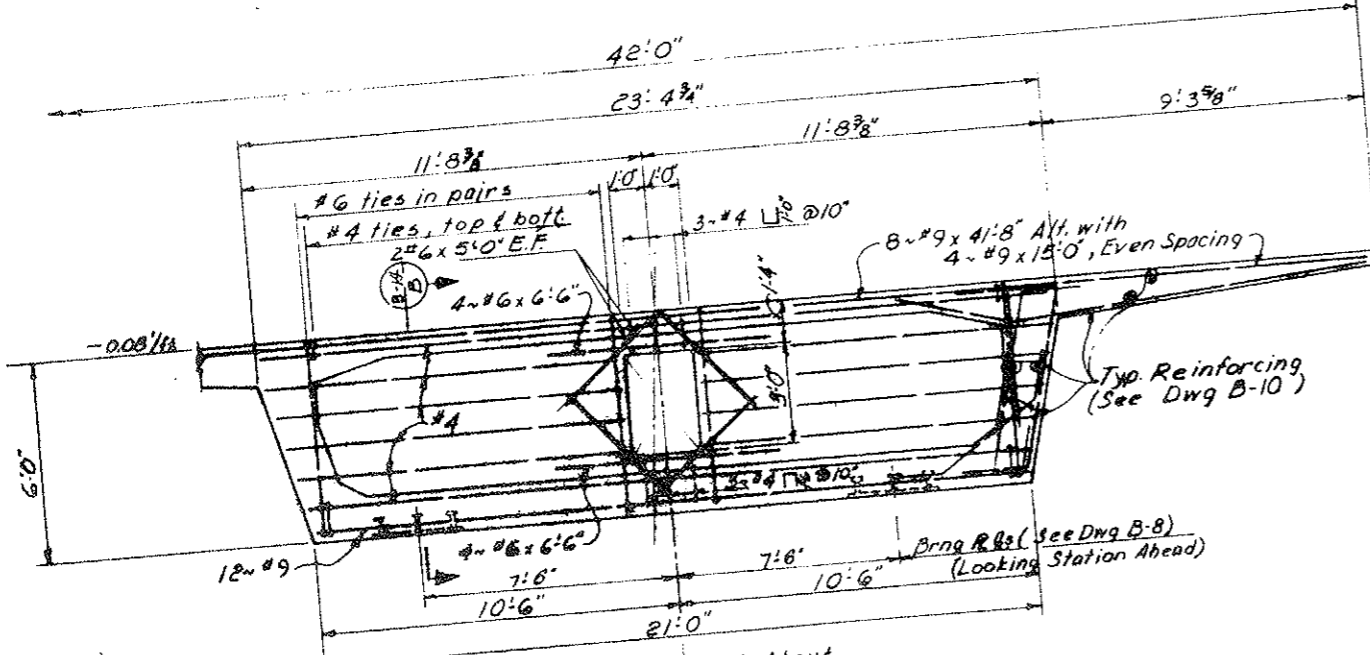

See Typ. Section Dwg B-10 for Add'l Dimensions
DIAPHRAGM ELEVATION AT PIER NO 2 (LOOKING STATION AHEAD)
Orig. Scale: 1/8"=1'-0"

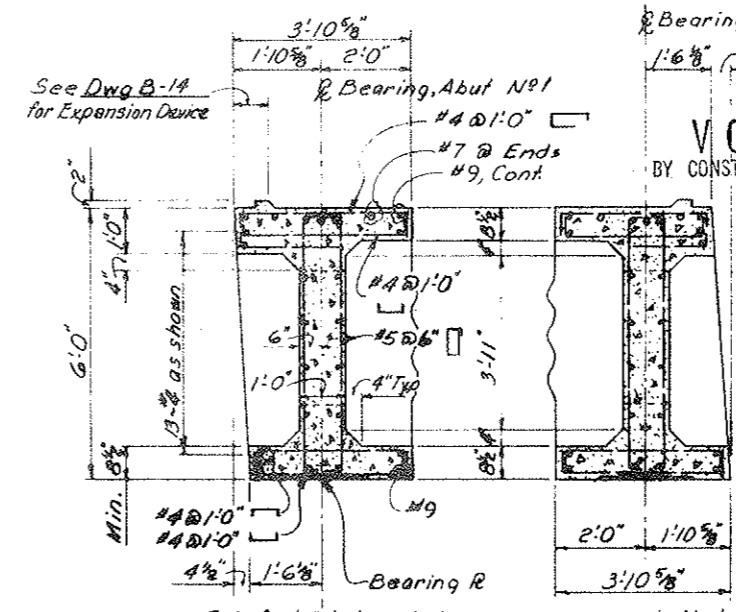


See Dwg B-14 for Expansion Device
END DIAPH. ABUT NO 1 **END DIAPH. ABUT NO 3**
SECTION (B-14) A
Orig. Scale: 1/8"=1'-0"

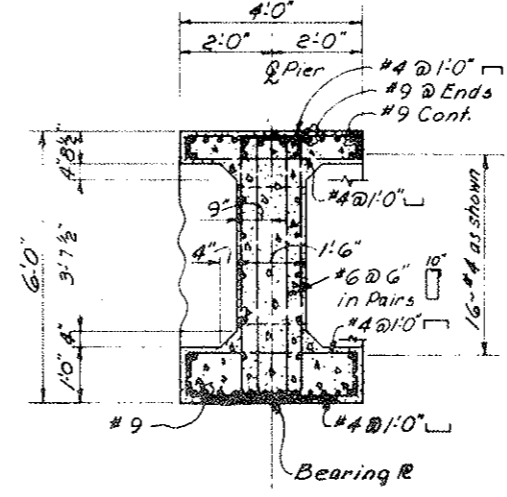

SECTION (B-14) B
Orig. Scale: 1/8"=1'-0"

Note: Coordinate with Bearing Manufacturer before casting diaphragms.

Bearing, Abut No 3
1'-6 3/8" (4 1/2")
VOID
BY CONSTRUCTION DATE 6-24-77

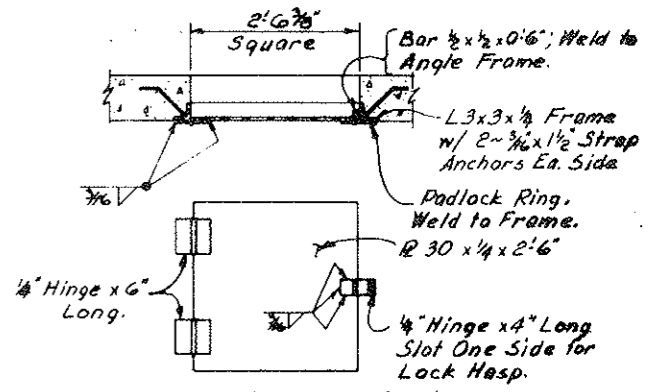

METAL ACCESS DOOR DETAIL
(See Dwg B-7 & B-9 for Abut's)
Orig. Scale: 1/4"=1'-0"

DATE	DESIGNED BY	CHECKED BY
5-7-75	A.E.	L.M.
5-7-75	A.G.	L.M.
5-7-75	L.M.	L.M.

DIVISION OF HIGHWAYS


DIAPHRAGM DETAILS

Designer A. Eriksen	Structure Number F-12-AM
Detailer L. McNamee	
Drawing Number B-14	of 17 Drawings




Revision Dates (Preliminary Stage Only)

FEDERAL ROAD REGION NO.	DISTRICT	PROJ. NO.	SHEET NO.	TOTAL SHEETS
XIII	COLORADO	170-2(52)197	55	

REVISIONS	

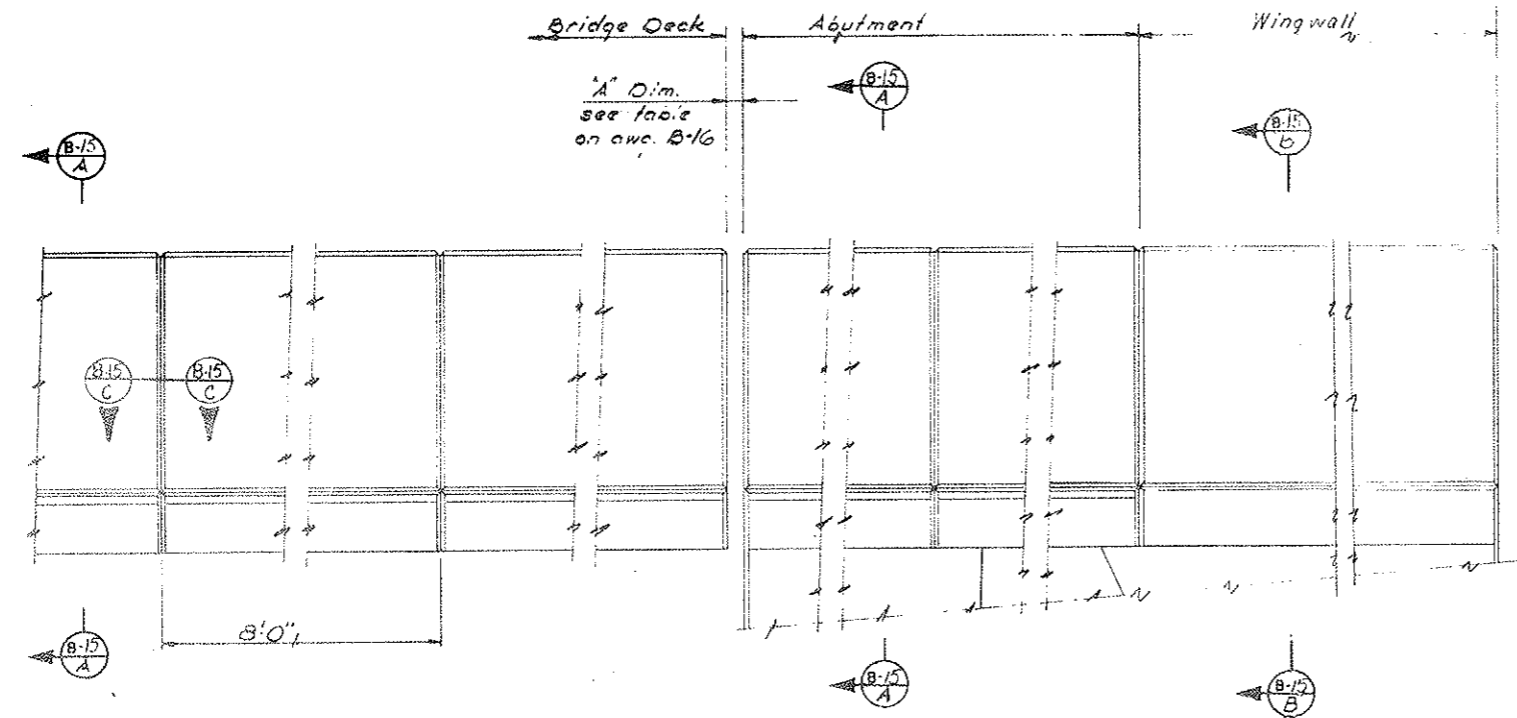

TYPICAL ELEVATION A-A ABUTMENT
Orig. Scale: 1" = 1'-0"

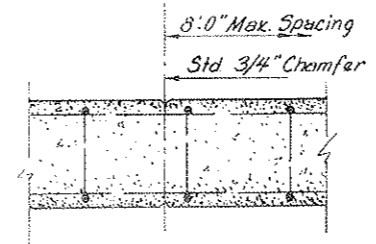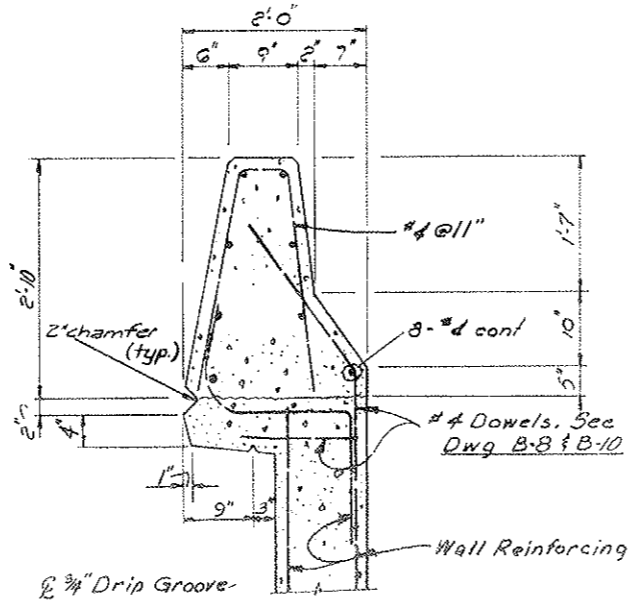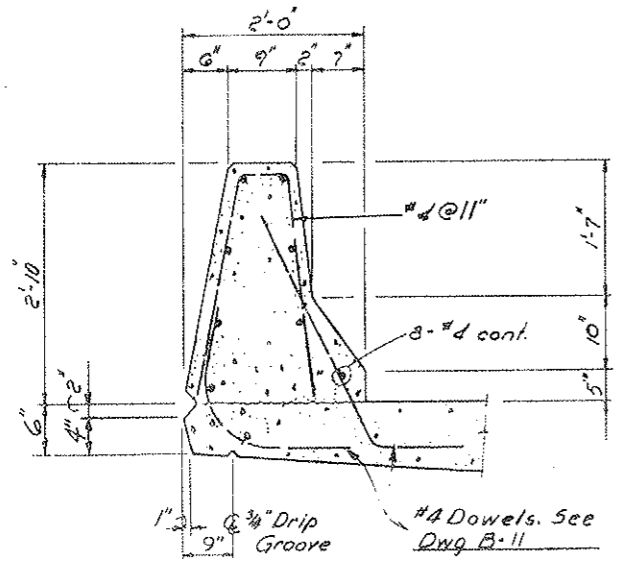

DESIGNED BY	CHECKED BY	DATE	QUANTITIES BY	CHECKED BY	DATE
AE	LH	3-75	AE	LH	3-75
LH	AE	3-75	AE	LH	3-75


VOID
BY CONSTRUCTION DATE 6-24-77

DIVISION OF HIGHWAYS

BRIDGE RAIL TYPE 4

Designer A. Eriksen	Structure Numbers	F-12-AM
Detaller L. McNamee	Number	
Drawing Number B-15		of 17 Drawings

FEDERAL ROAD REGION NO.	DIVISION	PROJ. NO.	SHEET NO.	TOTAL SHEETS
XIII	COLORADO	170-2(52)197	56	
REVISIONS				

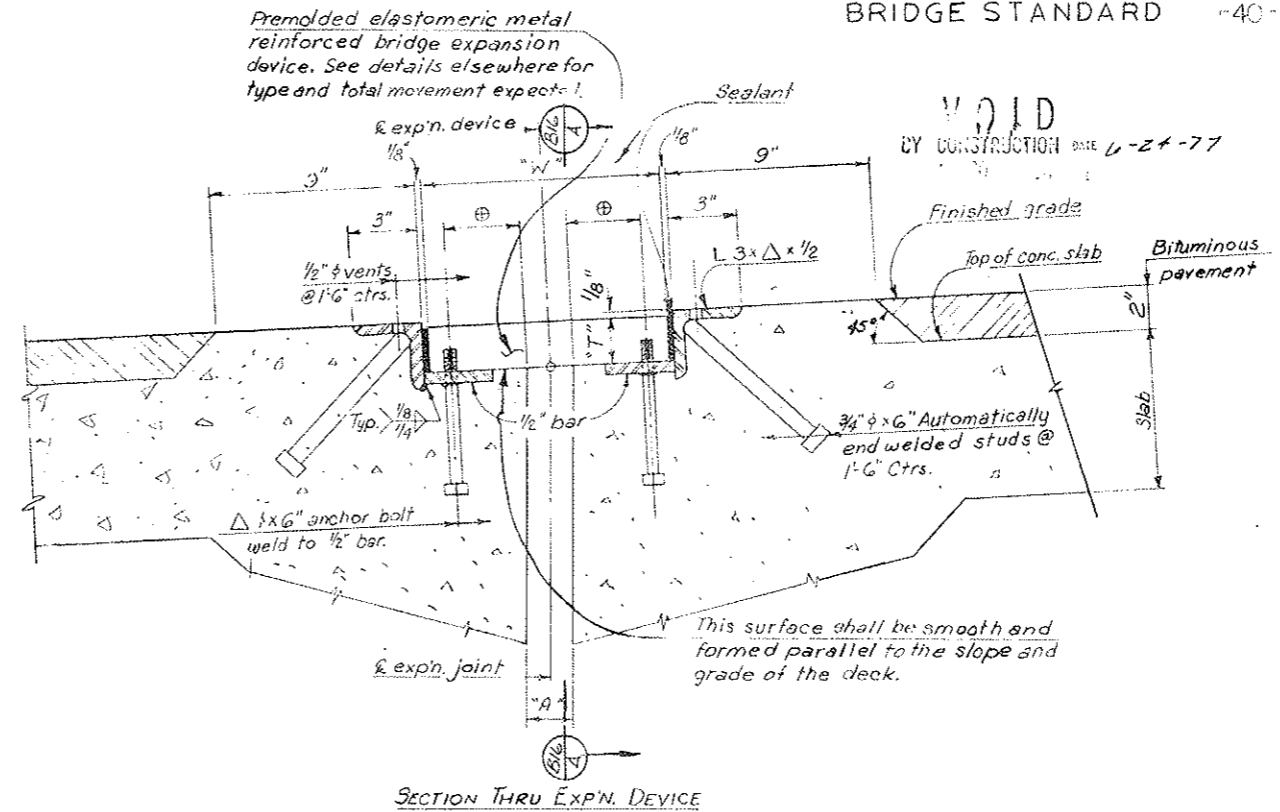

NOTES

THE EXPANSION DEVICE SHALL BE INSTALLED ON GRADE, PARALLEL TO THE SLOPE AND GRADE OF THE DECK.

AFTER THE CONCRETE HAS ATTAINED INITIAL SET, THE ATTACHMENTS USED TO HOLD THE ANGLE ASSEMBLY IN ITS PROPER POSITION SHALL BE REMOVED.

DO NOT PAINT STEEL SURFACES IN CONTACT WITH CONCRETE AND PREMOLDED EXPANSION DEVICE.

"W", "T", "Ø", AND "Δ" DIMENSIONS ARE DEPENDENT UPON THE PARTICULAR PREMOLDED DEVICE SUPPLIED, AND SHALL BE SHOWN ON THE SHOP DRAWINGS.

THE SHOP DRAWINGS SHALL INDICATE THE "W" DIMENSION AT A RANGE OF TEMPERATURES FROM 30° TO 100° ASSUMING A MID-POINT TEMPERATURE OF 40°.

ANGLE AND PLATE ASSEMBLIES TO EXTEND GUTTER TO GUTTER ONLY.


ALL SECTIONS OF THE PREMOLDED EXPANSION DEVICE SHALL BE JOINED BY USING THE MANUFACTURER'S STANDARD WATERPROOF JOINT.

ALL CURB UNITS SHALL BE FULL WIDTH, ON GUTTER LINE, FOR SKEW ANGLES AS SPECIFIED ON THE PLANS.

ALL ANCHORS SHALL BE CAST IN PLACE BOLTS OR THREADED CAST IN PLACE CONCRETE INSERTS EXCEPT FOR CURB AND WALK UNITS WHICH MAY BE INSTALLED BY THE USE OF APPROVED DRILLED IN PLACE ANCHOR UNITS.


OPENING IN CURB AND SIDEWALK TO BE CONSTRUCTED TO THE EXACT WIDTH OF THE EXISTING DECK OPENING.

SECTION THRU EXPN. DEVICE

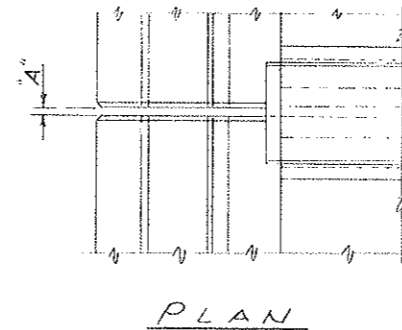


PLAN

* Bridge Expansion Device Type 1 to be used.

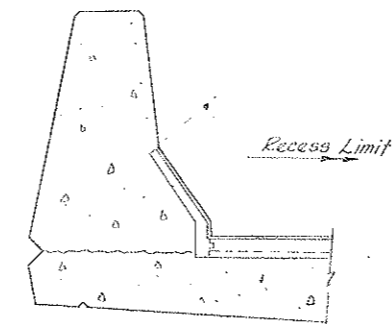

ELEVATION

DETAILS OF EXPANSION JOINT AT BRIDGE RAIL

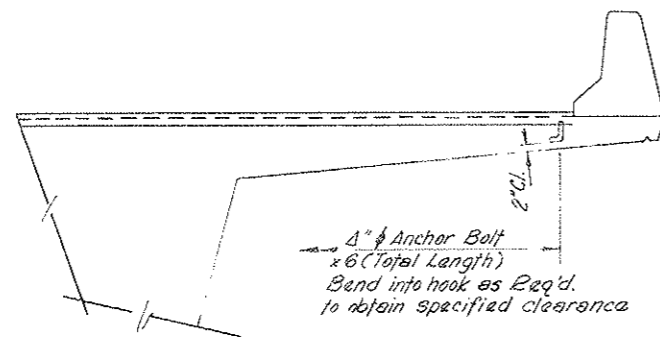

SECTION A

DESIGNED BY	CHECKED BY	DATE	QUANTITIES BY	CHECKED BY	DATE
	A.E.	11/77		J.R.E.	10-73
DETAILED BY	CHECKED BY	DATE	QUANTITIES BY	CHECKED BY	DATE

Outside Temp.	(Type 1)	(Type 2)	(Type 3)
	Dim. "A" (Min.)	Dim. "A" (Min.)	Dim. "A" (Min.)
30°	1 5/8"	2 1/4"	2 3/4"
40°	1 1/2"	2 1/8"	2 3/8"
50°	1 3/8"	2"	2 1/2"
60°	1 1/4"	1 7/8"	2 3/8"
70°	1 1/8"	1 3/4"	2 1/8"
80°	1"	1 1/2"	2"
90°	7/8"	1 1/4"	1 3/4"
100°	3/4"	1 1/4"	1 3/8"

Outside Temp.	(Type 4)	(Type 6)	(Type 7)
	Dim. "A" (Min.)	Dim. "A" (Min.)	Dim. "A" (Min.)
30°	4 3/8"	5 3/8"	
40°	4 1/8"	4 7/8"	
50°	3 7/8"	4 1/2"	
60°	3 3/8"	4"	
70°	3 1/4"	3 5/8"	
80°	3"	3 1/2"	
90°	2 3/4"	2 3/4"	
100°	2 1/2"	2 3/4"	

DIVISION OF HIGHWAYS

BRIDGE EXPANSION DEVICE
PREMOLDED ARMORED

Designer	A. Eriksen	Structure	F-12-AM
Detailer	J.R. EWERT	Numbers	
Drawing Number B-16		of 17 Drawings	


Revision Dates (Preliminary Stage Only)

111A)


FEDERAL ROAD DISTRICT NO.	DIVISION	PROJ. NO.	SHEET NO.	TOTAL SHEETS
VIII	COLORADO	170-2(52) 197	57	

REVISIONS	

VOID
BY CONSTRUCTION DATE 6-24-77

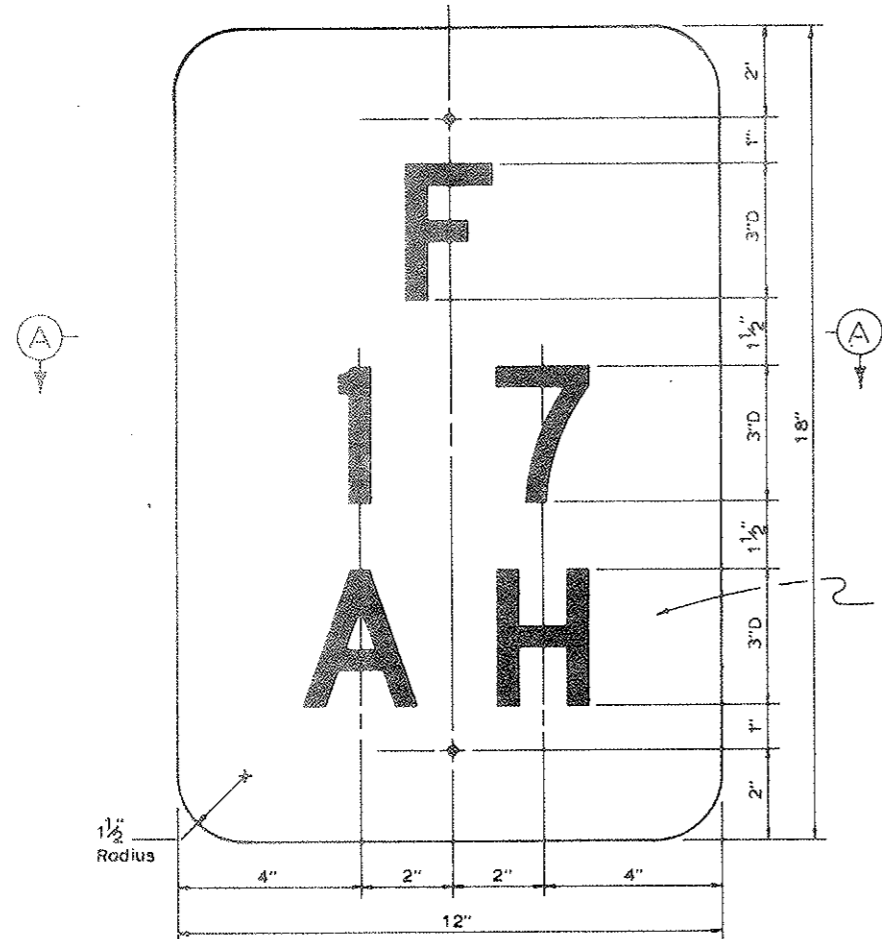


Black letters and numbers on white background.

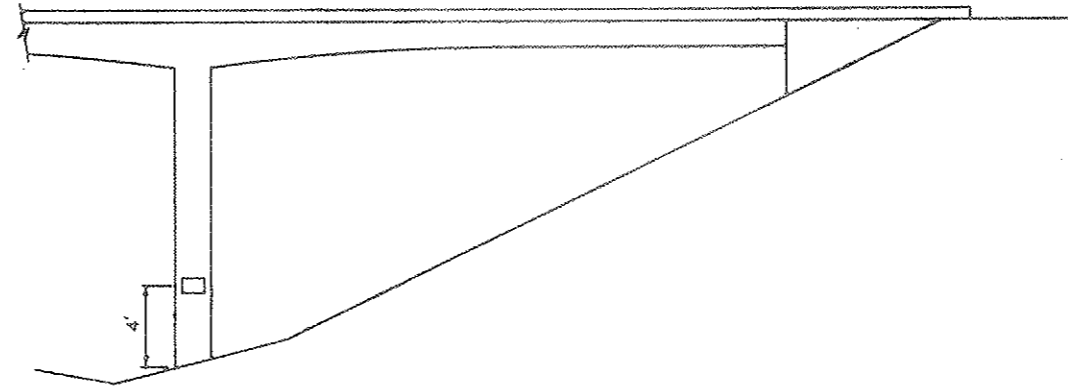


STRUCTURE NUMBER LOCATION ON PIERS


STRUCTURE IDENTIFICATION PANEL (SAMPLE NUMBERS & LETTERS)

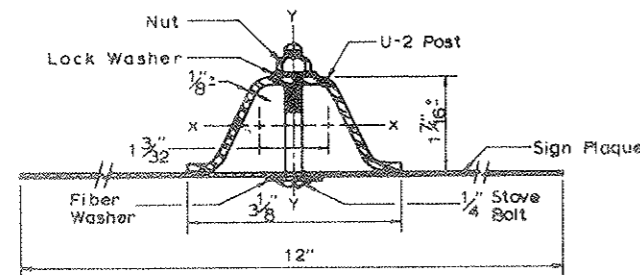

SECTION A

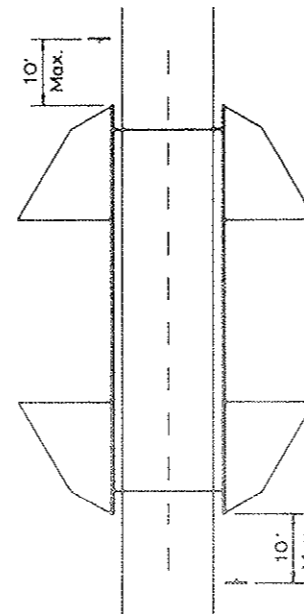

STANDARD LOCATION DETAIL

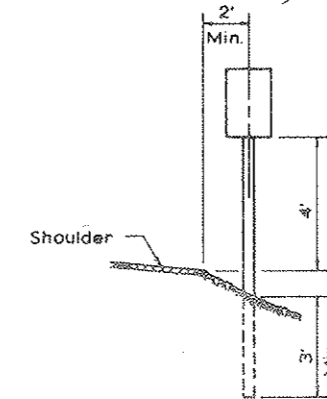

U-2 POST IN GROUND

ALL WORK SHALL BE DONE IN ACCORDANCE WITH THE STANDARD SPECIFICATIONS APPLICABLE TO THE PROJECT.
SIGN PANEL SHALL BE FABRICATED FROM EITHER SHEET STEEL 0.0598 MIN. THICKNESS OR SHEET ALUMINUM 0.080 MIN. THICKNESS.
SIGN PANEL SHALL BE GROUND MOUNTED.

U-2 POST SHALL MEET REQUIREMENTS OF PAR. 4.5 U.S. DEPT. OF COMMERCE, COMMERCIAL STANDARD 104-81. ACCEPTABLE MATERIAL INCLUDES REROLLED RAILROAD RAILS. U-2 POST SHALL WEIGH 2 LBS. PER FT. EXCEPT THAT A MILL TOLERANCE OF MINUS 3-1/2% OF THE WEIGHT OF ANY ONE POST WILL BE ALLOWED. ALTERNATE METAL POST WILL BE ACCEPTABLE IF SECTION MODULUS IS AT LEAST 0.200 IN.³ ABOUT THE X-X AXIS AND AT LEAST 0.280 IN.³ ABOUT THE Y-Y AXIS.

SIGN PANEL SHALL BE FASTENED DIRECTLY TO THE POST WITH TWO 1/4" GALVANIZED OR CADMIUM PLATED STOVE BOLTS. A PLASTIC FIBER WASHER SHALL BE PLACED BETWEEN THE BOLTS HEAD AND THE FACE OF THE PANEL. A GALVANIZED OR CADMIUM PLATED LOCK WASHER SHALL BE PLACED UNDER THE NUT ON THE BACK OF THE POST. EXPOSED BOLT HEADS AND FIBER WASHERS ON THE FACE OF THE SIGN PANEL SHALL BE PAINTED TO MATCH THE SURROUNDING COLOR.

LETTERS AND NUMBERS SHALL BE SERIES "D". THEY SHALL BE 3" HIGH.

THE CORRECT STRUCTURE NUMBER IS SHOWN ON THE PLANS.

① OMIT STRUCTURE NUMBER STANDARDS WHERE A RAILROAD TRACK CROSSES OVER THE ROADWAY.

STRUCTURE NUMBER STANDARD SHALL NOT BE PAID FOR SEPARATELY BUT INCLUDED IN THE WORK.

IN ADDITION TO THE REQUIREMENTS STATED ABOVE, STRUCTURE NUMBERS FOR HIGHWAYS PASSING UNDER CROSSROADS ARE TO BE PLACED AT THE FOLLOWING POINTS:

- (A) FOR STRUCTURES OF THREE OR MORE SPANS, THE STRUCTURE NUMBER SHALL BE STENCILED, FACING TRAFFIC, ON THE OUTSIDE FACE OF THE END COLUMN OF THE RIGHT HAND PIER.
- (B) FOR TWO SPAN STRUCTURES, THE STRUCTURE NUMBER SHALL BE STENCILED, FACING TRAFFIC, ON THE OUTSIDE FACE OF EACH END COLUMN OF THE CENTER PIER.

DIVISION OF HIGHWAYS			
STRUCTURE NUMBER STANDARD			
Designer <i>A. Eriksen</i>	Structure Number	<i>F-12-AM</i>	
Detailer <i>B.R. Lape</i>	Drawing Number	<i>B-17</i> of <i>17</i> Drawings	

GENERAL NOTES:

ALL WORK SHALL BE DONE ACCORDING TO THE STANDARD SPECIFICATIONS OF THE DIVISION OF HIGHWAYS, STATE OF COLORADO, APPLICABLE TO THE PROJECT.

ALL CONCRETE SURFACES AS REFERRED TO IN THE SPECIFICATIONS SHALL RECEIVE A CLASS 7 SURFACE FINISH.

ALL CONCRETE CHAMFERS SHALL BE 3/4 INCH UNLESS OTHERWISE NOTED.

EXPANSION JOINT MATERIAL SHALL MEET A.A.S.H.T.O. SPECIFICATION M 213-65 AND SHALL BE INCLUDED IN THE PAYMENT FOR ITEM NO. 601.

SOUNDINGS AND DEPTH OF FOOTINGS ARE IN ACCORDANCE WITH THE BEST AVAILABLE DATA. WHEN DIFFERENT CONDITIONS ARE ENCOUNTERED, THE BRIDGE ENGINEER WILL INSPECT AND DETERMINE IF REDESIGN IS NECESSARY.

WHEN EXCAVATING FOR FOOTINGS, THE FINAL SIX INCHES IN DEPTH SHALL BE DONE BY HAND LABOR METHODS.

FOOTINGS IN ROCK SHALL NOT BE FORMED BUT SHALL BE PLACED AGAINST UNDISTURBED ROCK.

FOR DETAILS OF STRUCTURE EXCAVATION AND STRUCTURE BACKFILL, SEE STANDARD M-206-AA.

ALL STRUCTURAL STEEL NOT OTHERWISE NOTED SHALL BE A.A.S.H.T.O. SPECIFICATION M-222 (A.S.T.M. A 588).

STRUCTURAL STEEL FOR ALL SECONDARY MEMBERS WITH THE EXCEPTION OF BEARING STIFFENERS AND LONGITUDINAL STIFFENERS IN THE BOTTOM FLANGE MAY BE AASHTO SPECIFICATION M-183 (A.S.T.M. A 36).

IF A.S.T.M. A 36 STRUCTURAL STEEL IS USED FOR SECONDARY MEMBERS, ALL SUCH MEMBERS SHALL BE PAINTED WITH TWO COAT SHOP PAINT EXCEPT FOR EXTERIOR DIAPHRAGMS. EXTERIOR DIAPHRAGMS SHALL BE LEFT UNPAINTED.

ALL STRUCTURAL STEEL NOT OTHERWISE NOTED SHALL BE PAINTED IN ACCORDANCE WITH SECTION 509 FOR () PAINT.

NO WELDING OF ANY KIND SHALL BE PERMITTED ON THE FLANGES OF STEEL GIRDERS UNLESS SPECIFICALLY CALLED FOR IN THE PLANS.

BOLTS SHALL BE FURNISHED IN THE AMOUNT OF TWOPERCENT IN EXCESS OF THE NOMINAL NUMBER REQUIRED.


STRUCTURE WAS ANALYZED USING LOAD FACTOR DESIGN EXCEPT TRANSVERSE DECK SLAB WHICH WAS ANALYZED USING SERVICE LOAD DESIGN.

GRADE 60 REINFORCING STEEL REQUIRED FOR #5 BARS AND LARGER. GRADE 40 OR GRADE 60 MAY BE FURNISHED FOR #4 BARS.

THE FOLLOWING TABLE SHOWS THE MINIMUM LAP FOR COMMON BAR SIZES.

BAR SIZE NUMBER	4	5	6	7	8	9	10	11
SPLICE GRADE 40	1'-0"	1'-3"	1'-6"	1'-9"	2'-2"	2'-8"	3'-5"	4'-3"
LENGTH GRADE 60	1'-6"	1'-11"	2'-3"	2'-8"	3'-0"	3'-5"	4'-2"	5'-0"

E. F. = EACH FACE
N. F. = NEAR FACE
F. F. = FAR FACE

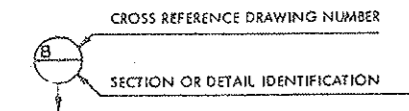

Bottom Elevations of Piling Shown are for Estimating Purposes. Final Elevations to be Determined in Field.

LOADING DATA:

LIVELOAD: A.A.S.H.T.O. HS-20-44 OR INTERSTATE ALTERNATE
DEADLOAD: ASSUMES 25 LBS. PER SQ. FT. FOR BITUMINOUS PAVEMENT.

DESIGN DATA:

A.A.S.H.T.O. 1973 UNIT STRESSES, AND 1974 INTERIM SPECIFICATIONS, EXCEPT AS NOTED.

REINFORCING STEEL: GRADE 60 - FY = 60,000 LBS. PER SQ. IN.
FS = 24,000 LBS. PER SQ. IN.
GRADE 40 - FY = 40,000 LBS. PER SQ. IN.
FS = 20,000 LBS. PER SQ. IN.


STRUCTURAL STEEL: A36, GRADE 36 - FY = 36,000 LBS. PER SQ. IN.
A588, GRADE 50 - FY = 50,000 LBS. PER SQ. IN.

CONCRETE: CLASS A & D - F'c = 3000 LBS. PER SQ. IN.
N = 9
CLASS 5 - F'c = 5000 LBS. PER SQ. IN.
(FOR LIMITS SEE PLANS.)

SUMMARY OF QUANTITIES

Item	Description	Unit	Super-Structure	Abut. 1	Pier 2	Abut. 3	Totals
206	Structure Excavation	Cu. Yd.		103	125	116	344
206	Structure Backfill (Class 2)	Cu. Yd.		54	82	56	192
① 403	Hot Bituminous Pavement ()	Ton	122				122
① 411	Asphalt Cement ()	Ton					
502	Steel Piling (HP 12X74)	Lin. Ft.		2371		383.3	2754.3
509	Structural Steel	Lbs.	275,192			349	275,541
② 512	Bearing Device (0 to 250 Tons Capacity)	Ea.		2		2	4
② 512	Bearing Device (251 to 500 Tons Capacity)	Ea.			2		2
① 515	Waterproofing (Membrane)	Sq. Yd.	1147				1147
① 518	Bridge Expansion Device (Type 1)	Lin. Ft.	76		35.39		111.39
601	Concrete Class A (Bridge)	Cu. Yd.			36		36
601	Concrete Class A (Bridge) (Colored)	Cu. Yd.		39.03		42.88	81.91
601	Concrete Class D (Bridge)	Cu. Yd.	272	207.18		59.85	539.03
601	Concrete Class D (Bridge) (Colored)	Cu. Yd.	92	141.63	63	57	353.23
602	Reinforcing Steel	Lbs.	90,491	10,020	2,826	9,728	113,065
			97,680	12,162	2,901	11,827	123,570
① 618	Concrete Segmental Pier (F-12-AM)	L.S.					1
626	Mobilization						0.2

- ① Future Items
- ② Includes Masonry Plates
- ③ Concrete Class 5 (Colored) - 61 Cu. Yd.
Pc = 5000 psi (Precast)
- Concrete Class 5 (Colored) - 20 Cu. Yd.
Pc = 5000 psi (Cast-in-Place)
- Reinforcing Steel - 8289 Lbs.
- Prestressng Strands - 1161 Lbs.

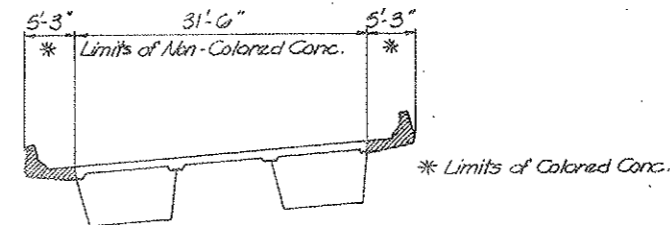

PORTIONS OF DECK TO BE POURED WITH COLORED CONCRETE
Orig. Scale: 1/4" = 1'-0"

The exterior face of the outside web of each steel box girder shall be sand blast cleaned in accordance with subsection 309.33 (b) 2 of the standard specifications. All other exposed surfaces shall be cleaned as outlined in section 509.33 (b) 1

Welds which are exposed to view will require weld metal with coloring characteristics similar to that of the base metal

FEDERAL ROAD REGION NO	DISTRICT	PROJ NO	SHEET NO	TOTAL SHEETS
VIII	COLORADO	110 2(52) 197	58	

REVISIONS			
R1	4-17-75	Rev. Summary	JRE
R2	4-29-75	Rev. Summary, Note	B.D.E.
R3	5-6-75	Note	WCB

INDEX OF DRAWINGS

Dwg. No.	Title
B-1	General Information - Summary of Quantities
B-2	General Layout
B-3	Engineering Geology
B-4	Elevations (Sht. 1 of 2)
B-5	Elevations (Sht. 2 of 2)
B-6	Construction Layout
B-7	Footing & Piling Layout
B-8	Abutment No. 1 Details
B-9	Pier No. 2 Details
B-10	Abutment No. 3 Details
B-11	Abutment No. 1 & No. 3 Details
B-12	Deck Plan & Typical Deck Section
B-13	Superstructure Framing Plan
B-14	Girder Details (Sht. 1 of 2)
B-15	Girder Details (Sht. 2 of 2)
B-16	Bridge Rail Type 4
B-17	Bridge Expansion Device (Prestressed)
B-18	Structure Number Standard


AS CONSTRUCTED
REVISED DATE: 6-24-77

BRIDGE EXPANSION DEVICES
TRANSFLEX, TYPES 150C, 200A, 400A, 650

BRIDGE DESCRIPTION

2 Cont. Spans (120'-0", 120'-0") Along Profile Line Composite Concrete Slab and welded Steel box Girders.

Over Smith Gulch Sta. 913+00 Near Vail Pass Curved, 1637.02' Radius, 8% Super, 38'-0" Roadway Curb to Curb, 2'-0" Bridge Rail Type 4

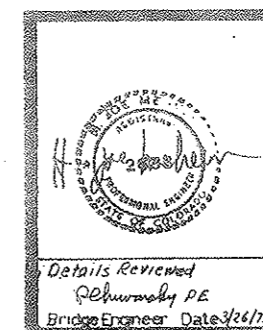

DIVISION OF HIGHWAYS

GENERAL INFORMATION
SUMMARY OF QUANTITIES

Station 913+08.75 to 915+81.25
Near Vail Pass Sec. T. 6 S. R. 79 W.



Designer A. Erikson
Detailer R. Burns
Drawing Number B-1 of 18 Drawings

Structure F-12-AM
Numbers

Details Reviewed
R. Burns PE
Bridge Engineer Date: 3/26/75

FEDERAL ROAD DISTRICT NO.	DISTRICT	PROJ. NO.	SHEET NO.	TOTAL SHEETS
III	COLORADO	I 70-2(32)197	59	

REVISIONS	

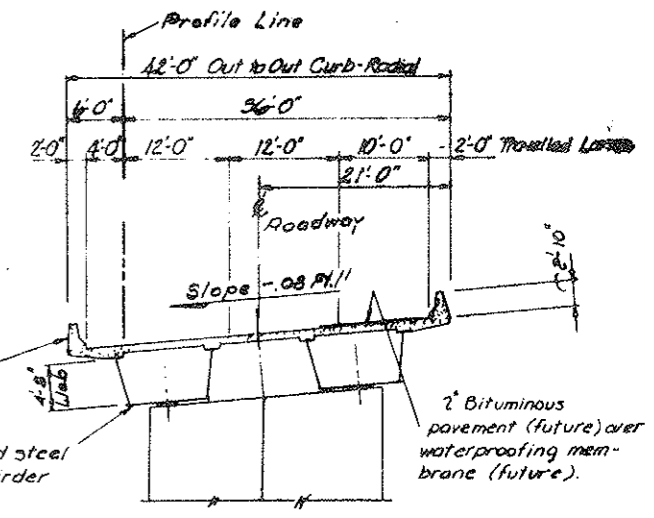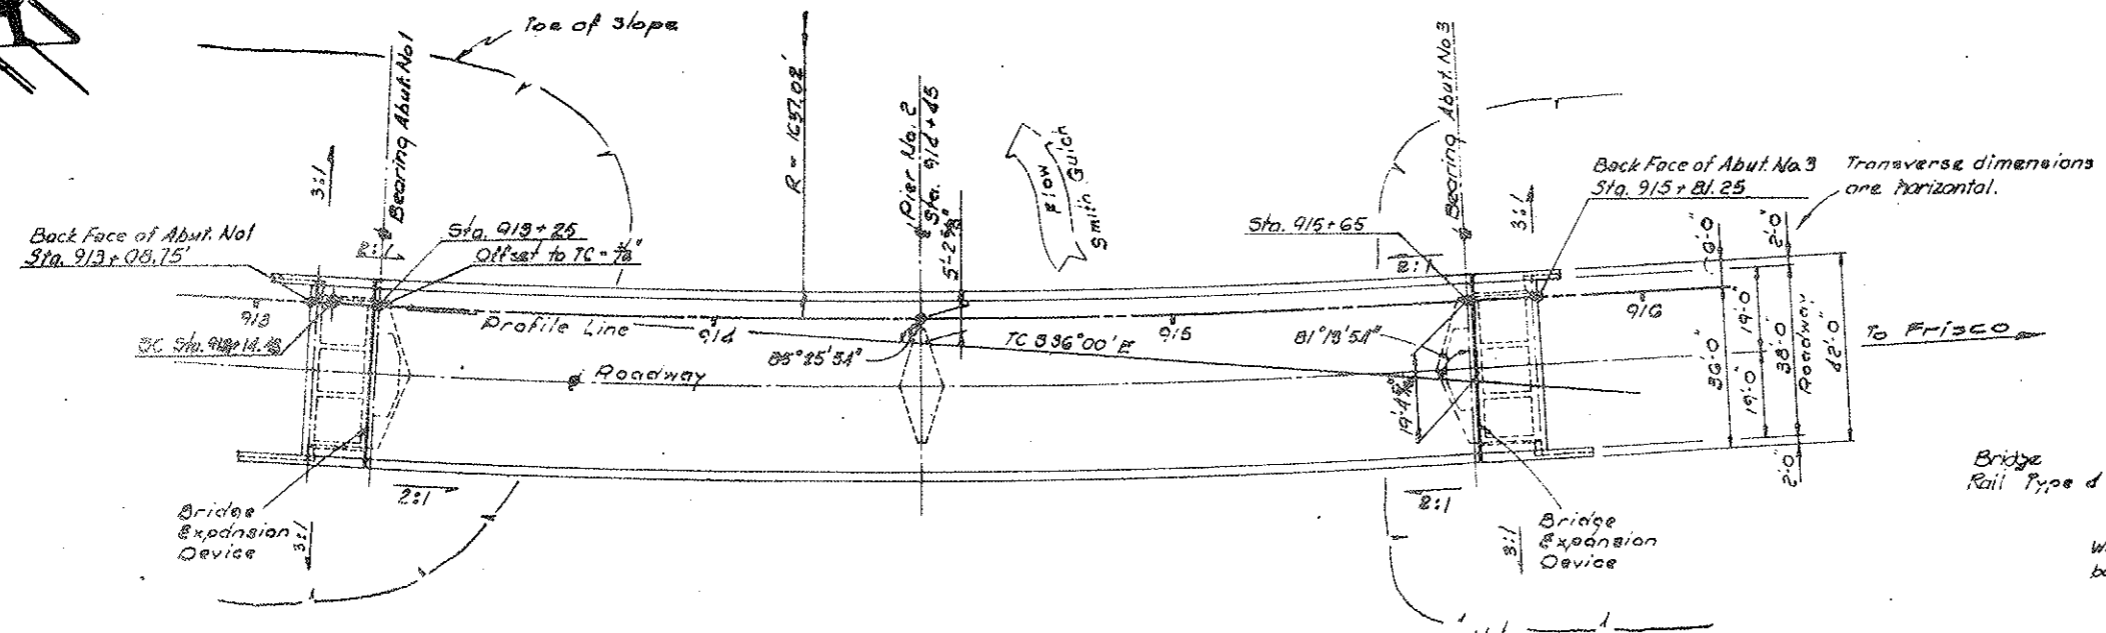

PLAN
Orig. Scale: 1" = 20'


Note:
All tangent offsets are radial

HORIZONTAL CURVE DATA

EO Projected	ES = 10° 20'
75 = 907 + 14.48	LS = 600'
BC = 913 + 14.48	LT = 400.71'
Δ = 41° 24' Lt.	ST = 280.64'
78 = 1022.28'	
EB = 160.80'	
Δ = 26° 24' Lt.	S = 100 Ft.
DC = 3° 30'	M.D.S. = 70 mph.
TC = 916 + 00.00	S.S.D. = 600'
LE = 754.29'	
EC = 1637.02'	

AS CONSTRUCTED
REVISED DATE: 6-24-77

DESIGNED BY	DATE	CHECKED BY
ALC	3/74	3/74
CONSTRUCTED BY	DATE	CHECKED BY
ALC	3/74	3/74
DETAILS BY	DATE	CHECKED BY
ALC	3/74	3/74

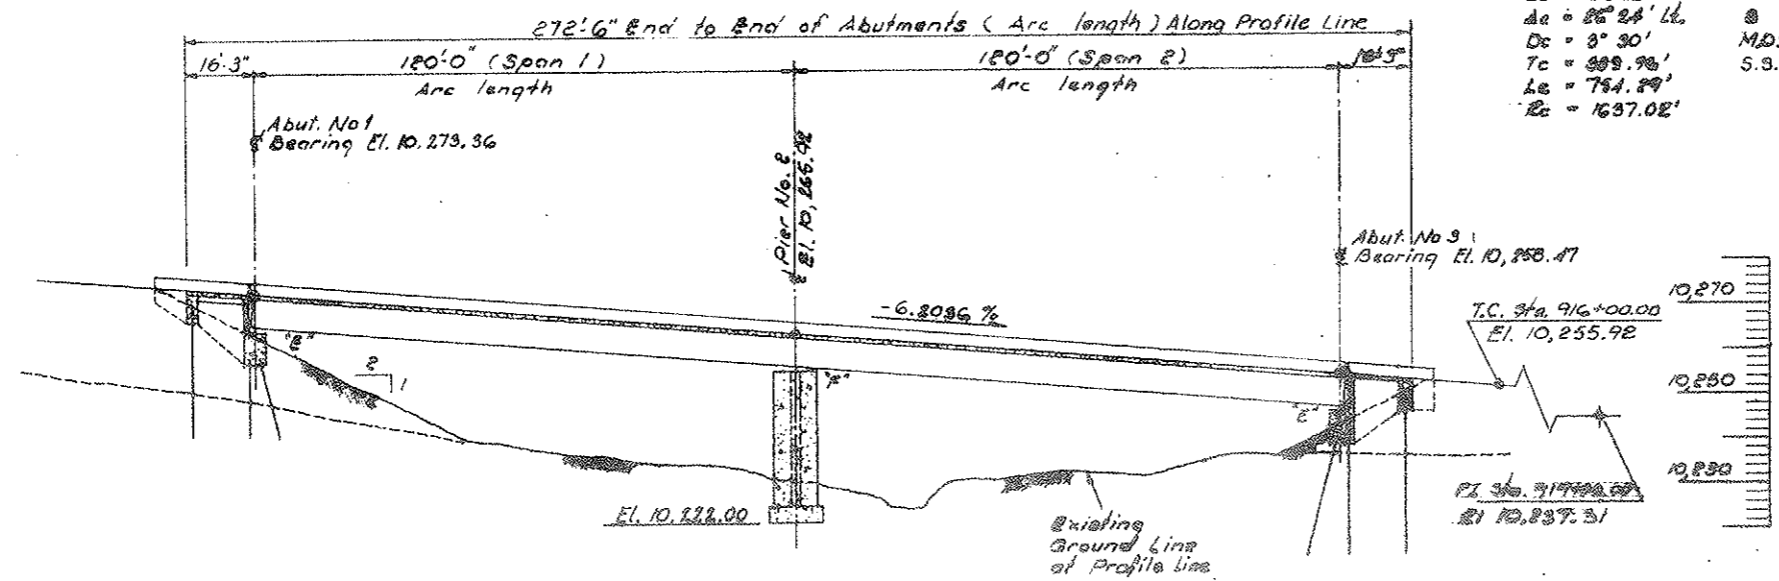

SECTION TAKEN AT ROADWAY
Orig. Scale: 1" = 20'

⊕ Indicates Expansion Bearing
⊖ Indicates Fixed Bearing
Elevations are to Finished Roadway Along Profile Line

PILING NOTES


Type	Location	Ext. Tm. Day
HP 12x24	Abut. No. 2	10/23/77
HP 12x24	Abut. No. 3	11/10/77

DIVISION OF HIGHWAYS

GENERAL LAYOUT

Designer: M. McRae
 Checker: G. [unclear]
 Drawing Number: 8-2 of 18 Drawings

FED. ROAD REG. NO.	DIVISION	PROJECT NO.	SHEET NO.	TOTAL SHEETS
VIII	COLO.	170-2(52)197	60	

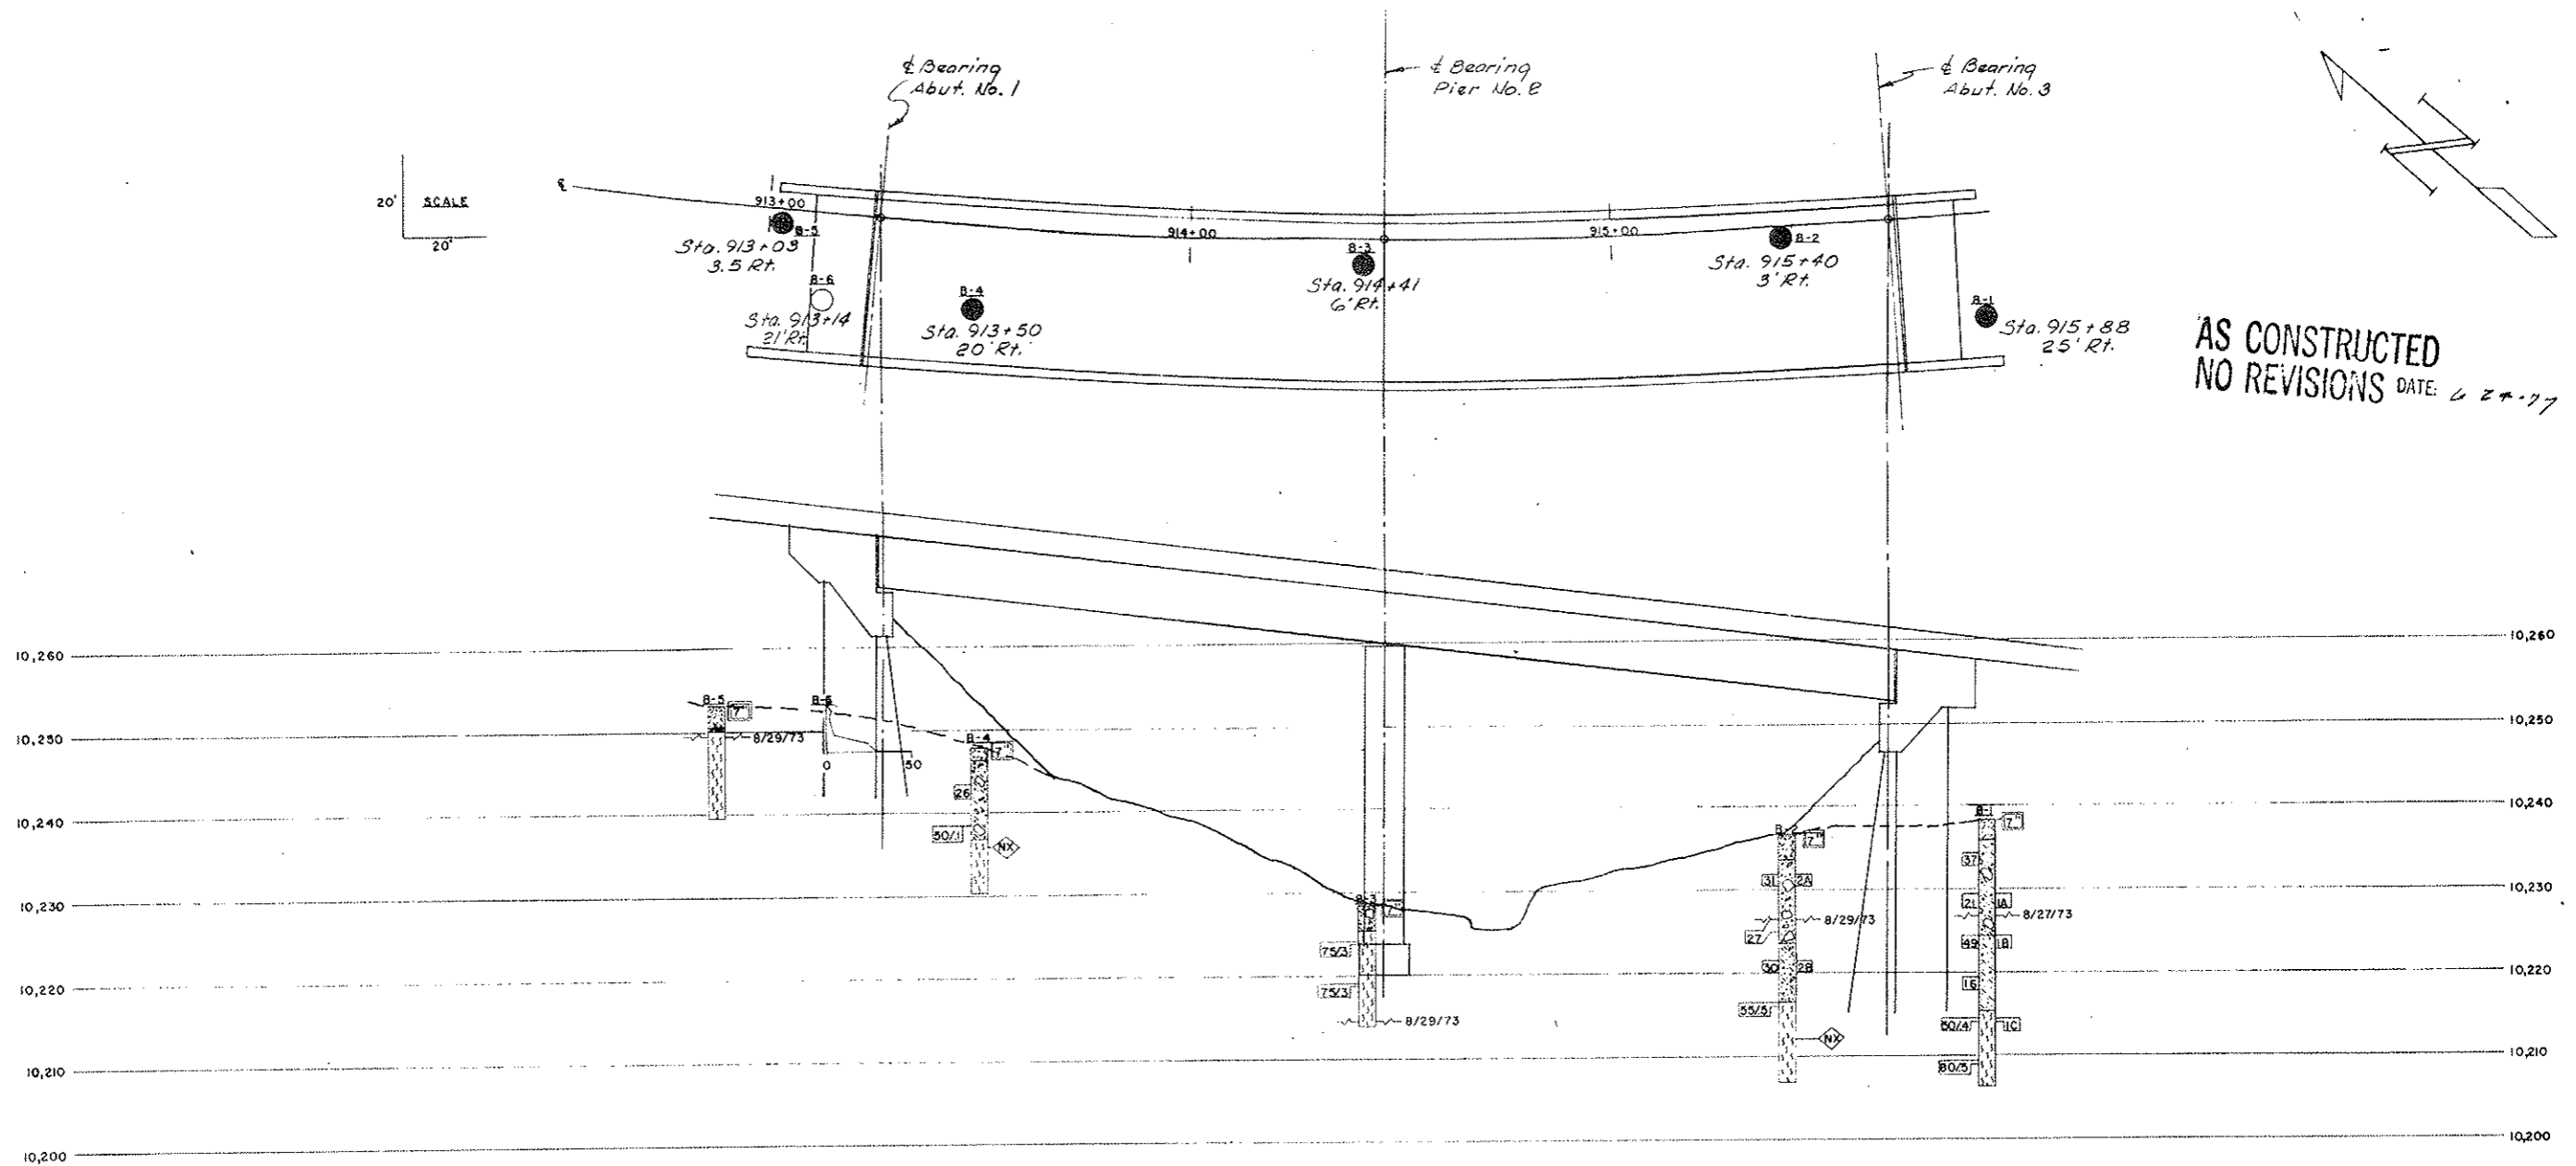

SUMMARY OF TEST RESULTS																	
Sample No.	Depth	Classification	Grading Analysis				Atterberg Limits			Water Cont. %	Max Unit Weight P.C.P.	Unconfined Strength Q _u T.S.F.	Triaxial Shear Strength				Dis. of Sample (inches)
			Percent		Silt and Clay	Liquid Limit %	Plastic Limit %	Plasticity Index %	Unconsolidated				Consolidated				
		Gravel	Coarse Sand	Fine Sand						LV	LP	LU	σ ₁	σ ₃	c	φ	Time
1A	9.0-10.5	GRAVELLY SAND	A-1-b(O)	40	31	19	10	NV	NP	NP	7.4						
1B	14.0-15.5	GRAVELLY SANDY SILT	A-4(O)	22	9	26	43	NV	NP	NP	20.2						
1C	24.0-24.4	SILTY SANDY GRAVEL	A-1-b(O)	51	11	16	22	19	19	0	10.4						
2A	4.5-6.0	SILTY SANDY GRAVEL	A-1-b(O)	53	17	19	11	NV	NP	NP	6.4						
2B	15.0-16.5	SILTY SANDY GRAVEL	A-1-b(O)	41	17	23	19	NV	NP	NP	14.1						

TYPE OF MATERIAL	
☐ SILT, GRAVELLY	☐ SILT, SANDY
☐ GRAVEL, SANDY W/COBBLES & BOULDERS	☐ SANDSTONE
☐ GRAVEL & COBBLES	☐ SILT, SANDY, GRAVELLY
☐ GRAVEL, SANDY, SILTY	
☐ SAND, GRAVELLY, SILTY W/COBBLES	
☐ GRAVEL, SANDY, SILTY W/BOULDERS	
☐ GRAVEL, SANDY, SILTY W/COBBLES & BOULDERS	

LEGEND

TEST BORING

- ☉ Location of Test Boring
- Location of Continuous Penetration Test
- ☐ Rotary Boring
- ☐ Auger Boring
- ◇ Core Boring

CONTINUOUS PENETRATION TEST

2 in. Dia. Drive Point
140 Lb. Hammer
30 in. Free Fall

Blows Per Foot Standard Penetration Test

Water Table

2/16/67

2 in. O.D. Split-Tube Sampler
140 Lb. Hammer
30 in. Free Fall

☐ Hole Size
☐ Sample No.
☐ Core Size

Blows per Foot

STRUCTURE NO. E-18-AM
DWG. NO. B-3 OF 12

**DIVISION OF HIGHWAYS
STATE OF COLORADO**

ENGINEERING GEOLOGY

Across SMITH GULCH
Sta. 913+00.75 to 915+81.25
Near VAN PASS Sec. 22 T. 68 R. 79W
Geologist A.C.B. Approved by _____
Made by D.L.S. Checked by G.C.P. Bridge Engineer _____
Date: _____ 19__

BRIDGE GEOMETRICS OUTPUT

BRIDGE BEGINS ON CIRCULAR CURVE... ENDS ON CIRCULAR CURVE

ARC LENGTH OF BRIDGE : 240.000000 FT
CHORD LENGTH OF BRIDGE : 239.705119 FT
BEGIN OF BRIDGE STATION : 913+25.000
END OF BRIDGE STATION : 915+65.000
DEFLECTION ANGLE BETWEEN BK TANGENT AND CHORD : 15 4 5.50
DEFLECTION ANGLE BETWEEN FWD TANGENT AND CHORD : 32 19 55.13
MAX NORMAL OFFSET FROM CHORD TO CONSTRUCTION CL : 4.3963

Table with columns: DISTANCE FROM REFERENCE LINE, DESCRIPTION OF BENT LINE, SKEW ANGLE OF BENT LINE, STATION OF INTERSECTION, ROADWAY ELEVATION AT INTERSECTION. Includes data for station 913+25.000 to 913+25.000.

Back Face Abut. 1

Table with columns: Station, Description, Elevation. Includes data for station 913+08.671 to 913+09.100.

1/4 Pt.

Table with columns: Station, Description, Elevation. Includes data for station 913+12.392 to 913+12.708.

1/2 Pt.

Table with columns: Station, Description, Elevation. Includes data for station 913+16.092 to 913+16.316.

3/4 Pt.

Table with columns: Station, Description, Elevation. Includes data for station 913+19.793 to 913+19.924.

Front Face Abut. 1

Table with columns: Station, Description, Elevation. Includes data for station 913+23.494 to 913+23.532.

Vertical table with columns: CHECKED BY, DESIGNED BY, DRAWN BY, DATE. Includes names like ERIKSEN, MCGLOTHLIN, and dates like 11/17/77.

Table with columns: Station, Description, Elevation. Includes data for station 913+55.000 to 913+55.000.

Table with columns: Station, Description, Elevation. Includes data for station 913+61.000 to 913+61.000.

Table with columns: Station, Description, Elevation. Includes data for station 913+67.000 to 913+67.000.

Table with columns: Station, Description, Elevation. Includes data for station 913+73.000 to 913+73.000.

Table with columns: Station, Description, Elevation. Includes data for station 913+79.000 to 913+79.000.

Table with columns: Station, Description, Elevation. Includes data for station 913+85.000 to 913+85.000.

Table with columns: Station, Description, Elevation. Includes data for station 913+91.000 to 913+91.000.

Table with columns: Station, Description, Elevation. Includes data for station 913+97.000 to 913+97.000.

Table with columns: Station, Description, Elevation. Includes data for station 914+3.000 to 914+3.000.

Table with columns: Station, Description, Elevation. Includes data for station 914+9.000 to 914+9.000.

Table with columns: Station, Description, Elevation. Includes data for station 914+63.000 to 914+63.000.

Table with columns: Station, Description, Elevation. Includes data for station 914+69.000 to 914+69.000.

Table with columns: Station, Description, Elevation. Includes data for station 914+75.000 to 914+75.000.

Table with columns: FEDERAL ROAD REGION NO, DISTRICT, PROJ NO, SHEET NO, TOTAL SHEETS. Values: VIII, COLORADO, 170-2(52) 197, 61, 61.

Table with columns: REVISIONS. Includes a grid for tracking revisions.

Note: Elevations are at top of concrete deck.

AS CONSTRUCTED NO REVISIONS DATE: 6-24-77

DIVISION OF HIGHWAYS
ELEVATIONS (SHEET 1 OF 2)
Designer: A. Eriksen, Structure: F-12-AM
Detailer: L. McNamee, Numbers:
Drawing Number: B-4 of 18 Drawings

FEDERAL ROAD REGION NO.	DISTRICT	PROJ. NO.	SHEET NO.	TOTAL SHEETS
VIII	COLORADO	170-2(52)197	62	

REVISIONS	

BRIDGE GEOMETRICS OUTPUT (CONT.)

***** BENT LINE INPUT ***** SKEW ANGLE
 DISTANCE FROM REFERENCE LINE (TYPE) DESCRIPTION OF BENT LINE OF BENT LINE OR TANGENT STATION OF INTERSECTION OF BENT LINE AND BENT LINE ROADWAY ELEVATION AT INTERSECTION OF LINE AND BENT LINE

ARC/REF B.T.	PT.	CONSTR.	CL	SKEW	STATION	ELEVATION
156.000000	6/20	2	CONSTR.	CL	914+81.000	10263.5189
162.000000	7/20	2	CONSTR.	CL	914+87.000	10263.1488
166.000000	8/20	2	CONSTR.	CL	914+93.000	10262.7764
174.000000	9/20	2	CONSTR.	CL	914+99.000	10262.4022
180.000000	10/20	2	CONSTR.	CL	915+5.000	10262.0300
186.000000	11/20	2	CONSTR.	CL	915+11.000	10261.6578
192.000000	12/20	2	CONSTR.	CL	915+17.000	10261.2856
198.000000	13/20	2	CONSTR.	CL	915+23.000	10260.9133

204.000000	14/20	2	CONSTR.	CL	915+29.000	10260.5411
210.000000	15/20	2	CONSTR.	CL	915+35.000	10260.1689
216.000000	16/20	2	CONSTR.	CL	915+41.000	10259.7967
222.000000	17/20	2	CONSTR.	CL	915+47.000	10259.4245
228.000000	18/20	2	CONSTR.	CL	915+53.000	10259.0523
234.000000	19/20	2	CONSTR.	CL	915+59.000	10258.6801
240.000000	CL BRG ABUT 3	CONSTR.	CL		915+65.000	10258.3078

Location	Profile Line	Elevation	Total
1/2 Pt.	N.E. Outside	915+29.000	10,257,2685
	Profile Line	915+29.000	10,257,7464
	C.L. Roadway	915+29.000	10,258,9431
	S.W. Outside	915+29.000	10,260,6178
3/4 Pt.	N.E. Outside	915+35.000	10,257,0354
	Profile Line	915+35.000	10,257,5138
	C.L. Roadway	915+35.000	10,258,7100
	S.W. Outside	915+35.000	10,260,3847
Back face Abut. 3	N.E. Outside	915+41.000	10,256,8023
	Profile Line	915+41.000	10,257,2807
	C.L. Roadway	915+41.000	10,258,4769
	S.W. Outside	915+41.000	10,260,1516
Front face Abut. 3	N.E. Outside	915+65.000	10,257,7344
	N.E. Inside	915+65.000	10,258,0613
	Profile Line	915+65.000	10,258,3797
	C.L. Roadway	915+65.000	10,259,5759
1/4 Pt.	N.E. Outside	915+70.000	10,257,5015
	Profile Line	915+70.000	10,257,9799
	C.L. Roadway	915+70.000	10,259,1761
	S.W. Outside	915+70.000	10,260,8508

AS CONSTRUCTED
 NO REVISIONS DATE: 6-24-77

Note:
 Elevations are at top of concrete deck.

DESIGNED BY	CHECKED BY
DRAWN BY	APPROVED BY
IN CHARGE	DATE

DIVISION OF HIGHWAYS


ELEVATIONS
(SHEET 2 OF 2)

Designer <i>A. Eriksen</i>	Structure <i>F-12-AM</i>
Detailer <i>L. McNamee</i>	Numbers
Drawing Number <i>B-5</i> of <i>18</i> Drawings	

Revision Dates	(Preliminary Stage Only)
----------------	--------------------------

FEDERAL ROAD REGION NO.	DISTRICT	PROJ. NO.	SHEET NO.	TOTAL SHEETS
VIII	COLORADO	170-2(52)197	63	

REVISIONS	

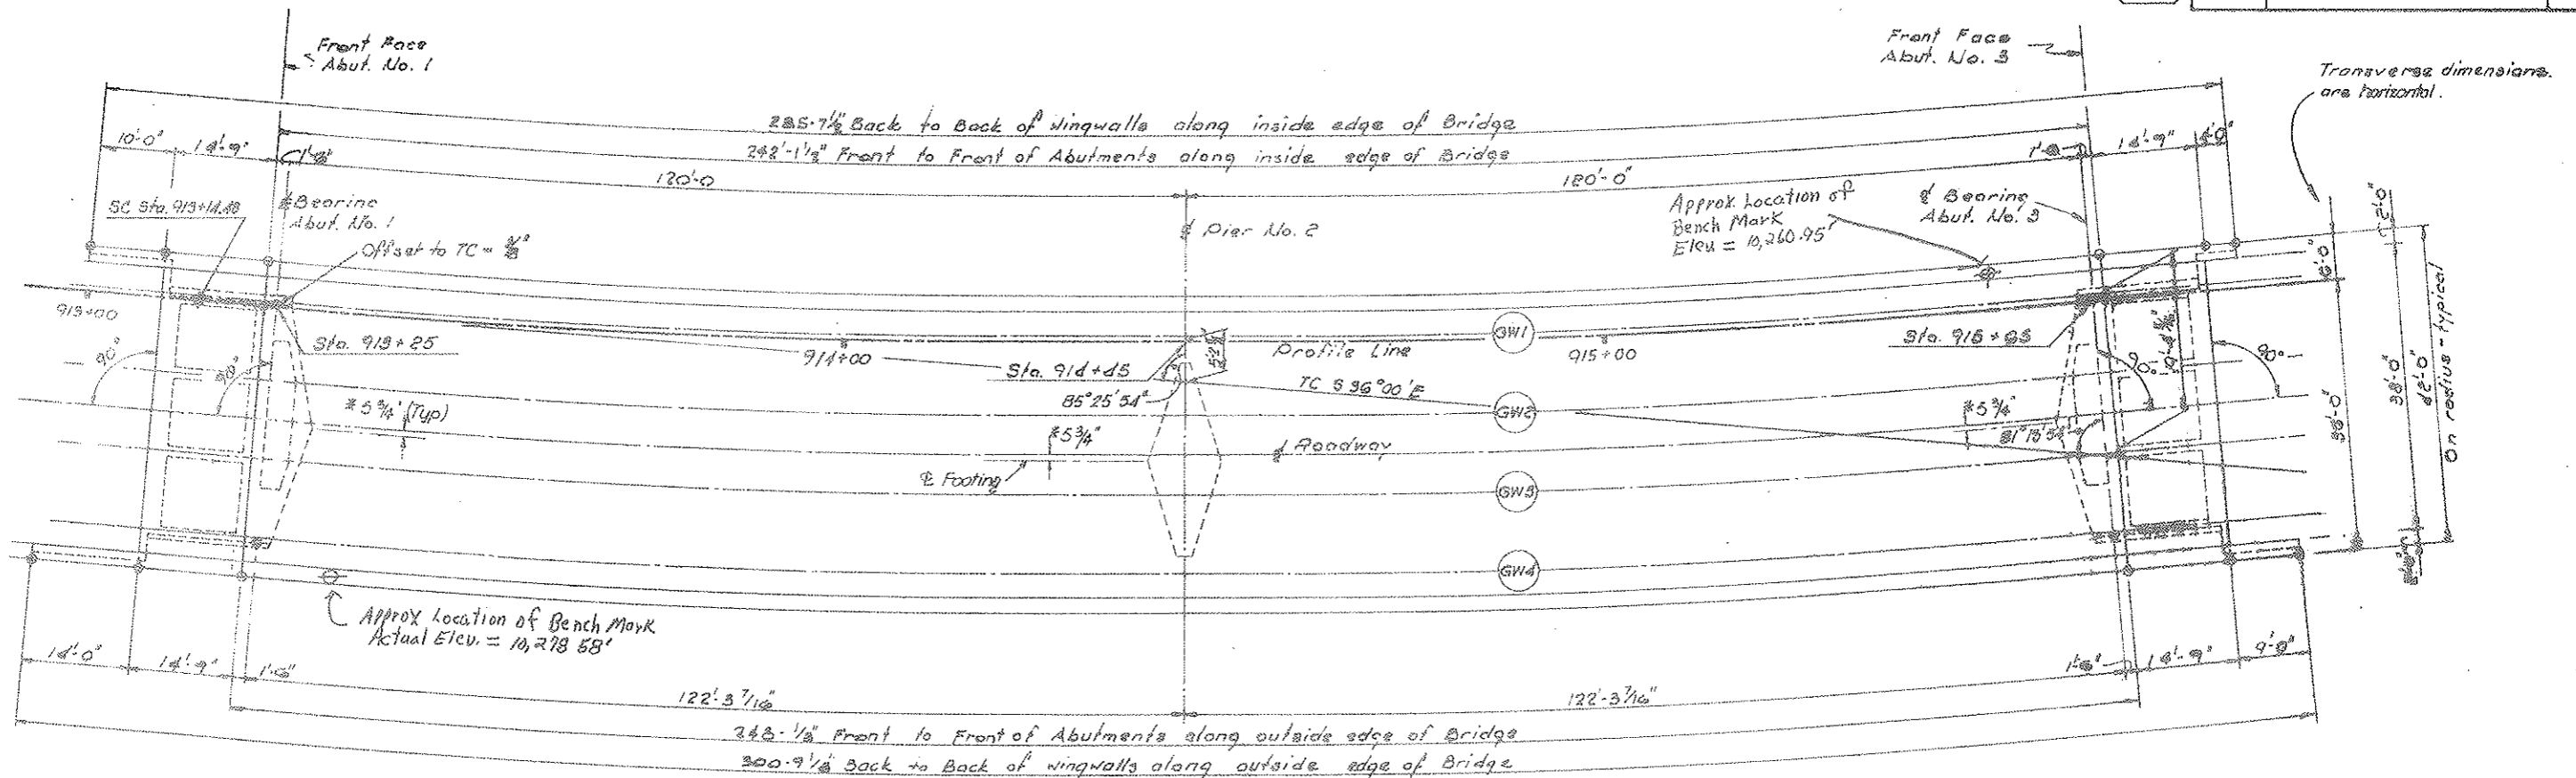

NO.	DATE	BY	REVISION
1			
2			
3			
4			
5			
6			
7			
8			
9			
10			

CONSTRUCTION LAYOUT

Orig. Scale: $\frac{1}{2}'' = 1'-0''$

* Location of Abutment and Pier Footing is offset by a distance equal to rate of Superelevation times 6'-0"



Note: Tangent offsets are radial.

AS CONSTRUCTED
REVISED DATE: 6-24-77

DIVISION OF HIGHWAYS			
CONSTRUCTION LAYOUT			
Designer	A. Erikson	Structure	F-12-AM
Detailer	O. Grogan	Members	
Drawing Number	B-6	of 18	Drawings
Revision		Date	
(Preliminary Stage Only)			

FEDERAL ROAD DISTRICT NO.	DISTRICT	PROJ. NO.	SHEET NO.	TOTAL SHEETS
VIII	COLORADO	I 70-2(52)197	64	

REVISIONS	

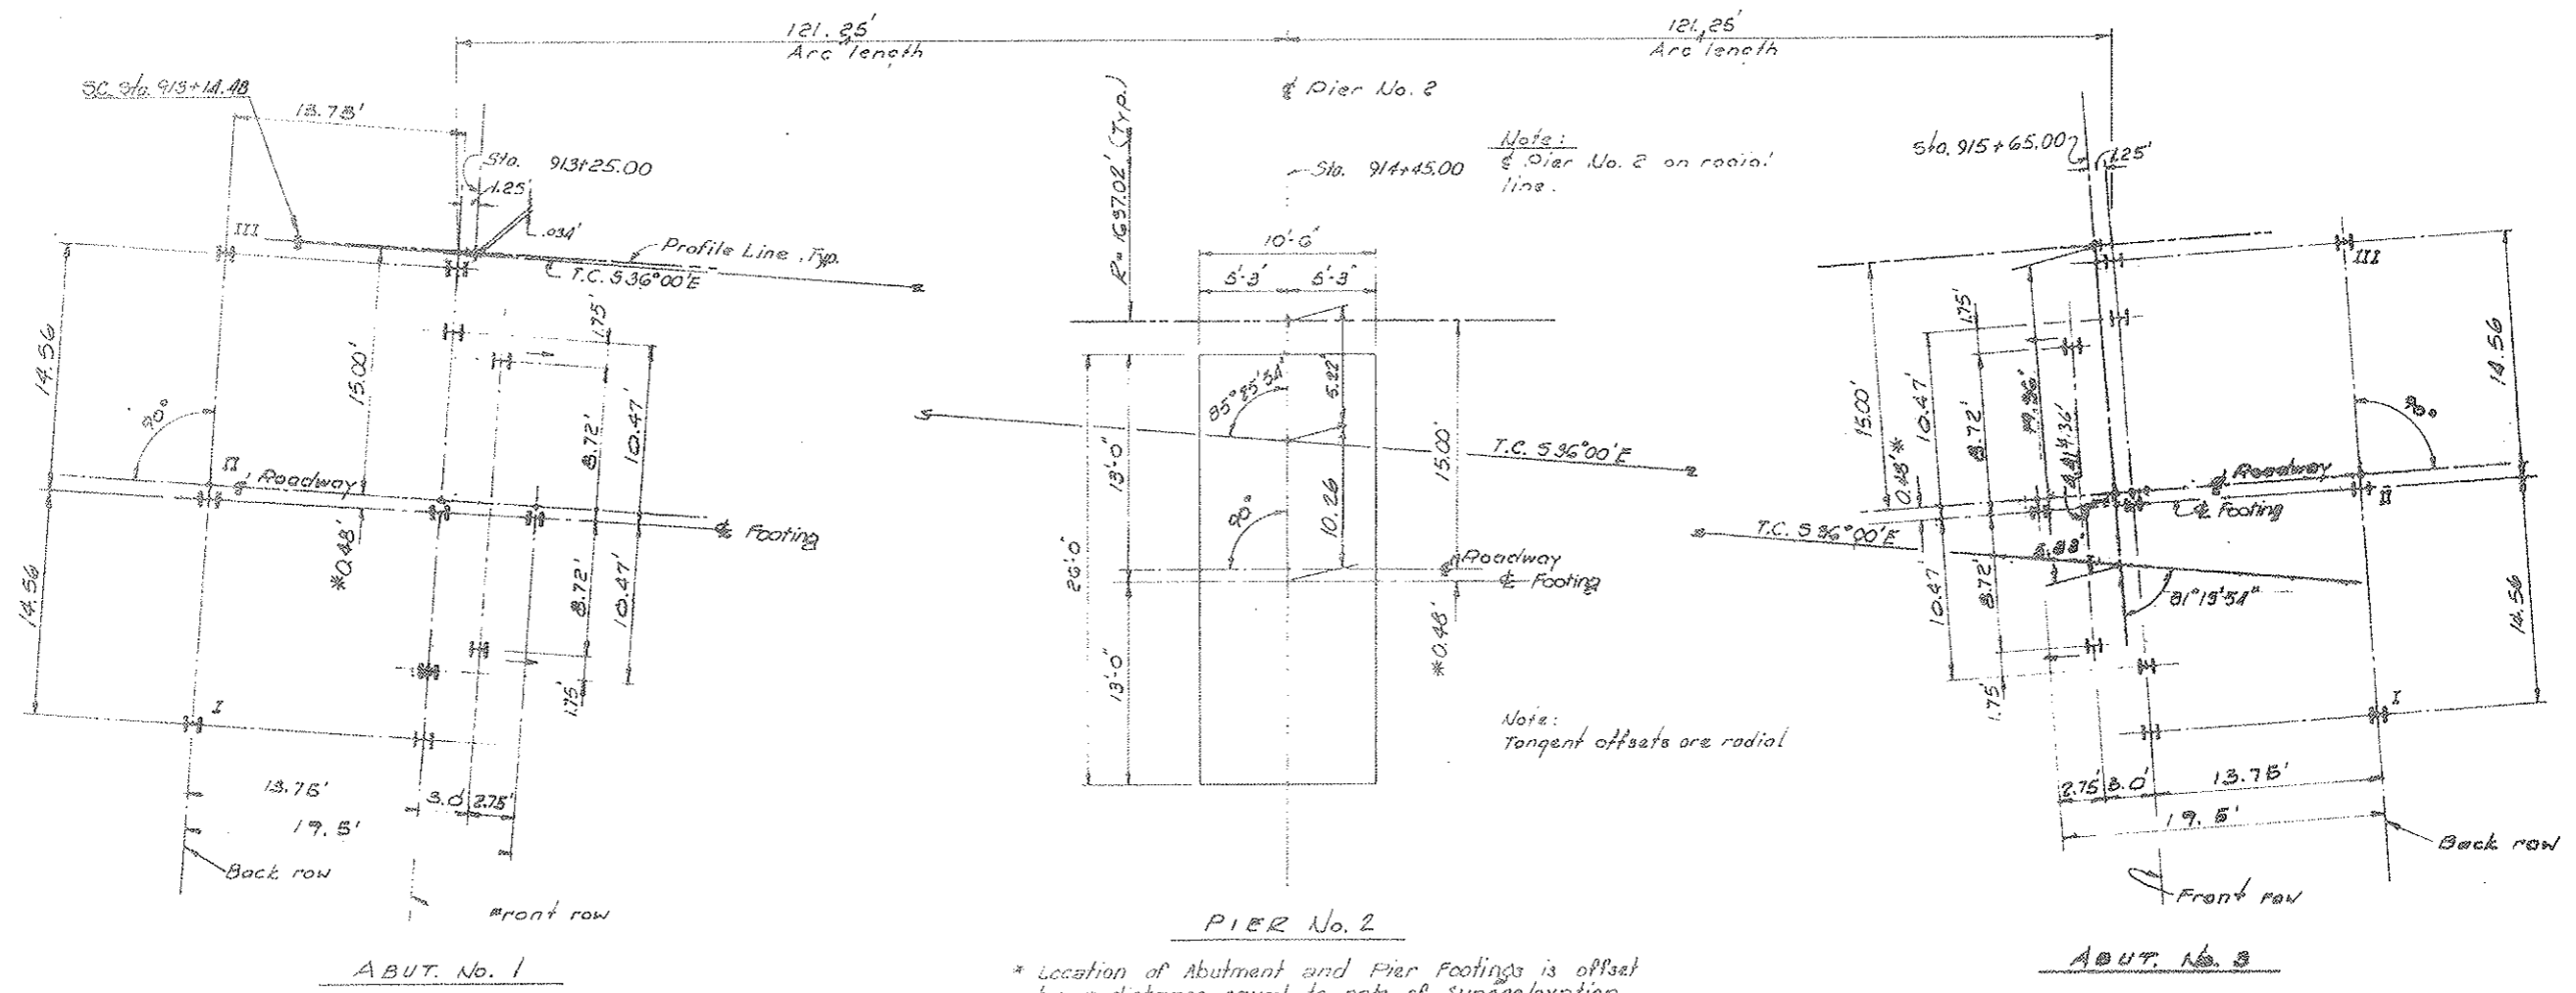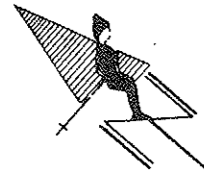

DESIGNED BY	CONSTRUCTED BY
CHECKED BY	QUANTITIES BY
DRAWN BY	CHECKED BY

PILING ELEVATIONS

Abut No.	Location	Pile No.	Top El.	Bot. El.
1	Back row	I	10,242.45	10,238.15
		II	10,242.24	10,243.74
		III	10,241.90	10,243.74
3	Back row	I	10,247.15	10,243.95
		II	10,215.00	10,214.75
		III	10,214.75	10,214.75
3	Front row	I	10,219.79	10,213.79
		II	10,213.42	10,213.42
		III	10,216.33	10,216.13

* Bot. elevations to be verified in field.

- 1 10,242.45
- 2 10,238.15
- 3 10,242.24
- 4 10,243.74
- 5 10,241.90
- 6 10,243.74
- 7 10,247.15
- 8 10,243.95
- 9 10,215.00
- 10 10,214.75
- 11 10,214.75
- 12 10,219.79
- 13 10,213.42
- 14 10,216.33
- 15 10,216.13
- 16 10,213.04

FOOTINGS AND PILING LAYOUT

Orig. Scale: 1/4" = 1'-0"

AS CONSTRUCTED
REVISED DATE: 6-22-77

DIVISION OF HIGHWAYS

FOOTINGS AND PILING LAYOUT



Designer A. G. Gibson	Checker P. J. A. J.
Detailer D. Gibson	Number
Drawing Number 3-7	of 34

- Notes:**
- All dimensions are at bottom of concrete.
 - Piling shall be 8x8 bearing MP12-7d with maximum allowable pile load of 98 Tons. Maximum pile design load = 70 Tons.
 - Indicates piling to be battered at 3:12 - 4 per abutment.
 - Max. allowable footing pressure = 5 Tons SAF. Max. design footing pressure = 5 Tons SAF.


FEDERAL ROAD REGION NO.	DISTRICT	PROJ. NO.	SHEET NO.	TOTAL SHEETS
VIII	COLORADO	I-70-2(111) 107	66	

REVISIONS			
K1	4-29-75	Addition to Note	B.D.E.

VOID
BY CONSTRUCTION DATE 6-24-77

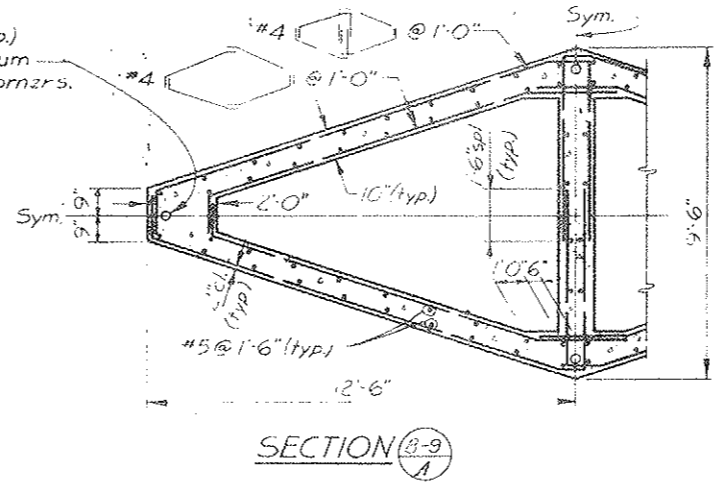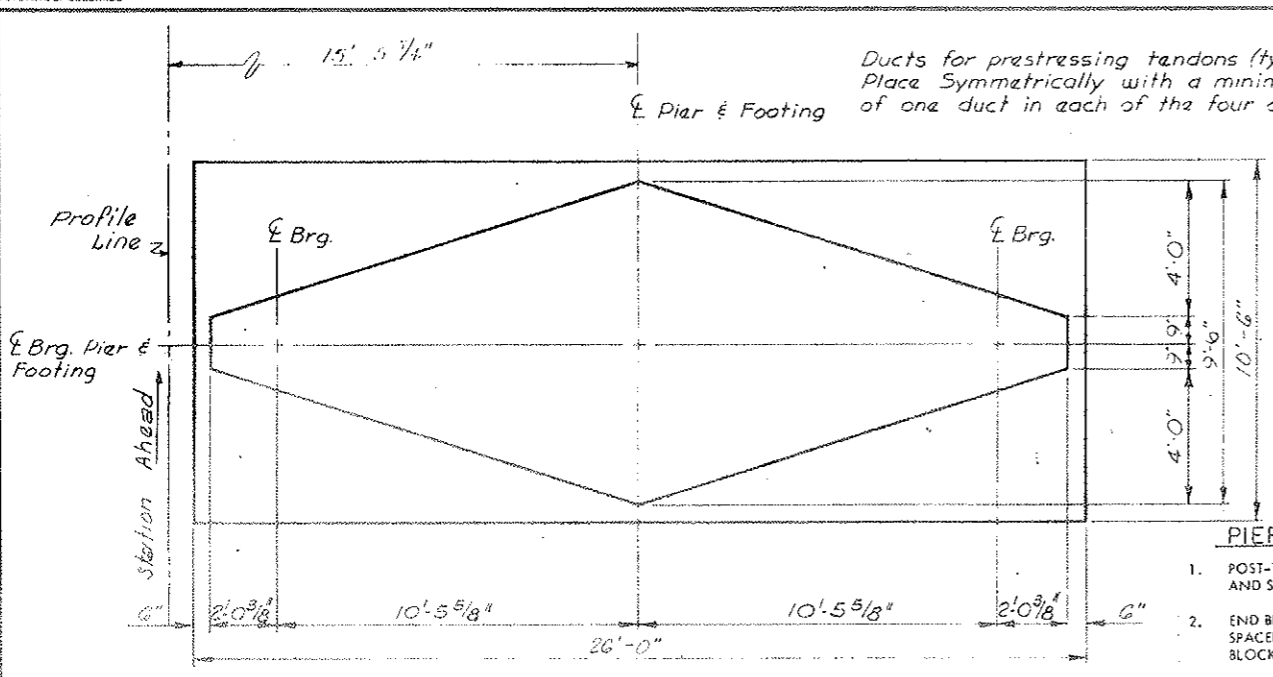




① Final Post-tensioning Force $F = 1600K$ or $400K$ Ea Corner

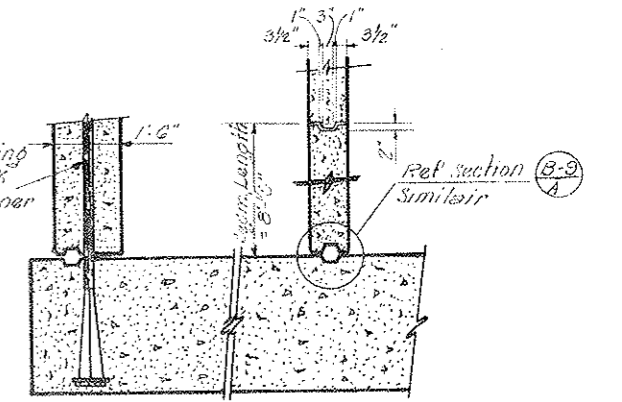


PIER NOTES:

1. POST-TENSIONING TENDON ANCHORAGES IN PIER FOOTINGS AND PIER CAPS SHALL BE DETERMINED BY THE MANUFACTURER AND SUBMITTED FOR APPROVAL.
2. END BLOCKS SHALL BE USED TO DISTRIBUTE THE CONCENTRATED POST-TENSIONING FORCES AT THE ANCHORAGE. CLOSELY SPACED REINFORCEMENT SHALL BE PLACED BOTH VERTICALLY AND HORIZONTALLY THROUGHOUT THE LENGTH OF THE END BLOCK IN ACCORDANCE WITH ACCEPTED METHODS OF END BLOCK ANALYSIS.
3. ALL SEGMENTS SHALL BE MATCH-CAST TO ENSURE PROPER FIT DURING THE ERECTION STAGE. PRECAST SEGMENT HEIGHT PER BRIDGE MAY BE REVISED IN ORDER TO MINIMIZE THE CAST-IN-PLACE PORTION.
4. CARE SHALL BE EXERCISED IN JOINING THE SEGMENTS WITH EPOXY TO ENSURE THAT COMPRESSION IS MAINTAINED OVER THE ENTIRE JOINT AREA UNTIL THE PERMANENT POST-TENSIONED TENDONS ARE STRESSED.
5. FOR CONCRETE CLASSES AND STRENGTHS, SEE DRAWINGS, THIS SHEET.

DESIGNED BY	CHECKED BY	DATE	QUANTITIES BY	ERECTED BY
A.E.	A.E.	3/75	A.E.	A.E.
A.E.	A.E.	3/75	A.E.	A.E.
A.E.	A.E.	3/75	A.E.	A.E.

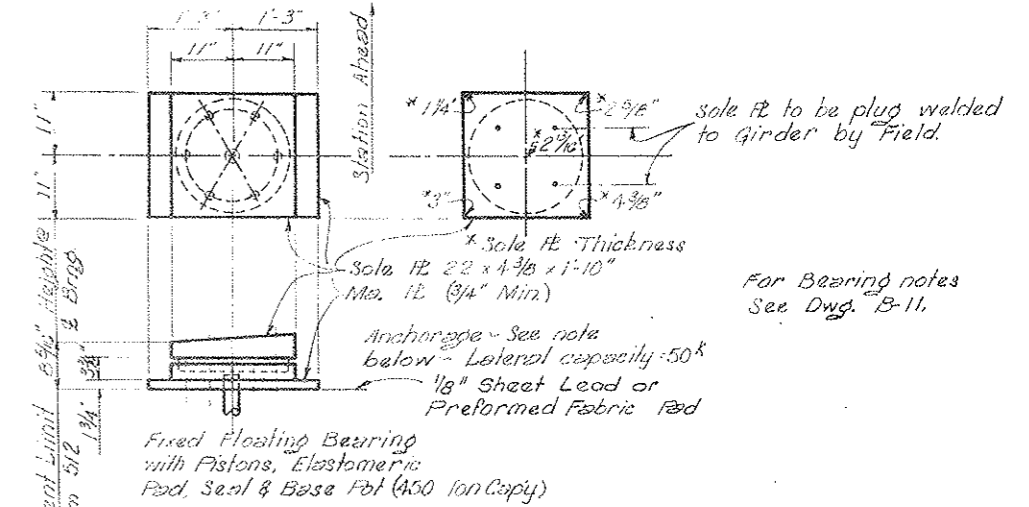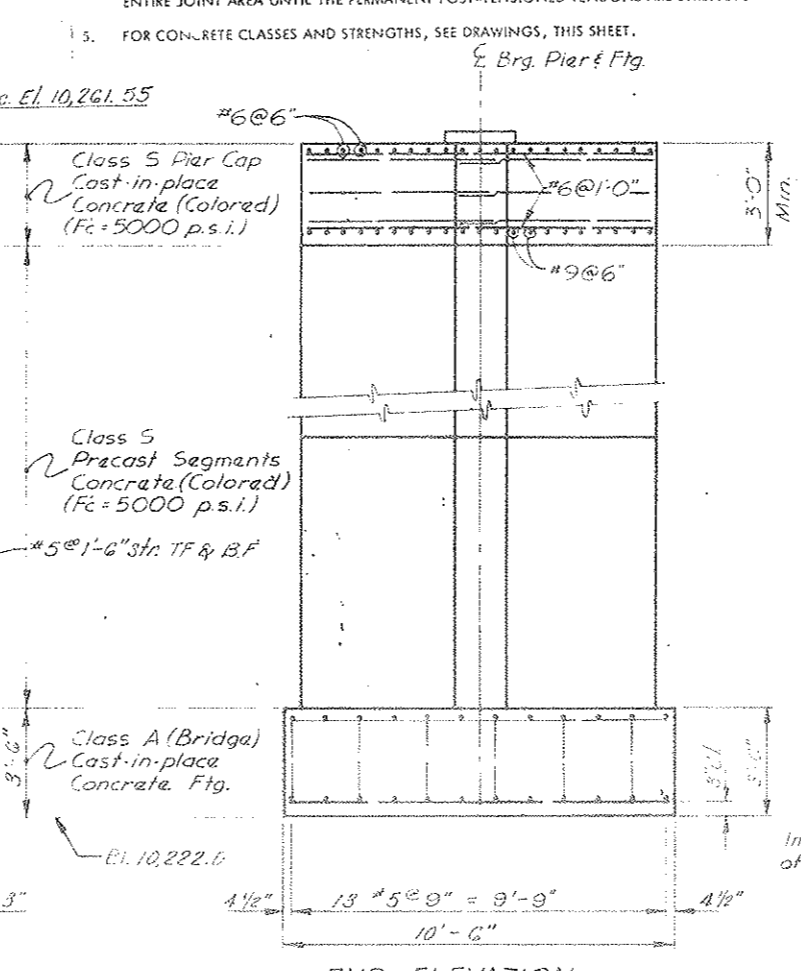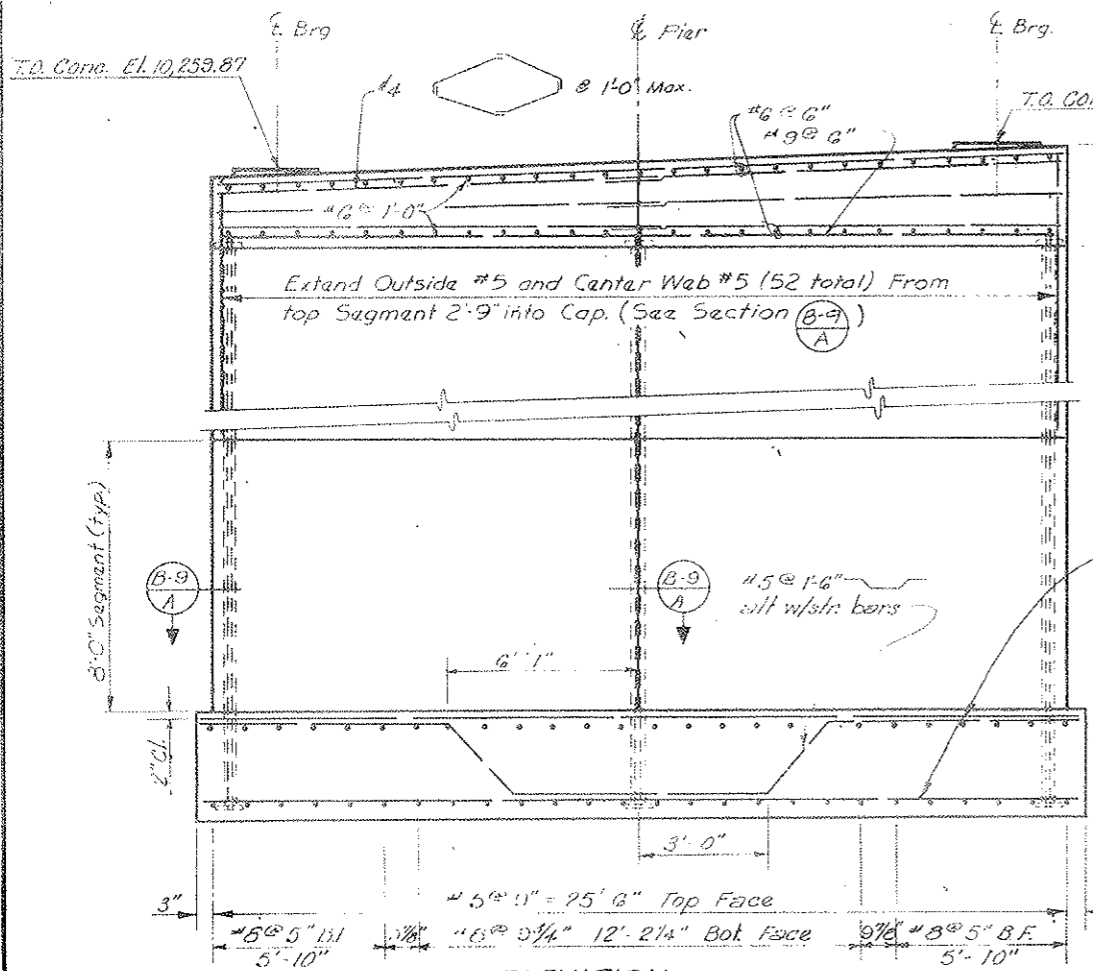

BEARING DETAIL
2 Reqd.
Orig. Scale: 3/4" = 1'-0"

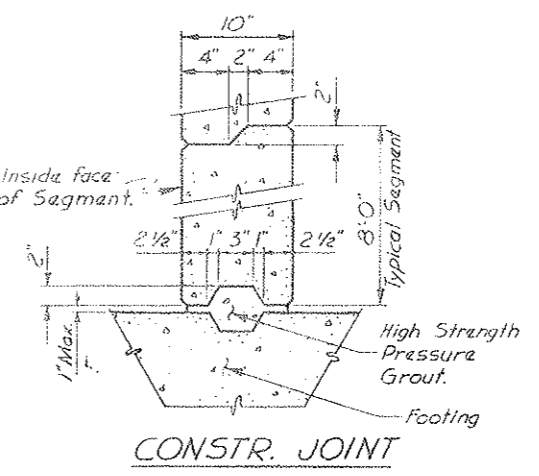

ELEVATION
Looking Ahead Station

END ELEVATION

CONSTR. JOINT

① FORCE F IS THE POST-TENSIONING FORCE REQUIRED IN THE PIERS AFTER ALL LOSSES INCLUDING CREEP, SHRINKAGE, FRICTION, AND ELASTIC SHORTENING FROM THE SUPERSTRUCTURE LOADS. POST-TENSIONING FORCE F IS TO BE THE SUM OF FOUR EQUAL FORCES, ONE AT EACH CORNER OF THE PIER AS SHOWN IN SECTION

IECO INTERNATIONAL ENGINEERING COMPANY, INC.
Boston, Sheddard, Milkskin and Mission Division
1777 S. Baseline St. Denver, Colorado 80222

DIVISION OF HIGHWAYS

PIER DETAILS


Designer: A. E. FROMAN
Detailer: D. FROMAN
Drawing Number: B-11 of 15 Drawings

Structure: F-12-AM


Revision Dates: (Preliminary Stage Only)

AS CONSTRUCTED
 REVISED DATE: 6-24-77

07253

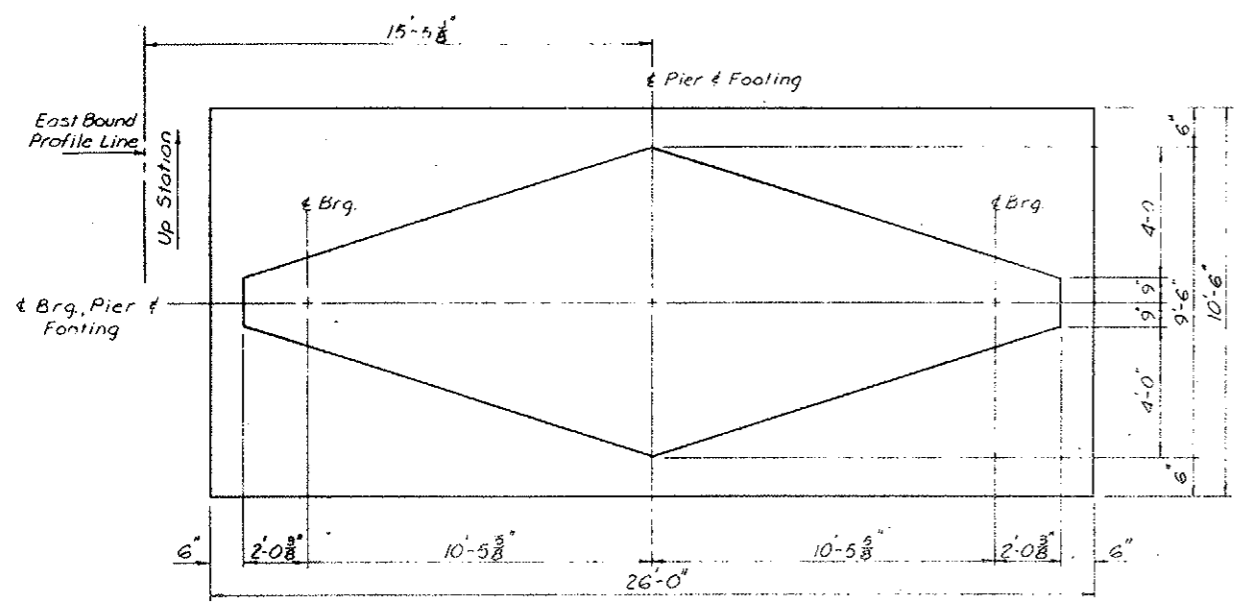


PLAN

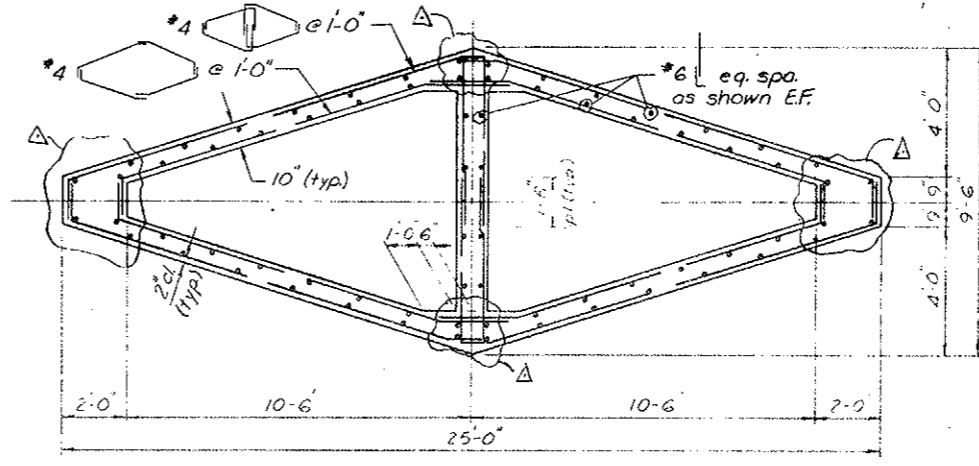


SECTION A


Do not lap bars at designated elevations (R-2)

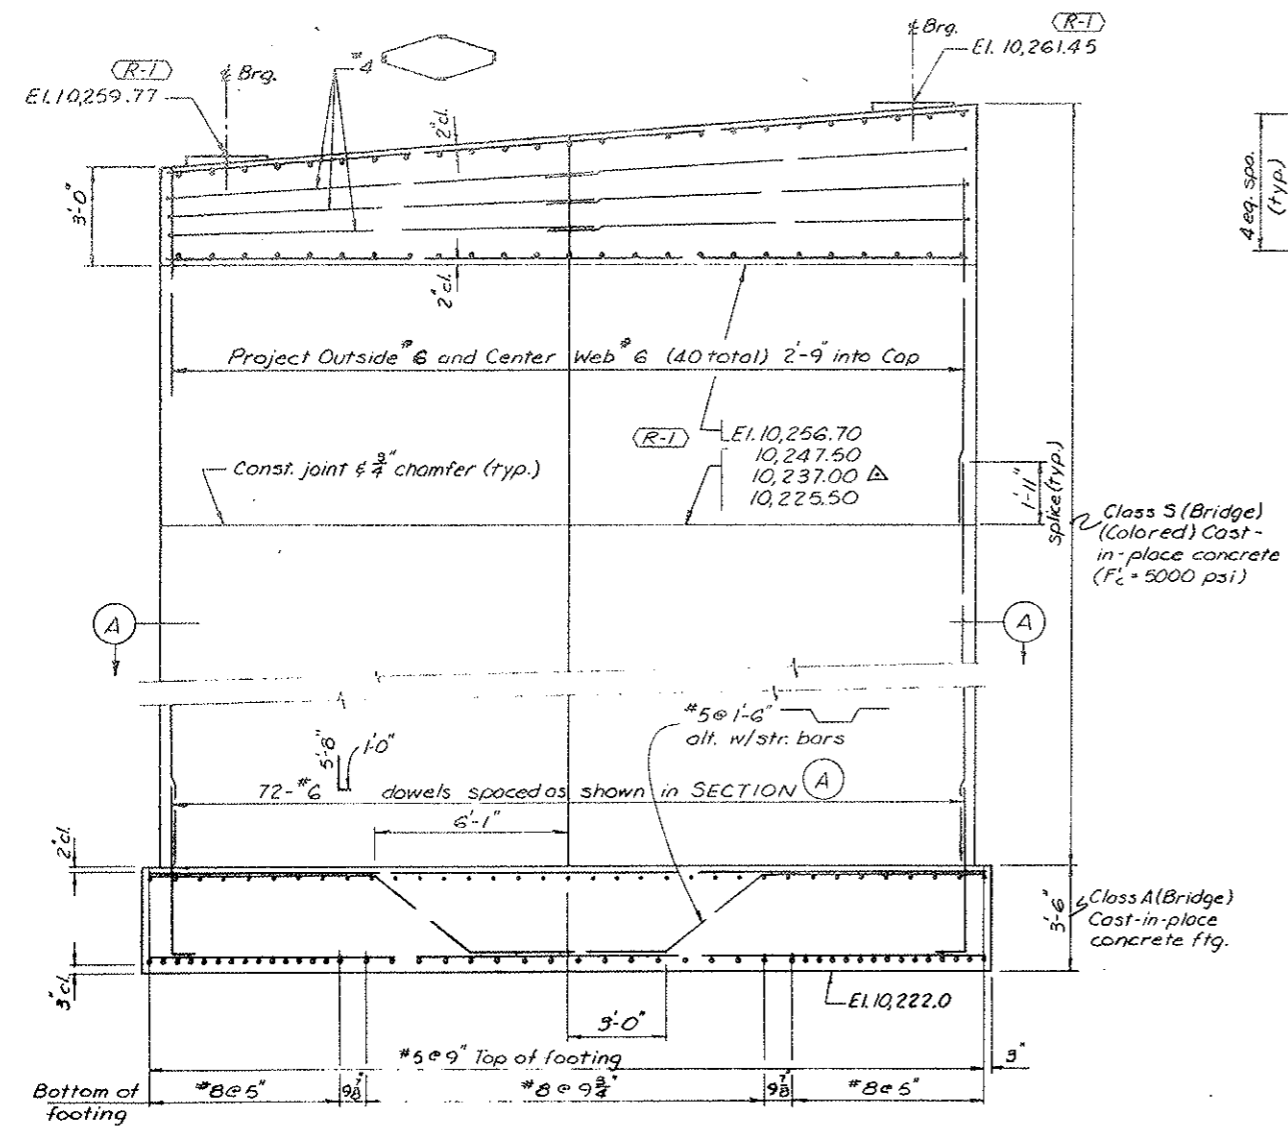

ELEVATION

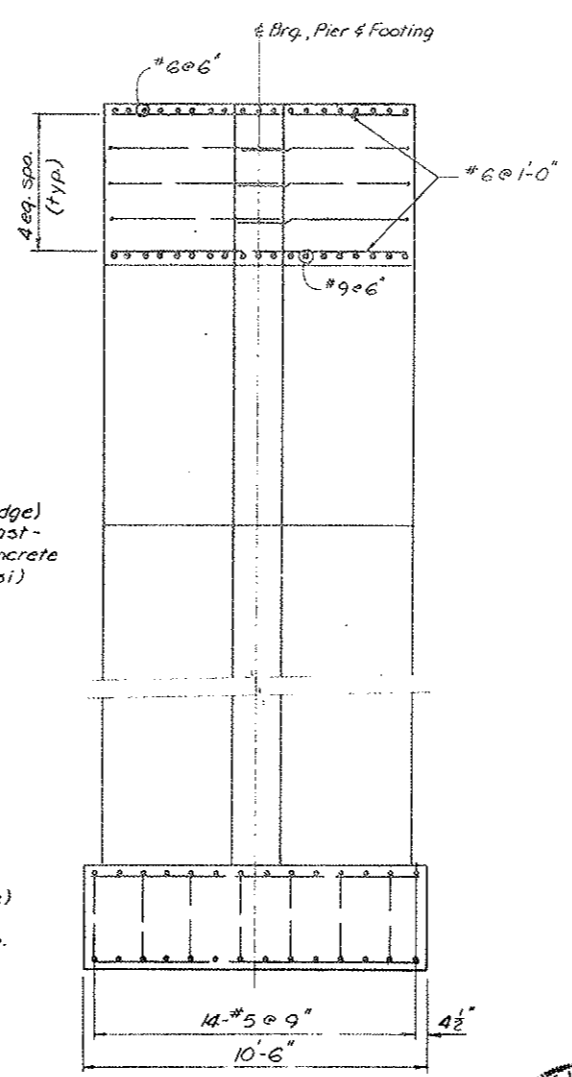

END ELEVATION

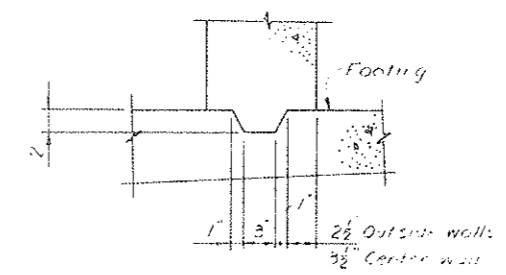

CONST. JOINT

QUANTITIES			
ITEM	DESCRIPTION	UNIT	PIER 2
601	Concrete Class A (Bridge)	Cu.Yd.	35.4
601	Concrete CLS (Bridge) (colored)	Cu.Yd.	87.0
①	602 Reinforcing Steel (Gr. 60)	Lb.	11,380 (R-1) (R-2)
①	Former Reinf Steel Quantity	Lb.	9594
	Additional Reinf Steel	Lb.	1286 (R-1) (R-2)



REVISIONS			
R-1	6-19-75	Rev. elev's, quant; Add const jt.	CLB
R-2	6-25-75	Rev laps & quant	HHH

I 70-2(52)197 VAIL PASS STR. F-12-AM

CONVENTIONAL REINFORCING FOR PIER 2

INTERNATIONAL ENGINEERING COMPANY, INC.






Designed RAH Chkd RAH Submitted _____
 Drawn TCF Insp. _____ Recommended _____
 Approved _____

DENVER, COLORADO
 DATE June 6, 1975

SHEET NO. 1

FEDERAL ROAD DISTRICT	PROJ. NO.	SHEET NO.	TOTAL SHEETS
VIII	COLORADO	170-2(52)197	67

REVISIONS	

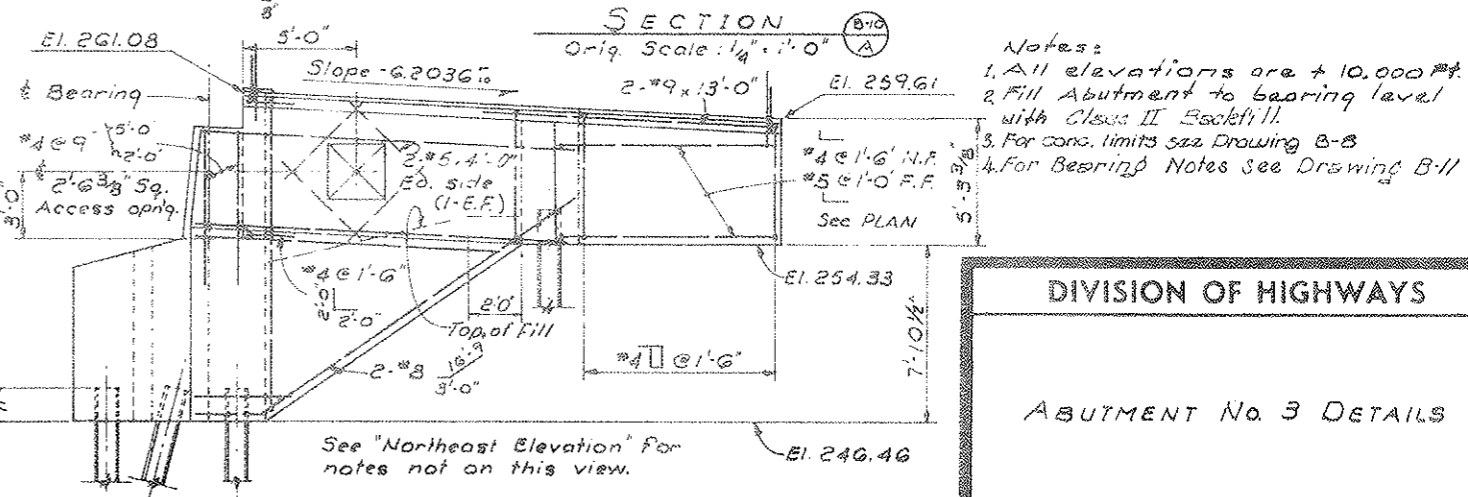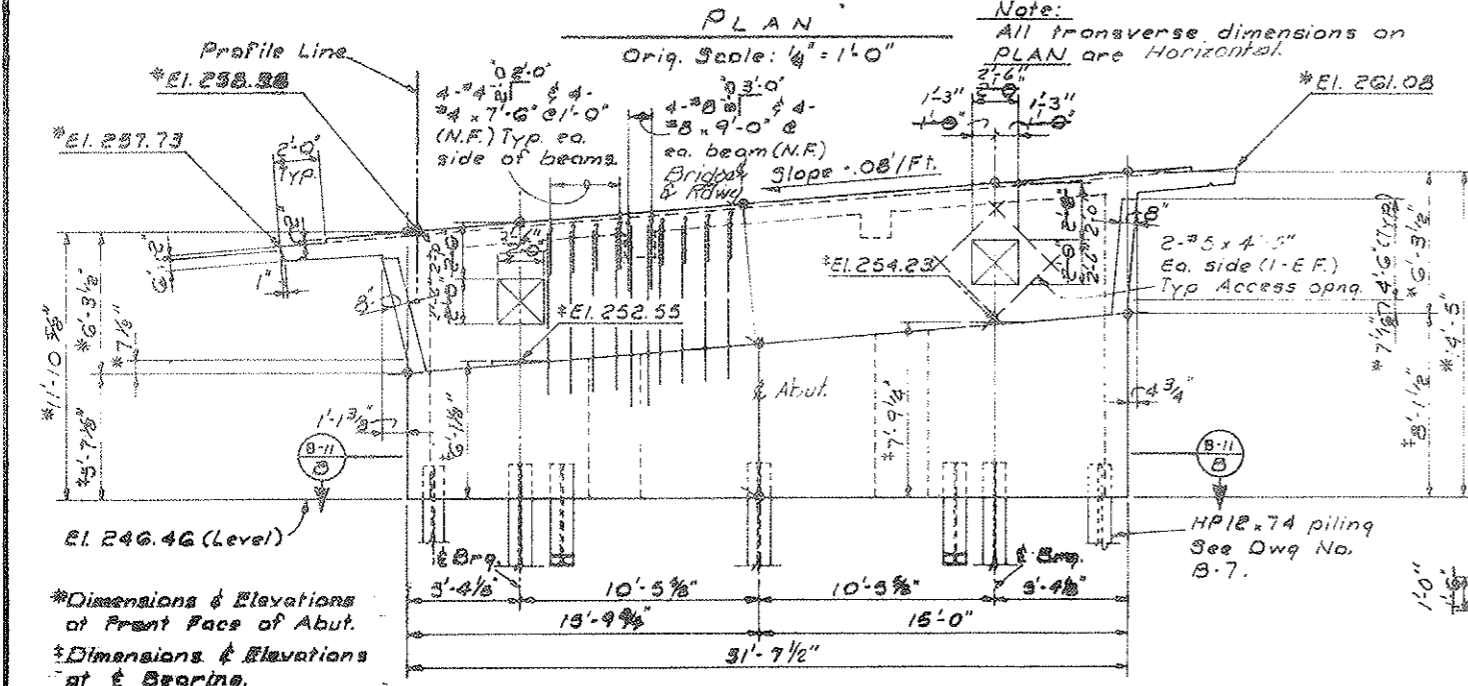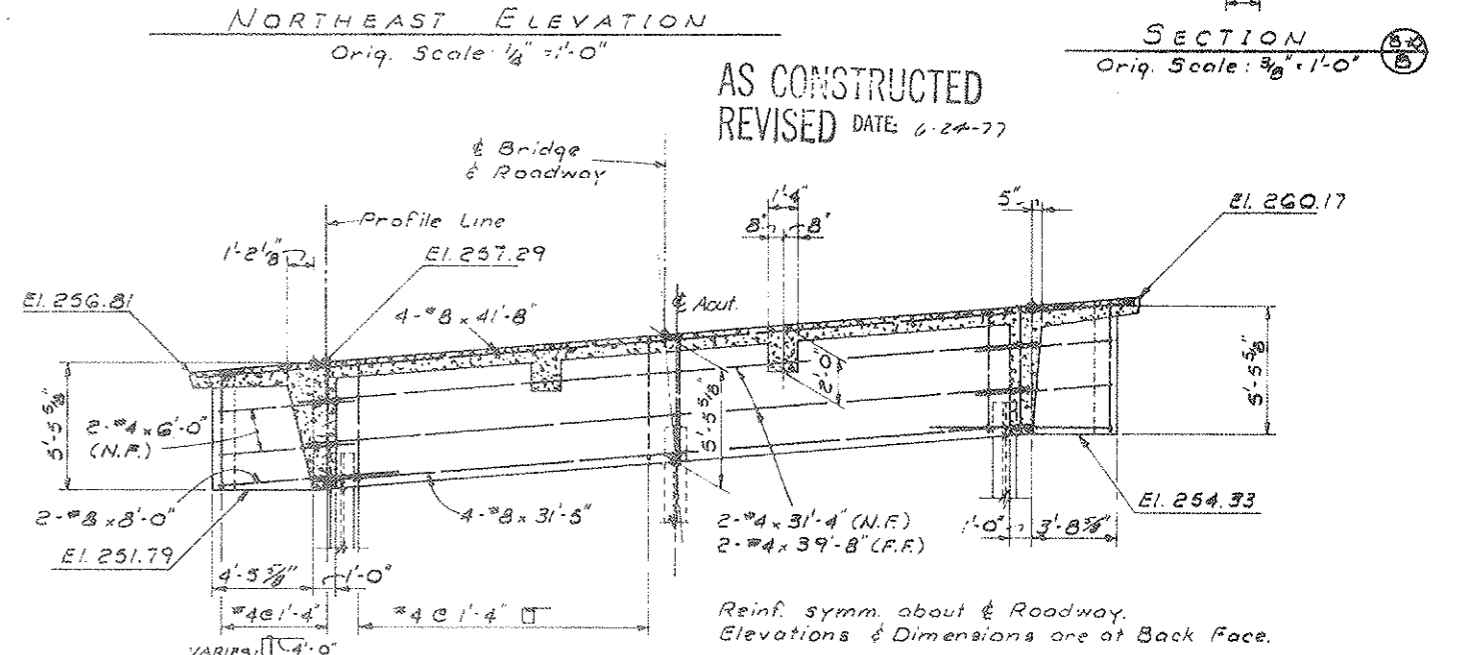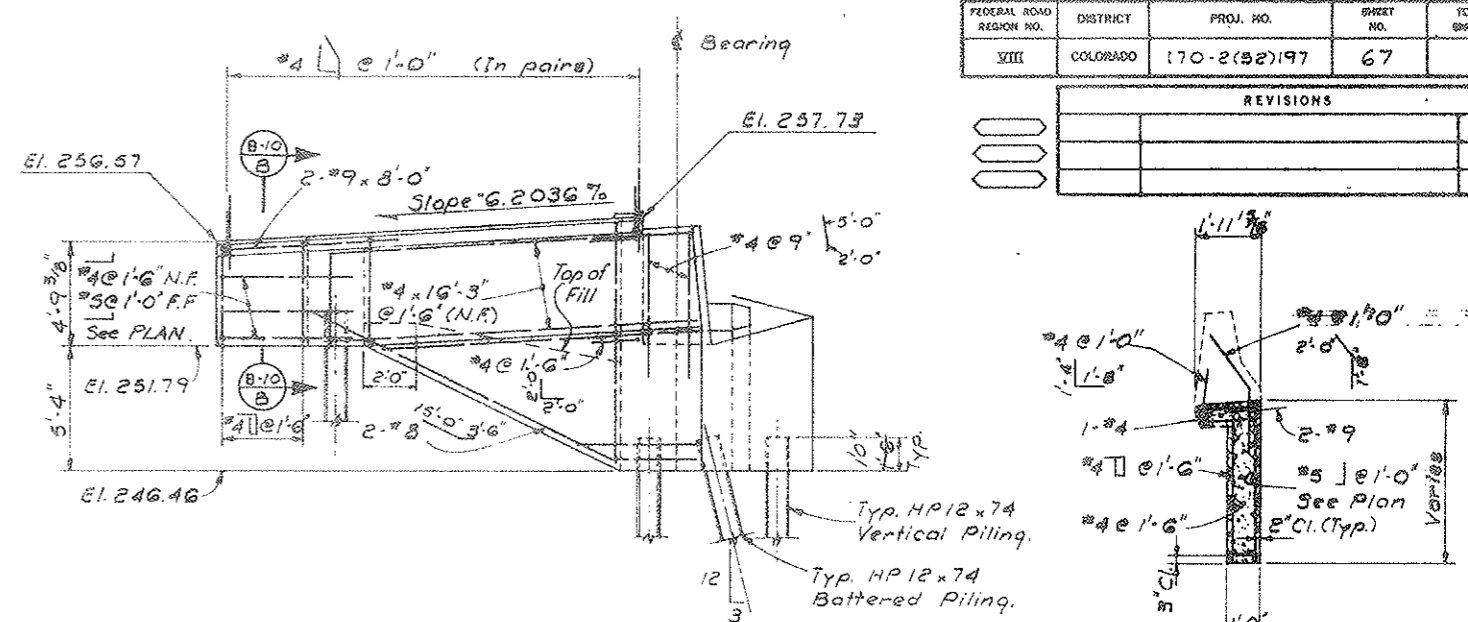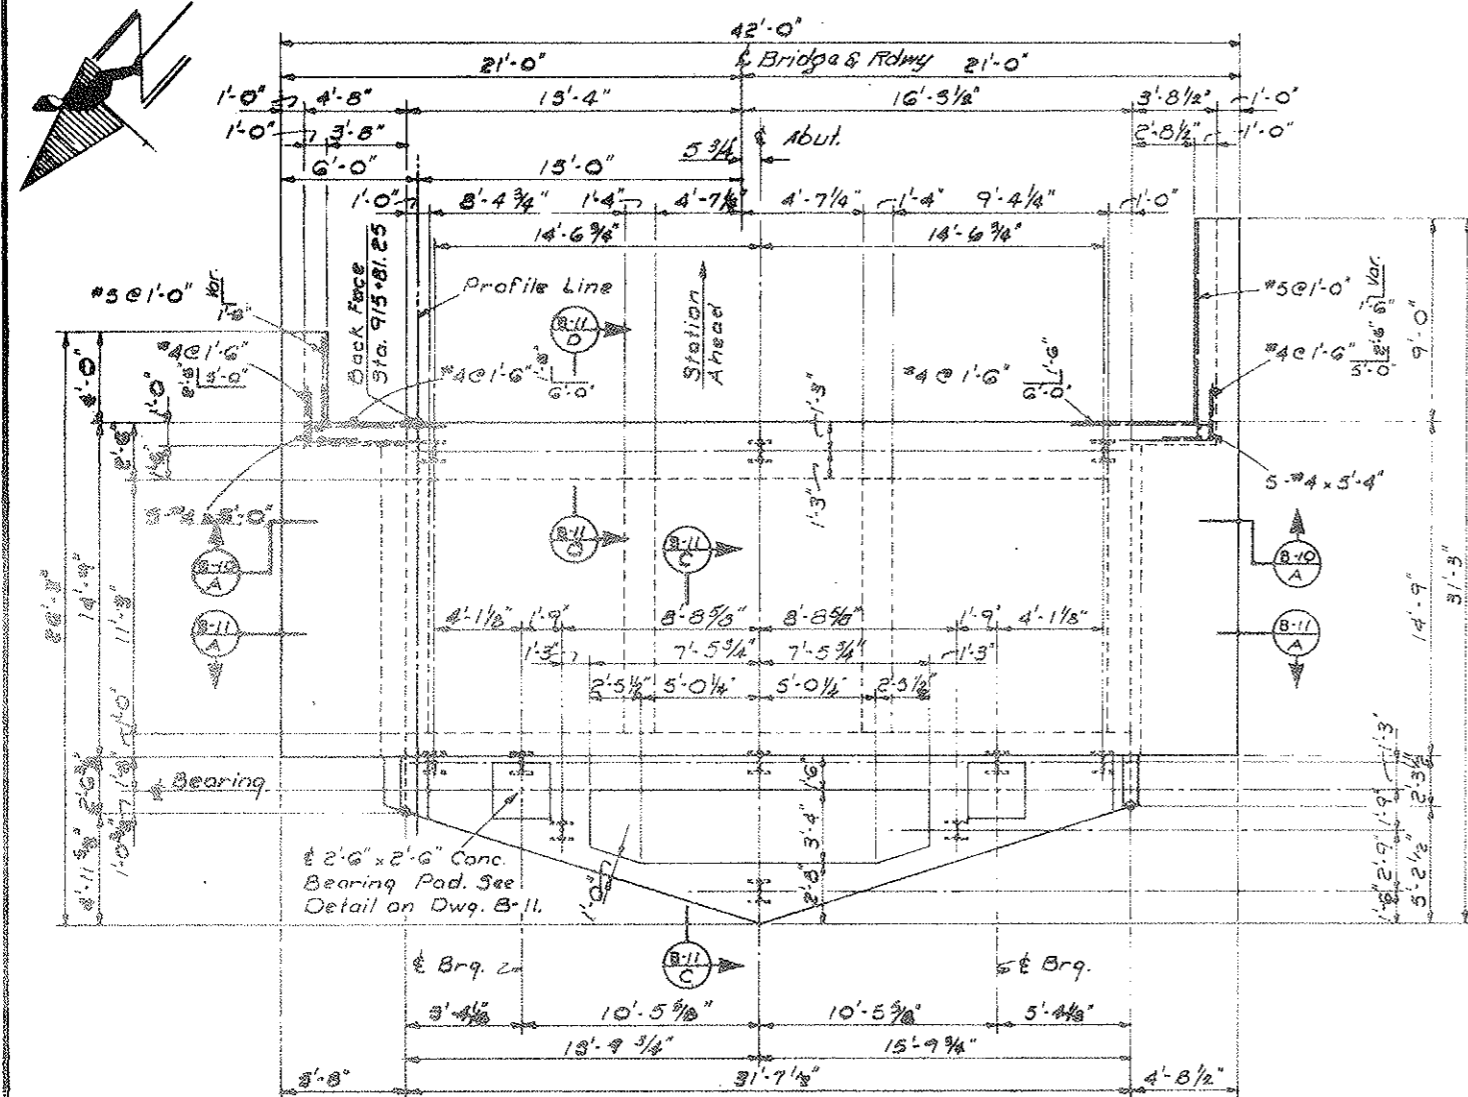

DIVISION OF HIGHWAYS

ABUTMENT No. 3 DETAILS






Designer	A. Erikson	Structure	F-12-AM
Detailer	D. Griner	Numbers	
Drawing Number	B-10	of	18 Drawings

Revision Dates: (Preliminary Stage Only)

FEDERAL ROAD DISTRICT NO.	DISTRICT	PROJ. NO.	SHEET NO.	TOTAL SHEETS
XIII	COLORADO	170-2 (82) 197	68	

REVISIONS				
R-1	4-14-75	PERCENT		WCB
R-2	4-17-75	Rev. Brq. Pressure, Added Note		CLB

AS CONSTRUCTED
NO REVISIONS DATE: 6-22-77

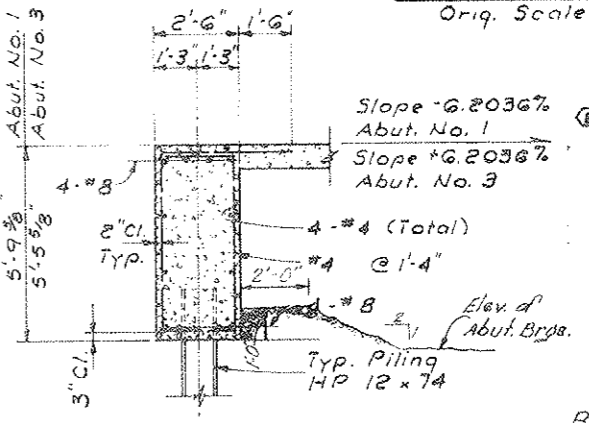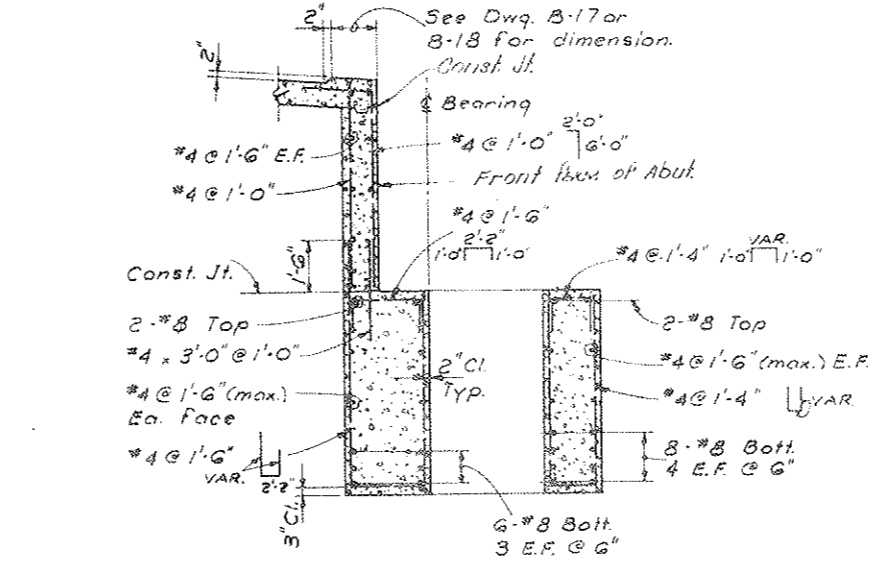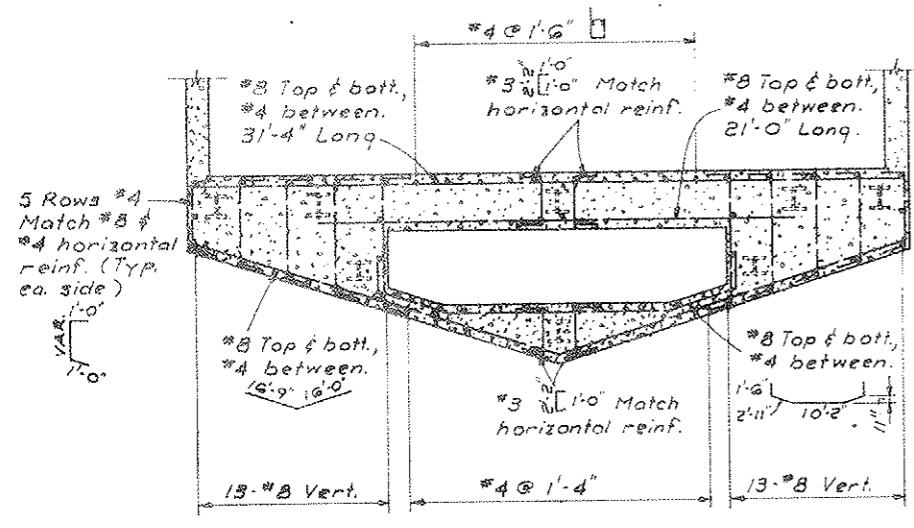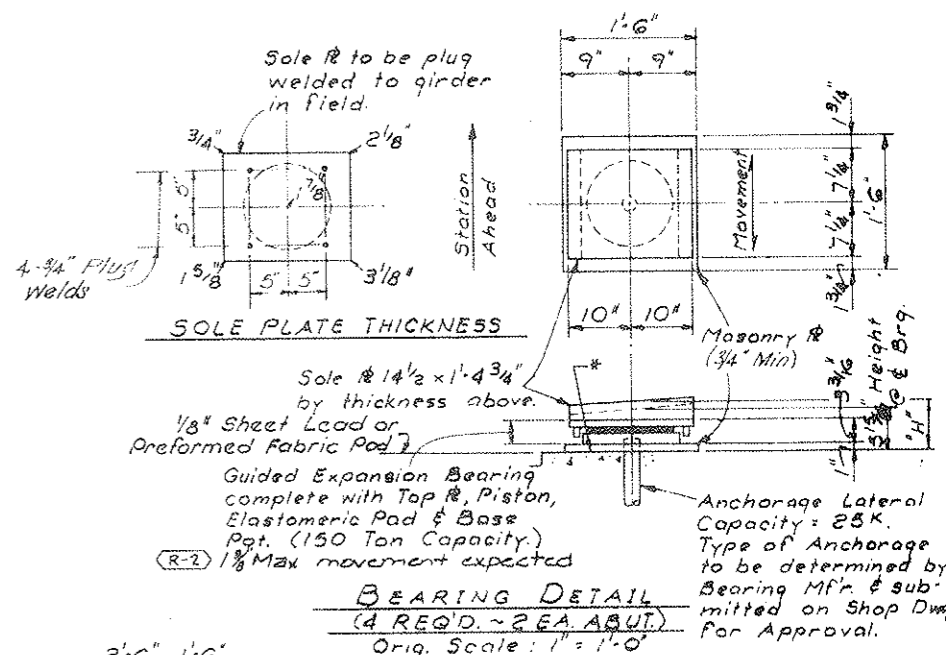
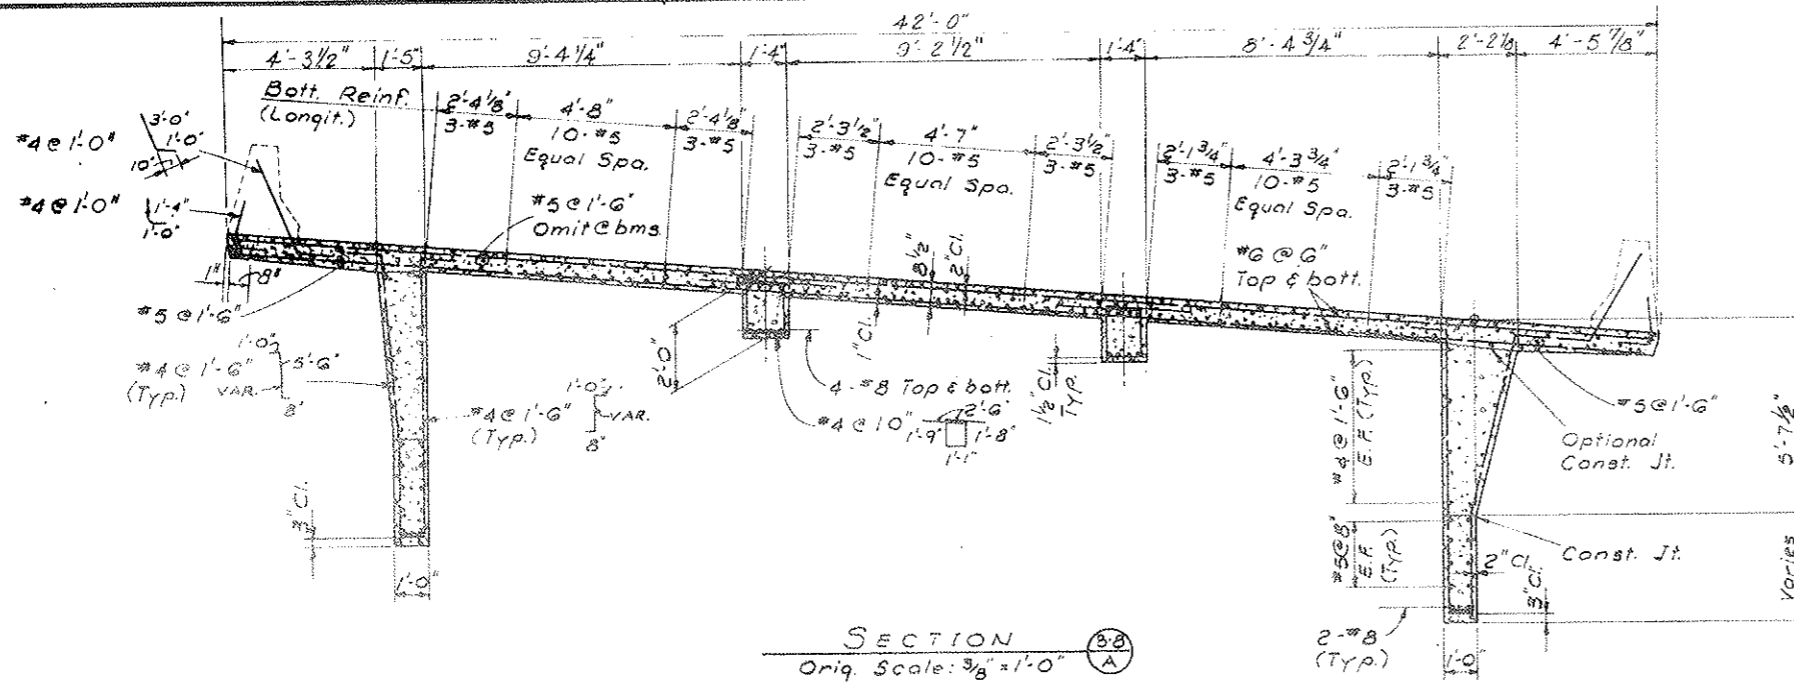


(R-2) ALLOWABLE ULTIMATE BEARING PRESSURES:

At Abutments:	(f'c = 3000 psi)
1768 psi	
At Piers:	(f'c = 3000 psi)
2975 psi	

BEARING DEVICES

Item	Bearing Type & Capacity	Horiz. Capacity Longitudinal (Kips)	Transverse (Kips)	Actual Load (Kips)	Ultimate Load (Kips)
Abut. 1	E 150	9	20	300	475
Pier 2	F 450	34	30	317	1253
Abut. 3	E 150	9	20	300	475

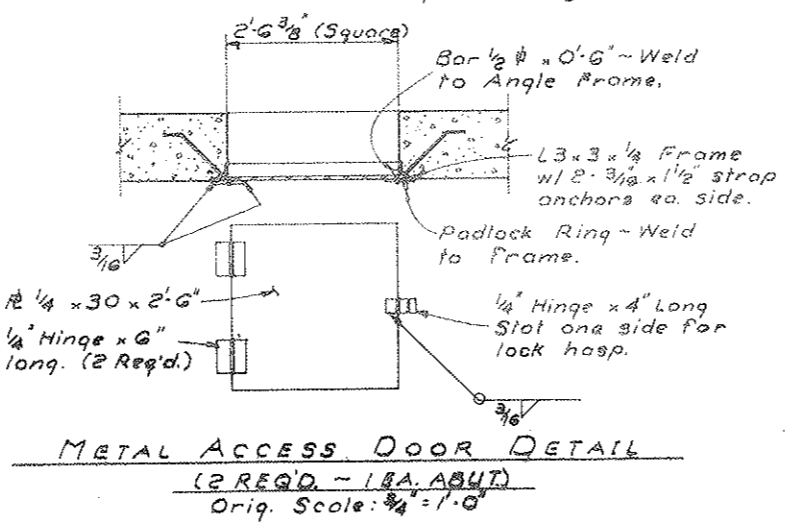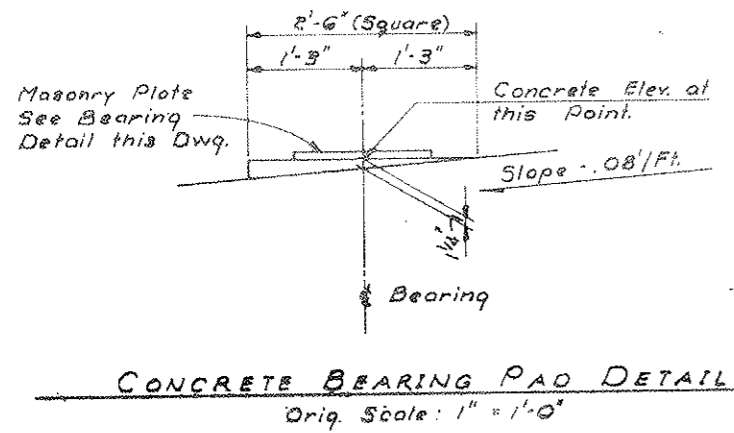

- BEARING NOTES:**
- STEEL FOR THE BEARING DEVICES, MASONRY PLATES, AND SOLE PLATES SHALL BE A.A.S.H.T.O. SPECIFICATION M-183 (A.S.T.M. A57).
 - THE TYPE OF ANCHORAGE FOR BEARING DEVICES SHALL BE DETERMINED BY THE CONTRACTOR AND SUBMITTED ON SHOP DRAWINGS FOR APPROVAL.
 - FOR ALLOWABLE BEARING PRESSURE ON CONCRETE, SEE DRAWINGS.
 - THE SOLE PLATES SHALL BE SUPPLIED WITH BEVELS AND CROSSFILLS AS REQUIRED FOR GRADE AND SUPERELEVATION.
 - DIMENSION "B" IS THE LIMIT REQUIRED FOR SD ITEM NO. 392, "BEARING DEVICES".
 - THE SIZE OF MASONRY PLATES SHALL BE DETERMINED BY THE BEARING MANUFACTURER. THE ALLOWABLE ULTIMATE BEARING PRESSURES AND THE ULTIMATE LOADS SHALL BE USED TO DETERMINE THE MASONRY PLATE SIZES.
 - ALL BEARING DETAILS, INCLUDING WELDS, ARE SHOWN FOR ILLUSTRATION PURPOSES ONLY. THE CONTRACTOR SHALL SUBMIT SHOP DRAWINGS SHOWING DETAIL OF THE SPECIFIC BEARING DEVICE TO BE USED.

Note: Capacity = D.L. + L.L. + I
E = Expansion, F = Fixed

DIVISION OF HIGHWAYS

ABUTMENT 1 AND 3 DETAILS

Designer: A. Erikson
Checker: D. Griffin
Drawing Number: B-11 of 18 Drawings


Structures Number: F-12-AM

Revision Dates: (Preliminary Stage Only)


DESIGNED BY	DATE	CHECKED BY	DATE
AG	3-7-75	AG	3-7-75
AG	3-7-75	OG	3-7-75
OG	3-7-75	OG	3-7-75

FEDERAL ROAD DISTRICT	PROJ. NO.	SHEET NO.	TOTAL SHEETS
XIII COLORADO	I 70-2(52)197	69	

REVISIONS			
1	4/4/75	REPRINT	WCB
2	4/17/75	Changed Movement Limitation	CCB

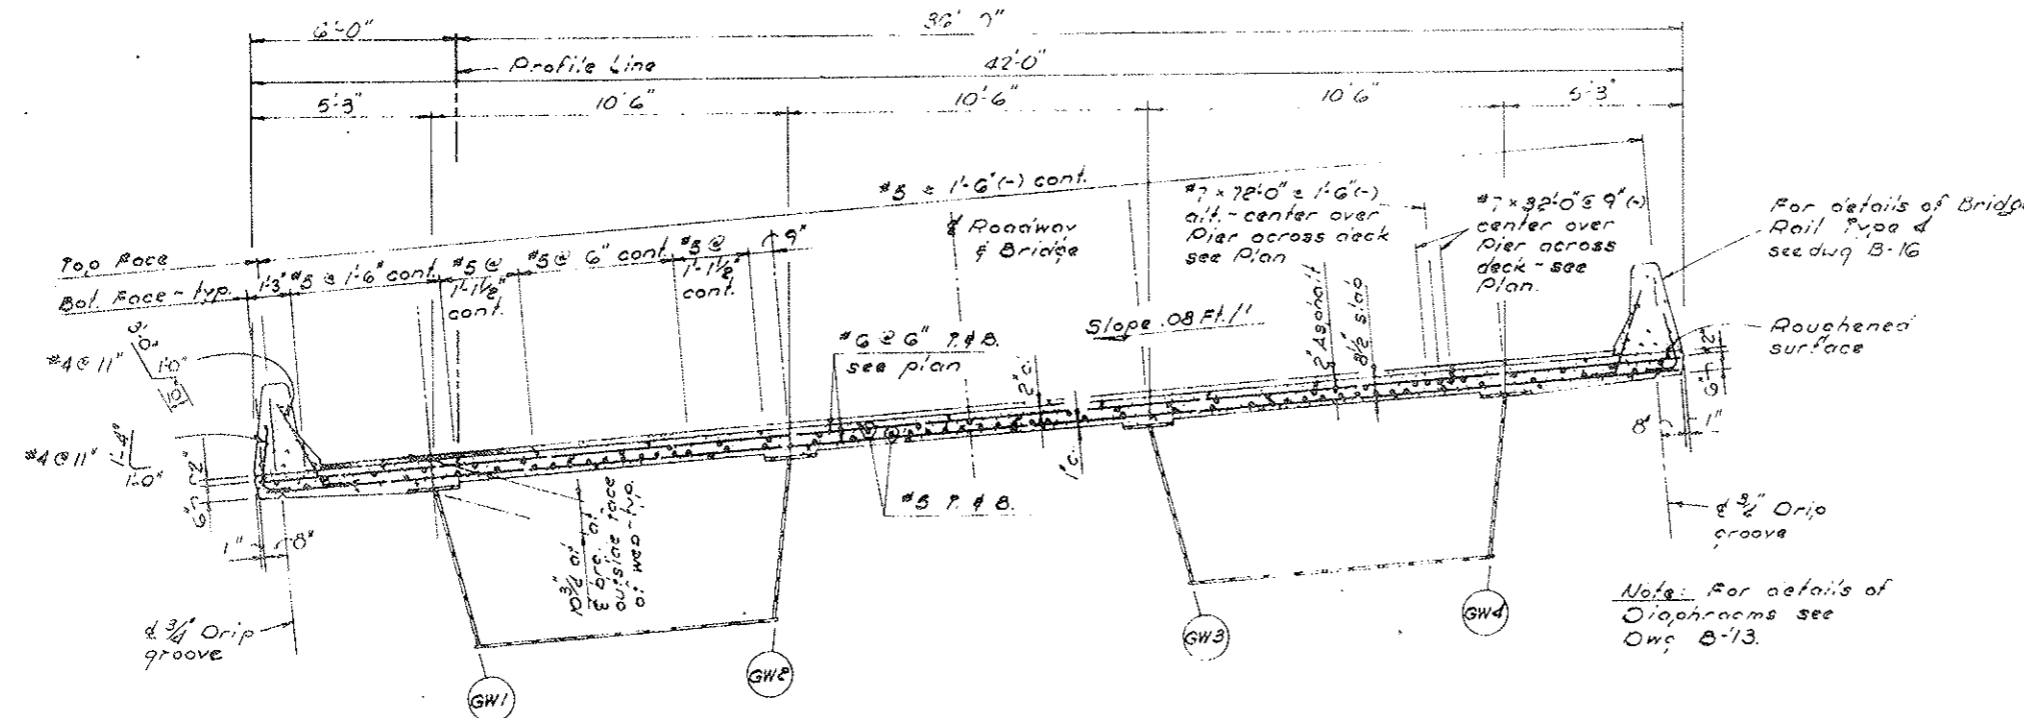


AS CONSTRUCTED
NO REVISIONS DATE: 6-28-77

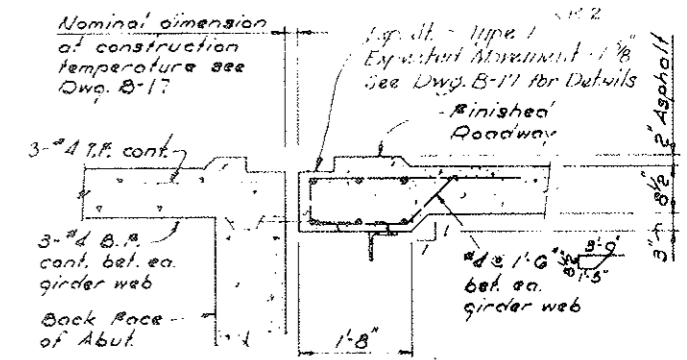

SECTION THRU END OF DECK
Orig. Scale: 3/4" = 1'-0"

TYPICAL DECK SECTION
Orig. Scale: 3/8" = 1'-0"

REVISION	DATE	CHECKED BY	QUANTITIES BY
1	3-7-75	LM	2/2
2	3-7-75	LM	2/2

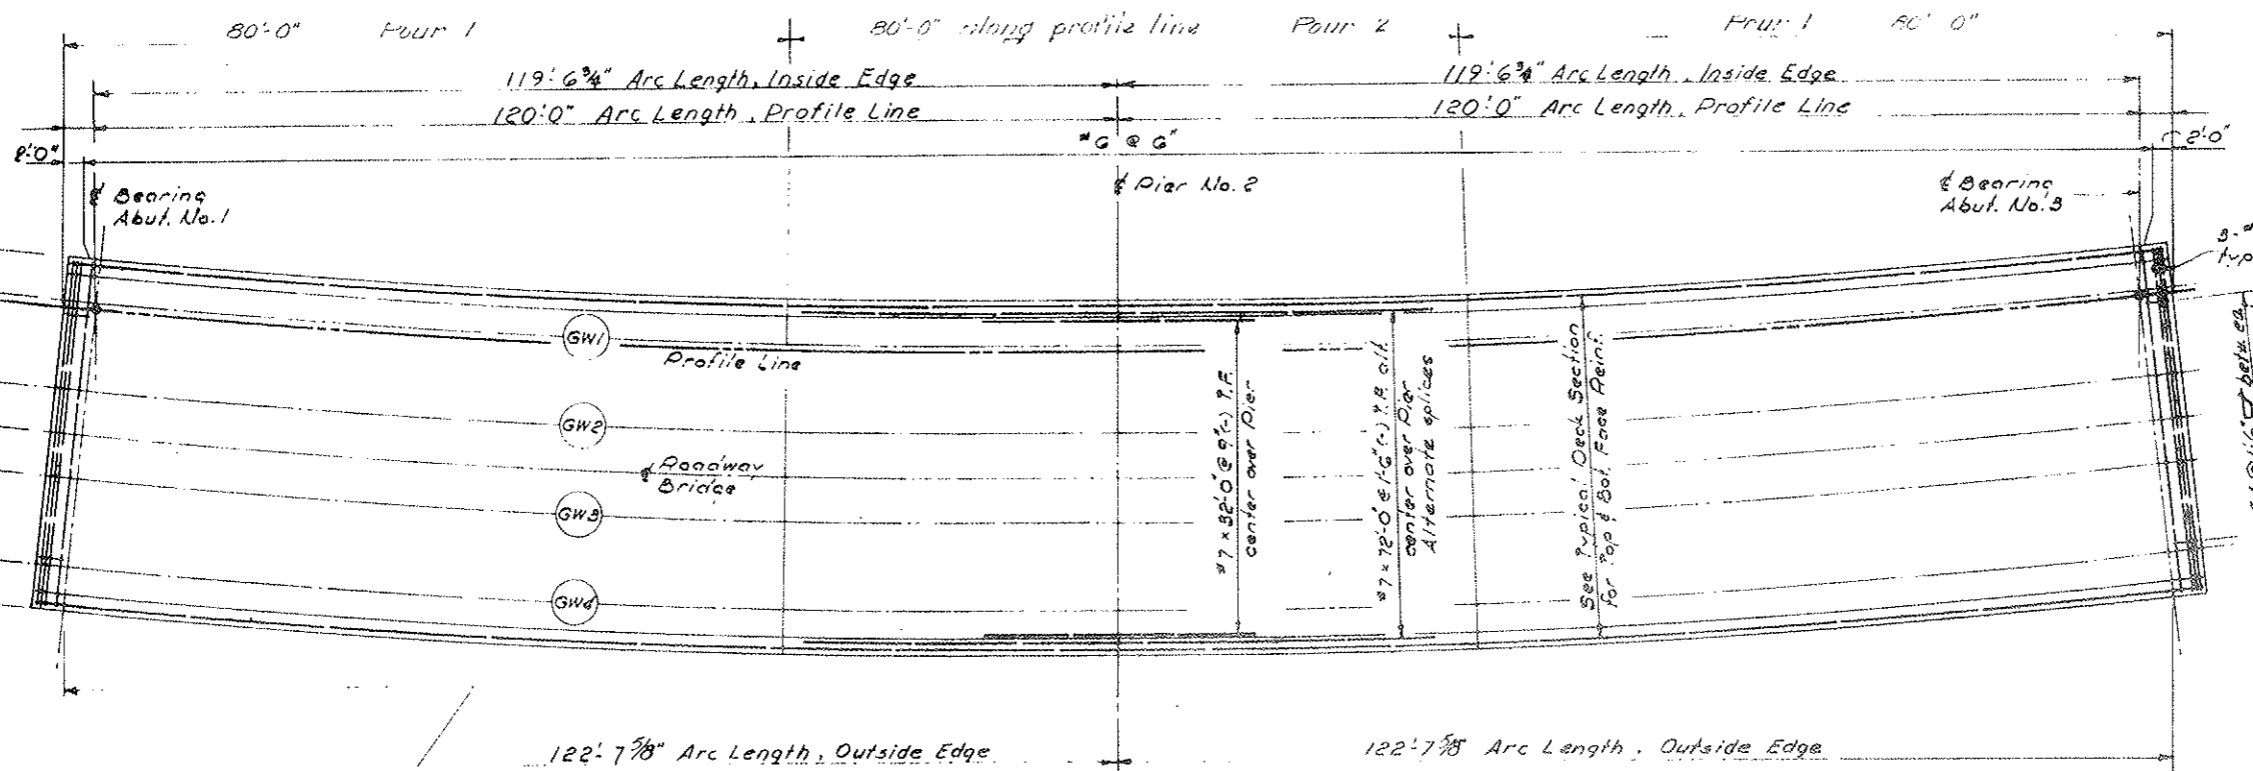

Deck Slab Pouring Sequence - Sections marked "Pour 1" must be in place prior to placing section marked "Pour 2"

Deck slab Pouring Sequence - Sections marked "Pour 1" must be in place prior to placing section marked "Pour 2"

DECK PLAN
Orig. Scale: 3/32" = 1'-0"

DIVISION OF HIGHWAYS


DECK PLAN AND TYPICAL DECK SECTION

Designer A. Griksen	Structure F-12-AM
Detailer O. Green	Numbers
Drawing Number B-12	of 18 Drawings



Revision Date (Preliminary Stage Only)

FEDERAL ROAD REGION NO.	DISTRICT	PROJ. NO.	SHEET NO.	TOTAL SHEETS
VIII	COLORADO	I 70-2(52) 197	70	


REVISIONS				
R-1	4-4-75	Reprint		H.C.B.
R-2	4-29-75	Added Note 4		B.O.E.

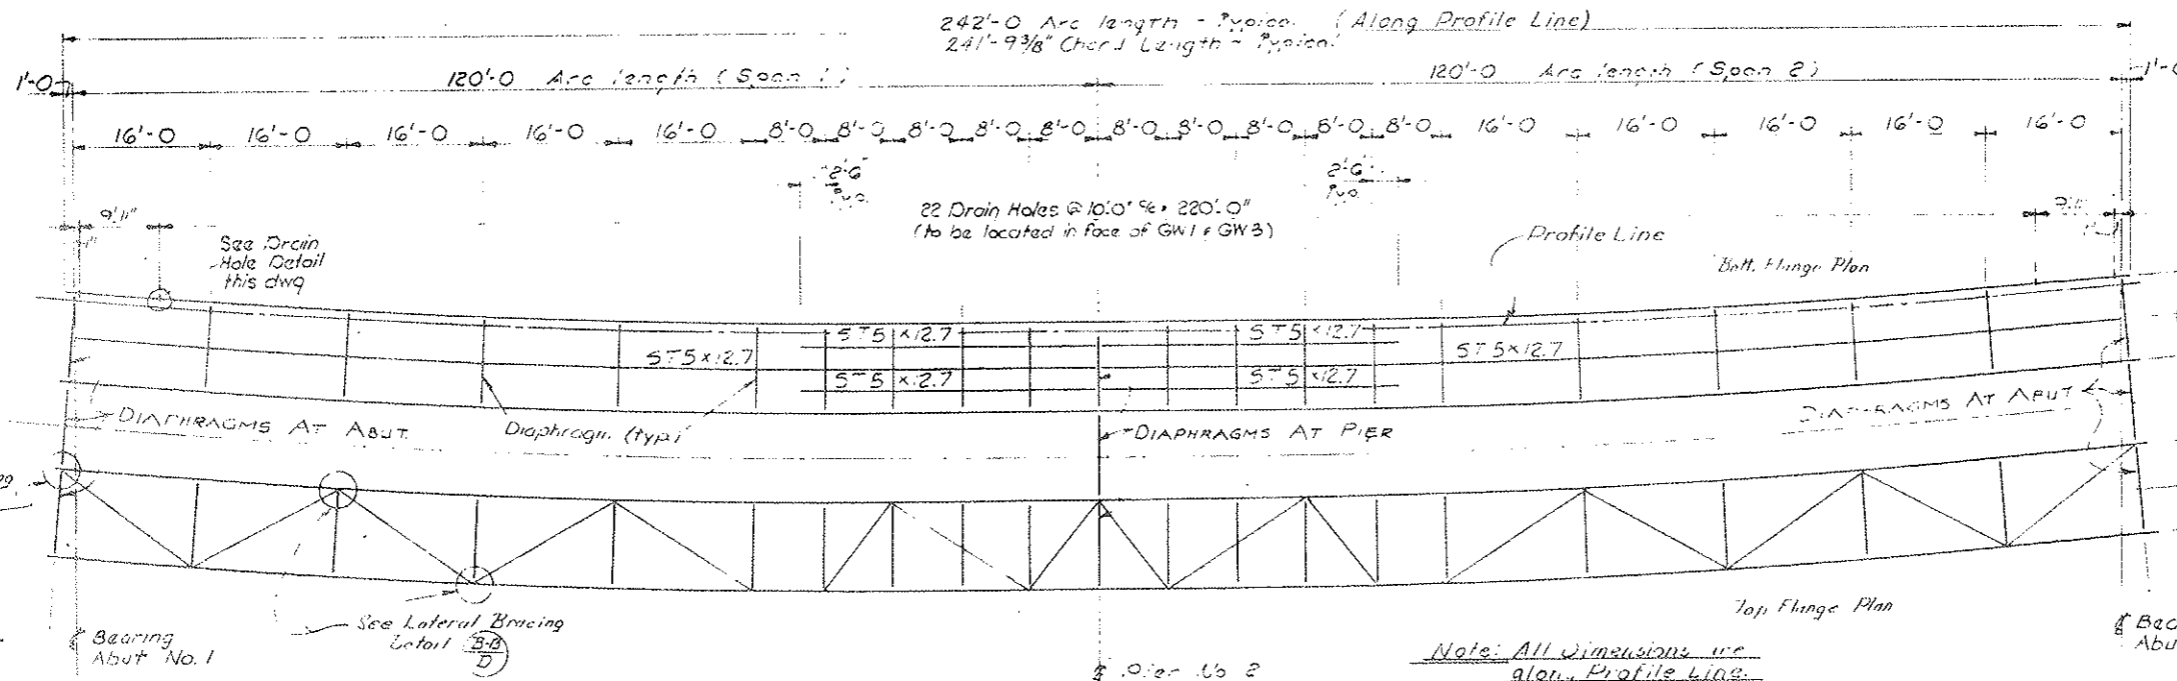

AS CONSTRUCTED
NO REVISIONS DATE: 6-24-77
* Out to Out of Girder Web

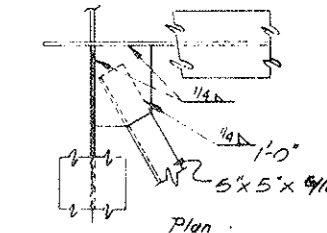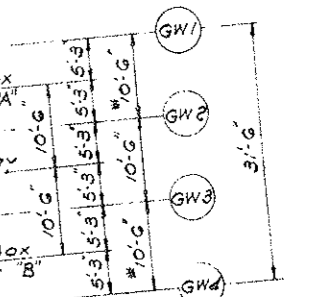


SUPERSTRUCTURE FRAMING PLAN
Orig. Scale: 3/32" = 1'-0"

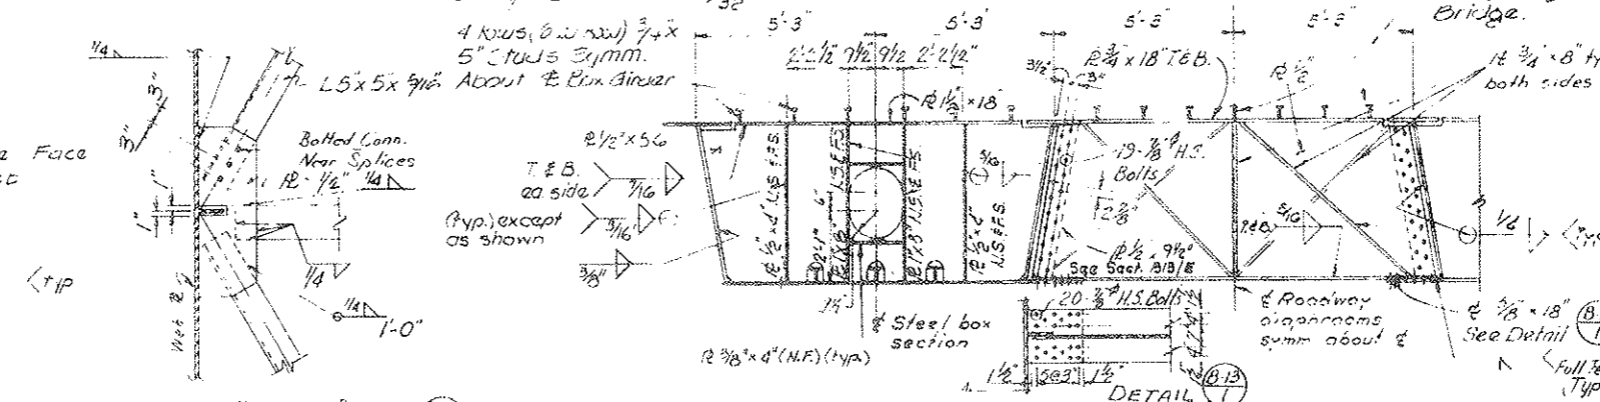


- Notes:**
- Interior connector plates - tight fit on tension flange - weld to compression flange.
 - Seal remaining washed contact surfaces between members and gusset plates with 3/8" minimum fillet weld.
 - Details shown for top and bottom flanges of the girder are similar for both boxes.
 - All bolts shall be ASTM A325 Grade 3 (R2)


DIAPHRAGMS AT PIERS
Orig. Scale: 3/8" = 1'-0"

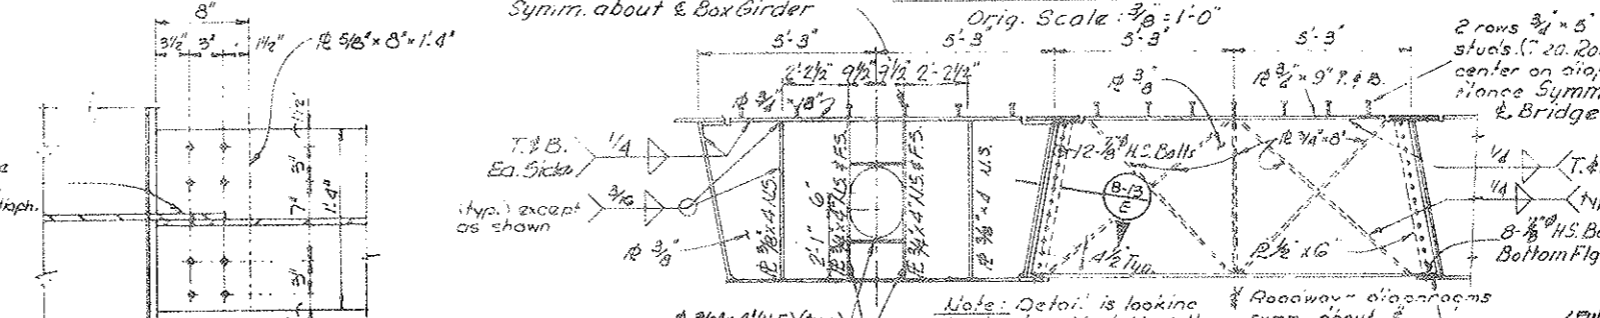


DIAPHRAGMS AT ABUTMENTS
Orig. Scale: 3/8" = 1'-0"

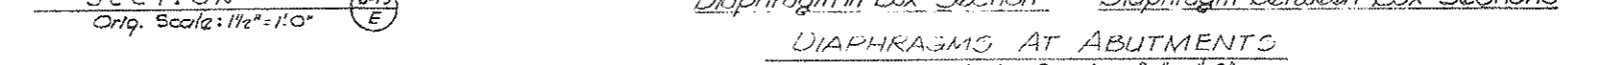

DRAIN HOLE DETAIL
Elevation
No Scale

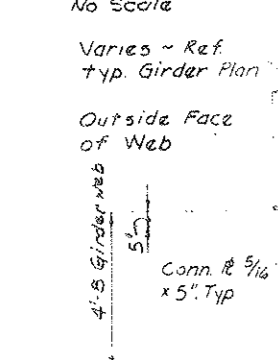

DIAPHRAGM DETAILS
Orig. Scale: 3/8" = 1'-0"

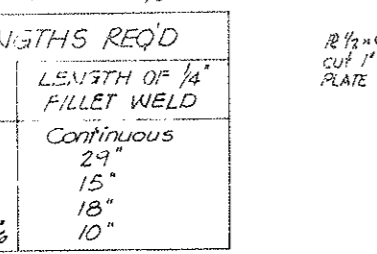

MEMBER	LENGTH OF 1/4" FILLET WELD
ST 5" x 12.7"	Continuous
C 10" x 20"	29"
L 5" x 5" x 5/16"	15"
L 5" x 5" x 3/8"	18"
L 3 1/2" x 3 1/2" x 5/16"	10"

NOTE: THESE ARE MINIMUM LENGTHS OF 1/4" FILLET WELDS TO SECURE MEMBERS TO GUSSET PLATES AND OTHER MEMBERS.

DIVISION OF HIGHWAYS

SUPERSTRUCTURE FRAMING PLAN AND DETAILS

Designer: A. Eriksen
Detailer: S. Martinez
Drawing Number: B-13 of 18 Drawings

Structure: F-18-AM




Revision Dates: Preliminary Stage Only

DATE	CHECKED BY	QUANTITIES BY	CHECKED BY
3-7-75	A.E.	A.E.	A.E.
3-10-75	A.E.	A.E.	A.E.
3-13-75	A.E.	A.E.	A.E.
3-17-75	A.E.	A.E.	A.E.
3-20-75	A.E.	A.E.	A.E.
3-23-75	A.E.	A.E.	A.E.
3-27-75	A.E.	A.E.	A.E.
3-30-75	A.E.	A.E.	A.E.
4-3-75	A.E.	A.E.	A.E.
4-6-75	A.E.	A.E.	A.E.
4-9-75	A.E.	A.E.	A.E.
4-13-75	A.E.	A.E.	A.E.
4-16-75	A.E.	A.E.	A.E.
4-19-75	A.E.	A.E.	A.E.
4-23-75	A.E.	A.E.	A.E.
4-26-75	A.E.	A.E.	A.E.
4-29-75	A.E.	A.E.	A.E.
5-3-75	A.E.	A.E.	A.E.
5-6-75	A.E.	A.E.	A.E.
5-10-75	A.E.	A.E.	A.E.
5-13-75	A.E.	A.E.	A.E.
5-17-75	A.E.	A.E.	A.E.
5-20-75	A.E.	A.E.	A.E.
5-24-75	A.E.	A.E.	A.E.
5-27-75	A.E.	A.E.	A.E.
5-31-75	A.E.	A.E.	A.E.

GIRDER RADIUS TABLE	
Girder	Radius
Girder Web 1	1636.27'
Girder Web 2	1646.77'
Girder Web 3	1657.27'
Girder Web 4	1667.77'

FEDERAL ROAD DISTRICT	PROJ. NO.	SHEET NO.	TOTAL SHEETS
VIII COLORADO	I 70-2(52) 197	71	


REVISIONS			
①	4-14-75	REPRINT	WCB
②	4-29-75	Added Note No. 11	BDE

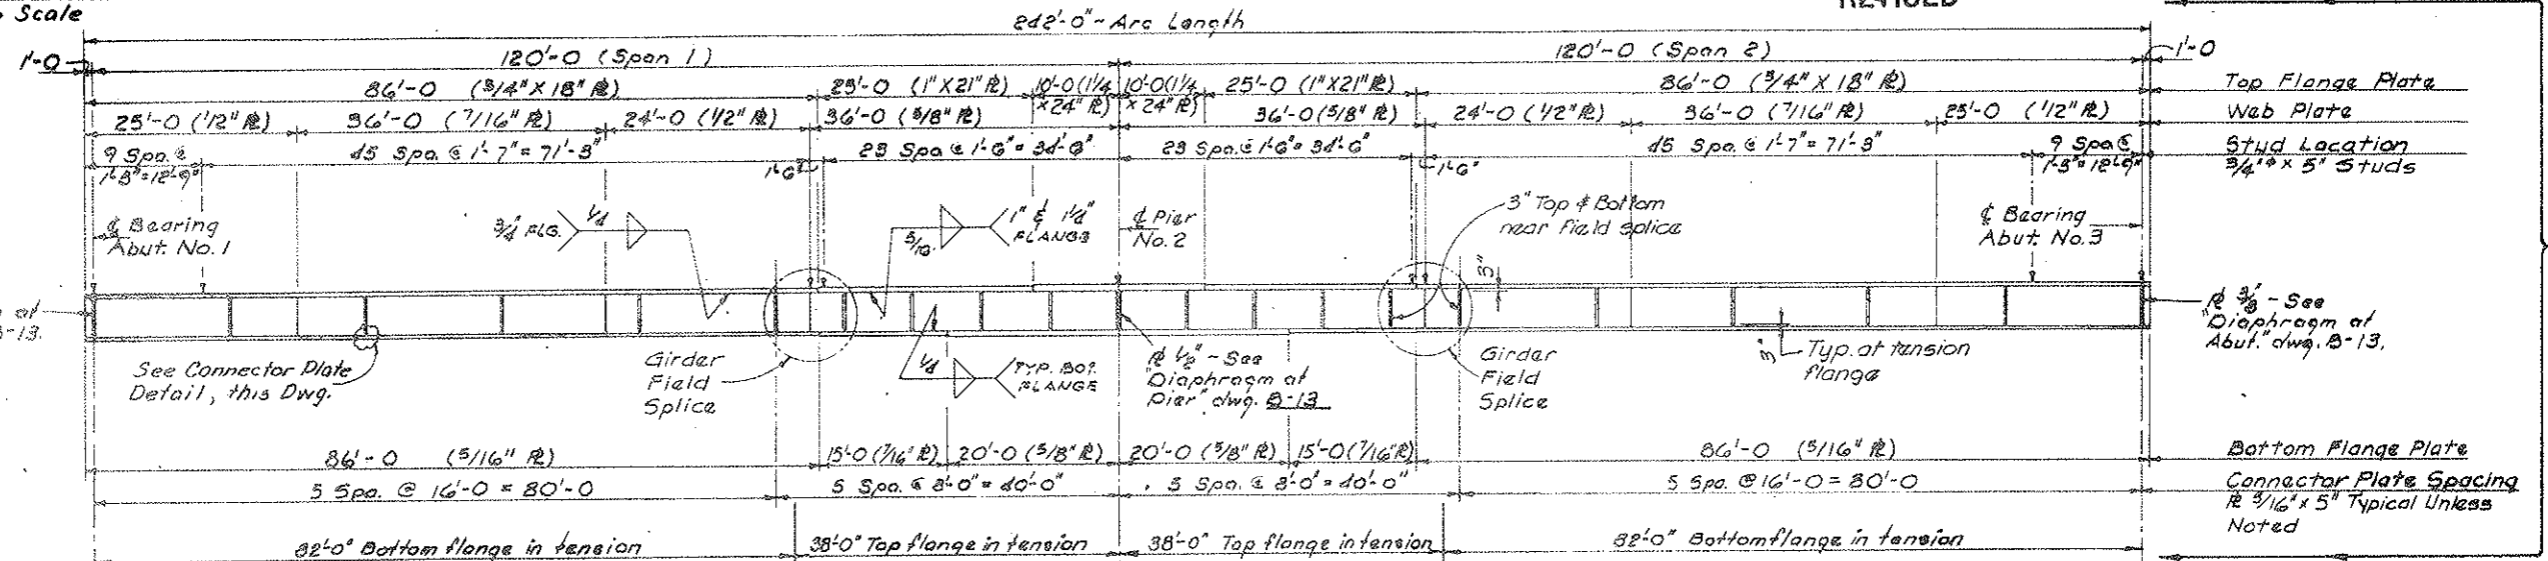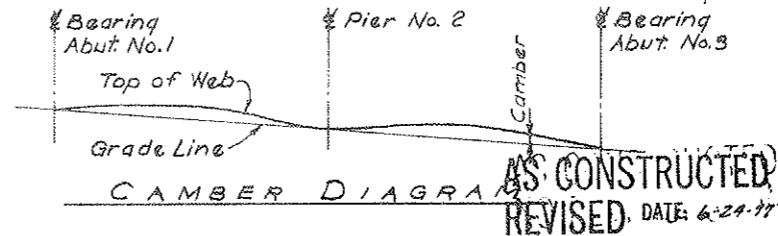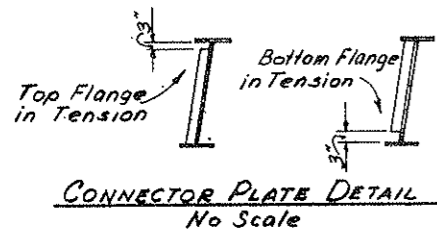

	2Brq.	05L	10L	15L	20L	25L	30L	35L	40L	45L	50L	55L	60L	65L	70L	75L	80L	85L	90L	95L	Brq.	05L	10L	15L	20L	25L	30L	35L	40L	45L	50L	55L	60L	65L	70L	75L	80L	85L	90L	95L	Brq.																						
GW 1 & GW 2	.00	.05	.09	.13	.17	.20	.22	.23	.23	.22	.20	.18	.15	.12	.09	.06	.04	.02	.01	.00	.01	.02	.04	.06	.09	.12	.15	.18	.20	.22	.23	.23	.22	.20	.18	.14	.10	.05	.00	.01	.02	.04	.07	.10	.13	.16	.19	.21	.23	.24	.25	.24	.23	.21	.18	.14	.10	.05	.00				
GW 3 & GW 4	.00	.05	.10	.14	.18	.21	.23	.24	.25	.24	.23	.21	.19	.16	.13	.10	.07	.04	.02	.01	.00	.01	.02	.04	.07	.10	.13	.16	.19	.21	.23	.24	.25	.24	.23	.21	.18	.14	.10	.05	.00	.01	.02	.04	.07	.10	.13	.16	.19	.21	.23	.24	.25	.24	.23	.21	.18	.14	.10	.05	.00		
Girder D.L.	.00	.01	.01	.02	.02	.02	.03	.03	.03	.03	.03	.03	.02	.02	.02	.01	.01	.01	.00	.00	.00	.00	.00	.01	.01	.01	.02	.02	.02	.03	.03	.03	.03	.03	.03	.03	.02	.02	.02	.01	.01	.00	.00	.00	.00	.00	.01	.01	.01	.02	.02	.02	.03	.03	.03	.03	.03	.03	.02	.02	.01	.01	.00


Location at 20th point
Dead Load Deflection
Dead Load of Girder
(Total wt acting on girder including wt of girder)

DESIGNED BY	CHECKED BY	DATE	QUANTITY	BY	DATE
AE	AE	3-7-75	1	AE	3-7-75
SM	SM	3-7-75	1	SM	3-7-75

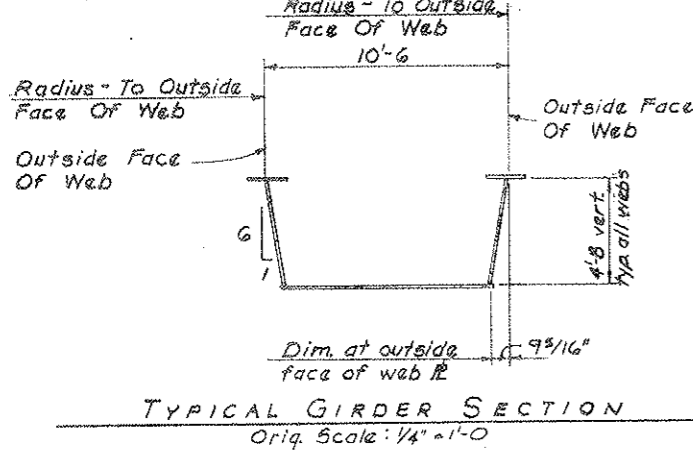

T	T1
Over 1/2 to 1	1/4
Over 1 to 1 1/2	1/2
Over 1 1/2 to 2	5/8

LIMITATIONS FOR JOINT B-L2C-5

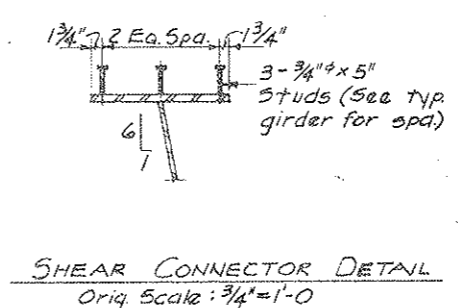

- ALTERNATE GIRDER SPLICES WILL BE PERMITTED SUBJECT TO APPROVAL BY THE ENGINEER.
- COMPLETE WEB TO FLANGE FILLET WELDS AFTER WELDING FLANGE AND WEB BUTT WELDS.
- GRINDING IS NOT REQUIRED FOR SHOP BUTT WELDS IN TOP FLANGES WHICH ARE IN COMPRESSION, EXCEPT THE EDGES OF ALL FLANGE BUTT WELDS SHALL BE GROUND. OTHER AREAS SHALL BE GROUND AS DIRECTED BY THE ENGINEER.
- WEB BUTT JOINTS SHALL BE FULL PENETRATION GROOVE WELDS. IF FIELD SPLICES ARE WELDED, WEB WELDS SHALL BE GROUND FLUSH.
- STIFFENERS NEAR A FIELD SPLICE MAY BE FIELD WELDED.
- GIRDER ENDS AND BEARING STIFFENERS SHALL BE VERTICAL EXCEPT THAT THEY MAY BE NORMAL TO GRADE FOR GRADES LESS THAN 2%.
- AT THE CONTRACTORS OPTION, WELDED GIRDER SPLICES MAY BE USED WHEN BOLTED SPLICES ARE SHOWN ON THE PLANS.
- METHOD OF SUPPORTING GIRDERS WHILE GIRDER FIELD WELDED SPLICES ARE BEING MADE SHALL BE SHOWN ON THE SHOP DRAWINGS.
- Girder view shown is inside face of one girder - A req'd. Typical girder detailed is Girder Web 1 & 3 as shown and similar for Girder Web 2 & 4.
- Connector plate locations shown shall be for inside face of box girder. See Superstructure Framing Plan on Dwg. B-13 for additional plates inside and outside of box girder.
- All bolts shall be ASTM A325 Grade 3

DIVISION OF HIGHWAYS

GIRDER DETAILS (SHEET 1 OF 2)


Designer A. Eriksen	Structure F-12-AM
Detailer S. Martinez	Numbers
Drawing Number B-14	of 13 Drawings

Revision Dates (Preliminary Stage Only)

All Dimensions are along Profile Line and are for Reference Only (See Dwg. B-13 for Actual Dim's)

FEDERAL ROAD DISTRICT	PROJ. NO.	SHEET NO.	TOTAL SHEETS
VIII COLORADO	170-2(52)197	72	

REVISIONS			
R-1	4/4/75	REPRINT	WCB

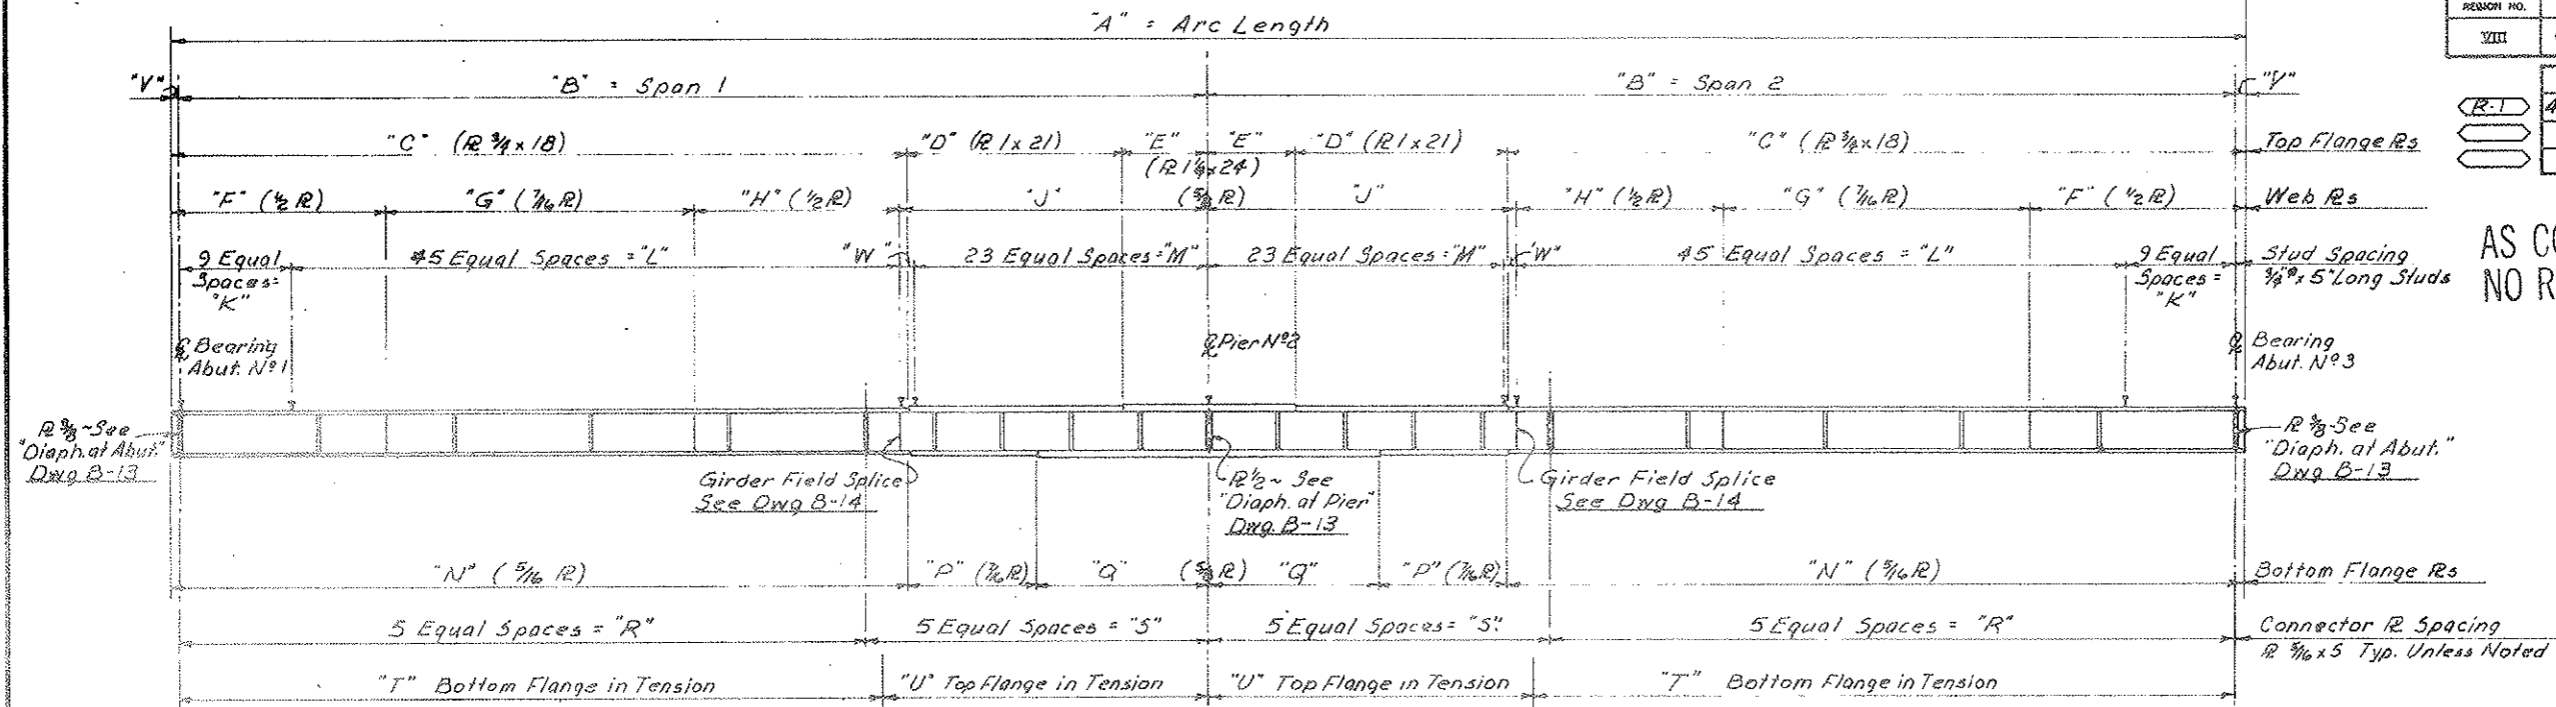

AS CONSTRUCTED
NO REVISIONS DATE: 6-24-77

See Dwg. B-14 for Welding Details

TYPICAL GIRDER
4 Required - Curved - See Schedule for Dimensions
Orig. Scale: None

GIRDER DIMENSION SCHEDULE

DIMENSION	A	B	C	D	E	F	G	H	J	K	L	M	N	P	Q	R	S	T	U	V	W
GIRDER (1)	241'-10"	119'-11"	85'-11"	24'-11"	9'-11"	24'-11"	35'-11"	23'-11"	35'-11"	12'-8"	71'-2"	34'-5"	85'-11"	14'-11"	19'-11"	79'-11"	39'-11"	81'-11"	37'-11"	1'-0"	1'-6"
GIRDER (2)	243'-5"	120'-8"	86'-6"	25'-1"	10'-0"	25'-1"	36'-2"	24'-1"	36'-2"	12'-9"	71'-8"	34'-8"	86'-6"	15'-1"	20'-1"	80'-5"	40'-2"	82'-5"	38'-2"	1'-0"	1'-6"
GIRDER (3)	244'-11"	121'-5"	87'-0"	25'-3"	10'-1"	25'-3"	36'-5"	24'-3"	36'-5"	12'-10"	72'-1"	34'-11"	87'-0"	15'-2"	20'-3"	80'-11"	40'-5"	83'-0"	38'-5"	1'-0"	1'-6"
GIRDER (4)	246'-6"	122'-3"	87'-7"	25'-5"	10'-2"	25'-5"	36'-8"	24'-5"	36'-8"	12'-11"	72'-7"	35'-1"	87'-7"	15'-3"	20'-4"	81'-6"	40'-9"	83'-6"	38'-8"	1'-0"	1'-6"

DESIGNED BY	DATE	REVISIONS BY
A.E.	5-7-72	L.M.
H.G.	5-7-72	L.M.
L.M.	5-7-72	L.M.
L.M.	5-7-72	L.M.


DIVISION OF HIGHWAYS

GIRDER DETAILS
- (SHEET 2 OF 2)

Designer: A. Eriksen Structure: F-12-AM
 Detailer: L. McNamee Numbers:
 Drawing Number B-15 of 18 Drawings




FEDERAL ROAD DISTRICT	PROJ. NO.	SHEET NO.	TOTAL SHEETS
VIII	170-2(82)197	73	

REVISIONS	

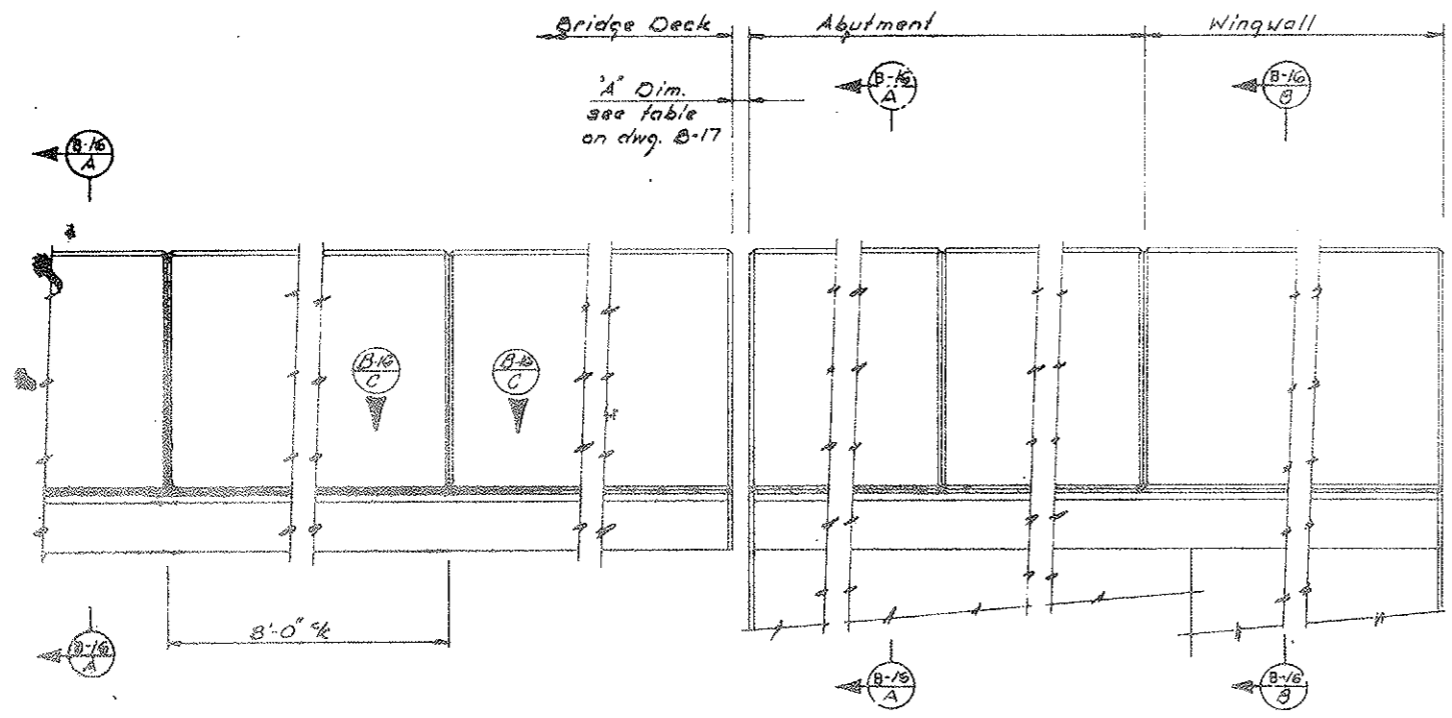

TYPICAL ELEVATION AT ABUTMENT
Orig. Scale: 1" = 1'-0"

AS CONSTRUCTED
NO REVISIONS DATE: 6-24-77

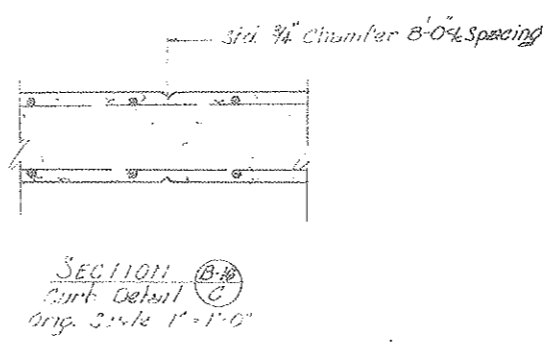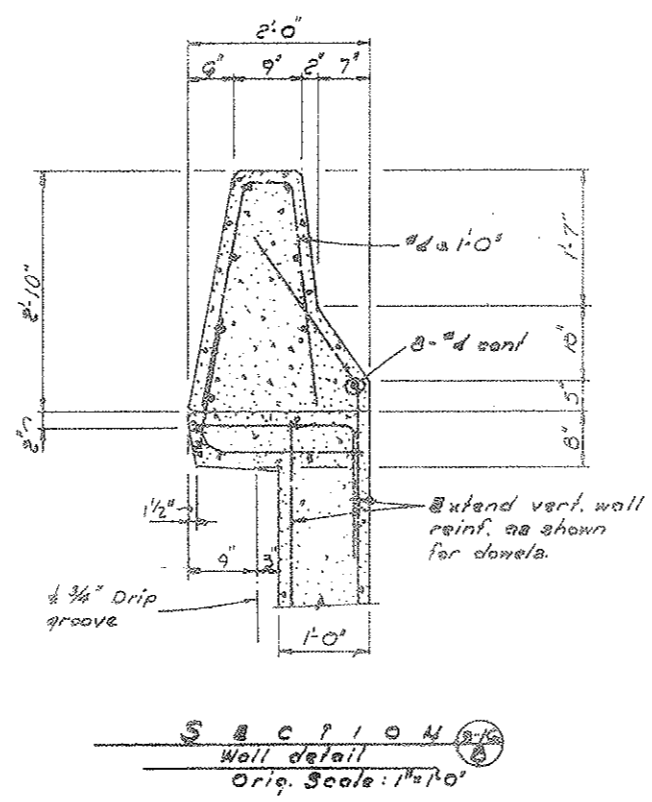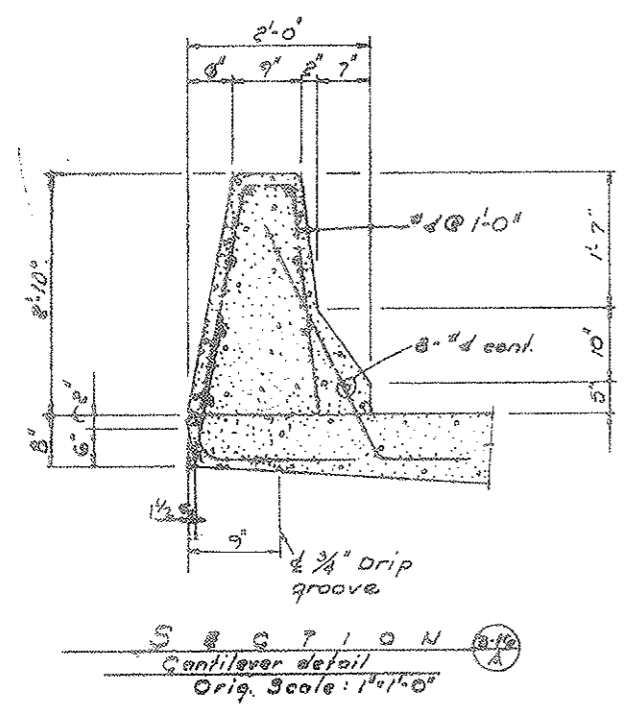

DIVISION OF HIGHWAYS			
BRIDGE RAIL TYPE A			
Designer	A. Eriksen	Structure	F-18-AM
Detailer	D. Groen	Number	
Drawing Number	B-16	of	10 Drawings
Revision Date		Preliminary Date	

FEDERAL ROAD DISTRICT NO.	DIVISION	PROJ. NO.	SHEET NO.	TOTAL SHEETS
XIII	COLORADO	I-70-2 (51) 17	74	

REVISIONS			

NOTES

THE EXPANSION DEVICE SHALL BE INSTALLED ON GRADE, PARALLEL TO THE SLOPE AND GRADE OF THE DECK.

AFTER THE CONCRETE HAS ATTAINED INITIAL SET, THE ATTACHMENTS USED TO HOLD THE ANGLE ASSEMBLY IN ITS PROPER POSITION SHALL BE REMOVED.

DO NOT PAINT STEEL SURFACES IN CONTACT WITH CONCRETE AND PREMOLDED EXPANSION DEVICE.

"M", "T", "G", AND "A" DIMENSIONS ARE DEPENDENT UPON THE PARTICULAR PREMOLDED DEVICE SUPPLIED, AND SHALL BE SHOWN ON THE SHOP DRAWINGS.

THE SHOP DRAWINGS SHALL INDICATE THE "W" DIMENSION AT A RANGE OF TEMPERATURES FROM 30° TO 100° ASSUMING A MID-POINT TEMPERATURE OF 40°.



ANGLE AND PLATE ASSEMBLIES TO EXTEND GUTTER TO GUTTER ONLY.

ALL SECTIONS OF THE PREMOLDED EXPANSION DEVICE SHALL BE JOINED BY USING THE MANUFACTURER'S STANDARD WATERPROOF JOINT.


ALL CURB UNITS SHALL BE FULL WIDTH, ON GUTTER LINE, FOR SKEW ANGLES AS SPECIFIED ON THE PLANS.

ALL ANCHORS SHALL BE CAST IN PLACE BOLTS OR THREADED CAST IN PLACE CONCRETE INSERTS EXCEPT FOR CURB AND WALK UNITS WHICH MAY BE INSTALLED BY THE USE OF APPROVED DRILLED IN PLACE ANCHOR UNITS.

OPENING IN CURB AND SIDEWALK TO BE CONSTRUCTED TO THE EXACT WIDTH OF THE EXISTING DECK OPENING.

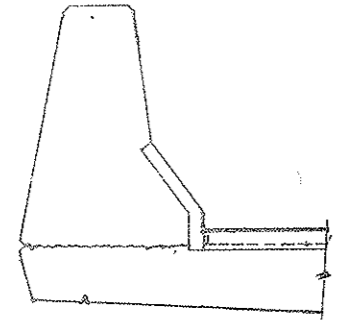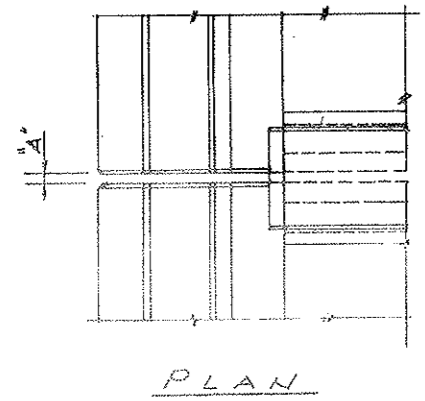

DETAILS OF EXPANSION JOINT @ GUARDRAIL

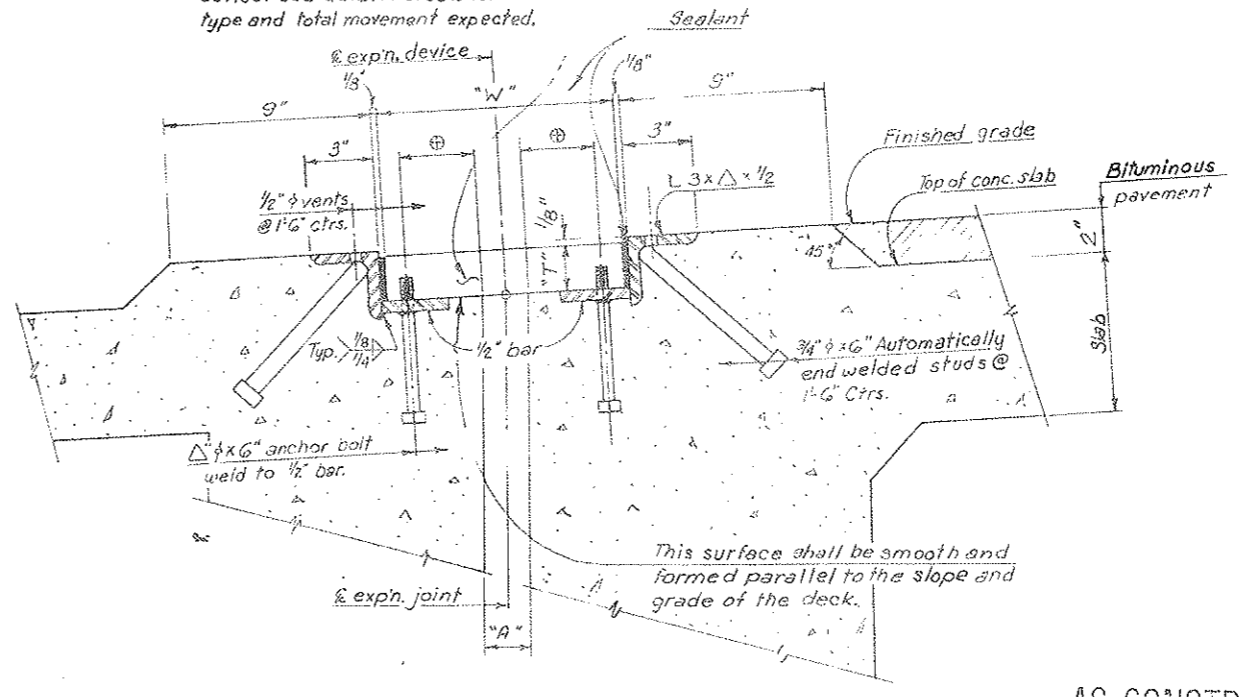

Premolded elastomeric metal reinforced bridge expansion device. See details elsewhere for type and total movement expected.

SECTION THRU EXPN. DEVICE

AS CONSTRUCTED
NO REVISIONS DATE: 6-24-77

* Bridge Expansion Device Type 1 to be used.

Premolded Bridge Expansion Device

Outside Temp.	(Type 1)	(Type 2)	(Type 3)
	Dim. "A" (Min.)	Dim. "A" (Min.)	Dim. "A" (Min.)
30°	1 3/8"	2 1/8"	2 3/8"
40°	1 1/2"	2 1/8"	2 5/8"
50°	1 5/8"	2"	2 1/2"
60°	1 3/4"	1 7/8"	2 3/8"
70°	1 1/2"	1 5/8"	2 1/8"
80°	1"	1 1/2"	2"
90°	3/8"	1 1/8"	1 3/4"
100°	3/8"	1 1/4"	1 5/8"

Premolded Bridge Expansion Device

Outside Temp.	(Type 4)	(Type 6)	(Type)
	Dim. "A" (Min.)	Dim. "A" (Min.)	Dim. "A" (Min.)
30°	4 3/8"	5 3/8"	
40°	4 1/8"	4 1/8"	
50°	3 7/8"	4 1/2"	
60°	3 5/8"	4"	
70°	3 1/4"	3 5/8"	
80°	3"	3 1/4"	
90°	2 3/4"	2 3/4"	
100°	2 1/2"	2 3/8"	

DIVISION OF HIGHWAYS

BRIDGE EXPANSION DEVICE
PREMOLDED ARMORED


Designer *A. Eriksen* Structure *F-12-AM*
 Detailer *J.R. Ewert* Numbers
 Drawing Number *B-17* of *15* Drawings

(7-1-74)

DESIGNED BY	CHECKED BY	DATE
CHECKED BY	QUANTITIES BY	
DATE	DATE	
CHECKED BY	DATE	
DATE		


FEDERAL ROAD DISTRICT NO.	DIVISION	PROJ. NO.	SHEET NO.	TOTAL SHEETS
VIII	COLORADO	1-2-57-177	75	

REVISIONS	

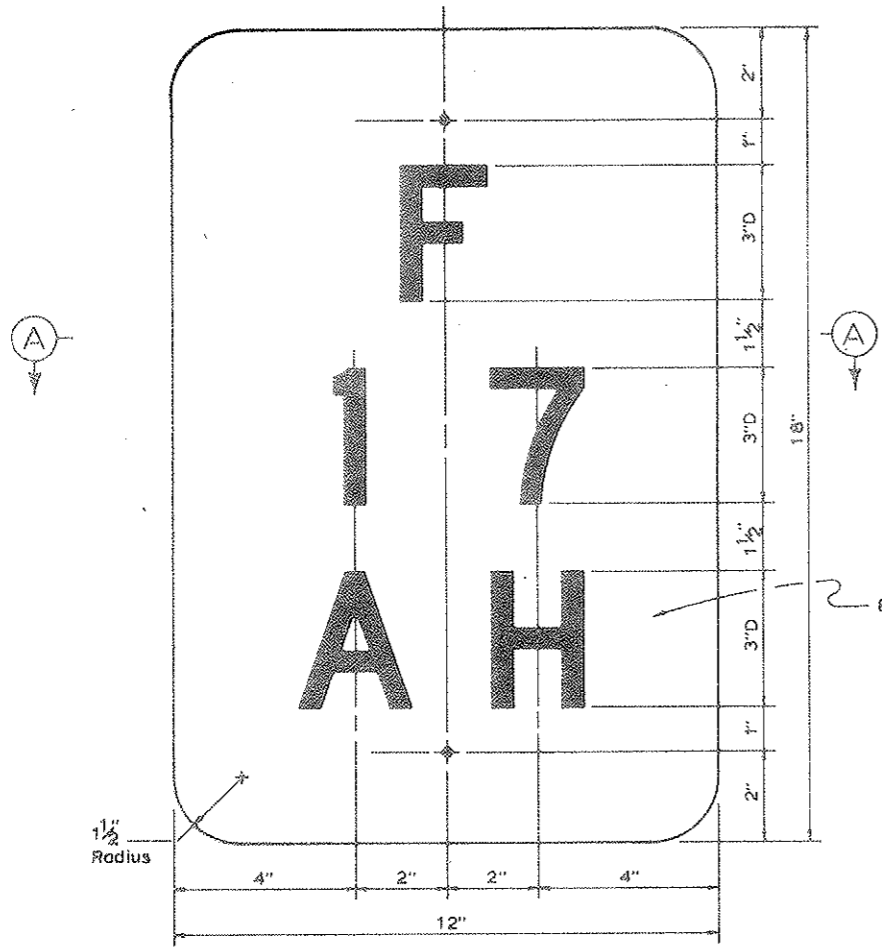


Black letters and numbers on white background.

STRUCTURE IDENTIFICATION PANEL
 (SAMPLE NUMBERS & LETTERS)

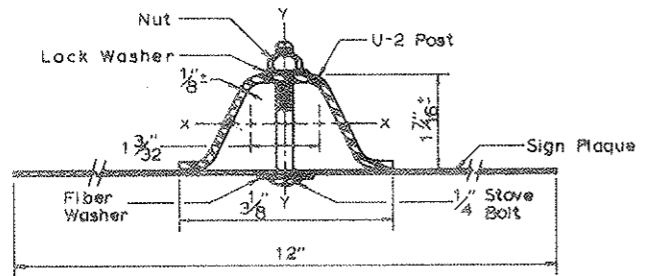


SECTION (A)

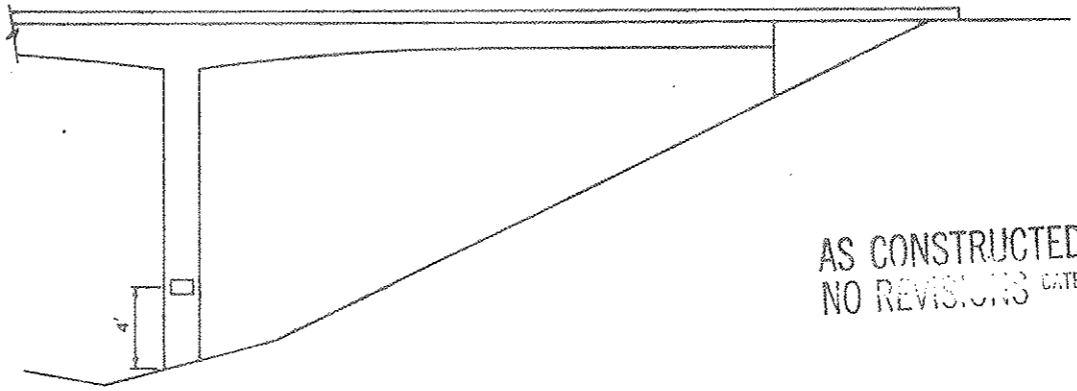


STRUCTURE NUMBER LOCATION ON PIERS

AS CONSTRUCTED
 NO REVISIONS DATE: 6-24-77

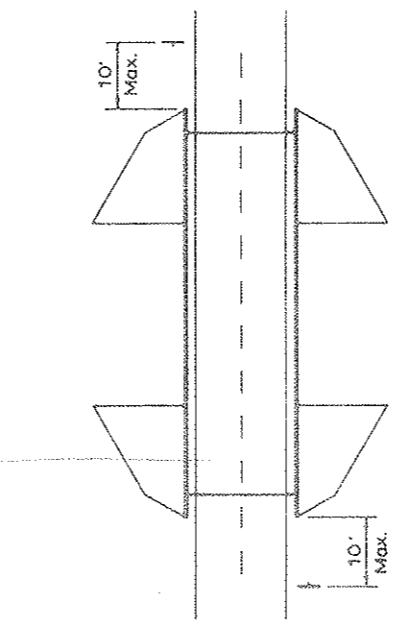

① STANDARD LOCATION DETAIL

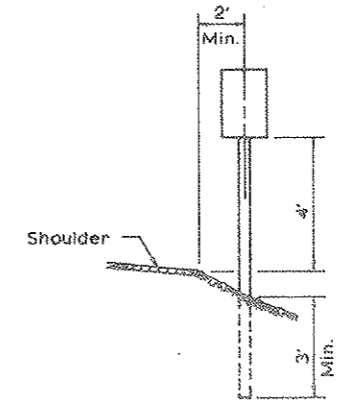

U-2 POST IN GROUND

ALL WORK SHALL BE DONE IN ACCORDANCE WITH THE STANDARD SPECIFICATIONS APPLICABLE TO THE PROJECT.

SIGN PANEL SHALL BE FABRICATED FROM EITHER SHEET STEEL 0.0598 MIN. THICKNESS OR SHEET ALUMINUM 0.080 MIN. THICKNESS.

SIGN PANEL SHALL BE GROUND MOUNTED.

U-2 POST SHALL MEET REQUIREMENTS OF PAR. 4.5 U.S. DEPT. OF COMMERCE, COMMERCIAL STANDARD 184-01. ACCEPTABLE MATERIAL INCLUDES REROLLED RAILROAD RAILS. U-2 POST SHALL BE 2 LBS. PER FT. EXCEPT THAT A HILL TOLERANCE OF MINUS 3-1/25 OF THE WEIGHT OF ANY ONE POST WILL BE ALLOWED. ALTERNATE METAL POST WILL BE ACCEPTABLE IF SECTION MODULUS IS AT LEAST 0.200 IN.³ ABOUT THE X-X AXIS AND AT LEAST 0.280 IN.³ ABOUT THE Y-Y AXIS.

SIGN PANEL SHALL BE FASTENED DIRECTLY TO THE POST WITH TWO 1/4" GALVANIZED OR CADMIUM PLATED STOVE BOLTS. A PLASTIC FIBER WASHER SHALL BE PLACED BETWEEN THE BOLTS HEAD AND THE FACE OF THE PANEL. A GALVANIZED OR CADMIUM PLATED LOCK WASHER SHALL BE PLACED UNDER THE NUT ON THE BACK OF THE POST. EXPOSED BOLT HEADS AND FIBER WASHERS ON THE FACE OF THE SIGN PANEL SHALL BE PAINTED TO MATCH THE SURROUNDING COLOR.

LETTERS AND NUMBERS SHALL BE SERIES "D". THEY SHALL BE 3" HIGH.

THE CORRECT STRUCTURE NUMBER IS SHOWN ON THE PLANS.

① OMIT STRUCTURE NUMBER STANDARDS WHERE A RAILROAD TRACK CROSSES OVER THE ROADWAY.

STRUCTURE NUMBER STANDARD SHALL NOT BE PAID FOR SEPARATELY BUT INCLUDED IN THE WORK.

IN ADDITION TO THE REQUIREMENTS STATED ABOVE, STRUCTURE NUMBERS FOR HIGHWAYS PASSING UNDER CROSSROADS ARE TO BE PLACED AT THE FOLLOWING POINTS:

(A) FOR STRUCTURES OF THREE OR MORE SPANS, THE STRUCTURE NUMBER SHALL BE STENCILED, FACING TRAFFIC, ON THE OUTSIDE FACE OF THE END COLUMN OF THE RIGHT HAND PIER.

(B) FOR TWO SPAN STRUCTURES, THE STRUCTURE NUMBER SHALL BE STENCILED, FACING TRAFFIC, ON THE OUTSIDE FACE OF EACH END COLUMN OF THE CENTER PIERS.

DIVISION OF HIGHWAYS			
STRUCTURE NUMBER STANDARD			
Designer	A. Erikson	Structure Number	F-12-AM
Detailer	B.P. Lutz	Sheet	of 15
Drawing Number	B.P.	Drawings	