

FEDERAL ROAD REGION NO.	DISTRICT	PROJ. NO.	SHEET NO.	TOTAL SHEETS
XIII	COLORADO	I-70-2(52)197	76	

REVISIONS		
R-1	4-17-75	Rev. Quantities
R-2	5-6-75	Rev. Steel Quantity, Note

VOID
BY CONSTRUCTION DATE 6-24-77

GENERAL NOTES:

ALL WORK SHALL BE DONE ACCORDING TO THE STANDARD SPECIFICATIONS OF THE DIVISION OF HIGHWAYS, STATE OF COLORADO, APPLICABLE TO THE PROJECT.

ALL CONCRETE SURFACES AS REFERRED TO IN THE SPECIFICATIONS SHALL RECEIVE A CLASS 7 SURFACE FINISH.

ALL CONCRETE CHAMFERS SHALL BE 3/4 INCH UNLESS OTHERWISE NOTED.

EXPANSION JOINT MATERIAL SHALL MEET A.A.S.H.O. SPECIFICATION M 213-65 AND SHALL BE INCLUDED IN THE PAYMENT FOR ITEM NO. 601.

SOUNDINGS AND DEPTH OF FOOTINGS ARE IN ACCORDANCE WITH THE BEST AVAILABLE DATA. WHEN DIFFERENT CONDITIONS ARE ENCOUNTERED, THE BRIDGE ENGINEER WILL INSPECT AND DETERMINE IF REDESIGN IS NECESSARY.

WHEN EXCAVATING FOR FOOTINGS, THE FINAL SIX INCHES IN DEPTH SHALL BE DONE BY HAND LABOR METHODS.

FOOTINGS IN ROCK SHALL NOT BE FORMED BUT SHALL BE PLACED AGAINST UNDISTURBED ROCK.

FOR DETAILS OF STRUCTURE EXCAVATION AND STRUCTURE BACKFILL, SEE STANDARD M-206-AA.

ALL STRUCTURAL STEEL NOT OTHERWISE NOTED SHALL BE A.A.S.H.O. SPECIFICATION M-183. (ASTM A36)

ALL STRUCTURAL STEEL NOT OTHERWISE NOTED SHALL BE PAINTED IN ACCORDANCE WITH SECTION 509 FOR () PAINT.

GRADE 60 REINFORCING STEEL REQUIRED FOR #5 BARS AND LARGER GRADE 40 OR GRADE 60 MAY BE FURNISHED FOR #4 BARS.

FORM, CONSTRUCTION EQUIPMENT, AND ADDITIONAL CONSTRUCTION LOADS WERE NOT CONSIDERED IN ANALYZING THIS STRUCTURE.

DESIGN PROVISIONS WERE MADE FOR A ONE SEGMENT UNBALANCED CANTILEVER MOMENT AT THE END OF THE CANTILEVER DURING CONSTRUCTION STAGES. FOR THE UNBALANCED MOMENT VALUES, SEE DWG. NO. B-9. THIS APPLIES TO THE FOOTINGS ONLY.

APPLIED WIND LOADS AND EARTHQUAKE LOADS WERE NOT CONSIDERED IN ANALYZING THE STRUCTURE FOR STABILITY DURING THE CONSTRUCTION STAGES.

THE SEQUENCE OF CONSTRUCTION SHALL BE AS SHOWN ON DWG. NO. B-11. ANY CHANGE IN THIS CONSTRUCTION SEQUENCE SHALL BE WITH THE APPROVAL OF THE ENGINEER.

APPLY EPOXY JOINT SEALER TO ALL MATCHING SURFACES OF PRECAST SEGMENTS IN ACCORDANCE WITH THE SPECIFICATIONS.

GROUP ALL ANCHORAGE BLOCKOUTS AND MATCH EXPOSED SURFACES TO PRECAST SEGMENTS. BEFORE ANY FORMS ARE REMOVED FROM THE PRECAST SEGMENTS, F_c SHALL OBTAIN A COMPRESSIVE STRENGTH OF 3000 P.S.I.

Summary of Quantities

Item	Description	Unit	Structure No. F-12-AN					Total
			Super-Structure	Abut. 1	Pier 2	Pier 3	Abut. 4	
200	Structure Excavation	Cu. Yd.		175	89	268	135	667
200	Structure Backfill (Class 2)	Cu. Yd.		96	42	182	87	407
403	Hot Bituminous Pavement (Grading)	Ton	178					178
411	Asphalt Cement (AC-57)	Ton	13					13
502	Steel Piling (HP 10X42)	Lin. Ft.		80				80
502	Steel Piling (HP 12X74)	Lin. Ft.		105				105
509	Structural Steel	Lbs.	700	70			70	840
512	Bearing Device (0 to 250 Tons)	Lin. Ft.		2			2	4
512	Bearing Device (501 to 750 Tons)	Lin. Ft.			2	2		4
515	Waterproofing (Membrane)	Sq. Yd.	1634					1634
518	Bridge Expansion Device (Type 1)	Lin. Ft.	76					76
601	Concrete Class A (Bridge)	Cu. Yd.		22	40	40	19	121
601	Concrete Class A (Bridge) (Colored)	Cu. Yd.		39			35	74
601	Concrete Class D (Bridge) (Colored)	Cu. Yd.		97	18		15	130
602	Reinforcing Steel	Lbs.	8205	11,530	3330	3330	10,300	36,695
618	Conc. Segmental Superstr. (F-12-AN)	L.S.	1					1
618	Conc. Segmental Pier (F-12-AN)	L.S.						1
626	Mobilization	L.S.						0.2

- ① Concrete Class S (Precast) (Colored) 830 Cu. Yd. (R-2)
- ① Reinforcing Steel 138,446 Lbs. (R-2)
- ① Prestressing Strands 28,960 Lbs. (R-2)
- ② Concrete Class S (Colored) 137 Cu. Yd.
- ② Reinforcing Steel 14,100 Lbs. (R-2)
- ② Prestressing Strands 970 Lbs. (R-2)
- ③ W 10X45 or HPS 10X42 May be used in lieu of the HP 10X42
- ④ Future Item

DESIGN FOUNDATION PRESSURES

Description	Allowable Pile Load	Computed Pile Load	Allowable Pile Pressure	Computed Pile Pressure
Abutment 1	78 Tons	96.7 Tons		
Abutment 1 Wingwall	55 Tons	54.9 Tons		
Pier 2			6 Tons per sq. ft.	5.9 Tons per sq. ft.
Pier 3			6 Tons per sq. ft.	5.9 Tons per sq. ft.
Abutment 4			6 Tons per sq. ft.	4 Tons per sq. ft.
Abutment 4 Wingwall			6 Tons per sq. ft.	4.2 Tons per sq. ft.

INDEX OF DRAWINGS


Dwg. No.	Title
B-1	General Information
B-2	General Layout
B-3	Engineering Geology
B-4	Elevations
B-5	Elevations
B-6	Construction Layout & Footing & Piling Layout
B-7	Abutment 1 Details
B-8	Abutment 4 Details
B-9	Pier Details
B-10	Superstructure Details
B-11	75 Ft. Cantilever & Sequence of Construction
B-12	Prestressing Details
B-13	Girder Details
B-14	Girder Elevations & Continuity Prestressing
B-15	Bearing Details
B-16	Expansion Device Details
B-17	Structure Numbers Standard

DESIGNED BY	DATE	CHECKED BY	DATE
DRAWN BY	DATE	QUANTITIES BY	DATE
DETAILS BY	DATE	APPROVED BY	DATE

THE FOLLOWING TABLE SHOWS THE MINIMUM LAP FOR COMMON BAR SIZES.

BAR SIZE NUMBER	4	5	6	7	8	9	10	11
SPLICE	GRADE 40 1'-0"	1'-3"	1'-6"	1'-9"	2'-2"	2'-8"	3'-5"	4'-3"
LENGTH	GRADE 60 1'-6"	1'-11"	2'-3"	2'-8"	3'-0"	3'-5"	4'-2"	5'-0"

E. F. = EACH FACE
N. F. = NEAR FACE
F. F. = FAR FACE

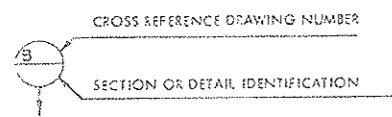

LOADING DATA

LIVELOAD: A.A.S.H.O. HS-20-44 OR INTERSTATE ALTERNATE
DEADLOAD: ASSUMES 25 LBS. PER SQ. FT. FOR BITUMINOUS PAVEMENT

DESIGN DATA:

A.A.S.H.O. 1973 UNIT STRESSES, AND 1974 INTERIM SPECIFICATIONS, EXCEPT AS NOTED.

REINFORCING STEEL: GRADE 60 - FY = 60,000 LBS. PER SQ. IN.
FS = 24,000 LBS. PER SQ. IN.
GRADE 40 - FY = 40,000 LBS. PER SQ. IN.
FS = 20,000 LBS. PER SQ. IN.


STRUCTURAL STEEL: A36, GRADE 36 - FY = 36,000 LBS. PER SQ. IN.
A588, GRADE 50 - FY = 50,000 LBS. PER SQ. IN.

CONCRETE: CLASS A & D - F_c = 3000 LBS. PER SQ. IN.
N = 9
CLASS S - (FOR LIMITS SEE PLANS.) F_c = 5000 LBS. PER SQ. IN.
F_c = 5500 LBS. PER SQ. IN.

BRIDGE DESCRIPTION

3 Span (100'-0", 150'-0", 100'-0")
Continuous Post Tensioned Prestressed Segmental Concrete Box Girder Bridge.

Over Stafford Gulch
38'-0" Roadway curb to curb, 90° Skew
Type 4 Bridge Rail

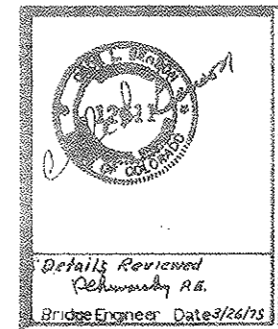

DIVISION OF HIGHWAYS			
GENERAL INFORMATION			
SUMMARY OF QUANTITIES			
Station 943+28.500		Station 947+11.500	
Near	Vail	Sec.	T. R.
Designer	J. Keller	Structure Number	F-12-AN
Detailer	P.S.	Drawing Number	B-1 of 17 Drawings


0(10-19-73)

Check dimensions of structure
 against the record plans or conditions
 on file on file
 on file.


FEDERAL ROAD DISTRICT NO.	DISTRICT	PROJ. NO.	SHEET NO.	TOTAL SHEETS
XIII	COLORADO	170-2(52)197	77	

REVISIONS	

VOID
 CONSTRUCTION DATE 6-24-77

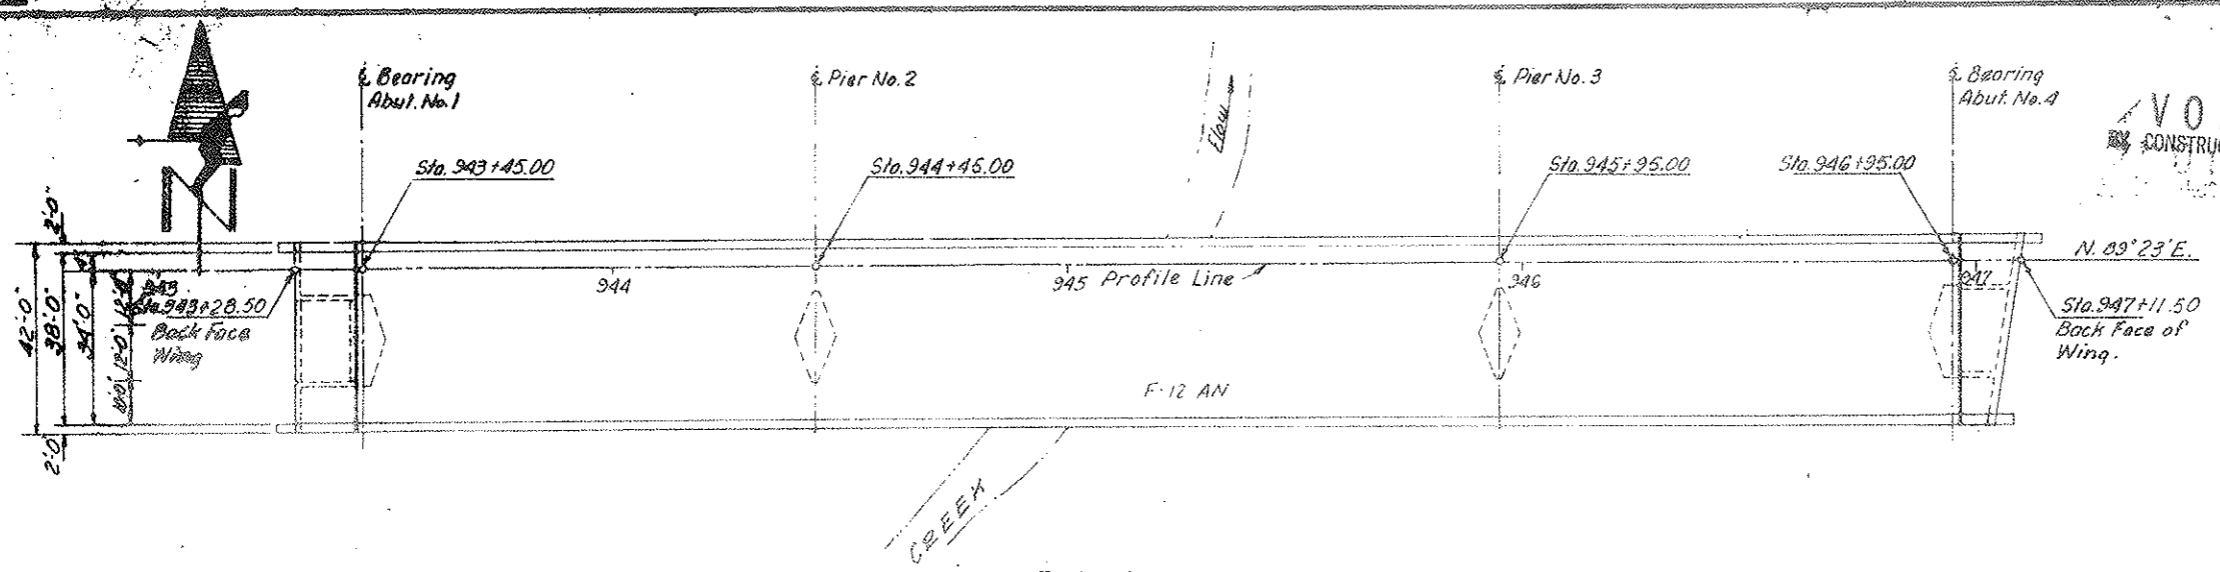


PLAN
 Orig. Scale: 1" = 20'

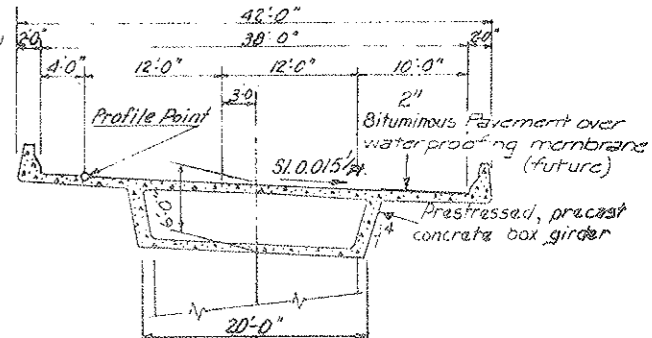


TYPICAL SECTION
 Orig. Scale: 1/8" = 1'-0"

DESIGNED BY	APPROVED BY
DRAWN BY	CHECKED BY
IN CHARGE	DATE

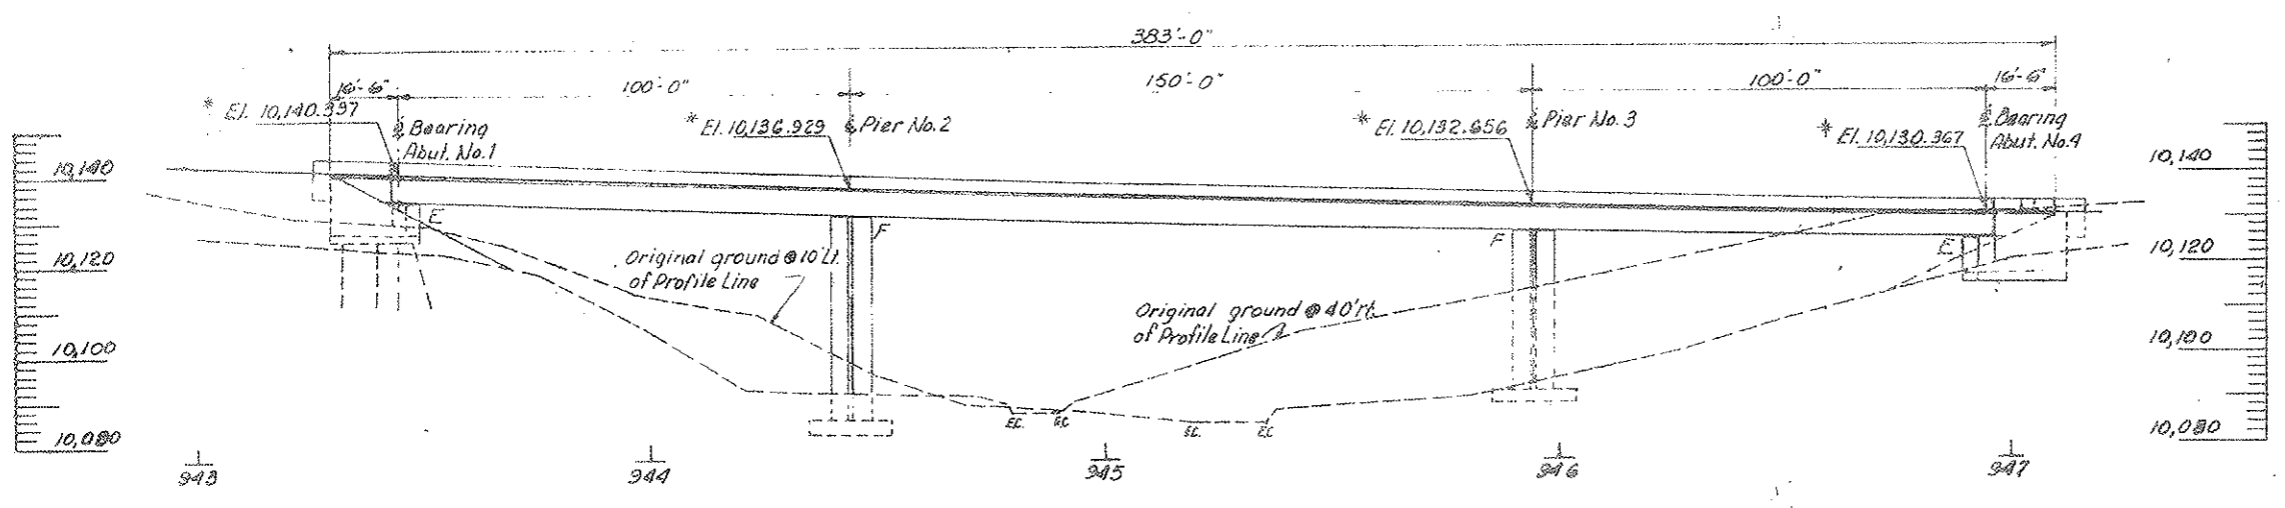

ELEVATION
 Taken along \pm of Roadway
 Orig. Scale: 1" = 20'
 * Finished roadway elevations and
 Horizontal dimensions are along profile lines

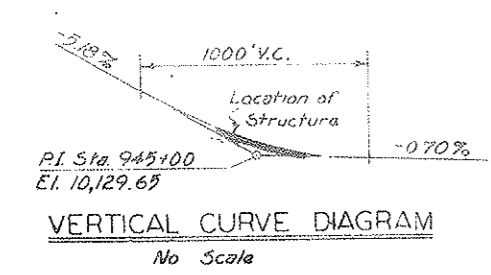



DIVISION OF HIGHWAYS

GENERAL LAYOUT

Designer	J. KELLER	Structure Numbers	F-12-AN
Detailer	P. H. S.		
Drawing Number	B-2	of 17	Drawings

FED. ROAD REG. NO.	DIVISION	PROJECT NO.	SHEET NO.	TOTAL SHEETS
XIII	COLO.	170-2()197	78	

VOID
BY CONSTRUCTION DATE 6-24-77

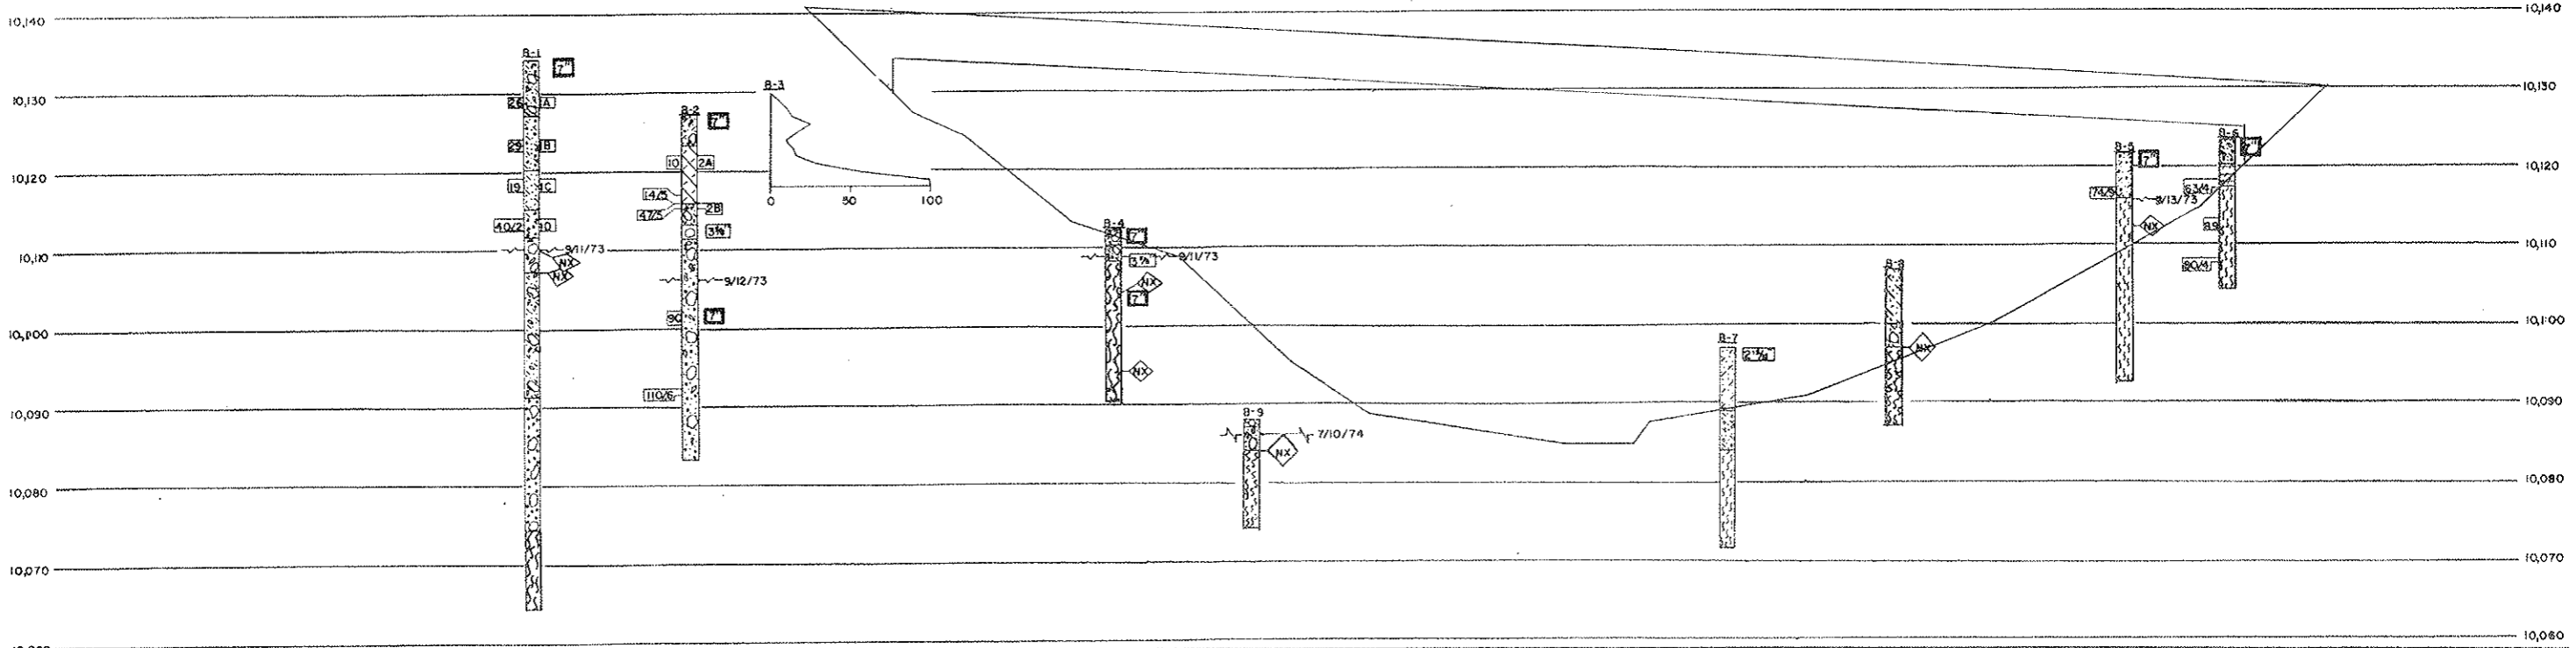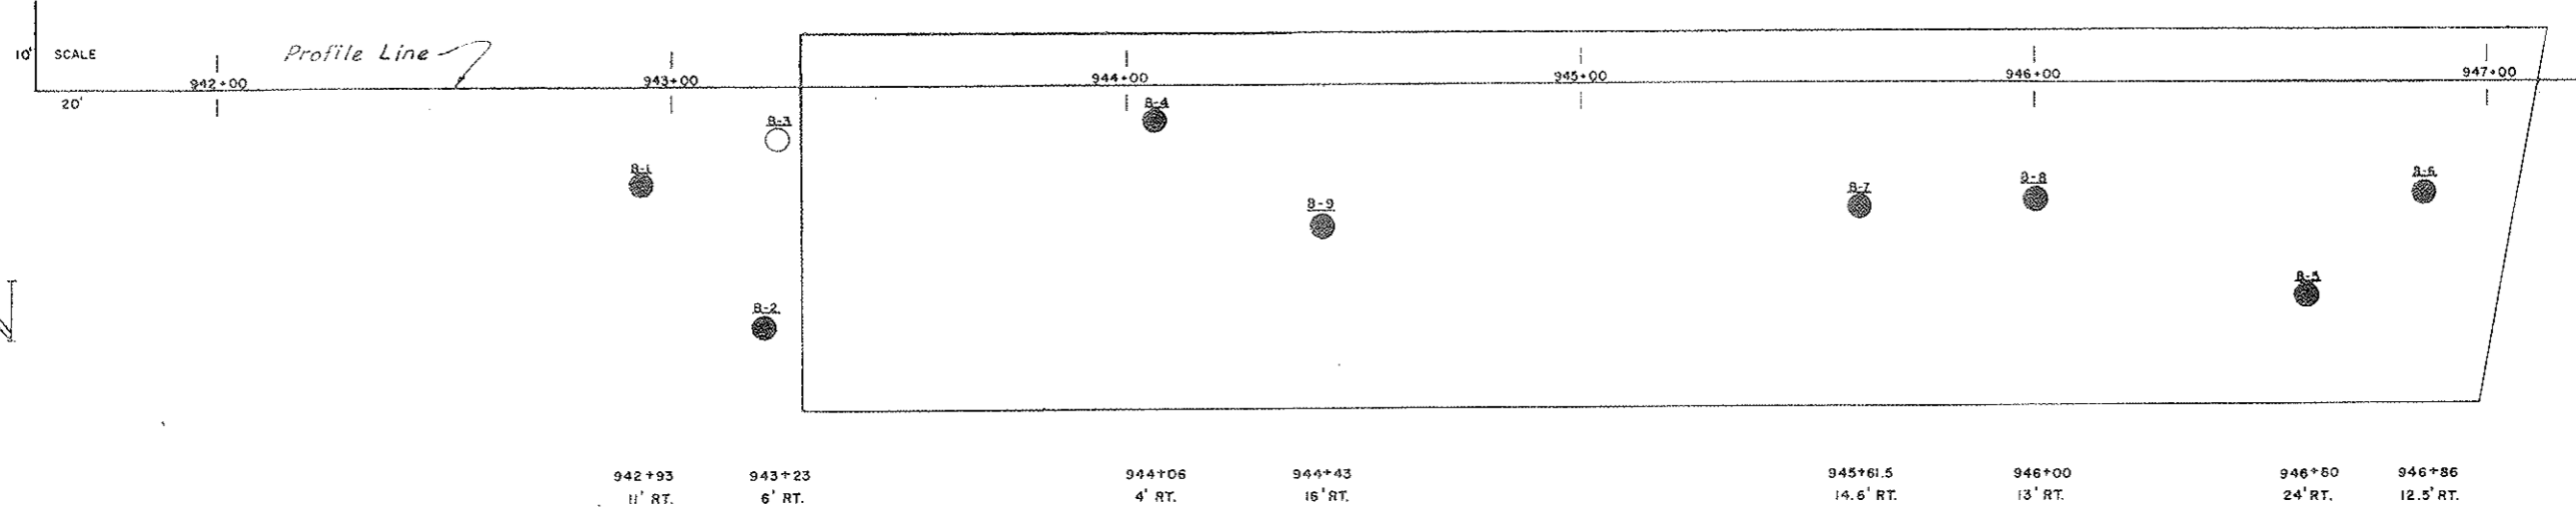

SUMMARY OF TEST RESULTS

Sample No.	Depth	Classification	Grading Analysis	Atterberg Limits			Water Cont. %	Unit Weight	Shrinkage	Triaxial Shear Strength						Dis. of Sample (inches)	
				Liquid Limit	Plastic Limit	Plastic Index				Unconsolidated		Consolidated		Time hrs.	Press. P.S.I.		
										σ _v	σ _h	σ _v	σ _h				
1A	4.5-6.0	SILTY GRAVELLY SAND	A-2-4(O)	31	20	22	27	22	16	6	6.5						
1B	10.0-11.5	SILTY GRAVELLY SAND	A-1-b(O)	39	23	27	11	NV	NP	NP	3.9						
1C	15.0-16.5	SANDY SILT	A-4(O)	2	1	37	60	NV	NP	NP	18.2						
1D	20.0-21.2	SILTY SAND	A-1-a(O)	63	11	11	15	NV	NP	NP	5.4						
2A	5.3-6.8	SANDY CLAY	A-4(5)	5	3	16	76	30	22	8	16.8						
2B	11.3-11.8	SILTY SANDY GRAVEL	A-2-4(O)	52	8	11	29	22	20	2	9.1						
5A	4.5-5.9	SILTY SAND	A-1-b(O)	10	46	32	12	NV	NP	NP	5.3						

TYPE OF MATERIAL

- ☐ SILTY, GRAVELLY SAND w/COBBLES & BOULDERS
- ☐ SILTY, GRAVELLY SAND
- ☐ COBBLES & BOULDERS
- ☐ SILTY SAND w/COBBLES & BOULDERS
- ☐ CLAYEY SILT
- ☐ GRAVELLY SILT w/COBBLES & BOULDERS
- ☐ SANDY SILT
- ☐ SILTY SAND
- ☐ SANDY, GRAVELLY SILT w/COBBLES
- ☐ SANDY GRAVEL w/COBBLES & BOULDERS
- ☐ SANDY, GRAVELLY SILT
- ☐ SANDY, GRAVELLY SILT w/COBBLES
- ☐ BOULDER
- ☐ SANDSTONE
- ☐ SILTSTONE

LEGEND

TEST BORING

CONTINUOUS PENETRATION TEST

Location of Test Boring

Location of Continuous Penetration Test

Rotary Boring

Auger Boring

Core Boring

Blows Per Foot Standard Penetration Test

Water Table

2 in. O.D. Split-Tube Sampler

140 Lb. Hammer

30 in. Free Fall

Blows per Foot

DIVISION OF HIGHWAYS
STATE OF COLORADO

ENGINEERING GEOLOGY

Across STAFFORD GULCH

Sta. 3957

Near VAIL PASS

Geologist A.C.E. Made by D.L.S. Checked by D.L.S.

Approved by Bridge Engineer Date: 19

STRUCTURE NO. E-12-AN
DWG. NO. 8-23 OF 17

DIVISION OF HIGHWAYS

STATE OF COLORADO

BRIDGE GEOMETRICS

DATE OF RUN : 74/10/23.

DATE OF DATA : 10/19/74

DESIGNER : JOE KELLER

CHECKER : J.K.

JOB DESCRIPTION : STAFFORD GULCH STA 945 CONC. BOX

FEDERAL ROAD REGION NO.	DISTRICT	PROJ. NO.	SHEET NO.	TOTAL SHEETS
VIII	COLORADO	70-2(5.1)97	79	

REVISIONS	
NO.	DESCRIPTION

VOID BY CONSTRUCTION DATE 6-24-77

INPUT DATA

HORIZONTAL ALIGNMENT DATA.....

DEGREE OF CURVATURE : -0 -0 -0

VERTICAL ALIGNMENT DATA.....

VERTICAL CURVE NO. 1 : PT STATION 945+ .00 PI ELEV 10129.543 VC LENGTH 1000.000 G1 -5.176100 G2 -.700000

SUPERELEVATION DATA.....

SUPERELEVATION NO. 1 : STATION 942+63.44 RATE LEFT .0000 RATE RIGHT -.0000
 SUPERELEVATION NO. 2 : STATION 943+63.44 RATE LEFT .0150 RATE RIGHT -.0150
 SUPERELEVATION NO. 3 : STATION 949+ .00 RATE LEFT .0150 RATE RIGHT -.0150

BENT LINE INPUT				BENT LINE INPUT				BENT LINE INPUT				BENT LINE INPUT					
DISTANCE FROM REFERENCE LINE (TYPE)	DESCRIPTION OF BENT LINE	DESCRIPTION OF LINE	SKW ANGLE OF BENT LINE REFERENCED TO CHORD OR TANGENT	STATION OF INTERSECTION OF LINE AND BENT LINE	ROADWAY ELEVATION AT INTERSECTION OF LINE AND BENT LINE	DISTANCE FROM REFERENCE LINE (TYPE)	DESCRIPTION OF BENT LINE	DESCRIPTION OF LINE	SKW ANGLE OF BENT LINE REFERENCED TO CHORD OR TANGENT	STATION OF INTERSECTION OF LINE AND BENT LINE	ROADWAY ELEVATION AT INTERSECTION OF LINE AND BENT LINE	DISTANCE FROM REFERENCE LINE (TYPE)	DESCRIPTION OF BENT LINE	DESCRIPTION OF LINE	SKW ANGLE OF BENT LINE REFERENCED TO CHORD OR TANGENT	STATION OF INTERSECTION OF LINE AND BENT LINE	ROADWAY ELEVATION AT INTERSECTION OF LINE AND BENT LINE
0.000000	REFERENCE LINE	CONSTR. CL	0 0 .0	943+28.500	10140.7961	0.000000	REFERENCE LINE	CONSTR. CL	0 0 .0	943+28.500	10140.7961	0.000000	REFERENCE LINE	CONSTR. CL	0 0 .0	943+28.500	10140.7961
0.000000	ABUT. 1	CONSTR. CL	0 0 .0	943+28.500	10140.7961	56.500000	8/ 20 PT.= 2	CONSTR. CL	0 0 .0	943+85.000	10138.7529	139.000000	3/ 20 PT.= 3	CONSTR. CL	0 0 .0	944+67.500	10136.0566
4.125000	1/ 6 PT.= 1	CONSTR. CL	0 0 .0	943+32.625	10140.6412	61.500000	9/ 20 PT.= 2	CONSTR. CL	0 0 .0	943+90.000	10138.5808	154.000000	5/ 20 PT.= 3	CONSTR. CL	0 0 .0	944+82.500	10135.5991
8.250000	2/ 4 PT.= 1	CONSTR. CL	0 0 .0	943+36.750	10140.4870	66.500000	10/ 20 PT.= 2	CONSTR. CL	0 0 .0	943+95.000	10138.4098	161.500000	6/ 20 PT.= 3	CONSTR. CL	0 0 .0	944+90.000	10135.3742
12.375000	3/ 4 PT.= 1	CONSTR. CL	0 0 .0	943+40.875	10140.3335	71.500000	11/ 20 PT.= 2	CONSTR. CL	0 0 .0	944+ .000	10138.2400	169.000000	7/ 20 PT.= 3	CONSTR. CL	0 0 .0	944+97.500	10135.1517
16.500000	CL BRG ABUT 1	CONSTR. CL	0 0 .0	943+45.000	10140.1809	76.500000	12/ 20 PT.= 2	CONSTR. CL	0 0 .0	944+ 5.000	10138.0713	176.500000	8/ 20 PT.= 3	CONSTR. CL	0 0 .0	945+ 5.000	10134.9318
21.500000	1/ 20 PT.= 2	CONSTR. CL	0 0 .0	943+50.000	10139.9968	81.500000	13/ 20 PT.= 2	CONSTR. CL	0 0 .0	944+10.000	10137.9037	186.000000	9/ 20 PT.= 3	CONSTR. CL	0 0 .0	945+12.500	10134.7144
26.500000	2/ 20 PT.= 2	CONSTR. CL	0 0 .0	943+55.000	10139.8139	86.500000	14/ 20 PT.= 2	CONSTR. CL	0 0 .0	944+15.000	10137.7372	191.500000	10/ 20 PT.= 3	CONSTR. CL	0 0 .0	945+20.000	10134.4995
31.500000	3/ 20 PT.= 2	CONSTR. CL	0 0 .0	943+60.000	10139.6321	91.500000	15/ 20 PT.= 2	CONSTR. CL	0 0 .0	944+20.000	10137.5718	199.000000	11/ 20 PT.= 3	CONSTR. CL	0 0 .0	945+27.500	10134.2871
36.500000	4/ 20 PT.= 2	CONSTR. CL	0 0 .0	943+65.000	10139.4524	96.500000	16/ 20 PT.= 2	CONSTR. CL	0 0 .0	944+25.000	10137.4076	206.500000	12/ 20 PT.= 3	CONSTR. CL	0 0 .0	945+35.000	10134.0772
41.500000	5/ 20 PT.= 2	CONSTR. CL	0 0 .0	943+70.000	10139.2758	101.500000	17/ 20 PT.= 2	CONSTR. CL	0 0 .0	944+30.000	10137.2444	214.000000	13/ 20 PT.= 3	CONSTR. CL	0 0 .0	945+42.500	10133.8699
46.500000	6/ 20 PT.= 2	CONSTR. CL	0 0 .0	943+75.000	10139.1004	106.500000	18/ 20 PT.= 2	CONSTR. CL	0 0 .0	944+35.000	10137.0824	221.500000	14/ 20 PT.= 3	CONSTR. CL	0 0 .0	945+50.000	10133.6851
51.500000	7/ 20 PT.= 2	CONSTR. CL	0 0 .0	943+80.000	10138.9261	111.500000	19/ 20 PT.= 2	CONSTR. CL	0 0 .0	944+40.000	10136.9215						

DESIGNED BY	JOE KELLER
CHECKED BY	J.K.
QUANTITIES BY	
CHECKED BY	

DIVISION OF HIGHWAYS

ELEVATIONS

Designer	J. Keller	Structure	F. 12 - AN
Detailer	P.H.S.	Numbers	
Drawing Number	B-4	of	17 Drawings

(Preliminary Stage Only)

FEDERAL ROAD REGION NO.	DISTRICT	PROJ. NO.	SHEET NO.	TOTAL SHEETS
VIII	COLORADO	I 70-2 (50) 197	80	

REVISIONS	

VOID
BY CONSTRUCTION DATE 6-24-77

DISTANCE FROM REFERENCE LINE (TYPE)	DESCRIPTION OF BENT LINE	DESCRIPTION OF LINE	SKW ANGLE OF BENT LINE TO CHORD OR TANGENT	STATION OF BENT LINE	ELEVATION OF LINE AND BENT LINE	ROADWAY ELEVATION AT INTERSECTION OF LINE AND BENT LINE
301.500000	7/ 20 PT. = 4	CONSTR. CL	0 0 .0	946+30.000	10131.6369	
BACK TANGENT			ZERO SKEW			
	NO. OUT			946+30.000	10131.7299	
	PRO. LINE			946+30.000	10131.2369	
	CL BRIDGE			946+30.000	10131.8119	
	SO. OUT			946+30.000	10131.0909	
306.500000	8/ 20 PT. = 4	CONSTR. CL	0 0 .0	946+35.000	10131.5196	
BACK TANGENT			ZERO SKEW			
	NO. OUT			946+35.000	10131.6096	
	PRO. LINE			946+35.000	10131.5196	
	CL BRIDGE			946+35.000	10131.2946	
	SO. OUT			946+35.000	10130.7796	
311.500000	9/ 20 PT. = 4	CONSTR. CL	0 0 .0	946+40.000	10131.4035	
BACK TANGENT			ZERO SKEW			
	NO. OUT			946+40.000	10131.4935	
	PRO. LINE			946+40.000	10131.4035	
	CL BRIDGE			946+40.000	10131.1785	
	SO. OUT			946+40.000	10130.8635	
316.500000	10/ 20 PT. = 4	CONSTR. CL	0 0 .0	946+45.000	10131.2885	
BACK TANGENT			ZERO SKEW			
	NO. OUT			946+45.000	10131.3785	
	PRO. LINE			946+45.000	10131.2885	
	CL BRIDGE			946+45.000	10131.0635	
	SO. OUT			946+45.000	10130.7485	
321.500000	11/ 20 PT. = 4	CONSTR. CL	0 0 .0	946+50.000	10131.1746	
BACK TANGENT			ZERO SKEW			
	NO. OUT			946+50.000	10131.2646	
	PRO. LINE			946+50.000	10131.1746	
	CL BRIDGE			946+50.000	10130.9496	
	SO. OUT			946+50.000	10130.6346	
326.500000	12/ 20 PT. = 4	CONSTR. CL	0 0 .0	946+55.000	10131.0618	
BACK TANGENT			ZERO SKEW			
	NO. OUT			946+55.000	10131.1518	
	PRO. LINE			946+55.000	10131.0618	
	CL BRIDGE			946+55.000	10130.8368	
	SO. OUT			946+55.000	10130.5218	
331.500000	13/ 20 PT. = 4	CONSTR. CL	0 0 .0	946+60.000	10130.9502	
BACK TANGENT			ZERO SKEW			
	NO. OUT			946+60.000	10131.0402	
	PRO. LINE			946+60.000	10130.9502	
	CL BRIDGE			946+60.000	10130.7252	
	SO. OUT			946+60.000	10130.4102	
336.500000	14/ 20 PT. = 4	CONSTR. CL	0 0 .0	946+65.000	10130.8397	
BACK TANGENT			ZERO SKEW			
	NO. OUT			946+65.000	10130.9297	
	PRO. LINE			946+65.000	10130.8397	
	CL BRIDGE			946+65.000	10130.6147	
	SO. OUT			946+65.000	10130.2997	
341.500000	15/ 20 PT. = 4	CONSTR. CL	0 0 .0	946+70.000	10130.7302	
BACK TANGENT			ZERO SKEW			
	NO. OUT			946+70.000	10130.8202	
	PRO. LINE			946+70.000	10130.7302	
	CL BRIDGE			946+70.000	10130.5052	
	SO. OUT			946+70.000	10130.1902	
346.500000	16/ 20 PT. = 4	CONSTR. CL	0 0 .0	946+75.000	10130.6219	
BACK TANGENT			ZERO SKEW			
	NO. OUT			946+75.000	10130.7119	
	PRO. LINE			946+75.000	10130.6219	
	CL BRIDGE			946+75.000	10130.3969	
	SO. OUT			946+75.000	10130.0819	
351.500000	17/ 20 PT. = 4	CONSTR. CL	0 0 .0	946+80.000	10130.5148	
BACK TANGENT			ZERO SKEW			
	NO. OUT			946+80.000	10130.6048	
	PRO. LINE			946+80.000	10130.5148	
	CL BRIDGE			946+80.000	10130.2898	
	SO. OUT			946+80.000	10129.9748	
356.500000	18/ 20 PT. = 4	CONSTR. CL	0 0 .0	946+85.000	10130.4087	
BACK TANGENT			ZERO SKEW			
	NO. OUT			946+85.000	10130.4987	
	PRO. LINE			946+85.000	10130.4087	
	CL BRIDGE			946+85.000	10130.1837	
	SO. OUT			946+85.000	10129.8687	
361.500000	19/ 20 PT. = 4	CONSTR. CL	0 0 .0	946+90.000	10130.3038	
BACK TANGENT			ZERO SKEW			
	NO. OUT			946+90.000	10130.3938	
	PRO. LINE			946+90.000	10130.3038	
	CL BRIDGE			946+90.000	10130.0788	
	SO. OUT			946+90.000	10129.7638	
366.500000	CL BRG ABUT 4	CONSTR. CL	0 0 .0	946+95.000	10130.1999	
BACK TANGENT			ZERO SKEW			
	NO. OUT			946+95.000	10130.2899	
	PRO. LINE			946+95.000	10130.1999	
	CL BRIDGE			946+95.000	10129.9749	
	SO. OUT			946+95.000	10129.6599	
370.825000	1/ 4 PT. = 1	CONSTR. CL	2 31 26.6	946+99.125	10130.1151	
BACK TANGENT			RIGHT SKEW			
	NO. OUT			946+99.389	10130.1997	
	PRO. LINE			946+99.125	10130.1151	
	CL BRIDGE			946+98.466	10129.9037	
	SO. OUT			946+97.538	10129.6077	
374.750000	2/ 4 PT. = 1	CONSTR. CL	5 2 18.1	947+ 3.250	10130.0311	
BACK TANGENT			RIGHT SKEW			
	NO. OUT			947+ 3.779	10130.1104	
	PRO. LINE			947+ 3.250	10130.0311	
	CL BRIDGE			947+ 1.928	10129.8330	
	SO. OUT			947+ .076	10129.5557	

DESIGNED BY	DATE	CHECKED BY
CHECKED BY	DATE	CHECKED BY

DIVISION OF HIGHWAYS

ELEVATIONS


Designer <i>J. Keller</i>	Structure Numbers	F-12-AJ
Detailer <i>R.H.S.</i>	of 17	Drawings

Revision Dates (Preliminary Stage Only)

STATE DEPARTMENT OF HIGHWAYS
DIVISION OF HIGHWAYS
DESIGN DIVISION
DESIGN NO. 101


FEDERAL ROAD DISTRICT	PROJ. NO.	SHEET NO.	TOTAL SHEETS
XIII COLORADO	I-70-2 (B2) 197	81	

REVISIONS	

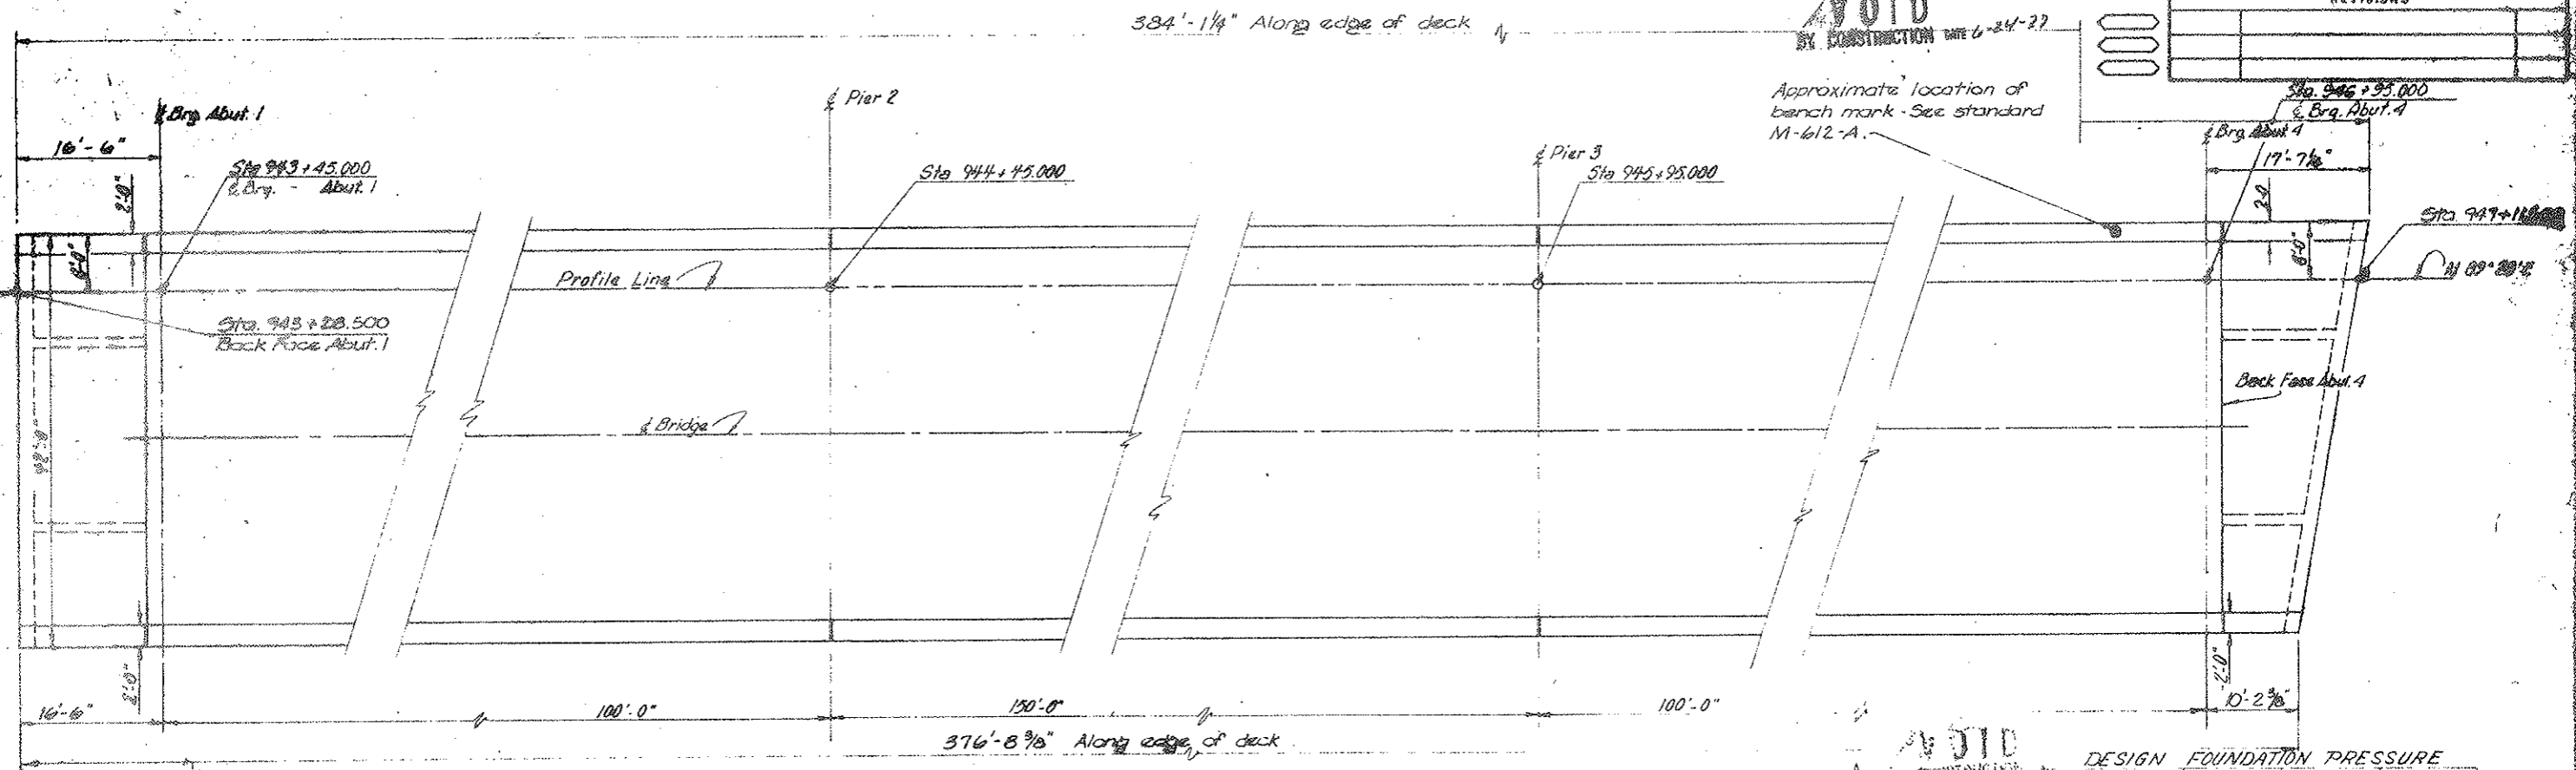

CONSTRUCTION LAYOUT
Orig. Scale: 1/8" = 1'-0"


* Location of Abutment and Pier footings is offset by a distance equal to a rate of cross slope times depth of Superstructure (6'-0").

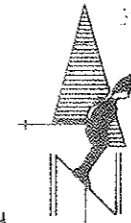

Description	DESIGN FOUNDATION PRESSURE		Allowable Pile Pressure (Tons Per sq. ft.)	Computed Pile Pressure (Tons Per sq. ft.)	Pile No.
	Allowable Pile Load (Tons)	Computed Pile Load (Tons)			
Abutment 1	98	96.7			HP 12x74
Abutment 1 Wingwall	55	54.9			HP 12x53
Pier 2			6	5.9	
Pier 3			6	5.9	
Abutment 4			6	4	
Abutment 4 Wingwall			6	4.2	

CUTOFF ELEVATIONS OF PILING

Pile No.	Elevation
1	10.126.000
2	10.126.000
3	10.126.000
4	10.126.000
5	10.126.000
6	10.126.000
7	10.126.000
8	10.126.000
9	10.126.000

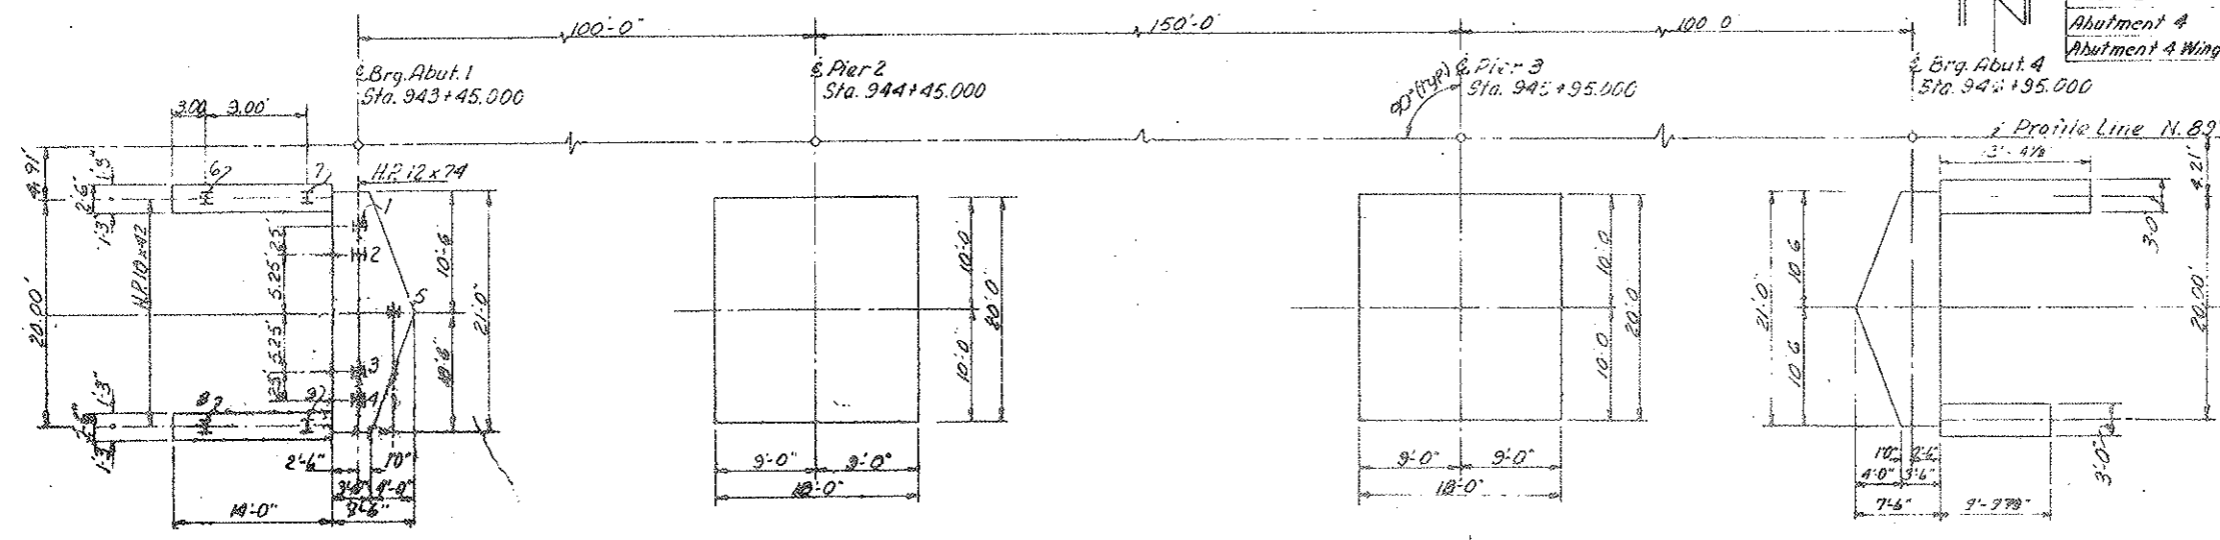

FOOTING & PILING LAYOUT
Orig. Scale: 1/8" = 1'-0"
Pile No. 5 Shall be battered 6 to 1

NOTE: All footing dimensions are at bottom of footing.

DIVISION OF HIGHWAYS


CONSTRUCTION LAYOUT AND FOOTING & PILING LAYOUT

Designer J. Keller
Detailer P.S.
Drawing Number B 6


Structure Numbers E-12-A-N
of 17

FEDERAL ROAD DISTRICT	PROJ. NO.	SHEET NO.	TOTAL SHEETS
VIII	COLORADO	1-70-2 (52) 117	82


REVISIONS			
2-1	4/4/75	REPRINT	WCS

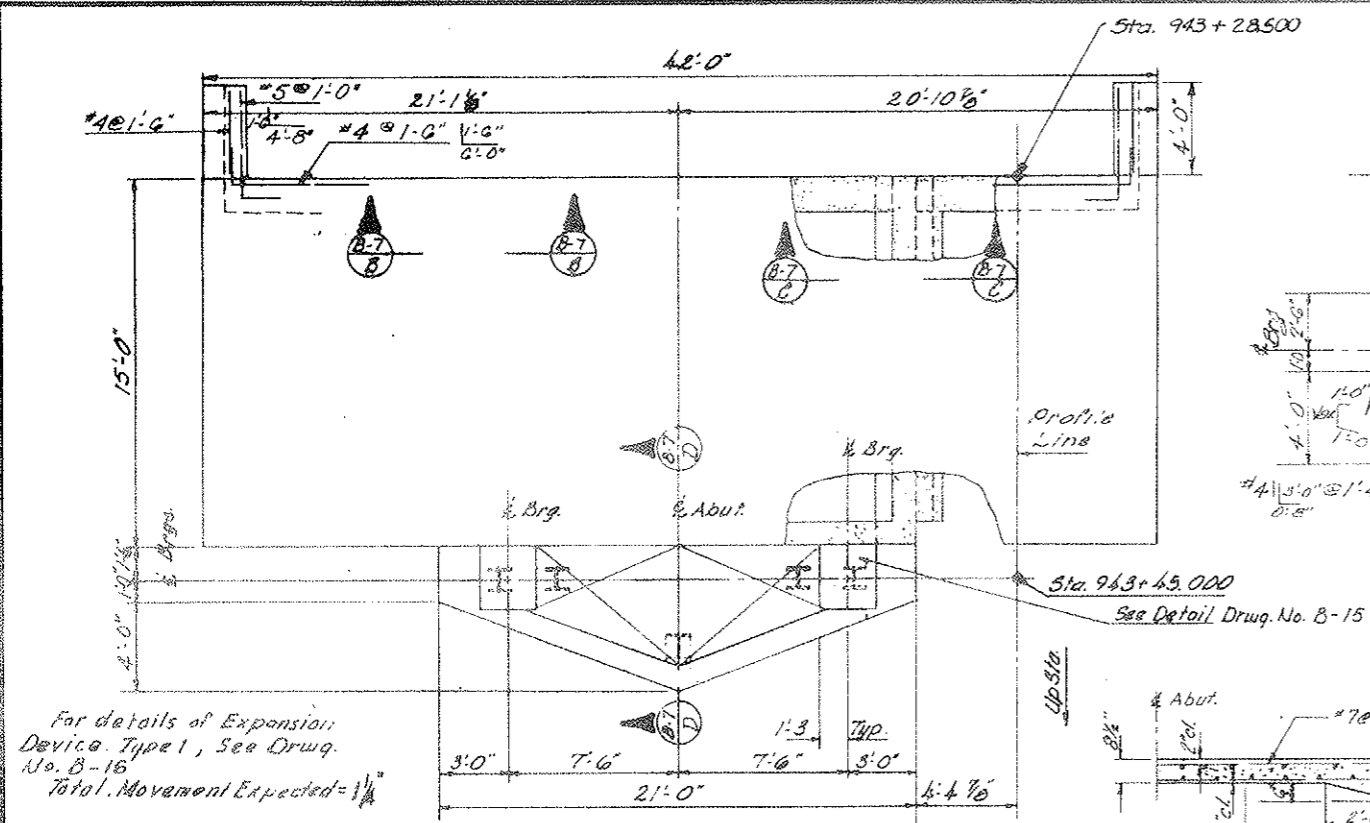


PLAN
Orig. Scale 1/4" = 1'-0"

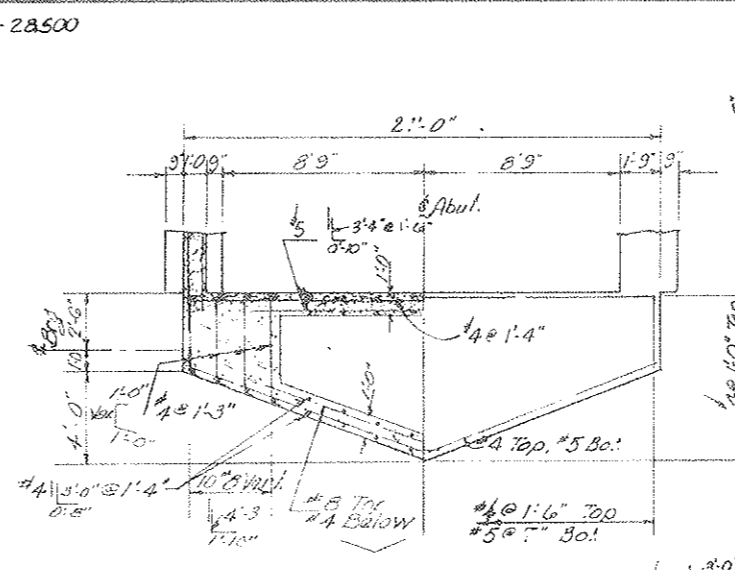

SECTION
Orig. Scale 1/4" = 1'-0"

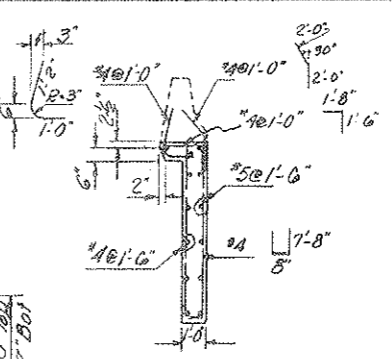


SECTION
Front Face

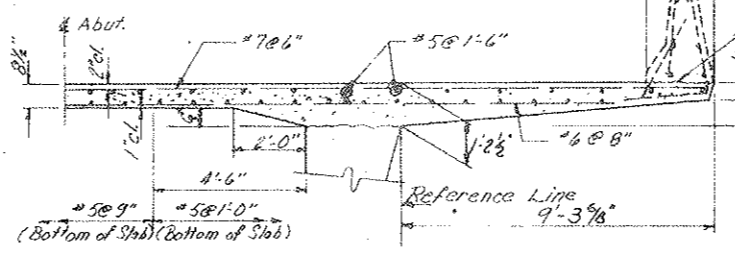


TYPICAL SECTION THRU APPROACH SLAB

For details of Expansion Device, Type 1, See Drawg. No. B-16.
Total Movement Expected = 1 1/2"

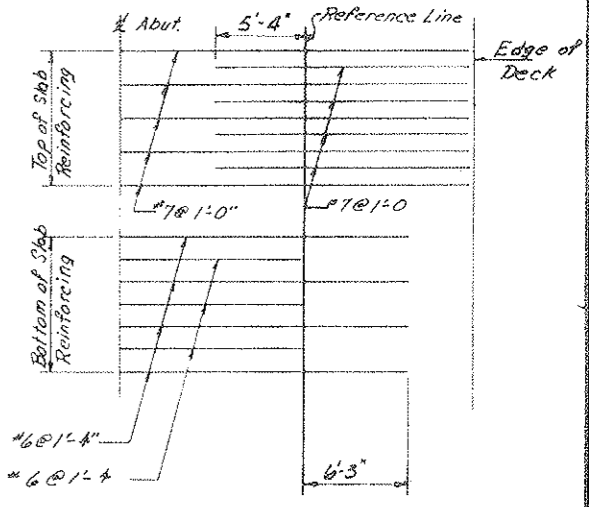


PLAN OF SLAB REINFORCING
Orig. Scale 3/16" = 1'-0"


AVOID
BY CONSTRUCTION DATE 6-24-77

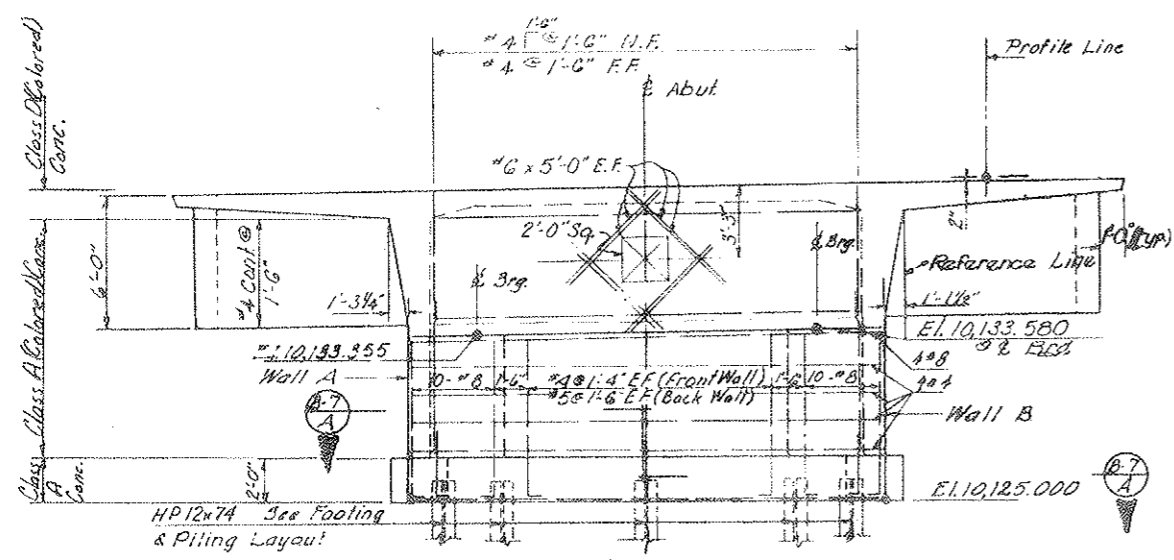

ELEVATION
Orig. Scale 1/4" = 1'-0"

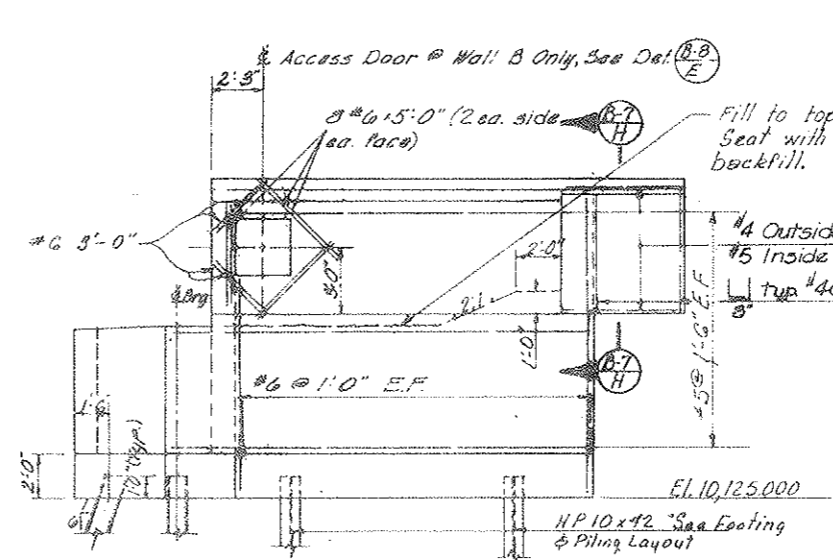

ELEVATION WALL B
Orig. Scale 1/4" = 1'-0"

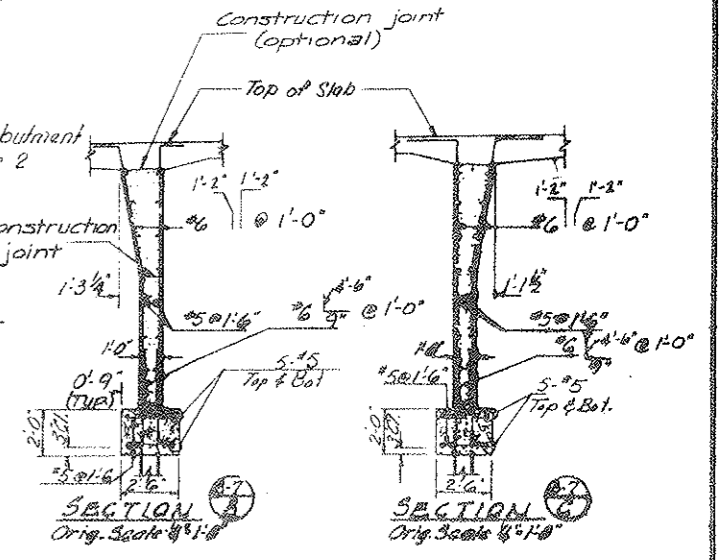

SECTION
Orig. Scale 1/4" = 1'-0"

SECTION
Orig. Scale 1/4" = 1'-0"

NOTE:
Footing Concrete shall be Class A (Bridge)
Abutment Cap & Wingwall concrete shall be Class A (Bridge) (Colored)
Approach Slab concrete shall be Class D (Bridge) (Colored).
Reinforcing at opening shall be field out.

DIVISION OF HIGHWAYS

ABUTMENT 1 DETAILS




Designer J. Keller	Structure F-12-AN
Detailer D. Lindley	Number 17
Drawing Number B-7	Drawings

Revision Dates (Preliminary Stage Only)

FEDERAL ROAD DISTRICT	PROJ. NO.	SHEET NO.	TOTAL SHEETS
VIII COLORADO	1-70-2 (52) 197	83	

REVISIONS			
4/4/75	REPRINT		WCB

VOID BY CONSTRUCTION DATE 6-24-77

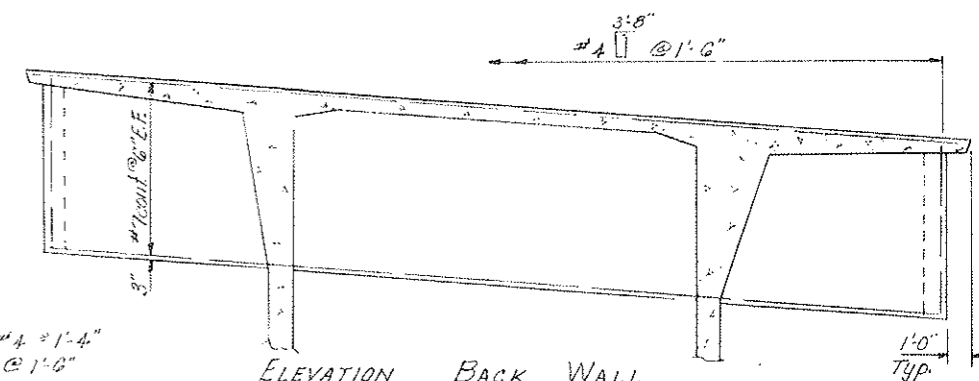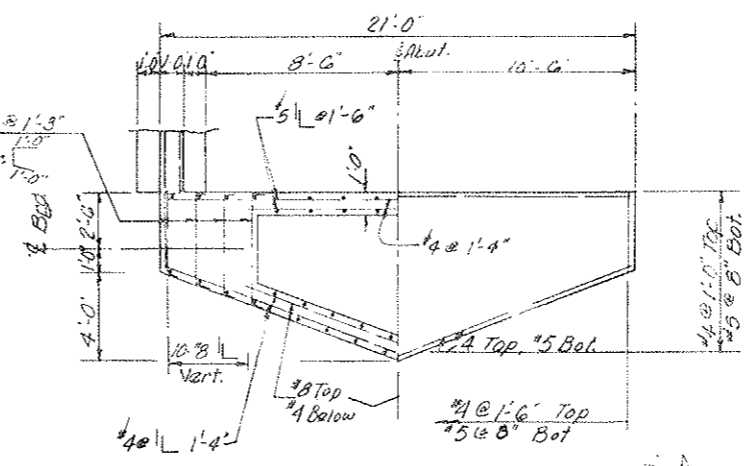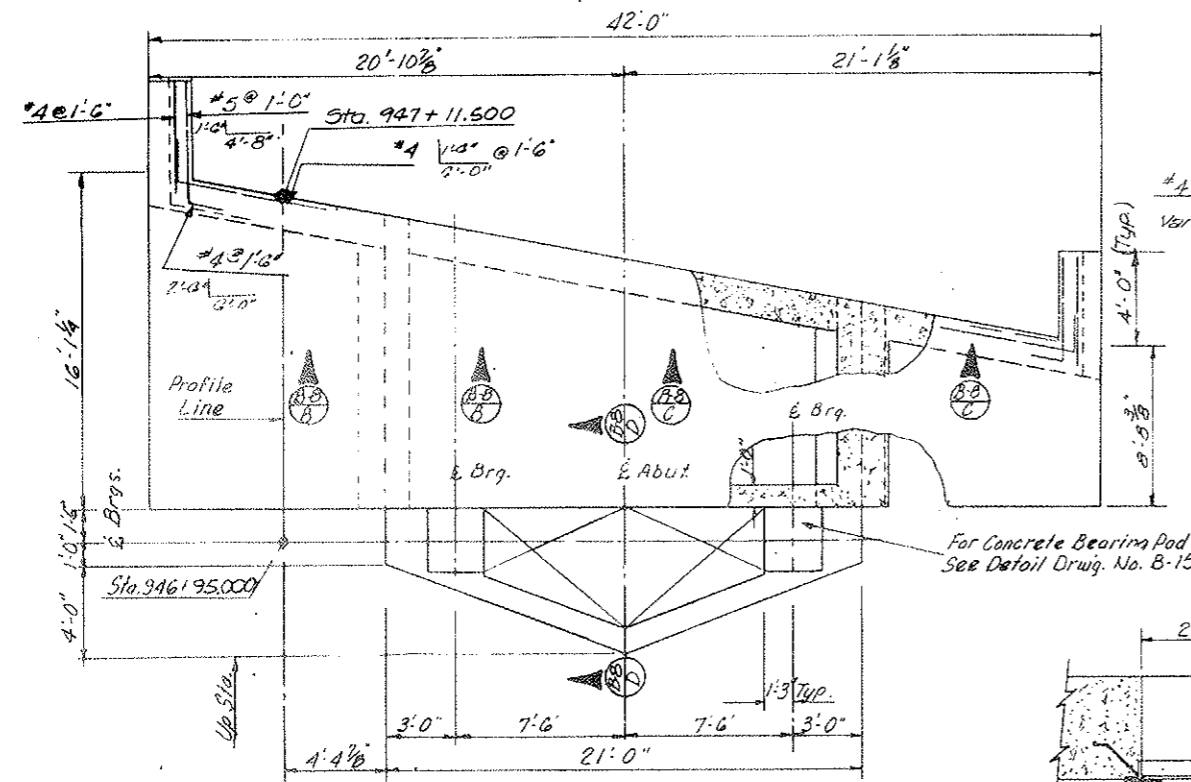


PLAN
 Orig. Scale: 1/4" = 1'-0"


SECTION
 Orig. Scale: 1/4" = 1'-0"

ELEVATION BACK WALL
 Typ.


For Details of Expansion Device
 Type 1, See Drawg. No. B-16
 Total movement Expected = 1 1/4"

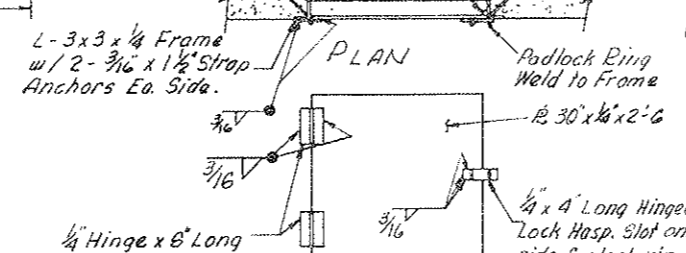


ACCESS DOOR DETAIL
 Orig. Scale: 3/4" = 1'-0"

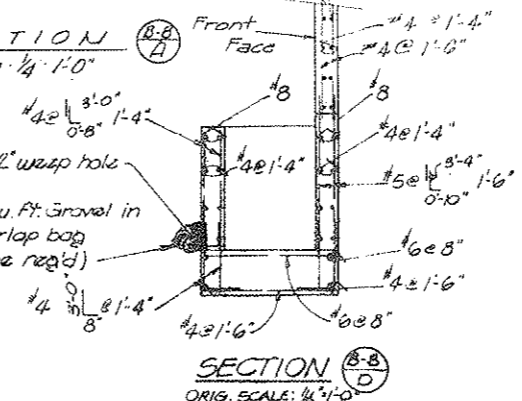


SECTION
 ORIG. SCALE: 1/4" = 1'-0"

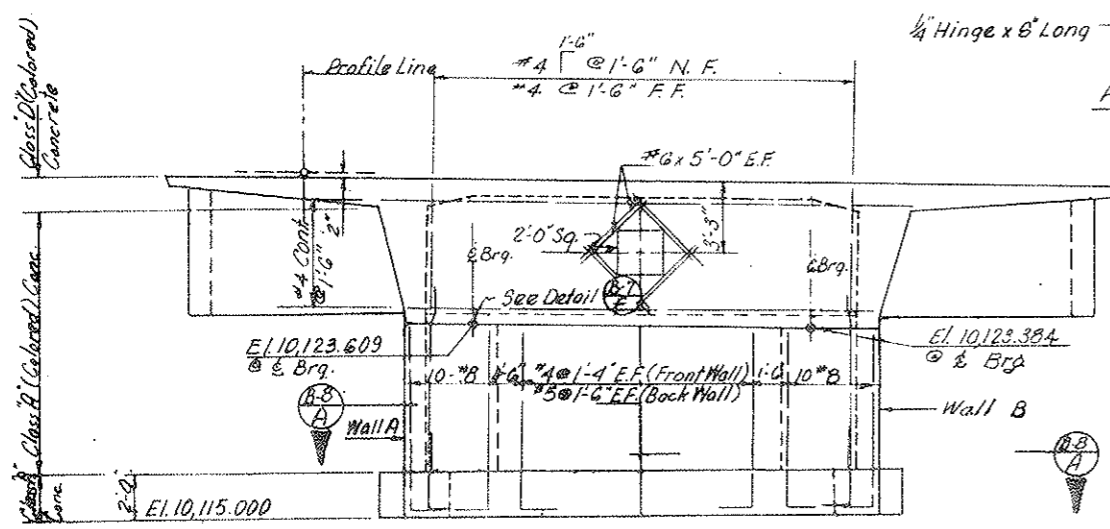

ELEVATION
 Orig. Scale: 1/4" = 1'-0"

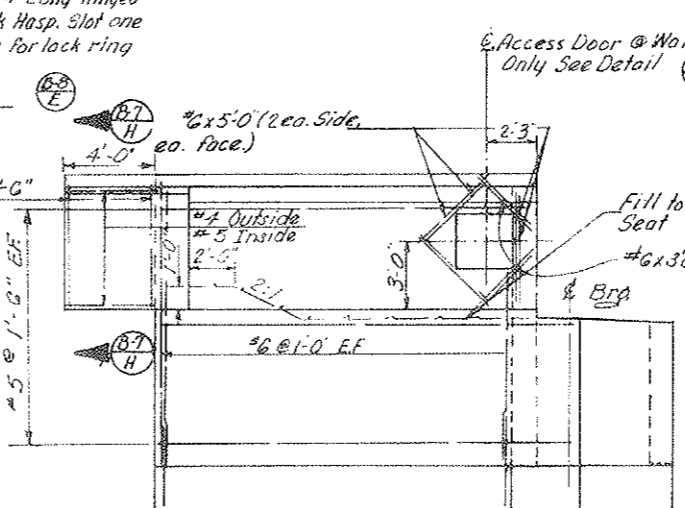

ELEVATION WALL A
 Orig. Scale: 1/4" = 1'-0"

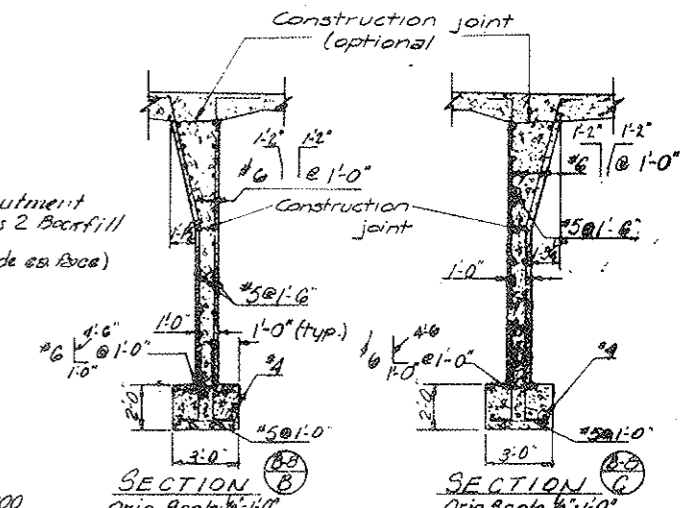

SECTION
 Orig. Scale: 1/4" = 1'-0"

SECTION
 Orig. Scale: 1/4" = 1'-0"

NOTE:
 Footing Concrete shall be Class A (Bridge)
 Abutment Cap & Wingwall concrete shall be Class A (Bridge), (Colored).
 Approach Slab concrete shall be Class D (Bridge), (Colored).

NOTE: Allowable soil pressure for Abutment and wingwalls is 6 T.S.F.
 Reinforcing at opening shall be Field Cut.


DIVISION OF HIGHWAYS

ABUTMENT 4 DETAILS


Designer J. Keller	Structure F-12-AN
Detailer D. Lindley	Number
Drawing Number B-8	of 17 Drawings

Revision Dates (Preliminary Stamp Only)


FEDERAL ROAD REGION NO.	DISTRICT	PROJ. NO.	SHEET NO.	TOTAL SHEETS
VIII	COLORADO	I-70-2(5.1)197	84	
REVISIONS				
RT	4-29-75	Addition To Note		B.O.E.

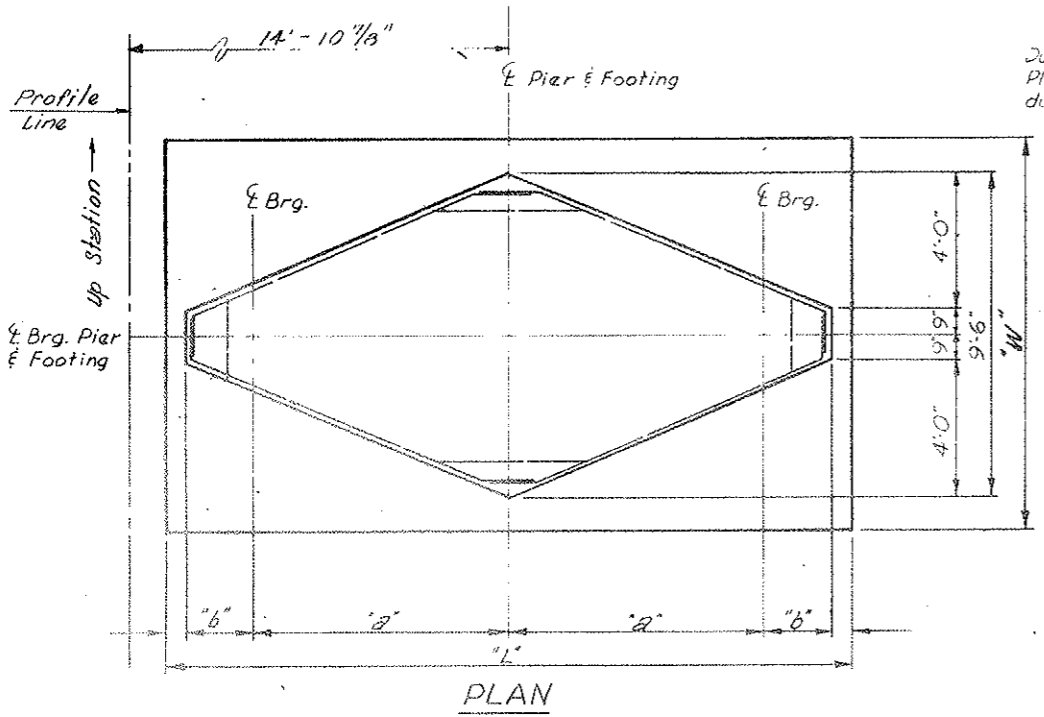

Ducts for prestressing tendons (typ)
Place symmetrically with a minimum of one duct in each of the four corners.

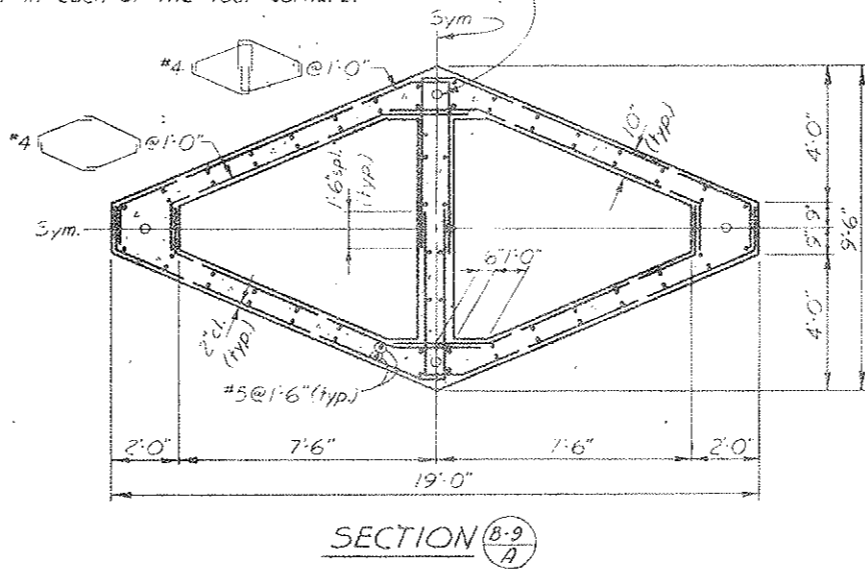


VOID BY CONSTRUCTION LINE 6-24-77

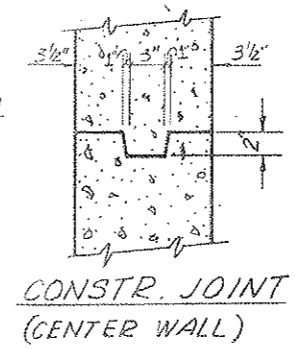

	PIER 2	PIER 3
El. A	10,083.000	10,089.000
El. B	10,130.160	10,125.887
El. C	10,129.935	10,125.662
Dim. "a"	7'-6"	7'-6"
Dim. "b"	2'-0"	2'-0"
Dim. "T"	3'-0"	3'-0"
Dim. "W"	18'-0"	18'-0"
Dim. "L"	20'-0"	20'-0"
M-Bars	#6 @ 7"	#6 @ 7"
N-Bars	#6 @ 7"	#6 @ 7"
R-Bars	#9 @ 8"	#9 @ 8"
S-Bars	#6 @ 7"	#6 @ 7"
Force F	2695 kips	2240 kips


DESIGNED BY	DATE	CHECKED BY	DATE
BY	6-7-75	BY	6-7-75
CHECKED BY		CHECKED BY	
DATE		DATE	
BY		BY	

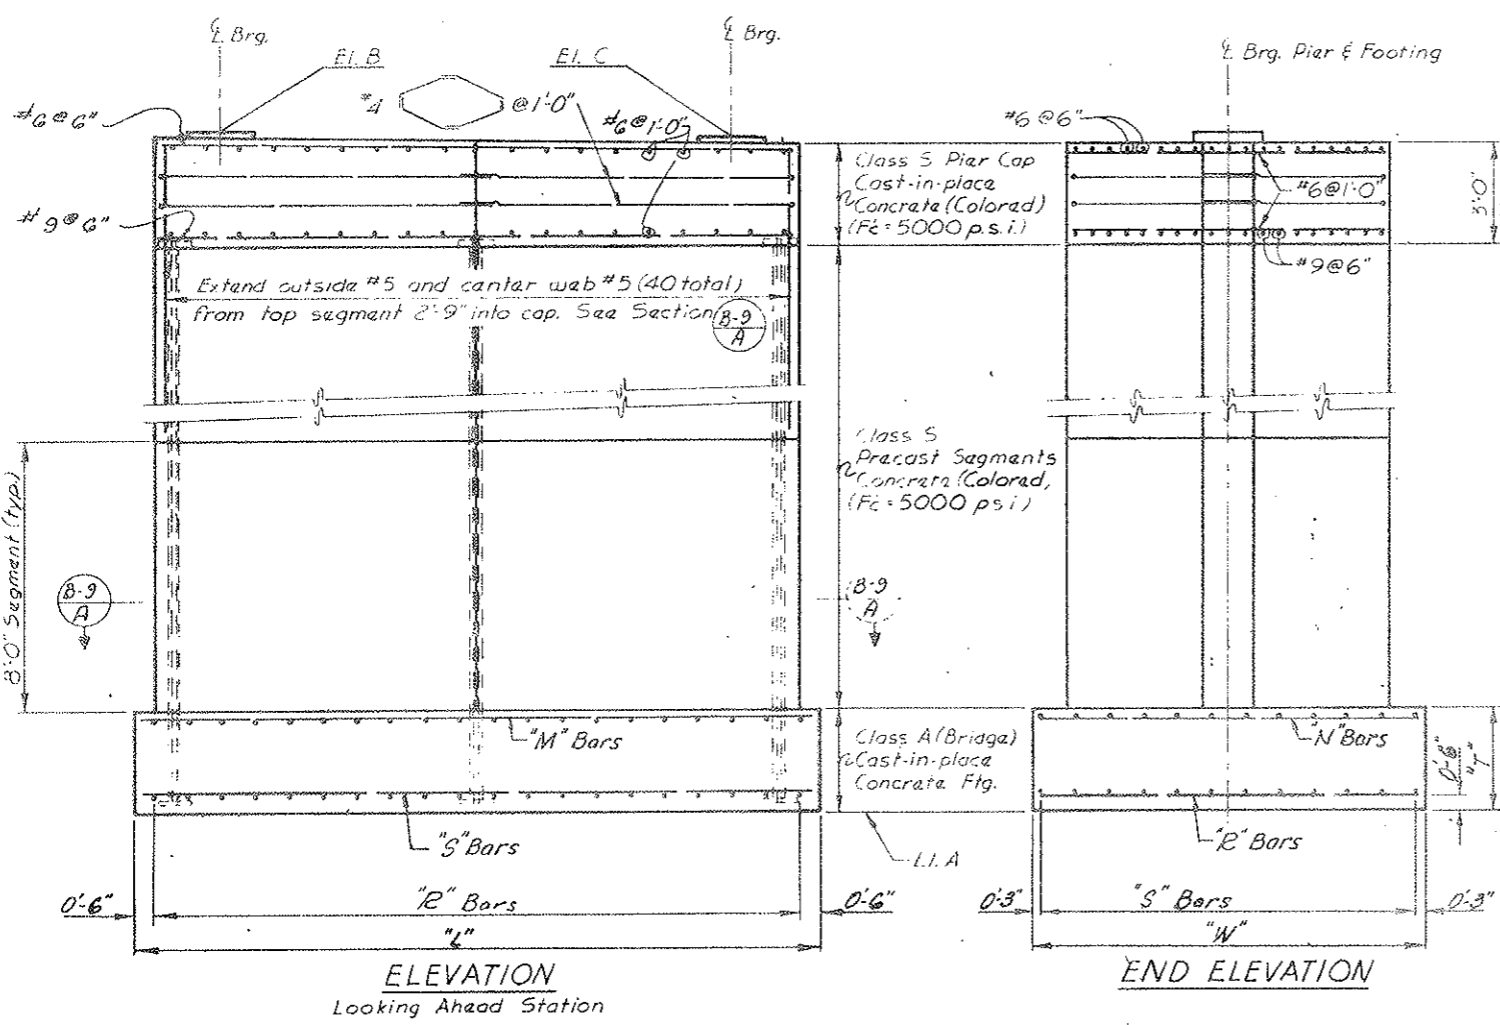

- ① FORCE F IS THE POST-TENSIONING FORCE REQUIRED IN THE PIERS AFTER ALL LOSSES INCLUDING CREEP, SHRINKAGE, FRICTION, AND ELASTIC SHORTENING FROM THE SUPERSTRUCTURE LOADS. POST-TENSIONING FORCE F IS TO BE THE SUM OF FOUR EQUAL FORCES, ONE AT EACH CORNER OF THE PIER AS SHOWN IN SECTION
- ② FORCE F IS THE POST-TENSIONING FORCE REQUIRED FOR SERVICE LOADS. IF THE PIER IS TO BE SUBJECT TO THE ONE SEGMENT, UNBALANCED MOMENT THAT THE FOOTINGS ARE DESIGNED FOR, CALCULATIONS MUST BE SUBMITTED FOR THE ADDITIONAL POST-TENSIONING FORCE NEEDED.

PIER NOTES:

- DESIGN PROVISIONS WERE MADE FOR A ONE SEGMENT, UNBALANCED CANTILEVER MOMENT AT THE END OF THE CANTILEVER DURING THE CONSTRUCTION STAGE. THE PIER COLUMNS ARE NOT DESIGNED FOR SUCH UNBALANCED MOMENTS, BUT ALL PIER FOOTINGS ARE DESIGN FOR AN UNBALANCED MOMENT OF 9313 FOOT KIPS WITH COMBINED AXIAL LOAD OF 1356 KIPS (EXCLUDING FOOTING WEIGHT.)
- POST-TENSIONING TENDON ANCHORAGES IN PIER FOOTINGS AND PIER CAPS SHALL BE DETERMINED BY THE MANUFACTURER AND SUBMITTED FOR APPROVAL.
- END BLOCKS SHALL BE USED TO DISTRIBUTE THE CONCENTRATED POST-TENSIONING FORCES AT THE ANCHORAGE. CLOSELY SPACED REINFORCEMENT SHALL BE PLACED BOTH VERTICALLY AND HORIZONTALLY THROUGHOUT THE LENGTH OF THE END BLOCK IN ACCORDANCE WITH ACCEPTED METHODS OF END BLOCK ANALYSIS.
- ALL SEGMENTS SHALL BE MATCH-CAST TO ENSURE PROPER FIT DURING THE ERECTION STAGE. PRECAST SEGMENT HEIGHT PER BRIDGE MAY BE REVISED IN ORDER TO MINIMIZE THE CAST-IN-PLACE PORTION
- CARE SHALL BE EXERCISED IN JOINING THE SEGMENTS WITH EPOXY TO ENSURE THAT COMPRESSION IS MAINTAINED OVER THE ENTIRE JOINT AREA UNTIL THE PERMANENT POST-TENSIONED TENDONS ARE STRESSED.
- FOR CONCRETE CLASSES AND STRENGTHS, SEE DRAWINGS, THIS SHEET.

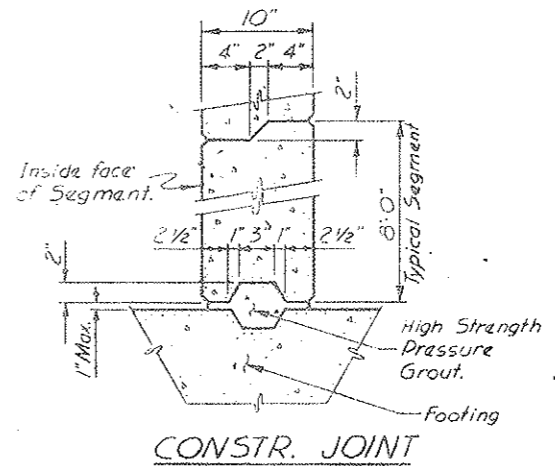

IECO INTERNATIONAL ENGINEERING COMPANY, INC.
Berlton, Stoddard, Mihalchin and Higgins Division
1777 S. Bellvue St. Denver, Colorado 80222

DIVISION OF HIGHWAYS


PIER DETAILS

Designer	J. Keller	Structure Numbers	F-12-AJ
Detailer	R.H.S.	Number	
Drawing Number	B 9	of	17 Drawings

FEDERAL ROAD DISTRICT NO.	DISTRICT	PROJ. NO.	SHEET NO.	TOTAL SHEETS
XIII	COLORADO	1-70-2 (52) 97	85	


REVISIONS				
R-1	4/4/75	REPRINT		WCB
R-2	4/17/75	Changed bar size		CLB

VOID
BY CONSTRUCTION DATE 6-24-77

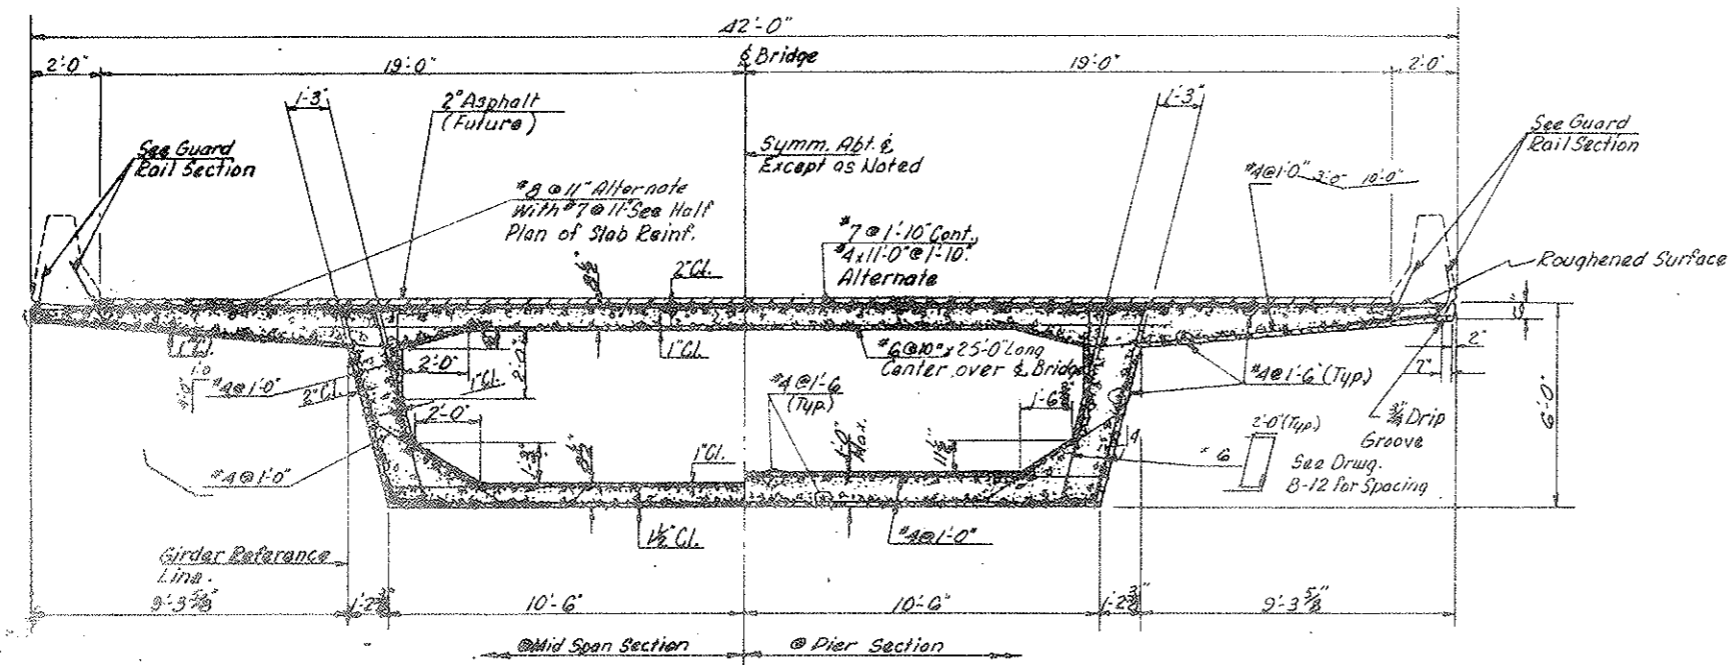


TYPICAL SECTION
Orig. Scale: 3/8" = 1'-0"

NOTE: Concrete shall be class 5 (Bridge) (Colored) unless otherwise noted.
For prestressing notes see Drawing No. B-12

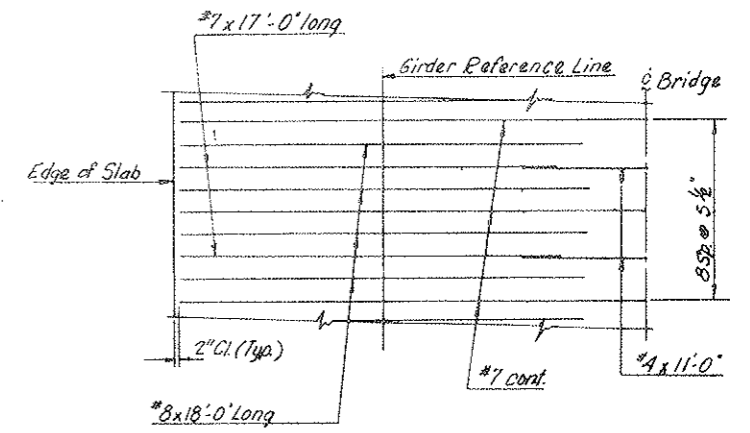

HALF PLAN
TOP SLAB REINFORCING

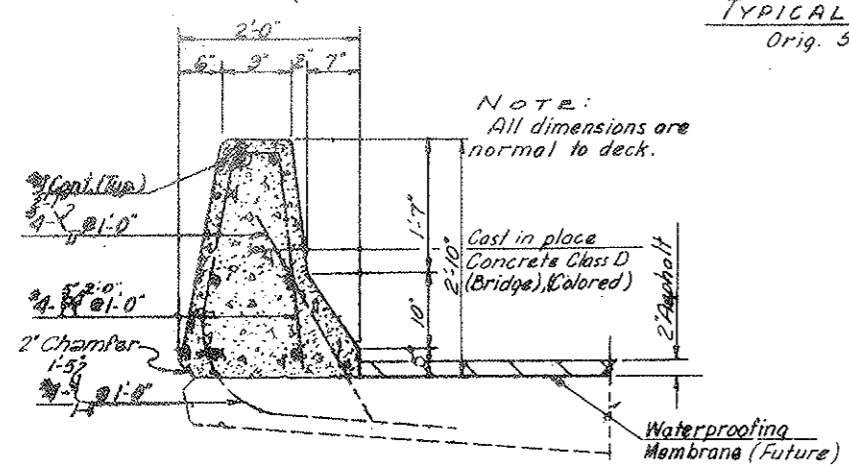

TYPICAL GUARD RAIL SECTION
Orig. Scale: 1" = 1'-0"

DESIGNED BY	PHS
CHECKED BY	PHS
DATE	10-10-77

DIVISION OF HIGHWAYS

SUPERSTRUCTURE DETAILS


Designer <i>J. Keller</i>	Structure Numbers	F-12-AN
Draftsman <i>PHS</i>		
Drawing Number B-10	of 17	Drawings

Revision Dates (Preliminary Stage Only)


FEDERAL ROAD DISTRICT NO.	DISTRICT	PROJ. NO.	SHEET NO.	TOTAL SHEETS
XIII	COLORADO	1-70-2-(52)97	86	

REVISIONS	

VOID
 BY CONSTRUCTION DATE 6-24-77

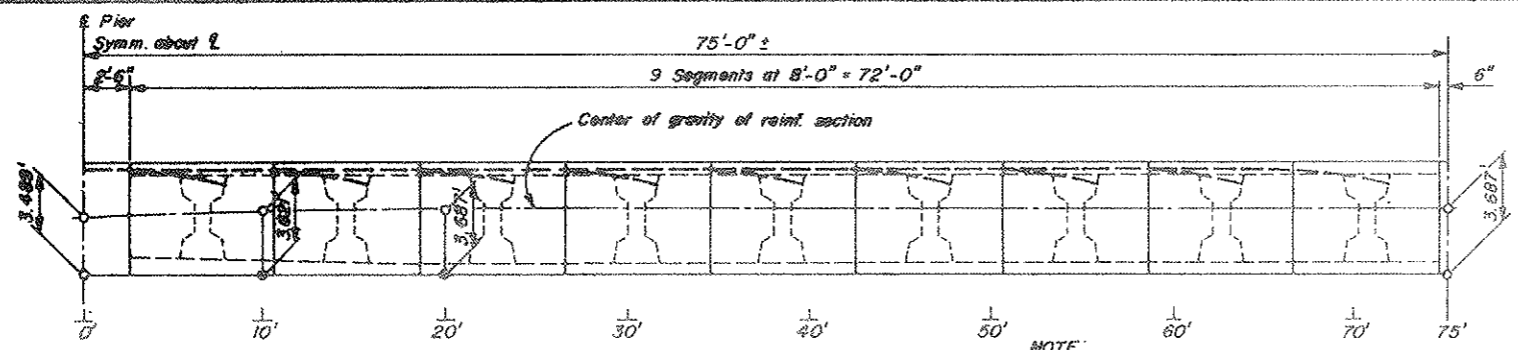

NOTE:
 Tendon paths are for illustrations only.

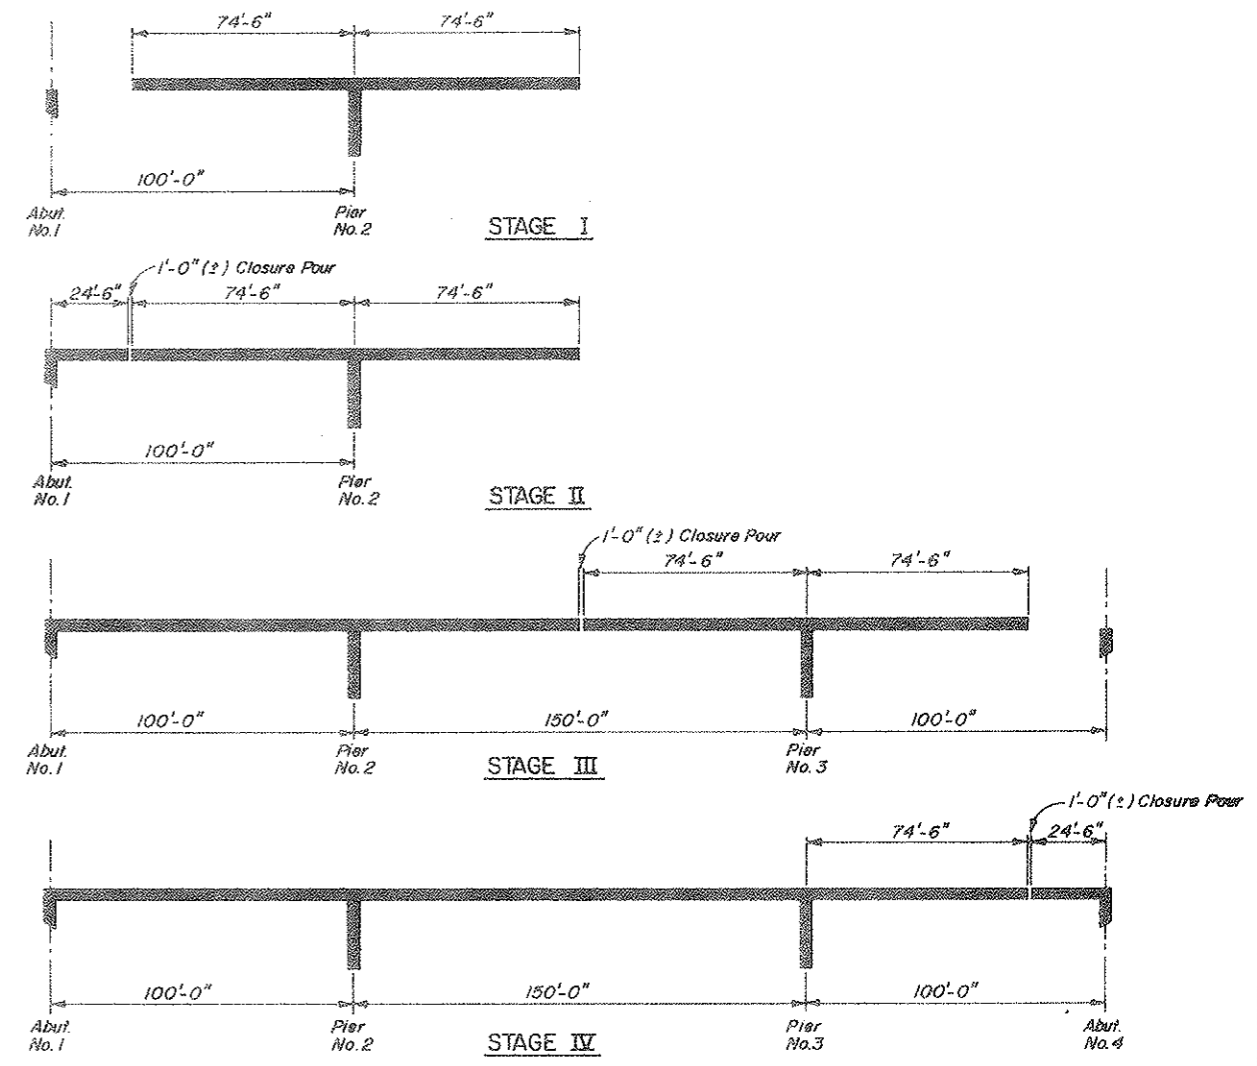


NOTE:
 Stages II, III & IV include the pouring of the closure and Post-Tensioning of Continuity Steel.
 All Longitudinal Dimensions shall be along & of girder.

SEQUENCE OF CONSTRUCTION
 (Assumed in Design)

DIVISION OF HIGHWAYS			
74'-6" FOOT CANTILEVER AND CONSTRUCTION SEQUENCE DIAGRAM			
Designer	J. KELLER	Structure Numbers	F-12-AN
Detailer	D.A.H.		
Drawing Number	B-11	of 17	Drawings

DESIGNED BY	J.W.	CHECKED BY	L.C.K.	DATE	7-1-70
DRAWN BY	B.H.S.	APPROVED BY	L.C.K.		
DETAILS BY					

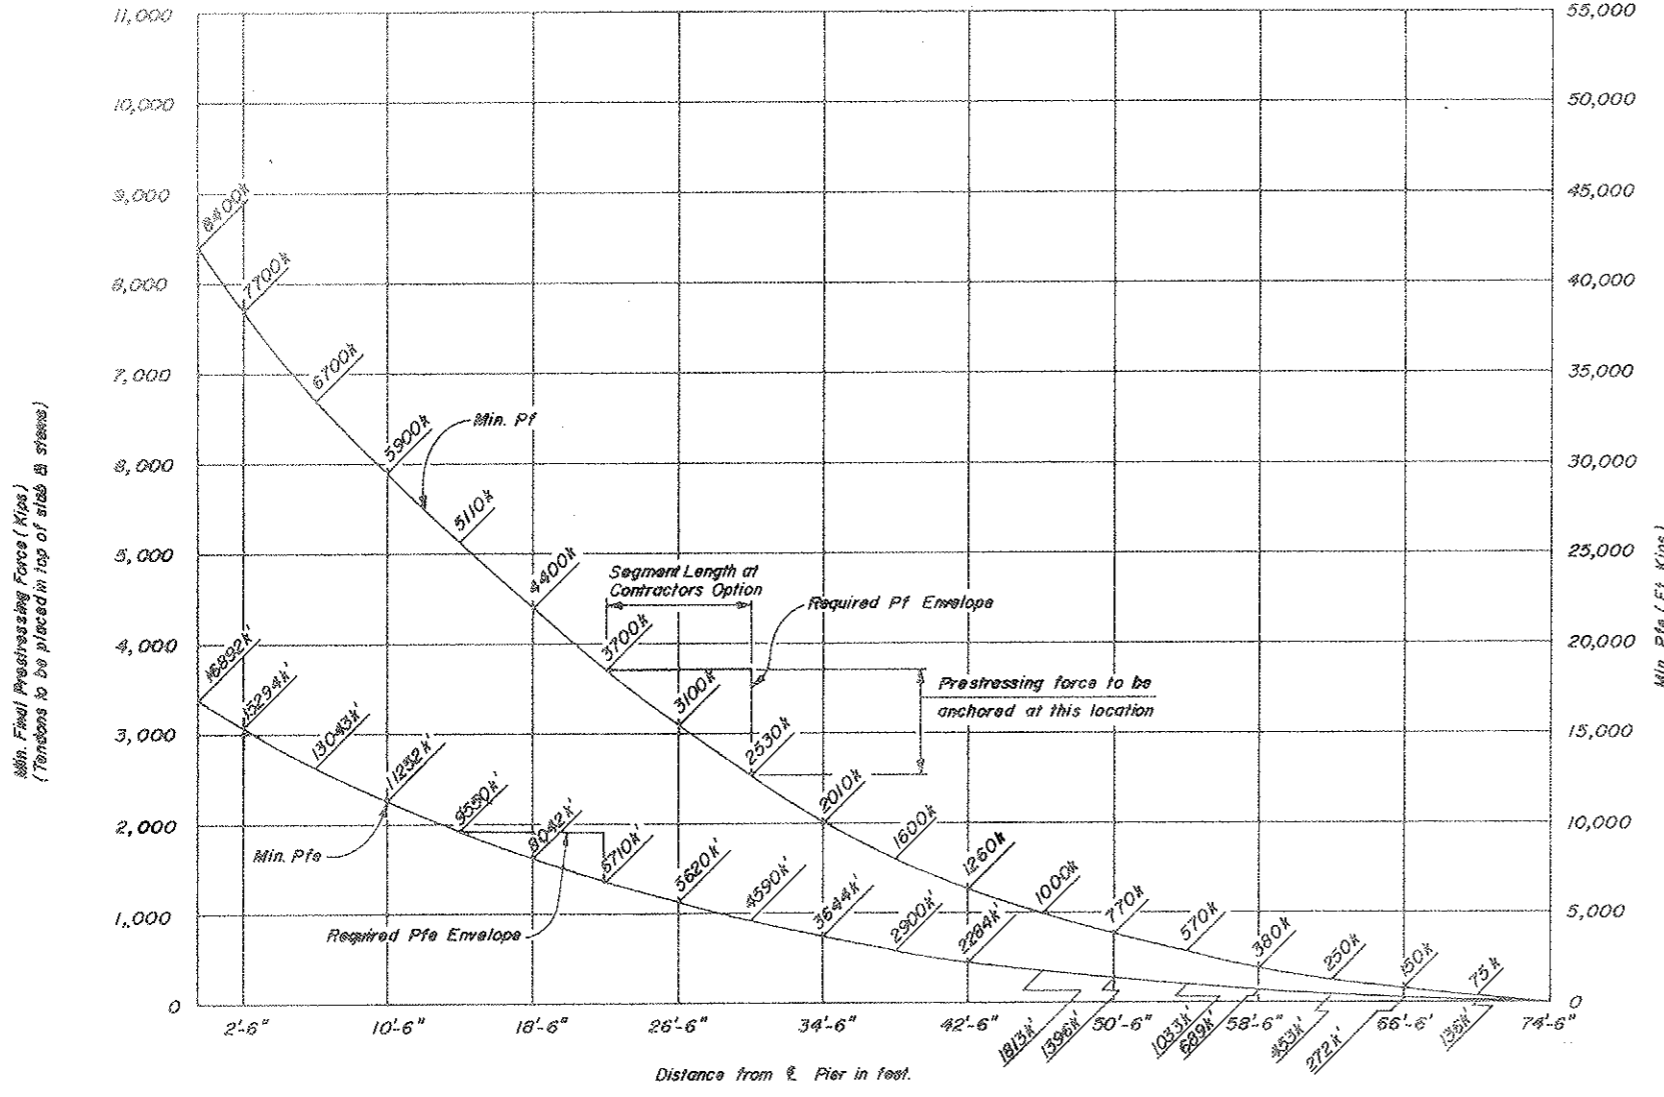


For Prestressing notes see drawing No. B-12

FEDERAL ROAD REGION NO.	DISTRICT	PROJ. NO.	SHEET NO.	TOTAL SHEETS
XIII	COLORADO	1-70-2(52)197	87	


REVISIONS			
R-1	5-14-75	Added Note	CLB

VOID
BY CONSTRUCTION DATE 6-24-77


Post Tensioning Tendon Ducts
(Shown for illustration purpose only.)

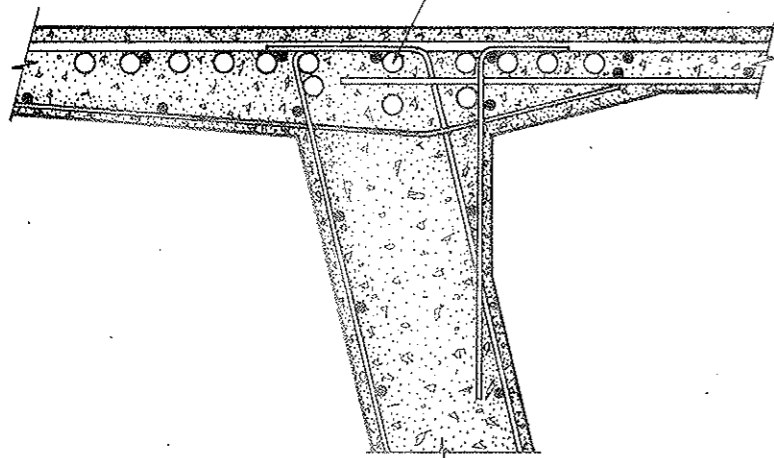


PART SECTION NEAR PIER
NO SCALE

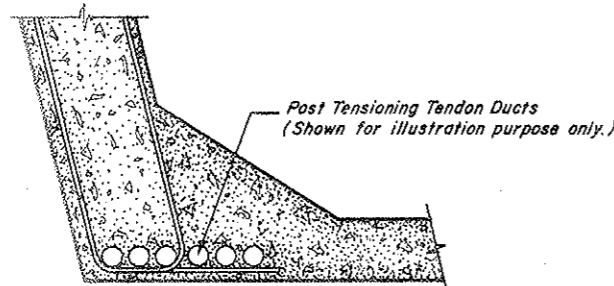


PART SECTION NEAR MID-SPAN
NO SCALE

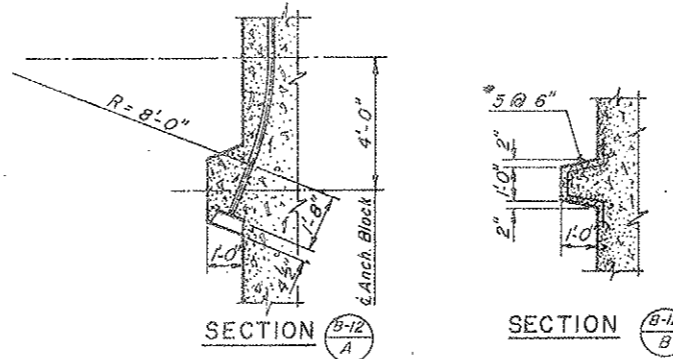


SECTION B-12 A
SECTION B-12 B

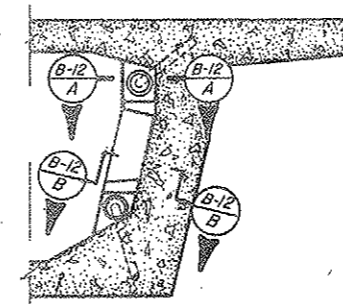

ANCHOR BLOCK DETAIL

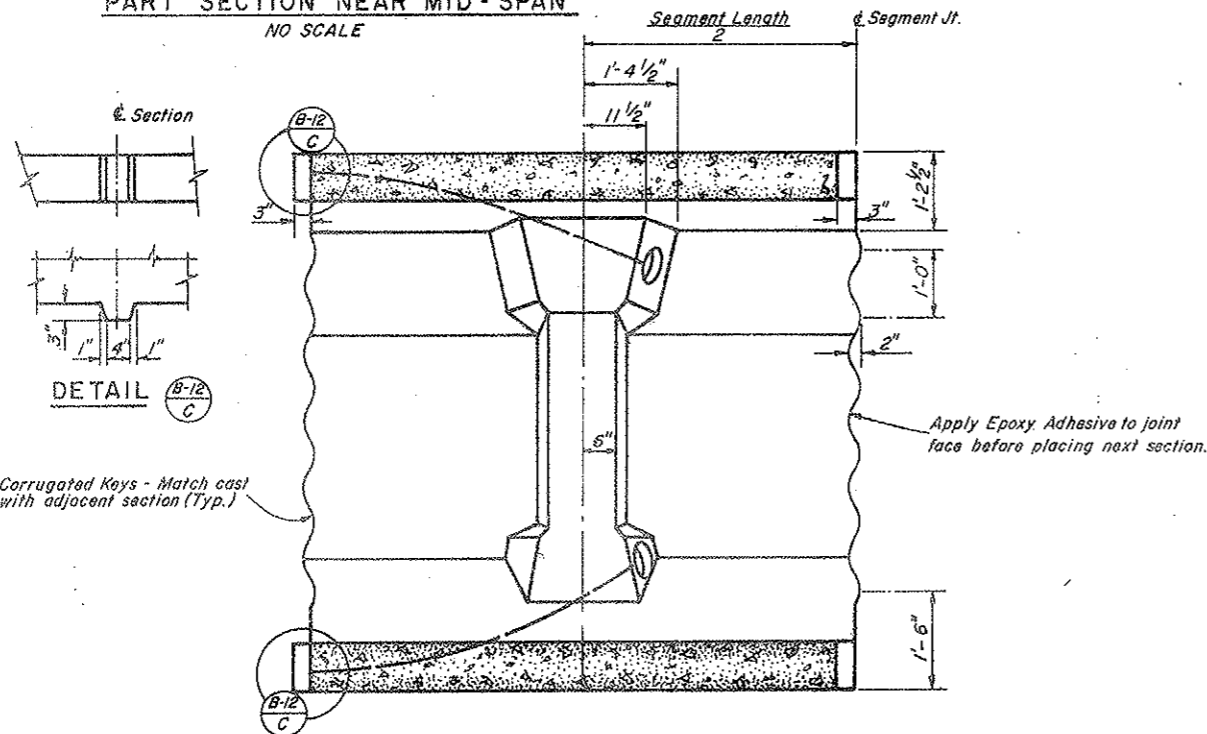

TYPICAL SEGMENT ELEVATION
NO SCALE

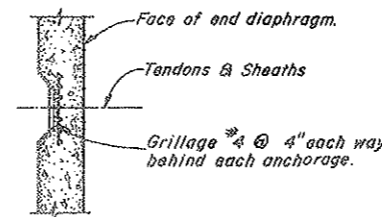

PART PLAN ANCHORAGE AT ABUTMENTS
NO SCALE

PRESTRESSING NOTES:

- "P_t" IS THE TOTAL PRESTRESSING FORCE REMAINING AT A SPECIFIC POINT AFTER ALL LOSSES INCLUDING CREEP, SHRINKAGE AND ELASTIC SHORTENING OF CONCRETE, CREEP AND ELONGATION OF STEEL TENDONS AND FRICTION.
- THE VALUE OF P_t SHALL BE FURNISHED AT THE MIDDLE OF LENGTH FOR WHICH IT IS GIVEN IN THE CASE OF BOTTOM PRESTRESSING THROUGH THE CLOSURE POURS. P_t FOR ALL OTHER BOTTOM PRESTRESSING SHALL BE FURNISHED AT THE END NEAREST MID-SPAN OF THE LENGTH FOR WHICH IT IS GIVEN. P_t FOR TOP PRESTRESSING SHALL BE FURNISHED AT END NEAREST THE SUPPORT OF THE LENGTH FOR WHICH IT IS GIVEN.
- "e" IS THE ECCENTRICITY OF THE PRESTRESSING FORCE ABOVE OR BELOW THE CENTER OF GRAVITY OF THE CONCRETE BOX CROSS-SECTION.
- PRESTRESSING OF THE STRUCTURES SHALL BE DONE IN A MANNER SUCH THAT NO TENSILE STRESSES ARE CREATED IN THE CONCRETE.
- ALL SEGMENTS SHALL BE MATCH CAST TO ENSURE PROPER FIT DURING THE ERECTION STAGES. DURING CASTING, SEGMENTS MUST BE ALIGNED TO ACHIEVE FINAL STRUCTURE GEOMETRY. AT THIS TIME, ALL CORRECTIONS FOR DEFLECTIONS, CAMBER, AND DEFORMATIONS DUE TO CREEP, ELASTIC SHORTENING, ETC. MUST BE COMPENSATED FOR IN THE FORM.
- PRESTRESSING STEEL PROPERTIES USED IN THE DESIGN CALCULATIONS ARE FOR SEVEN-WIRE, 1/2" Ø STRANDS WITH AN ULTIMATE STRENGTH OF 270 K.S.I. CALCULATIONS MUST BE SUBMITTED FOR DEPARTMENT APPROVAL IF ANOTHER TYPE OF PRESTRESSING STEEL IS SUBSTITUTED. TENDONS SHALL BE SHIPPED IN MOISTURE-PROOF CONTAINERS THAT CAN BE STORED AT THE JOB SITE FOR AN EXTENDED PERIOD OF TIME WITHOUT CORRODING FROM ATMOSPHERIC CONDITIONS.
- REQUIRED PRESTRESSING FORCES (P_t) AND MOMENTS (P_t x e) ARE BASED ON A SEGMENT LENGTH OF 8'-0" AND ON THE CONSTRUCTION SEQUENCE SHOWN ON DRAWING NUMBER B-13. DESIGN CALCULATIONS FOR ALTERNATIVE CONSTRUCTION SCHEMES MUST BE SUBMITTED TO THE ENGINEER FOR APPROVAL.
- PROVISIONAL PRESTRESSING USED DURING CONSTRUCTION MUST HAVE ENGINEERS APPROVAL.
- IF ONE END STRESSING IS USED, ALTERNATE TENDONS SHALL BE STRESSED FROM OPPOSITE ENDS. LONGITUDINAL TENDONS LOCATED IN BOTTOM SLAB SHALL BE STRESSED AFTER CLOSURE POUR IS MADE AND TOP SLAB TENDONS ARE STRESSED.
- RECTANGULAR ANCHOR PLATES SHALL BE USED TO MINIMIZE FLARES. ALTERNATE ANCHORAGE AND CONSTRUCTION JOINT DETAILS, TO FIT THE PRESTRESSING SYSTEM USED, SHALL BE SUBMITTED TO THE ENGINEER FOR APPROVAL.
- GIRDER WEBS SHALL BE FLARED AS NECESSARY NEAR ANCHORAGE TO PROVIDE A 2" MINIMUM OF CONCRETE COVERING THE DUCTS. THE FLARE SHALL BE ON INSIDE OF THE GIRDER ONLY.
- BAR REINFORCING INTERFACING WITH THE PRESTRESSING TENDON ALIGNMENT SHALL BE ADJUSTED AS DIRECTED BY ENGINEER.
- TENDON DUCTS MUST BE PRECISELY ALIGNED DURING PRODUCTION. INFLATABLE RUBBER OR SUITABLY RIGID MATERIAL SHALL BE USED TO PREVENT ANY INDENTATIONS OR COLLAPSE OF DUCTS.
- PROVIDE ADEQUATE SUPPORT FOR TENDON DUCTS TO PREVENT ALIGNMENT CHANGES DURING CONCRETE PLACEMENT.
- A MAXIMUM OF 3 DUCTS MAY BE BUNDLED INTO VERTICAL UNITS. MINIMUM HORIZONTAL CLEARANCE BETWEEN DUCT UNITS SHALL BE 2-1/2 IN. MINIMUM VERTICAL CLEARANCE BETWEEN DUCT UNITS SHALL BE 3 IN.
- GROUTING IS TO BE DONE AFTER PRESTRESSING IS COMPLETED IN ANY ONE SPAN IN SUCH A WAY THAT GROUTING CANNOT INTERFERE WITH THREADING AND STRESSING OF TENDONS.
- CARE SHALL BE EXERCISED IN JOINING THE SEGMENTS WITH EPOXY TO ENSURE THAT COMPRESSION IS MAINTAINED OVER THE ENTIRE JOINT AREA UNTIL THE PERMANENT POST-TENSIONED TENDONS ARE STRESSED.
- SEGMENT JOINTS SHALL HAVE A THOROUGH COATING OF EPOXY TO ELIMINATE VOIDS BETWEEN TENDON DUCTS.
- A COMPLETE SET OF DEFLECTION CALCULATIONS SHALL BE SUBMITTED TO ENGINEER FOR APPROVAL 60 DAYS PRIOR TO STARTING SUPERSTRUCTURE CONSTRUCTION.
- THE CAMBER TO BE USED WILL DEPEND ON SEGMENT LENGTH, STRENGTH, WEIGHT AND CREEP OF CONCRETE, PRESTRESSING, WEIGHT OF FALSE-WORK, AND INCIDENTAL CONSTRUCTION LOADS.
- CONTRACTOR WILL BE REQUIRED TO CHECK CAMBER AT INTERMEDIATE ERECTION STEPS AND PROVIDE CAMBER ADJUSTMENTS WITH SUPPORTING CALCULATIONS.
- FALSEWORK AT CLOSURE POURS SHALL BE SUPPORTED SUCH THAT APPLIED LOADS WILL RESULT IN EQUAL DEFLECTIONS OF EACH CANTILEVER.
- TYPICAL SECTION REINFORCING (SEE DWG. NO. B-10) SHALL EXTEND INTO CLOSURE POURS.
- A MINIMUM OF 30 P.S.I. COMPRESSION SHALL BE REQUIRED DURING AND AFTER INITIAL PRESTRESSING.
- MINIMUM RESIDUAL COMPRESSIVE STRESS OF 30 PSI SHALL BE MAINTAINED AT SEGMENT JOINTS DURING CONSTRUCTION ONCE EPOXY AND PROVISIONAL OR FINAL POST TENSIONING HAVE BEEN PROVIDED.
- WEB STIFFENERS AS SHOWN ON THE PLANS ARE FOR ILLUSTRATION ONLY. THE CONTRACTOR MUST SUBMIT CALCULATIONS FOR APPROVAL IF OTHER TYPES OF ANCHORAGE DETAILS ARE TO BE USED.
- WEB STIFFENER REINFORCING DETAILS SHALL BE SUBMITTED FOR THE ANCHORAGE SYSTEM USED.

DIVISION OF HIGHWAYS

PRESTRESSING DETAILS


Designer J. KELLER	Structure Numbers	F-12-AN
Detaller PHS		
Drawing Number B-12	of 17	Drawings

INITIAL	DATE	CHECKED BY	DATE
J.C.K.	7-16-74	J.C.K.	7-16-74
J.C.K.	8-27-74	J.C.K.	8-27-74
J.C.K.	8-27-74	J.C.K.	8-27-74
J.C.K.	7-1-75	J.C.K.	7-1-75
J.C.K.	10-10-75	J.C.K.	10-10-75
J.C.K.	10-10-75	J.C.K.	10-10-75


FEDERAL ROAD DISTRICT	PROJ. NO.	SHEET NO.	TOTAL SHEETS
III	COLORADO	I-70-2(52)97	88

REVISIONS		
(R-1)	4/8/75	REPRINT WCB
()		
()		


Horiz. Dimensions & Brg. Abut. 1
Along Profile Line

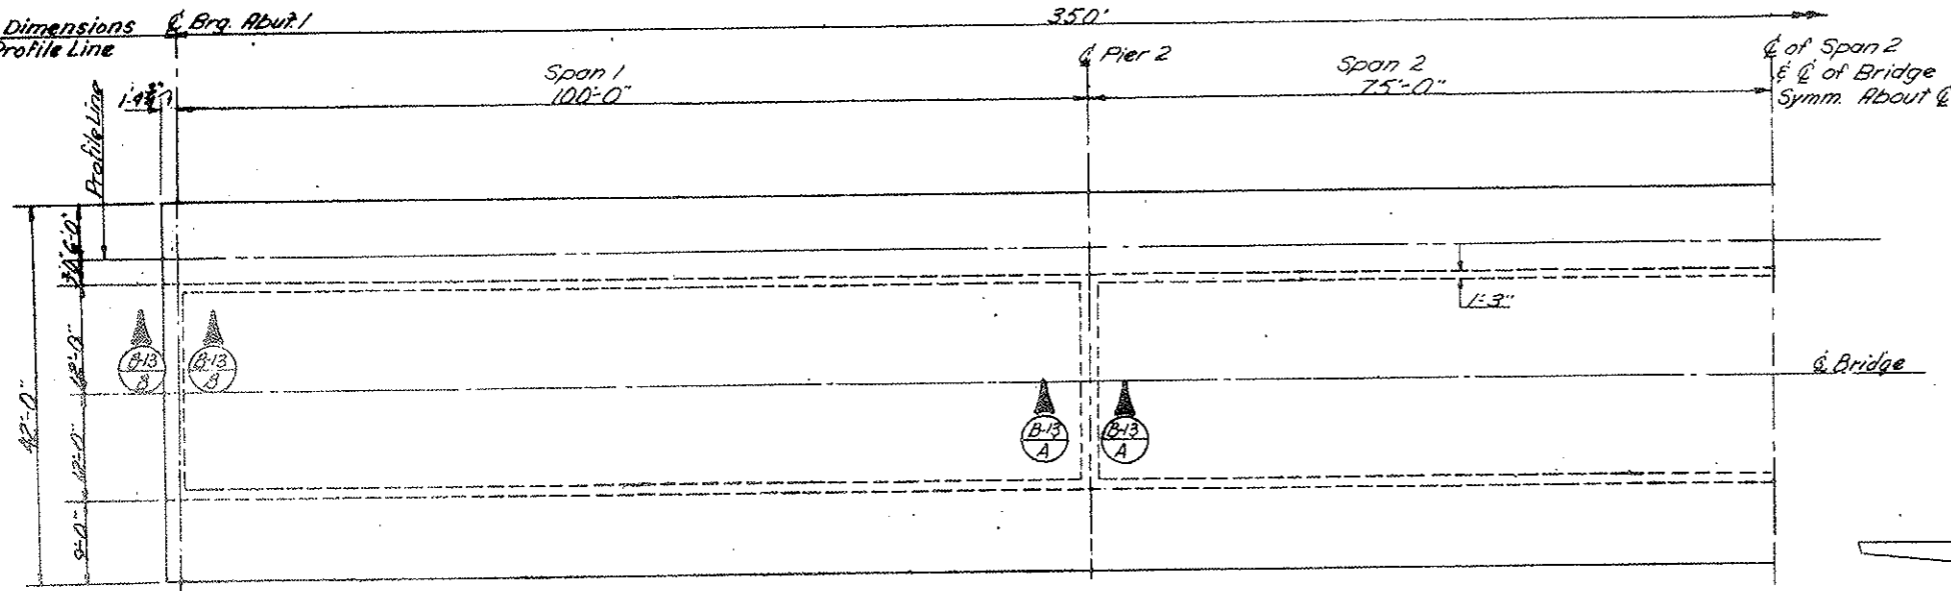


PLAN
Orig. Scale: 1" = 10'-0"

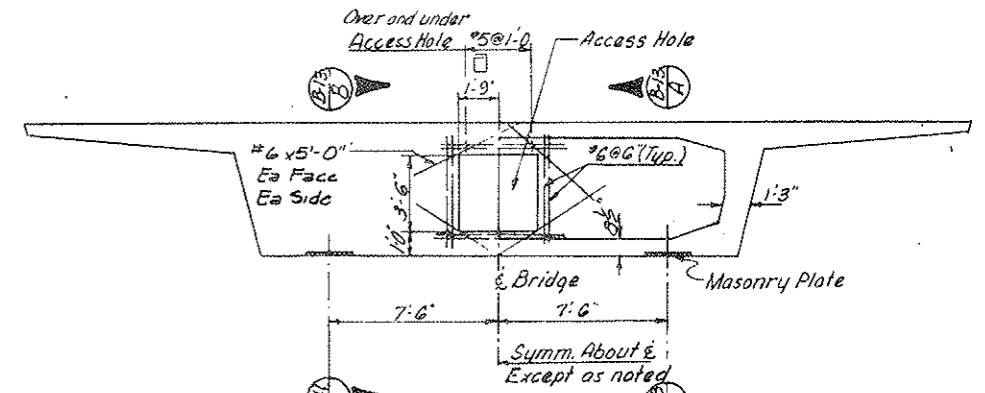

ELEVATION OF DIAPHRAGM AT PIERS & ABUTMENTS

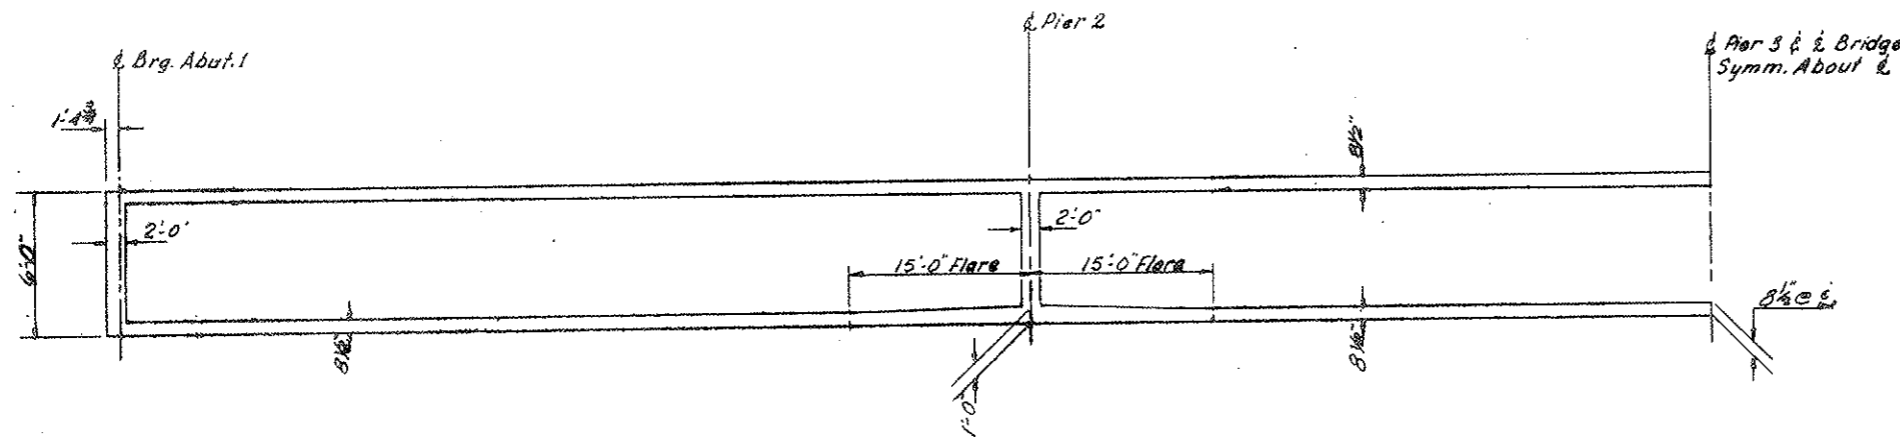


GIRDER ELEVATION
Orig. Scale: Horiz: 1" = 10'

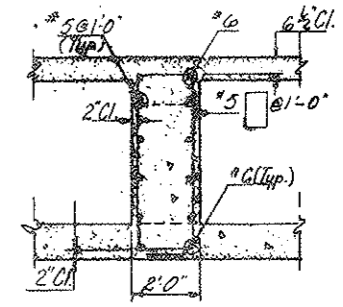

SECTION B-B A
Orig. Scale 3/8" = 1'

For Details of Expansion in Deck Overhang See Draw B-16

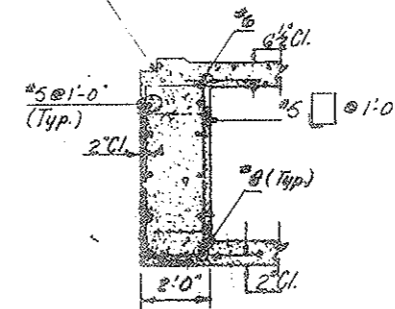


SECTION B-13 B
Orig. Scale 3/8" = 1'

DIVISION OF HIGHWAYS	
GIRDER DETAILS	
Designer J. Keller	Structure F-12-AN
Detailer P.S.	Number
Drawing Number B-13	of 17 Drawings

DESIGNED BY	DATE	CHECKED BY	DATE
U.C.K.	6-3-74	J.C.K.	7-10-74
CHECKED BY	DATE	QUANTITIES BY	DATE
U.C.K.	6-3-74	P.H.S.	10-10-74
DETAILS BY	DATE	CHECKED BY	DATE
U.C.K.	7-17-74	U.C.K.	10-10-74

FEDERAL ROAD DISTRICT NO.	DISTRICT	PROJ. NO.	SHEET NO.	TOTAL SHEETS
111	COLORADO	I-70-2(52)197	89	

REVISIONS			
R-1	4/14/75	REPRINT	WCB
R-2	4/17/75	Changed bar size.	CLB

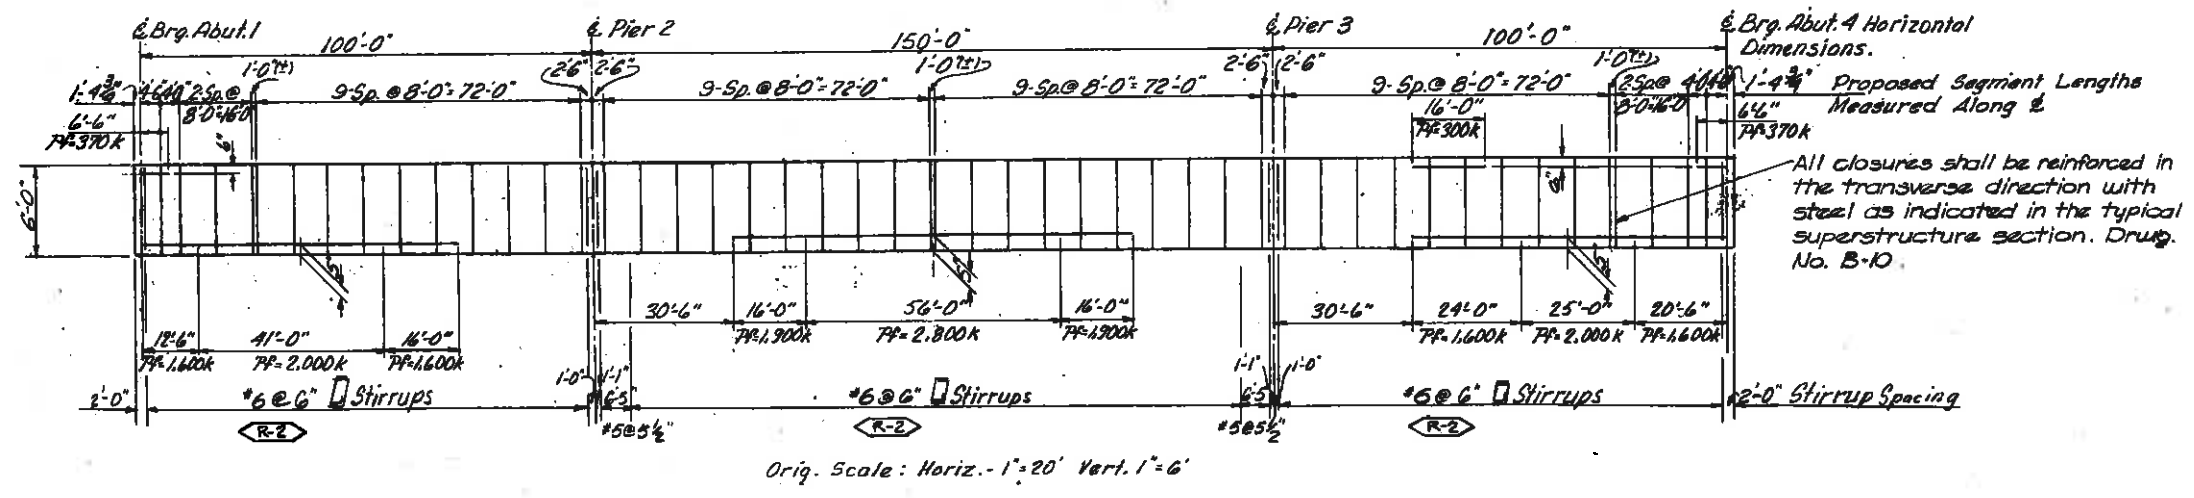

DESIGNED BY	CHECKED BY	DATE
U.S.K.	U.S.K.	7-2-74
QUANTITIES BY	CHECKED BY	DATE
U.S.K.	U.S.K.	10-10-74
DETAILS BY	CHECKED BY	DATE
P.H.S.	P.H.S.	11-1-74

- NOTES:**
- For prestressing notes refer to Drawing No. B-12.
 - $\frac{1}{6}$ stirrups to be included in closure pours also.

DIVISION OF HIGHWAYS


*GIRDER ELEVATIONS
AND CONTINUITY PRESTRESSING*

Designer <i>J. Keller</i>	Structure Number <i>F-12-AN</i>
Detailer <i>P.S.</i>	
Drawing Number <i>B-14</i>	of 17 Drawings


FEDERAL ROAD REGION NO.	DISTRICT	PROJ. NO.	SHEET NO.	TOTAL SHEETS
VIII	COLORADO	170-2(52)197	90	

REVISIONS	
R-1	2-17-75 Rev. Piers, Piers, Added Movement Notes
	Changed Anchorage, Add dimen. A
	CLB


VOID BY CONSTRUCTION DATE 6-24-77

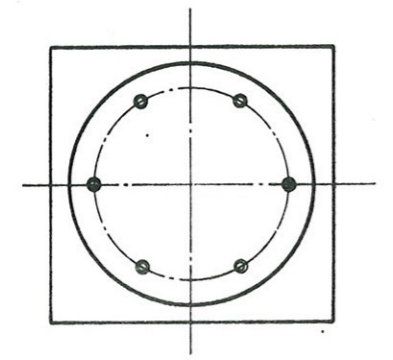

SOLE PLATE (INVERTED)

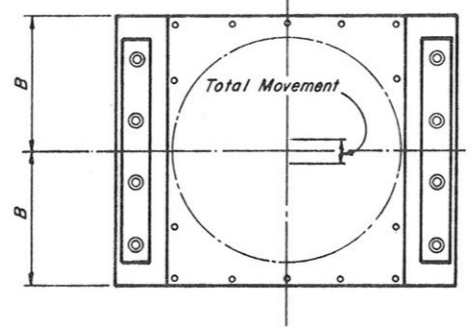


TOP PLATE (INVERTED)

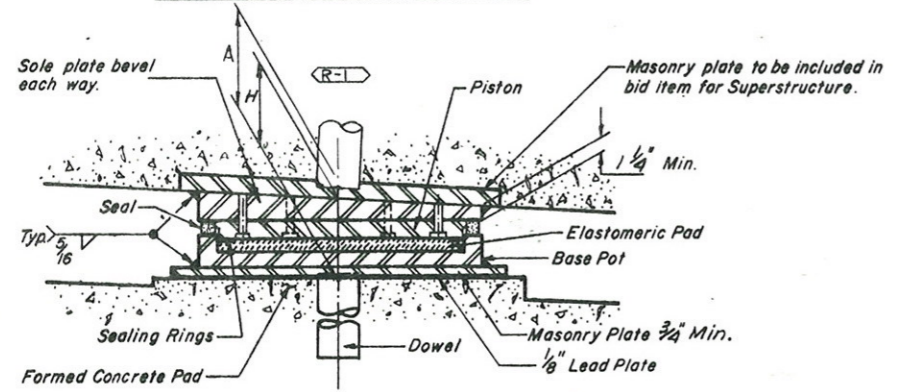

SECTION THRU ASSEMBLED BEARING

FIXED FLOATING BEARING

No Scale

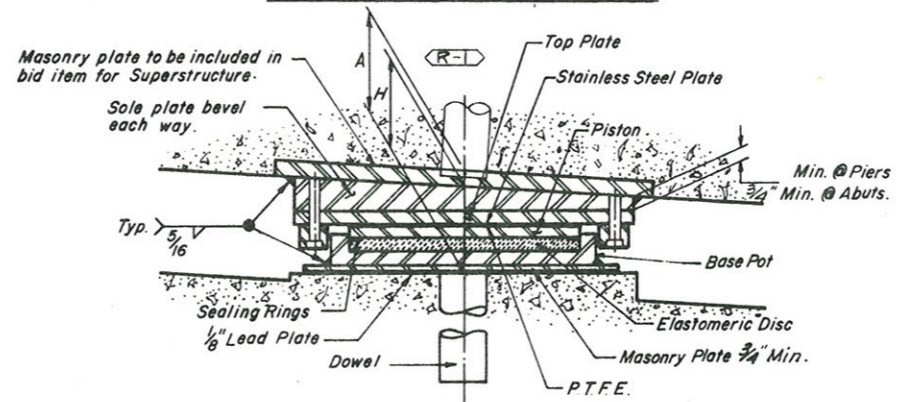

SECTION THRU ASSEMBLED BEARING

GUIDED EXPANSION BEARING


No Scale

BEARING NOTES:

- STEEL FOR THE BEARING DEVICES, MASONRY PLATES, AND SOLE PLATES SHALL BE A.A.S.H.T.O. SPECIFICATION M-183 (A.S.T.M. A36).
- THE TYPE OF ANCHORAGE FOR BEARING DEVICES SHALL BE DETERMINED BY THE CONTRACTOR AND SUBMITTED ON SHOP DRAWINGS FOR APPROVAL.
- FOR ALLOWABLE BEARING PRESSURE ON CONCRETE, SEE DRAWINGS.
- THE SOLE PLATES SHALL BE SUPPLIED WITH BEVELS AND CROSSFALLS AS REQUIRED FOR GRADE AND SUPERELEVATION.
- DIMENSION "A" IS THE LIMIT REQUIRED FOR BID ITEM NO. 512, "BEARING DEVICES".
- THE SIZES OF MASONRY PLATES SHALL BE DETERMINED BY THE BEARING MANUFACTURER. THE ALLOWABLE ULTIMATE BEARING PRESSURES AND THE ULTIMATE LOADS SHALL BE USED TO DETERMINE THE MASONRY PLATE SIZES.
- ALL BEARING DETAILS, INCLUDING WELDS, ARE SHOWN FOR ILLUSTRATION PURPOSES ONLY. THE CONTRACTOR SHALL SUBMIT SHOP DRAWINGS SHOWING DETAILS OF THE SPECIFIC BEARING DEVICE TO BE USED.

ALLOWABLE ULTIMATE BEARING PRESSURES:

- At Abutments: ($f'_c = 3000$ psi) 1785 psi
- At Piers: ($f'_c = 5000$ psi) 2975 psi
- In Superstructure: ($f'_c = 5500$ psi) 3273 psi

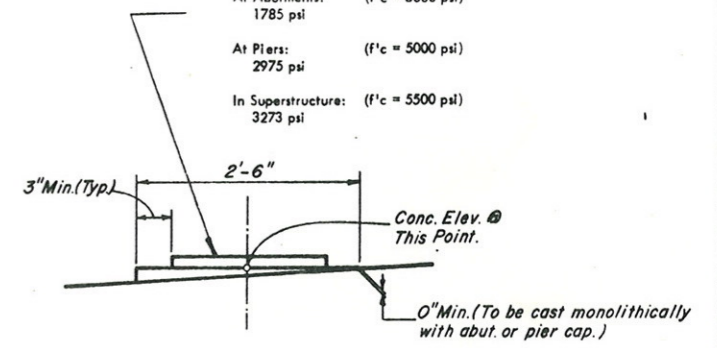

CONCRETE BEARING PAD DETAIL

No Scale

DESIGNED BY	DATE	CHECKED BY
PHS	6-28-78	PHS
CHECKED BY	DATE	QUANTITIES BY
PHS	6-28-78	PHS
DETAILED BY	DATE	CHECKED BY
PHS	7-1-78	PHS

FIXED FLOATING BEARING

LOCATION	PIER 2	PIER 3
Capacity	550 Tons	550 Tons
Min. Horiz. Capacity	60 Tons	60 Tons
* Computed Reaction-DL+LL+I	528.5 Tons	528.5 Tons
Ultimate Reaction	768.1 Tons	768.1 Tons
H	5 1/8 in.	5 7/8 in.
Max Movement (in.)	0	0

* Computed reactions shall be used to determine bearing capacity.

GUIDED EXPANSION BEARING

LOCATION	ABUT. 1	ABUT. 4
Capacity	175 Tons	175 Tons
Min. Horiz. Capacity	15 Tons	15 Tons
* Computed Reaction-DL+LL+I	152.5 Tons	152.5 Tons
Ultimate Reaction	243.8 Tons	243.8 Tons
H	5 in.	5 in.
Max Movement (in.)	1 1/4	1 1/4

NOTE: Capacity includes dead load plus live load plus impact.

DIVISION OF HIGHWAYS


BEARING DETAILS

Designer	J. Keller	Structure	F-12-AN
Detailer	PHS	Numbers	
Drawing Number B-15		of 17 Drawings	


FEDERAL ROAD REGION NO.	DIVISION	PROJ. NO.	SHEET NO.	TOTAL SHEETS
XIII	COLORADO	1-2-2,197	91	

REVISIONS	


NOTES
 THE EXPANSION DEVICE SHALL BE INSTALLED ON GRADE, PARALLEL TO THE SLOPE AND GRADE OF THE DECK.
 AFTER THE CONCRETE HAS ATTAINED INITIAL SET, THE ATTACHMENTS USED TO HOLD THE ANGLE ASSEMBLY IN ITS PROPER POSITION SHALL BE REMOVED.
 DO NOT PAINT STEEL SURFACES IN CONTACT WITH CONCRETE AND PREMOLDED EXPANSION DEVICE.
 "W", "T", "Ø", AND "Δ" DIMENSIONS ARE DEPENDENT UPON THE PARTICULAR PREMOLDED DEVICE SUPPLIED, AND SHALL BE SHOWN ON THE SHOP DRAWINGS.
 THE SHOP DRAWINGS SHALL INDICATE THE "W" DIMENSION AT A RANGE OF TEMPERATURES FROM 30° TO 100° ASSUMING A MID-POINT TEMPERATURE OF 40°.
 ANGLE AND PLATE ASSEMBLIES TO EXTEND GUTTER TO GUTTER ONLY.
 ALL SECTIONS OF THE PREMOLDED EXPANSION DEVICE SHALL BE JOINED BY USING THE MANUFACTURER'S STANDARD WATERPROOF JOINT.
 ALL CURB UNITS SHALL BE FULL WIDTH, ON GUTTER LINE, FOR SKEW ANGLES AS SPECIFIED ON THE PLANS.
 ALL ANCHORS SHALL BE CAST IN PLACE BOLTS OR THREADED CAST IN PLACE CONCRETE INSERTS EXCEPT FOR CURB AND WALK UNITS WHICH MAY BE INSTALLED BY THE USE OF APPROVED DRILLED IN PLACE ANCHOR UNITS.
 OPENING IN CURB AND SIDEWALK TO BE CONSTRUCTED TO THE EXACT WIDTH OF THE EXISTING DECK OPENING.

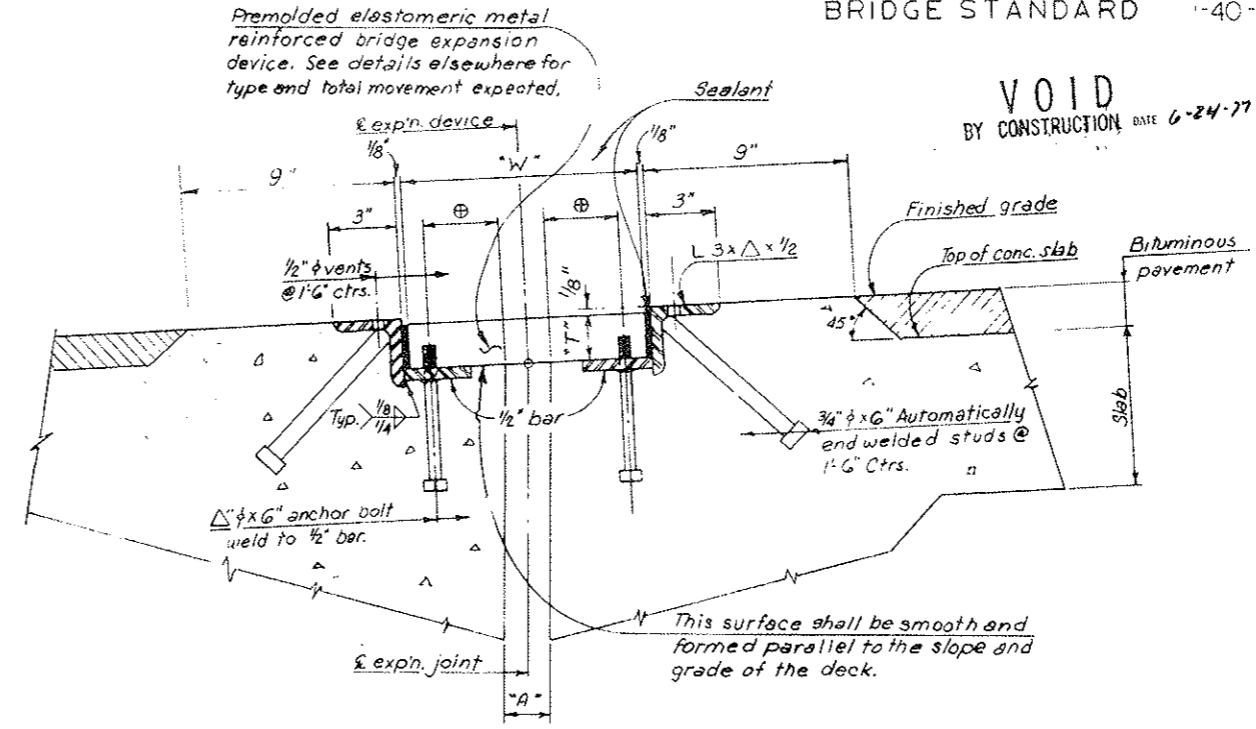


SECTION THRU EXPN. DEVICE

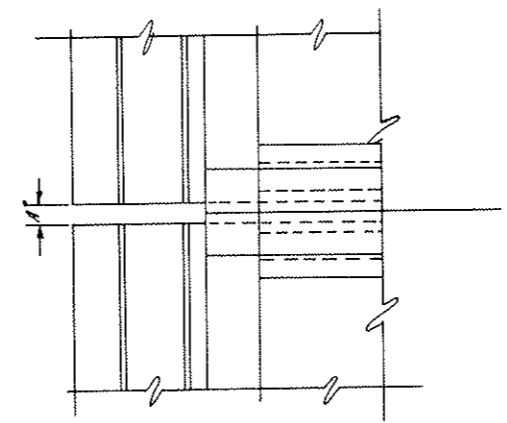

PLAN

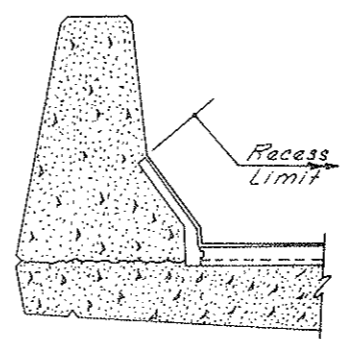

ELEVATION

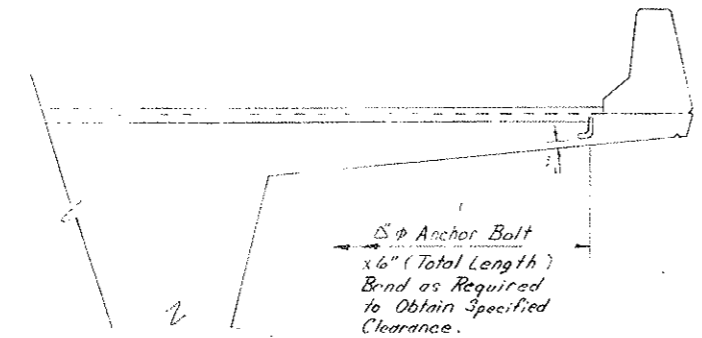

DETAILS OF EXPANSION JOINT AT GUARDRAIL

Outside Temp.	Premolded Bridge Expansion Device		
	(Type 1)	(Type 2)	(Type 3)
	Dim. "A" (Min.)	Dim. "A" (Min.)	Dim. "A" (Min.)
30°	1 7/8"	2 1/4"	2 3/4"
40°	1 1/2"	2 1/8"	2 3/8"
50°	1 3/8"	2"	2 1/2"
60°	1 1/4"	1 7/8"	2 3/8"
70°	1 1/8"	1 5/8"	2 1/8"
80°	1"	1 1/2"	2"
90°	7/8"	1 3/8"	1 7/8"
100°	3/4"	1 1/4"	1 5/8"

Outside Temp.	Premolded Bridge Expansion Device		
	(Type 4)	(Type 6)	(Type)
	Dim. "A" (Min.)	Dim. "A" (Min.)	Dim. "A" (Min.)
30°	4 3/8"	5 3/8"	
40°	4 1/8"	4 3/8"	
50°	3 7/8"	4 1/2"	
60°	3 3/8"	4"	
70°	3 1/4"	3 3/8"	
80°	3"	3 1/4"	
90°	2 3/4"	2 3/4"	
100°	2 1/2"	2 1/8"	

DIVISION OF HIGHWAYS

BRIDGE EXPANSION DEVICE
 PREMOLDED ARMORED


Designer	Structure	F-12-AN
Detailer J.R. EWERT	Numbers	
Drawing Number B-10	of 17	Drawings

DESIGNED BY	CHECKED BY	DATE
P.H.P.	J.C.K.	7-16-74
QUANTITIES BY	CHECKED BY	DATE
J.C.K.	J.C.K.	10-10-74
DETAILS BY	CHECKED BY	DATE
P.H.S.	J.C.K.	10-10-74


FEDERAL ROAD DISTRICT NO.	DIVISION	PROJ. NO.	SHEET NO.	TOTAL SHEETS
VIII	COLORADO	I 70-2(52)197	92	

REVISIONS	

VOID
BY CONSTRUCTION DATE 6-28-77

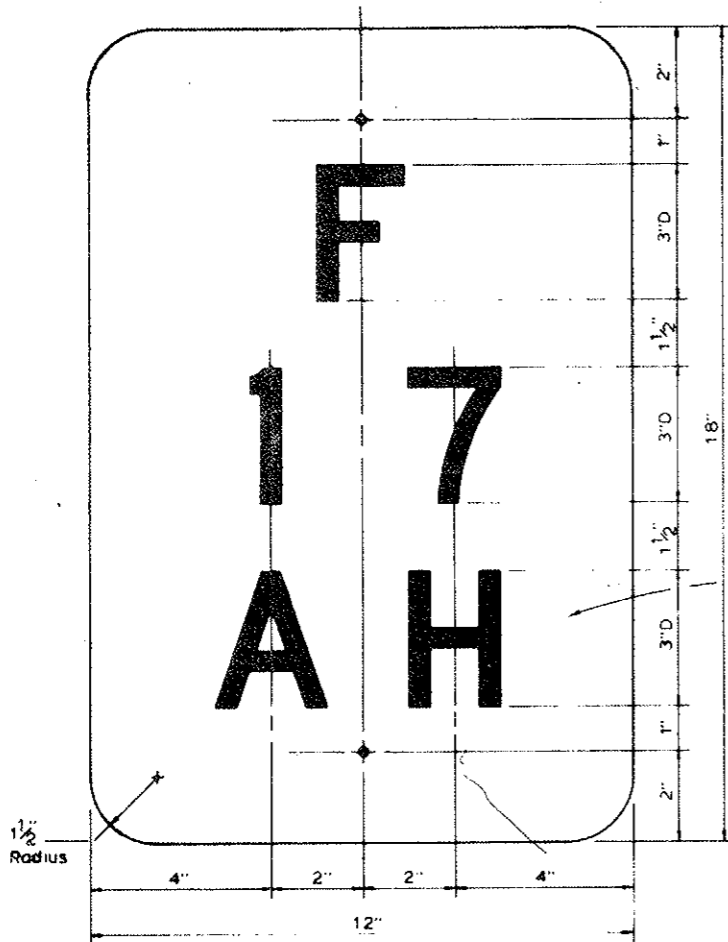

Black letters and numbers on white background

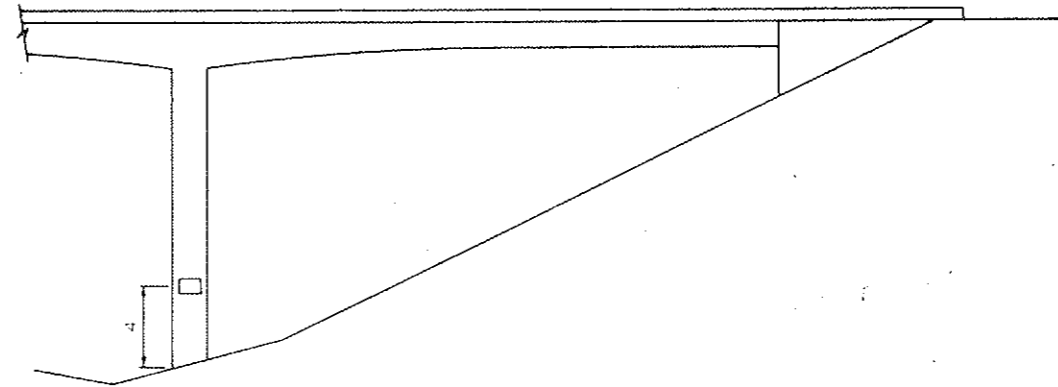


STRUCTURE NUMBER LOCATION ON PIERS


- ALL WORK SHALL BE DONE IN ACCORDANCE WITH THE STANDARD SPECIFICATIONS APPLICABLE TO THE PROJECT.
- SIGN PANELS SHALL BE FABRICATED FROM EITHER SHEET STEEL OR GALVANIZED STEEL SHEET ALUMINUM 0.060 MIN. THICKNESS.
- SIGN PANELS SHALL BE GROUND MOUNTED.
- U-2 POST SHALL MEET REQUIREMENTS OF PAR. 4.1 U.C. DEPT. OF COMMERCE, COMMERCIAL STANDARD 134 5.1. ACCEPTABLE MATERIAL INCLUDES PERU, LLOYD, RAILROAD RAILS. U-2 POST SHALL WEIGH 2 LBS. PER FT. EXCEPT THAT A MILL TOLERANCE OF MINUS 3-1/2% OF THE WEIGHT OF THE U-2 POST WILL BE ALLOWED. ALTERNATE METAL POST WILL BE ACCEPTABLE IF SECTION MODULUS IS AT LEAST 0.00 IN³ ABOUT THE Z-Axis AND AT LEAST 0.250 IN. \bar{I} ABOUT THE Y-Axis.
- SIGN PANELS SHALL BE FASTENED DIRECTLY TO THE POST WITH TWO (2) GALVANIZED OR CADMIUM PLATED STOVE BOLTS. A PLASTIC FIBER WASHER SHALL BE PLACED BETWEEN THE BOLTS HEAD AND THE FACE OF THE PANEL. A GALVANIZED OR CADMIUM PLATED LOCK WASHER SHALL BE PLACED UNDER THE NUT ON THE BACK OF THE POST. GALVANIZED OR CADMIUM PLATED FIBER WASHERS ON THE FACE OF THE SIGN PANEL SHALL BE MATCHED TO MATCH THE SURROUNDING COLOR.
- LETTERS AND NUMBERS SHALL BE SERIALIZED. THEY SHALL BE 1/4 IN. HIGH.
- THE CORRECT STRUCTURE NUMBER IS SHOWN ON THE PLAN.
- UNIT STRUCTURE NUMBER STANDARDS WHERE A RAILROAD TRACK CROSSES OVER THE ROADWAY.
- STRUCTURE NUMBER STANDARD SHALL NOT BE PAID FOR SEPARATELY BUT INCLUDED IN THE WORK.
- IN ADDITION TO THE REQUIREMENTS STATED ABOVE, STRUCTURE NUMBERS FOR ROADWAYS PASSING UNDER CROSSROADS ARE TO BE PLACED AT THE FOLLOWING POINTS:
- FOR STRUCTURES OF THREE OR MORE SPANS, THE STRUCTURE NUMBER SHALL BE STENCILED, FACING TRAFFIC, ON THE OUTSIDE FACE OF THE END COLUMN OF THE RIGHT HAND PIER.
 - FOR TWO SPAN STRUCTURES, THE STRUCTURE NUMBER SHALL BE STENCILED, FACING TRAFFIC, ON THE OUTSIDE FACE OF EACH END COLUMN OF THE CENTER PIER.

DESIGNED BY	U.C.A.	7-1-74
CHECKED BY	U.C.A.	7-1-74
APPROVED BY	U.C.A.	7-1-74
DATE	7-1-74	
DESIGNED BY	U.C.A.	7-1-74
CHECKED BY	U.C.A.	7-1-74
APPROVED BY	U.C.A.	7-1-74
DATE	7-1-74	


STRUCTURE IDENTIFICATION PANEL (SAMPLE NUMBERS & LETTERS)

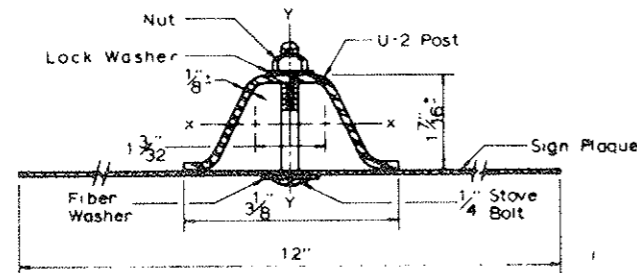

SECTION A-A

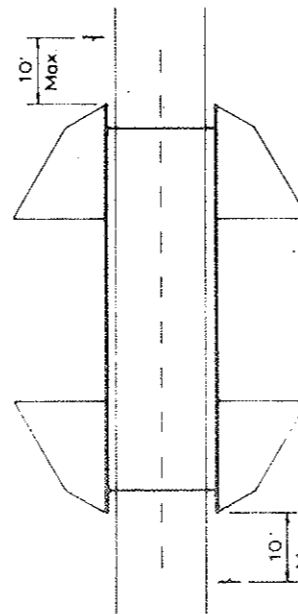

STANDARD LOCATION DETAIL

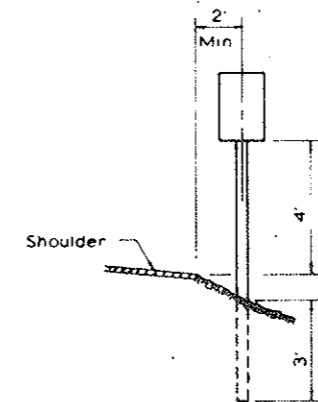

U-2 POST IN GROUND

DIVISION OF HIGHWAYS	
STRUCTURE NUMBER STANDARD	
Designer	Structure F-12-AN
Designer B.P. LEE	Numbers
Drawing Number B-17	of 17 Drawings

GENERAL NOTES:

ALL WORK SHALL BE DONE ACCORDING TO THE STANDARD SPECIFICATIONS OF THE DIVISION OF HIGHWAYS, STATE OF COLORADO, APPLICABLE TO THE PROJECT.

ALL CONCRETE SURFACES AS REFERRED TO IN THE SPECIFICATIONS SHALL RECEIVE A CLASS 7 SURFACE FINISH.

ALL CONCRETE CHAMFERS SHALL BE 3/4 INCH UNLESS OTHERWISE NOTED.

EXPANSION JOINT MATERIAL SHALL MEET A. A. S. H. T. O. SPECIFICATION M 213-65 AND SHALL BE INCLUDED IN THE PAYMENT FOR ITEM NO. 601.

SOUNDINGS AND DEPTH OF FOOTINGS ARE IN ACCORDANCE WITH THE BEST AVAILABLE DATA. WHEN DIFFERENT CONDITIONS ARE ENCOUNTERED, THE BRIDGE ENGINEER WILL INSPECT AND DETERMINE IF REDESIGN IS NECESSARY.

WHEN EXCAVATING FOR FOOTINGS, THE FINAL SIX INCHES IN DEPTH SHALL BE DONE BY HAND LABOR METHODS.

FOOTINGS IN ROCK SHALL NOT BE FORMED BUT SHALL BE PLACED AGAINST UNDISTURBED ROCK.

FOR DETAILS OF STRUCTURE EXCAVATION AND STRUCTURE BACKFILL, SEE STANDARD M-206-AA.

ALL STRUCTURAL STEEL NOT OTHERWISE NOTED SHALL BE A. A. S. H. T. O. SPECIFICATION M-222 (A. S. T. M. A 588).

STRUCTURAL STEEL FOR ALL SECONDARY MEMBERS WITH THE EXCEPTION OF BEARING STIFFENERS AND LONGITUDINAL STIFFENERS IN THE BOTTOM FLANGE MAY BE AASHTO SPECIFICATION M-183 (A. S. T. M. A 36).

IF A. S. T. M. A 36 STRUCTURAL STEEL IS USED FOR SECONDARY MEMBERS, ALL SUCH MEMBERS SHALL BE PAINTED WITH 2 COATS SHOP PAINT EXCEPT FOR EXTERIOR DIAPHRAGMS. EXTERIOR DIAPHRAGMS SHALL BE LEFT UNPAINTED.

ALL STRUCTURAL STEEL NOT OTHERWISE NOTED SHALL BE PAINTED IN ACCORDANCE WITH SECTION 509 FOR PAINT.

NO WELDING OF ANY KIND SHALL BE PERMITTED ON THE FLANGES OF STEEL GIRDERS UNLESS SPECIFICALLY CALLED FOR IN THE PLANS.

BOLTS SHALL BE FURNISHED IN THE AMOUNT OF TWOPERCENT IN EXCESS OF THE NOMINAL NUMBER REQUIRED.

STRUCTURE WAS ANALYZED USING LOAD FACTOR DESIGN EXCEPT TRANSVERSE DECK SLAB WHICH WAS ANALYZED USING SERVICE LOAD DESIGN.

GRADE 60 REINFORCING STEEL REQUIRED FOR DECK AND LAPERS. GRADE 40 OR GRADE 50 MAY BE USED FOR LAPERS.


THE EXTERIOR FACE OF THE OUTSIDE WEB OF EACH STEEL BOX GIRDER SHALL BE SAND BLAST CLEANED IN ACCORDANCE WITH SUBSECTION 509.33 (b) 2 OF THE STANDARD SPECIFICATIONS. ALL OTHER EXPOSED SURFACES SHALL BE CLEANED AS OUTLINED IN SECTION 509.33 (b) 1.

WELDS WHICH ARE EXPOSED TO VIEW WILL REQUIRE WELD METAL WITH COLORING CHARACTERISTICS SIMILAR TO THAT OF THE BASE METAL.

THE FOLLOWING TABLE SHOWS THE MINIMUM LAP FOR COMMON BAR SIZES.

BAR SIZE NUMBER	4	5	6	7	8	9	10	11
SPLICE GRADE 40	1'-0"	1'-3"	1'-6"	1'-9"	2'-2"	2'-8"	3'-5"	4'-3"
LENGTH GRADE 60	1'-6"	1'-11"	2'-3"	2'-8"	3'-0"	3'-5"	4'-2"	5'-0"

E. F. = EACH FACE
N. F. = NEAR FACE
F. F. = FAR FACE

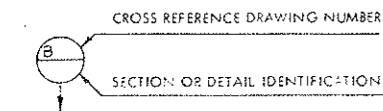

LOADING DATA

LIVELOAD: A. A. S. H. T. O. HS 20-44 OR INTERSTATE ALTERNATE
DEADLOAD: ASSUMES 25 LBS. PER SQ. FT. FOR BITUMINOUS PAVEMENT

DESIGN DATA:

A. A. S. H. T. O. 1973 UNIT STRESSES, AND 1974 INTERIM SPECIFICATIONS, EXCEPT AS NOTED.

REINFORCING STEEL:	GRADE 60 -	F _y = 60,000 LBS. PER SQ. IN. F _s = 24,000 LBS. PER SQ. IN.
	GRADE 40 -	F _y = 40,000 LBS. PER SQ. IN. F _s = 20,000 LBS. PER SQ. IN.
STRUCTURAL STEEL:	A36, GRADE 36 -	F _y = 36,000 LBS. PER SQ. IN.
	A588, GRADE 50 -	F _y = 50,000 LBS. PER SQ. IN.
CONCRETE:	CLASS A & D -	F _c = 3000 LBS. PER SQ. IN. N = 9
	CLASS 5 - (FOR LIMITS SEE PLANS.)	F _c = 5000 LBS. PER SQ. IN.


Summary of Quantities

Item	Description	Unit	Structure No. P-12-AN						
			Super-Structure	Abut. 1/2	Pier 2/3	Abut. 4/5	Total		
206	Structure Excavation	Cu. Yd.		135	110	320	170	735	
206	Structure Backfill (Class 2)	Cu. Yd.		65	50	210	100	425	
				85	145	225	27	475	
③	205 Hot Bituminous Pavement (Grading)	Ton	178					178	
③	411 Asphalt Cement (AC-5)	Ton	13					13	
②	502 Steel Piling (HP 10x42)	Lin. Ft.		81.7			18.1	100.8	
	502 Steel Piling (HP 12x74)	Lin. Ft.		72			39	111	22.2
⑤	509 Structural Steel	Lbs.	415,000	70			70	415,140	
④	512 Bearing Devices (0 to 250 Tons)	Eq.		2			2	4	
④	512 Bearing Devices (251 to 500 Tons)	Eq.			2	2		4	
④	515 Waterproofing (Membrane)	Sq. Yds.	1034					1034	
(R-1)	518 Bridge Expansion Device (Type 2)	Lin. Ft.	76					76	
	601 Concrete Class A (Bridge)	Cu. Yd.		13.46	45	45	13.46	115.38	144.52
	601 Concrete Class A (Bridge) (Colored)	Cu. Yd.		30.25	18	24.8	30	80	50.62
	601 Concrete Class D (Bridge)	Cu. Yd.	318				57.53	318	296.76
	601 Concrete Class D (Bridge) (Colored)	Cu. Yd.	264	50.10			75	298	378.89
	602 Reinforcing Steel	Lbs.	127,483	10,177	4830	4830	9,669	157,000	156,989
①	618 Concrete Cylinders: 1 Pier	L.S.						1	
	626 Mobilization	L.S.						0.2	

- ① Concrete Class S (Colored) 163 Cu. Yd.
Reinforcing Steel 42,610 Lbs.
Reinforcing Strands 6,620 Lbs.
- ② HPS 10x42 May be used in lieu of the HP 10x42
- ③ Future Items
- ④ Includes the wedged sole plate and the masonry plate
- ⑤ Item 509 includes 140 #A36 for access doors

(R-3) ① Approximate Quantities for Information only.

PORTIONS OF DECK TO BE POURED WITH COLORED CONCRETE

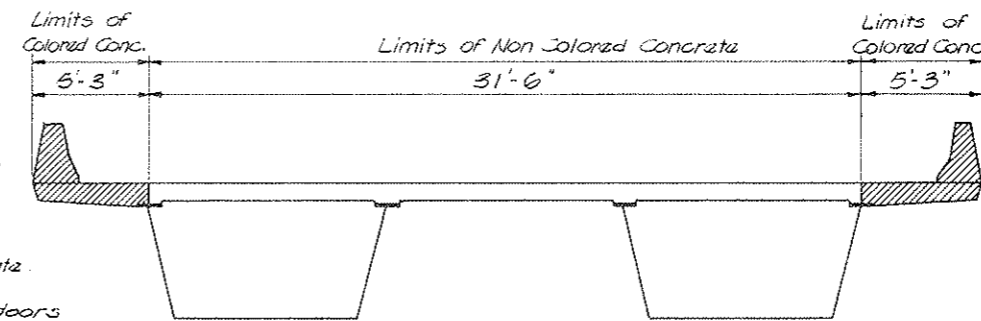

FEDERAL ROAD REGION NO.	DISTRICT	PROJ NO.	SHEET NO.	TOTAL SHEETS
VIII	COLORADO	I 70-2(52)197	93	

REVISIONS			
(R-1)	4/11/75	Changed Expn. Device Type	CLB
(R-2)	4-29-75	Removed "D 2" from note	B.D.E.
(R-3)	5-6-75	Note	WGB

INDEX OF DRAWINGS

Dwg. No.	Title
B-1	General Information
B-2	General Layout
B-3	Engineering Geology
B-4	Elevations
B-5	Elevations
B-6	Elevations
B-7	Construction Layout and Footing and Piling Layout
B-8	Abutment 1 Details
B-9	Abutment 4 Details
B-10	Pier Details
B-11	Framing Plan
B-12	Girder Details
B-13	Half Deck Section, Deck Plan
B-14	Bearing Details
B-15	Expansion Device Detail
B-16	Structure Numbers Standard

AS CONSTRUCTED
REVISED DATE: 6-24-79

BRIDGE EXPANSION DEVICES
TRANSFLEX TYPES 1500, 200A, 400A, 650
2


BRIDGE DESCRIPTION

3 Span (100'-0", 150'-0", 100'-0")
Continuous Composite Concrete Slab and
welded steel box girder bridge.

Over Stafford Gulch
38'-0" Roadway, Curb to Curb, 90° Skew
Type 4 Bridge Rail.

DESIGN FOUNDATION PRESSURES

Description	Allowable Pile Load	Computed Pile Load	Allowable Fig. Pressure	Computed Fig. Pressure
Abutment 1	98 Tons	80 Tons		
Abutment 1 Backwall	55 Tons	36 Tons		
Pier 2			6 Tons per sq. ft.	5.8 Tons per sq. ft.
Pier 3			6 Tons per sq. ft.	5.8 Tons per sq. ft.
Abutment 4			6 Tons per sq. ft.	5.8 Tons per sq. ft.
Abutment 4 Backwall	55 Tons	36 Tons		

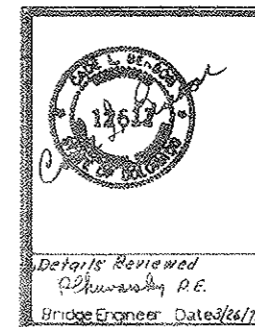

Details Reviewed
R. L. B.
Bridge Engineer Date 3/26/75

DIVISION OF HIGHWAYS



**GENERAL INFORMATION
SUMMARY OF QUANTITIES**

Station 943 + 28.500 to	
Station 947 + 11.500	
Near Vail Sec.	T. 5 S. R. 79 W.
Designer RUP	Structure Numbers F-12-AN
Detailer DDL	
Drawing Number B-1	of 12 Drawings


THIS DEPARTMENT OF HIGHWAYS
 DOES NOT GUARANTEE THE
 ACCURACY OF ANY INFORMATION
 CONTAINED HEREIN

PROJECT NO.	DISTRICT	PLAN NO.	SHEET NO.	TOTAL SHEETS
170-2(S2)197	COLORADO	170-2(S2)197	94	


REVISIONS	

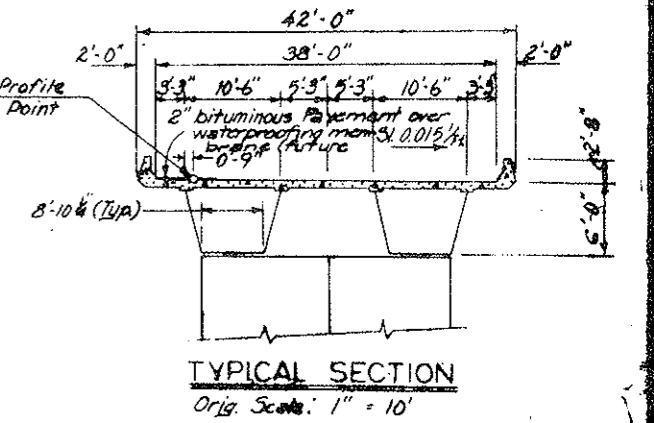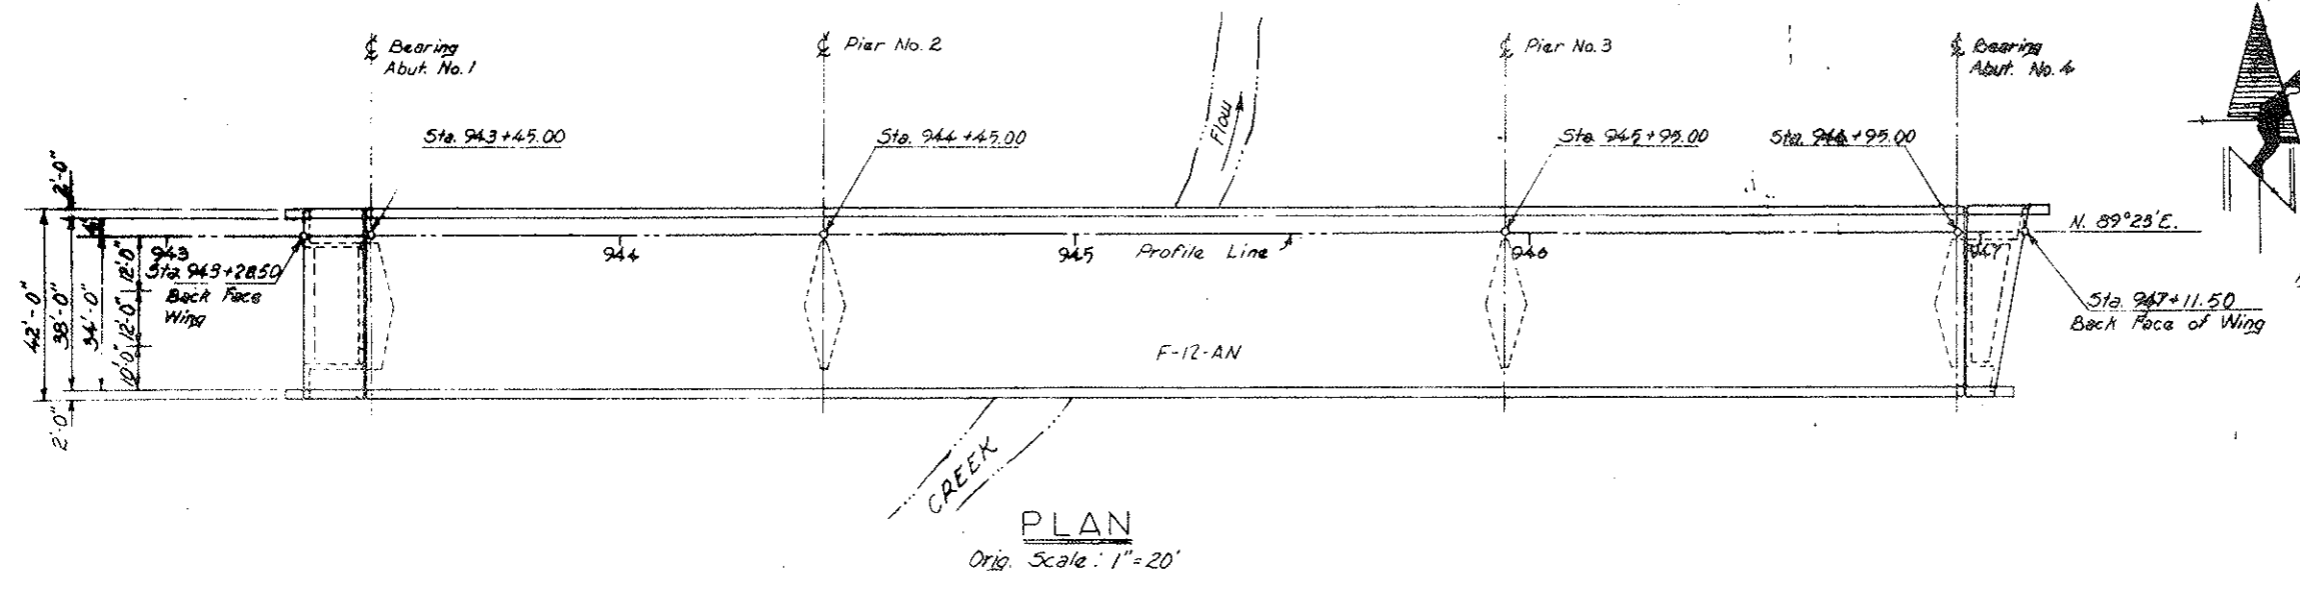

DESIGNED BY	DATE	CHECKED BY	DATE
QUANTIFIED BY			
CHECKED BY			
DETAILED BY			

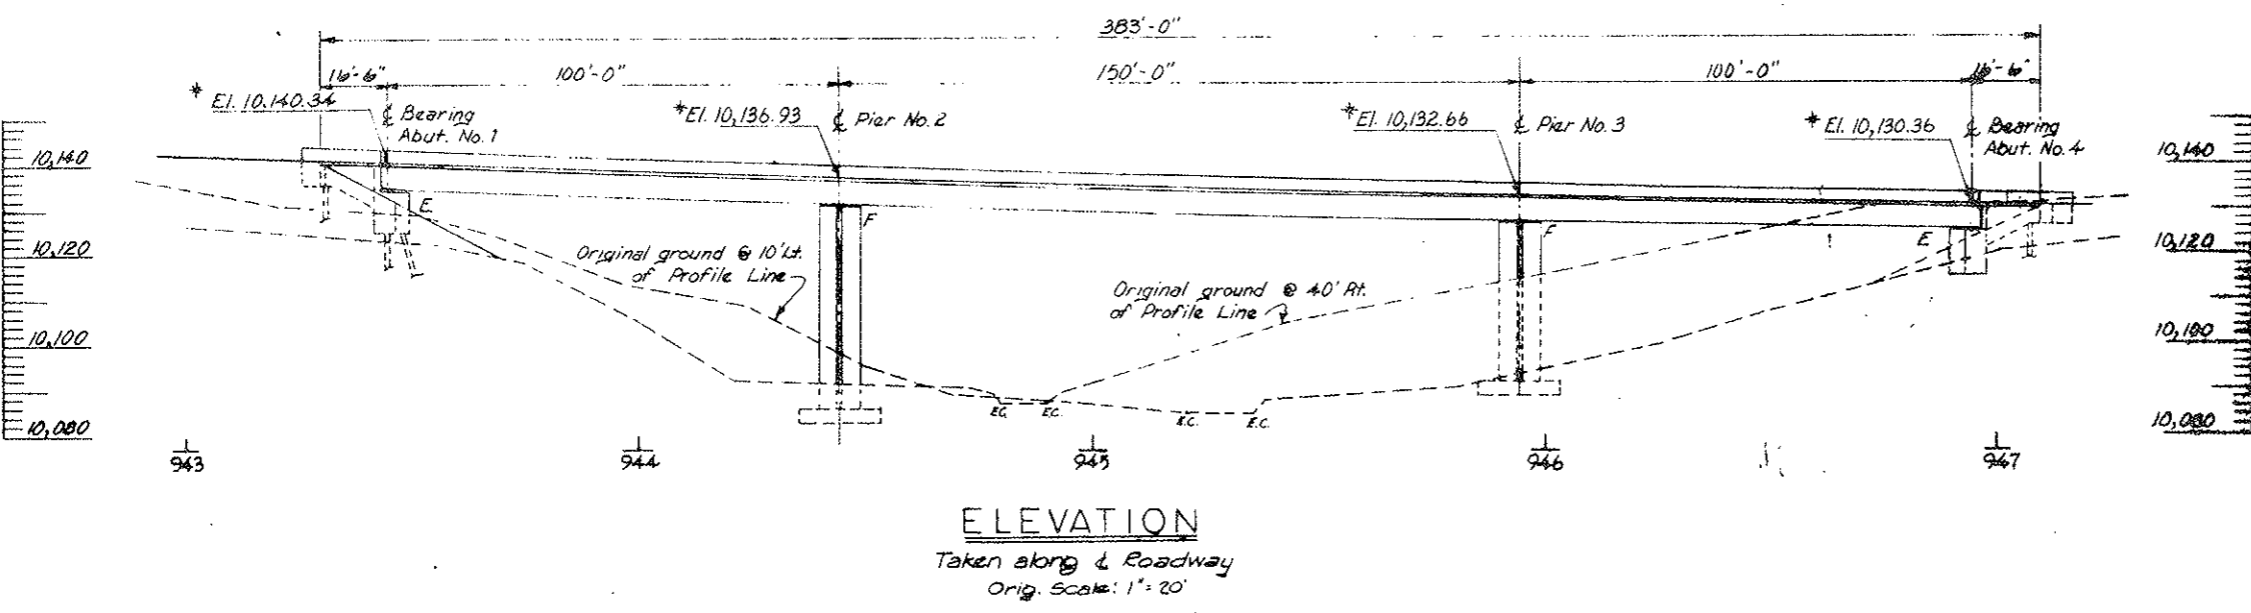

AS CONSTRUCTED
 NO REVISIONS DATE: 6-24-77

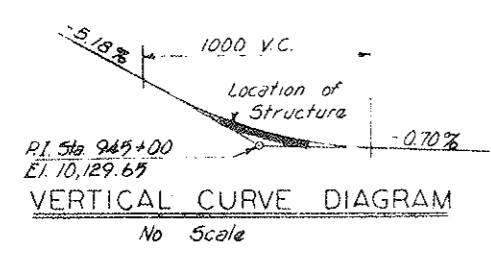


DIVISION OF HIGHWAYS

GENERAL LAYOUT

DESIGNED BY	DATE	CHECKED BY	DATE
QUANTIFIED BY			
CHECKED BY			
DETAILED BY			

FED. ROAD REG. NO.	DIVISION	PROJECT NO.	SHEET NO.	TOTAL SHEETS
XIII	COLO.	170-2(1)197	95	

AS CONSTRUCTED
NO REVISIONS DATE: 6-24-77

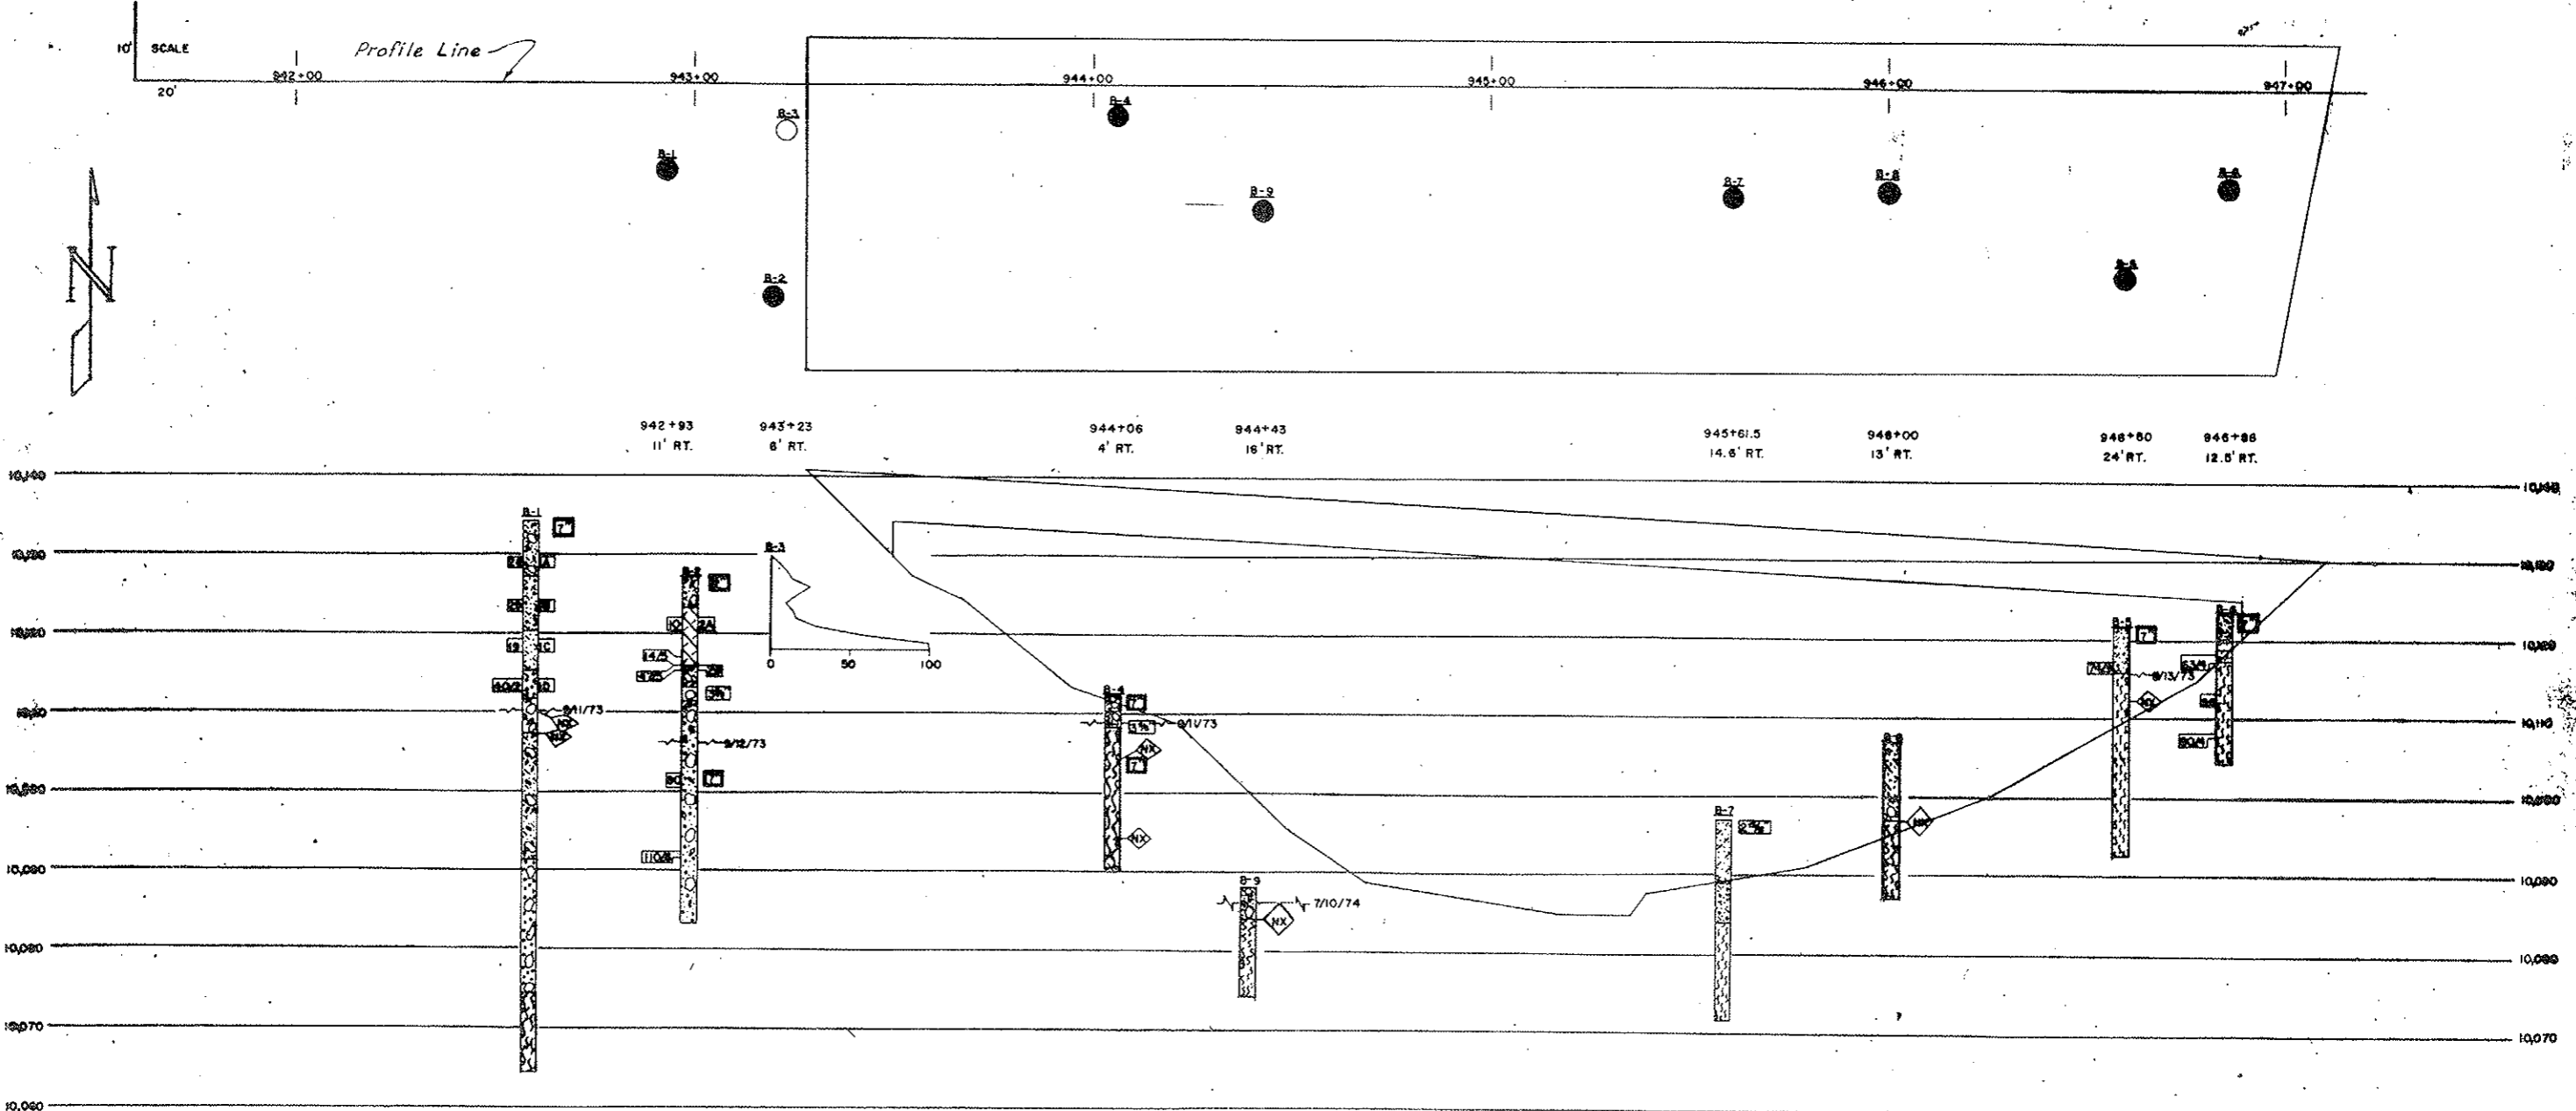

SUMMARY OF TEST RESULTS

Sample No.	Depth	Classification	AASHTO	Grading Analysis				Atterberg Limits			Water Cont. %	Unconfined Strength	Triaxial Shear Strength			Dia. of Sample (inches)
				Gravel	Coarse Sand	Fine Sand	Silt and Clay	Liquid Limit	Plastic Limit	Plastic Index			Unconsolidated	Consolidated	Time	
1A	4.5-6.0	SILTY GRAVEL	A-2-4(O)	31	20	22	27	22	16	6	6.5					
1B	10.0-11.5	SILTY GRAVEL	A-1-B(O)	39	23	27	11	NV	NP	NP	3.9					
1C	15.0-16.5	SANDY SILT	A-4(O)	2	1	37	60	NV	NP	NP	3.2					
1D	20.0-21.2	SILTY SAND	A-1-a(O)	63	11	11	15	NV	NP	NP	5.4					
2A	5.3-6.6	SANDY CLAY	A-4(5)	5	3	16	76	30	22	8	16.8					
2B	11.3-11.8	SILTY SANDY GRAVEL	A-2-4(O)	52	8	11	29	22	20	2	9.1					
5A	4.5-5.9	SILTY SAND	A-1-B(O)	10	46	32	12	NV	NP	NP	5.3					

TYPE OF MATERIAL

- SILTY, GRAVELLY SAND w/COBBLES & BOULDERS
- SILTY, GRAVELLY SAND
- COBBLES & BOULDERS
- SILTY SAND w/COBBLES & BOULDERS
- CLAYEY SILT
- GRAVELLY SILT w/COBBLES & BOULDERS
- SANDY SILT
- SILTY SAND
- SANDY, GRAVELLY SILT w/COBBLES
- SILTY GRAVEL
- GRAVEL & BOULDERS
- SANDY GRAVEL w/COBBLES & BOULDERS
- SANDY, GRAVELLY SILT
- SANDY, GRAVELLY SILT w/COBBLES
- BOULDER

LEGEND

SANDSTONE
SILTSTONE

TEST BORING

 Hole Size
 Sample No.
 Water Table
 2 in. O.D. Split-Tube Sampler
 140 Lb. Hammer
 30 in. Free Fall

CONTINUOUS PENETRATION TEST

 2 in. Dia. Drive Point
 140 Lb. Hammer
 30 in. Free Fall
 Blows per Foot

- Location of Test Boring
- Location of Continuous Penetration Test
- Recovery Boring
- Auger Boring
- Core Boring

**DIVISION OF HIGHWAYS
STATE OF COLORADO**

ENGINEERING GEOLOGY

Across STAFFORD SLASH
 Sta. 816
 Near VAN PASS Sec. T. R.
 Geologist A.C.E. Approved by
 Made by O.L.S. Checked by
 Checked by D.L.S. Date: 19

STRUCTURE NO. 18-AH
 DWG. NO. B-25 OF 10

DIVISION OF HIGHWAYS
STATE OF COLORADO
BRIDGE GEOMETRICS
DATE OF RUN 1 75/04/94.
DATE OF DATA: 10/11/74
DESIGNER: JOE KELLER
CHECKER 1 J.K.
JOB DESCRIPTION: STAFFORD BULCH STA 945 STEEL BOX

FEDERAL ROAD REGION NO	DISTRICT	PROJ. NO	SHEET NO	TOTAL SHEETS
VIII	COLORADO	170-2(52)197	96	

REVISIONS				
R-1	4-4-75	Reprint		

INPUT DATA

HORIZONTAL ALIGNMENT DATA.....

DEGREE OF CURVATURE: -0 -0 -0

VERTICAL ALIGNMENT DATA.....

* ELEVATIONS ARE 0.1667 FT. BELOW FINISHED GRADE.

VERTICAL CURVE NO. 1: PI STATION 945.00 PI ELEV 10129.843 VC LENGTH 1000.000 01 -5.176100 02 -.700000

SUPERELEVATION DATA.....

SUPERELEVATION NO. 1: STATION 942+63.44 RATE LEFT .0000 RATE RIGHT -.0000
 SUPERELEVATION NO. 2: STATION 943+63.44 RATE LEFT -.0150 RATE RIGHT -.0150
 SUPERELEVATION NO. 3: STATION 949+.00 RATE LEFT .0150 RATE RIGHT -.0150

BENT LINE INPUT ***** SKEW ANGLE OF BENT LINE REFERENCE TO CHORD OF BENT LINE
 DISTANCE FROM REFERENCE LINE (TYPE) DESCRIPTION OF BENT LINE STATION OF INTERSECTION OF BENT LINE AND OF LINE AND BENT LINE ELEVATION AT INTERSECTION

STATION	DESCRIPTION	ELEVATION	STATION	DESCRIPTION	ELEVATION
942+00.00	BACK TANGENT	10140.7961	942+00.00	BACK TANGENT	10140.7961
942+25.00	CL GIR.1	10140.8547	942+25.00	CL GIR.1	10140.8547
942+25.00	PRO. LINE	10140.8034	942+25.00	PRO. LINE	10140.8034
942+25.00	CL NO. BOX	10140.7961	942+25.00	CL NO. BOX	10140.7961
942+25.00	CL GIR.2	10140.7522	942+25.00	CL GIR.2	10140.7522
942+25.00	CL BRIDGE	10140.7010	942+25.00	CL BRIDGE	10140.7010
942+25.00	CL GIR.3	10140.6497	942+25.00	CL GIR.3	10140.6497
942+25.00	CL SO. BOX	10140.5985	942+25.00	CL SO. BOX	10140.5985
942+25.00	CL GIR.4	10140.5473	942+25.00	CL GIR.4	10140.5473
942+25.00	SO. OUT	10140.4960	942+25.00	SO. OUT	10140.4960
942+25.00	CL GIR.4	10140.4448	942+25.00	CL GIR.4	10140.4448

DATE	CHECKED BY	QUANTITIES BY
INITIAL	CHECKED BY	CHECKED BY
DESIGNED BY	CHECKED BY	DETAILED BY

STATION	DESCRIPTION	ELEVATION	STATION	DESCRIPTION	ELEVATION
943+00.00	BACK TANGENT	10136.5868	943+00.00	BACK TANGENT	10136.5868
943+00.00	CL GIR.1	10138.6798	943+00.00	CL GIR.1	10138.6798
943+00.00	PRO. LINE	10138.5920	943+00.00	PRO. LINE	10138.5920
943+00.00	CL NO. BOX	10138.5868	943+00.00	CL NO. BOX	10138.5868
943+00.00	CL GIR.2	10138.5133	943+00.00	CL GIR.2	10138.5133
943+00.00	CL BRIDGE	10138.4345	943+00.00	CL BRIDGE	10138.4345
943+00.00	CL GIR.3	10138.3558	943+00.00	CL GIR.3	10138.3558
943+00.00	CL SO. BOX	10138.2770	943+00.00	CL SO. BOX	10138.2770
943+00.00	CL GIR.4	10138.1983	943+00.00	CL GIR.4	10138.1983
943+00.00	SO. OUT	10138.1195	943+00.00	SO. OUT	10138.1195
943+00.00	CL GIR.4	10138.0408	943+00.00	CL GIR.4	10138.0408

AS CONSTRUCTED
NO REVISIONS DATE: 6-14-77

DIVISION OF HIGHWAYS

ELEVATIONS

Designer J. Keller	Structure F 12 AN
Detailer	Numbers
Drawing Number B 4	of 16 Drawings

FEDERAL ROAD REGION NO.	DISTRICT	PROJ. NO.	SHEET NO.	TOTAL SHEETS
VIII	COLORADO	I 70-2(52)197	98	
REVISIONS				

AS CONSTRUCTED
NO REVISIONS DATE: 6-24-77

INITIAL	DATE	CHECKED BY
DESIGNED BY		
CHECKED BY		
DETAILED BY		

STATION OF BENT LINE	ROADWAY ELEVATION AT INTERSECTION OF BENT LINE	SKW ANGLE OF BENT LINE REFERENCED TO CHORD OR TANGENT	DESCRIPTION OF BENT LINE	DESCRIPTION OF LINE	STATION OF INTERSECTION OF LINE AND BENT LINE	ELEVATION AT INTERSECTION OF LINE AND BENT LINE
351.500000	10130.5148	0 0 .0	CONSTR. CL	NO. OUT	946+80.000	10130.6048
BACK TANGENT		ZERO SKEW		CL GIR.1	946+80.000	10130.5208
				PRO. LINE	946+80.000	10130.5148
				CL NO. BOX	946+80.000	10130.4473
				CL GIR.2	946+80.000	10130.3685
				CL BRIDGE	946+80.000	10130.2898
				CL GIR.3	946+80.000	10130.2110
				CL SO. BOX	946+80.000	10130.1323
				CL GIR.4	946+80.000	10130.0535
				SO. OUT	946+80.000	10129.9748
356.500000	10130.4087	0 0 .0	CONSTR. CL	NO. OUT	946+85.000	10130.4987
BACK TANGENT		ZERO SKEW		CL GIR.1	946+85.000	10130.4200
				PRO. LINE	946+85.000	10130.4087
				CL NO. BOX	946+85.000	10130.3412
				CL GIR.2	946+85.000	10130.2625
				CL BRIDGE	946+85.000	10130.1837
				CL GIR.3	946+85.000	10130.1050
				CL SO. BOX	946+85.000	10130.0262
				CL GIR.4	946+85.000	10129.9475
				SO. OUT	946+85.000	10129.8687
361.500000	10130.3038	0 0 .0	CONSTR. CL	NO. OUT	946+90.000	10130.3938
BACK TANGENT		ZERO SKEW		CL GIR.1	946+90.000	10130.3150
				PRO. LINE	946+90.000	10130.3038
				CL NO. BOX	946+90.000	10130.2363
				CL GIR.2	946+90.000	10130.1575
				CL BRIDGE	946+90.000	10130.0788
				CL GIR.3	946+90.000	10130.0000
				CL SO. BOX	946+90.000	10129.9213
				CL GIR.4	946+90.000	10129.8425
				SO. OUT	946+90.000	10129.7638
366.500000	10130.1999	0 0 .0	CONSTR. CL	NO. OUT	946+95.000	10130.2899
BACK TANGENT		ZERO SKEW		CL GIR.1	946+95.000	10130.2112
				PRO. LINE	946+95.000	10130.1999
				CL NO. BOX	946+95.000	10130.1324
				CL GIR.2	946+95.000	10130.0537
				CL BRIDGE	946+95.000	10129.9749
				CL GIR.3	946+95.000	10129.8962
				CL SO. BOX	946+95.000	10129.8174
				CL GIR.4	946+95.000	10129.7387
				SO. OUT	946+95.000	10129.6599
370.625000	10130.1151	2 31 26.6	CONSTR. CL	NO. OUT	946+99.125	10130.1997
BACK TANGENT		RIGHT SKEW		CL GIR.1	946+99.158	10130.1257
				PRO. LINE	946+99.125	10130.1151
				CL NO. BOX	946+98.927	10130.0517
				CL GIR.2	946+98.695	10129.9777
				CL BRIDGE	946+98.464	10129.9037
				CL GIR.3	946+98.232	10129.8297
				CL SO. BOX	946+98.001	10129.7557
				CL GIR.4	946+97.769	10129.6817
				SO. OUT	946+97.538	10129.6077
374.750000	10130.0311	5 2 18.1	CONSTR. CL	NO. OUT	947+ 3.250	10130.1104
BACK TANGENT		RIGHT SKEW		CL GIR.1	947+ 3.316	10130.0410
				PRO. LINE	947+ 3.250	10130.0311
				CL NO. BOX	947+ 2.853	10129.9716
				CL GIR.2	947+ 2.390	10129.9023
				CL BRIDGE	947+ 1.928	10129.8330
				CL GIR.3	947+ 1.465	10129.7636
				CL SO. BOX	947+ 1.002	10129.6943
				CL GIR.4	947+ .539	10129.6250
				SO. OUT	947+ .076	10129.5557
378.875000	10129.9478	7 32 .2	CONSTR. CL	NO. OUT	947+ 7.375	10129.9478
BACK TANGENT		RIGHT SKEW		CL GIR.1	947+ 8.168	10130.0219
				PRO. LINE	947+ 7.476	10129.9571
				CL NO. BOX	947+ 6.780	10129.8923
				CL GIR.2	947+ 6.086	10129.8275
				CL BRIDGE	947+ 5.391	10129.7628
				CL GIR.3	947+ 4.697	10129.6980
				CL SO. BOX	947+ 4.003	10129.6333
				CL GIR.4	947+ 3.308	10129.5687
				SO. OUT	947+ 2.614	10129.5040
383.000000	10129.8653	10 0 .0	CONSTR. CL	NO. OUT	947+11.500	10129.9342
BACK TANGENT		RIGHT SKEW		CL GIR.1	947+11.632	10129.8739
				PRO. LINE	947+11.500	10129.8653
				CL NO. BOX	947+10.707	10129.8136
				CL GIR.2	947+ 9.781	10129.7533
				CL BRIDGE	947+ 8.855	10129.6931
				CL GIR.3	947+ 7.929	10129.6329
				CL SO. BOX	947+ 7.004	10129.5728
				CL GIR.4	947+ 6.078	10129.5127
				SO. OUT	947+ 5.152	10129.4526

DIVISION OF HIGHWAYS


ELEVATIONS

Designer <i>J. Keller</i>	Structure Numbers	F-12-AN
Detailer <i>P.S.</i>	Drawing Number	B-6 of 16 Drawings

Revision Dates (Preliminary Stage Only)

FEDERAL ROAD REGION NO.	DISTRICT	PROJ. NO.	SHEET NO.	TOTAL SHEETS
XIII	COLORADO	I-70-2(52)197	99	

REVISIONS			

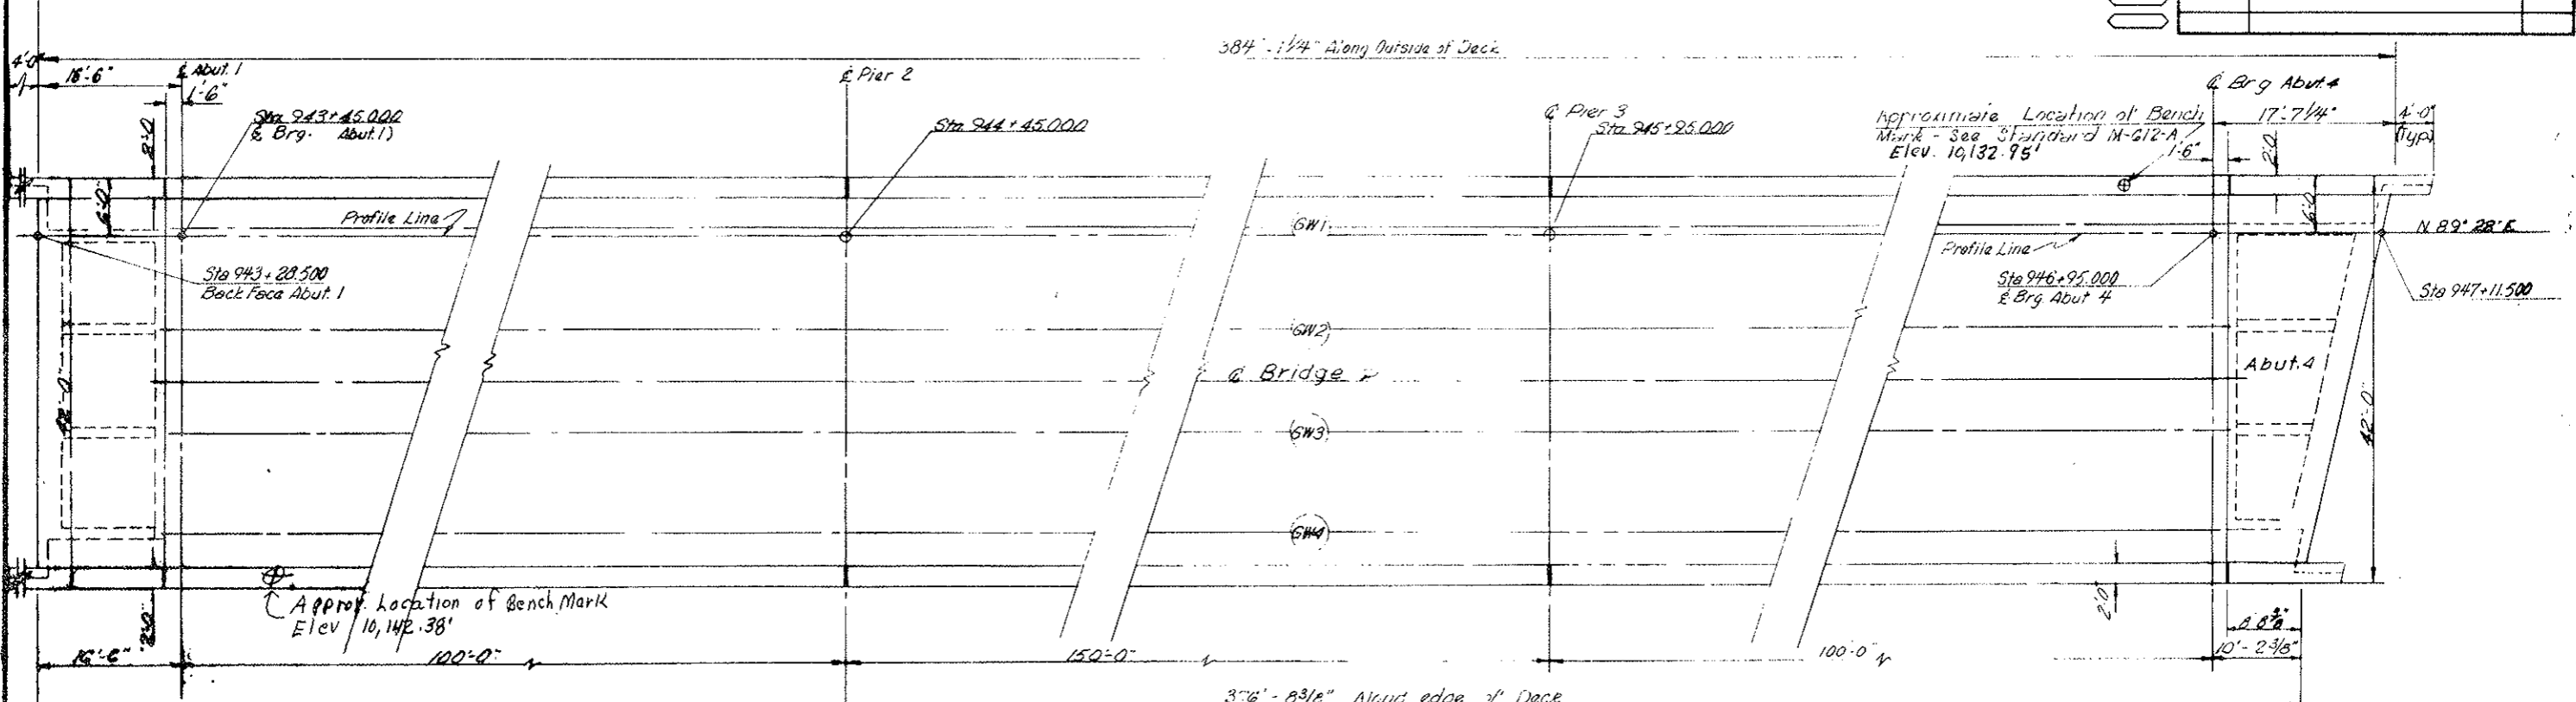

DATE	BY	REVISION
7-23-77		


CUTOFF ELEVATIONS OF PILING

No.	Elevation
1	10,135.0
2	10,135.6
3	10,135.3
4	10,126.0
5	10,126.0
6	10,126.0
7	10,126.0
8	10,126.0
9	10,126.0
10	10,124.0
11	10,124.0
12	10,120.0

DELETED

CONSTRUCTION LAYOUT
Orig. Scale: 1/8" = 1'-0"

* Location of Abutment and Pier Footings is offset by a distance equal to a rate of cross slope times depth of structure (6'-0").

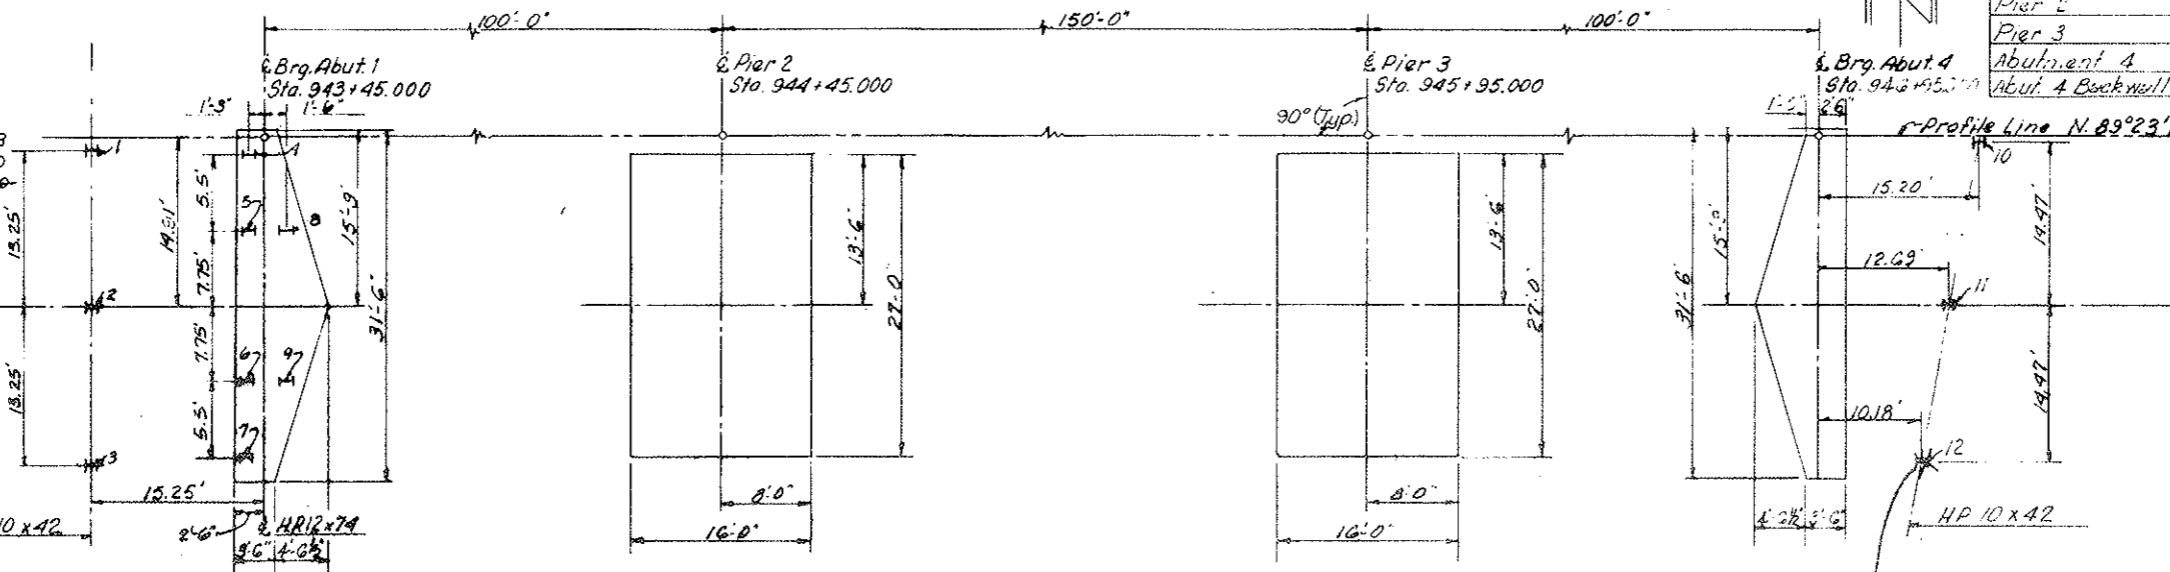

Description	FOUNDATION PRESSURE	
	Allowable pile load (Tons)	Computed pile load (Tons)
Abutment 1	38	32.5
Abut. 1 Backwell	55	36
Pier 2	6	5.8
Pier 3	6	5.8
Abutment 4	6	2.5
Abut. 4 Backwell	55	36

FOOTING & PILING LAYOUT
Orig. Scale: 1/8" = 1'-0"

All Footing dimensions are at bottom of concrete.
Piles No. 849 Shall be battered 6 to 1



Deleted by Project Engineer

AS CONSTRUCTED
REVISED DATE: 6-24-77

DIVISION OF HIGHWAYS	
CONSTRUCTION LAYOUT FOOTINGS AND PILING LAYOUT	
Designer R.M.P.	Structure F-12-A
Detailer P.S.	Number 16
Drawing Number B-7	of 16

FEDERAL ROAD REGION NO.	DISTRICT	PROJ. NO.	SHEET NO.	TOTAL SHEETS
VIII	COLORADO	I-70-2(52)197	100	



REVISIONS			
R-1	4/4/75	REPRINT	WCB
R-2	4/17/75	Changed movement dimension	CLB

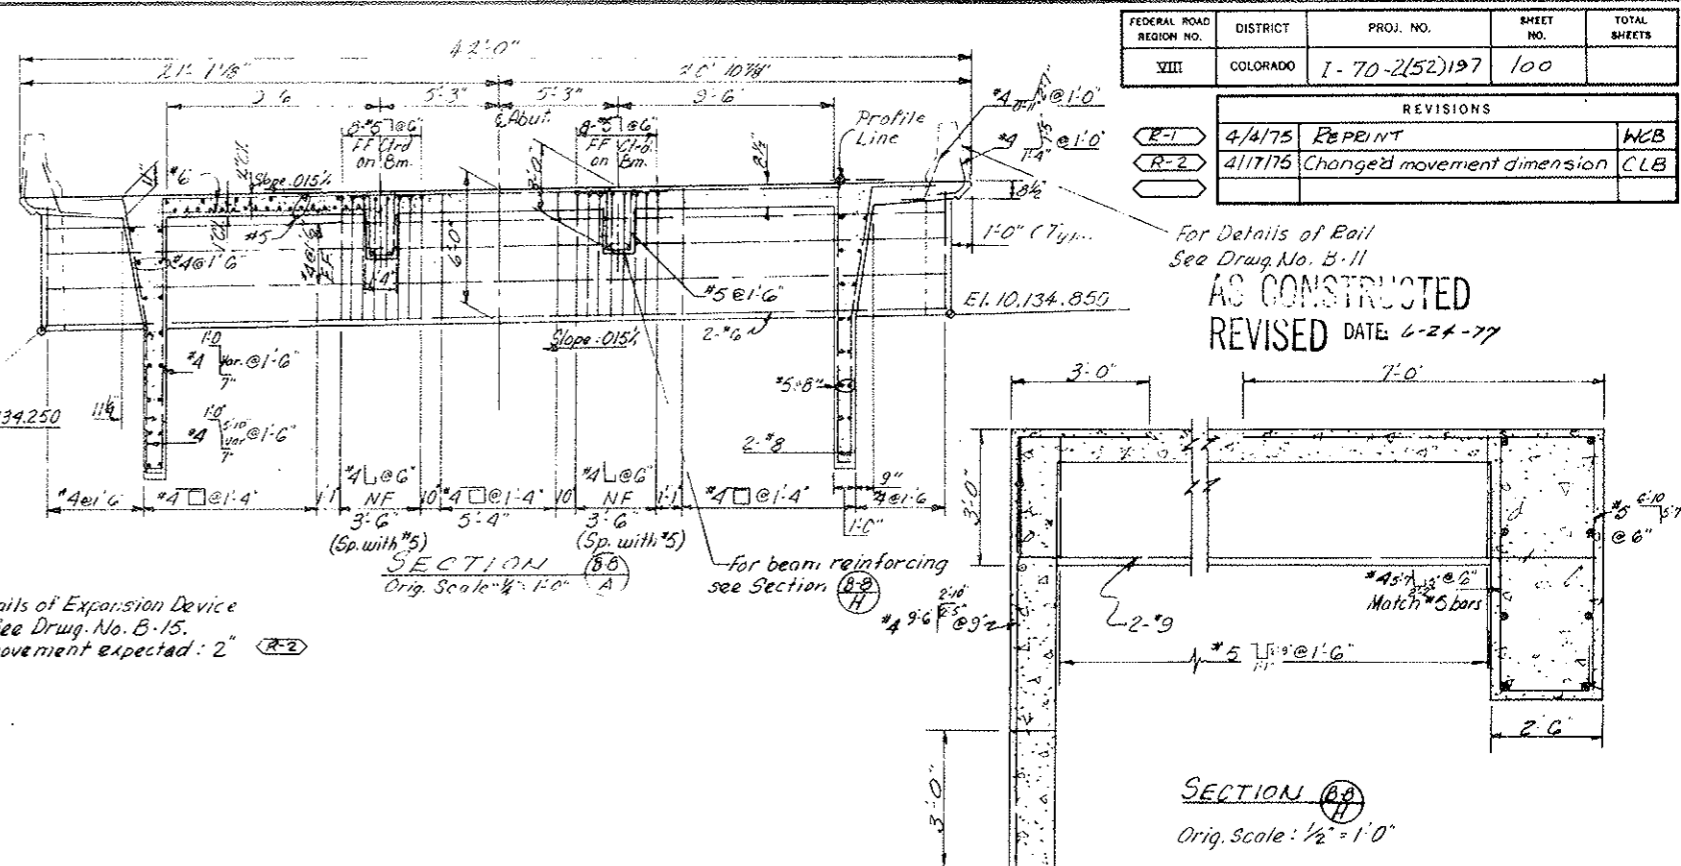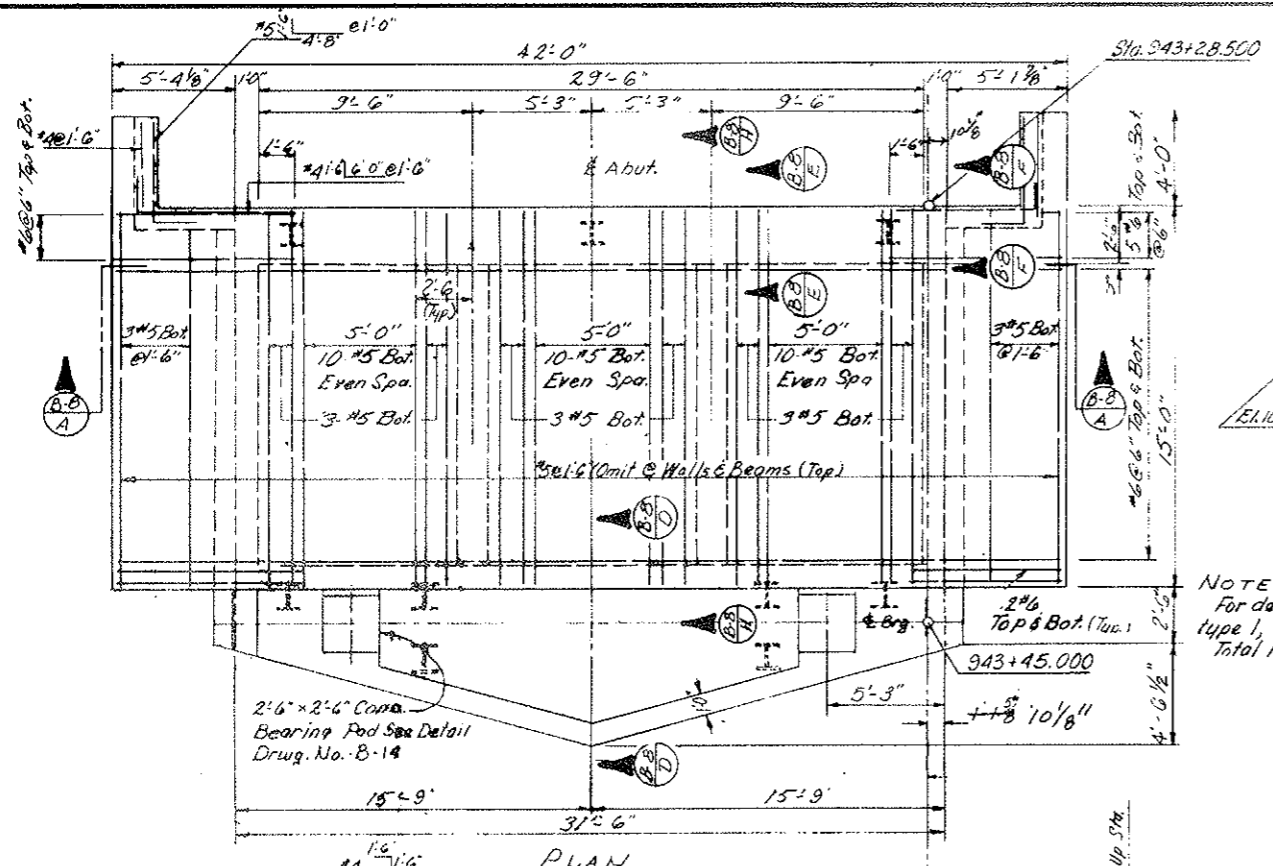





For Details of Rail
See Drawg. No. B-11
AS CONSTRUCTED
REVISED DATE: 6-24-77

NOTE:
For details of Expansion Device
type 1, See Drawg. No. B-15.
Total movement expected: 2" R-2

DESIGNED BY	DATE	CHECKED BY	DATE
W.C.K.	7-23-74	W.C.K.	7-23-74
CHECKED BY	DATE	QUANTITIES BY	DATE
W.C.K.	7-23-74	D.A.A.	6-21-74
DESIGNED BY	DATE	CHECKED BY	DATE
W.C.K.	7-23-74	D.A.A.	6-21-74

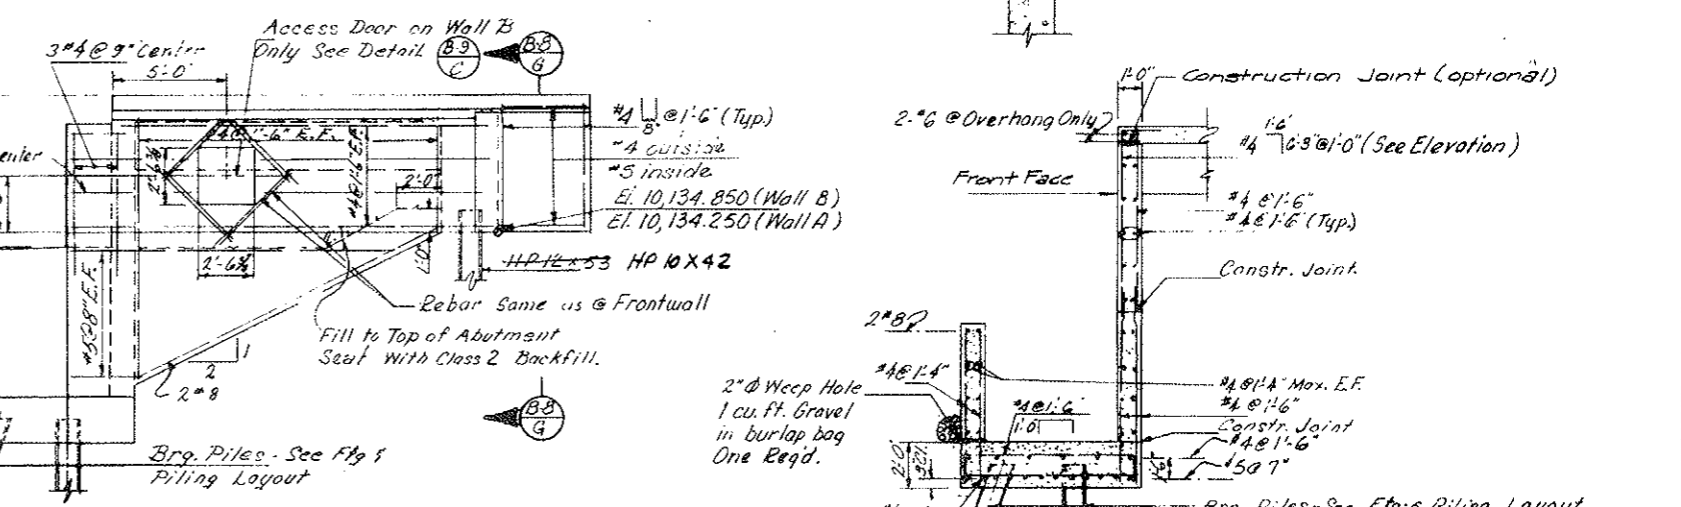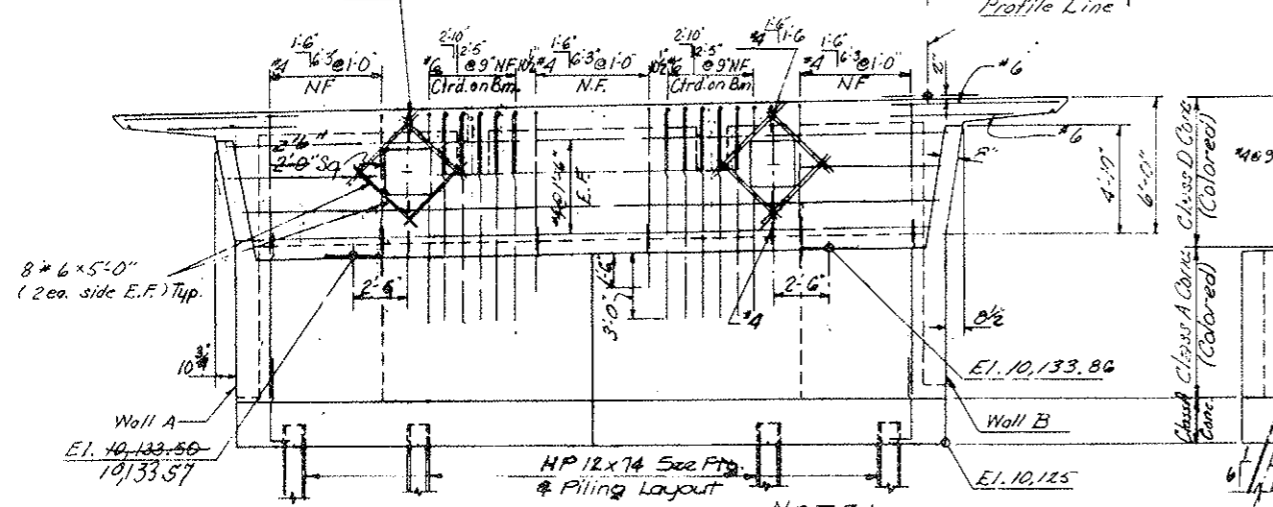

NOTE:
Footings Concrete shall be Class A (Bridge).
Abutment Cap & Wingwall Concrete shall be Class A (Bridge), (Colored).
Approach Slab Concrete shall be Class D (Bridge), (Colored).
Reinforcing at openings to be field cut.

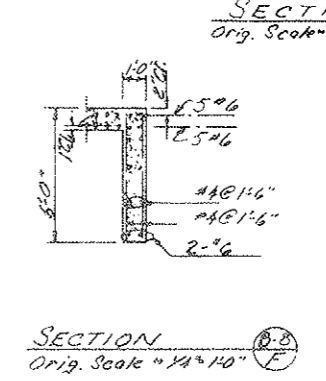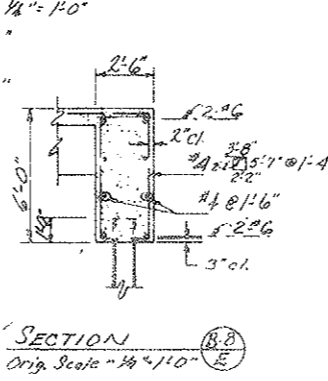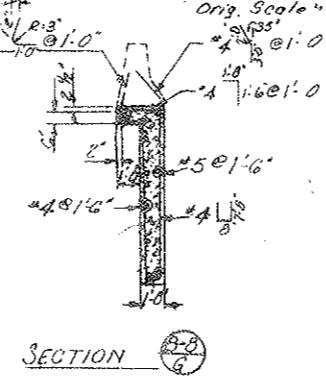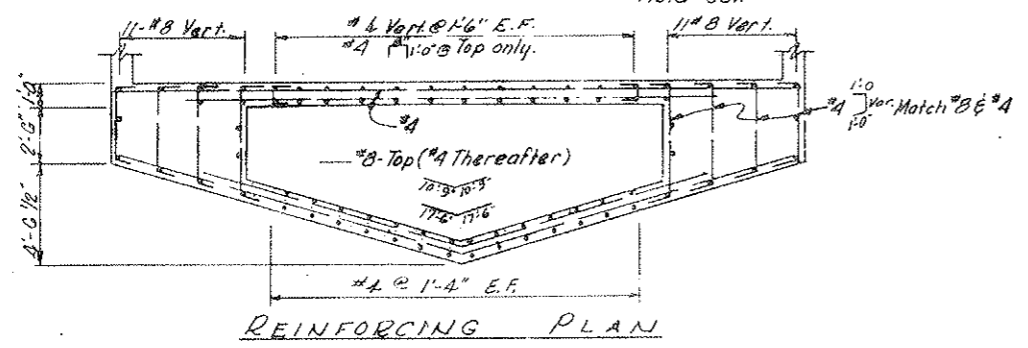

DIVISION OF HIGHWAYS


ABUTMENT I DETAILS

Designer J. Keller	Structure F-12-AN
Detailer D.P. Hubble	Number 1 of 16 Drawings
Drawing Number B-3	

Revision Date _____ (Preliminary Stage Only)

FEDERAL ROAD REGION NO.	DISTRICT	PROJ. NO.	SHEET NO.	TOTAL SHEETS
VIII	COLORADO	1-70-2 (52)	101	







REVISIONS		
1	1/11/74	Worked movement dimension CLB

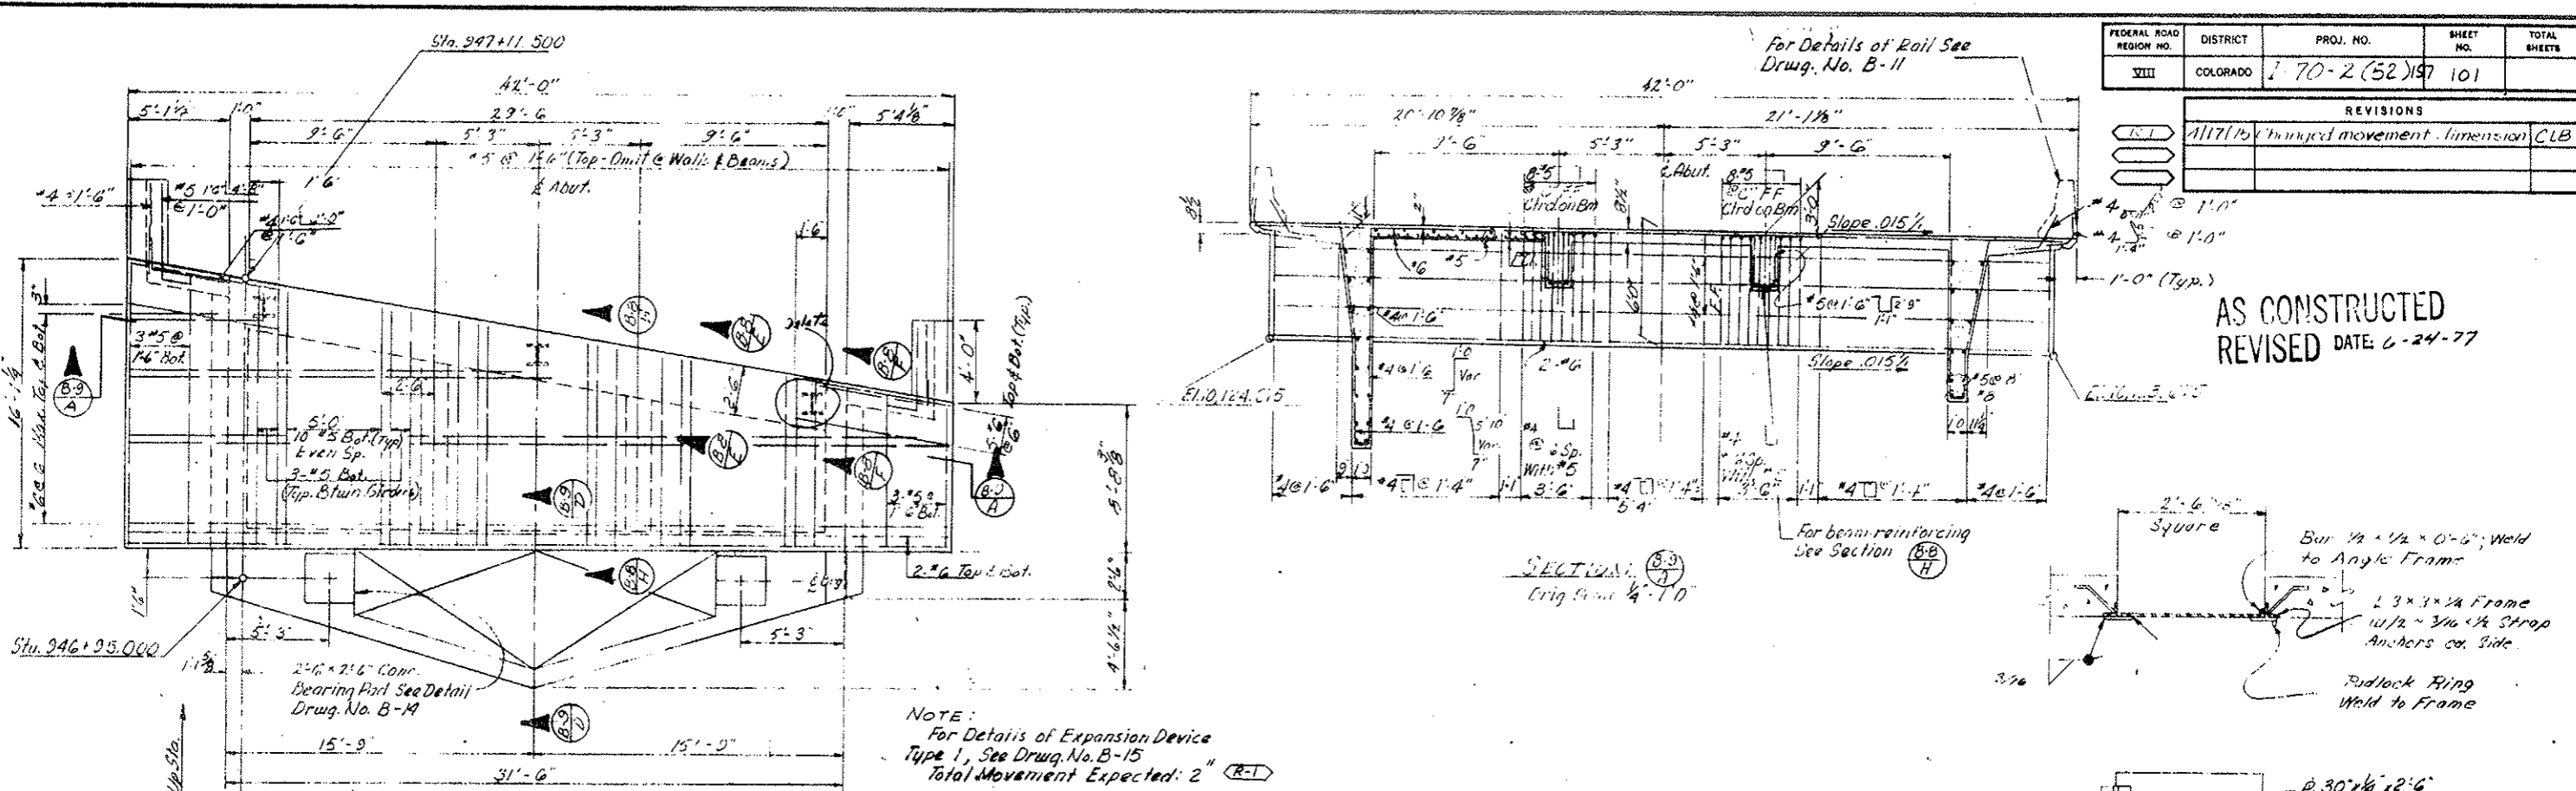

AS CONSTRUCTED
REVISED DATE: 6-24-77

NOTE:
For Details of Expansion Device
Type 1, See Drawg. No. B-15
Total Movement Expected: 2" (R-1)

DESIGNED BY	CHECKED BY	DATE	QUANTITIES BY	CHECKED BY	DATE
P. P. ...	J. P. ...	5-25-74	D. A. ...	J. P. ...	5-25-74
Detailed by	Checked by		Checked by		

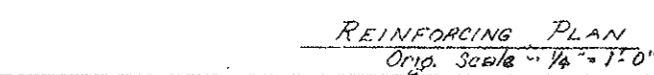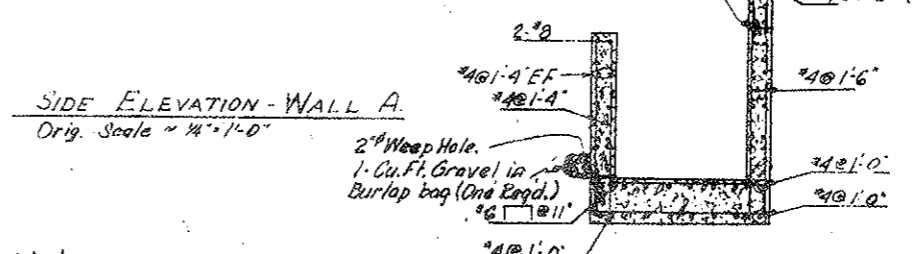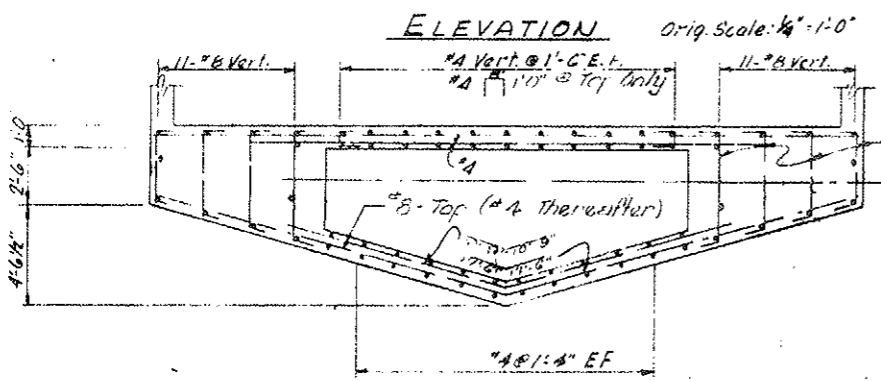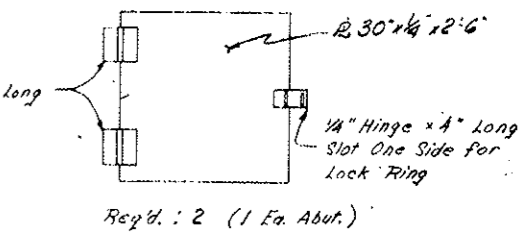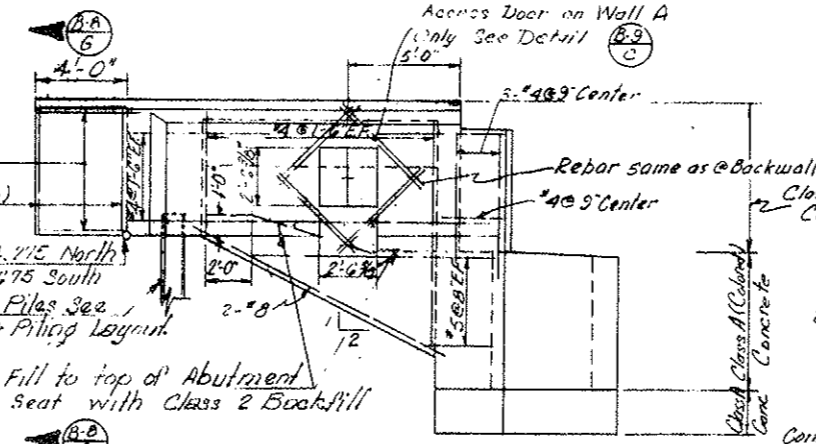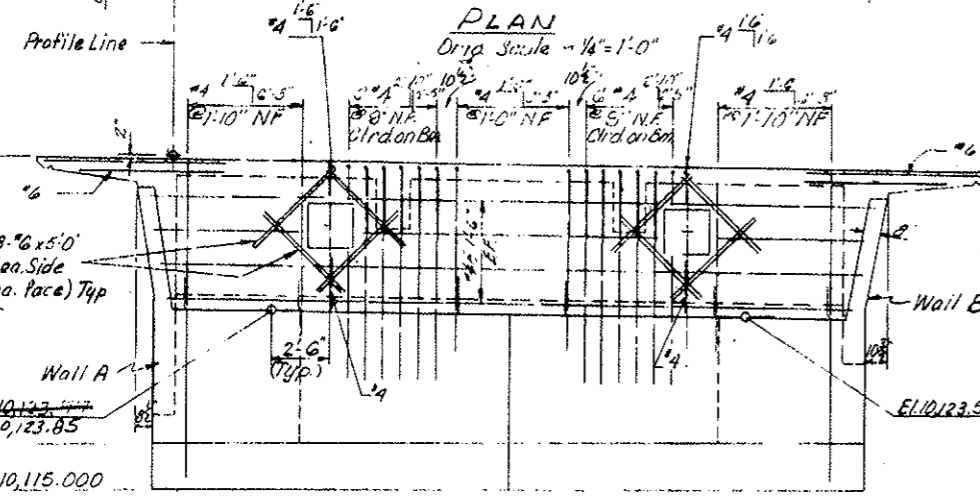

NOTE:
Footings Concrete shall be Class A (Bridge)
Abutment Cap shall be Class A (Bridge), (Colored)
Approach Slab & Wingwall Concrete shall be Class D (Bridge), (Colored)
Reinforcing at opening to be field cut.

DIVISION OF HIGHWAYS




ABUTMENT 4 DETAILS

Designer J. Keller	Structures F-12-AN
Detailer D. A. Hubble	Numbers
Drawing Number 5-9	of 16 Drawings

Revision Data (Preliminary Stage Only)


FEDERAL ROAD REGION NO.	DISTRICT	PROJ. NO.	SHEET NO.	TOTAL SHEETS
VIII	COLORADO	1-70-2(52)197	102	
REVISIONS				
RI	4-29-75	Addition to Note 3		BDE

VOID
BY CONSTRUCTION DATE 6-28-77

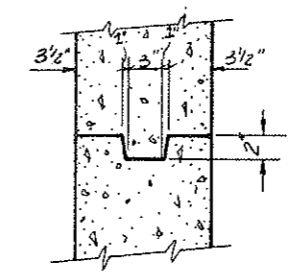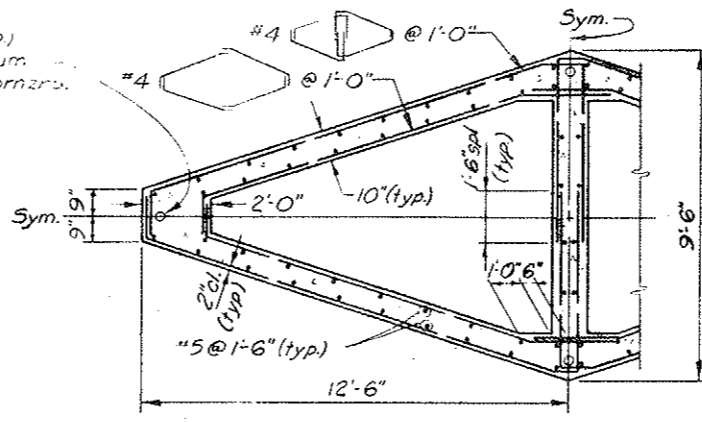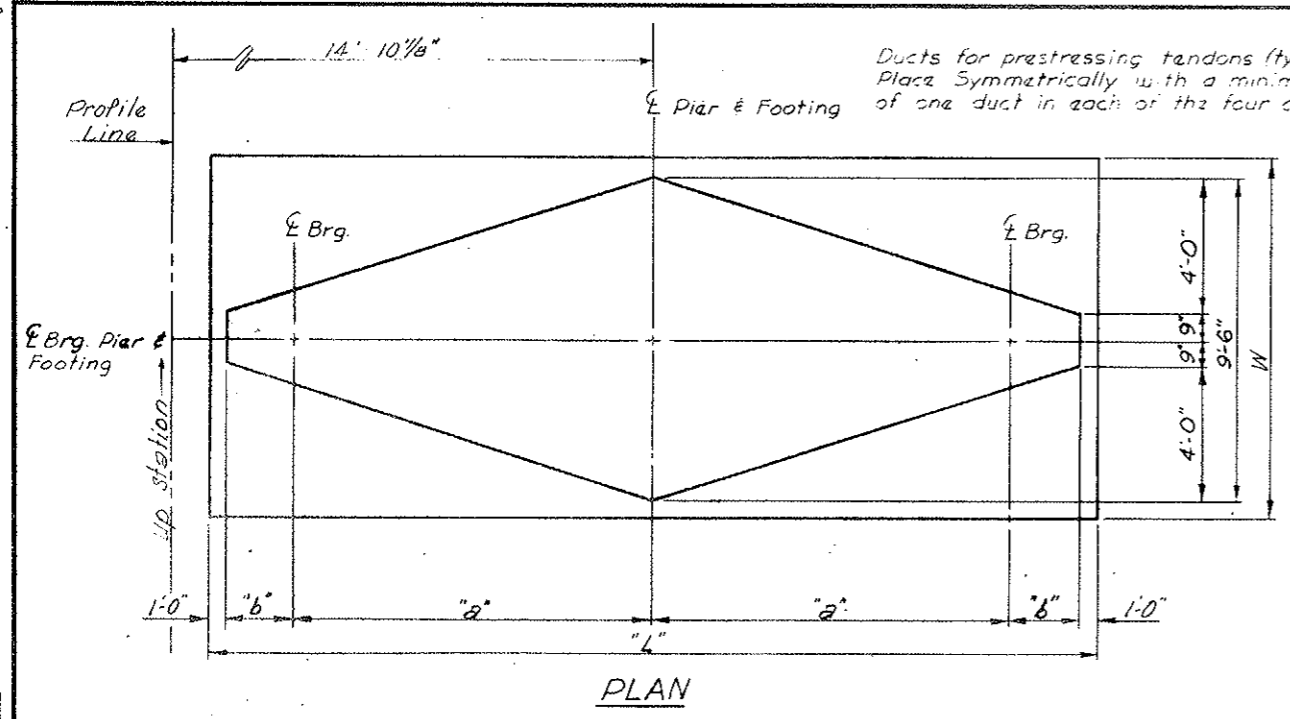

	PIER 2	PIER 3	
El. A	10,083.000	10,089.000	
El. B	10,130.218	10,125.945	10,125.99
El. C	10,129.993	10,125.630	10,125.68
Dim. "a"	10'-6"	10'-6"	
Dim. "b"	2'-0"	2'-0"	
Dim. "T"	3'-0"	3'-0"	
Dim. "W"	16'-0"	16'-0"	
Dim. "L"	27'-0"	27'-0"	
"M" Bars	"6 @ 7"	"6 @ 7"	
"N" Bars	"6 @ 7"	"6 @ 7"	
"B" Bars	"8 @ 7"	"8 @ 7"	
"S" Bars	"6 @ 7"	"6 @ 7"	
Force "F"	5435 Kips	5435 Kips	


DESIGNED BY	DATE	CHECKED BY	DATE
BY	5-74	BY	5-74
CHECKED BY	5-74	CHECKED BY	5-74
QUANTITIES BY	5-74	QUANTITIES BY	5-74
DETAILS BY	5-74	DETAILS BY	5-74

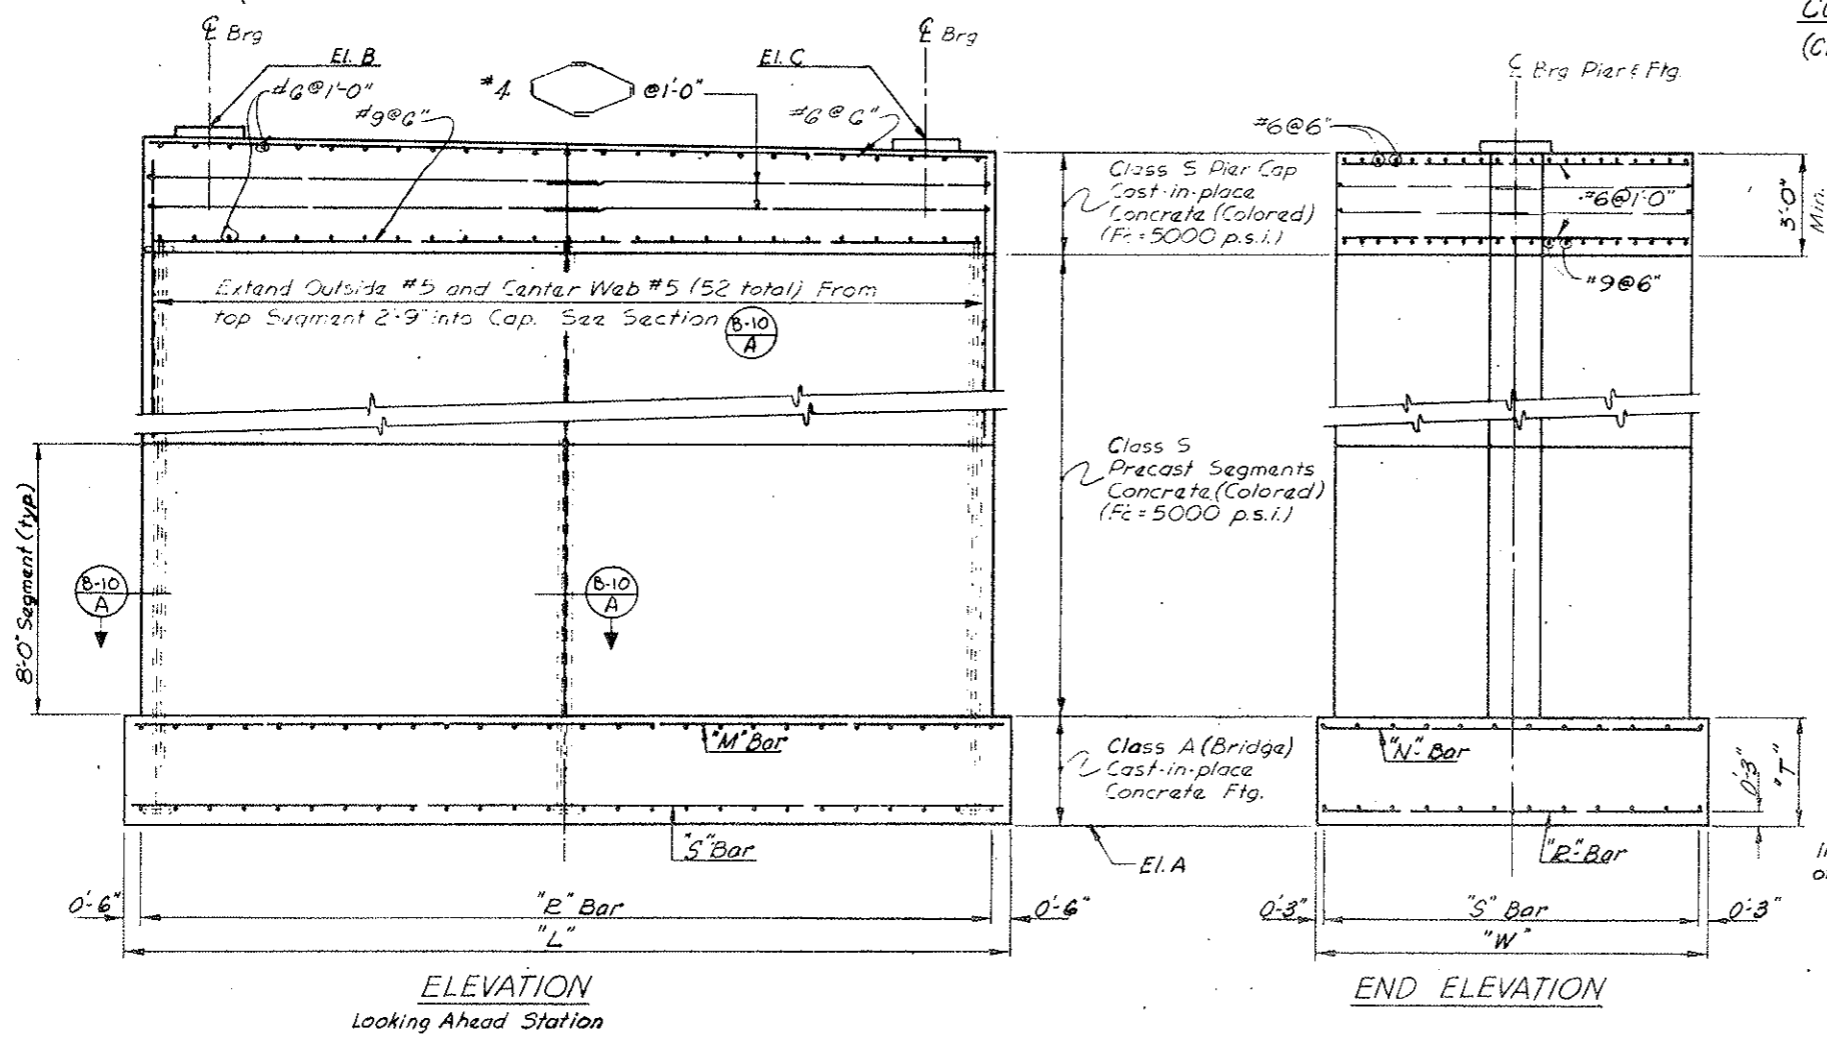

① FORCE F IS THE POST-TENSIONING FORCE REQUIRED IN THE PIERS AFTER ALL LOSSES INCLUDING CREEP, SHRINKAGE, FRICTION, AND ELASTIC SHORTENING FROM THE SUPERSTRUCTURE LOADS. POST-TENSIONING FORCE F IS TO BE THE SUM OF FOUR EQUAL FORCES, ONE AT EACH CORNER OF THE PIER AS SHOWN IN SECTION

PIER NOTES:

- POST-TENSIONING TENDON ANCHORAGES IN PIER FOOTINGS AND PIER CAPS SHALL BE DETERMINED BY THE MANUFACTURER AND SUBMITTED FOR APPROVAL.
- END BLOCKS SHALL BE USED TO DISTRIBUTE THE CONCENTRATED POST-TENSIONING FORCES AT THE ANCHORAGE. CLOSELY SPACED REINFORCEMENT SHALL BE PLACED BOTH VERTICALLY AND HORIZONTALLY THROUGHOUT THE LENGTH OF THE END BLOCK IN ACCORDANCE WITH ACCEPTED METHODS OF END BLOCK ANALYSIS.
- ALL SEGMENTS SHALL BE MATCH-CAST TO ENSURE PROPER FIT DURING THE ERECTION STAGE. PRECAST SEGMENT HEIGHT PER BRIDGE MAY BE REVISED IN ORDER TO MINIMIZE THE CAST-IN-PLACE PORTION. CARE SHALL BE EXERCISED IN JOINING THE SEGMENTS WITH EPOXY TO ENSURE THAT COMPRESSION IS MAINTAINED OVER THE ENTIRE JOINT AREA UNTIL THE PERMANENT POST-TENSIONED TENDONS ARE STRESSED.
- FOR CONCRETE CLASSES AND STRENGTHS, SEE DRAWINGS, THIS SHEET.

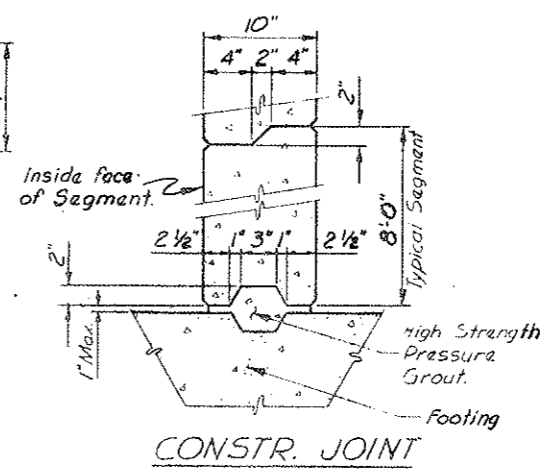

IECO INTERNATIONAL ENGINEERING COMPANY, INC.
Barton, Stoddard, Withelin and Higgins Division
1777 S. Ballou St. Denver, Colorado 80222

DIVISION OF HIGHWAYS

PIER DETAILS


Designer	J. Keller	Structure	F-12-AN
Detailer	P.S.	Numbers	
Drawing Number	B-10	of	16 Drawings

Revision Dates: (Preliminary Stage Only)


AS CONSTRUCTED
REVISED DATE:

6-27-77

REVISED FOR
CHANGE ORDER
NO. 07253

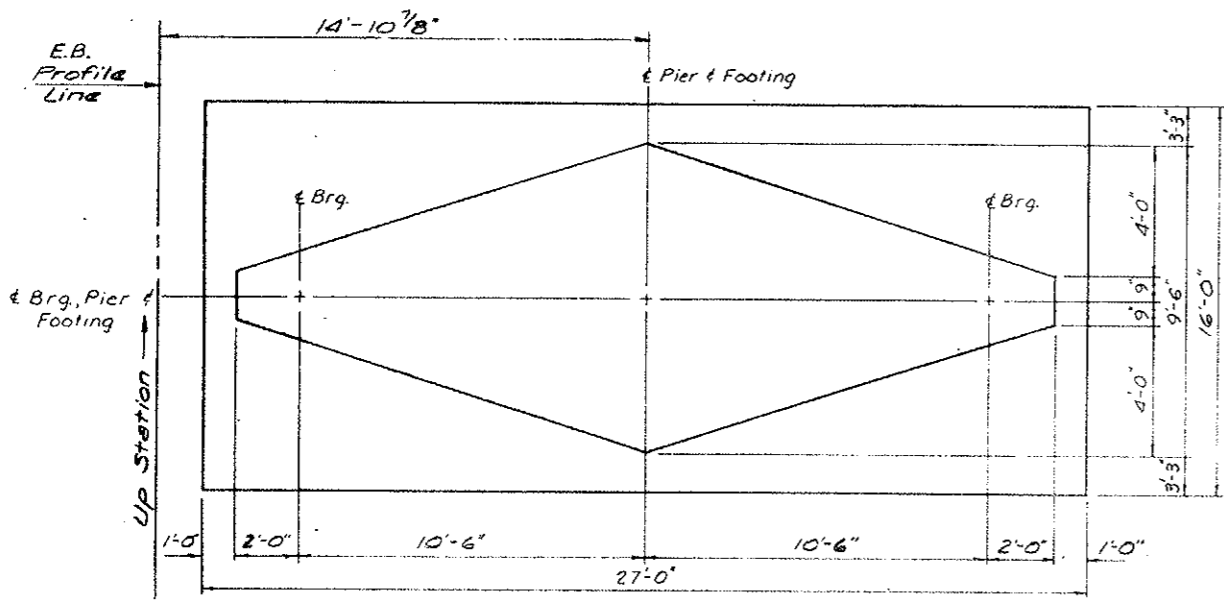


PLAN

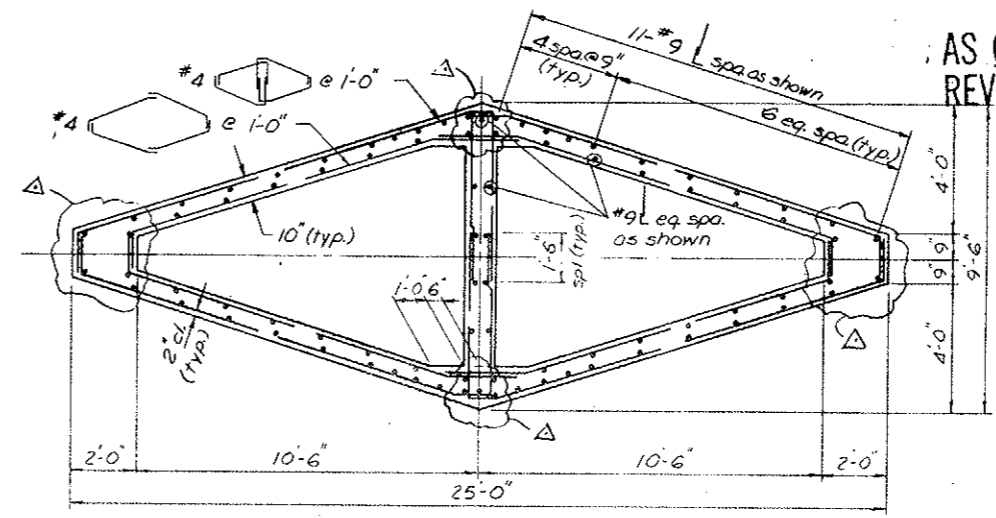


SECTION (B)

Do not lap bars at designated elevations (R-2)


	PIER 2	PIER 3
EI. A	10,083.0	10,089.0
(R-1) EI. B	10,130.26	10,125.99
(R-1) EI. C	10,129.95	10,125.68

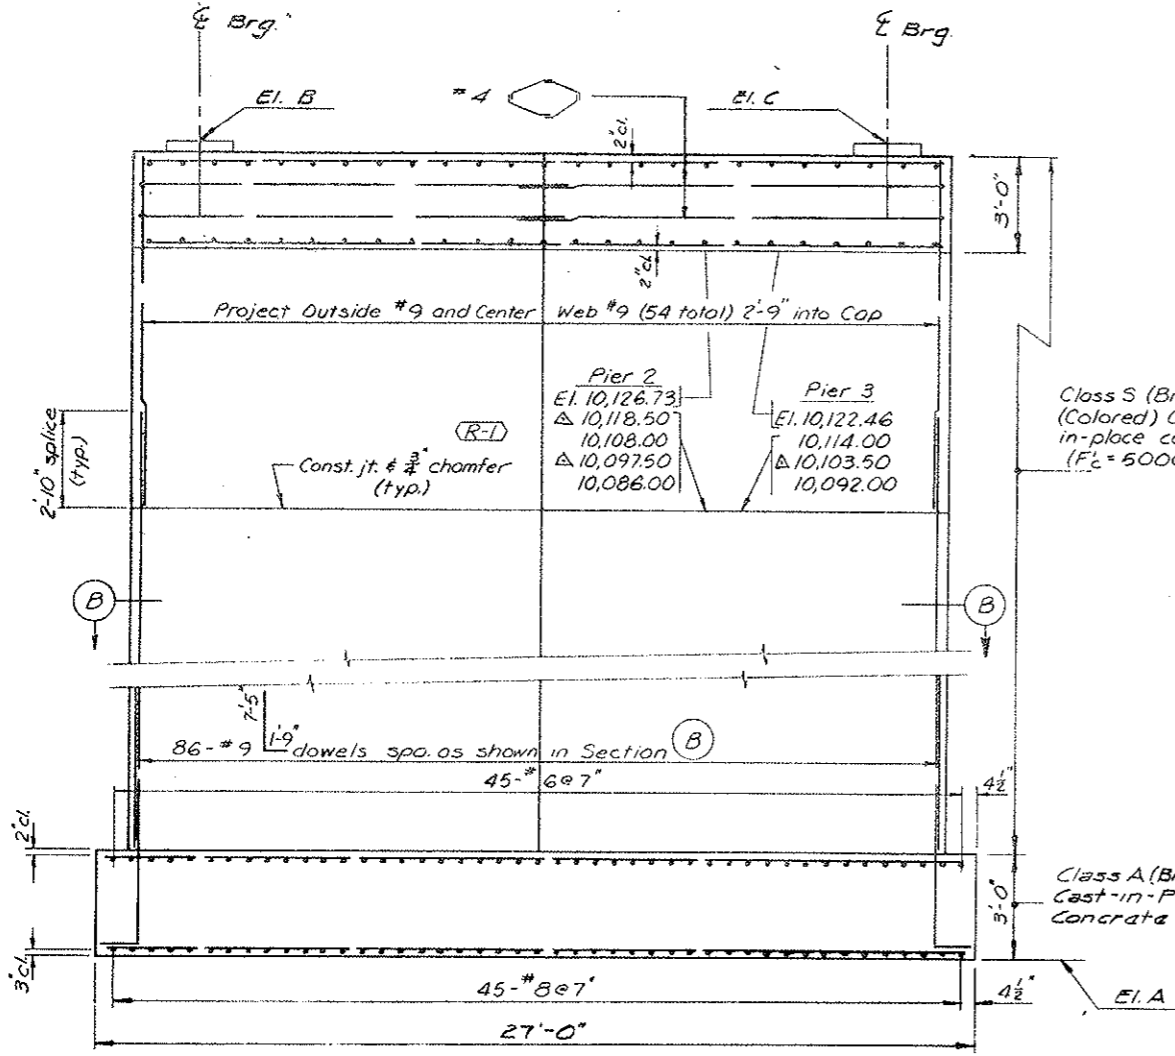

ELEVATION
Looking Ahead Station

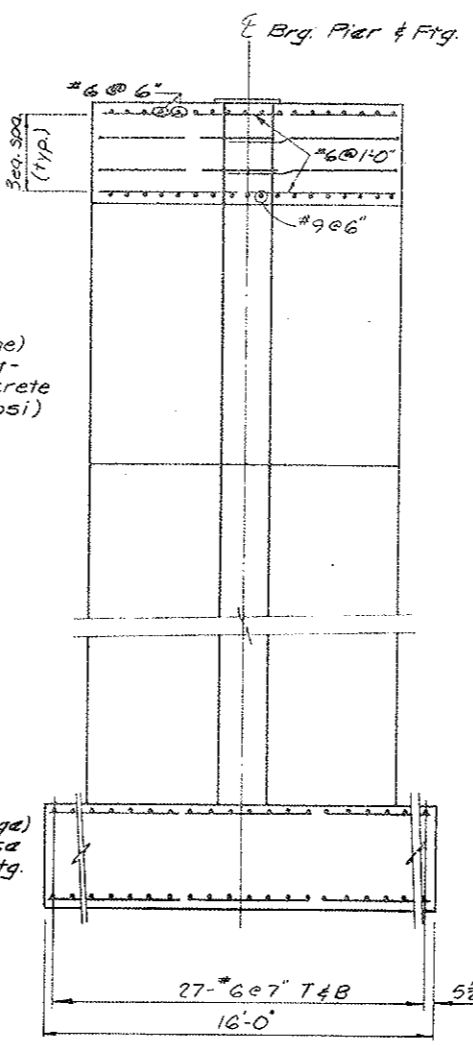

END ELEVATION

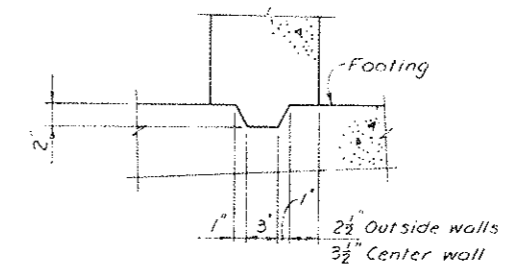

CONST. JOINT

QUANTITIES					
ITEM	DESCRIPTION	UNIT	PIER 2	PIER 3	
601	Concrete Class A (Bridge)	Cu.Yd.	48.0	48.0	
601	Concrete Class S (Bridge) (Colored)	Cu.Yd.	97.8	77.4	
602	Reinforcing Steel (Gr. 60)	Lb.	28,607	24,038	
			Former Reinf. Steel Quantity =		
			Lb.	14,366	12,524
			Additional Reinf. Steel =		
			Lb.	14,238	11,512
			Total = 25,750 Lbs.		



REVISIONS		
R-1	6-19-75	Rev elevs, quant, Add const. jt.
R-2	6-25-75	Rev laps & quant.

I 70-2(52)197 VAIL PASS STR. F-12-AN

CONVENTIONAL REINFORCING FOR PIERS



INTERNATIONAL ENGINEERING COMPANY, INC.

Designed JK Chd. RAH Submitted
Drawn BE Insp. Recommended
Approved


DENVER, COLORADO
DATE June 6, 1975 SHEET NO. 2

FEDERAL ROAD DISTRICT NO.	DISTRICT	PROJ. NO.	SHEET NO.	TOTAL SHEETS
VIII	COLORADO	170-2(52)97	103	

REVISIONS			
21	4/4/75	REPRINT	WCB

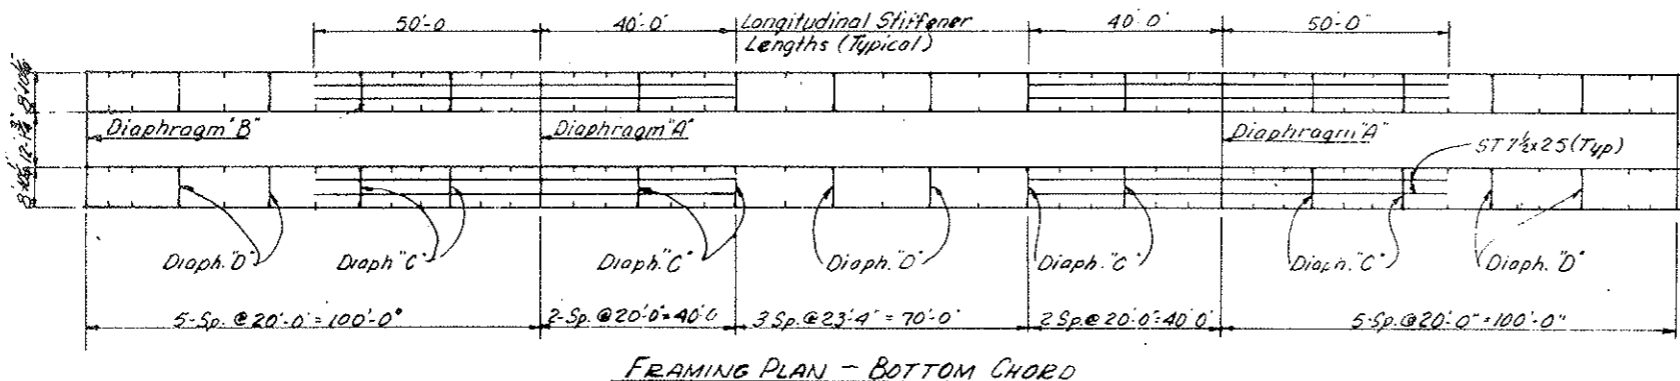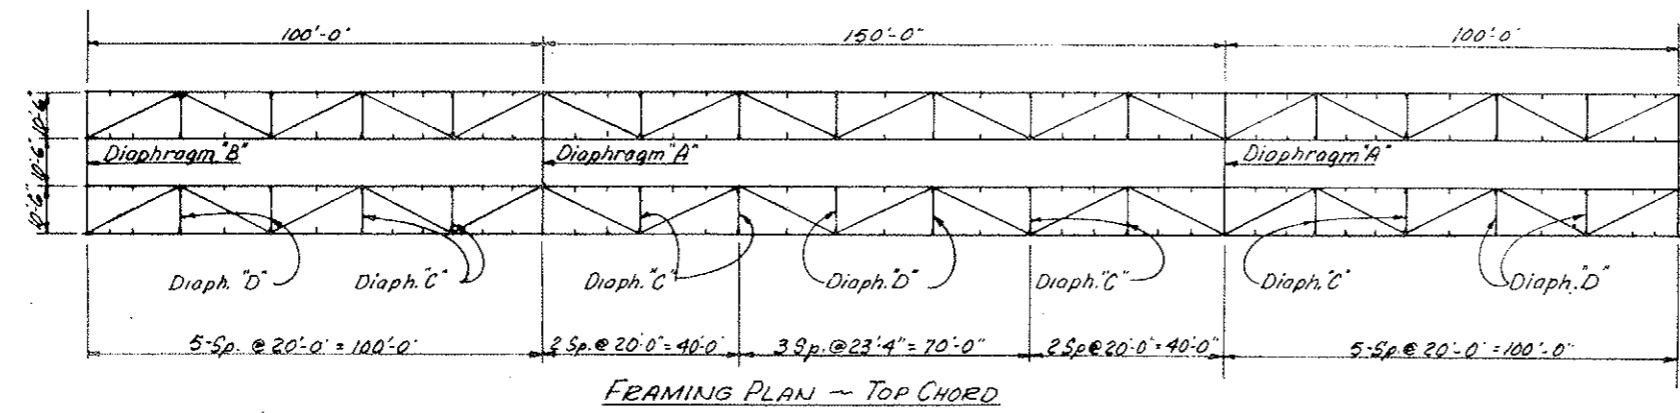







NOTE:
Bearing Stiffeners - grind to bear on bottom flange - tight fit on top flange.

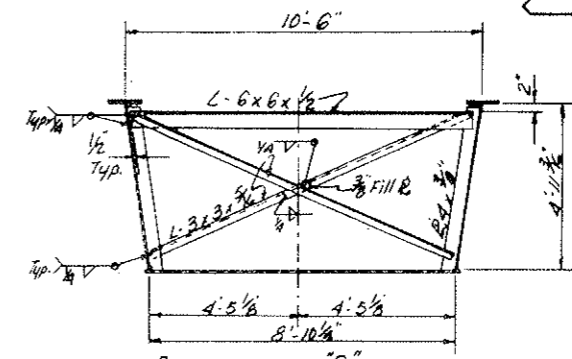




WELD LENGTHS REQ'D.

Member	Length of Fillet Weld
L-3x3x5/16	6" @ 14"
L-5x5x5/16	12"
L-6x6x1/2	9"
ST 7x25	Continuous

NOTE: These are minimum lengths of 1/4" fillet welds to secure members to gusset plates and other members.

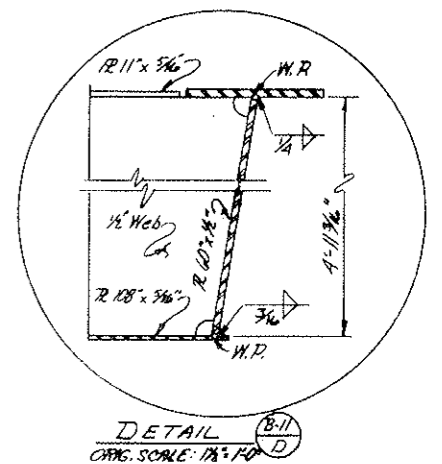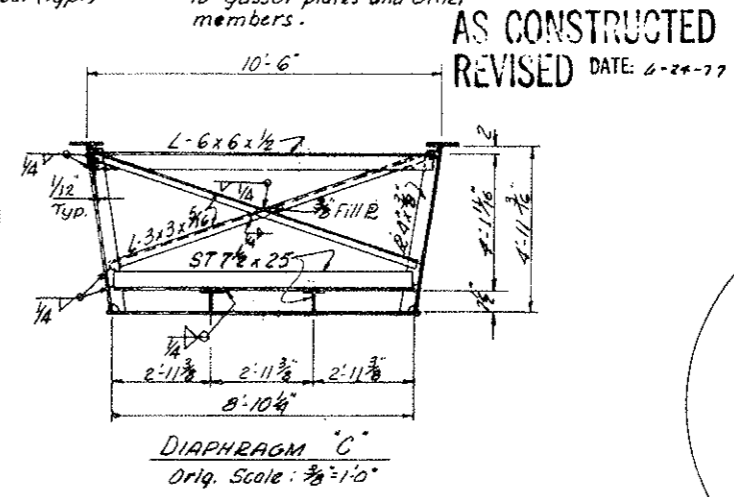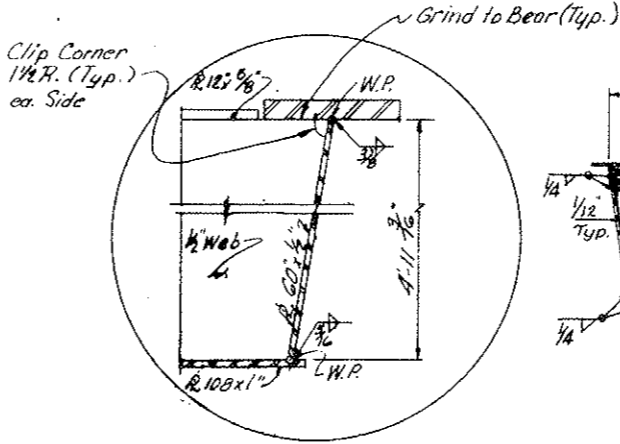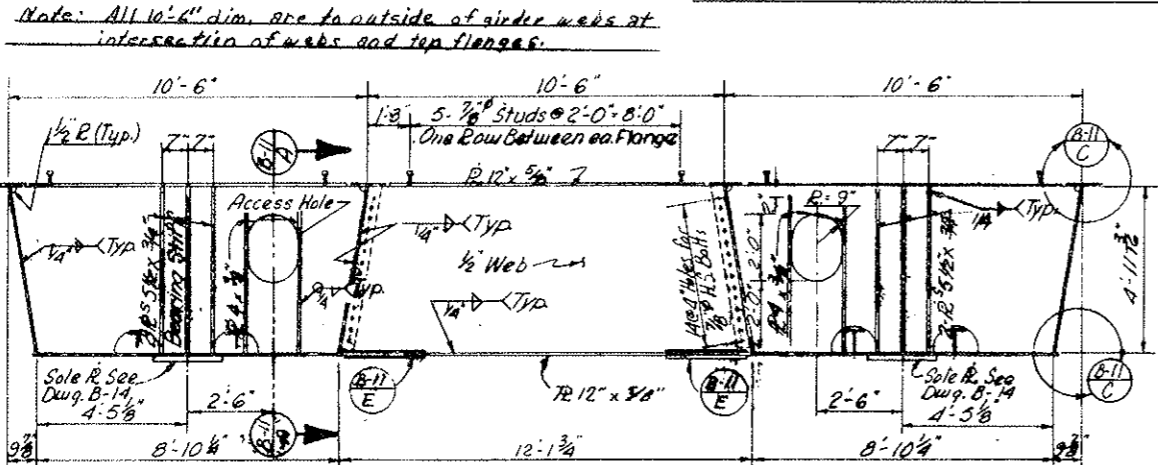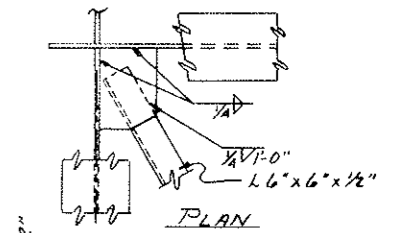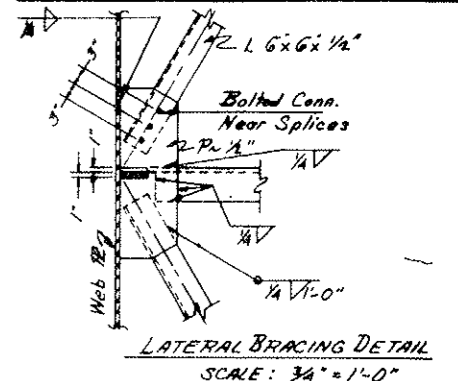

Note: All bolts shall be 7/8" ASTM A-325 Type 3 weathering steel. No substitutions will be allowed.

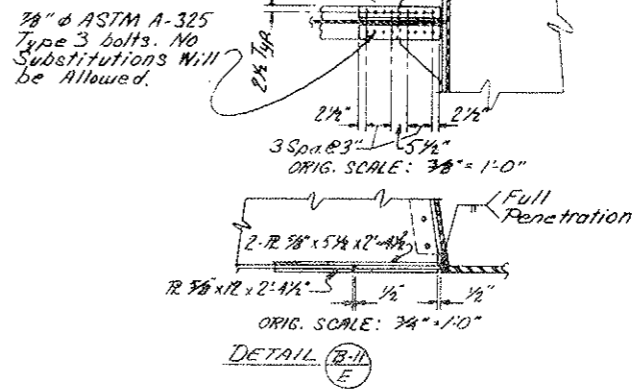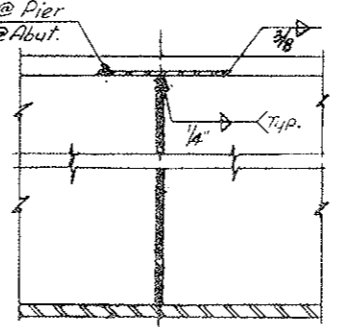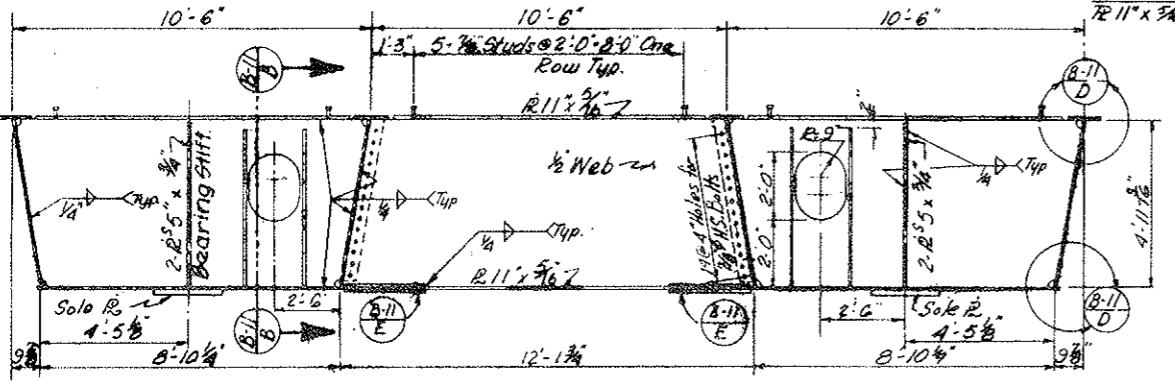

DIVISION OF HIGHWAYS

FRAMING PLAN



Designer RWP	Structure F-12-AA1
Draftsman R.S.	Numbers
Drawing Number B-11	of 10 Drawings

DATE	CHECKED BY	DATE	CHECKED BY
12-1-74	RWP	12-1-74	RWP
12-1-74	RWP	12-1-74	RWP
12-1-74	RWP	12-1-74	RWP


FEDERAL ROAD DISTRICT	PROJ. NO.	SHEET NO.	TOTAL SHEETS
VIII	1-70-2(52)197	104	

REVISIONS	

AS CONSTRUCTED
 REVISED DATE 6-24-77

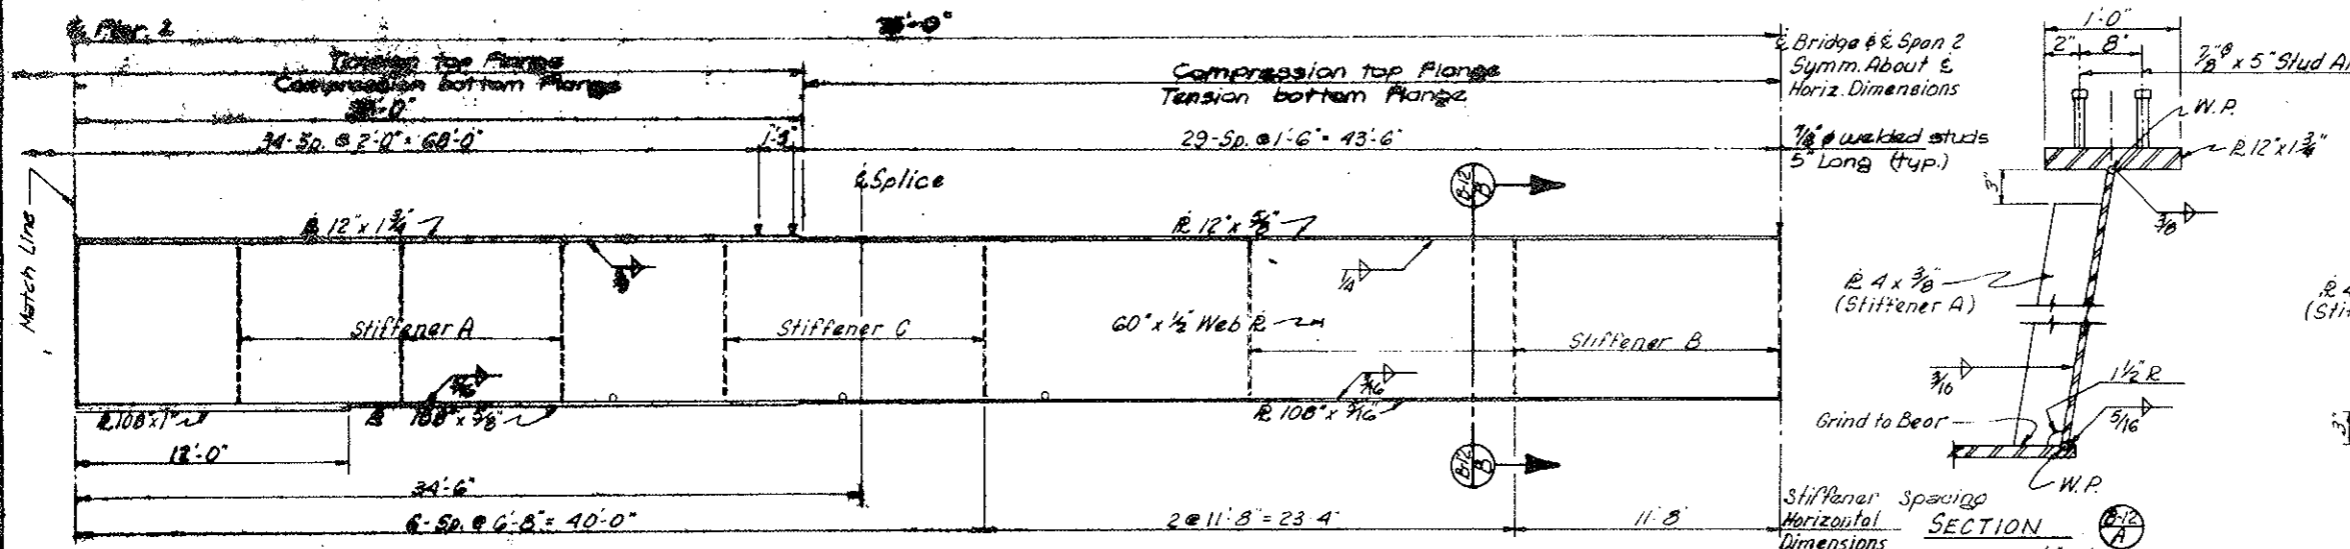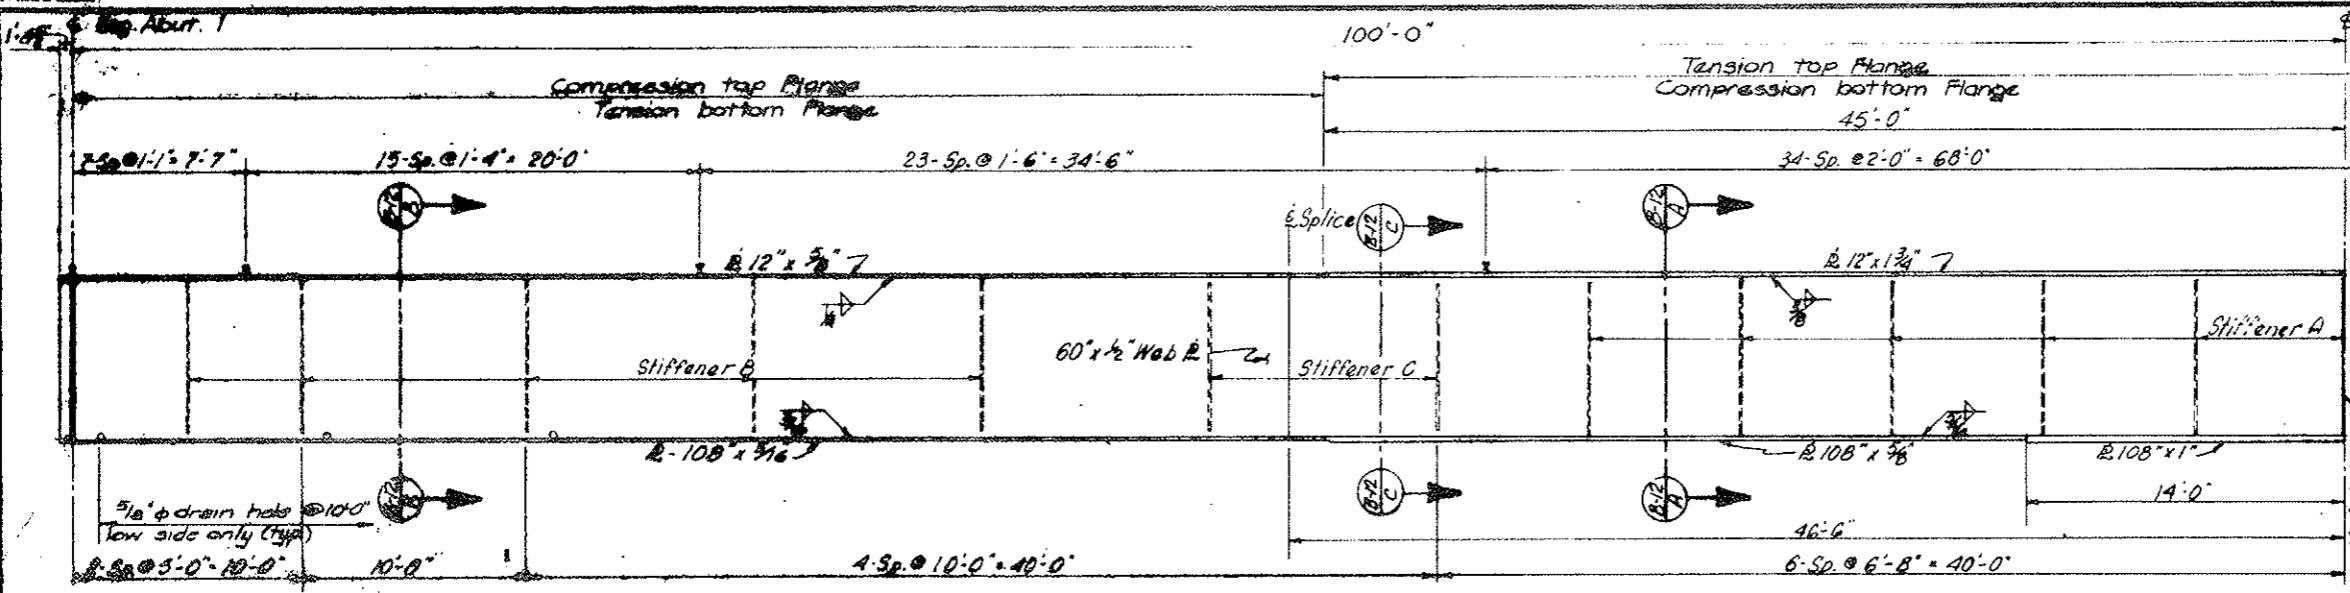

GIRDER ELEVATION
 Orig. Scale: 1/4" = 1'-0"

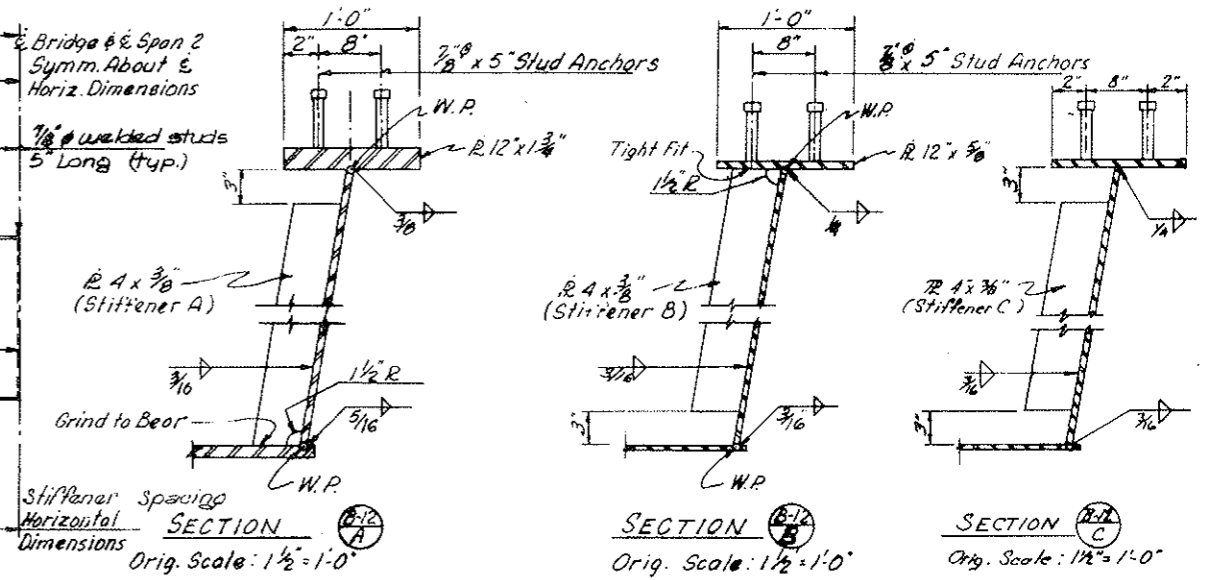

SECTION A
 Horizontal Dimensions
 Orig. Scale: 1/2" = 1'-0"

SECTION B
 Orig. Scale: 1/2" = 1'-0"



SECTION C
 Orig. Scale: 1/2" = 1'-0"

Location	1.0	1.1	1.2	1.3	1.4	1.5	1.6	1.7	1.8	1.9	2.0	2.1	2.2	2.3	2.4	2.5	2.6	2.7	2.8	2.9	3.0	3.1	3.2	3.3	3.4	3.5	3.6	3.7	3.8	3.9	4.0
Girder #	0	0	01	01	01	01	01	01	01	01	01	01	01	01	01	01	01	01	01	01	01	01	01	01	01	01	01	01	01	01	01
Shd & Girder	0	03	03	03	03	03	03	03	03	03	03	03	03	03	03	03	03	03	03	03	03	03	03	03	03	03	03	03	03	03	03
Vert Curves	0	0	04	04	04	04	04	04	04	04	04	04	04	04	04	04	04	04	04	04	04	04	04	04	04	04	04	04	04	04	04
Total	0	0	04	04	04	04	04	04	04	04	04	04	04	04	04	04	04	04	04	04	04	04	04	04	04	04	04	04	04	04	04


NOTES:

- ALTERNATE GIRDER SPICES WILL BE PERMITTED SUBJECT TO APPROVAL BY THE ENGINEER.
- COMPLETE ALL BEAD TO FLANGE FILLET WELDS AFTER WELDING FLANGE AND WEB BUTT WELDS.
- GRINDING IS NOT REQUIRED FOR SHOP BUTT WELDS IN TOP FLANGES WHICH ARE IN COMPRESSION, EXCEPT THE EDGES OF ALL FLANGE BUTT WELDS SHALL BE GROUND. OTHER AREAS SHALL BE GROUND AS DIRECTED BY THE ENGINEER.
- WEB BUTT JOINTS SHALL BE FULL PENETRATION GROOVE WELDS. IF FIELD SPICES ARE WELDED, WEB WELDS SHALL BE GROUND FLUSH.
- STIFFENERS NEAR A FIELD SPICE MAY BE FIELD WELDED.
- GIRDER ENDS AND BEARING STIFFENERS SHALL BE VERTICAL EXCEPT THAT THEY MAY BE NORMAL TO GRADE FOR GRADES LESS THAN 2%.
- AT THE CONTRACTOR'S OPTION, WELDED GIRDER SPICES MAY BE USED WHEN BOLTED SPICES ARE SHOWN ON THE PLANS.
- METHOD OF SUPPORTING GIRDER ENDS WHILE GIRDER FIELD WELDED SPICES ARE BEING MADE SHALL BE SHOWN ON THE SHOP DRAWINGS.

DEAD LOAD DEFLECTIONS (TENTH POINTS)
 (Units in Feet)

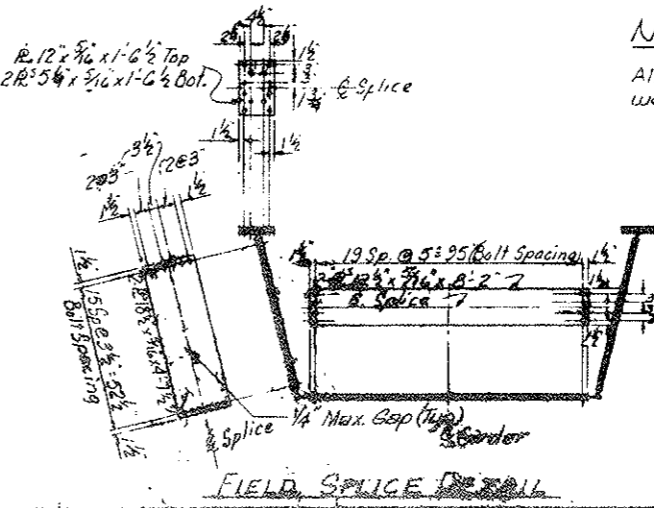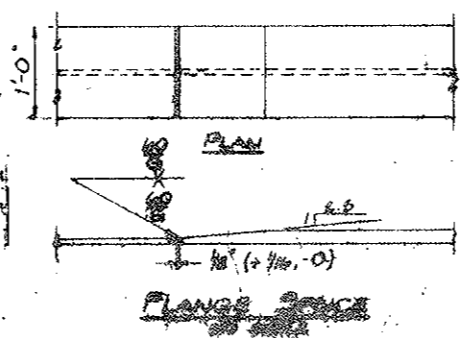


NOTE:
 All bolts shall be 3/8" ASTM A325 Type 3 weathering steel. No substitutions will be allowed.

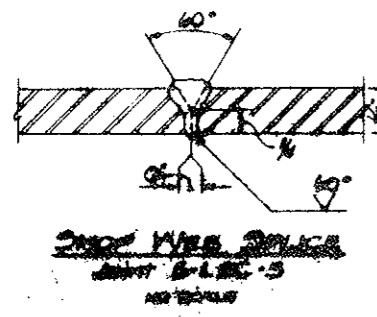


DIVISION OF HIGHWAYS			
GIRDER DETAILS			
Designer: B.W.P.	Structure: F-12-AN	Members: _____	
Detailer: P.S.	Drawing Number: 8-12		of 16 Drawings

FEDERAL ROAD REGION NO.	DISTRICT	PROJ. NO.	SHEET NO.	TOTAL SHEETS
XIII	COLORADO	170-2(54)197	105	

REVISIONS	

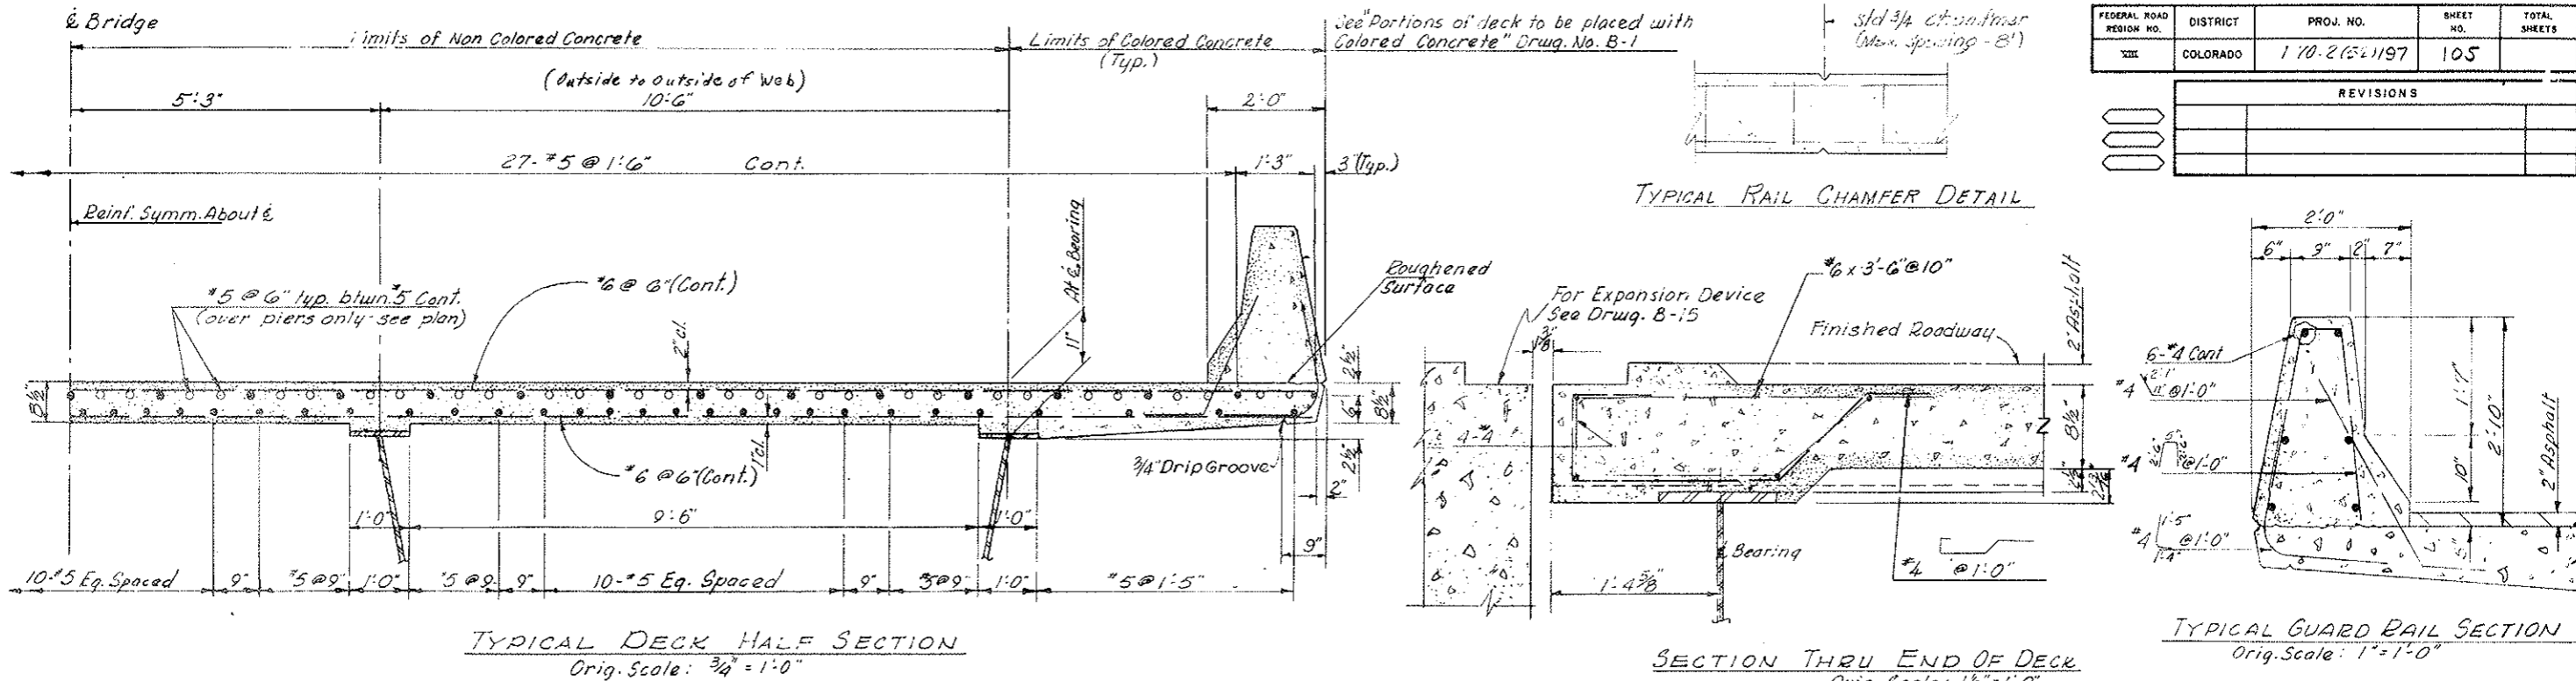

DESIGNED BY	DATE	CHECKED BY
EWP	5-22-76	JCK
CHECKED BY	QUANTITIES BY	
JCK	PJS	
DETAILED BY	CHECKED BY	
PHS	EA	

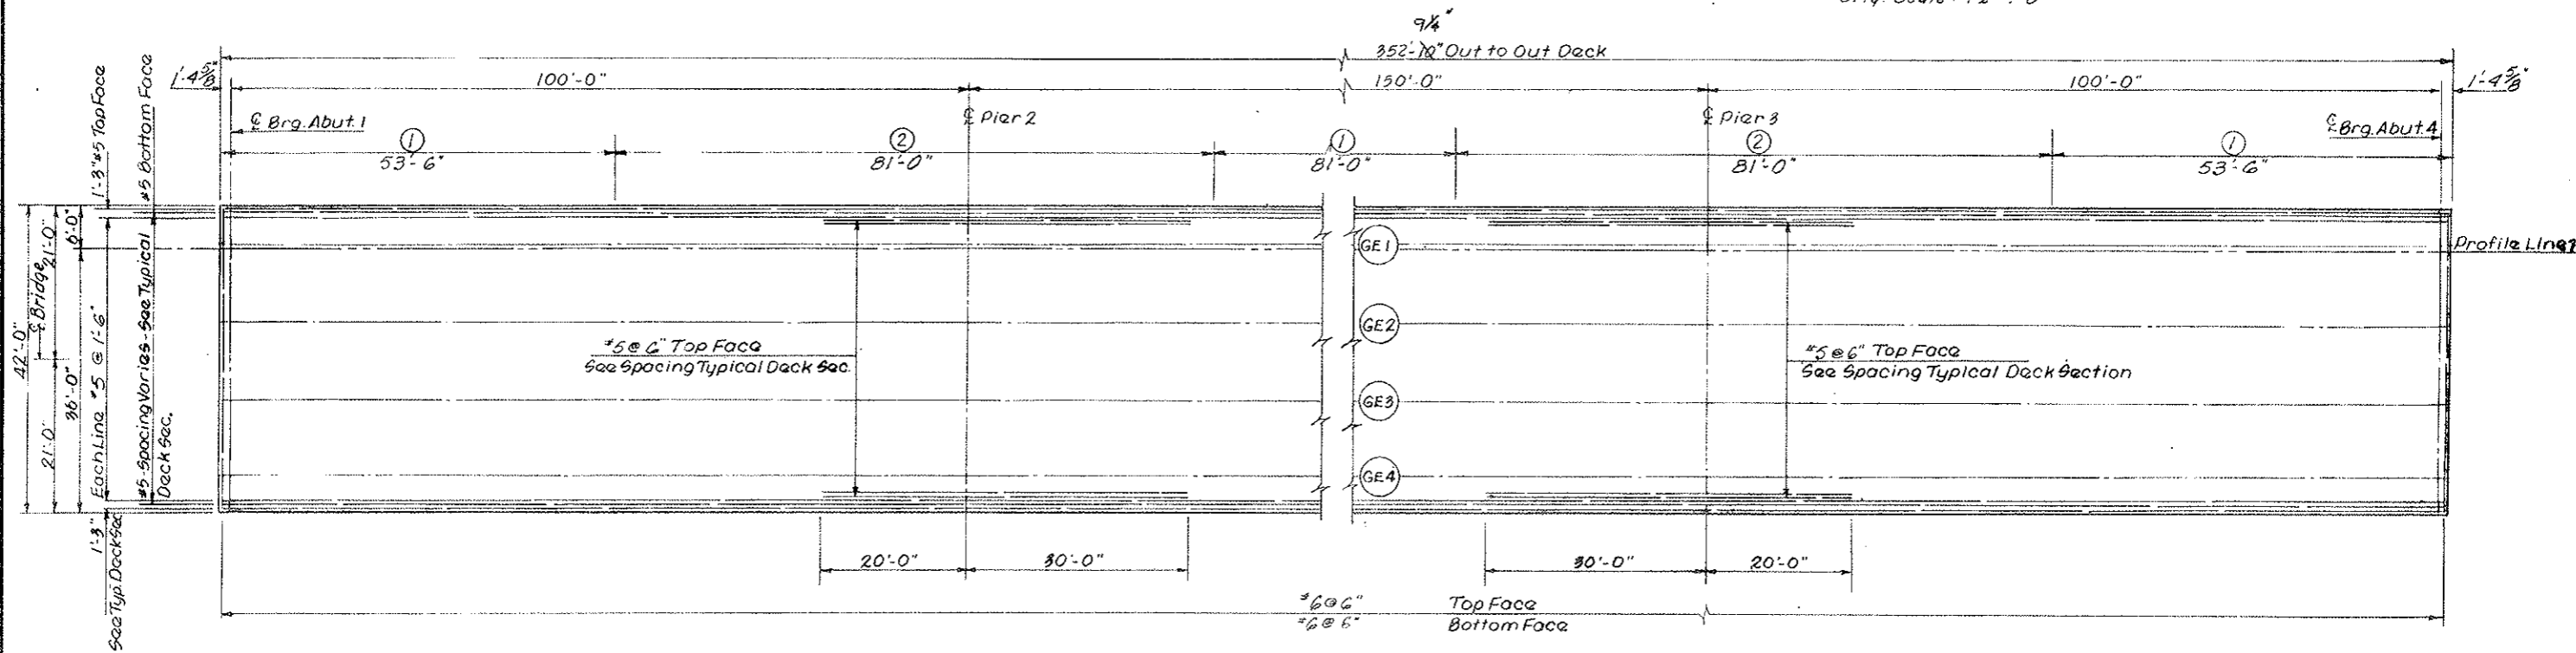

AS CONSTRUCTED
 REVISED DATE: 6-24-77




NOTE:
 Slab pour sequence shall be as shown. Areas marked ① shall be poured before areas marked ②, but areas of the same number need not be poured simultaneously.

DIVISION OF HIGHWAYS	
HALF DECK SECTION DECK PLAN	
Designer EWP	Structure Numbers F-12-AN
Detailer S.S.	
Drawing Number B-13	of 16 Drawings


FEDERAL ROAD REGION NO.	DISTRICT	PROJ. NO.	SHEET NO.	TOTAL SHEETS
VIII	COLORADO	170-2(52)197	106	

REVISIONS	
②-1	4-17-75 (See Eng. Files Added Movement & Notes) CLB
③	
④	

AS CONSTRUCTED
NO REVISIONS DATE 6-27-77

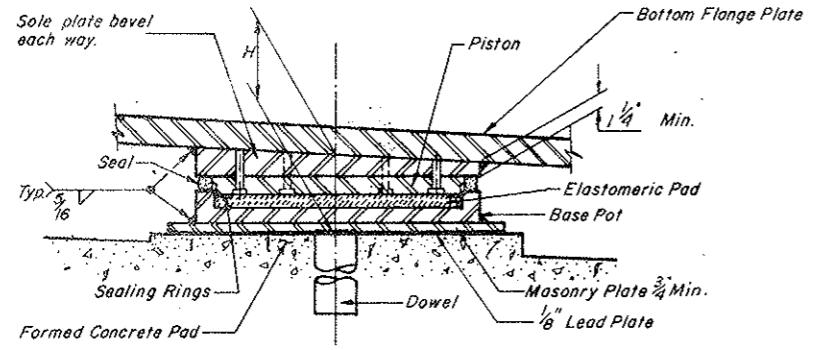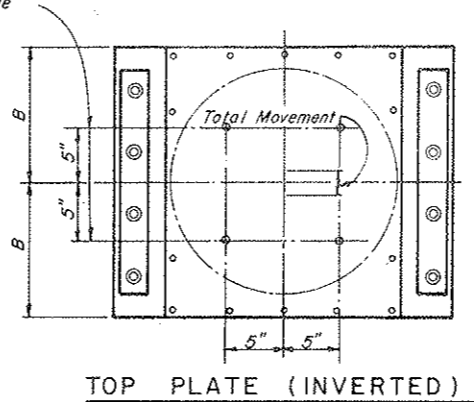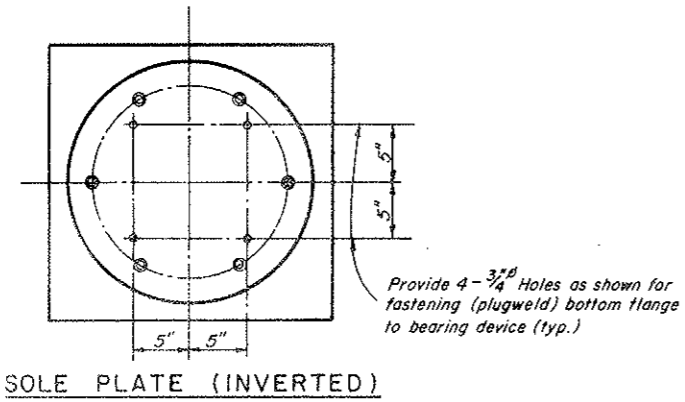

SECTION THRU ASSEMBLED BEARING
FIXED FLOATING BEARING
No Scale

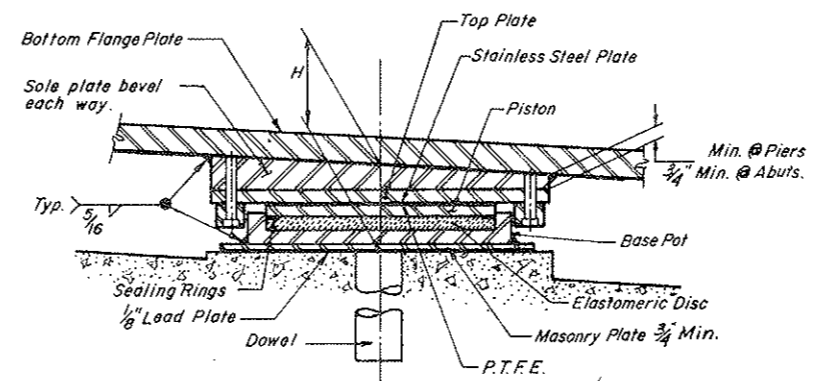


SECTION THRU ASSEMBLED BEARING
GUIDED EXPANSION BEARING
No Scale

- BEARING NOTES:**
- STEEL FOR BEARING DEVICES, MASONRY PLATES, AND SOLE PLATES SHALL BE A.A.S.H.T.O. SPECIFICATION M-183 (A.S.T.M. A36).
 - THE TYPE OF ANCHORAGE FOR BEARING DEVICES SHALL BE DETERMINED BY THE CONTRACTOR AND SUBMITTED ON SHOP DRAWINGS FOR APPROVAL.
 - FOR ALLOWABLE BEARING PRESSURE ON CONCRETE, SEE DRAWINGS.
 - THE SOLE PLATES SHALL BE SUPPLIED WITH BEVELS AND CROSSFALLS AS REQUIRED FOR GRADE AND SUPERELEVATION.
 - DIMENSION "H" IS THE LIMIT REQUIRED FOR BID ITEM NO. 512, "BEARING DEVICES".
 - THE SIZES OF MASONRY PLATES SHALL BE DETERMINED BY THE BEARING MANUFACTURER. THE ALLOWABLE ULTIMATE BEARING PRESSURES AND THE ULTIMATE LOADS SHALL BE USED TO DETERMINE THE MASONRY PLATE SIZES.
 - ALL BEARING DETAILS, INCLUDING WELDS, ARE SHOWN FOR ILLUSTRATION PURPOSES ONLY. THE CONTRACTOR SHALL SUBMIT SHOP DRAWINGS SHOWING DETAIL OF THE SPECIFIC BEARING DEVICE TO BE USED.

ALLOWABLE ULTIMATE BEARING PRESSURES:

At Abutments:	(f'c = 3000 psi)
	1785 psi
At Piers:	(f'c = 5000 psi)
	2975 psi

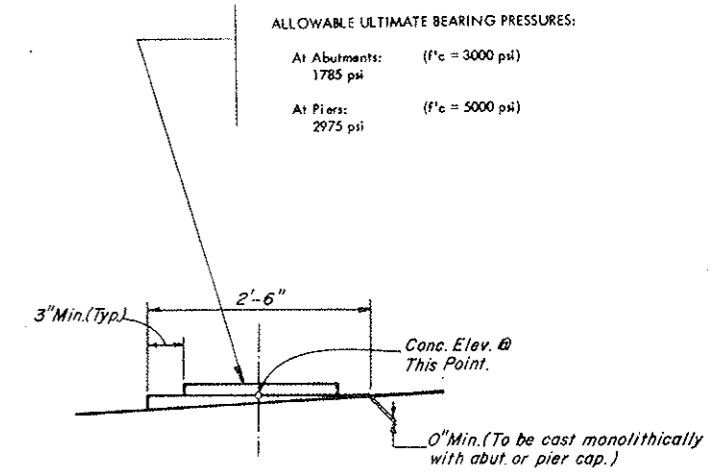

CONCRETE BEARING PAD DETAIL
No Scale

CHECKED BY	DATE	QUANTITIES BY	DATE
CHK	5/28/77	CHK	5/28/77
DRAWN BY	DATE	CHECKED BY	DATE
PHS	5/28/77	PHS	5/28/77

FIXED FLOATING BEARING

LOCATION	PIER 2	PIER 3
Capacity	400 Tons	400 Tons
Min. Horiz. Capacity	40 Tons	40 Tons
* Computed Reaction-DL+LL+I	387 Tons	387 Tons
Ultimate Reaction	600 Tons	600 Tons
H	5 3/8 in.	5 3/8 in.
Max. Movement (in)	0	0

* Computed reactions shall be used to determine bearing capacity.

GUIDED EXPANSION BEARING

LOCATION	ABUT. 1	ABUT. 4
Capacity	125 Tons	125 Tons
Min. Horiz. Capacity	12 Tons	12 Tons
* Computed Reaction-DL+LL+I	121 Tons	121 Tons
Ultimate Reaction	121 Tons	121 Tons
H	4 3/8 in.	4 3/8 in.
Max. Movement (in)	1 3/8	1 3/8

NOTE: Capacity includes dead load plus live load plus impact.

DIVISION OF HIGHWAYS

BEARING DETAILS

Designer	RWP	Structure	F-12-AN
Detailer	PHS	Numbers	
Drawing Number B-14		of 16 Drawings	

FEDERAL ROAD REGION NO.	DIVISION	PROJ. NO.	SHEET NO.	TOTAL SHEETS
XIII	COLORADO	I 10 2 (52) 197	107	

REVISIONS	

NOTES
THE EXPANSION DEVICE SHALL BE INSTALLED ON GRADE, PARALLEL TO THE SLOPE AND GRADE OF THE DECK.

AFTER THE CONCRETE HAS ATTAINED INITIAL SET, THE ATTACHMENTS USED TO HOLD THE ANGLE ASSEMBLY IN ITS PROPER POSITION SHALL BE REMOVED.

DO NOT PAINT STEEL SURFACES IN CONTACT WITH CONCRETE AND PREMOLDED EXPANSION DEVICE.

"W", "T", "Ø", AND "Δ" DIMENSIONS ARE DEPENDENT UPON THE PARTICULAR PREMOLDED DEVICE SUPPLIED, AND SHALL BE SHOWN ON THE SHOP DRAWINGS.

THE SHOP DRAWINGS SHALL INDICATE THE "W" DIMENSION AT A RANGE OF TEMPERATURES FROM 30° TO 100° ASSUMING A MID-POINT TEMPERATURE OF 40°.


ANGLE AND PLATE ASSEMBLIES TO EXTEND GUTTER TO GUTTER ONLY.

ALL SECTIONS OF THE PREMOLDED EXPANSION DEVICE SHALL BE JOINED BY USING THE MANUFACTURER'S STANDARD WATERPROOF JOINT.

ALL CURB UNITS SHALL BE FULL WIDTH, ON GUTTER LINE, FOR SKEW ANGLES AS SPECIFIED ON THE PLANS.

ALL ANCHORS SHALL BE CAST IN PLACE BOLTS OR THREADED CAST IN PLACE CONCRETE INSERTS EXCEPT FOR CURB AND WALK UNITS WHICH MAY BE INSTALLED BY THE USE OF APPROVED DRILLED IN PLACE ANCHOR UNITS.


OPENING IN CURB AND SIDEWALK TO BE CONSTRUCTED TO THE EXACT WIDTH OF THE EXISTING DECK OPENING.

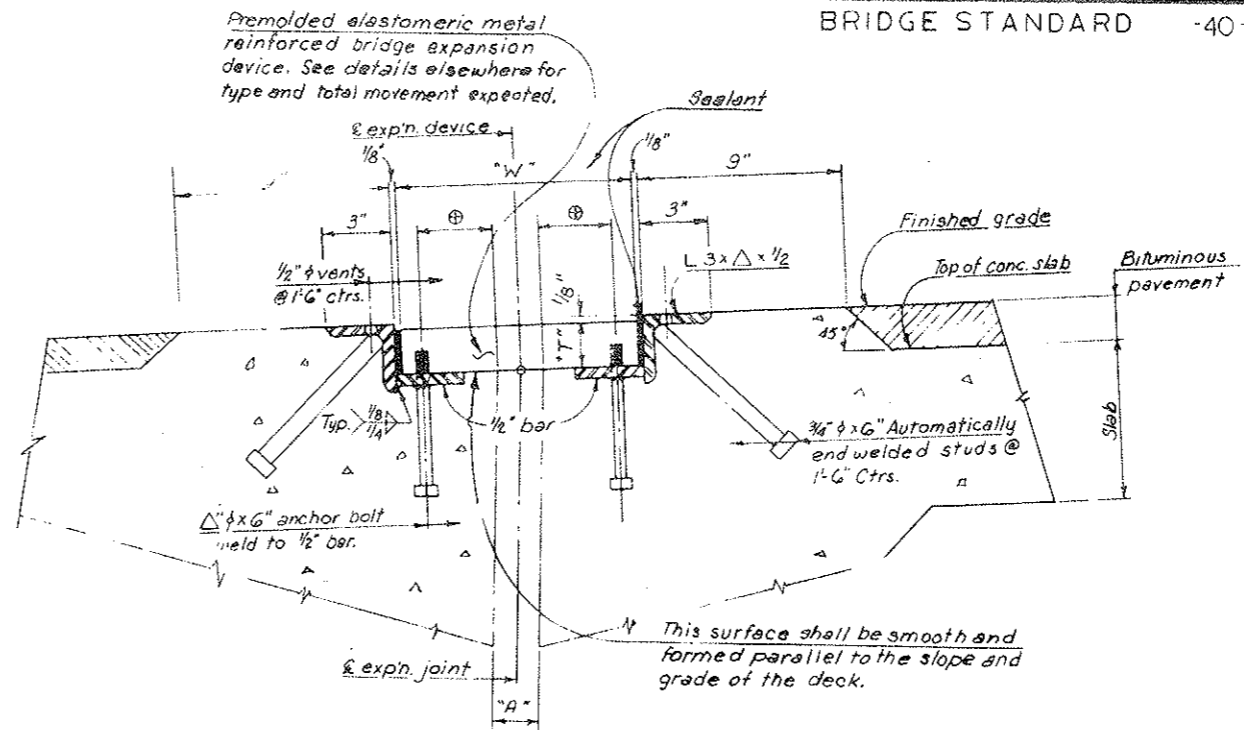


SECTION THRU EXPN. DEVICE

AS CONSTRUCTED
NO REVISIONS DATE: 6-24-77

DATE	CHECKED BY	DATE	CHECKED BY
5/18/74	J.C.K.	10/23	J.R.E.
7/18/74	J.C.K.	10/23	J.R.E.
8/9/74	J.C.K.	10/23	J.R.E.
8/11/74	J.C.K.	10/23	J.R.E.

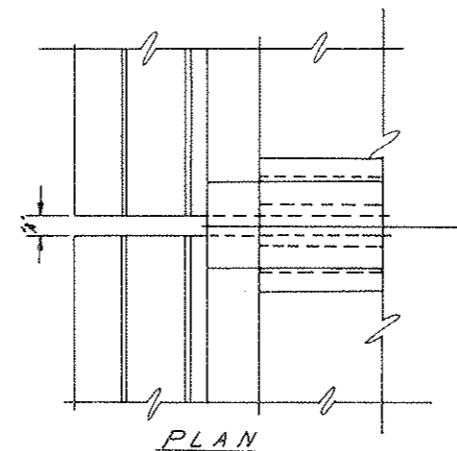

PLAN

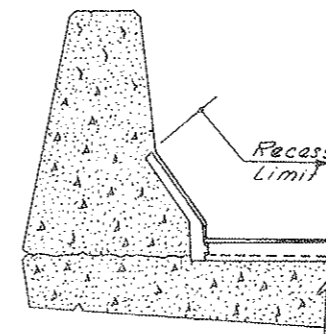

ELEVATION

DETAILS OF EXPANSION JOINT AT GUARDRAIL

Outside Temp.	Premolded Bridge Expansion Device		
	(Type 1) Dim. "A" (Min.)	(Type 2) Dim. "A" (Min.)	(Type 3) Dim. "A" (Min.)
30°	1 5/8"	2 1/4"	2 3/4"
40°	1 1/2"	2 1/8"	2 3/8"
50°	1 3/8"	2"	2 1/2"
60°	1 1/4"	1 7/8"	2 3/8"
70°	1 1/8"	1 3/4"	2 1/8"
80°	1"	1 1/2"	2"
90°	7/8"	1 1/8"	1 3/4"
100°	3/4"	1 1/4"	1 3/8"

Outside Temp.	Premolded Bridge Expansion Device		
	(Type 4) Dim. "A" (Min.)	(Type 6) Dim. "A" (Min.)	(Type) Dim. "A" (Min.)
30°	4 3/8"	3 3/8"	
40°	4 1/8"	4 3/8"	
50°	3 7/8"	4 1/2"	
60°	3 3/8"	4"	
70°	3 1/4"	3 3/8"	
80°	3"	3 1/4"	
90°	2 3/4"	2 3/4"	
100°	2 1/2"	2 1/8"	


DIVISION OF HIGHWAYS

BRIDGE EXPANSION DEVICE
PREMOLDED ARMORED


Designer	Structure	F-12-AN
Detailer J.R. EWERT	Numbers	
Drawing Number 8 15	of 16	Drawings

FEDERAL ROAD DISTRICT NO.	DIVISION	PROJ. NO.	SHEET NO.	TOTAL SHEETS
VIII	COLORADO	10 2 (52)197	108	

REVISIONS	

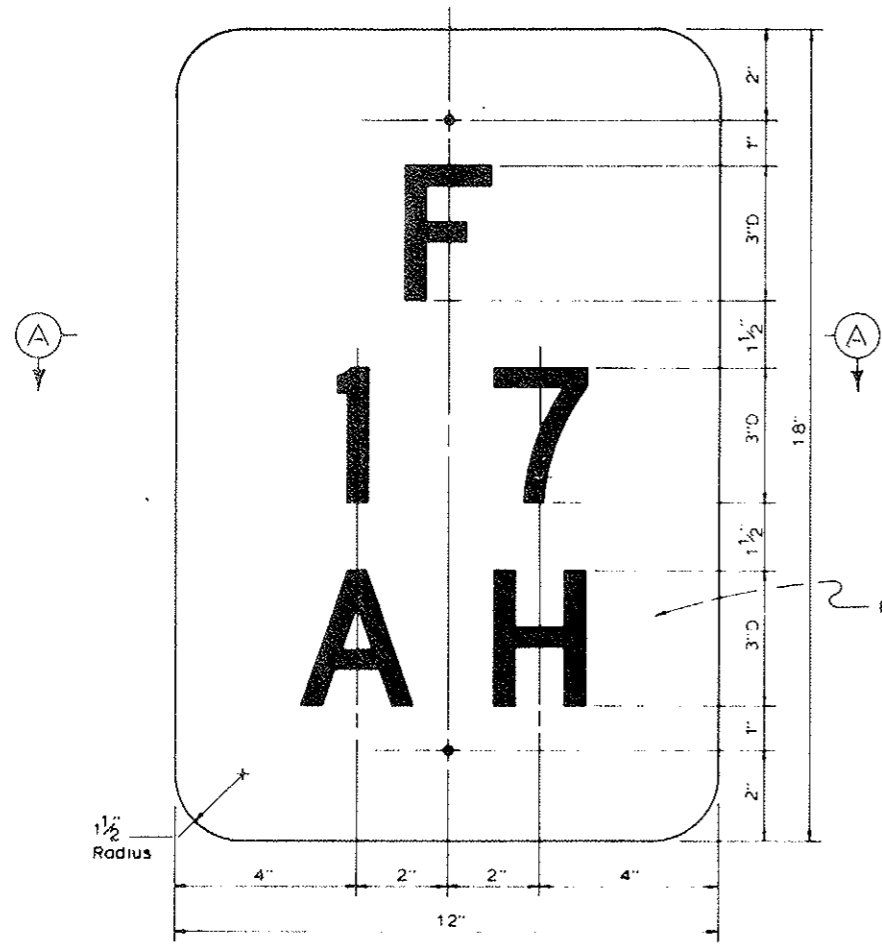


Black letters and numbers on white background

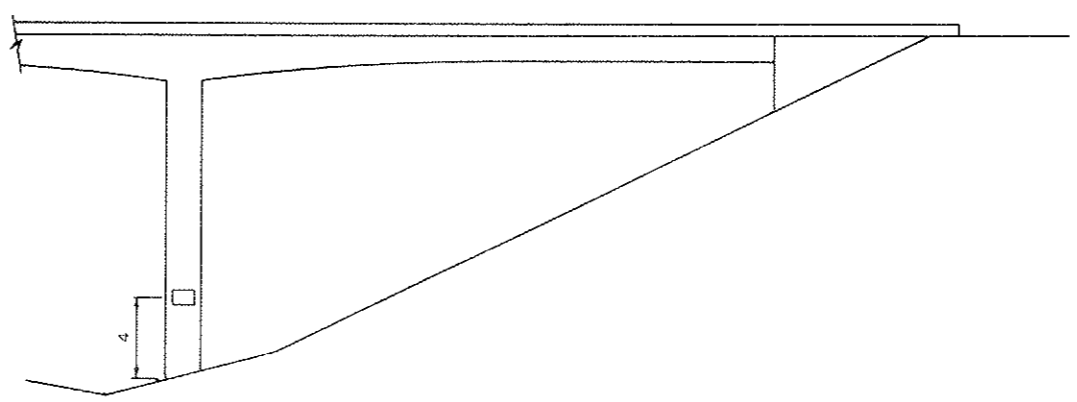


STRUCTURE NUMBER LOCATION ON PIERS

DESIGNED BY	DATE	CHECKED BY	DATE
CHECKED BY	DATE	QUANTITIES BY	DATE
DETAILED BY	DATE	CHECKED BY	DATE


STRUCTURE IDENTIFICATION PANEL (SAMPLE NUMBERS & LETTERS)

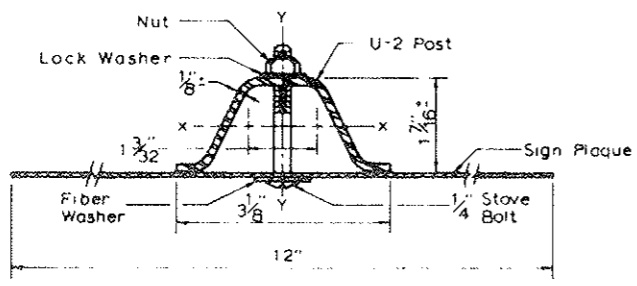

SECTION A-A

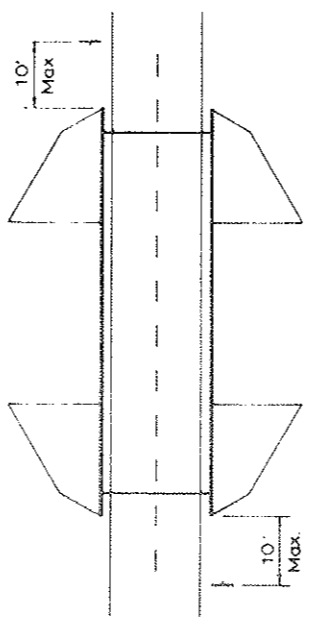

STANDARD LOCATION DETAIL

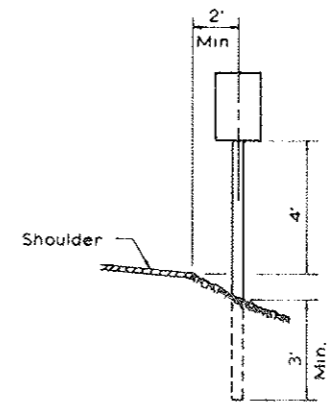

U-2 POST IN GROUND

ALL WORK SHALL BE DONE IN ACCORDANCE WITH THE STANDARD SPECIFICATIONS APPLICABLE TO THE PROJECT.

SIGN PANEL SHALL BE FABRICATED FROM EITHER SHEET STEEL 0.0509 MIN. THICK OR SHEET ALUMINUM 0.040 MIN. THICKNESS.

SIGN PANEL SHALL BE GROUND MOUNTED.

U-2 POST SHALL MEET REQUIREMENTS OF PAR. 4.00 DIST. DEPT. OF COMMERCE, COMMERCIAL STANDARD 134.51. ACCEPTABLE MATERIAL INCLUDES PERULCO RAILROAD RAIL; U-2 POST SHALL WEIGH 2 LBS. PER FT. EXCEPT THAT A MILL TOLERANCE OF MINUS 0.1% OF THE WEIGHT OF ANY ONE POST WILL BE ALLOWED. ALTERNATE METAL POSTS WILL BE ACCEPTABLE IF SECTION MODULUS IS AT LEAST 0.000 IN³ ABOUT THE X-X AXIS AND AT LEAST 0.250 IN³ ABOUT THE Y-Y AXIS.

SIGN PANEL SHALL BE FASTENED DIRECTLY TO THE POST WITH TWO (2) GALVANIZED OR CADMIUM PLATED STOVE BOLTS. A PLASTIC FIBER WASHER SHALL BE PLACED BETWEEN THE BOLTS HEAD AND THE FACE OF THE PANEL. A GALVANIZED OR CADMIUM PLATED LOCK WASHER SHALL BE PLACED UNDER THE NUT ON THE BACK OF THE POST. FIBER WASHERS SHALL BE USED UNDER THE HEAD OF THE STOVE BOLTS AND UNDER THE FIBER WASHERS ON THE FACE OF THE SIGN PANEL. THE COLOR OF THE FIBER WASHERS SHALL MATCH THE SURROUNDING COLOR.

LETTERS AND NUMBERS SHALL BE SERIC "D". THEY SHALL BE 2 1/2 IN. H.

THE CORRECT STRUCTURE NUMBER IS SHOWN ON THE PLAN.

(1) OMIT STRUCTURE NUMBER STANDARDS WHERE A RAILROAD TRACK CROSSES OVER THE ROADWAY.

STRUCTURE NUMBER STANDARD SHALL NOT BE PAID FOR SEPARATELY BUT INCLUDED IN THE CHECK.

IN ADDITION TO THE REQUIREMENTS STATED ABOVE, STRUCTURE NUMBERS FOR ROADWAYS PASSING UNDER CROSSROADS ARE TO BE PLACED AT THE FOLLOWING POINTS:

(A) FOR STRUCTURES OF THREE OR MORE SPANS, THE STRUCTURE NUMBER SHALL BE STENCILED, FACING TRAFFIC, ON THE OUTSIDE FACE OF THE END COLUMN OF THE RIGHT HAND PIER.

(B) FOR TWO SPAN STRUCTURES, THE STRUCTURE NUMBER SHALL BE STENCILED, FACING TRAFFIC, ON THE OUTSIDE FACE OF THE END COLUMN OF THE CENTER PIER.

AS CONSTRUCTED
NO REVISIONS DATE: 6-24-71

DIVISION OF HIGHWAYS	
STRUCTURE NUMBER STANDARD	
Designer	Structure Number F-12-AN
Datater B. R. LEASE	of 10 Drawings
Drawing Number B-10	