

MAR 22 1978

SEE STANDARD M-100-A FOR STANDARD SYMBOLS

STATE DEPARTMENT OF HIGHWAYS DIVISION OF HIGHWAYS—STATE OF COLORADO

PLAN AND PROFILE OF PROPOSED FEDERAL AID PROJECT NO. I 70-2(57)197 STATE HIGHWAY NO. 70 SUMMIT COUNTY

FEDERAL ROAD REGION NO.	DIVISION	PROJECT NO.	SHEET NO.
VIII	COLORADO	I 70-2(57)197	1

AS CONSTRUCTED

NO REVISIONS REVISED 1-31-78 VOID

P.E., R.O.W. and Utilities under Project No. I 70-2(38)
(R-1) 5-24-76, Pits on Sketch & Index, W.C.B.

INDEX OF SHEETS

SHEET NO.	DESCRIPTION
1	TITLE SHEET AND SKETCH MAP
2	TYPICAL SECTION, AND DETAIL OF WIDENING FOR GUARD RAIL
3-4	SUMMARY OF APPROXIMATE QUANTITIES
5	GENERAL NOTES AND TABULATION OF LENGTH AND DESIGN DATA
6	STRUCTURE QUANTITIES
7	TABULATION OF DELINEATORS, GUARD RAIL AND WATERPROOFING (MEMBRANE)
8	SURFACING PLAN
9	U.S. FOREST SERVICE PIT (WHEELER FLATS)
10-11	DELETED.
12	DETAILS OF SLOTTED PIPE INLET
13	DETAIL OF CONCRETE BARRIER DELINEATOR
14	GUARD RAIL - TYPE 4 PRECAST-PORTABLE CONCRETE
15-29	ALIGNMENT PLAN AND PROFILE SHEETS
30-33	Structures
M-100-A	STANDARD SYMBOLS 5-11-73
M-107-A	TEMPORARY EROSION CONTROL 4-21-75
M-203-C	DITCH TYPES 7-23-68
M-203-SD	SUPERELEVATION OF CURVES - DIVIDED HIGHWAYS 3-24-75
M-206-AB	EXCAVATION AND BACKFILL FOR STRUCTURES (3 SHEETS) 4-16-76
M-603-CA	CONCRETE AND METAL END SECTIONS 8-21-75
M-603-HA	METAL CULVERT PIPE - H-20 LOADING 8-20-75
M-604-AB	CONCRETE INLET, TYPE 13 5-2-74
M-614-TB	TRAFFIC SIGNING FOR HIGHWAY CONSTRUCTION (3 SHEETS) 11-22-71

"No Revisions" sheets No 2, 12-16, 18-20, 22, 24, 26, 28, 29

"S" STANDARDS	DESCRIPTION
S-612-51A	TYPICAL DELINEATOR INSTALLATIONS (2 SHEETS) 10-26-72
S-614-52A	BARRICADES, DRUMS AND VERTICAL PANEL CHANNELIZING DEVICES 12-4-74

SCALES OF ORIGINAL DRAWINGS


ON PLAN 1 IN = 100 FT

ON PROFILE 1 IN = 100 FT HORIZONTAL
1 IN = 10 FT VERTICAL

GRADE LINE ON PROFILE IS SHOWN AS GRADE OF FINISHED ROAD

GROSS LENGTH OF PROJECT 17,724.18 LIN. FT. = 3.357 MILES

NET LENGTH OF PROJECT

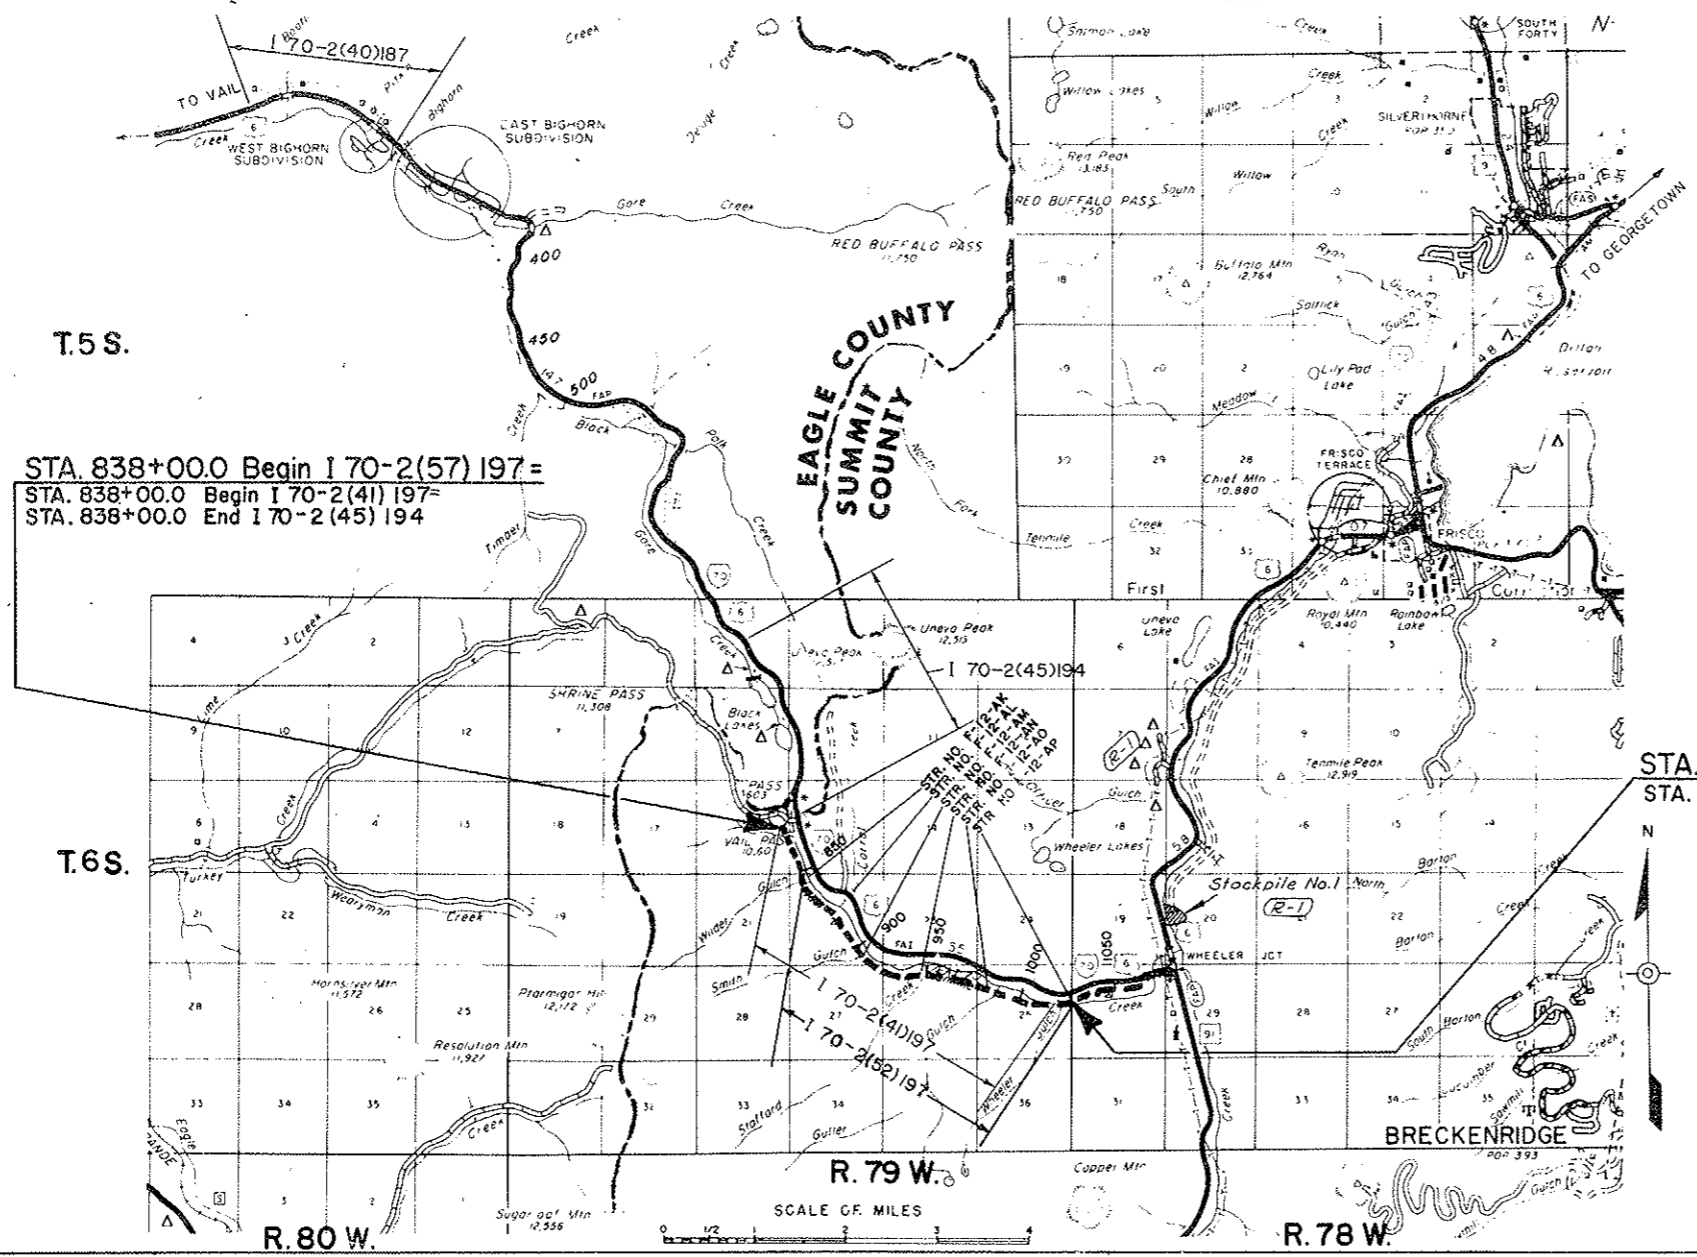

STA. 838+00.0 Begin I 70-2(57)197=
STA. 838+00.0 Begin I 70-2(41)197=
STA. 838+00.0 End I 70-2(45)194

STA. 1015+58.14 End I 70-2(57)197=
STA. 1015+58.14 End I 70-2(52)197

DIVISION OF HIGHWAYS

APPROVED

E.W. [Signature] *5/16/78*
CHIEF ENGINEER DATE

AS CONSTRUCTED INFORMATION

CONTRACTOR Avery Construction Co

Project ENGINEER Rick Yowell
(Project or Resident)

PROJECT STARTED 8-23-76

PROJECT COMPLETED 9-1-77

AS CONSTRUCTED PLANS R.A. [Signature] by
APPROVED Gary A. [Signature]
Coast Eng'g 2-21-78
TITLE DATE

DEPARTMENT OF TRANSPORTATION
FEDERAL HIGHWAY ADMINISTRATION

APPROVED _____ DATE _____

DIVISION ADMINISTRATOR

W.C.B.

TITLE SHEET



(R-1) 5-24-76, Surfacing Rates, WCB

FEDERAL ROAD REGION NO.	DIVISION	PROJ. NO.	SHEET NO.	TOTAL SHEETS
VIII	COLORADO	170-2(57)197	2	33

AS CONSTRUCTED

NO REVISION 1-31-76 REVISED [] VOID []

TYPICAL SECTION
 (EAST BOUND ONLY)

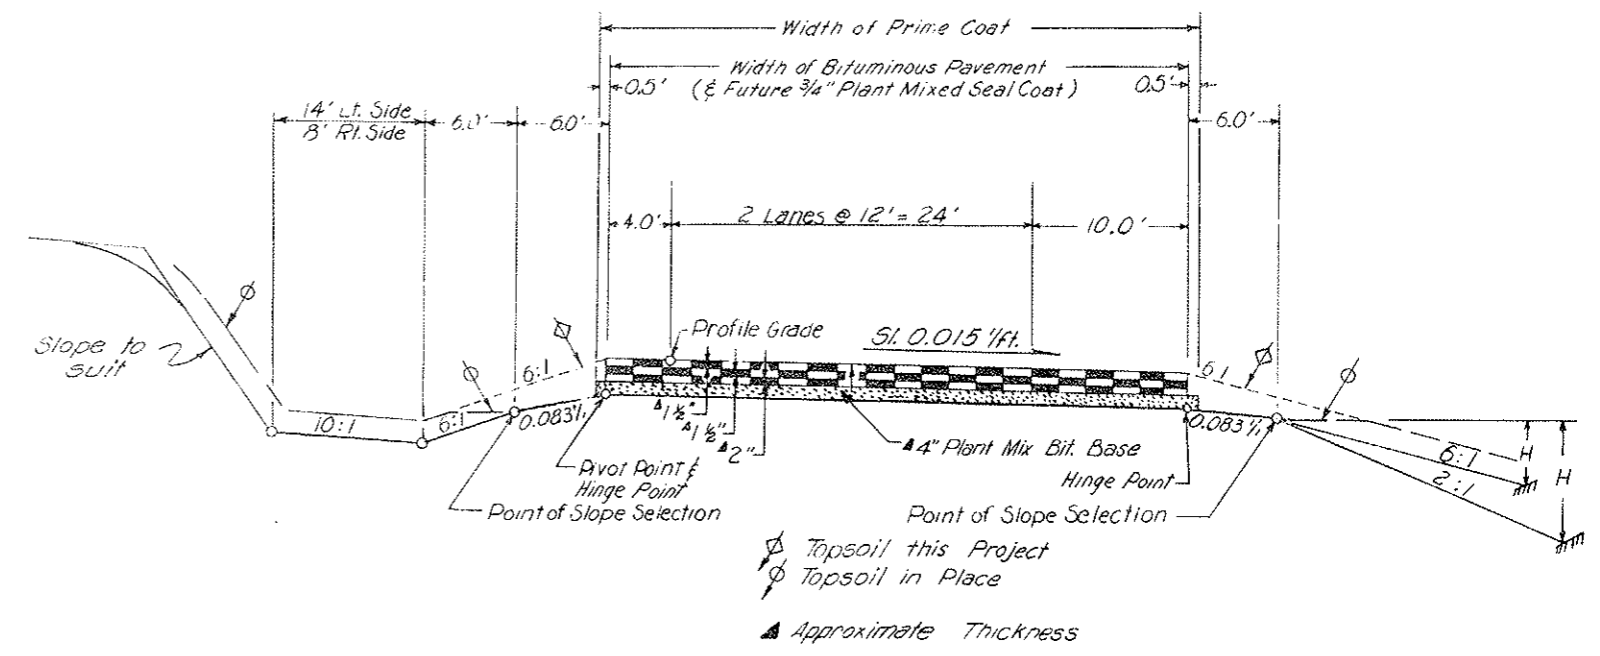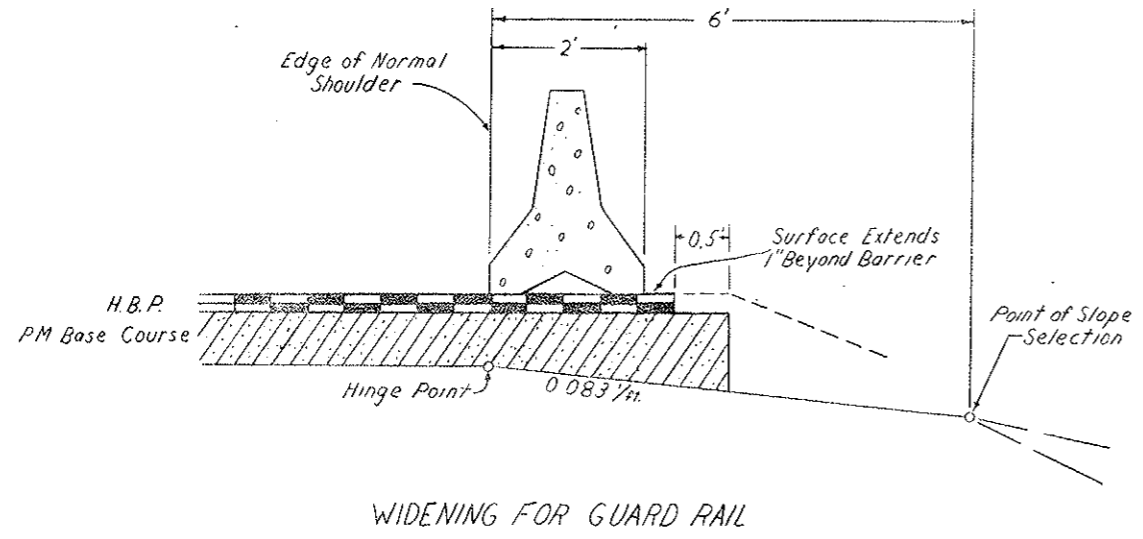

Material shall be placed in separate courses at the following approximate rate per 100 lin. ft. of roadway:

Bituminous Pavement - Top Layer	34 Tons
Middle Layer	34 Tons
Bottom Layer	45 Tons
Plant Mix Bituminous Base	92 Tons

(R-1)

The rates shown have been determined from information available at the time of design. Rates should be adjusted during construction to obtain the required approximate thickness.

Hot Bituminous Pavement may be placed in two lifts when approved by the Engineer.

(R-1) 5-24-76, Quantities, WCB

SUMMARY OF APPROXIMATE QUANTITIES

AS CONSTRUCTED			FEDERAL ROAD DISTRICT NO.	DIVISION	PROJ. NO.	SHEET NO.	TOTAL SHEETS
NO REVISION	REVISED 1-31-78	VOID	XIII	COLORADO	170-2(57)197	3	33

INDEX BOOK PAGE SHEET	CONTRACT ITEM NO.	CONTRACT ITEM	UNIT	ROADWAY	MAJOR STR. NO. F-12-AK	MAJOR STR. NO. F-12-AM	MAJOR STR. NO. F-12-AN	MAJOR STR. NO. F-12-AO	MAJOR STR. NO. F-12-AP	PROJECT TOTALS	Final	±	%	
											Total			
(R-1)		202	Removal of Structure (C.M.O. 4563)	Each							1	0	-1	0
(R-1)	Form 7	203	Truck (C.M.O. 1058)									45 1/2	+45 1/2	91
(R-1)	Form 7	203	Blading	Hour							50	70 1/2	+20 1/2	141
	Form 7	203	Combination Loader	Hour							50	47	-3	94
	Form 7	203	Roller (C.M.O. 1058)	Hour								35 1/2	+35 1/2	89
(R-1)	computation sheets	204	Haul	Ton Mi.							164,700	145,294	-19,406	88
(R-1)	1 31 6	206	Structure Excavation	Cu. Yd.							240	193	-47	80
(R-1)	1 31 6	206	Structure Backfill (Class 1)	Cu. Yd.							240	152	-88	63
	1 43	207	Topsoil (Haul)	Cu. Yd.							4,900	4015	-885	82
	Form 7	209	Water (Landscaping)	M. Gal.							250	105	-145	42
	Form 7	209	Water (C.M.O. 1058)	M. Gal.								123	+123	82
	2 17	212	Seeding (Native)	Lb.							400	374	-26	94
	2 17	212	Fertilizer	Lb.							5,000	4,671	-329	93
	2 17	212	Soil Preparation (Native) (C.M.O. 4563)	Acre							10	deleted	-10	0
	2 17	212	Soil Preparation (Sod)	Sq. Ft.							9,000	9,327	+327	104
	2 17	212	Sod	Sq. Ft.							9,000	9,327	+327	104
	2 17	213	Mulching	Ton							20	17	-1	95
(R-1)	3 12	301	Plant Mix Bituminous Base (Class 6)	Ton							17,300	18,198.70	+898.70	105
(R-1)	3 13	403	Hot Bituminous Pavement (Grading E)	Ton							19,300	21,334.40	+2,034.40	111
(R-1)	Asph. Tab	411	Asphalt Cement (AC-5) (C.M.O. 1054)	Ton							2,020	2,064.16	+44.16	102
(R-1)	Asph. Tab	411	Emulsified Asphalt (CSS-1A) (C.M.O. 1057)	Gal.							8,500	3,975	-4,525	47
		411	Liquid Asphaltic Material (MC-70)	Gal.							30,800	12,581	-18,219	41
(R-1)														
(R-1)	3 8	515	Waterproofing (Membrane)	Sq. Yd.							8,261	8,121	-140	98
(R-1)	1 31 6	603	18 Inch Corrugated Steel Pipe	Lin. Ft.							308	429	+121	139
(R-1)	1 31 6	603	72 Inch Corrugated Steel Pipe (C.M.O. 4563)	Lin. Ft.							148	deleted	-148	
(R-1)	1 31 6	603	18 Inch Steel End Section	Each							8	10	+2	125
	1 31 6	604	Inlet Type 13 (5 Foot)	Each							3	5	+2	167
	1 31 6	604	18 Inch Slotted Pipe Inlet	Lin. Ft.							50	50	0	100
	3 11 7	606	Guard Rail Type A (Precast-Portable) (Colored)	Lin. Ft.							1,616	1,416	-200	100
	3 11	606	Sandblast Guard Rail (C.M.O. 1052)	Lin. Ft.								1,616	+1616	100

Final Quantity Paid

(R-1) 5-24-76, Quantities, WCB

SUMMARY OF APPROXIMATE QUANTITIES

AS CONSTRUCTED			FEDERAL ROAD REGION NO.	DIVISION	PROJ. NO.	SHEET NO.	TOTAL SHEETS
NO REVISIONS	REVISED 1-31-78	VOID	III	COLORADO	I 70-2(57)197	4	33

INDEX			CONTRACT ITEM NO.	CONTRACT ITEM	UNIT	ROADWAY	MAJOR STR. NO. F-12-AK	MAJOR STR. NO. F-12-AM	MAJOR STR. NO. F-12-AN	MAJOR STR. NO. F-12-AO	MAJOR STR. NO. F-12-AP	PROJECT TOTALS	Final Total	+ -	%	
BOOK	PAGE	SHEET														
1	34	7	612	Delineator (Type I)	Each	169						169	134	-35	79	
1	34	7	612	Delineator (Type II)	Each	8						8	8	0	100	
		7	612	Delineator (Type I) (Barrier) (C.M.O. 4563)	Each	7						7	Deleted	-7	0	
1	34	7	612	Delineator (Type III) (Barrier)	Each	10						10	10	0	100	
Form	7		614	Flagging	Hour	3,000						3,000	1,369	-1,631	46	
(R-1)																
3	15		620	Field Laboratory	Each	1						1	1		100	
3	15		620	Sanitary Facility	Each	1						1	1		100	
(R-1)																
3	15		626	Mobilization	L. S.	1						1	1		100	
<u>FORCE ACCOUNT</u>																
cmo	105B		F/A01	Minor Contract Revisions $(35\frac{1}{2} \text{ hr} \times 47.95) + (45\frac{1}{2} \times 47) + (13 \text{ m} \times 45)$	L. S.	1						ESTIMATED AMOUNT \$5,000	FINAL TOTAL \$4,394.23	1	\$-605.77	86
Contr	Billing		F/A02	On-The-Job Trainee	Each	2						\$1,600	\$3,872.00	2	-1212.00	24
			F/A03	Obliterate Existing Haul Roads	L. S.	1						\$10,000	---	1	0	0
			F/A04	Erosion Control	L. S.	1						\$5,000	---	1		
(R-1)																
Contr	Billing		CMO 1060	STABILIZING SOFT SPOT								\$3008.55	\$2952.15		\$-56.40	98

FEDERAL ROAD REGION NO.	DIVISION	PROJ. NO.	SHEET NO.	TOTAL SHEETS
VIII	COLORADO	170-2(57)197	5	33
AS CONSTRUCTED				
NO REVISIONS		REVISED	Jun 31 1974	VOID

TABULATION OF LENGTH & DESIGN DATA

STATION	ROADWAY LIN. FT.	MAJOR STRUCTURES LIN. FT.
838+00.0 BEGIN I 70-2(57)197 = 838+00.0 END I 70-2(45)194 = 838+00.0 BEGIN I 70-2(41)197		
	2,226.50	
860+26.50		227.00
862+53.50 STR. NO. F-12-AK		
878+22.62 BK. = EQUATION	1,569.12	
878+34.33 AH.		
913+08.75	3,474.42	
915+81.25 STR. NO. F-12-AH		272.50
942+63.44 BK. = EQUATION	2,682.19	
942+73.35 AH.		
943+28.50	56.15	
947+11.50 STR. NO. F-12-AH		383.00
965+94.76 BK. = EQUATION	1,883.26	
966+07.10 AH.		
989+22.0	2,314.90	
993+33.0 STR. NO. F-12-A0		411.00
1009+16.14	1,583.14	
1015+58.14 STR. NO. F-12-AP		642.00
1015+58.14 END I 70-2(57)197 = 1015+58.14 END I 70-2(52)197		
TOTALS	15,789.68	1,935.5
SUMMARY		
	LIN. FT.	MILES
ROADWAY	15,789.68	2.990
MAJOR STRUCTURES	1,935.5	.367
TOTAL (NET AND GROSS)	17,725.18	3.357
DESIGN DATA		
MAXIMUM DEGREE OF CURVE	3°30'	
MAXIMUM GRADE	6.26%	
MINIMUM SSD HORIZONTAL	>600'	
MINIMUM SSD VERTICAL	600'	
MAXIMUM DESIGN SPEED	70 MPH	
1995 DESIGN TRAFFIC A.D.T.	12,000	
D.H.V.	2,400	

GENERAL NOTES

ALL SIGNING FOR THIS PROJECT WILL BE ACCOMPLISHED ON FUTURE PROJECTS.

DEPTH OF MOISTURE-DENSITY CONTROL FOR THIS PROJECT SHALL BE AS FOLLOWS:

FULL DEPTH OF ALL EMBANKMENTS

COMPACTION FOR THIS PROJECT SHALL BE AASHTO T 180.

FOR PRELIMINARY PLAN QUANTITIES OF BITUMINOUS MATERIALS, THE FOLLOWING RATES OF APPLICATION WERE USED:

PRIME COAT MC-70 @ ~~0.40~~ ²⁰ GALS. PER SQ. YD.
TACK COAT CCS-1 @ 0.05 GALS. PER SQ. YD.

DILUTED EMULSIFIED ASPHALT FOR TACK COAT SHALL CONSIST OF ONE PART EMULSIFIED ASPHALT AND ONE PART WATER.

RATES OF APPLICATION SHALL BE AS DETERMINED BY THE ENGINEER AT THE TIME OF APPLICATION.

ANY LAYER OF BITUMINOUS PAVEMENT THAT IS TO HAVE A SUCCEEDING LAYER PLACED THEREON SHALL BE COMPLETED FULL WIDTH BEFORE SUCCEEDING LAYER IS PLACED. THE FOLLOWING SHALL BE FURNISHED WITH EACH BITUMINOUS PAYER:

1. A SKI TYPE DEVICE AT LEAST 30 FEET IN LENGTH.
2. AT LEAST 5,000 FEET OF CONTROL LINE AND STAKES.

THE MINIMUM THICKNESS OF TOPSOIL SHALL BE FOUR INCHES. IT IS ESTIMATED 4,900 CU. YDS. WILL BE REQUIRED AND WILL BE OBTAINED FROM STOCKPILES LEFT OF STATION 949+ & 843+.

SEEDING, SOIL PREPARATION, FERTILIZING WITH COMMERCIAL FERTILIZER, AND MULCHING FOR APPROXIMATELY 10 ACRES WILL BE REQUIRED WITHIN RIGHT OF WAY LIMITS ON ALL AREAS NOT SURFACED. THE FOLLOWING TYPES AND RATES SHALL BE USED:

COMMON NAME	BOTANICAL NAME	PER CENT PURITY	PER CENT GERMINATION	RATE PLS/ACRE
STREAMBANK WHEATGRASS	AGROPYRON RIPARIUM	97	92	7
WESTERN WHEATGRASS	AGROPYRON SMITHII	85	70	4
KENTUCKY BLUEGRASS	POA PRATENSIS	85	75	3
SMOOTH BROME (MANCHAR)	BROMUS INERMIS	85	80	5
TIMOTHY	PHLEUM PRATENSE	99	90	4
RED FESCUE	FESTUCA RUBRA	98	85	3
MEADOW FOXTAIL	ALOPECURUS PRATENSIS	95	80	4
SLENDER WHEATGRASS	AGROPYRON PAUCIFLORUM	90	85	5
WHITE DUTCH CLOVER	TRIFOLIUM REPENS	98-1/2	90	2
ALSIKE CLOVER	TRIFOLIUM HYBRIDUM	98-1/2	90	3
TOTAL PLS/ACRE SEEDING				40

COMMERCIAL FERTILIZER (FOR SEEDING)	PER CENT AVAILABLE	LBS/ACRE AVAILABLE NITROGEN	LBS/ACRE AVAILABLE SUPERPHOSPHATE	RATE LBS/ACRE
AVAILABLE NITROGEN (18-0-0)	18	50		278
AVAILABLE SUPERPHOSPHATE (0-45-0)	45		100	222
TOTAL LBS/ACRE FERTILIZER				500

MULCHING (STRAW) 2 TONS PER ACRE

CLASS "AX" CONCRETE WILL BE PERMITTED ON THIS PROJECT IN LIEU OF CLASS "A".

IT IS ESTIMATED THAT ~~3,000~~ ¹³⁶⁹ HOURS OF FLAGGING FOR CONTROLLING TRAFFIC WILL BE REQUIRED FOR THIS PROJECT.

FLEXIBLE CONDUITS ON THIS PROJECT WITH HELICAL CORRUGATIONS, JOINED BY DIMPLED CONNECTING BANDS, SHALL USE A SEALING COMPOUND OR GASKET MEETING FEDERAL SPECIFICATIONS SS-5-00210 WITH THE CONNECTING BAND.

SOD WILL BE REQUIRED ON ALL SLOPES 2:1 OR STEEPER OR AS DESIGNATED BY THE ENGINEER. IT IS ESTIMATED THAT ~~7,000~~ ^{9,327} SQ. FT. OF SOD WILL BE REQUIRED.

IT IS ESTIMATED THAT THE FOLLOWING WILL BE REQUIRED FOR SHAPING EXISTING ROADBED AND EROSION CONTROL.

ITEM	HOURS
BLADING	50 20.5
COMBINATION LOADER	50 47

(R-1) 5-24-76, Quantities, WCB
STRUCTURE QUANTITIES

AS CONSTRUCTED
NO REVISIONS REVISED 1-31-78 VOID

FEDERAL ROAD REGION NO.	DIVISION	PROJECT NO.	SHEET NO.
VIII	COLORADO	I 70-2(57)197	6

INDEX			LOCATION	UNCLASSIFIED EXCAVATION CUBIC YARD			STRUCTURE EXCAVATION	STRUCTURE BACKFILL	REMOVAL OF STRUCTURE	AGGREGATE BASE COURSE SURFACING	HOT BITUMINOUS PAVEMENT	INLET TYPE 13 (5 FOOT)	18 SLOTTED PIPE INLET	(R-1) CONCRETE INLET	(R-1) REBAR	CORRUGATED STEEL PIPE LINEAR FEET				"H" OVER CULV.	GROUTED SLOPE AND DITCH PAVING	STEEL END SECTIONS EACH	MISCELLANEOUS
BOOK	PAGE	SHEET		EXCAV.	EMB.	DITCH	CUBIC YARD	CUBIC YARD	EACH	TON	TON	EACH	"H"	LN. FT.	LN. FT.	CU. YD.	18"	72"	FT.	CUBIC YARD	18"		
1	8		850+18.50			3	4						10						1			1	
1	10		862+62			18	15					1	30'						2			1	
1	12		863+90.42			5	6						10						1			1	
1	14		907+14.48			4	4						10						1			1	
1	16		912+94			39	32					1										1	
1	18		915+87			37	31					1	30'						2			1	
1	20		927+82.33			5	6						10						1			1	
1	24		986+48.10			5	6						10						1			1	
1	26		989+13			13	11					1										1	
1	28		1015+82			64	37					1	30'						2			1	
(R-1)			Pit Structure Requirements Deleted			90	130												1				1 - Removal of Structure
(R-1)			TOTALS			231 193	237 152					4 5	50						308 429		148 Deleted	8 10	

* Includes Elbow

(R-1)
(R-1)

FEDERAL ROAD REGION NO.	DIVISION	PROJ. NO.	SHEET NO.	TOTAL SHEETS
VIII	COLORADO	I 70-2(57)197	7	33
AS CONSTRUCTED				
NO REVISIONS		REVISED	1-31-78	VOID

Book No 1 Page 29
DELINEATORS

STATION	SIDE	SPACING	TYPE I		TYPE II		TYPE I BARRIER		TYPE III BARRIER	
			EACH		EACH		EACH		EACH	
<i>Main Line (E.D.)</i>										
838+00 - 845+50	Rt.	Accel.			8					
838+00 - 845+50	Lt.	1°15'	6							
845+50 - 858+44.17	Both	1°00'	14	10						
860+26.5	Both	Bridge						2	2	
862+99.42 - 880+80.00	Both	2°00'	26	14						
880+80.00 - 895+81.21	Both	3°00'	18	10						
895+81.21 - 907+70.48	Both	Tangent	3	4			1	0		
907+70.48 - 926+45.00	Both	3°30'	18	10			6	0		
913+14.48	Both	Bridge							2	2
926+45.00 - 941+45.97	Both	1°30'	20	30						
943+28.5	Both	Bridge							2	2
947+95.00 - 972+50.40	Both	1°00'	30	20						
972+50.40 - 986+56.24	Both	1°00'	14							
989+22.00	Both	Bridge							2	2
994+06.55 - 1007+75.43	Both	1°00'	20	16						
1009+16.14	Both	Bridge							2	2
TOTALS			169*	134	8	8	7	4	10	10

* Includes 84 Amber Type I for Median Side.
 † Includes 7 Amber Type I Barrier for Median Side. (Future Const.)
 ● Includes 5 Amber Type III Barrier for Median Side.

Delineators to be placed 6' from shoulder.

Book No 3 Page 5
WATERPROOFING (MEMBRANE)

STATION	STR No.	WATERPROOFING (MEMBRANE)	
		SQ YD.	Final
860+26.5	F-12-AK	950	931
913+08.75	F-12-AM	447	164
943+28.5	F-12-AN	1634	1634
989+22	F-12-AO	1819	181
1009+16.14	F-12-AP	2711	2711
TOTAL		8261	8121

Book 3 Page 11
GUARD RAIL

STATION	SIDE	GUARD RAIL TYPE 4		"W" FEET
		LINE FT	Final	
*858+68.5 to 860+20.5 ^Δ	Lt & Rt	304	304	4
Δ862+59.5 to 862+71.5*	Lt & Rt	24	24	
876+50 to 899+54	Lt.	(Future)		
897+26 to 901+50	Lt.	(Future)		
*911+46.75 to 912+98.75 ^Δ	Lt	152	152	4
*911+42.75 to 912+94.75 ^Δ	Rt	152	152	4
Δ915+85.25 to 921+47.25*	Lt	12	12	
Δ915+90.25 to 916+02.25*	Rt	12	12	
*941+63.6 to 943+24.5 ^Δ	Lt. & Rt.	304	304	4
Δ947+09.2 to 947+21.2*	Rt	12	12	
Δ947+16.6 to 947+28.6*	Lt	12	12	
955+50 to 967+56	Lt.	(Future)		
*987+66 to 989+18 ^Δ	Lt. & Rt.	304	304	4
Δ993+306 to 993+426*	Rt	12	12	
Δ993+381 to 993+501*	Lt	12	12	
*1007+48.0 to 1009+00.0 ^Δ	Lt	152	152	4
*1007+56.0 to 1009+08.0 ^Δ	Rt	152	152	4
TOTAL		1,616	1,616	

* Includes 12' Transition Section

Δ Connect to Bridge Rail

■ 72 Foot Flare on Approach End

● (Precast - Portable) (Colored)

(R-1) 5-24-76, Quantities & Source, WCB



FEDERAL ROAD REGION NO.	DIVISION	PROJ. NO.	SHEET NO.	TOTAL SHEETS
VIII	COLORADO	I 70-2(57) 197	8	33
AS CONSTRUCTED				
NO REVISIONS		REVISED 1-31-78	VOID	

(R-1) SURFACING PLAN

STATION	SOURCE	QUANTITY - TONS								HAUL - TON MILE			
		BASE COURSE		SURFACE COURSE - HOT BITUMINOUS PAVEMENT				BASE COURSE		SURFACE COURSE - HOT BITUMINOUS PAVEMENT			
		PLANT MIX BIT BASE CL 6		BOTTOM LAYER G.R.E.	MIDDLE LAYER G.R.E.	TOP LAYER G.R.E.		CL 6		BOTTOM LAYER	MIDDLE LAYER	TOP LAYER	
*838+00 to 845+50		803		397	294	294		4,438		2,192	1,625	1,625	
845+50 to 860+26.50		1,359		665	502	502		7,795		3,814	2,879	2,879	
STR NO F-12-AK 862+53.50 to 878+22.62		1,443		102	706	533	533	7,473		545	3,657	2,760	
878+34.33 to 913+08.75		3,196		1,564	1,182	1,182		17,129		8,382	6,335	6,335	
STR NO F-12-AM				122						495			
915+81.25 to 942+63.44	U.S. FOREST SERVICE PIT - STOCKPILE NO. 1	2,467		1,207	912	912		9,306		4,553	3,441	3,441	
942+72.35 to 943+28.50		52		25	19	19		183		88	67	67	
STR NO. F-12-AN 947+11.50 to 959+00		1,094		172	535	404	404		4,089		2,000	1,510	1,510
959+00 to 965+99.76		639		313	237	237	237		2,359		1,155	875	875
966+07.10 to 989+22.0		2,130		1,042	787	787		8,469		4,143	3,129	3,129	
STR NO. F-12-AO 993+33.0 to 1009+16.14		1,457		185	713	539	539	6,709		784	3,282	2,482	
STR NO. F-12-AP 1015+58.14 (End Project)				289						612			
▲ Widening for Guard Rail Est for Irregularities		353		177	118	118							
ROADWAY TOTALS		17,241		7,344	5,527	5,527		78,143		33,267	25,103	25,103	
PROJECT TOTALS		17,241		8,214	5,527	5,527		78,143		36,313	25,103	25,103	

* Includes "A" Lane
 ▲ See Guard Rail Tabulation for Locations
 Note: Stabilization Based On:
 1. E.D.L.A. 18 Kip: 185
 2. Regional Factor: 3.0
 3. Serviceability Index: 2.5
 4. Subgrade R Value: 51 to 76
 Strength Coefficients:
 5. Hot Bituminous Pavement: 0.44
 6. Plant Mix Bituminous Base: 0.34
 7. Future Seal Coat: 0.25

Project Totals	Plan	Final
Base Course, Plant Mix Bit Base, Cl 6 =	17,300	18,198.70
Hot Bituminous Pavement, Gr. E =	19,300	21,334.40
Haul, Ton Mile =	164,700	145,294

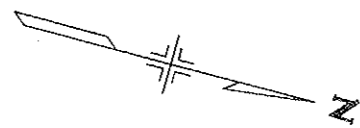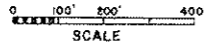


U.S. FOREST SERVICE PIT
 (WHEELER FLATS)

FEDERAL ROAD REGION NO.	DIVISION	PROJ. NO.	SHEET NO.	TOTAL SHEETS
VIII	COLORADO	170-2(57)197	9	33

AS CONSTRUCTED				
NO REVISIONS	REVISED	VOID	7-31-78	

(R-1) 5-24-76 New Sheet, WCB

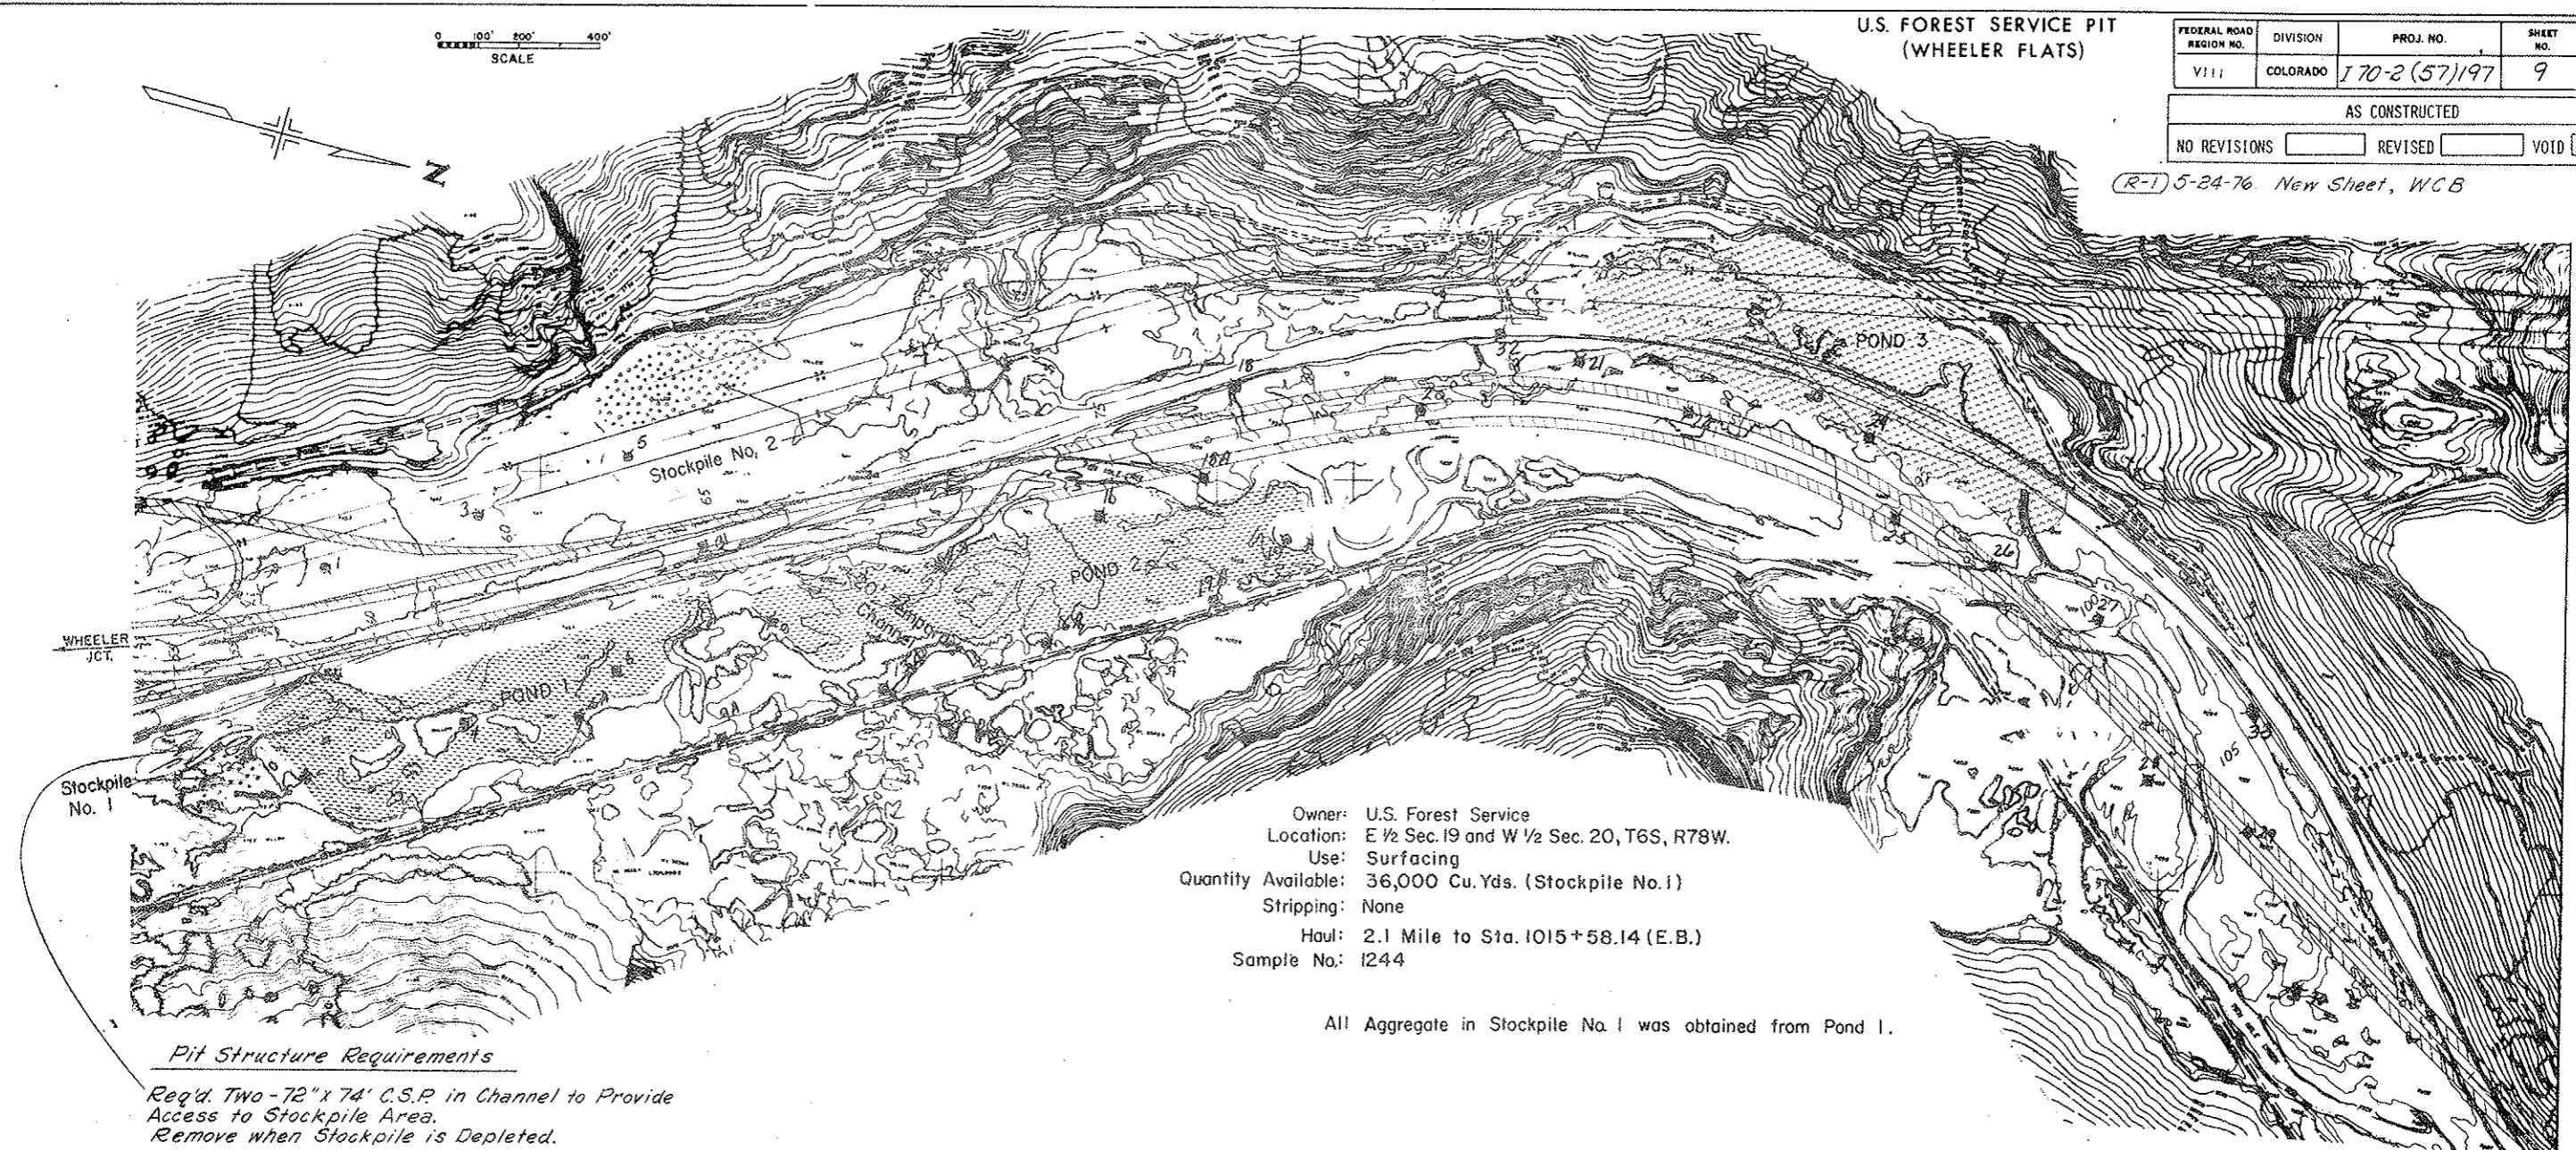


Owner: U.S. Forest Service
 Location: E 1/2 Sec. 19 and W 1/2 Sec. 20, T6S, R78W.
 Use: Surfacing
 Quantity Available: 36,000 Cu. Yds. (Stockpile No. 1)
 Stripping: None
 Haul: 2.1 Mile to Sta. 1015+58.14 (E.B.)
 Sample No.: 1244

All Aggregate in Stockpile No. 1 was obtained from Pond 1.

Pit Structure Requirements

Req'd. Two - 72" x 74' C.S.P. in Channel to Provide Access to Stockpile Area.
 Remove when Stockpile is Depleted.

PIT LOG

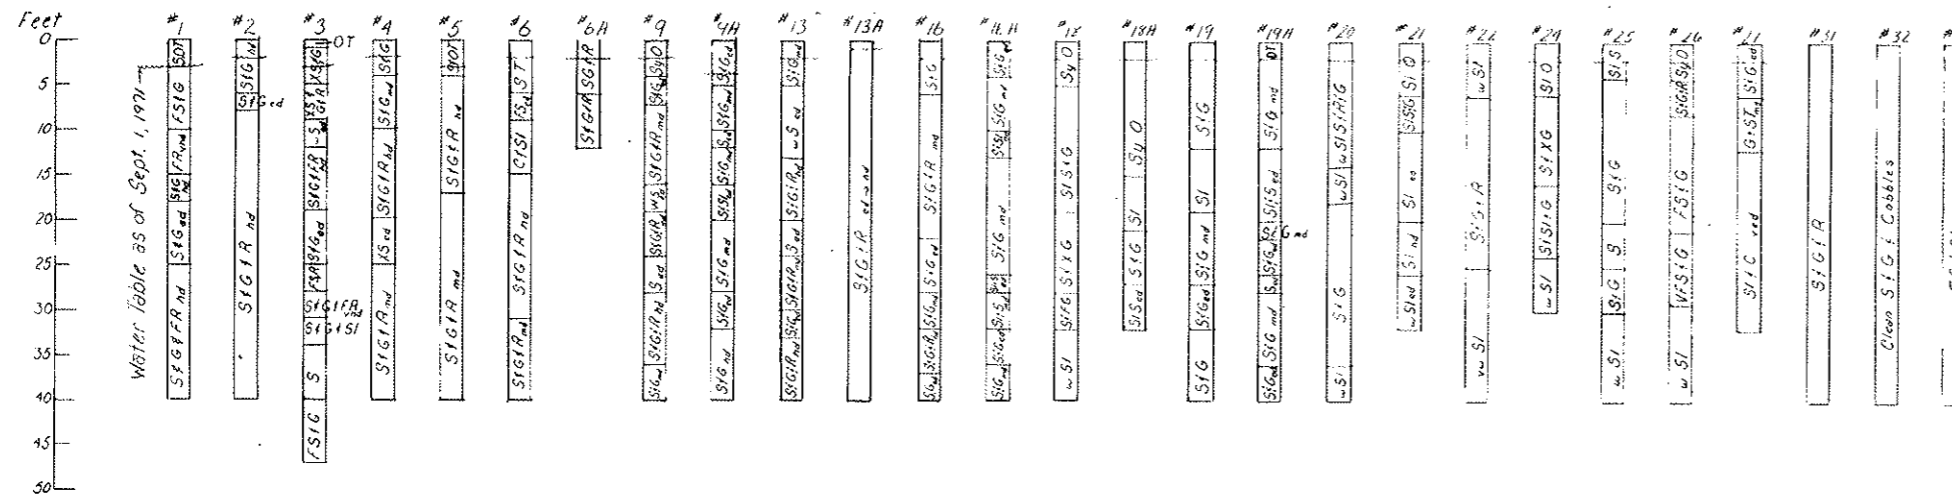

LEGEND


- Surfacing Pit
- Borrow Pit
- Sy0 - - - - Sandy Overburden
- Si0 - - - - Silty Overburden
- OT - - - - Organic Topsoil
- ST - - - - Sand Tailings
- S&G - - - - Sand & Gravel
- R - - - - Rock
- FR - - - - Fractured Rock
- S - - - - Sand
- Sl - - - - Silt
- FS - - - - Fine Sand
- XS - - - - Course Sand
- C - - - - Clay
- SIS - - - - Silty Sand
- ed - - - - Easy Drill
- md - - - - Medium Drill
- hd - - - - Hard Drill
- vhd - - - - Very Hard Drill
- w - - - - Wet
- vw - - - - Very Wet
- - - - Water Table

DETAILS OF SLOTTED PIPE INLET

FEDERAL ROAD REGION NO.	DIVISION	PROJ. NO.	SHEET NO.	TOTAL SHEETS
VIII	COLORADO	I 70-2(57) 197	12	33

AS CONSTRUCTED


NO REVISIONS 1-31-78 REVISED VOID

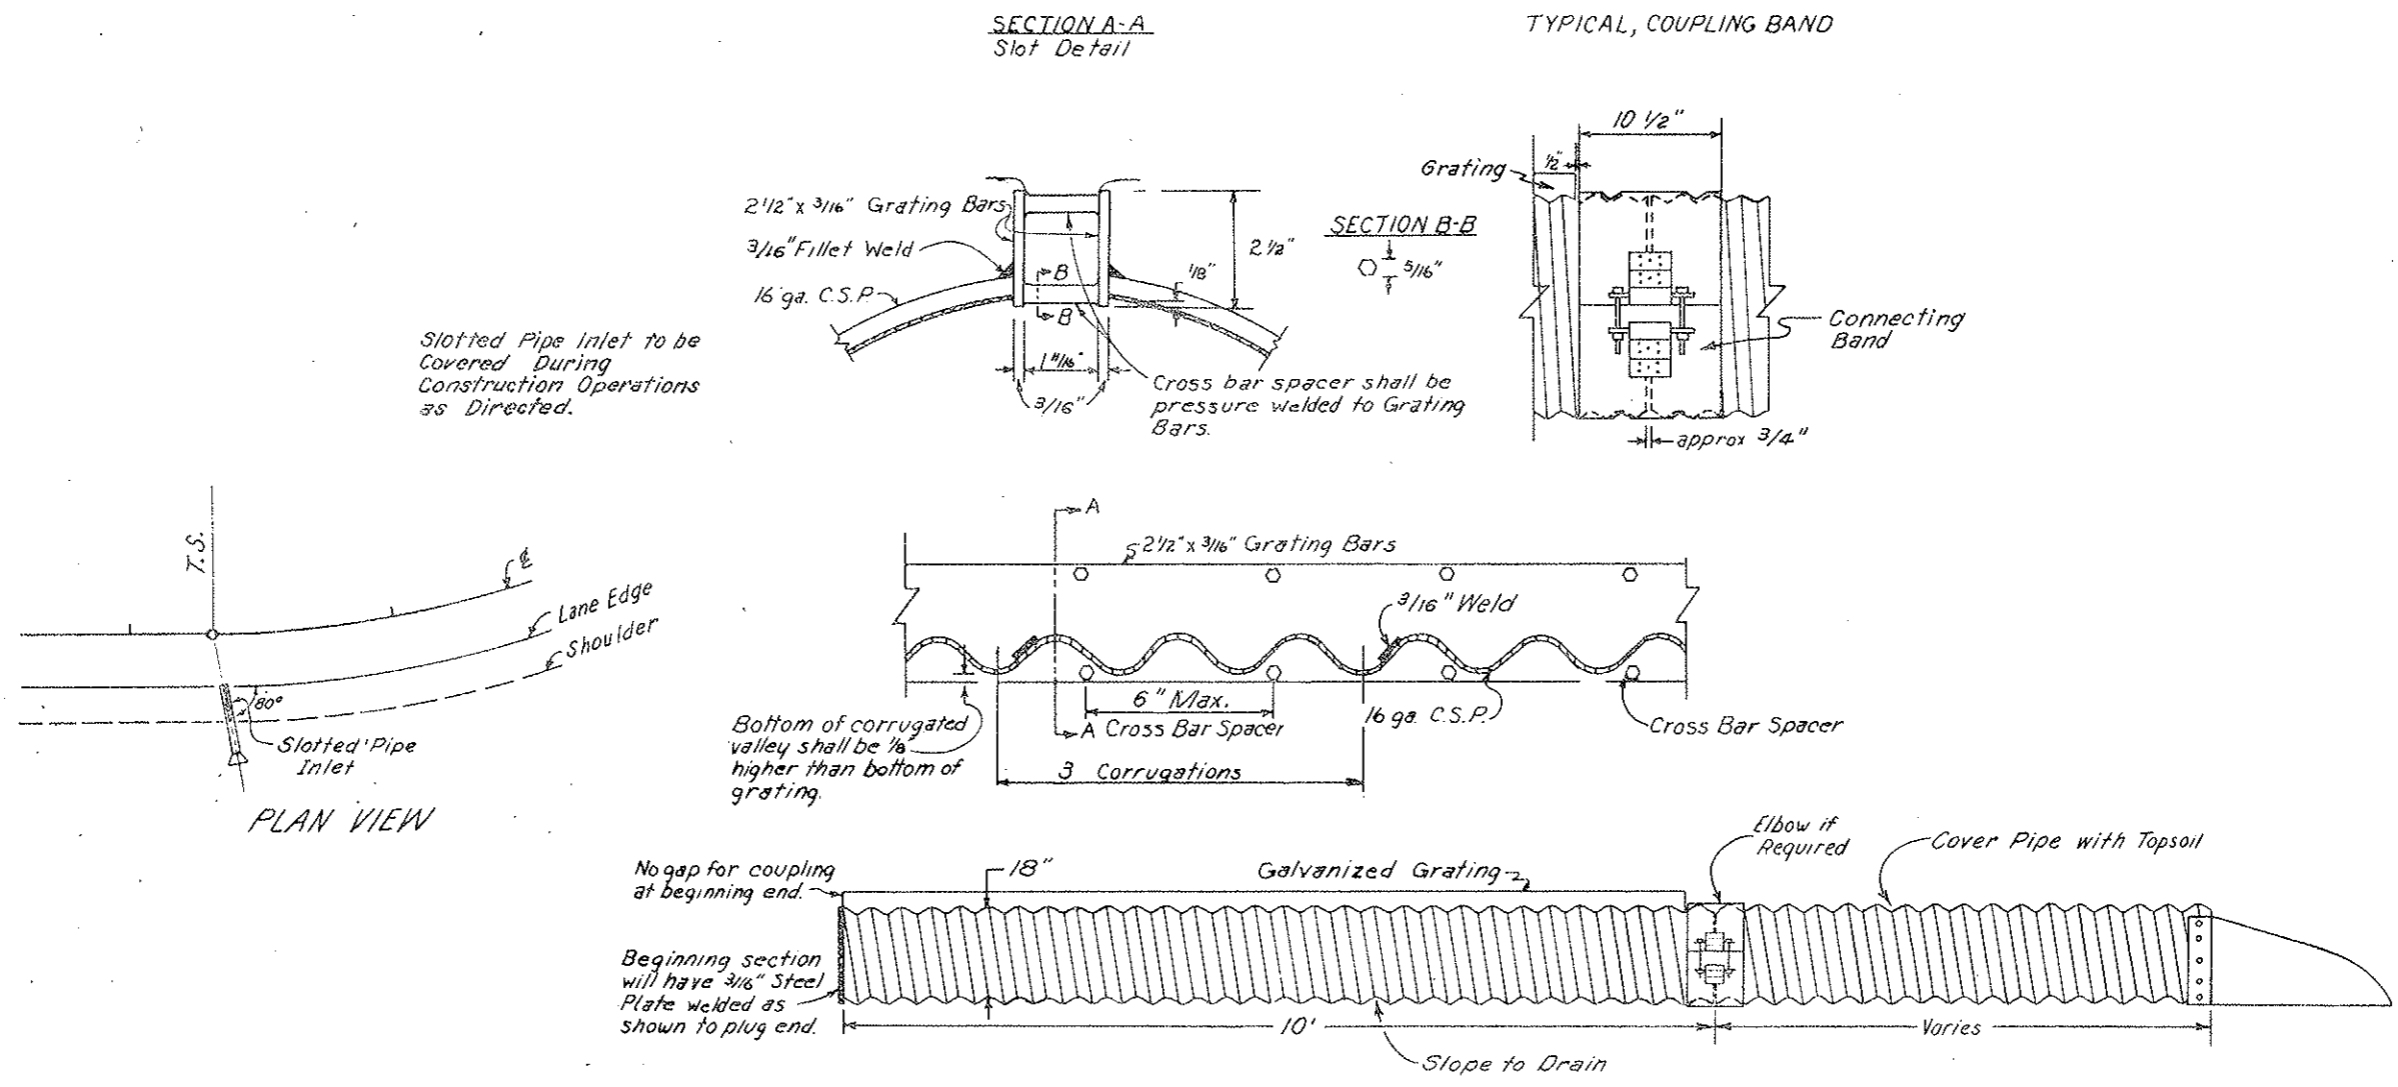

Slotted Pipe Inlet to be Covered During Construction Operations as Directed.

FEDERAL ROAD REGION NO.	DIVISION	PROJ. NO.	SHEET NO.	TOTAL SHEETS
VIII	COLORADO	I 70-2(57)197	13	33
AS CONSTRUCTED				
NO REVISIONS		1-31-78	REVISED	VOID
(R-1) 5-24-76, Deleted Officer Gulch Dam, WCB				

DETAIL OF
 CONCRETE BARRIER DELINEATOR

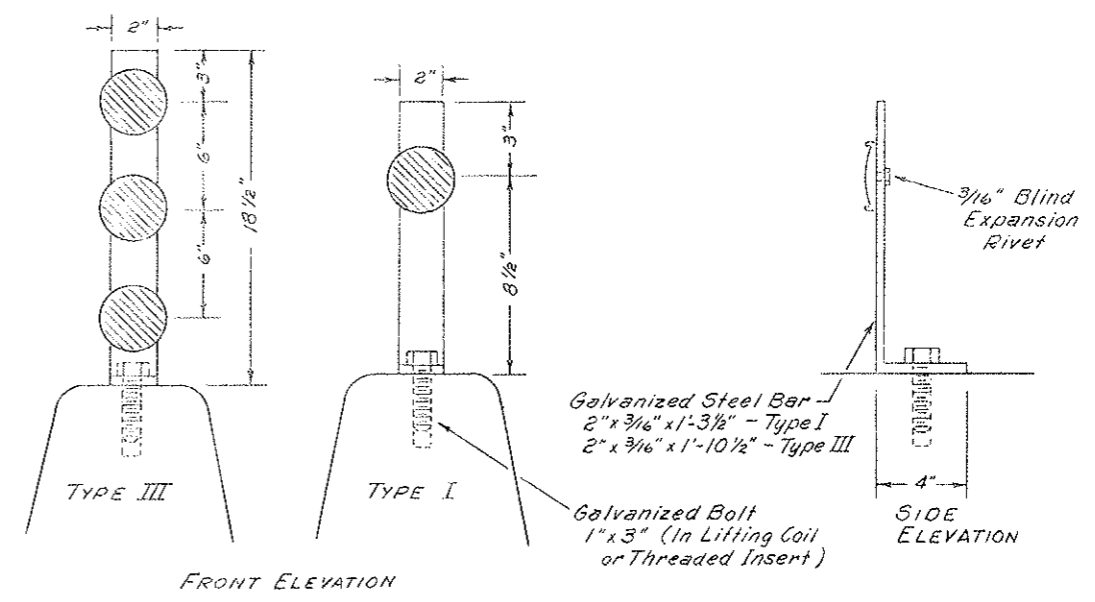








For further information see Standard
 S-612-51A and Guard Rail Details

STANDARD M-606-EA

(PROPOSED APRIL, 1976) (SPECIAL THIS PROJECT)

FEDERAL ROAD REGION NO.	DIVISION	PROJ. NO.	SHEET NO.	TOTAL SHEETS
VIII	COLORADO	170-2(57)197	14	33

REVISIONS		
(R-1)	5-24-76, Dimensions	WCB

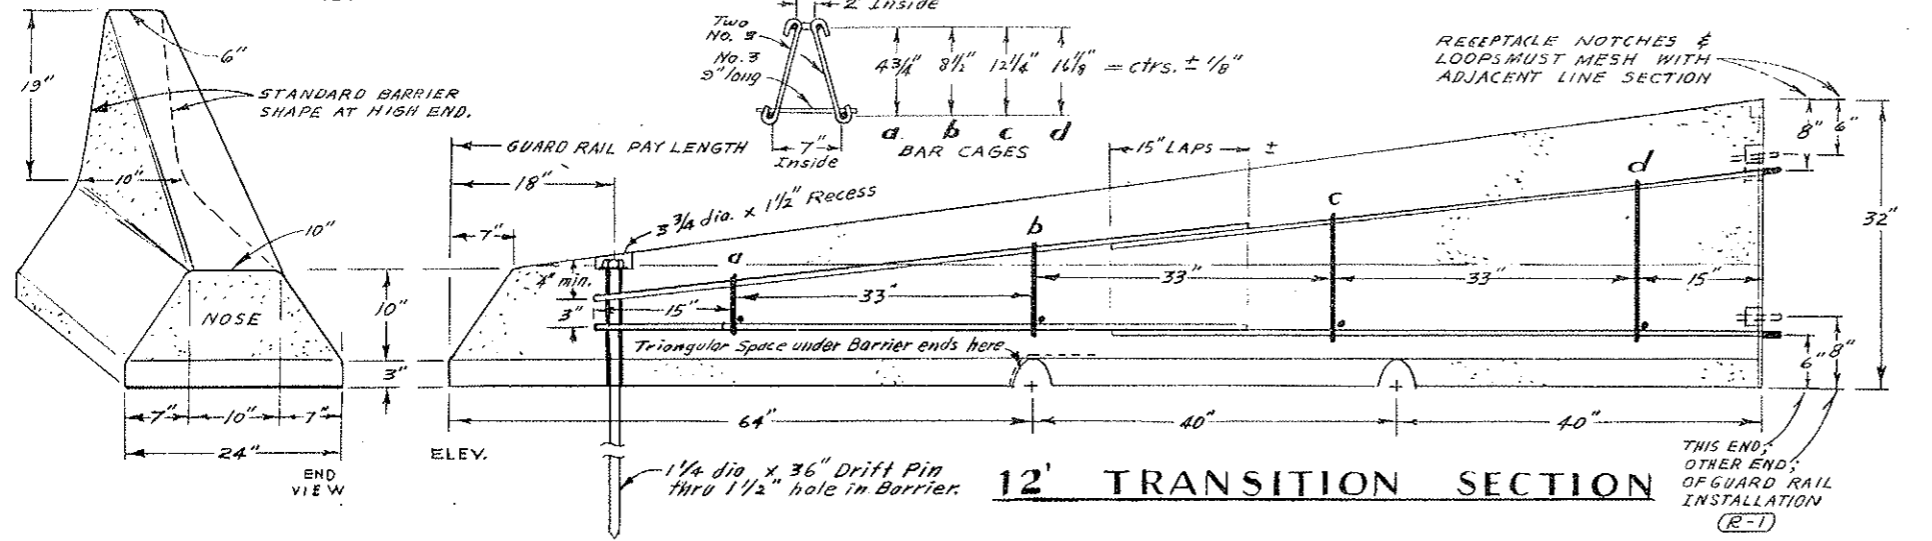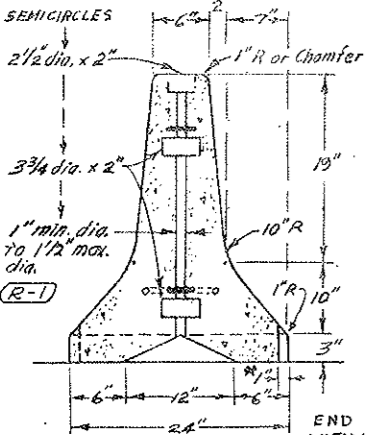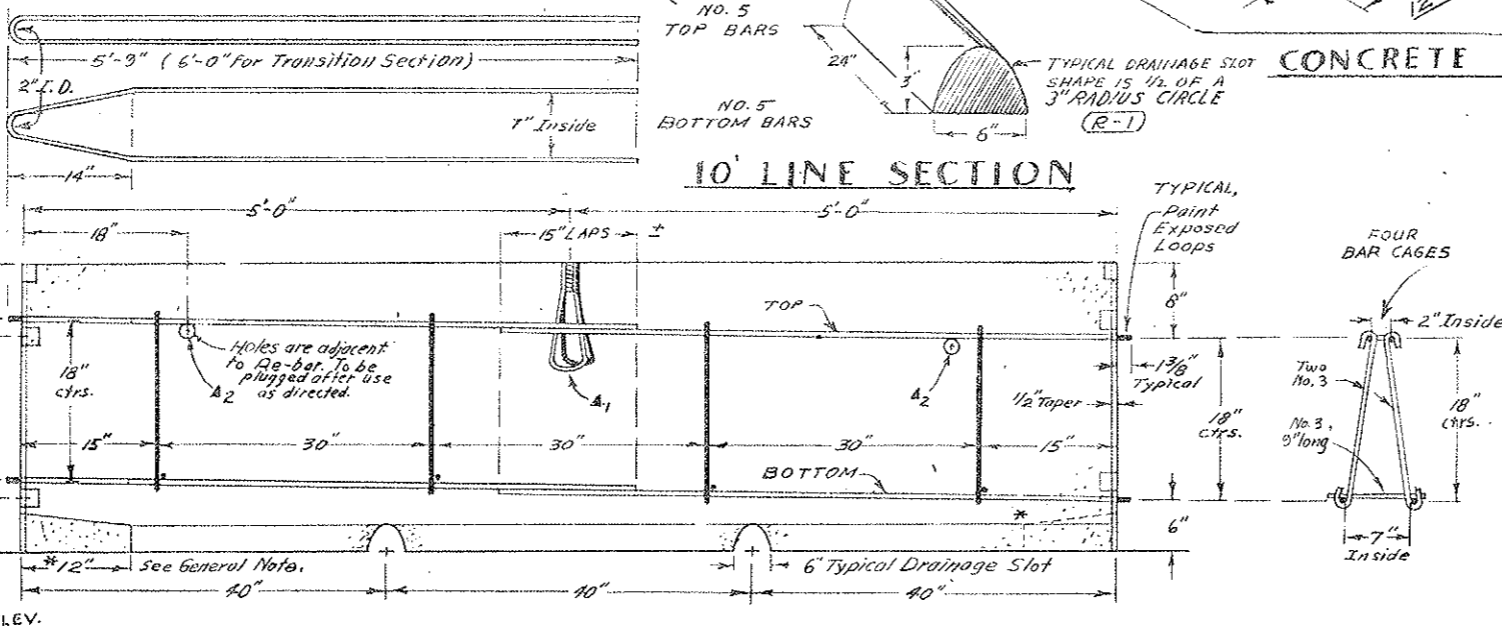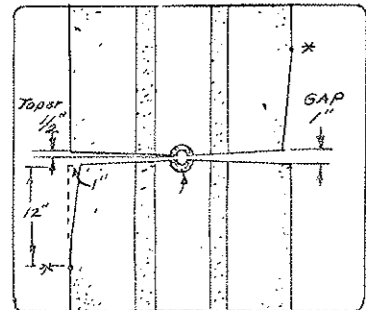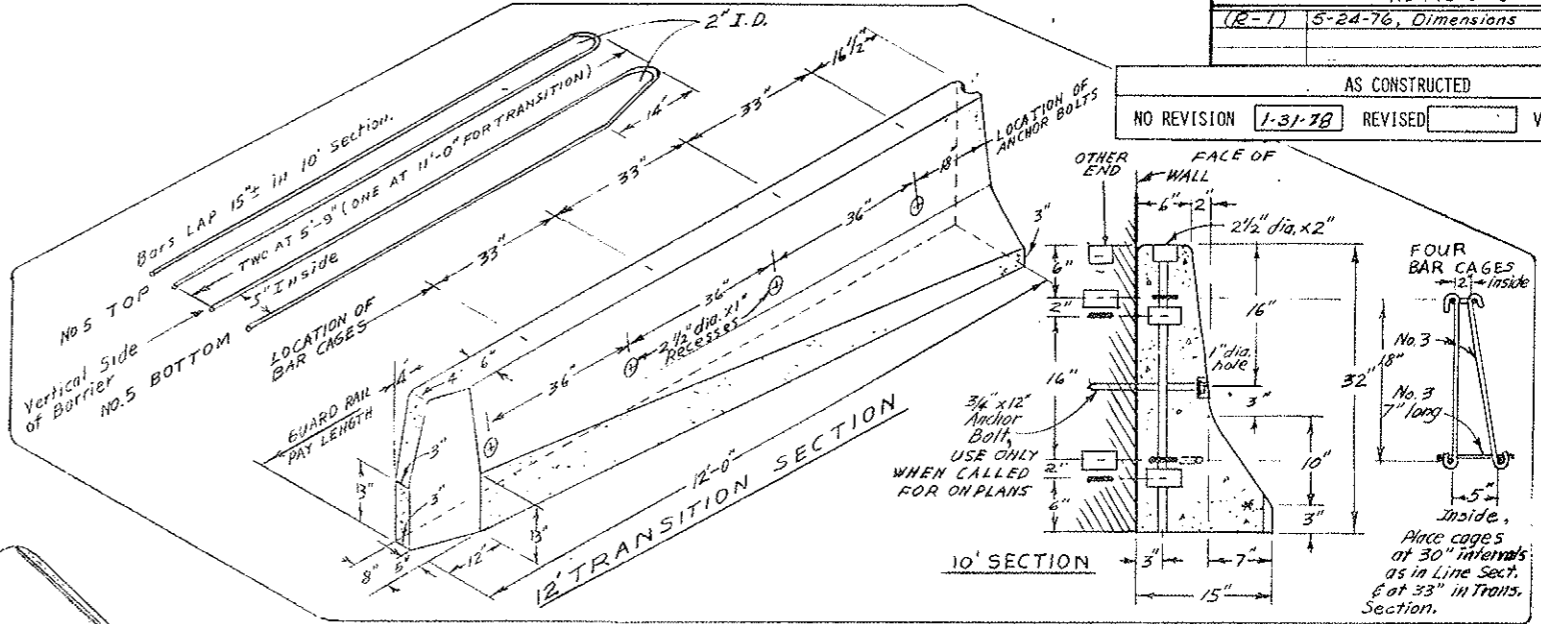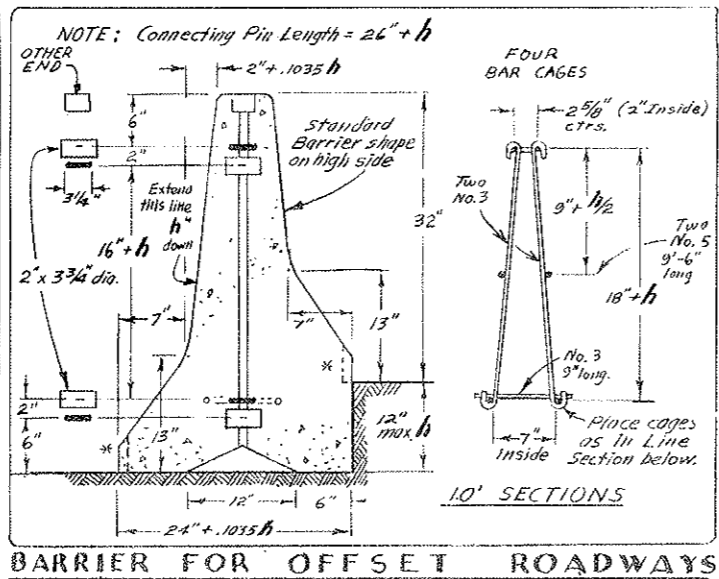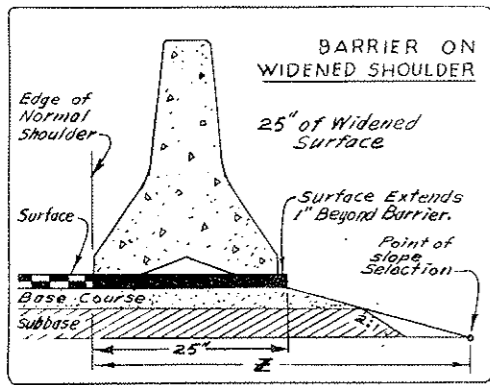

GENERAL NOTES

All work shall be done in accordance with the Standard Specifications applicable to the project.

Concrete shall be Class A, B or D.

All exposed loops shall be thoroughly cleaned and painted in accordance with Section 509.

Drainage Slots may be omitted on: median installations with inlet drainage; shoulder barrier on high outside superelevated shoulders; and median barrier on curves except on vertical sag.

Existing asphaltic surface shall be patched along the barrier foundation.



Nuts, washers, lifting hardware, connecting pins, drift pins and anchor bolts shall be galvanized.

Where transition is required (see "h" in offset roadways), cast-in-place barrier shall be constructed, complete with matching reinforcement and hardware, to abut precast barrier.

* Taper shall be 1"x12" at traffic approach corners of section to eliminate snagging of plow blade.

⊕1 OPTIONAL: 1"x12" Lifting Coil with double flared loops. (safe working load, 8000 lbs.)

⊕2 OPTIONAL: Holes through Barrier for lifting by Rods and Yoke.

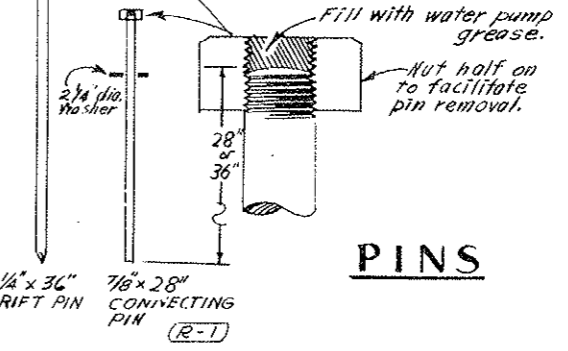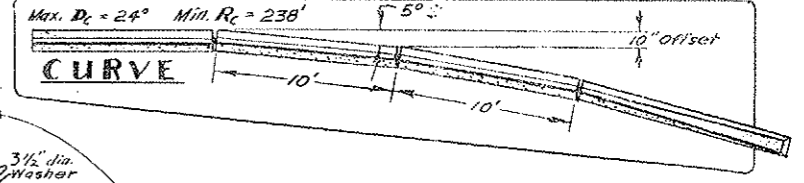

DEPARTMENT OF HIGHWAYS
 STATE OF COLORADO
 DIVISION OF HIGHWAYS

**GUARD RAIL - TYPE 4
 PRECAST - PORTABLE
 CONCRETE**

Designed by TAL
 Made by JRB
 Checked by RJH

Approved by
 Staff Design Engineer
 Date:

FEDERAL ROAD REGION NO.	DIVISION	PROJ. NO.	SHEET NO.	TOTAL SHEETS
VIII	COLORADO	I 70-2(57)197	15	33

AS CONSTRUCTED

NO REVISIONS 7-31-78 REVISED VOID

LEGEND

- T Topsoil Stockpile
- CE Construction Equipment Area

W. B.
 Δs 34° 09' 00" Lt.
 Ts 833.22' Ts_2 767.36'

Δc 21° 24'
 Dc 3° 00'
 Tc 360.87'
 Lc 713.33'
 Rc 1909.859
 S 0.0781/ft
 MDS 70 mph
 rSD


θ_s 7° 30'
 Ls 500'
 LT_1 333.63'
 ST_1 166.94'

θ_s 5° 15'
 Ls 350'
 LT_2 233.44'
 ST_2 116.76'

E. B.
 Δs 28° 59' 00" Lt.
 Ts 1334.91'

Δc 25° 14'
 Dc 1° 15'
 Tc 1025.97'
 Lc 2018.67'
 Rc 4583.662'
 S 0.0561/ft
 MDS 60 mph
 rSD

θ_s 1° 52' 30"
 Ls 300'
 LT 200.01'
 ST 100.01'

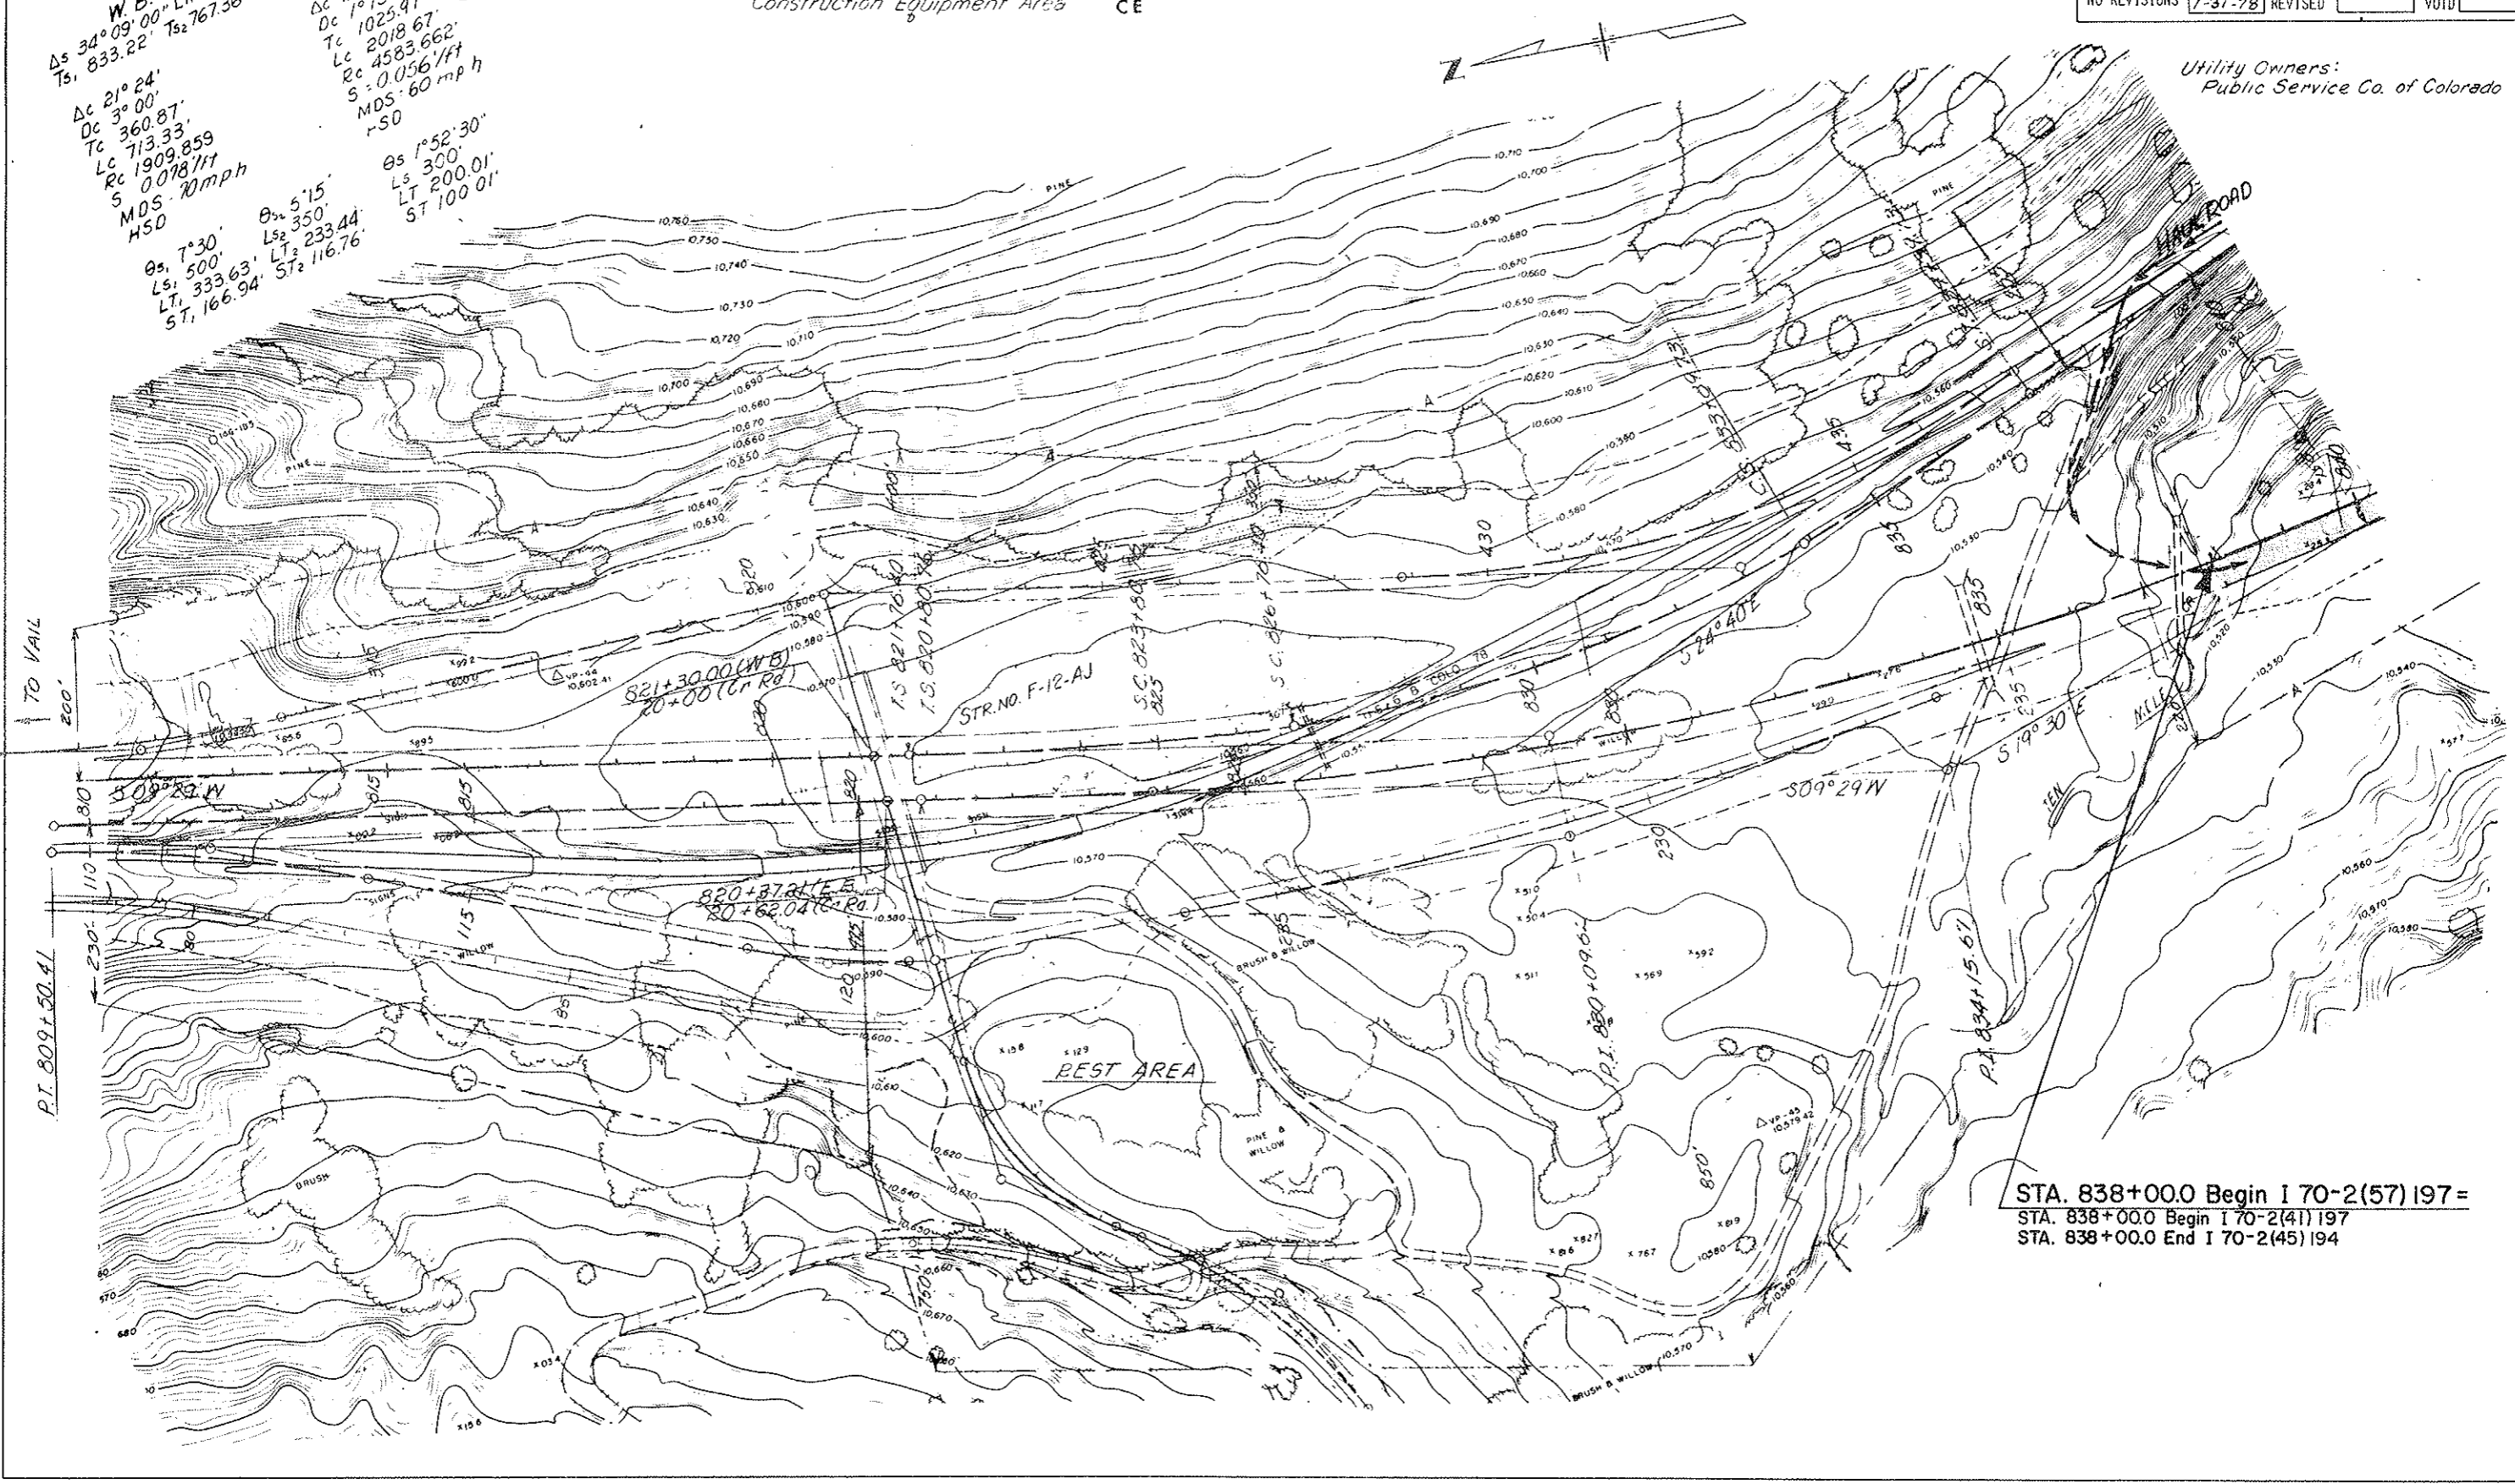

Utility Owners:
 Public Service Co. of Colorado

STA. 838+00.0 Begin I 70-2(57)197 =
 STA. 838+00.0 Begin I 70-2(41)197
 STA. 838+00.0 End I 70-2(45)194

FEDERAL ROAD REGION NO.	DIVISION	PROJ. NO.	SHEET NO.	TOTAL SHEETS
VIII	COLORADO	I 70-2(57)197	16	33

AS CONSTRUCTED
 NO REVISIONS 1-31-78 REVISED _____ VOID _____


TEST NO. 1
 R = 10
 LL = 12
 PL = 2
 26.200 - 112
 R = 68

FINAL SURVEY PLOTTED
 NOTE BOOK AREAS CHECKED

ORIGINAL SURVEY PLOTTED
 NOTE BOOK AREAS CHECKED

SOIL SURVEY OF THE COMPLETED ROADBED
 SAMPLE NOS. C1873, C1935, C1936 & C1061
 PROJECT NO. I 70-2(41)197 DATE: 10-6-75

STA. 838+00 BEGIN I 70-2(57)197
 STA. 838+00 Begin I 70-2(41)197
 STA. 838+00 End I 70-2(43)197A

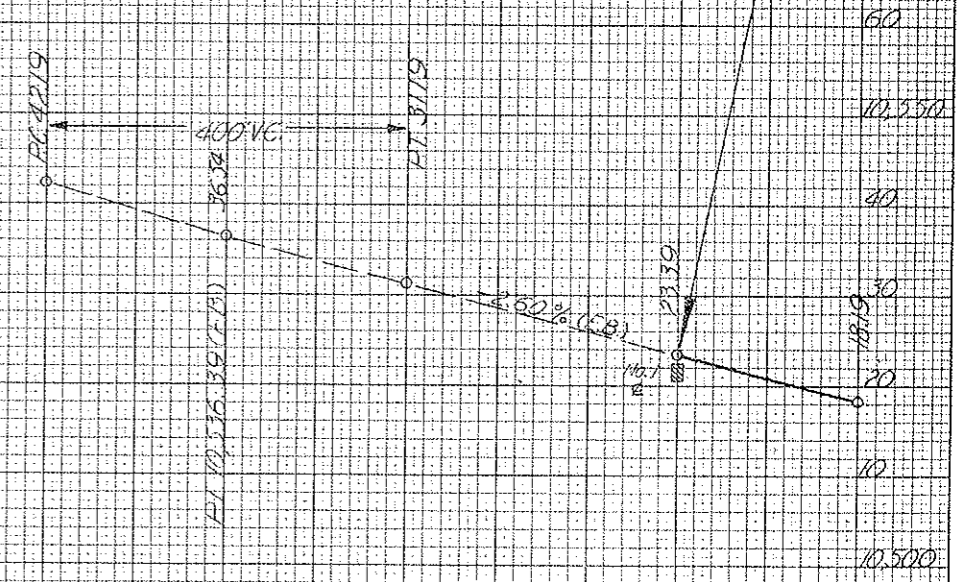


FEDERAL ROAD REGION NO.	DIVISION	PROJ. NO.	SHEET NO.	TOTAL SHEETS
VIII	COLORADO	I 70-E(57)197	17	33

AS CONSTRUCTED

NO REVISIONS REVISED 1-31-78 VOID

W.B. Lanes
 $\Delta_s = 3^{\circ}11' Lt.$
 $T_s = 483.64'$
 $E_s = 45.15'$
 $D_c = 0'30"$
 $T_c = 318.42'$
 $L_c = 636.67'$
 $R_c = 11,459.16'$
 $S = 0.024' / ft.$
 M.D.S. = 80 m.p.h.
 S.S.D. =

W.B. Lanes
 $\Delta_s = 30^{\circ}03' Lt.$
 $T_s = 483.64'$
 $E_s = 45.15'$
 $\theta_s = 8'45"$
 $L_s = 350'$
 $LT = 233.62'$
 $S.T. = 116.93'$
 $\Delta_c = 12^{\circ}33'$
 $D_c = 5'00"$
 $T_c = 126.00'$
 $L_c = 251.00'$
 $R_c = 1145.72'$
 $S = 0.060' / ft.$
 M.D.S. = 60 m.p.h.
 S.S.D. =

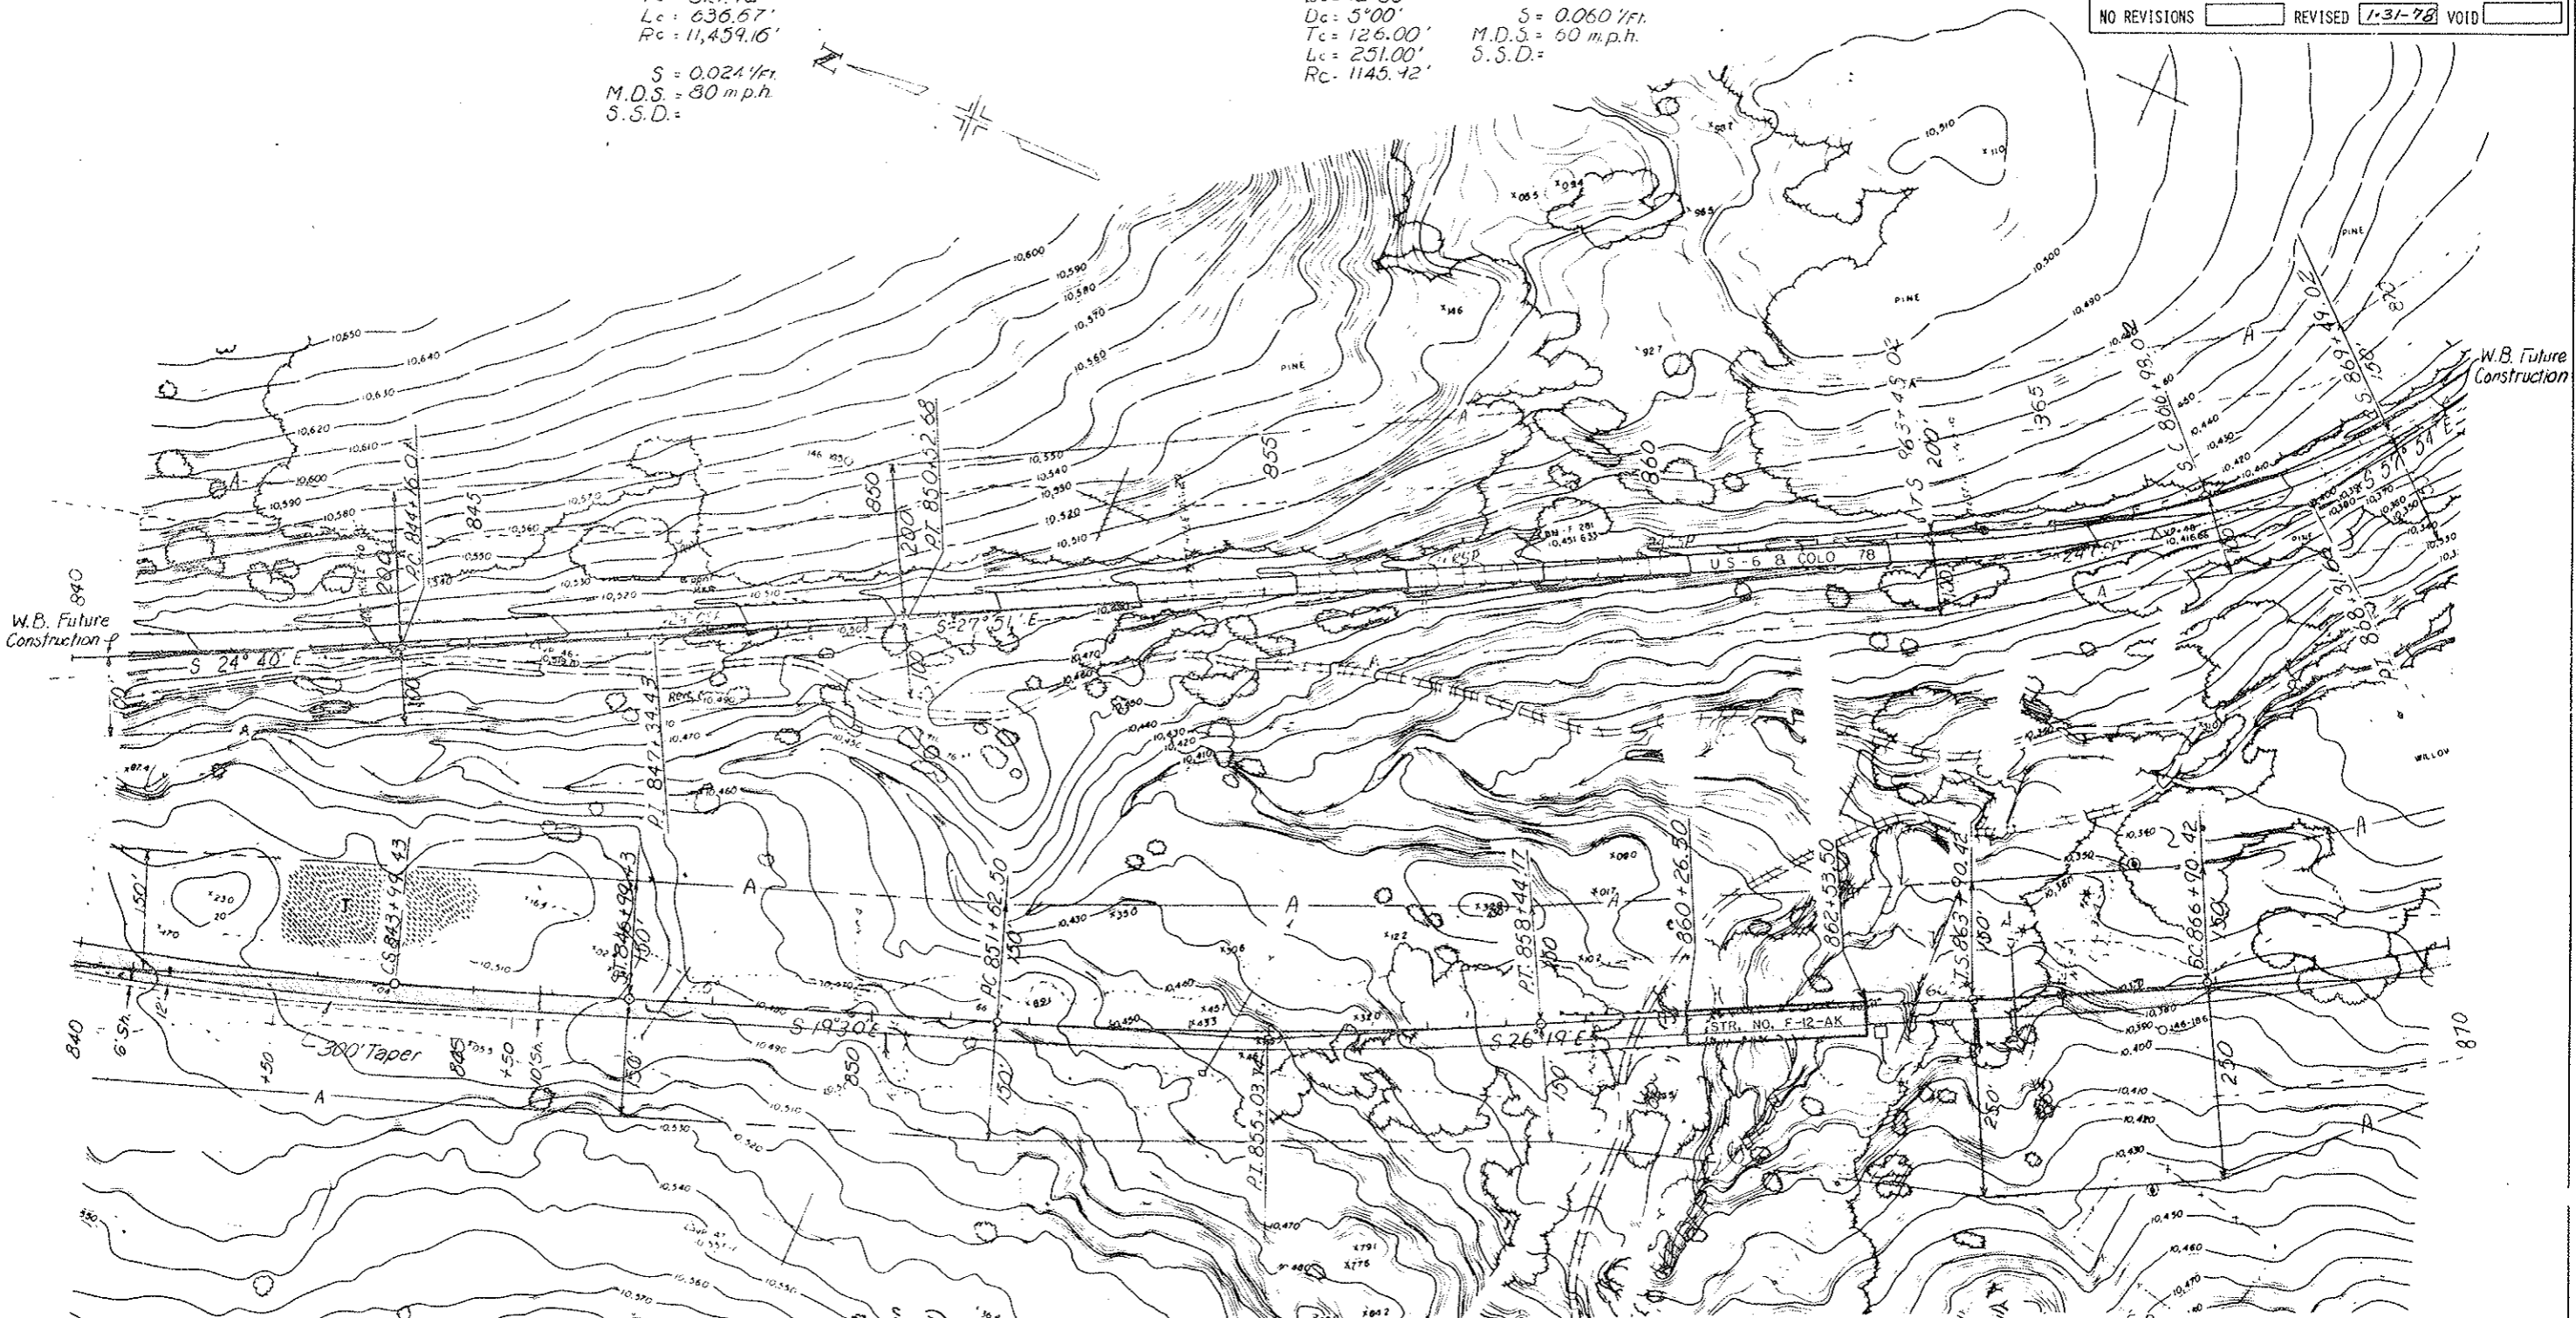

E.B. Lanes
 $\Delta_s = 28^{\circ}59' Lt.$
 $T_s = 134.91'$
 $E_s = 150.60'$
 $\theta_s = 1^{\circ}52'30"$
 $L_s = 300'$
 $LT = 200.01'$
 $S.T. = 100.01'$
 $\Delta_c = 25^{\circ}14'$
 $D_c = 1^{\circ}15'$
 $T_c = 1025.97'$
 $L_c = 2013.67'$
 $R_c = 4583.66'$
 $S = 0.056' / ft.$
 M.D.S. = 80 m.p.h.
 S.S.D. > 600'

850+19.0
 Sta 850+19.0 Reg'd
 18" x 10" Sloped Pipe
 Inlet with 18" x 8"
 C.S.P. with End Section
 RT, Cover Pipe with
 Topsoil Rt. (See Detail)

E.B. Lanes
 $\Delta_s = 6^{\circ}49' Lt.$
 $D_c = 1^{\circ}00"$
 $T_c = 341.24'$
 $E_c = 10.15'$
 $R_c = 5729.58'$
 $S = 0.047' / ft.$
 M.D.S. = 80 m.p.h.
 S.S.D. > 600'

862+65
 Sta 862+65 Reg'd
 Type 13 Inlet (H=30)
 8" x 18" x 42" C.S.P.
 with End Section, Rt.

863+90.42
 Sta 863+90.42 Reg'd
 18" x 10" Sloped Pipe
 Inlet with 18" x 22"
 C.S.P. with End Section
 RT, Cover Pipe with
 Topsoil Rt. (See Detail)

E.B. Lanes
 $\Delta_s = 21^{\circ}41' Lt.$
 $T_s = 698.88'$
 $E_s = 53.45'$
 $\theta_s = 3^{\circ}00"$
 $L_s = 300'$
 $LT = 200.05'$
 $S.T. = 100.03'$
 $\Delta_c = 15^{\circ}41'$
 $D_c = 2^{\circ}00"$
 $T_c = 394.55'$
 $L_c = 784.17'$
 $R_c = 2864.79'$
 $S = 0.065' / ft.$
 M.D.S. = 10 m.p.h.
 S.S.D. > 600'


FINAL SURVEY PLOTTED BY DATE
 NOTE BOOK NO. DATE
 AREAS CHECKED

ORIGINAL SURVEY PLOTTED BY DATE
 NOTE BOOK NO. DATE
 AREAS CHECKED

FEDERAL ROAD REGION NO.	DIVISION	PROJ. NO.	SHEET NO.	TOTAL SHEETS
XIII	COLORADO	170-2(57)197	18	33

TEST NO. 5
 A=2-A(0)
 LL=20
 PL=3
 %200=28
 R=51

AS CONSTRUCTED
 NO REVISIONS 1-31-78 REVISED VOID

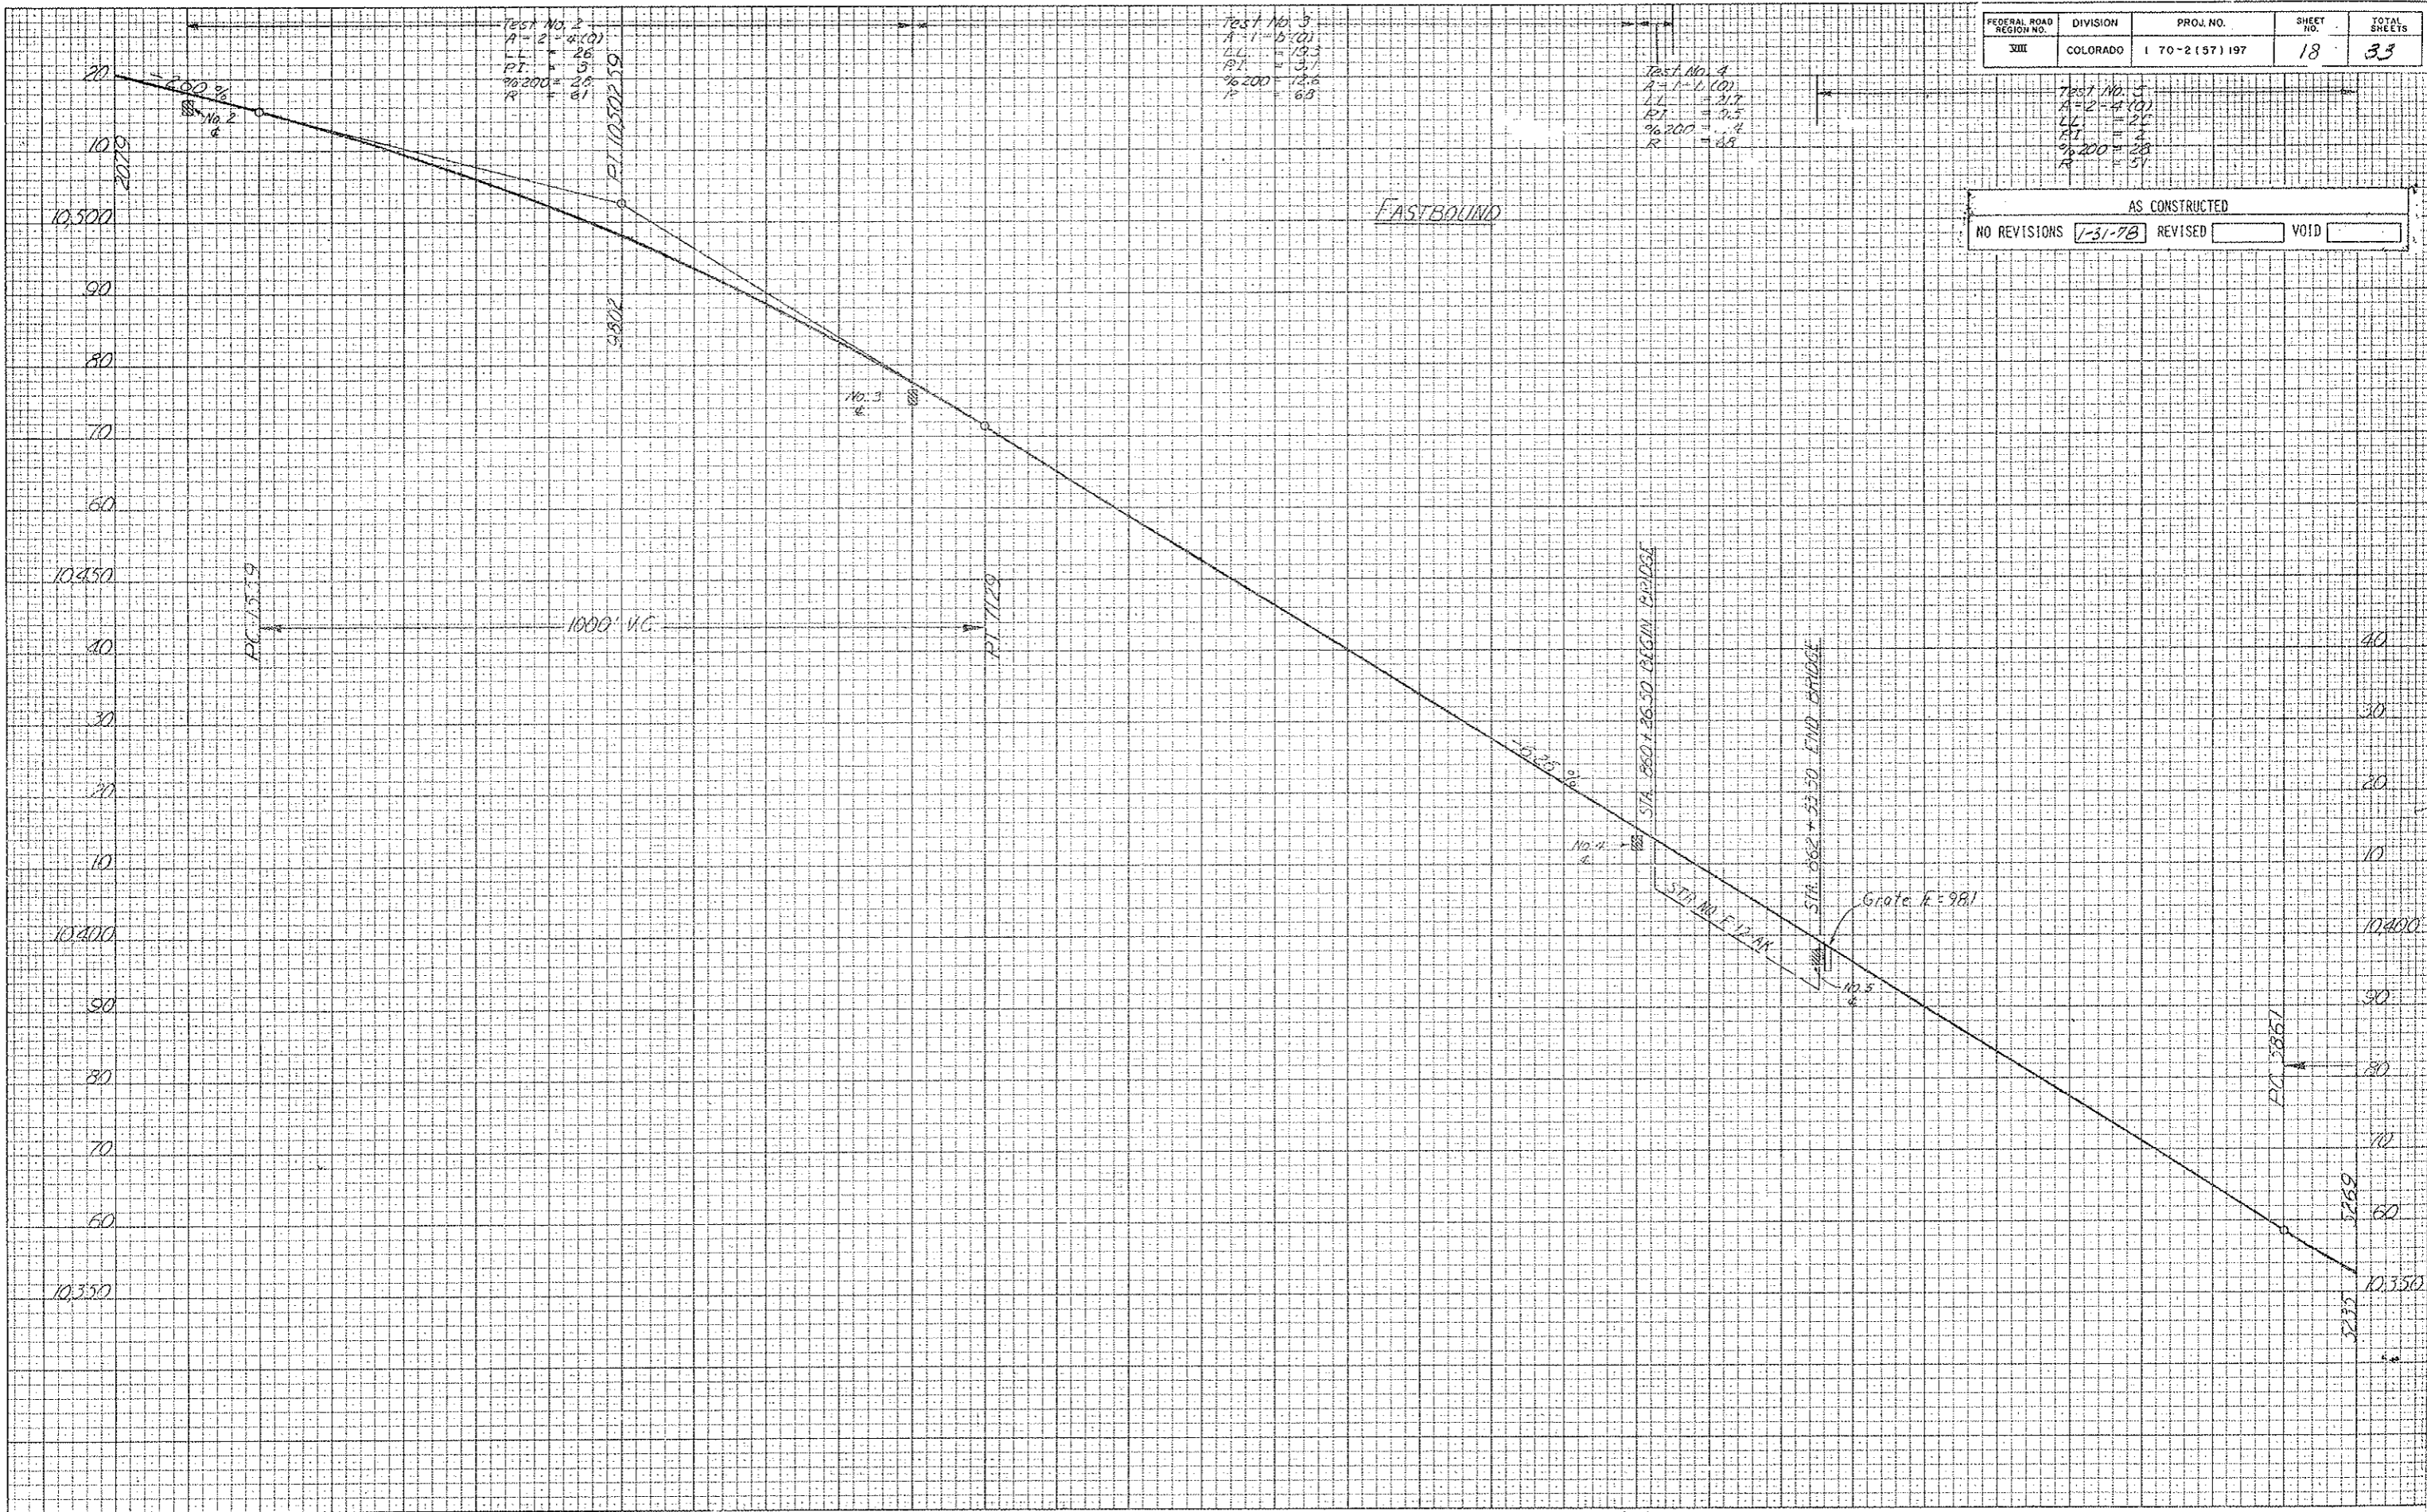


TEST NO. 2
 A=2-A(0)
 LL=26
 PL=3
 %200=28
 R=61

TEST NO. 3
 A=1-B(0)
 LL=13.3
 PL=3.7
 %200=12.6
 R=69

TEST NO. 4
 A=1-A(0)
 LL=21.7
 PL=3.5
 %200=1.4
 R=68

W.B. Lanes
 $\Delta s = 31^{\circ}36' R$ $\theta s = 8^{\circ}45'$
 $Ts = 500.38'$ $Ls = 350'$
 $Es = 49.64'$ $LT = 233.62'$
 $ST = 116.93'$
 $\Delta c = 14^{\circ}06'$ $S = 0.060 \text{ /ft.}$
 $Dc = 5^{\circ}00'$ $M.D.S. = 60 \text{ mph}$
 $Tc = 141.72'$ $S.S.D. =$
 $Lc = 282.00'$
 $Rc = 1145.92'$

FEDERAL ROAD REGION NO.	DIVISION	PROJ. NO.	SHEET NO.	TOTAL SHEETS
VIII	COLORADO	I 70-2(57)197	19	33
AS CONSTRUCTED				
NO REVISION		1-31-78	REVISED	VOID

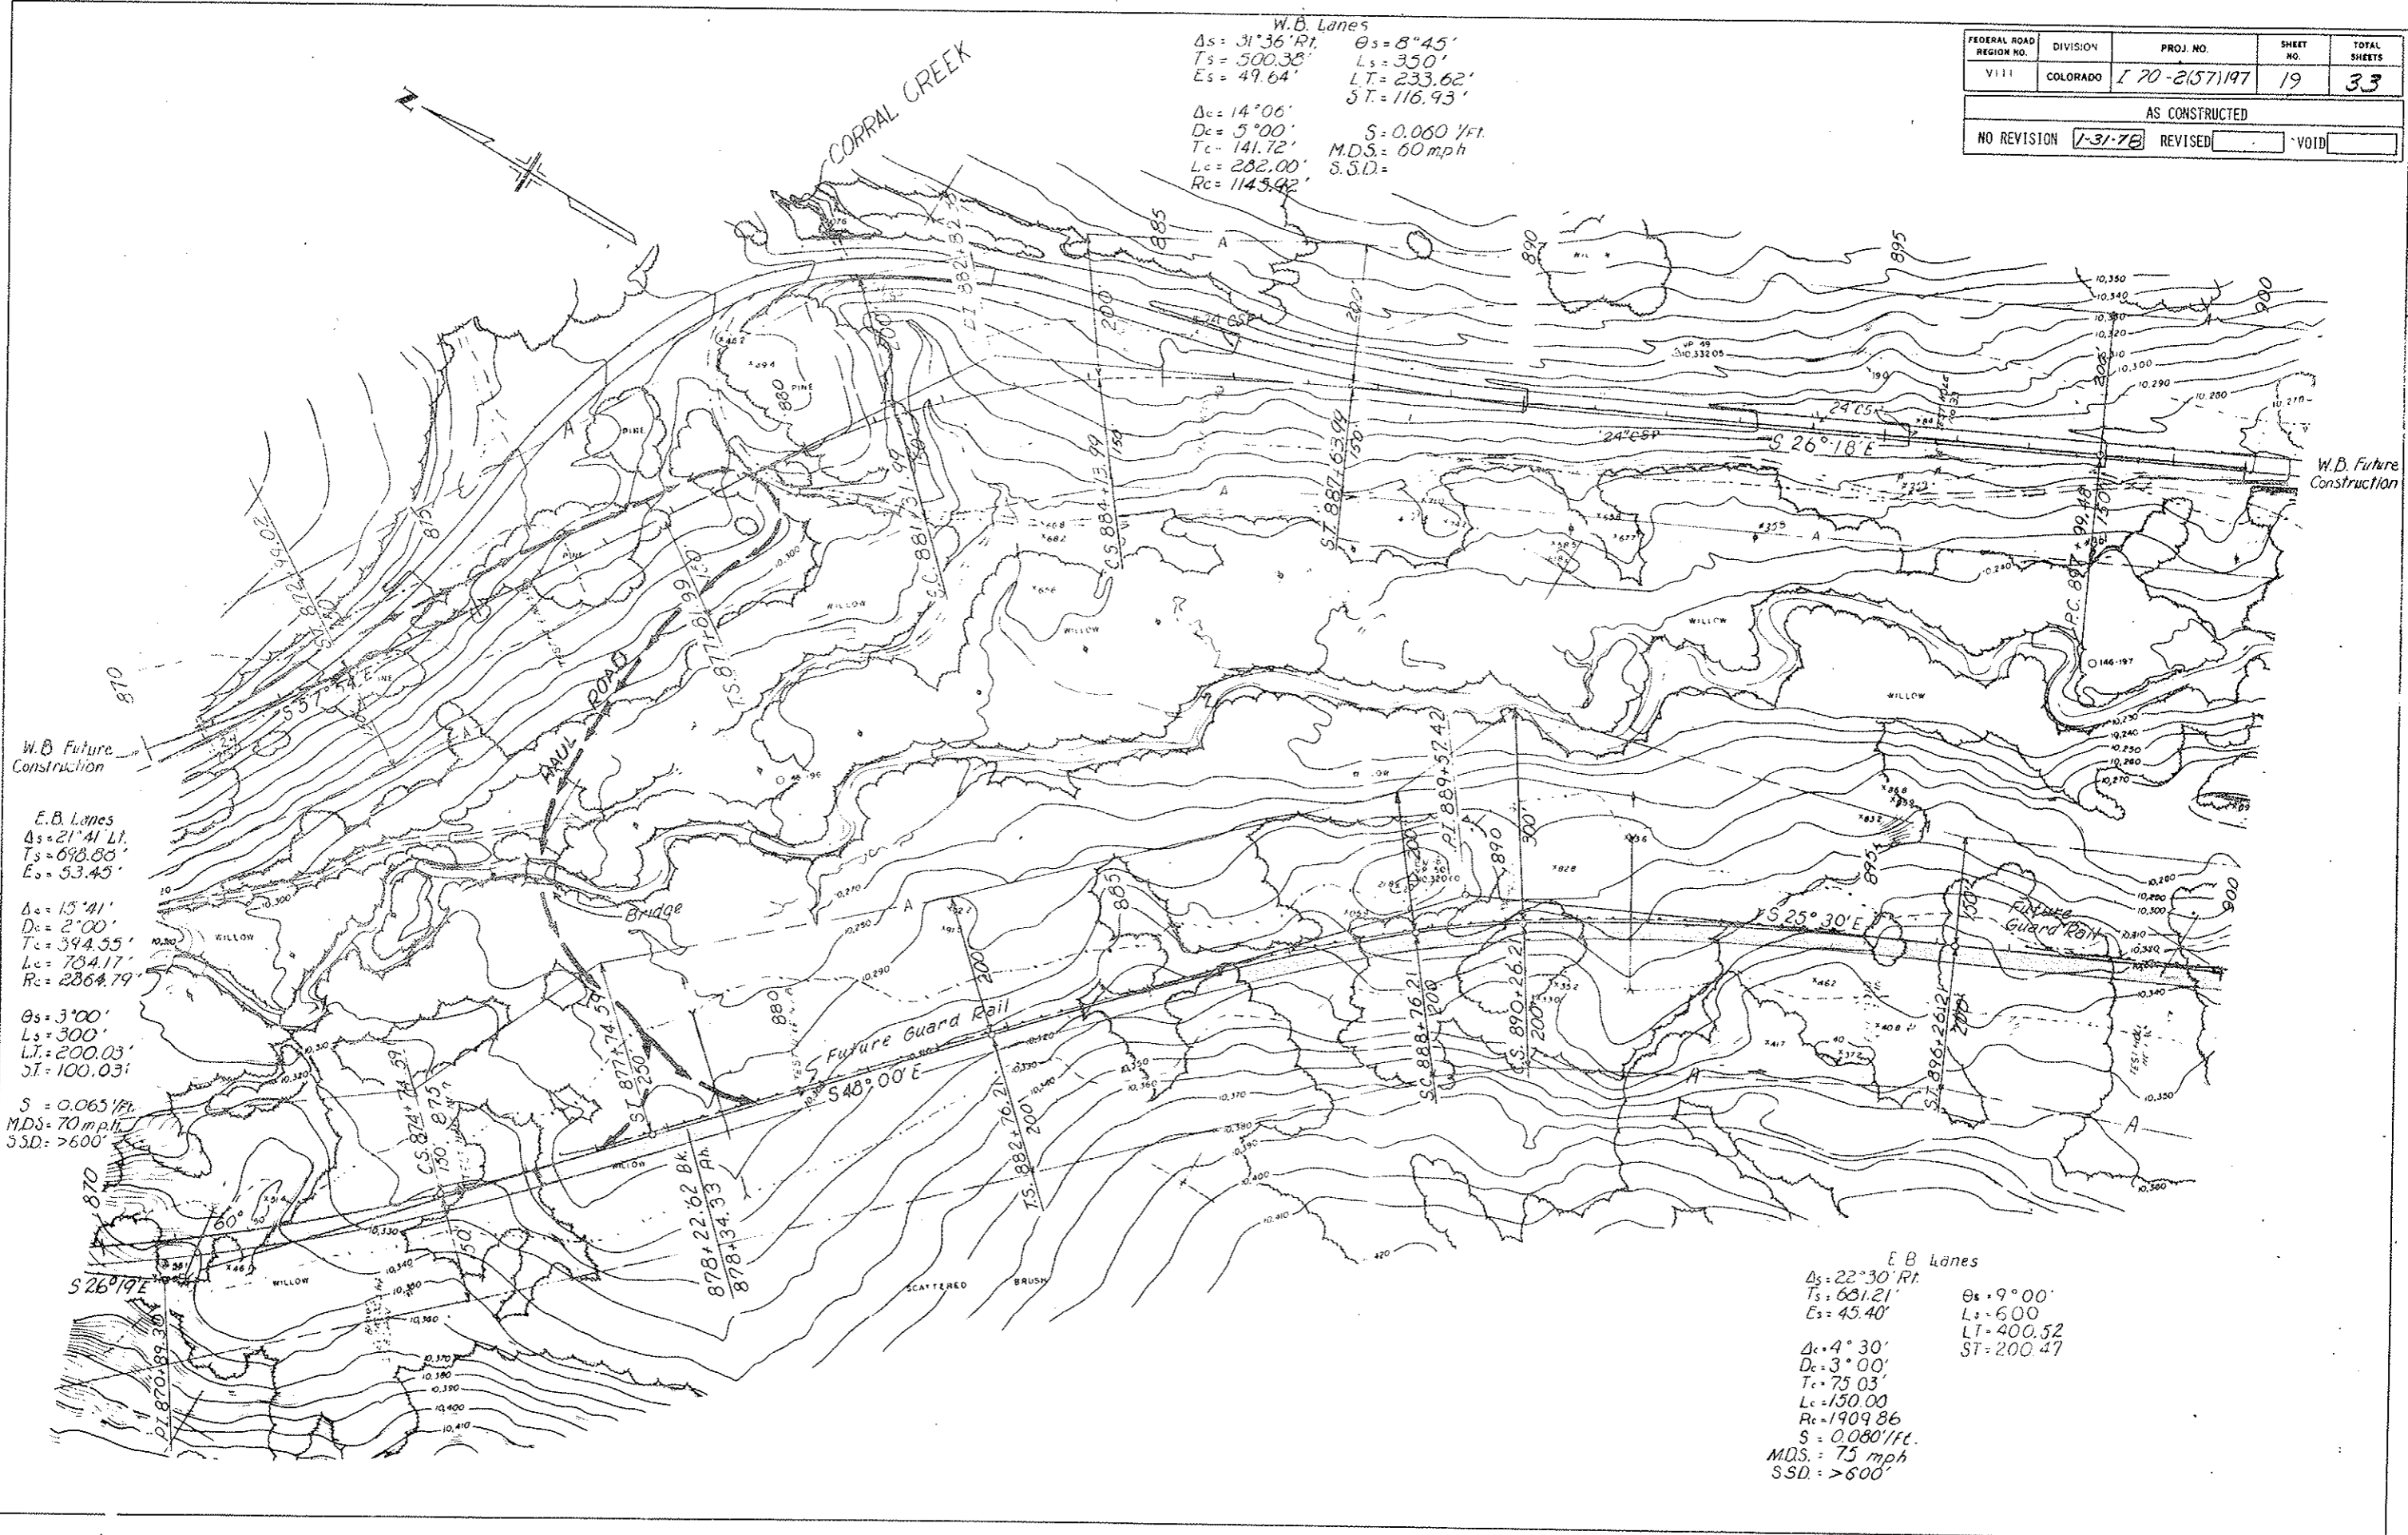

W.B. Future Construction
 E.B. Lanes
 $\Delta s = 21^{\circ}41' L$
 $Ts = 698.88'$
 $Es = 53.45'$
 $\Delta c = 15^{\circ}41'$
 $Dc = 2^{\circ}00'$
 $Tc = 394.55'$
 $Lc = 784.17'$
 $Rc = 2368.79'$
 $\theta s = 3^{\circ}00'$
 $Ls = 300'$
 $LT = 200.03'$
 $ST = 100.03'$
 $S = 0.065 \text{ /ft.}$
 $M.D.S. = 70 \text{ mph}$
 $S.S.D. = >600'$

E.B. Lanes
 $\Delta s = 22^{\circ}30' R$ $\theta s = 9^{\circ}00'$
 $Ts = 681.21'$ $Ls = 600'$
 $Es = 45.40'$ $LT = 400.52'$
 $\Delta c = 4^{\circ}30'$ $ST = 200.47'$
 $Dc = 3^{\circ}00'$
 $Tc = 75.03'$
 $Lc = 150.00'$
 $Rc = 1909.86'$
 $S = 0.080 \text{ /ft.}$
 $M.D.S. = 75 \text{ mph}$
 $S.S.D. = >600'$

AS CONSTRUCTED
 NO REVISION 1-31-78 REVISED VOID

FEDERAL ROAD REGION NO.	DIVISION	PROJ. NO.	SHEET NO.	TOTAL SHEETS
VIII	COLORADO	1 70-2 (57) 197	20	33

Test No. 6
 A-1 = 10
 L.L. = 20
 P.I. = 1.3
 P.C. 200 = 178
 R = 68


Test No. 7
 A-1 = 10
 L.L. = 26
 P.I. = 4
 P.C. 200 = 21
 R = 61

Test No. 8
 A-1 = 10
 L.L. = 20
 P.I. = 1.6
 P.C. 200 = 17
 R = 68

FINAL SURVEY
 SURVEY PLANNED
 ROUTE BOOK NO. _____
 DATE _____
 BY _____
 CHECKED _____

ORIGINAL SURVEY
 SURVEY PLANNED
 ROUTE BOOK NO. _____
 DATE _____
 BY _____
 CHECKED _____

EASTBOUND

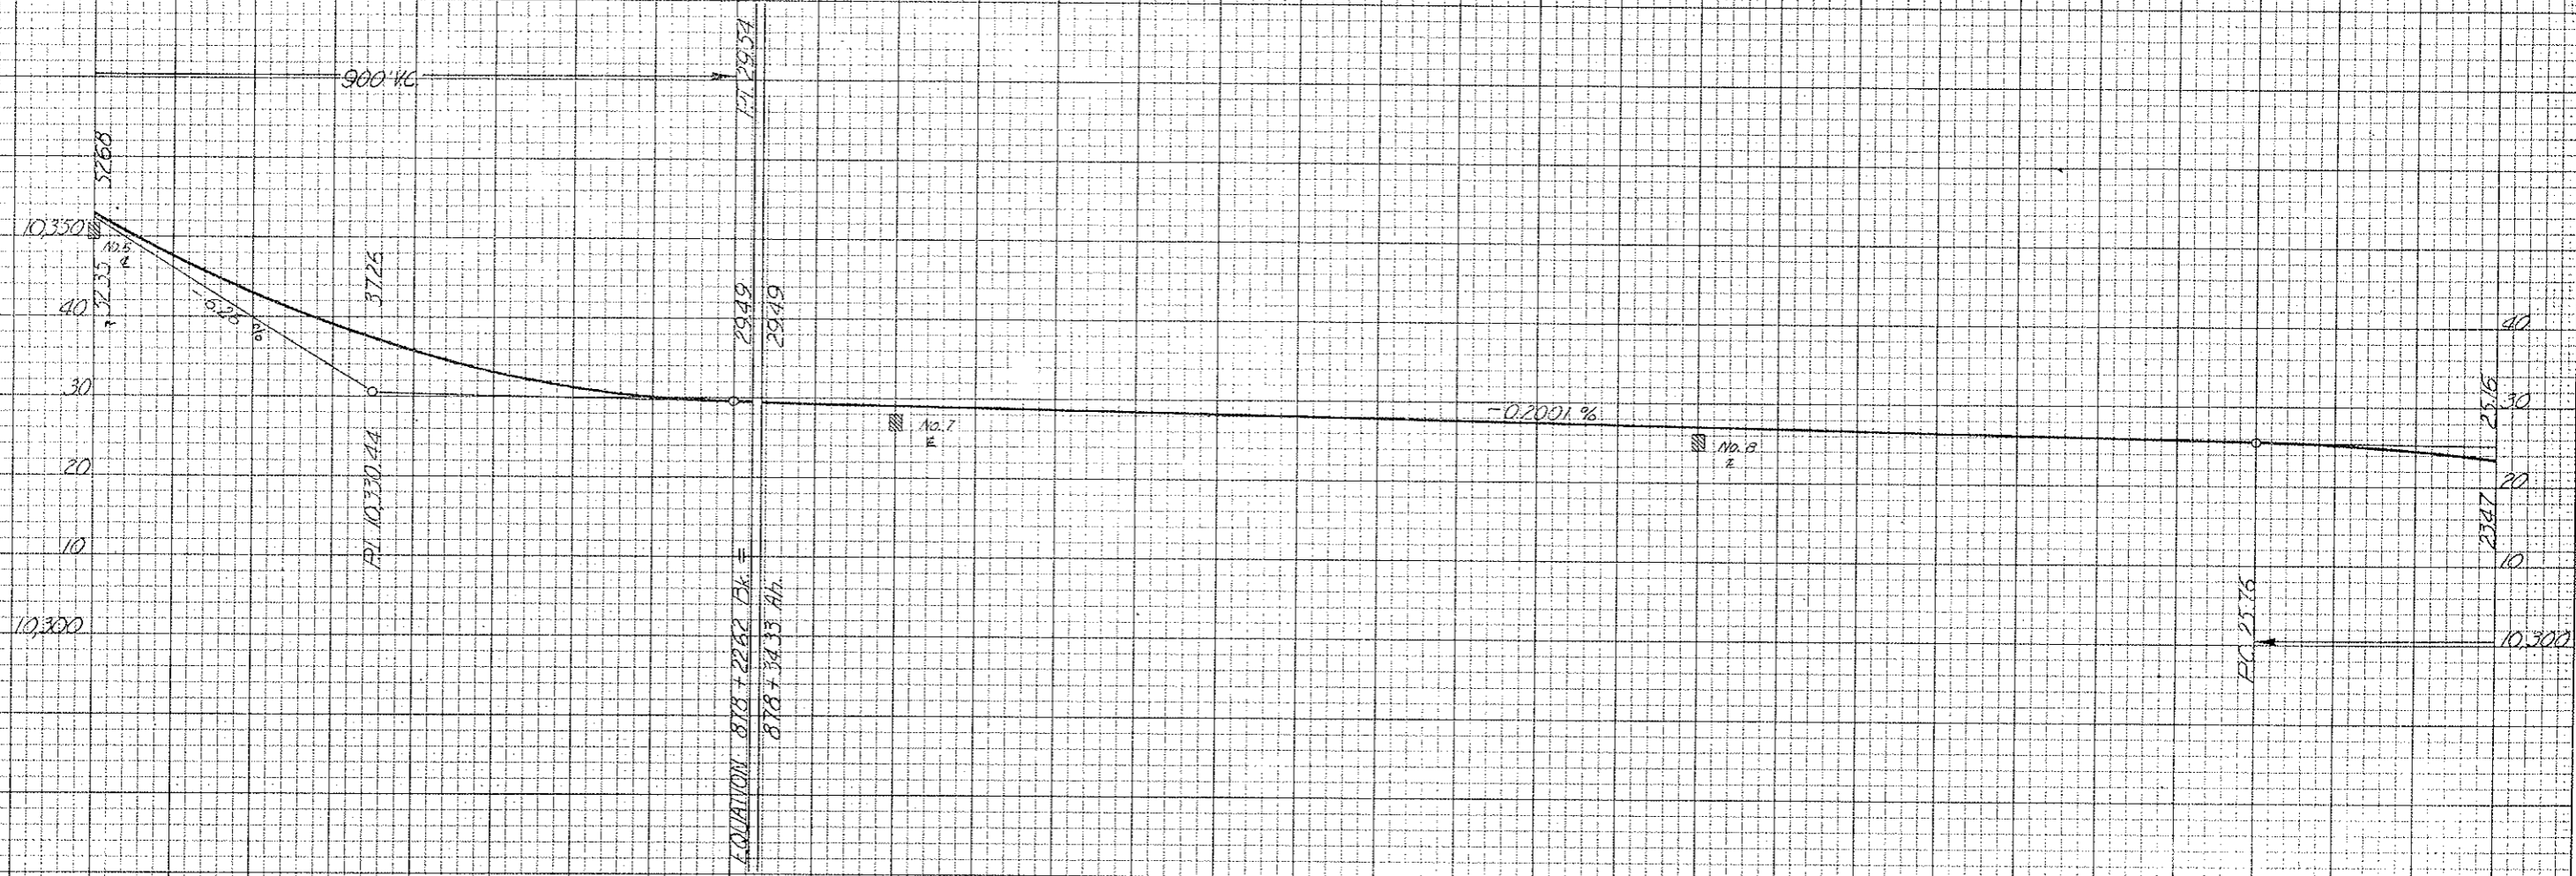

FEDERAL ROAD REGION NO.	DIVISION	PROJ. NO.	SHEET NO.	TOTAL SHEETS
VIII	COLORADO	170-2071197	21	33

AS CONSTRUCTED

NO REVISIONS	REVISED	VOID
	1-31-78	


W.B. Lanes
 $\Delta c = 1'55''$ Pt.
 $E_c = 3.20'$
 $D_c = 0'15''$
 $T_c = 383.37'$
 $L_c = 766.67'$
 $R_c = 22,918.31'$

$S = 0.015$ /ft
 M.D.S. = 80 m.p.h.
 S.S.D. =

W.B. Lanes
 $\Delta s_1 = 40'13''$ Lt
 $T_{s1} = 598.14'$ $T_{s2} = 619.35'$ $L_{s1} = 350'$ $L_{s2} = 400'$
 $E_s = 79.86'$ $L.T. = 233.62'$ $L.T. = 267.09'$
 $S.T. = 116.93'$ $S.T. = 133.72'$

$\Delta c = 21'28''$
 $D_c = 5'00''$
 $T_c = 217.21'$
 $L_c = 429.33'$
 $R_c = 1145.92'$

$S = 0.060$ /ft
 M.D.S. = 60 m.p.h.
 S.S.D. =

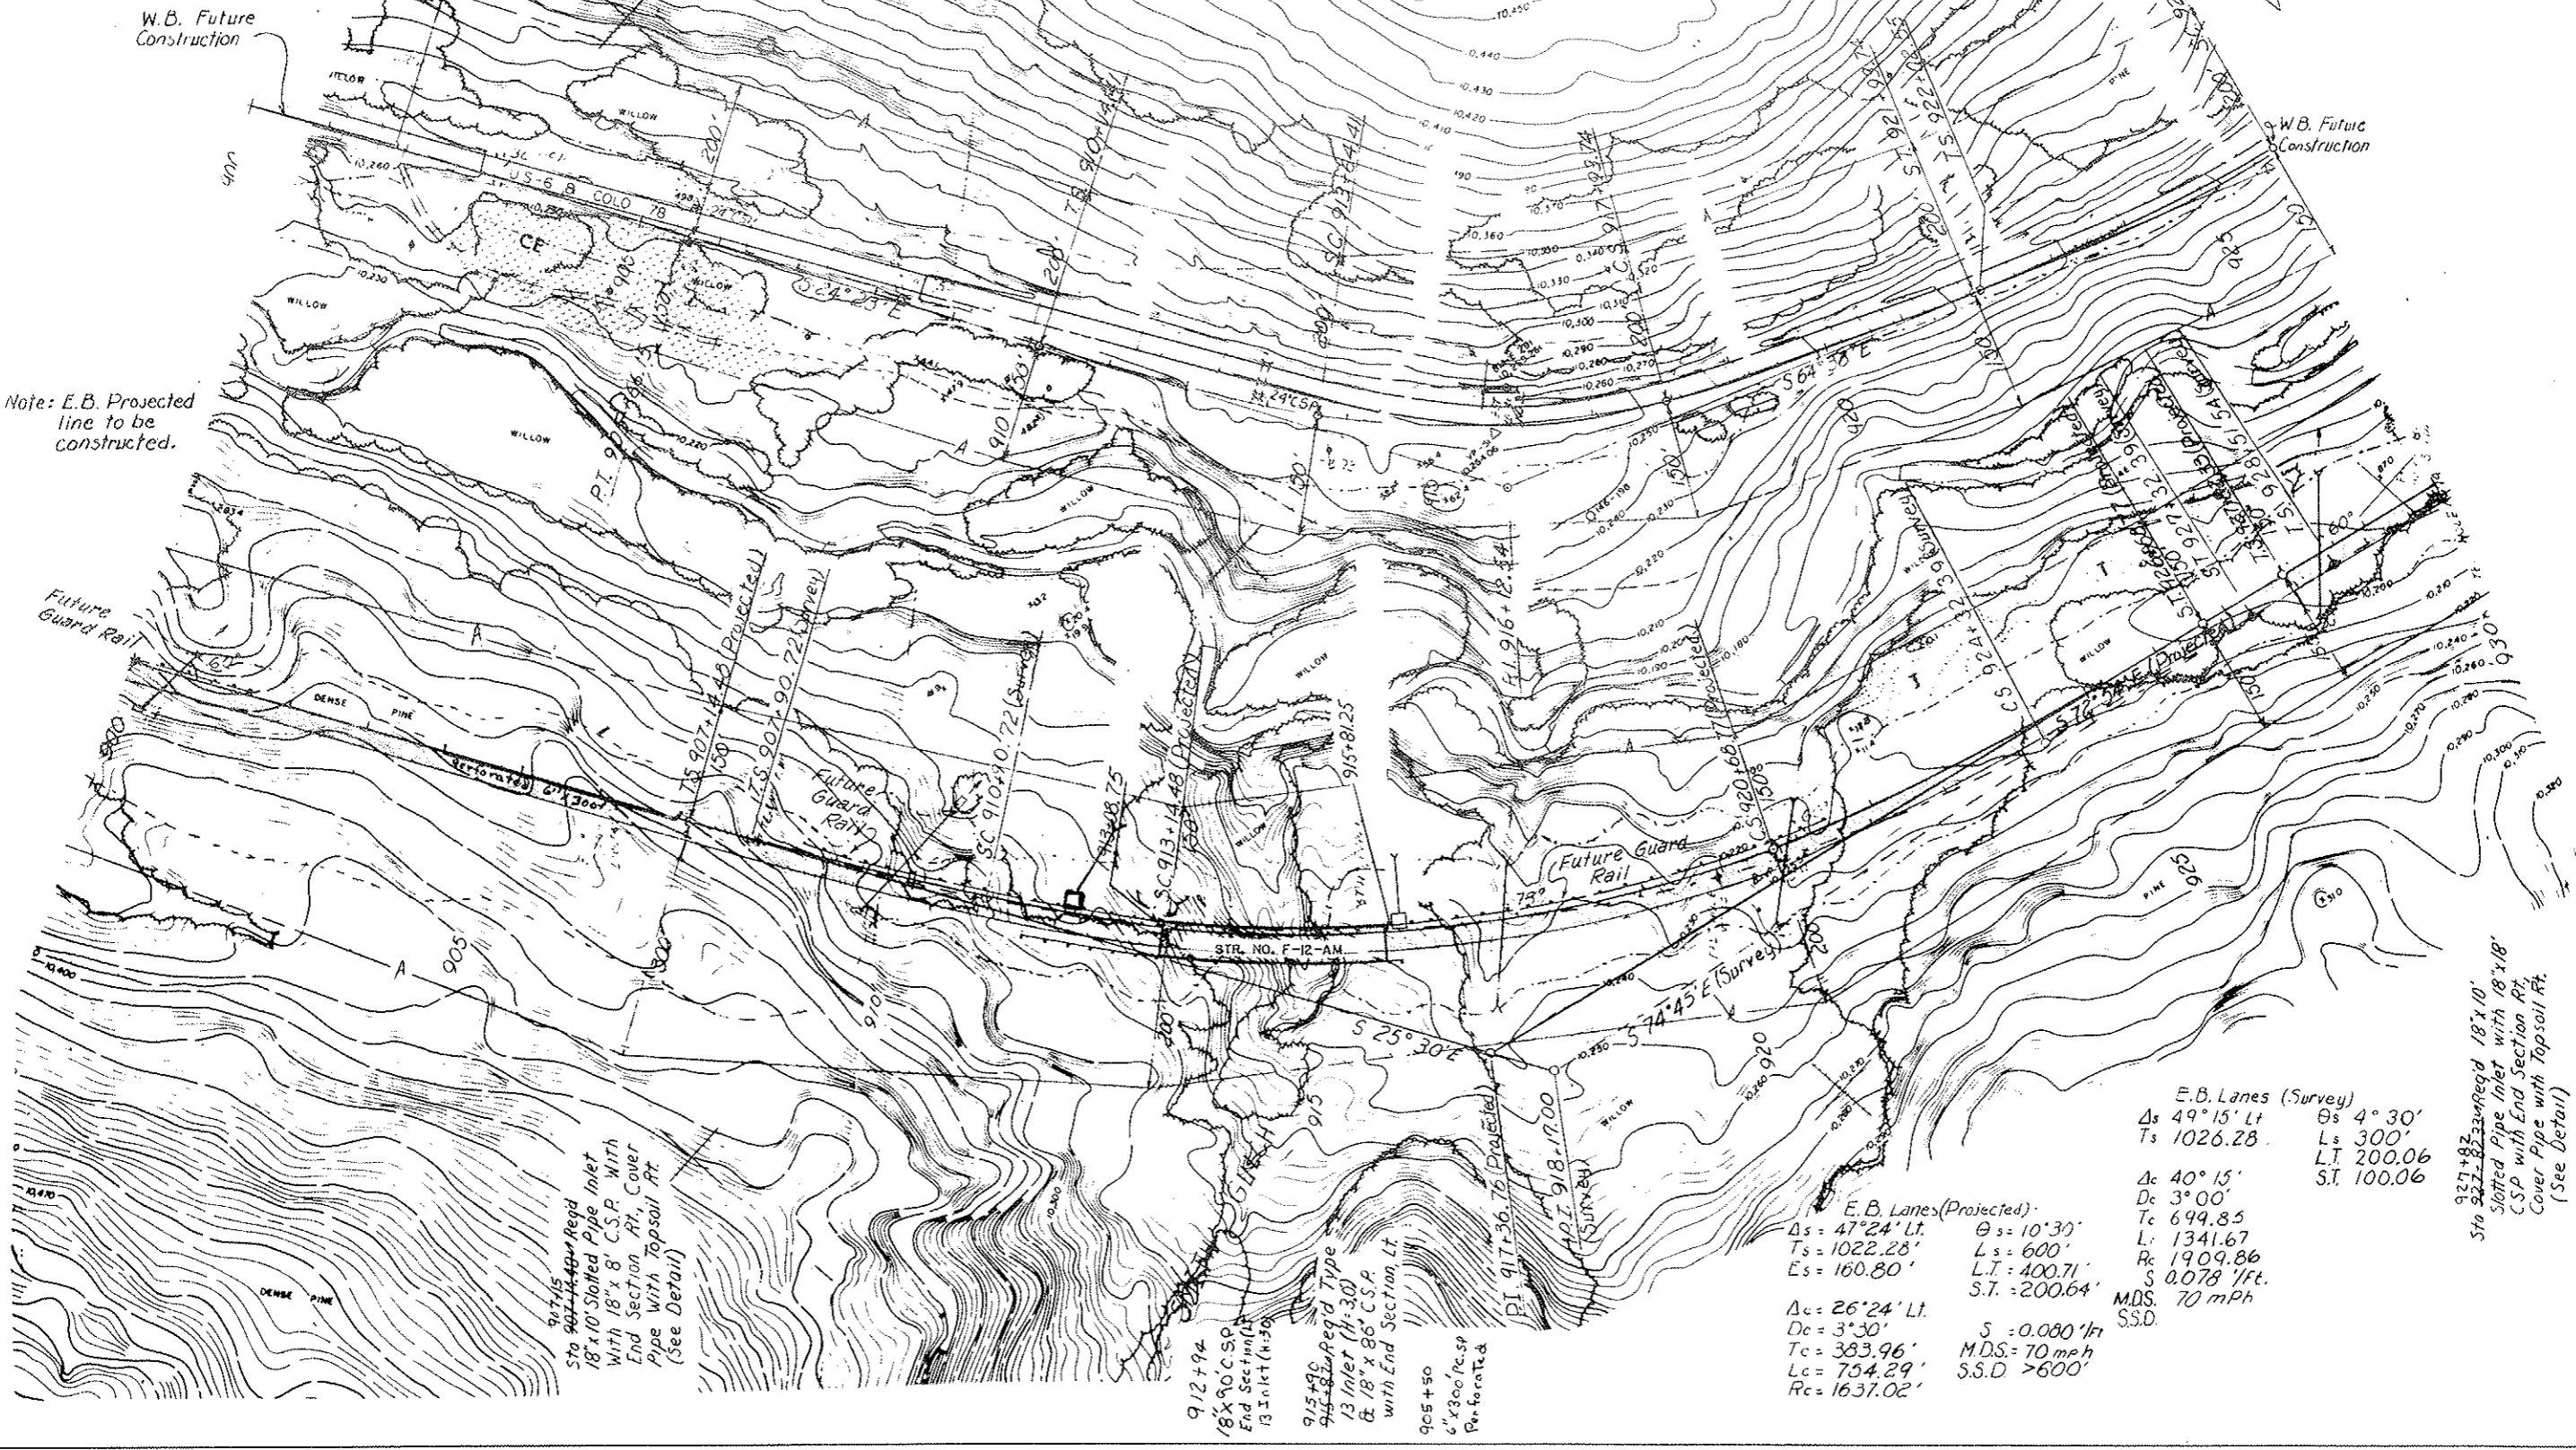

Note: E.B. Projected line to be constructed.

917+15
 18" x 10" Slotted Pipe Inlet
 with 18" x 8" C.S.P. with
 End Section Rt. Cover
 Pipe with Topsoil Rt.
 (See Detail)

912+94
 18" x 10" C.S.P.
 End Section Lt.
 13 Inlet (H=30)
 18" x 8" C.S.P.
 with End Section Lt.

E.B. Lanes (Projected)
 $\Delta s = 47'24''$ Lt. $\theta_s = 10'30''$
 $T_s = 1022.28'$ $L_s = 600'$
 $E_s = 160.80'$ $L.T. = 400.71'$
 $S.T. = 200.64'$

$\Delta c = 26'24''$ Lt.
 $D_c = 3'30''$
 $T_c = 383.96'$
 $L_c = 754.29'$
 $R_c = 1637.02'$

$S = 0.080$ /ft
 M.D.S. = 70 mph
 S.S.D. > 600'

E.B. Lanes (Survey)
 $\Delta s = 49'15''$ Lt $\theta_s = 4'30''$
 $T_s = 1026.28'$ $L_s = 300'$
 $L.T. = 200.06'$
 $S.T. = 100.06'$

$\Delta c = 40'15''$
 $D_c = 3'00''$
 $T_c = 699.85'$
 $L_c = 1341.67'$
 $R_c = 1909.86'$
 $S = 0.078$ /ft.
 M.D.S. = 70 mph
 S.S.D. =

927+82.85
 18" x 10" Slotted Pipe Inlet with 18" x 18" C.S.P. with End Section Rt. Cover Pipe with Topsoil Rt. (See Detail)

AS CONSTRUCTED		FEDERAL ROAD REGION NO.	DIVISION	PROJ. NO.	SHEET NO.	TOTAL SHEETS
NO REVISIONS	1-31-78	REVIS	VOID	XIII	COLORADO	70-2 (57) 197
						22
						33

Test No. 9
 A-1 = 5.01
 L.L. = 11.1
 P.T. = 11.1
 % 200 = 10.1
 R = 6.9

Test No. 10
 A-1 = 0.10
 L.L. = 11.1
 P.T. = 11.1
 % 200 = 10.1
 R = 7.6

Test No. 11
 A-2 = 4.2
 L.L. = 22.8
 P.T. = 3.8
 % 200 = 22.7
 R = 6.0

Test No. 12
 A-4 = 4.0
 L.L. = 2.4
 P.T. = 2.0
 % 200 = 3.8
 R = 6.3

-0.2001 %

EASTBOUND

STA 913+28.75 BEGIN PARABOLA
 STA 915+81.25 END BRIDGE
 PI 74.33

600' VC

1600' VC
 SSD = 610
 M.S. = 70 mph


Grafe E = 568

5% 20' 36" %
 STR NO. F-12-AM

-3.5225 %

NO.	DATE

NO.	DATE

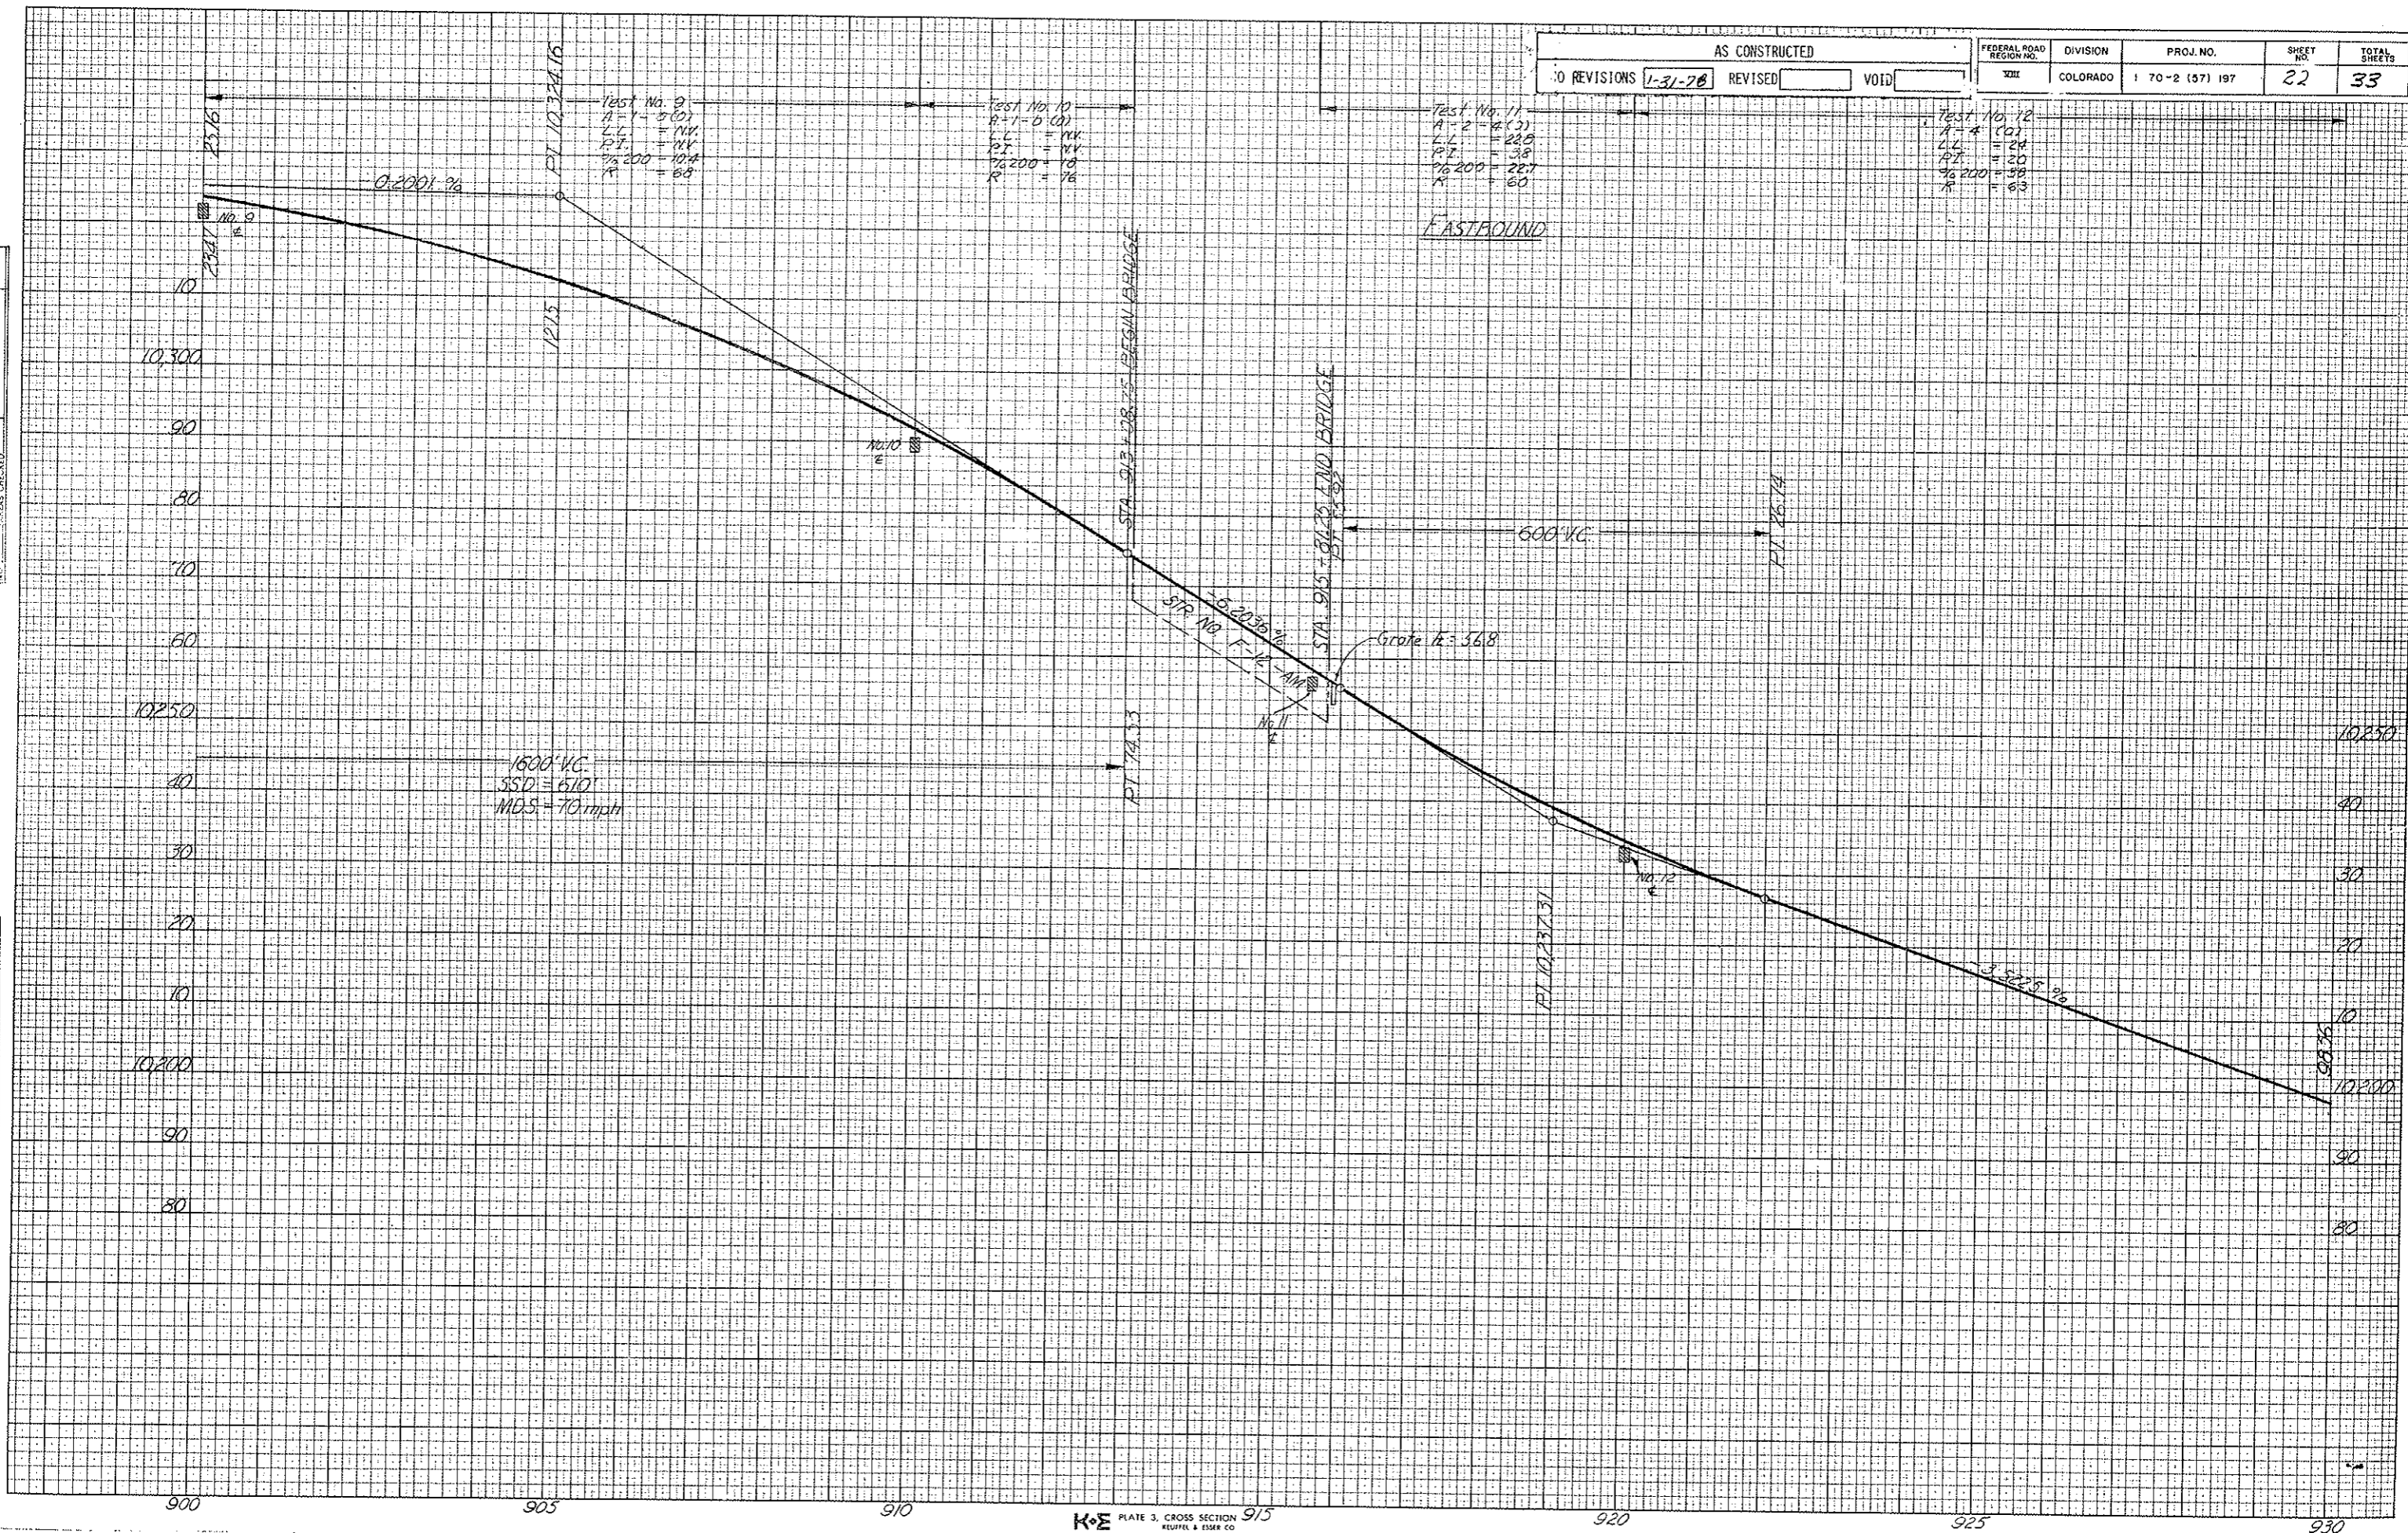


AS CONSTRUCTED		FEDERAL ROAD REGION NO.	DIVISION	PROJ. NO.	SHEET NO.	TOTAL SHEETS
NO REVISIONS	REVISED 1-31-78	VIII	COLORADO	170-2(57)197	23	33

W.B. Lanes
 $\Delta s = 34^{\circ}21' LT$
 $Ts = 553.35'$
 $Es = 58.86'$
 $\Delta c = 15^{\circ}36'$
 $Dc = 500'$
 $Tc = 156.97'$
 $Lc = 312.00'$
 $Rc = 1145.92'$
 $\theta s_1 = 10^{\circ}00'$
 $\theta s_2 = 3^{\circ}45'$
 $Ls_1 = 400'$
 $Ls_2 = 350'$
 $LT = 267.09'$
 $LT_1 = 233.62'$
 $ST = 133.72'$
 $ST_1 = 116.73'$
 $S = 0.060 / ft$
 $MDS = 60 \text{ m.p.h.}$
 $S.S.D. =$

E.B. Lanes (Survey)
 $\Delta s = 15^{\circ}52' LT$
 $Ts = 682.42'$
 $Dc = 11^{\circ}22' LT$
 $Tc = 380.14'$
 $Lc = 757.78'$
 $Rc = 3819.72'$
 $S = .060 / ft$
 $MDS = 75 \text{ mph}$
 $S.S.D. =$
 $\theta s = 2^{\circ}15'$
 $Ls = 300'$
 $LT = 200.02'$
 $ST = 100.01'$

E.B. Lanes (Projected)
 $\Delta s = 17^{\circ}43' LT$
 $Ts = 745.45'$
 $Ls = 47.13'$
 $\Delta c = 13^{\circ}13'$
 $Dc = 1^{\circ}30'$
 $Tc = 442.52'$
 $Lc = 631.11'$
 $Rc = 3319.72'$
 $S = 0.060 / ft$
 $MDS = 75 \text{ m.p.h.}$
 $S.S.D. = 7900'$

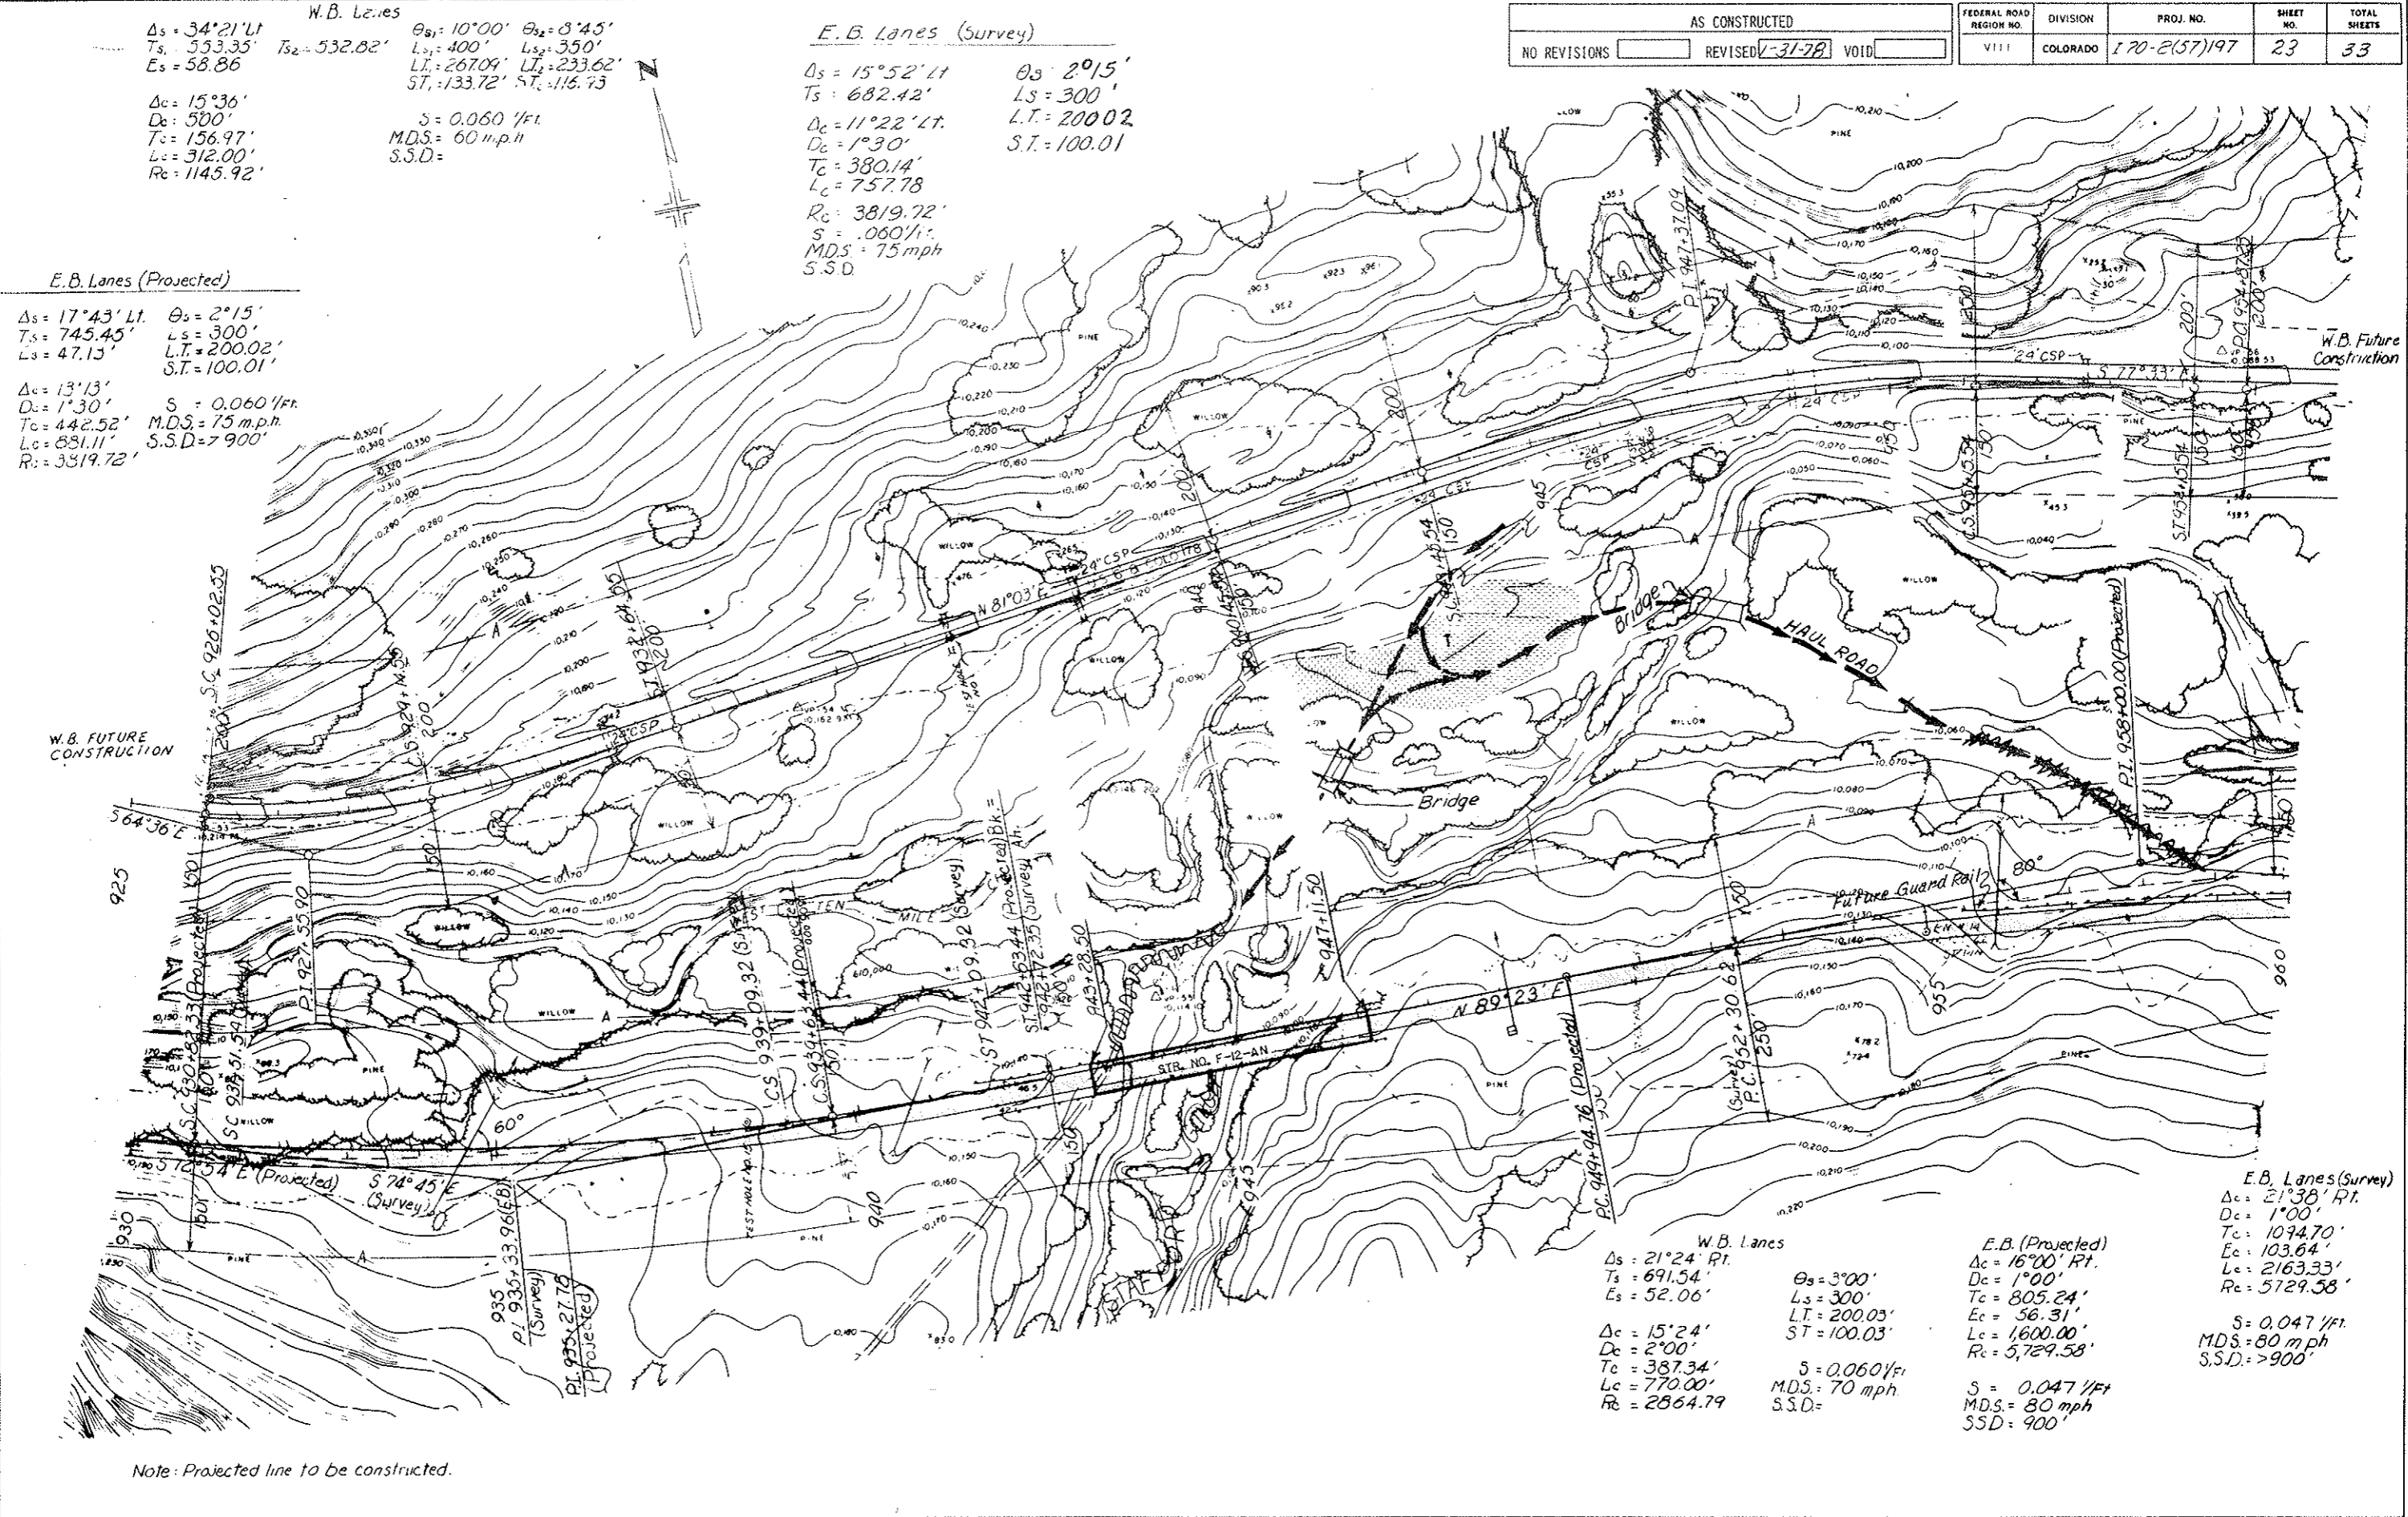

W.B. Lanes
 $\Delta s = 21^{\circ}24' Rt$
 $Ts = 691.54'$
 $Es = 52.06'$
 $\Delta c = 15^{\circ}24'$
 $Dc = 2^{\circ}00'$
 $Tc = 387.34'$
 $Lc = 770.00'$
 $Rc = 2864.79'$
 $\theta s = 3^{\circ}00'$
 $Ls = 300'$
 $LT = 200.03'$
 $ST = 100.03'$
 $S = 0.060 / ft$
 $MDS = 70 \text{ mph}$
 $S.S.D. =$

E.B. (Projected)
 $\Delta c = 16^{\circ}00' Rt$
 $Dc = 1^{\circ}00'$
 $Tc = 805.24'$
 $Ec = 56.31'$
 $Lc = 1,600.00'$
 $Rc = 5,729.58'$
 $S = 0.047 / ft$
 $MDS = 80 \text{ mph}$
 $SSD = 900'$

E.B. Lanes (Survey)
 $\Delta c = 21^{\circ}38' Rt$
 $Dc = 1^{\circ}00'$
 $Tc = 1094.70'$
 $Ec = 103.64'$
 $Lc = 2163.33'$
 $Rc = 5129.58'$
 $S = 0.047 / ft$
 $MDS = 80 \text{ mph}$
 $S.S.D. = >900'$

Note: Projected line to be constructed.

Test No. 13
 A-1-D (2)
 L.L. = 25.1
 P.I. = 3.0
 %200 = 23.4
 R = 6.8

Test No. 14
 A-1-D (2)
 L.L. = 22.0
 P.I. = 1.3
 %200 = 20.7
 R = 6.8


Test No. 15
 A-1-D (2)
 L.L. = 14.4
 P.I. = 14.4
 %200 = 20
 R = 7.8

Test No. 16
 A-1-D (2)
 L.L. = 20.1
 P.I. = 1.2
 %200 = 17.3
 R = 6.8

Test No. 17
 A-1-D (2)
 L.L. = 14.4
 P.I. = 14.4
 %200 = 20
 R = 6.8

DATE: _____ BY: _____
 ORIGINAL SURVEY PLOTTED: _____
 NOTE BOOK: _____
 AREAS CHECKED: _____

DATE: _____ BY: _____
 ORIGINAL SURVEY PLOTTED: _____
 NOTE BOOK: _____
 AREAS CHECKED: _____

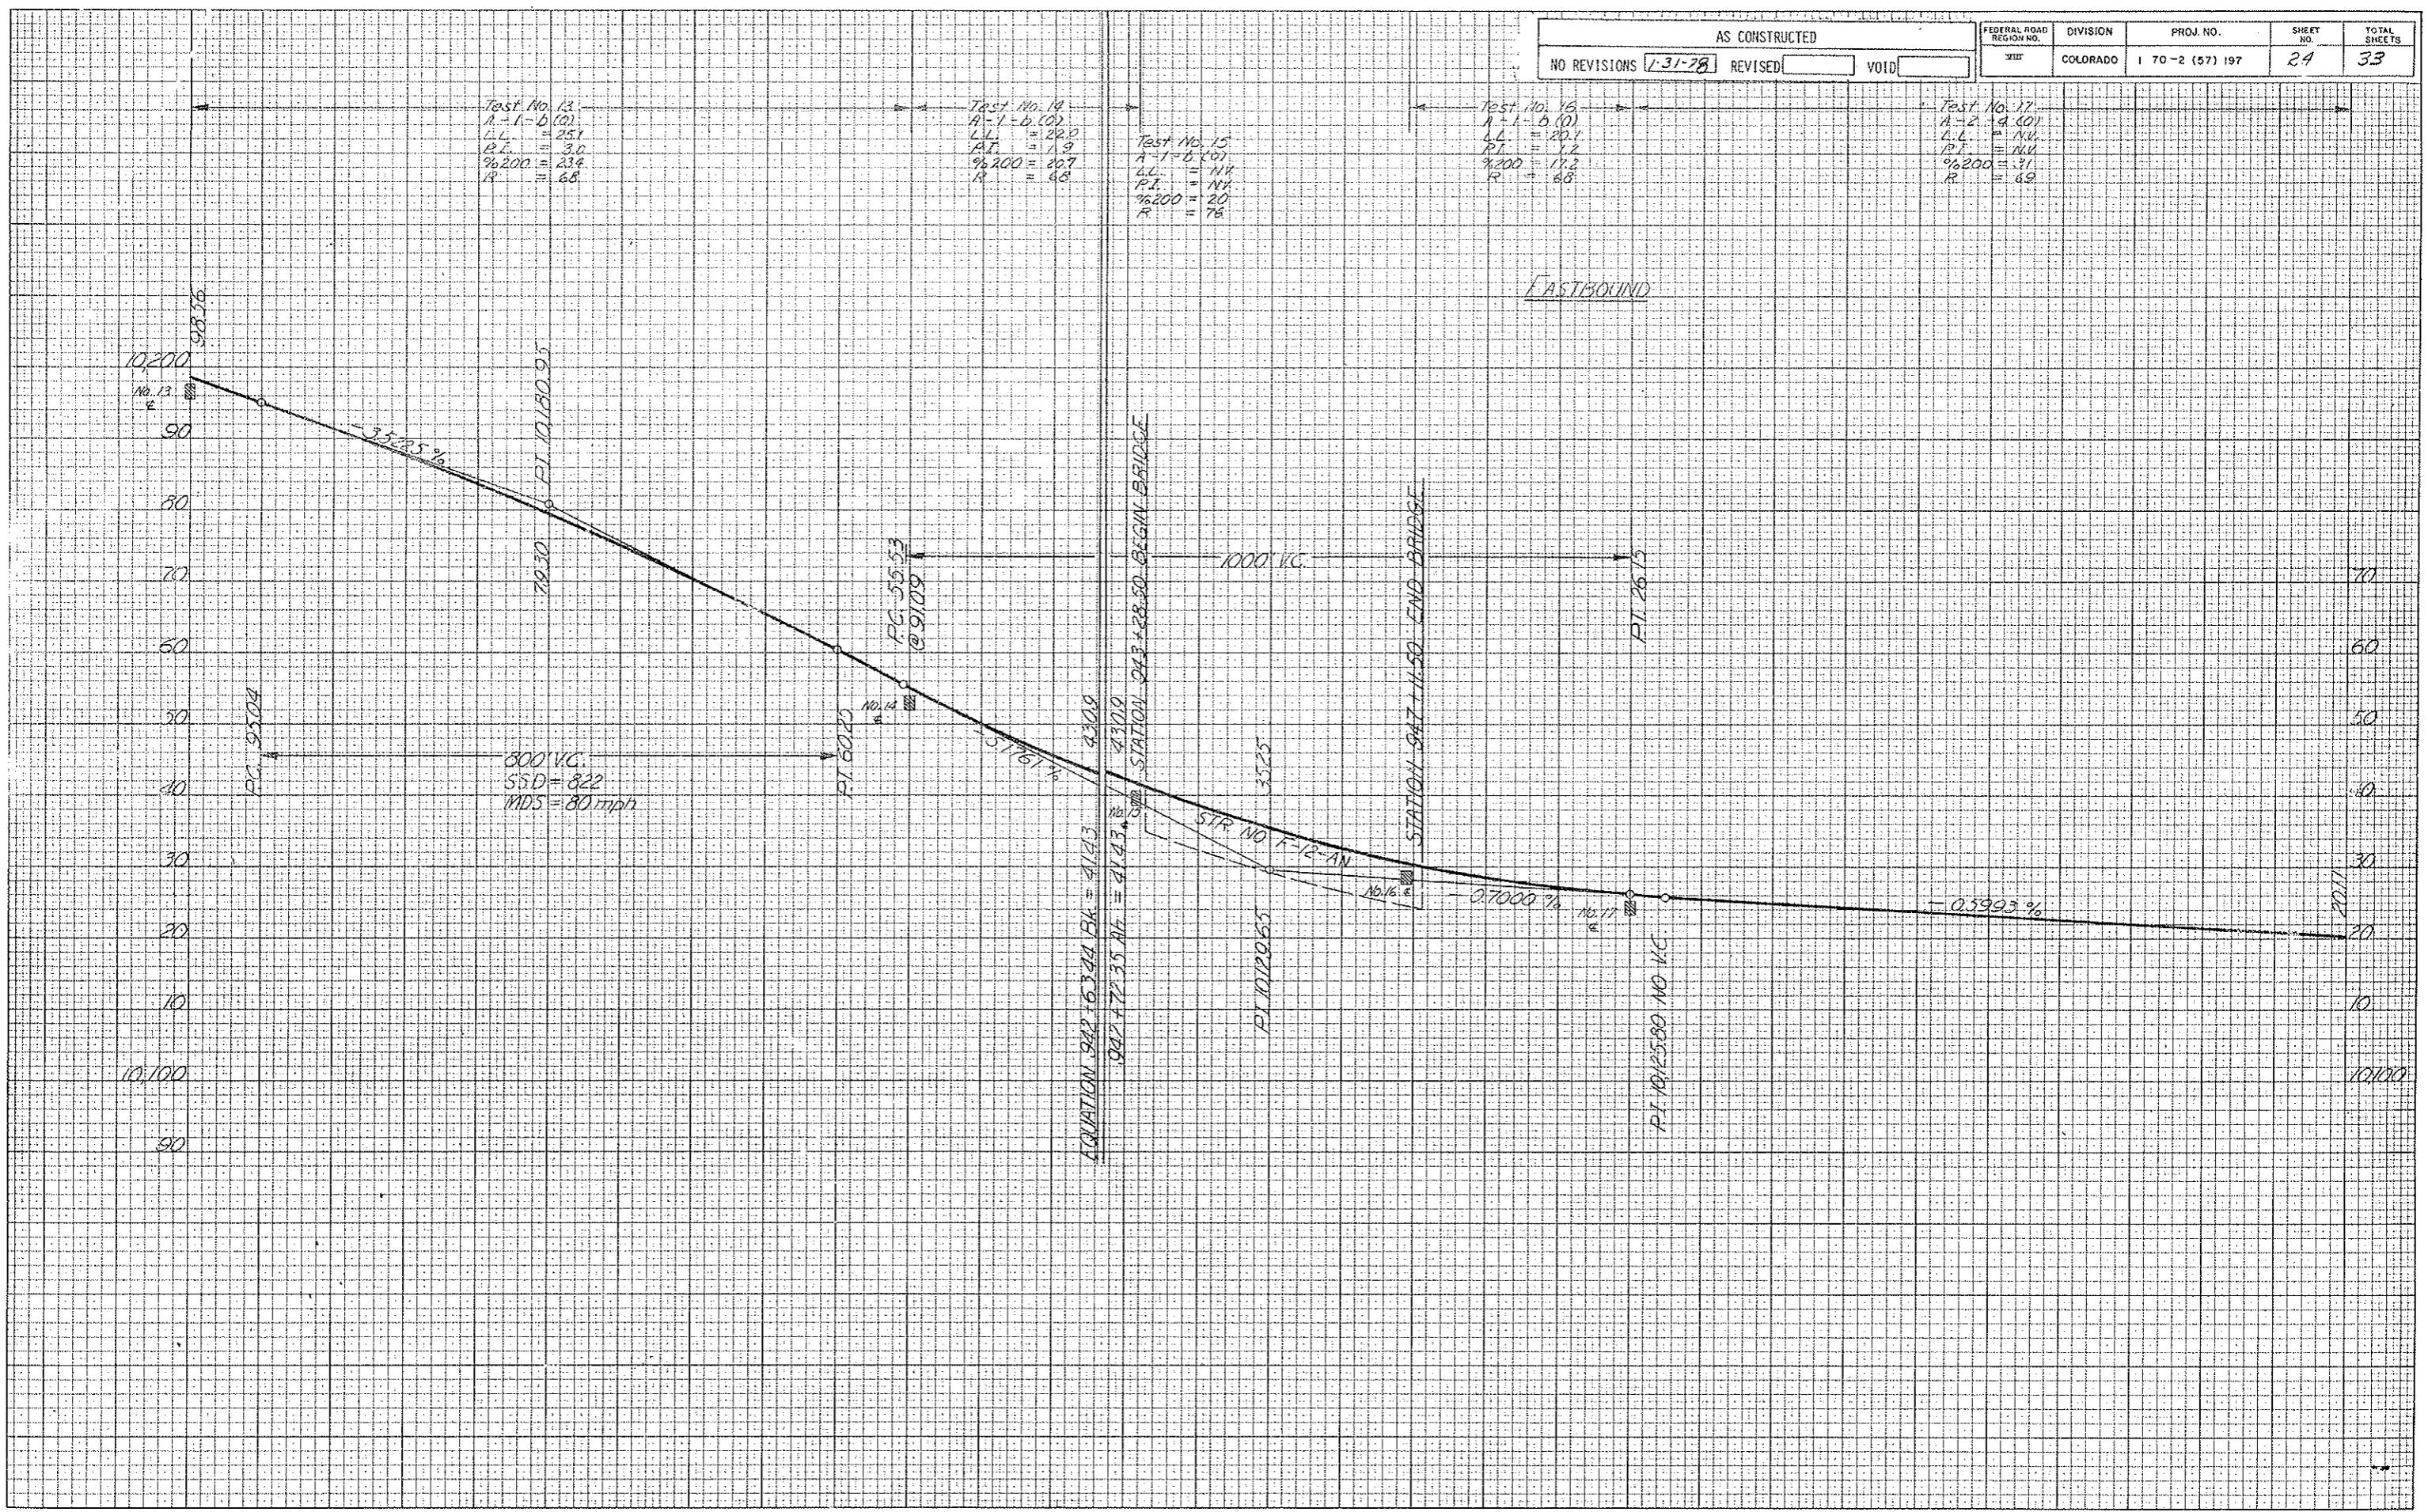

W.B. Lanes
 $\Delta s = 2^\circ 49' \text{ RT}$ $S = 0.015 \text{ /ft.}$
 $E_s = 6.92'$ $MDS = 80 \text{ m.p.h.}$
 $D_c = 0'15"$ $SSD =$
 $T_c = 563.45'$
 $L_c = 1126.67'$
 $R_c = 22,918.31'$

W.B. Lanes
 $\Delta s = 22^\circ 29' \text{ RT}$ $\theta_s = 7^\circ 30'$
 $T_s = 378.33'$ $L_s = 300'$
 $E_s = 25.77'$ $LT = 200.18'$
 $S.T. = 100.16'$
 $\Delta c = 7^\circ 29'$
 $D_c = 5'00"$ $S = 0.080 \text{ /ft.}$
 $T_c = 74.94'$ $MDS = 60 \text{ m.p.h.}$
 $L_c = 149.67'$ $SSD =$
 $R_c = 1145.92'$

W.B. LANES
 $\Delta s = 27^\circ 16' \text{ LT}$ $\theta_s = 1^\circ 7'00"$
 $T_s = 523.19'$ $L_s = 350'$
 $E_s = 45.23'$ $LT = 233.52'$
 $\Delta c = 13^\circ 16' \text{ LT}$ $ST = 116.83'$
 $D_c = 4'00"$
 $T_c = 166.57'$
 $L_c = 331.67'$
 $R_c = 1432.39'$
 $S = 0.079 \text{ /ft.}$
 $MDS = 65 \text{ m.p.h.}$
 $SSD =$

FEDERAL ROAD REGION NO.	DIVISION	PROJ. NO.	SHEET NO.	TOTAL SHEETS
VIII	COLORADO	I 70-2(57)197	25	33

AS CONSTRUCTED

NO REVISIONS REVISED J-31-76 VOID



E.B. Lanes (Survey)
 $\Delta c = 21^\circ 38' \text{ RT}$
 $D_c = 1'00"$
 $T_c = 1094.70'$
 $E_c = 103.64'$
 $L_c = 2163.33'$
 $R_c = 5729.58'$
 $S = 0.047 \text{ /ft.}$
 $MDS = 80 \text{ m.p.h.}$
 $SSD = 7900'$

E.B. Lanes (Projected)
 $\Delta c = 5^\circ 38' \text{ RT}$
 $D_c = 1'00"$
 $T_c = 281.89'$
 $E_c = 6.93'$
 $L_c = 563.34'$
 $R_c = 5,729.58'$
 $S = 0.047 \text{ /ft.}$
 $MDS = 80 \text{ m.p.h.}$
 $SSD = 900'$

986+48
 Sta. 986+48
 18"x10" Sloated Pipe
 Inlet with 18"x20"
 C.S.P. with End Section
 RT. Cover Pipe with
 Topsoil (See Detail)

989+13
 18"x30" C.S.P. (14")
 13' Inlet (H=30)

DATE	
BY	
NO.	
AREA CHECKED	
NOTE BOOK	
SURVEY	
ORIGINAL	

DATE	
BY	
NO.	
AREA CHECKED	
NOTE BOOK	
SURVEY	
ORIGINAL	


AS CONSTRUCTED		FEDERAL ROAD REGION NO.	DIVISION	PROJ. NO.	SHEET NO.	TOTAL SHEETS
NO REVISIONS	1-31-78	REVISED	VOID	XIII	COLORADO	1 70-2 (57) 197
					26	33

Test No. 18
 P-L = 0.101
 L.L. = 216
 P.T. = 3.3
 %200 = 21.3
 R = 60

Test No. 19
 A-L = 6 (0)
 L.L. = 27
 P.T. = 3
 %200 = 21
 R = 72

Test No. 20
 A-L = 5 (0)
 L.L. = 19.8
 P.T. = 0.9
 %200 = 18.7
 R = 68


Test No. 21
 A-L = 4 (0)
 L.L. = 24
 P.T. = 1.8
 %200 = 18
 R = 72

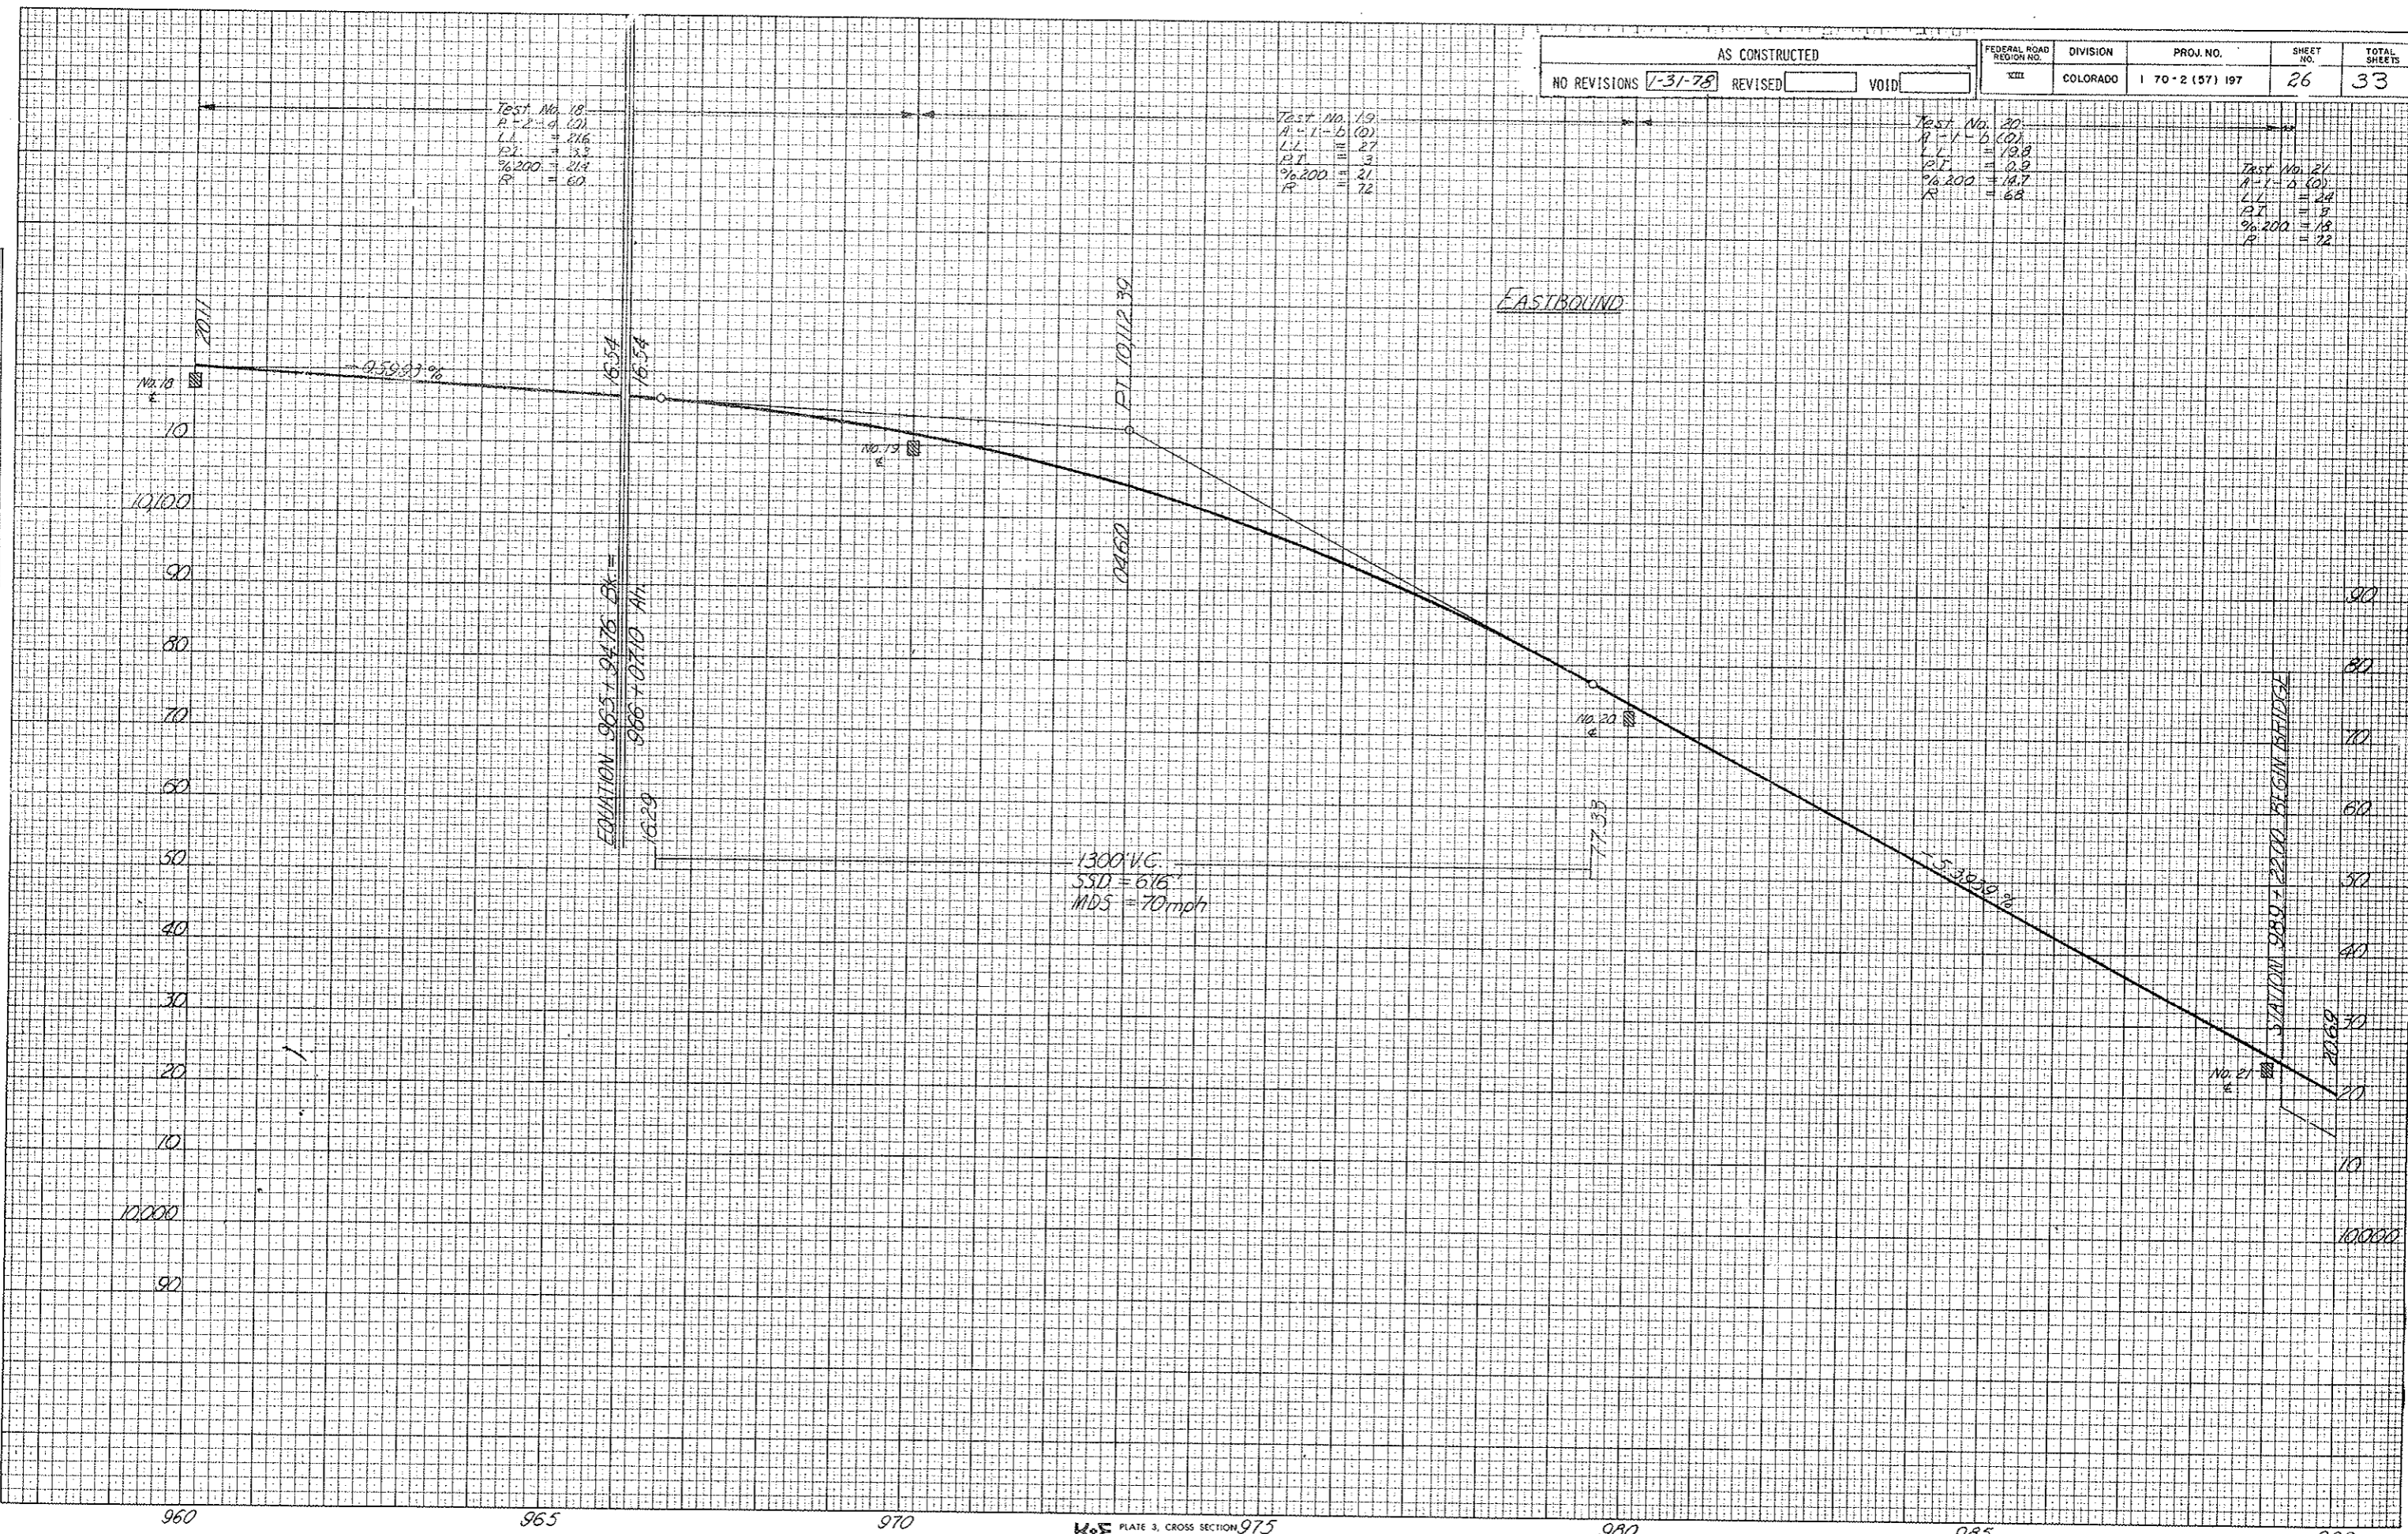

AS CONSTRUCTED			FEDERAL ROAD REGION NO.	DIVISION	PROJ. NO.	SHEET NO.	TOTAL SHEETS
NO REVISIONS	REVISED 1-31-78	VOID	VIII	COLORADO	I 70-2(57)197	27	33

W.B. Lanes

$\Delta_s = 25^\circ 44' \text{ Lt.}$	$\theta_{s1} = 4^\circ 30'$
$T_{s1} = 600.22'$	$\theta_{s2} = 9^\circ 00'$
$T_{s2} = 724.24'$	$L_{s1} = 300'$
$E_s = 54.22'$	$L_{s2} = 200.06'$
$\Delta_c = 12^\circ 14' \text{ Lt.}$	$S.T. = 100.06'$
$D_c = 3^\circ 00'$	$L_{s2} = 600'$
$T_c = 204.67'$	$L.T. = 400.52'$
$L_c = 407.78'$	$S.T. = 200.47'$
$R_c = 1409.85'$	
$S = 0.060 \text{ 1/ft.}$	
$M.D.S. = 60 \text{ m.p.h.}$	
$S.S.D. =$	

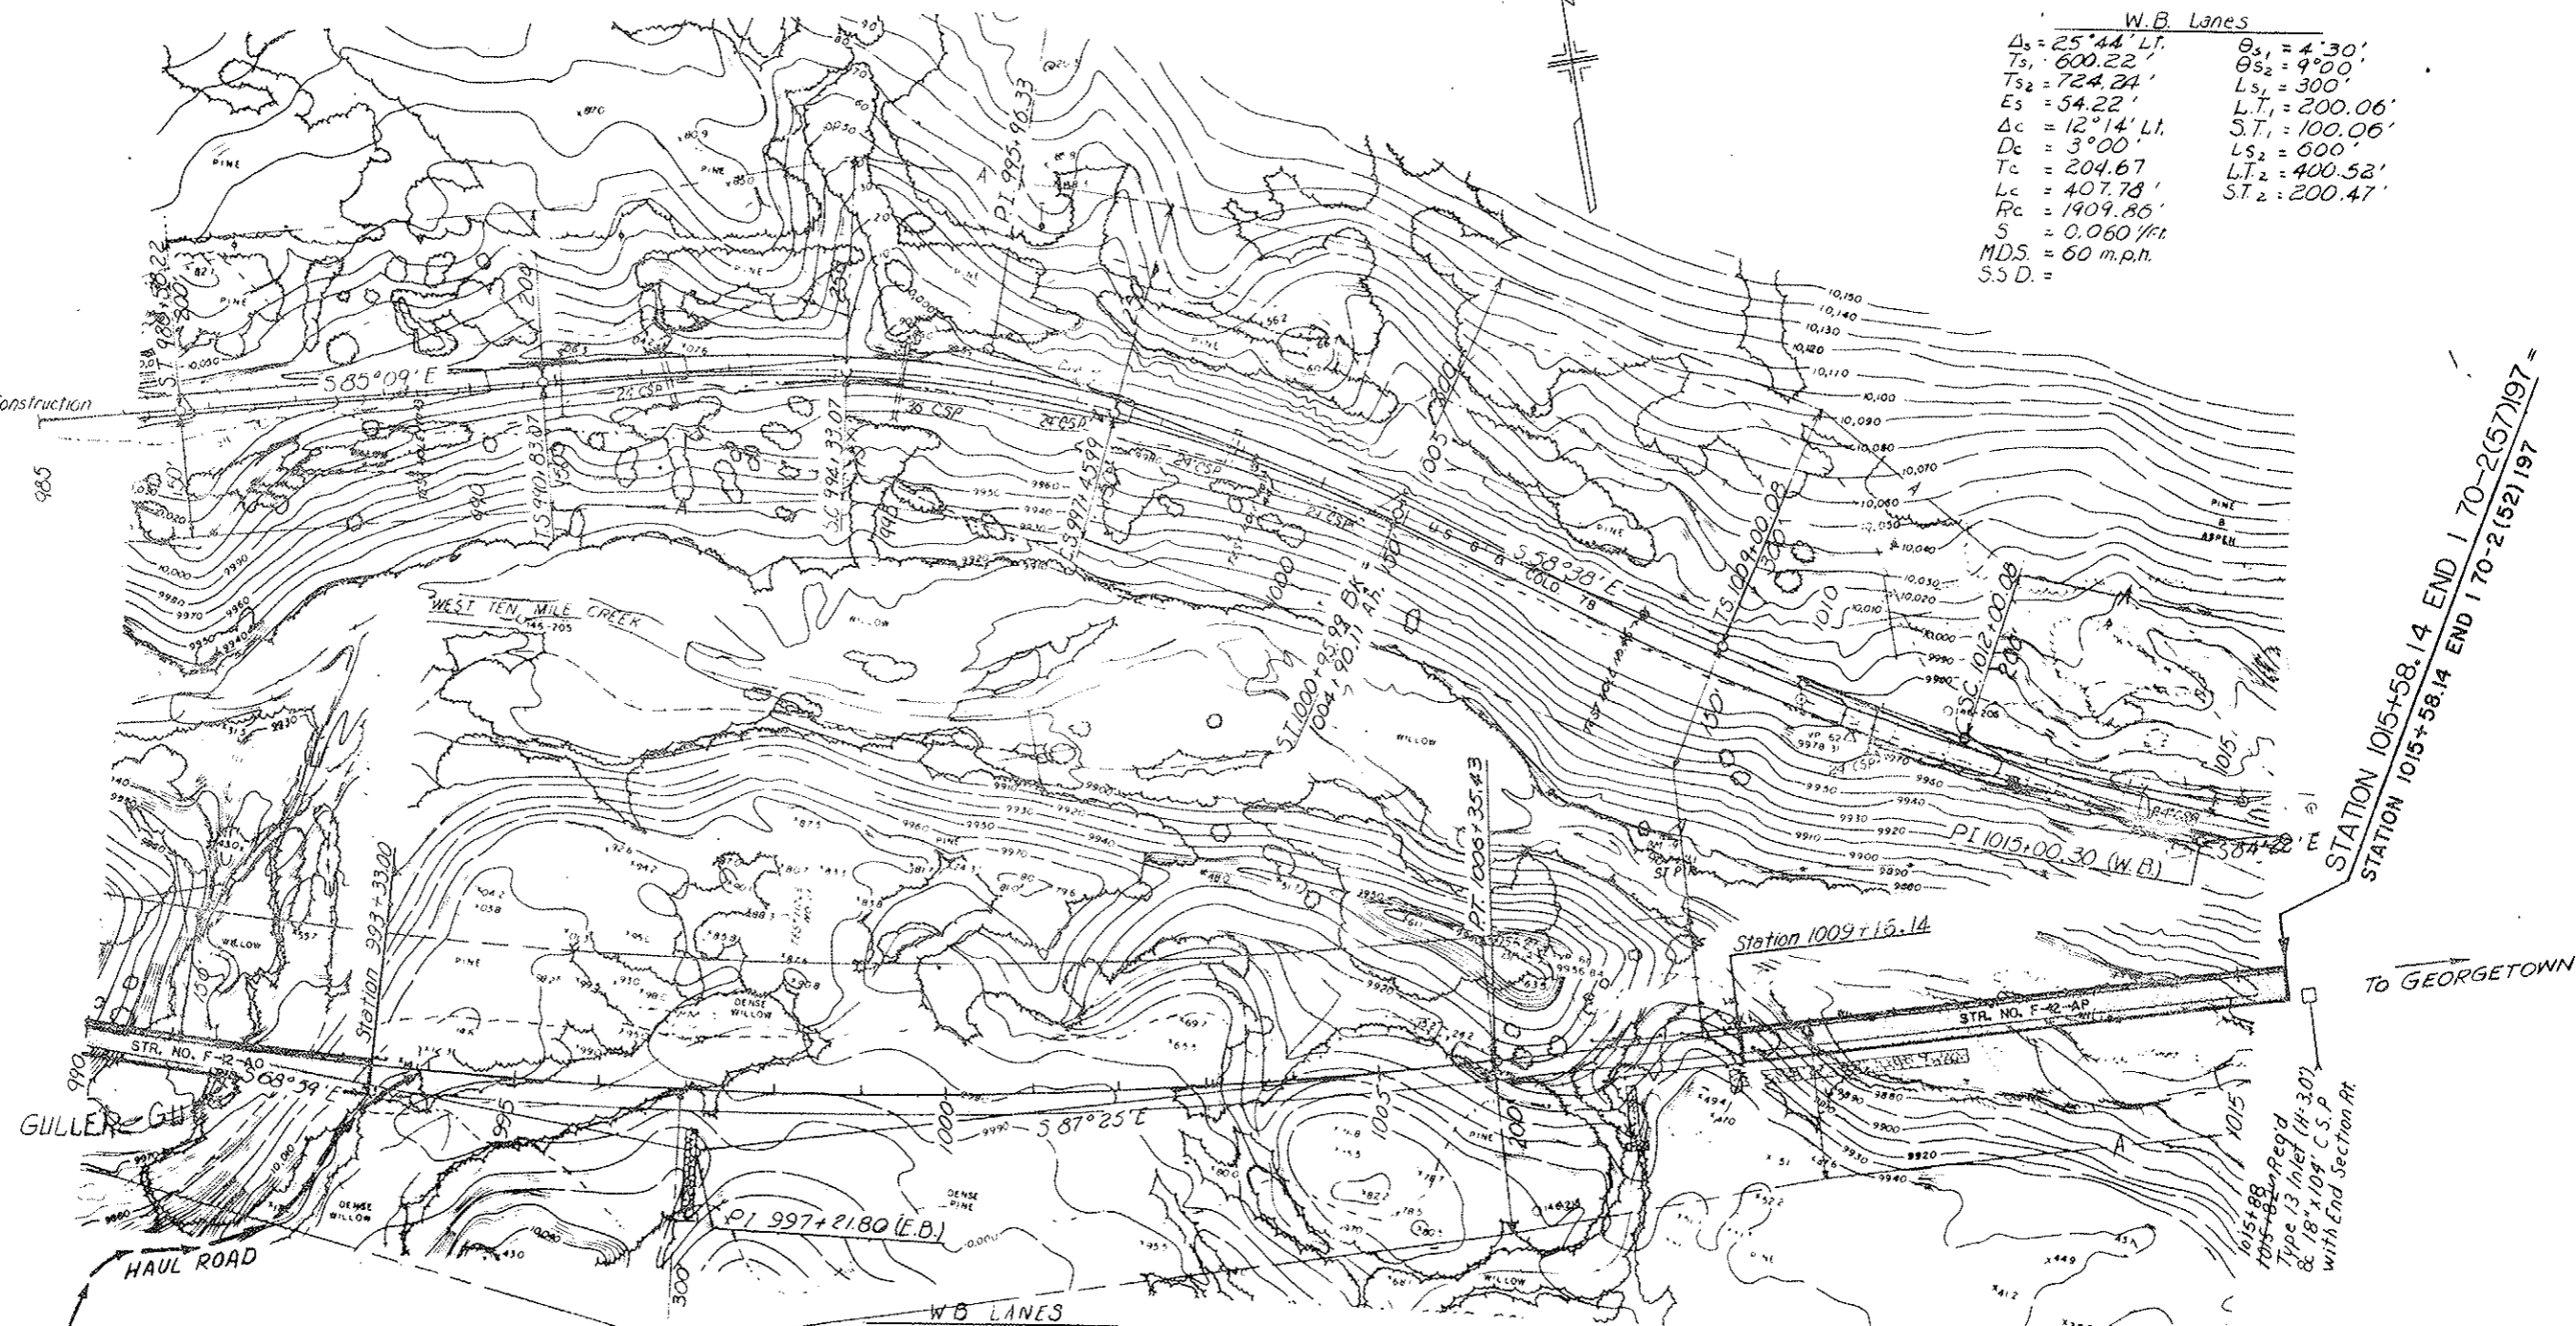

E.B. Lanes

$\Delta_c = 18^\circ 26' \text{ Lt.}$
$D_c = 1^\circ 00'$
$T_c = 929.70'$
$E_c = 74.94'$
$L_c = 1843.33'$
$R_c = 5729.58'$
$S = 0.047 \text{ 1/ft.}$
$M.D.S. = 80 \text{ m.p.h.}$
$S.S.D. = > 900'$

W.B. Lanes

$\Delta_s = 26^\circ 31' \text{ Rt.}$	$\theta_s = 7^\circ 00'$
$T_s = 513.26'$	$L_s = 350'$
$E_s = 42.90'$	$L.T. = 233.52'$
$\Delta_c = 12^\circ 31' \text{ Rt.}$	$S.T. = 116.83'$
$D_c = 4^\circ 00'$	
$T_c = 157.08'$	
$L_c = 312.92'$	
$R_c = 1432.39'$	
$S = 0.060$	
$M.D.S. = 60 \text{ mph}$	
$S.S.D. =$	

STATION 1015+58.14 END I 70-2(57)197
 STATION 1015+58.14 END I 70-2(52)197

TO GEORGETOWN

1015+88
 1015+88 Reg'd
 Type 13 Inlet (4'-3.0')
 & 18" x 104" C.S.P.
 with End Section Rt.

FEDERAL ROAD REGION NO.	DIVISION	PROJ. NO.	SHEET NO.	TOTAL SHEETS
XIII	COLORADO	170-2(57)197	28	33
AS CONSTRUCTED				
NO REVISIONS		1-31-78	REVISED	VOID

Test No. 22
 A-1-b(2)
 L.L. = NV
 P.T. = NV
 % 200 = 15.3
 R = 68

Test No. 23
 A-1-b(2)
 L.L. = 26
 P.T. = 3
 % 200 = 20
 R = 68

Test No. 24
 A-1-b(2)
 L.L. = NV
 P.T. = 19
 % 200 = 88
 R = 88

STATION 983+33.00 END BRIDGE

FASTBOUND

STR. NO. F-12-AD
 No. 22

-5.5938%

No. 23

PC 29.00

800' V.C.

PT 08.62

STATION 1015+38.14 END I 70-2(57)197
 STATION 1015+58.14 END I 70-2(52)197

Grate H: 057

0.20%


STR. NO. F-12-AD

PT 9007.42

PT 05.42

DATE	
BY	
CHECKED	

DATE	
BY	
CHECKED	
ORIGINAL SURVEY	
REPRODUCTION	
REPLACEMENT	
REVISIONS	
NO. AREAS CHECKED	

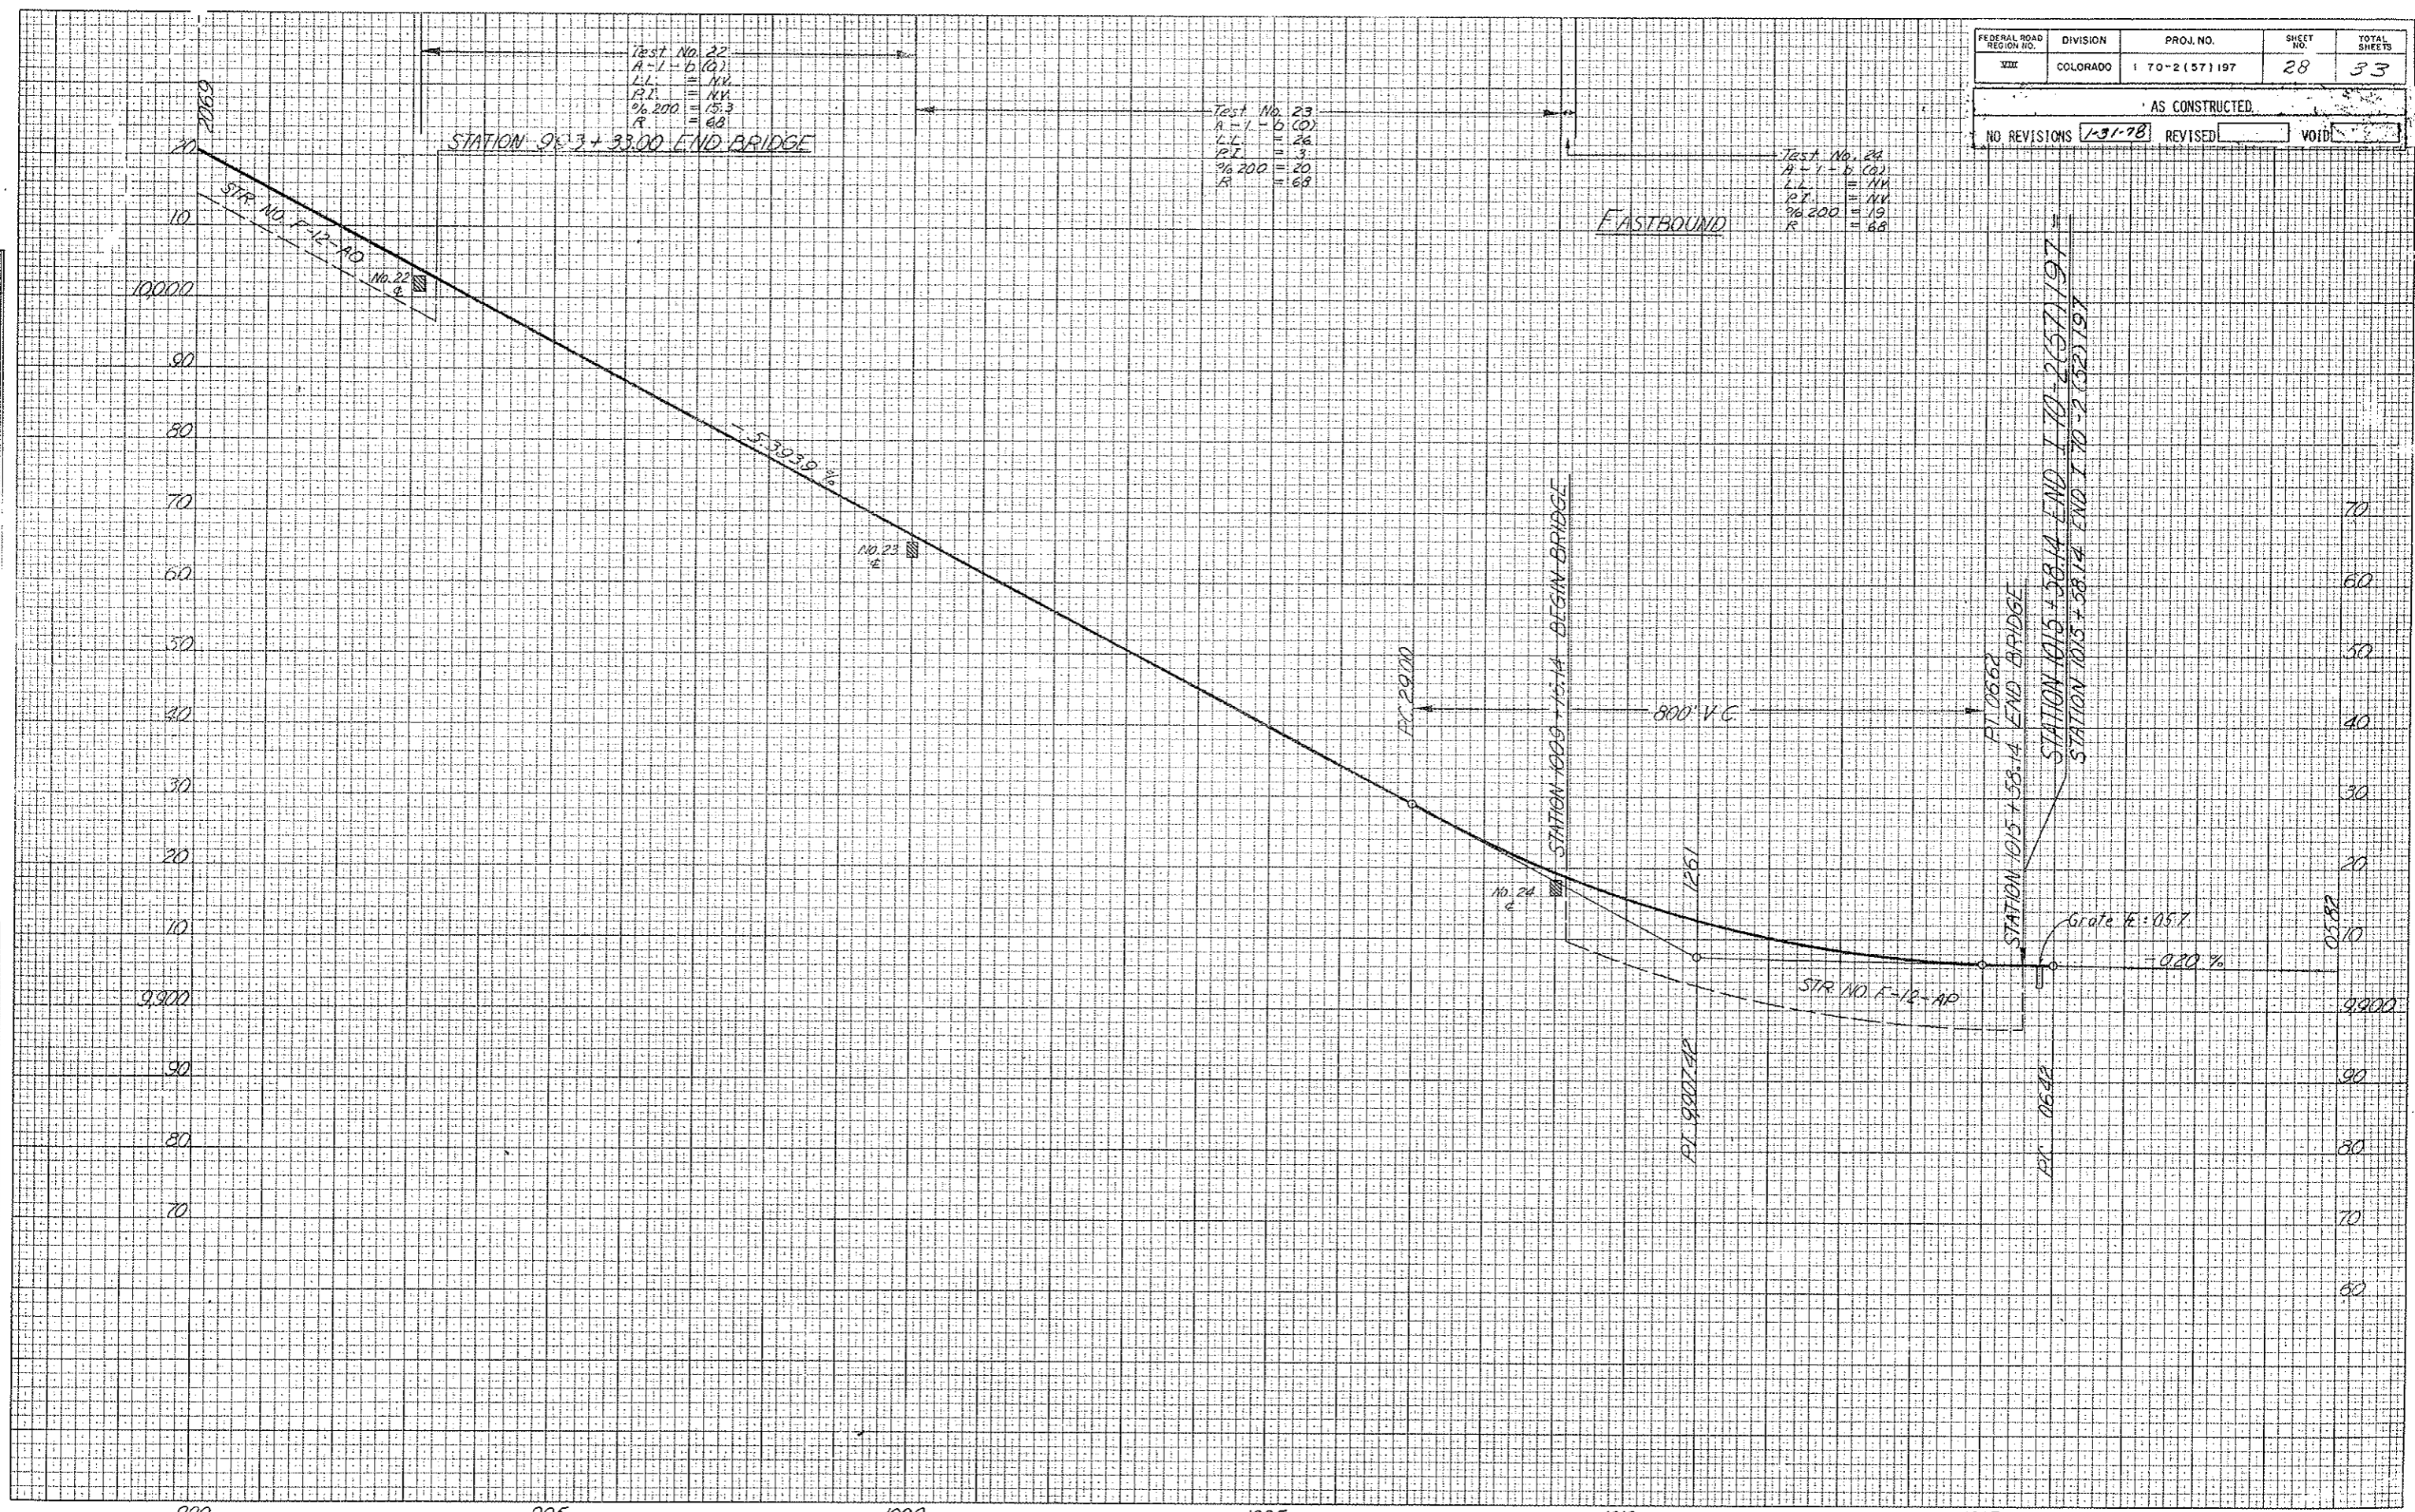

990

995

1000

K&E PLATE 3, CROSS SECTION/1005
 KEUFFEL & ESSER CO.

1010

1015

1020

NOTE: Projected line to be constructed.

W.B. LANES (SURV.)

$\Delta_2 = 27^{\circ}42' Lt$ $\theta_{s1} = 12^{\circ}00'$
 $T_{s1} = 640.5'$ $L_{s1} = 600'$
 $T_{s2} = 543.8'$ $LT = 400.9'$
 $\Delta_c = 8^{\circ}42' Lt$ $\theta_{s2} = 7^{\circ}00'$
 $D_c = 4^{\circ}00'$ $L_{s2} = 350'$
 $T_c = 109.0'$ $LT_2 = 233.5'$
 $L_c = 217.5'$ $ST_2 = 116.8'$
 $R_c = 1432.4'$
 $S = 0.079$
 $MDS = 65 \text{ mph}$
 $SSD =$

W.B. PROJ.

$\Delta_s = 31^{\circ}30' Lt$ $\theta_{s1} = 11^{\circ}00'$
 $T_{s1} = 671.1$ $L_{s1} = 550$
 $T_{s2} = 589.9'$ $LT_1 = 367.4$
 $\Delta_c = 13^{\circ}30' Lt$ $\theta_{s2} = 7^{\circ}00'$
 $D_c = 4^{\circ}00'$ $L_{s2} = 350'$
 $T_c = 169.5'$ $LT_2 = 233.5$
 $L_c = 337.5'$ $ST_2 = 116.8$
 $R_c = 1432.4'$
 $e = .000 \text{ 1/ft}$
 $MDS = 65 \text{ mph}$
 $SSD = 844'$

E.B. PROJ.

$\Delta_s = 26^{\circ}51' Lt$
 $T_s = 541.3$
 $E_s = 48.4$
 $\Delta_c = 16^{\circ}21' Lt$
 $D_c = 3^{\circ}30'$
 $T_c = 235.2$
 $L_c = 467.1'$
 $R_c = 1637.0'$
 $e = .073 \text{ 1/ft}$
 $MDS = 70 \text{ mph}$
 $SSD = 657'$

E.B. LANE (SURV.)

$\Delta = 27^{\circ}43'31" Lt$
 $T_s = 554.5'$
 $\Delta_c = 17^{\circ}33' Lt$
 $D_c = 3^{\circ}30'$
 $T_c = 248.0'$
 $L_c = 492.2'$
 $R_c = 1637.0'$
 $S = 0.080 \text{ 1/ft}$
 $MDS = 70 \text{ mph}$
 $SSD =$


$\theta_s = 5^{\circ}15'$
 $L_s = 300'$
 $LT = 200.1'$
 $ST = 100.1'$

FEDERAL ROAD REGION NO.	DIVISION	PROJ. NO.	SHEET NO.	TOTAL SHEETS
V:11	COLORADO	170-2157197	29	33

AS CONSTRUCTED

NO REVISIONS 1-31-78 REVISED VOID

Sta 1015+82 Prop'd Type 13
 Inlet (H=3.0' @ 18" x 104" C.S.P.
 with End Section, Pt

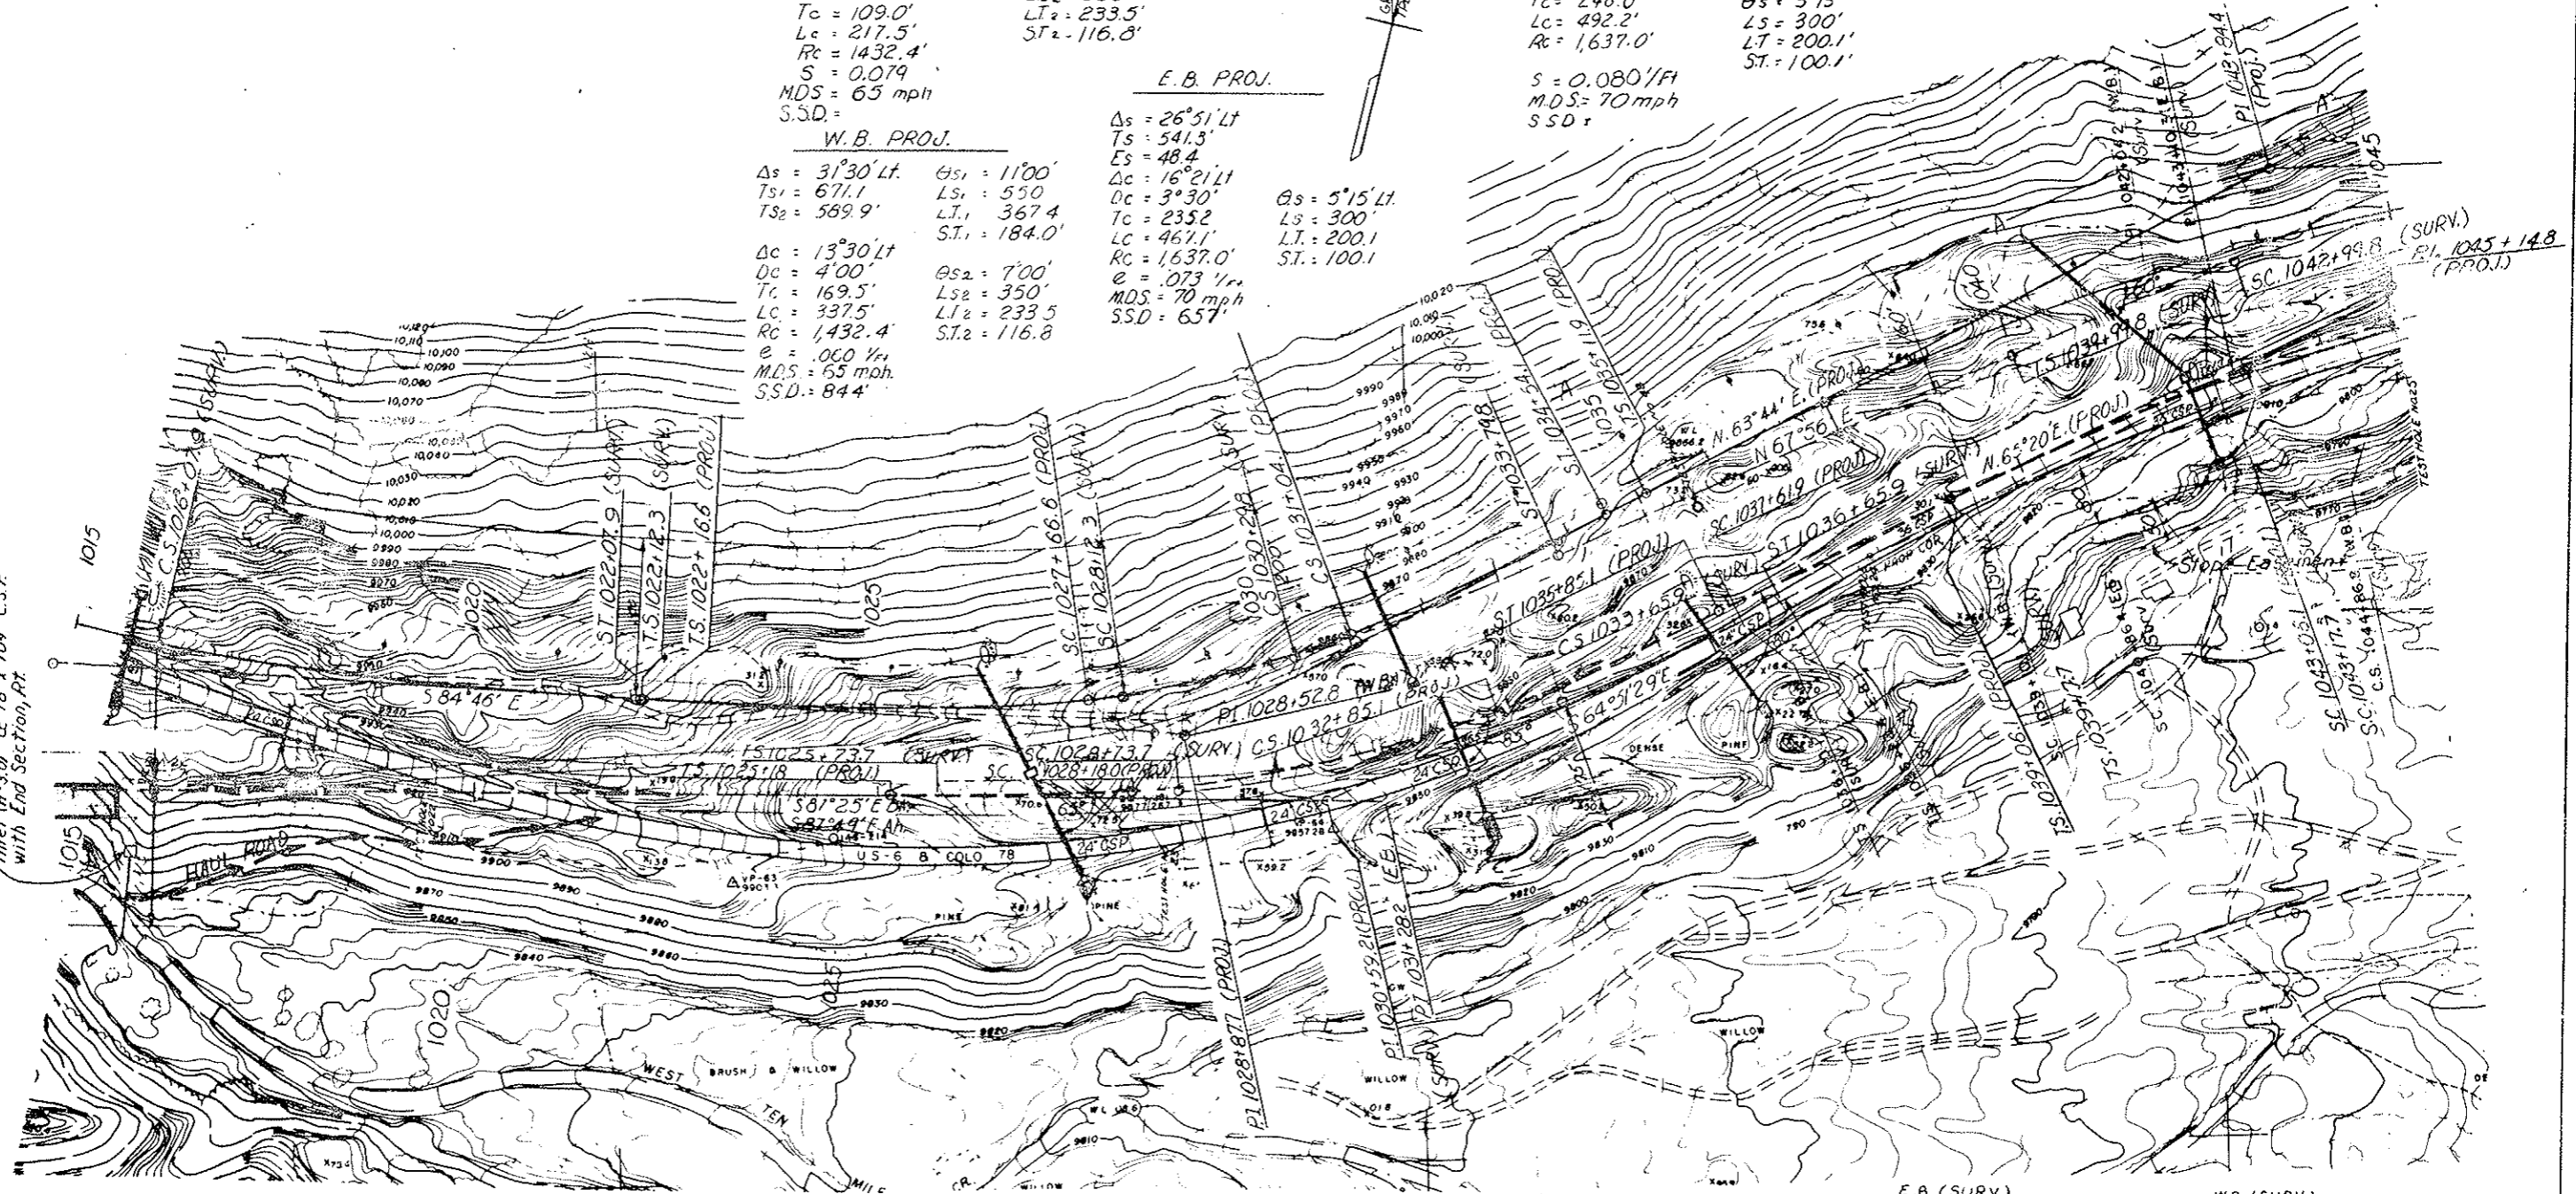

E.B (SURV)
 $\Delta = 24^{\circ}59'31"$ $\theta_s = 6^{\circ}00'$
 $T_s = 624.0$ $L_s = 400'$
 $\Delta_c = 12^{\circ}59'31"$ $LT = 266.8'$
 $D_c = 3^{\circ}00'$ $ST = 133.5'$
 $T_c = 216.9'$
 $L_c = 433.1'$
 $R_c = 1909.9'$
 $S = 0.077$
 $MDS = 70 \text{ MPH}$
 $SSD =$

WB (SURV)
 $\Delta = 21^{\circ}55'$ $\theta_s = 3^{\circ}45'$
 $T_s = 594.1'$ $L_s = 300'$
 $\Delta_c = 14^{\circ}25'$ $LT = 200.0'$
 $D_c = 2^{\circ}30'$
 $T_c = 289.9'$
 $L_c = 576.7'$
 $R_c = 2291.8'$
 $S = 0.069$
 $MDS = 70 \text{ MPH}$
 $SSD =$