



* 6' 6" MIN. IF RIPRAP IS ON 10% OR STEEPER GRADE

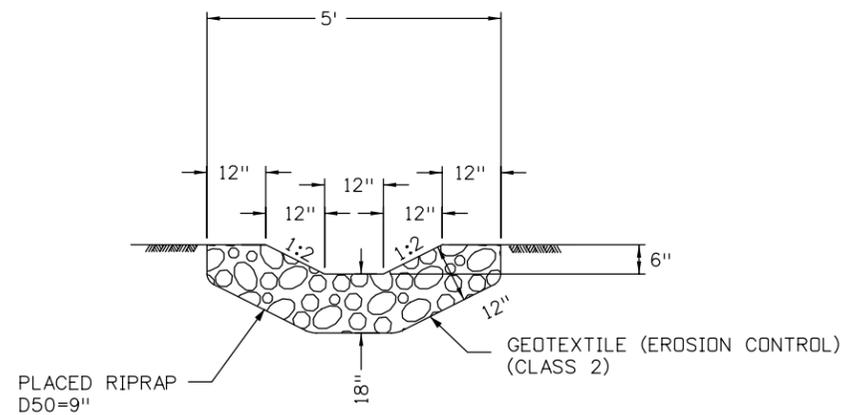

RIPRAP RUNDOWN

APPROXIMATE STATION: 725+03 AND 733+67
FHWA DETAIL CM608-50

4 #4 BARS ALL AROUND
8 #4 BARS, EQUALLY SPACED

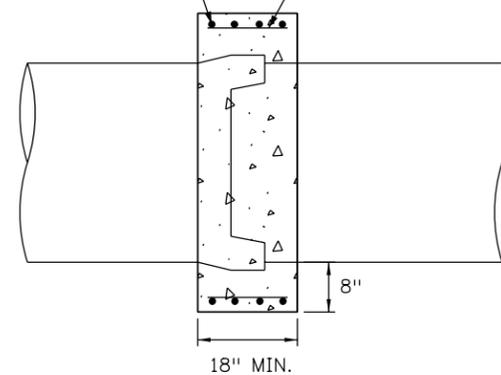

CONCRETE COLLARS

NOTES FOR CONCRETE COLLARS:

1. DIMENSIONS ARE MINIMUM. COLLAR MAY BE SQUARE, ROUND OR SHAPE MAY VARY SO LONG AS MINIMUM DIMENSIONS ARE OBTAINED.
2. ALL CONCRETE COLLARS ARE TO BE CONSTRUCTED WITH SPECIAL TYPE V CONCRETE.
3. ALL REINFORCEMENT SHALL MAINTAIN A 2" MINIMUM CLEARANCE.

12244 2:11:30 PM S:\Tranproj\100002375\14679\Consultants\Hydraulics\Drawings\14679_dDD-001.dgn

Print Date: 1/15/2010
File Name: 14679_dDD-001.dgn
Horiz. Scale: N/A Vert. Scale: N/A

| Sheet Revisions | | |
|-----------------|----------|-------|
| Date: | Comments | Init. |
| | | |
| | | |
| | | |

Colorado Department of Transportation
8833 South Wadsworth Court
Littleton, CO 80128
Phone: 303-972-9112 FAX: 303-972-9114
Region 6 RLB

| |
|----------------|
| As Constructed |
| No Revisions: |
| Revised: |
| Void: |



| DRAINAGE DETAILS | | | |
|------------------|----------|-------------------|--------|
| Designer: | AJF | Structure Numbers | |
| Detailer: | AJF | | |
| Sheet Subset: | DRAIN DE | Subset Sheets: | 1 of 3 |

| | |
|------------------|--------------|
| Project No./Code | ES6 0852-103 |
| | 17679 |
| Sheet Number | 90 |



CONSTRUCTION NOTES:



1. CONSTRUCTION OF THE TRENCH SHOULD TAKE PLACE AFTER THE SITE HAS BEEN STABILIZED.
2. SILT FENCE SHOULD BE PLACED AROUND THE PERIMETER OF THE TRENCH DURING ALL PHASES OF CONSTRUCTION.
3. HEAVY EQUIPMENT SHOULD NOT OPERATE ON THE SURFACE OF THE TRENCH LOCATION TO AVOID COMPACTION OF TRENCH MEDIA AND SURROUNDING SOILS.
4. DURING CONSTRUCTION OF THE TRENCH ONLY LIGHT EQUIPMENT SHOULD BE USED TO MINIMIZE COMPACTION OF THE TRENCH FLOOR AND SIDESLOPES THAT REDUCES THE PERCOLATION CAPACITY.
5. TRENCH SHOULD NOT BE USED AS A TEMPORARY SEDIMENT TRAP DURING CONSTRUCTION.

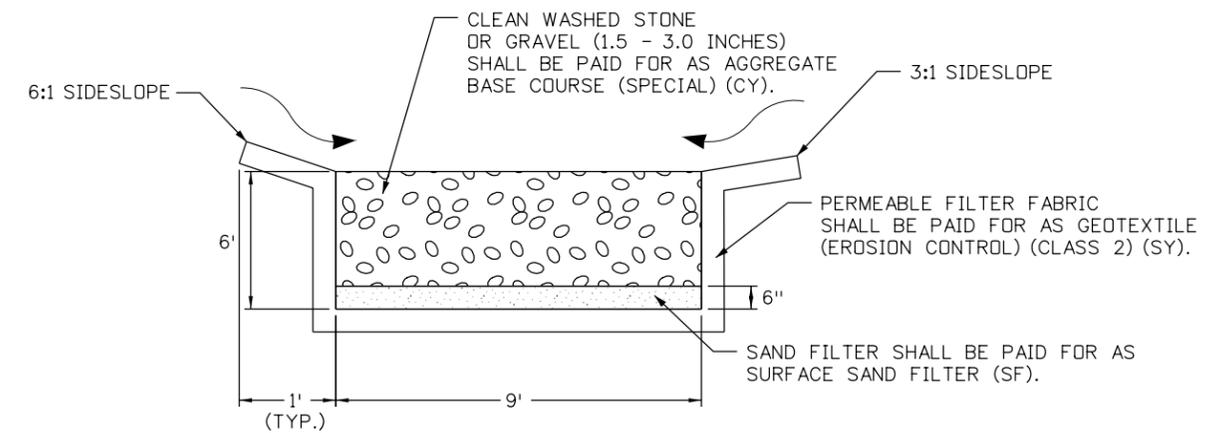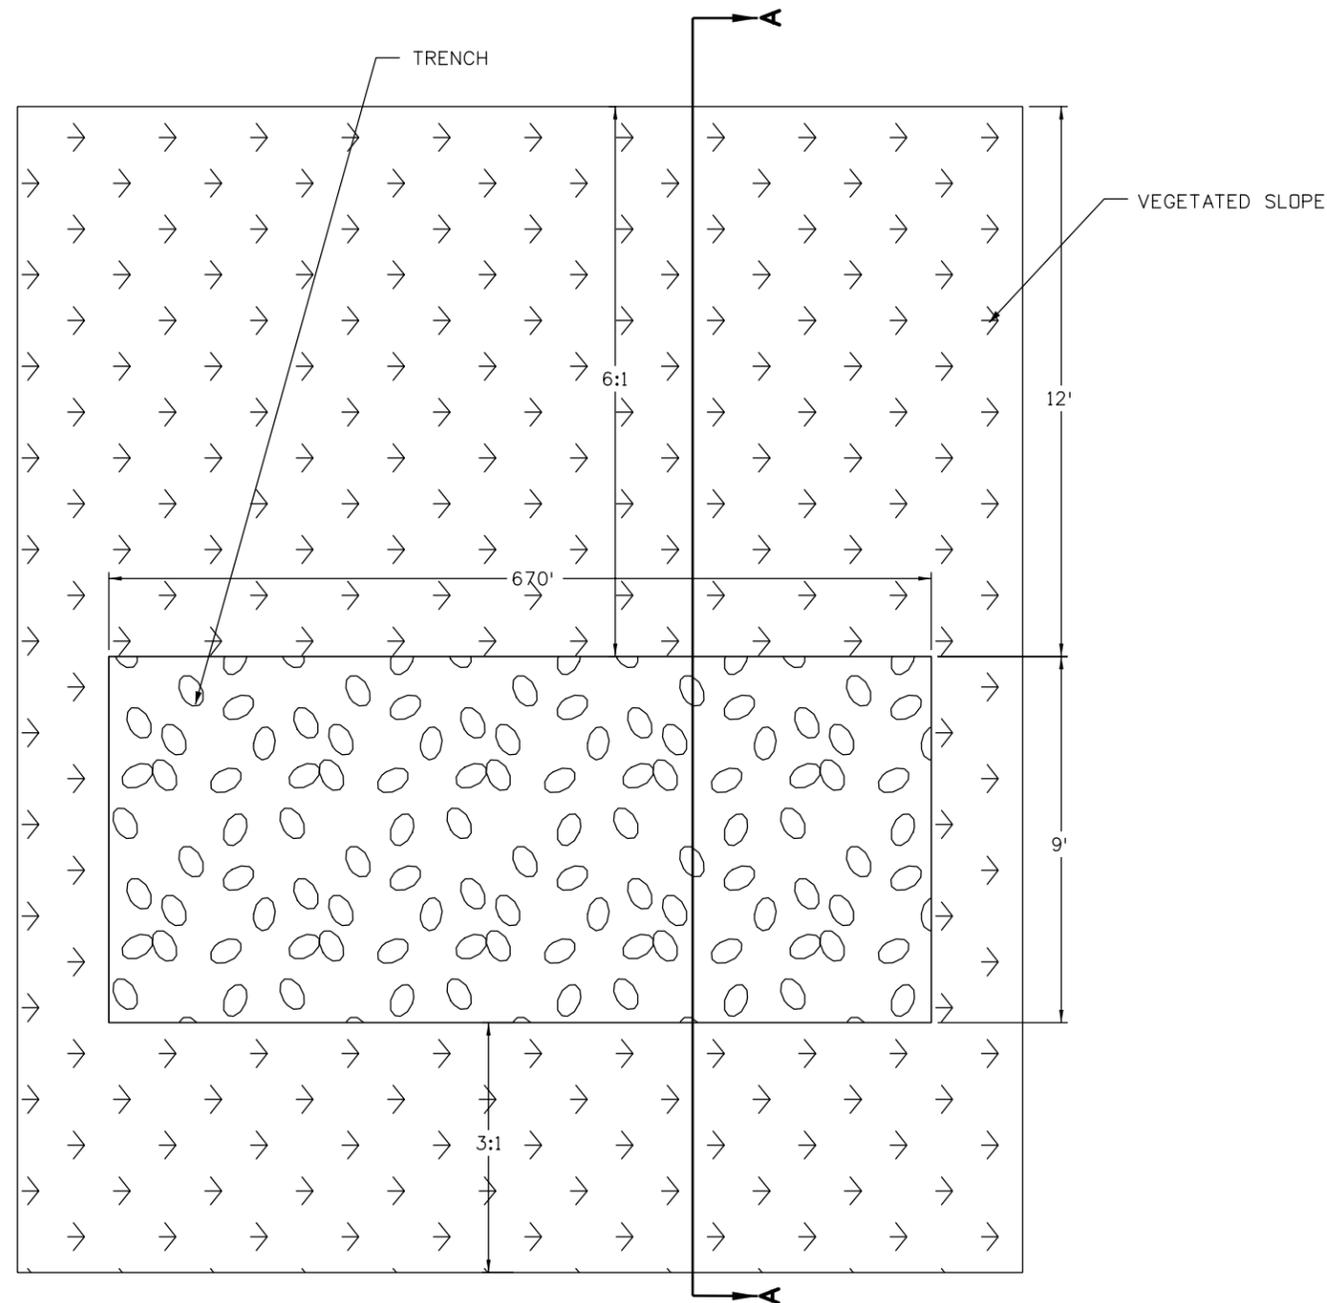




SECTION A - A

**PLAN VIEW
(NOT TO SCALE)**


| | | | | | | | | | | |
|---|------|------------------------|-----------|-------|--|-----------------------|---------------------------------------|--------------------|--|-------------------------|
| Print Date: 1/15/2010 | 0000 | Sheet Revisions | | | Colorado Department of Transportation  8833 South Wadsworth Court Littleton, CO 80128 Phone: 303-972-9112 FAX: 303-972-9114 Region 6 | As Constructed | INFILTRATION TRENCH DETAIL | | | Project No./Code |
| File Name: 14679_dDD-002.dgn | | Date: | Comments: | Init. | | No Revisions: | | | | ES6 0852-103 |
| Horiz. Scale: N/A Vert. Scale: N/A | | | | | | Revised: | Designer: AJF | Structure Numbers: | | 17679 |
|  4601 DTC Boulevard Suite 700 Denver, CO 80237 | | | | | Detailer: AJF | Subset Sheets: 2 of 3 | | Sheet Number 91 | | |

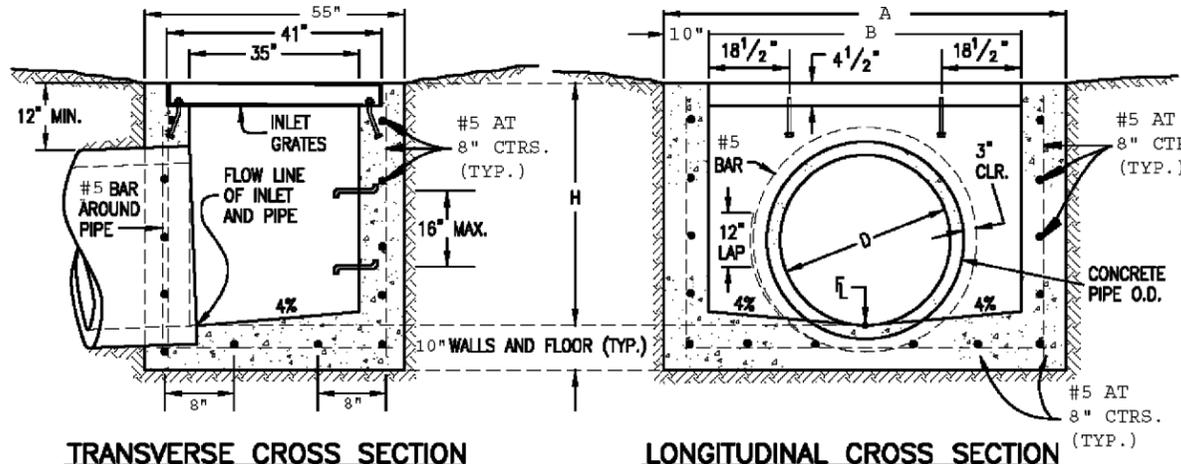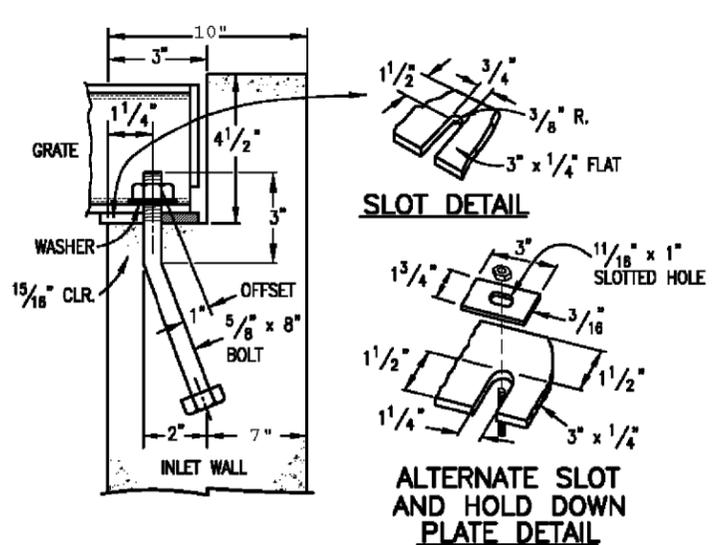

- GENERAL NOTES**
1. CONCRETE SHALL BE CLASS B. INLET MAY BE CAST-IN-PLACE OR PRECAST.
 2. SEE PLANS FOR SIZE AND LOCATION OF PIPE.
 3. STRUCTURAL STEEL FOR GRATES AND GRATE INSTALLATION HARDWARE SHALL BE GALVANIZED AND SHALL BE IN ACCORDANCE WITH SUBSECTION 712.06.
 4. STEPS SHALL BE PROVIDED WHEN INLET DIMENSION "H" IS EQUAL TO OR GREATER THAN 3 FT.-6 IN. AND SHALL CONFORM WITH AASHTO M 199.
 5. REINFORCING BARS SHALL BE EPOXY COATED AND DEFORMED #5 AND SHALL HAVE A 2 IN. MIN. CLEARANCE MEASURED FROM THE INSIDE FACE OF INLET. CUT OR BEND BARS AROUND PIPE AS REQUIRED.

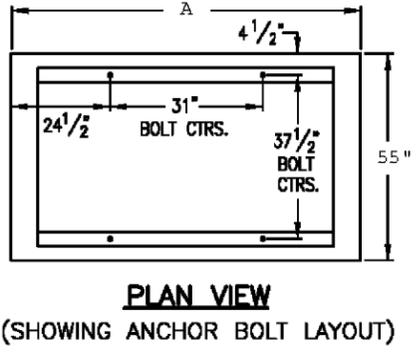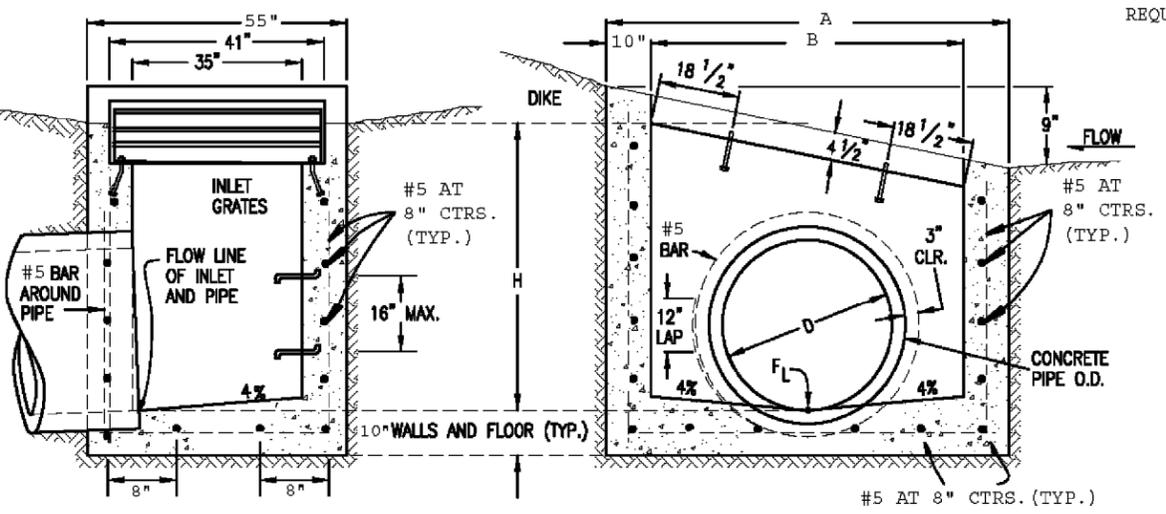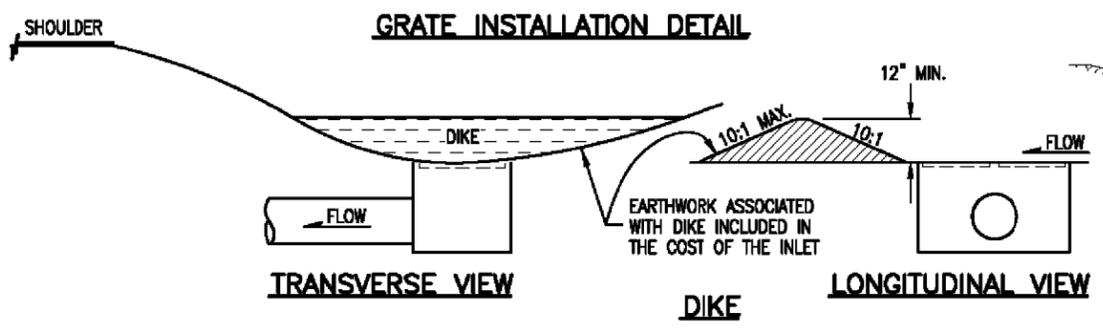

| | INSIDE DIA., IN. | |
|---|------------------|-----------|
| | 42" | 60" X 38" |
| A | 88" | 116" |
| B | 68" | 96" |

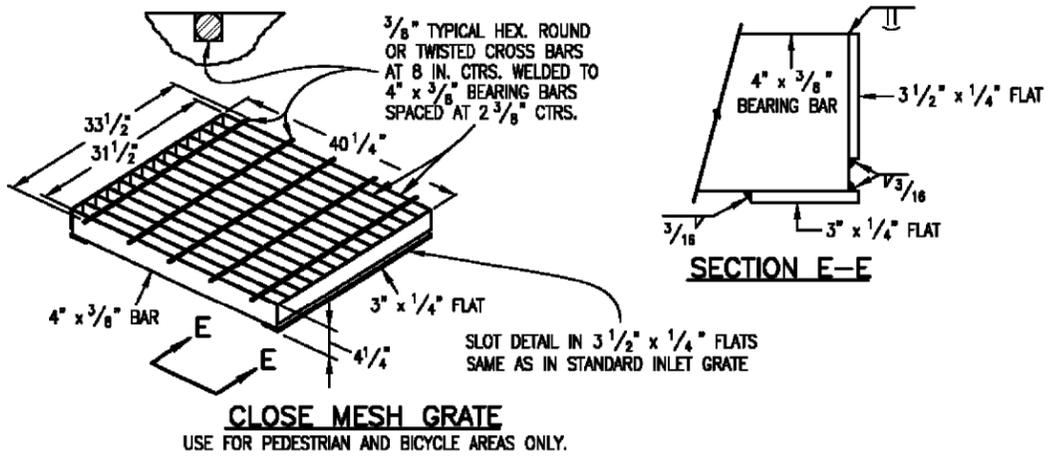


| "H" FT. | CONCRETE CU. YDS. | STEEL LBS. | WIDTH OF INLET | INSIDE DIA., IN. - "D" |
|---------|-------------------|------------|----------------|------------------------|
| 10 | 9 | 1009 | 116" | 60 X 38 |
| 11 | 8 | 924 | 88" | 42 |

CONCRETE AND STEEL QUANTITIES ARE FOR ONE ENTIRE INLET BEFORE DEDUCTION FOR VOLUME OCCUPIED BY PIPE. WEIGHT OF STEEL INCLUDES A RING FOR THE MAXIMUM PIPE DIAMETER.

QUANTITIES FOR ONE INLET

* UNDER STRUCTURAL REVISIONS

| | | | | | | | | | | |
|---|------------------------|-----------|-------|--|----------------|--|--|--|-----------------------|-----------------|
| Print Date: 1/6/2010 | Sheet Revisions | | | Colorado Department of Transportation | As Constructed | SPECIAL TYPE D INLET DETAIL | | | Project No./Code | |
| File Name: 14679_dDD-003.dgn | Date: | Comments: | Init. | 8833 South Wadsworth Court Littleton, CO 80128 Phone: 303-972-9112 FAX: 303-972-9114 | No Revisions: | Designer: TYK Detailer: SDH Sheet Subset: DRAIN DE | | | ES6 0852-103 | |
| Horiz. Scale: N/A | | | | | Revised: | | | | Structure Numbers | 17679 |
| Vert. Scale: N/A | | | | | Void: | | | | Subset Sheets: 3 of 3 | Sheet Number 92 |
| 4601 DTC Boulevard Suite 700 Denver, CO 80237 | | | | Region 6 | RLB | | | | | |

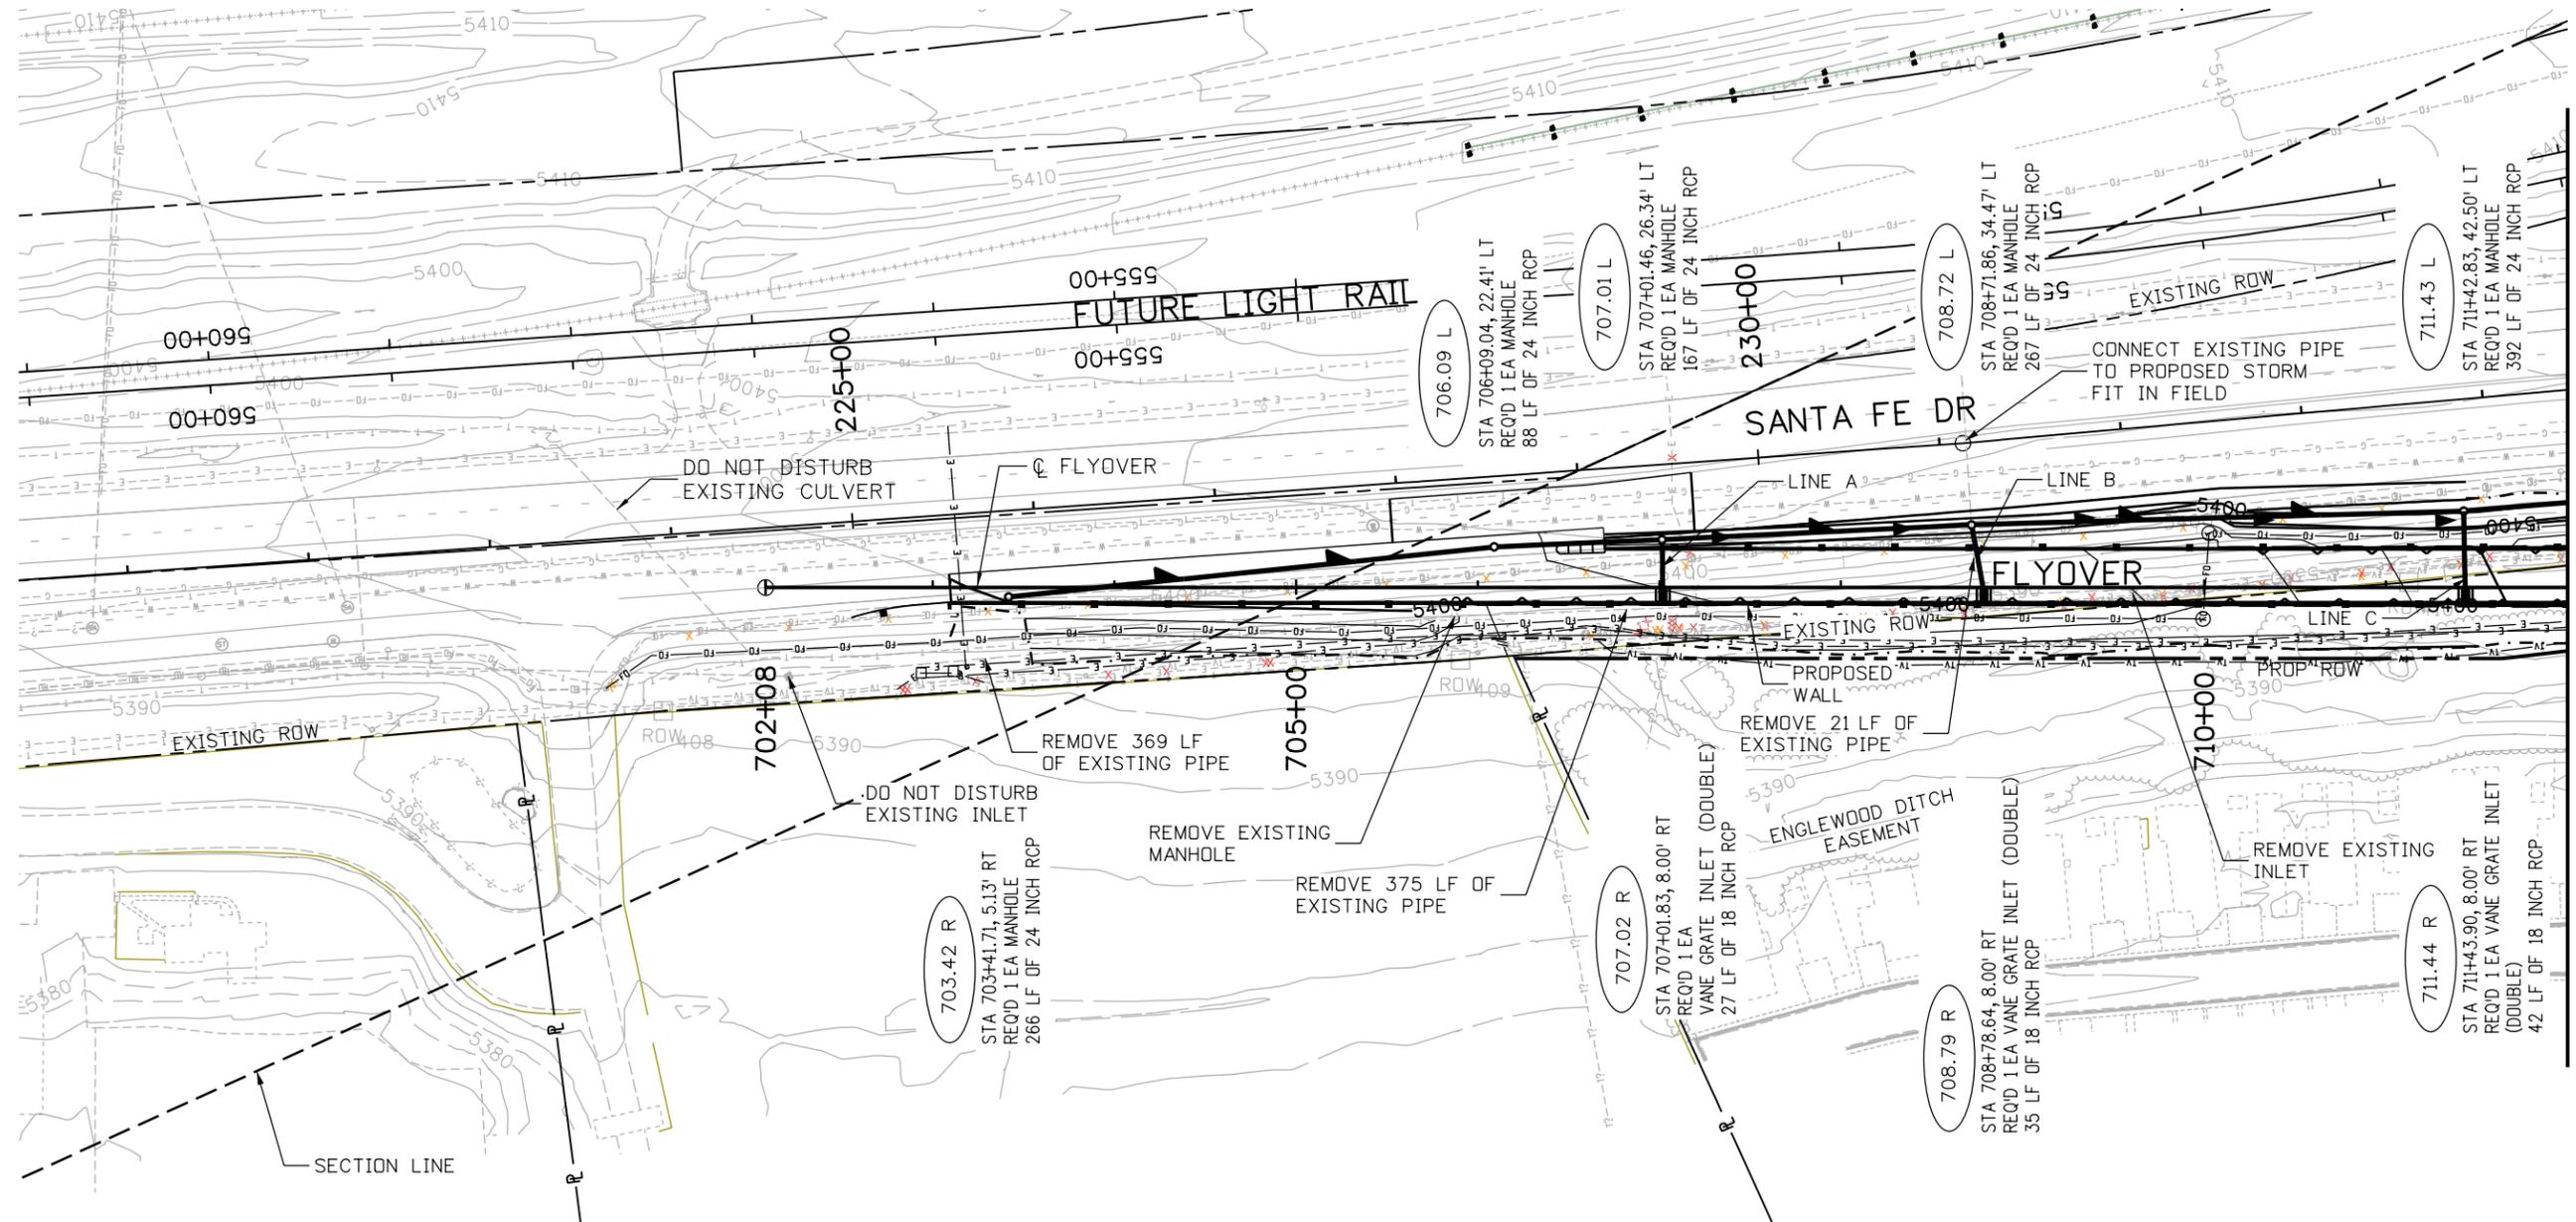

NOTES:



1. FROM EDGE OF ROADWAY TO DOUBLE VANE GRATE, GRADE APRON TO TRANSITION TO MATCH ROADWAY CROSS SLOPE
2. CLASS III CONCRETE PIPE PER ASTM C76 IS TO BE USED UNLESS OTHERWISE NOTED. ALL CONCRETE IS TO MEET A CLASS II SULFATE RESISTANCE LEVEL.
3. SEE WALL PLANS FOR INLET DETAILS.
4. USE CLOSE MESH GATE FOR TYPE C AND TYPE D INLETS UNLESS INDICATED.



MATCH LINE STA 712+00

12244 3:42:39 PM S:\Tranpro\100002375\14679\Consultants\Hydraulics\Drawings\14679_pDD-P701.dgn

| | | | | | | | | | | |
|---|------------------------|----------|-------|--|------------|------------------------|----------------------|-----------------------|-------------------------|--|
| Print Date: 1/6/2010 | Sheet Revisions | | | Colorado Department of Transportation | | As Constructed | DRAINAGE PLAN | | Project No./Code | |
| File Name: 14679_pDD-P701.dgn | Date: | Comments | Init. | 8833 South Wadsworth Court Littleton, CO 80128 Phone: 303-972-9112 FAX: 303-972-9114 | | No Revisions: | FLYOVER | | ES6 0852-103 | |
| Horiz. Scale: 1:100 Vert. Scale: As Noted | | | | | | Revised: | Designer: AJF | Structure Numbers | 17679 | |
| 4601 DTC Boulevard Suite 700 Denver, CO 80237 | | | | | | Void: | Detailer: AJF | | Sheet Number 93 | |
| | | | | Region 6 | RLB | Sheet Subset: DRAIN PL | | Subset Sheets: 1 of 6 | | |

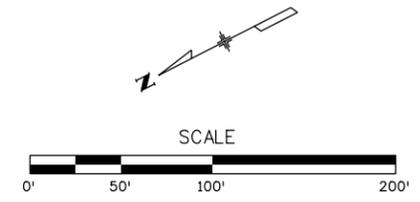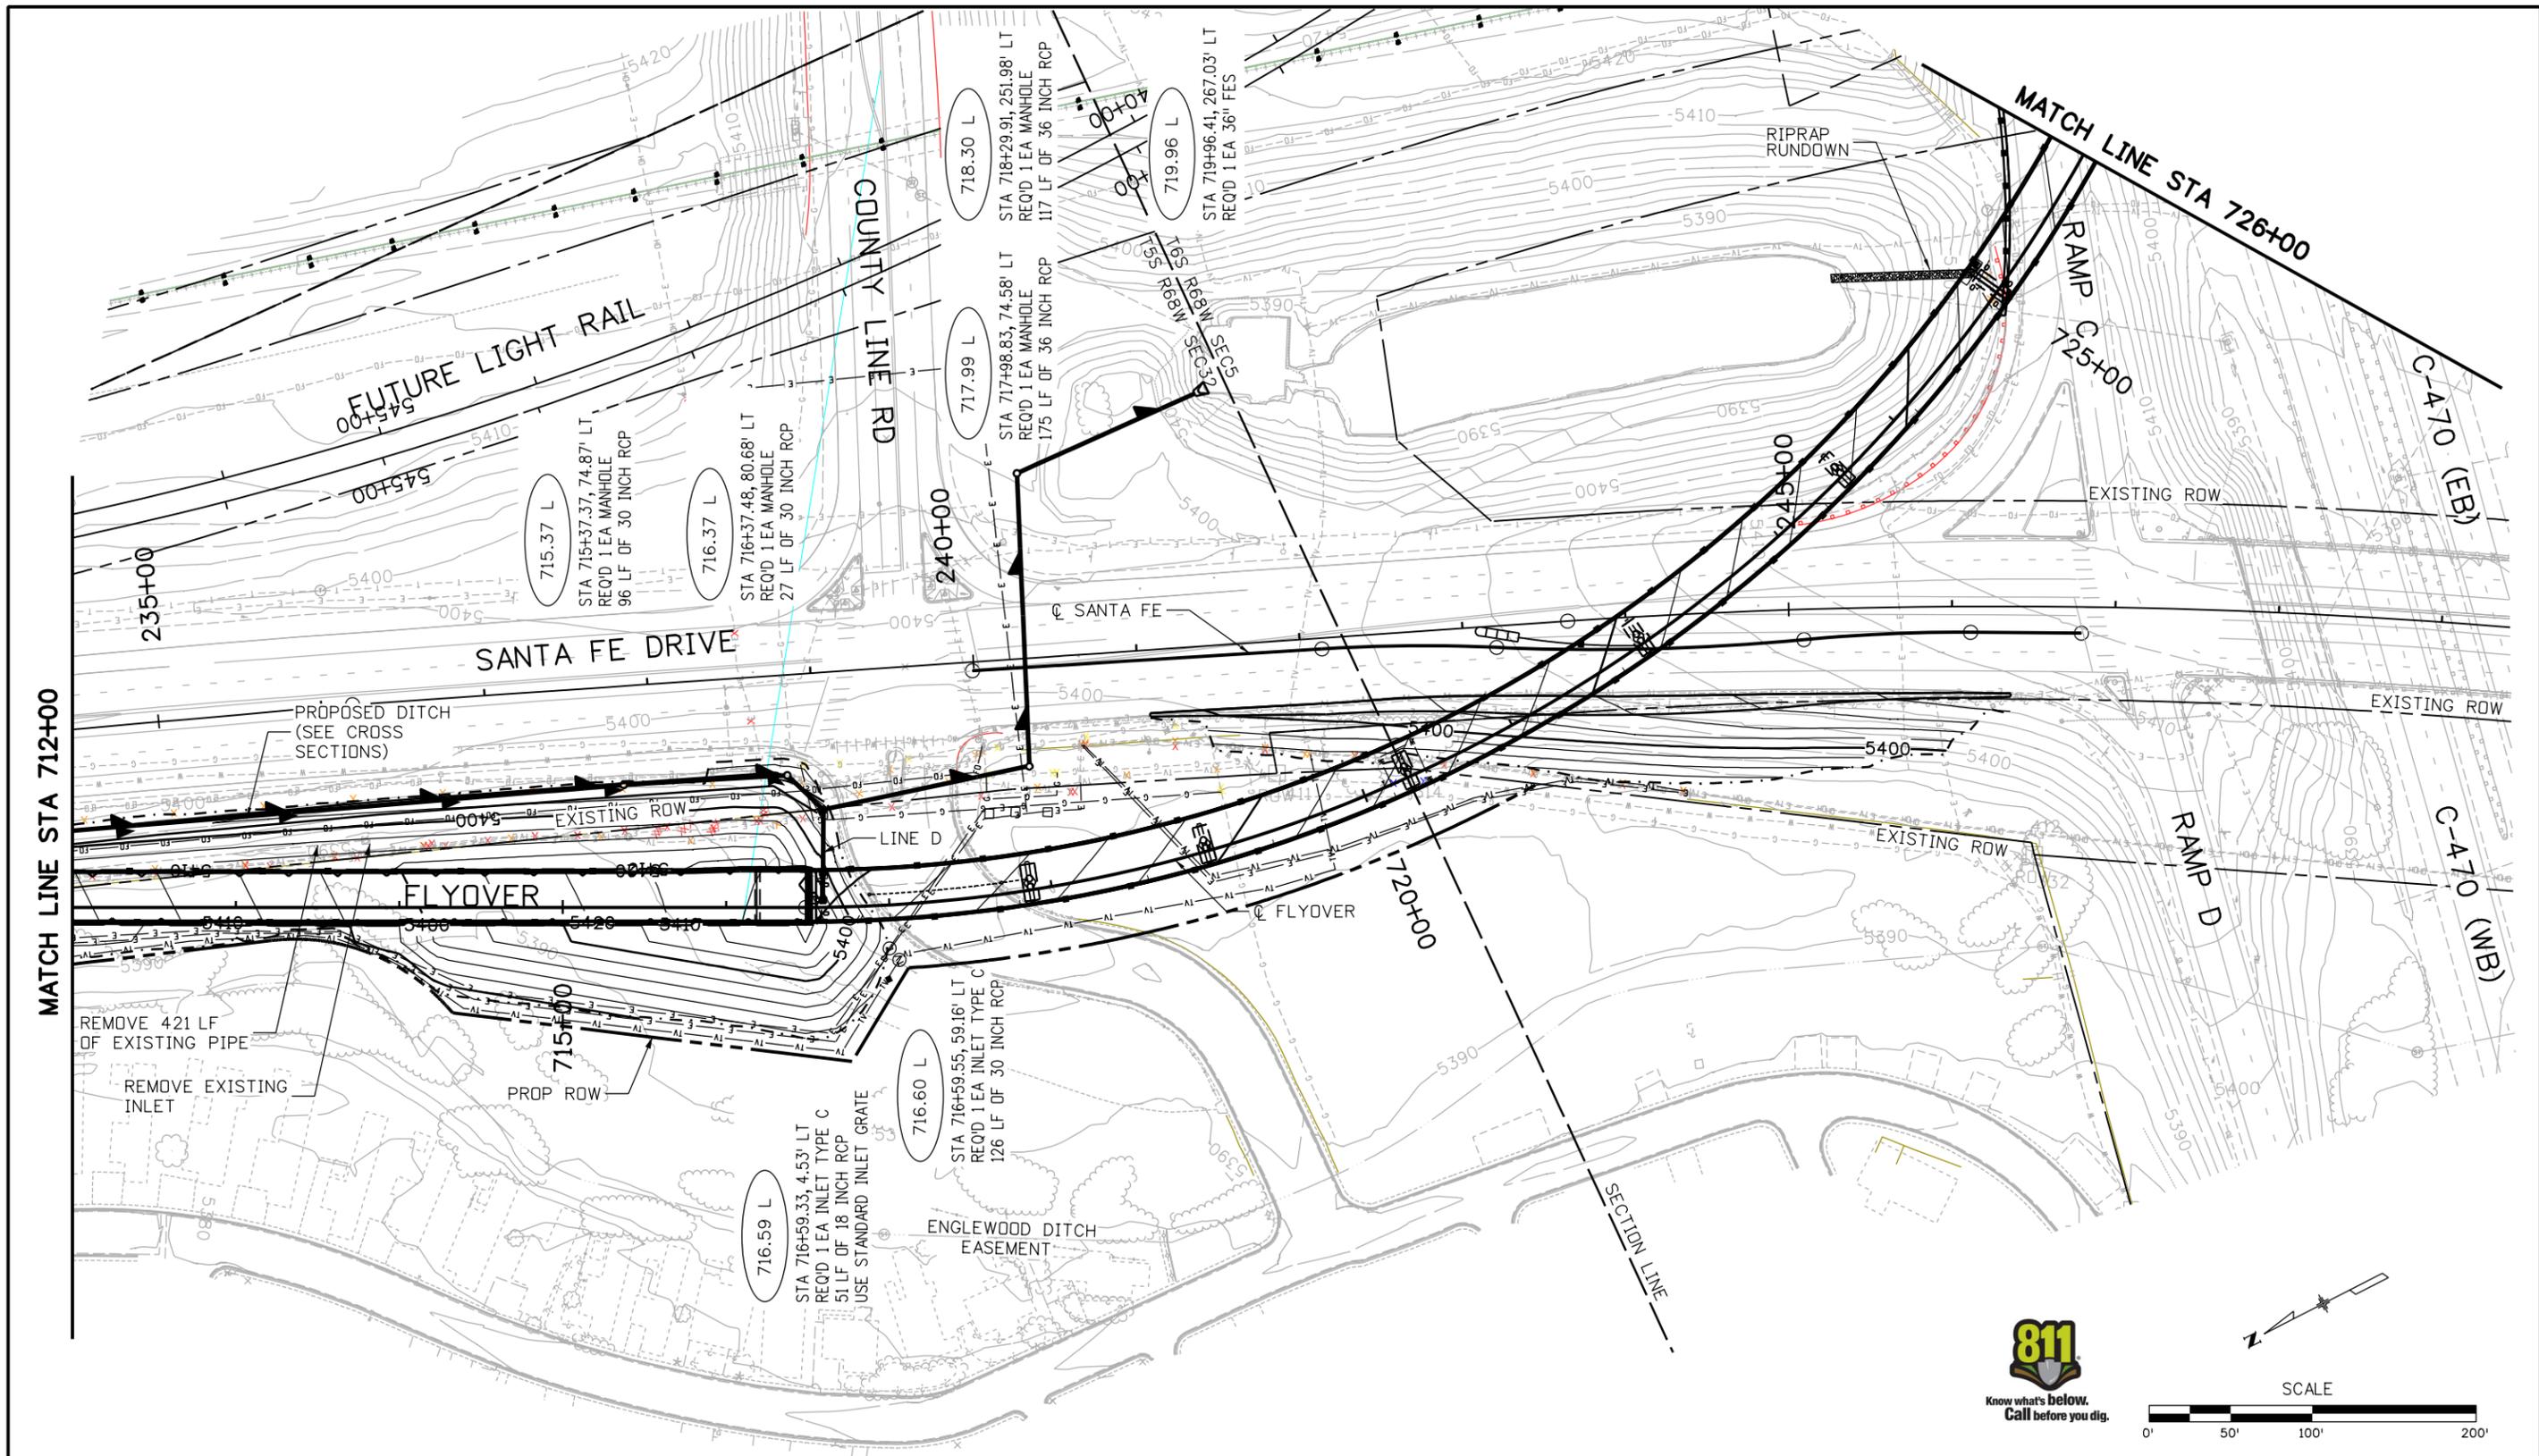

Print Date: 1/6/2010
 File Name: 14679_pdD-P702.dgn
 Horiz. Scale: 1:100 Vert. Scale: As Noted

| Sheet Revisions | | |
|-----------------|----------|-------|
| Date: | Comments | Init. |
| | | |
| | | |

Colorado Department of Transportation

 8833 South Wadsworth Court
 Littleton, CO 80128
 Phone: 303-972-9112 FAX: 303-972-9114
 Region 6 RLB



As Constructed
 No Revisions:
 Revised:
 Void:

DRAINAGE PLAN
FLYOVER
 Designer: AJF
 Detailer: AJF
 Sheet Subset: DRAIN PL Subset Sheets: 2 of 6

Project No./Code
 ES6 0852-103
 17679
 Sheet Number 94

12244 3:42:57 PM S:\Tranpro\100002375\14679\Consultants\Hydraulics\Drawings\14679_pdB-P702.dgn

12244 3:46:53 PM S:\Trampro\100002375\14679\Consultants\Hydraulics\Drawings\14679_pDD-P703.dgn

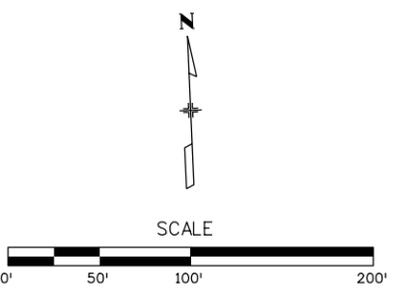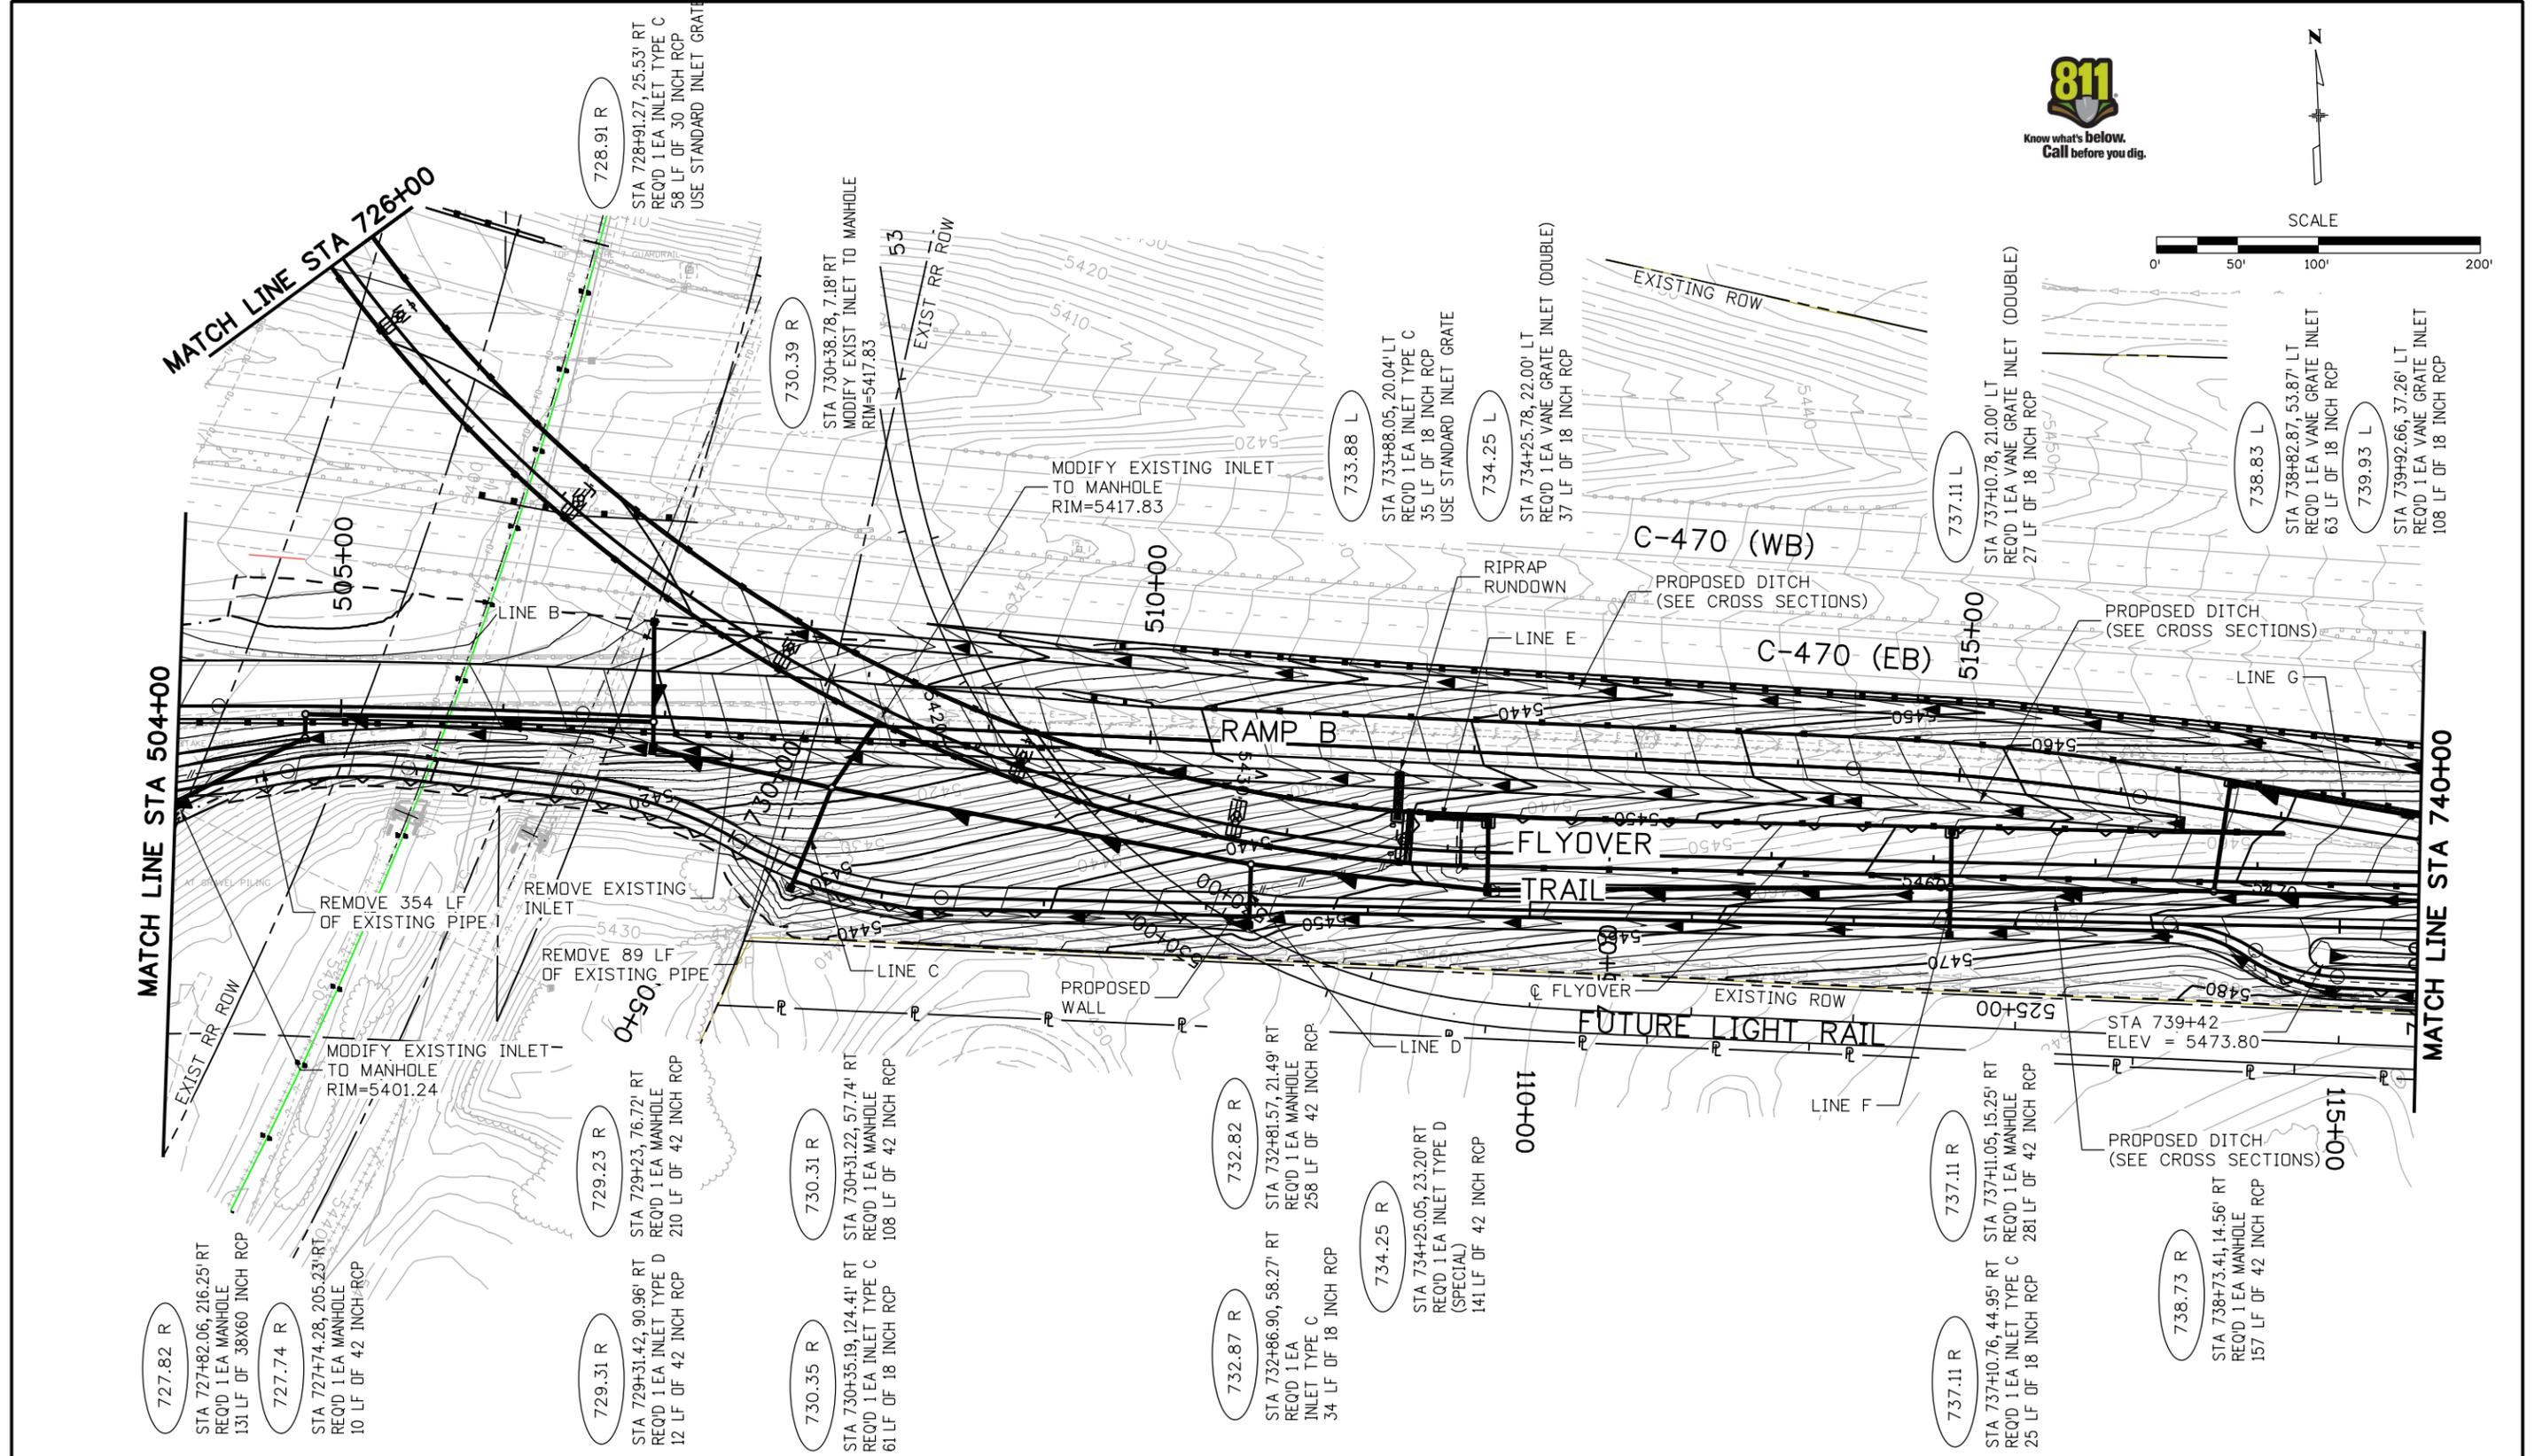

| |
|---|
| Print Date: 1/6/2010 |
| File Name: 14679_pDD-P703.dgn |
| Horiz. Scale: 1:100 Vert. Scale: As Noted |
| PBSJ 4601 DTC Boulevard Suite 700 Denver, CO 80237 |

| Sheet Revisions | | |
|-----------------|----------|-------|
| Date: | Comments | Init. |
| | | |
| | | |
| | | |

Colorado Department of Transportation



8833 South Wadsworth Court
Littleton, CO 80128
Phone: 303-972-9112 FAX: 303-972-9114

Region 6 RLB

| |
|----------------|
| As Constructed |
| No Revisions: |
| Revised: |
| Void: |

| DRAINAGE PLAN FLYOVER | | | |
|------------------------|-----------------------|-----------|--|
| Designer: | AJF | Structure | |
| Detailer: | AJF | Numbers | |
| Sheet Subset: DRAIN PL | Subset Sheets: 4 of 6 | | |

| | |
|------------------|--------------|
| Project No./Code | ES6 0852-103 |
| | 17679 |
| Sheet Number | 96 |

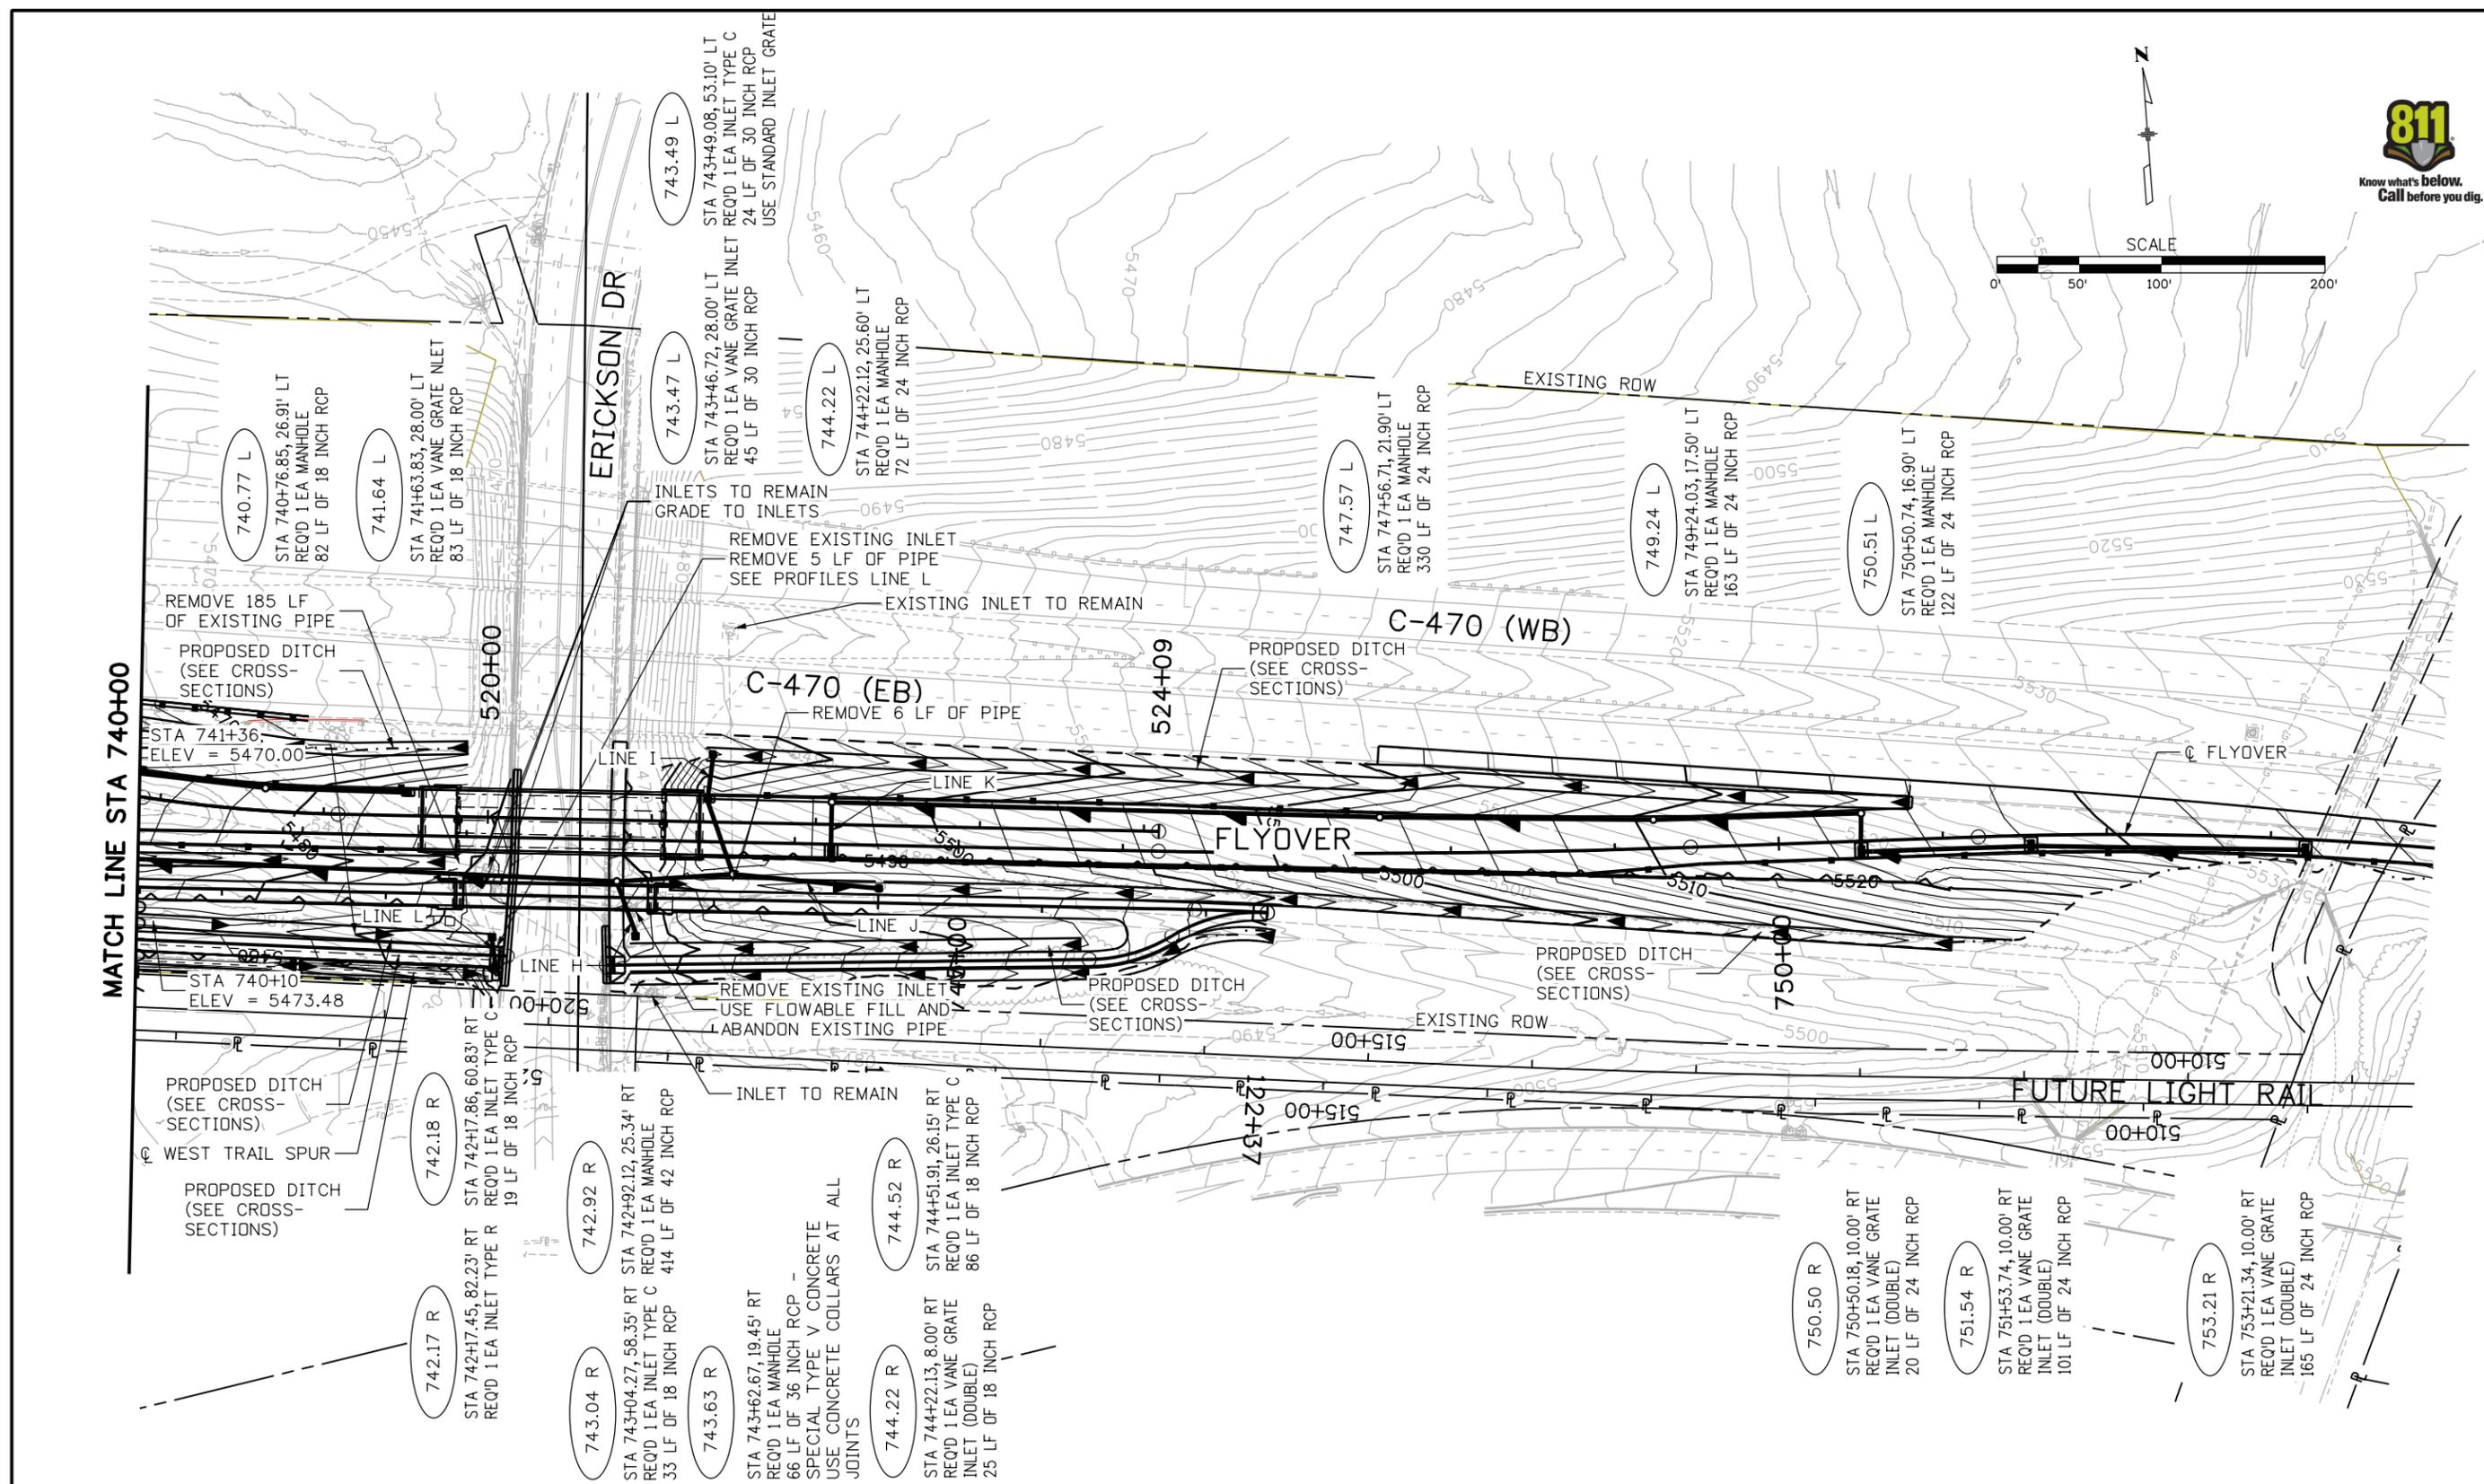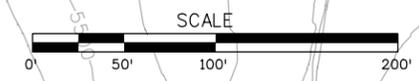

Print Date: 1/6/2010
 File Name: 14679_pDD-P704.dgn
 Horiz. Scale: 1:100 Vert. Scale: As Noted

| Sheet Revisions | | |
|-----------------|----------|-------|
| Date: | Comments | Init. |
| | | |
| | | |

Colorado Department of Transportation
 8833 South Wadsworth Court
 Littleton, CO 80128
 Phone: 303-972-9112 FAX: 303-972-9114
 Region 6 RLB


As Constructed
 No Revisions:
 Revised:
 Void:

| DRAINAGE PLAN | |
|------------------------|-----------------------|
| FLYOVER | |
| Designer: | AJF |
| Detailer: | AJF |
| Structure Numbers | |
| Sheet Subset: DRAIN PL | Subset Sheets: 5 of 6 |

Project No./Code
 ES6 0852-103
 17679
 Sheet Number 97

12244 3:47:09 PM S:\Tranpro\100002375\14679\Consultants\Hydraulics\Drawings\14679_pDD-P704.dgn



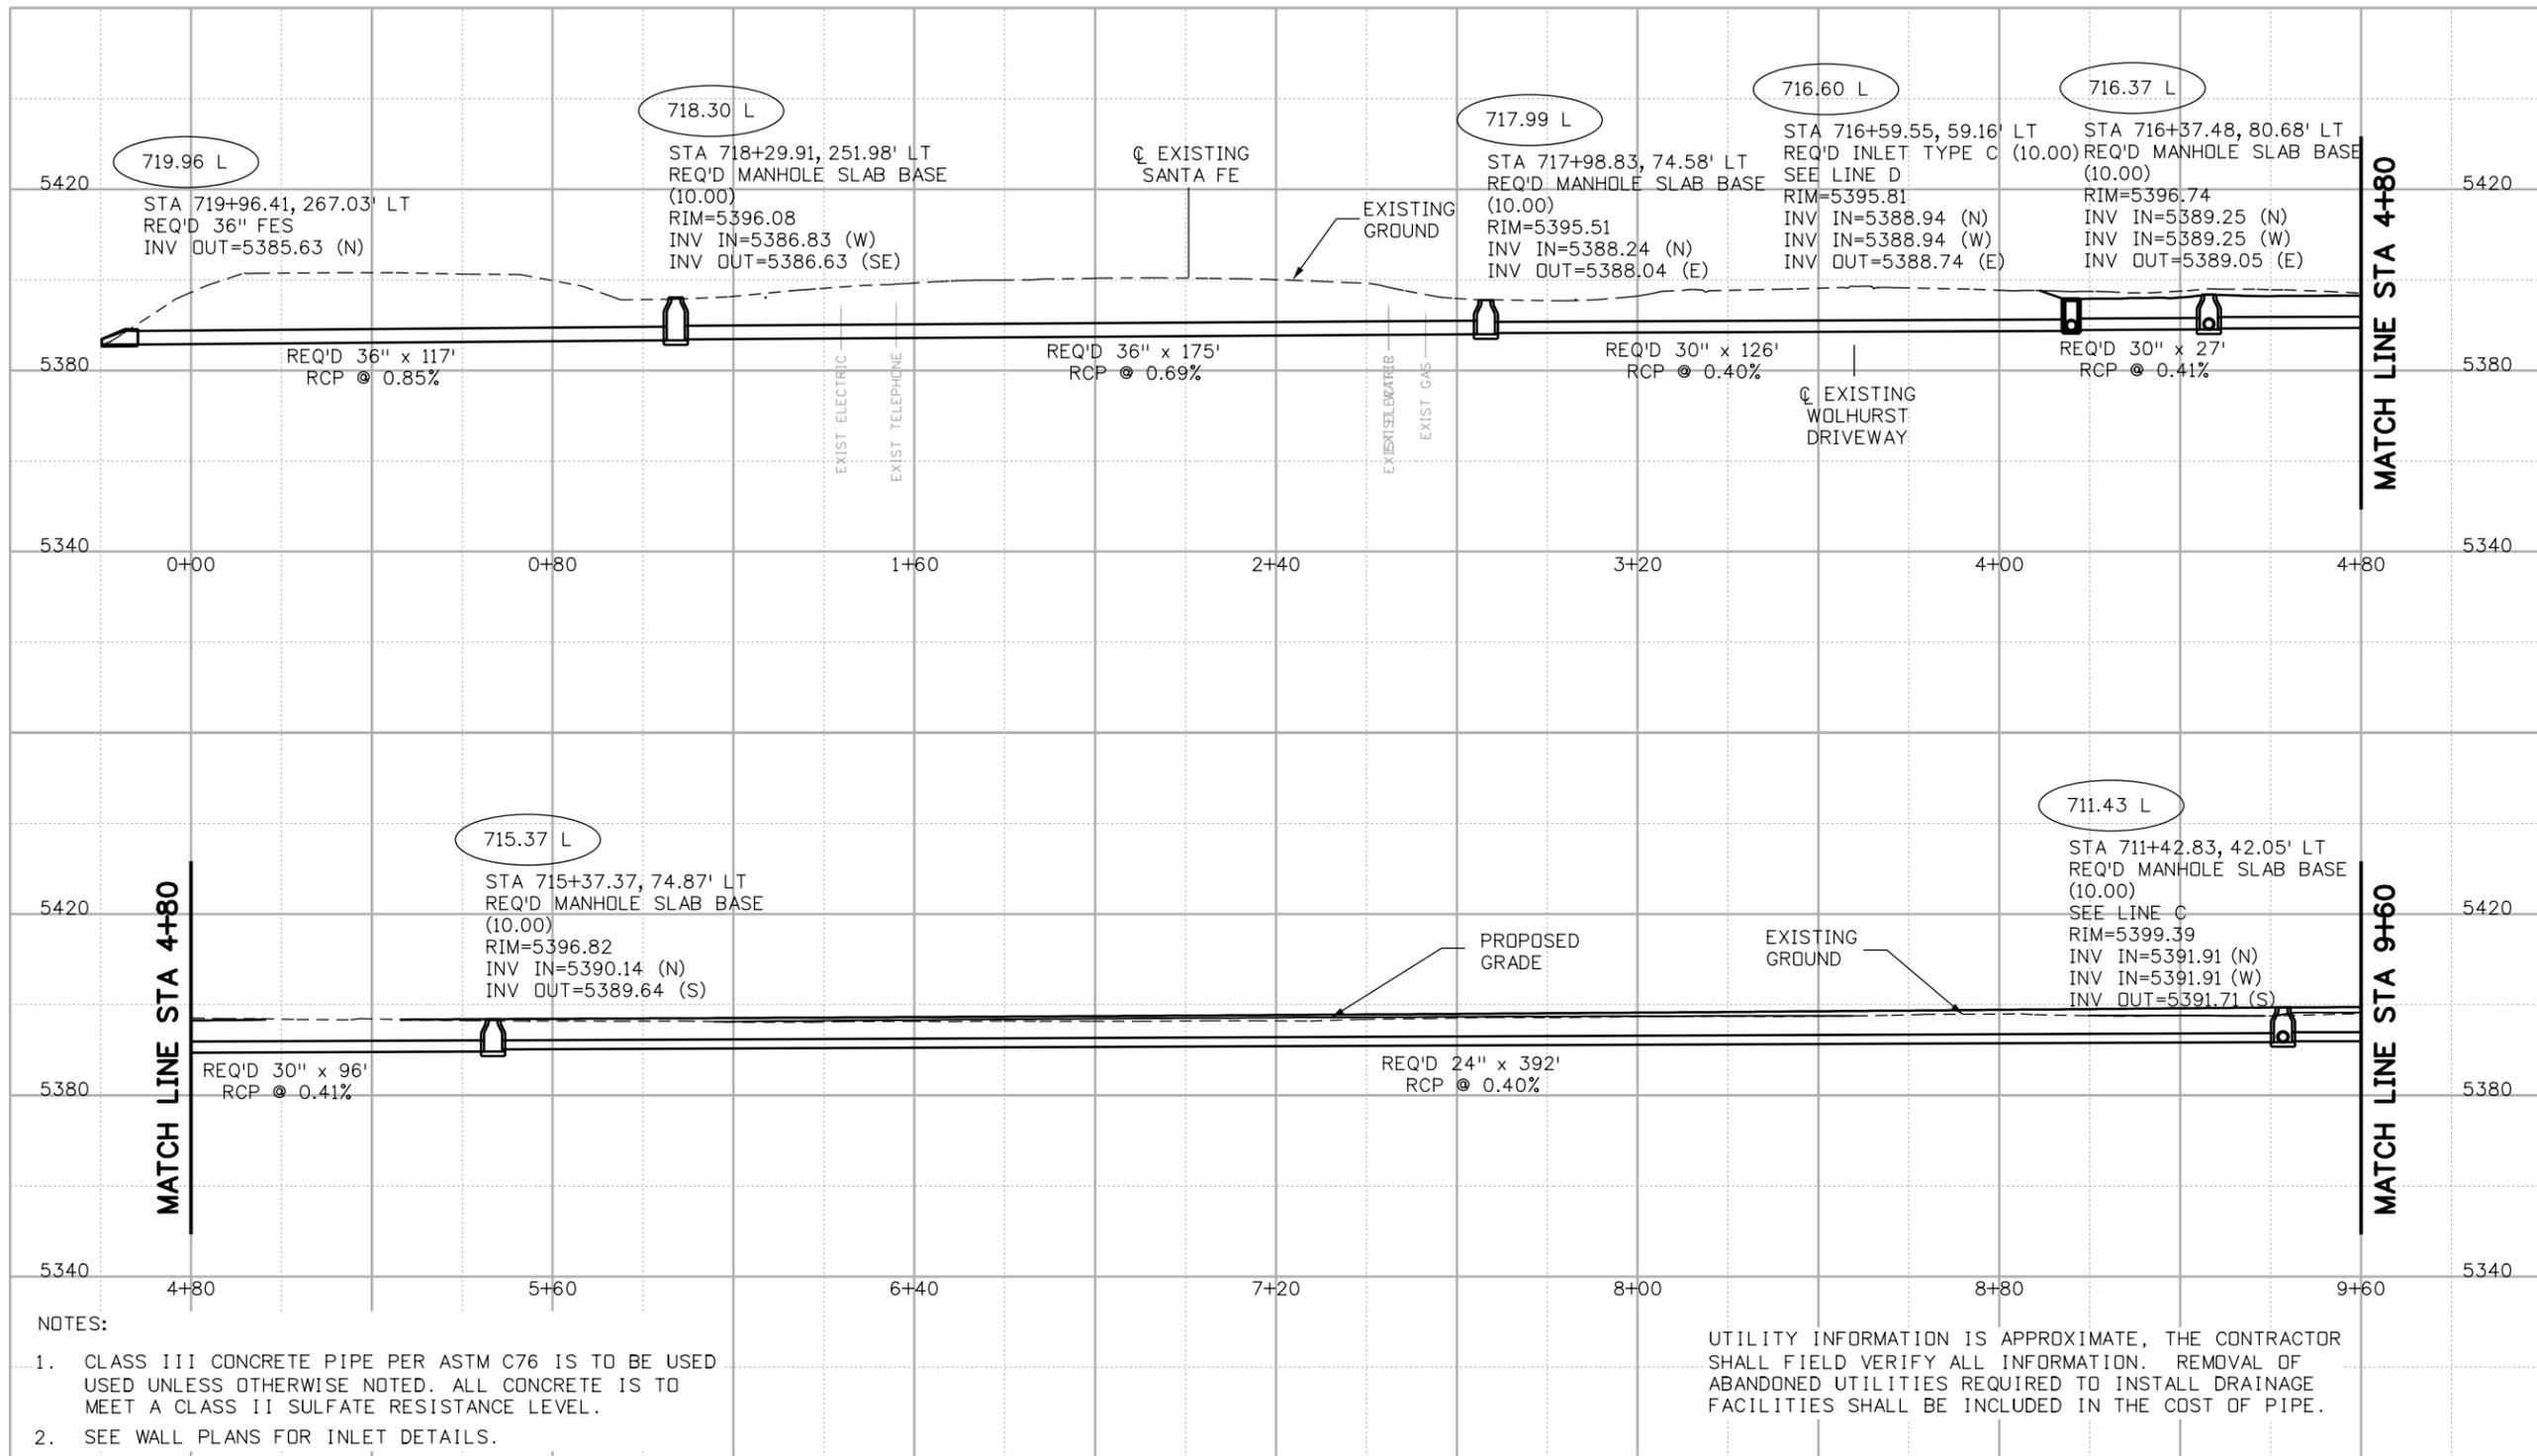

NOTES:

- CLASS III CONCRETE PIPE PER ASTM C76 IS TO BE USED UNLESS OTHERWISE NOTED. ALL CONCRETE IS TO MEET A CLASS II SULFATE RESISTANCE LEVEL.
- SEE WALL PLANS FOR INLET DETAILS.

UTILITY INFORMATION IS APPROXIMATE, THE CONTRACTOR SHALL FIELD VERIFY ALL INFORMATION. REMOVAL OF ABANDONED UTILITIES REQUIRED TO INSTALL DRAINAGE FACILITIES SHALL BE INCLUDED IN THE COST OF PIPE.

12244 3:47:30 PM S:\Tranpro\100002375\14679\Consultants\Hydraulics\Drawings\14679_pDP-V701.dgn

Print Date: 1/6/2010
 File Name: 14679_pDP-V701.dgn
 Horiz. Scale: 1:40 Vert. Scale: 1:40

| Sheet Revisions | | |
|-----------------|----------|-------|
| Date: | Comments | Init. |
| | | |
| | | |
| | | |

Colorado Department of Transportation
 8833 South Wadsworth Court
 Littleton, CO 80128
 Phone: 303-972-9112 FAX: 303-972-9114
 Region 6 RLB


As Constructed
 No Revisions:
 Revised:
 Void:

DRAINAGE PROFILES
 SANTA FE/FLYOVER

| | | | |
|-----------|--------|-------------------|---------|
| Designer: | WRC/NB | Structure Numbers | |
| Detailer: | WRC/NB | Subset Sheets: | 1 of 11 |

Project No./Code
 ES6 0852-103
 17679
 Sheet Number 99



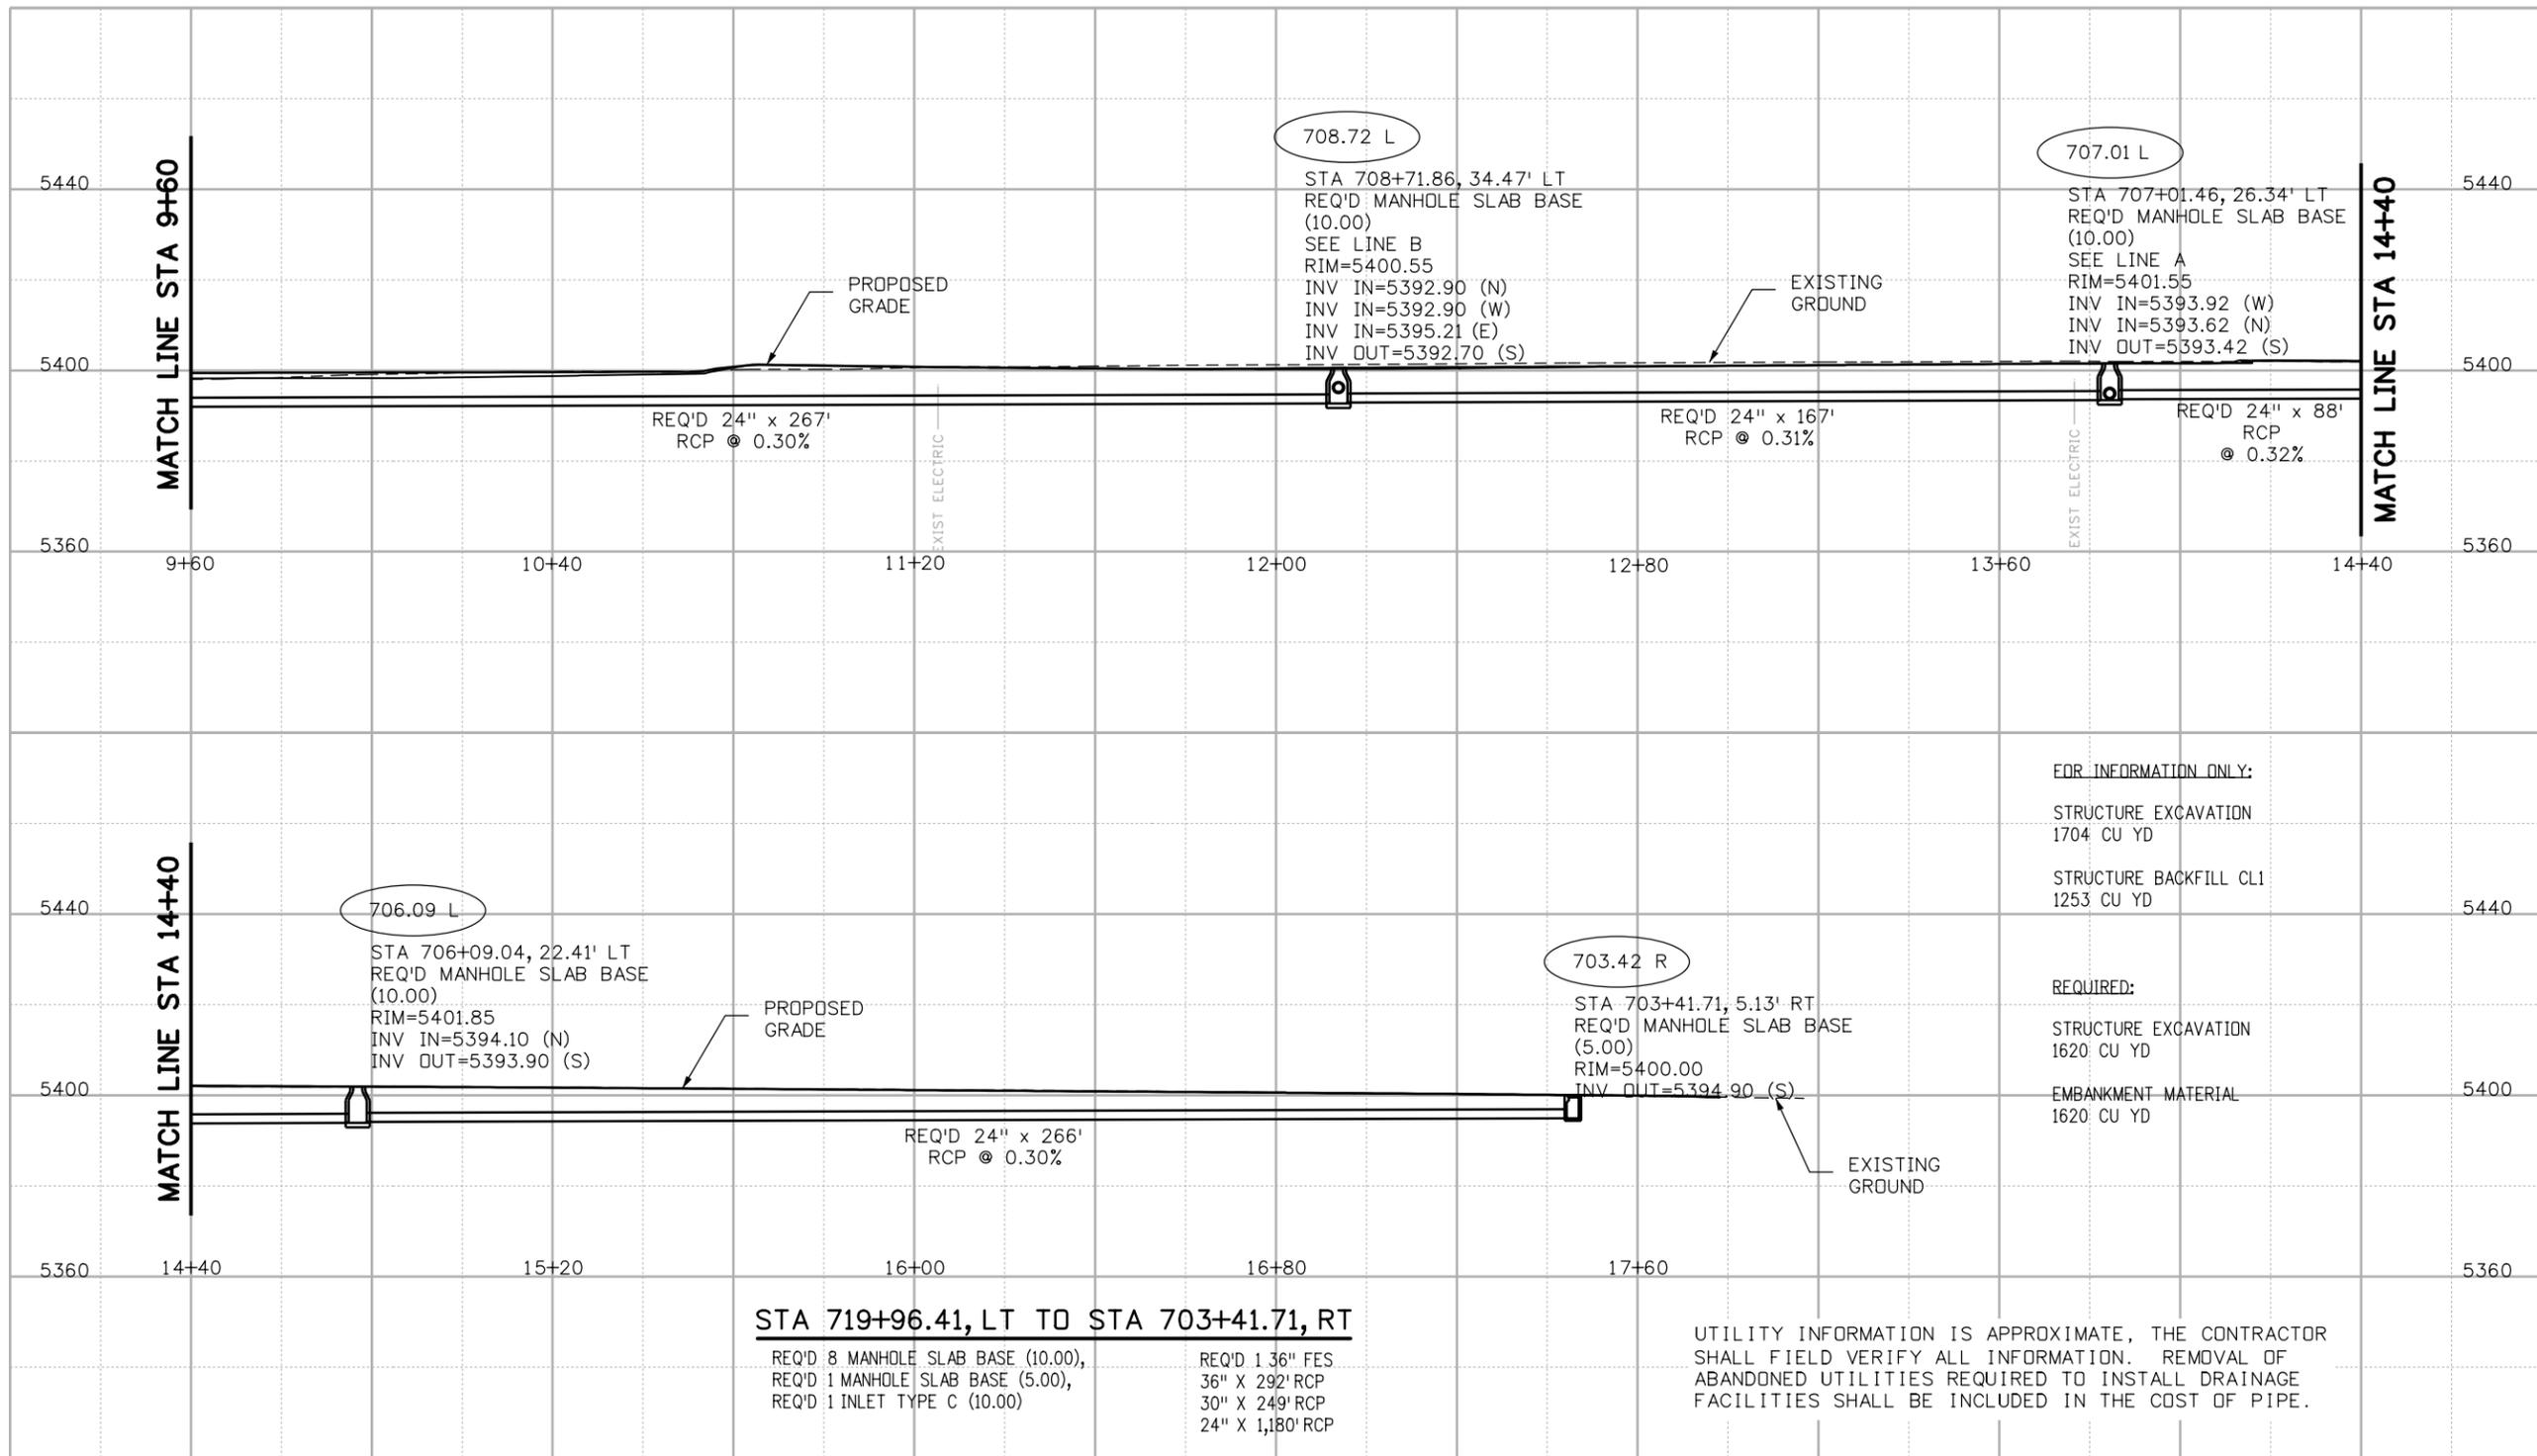

12244 3:47:33 PM S:\Tranpro\100002375\14679\Consultants\Hydraulics\Drawings\14679_pDP-V702.dgn

Print Date: 1/6/2010
 File Name: 14679_pDP-V702.dgn
 Horiz. Scale: 1:40 Vert. Scale: 1:40

| Sheet Revisions | | |
|-----------------|----------|-------|
| Date: | Comments | Init. |
| | | |
| | | |
| | | |

Colorado Department of Transportation
 8833 South Wadsworth Court
 Littleton, CO 80128
 Phone: 303-972-9112 FAX: 303-972-9114
 Region 6 RLB

As Constructed
 No Revisions:
 Revised:
 Void:


DRAINAGE PROFILES
SANTA FE/FLYOVER

Designer: WRC/NB
 Detailer: WRC/NB
 Sheet Subset: DRAIN PR
 Structure Numbers
 Subset Sheets: 2 of 11

Project No./Code
 ES6 0852-103
 17679
 Sheet Number 100



12244 3:47:36 PM S:\Tranpro\100002375\14679\Consultants\Hydraulics\Drawings\14679_pDP-V703.dgn

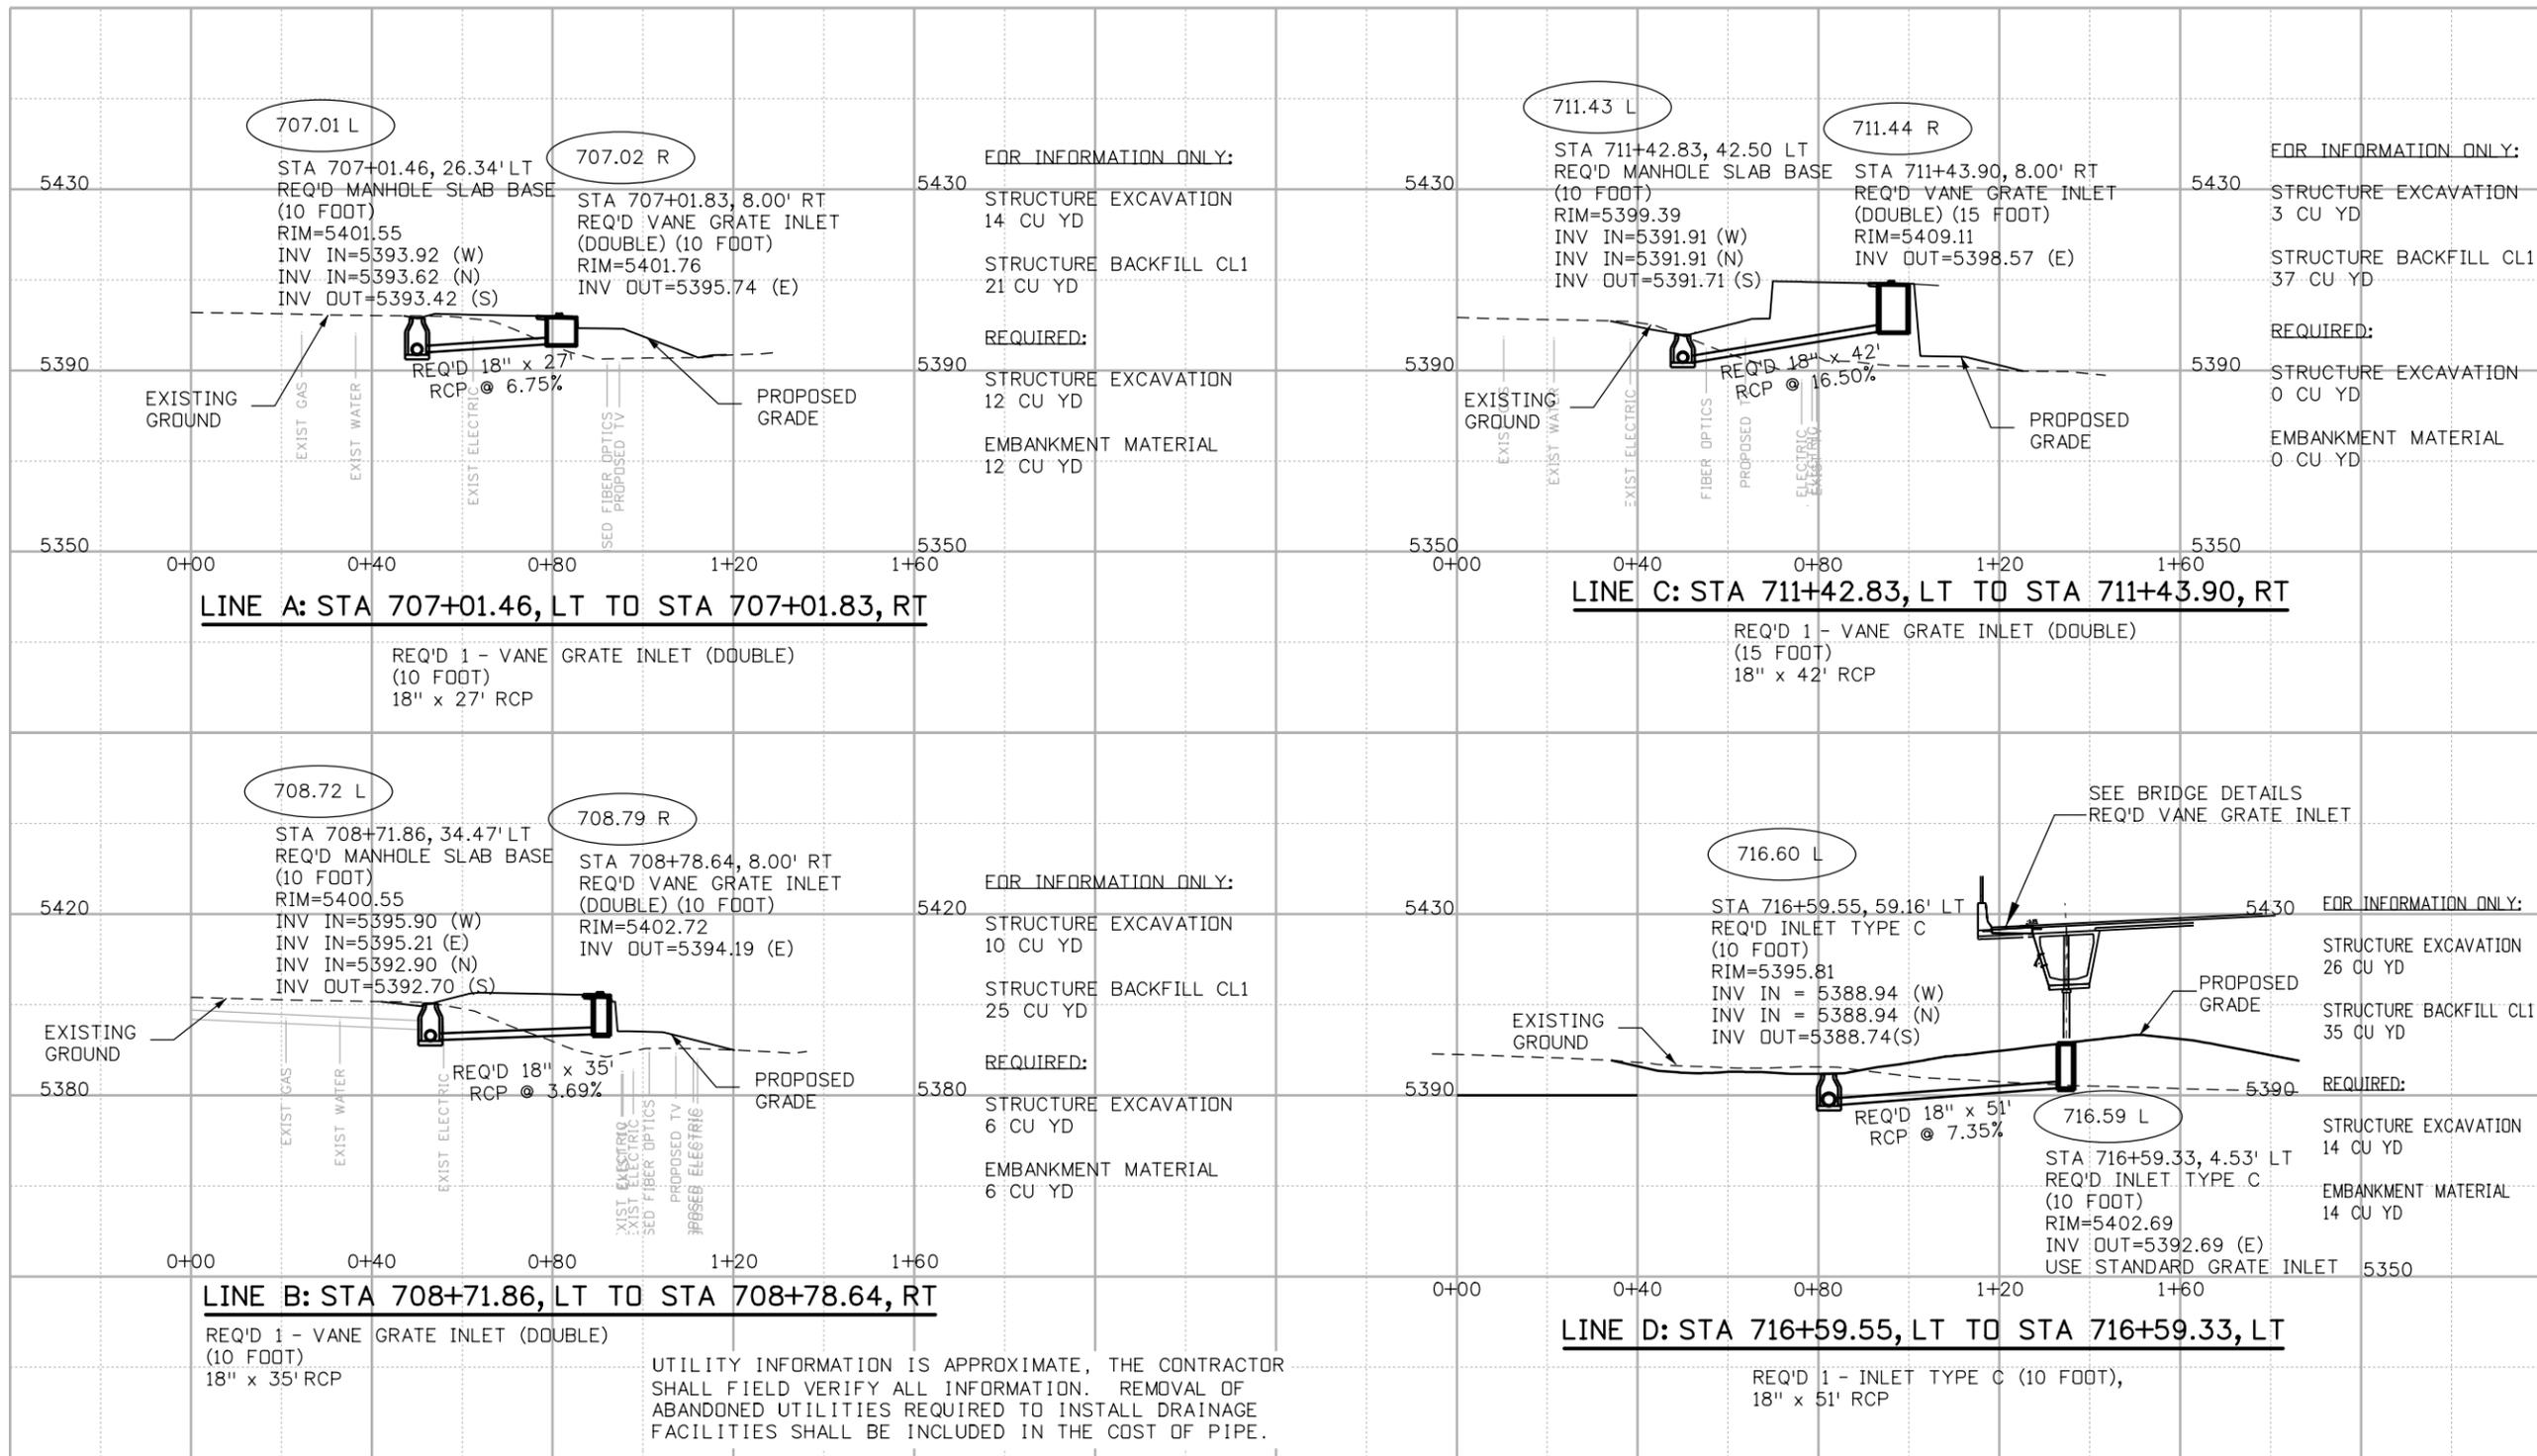

Print Date: 1/6/2010
 File Name: 14679_pDP-V703.dgn
 Horiz. Scale: 1:40 Vert. Scale: 1:40

PBSJ 4601 DTC Boulevard
 Suite 700
 Denver, CO 80237

| Sheet Revisions | | |
|-----------------|----------|-------|
| Date: | Comments | Init. |
| | | |
| | | |
| | | |

Colorado Department of Transportation

DOT
 DEPARTMENT OF TRANSPORTATION

8833 South Wadsworth Court
 Littleton, CO 80128
 Phone: 303-972-9112 FAX: 303-972-9114

Region 6 RLB

As Constructed

No Revisions:

Revised:

Void:

**DRAINAGE PROFILES
 SANTA FE/FLYOVER**


Designer: WRC/NB
 Detailer: WRC/NB
 Sheet Subset: DRAIN PR

Structure Numbers
 Subset Sheets: 3 of 11

Project No./Code
 ES6 0852-103

17679

Sheet Number 101

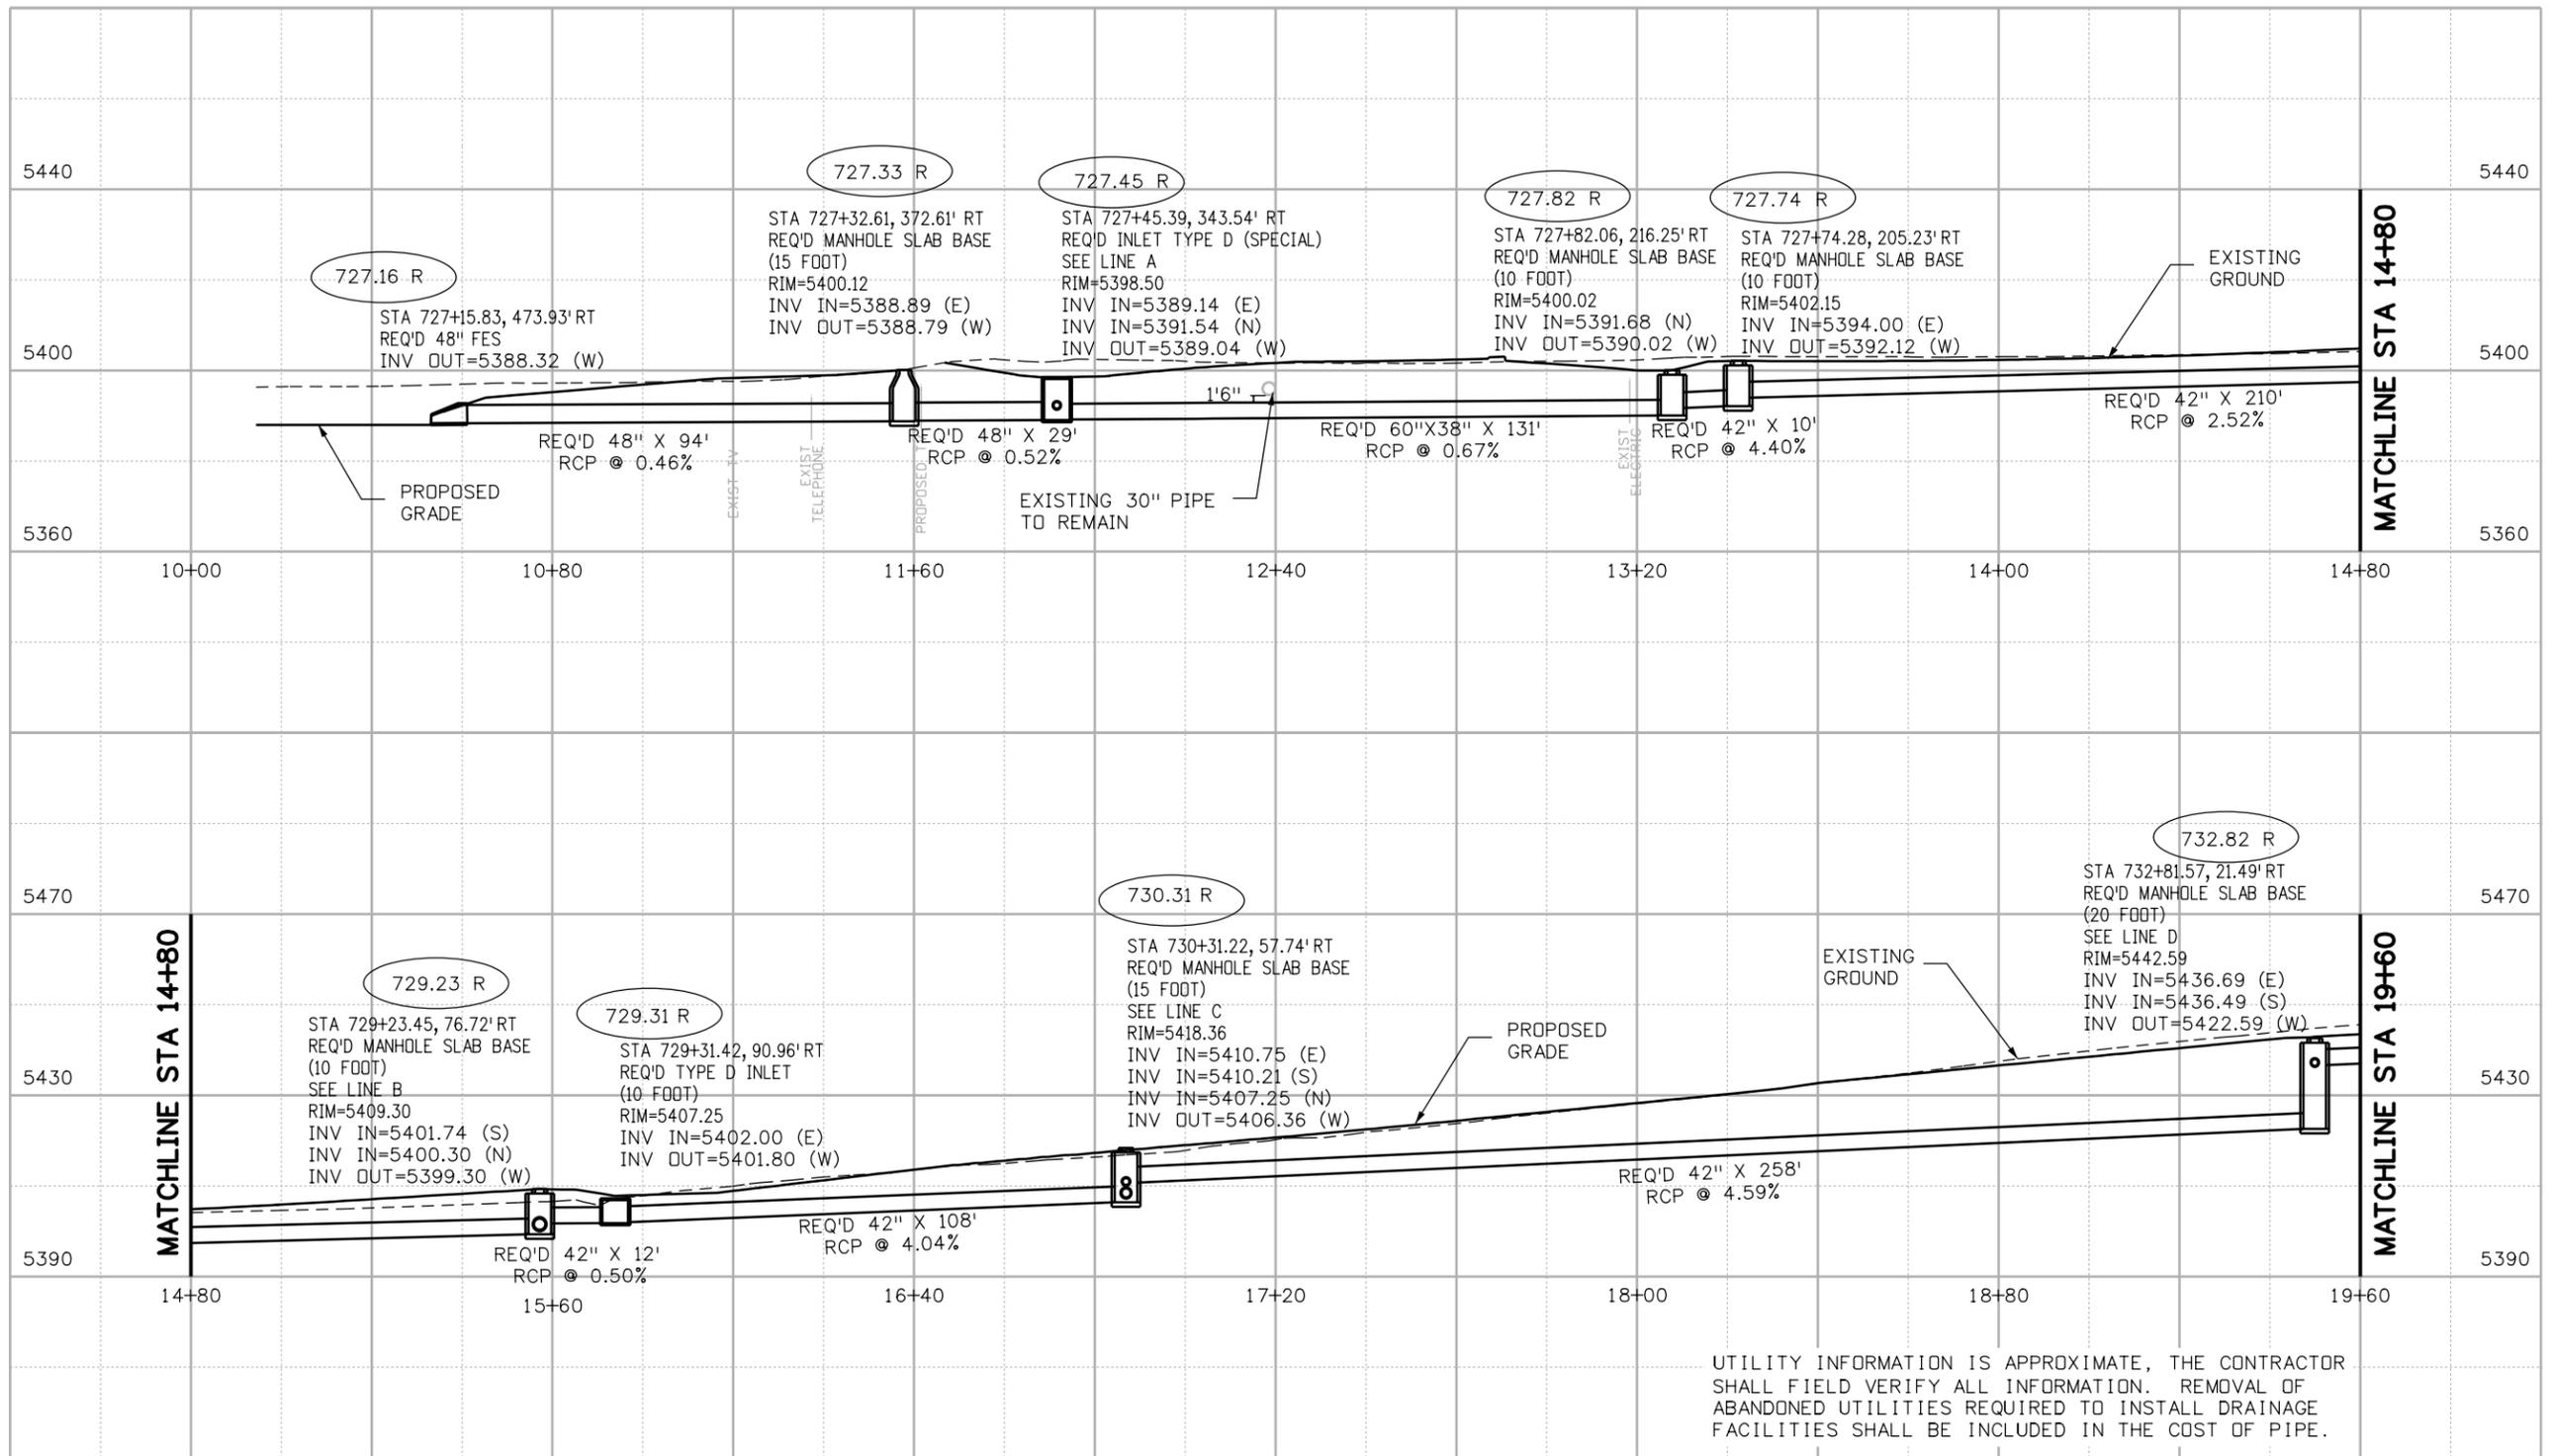

UTILITY INFORMATION IS APPROXIMATE, THE CONTRACTOR SHALL FIELD VERIFY ALL INFORMATION. REMOVAL OF ABANDONED UTILITIES REQUIRED TO INSTALL DRAINAGE FACILITIES SHALL BE INCLUDED IN THE COST OF PIPE.

Print Date: 1/6/2010
 File Name: 14679_pDP-V705.dgn
 Horiz. Scale: 1:40 Vert. Scale: 1:40

| Sheet Revisions | | |
|-----------------|----------|-------|
| Date: | Comments | Init. |
| | | |
| | | |
| | | |

Colorado Department of Transportation
 8833 South Wadsworth Court
 Littleton, CO 80128
 Phone: 303-972-9112 FAX: 303-972-9114
 Region 6 RLB


As Constructed
 No Revisions:
 Revised:
 Void:

DRAINAGE PROFILES
 C-470/FLYOVER
 Designer: WRC/NB
 Detailer: WRC/NB
 Sheet Subset: DRAIN PR
 Structure Numbers
 Subset Sheets: 4 of 11

Project No./Code
 ES6 0852-103
 17679
 Sheet Number 102

12244 3:47:41 PM S:\Tranpro\100002375\14679_Consultants\Hydraulics\Drawings\14679_pDP-V705.dgn



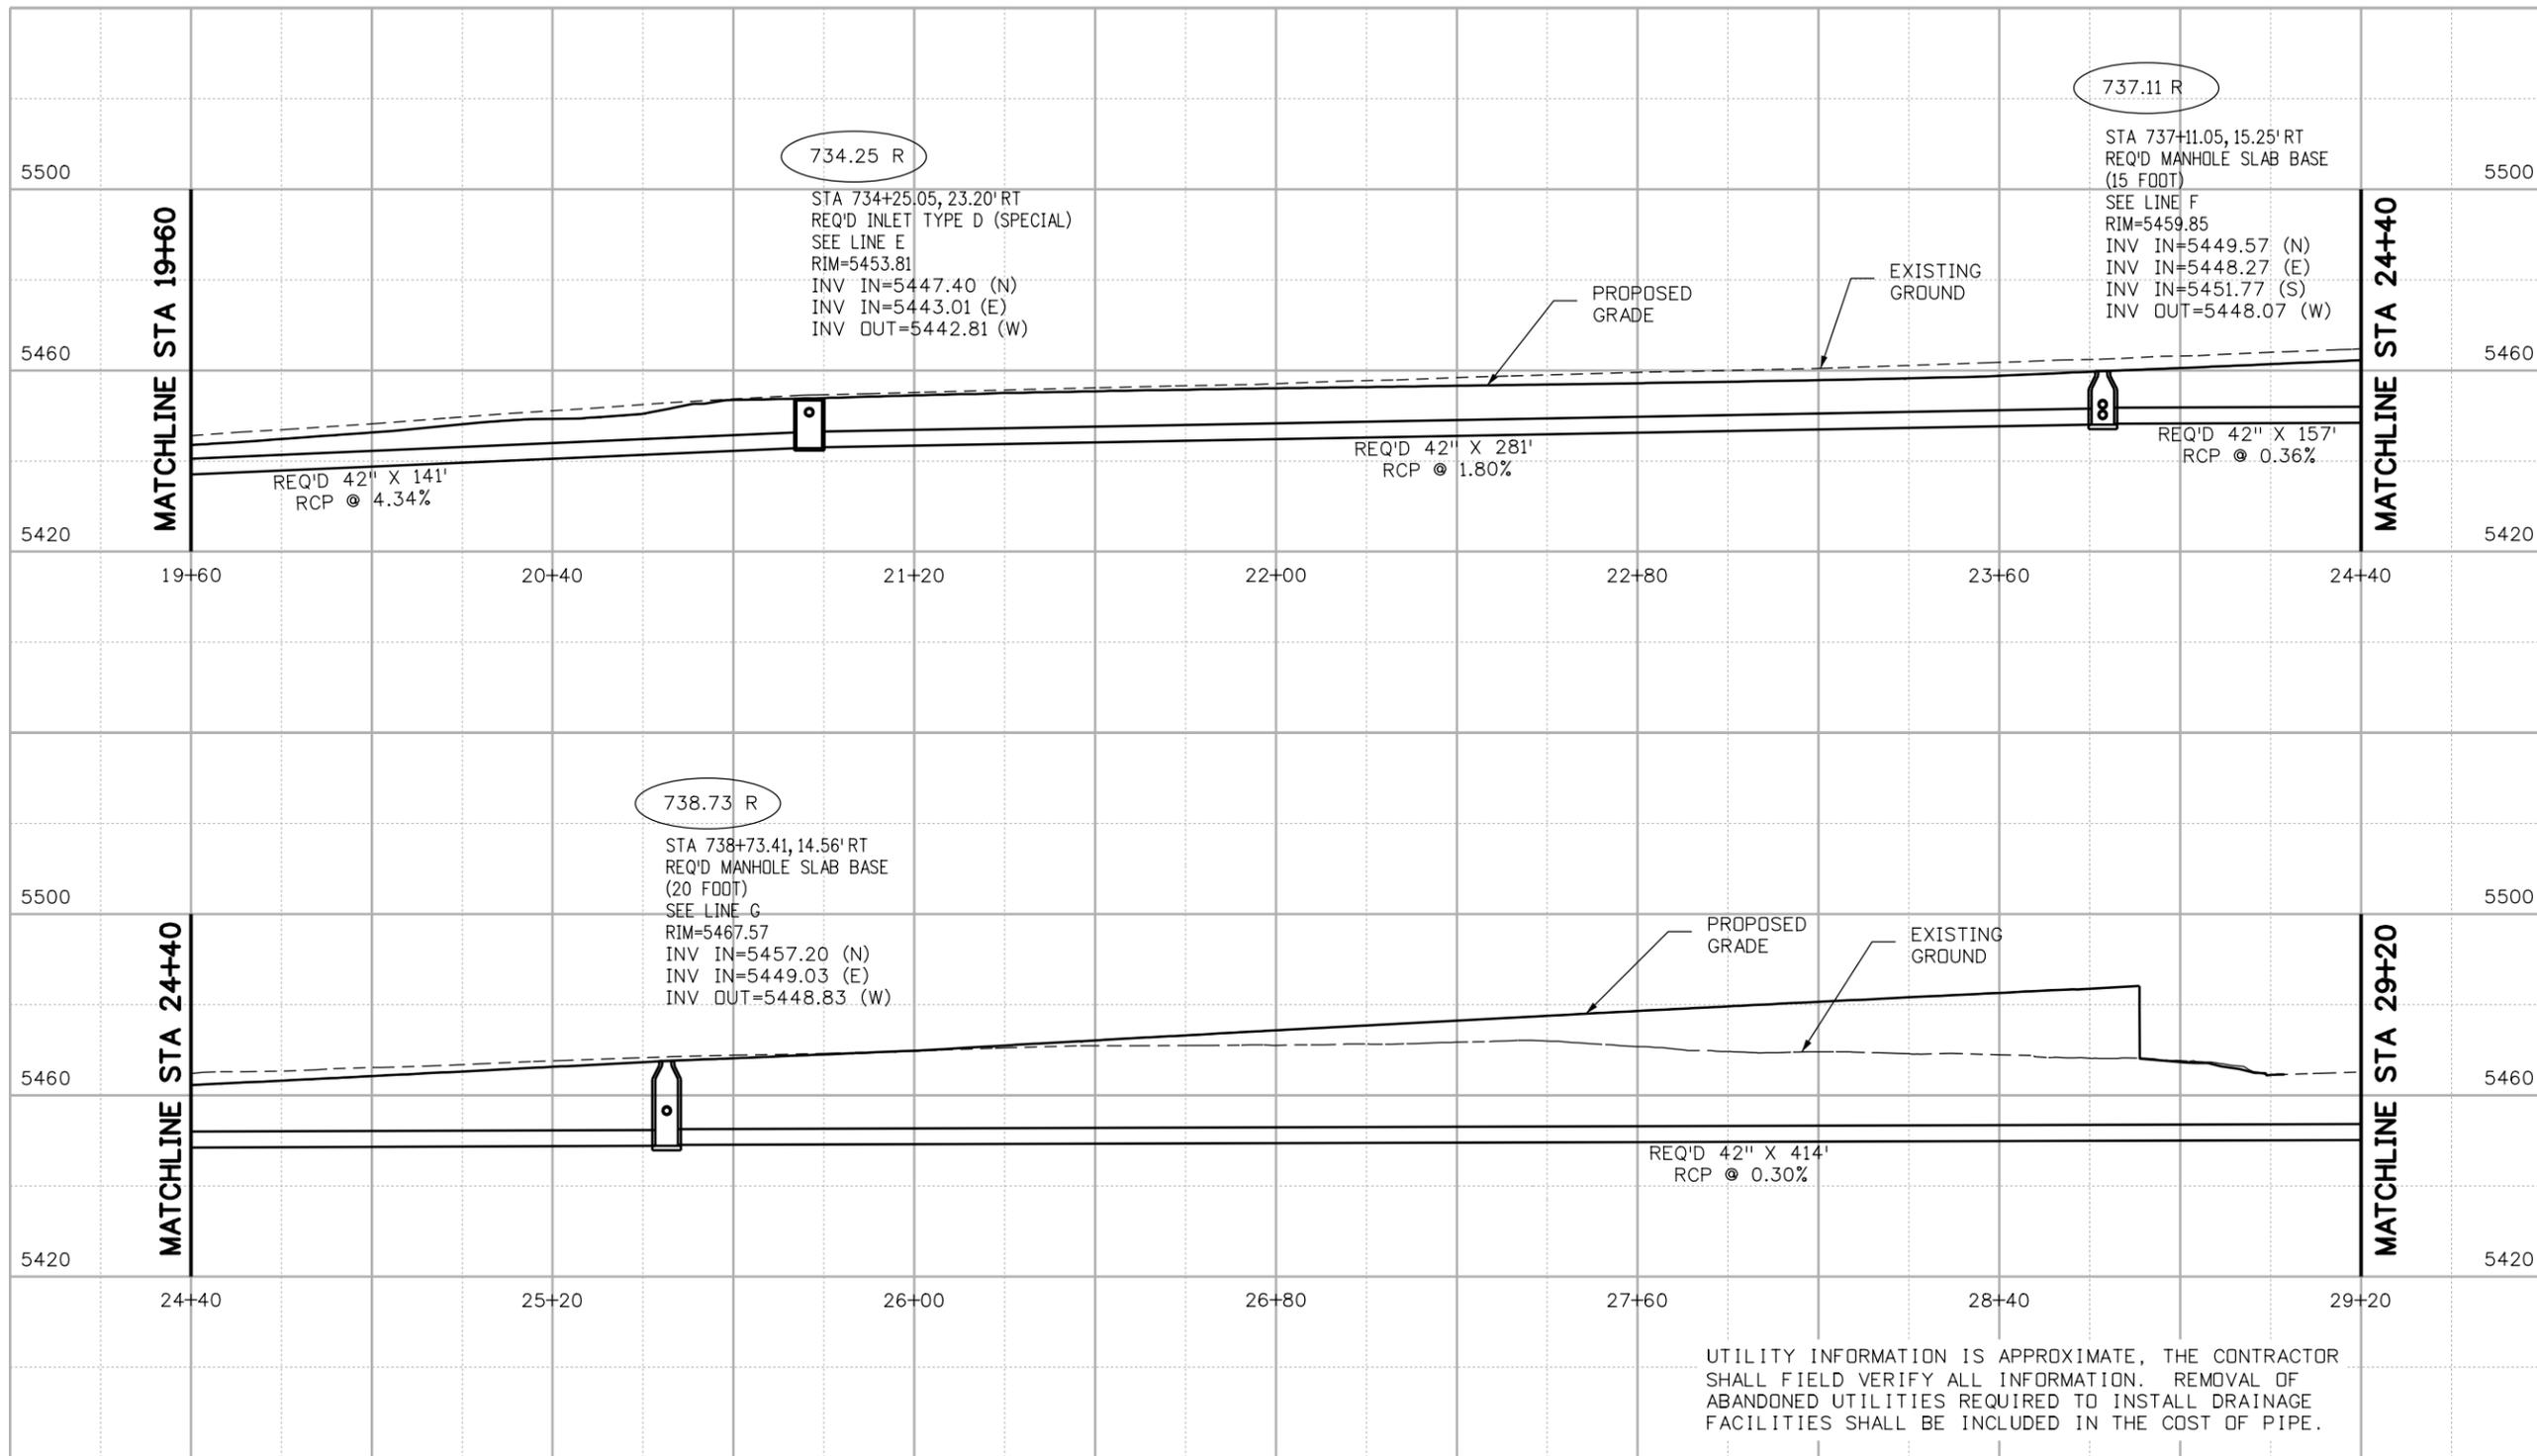

Print Date: 1/6/2010
 File Name: 14679_pDP-V706.dgn
 Horiz. Scale: 1:40 Vert. Scale: 1:40

| Sheet Revisions | | |
|-----------------|----------|-------|
| Date: | Comments | Init. |
| | | |
| | | |
| | | |

Colorado Department of Transportation
 8833 South Wadsworth Court
 Littleton, CO 80128
 Phone: 303-972-9112 FAX: 303-972-9114
Region 6 **RLB**

As Constructed
 No Revisions:
 Revised:
 Void:


| DRAINAGE PROFILES C-470/FLYOVER | | |
|------------------------------------|----------|------------------------|
| Designer: | WRC/NB | Structure Numbers |
| Detailer: | WRC/NB | |
| Sheet Subset: | DRAIN PR | Subset Sheets: 5 of 11 |

Project No./Code
 ES6 0852-103
 17679
 Sheet Number 103

12244 3:47:45 PM S:\Tranpro\100002375\14679\Consultants\Hydraulics\Drawings\14679_pDP-V706.dgn



12244 3:47:47 PM S:\Tranpro\100002375\14679\Consultants\Hydraulics\Drawings\14679_pDP-V707.dgn

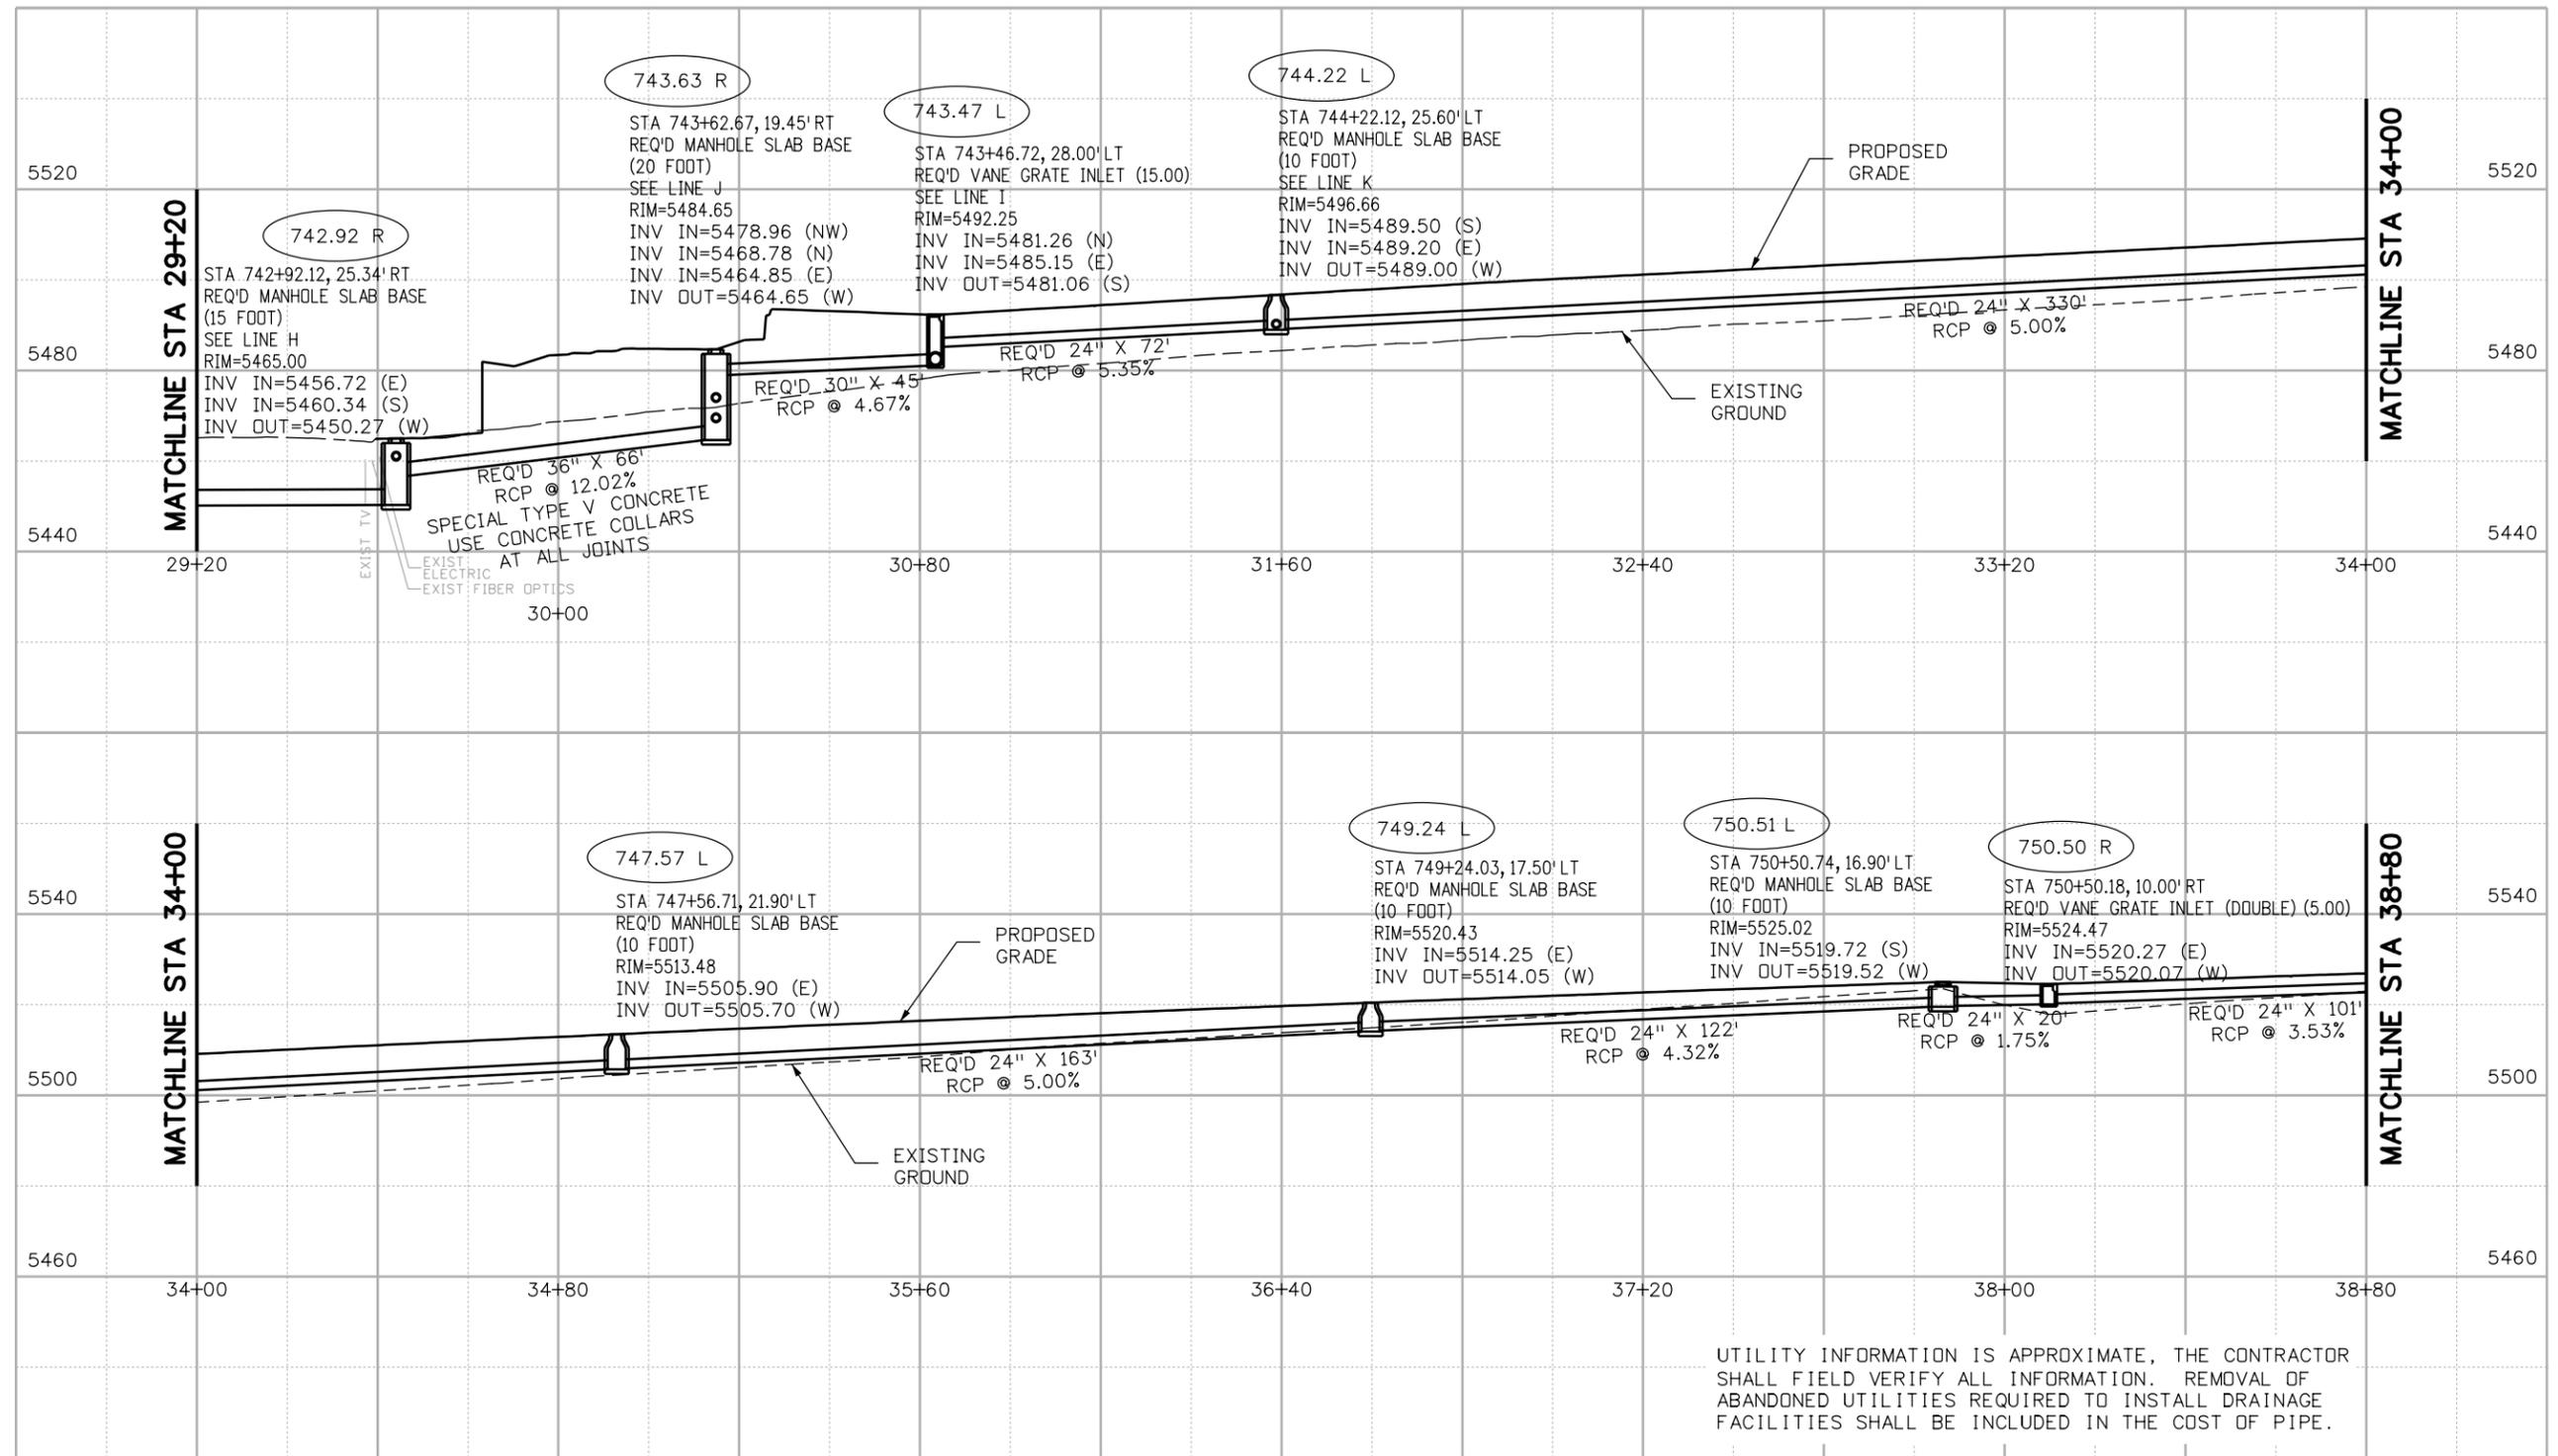

UTILITY INFORMATION IS APPROXIMATE, THE CONTRACTOR SHALL FIELD VERIFY ALL INFORMATION. REMOVAL OF ABANDONED UTILITIES REQUIRED TO INSTALL DRAINAGE FACILITIES SHALL BE INCLUDED IN THE COST OF PIPE.

| | |
|---|-------------------|
| Print Date: 1/6/2010 | |
| File Name: 14679_pDP-V707.dgn | |
| Horiz. Scale: 1:40 | Vert. Scale: 1:40 |
| 4601 DTC Boulevard Suite 700 Denver, CO 80237 | |

| Sheet Revisions | | |
|-----------------|----------|-------|
| Date: | Comments | Init. |
| | | |
| | | |
| | | |

Colorado Department of Transportation


8833 South Wadsworth Court
 Littleton, CO 80128
 Phone: 303-972-9112 FAX: 303-972-9114

Region 6 RLB

| |
|----------------|
| As Constructed |
| No Revisions: |
| Revised: |
| Void: |

| DRAINAGE PROFILES C-470/FLYOVER | | |
|------------------------------------|----------|------------------------|
| Designer: | WRC/NB | Structure Numbers |
| Detailer: | WRC/NB | |
| Sheet Subset: | DRAIN PR | Subset Sheets: 6 of 11 |

| | |
|------------------|--------------|
| Project No./Code | ES6 0852-103 |
| | 17679 |
| Sheet Number | 104 |

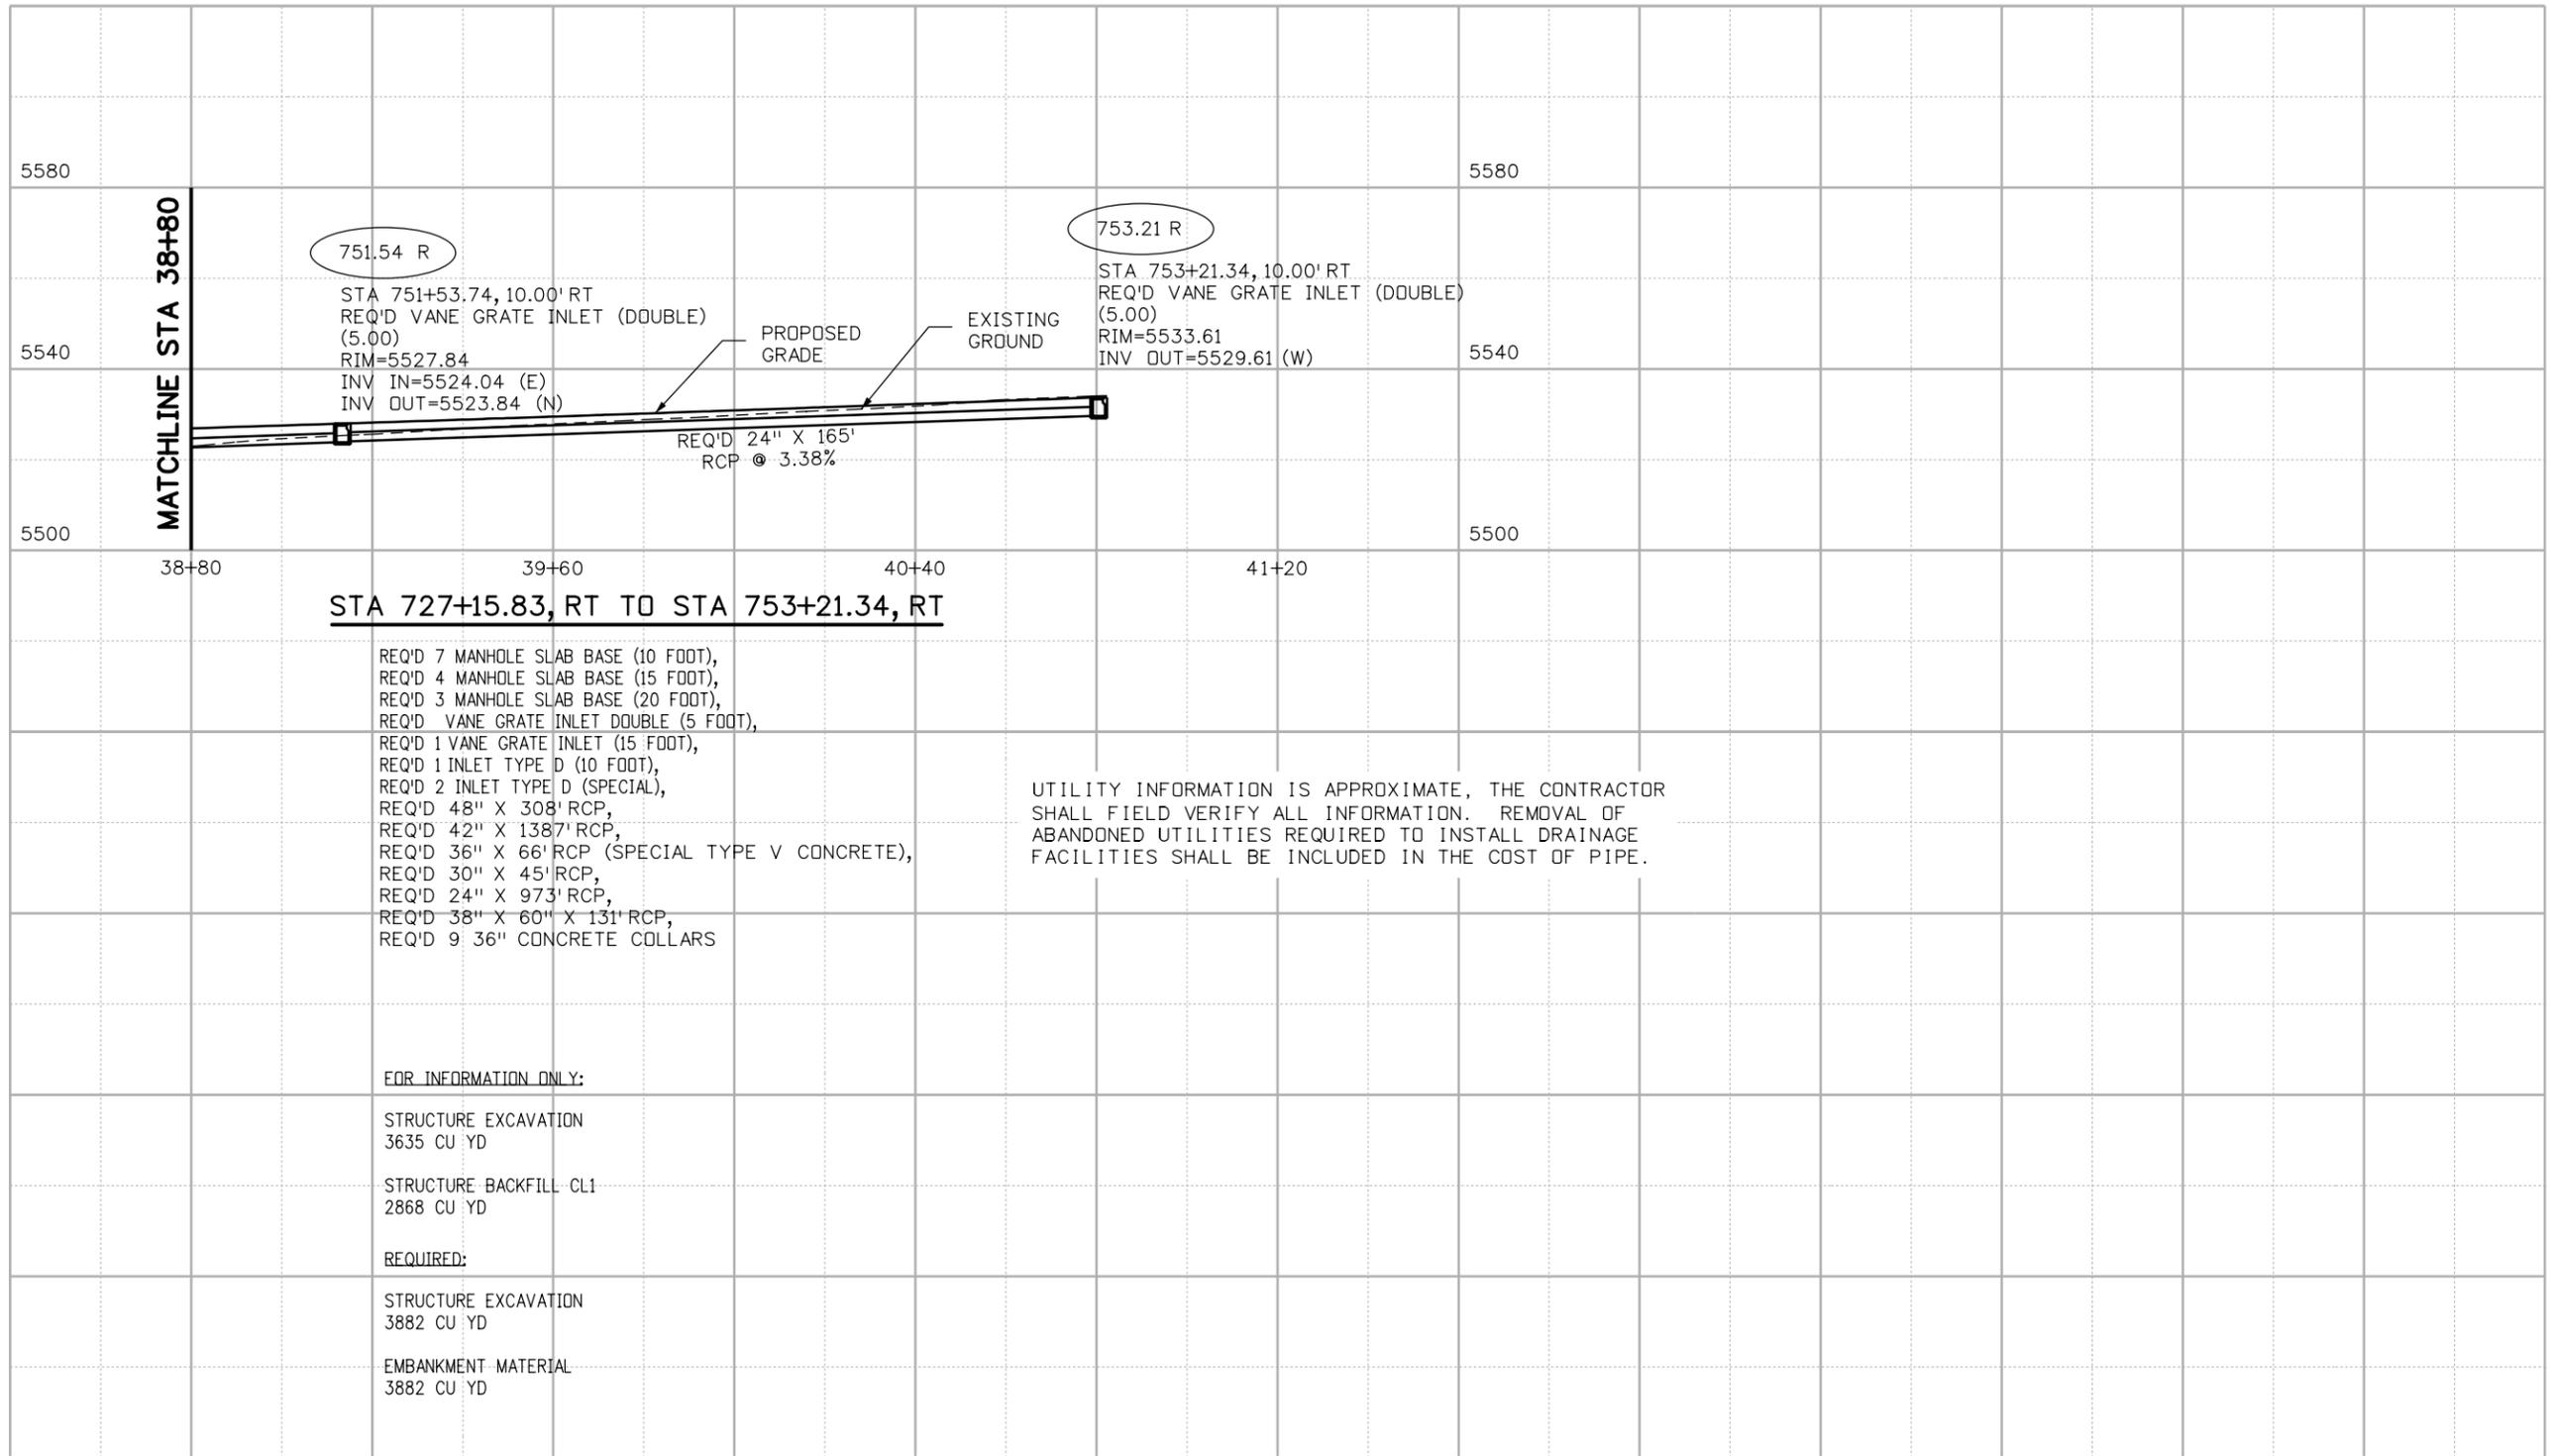

12244 3:47:50 PM S:\Tranpro\100002375\14679\Consultants\Hydraulics\Drawings\14679_pDP-V708.dgn

| | |
|---|-------------------|
| Print Date: 1/6/2010 | |
| File Name: 14679_pDP-V708.dgn | |
| Horiz. Scale: 1:40 | Vert. Scale: 1:40 |
| 4601 DTC Boulevard Suite 700 Denver, CO 80237 | |

| Sheet Revisions | | |
|-----------------|----------|-------|
| Date: | Comments | Init. |
| | | |
| | | |
| | | |

Colorado Department of Transportation


8833 South Wadsworth Court
 Littleton, CO 80128
 Phone: 303-972-9112 FAX: 303-972-9114

Region 6 **RLB**

| |
|-----------------------|
| As Constructed |
| No Revisions: |
| Revised: |
| Void: |

| | | | |
|--|----------|----------------|---------|
| DRAINAGE PROFILES C-470/FLYOVER | | | |
| Designer: | WRC/NB | Structure | |
| Detailer: | WRC/NB | Numbers | |
| Sheet Subset: | DRAIN PR | Subset Sheets: | 7 of 11 |

| |
|-------------------------|
| Project No./Code |
| ES6 0852-103 |
| 17679 |
| Sheet Number 105 |

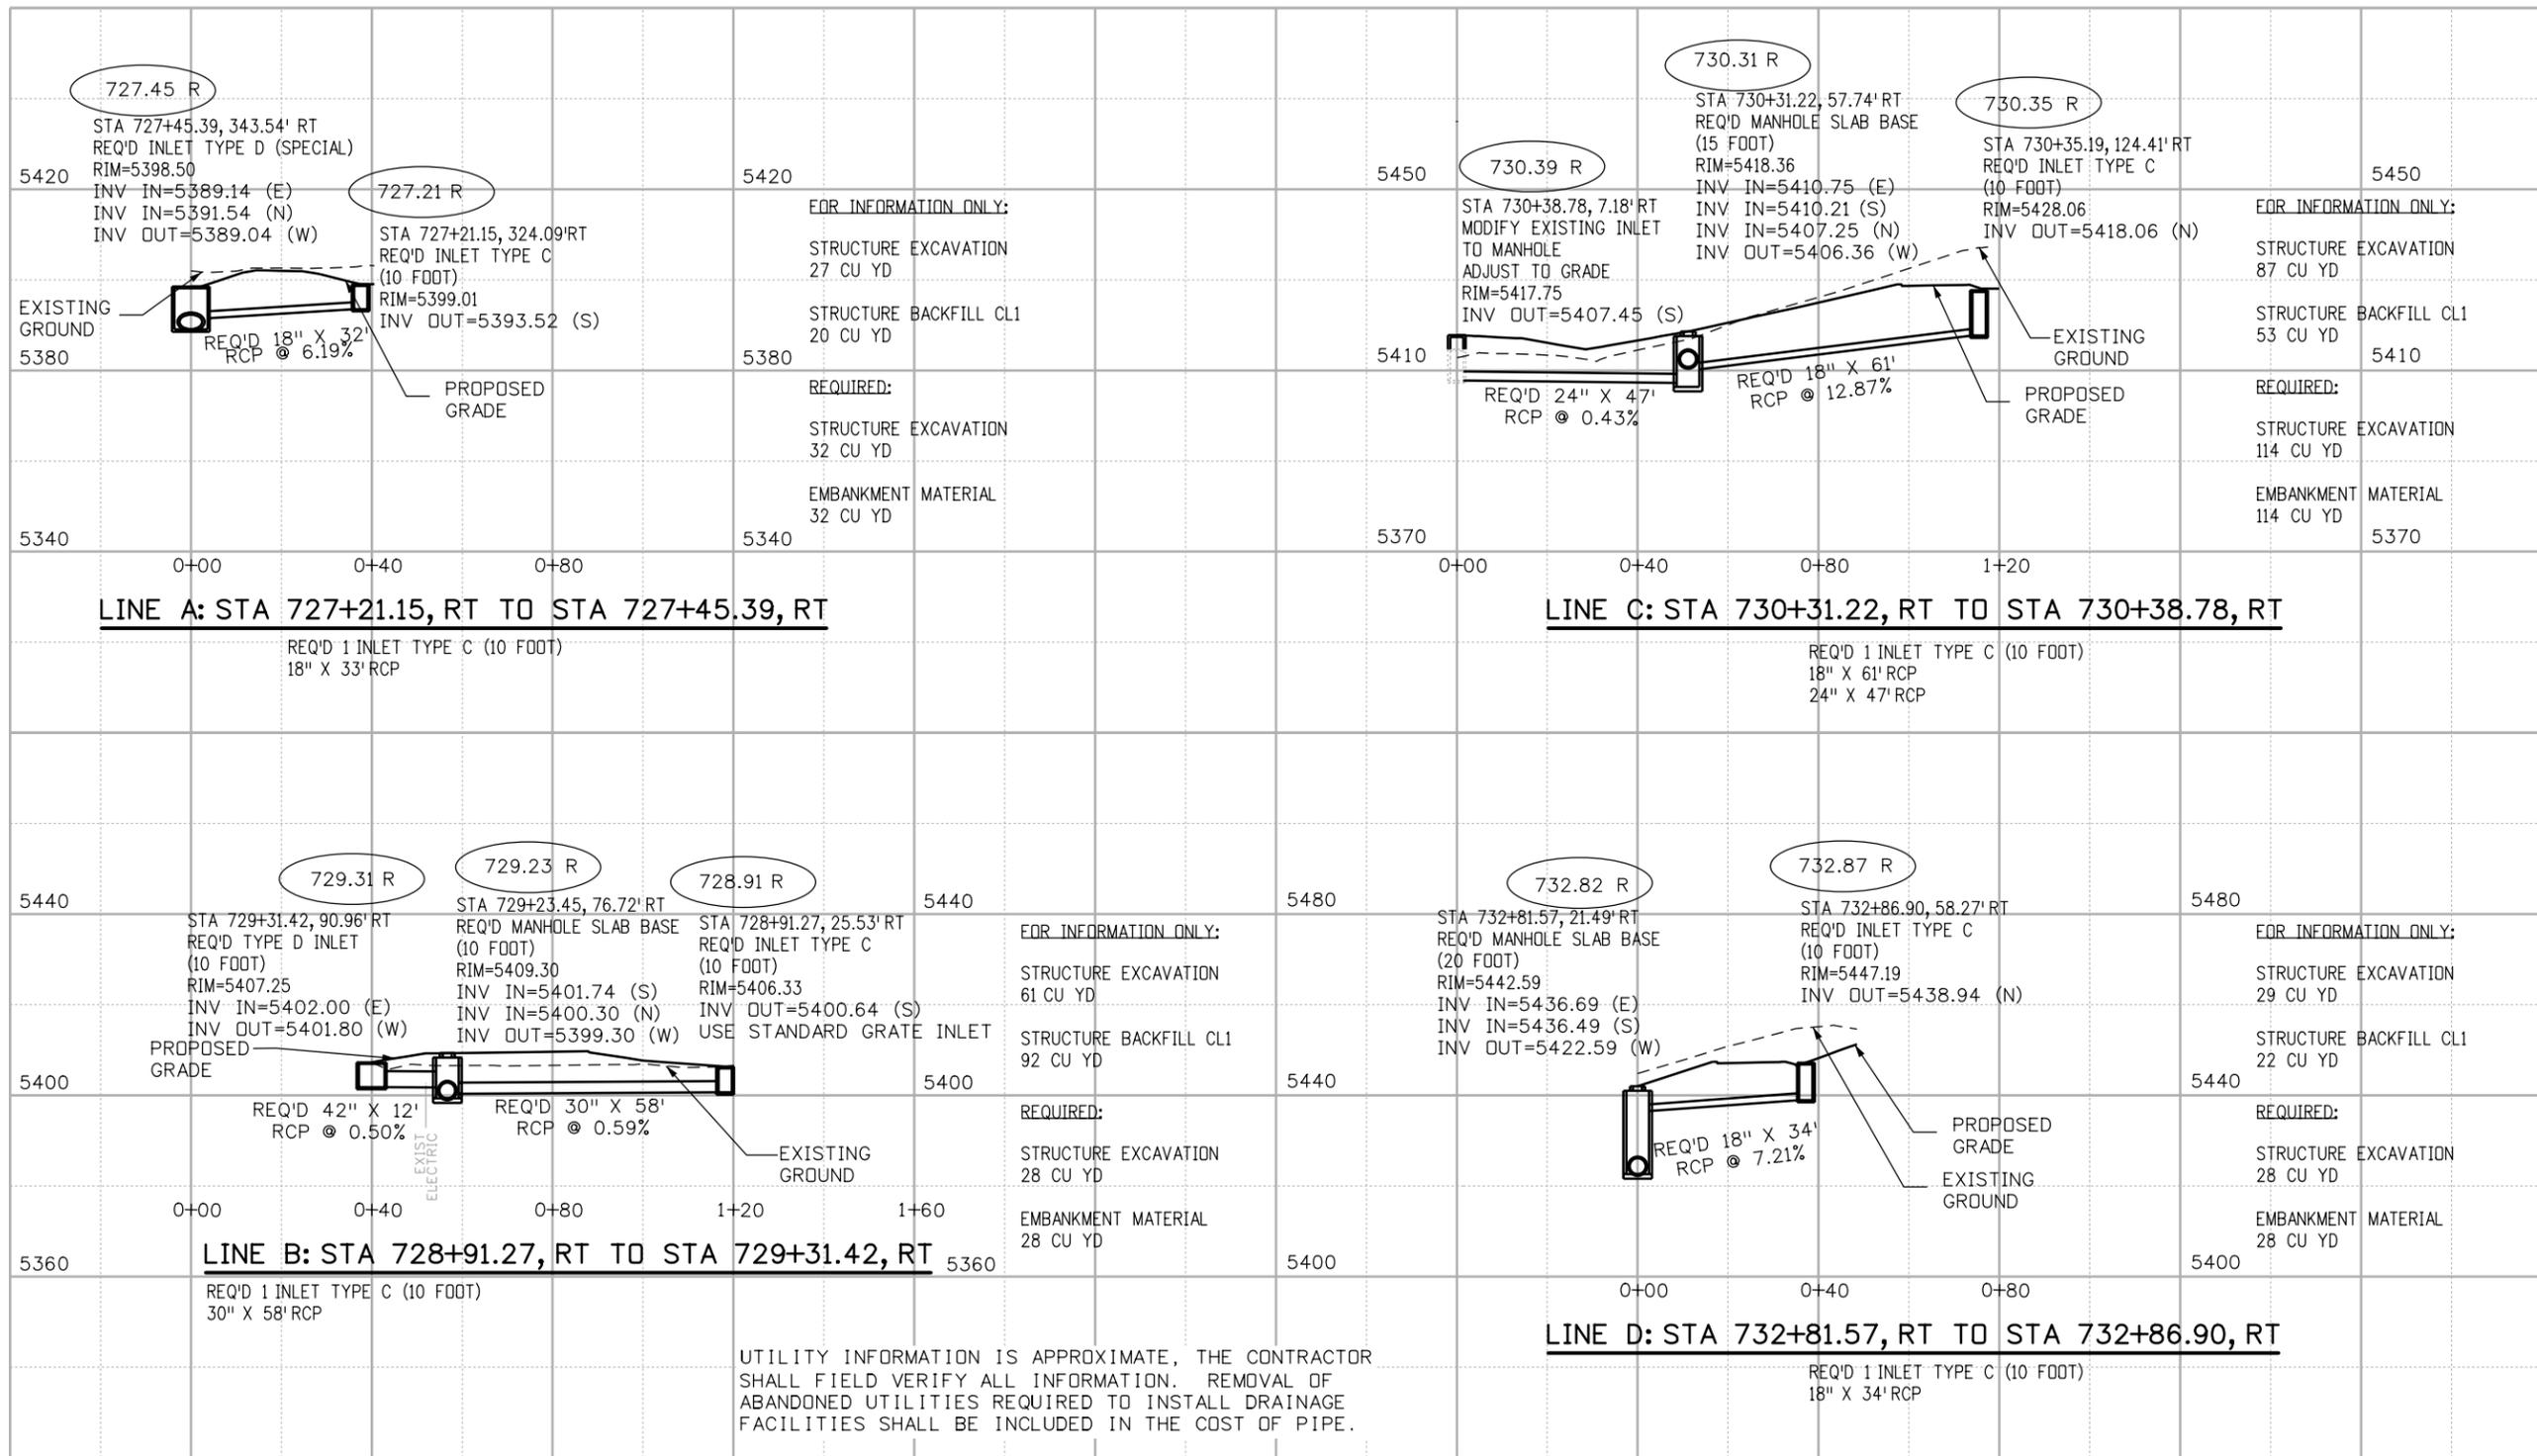

12244 3:47:54 PM S:\Tranpro\100002375\14679\Consultants\Hydraulics\Drawings\14679_pDP-V709.dgn

Print Date: 1/6/2010
 File Name: 14679_pDP-V709.dgn
 Horiz. Scale: 1:40 Vert. Scale: 1:40

| Sheet Revisions | | |
|-----------------|----------|-------|
| Date: | Comments | Init. |
| | | |
| | | |
| | | |

Colorado Department of Transportation
 8833 South Wadsworth Court
 Littleton, CO 80128
 Phone: 303-972-9112 FAX: 303-972-9114
 Region 6 RLB


As Constructed
 No Revisions:
 Revised:
 Void:

DRAINAGE PROFILES
 C-470/FLYOVER
 Designer: WRC/NB
 Detailer: WRC/NB
 Sheet Subset: DRAIN PR
 Structure Numbers
 Subset Sheets: 8 of 11

Project No./Code
 ES6 0852-103
 17679
 Sheet Number 106



12244 3:47:58 PM S:\Tranpro\100002375\14679\Consultants\Hydraulics\Drawings\14679_pDP-V710.dgn

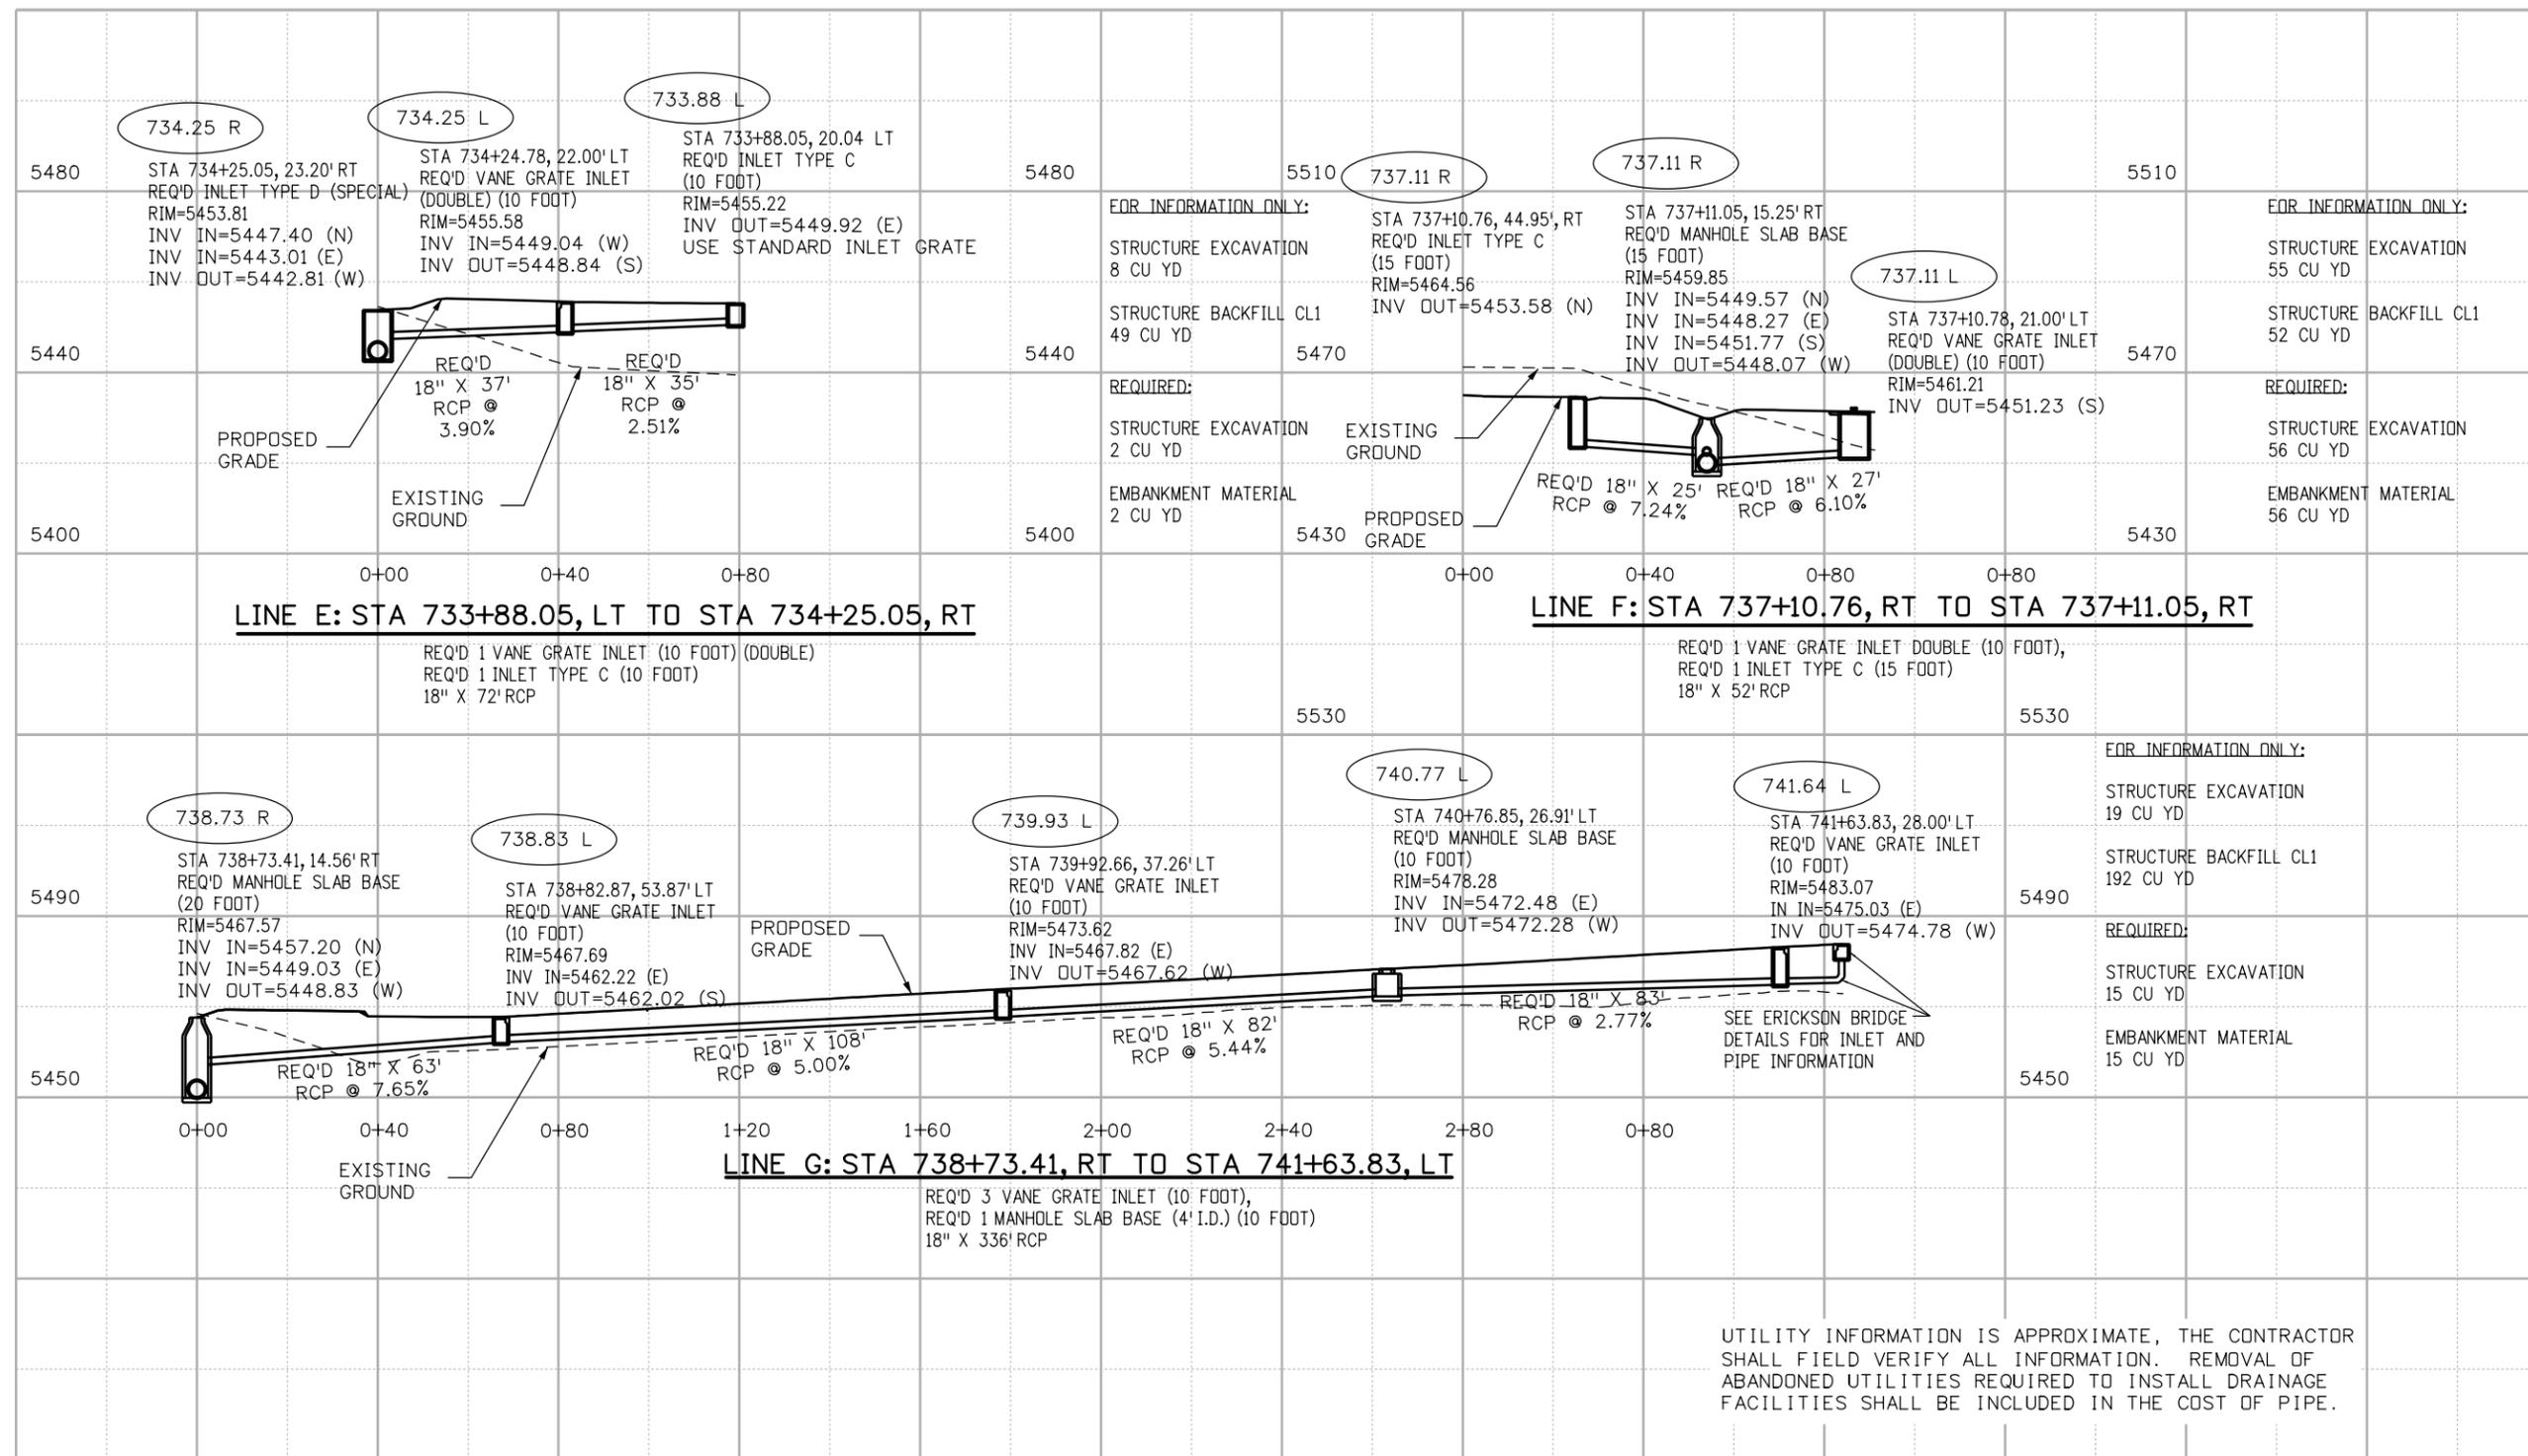

| |
|---|
| Print Date: 1/6/2010 |
| File Name: 14679_pDP-V710.dgn |
| Horiz. Scale: 1:40 Vert. Scale: 1:40 |
| PBSJ 4601 DTC Boulevard Suite 700 Denver, CO 80237 |

| Sheet Revisions | | |
|-----------------|----------|-------|
| Date: | Comments | Init. |
| | | |
| | | |
| | | |

Colorado Department of Transportation




8833 South Wadsworth Court
Littleton, CO 80128
Phone: 303-972-9112 FAX: 303-972-9114

Region 6 RLB

| |
|-----------------------|
| As Constructed |
| No Revisions: |
| Revised: |
| Void: |

| DRAINAGE PROFILES C-470/FLYOVER | | |
|------------------------------------|----------|------------------------|
| Designer: | WRC/NB | Structure Numbers |
| Detailer: | WRC/NB | |
| Sheet Subset: | DRAIN PR | Subset Sheets: 9 of 11 |

| |
|-------------------------|
| Project No./Code |
| ES6 0852-103 |
| 17679 |
| Sheet Number 107 |

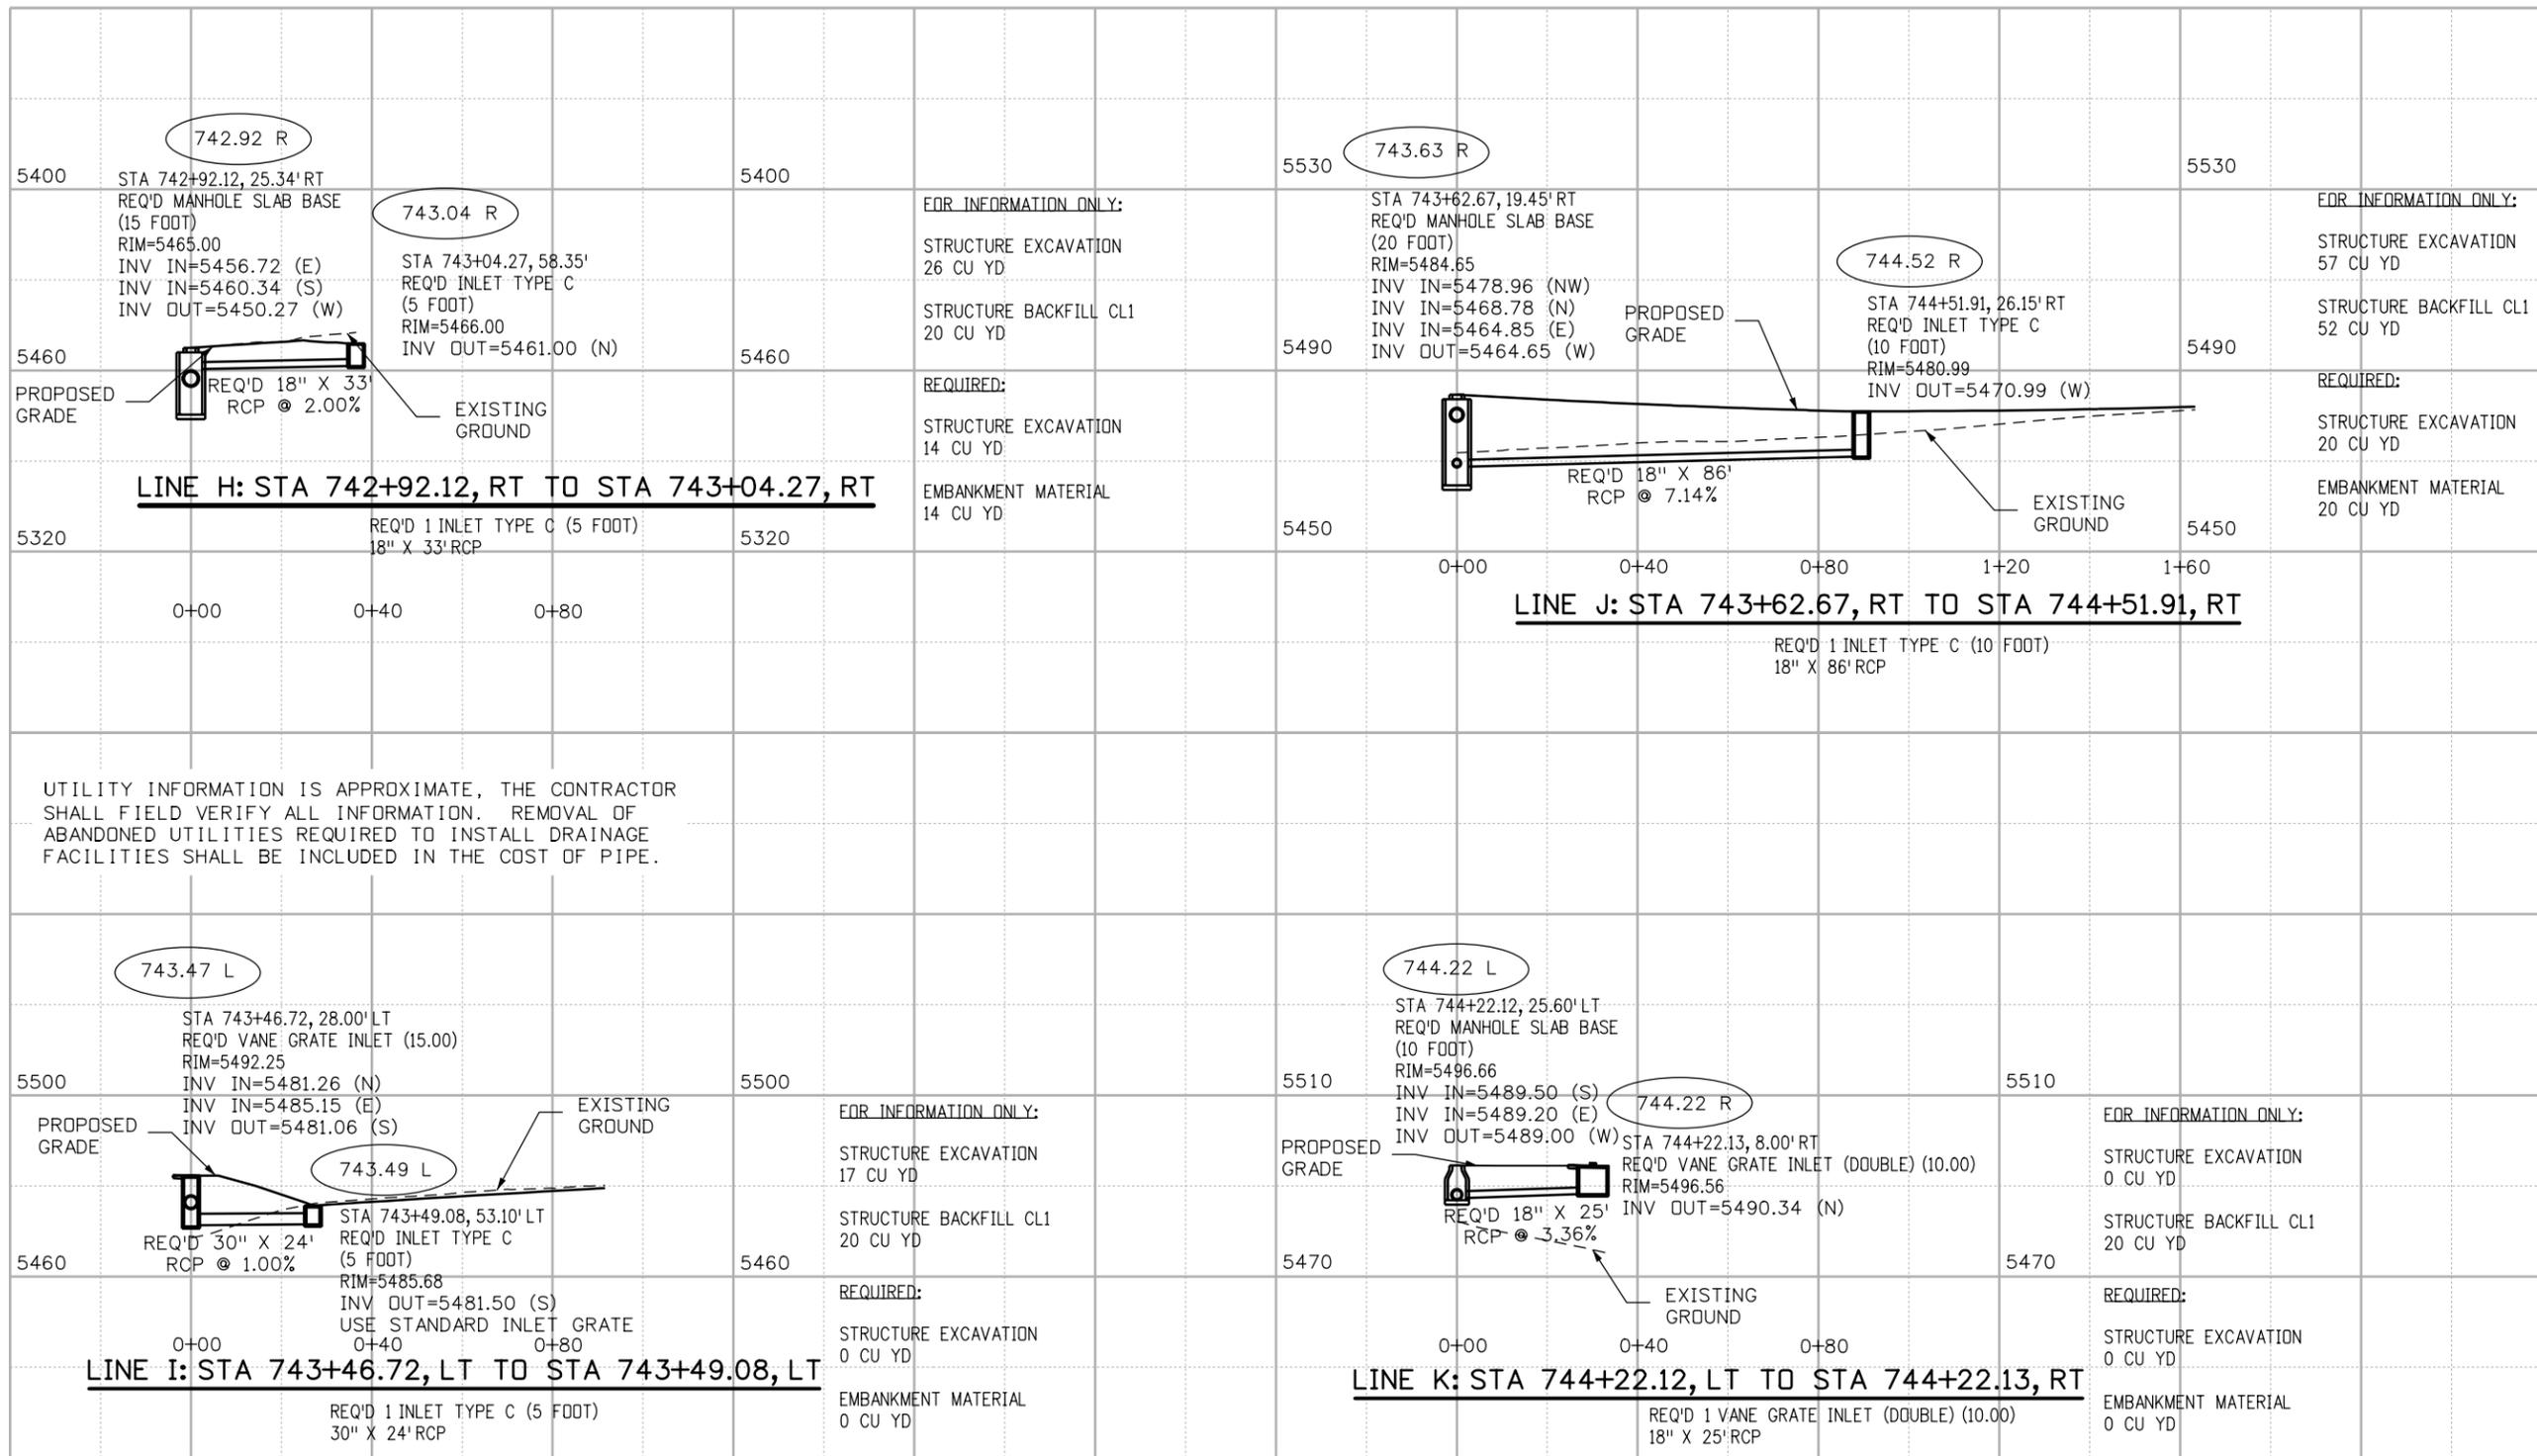

UTILITY INFORMATION IS APPROXIMATE, THE CONTRACTOR SHALL FIELD VERIFY ALL INFORMATION. REMOVAL OF ABANDONED UTILITIES REQUIRED TO INSTALL DRAINAGE FACILITIES SHALL BE INCLUDED IN THE COST OF PIPE.

12244 3:48:02 PM S:\Tranpro\100002375\14679\Consultants\Hydraulics\Drawings\14679_pDP-V711.dgn

| |
|---|
| Print Date: 1/6/2010 |
| File Name: 14679_pDP-V711.dgn |
| Horiz. Scale: 1:40 Vert. Scale: 1:40 |
| PBSJ 4601 DTC Boulevard Suite 700 Denver, CO 80237 |

| Sheet Revisions | | |
|-----------------|----------|-------|
| Date: | Comments | Init. |
| | | |
| | | |
| | | |

Colorado Department of Transportation




8833 South Wadsworth Court
Littleton, CO 80128
Phone: 303-972-9112 FAX: 303-972-9114

Region 6 RLB

| |
|-----------------------|
| As Constructed |
| No Revisions: |
| Revised: |
| Void: |

| DRAINAGE PROFILES C-470/FLYOVER | | |
|------------------------------------|----------|-------------------------|
| Designer: | WRC/NB | Structure Numbers |
| Detailer: | WRC/NB | |
| Sheet Subset: | DRAIN PR | Subset Sheets: 10 of 11 |

| |
|-------------------------|
| Project No./Code |
| ES6 0852-103 |
| 17679 |
| Sheet Number 108 |

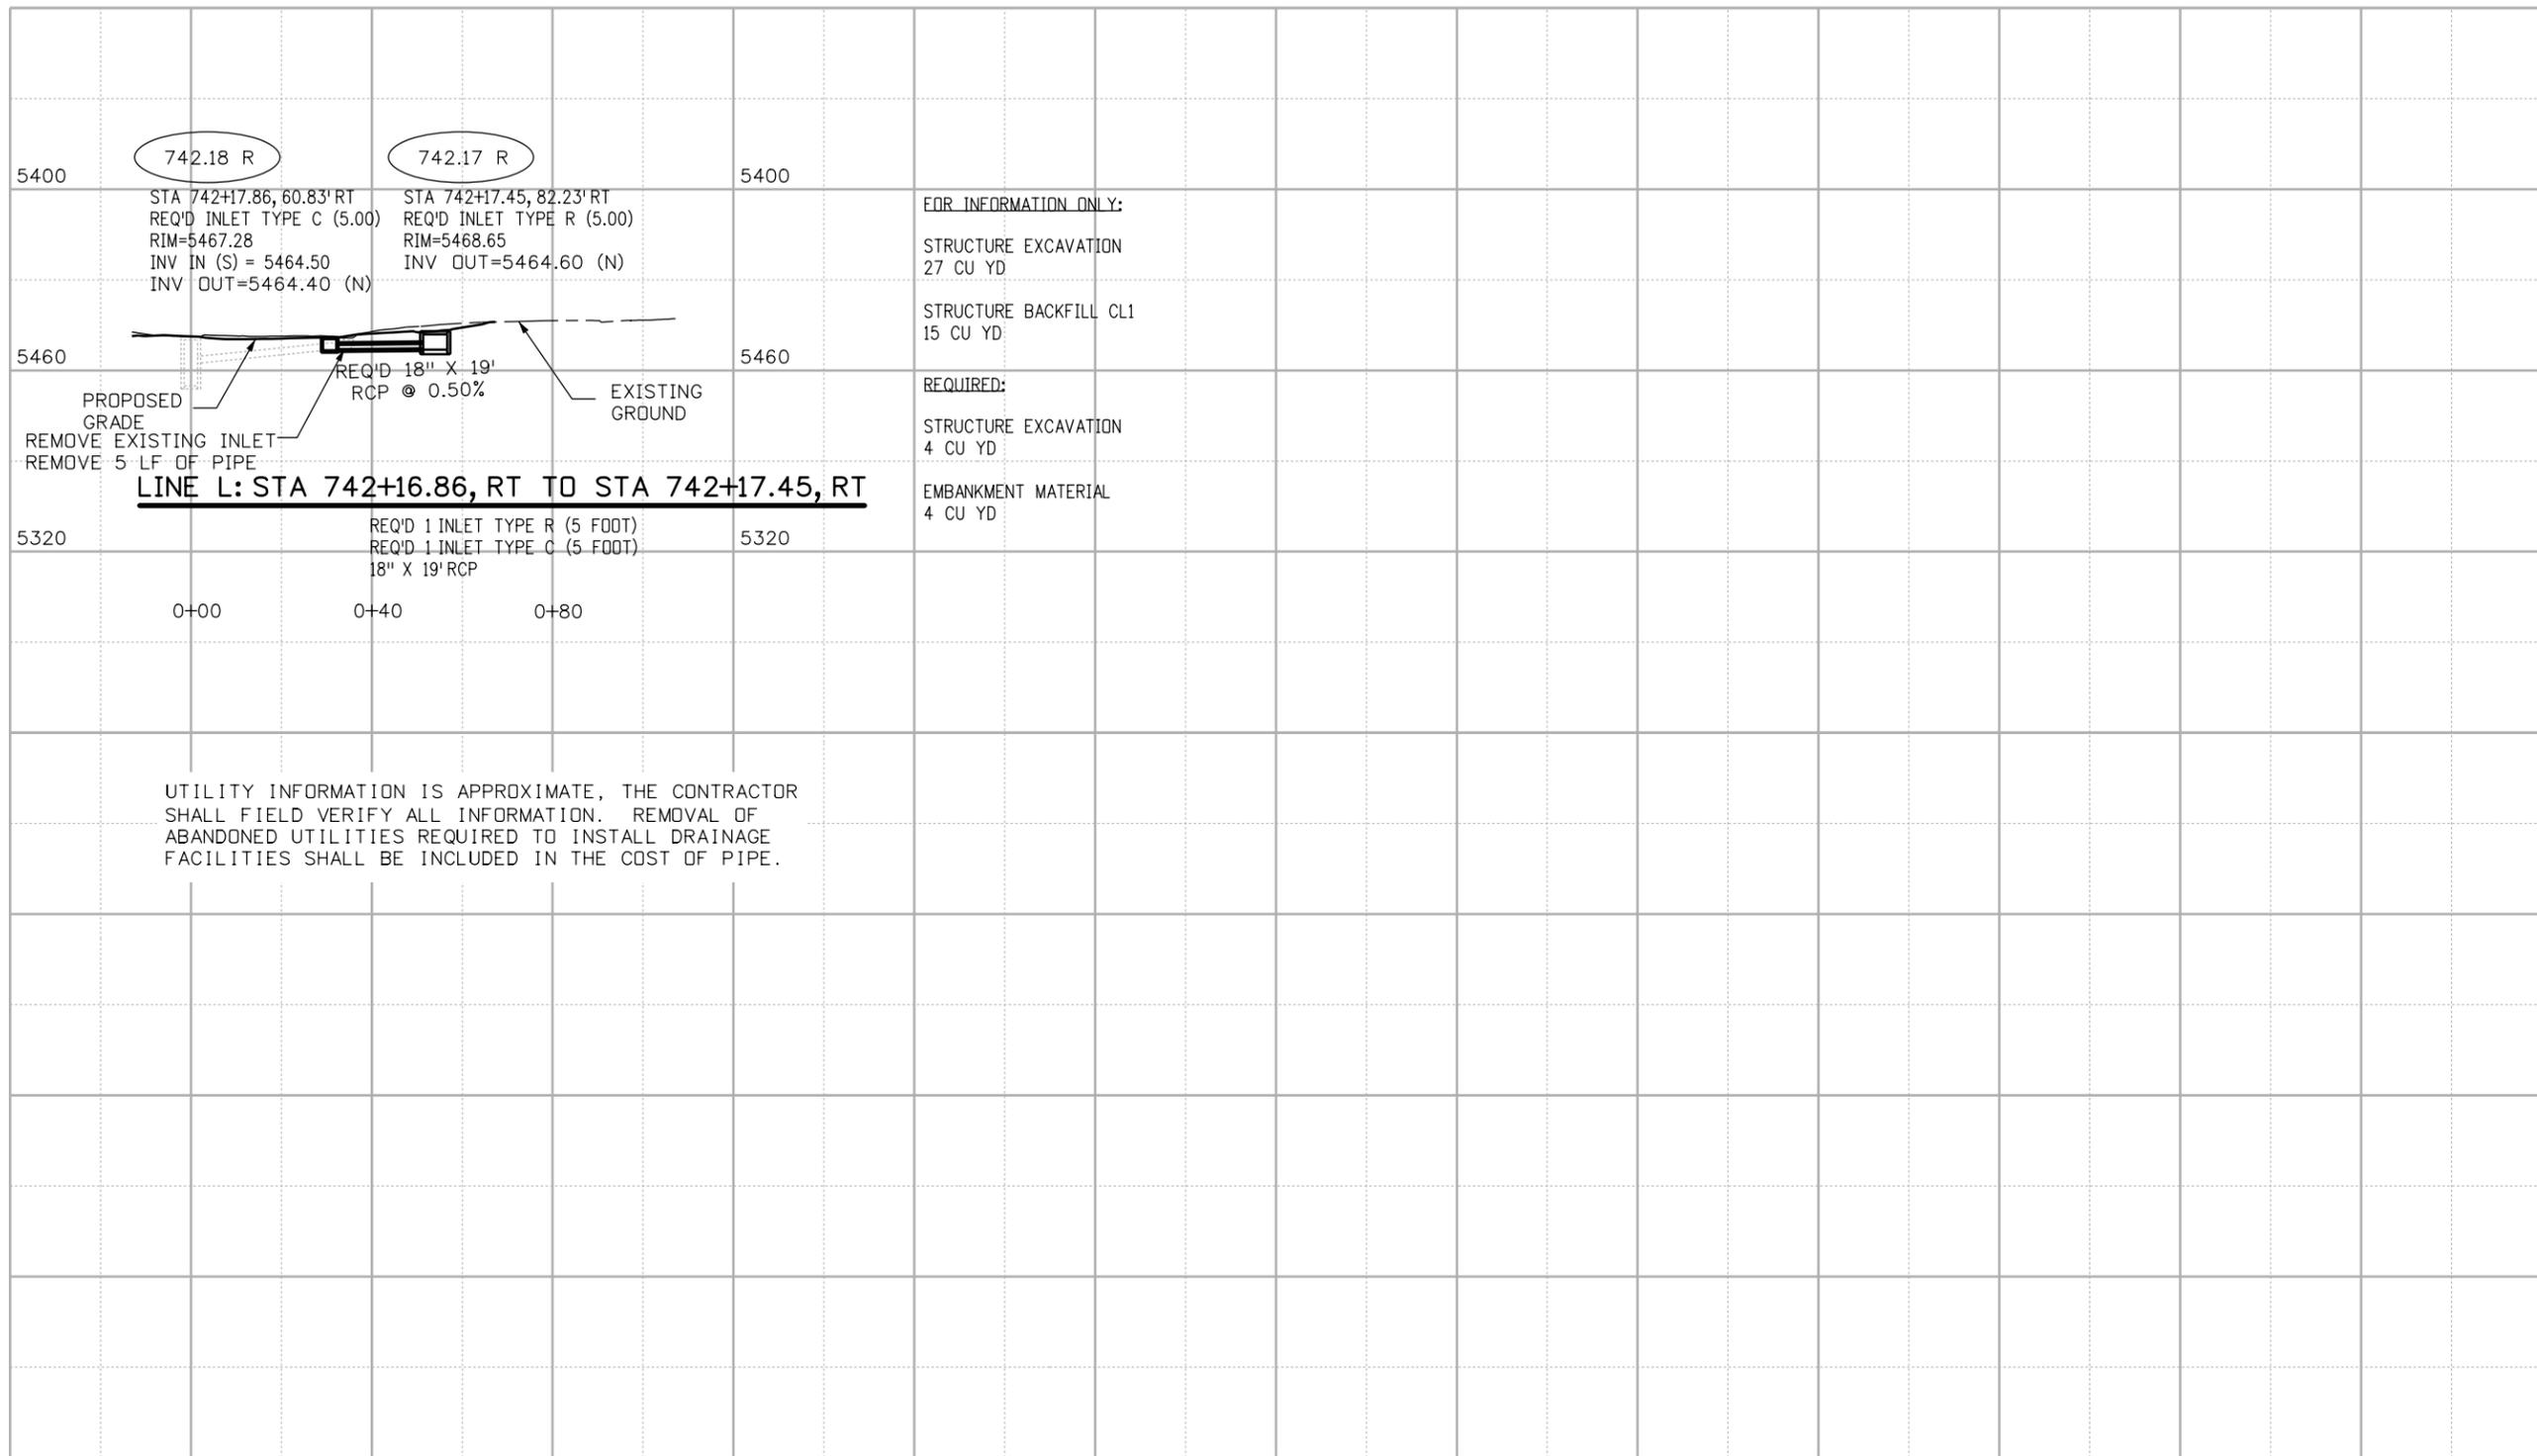

742.18 R 742.17 R
 STA 742+17.86, 60.83' RT STA 742+17.45, 82.23' RT
 REQ'D INLET TYPE C (5.00) REQ'D INLET TYPE R (5.00)
 RIM=5467.28 RIM=5468.65
 INV IN (S) = 5464.50 INV OUT=5464.60 (N)
 INV OUT=5464.40 (N)

PROPOSED GRADE
 REMOVE EXISTING INLET
 REMOVE 5 LF OF PIPE
 REQ'D 18" X 19" RCP @ 0.50%
 EXISTING GROUND

LINE L: STA 742+16.86, RT TO STA 742+17.45, RT

0+00 0+40 0+80

FOR INFORMATION ONLY:
 STRUCTURE EXCAVATION
 27 CU YD
 STRUCTURE BACKFILL CL1
 15 CU YD
REQUIRED:
 STRUCTURE EXCAVATION
 4 CU YD
 EMBANKMENT MATERIAL
 4 CU YD

UTILITY INFORMATION IS APPROXIMATE, THE CONTRACTOR SHALL FIELD VERIFY ALL INFORMATION. REMOVAL OF ABANDONED UTILITIES REQUIRED TO INSTALL DRAINAGE FACILITIES SHALL BE INCLUDED IN THE COST OF PIPE.

Print Date: 1/6/2010
 File Name: 14679_pDP-V712.dgn
 Horiz. Scale: 1:40 Vert. Scale: 1:40

PBSJ 4601 DTC Boulevard
 Suite 700
 Denver, CO 80237

| Sheet Revisions | | |
|-----------------|----------|-------|
| Date: | Comments | Init. |
| | | |
| | | |
| | | |

Colorado Department of Transportation
 8833 South Wadsworth Court
 Littleton, CO 80128
 Phone: 303-972-9112 FAX: 303-972-9114
Region 6 **RLB**


As Constructed
 No Revisions:
 Revised:
 Void:

DRAINAGE PROFILES
C-470/FLYOVER

| | | | |
|---------------|----------|-------------------|----------|
| Designer: | WRC/NB | Structure Numbers | |
| Detailer: | WRC/NB | | |
| Sheet Subset: | DRAIN PR | Subset Sheets: | 11 of 11 |


Project No./Code
 ES6 0852-103
 17679
 Sheet Number 109

12244 3:48:18 PM S:\Transport\100002375\14679\Hydraulics\Drawings\14679_pDWQ-V701.dgn

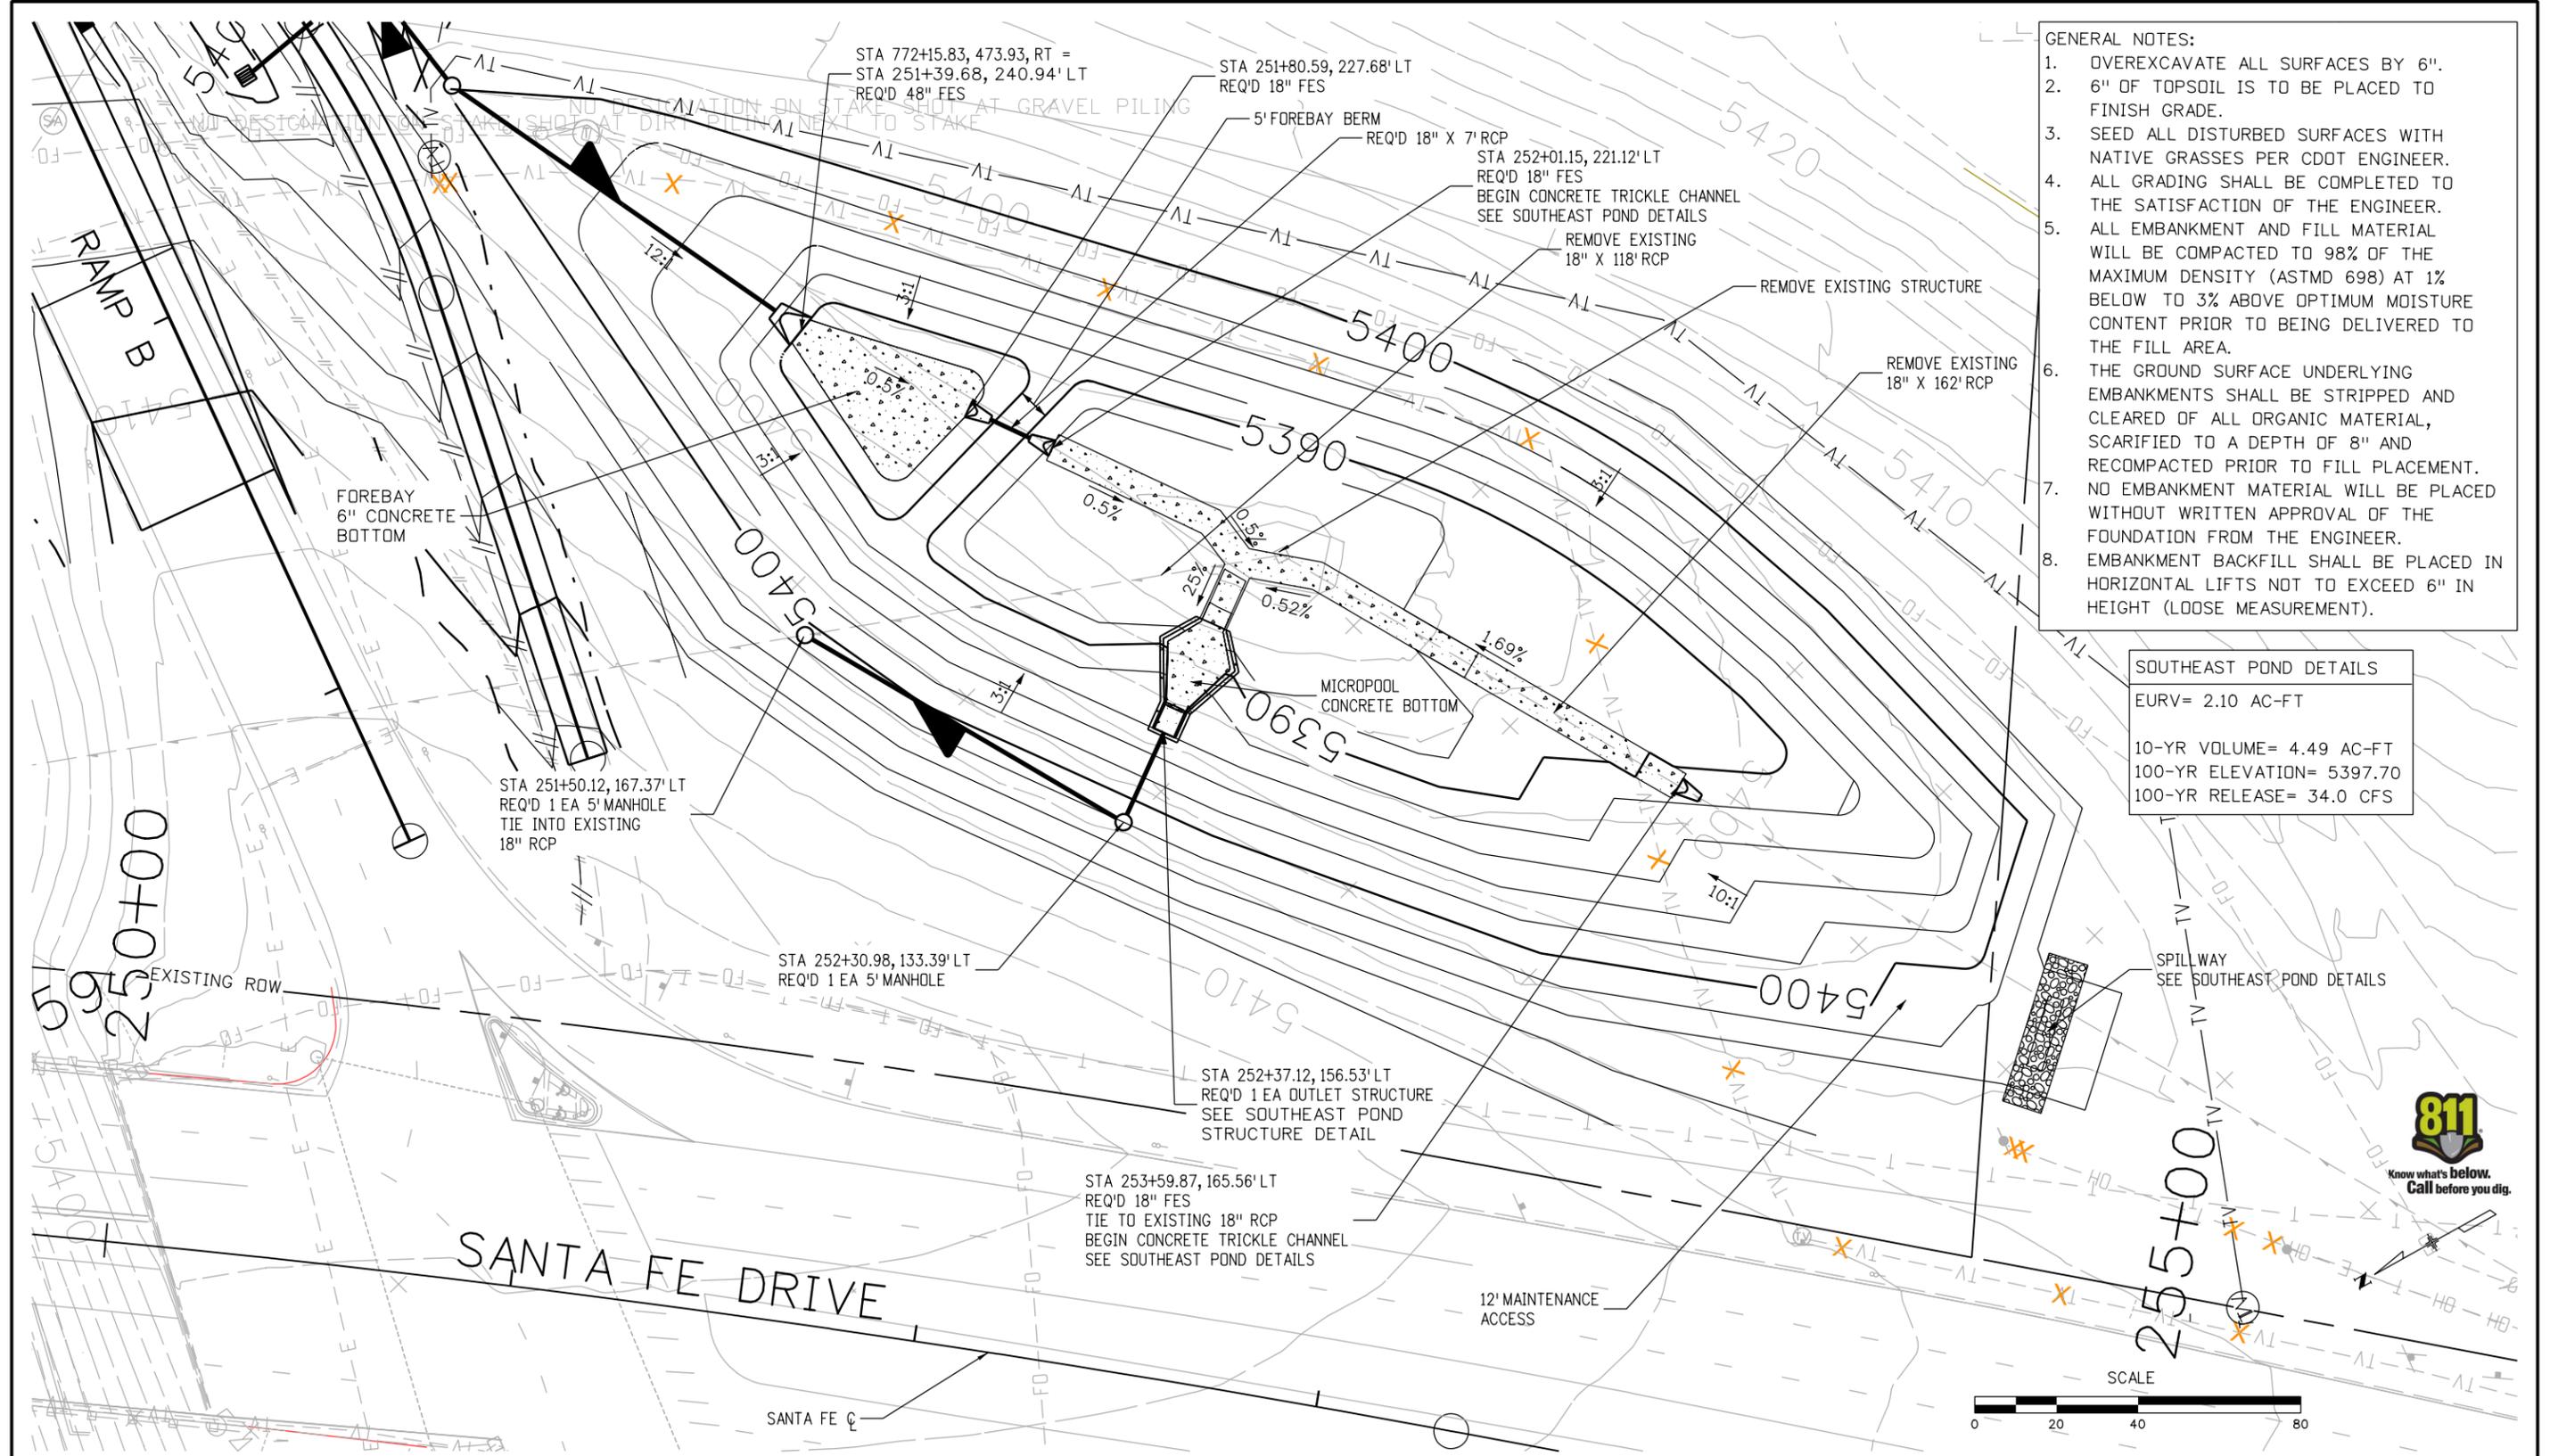

- GENERAL NOTES:**
1. OVEREXCAVATE ALL SURFACES BY 6".
 2. 6" OF TOPSOIL IS TO BE PLACED TO FINISH GRADE.
 3. SEED ALL DISTURBED SURFACES WITH NATIVE GRASSES PER CDDT ENGINEER.
 4. ALL GRADING SHALL BE COMPLETED TO THE SATISFACTION OF THE ENGINEER.
 5. ALL EMBANKMENT AND FILL MATERIAL WILL BE COMPACTED TO 98% OF THE MAXIMUM DENSITY (ASTM D 698) AT 1% BELOW TO 3% ABOVE OPTIMUM MOISTURE CONTENT PRIOR TO BEING DELIVERED TO THE FILL AREA.
 6. THE GROUND SURFACE UNDERLYING EMBANKMENTS SHALL BE STRIPPED AND CLEARED OF ALL ORGANIC MATERIAL, SCARIFIED TO A DEPTH OF 8" AND RECOMPACTED PRIOR TO FILL PLACEMENT.
 7. NO EMBANKMENT MATERIAL WILL BE PLACED WITHOUT WRITTEN APPROVAL OF THE FOUNDATION FROM THE ENGINEER.
 8. EMBANKMENT BACKFILL SHALL BE PLACED IN HORIZONTAL LIFTS NOT TO EXCEED 6" IN HEIGHT (LOOSE MEASUREMENT).

SOUTHEAST POND DETAILS
 EURV = 2.10 AC-FT
 10-YR VOLUME = 4.49 AC-FT
 100-YR ELEVATION = 5397.70
 100-YR RELEASE = 34.0 CFS

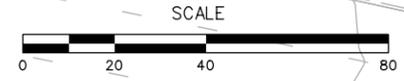

Print Date: 1/6/2010
 File Name: 14679_pDWQ-V701.dgn
 Horiz. Scale: 1:40 Vert. Scale: As Noted

| Sheet Revisions | | |
|-----------------|----------|-------|
| Date: | Comments | Init. |
| | | |
| | | |
| | | |

Colorado Department of Transportation
 8833 South Wadsworth Court
 Littleton, CO 80128
 Phone: 303-972-9112 FAX: 303-972-9114
Region 6 **RLB**


As Constructed
 No Revisions:
 Revised:
 Void:

WATER QUALITY SOUTHEAST POND LAYOUT
 Designer: TYK
 Detailer: TYK
 Sheet Subset: DRAIN WQ
 Structure Numbers:
 Subset Sheets: 1 of 9

Project No./Code
 ES6 0852-103
 17679
 Sheet Number 110



12244 3:48:28 PM S:\Tranpro\100002375\14679\Consultants\Hydraulics\Drawings\14679_pDWQ-V702.dgn

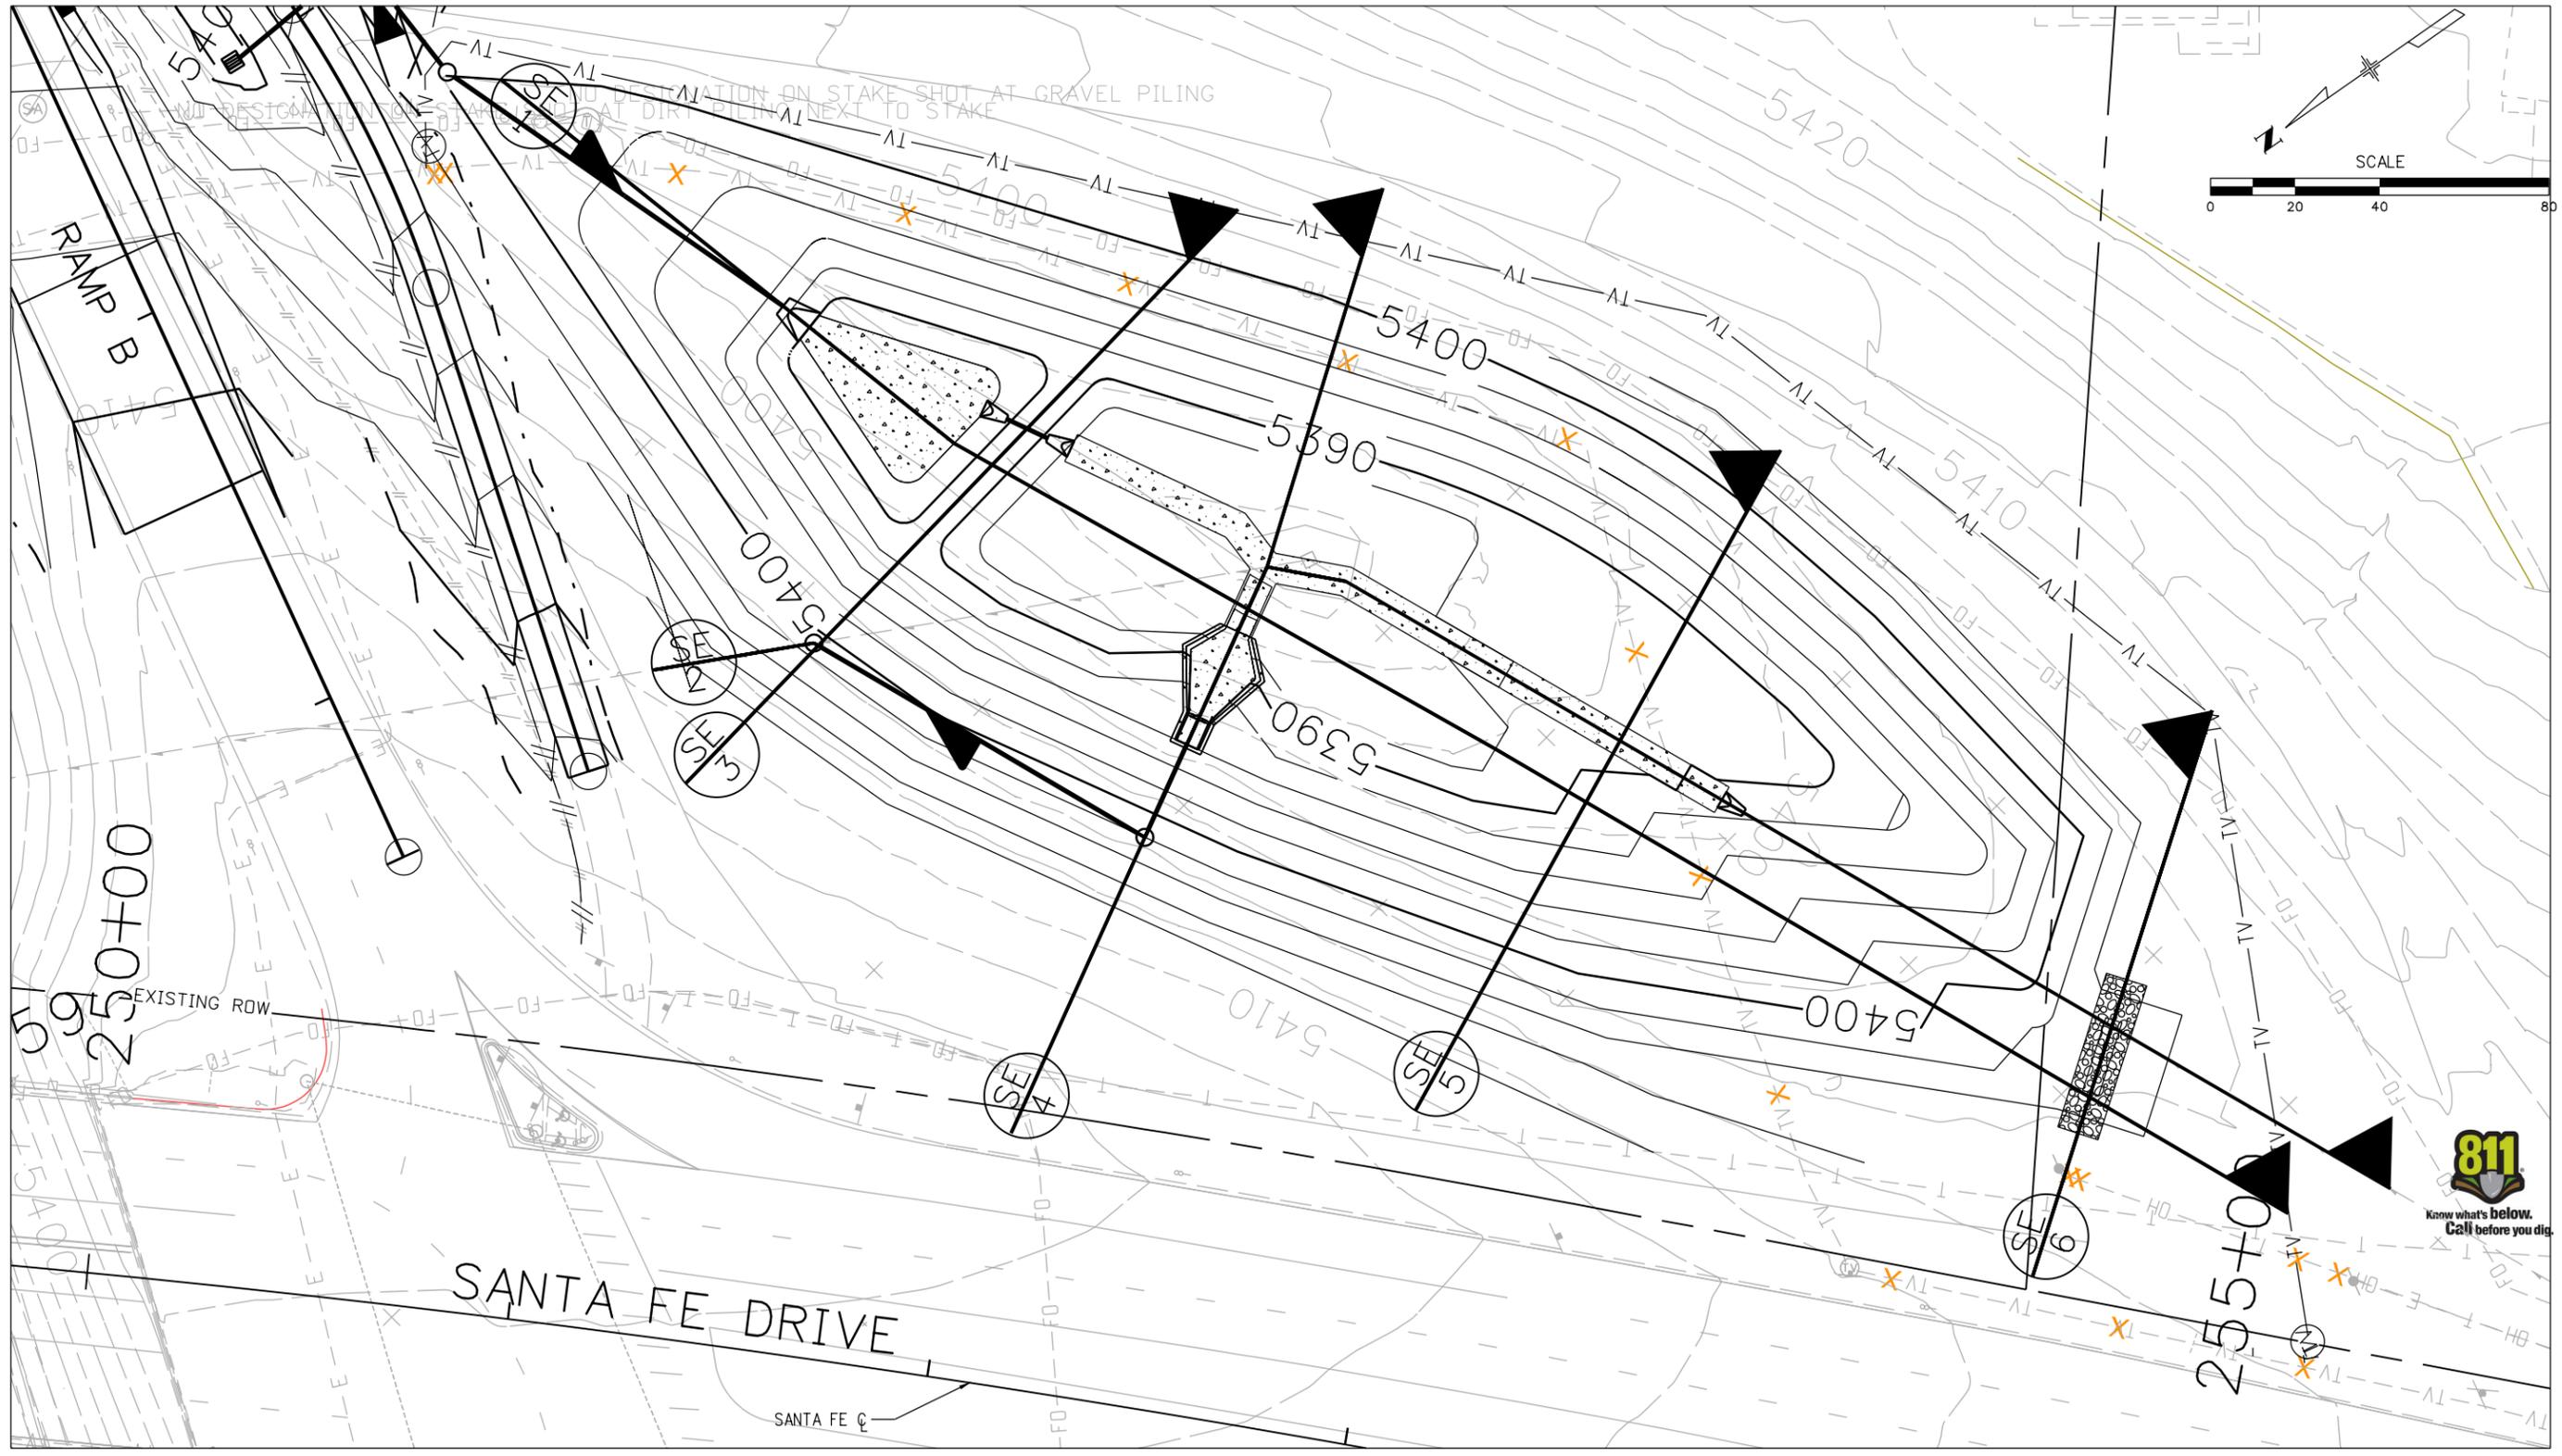

Print Date: 1/6/2010
 File Name: 14679_pDWQ-V702.dgn
 Horiz. Scale: 1:40 Vert. Scale: As Noted

| Sheet Revisions | | |
|-----------------|----------|-------|
| Date: | Comments | Init. |
| | | |
| | | |
| | | |

Colorado Department of Transportation

 8833 South Wadsworth Court
 Littleton, CO 80128
 Phone: 303-972-9112 FAX: 303-972-9114
 Region 6 RLB


As Constructed
 No Revisions:
 Revised:
 Void:

**WATER QUALITY
 SOUTHEAST POND SECTION LINES**
 Designer: TYK Structure Numbers
 Detailer: TYK
 Sheet Subset: DRAIN WQ Subset Sheets: 2 of 9

Project No./Code
 ES6 0852-103
 17679
 Sheet Number 111



0000

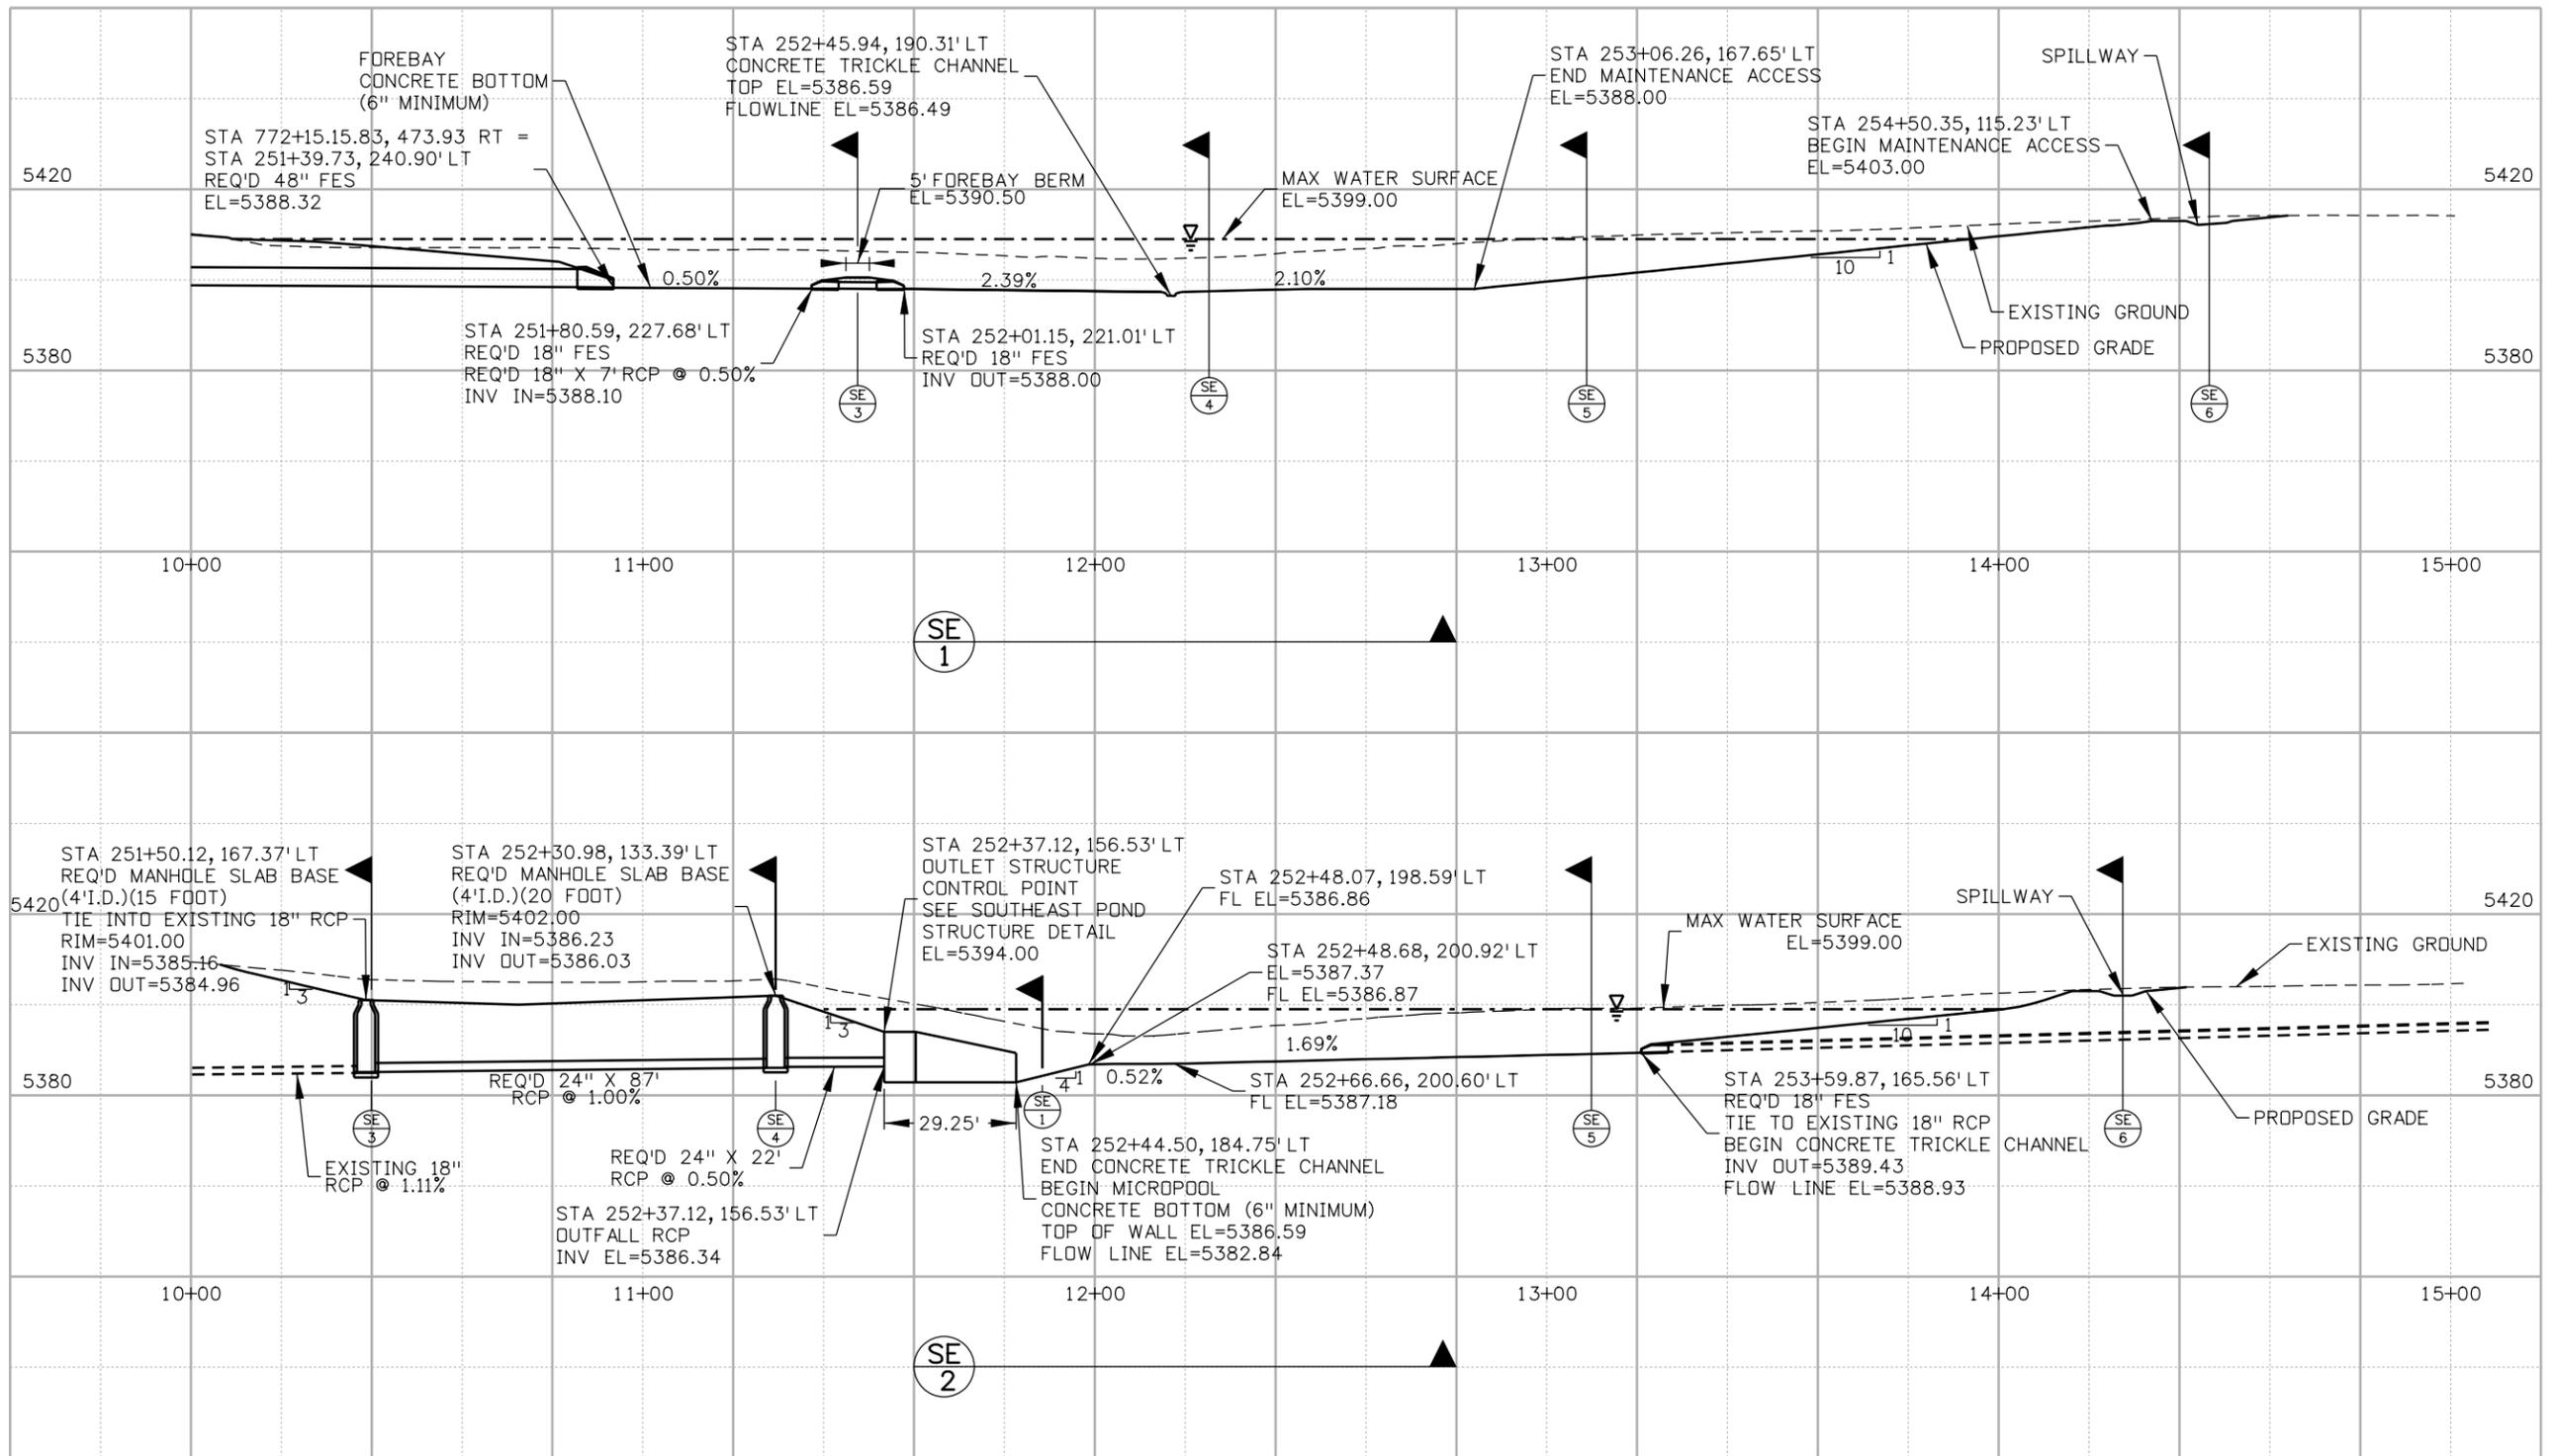

12244 3:48:33 PM S:\Tranpro\100002375\14679\Consultants\Hydraulics\Drawings\14679_pDWQ-V703.dgn

Print Date: 1/6/2010
 File Name: 14679_pDWQ-V703.dgn
 Horiz. Scale: 1:40 Vert. Scale: 1:40

| Sheet Revisions | | |
|-----------------|----------|-------|
| Date: | Comments | Init. |
| | | |
| | | |
| | | |

Colorado Department of Transportation

 8833 South Wadsworth Court
 Littleton, CO 80128
 Phone: 303-972-9112 FAX: 303-972-9114
 Region 6 RLB

As Constructed
 No Revisions:
 Revised:
 Void:


WATER QUALITY
 SOUTHEAST POND CROSS SECTION

Designer: TYK
 Detailer: TYK

Structure Numbers
 Sheet Subset: DRAIN WQ
 Subset Sheets: 3 of 9

Project No./Code
 ES6 0852-103
 17679
 Sheet Number 112



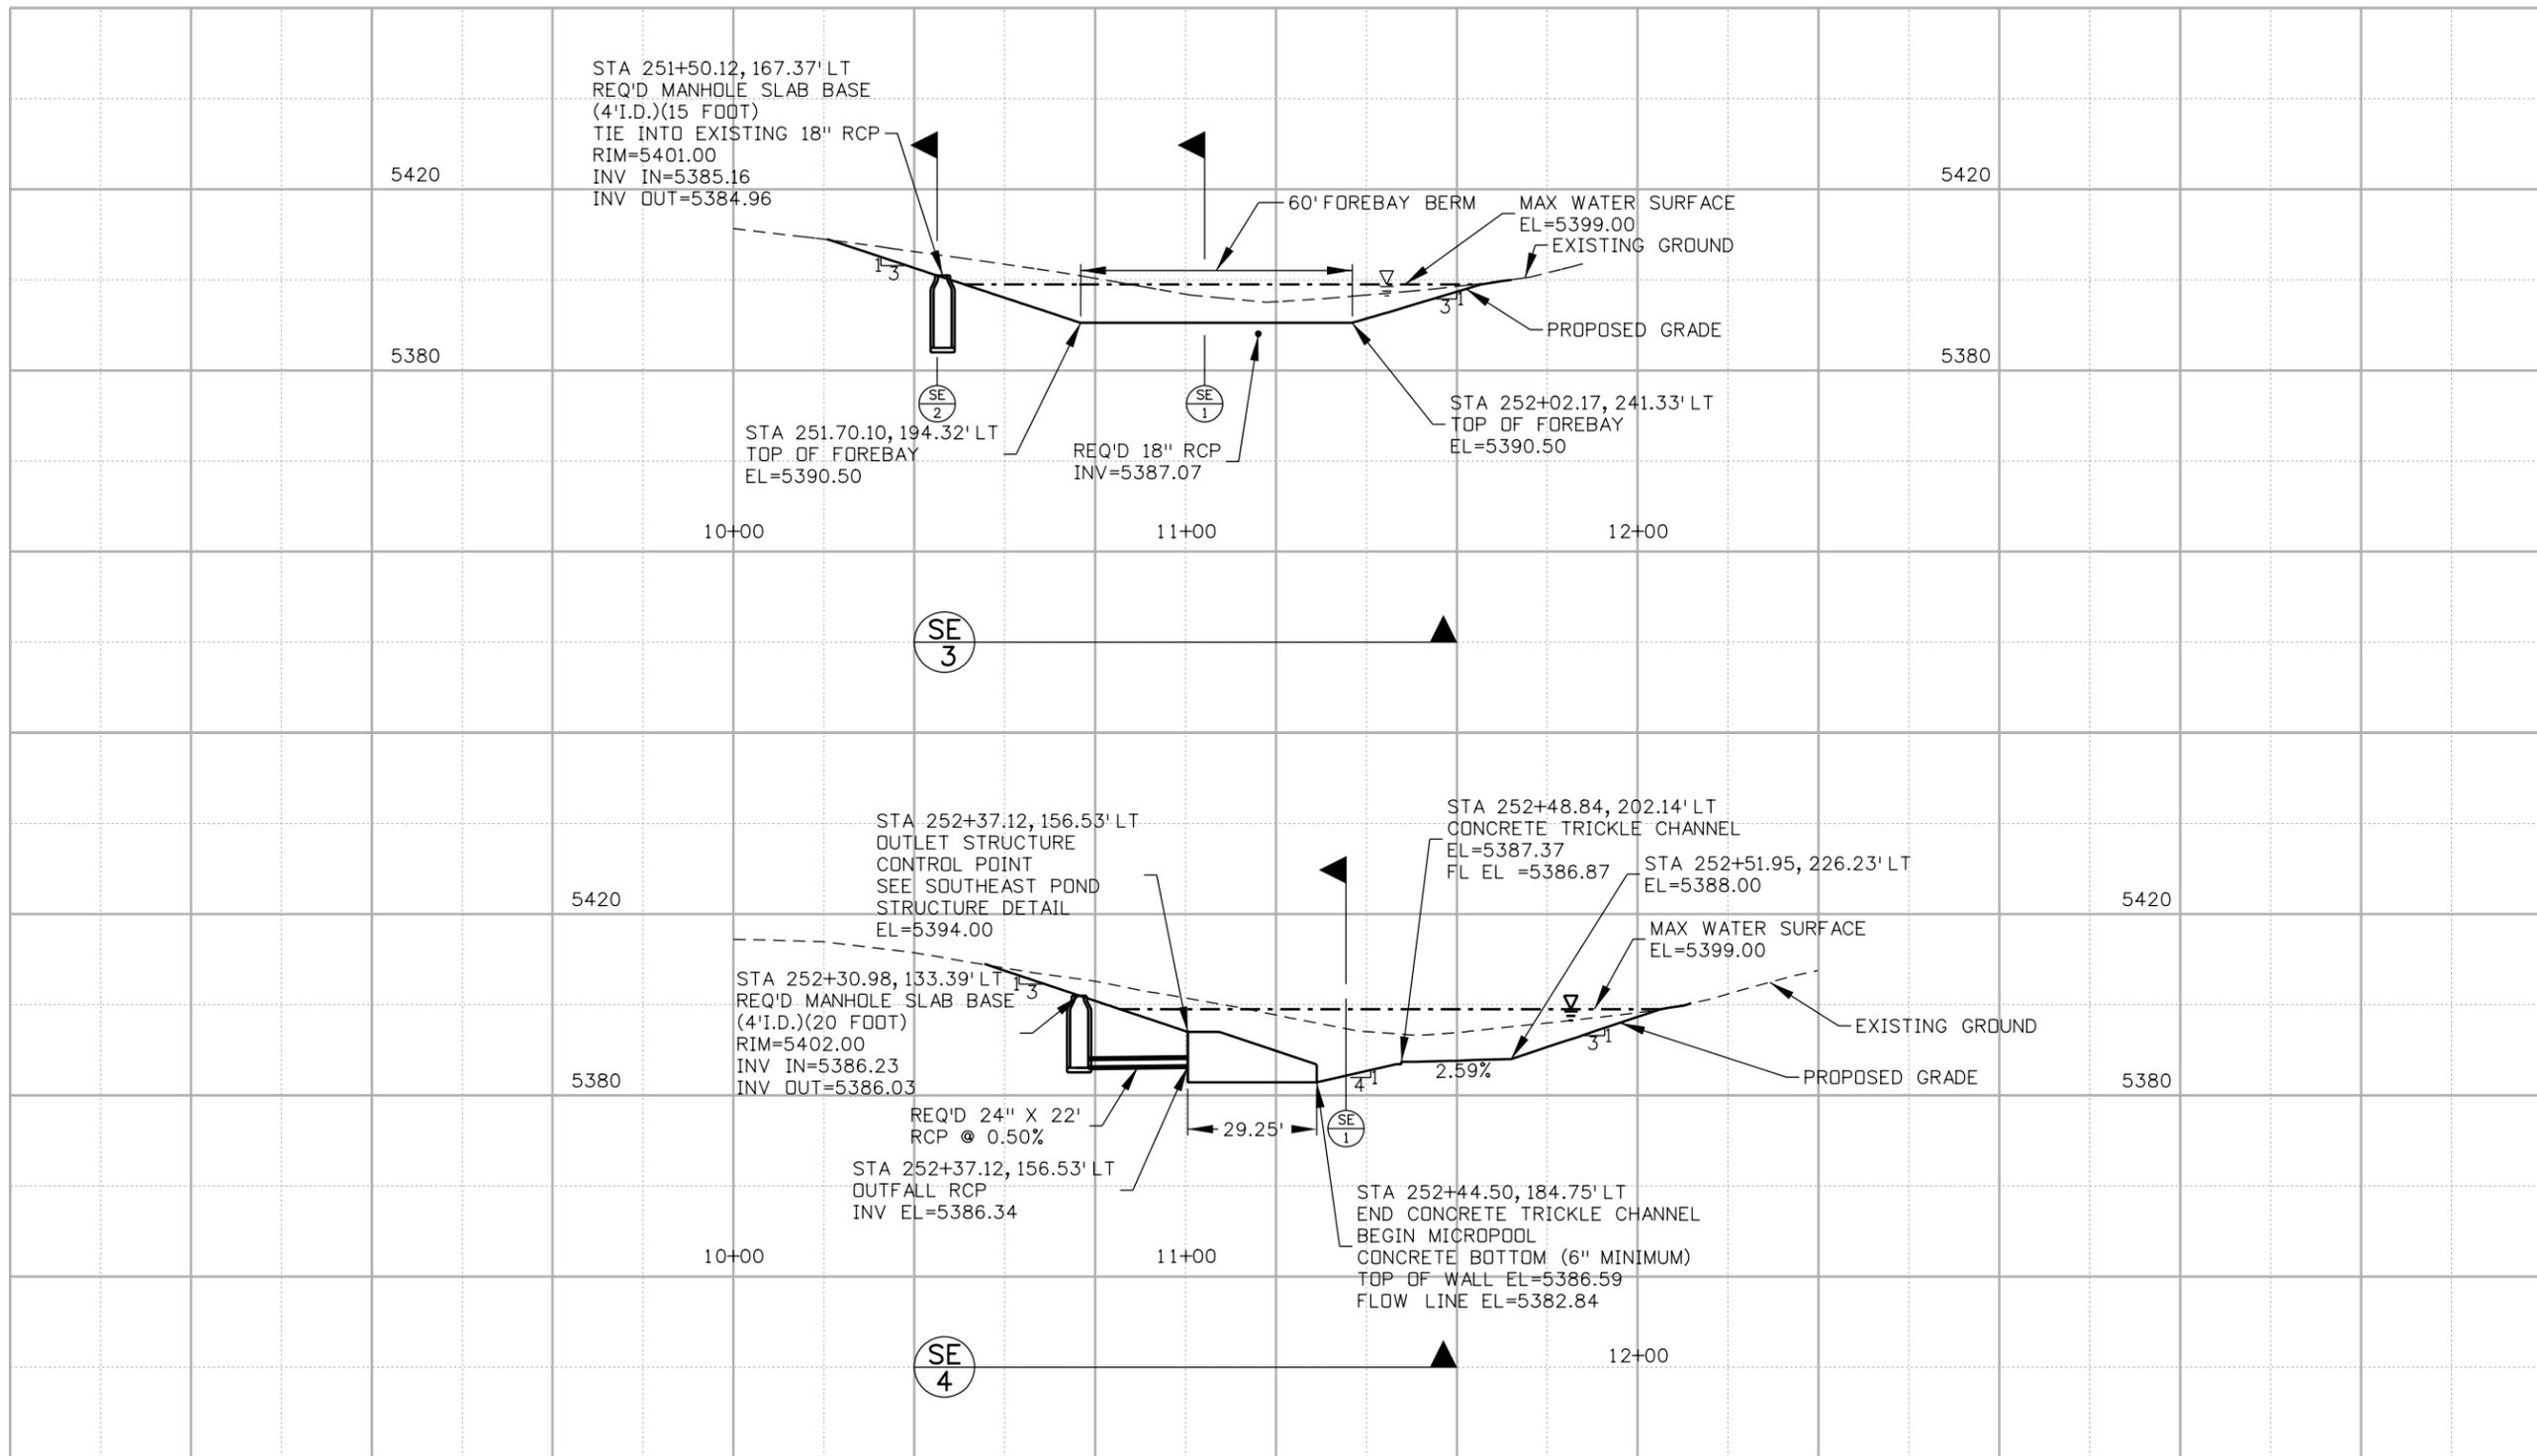

12244 3:48:36 PM S:\Tranpro\100002375\14679\Consultants\Hydraulics\Drawings\14679_pDWQ-V704.dgn

| |
|---|
| Print Date: 1/6/2010 |
| File Name: 14679_pDWQ-V704.dgn |
| Horiz. Scale: 1:40 Vert. Scale: 1:40 |
| PBSJ 4601 DTC Boulevard Suite 700 Denver, CO 80237 |

| Sheet Revisions | | |
|-----------------|----------|-------|
| Date: | Comments | Init. |
| | | |
| | | |
| | | |

Colorado Department of Transportation




8833 South Wadsworth Court
Littleton, CO 80128
Phone: 303-972-9112 FAX: 303-972-9114

Region 6 **RLB**

| |
|-----------------------|
| As Constructed |
| No Revisions: |
| Revised: |
| Void: |

| | | | |
|-------------------------------------|----------|----------------|--------|
| WATER QUALITY | | | |
| SOUTHEAST POND CROSS SECTION | | | |
| Designer: | TYK | Structure | |
| Detailer: | TYK | Numbers | |
| Sheet Subset: | DRAIN WQ | Subset Sheets: | 4 of 9 |

| |
|-------------------------|
| Project No./Code |
| ES6 0852-103 |
| 17679 |
| Sheet Number 113 |

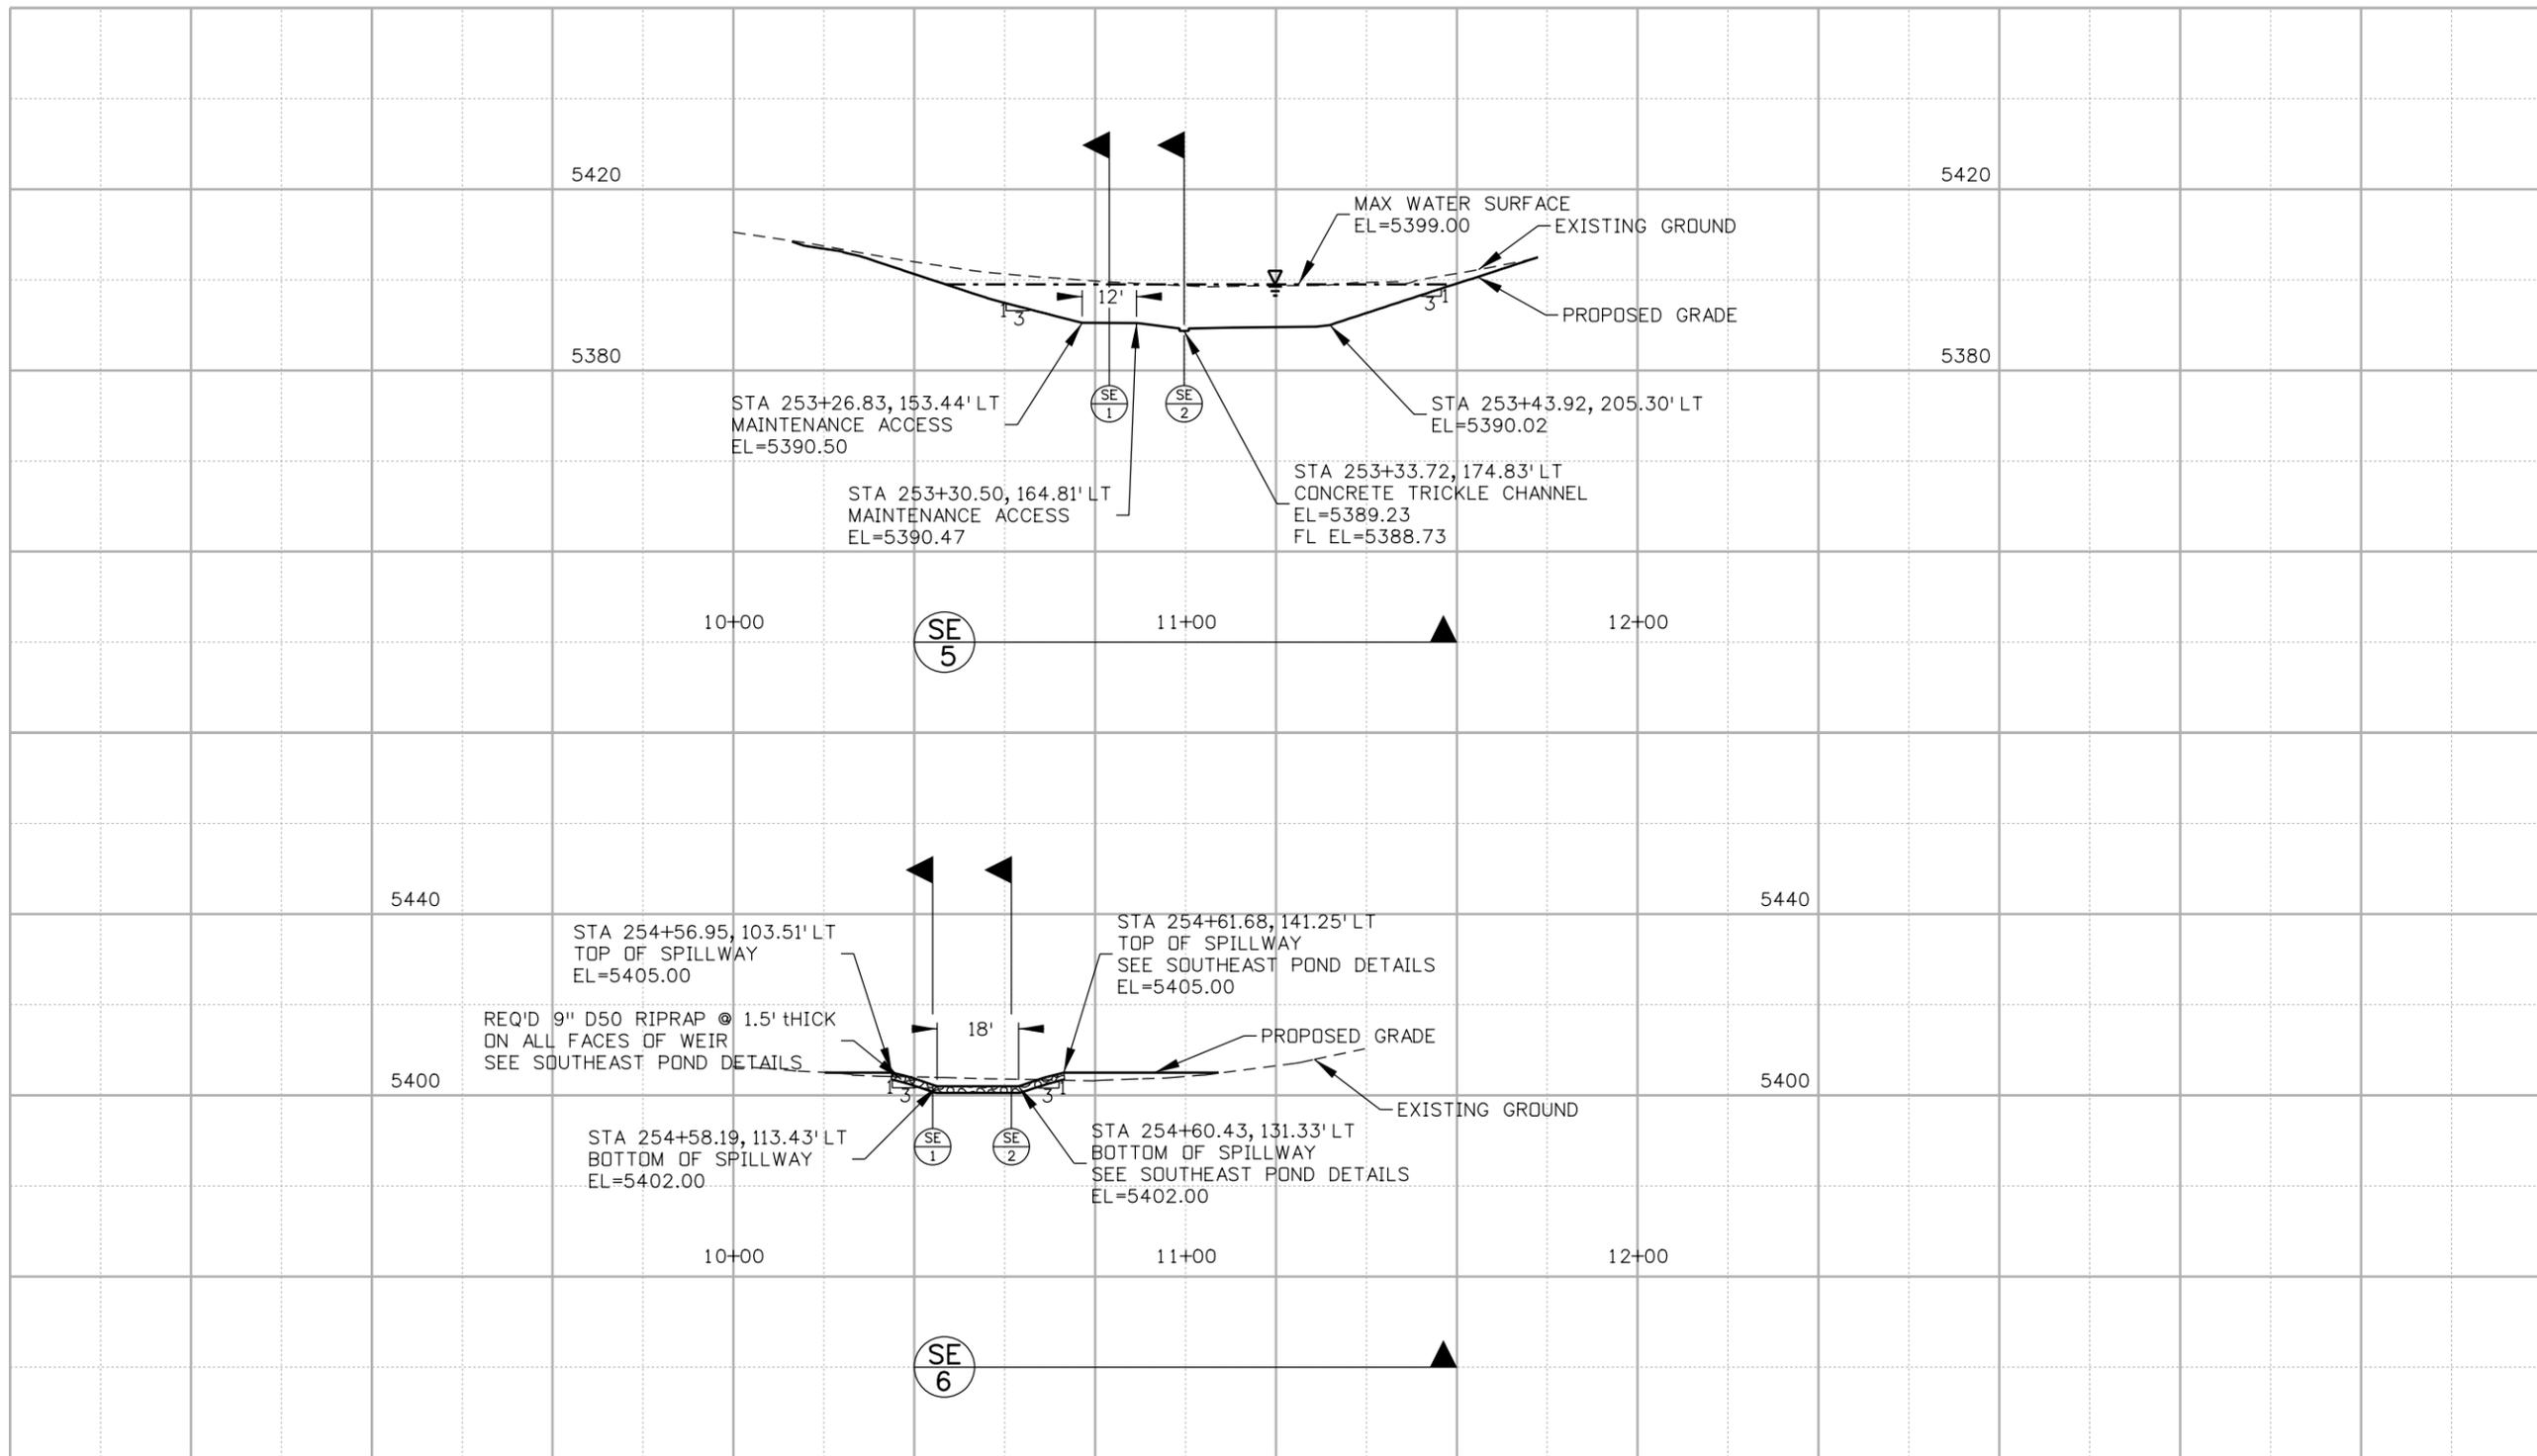

12244 3:48:39 PM S:\Tranpro\100002375\14679\Consultants\Hydraulics\Drawings\14679_pDWQ-V705.dgn

| |
|---|
| Print Date: 1/6/2010 |
| File Name: 14679_pDWQ-V705.dgn |
| Horiz. Scale: 1:40 Vert. Scale: 1:40 |
| PBSJ 4601 DTC Boulevard Suite 700 Denver, CO 80237 |

| Sheet Revisions | | |
|-----------------|----------|-------|
| Date: | Comments | Init. |
| | | |
| | | |
| | | |

Colorado Department of Transportation



8833 South Wadsworth Court
Littleton, CO 80128
Phone: 303-972-9112 FAX: 303-972-9114


Region 6 **RLB**

| |
|-----------------------|
| As Constructed |
| No Revisions: |
| Revised: |
| Void: |


| | | | |
|---|-----|-----------------------|--|
| WATER QUALITY SOUTHEAST POND CROSS SECTION | | | |
| Designer: | TYK | Structure Numbers | |
| Detailer: | TYK | | |
| Sheet Subset: DRAIN WQ | | Subset Sheets: 5 of 9 | |

| |
|-------------------------|
| Project No./Code |
| ES6 0852-103 |
| 17679 |
| Sheet Number 114 |

12244 3:48:51 PM S:\Tranpro\00002375\14679_Consultants\Hydraulics Drawings\14679_pDWQ-V706.dgn

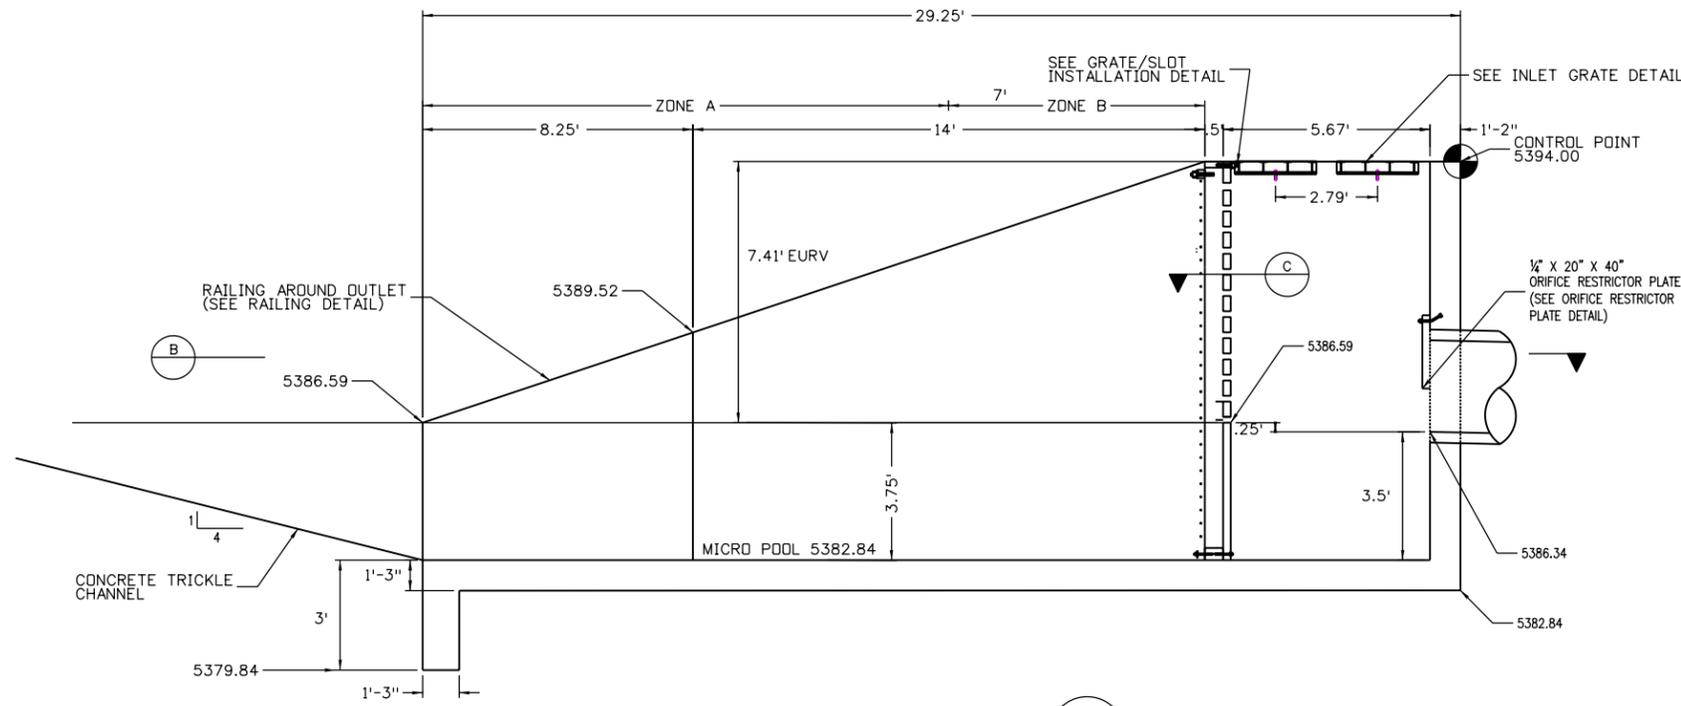



A SECTION 24" OUTLET STRUCTURE

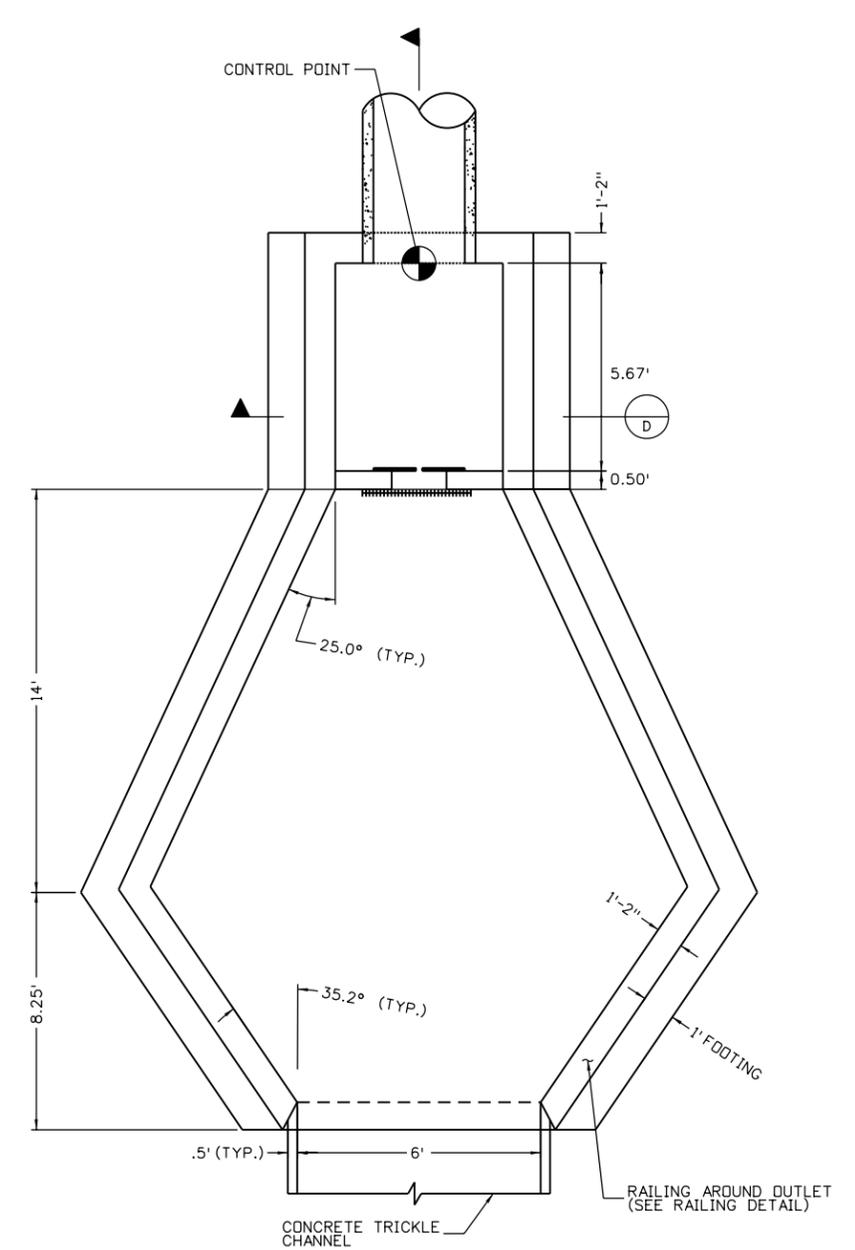

B SECTION 24" OUTLET STRUCTURE

GENERAL NOTES:

1. CONCRETE SHALL BE CLASS D.
2. EXPOSED CONCRETE CORNERS SHALL BE CHAMFERED 3/4".
3. OUTLET WALLS SHALL BE FORMED BOTH INSIDE AND OUTSIDE. CASTING OF SIDEWALLS AGAINST EARTH IS NOT PERMITTED.
4. SCREEN PANEL SHALL BE KLEMP KRP SERIES ALUMINUM BAR GRATE WITH 3/16" X 2 1/4" BARS ON 1 3/16" CENTERS, OR EQUAL AS APPROVED BY CDOT ENGINEER. PANEL SHALL BE ATTACHED TO INLET BY INTERMITTENT STAINLESS STEEL BOLTS ALONG EDGES OF FRAME.
5. HARDWARE SHALL BE STAINLESS STEEL OR GALVANIZED.
6. ALL MATERIALS AND WORKMANSHIP NECESSARY FOR CONSTRUCTION OF OUTLET STRUCTURE SHALL BE INCLUDED IN THE COST OF OUTLET STRUCTURE.
7. STEPS SHALL BE PROVIDED AND SHALL BE IN ACCORDANCE WITH AASHTO M199.
8. RAILING SHALL BE INSTALLED ON STRUCTURE AND WINGWALLS (SEE RAILING DETAIL).
9. A WORKING DRAWING SUBMITTAL IS REQUIRED.

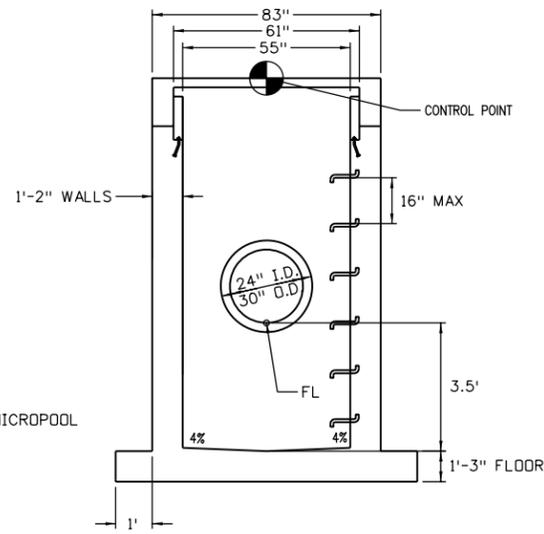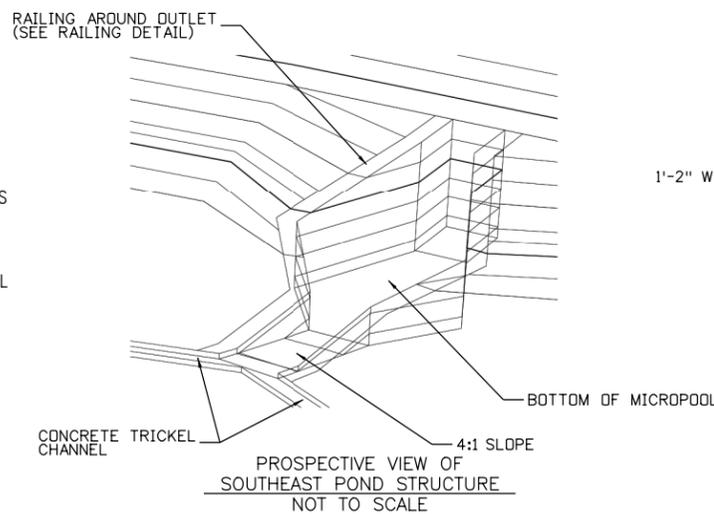

D SECTION 24" OUTLET STRUCTURE

Print Date: 1/6/2010
File Name: 14679_pDWQ-V706.dgn
Horiz. Scale: N/A Vert. Scale: As Noted

| Sheet Revisions | | | |
|-----------------|----------|-------|--|
| Date: | Comments | Init. | |
| | | | |
| | | | |

Colorado Department of Transportation
8833 South Wadsworth Court
Littleton, CO 80128
Phone: 303-972-9112 FAX: 303-972-9114
Region 6 **RLB**


| As Constructed | |
|----------------|--|
| No Revisions: | |
| Revised: | |
| Void: | |

| WATER QUALITY SOUTHEAST POND STRUCTURE | | | |
|---|------------------|-----------|--|
| Designer: | TYK | Structure | |
| Detailer: | TYK | Numbers | |
| Sheet Subset: DRAIN WQ | Subset Sheets: 6 | of 9 | |

| Project No./Code | |
|------------------|-----|
| ES6 0852-103 | |
| 17679 | |
| Sheet Number | 115 |




12244 3:48:57 PM S:\Tranpro\100002375\14679\Consultants\Hydraulics\Drawings\14679_pDWQ-V707.dgn

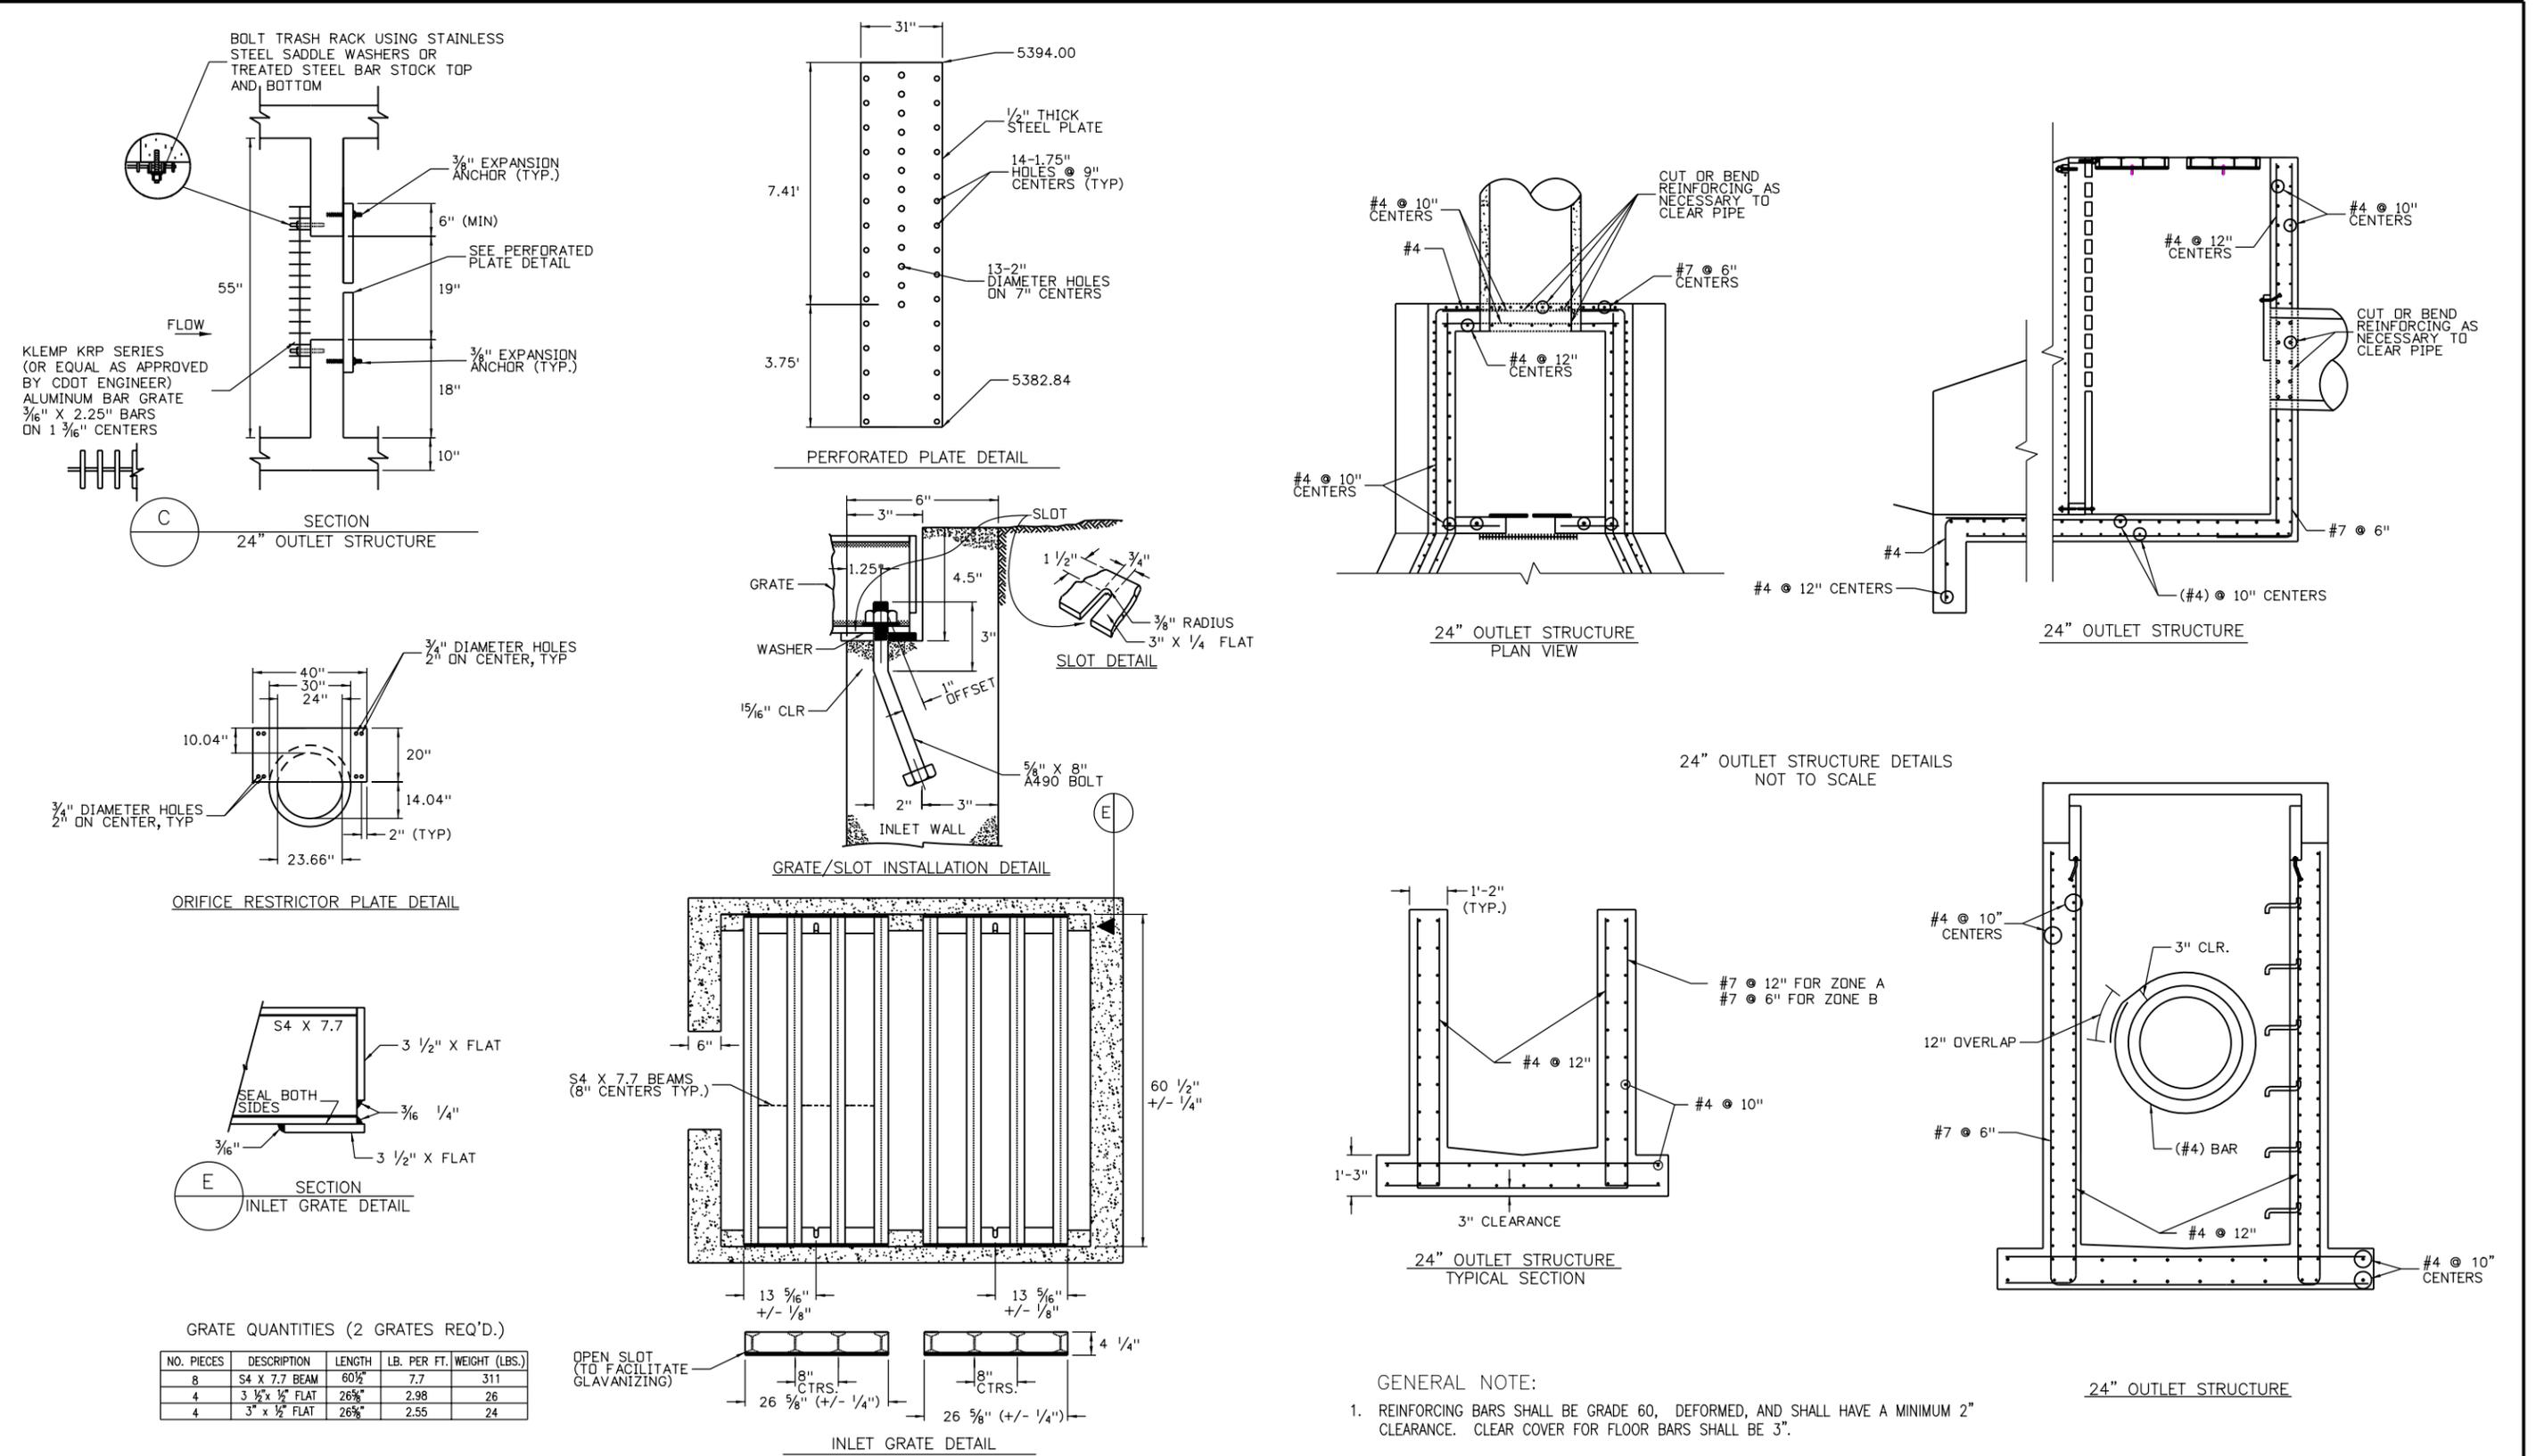


GENERAL NOTE:
 1. REINFORCING BARS SHALL BE GRADE 60, DEFORMED, AND SHALL HAVE A MINIMUM 2" CLEARANCE. CLEAR COVER FOR FLOOR BARS SHALL BE 3".


| | | | | | | | | | |
|---|------------------------|----------|-------|---|--|-----------------------|--|---|--|
| Print Date: 1/6/2010 | Sheet Revisions | | | Colorado Department of Transportation | | As Constructed | | Project No./Code | |
| File Name: 14679_pDWQ-V707.dgn | Date: | Comments | Init. | 8833 South Wadsworth Court Littleton, CO 80128 Phone: 303-972-9112 FAX: 303-972-9114 Region 6 | | No Revisions: | | WATER QUALITY SOUTHEAST POND STRUCTURE | |
| Horiz. Scale: N/A Vert. Scale: As Noted | | | | | | Revised: | | Designer: TYK Detailer: TYK | |
| 4601 DTC Boulevard Suite 700 Denver, CO 80237 | | | | RLB | | Void: | | Structure Numbers Sheet Subset: DRAIN WQ | |
| | | | | | | | | Subset Sheets: 7 of 9 | |
| | | | | | | | | Sheet Number 116 | |

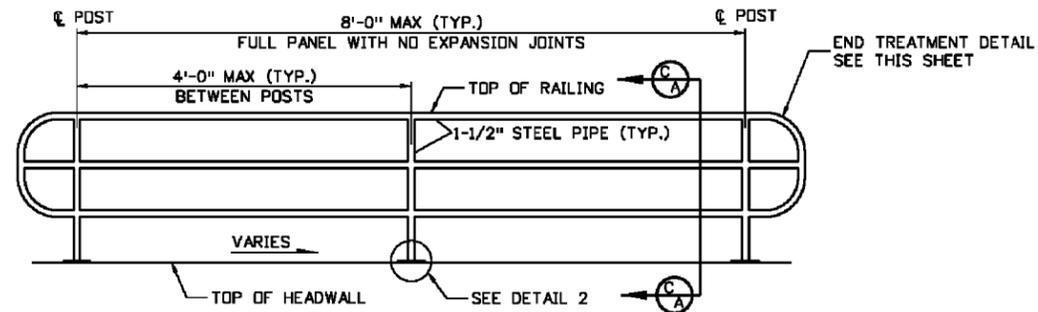


ELEVATION VIEW OF HEADWALL RAILING
N.T.S.

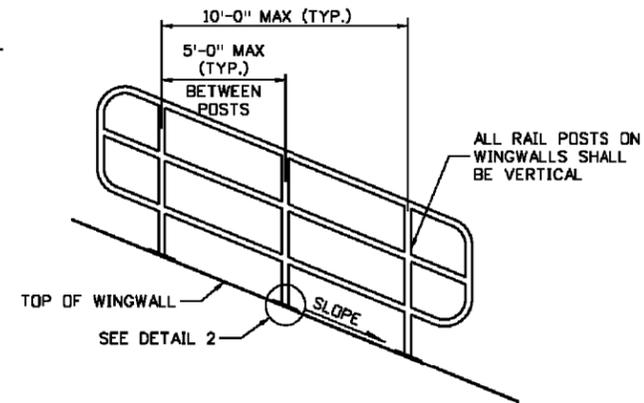


ELEVATION VIEW OF WINGWALL "A" & "B" RAILING
N.T.S.

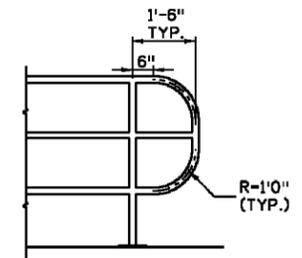


TYPICAL END TREATMENT DETAIL
N.T.S.

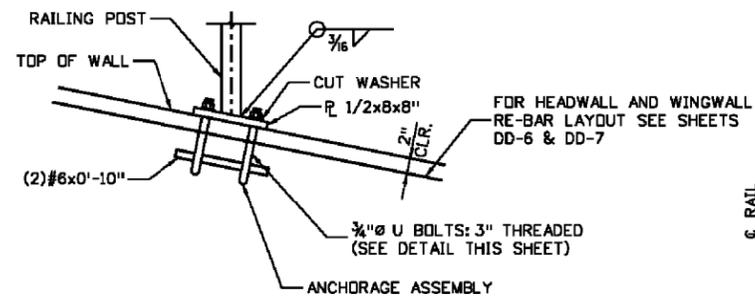


DETAIL 2 ANCHORAGE DETAIL
N.T.S.

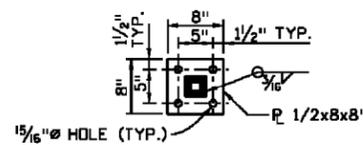

BASE PLATE DETAIL
N.T.S.

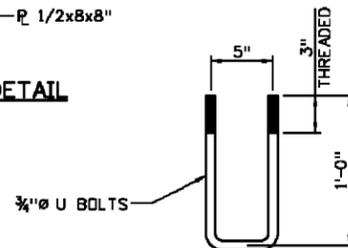

U BOLT DETAIL
N.T.S.

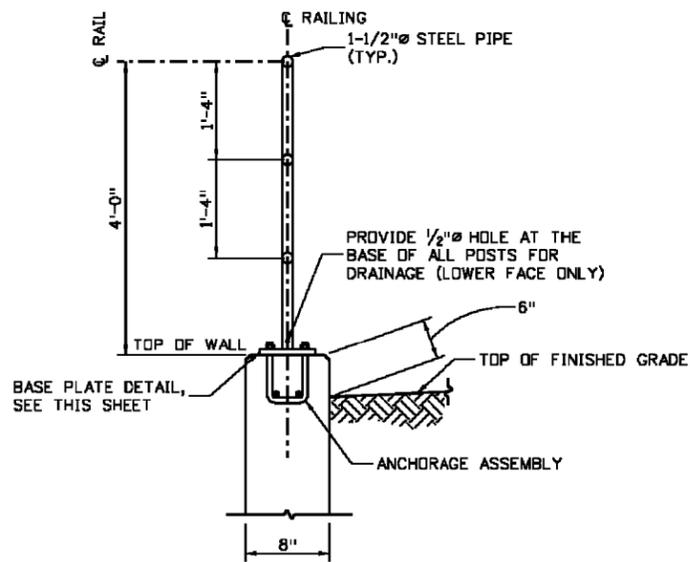

SECTION C-A
N.T.S.

NOTES:

1. ALL PIPE SHALL BE 1 1/2" NOMINAL DIAMETER, SCH. 40 STEEL CONFORMING TO THE REQUIREMENTS IN ASTM A53 GRADE B STEEL (fy=35 ksi), AND ALL PLATES, BOLTS AND NUTS SHALL MEET THE REQUIREMENTS IN AASHTO M270 FOR GRADE 36 ksi STEEL.
2. ALL STEEL SHALL BE PAINTED AFTER FABRICATION IN ACCORDANCE WITH SECTION 509 OF CDOT STANDARD SPECIFICATION.
3. RAILINGS, ANCHORAGE ASSEMBLIES AND ALL PLATES, BOLTS, AND NUTS SHALL BE PAID FOR AS ITEM 514 PIPE RAILING.
4. PIPE RAILING SHALL BE PAINTED WITH A TWO-COAT INORGANIC ZINC POLYURETHANE PAINT SYSTEM AS SPECIFIED IN SECTION 708.03 AND SHALL HAVE A MINIMUM DRY FILM THICKNESS OF 4.0 MILS. THE TOP COAT SHALL BE A COLOR MATCHING FEDERAL STANDARD 595B COLOR NO. 17000-BLACK.
5. ANCHORAGE ASSEMBLY (PLATES, BOLTS & NUTS) SHALL BE GALVANIZED AFTER FABRICATION.
6. THE CONTRACTOR SHALL FIELD-MEASURE THE WINGWALLS AND BASE PLATE LOCATIONS PRIOR TO FABRICATION OF PIPE RAILING TO VERIFY DIMENSION REQUIREMENTS.

Print Date: 1/6/2010
File Name: 14679_pDWQ-V709.dgn
Horiz. Scale: N/A Vert. Scale: N/A



Sheet Revisions

| Date: | Comments | Init. |
|-------|----------|-------|
| | | |
| | | |
| | | |

Colorado Department of Transportation

 8833 South Wadsworth Court
 Littleton, CO 80128
 Phone: 303-972-9112 FAX: 303-972-9114
 Region 6 RLB

As Constructed

No Revisions:
Revised:
Void:

WATER QUALITY SOUTHEAST POND DETAILS

| | | | |
|---------------|-----|-------------------|----------|
| Designer: | AJF | Structure Numbers | |
| Detailer: | AJF | Sheet Subset: | DRAIN WQ |
| Subst Sheets: | | 9 of 9 | |

Project No./Code

ES6 0852-103
17679
Sheet Number 118

SITE DESCRIPTION

Additional information for permitted projects.
For information only to fulfill the CDPS-SCP (Colorado Discharge Permit – Stormwater Construction Permit)

A. PROJECT SITE DESCRIPTION:

Project is to construct a flyover bridge from southbound Santa Fe Drive beginning at West Mineral Avenue Drive to eastbound C-470 east of Lucent Boulevard, roadway widening on Santa Fe Drive to accommodate placement of flyover bridge piers, grading and paving on the C-470 eastbound on-ramp and merge into the flyover bridge, new bridge at Erickson Drive, continuous auxiliary lane between flyover/ramp merge with C-470 and the eastbound off-ramp to Lucent Boulevard, retaining walls and grading and paving to bike path. Construction activities include utility relocations, grading, paving, wall and bridge construction, drainage improvements, bike path relocation, signing improvements, lighting improvements and seeding. Onsite drainage will be collected and treated in water quality ponds and an infiltration located along the corridor. Roadway widening and bike path includes excavations and embankments.

B. PROPOSED SEQUENCING FOR MAJOR ACTIVITIES:

1. Utility relocation
2. Embankment for roadway widening
3. Water quality/sediment pond installation
4. Storm drain system installation
5. Construct new bridges
6. Paving
7. Bike path relocation
8. 9. Signing and striping
10. Seeding

C. ACRES OF DISTURBANCE:

Total area of construction site: 43.1 acres
Total area of disturbance: 43.1 acres
Acreage of seeding: 12.9 acres

D. EXISTING SOIL DATA:

Based on the Natural Resources Conservation Service (NRCS) Soil Survey of Douglas County, Colorado the soils in the vicinity of C-470 are comprised of the Bresser-Truckton, Buick-Satanta, Fondis and Renohill-Buick. These soils are classified as a Type B or C hydrologic soil group. Type C will be used for analysis. These soils have a slow infiltration rate when thoroughly wet and consist chiefly of soils having a layer that impedes the downward movement of water or soils of moderately fine texture or fine texture. The rate of water transmission is slow.

E. EXISTING VEGETATION, INCLUDING PERCENT COVER:

Documentation is required to support that the site has been stabilized to 70 percent of pre-disturbance cover and does not show signs of accelerated erosion. Accelerated erosion shall be defined as rills of 2-inches deep or more, earth slides, mud flows, sediment deposition, or evidence of concentrated flows of water over bare soils. Prior to construction disturbance the Contractor shall create photographic documentation and measure existing plant cover: One 50-foot transect/5 acres of disturbance in accordance with Section 4:11:2 item of the CDOT Erosion Control and Stormwater Quality guide (2002). Photographs at each transect shall support the measurements of pre-disturbance and final stabilization. Measurements will not be paid separately but included in the price of the work.

Date of survey: To be determined by Contractor

F. POTENTIAL POLLUTANT SOURCES:

Potential Pollutant Sources include the following activities: disturbed soils, stock piles, vehicle tracking of sediments, management of contaminated soils, loading and unloading operations, vehicle and equipment maintenance and fueling, dust or particulate generating processes, routine maintenance activities involving fertilizers, pesticides, detergents, fuels, solvents, or oils; on-site waste management practices, concrete truck/equipment washing, dedicated asphalt and concrete batch plants, non-industrial waste sources (worker trash and portable toilets). Any other potential pollutant sources that can be identified by the Contractor shall be documented in the SWMP. See Section 4.B.

See First Construction Activities under *Potential Pollutant Sources*. The ECS shall prepare a list of all potential pollutants and their locations in accordance with subsection 107.25.

G. RECEIVING WATER:

1. Outfall locations:

TABLE 1. OUTFALL LOCATIONS

| SIZE | TYPE | LOCATION | OUTFALL | RECEIVING WATERS |
|------|--------|----------|---------------|------------------|
| 18" | RCP | 724+43 L | Pond Outlet | South Platte |
| 24" | RCP | 727+11 R | Pond Outlet | South Platte |
| | Trench | 776+48 R | Exist 36" RCP | High Line Canal |

2. Names of receiving water(s) on site and the ultimate receiving water: South Platte River and Highline Canal
3. Distance ultimate receiving water is from project: Varies, approximately 1,056 feet from junction of nearest outfall pipe.
4. Does the receiving water have an approved TMDL: No

H. ALLOWABLE NON-STORMWATER DISCHARGES:

The Contractor may require a dewatering permit from the Colorado Department of Public Health and Environment (CDPHE). Discharges to the ground of water from construction dewatering activities may be authorized by the general permit if the following conditions apply:

1. The source is groundwater and/or groundwater combined with stormwater that does not contain pollutants in concentrations exceeding the State groundwater standards in Regulations 5 CCR 1002-41 and 42;
2. The source is identified in the SWMP;
3. BMPs are included in the SWMP, as required by Part I.C.3(c)(8) of the CDPS General Permit No. COR-030000; and
4. The above discharges do not leave the site as surface runoff or to surface waters.

If discharges to the ground from construction dewatering activities that do not meet the above criteria must be covered under a separate CDPS discharge permit. Contaminated groundwater requiring coverage under a separate CDPS discharge permit may include groundwater contaminated with pollutants from a landfill, mining activity, industrial pollutant plume, underground storage tank, or other source.

I. ENVIRONMENTAL IMPACTS:

1. Wetland Impacts: No
2. Stream Impacts: No
3. Threatened and Endangered Species: No
4. Historic Impacts: No

2. SITE MAP COMPONENTS:

Pre-construction

- A. Construction Site Boundaries: See Erosion Control Plan/SWMP Site Map
- B. All Areas Of Ground Surface Disturbance: See Erosion Control Plan/SWMP Site Map
- C. Areas Of Cut And Fill: See Erosion Control Plan/SWMP Site Map

| | | | | | | | | | | | | |
|---|--|------------------------|----------|-------|---|-----------------------|--|--|------------------|--|-------------------------|--|
| Print Date: 1/15/2010 | | Sheet Revisions | | | Colorado Department of Transportation 8833 South Wadsworth Court Littleton, CO 80128 Phone: 303-972-9112 FAX: 303-972-9114 Region 6 RLB | As Constructed | | STORMWATER MANAGEMENT PLAN | | | Project No./Code | |
| File Name: 14679_SWMP.dgn | | Date: | Comments | Init. | | No Revisions: | Designer: AJF Structure Detailer: SDH Numbers | | | | ES6 0852-103 | |
| Horiz. Scale: 1:1 Vert. Scale: As Noted | | | | | | | Revised: | Sheet Subset: SWMP Subset Sheets: 1 of 5 | | | 17679 | |
| 4601 DTC Boulevard Suite 700 Denver, CO 80237 | | | | | Void: | | | | Sheet Number 119 | | | |

- A. Location Of All Structural BMPs Identified In The SWMP: See Erosion Control Plan/SWMP Site Map
- B. Location Of Non-Structural BMPs As Applicable In The SWMP: See Erosion Control Plan/SWMP Site Map
- C. Springs, Stream, Wetlands And Other Surface Water: See Erosion Control Plan/SWMP Site Map
- D. Protection Of Trees, Shrubs, Cultural Resources And Mature Vegetation: See Erosion Control Plan/SWMP Site Map

3. SWMP ADMINISTRATOR FOR DESIGN:

The original design for this project, including drainage plans and SWMP have been designed by the following Engineer:

SWMP Engineering Firm: PBS&J
 SWMP Engineer: Tammy Kirkbride, P.E.
 Address: 4601 DTC Blvd, Suite 700
 Denver, CO 80237
 Phone: 303.221.7275

Once the Contractor takes ownership of the SWMP they will become the Owner and assume responsibility for all design changes to the SWMP, implementation and maintenance.

4. STORMWATER MANAGEMENT CONTROLS FIRST CONSTRUCTION ACTIVITIES

The Contractor Shall Perform The Following:

- A. DESIGNATE A SWMP ADMINISTRATOR/EROSION CONTROL SUPERVISOR (ECS) (To be filled out at time of construction; designate the individual(s) responsible for implementing, maintaining and revising SWMP, including the title and contact information. The activities and responsibilities of the administrator shall address all aspects of the projects SWMP.)
- B. POTENTIAL POLLUTANT SOURCES
 Evaluate, identify and describe all potential sources of pollutants at the site in accordance with CDOT Construction Details subsection 107.25 and place in the SWMP notebook. All BMPs related to potential pollutants shall be shown on the SWMP site map by the contractor's ECS.
- C. BEST MANAGEMENT PRACTICES (BMPs) FOR STORMWATER POLLUTION PREVENTION PHASED BMP IMPLEMENTATION

During design: Fields in Table 2 are marked when used in the SWMP.
 During construction: The ECS shall update the checked boxes to match site conditions.

Structural BMP practices for erosion and sediment control are listed in Table 2. Structural BMP practices may include, but are not limited to:

TABLE 2. STRUCTURAL BMPs FOR EROSION AND SEDIMENT CONTROL

| BMP | TYPE OF CONTROL | BMP AS DESIGNED | IN USE ON SITE | FIRST CONSTRUCTION ACTIVITIES | DURING CONSTRUCTION | INTERIM/FINAL STABILIZATION |
|--------------------------------|-----------------|-----------------|----------------|-------------------------------|---------------------|-----------------------------|
| Check Dams/Erosion Logs | Sediment | X | | X | X | |
| Silt Fence | Sediment | X | | X | X | |
| Erosion Logs | Sediment | X | | X | X | X |
| Infiltration Trench | Sediment | X | | | | X |
| Inlet Protection/Erosion Logs | Sediment | X | | X | X | |
| Outlet Protection/Erosion Logs | Erosion | X | | | X | |
| Concrete Washout | Construction | X | | | X | |

| BMP | TYPE OF CONTROL | BMP AS DESIGNED | IN USE ON SITE | FIRST CONSTRUCTION ACTIVITIES | DURING CONSTRUCTION | INTERIM/FINAL STABILIZATION |
|----------------------------------|-----------------|-----------------|----------------|-------------------------------|---------------------|-----------------------------|
| Stabilized Construction Entrance | Construction | X | | X | X | |
| Dewatering | Sediment | X | | | X | |
| OTHER | | | | | | |

NON-STRUCTURAL BMP practices for erosion and sediment control are listed in Table 3. Non-structural BMPs may include but are not limited to the following:

TABLE 3. NON-STRUCTURAL BMPs FOR EROSION AND SEDIMENT CONTROL

| BMP | TYPE OF CONTROL | BMP AS DESIGNED | IN USE ON SITE | FIRST CONSTRUCTION ACTIVITIES | DURING CONSTRUCTION | INTERIM/FINAL STABILIZATION |
|-----------------------------------|-----------------|-----------------|----------------|-------------------------------|---------------------|-----------------------------|
| Soil Conditioning | Erosion | X | | | X | |
| Seeding, Permanent | Erosion | X | | | | X |
| Mulch/Mulch Tackifier | Erosion | X | | | X | X |
| Soil Binder | Erosion | | | | X | |
| Soil Retention Blanket | Erosion | X | | | X | X |
| Vegetative Buffer Strips | Erosion | | | X | X | X |
| Protection of Vegetation/Trees | Erosion | X | | X | X | X |
| Preservation of Mature Vegetation | Erosion | X | | X | X | X |
| Flexible Growth Medium | Erosion | X | | | X | X |
| OTHER | | | | | | |

Erosion control devices are surface treatments that stabilize soil exposed by excavation or grading and are used to limit the amount of erosion on site. Sediment control BMPs capture soil that has been eroded, devices are designed to capture sediment on the project site. Construction BMPs are used to control sediment associated with construction access and staging. BMPs are indicated on the Erosion Control Plans. BMP installation details and general narratives are in the SWMP notebook.

NARRATIVES

STATE HIGHWAY NO. C-470 AND SANTA FE DR/US 85

General Design BMP placement: Prior to construction commencing silt fence shall be placed to prevent the initial construction activity from causing sediment to leave the site. Inlet protection should be placed on existing inlets in the project area. Construction Entrances and Concrete Washouts should be placed.

During construction check dams, erosion logs, and erosion control blankets should be placed as identified on the Erosion Control Plans. Once drainage structures have been placed, inlet protection should be placed around the perimeter of the inlet.

Once BMPs are installed, they shall be maintained continuously throughout the duration of the project and into the establishment phase. Once final grading has been established BMPs listed in Table 3 should be placed. Once vegetation has reached 70-percent of pre-disturbance cover temporary BMPs may be removed.

Narratives for BMPs used for Design are listed below.

| | | | | | | | | | |
|---|--|------------------------|--|-----------------------|-----------------------------------|--------------------|-------------------------|-------------------|--------------|
| Print Date: 1/15/2010 | | Sheet Revisions | Colorado Department of Transportation 8833 South Wadsworth Court Littleton, CO 80128 Phone: 303-972-9112 FAX: 303-972-9114 Region 6 | As Constructed | STORMWATER MANAGEMENT PLAN | | Project No./Code | | |
| File Name: 14679_SWMP.dgn | | Date: | | Comments | Init. | No Revisions: | | | ES6 0852-103 |
| Horiz. Scale: 1:1 Vert. Scale: As Noted | | | | | | Revised: | Designer: AJF | Structure Numbers | 17679 |
| 4601 DTC Boulevard Suite 700 Denver, CO 80237 | | | | Void: | Detailer: SDH | Sheet Subset: SWMP | Sheet Number 120 | | |
| | | | | | Subset Sheets: 2 of 5 | | | | |

EROSION LOGS

Erosion Logs are used to capture and filter sediment laden run-off from disturbed areas during construction.

As Outlet Protection: shall be placed at existing culverts as shown in the plans and where disturbance may be occurring adjacent to the outlet and cause sediment laden water to enter pipe. Logs shall be placed prior to work commencing at these locations to filter sediment laden runoff. Where the slope has been worked above new and/or existing pipes (inlet/outlet) and sediment may enter the pipe from above, a log shall wrap the top of pipe and run down slope to direct water away from pipe. Logs shall be j-hooked or placed in such a manner at these locations that sediment laden water will not go around the ends of logs directly into the pipe or ditch. Outlet protection is used as an energy dissipation device to prevent scour and erosion at the pipe outlet by reducing the velocity and energy of the concentrated flow. Outlet protection shall be placed at the outlet of pipes immediately after the pipe is installed. See Erosion Control Plans for locations.

As Check Dam: shall be placed in areas indicated in the plans or as directed as soon as possible, immediately in most cases after ditch grading has been completed (a completed ditch is one that is acting as a conduit for water). Ditches not directed to have riprap placed shall be permanently stabilized with-in 48 hours of completion during the seeding season. When seeding cannot occur due to seasonal constraints mulch/mulch tackifier shall be placed along with checks at intervals specified. If erosion occurs in the ditch, mulch and mulch tackifier shall be replaced by a blanket (straw/coconut) as a temporary measure. Seeding and crimping in ditch lines shall follow contour; crimping and drill rows running down a ditch line will not be allowed. Concrete lined ditches shall use erosion logs as temporary protection until concrete lining has been complete.

Erosion logs shown in the Erosion Control Plans are a graphical representation only and do not represent the actual length or configuration of erosion logs be installed.

SILT FENCE

Silt fence shall be used to capture sediment laden run-off from disturbed areas during construction. It shall be placed on the contour; ends shall be j-hooked to prevent water from running around the ends of fence. A maximum drainage area of one-quarter acre per 100-feet of silt fence length; maximum slope length behind the barrier is 100-feet; maximum gradient behind the barrier is 2:1. Posts shall be spaced a maximum of three-feet apart. Along the toe of fills, install the silt fence for runoff to pond and sediment to settle. A minimum distance of five-feet from the toe of the fill is recommended. The height of the silt fence from the ground surface shall be a minimum of 24-inches and shall not exceed 36-inches.

INFILTRATION TRENCH

An infiltration trench will be used to treat roadway runoff. Roadway runoff will drain through a grass swale to the infiltration trench where it will be treated for 48-hours. Construction of the trench should take place after the site has been stabilized. Silt fence should be placed around the perimeter of the infiltration trench during all phases of construction. Heavy equipment should not operate on the surface where the trench will be located to avoid soil compaction. During construction of the trench only light equipment such as backhoes or wheel and ladder type trenchers should be used to minimize compaction of the surrounding soils. During and after excavation, all excavated materials should be placed downstream, away from the trench, to prevent redepositing during runoff events. Infiltration trenches should not be used as temporary sediment traps during construction.

GRAVEL BAG - INLET PROTECTION

Single and Double Vane Grates, Type C and Type D Inlets will be used for this project. Inlet Protection is used to intercept and filter sediment-laden runoff and prevent it from entering storm drainage systems. Inlet protection should be used throughout construction, but used as a temporary feature. Storm drain inlet protection shall be placed immediately after installation of inlets and on existing inlets prior to clearing and grubbing. During construction, the erosion control supervisor shall place the appropriate BMP at the inlet openings to prevent sediment and/or pollutants from entering. See Erosion Control Plans for placement.

CONCRETE WASHOUTS

Facilities or designated work areas where concrete waste is generated from demolition activities; where concrete is used as a construction material; where concrete trucks or concrete coated equipment are washed on site as permitted by the engineer; where slurries containing Portland cement concrete (PCC) or asphalt concrete are generated; and where mortar-mixing areas exist. During construction, the contractor may move the concrete washouts to convenient locations on the site. Concrete Washout location can be determined by the Contractor and checked by the ECS and maintained as required. Temporary concrete washout facilities shall be located 50 horizontal feet from drainage ways, inlets, and receiving waters unless otherwise approved by the Engineer. If a concrete washout is within 300-feet of a road or highway access, a stabilized construction entrance must be built as part of the washout, or at the entrance to the road or highway. When approved by the engineer an "urban" concrete washout structure may be used. Urban concrete washout examples are wooden boxes lined with heavy duty plastic or waterproof 55 gallon drums. After use the structure must be removed from the project site and properly vegetated.

STABILIZED CONSTRUCTION ENTRANCE

Used to reduce the amount of mud tracked onto paved public roads by vehicles or runoff leaving the construction site. Used as a temporary feature. See CDOT Standard Plan M-208-01 for detail.

DEWATERING

Shall be performed to remove accumulated water and sediments from sediment traps, basins and excavated areas. The contractor shall notify the engineer of all planned discharges. All dewatering operations must comply with applicable CDPS and local permits as well as regional and watershed-specific discharge requirements, including CDOT Standard Specifications. Sediment control measures, such as sediment traps (SC5) sediment basins (SC 6) and dewatering structures (SC 7) shall be implemented to treat sediment-laden excess water from construction sites. Other sediment control measures such as filtration devices can be utilized on if approved by the engineer. Perform routine spot-checks to ensure dewatering techniques are properly implemented.

SOIL CONDITIONING

Soil surface roughening, terracing and round at tops of cuts, transitions and roadway ditches to facilitate plant establishment and minimize soil erosion. Used to temporarily stabilize disturbed areas and to protect from wind and water erosion. Disturbed surfaces shall be left in the roughened condition at all times by equipment tracking, scarifying or disking the surface on the contour with a 2 to 4 inch minimum variation in the soil surface. Round channel bottoms to avoid V-shaped ditches and round the tops of cuts and the toes of fill slopes.

PERMANENT SEEDING - SEEDING(NATIVE)

Seeding is used to control runoff and erosion on disturbed areas. Drill seeding shall occur on slopes flatter than 3:1 and shall occur on the contour of the slope. Completed areas shall be seeded within 48 hours during seeding season. Seeded areas shall be inspected frequently for areas of failure. Slopes that are too steep for drill seeding shall have seed broadcast at double the rate and raked into the surface.

MULCH/MULCH TACKIFIER

Mulching and mulch tackifier is used for temporary erosion control on incomplete slope, stockpiles and on slopes when seeding is not allowed due to seasonal constraints. It is also used to cover permanent or temporary seeded areas. Mulch and mulch tackifier shall be in accordance with CDOT Construction Details subsection 213.03 (a). Crimping in ditch lines shall follow the contour, crimp rows running down a ditch line shall not be allowed.

SOIL BINDER

Shall be sprayed onto the surface of exposed soils to hold the soil in place and minimize erosion from runoff and wind. Shall be used in combination with mulches to temporarily stabilize soils in stockpiles, berms or when slopes cannot be seeded due to seasonal constraints. Apply soil binder over roughened soil surface. If rill erosion occurs, this is an indication of poor product mixture and/or application and shall be reapplied at the contractor's expense. Do not use in areas with vehicular traffic. Soil binder shall be reapplied every 6 to 12 months or when the surface has been disturbed/broken.

12244 1:56:56 PM S:\Tranprojo\100002375\14679_Consultants\Hydraulics\Drawings\14679_SWMP.dgn

Print Date: 1/15/2010
File Name: 14679_SWMP.dgn
Horiz. Scale: 1:1 Vert. Scale: As Noted

| Sheet Revisions | | |
|-----------------|----------|-------|
| Date: | Comments | Init. |
| | | |
| | | |
| | | |

Colorado Department of Transportation



8833 South Wadsworth Court
Littleton, CO 80128
Phone: 303-972-9112 FAX: 303-972-9114

Region 6 RLB

| |
|-----------------------|
| As Constructed |
| No Revisions: |
| Revised: |
| Void: |

| | | | |
|-----------------------------------|------|----------------|--------|
| STORMWATER MANAGEMENT PLAN | | | |
| Designer: | AJF | Structure | |
| Detailer: | SDH | Numbers | |
| Sheet Subset: | SWMP | Subset Sheets: | 3 of 5 |

| |
|-------------------------|
| Project No./Code |
| ES6 0852-103 |
| 17679 |
| Sheet Number 121 |



SOIL RETENTION BLANKET

Shall be placed in areas shown on the Site Map or as directed; all slopes 3:1 and steeper shall receive a blanket. Slopes shall be properly prepared prior to placement of blanket. If rills, rocks, etc. are present they shall be removed prior to placing blanket to ensure blanket is placed on the soil with no tenting; see specification and M&S Standards. Plastic soil retention blankets will be placed in all ditches exceeding 2% and straw/coconut soil retention blankets will be used on all slopes steeper than 3:1.

VEGETATIVE BUFFER STRIPS AND PROTECTION ON EXISTING VEGETATION

Existing vegetation shall be used as a BMP on the project. Existing vegetation helps with erosion and sediment control and protects water quality. Areas of preserved vegetation shall be marked on the Erosion Control Plans by the ECS. The amount of sediment reaching buffer strips shall be kept to a minimum by placing temporary and permanent erosion control features on disturbed slopes. If sediment does enter buffer strips and covers existing vegetation it shall be cleaned and re-seeded as directed. Sediment in vegetative ditches shall be avoided to prevent sediment laden water from exiting the project site. All vegetative ditch outfalls (from CDOT right of way) shall be protected with erosion logs or berms as shown in the plans or as directed.

PROTECTION OF WETLANDS AND MATURE TREES

There are no wetlands that have been identified on this project. A combination of erosion logs and fence (plastic) shall be used as directed by the engineer and/or CDOT Landscape Architect to protect mature trees. Erosion logs shall be installed prior to performing any construction work that disturbs vegetation.

FLEXIBLE GROWTH MEDIUM

Flexible Growth Medium (FGM) shall consist of wood fibers bound together by adhesive and photodegradable synthetic fibers and premixed in an air stream at the factory. The fibers may be crimped or uncrimped. The wood fibers shall be manufactured expressly from clean whole wood chips and contain a range of fiber lengths, with a minimum of 25 percent of the fibers averaging 0.4 inches long. The adhesive binder shall be formulated to form a water resistant bond. The fibers shall be colored yellow or green with a water-soluble, non-toxic dye to help the operator apply the material uniformly. The mixture shall also contain a copolymer gel. A sample of the FGM shall be submitted for approval at least two weeks in advance of its use on the project. The FGM shall be applied at the rate of 2600 lbs per acre. There shall be no cure time once placed on the area of application. FGM shall not be applied in ditches or other areas of concentrated flow.

D. OFFSITE DRAINAGE (RUN ON WATER)

- Describe and record BMPs on the SWMP site map that have been implemented to address run-on water in accordance with subsection 208.03.

E. STABILIZED CONSTRUCTION ENTRANCE

- BMPs shall be implemented in accordance with subsection 208.04.

F. PERIMETER CONTROL

- Perimeter control shall be established as the first item on the SWMP to prevent the potential for pollutants leaving the construction site boundaries, entering the stormwater drainage system, or discharging to state waters.
- Perimeter control may consist of vegetation buffers, berms, silt fence, erosion logs, existing landforms, or other BMPs as approved.
- Perimeter control shall be in accordance with subsection 208.04.

5. DURING CONSTRUCTION

RESPONSIBILITIES OF THE SWMP ADMINISTRATOR/EROSION CONTROL SUPERVISOR DURING CONSTRUCTION

The SWMP should be considered a "living document" that is continuously reviewed and modified. During construction, the following items shall be added, updated, or amended as needed by the SWMP Administrator/Erosion Control Supervisor (ECS) in accordance with section 208.

- A. **MATERIALS HANDLING AND SPILL PREVENTION** – The Contractor shall prepare a Spill Prevention, Control and Countermeasure (SPCC) Plan prior to construction that lists all potential contaminants that will be kept with the SWMP on site.
- B. **STOCKPILE MANAGEMENT** – topsoil stockpiles shall be stabilized by spraying a flexible growth medium on soil immediately upon completion of stockpile completion. Toes of stockpiles shall be protected immediately with a berm, silt fence, etc. as directed by the ECS with the Engineers approval. Stockpiles and BMPs shall be marked on the site map. Other erodible stockpiles (including spoils piles) shall be protected immediately with gravel bags, berms, erosion logs, etc. as directed. BMP shall be indicated on the Erosion Control Plans. When piles need to be accessed during the day, BMP may be removed for short periods of time for access to the pile. BMP shall be back in place at the end of the day.
- C. **GRADING AND SLOPE STABILIZATION**
- D. **SURFACE ROUGHENING**
- E. **STABILIZED CONSTRUCTION ENTRANCE**
- F. **TEMPORARY STABILIZATION** – see section 4C and 5B.
- G. **CONCRETE WASHOUT** – No concrete batch will be allowed on CDOT right of way
 - Concrete washout water or waste from field laboratories and paving equipment shall be contained in accordance with subsection 208.05.
- H. **SAW CUTTING**
- I. **NEW INLET/CULVERT PROTECTION** – See Narrative in Section 4
- J. **STREET CLEANING** – should be used to remove sediment transported onto streets to prevent the sediment from entering a storm drain or watercourse. Visible sediment tracking shall be swept and vacuumed on a daily basis.

6. INSPECTIONS

- A. Inspections shall be in accordance with CDOT Construction Details subsection 208.03 (c).

7. BMP MAINTENANCE

- A. Maintenance shall be in accordance with CDOT Construction Details subsection 208.04 (e). In addition CDPHE has the following requirements. All erosion and sediment control practices and other protective measures identified in the SWMP must be maintained in effective operating condition. Proper selection and installation of BMPs and implementation of comprehensive Inspection and Maintenance procedures, in accordance with the SWMP, should be adequate to meet this condition. BMPs that are not adequately maintained in accordance with good engineering, hydrologic and pollution control practices, including removal of collected sediment outside the acceptable tolerances of the BMPs, are considered to be no longer operating effectively and must be addressed in accordance with Part I.D.8 of the CDPS General Permit for Stormwater Discharges Associated with Construction Activity see 7.B. A specific timeline for implementing maintenance procedures is not included in this permit because BMP maintenance is expected to be proactive, not responsive. Observations resulting in BMP maintenance activities can be made during a site inspection, or during general observations of site conditions.
- B. **REPLACEMENT AND FAILED BMPs:** Adequate site assessment must be performed as part of comprehensive Inspection and Maintenance procedures, to assess the adequacy of BMPs at the site, and necessity of changes to those BMPs to ensure continued effective performance. Where site assessment results in the determination that new or replacement BMPs are necessary, the BMPs must be installed to ensure on-going implementation of BMPs. Where BMPs have failed, resulting in noncompliance with Part I.D.2, they must be addressed as soon as possible, immediately in most cases to minimize the discharge of pollutants. When new BMPs are installed or BMPs are replaced, the SWMP must be updated in accordance with Part I.D.5(c) of the Permit.
- C. **REPORTING:** No scheduled reporting requirements are included in the permit; however, CDPHE reserves the right to request that a copy of the inspection reports be submitted.

12244 1:56:56 PM S:\Tranpro\100002375\14679_Consultants\Hydraulics\Drawings\14679_SWMP.dgn

| | | | | | | | | | | | | |
|---|---|------------------------|----------|-------|---|-----------------------|-------------------------|-----------------------------------|-------|--|-------------------------|--|
| Print Date: 1/15/2010 |  | Sheet Revisions | | | Colorado Department of Transportation  8833 South Wadsworth Court Littleton, CO 80128 Phone: 303-972-9112 FAX: 303-972-9114 Region 6 RLB | As Constructed | | STORMWATER MANAGEMENT PLAN | | | Project No./Code | |
| File Name: 14679_SWMP.dgn | | Date: | Comments | Init. | | No Revisions: | Designer: AJF Structure | | | | ES6 0852-103 | |
| Horiz. Scale: 1:1 Vert. Scale: As Noted | | | | | | Revised: | Detailer: SDH Numbers | | 17679 | | | |
|  4601 DTC Boulevard Suite 700 Denver, CO 80237 | | | | Void: | Sheet Subset: SWMP Subset Sheets: 4 of 5 | | Sheet Number 122 | | | | | |

Record Keeping

A. Records shall be in accordance with CDOT Construction Details subsection 208.03 (c). The permittee shall retain copies of the SWMP and all reports required by this permit and records of all data used to complete the application to be covered by the permit, for three years after expiration or inactivation of permit coverage. The permittee shall retain a copy of the SWMP required by this permit at the construction site from the date of project initiation to the date of expiration or inactivation of permit coverage, unless another location, specified by the permittee, is approved by CDPHE.

9. INTERIM AND FINAL STABILIZATION

A. SEEDING PLAN

Soil preparation, soil conditioning or topsoil, seeding (native), mulching (weed free), and mulch tackifier will be required for an estimated 11.1 acres of disturbed area within the right-of-way limits which are not surfaced. The following type and rates shall be used:

| COMMON NAME | BOTANICAL NAME | POUNDS PLS/ACRE |
|-----------------------|----------------------------------|-----------------|
| Western wheatgrass | Pascopyrum smithii v. Arriba | 4.0 |
| Sideoats grama | Bouteloua curtipendula v. Vaughn | 2.0 |
| Smooth brome | Bromus inermis v. Lincoln | 10.0 |
| Canby bluegrass (wet) | Poa canbyi | 2.0 |
| Sanburg bluegrass | Poa sandbergii | 2.0 |
| Prairie junegrass | Koeleria cristata | 0.2 |
| Blue grama | Bouteloua gracilis v. Hachita | 2.0 |
| Gaillardia | Gaillardia aristata | 1.0 |
| Blue flax | Linum lewisii | 0.2 |
| Prairie coneflower | Ratibida columnaris | 0.3 |
| Flanders poppy | Papaver rhoeas | 0.1 |
| Regreen/Triticum | Aestivum x Elytrigia elongate | 3.0 |
| | Total | 27.4 |

- B. **SEEDING APPLICATION:** Drill seed 0.25 inch to 0.5 inch into the soil. In small areas not accessible to a drill, hand broadcast at double the rate and rake 0.25 inch to 0.5 inch into soil.
- C. **MULCHING APPLICATION:** Apply 1 ½ tons of certified weed free hay per acre mechanically crimped into the soil in combination with an organic mulch tackifier.
- D. **SPECIAL REQUIREMENTS:** Due to high failure rates, hydromulching and/or hydroseeding will not be allowed.
- E. **SOIL CONDITIONING AND FERTILIZER REQUIREMENTS:**
- Humate shall be applied at 1,200 lbs./acre.
 - Fertilizer shall consist of 90% fungal biomass (mycelium) and 10% potassium-magnesia with a grade of 6-1-3 or approved equal. Fertilizer shall be applied at 2,000 lbs/acre.

F. RESEEDING OPERATIONS/CORRECTIVE STABILIZATION

Prior to final acceptance:

- Seeded areas shall be reviewed during the 14 day inspections by the Erosion Control Supervisor for bare soils caused by surface or wind erosion. Bare areas caused by surface or gully erosion, blown away mulch, etc. shall be regraded, seeded, mulched and have mulch tackifier (or blanket) applied as necessary.
- Areas where seed has not germinated after one season shall be evaluated by the Engineer and CDOT Landscape Architect. Areas that have not germinated shall have seed, mulch and mulch tackifier (or blanket) applied. Work shall be paid for by the appropriate bid item.
- The Contractor shall maintain seeding/mulch/tackifier, mow to control weeds or apply herbicide to control weeds in the seeded areas until final acceptance.

10. PRIOR TO FINAL ACCEPTANCE

A. Final acceptance shall be in accordance with CDOT Construction Details subsection 208.061.

11. TABULATION OF STORMWATER QUANTITIES

| PAY ITEM | DESCRIPTION | UNIT | QUANTITY |
|----------|--|-------|----------|
| 208 | Erosion Log (12 Inch) | LF | 11,900 |
| 208 | Concrete Washout Structure | Each | 8 |
| 208 | Gravel Bag | LF | 2,110 |
| 208 | Stabilized Construction Entrance | Each | 49 |
| 208 | Sediment Removal And Disposal (Equip.) | Hour | 100 |
| 208 | Sediment Removal And Disposal (Labor) | Hour | 100 |
| 208 | Erosion Control Supervisor | Day | 420 |
| 208 | Silt Fence | LF | 17,600 |
| 211 | Dewatering | LS | 1 |
| 212 | Seeding (Native) | Acre | 52 |
| 212 | Soil Conditioning | Acre | 52 |
| 213 | Soil Binder | Acre | 52 |
| 213 | Flexible Growth Medium | Acre | 52 |
| 213 | Mulching (Weed Free Hay) | Acre | 52 |
| 213 | Mulch Tackifier | Lb | 5,200 |
| 216 | Soil Retention Blanket (Straw/Coconut) | Sq Yd | 53,724 |
| 217 | Herbicide Treatment | Hour | 15 |
| 700 | Erosion Control | Fa | - |

- BMP maintenance shall be paid for as: 208 Sediment Removal and Disposal Hours
- It is estimated that 8 concrete washout structures will be required on the project. One concrete washout structure shall be used for the field laboratories.
- It is estimated that 60 hours of Sediment Removal and Disposal (Equipment) and Sediment Removal and Disposal (Labor) may be required for miscellaneous erosion control work as directed by the Engineer. Work shall be paid for as 208 Sediment Removal and Disposal.
- It is estimated that 49 stabilized construction entrances will be required as directed to minimize vehicle tracking control. Locate BMP on the Erosion Control Plans.
- Maintenance of seeded areas shall be paid for as: 700 Erosion Control.
- Quantities are shown as estimated project totals. Erosion logs, vehicle tracking pads, gravel bags (inlet protection) along traffic areas and concrete washouts shall be replaced every 3 months or as needed. Silt fence and gravel bags along non-traffic areas shall be replaced every 6 months or as needed.
- Estimated 3 permanent seeding applications.
- Estimated project duration is 20 months.

Print Date: 1/15/2010
 File Name: 14679_SWMP.dgn
 Horiz. Scale: 1:1 Vert. Scale: As Noted

| Sheet Revisions | | |
|-----------------|----------|-------|
| Date: | Comments | Init. |
| | | |
| | | |
| | | |

Colorado Department of Transportation



8833 South Wadsworth Court
 Littleton, CO 80128
 Phone: 303-972-9112 FAX: 303-972-9114

Region 6 RLB

| As Constructed |
|----------------|
| No Revisions: |
| Revised: |
| Void: |


| STORMWATER MANAGEMENT PLAN | | | |
|----------------------------|------|----------------|--------|
| Designer: | AJF | Structure | |
| Detailer: | SDH | Numbers | |
| Sheet Subset: | SWMP | Subset Sheets: | 5 of 5 |

| Project No./Code |
|------------------|
| ES6 0852-103 |
| 17679 |
| Sheet Number 123 |



LEGEND

-  EROSION LOGS
-  INLET PROTECTION-GRAVEL BAGS
-  LIMITS OF DISTURBANCE
-  SILT FENCE
-  TOP OF FILL
-  TOP OF CUT
-  STABILIZED CONSTRUCTION ENTRANCE
-  SEEDING AND MULCHING

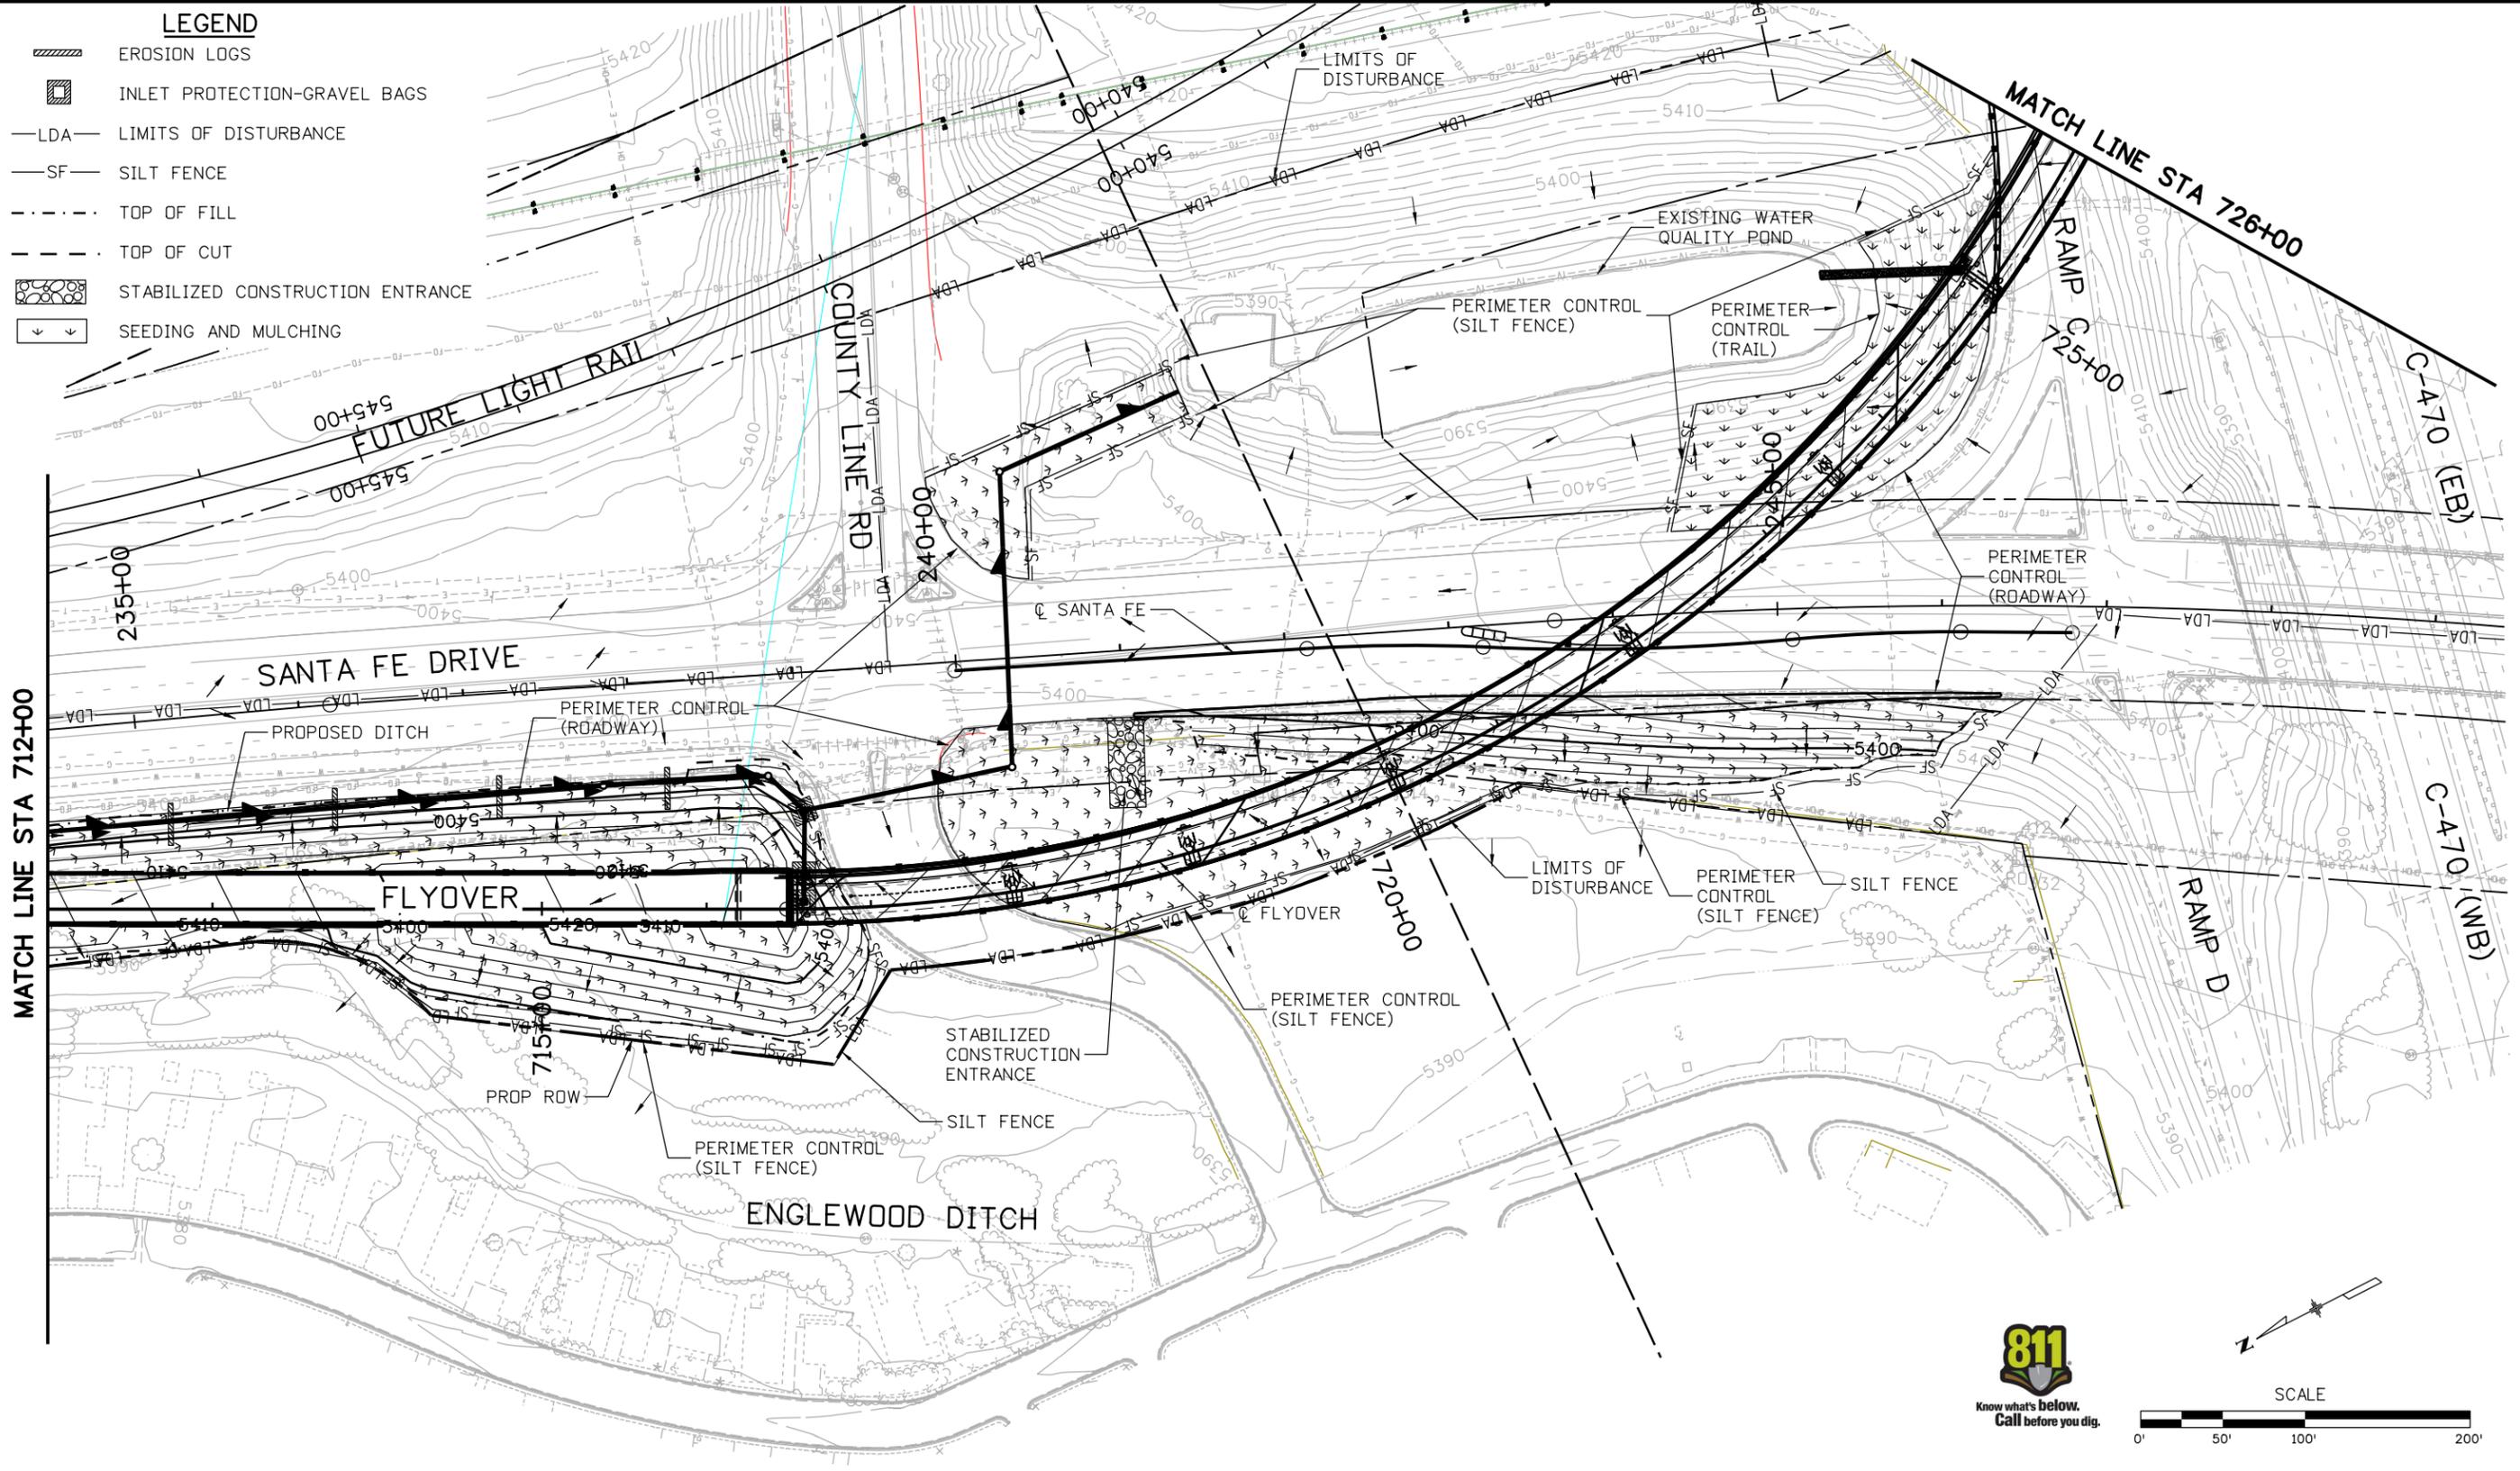

12244 1:58:03 PM S:\Tranpro\100002375\14679\Consultants\Hydraulics\Drawings\14679_pES-P702.dgn

| | |
|---|-----------------------|
| Print Date: 1/15/2010 | |
| File Name: 14679_pES-P702.dgn | |
| Horiz. Scale: 1:100 | Vert. Scale: As Noted |
|  | |
| 4601 DTC Boulevard Suite 700 Denver, CO 80237 | |

| Sheet Revisions | | |
|-----------------|----------|-------|
| Date: | Comments | Init. |
| 0000 | | |

Colorado Department of Transportation

 8833 South Wadsworth Court
Littleton, CO 80128
Phone: 303-972-9112 FAX: 303-972-9114

Region 6 **RLB**


| |
|-----------------------|
| As Constructed |
| No Revisions: |
| Revised: |
| Void: |

| | | | |
|---------------------------------------|---------|----------------|--------|
| EROSION CONTROL SWMP SITE PLAN | | | |
| Designer: | SDH | Structure | |
| Detailer: | SDH | Numbers | |
| Sheet Subset: | EROSION | Subset Sheets: | 2 of 7 |

| |
|-------------------------|
| Project No./Code |
| ES6 0852-103 |
| 17679 |
| Sheet Number 125 |

LEGEND

-  EROSION LOGS
-  INLET PROTECTION-GRAVEL BAGS
- LDA— LIMITS OF DISTURBANCE
- SF— SILT FENCE
- - - - - TOP OF FILL
- - - - - TOP OF CUT
-  STABILIZED CONSTRUCTION ENTRANCE
-  SEEDING AND MULCHING

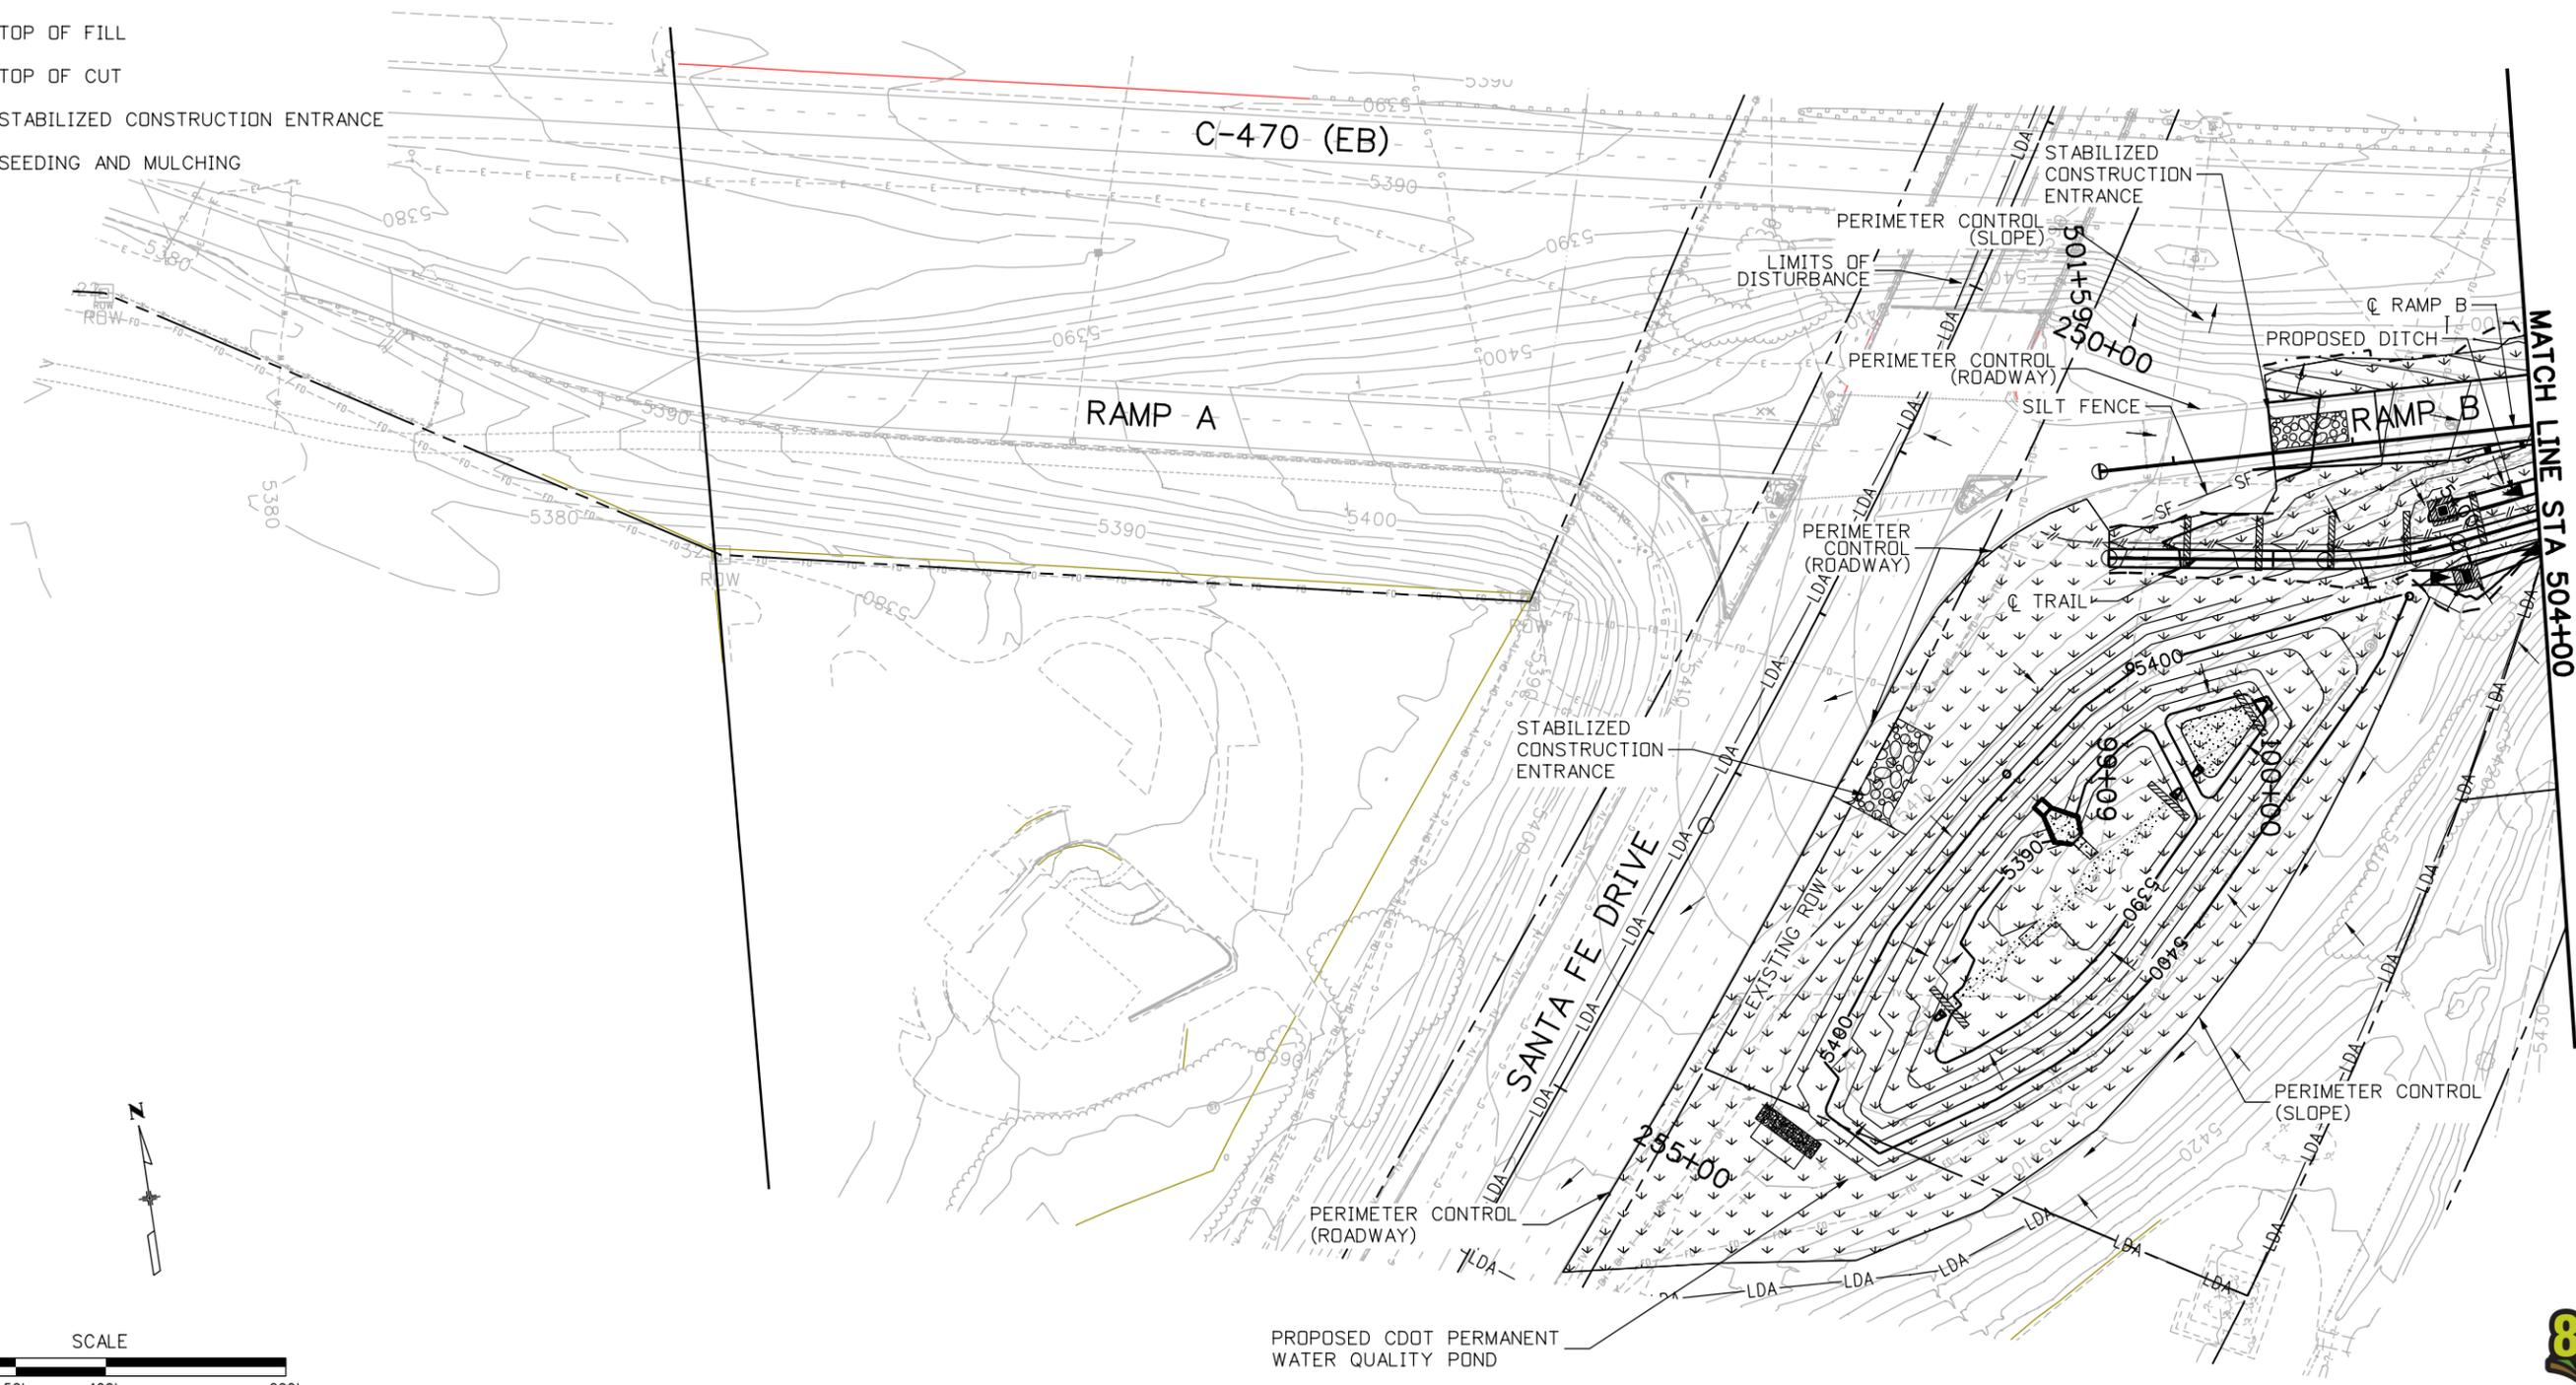

| | |
|---|-----------------------|
| Print Date: 1/15/2010 | |
| File Name: 14679_pES-P401.dgn | |
| Horiz. Scale: 1:100 | Vert. Scale: As Noted |
|  | |
| 4601 DTC Boulevard Suite 700 Denver, CO 80237 | |

| Sheet Revisions | | |
|-----------------|----------|-------|
| Date: | Comments | Init. |
| | | |
| | | |
| | | |

Colorado Department of Transportation

8833 South Wadsworth Court
Littleton, CO 80128
Phone: 303-972-9112 FAX: 303-972-9114


Region 6 **RLB**

| |
|-----------------------|
| As Constructed |
| No Revisions: |
| Revised: |
| Void: |

| | | | |
|---------------------------------------|---------|----------------|--------|
| EROSION CONTROL SWMP SITE PLAN | | | |
| Designer: | SDH | Structure | |
| Detailer: | SDH | Numbers | |
| Sheet Subset: | EROSION | Subset Sheets: | 3 of 7 |

| |
|-------------------------|
| Project No./Code |
| ES6 0852-103 |
| 17679 |
| Sheet Number 126 |

12244 11:57:19 PM S:\Tranproj\100002375\14679_Consultants\Hydraulics\Drawings\14679_pES-P401.dgn

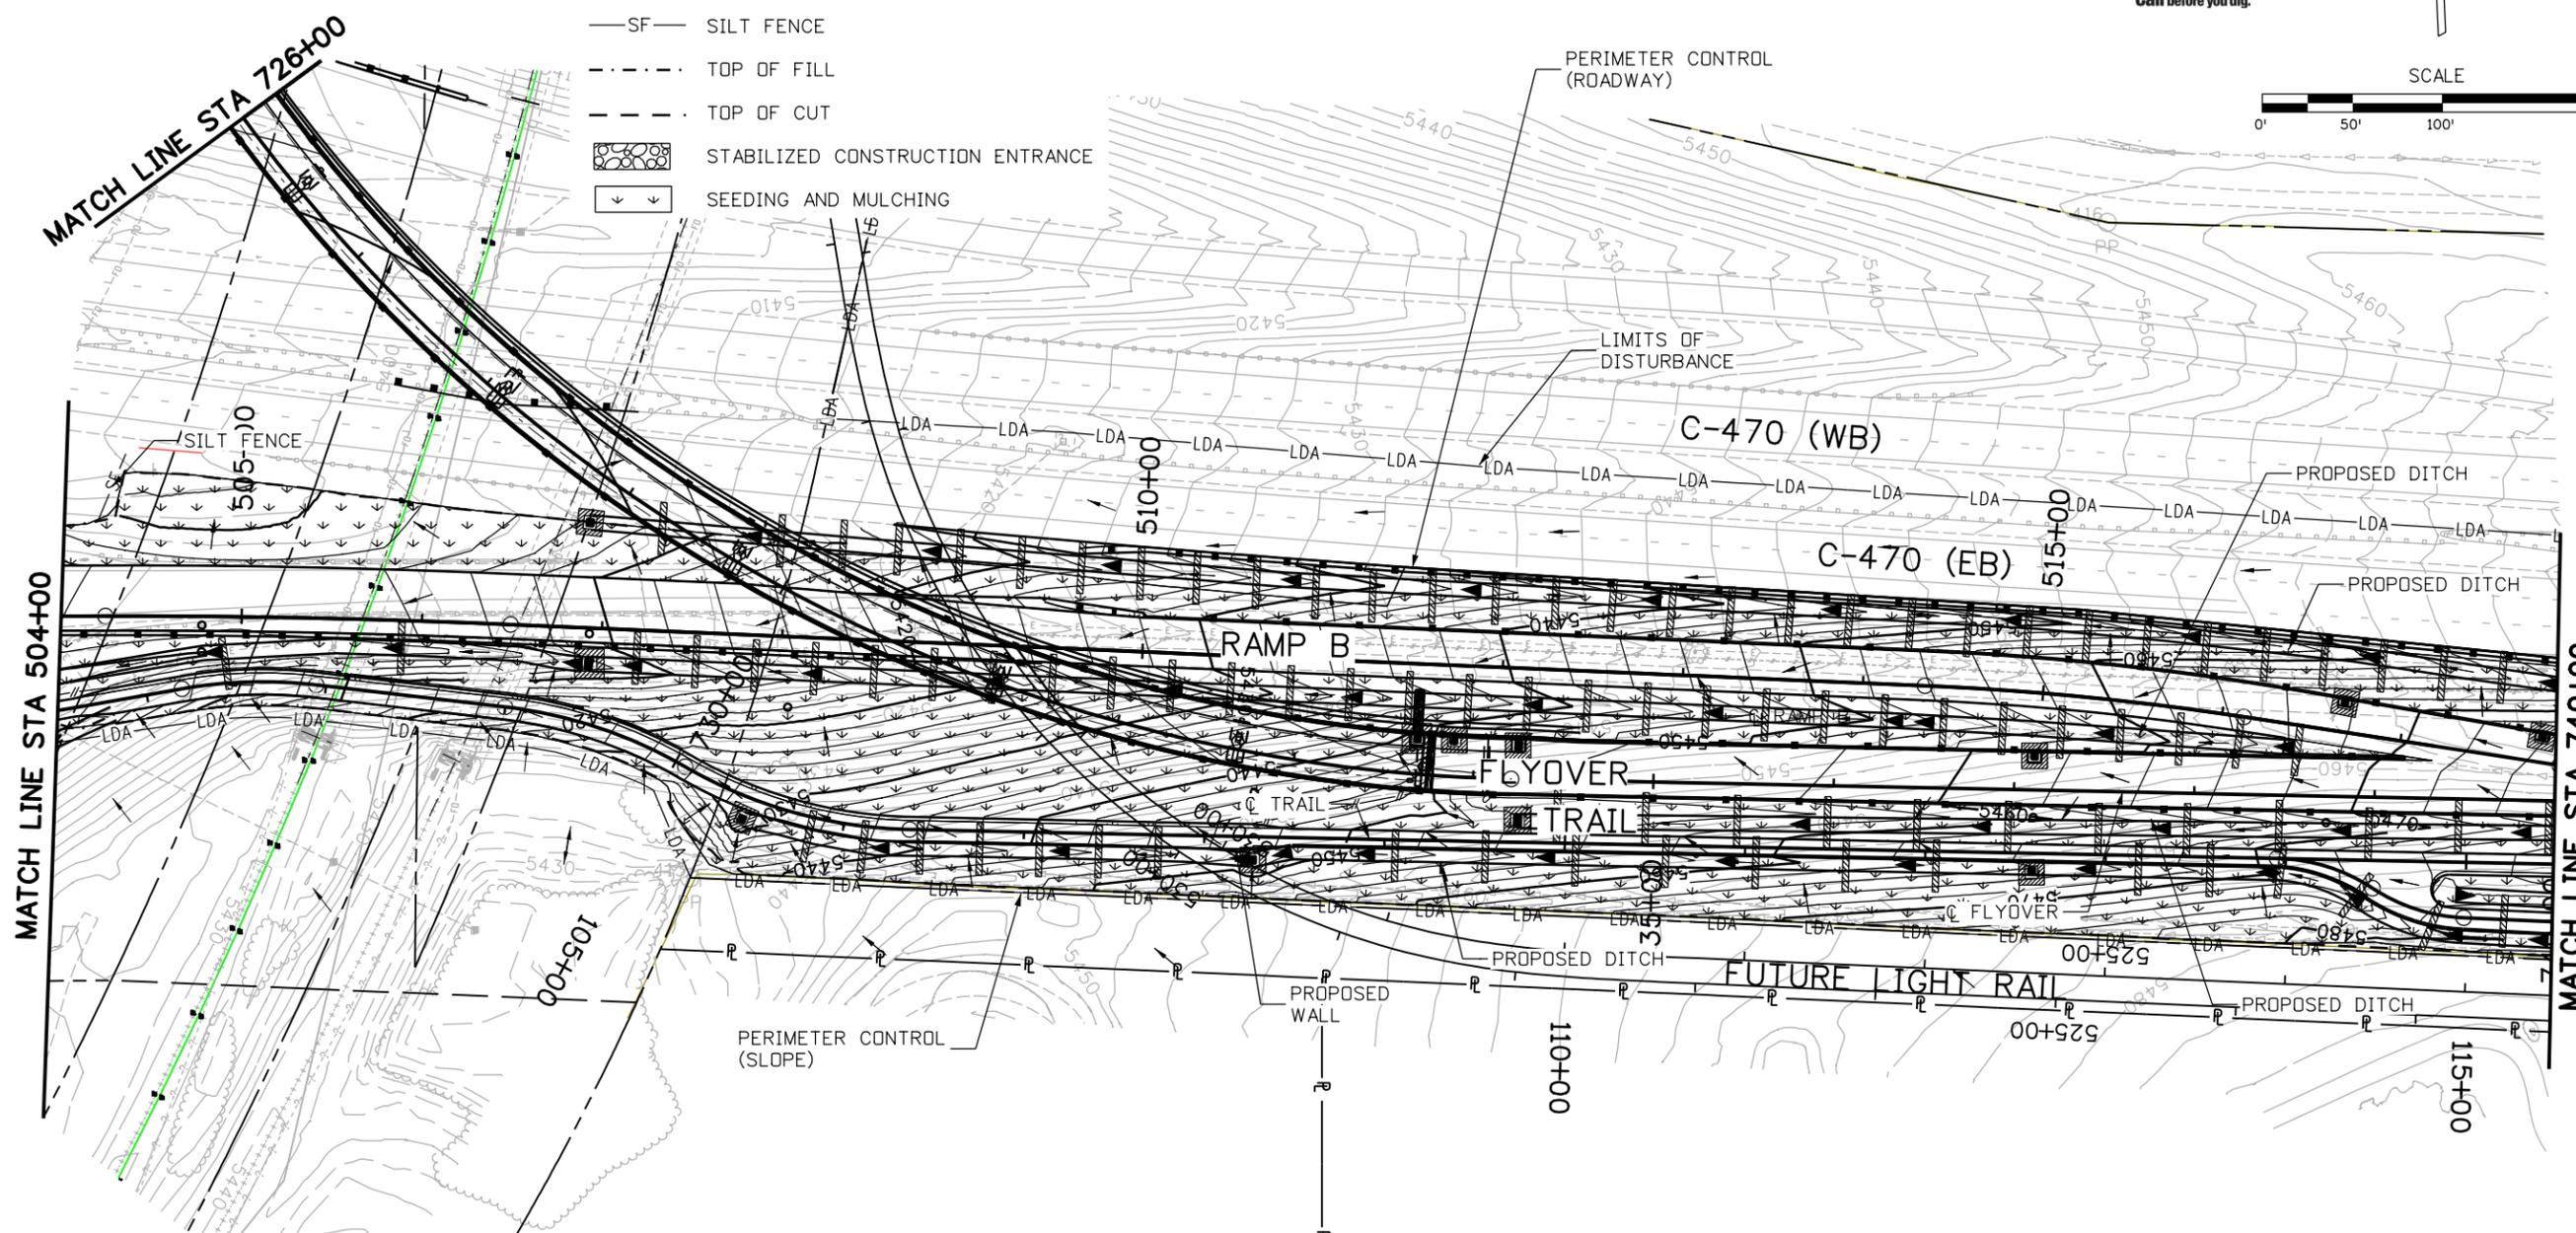

LEGEND

- EROSION LOGS
- INLET PROTECTION-GRAVEL BAGS
- LDA LIMITS OF DISTURBANCE
- SF SILT FENCE
- TOP OF FILL
- TOP OF CUT
- STABILIZED CONSTRUCTION ENTRANCE
- SEEDING AND MULCHING



Print Date: 1/15/2010
 File Name: 14679_pES-P703.dgn
 Horiz. Scale: 1:100 Vert. Scale: As Noted

| Sheet Revisions | | |
|-----------------|----------|-------|
| Date: | Comments | Init. |
| | | |
| | | |

Colorado Department of Transportation

 8833 South Wadsworth Court
 Littleton, CO 80128
 Phone: 303-972-9112 FAX: 303-972-9114
 Region 6 RLB


As Constructed
 No Revisions:
 Revised:
 Void:

| EROSION CONTROL SWMP SITE PLAN | | | |
|-----------------------------------|---------|----------------|--------|
| Designer: | SDH | Structure | |
| Detailer: | SDH | Numbers | |
| Sheet Subset: | EROSION | Subset Sheets: | 4 of 7 |

Project No./Code
 ES6 0852-103
 17679
 Sheet Number 127

12244 1:58:23 PM S:\Tranpro\100002375\14679\Consultants\Hydraulics\Drawings\14679_pES-P703.dgn

12244 1:58:51 PM S:\Tranpro\100002375\14679\Consultants\Hydraulics\Drawings\14679_pES-P705.dgn

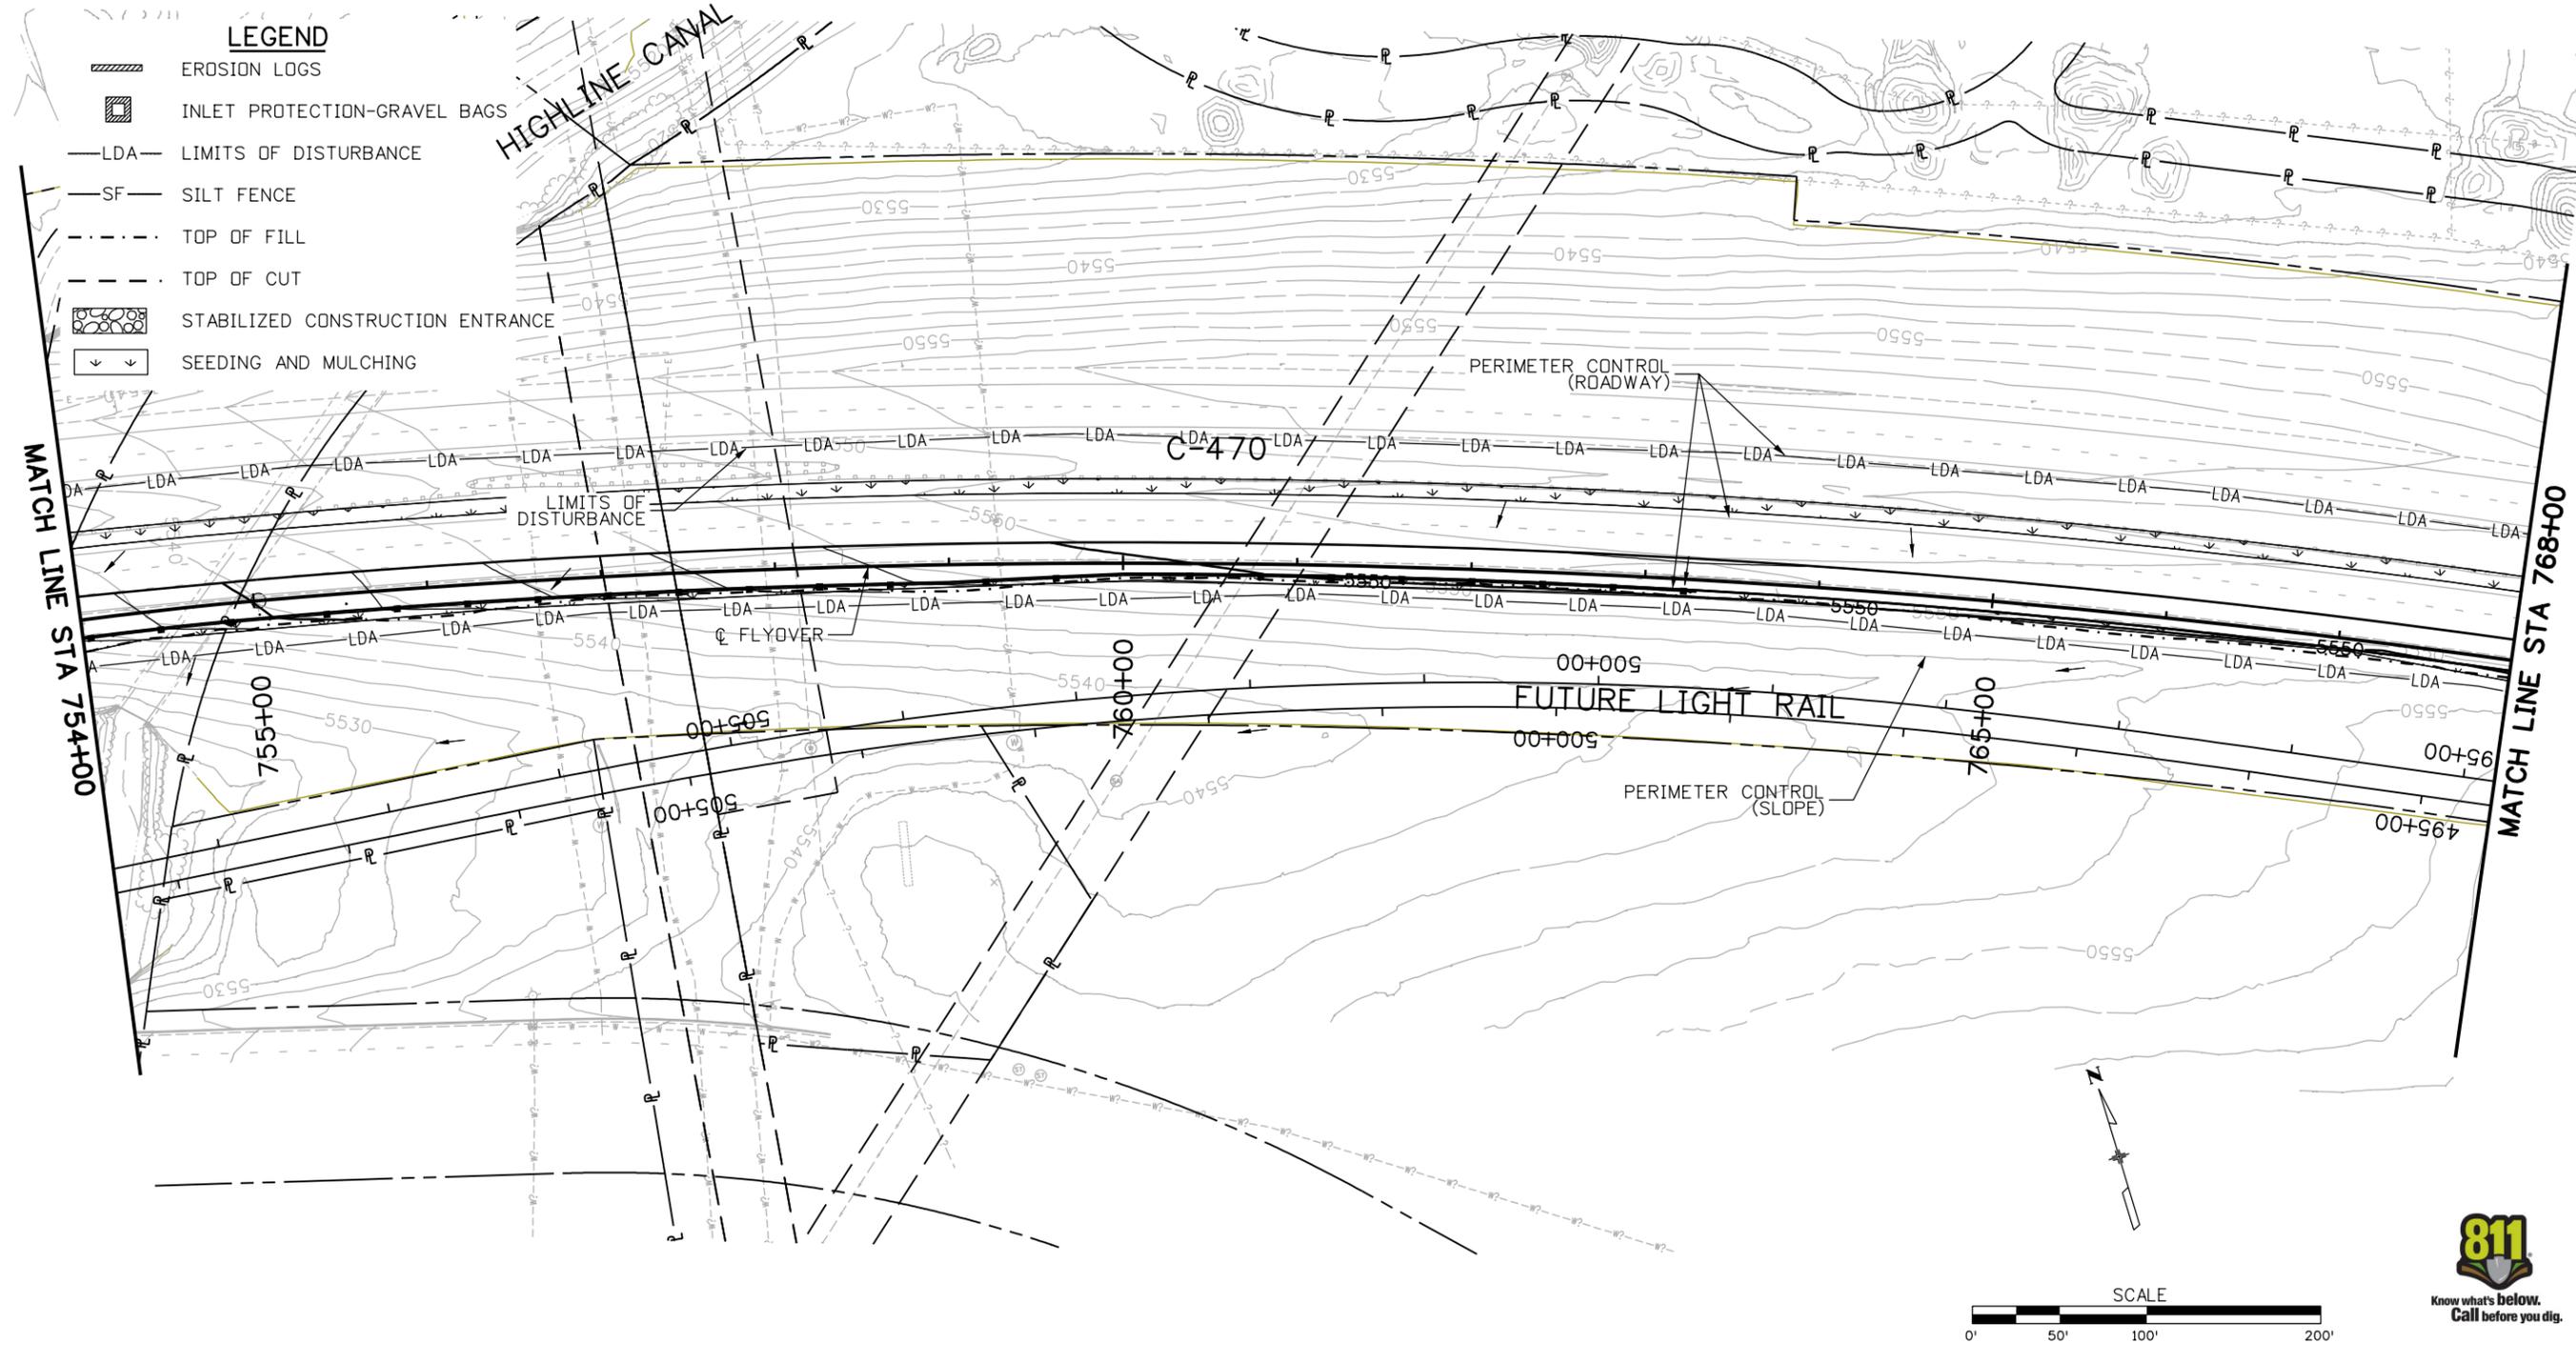

LEGEND

- EROSION LOGS
- INLET PROTECTION-GRAVEL BAGS
- LDA— LIMITS OF DISTURBANCE
- SF— SILT FENCE
- TOP OF FILL
- - - - TOP OF CUT
- STABILIZED CONSTRUCTION ENTRANCE
- SEEDING AND MULCHING

Print Date: 1/15/2010
 File Name: 14679_pES-P705.dgn
 Horiz. Scale: 1:100 Vert. Scale: As Noted

| Sheet Revisions | | |
|-----------------|----------|-------|
| Date: | Comments | Init. |
| 0000 | | |

Colorado Department of Transportation
 8833 South Wadsworth Court
 Littleton, CO 80128
 Phone: 303-972-9112 FAX: 303-972-9114
 Region 6 RLB

As Constructed
 No Revisions:
 Revised:
 Void:

EROSION CONTROL SWMP SITE PLAN



Designer: SDH Structure Numbers
 Detailer: SDH
 Sheet Subset: EROSION Subset Sheets: 6 of 7

Project No./Code
 ES6 0852-103
 17679
 Sheet Number 129



LEGEND

-  EROSION LOGS
-  INLET PROTECTION-GRAVEL BAGS
- LDA— LIMITS OF DISTURBANCE
- SF— SILT FENCE
- - - - TOP OF FILL
- - - - TOP OF CUT
-  STABILIZED CONSTRUCTION ENTRANCE
-  SEEDING AND MULCHING

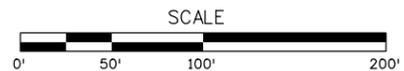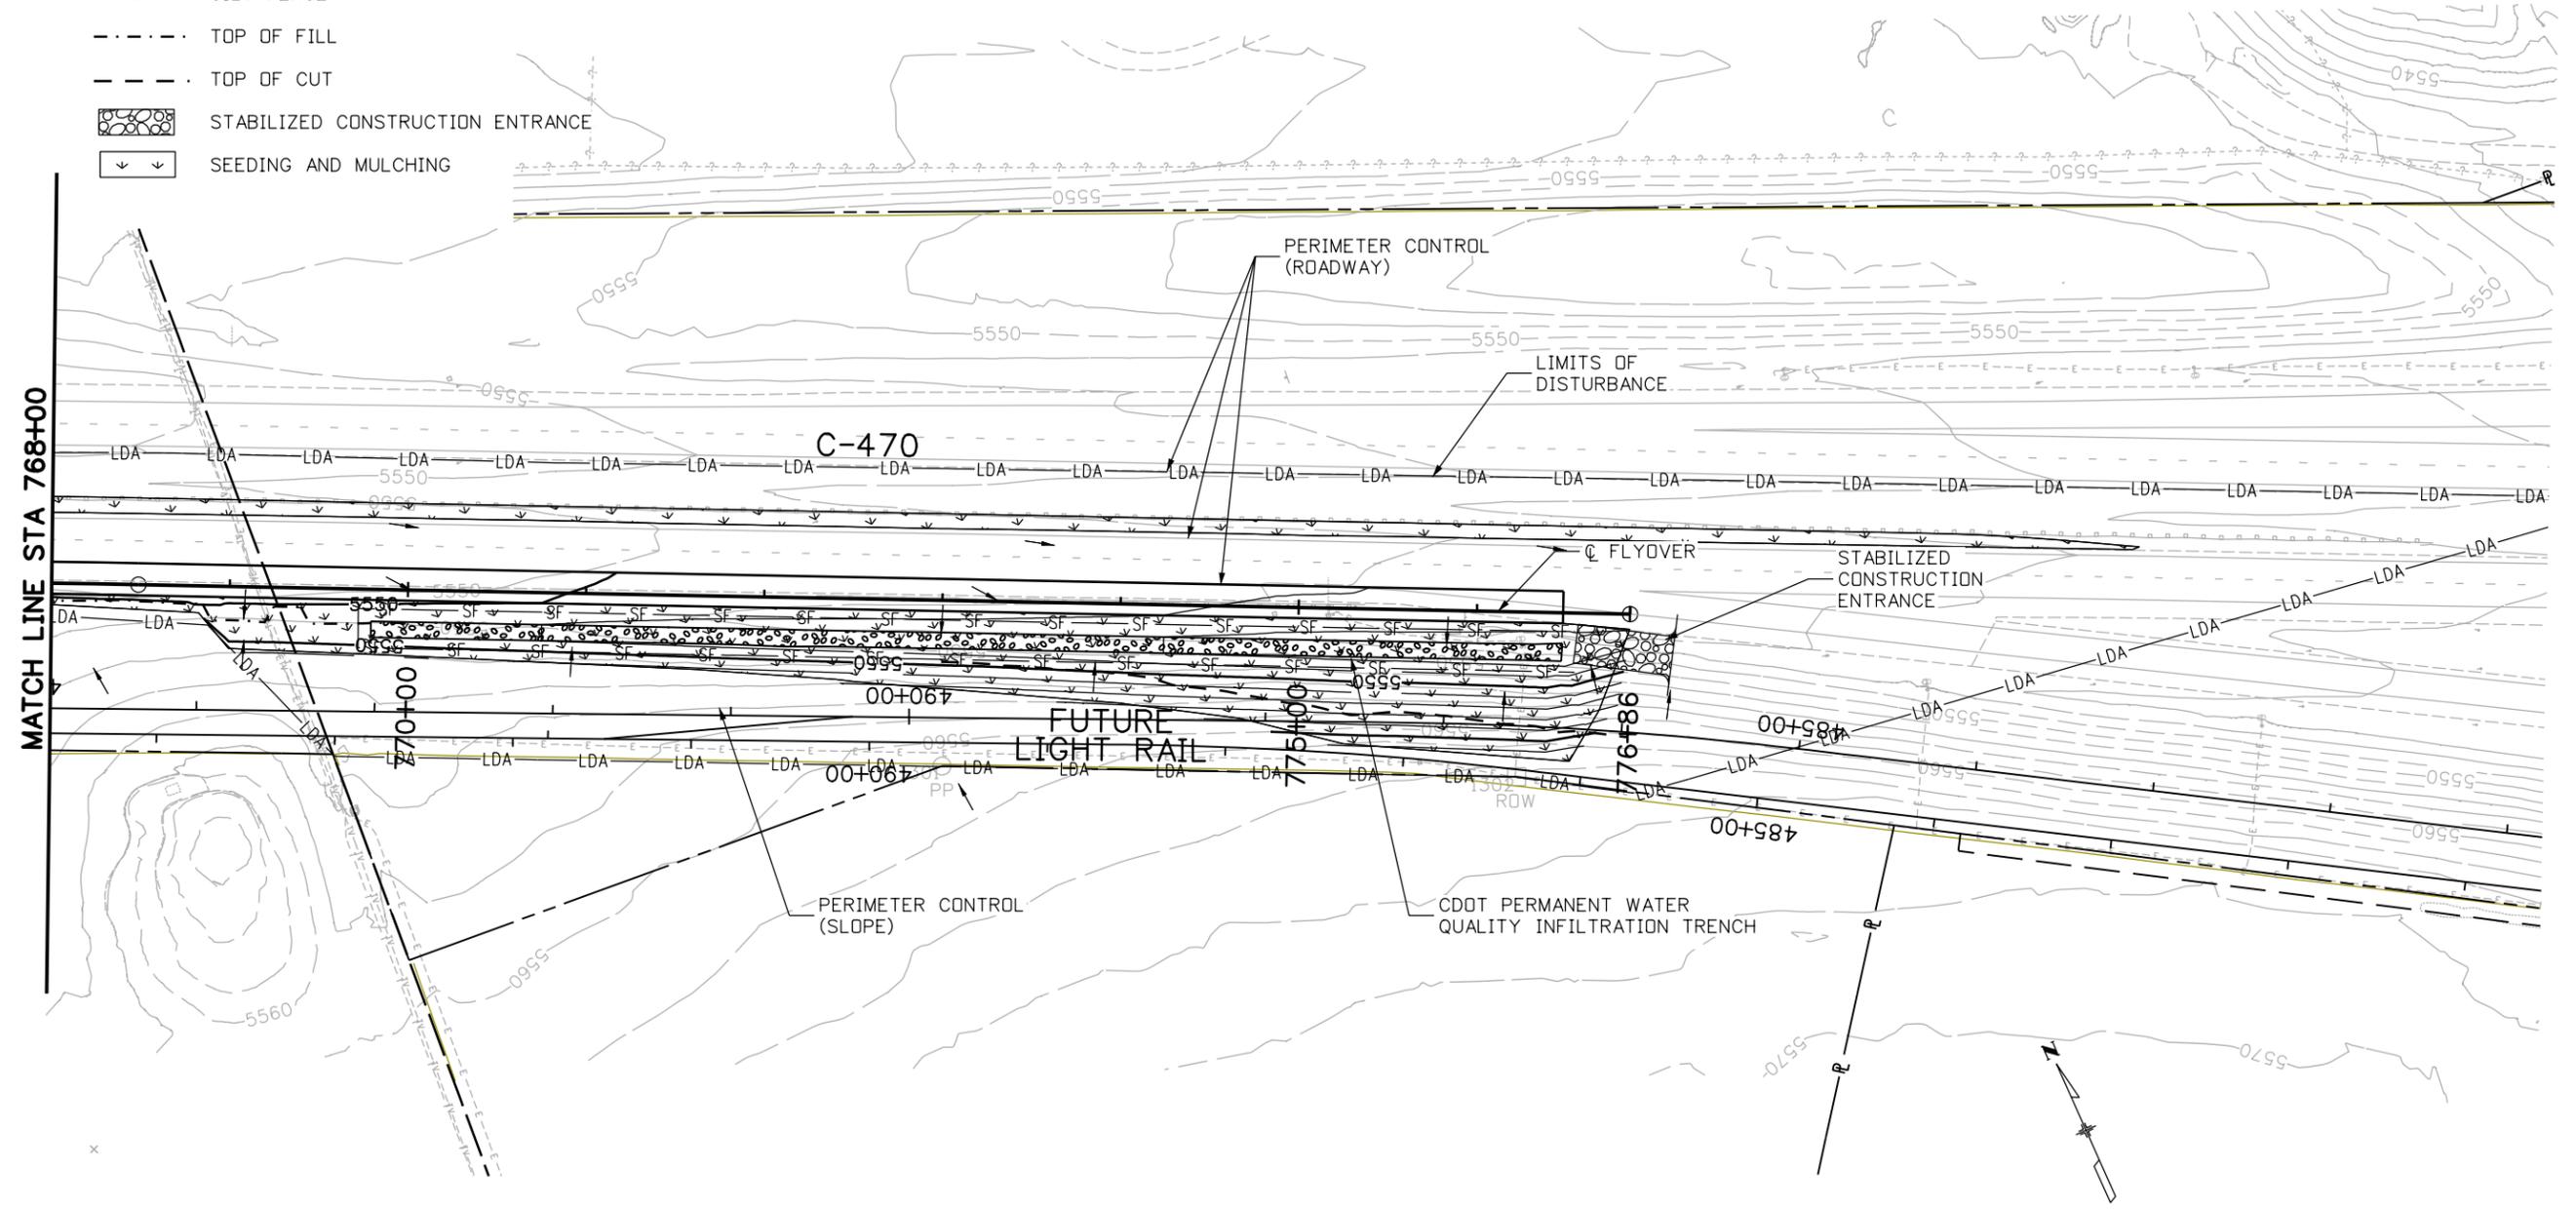

12244 1:59:00 PM S:\Tranproj\100002375\14679\Consultants\Hydraulics\Drawings\14679_pES-P706.dgn

| | |
|---|-----------------------|
| Print Date: 1/15/2010 | |
| File Name: 14679_pES-P706.dgn | |
| Horiz. Scale: 1:100 | Vert. Scale: As Noted |
|  4601 DTC Boulevard Suite 700 Denver, CO 80237 | |

| Sheet Revisions | | |
|-----------------|----------|-------|
| Date: | Comments | Init. |
| 0000 | | |
| | | |
| | | |

Colorado Department of Transportation


 8833 South Wadsworth Court
 Littleton, CO 80128
 Phone: 303-972-9112 FAX: 303-972-9114

Region 6 **RLB**

| |
|-----------------------|
| As Constructed |
| No Revisions: |
| Revised: |
| Void: |

| EROSION CONTROL SWMP SITE PLAN | | | |
|--------------------------------|---------|-------------------|--------|
| Designer: | SDH | Structure Numbers | |
| Detailer: | SDH | Subset Sheets: | 7 of 7 |
| Sheet Subset: | EROSION | | |

| |
|---|
| Project No./Code |
| ES6 0852-103 |
| 17679 |
| Sheet Number 130 |