



"AS BUILT"
3/4" / 85 BT

ALL FIRE HYDRANTS & STUBOUTS ARE SET ON INFORMATION FURNISHED BY DEVELOPER AT TIME OF DESIGN ANY REALIGNMENT, HORIZ. OR VERT., SHALL BE AT THE EXPENSE OF DEVELOPER. ALSO ANY STUBOUTS & APPURTENANCES NOT USED AS PROPOSED FOR DEVELOPMENT SHALL BE REMOVED AND REPLACED, WITH AN ACCEPTABLE SECTION OF PIPE, AT THE EXPENSE OF THE DEVELOPER.

John Hancock
 DEVELOPER 9-30-85
DATE

Date Started 10/2/85 Date Finished 10/9/85

Contractor CITY Phone No. _____

Inspected By REN WELCH

Staked By _____

Field Book _____ Page No. _____

Job No. 192-312
 Water Div. P.A. No. 85-114

DEPARTMENT OF UTILITIES

WATER DIVISION

WATER MAIN RELOCATION, NORTH EAST MARTIN DRAKE POWER PLANT

Approvals

APPROVED FOR CONSTRUCTION
 BY _____ DATE _____
 TITLE _____



DESIGN RELEASED _____ BY _____ DATE _____

RECORDED PLATS AND/OR EASEMENTS VERIFIED
 _____ BY _____ DATE _____

RELEASED BY ESTIMATORS _____ BY _____ DATE _____

- MATERIAL FURNISHED BY CITY
- MATERIAL SUPPLIED BY DEVELOPER

As Built WriteUp

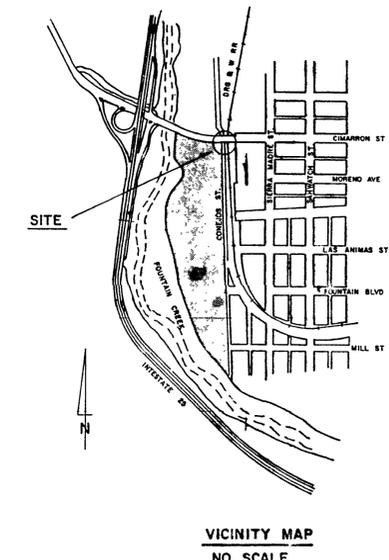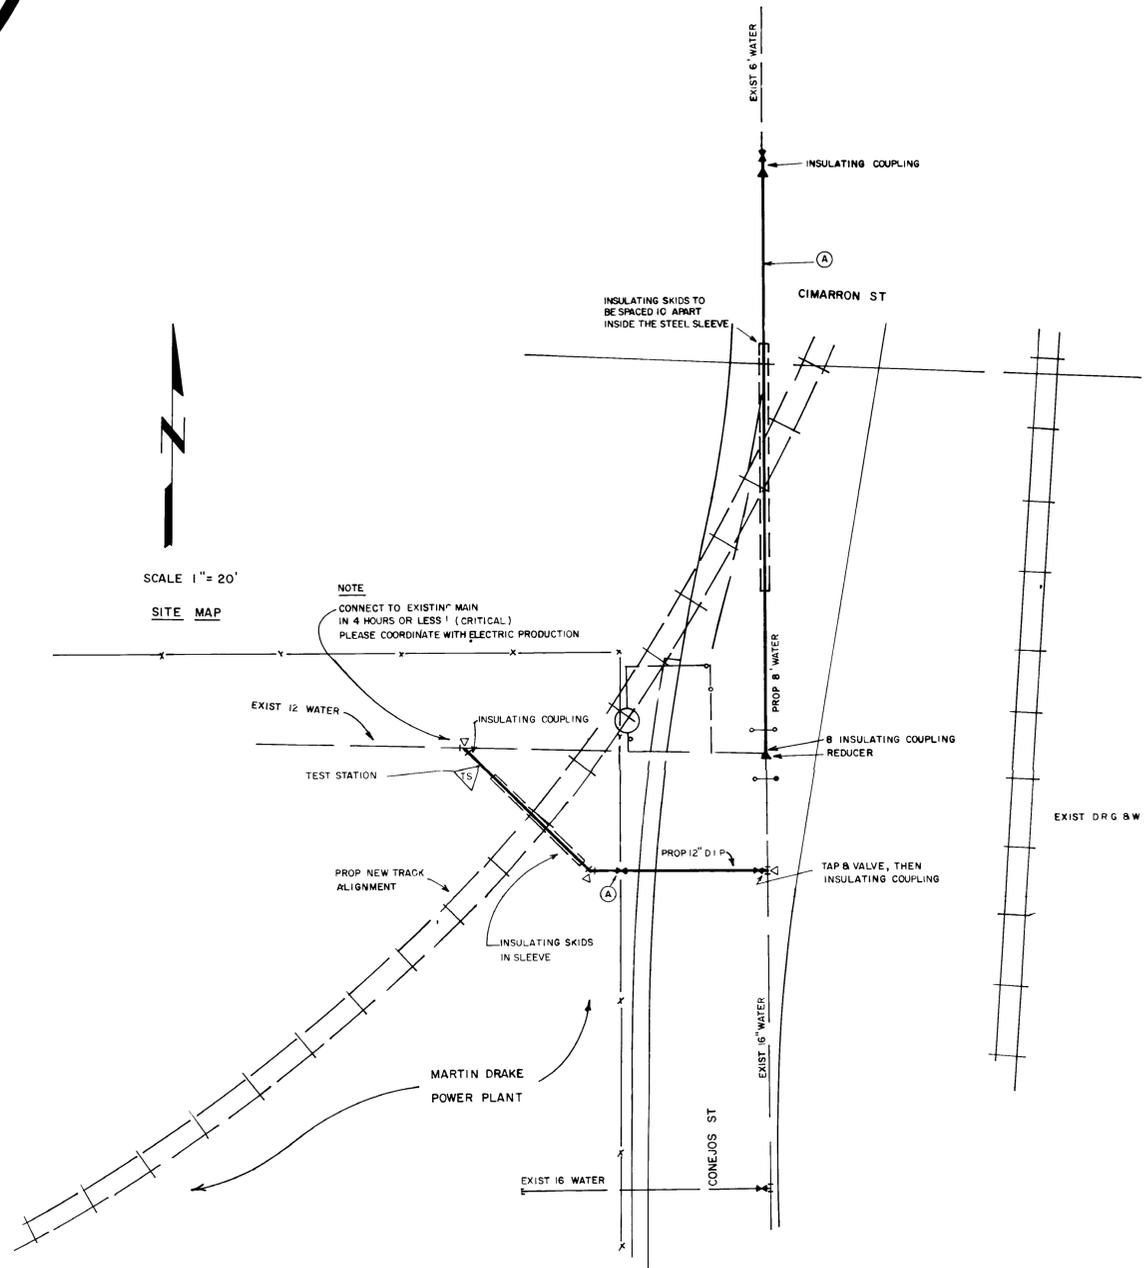

VICINITY MAP
 NO. SCALE

Map No(s).

