

GENERAL NOTES

EXPANSION JOINT MATERIAL SHALL MEET AASHTO SPECIFICATIONS M-213.

THE FINAL FINISH FOR THE SURFACES OF THE SLAB OVERHANGS, CURBS AND MONUMENTS SHALL BE CLASS 2. ALL OTHER EXPOSED CONCRETE SURFACES SHALL RECEIVE A CLASS 1 FINAL FINISH TO ONE FOOT BELOW THE FINISHED GROUND LINE.

THE STEEL BRIDGE RAIL AND PEDESTRIAN FENCE SHALL BE PAINTED IN ACCORDANCE WITH SECTION 509 OF THE CDOT STANDARD SPECIFICATIONS. THE COLOR OF THE BRIDGE RAIL AND PEDESTRIAN FENCE SHALL BE FOREST GREEN, EQUIVALENT TO FEDERAL STANDARD 5958 COLOR NO 14056.

THE FOLLOWING STRUCTURAL STEEL SHALL BE AASHTO M-183 (ASTM A-36): INTERMEDIATE DIAPHRAGMS.

ALL BOLTS SHALL BE 7/8" DIAMETER, HIGH STRENGTH, ASTM A325 UNLESS OTHERWISE NOTED.

GRADE 60 REINFORCING STEEL IS REQUIRED.

ALL REINFORCING STEEL SHALL BE EPOXY COATED UNLESS OTHERWISE NOTED.

(B) DENOTES NONCOATED REINFORCING STEEL.

CHAMFER ALL EXPOSED EDGES OF CONCRETE 3/4" UNLESS OTHERWISE NOTED.

LEVELING PADS ARE UNLAMINATED BEARINGS. THEY SHALL BE CUT OR MOLDED FROM AASHTO ELASTOMER GRADE 3, 4 OR 5 AS DESCRIBED IN TABLES 705-1 AND 705-2 OF THE STANDARD SPECIFICATIONS WITH A DUROMETER (SHORE "A") HARDNESS OF 60.

THE FOLLOWING TABLE GIVES THE MINIMUM LAP SPLICE LENGTH FOR REINFORCING BARS PLACED IN ACCORDANCE WITH SUBSECTION 602.06.

		BAR SIZE							
	CONCRETE	#4	#5	#6	#7	#8	#9	#10	#11
EPOXY	CLASS B	1'-7"	2'-0"	2'-7"	3'-6"	4'-7"	5'-9"	7'-3"	8'-11"
COATED	CLASS D	1'-7"	2'-0"	2'-5"	2'-10"	3'-9"	4'-8"	5'-11"	7'-4"
BLACK	CLASS B	1'-1"	1'-4"	1'-9"	2'-4"	3'-1"	3'-10"	4'-10"	6'-0"
REBAR	CLASS D	1'-1"	1'-4"	1'-7"	1'-11"	2'-6"	3'-2"	4'-0"	4'-11"

THESE SPLICES SHALL BE MODIFIED BY THE FOLLOWING FACTORS WHEN:

- REINFORCING IS SPACED BY LESS THAN 6" ON CENTER.....1.25
- TOP REINFORCEMENT - SO PLACED THAT MORE THAN 12" OF CONCRETE IS CAST BELOW THE REINFORCEMENT
 - EPOXY COATED.....1.15
 - BLACK BARS.....1.40

MECHANICAL COUPLER SHALL PRODUCE 125% OF REBAR STRENGTH.

THE ABOVE SPLICE LENGTHS SHALL BE INCREASED BY 20 PERCENT FOR 3 BAR BUNDLES AND 33 PERCENT FOR 4 BAR BUNDLES.

THE CONTRACTOR SHALL BE RESPONSIBLE FOR THE STABILITY OF THE STRUCTURE DURING CONSTRUCTION.

STATIONS, ELEVATIONS, AND DIMENSIONS CONTAINED IN THESE PLANS ARE CALCULATED FROM A RECENT FIELD SURVEY. THE CONTRACTOR SHALL VERIFY ALL DEPENDENT DIMENSIONS IN THE FIELD BEFORE ORDERING OR FABRICATING ANY MATERIAL.

CONTRACTOR SHALL FOLLOW THE DIG SAFE PROGRAM ESTABLISHED FOR THIS PROJECT.

UTILITY LOCATIONS SHOWN ARE APPROXIMATE. THE CONTRACTOR SHALL VERIFY ALL LOCATIONS PRIOR TO CONSTRUCTION.

CONTRACTOR SHALL SEAL THE BRIDGE DECK AND APPROACH SLAB SURFACE NO EARLIER THAN ONE YEAR AFTER THE DECK HAS BEEN POURED. SEALANT SHALL BE ONE OF THE FOLLOWING PRODUCTS AT SECC'S DISCRETION: SIKAPRINTO 19TF, SIKADUR 55SLV, OR DENEFF DENEDECK PER MANUFACTURER'S SPECS.

DESIGN DATA

AASHTO, STANDARD SPECIFICATION FOR HIGHWAY BRIDGES 16TH EDITION WITH 1997, 1998, 1999 AND 2000 INTERIMS; CDOT BRIDGE DESIGN MANUAL

DESIGN METHOD: LOAD FACTOR DESIGN - BRIDGE DESIGN
SERVICE LOAD DESIGN - FOUNDATION DESIGN

LIVE LOAD: HS-25-44, COLORADO PERMIT VEHICLE AND INTERSTATE ALTERNATE.
DEAD LOAD: ASSUMES 36 LBS PER SQ FT FOR FUTURE ROADWAY OVERLAY AND 5 LBS PER SQ FT FOR UTILITIES.

REINFORCED CONCRETE:

CLASS B CONCRETE: f'c = 3,000 psi AT 28 DAYS
REINFORCING STEEL: fy = 60,000 psi AT 28 DAYS

CAISSON CONCRETE:

CLASS BZ CONCRETE: f'c = 4,000 psi AT 28 DAYS
CLASS D CONCRETE: f'c = 4,500 psi AT 28 DAYS
REINFORCING STEEL: fy = 60,000 psi AT 28 DAYS
STRUCTURAL STEEL: AASHTO M-183 (ASTM A-36) Fy = 36,000 psi
AASHTO M-270 (ASTM A-709) Fy = 50,000 psi

PRESTRESSED CONCRETE: CLASS S CONCRETE f'c = (SEE DETAILS ON BT SHEETS)
f's = 270,000 psi (LOW RELAXATION)

INDEX OF DRAWINGS

DWG NO	DESCRIPTION
B501	GENERAL INFORMATION
B502	GENERAL LAYOUT
B503	TYPICAL SECTION
B504	PHASING PLAN (1)
B505	PHASING PLAN (2)
B506	ENGINEERING GEOLOGY
B507	CONSTRUCTION LAYOUT
B508	FOUNDATION PLAN AND LAYOUT
B509	CAISSON DETAILS
B510	ABUTMENT 1 LAYOUT (1)
B511	ABUTMENT 1 LAYOUT (2)
B512	ABUTMENT 3 LAYOUT (1)
B513	ABUTMENT 3 LAYOUT (2)
B514	ABUTMENT DETAILS (1)
B515	ABUTMENT DETAILS (2)
B515A	ABUTMENT DETAILS (3)
B516	PIER 2 LAYOUT (1)
B517	PIER 2 LAYOUT (2)
B518	PIER DETAILS
B519	BT54 GIRDER
B520	UTILITY DETAILS (1)
B521	UTILITY DETAILS (2)
B522	INTERMEDIATE DIAPHRAGM DETAILS
B523	BRIDGE DECK TYPICAL SECTION
B524	PRECAST PANEL DECK FORM (1)
B525	PRECAST PANEL DECK FORM (2)
B526	APPROACH SLAB DETAILS
B526A	APPROACH SLAB DRAIN DETAILS
B527	BRIDGE RAIL TYPE 10M
B528	BRIDGE RAIL TYPE 7
B528A	BRIDGE EXPANSION DEVICE (BRIDGE RAIL & SIDEWALK)
B529	PEDESTRIAN FENCE DETAILS
B530	MONUMENT DETAILS
B531	SIDEWALK JOINT LAYOUT
B532	ABUTMENT BACKFILL DETAILS
B533	BRIDGE DECK ELEVATIONS (1)
B534	BRIDGE DECK ELEVATIONS (2)
B535	BRIDGE DECK ELEVATIONS (3)
B536	BRIDGE DECK ELEVATIONS (4)

BRIDGE DESCRIPTION

2 - SPAN (101'-10 1/4", 119'-6" @ BRG TO @ BRG)
226'-7 1/2" BRIDGE


CONCRETE PRESTRESSED I-GIRDERS, CONTINUOUS

120'-0" ROADWAY, 144'-0" TOTAL WIDTH WITH SIDEWALKS AND CURBS

COLORADO BLVD OVER I-25

71°51'31" SKEW

BRIDGE RAIL TYPE 10M

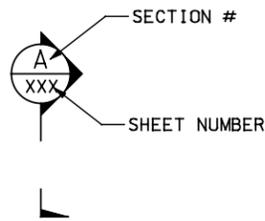

SECTION

File Name: C:\PWORKING\DMS07719\13STN00008.DGN
User: PAUL.NIKOLAI
Date Plotted: 03/15/2007
Time Plotted: 09:57:06 AM
Pen Table: S:\MICROSTATION\PLOTTABLES\T-REX-GRAY.TBL

DESIGNED BY: BO	ISSUE RECORD		
	NO.	DESCRIPTION	DATE
DRAFTED BY: RB	1	APPROVED FOR CONSTRUCTION	03SEP03
	2	FDC S1096 - REVISED ABUT DETAIL	16JAN04
	3	FDC S1095 - REVISED DRAINS	26JAN04
CHECKED BY: JB	4	AFC - FDC S1388 - ADD EXPANSION PLATES	26JUL04
	AB	AS-BUILT	16FEB07




SOUTHEAST CORRIDOR MULTI-MODAL PROJECT
AREA 1.3
COLORADO BLVD OVER I-25
GENERAL INFORMATION

STRUCTURE NO F-17-0C SECC STRUCTURE NO 87

PROJECT NO./CODE	NH 0252-299 11584
FILE NAME	13STN00008
DRAWING NUMBER	B501

AS-BUILT

File Name: C:\PWORKING\DM507719\13STPP0006.DGN
 User: PAUL_NIKOLAI
 Date Plotted: 03/15/2007
 Time Plotted: 09:57:33 AM
 Pen Table: S:\MICROSTATION\PLOTTING\TABLES\T-REX-GRAY.TBL

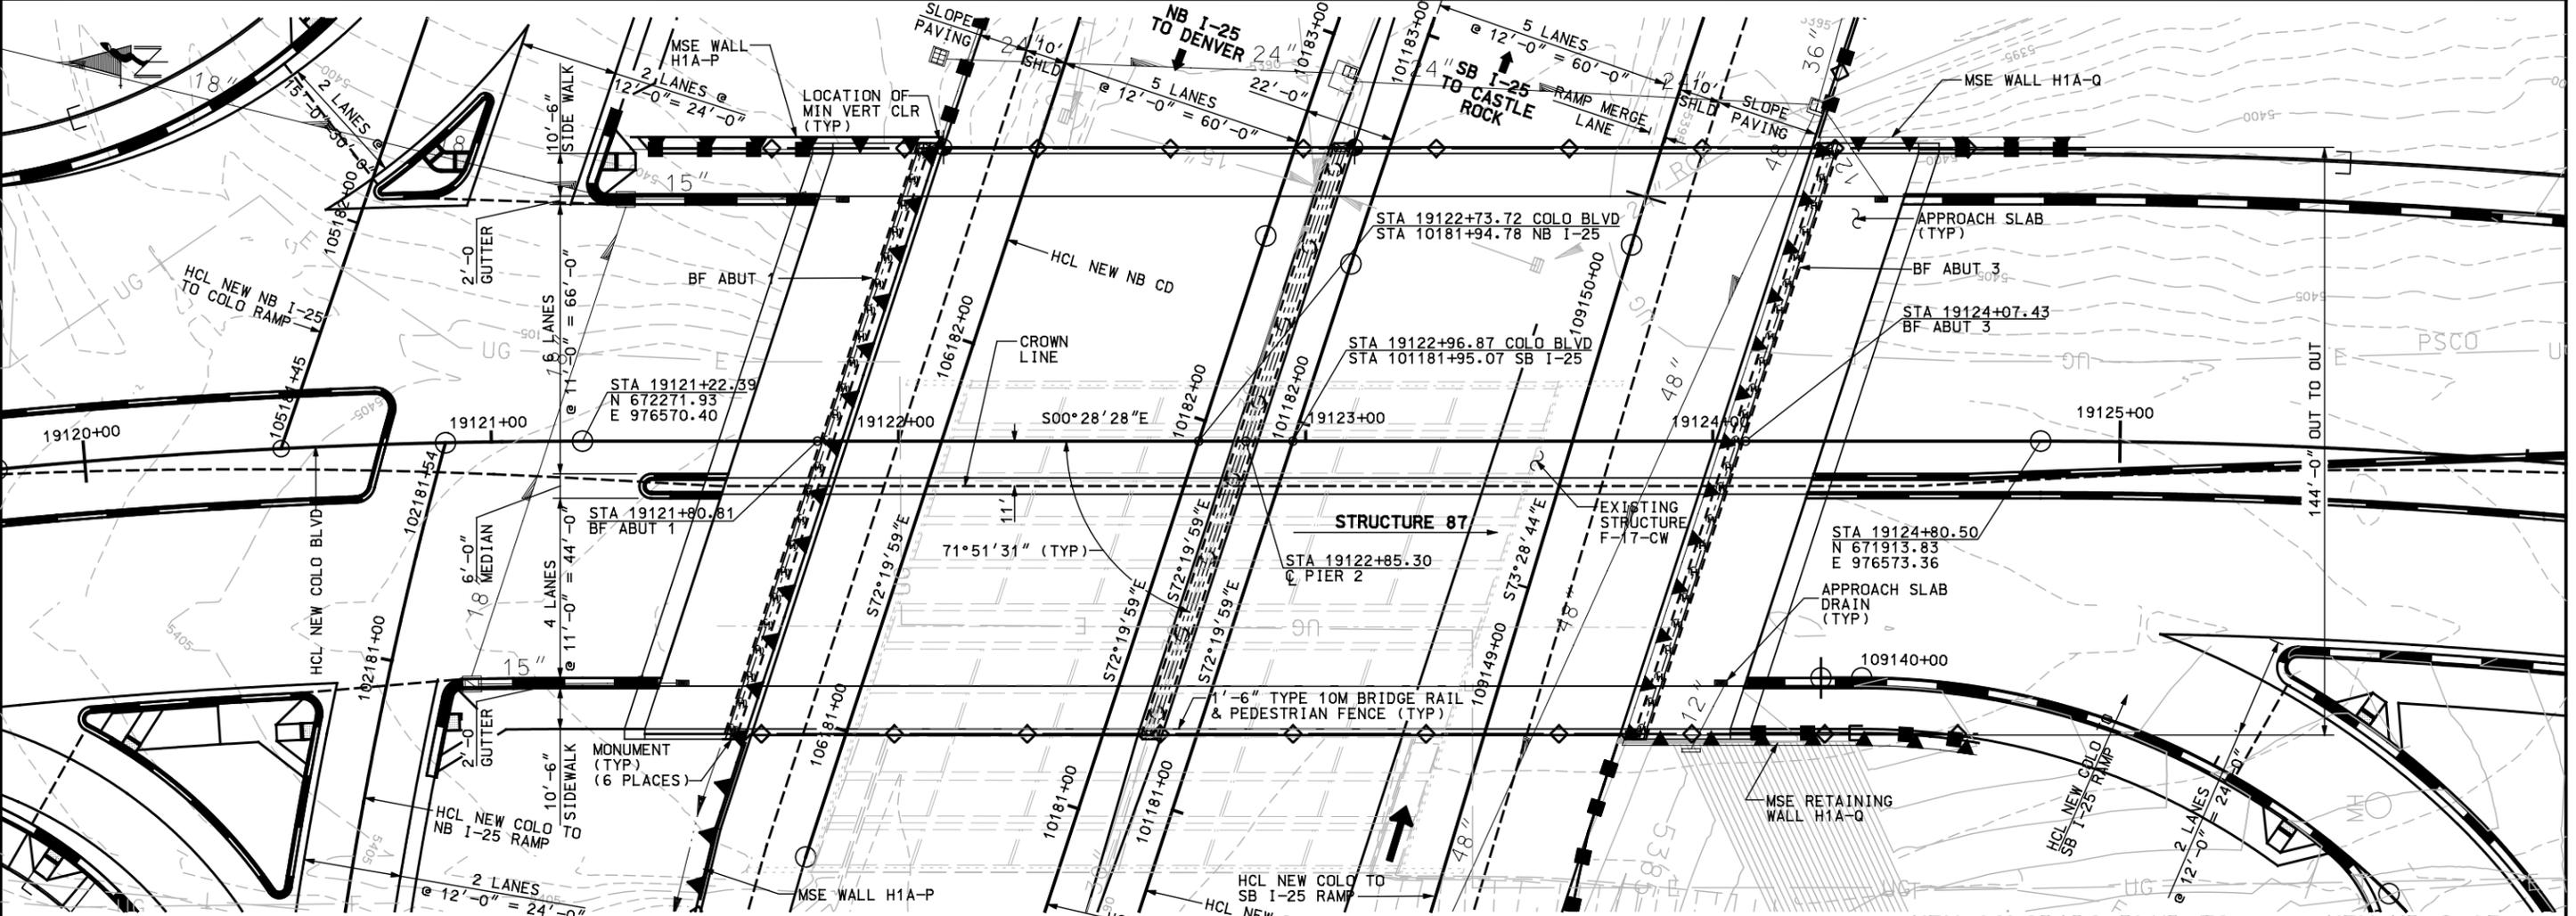

PLAN

NEW COLORADO BLVD TO SB I-25 RAMP CURVE DATA


PC STA	109150+25.57
PT STA	101952+93.11
Δ	07° 17' 58" RT
D	02° 43' 42"
R	2100.00'
T	133.95'
L	267.53'

NEW NB I-25 CURVE DATA

PC STA	10182+47.68
PT STA	10191+10.41
Δ	17° 20' 39" RT
D	02° 00' 37"
R	2850.00'
T	434.69'
L	862.73'

NEW SB I-25 CURVE DATA

PC STA	101182+40.76
PT STA	101191+24.59
Δ	17° 54' 23" RT
D	02° 01' 34"
R	2828.00'
T	445.55'
L	883.83'

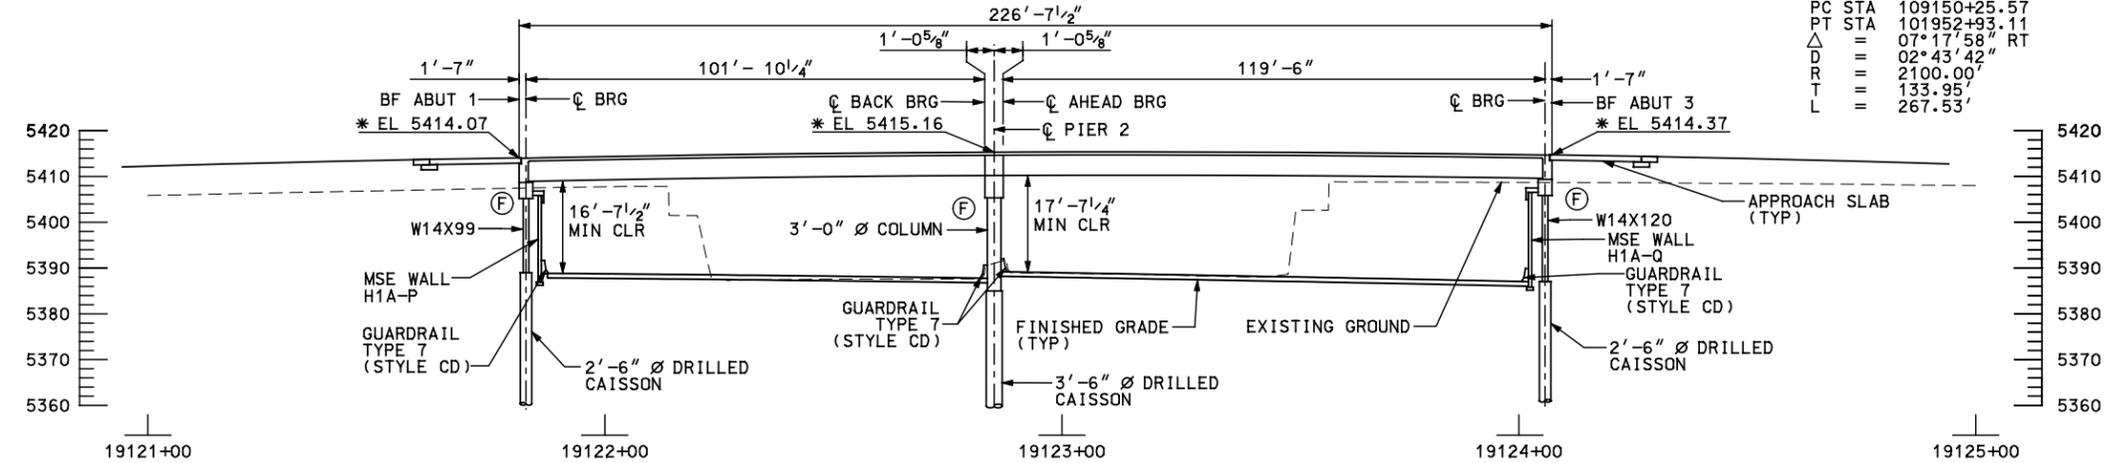

SECTION

(TAKEN ALONG COLORADO BLVD HORIZONTAL CONTROL LINE)
 * ELEVATIONS ARE AT FINISHED GRADE




ISSUE RECORD			
DESIGNED BY:	NO.	DESCRIPTION	DATE
BO	B	IN-PROCESS DESIGN SUBMITTAL	03JUL03
AHQ	C	FINAL DESIGN SUBMITTAL	14AUG03
	1	APPROVED FOR CONSTRUCTION	03SEP03
	2	FDC S1095 - REVISED DRAINS	29JAN04
JB	AB	AS-BUILT	16FEB07



SOUTHEAST CORRIDOR MULTI-MODAL PROJECT		PROJECT NO./CODE
AREA 1.3		NH 0252-299
COLORADO BLVD OVER I-25		11584
GENERAL LAYOUT		FILE NAME 13STPP0006
STRUCTURE NO F-17-0C	SECC STRUCTURE NO 87	DRAWING NUMBER B502


AS-BUILT

File Name: C:\pwworking\dms07719\13STTY0067.DGN
 User: PAUL.NIKOLAI
 Date Plotted: 03/15/2007
 Time Plotted: 09:59:40 AM
 Pen Table: S:\MICROSTATION\PLOTTABLES\T-REX-GRAY.TBL

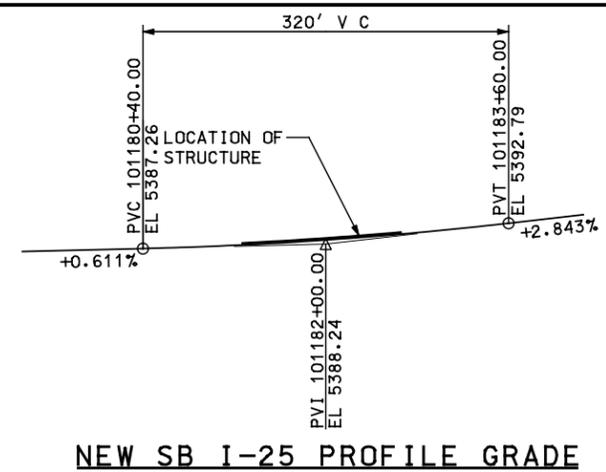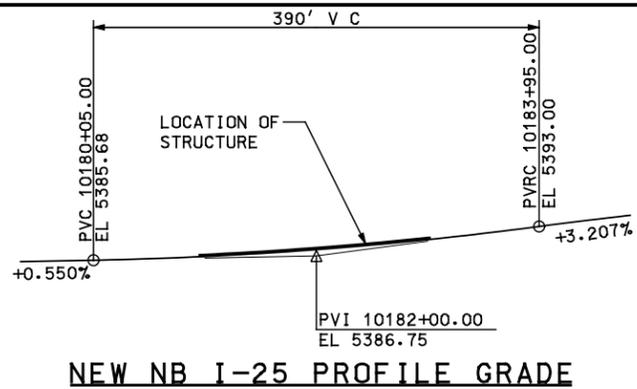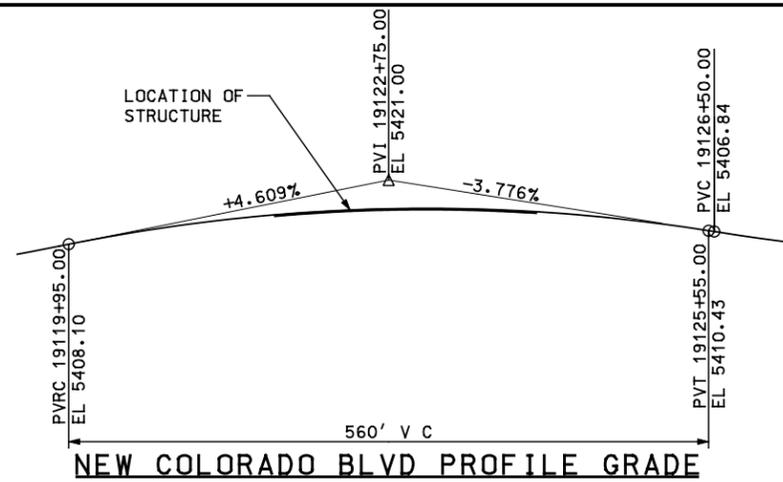


NEW NB I-25 PROFILE GRADE

NEW SB I-25 PROFILE GRADE

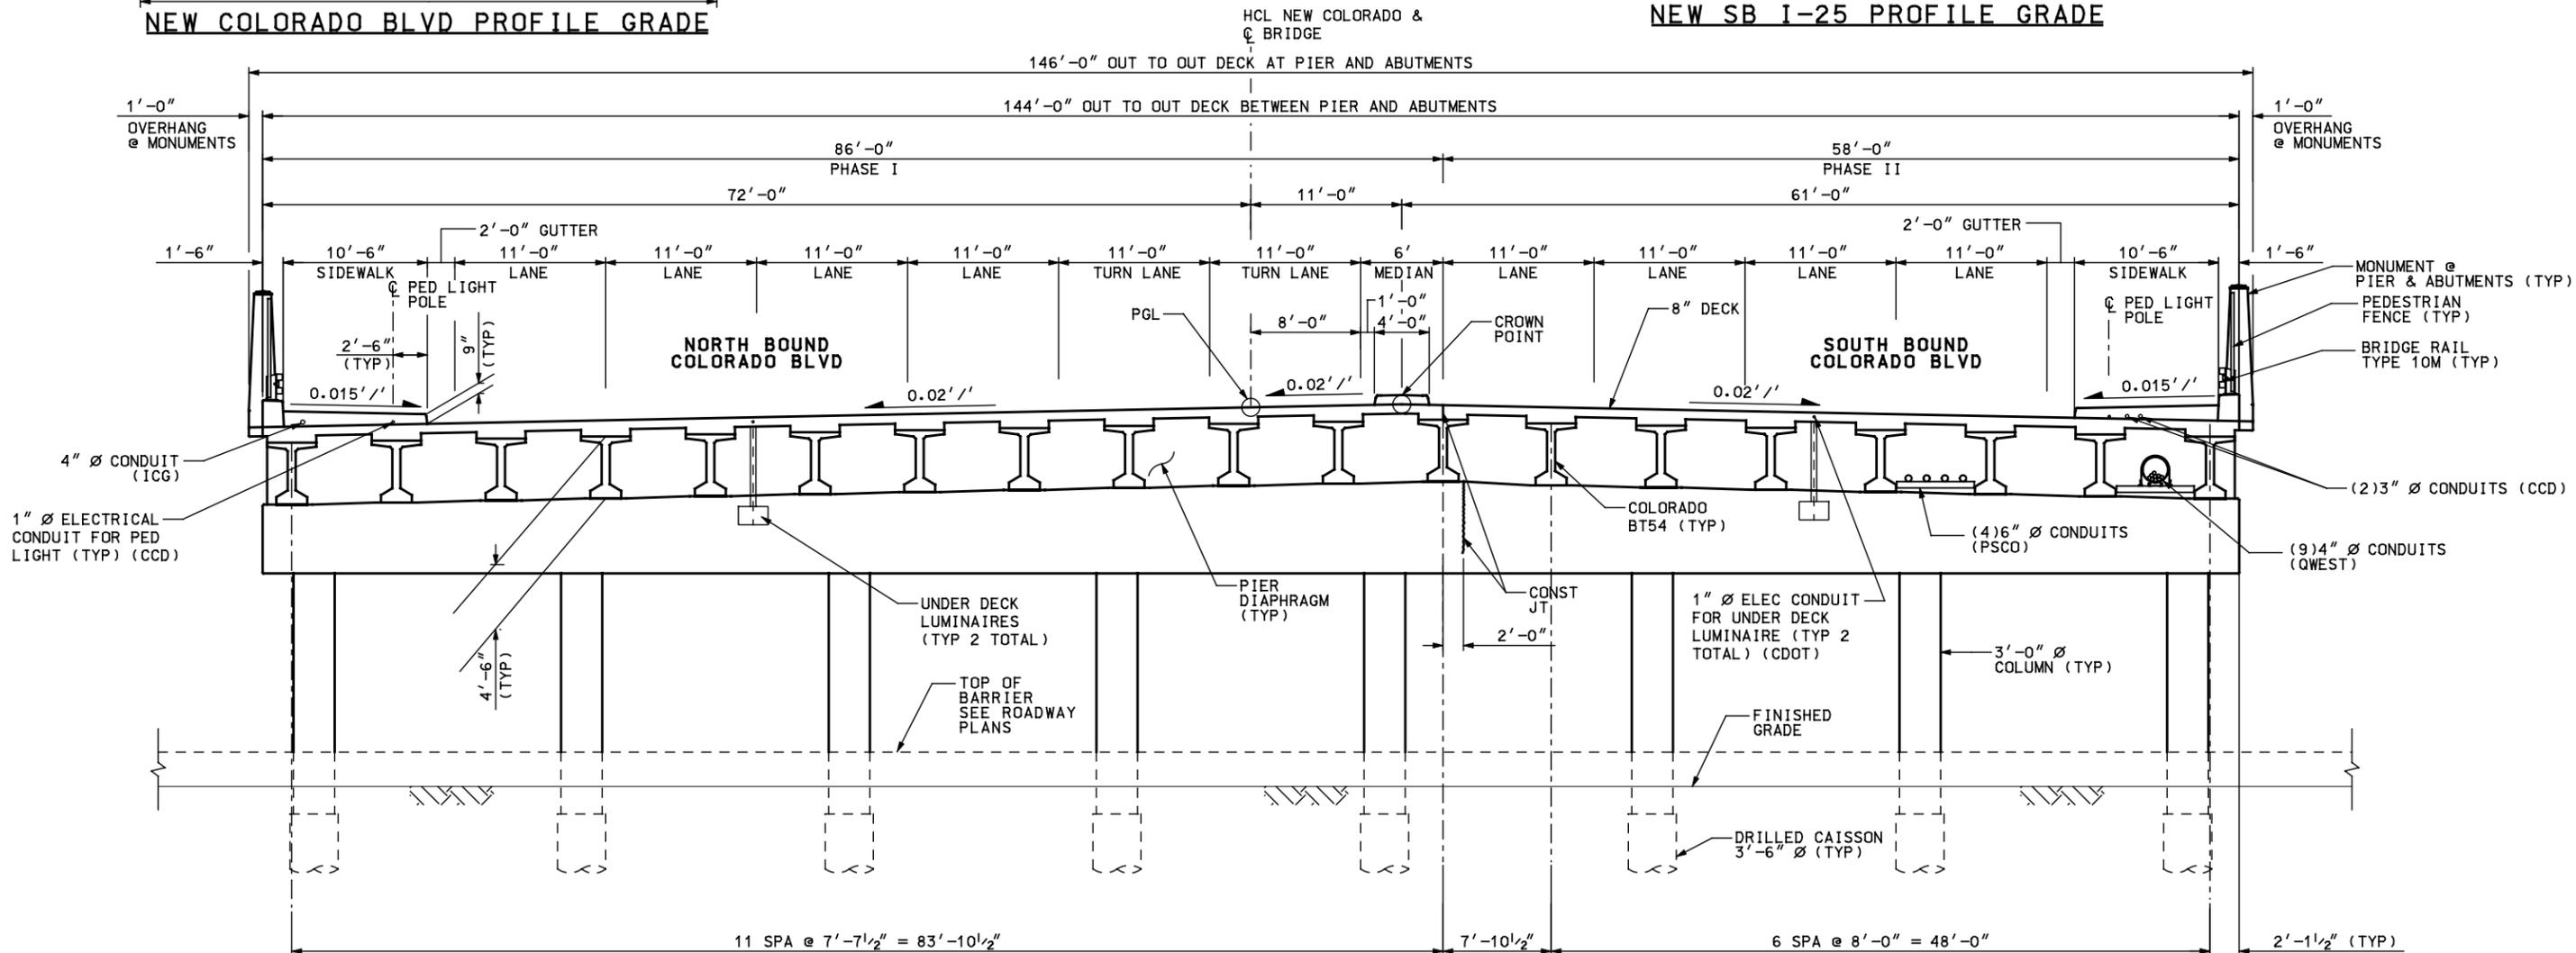

TYPICAL SECTION
(LOOKING UPSTATION)
DIMENSIONS PERPENDICULAR TO C BRIDGE

ISSUE RECORD			
DESIGNED BY:	NO.	DESCRIPTION	DATE
BO	B	IN-PROCESS DESIGN SUBMITTAL	03JUL03
DRAFTED BY:	C	FINAL DESIGN SUBMITTAL	14AUG03
RB	1	APPROVED FOR CONSTRUCTION	03SEP03
CHECKED BY:	2	AFC - FDC S953 (LABEL UTILITY OWNER)	06FEB04
JB	AB	AS-BUILT	16FEB07

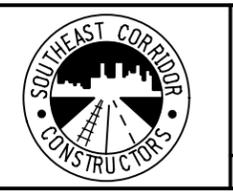


SOUTHEAST CORRIDOR MULTI-MODAL PROJECT
 AREA 1.3
 COLORADO BLVD OVER I-25
 TYPICAL SECTION
 STRUCTURE NO F-17-0C SECC BRIDGE NO 87

PROJECT NO./CODE	NH 0252-299 11584
FILE NAME	13STTY0067
DRAWING NUMBER	B503


AS-BUILT

File Name: C:\PWORKING\MS07719\13STDT0223.DGN
 User: PAUL_NIKOLAI
 Date Plotted: 03/15/2007
 Time Plotted: 09:55:05 AM
 Pen Table: S:\MICROSTATION\PLOTTABLES\T-REX-GRAY.TBL

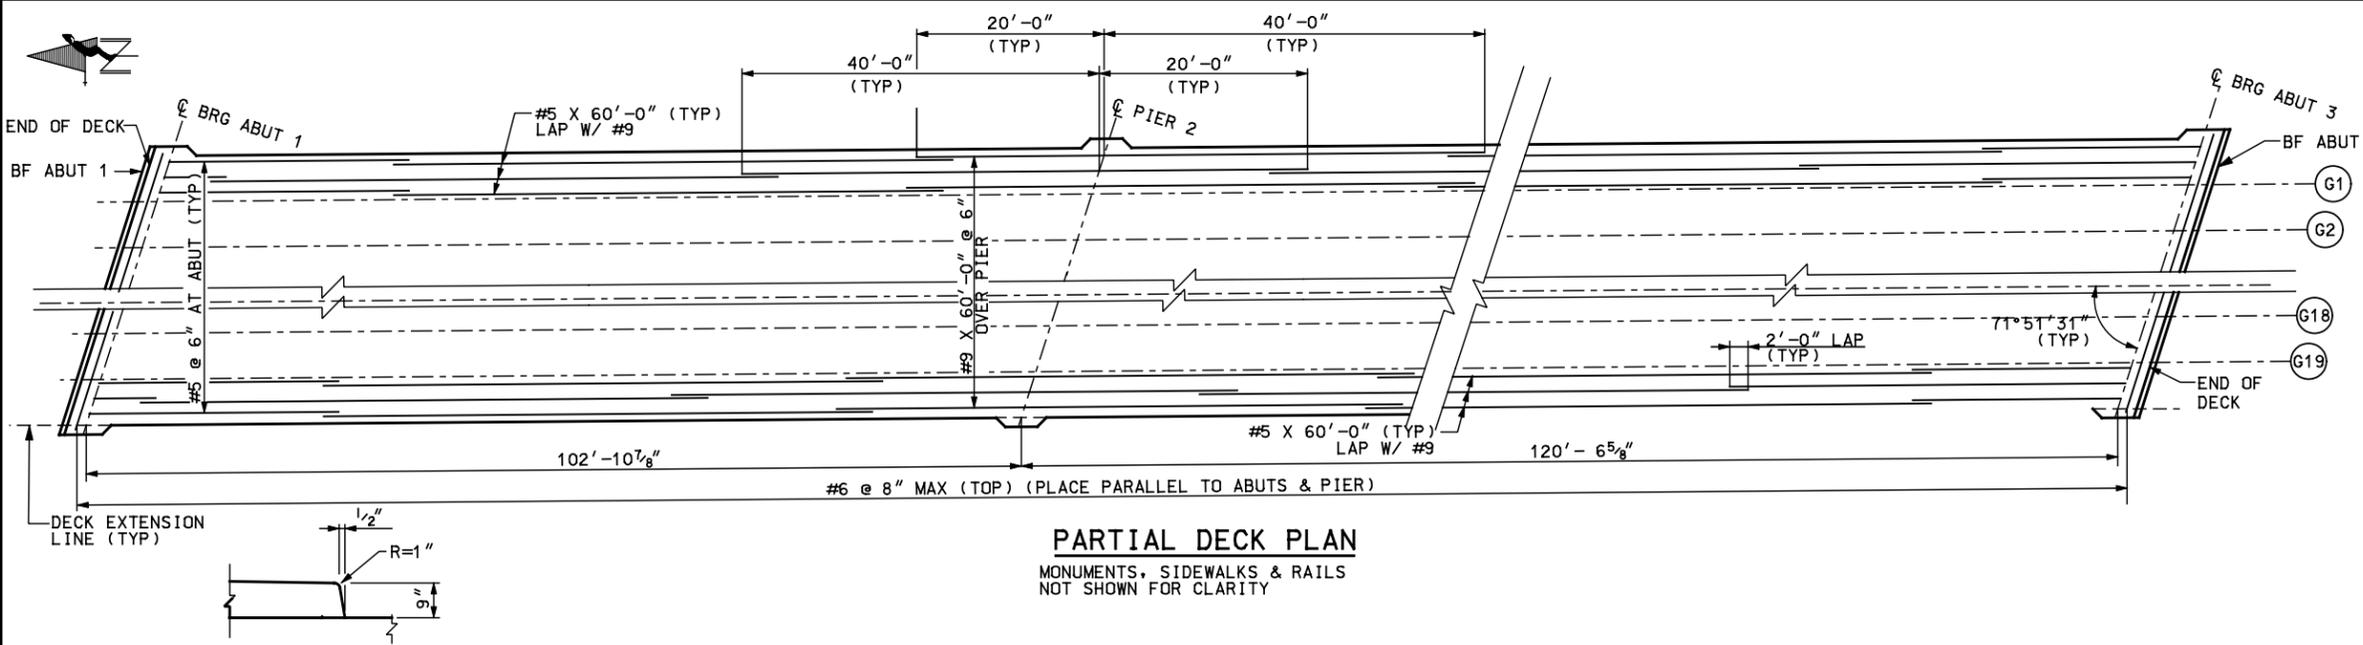

- NOTES:**
- ALL REINFORCING SHALL BE EPOXY COATED.
 - 3/4" THREADED INSERTS WILL BE REQUIRED ON WEST SIDE OF BRIDGE DURING PHASING. INSERTS SHALL BE PLACED IN DECK FOR MEDIAN. 3/4" THREADED RODS SHALL BE ASTM A36 OR ASTM A193 GRADE B-7 STEEL. ALTERNATE: CONTRACTOR MAY DRILL AND EPOXY GROUT MEDIAN REINFORCING USING HILTI HSE 2421 OR APPROVED EQUAL. CONTRACTOR SHALL ENSURE THAT DRILL HOLES ARE SPACED BETWEEN DECK REINFORCING.
 - FOR DECK REINFORCING AT MONUMENT OVERHANGS, SEE MONUMENT DETAILS SHEET.
 - AT THE PHASING CONSTRUCTION JOINT THE CONTRACTOR SHALL MECHANICALLY SPLICE BARS. MECHANICAL SPLICES SHALL BE BARSPLICE PRODUCTS, INC. BAR-GRIP SYSTEMS OR APPROVED EQUAL. USING A NON-STAGGERED LAP LENGTH OF 2'-10" IS ACCEPTABLE.
 - CONSTRUCTION JOINT BETWEEN PHASES MAY BE MOVED 6" EAST TO ACCOMMODATE REBAR TIES AT G12.
 - CONTRACTOR HAS OPTION TO DRILL AND BOND #4 Z BARS INTO DECK. USE EQUIVALENT "L" BARS THAT MATCH THE PROJECTION OF THE "Z".

DETAIL 1

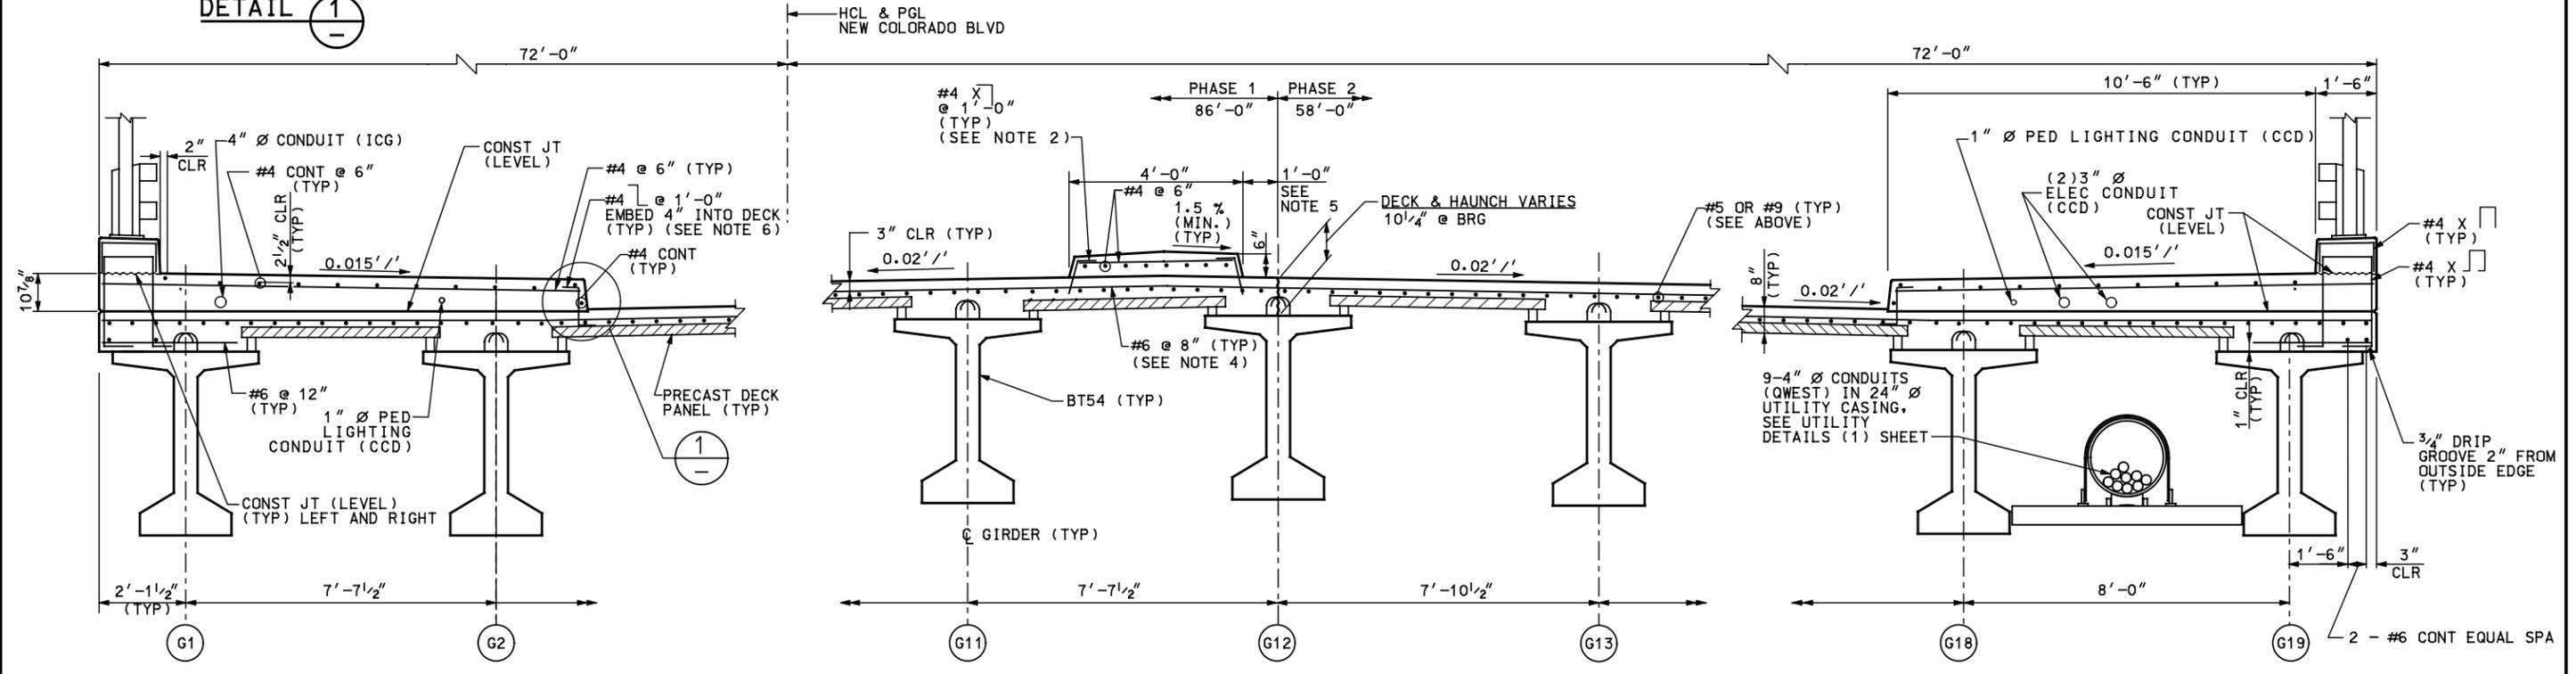


ISSUE RECORD		
NO.	DESCRIPTION	DATE
A	IN-PROCESS DESIGN SUBMITTAL	03JUL03
B	FINAL DESIGN SUBMITTAL	14AUG03
1	APPROVED FOR CONSTRUCTION	03SEP03
2	AFC - FDC S953 (LABEL UTILITY OWNER)	06FEB04
AB	AS-BUILT	16FEB07




SOUTHEAST CORRIDOR MULTI-MODAL PROJECT		PROJECT NO./CODE
AREA 1.3		NH 0252-299
COLORADO BLVD OVER I-25		11584
BRIDGE DECK TYPICAL SECTION		FILE NAME 13STDT0223
STRUCTURE NO	F-17-OC	DRAWING NUMBER B523
SECC STRUCTURE NO	87	

AS-BUILT


File Name: C:\PWORKING\MS07719\13STDT0224.DGN
 User: PAUL_NIKOLAI
 Date Plotted: 03/15/2007
 Time Plotted: 09:55:11 AM
 Pen Table: S:\MICROSTATION\PLOTTABLES\T-REX-GRAY.TBL

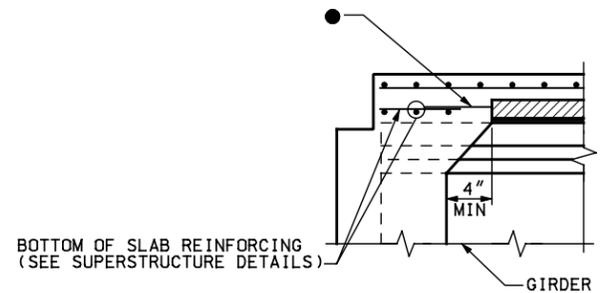


SECTION AT ABUTMENT

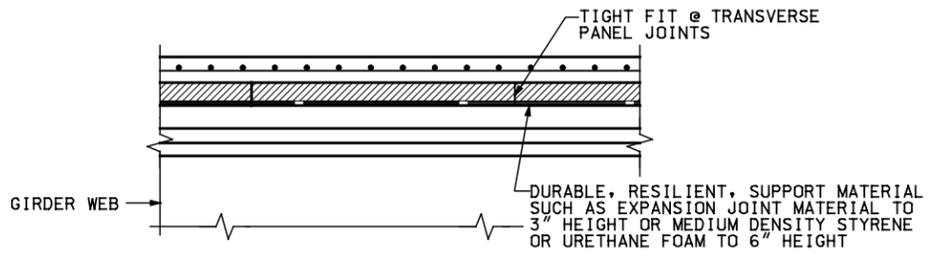


SECTION THRU TRANSVERSE PANEL JOINTS

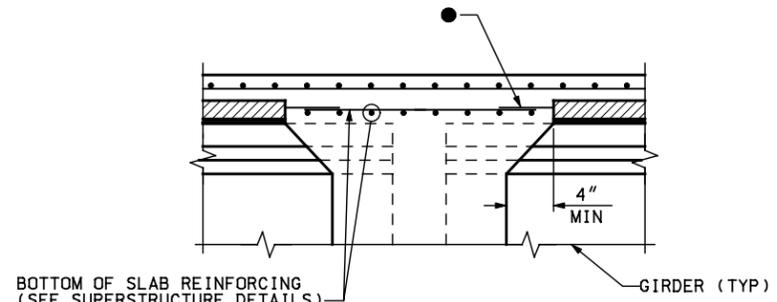


SECTION AT PIER

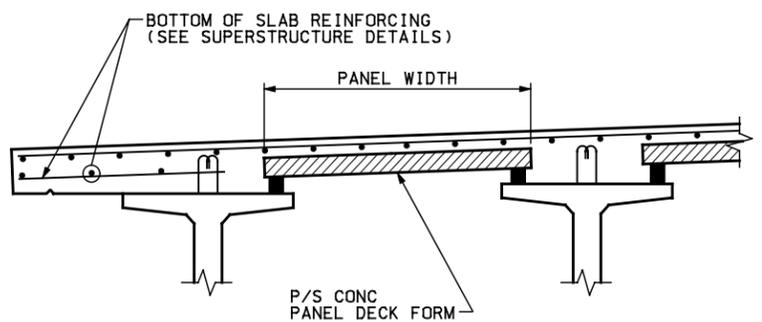

SECTION

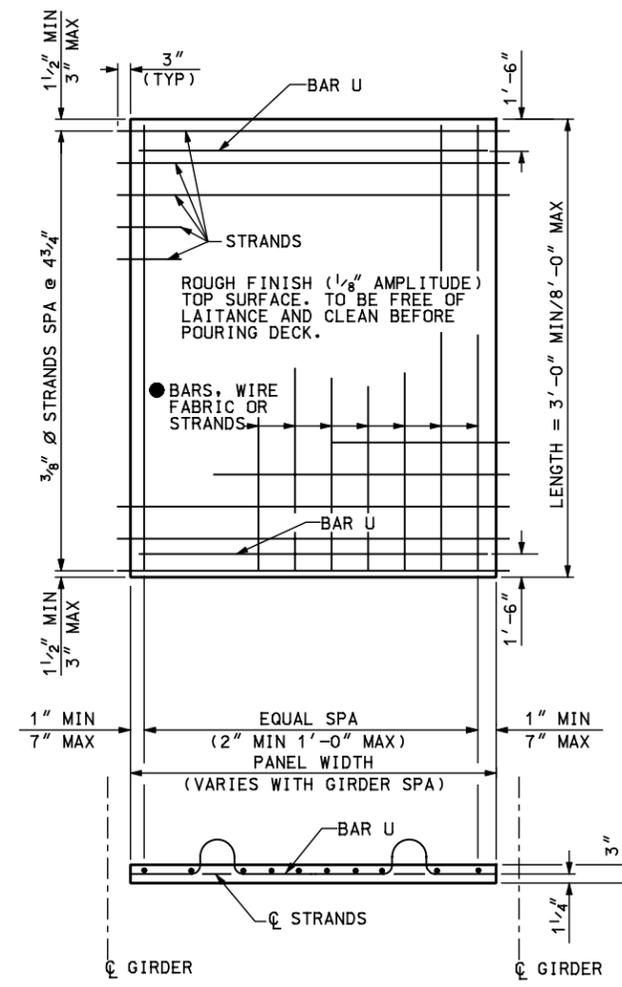

PRESTRESSED PANEL DETAILS

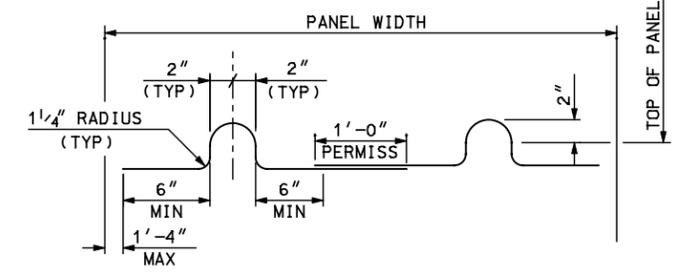

**BAR U (#3)
PRESTRESSED PANEL DETAILS**

NOTES:

- SAWING OF PANELS IS ACCEPTABLE IN AREAS WHERE PROJECTING REINFORCEMENT IS NOT REQUIRED. IT IS DESIRABLE TO HAVE THE PRESTRESSING STRANDS PROJECT FROM THE PANELS AS LONG AS THE PROJECTING STRANDS DO NOT INTERFERE WITH OTHER BRIDGE COMPONENTS.
- REINFORCING PERPENDICULAR TO STRANDS MAY BE DEFORMED REINF. BARS, WELDED WIRE FABRIC, OR WELDED DEFORMED BAR MATS, AND SHALL BE PLACED DIRECTLY ABOVE THE STRANDS. MINIMUM AREA OF REINFORCING PERPENDICULAR TO STRANDS SHALL BE 0.11 SQ IN PER FT TENSIONED OR UNTENSIONED STRANDS MAY ALSO BE USED. THESE INDIVIDUAL BARS OR WIRES SHALL BE NO LARGER THAN 0.375" DIAMETER. FOR LOCATION OF LONGITUDINAL BAR EXTENSIONS, SEE PRECAST PANEL DECK FORM (2) SHEET.
- THE LONGITUDINAL REINFORCING STEEL IN THE CAST-IN-PLACE PORTION OF THE DECK MAY REST DIRECTLY ON THE PANELS AS NECESSARY TO OBTAIN CLEARANCES AT THE TOP OF DECK, UNLESS OTHERWISE NOTED.
- THE TOLERANCE ON STRAND PLACEMENT SHALL NOT EXCEED $\pm 1/4$ ". THE TOLERANCE ON PANEL THICKNESS SHALL NOT EXCEED $\pm 1/4$ ".
- CONCENTRATED CONSTRUCTION LOADS SHALL NOT EXCEED 500 LB UNLESS THE LOAD IS DISTRIBUTED TO LESS THAN 117 PSF. TOTAL LOADS APPLIED TO ANY PANEL DURING CONSTRUCTION SHALL NOT EXCEED 117 PSF.
- BOTTOM FLEXURAL CRACKS GREATER THAN 0.010", OR CAMBERS & SAGS GREATER THAN 0.5" WILL BE CONSIDERED EVIDENCE OF MISHANDLING, OVERLOADING, OR EXCEEDING ALLOWABLE TOLERANCES, AND MAY BE CAUSE FOR REJECTING PANELS AT THE ENGINEER'S DISCRETION.

DESIGNED BY: BO	NO.	DESCRIPTION	DATE
DRAFTED BY: RB	A	IN-PROCESS DESIGN SUBMITTAL	03JUL03
CHECKED BY: JB	B	FINAL DESIGN SUBMITTAL	14AUG03
	1	APPROVED FOR CONSTRUCTION	03SEP03
	AB	AS-BUILT	16FEB07

ISSUE RECORD			
NO.	DESCRIPTION	DATE	
A	IN-PROCESS DESIGN SUBMITTAL	03JUL03	
B	FINAL DESIGN SUBMITTAL	14AUG03	
1	APPROVED FOR CONSTRUCTION	03SEP03	
AB	AS-BUILT	16FEB07	

TRC
METRO DENVER / COLORADO

Southeast Corridor Constructors
7200 South Alton Way
Englewood, CO 80112

SOUTHEAST CORRIDOR CONSTRUCTORS

SOUTHEAST CORRIDOR MULTI-MODAL PROJECT
AREA 1.3
COLORADO BLVD OVER I-25
PRECAST PANEL DECK FORM (1)


STRUCTURE NO F-17-OC SECC STRUCTURE NO 87

PROJECT NO./CODE NH 0252-299 11584
FILE NAME 13STDT0224
DRAWING NUMBER B524

AS-BUILT

NOTES:

1. COMPOSITE TOTAL SLAB DESIGNED FOR HS 25-44 AND ALTERNATE MILITARY LOADING.
2. ALL CONCRETE SHALL BE CLASS S WITH RELEASE STRENGTH $f'_{ci} = 4500$ PSI AND MINIMUM 28 DAY STRENGTH $f'_c = 6000$ PSI. THE STRENGTH SHALL BE AT LEAST 5000 PSI AT THE TIME OF THE DECK POUR.
3. USE $\frac{3}{8}$ " \varnothing LOW RELAXATION STRANDS MEETING THE REQUIREMENTS OF ASTM A-416 GRADE 270. JACKING FORCE PER STRAND (F_J) SHALL BE AT LEAST 17.2 KIPS. FINAL FORCE PER STRAND (F_F) IS ESTIMATED TO BE 14.2 KIPS.
4. INSTALLATION OF BAR U (#3) IS MANDATORY. ALL FOUR BAR U (#3) LOOPS SHALL BE USED SIMULTANEOUSLY FOR LIFTING THE PANELS. ALTERNATE METHODS MAY BE USED, FOR LIFTING, PROVIDED THEY ARE SHOWN ON THE SHOP PLANS AND APPROVED BY THE ENGINEER.
5. CARE MUST BE TAKEN TO ENSURE PROPER CLEANING OF CONSTRUCTION DEBRIS AND CONSOLIDATION OF CONCRETE MORTAR UNDER THE EDGES OF THE PANELS. IT IS ALSO IMPORTANT THAT ADEQUATE SPACE (Δ MIN 1" X 2") IS PROVIDED FOR THE CONCRETE TO FILL THE SPACE UNDER THE PANEL AS THE SLAB CONCRETE IS PLACED. PANEL LENGTHS AND WIDTH SHALL BE DETERMINED BY THE CONTRACTOR AND SHOWN ON THE SHOP PLANS.
6. THE CONTRACTOR IS RESPONSIBLE FOR THE STABILITY OF THE PANELS ON THE GIRDERS. ERECTED PANELS SHALL BE UNIFORMLY SUPPORTED ALONG THE LENGTH OF THE PANEL. THE CONTRACTOR IS RESPONSIBLE FOR MEETING THE TOTAL SLAB THICKNESS SHOWN ON THE SUPERSTRUCTURE DETAILS.
7. ALL PLANES OF REINFORCING STEEL SHOWN IN THE SUPERSTRUCTURE DETAILS ARE REQUIRED FOR AREAS NOT FORMED WITH PRECAST PANELS.

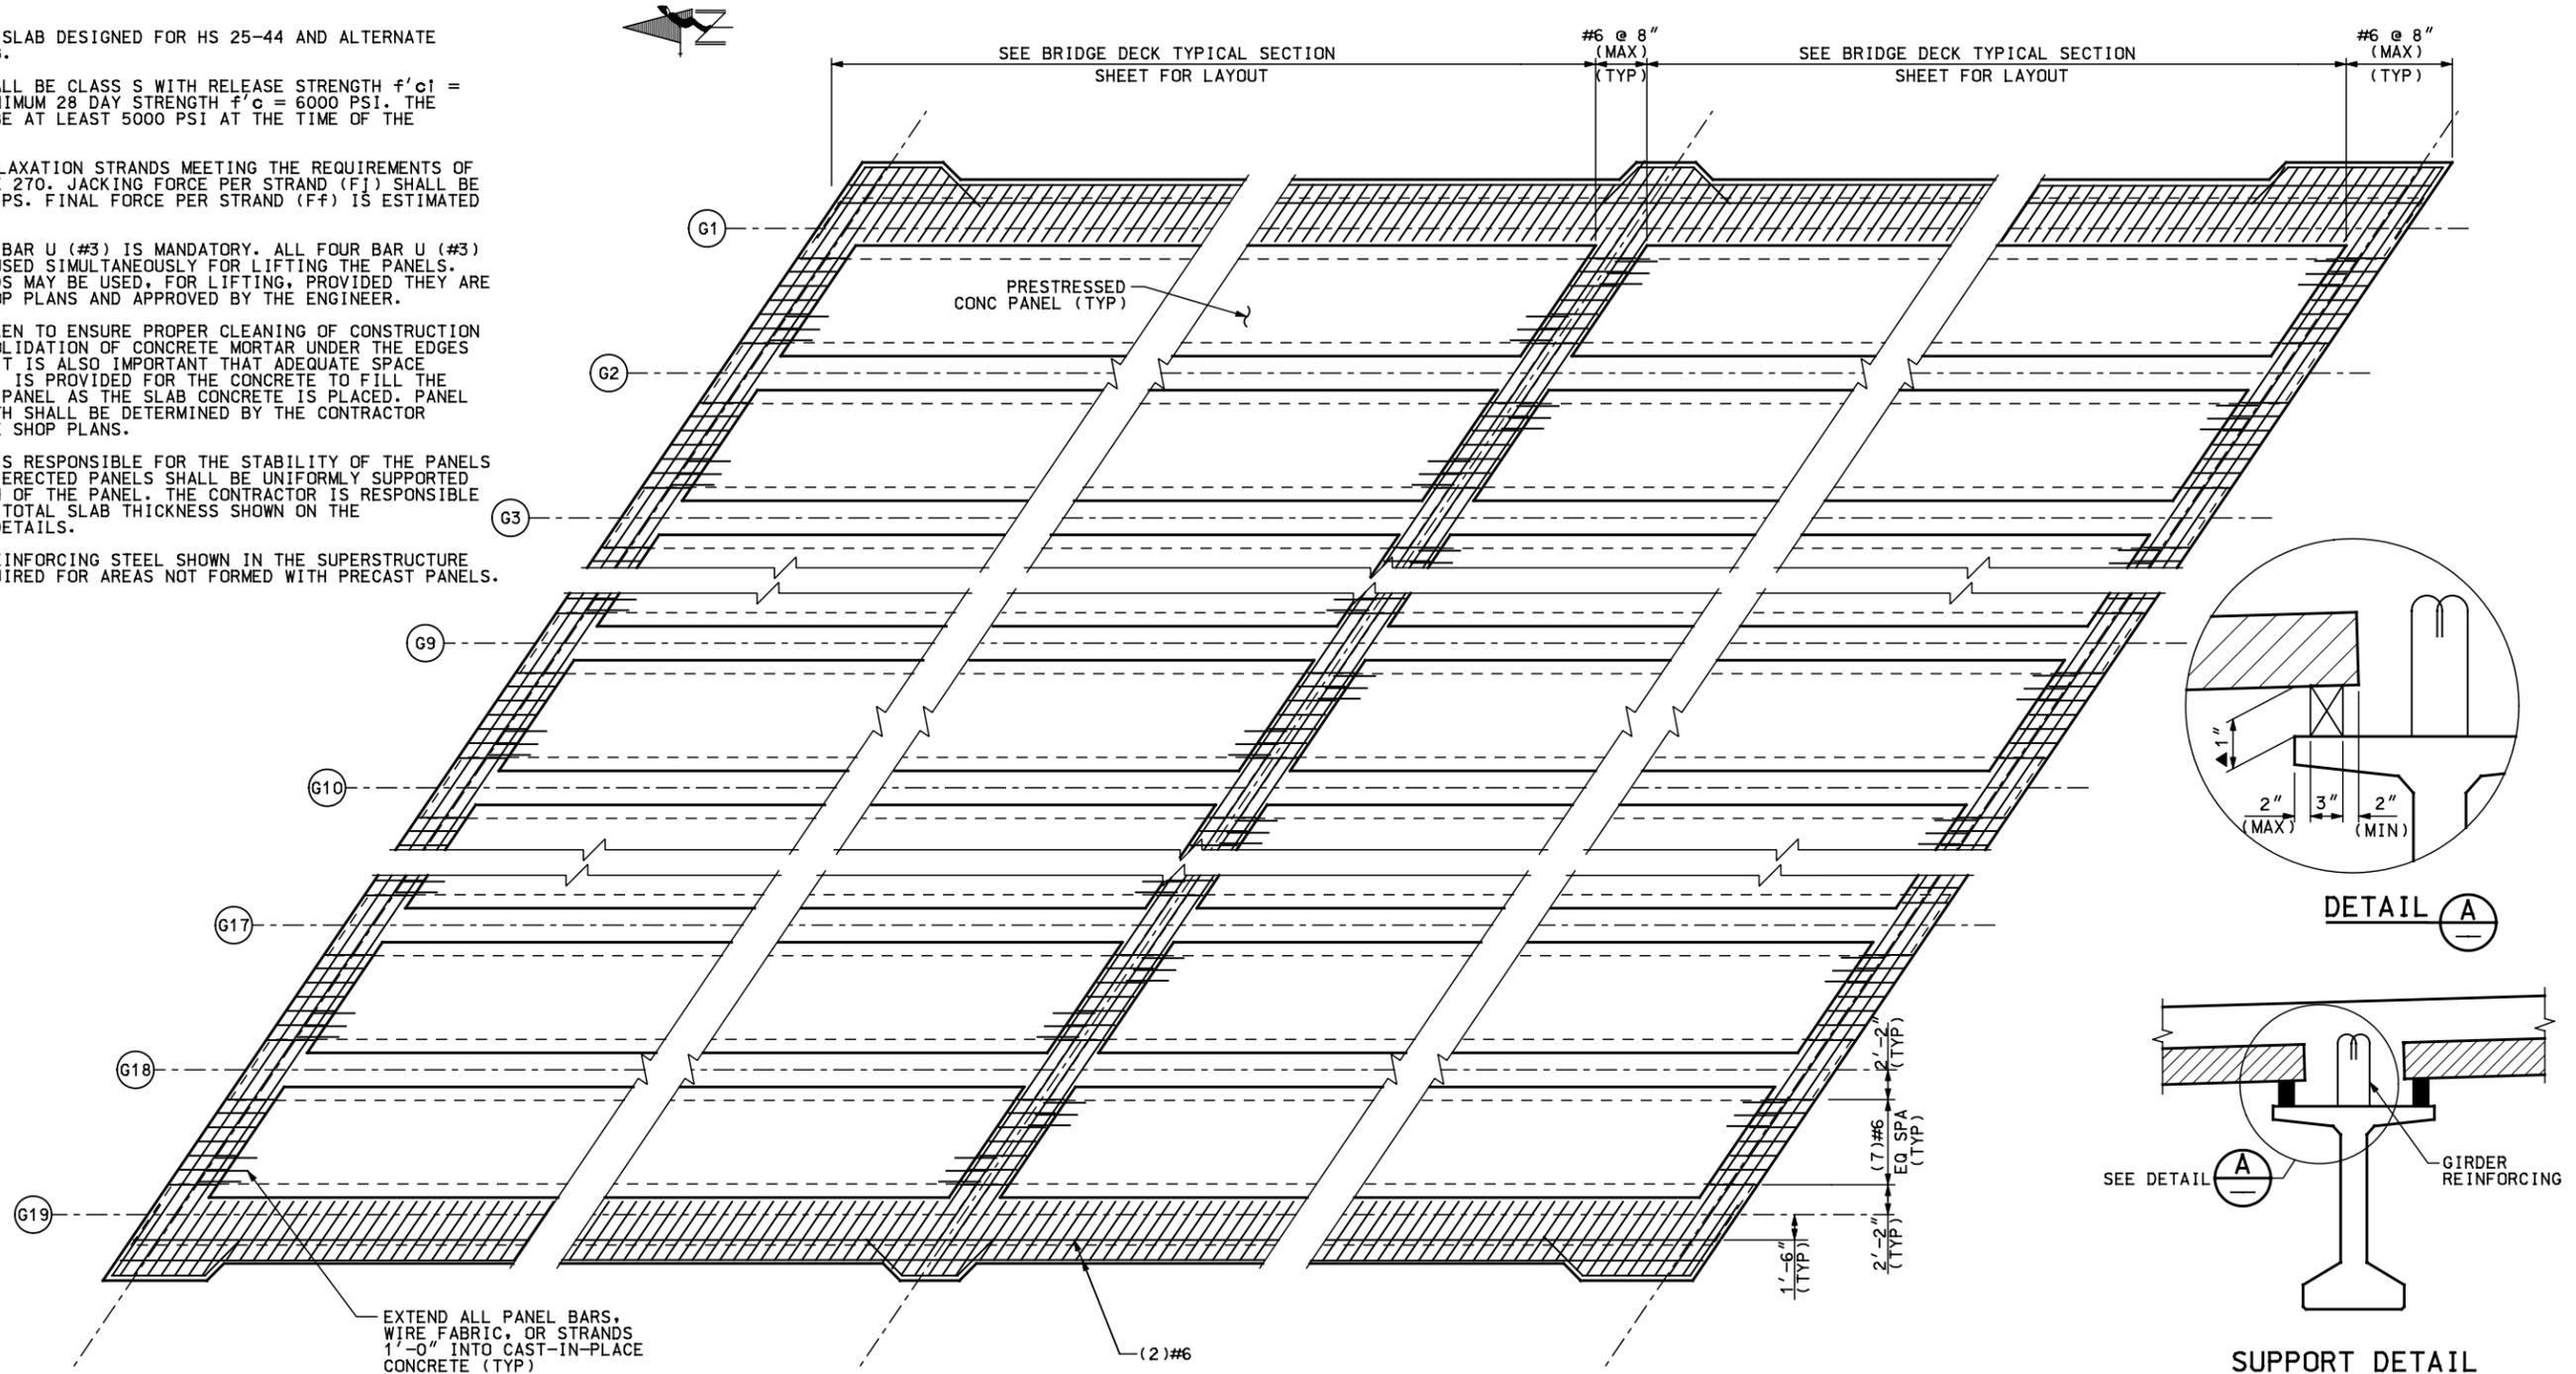

PART PLAN AND BOTTOM SLAB REINFORCING

TOP REINFORCING NOT SHOWN FOR CLARITY.
SEE BRIDGE DECK TYPICAL SECTION SHEET FOR LAYOUT

File Name: C:\PWORKING\DMS07719\13STDT0225.DGN
User: PAUL_NIKOLAI
Date Plotted: 03/15/2007
Time Plotted: 09:55:16 AM
Pen Table: S:\MICROSTATION\PLOTTING\TABLES\T-REX-GRAY.TBL

ISSUE RECORD		
NO.	DESCRIPTION	DATE
A	IN-PROCESS DESIGN SUBMITTAL	03JUL03
B	FINAL DESIGN SUBMITTAL	14AUG03
1	APPROVED FOR CONSTRUCTION	03SEP03
AB	AS-BUILT	16FEB07


SOUTHEAST CORRIDOR MULTI-MODAL PROJECT
AREA 1.3
COLORADO BLVD OVER I-25
PRECAST PANEL DECK FORM (2)

STRUCTURE NO F-17-OC SECC STRUCTURE NO 87


PROJECT NO./CODE	NH 0252-299 11584
FILE NAME	13STDT0225
DRAWING NUMBER	B525

AS-BUILT


File Name: C:\PWORKING\DMS07719\13STD0234.DGN
 User: PAUL_NIKOLAI
 Date Plotted: 03/15/2007
 Time Plotted: 09:56:13 AM
 Pen Table: S:\MICROSTATION\PLOTTING\TABLES\T-REX-GRAY.TBL

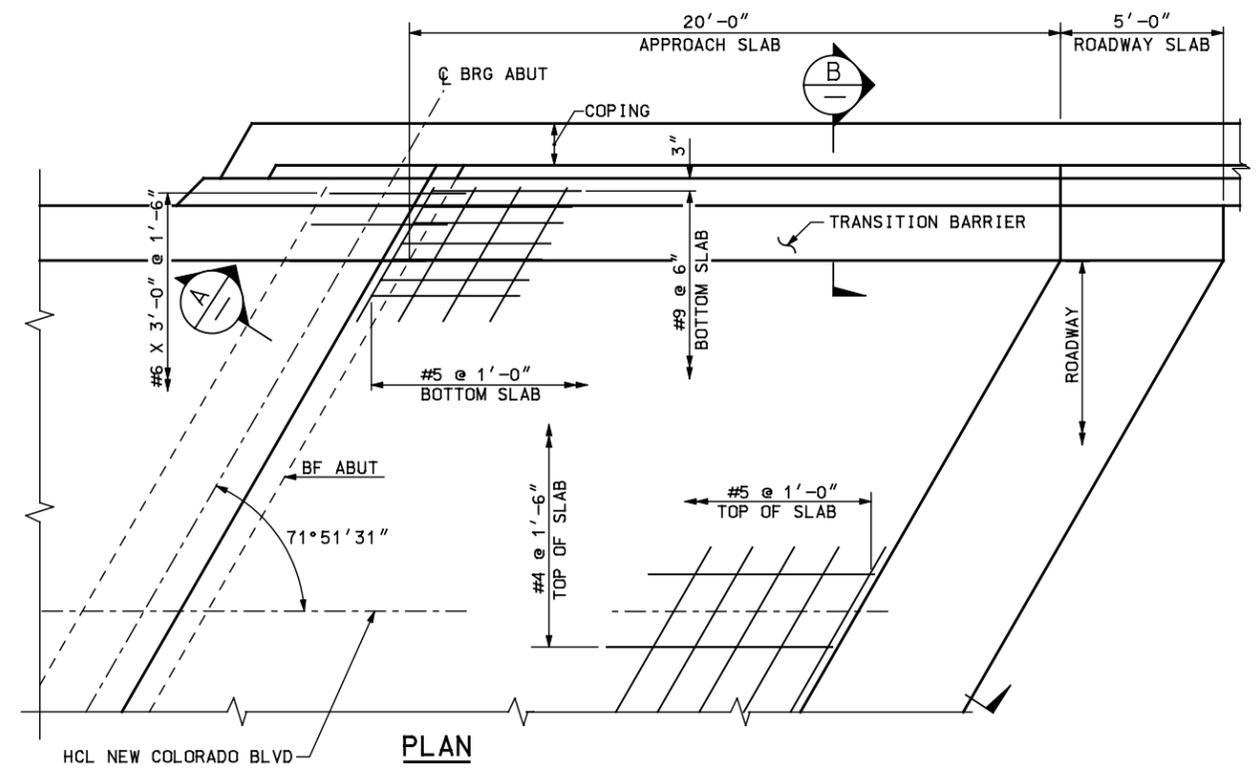


PLAN

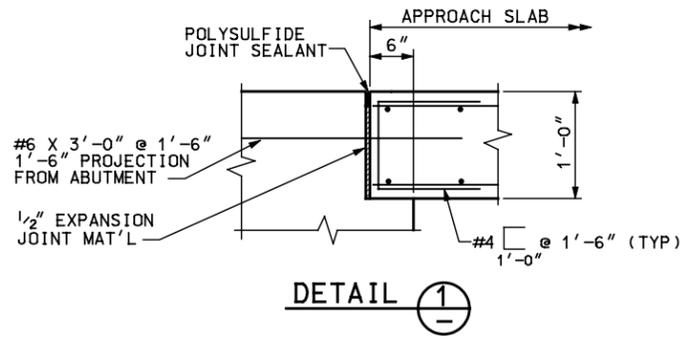


DETAIL 1

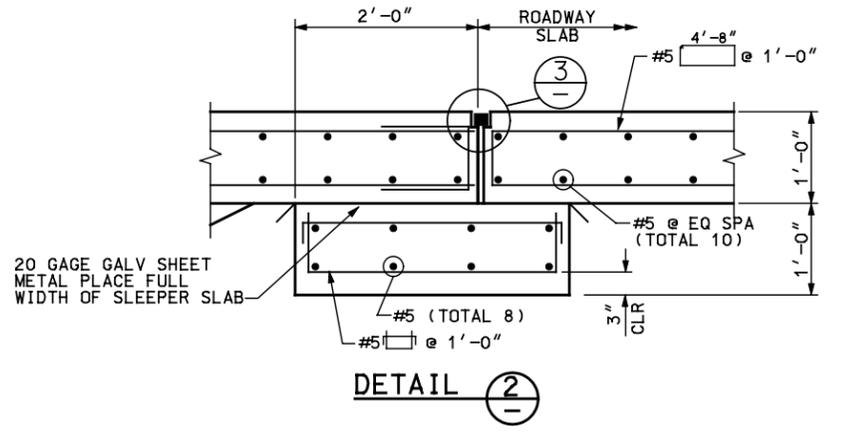


DETAIL 2

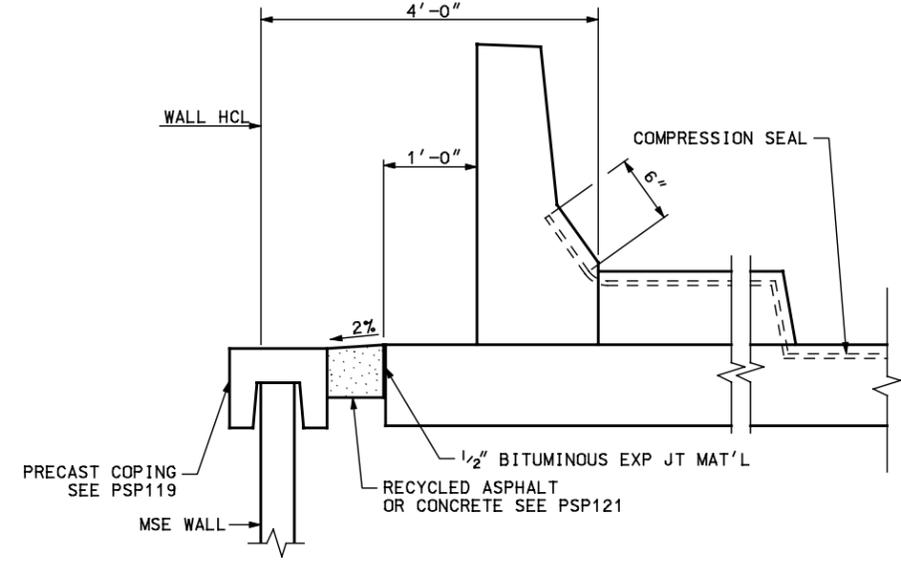

SECTION B

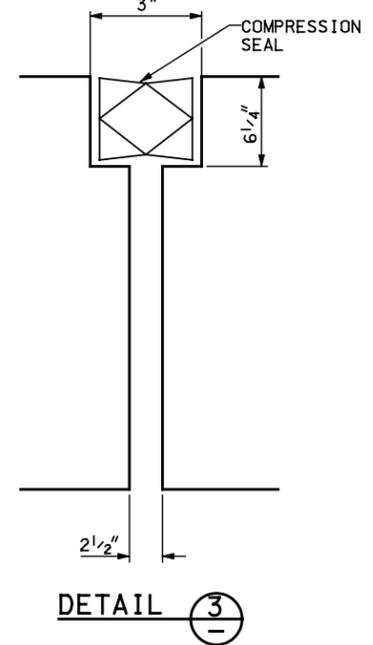

DETAIL 3

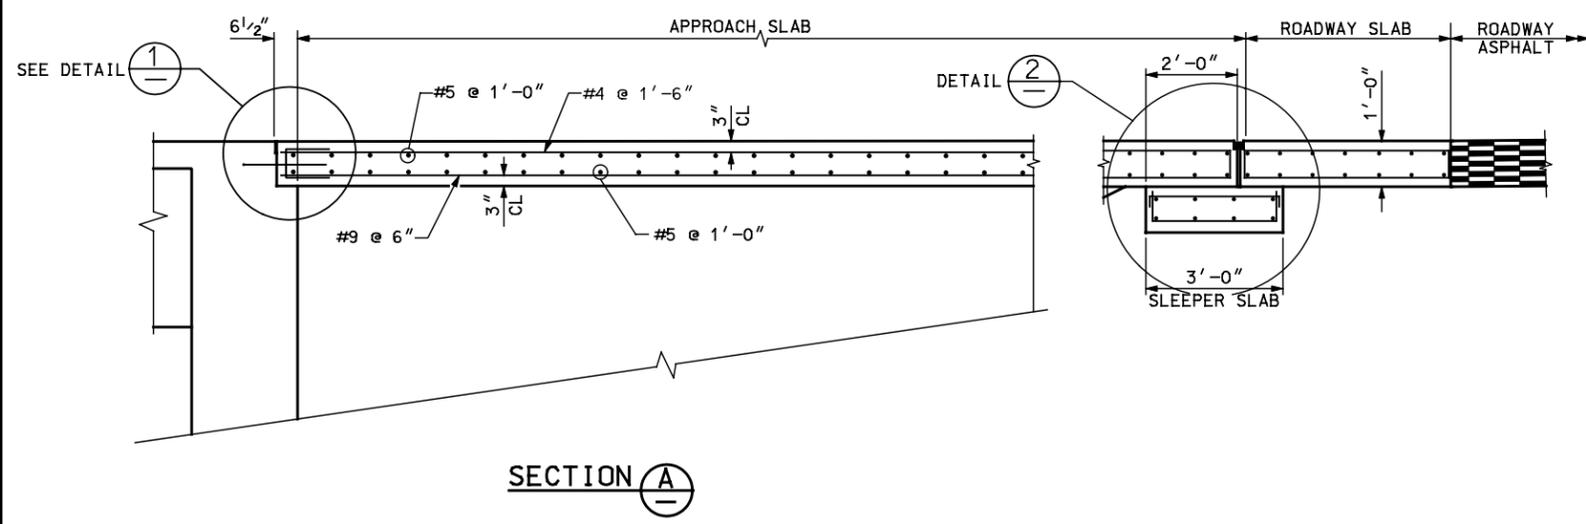

SECTION A

- NOTES:**
1. CONCRETE CLASS D (BRIDGE) SHALL BE USED FOR APPROACH SLABS.
 2. FOR RAIL DETAILS SEE BRIDGE RAIL TYPE 7 SHEET.
 3. DO NOT INSTALL JOINT SEALANT ABOVE 80°F OR BELOW 35°F.
 4. COMPRESSION SEAL TO BE D. S. BROWN CV-4500 OR APPROVED EQUAL.
 5. MECHANICAL SPLICES SHALL BE USED FOR #5 REBAR IN APPROACH SLAB AND ROADWAY SLAB IF 2'-0" LAP SPLICE CANNOT BE ACHIEVED. MECHANICAL SPLICES SHALL BE BARSPLICE PRODUCTS, INC. BAR-GRIP SYSTEMS OR APPROVED EQUAL.
 6. SEE BRIDGE EXPANSION DEVICE (BRIDGE RAIL & SIDEWALK) SHEET FOR COVER PLATE DETAILS.

DESIGNED BY: BO
DRAFTED BY: RB
CHECKED BY: JB

ISSUE RECORD		
NO.	DESCRIPTION	DATE
A	IN-PROCESS DESIGN SUBMITTAL	03JUL03
B	FINAL DESIGN SUBMITTAL	14AUG03
1	APPROVED FOR CONSTRUCTION	03SEP03
2	AFC - FDC S1388 - ADD EXPANSION PLATES	26JUL04
AB	AS-BUILT	16FEB07




SOUTHEAST CORRIDOR MULTI-MODAL PROJECT
 AREA 1.3
 COLORADO BLVD OVER I-25
 APPROACH SLAB DETAILS
 STRUCTURE NO F-17-0C SECC STRUCTURE NO 87


PROJECT NO./CODE	NH 0252-299 11584
FILE NAME	13STD0234
DRAWING NUMBER	B526

AS-BUILT


File Name: C:\PWORKING\DM507719\13STDT0244.DGN
 User: PAUL_NIKOLAI
 Date Plotted: 03/15/2007
 Time Plotted: 09:56:46 AM
 Pen Table: S:\MICROSTATION\PLOT\ING\PENTABLES\T-REX-GRAY.TBL

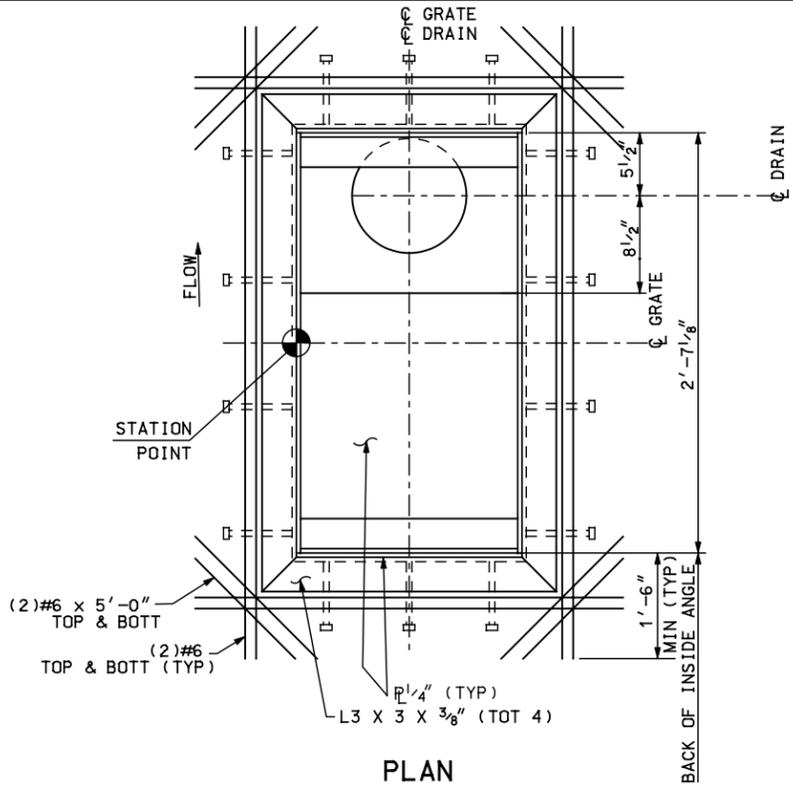


PLAN

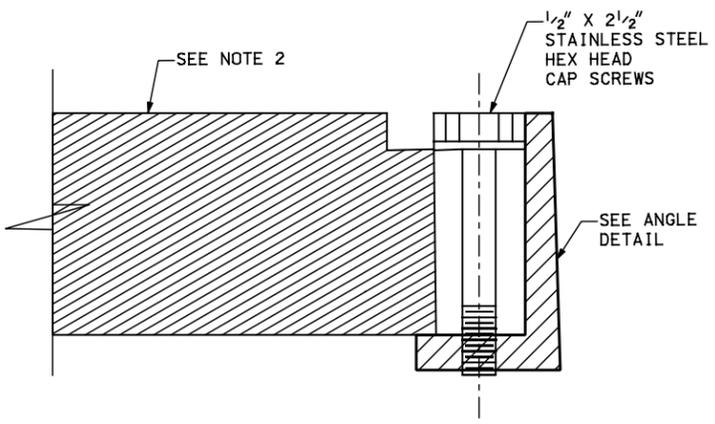


DETAIL 1

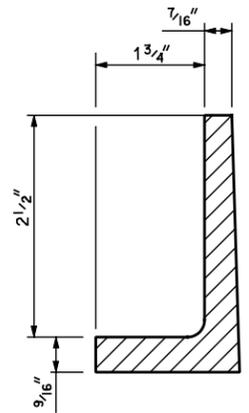

ANGLE DETAIL

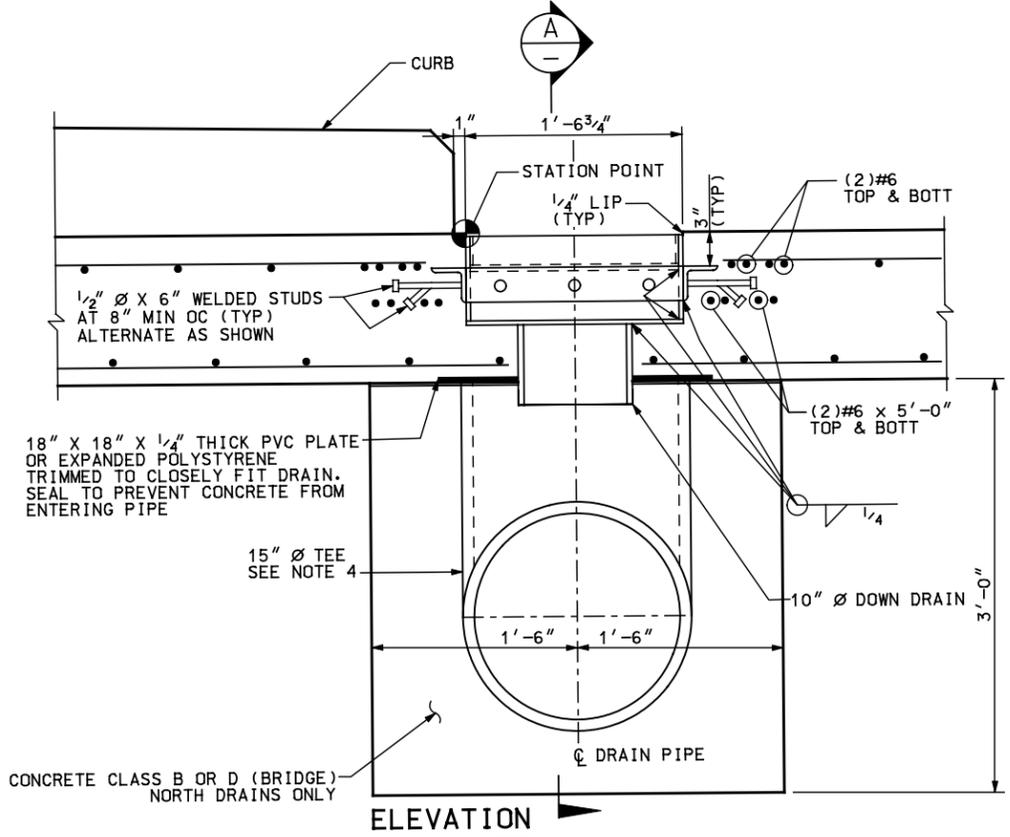

ELEVATION

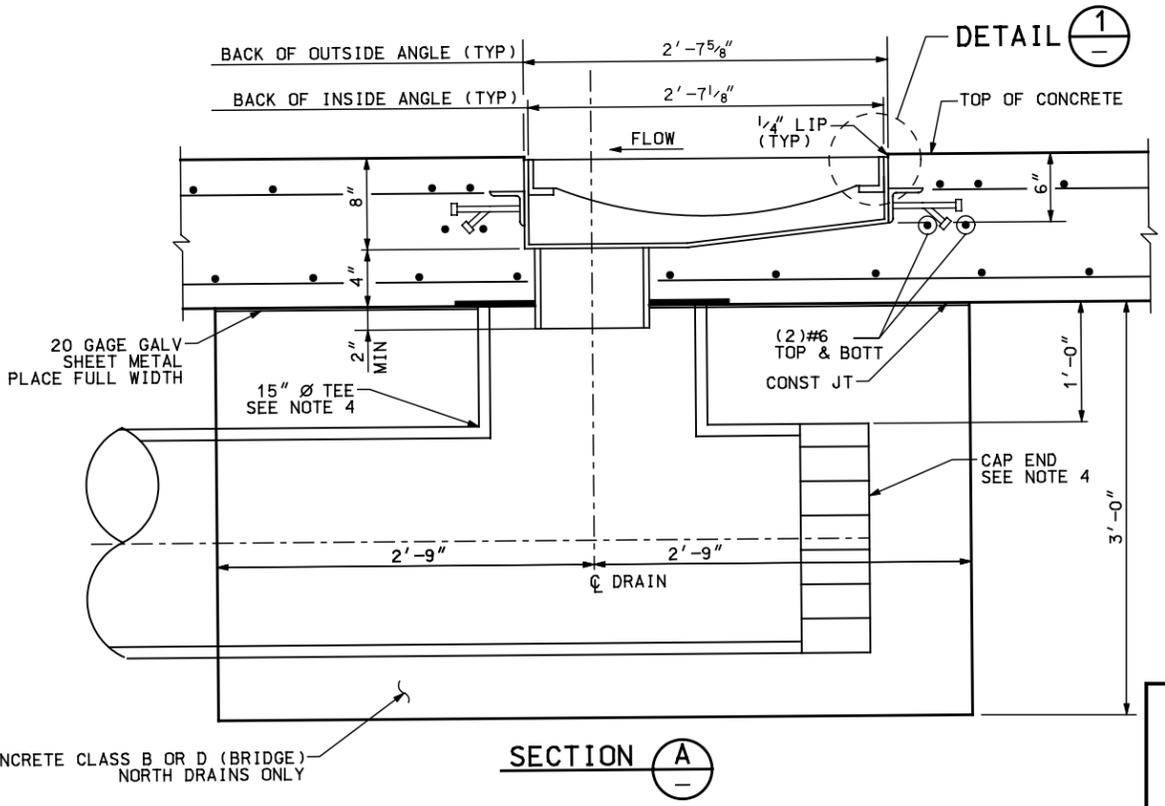

SECTION A

- NOTES:**
- FOR LOCATION OF APPROACH SLAB DRAINS, SEE CONSTRUCTION LAYOUT SHEET. FOR LOCATION OF OUTLET PIPE, SEE DRAINAGE PLANS.
 - SEE CDOT STANDARD M-604-25, SHEET 1 OF 5 FOR VANE GRATE DETAILS.
 - ORIENT 15" Ø PIPE AS SHOWN ON DRAINAGE PLANS.
 - 15" Ø DRAIN AND TEE MAY BE REPLACED BY 12" Ø PVC DOWN DRAIN (NO TEE REQUIRED) AS SHOWN ON DRAINAGE PLANS.






ISSUE RECORD		
NO.	DESCRIPTION	DATE
1	FDC S1095 - REVISED DRAINS	29JAN04
AB	AS-BUILT	16FEB07



SOUTHEAST CORRIDOR MULTI-MODAL PROJECT AREA 1.3 COLORADO BLVD OVER I-25 APPROACH SLAB DRAIN DETAILS		PROJECT NO./CODE NH 0252-299 11584
STRUCTURE NO F-17-OC	SECC STRUCTURE NO 87	FILE NAME 13STDT0244
		DRAWING NUMBER B526A

AS-BUILT

File Name: C:\PWORKING\DMS07719\13STDT0245.DGN
 User: PAUL_NIKOLAI
 Date Plotted: 03/15/2007
 Time Plotted: 09:56:50 AM
 Pen Table: S:\MICROSTATION\PLOTTABLES\T-REX-GRAY.TBL

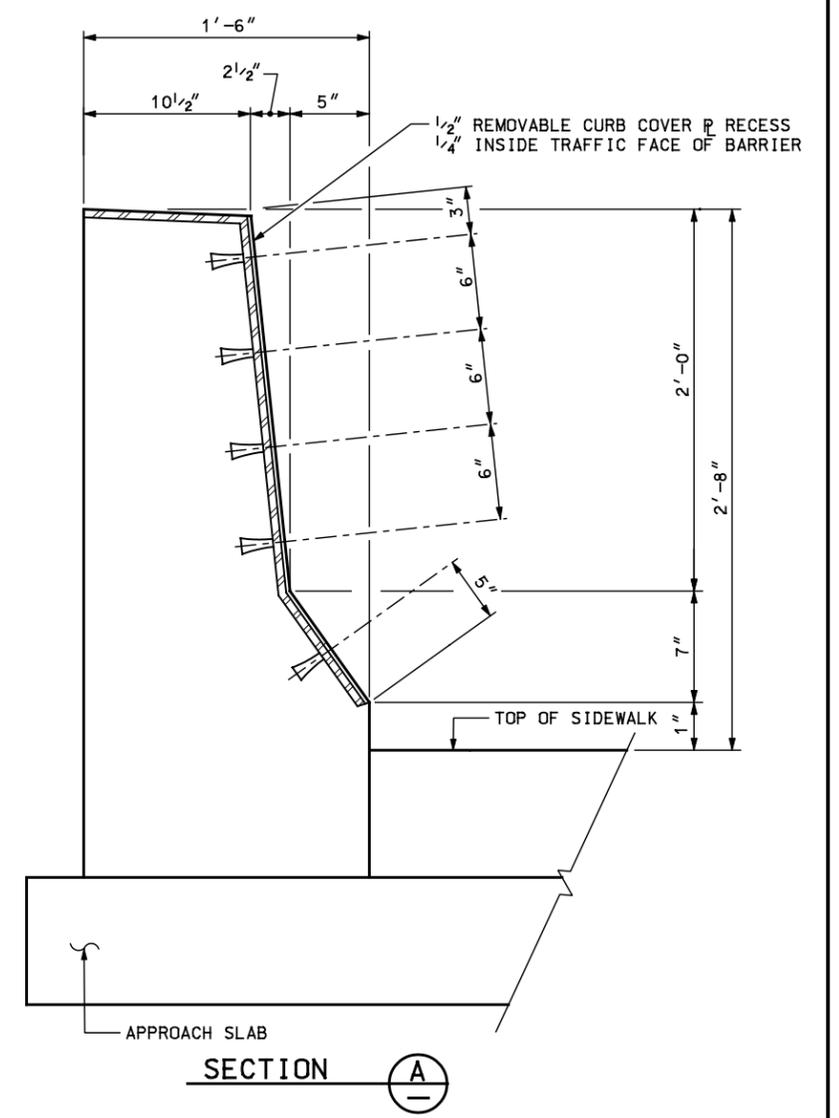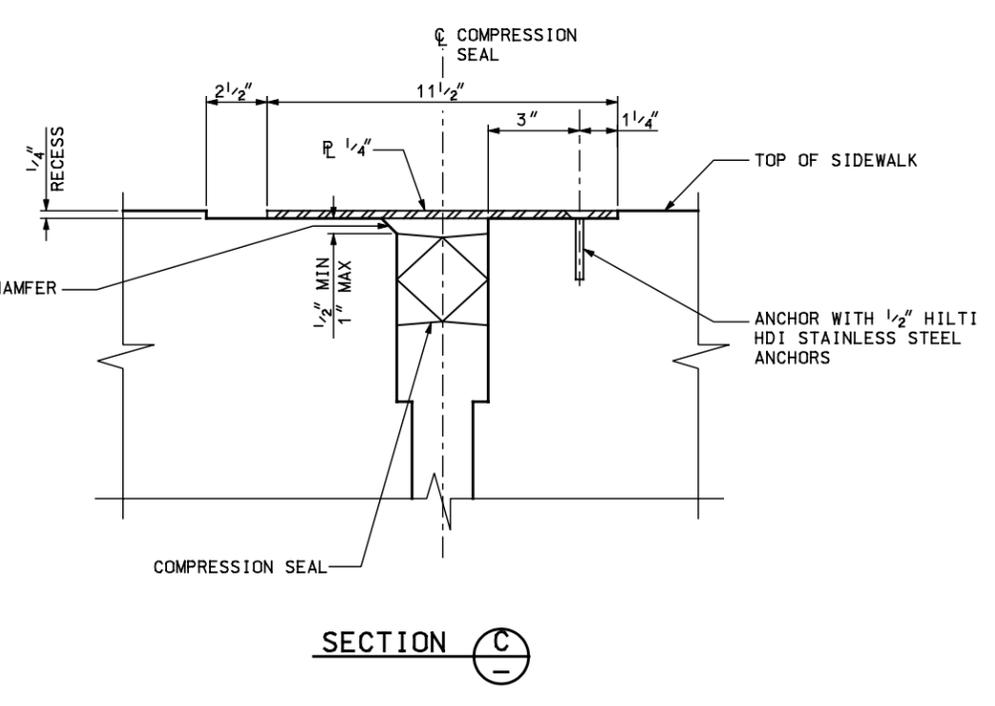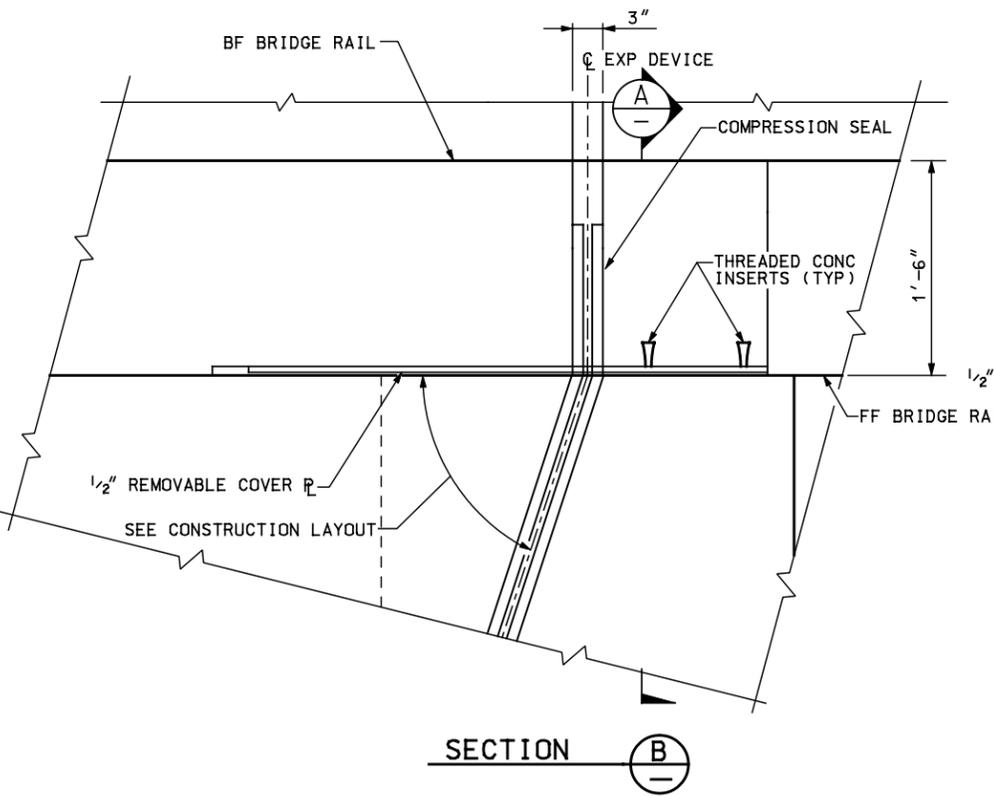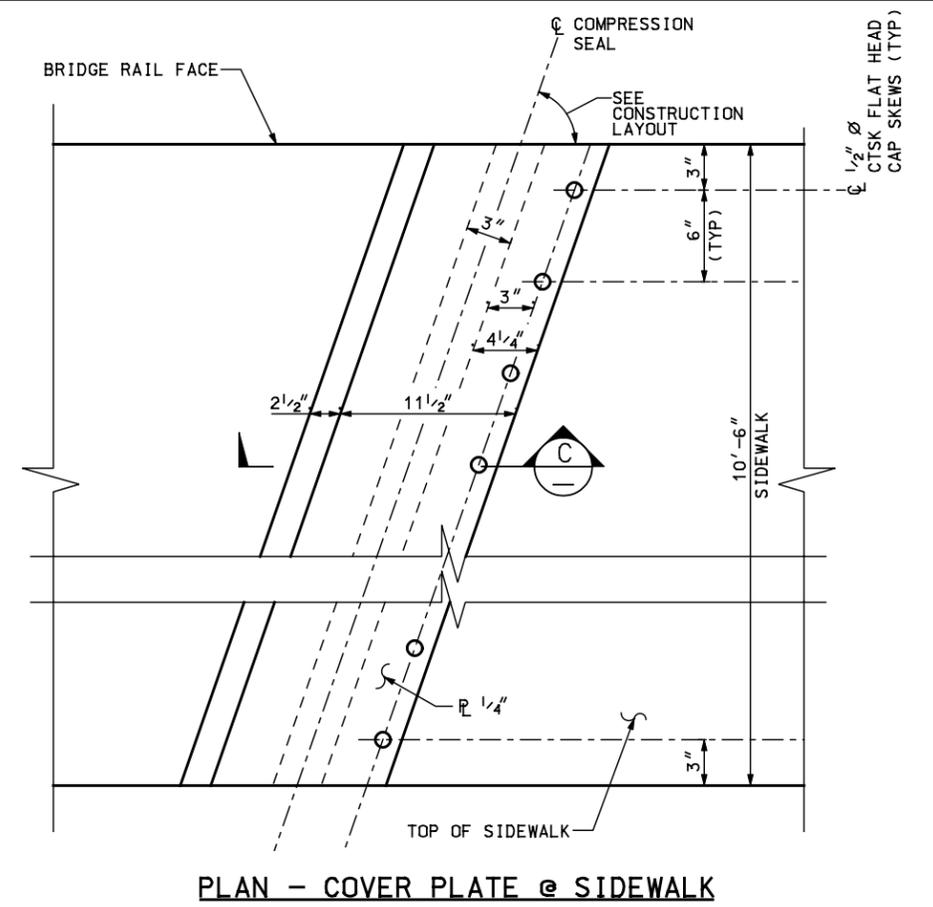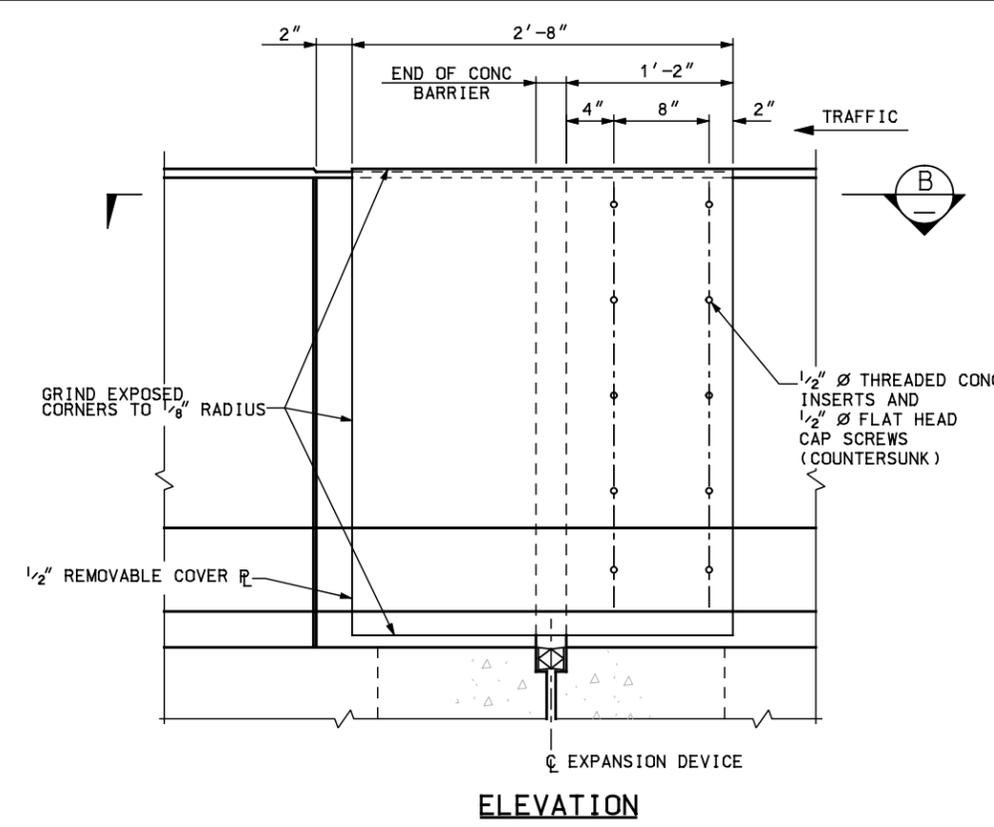

ISSUE RECORD			
DESIGNED BY:	NO.	DESCRIPTION	DATE
JER	1	AFC - FDC S1388 - ADD EXPANSION PLATES	26JUL04
DRAFTED BY:	AB	AS-BUILT	16FEB07
CHECKED BY:	BO		



SOUTHEAST CORRIDOR MULTI-MODAL PROJECT
 AREA 1.3
 COLORADO BLVD OVER I-25
 BRIDGE EXPANSION DEVICE (BRIDGE RAIL & SIDEWALK)

STRUCTURE NO F-17-OC SECC STRUCTURE NO 87

PROJECT NO./CODE	NH 0252-299 11584
FILE NAME	13STDT0245
DRAWING NUMBER	B528A

AS-BUILT