
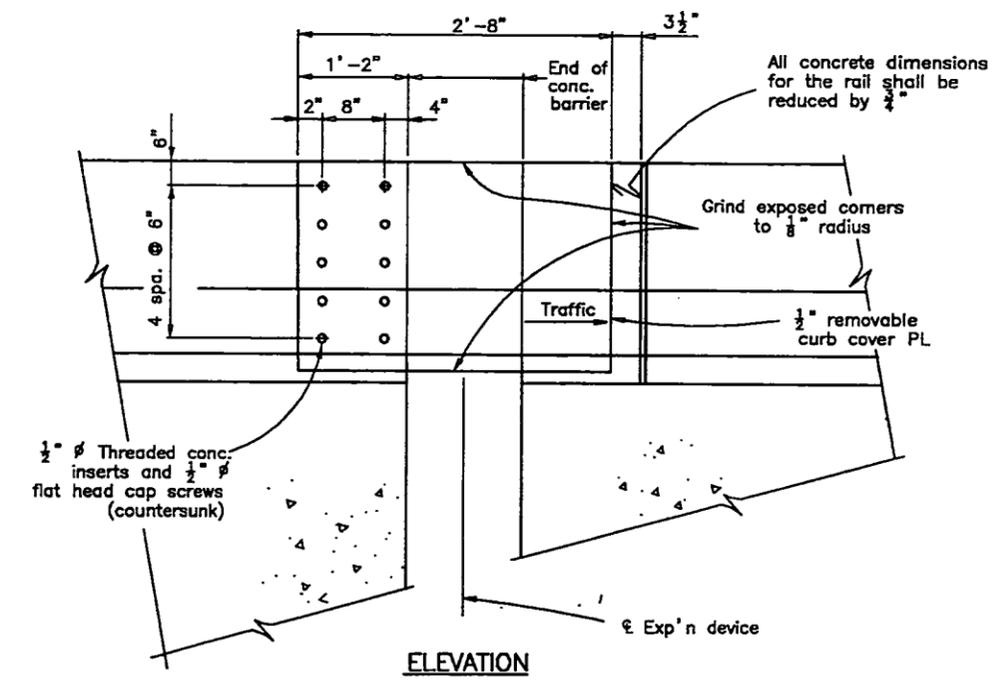
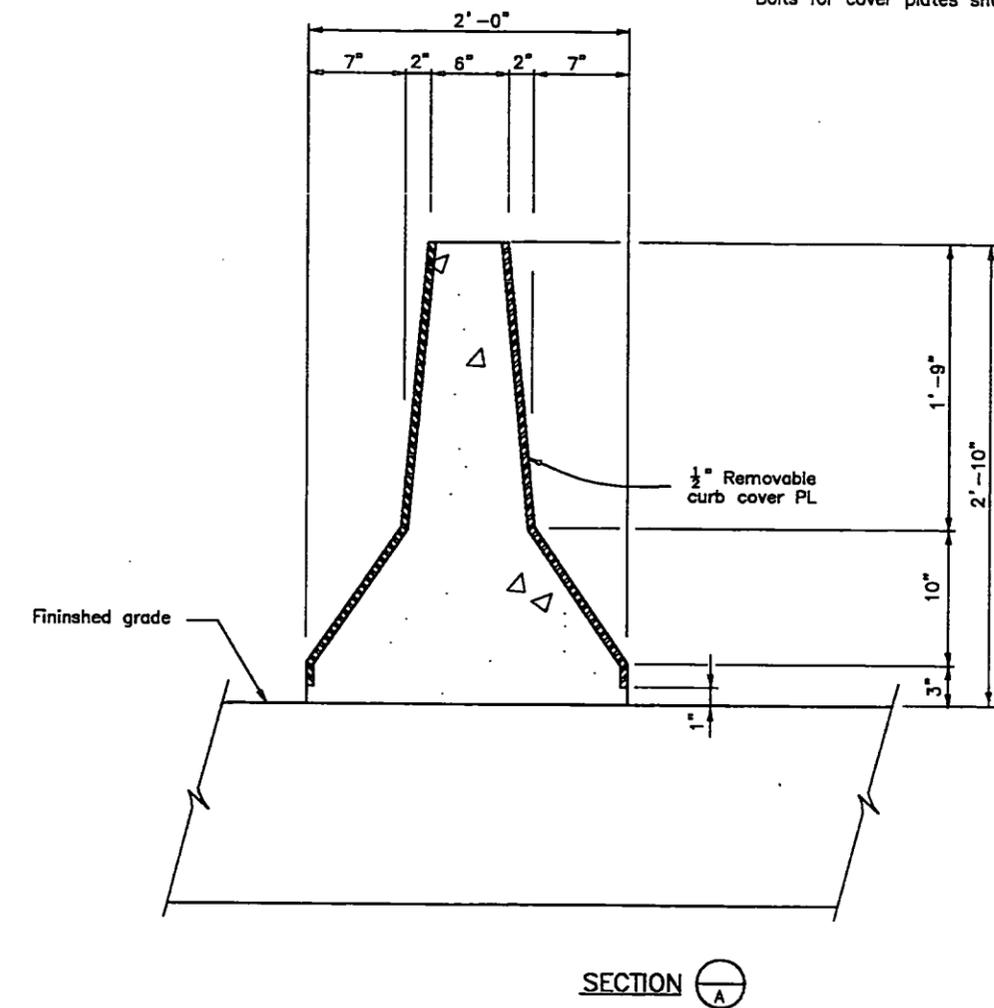


|                |         |      |                         |          |                |              |
|----------------|---------|------|-------------------------|----------|----------------|--------------|
| AS CONSTRUCTED |         |      | FEDERAL ROAD REGION NO. | DIVISION | PROJECT NUMBER | SHEET NUMBER |
| NO REVISIONS   | REVISED | VOID | 3K                      | COLORADO | BR 0243-043    | 34           |
| REVISIONS      |         |      |                         |          |                |              |
|                |         |      |                         |          |                |              |
|                |         |      |                         |          |                |              |

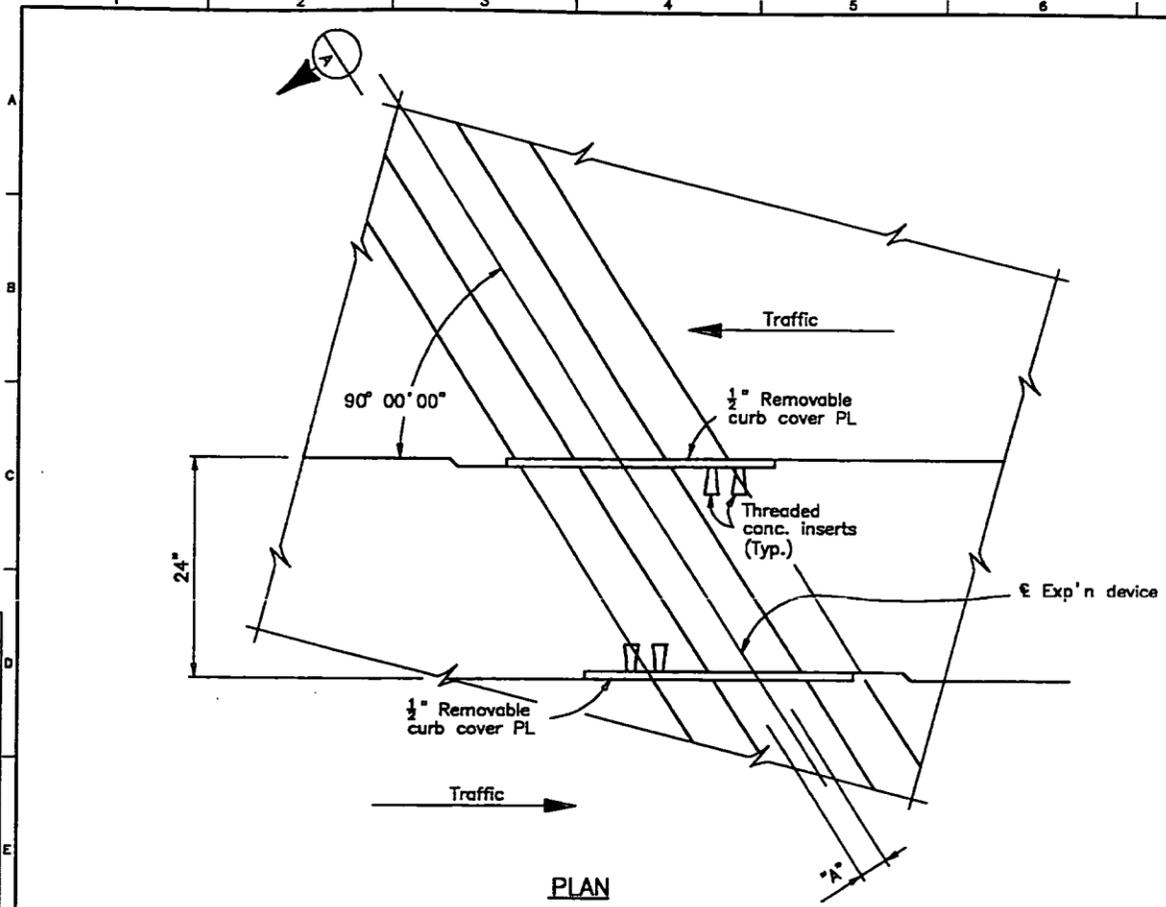

Cover plates shall be galvanized after fabrication. Cover plates shall be painted, see revision of section 509 and 708. Cover plates and related work shall not be paid for separately, but shall be included in the payment for Item No. 518 Bridge Expansion Device (0 - 2 inch)

Bolts for cover plates shall be Zinc or Cadmium plated.

Note:  
Use at 4 locations - Abut. 1, Joint 1, Joint 2, and Abut. 4.

**COLORADO**  
**DEPARTMENT OF TRANSPORTATION**

BRIDGE EXPANSION DEVICE

|                                    |           |         |
|------------------------------------|-----------|---------|
| Designer M. Condiotti              | Structure | I-17-GN |
| Detailer J. Viridi                 | Numbers   |         |
| Drawing Number B 14 of 18 Drawings |           |         |

|                |                          |
|----------------|--------------------------|
| Revision Dates | (Preliminary Stage Only) |
| 8-94           |                          |

| DESIGN      |            | DETAIL      |            | QUANTITIES    |            |
|-------------|------------|-------------|------------|---------------|------------|
| Initial     | Date       | Initial     | Date       | Initial       | Date       |
| M C         | 07/95      | J S V       | 07/95      | J S V         | 07/95      |
| Designed by | Checked by | Designed by | Checked by | Quantities by | Checked by |
| Z A         | 06/95      | S L W       | 09/95      | M C           | 07/95      |

Jan 31, 1997 3:00 C:\17gn\expdev2 JSV