

DEPARTMENT OF TRANSPORTATION
Region 6 Utilities Unit
2000 South Holly Street
Denver, Colorado 80222
(303) 757-9910



Utility Information Sheet (UIS)

PE Project No.: STA 1281-011; WBS #: 15782
CN Project No.: STA C800-001; WBS #: 16501

Project Description: 120th Avenue Connection- Phase I
Construct new 120th Avenue Connection alignment from Wadsworth Pkwy (SH 121) to Old Wadsworth Blvd. Construct new Commerce Street from Park Street to 118th Avenue. Also, minor realignment of Old Wadsworth Blvd.

UIS #: 02-001
Utility Company: **Arista Metropolitan District (Public)**

Work Performed by: Contractor

Location: 120th Sta. 41+30


Existing Utility: 12" Raw Water Line- Sleeved

Expected Impact: None-Contractor shall avoid impacts to this facility.

Attached: Plan Sheet and Broomfield Urban Transit Village (Artista) as-builts.


CDOT Representative: 
Ron Dickey – Region 6 Utility Manager

6-20-08
Date

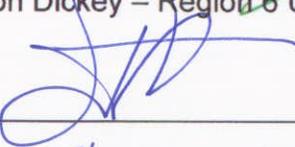Utility Representative: 
(Print name): JOSEPH L. ZEPEDA

7/18/08
Date

naszkowski 2:22:43 PM J:\transportation\072208.405\15782\utilities\drawings\15782\utilities02.dgn

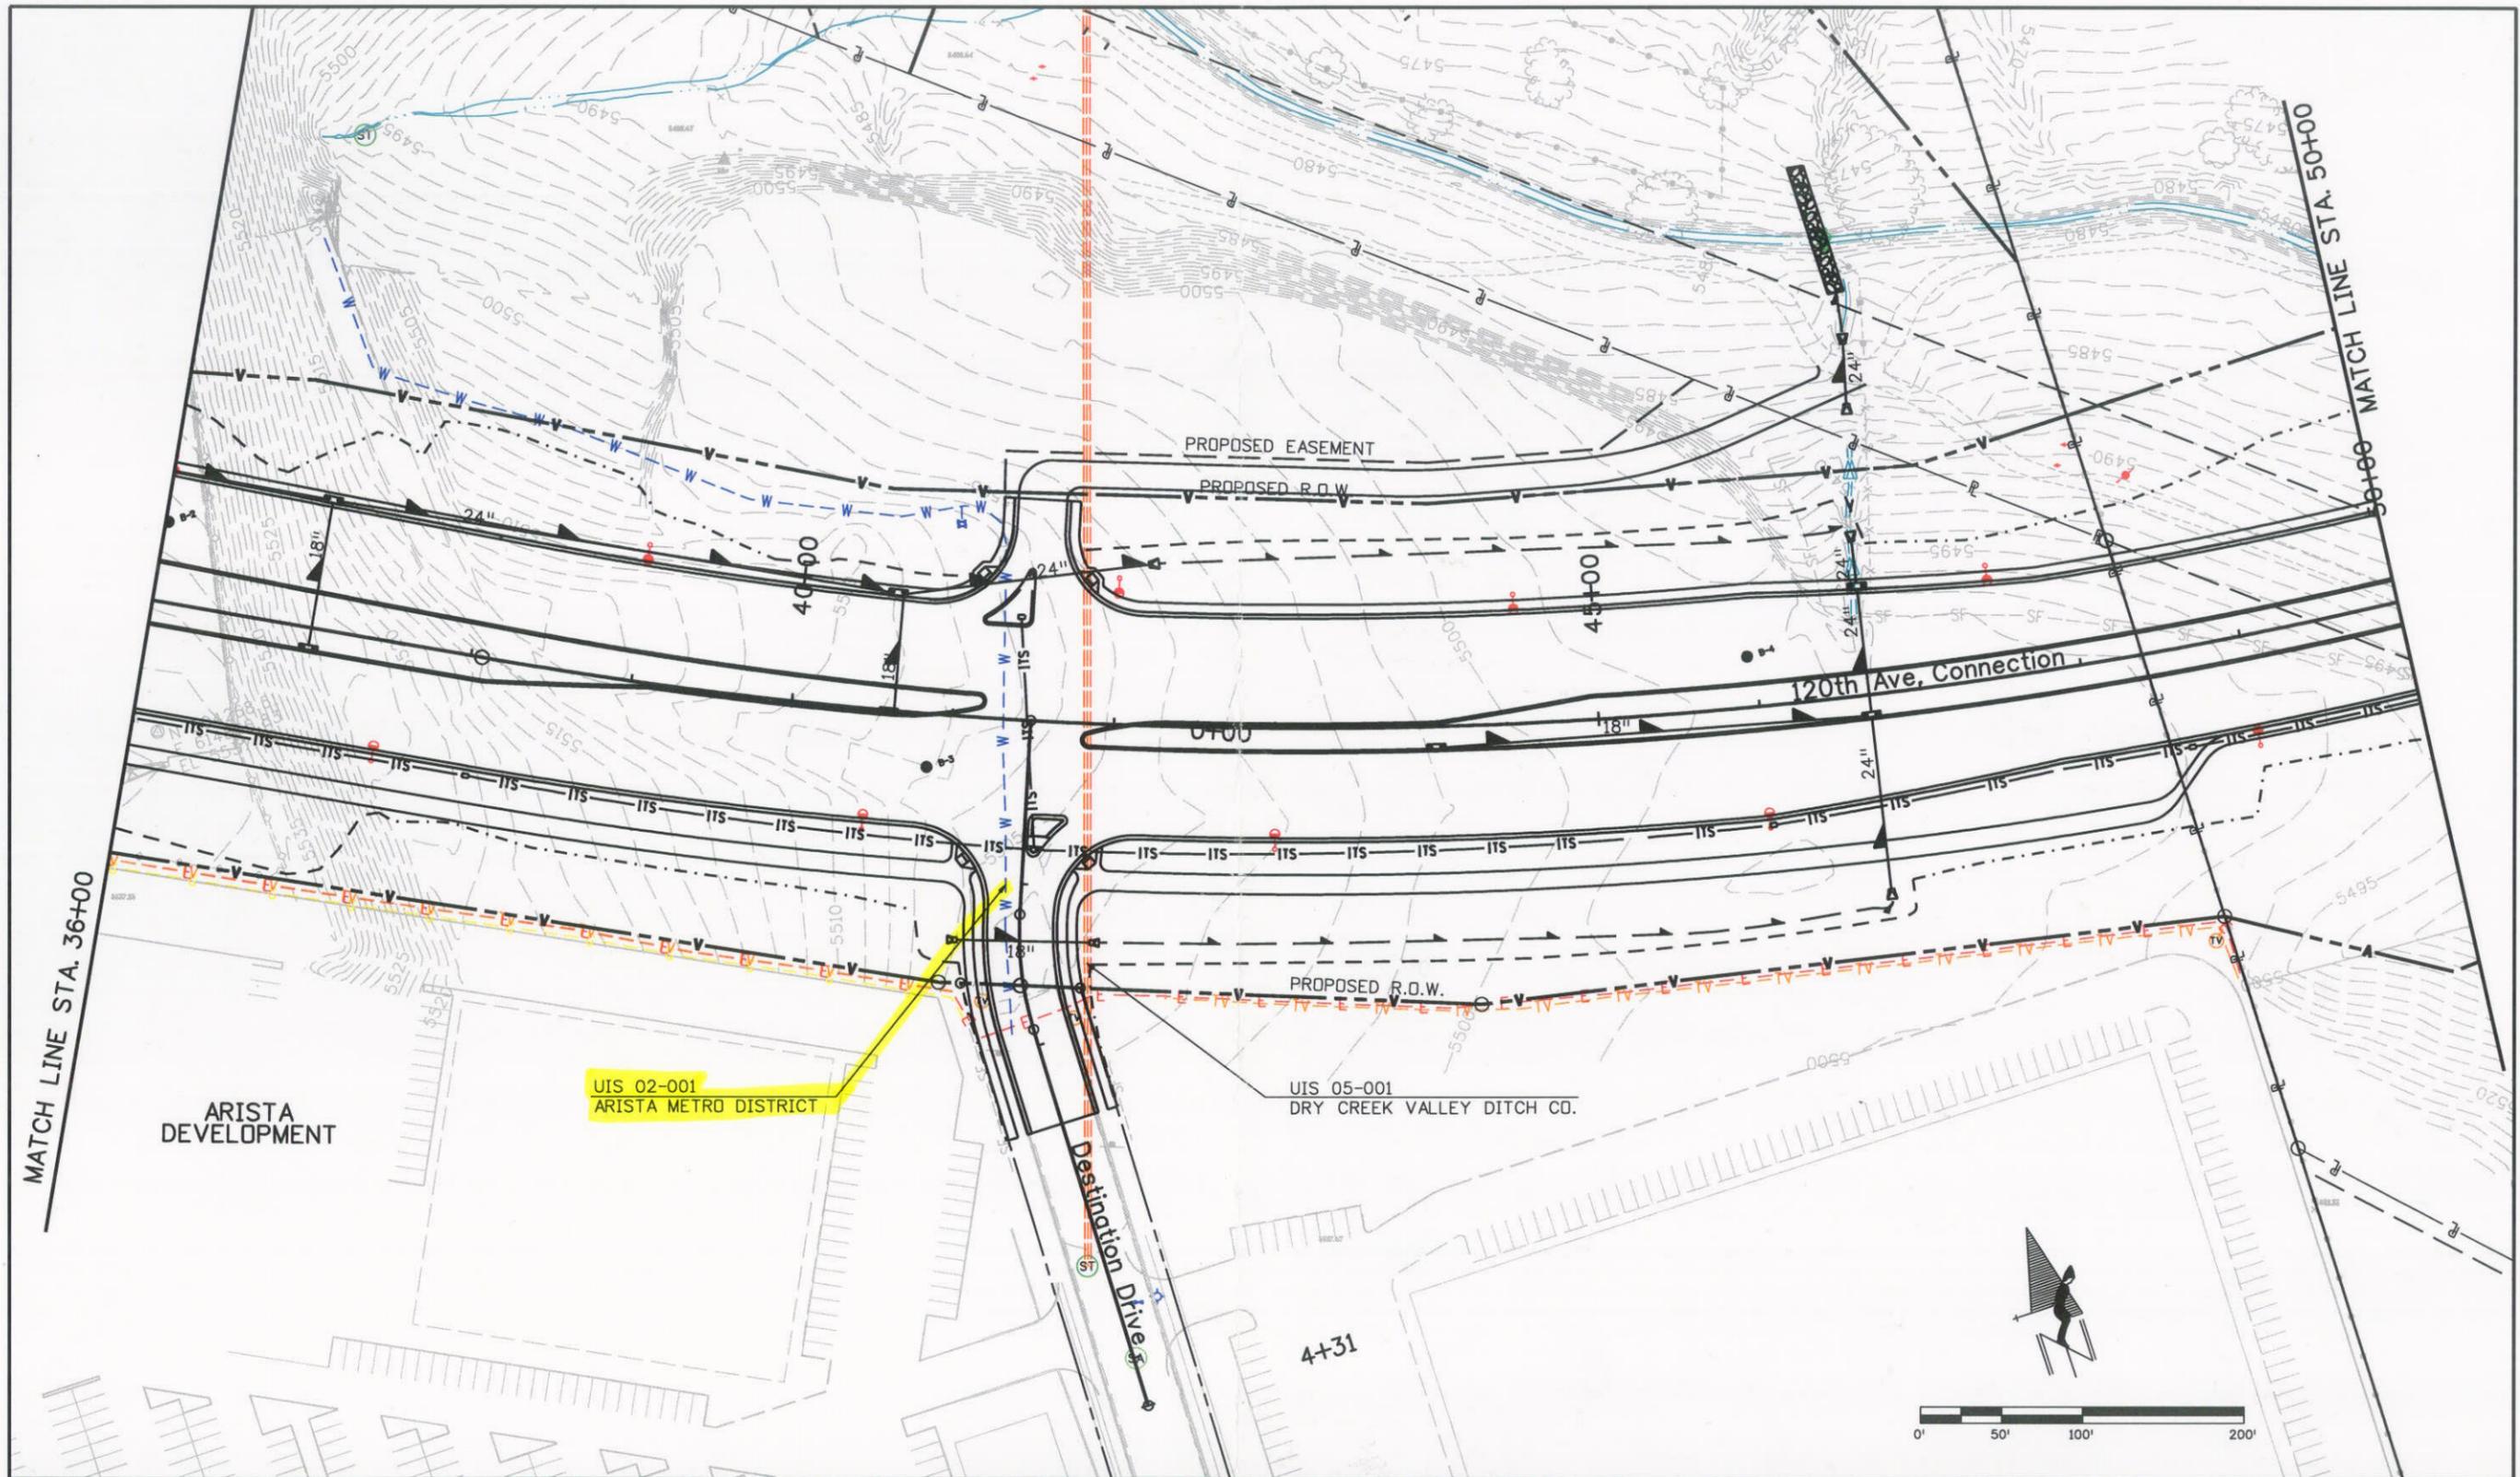

Print Date: 5/5/2008	
File Name: 15782Utilities02.dgn	
Horiz. Scale: 1:100	Vert. Scale: As Noted
Unit Information	Unit Leader Initials

Sheet Revisions		
Date:	Comments	Init.

Colorado Department of Transportation



4670 Holly Street
Denver, CO 80216-6408
Phone: 303-398-6765 FAX: 303-398-6781

Region 6 IDM


As Constructed
No Revisions:
Revised:
Void:

120TH AVE. CONNECTION UTILITIES			
Designer: XXXXXXXX	Structure Numbers: X-XX-XX		
Detailer: XXXXXXXX			
Sheet Subset: UT	Subset Sheets: 02 of 10		

Project No./Code
STA 1281-011
16501
Sheet Number 27

Job Number: W24-25-02
 Project Manager: PFH
 Location: E:\ON-SITE WATER
 Drawn By: BCD
 Model Space
 Paper Space
 Plot View: PLAN
 Other View: Profile View(s)
 Plot Date: 7/1/05
 Tab Name: W24
 Dwg. Name: AB-25-W24.DWG
 X References:

RECORD DRAWING
 Job Number: W24-25-02

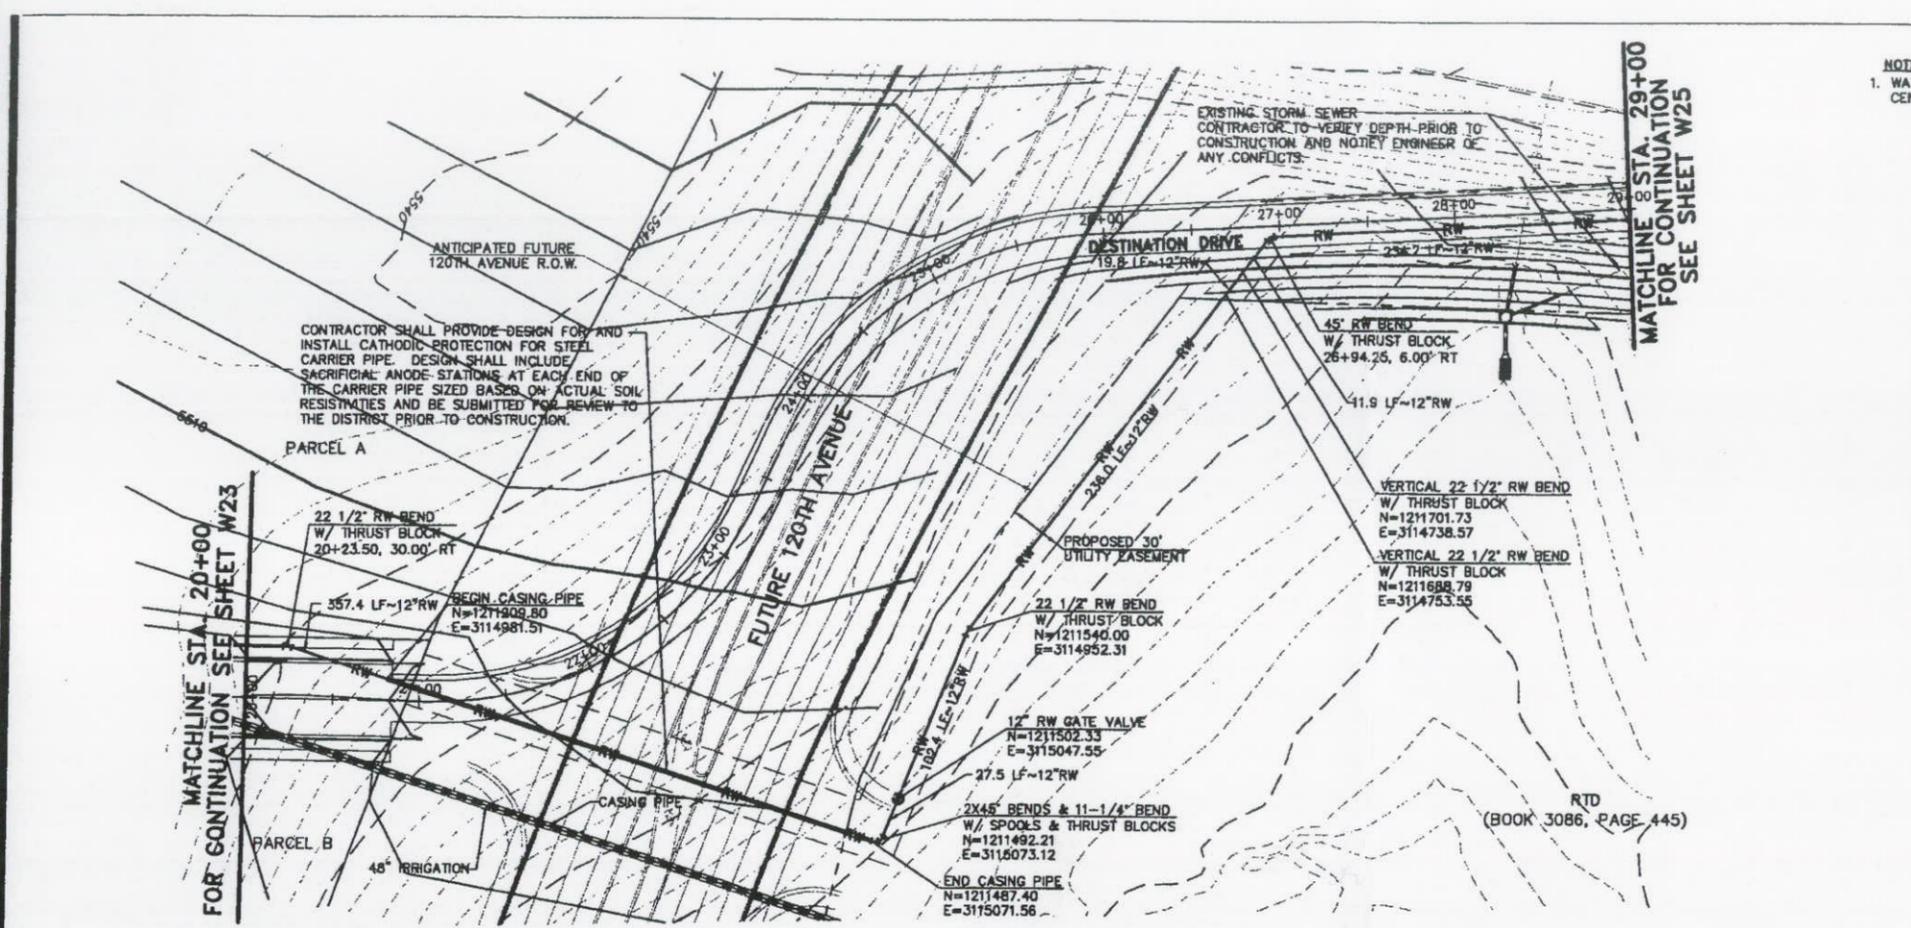

NOTE:
 1. WATER MAIN LOCATIONS ARE BASED ON STREET CENTERLINE STATIONING UNLESS OTHERWISE NOTED.



CALL UTILITY NOTIFICATION CENTER OF COLORADO
 1-800-922-1937
 OR 232-19911 METRO DENVER

CALL 2-BUSINESS DAYS IN ADVANCE BEFORE YOU DIG, GRADE OR EXCAVATE FOR MARKING OF UNDERGROUND MEMBER UTILITIES


RECORD DRAWING
 MARTIN/MARTIN BY:BCD DATE:7-19-07

This "drawing" is a record document prepared from and based upon, in part, information provided by others. Neither MARTIN/MARTIN nor the Engineer of Record has verified the accuracy of this information and shall not be responsible for any errors or omissions which may be incorporated herein as a result.

NOTE: AS CONSTRUCTED INFORMATION NOTED HEREIN IS ONLY SHOWN FOR HORIZONTAL LOCATION AS PROVIDED BY OTHERS.

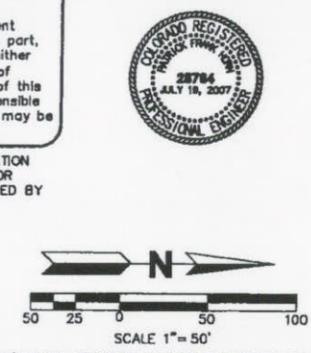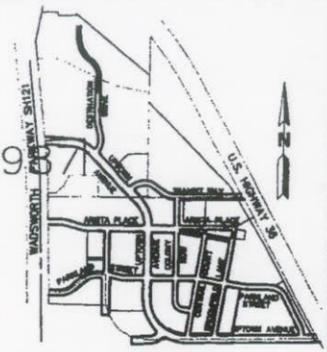

MARTIN/MARTIN ASSUMES NO RESPONSIBILITY FOR UTILITY LOCATIONS. THE UTILITIES SHOWN ON THIS DRAWING HAVE BEEN PLOTTED FROM THE BEST AVAILABLE INFORMATION. IT IS, HOWEVER, THE CONTRACTORS RESPONSIBILITY TO FIELD VERIFY THE LOCATION OF ALL UTILITIES PRIOR TO THE COMMENCEMENT OF ANY CONSTRUCTION.

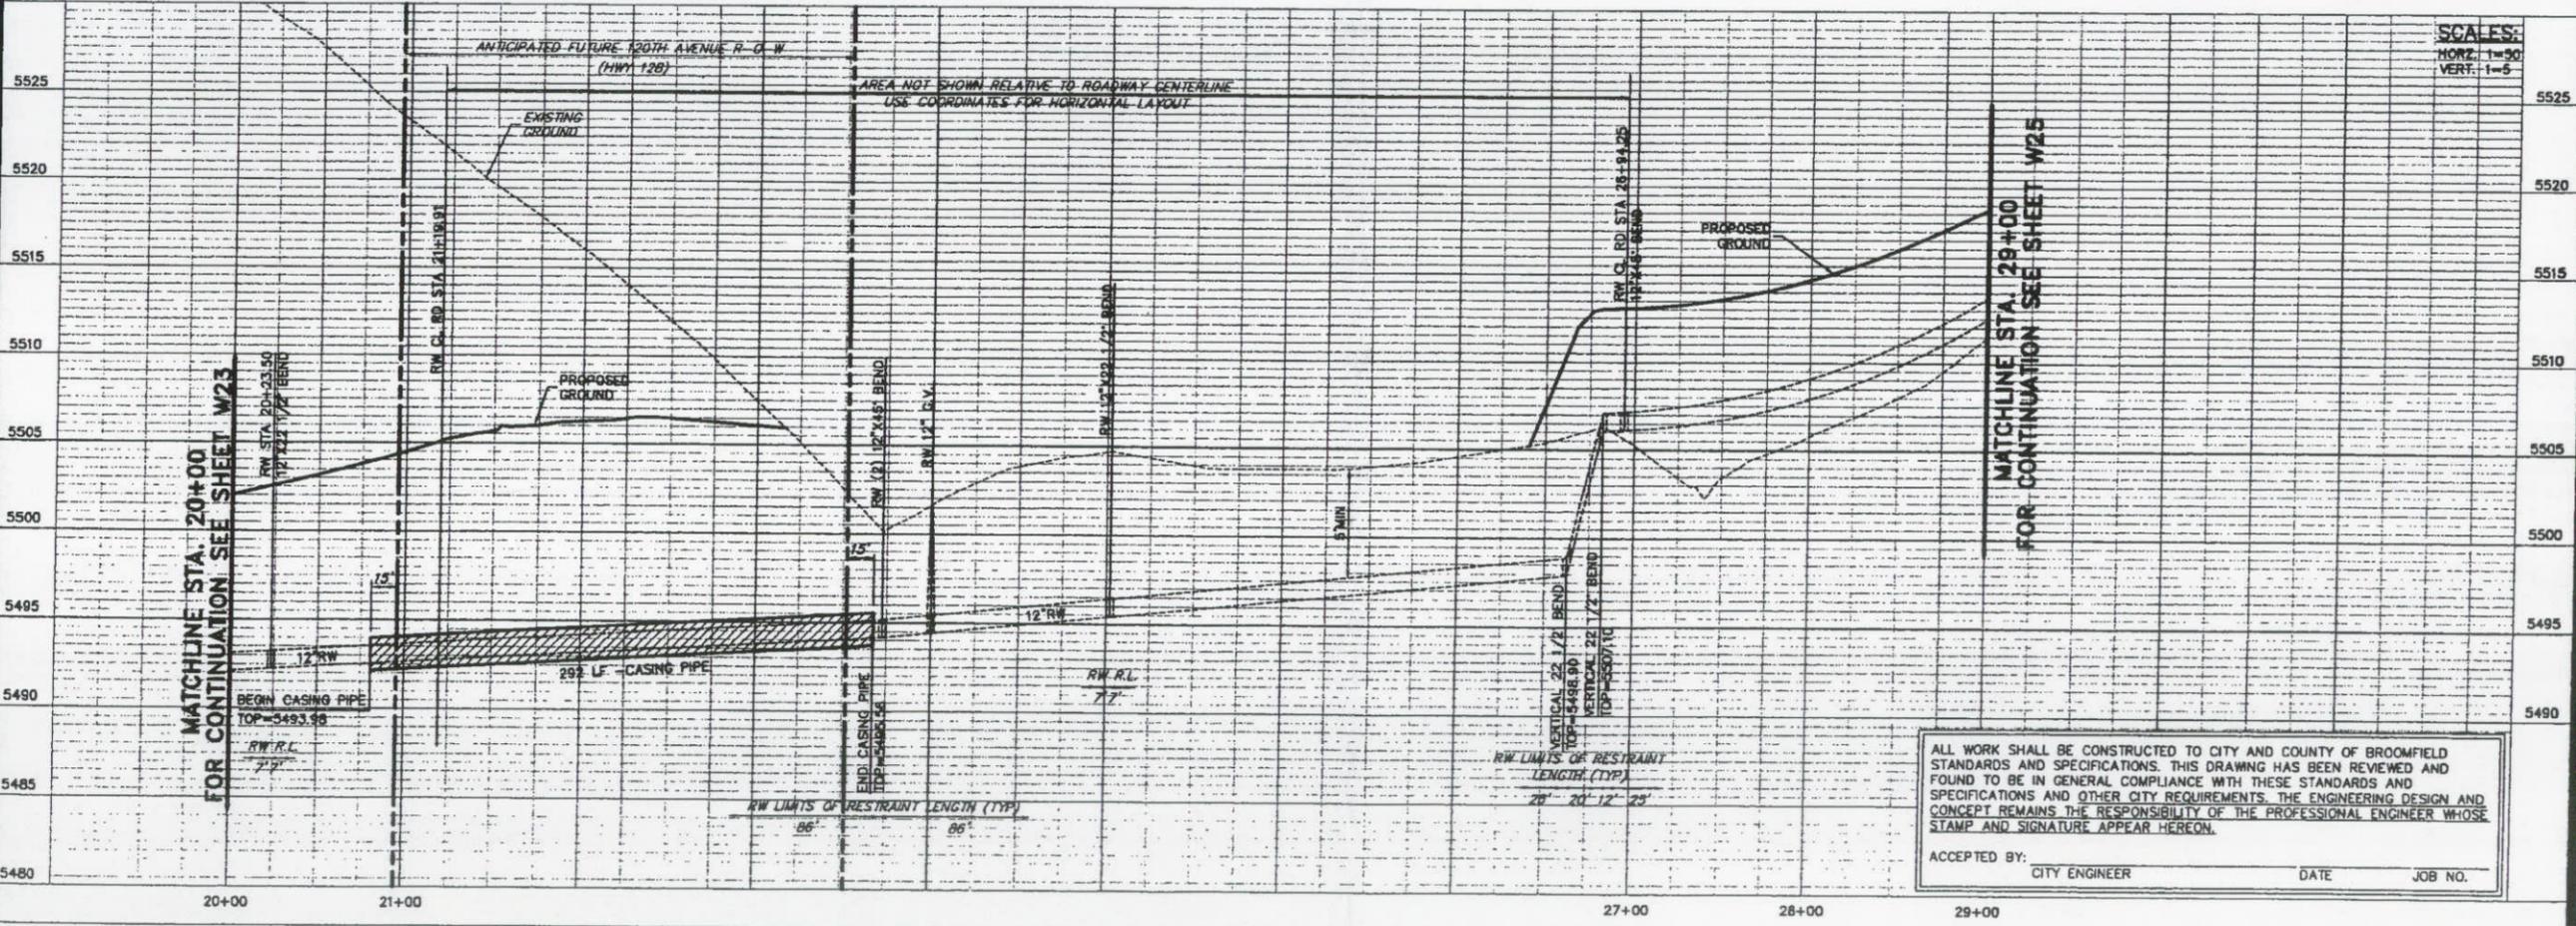

ACCEPTED BY: _____ DATE _____ JOB NO. _____
 CITY ENGINEER

MARTIN / MARTIN
 CONSULTING ENGINEERS
 12499 WEST COLFAX AVE.
 P.O. BOX 151500
 LAKEWOOD, CO 80215
 303.431.6100
 FAX 303.431.4028



BROOMFIELD URBAN TRANSIT VILLAGE
 ARISTA
 WATER MAIN
 PLAN & PROFILE

No.	Description of Revisions	Date	Name
1	SUBMITTED TO CITY	8/21/05	PFH
2	ISSUE FOR BID	09/21/05	PFH
3	ISSUE FOR CITY APPROVAL	11/09/05	BCD
4	REVISED PER CITY COMMENTS	1/20/06	BCD
5	REV. PER CITY COMMENTS	2/16/06	BCD
6	REV. ALIGNMENT PER CITY COMMENTS	05/17/06	BCD
7	REV. VERTICAL ALIGNMENT & ADD AIR RELIEF	05/23/06	BCD
8	RECORD DRAWING	07/18/07	BCD

Date: MAY 18, 2005
 Job Number: 17034.C.38
 Design By: B. DUMMER
 Drawn By: M. WINGERTER
 Checked By: P. HORN


Sheet Number:
W24
 25 OF 29

Job Number: 17034.C.38 Sheet Number: W25 26 OF 29
 RECORD DRAWING
 Location: E:\ON-SITE WATER
 Project Manager: BCD
 Designed By: BCD
 Drawn By: MRW
 Plot Date: 7/1/05
 Plot Name: W25
 Model Space
 Plan view(s): PLAN
 Profile View(s):
 Other View:
 Dwg. Name: AB-26-W25.DWG
 Paper Space
 Plot view:
 Plot:

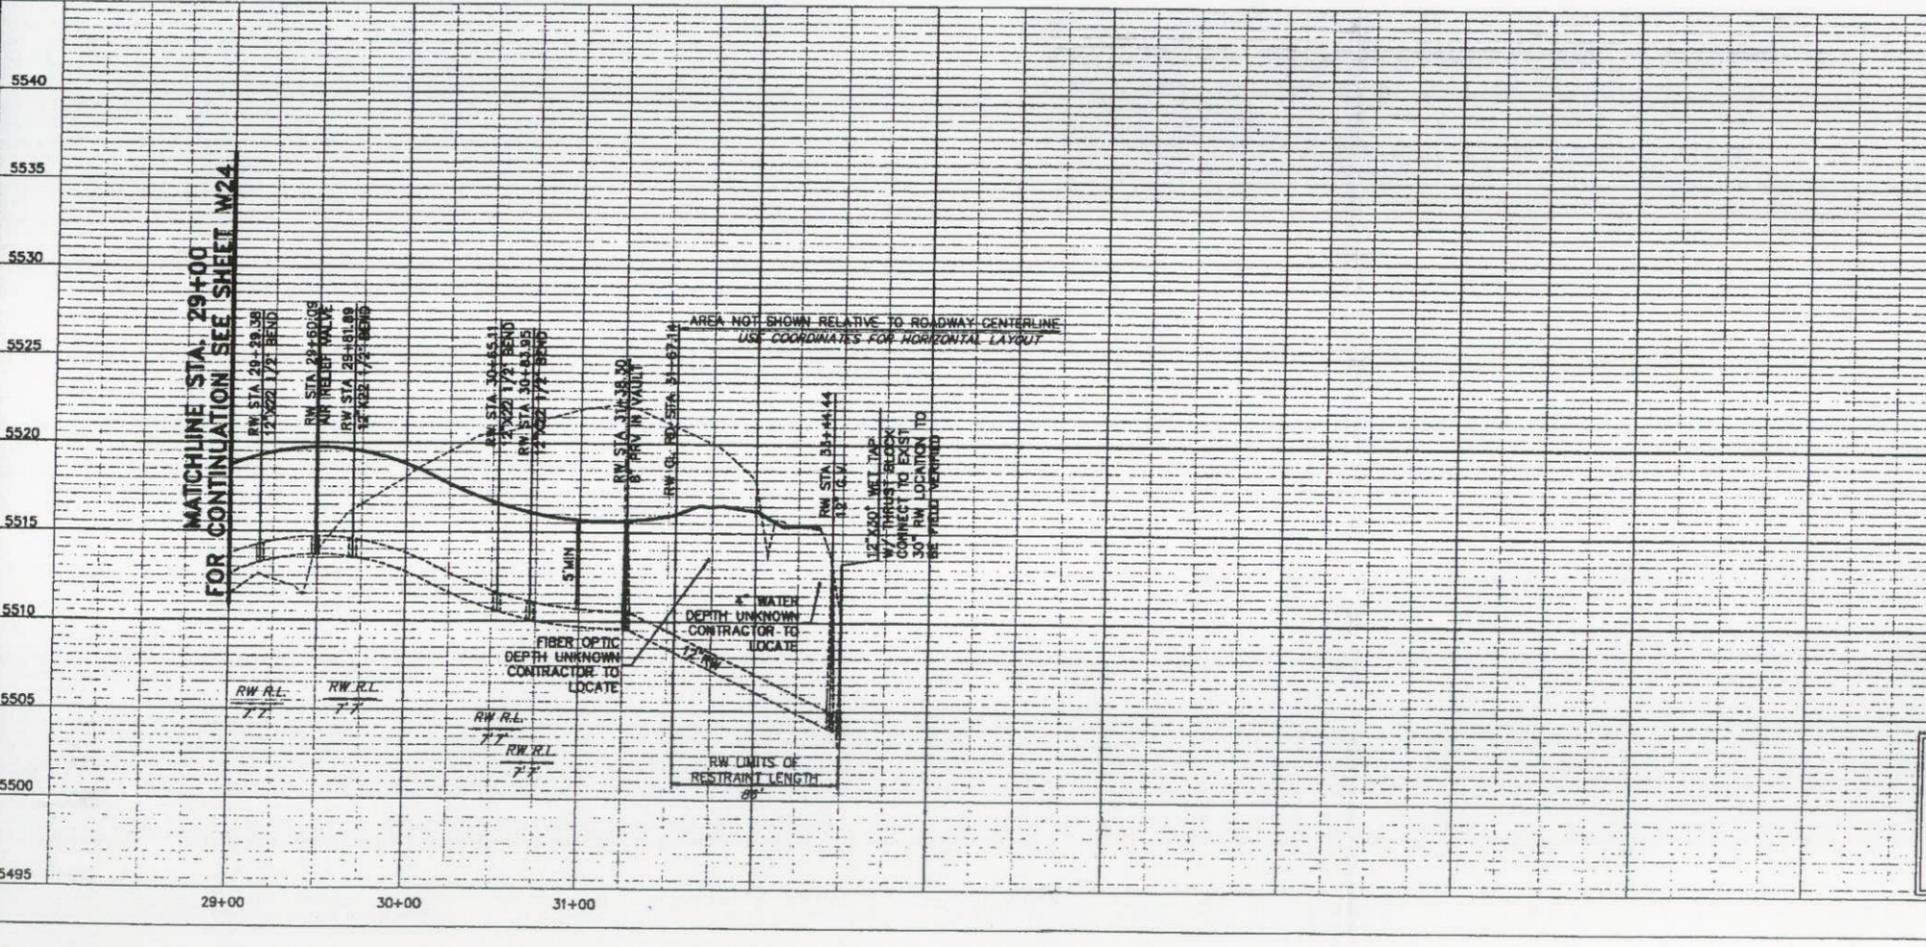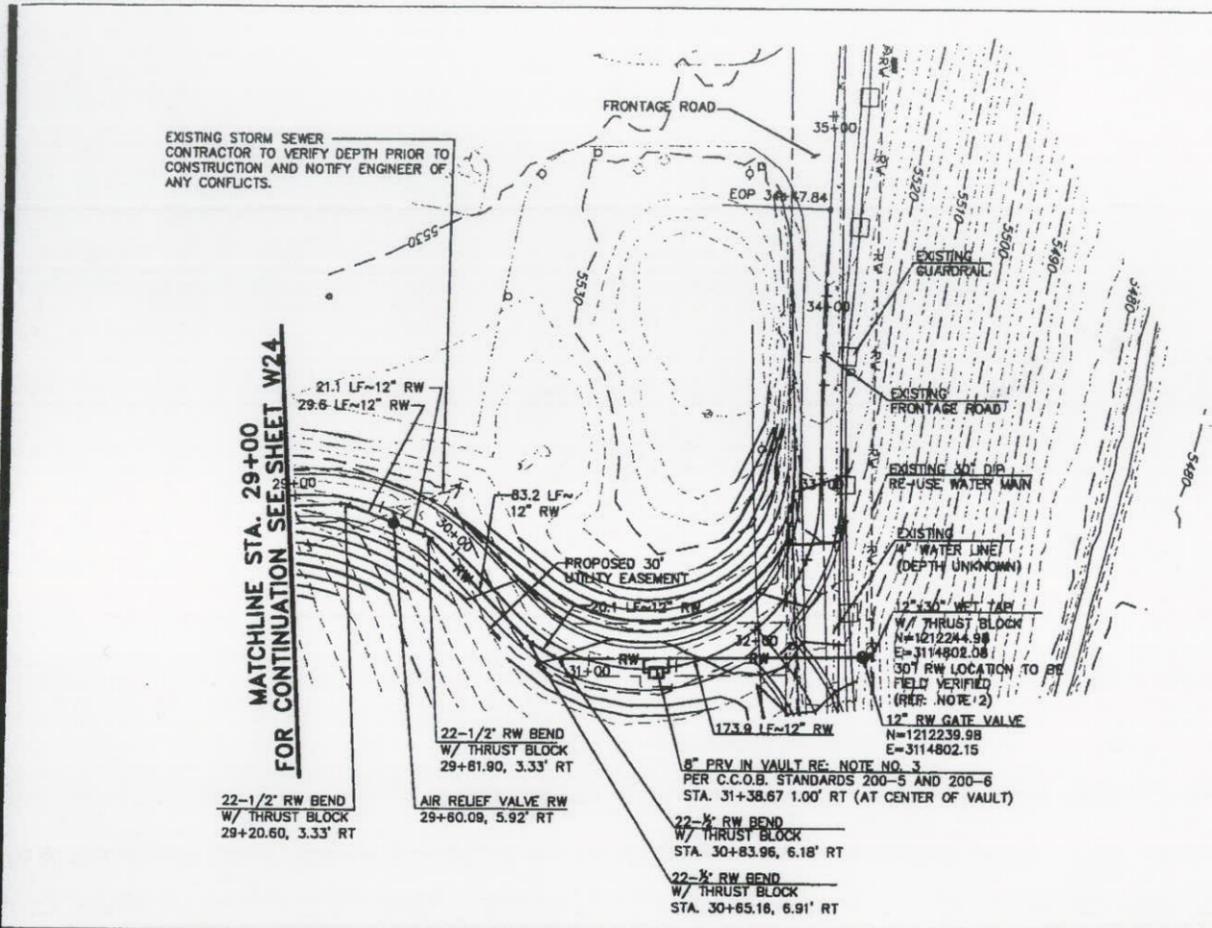


- NOTE:**
1. WATER MAIN LOCATIONS ARE BASED ON STREET CENTERLINE STATIONING UNLESS OTHERWISE NOTED.
 2. CONTRACTOR RESPONSIBLE FOR CUT AND PATCH OF EXISTING ROAD AND GUARDRAIL PER CITY AND COUNTY OF BROOMFIELD STANDARDS AND COORDINATION WITH PUBLIC WORKS DEPARTMENT.
 3. PRV WILL REQUIRE SPECIFIC DESIGN APPROVAL AND BROOMFIELD AGREEMENT REGARDING SUBMITTALS PRIOR TO INSTALLATION

CALL UTILITY NOTIFICATION
 CENTER OF COLORADO
 1-800-922-1987
 OR 232-199 IN METRO DENVER

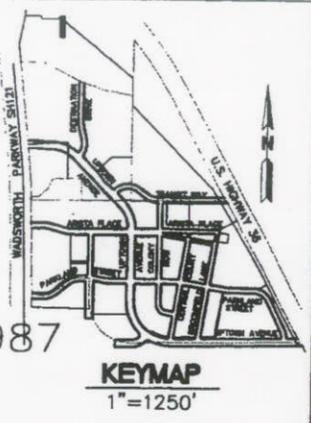

RECORD DRAWING
 MARTIN/MARTIN BY: BCD DATE: 7-19-07

This "drawing" is a record document prepared from and based upon, in part, information provided by others. Neither MARTIN/MARTIN nor the Engineer of Record has verified the accuracy of this information and shall not be responsible for any errors or omissions which may be incorporated herein as a result.

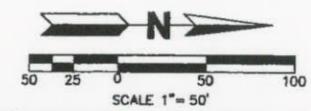

NOTE: AS CONSTRUCTED INFORMATION NOTED HEREIN IS ONLY SHOWN FOR HORIZONTAL LOCATION AS PROVIDED BY OTHERS.

MARTIN/MARTIN ASSUMES NO RESPONSIBILITY FOR UTILITY LOCATIONS. THE UTILITIES SHOWN ON THIS DRAWING HAVE BEEN PLOTTED FROM THE BEST AVAILABLE INFORMATION. IT IS, HOWEVER, THE CONTRACTOR'S RESPONSIBILITY TO FIELD VERIFY THE LOCATION OF ALL UTILITIES PRIOR TO THE COMMENCEMENT OF ANY CONSTRUCTION.

ALL WORK SHALL BE CONSTRUCTED TO CITY AND COUNTY OF BROOMFIELD STANDARDS AND SPECIFICATIONS. THIS DRAWING HAS BEEN REVIEWED AND FOUND TO BE IN GENERAL COMPLIANCE WITH THESE STANDARDS AND SPECIFICATIONS AND OTHER CITY REQUIREMENTS. THE ENGINEERING DESIGN AND CONCEPT REMAINS THE RESPONSIBILITY OF THE PROFESSIONAL ENGINEER WHOSE STAMP AND SIGNATURE APPEAR HEREON.

ACCEPTED BY: CITY ENGINEER DATE JOB NO.

BROOMFIELD URBAN
 TRANSIT VILLAGE
 ARISTA
 WATER MAIN
 PLAN & PROFILE

No.	Description of Revisions	Date	Name
1	PROGRESS SET	7/1/05	PHH
2	SUBMITTED TO CITY	8/31/05	PHH
3	ISSUE FOR BID	09/27/05	PHH
4	ISSUE FOR CITY APPROVAL	11/29/05	BOJ
5	REVISED PER CITY COMMENTS	1/20/06	BOJ
6	REV. PER CITY COMMENTS	2/16/06	BOJ
7	REV. ALIGNMENT PER CITY COMMENTS	05/17/06	BOJ
8	RECORD DRAWING	07/19/07	BOJ

Date: MAY 18, 2005
 Job Number: 17034.C.38
 Design By: B. DUMMER
 Drawn By: M. WINGERTER
 Checked By: P. HORN

Sheet Number:
 W25
 26 OF 29

MARTIN / MARTIN
 CONSULTING ENGINEERS
 12499 WEST COLFAX AVE.
 P.O. BOX 151500
 LAKEWOOD, CO 80215
 303.431.6100
 FAX 303.431.4028

RECORD DRAWING

