

DEPARTMENT OF TRANSPORTATION
Region 6 Utilities Unit
2000 South Holly Street
Denver, Colorado 80222
(303) 757-9910



Utility Information Sheet (UIS)

PE Project No.: STA 1281-011; WBS #: 15782

CN Project No.: ~~STU 1281-012~~; WBS #: 16501

STA C800-001

Project Description: 120th Avenue Connection- Phase I

Construct new 120th Avenue Connection alignment from Wadsworth Pkwy (SH 121) to Old Wadsworth Blvd. Construct new Commerce Street from Park Street to 118th Avenue. Also, minor realignment of Old Wadsworth Blvd.

UIS #: 03-001

Utility Company: City and County of Broomfield (Public)

Work Performed by: Contractor

Location: 120th Sta. 30+00 to 32+00

Existing Utility: 4" Water Line

Expected Impact: Once the Park -N- Ride is abandoned the contractor shall design and construct the abandonment of the 4" water line by capping the existing 4" tap at the 12" water line. The 4" tap on the 12" water line is located in the eastbound lane of Uptown Ave, just east of Wadsworth Pkwy. The 4" abandoned water line will remain in place and the as-builts will show as an abandoned facility.

Attached: Plan Sheet


CDOT Representative: Ron Dickey
Ron Dickey – Region 6 Utility Manager

7-3-2008
Date

Utility Representative: Burt Knight
(Print name): Burt Knight

7/2/08
Date

nazkowskoar 2:22:15 PM j:\transportation\072208.405\15782\utilities\drawings\15782utilities01.dgn

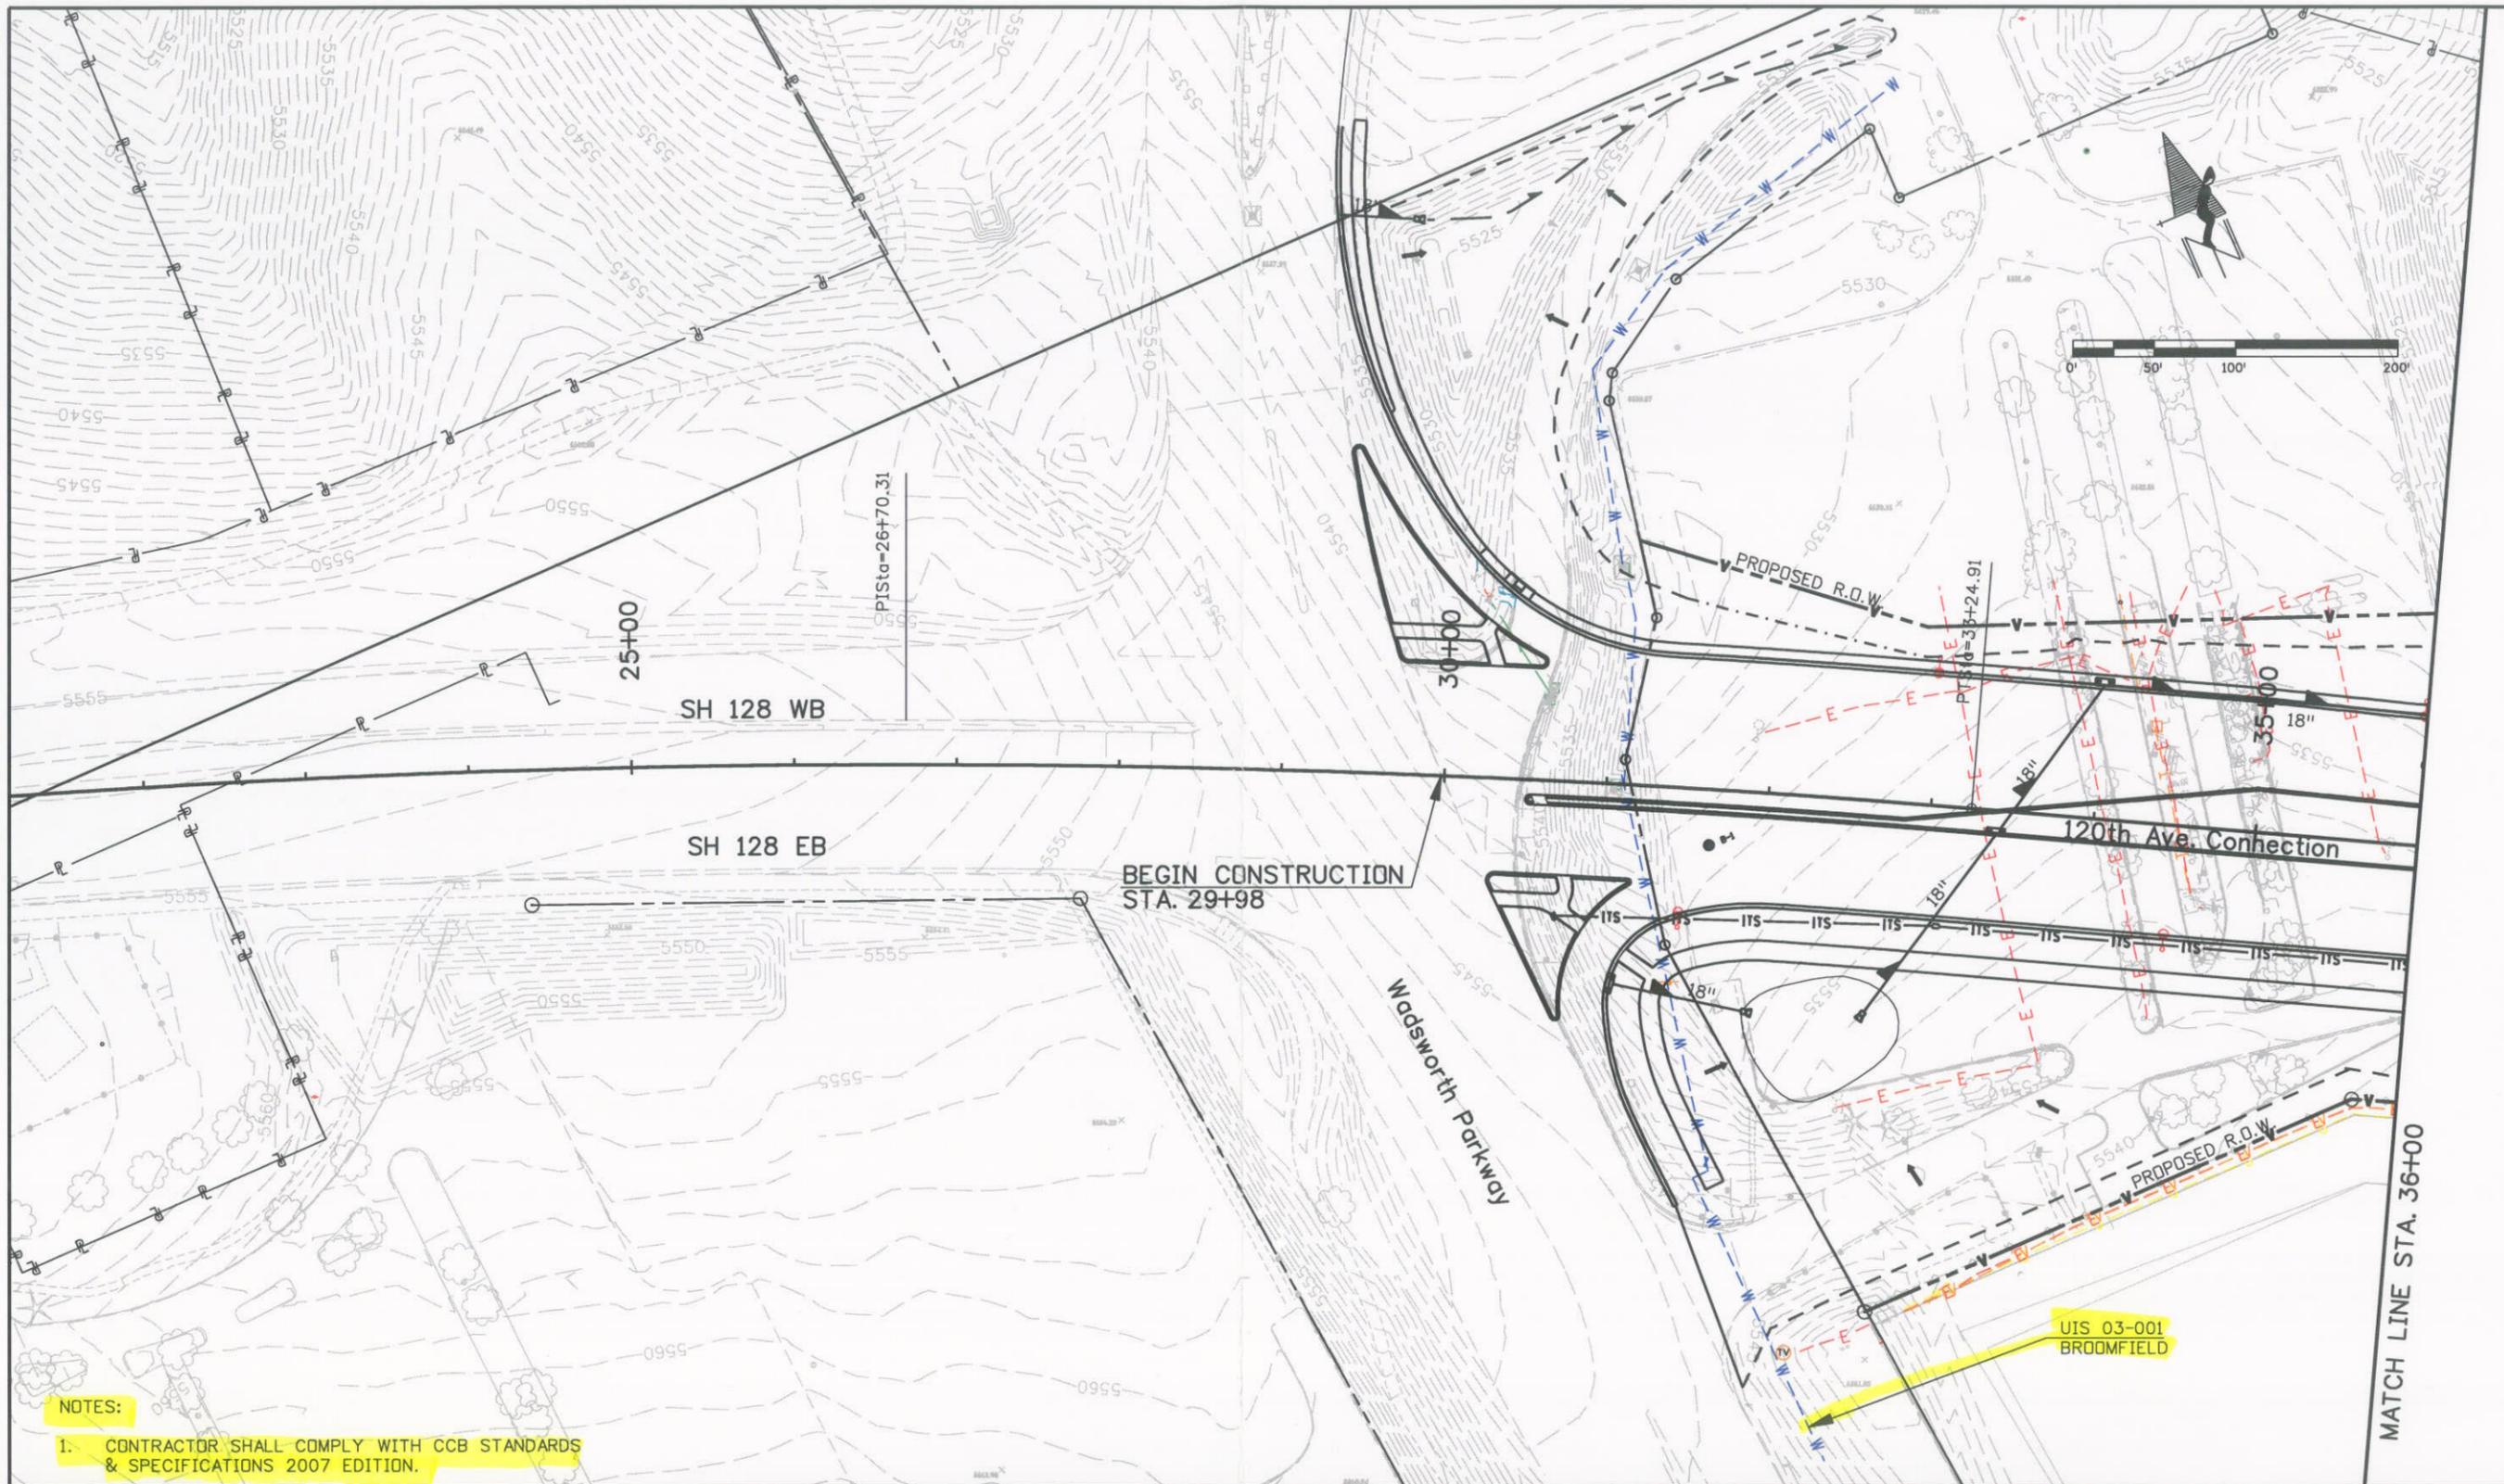

NOTES:

- CONTRACTOR SHALL COMPLY WITH CCB STANDARDS & SPECIFICATIONS 2007 EDITION.

Print Date: 5/5/2008	
File Name: 15782Utilities01.dgn	
Horiz. Scale: 1:100 Vert. Scale: As Noted	
Unit Information Unit Leader Initials	

Sheet Revisions		
Date:	Comments	Init.

Colorado Department of Transportation

4670 Holly Street
 Denver, CO 80216-6408
 Phone: 303-398-6765 FAX: 303-398-6781

Region 6 **IDM**

As Constructed
No Revisions:
Revised:
Void:

120TH AVE. CONNECTION UTILITIES			
Designer: XXXXXXXX	Structure Numbers	X-XX-XX	X-XX-XX
Detailer: XXXXXXXX			
Sheet Subset: UT	Subset Sheets: 01 of 10		

Project No./Code
STA 1281-011
16501
Sheet Number 26