




Know what's below.
Call before you dig.

kingem 8:49:46 AM J:_Transportation\WXXW7000.CDDT_US36_D-B\7000CADD\17516_Design\Exhibits\17516_200scale_PLan_112th_Enviro-RDW_Impacts.dgn

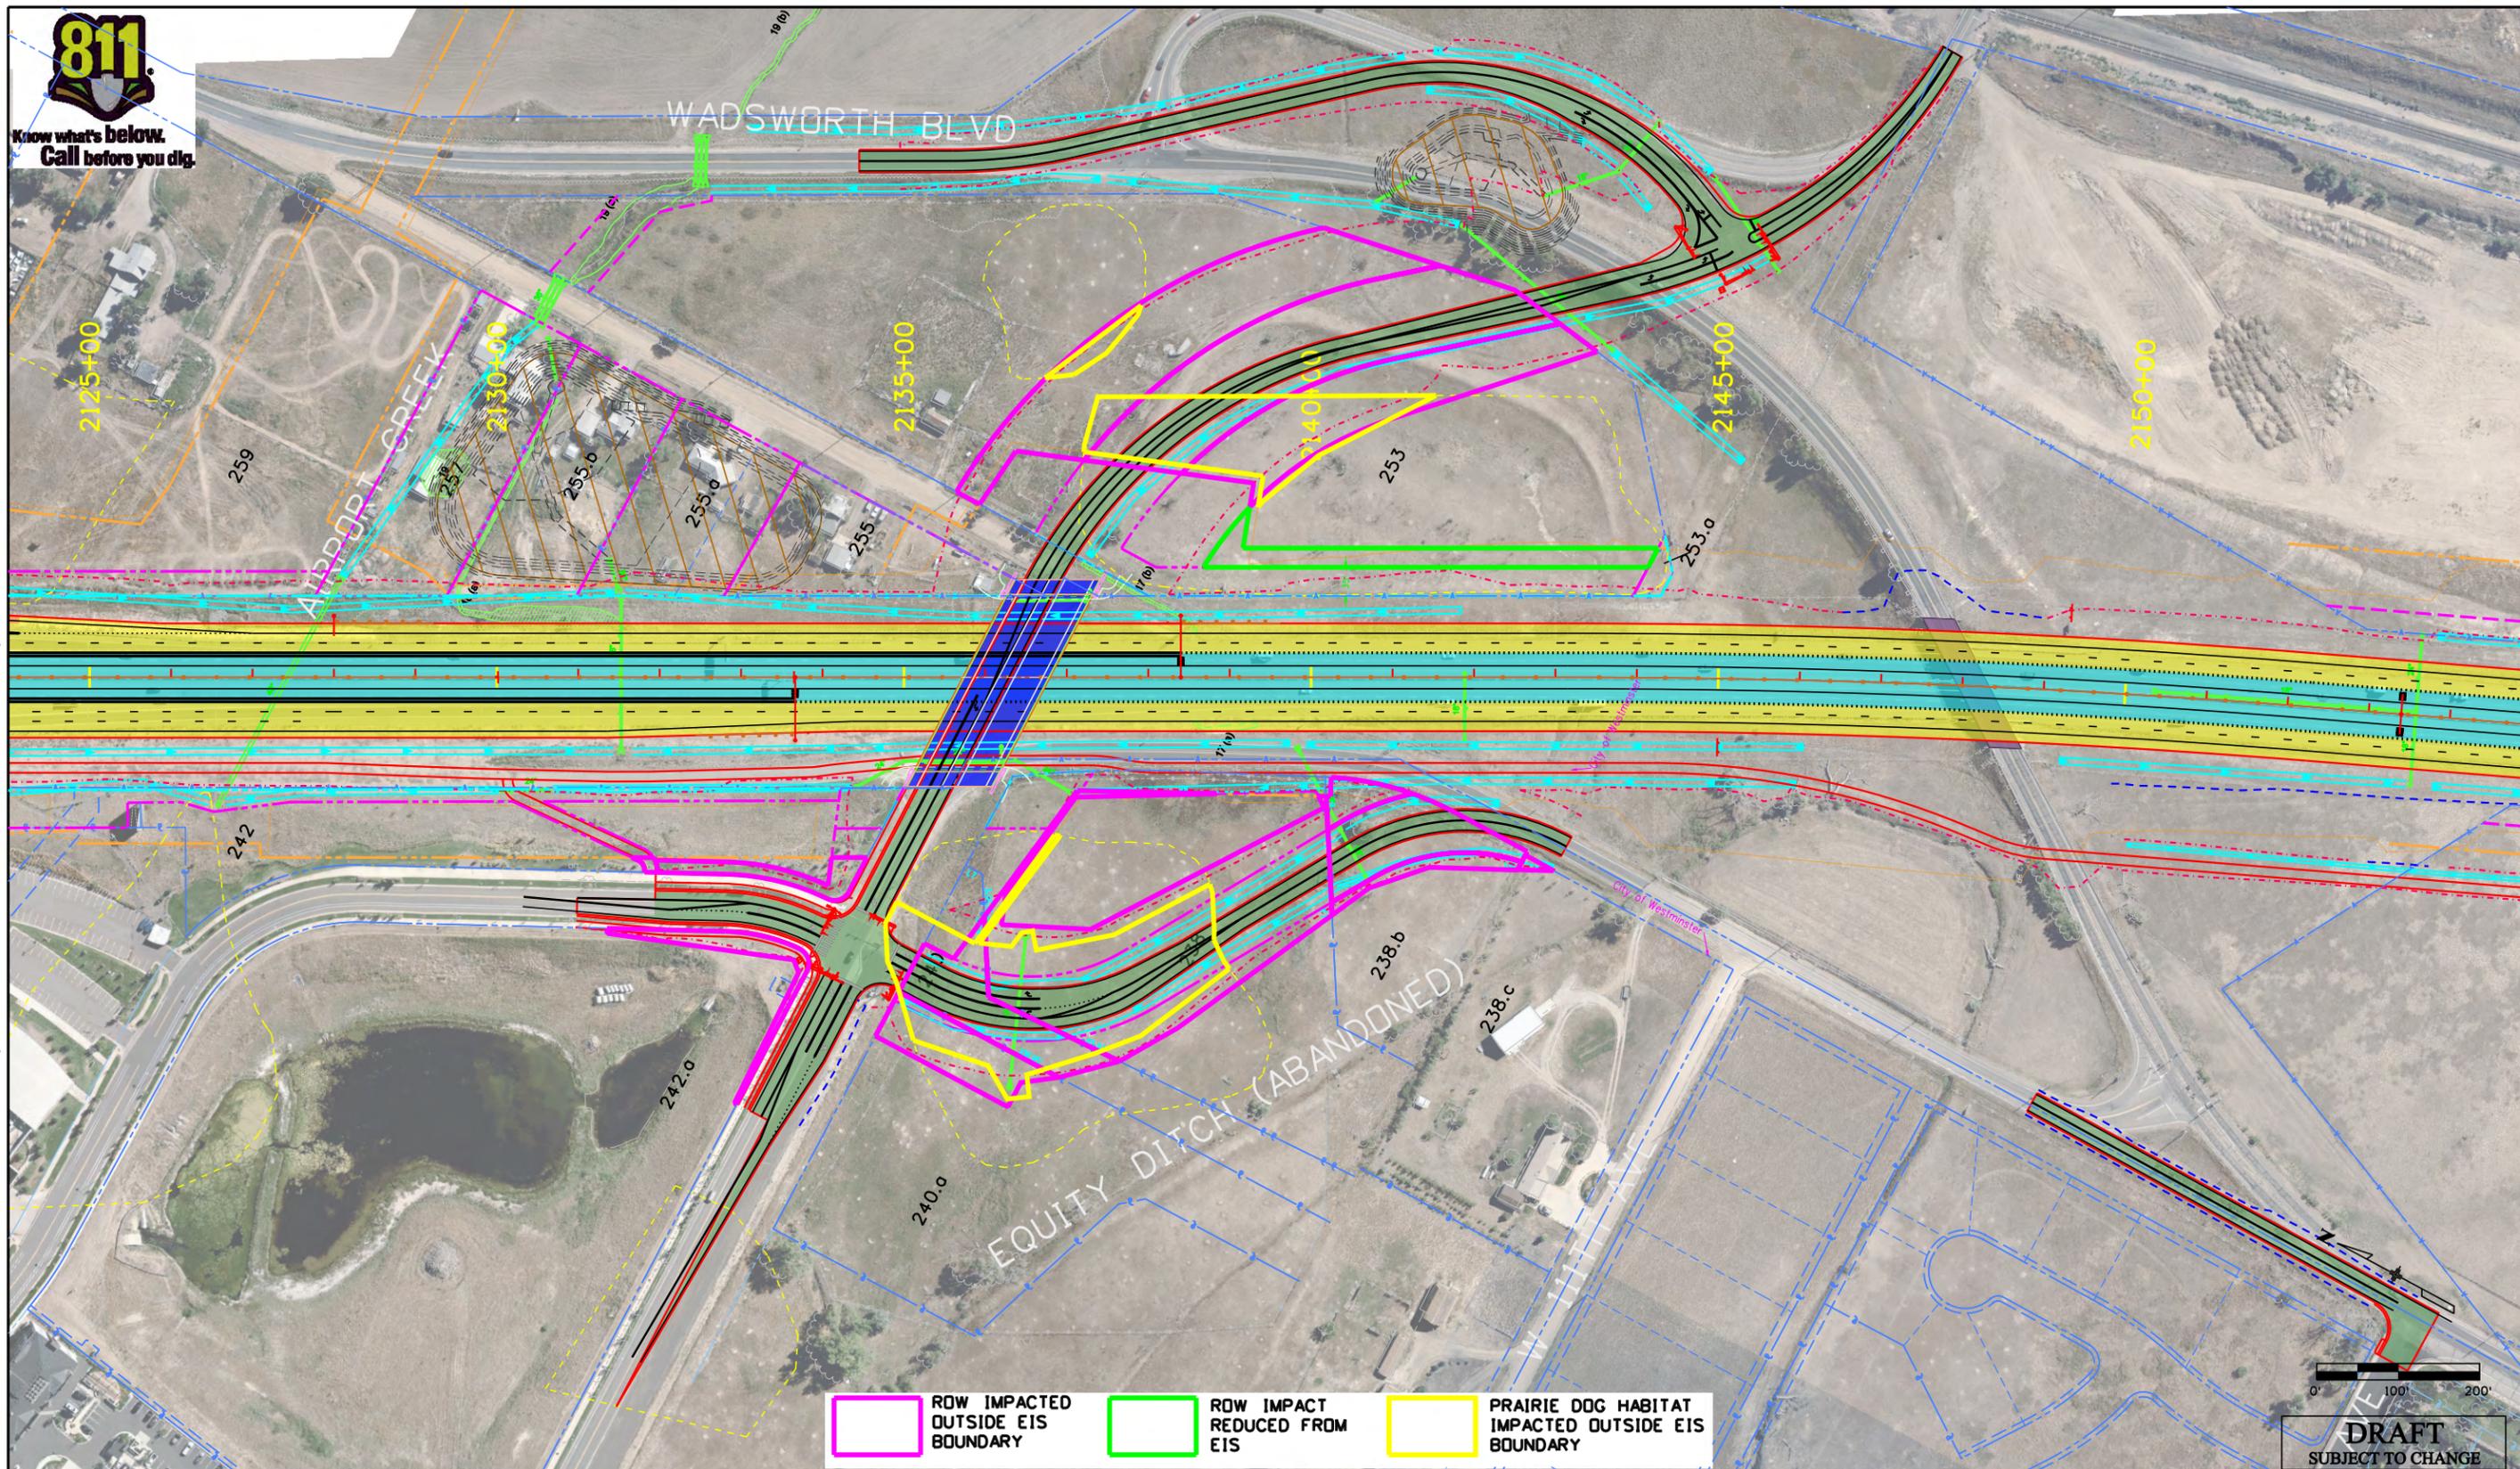

	ROW IMPACTED OUTSIDE EIS BOUNDARY		ROW IMPACT REDUCED FROM EIS		PRAIRIE DOG HABITAT IMPACTED OUTSIDE EIS BOUNDARY
--	---	--	-----------------------------------	--	---



DRAFT
SUBJECT TO CHANGE

Print Date: 12/9/2011
 File Name: 17516_200scale_PLan_112th_Enviro-RDW_Impacts.dgn
 Horiz. Scale: 1"=200' Vert. Scale: As Noted

Sheet Revisions			
Date:	Comments	Init.	
0000			

Colorado Department of Transportation



2000 South Holly Street
 Denver, Co 80222
 Phone: 303-972-9112 FAX: 303-972-9114

As Constructed
No Revisions:
Revised:
Void:

EXHIBIT 1
112TH OVERCROSSING IMPACTS

Designer:	Structure Numbers:
Detailer:	Subset Sheets:
Sheet Subset:	

Project No./Code
NH 0361-093
17516
Sheet Number