

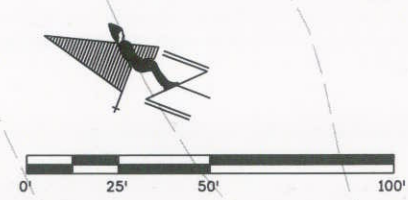


naszkowskiar 2:24:54 PM j:\transportation\072208.405\15782\utilities\drawings\15782\utilities07.dgn

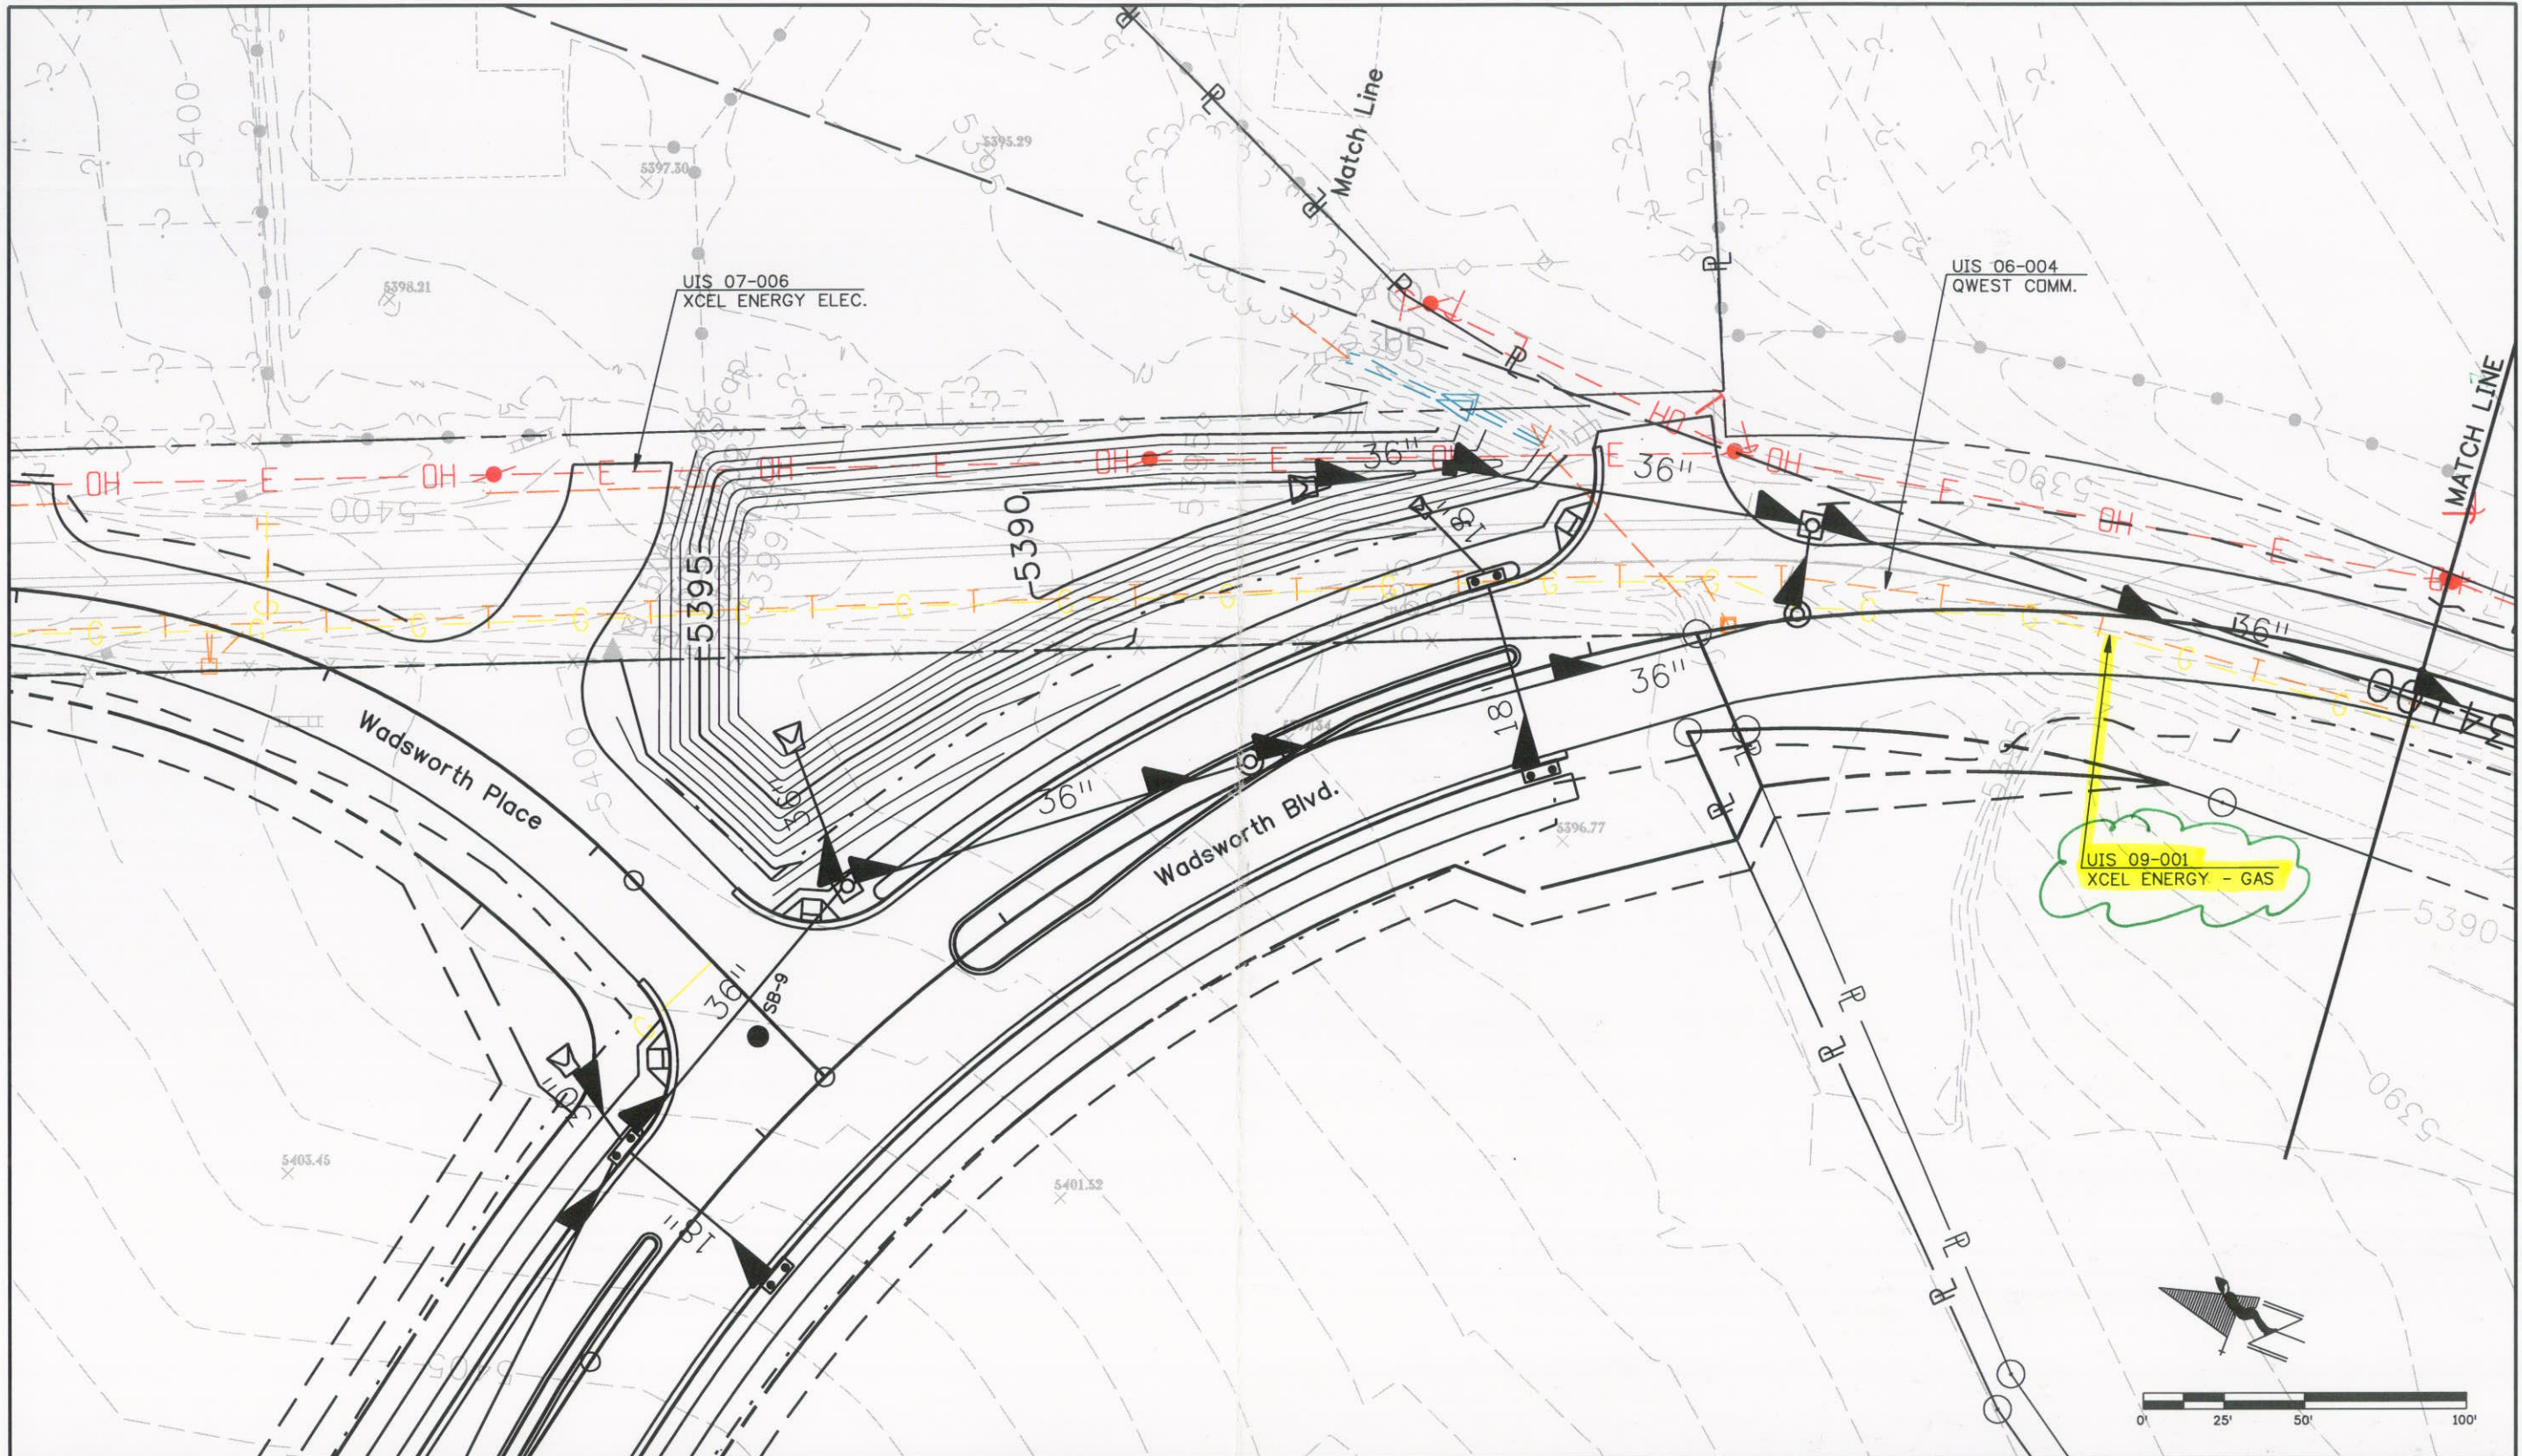

Print Date: 5/5/2008		Sheet Revisions Date: Comments Init. <hr/> <hr/> <hr/>		Colorado Department of Transportation  4670 Holly Street Denver, CO 80216-6408 Phone: 303-398-6765 FAX: 303-398-6781 Region 6		As Constructed No Revisions: <hr/> Revised: <hr/> Void:		WADSWORTH BLVD. UTILITIES Designer: XXXXXXXX Structure X-XX-XX Detailer: XXXXXXXX Numbers X-XX-XX Sheet Subset: UT Subset Sheets: 07 of 10			Project No./Code	
File Name: 15782Utilities07.dgn											STA 1281-011	
Horiz. Scale: 1:50 Vert. Scale: As Noted								16501				
Unit Information Unit Leader Initials				IDM				Sheet Number 32				

naazkowskear 2:25:07 PM j:\transportation\072208.405\15782\utilities\drawings\15782\utilities08.dgn

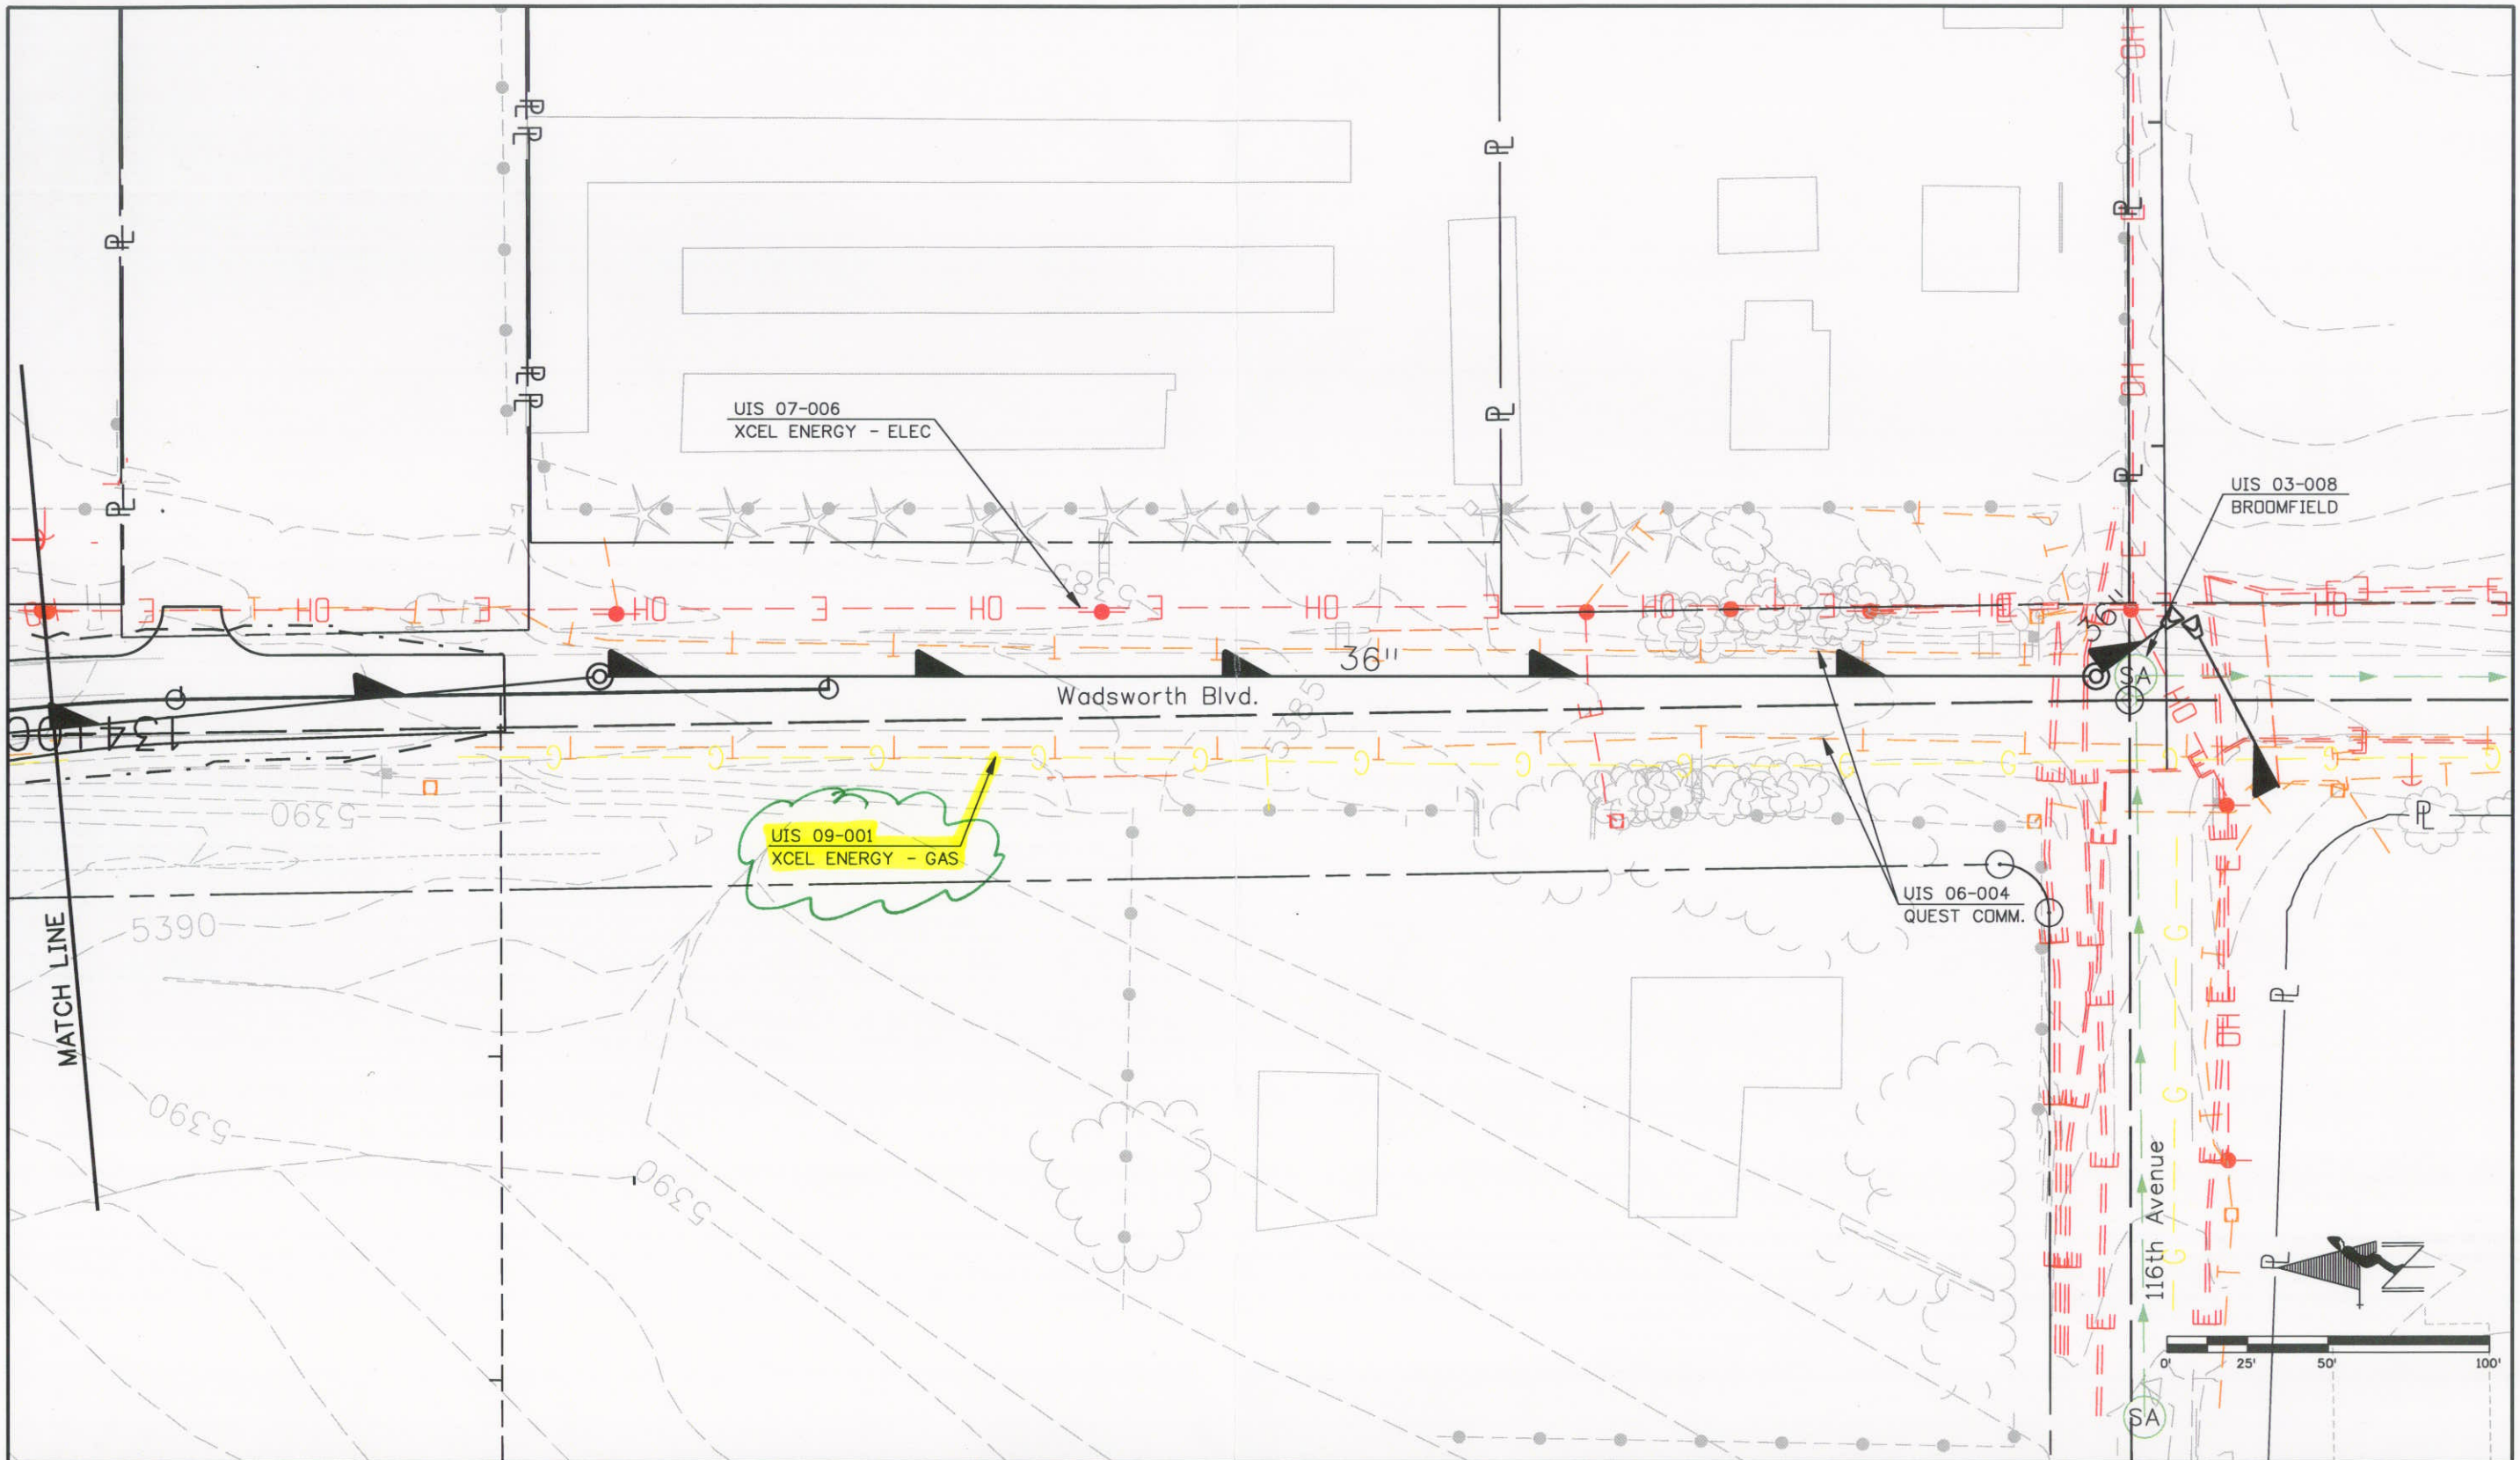

Print Date: 5/5/2008
File Name: 15782Utilities08.dgn
Horiz. Scale: 1:50 Vert. Scale: As Noted
Unit Information Unit Leader Initials

Sheet Revisions		
Date:	Comments	Init.

Colorado Department of Transportation

 4670 Holly Street
 Denver, CO 80216-6408
 Phone: 303-398-6765 FAX: 303-398-6781
 Region 6 IDM

As Constructed
No Revisions:
Revised:
Void:

WADSWORTH BLVD. UTILITIES			
Designer:	EN	Structure	X-XX-XX
Detailer:	EN	Numbers	X-XX-XX
Sheet Subset:	UT	Subset Sheets:	08 of 10

Project No./Code
STA 1281-011
16501
Sheet Number 33