

DEPARTMENT OF TRANSPORTATION
Region 6 Utilities Unit
2000 South Holly Street
Denver, Colorado 80222
(303) 757-9910



Utility Information Sheet (UIS)

PE Project No.: STA 1281-011; WBS #: 15782
CN Project No.: STA C800-001; WBS #: 16501

Project Description: 120th Avenue Connection- Phase I
Construct new 120th Avenue Connection alignment from Wadsworth Pkwy (SH 121) to Old Wadsworth Blvd. Construct new Commerce Street from Park Street to 118th Avenue. Also, minor realignment of Old Wadsworth Blvd.

UIS #: 09- 001
Utility Company: Xcel Energy Gas Distribution (Private)

Work Performed by: Utility Owner

Location: Wadsworth Blvd Sta 21+00 to 32+00

Existing Utility: 2" MW Buried Gas Facilities


Expected Impact: The Utility Owner shall relocate the existing buried gas facilities to accommodate the construction of the proposed Airport Creek Detention Pond and proposed drainage features (open ditch or RCP).

Attached: Plan Sheets

CDOT Representative: *Ron Dickey* 5-22-08
Ron Dickey – Region 6 Utility Manager Date

Utility Representative: *Michelle O'Nan* 5.22.08
(Print name): Michelle O'Nan Date

nazkowskeier 2:25:07 PM j:\transportation\072208.405\15782\Utilities\Drawings\15782\Utilities08.dgn

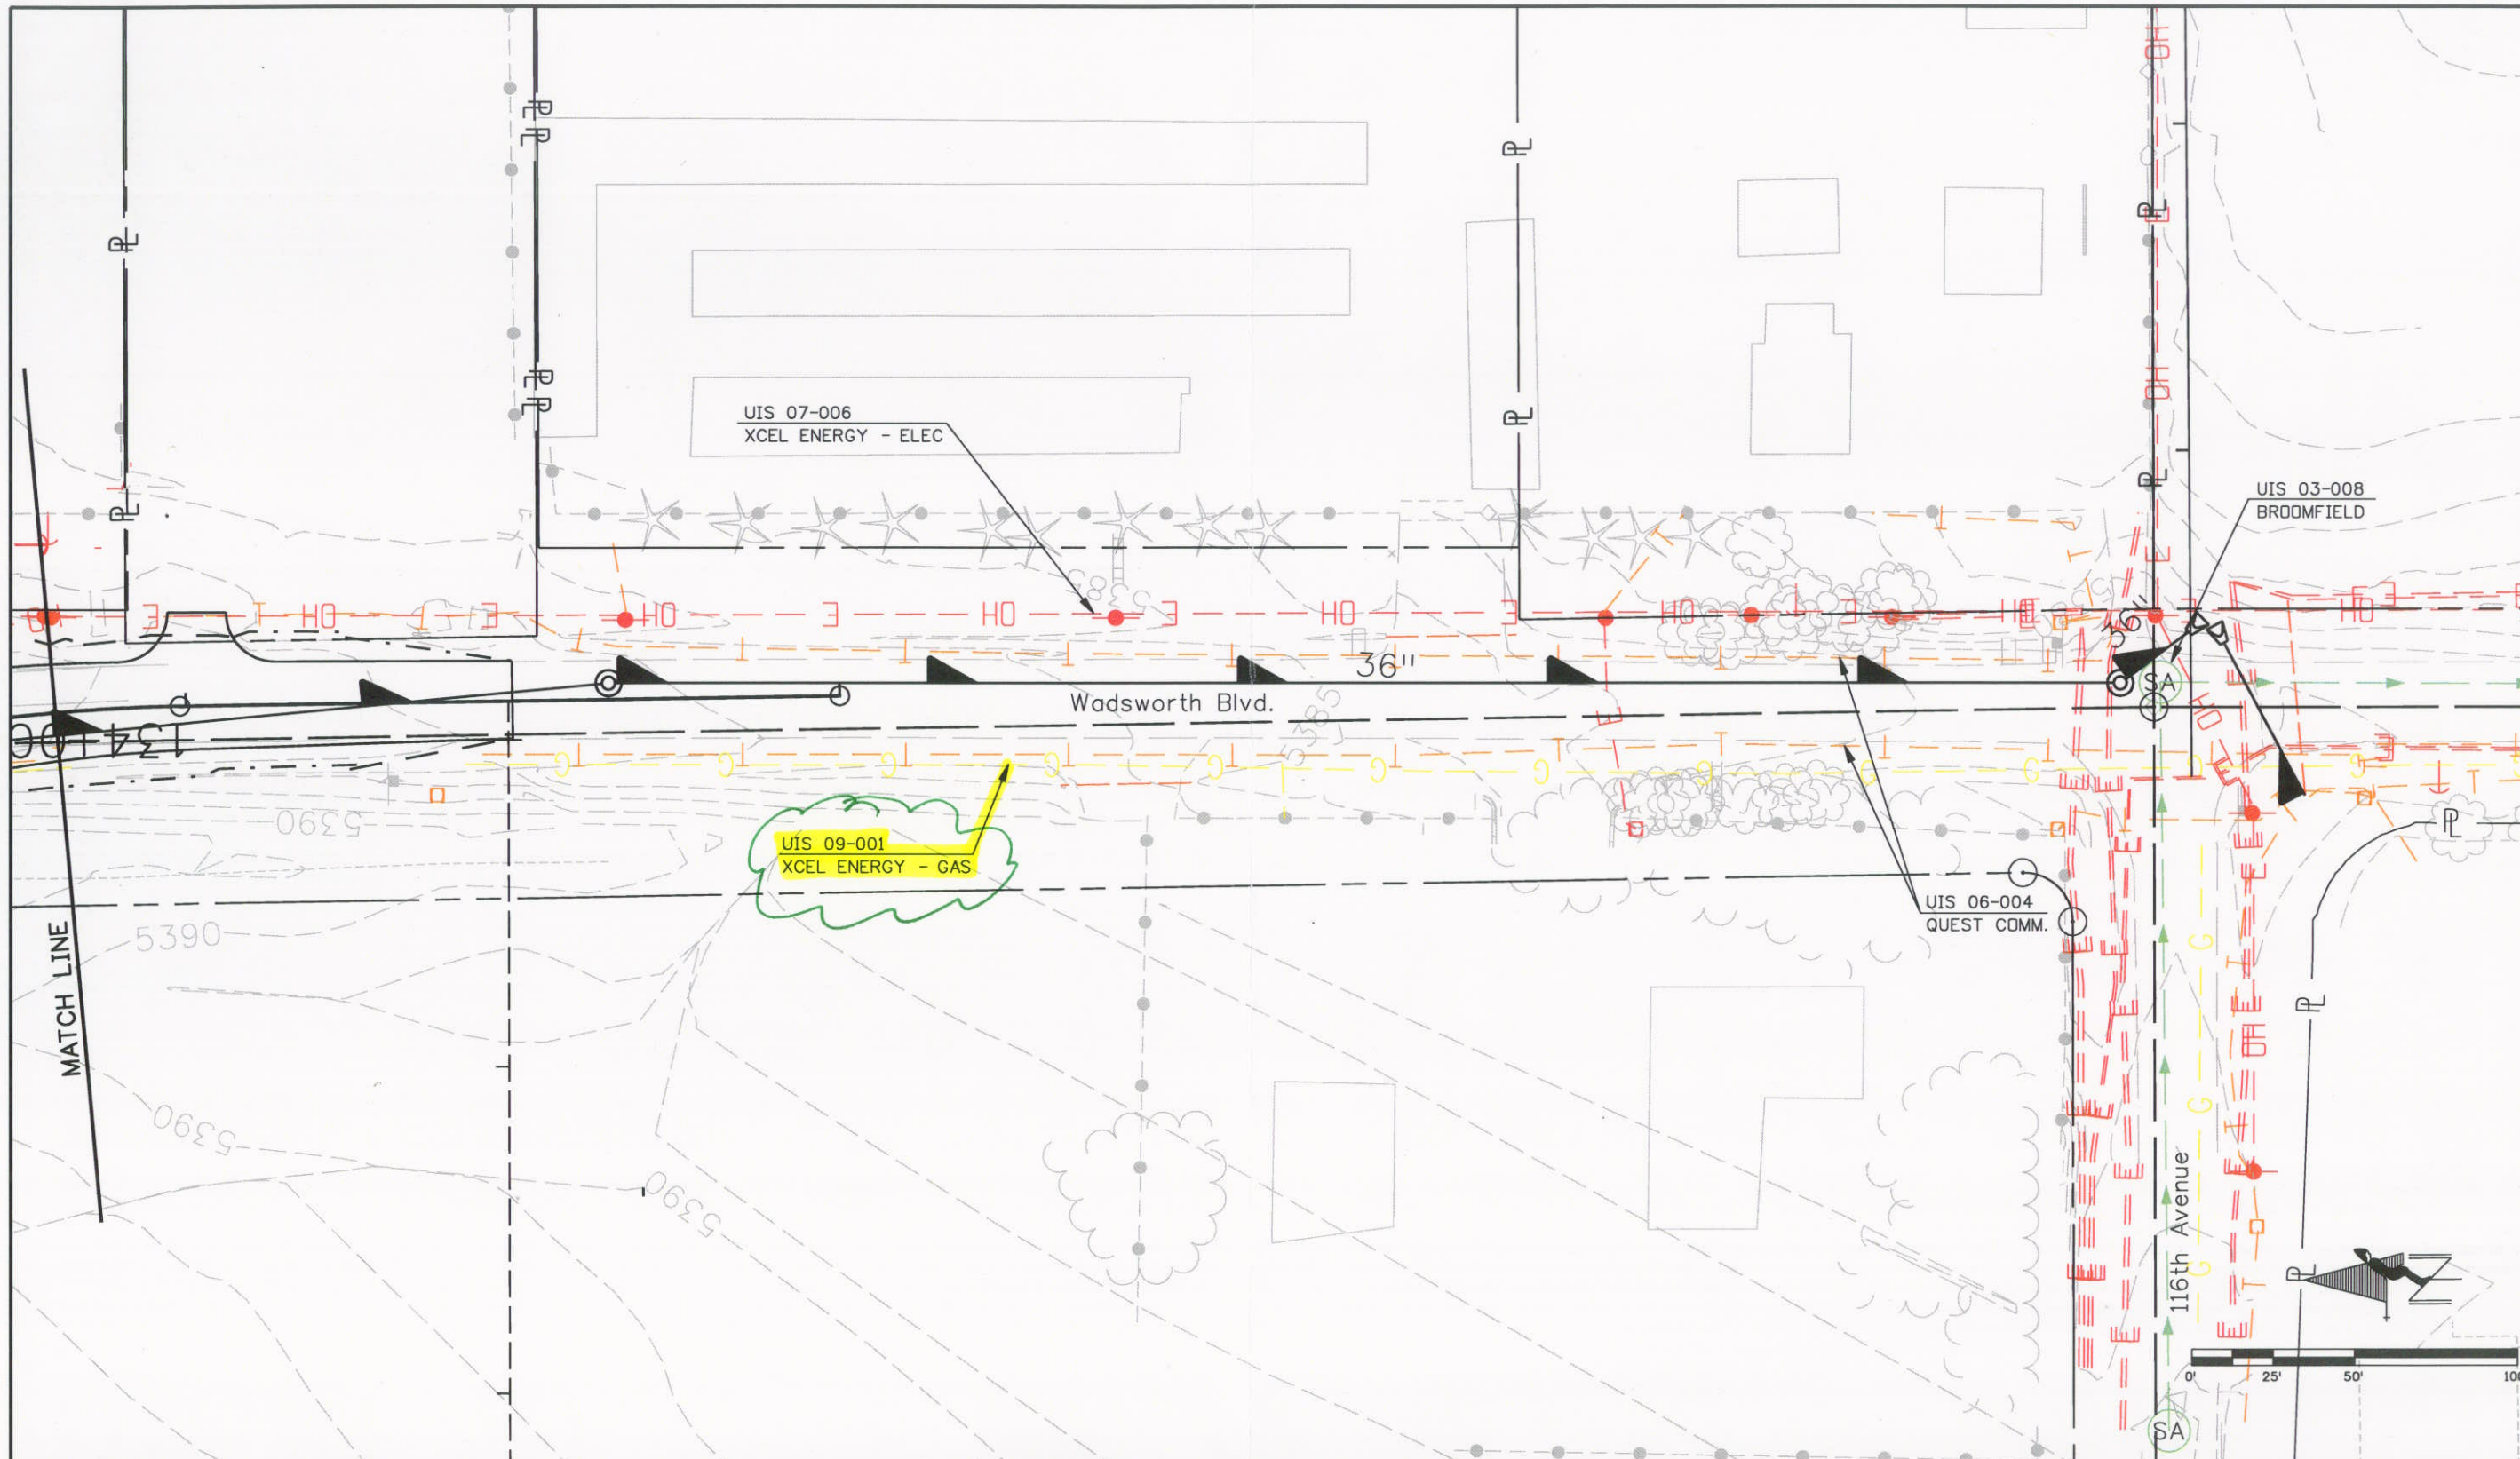

Print Date: 5/5/2008 File Name: 15782Utilities08.dgn Horiz. Scale: 1:50 Unit Information	R-X 0000	Sheet Revisions			Colorado Department of Transportation 4670 Holly Street Denver, CO 80216-6408 Phone: 303-398-6765 FAX: 303-398-6781 Region 6	As Constructed No Revisions: Revised: Void:	WADSWORTH BLVD. UTILITIES				Project No./Code
		Date:	Comments	Init.			STA 1281-011		Designer: EN Detailer: EN Sheet Subset: UT	Structure Numbers Subset Sheets: 08 of 10	X-XX-XX X-XX-XX