

EXHIBIT B UTILITY DESIGN SHEET

PROJECT

Utility Co. #	Conflict #
---------------	------------

Utility Owner: Woodmoor Water & Sanitation Public Private

SECTION TO BE COMPLETED PRIOR TO NEGOTIATION MEETING

Existing Condition 1524+ (at Higby Rd)

1. General Location _____

2. Utility type: Electric Gas Communications Water Sanitary Cable TV Irr. Canal
 Other _____

3. Location by: Utility plat maps; Field located and surveyed: Yes No; Pothole: Yes No
 If pothole, # _____ from: CDOT pothole or DBC pothole HCL used: _____
 Station: _____ to Station: _____ Dist. from HCL: _____ Rt. / Lt. _____

4. Utility size & type of materials: 12" PVC in 42" x 270' casing - by Asbuilt - 10' under I-25

5. Environmental Concerns: mouse

6. Encased: No Yes, if so size & material: 42" Steel
 This section completed by DBC Rep.: _____ Date: _____

SECTION TO BE COMPLETED AT NEGOTIATION MEETING

Proposed Resolution

1. Recommendation: left alone modified removed relocated upgraded abandoned in place
 Conflict with: _____

2. This utility may be modified/relocated to: _____
 Station: _____ to Station: _____ Dist. from HCL: _____ Rt./Lt. _____

3. Utility in: CDOT ROW other public ROW Easement (attach copy) other _____

4. Who will do the Utility Relocation Plan: Utility Company (UC) Design/Build Contractor (DBC)

5. Who will do the construction: Utility Company (UC) Design/Build Contractor (DBC)

6. UC to perform inspection? No Yes, if so conditions: _____

7. Number of days required for prior notification by DBC for construction by UC: _____ days



8. Number of days required by UC or DBC to complete Utility Relocation Plan: _____ days; Construction: _____ days.

9. Any construction details unique to this location? No Yes, if yes describe: _____

10. Utility can be disconnected for: _____ days/hours.

11. Other proposed action: _____

12. Contractor Drawings confirming conflict must be attached
 This section completed by: Utility Co. _____ Date; _____ DBC _____ Date; _____

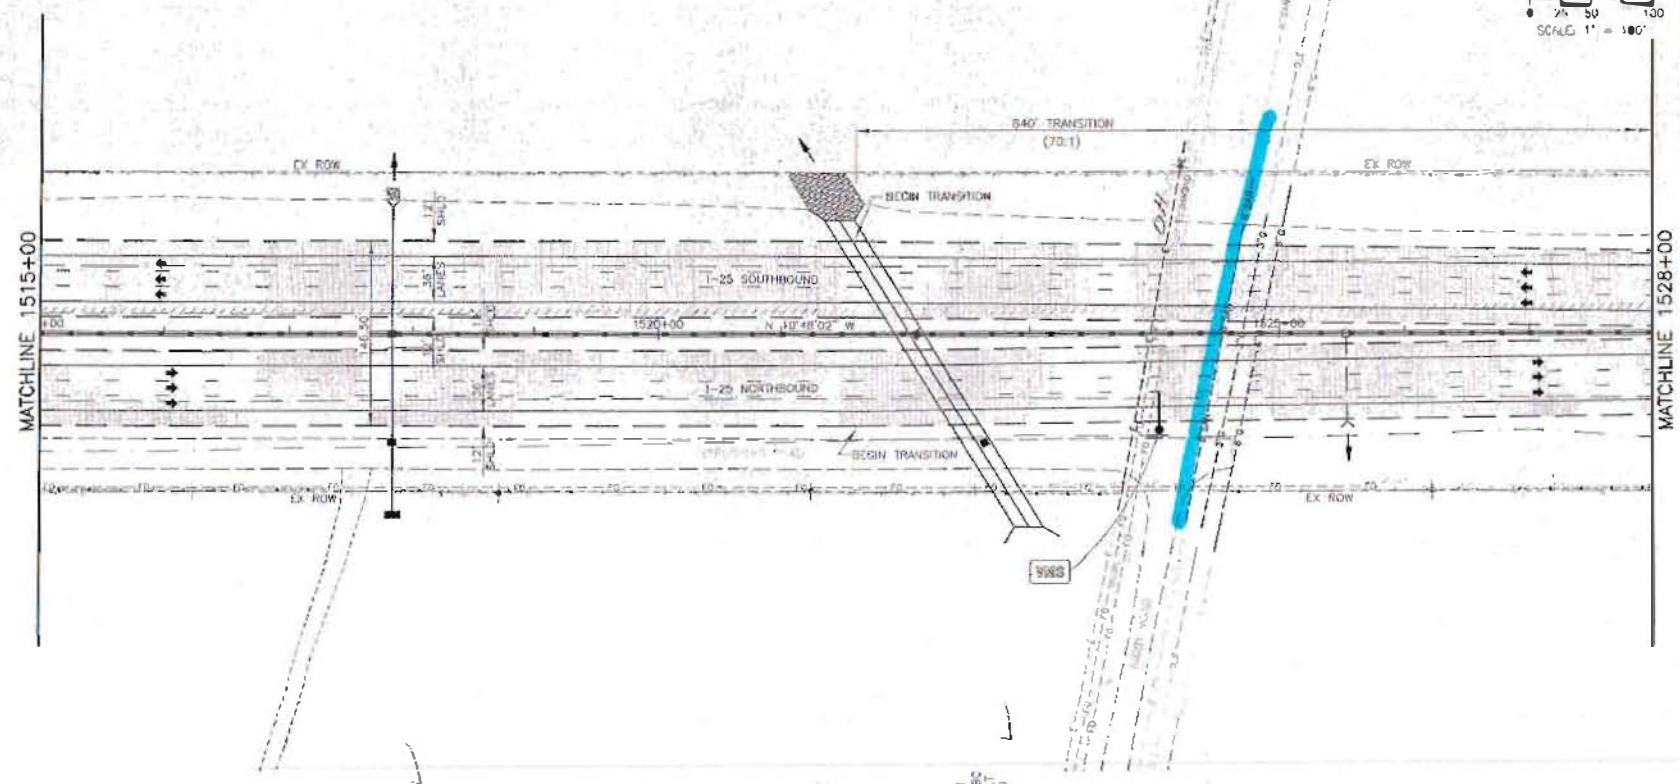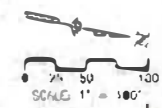

1517-84
 REMOVE 2' X 2' X 68' CONC
 24' X 125' RCP, 2 IM C/S
 RE-OPEN 30' X 245' RCP @ 0.8%
 INLET TYPE C MEDIAN AND RT,
 INLET TYPE C RT, END SECTION
 DIA 10 AC DIA 10 C/S
 DIA 25 C/S
 ALT - 4' DRAIN - 2.5'

1522-20
 REMOVE 4' X 4' X 225' CONC,
 HOWAL AND WINGWALLS LT AND RT
 RE-OPEN DOUBLE 10' X 6' X 205' CONC
 INLET TYPE C MEDIAN AND RT
 DIA 10 AC DIA 10 C/S
 DIA 25 C/S
 ALT - 4' DRAIN - 7.5'

1525-53
 REMOVE 24' X 30' RCP,
 INLET

WILSON & COMPANY
 Engineers & Architects

Computer File Information	
Creation Date: 11/13/01	Initials: MAK
Last Modification Date: 01/30/03	Initials: MAB
Full Path: P:\98310091\ACAD\SHETS	
Drawing File Name: RDPL106-113.DWG	
Acad Ver: 2000	Scale: As Shown Units: English

Sheet Revisions	

Colorado Department of Transportation



1480 Quail Lake Loop - Suite A
 Colorado Springs, Colorado 80906
 Phone: (719) 634-2323 Fax: (719) 227-5288

Region 2 JFF

As Constructed
No. Revisions:
Revised:
Void:

I-25 Roadway Plan 1515+00 to 1528+00	
Designer: MAB	
Checker: MAB	
Sheet Subst: ROADWAY	Subst Sheet: 165 of 113

Project No./Code
C 0252-316
12210
Sheet Number