


FEDERAL ROAD REGION NO.	DIVISION	PROJ. NO.	SHEET NO.	TOTAL SHEETS
9	COLORADO	I 25-2(44) 150	1	

# COLORADO DEPARTMENT OF HIGHWAYS

## PLAN AND PROFILE OF PROPOSED FEDERAL AID PROJECT NO. I 25-2(44) 150 STATE HIGHWAY NO. # 25 EL PASO COUNTY

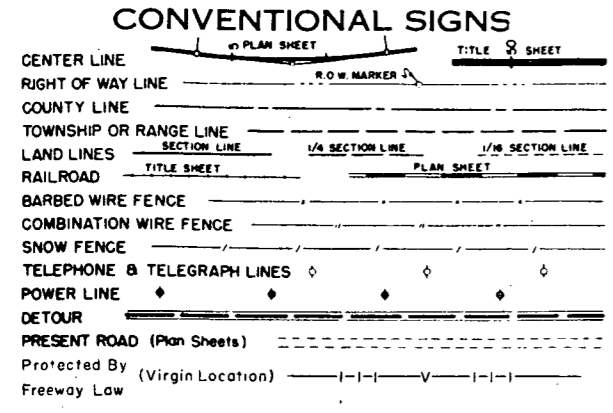


SCALES OF ORIGINAL DRAWINGS  
 ON PLAN 1 IN = 100 FT.  
 ON PROFILE 1 IN = 100 FT. HORIZONTAL  
 1 IN = 10 FT. VERTICAL  
 GRADE LINE ON PROFILE IS SHOWN AS GRADE OF FINISHED ROAD  
 GROSS LENGTH OF PROJECT } NO CENTERLINE LENGTH INVOLVED  
 NET LENGTH OF PROJECT }

### INDEX OF SHEETS

SHEET NO.	DESCRIPTION	REFERENCE
1	SKETCH MAP & TITLE PAGE.	
2	TYPICAL SECTIONS & GENERAL NOTES.	
3	SUMMARY OF APPROXIMATE QUANTITIES.	
4	SURFACING PLAN, SUMMARY OF EARTHWORK QUANTITIES, TABULATIONS OF CURB & GUTTER, SHOULDER ROLL & TIMBER GUARD POSTS.	
5	LIST OF STRUCTURE QUANTITIES.	
6	STANDARD METHODS FOR SUPERELEVATION & WIDENING OF CURVES.	
7	STANDARD SIDE APPROACH ROADS, FLARING, CUT SLOPE TREATMENT & WIDENING AT BRIDGES AND AT CREST OF GRADES.	M-1-D-1
8	STANDARD LETTERS & FIGURES FOR YEAR NUMBERS AND STRUCTURE NUMBERS.	M-2-EN
9	STANDARD NO. 12 AND NO. 13 CONCRETE INLETS.	M-10-D
10	STANDARD EMBANKMENT PROTECTORS.	M-12-E-13
11	STANDARD TIMBER GUARD POSTS.	M-13-C
12-13	STANDARD ROADWAY CONSTRUCTION TRAFFIC SIGNS.	M-19-E
14	STANDARD CURBS AND GUTTERS.	M-29-C
15	STANDARD CONCRETE INLET FOR MEDIAN DITCH.	M-45-A
16	STANDARD SINGLE & DOUBLE CONCRETE BOX CULVERTS.	M-46-B
17	STANDARD WINGWALLS FOR VARIOUS TYPES OF CONCRETE BOX CULVERTS.	M-50-B
18	STANDARD METHODS OF BACKFILL AROUND STRUCTURES.	M-50-B
19	STANDARD TYPES OF DITCHES & CONSTRUCTION METHODS.	M-60-B
20	REINFORCED CONCRETE CULVERT PIPE AND CONCRETE SEWER PIPE.	M-107-D
21	STANDARD END & ANGLE SECTIONS, & EXPANSION JOINTS FOR CONCRETE PIPE.	M-112-F
22	DETAILS OF INTERCHANGE, STA. 311+ ON S.H. NO. 1.	M-118-B
23-26	ALIGNMENT PLAN & PROFILE.	
27-52	CROSS SECTIONS.	
53	STRUCTURE CROSS SECTION.	

Location of  
 Project No.  
 I 25-2(44) 150

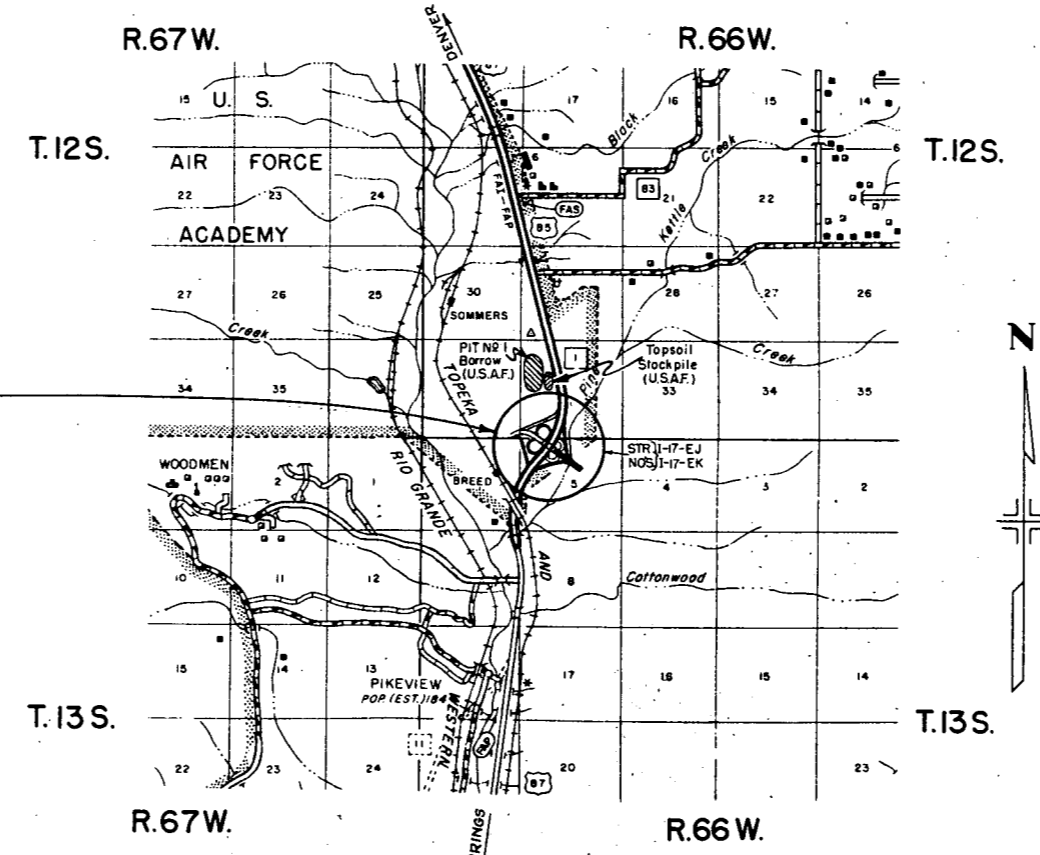

SEE SPECIAL PROVISIONS FOR NOTICE TO BIDDERS

COLORADO  
 DEPARTMENT OF HIGHWAYS  
 APPROVED  
  
 CHIEF ENGINEER 3-7-60  
 DATE


DEPARTMENT OF COMMERCE  
 BUREAU OF PUBLIC ROADS  
 APPROVED  
 DIVISION ENGINEER

# TYPICAL CROSS SECTIONS

FEDERAL ROAD REGION NO.	DIVISION	PROJ. NO.	SHEET NO.	TOTAL SHEETS
9	COLORADO	I 25-2(44)150	2	


Rev. Sect. To Show Future Overlay, E.E.Q. 1-12-61

TYPICAL SECTION "A", ROAD 80

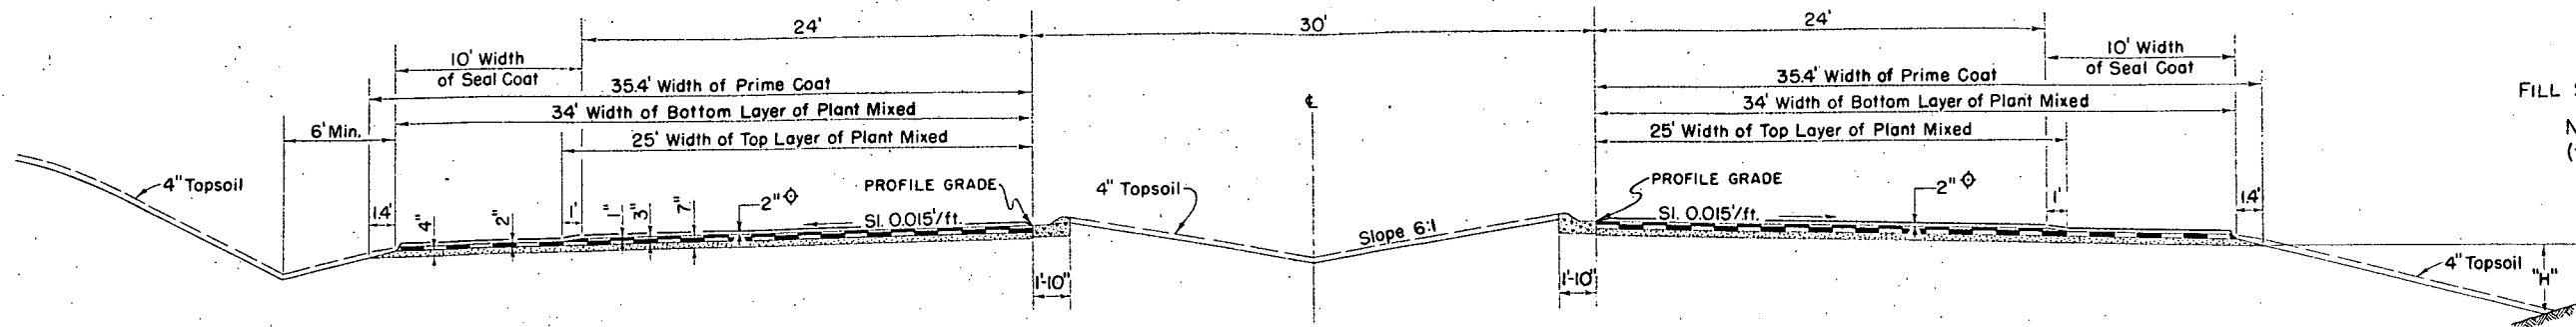

FILL SLOPES - Sections "A", "B" & "C"  
Not steeper than 4:1  
(for placing Topsoil)

TYPICAL SECTION "B"  
RAMPS 80D & 80F

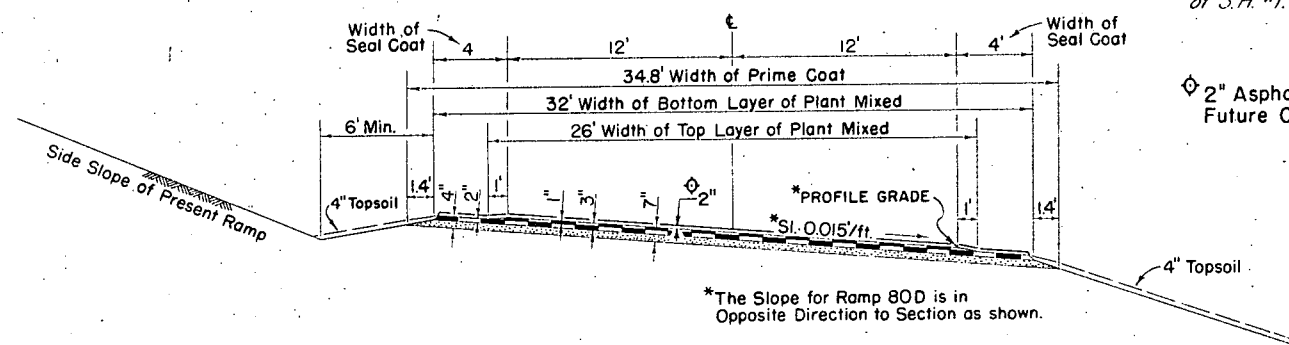


Note: Approximately 5200 Cu. Yds of "Placing Topsoil" will be required for this project. Material will be available on the U.S.A.F. Academy Grounds, 1 mile from center of interchange, near Kettle Creek on N.W. side of S.H. #1.

2" Asphaltic Concrete Pavement  
Future Overlay


\*The Slope for Ramp 80D is in Opposite Direction to Section as shown.

TYPICAL SECTION "D"

Assumed Typical Section for Construction of County Road to connect to Road 80.

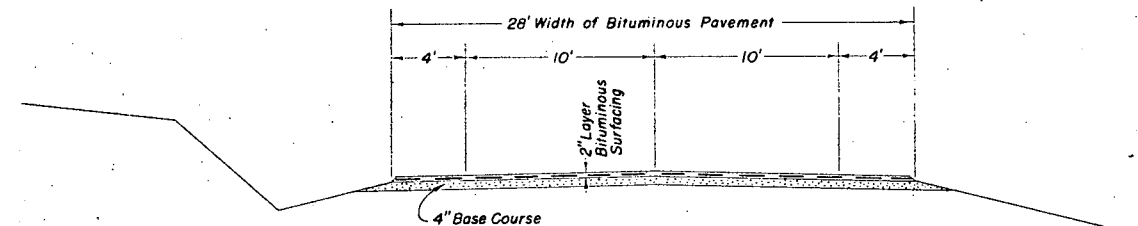

TYPICAL SECTION "C"  
RAMPS 80G & 80H

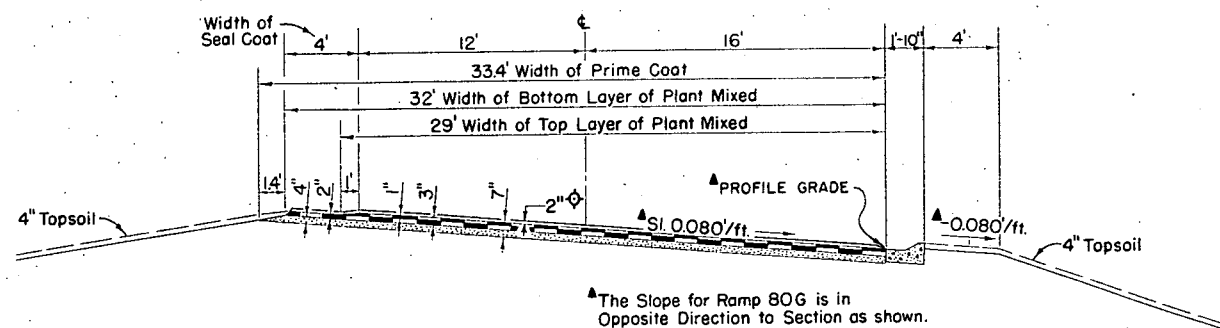

\*The Slope for Ramp 80G is in Opposite Direction to Section as shown.

## GENERAL NOTES

- ✓ This project is to be constructed in conformity with the Standard Specifications of the Colorado Department of Highways, adopted January 1, 1958.
- All quantities on preliminary plans are to be considered approximate only.
- All poles encroaching on construction are to be moved by the owners.
- All curves are to be superelevated and widened as provided by the Standard Superlevation sheet included with the plans.
- For preliminary plan quantities of Asphaltic Road Materials and Stone Screenings, the following rates of application were used:
 

PRIME COAT	MC	@ 0.40 Gals. per Sq. Yd.
PAVING ASPHALT	(85-100 Pen)	@ 6.67 Lbs./Sq. Yd./inch
SEAL COAT	RC	@ 0.22 Gals. per Sq. Yd.
STONE SCREENINGS	Type I	@ 24 Lbs. per Sq. Yd.

- Application methods for liquid asphaltic road material which result in the discoloration of concrete pavement, curbs or gutters will not be permitted.
- Approximate 7" compacted thickness of Gravel or Crushed Rock Surfacing shall be placed in separate courses at the following rates per square yard of roadway:
 

1" Top Layer Plant Mixed Asph. Surf.	111.2 Lbs.
2" Bottom Layer Plant Mixed Asph. Surf.	222.4 Lbs.
4" Base Course Surfacing	400 Lbs.
- The bottom 2" layer of Bituminous Surfacing shall be completed for full width before top 1" layer is placed. Paving joints in top layer will overlap a minimum of 1 ft. over joint in bottom layer.
- When ordered by the Engineer, a tack coat is to be applied between pavement courses to improve bond. Tack coat will be placed at the approximate rate of 0.07 to 0.10 gallon per square yard if required.



# SUMMARY OF APPROXIMATE QUANTITIES

FEDERAL ROAD REGION NO.	DIVISION	PROJ. NO.	SHEET NO.	TOTAL SHEETS
9	COLORADO	1 25-2(44)150	3	

ITEM NO.	ITEM	UNIT	TOTAL
10	Clearing and Grubbing Entire Project	L. S.	•
11	Reset Concrete Flared End Sections	Each	3
12	Removing Fence	Lin. Ft.	100
13	Unclassified Excavation	Cu. Yd.	201,000
13	Unclassified Ditch Excavation	Cu. Yd.	50
14	Unclassified Structural Excavation - Miscellaneous	Cu. Yd.	230
16	Structure Backfill (Class I)	Cu. Yd.	300
17	Compaction (Modified)	Cu. Yd.	225,000
17	Wellring	M. Gal.	5,710
18	Station Yard Overhaul	Sta. Yd.	2,242,000
18	Yard Mile Overhaul	Yd. Mi.	184,800
19	Placing Top Soil	Cu. Yd.	5,200
26	Gravel or Crushed Rock Surfacing (Grading C)	Ton	6,300
29	Asphalt (85 - 100 Penetration) (Tack Coat)	Ton	10
30	Asphaltic Road Material MC (Prime)	Gal.	12,900
30	Asphaltic Road Material RC (Seal)	Gal.	1,400
31	Stone Screenings (Type I)	Ton	90
32	Plant Mixed Asphaltic Surfacing	Ton	4,780
32	Plant Mixed Asphaltic Shoulder Roll	Ton	40
46	Class "A" Concrete	Cu. Yd.	132
47	Reinforcing Steel	Lb.	11,000
52	18" Reinforced Concrete Culvert Pipe (Class II)	Lin. Ft.	70
52	24" Reinforced Concrete Culvert Pipe (Class II)	Lin. Ft.	374
52	24" Reinforced Concrete Culvert Pipe (Class III)	Lin. Ft.	146
52	24" Reinforced Concrete Culvert Pipe (Class III)	Lin. Ft.	172
52	36" Reinforced Concrete Culvert Pipe (Class II)	Lin. Ft.	96
53	12" Corrugated Metal Culvert Pipe	Lin. Ft.	94
63	Grouted Rubble Slope and Ditch Paving	Cu. Yd.	10
84	Concrete Combination Curb and Gutter (Type F-M)	Lin. Ft.	4810
92	Timber Guard Posts	Each	86
93	Metal Embankment Protectors (Type 3)	Each	3
132	No 12 Inlet Grating and Frame	Each	2
132	Inlet Grating and Frame (Median)	Each	1
152	18" Flared End Sections for Reinf. Conc. Culv. Pipe	Each	1
152	24" " " " " " " " " " " " "	Each	1
152	36" " " " " " " " " " " " "	Each	2
<u>FORCE ACCOUNT</u>			
	Relocate Telephone Poles (Work by A.T.&T. Co Forces)	L. S.	•
	Relocate Power Poles (Work by City of Colorado Springs Forces) (Non Federal Aid)	L. S.	•
<u>STATE FORCES</u>			
	Signing and Striping Entire Project (Non Fed Aid)	L. S.	•

### SUMMARY OF EARTHWORK QUANTITIES

<b>EXCAVATION</b>	
FROM CROSS SECTIONS	1,781 ✓
BORROW	180,248 ✓
EST. FOR SUBSIDENCE	18,203 ✓
LIST OF STRUCTURES AS EXCAVATION	90 ✓
LIST OF STRUCTURES AS EMBANKMENT	10 ✓
EST. FOR CUT SLOPE TREATMENT	100 ✓
<b>TOTALS</b>	<b>200,432 Cu. Yds. ✗</b>
<b>EXCAVATION</b>	
FROM CROSS SECTIONS	1,781
BORROW	180,248
<b>TOTALS</b>	<b>182,029 Cu. Yds. ✗</b>
<b>EMBANKMENT</b>	
FROM CROSS SECTIONS	158,285 Cu. Yds. ✗
<b>EMBANKMENT X FACTOR</b>	182,029 Cu. Yds. ✗
<b>STATION YARD OVERHAUL</b>	
FROM MASS DIAGRAM	1,982,728 ✓
EST. FOR SUBSIDENCE	198,273 ✓
EST. FOR TOPSOIL	57,112 ✓
EST. FOR STRUCTURE BACKFILL	3,190 ✓
<b>TOTALS</b>	<b>2,241,303 Sta. Yds. ✗</b>
<b>YARD MILE OVERHAUL</b>	
FROM MASS DIAGRAM	163,271 ✓
EST. FOR SUBSIDENCE	16,327 ✓
EST. FOR TOPSOIL	4,917 ✓
EST. FOR STRUCTURE BACKFILL	277 ✓
<b>TOTALS</b>	<b>184,792 Yd. Mi. ✗</b>
<b>COMPACTION</b>	
EXCAVATION FROM EARTHWORK SUMMARY	200,432 ✓
BASE OF CUTS AND FILLS	24,050
<b>TOTALS</b>	<b>224,482 Cu. Yds. ✗</b>

### TIMBER GUARD POSTS

STATION	SIDE	SPACING	NO.
<i>Ramp 80G</i>			
0+50	Rt.	Exit	2
1+50 to 8+50	"	50'	15
9+16	Lt.	Culvert	1
9+50	Rt.	Entrance	5
<i>Ramp 80H</i>			
0+90	Lt.	Entrance	5
1+50 to 9+50	"	50'	17
8+75	Rt. & Lt.	Culvert	2
9+40	Rt.	"	1
10+06	Lt.	Exit	2
<i>Ramp 80D</i>			
1+38	Rt.	Exit	2
3+38 to 5+76	Rt. & Lt.	11° Curve	10
16+22	Rt.	Entrance	5
<i>Ramp 80F</i>			
1+78	Lt.	Entrance	5
3+26 to 5+78	"	11° Curve	5
11+60 to 15+18	"	"	5
16+10	"	Exit	2
<i>Road 80</i>			
182+80	Rt. & Lt.	Culvert	2
<b>Total</b>			<b>86</b>

### CURB & GUTTER TABULATION

STATION TO STATION	SIDE	LIN. FT.
<i>Ramp 80G</i> 0+00 to 10+36.7	Lt.	1,037
<i>Ramp 80H</i> 0+00 to 10+36.7	Rt.	1,037
<i>Weaving Lane</i> 308+55.6 to 313+97.6 (85-87)	Lt.	542
<i>Road 80</i> 171+05.7 to 182+00	Median	2,194
<b>TOTAL</b>		<b>4,810</b>

### SHOULDER ROLL TABULATION

STATION TO STATION	SIDE	LIN. FT.
<i>Ramp 80D</i> 0+00 to 2+00	Lt.	200
6+50 to 12+50	Lt.	600
<i>Ramp 80F</i> 0+00 to 4+10	Rt.	410
<i>Road 80</i> 175+00 to 179+95	Lt.	495
181+74.6 to 182+50	Lt.	76
175+00 to 180+65	Rt.	565
181+99 to 182+50	Rt.	51
<b>TOTAL</b>		<b>2,397 = 37 Tons</b>

### SURFACING PLAN

The source for Surfacing Material on this project is undesignated. Estimated quantities of Surfacing are shown below. Alteration of the plan as here outlined will be allowed only on written permission from the Department.

FEDERAL ROAD REGION NO.	DIVISION	PROJ. NO.	SHEET NO.	TOTAL SHEETS
9	COLORADO	125-2(AA)150	4	


MATERIAL TO BE PLACED	TONS USED GRADING C		
	TOP COURSE PLANT MIXED	BOTTOM COURSE PLANT MIXED	BASE COURSE
<i>Ramp 80G</i> Exit (-1+40 to 2+00)	31	70	127
2+00 to 8+00	108	240	438
Entrance (8+00 to 10+86.7)	42	97	180
<i>Ramp 80H</i> Entrance (-1+40 to 2+50)	42	97	180
2+50 to 8+00	99	220	402
Exit (8+00 to 10+86.7)	37	86	157
<i>Weaving Lane (Road 85-87)</i>	33	66	118
<i>Ramp 80D</i> Exit (0+00 to 3+00)	25	76	143
3+00 to 14+50	173	460	851
Entrance (14+50 to 17+92.4)	47	124	233
<i>Deceleration Lane</i>	32	84	158
<i>Ramp 80F</i> Entrance (0+00 to 3+00)	31	87	164
3+00 to 14+00	165	440	814
Exit (14+00 to 16+79.7)	35	91	171
<i>Acceleration Lane</i>	61	163	306
<i>Road 80</i> Connection (172+27.2 to 173+84)	26	54	98
173+84 to 178+98.6 Lt.	77	216	396
173+84 to 180+17.5 Rt.	95	266	488
178+98.6 to 181+99 Lt.	45	90	159
180+17.5 to 181+99 Rt.	27	54	96
<i>Taper (181+99 to 185+30.0)</i>	144	317	573
<b>TOTALS</b>	<b>4,773 ✓</b>		<b>6,252 ✓</b>

# LIST OF STRUCTURE QUANTITIES

FEDERAL ROAD DIVISION NO.	DISTRICT	PROJ. NO.	SHEET NO.	TOTAL SHEETS
9	COLORADO	I 25-2(44)150	5	

LOCATION	MISCELLANEOUS	REMOVE STRUCTURE	EXCAVATION			UNCLASSIFIED STRUCTURAL EXCAVATION MISCELLANEOUS CUBIC YARDS	STRUCTURE BACKFILL CUBIC YARDS	GRAVEL OR CRUSHED ROCK SURFACING TONS	CONCRETE CUBIC YARDS	REINFORCING STEEL LBS.	GROUTED RUBBLE SLOPE & DITCH PAVING CU. YDS	REINFORCED CONC. CULVERT PIPE					FLARED END SECTIONS FOR R.C.C.P.			METAL APRONS FOR C.M.P. CULVERTS NO.				
			CUBIC YARDS									CL. 1	CL. 2	CL. 3	CL. 4	CL. 5	CL. 6	18"	24"		36"	EACH		
			UNCL.	EMB.	UNCL. DITCH																	18"	24"	36"
<u>RAMP 80 G</u> 9+	1-Reset Flared End Section 1-No 12 Inlet Grating and Frame		3			22	12		72	137														
<u>RAMP 80 H</u> 2+50 8+75 9+40	1-Reset Flared End Section 1-No. 12 Inlet Grating and Frame					21 6 8	25 19 6																	
<u>RAMP 80 D</u> 4+18 12+30 12+50 14+70	1-Metal Embankment Protector (Type 3) 35 Lin. Ft. of 12" C.M.P.					39 26 1 11	47 52 20		0.4															
<u>RAMP 80 F</u> 3+50 10+30 326+00 (S.H.#1)	1-Reset Flared End Section					34 26 3	41 31 4																	
<u>ROAD 80</u> 181+50 182+40 182+80 183+	1-Inlet Grating and Frame (Median) 2-Metal Embankment Protectors (Type 3) 22 Lin. Ft. of 12" C.M.P. & 34 Lin. Ft. of 12" C.M.P. 100-Lin. Ft. Removing Fence		10			11 2 16	15 18		1.71 0.8 12680	127 10,517	3	70												
<b>Project Totals</b>			90	10	5	226	290		131.5	10,900	3	70	374	146	172	96	1	11	2					
⊕ Class of pipe based on Ordinary Bedding																								

FEDERAL ROAD DISTRICT NO.	DIVISION	PROJ. NO.	SHEET NO.	TOTAL SHEETS
9	COLORADO	125-2 (44) 150	6	

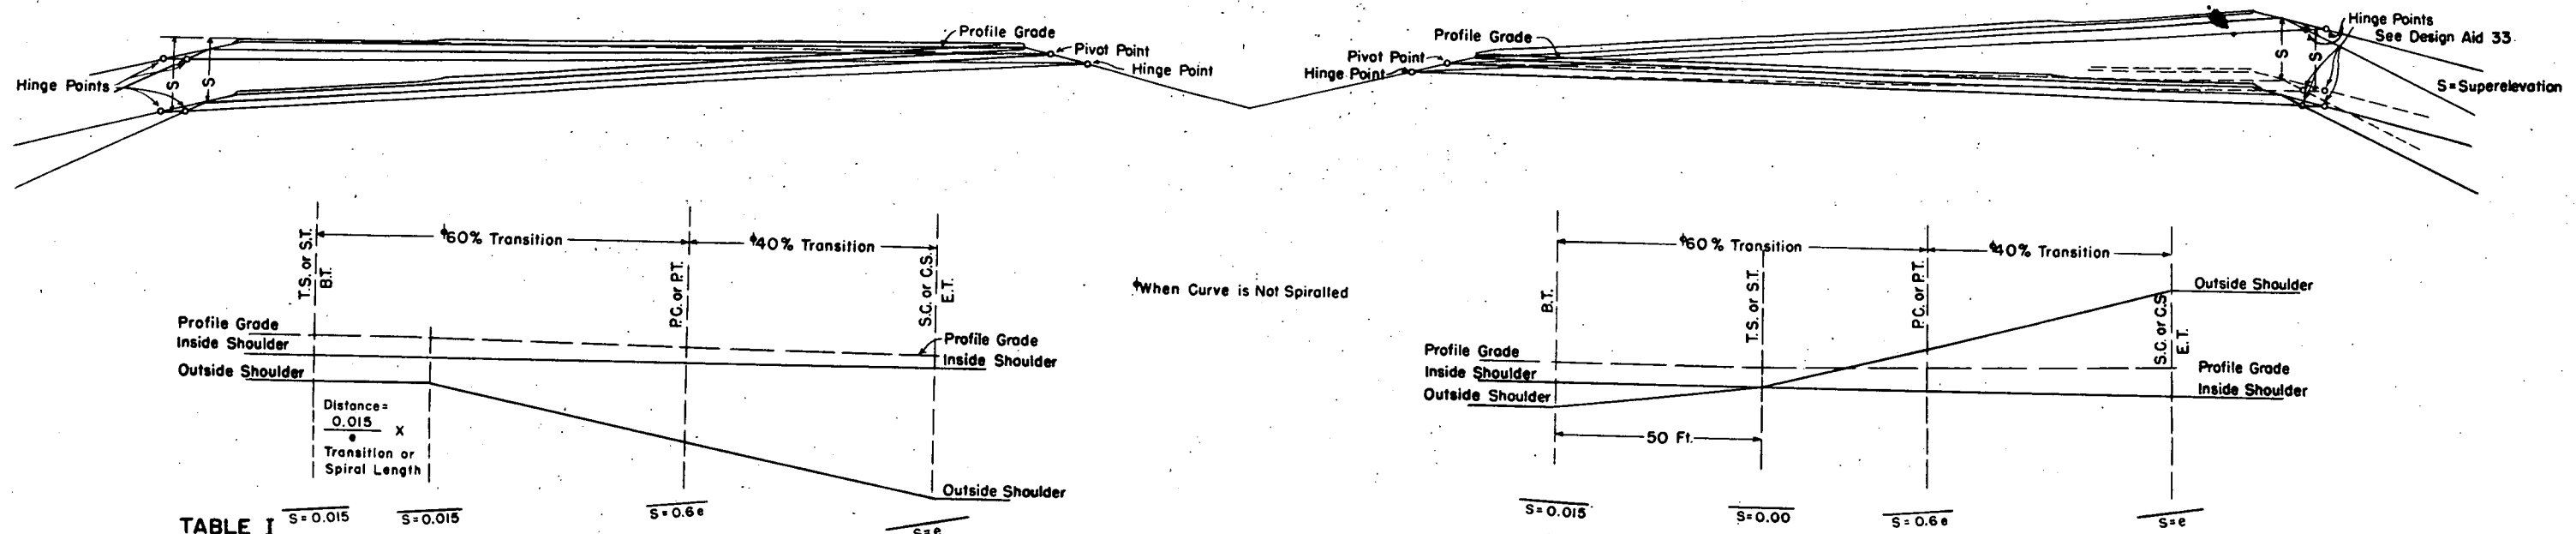

**TABLE I**  
MAXIMUM SPEEDS & REQUIRED TRANSITION OR SPIRAL LENGTHS FOR FOUR LANE DIVIDED HIGHWAYS

Degree of Curve	Maximum Superelevation = 0.08			Maximum Superelevation = 0.12		
	Super. Rate Ft./Ft.	Maximum Design Speed M.P.H.	Minimum Transition or Spiral Length	Super. Rate Ft./Ft.	Maximum Design Speed M.P.H.	Minimum Transition or Spiral Length
0° 15'	0.015	>70	100'	0.015	>70	100'
0° 30'	0.015	>70	100'	0.015	>70	100'
0° 45'	0.021	>70	100'	0.021	>70	100'
1° 00'	0.028	>70	100'	0.029	>70	100'
1° 30'	0.042	>70	150'	0.043	>70	150'
2° 00'	0.056	>70	200'	0.057	>70	200'
2° 30'	0.069	>70	250'	0.071	>70	250'
3° 00'	0.077	>70	300'	0.086	>70	300'
3° 30'	0.080	70	350'	0.100	>70	350'
4° 00'	0.080	66	350'	0.114	70	400'
5° 00'	0.080	60	300'	0.120	65	400'
6° 00'	0.080	55	300'	0.120	60	350'
7° 00'	0.080	52	300'	0.120	56	350'
8° 00'	0.080	49	300'	0.120	53	350'
9° 00'	0.080	46	250'	0.120	50	300'
10° 00'	0.080	44	250'	0.120	48	300'
11° 00'	0.080	42	250'	0.120	46	300'
12° 00'	0.080	41	250'	0.120	44	300'
13° 00'	0.080	39	200'	0.120	42	300'
14° 00'	0.080	38	200'	0.120	41	250'
15° 00'	0.080	37	200'	0.120	39	250'
16° 00'	0.080	36	200'	0.120	38	250'
17° 00'	0.080	35	200'	0.120	37	250'
18° 00'	0.080	34	200'	0.120	36	250'
19° 00'	0.080	33	200'	0.120	35	250'
20° 00'	0.080	32	200'	0.120	34	250'
21° 00'	0.080	31	200'	0.120	34	250'
22° 00'	0.080	30	200'	0.120	33	250'
23° 00'	0.080	30	200'	0.120	32	250'
24° 00'	0.080	29	150'	0.120	32	200'
25° 00'	0.080	29	150'	0.120	31	200'
26° 00'	0.080	28	150'	0.120	30	200'
27° 00'	0.080	28	150'	0.120	30	200'

NOTE - Plains Areas use 0.12 Superelevation. Mountainous Areas & areas where icing conditions frequently exist, use 0.08 Superelevation.

**TABLE II**  
MINIMUM SUPERELEVATION RATES & TRANSITION LENGTHS TO BE USED WHEN MAXIMUM SPEED IS FIXED, AS IN URBAN ROADWAYS

Degree of Curve	25 M.P.H.		30 M.P.H.		35 M.P.H.		40 M.P.H.		45 M.P.H.		50 M.P.H.		55 M.P.H.		60 M.P.H.		
	Minimum Super. Rate Ft./Ft.	Minimum Transition or Spiral	Minimum Super. Rate Ft./Ft.	Minimum Transition or Spiral	Minimum Super. Rate Ft./Ft.	Minimum Transition or Spiral	Minimum Super. Rate Ft./Ft.	Minimum Transition or Spiral	Minimum Super. Rate Ft./Ft.	Minimum Transition or Spiral	Minimum Super. Rate Ft./Ft.	Minimum Transition or Spiral	Minimum Super. Rate Ft./Ft.	Minimum Transition or Spiral	Minimum Super. Rate Ft./Ft.	Minimum Transition or Spiral	
0° 15'	Normal Slope		Normal Slope		Normal Slope		Normal Slope		Normal Slope		Normal Slope		Normal Slope		N. S.	0.015	100'
0° 30'	"		"		"		"		"		"		"		0.015	100'	100'
0° 45'	"		"		"		"		"		"		"		0.015	100'	100'
1° 00'	"		"		"		"		"		"		"		0.015	100'	100'
1° 30'	"		0.015	100'	0.015	100'	0.015	100'	0.015	100'	0.015	100'	0.015	100'	0.015	100'	100'
2° 00'	"		0.015	100'	0.015	100'	0.015	100'	0.015	100'	0.015	100'	0.015	100'	0.015	100'	100'
2° 30'	"		0.015	100'	0.015	100'	0.015	100'	0.015	100'	0.015	100'	0.015	100'	0.015	100'	100'
3° 00'	0.015	100'	0.015	100'	0.015	100'	0.015	100'	0.015	100'	0.015	100'	0.015	100'	0.015	100'	100'
3° 30'	0.015	100'	0.015	100'	0.015	100'	0.015	100'	0.015	100'	0.015	100'	0.015	100'	0.015	100'	100'
4° 00'	0.015	100'	0.015	100'	0.015	100'	0.015	100'	0.015	100'	0.015	100'	0.015	100'	0.015	100'	100'
5° 00'	0.015	100'	0.015	100'	0.015	100'	0.015	100'	0.015	100'	0.015	100'	0.015	100'	0.015	100'	100'
40° 00'	0.120	150'			0.073	200'	0.073	250'	0.073	250'	0.073	250'	0.073	250'	0.073	250'	250'

NOTES - Includes 50 Ft. of Runout when Spiralled. Transition or Spiral Lengths are shown in the tables for 4 Lane Divided Highways. For 6 Lane Divided Highways use 1.2 times the lengths shown, rounded to the nearest 50 feet.

FORMULAE FOR TABLES

$$D = \frac{95,950(e+f)}{V^2}$$

$$L_s = \frac{1.6 \times D \times V^3}{5730}$$

D = Degree of Curve  
 e = Superelevation Rate - Ft. per Ft. of Width  
 f = Side Friction Factor (varies from 0.12 at 70 M.P.H. to 0.16 at 30 M.P.H.)  
 V = Velocity - M.P.H.  
 L<sub>s</sub> = Spiral Length - Feet  
 Note for Table II - A straight line transition was used for e from 0.015 to 0.06.


**COLORADO DEPARTMENT OF HIGHWAYS**  
**METHODS FOR SUPERELEVATION OF CURVES DIVIDED HIGHWAYS**  
 Designed by R.W.L. Approved by S.B.L.  
 Made by S.B.L.

# STANDARD SIDE APPROACH ROADS, FLARING, CUT SLOPE TREATMENT & WIDENING AT BRIDGES AND AT CREST OF GRADES



# STANDARD M-2-EN

FED. ROAD RES. NO.	DIVISION	SHEET NO.	TOTAL SHEETS
9	COLO.	150 7	150 7


## GENERAL DETAILS FOR FLARING OF EARTH CUTS, CUT SLOPE TREATMENT & WIDENING AT BRIDGES

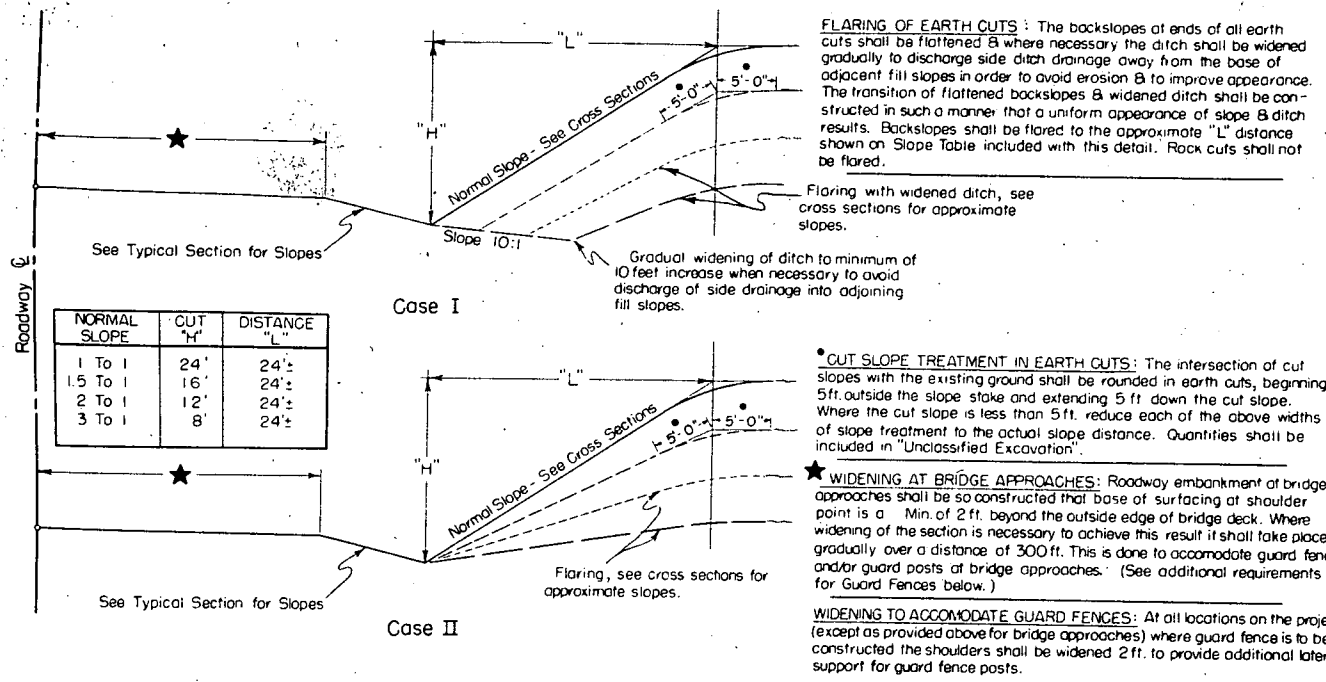


PLAN OF FLARING IN EARTH CUTS

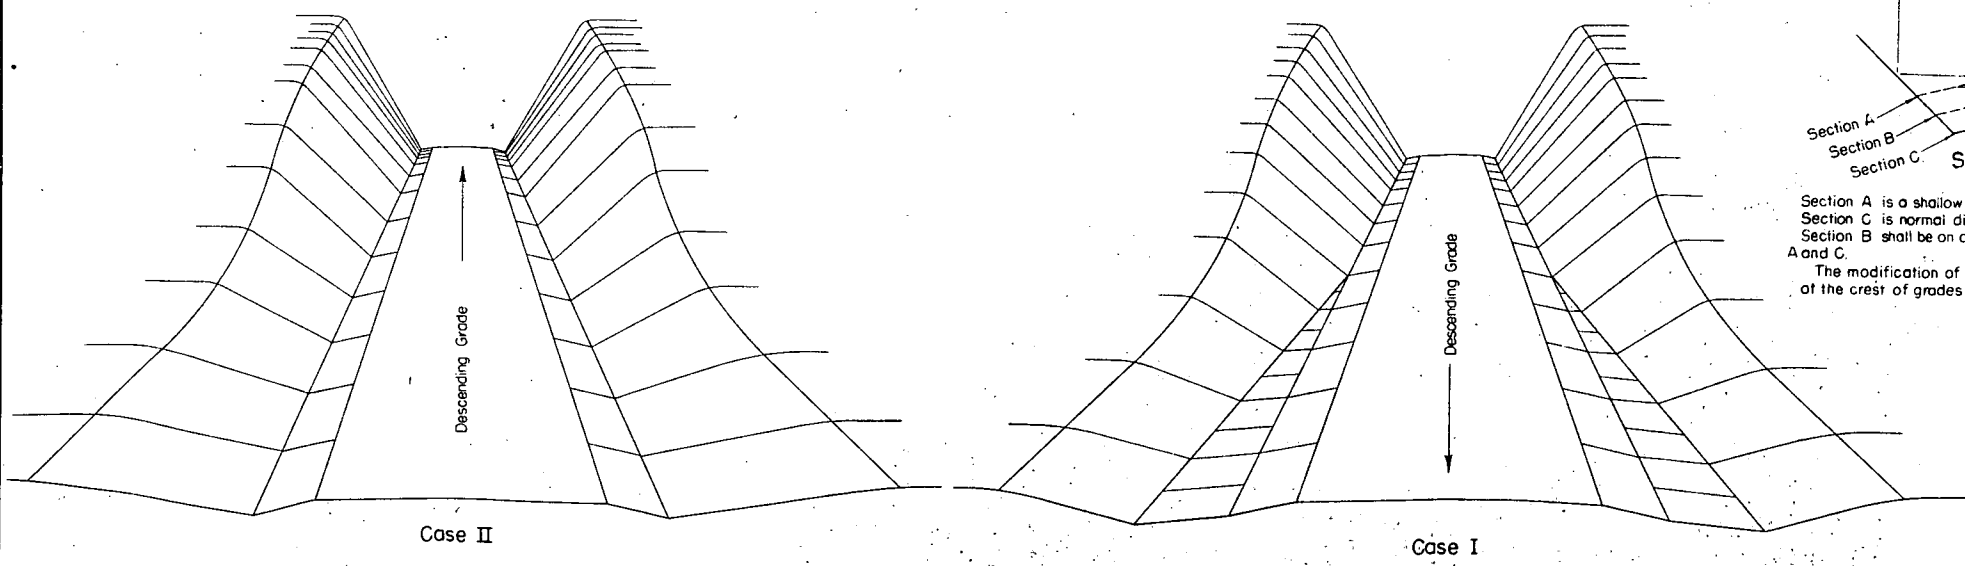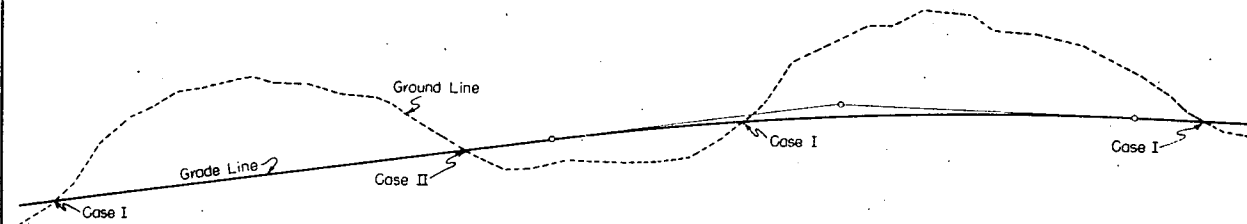

## TYPICAL PLANS FOR SIDE APPROACH ROADS

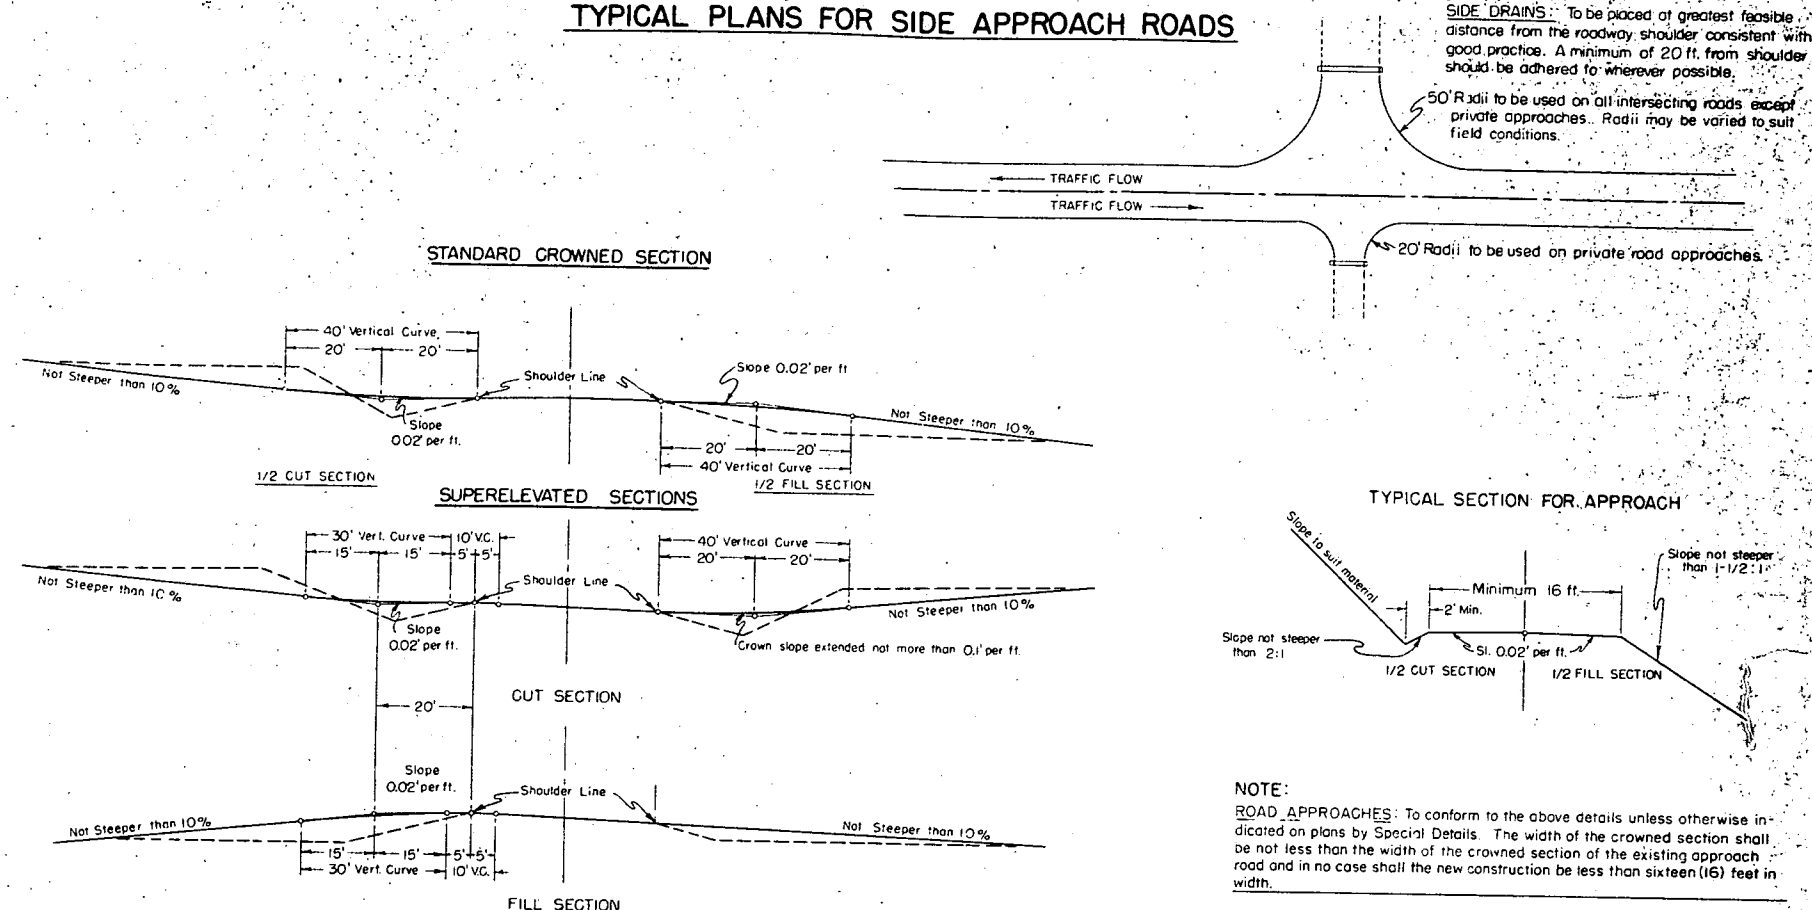

## DETAILS FOR DITCH & WIDENED SHOULDERS AT CREST OF GRADES (TO BE USED ONLY WHERE SIGHT DISTANCE AT CREST OF GRADE IS 600 FT. OR LESS)

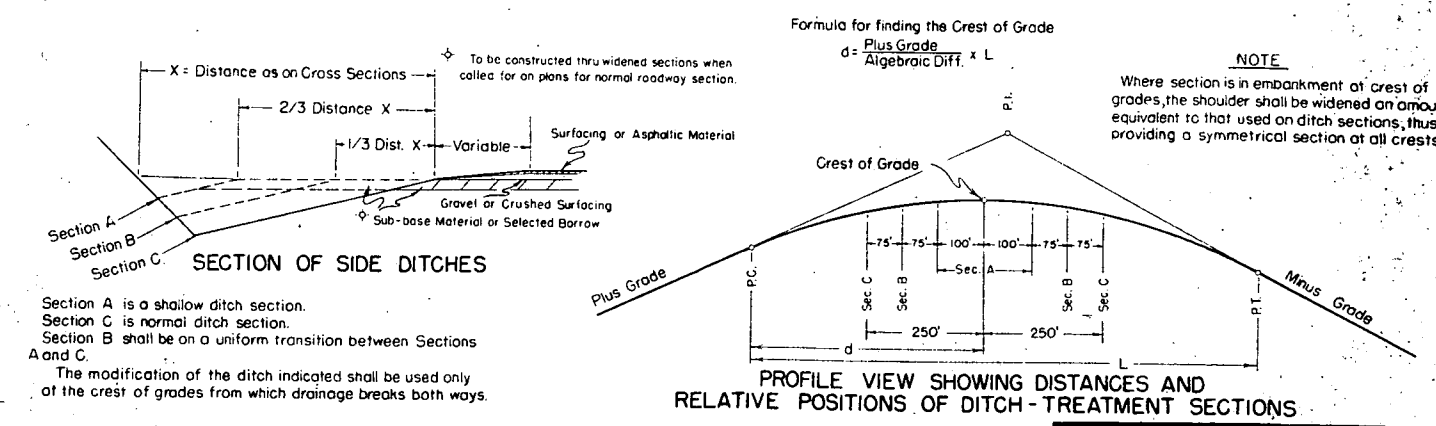

## GENERAL NOTES

All work shall be done in accordance with the Standard Specifications of the Colorado Department of Highways applicable to the Project.

All side approach roads to the Project shall be Gravel Surfaced with a four (4) inch thickness of "Gravel or Crushed Rock Surfacing" extending approximately to the Right of Way Line. Estimated tonnage & type of material required for this operation are shown in the Surfacing Plan.

The maximum grades shown are to be the limiting grades for all road approaches. Modifications of grades will be permitted where adherence to the grades as shown would cause damage to property or create other unsatisfactory conditions. Grades less than the maximum shown are to be used wherever feasible.

**COLORADO DEPARTMENT OF HIGHWAYS**

**STANDARD SIDE APPROACH ROADS, FLARING, CUT SLOPE TREATMENT, AND WIDENING AT BRIDGES AND AT CREST OF GRADES**

Designed by A.Z. Approved by A. Julian  
 Made by SJM & ABH  
 Checked by C.R.S. Date: November 1, 1953






FED. ROAD REG. NO.	DIVISION	PROJECT NO.	SHEET NO.	TOTAL SHEETS
9	COLO.	125-2 (44)	150 8	



Scale in inches  
 0 1 2 3

Initial	Date

abcdefghijklmnopqrstuvwxyz

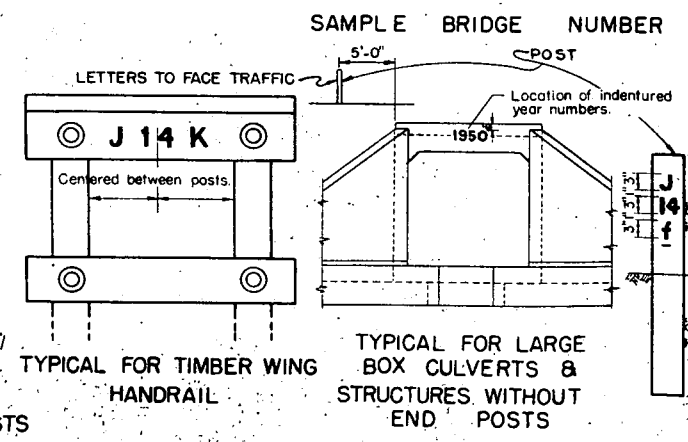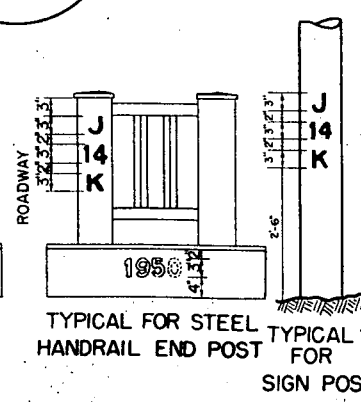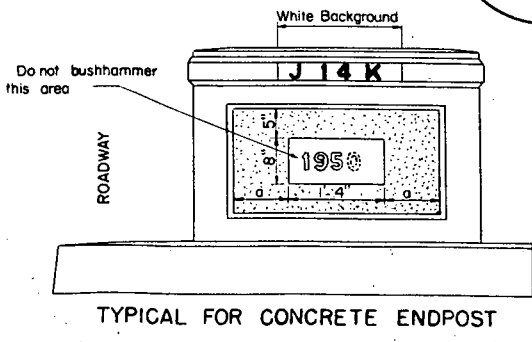

SAMPLE BRIDGE NUMBER

SAMPLE YEAR NUMBER

**GENERAL NOTES**

ALL WORK SHALL BE DONE IN ACCORDANCE WITH THE STANDARD SPECIFICATIONS OF THE COLORADO DEPARTMENT OF HIGHWAYS APPLICABLE TO THE PROJECT. THE SIZE SHAPE AND SPACING OF THE LETTERS AND FIGURES SHALL BE IN ACCORDANCE WITH THE FULL SIZE SHOWN ON THIS SHEET. ADDITIONAL COPIES OF THIS FULL SIZE SHEET CAN BE OBTAINED FROM THE DEPARTMENT WITHOUT CHARGE.

THE YEAR NUMBERS ARE RECESSED IN CONCRETE 1/2" MINIMUM AS SHOWN IN THE PANEL OF THE ENDPPOST ON THE RIGHT HAND SIDE OF EACH BRIDGE END AND INTO THE FACE OF THE DOWNSTREAM HEADWALL OF CULVERTS AS SHOWN ON PLAN DETAILS. NUMBERS TO BE MADE OF WOOD, METAL OR OTHER SUITABLE MATERIAL AND ATTACHED TO THE FORMS BEFORE CONCRETE IS POURED. THE YEAR NUMBER OF EACH STRUCTURE SHALL CORRESPOND WITH THE YEAR IN WHICH THE CONCRETE IS POURED.

THE STRUCTURE NUMBER SHALL BE STENCILED ON THE BRIDGE. THE CORRECT STRUCTURE NUMBER SHALL BE SHOWN ON THIS STANDARD AND AS SPECIFIED WHERE THE STRUCTURE HAS NO END POSTS THE NUMBER SHALL BE PLACED ON A POST ON THE RIGHT HAND SIDE OF THE ROAD AS SHOWN. FOR SIGNS THE NUMBER SHALL BE PLACED ON SIGN POSTS ON THE RIGHT HAND SIDE OF THE ROADWAY.

THE CORRECT NUMBER FOR EACH BRIDGE OR SIGN IS SHOWN ON THE PLANS.

THE NUMBERS FOR MAJOR STRUCTURES OF OVER 20 FEET CLEAR SPAN SHALL BE UPPER CASE LETTERS. THE NUMBERS FOR MINOR STRUCTURES OF 12 TO 20 FEET CLEAR SPAN SHALL BE LOWER CASE LETTERS. SIGN BRIDGES SHALL BE CONSIDERED AS MAJOR STRUCTURES.

A PROPER WHITE BACKGROUND RECTANGULAR IN SHAPE AND EXTENDING THREE INCHES BEYOND THE LIMITS OF THE NUMBER SHALL BE PAINTED WITH TWO COATS OF ACCEPTABLE WHITE PAINT UNLESS AN APPROVED WHITE CONCRETE PAINT IS USED. BEFORE PAINTING THE SURFACE MUST BE THOROUGHLY DRIED, CLEANED AND PROPERLY SIZED ON TIMBER HANDRAILS THE WHITE PAINT USED ON THE BRIDGE WILL BE SATISFACTORY.

AFTER THE WHITE BACKGROUND HAS DRIED SUFFICIENTLY, THE CORRECT STRUCTURE NUMBER SHALL BE CAREFULLY STENCILED ON IT, WITH TWO COATS OF "SECOND FIELD COATS" DARK OR EXTERIOR BLACK PAINT (MAINT) AS SPECIFIED UNDER ITEM 30 "PAINTS AND PAINTING". THE BRACES OF THE STENCILED LETTERS AND FIGURES SHALL BE CAREFULLY FILLED IN BY HAND TO MAKE SOLID FIGURES.

SUFFICIENT TIME BETWEEN SUCCESSIVE COATS SHALL BE ALLOWED TO PERMIT THORO DRYING.

THE COST OF PAINTING OF STRUCTURE NUMBERS AND FURNISHING AND PLACING POSTS FOR STRUCTURE NUMBERS SHALL BE CONSIDERED SUBSIDIARY WORK AND SHALL BE INCLUDED IN THE ORIGINAL CONTRACT ITEMS AND WILL NOT PAID FOR AS A SEPARATE ITEM.

THE LENGTH OF SPAN OF STRUCTURE SHALL BE MEASURED ALONG CENTER LINE OF ROADWAY. IN CASE OF DOUBLE OR MULTIPLE BOX CULVERTS THE CENTER WALL OR WALLS SHALL BE DISREGARDED AND CLEAR SPAN MEASURED FROM INSIDE OF END WALLS.

**COLORADO DEPARTMENT OF HIGHWAYS**

STANDARD LETTERS AND FIGURES FOR YEAR NUMBERS AND STRUCTURE NUMBERS

Designed by \_\_\_\_\_  
 Made by \_\_\_\_\_  
 Checked by \_\_\_\_\_

Approved by \_\_\_\_\_  
 Bridge Engineer  
 Date: Feb. 17, 1950

STRUCTURE NO.



# STANDARD M-12-E-13

## NO. 12 CONCRETE INLET

FED. ROAD REGION NO.	DIVISION	SHEET NO.	TOTAL SHEETS
9	COLO.	125-2 (44) 150 9	


## NO. 12 CONCRETE INLET

### BAR LIST FOR H = 3' 0"

MARK	SIZE	NO. REQD.	LENGTH	TYPE	DIMENSIONS		BENDING DIAGRAM ALL DIMENSIONS ARE OUT TO OUT OF BAR
					l	m	
601	3/4"	Note	2' 6"	I	1'-0"	0'-10"	
401	1/2"	3	11'-10"	III	2'-6"	2'-6"	
402	1/2"	5	5'-6"	I	2'-5"	1'-7"	
403	1/2"	5	7'-1"	I	2'-7"	1'-8"	
404	1/2"	2	2'-7"	STR.	-	-	

\* Omit 601 when H is 4'-0" or less.  
 \* These dimensions to be increased in increments of 6" for H above 3'-0".  
 Add 1-401 for each 6" additional height above 3'-0".  
 601 required as follows:  
 H = 4'-6" to 5'-6" - 1 bar; H = 9'-0" to 10'-0" - 4 bars  
 H = 6'-0" to 7'-0" - 2 bars;  
 H = 7'-6" to 8'-6" - 3 bars;  
 Cut or bend bars around pipes as required.


See Plans for size and locations of outlets.

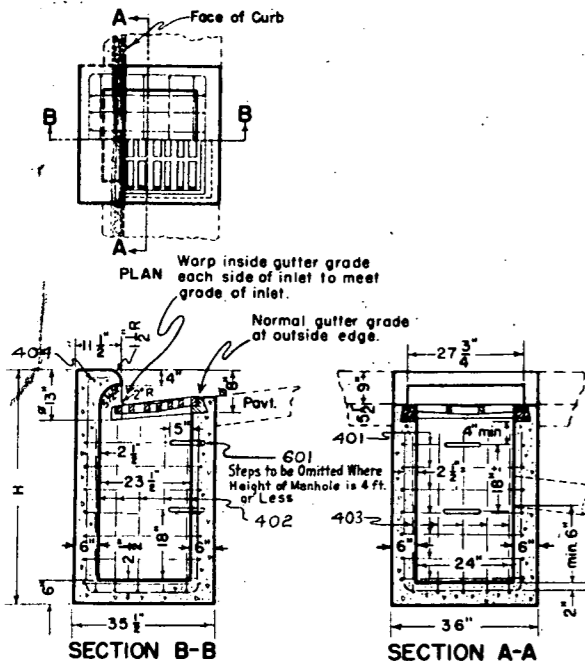

\* These dimensions for 6" curb. Dimensions to be modified as required for other heights of curb.

### NO. 12 INLET GRATING & FRAME

Approx. Weight 340 lbs.

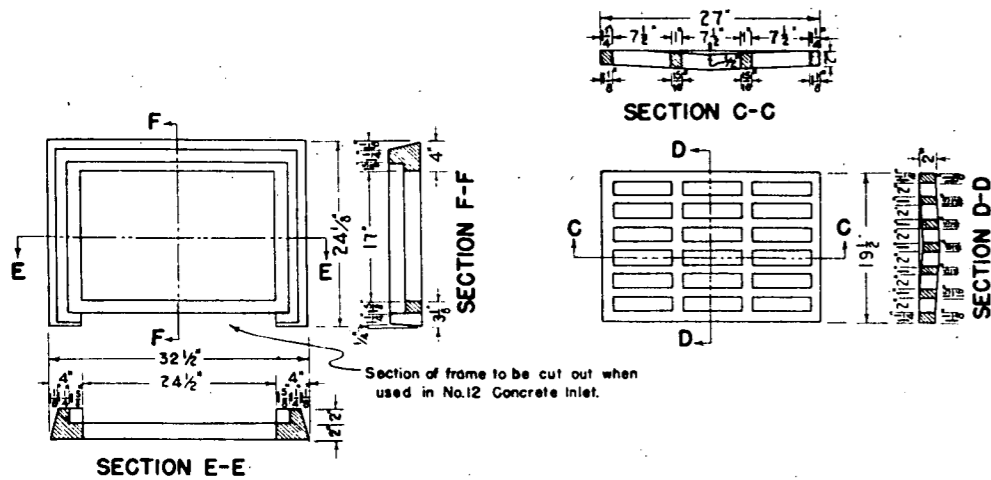

H	CLASS "A" CONCRETE CU. YDS.	REINFORCING STEEL
3' 0"	0.54	70 lbs.
3' 6"	0.63	85 "
4' 0"	0.72	100 "
4' 6"	0.81	119 "
5' 0"	0.90	137 "
5' 6"	0.99	152 "
6' 0"	1.08	166 "
6' 6"	1.17	185 "
7' 0"	1.27	200 "
7' 6"	1.36	215 "
8' 0"	1.45	233 "
8' 6"	1.54	248 "
9' 0"	1.63	263 "
9' 6"	1.73	282 "
10' 0"	1.82	297 "

\* Volume for inlet - volume occupied by pipes to be deducted for pay quantity of concrete.  
 \* Includes 1% allowance for overrun.

#### GENERAL NOTES

All work shall be done in accordance with the Standard Specifications of the Colorado Department of Highways applicable to the project.  
 All reinforced concrete shall be class "A" AND AIR ENTRAINMENT AS SPECIFIED.  
 All concrete walls shall be formed on both sides.  
 All exposed concrete corners shall be beveled to a 1" face.  
 All reinforcing bars shall be deformed, of intermediate grade, and shall be tagged with BAR designation and station number.  
 All castings shall be painted with two coats of asphalt or coal tar and oil.

ALL DIMENSIONS NOT SHOWN AS CLEAR ARE TO  $\frac{1}{2}$  OF BAR.  
 ALL REINFORCING STEEL BARS SHALL CONFORM TO A.S.T.M. SPECIFICATION A-305-50T OR LATEST REVISION THEREOF.


## NO. 13 CONCRETE INLET

### BAR LIST FOR H = 3' 0"

MARK	SIZE	NO. REQD.	LENGTH	TYPE	DIMENSIONS		BENDING DIAGRAM ALL DIMENSIONS ARE OUT TO OUT OF BAR
					p	q	
601	3/4"	Note	2' 6"	I	1'-0"	0'-10"	
401	1/2"	4	12'-10"	II	3'-5"	2'-1"	
402	1/2"	7	6'-1"	I	2'-0"	2'-1"	
403	1/2"	4	7'-5"	I	3'-4"	2'-1"	

\* Omit 601 when H is 4'-0" or less.  
 \* These dimensions to be increased in increments of 6" for H above 3'-0".  
 Add 1-401 for each 6" additional height above 3'-0".  
 601 required as follows:  
 H = 4'-6" to 5'-6" - 1 bar; 9'-0" to 10'-0" - 4 bars.  
 H = 6'-0" to 7'-0" - 2 bars;  
 H = 7'-6" to 8'-6" - 3 bars;  
 Cut or bend bars around pipes as required.

See Plans for size and locations of outlets.

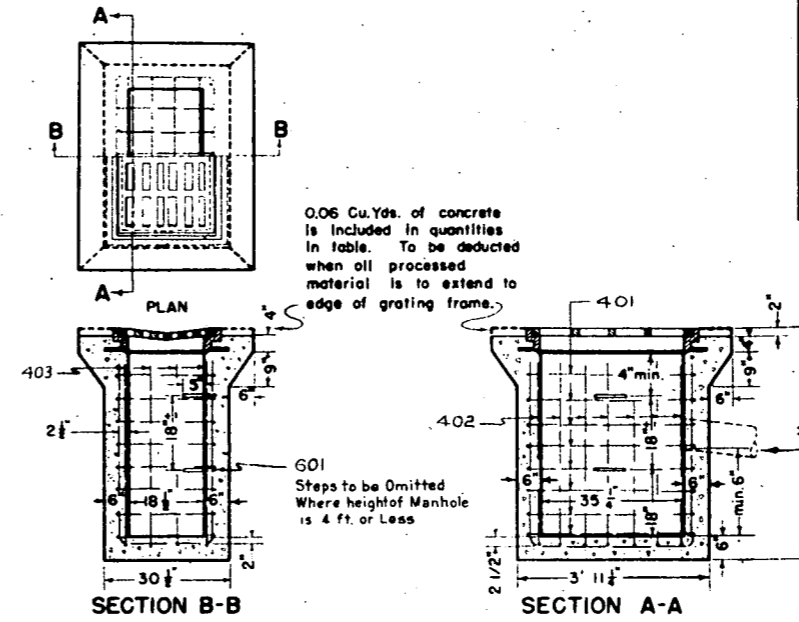


0.06 Cu. Yds. of concrete is included in quantities in table. To be deducted when all processed material is to extend to edge of grating frame.

601 Steps to be Omitted Where height of Manhole is 4 ft. or Less

### NO. 13 INLET GRATING & FRAME

Approx. Weight 680 lbs.

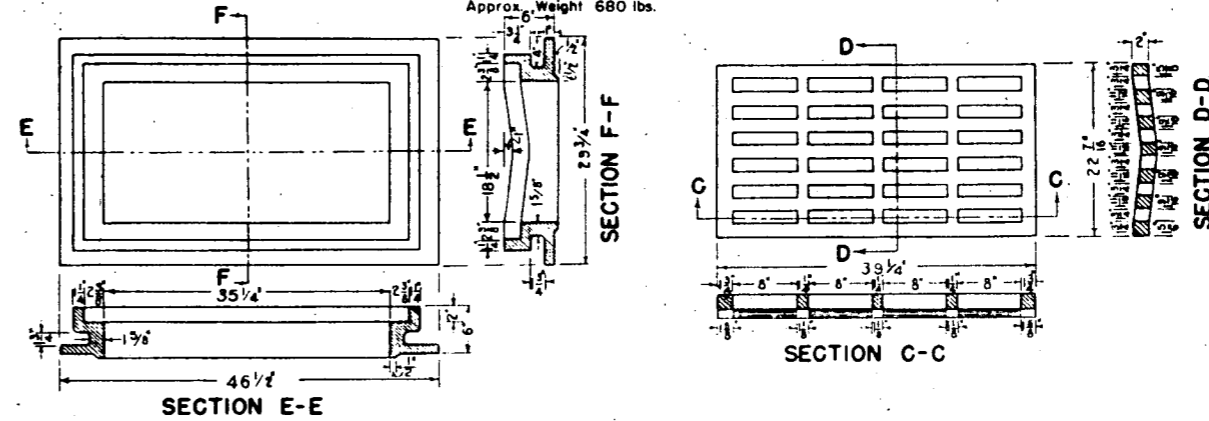

\* VOLUME TO BE DEDUCTED FOR EACH OPENING

	C.M.P.	R.C.P.
18"	0.03	0.05
24"	0.06	0.09
30"	0.09	0.14
36"	0.13	-

#### QUANTITIES

 
H	CLASS "A" CONCRETE CU. YDS.	REINFORCING STEEL
3' 0"	.86	84 lbs.
3' 6"	.96	100 "
4' 0"	1.08	116 "
4' 6"	1.16	136 "
5' 0"	1.26	156 "
5' 6"	1.36	172 "
6' 0"	1.46	192 "
6' 6"	1.57	208 "
7' 0"	1.67	225 "
7' 6"	1.77	245 "
8' 0"	1.87	261 "
8' 6"	1.97	277 "
9' 0"	2.07	297 "
9' 6"	2.17	313 "
10' 0"	2.28	329 "

\* Volume for inlet - volume occupied by pipes to be deducted for pay quantity of concrete.

\* Includes 1% allowance for overrun.

COLORADO DEPARTMENT OF HIGHWAYS STANDARD NO. 12 AND NO. 13 CONCRETE INLETS

Designed by A.R.G. Made by A.R.G. Check Design A.Z. Check Detail C.R.S. Approved by P.J. Bailey Bridge Engineer Date JUL 10, 1951.





# STANDARD TIMBER GUARD POSTS

# STANDARD M-19-E

## SPECIFICATIONS


FED. ROAD REGION NO.	DIVISION	SHEET NO.	TOTAL SHEETS
9	COLO.	25-2 (4)	50 11

REVISIONS		
10-9-58	Added Spacing Table	J.C.R.

### Typical Installation on Curves & Tangents

INSTALLATION of guard posts on curves shall be in accordance with details shown below. Spacing shall be in conformity with table shown below.

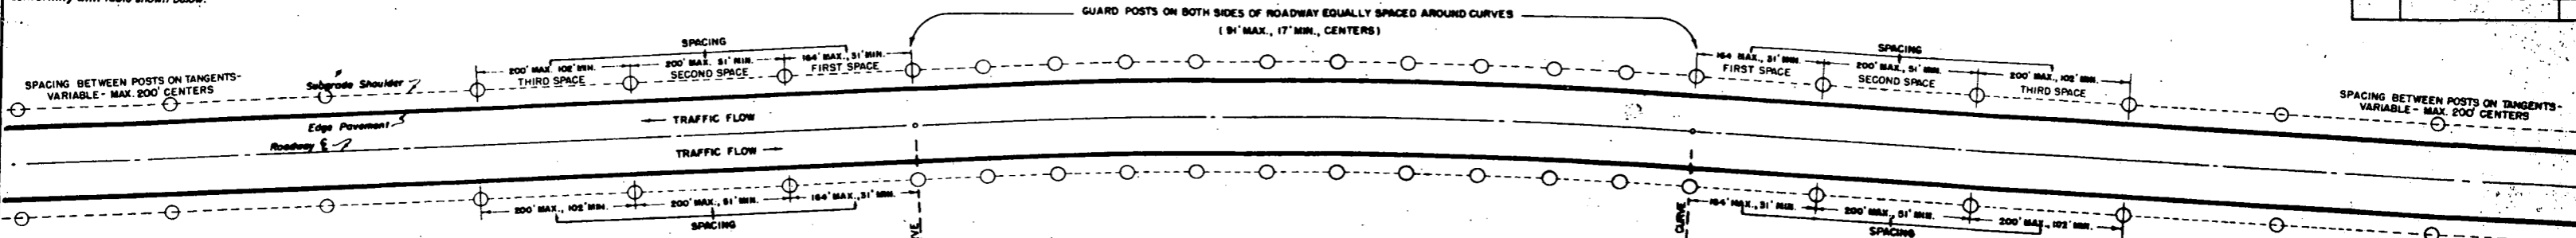


### SPACING FOR DELINEATORS ON HORIZONTAL CURVES


DEGREE OF CURVE	RADIUS	SPACING ON CURVE	SPACING IN ADVANCE OF AND BEYOND CURVE			DEGREE OF CURVE	RADIUS	SPACING ON CURVE	SPACING IN ADVANCE OF AND BEYOND CURVE		
			FIRST SPACE	SECOND SPACE	THIRD SPACE				FIRST SPACE	SECOND SPACE	THIRD SPACE
		FEET	FEET	FEET	FEET			FEET	FEET	FEET	FEET
0°30'	11460.0'	129	200	200	200	8°00'	716.3'	33	59	99	198
1°00'	5730.0'	91	164	200	200	8°30'	674.1'	32	58	96	192
1°30'	3820.0'	74	133	200	200	9°00'	636.7'	31	56	93	186
2°00'	2865.0'	64	115	192	200	9°30'	603.2'	30	54	90	180
2°30'	2292.0'	58	104	174	200	10°00'	573.0'	29	52	87	174
3°00'	1910.0'	53	95	159	200	10°30'	545.7'	28	50	84	168
3°30'	1637.1'	49	88	147	200	11°00'	520.9'	28	50	84	168
4°00'	1432.5'	46	83	138	200	11°30'	498.3'	27	49	81	162
4°30'	1273.3'	43	77	129	200	12°00'	477.5'	27	49	81	162
5°00'	1146.0'	41	75	123	200	15°00'	382.0'	24	43	72	144
5°30'	1041.8'	39	70	117	200	18°00'	318.3'	22	40	66	132
6°00'	955.0'	37	67	111	200	21°00'	272.9'	20	36	60	120
6°30'	881.5'	36	65	108	200	25°00'	229.2'	19	34	57	114
7°00'	818.6'	35	63	105	200	30°00'	191.0'	17	31	51	102
7°30'	764.0'	34	61	102	200						

$S = 1.2 \sqrt{R+18}$  1-ST. SPACE = 1.8S 2-ND. SPACE = 3S 3-RD. SPACE = 6S  
NO SPACES TO EXCEED 200 FT.



### Plan View Showing Placement at Isolated Minor Structures

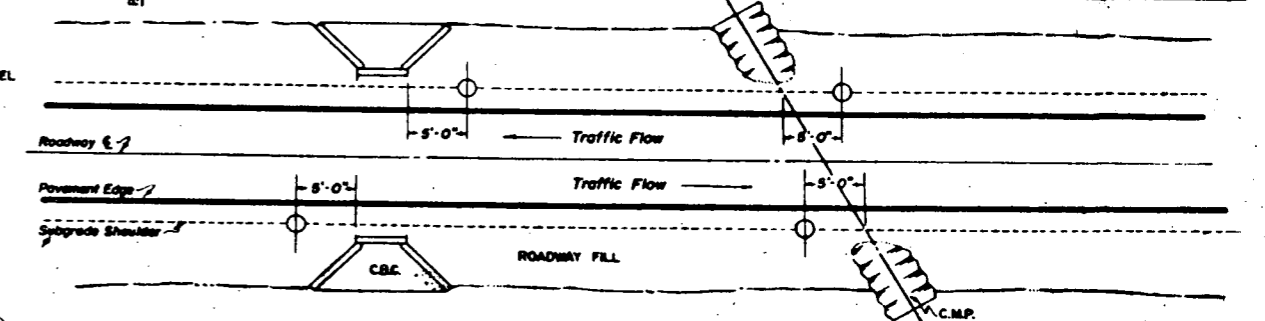

### Pictorial View Showing Location at Isolated Minor Structures

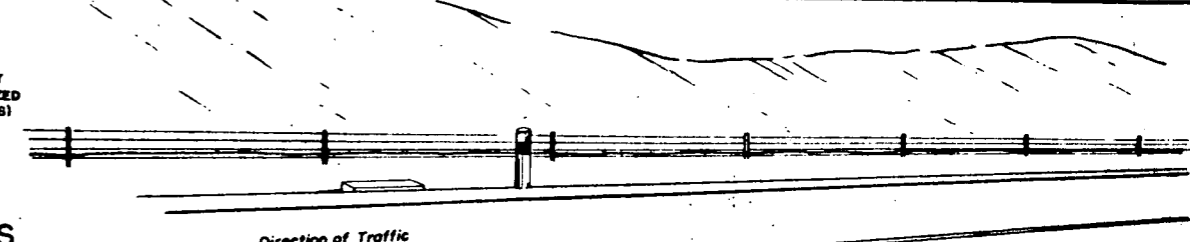

### Typical Installation At Bridge Approaches

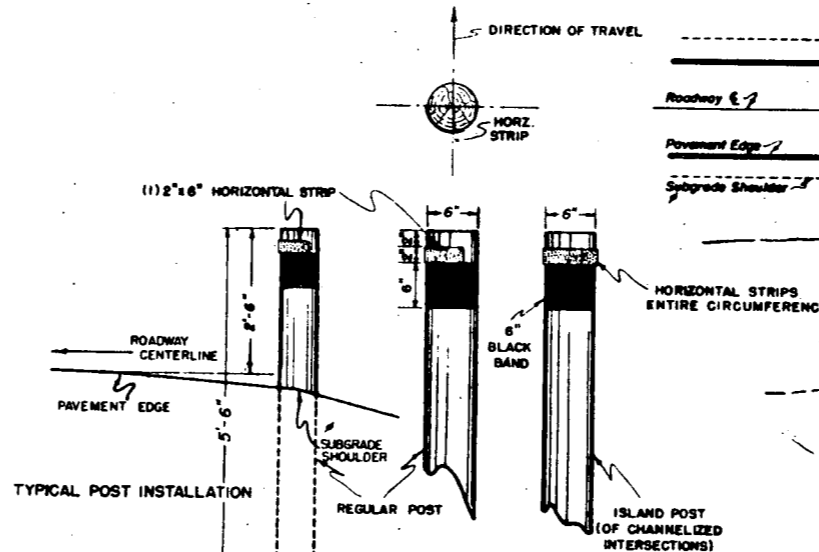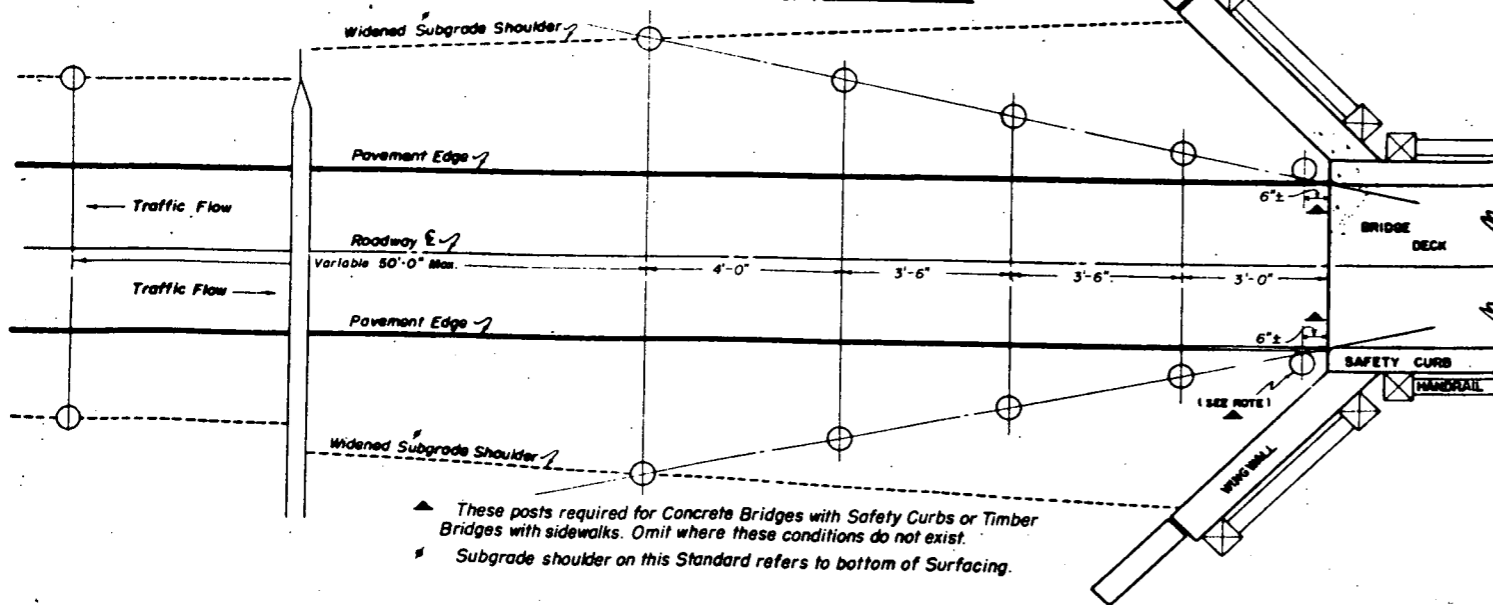

### INSTALLATION DETAILS OF REFLECTORIZED STRIPS

### GENERAL NOTES

- (Work By Contractor)
- All work shall be done in accordance with the Standard Specifications of the Colorado Department of Highways applicable to the project.
- All posts shall be set and tamped in, plumb and firm, to the line and grades established by the Engineer.
- INSTALLATION of Timber Guard Posts on Tangents, Curves and at Bridge Approaches shall be in conformity with details on this sheet. The number, location and spacing of Timber Guard Posts is shown on plans.
- (Work By State Forces)
- Reflective delineators shall be furnished and installed by State Forces after the Contractor has finished his operations.
- Installation of reflective delineators shall be in accordance with the following: Wrap Around Reflective Sheeting Strips shall be installed horizontally one (1) sheet on all posts. Island posts shall have Wrap Around Reflective Sheeting Strips placed horizontally to cover entire circumference of Post.
- On Divided Highways and Islands, Reflective Sheeting Strips shall be placed in a manner to obtain maximum visibility for the primary direction of travel. In all instances tests shall be made to insure the maximum effectiveness of reflective delineators.
- All Traffic Islands shall be marked with Island Posts as indicated hereon.

**COLORADO DEPARTMENT OF HIGHWAYS**

**STANDARD TIMBER GUARD POSTS**

Designed by  
Made by  
Checked by

Approved by G. Julian  
Engineer, Survey & Plans  
Date: March 25, 1953

# STANDARD ROADWAY CONSTRUCTION TRAFFIC SIGNS


STANDARD M-29-C  
(SHEET 1 OF 2 SHEETS)

FED. ROAD REC. NO.	DIVISION	SHEET NO.	TOTAL SHEETS
9	COLO.	225-2 (44) 150/12	


REVISIONS		
10-23-53	General	J.C.R.

## TYPICAL METHODS OF MARKING HIGHWAYS & DETOURS

Detour Condition Where Traffic is Prohibited Along Construction

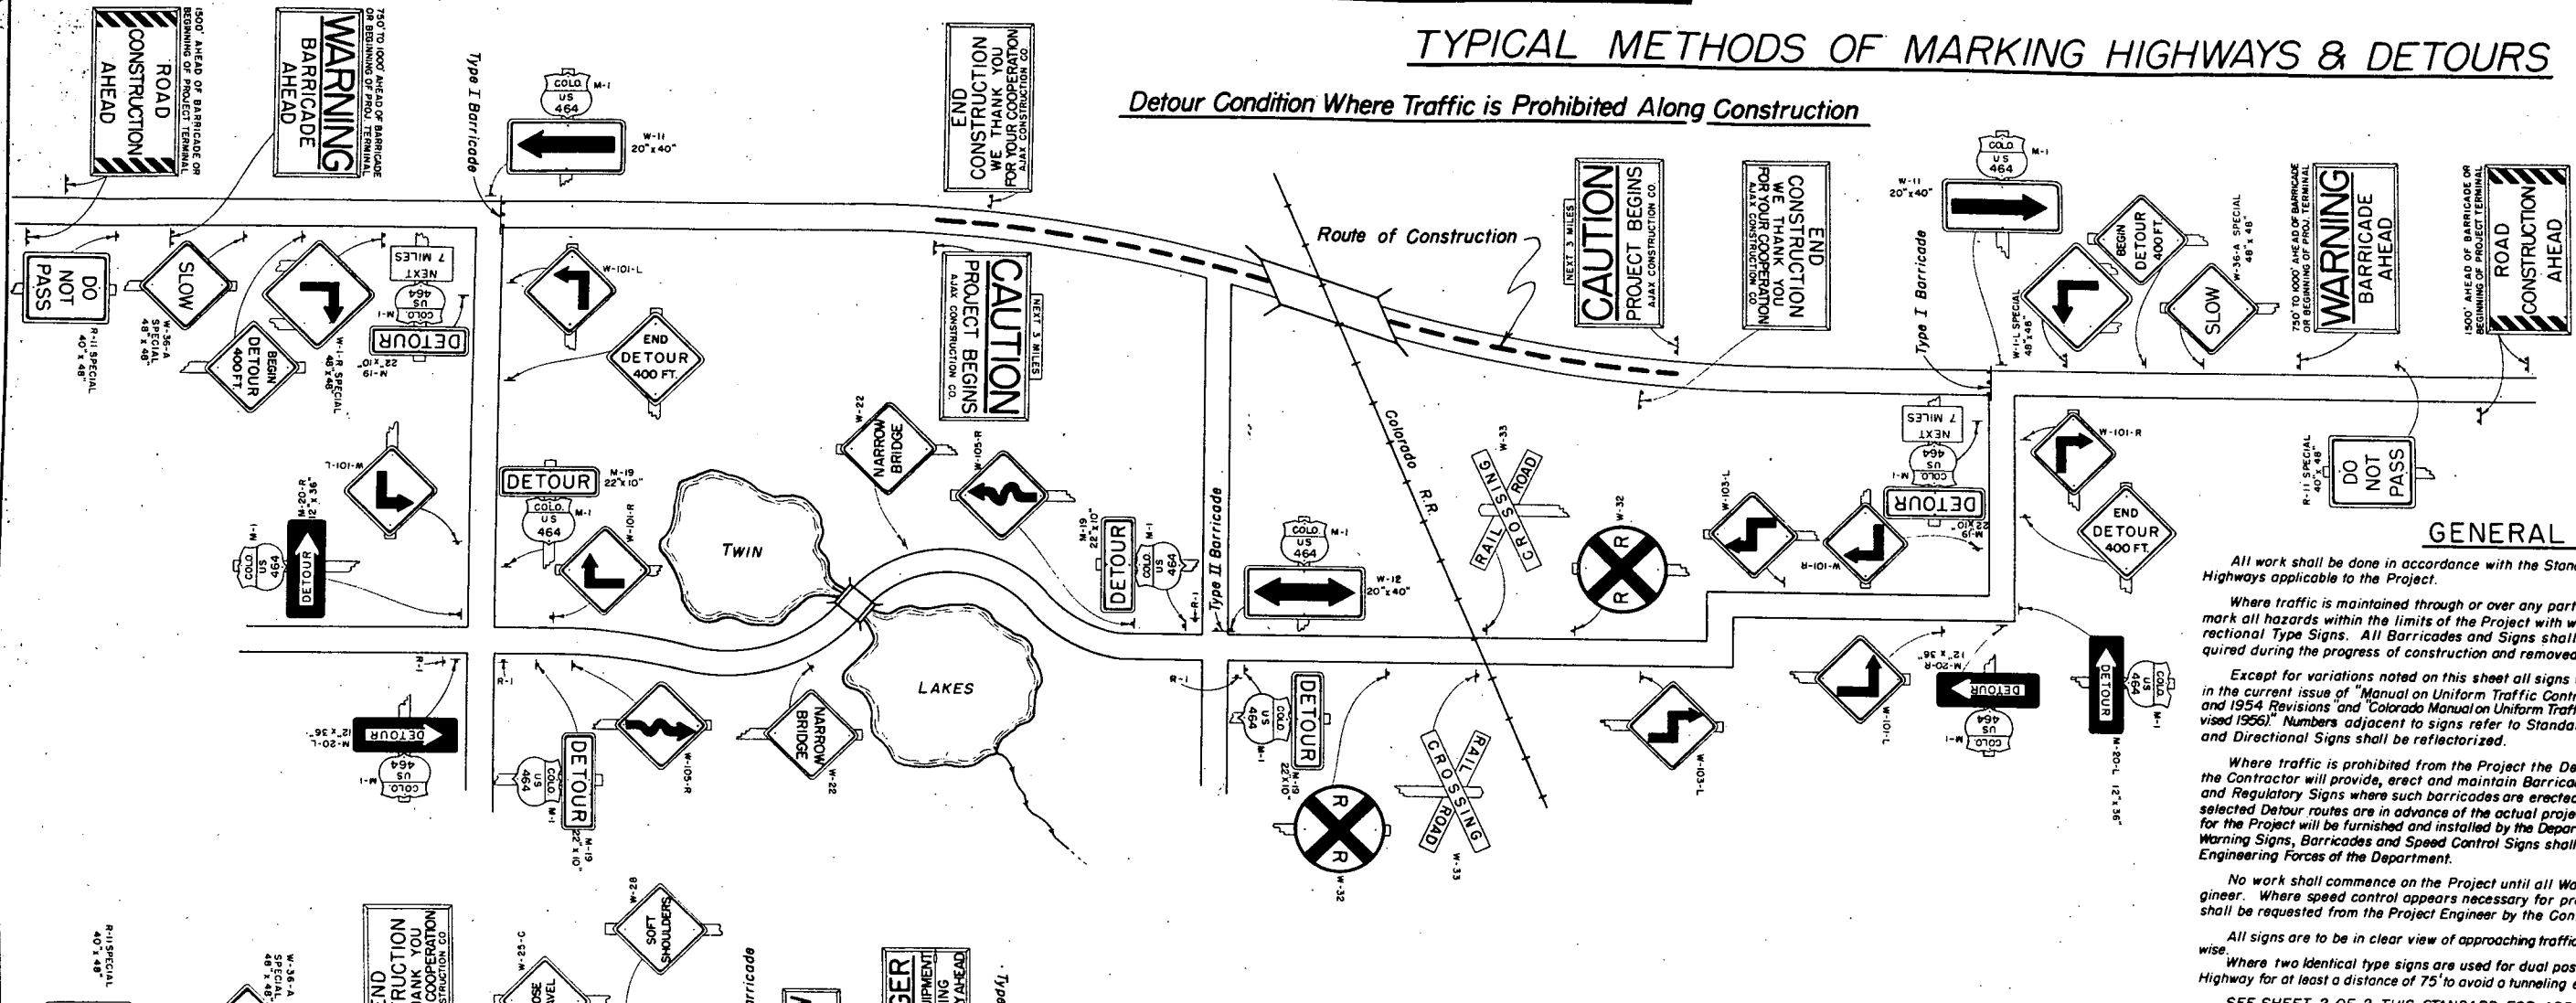

Condition Where Traffic is Permitted Along Construction

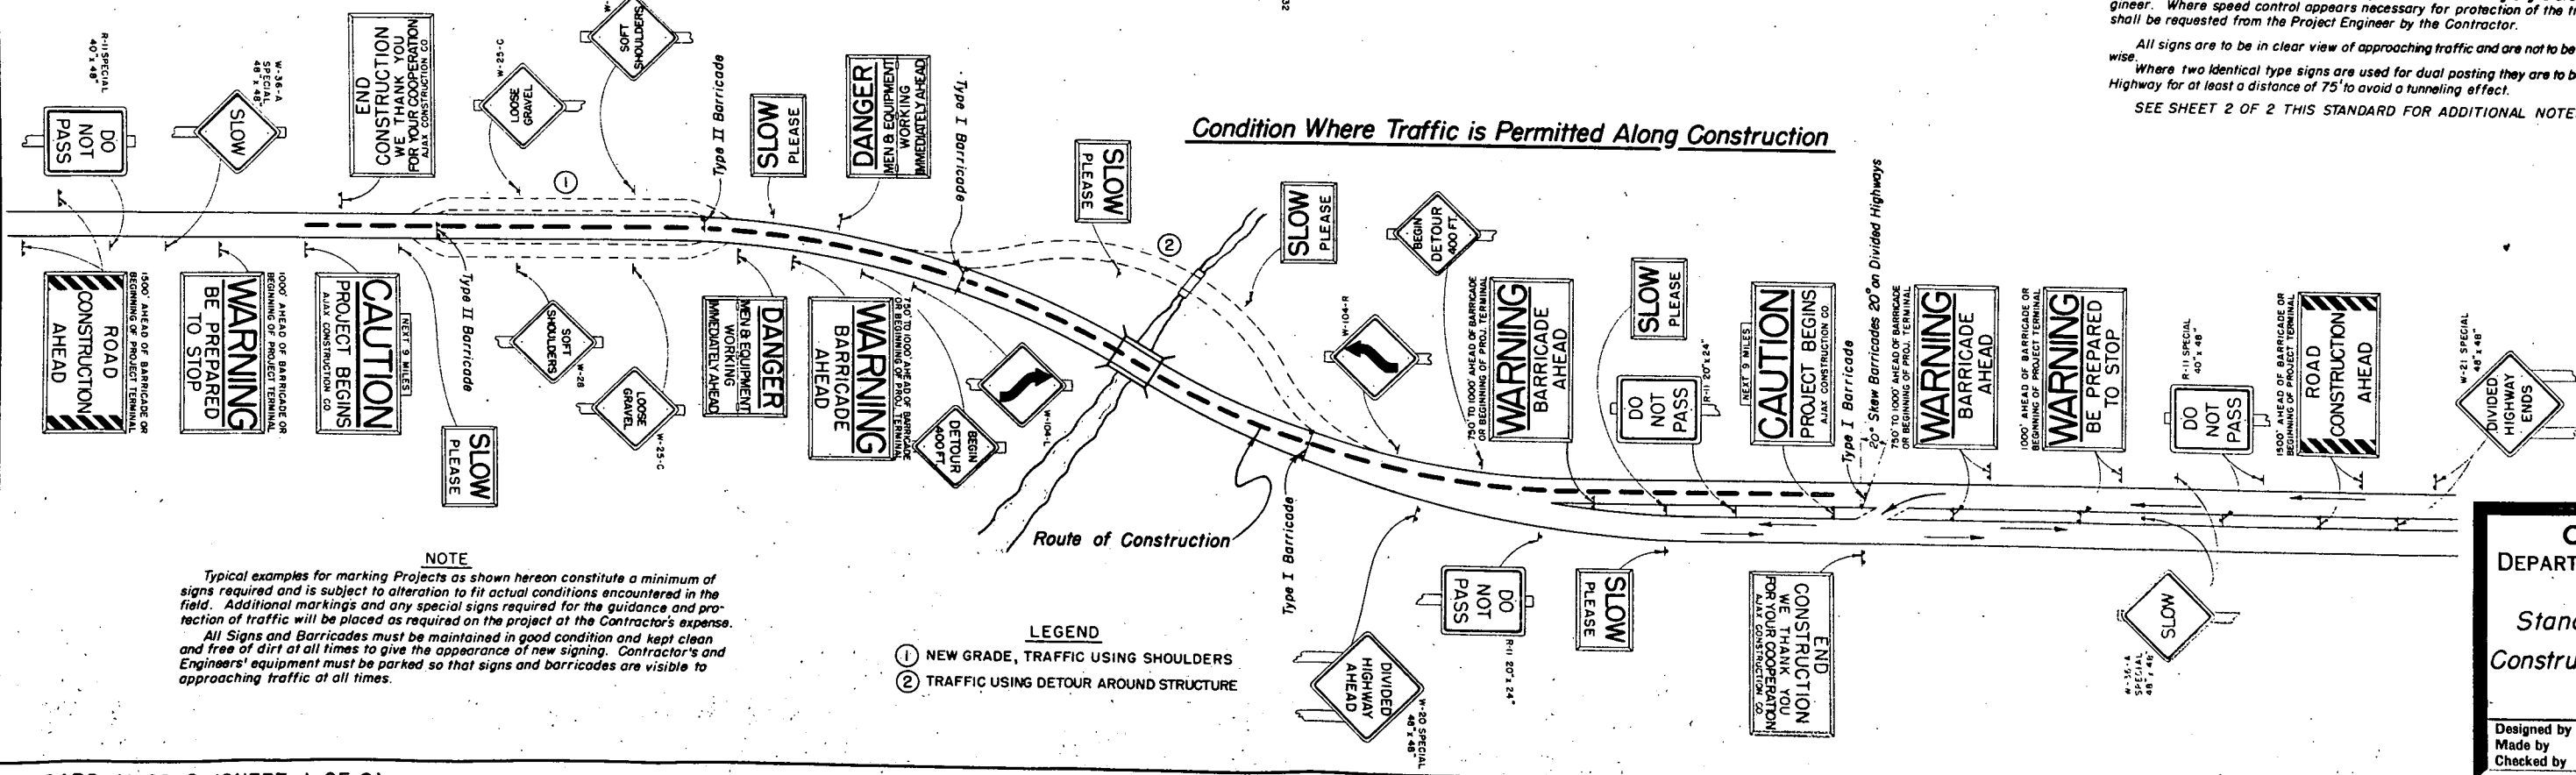

### GENERAL NOTES

All work shall be done in accordance with the Standard Specifications of the Colorado Department of Highways applicable to the Project.

Where traffic is maintained through or over any part of the Project, the Contractor will be required to mark all hazards within the limits of the Project with well maintained Barricades, Warning Signs and Directional Type Signs. All Barricades and Signs shall be moved, added to, changed or removed as required during the progress of construction and removed entirely when project is completed.

Except for variations noted on this sheet all signs will be in conformity with the specification outlined in the current issue of "Manual on Uniform Traffic Control Devices for Streets & Highways, PRA August 1948 and 1954 Revisions" and "Colorado Manual on Uniform Traffic Control Devices for Streets & Highways CDOH 1952 (Revised 1956)". Numbers adjacent to signs refer to Standards in the manual. Standard Warning, Regulatory and Directional Signs shall be reflectorized.

Where traffic is prohibited from the Project the Detour will be marked by the Department except that the Contractor will provide, erect and maintain Barricades complete with approved Directional Arrows and Regulatory Signs where such barricades are erected and maintained at the ends of the Project or where selected Detour routes are in advance of the actual project terminal. U.S. or State Route Markers required for the Project will be furnished and installed by the Department. The location and positioning of Advance Warning Signs, Barricades and Speed Control Signs shall be as recommended by the appropriate District Engineering Forces of the Department.

No work shall commence on the Project until all Warning Signs are in place and approved by the Engineer. Where speed control appears necessary for protection of the travelling public, such speed control shall be requested from the Project Engineer by the Contractor.

All signs are to be in clear view of approaching traffic and are not to be obstructed by equipment, weeds or otherwise. Where two identical type signs are used for dual posting they are to be staggered on the two sides of the Highway for at least a distance of 75' to avoid a tunneling effect.

SEE SHEET 2 OF 2 THIS STANDARD FOR ADDITIONAL NOTES AND DETAILS.

**NOTE**  
Typical examples for marking Projects as shown hereon constitute a minimum of signs required and is subject to alteration to fit actual conditions encountered in the field. Additional markings and any special signs required for the guidance and protection of traffic will be placed as required on the project at the Contractor's expense. All Signs and Barricades must be maintained in good condition and kept clean and free of dirt at all times to give the appearance of new signing. Contractor's and Engineers' equipment must be parked so that signs and barricades are visible to approaching traffic at all times.

- LEGEND**
- ① NEW GRADE, TRAFFIC USING SHOULDERS
  - ② TRAFFIC USING DETOUR AROUND STRUCTURE

**COLORADO DEPARTMENT OF HIGHWAYS**  
Standard Roadway Construction Traffic Signs

Designed by J.C.R. Approved by *A. Julian*  
Made by J.C.R. Engineer, Surveys & Plans  
Checked by \_\_\_\_\_ Date: July 22, 1955


# STANDARD ROADWAY CONSTRUCTION TRAFFIC SIGNS

STANDARD M-29-C  
(SHEET 2 OF 2 SHEETS)

FEDERAL ROAD REGION NO.	DIVISION	PROJ. NO.	SHEET NO.	TOTAL SHEETS
9	COLORADO	I-25-2(44)15	13	

Rev. 10-23-58 J.C.R.

## DETAILS OF BARRICADES

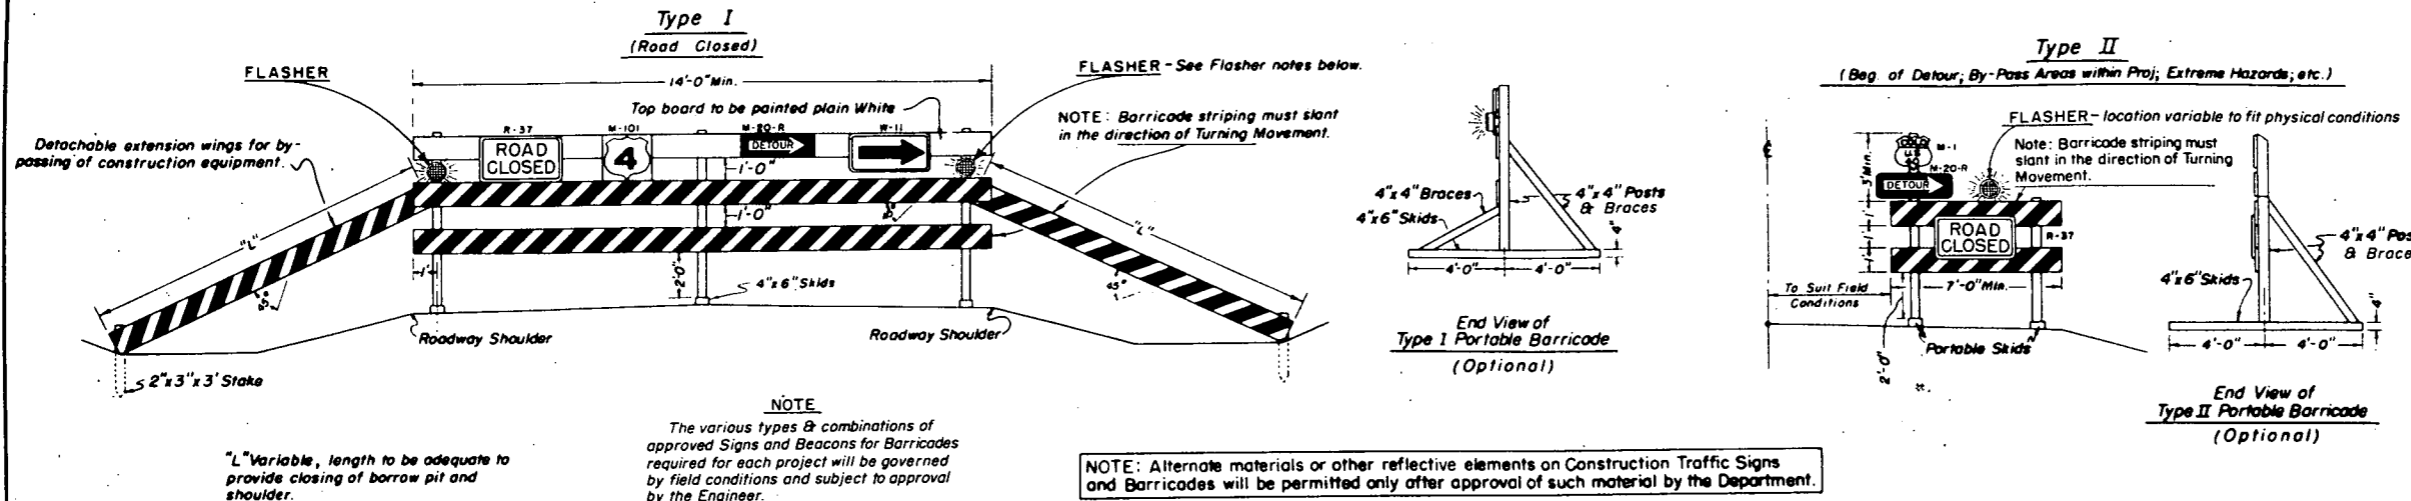

### SPECIFICATIONS

**PAINT** - All paint and methods of painting shall be in conformity with the Standard Specifications of the Colorado Department of Highways for painting of Timber Structures.

**STRIPING** - Planking and Wings shall be painted with Maintenance Flat Black on both sides before adding any one of the following acceptable Reflective Strips:  
(a) Wide Angle White, 7" strip, spaced 8" apart.  
(b) Flat Top Silver, 3" strip, spaced 7" apart.  
(c) Direct Process of Glass Beads on Paint, 3" strip, spaced 7" apart.  
Stripes shall be applied on both front and back of barricades for opposite direction use. Diversion of traffic will be accomplished as follows:  
1- Stripes for barricades diverting traffic to the left shall start on the right hand side of the lower plank and progress up to the left. Traffic diversion to the right will be just the opposite.  
2- Stripes on barricades diverting traffic in both directions shall begin at the center of the lower plank and progress up in both directions.


**TIMBER** - All timber used shall conform to the Standard Specifications for Miscellaneous Untreated Timber.  
Planking 1"x12" or 2"x12" S4S  
Posts (Barricades) 6"x6" S4S  
Posts (Signs) 4"x4" S4S

The ReflectORIZED Stripes on planking & wings on all barricades shall be reflectORIZED with White or Silver Reflective Material of a type acceptable to the Department.


Barricades may be either portable as shown or fixed with posts set into the ground.  
All skids, braces and posts to be painted white and nailed together with No. 20d nails.  
Bases to be weighted where necessary to provide stability.

When this method is used as described above or when white binder and beads are applied to planking and wings, alternate black stripes using Maintenance Flat Black paint shall be applied over the reflective material in the prescribed pattern. All measurements for striping are to be made along the horizontal axis of the board.


## DETAILS OF CONSTRUCTION SIGNS

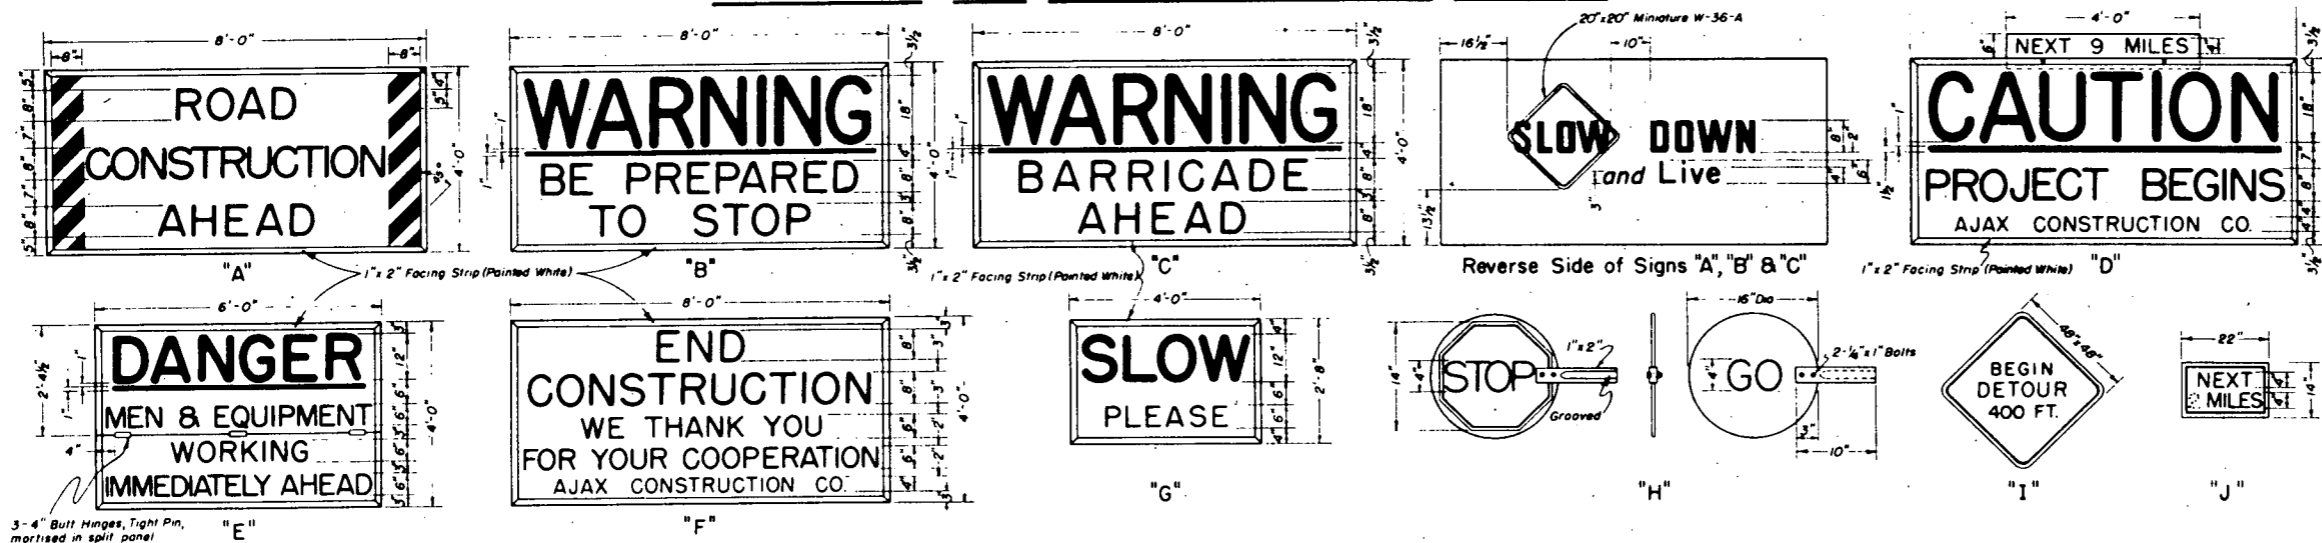

### Details of ReflectORIZED Arrows

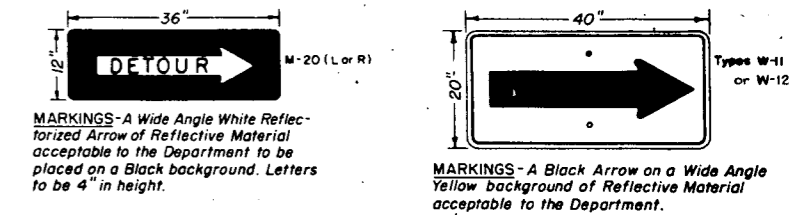

### Position of Signs Relative to Roadbed & Hazards

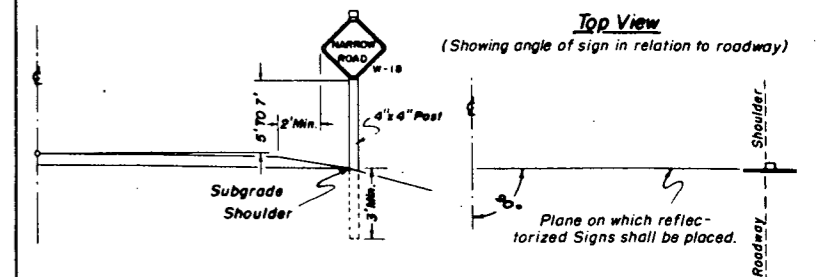

## DETAILS OF SIGN AND BEACON FABRICATION AND USAGE

Construction Signs "A" through and including "G" shall be made of 3/4" Plywood or other material after approval by the Department, and as per details above. Signs shall be reflectORIZED with reflective sheeting or other reflective materials of types approved by the Department.

**CONSTRUCTION SIGN "A"** - Wide Angle White background with painted Black lettering. Barricade stripes of 4" Wide Angle White placed over Black painted vertical stripes spaced as shown above. This sign is the First advance warning sign and shall be placed 1500 feet ahead of barricade or beginning of project terminal and on both sides of the travelled way in all cases.

**CONSTRUCTION SIGN "B"** - Apply top 23" strip of Flat Top Silver, reversed screened or sprayed with Transparent Red Paint allowing the words "WARNING" and 1-inch Underline to remain as Flat Top Silver. Balance of lettering painted Black on a 22" strip of Wide Angle White. This sign is the Second advance warning sign and shall be placed 1000 feet ahead of barricade or beginning of project terminal and on both sides of the travelled way on divided highways and singly on two-lane highways.

**CONSTRUCTION SIGN "C"** - Apply top 23" strip of Flat Top Silver, reversed screened or sprayed with Transparent Red Paint allowing the words "WARNING" and 1-inch Underline to remain as Flat Top Silver. Balance of lettering painted Black on a 22" strip of Wide Angle White. This sign is the Second advance warning sign in cases where barricades are used and shall be placed 750 to 1000 feet ahead of barricade or beginning of project terminal and on both sides of the travelled way on divided highways and singly on two-lane highways.

**REVERSE SIDES OF SIGNS "A", "B" and "C"** - The word "SLOW" shall be painted Black and superimposed over a Yellow miniature W-36-A background panel. Balance of lettering shall be painted Black on a White background.

**CONSTRUCTION SIGN "D"** - Apply top 24 1/2" strip of Flat Top Silver, reversed screened or sprayed with Transparent Red Paint allowing the words "CAUTION" and 1/2-inch Underline to remain as Flat Top Silver. Balance of lettering painted Black on a 20 1/2" strip of Wide Angle White. This sign will be provided with a detachable 1" material board mounted on back of sign with 2 1/2" x 2" bolts. This board shall be painted White with Black lettering. (Indicate to the nearest Mile). This sign shall be placed to mark the Beginning of the Project. To be placed singly and may be placed opposite barricade if desirable.

**CONSTRUCTION SIGN "E"** - Apply top 17 1/2" strip of Flat Top Silver, reversed screened or sprayed with Transparent Red Paint allowing the words "DANGER" and 1-inch Underline to remain as Flat Top Silver. Balance of lettering painted Black on a 27 1/2" strip of Wide Angle White. The sign is of the hinged and fold type to facilitate the closing down of sign when the need is not prevalent. This sign shall be placed 500 feet ahead of the situation on hand.

**CONSTRUCTION SIGN "F"** - The words "END CONSTRUCTION" and "CONTRACTORS NAME" shall be painted Black on strips 22" and 6 1/2" respectively of Wide Angle White. For balance of lettering, apply 16 1/2" strip of Flat Top Silver, reversed screened or sprayed with Transparent Red Paint allowing "WE THANK YOU FOR YOUR COOPERATION" remaining in Flat Top Silver. This sign shall be placed to mark the Ending of the Project. To be placed singly and may be placed opposite barricade if desirable.

**CONSTRUCTION SIGN "G"** - The words "SLOW" and "PLEASE" shall be painted Black on a background of Wide Angle Yellow. This sign shall be used frequently within the limits of the Project. All of the preceding signs shall be fastened to 2-4 x 4" posts set 4 feet in the ground with a minimum of 3-1 x 4" nailing strips on the back. Bottom of sign to be not less than 36" above the ground.

**FLAGMAN WARNING SIGN "H"** - This sign shall be made of Plastic or other lightweight material, painted Red background with White lettering on the "STOP" side and painted Green background with White lettering on the "GO" side. Handle to be grooved on one side to indicate reading of sign to flagman. This sign will be used whenever flagmen are necessary. Sign to be reflectORIZED if used to stop traffic at night.

**DETOUR WARNING SIGN "I"** - To be of 3/8" (Min.) plywood or No. 16 (Min.) gauge metal with Black painted letters on a Wide Angle Yellow Background.

**CONSTRUCTION SIGN "J"** - 3/4" x 9" metal slides to be placed between "NEXT MILES," spaced so as to accommodate appropriate size numerals. Required numerals to be furnished by the Department and to be installed by the Contractor. Numerals calculated to the nearest Mile.

All material shall be sound and durable. Barricades, signs, symbols and lettering conforming to styles noted hereon will be of good workmanship and well maintained. Uneven lettering will not be accepted.

**FLARES AND TORCHES** shall be either of the oil burning or electrical type approved by the Department and shall be placed 3 feet to 5 feet ahead of the object to be illuminated. Particular care shall be taken to protect all signs and barricades from smoke and smudge arising from the use thereof.

**FLASHERS** used on Type I or II Barricade shall be of the Battery or Electrical Type and shall have no less than 12,566 sq. inches of light area (4" dia. lens). The illuminating element in a flashing amber beacon or signal shall be flashed continuously at a rate between 50 or 60

flashes per minute which will be clearly distinguishable to traffic. The duration in which Flashers will be left in operation will be governed by field conditions and subject to approval by the Engineer.

Alternate methods of processing signs or the substitution of symbols or other reflecting elements for painted symbols will be permitted only after approval of such methods or materials by the Department.

The Department shall furnish and install the following as required OUTSIDE THE LIMITS of the Project:

- "ROAD CONSTRUCTION AHEAD" Minimum 4
- "WARNING BE PREPARED TO STOP" Minimum 2
- "WARNING BARRICADE AHEAD" As Required
- Standard Warning & Directional Signs As Required

The Contractor shall furnish and install the following as required WITHIN THE LIMITS of the Project:

- All Barricades As Required
- "CAUTION PROJECT BEGINS" Minimum 2
- "DANGER MEN & EQUIPMENT WORKING IMMEDIATELY AHEAD" As Required
- "END CONSTRUCTION WE THANK YOU FOR YOUR COOPERATION" Minimum 2
- "SLOW PLEASE" As Required
- Standard Warning & Directional Signs As Required
- Approved Directional Arrows & Regulatory Signs for Barricades As Required
- Torches and Flares as follows: Type I Barricade Minimum 3, Type II Barricade Minimum 1
- Flashers - Type I Barricade 2 Required, Type II Barricade As Required

Including Type I Barricade located immediately inside of Project terminal points.

**COLORADO DEPARTMENT OF HIGHWAYS**

Standard Roadway Construction Traffic Signs

Designed by J.C.R. Approved by J.C.R. Engineer, Surveys & Plans  
Made by J.C.R. Checked by J.C.R. Date: July 22, 1955



# STANDARD CURBS AND GUTTERS


STANDARD M-45-A

FED. ROAD REG. NO.	DIVISION	PROJECT NO.	SHEET NO.	TOTAL SHEETS
9	COLO.	125-2(47) 150 14		


REVISIONS		
12-9-58	Curb Dimension	G.L.S.
3-26-59	Curb Dimension	J.C.R.

LEGEND FOR RADII	
A	= 1/8"
B	= 1"
C	= 1 1/2"
D	= 1 1/2" to 2"

## CONCRETE PAVEMENT (DRIVEWAYS)

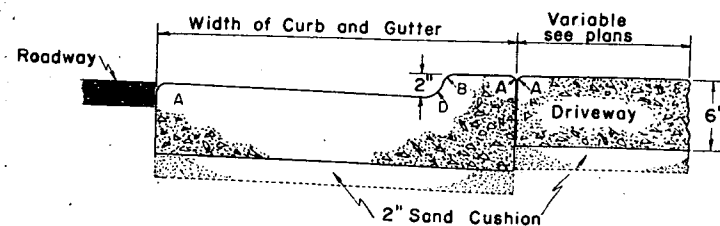


## DETAIL OF CURB CUT FOR DRIVEWAYS

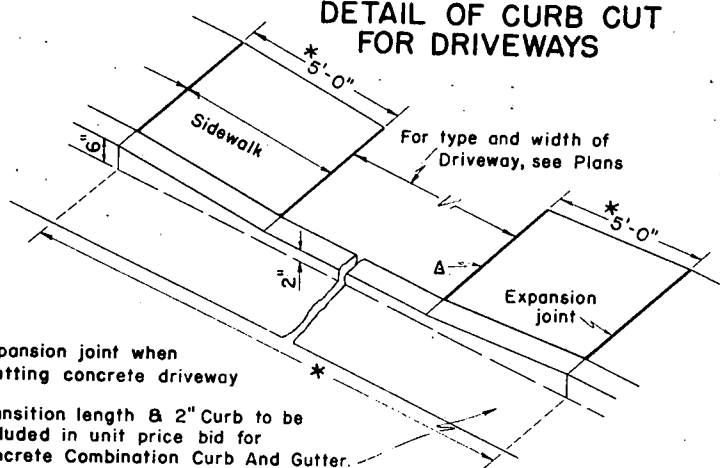

A Expansion joint when abutting concrete driveway


\* Transition length & 2" Curb to be included in unit price bid for Concrete Combination Curb And Gutter.

## TRANSVERSE WEAKENED PLANE JOINT FOR CONCRETE PAVEMENT (DRIVEWAYS)

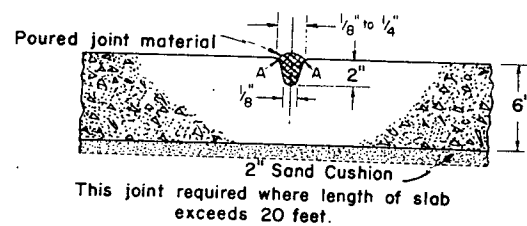

This joint required where length of slab exceeds 20 feet.

## CONSTRUCTION OF CONCRETE GUTTERS AT INTERSECTIONS

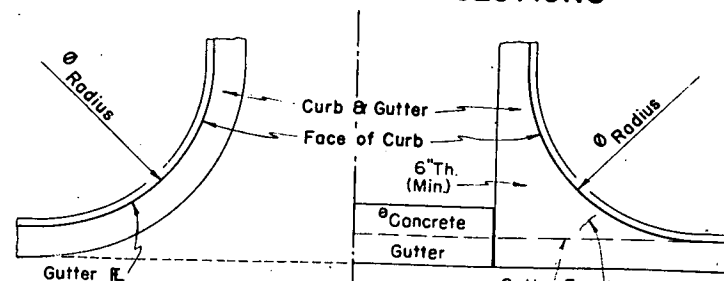


Length of Radius as shown elsewhere on Plans.


This section to be built when Concrete Gutter is not required.

This section to be built when Concrete Gutter is required.


## CONCRETE SIDEWALKS

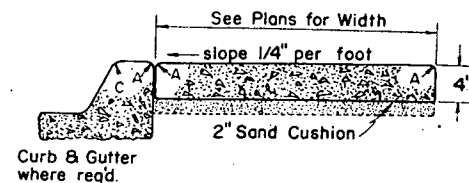


## CONCRETE GUTTER

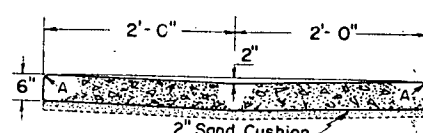

## CONCRETE CURB (6\"/>

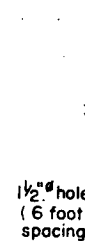


## CONCRETE CURB (6\"/>

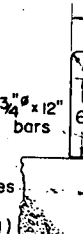


3/4" x 12" reinforcing bars at 6 foot spacing. Cost of installation to be included in unit price bid for Curb. Bars to be grouted in 1 1/2" holes in present concrete. Grout to consist of 2 parts clean sand and 1 part cement.


## CONCRETE CURB (6\"/>

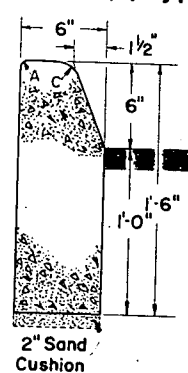


## CONCRETE CURB (6\"/>

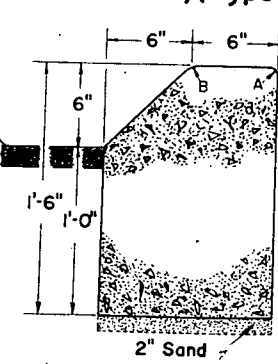


## CONCRETE COMBINATION CURB AND GUTTER (6\"/>

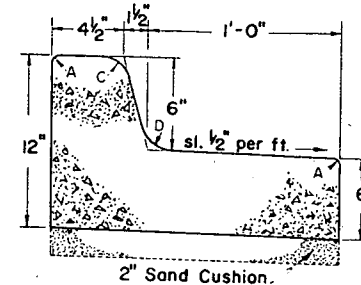


## CONCRETE COMBINATION CURB AND GUTTER (6\"/>

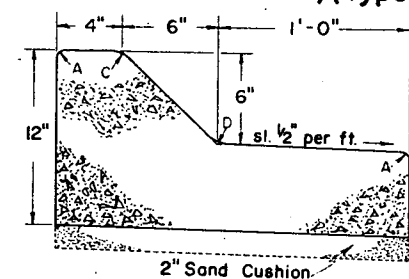


## CONCRETE COMBINATION CURB AND GUTTER (6\"/>

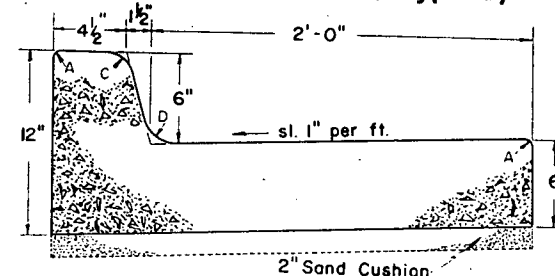

## CONCRETE COMBINATION CURB AND GUTTER (6\"/>

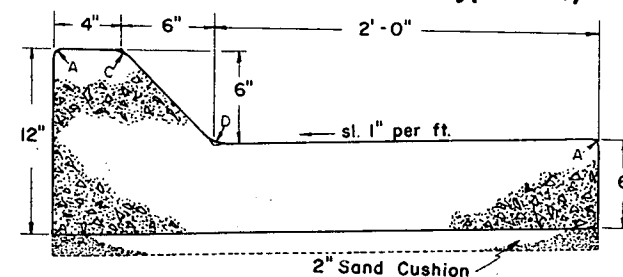

## ASPHALTIC SHOULDER ROLL

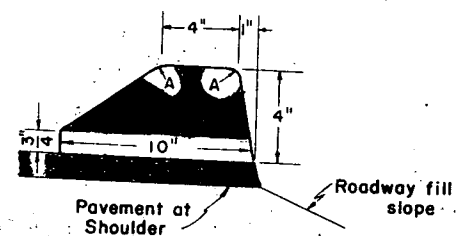

## GENERAL NOTES

All work shall done in accordance with the Specifications of the Colorado Department of Highways.

All Concrete used in the construction of concrete items on this sheet shall be Class "A" Concrete.

On Curves 3 degrees and sharper, Curbs and/or Gutters are to be placed on the Arc of the Curve unless otherwise noted on plans. A maximum chord length of 10 feet may be used when the degree of curve is less than 3 degrees.

Sand Cushion to be used only when called for on Plans.

At locations where in-place concrete pavement has been overlaid with asphalt, the asphalt shall be removed before placement of Doweled-type Curb.

COLORADO  
DEPARTMENT OF HIGHWAYS  
STANDARD  
CURBS AND GUTTERS


Designed by [Signature] Approved by [Signature]



# STANDARD M-46-B


FED. ROAD REGION NO.	DIVISION	SHEET NO.	TOTAL SHEETS
9	COLO.	125-2 (15)	15

## TYPE A FOR USE AT BOTTOM OF VERTICAL CURVE

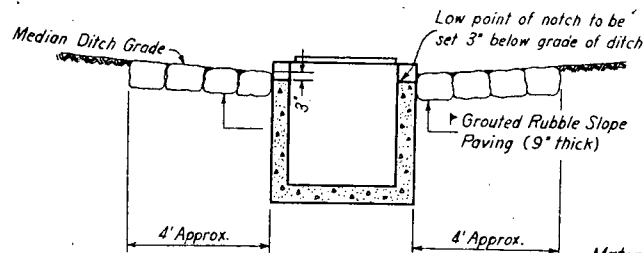


SECT. "A-A"

Materials used in the construction of Inlet gratings shall meet with the requirements of Item 4B, Structural Steel, in the Standard Specifications.

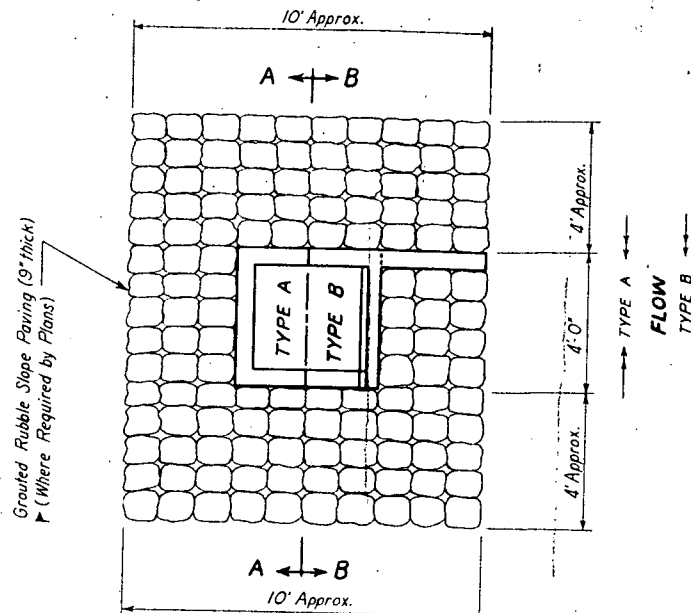

LAYOUT OF INLET IN MEDIAN DITCH

## TYPE B FLOW FROM ONE DIRECTION

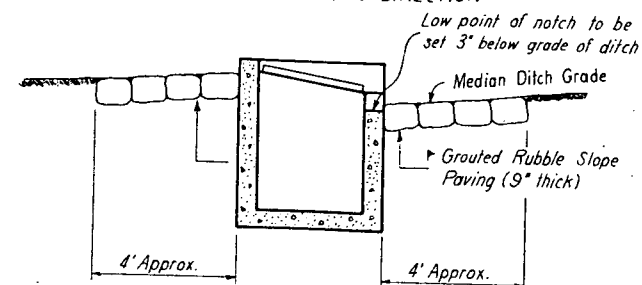

SECT. "B-B"


### QUANTITIES FOR ONE INLET

H	CLASS "A" CONCRETE		REINFORCING STEEL	
	CU. YDS.	TYPE A	TYPE B	TYPE A
3'-6"	1.05	1.36	98	127
4'-0"	1.18	1.49	104	133
4'-6"	1.31	1.62	115	143
5'-0"	1.44	1.75	135	163
5'-6"	1.56	1.88	141	169
6'-0"	1.69	2.01	158	185
6'-6"	1.82	2.13	168	195
7'-0"	1.95	2.26	184	212
7'-6"	2.08	2.39	190	218
8'-0"	2.21	2.52	211	238
8'-6"	2.34	2.65	217	244
9'-0"	2.47	2.78	233	261
9'-6"	2.60	2.91	243	270
10'-0"	2.73	3.04	259	287
10'-6"	2.86	3.17	265	293
11'-0"	2.99	3.30	286	313
11'-6"	3.12	3.43	292	320
12'-0"	3.25	3.56	308	336


o Includes 1/2% for overrun

▲ Volume occupied by pipes to be deducted for pay quantity of concrete


SIZE	C.M.P.	CONCRETE PIPE
18"	0.03 Cu.Yd./pipe	0.05 Cu.Yd./pipe
24"	0.06 " " "	0.09 " " "
30"	0.09 " " "	0.14 " " "
36"	0.13 " " "	0.20 " " "

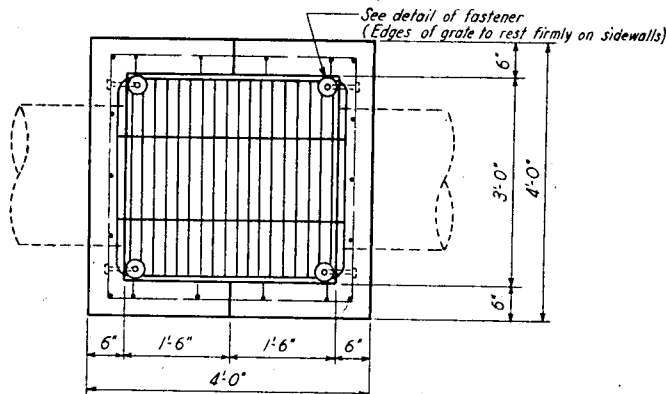

PLAN

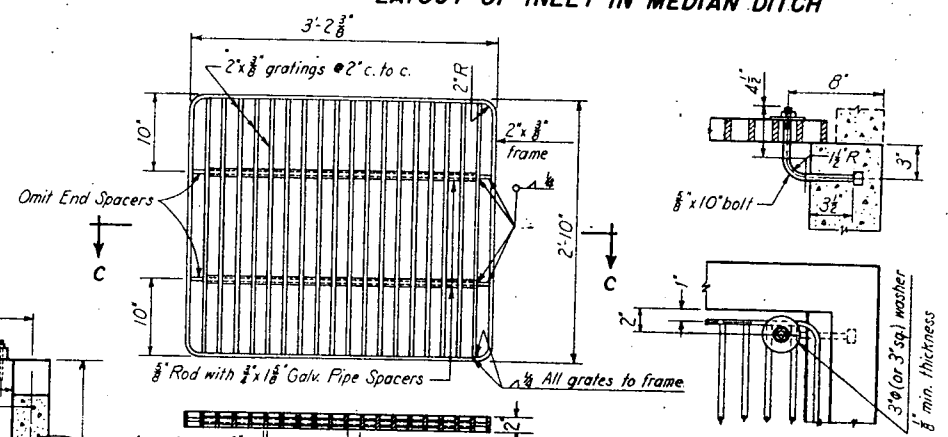

DETAIL OF FASTENER  
4 REQ'D FOR EACH INLET

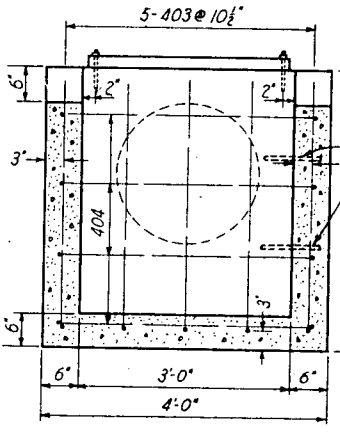


SECT. "D-D"


DETAIL OF GRATING  
MATERIAL LIST FOR GRATING AND FASTENERS:

Strap Iron Frame	1 pc.	2" x 3/8" x 11'-9 1/2"	• 2.55 lb. per ft. = 30.0 lb.
Strap Iron Gratings	18 pcs.	2" x 3/8" x 2'-9 1/2"	• 2.55 lb. per ft. = 127.2 lb.
Galv. Iron Pipe Spacers	34 pcs.	3/4" x 1 3/8"	• 1.13 lb. per ft. = 5.2 lb.
Tie Rods	2 pcs.	3/8" x 3'-1 3/8"	• 1.04 lb. per ft. = 6.5 lb.
Bolts	4 pcs.	3/8" x 10"	• 1.03 lb. ea. = 4.1 lb.
Washers	4 pcs.	3/8" x 10"	• 0.23 lb. ea. = 0.9 lb.


▲ Note: Acceptable equivalent Gratings maybe substituted after approval by the Engineer.

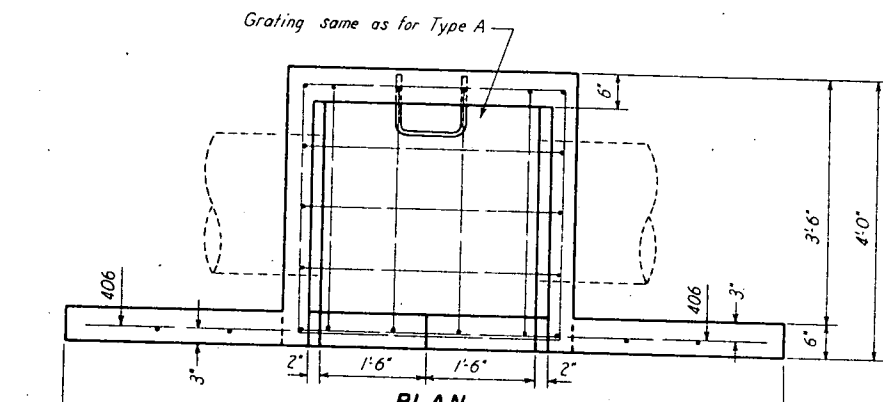

PLAN

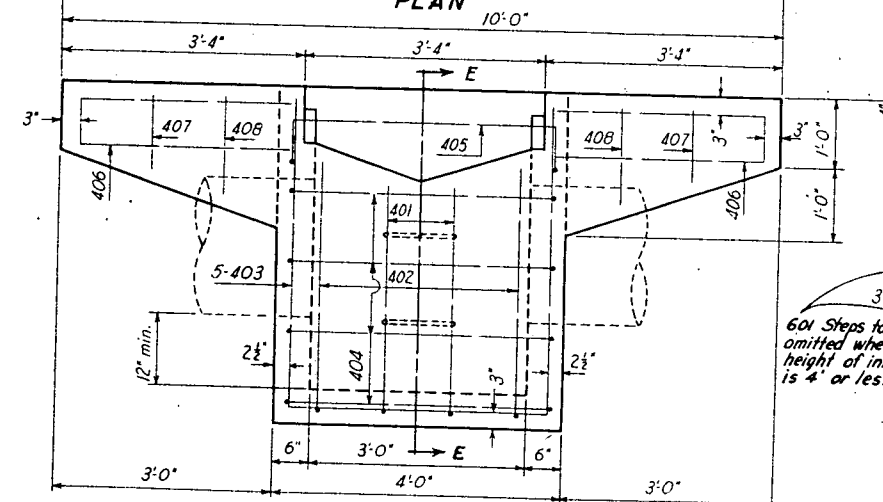

FRONT ELEV.

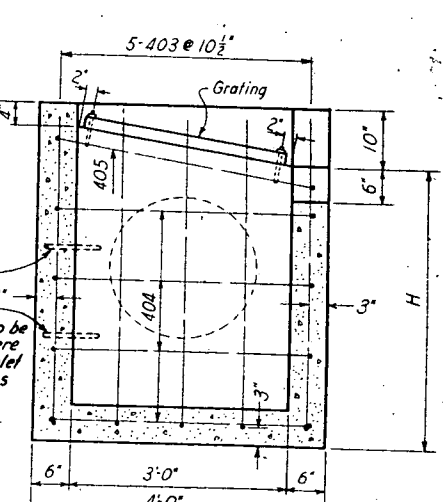

SECT. "E-E"


FRONT ELEV.

\* Note for Longitudinal Pipe: 6" minimum between bottom of Inlet Opening and top of Longitudinal Pipe.

### BAR LIST FOR H=4'-0"

MARK	NO. REQ'D	KIND	TYPE A				TYPE B			
			M	N	O	LENGTH	M	N	O	LENGTH
401	2	I	3'-5"	3'-3"	3'-3"	9'-10"	3'-5"	3'-3"	4'-5"	11'-0"
402	2	I	3'-5"	3'-6"	3'-6"	10'-4"	3'-5"	3'-6"	4'-5"	11'-3"
403	5	I	3'-6"	3'-7"	3'-7"	10'-7"	3'-7"	4'-5"	4'-5"	12'-4"
404	4	II	3'-7"	3'-7"		15'-4"	3'-8"	3'-6"		15'-4"
405	1	I					3'-8"	3'-7"	3'-7"	10'-9"
406	2	I					0'-8"	2'-10"	2'-10"	6'-3"
407	2	Str.								1'-1"
408	2	Str.								1'-5"
601	1	IV	1'-0"	0'-10"	0'-10"	2'-6"	1'-0"	0'-10"	0'-10"	2'-6"

All reinforcing bars to be 1/2" φ.

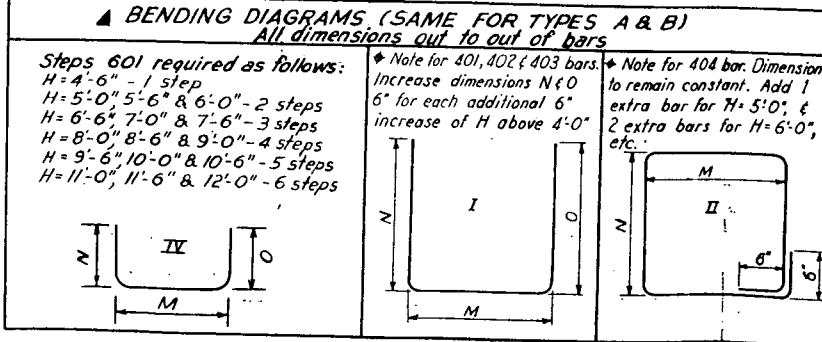

▲ Note: Cut or bend bars to fit around pipes as required

### GENERAL NOTES

All work shall be done according to the Standard Specifications of the Colorado Department of Highways applicable to the project.  
 All concrete shall be Class "A" and air entrained as specified.  
 All walls shall have forms on both sides. Bevel all exposed corners to a 1" face.  
 All reinforcing bars shall be deformed, of intermediate grade, and shall be tagged with the station number and bar designation.  
 All reinforcing steel bars shall conform to ASTM specification A305-50T or latest revision thereof.  
 All edge distances not marked clear are to the E of the bar.  
 Inlet grating to be painted as per specifications for structural steel. One Shop Coat of Zinc Chromate primer and two field coats of Aluminum.

**COLORADO DEPARTMENT OF HIGHWAYS**  
**TYPES A & B CONCRETE INLETS FOR MEDIAN DITCH**  
 18", 24", 30" and 36" CULVERTS  
 Designed by W.M.L. Approved by J.P. Bailey  
 Made by P.C. Builders Exchange


### SINGLE CONCRETE BOX CULVERT

### STANDARD M-50-B

FED. ROAD REG. NO.	DIVISION	SHEET NO.	TOTAL SHEETS
9	COLO.	125-2(44) 150 16	

Dimensions & Quantities (see Standard M-50-BW for Wings)

Height of Fill Allowed	Type	Span S	Height H	Slab T	Wall W	Bar Size & Spacing		No. Bars Required	Quantities for One Lin. Ft. of Box		Quantities for Two Headwalls	
						V <sub>1</sub>	V <sub>2</sub>		Concrete Cu. Yds.	Steel Lbs.	Concrete Cu. Yds.	Steel Lbs.
35'-0"	2A	2'-0"	2'-0"	6"	8"	3/4"	12"	8	0.232	17.5	1.30	81
30'-0"	3A	3'-0"	3'-0"	7"	8"	3/4"	12"	10	0.299	23.3	1.50	112
20'-0"	4A	4'-0"	4'-0"	7 1/2"	8"	3/4"	12"	12	0.362	31.8	1.75	150
16'-0"	5A	5'-0"	4'-0"	8"	8"	3/4"	12"	14	0.424	34.8	1.90	164
20'-0"	5B	5'-0"	5'-0"	8 1/2"	8"	3/4"	12"	16	0.461	37.3	2.10	158
14'-0"	6A	6'-0"	5'-0"	8 1/2"	8"	3/4"	12"	18	0.530	42.7	2.40	157
20'-0"	6B	6'-0"	6'-0"	10"	8"	3/4"	12"	20	0.579	52.0	2.60	161
12'-0"	7A	7'-0"	9'-0"	9"	9"	3/4"	7"	26	0.832	75.5	3.40	212
15'-0"	7B	7'-0"	10'-0"	9"	9"	3/4"	8"	26	0.883	85.5	3.25	262
20'-0"	7C	7'-0"	11'-0"	9"	9"	3/4"	7"	26	0.883	90.0	3.45	262
10'-0"	8A	8'-0"	9 1/2"	10"	8"	3/4"	7"	26	0.938	94.5	3.75	273
16'-0"	8B	8'-0"	11 1/2"	10"	8"	3/4"	7"	26	0.938	105.5	3.70	297
20'-0"	8C	8'-0"	12 1/2"	10"	8"	3/4"	6"	26	0.938	110.8	3.90	303
7'-0"	9A	9'-0"	10"	11"	8"	3/4"	8"	26	1.040	102.7	4.00	326
14'-0"	9B	9'-0"	12"	11"	8"	3/4"	6"	26	1.040	124.7	4.60	338
20'-0"	9C	9'-0"	14"	11"	8"	3/4"	7"	26	1.040	148.6	4.90	344
5'-0"	10A	10'-0"	10 1/2"	12"	8"	3/4"	8"	32	1.260	117.0	4.60	355
10'-0"	10B	10'-0"	12"	12"	8"	3/4"	7"	32	1.260	130.4	4.70	367
16'-0"	10C	10'-0"	14"	12"	8"	3/4"	6"	32	1.260	159.7	4.80	449
5'-0"	11A	11'-0"	11"	12"	7"	1"	7"	36	1.558	132.2	5.25	387
9'-0"	11B	11'-0"	12"	12"	7"	1"	8"	36	1.558	157.3	5.65	418
13'-0"	11C	11'-0"	14"	12"	7"	1"	6"	36	1.558	172.0	5.70	497
5'-0"	12A	12'-0"	12"	12"	7"	1"	7"	42	1.727	144.7	5.20	419
10'-0"	12B	12'-0"	14"	12"	7"	1"	6"	42	1.727	172.0	5.40	497
4'-0"	13A	13'-0"	12"	12"	7"	1"	7"	44	1.754	153.3	6.20	446
8'-0"	13B	13'-0"	14"	12"	7"	1"	6"	44	1.754	188.8	6.55	454
4'-0"	14A	14'-0"	13 1/2"	12"	7"	1"	8"	46	1.827	177.2	5.95	471
8'-0"	14B	14'-0"	15"	12"	7"	1"	7"	46	1.827	204.5	6.10	508

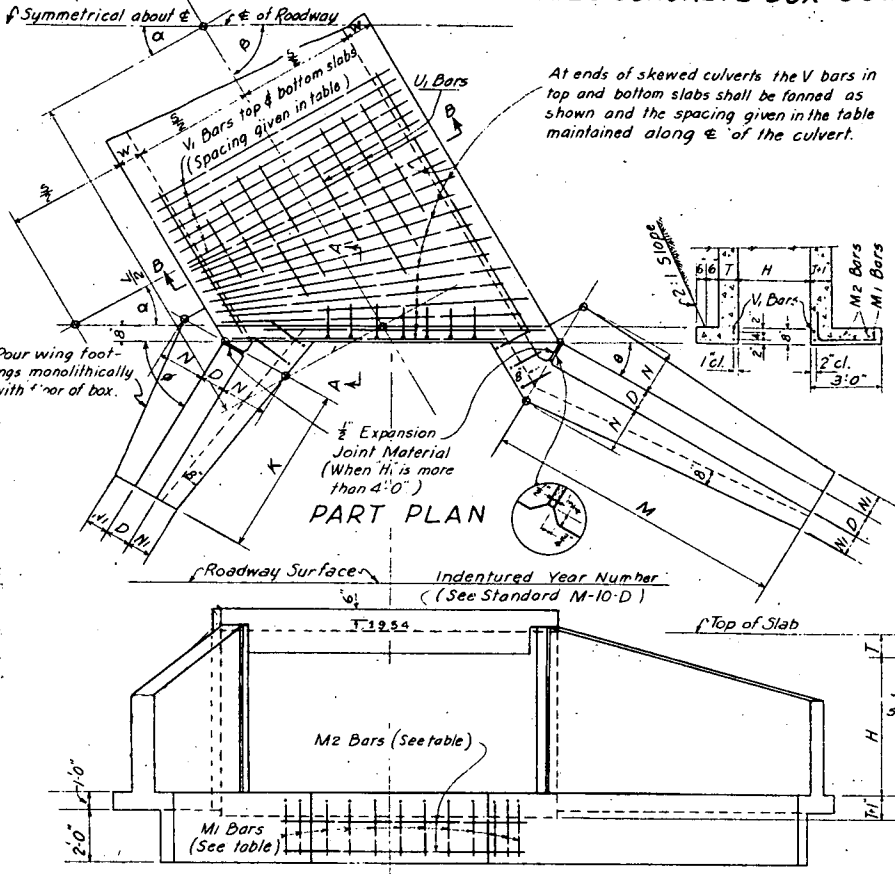


Bar List for Culvert & Headwalls (See Standard M-50-BW for Wings)

Mark	Size	No. Req'd	Type	Length
V <sub>1</sub>	See table	10 + 24L/Spa	I	S + 2W - 6
W <sub>1</sub>	See table	6 + 24L/Spa	I	H + 2T - 5
M <sub>1</sub>	3/8"	See table	I	L + 1'-0"
M <sub>2</sub>	3/8"	4	I	S + 2W - 6 Cos α

Possible Combinations (Span & Height)

Span	Height	Span	Height	Span	Height	Span	Height
2'-2"	5'-5"	9'-5"	10'-7"	11'-8"	11'-10"		
3'-2"	7'-4"	8'-6"	9'-8"	10'-9"	14'-8"		
4'-2"	6'-5"	7'-7"	12'-6"	13'-7"	13'-9"		
3'-3"	8'-4"	9'-6"	11'-7"	12'-8"	12'-10"		
4'-3"	7'-5"	8'-7"	13'-6"	14'-7"	14'-9"		
5'-3"	6'-6"	10'-6"	10'-8"	11'-9"	13'-10"		
4'-4"	8'-5"	9'-7"	9'-9"	10'-10"	14'-10"		
5'-4"	6'-7"	8'-8"	12'-7"	13'-8"			
6'-4"	7'-6"	11'-6"	14'-6"	12'-9"			

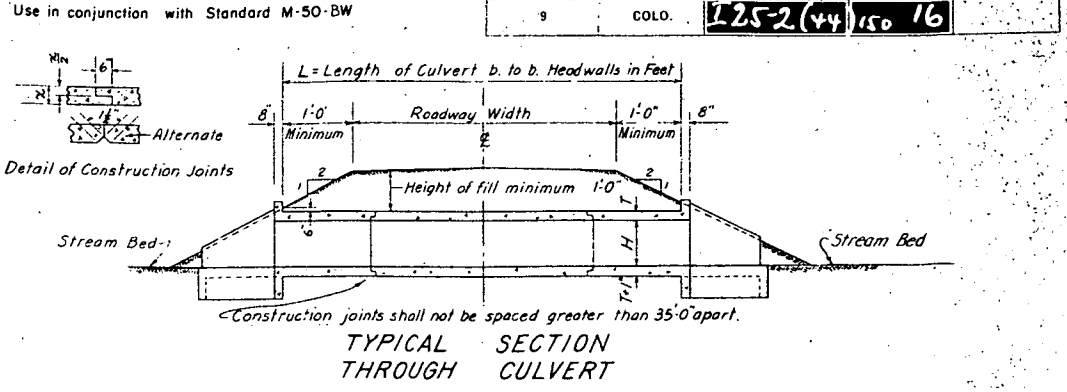

Quantities for one culvert shall be (quantity for one lin. ft. of box times L) plus (quantity for two Head Walls) plus (quantities for four wings).  
Note: This design not to be used when height of fill exceeds the allowed amount tabulated.


END ELEVATION  
Note: All wing faces to receive ordinary surface finish.

SECTION B-B  
Bar dimensions are to center of bar unless marked 'cl.' (clear).

STANDARD M-50-B  
Use in conjunction with Standard M-50-BW  
Note: K, M, N, Ni and D are dimensioned on Standard M-50-BW for the various heights of culverts.

Dimensions & Quantities (see Standard M-50-BW for Wings)

Height of fill allowed	Type	Span S	Height H	Slab T	Wall W	Bar Size & Spacing		No. Bars Required	Quantities for One Lin. Ft. of Box		Quantities for Two Headwalls		
						V <sub>1</sub>	V <sub>2</sub>		Concrete Cu. Yds.	Steel Lbs.	Concrete Cu. Yds.	Steel Lbs.	
10'-0"	6'-6-A	6'-0"	3'-0"	8 1/2"	8"	1/2"	12"	48	32	1.000	112.3	3.85	327
15'-0"	6'-6-B	6'-0"	4'-0"	9 1/2"	8"	1/2"	12"	52	32	1.073	117.7	4.60	335
20'-0"	6'-6-C	6'-0"	5'-0"	10 1/2"	8"	1/2"	12"	56	32	1.148	123.1	4.85	343
10'-0"	8'-8-A	8'-0"	4'-0"	10"	10"	1/2"	12"	48	40	1.252	128.5	5.05	351
15'-0"	8'-8-B	8'-0"	5'-0"	11"	10"	1/2"	12"	52	40	1.316	135.7	4.85	357
20'-0"	8'-8-C	8'-0"	6'-0"	12"	10"	1/2"	12"	56	40	1.385	141.9	4.90	346
10'-0"	10'-10-A	10'-0"	4'-0"	10"	12"	1/2"	12"	48	40	1.477	144.4	5.80	366
15'-0"	10'-10-B	10'-0"	5'-0"	11"	12"	1/2"	12"	52	40	1.569	150.6	6.05	374
20'-0"	10'-10-C	10'-0"	6'-0"	12"	12"	1/2"	12"	56	40	1.662	156.8	6.30	382
5'-0"	12'-12-A	12'-0"	4'-0"	12"	12"	3/8"	12"	48	48	1.754	163.0	6.55	391
10'-0"	12'-12-B	12'-0"	5'-0"	13"	12"	3/8"	12"	52	48	1.846	169.2	6.80	399
15'-0"	12'-12-C	12'-0"	6'-0"	14"	12"	3/8"	12"	56	48	1.938	175.4	7.05	407
5'-0"	14'-14-A	14'-0"	4'-0"	12"	12"	3/8"	12"	48	48	2.030	181.6	7.30	415
10'-0"	14'-14-B	14'-0"	5'-0"	13"	12"	3/8"	12"	52	48	2.122	187.8	7.55	423

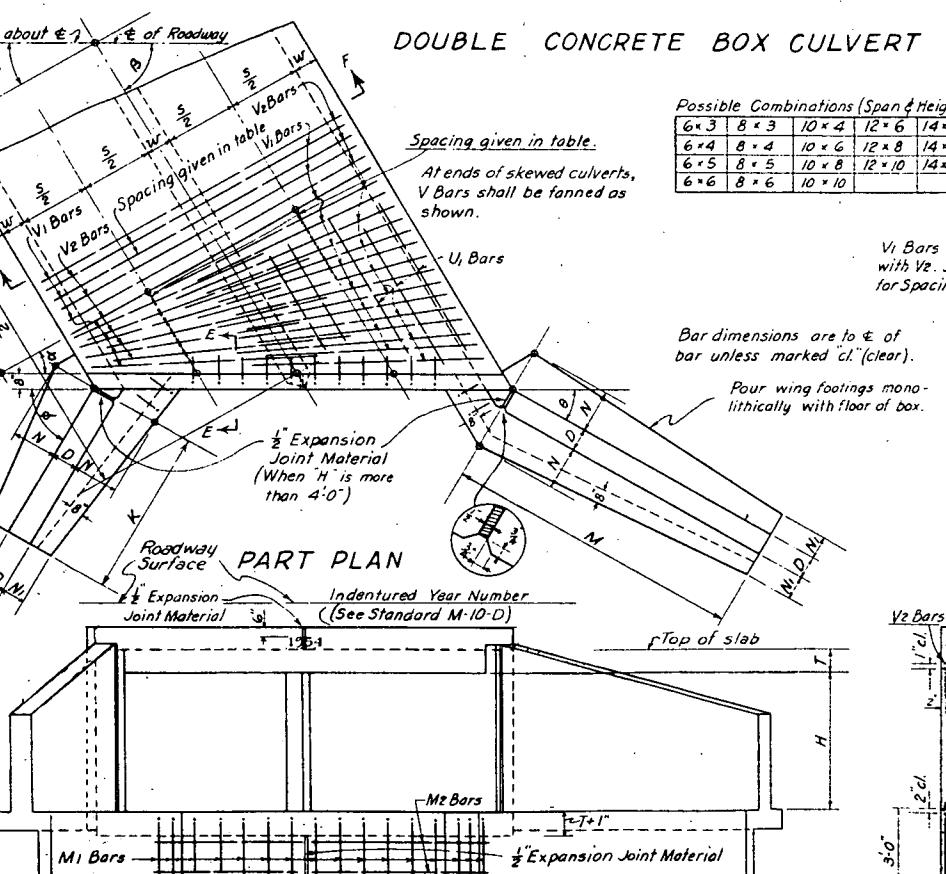

Possible Combinations (Span & Height)

Span	Height	Span	Height	Span	Height	Span	Height
6'-3"	8'-3"	10'-4"	12'-6"	14'-6"			
6'-4"	8'-4"	10'-6"	12'-8"	14'-8"			
6'-5"	8'-5"	10'-8"	12'-10"	14'-10"			
6'-6"	8'-6"	10'-10"	14'-10"				

Bar List for Culvert and Two Headwalls (See Standard M-50-BW for Wings)

Mark	Size	Number Required	Type	L	Total Length
V <sub>1</sub>	See table	24(L+2)	I	S + 15W + 4"	L
V <sub>2</sub>	See table	Spacing	II	0.75S + 4"	2L + m
W <sub>1</sub>	1/2"	2(L+2)	I	H + 2T - 4"	L
W <sub>2</sub>	1/2"	See Table	I	H + 2T - 4"	L
M <sub>1</sub>	3/8"	See Table	I	L + 12"	L
M <sub>2</sub>	3/8"	8	I	S + 2W - 6"	3'-6"

Quantities for one culvert shall be (quantity for one lin. ft. of box times L) plus (quantity for two headwalls) plus (quantities for four wings).

END ELEVATION  
Note: All wing faces to receive ordinary surface finish.


**COLORADO**  
DEPARTMENT OF HIGHWAYS  
STANDARD SINGLE AND DOUBLE  
CONCRETE BOX CULVERTS  
(FOR SIZES SEE TABLE OF POSSIBLE COMBINATIONS)

Designed by: WWD Approved by: T.J.M.  
Made by: WWD Bridge Engineer  
Checked by: T.J.M. Date: Aug 30, 1954

TABLE SHOWING VALUES OF K AND M WHEN  $\beta$  AND H ARE GIVEN

$\beta$	$\alpha$	$\phi$	$\theta$	H=2'-0"	H=3'-0"	H=4'-0"	H=5'-0"	H=6'-0"	H=7'-0"	H=8'-0"	H=9'-0"	H=10'-0"
45°	45°	67°30'	22°30'	2.4	3.7	4.7	5.5	6.1	6.6	7.0	7.4	7.7
60°	30°	60°	30°	2.9	4.9	6.7	8.1	9.0	9.7	10.2	10.6	10.9
75°	15°	52°30'	37°30'	3.0	5.1	7.3	9.0	10.3	11.2	11.8	12.2	12.5
90°	0°	45°	45°	3.4	6.0	9.0	12.0	14.5	16.5	18.0	19.0	19.6
105°	15°	37°30'	52°30'	3.1	5.5	8.1	10.5	12.5	14.0	15.0	15.5	15.9
120°	30°	30°	60°	4.9	9.0	13.5	18.0	21.5	24.0	25.5	26.5	27.0
135°	45°	22°30'	67°30'	6.2	12.4	19.5	27.0	32.5	36.0	38.0	39.5	40.5


$\beta$  EQUALS THE ANGLE BETWEEN  $\phi$  OF CULVERT AND  $\phi$  OF ROADWAY.  $\theta$  EQUALS THE ANGLE BETWEEN  $\phi$  OF CULVERT AND A NORMAL TO  $\phi$  OF ROADWAY.  $\phi$  AND  $\theta$  ARE ANGLES BETWEEN THE WINGWALL AND A LINE PARALLEL WITH THE CENTER LINE OF ROADWAY. EXAMPLE FOR USING THE ABOVE TABLE: SUPPOSE A STREAM MAKES AN ANGLE OF  $\beta$  65° WITH THE CENTER LINE OF ROADWAY, THEN FROM THE TABLE, SELECT THE NEAREST ANGLE  $\beta$  = 60°, THEN  $\alpha$ ,  $\phi$  AND  $\theta$  EQUAL 30°, 60° AND 30° RESPECTIVELY. IF THE DESIRED HEIGHT "H" OF CULVERT IS 8'-0", THEN "K" AND "M" WILL BE 9'-3" AND 16'-0". LOCATE THE WING DETAIL WHEN H=8'-0" ON THIS SHEET.

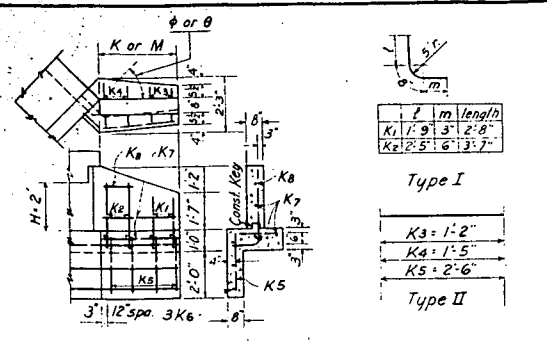

BAR LIST & QUANTITIES FOR ONE WING WHEN H=2'-0"

When $\phi$ or $\theta$ equals	Number of Bars Required	Length of Bars	Quantities for One Wing
22°30'	4	3-8' 3"	Concrete 1.07, Steel 64
30°	3	3-6' 2"	Concrete 0.82, Steel 47
37°30'	2	3-5' 0"	Concrete 0.68, Steel 40
45°	2	3-4' 4"	Concrete 0.57, Steel 36
52°30'	2	3-4' 0"	Concrete 0.52, Steel 33
60°	2	3-3' 6"	Concrete 0.48, Steel 28
67°30'	2	3-3' 0"	Concrete 0.40, Steel 26


WING DETAIL WHEN H=2'-0"

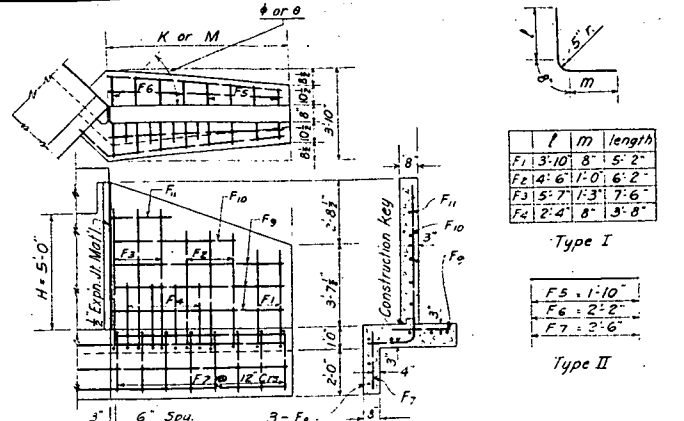

BAR LIST & QUANTITIES FOR ONE WING WHEN H=5'-0"

When $\phi$ or $\theta$ equals	Number of Bars Required	Length of Bars	Quantities for One Wing
22°30'	5	3-13' 3"	Concrete 2.37, Steel 180
30°	4	3-11' 0"	Concrete 1.87, Steel 147
37°30'	3	3-9' 6"	Concrete 1.30, Steel 103
45°	2	3-8' 6"	Concrete 0.96, Steel 73
52°30'	2	3-7' 9"	Concrete 0.79, Steel 61
60°	2	3-7' 3"	Concrete 0.73, Steel 57
67°30'	2	3-7' 0"	Concrete 0.69, Steel 54


WING DETAIL WHEN H=5'-0"

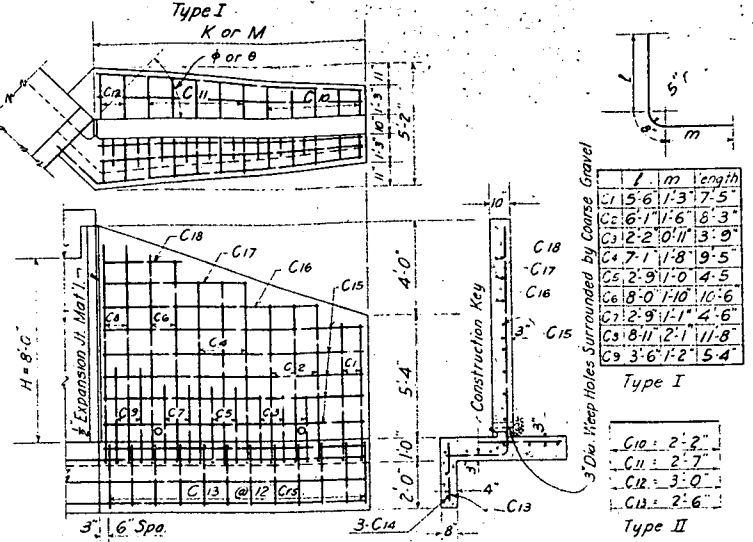

BAR LIST & QUANTITIES FOR ONE WING WHEN H=8'-0"

When $\phi$ or $\theta$ equals	Number of Bars Required	Length of Bars	Quantities for One Wing
22°30'	5	3-25' 8"	Concrete 9.00, Steel 526
30°	4	3-20' 6"	Concrete 6.91, Steel 402
37°30'	3	3-16' 0"	Concrete 5.69, Steel 330
45°	2	3-14' 3"	Concrete 4.89, Steel 287
52°30'	2	3-13' 2"	Concrete 4.35, Steel 257
60°	1	3-12' 0"	Concrete 3.99, Steel 242
67°30'	1	3-10' 3"	Concrete 3.74, Steel 228


WING DETAIL WHEN H=8'-0"

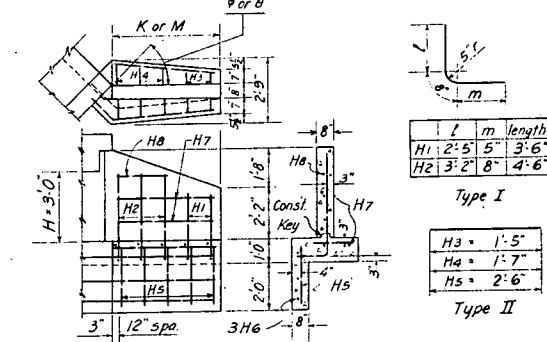

BAR LIST & QUANTITIES FOR ONE WING WHEN H=3'-0"

When $\phi$ or $\theta$ equals	Number of Bars Required	Length of Bars	Quantities for One Wing
22°30'	4	3-10' 10"	Concrete 1.78, Steel 99
30°	3	3-8' 4"	Concrete 1.36, Steel 76
37°30'	3	3-7' 8"	Concrete 1.12, Steel 63
45°	2	3-6' 5"	Concrete 0.97, Steel 54
52°30'	2	3-5' 4"	Concrete 0.86, Steel 52
60°	2	3-4' 10"	Concrete 0.79, Steel 44
67°30'	2	3-4' 8"	Concrete 0.74, Steel 43


WING DETAIL WHEN H=3'-0"

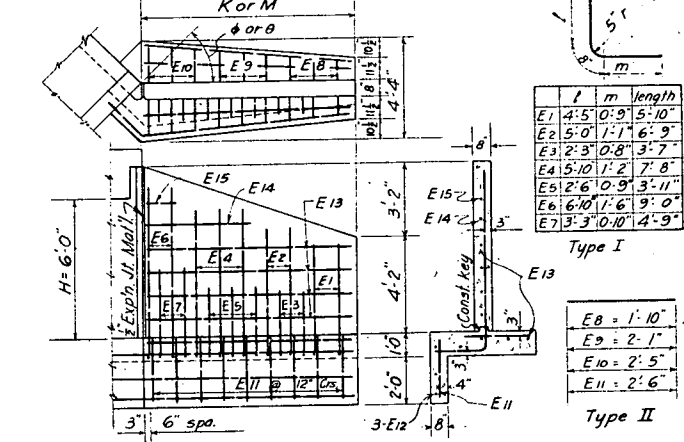

BAR LIST & QUANTITIES FOR ONE WING WHEN H=6'-0"

When $\phi$ or $\theta$ equals	Number of Bars Required	Length of Bars	Quantities for One Wing
22°30'	4	3-20' 9"	Concrete 5.21, Steel 317
30°	3	3-15' 0"	Concrete 3.99, Steel 243
37°30'	2	3-12' 6"	Concrete 2.83, Steel 171
45°	2	3-11' 0"	Concrete 2.51, Steel 156
52°30'	1	3-10' 9"	Concrete 2.30, Steel 145
60°	1	3-9' 8"	Concrete 2.17, Steel 134
67°30'	1	3-8' 6"	Concrete 2.03, Steel 124


WING DETAIL WHEN H=6'-0"

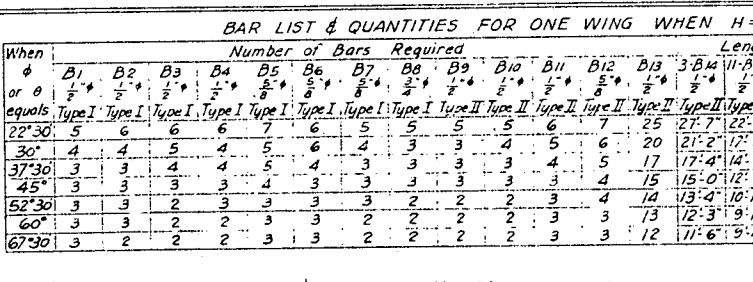

BAR LIST & QUANTITIES FOR ONE WING WHEN H=9'-0"

When $\phi$ or $\theta$ equals	Number of Bars Required	Length of Bars	Quantities for One Wing
22°30'	5	3-25' 7"	Concrete 11.56, Steel 666
30°	4	3-21' 2"	Concrete 8.86, Steel 510
37°30'	3	3-17' 4"	Concrete 7.27, Steel 427
45°	3	3-15' 0"	Concrete 6.28, Steel 370
52°30'	3	3-13' 2"	Concrete 5.57, Steel 322
60°	3	3-12' 3"	Concrete 5.11, Steel 294
67°30'	3	3-11' 6"	Concrete 4.82, Steel 279


WING DETAIL WHEN H=9'-0"

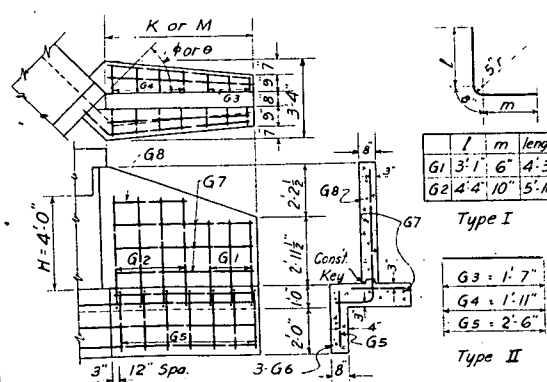

BAR LIST & QUANTITIES FOR ONE WING WHEN H=4'-0"

When $\phi$ or $\theta$ equals	Number of Bars Required	Length of Bars	Quantities for One Wing
22°30'	6	3-11' 3"	Concrete 2.89, Steel 164
30°	4	3-8' 6"	Concrete 2.21, Steel 125
37°30'	4	3-8' 0"	Concrete 2.11, Steel 121
45°	3	3-7' 8"	Concrete 1.96, Steel 116
52°30'	3	3-6' 9"	Concrete 1.80, Steel 107
60°	3	3-6' 4"	Concrete 1.72, Steel 100
67°30'	2	3-6' 0"	Concrete 1.67, Steel 97

WING DETAIL WHEN H=4'-0"

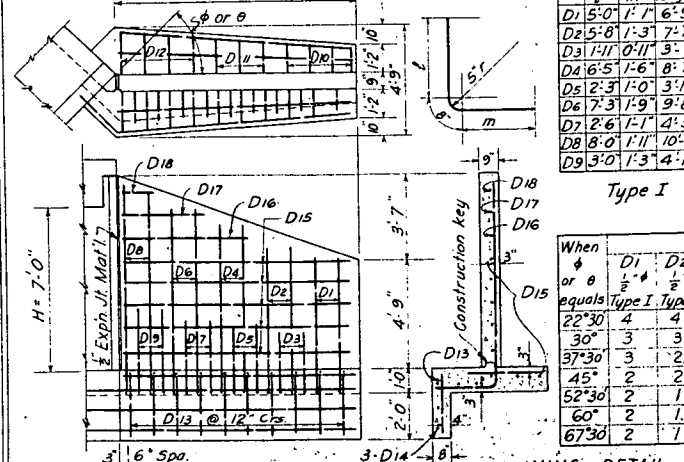


WING DETAIL WHEN H=7'-0"

BAR LIST & QUANTITIES FOR ONE WING WHEN H=7'-0"

When $\phi$ or $\theta$ equals	Number of Bars Required	Length of Bars	Quantities for One Wing
22°30'	4	3-18' 4"	Concrete 7.01, Steel 436
30°	3	3-14' 6"	Concrete 5.42, Steel 339
37°30'	3	3-12' 0"	Concrete 4.41, Steel 267
45°	2	3-11' 0"	Concrete 3.82, Steel 238
52°30'	2	3-10' 9"	Concrete 3.58, Steel 212
60°	2	3-10' 0"	Concrete 3.10, Steel 191
67°30'	2	3-9' 6"	Concrete 2.91, Steel 184

WING DETAIL WHEN H=7'-0"

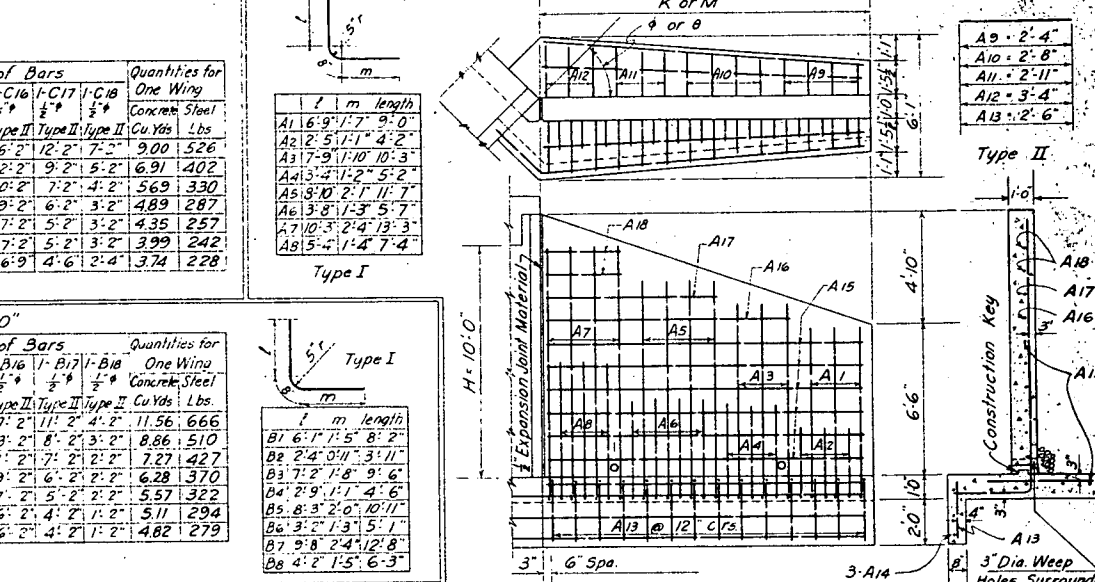

BAR LIST & QUANTITIES FOR ONE WING WHEN H=10'-0"

When $\phi$ or $\theta$ equals	Number of Bars Required	Length of Bars	Quantities for One Wing
22°30'	6	3-30' 0"	Concrete 14.35, Steel 830
30°	5	3-23' 0"	Concrete 11.01, Steel 636
37°30'	4	3-19' 0"	Concrete 9.03, Steel 523
45°	3	3-16' 3"	Concrete 7.76, Steel 440
52°30'	3	3-14' 9"	Concrete 6.92, Steel 394
60°	2	3-13' 6"	Concrete 6.35, Steel 363
67°30'	2	3-12' 10"	Concrete 5.97, Steel 348

WING DETAIL WHEN H=10'-0"

**GENERAL NOTES**  
 ALL WORK SHALL BE DONE ACCORDING TO THE STANDARD SPECIFICATIONS OF THE COLORADO DEPARTMENT OF HIGHWAYS APPLICABLE TO THE PROJECT.  
 ALL CONCRETE SHALL BE CLASS "A" AND AIR ENTRAINMENT AS SPECIFIED.  
 ALL WING SURFACES TO RECEIVE ORDINARY SURFACE FINISH.  
 WING FOOTINGS AND FLOOR OF BOX SHALL BE FORMED MONOLITHICALLY.  
 FORMS FOR CONCRETE SURFACES EXPOSED IN THE FINISHED WORK SHALL BE CONSTRUCTED OF SHUPLAP OR TONGUE AND GROOVE LUMBERS 3" UNLESS FACED WITH PANEL BOARD.  
 FOOTINGS IN ROCK SHALL BE FOUED OUT TO ROCK AND NOT FORMED.  
 SOUNDINGS AND DEPTH OF FOOTING SHOWN ARE IN ACCORDANCE WITH THE BEST AVAILABLE DATA AND WHEN DIFFERENT CONDITIONS ARE ENCOUNTERED THE BRIDGE ENGINEER WILL IN SPECT AND DETERMINE IF REVISION IS NECESSARY.  
 ALL REINFORCING STEEL SHALL CONFORM TO ASTM SPECIFICATION A 305 SPT OR THE LATEST REVISION THEREOF, AND SHALL BE INTERMEDIATE GRADE STEEL OF A DEFORMED TYPE. EACH BAR SHALL BE TAGGED WITH THE NUMBER DESIGNATION AND THE STATION NUMBER OF THE PROJECT. PRIMARY BARS SHALL NOT BE SPLICED AND SECONDARY BARS WHEN SPICED SHALL LAP 17 DIAMETERS OF THE BAR. DIMENSIONS FOR REINFORCING STEEL NOT SHOWN AS CLEAR SHALL BE TO THE CENTER LINE OF THE BAR. OUT TO OUT DIMENSIONS SHALL BE USED ON BAR BENDING DETAILS.  
 SUPPORTING SOILS FOR ALL CULVERTS MUST BE COMPOSED OF FIRM AND UNIFORM MATERIAL THROUGHOUT THE ENTIRE LENGTH OF THE CULVERT.  
 HORIZONTAL CONSTRUCTION KEYS ARE NOT REQUIRED WHEN FOOTINGS AND WALL ARE POURED MONOLITHICALLY.  
 ALL CONSTRUCTION KEYS SHOWN BETWEEN FOOTINGS AND WALLS ARE 3" X 3".  
 WHEN EXCAVATING FOR FOOTINGS THE FINAL ONE FOOT IN DEPTH SHALL BE DONE BY HAND LABOR METHODS.  
 FOR STD METHODS OF STRUCTURE BACKFILL SEE STD M-60-B.

**LOADING DATA** INTERSTATE INTERFERE  
 LIVE LOAD: A 5 S.H.O. (120-516-44)  
 DEAD LOAD: CONCRETE 150 POUNDS PER CUBIC FOOT.  
 EARTH 84 POUNDS PER CUBIC FOOT.

**DESIGNING DATA**  
 A 5 S.H.O. 1953 UNIT STRESSES, EXCEPT AS NOTED.  
 Reinforcing Steel fs 20000 lbs. per sq. in.  
 Structural Steel fs 18000 lbs. per sq. in.  
 fc 1000 lbs. per sq. in.  
 in 10.

**COLORADO DEPARTMENT OF HIGHWAYS**  
**WINGWALLS FOR VARIOUS TYPES OF CONCRETE BOX CULVERTS**

Designed by: W.W.D. Approved by: T.J.M.  
 Made by: W.W.D. Bridge Engineer  
 Checked by: T.J.M. Date: Aug 30, 1954



RE-TRACING  
PLAIN


REVISIONS

# STANDARD M-60-B


FED. ROAD REGION NO.	DIVISION	SHEET NO.	TOTAL SHEETS
9	COLO.	1252(44) 150 18	

REVISIONS		
2-9-59	Dbi. Cond. & Cond. in Tr.	H.E.P.


## CONCRETE BOX CULVERTS & WINGWALLS

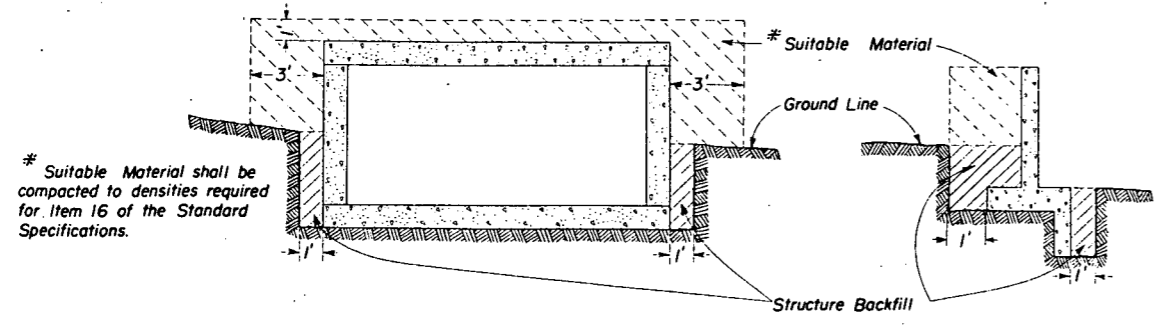

## CIRCULAR CONDUIT

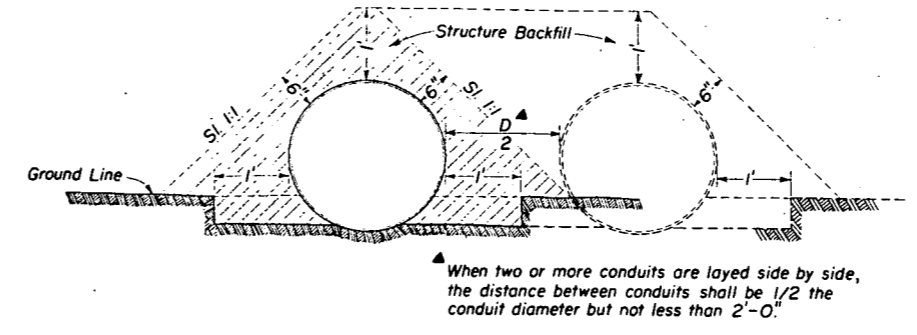


## SIPHONS OR CONDUIT IN TRENCH


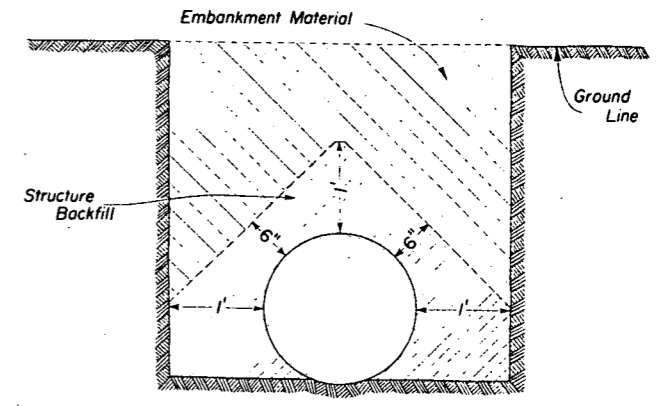


## PIERS, ABUTMENTS, RETAINING WALLS ETC.


All material that is to be compacted shall be placed in horizontal layers not more than 6" inches in depth and compacted before the next layer is placed. For Arches, Rigid Frames and Box Culverts the fill shall be brought up uniformly on both sides of the center of structure to avoid stresses in the structure caused by unsymmetrical loading.

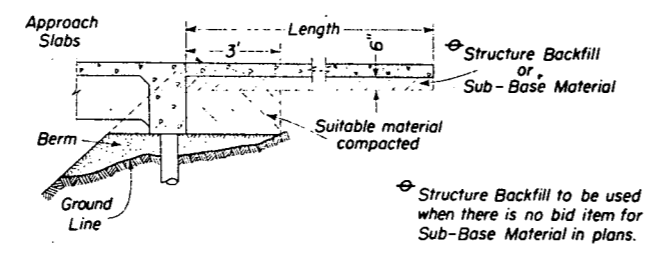



## ELLIPTICAL OR ARCH CONDUIT

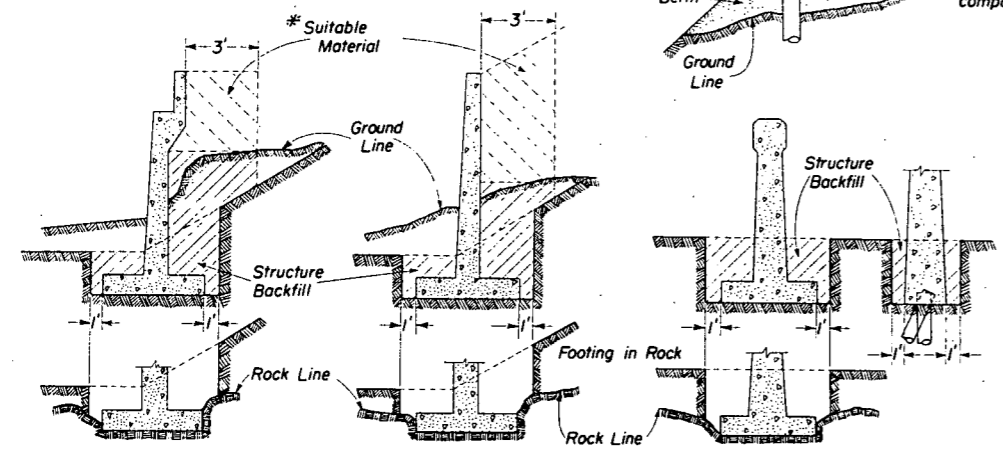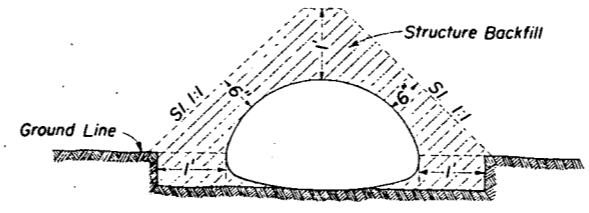

## DROP INLETS, DIVISION BOXES, INTERCEPTING HEADWALLS ETC.

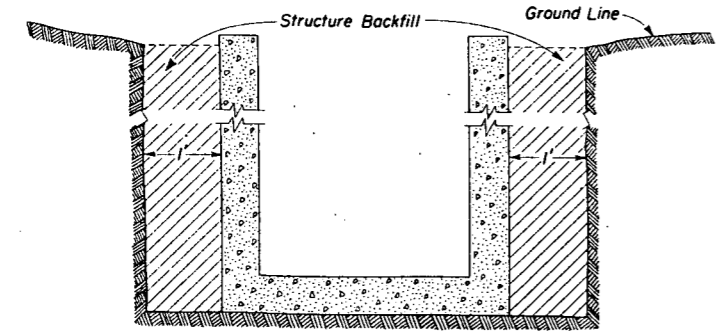

## HEADWALLS AND END OF CULVERTS

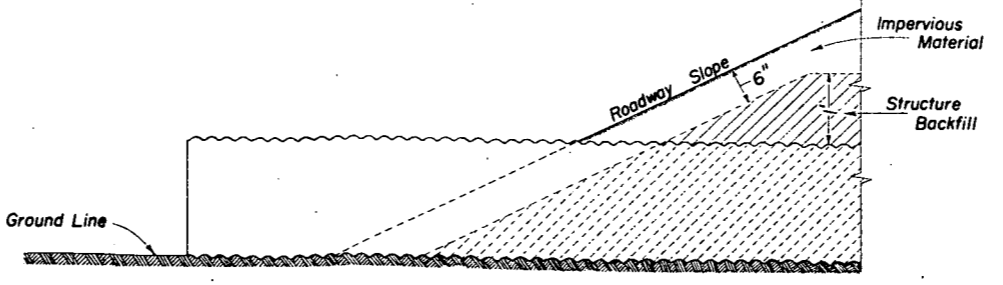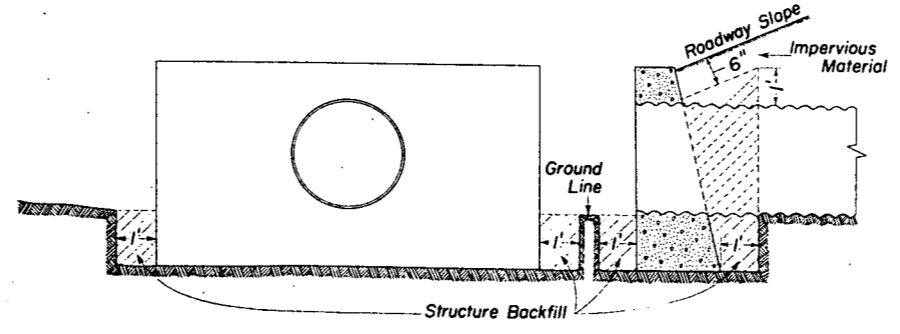

## GENERAL NOTES

All work shall be done according to the Standard Specifications of the Colorado Department of Highways applicable to the Project.  
If, in the opinion of the Engineer, the material beneath the Structure is of such character as to cause unequal settlement along the length of the Structure, the material shall be removed to such a depth ordered, and backfilled with gravel or other suitable material and compacted in accordance with Item 16 of the Standard Specifications.  
Suitable Material shall be any "Unclassified Excavation" material developed on the project except large rock, boulders or other materials considered by the Engineer to be undesirable for backfill around culverts, boxes etc.

**COLORADO DEPARTMENT OF HIGHWAYS**  
STANDARD METHODS OF BACKFILL AROUND STRUCTURES

Designed by H.E.P. Made by D.M.E. Checked by L.E.O.  
Approved by *L.S. Newhall* Bridge Engineer Date: *May 2, 1958*


# STANDARD TYPES OF DITCHES and CONSTRUCTION METHODS

STANDARD M-107-D

FFD. ROAD REG. NO.	DIVISION	SHEET NO.	TOTAL SHEETS
94	COLO.	150 19	

## DETAILS for CONTOUR INTERCEPTING DITCHES

### Typical Section for Contour Intercepting Ditches

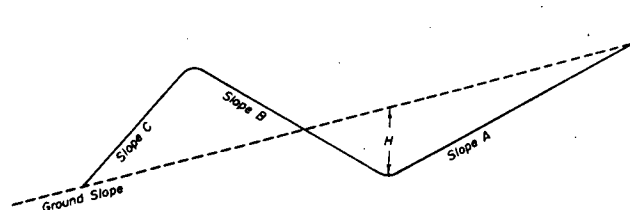

#### PURPOSE & USE OF THE TABLE

The primary purpose of the information for Contour and Intercepting Ditches shown on this sheet is to serve as a guide in construction and to readily arrive at yardages of excavation involved. Foremost consideration in constructing these ditches is given first to the natural ground line slope confronted in construction, thence to the other values shown on the Typical Section. By properly arriving at the combination of values shown on the Typical Section and in the Table for a specified condition, the number of cubic yards of excavation per 100 lin. ft. of ditch may be read under the appropriate column for this item.

### Typical Construction Layouts


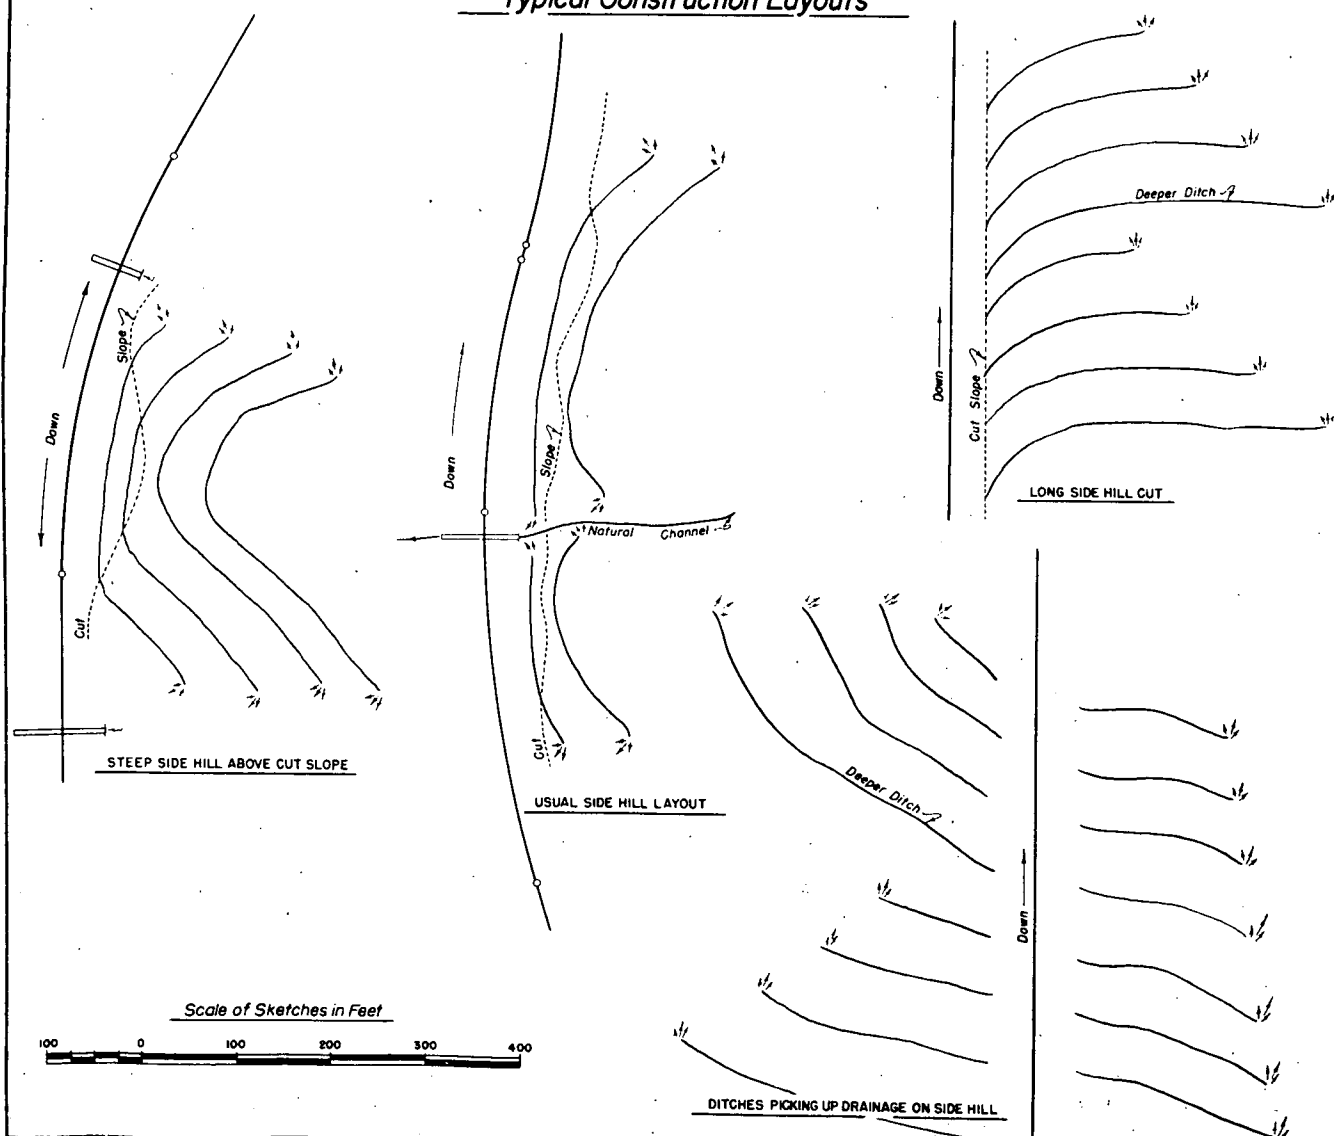


Table of Slopes and Yardages

Ground	SLOPES			H	Cubic Yards per 100 lin. ft. of Ditch	
	A	B	C			
5:1 Or Flatter	2:1	4:1	2:1	15"	16	
				18"	23	
				21"	32	
		3:1	2:1	15"	15	
				18"	22	
				21"	30	
	1-1/2:1	1-1/2:1	1-1/2:1	15"	14	
				18"	20	
				21"	27	
		4:1	1-1/2:1	1-1/2:1	15"	13
					18"	19
					21"	25
4:1	2:1	4:1	2:1	15"	12	
				18"	18	
				21"	25	
		3:1	2:1	2:1	15"	12
					18"	17
					21"	23
	1-1/2:1	1-1/2:1	1-1/2:1	15"	10	
				18"	15	
				21"	20	
		3:1	1-1/2:1	1-1/2:1	15"	10
					18"	14
					21"	19
3:1	2:1	4:1	2:1	15"	17	
				18"	25	
				21"	34	
		3:1	2:1	2:1	15"	17
					18"	24
					21"	32
	1-1/2:1	1-1/2:1	1-1/2:1	15"	15	
				18"	22	
				21"	30	
		3:1	1-1/2:1	1-1/2:1	15"	15
					18"	21
					21"	29
2:1	1-1/2:1	4:1	1-1/2:1	15"	13	
				18"	18	
				21"	25	
		3:1	2:1	2:1	15"	12
					18"	17
					21"	23
	1-1/2:1	1-1/2:1	1-1/2:1	15"	16	
				18"	21	
				21"	29	
		3:1	1-1/2:1	1-1/2:1	15"	10
					18"	14
					21"	20
1-1/2:1	2:1	3:1	2:1	15"	22	
				18"	31	
				21"	43	
		3:1	2:1	2:1	15"	21
					18"	30
					21"	41
	1-1/2:1	1-1/2:1	1-1/2:1	15"	20	
				18"	29	
				21"	40	
		3:1	1-1/2:1	1-1/2:1	15"	13
					18"	19
					21"	26
1-1/2:1	1-1/2:1	2:1	1-1/2:1	15"	12	
				18"	17	
				21"	24	
		3:1	1-1/2:1	1-1/2:1	15"	12
					18"	17
					21"	23
	1-1/2:1	1-1/2:1	1-1/2:1	15"	20	
				18"	29	
				21"	40	
		3:1	1-1/2:1	1-1/2:1	15"	13
					18"	19
					21"	26
1-1/2:1	1:1	2:1	1:1	15"	9	
				18"	13	
				21"	17	
		3:1	1-1/2:1	1-1/2:1	15"	8
					18"	12
					21"	16
	1-1/2:1	1:1	1-1/2:1	1:1	15"	11
					18"	16
					21"	21


▲ Slopes are approximate and may be varied to suit conditions encountered during construction.

## TYPICAL SECTIONS for DRAINAGE, IRRIGATION DITCHES and CHANNEL CHANGES

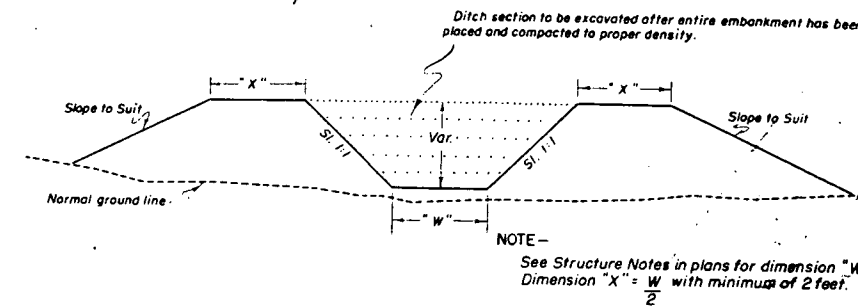

### For Embankment Sections

( Generally for use in Irrigation Ditches & Channel Changes )

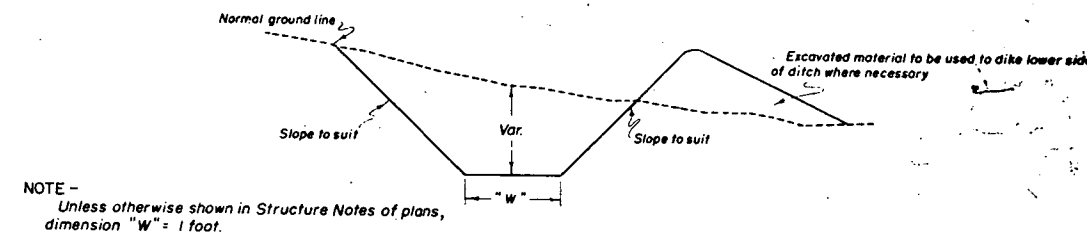

### For Cut Sections

## GENERAL NOTES

All work shall be done in accordance with the Standard Specifications of the Colorado State Highway Department applicable to the Project.

All ditches are to be constructed to lines and grades as staked by the Engineer using the ditch section shown on plans or as ordered by the Engineer.

CONTOUR INTERCEPTING DITCHES: Ditches are to be laid out along the ground contour on a grade of not over 1% (Type of soil shall govern the grade).

Ends of ditches are to be lined up so that concentration of flow from a higher contour ditch into one of lower contour is, as far as possible avoided. The use of a deeper ditch is recommended where this condition is encountered.

The following horizontal spacing of ditches is recommended:

4% to 6%	Approximately 70' Centers
8% to 10%	Approximately 60' Centers
20% to 4:1 Slope	Approximately 55' Centers
30% to 1-1/2:1 Slope	Approximately 50' Centers

Where ditch checks are required the intervening ditch between one set of ditch checks shall not exceed a grade of 1.0%. Details of checks will be shown on plans when required.

**COLORADO**  
DEPARTMENT OF HIGHWAYS


Standard Types of Ditches  
and  
Construction Methods

Designed by C.G.M. Approved by *W. Marshall*  
Made by C.G.M. Engineer, Surveyors & Planners  
Checked by Date: Aug. 18, 1950


# STANDARD M-112-F

FED. ROAD REGION NO.	DIVISION	PROJECT NO.	SHEET NO.	TOTAL SHEETS
9	COLO.	125-2(44)	50 20	


Rev. / Ref. of Conc. Pipe to Class - 7-9-58 E.E.O.

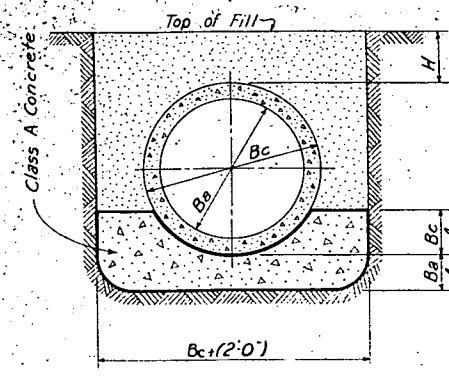

**CONCRETE CRADLE BEDDING IN TRENCHES**

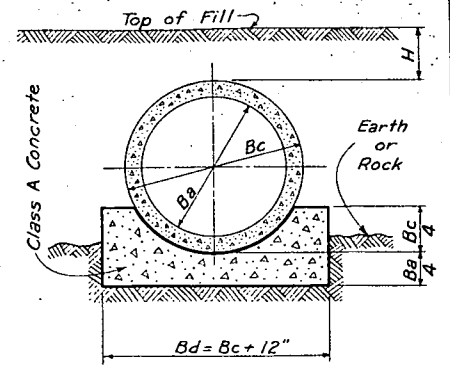

**CONCRETE CRADLE BEDDING IN FILLS**

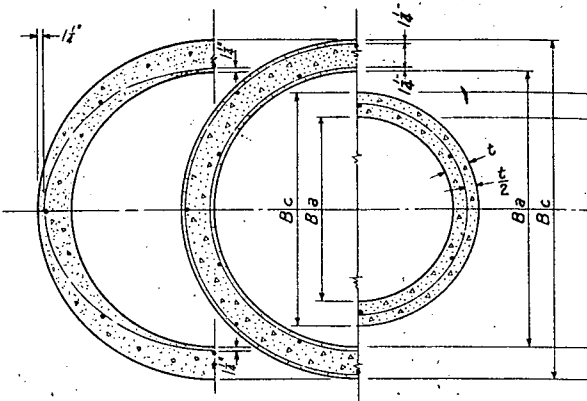

Sections with elliptical reinforcement or two lines of circular reinforcement. Section with one line of circular reinforcement.

**PIPE CROSS SECTIONS**

Where two lines of steel are contemplated a single line placed elliptically may be used, and the area of this shall be at least 50% of the total steel area required for two lines of reinforcement. Pipe with elliptical reinforcing shall have the word "Top" or "Bottom" clearly stenciled on the inside of the pipe at the correct place to indicate the proper position when laid.


Not less than 3 ft. or more than 8 ft. in length.

**LONGITUDINAL SECTIONS**

If machine made pipe is used a modified bell will be acceptable to the department.

**CONCRETE COLLAR**

Where the flow line grade of the pipe is 10% or greater, all pipe shall be the bell and spigot type or shall be tongue and groove pipe with concrete collars as detailed above or a type approved in writing by the Engineer.

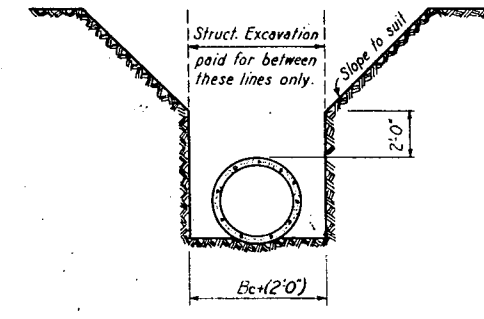

Where it is necessary to bed the pipe in a deep trench the contractor may, for his own convenience and at his own expense, slope the cut from a point 2'-0" above the top of the pipe as shown above. Note: For Concrete Sewer Pipe Structural Excavation is not a separate pay item.

**GENERAL NOTES**

All work shall be done according to the Standard Specifications of the Colorado State Highway Department applicable to the project.

The type of Pipe Joint used and the field construction there-of to make the joint reasonably water-tight shall be submitted to the Department for approval.


Unless otherwise noted the type of bedding shall be Ordinary Bedding. When the maximum fill height as noted hereon, for this type of bedding, is exceeded then that type of bedding which is indicated by the allowable fill height shall be used.

All culverts shall have headwalls or flared end sections if and as shown on the plans in accordance with Department Standards.

For size, type and location of pipe see plan sheets for project. Supporting soils shall be composed of firm and uniform material throughout the entire length of Culvert. The soil shall be accurately shaped to fit the pipe in accordance with the bedding conditions shown.

The Pipe shall be laid with the Bell or Groove end placed upstream.

If the desired fill height for pipe in a fill exceeds that given in the table, new embankment may be constructed to an elevation of two feet above the top of the pipe; a trench may then be excavated in the embankment and the pipe installed in accordance with a pipe in a trench. This work shall conform to the requirements for "Embankments" as shown in the specifications.

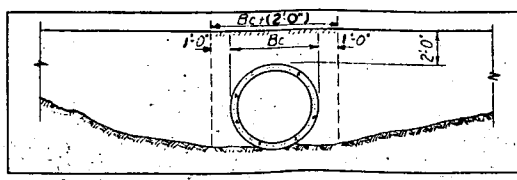


For Std. Methods of Structure Backfill See Std. M-60-B.

* Int. Dia. (Inches)	Bc	Three Edge Crack Point (Pounds)	Ultimate Load (Pounds)	Max. depth of fill "H" in ft. for 3 types of bedding							
				Concrete Cradle	First Class	Ordinary	Concrete Cradle	First Class	Ordinary		
12	16	2250	3500				30	No Limit	19	No Limit	16
15	19 1/2	2625	4065				28	No Limit	18	No Limit	15
18	23	3000	4500				28	No Limit	18	No Limit	15
24	30	3000	5000				22	No Limit	14	No Limit	12
30	37	3375	5750				21	No Limit	14	No Limit	12
36	44	4050	6600				21	No Limit	14	No Limit	12
42	51	4725	7350				22	No Limit	14	No Limit	12
48	58	5400	8000				22	No Limit	14	No Limit	12
54	65	5850	9000				22	No Limit	14	No Limit	12
60	72	6000	10000				21	No Limit	14	No Limit	12
66	79	6300	11000				20	No Limit	13	No Limit	12
72	86	6600	12000				20	No Limit	13	No Limit	12
84	100						20	No Limit	13	No Limit	12
24	30	4000	6000				29	No Limit	18	No Limit	15
30	37	5000	7500				30	No Limit	19	No Limit	16
36	44	6000	9000				30	No Limit	19	No Limit	16
42	51	7000	10500				31	No Limit	20	No Limit	17
48	58	8000	12000				31	No Limit	20	No Limit	17
54	65	9000	13500				32	No Limit	20	No Limit	17
60	72	9000	15000				29	No Limit	19	No Limit	16
66	79	9500	16500				28	No Limit	19	No Limit	16
72	86	9900	18000				28	No Limit	18	No Limit	15
84	100						28	No Limit	18	No Limit	15
12	16	1800	2700				24	No Limit	15	No Limit	13
15	19 1/2	2000	3000				22	No Limit	14	No Limit	12
18	23	2200	3300				21	No Limit	13	No Limit	11
21	26 1/2	2400	3600				20	No Limit	13	No Limit	11
24	30	2400	3600				18	No Limit	12	No Limit	10
27	33	2550	3800				18	No Limit	11	No Limit	10
30	37	2700	4050				17	No Limit	11	No Limit	9
33	40 1/2	2850	4300				17	No Limit	11	No Limit	9
36	44	3000	4500				16	No Limit	11	No Limit	9
42	51	3200	4800				16	No Limit	10	No Limit	9
48	58	3400	5100				15	No Limit	10	No Limit	9
54	65	3700	5550				15	No Limit	10	No Limit	9
60	72	4000	6000				16	No Limit	10	No Limit	9
66	79	4250	6350				16	No Limit	10	No Limit	9
72	86	4500	6750				15	No Limit	10	No Limit	9
4	5 1/2	1000					35	No Limit	24	No Limit	20
6	7 1/2	1100					31	No Limit	20	No Limit	17
8	9 1/2	1300					28	No Limit	18	No Limit	15
10	11 1/2	1400					25	No Limit	16	No Limit	13
12	14	1500					23	No Limit	14	No Limit	12
15	17 1/2	1750					21	No Limit	13	No Limit	11
18	21	2000					21	No Limit	13	No Limit	11
21	24 1/2	2200					20	No Limit	12	No Limit	11
24	28 1/2	2400					19	No Limit	12	No Limit	10


Note: External diameter of pipe shown in the table is approximate only, having been determined by using 3000 lbs. per sq. in. concrete. If greater strength concrete is used this diameter may be decreased accordingly.

Minimum Depth of Fill over Concrete Pipe:  
Main Roadways ..... 2 Foot  
Approach Roadways ..... 1 Foot


**COLORADO DEPARTMENT OF HIGHWAYS**  
 REINFORCED CONCRETE CULVERT PIPE  
 STD. STRENGTH 12", 15", 18", 24", 30", 36", 42", 48", 54", 60", 66", 72", 84"  
 EXTRA STR. 24", 30", 36", 42", 48", 54", 60", 66", 72", 84"  
 CONCRETE SEWER PIPE  
 REIN. 12", 15", 18", 21", 24", 27", 30", 33", 36", 42", 48", 54", 60", 66", 72"  
 UNREIN. 4", 6", 8", 10", 12", 15", 18", 21", 24"  
 Designed by W.W.D. Approved by J. J. [Signature]  
 Made by W.W.D. Bridge Engineer  
 Checked by P.C. Date: Mar. 17, 1958.

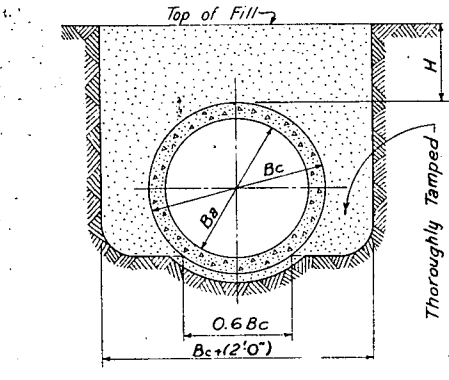


**FIRST CLASS BEDDING IN TRENCHES**

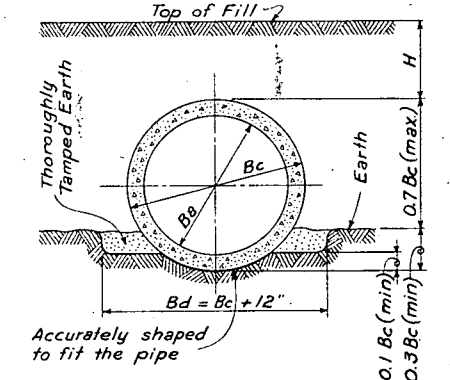


**FIRST CLASS BEDDING IN FILLS**

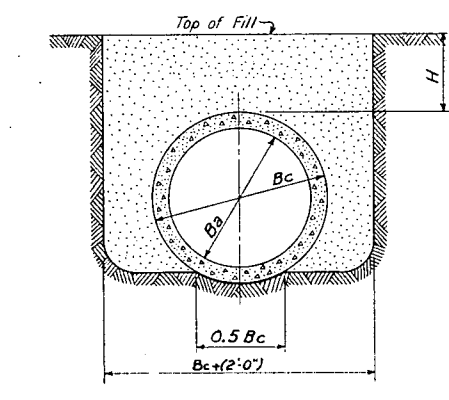

**ORDINARY BEDDING IN TRENCHES**

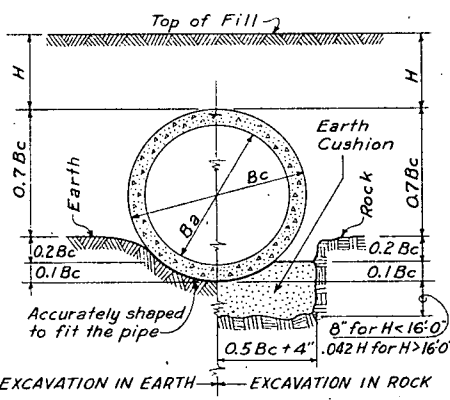


**ORDINARY BEDDING IN FILLS**

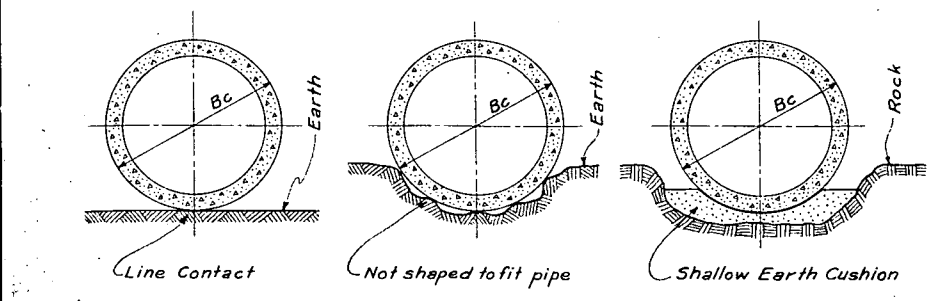

**IMPERMISSIBLE BEDDINGS IN TRENCHES OR FILLS**  
 THESE THREE TYPES SHALL NOT BE USED

FLARED END SECTION FOR CONCRETE PIPE

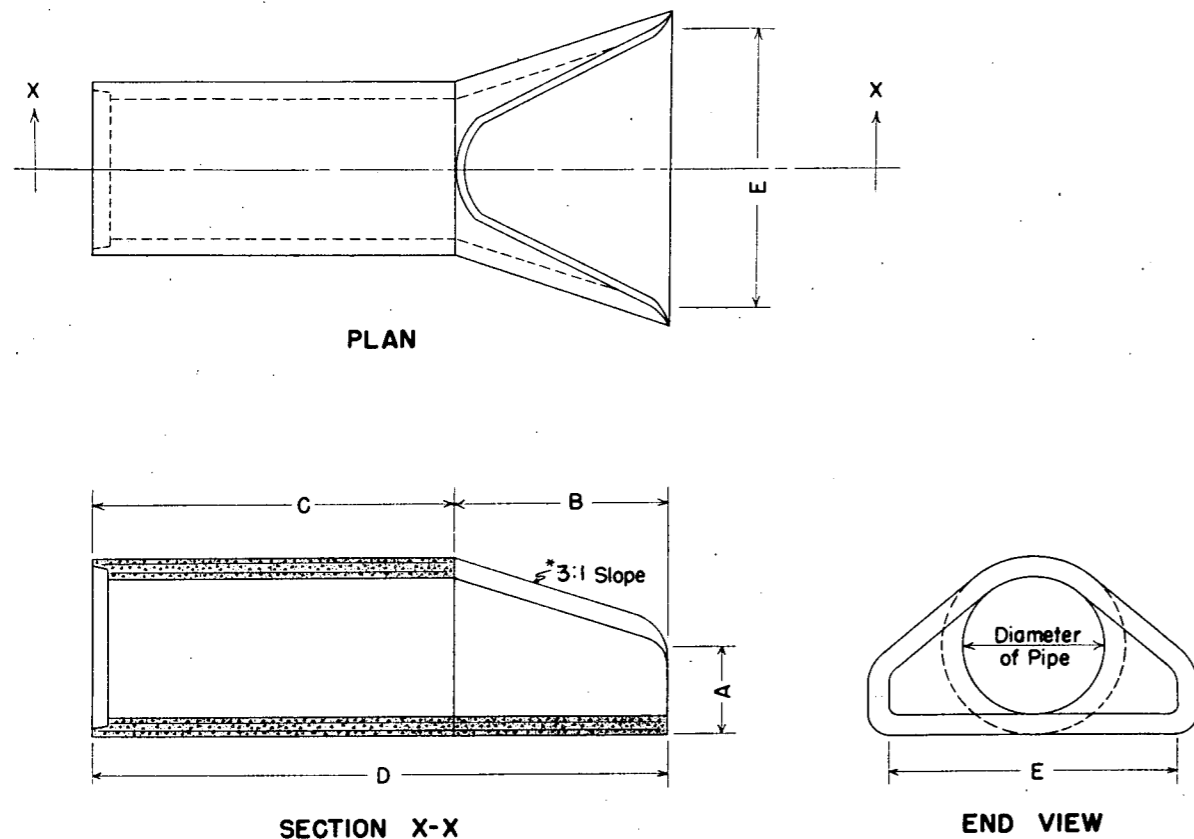


DIMENSIONS FOR FLARED END SECTIONS

DIAMETER	A	B	C	D	E
12"	4"	2'-0"	4'-0 7/8"	6'-0 7/8"	2'-0"
15"	6"	2'-3"	3'-10"	6'-1"	2'-6"
18"	9"	2'-3"	3'-10"	6'-1"	3'-0"
24"	9 1/2"	3'-7 1/2"	4'-6"	8'-1 1/2"	4'-0"
30"	1'-0"	4'-6"	3'-7 3/4"	8'-1 3/4"	5'-0"
36"	1'-3"	5'-3"	2'-10 3/4"	8'-1 3/4"	6'-0"
42"	1'-9"	5'-3"	2'-11"	8'-2"	6'-6"
48"	2'-0"	6'-0"	2'-2"	8'-2"	7'-0"
54"	2'-6"	6'-0"	2'-3"	8'-3"	7'-6"
*60"	2'-6"	5'-0"	3'-3"	8'-3"	8'-0"

\*60" end section is based on a slope of 2:1

7°30' ANGLE SECTION FOR CONCRETE PIPE

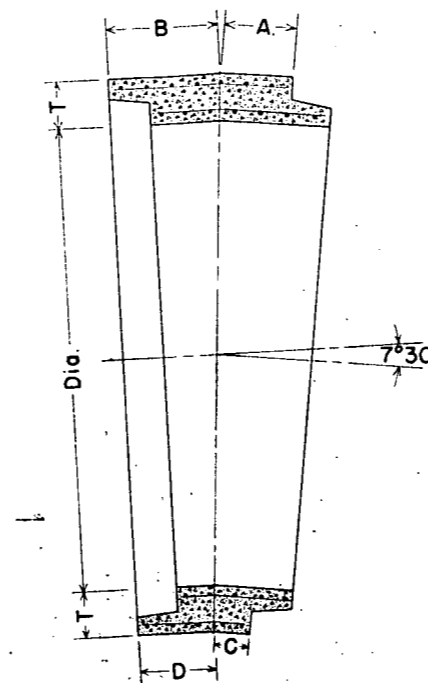


DIMENSIONS FOR 7°30' ANGLE SECTIONS

DIAMETER OF PIPE	LENGTH ON OUTSIDE OF PIPE				AVERAGE LAYING LENGTH ON E
	A	B	C	D	
12"	4 1/2"	4 1/2"	3 1/2"	3 1/2"	8"
15"	5 1/2"	5 1/8"	4 1/4"	3 7/8"	9 3/8"
18"	3 1/2"	6 1/2"	2"	5"	8 1/2"
24"	4"	6 1/2"	2"	4 9/16"	8 1/2"
30"	4 1/2"	7"	2"	4 1/2"	9"
36"	4 7/8"	8 7/16"	2"	5 9/16"	10 7/16"
42"	6"	9 1/2"	2 7/8"	6 1/8"	12 1/8"
48"	7"	11"	3 7/16"	7 3/16"	14 3/16"
54"	8 1/8"	12 1/8"	4"	8"	16 1/8"
60"	9 1/8"	14"	4 7/8"	9 1/4"	18 3/8"


A, B, C and D apply to Tongue and Groove type of Joint only and can be varied for other types of Joints.

COPPER EXPANSION JOINT FOR CONCRETE PIPE  
(WHEN REQUIRED ON PLANS)

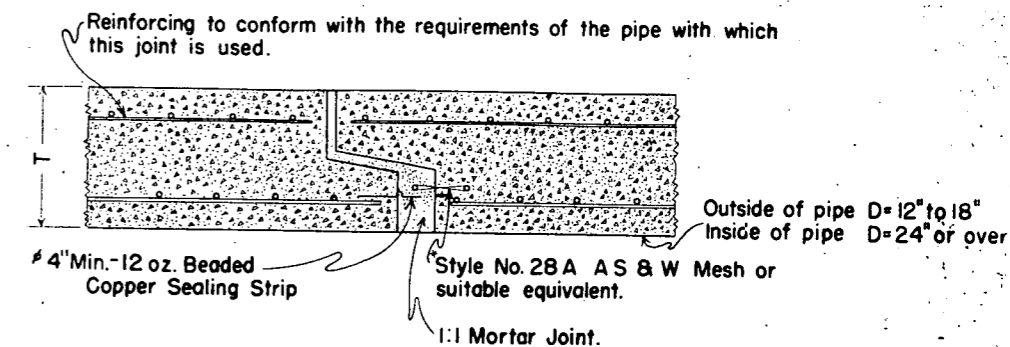

\*When Welded Rectangular Mesh is used for the reinforcing steel in the pipe the inner line of Mesh may be extended into the joint space instead of using a separate strip of Triangular Mesh.

COPPER SEALING STRIP

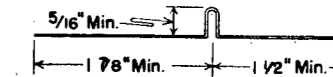

Copper Sealing Strips shall be made from sheet copper, 4" min. width, bent as shown and weighing 12 oz. per sq. ft. Both legs of strip shall be perforated in a satisfactory manner to secure bond. Each sealing strip shall be continuous around each pipe joint with a 1 1/4" end lap.

GENERAL NOTES

Joints other than Tongue and Groove may be used for Flared End Sections, 7°30' Angle and for the Copper Expansion Joint but all Joints for any one pipe structure must be uniform.

Concrete, wall thickness and reinforcing steel in Flared End Sections and 7°30' Angle Sections must conform with the requirements of the pipe with which they are used.

Alternate types of expansion joints may be substituted for the expansion joint shown on this sheet after approval by the Department.

Flared end sections are to be furnished with tongue or groove, and/or bell or spigot as required, in order that joints may be laid with the bell or groove end upstream.



COLORADO  
DEPARTMENT OF HIGHWAYS  
STANDARD  
FLARED END SECTION  
7°30' ANGLE SECTION  
AND  
COPPER EXPANSION JOINT  
FOR  
CONCRETE PIPE STRUCTURES

Designed by R.S.M. Approved by  
Made by J.M.K. *John Marshall*  
Checked by R.S.M. Date: January 14, 1949




FED. ROAD DIST. NO.	STATE	PROJ. NO.	SHEET NO.	TOTAL SHEETS
3	COLO.	125-2(44)150	22	

**DETAILS OF INTERCHANGE  
STA. 311+ ON S.H. NO. 1**

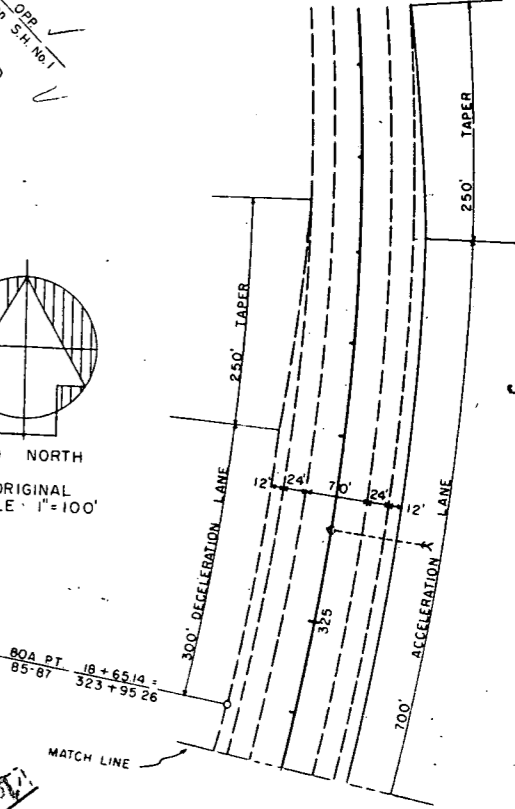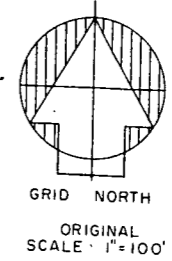

85-87  
 $\Delta_s = 73^\circ 45' LT.$   
 $T_s = 2274.8'$   
 $E_s = 717.6'$   
 $\Delta_c = 68^\circ 45'$   
 $D_c = 2^\circ 00'$   
 $L_c = 1459.9'$   
 $R_c = 2865.0'$   
 $\theta_s = 2^\circ 30'$   
 $L_s = 290'$   
 $LT = 1666.8'$   
 $ST = 83.35'$


$X_c = 249.95$   
 $Y_c = 3.64$

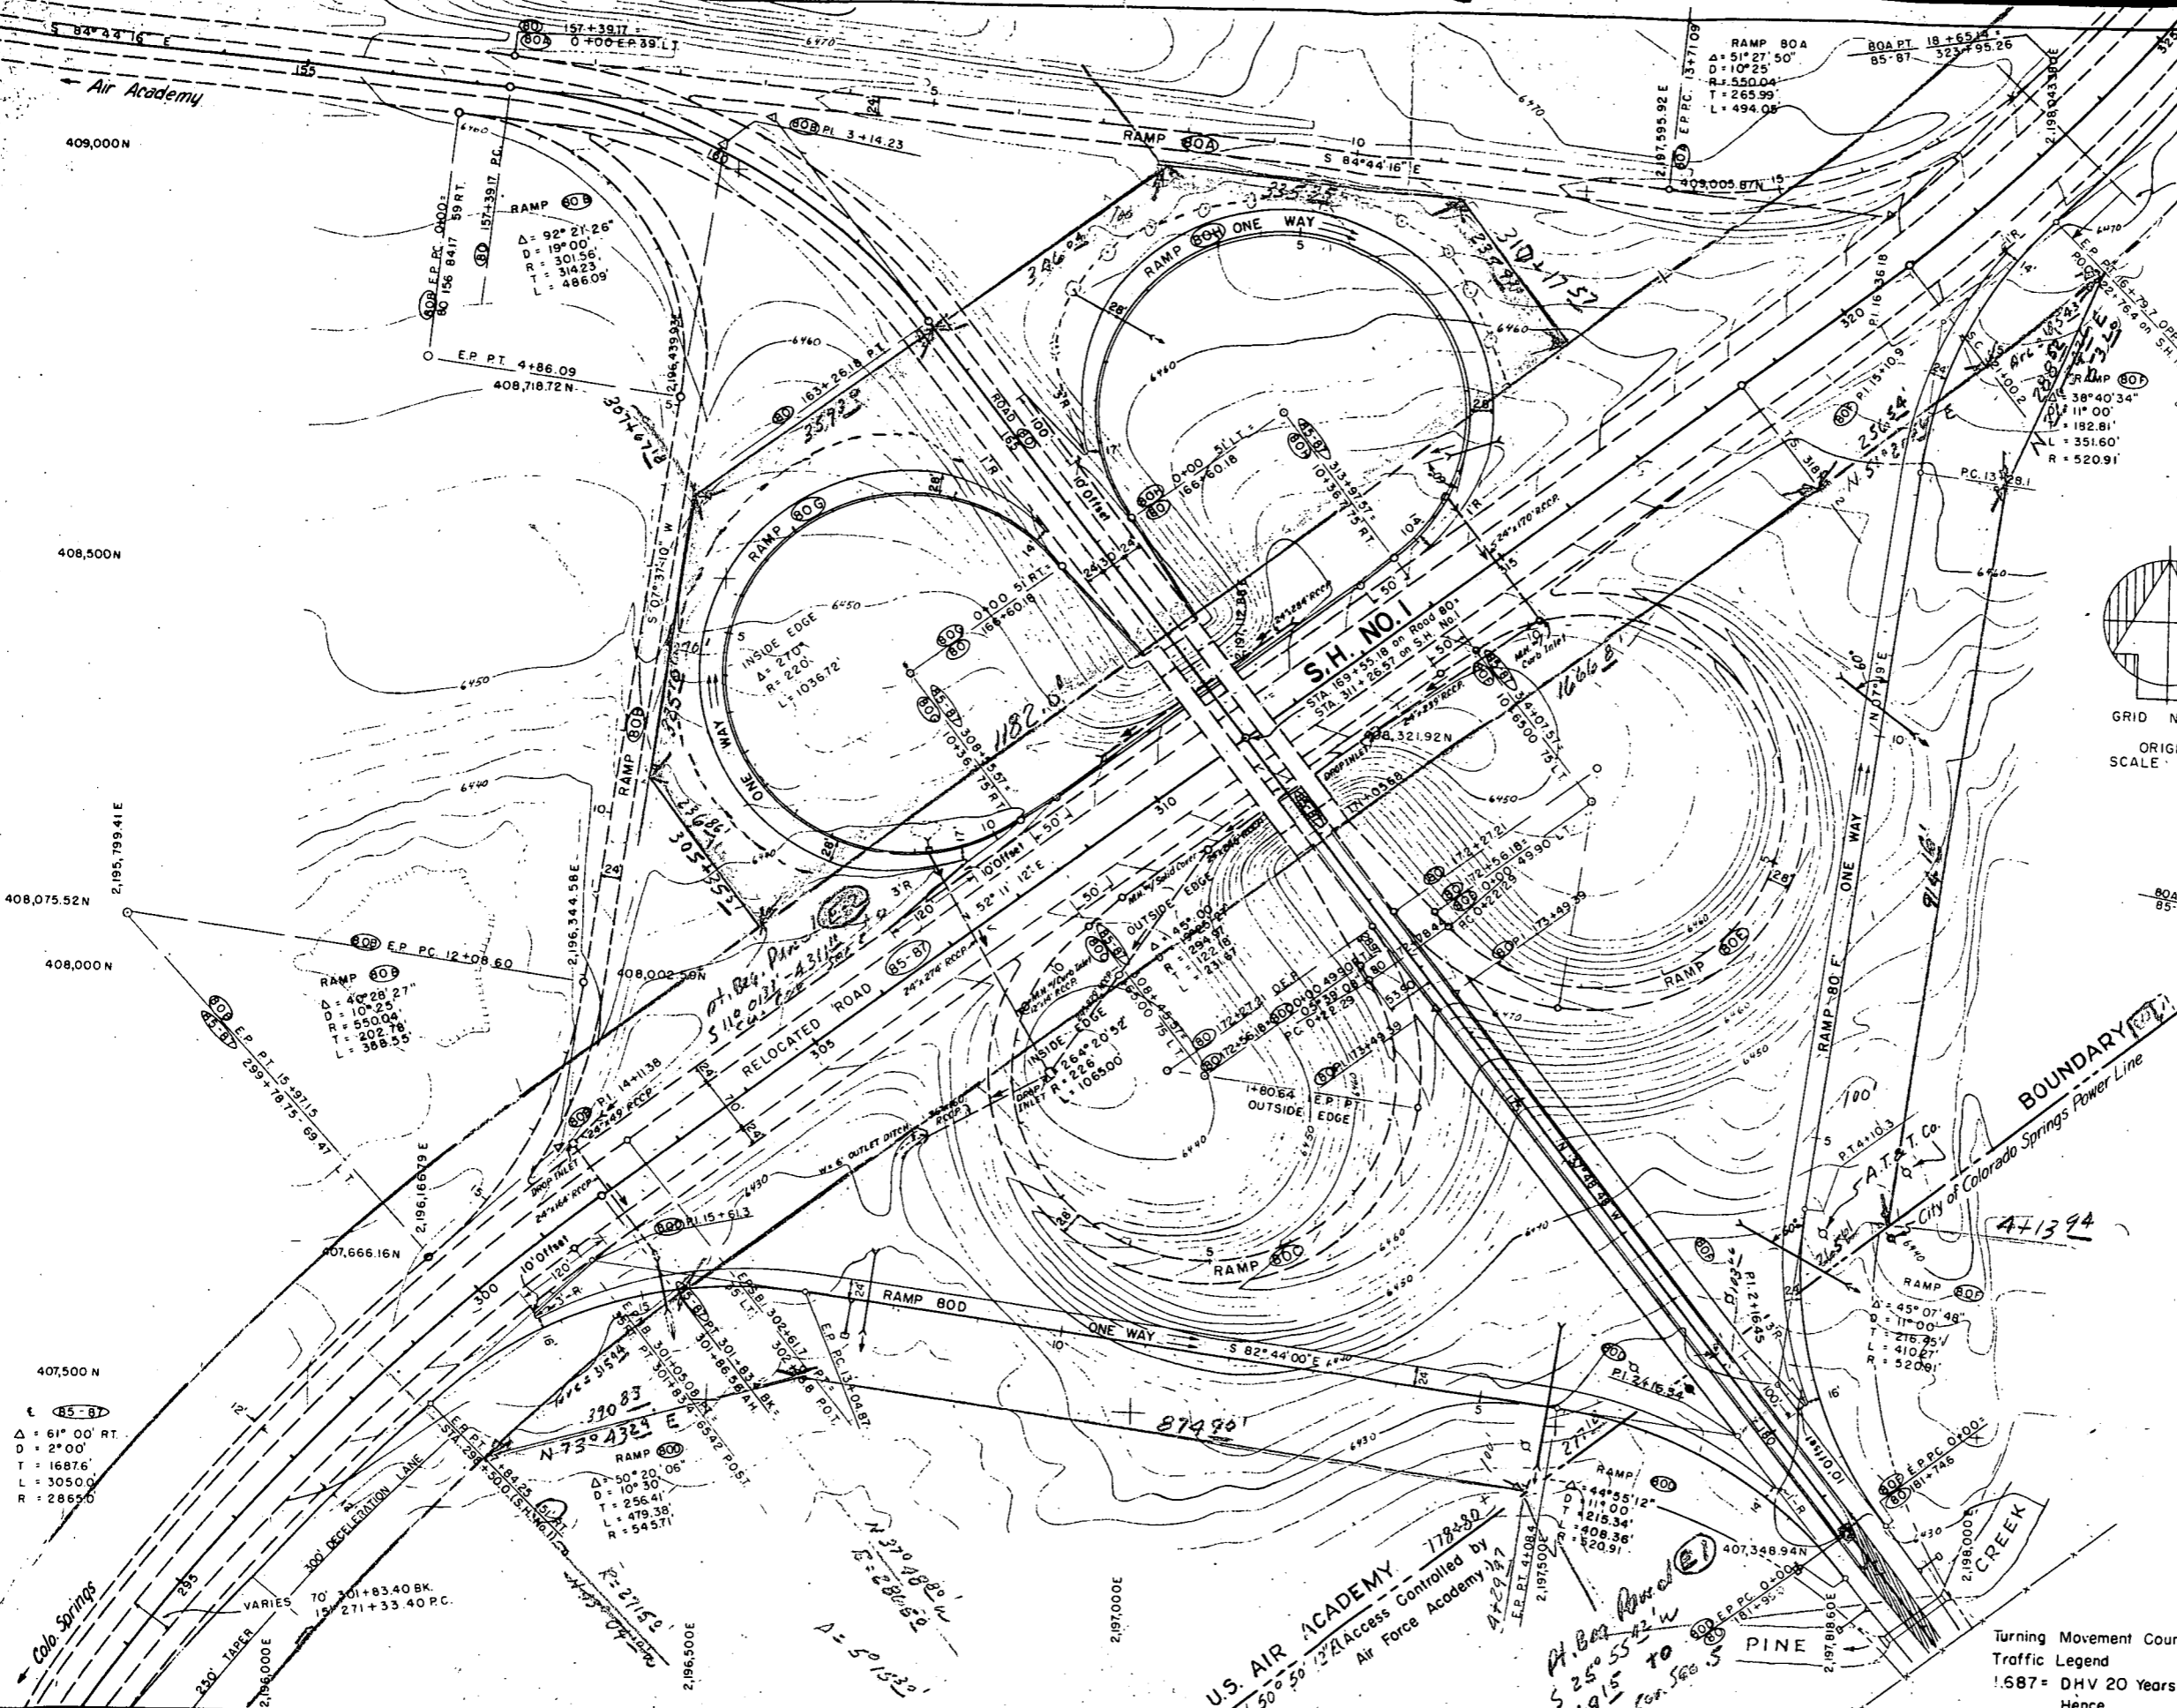

85-87  
 $\Delta = 61^\circ 00' RT.$   
 $D = 2^\circ 00'$   
 $T = 1687.6'$   
 $L = 3050.0'$   
 $R = 2865.0'$

**U.S. AIR ACADEMY**  
 Access Controlled by  
 Air Force Academy

Turning Movement Count  
 Traffic Legend  
 1.687 = DHV 20 Years  
 Hence

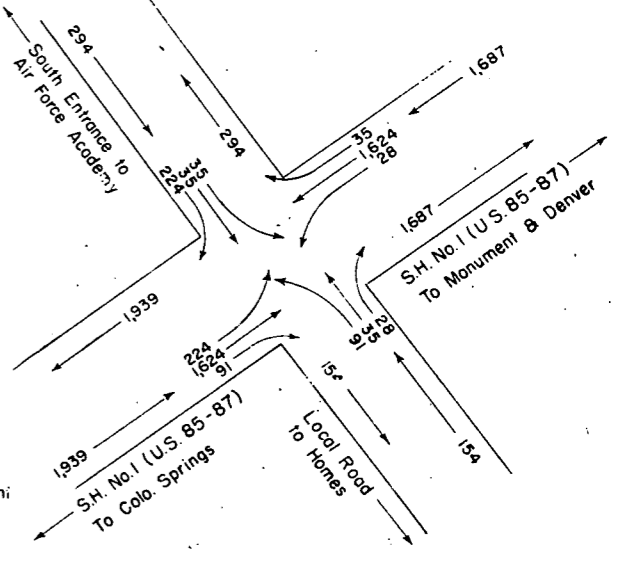


**NOTE:**  
Alignment and Grades as shown are subject to modification during construction after approval by the Denver Office.


# RAMP 80G & RAMP 80H

FED. ROAD REC. NO.	DIVISION	PROJ. NO.	SHEET NO.	TOTAL SHEETS
9	COLO.	1 25-2 (44) 150	23	

PLAN	DATE
SURVEYED	
PLOTTED	
ALIGNED	
CHECKED	
NO. 22069	

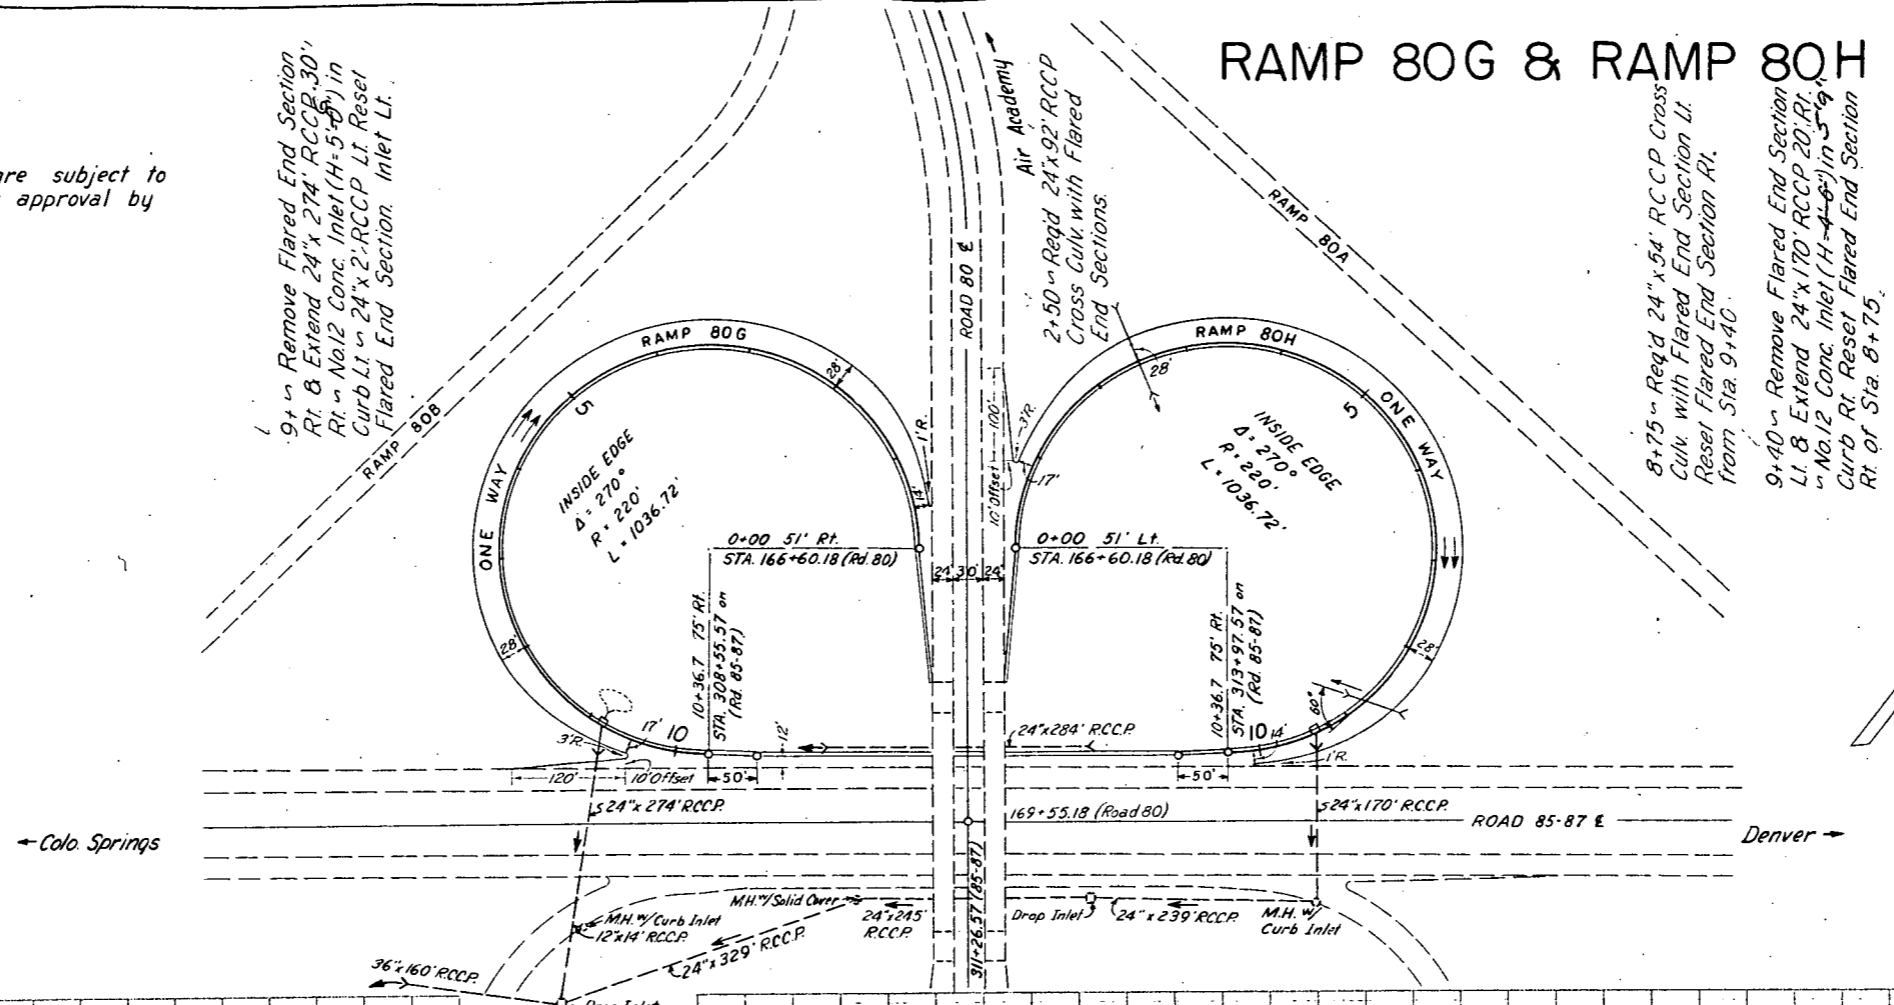


PROFILE	DATE
SURVEYED	
PLOTTED	
GRADE CHECKED	
STRUCTURE MATERIALS CHECKED	
NO. 22069	

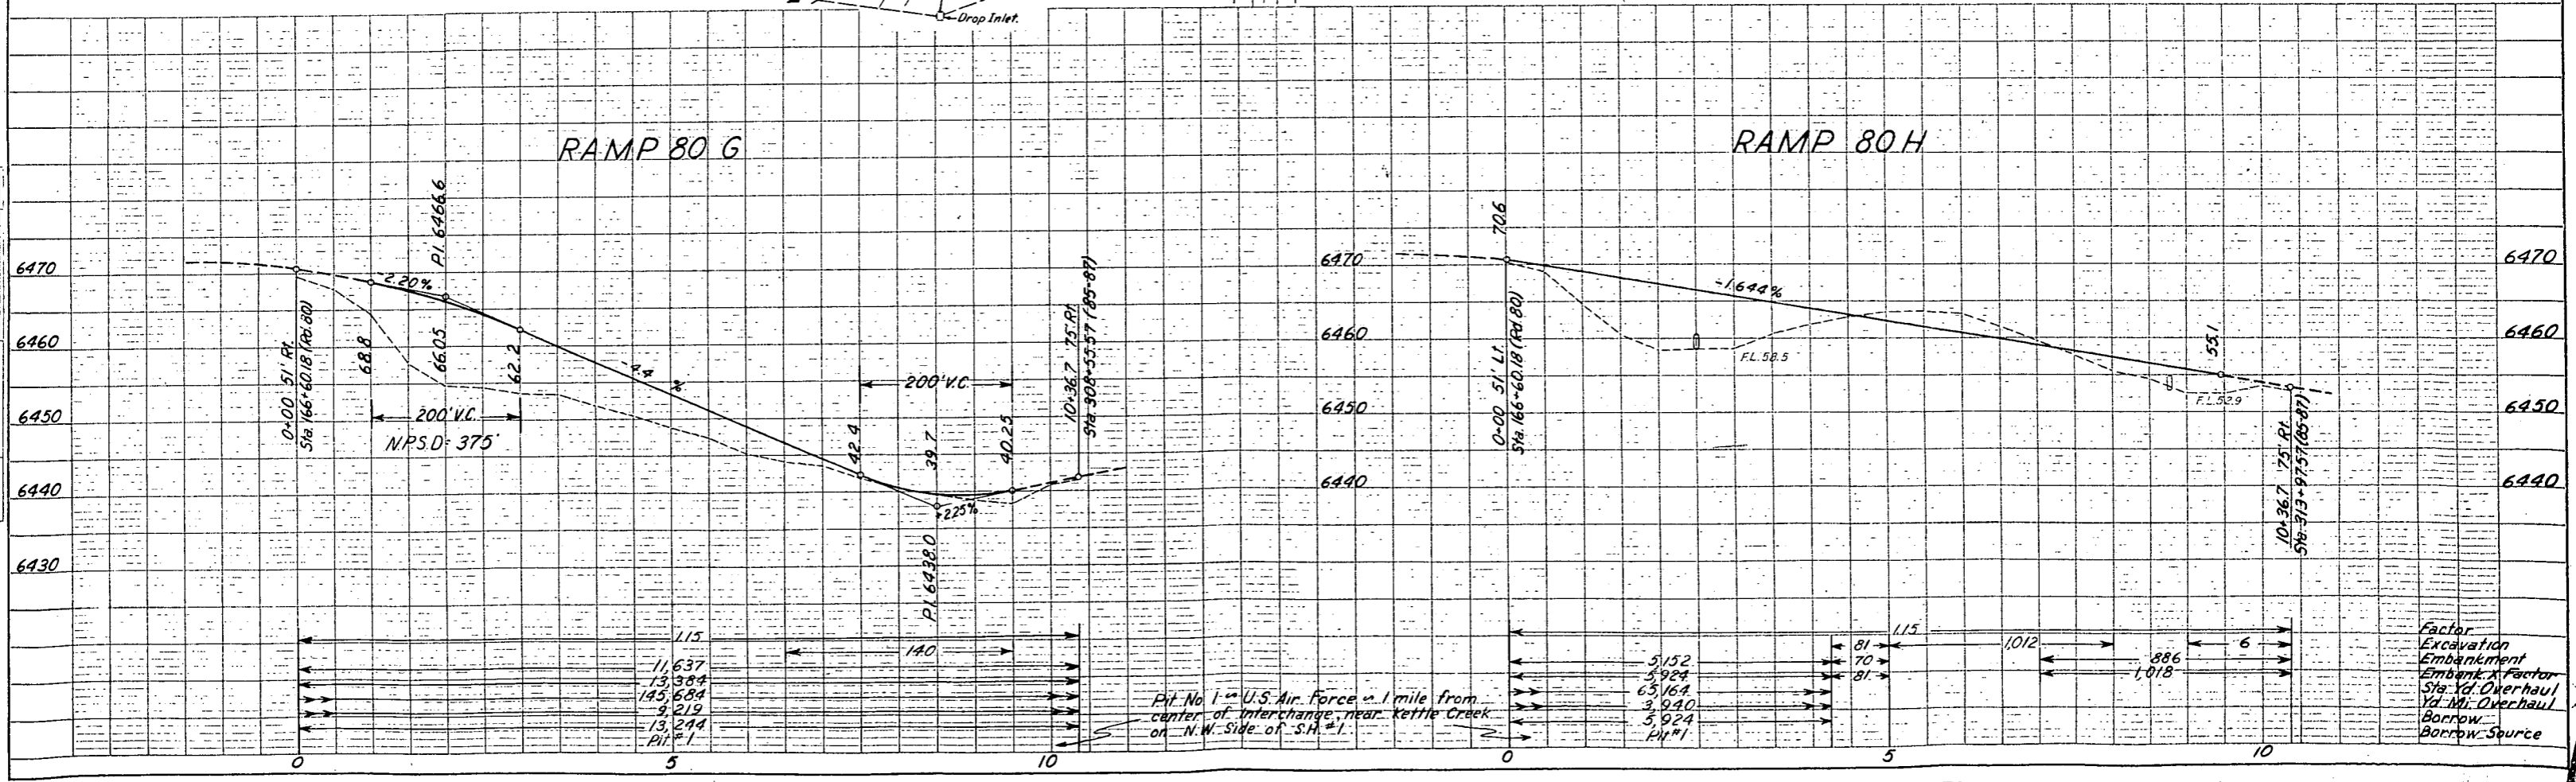


# RAMP 80D

FED. ROAD REC. NO.	DIVISION	PROJ. NO.	SHEET NO.	TOTAL SHEETS
9	COLO.	125-2(44)150	24	

PLAN	DATE
SURVEYED	
NOTE BOOK NO. 22069	
ALIGNED CHECKED	
RT. OF WAY CHECKED	

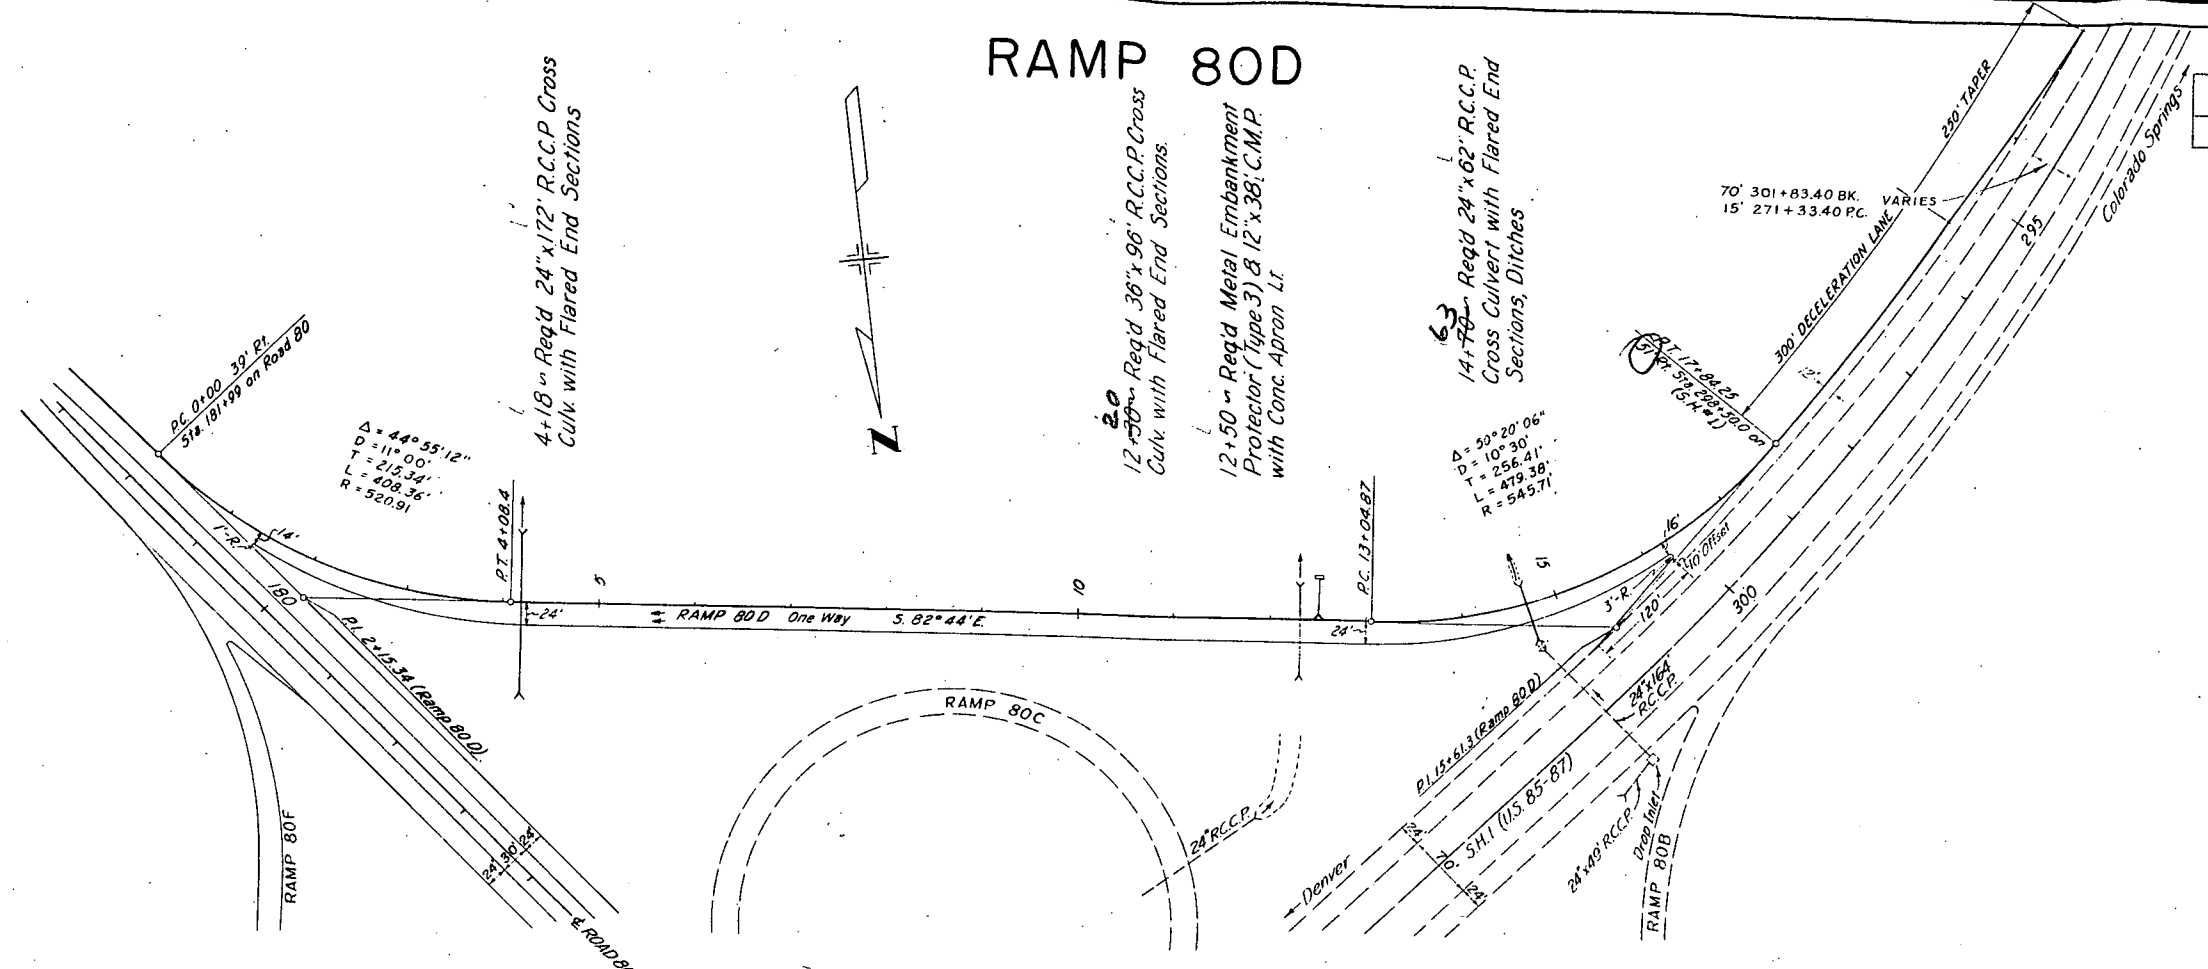

PROFILE	DATE
SURVEYED	
NOTE BOOK NO. 22069	
GRADES CHECKED	
B. M. NOTED	
STRUCTURE NOTATIONS CROD	

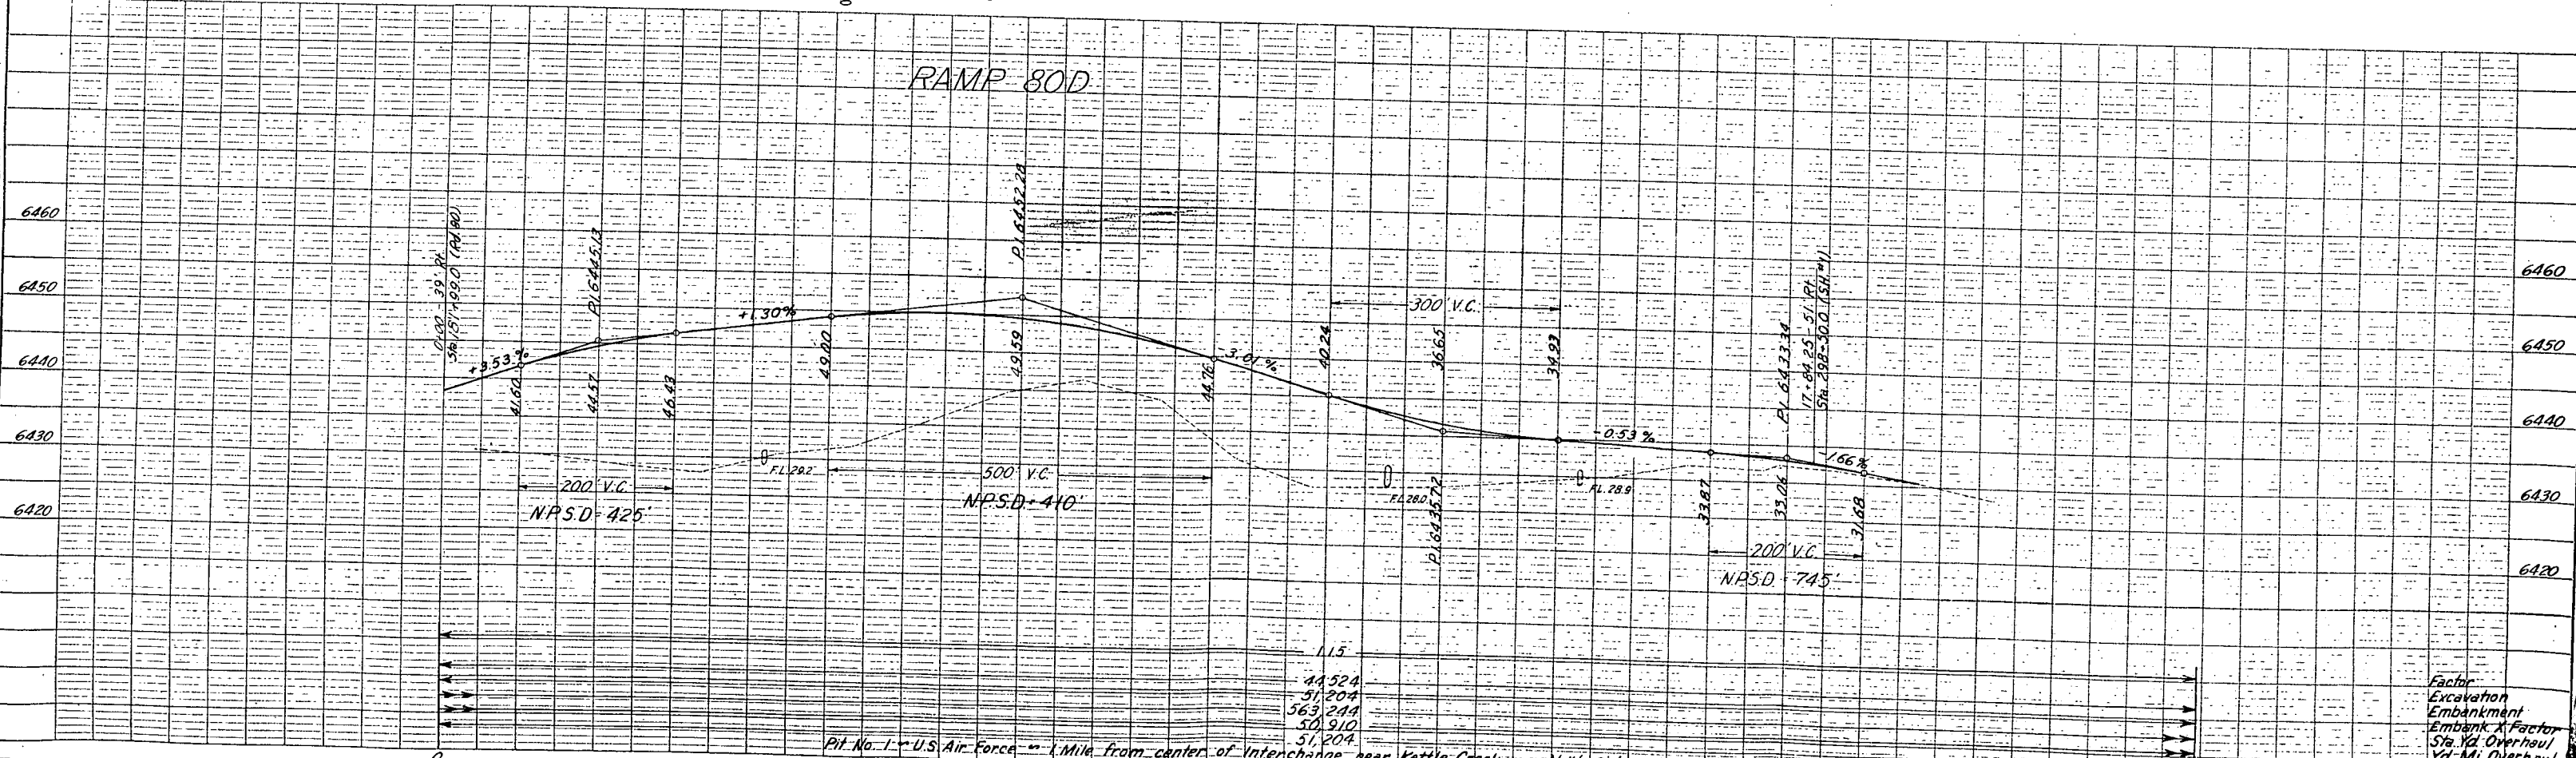


Pit No. 1 - U.S. Air Force - 1/4 Mile from center of Interchange near Kettle Creek


# RAMP 80F

FED. ROAD REG. NO.	DIVISION	PROJ. NO.	SHEET NO.	TOTAL SHEETS
9	COLO.	125-2(44)150	25	

PLAN	DATE
SUBMITTED	
PLOTTED	
ALIGNMENT CHECKED	
RT. OF WAY CHECKED	
NOTE BOOK NO. 22062	

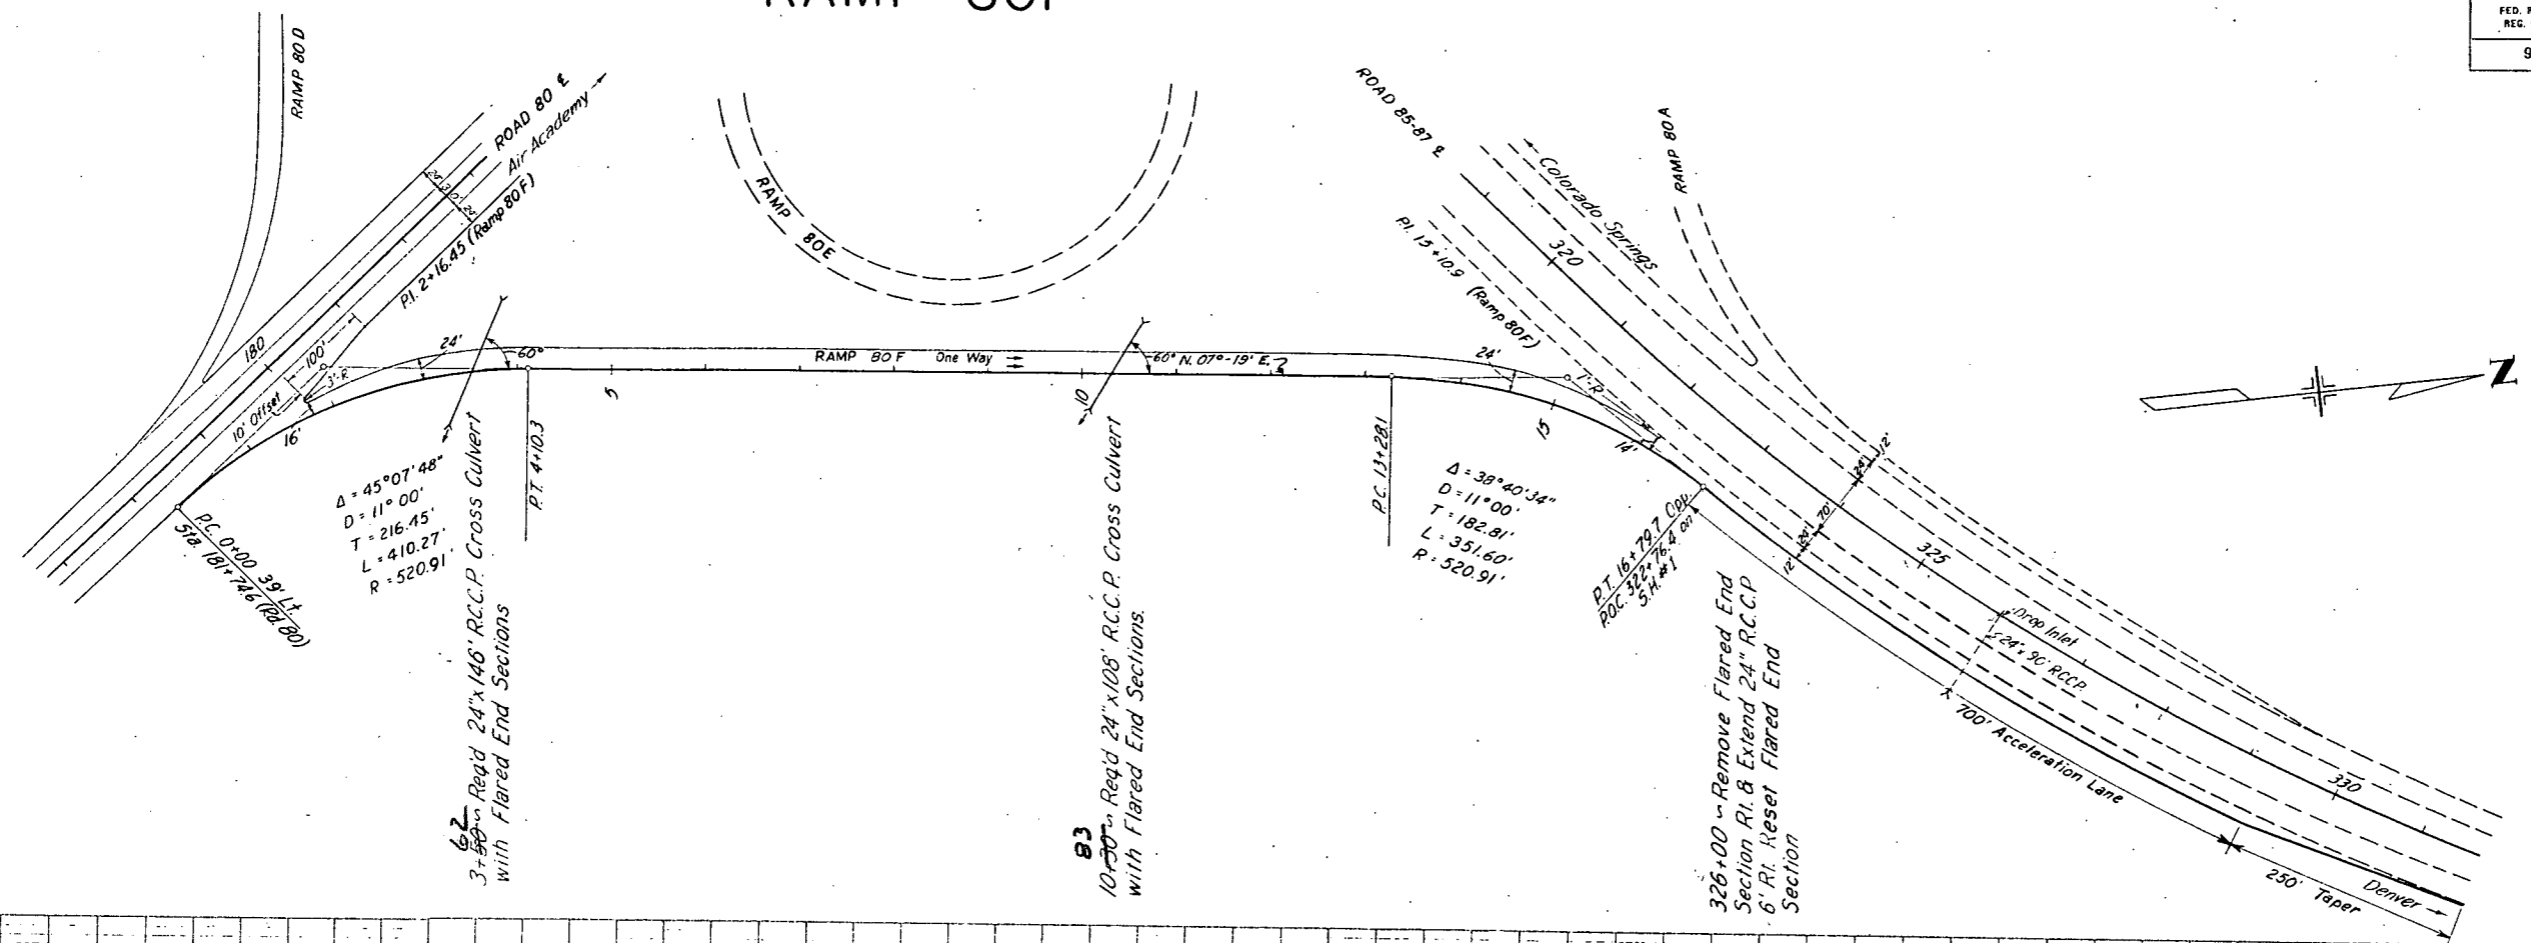

PROFILE	DATE
SUBMITTED	
GRADES CHECKED	
B.M.'S. NOTED	
STRUCTURE NOTATIONS CHECKED	
NOTE BOOK NO. 22062	

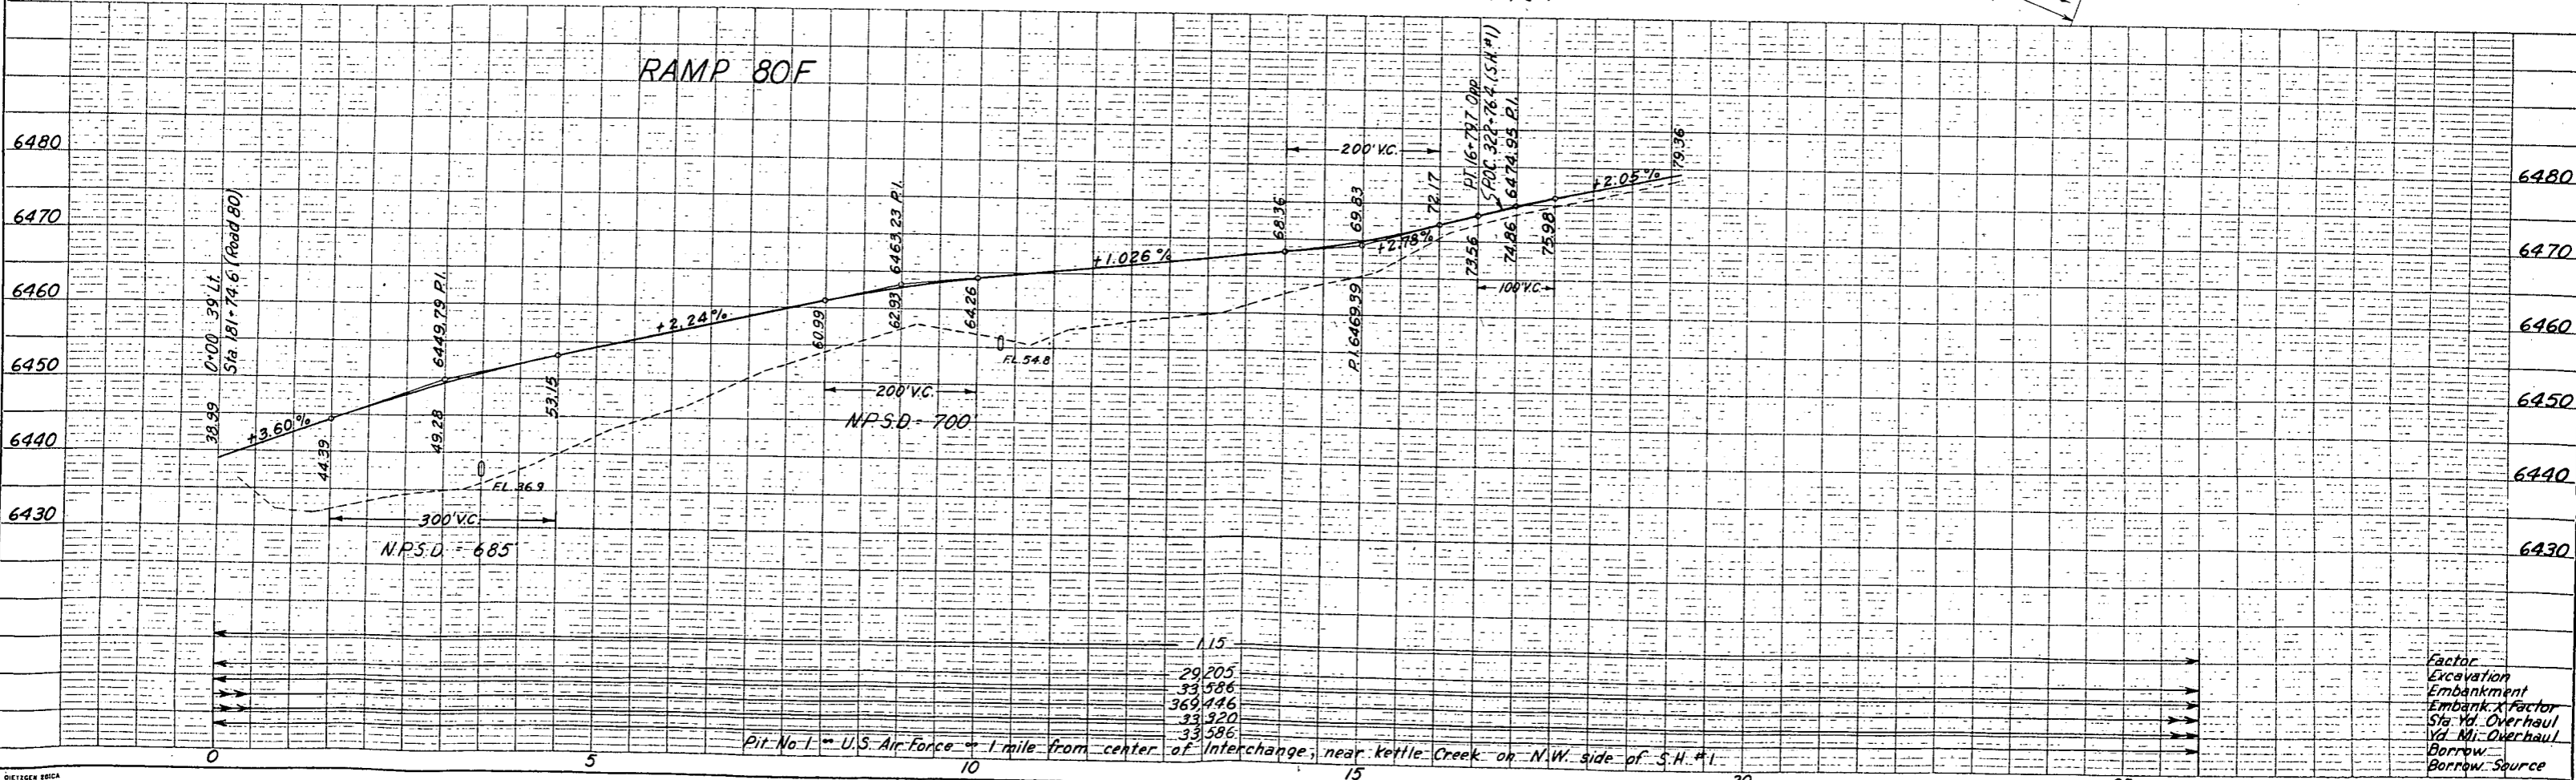



FED. ROAD REG. NO.	DIVISION	PROJ. NO.	SHEET NO.	TOTAL SHEETS
9	COLO.	I 25-2(44)150	26	

PLAN	DATE	BY
NO. 22069		

PROFILE	DATE	BY
NO. 22069		

