


CROSS SECTION LEGEND

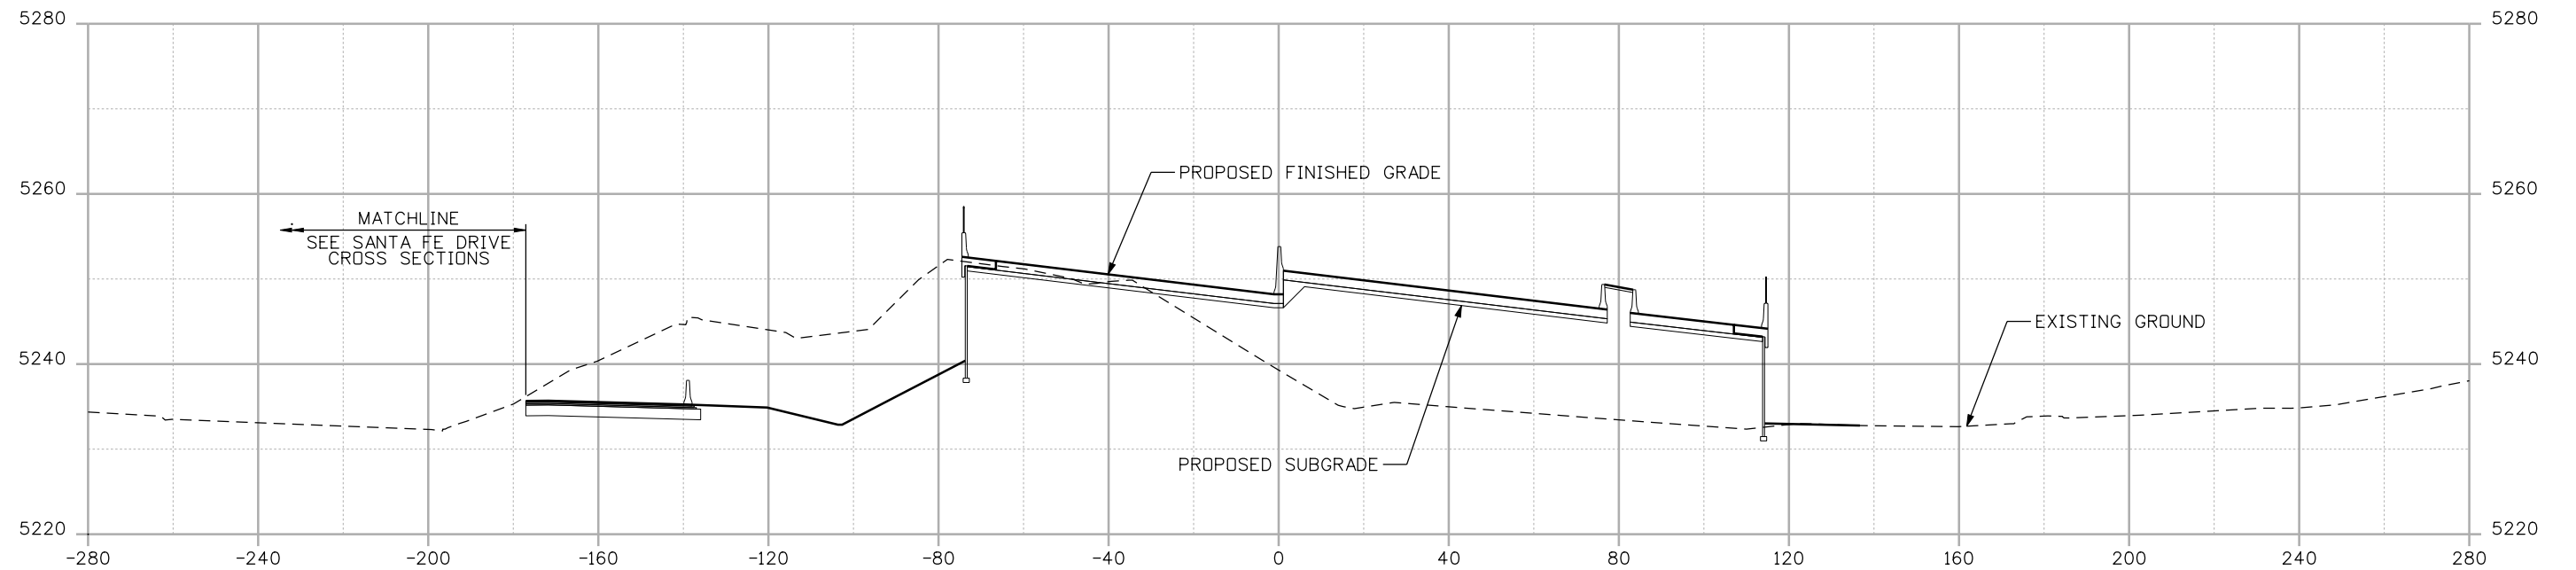


NOTES:

1. CROSS SECTIONS REFLECT EARTHWORK VOLUMES THAT ARE CALCULATED FROM THE PROPOSED SUBGRADE TO THE EXISTING GROUND WITHOUT ADJUSTMENT FOR EXISTING TOPSOIL STRIPPING AND STOCKPILE, EXISTING PAVEMENT REMOVAL, PROPOSED TOPSOIL, AND PROPOSED STRUCTURAL EXCAVATION AND BACKFILL QUANTITIES. REFER TO THE EARTHWORK TABULATION FOR QUANTITY ADJUSTMENTS.
2. ALL STRUCTURES ARE SHOWN FOR INFORMATION ONLY.

Print Date: 10/14/2010		Sheet Revisions	Colorado Department of Transportation	As Constructed	I-25/SANTA FE INTERCHANGE CROSS SECTION LEGEND	Project No./Code
File Name: 16311DES_PH2_AD_CrossSectionsLegend1.dgn		Date: Comments Init.	2000 South Holly Street Denver, CO 80222 Phone: 303-972-9112 FAX: 303-972-9114	No Revisions:	Designer: DCS Structure	BR 0252-407
Horiz. Scale: 1:40 Vert. Scale: 1:20	Unit Information Unit Leader Initials		Region 6	Revised:	Detailer: DCS Numbers	17783
6300 South Syracuse Way Centennial, CO 80111	(R-X) OOO		RLB	Void:	Sheet Subset: SECTIONS Subset Sheets: XS-1 of 104	Sheet Number 1

Dusty 10:43:13 AM K:\08276\16311\Phase 2\Design\Drawings\Cross_Sections\16311DES_PH2_AD_CrossSectionsLegend1.dgn

CROSS SECTION MAPKEY

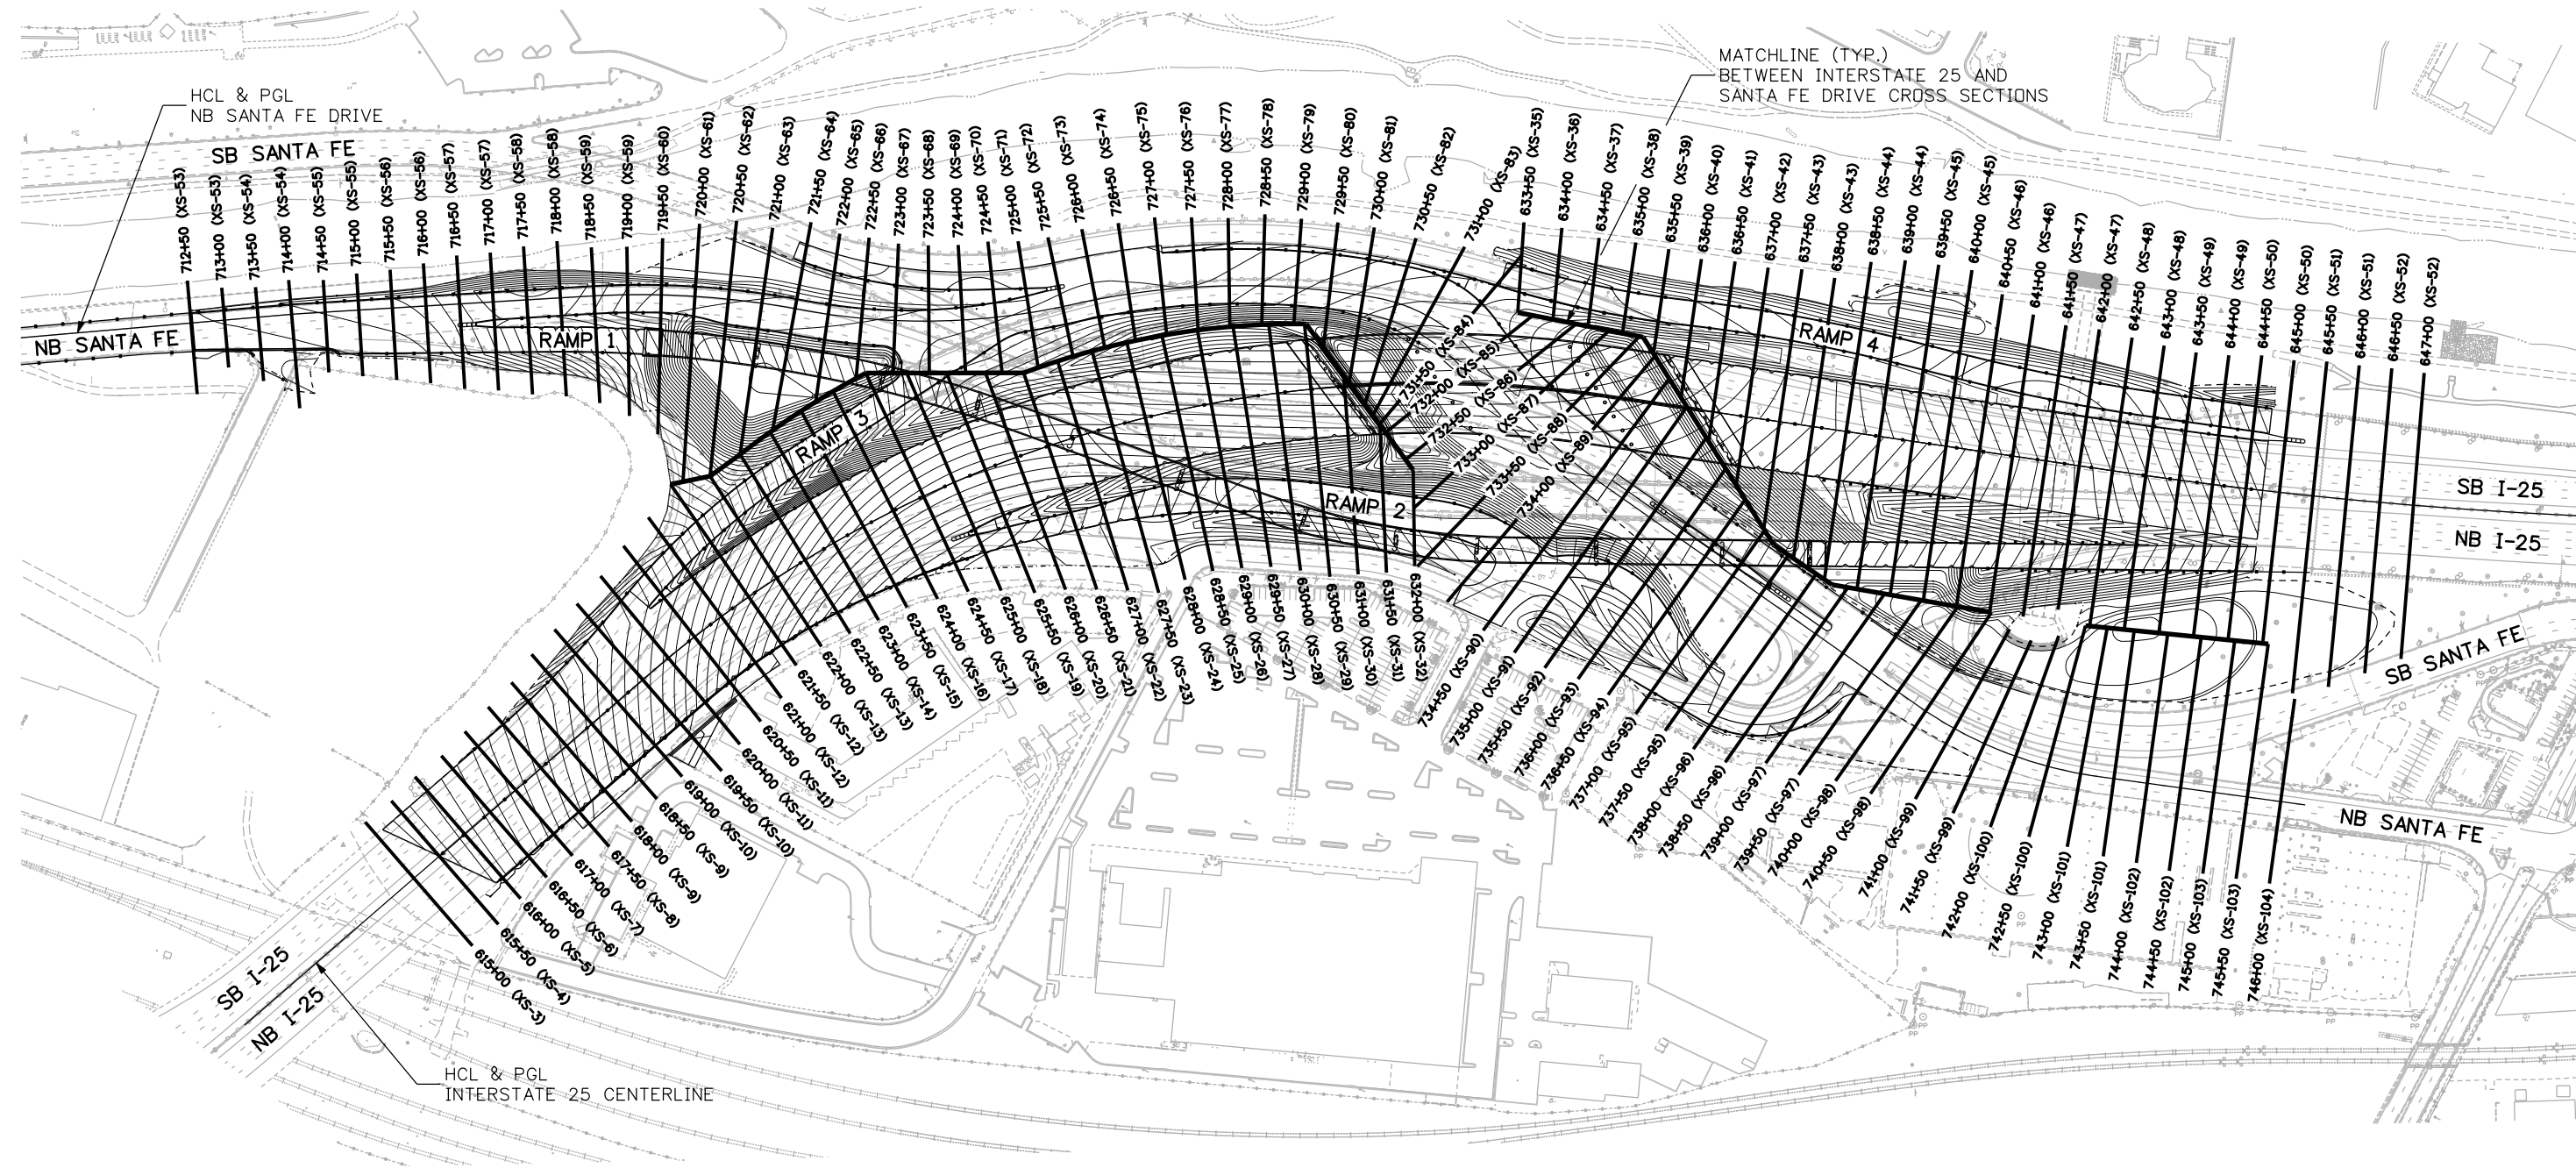

NOTES:

- ALL CROSS SECTIONS ARE CUT ALONG THE INTERSTATE 25 CENTERLINE HCL & PGL OR THE NB SANTA FE DRIVE HCL & PGL.

Print Date: 10/11/2010

File Name: 16311DES_PH2_CrossSectionsMapkey1.dgn

Horiz. Scale: 1:250

Vert. Scale: N/A

Unit Information

Unit Leader Initials



Sheet Revisions		
Date:	Comments	Init.

Colorado Department of Transportation



2000 South Holly Street
Denver, CO 80222
Phone: 303-972-9112 FAX: 303-972-9114

Region 6 RLB


As Constructed
No Revisions:
Revised:
Void:

**I-25/SANTA FE INTERCHANGE
CROSS SECTION MAPKEY**

Designer: DCS	Structure Numbers
Detailer: DCS	
Sheet Subset: SECTIONS	Subset Sheets: XS-2 of 104

Project No./Code
BR 0252-407
17783
Sheet Number 2

Dusty 9:04:47 AM K:\08276\16311\Phase 2\Design\Drawings\Cross_Sections\16311DES_PH2_CrossSections1.dgn

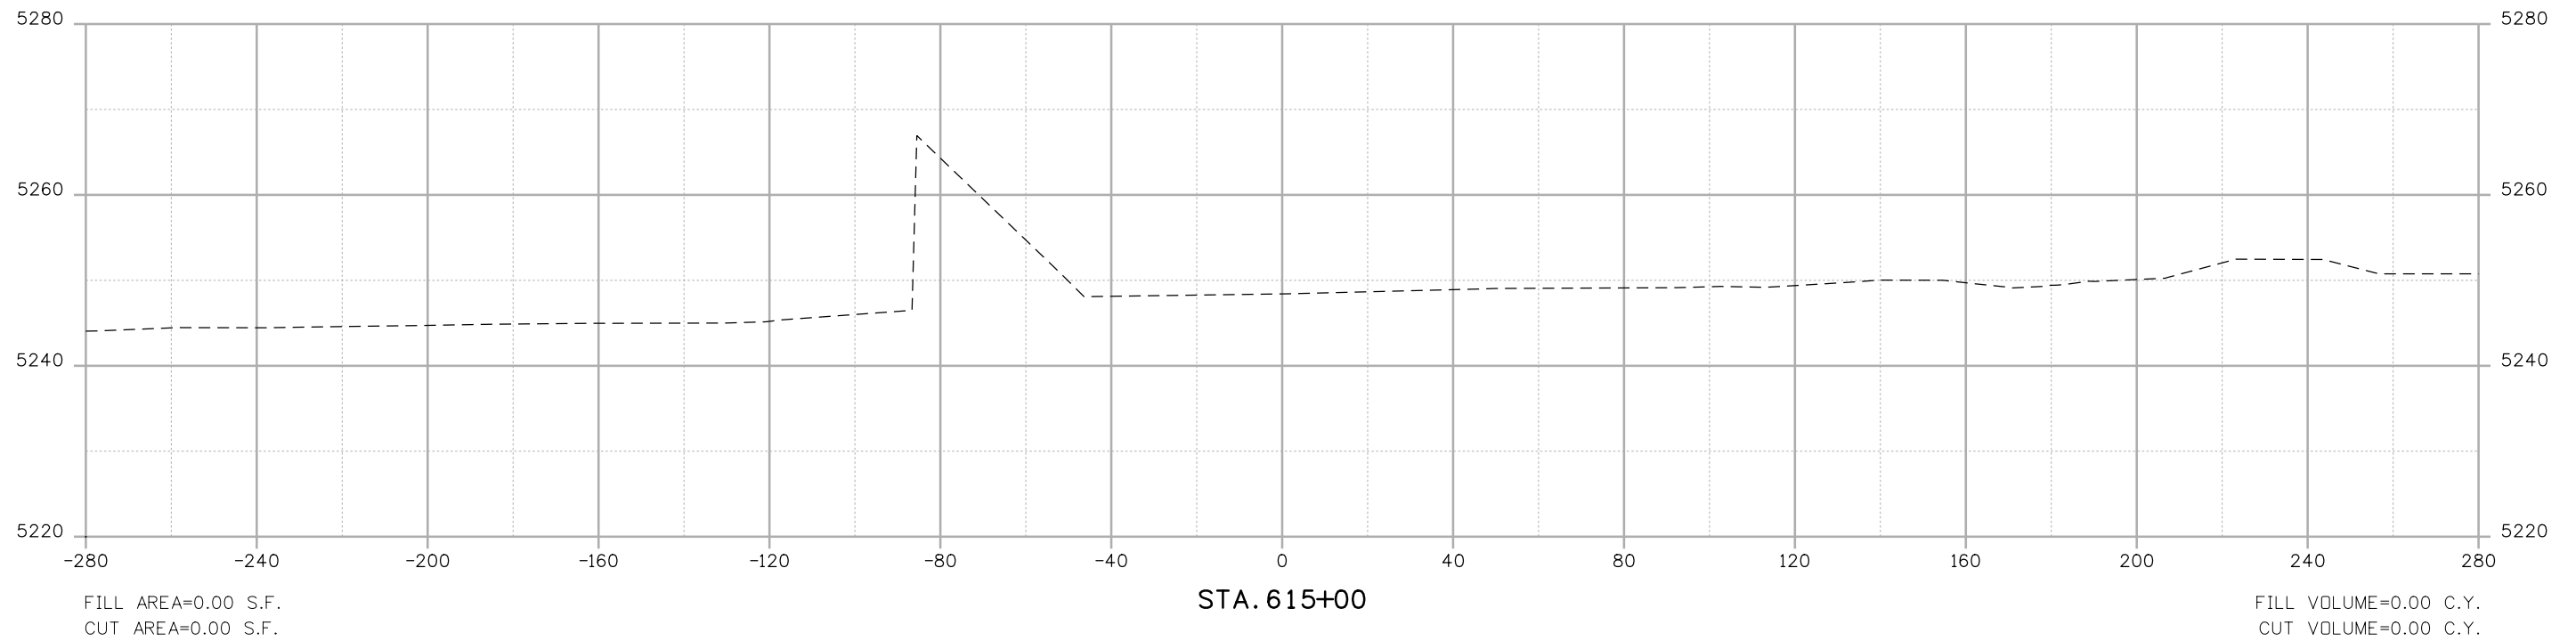

Print Date: 10/12/2010	
File Name: 16311DES_PH2_CrossSections1.dgn	
Horiz. Scale: 1:40	Vert. Scale: 1:20
Unit Information	Unit Leader Initials

Sheet Revisions		
Date:	Comments	Init.

Colorado Department of Transportation

2000 South Holly Street
 Denver, CO 80222
 Phone: 303-972-9112 FAX: 303-972-9114


Region 6 RLB


As Constructed
No Revisions:
Revised:
Void:

I-25/SANTA FE INTERCHANGE INTERSTATE 25 CROSS SECTIONS		
Designer: DCS	Structure Numbers	
Detailer: DCS		
Sheet Subset: SECTIONS	Subset Sheets: XS-3 of 104	

Project No./Code
BR 0252-407
17783
Sheet Number 3

Dusty 9:05:02 AM K:\08276\16311\Phase 2\Design\Drawings\Cross Sections\16311DES_PH2_CrossSections1.dgn

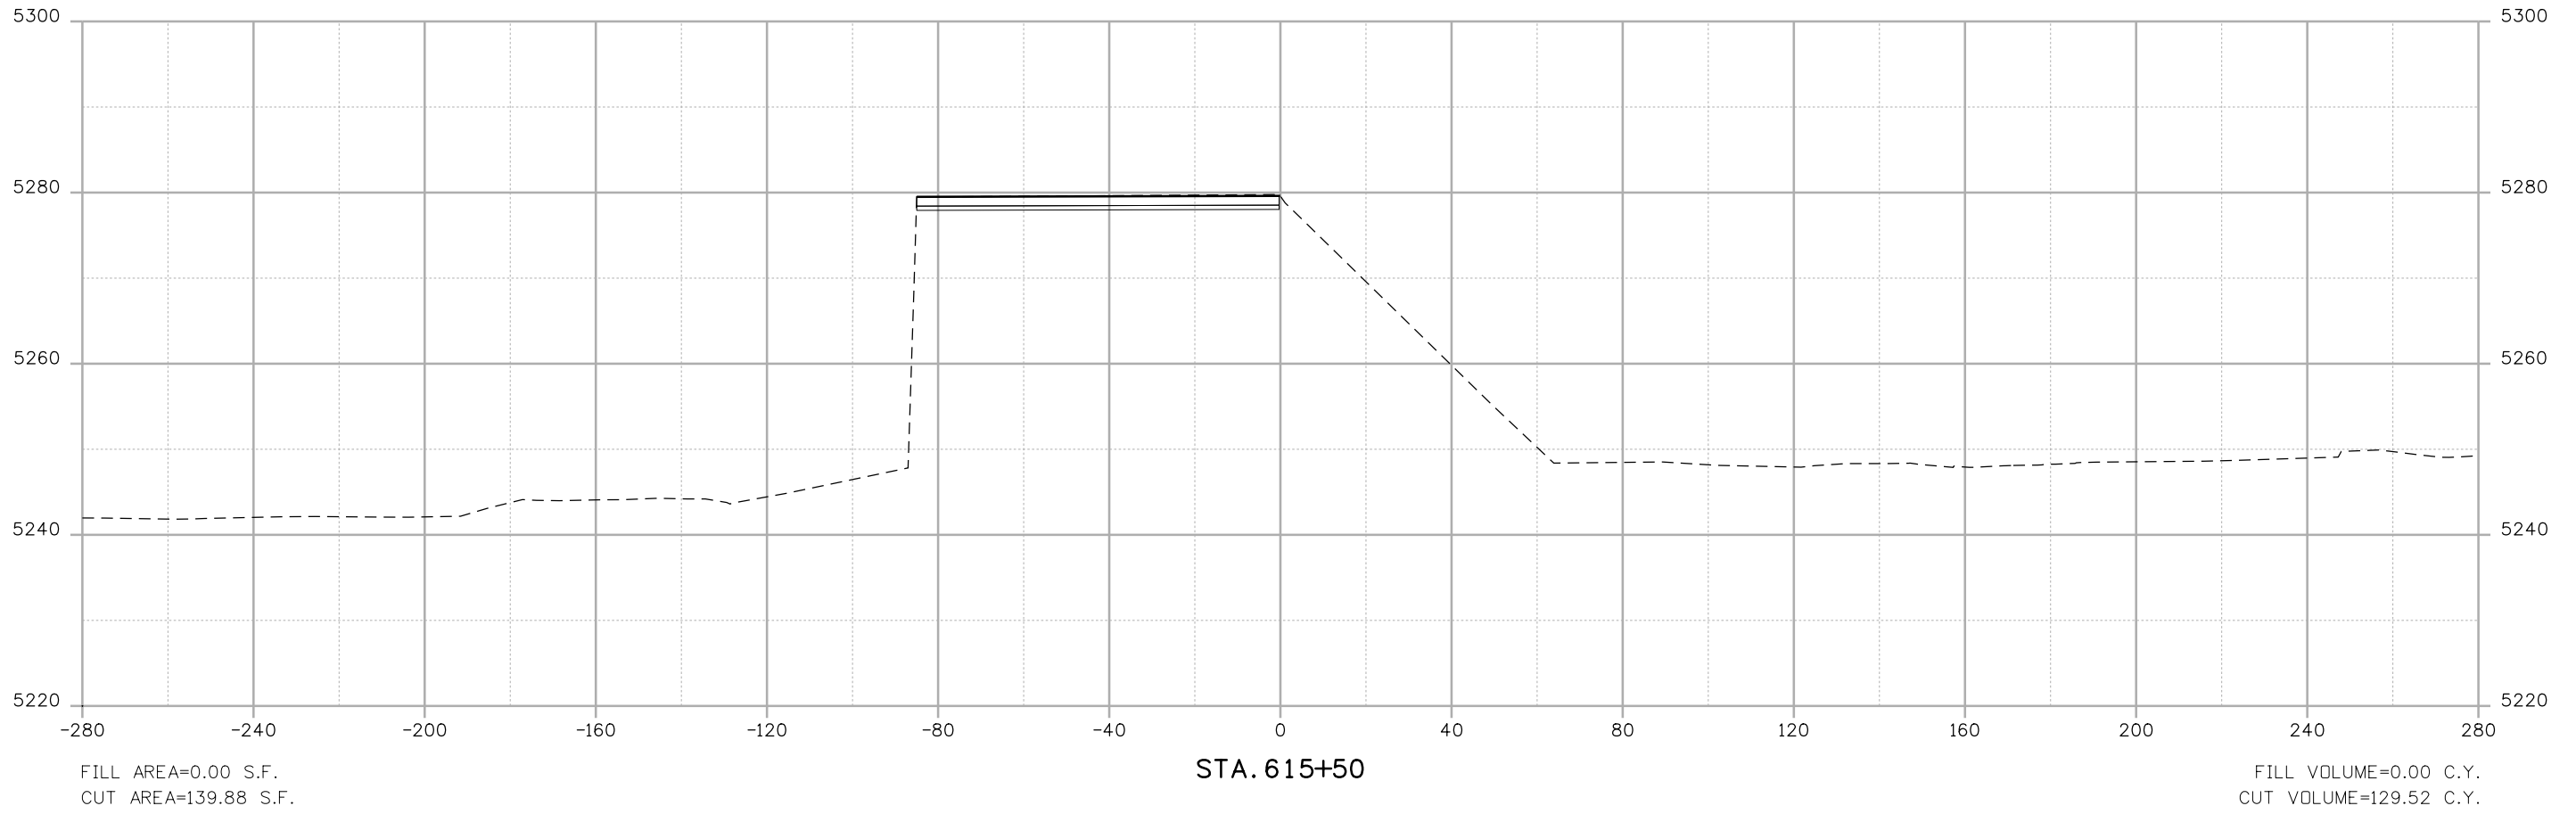

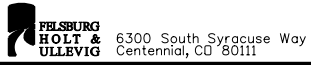Print Date: 10/12/2010	
File Name: 16311DES_PH2_CrossSections1.dgn	
Horiz. Scale: 1:40	Vert. Scale: 1:20
Unit Information	Unit Leader Initials
 6300 South Syracuse Way Centennial, CO 80111	

Sheet Revisions		
Date:	Comments	Init.

Colorado Department of Transportation



2000 South Holly Street
Denver, CO 80222
Phone: 303-972-9112 FAX: 303-972-9114


Region 6 **RLB**

As Constructed
No Revisions:
Revised:
Void:

I-25/SANTA FE INTERCHANGE INTERSTATE 25 CROSS SECTIONS		
Designer: DCS	Structure Numbers	
Detailer: DCS		
Sheet Subset: SECTIONS	Subset Sheets: XS-4 of 104	

Project No./Code
BR 0252-407
17783
Sheet Number 4

Dusty 9:05:13 AM K:\08276\16311\Phase 2\Design\Drawings\Cross_Sections\16311DES_PH2_CrossSections1.dgn

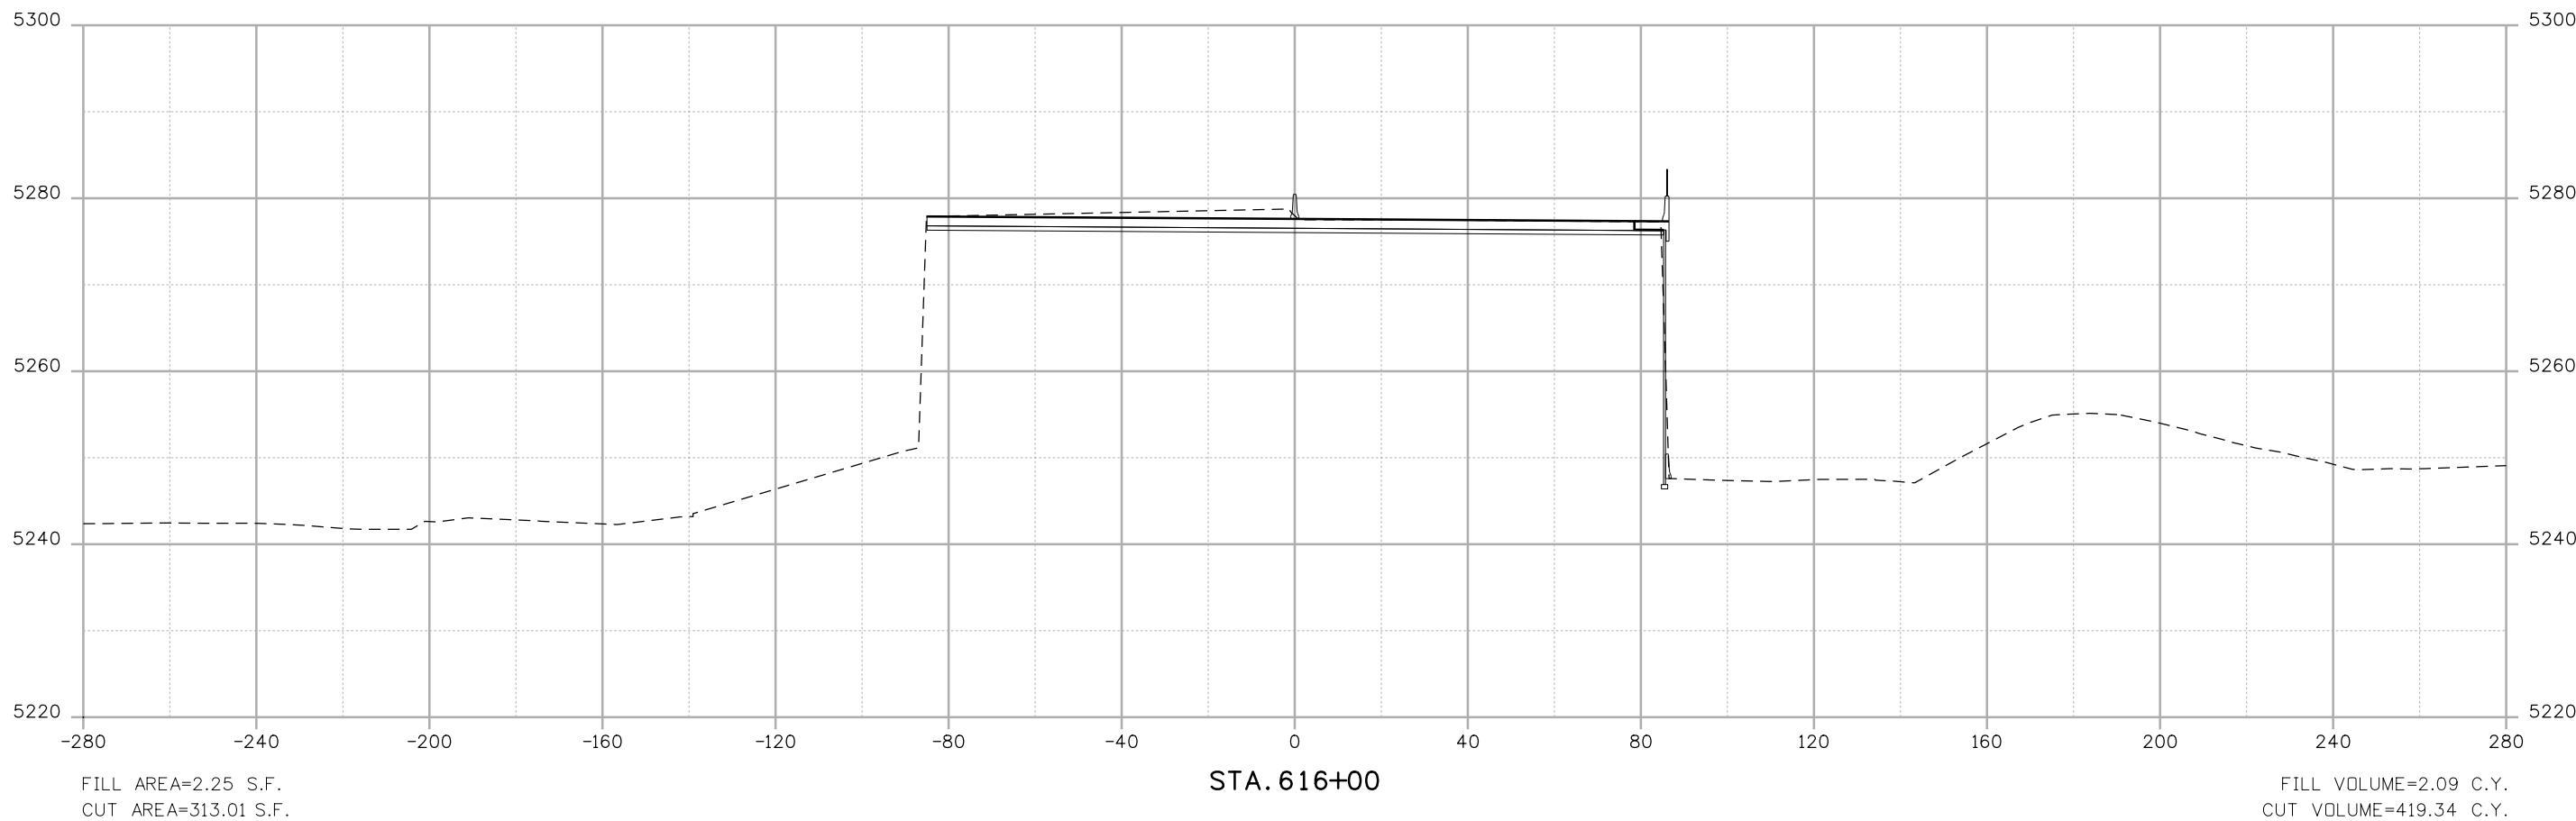

Print Date: 10/12/2010	
File Name: 16311DES_PH2_CrossSections1.dgn	
Horiz. Scale: 1:40	Vert. Scale: 1:20
Unit Information	Unit Leader Initials
6300 South Syracuse Way Centennial, CO 80111	

Sheet Revisions		
Date:	Comments	Init.

Colorado Department of Transportation

2000 South Holly Street
 Denver, CO 80222
 Phone: 303-972-9112 FAX: 303-972-9114


Region 6 **RLB**

As Constructed
No Revisions:
Revised:
Void:

I-25/SANTA FE INTERCHANGE INTERSTATE 25 CROSS SECTIONS		
Designer: DCS	Structure Numbers	
Detailer: DCS		
Sheet Subset: SECTIONS	Subset Sheets: XS-5 of 104	

Project No./Code
BR 0252-407
17783
Sheet Number 5

Dusty 9:05:27 AM K:\08276\16311\Phase 2\Design\Drawings\Cross Sections\16311DES_PH2_CrossSections1.dgn

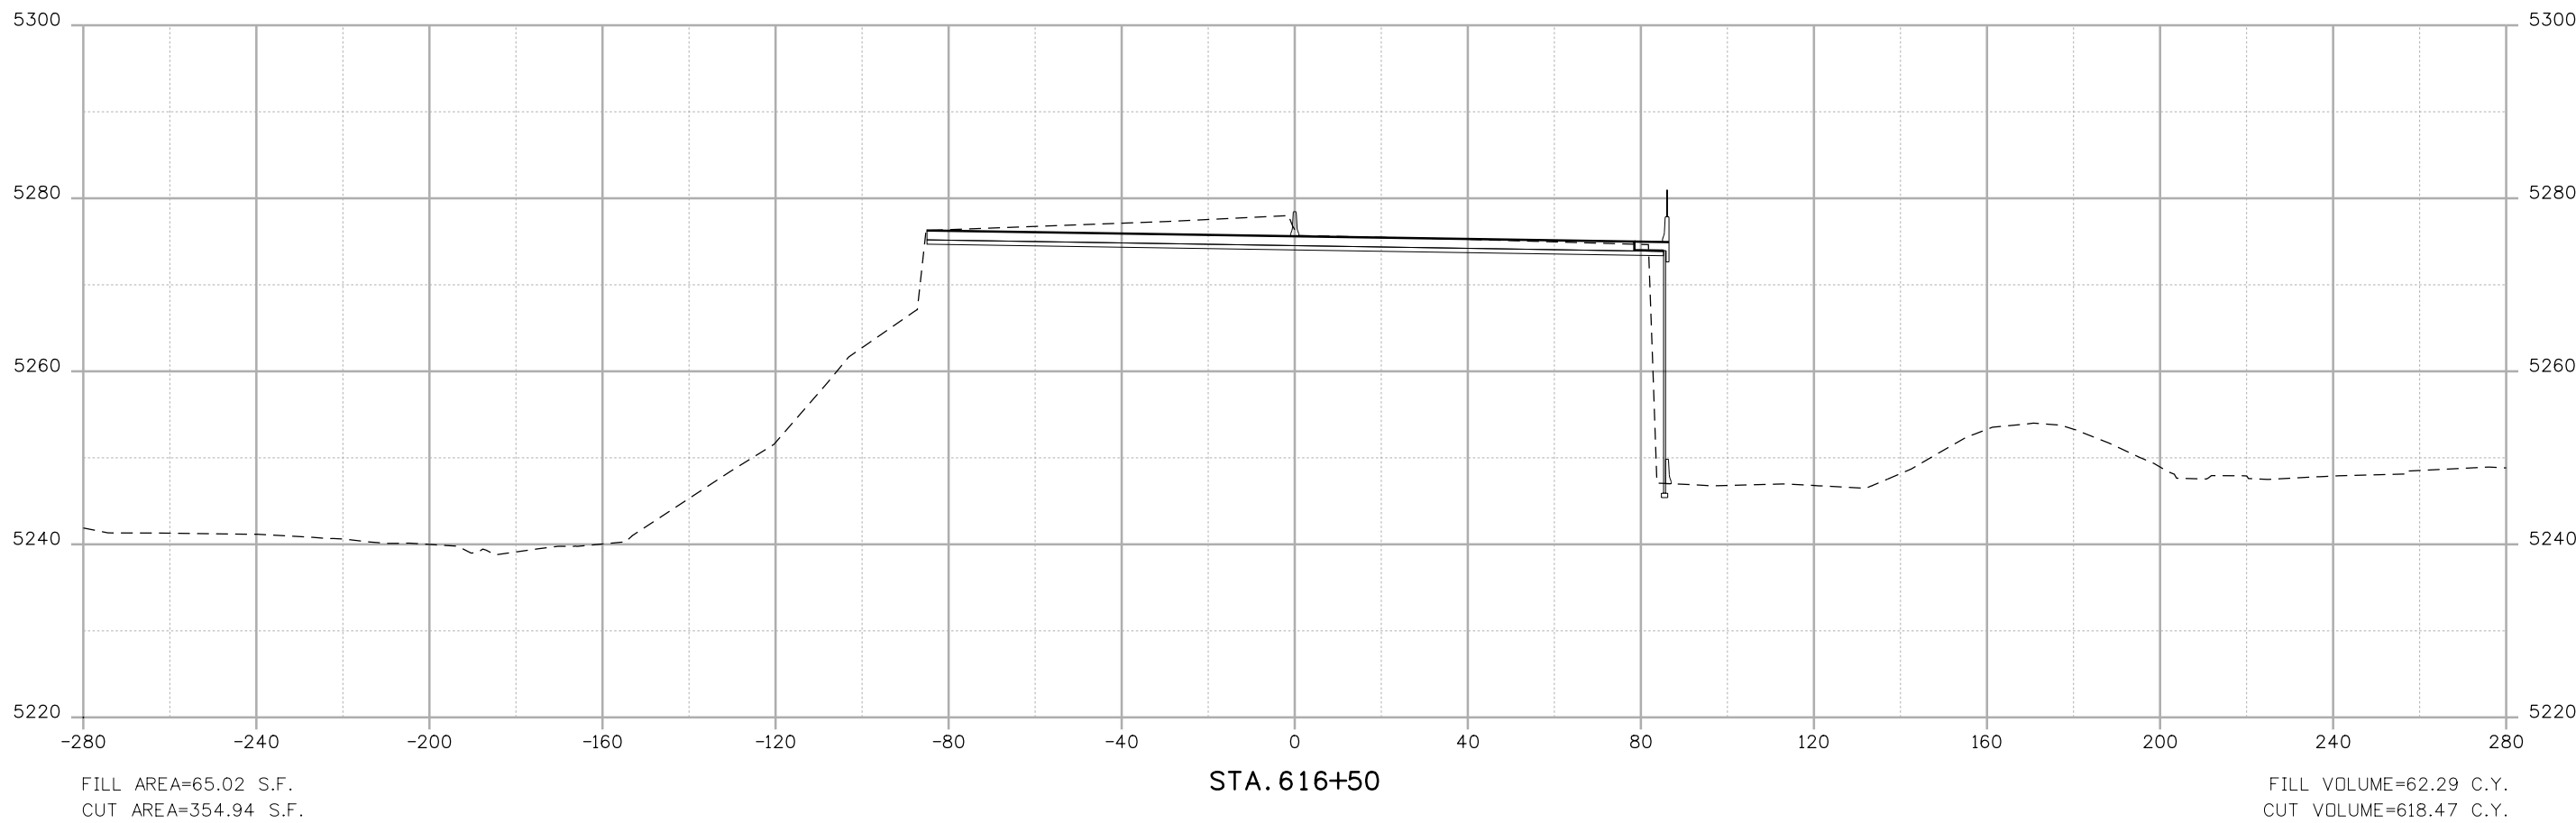

Print Date: 10/12/2010	
File Name: 16311DES_PH2_CrossSections1.dgn	
Horiz. Scale: 1:40	Vert. Scale: 1:20
Unit Information	Unit Leader Initials

Sheet Revisions		
Date:	Comments	Init.

Colorado Department of Transportation

2000 South Holly Street
 Denver, CO 80222
 Phone: 303-972-9112 FAX: 303-972-9114


Region 6 RLB

As Constructed
No Revisions:
Revised:
Void:

I-25/SANTA FE INTERCHANGE INTERSTATE 25 CROSS SECTIONS		
Designer: DCS	Structure Numbers	
Detailer: DCS		
Sheet Subset: SECTIONS	Subset Sheets: XS-6 of 104	

Project No./Code
BR 0252-407
17783
Sheet Number 6

Dusty 9:05:39 AM K:\08276\16311\Phase 2\Design\Drawings\Cross-Sections\16311DES_PH2_CrossSections1.dgn

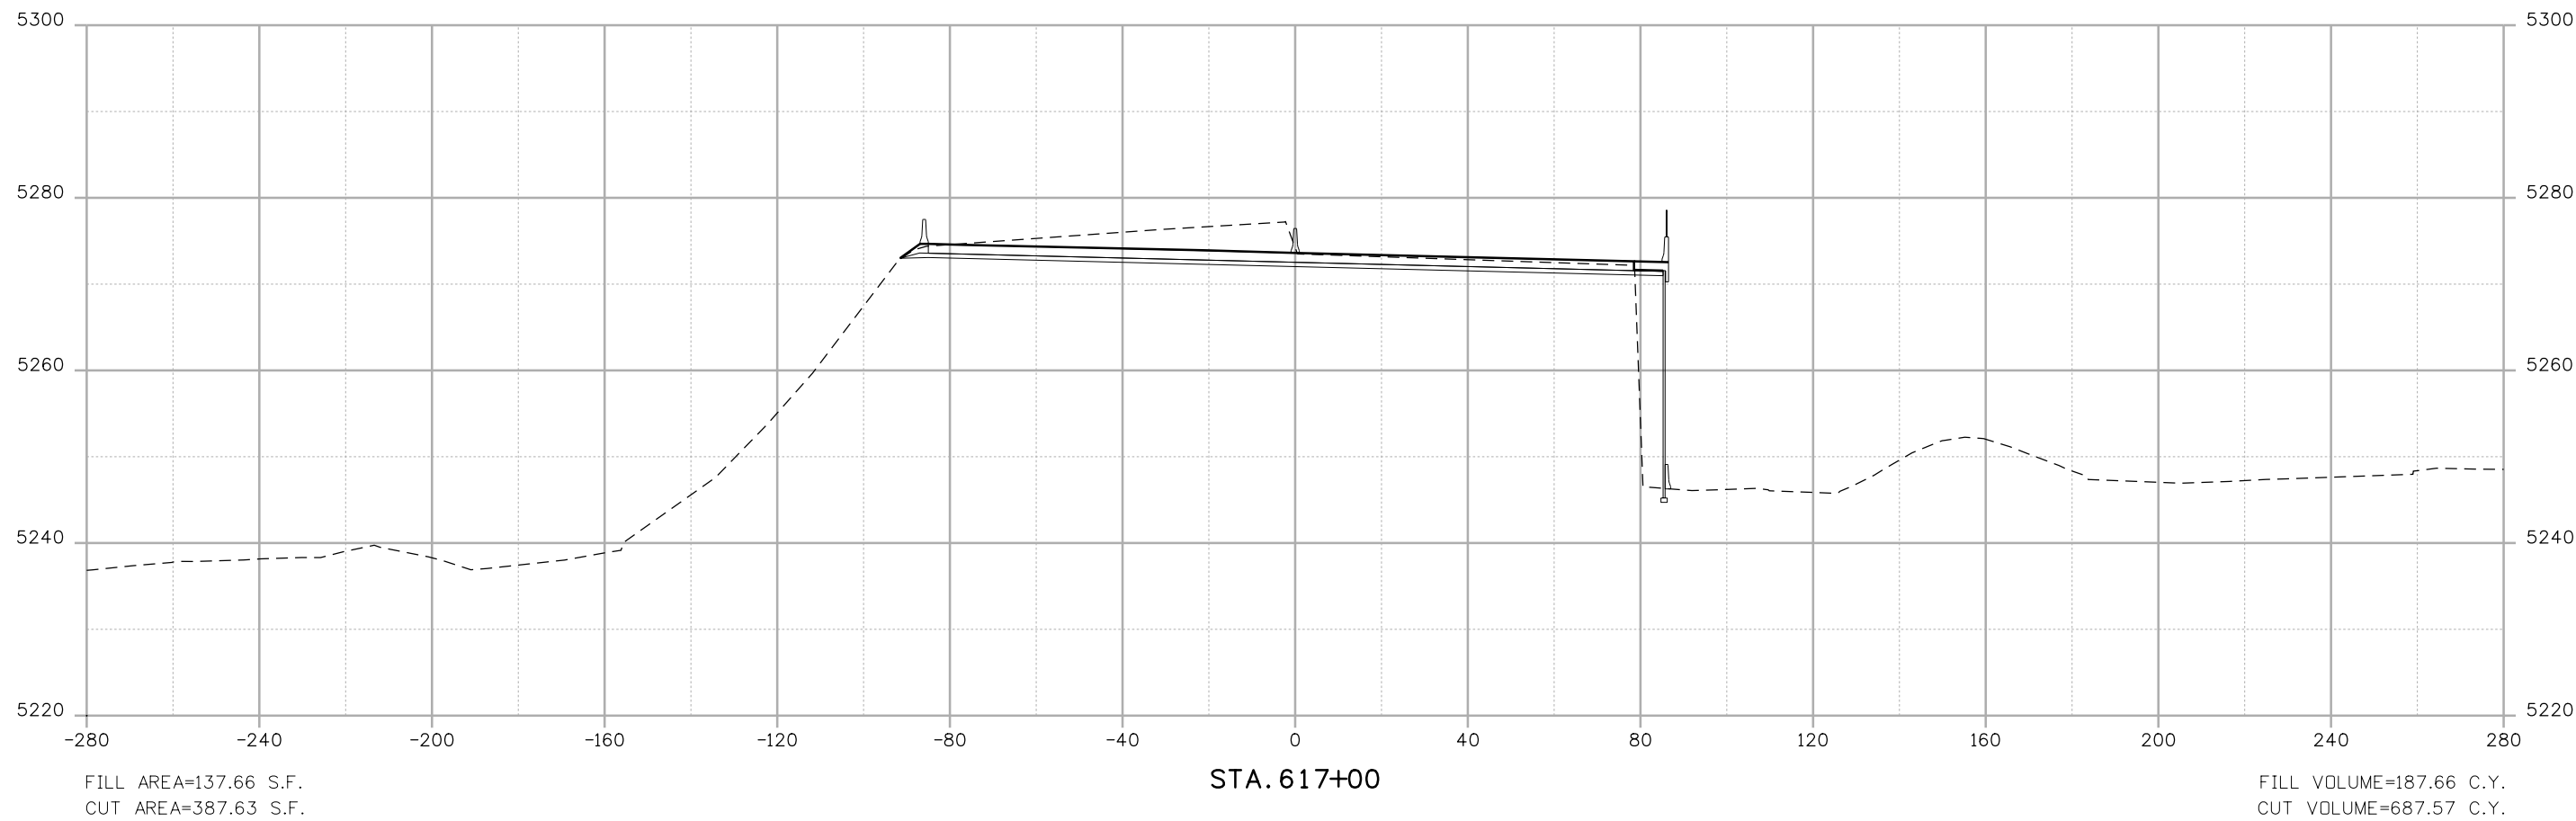

Print Date: 10/12/2010
 File Name: 16311DES_PH2_CrossSections1.dgn
 Horiz. Scale: 1:40 Vert. Scale: 1:20
 Unit Information Unit Leader Initials

Sheet Revisions		
Date:	Comments	Init.

Colorado Department of Transportation
 2000 South Holly Street
 Denver, CO 80222
 Phone: 303-972-9112 FAX: 303-972-9114


Region 6 **RLB**

As Constructed
 No Revisions:
 Revised:
 Void:


**I-25/SANTA FE INTERCHANGE
 INTERSTATE 25
 CROSS SECTIONS**

Designer: DCS Structure Numbers
 Detailer: DCS
 Sheet Subset: SECTIONS Subset Sheets: XS-7 of 104

Project No./Code
 BR 0252-407
 17783
 Sheet Number **7**

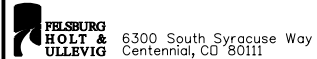

Dusty 9:05:52 AM K:\08276\16311\Phase 2\Design\Drawings\Cross_Sections\16311DES_PH2_CrossSections1.dgn

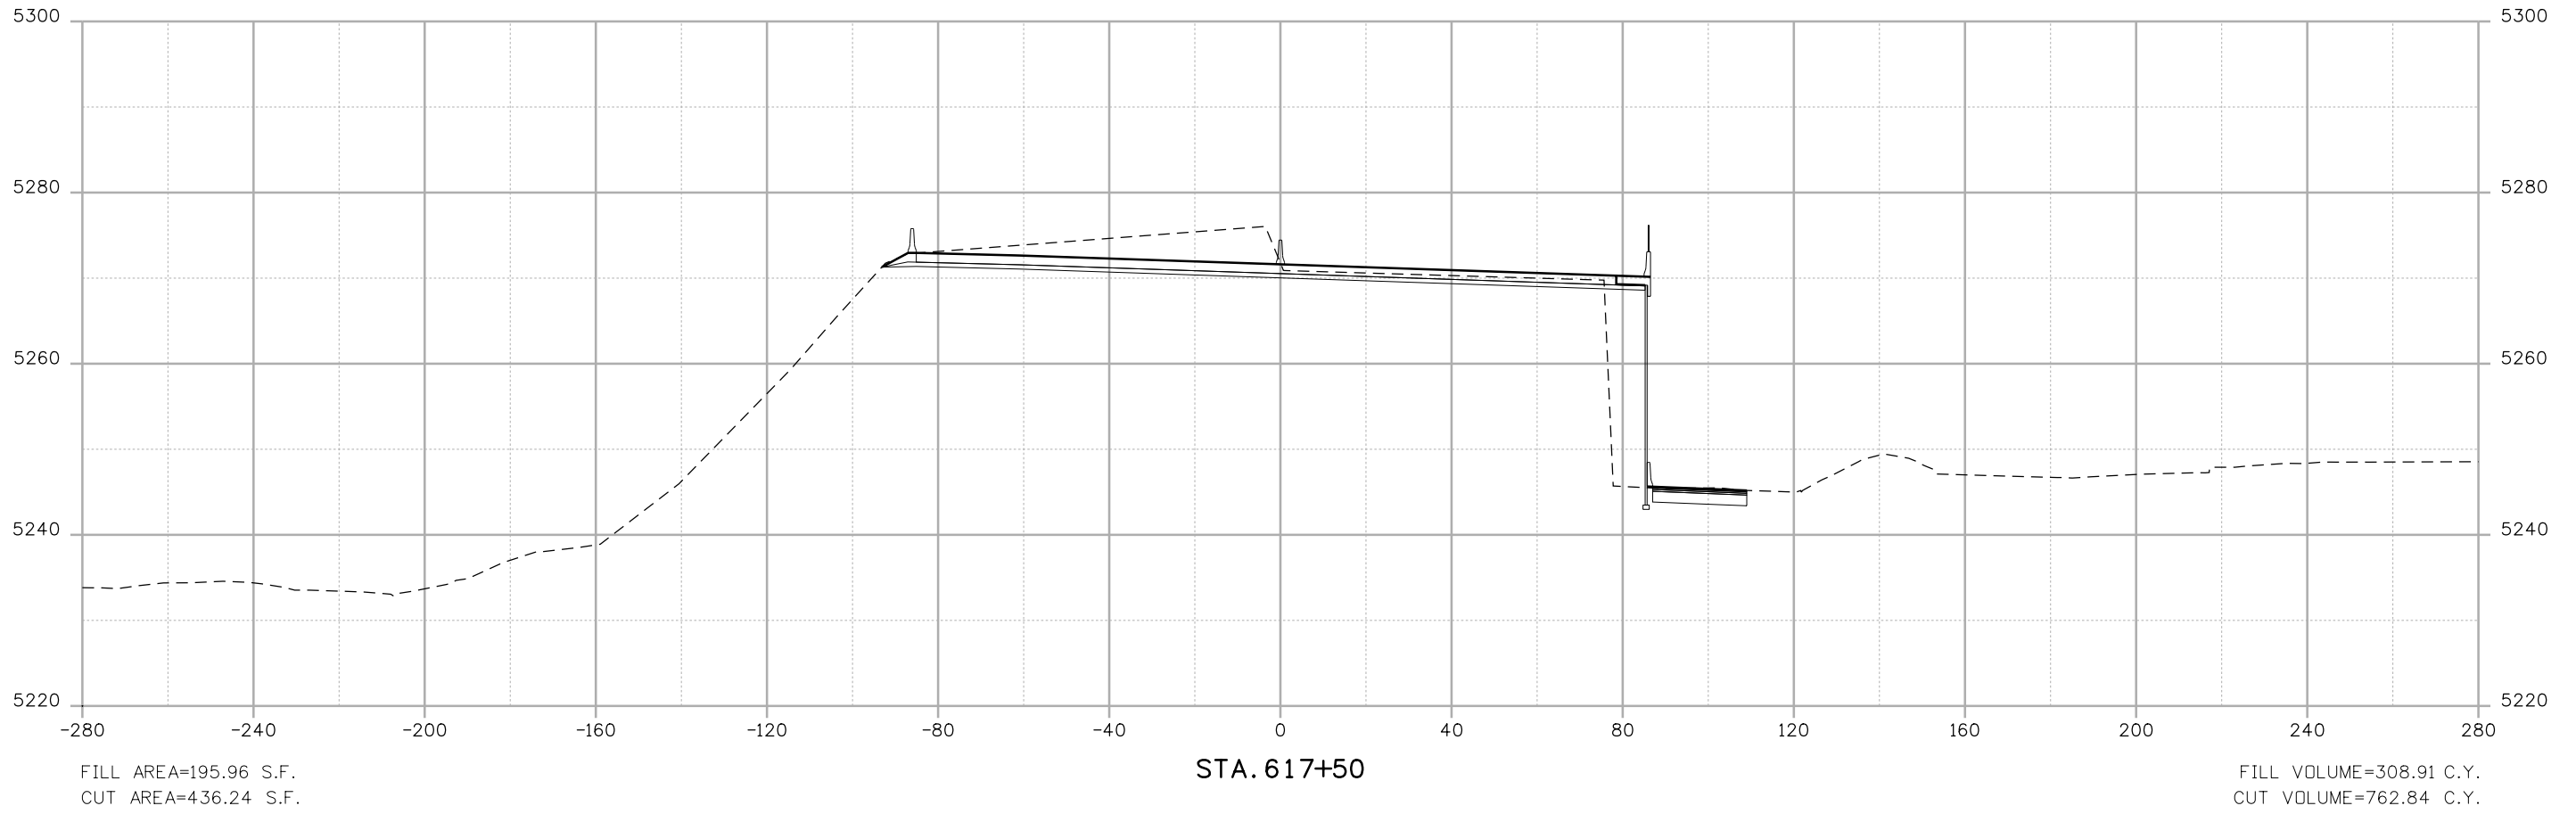

Print Date: 10/12/2010	
File Name: 16311DES_PH2_CrossSections1.dgn	
Horiz. Scale: 1:40 Vert. Scale: 1:20	
Unit Information Unit Leader Initials	
6300 South Syracuse Way Centennial, CO 80111	

Sheet Revisions		
Date:	Comments	Init.

Colorado Department of Transportation



2000 South Holly Street
Denver, CO 80222
Phone: 303-972-9112 FAX: 303-972-9114

Region 6 **RLB**


As Constructed
No Revisions:
Revised:
Void:

I-25/SANTA FE INTERCHANGE INTERSTATE 25 CROSS SECTIONS		
Designer: DCS	Structure Numbers	
Detailer: DCS		
Sheet Subset: SECTIONS	Subset Sheets: XS-8 of 104	

Project No./Code
BR 0252-407
17783
Sheet Number 8

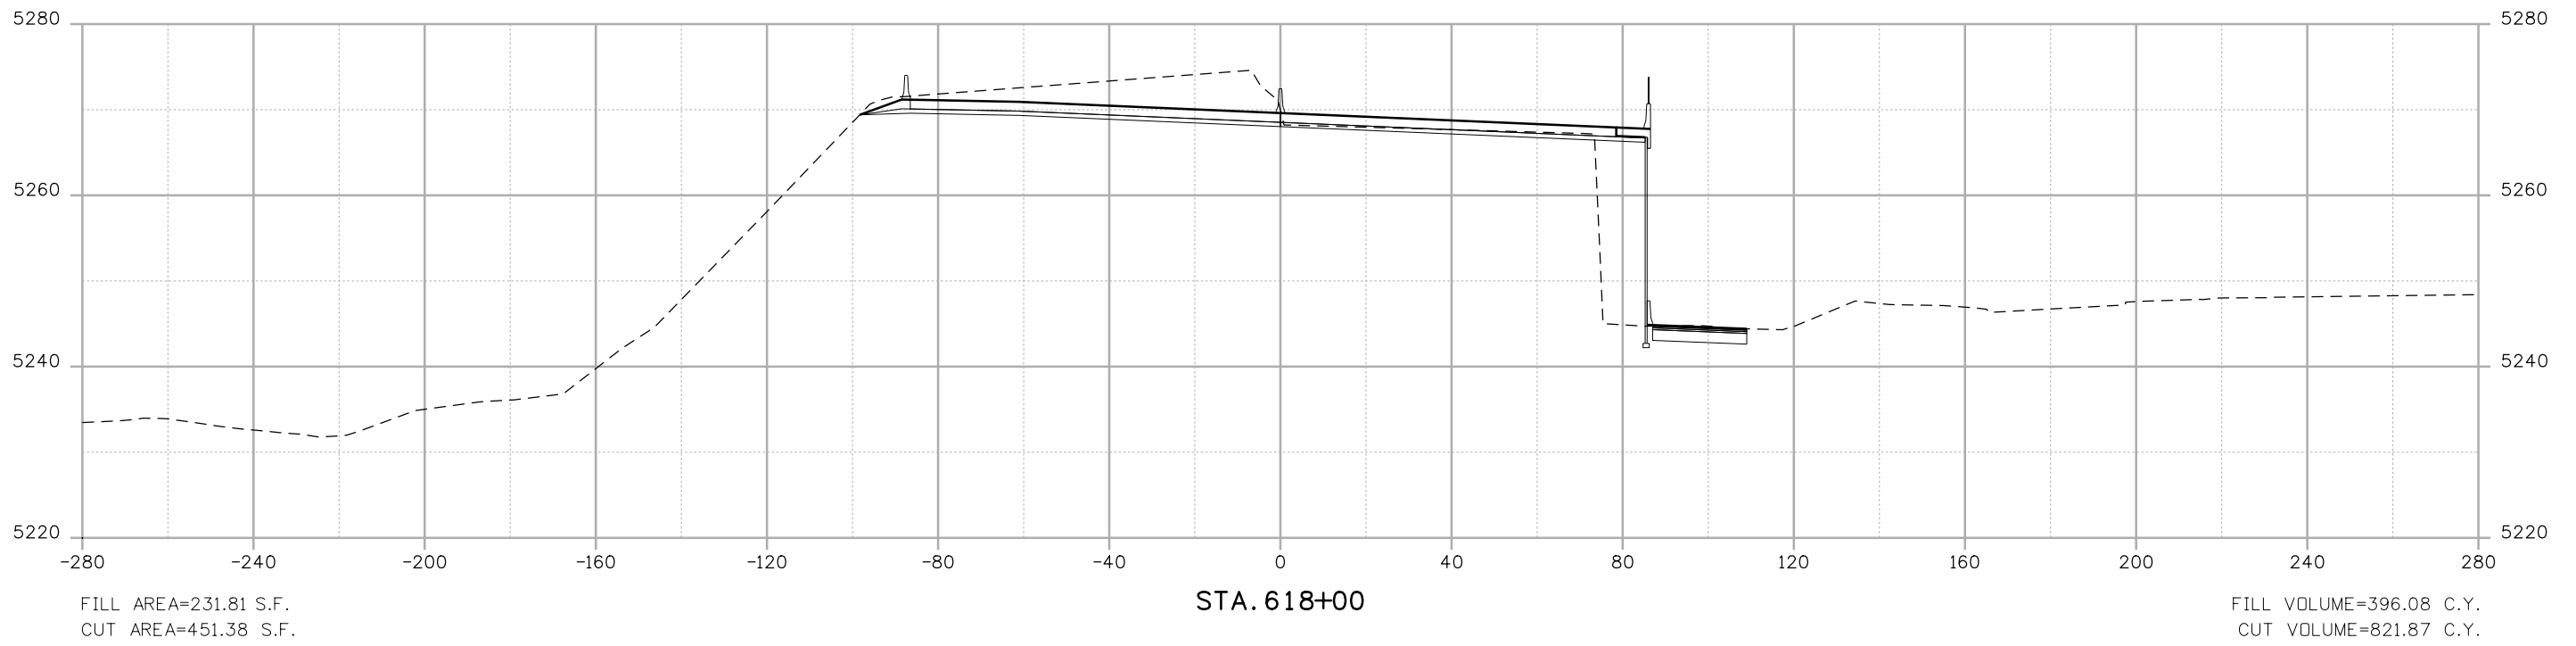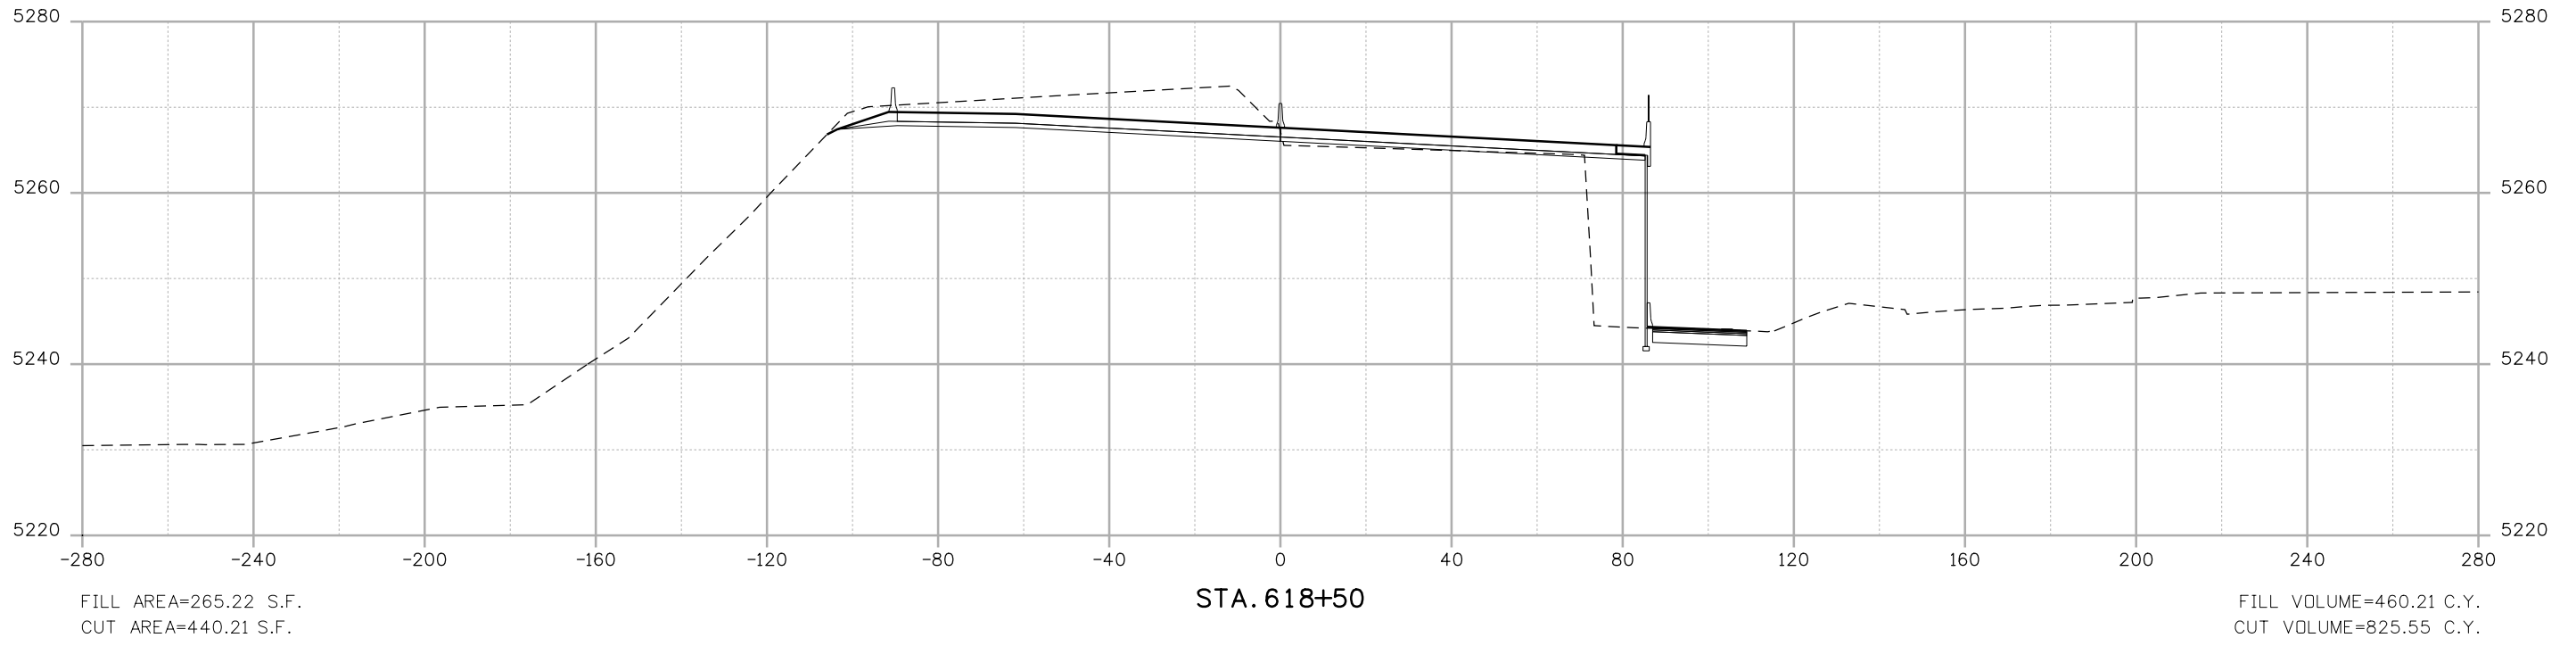

Dusty 9:06:05 AM K:\08276\16311\Phase 2\Design\Drawings\Cross-Sections\16311DES_PH2_CrossSections1.dgn

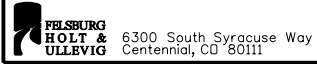Print Date: 10/12/2010	
File Name: 16311DES_PH2_CrossSections1.dgn	
Horiz. Scale: 1:40	Vert. Scale: 1:20
Unit Information	Unit Leader Initials
 6300 South Syracuse Way Centennial, CO 80111	

Sheet Revisions		
Date:	Comments	Init.

Colorado Department of Transportation



 2000 South Holly Street
Denver, CO 80222
Phone: 303-972-9112 FAX: 303-972-9114

Region 6 **RLB**

As Constructed
No Revisions:
Revised:
Void:

I-25/SANTA FE INTERCHANGE INTERSTATE 25 CROSS SECTIONS		
Designer: DCS	Structure Numbers	
Detailer: DCS		
Sheet Subset: SECTIONS	Subset Sheets: XS-9 of 104	

Project No./Code
BR 0252-407
17783
Sheet Number 9

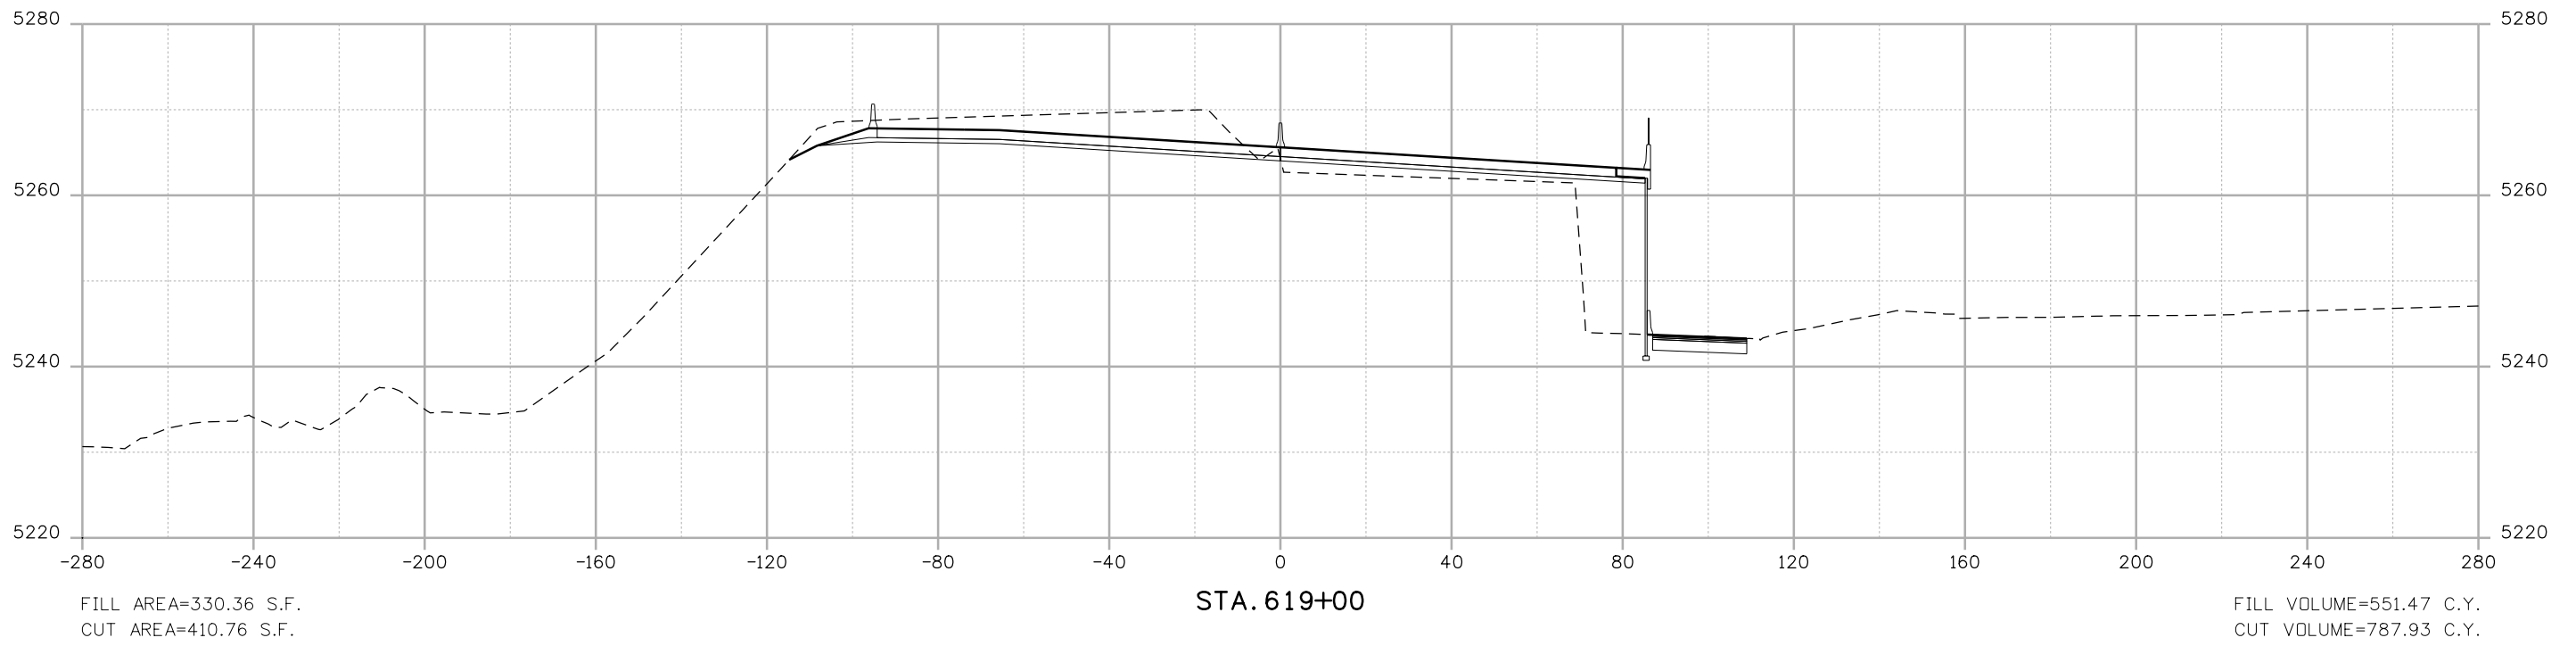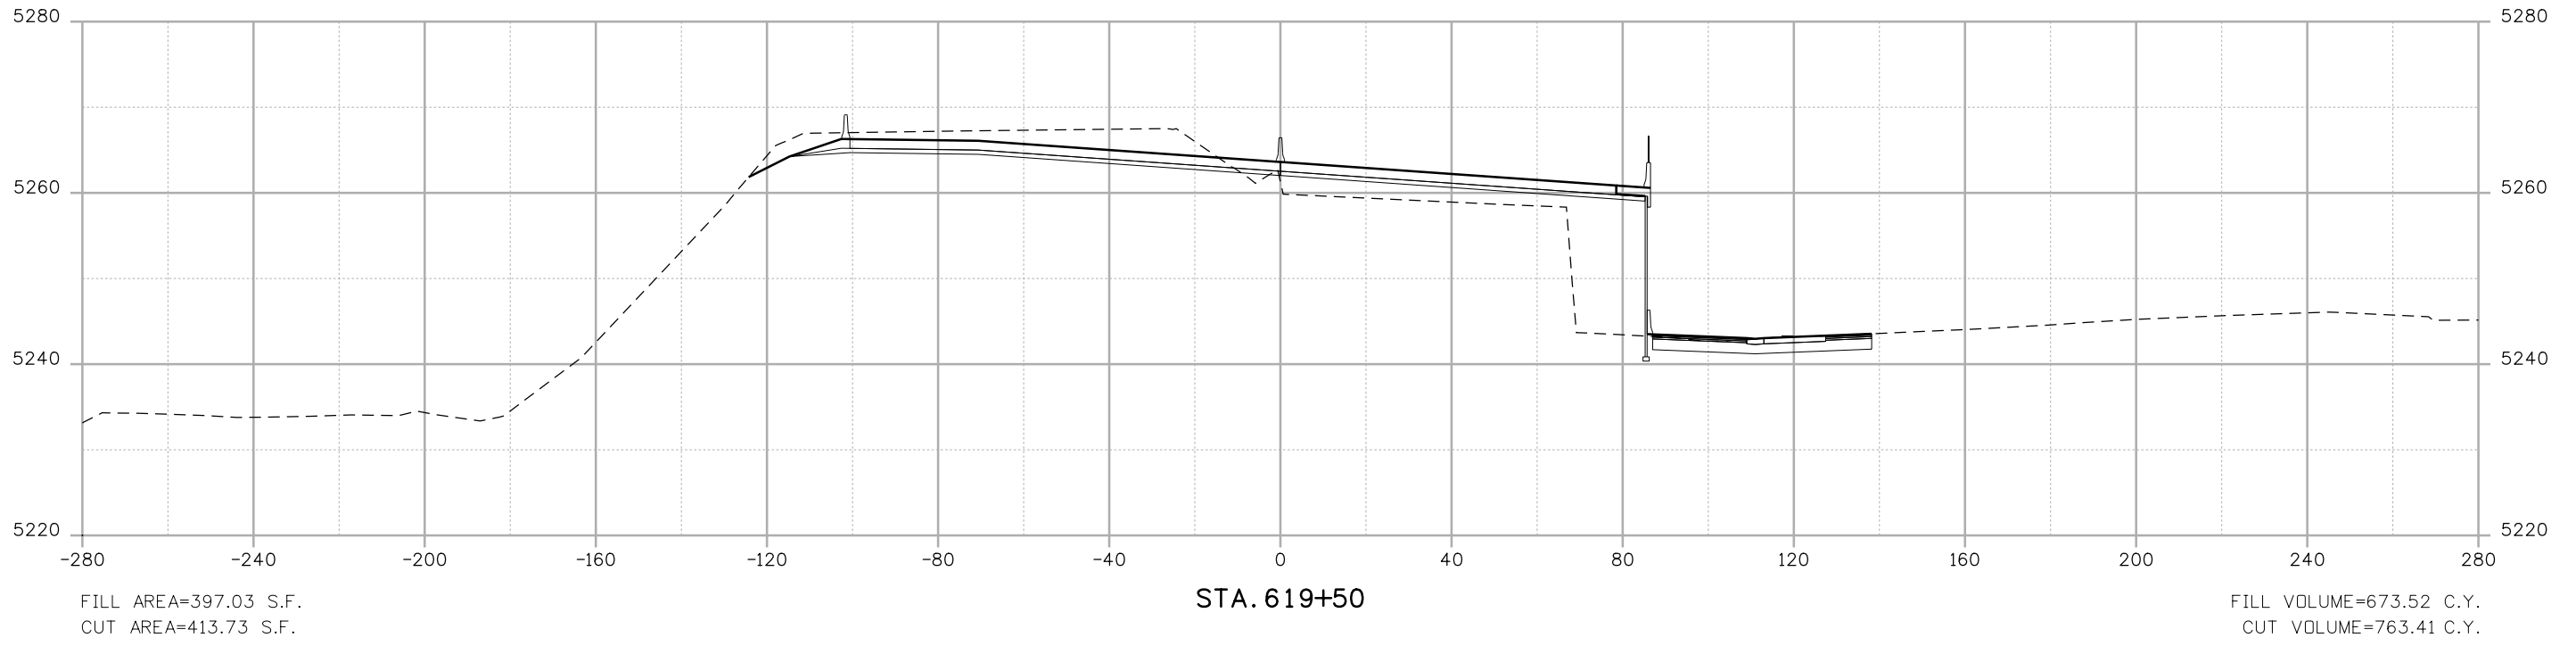

Dusty 9:06:23 AM K:\08276\16311\Phase 2\Design\Drawings\Cross-Sections\16311DES_PH2_CrossSections1.dgn

Print Date: 10/12/2010	
File Name: 16311DES_PH2_CrossSections1.dgn	
Horiz. Scale: 1:40	Vert. Scale: 1:20
Unit Information	Unit Leader Initials

Sheet Revisions		
Date:	Comments	Init.

Colorado Department of Transportation


2000 South Holly Street
Denver, CO 80222
Phone: 303-972-9112 FAX: 303-972-9114

Region 6 RLB

As Constructed
No Revisions:
Revised:
Void:

I-25/SANTA FE INTERCHANGE INTERSTATE 25 CROSS SECTIONS		
Designer: DCS	Structure Numbers	
Detailer: DCS		
Sheet Subset: SECTIONS	Subset Sheets: XS-10 of 104	


Project No./Code
BR 0252-407
17783
Sheet Number 10

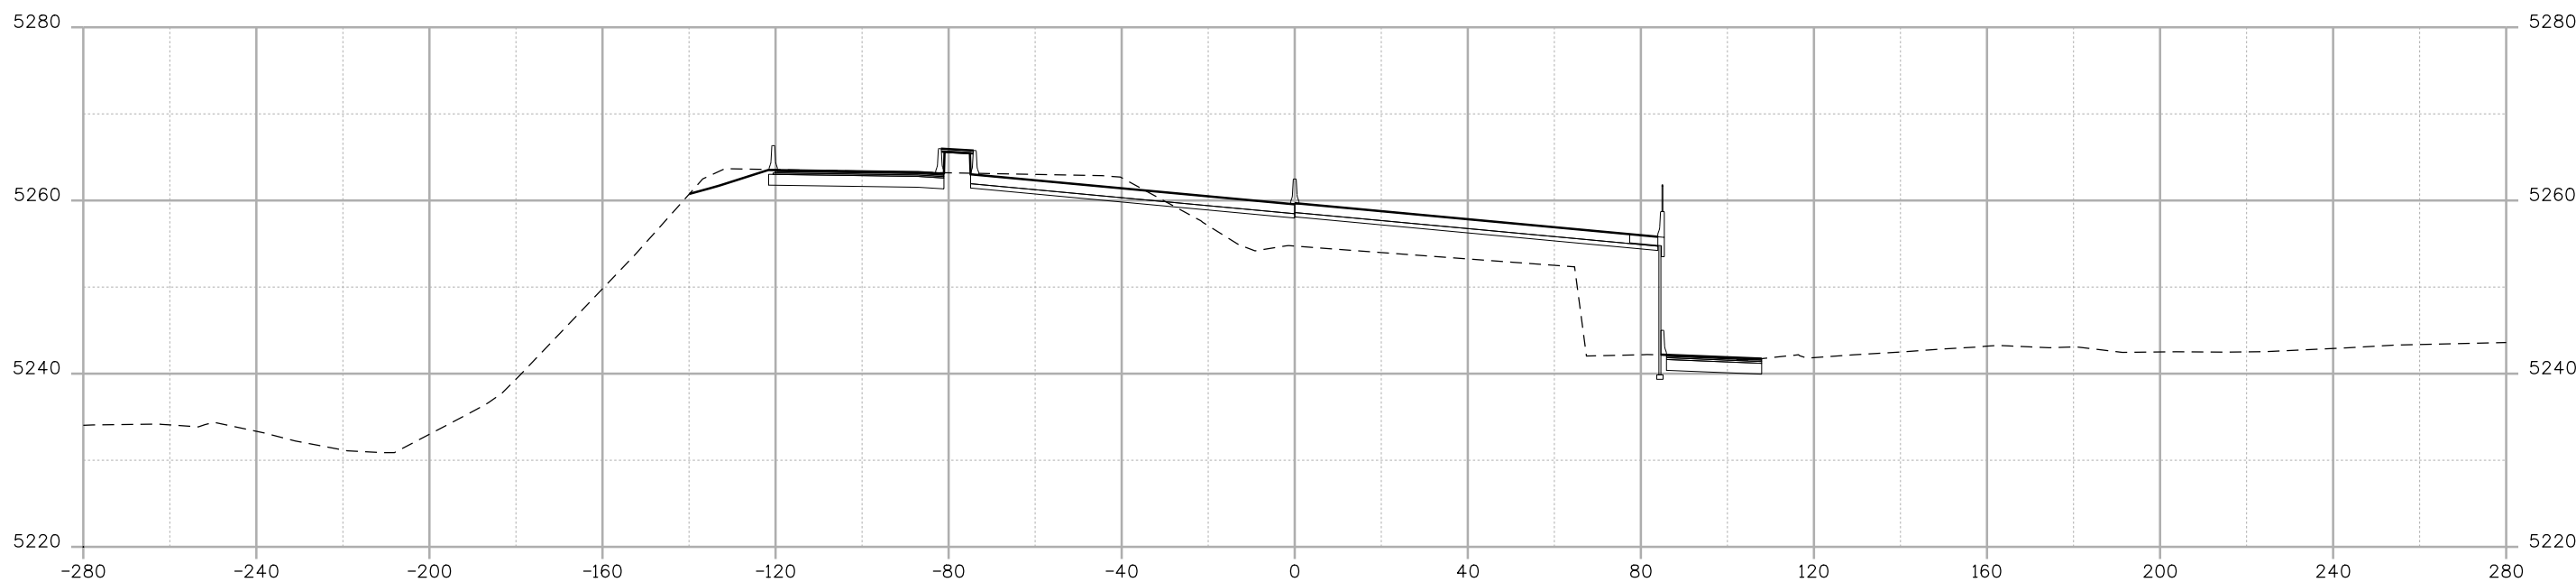

FILL AREA=515.09 S.F.
CUT AREA=226.90 S.F.

STA. 620+50

FILL VOLUME=867.26 C.Y.
CUT VOLUME=503.78 C.Y.

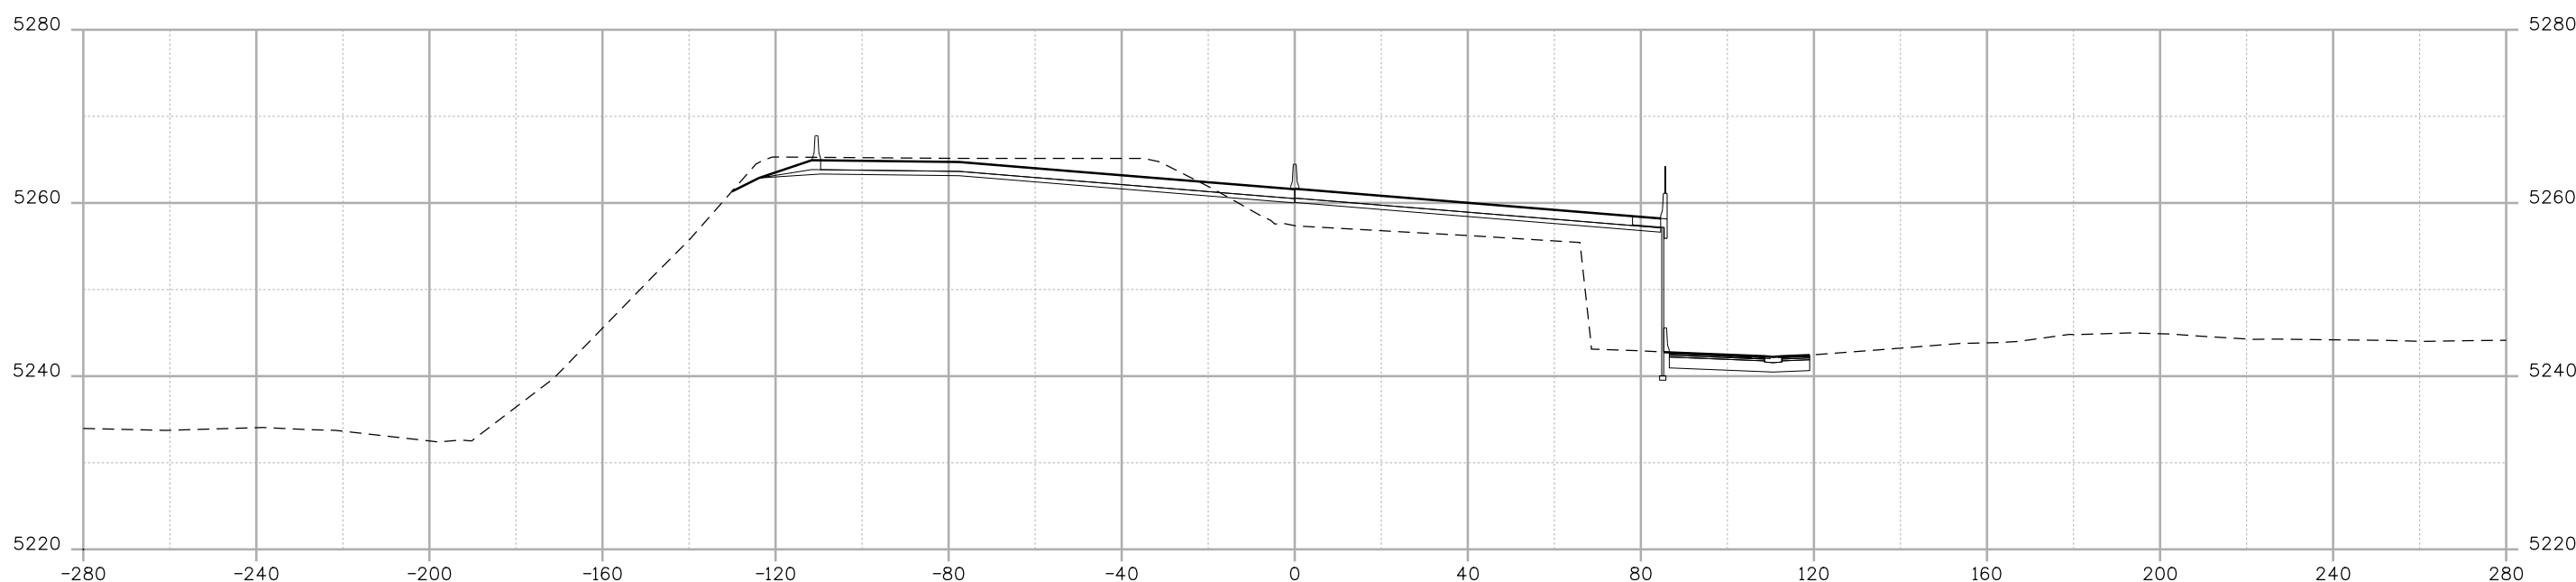

FILL AREA=421.55 S.F.
CUT AREA=317.19 S.F.

STA. 620+00

FILL VOLUME=757.94 C.Y.
CUT VOLUME=676.77 C.Y.

Dusty 9:06:35 AM K:\08276\16311\Phase 2\Design\Drawings\Cross_Sections\16311DES_PH2_CrossSections1.dgn

Print Date: 10/12/2010	
File Name: 16311DES_PH2_CrossSections1.dgn	
Horiz. Scale: 1:40	Vert. Scale: 1:20
Unit Information	Unit Leader Initials

Sheet Revisions		
Date:	Comments	Init.

Colorado Department of Transportation



2000 South Holly Street
Denver, CO 80222
Phone: 303-972-9112 FAX: 303-972-9114

Region 6 RLB

As Constructed
No Revisions:
Revised:
Void:

I-25/SANTA FE INTERCHANGE INTERSTATE 25 CROSS SECTIONS		
Designer: DCS	Structure Numbers	
Detailer: DCS		
Sheet Subset: SECTIONS	Subset Sheets: XS-11 of 104	

Project No./Code
BR 0252-407
17783
Sheet Number 11

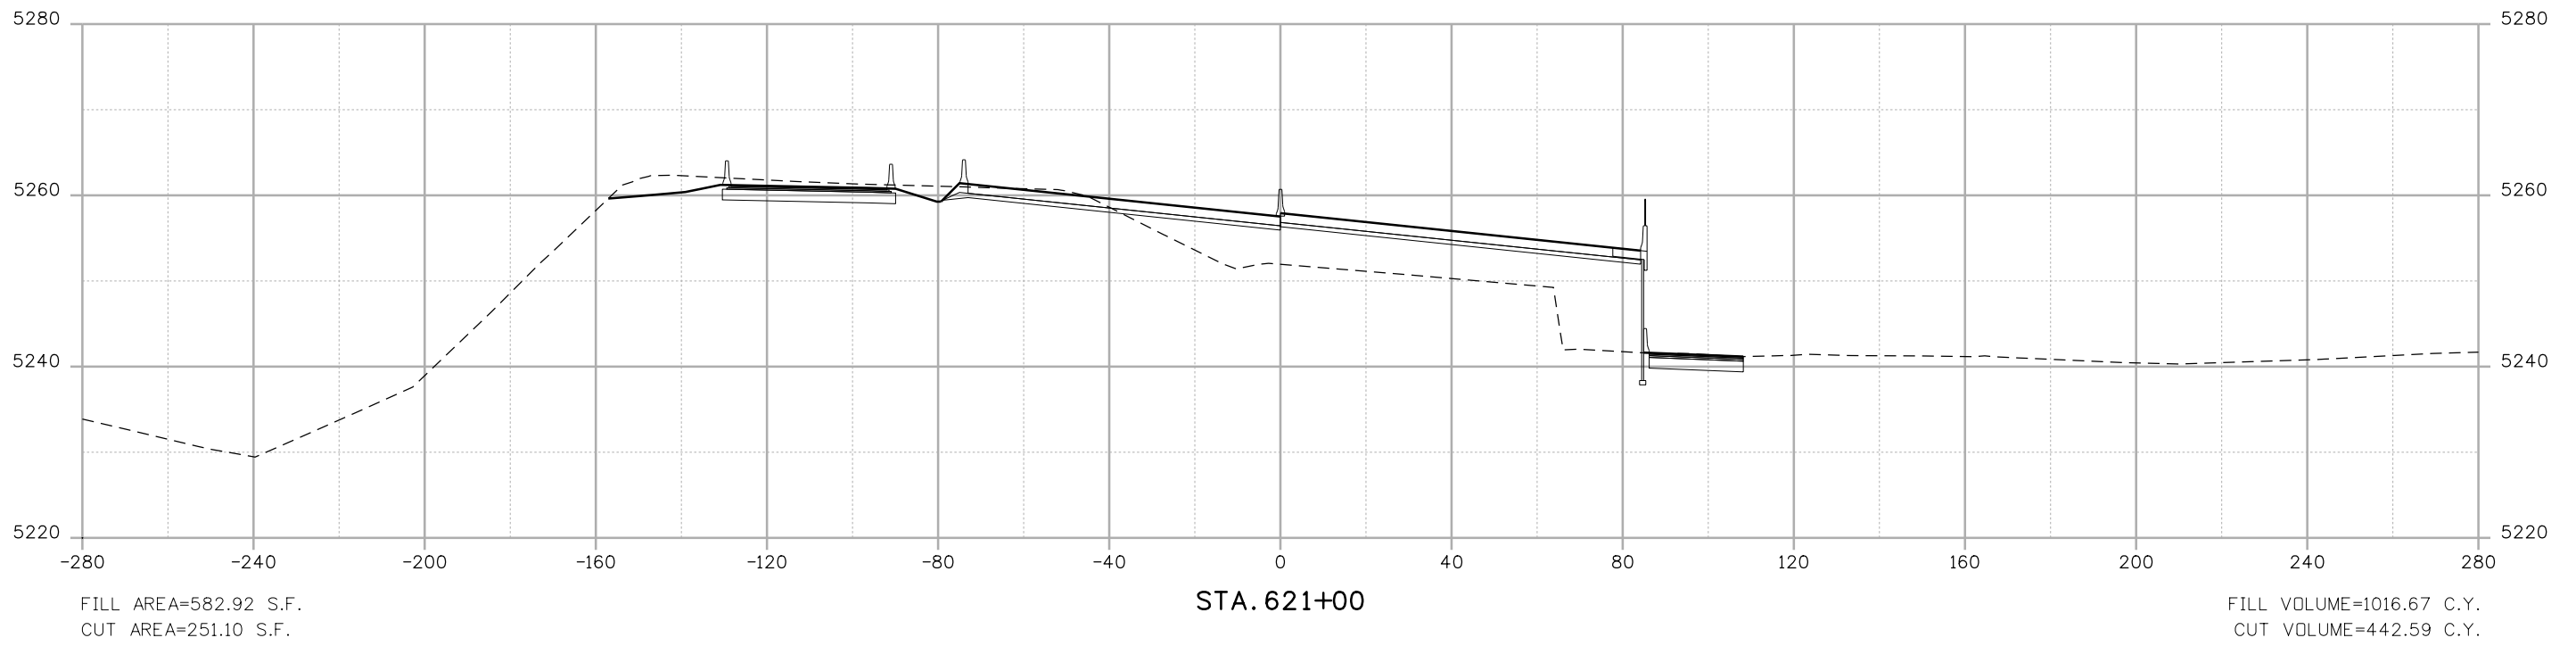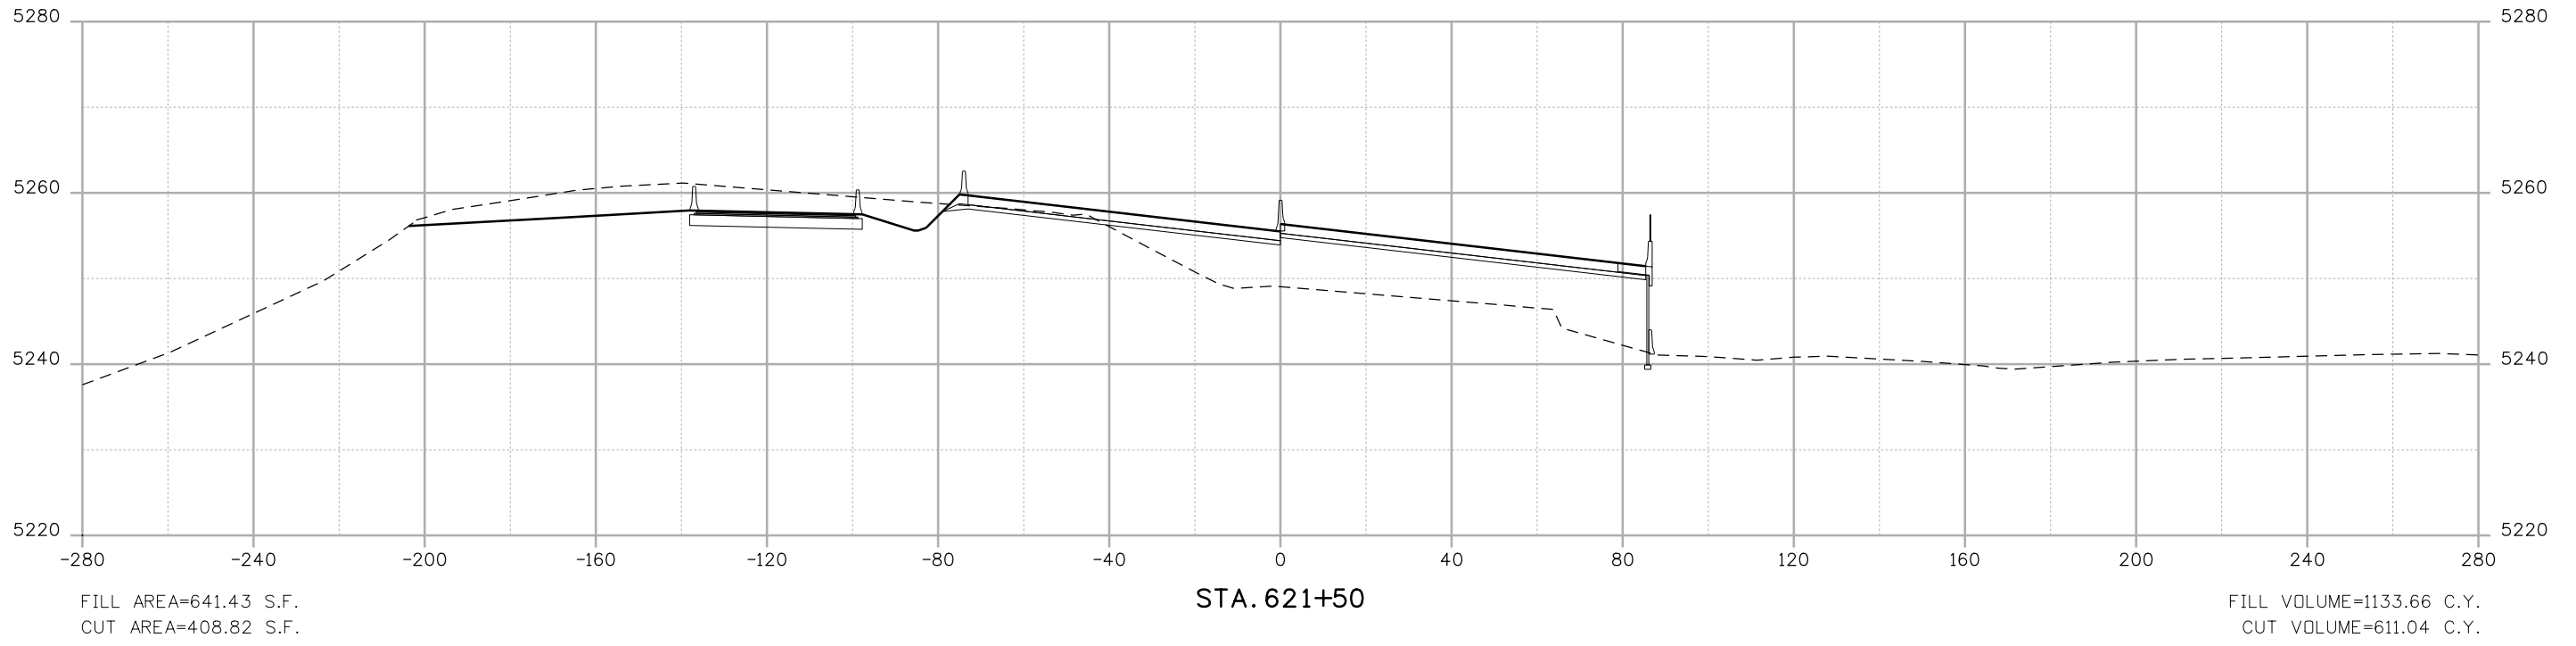

Print Date: 10/12/2010
 File Name: 16311DES_PH2_CrossSections1.dgn
 Horiz. Scale: 1:40 Vert. Scale: 1:20
 Unit Information Unit Leader Initials

Sheet Revisions		
Date:	Comments	Init.

Colorado Department of Transportation
 2000 South Holly Street
 Denver, CO 80222
 Phone: 303-972-9112 FAX: 303-972-9114

Region 6 **RLB**


As Constructed
 No Revisions:
 Revised:
 Void:



**I-25/SANTA FE INTERCHANGE
 INTERSTATE 25
 CROSS SECTIONS**

Designer: DCS Structure Numbers
 Detailer: DCS
 Sheet Subset: SECTIONS Subset Sheets: XS-12 of 104


Project No./Code
 BR 0252-407
 17783
 Sheet Number **12**

Dusty 9:06:48 AM K:\08276\16311\Phase 2\Design\Drawings\Cross_Sections\16311DES_PH2_CrossSections1.dgn

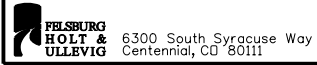

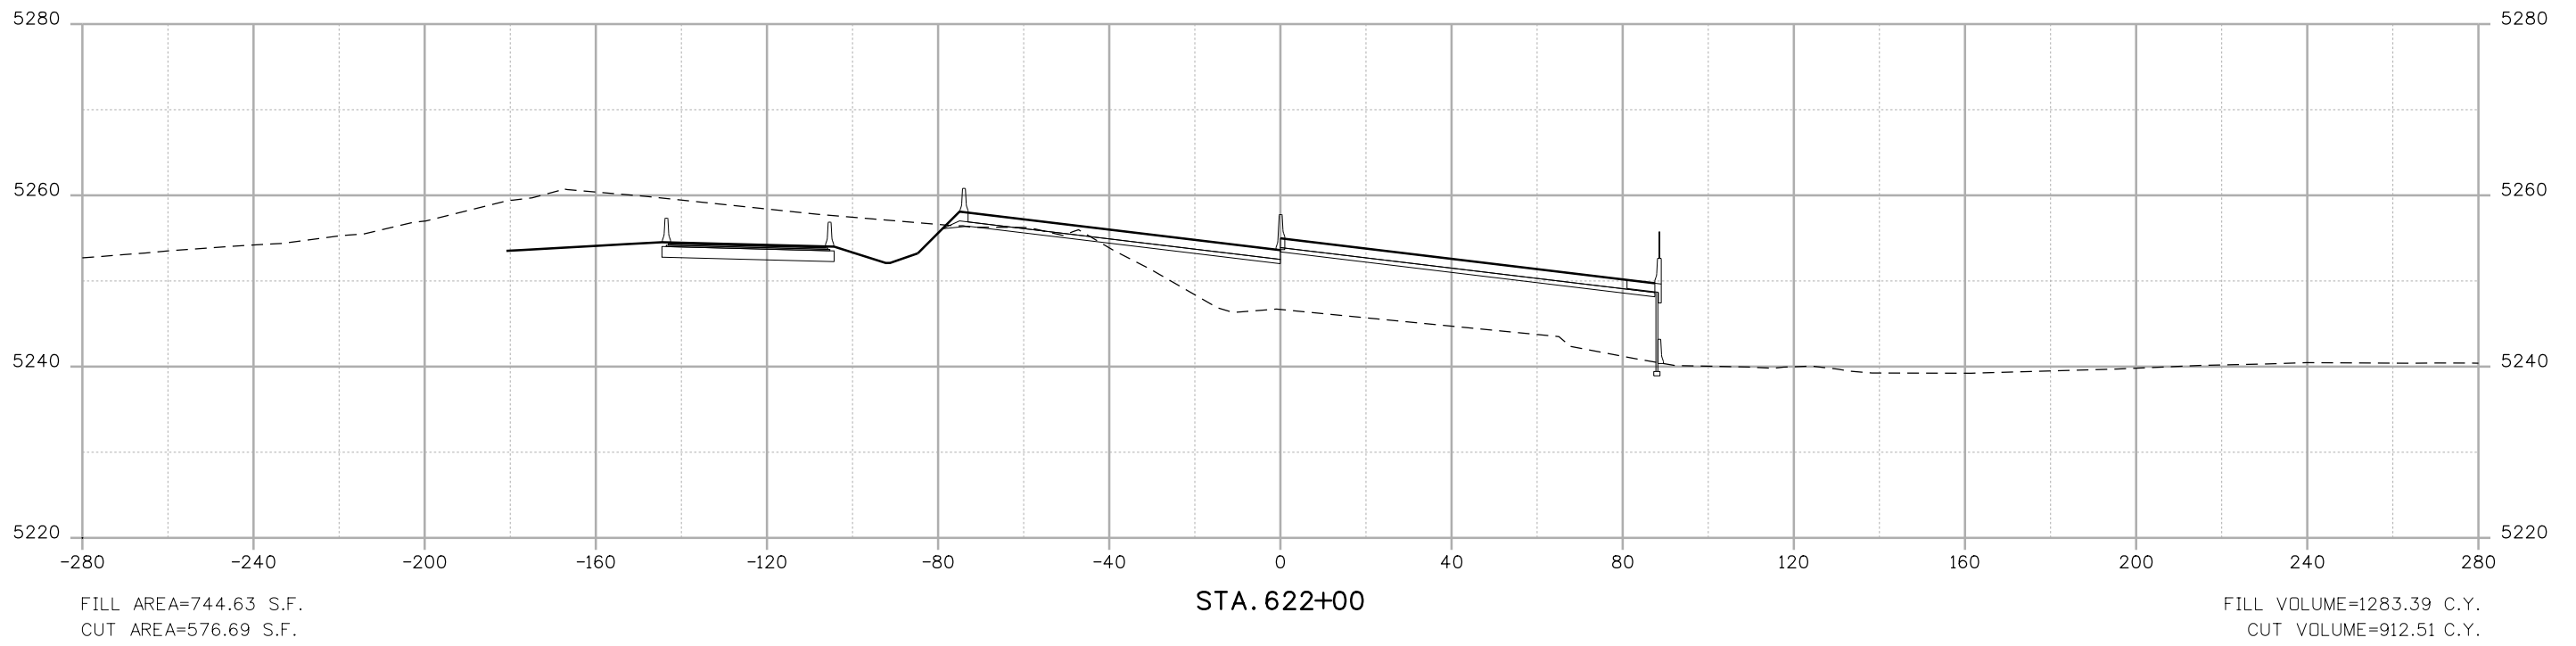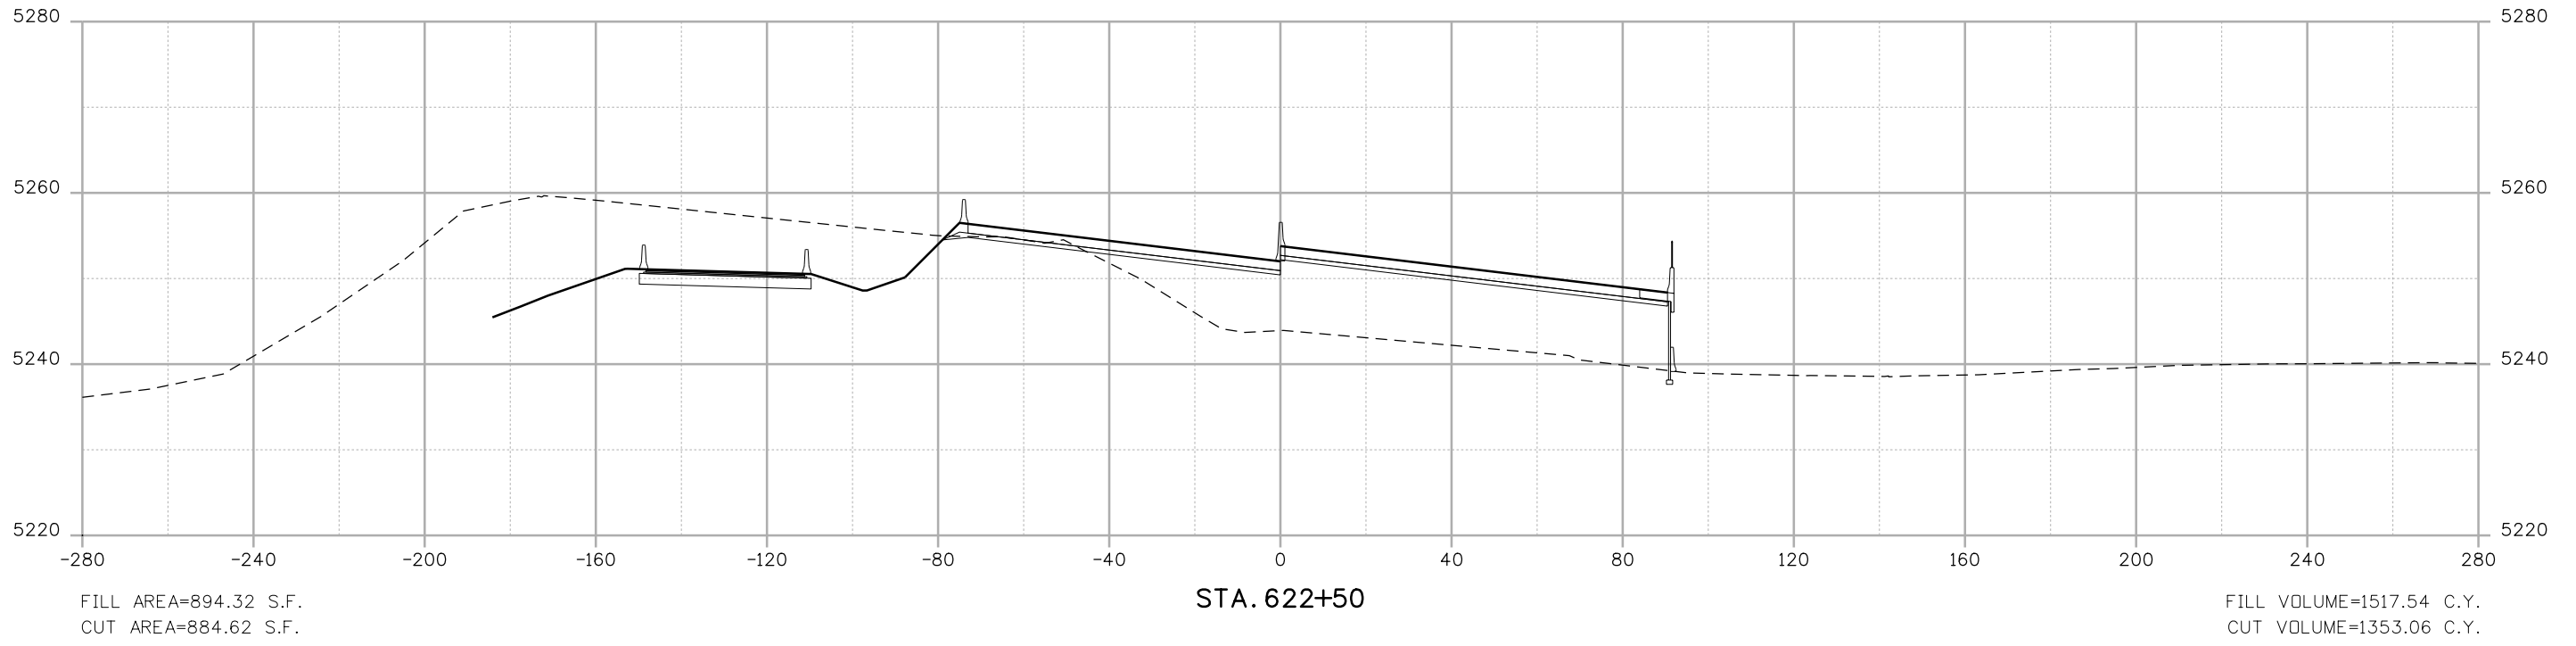

Dusty 9:07:00 AM K:\08276\16311\Phase 2\Design\Drawings\Cross_Sections\16311DES_PH2_CrossSections1.dgn

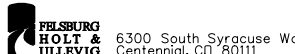Print Date: 10/12/2010	
File Name: 16311DES_PH2_CrossSections1.dgn	
Horiz. Scale: 1:40	Vert. Scale: 1:20
Unit Information	Unit Leader Initials
 6300 South Syracuse Way Centennial, CO 80111	

Sheet Revisions		
Date:	Comments	Init.

Colorado Department of Transportation


 2000 South Holly Street
 Denver, CO 80222
 Phone: 303-972-9112 FAX: 303-972-9114


Region 6 RLB

As Constructed
No Revisions:
Revised:
Void:

I-25/SANTA FE INTERCHANGE INTERSTATE 25 CROSS SECTIONS		
Designer: DCS	Structure Numbers	
Detailer: DCS		
Sheet Subset: SECTIONS	Subset Sheets: XS-13 of 104	

Project No./Code
BR 0252-407
17783
Sheet Number 13

Dusty 9:07:22 AM K:\08276\16311\Phase 2\Design\Drawings\Cross_Sections\16311DES_PH2_CrossSections1.dgn

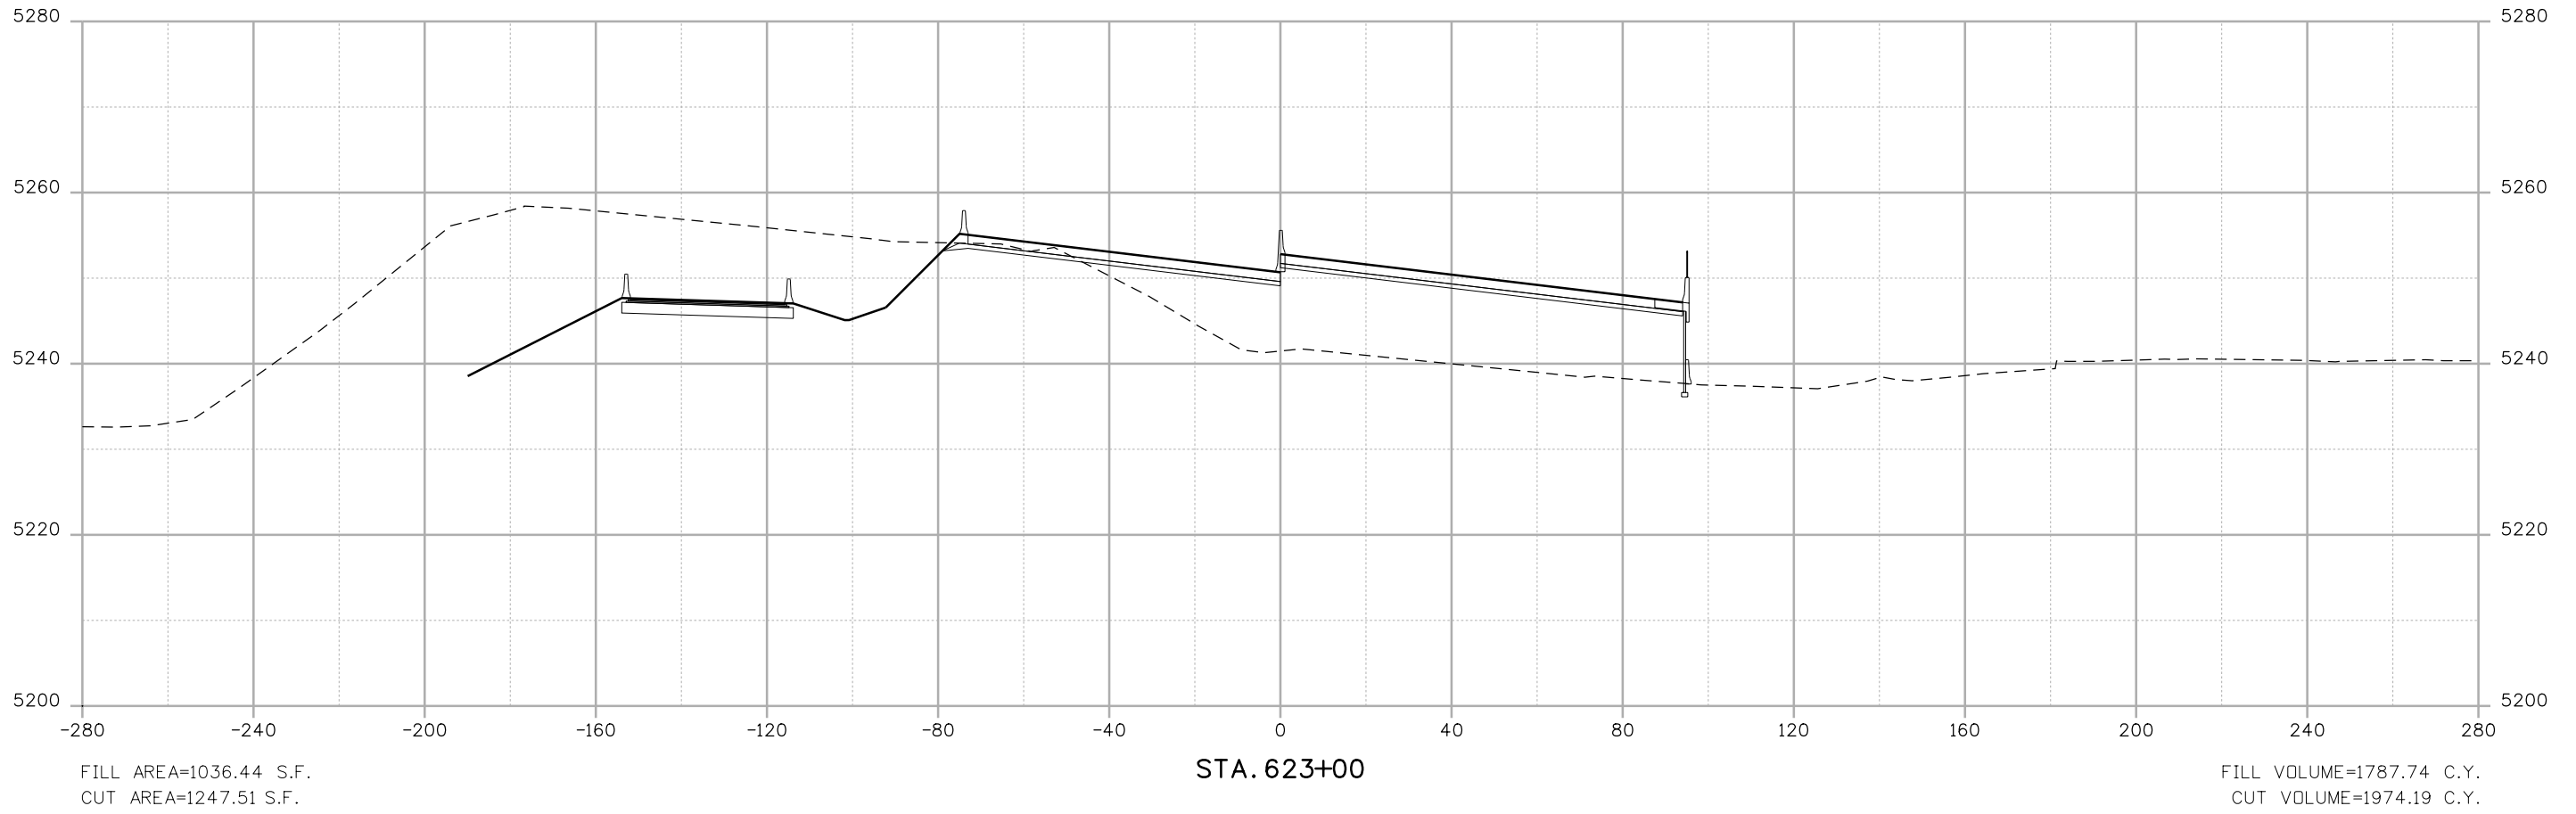

Print Date: 10/12/2010	
File Name: 16311DES_PH2_CrossSections1.dgn	
Horiz. Scale: 1:40	Vert. Scale: 1:20
Unit Information	Unit Leader Initials

Sheet Revisions		
Date:	Comments	Init.

Colorado Department of Transportation

2000 South Holly Street
Denver, CO 80222
Phone: 303-972-9112 FAX: 303-972-9114


Region 6 **RLB**

As Constructed
No Revisions:
Revised:
Void:

I-25/SANTA FE INTERCHANGE INTERSTATE 25 CROSS SECTIONS		
Designer: DCS	Structure Numbers	
Detailer: DCS		
Sheet Subset: SECTIONS	Subset Sheets: XS-14 of 104	

Project No./Code
BR 0252-407
17783
Sheet Number 14

Dusty 9:07:34 AM K:\08276\16311\Phase 2\Design\Drawings\Cross_Sections\16311DES_PH2_CrossSections1.dgn

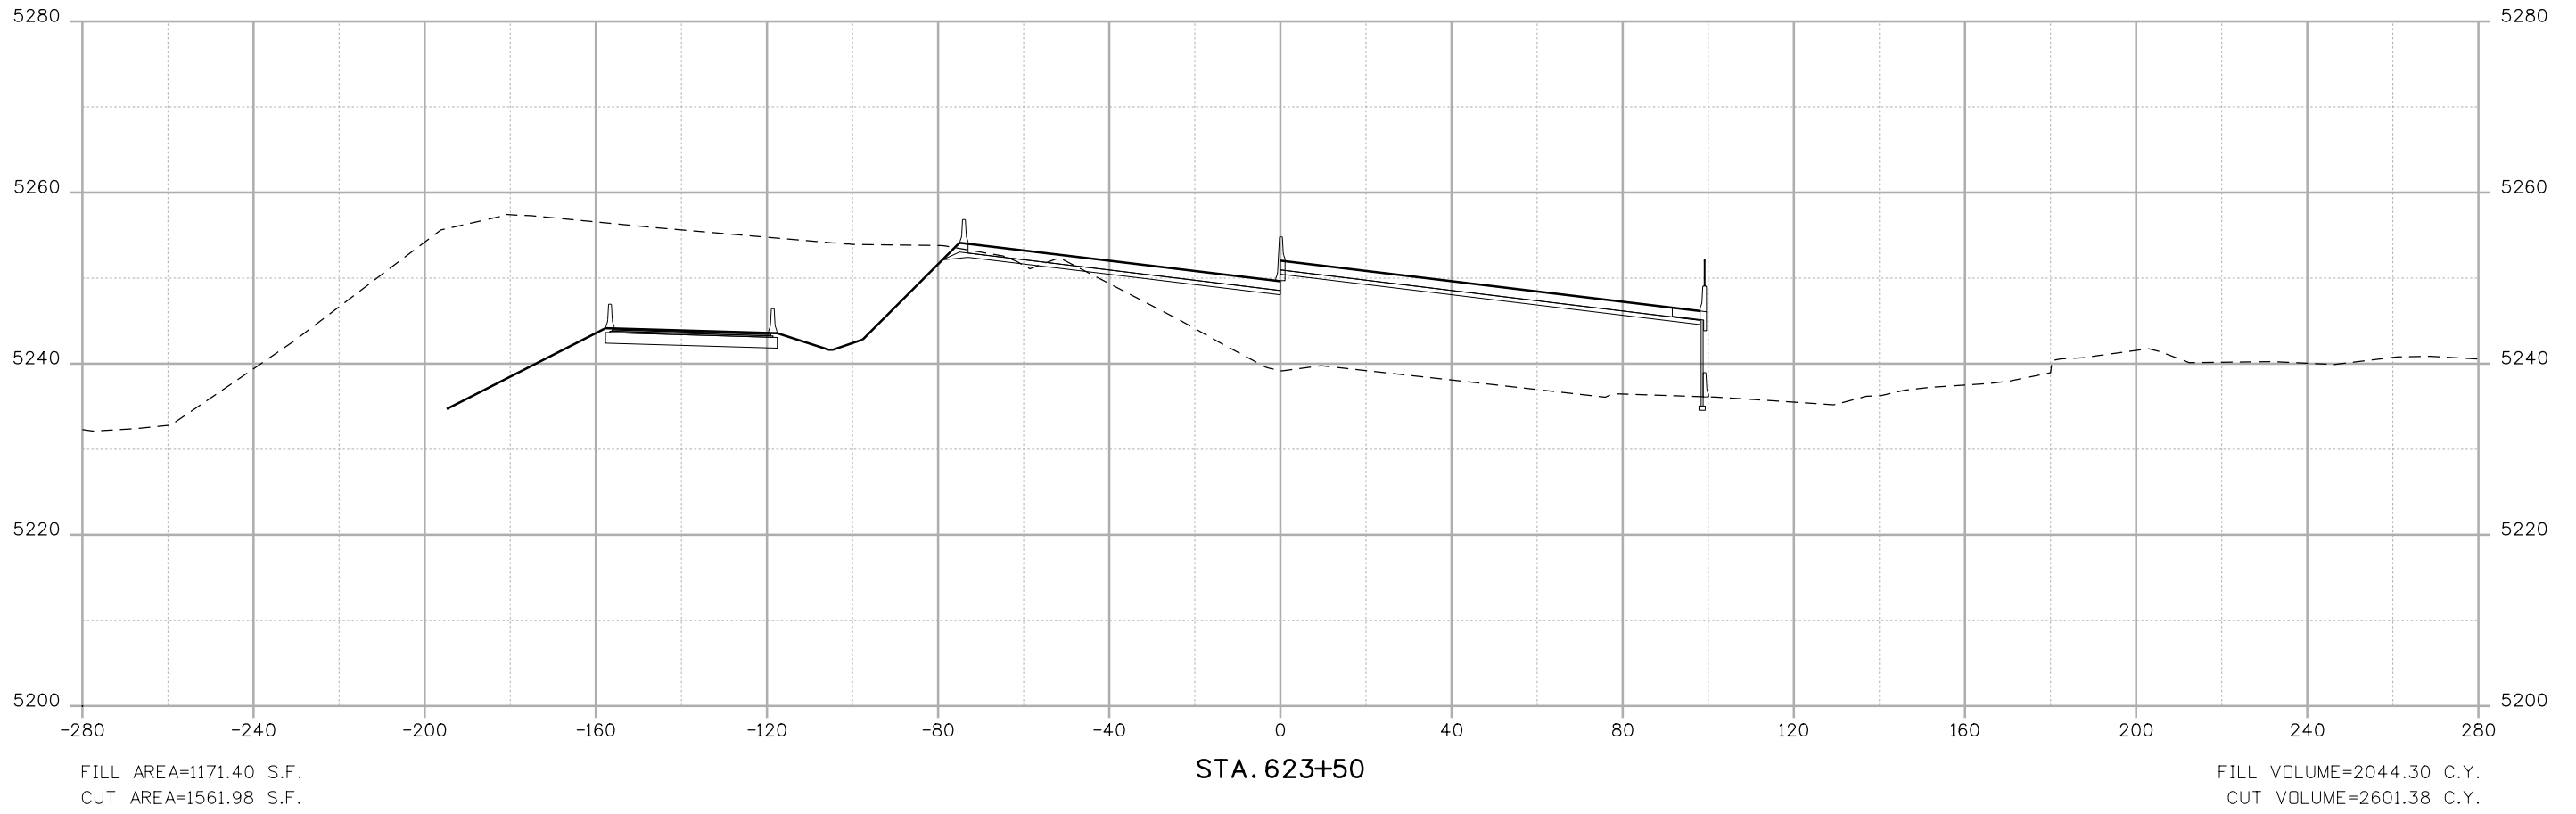

Print Date: 10/12/2010
 File Name: 16311DES_PH2_CrossSections1.dgn
 Horiz. Scale: 1:40 Vert. Scale: 1:20
 Unit Information Unit Leader Initials

Sheet Revisions		
Date:	Comments	Init.

Colorado Department of Transportation


 2000 South Holly Street
 Denver, CO 80222
 Phone: 303-972-9112 FAX: 303-972-9114
Region 6 **RLB**

As Constructed
 No Revisions:
 Revised:
 Void:


**I-25/SANTA FE INTERCHANGE
 INTERSTATE 25
 CROSS SECTIONS**

Designer: DCS Structure Numbers
 Detailer: DCS
 Sheet Subset: SECTIONS Subset Sheets: XS-15 of 104

Project No./Code
 BR 0252-407
 17783
 Sheet Number **15**

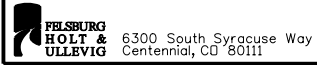

Dusty 9:07:45 AM K:\08276\16311\Phase 2\Design\Drawings\Cross_Sections\16311DES_PH2_CrossSections1.dgn

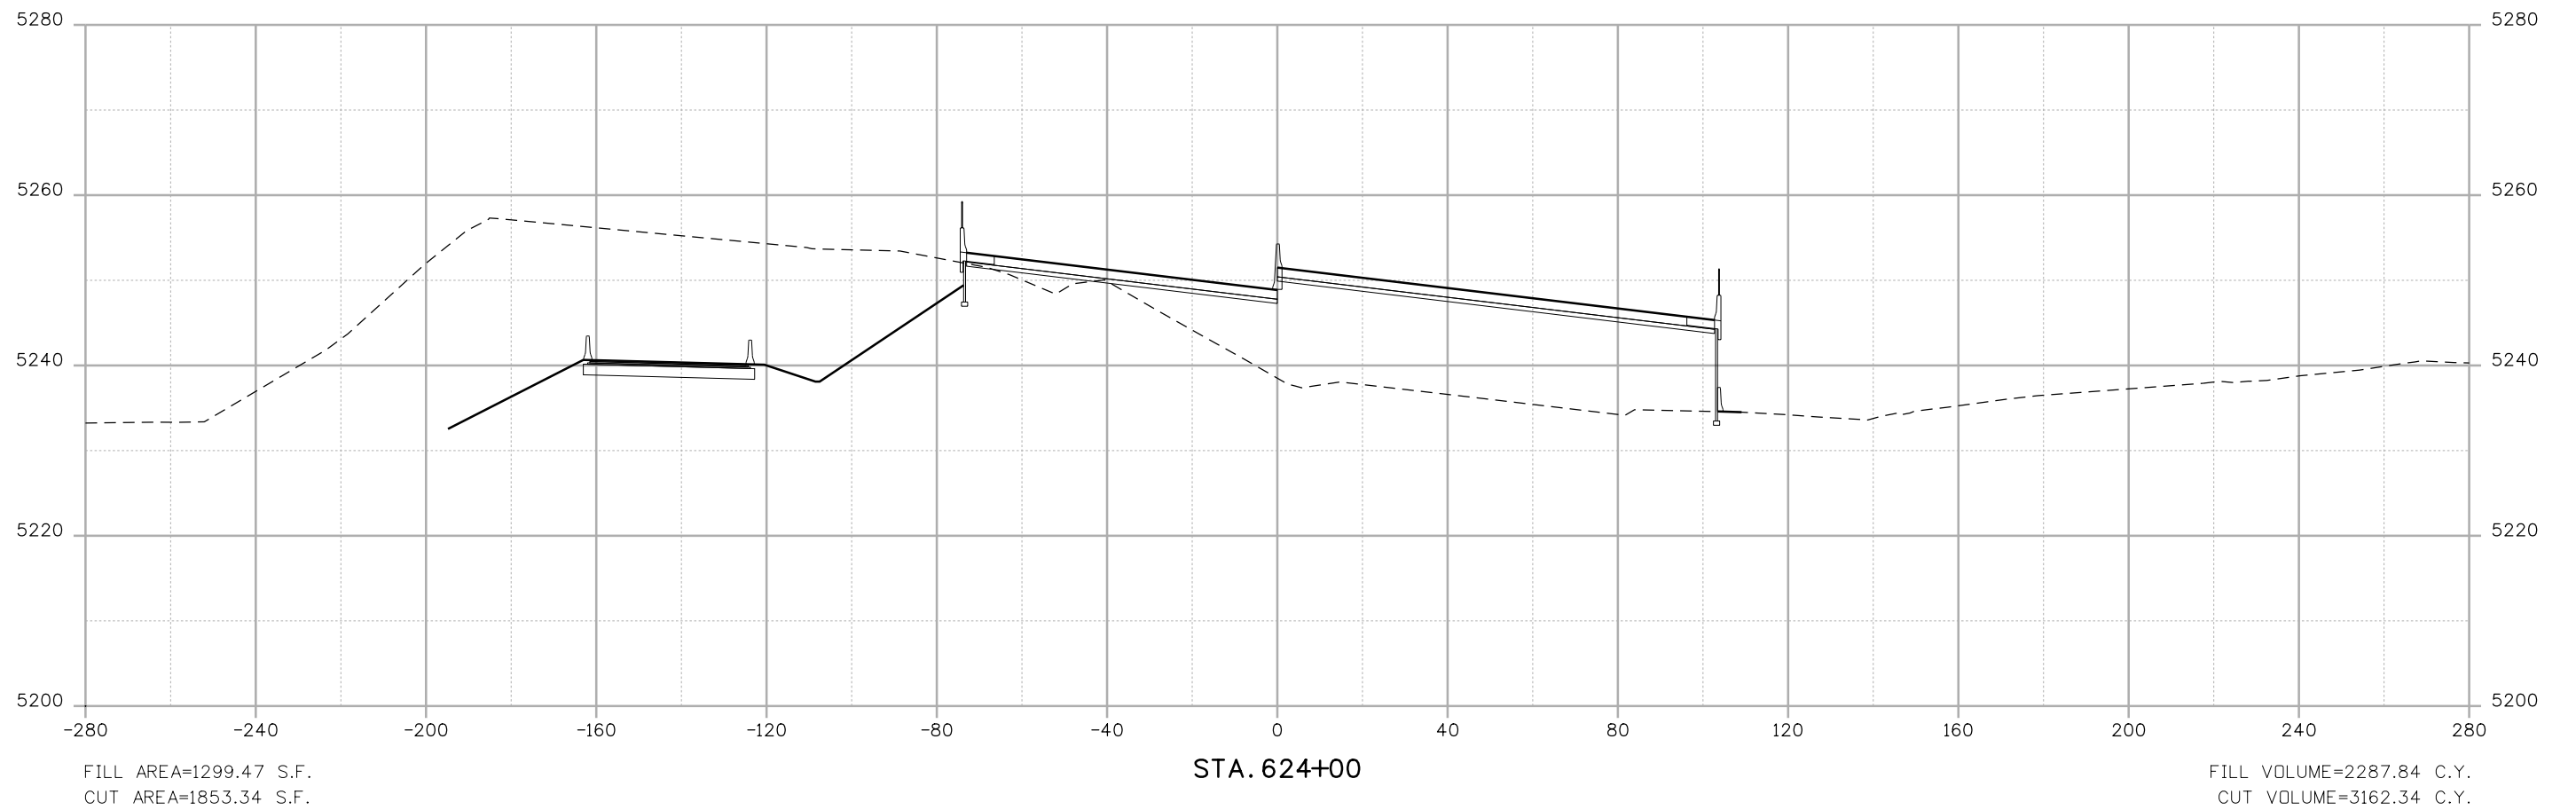

Print Date: 10/12/2010	
File Name: 16311DES_PH2_CrossSections1.dgn	
Horiz. Scale: 1:40	Vert. Scale: 1:20
Unit Information	Unit Leader Initials

Sheet Revisions		
Date:	Comments	Init.

Colorado Department of Transportation

2000 South Holly Street
 Denver, CO 80222
 Phone: 303-972-9112 FAX: 303-972-9114


Region 6 RLB

As Constructed	
No Revisions:	
Revised:	
Void:	

I-25/SANTA FE INTERCHANGE INTERSTATE 25 CROSS SECTIONS		
Designer: DCS	Structure Numbers	
Detailer: DCS		
Sheet Subset: SECTIONS	Subset Sheets: XS-16 of 104	

Project No./Code	BR 0252-407
	17783
Sheet Number	16

Dusty 9:07:56 AM K:\08276\16311\Phase 2\Design\Drawings\Cross-Sections\16311DES_PH2_CrossSections1.dgn

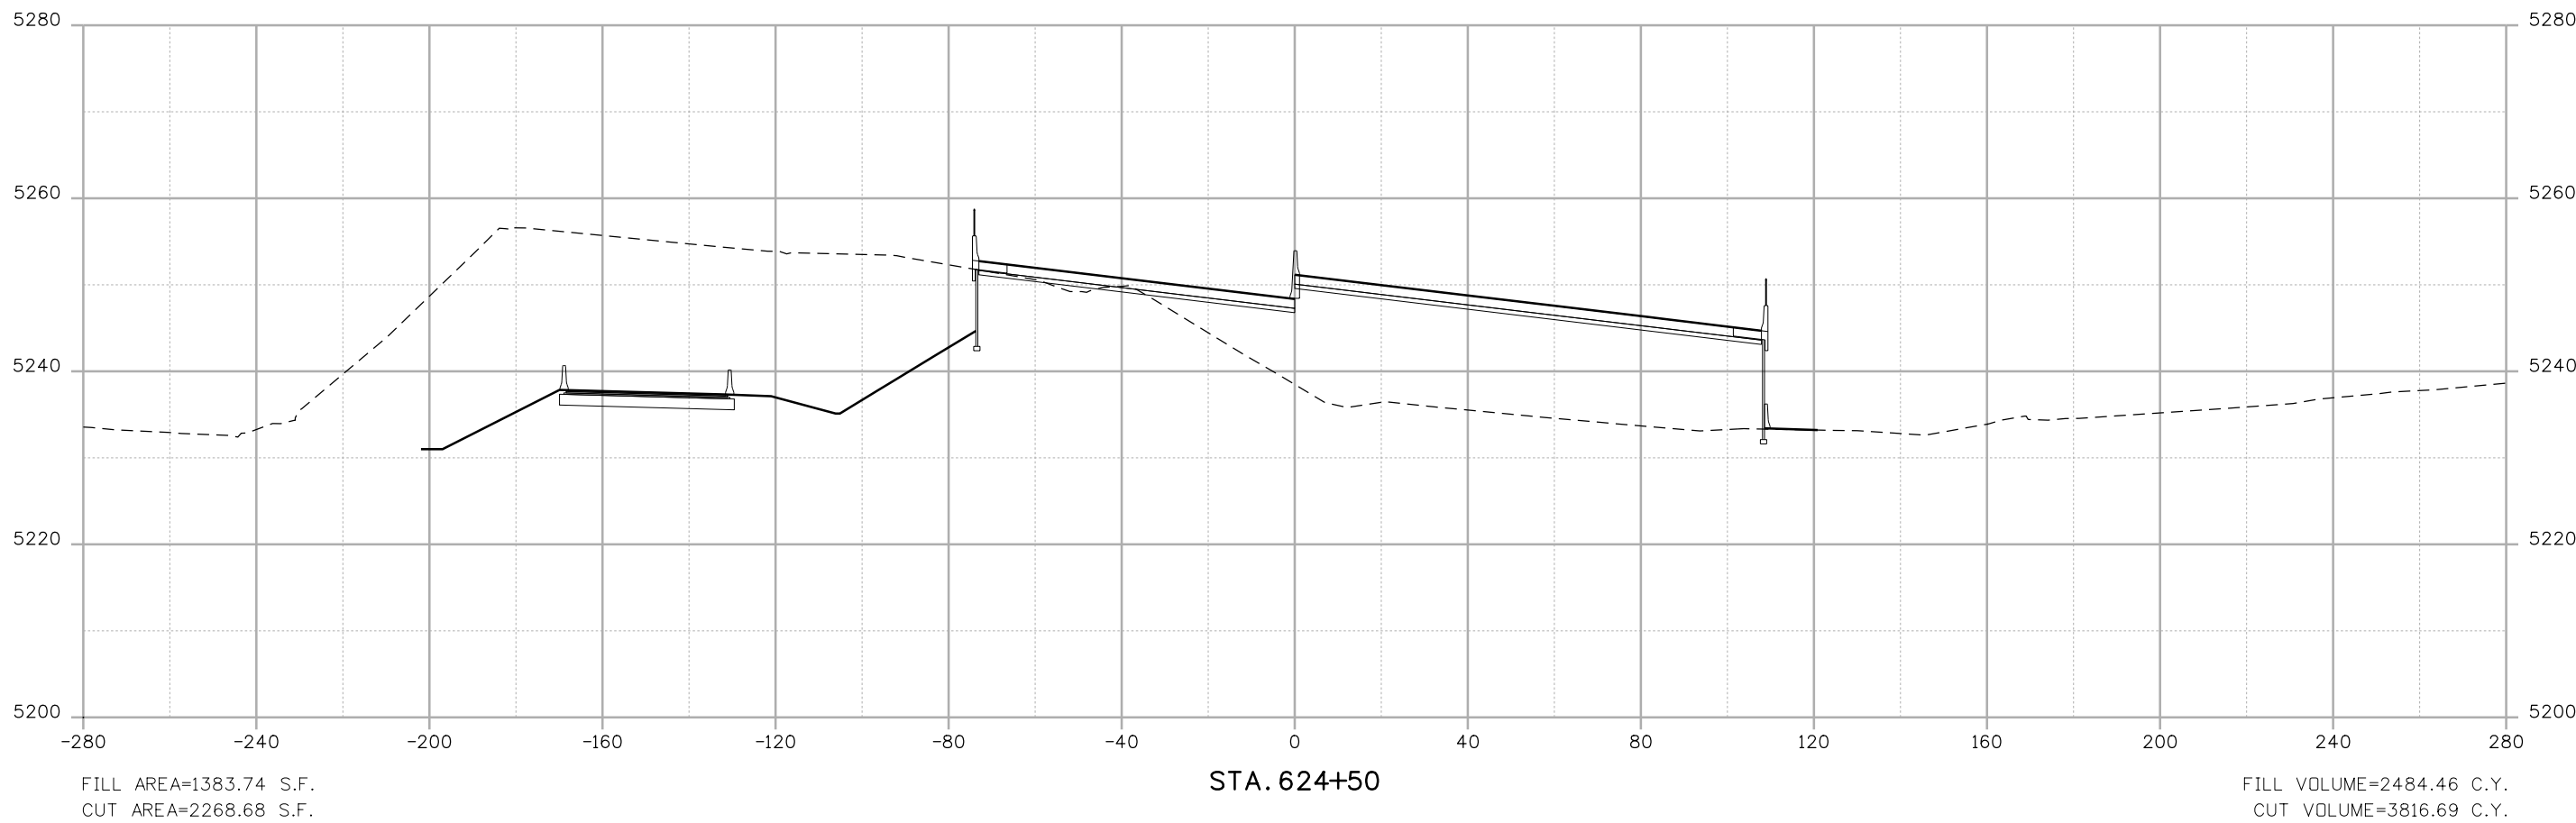

Print Date: 10/12/2010	
File Name: 16311DES_PH2_CrossSections1.dgn	
Horiz. Scale: 1:40	Vert. Scale: 1:20
Unit Information	Unit Leader Initials

Sheet Revisions		
Date:	Comments	Init.

Colorado Department of Transportation

2000 South Holly Street
 Denver, CO 80222
 Phone: 303-972-9112 FAX: 303-972-9114


Region 6 RLB

As Constructed
No Revisions:
Revised:
Void:

I-25/SANTA FE INTERCHANGE INTERSTATE 25 CROSS SECTIONS		
Designer: DCS	Structure Numbers	
Detailer: DCS		
Sheet Subset: SECTIONS	Subset Sheets: XS-17 of 104	

Project No./Code
BR 0252-407
17783
Sheet Number 17

Dusty 9:08:08 AM K:\08276\16311\Phase 2\Design\Drawings\Cross_Sections\16311DES_PH2_CrossSections1.dgn

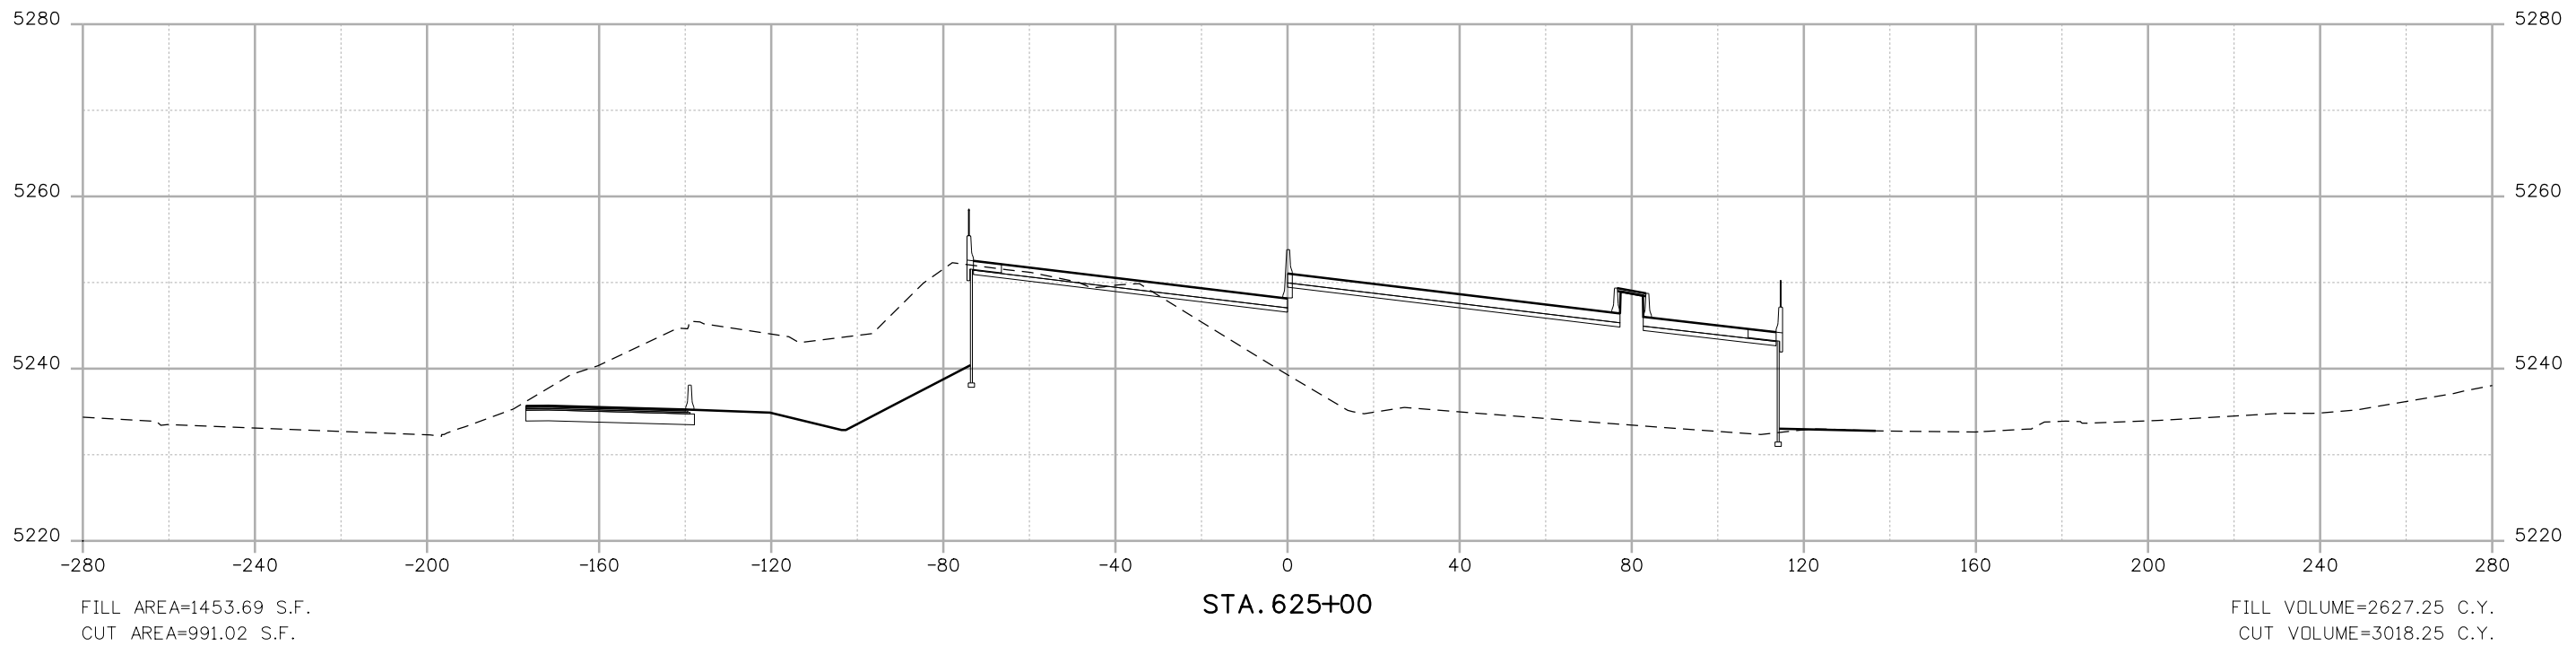

Print Date: 10/12/2010
 File Name: 16311DES_PH2_CrossSections1.dgn
 Horiz. Scale: 1:40 Vert. Scale: 1:20
 Unit Information Unit Leader Initials

R-X
 O
 O
 O

Sheet Revisions		
Date:	Comments	Init.

Colorado Department of Transportation

 2000 South Holly Street
 Denver, CO 80222
 Phone: 303-972-9112 FAX: 303-972-9114
Region 6 **RLB**


As Constructed
 No Revisions:
 Revised:
 Void:

**I-25/SANTA FE INTERCHANGE
 INTERSTATE 25
 CROSS SECTIONS**

Designer: DCS Structure Numbers
 Detailer: DCS
 Sheet Subset: SECTIONS Subset Sheets: XS-18 of 104

Project No./Code
 BR 0252-407
 17783
 Sheet Number **18**

Dusty 9:08:20 AM K:\08276\16311\Phase 2\Design\Drawings\Cross_Sections\16311DES_PH2_CrossSections1.dgn

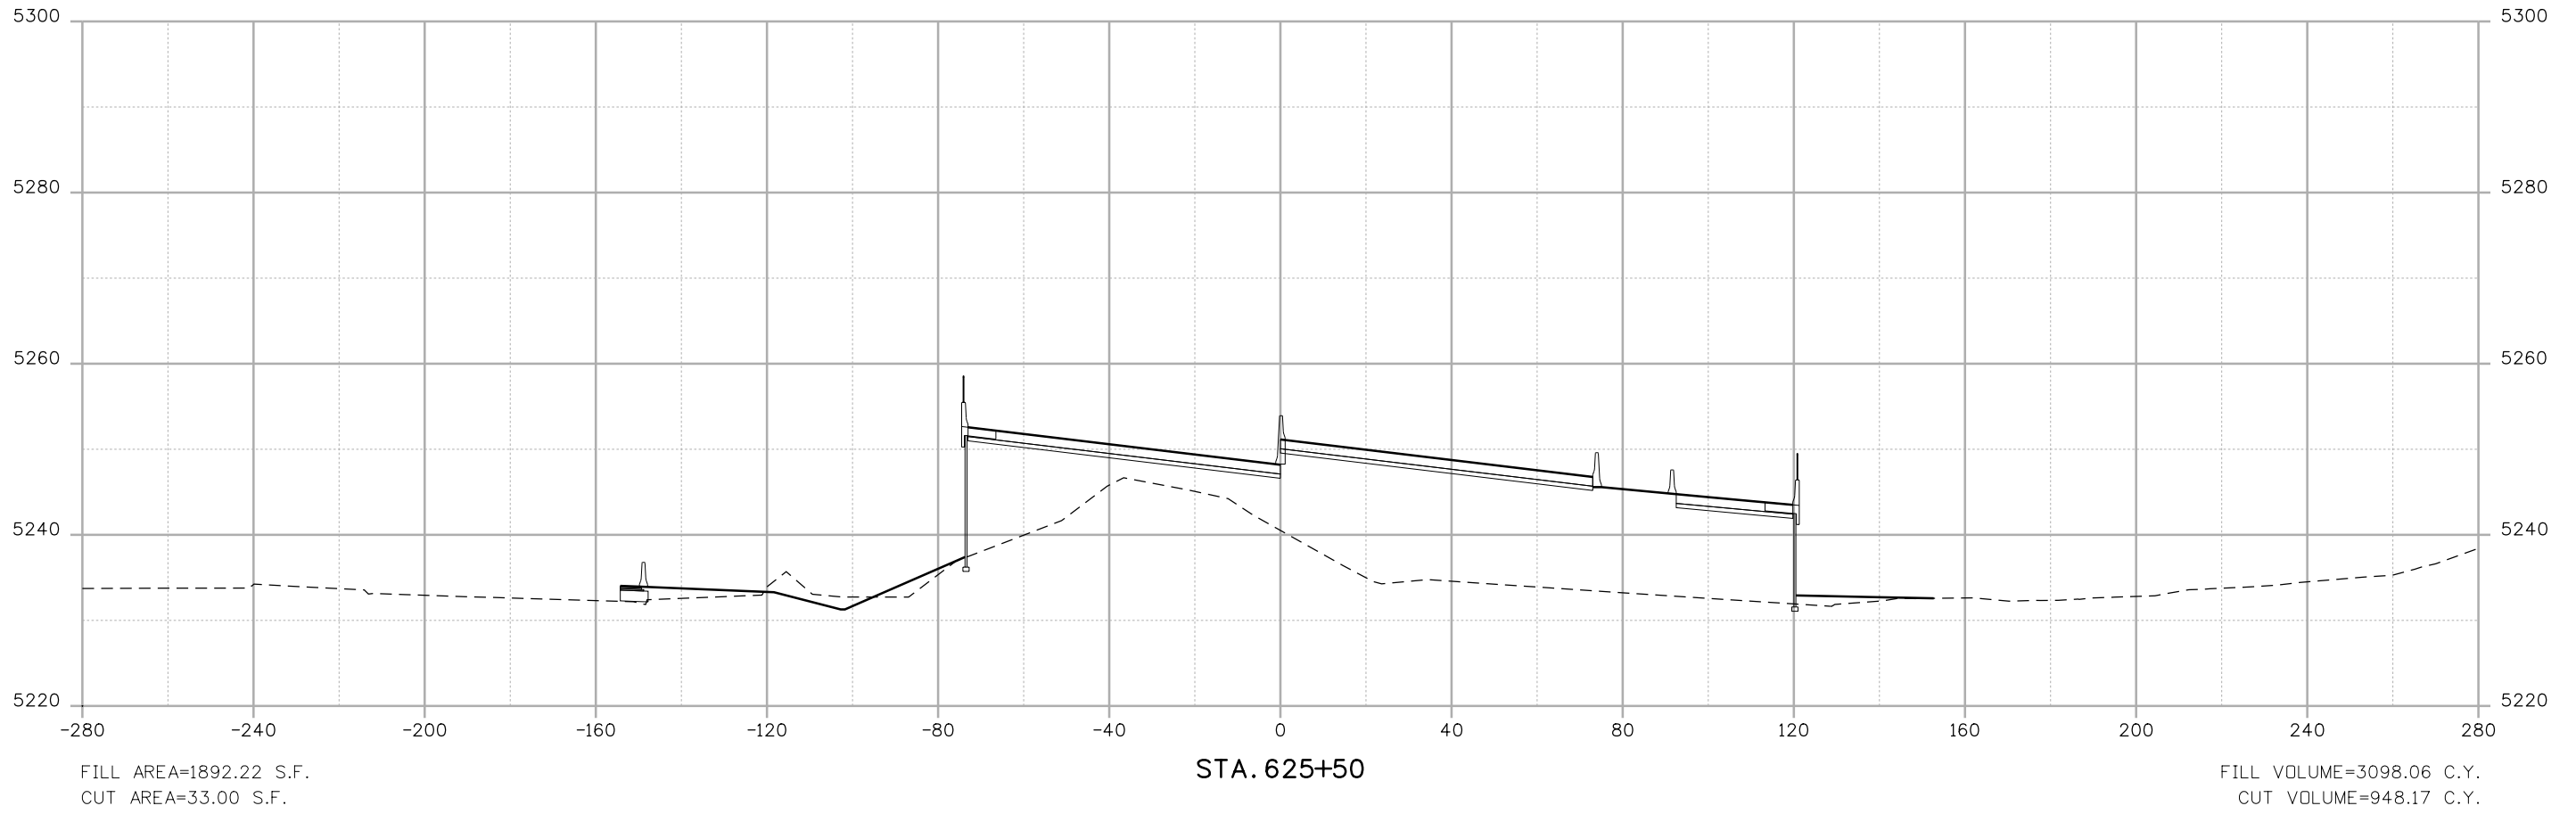

Print Date: 10/12/2010	
File Name: 16311DES_PH2_CrossSections1.dgn	
Horiz. Scale: 1:40	Vert. Scale: 1:20
Unit Information	Unit Leader Initials

Sheet Revisions		
Date:	Comments	Init.

Colorado Department of Transportation

2000 South Holly Street
Denver, CO 80222
Phone: 303-972-9112 FAX: 303-972-9114

Region 6 **RLB**


As Constructed
No Revisions:
Revised:
Void:

**I-25/SANTA FE INTERCHANGE
INTERSTATE 25
CROSS SECTIONS**

Designer: DCS	Structure Numbers
Detailer: DCS	
Sheet Subset: SECTIONS	Subset Sheets: XS-19 of 104

Project No./Code
BR 0252-407
17783
Sheet Number 19

Dusty 9:08:32 AM K:\08276\16311\Phase 2\Design\Drawings\Cross_Sections\16311DES_PH2_CrossSections1.dgn

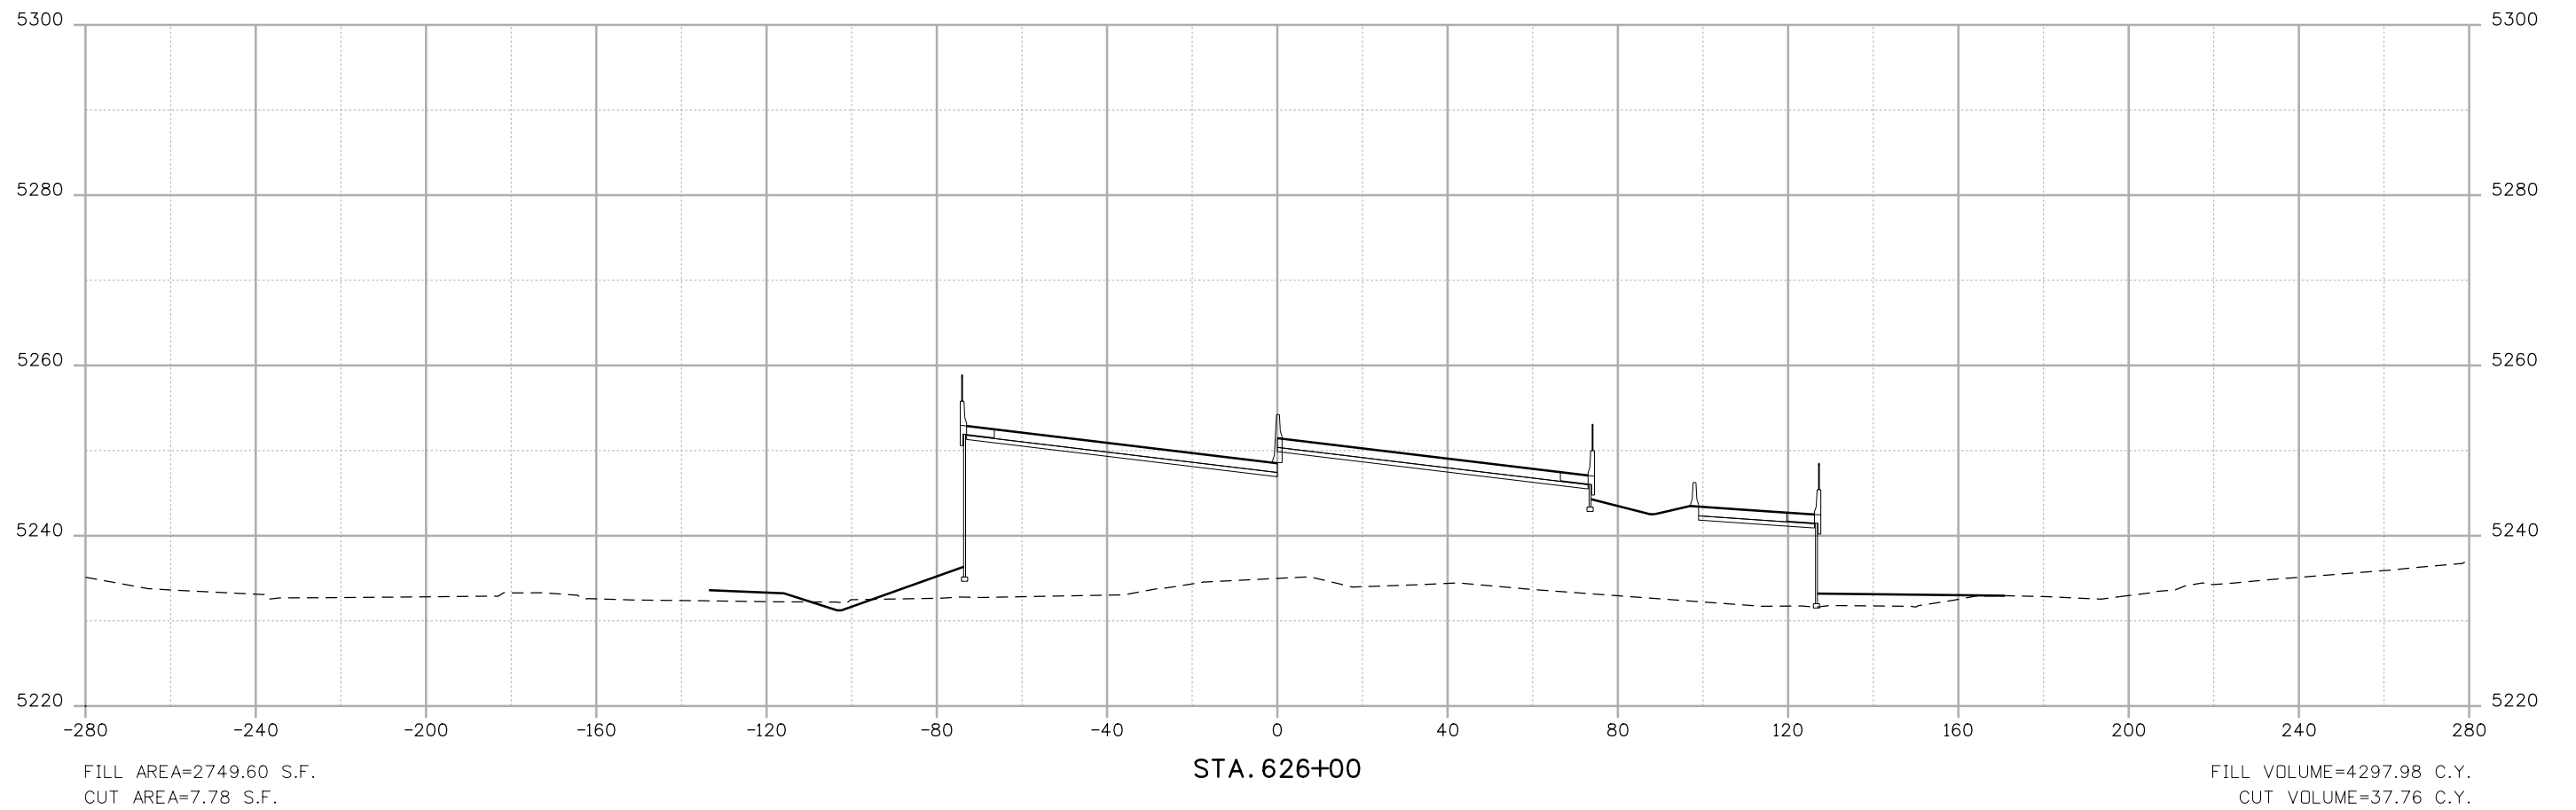

Print Date: 10/12/2010	
File Name: 16311DES_PH2_CrossSections1.dgn	
Horiz. Scale: 1:40	Vert. Scale: 1:20
Unit Information	Unit Leader Initials

Sheet Revisions		
Date:	Comments	Init.

Colorado Department of Transportation

2000 South Holly Street
Denver, CO 80222
Phone: 303-972-9112 FAX: 303-972-9114


Region 6 **RLB**

As Constructed
No Revisions:
Revised:
Void:

I-25/SANTA FE INTERCHANGE INTERSTATE 25 CROSS SECTIONS		
Designer: DCS	Structure Numbers	
Detailer: DCS		
Sheet Subset: SECTIONS	Subset Sheets: XS-20 of 104	

Project No./Code
BR 0252-407
17783
Sheet Number 20

Dusty 9:08:41 AM K:\08276\16311\Phase 2\Design\Drawings\Cross_Sections\16311DES_PH2_CrossSections1.dgn

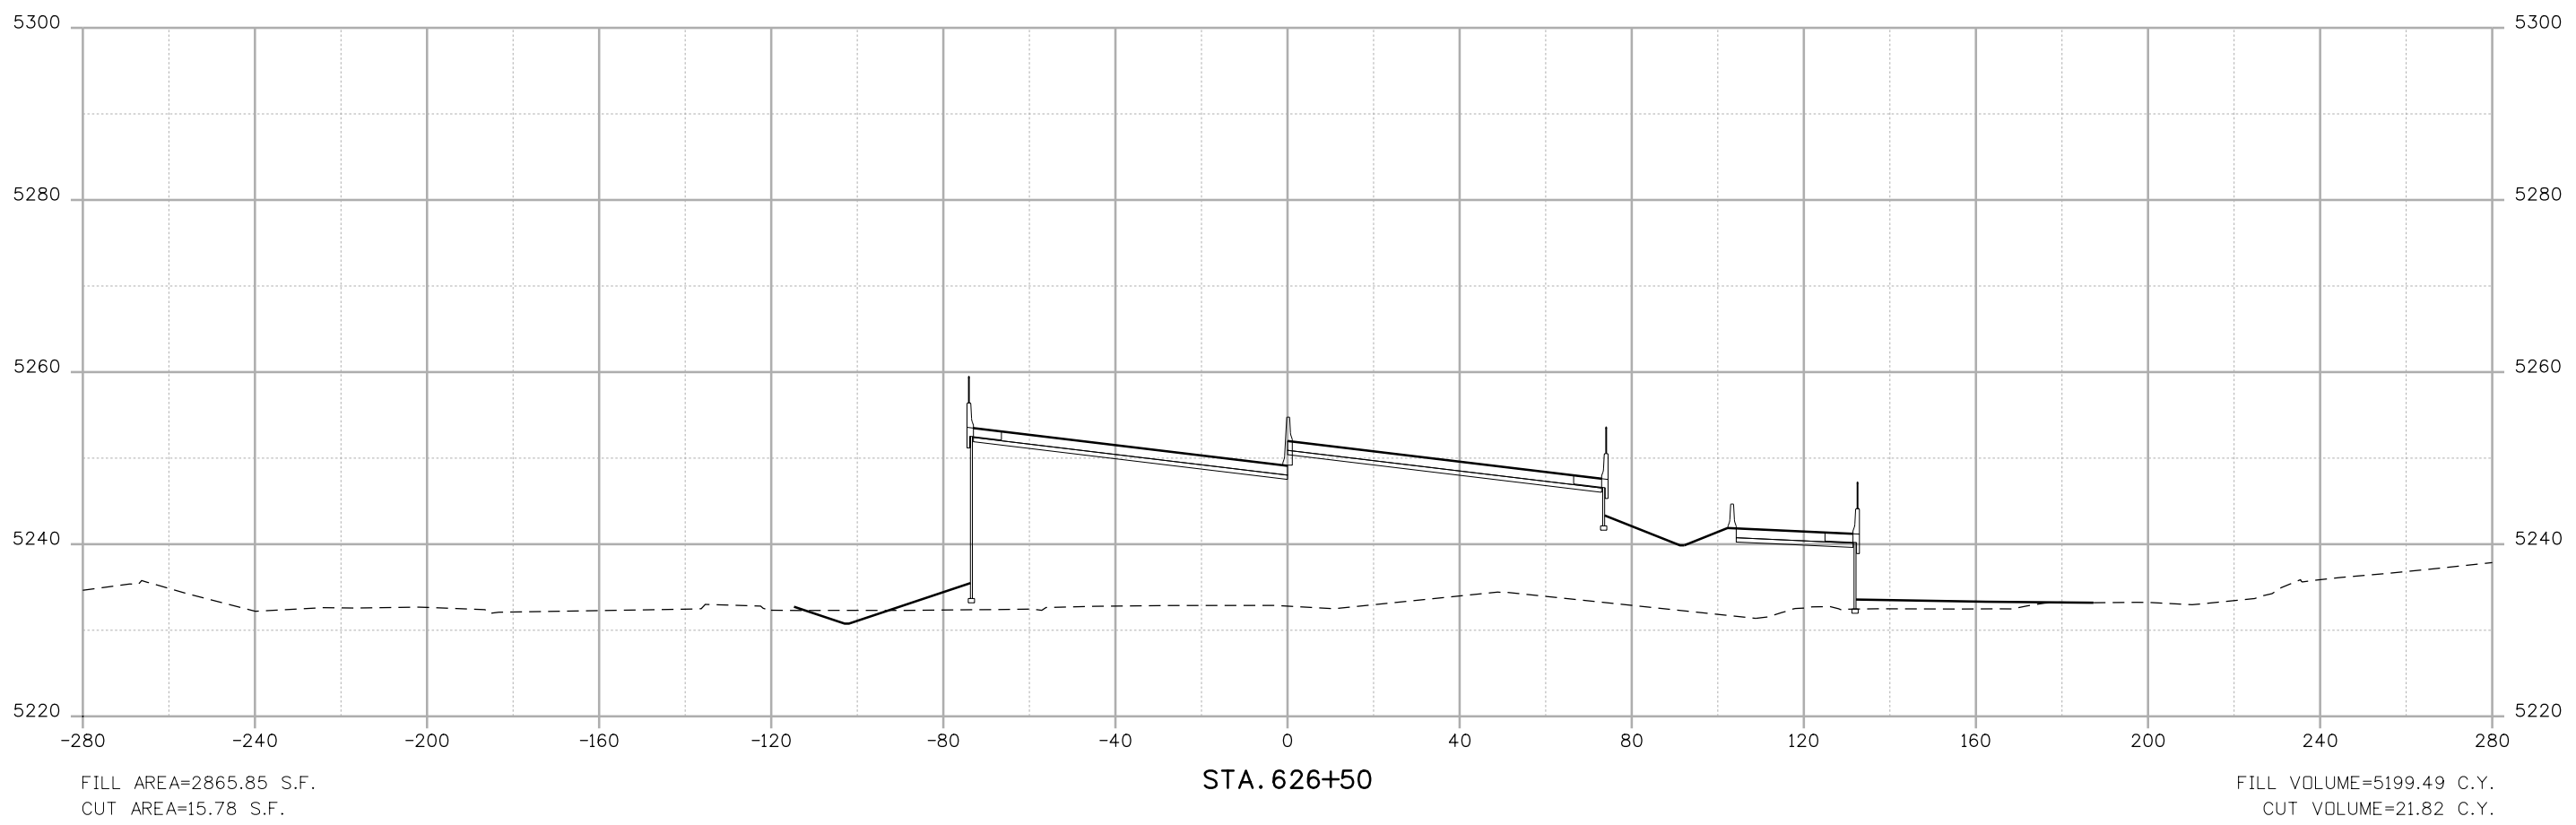

Print Date: 10/12/2010
 File Name: 16311DES_PH2_CrossSections1.dgn
 Horiz. Scale: 1:40 Vert. Scale: 1:20
 Unit Information Unit Leader Initials

Sheet Revisions		
Date:	Comments	Init.


Colorado Department of Transportation
 2000 South Holly Street
 Denver, CO 80222
 Phone: 303-972-9112 FAX: 303-972-9114
Region 6 **RLB**

As Constructed
 No Revisions:
 Revised:
 Void:


**I-25/SANTA FE INTERCHANGE
 INTERSTATE 25
 CROSS SECTIONS**

Designer: DCS Structure Numbers
 Detailer: DCS
 Sheet Subset: SECTIONS Subset Sheets: XS-21 of 104

Project No./Code
 BR 0252-407
 17783
 Sheet Number **21**

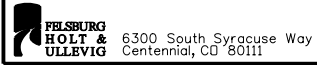

Dusty 9:08:52 AM K:\08276\16311\Phase 2\Design\Drawings\Cross-Sections\16311DES_PH2_CrossSections1.dgn

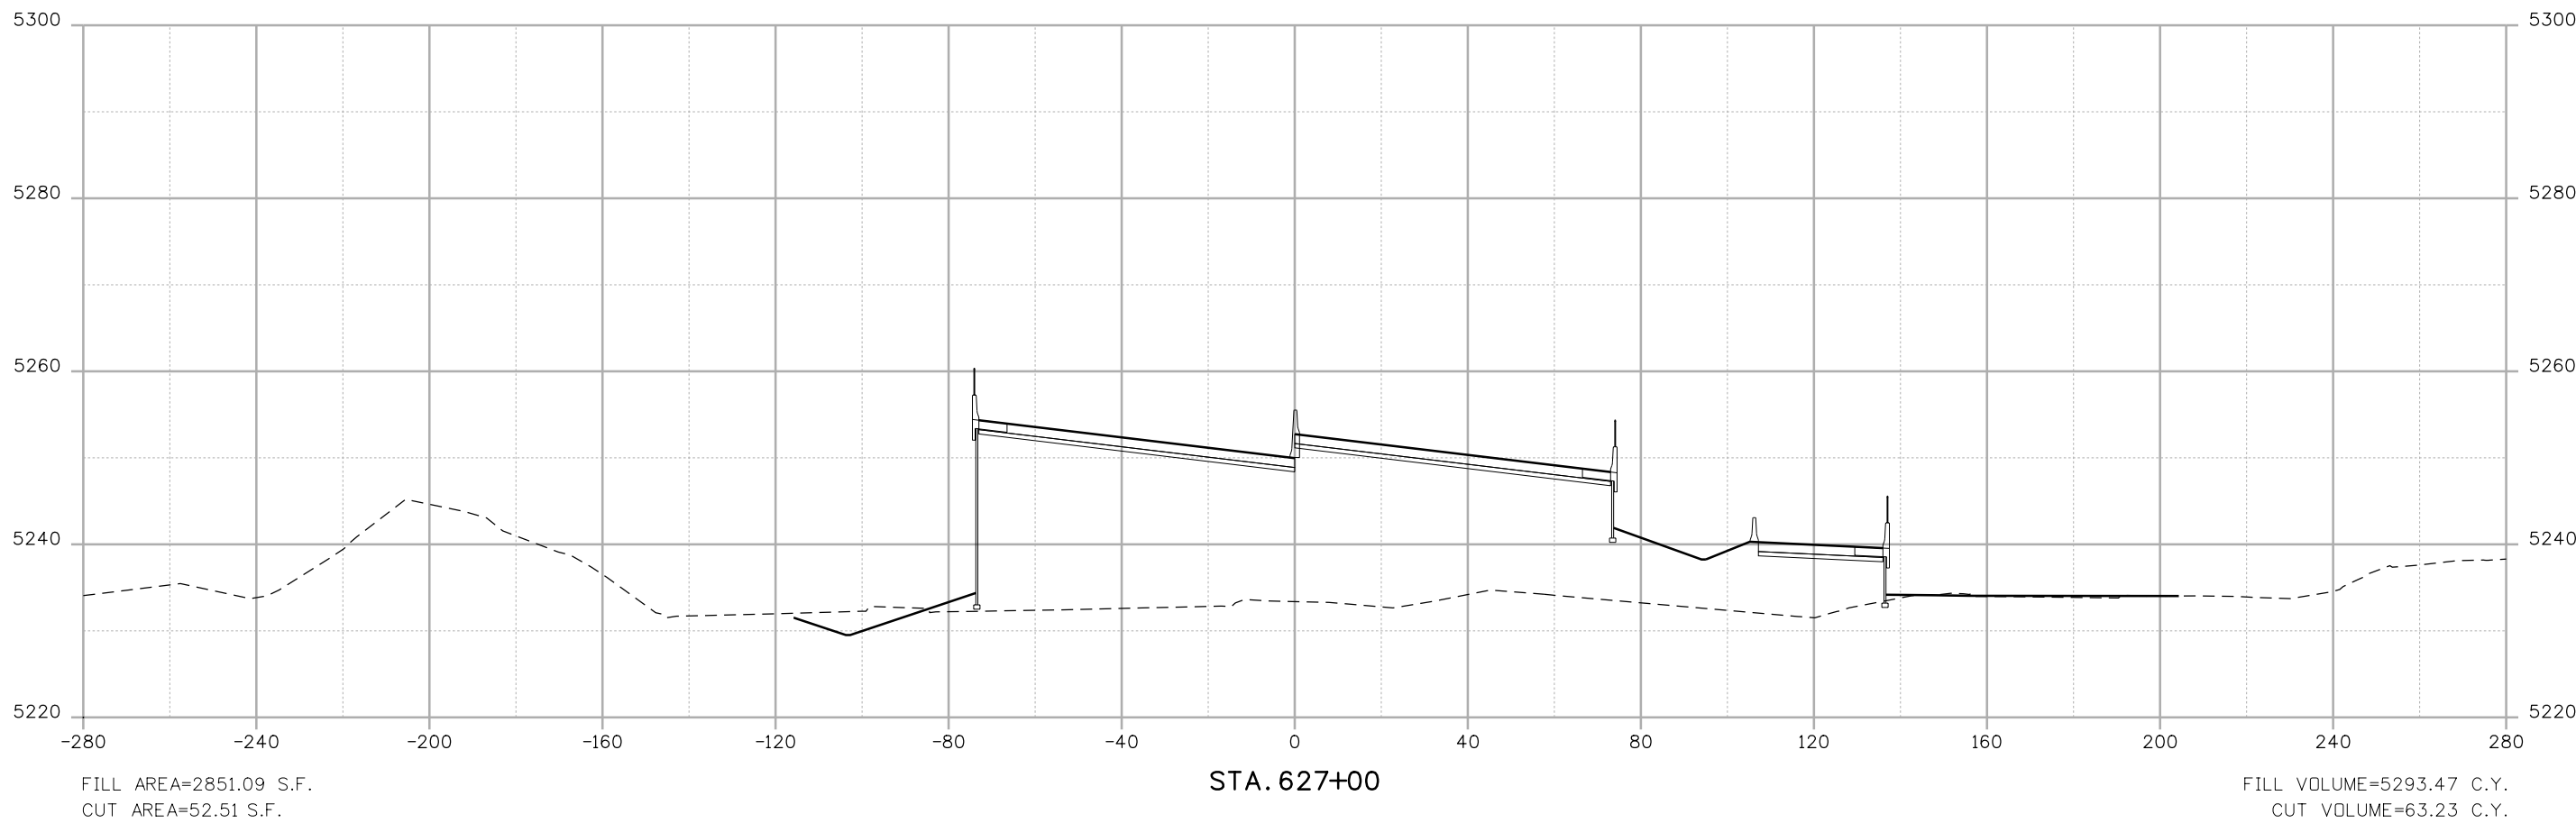

Print Date: 10/12/2010	
File Name: 16311DES_PH2_CrossSections1.dgn	
Horiz. Scale: 1:40	Vert. Scale: 1:20
Unit Information	Unit Leader Initials

Sheet Revisions		
Date:	Comments	Init.

Colorado Department of Transportation

2000 South Holly Street
Denver, CO 80222
Phone: 303-972-9112 FAX: 303-972-9114


Region 6 **RLB**

As Constructed
No Revisions:
Revised:
Void:

I-25/SANTA FE INTERCHANGE INTERSTATE 25 CROSS SECTIONS		
Designer: DCS	Structure Numbers	
Detailer: DCS		
Sheet Subset: SECTIONS	Subset Sheets: XS-22 of 104	

Project No./Code
BR 0252-407
17783
Sheet Number 22

Dusty 9:09:02 AM K:\08276\16311\Phase 2\Design\Drawings\Cross_Sections\16311DES_PH2_CrossSections1.dgn

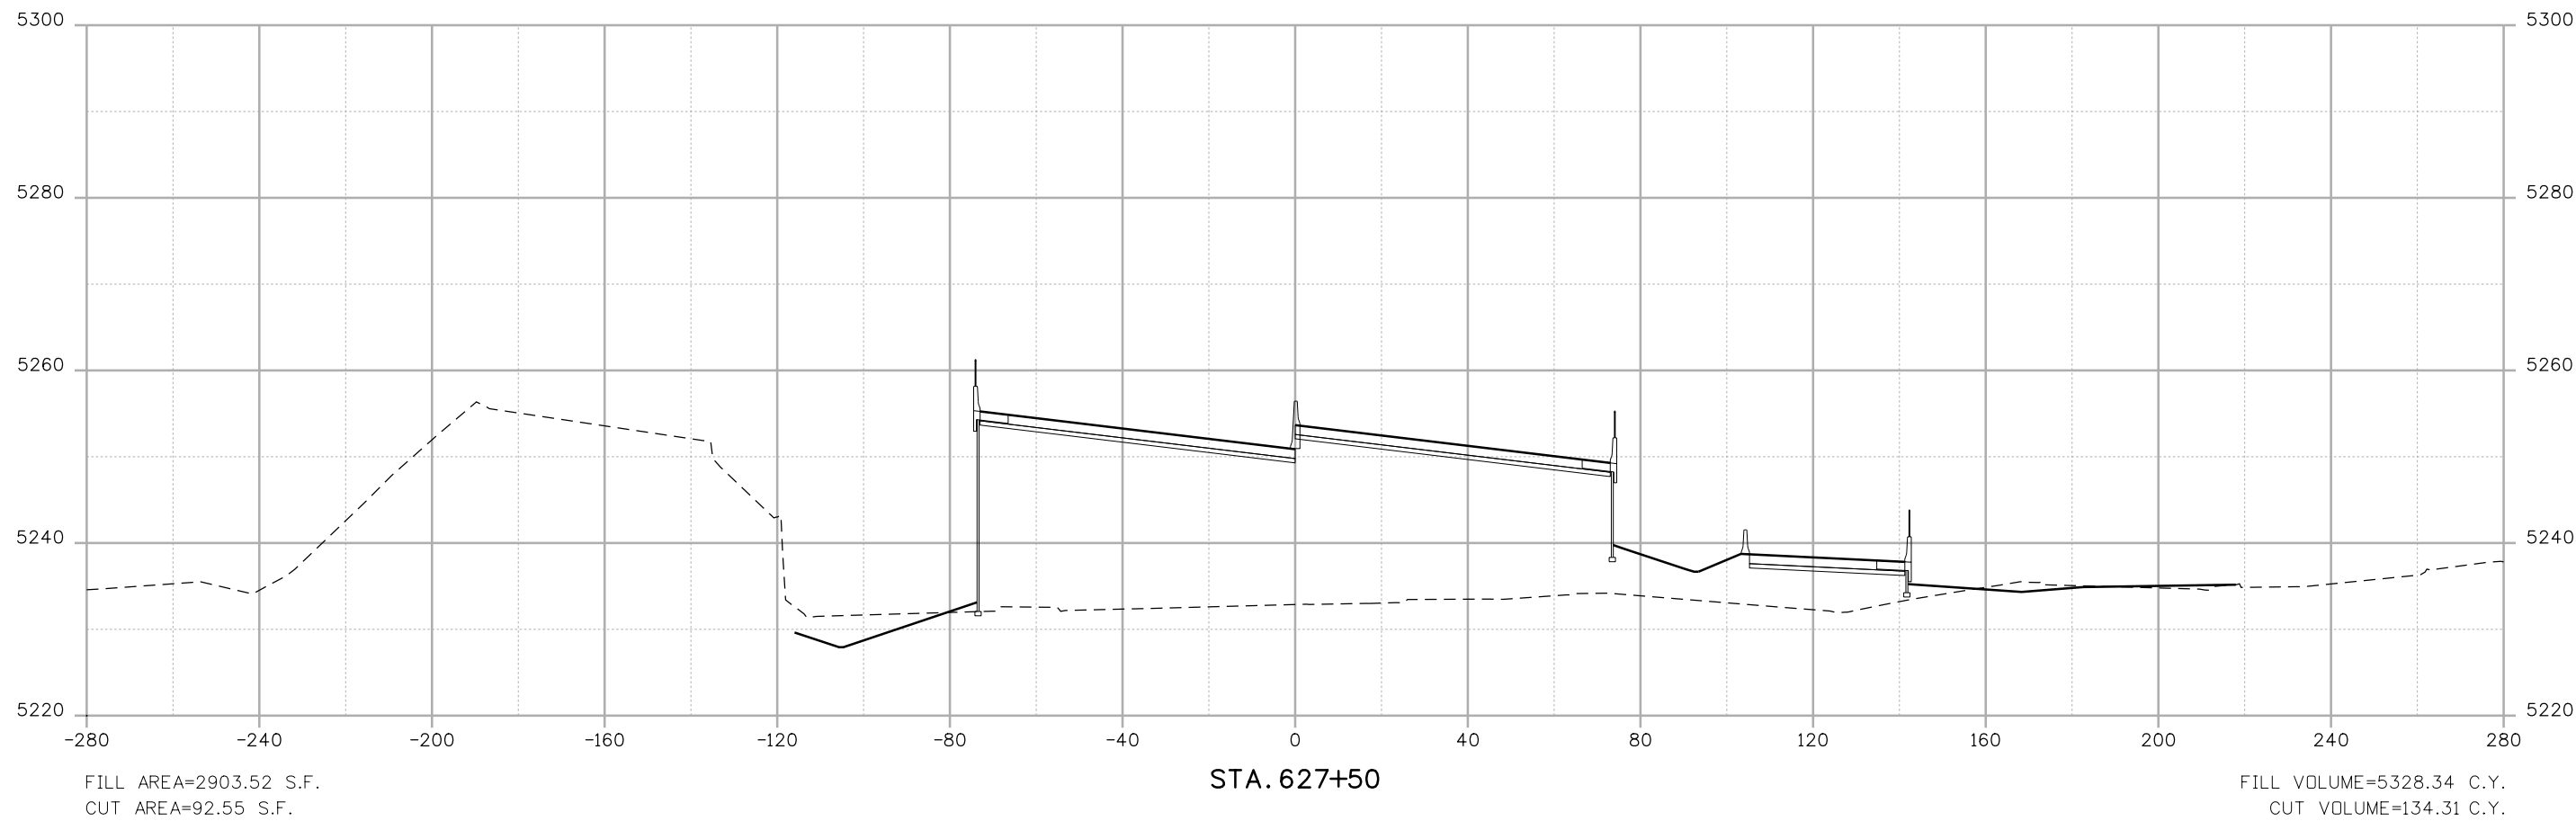

Print Date: 10/12/2010	
File Name: 16311DES_PH2_CrossSections1.dgn	
Horiz. Scale: 1:40	Vert. Scale: 1:20
Unit Information	Unit Leader Initials

Sheet Revisions		
Date:	Comments	Init.

Colorado Department of Transportation

2000 South Holly Street
Denver, CO 80222
Phone: 303-972-9112 FAX: 303-972-9114


Region 6 **RLB**

As Constructed
No Revisions:
Revised:
Void:

I-25/SANTA FE INTERCHANGE INTERSTATE 25 CROSS SECTIONS		
Designer: DCS	Structure Numbers	
Detailer: DCS		
Sheet Subset: SECTIONS	Subset Sheets: XS-23 of 104	

Project No./Code
BR 0252-407
17783
Sheet Number 23

Dusty 9:09:13 AM K:\08276\16311\Phase 2\Design\Drawings\Cross_Sections\16311DES_PH2_CrossSections1.dgn

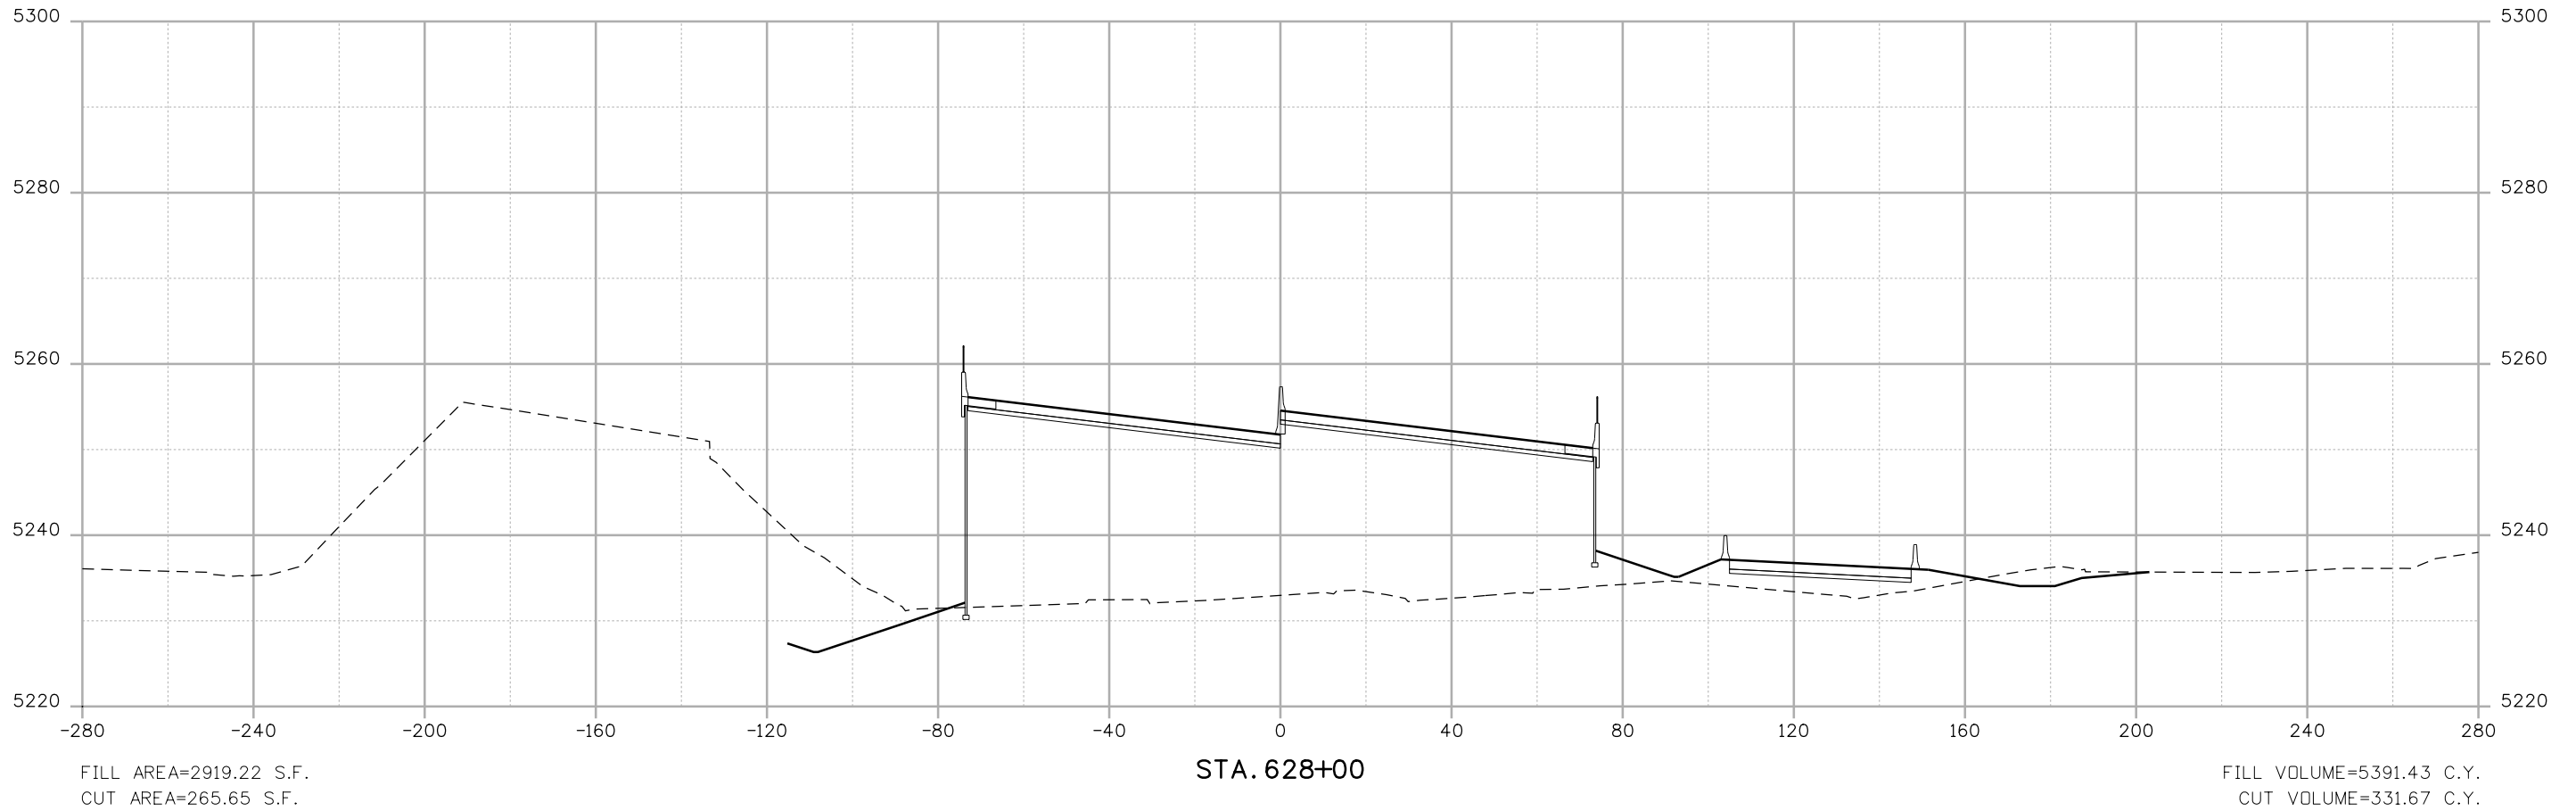

Print Date: 10/12/2010	
File Name: 16311DES_PH2_CrossSections1.dgn	
Horiz. Scale: 1:40	Vert. Scale: 1:20
Unit Information	Unit Leader Initials

Sheet Revisions		
Date:	Comments	Init.

Colorado Department of Transportation

2000 South Holly Street
 Denver, CO 80222
 Phone: 303-972-9112 FAX: 303-972-9114


Region 6 **RLB**

As Constructed
No Revisions:
Revised:
Void:

I-25/SANTA FE INTERCHANGE INTERSTATE 25 CROSS SECTIONS		
Designer: DCS	Structure Numbers	
Detailer: DCS		
Sheet Subset: SECTIONS	Subset Sheets: XS-24 of 104	

Project No./Code
BR 0252-407
17783
Sheet Number 24

Dusty 9:09:22 AM K:\08276\16311\Phase 2\Design\Drawings\Cross-Sections\16311DES_PH2_CrossSections1.dgn

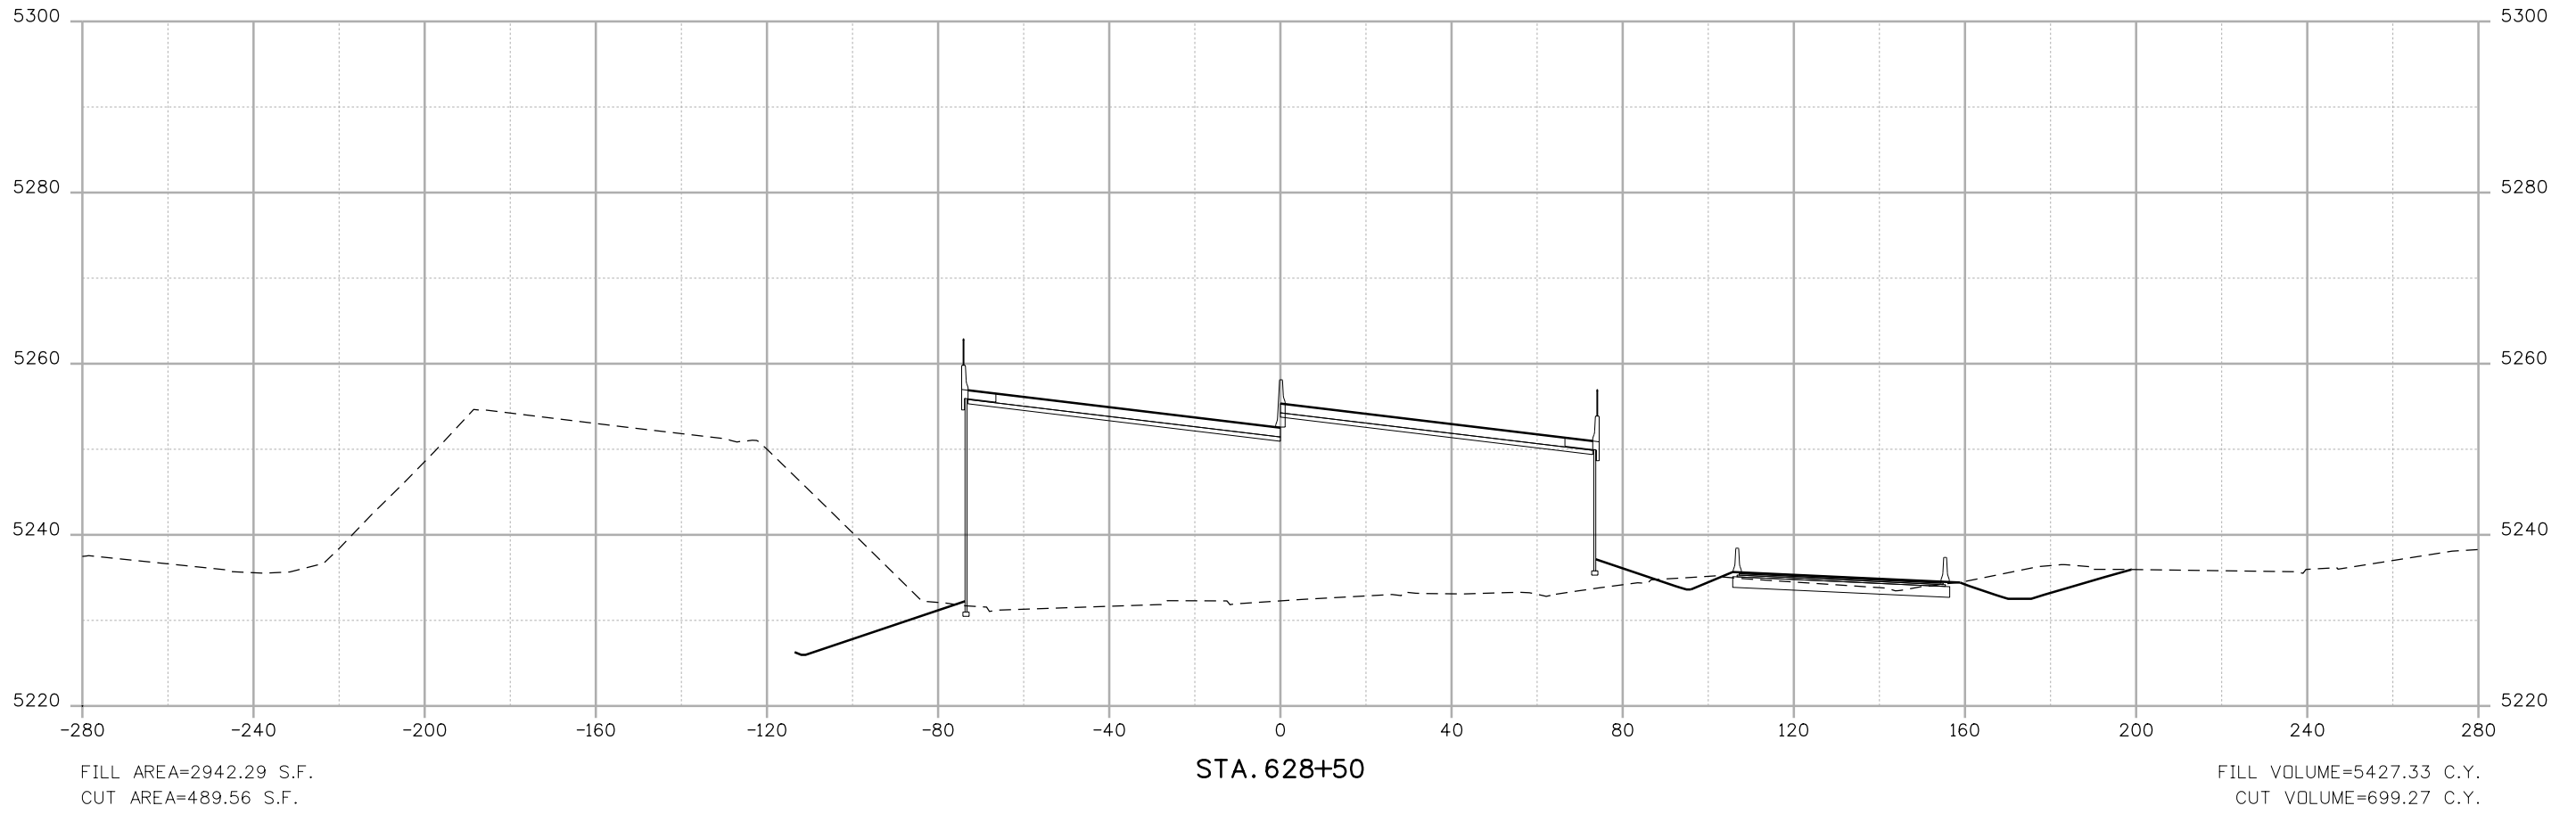

Print Date: 10/12/2010
 File Name: 16311DES_PH2_CrossSections1.dgn
 Horiz. Scale: 1:40 Vert. Scale: 1:20
 Unit Information Unit Leader Initials

Sheet Revisions		
Date:	Comments	Init.

Colorado Department of Transportation
 2000 South Holly Street
 Denver, CO 80222
 Phone: 303-972-9112 FAX: 303-972-9114


Region 6 **RLB**

As Constructed
 No Revisions:
 Revised:
 Void:


**I-25/SANTA FE INTERCHANGE
 INTERSTATE 25
 CROSS SECTIONS**

Designer: DCS Structure Numbers
 Detailer: DCS
 Sheet Subset: SECTIONS Subset Sheets: XS-25 of 104

Project No./Code
 BR 0252-407
 17783
 Sheet Number **25**

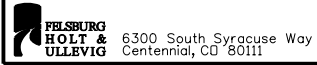

Dusty 9:09:32 AM K:\08276\16311\Phase 2\Design\Drawings\Cross-Sections\16311DES_PH2_CrossSections1.dgn

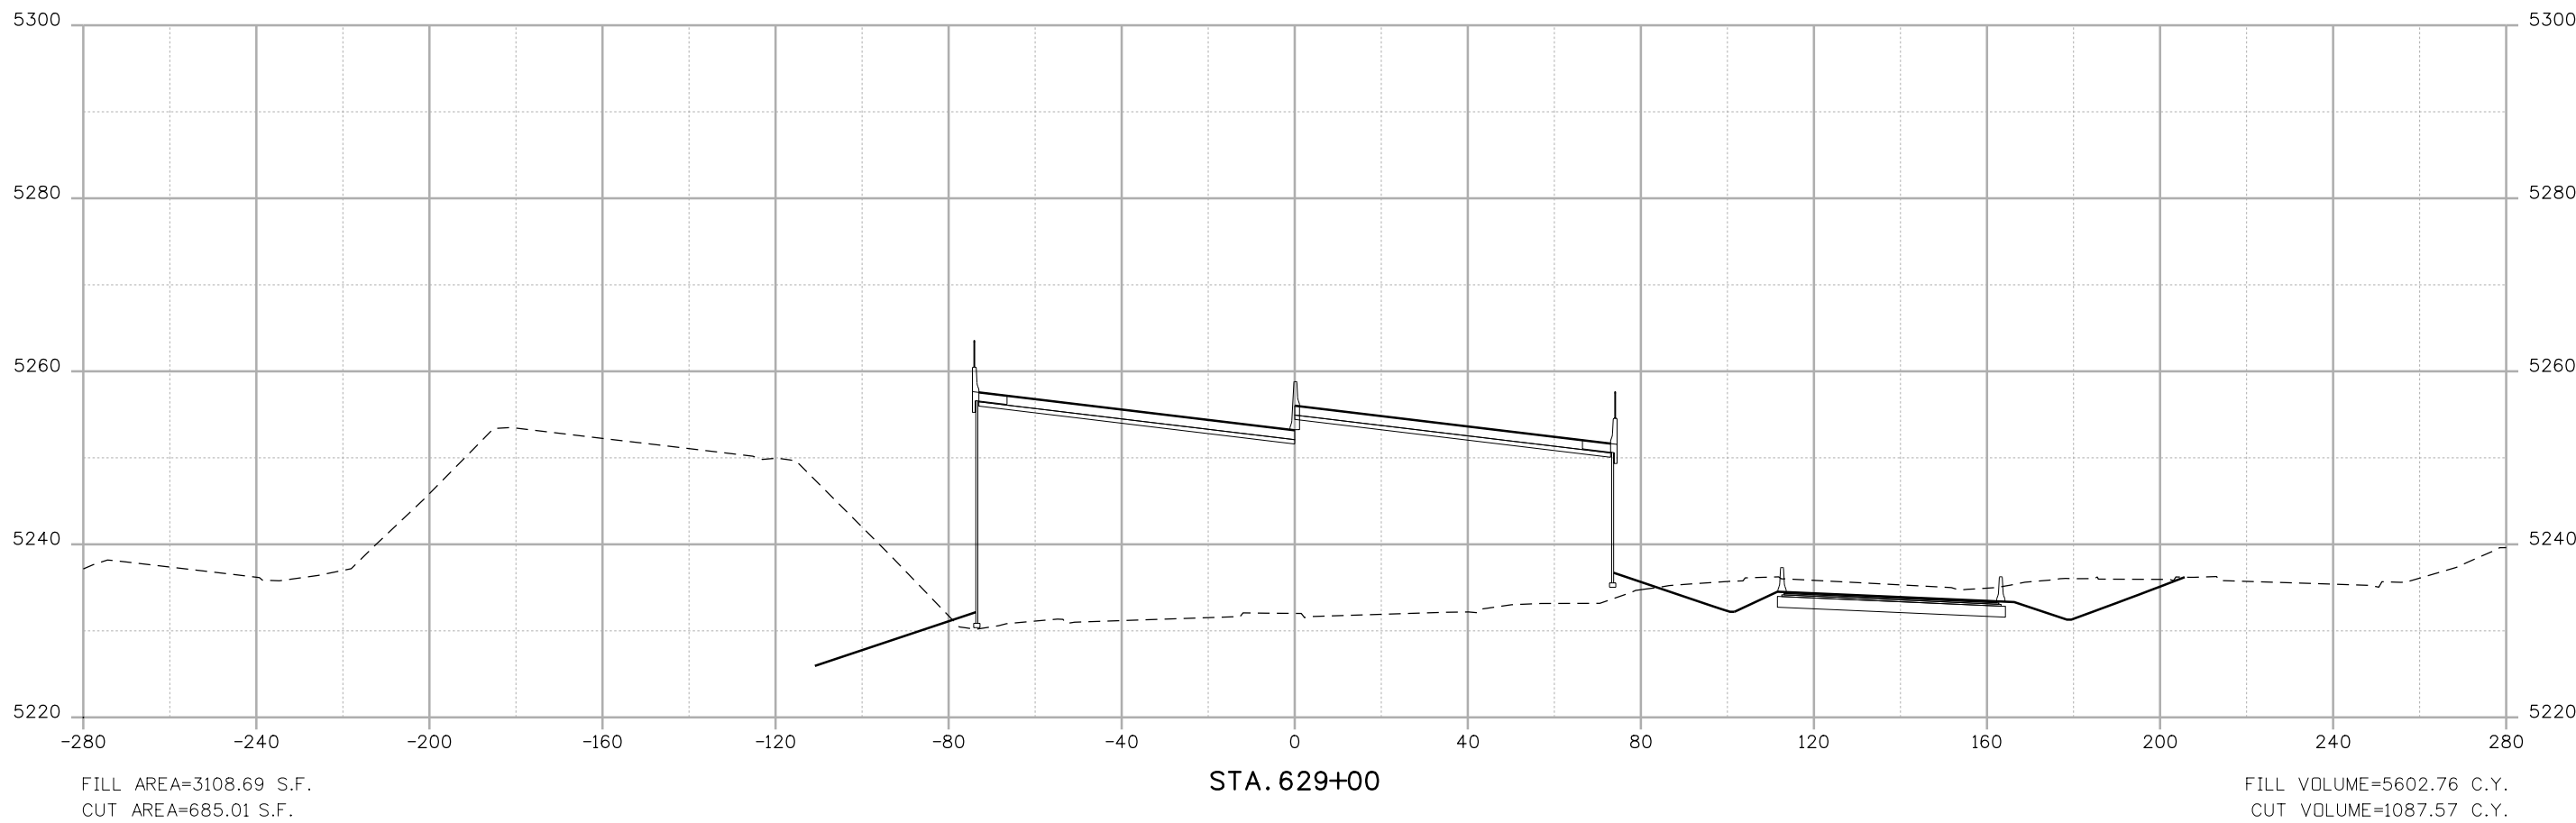

Print Date: 10/12/2010	
File Name: 16311DES_PH2_CrossSections1.dgn	
Horiz. Scale: 1:40	Vert. Scale: 1:20
Unit Information	Unit Leader Initials

Sheet Revisions		
Date:	Comments	Init.

Colorado Department of Transportation

2000 South Holly Street
Denver, CO 80222
Phone: 303-972-9112 FAX: 303-972-9114


Region 6 **RLB**

As Constructed
No Revisions:
Revised:
Void:

I-25/SANTA FE INTERCHANGE INTERSTATE 25 CROSS SECTIONS		
Designer: DCS	Structure Numbers	
Detailer: DCS		
Sheet Subset: SECTIONS	Subset Sheets: XS-26 of 104	

Project No./Code
BR 0252-407
17783
Sheet Number 26

Dusty 9:09:43 AM K:\08276\16311\Phase 2\Design\Drawings\Cross_Sections\16311DES_PH2_CrossSections1.dgn

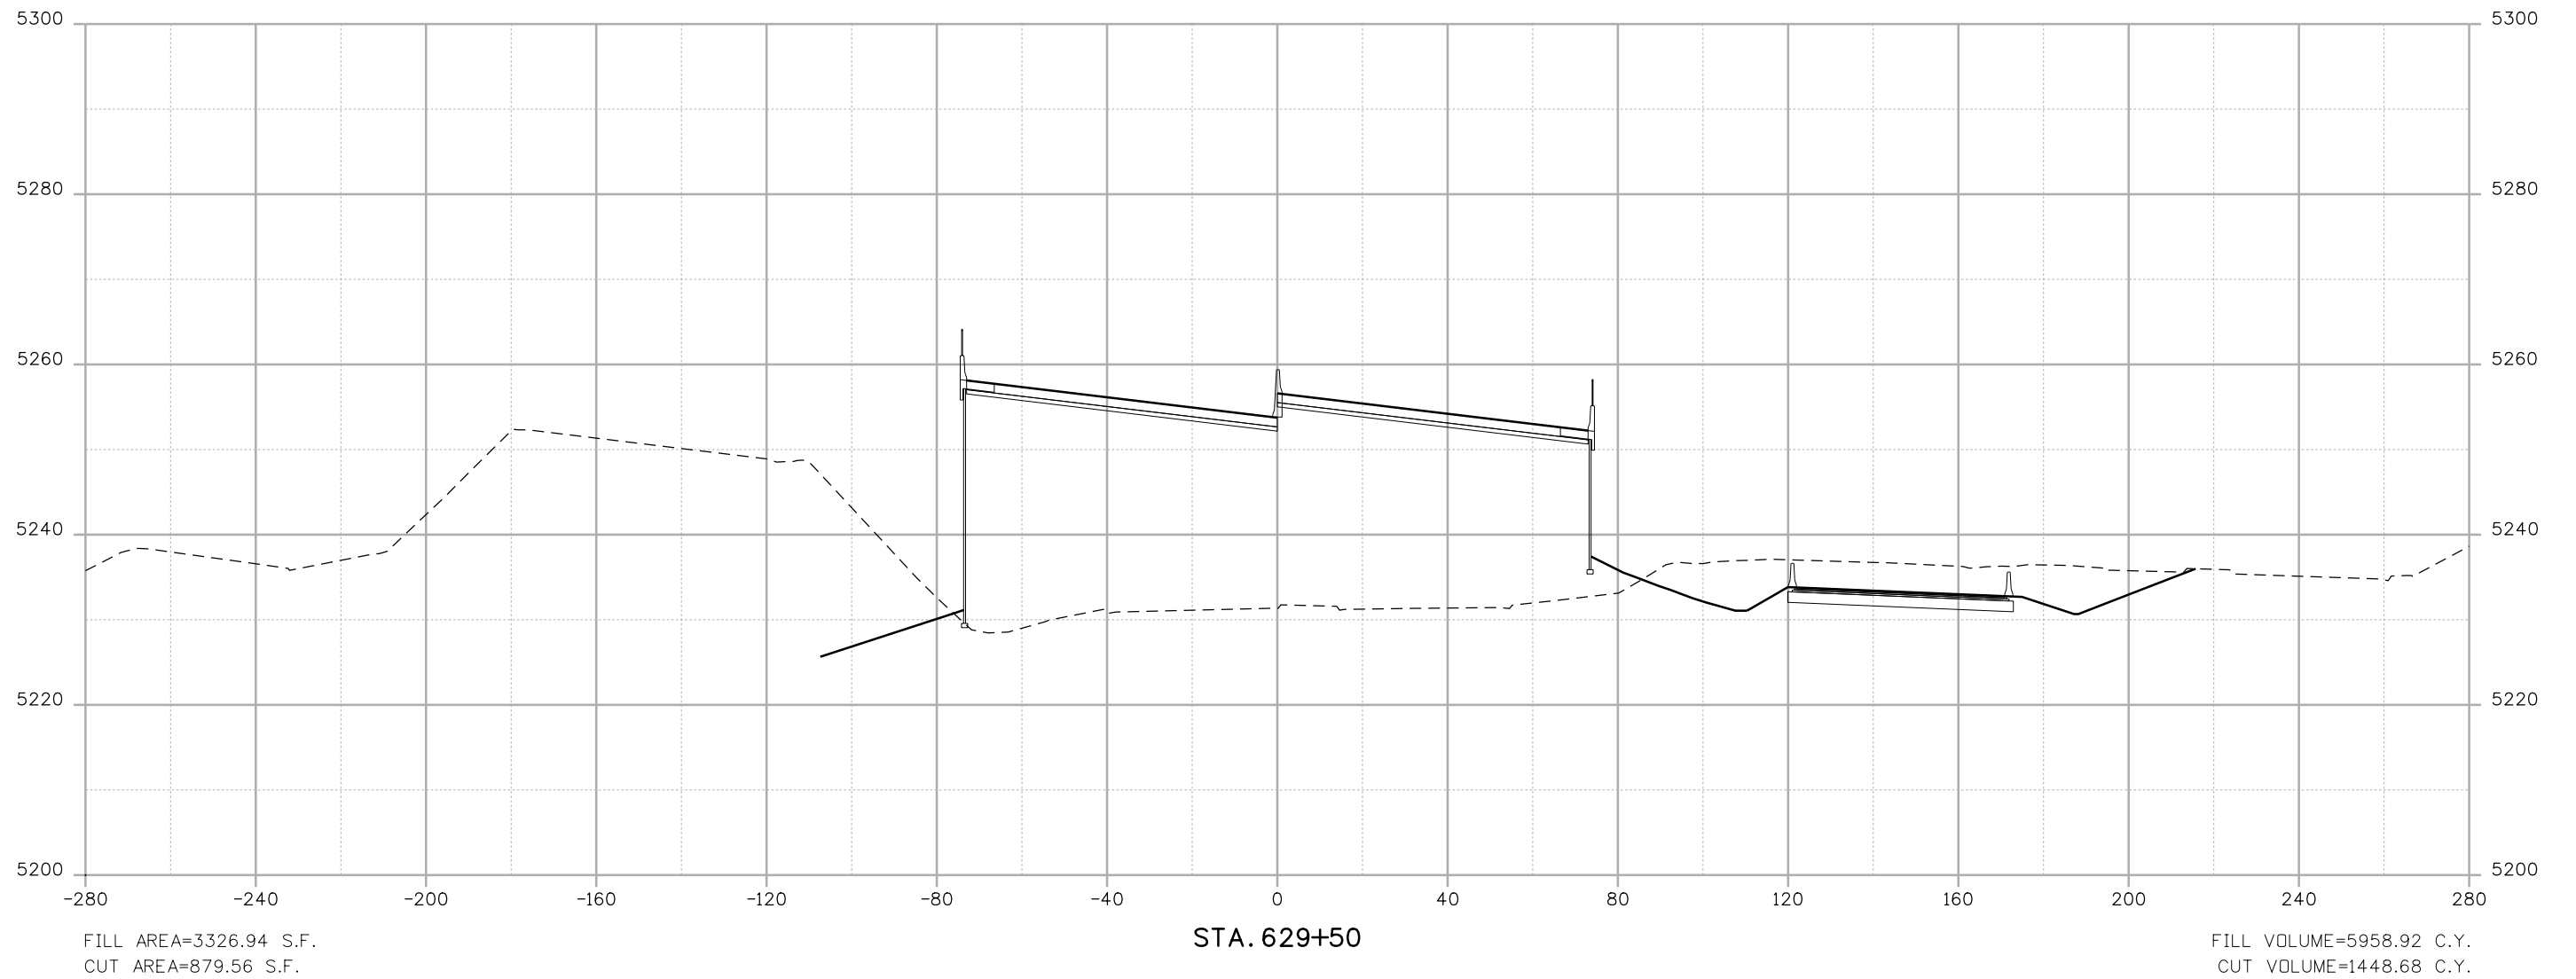

Print Date: 10/12/2010	
File Name: 16311DES_PH2_CrossSections1.dgn	
Horiz. Scale: 1:40	Vert. Scale: 1:20
Unit Information	Unit Leader Initials

Sheet Revisions		
Date:	Comments	Init.

Colorado Department of Transportation

2000 South Holly Street
Denver, CO 80222
Phone: 303-972-9112 FAX: 303-972-9114


Region 6 **RLB**

As Constructed
No Revisions:
Revised:
Void:

I-25/SANTA FE INTERCHANGE INTERSTATE 25 CROSS SECTIONS		
Designer: DCS	Structure Numbers	
Detailer: DCS		
Sheet Subset: SECTIONS	Subset Sheets: XS-27 of 104	

Project No./Code
BR 0252-407
17783
Sheet Number 27

Dusty 9:09:55 AM K:\08276\16311\Phase 2\Design\Drawings\Cross_Sections\16311DES_PH2_CrossSections1.dgn

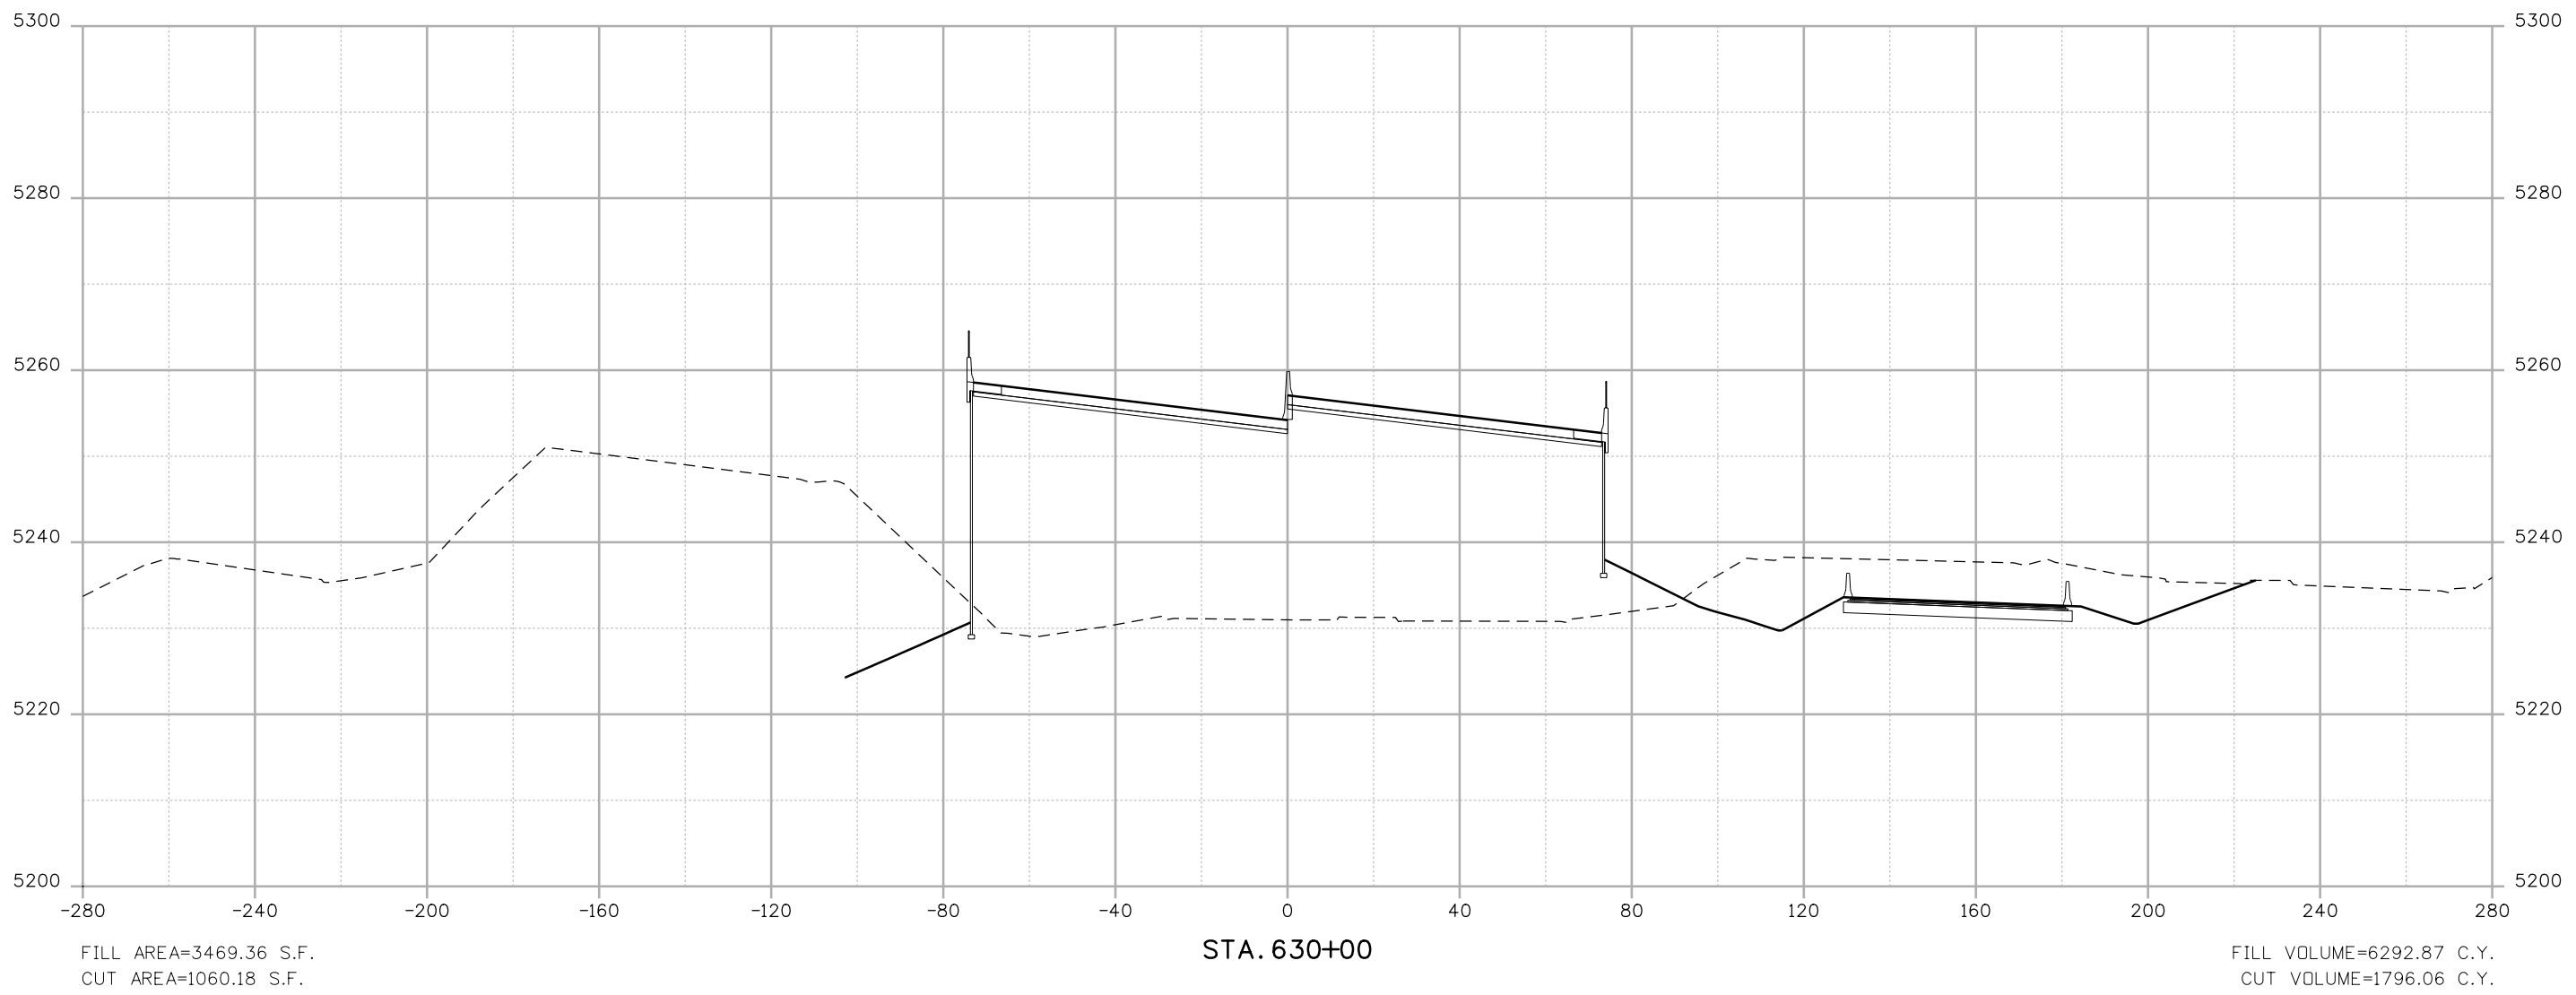

Print Date: 10/12/2010	
File Name: 16311DES_PH2_CrossSections1.dgn	
Horiz. Scale: 1:40	Vert. Scale: 1:20
Unit Information	Unit Leader Initials

Sheet Revisions		
Date:	Comments	Init.

Colorado Department of Transportation

2000 South Holly Street
Denver, CO 80222
Phone: 303-972-9112 FAX: 303-972-9114


Region 6 **RLB**

As Constructed
No Revisions:
Revised:
Void:

I-25/SANTA FE INTERCHANGE INTERSTATE 25 CROSS SECTIONS		
Designer: DCS	Structure Numbers	
Detailer: DCS		
Sheet Subset: SECTIONS	Subset Sheets: XS-28 of 104	

Project No./Code
BR 0252-407
17783
Sheet Number 28

Dusty 9:10:06 AM K:\08276\16311\Phase 2\Design\Drawings\Cross_Sections\16311DES_PH2_CrossSections1.dgn

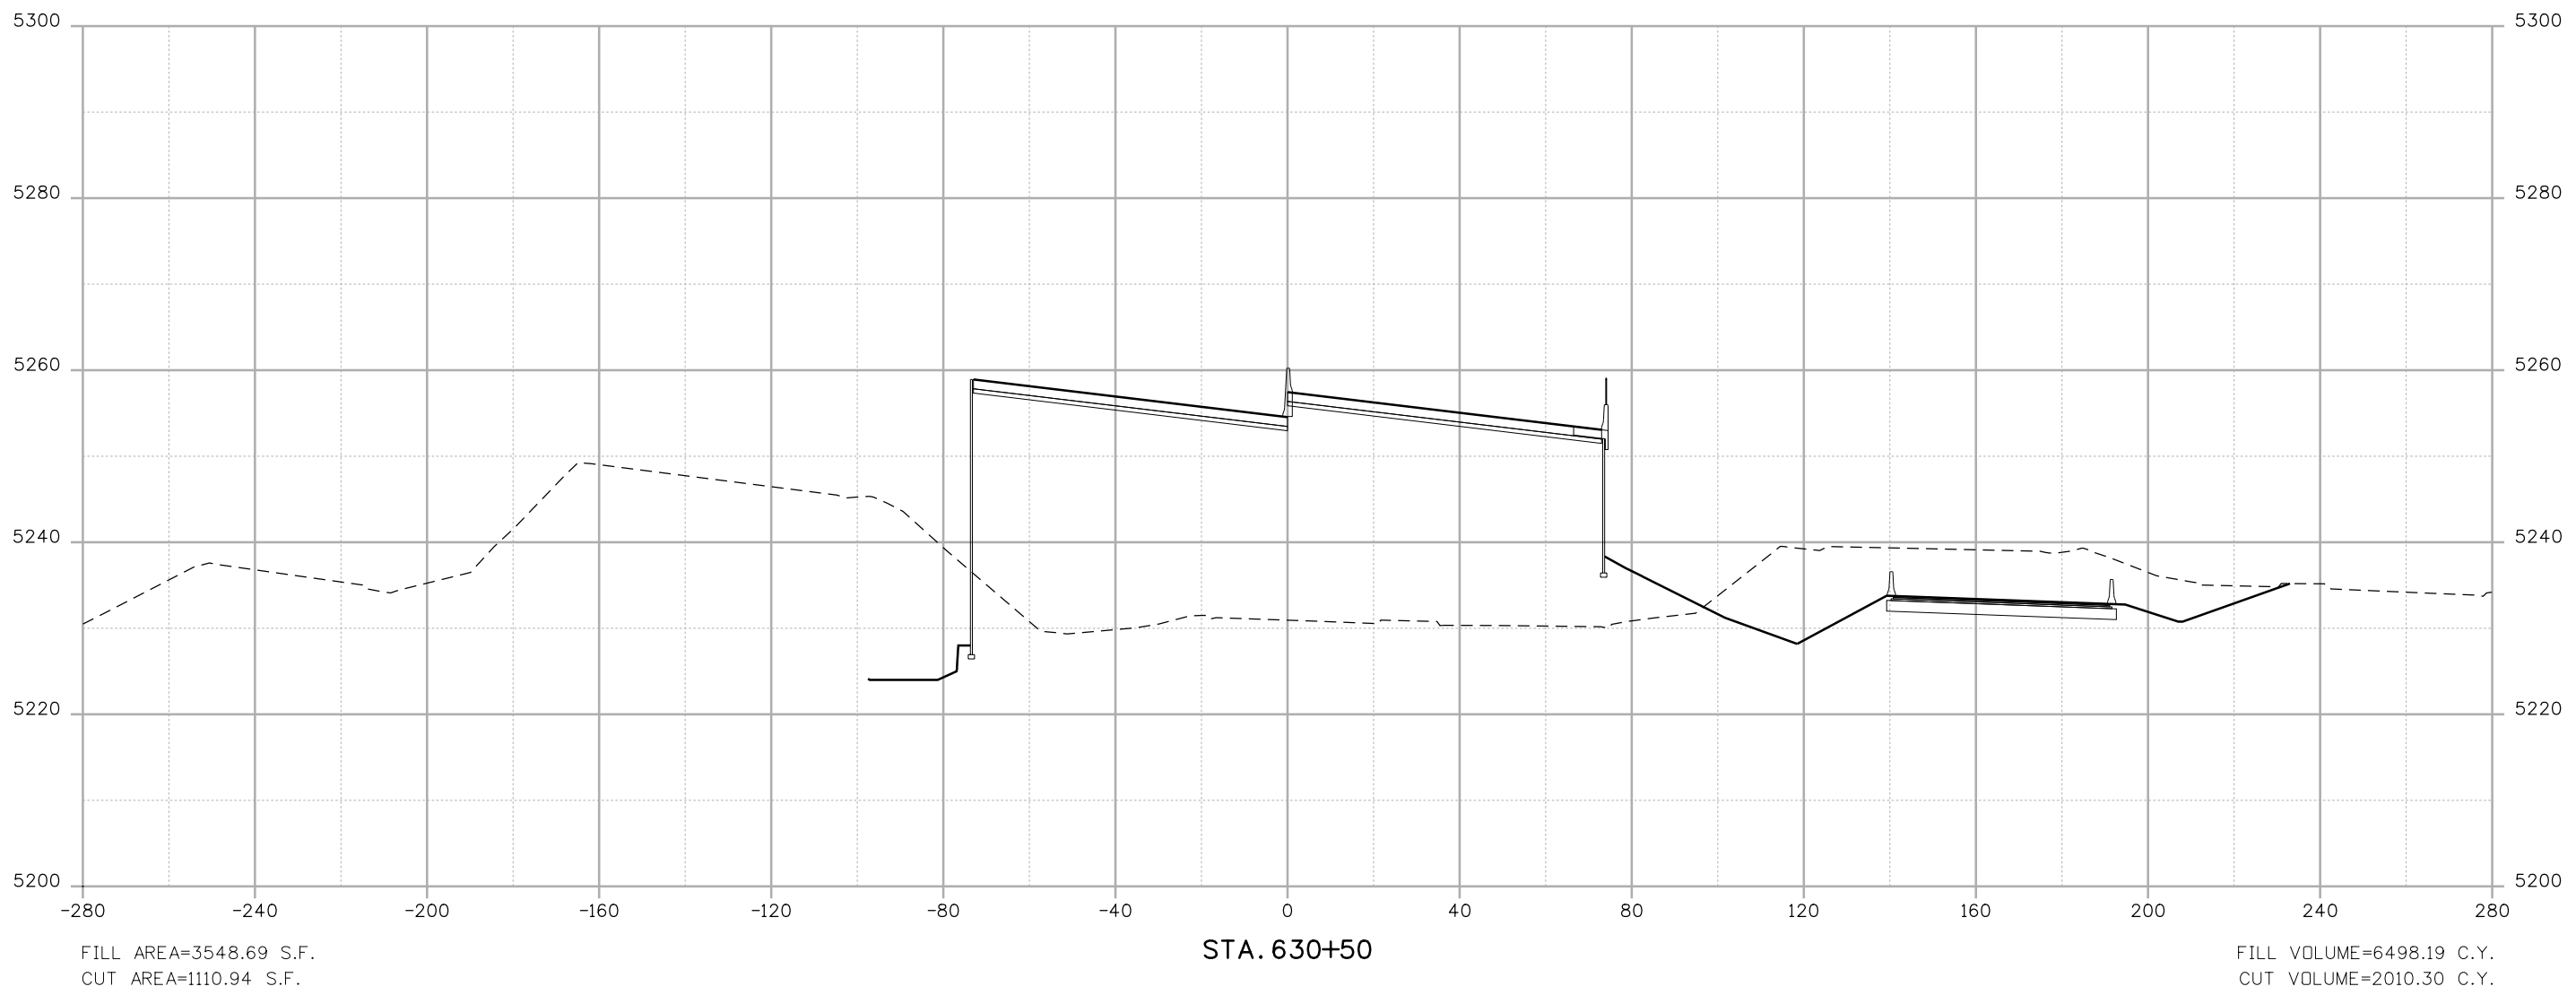

Print Date: 10/12/2010	
File Name: 16311DES_PH2_CrossSections1.dgn	
Horiz. Scale: 1:40	Vert. Scale: 1:20
Unit Information	Unit Leader Initials

Sheet Revisions		
Date:	Comments	Init.

Colorado Department of Transportation

2000 South Holly Street
Denver, CO 80222
Phone: 303-972-9112 FAX: 303-972-9114


Region 6 **RLB**

As Constructed
No Revisions:
Revised:
Void:

I-25/SANTA FE INTERCHANGE INTERSTATE 25 CROSS SECTIONS		
Designer: DCS	Structure Numbers	
Detailer: DCS		
Sheet Subset: SECTIONS	Subset Sheets: XS-29 of 104	

Project No./Code
BR 0252-407
17783
Sheet Number 29

Dusty 9:10:17 AM K:\08276\16311\Phase 2\Design\Drawings\Cross_Sections\16311DES_PH2_CrossSections1.dgn

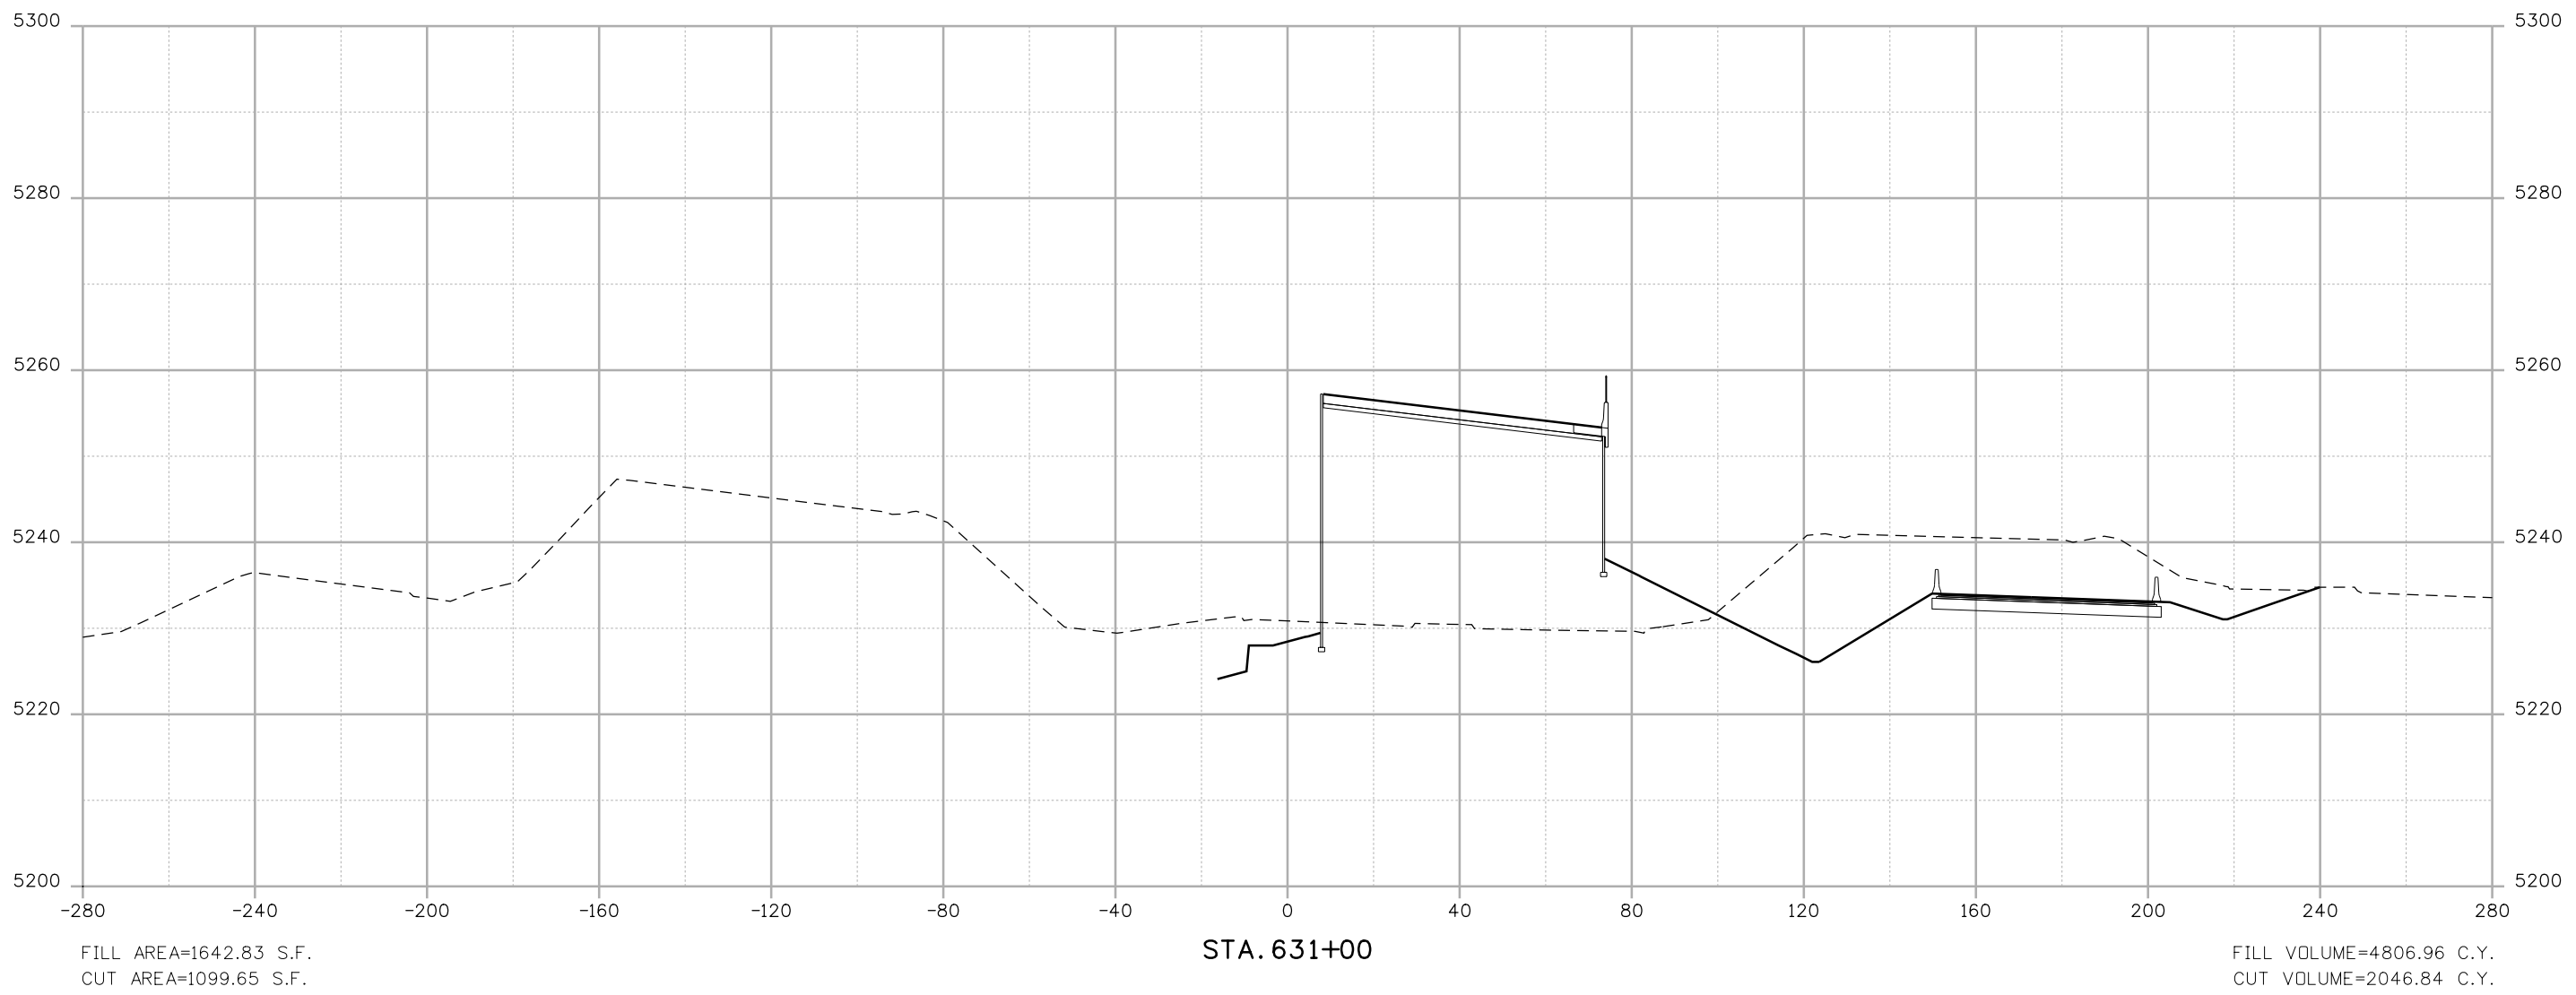

Print Date: 10/12/2010	
File Name: 16311DES_PH2_CrossSections1.dgn	
Horiz. Scale: 1:40	Vert. Scale: 1:20
Unit Information	Unit Leader Initials

Sheet Revisions		
Date:	Comments	Init.

Colorado Department of Transportation

2000 South Holly Street
Denver, CO 80222
Phone: 303-972-9112 FAX: 303-972-9114


Region 6 **RLB**

As Constructed
No Revisions:
Revised:
Void:

I-25/SANTA FE INTERCHANGE INTERSTATE 25 CROSS SECTIONS		
Designer: DCS	Structure Numbers	
Detailer: DCS		
Sheet Subset: SECTIONS	Subset Sheets: XS-30 of 104	

Project No./Code
BR 0252-407
17783
Sheet Number 30

Dusty 9:10:27 AM K:\08276\16311\Phase 2\Design\Drawings\Cross_Sections\16311DES_PH2_CrossSections1.dgn

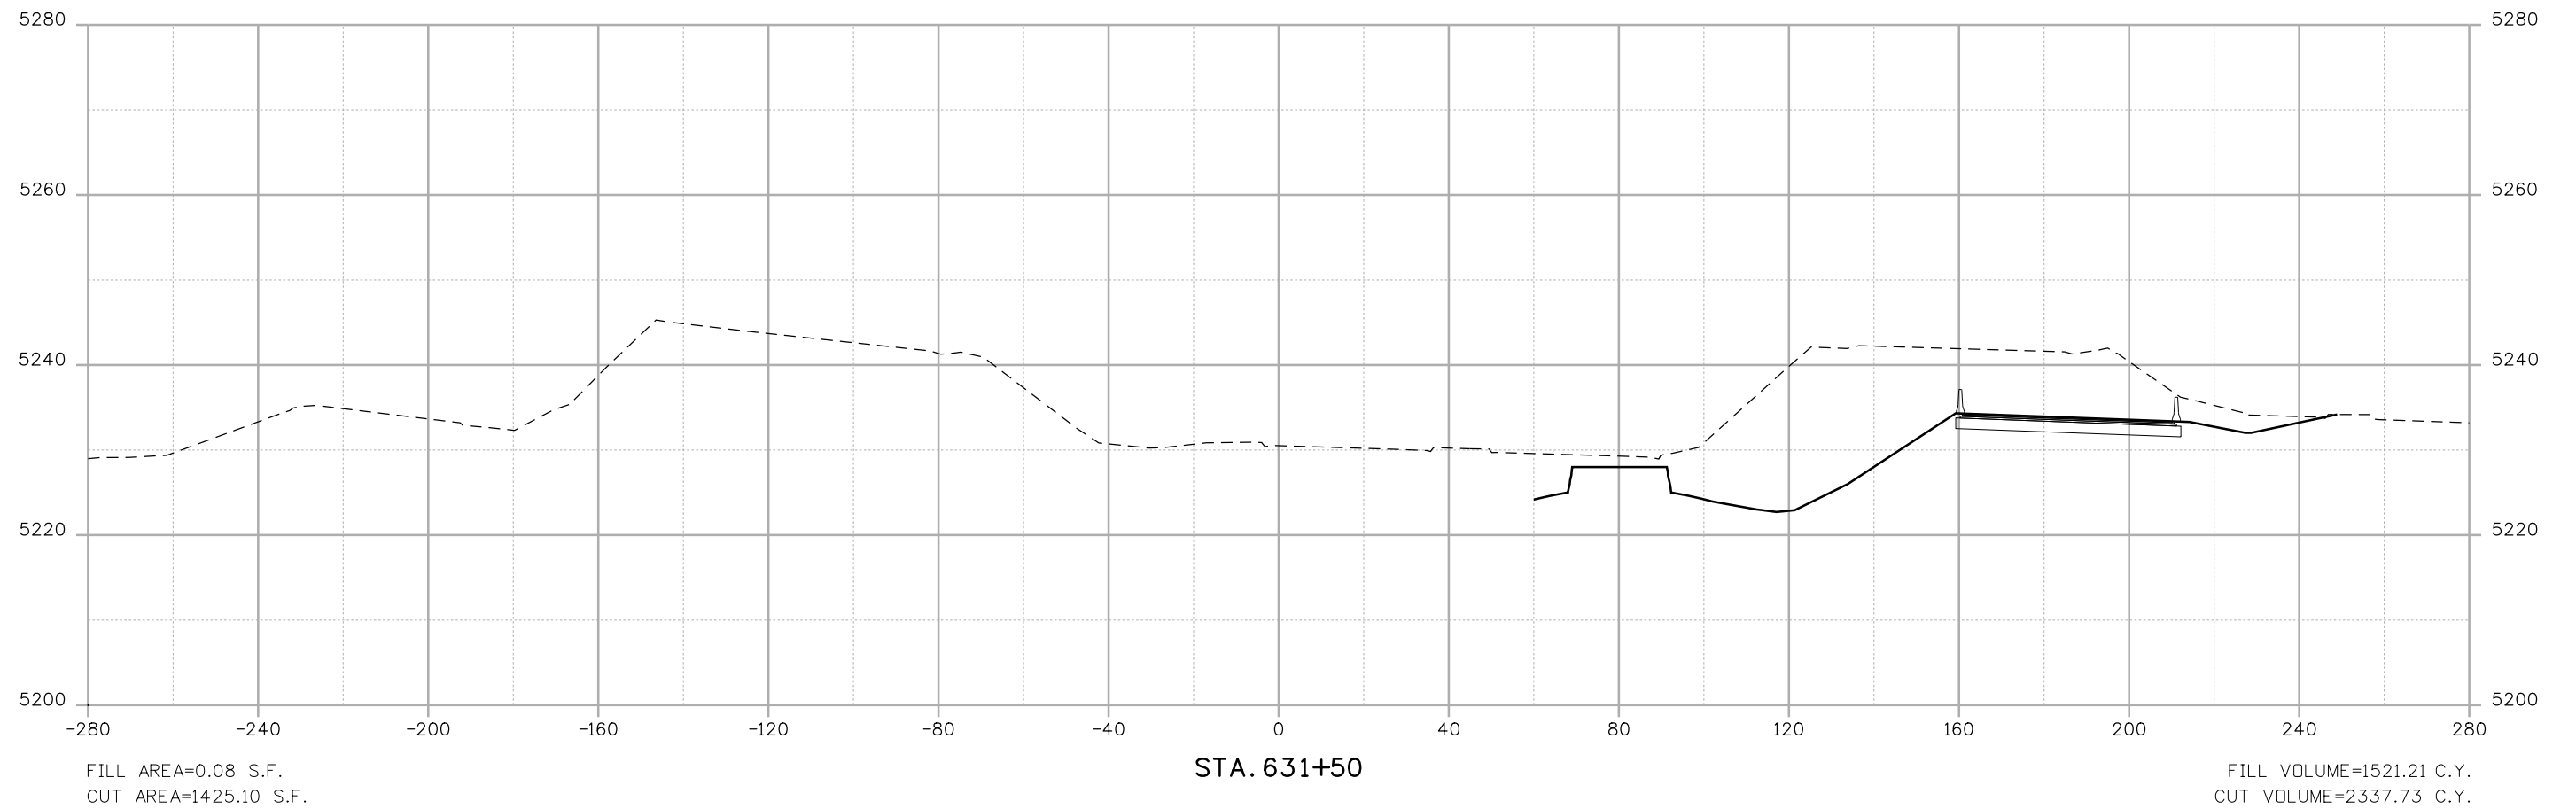

Print Date: 10/12/2010	
File Name: 16311DES_PH2_CrossSections1.dgn	
Horiz. Scale: 1:40	Vert. Scale: 1:20
Unit Information	Unit Leader Initials

Sheet Revisions		
Date:	Comments	Init.

Colorado Department of Transportation



2000 South Holly Street
 Denver, CO 80222
 Phone: 303-972-9112 FAX: 303-972-9114


Region 6 **RLB**

As Constructed
No Revisions:
Revised:
Void:

I-25/SANTA FE INTERCHANGE INTERSTATE 25 CROSS SECTIONS		
Designer: DCS	Structure Numbers	
Detailer: DCS		
Sheet Subset: SECTIONS	Subset Sheets: XS-31 of 104	

Project No./Code
BR 0252-407
17783
Sheet Number 31

Dusty 9:10:38 AM K:\08276\16311\Phase 2\Design\Drawings\Cross_Sections\16311DES_PH2_CrossSections1.dgn

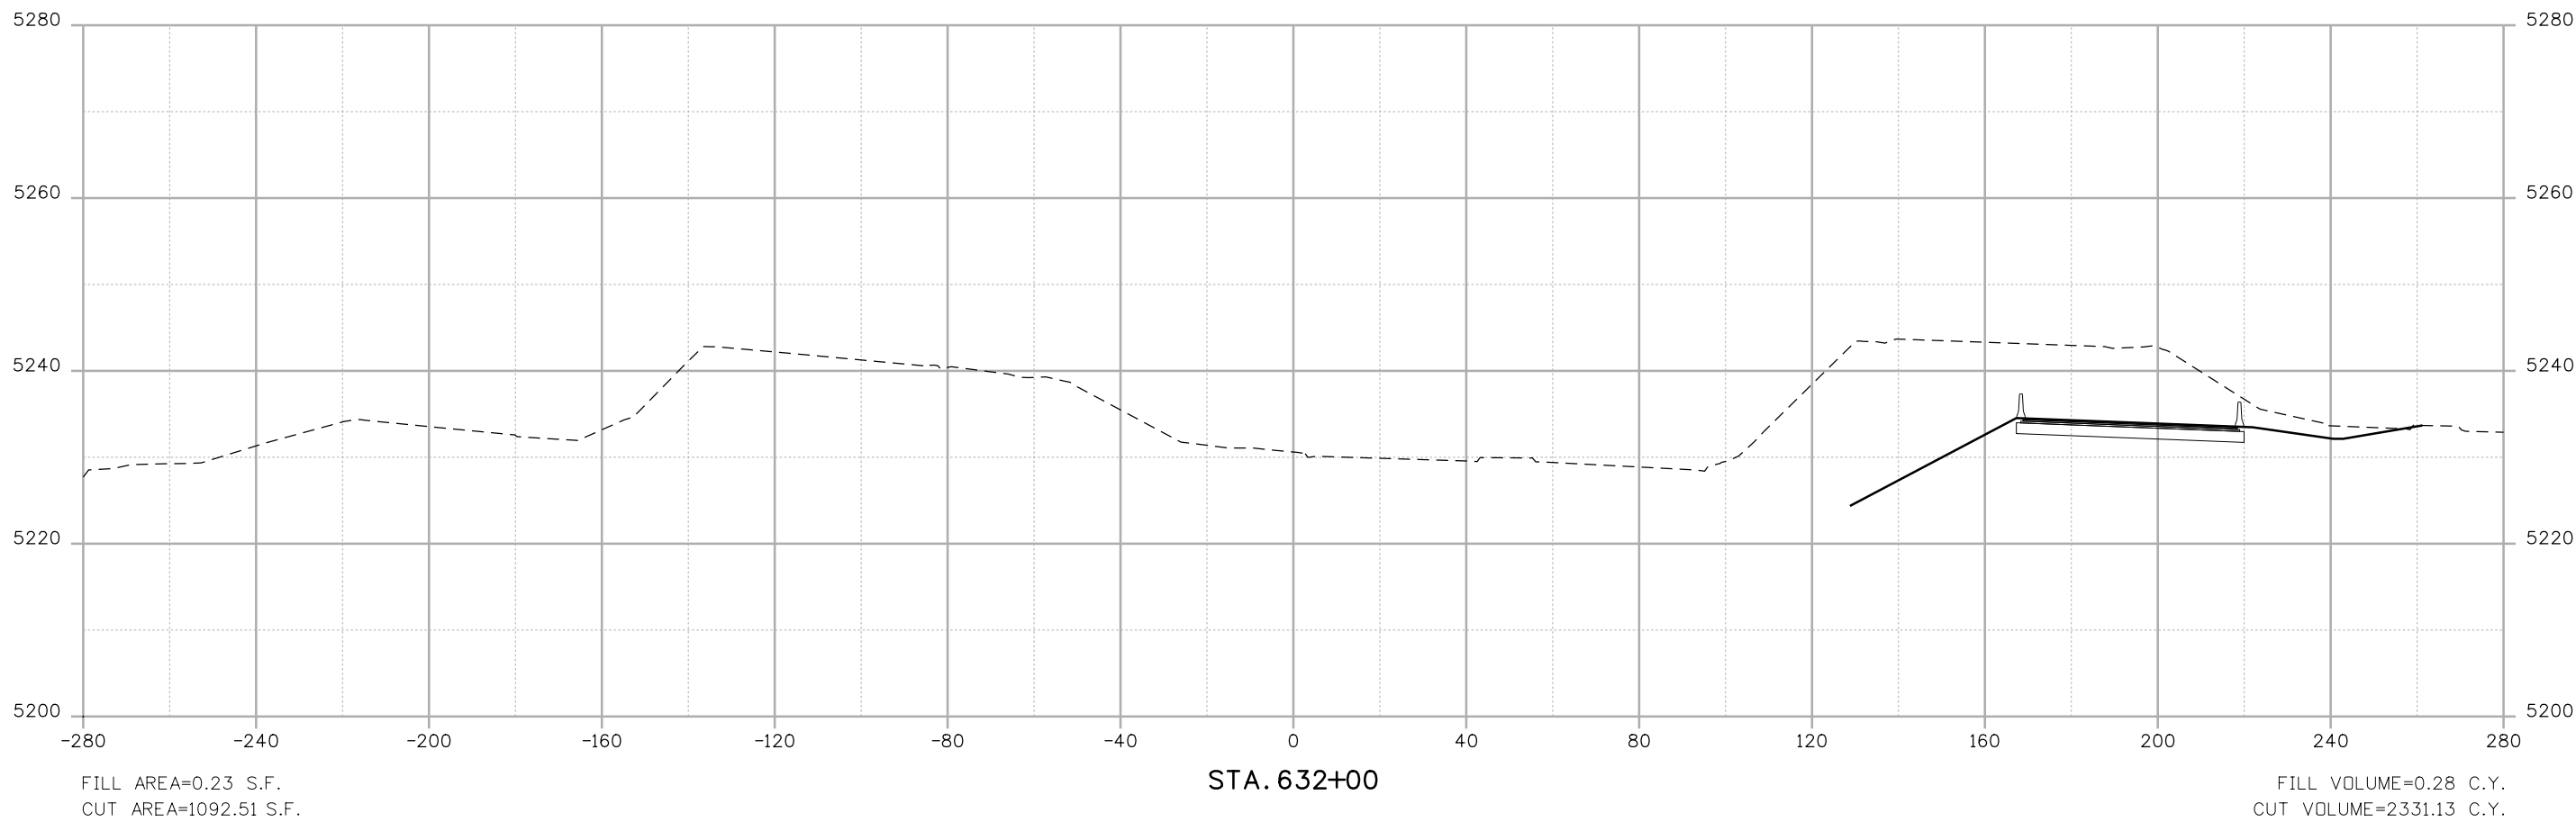

Print Date: 10/12/2010	
File Name: 16311DES_PH2_CrossSections1.dgn	
Horiz. Scale: 1:40	Vert. Scale: 1:20
Unit Information	Unit Leader Initials

Sheet Revisions		
Date:	Comments	Init.

Colorado Department of Transportation

2000 South Holly Street
Denver, CO 80222
Phone: 303-972-9112 FAX: 303-972-9114


Region 6 **RLB**

As Constructed
No Revisions:
Revised:
Void:

I-25/SANTA FE INTERCHANGE INTERSTATE 25 CROSS SECTIONS		
Designer: DCS	Structure Numbers	
Detailer: DCS		
Sheet Subset: SECTIONS	Subset Sheets: XS-32 of 104	

Project No./Code
BR 0252-407
17783
Sheet Number 32

Dusty 9:10:47 AM K:\08276\16311\Phase 2\Design\Drawings\Cross_Sections\16311DES_PH2_CrossSections1.dgn

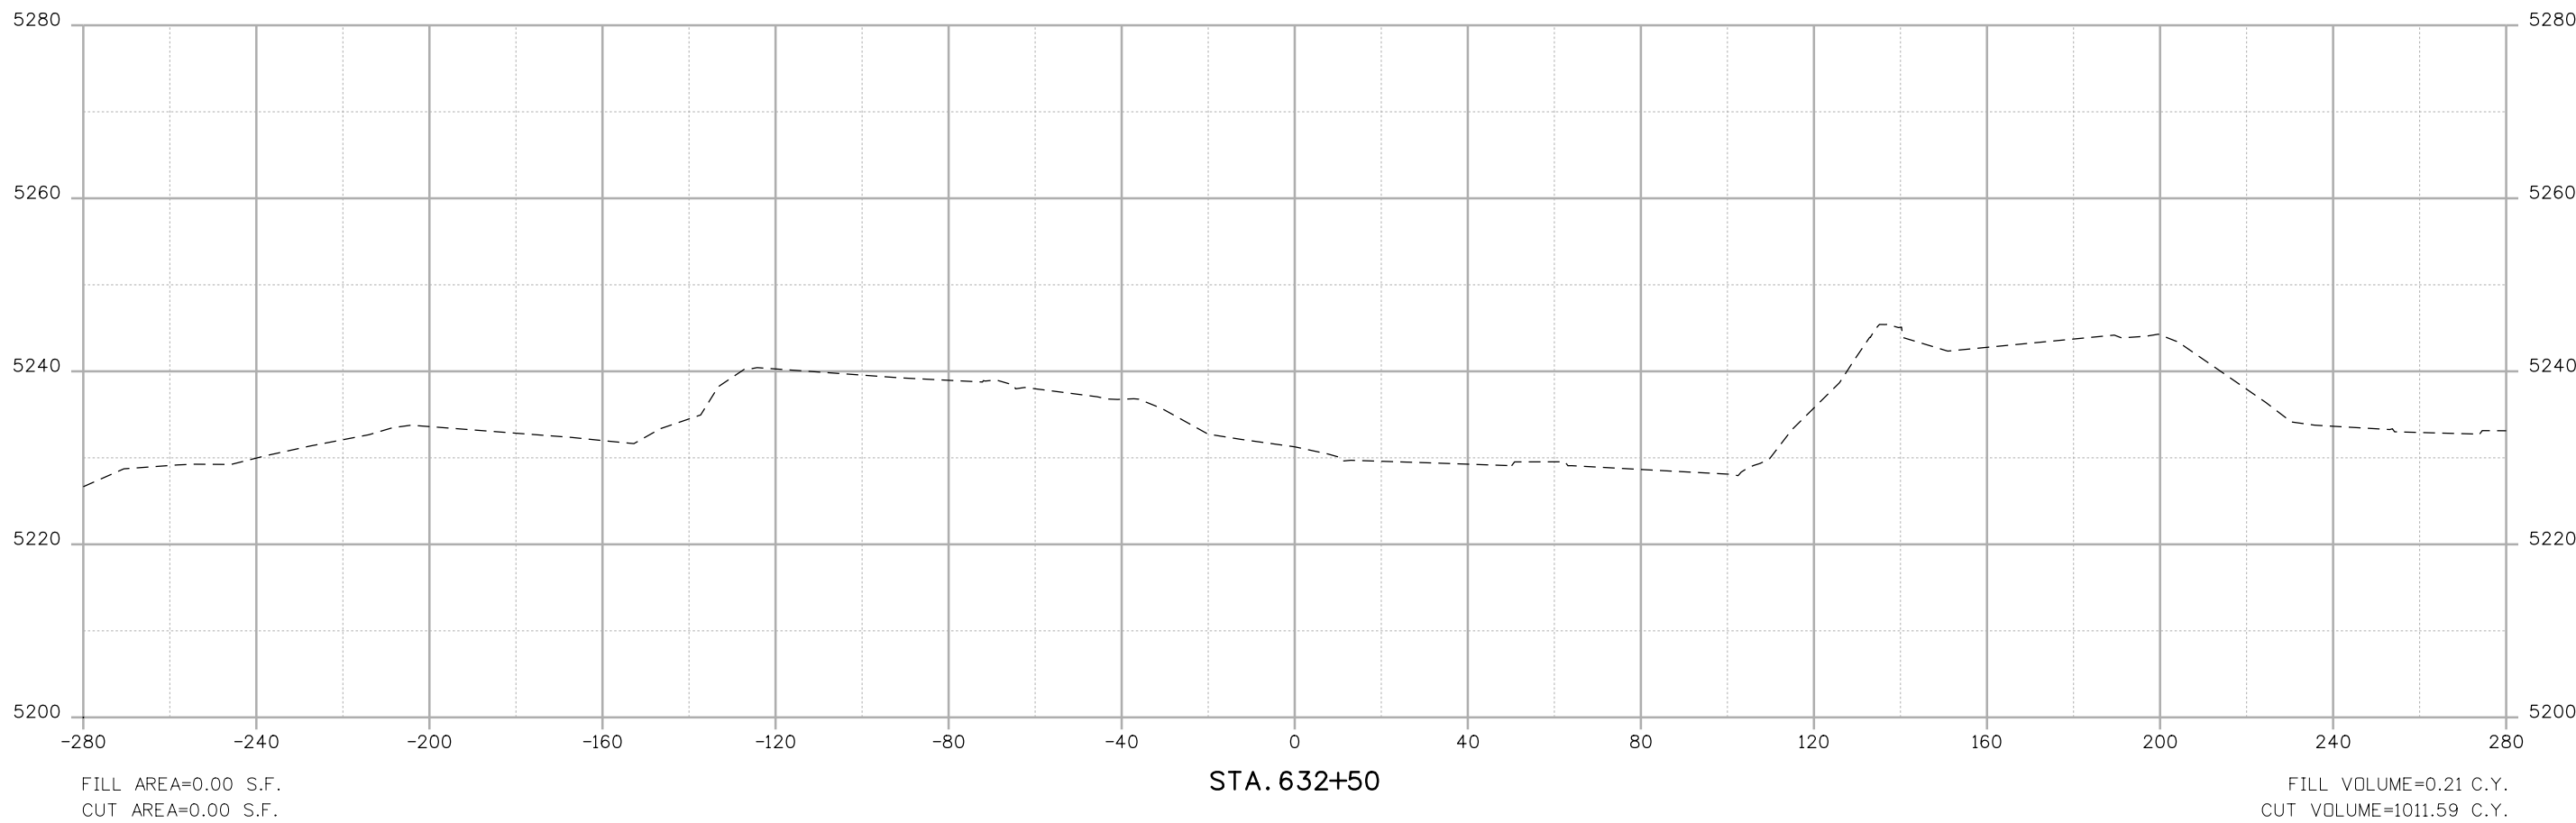

Print Date: 10/12/2010	
File Name: 16311DES_PH2_CrossSections1.dgn	
Horiz. Scale: 1:40	Vert. Scale: 1:20
Unit Information	Unit Leader Initials

Sheet Revisions		
Date:	Comments	Init.

Colorado Department of Transportation

2000 South Holly Street
Denver, CO 80222
Phone: 303-972-9112 FAX: 303-972-9114


Region 6 **RLB**

As Constructed
No Revisions:
Revised:
Void:

I-25/SANTA FE INTERCHANGE INTERSTATE 25 CROSS SECTIONS		
Designer: DCS	Structure Numbers	
Detailer: DCS		
Sheet Subset: SECTIONS	Subset Sheets: XS-33 of 104	

Project No./Code
BR 0252-407
17783
Sheet Number 33

Dusty 9:10:56 AM K:\08276\16311\Phase 2\Design\Drawings\Cross_Sections\16311DES_PH2_CrossSections1.dgn

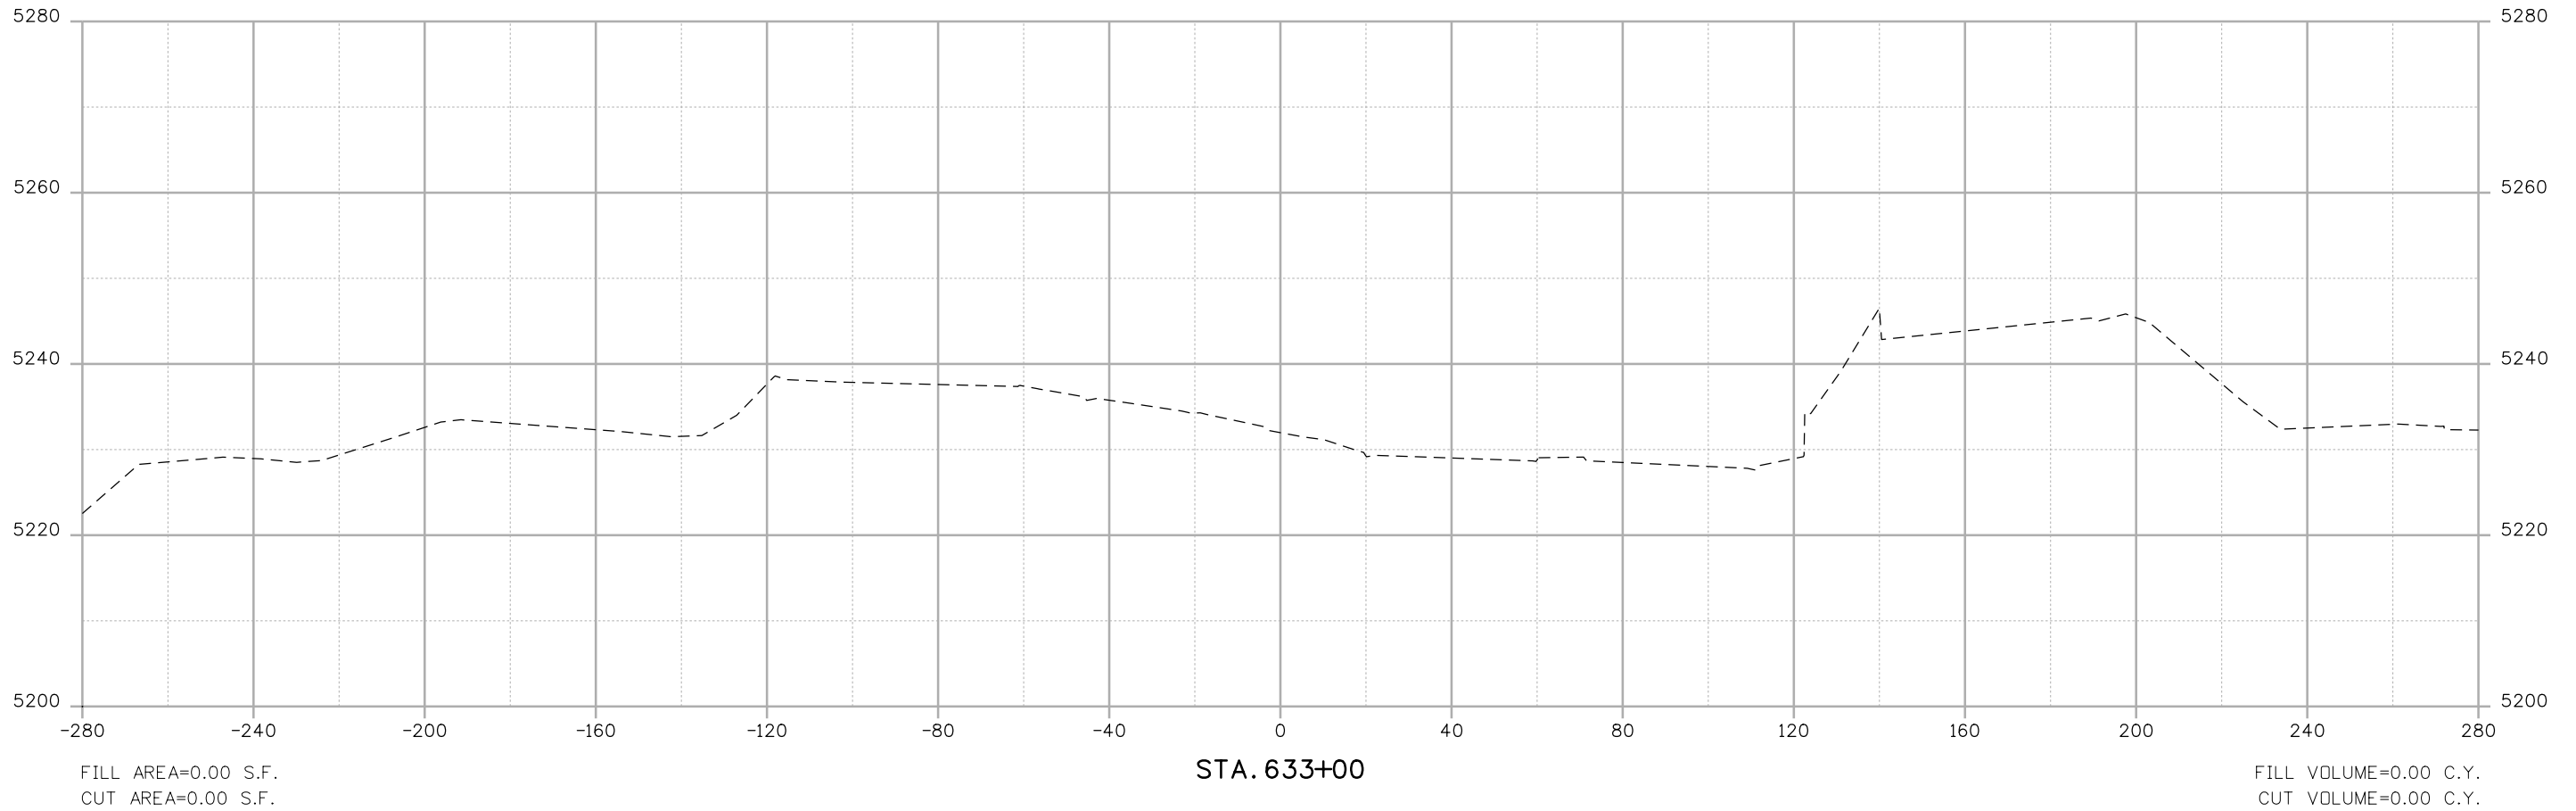

Print Date: 10/12/2010	
File Name: 16311DES_PH2_CrossSections1.dgn	
Horiz. Scale: 1:40	Vert. Scale: 1:20
Unit Information	Unit Leader Initials

Sheet Revisions		
Date:	Comments	Init.

Colorado Department of Transportation



2000 South Holly Street
Denver, CO 80222
Phone: 303-972-9112 FAX: 303-972-9114


Region 6 **RLB**

As Constructed
No Revisions:
Revised:
Void:

I-25/SANTA FE INTERCHANGE INTERSTATE 25 CROSS SECTIONS		
Designer: DCS	Structure Numbers	
Detailer: DCS		
Sheet Subset: SECTIONS	Subset Sheets: XS-34 of 104	

Project No./Code
BR 0252-407
17783
Sheet Number 34

Dusty 9:11:07 AM K:\08276\16311\Phase 2_Design\Drawings\Cross_Sections\16311DES_PH2_CrossSections1.dgn

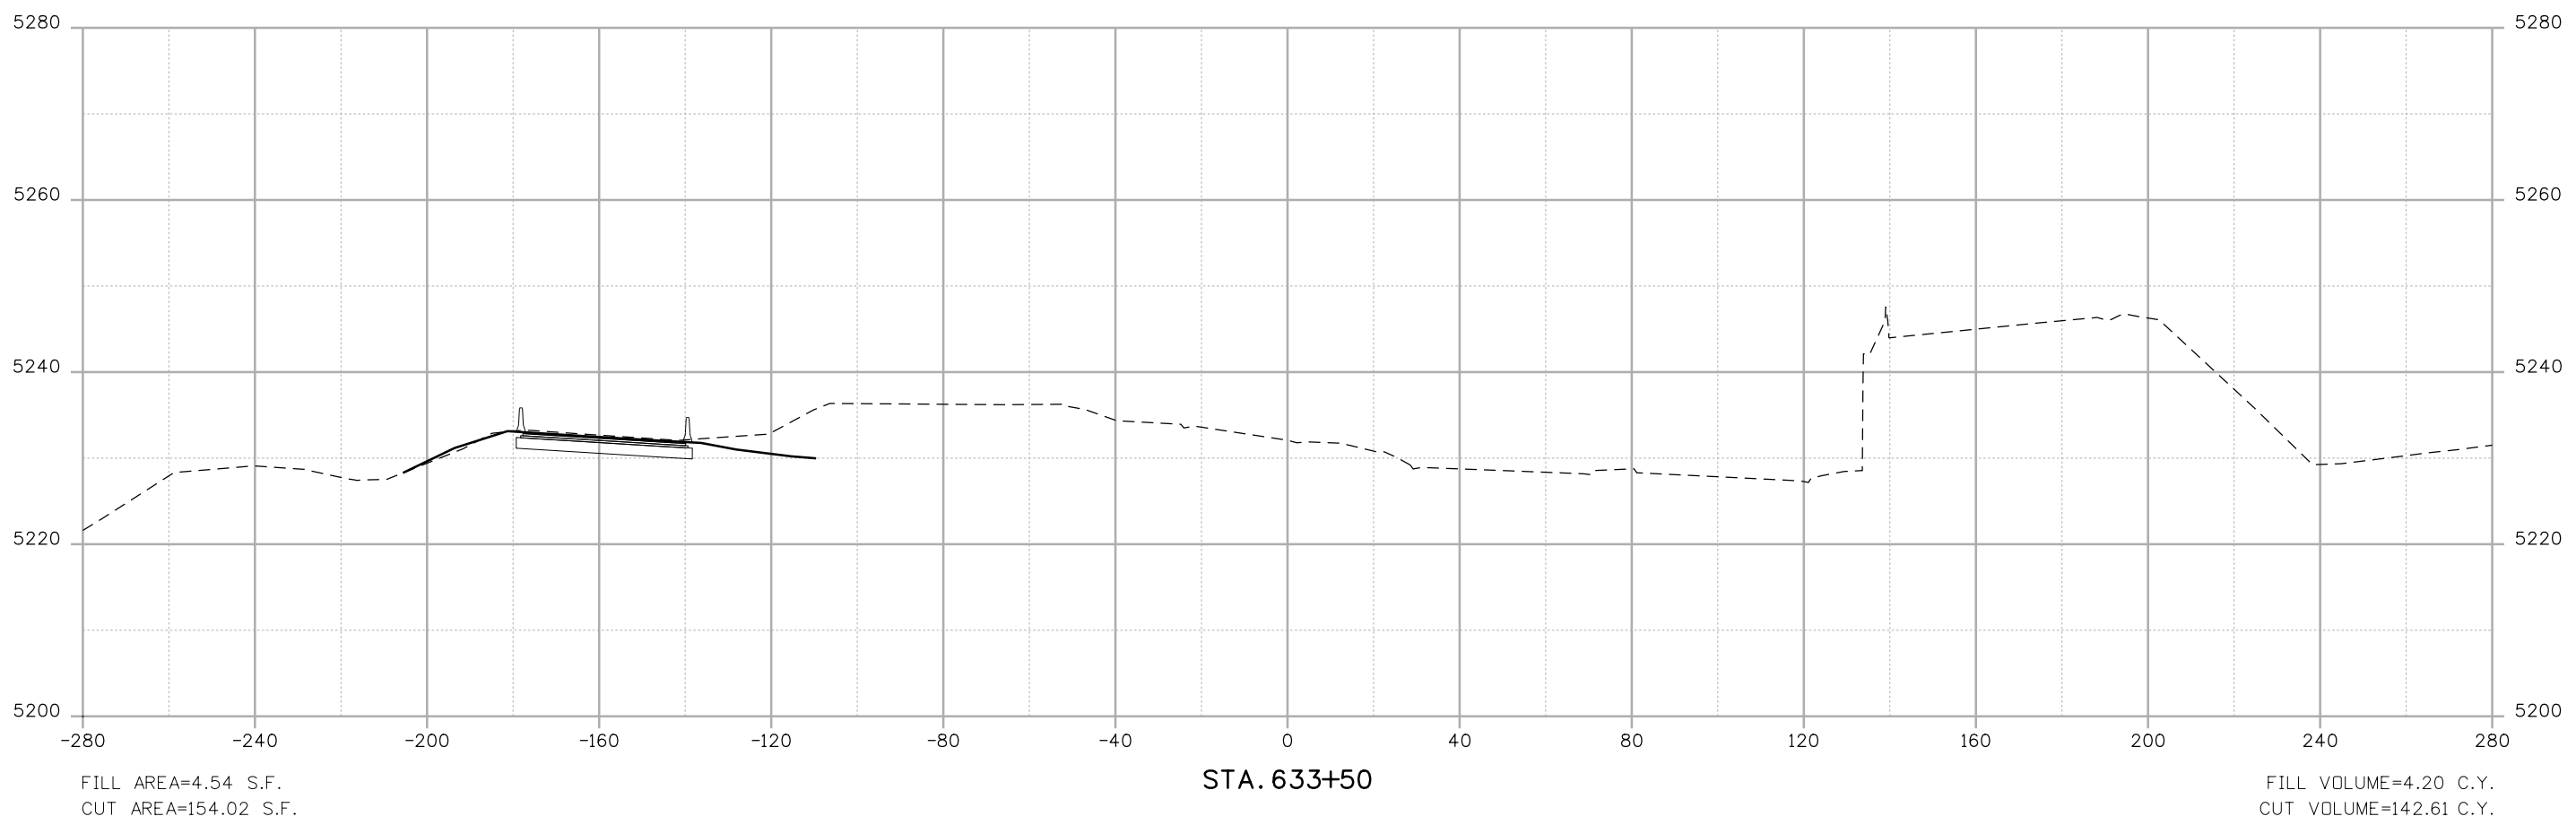

Print Date: 10/12/2010
 File Name: 16311DES_PH2_CrossSections1.dgn
 Horiz. Scale: 1:40 Vert. Scale: 1:20
 Unit Information Unit Leader Initials

Sheet Revisions		
Date:	Comments	Init.

Colorado Department of Transportation


 2000 South Holly Street
 Denver, CO 80222
 Phone: 303-972-9112 FAX: 303-972-9114
Region 6 **RLB**

As Constructed
 No Revisions:
 Revised:
 Void:


**I-25/SANTA FE INTERCHANGE
 INTERSTATE 25
 CROSS SECTIONS**

Designer: DCS Structure Numbers
 Detailer: DCS
 Sheet Subset: SECTIONS Subset Sheets: XS-35 of 104

Project No./Code
 BR 0252-407
 17783
 Sheet Number **35**

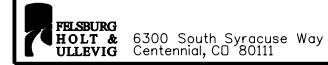

Dusty 9:11:18 AM K:\08276\16311\Phase 2\Design\Drawings\Cross_Sections\16311DES_PH2_CrossSections1.dgn

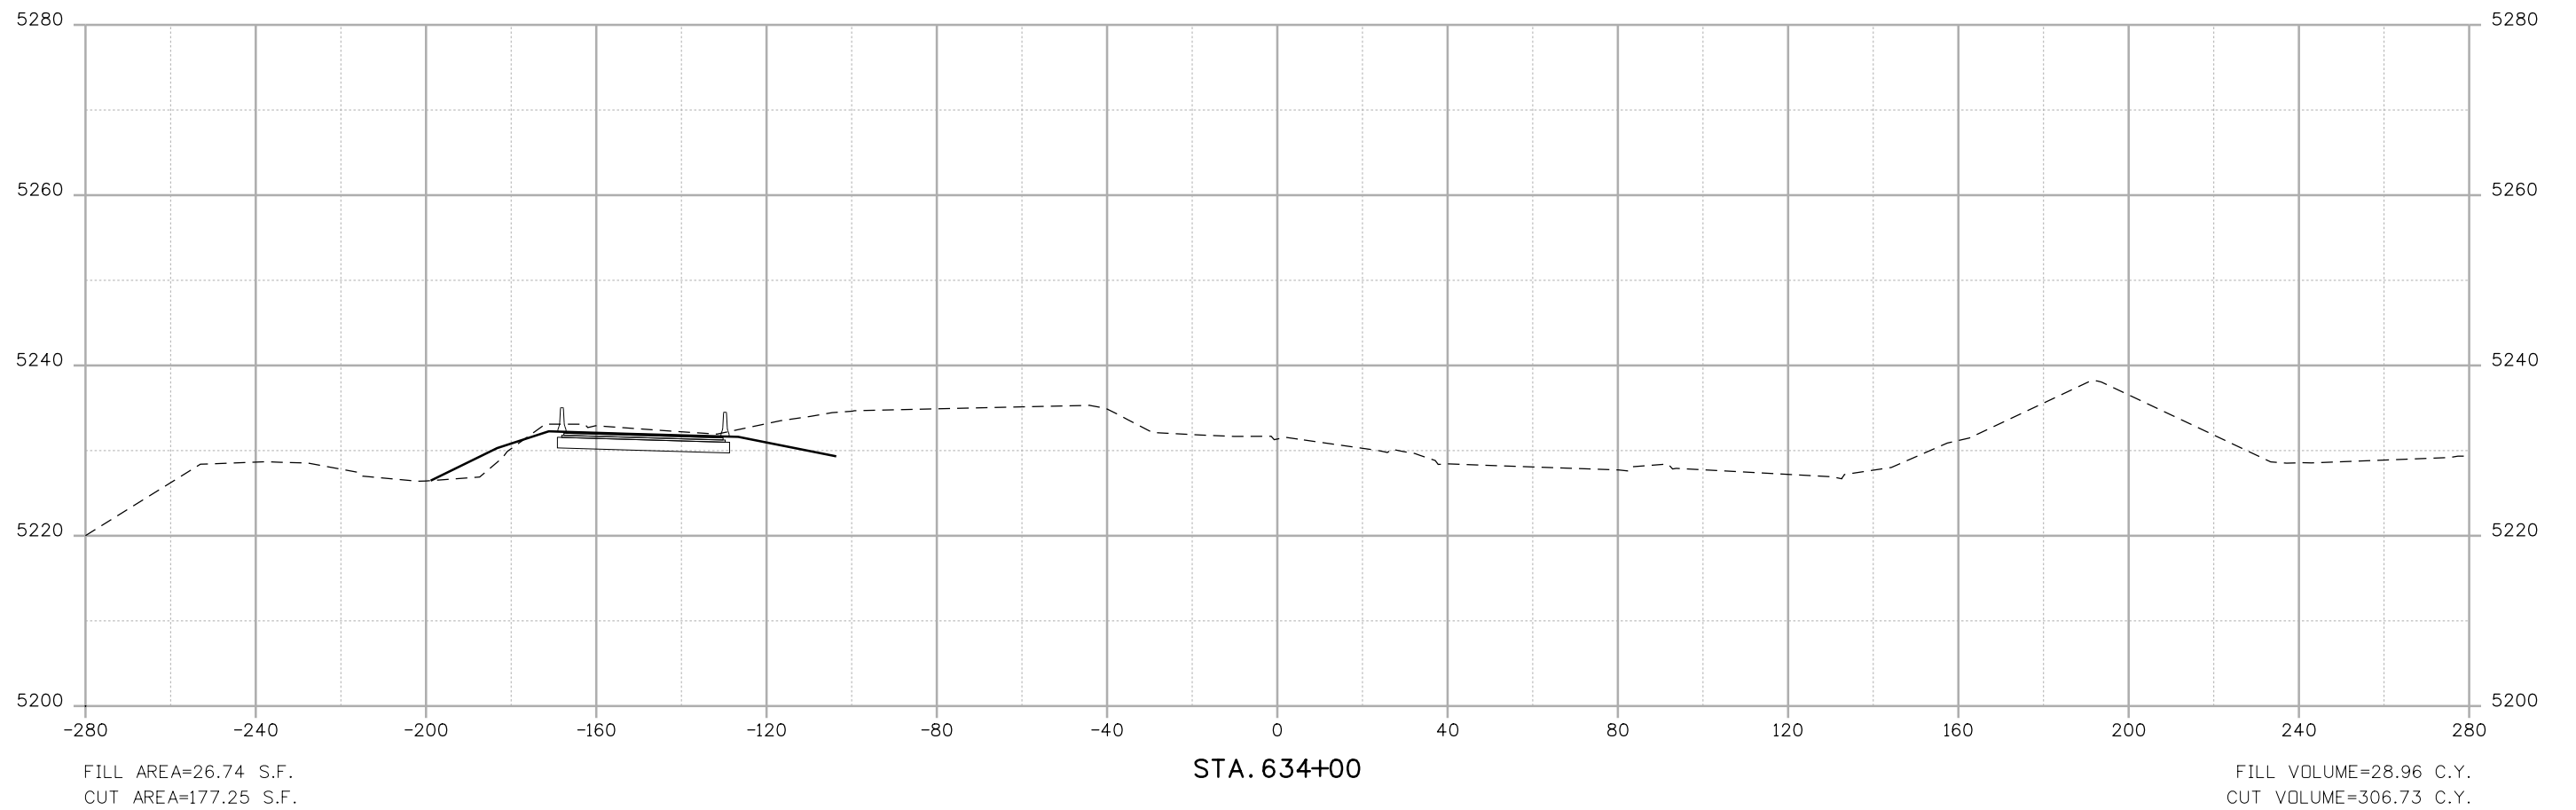

Print Date: 10/12/2010	
File Name: 16311DES_PH2_CrossSections1.dgn	
Horiz. Scale: 1:40	Vert. Scale: 1:20
Unit Information	Unit Leader Initials

Sheet Revisions		
Date:	Comments	Init.

Colorado Department of Transportation

2000 South Holly Street
Denver, CO 80222
Phone: 303-972-9112 FAX: 303-972-9114


Region 6 **RLB**

As Constructed
No Revisions:
Revised:
Void:

I-25/SANTA FE INTERCHANGE INTERSTATE 25 CROSS SECTIONS		
Designer: DCS	Structure Numbers	
Detailer: DCS		
Sheet Subset: SECTIONS	Subset Sheets: XS-36 of 104	

Project No./Code
BR 0252-407
17783
Sheet Number 36

Dusty 9:11:30 AM K:\08276\16311\Phase 2\Design\Drawings\Cross_Sections\16311DES_PH2_CrossSections1.dgn

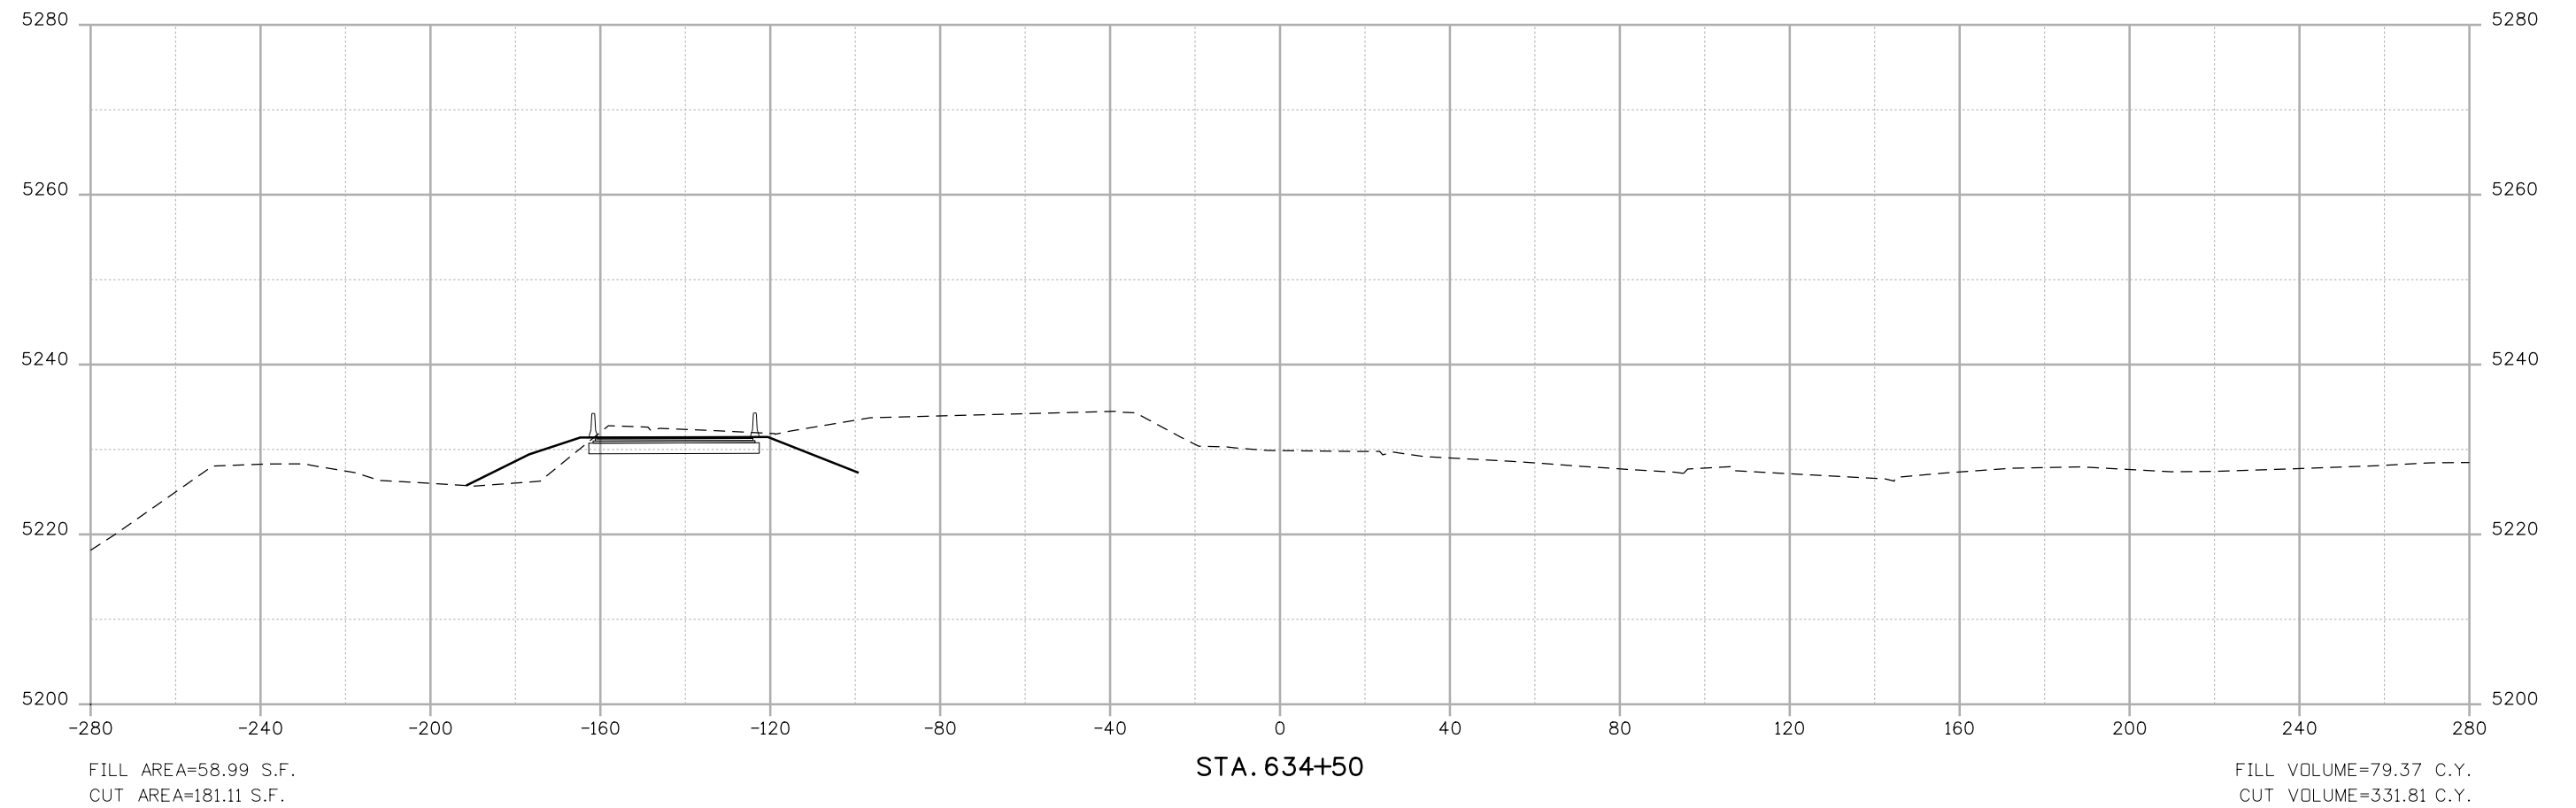

Print Date: 10/12/2010
 File Name: 16311DES_PH2_CrossSections1.dgn
 Horiz. Scale: 1:40 Vert. Scale: 1:20
 Unit Information Unit Leader Initials

Sheet Revisions		
Date:	Comments	Init.

Colorado Department of Transportation


 2000 South Holly Street
 Denver, CO 80222
 Phone: 303-972-9112 FAX: 303-972-9114
Region 6 **RLB**

As Constructed
 No Revisions:
 Revised:
 Void:


**I-25/SANTA FE INTERCHANGE
 INTERSTATE 25
 CROSS SECTIONS**

Designer: DCS Structure Numbers
 Detailer: DCS
 Sheet Subset: SECTIONS Subset Sheets: XS-37 of 104

Project No./Code
 BR 0252-407
 17783
 Sheet Number **37**

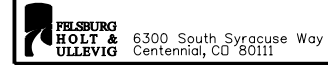

Dusty 9:11:40 AM K:\08276\16311\Phase 2\Design\Drawings\Cross_Sections\16311DES_PH2_CrossSections1.dgn

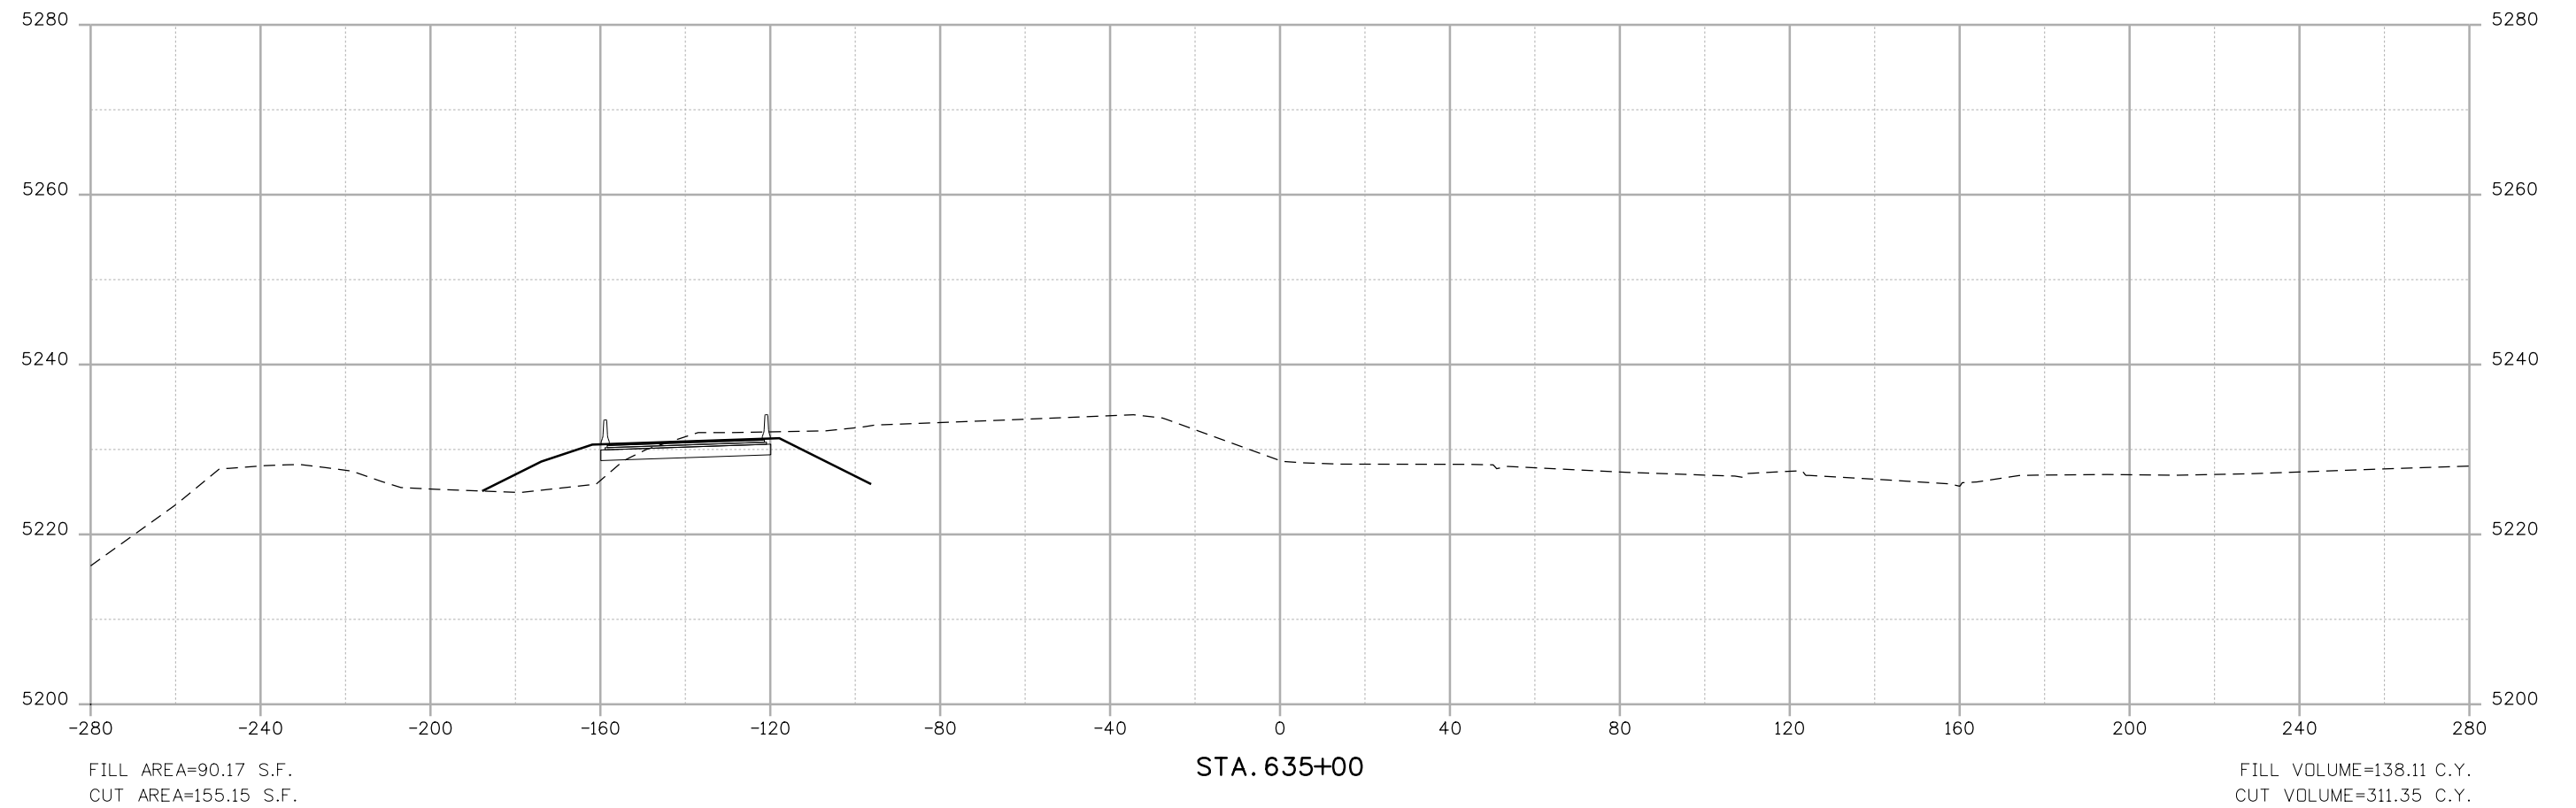

Print Date: 10/12/2010	
File Name: 16311DES_PH2_CrossSections1.dgn	
Horiz. Scale: 1:40	Vert. Scale: 1:20
Unit Information	Unit Leader Initials

Sheet Revisions		
Date:	Comments	Init.


Colorado Department of Transportation
 2000 South Holly Street
 Denver, CO 80222
 Phone: 303-972-9112 FAX: 303-972-9114
Region 6 **RLB**

As Constructed
No Revisions:
Revised:
Void:

I-25/SANTA FE INTERCHANGE INTERSTATE 25 CROSS SECTIONS		
Designer: DCS	Structure Numbers	
Detailer: DCS		
Sheet Subset: SECTIONS	Subset Sheets: XS-38 of 104	

Project No./Code
BR 0252-407
17783
Sheet Number 38

Dusty 9:11:52 AM K:\08276\16311\Phase 2_Design\Drawings\Cross_Sections\16311DES_PH2_CrossSections1.dgn

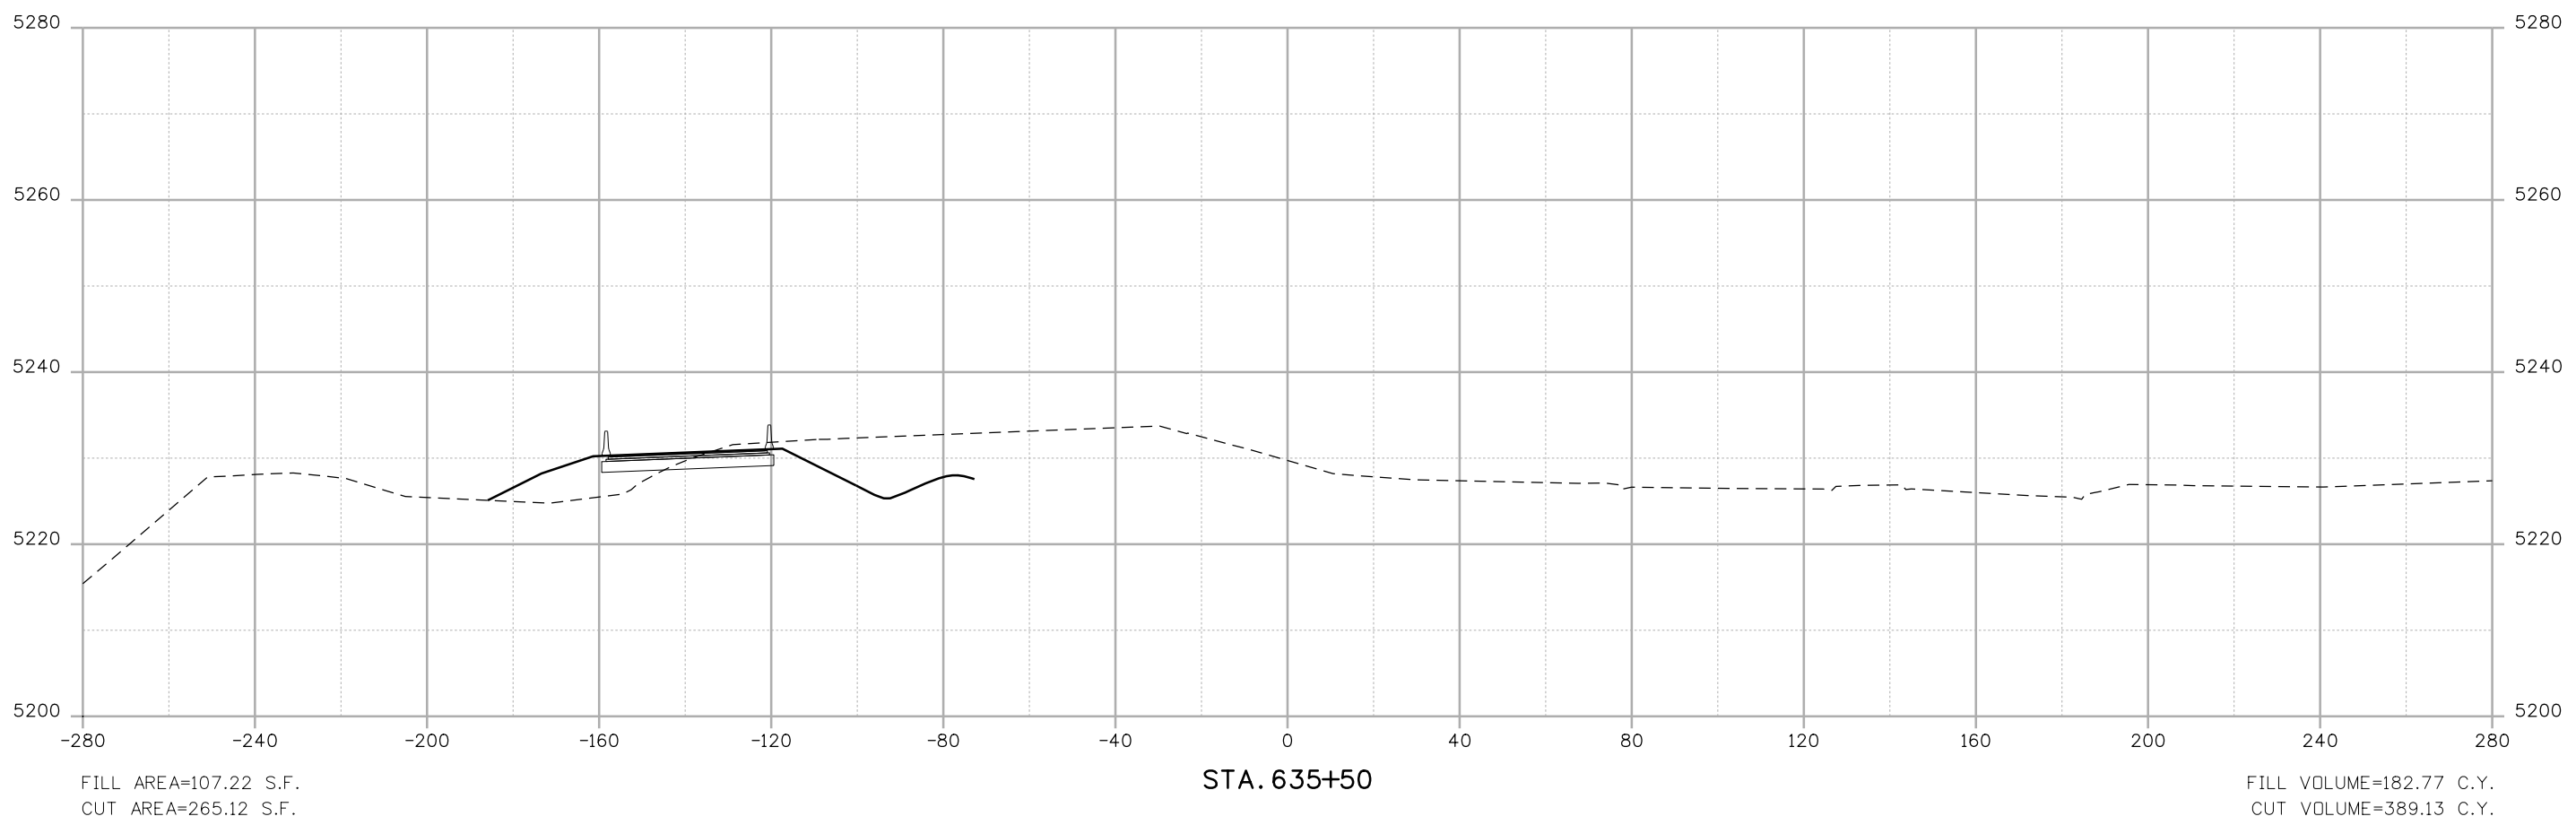

Print Date: 10/12/2010	
File Name: 16311DES_PH2_CrossSections1.dgn	
Horiz. Scale: 1:40	Vert. Scale: 1:20
Unit Information	Unit Leader Initials

Sheet Revisions		
Date:	Comments	Init.


Colorado Department of Transportation
 2000 South Holly Street
 Denver, CO 80222
 Phone: 303-972-9112 FAX: 303-972-9114
Region 6 **RLB**


As Constructed
No Revisions:
Revised:
Void:

I-25/SANTA FE INTERCHANGE INTERSTATE 25 CROSS SECTIONS		
Designer: DCS	Structure Numbers	
Detailer: DCS		
Sheet Subset: SECTIONS	Subset Sheets: XS-39 of 104	

Project No./Code
BR 0252-407
17783
Sheet Number 39

Dusty 9/12/02 AM K:\08276\16311\Phase 2\Design\Drawings\Cross_Sections\16311DES_PH2_CrossSections1.dgn

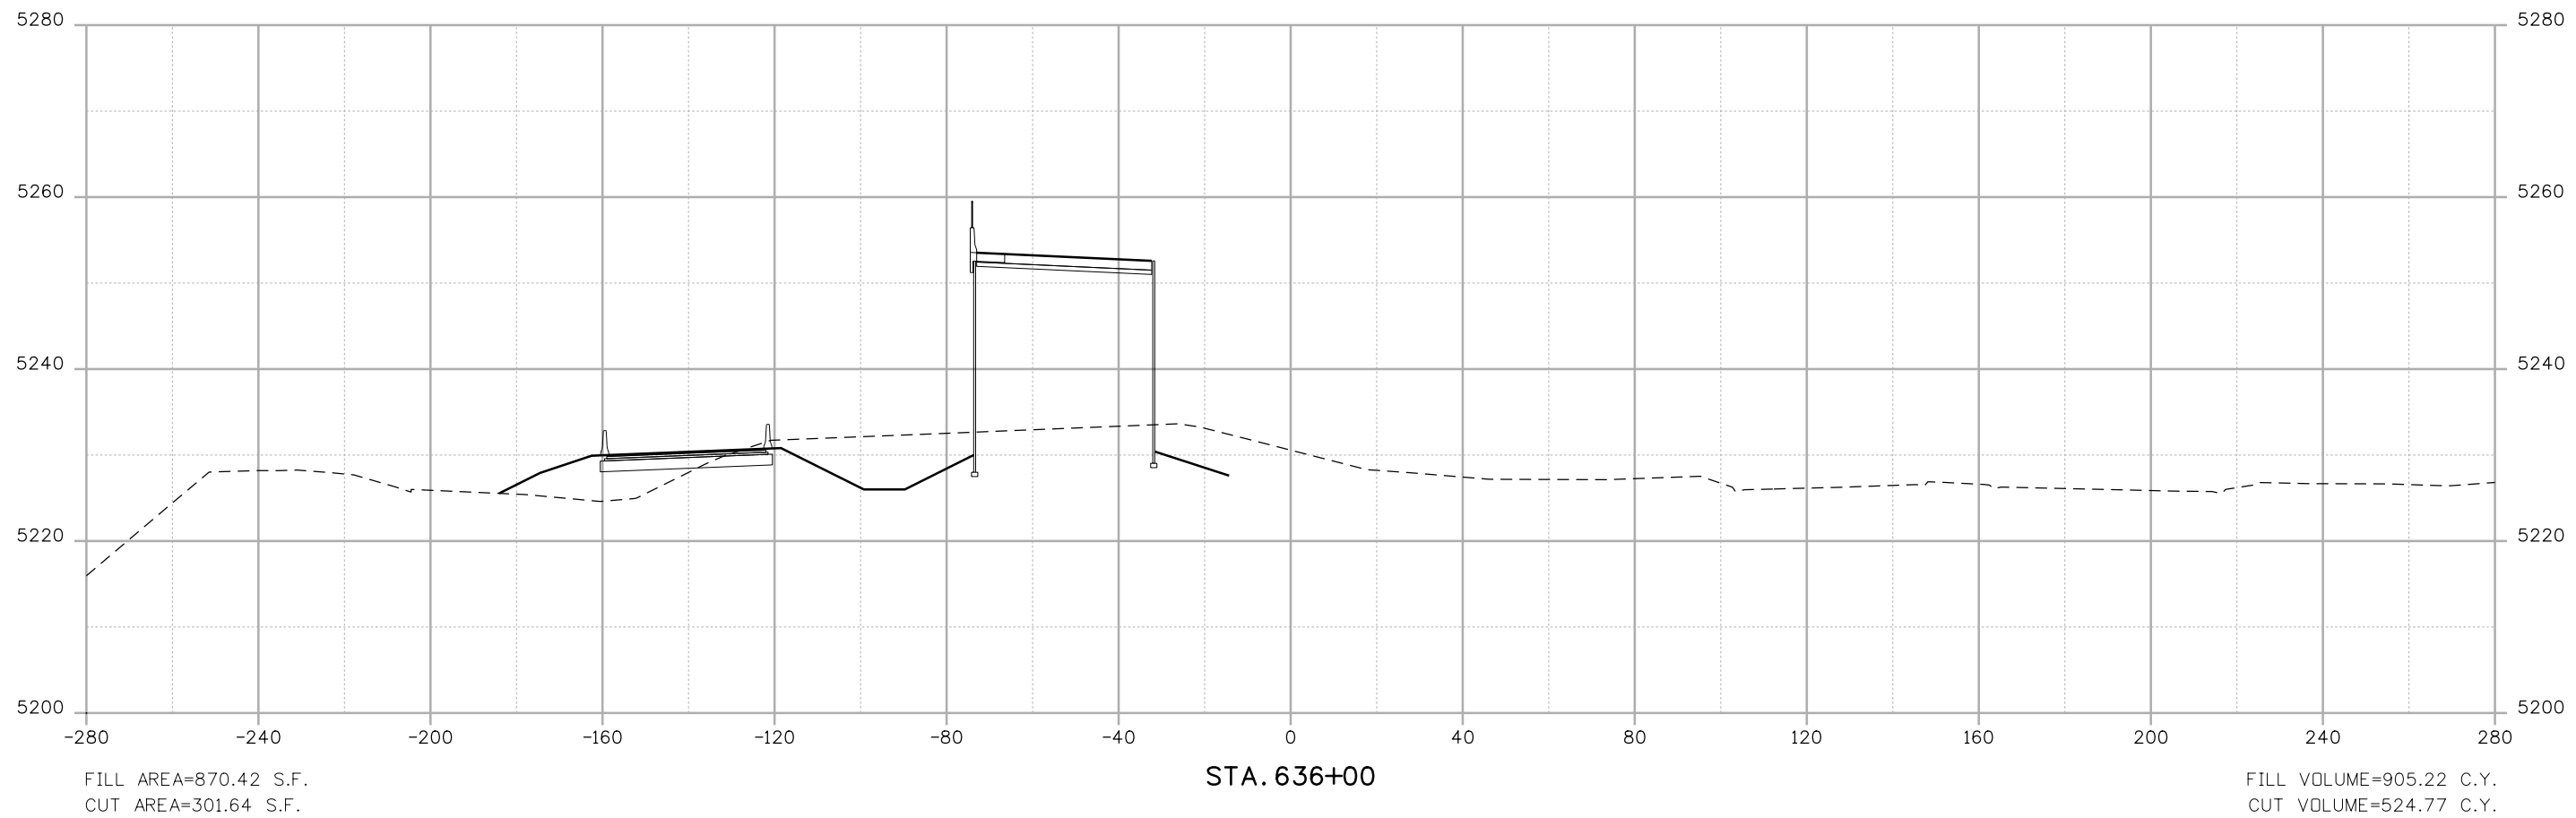

Print Date: 10/12/2010	
File Name: 16311DES_PH2_CrossSections1.dgn	
Horiz. Scale: 1:40	Vert. Scale: 1:20
Unit Information	Unit Leader Initials
 6300 South Syracuse Way Centennial, CO 80111	

Sheet Revisions		
Date:	Comments	Init.

Colorado Department of Transportation



2000 South Holly Street
 Denver, CO 80222
 Phone: 303-972-9112 FAX: 303-972-9114


Region 6 **RLB**


As Constructed
No Revisions:
Revised:
Void:

I-25/SANTA FE INTERCHANGE INTERSTATE 25 CROSS SECTIONS		
Designer: DCS	Structure Numbers	
Detailer: DCS		
Sheet Subset: SECTIONS	Subset Sheets: XS-40 of 104	

Project No./Code
BR 0252-407
17783
Sheet Number 40

Dusty 9:12:13 AM K:\08276\16311\Phase 2\Design\Drawings\Cross_Sections\16311DES_PH2_CrossSections1.dgn

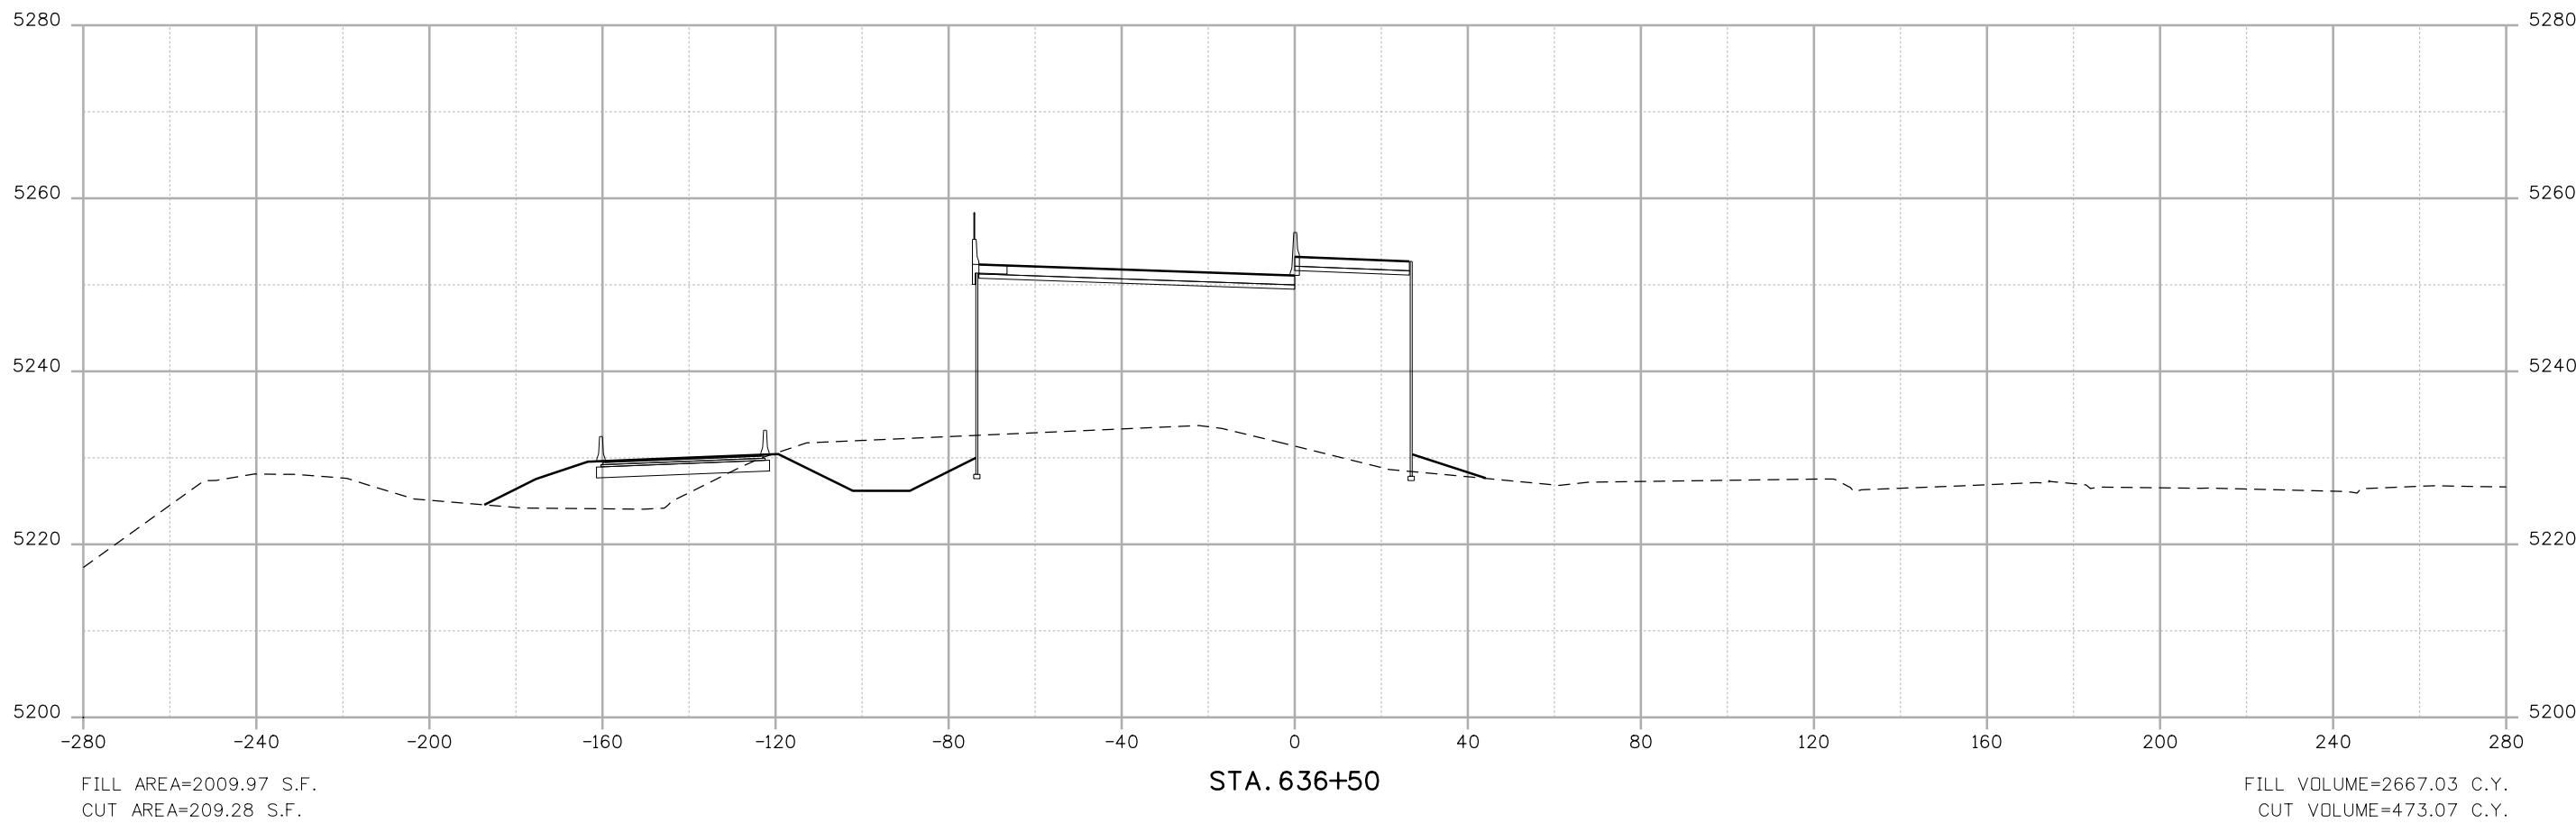

Print Date: 10/12/2010	
File Name: 16311DES_PH2_CrossSections1.dgn	
Horiz. Scale: 1:40	Vert. Scale: 1:20
Unit Information	Unit Leader Initials
 FELSBUURG HOLT & ULLEVIG 6300 South Syracuse Way Centennial, CO 80111	

Sheet Revisions		
Date:	Comments	Init.

Colorado Department of Transportation


 2000 South Holly Street
 Denver, CO 80222
 Phone: 303-972-9112 FAX: 303-972-9114


Region 6 **RLB**

As Constructed
No Revisions:
Revised:
Void:

I-25/SANTA FE INTERCHANGE INTERSTATE 25 CROSS SECTIONS		
Designer:	DCS	Structure Numbers
Detailer:	DCS	
Sheet Subset: SECTIONS	Subset Sheets: XS-41 of 104	

Project No./Code
BR 0252-407
17783
Sheet Number 41

Dusty 9:12:27 AM K:\08276\16311\Phase 2\Design\Drawings\Cross_Sections\16311DES_PH2_CrossSections1.dgn

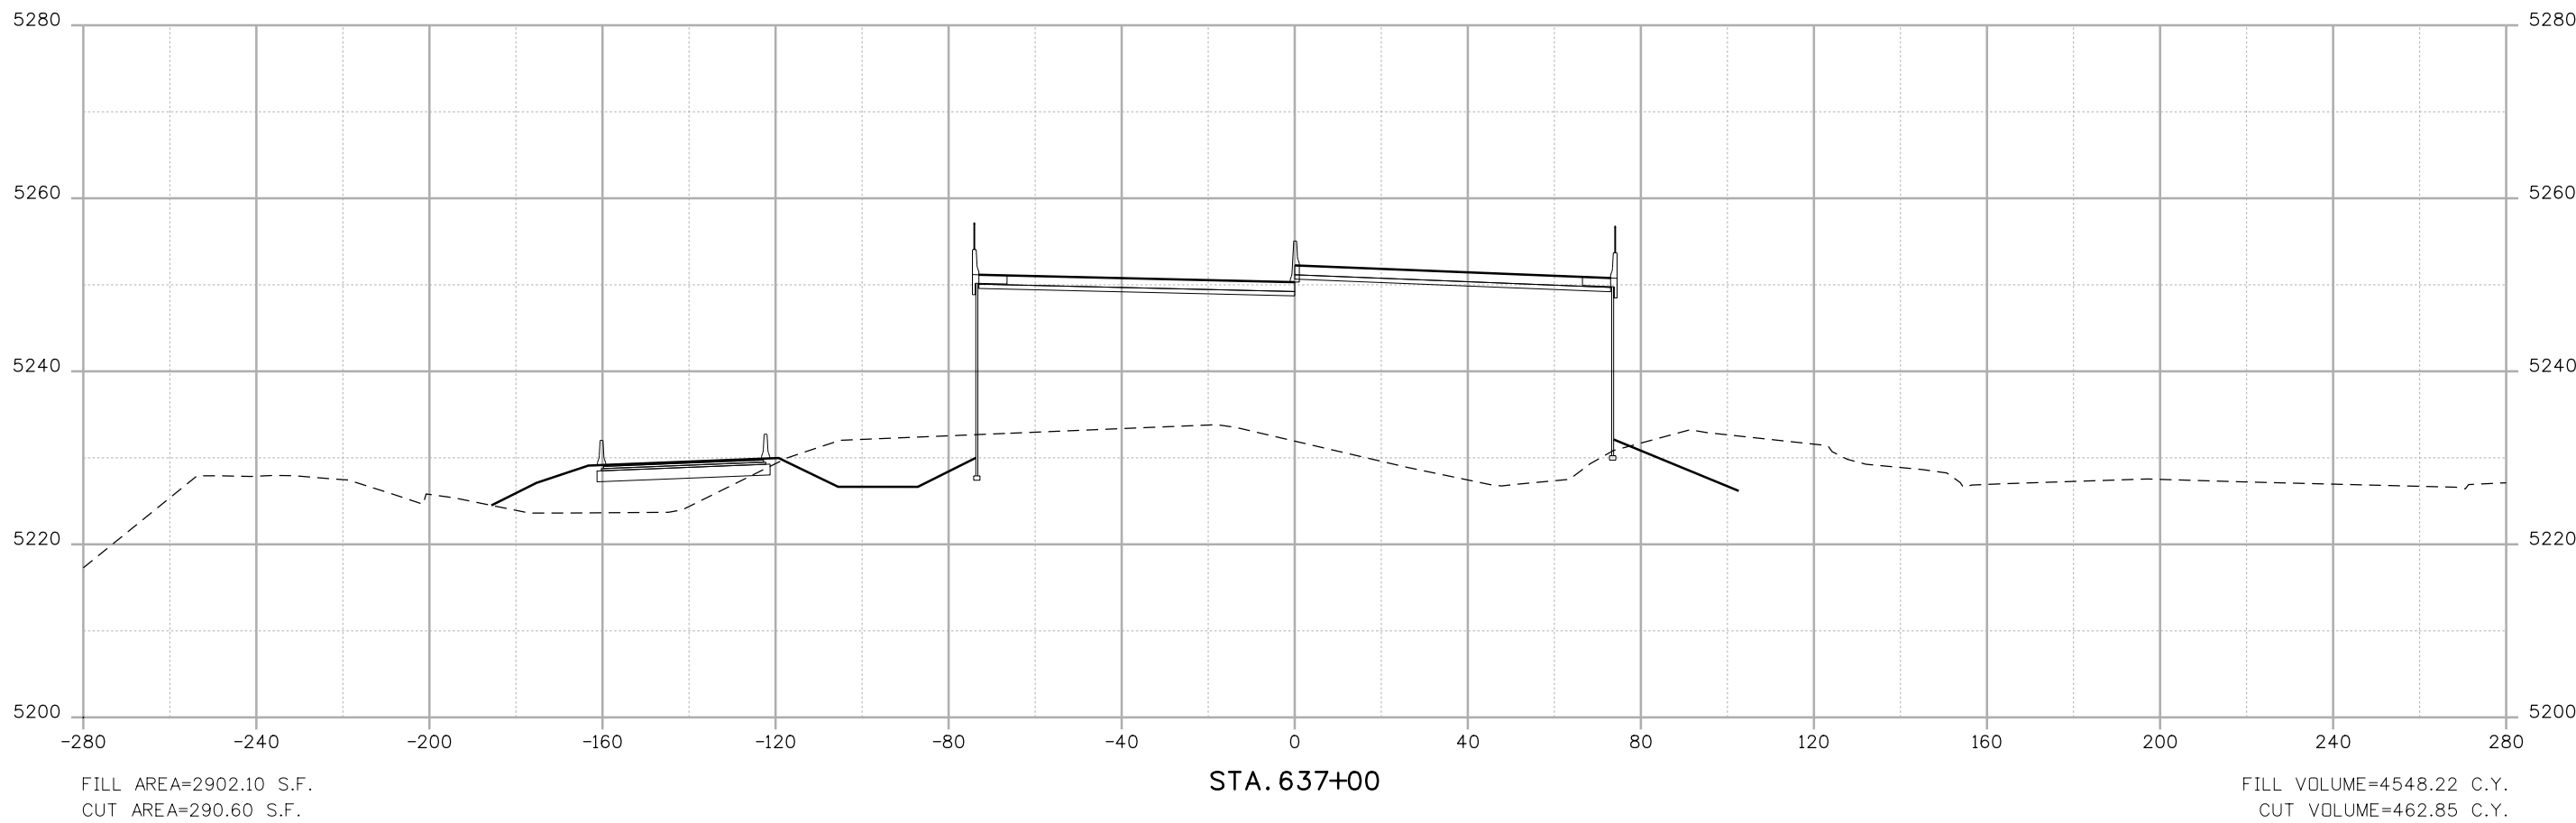

Print Date: 10/12/2010	
File Name: 16311DES_PH2_CrossSections1.dgn	
Horiz. Scale: 1:40	Vert. Scale: 1:20
Unit Information	Unit Leader Initials

Sheet Revisions		
Date:	Comments	Init.

Colorado Department of Transportation


2000 South Holly Street
Denver, CO 80222
Phone: 303-972-9112 FAX: 303-972-9114

Region 6 **RLB**

As Constructed
No Revisions:
Revised:
Void:

I-25/SANTA FE INTERCHANGE INTERSTATE 25 CROSS SECTIONS		
Designer: DCS	Structure Numbers	
Detailer: DCS		
Sheet Subset: SECTIONS	Subset Sheets: XS-42 of 104	


Project No./Code
BR 0252-407
17783
Sheet Number 42

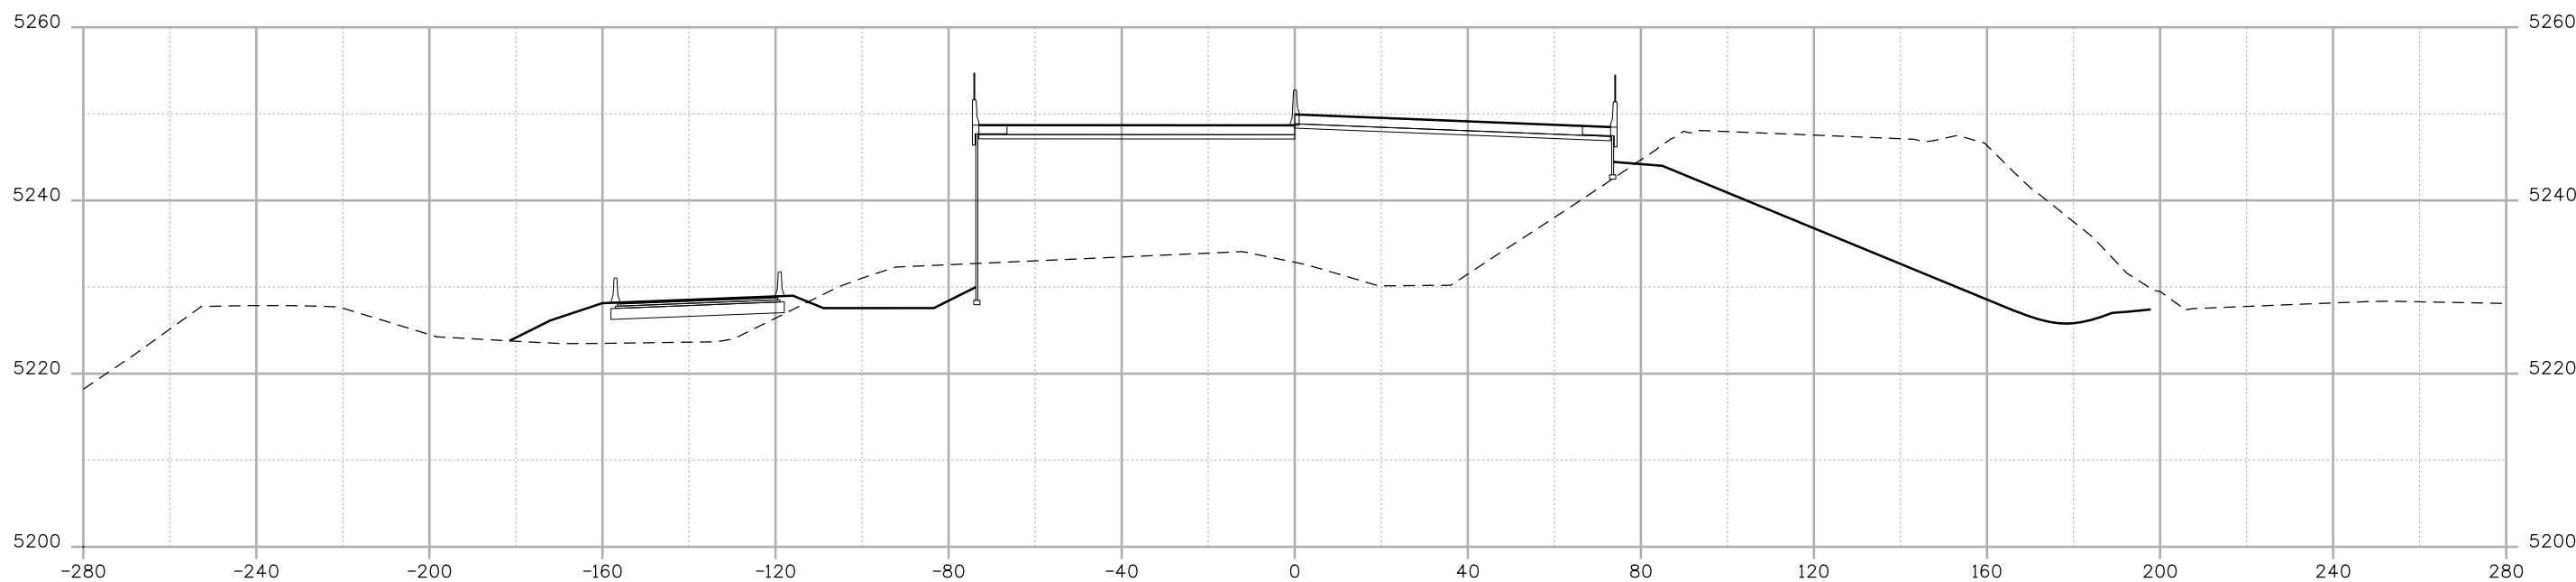

FILL AREA=2199.57 S.F.
CUT AREA=1402.21 S.F.

STA. 638+00

FILL VOLUME=4398.72 C.Y.
CUT VOLUME=2800.98 C.Y.

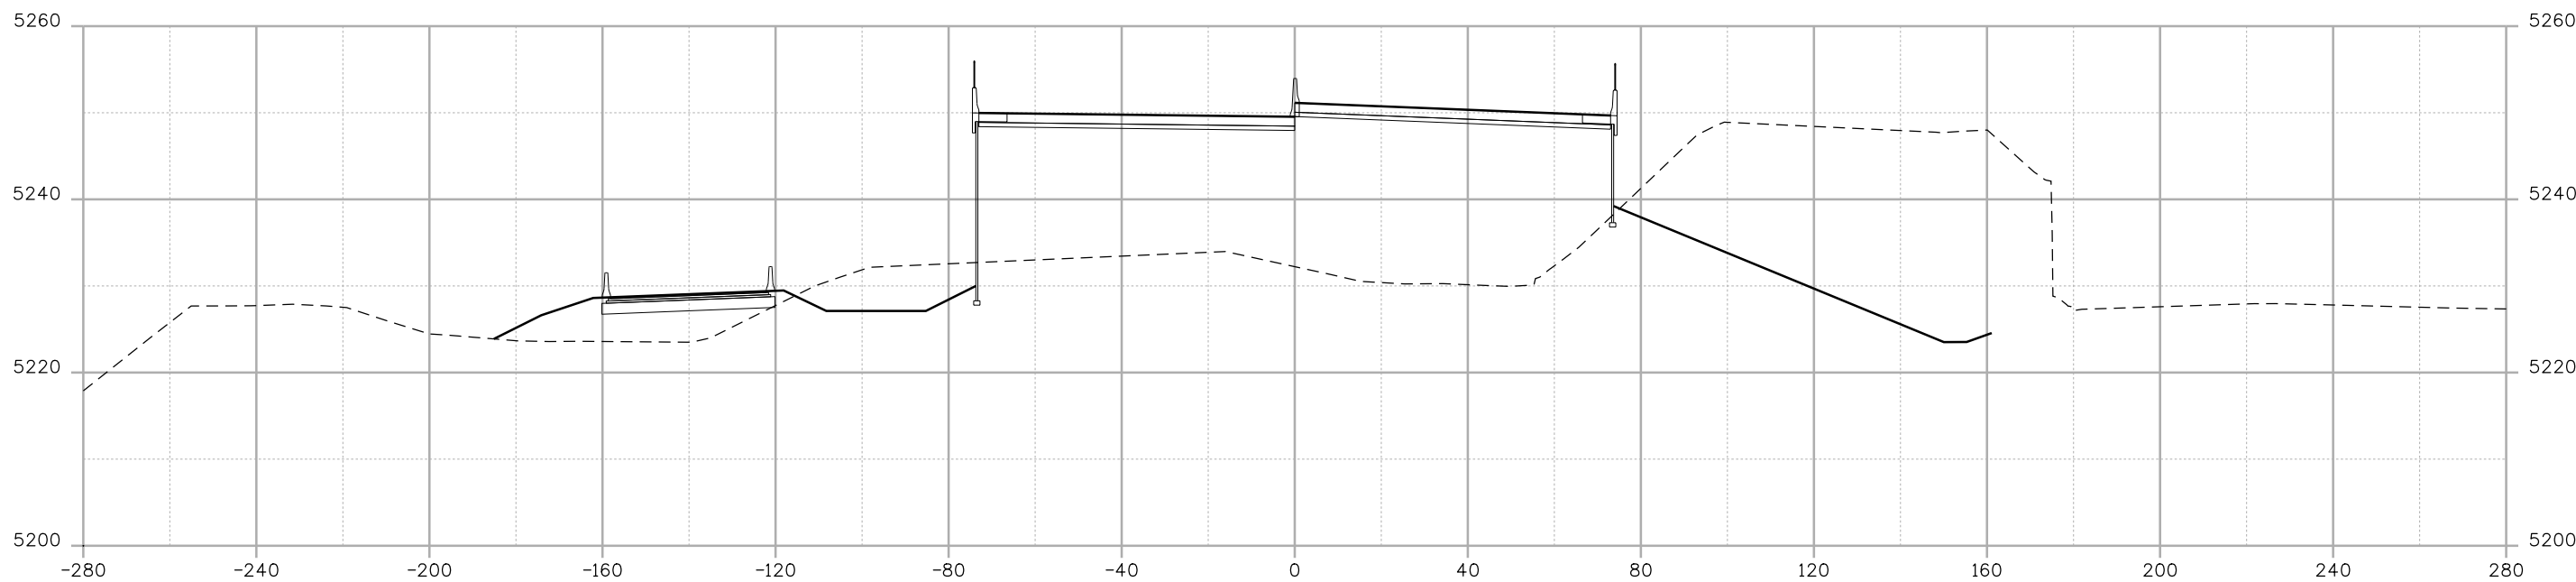

FILL AREA=2551.05 S.F.
CUT AREA=1622.85 S.F.

STA. 637+50

FILL VOLUME=5049.21 C.Y.
CUT VOLUME=1771.71 C.Y.

Print Date: 10/12/2010


File Name: 16311DES_PH2_CrossSections1.dgn

Horiz. Scale: 1:40

Vert. Scale: 1:20

Unit Information

Unit Leader Initials

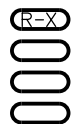

Sheet Revisions

Date:	Comments	Init.

Colorado Department of Transportation



2000 South Holly Street
Denver, CO 80222
Phone: 303-972-9112 FAX: 303-972-9114

Region 6

RLB

As Constructed

No Revisions:

Revised:

Void:

I-25/SANTA FE INTERCHANGE
INTERSTATE 25
CROSS SECTIONS

Designer:	DCS	Structure Numbers	
Detailer:	DCS		
Sheet Subset:	SECTIONS	Subset Sheets:	XS-43 of 104



Project No./Code

BR 0252-407


17783

Sheet Number 43

Dusty 9:12:37 AM K:\08276\16311\Phase 2\Design\Drawings\Cross_Sections\16311DES_PH2_CrossSections1.dgn

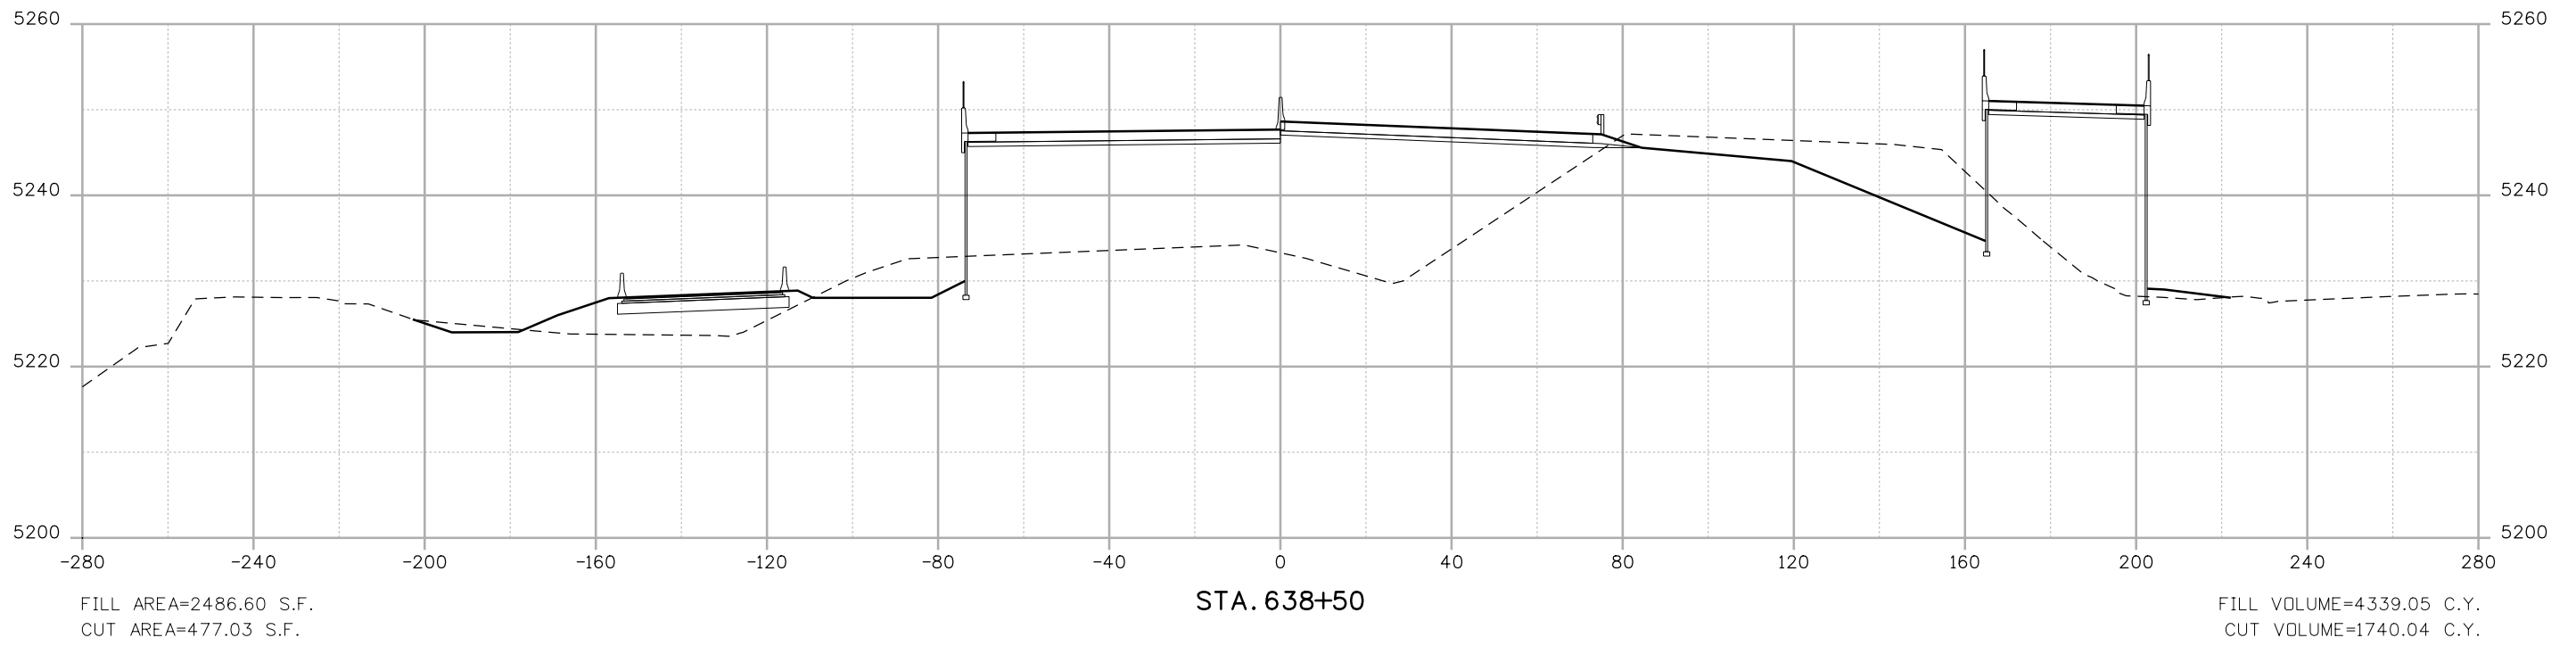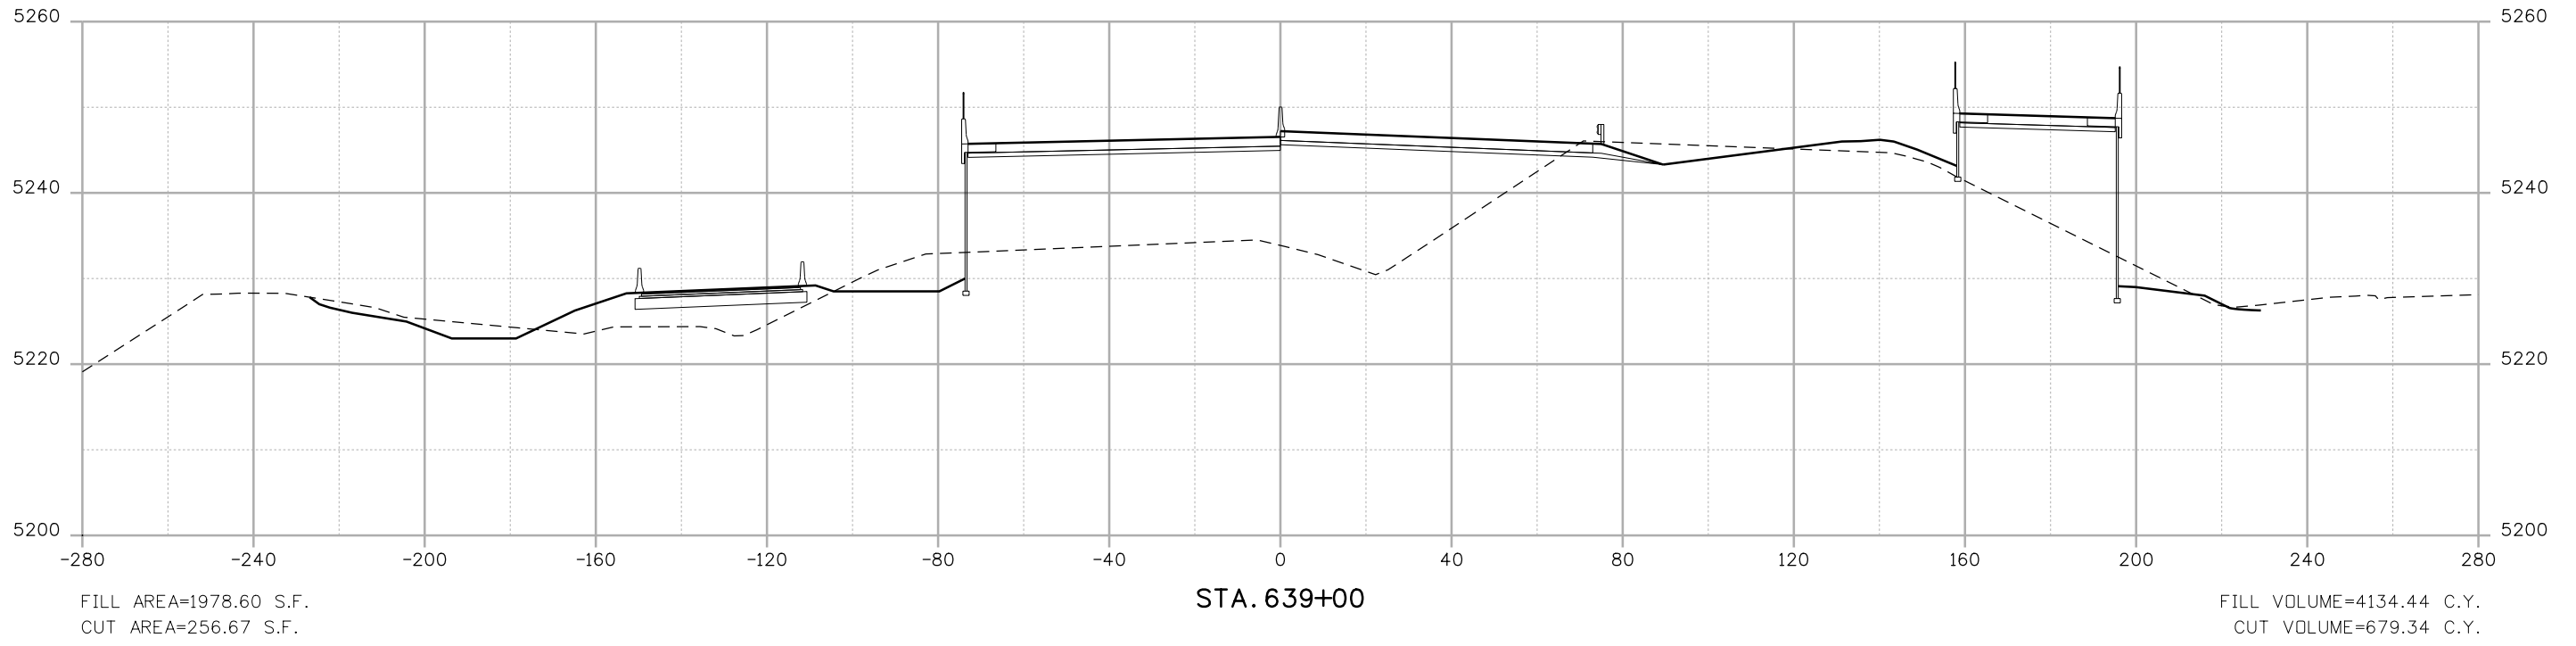

Dusty 9:12:48 AM K:\08276\16311\Phase 2\Design\Drawings\Cross_Sections\16311DES_PH2_CrossSections1.dgn

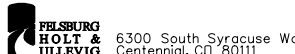Print Date: 10/12/2010	
File Name: 16311DES_PH2_CrossSections1.dgn	
Horiz. Scale: 1:40	Vert. Scale: 1:20
Unit Information	Unit Leader Initials
 6300 South Syracuse Way Centennial, CO 80111	

Sheet Revisions		
Date:	Comments	Init.

Colorado Department of Transportation



2000 South Holly Street
Denver, CO 80222
Phone: 303-972-9112 FAX: 303-972-9114

Region 6 **RLB**


As Constructed
No Revisions:
Revised:
Void:

I-25/SANTA FE INTERCHANGE INTERSTATE 25 CROSS SECTIONS		
Designer: DCS	Structure Numbers	
Detailer: DCS		
Sheet Subset: SECTIONS	Subset Sheets: XS-44 of 104	

Project No./Code
BR 0252-407
17783
Sheet Number 44

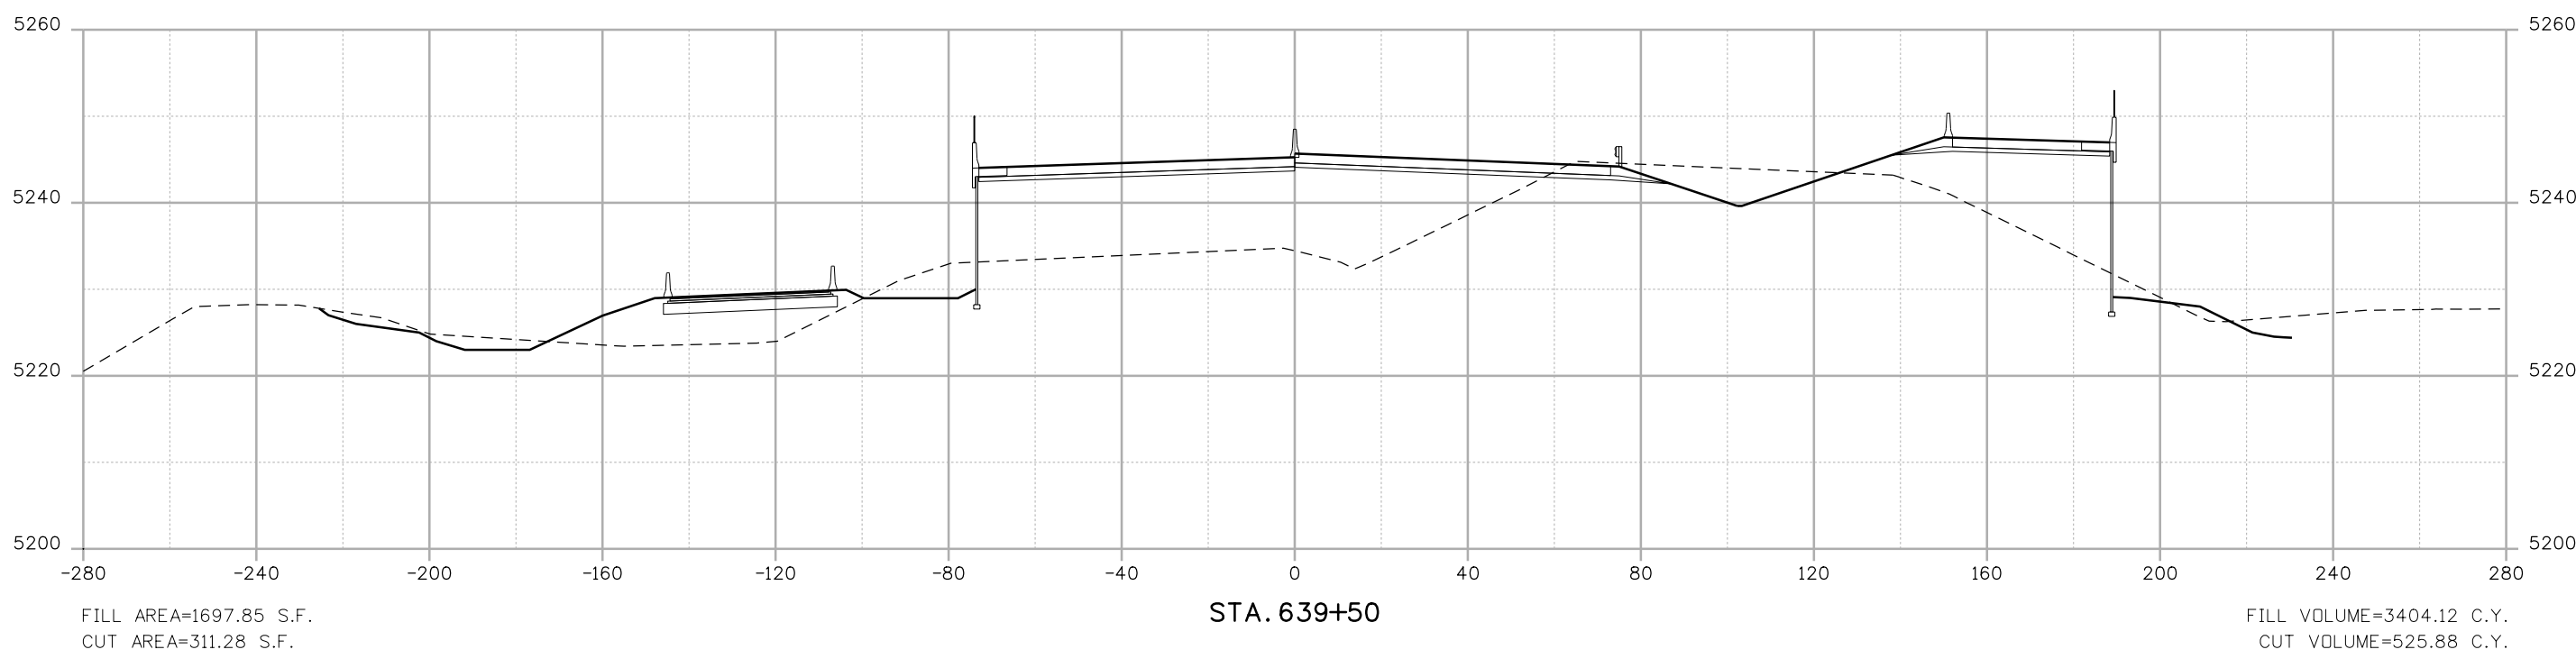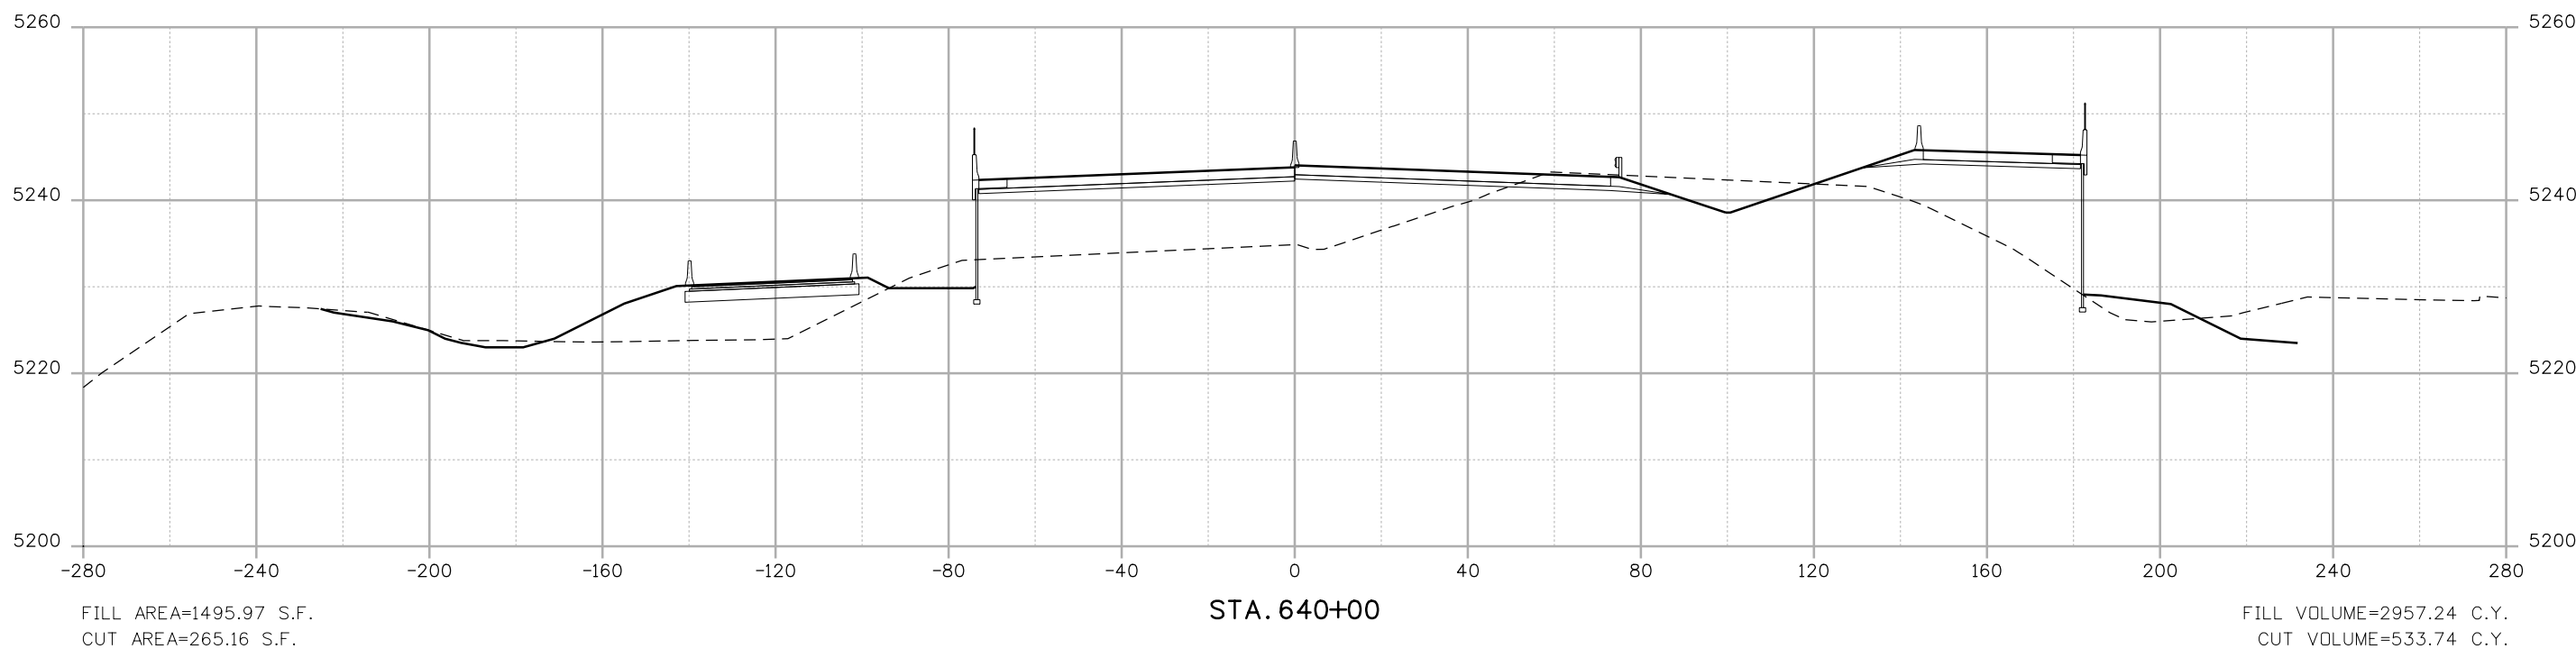

Dusty 9:12:59 AM K:\08276\16311\Phase 2\Design\Drawings\Cross_Sections\16311DES_PH2_CrossSections1.dgn

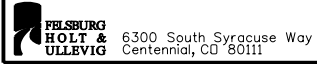Print Date: 10/12/2010	
File Name: 16311DES_PH2_CrossSections1.dgn	
Horiz. Scale: 1:40	Vert. Scale: 1:20
Unit Information	Unit Leader Initials
 6300 South Syracuse Way Centennial, CO 80111	

Sheet Revisions		
Date:	Comments	Init.

Colorado Department of Transportation




 2000 South Holly Street
 Denver, CO 80222
 Phone: 303-972-9112 FAX: 303-972-9114

Region 6 **RLB**

As Constructed
No Revisions:
Revised:
Void:

I-25/SANTA FE INTERCHANGE INTERSTATE 25 CROSS SECTIONS		
Designer: DCS	Structure Numbers	
Detailer: DCS		
Sheet Subset: SECTIONS	Subset Sheets: XS-45 of 104	

Project No./Code
BR 0252-407
17783
Sheet Number 45

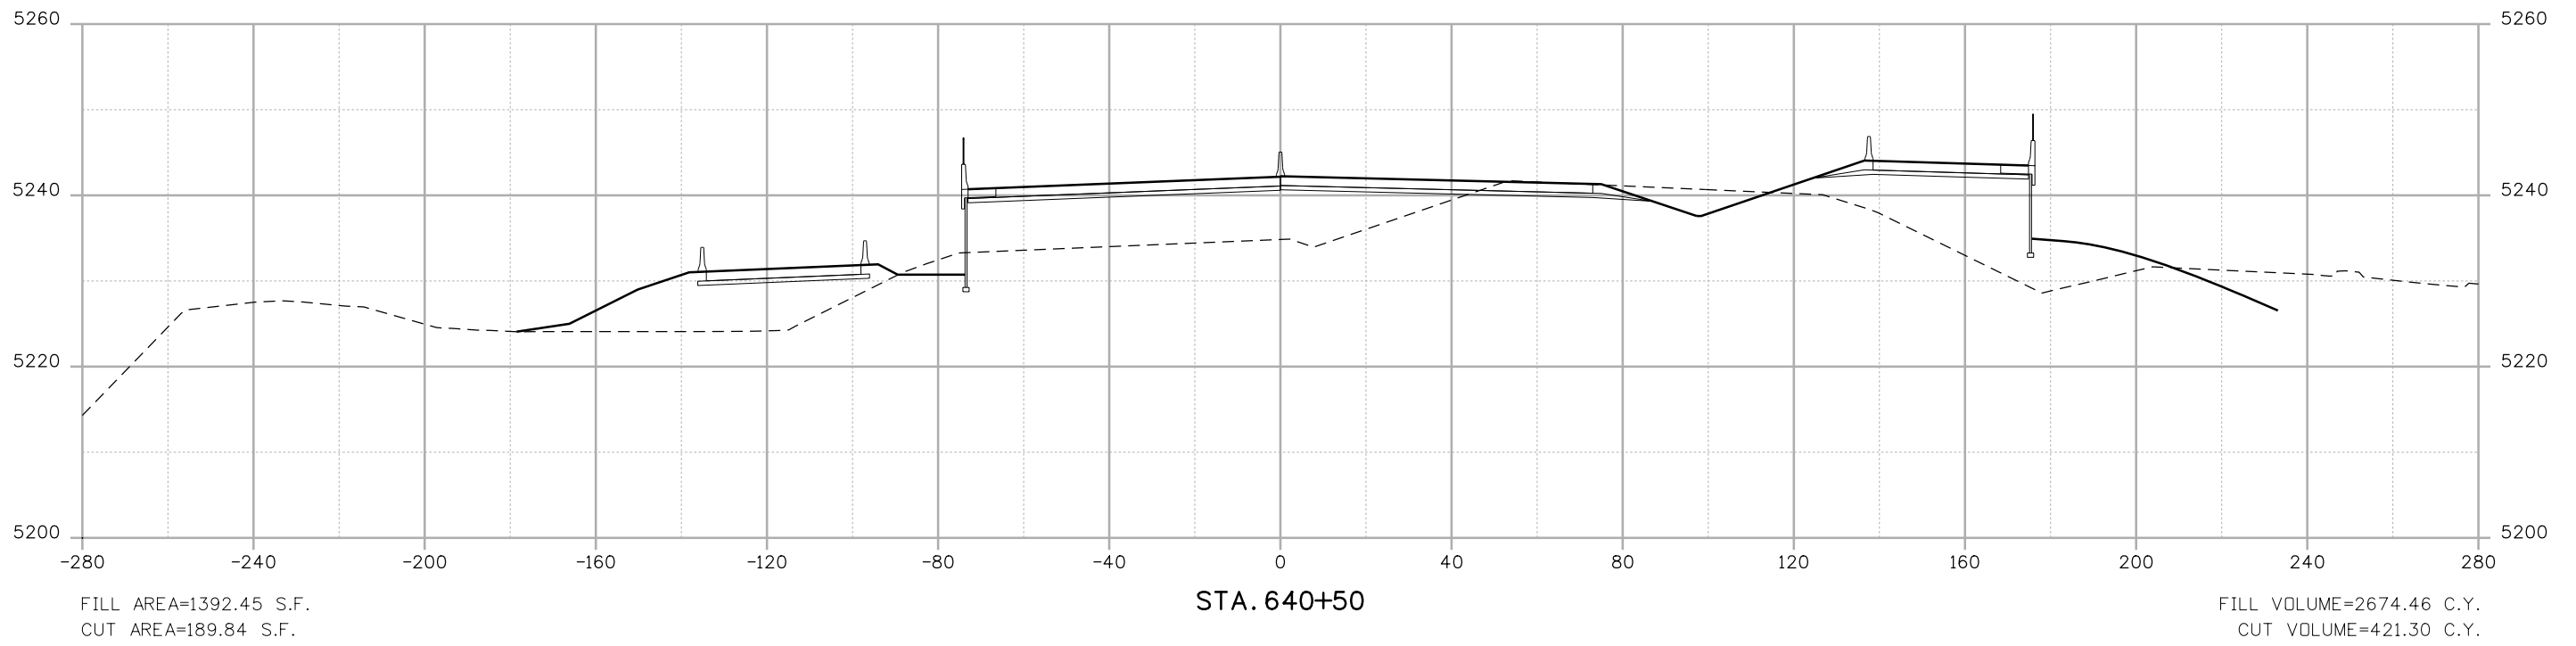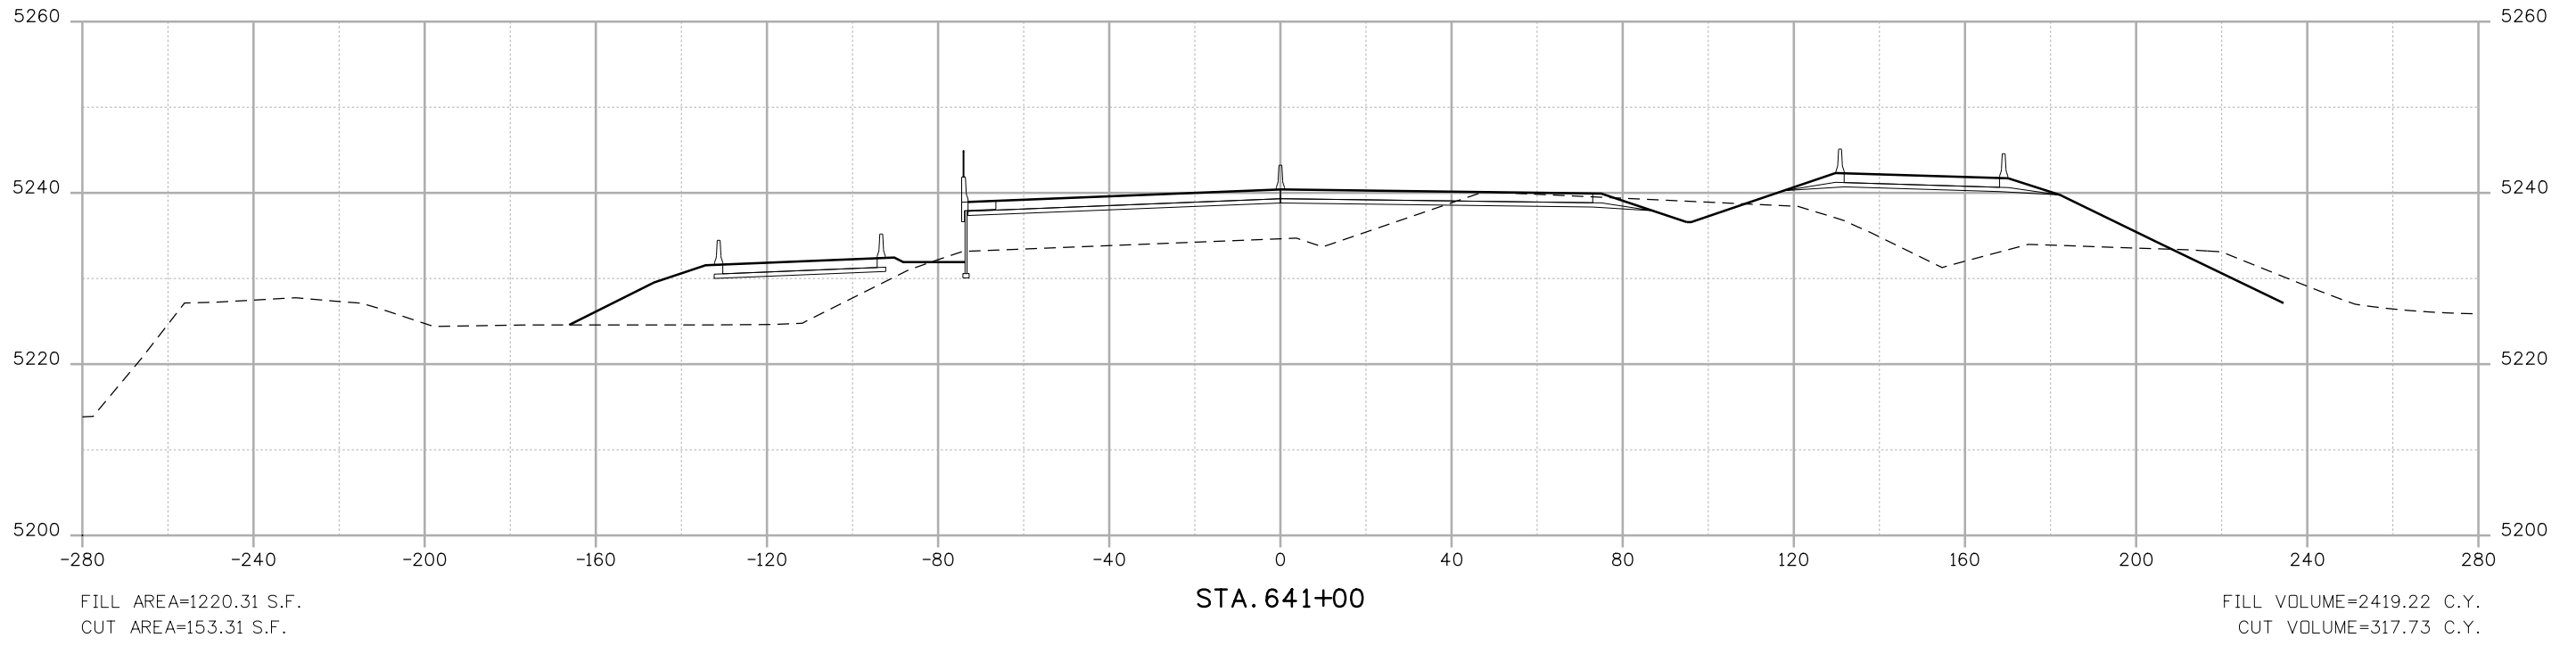

Dusty 9:15:09 AM K:\08276\16311\Phase 2\Design\Drawings\Cross_Sections\16311DES_PH2_CrossSections1.dgn

Print Date: 10/12/2010	
File Name: 16311DES_PH2_CrossSections1.dgn	
Horiz. Scale: 1:40	Vert. Scale: 1:20
Unit Information	Unit Leader Initials

Sheet Revisions		
Date:	Comments	Init.

Colorado Department of Transportation



2000 South Holly Street
Denver, CO 80222
Phone: 303-972-9112 FAX: 303-972-9114

Region 6 **RLB**


As Constructed
No Revisions:
Revised:
Void:

I-25/SANTA FE INTERCHANGE INTERSTATE 25 CROSS SECTIONS		
Designer: DCS	Structure Numbers	
Detailer: DCS		
Sheet Subset: SECTIONS	Subset Sheets: XS-46 of 104	

Project No./Code
BR 0252-407
17783
Sheet Number 46

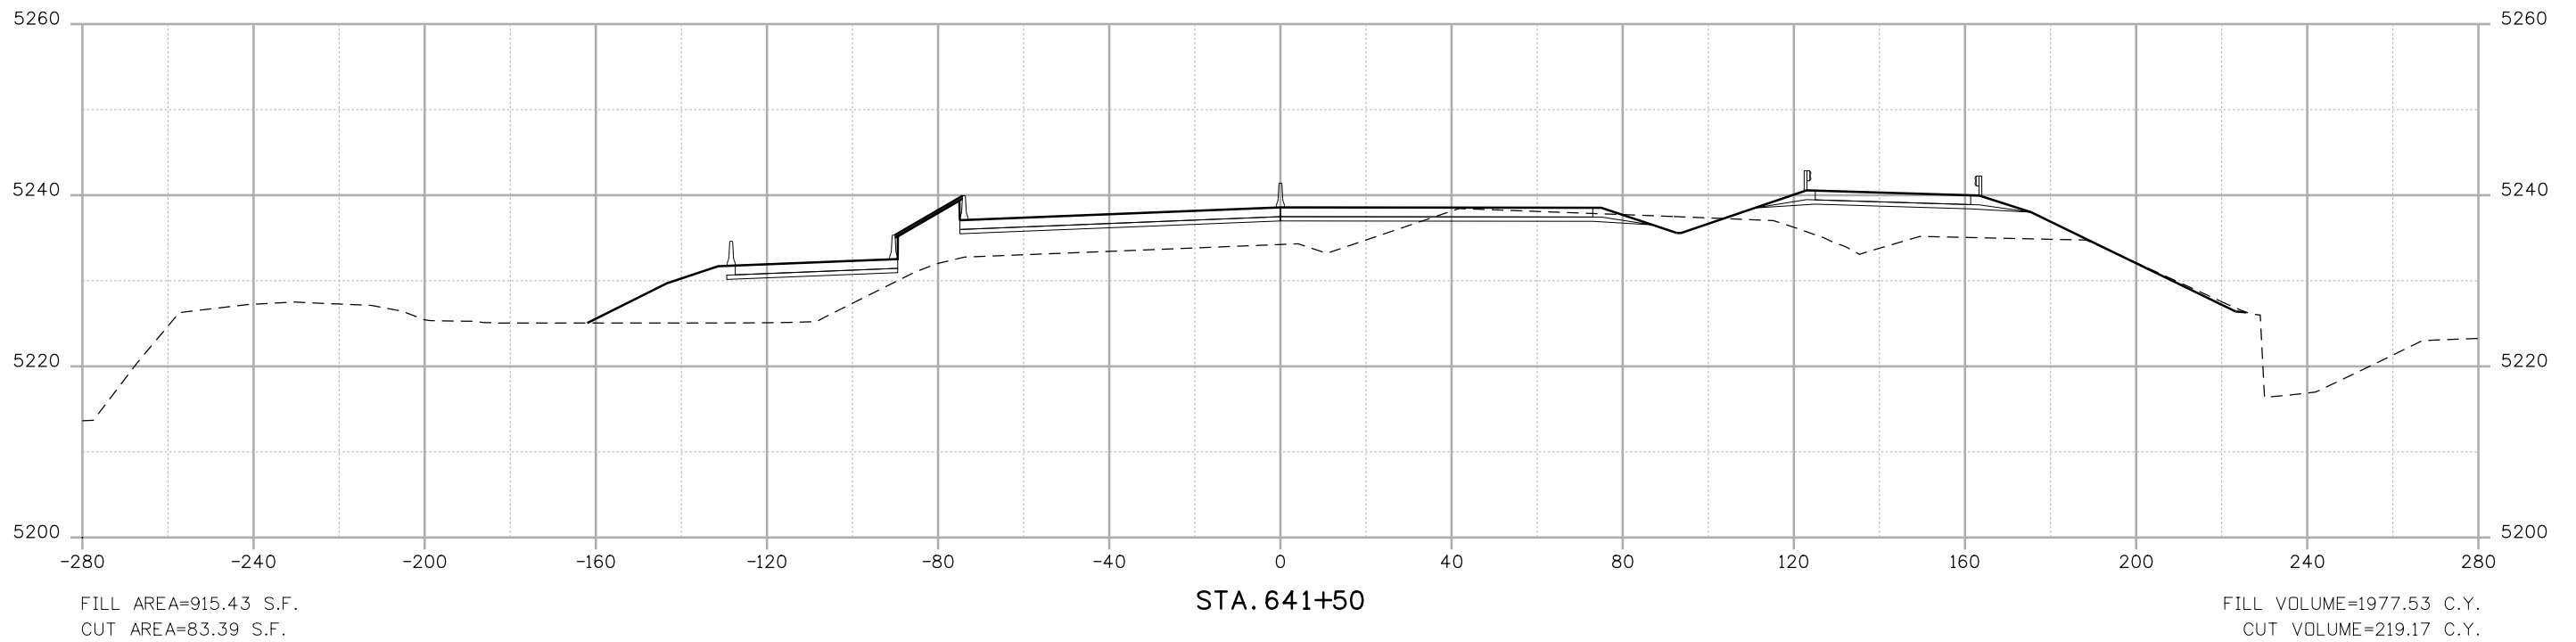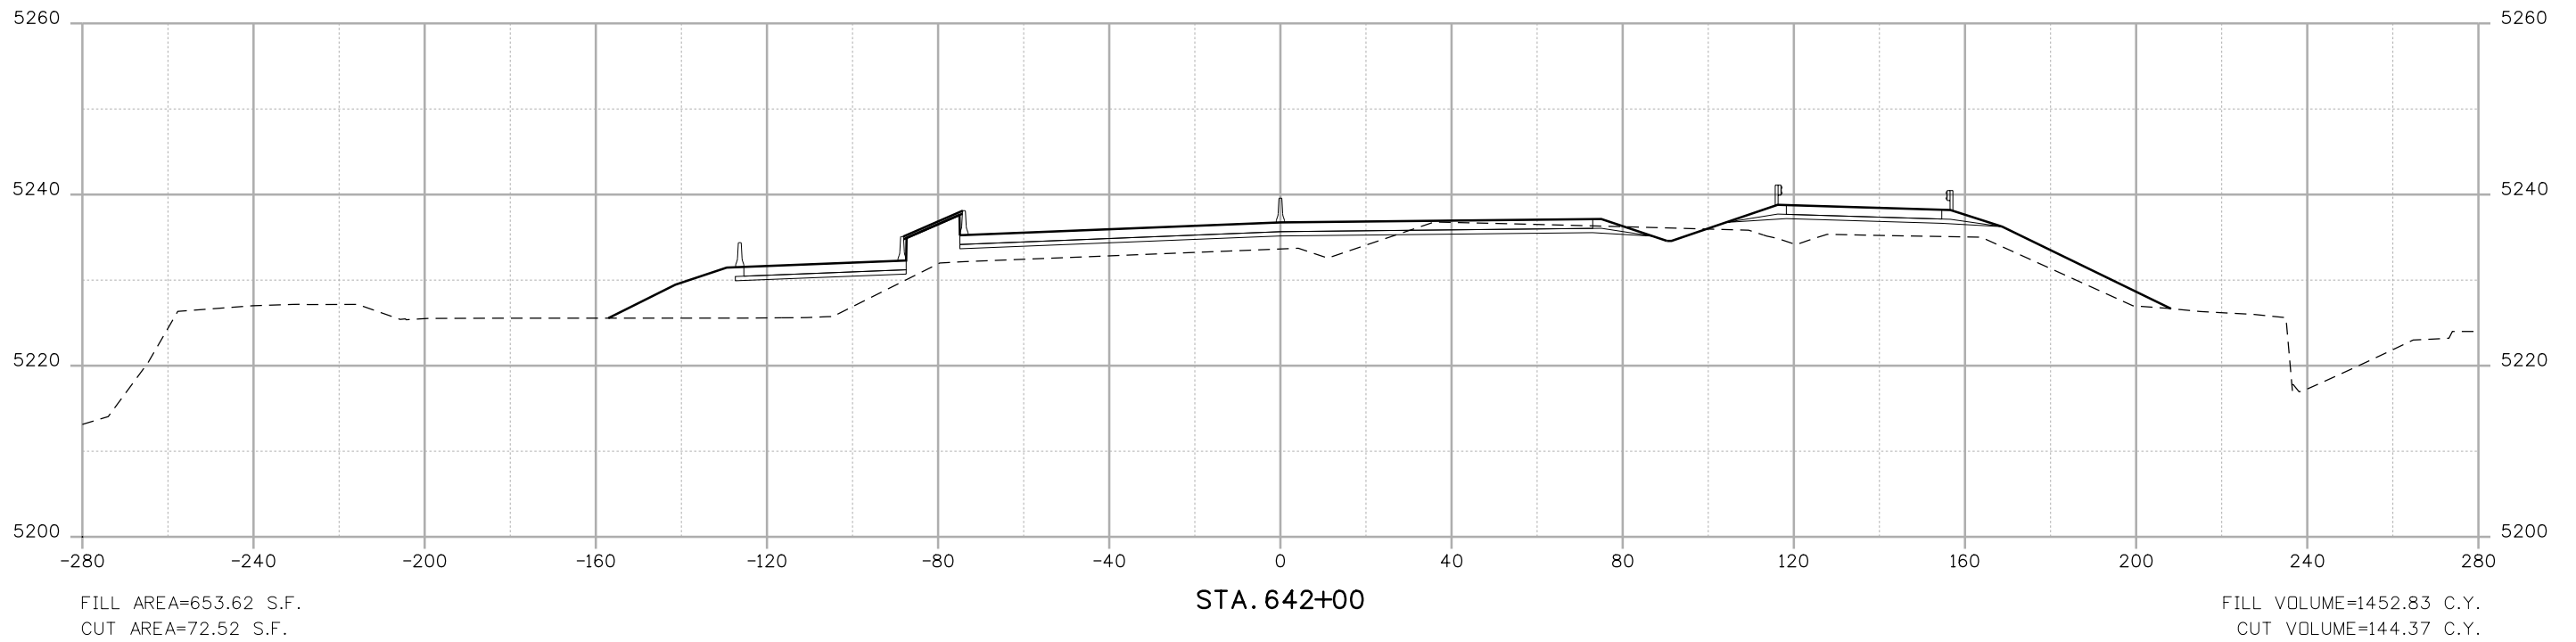

Dusty 9:15:20 AM K:\08276\16311\Phase 2\Design\Drawings\Cross_Sections\16311DES_PH2_CrossSections1.dgn

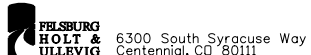Print Date: 10/12/2010	
File Name: 16311DES_PH2_CrossSections1.dgn	
Horiz. Scale: 1:40	Vert. Scale: 1:20
Unit Information	Unit Leader Initials
 6300 South Syracuse Way Centennial, CO 80111	

Sheet Revisions		
Date:	Comments	Init.

Colorado Department of Transportation



2000 South Holly Street
Denver, CO 80222
Phone: 303-972-9112 FAX: 303-972-9114

Region 6 **RLB**


As Constructed
No Revisions:
Revised:
Void:

I-25/SANTA FE INTERCHANGE INTERSTATE 25 CROSS SECTIONS		
Designer: DCS	Structure Numbers	
Detailer: DCS		
Sheet Subset: SECTIONS	Subset Sheets: XS-47 of 104	

Project No./Code
BR 0252-407
17783
Sheet Number 47

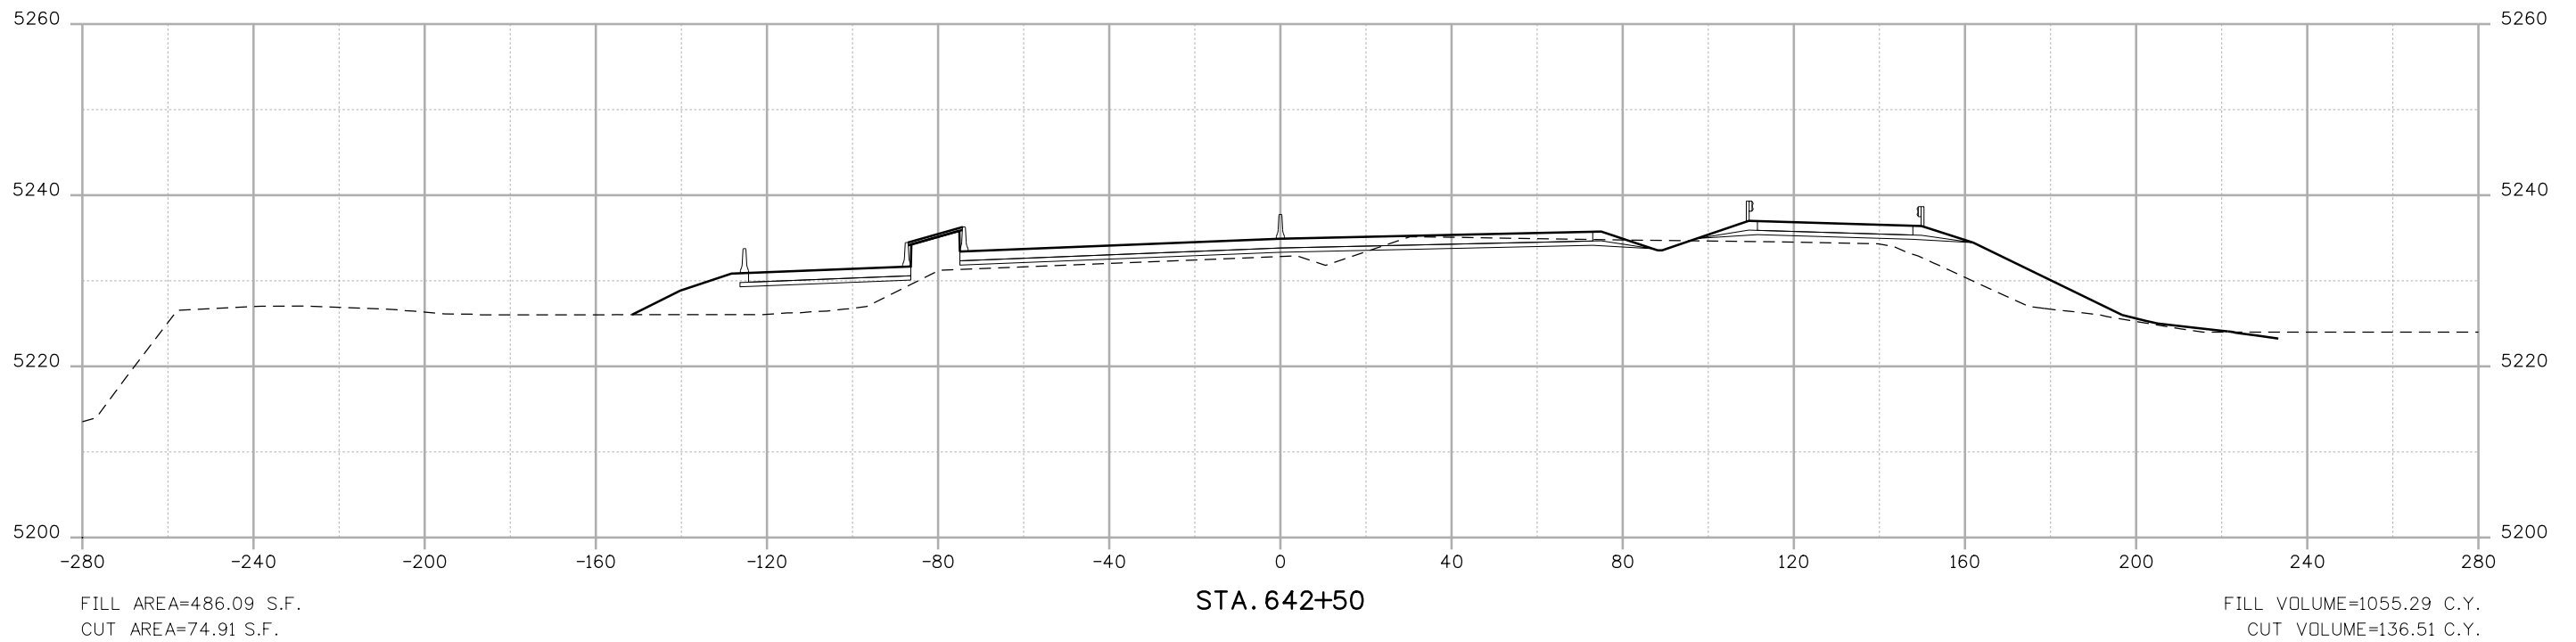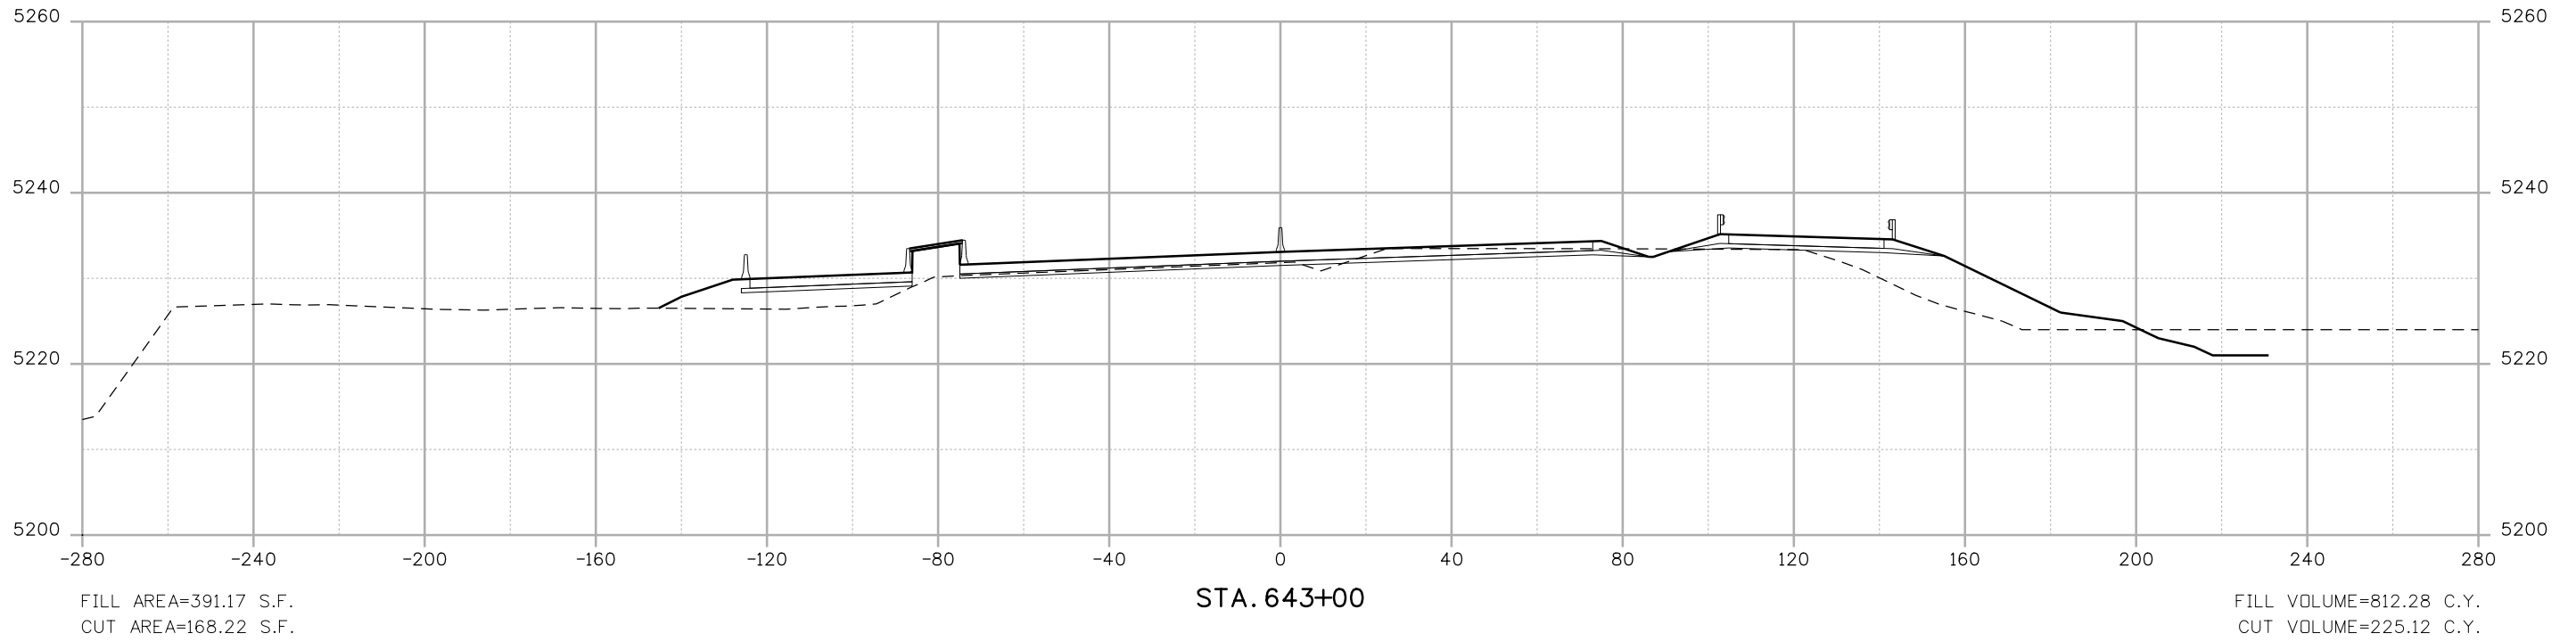

Dusty 9:13:31 AM K:\08276\16311\Phase 2\Design\Drawings\Cross_Sections\16311DES_PH2_CrossSections1.dgn

Print Date: 10/12/2010	
File Name: 16311DES_PH2_CrossSections1.dgn	
Horiz. Scale: 1:40	Vert. Scale: 1:20
Unit Information	Unit Leader Initials
 6300 South Syracuse Way Centennial, CO 80111	

Sheet Revisions		
Date:	Comments	Init.

Colorado Department of Transportation

2000 South Holly Street
Denver, CO 80222
Phone: 303-972-9112 FAX: 303-972-9114



Region 6 **RLB**


As Constructed
No Revisions:
Revised:
Void:

I-25/SANTA FE INTERCHANGE INTERSTATE 25 CROSS SECTIONS		
Designer: DCS	Structure Numbers	
Detailer: DCS		
Sheet Subset: SECTIONS	Subset Sheets: XS-48 of 104	

Project No./Code
BR 0252-407
17783
Sheet Number 48

Dusty 9:13:40 AM K:\08276\16311\Phase 2\Design\Drawings\Cross_Sections\16311DES_PH2_CrossSections1.dgn

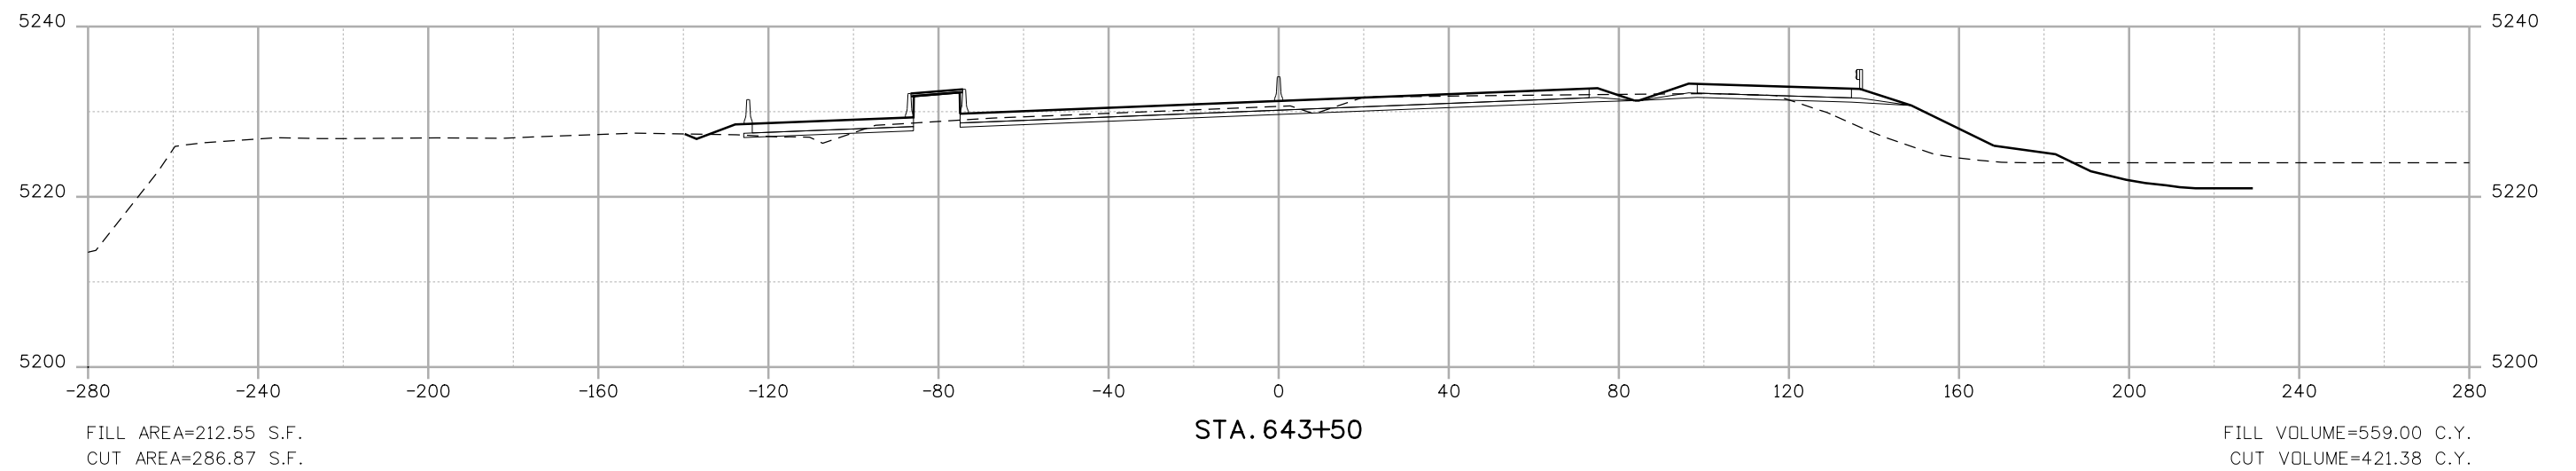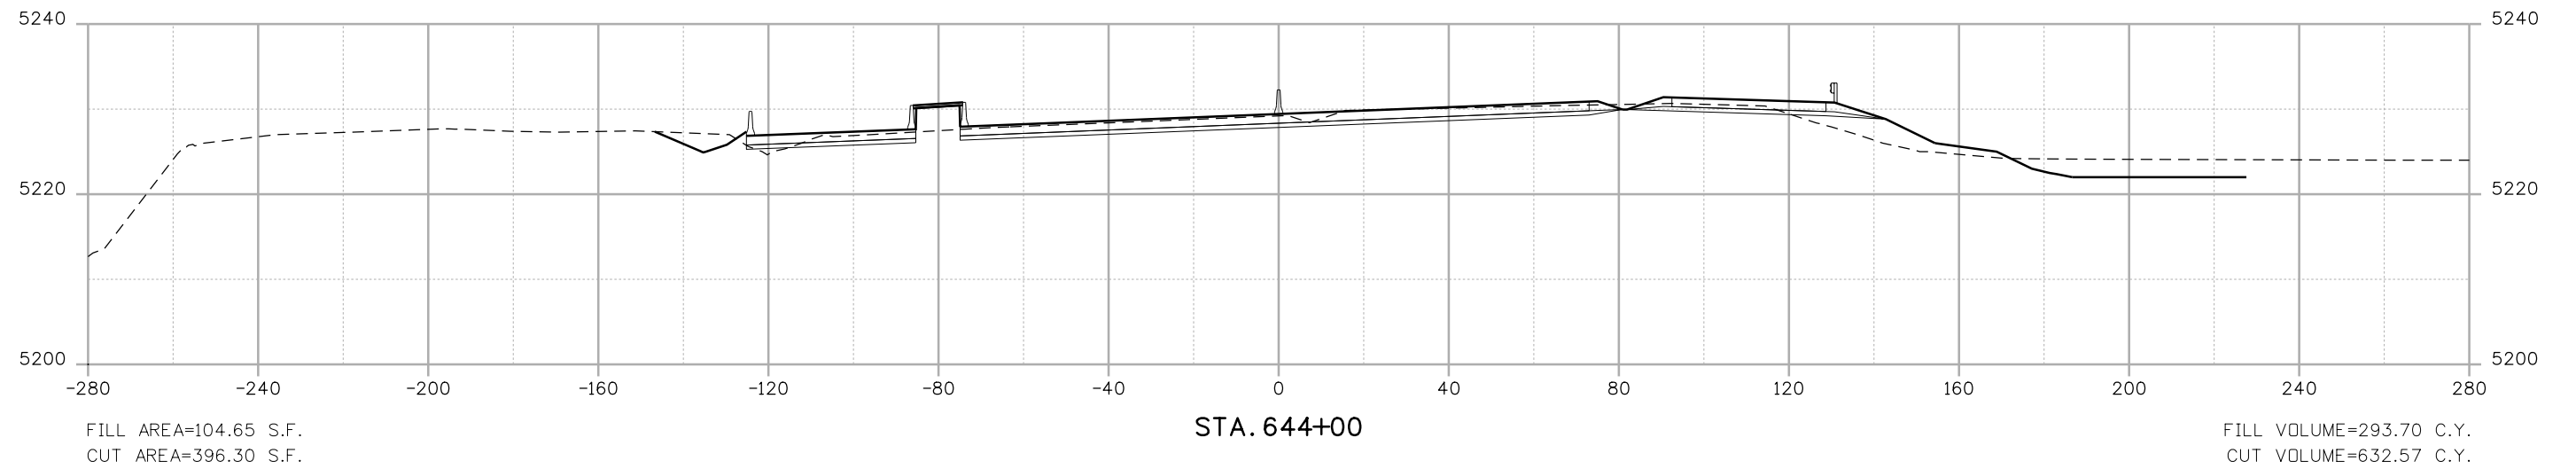

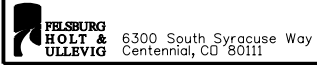Print Date: 10/12/2010	
File Name: 16311DES_PH2_CrossSections1.dgn	
Horiz. Scale: 1:40	Vert. Scale: 1:20
Unit Information	Unit Leader Initials
 6300 South Syracuse Way Centennial, CO 80111	

Sheet Revisions		
Date:	Comments	Init.

Colorado Department of Transportation

2000 South Holly Street
Denver, CO 80222
Phone: 303-972-9112 FAX: 303-972-9114



Region 6 **RLB**

As Constructed
No Revisions:
Revised:
Void:

I-25/SANTA FE INTERCHANGE INTERSTATE 25 CROSS SECTIONS		
Designer: DCS	Structure Numbers	
Detailer: DCS		
Sheet Subset: SECTIONS	Subset Sheets: XS-49 of 104	

Project No./Code
BR 0252-407
17783
Sheet Number 49

Dusty 9:15:50 AM K:\08276\16311\Phase 2\Design\Drawings\Cross_Sections\16311DES_PH2_CrossSections1.dgn

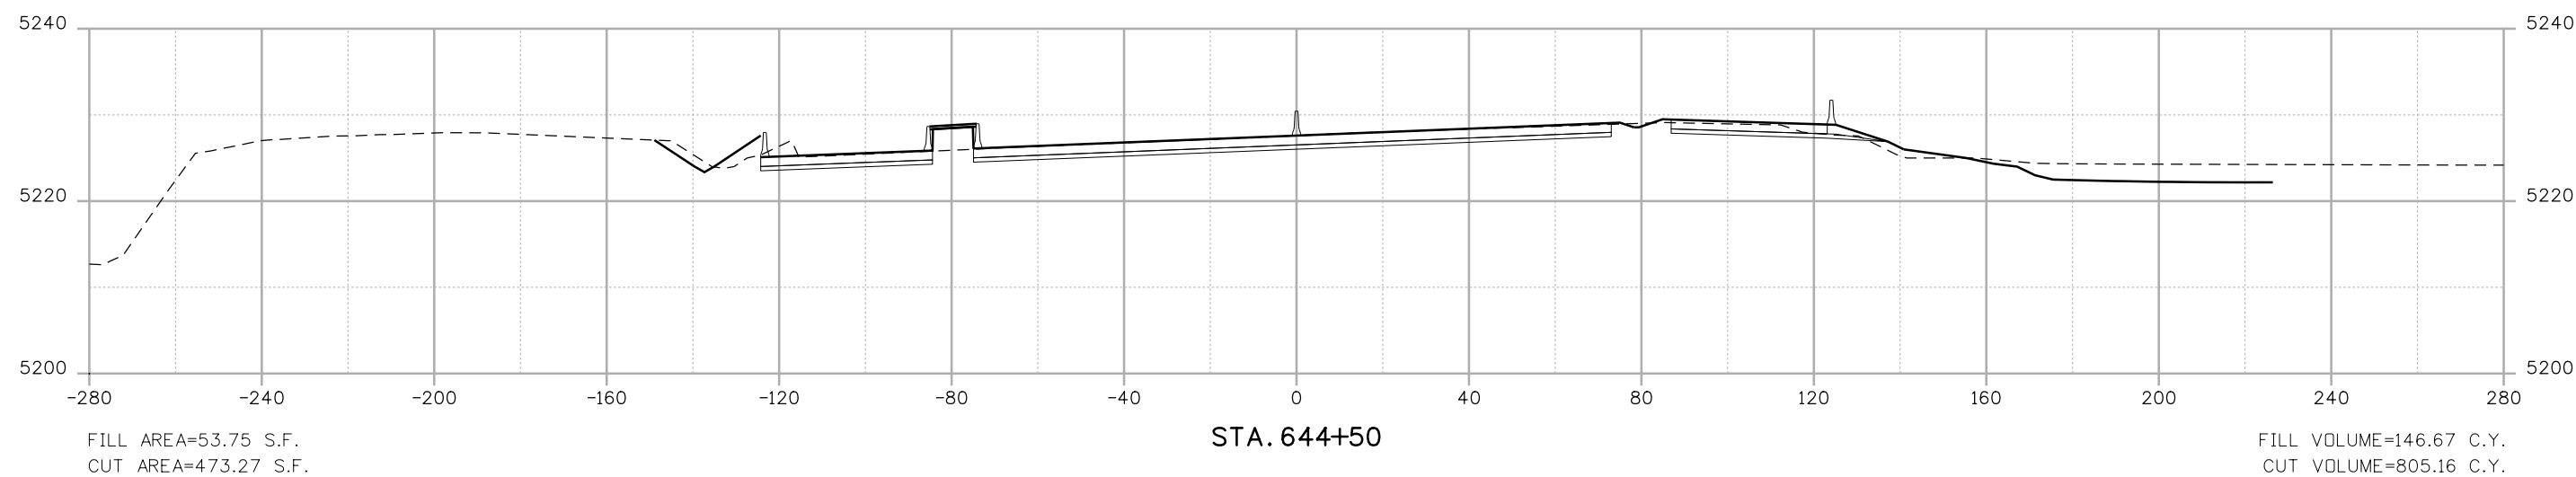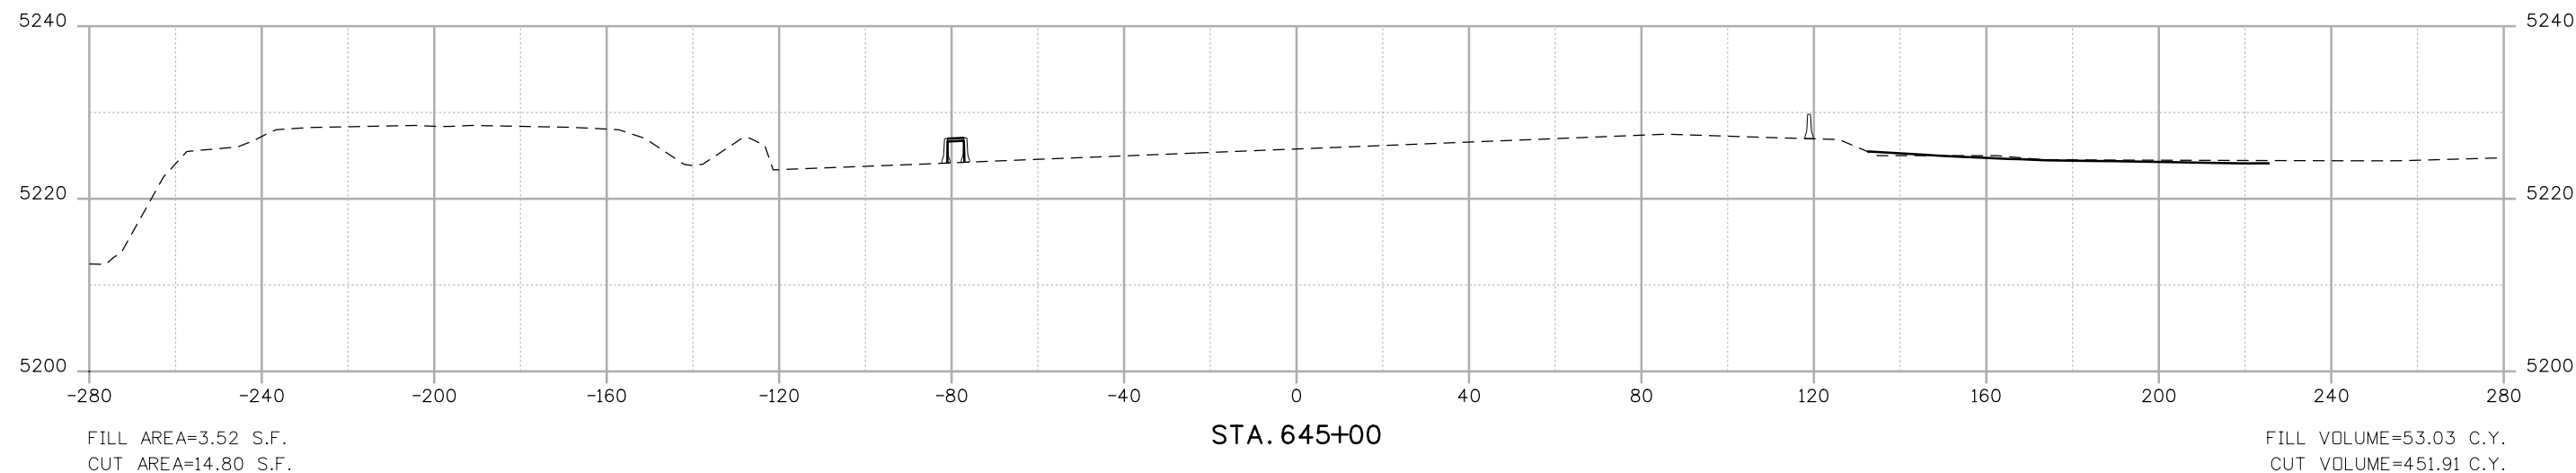

Print Date: 10/12/2010	
File Name: 16311DES_PH2_CrossSections1.dgn	
Horiz. Scale: 1:40	Vert. Scale: 1:20
Unit Information	Unit Leader Initials

Sheet Revisions		
Date:	Comments	Init.

Colorado Department of Transportation

2000 South Holly Street
Denver, CO 80222
Phone: 303-972-9112 FAX: 303-972-9114



Region 6 **RLB**


As Constructed
No Revisions:
Revised:
Void:

I-25/SANTA FE INTERCHANGE INTERSTATE 25 CROSS SECTIONS		
Designer: DCS	Structure Numbers	
Detailer: DCS		
Sheet Subset: SECTIONS	Subset Sheets: XS-50 of 104	

Project No./Code
BR 0252-407
17783
Sheet Number 50

Dusty 9:14:00 AM K:\08276\16311\Phase 2\Design\Drawings\Cross_Sections\16311DES_PH2_CrossSections1.dgn

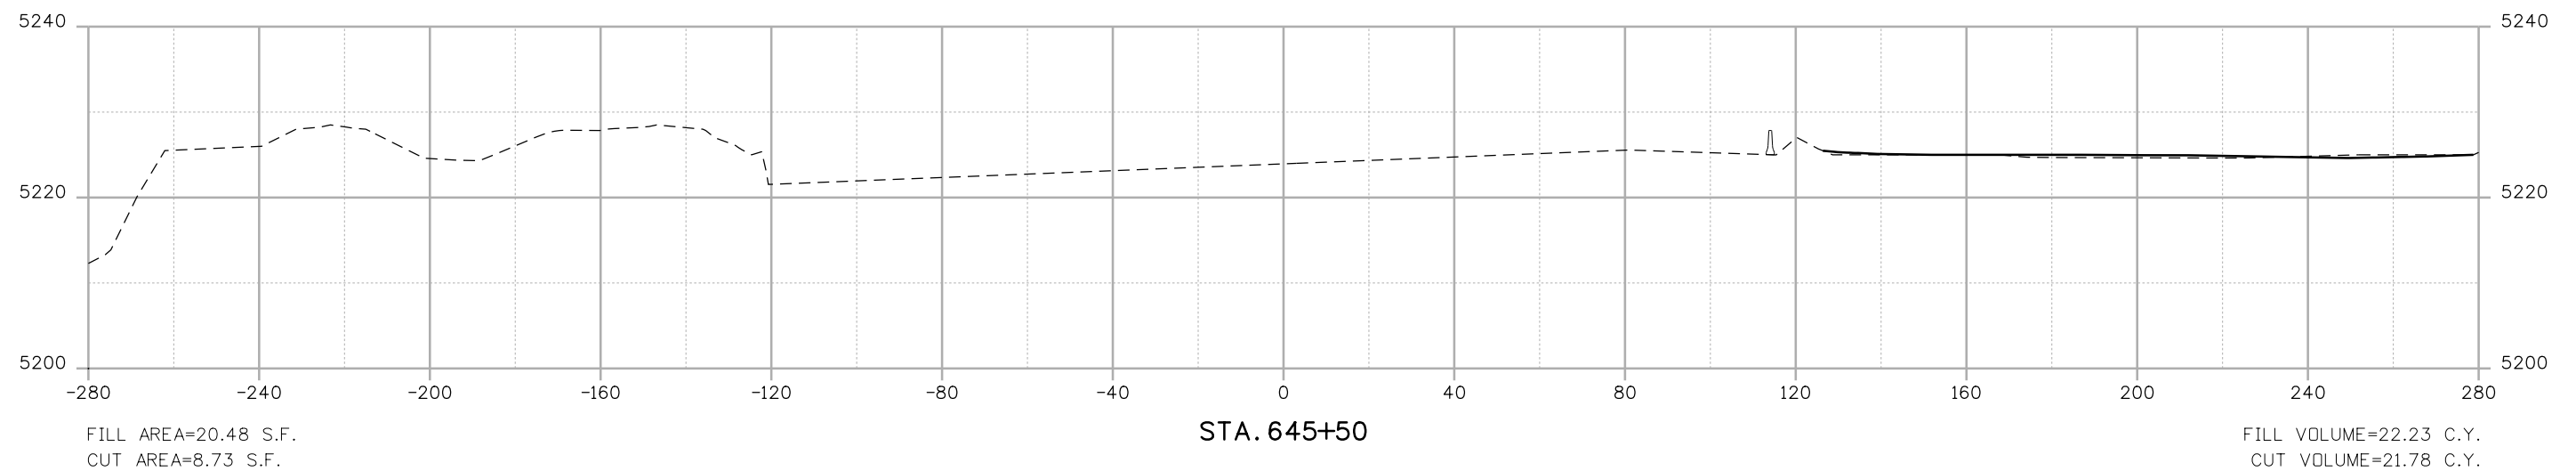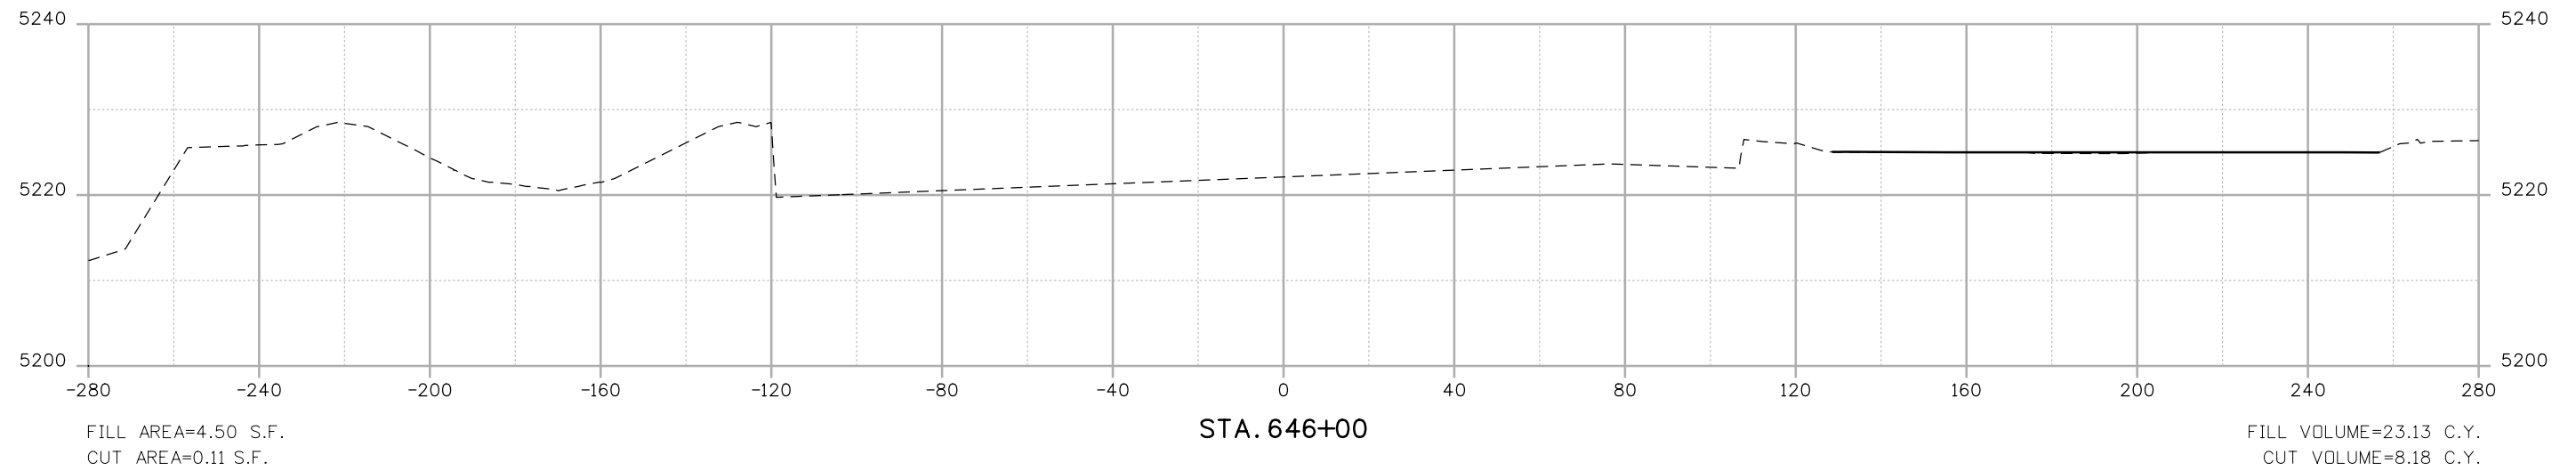

Print Date: 10/12/2010	
File Name: 16311DES_PH2_CrossSections1.dgn	
Horiz. Scale: 1:40	Vert. Scale: 1:20
Unit Information	Unit Leader Initials
 6300 South Syracuse Way Centennial, CO 80111	

Sheet Revisions		
Date:	Comments	Init.

Colorado Department of Transportation

2000 South Holly Street
Denver, CO 80222
Phone: 303-972-9112 FAX: 303-972-9114


Region 6 **RLB**

As Constructed
No Revisions:
Revised:
Void:

I-25/SANTA FE INTERCHANGE INTERSTATE 25 CROSS SECTIONS		
Designer: DCS	Structure Numbers	
Detailer: DCS		
Sheet Subset: SECTIONS	Subset Sheets: XS-51 of 104	

Project No./Code
BR 0252-407
17783
Sheet Number 51


Dusty 9:14:11 AM K:\08276\16311\Phase 2\Design\Drawings\Cross_Sections\16311DES_PH2_CrossSections1.dgn

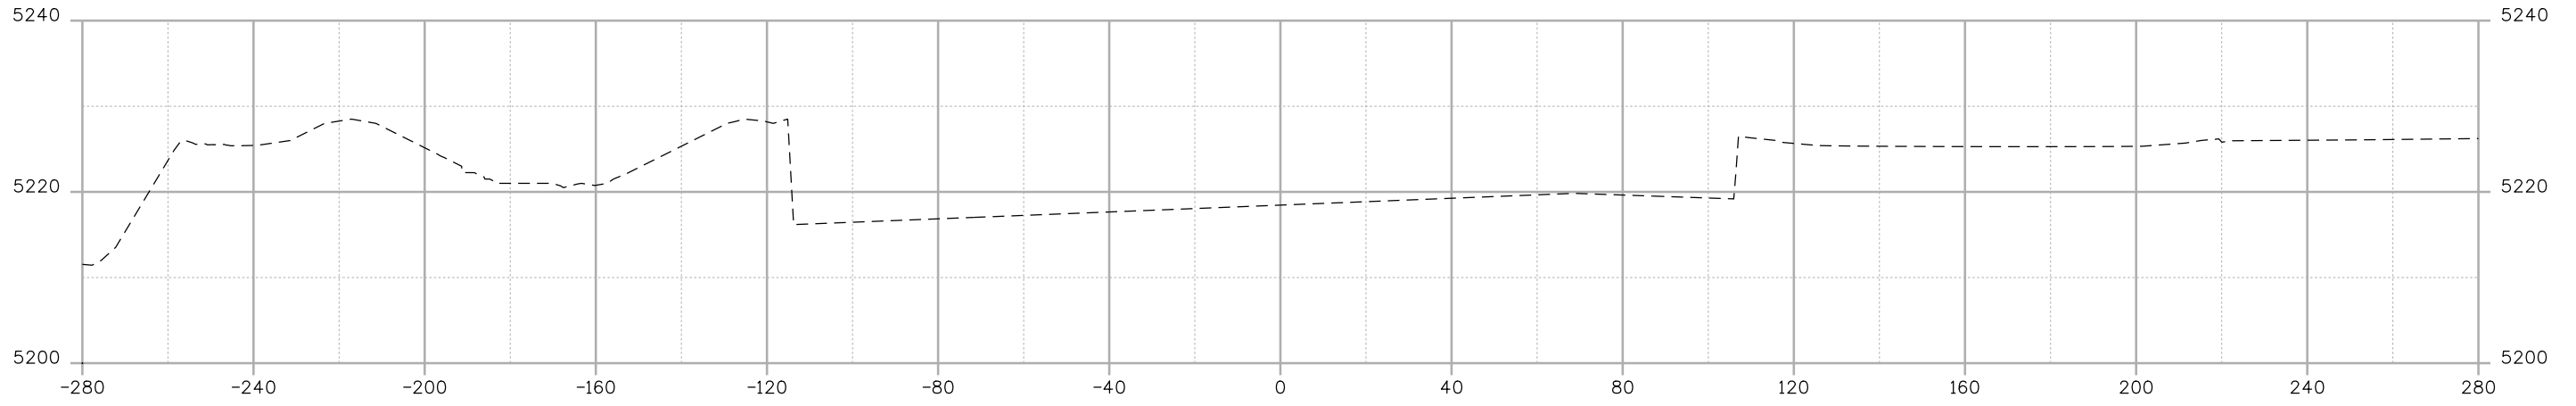

STA. 647+00

FILL AREA=0.00 S.F.
CUT AREA=0.00 S.F.

FILL VOLUME=0.00 C.Y.
CUT VOLUME=4.22 C.Y.

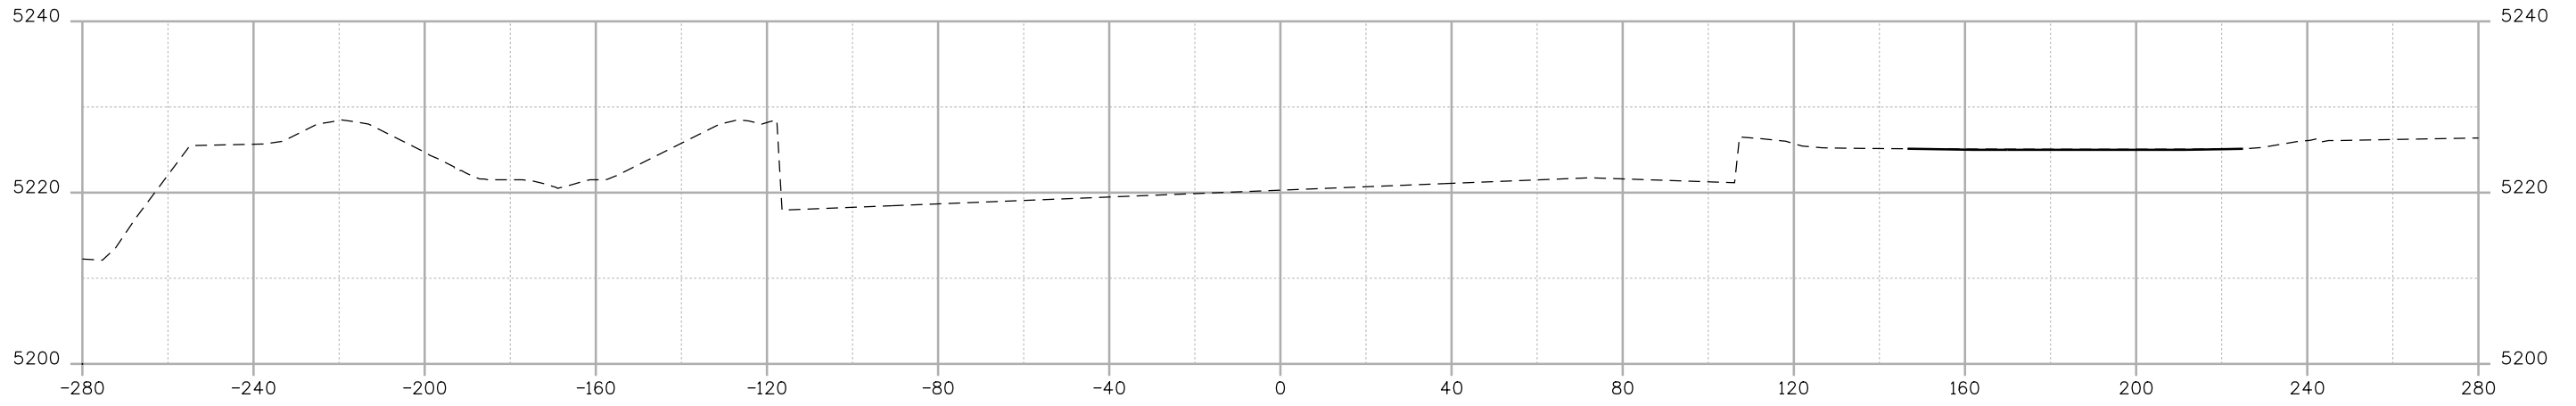

STA. 646+50

FILL AREA=0.00 S.F.
CUT AREA=4.56 S.F.

FILL VOLUME=4.16 C.Y.
CUT VOLUME=4.32 C.Y.

Print Date: 10/12/2010	
File Name: 16311DES_PH2_CrossSections1.dgn	
Horiz. Scale: 1:40	Vert. Scale: 1:20
Unit Information	Unit Leader Initials

Sheet Revisions		
Date:	Comments	Init.

Colorado Department of Transportation



2000 South Holly Street
 Denver, CO 80222
 Phone: 303-972-9112 FAX: 303-972-9114

Region 6 RLB


As Constructed
No Revisions:
Revised:
Void:

I-25/SANTA FE INTERCHANGE INTERSTATE 25 CROSS SECTIONS		
Designer: DCS	Structure Numbers	
Detailer: DCS	Sheet Subset: SECTIONS	Subset Sheets: XS-52 of 104

Project No./Code	BR 0252-407
	17783
Sheet Number	52

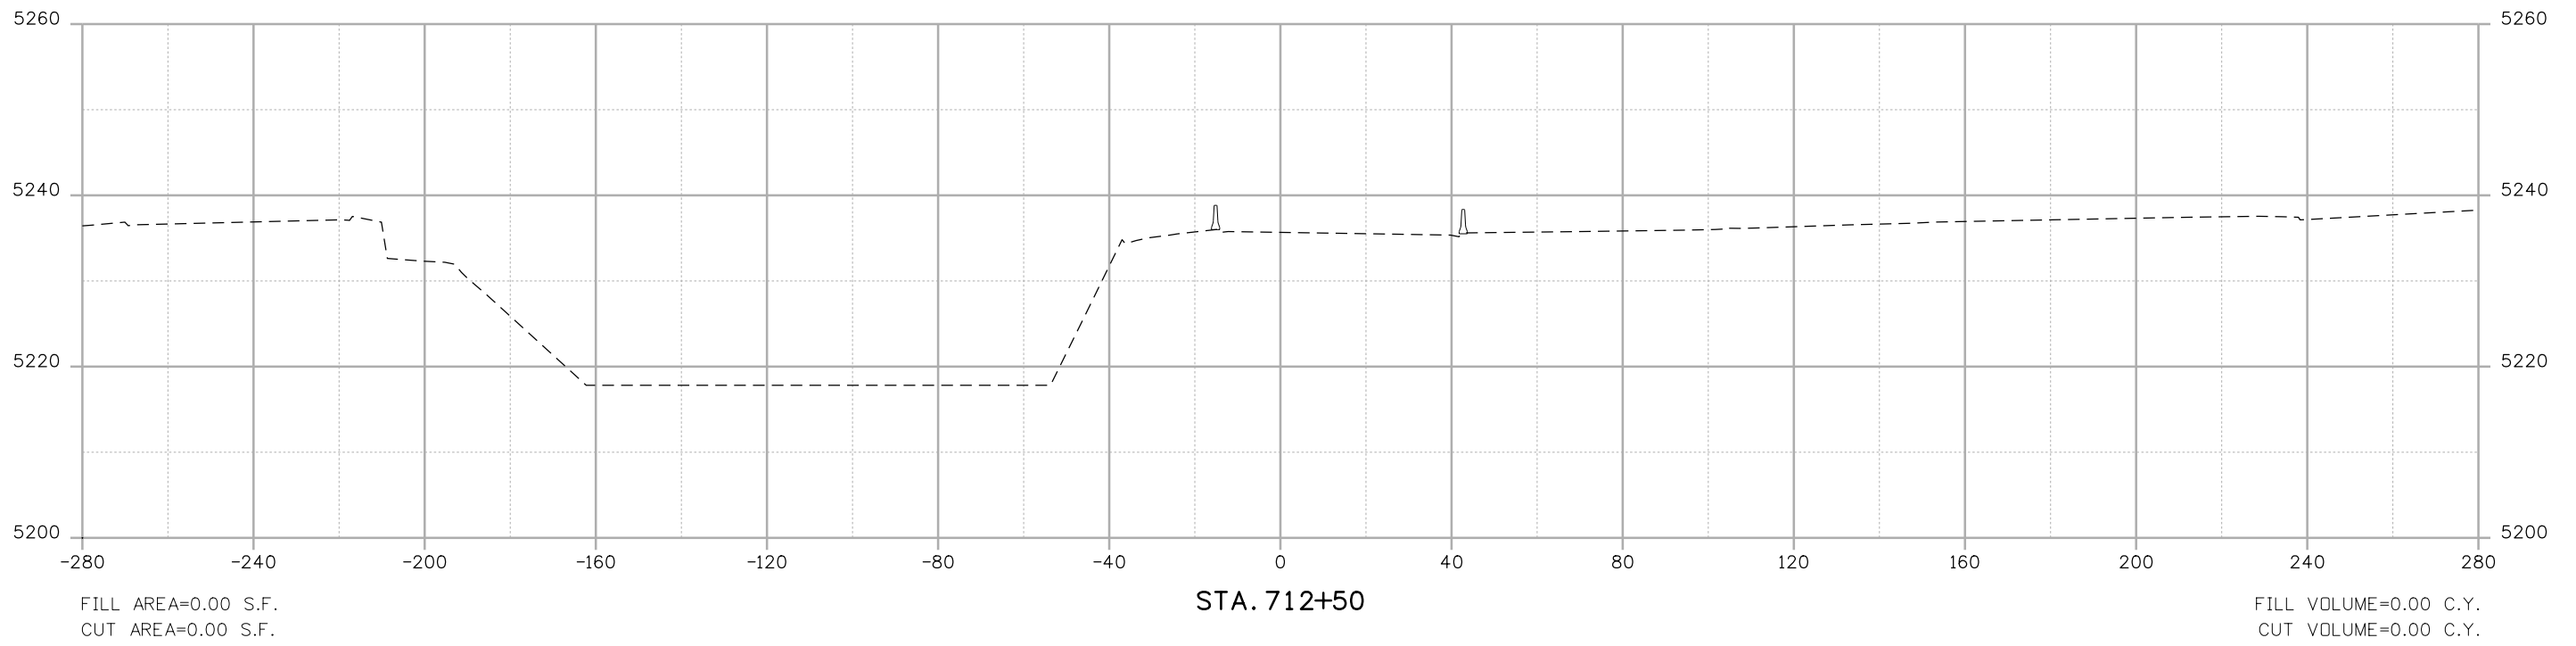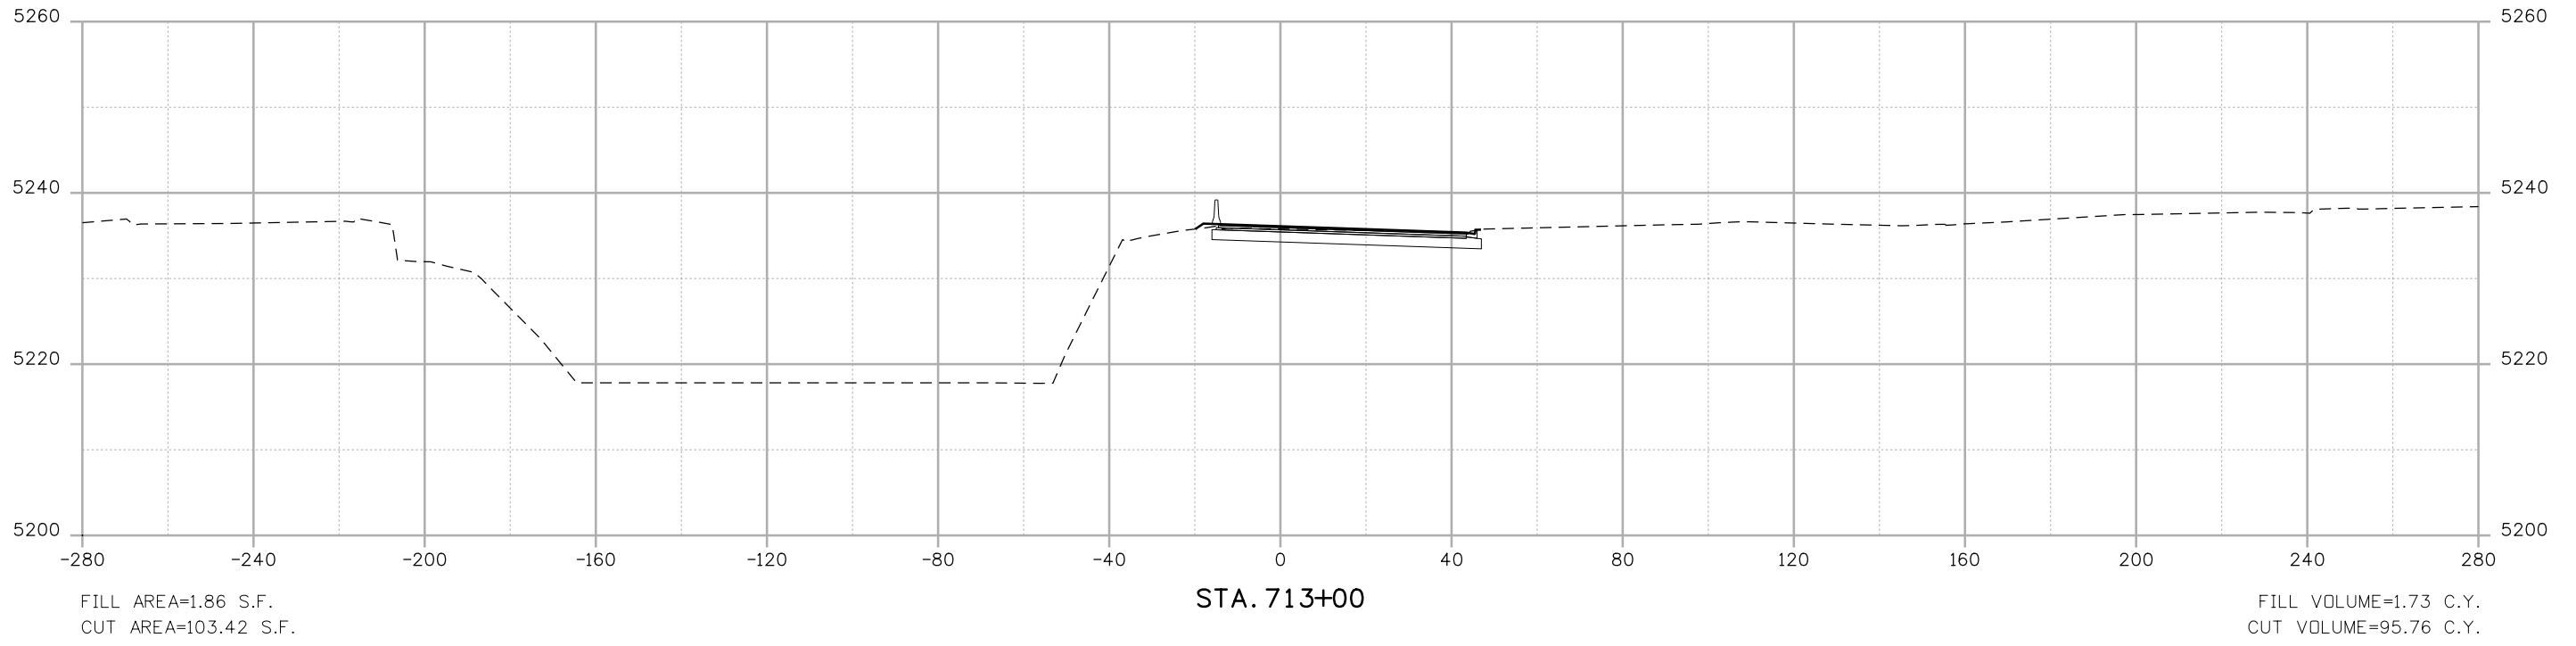

Dusty 9/14/24 AM K:\08276\16311\Phase 2\Design\Drawings\Cross_Sections\1631DES_PH2_CrossSections1.dgn

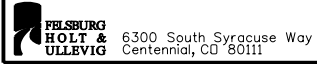Print Date: 10/12/2010	
File Name: 16311DES_PH2_CrossSections1.dgn	
Horiz. Scale: 1:40	Vert. Scale: 1:20
Unit Information	Unit Leader Initials
 6300 South Syracuse Way Centennial, CO 80111	

Sheet Revisions		
Date:	Comments	Init.

Colorado Department of Transportation



2000 South Holly Street
Denver, CO 80222
Phone: 303-972-9112 FAX: 303-972-9114

Region 6 **RLB**

As Constructed
No Revisions:
Revised:
Void:

I-25/SANTA FE INTERCHANGE SANTA FE DRIVE CROSS SECTIONS		
Designer: DCS	Structure Numbers	
Detailer: DCS		
Sheet Subset: SECTIONS	Subset Sheets: XS-53 of 104	

Project No./Code
BR 0252-407
17783
Sheet Number 53

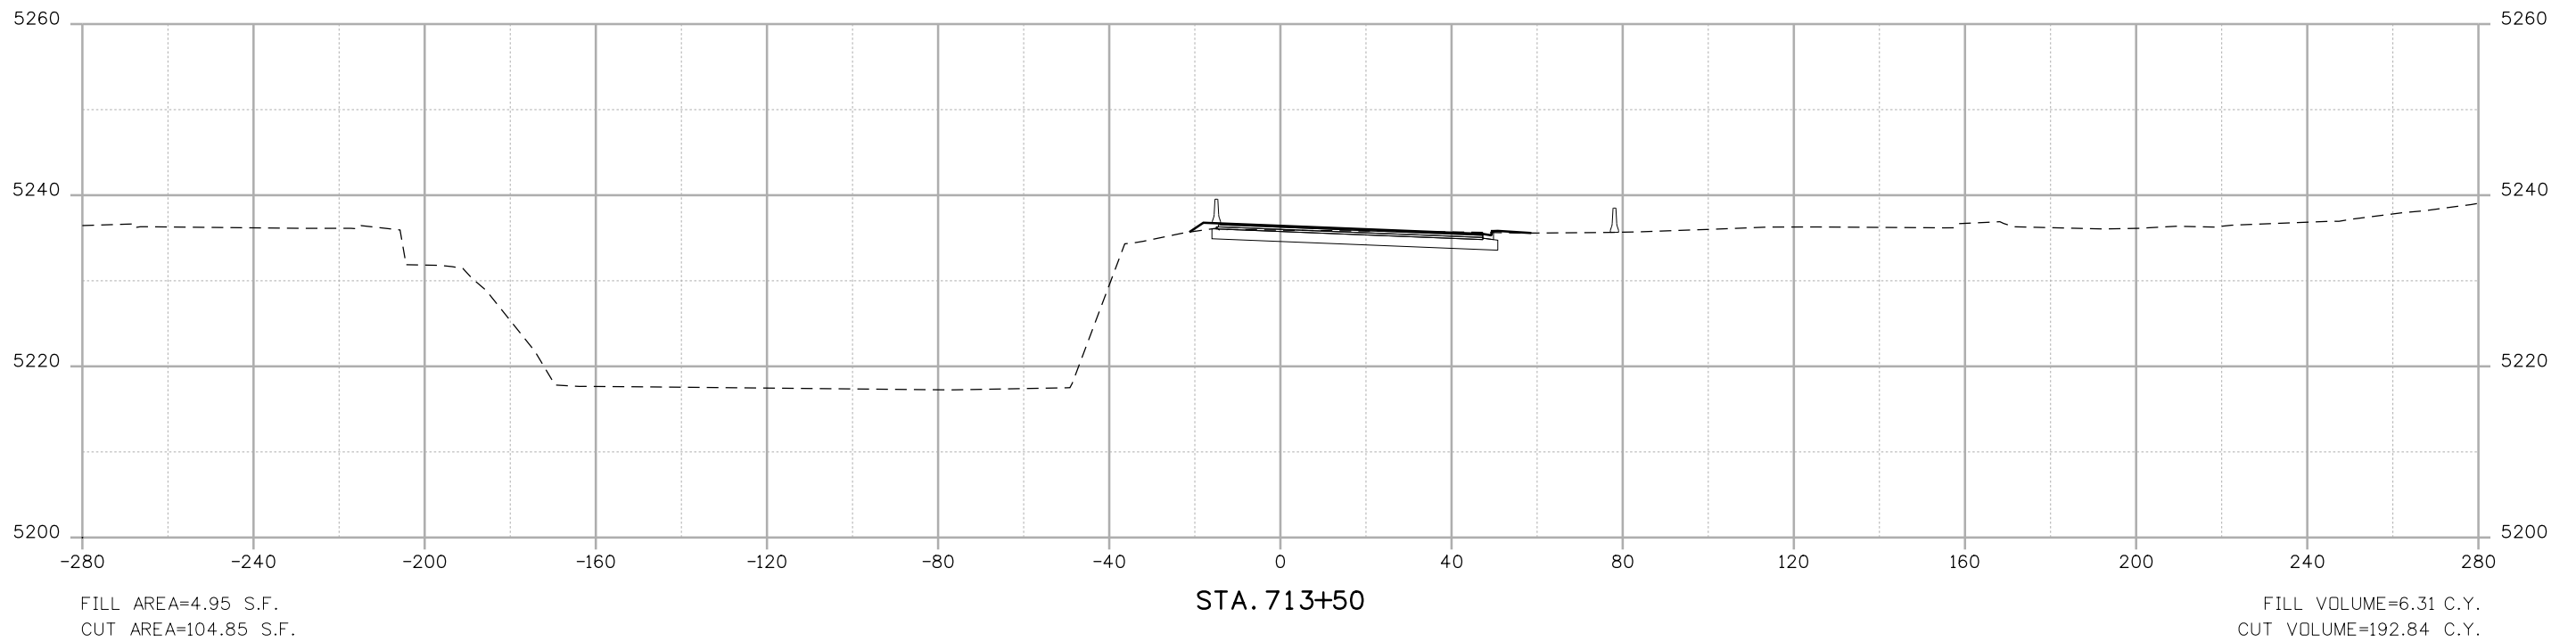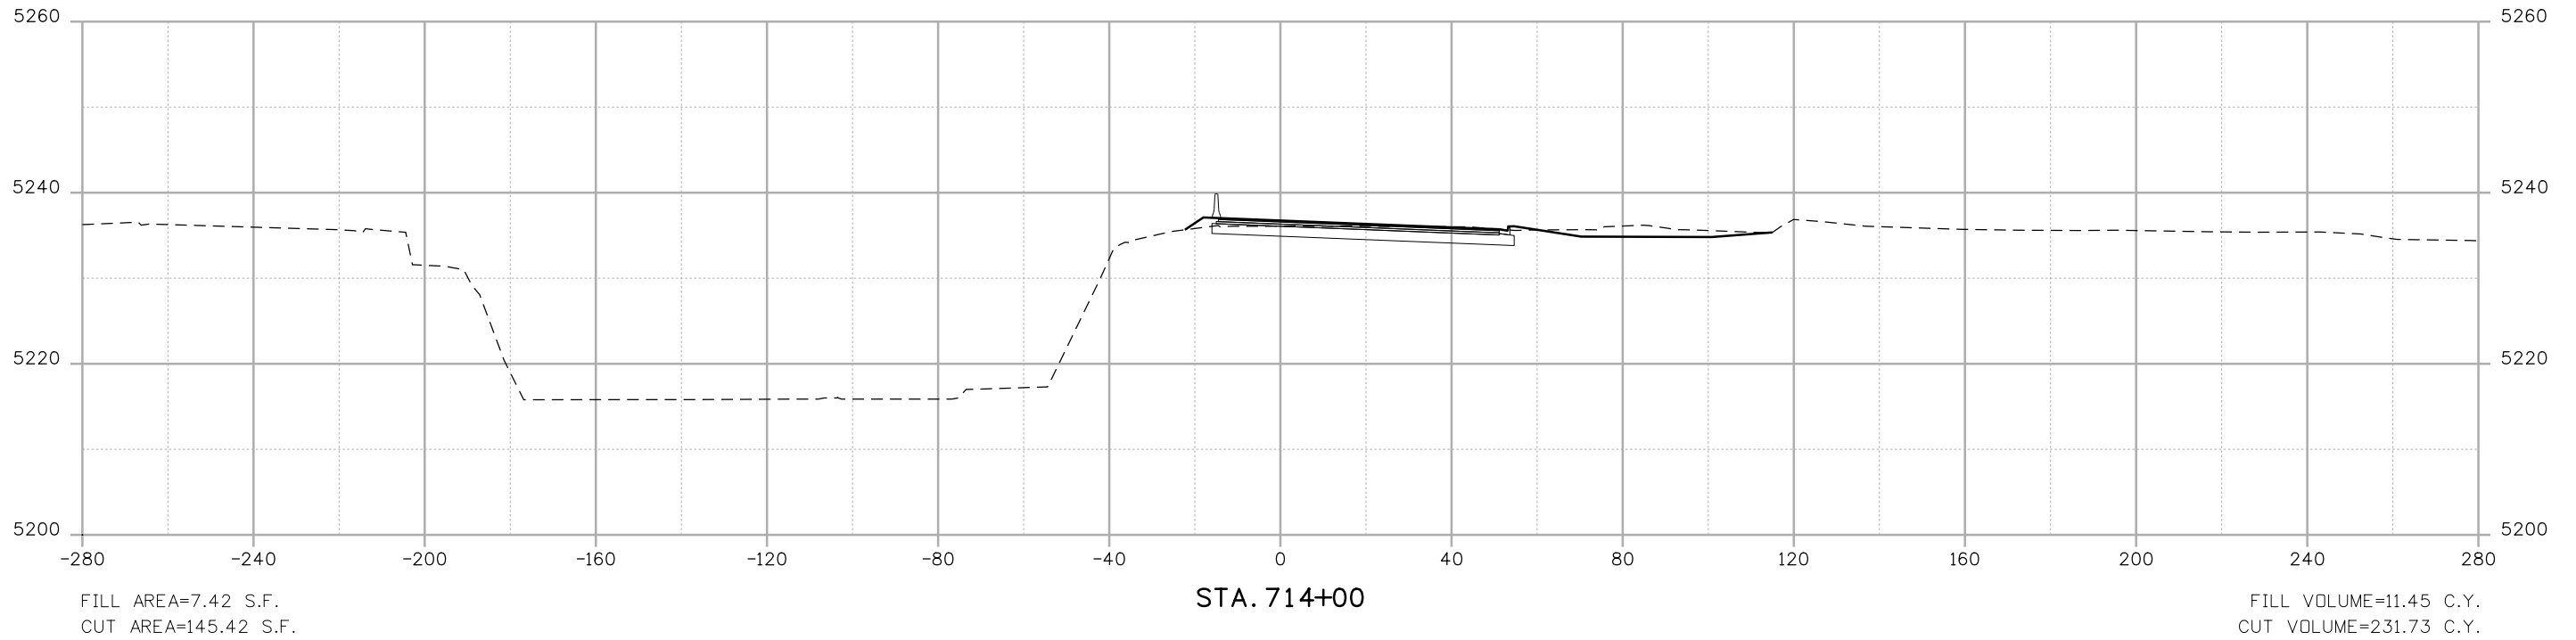

Dusty 9/14/14 AM K:\08276\16311\Phase 2\Design\Drawings\Cross_Sections\1631DES_PH2_CrossSections1.dgn

Print Date: 10/12/2010	
File Name: 16311DES_PH2_CrossSections1.dgn	
Horiz. Scale: 1:40	Vert. Scale: 1:20
Unit Information	Unit Leader Initials

Sheet Revisions		
Date:	Comments	Init.

Colorado Department of Transportation



2000 South Holly Street
Denver, CO 80222
Phone: 303-972-9112 FAX: 303-972-9114

Region 6 RLB


As Constructed
No Revisions:
Revised:
Void:

I-25/SANTA FE INTERCHANGE SANTA FE DRIVE CROSS SECTIONS		
Designer: DCS	Structure Numbers	
Detailer: DCS		
Sheet Subset: SECTIONS	Subset Sheets: XS-54 of 104	

Project No./Code
BR 0252-407
17783
Sheet Number 54

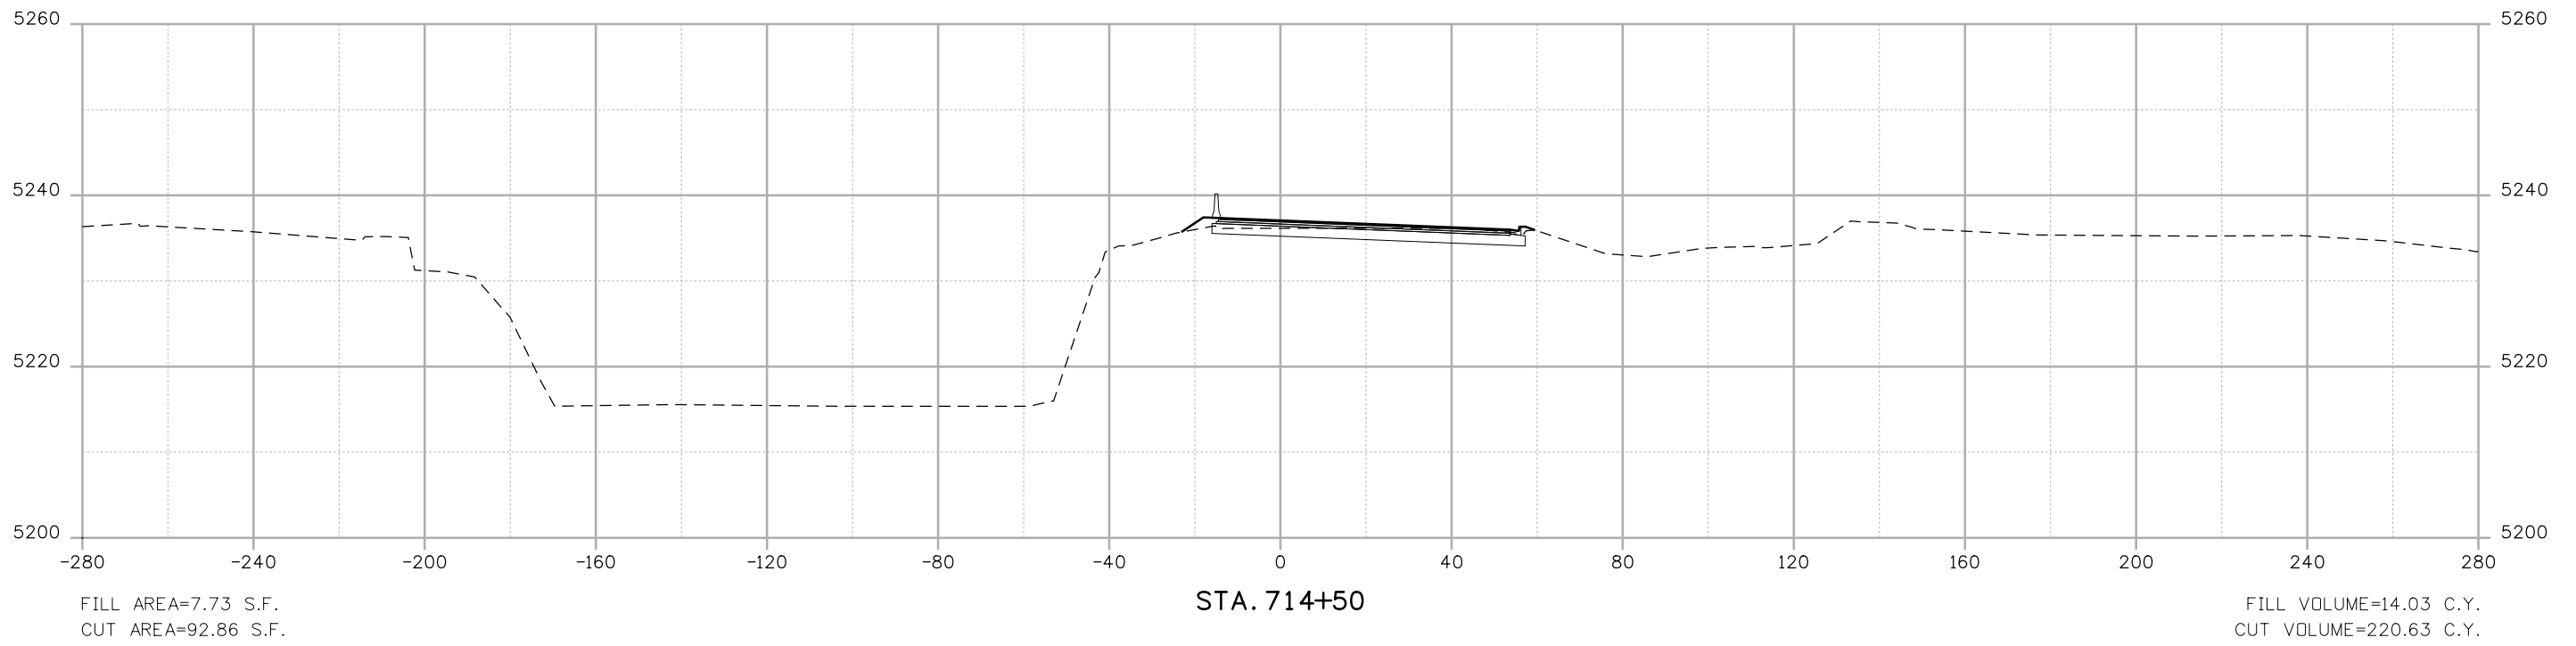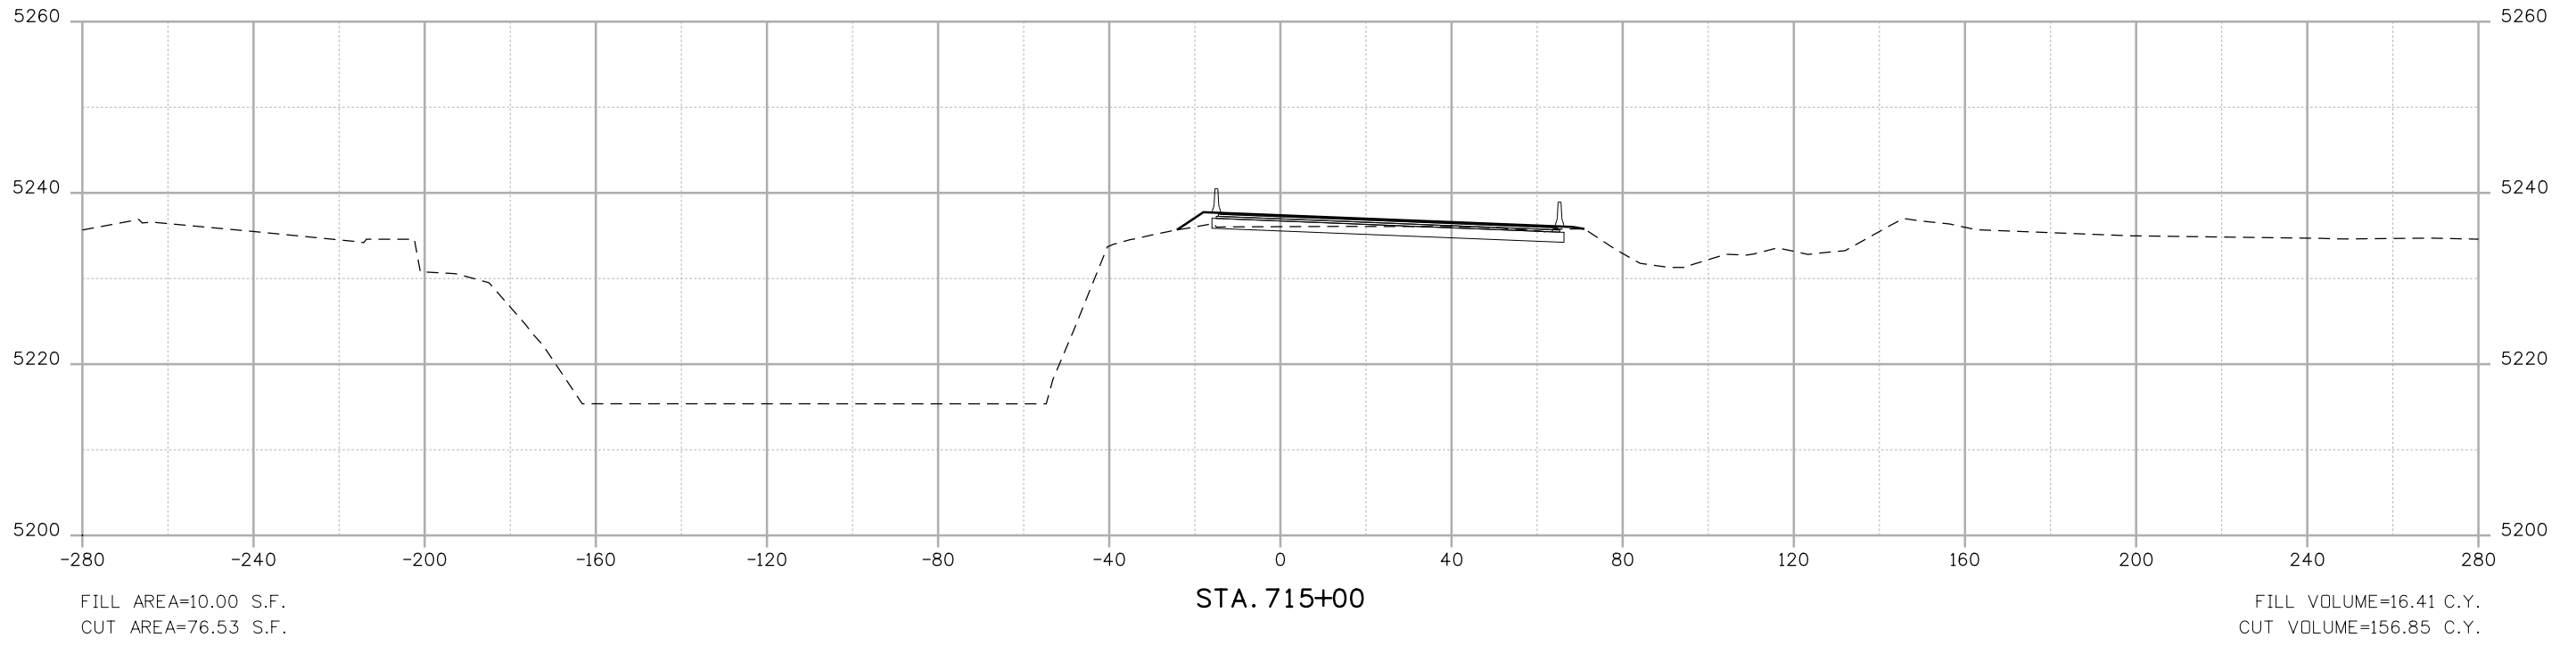

Dusty 9:14:44 AM K:\08276\16311\Phase 2\Design\Drawings\Cross-Sections\1631DES_PH2_CrossSections1.dgn

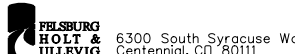Print Date: 10/12/2010	
File Name: 16311DES_PH2_CrossSections1.dgn	
Horiz. Scale: 1:40	Vert. Scale: 1:20
Unit Information	Unit Leader Initials
 6300 South Syracuse Way Centennial, CO 80111	

Sheet Revisions		
Date:	Comments	Init.

Colorado Department of Transportation


2000 South Holly Street
Denver, CO 80222
Phone: 303-972-9112 FAX: 303-972-9114

 Region 6 RLB

As Constructed
No Revisions:
Revised:
Void:

I-25/SANTA FE INTERCHANGE SANTA FE DRIVE CROSS SECTIONS		
Designer: DCS	Structure Numbers	
Detailer: DCS		
Sheet Subset: SECTIONS	Subset Sheets: XS-55 of 104	


Project No./Code
BR 0252-407
17783
Sheet Number 55

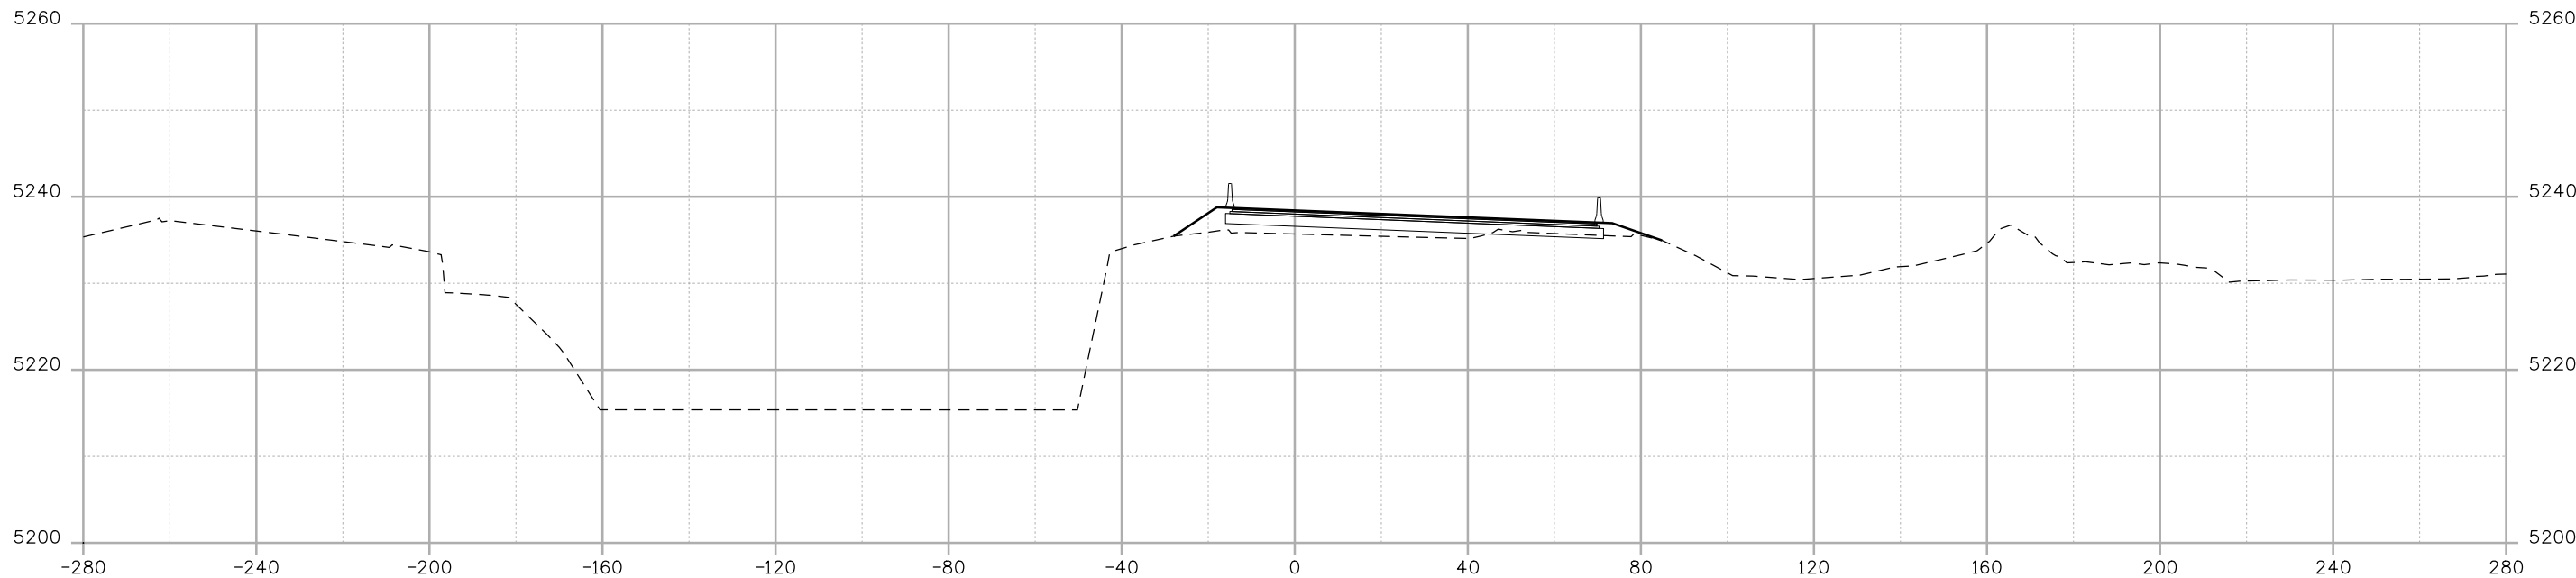

FILL AREA=77.00 S.F.
CUT AREA=10.32 S.F.

STA. 716+00

FILL VOLUME=88.46 C.Y.
CUT VOLUME=38.86 C.Y.

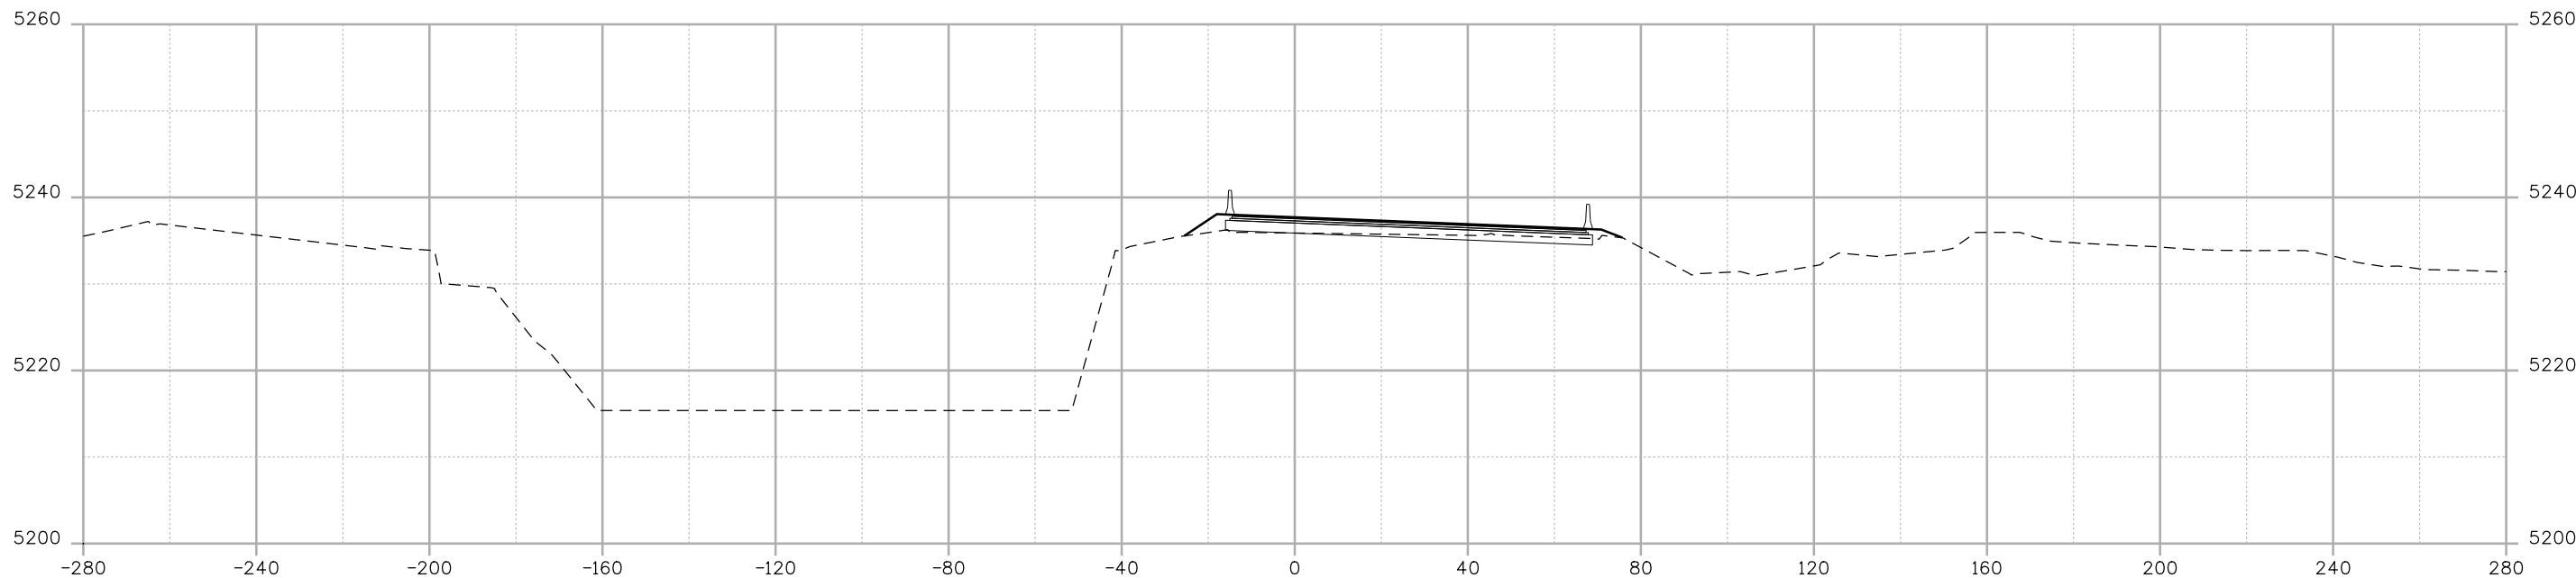


FILL AREA=18.53 S.F.
CUT AREA=31.64 S.F.

STA. 715+50

FILL VOLUME=26.41 C.Y.
CUT VOLUME=100.16 C.Y.

Dusty 9:14:54 AM K:\08276\16311\Phase 2\Design\Drawings\Cross_Sections\1631DES_PH2_CrossSections1.dgn

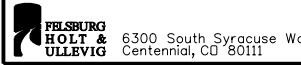Print Date: 10/12/2010	
File Name: 16311DES_PH2_CrossSections1.dgn	
Horiz. Scale: 1:40	Vert. Scale: 1:20
Unit Information	Unit Leader Initials
 6300 South Syracuse Way Centennial, CO 80111	

Sheet Revisions		
Date:	Comments	Init.

Colorado Department of Transportation





2000 South Holly Street
Denver, CO 80222
Phone: 303-972-9112 FAX: 303-972-9114

Region 6 RLB

As Constructed
No Revisions:
Revised:
Void:

I-25/SANTA FE INTERCHANGE SANTA FE DRIVE CROSS SECTIONS		
Designer: DCS	Structure Numbers	
Detailer: DCS		
Sheet Subset: SECTIONS	Subset Sheets: XS-56 of 104	

Project No./Code
BR 0252-407
17783
Sheet Number 56

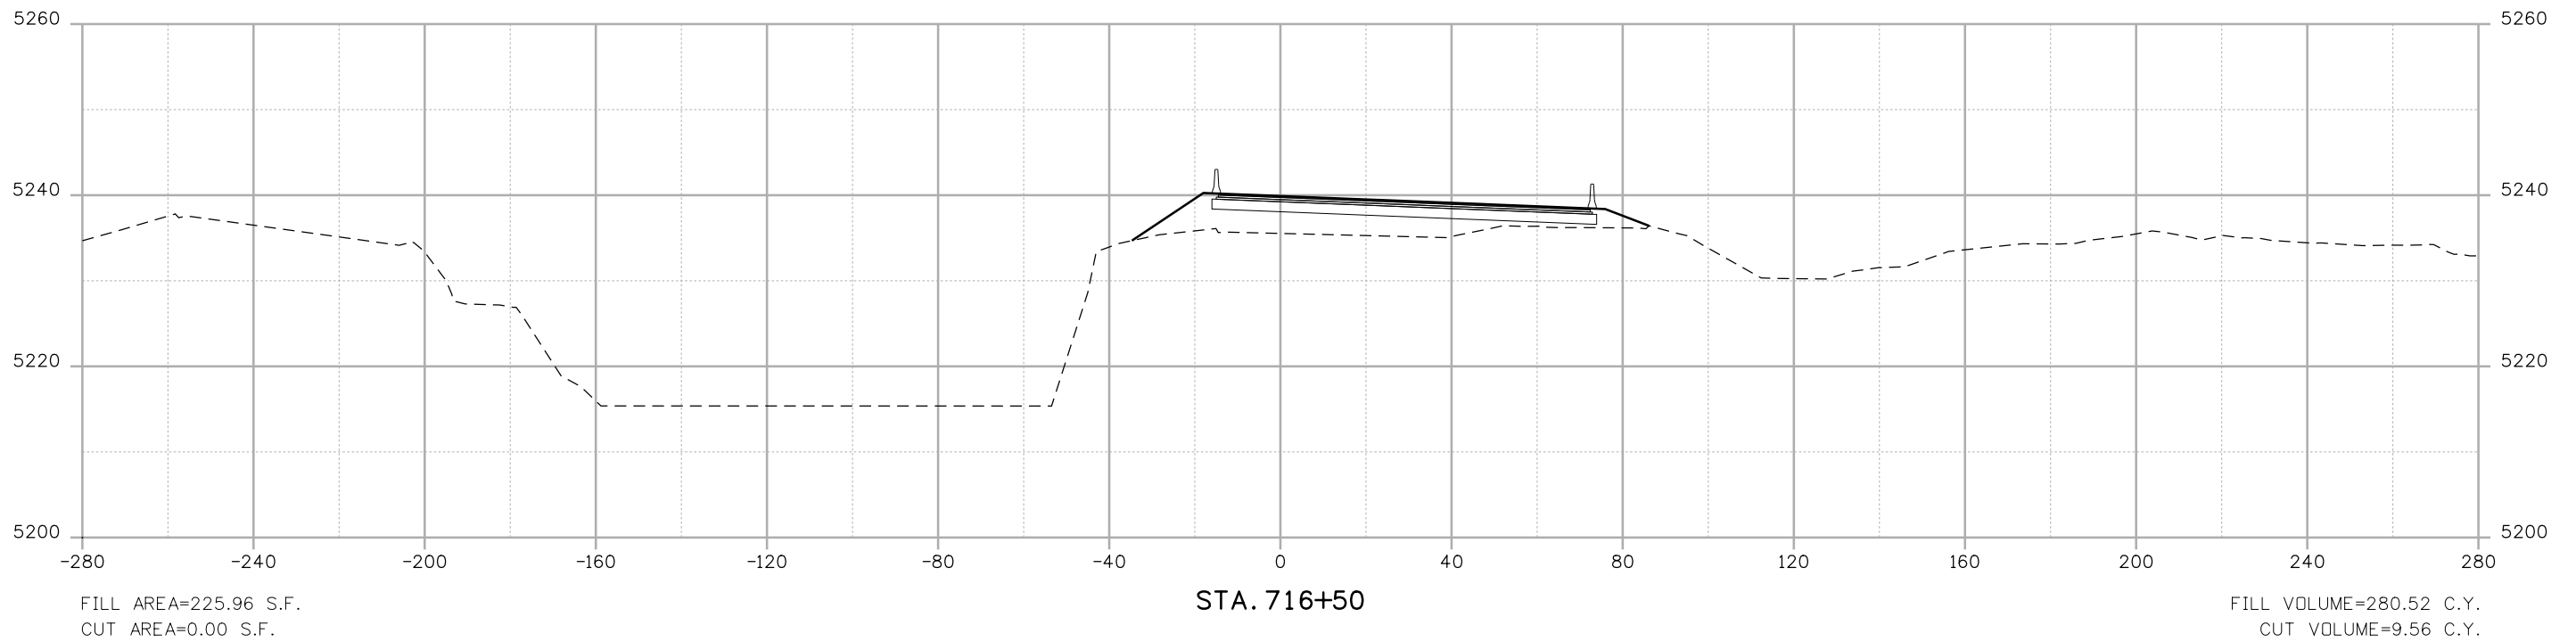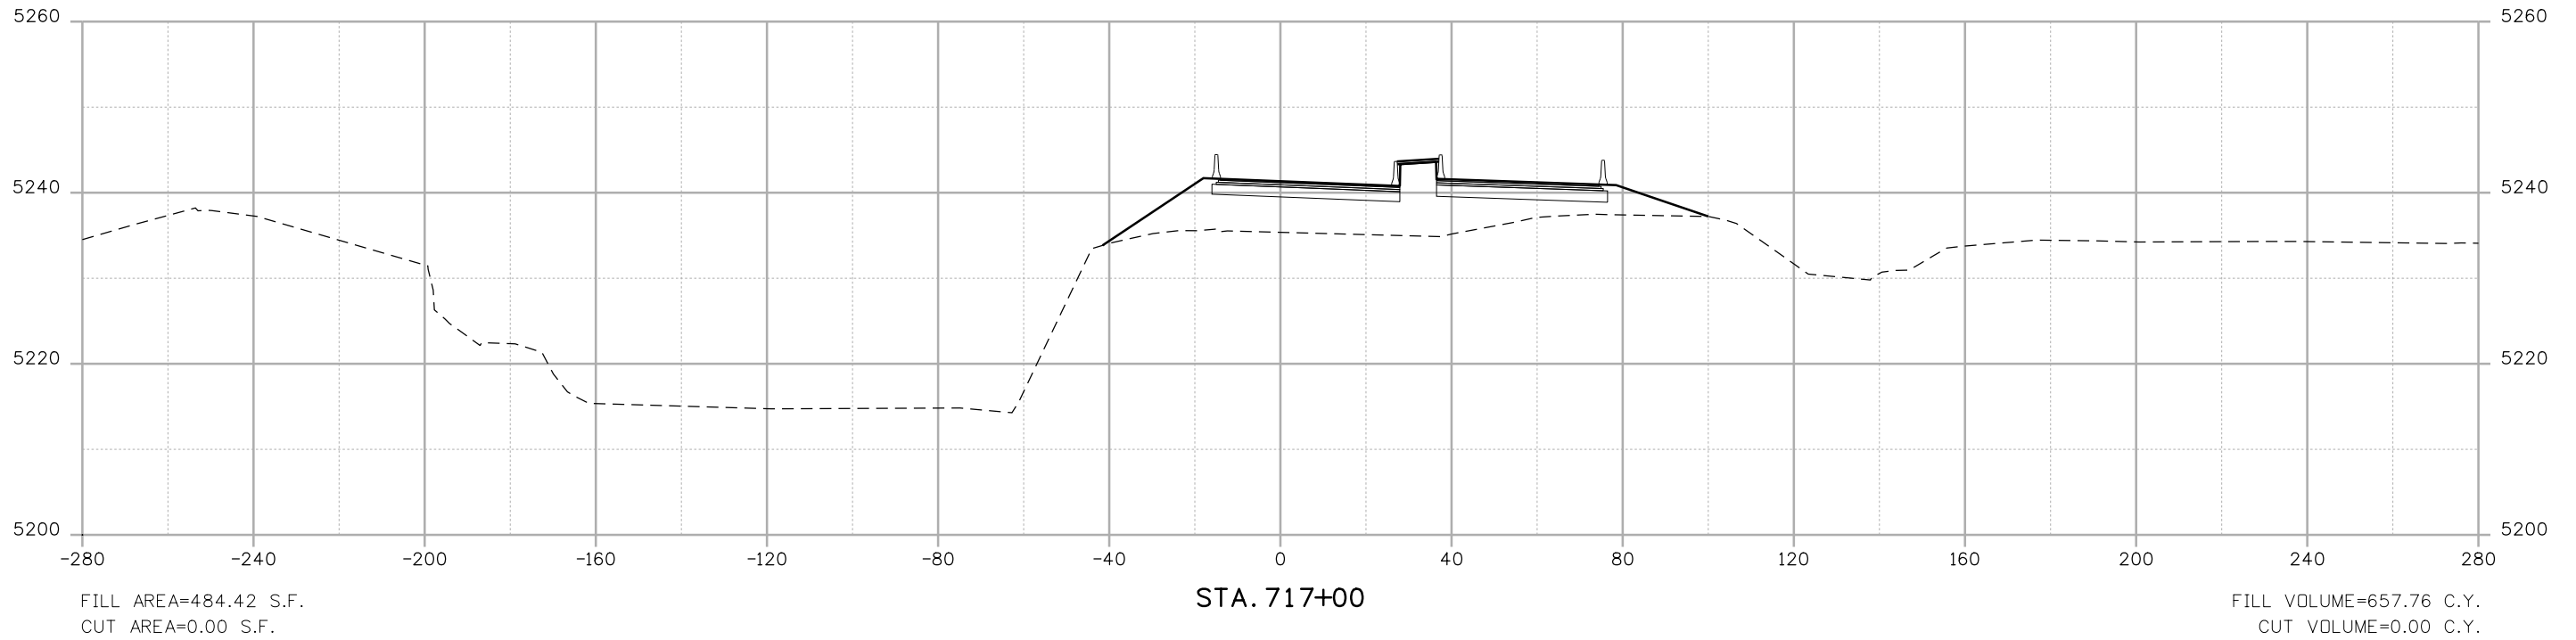

Print Date: 10/12/2010
 File Name: 16311DES_PH2_CrossSections1.dgn
 Horiz. Scale: 1:40 Vert. Scale: 1:20
 Unit Information Unit Leader Initials
 FELSBURG
 HOLT &
 ULLEVIG
 6300 South Syracuse Way
 Centennial, CO 80111

Sheet Revisions		
Date:	Comments	Init.


Colorado Department of Transportation
 2000 South Holly Street
 Denver, CO 80222
 Phone: 303-972-9112 FAX: 303-972-9114
 Region 6 RLB

As Constructed
 No Revisions:
 Revised:
 Void:

I-25/SANTA FE INTERCHANGE
 SANTA FE DRIVE
 CROSS SECTIONS
 Designer: DCS Structure Numbers
 Detailer: DCS
 Sheet Subset: SECTIONS Subset Sheets: XS-57 of 104

Project No./Code
 BR 0252-407
 17783
 Sheet Number 57


Dusty 9:15:07 AM K:\08276\16311\Phase 2\Design\Drawings\Cross_Sections\16311DES_PH2_CrossSections1.dgn

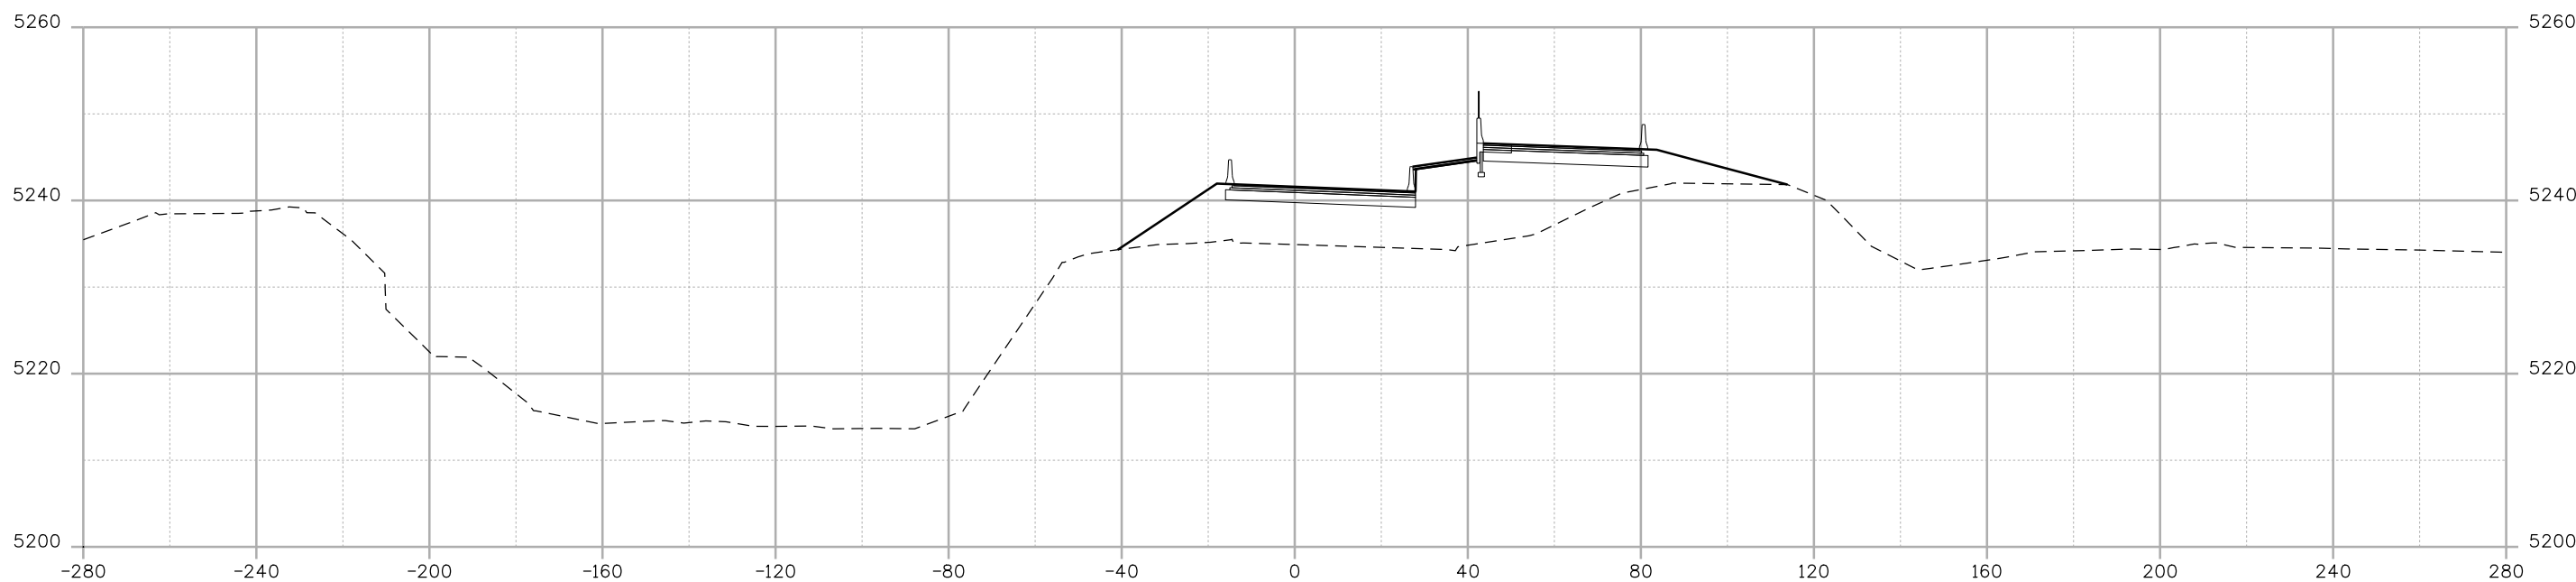

FILL AREA=740.69 S.F.
CUT AREA=0.00 S.F.

STA. 718+00

FILL VOLUME=1293.78 C.Y.
CUT VOLUME=0.00 C.Y.

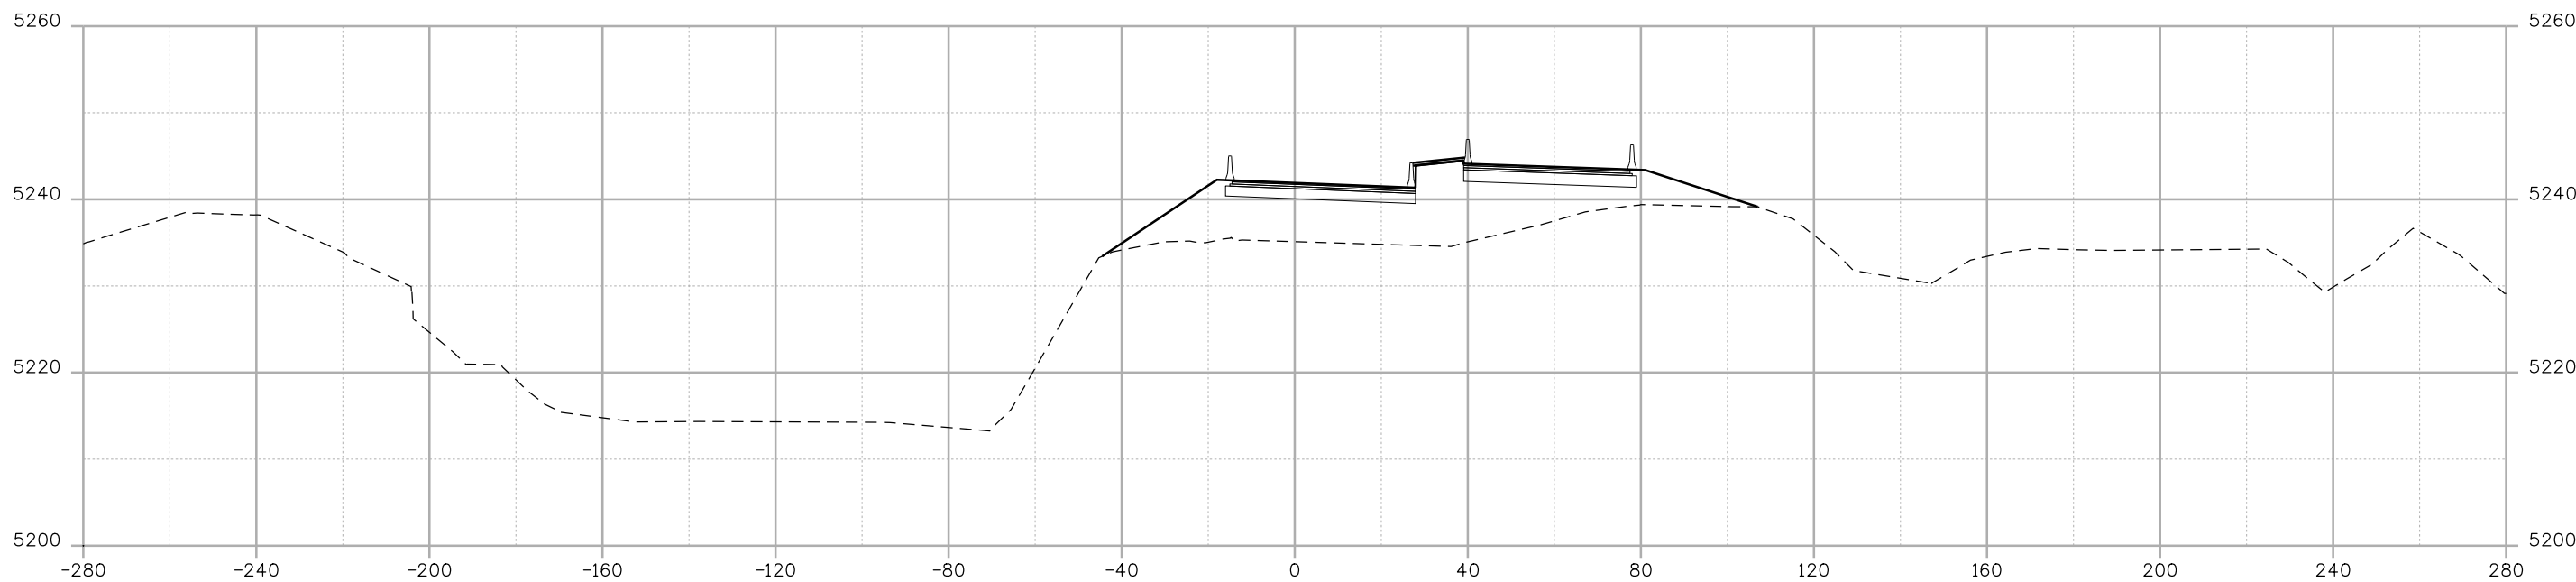

FILL AREA=656.59 S.F.
CUT AREA=0.00 S.F.

STA. 717+50

FILL VOLUME=1056.50 C.Y.
CUT VOLUME=0.00 C.Y.

Print Date: 10/12/2010



File Name: 16311DES_PH2_CrossSections1.dgn

Horiz. Scale: 1:40

Vert. Scale: 1:20

Unit Information

Unit Leader Initials

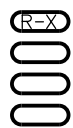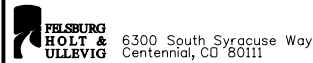

Sheet Revisions

Date:	Comments	Init.

Colorado Department of Transportation



2000 South Holly Street
Denver, CO 80222
Phone: 303-972-9112 FAX: 303-972-9114

Region 6

RLB

As Constructed

No Revisions:

Revised:

Void:

I-25/SANTA FE INTERCHANGE
SANTA FE DRIVE
CROSS SECTIONS

Designer:	DCS	Structure Numbers	
Detailer:	DCS		
Sheet Subset:	SECTIONS	Subset Sheets:	XS-58 of 104



Project No./Code

BR 0252-407


17783

Sheet Number 58

Dusty 9:15:18 AM K:\08276\16311\Phase 2_Design\Drawings\Cross_Sections\16311DES_PH2_CrossSections1.dgn

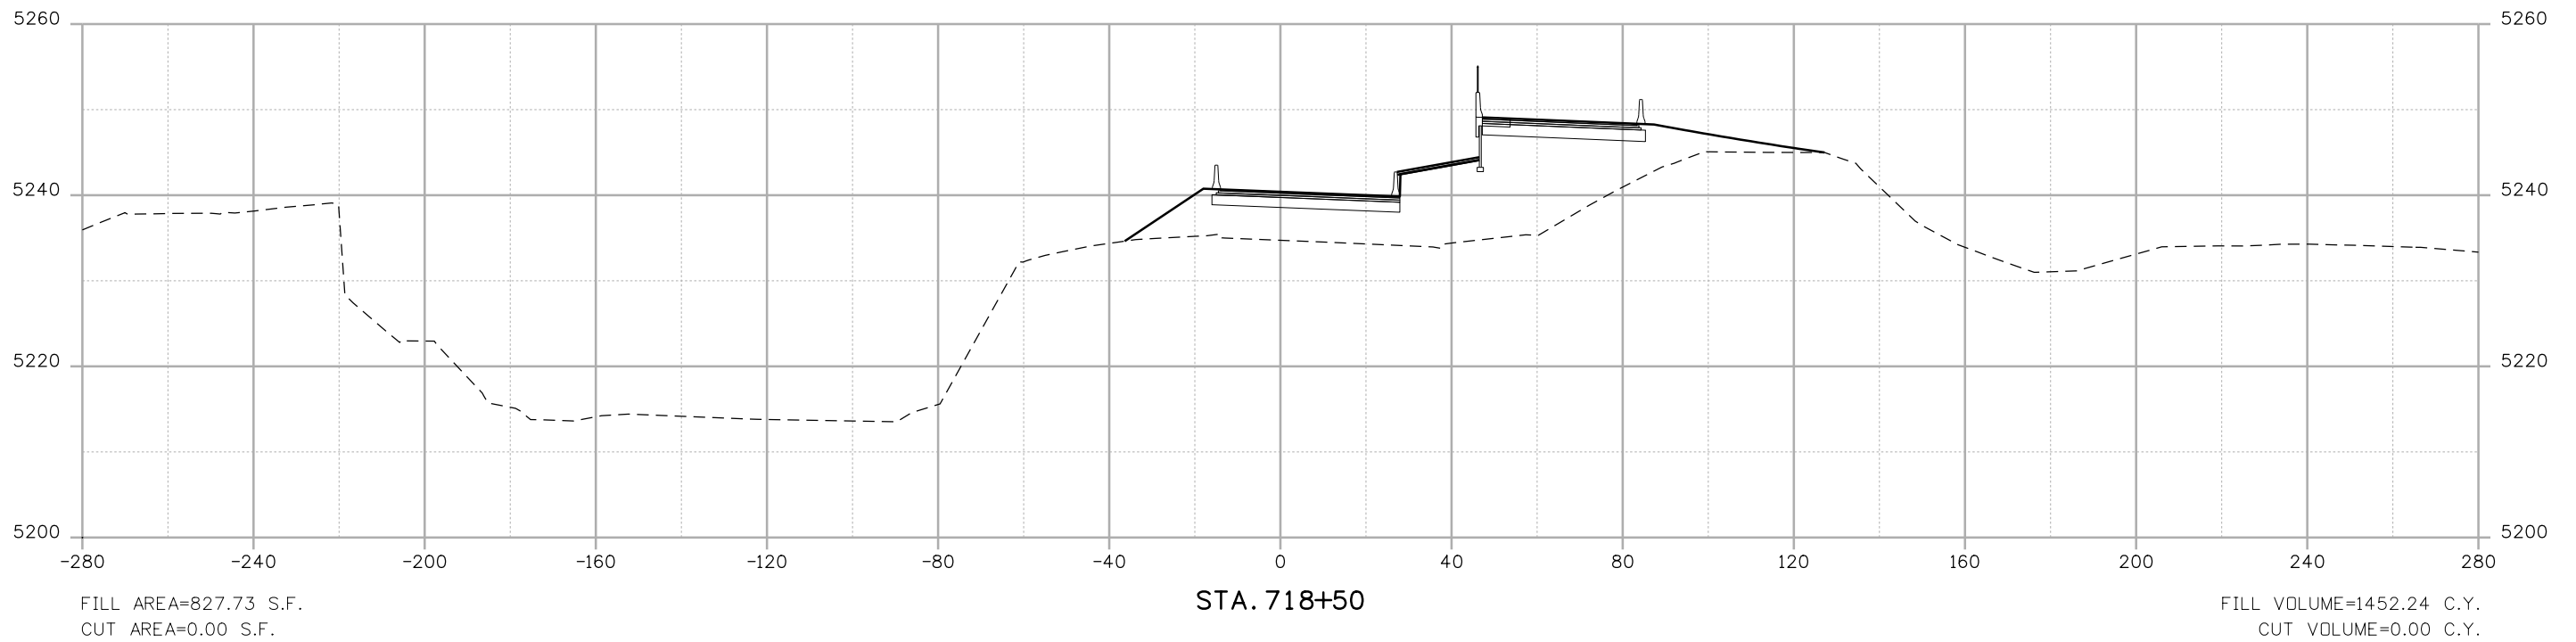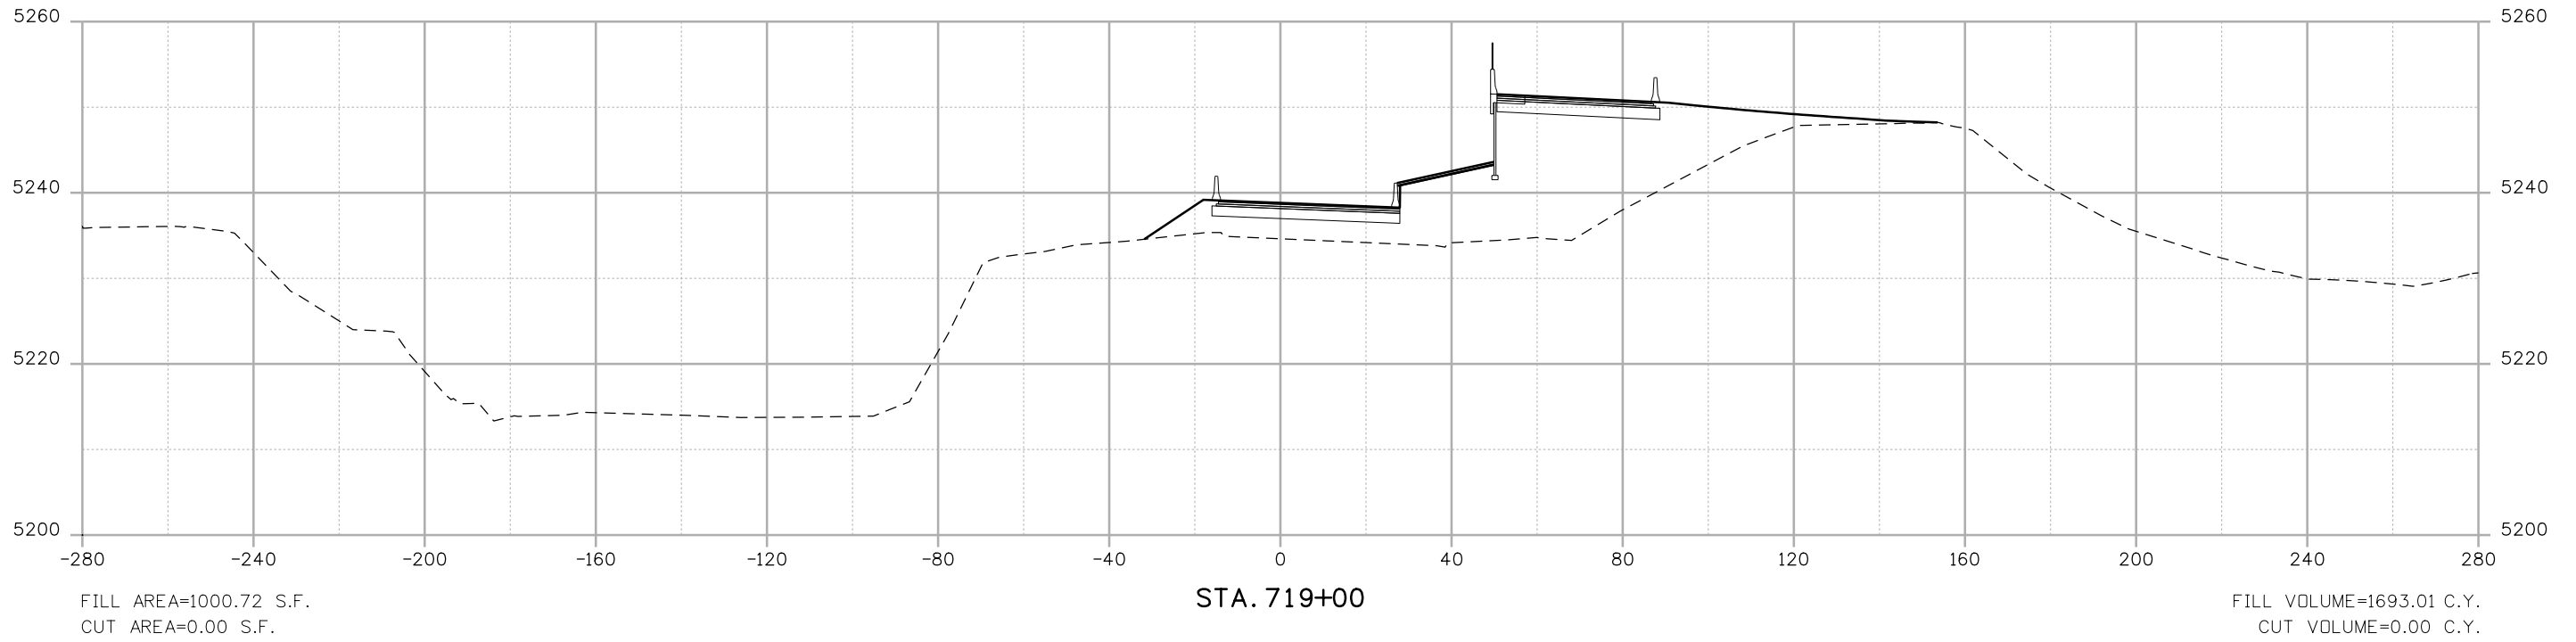

Dusty 9:15:30 AM K:\08276\16311\Phase 2\Design\Drawings\Cross_Sections\16311DES_PH2_CrossSections1.dgn

Print Date: 10/12/2010	
File Name: 16311DES_PH2_CrossSections1.dgn	
Horiz. Scale: 1:40	Vert. Scale: 1:20
Unit Information	Unit Leader Initials
 6300 South Syracuse Way Centennial, CO 80111	

Sheet Revisions		
Date:	Comments	Init.

Colorado Department of Transportation

2000 South Holly Street
Denver, CO 80222
Phone: 303-972-9112 FAX: 303-972-9114


Region 6 **RLB**

As Constructed
No Revisions:
Revised:
Void:

I-25/SANTA FE INTERCHANGE SANTA FE DRIVE CROSS SECTIONS		
Designer: DCS	Structure Numbers	
Detailer: DCS		
Sheet Subset: SECTIONS	Subset Sheets: XS-59 of 104	

Project No./Code
BR 0252-407
17783
Sheet Number 59

Dusty 9:15:41 AM K:\06276\16311\Phase 2\Design\Drawings\Cross_Sections\16311DES_PH2_CrossSections1.dgn

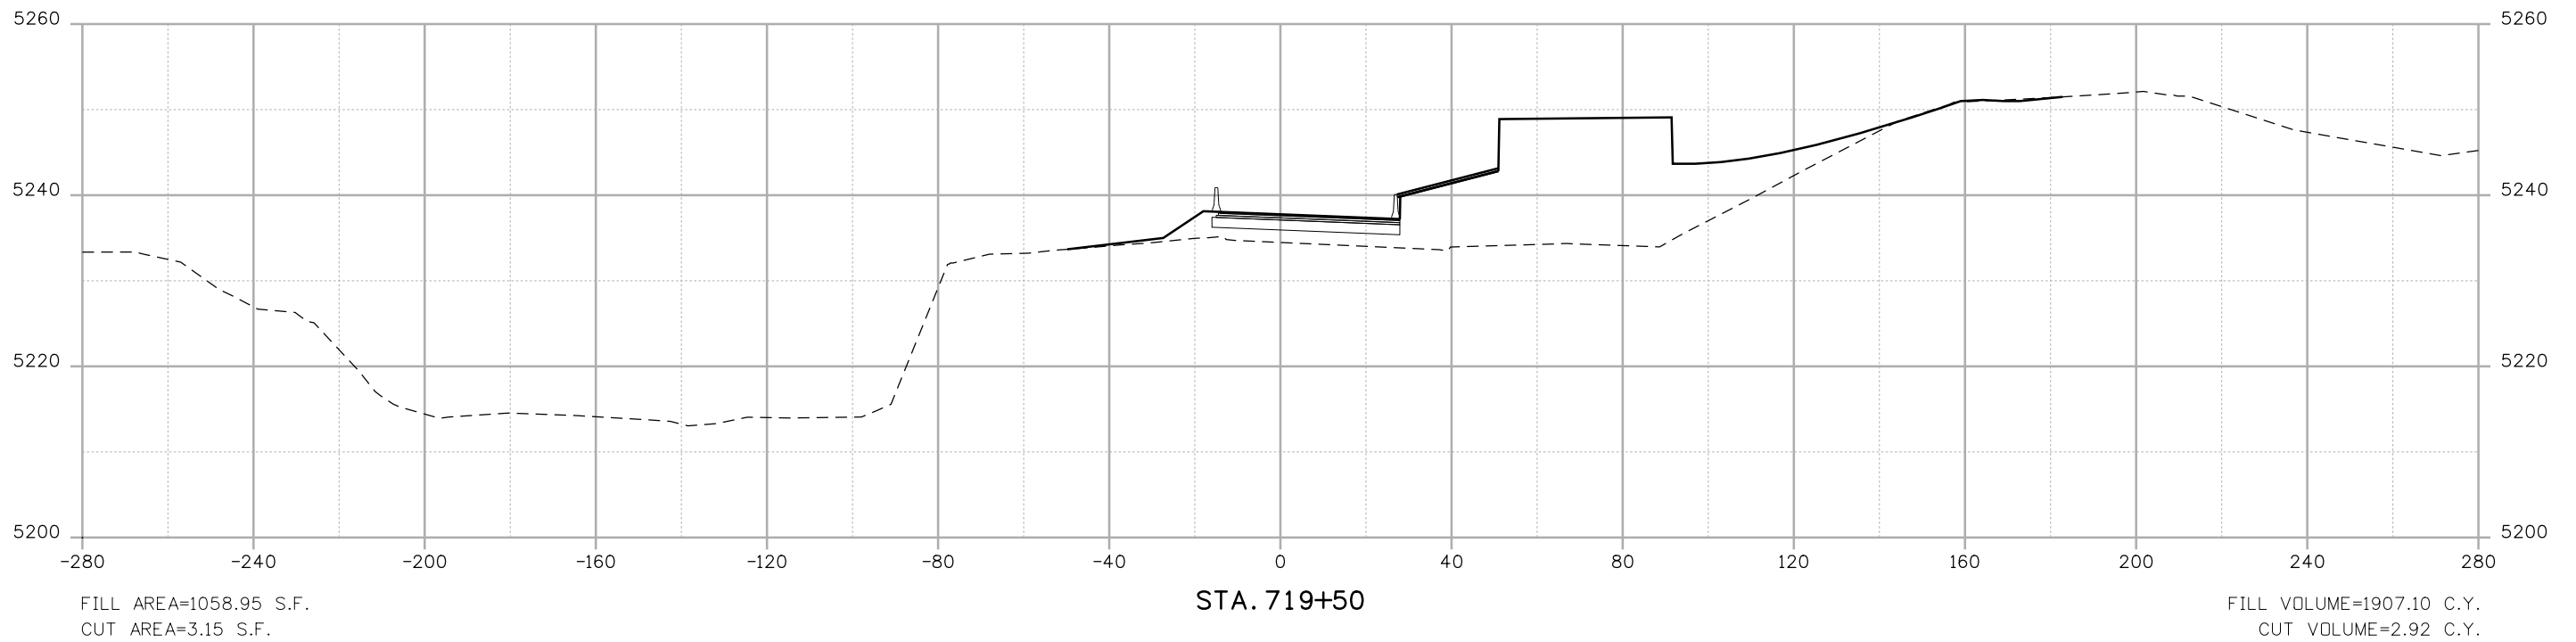

Print Date: 10/12/2010	
File Name: 16311DES_PH2_CrossSections1.dgn	
Horiz. Scale: 1:40	Vert. Scale: 1:20
Unit Information	Unit Leader Initials

Sheet Revisions		
Date:	Comments	Init.

Colorado Department of Transportation

2000 South Holly Street
Denver, CO 80222
Phone: 303-972-9112 FAX: 303-972-9114


Region 6 **RLB**


As Constructed
No Revisions:
Revised:
Void:

I-25/SANTA FE INTERCHANGE SANTA FE DRIVE CROSS SECTIONS		
Designer: DCS	Structure Numbers	
Detailer: DCS		
Sheet Subset: SECTIONS	Subset Sheets: XS-60 of 104	

Project No./Code
BR 0252-407
17783
Sheet Number 60

Dusty 9:15:53 AM K:\08276\16311\Phase 2\Design\Drawings\Cross_Sections\16311DES_PH2_CrossSections1.dgn

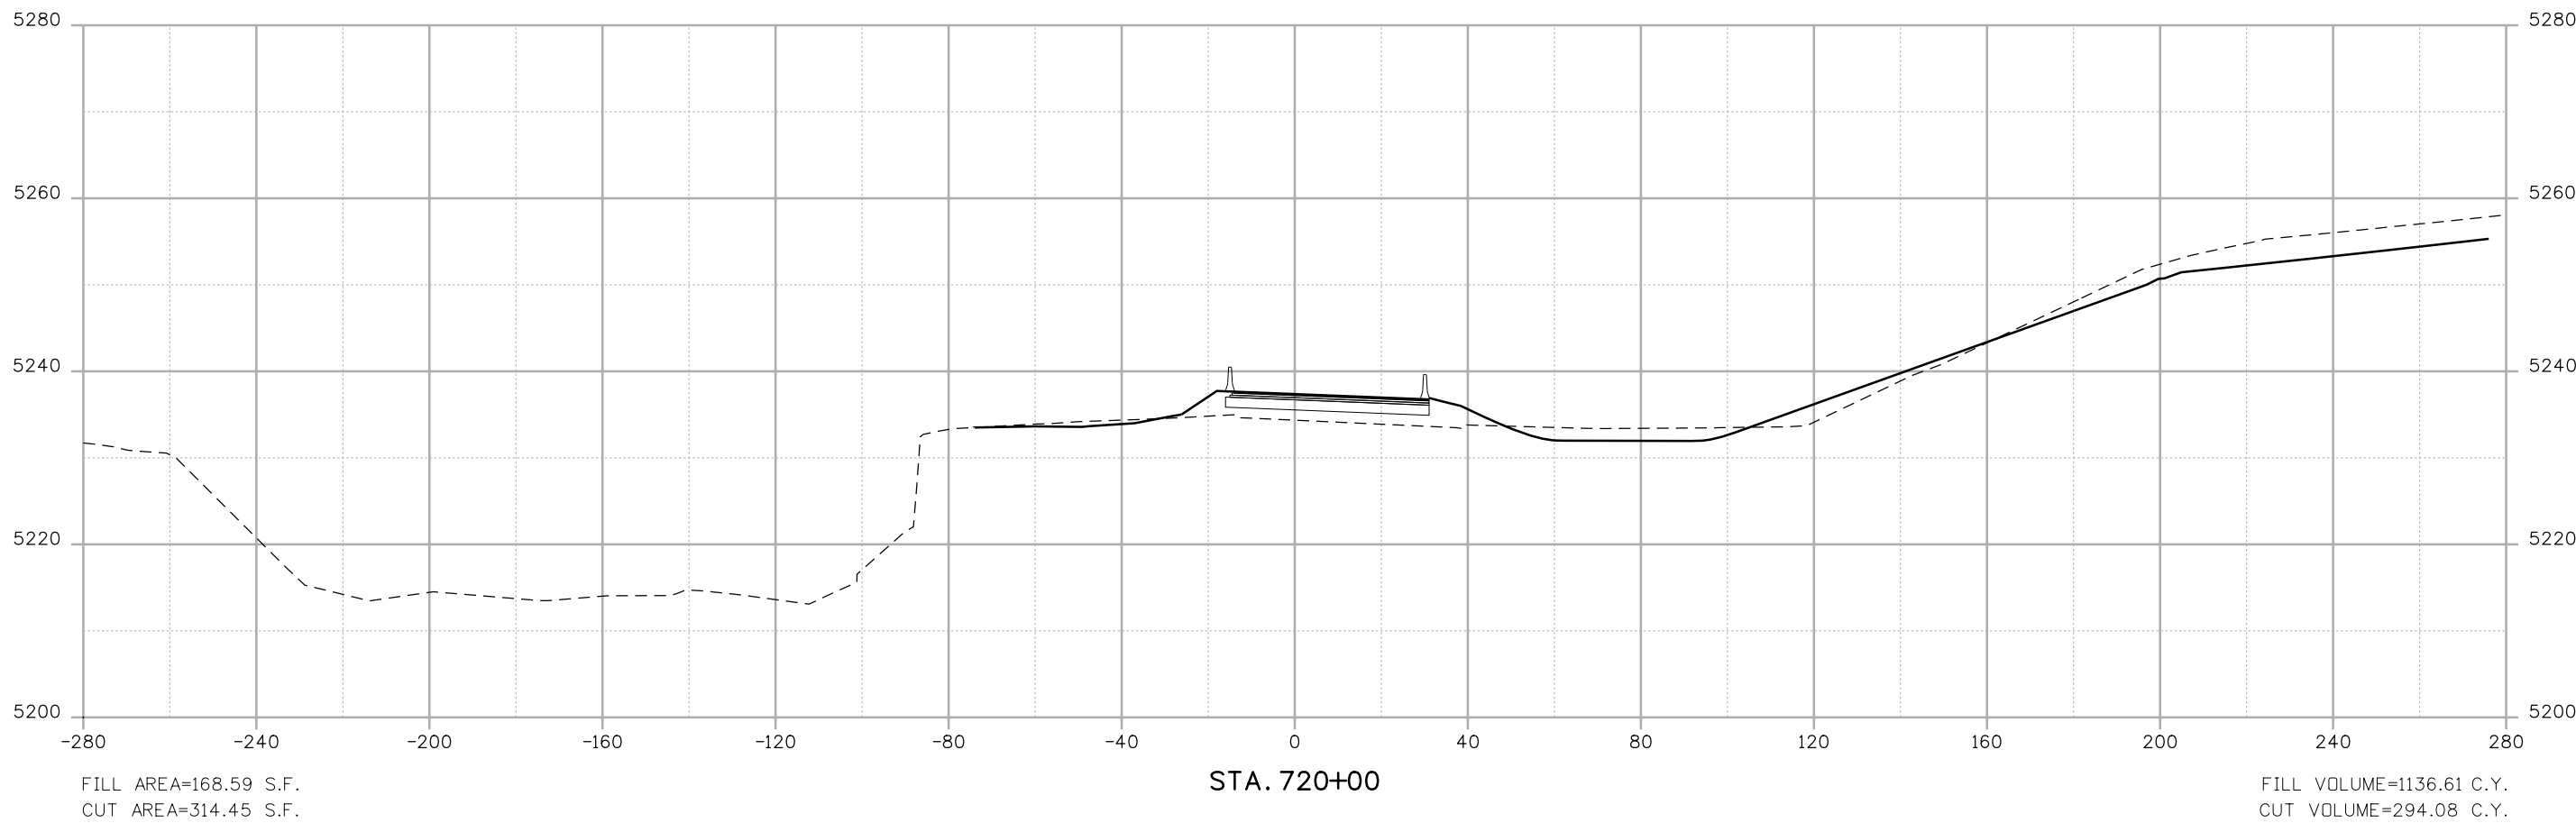

Print Date: 10/12/2010	
File Name: 16311DES_PH2_CrossSections1.dgn	
Horiz. Scale: 1:40	Vert. Scale: 1:20
Unit Information	Unit Leader Initials
 6300 South Syracuse Way Centennial, CO 80111	

Sheet Revisions		
Date:	Comments	Init.

Colorado Department of Transportation


 2000 South Holly Street
 Denver, CO 80222
 Phone: 303-972-9112 FAX: 303-972-9114


Region 6 RLB

As Constructed
No Revisions:
Revised:
Void:

I-25/SANTA FE INTERCHANGE SANTA FE DRIVE CROSS SECTIONS		
Designer: DCS	Structure Numbers	
Detailer: DCS		
Sheet Subset: SECTIONS	Subset Sheets: XS-61 of 104	

Project No./Code
BR 0252-407
17783
Sheet Number 61

Dusty 9:16:04 AM K:\08276\16311\Phase 2\Design\Drawings\Cross_Sections\16311DES_PH2_CrossSections1.dgn

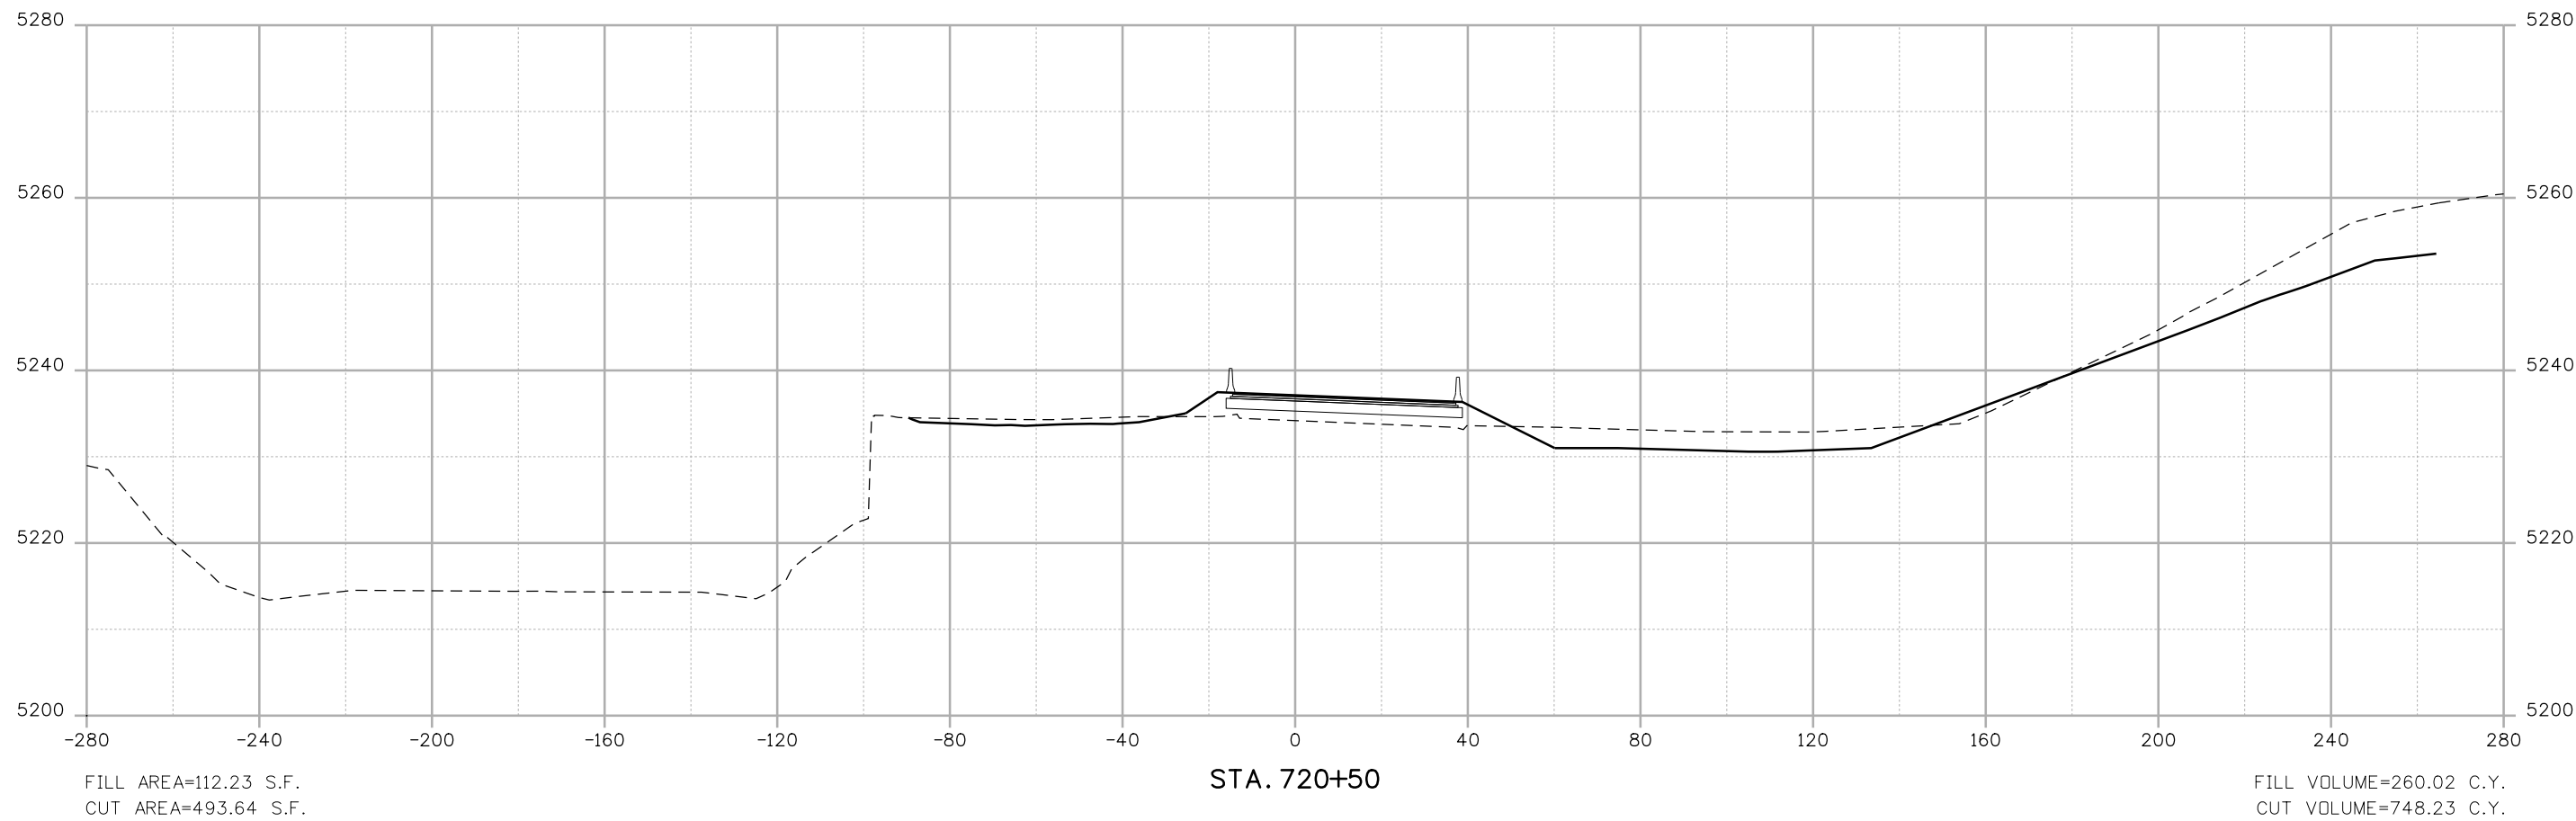

Print Date: 10/12/2010	
File Name: 16311DES_PH2_CrossSections1.dgn	
Horiz. Scale: 1:40	Vert. Scale: 1:20
Unit Information	Unit Leader Initials

Sheet Revisions		
Date:	Comments	Init.

Colorado Department of Transportation

2000 South Holly Street
 Denver, CO 80222
 Phone: 303-972-9112 FAX: 303-972-9114


Region 6 RLB


As Constructed
No Revisions:
Revised:
Void:

I-25/SANTA FE INTERCHANGE SANTA FE DRIVE CROSS SECTIONS		
Designer: DCS	Structure Numbers	
Detailer: DCS		
Sheet Subset: SECTIONS	Subset Sheets: XS-62 of 104	

Project No./Code
BR 0252-407
17783
Sheet Number 62

Dusty 9:16:16 AM K:\08276\16311\Phase 2\Design\Drawings\Cross_Sections\16311DES_PH2_CrossSections1.dgn

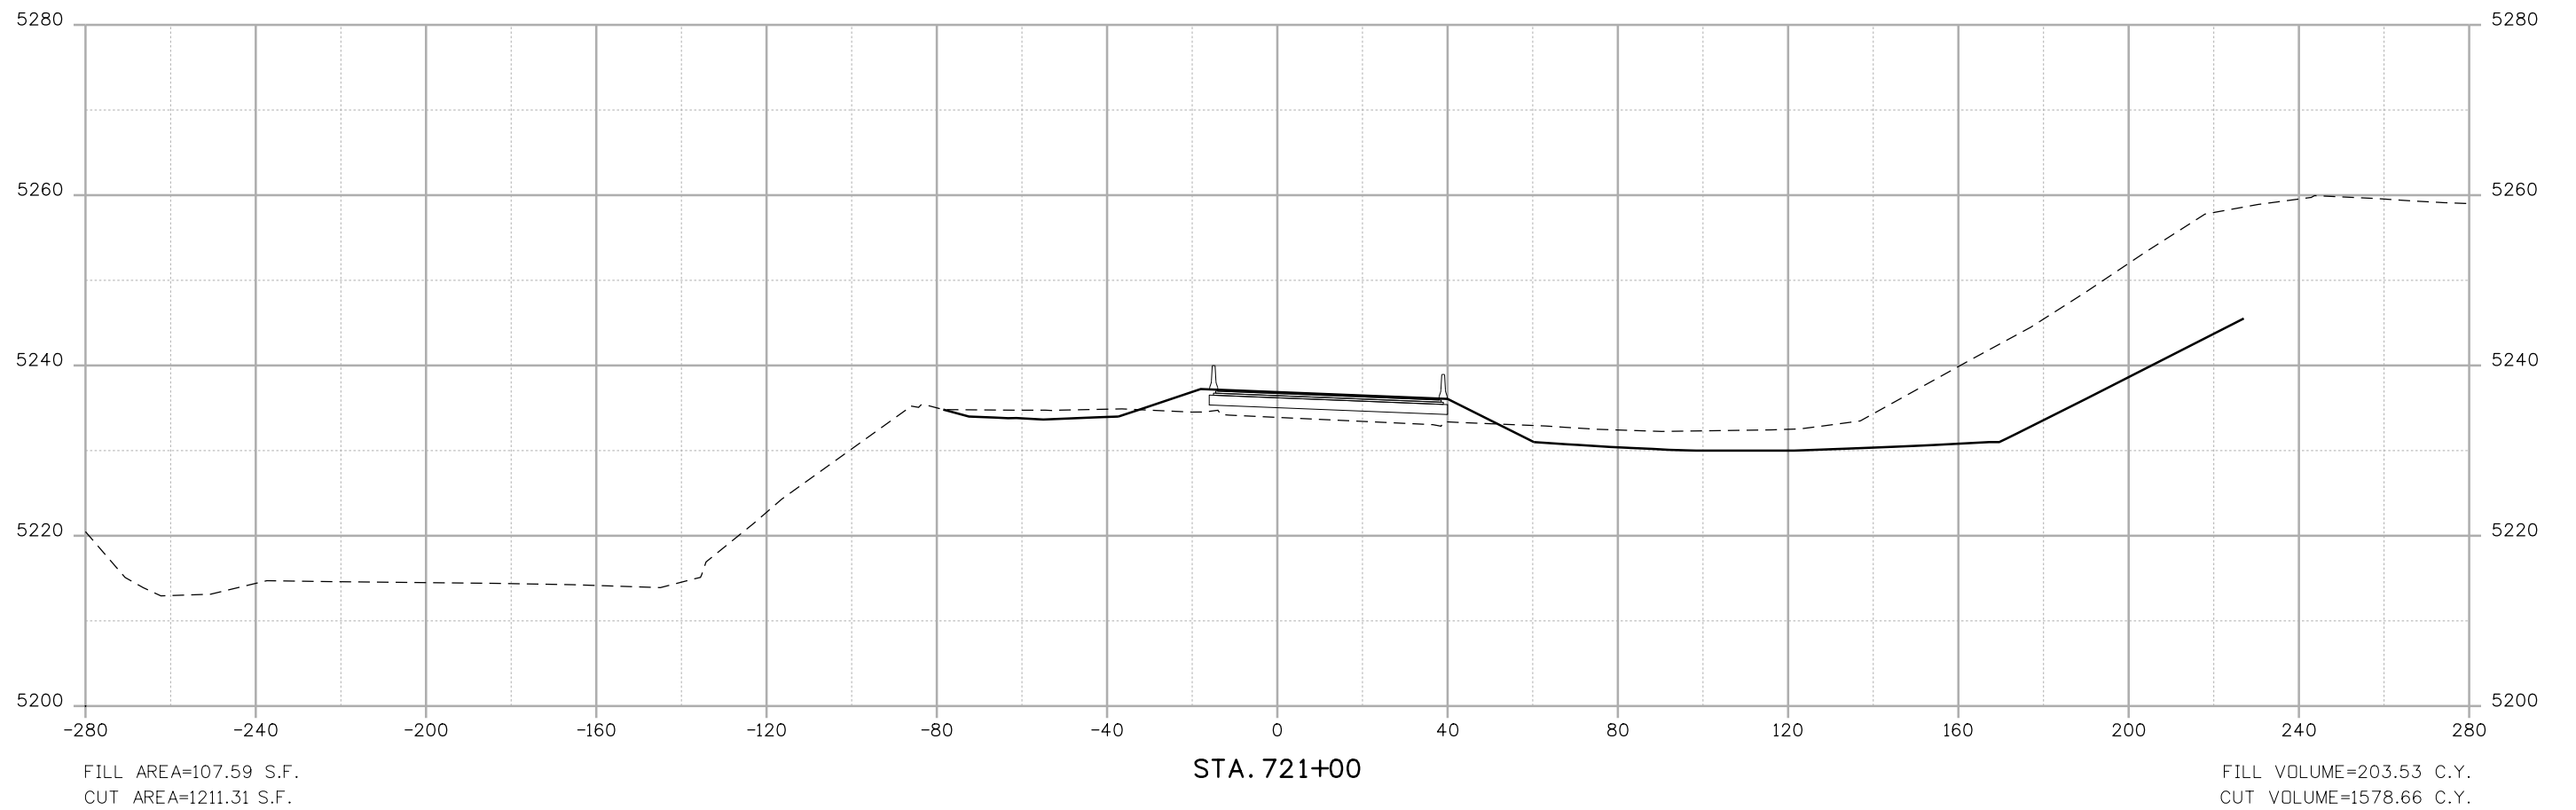

Print Date: 10/12/2010	
File Name: 16311DES_PH2_CrossSections1.dgn	
Horiz. Scale: 1:40	Vert. Scale: 1:20
Unit Information	Unit Leader Initials
 6300 South Syracuse Way Centennial, CO 80111	

Sheet Revisions		
Date:	Comments	Init.

Colorado Department of Transportation



2000 South Holly Street
Denver, CO 80222
Phone: 303-972-9112 FAX: 303-972-9114


Region 6 **RLB**

As Constructed
No Revisions:
Revised:
Void:

I-25/SANTA FE INTERCHANGE SANTA FE DRIVE CROSS SECTIONS		
Designer: DCS	Structure Numbers	
Detailer: DCS		
Sheet Subset: SECTIONS	Subset Sheets: XS-63 of 104	

Project No./Code
BR 0252-407
17783
Sheet Number 63

Dusty 9:16:28 AM K:\08276\16311\Phase 2\Design\Drawings\Cross_Sections\16311DES_PH2_CrossSections1.dgn

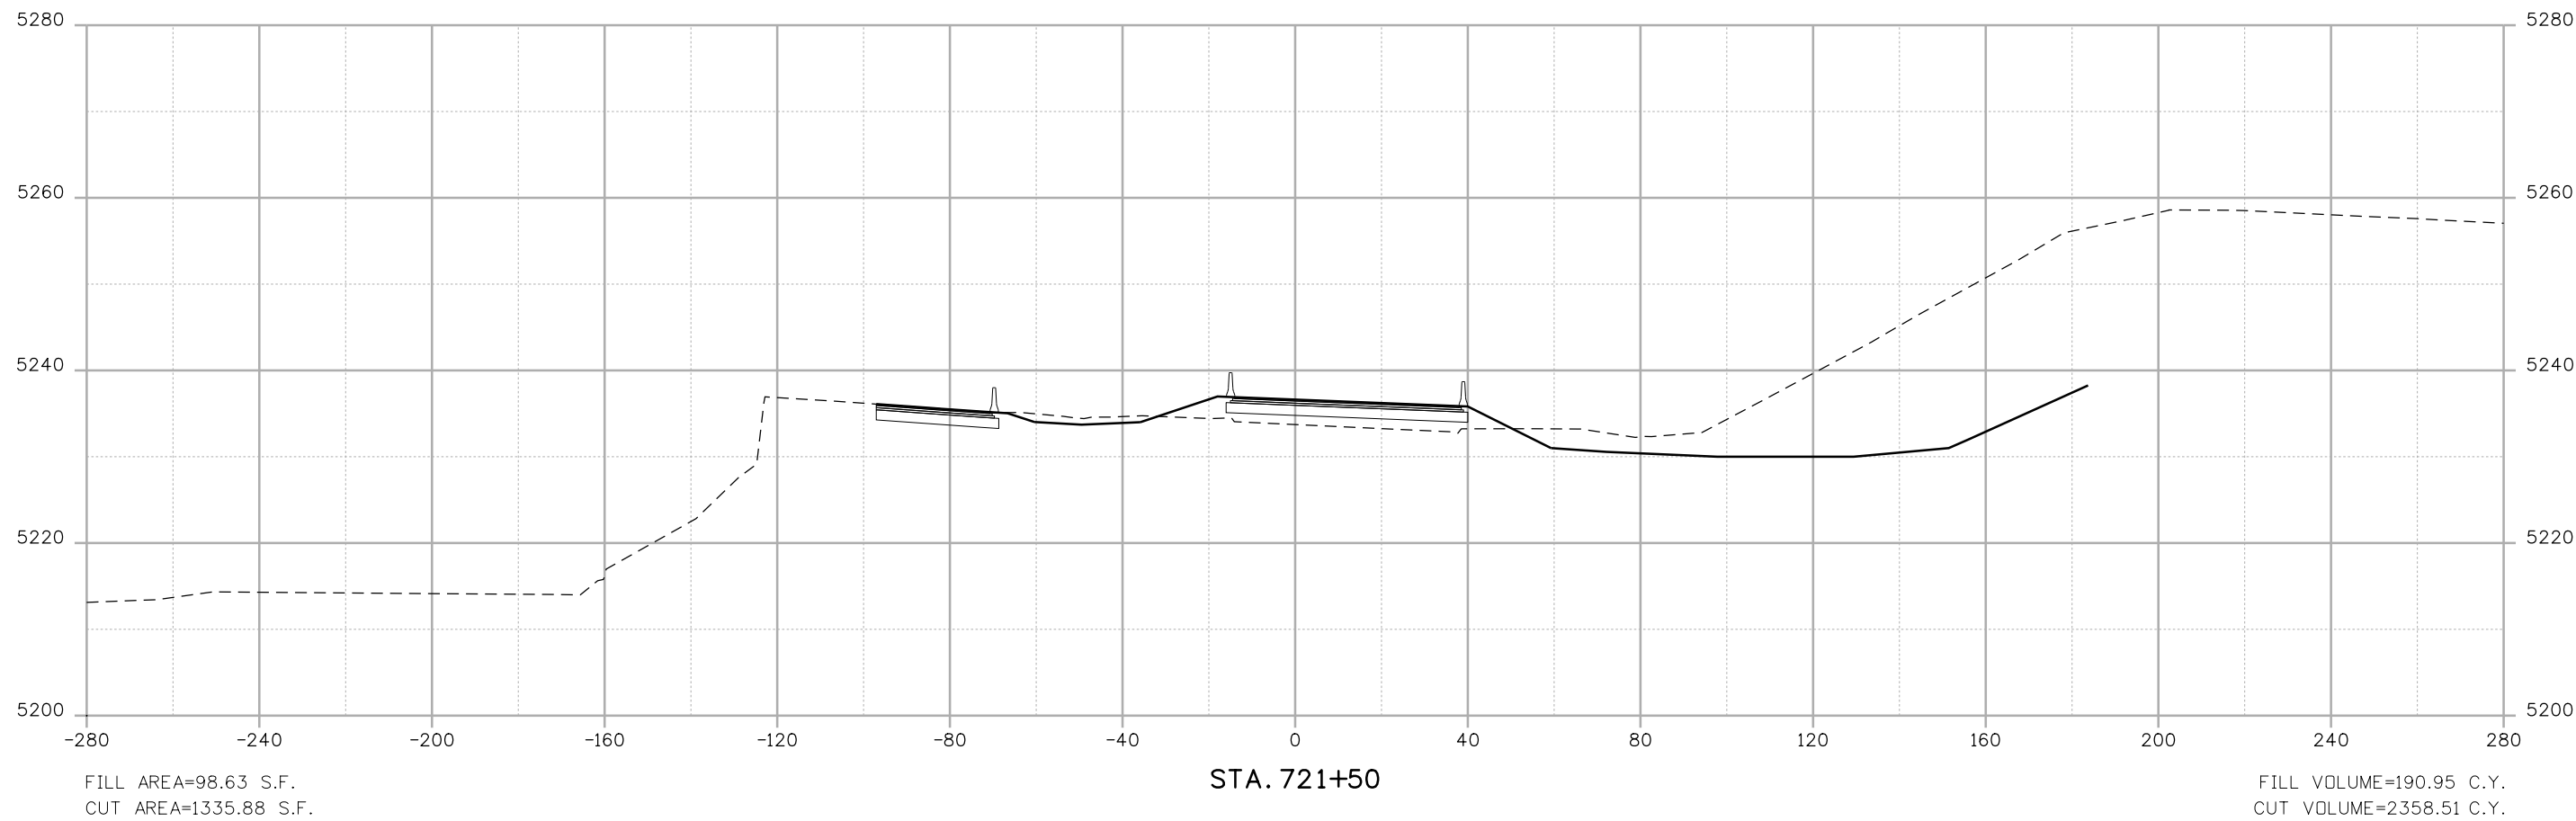

Print Date: 10/12/2010	
File Name: 16311DES_PH2_CrossSections1.dgn	
Horiz. Scale: 1:40	Vert. Scale: 1:20
Unit Information	Unit Leader Initials

Sheet Revisions		
Date:	Comments	Init.

Colorado Department of Transportation

2000 South Holly Street
Denver, CO 80222
Phone: 303-972-9112 FAX: 303-972-9114


Region 6 **RLB**


As Constructed
No Revisions:
Revised:
Void:

I-25/SANTA FE INTERCHANGE SANTA FE DRIVE CROSS SECTIONS		
Designer: DCS	Structure Numbers	
Detailer: DCS		
Sheet Subset: SECTIONS	Subset Sheets: XS-64 of 104	

Project No./Code
BR 0252-407
17783
Sheet Number 64

Dusty 9:16:40 AM K:\08276\16311\Phase 2\Design\Drawings\Cross_Sections\16311DES_PH2_CrossSections1.dgn

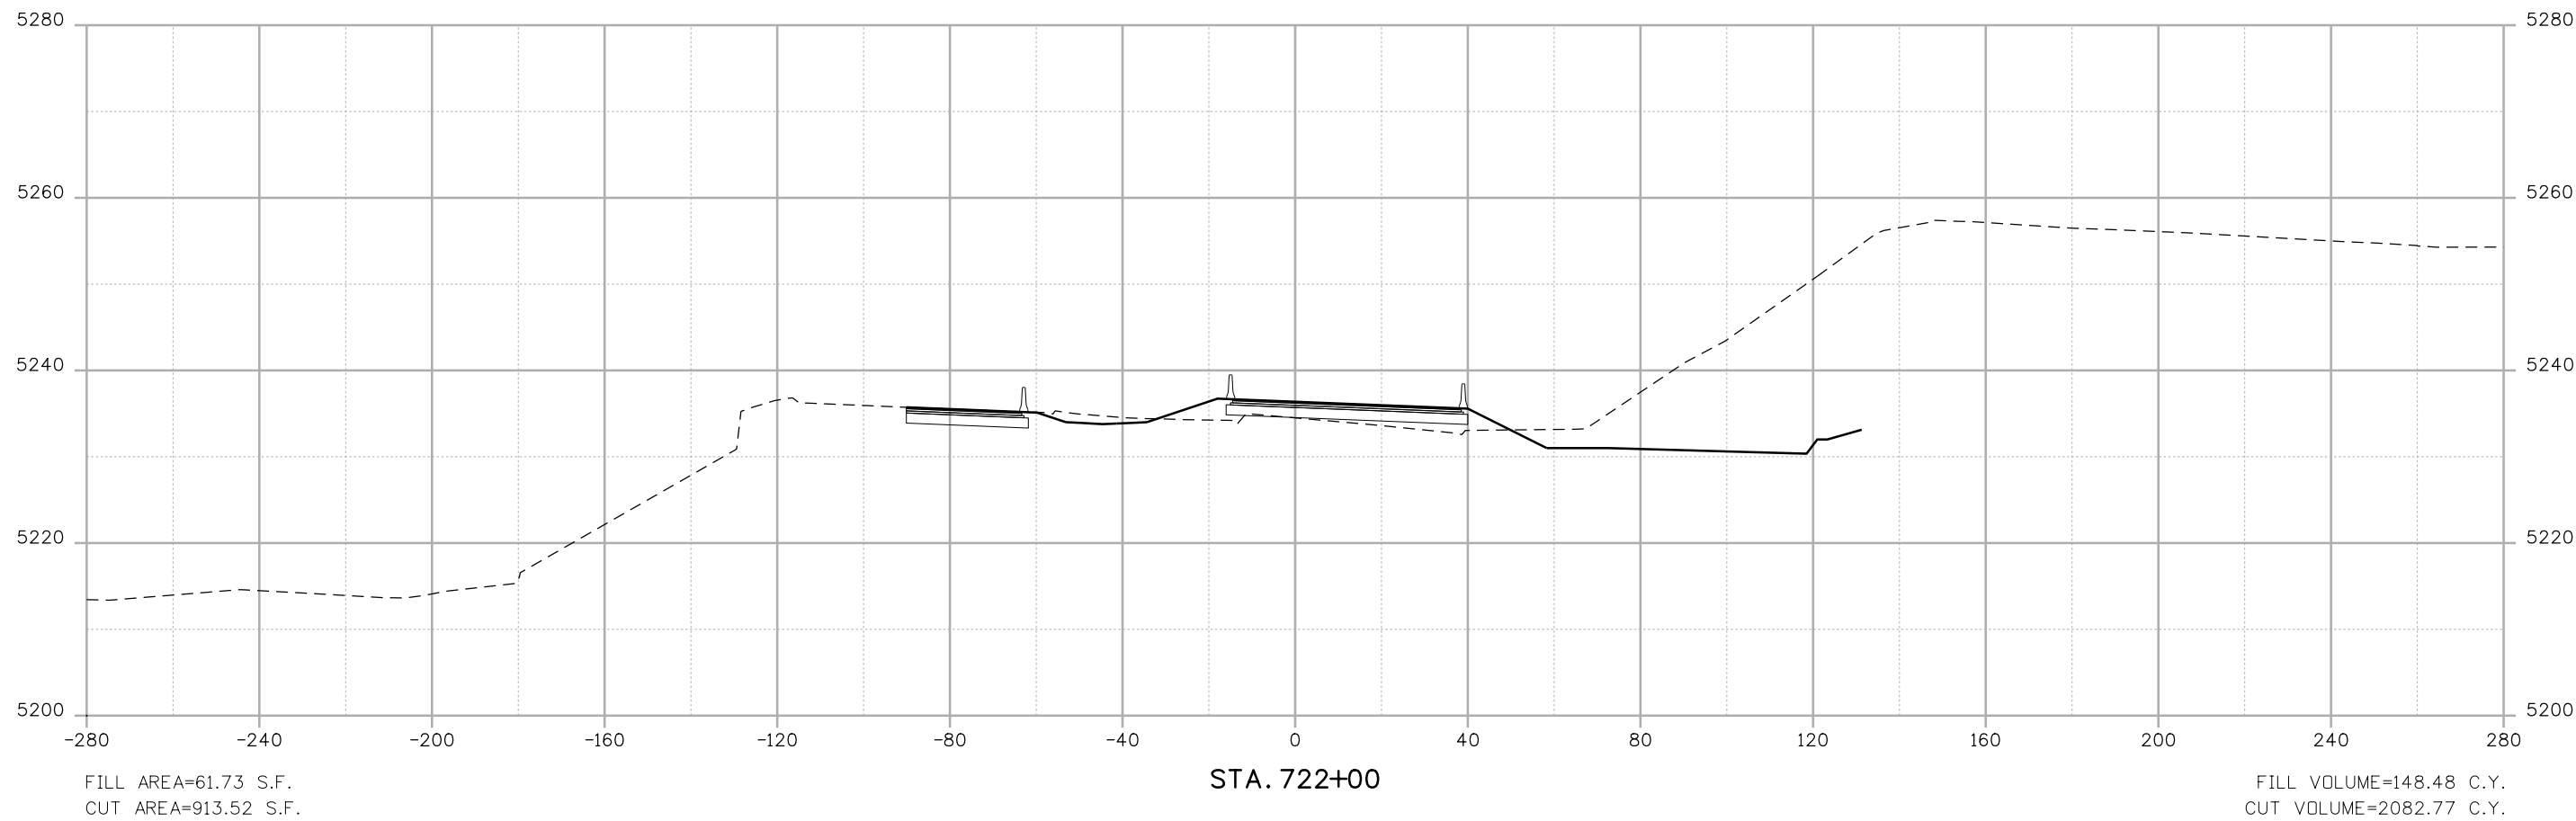

Print Date: 10/12/2010	
File Name: 16311DES_PH2_CrossSections1.dgn	
Horiz. Scale: 1:40	Vert. Scale: 1:20
Unit Information	Unit Leader Initials
 FELSBERG HOLT & ULLEVIG 6300 South Syracuse Way Centennial, CO 80111	

Sheet Revisions		
Date:	Comments	Init.

Colorado Department of Transportation



2000 South Holly Street
Denver, CO 80222
Phone: 303-972-9112 FAX: 303-972-9114


Region 6 **RLB**

As Constructed
No Revisions:
Revised:
Void:

I-25/SANTA FE INTERCHANGE SANTA FE DRIVE CROSS SECTIONS		
Designer: DCS	Structure Numbers	
Detailer: DCS		
Sheet Subset: SECTIONS	Subset Sheets: XS-65 of 104	

Project No./Code
BR 0252-407
17783
Sheet Number 65

Dusty 9:16:50 AM K:\08276\16311\Phase 2\Design\Drawings\Cross_Sections\16311DES_PH2_CrossSections1.dgn

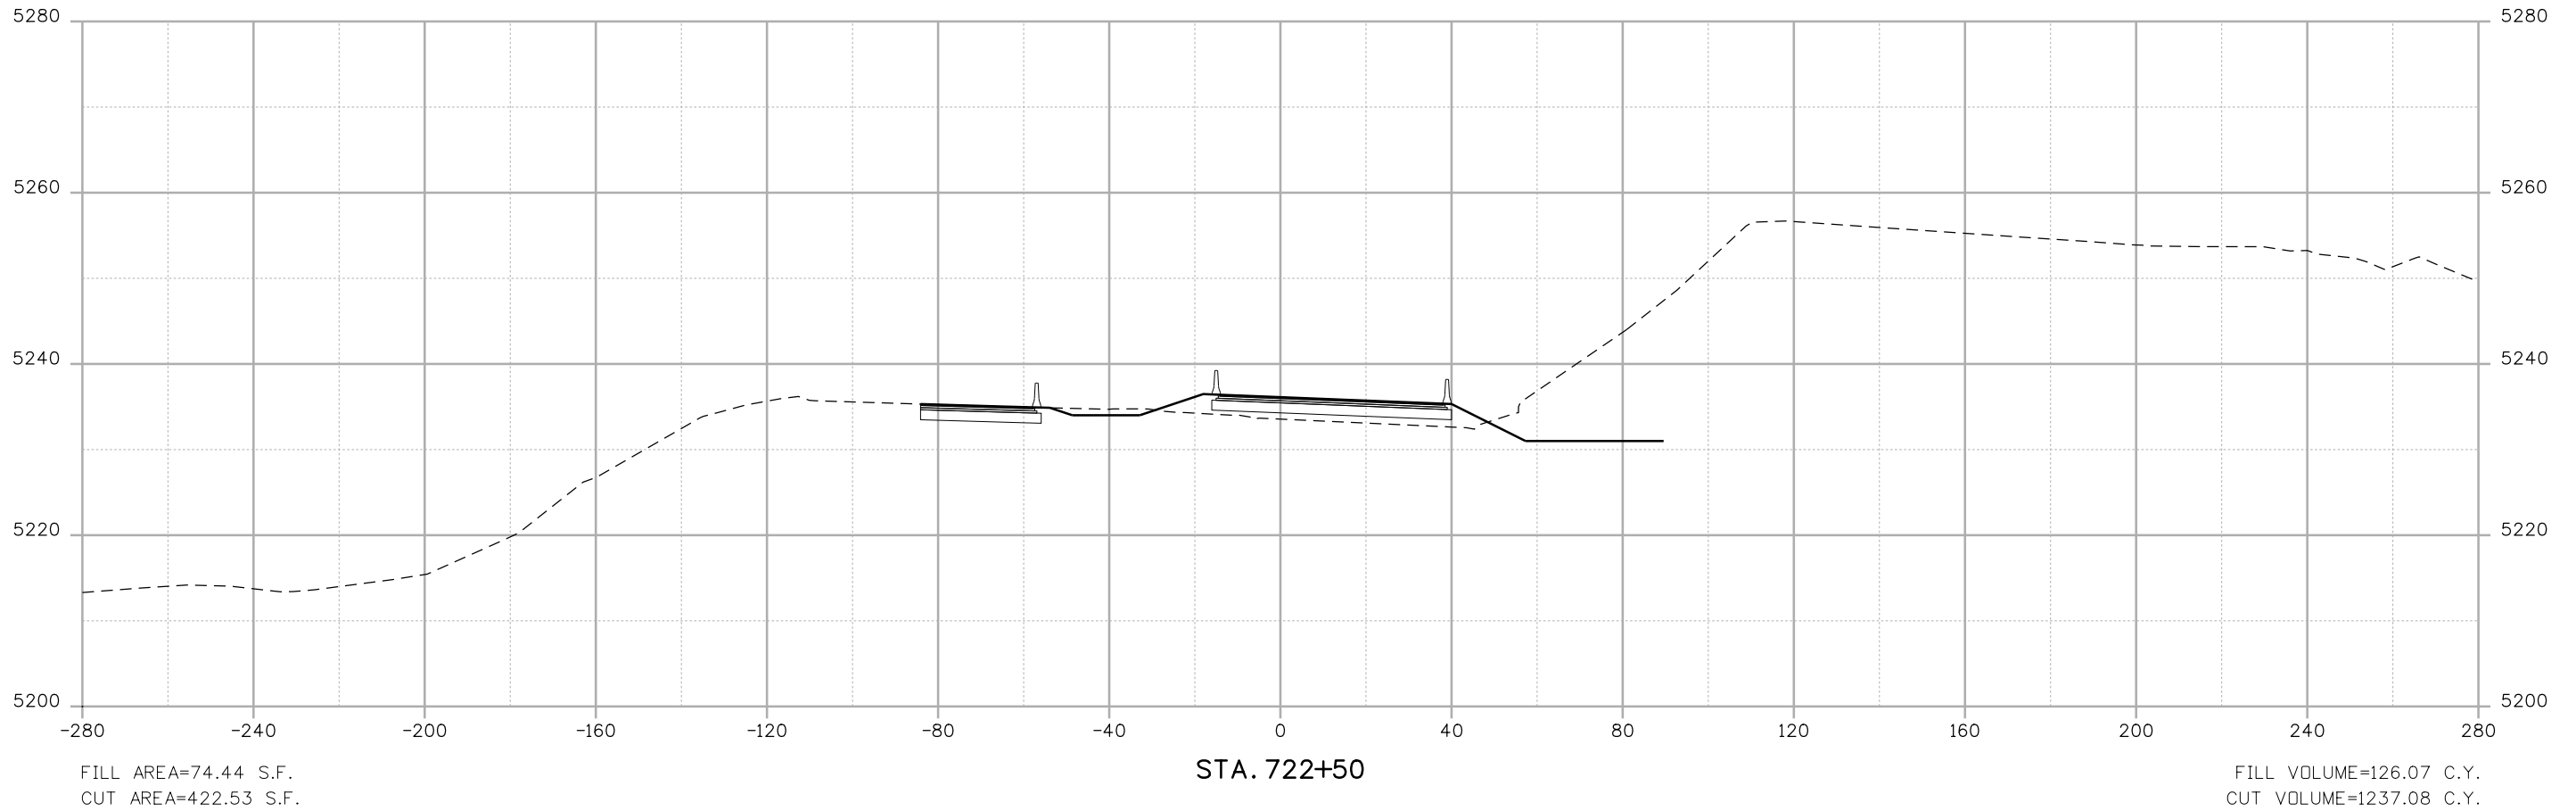

Print Date: 10/12/2010	
File Name: 16311DES_PH2_CrossSections1.dgn	
Horiz. Scale: 1:40 Vert. Scale: 1:20	
Unit Information Unit Leader Initials	
6300 South Syracuse Way Centennial, CO 80111	

Sheet Revisions		
Date:	Comments	Init.

Colorado Department of Transportation

2000 South Holly Street
Denver, CO 80222
Phone: 303-972-9112 FAX: 303-972-9114


Region 6 **RLB**

As Constructed
No Revisions:
Revised:
Void:

I-25/SANTA FE INTERCHANGE SANTA FE DRIVE CROSS SECTIONS		
Designer: DCS	Structure Numbers	
Detailer: DCS		
Sheet Subset: SECTIONS	Subset Sheets: XS-66 of 104	

Project No./Code
BR 0252-407
17783
Sheet Number 66

Dusty 9:16:59 AM K:\08276\16311\Phase 2\Design\Drawings\Cross_Sections\16311DES_PH2_CrossSections1.dgn

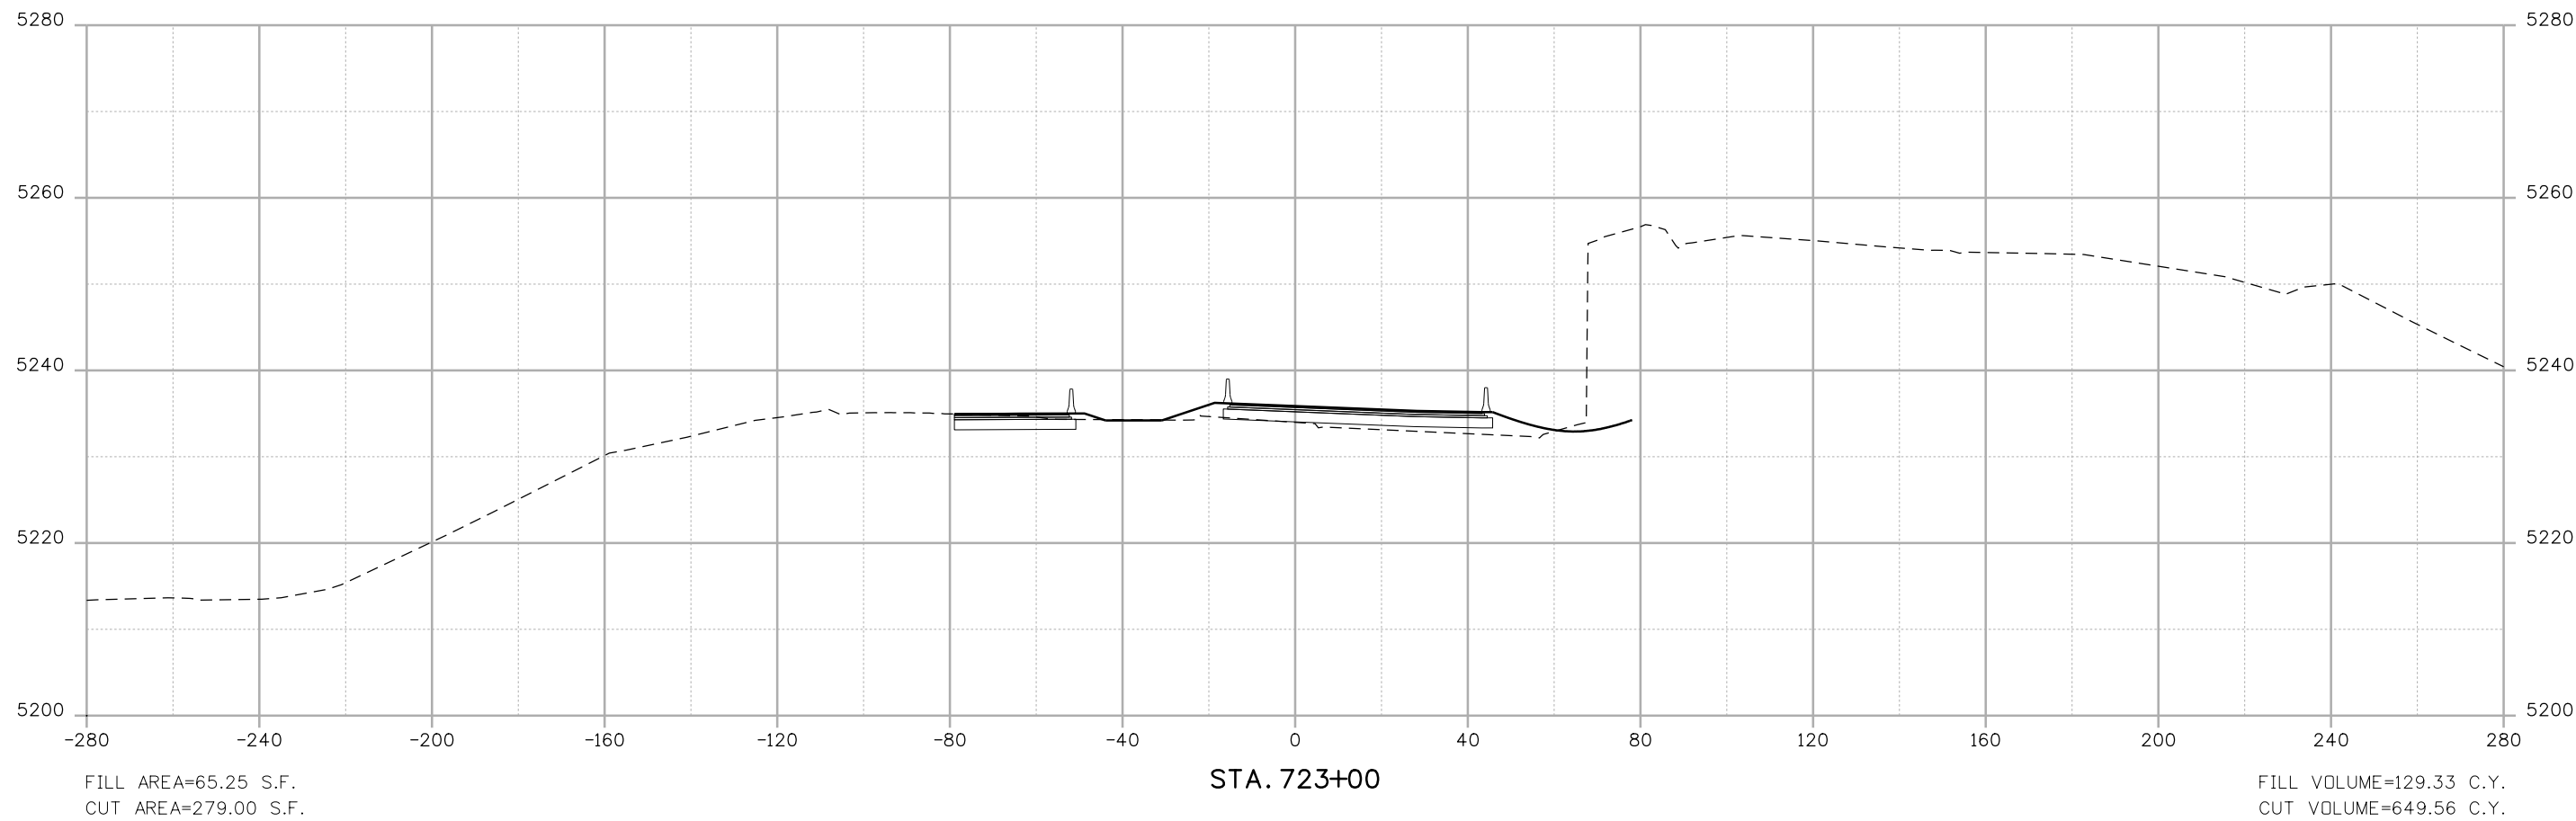

Print Date: 10/12/2010	
File Name: 16311DES_PH2_CrossSections1.dgn	
Horiz. Scale: 1:40	Vert. Scale: 1:20
Unit Information	Unit Leader Initials

Sheet Revisions		
Date:	Comments	Init.

Colorado Department of Transportation

2000 South Holly Street
 Denver, CO 80222
 Phone: 303-972-9112 FAX: 303-972-9114


Region 6 RLB

As Constructed	
No Revisions:	
Revised:	
Void:	

I-25/SANTA FE INTERCHANGE SANTA FE DRIVE CROSS SECTIONS		
Designer: DCS	Structure Numbers	
Detailer: DCS		
Sheet Subset: SECTIONS	Subset Sheets: XS-67 of 104	

Project No./Code	BR 0252-407
	17783
Sheet Number	67

Dusty 9:17:10 AM K:\08276\16311\Phase 2\Design\Drawings\Cross_Sections\16311DES_PH2_CrossSections1.dgn

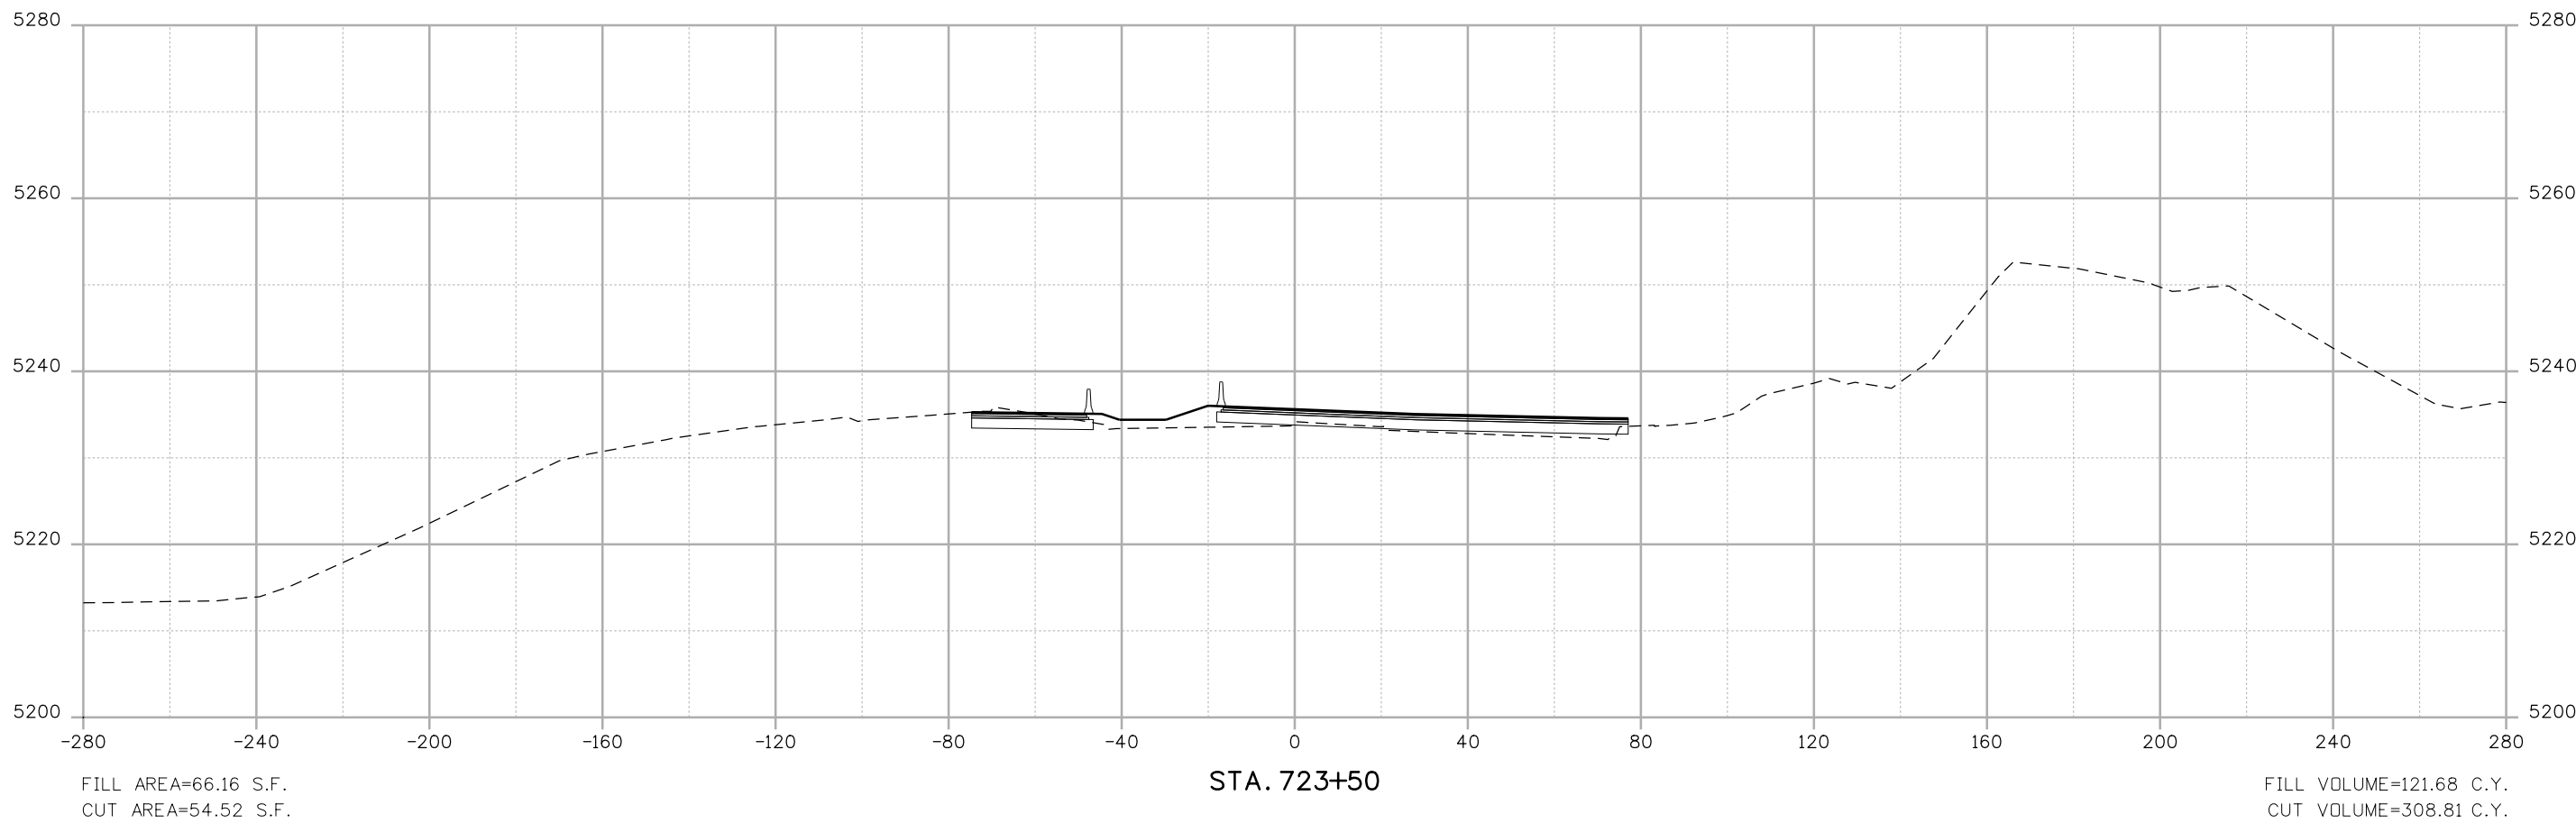

Print Date: 10/12/2010	
File Name: 16311DES_PH2_CrossSections1.dgn	
Horiz. Scale: 1:40	Vert. Scale: 1:20
Unit Information	Unit Leader Initials
6300 South Syracuse Way Centennial, CO 80111	

Sheet Revisions		
Date:	Comments	Init.

Colorado Department of Transportation

2000 South Holly Street
 Denver, CO 80222
 Phone: 303-972-9112 FAX: 303-972-9114


Region 6 **RLB**

As Constructed
No Revisions:
Revised:
Void:

I-25/SANTA FE INTERCHANGE SANTA FE DRIVE CROSS SECTIONS		
Designer: DCS	Structure Numbers	
Detailer: DCS		
Sheet Subset: SECTIONS	Subset Sheets: XS-68 of 104	

Project No./Code
BR 0252-407
17783
Sheet Number 68

Dusty 9:17:20 AM K:\08276\16311\Phase 2\Design\Drawings\Cross_Sections\16311DES_PH2_CrossSections1.dgn

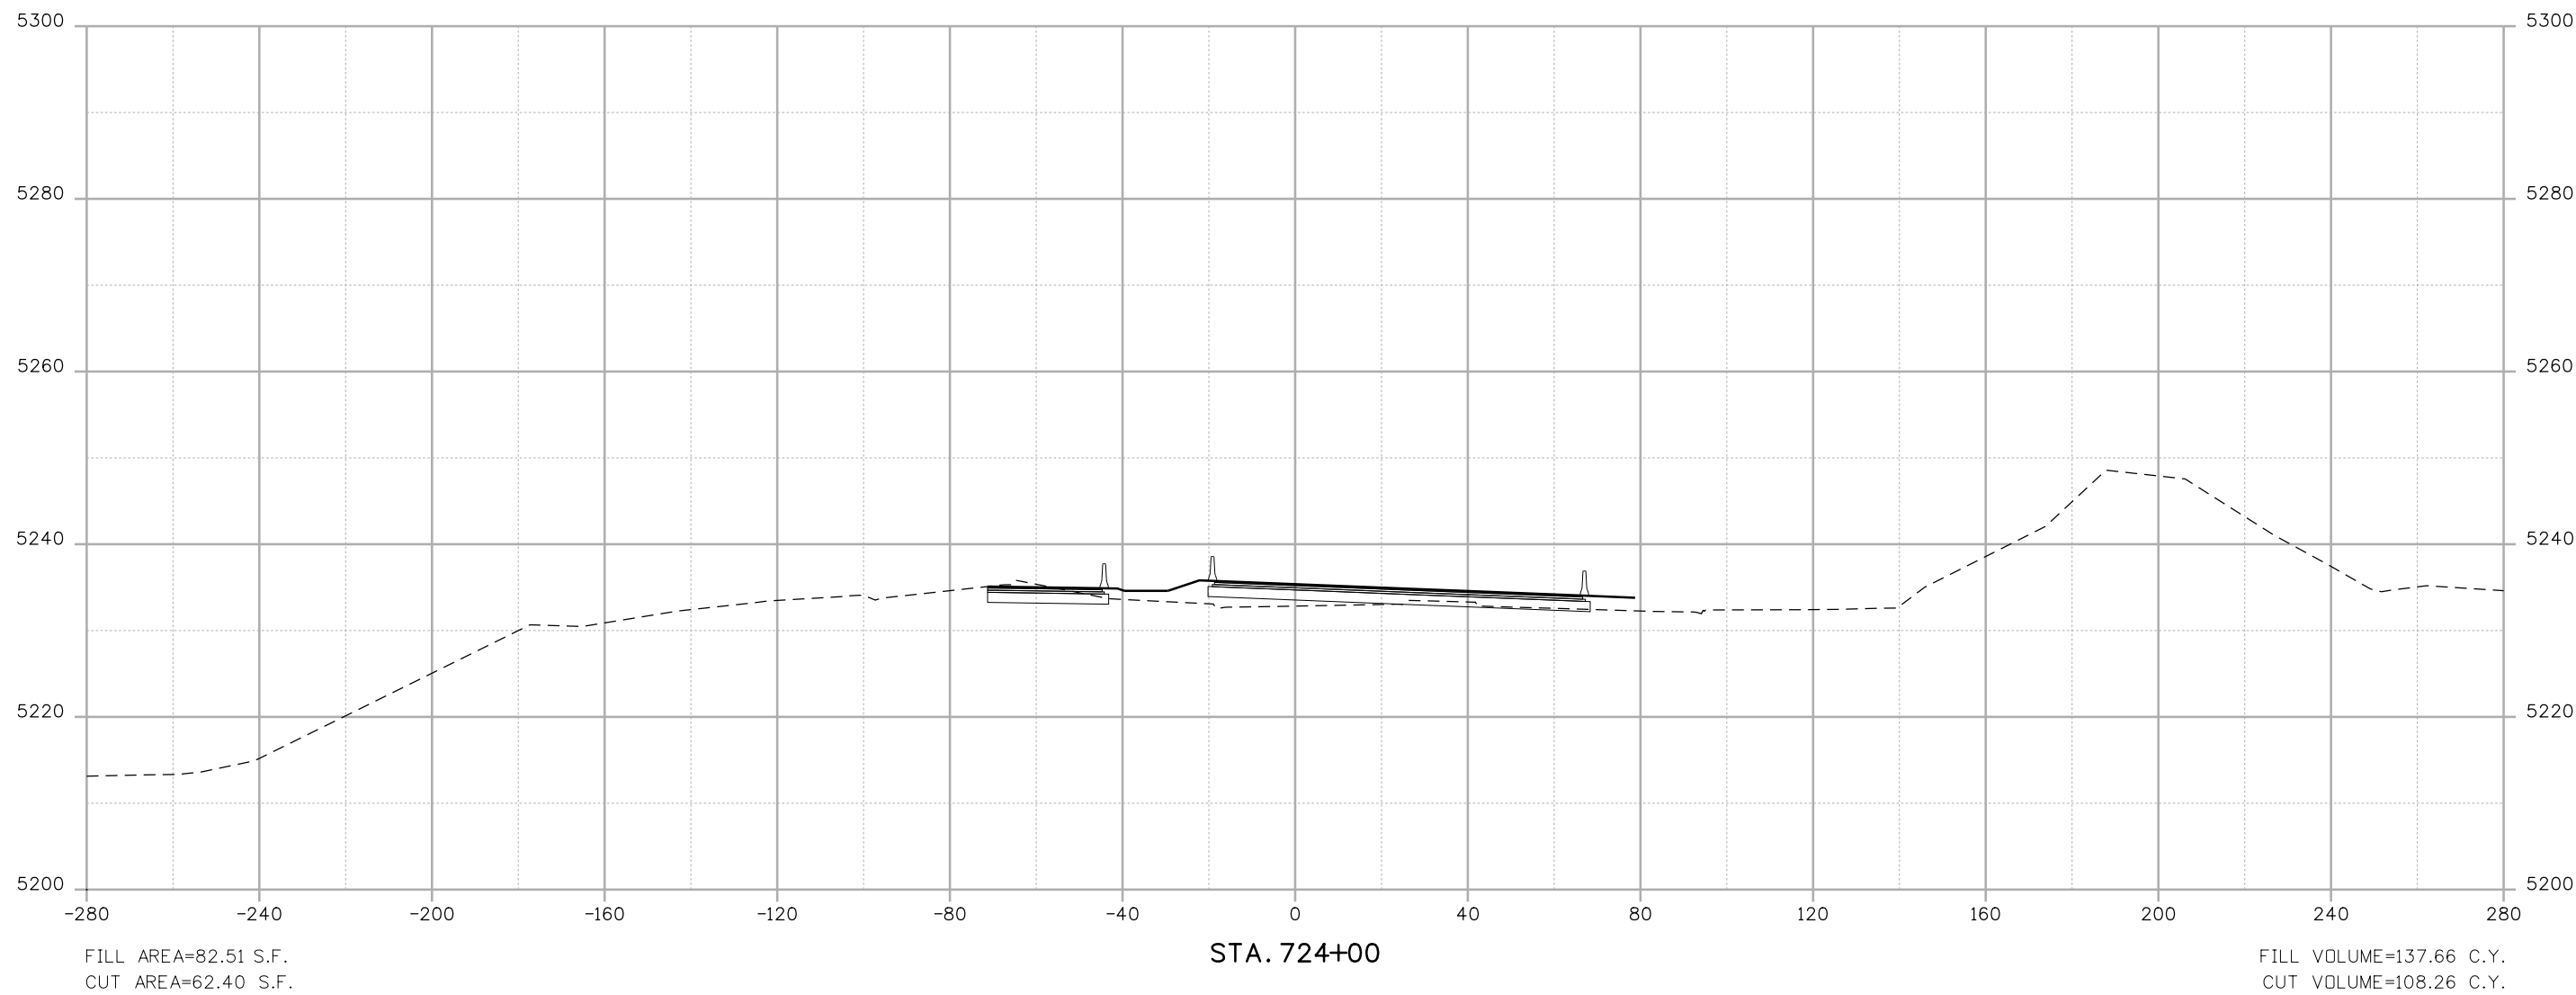

Print Date: 10/12/2010	
File Name: 16311DES_PH2_CrossSections1.dgn	
Horiz. Scale: 1:40	Vert. Scale: 1:20
Unit Information	Unit Leader Initials

Sheet Revisions		
Date:	Comments	Init.

Colorado Department of Transportation

2000 South Holly Street
Denver, CO 80222
Phone: 303-972-9112 FAX: 303-972-9114


Region 6 **RLB**

As Constructed
No Revisions:
Revised:
Void:

I-25/SANTA FE INTERCHANGE SANTA FE DRIVE CROSS SECTIONS		
Designer: DCS	Structure Numbers	
Detailer: DCS		
Sheet Subset: SECTIONS	Subset Sheets: XS-69 of 104	

Project No./Code
BR 0252-407
17783
Sheet Number 69


Dusty 9:17:30 AM K:\08276\16311\Phase 2\Design\Drawings\Cross_Sections\16311DES_PH2_CrossSections1.dgn

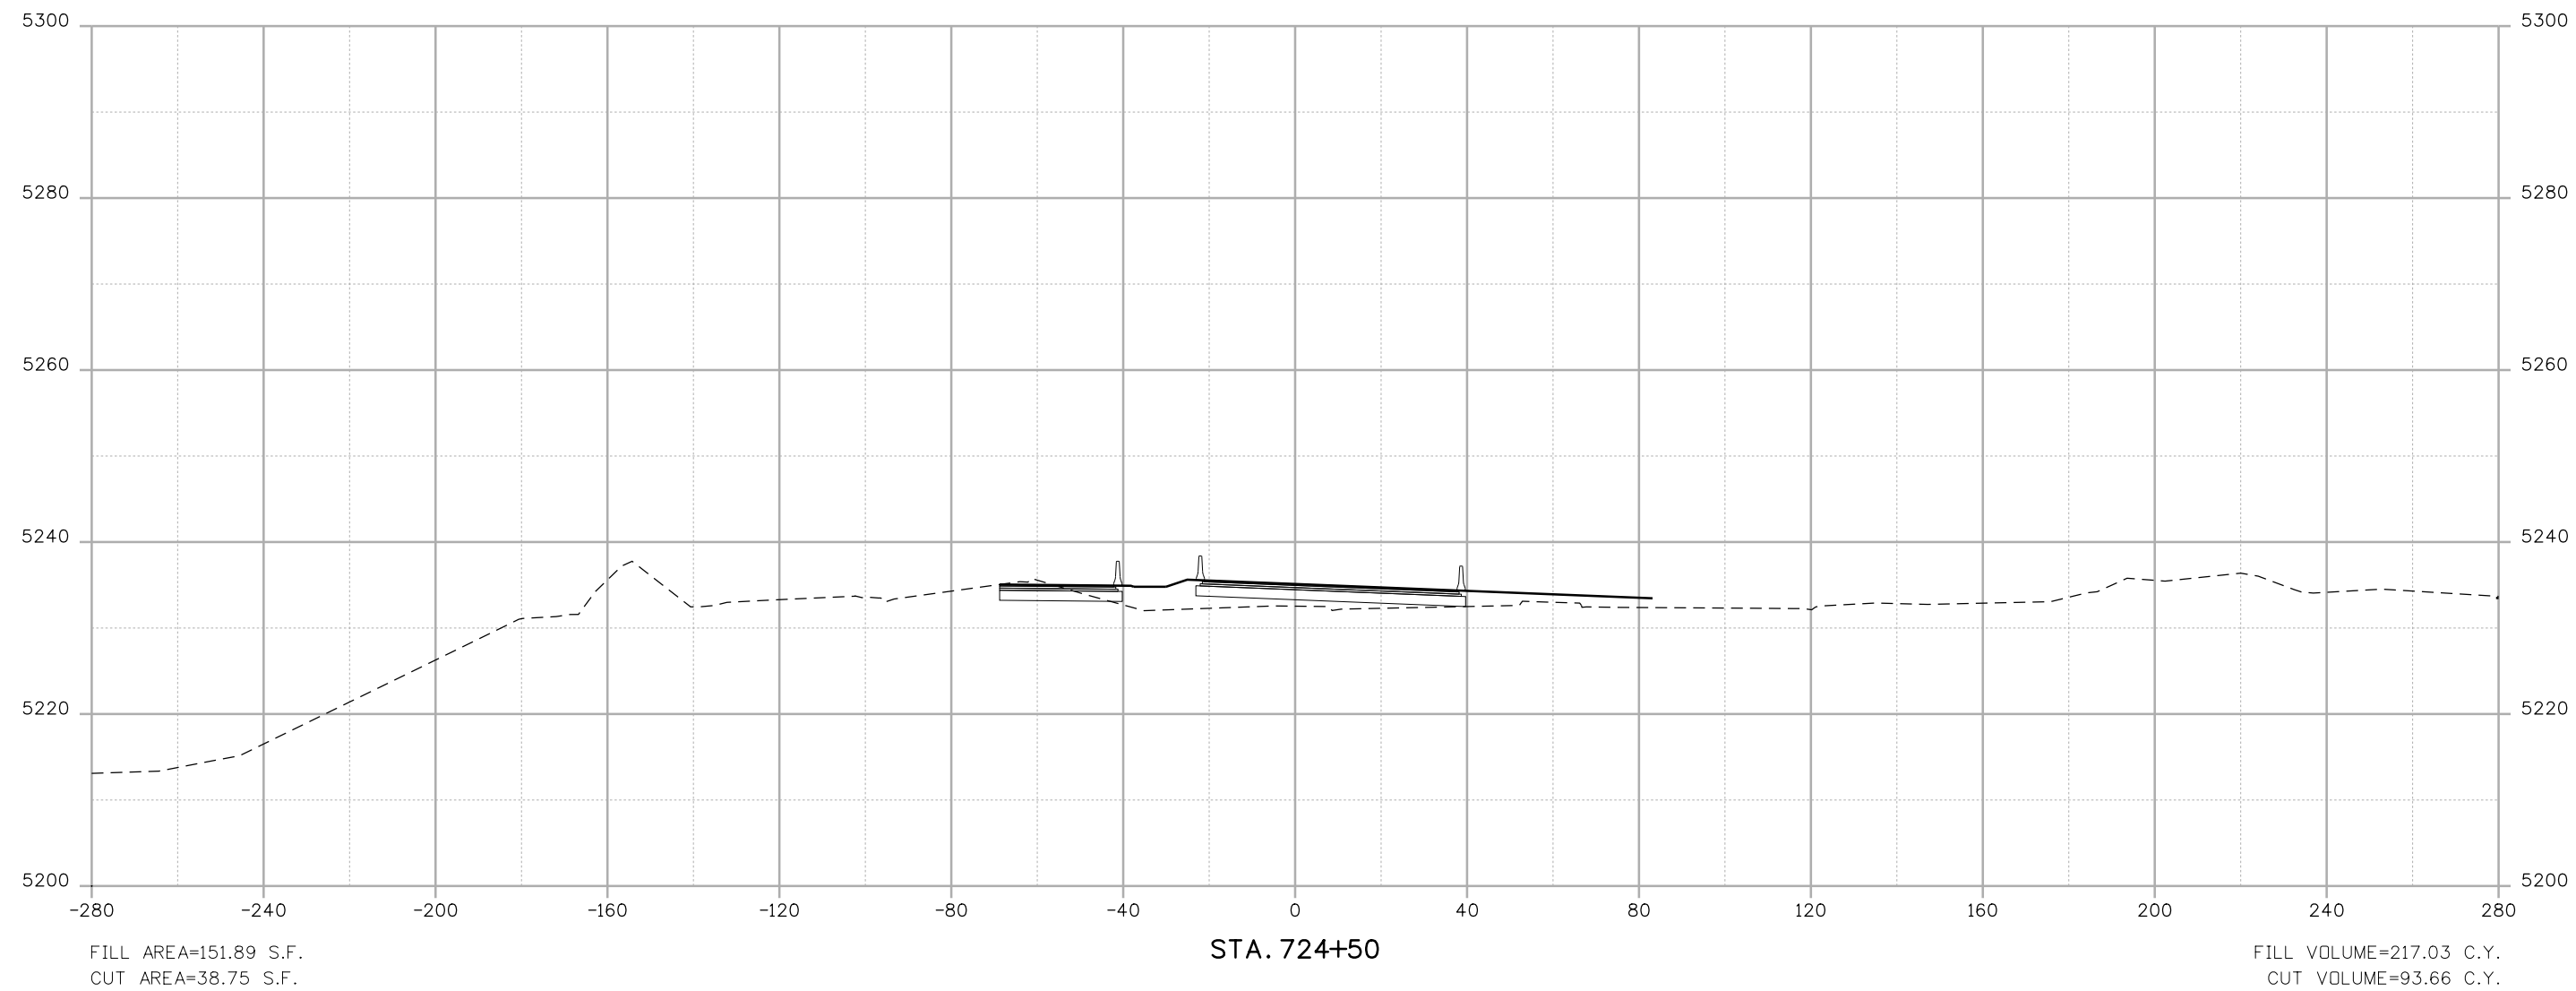

Print Date: 10/12/2010	
File Name: 16311DES_PH2_CrossSections1.dgn	
Horiz. Scale: 1:40	Vert. Scale: 1:20
Unit Information	Unit Leader Initials

Sheet Revisions		
Date:	Comments	Init.

Colorado Department of Transportation



2000 South Holly Street
Denver, CO 80222
Phone: 303-972-9112 FAX: 303-972-9114


Region 6 **RLB**

As Constructed
No Revisions:
Revised:
Void:

I-25/SANTA FE INTERCHANGE SANTA FE DRIVE CROSS SECTIONS		
Designer: DCS	Structure Numbers	
Detailer: DCS		
Sheet Subset: SECTIONS	Subset Sheets: XS-70 of 104	

Project No./Code
BR 0252-407
17783
Sheet Number 70

Dusty 9:17:40 AM K:\08276\16311\Phase 2\Design\Drawings\Cross_Sections\16311DES_PH2_CrossSections1.dgn

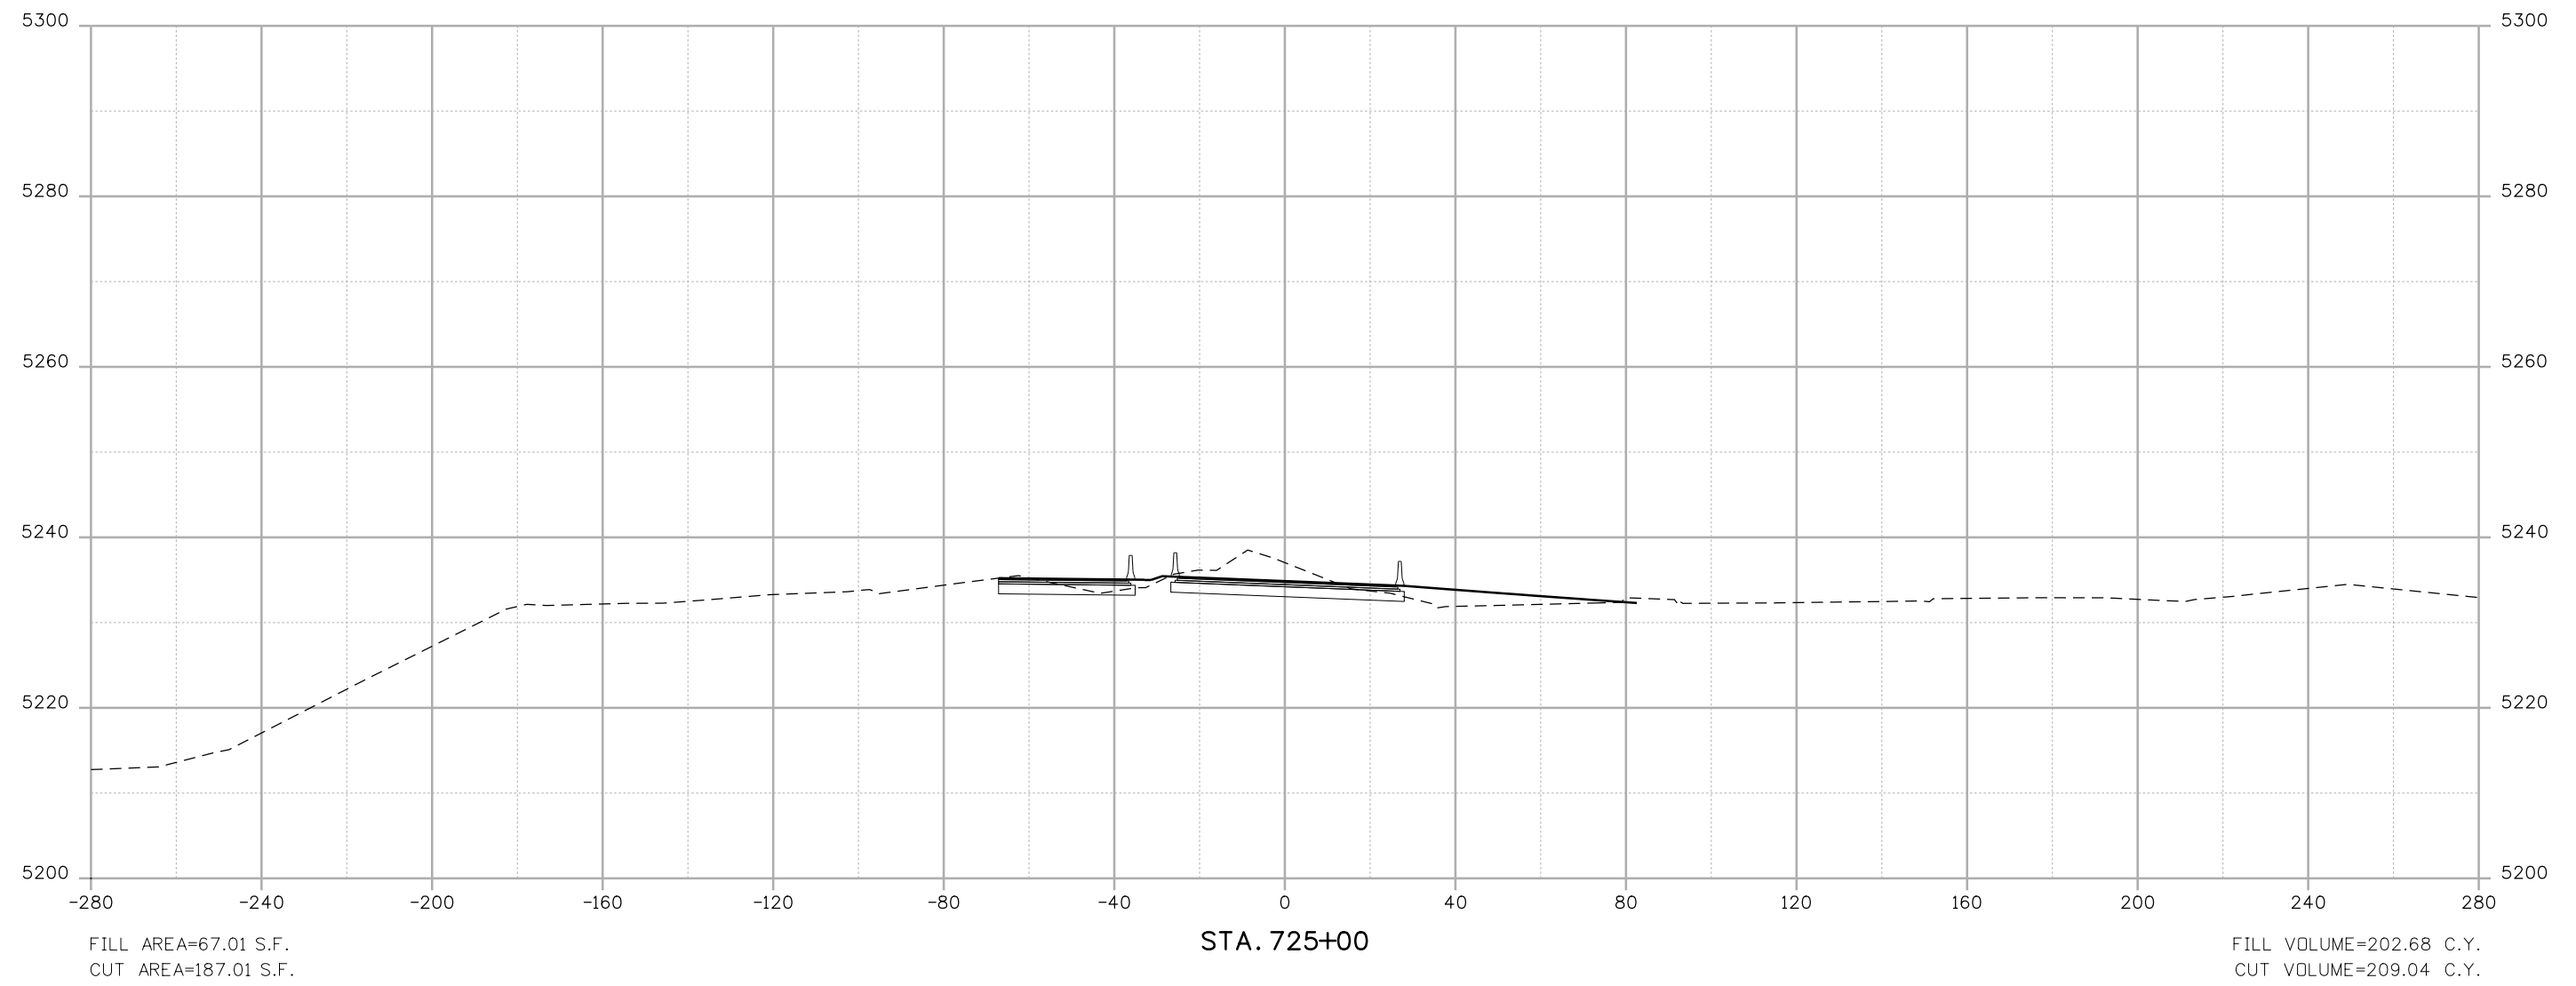

Print Date: 10/12/2010	
File Name: 16311DES_PH2_CrossSections1.dgn	
Horiz. Scale: 1:40	Vert. Scale: 1:20
Unit Information	Unit Leader Initials

Sheet Revisions		
Date:	Comments	Init.

Colorado Department of Transportation



2000 South Holly Street
Denver, CO 80222
Phone: 303-972-9112 FAX: 303-972-9114


Region 6 **RLB**

As Constructed
No Revisions:
Revised:
Void:

I-25/SANTA FE INTERCHANGE SANTA FE DRIVE CROSS SECTIONS		
Designer: DCS	Structure Numbers	
Detailer: DCS		
Sheet Subset: SECTIONS	Subset Sheets: XS-71 of 104	

Project No./Code
BR 0252-407
17783
Sheet Number 71

Dusty 9:17:51 AM K:\08276\16311\Phase 2\Design\Drawings\Cross_Sections\16311DES_PH2_CrossSections1.dgn

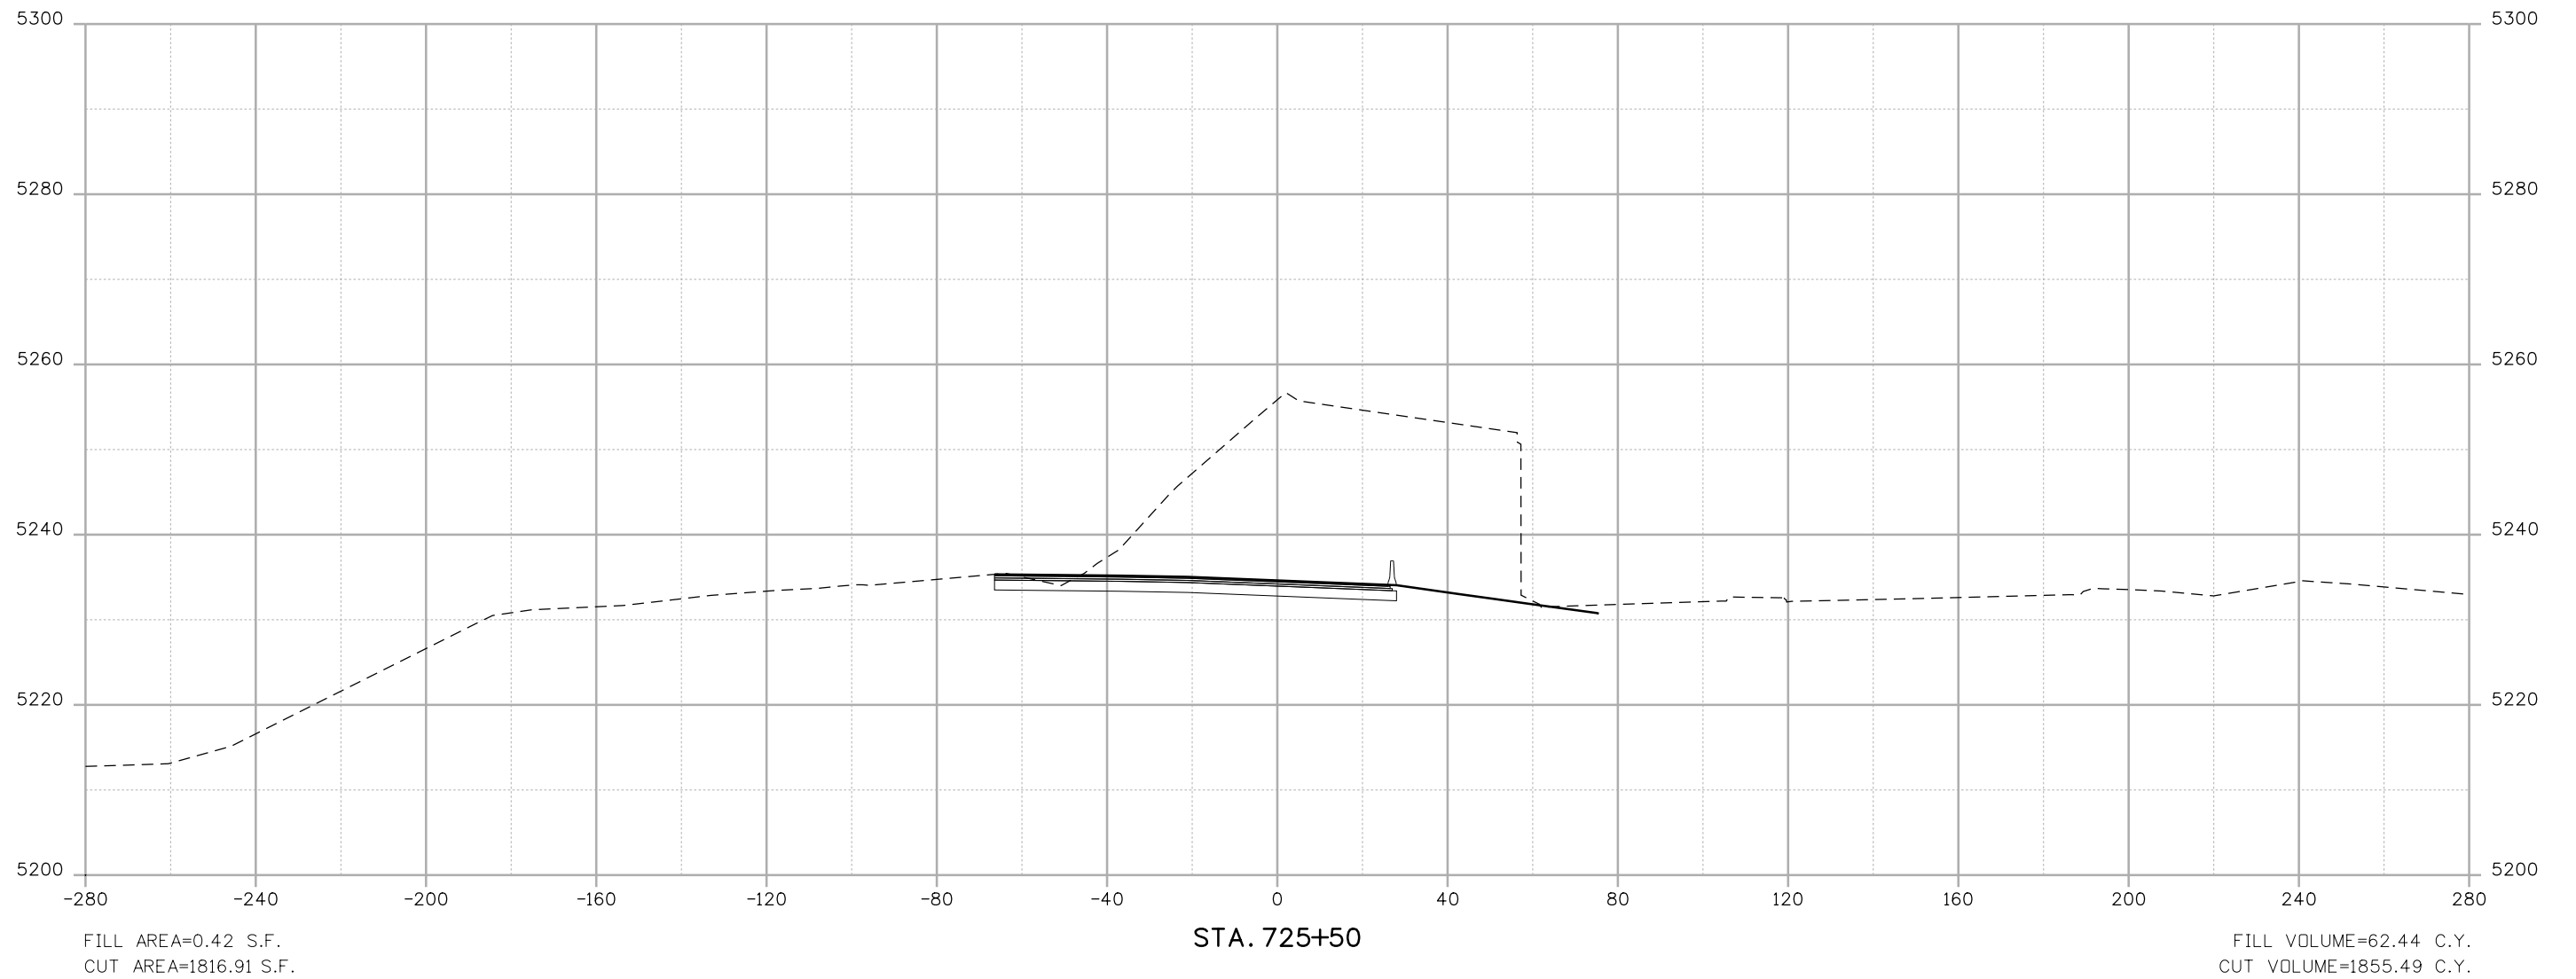

Print Date: 10/12/2010	
File Name: 16311DES_PH2_CrossSections1.dgn	
Horiz. Scale: 1:40	Vert. Scale: 1:20
Unit Information	Unit Leader Initials

Sheet Revisions		
Date:	Comments	Init.

Colorado Department of Transportation

2000 South Holly Street
Denver, CO 80222
Phone: 303-972-9112 FAX: 303-972-9114


Region 6 **RLB**

As Constructed
No Revisions:
Revised:
Void:

I-25/SANTA FE INTERCHANGE SANTA FE DRIVE CROSS SECTIONS		
Designer: DCS	Structure Numbers	
Detailer: DCS		
Sheet Subset: SECTIONS	Subset Sheets: XS-72 of 104	

Project No./Code
BR 0252-407
17783
Sheet Number 72

Dusty 9:16:03 AM K:\08276\16311\Phase 2\Design\Drawings\Cross_Sections\16311DES_PH2_CrossSections1.dgn

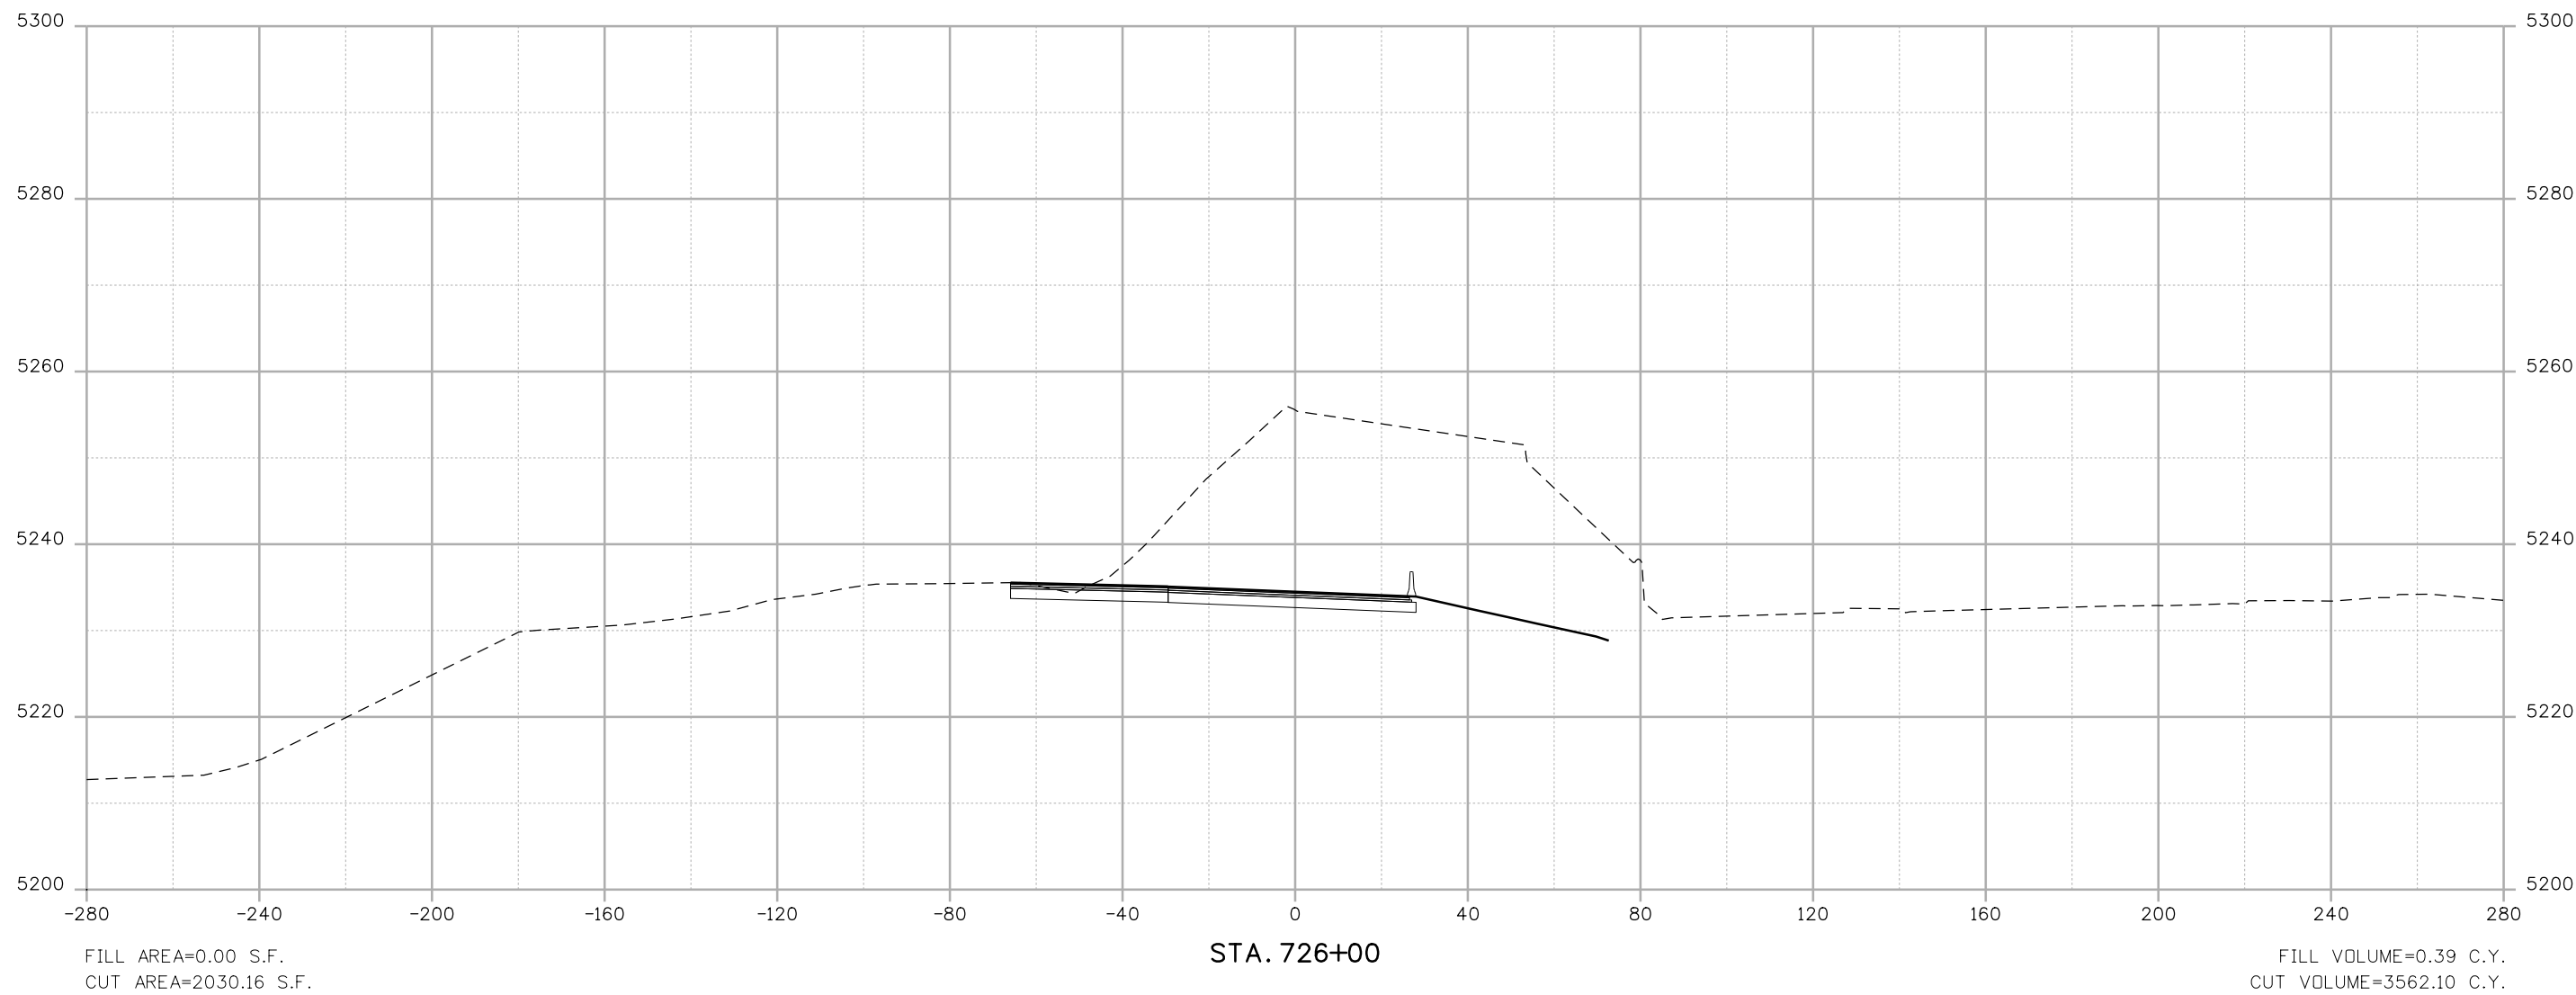

Print Date: 10/12/2010	
File Name: 16311DES_PH2_CrossSections1.dgn	
Horiz. Scale: 1:40	Vert. Scale: 1:20
Unit Information	Unit Leader Initials

Sheet Revisions		
Date:	Comments	Init.

Colorado Department of Transportation



2000 South Holly Street
Denver, CO 80222
Phone: 303-972-9112 FAX: 303-972-9114


Region 6 **RLB**


As Constructed
No Revisions:
Revised:
Void:

I-25/SANTA FE INTERCHANGE SANTA FE DRIVE CROSS SECTIONS		
Designer: DCS	Structure Numbers	
Detailer: DCS		
Sheet Subset: SECTIONS	Subset Sheets: XS-73 of 104	

Project No./Code
BR 0252-407
17783
Sheet Number 73

Dusty 9:18:13 AM K:\08276\16311\Phase 2\Design\Drawings\Cross_Sections\16311DES_PH2_CrossSections1.dgn

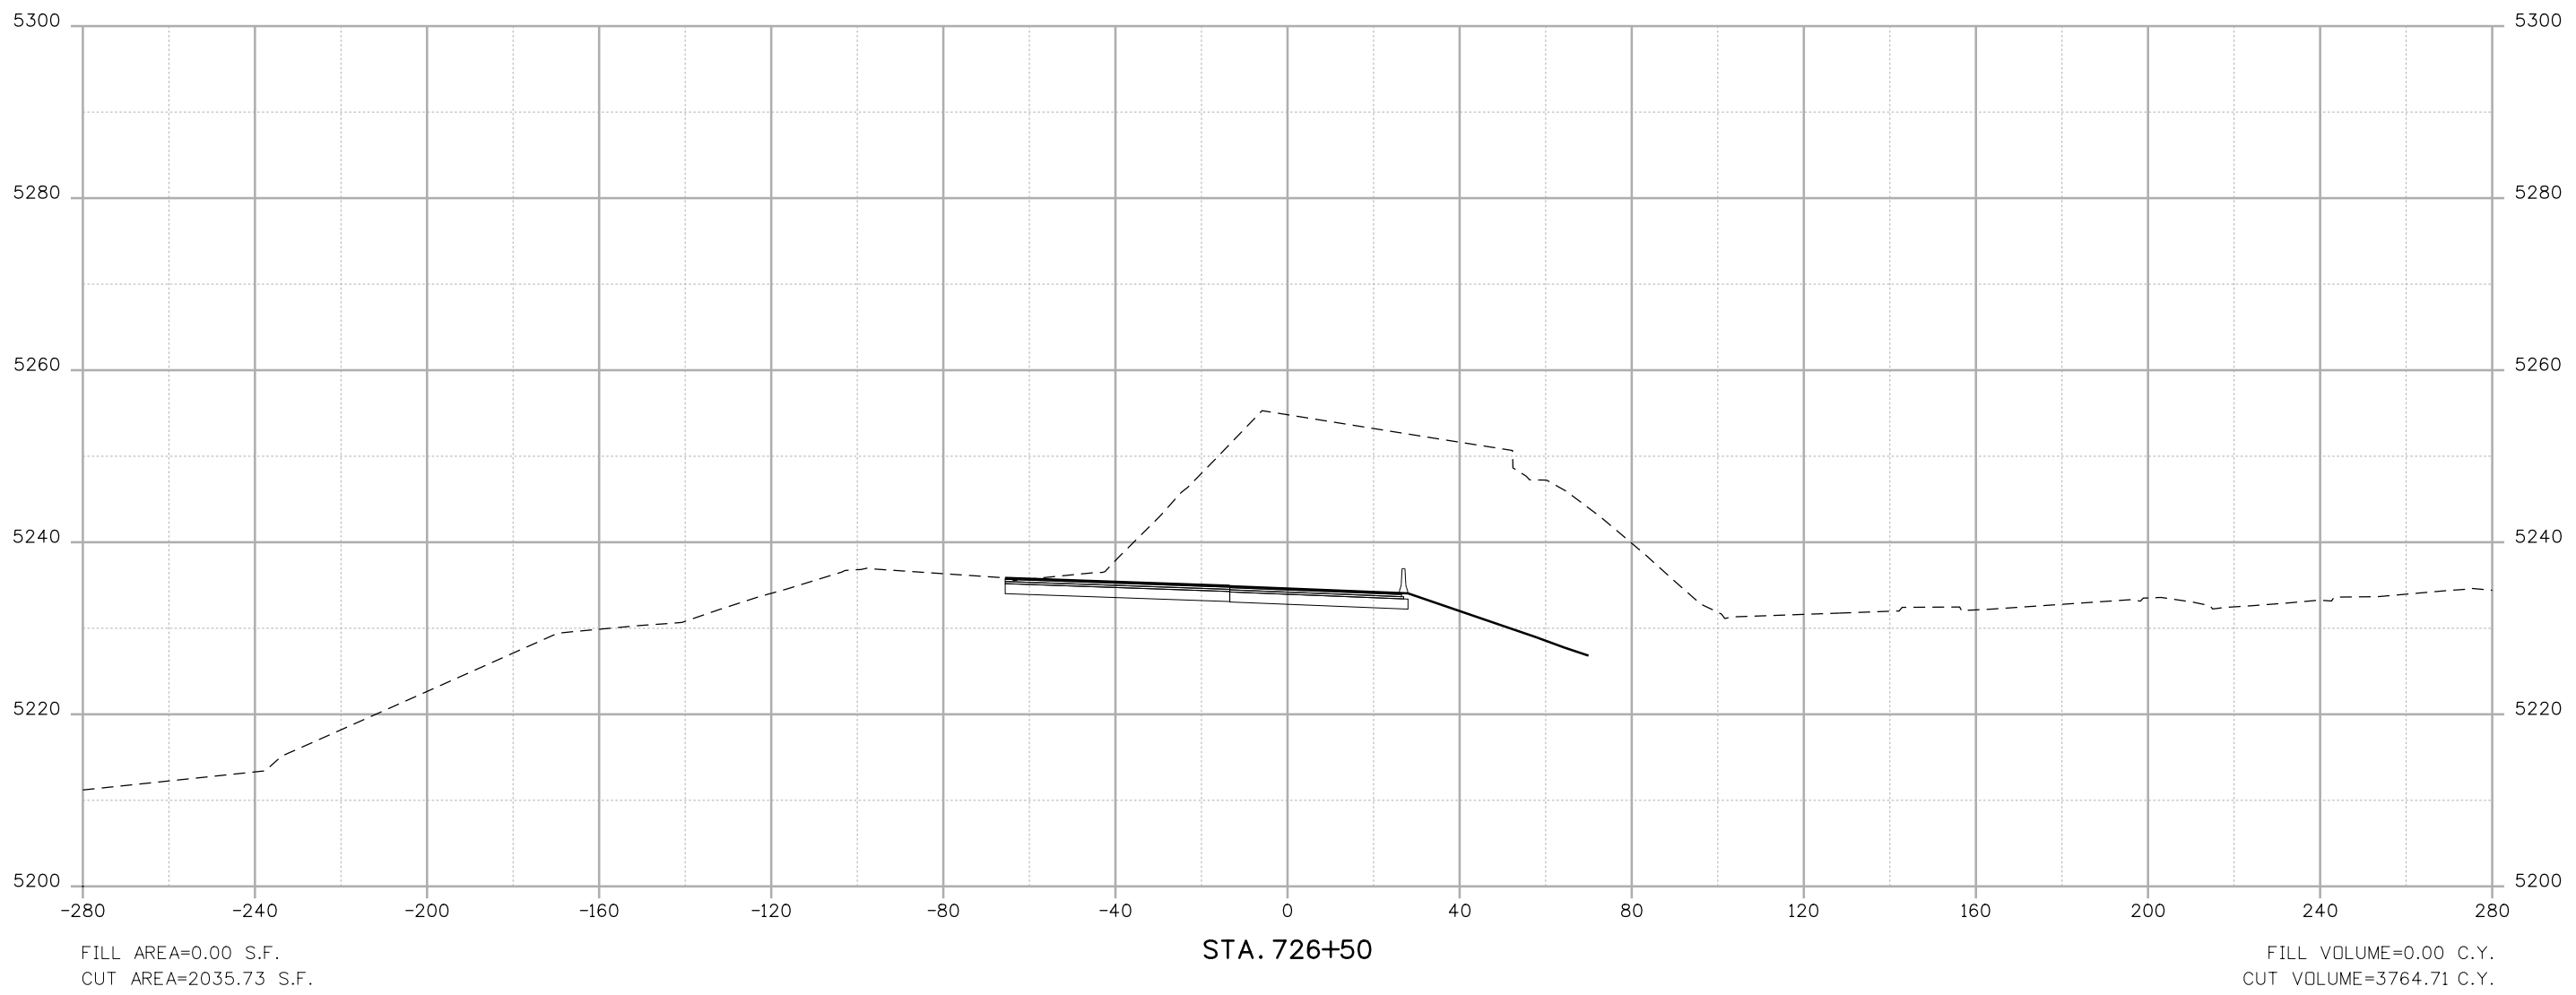

Print Date: 10/12/2010
 File Name: 16311DES_PH2_CrossSections1.dgn
 Horiz. Scale: 1:40 Vert. Scale: 1:20
 Unit Information Unit Leader Initials
 6300 South Syracuse Way
 Centennial, CO 80111

Sheet Revisions		
Date:	Comments	Init.


Colorado Department of Transportation
 2000 South Holly Street
 Denver, CO 80222
 Phone: 303-972-9112 FAX: 303-972-9114
Region 6 **RLB**


As Constructed
 No Revisions:
 Revised:
 Void:

**I-25/SANTA FE INTERCHANGE
 SANTA FE DRIVE
 CROSS SECTIONS**
 Designer: DCS Structure Numbers
 Detailer: DCS
 Sheet Subset: SECTIONS Subset Sheets: XS-74 of 104

Project No./Code
 BR 0252-407
 17783
 Sheet Number **74**

Dusty 9:18:26 AM K:\08276\16311\Phase 2\Design\Drawings\Cross_Sections\16311DES_PH2_CrossSections1.dgn

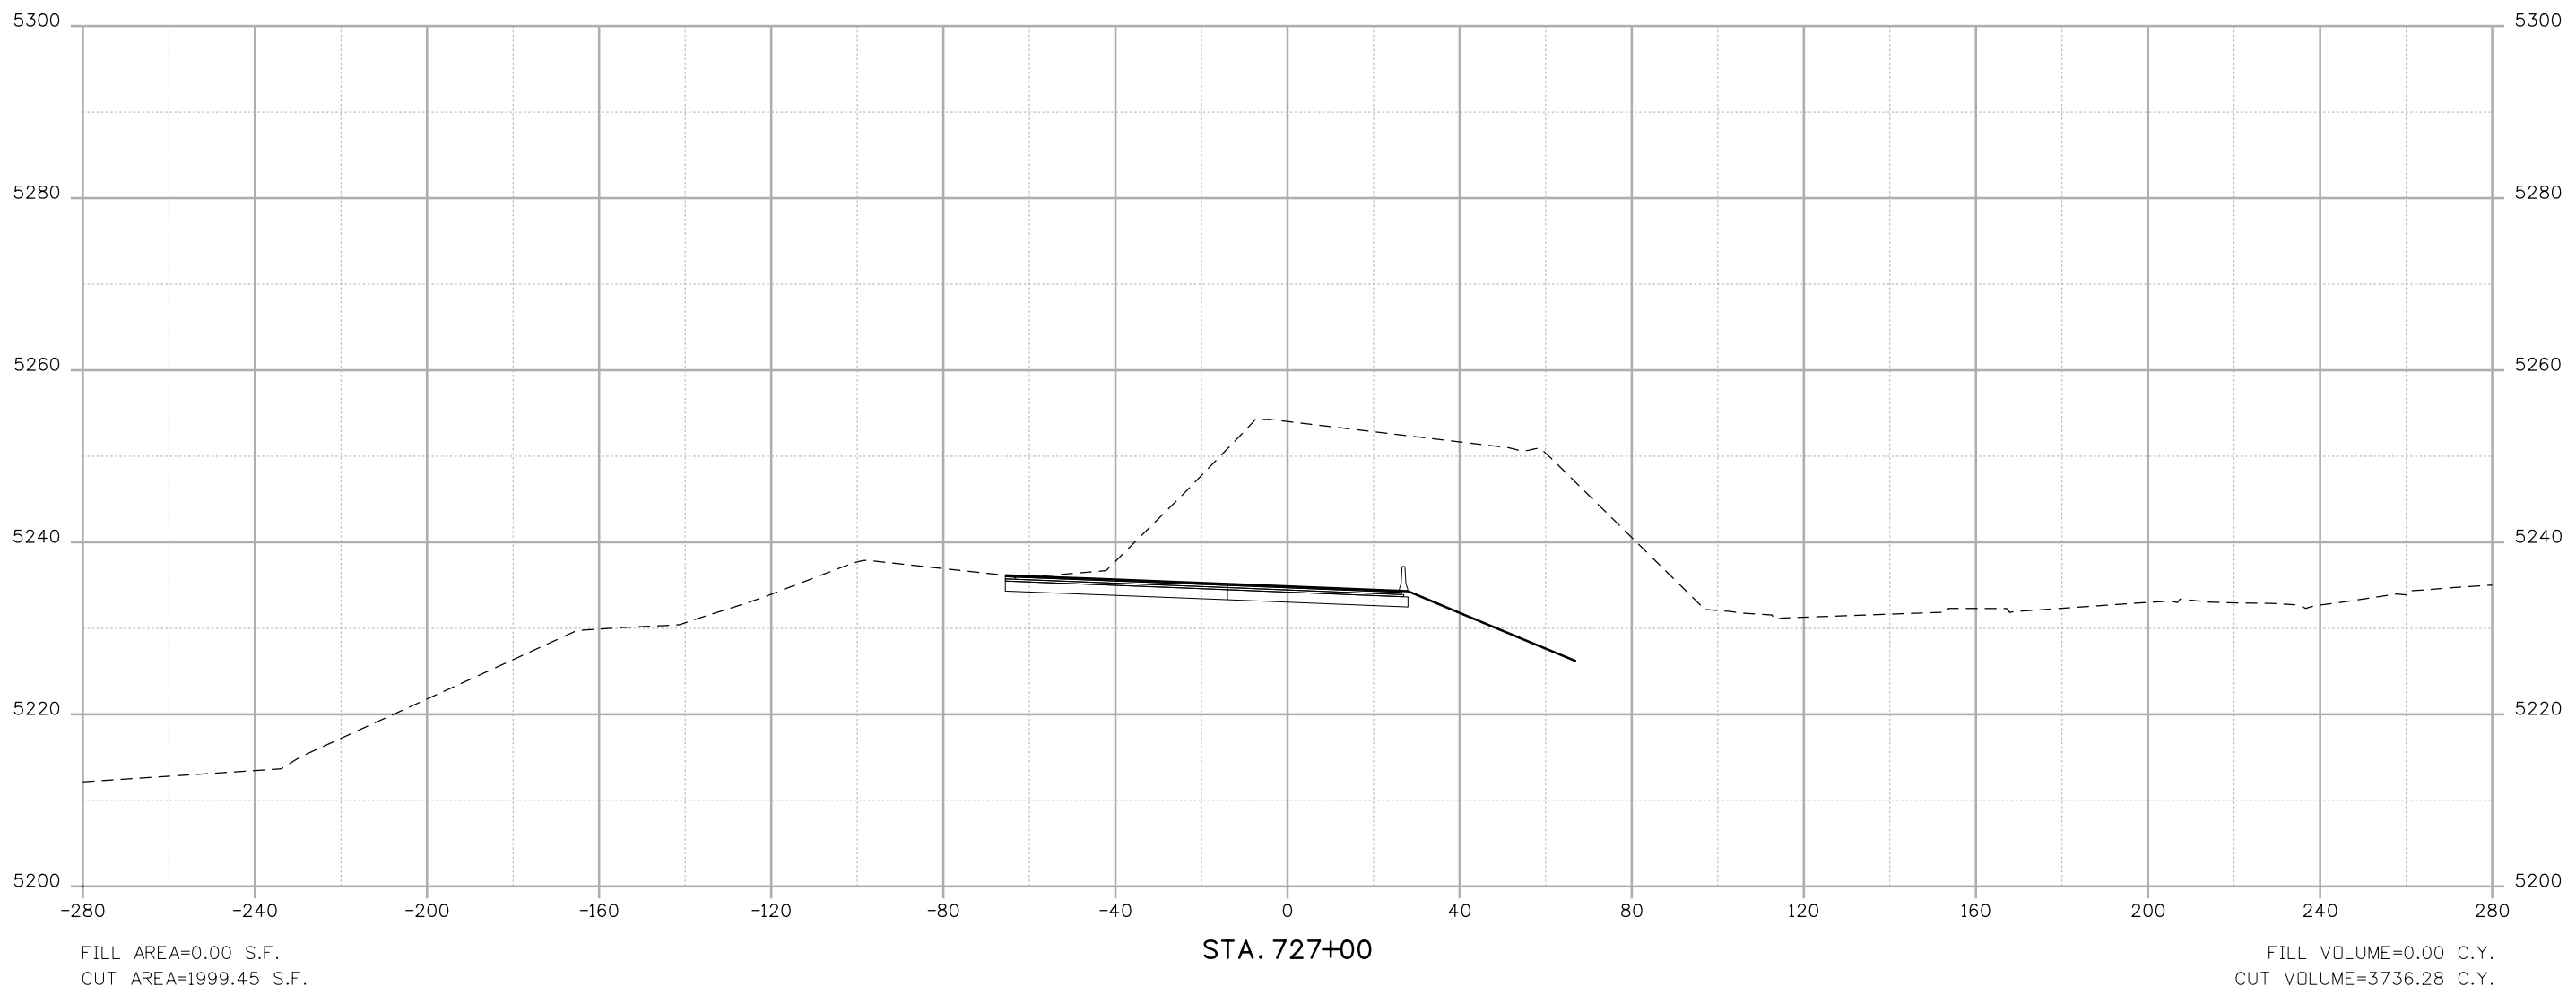

Print Date: 10/12/2010
 File Name: 16311DES_PH2_CrossSections1.dgn
 Horiz. Scale: 1:40 Vert. Scale: 1:20
 Unit Information Unit Leader Initials
 6300 South Syracuse Way
 Centennial, CO 80111

Sheet Revisions		
Date:	Comments	Init.


Colorado Department of Transportation
 2000 South Holly Street
 Denver, CO 80222
 Phone: 303-972-9112 FAX: 303-972-9114
Region 6 **RLB**

As Constructed
 No Revisions:
 Revised:
 Void:

**I-25/SANTA FE INTERCHANGE
 SANTA FE DRIVE
 CROSS SECTIONS**
 Designer: DCS Structure Numbers
 Detailer: DCS
 Sheet Subset: SECTIONS Subset Sheets: XS-75 of 104

Project No./Code
 BR 0252-407
 17783
 Sheet Number **75**


Dusty 9:16:37 AM K:\08276\16311\Phase 2\Design\Drawings\Cross_Sections\16311DES_PH2_CrossSections1.dgn

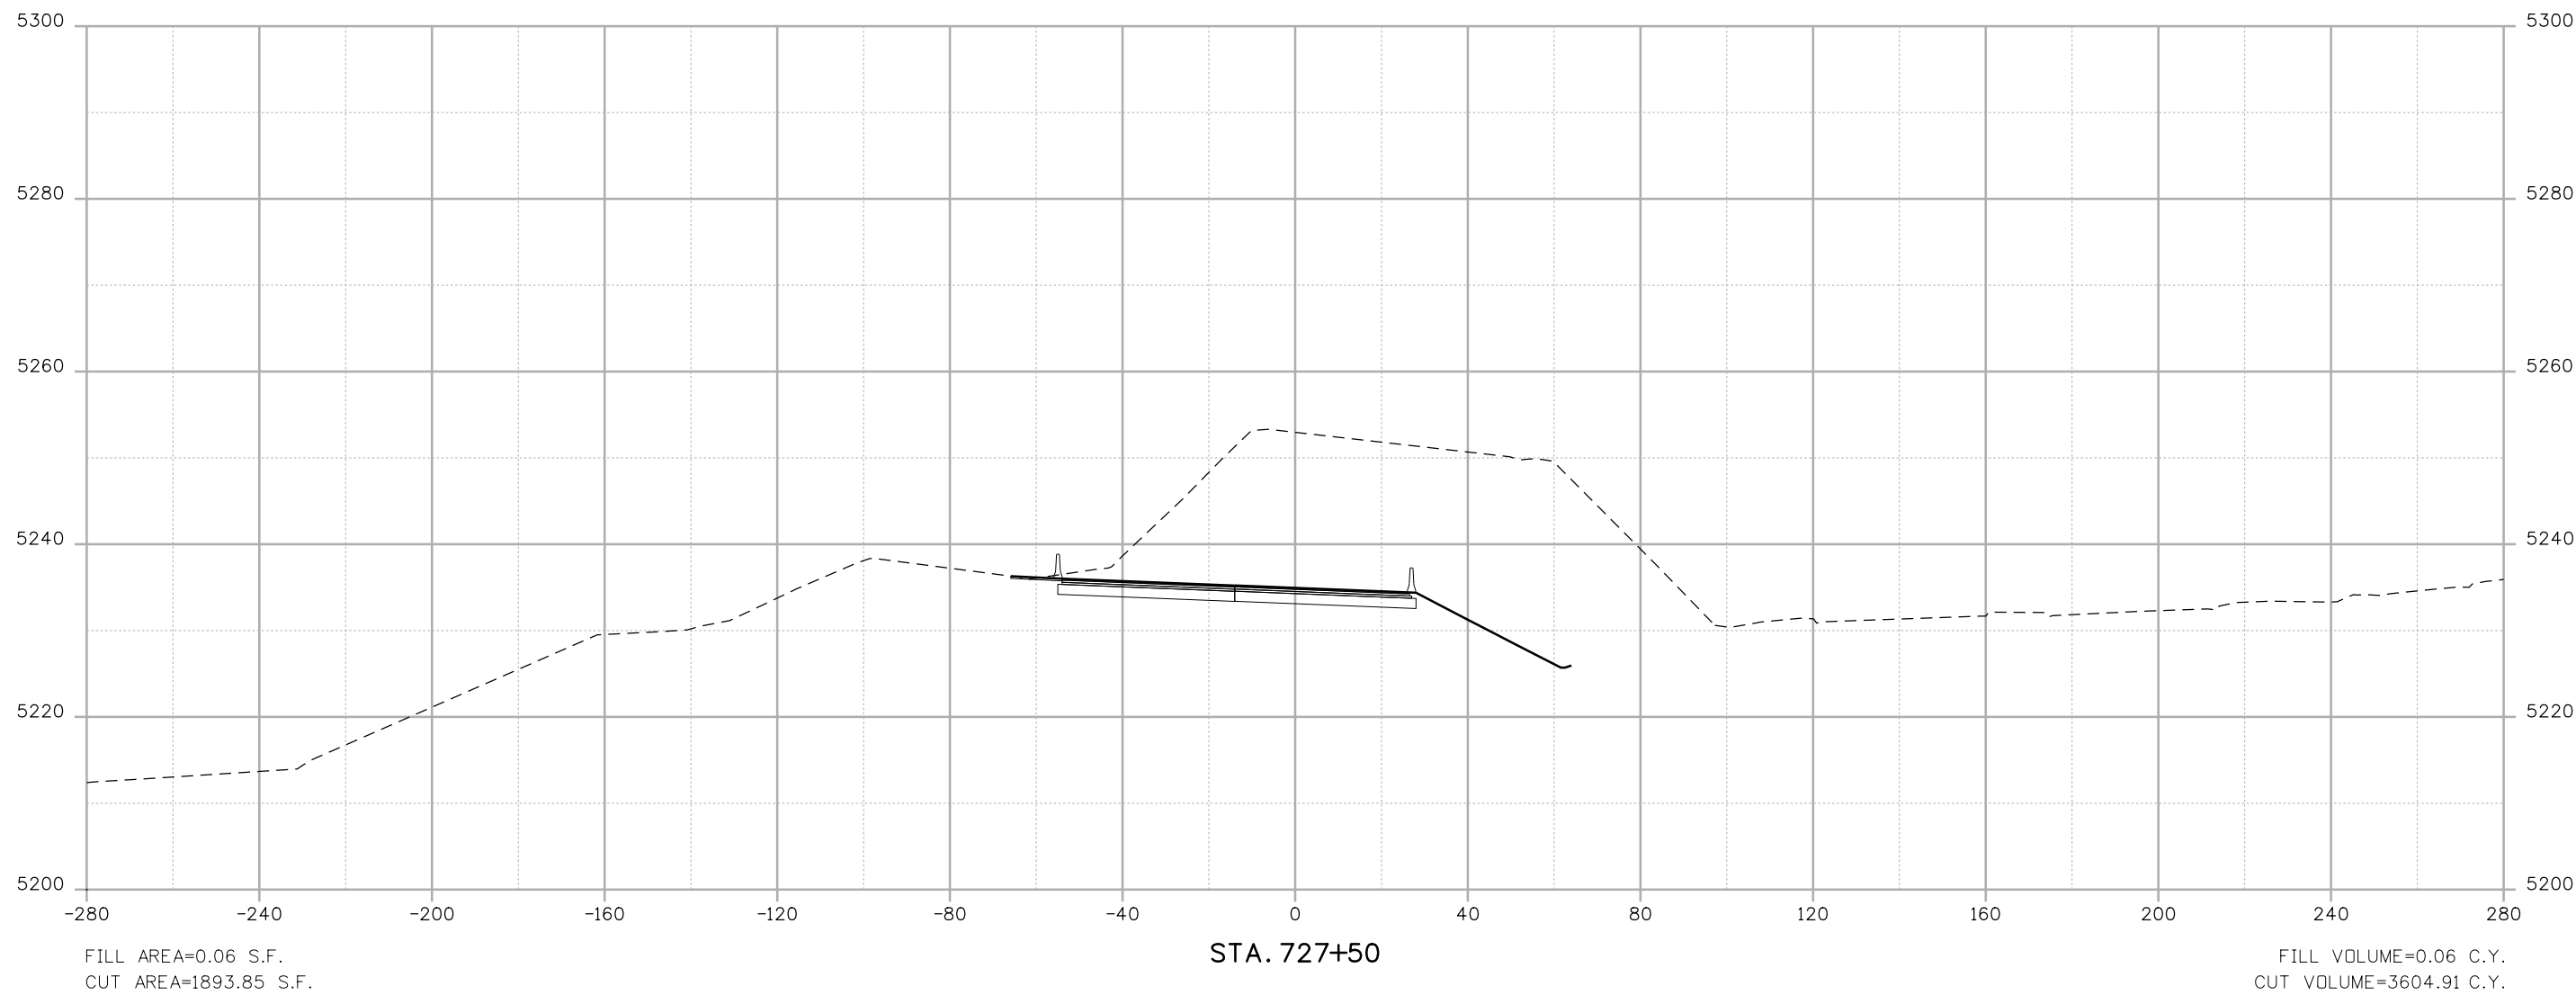

Print Date: 10/12/2010	
File Name: 16311DES_PH2_CrossSections1.dgn	
Horiz. Scale: 1:40	Vert. Scale: 1:20
Unit Information	Unit Leader Initials

Sheet Revisions		
Date:	Comments	Init.

Colorado Department of Transportation



2000 South Holly Street
Denver, CO 80222
Phone: 303-972-9112 FAX: 303-972-9114


Region 6 **RLB**

As Constructed
No Revisions:
Revised:
Void:

I-25/SANTA FE INTERCHANGE SANTA FE DRIVE CROSS SECTIONS		
Designer: DCS	Structure Numbers	
Detailer: DCS		
Sheet Subset: SECTIONS	Subset Sheets: XS-76 of 104	

Project No./Code
BR 0252-407
17783
Sheet Number 76

Dusty 9:18:49 AM K:\08276\16311\Phase 2\Design\Drawings\Cross_Sections\16311DES_PH2_CrossSections1.dgn

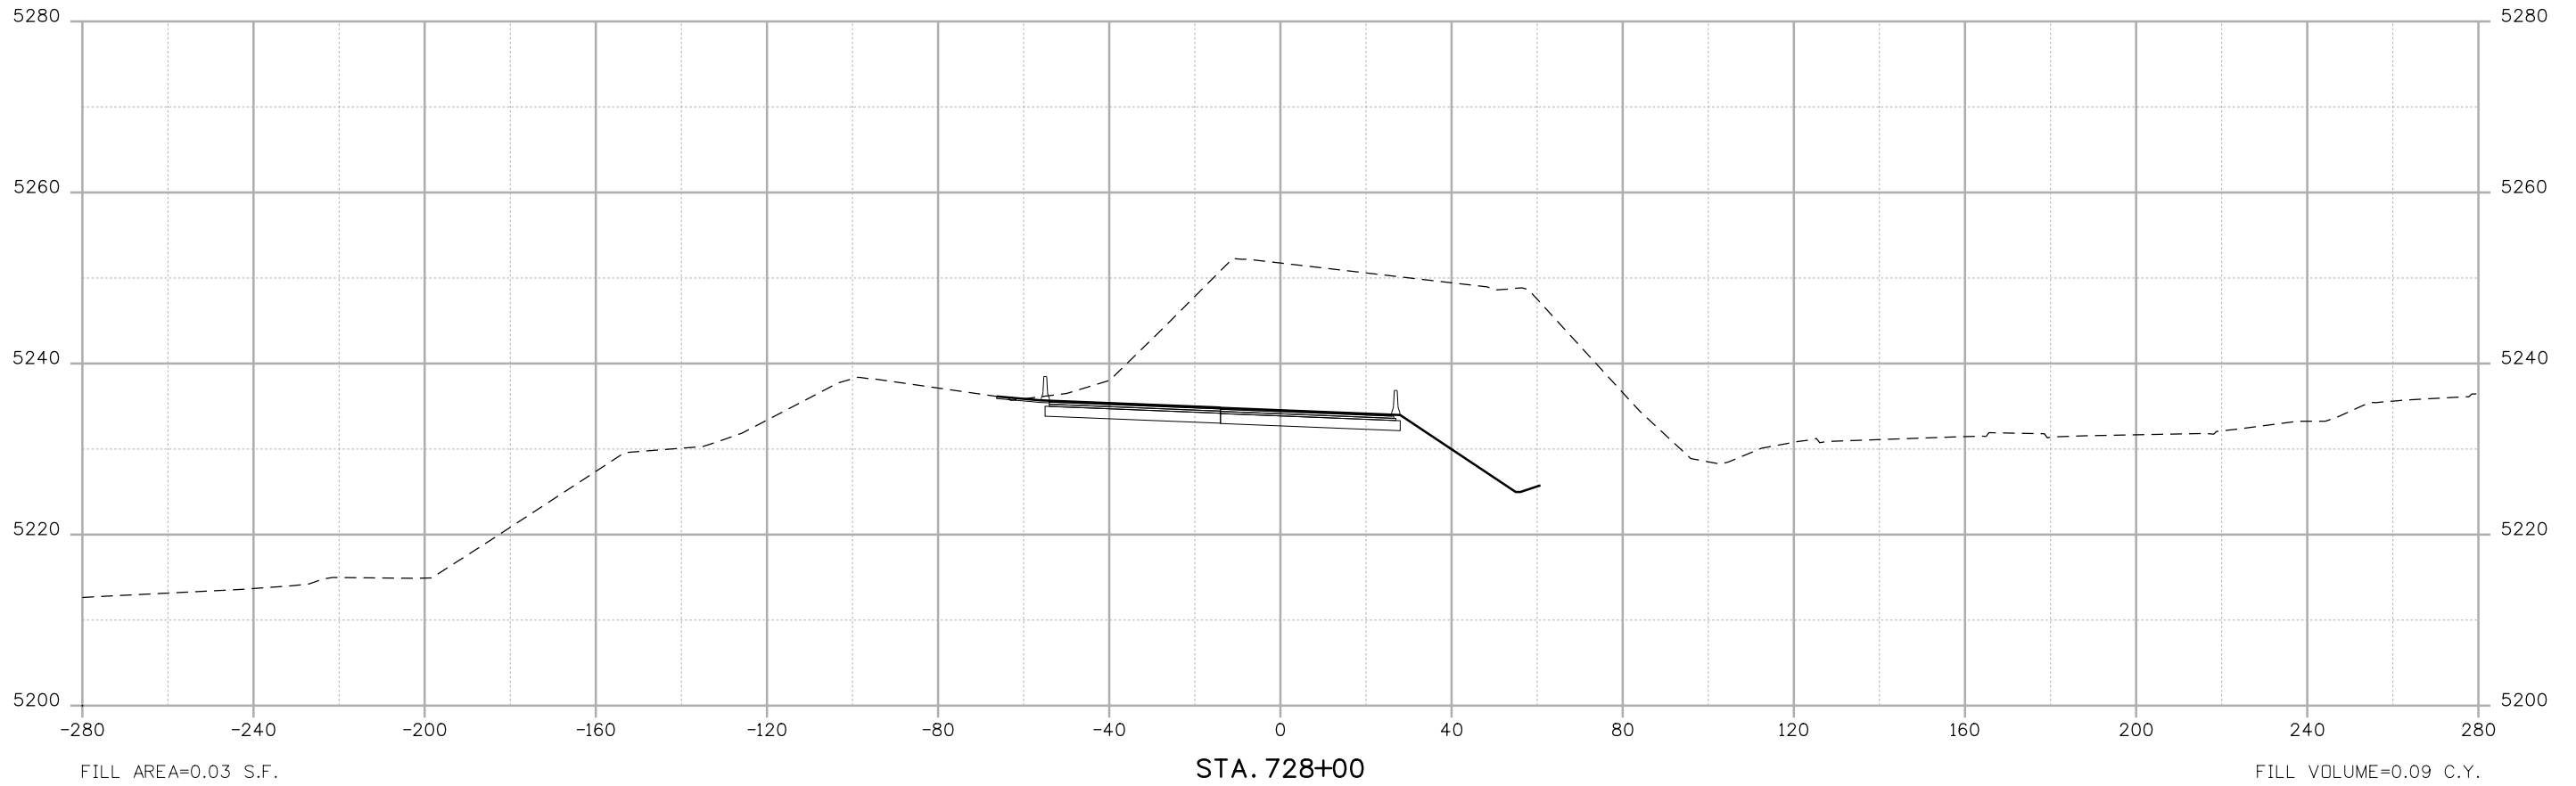

Print Date: 10/12/2010	
File Name: 16311DES_PH2_CrossSections1.dgn	
Horiz. Scale: 1:40	Vert. Scale: 1:20
Unit Information	Unit Leader Initials

Sheet Revisions		
Date:	Comments	Init.

Colorado Department of Transportation



2000 South Holly Street
Denver, CO 80222
Phone: 303-972-9112 FAX: 303-972-9114


Region 6 **RLB**

As Constructed
No Revisions:
Revised:
Void:

I-25/SANTA FE INTERCHANGE SANTA FE DRIVE CROSS SECTIONS		
Designer: DCS	Structure Numbers	
Detailer: DCS		
Sheet Subset: SECTIONS	Subset Sheets: XS-77 of 104	

Project No./Code
BR 0252-407
17783
Sheet Number 77

Dusty 9:23:09 AM K:\08276\16311\Phase 2\Design\Drawings\Cross-Sections\16311DES_PH2_CrossSections1.dgn

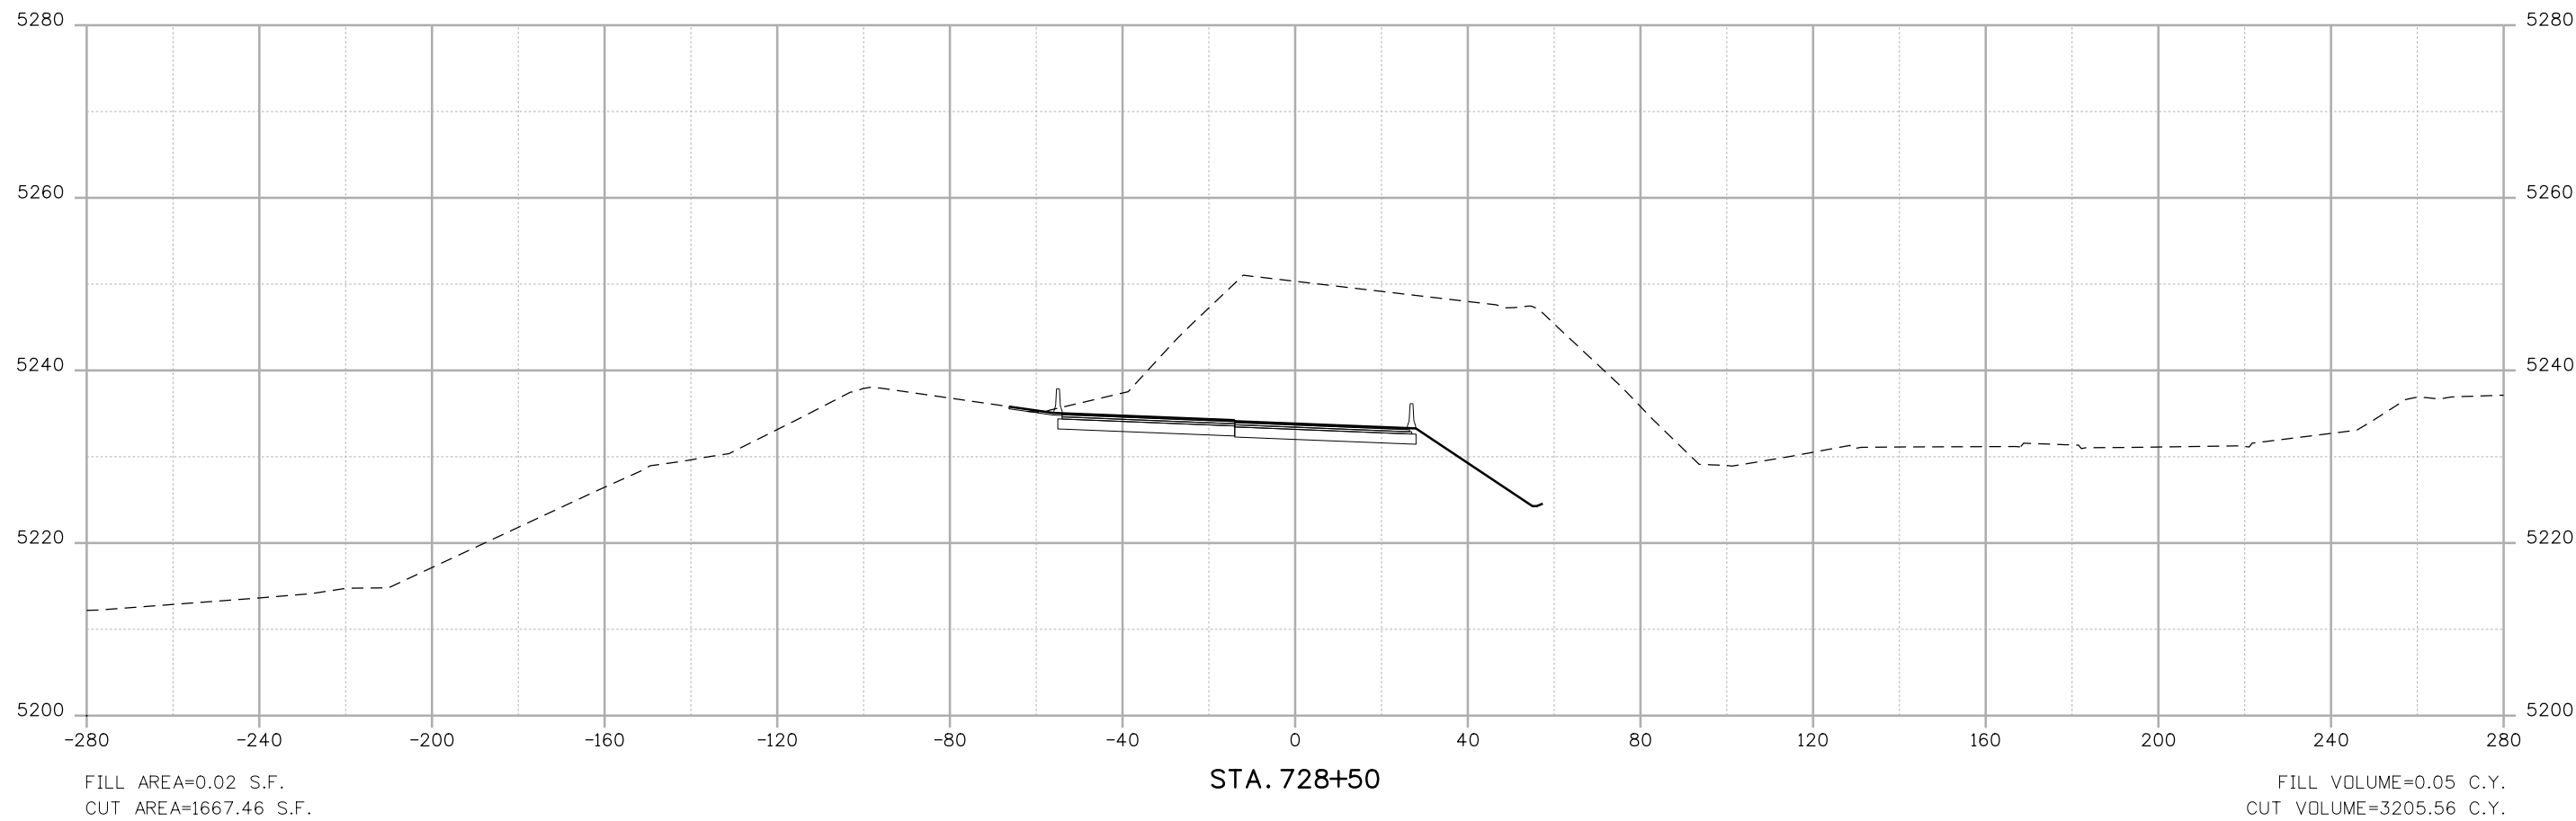

Print Date: 10/12/2010	
File Name: 16311DES_PH2_CrossSections1.dgn	
Horiz. Scale: 1:40	Vert. Scale: 1:20
Unit Information	Unit Leader Initials

Sheet Revisions		
Date:	Comments	Init.

Colorado Department of Transportation

2000 South Holly Street
Denver, CO 80222
Phone: 303-972-9112 FAX: 303-972-9114


Region 6 **RLB**

As Constructed
No Revisions:
Revised:
Void:

I-25/SANTA FE INTERCHANGE SANTA FE DRIVE CROSS SECTIONS		
Designer: DCS	Structure Numbers	
Detailer: DCS		
Sheet Subset: SECTIONS	Subset Sheets: XS-78 of 104	

Project No./Code
BR 0252-407
17783
Sheet Number 78

Dusty 9:23:25 AM K:\08276\16311\Phase 2\Design\Drawings\Cross Sections\16311DES_PH2_CrossSections1.dgn

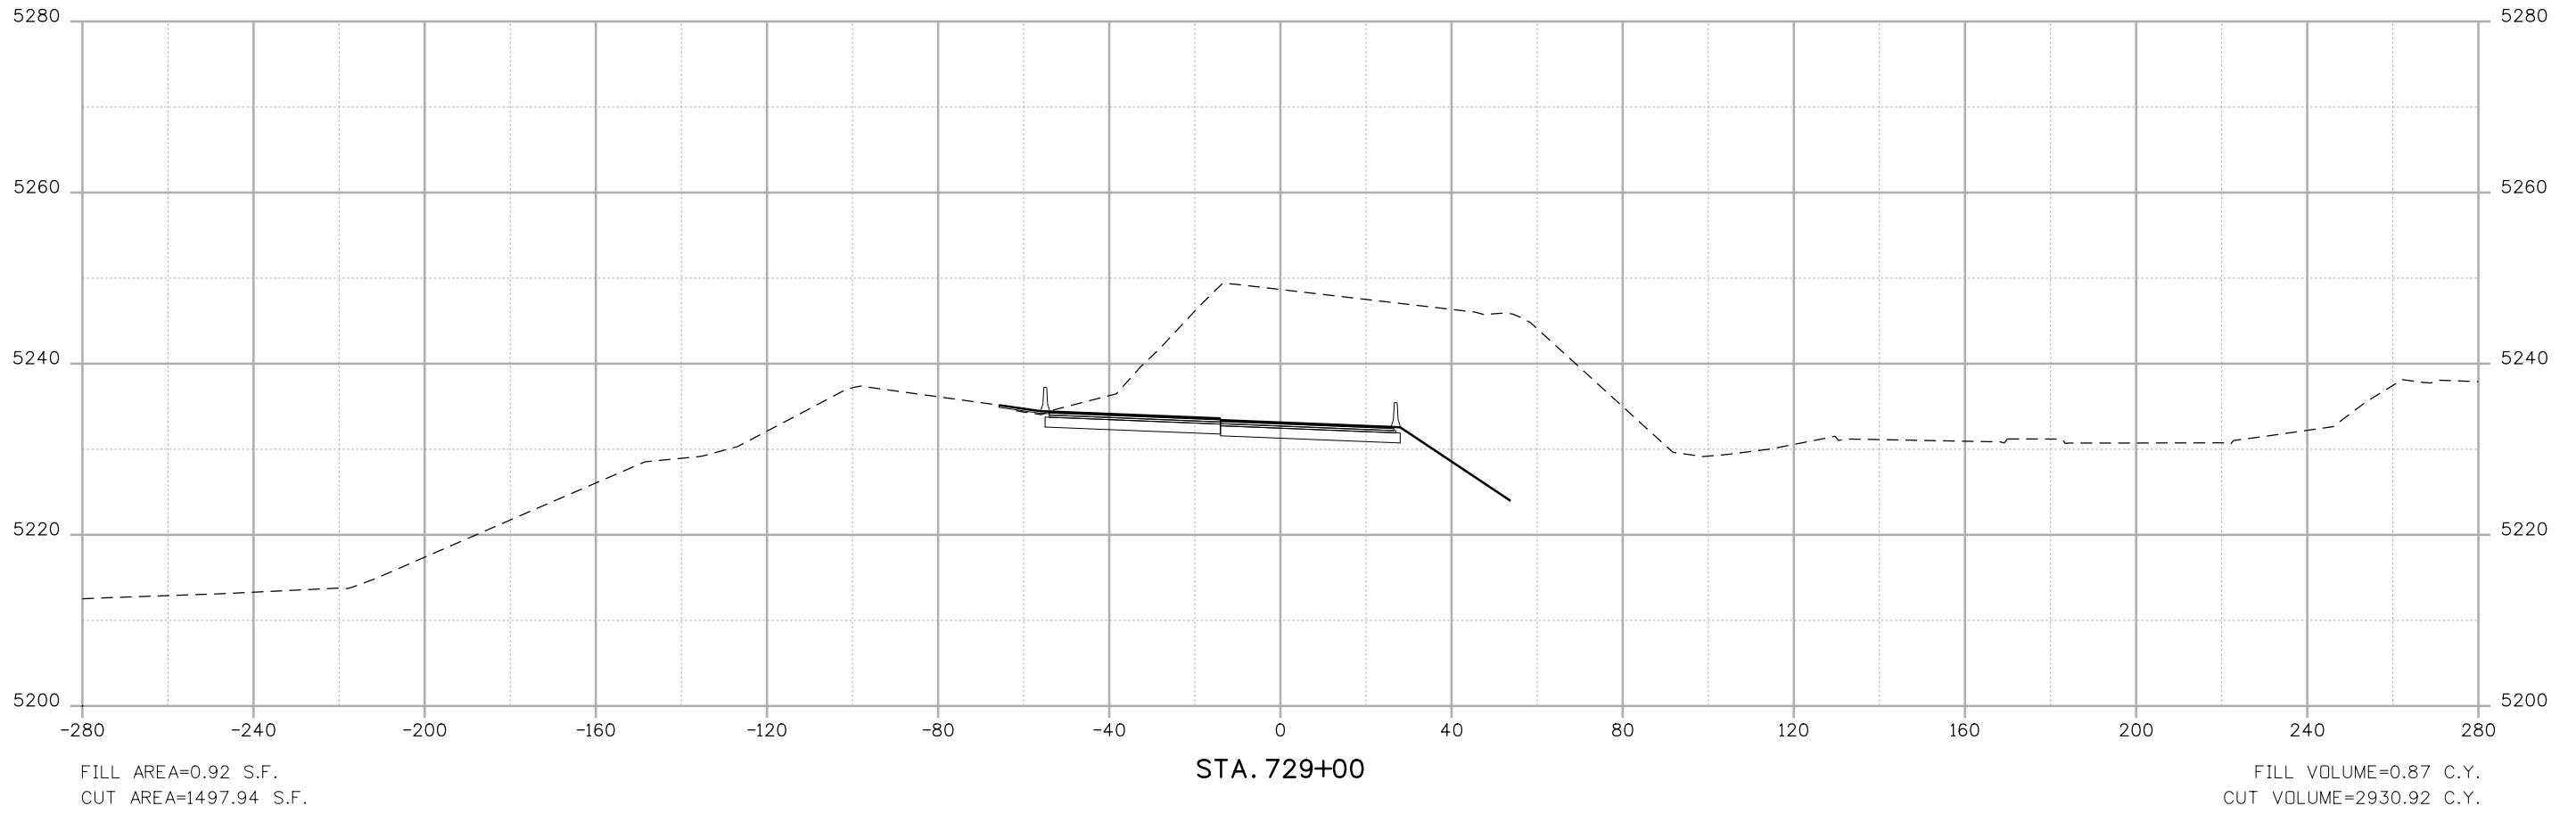

Print Date: 10/12/2010	
File Name: 16311DES_PH2_CrossSections1.dgn	
Horiz. Scale: 1:40	Vert. Scale: 1:20
Unit Information	Unit Leader Initials

Sheet Revisions		
Date:	Comments	Init.

Colorado Department of Transportation

2000 South Holly Street
Denver, CO 80222
Phone: 303-972-9112 FAX: 303-972-9114


Region 6 **RLB**

As Constructed
No Revisions:
Revised:
Void:

I-25/SANTA FE INTERCHANGE SANTA FE DRIVE CROSS SECTIONS		
Designer: DCS	Structure Numbers	
Detailer: DCS		
Sheet Subset: SECTIONS	Subset Sheets: XS-79 of 104	

Project No./Code
BR 0252-407
17783
Sheet Number 79

Dusty 9:23:40 AM K:\08276\16311\Phase 2\Design\Drawings\Cross_Sections\16311DES_PH2_CrossSections1.dgn

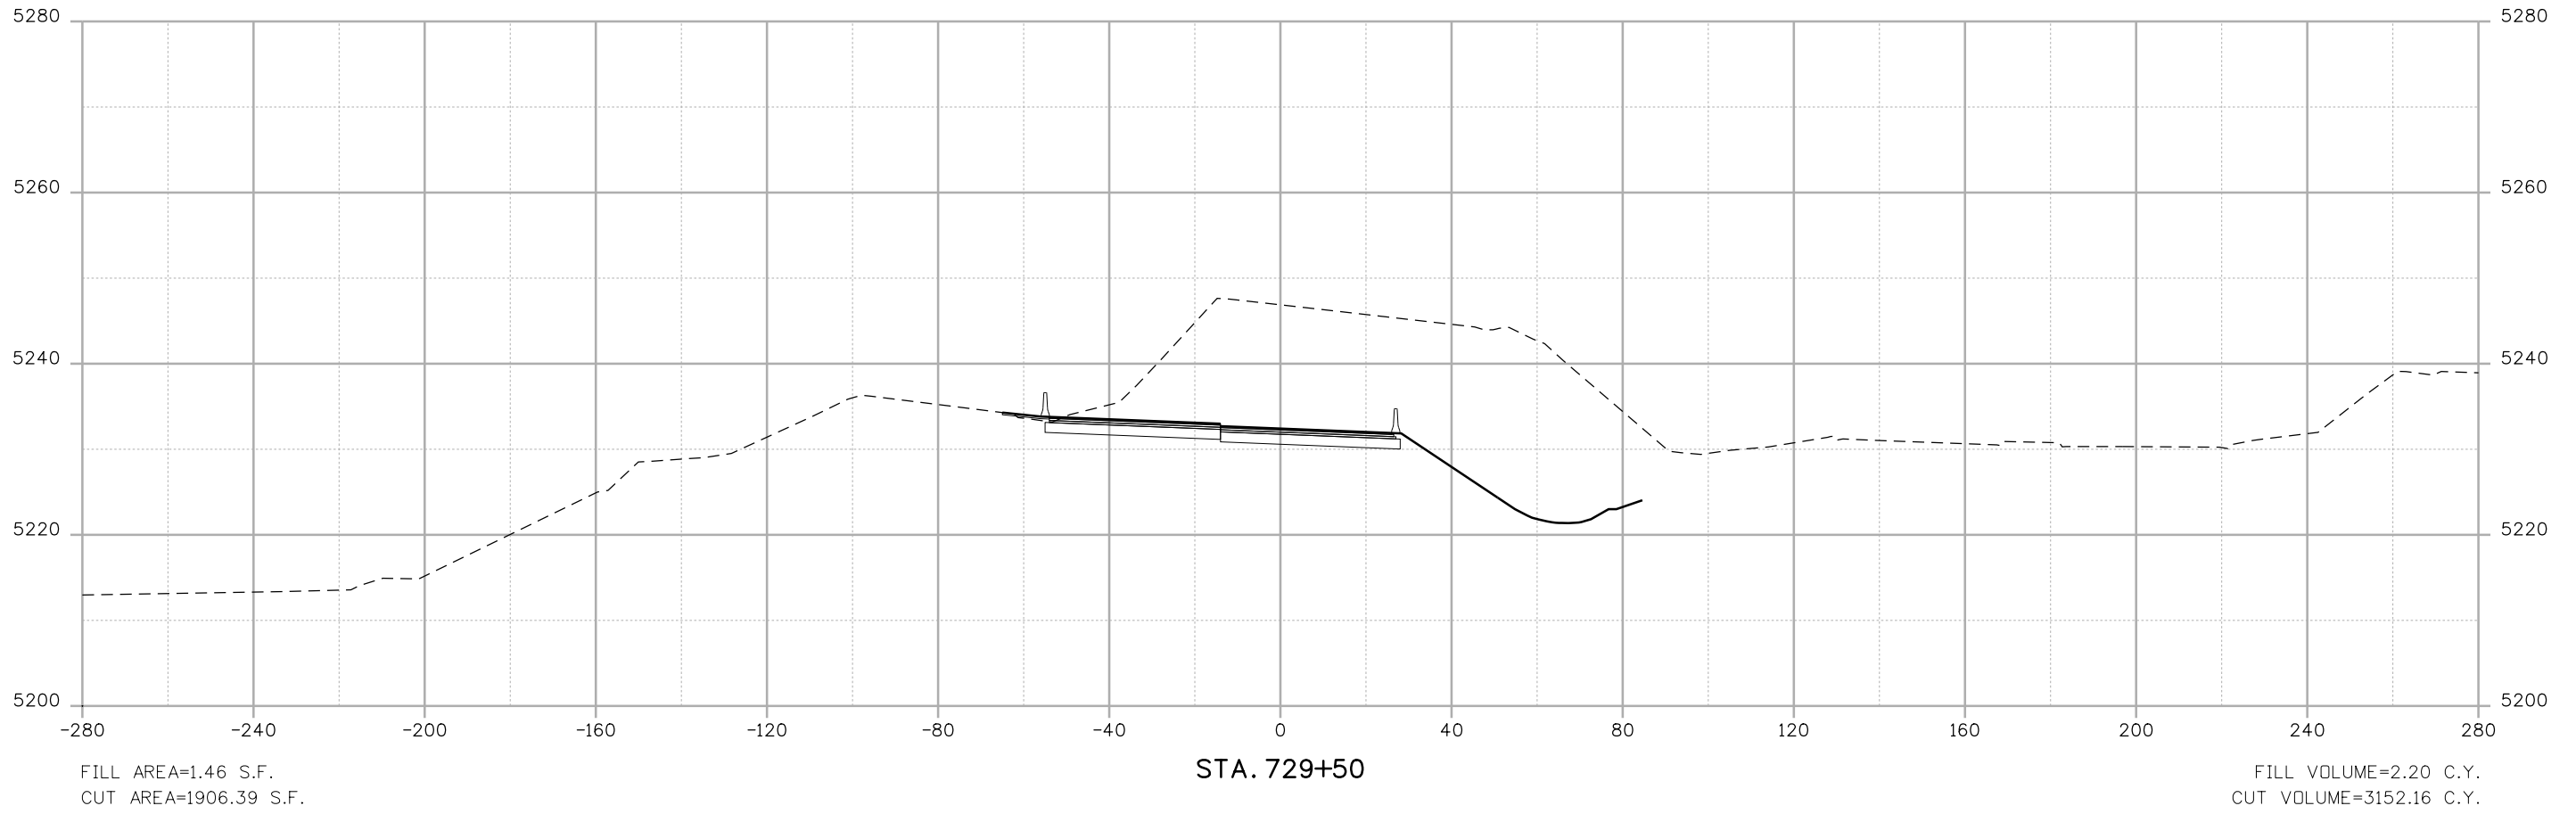

Print Date: 10/12/2010	
File Name: 16311DES_PH2_CrossSections1.dgn	
Horiz. Scale: 1:40	Vert. Scale: 1:20
Unit Information	Unit Leader Initials

Sheet Revisions		
Date:	Comments	Init.

Colorado Department of Transportation

2000 South Holly Street
Denver, CO 80222
Phone: 303-972-9112 FAX: 303-972-9114


Region 6 **RLB**

As Constructed
No Revisions:
Revised:
Void:

I-25/SANTA FE INTERCHANGE SANTA FE DRIVE CROSS SECTIONS		
Designer: DCS	Structure Numbers	
Detailer: DCS		
Sheet Subset: SECTIONS	Subset Sheets: XS-80 of 104	

Project No./Code
BR 0252-407
17783
Sheet Number 80

Dusty 9:23:51 AM K:\08276\16311\Phase 2\Design\Drawings\Cross_Sections\16311DES_PH2_CrossSections1.dgn

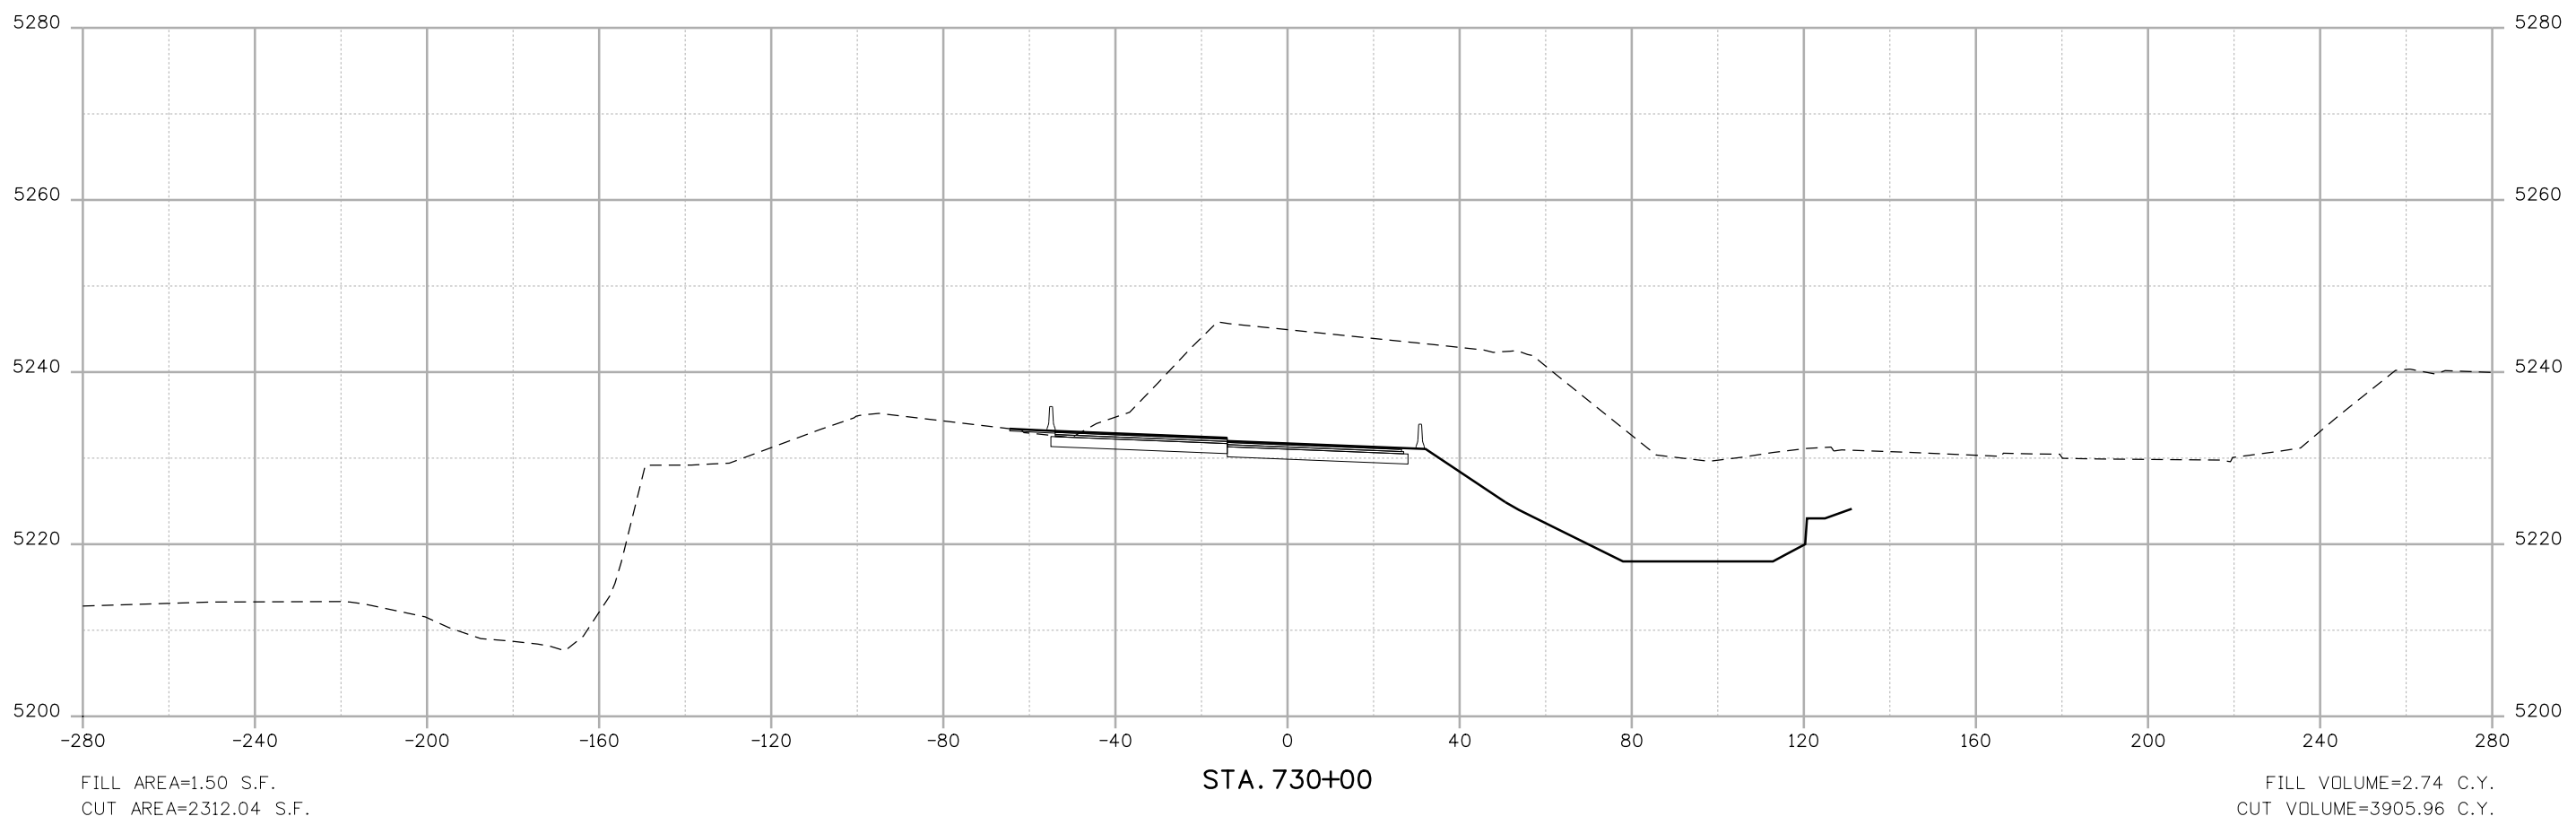

Print Date: 10/12/2010	
File Name: 16311DES_PH2_CrossSections1.dgn	
Horiz. Scale: 1:40 Vert. Scale: 1:20	
Unit Information Unit Leader Initials	
6300 South Syracuse Way Centennial, CO 80111	

Sheet Revisions		
Date:	Comments	Init.

Colorado Department of Transportation


 2000 South Holly Street
 Denver, CO 80222
 Phone: 303-972-9112 FAX: 303-972-9114
Region 6 **RLB**

As Constructed
No Revisions:
Revised:
Void:

I-25/SANTA FE INTERCHANGE SANTA FE DRIVE CROSS SECTIONS		
Designer: DCS	Structure Numbers	
Detailer: DCS		
Sheet Subset: SECTIONS	Subset Sheets: XS-81 of 104	

Project No./Code
BR 0252-407
17783
Sheet Number 81

Dusty 9:24:03 AM K:\08276\16311\Phase 2\Design\Drawings\Cross Sections\16311DES_PH2_CrossSections1.dgn

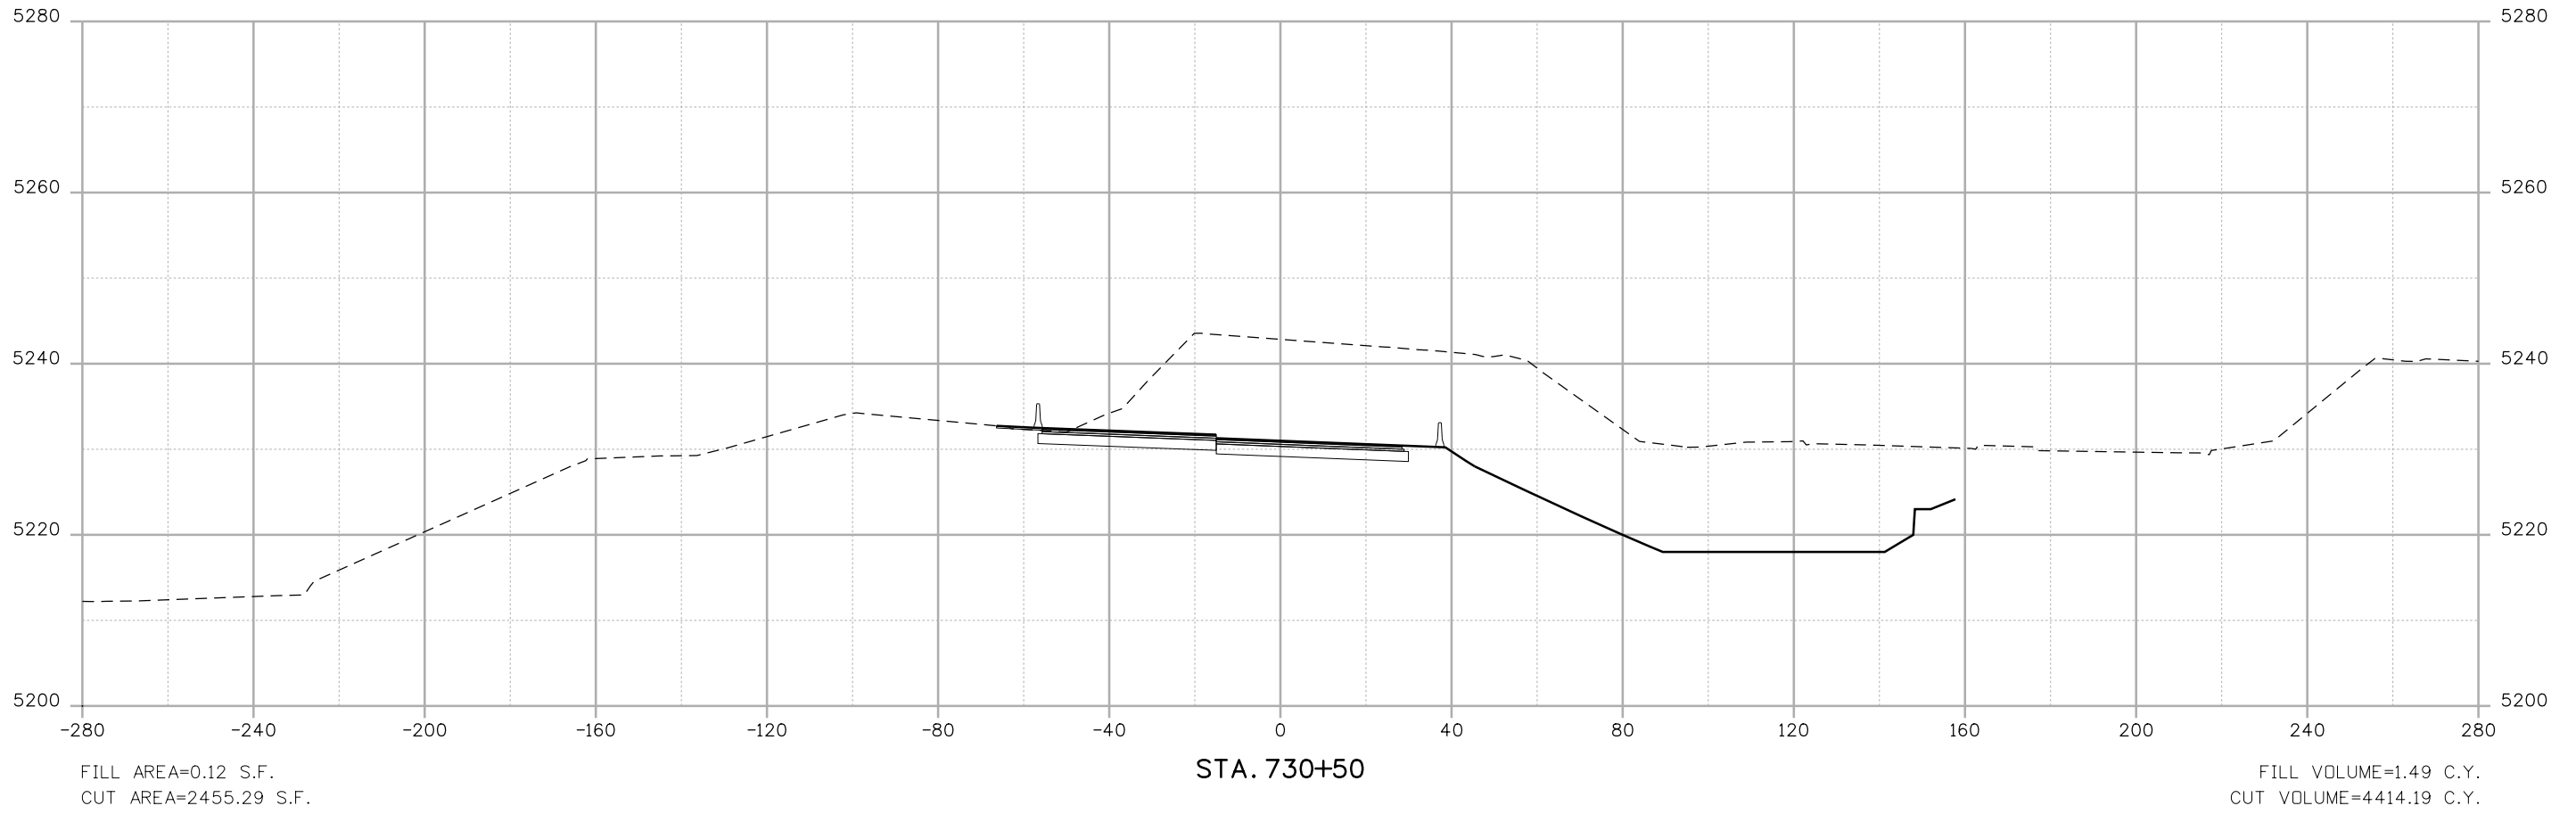

Print Date: 10/12/2010	
File Name: 16311DES_PH2_CrossSections1.dgn	
Horiz. Scale: 1:40	Vert. Scale: 1:20
Unit Information	Unit Leader Initials

Sheet Revisions		
Date:	Comments	Init.

Colorado Department of Transportation



2000 South Holly Street
Denver, CO 80222
Phone: 303-972-9112 FAX: 303-972-9114


Region 6 **RLB**

As Constructed
No Revisions:
Revised:
Void:

I-25/SANTA FE INTERCHANGE SANTA FE DRIVE CROSS SECTIONS		
Designer: DCS	Structure Numbers	
Detailer: DCS		
Sheet Subset: SECTIONS	Subset Sheets: XS-82 of 104	

Project No./Code
BR 0252-407
17783
Sheet Number 82

Dusty 9:24:21 AM K:\08276\16311\Phase 2\Design\Drawings\Cross_Sections\16311DES_PH2_CrossSections1.dgn

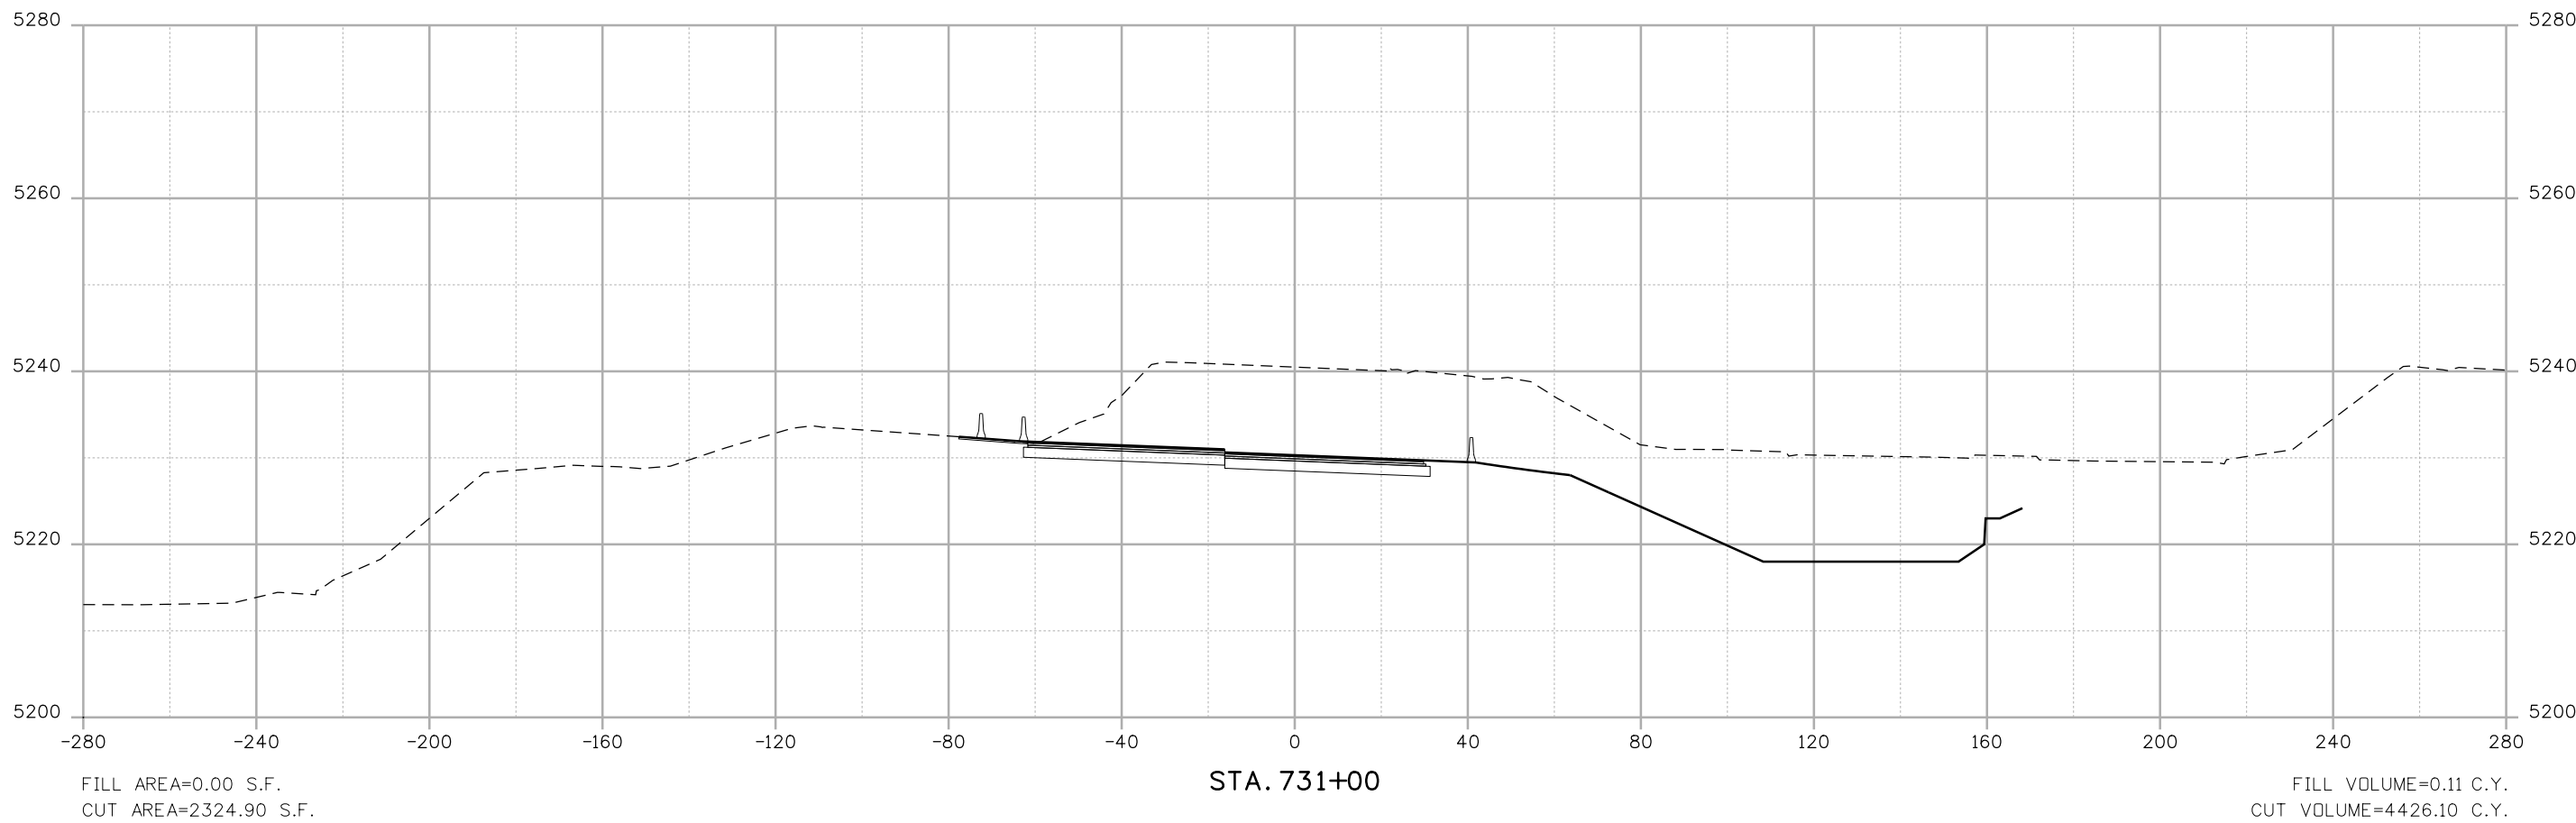

Print Date: 10/12/2010	
File Name: 16311DES_PH2_CrossSections1.dgn	
Horiz. Scale: 1:40	Vert. Scale: 1:20
Unit Information	Unit Leader Initials

Sheet Revisions		
Date:	Comments	Init.

Colorado Department of Transportation

2000 South Holly Street
Denver, CO 80222
Phone: 303-972-9112 FAX: 303-972-9114


Region 6 **RLB**

As Constructed
No Revisions:
Revised:
Void:

I-25/SANTA FE INTERCHANGE SANTA FE DRIVE CROSS SECTIONS		
Designer: DCS	Structure Numbers	
Detailer: DCS		
Sheet Subset: SECTIONS	Subset Sheets: XS-83 of 104	

Project No./Code
BR 0252-407
17783
Sheet Number 83

Dusty 9:24:32 AM K:\08276\16311\Phase 2\Design\Drawings\Cross_Sections\16311DES_PH2_CrossSections1.dgn

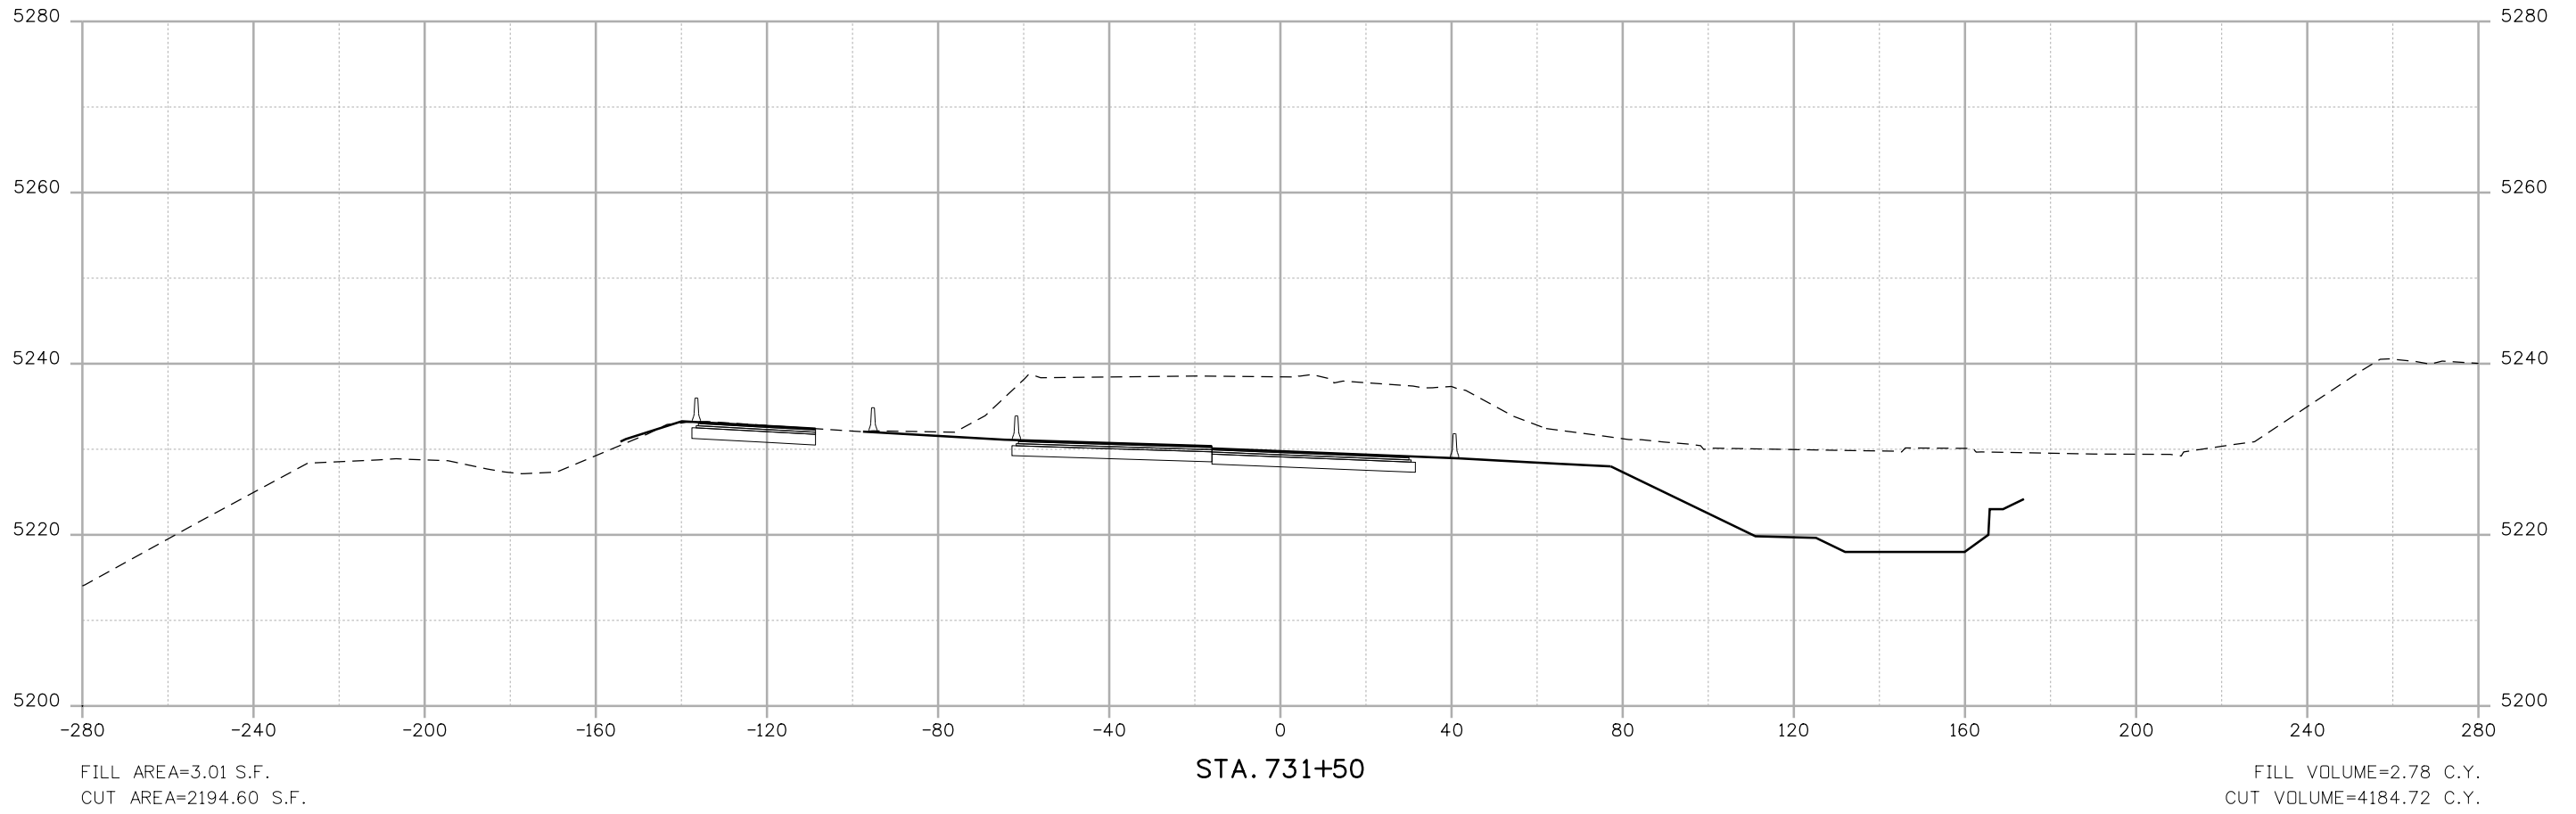

Print Date: 10/12/2010	
File Name: 16311DES_PH2_CrossSections1.dgn	
Horiz. Scale: 1:40 Vert. Scale: 1:20	
Unit Information Unit Leader Initials	
6300 South Syracuse Way Centennial, CO 80111	

Sheet Revisions		
Date:	Comments	Init.

Colorado Department of Transportation

2000 South Holly Street
Denver, CO 80222
Phone: 303-972-9112 FAX: 303-972-9114


Region 6 RLB


As Constructed
No Revisions:
Revised:
Void:

I-25/SANTA FE INTERCHANGE SANTA FE DRIVE CROSS SECTIONS		
Designer: DCS	Structure Numbers	
Detailer: DCS		
Sheet Subset: SECTIONS	Subset Sheets: XS-84 of 104	

Project No./Code
BR 0252-407
17783
Sheet Number 84

Dusty 9:24:41 AM K:\08276\16311\Phase 2\Design\Drawings\Cross_Sections\16311DES_PH2_CrossSections1.dgn

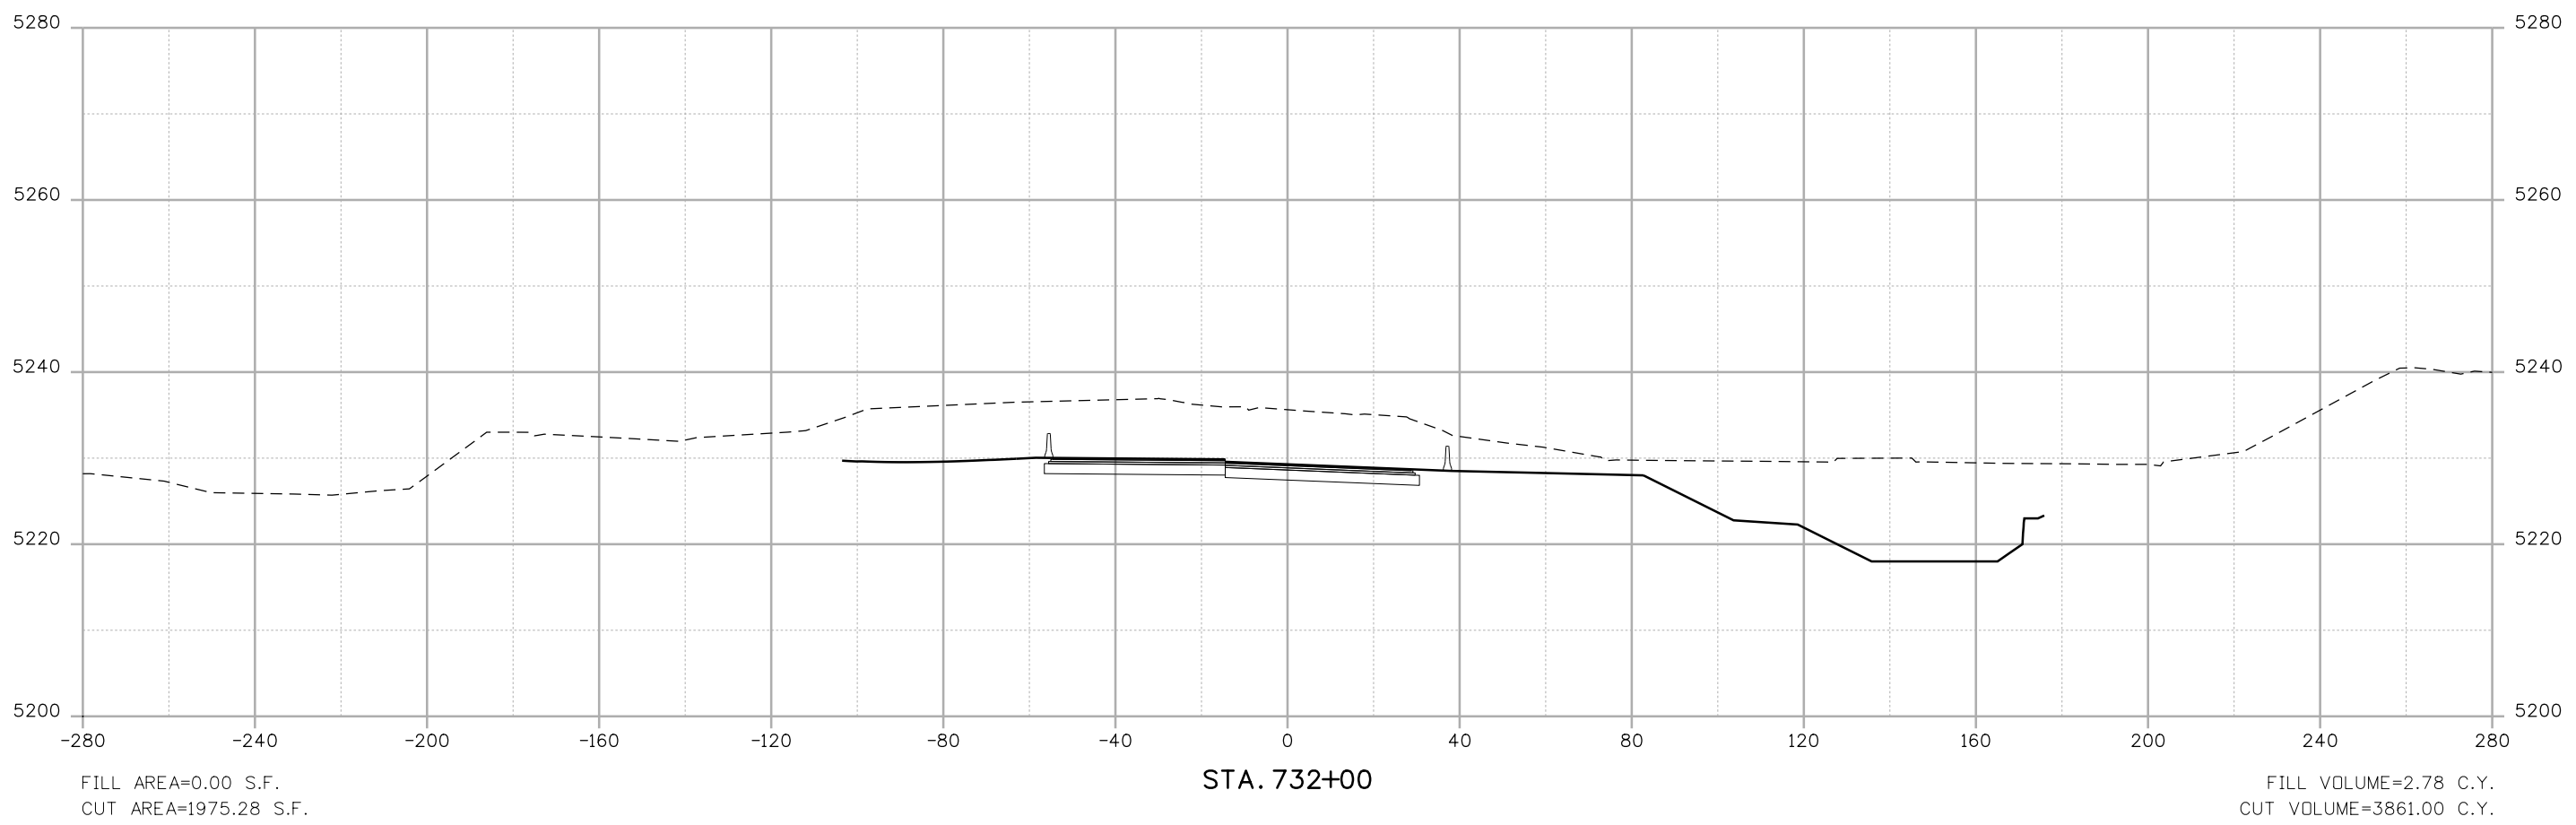

Print Date: 10/12/2010
 File Name: 16311DES_PH2_CrossSections1.dgn
 Horiz. Scale: 1:40 Vert. Scale: 1:20
 Unit Information Unit Leader Initials
 6300 South Syracuse Way
 Centennial, CO 80111

Sheet Revisions		
Date:	Comments	Init.


Colorado Department of Transportation
 2000 South Holly Street
 Denver, CO 80222
 Phone: 303-972-9112 FAX: 303-972-9114
Region 6 **RLB**

As Constructed
 No Revisions:
 Revised:
 Void:

**I-25/SANTA FE INTERCHANGE
 SANTA FE DRIVE
 CROSS SECTIONS**
 Designer: DCS Structure Numbers
 Detailer: DCS
 Sheet Subset: SECTIONS Subset Sheets: XS-85 of 104

Project No./Code
 BR 0252-407
 17783
 Sheet Number **85**

Dusty 9:24:53 AM K:\08276\16311\Phase 2\Design\Drawings\Cross_Sections\16311DES_PH2_CrossSections1.dgn

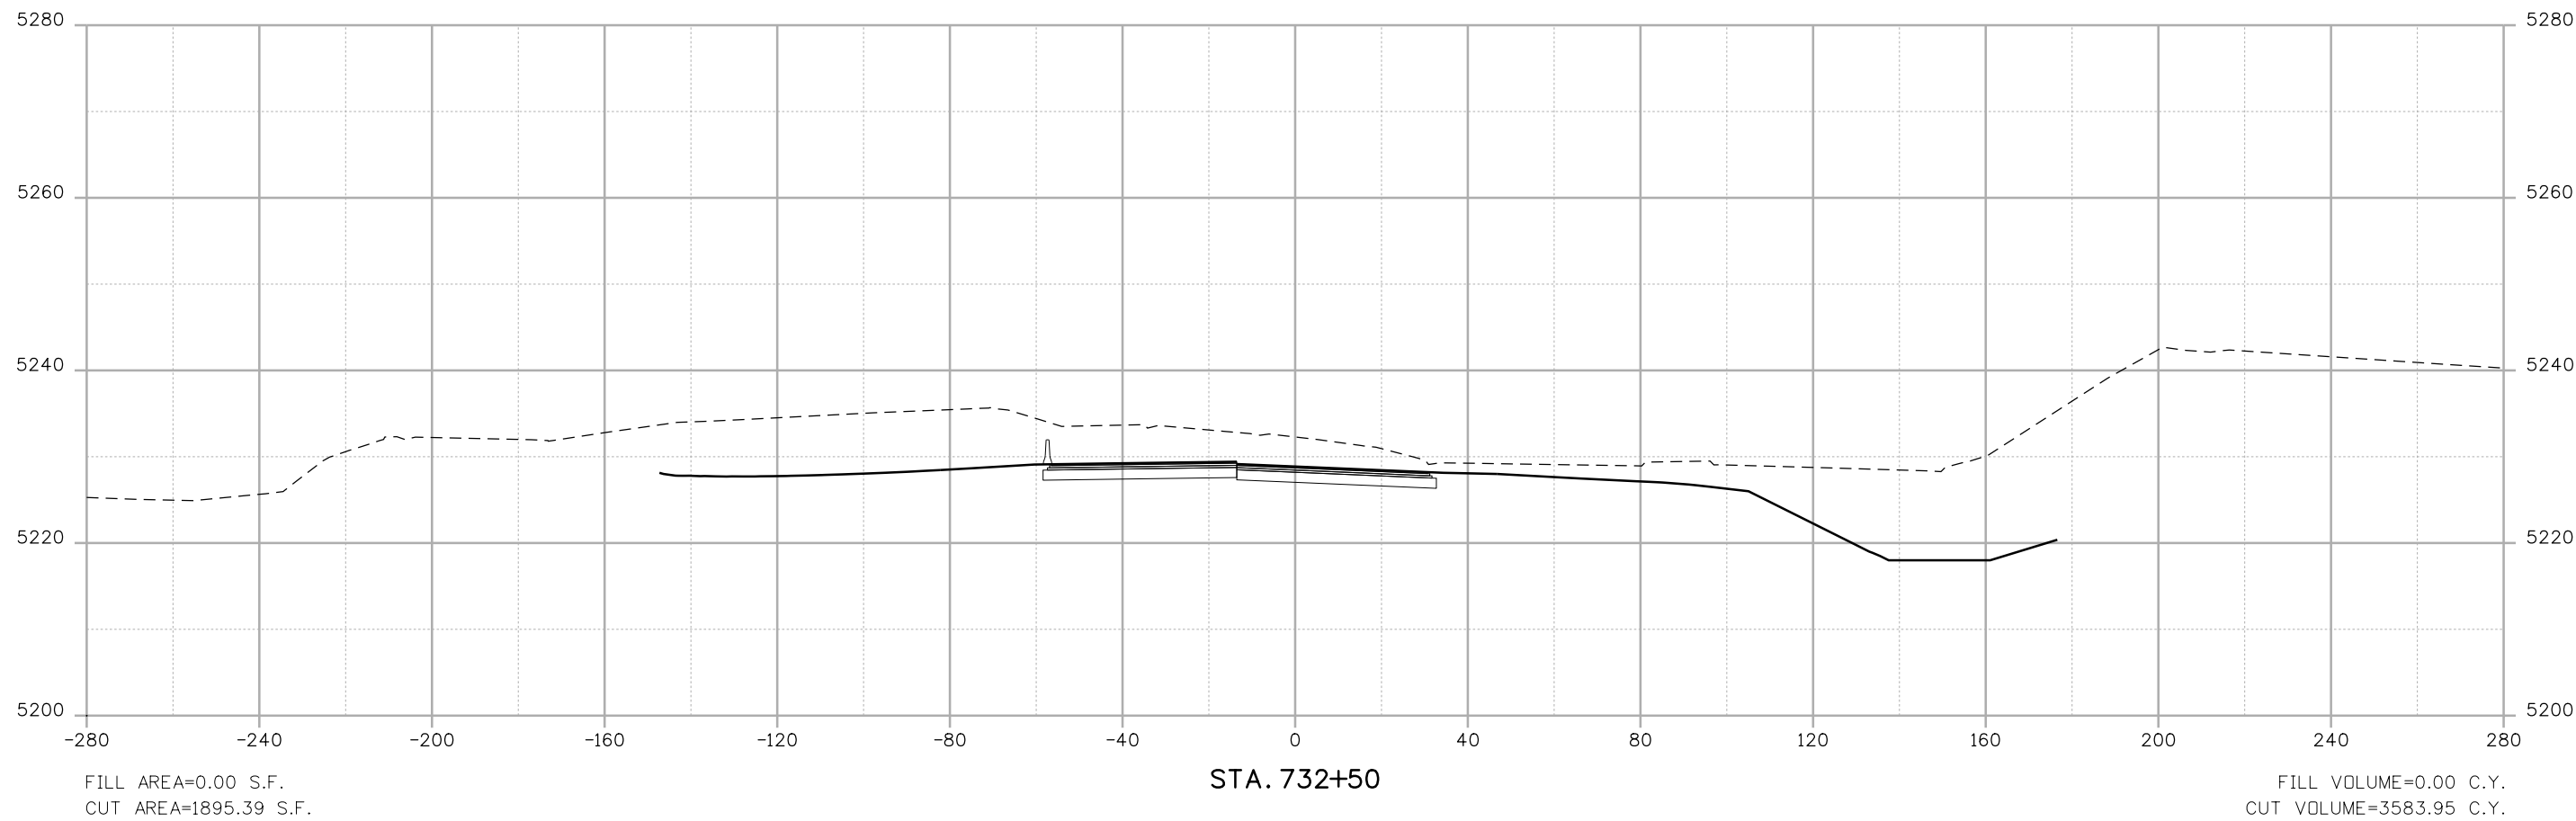

Print Date: 10/12/2010	
File Name: 16311DES_PH2_CrossSections1.dgn	
Horiz. Scale: 1:40	Vert. Scale: 1:20
Unit Information	Unit Leader Initials
6300 South Syracuse Way Centennial, CO 80111	

Sheet Revisions		
Date:	Comments	Init.

Colorado Department of Transportation

2000 South Holly Street
Denver, CO 80222
Phone: 303-972-9112 FAX: 303-972-9114


Region 6 **RLB**

As Constructed
No Revisions:
Revised:
Void:

I-25/SANTA FE INTERCHANGE SANTA FE DRIVE CROSS SECTIONS		
Designer: DCS	Structure Numbers	
Detailer: DCS		
Sheet Subset: SECTIONS	Subset Sheets: XS-86 of 104	

Project No./Code
BR 0252-407
17783
Sheet Number 86

Dusty 9:25:03 AM K:\08276\16311\Phase 2\Design\Drawings\Cross_Sections\16311DES_PH2_CrossSections1.dgn

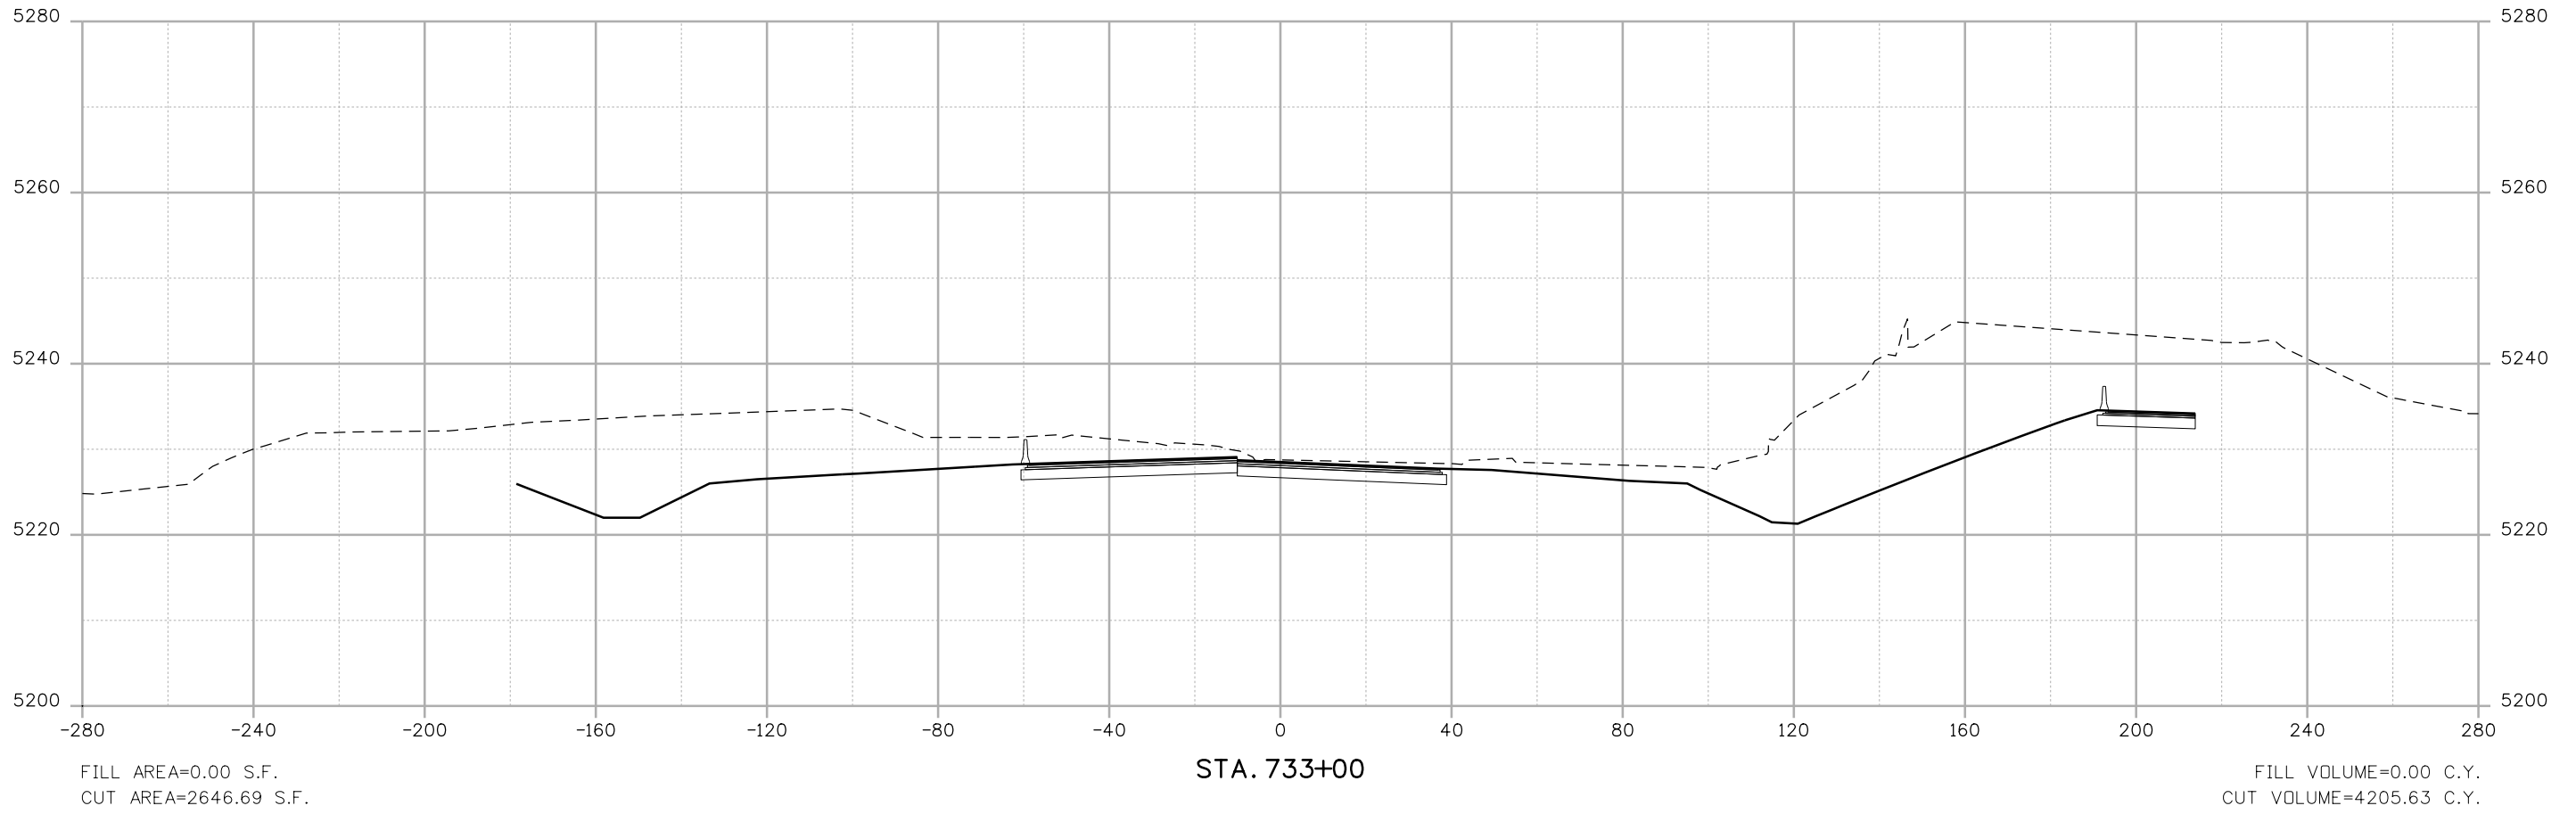

Print Date: 10/12/2010	
File Name: 16311DES_PH2_CrossSections1.dgn	
Horiz. Scale: 1:40	Vert. Scale: 1:20
Unit Information	Unit Leader Initials
6300 South Syracuse Way Centennial, CO 80111	

Sheet Revisions		
Date:	Comments	Init.

Colorado Department of Transportation

2000 South Holly Street
 Denver, CO 80222
 Phone: 303-972-9112 FAX: 303-972-9114


Region 6 **RLB**

As Constructed
No Revisions:
Revised:
Void:

I-25/SANTA FE INTERCHANGE SANTA FE DRIVE CROSS SECTIONS		
Designer: DCS	Structure Numbers	
Detailer: DCS		
Sheet Subset: SECTIONS	Subset Sheets: XS-87 of 104	

Project No./Code
BR 0252-407
17783
Sheet Number 87

Dusty 9:25:12 AM K:\08276\16311\Phase 2\Design\Drawings\Cross_Sections\16311DES_PH2_CrossSections1.dgn

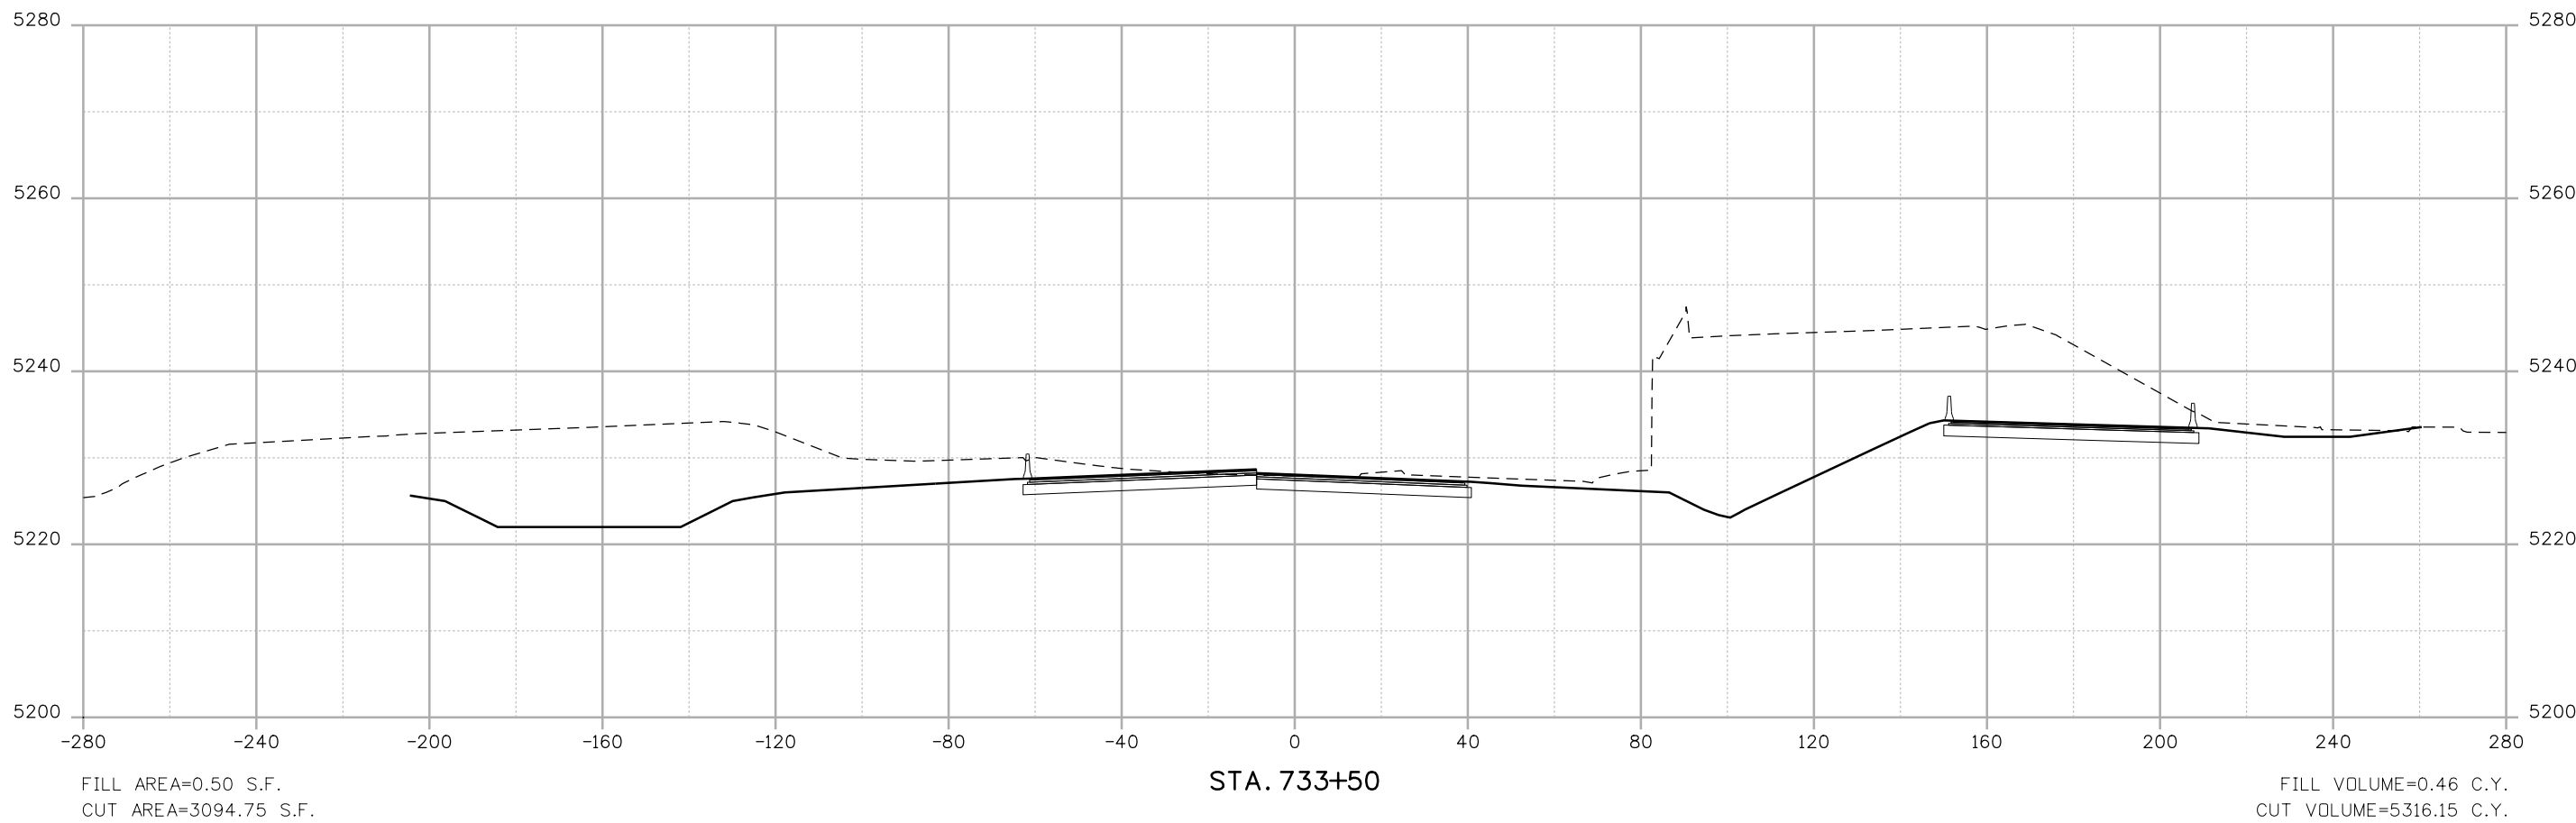

Print Date: 10/12/2010	
File Name: 16311DES_PH2_CrossSections1.dgn	
Horiz. Scale: 1:40	Vert. Scale: 1:20
Unit Information	Unit Leader Initials
6300 South Syracuse Way Centennial, CO 80111	

Sheet Revisions		
Date:	Comments	Init.

Colorado Department of Transportation

2000 South Holly Street
 Denver, CO 80222
 Phone: 303-972-9112 FAX: 303-972-9114


Region 6 RLB

As Constructed	
No Revisions:	
Revised:	
Void:	

I-25/SANTA FE INTERCHANGE SANTA FE DRIVE CROSS SECTIONS		
Designer: DCS	Structure Numbers	
Detailer: DCS		
Sheet Subset: SECTIONS	Subset Sheets: XS-88 of 104	

Project No./Code	
BR 0252-407	
17783	
Sheet Number	88

Dusty 9:25:23 AM K:\08276\16311\Phase 2\Design\Drawings\Cross_Sections\16311DES_PH2_CrossSections1.dgn

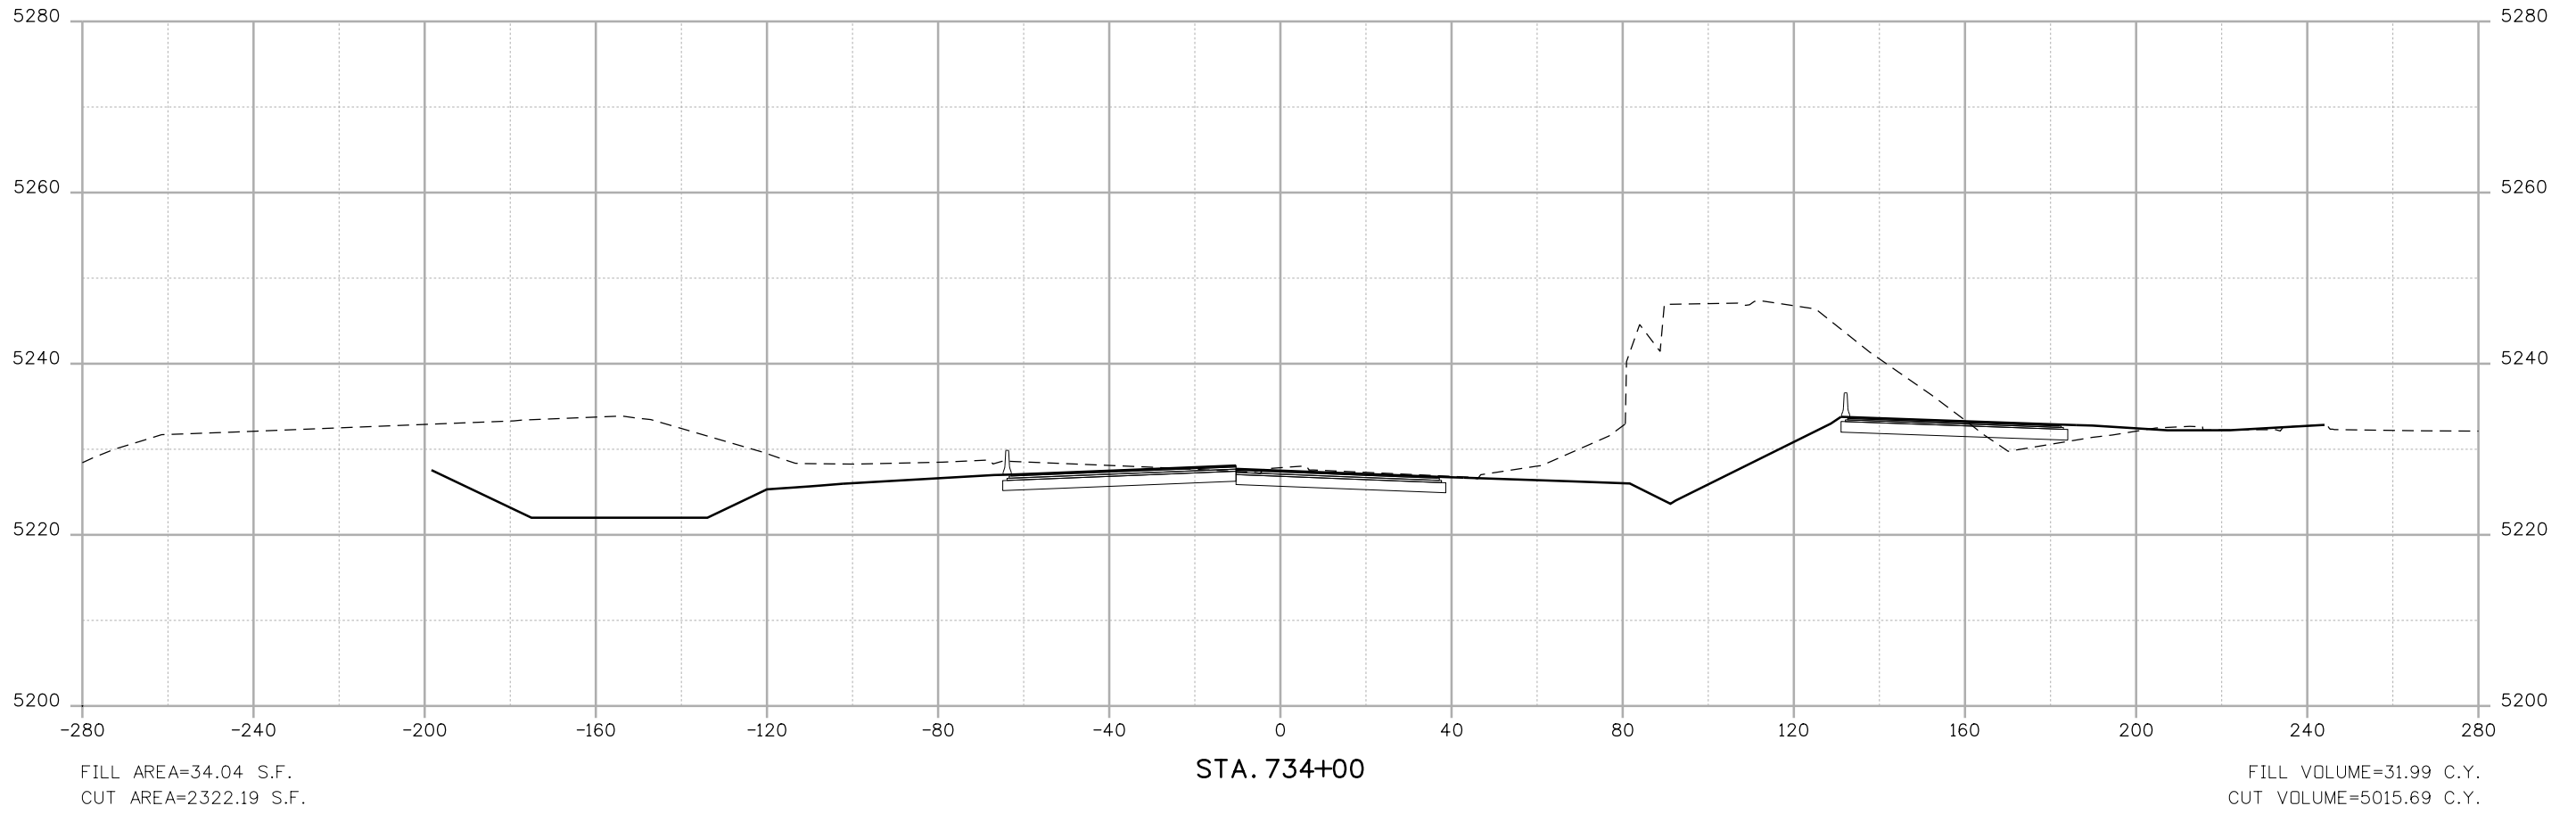

Print Date: 10/12/2010	
File Name: 16311DES_PH2_CrossSections1.dgn	
Horiz. Scale: 1:40 Vert. Scale: 1:20	
Unit Information Unit Leader Initials	
6300 South Syracuse Way Centennial, CO 80111	

Sheet Revisions		
Date:	Comments	Init.

Colorado Department of Transportation

2000 South Holly Street
Denver, CO 80222
Phone: 303-972-9112 FAX: 303-972-9114


Region 6 **RLB**

As Constructed
No Revisions:
Revised:
Void:

I-25/SANTA FE INTERCHANGE SANTA FE DRIVE CROSS SECTIONS		
Designer: DCS	Structure Numbers	
Detailer: DCS		
Sheet Subset: SECTIONS	Subset Sheets: XS-89 of 104	

Project No./Code
BR 0252-407
17783
Sheet Number 89

Dusty 9:25:32 AM K:\08276\16311\Phase 2\Design\Drawings\Cross Sections\16311DES_PH2_CrossSections1.dgn

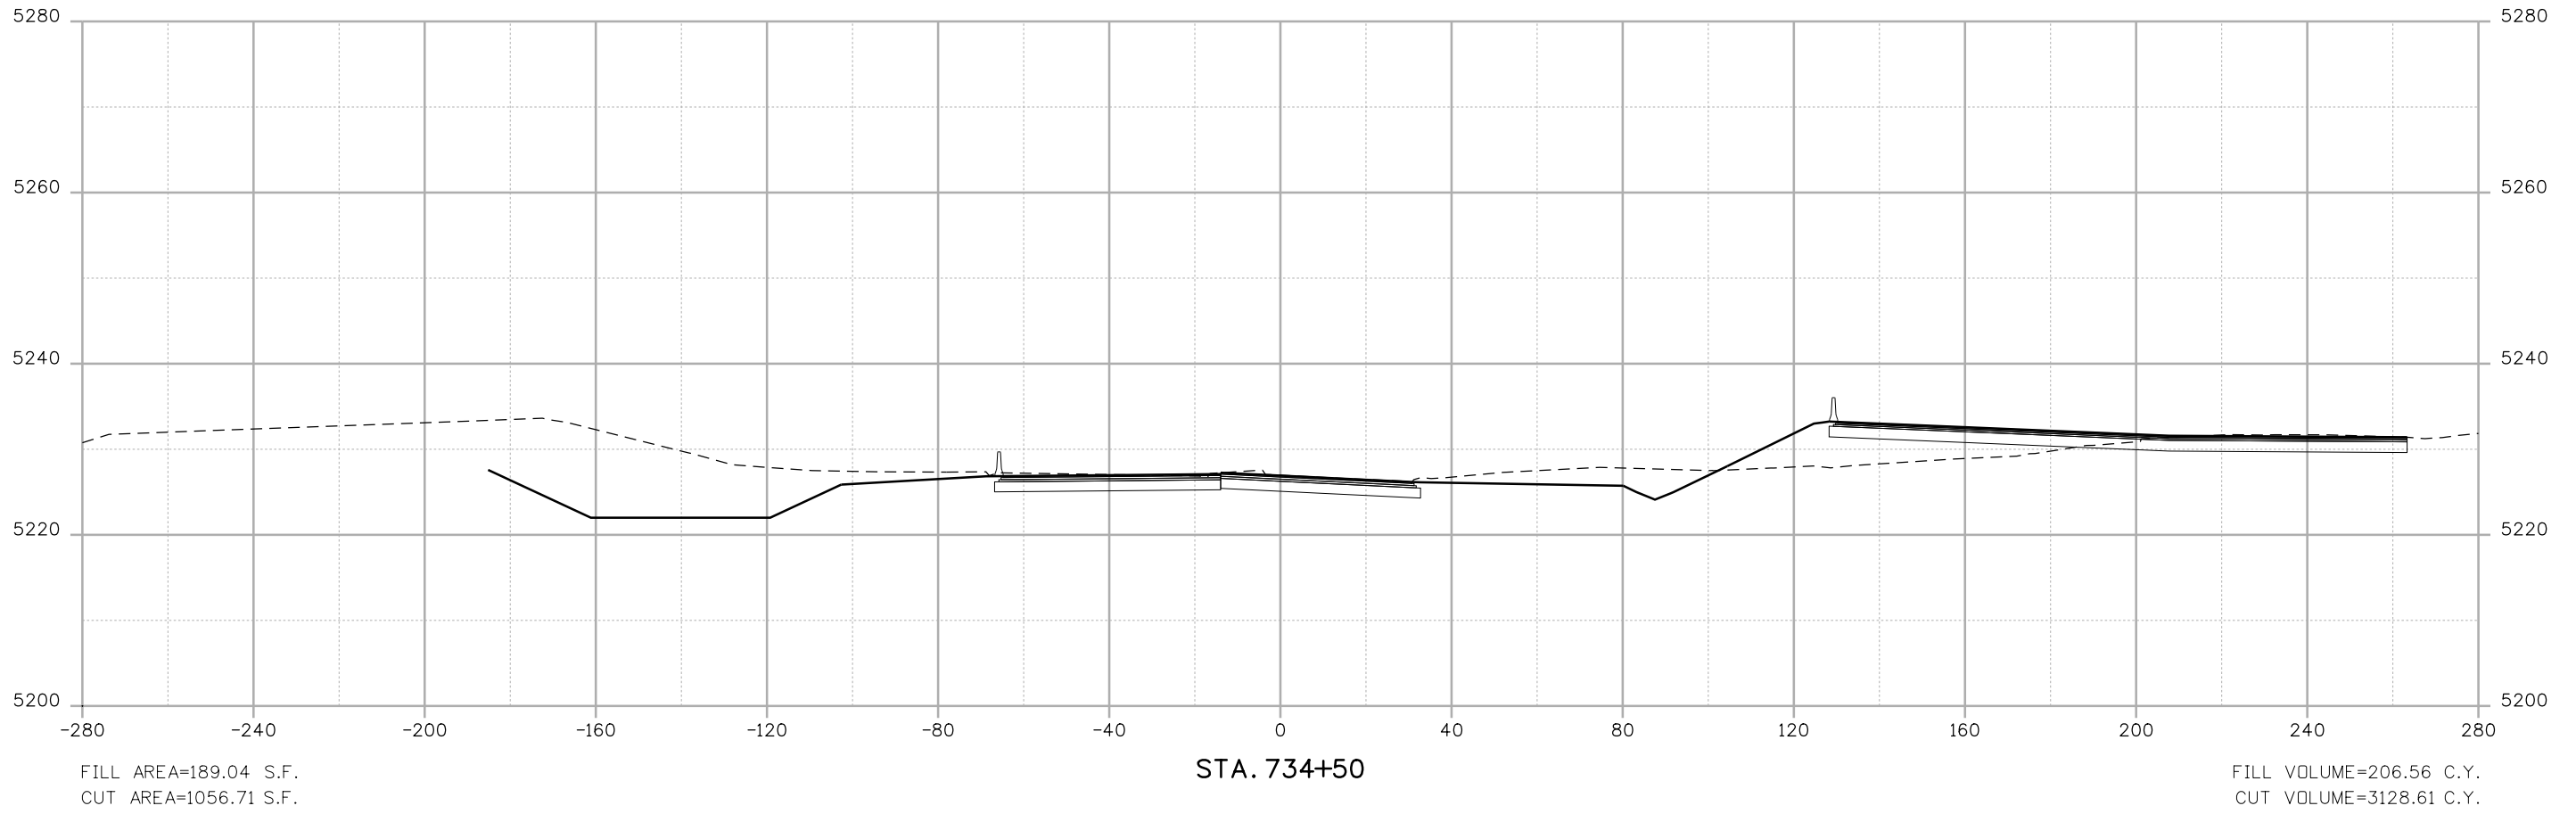

Print Date: 10/12/2010	
File Name: 16311DES_PH2_CrossSections1.dgn	
Horiz. Scale: 1:40	Vert. Scale: 1:20
Unit Information	Unit Leader Initials

Sheet Revisions		
Date:	Comments	Init.

Colorado Department of Transportation



2000 South Holly Street
Denver, CO 80222
Phone: 303-972-9112 FAX: 303-972-9114


Region 6 **RLB**

As Constructed
No Revisions:
Revised:
Void:

I-25/SANTA FE INTERCHANGE SANTA FE DRIVE CROSS SECTIONS		
Designer: DCS	Structure Numbers	
Detailer: DCS		
Sheet Subset: SECTIONS	Subset Sheets: XS-90 of 104	

Project No./Code
BR 0252-407
17783
Sheet Number 90

Dusty 9:25:43 AM K:\08276\16311\Phase 2\Design\Drawings\Cross_Sections\16311DES_PH2_CrossSections1.dgn

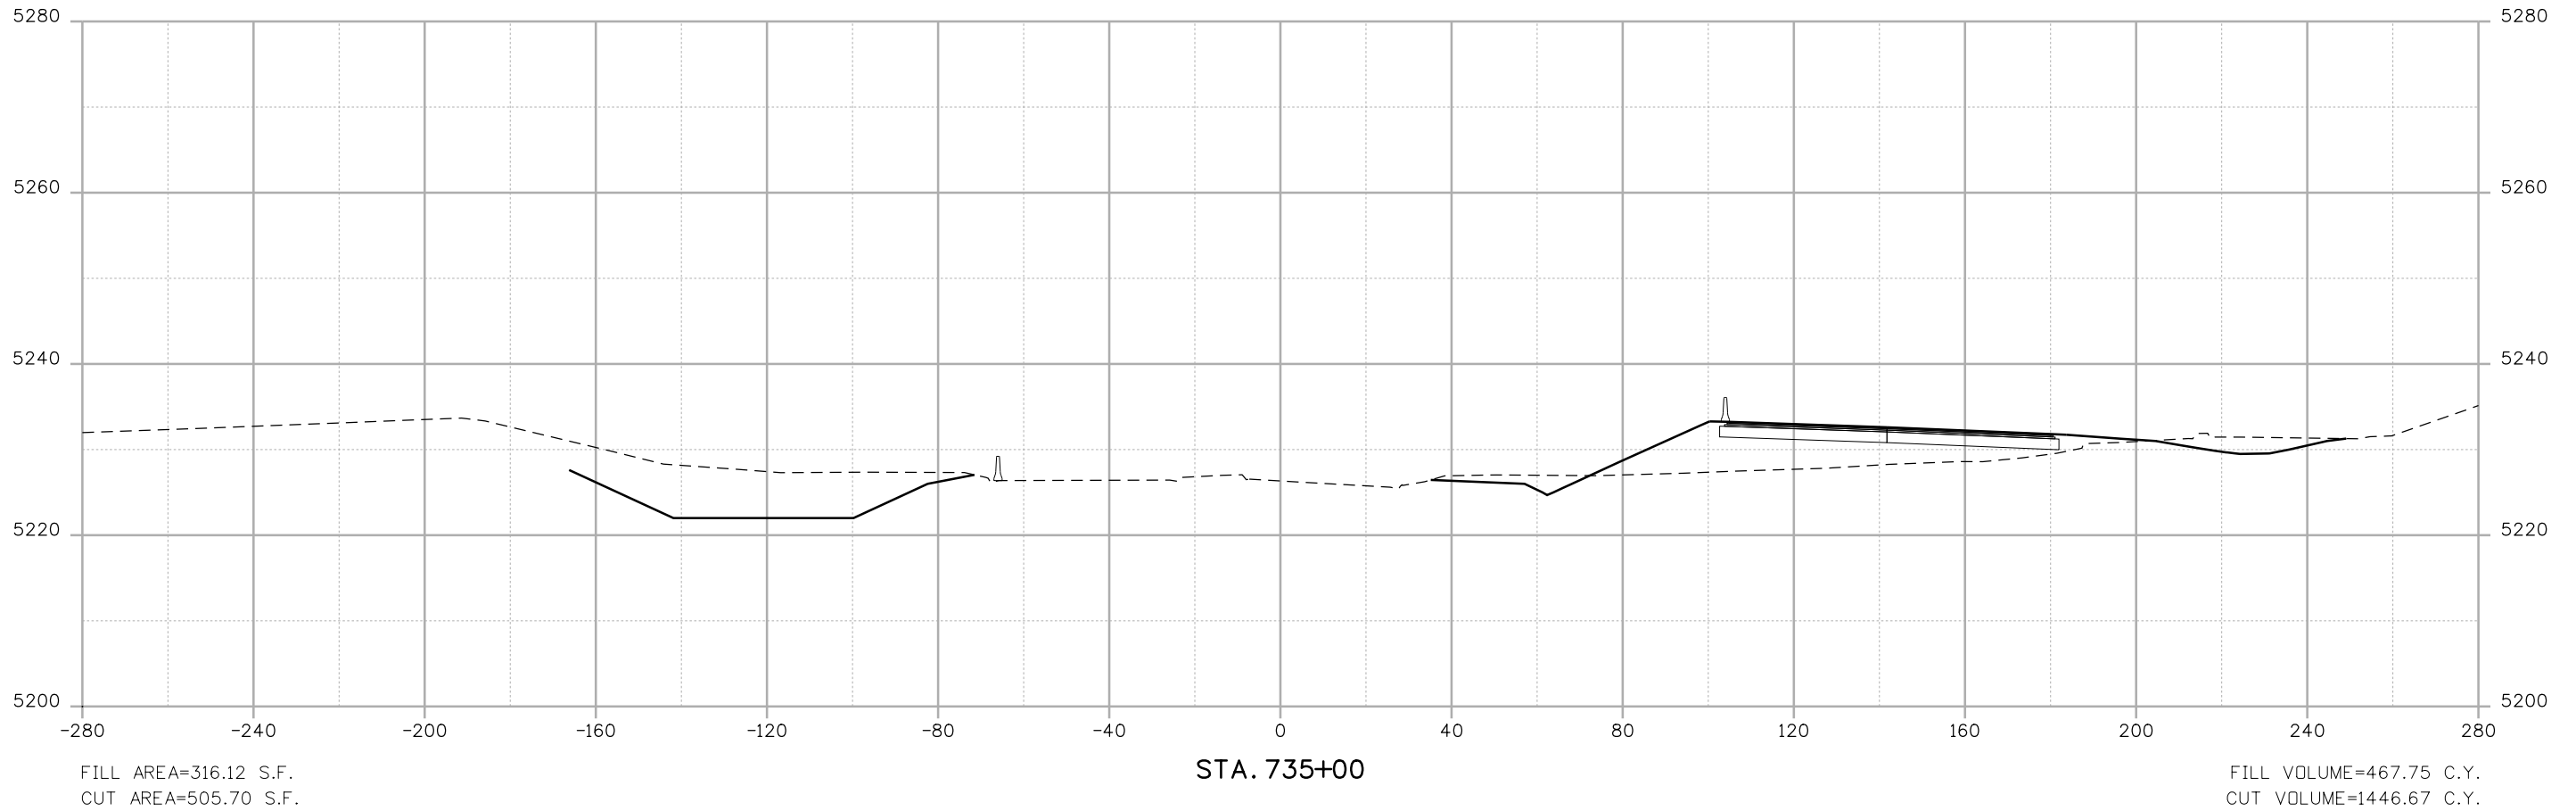

Print Date: 10/12/2010	
File Name: 16311DES_PH2_CrossSections1.dgn	
Horiz. Scale: 1:40	Vert. Scale: 1:20
Unit Information	Unit Leader Initials

Sheet Revisions		
Date:	Comments	Init.

Colorado Department of Transportation

2000 South Holly Street
Denver, CO 80222
Phone: 303-972-9112 FAX: 303-972-9114


Region 6 **RLB**

As Constructed
No Revisions:
Revised:
Void:

I-25/SANTA FE INTERCHANGE SANTA FE DRIVE CROSS SECTIONS		
Designer: DCS	Structure Numbers	
Detailer: DCS		
Sheet Subset: SECTIONS	Subset Sheets: XS-91 of 104	

Project No./Code
BR 0252-407
17783
Sheet Number 91

Dusty 9:25:52 AM K:\08276\16311\Phase 2\Design\Drawings\Cross Sections\16311DES_PH2_CrossSections1.dgn

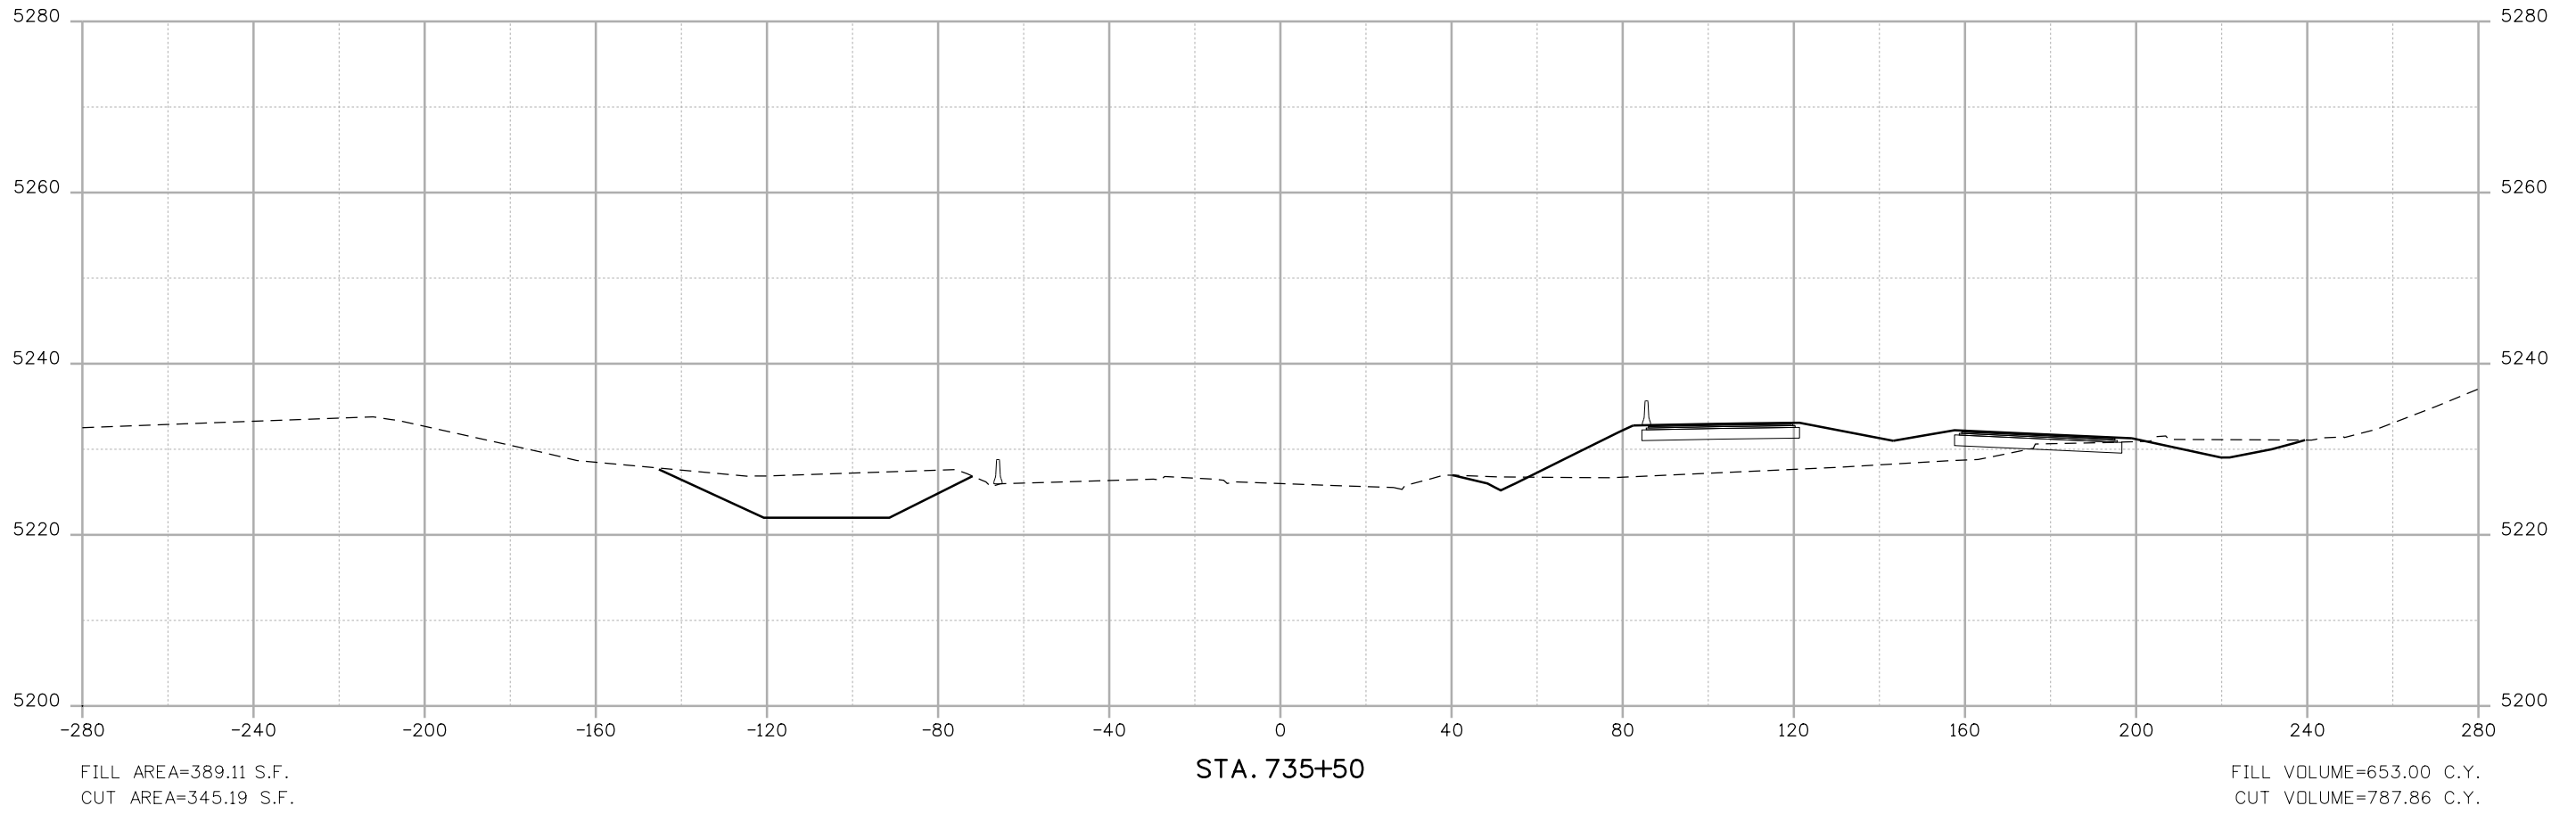

Print Date: 10/12/2010	
File Name: 16311DES_PH2_CrossSections1.dgn	
Horiz. Scale: 1:40	Vert. Scale: 1:20
Unit Information	Unit Leader Initials

Sheet Revisions		
Date:	Comments	Init.

Colorado Department of Transportation

2000 South Holly Street
Denver, CO 80222
Phone: 303-972-9112 FAX: 303-972-9114


Region 6 **RLB**

As Constructed
No Revisions:
Revised:
Void:

I-25/SANTA FE INTERCHANGE SANTA FE DRIVE CROSS SECTIONS		
Designer: DCS	Structure Numbers	
Detailer: DCS		
Sheet Subset: SECTIONS	Subset Sheets: XS-92 of 104	

Project No./Code
BR 0252-407
17783
Sheet Number 92

Dusty 9:26:02 AM K:\08276\16311\Phase 2\Design\Drawings\Cross-Sections\16311DES_PH2_CrossSections1.dgn

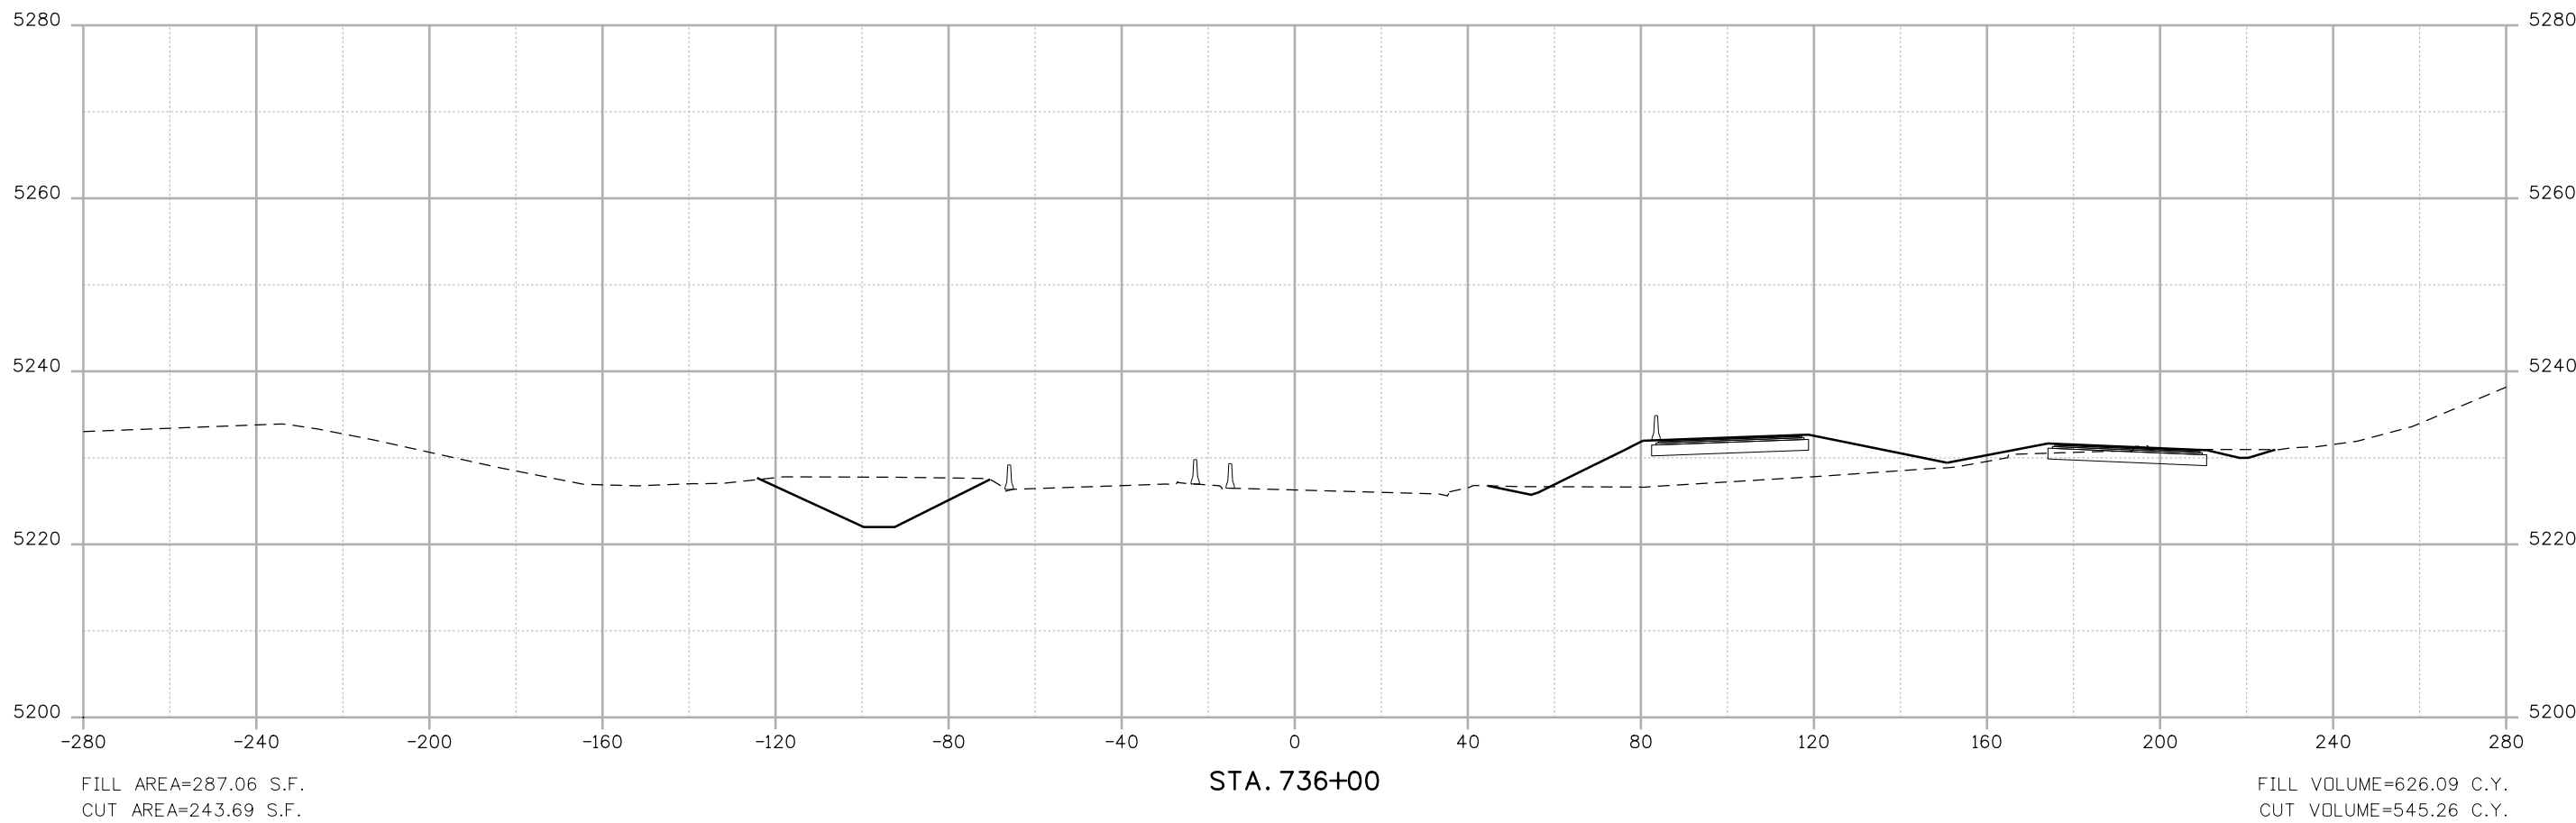

Print Date: 10/12/2010	
File Name: 16311DES_PH2_CrossSections1.dgn	
Horiz. Scale: 1:40	Vert. Scale: 1:20
Unit Information	Unit Leader Initials

Sheet Revisions		
Date:	Comments	Init.

Colorado Department of Transportation

2000 South Holly Street
Denver, CO 80222
Phone: 303-972-9112 FAX: 303-972-9114


Region 6 **RLB**


As Constructed
No Revisions:
Revised:
Void:

I-25/SANTA FE INTERCHANGE SANTA FE DRIVE CROSS SECTIONS		
Designer: DCS	Structure Numbers	
Detailer: DCS		
Sheet Subset: SECTIONS	Subset Sheets: XS-93 of 104	

Project No./Code
BR 0252-407
17783
Sheet Number 93

Dusty 9:26:12 AM K:\08276\16311\Phase 2\Design\Drawings\Cross_Sections\16311DES_PH2_CrossSections1.dgn

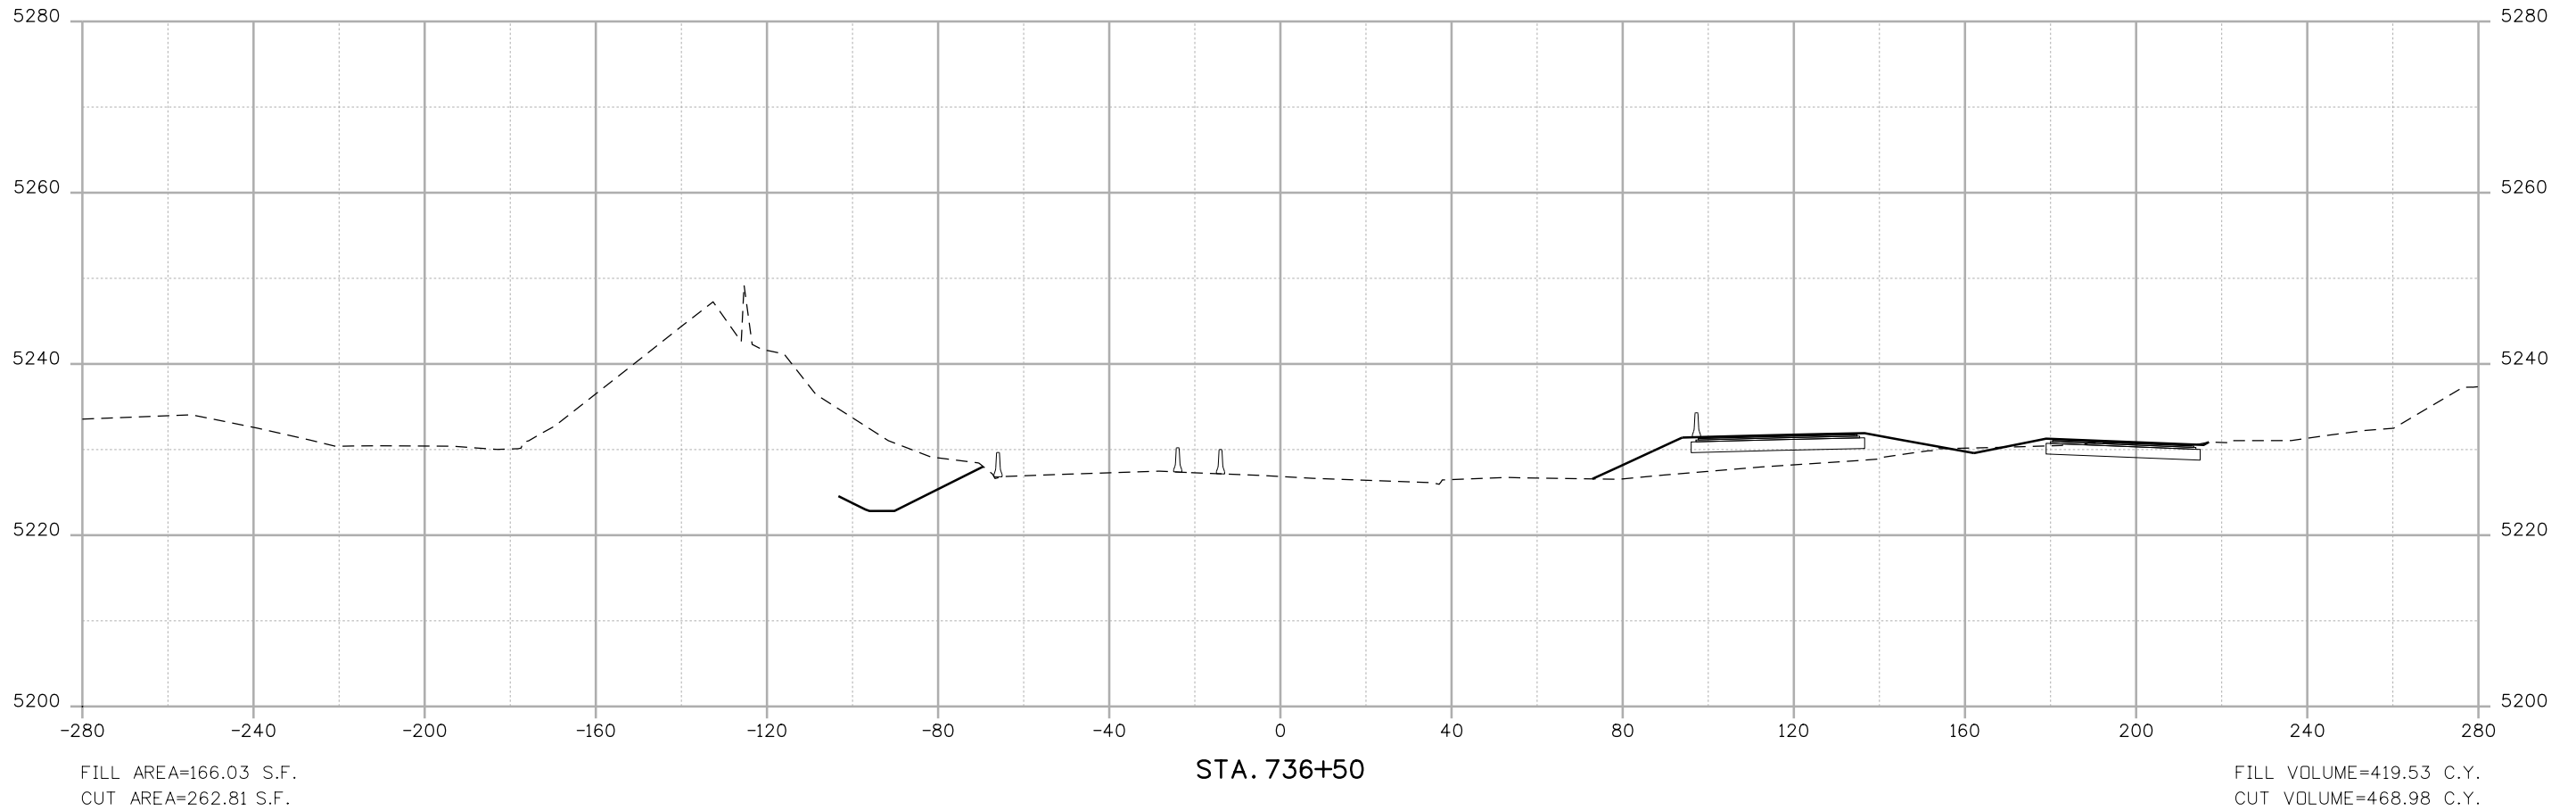

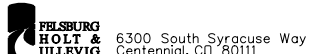Print Date: 10/12/2010	
File Name: 16311DES_PH2_CrossSections1.dgn	
Horiz. Scale: 1:40	Vert. Scale: 1:20
Unit Information	Unit Leader Initials
 6300 South Syracuse Way Centennial, CO 80111	

Sheet Revisions		
Date:	Comments	Init.

Colorado Department of Transportation



2000 South Holly Street
 Denver, CO 80222
 Phone: 303-972-9112 FAX: 303-972-9114



Region 6 **RLB**

As Constructed
No Revisions:
Revised:
Void:

I-25/SANTA FE INTERCHANGE SANTA FE DRIVE CROSS SECTIONS		
Designer: DCS	Structure Numbers	
Detailer: DCS		
Sheet Subset: SECTIONS	Subset Sheets: XS-94 of 104	

Project No./Code
BR 0252-407
17783
Sheet Number 94

Dusty 9:26:20 AM K:\08276\16311\Phase 2\Design\Drawings\Cross-Sections\16311DES_PH2_CrossSections1.dgn

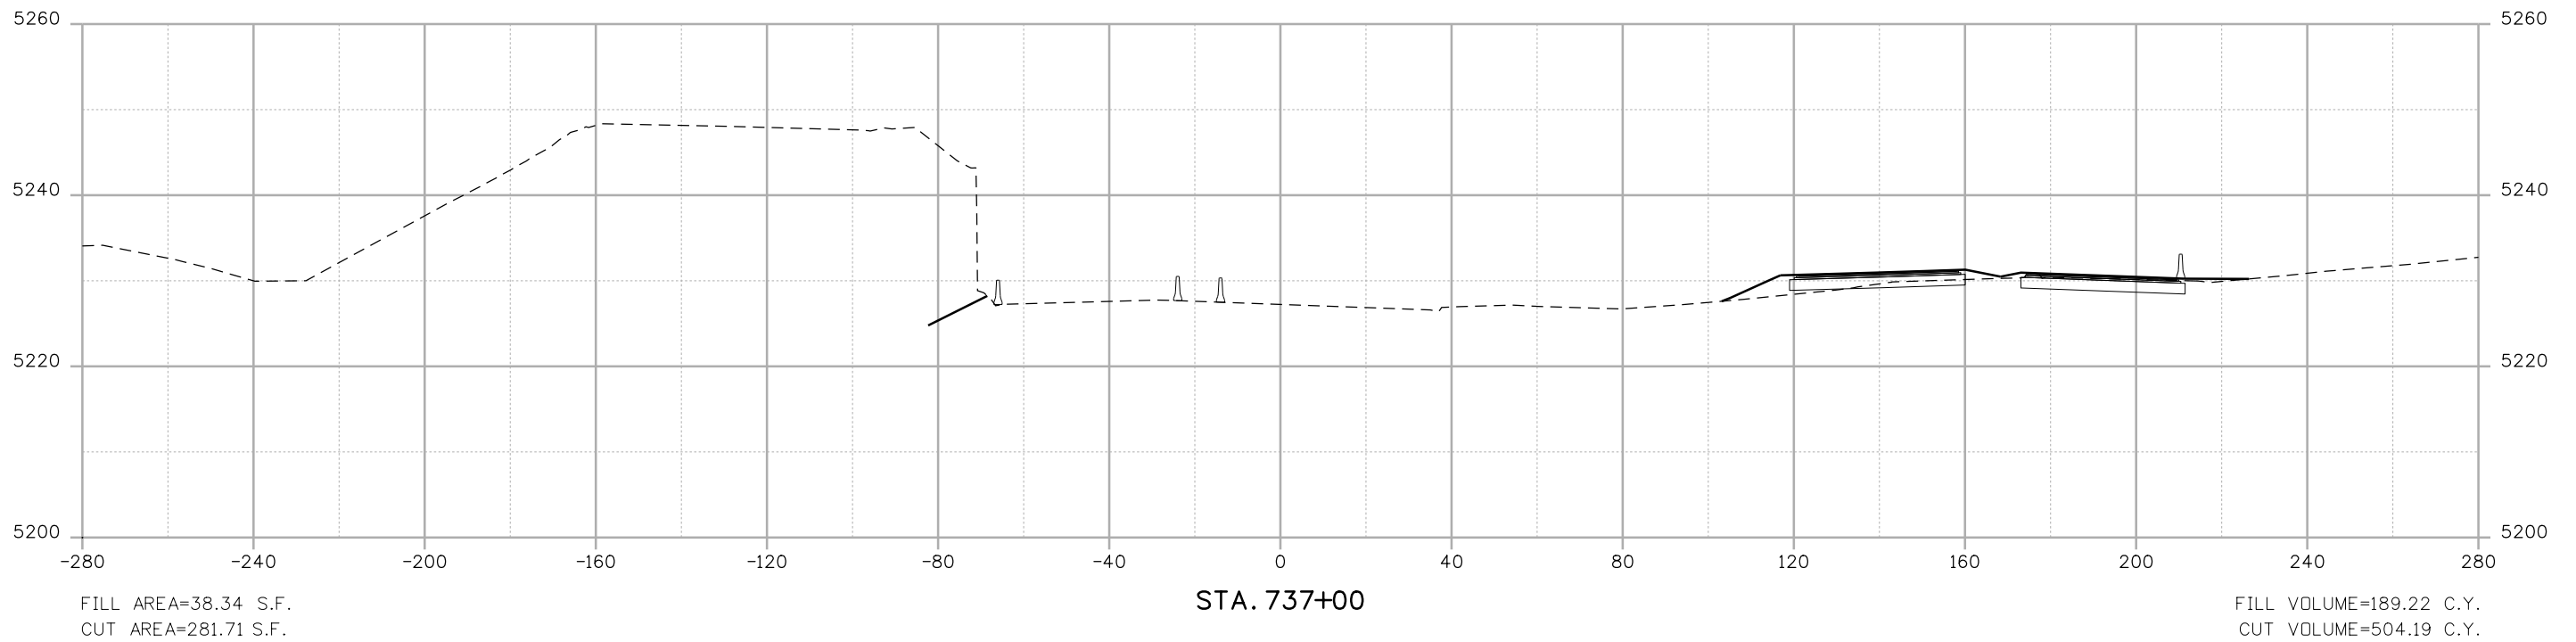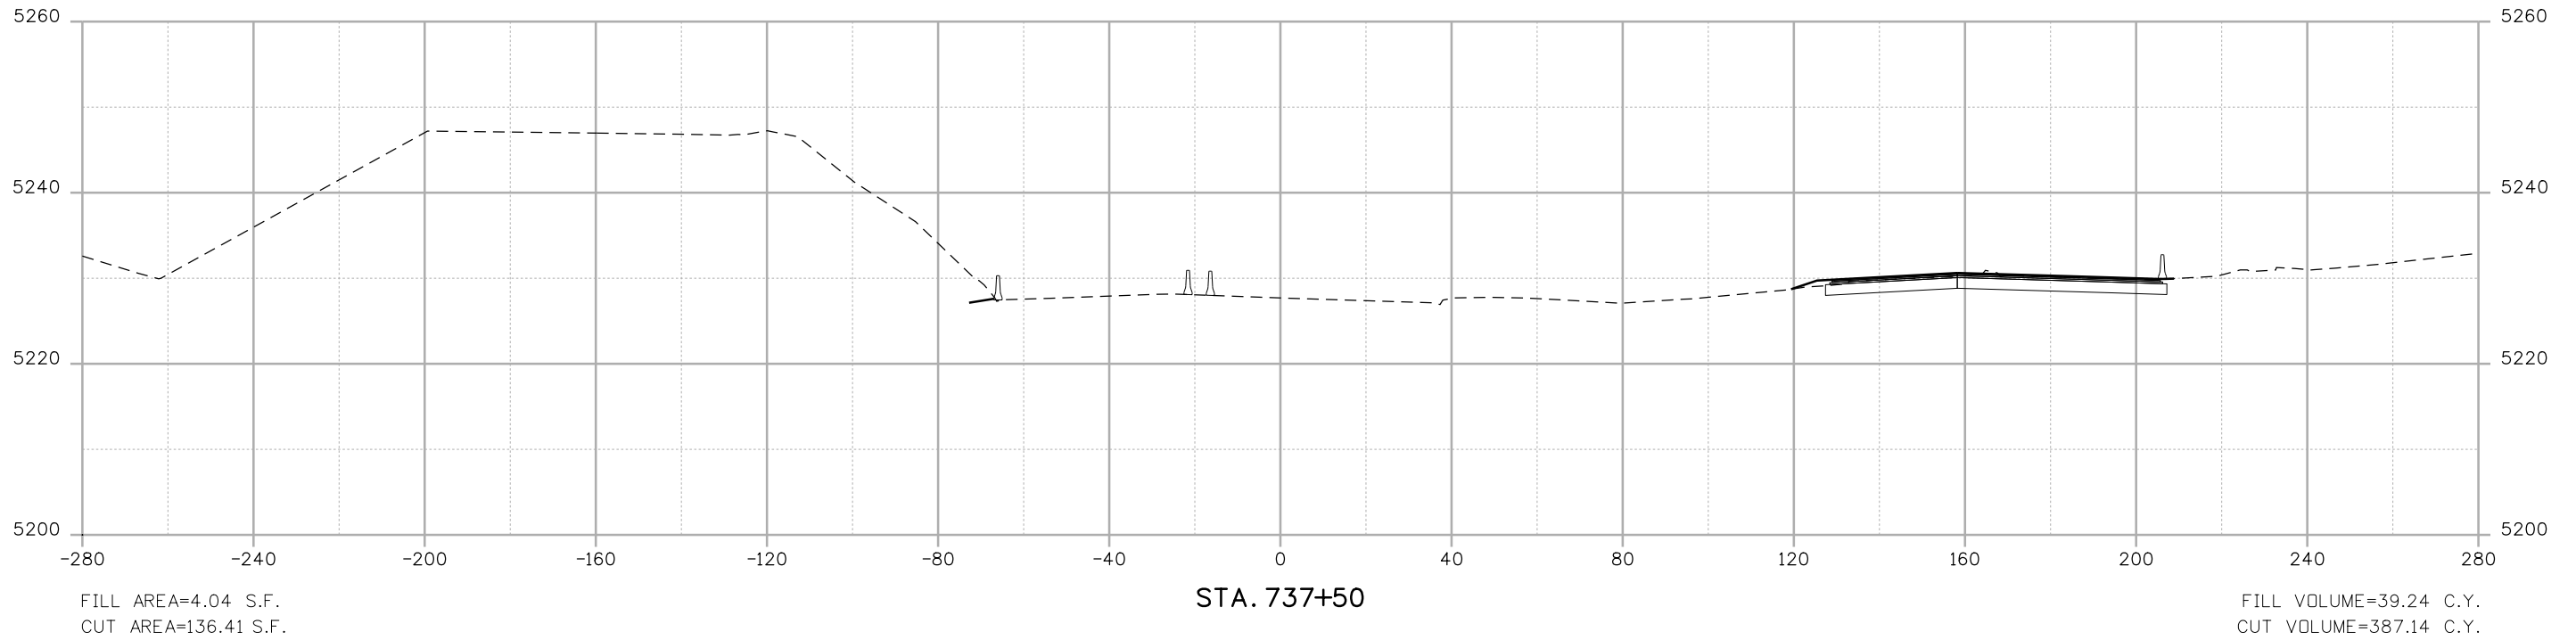

Print Date: 10/12/2010
 File Name: 16311DES_PH2_CrossSections1.dgn
 Horiz. Scale: 1:40 Vert. Scale: 1:20
 Unit Information Unit Leader Initials

Sheet Revisions		
Date:	Comments	Init.


Colorado Department of Transportation
 2000 South Holly Street
 Denver, CO 80222
 Phone: 303-972-9112 FAX: 303-972-9114
Region 6 **RLB**

As Constructed
 No Revisions:
 Revised:
 Void:



**I-25/SANTA FE INTERCHANGE
 SANTA FE DRIVE
 CROSS SECTIONS**

Designer: DCS Structure Numbers
 Detailer: DCS
 Sheet Subset: SECTIONS Subset Sheets: XS-95 of 104

Project No./Code
 BR 0252-407
 17783
 Sheet Number **95**

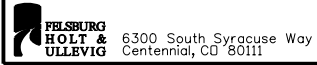

Dusty 9:26:30 AM K:\08276\16311\Phase 2\Design\Drawings\Cross-Sections\16311DES_PH2_CrossSections1.dgn

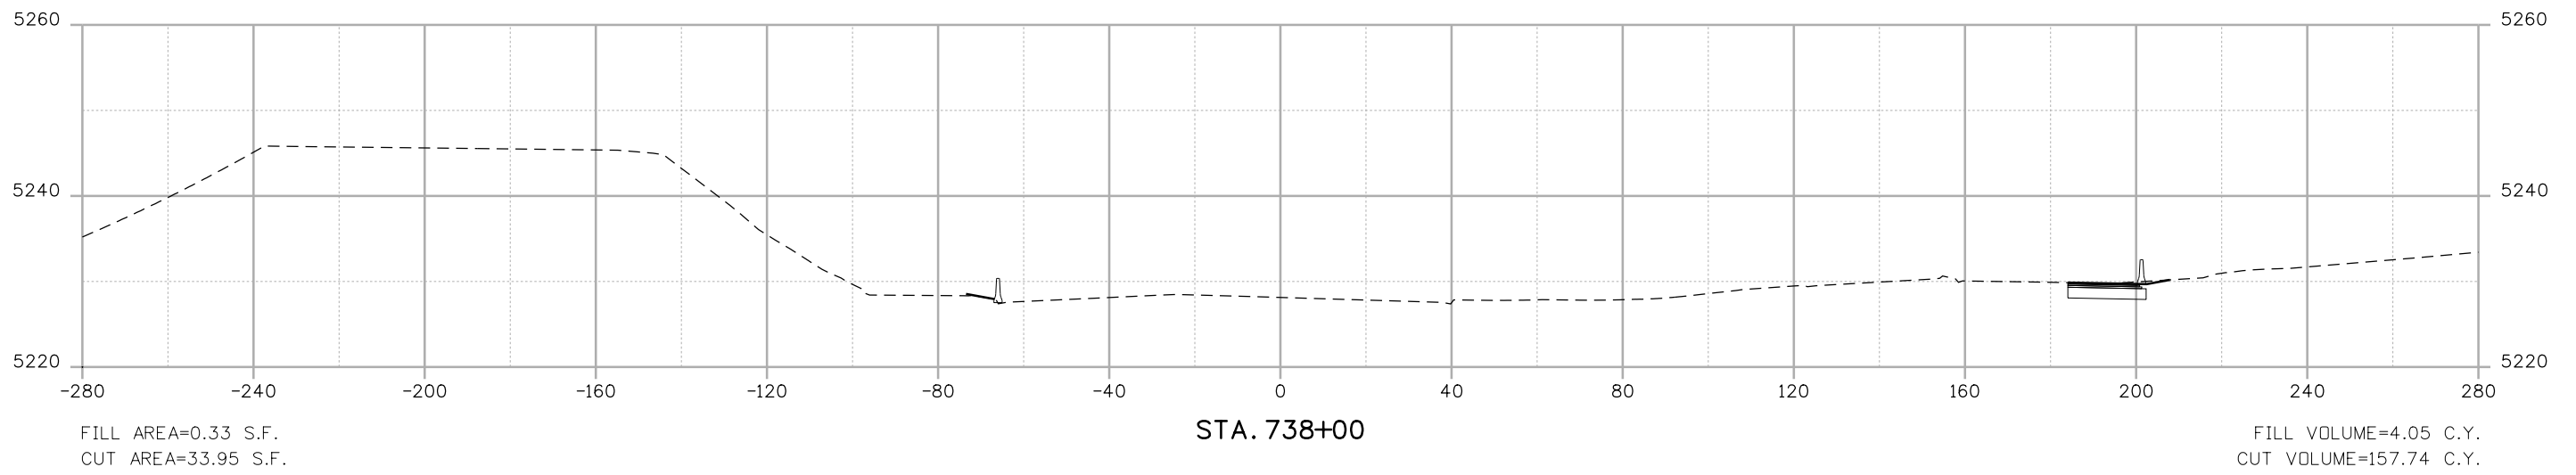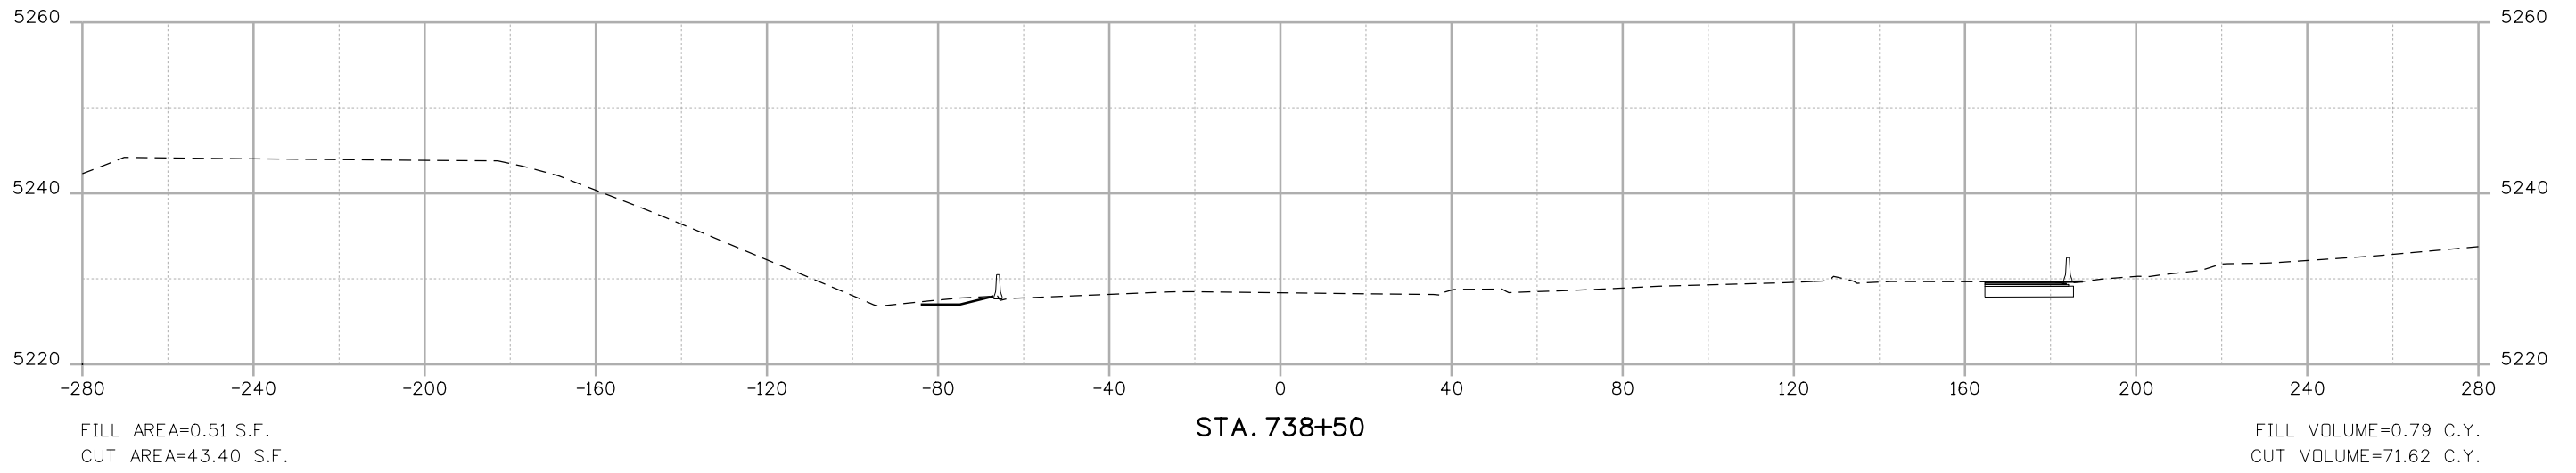

Print Date: 10/12/2010
 File Name: 16311DES_PH2_CrossSections1.dgn
 Horiz. Scale: 1:40 Vert. Scale: 1:20
 Unit Information Unit Leader Initials

Sheet Revisions		
Date:	Comments	Init.

Colorado Department of Transportation
 2000 South Holly Street
 Denver, CO 80222
 Phone: 303-972-9112 FAX: 303-972-9114

Region 6 **RLB**


As Constructed



No Revisions:
 Revised:
 Void:

**I-25/SANTA FE INTERCHANGE
 SANTA FE DRIVE
 CROSS SECTIONS**


Designer: DCS Structure Numbers
 Detailer: DCS
 Sheet Subset: SECTIONS Subset Sheets: XS-96 of 104

Project No./Code
 BR 0252-407
 17783
 Sheet Number **96**

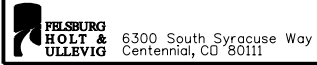

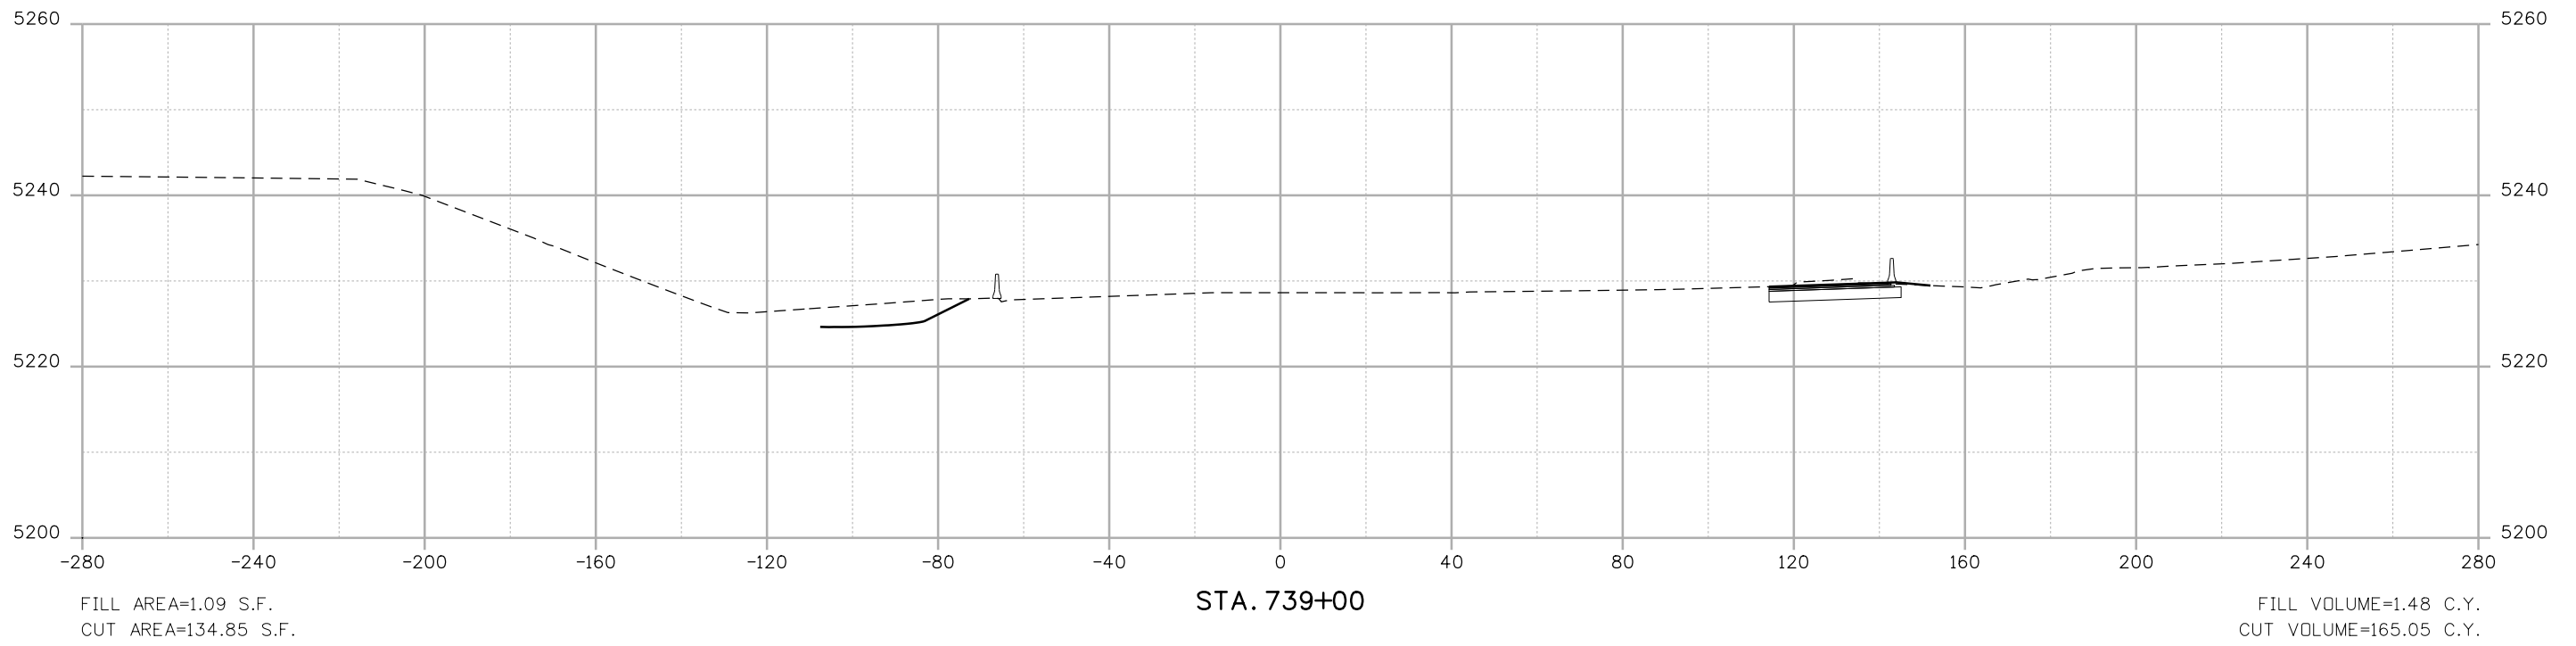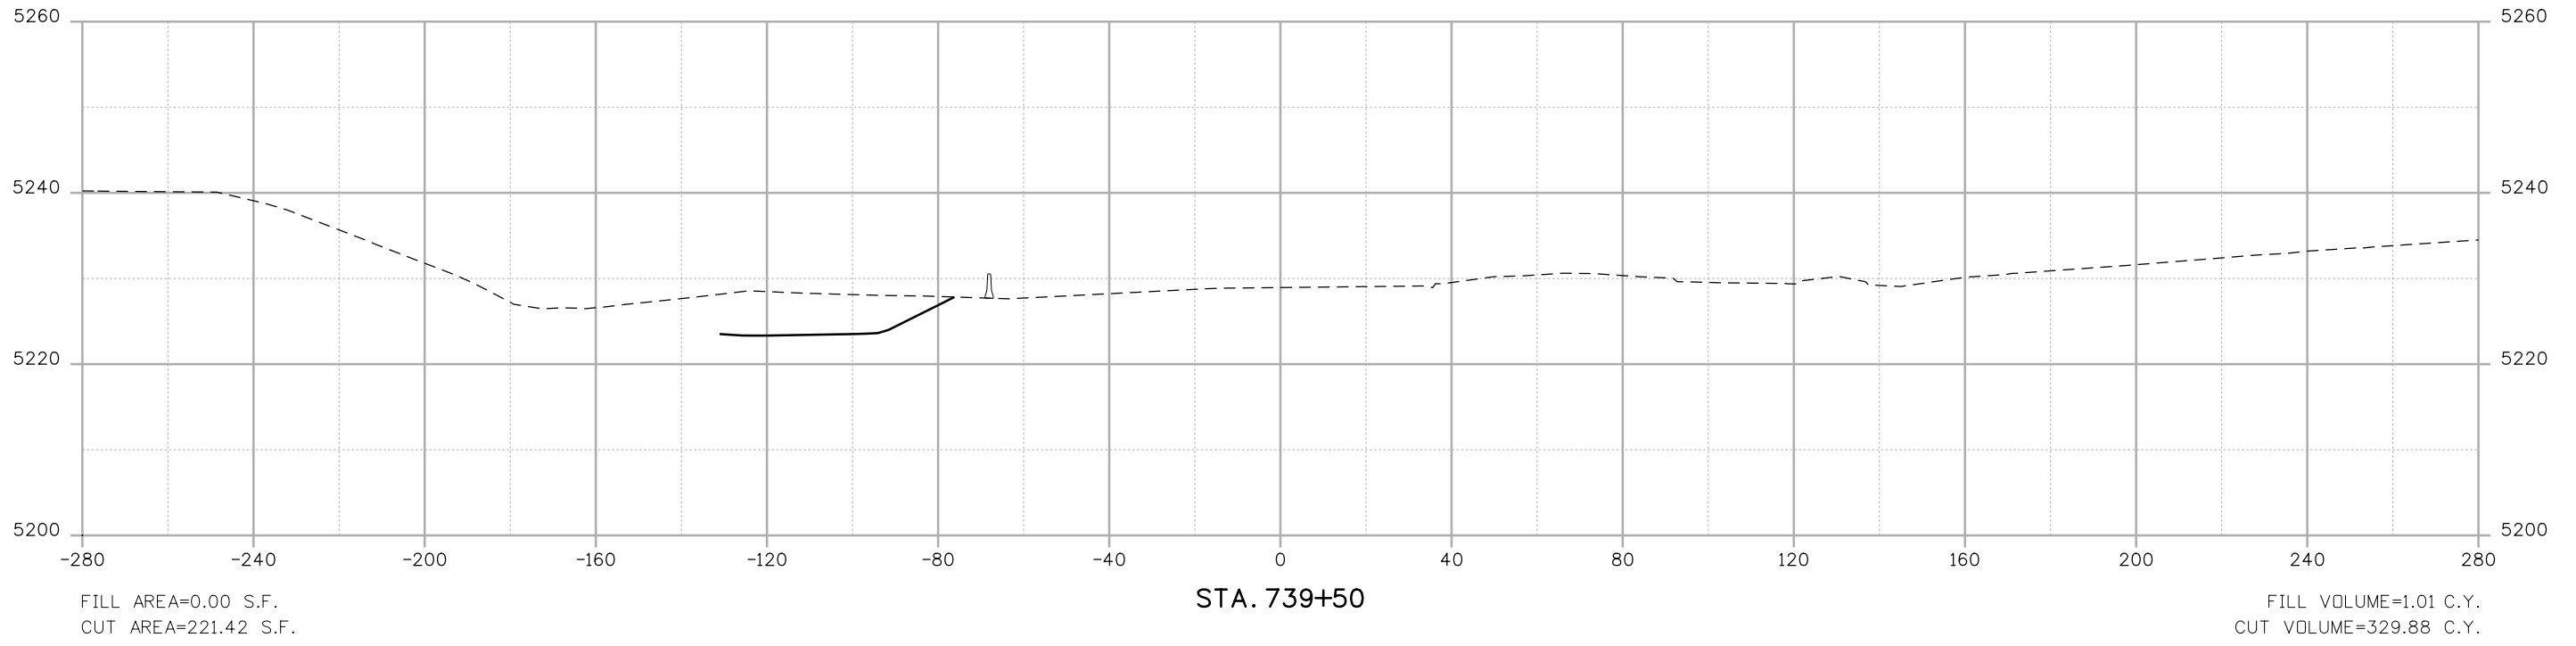

Dusty 9:26:40 AM K:\08276\16311\Phase 2\Design\Drawings\Cross_Sections\16311DES_PH2_CrossSections1.dgn

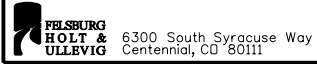Print Date: 10/12/2010	
File Name: 16311DES_PH2_CrossSections1.dgn	
Horiz. Scale: 1:40	Vert. Scale: 1:20
Unit Information	Unit Leader Initials
 6300 South Syracuse Way Centennial, CO 80111	

Sheet Revisions		
Date:	Comments	Init.

Colorado Department of Transportation


 2000 South Holly Street
 Denver, CO 80222
 Phone: 303-972-9112 FAX: 303-972-9114



Region 6 RLB

As Constructed
No Revisions:
Revised:
Void:


**I-25/SANTA FE INTERCHANGE
SANTA FE DRIVE
CROSS SECTIONS**

Designer: DCS	Structure Numbers
Detailer: DCS	
Sheet Subset: SECTIONS	Subset Sheets: XS-97 of 104

Project No./Code
BR 0252-407
17783
Sheet Number 97

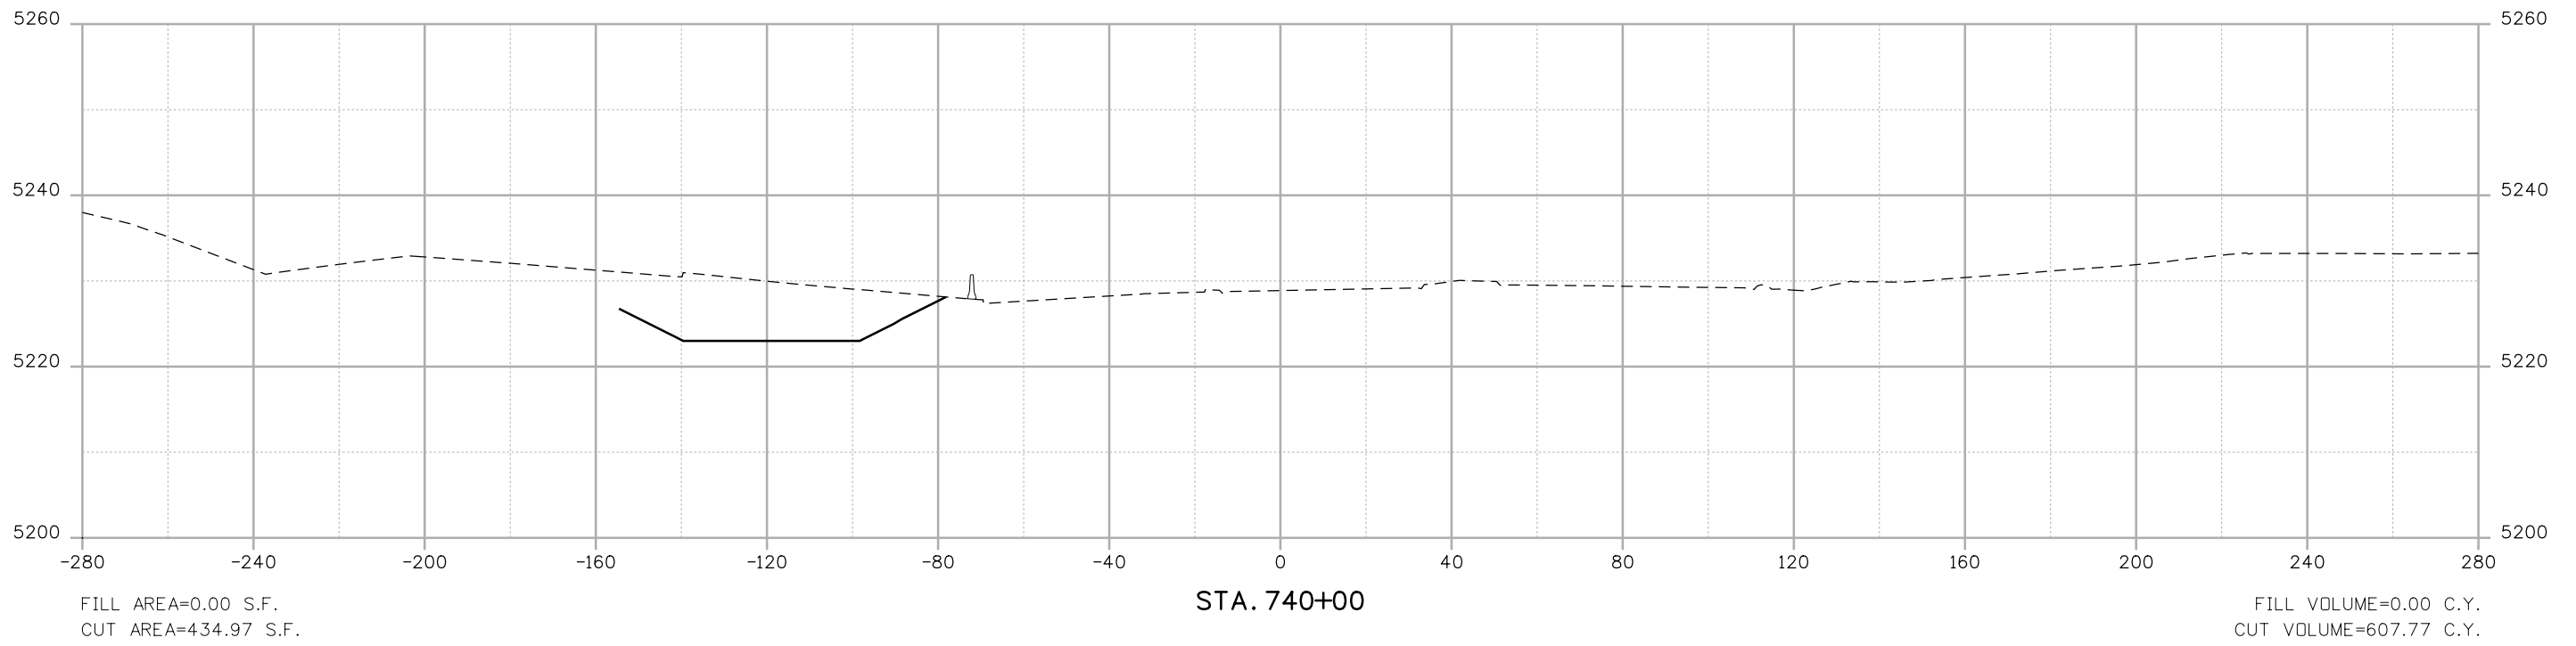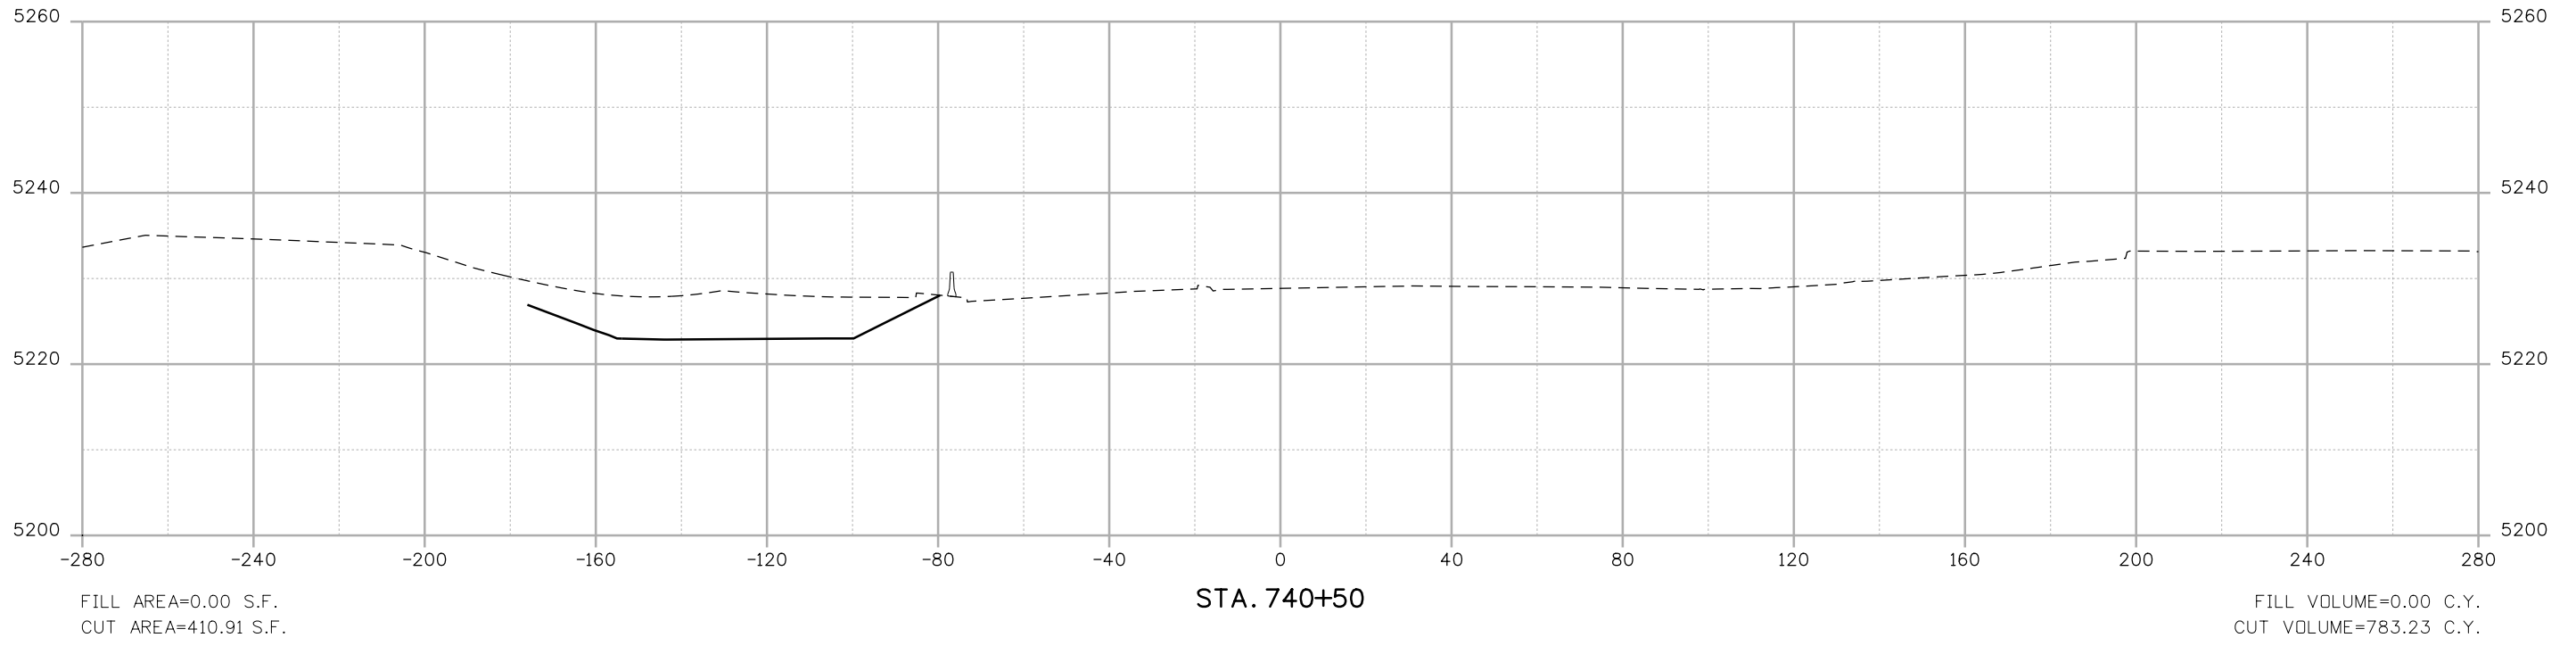

Dusty 9:26:49 AM K:\08276\16311\Phase 2\Design\Drawings\Cross-Sections\16311DES_PH2_CrossSections1.dgn

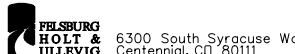Print Date: 10/12/2010	
File Name: 16311DES_PH2_CrossSections1.dgn	
Horiz. Scale: 1:40	Vert. Scale: 1:20
Unit Information	Unit Leader Initials
 6300 South Syracuse Way Centennial, CO 80111	

Sheet Revisions		
Date:	Comments	Init.

Colorado Department of Transportation



2000 South Holly Street
Denver, CO 80222
Phone: 303-972-9112 FAX: 303-972-9114


 Region 6 RLB

As Constructed
No Revisions:
Revised:
Void:


I-25/SANTA FE INTERCHANGE SANTA FE DRIVE CROSS SECTIONS		
Designer: DCS	Structure Numbers	
Detailer: DCS		
Sheet Subset: SECTIONS	Subset Sheets: XS-98 of 104	

Project No./Code
BR 0252-407
17783
Sheet Number 98

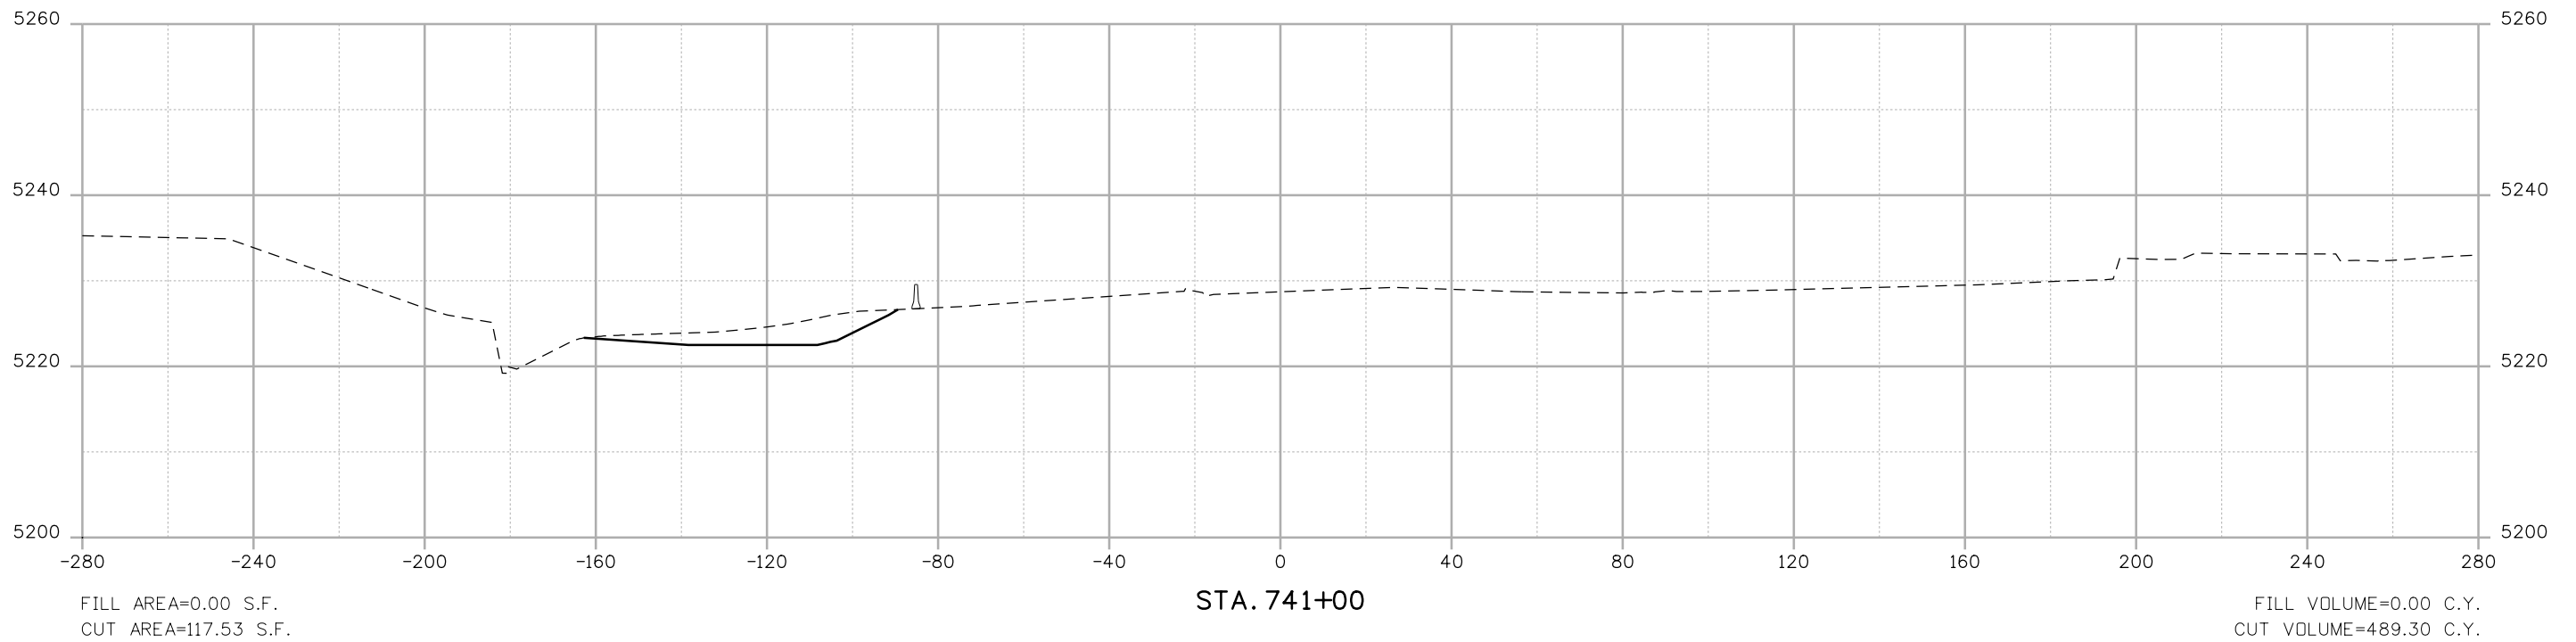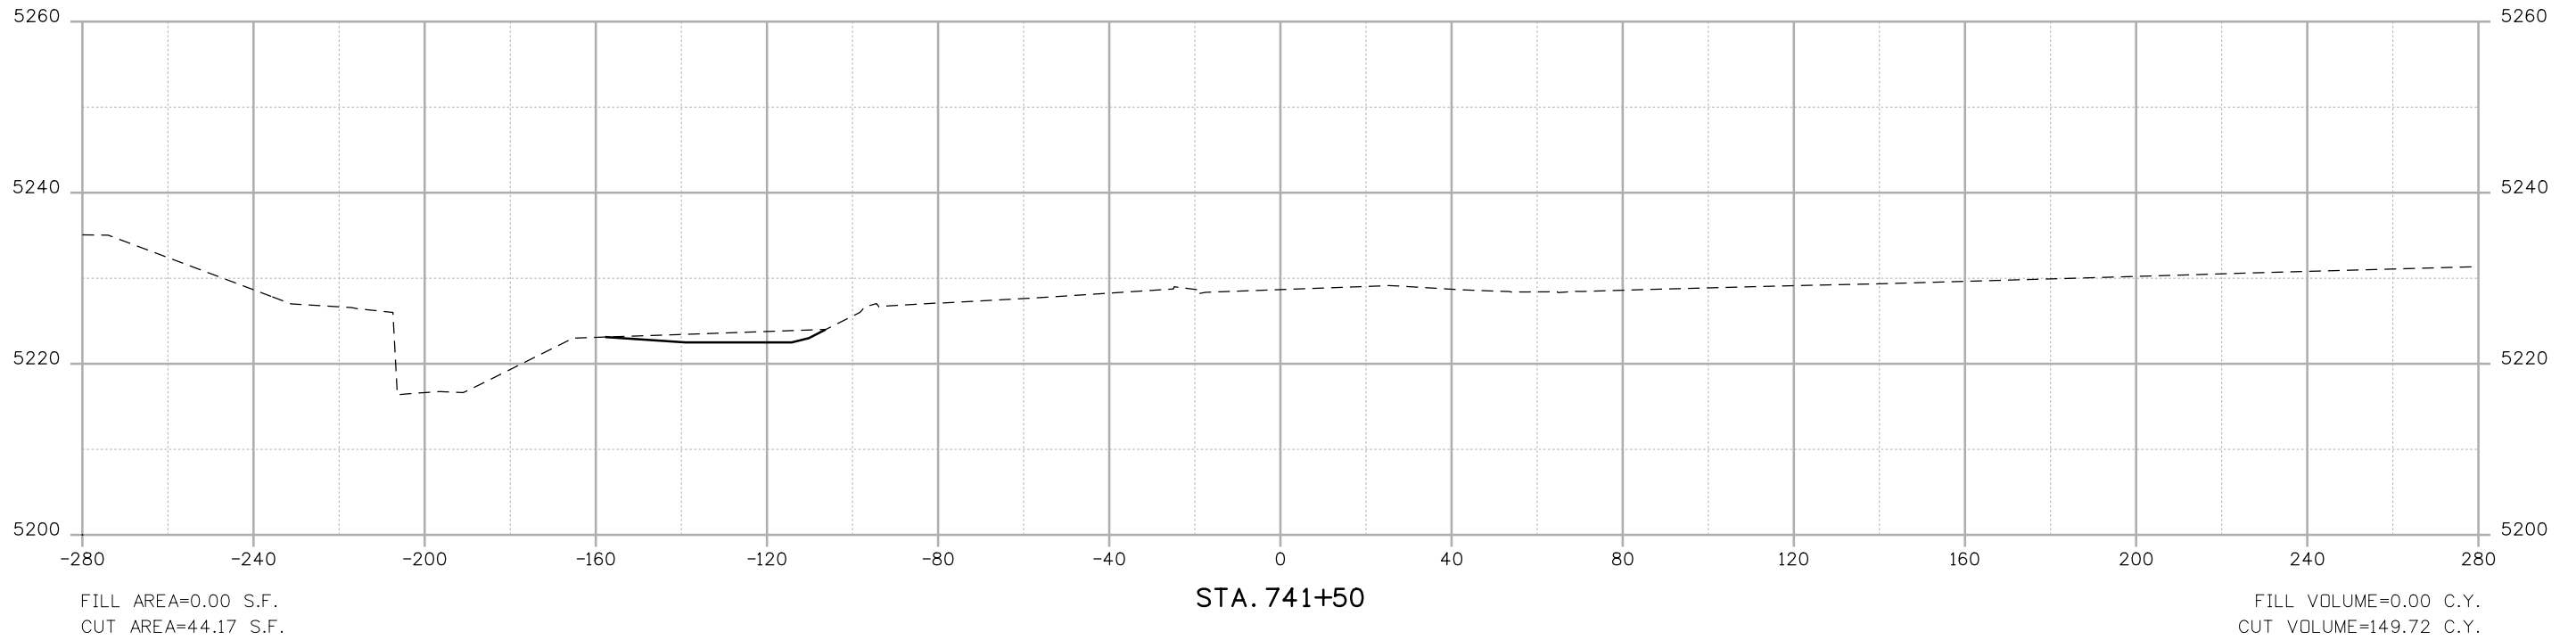

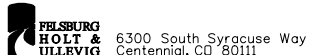Print Date: 10/12/2010
 File Name: 16311DES_PH2_CrossSections1.dgn
 Horiz. Scale: 1:40 Vert. Scale: 1:20
 Unit Information Unit Leader Initials
 6300 South Syracuse Way
 Centennial, CO 80111

Sheet Revisions		
Date:	Comments	Init.

Colorado Department of Transportation

 2000 South Holly Street
 Denver, CO 80222
 Phone: 303-972-9112 FAX: 303-972-9114
 Region 6 RLB

As Constructed
No Revisions:
Revised:
Void:



**I-25/SANTA FE INTERCHANGE
 SANTA FE DRIVE
 CROSS SECTIONS**


Designer: DCS Structure Numbers
 Detailer: DCS
 Sheet Subset: SECTIONS Subset Sheets: XS-99 of 104

Project No./Code
 BR 0252-407
 17783
 Sheet Number **99**

Dusty 9:27:00 AM K:\08276\16311\Phase 2\Design\Drawings\Cross_Sections\16311DES_PH2_CrossSections1.dgn

Dusty 9:27:10 AM K:\08276\16311\Phase 2\Design\Drawings\Cross_Sections\16311DES_PH2_CrossSections1.dgn

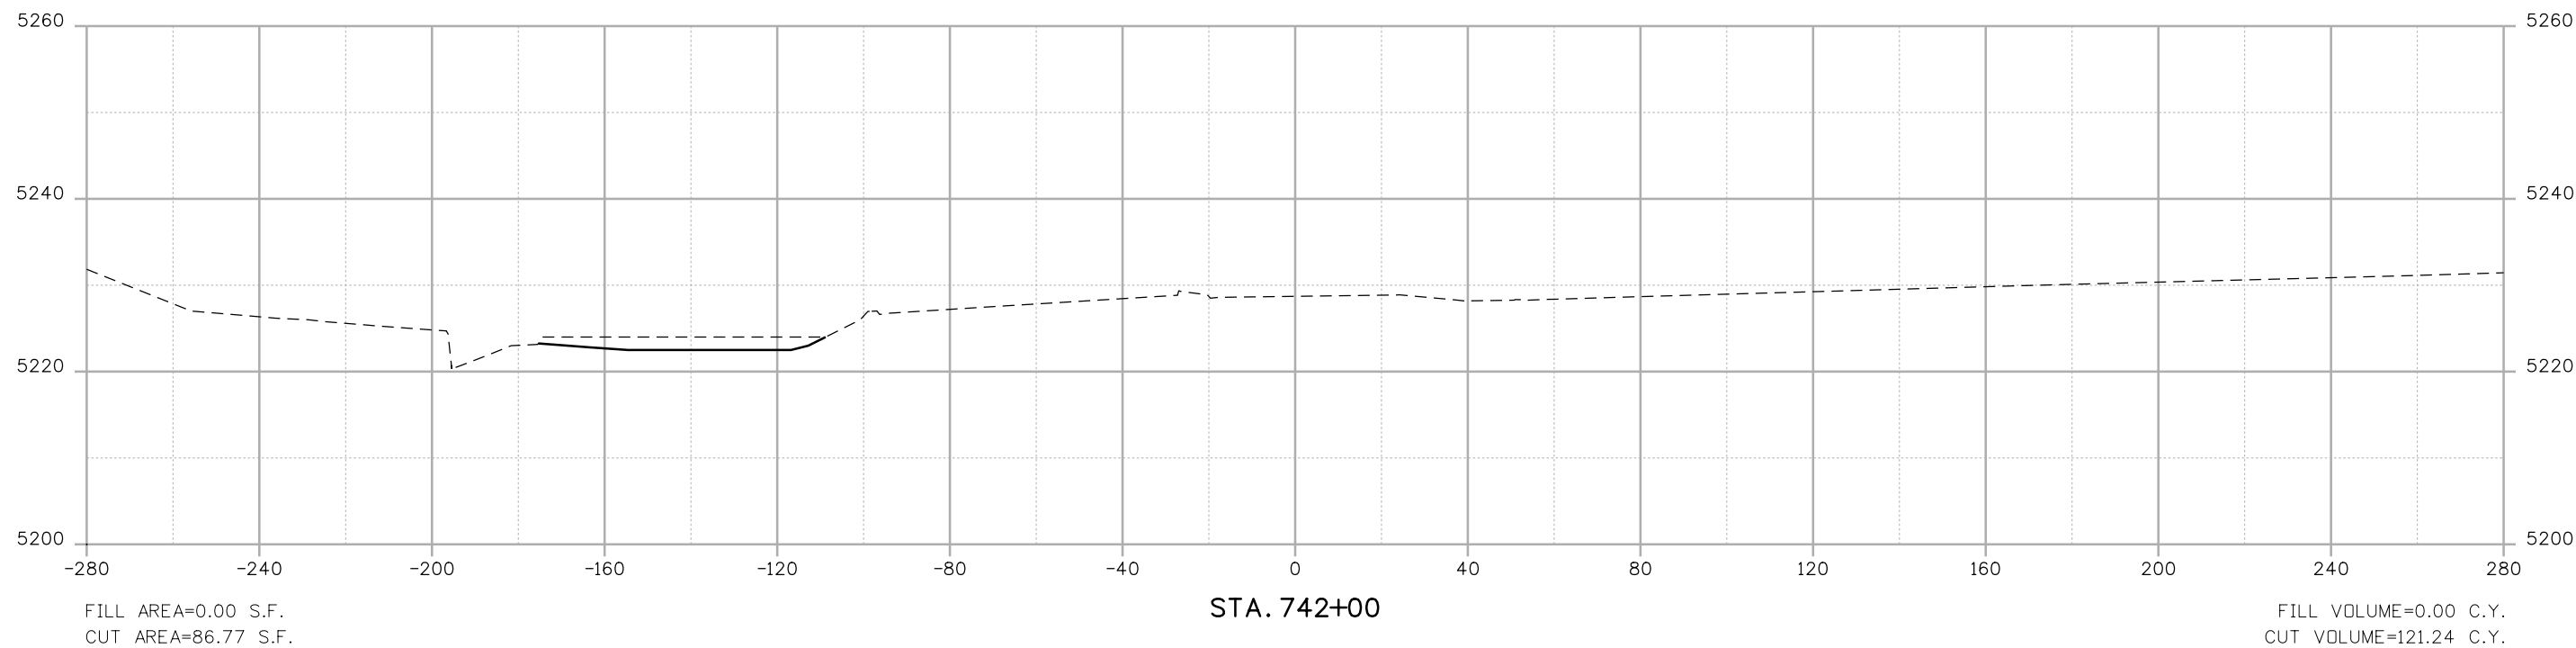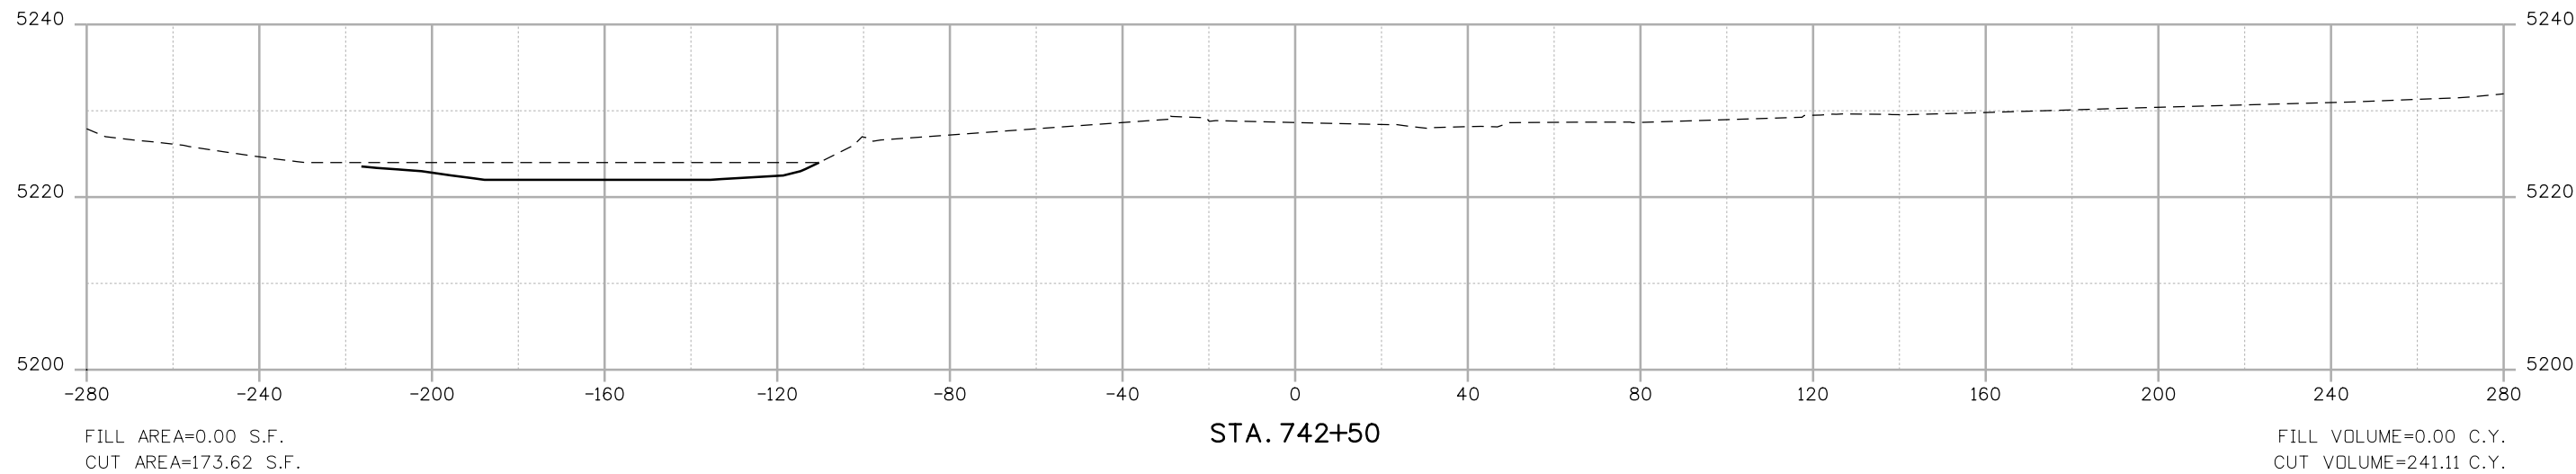

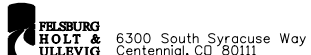Print Date: 10/12/2010
 File Name: 16311DES_PH2_CrossSections1.dgn
 Horiz. Scale: 1:40 Vert. Scale: 1:20
 Unit Information Unit Leader Initials
 6300 South Syracuse Way
 Centennial, CO 80111

Sheet Revisions		
Date:	Comments	Init.

Colorado Department of Transportation
 2000 South Holly Street
 Denver, CO 80222
 Phone: 303-972-9112 FAX: 303-972-9114
Region 6 **RLB**



As Constructed
 No Revisions:
 Revised:
 Void:

**I-25/SANTA FE INTERCHANGE
 SANTA FE DRIVE
 CROSS SECTIONS**

Designer: DCS Structure Numbers
 Detailer: DCS
 Sheet Subset: SECTIONS Subset Sheets: XS-100 of 104

Project No./Code
 BR 0252-407
 17783
 Sheet Number **100**

Dusty 9:27:20 AM K:\08276\16311\Phase 2\Design\Drawings\Cross Sections\16311DES_PH2_CrossSections1.dgn

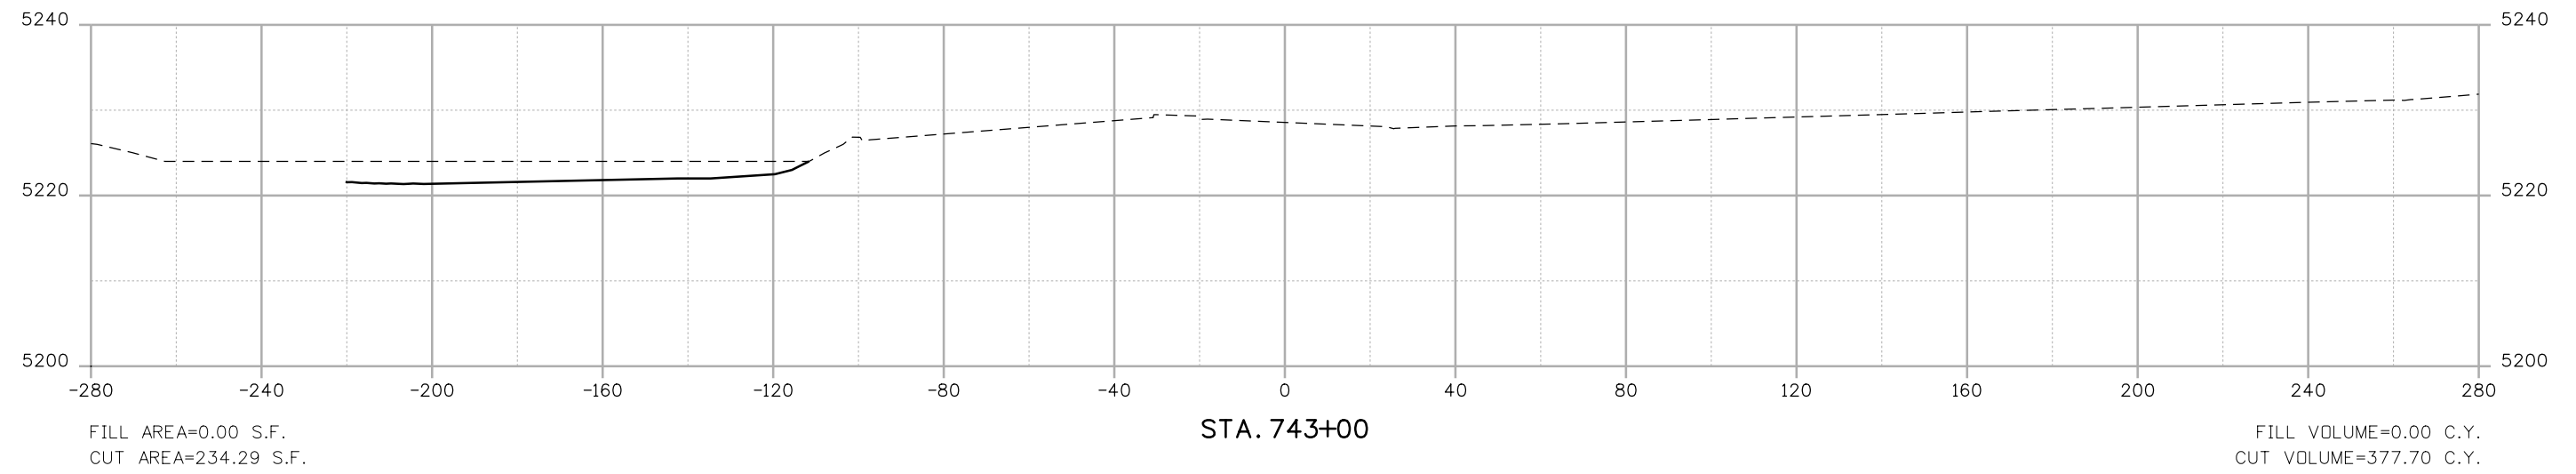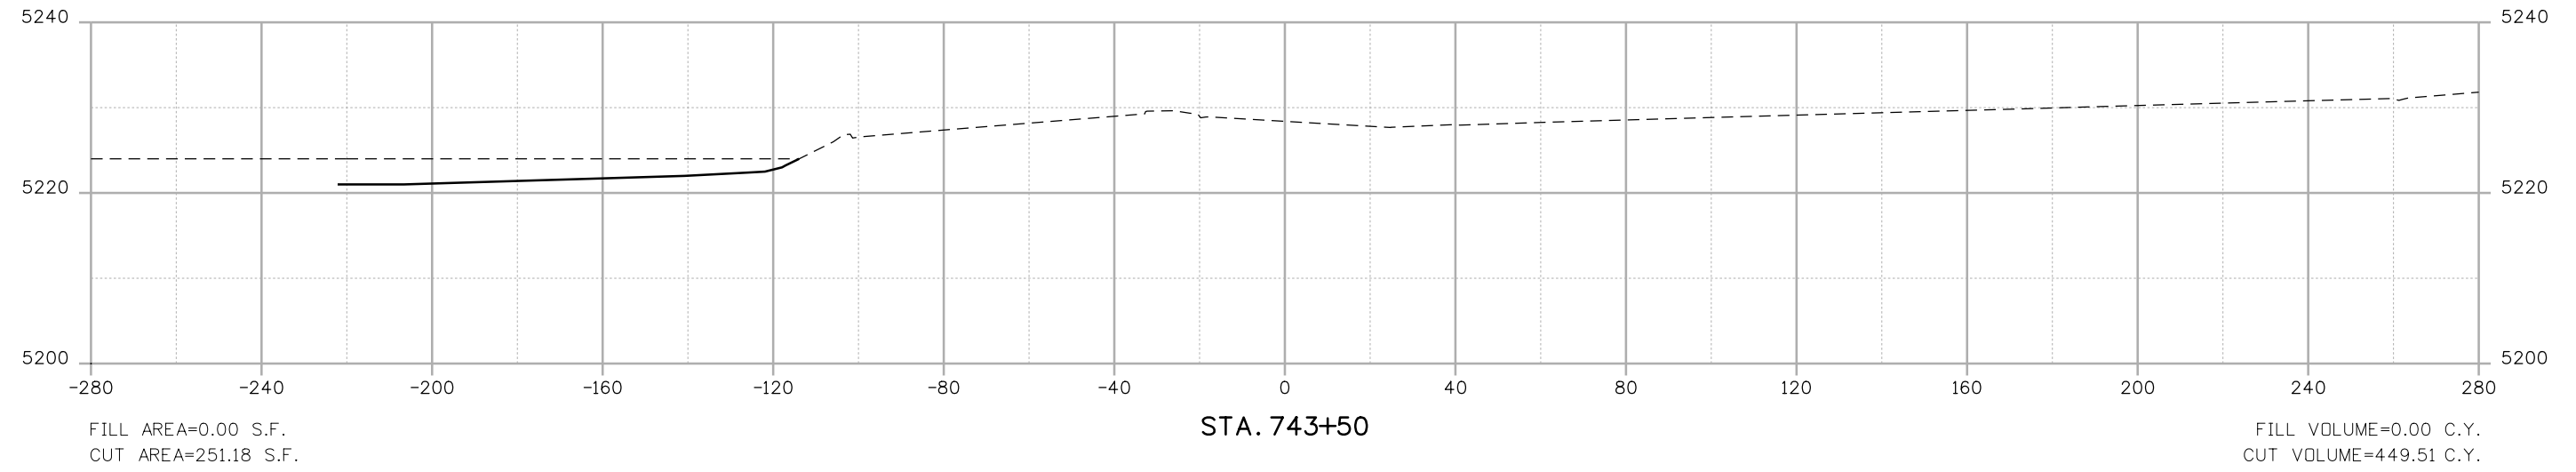

Print Date: 10/12/2010
 File Name: 16311DES_PH2_CrossSections1.dgn
 Horiz. Scale: 1:40 Vert. Scale: 1:20
 Unit Information Unit Leader Initials

Sheet Revisions		
Date:	Comments	Init.

Colorado Department of Transportation
 2000 South Holly Street
 Denver, CO 80222
 Phone: 303-972-9112 FAX: 303-972-9114


Region 6 **RLB**

As Constructed
 No Revisions:
 Revised:
 Void:


**I-25/SANTA FE INTERCHANGE
 SANTA FE DRIVE
 CROSS SECTIONS**

Designer: DCS Structure Numbers
 Detailer: DCS
 Sheet Subset: SECTIONS Subset Sheets: XS-101 of 104

Project No./Code
 BR 0252-407
 17783
 Sheet Number **101**

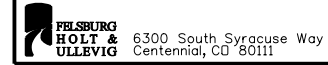


Dusty 9:27:30 AM K:\08276\16311\Phase 2\Design\Drawings\Cross_Sections\16311DES_PH2_CrossSections1.dgn

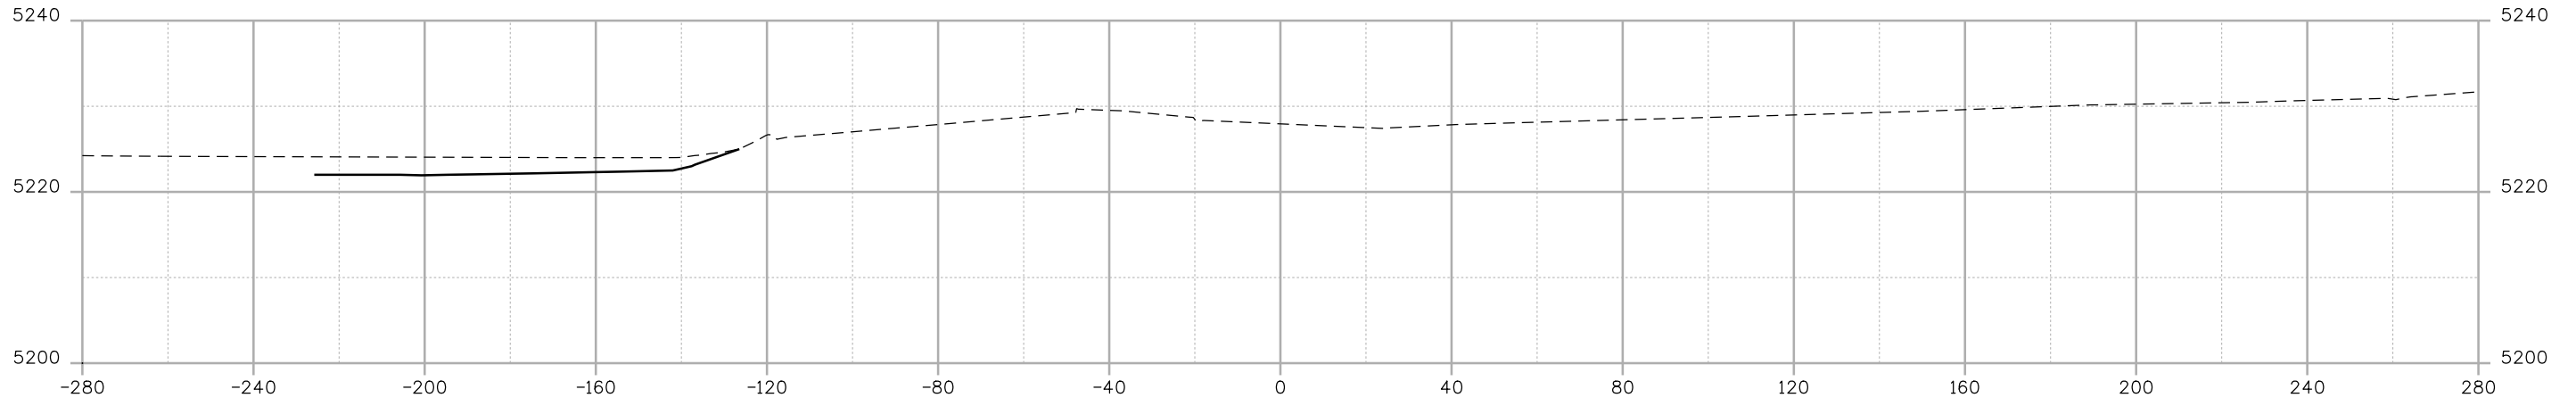

FILL AREA=0.00 S.F.
CUT AREA=170.34 S.F.

STA. 744+50

FILL VOLUME=0.00 C.Y.
CUT VOLUME=364.11 C.Y.

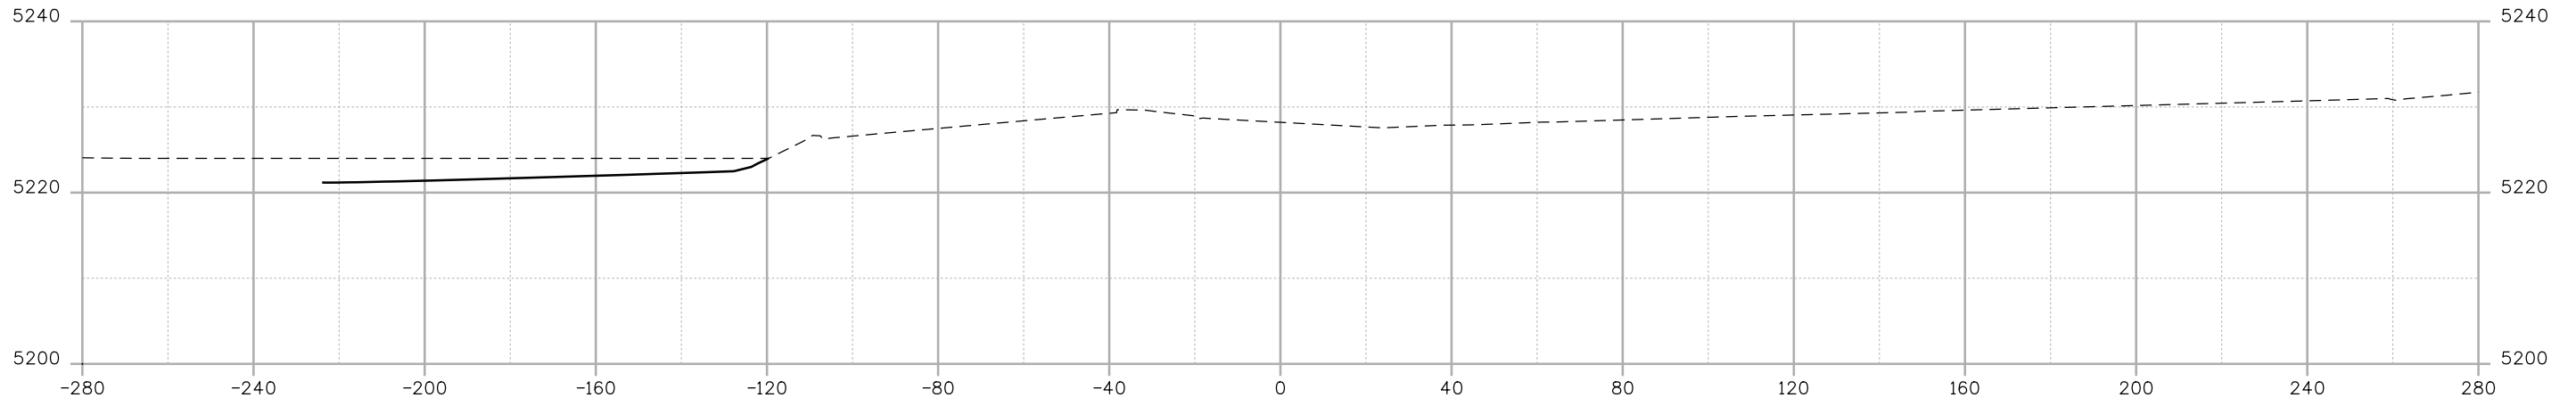

FILL AREA=0.00 S.F.
CUT AREA=222.90 S.F.

STA. 744+00

FILL VOLUME=0.00 C.Y.
CUT VOLUME=438.97 C.Y.

Print Date: 10/12/2010	
File Name: 16311DES_PH2_CrossSections1.dgn	
Horiz. Scale: 1:40	Vert. Scale: 1:20
Unit Information	Unit Leader Initials

Sheet Revisions		
Date:	Comments	Init.

Colorado Department of Transportation

2000 South Holly Street
Denver, CO 80222
Phone: 303-972-9112 FAX: 303-972-9114



Region 6 RLB


As Constructed
No Revisions:
Revised:
Void:

I-25/SANTA FE INTERCHANGE SANTA FE DRIVE CROSS SECTIONS		
Designer: DCS	Structure Numbers	
Detailer: DCS		
Sheet Subset: SECTIONS	Subset Sheets: XS-102 of 104	

Project No./Code
BR 0252-407
17783
Sheet Number 102

Dusty 9:27:40 AM K:\08276\16311\Phase 2\Design\Drawings\Cross_Sections\16311DES_PH2_CrossSections1.dgn

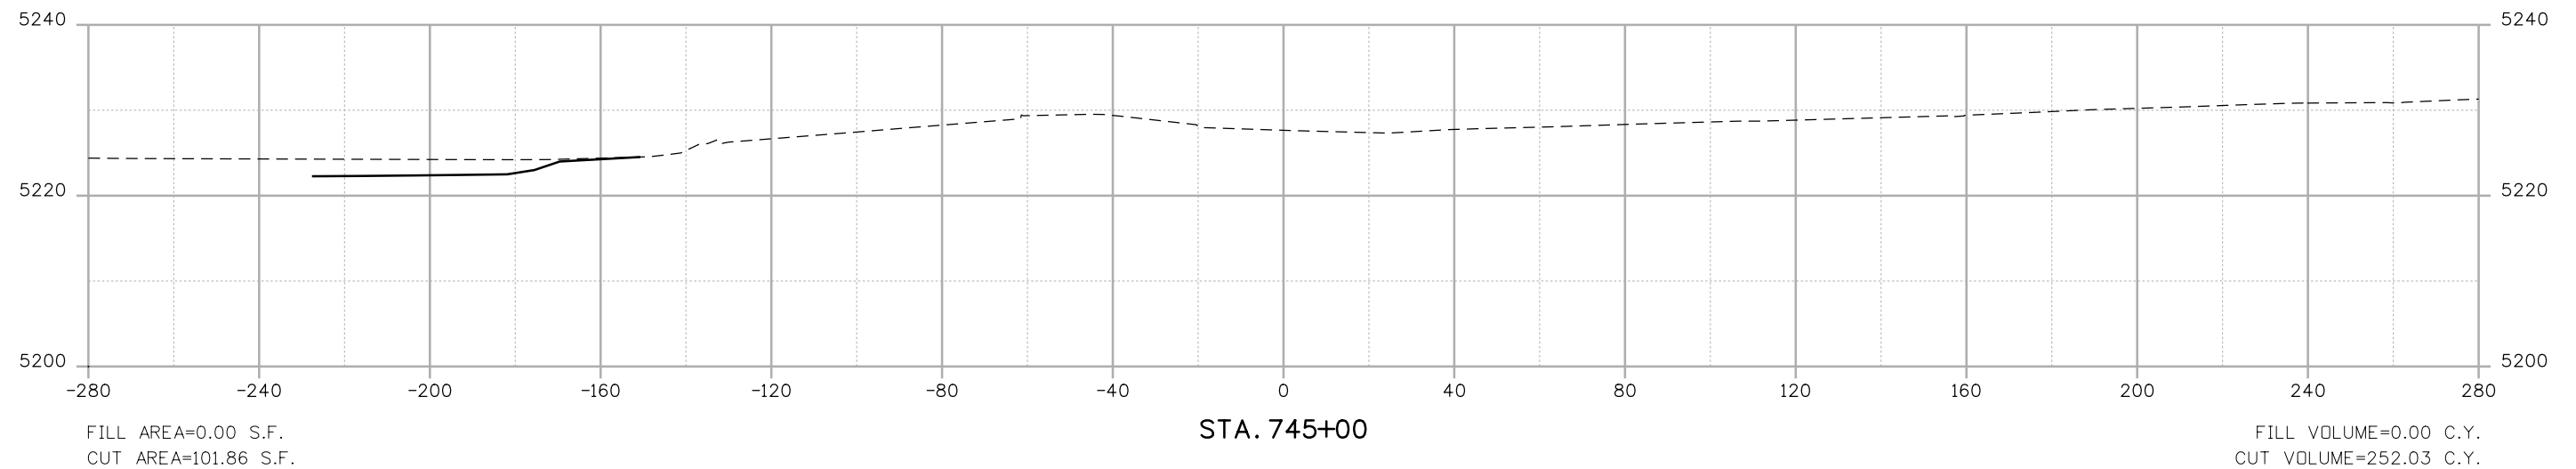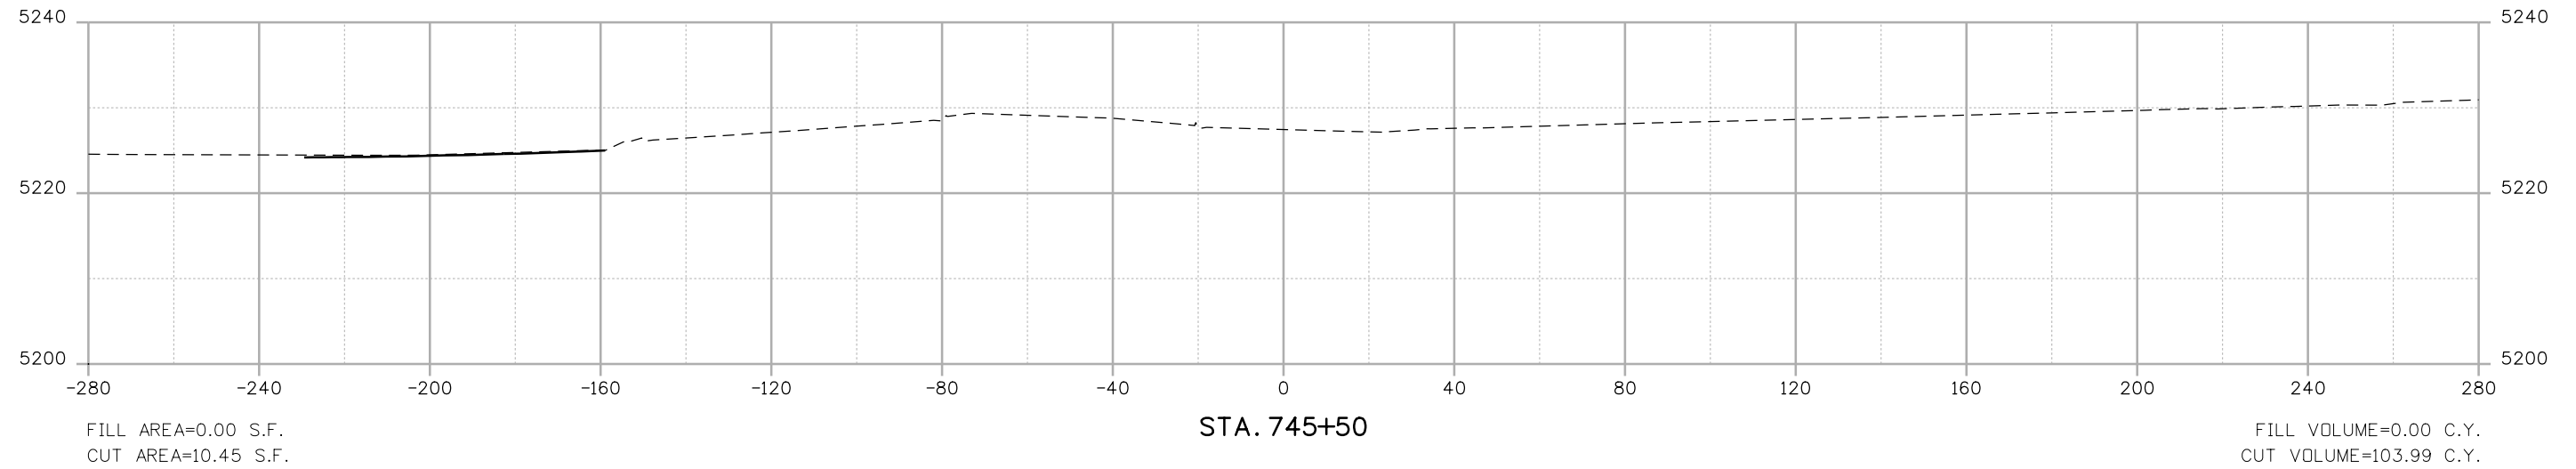

Print Date: 10/12/2010
 File Name: 16311DES_PH2_CrossSections1.dgn
 Horiz. Scale: 1:40 Vert. Scale: 1:20
 Unit Information Unit Leader Initials
 6300 South Syracuse Way
 Centennial, CO 80111

Sheet Revisions		
Date:	Comments	Init.

Colorado Department of Transportation
 2000 South Holly Street
 Denver, CO 80222
 Phone: 303-972-9112 FAX: 303-972-9114
Region 6 **RLB**


As Constructed
 No Revisions:
 Revised:
 Void:

**I-25/SANTA FE INTERCHANGE
 SANTA FE DRIVE
 CROSS SECTIONS**

Designer: DCS Structure Numbers
 Detailer: DCS
 Sheet Subset: SECTIONS Subset Sheets: XS-103 of 104

Project No./Code
 BR 0252-407
 17783
 Sheet Number **103**

Dusty 9:27:52 AM K:\08276\16311\Phase 2\Design\Drawings\Cross Sections\16311DES_PH2_CrossSections1.dgn

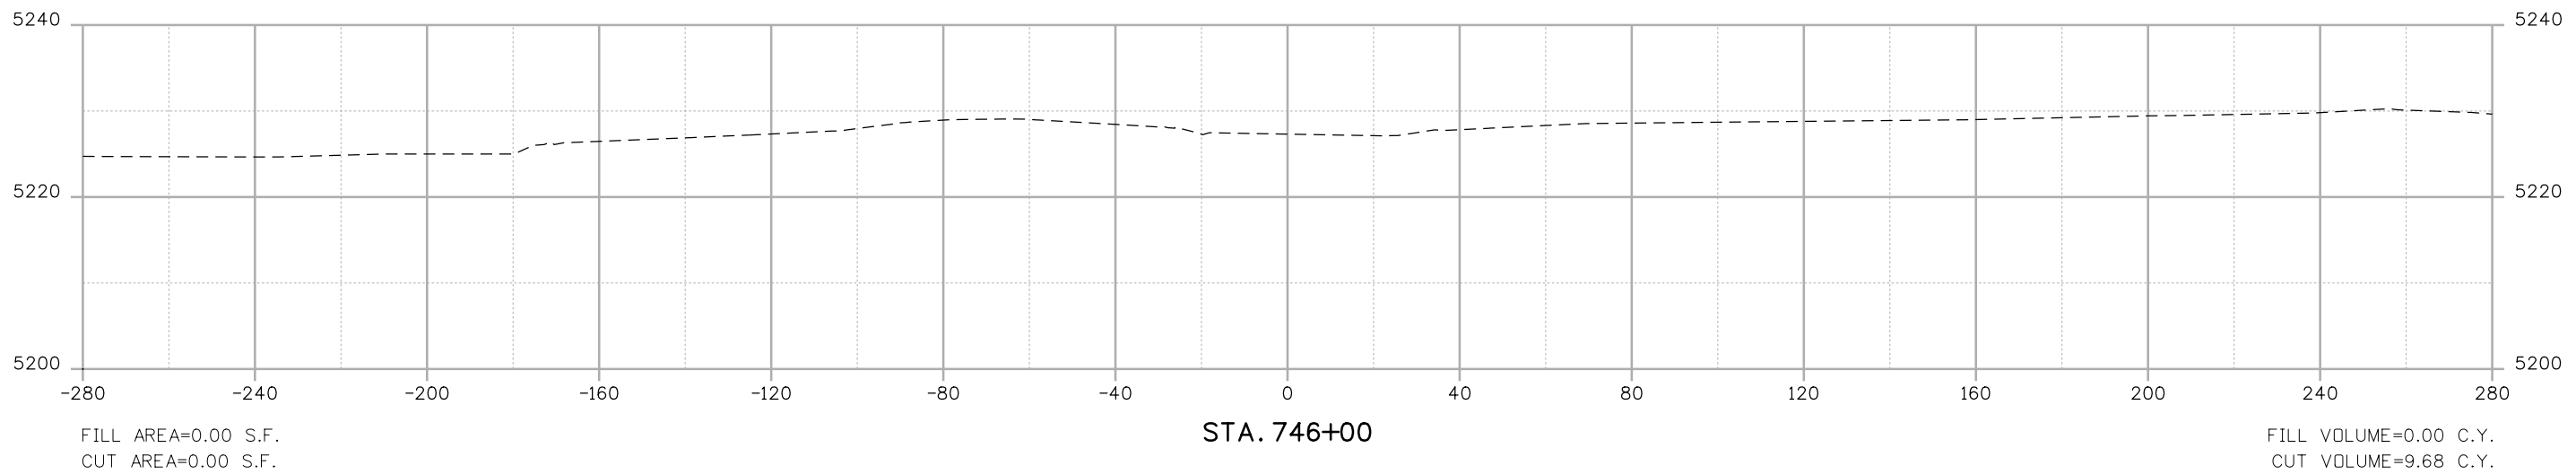

Print Date: 10/12/2010	
File Name: 16311DES_PH2_CrossSections1.dgn	
Horiz. Scale: 1:40	Vert. Scale: 1:20
Unit Information	Unit Leader Initials

Sheet Revisions		
Date:	Comments	Init.

Colorado Department of Transportation

2000 South Holly Street
 Denver, CO 80222
 Phone: 303-972-9112 FAX: 303-972-9114

Region 6 RLB

As Constructed
No Revisions:
Revised:
Void:

I-25/SANTA FE INTERCHANGE SANTA FE DRIVE CROSS SECTIONS	
Designer: DCS	Structure Numbers
Detailer: DCS	
Sheet Subset: SECTIONS	Subset Sheets: XS-104 of 104

Project No./Code
BR 0252-407
17783
Sheet Number 104