


VERTICAL AND LATERAL UNDERCLEARANCE REPORT

HWY UNDER 25A

REF PT (MP) 209.211

STR # F-16-DU

HWY ON US 6 ML

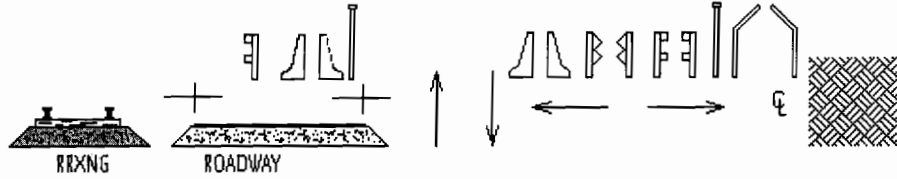

MP ITEM 135


(Direction in which MP is decreasing)

MP ITEM 134





(Direction in which MP is increasing)

MAX 16'-02" MIN 15'-00"

MAX 17'-11" MIN 17'-00"

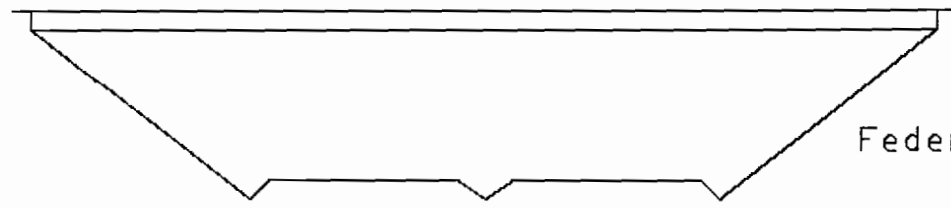

Federal Blvd

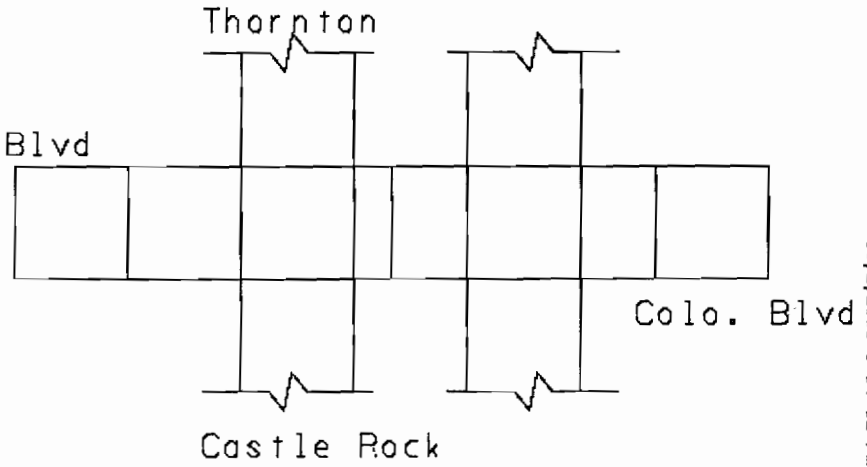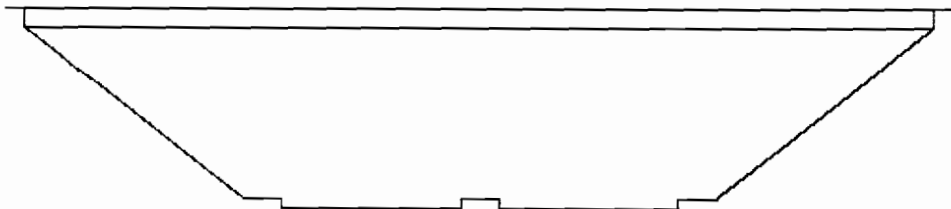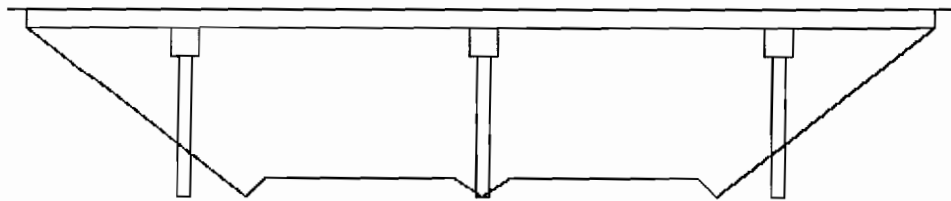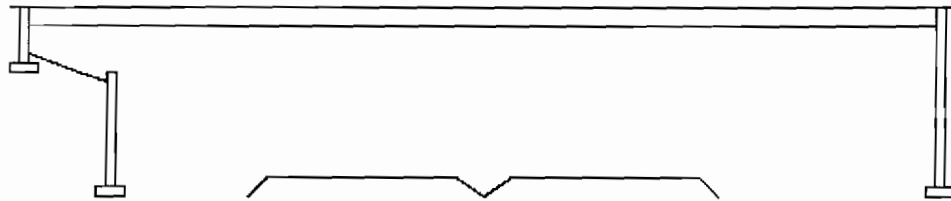

11/2/2005 11:34:32 PM


STRUCTURE NO.

F-16-DU

PARABOLIC X

NON-PARABOLIC _____

HWY NO. US 6 ML

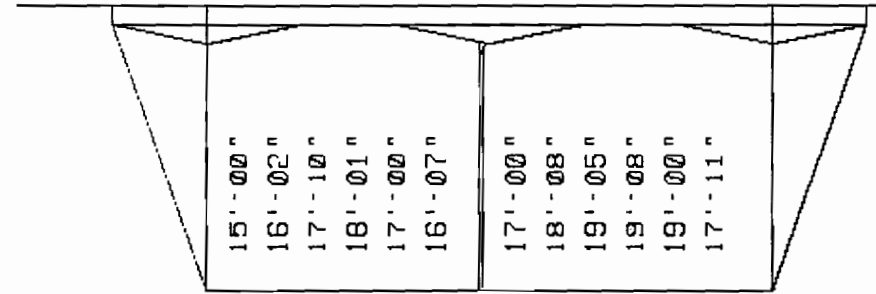

(SB) (NB)

INVENTORY DIRECTION SB/WB or NB/EB
LOOKING IN DIRECTION OF INCREASING MP

INSPECTORS Clearance Master

DATE 10/20/2005

Entered by Tony M

Lateral clearances measured on 7-23-90


- 5'-9"
- 3'-4"
- 2'-12"
- 3'-6"

F-16-DU


VERTICAL AND LATERAL UNDERCLEARANCE REPORT

<u>N./E. BND.</u>		<u>S./W. BND.</u>	
MIN. <u>16'7"</u>	MIN. <u>15'0"</u>		
*MAX. <u>18'9"</u>	*MAX. <u>16'07"</u>		
POSTED _____	POSTED _____		
*Max. Clearance for 10' wide lane			

S. H. NO. 25
 STR. NO. F-16-DU
 LOG/MILE PT. 209.00
 DISTRICT NO. _____




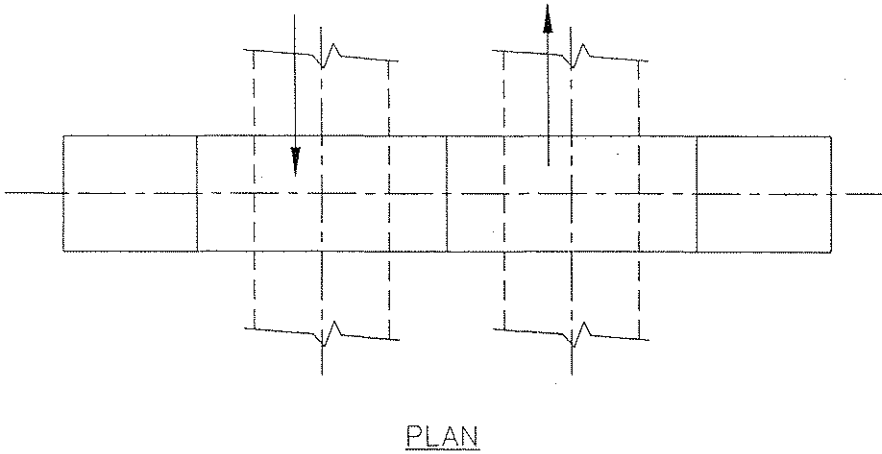


PARABOLIC _____
 NON-PARABOLIC _____

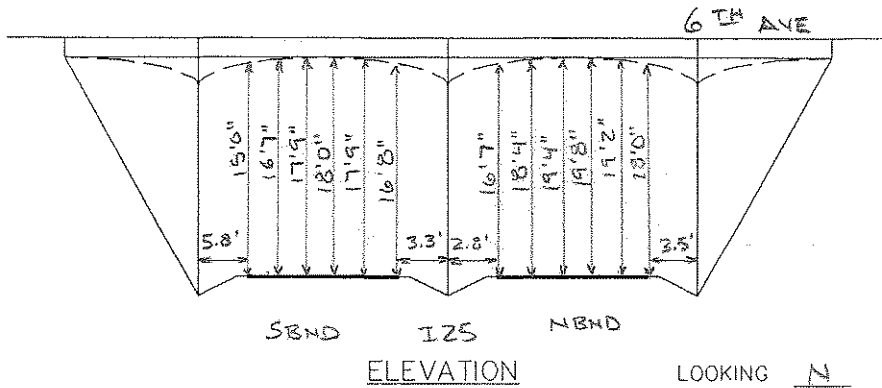


INSPECTORS TONY MACIAS DATE 7/23/90

LATERAL UNDERCLEARANCES

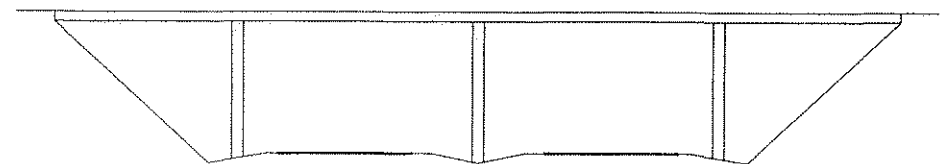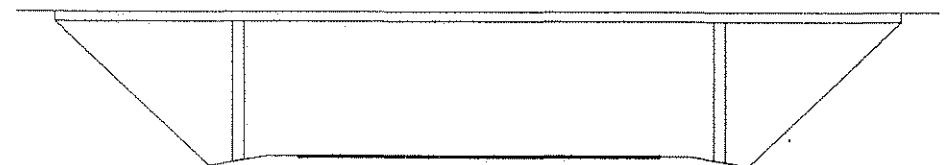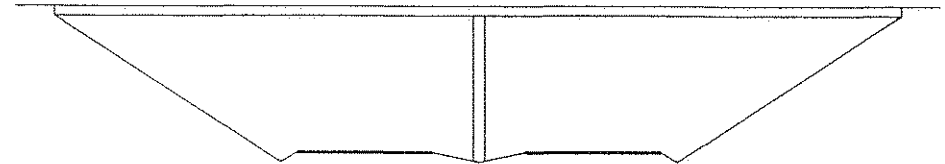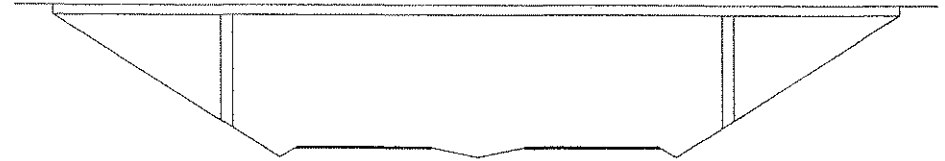





VERTICAL AND LATERAL UNDERCLEARANCE REPORT

HWY UNDER 25A REF PT (MP) 209.211 STR # F-16-DU HWY ON US 6 ML

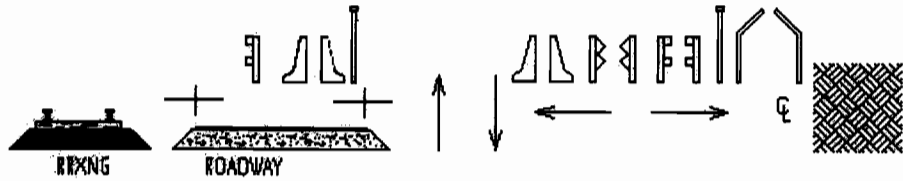

MP ITEM 135 (Direction in which MP is decreasing) MP ITEM 134 (Direction in which MP is increasing)

MAX ~~16'-02"~~ MIN 15'-00" MAX ~~17'-11"~~ MIN 17'-00"
17'-10" *19'-05"*

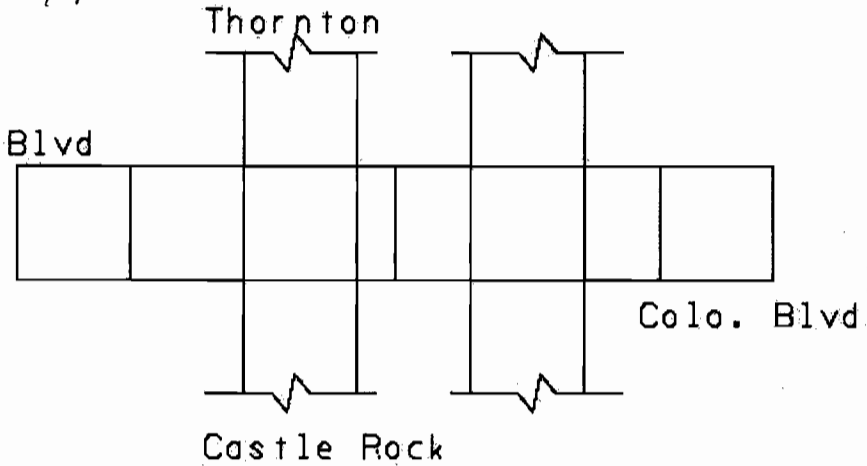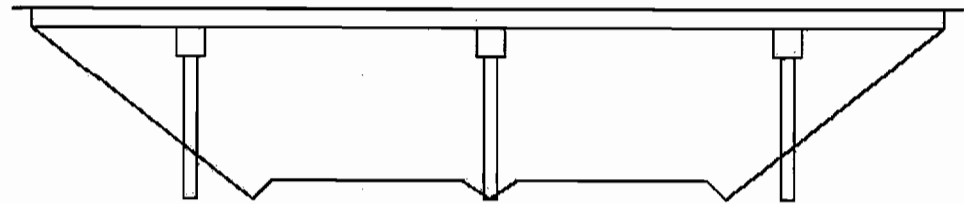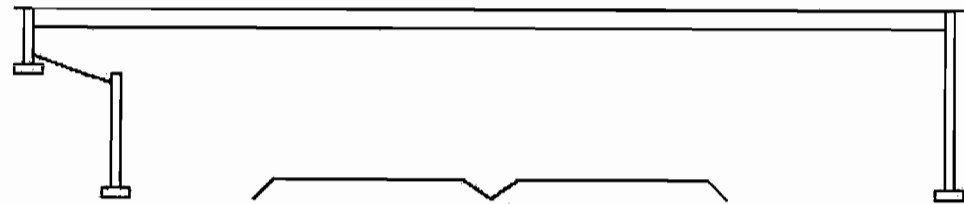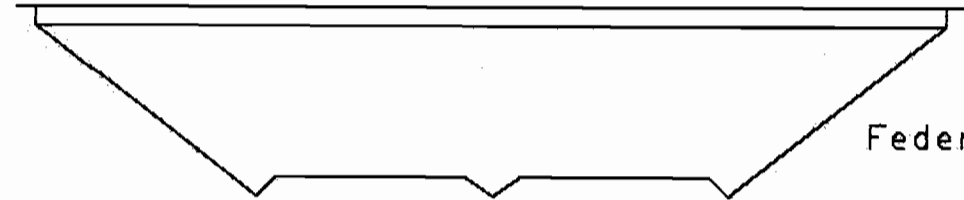

PARABOLIC X
 NON-PARABOLIC _____ HWY NO. US 6 ML

POSTED 15'-02"

OFF SB Ramp

15'-00"	16'-02"	17'-10"	18'-01"	17'-00"	16'-07"	17'-00"	18'-08"	19'-05"	18'-08"	19'-00"	11'-11"
(SB)	(SB)	(SB)	(SB)	(NB)	(NB)	(NB)	(NB)	(NB)	(NB)	(NB)	(NB)

INVENTORY DIRECTION SB/WB or NB/EB
 LOOKING IN DIRECTION OF INCREASING MP

INSPECTORS Clearance Master DATE 10/20/2005

Entered by Tony M

Lateral clearances measured on 7-23-90

6

5'-9"
 3'-4"
 2'-9"
 3'-6"

11/2/2005 11:34:32 PM

STRUCTURE NO. F-16-DU