



FED. ROAD DIV. NO.	DISTRICT	PROJECT NO.	SHEET NO.	TOTAL SHEETS
9	COLO.	U 012-2(3)	43	

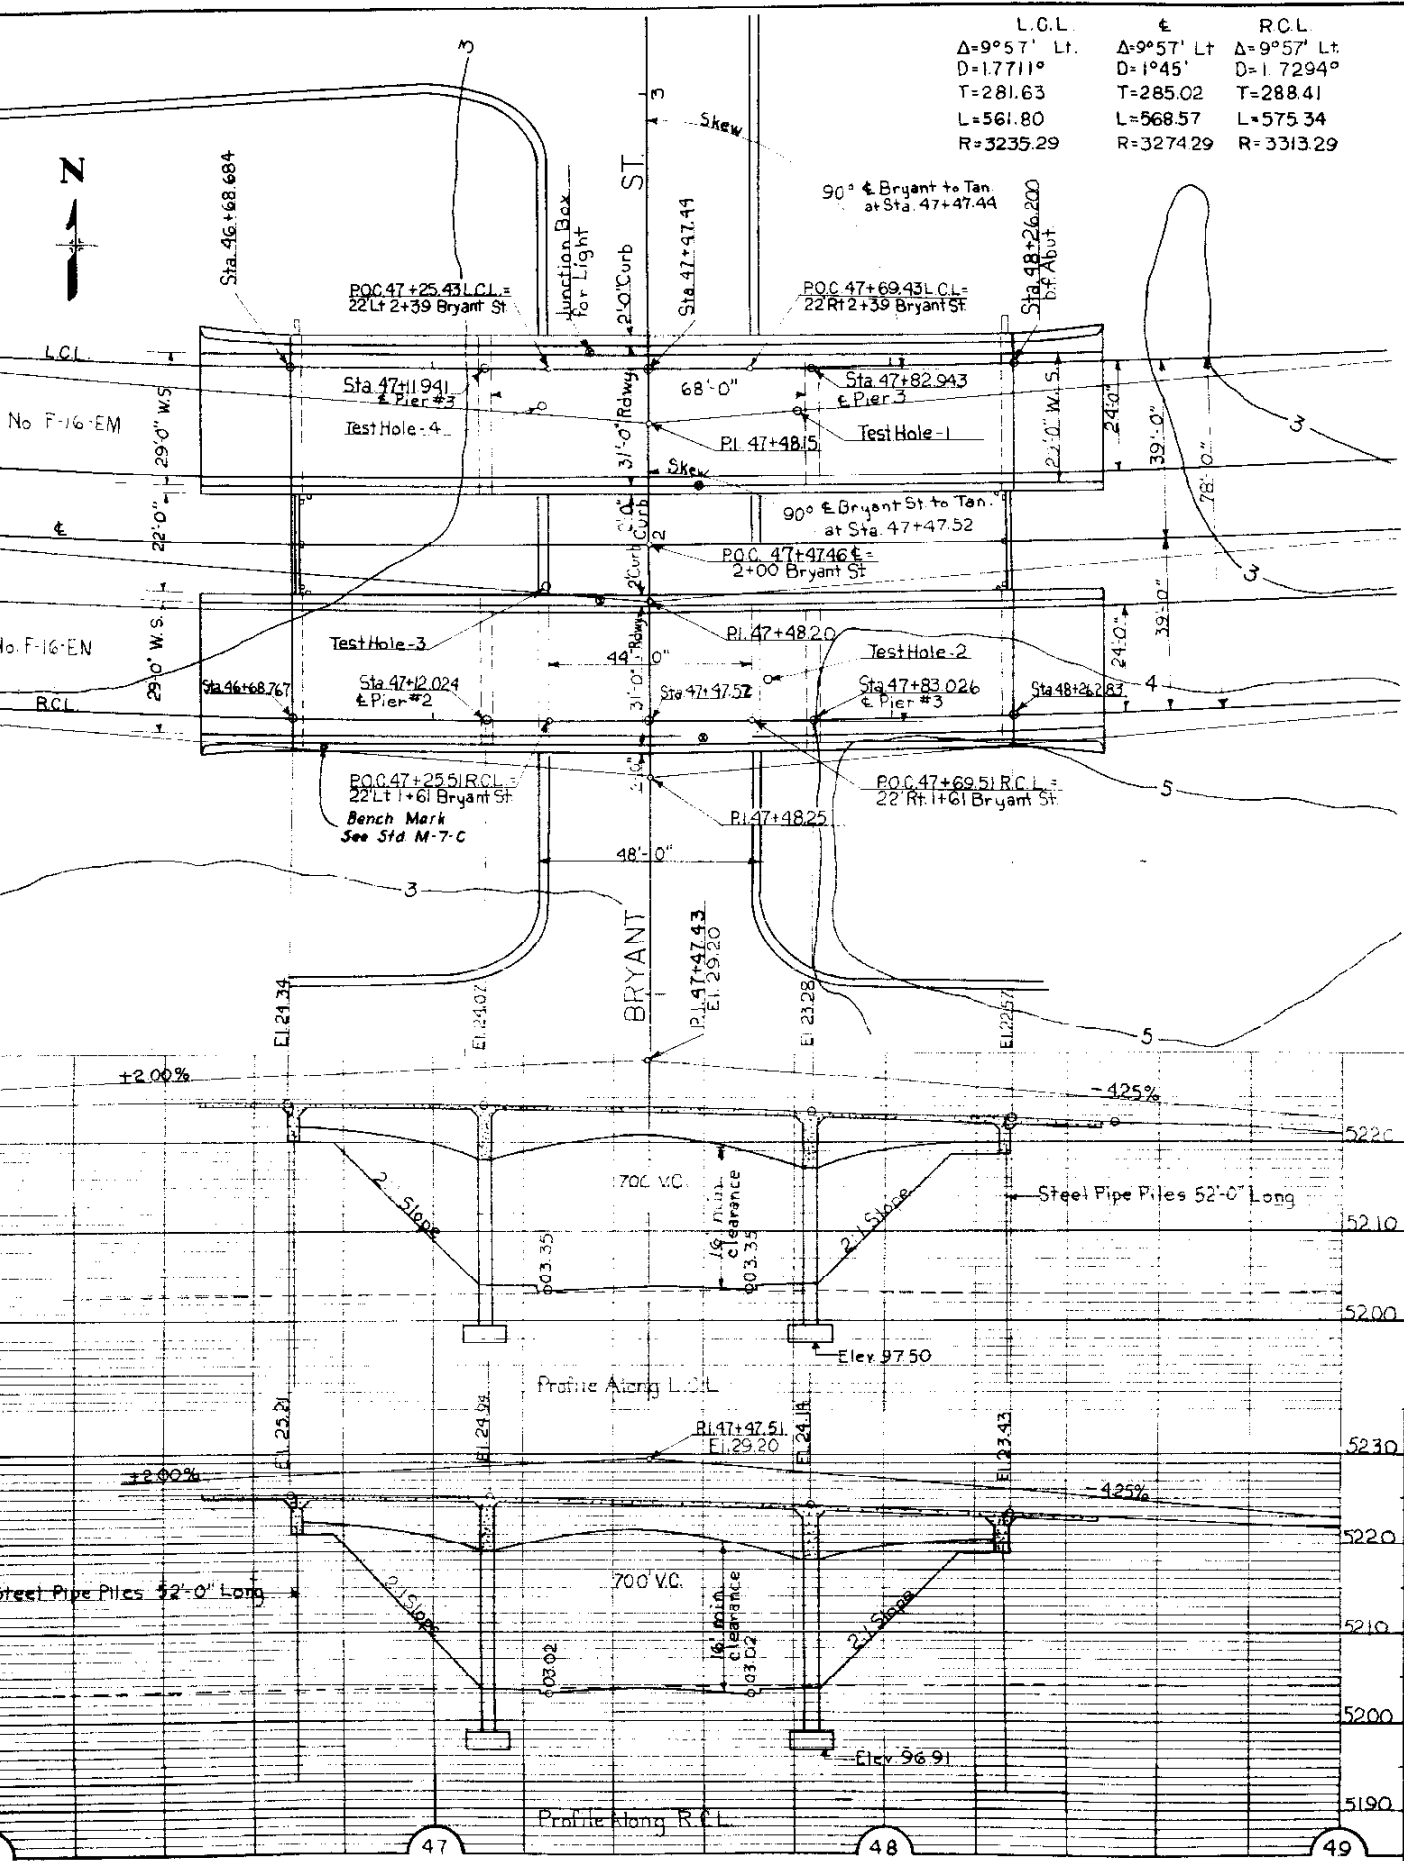

GENERAL LAYOUT

SUMMARY OF QUANTITIES		STRUCTURE F-16-EM						STRUCTURE F-16-EM								
Item	Description	Unit	Super structure	Abut #1 Median	Pier #2	Pier #3	Abut #4	2 Approach Slabs A	Total	Super Structure	Abut #1	Pier #2	Pier #3	Abut #4 Median	2 Approach Slabs A	total
14a	Removal of Bridges	Lump Sum														
14b	Dry Common Excavation (Str.)	Cu. Yards			96	96			192		93	93				186
16a	Structure Backfill (Class I)	Cu. Yards			69	69			138		67	66				133
16c	Mechanical Tamping	Hours			8	7	7		26		4	7	7	8		26
46a	Class A Concrete	Cu. Yards	262.2	22.2	40.1	39.6	13.9	41.0	378.0	261.8	13.6	39.6	39.1	21.9	40.3	376.0
47	Reinforcing Steel (Includes 1% for Overrun)	Lbs.	78380	1290	4725	4660	780	4980	89335	78375	780	4620	4550	1290	4980	89615
18a	Station Yard Overhaul	Sta. Yards														
18b	Yard Mile Overhaul	Yard Mile														
61a	Steel Pipe Piling (10 3/4" O.D. x 100")	Lin. Ft.		208			208		416		208			208		416
60a	Holes to Facilitate Pile Driving	Lin. Ft.		72			60		132		68			63		131
90b	1/4" Electric Conduit with Junction Boxes	Lin. Ft.	248						248	248						248
*	1/2" Expansion Joint Material Type III	Sq. Ft.		4			4		8		4			4		8
31a	Steel Railings	Lin. Ft.							366							366


* To be included in the bid price of Class "A" Concrete. Expansion joint material shall be in accordance with A.S.H.O. Spec. M153-54 and of the Type shown.
 Δ Quantities for two Approach Slabs are not included in total.

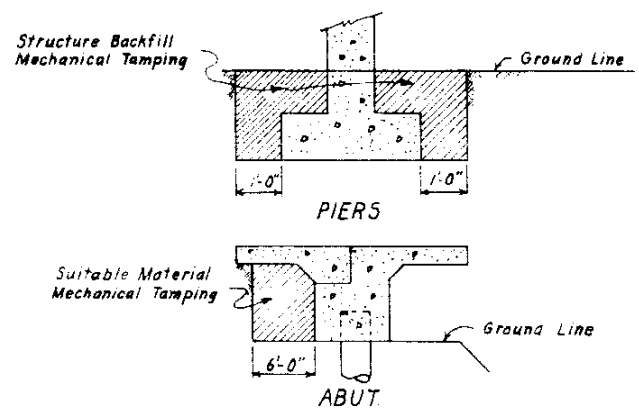

STRUCTURE BACKFILL & MECHANICAL TAMPING DIAGRAMS

All material that is to be mechanically tamped shall be placed in horizontal layers not more than 6 inches in depth and tamped before the next layer is placed.

Note: Earth fill at abutments shall be made to bottom of cap before driving piles

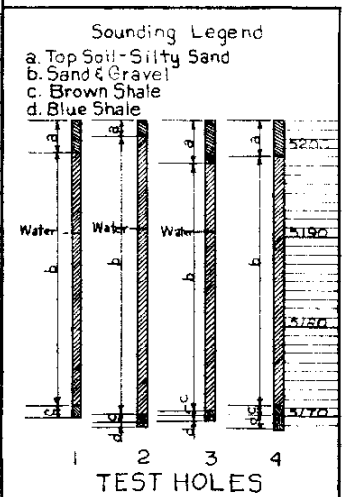

TEST HOLES

GENERAL NOTES

ALL WORK SHALL BE DONE ACCORDING TO THE STANDARD SPECIFICATIONS OF THE COLORADO DEPARTMENT OF HIGHWAYS APPLICABLE TO THE PROJECT.
 ALL CONCRETE SHALL BE CLASS "A" AND AIR ENTRAINMENT AS SPECIFIED.
 ALL CONCRETE SURFACES EXPOSED TO NORMAL VIEW BY HIGHWAY TRAFFIC, INCLUDING WORK SURFACES, SHALL RECEIVE CLASS "2" SURFACE FINISH.
 CONCRETE GIRDERS, FLOOR SLABS, AND CURBS SHALL BE FORMED MONOLITHICALLY.
 FORMS FOR CONCRETE SURFACES EXPOSED IN THE FINISHED WORK SHALL BE CONSTRUCTED OF SHIP LAP OR TONGUE AND GROOVE LUMBER 3" S UNLESS FACED WITH PANEL BOARD.
 FOOTINGS IN ROCK SHALL BE POURED OUT TO ROCK AND NOT FORMED.
 SOUNDINGS AND DEPTH OF FOOTING SHOWN ARE IN ACCORDANCE WITH THE BEST AVAILABLE DATA AND WHEN DIFFERENT CONDITIONS ARE ENCOUNTERED THE BRIDGE ENGINEER WILL IN SPECT AND DETERMINE IF REVISION IS NECESSARY.
 ALL REINFORCING STEEL SHALL CONFORM TO ASTM SPECIFICATION A 305-50T OR THE LATEST REVISION THEREOF, AND SHALL BE INTERMEDIATE GRADE STEEL OF A DEFORMED TYPE. EACH BAR SHALL BE TAGGED WITH THE NUMBER DESIGNATION AND THE STATION NUMBER OF THE PROJECT.
 SECONDARY BARS WHEN SPICED SHALL LAP 20 DIAMETERS OF THE BAR. DIMENSIONS FOR REINFORCING STEEL NOT SHOWN AS CLEAR SHALL BE TO THE CENTER LINE OF THE BAR.
 ALL STRUCTURAL STEEL SHALL BE PAINTED ONE SHOP COAT OF ZINC CHROMATE AND TWO FIELD COATS OF ALUMINUM, UNLESS OTHERWISE NOTED. EXCEPT THE UNEXPOSED PORTION OF STEEL PILING NEED NOT BE PAINTED.
 HANDRAIL BOLTS SHALL HAVE HEX HEADS, NUTS, AND LOCK WASHERS UNLESS OTHERWISE SPECIFIED AND ALL BOLTS EXCEPT AS NOTED ARE 1/2" DIA. AND SHALL BE POWER DRIVEN WHEN TREATED TIMBER OR PILING IS SHOWN ON THE DRAWING. THE PRESERVATIVE FOR TREATMENT SHALL BE CREOSOTE OIL.
 WHEN EXCAVATING FOR FOOTINGS THE FINAL ONE FOOT IN DEPTH SHALL BE DONE BY HAND LABOR METHODS.
 PRIMARY BARS SHALL NOT BE SPICED EXCEPT BY PERMISSION OF THE ENGINEER. WHEN PRIMARY BARS ARE SPICED THEY SHALL LAP 36 DIAMETERS FOR GIRDER AND NEAR TOP OF DEAMTS AND GIRDERS HAVING MORE THAN 12 INCHES OF CONCRETE UNDER THE BARS AND 20 DIAMETERS FOR BARS NEAR BOTTOM OF MEMBERS.

LOADING DATA

LIVE LOAD: A A S.H.O. 1420-S16-443
 DEAD LOAD ASSUMES 15 LBS PER SQ. FT. ADDITIONAL WEARING SURFACE WHICH INCLUDES THE 1/2 INCH CONCRETE MONOLITHIC WEARING SURFACE SHOWN.
 DESIGNING DATA
 A A S.H.O. 1953 UNIT STRESSES EXCEPT AS NOTED.
 Reinforcing Steel fs 20000 lbs per sq in.
 Structural Steel fs 18000 lbs per sq in.
 fc 1200 lbs per sq in.
 n 10

COLORADO
 DEPARTMENT OF HIGHWAYS
 2-3 SPANS (42'71'42") CONCRETE SLAB & GIRDER BRIDGES. 31'-0" RDWY
 GENERAL LAYOUT, SUMMARY OF QUANTITIES & NOTES
 Over Bryant St on West 6th Ave.
 Sta. 46+
 In Denver Sec. 8 T. 45 R. 66W
 Designed by G.H.W. Approved by *R.W. Newhall*
 Made by F.L. Bridge Engineer
 Checked by Date: *May 12, 1956*

STRUCTURE NO F-16-EM Sta 46+68.68 to 48+26.20
 STRUCTURE NO F-16-EM Sta 46+68.77 to 48+26.28

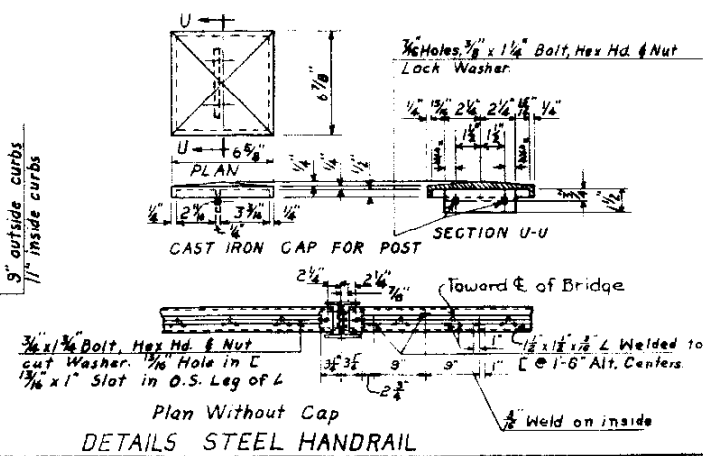
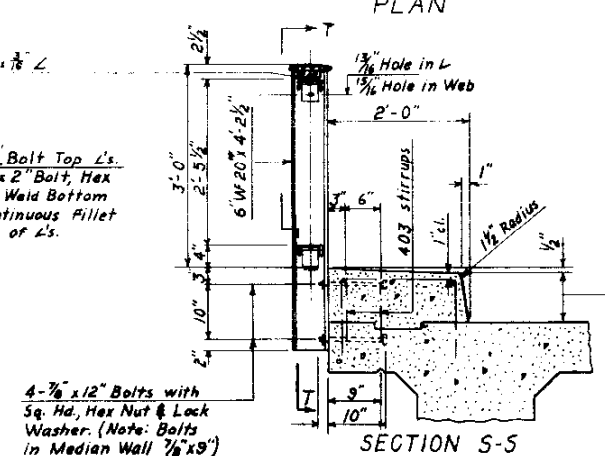
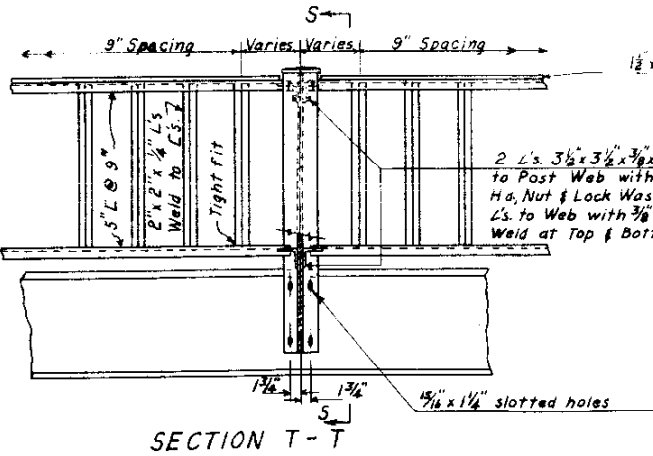
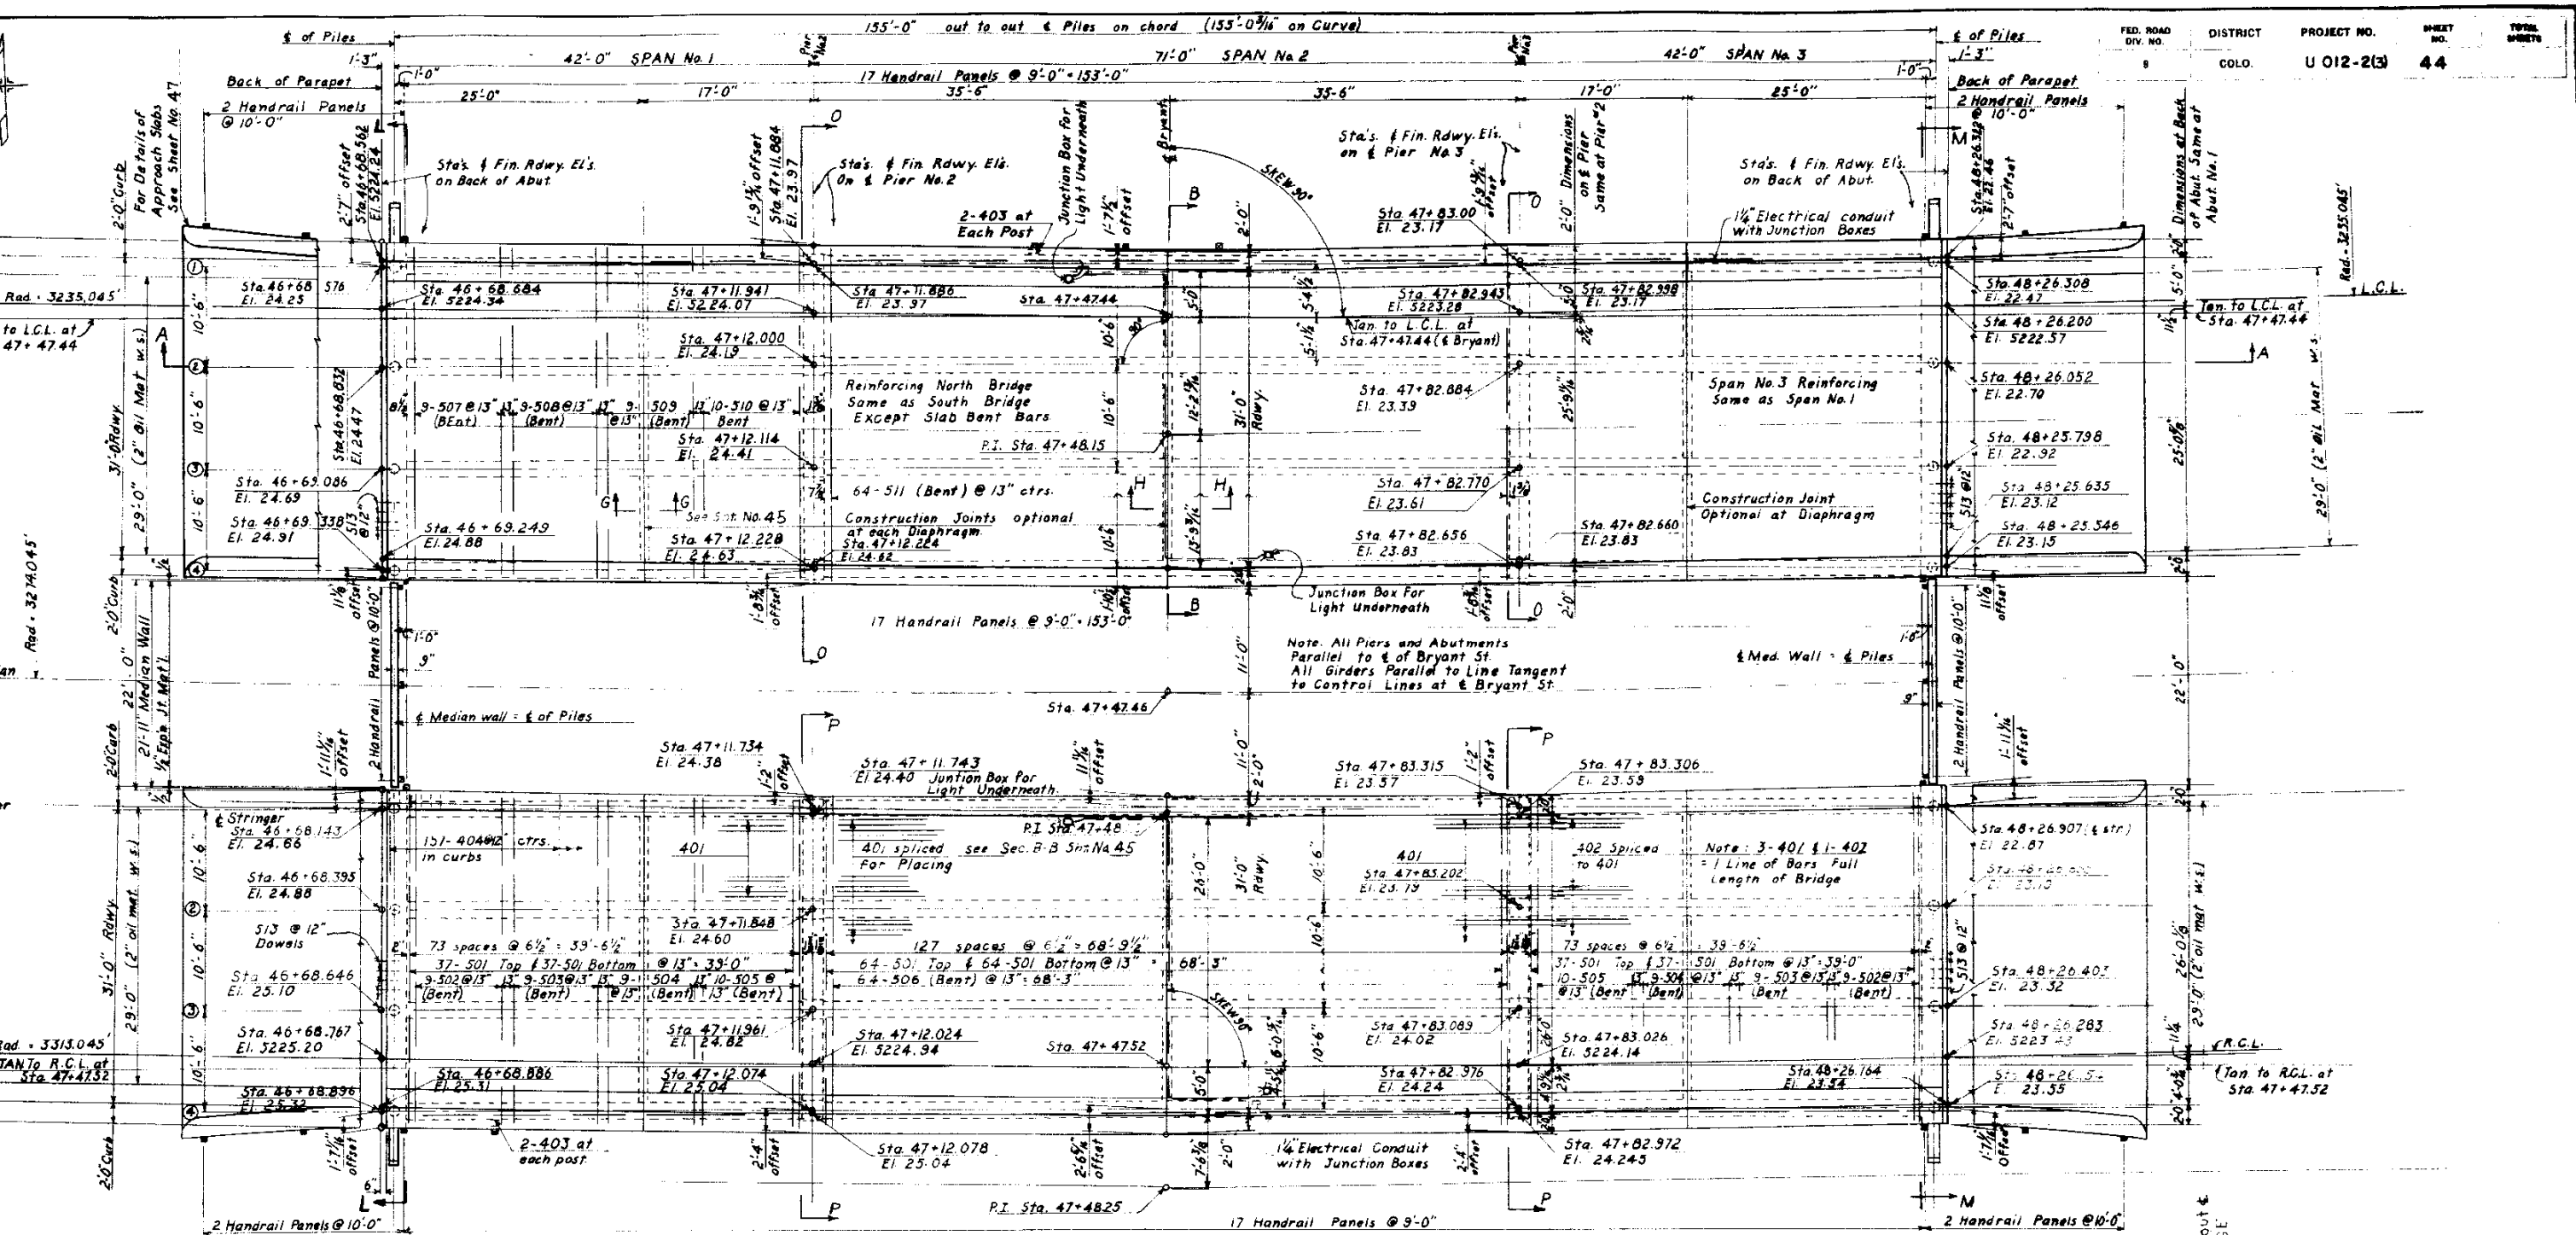



Table with 2 columns: NORTH EDGE OF NORTH BRIDGE, SOUTH EDGE OF NORTH BRIDGE, NORTH EDGE OF SOUTH BRIDGE, SOUTH EDGE OF SOUTH BRIDGE. Rows show dimensions for 7 spaces @ 10'-0" = 70'-0".

COLORADO DEPARTMENT OF HIGHWAYS 2-3 SPANS (42' 71' 42') CONCRETE SLAB & GIRDER BRIDGES 31'-0" ROADWAY DETAIL OF SUPERSTRUCTURE Over Bryant St. on West 67th Ave. Sta. 46.7




STRUCTURE NO. F-16-EM. Sta. 46+68.88 to 48+26.20 STRUCTURE NO. F-16-EM. Sta. 46+68.77 to 48+26.26

FED. ROAD DIV. NO.	DISTRICT	PROJECT NO.	SHEET NO.	TOTAL SHEETS
9	COLO.	U 012-2(3)	45	





POINT	1	2	3	4	5	6	7	8	9	0	1	2	3	4	5	6	7	8	9	0	1	2	3	4	5	6	7	8	9		
FOR DEAD LOAD (NOT IN ELEVATIONS BELOW) FEET:	-0.000	-0.001	-0.004	-0.007	-0.011	-0.013	-0.014	-0.011	-0.006	0.004	0.024	0.032	0.041	0.045	0.041	0.032	0.024	0.004	-0.006	-0.011	-0.019	-0.013	-0.011	-0.007	-0.004	-0.001	-0.000				
NORTH LINE BRIDGE	24.467	24.446	24.423	24.399	24.373	24.346	24.317	24.286	24.254	24.221	24.186	24.125	24.059	23.990	23.917	23.839	23.757	23.671	23.581	23.486	23.388	23.262	23.197	23.131	23.063	22.993	22.922	22.849	22.774	22.699	
SOUTH LINE BRIDGE	24.879	24.857	24.835	24.810	24.785	24.757	24.728	24.698	24.666	24.632	24.597	24.535	24.470	24.400	24.326	24.248	24.166	24.079	23.988	23.893	23.794	23.731	23.667	23.601	23.534	23.465	23.395	23.323	23.250	23.175	23.098
FROM TOP OF 2" OIL W.S. TO BOTTOM OF GIRDER	2'-8 1/4"	2'-9 3/8"	2'-11 7/8"	3'-2 7/8"	3'-6 3/8"	3'-11 1/4"	4'-5"	4'-11 3/4"	5'-7 1/8"	6'-4"	5'-2 7/16"	4'-4 7/16"	3'-8 9/16"	3'-8 9/16"	3'-4 1/2"	3'-3"	3'-4 1/2"	3'-8 1/16"	4'-4 3/16"	5'-2 1/16"	6'-4"	5'-7 7/16"	4'-11 1/4"	4'-5"	3'-11 1/4"	3'-6 3/8"	3'-2 7/8"	2'-11 1/8"	2'-9 3/8"	2'-8 1/4"	

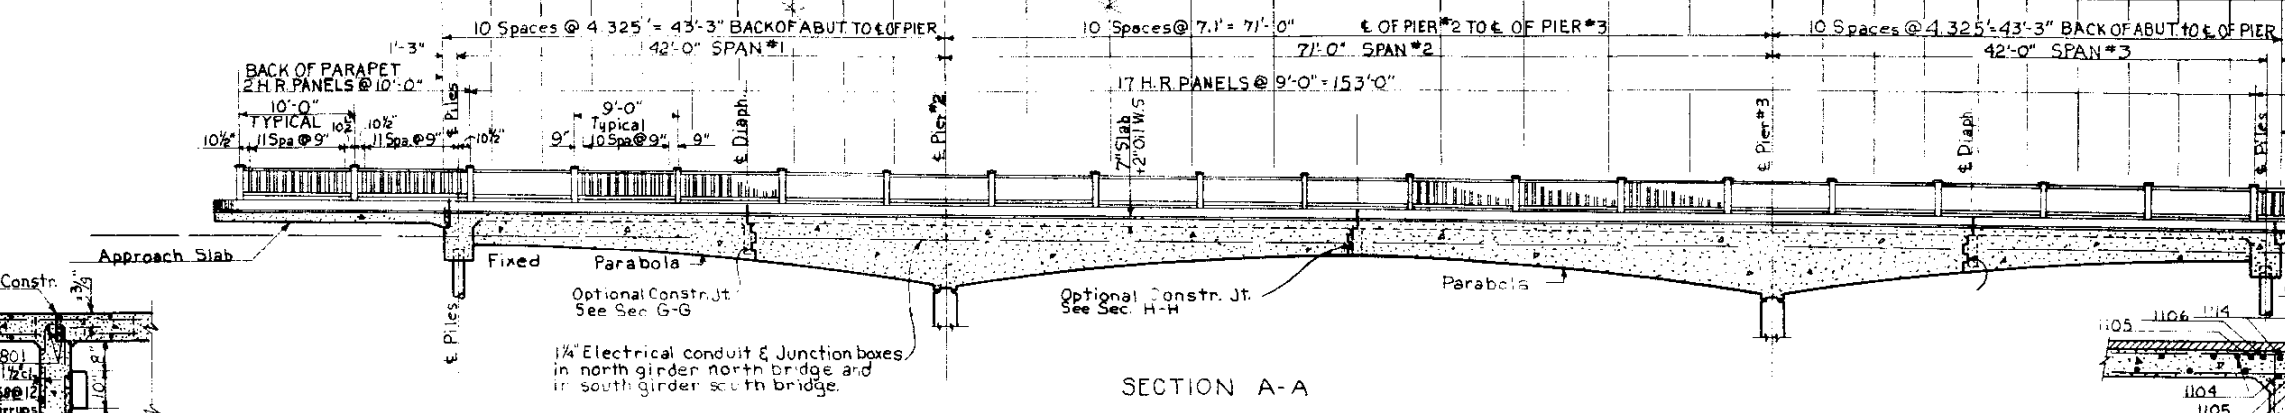

ALL REINFORCING DIMENSIONS TO ϵ BAR UNLESS MARKED "CL" CLEAR

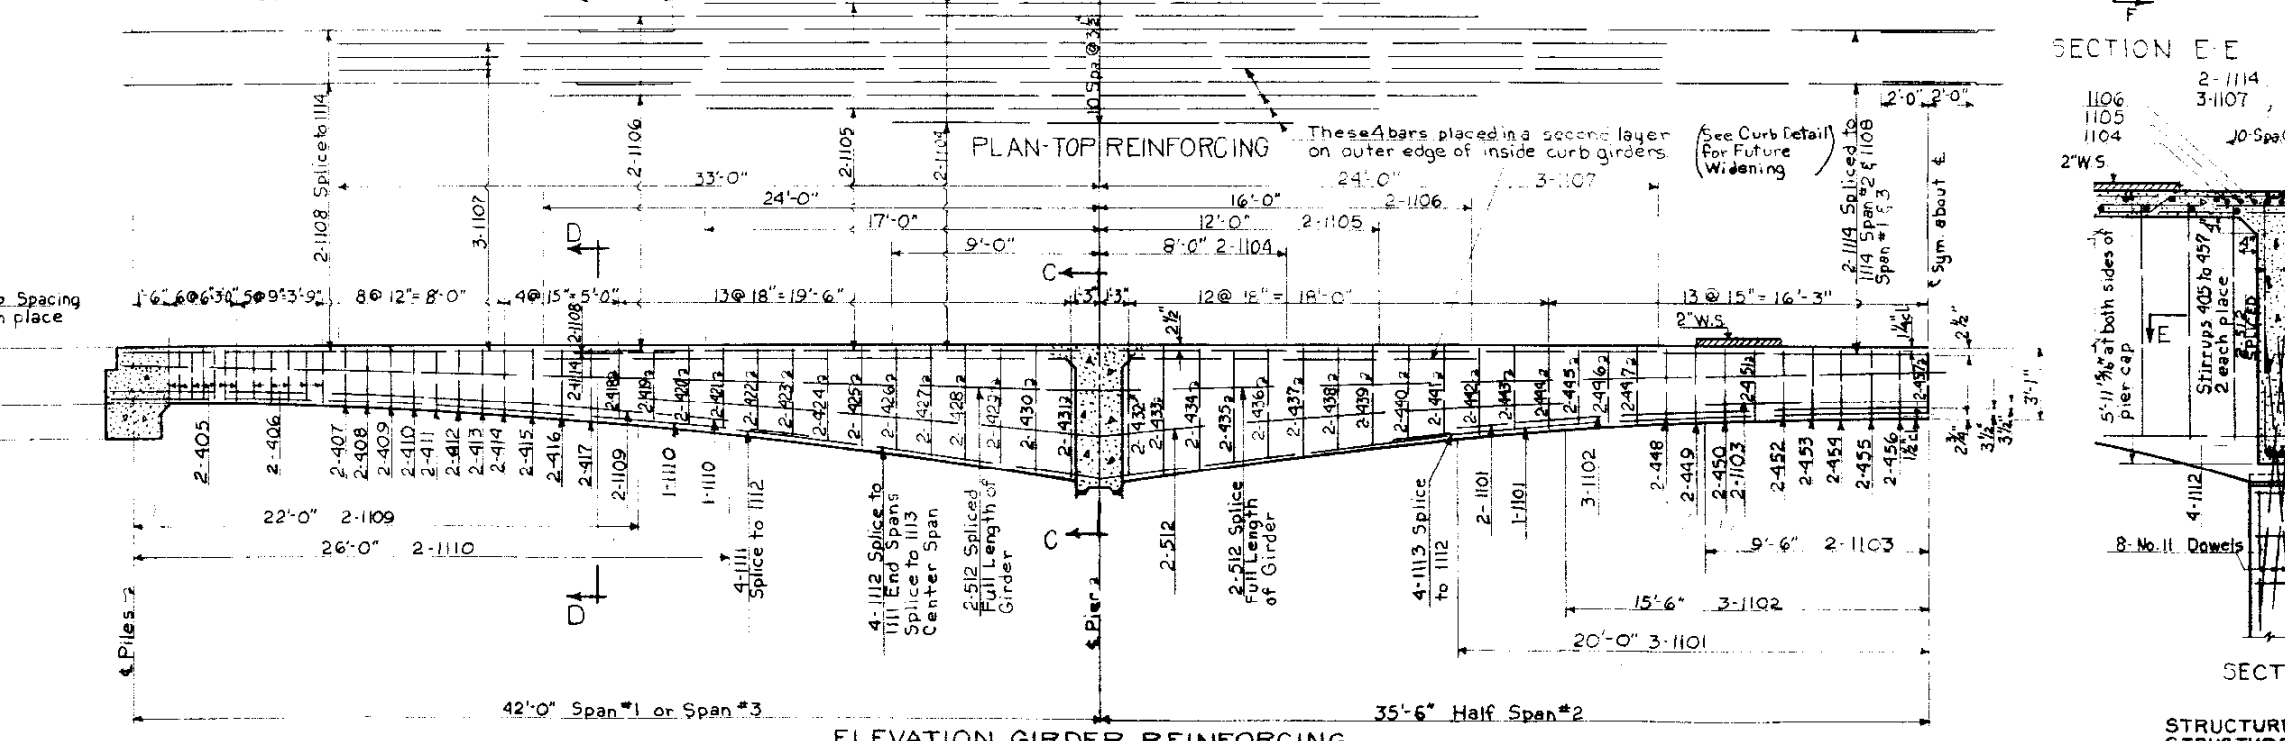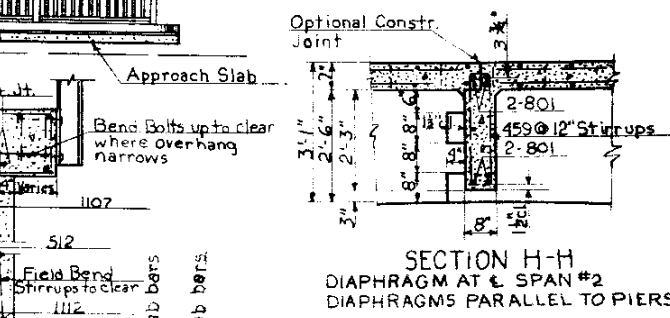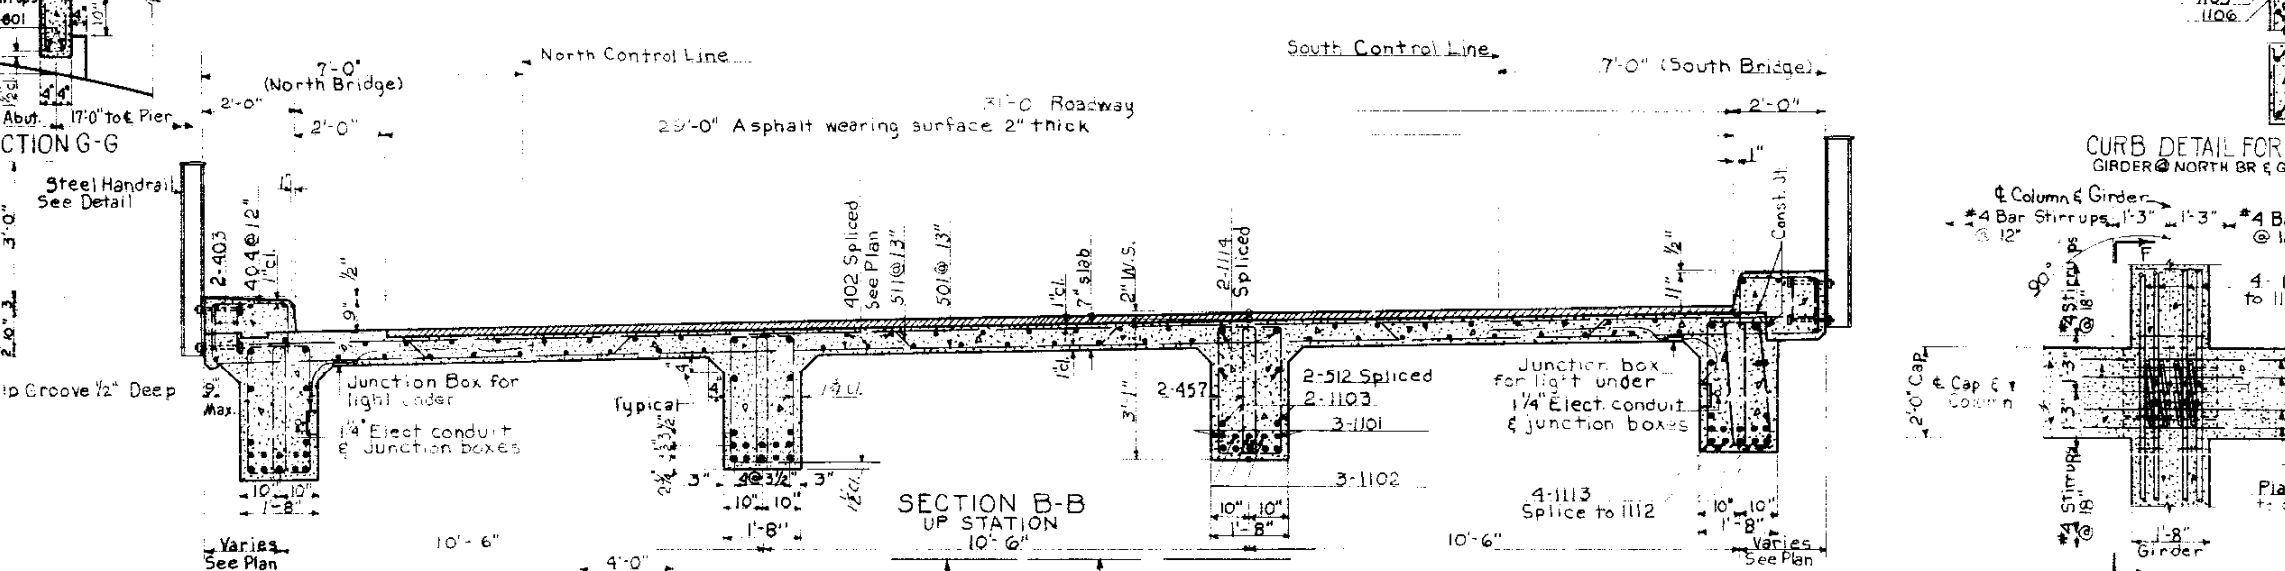


CURB DETAIL FOR FUTURE WIDENING
GIRDER @ NORTH BR & GIRDER @ SOUTH BR.

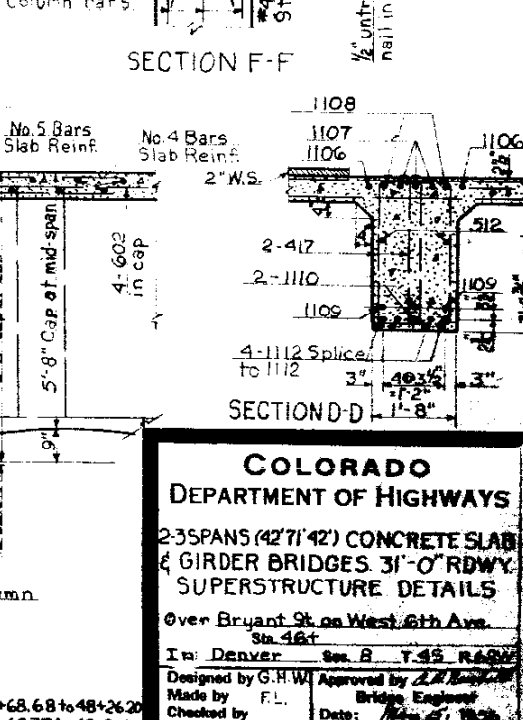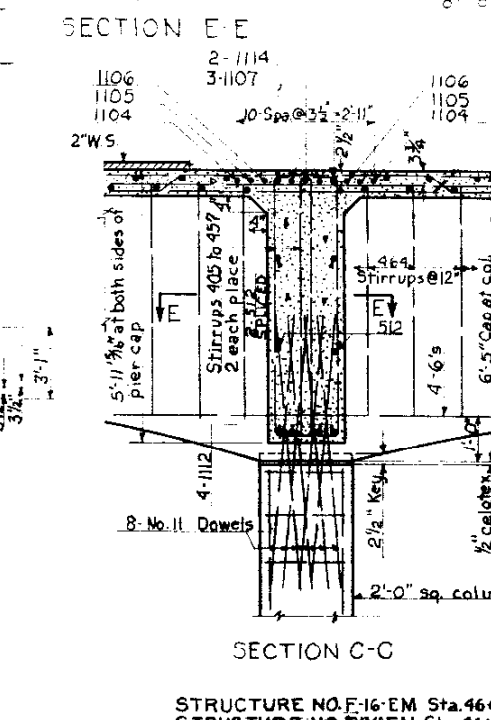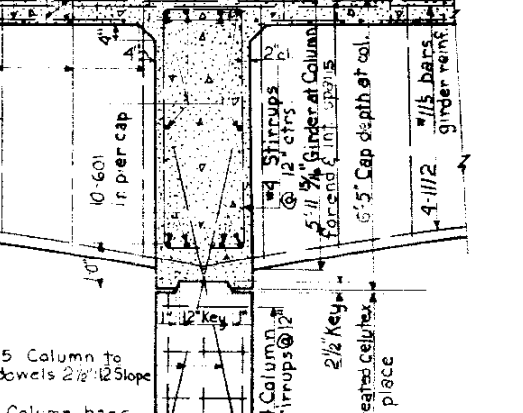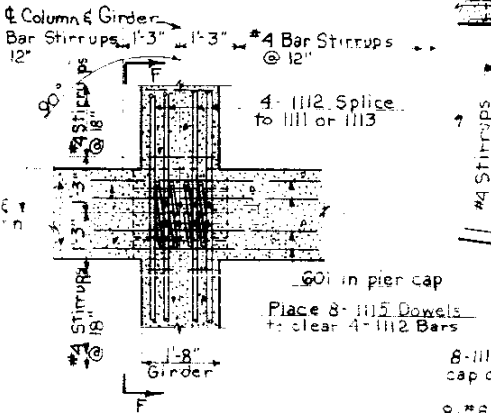


COLORADO DEPARTMENT OF HIGHWAYS
 2-3 SPANS (42'7" 42') CONCRETE SLAB & GIRDER BRIDGES 31'-0" RDWY. SUPERSTRUCTURE DETAILS
 Over Bryant St on West 6th Ave. Sta. 46+
 In Denver See B T-45 R-49
 Designed by G.H.W. Approved by J.L. RAGAN
 Made by F.L. Bridge Engineer
 Checked by Date: 12/27/53


STRUCTURE NO. F-16-EM Sta. 46+68.68 to 48+26.20
 STRUCTURE NO. B-4-EN Sta. 46+68.77 to 48+26.28

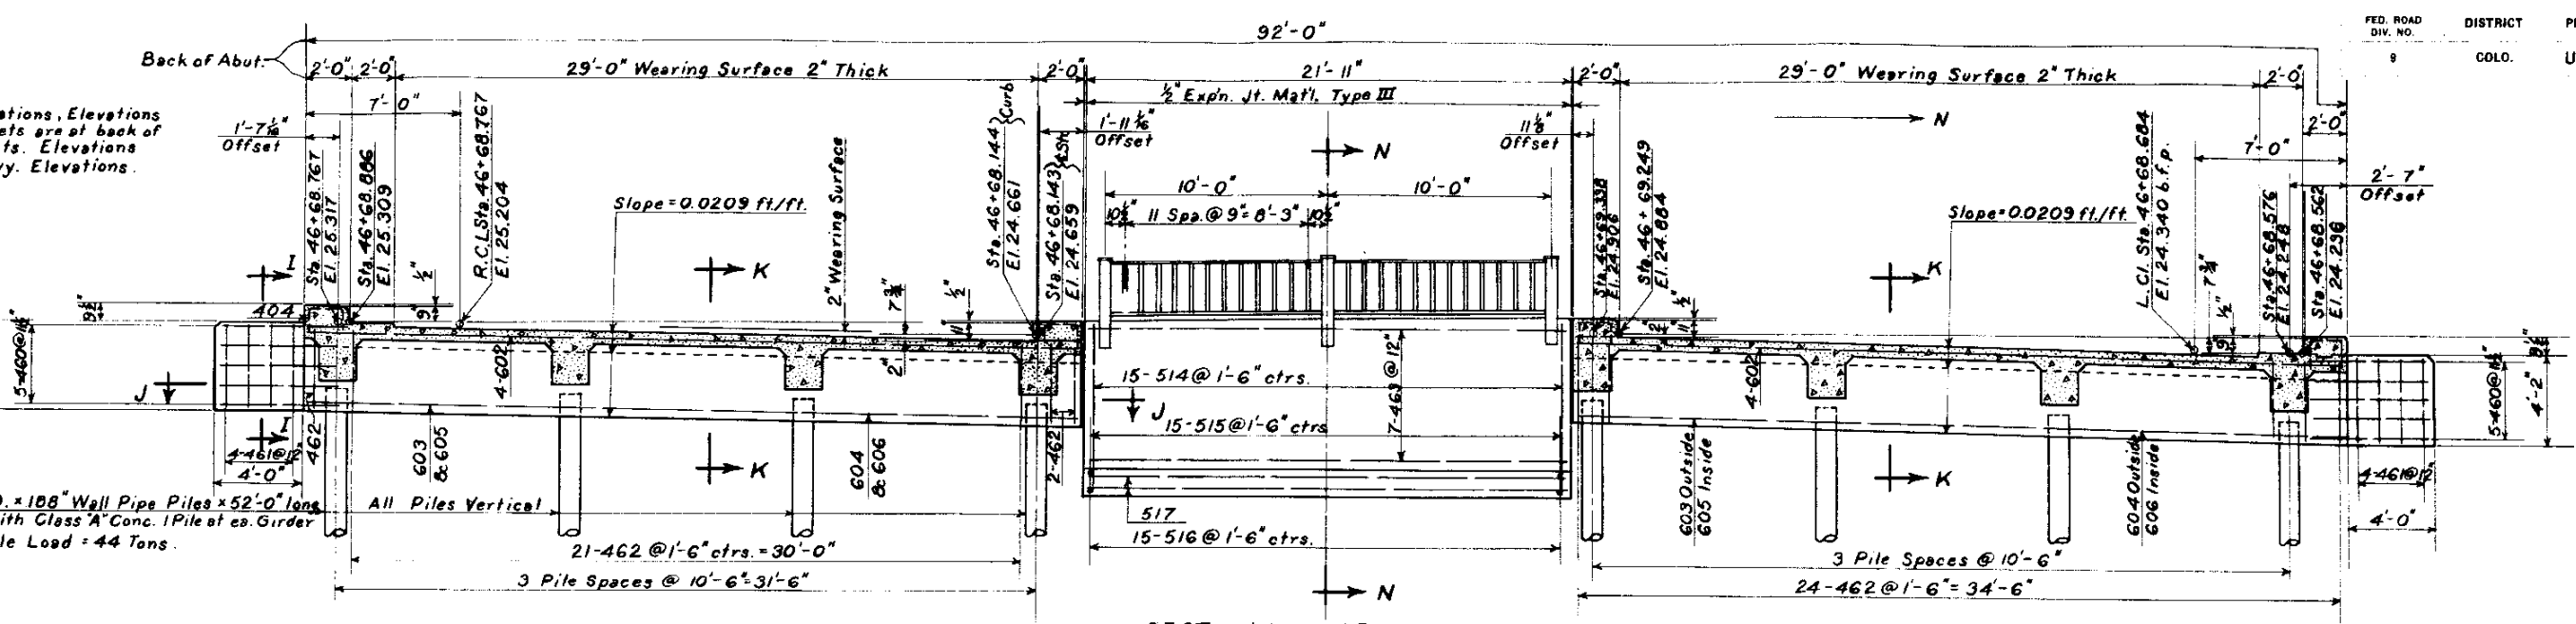


SECTION L-L ABUT. NO. 1

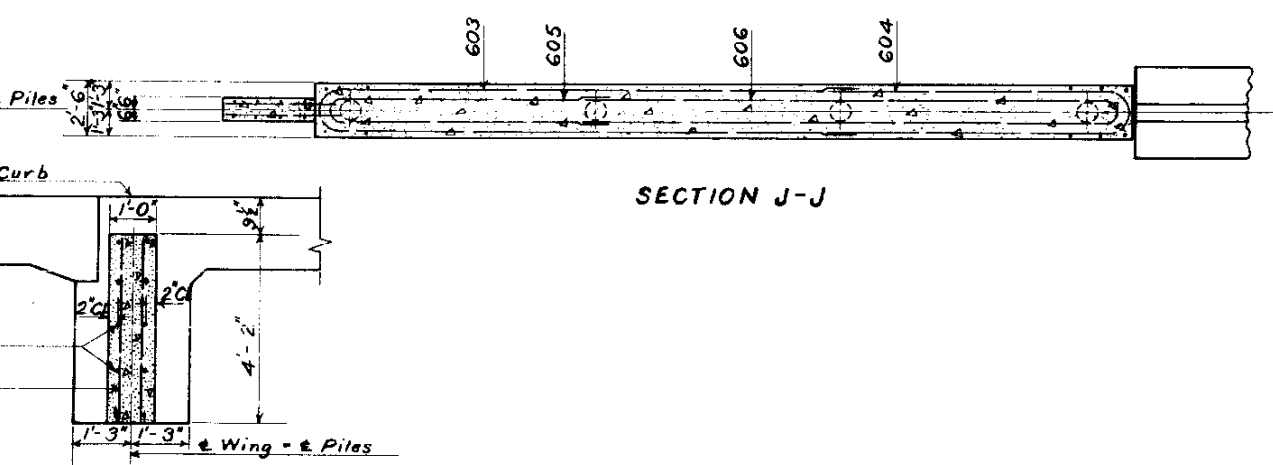


SECTION J-J

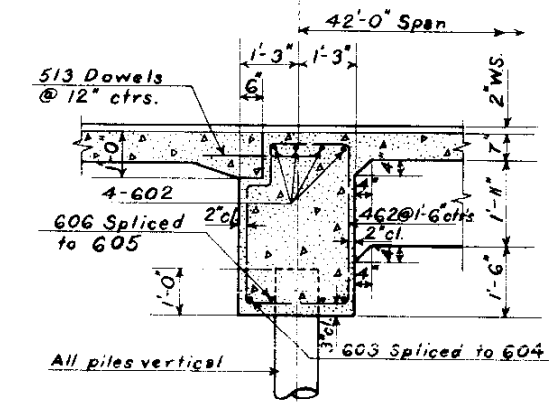

SECTION K-K

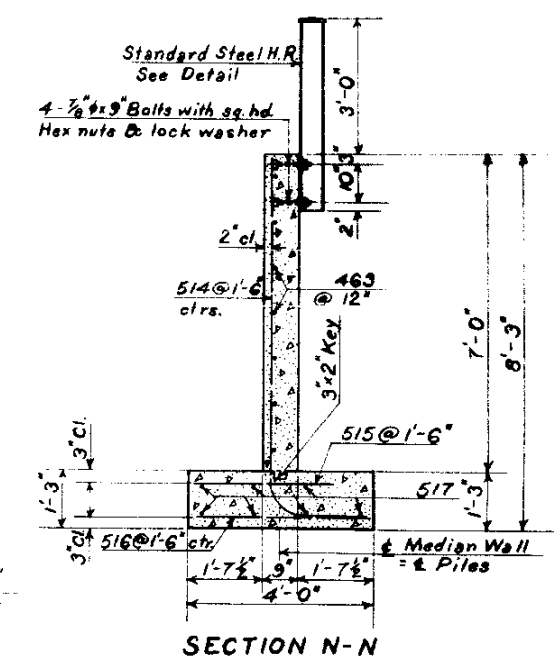


SECTION N-N

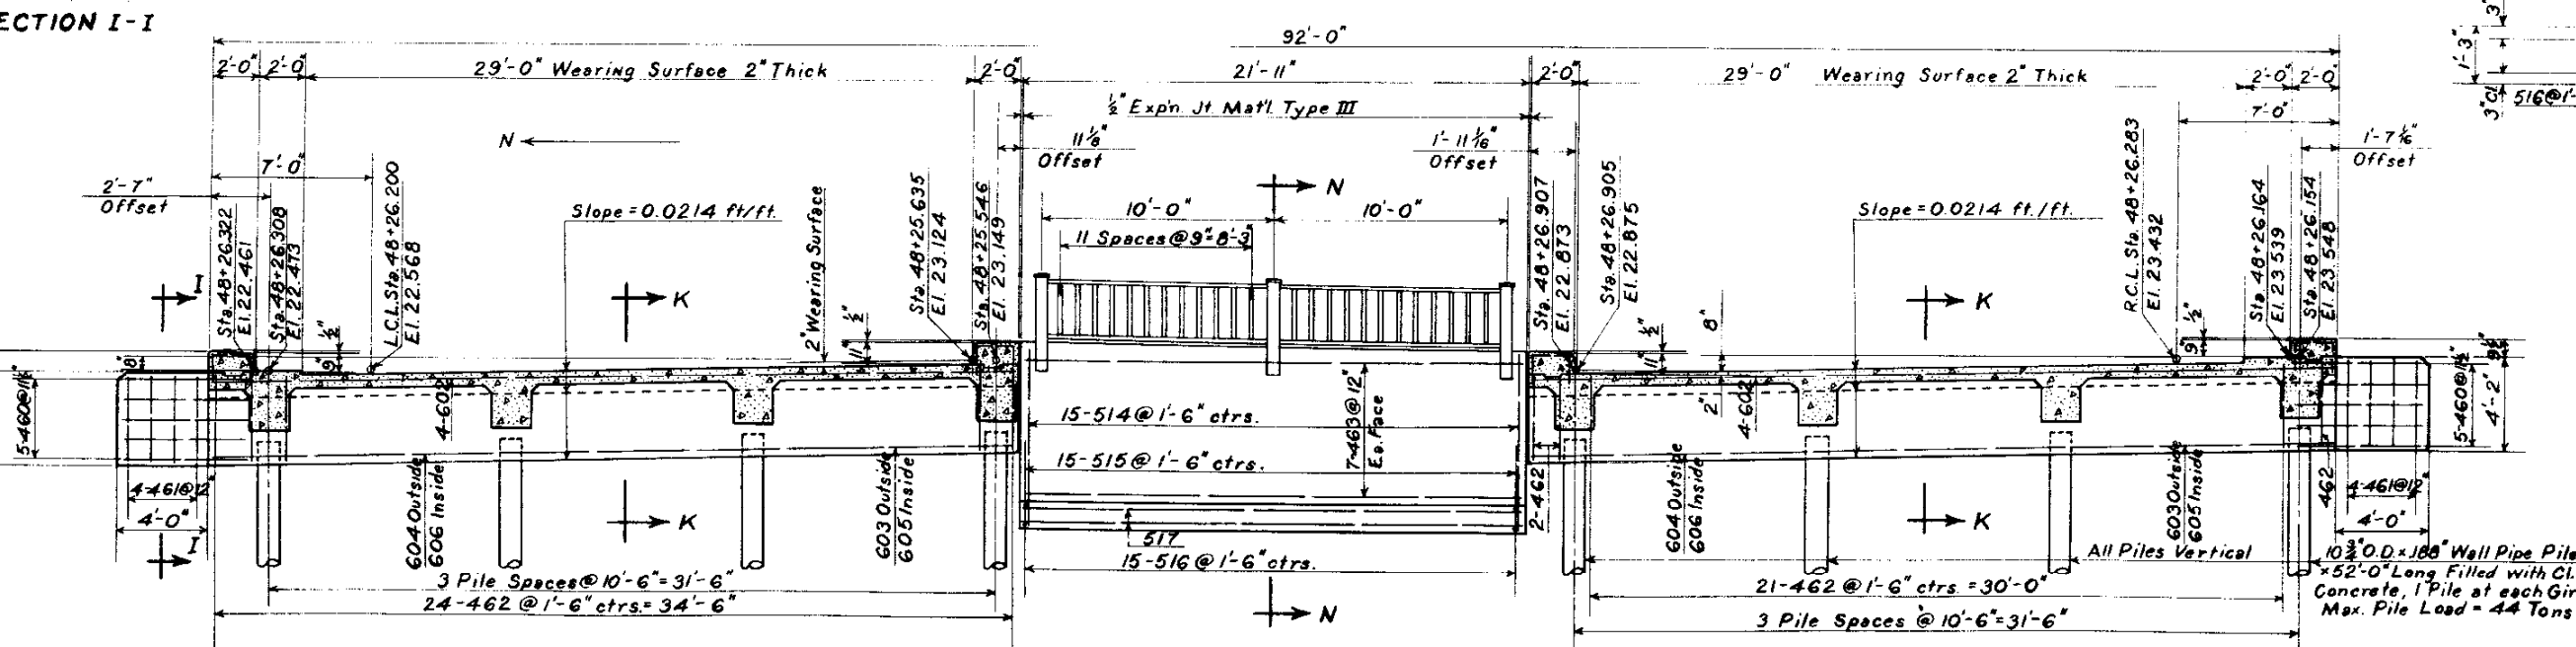


SECTION M-M ABUT. NO. 4

COLORADO
 DEPARTMENT OF HIGHWAYS
 3 SPAN CONG. GIRDER (42', 71', 42')
 31'-0" RDWY.
 DETAILS OF ABUTMENTS
 Over BRYANT ST.
 Sta. 46+
 In Denver Sec. 6 T. 43 R. 60W
 Designed by G.H.W. Approved by Z.H. Neuharth
 Made by F.L. Bridge Engineer
 Checked by Date: May 15, 1956


STRUCTURE NO. F-16-EN Sta. 46+68.77 to 46+262
 STRUCTURE NO. F-16-EN Sta. 46+68.77 to 46+262

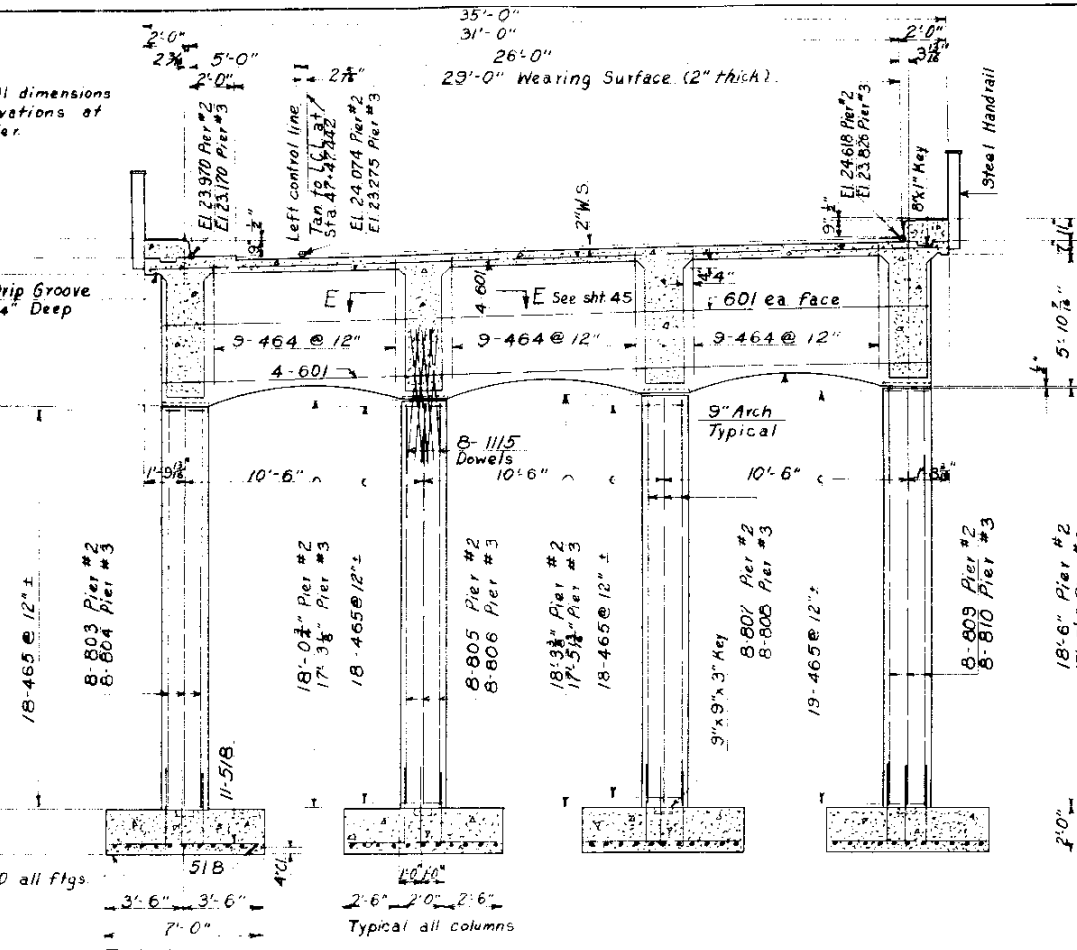


SECTION O-O
Elevation Pier #2 & Pier #3 North Bridge Up Station
Maximum soil pressure = 30 Tons per square foot

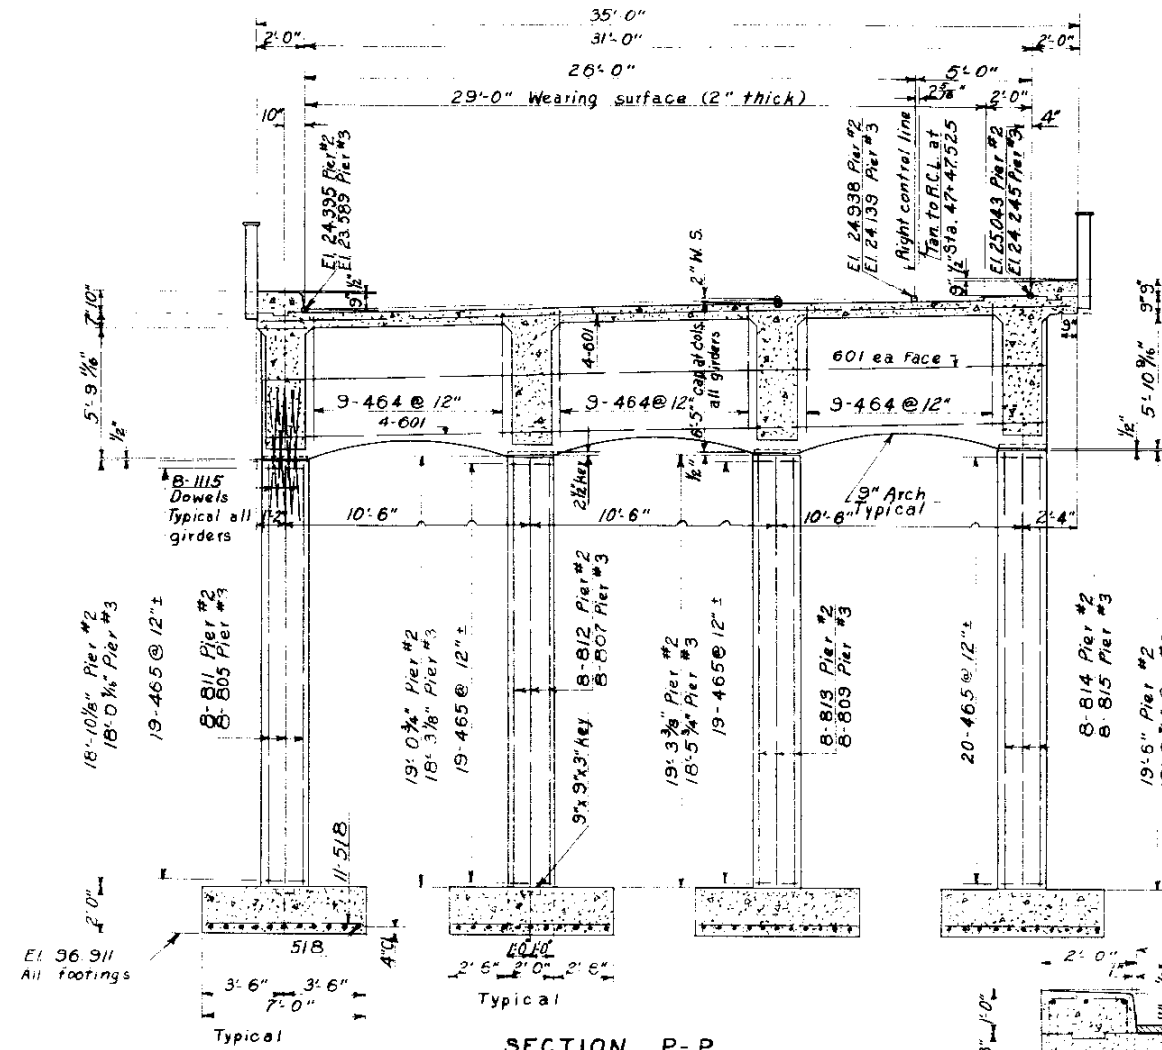


SECTION P-P
Elevation Pier #2 & Pier #3 South Bridge, Up Station
Maximum soil pressure = 3.0 Tons per square foot

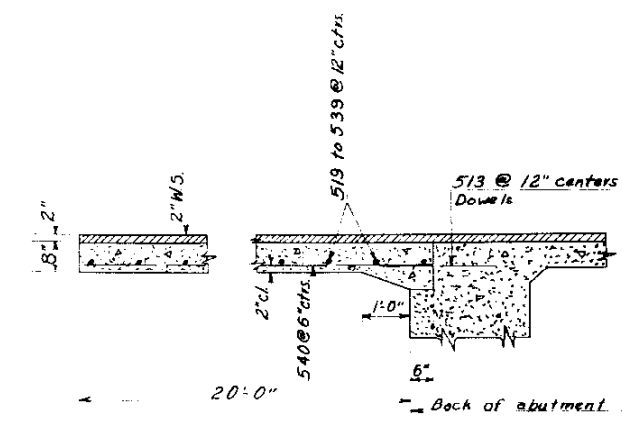


SECTION R-R

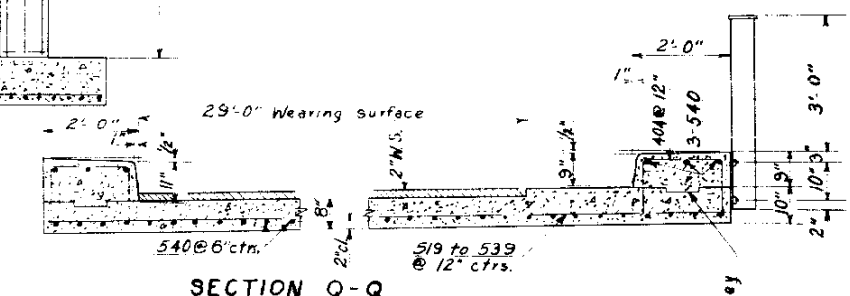


SECTION Q-Q

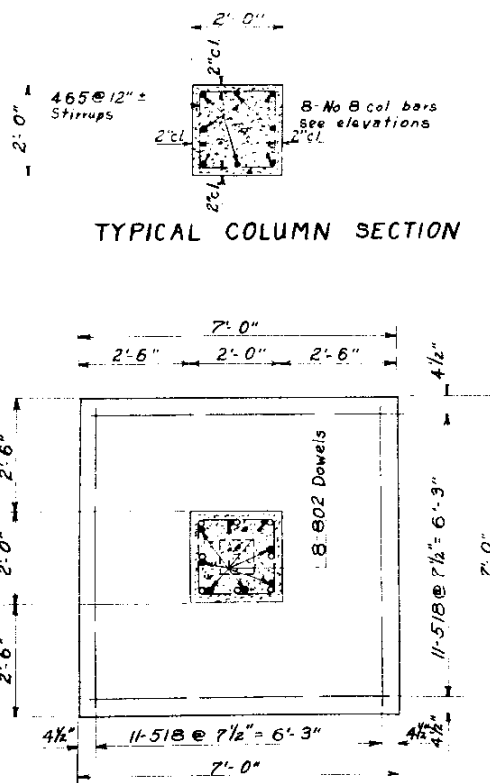

TYPICAL COLUMN SECTION

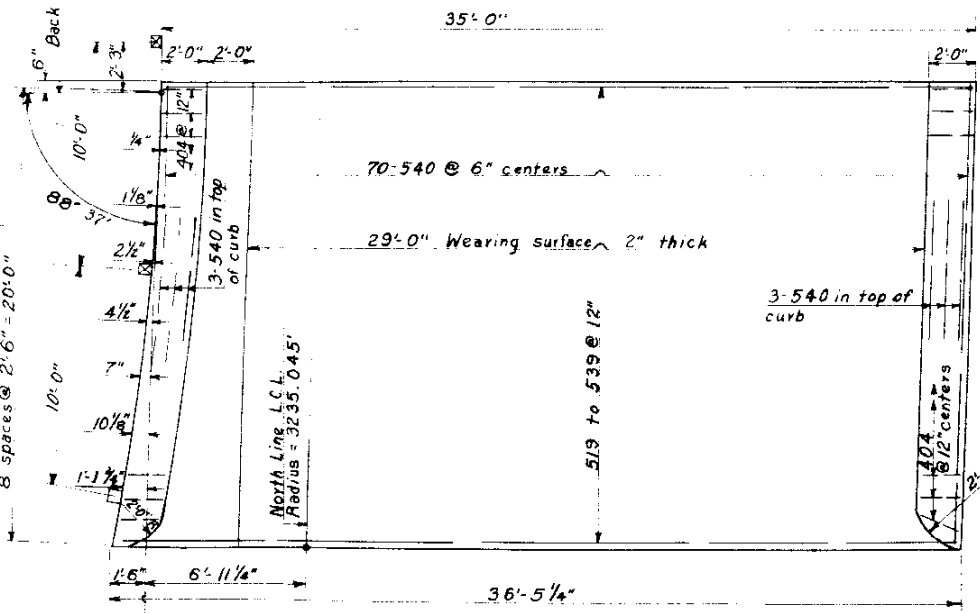

NORTH BRIDGE APPROACH SLAB AT ABUTMENT NO.1
Approach slab at Abutment No. 4 opposite hand

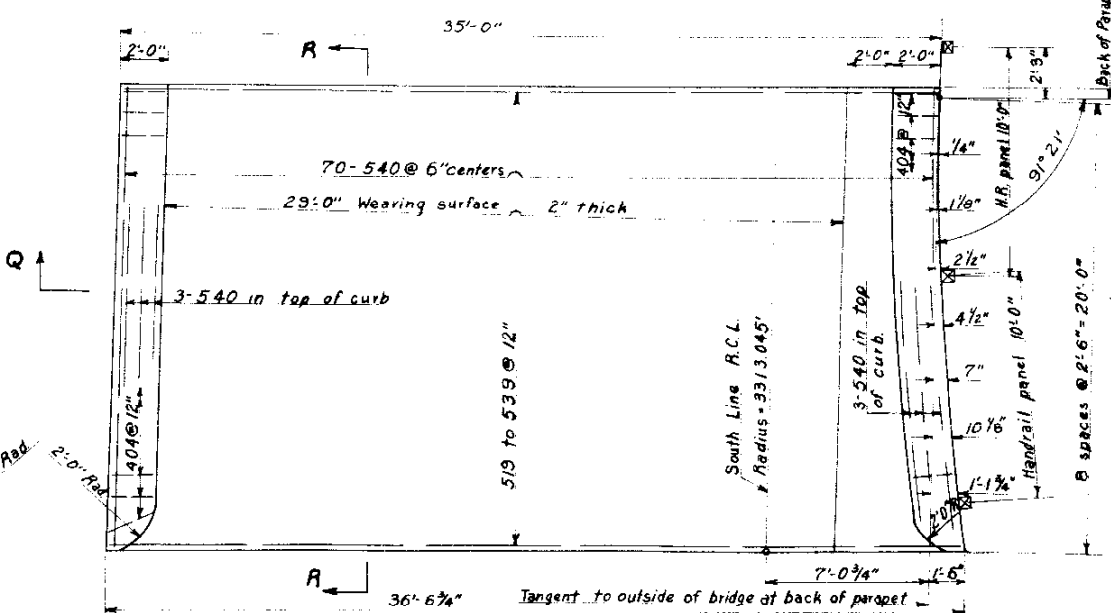

SOUTH BRIDGE APPROACH SLAB AT ABUTMENT NO.1
Approach slab at Abutment No. 4 opposite hand

COLORADO
DEPARTMENT OF HIGHWAYS
2-3 SPAN (42'-7 1/2" x 42') CONCRETE
SLAB & GIRDER BRIDGES, 3'-0" PDWY
DETAILS OF PIERS &
APPROACH SLABS
Over Bryant St on West 6th Ave.
Sta. 46+
In Denver Sec. 8 T. 4S. R. 68W
Designed by G.H.W. Approved by D. K. ...
Made by F.L. Bridge Engineer
Checked by Date: May 15, 1956

All Reinforcing Bar dimensions not marked (C) shall be to ϕ of bar.

STRUCTURE NO. F-16-EM Sta. 46+68.68 to 48+26.20
STRUCTURE NO. F-16-EM Sta. 46+68.77 to 48+26.28

ABUT NORTH BRIDGE ALL ABUTS. SAME

Table with columns: Size, No. Req'd, Length, Type, Dimensions. Rows include various bar sizes like 1/2" #10, 1/2" #8, etc.

SUMMARY ONE ABUT 4 Req'd. Lin ft 1/2" # @ 668"/Lin ft = 251 Lbs. Lin ft 5/8" # @ 1043"/Lin ft = 92 Lbs. Lin ft 3/4" # @ 1502"/Lin ft = 426 Lbs. +1% Overrun = 91 Lbs. Total = 780 Lbs.

APPROACH SLABS F-16-EM

Table with columns: Size, No. Req'd, Length, Type, Dimensions. Rows include 2" #80, 3/4" #152, etc.

SUMMARY 2 SLABS F-16-EM. Lin ft 1/2" # @ 668"/Lin ft = 214 Lbs. Lin ft 3/4" # @ 1043"/Lin ft = 471 Lbs. +1% Overrun = 48 Lbs. Total = 490 Lbs. F-16-EN Similar

THE MEDIAN WALL F-16-EM

Table with columns: Size, No. Req'd, Length, Type, Dimensions. Rows include 1/2" #7, 1/2" #15, etc.

SUMMARY ONE MEDIAN WALL 2 Req'd. Lin ft 1/2" # @ 668"/Lin ft = 101 Lbs. Lin ft 3/4" # @ 1043"/Lin ft = 405 Lbs. +1% Overrun = 4 Lbs. Total = 510 Lbs.

BAR LIST SUPERSTRUCTURE F-16-N

Bars for F-16-EM are similar except -507 to 511 replace 502 to 506

Main bar list table for F-16-N with columns: Mark, Size, No. Req'd, Length, Type, Dimensions. Rows 401-450.

BAR SUMMARY SUPERSTRUCTURE F-16-EN. 20,935 Lin ft 1/2" # @ 668"/Lin ft = 13,985 Lbs. 16,404 Lin ft 3/8" # @ 1043"/Lin ft = 17,109 Lbs. 384 Lin ft 1" # @ 267"/Lin ft = 1,025 Lbs. 8,561 Lin ft 1 1/8" # @ 5313"/Lin ft = 45,485 Lbs. +1% Overrun = 776 Lbs. Total = 78,380 Lbs.

BAR SUMMARY SUPERSTRUCTURE F-16-EM. 20935 Lin ft 1/2" # @ 668"/Lin ft = 13985 Lbs. 16399 Lin ft 3/8" # @ 1043"/Lin ft = 17104 Lbs. 384 Lin ft 1" # @ 267"/Lin ft = 1025 Lbs. 8561 Lin ft 1 1/8" # @ 5313"/Lin ft = 45485 Lbs. +1% Overrun = 776 Lbs. Total = 78375 Lbs.

SOUTH BRIDGE F-16-EN

PIER No. 2

Table with columns: Mark, Size, No. Req'd, Length, Type, Dimensions. Rows 464-465, 518, 601, 802-814, 1115.

BAR SUMMARY PIER No 2. 956 Lin ft 1/2" # @ 668"/Lin ft = 639 Lbs. 587 Lin ft 3/8" # @ 1043"/Lin ft = 612 Lbs. 328 Lin ft 3/4" # @ 1502"/Lin ft = 493 Lbs. 717 Lin ft 1" # @ 267"/Lin ft = 194 Lbs. 192 Lin ft 1 1/8" # @ 5313"/Lin ft = 1020 Lbs. +1% Overrun = 47 Lbs. Total = 4725 Lbs.

SOUTH BRIDGE F-16-EN

PIER No. 3

Table with columns: Mark, Size, No. Req'd, Length, Type, Dimensions. Rows 464-465, 518, 601, 802-815, 1115.

BAR SUMMARY PIER No 3. 956 Lin ft 1/2" # @ 668"/Lin ft = 639 Lbs. 587 Lin ft 3/8" # @ 1043"/Lin ft = 612 Lbs. 328 Lin ft 3/4" # @ 1502"/Lin ft = 493 Lbs. 692 Lin ft 1" # @ 267"/Lin ft = 1848 Lbs. 192 Lin ft 1 1/8" # @ 5313"/Lin ft = 1020 Lbs. +1% Overrun = 48 Lbs. Total = 4660 Lbs.

NORTH BRIDGE F-16-EM

PIER No. 2

Table with columns: Mark, Size, No. Req'd, Length, Type, Dimensions. Rows 464-465, 518, 601, 802-809, 1115.

BAR SUMMARY PIER No 2. 927 Lin ft 1/2" # @ 668"/Lin ft = 619 Lbs. 587 Lin ft 3/8" # @ 1043"/Lin ft = 612 Lbs. 328 Lin ft 3/4" # @ 1502"/Lin ft = 493 Lbs. 685 Lin ft 1" # @ 267"/Lin ft = 1829 Lbs. 192 Lin ft 1 1/8" # @ 5313"/Lin ft = 1020 Lbs. +1% Overrun = 47 Lbs. Total = 4620 Lbs.

NORTH BRIDGE F-16-EM


PIER No. 3

Table with columns: Mark, Size, No. Req'd, Length, Type, Dimensions. Rows 464-465, 518, 601, 802-810, 1115.

BAR SUMMARY PIER No 3. 927 Lin ft 1/2" # @ 668"/Lin ft = 619 Lbs. 587 Lin ft 3/8" # @ 1043"/Lin ft = 612 Lbs. 328 Lin ft 3/4" # @ 1502"/Lin ft = 493 Lbs. 659 Lin ft 1" # @ 267"/Lin ft = 1760 Lbs. 192 Lin ft 1 1/8" # @ 5313"/Lin ft = 1020 Lbs. +1% Overrun = 46 Lbs. Total = 4550 Lbs.

BENDING DIAGRAMS

Dimensions are out to out of bars

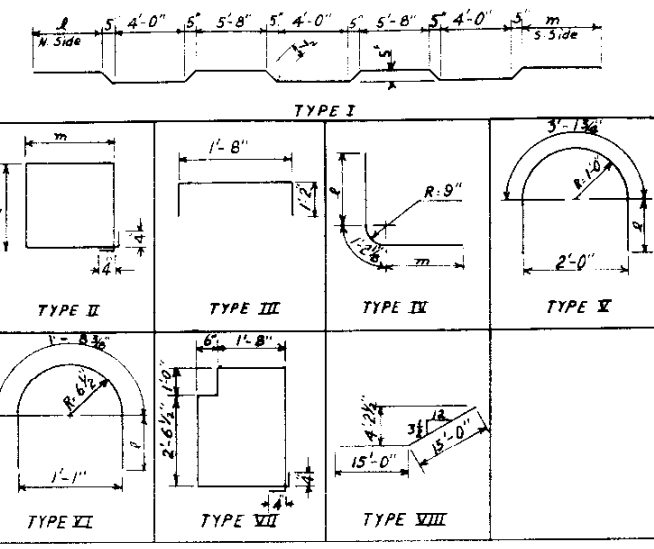

COLORADO DEPARTMENT OF HIGHWAYS 2-3 SPANS (42 71 42) CONCRETE SLAB GIRDER BRIDGES 31'-0" ROADWAY BAR LIST BRIDGES F-16-EN & F-16-EM Over Bryant St on West 6th Ave Sta. 46+00 Denver Sec. 8 T. 45 R. 64W Designed by G.H.W. Approved by R.E.S. Bridge Engineer Checked by Date: May 15, 1954