

# STATE DEPARTMENT OF HIGHWAYS DIVISION OF HIGHWAYS - STATE OF COLORADO

P.E., R.O.W. & UTILITIES  
UNDER IR 25-2(174)

FEDERAL ROAD DISTRICT NO.	STATE	PROJECT NO.	SHEET NO.
	COLORADO	IR 25-2(191)	1

AS CONSTRUCTED	
NO REVISIONS	REVISED 7-21-87 VCID


REVISIONS	
F-1	3-25-87 1, 11, 12, 15, 16, 25, 63, 119, 127, 127, 130, 175, 184 J.K.K.

## PLAN AND PROFILE OF PROPOSED AS CONSTRUCTED FEDERAL AID PROJECT NO. IR 25-2(191) STATE HIGHWAY NOS. 6 & 25 DENVER COUNTY

PROJECT NO. IR 25-2(191)				
TABULATION OF LENGTH AND DESIGN DATA				
STATION	STRUCTURE		ROADWAY	
	LIN. FT.	MILE	LIN. FT.	MILE
<b>RAMP 'E'</b> STR. NO. F-16-06 602+78.57 TO 616+56.62	1,378.05	0.2610		
<b>RAMP 'H'</b> 900+39.86 TO 903+07.50 STR. NO. F-16-OK 903+07.50 TO 906+18.00 STR. NO. F-16-NO 906+18.00 TO 912+85.32	310.50	0.0588	267.64	0.0507
<b>RAMP 'I'</b> 1000+00.00 TO 1008+95.32	667.32	0.1264	895.32	0.1696
<b>OSAGE RAMP</b> 0+00.00 TO 3+89.19			389.19	0.0737
<b>SUMMARY</b>	<b>LIN. FT.</b>	<b>MILES</b>		
STRUCTURE F-16-06	1,378.05	0.2610		
STRUCTURE F-16-OK	310.50	0.0588		
STRUCTURE F-16-NO	667.32	0.1264		
ROADWAY	1,552.15	0.2940		
PROJECT GROSS LENGTH	3,908.02	0.7402		


DESIGN DATA	RAMP 'E'	RAMP 'H'	RAMP 'I'	OSAGE RAMP
MAXIMUM DEGREE OF CURVATURE	14°19'26"	10°52'51"	8°00'00"	38°11'50"
MAXIMUM GRADE	4.176%	5.640%	-3.430%	-1.580%
MINIMUM S.S.D. HORIZONTAL	227	258	300	180
MINIMUM S.S.D. VERTICAL	340	248	284	910
MAXIMUM DESIGN SPEED	35 MPH	35 MPH	35 MPH	20 MPH

SCALES OF ORIGINAL DRAWINGS  
ON PLAN, 1 IN. = 50 FT.  
ON PROFILE { 1 IN. = 50 FT. HORIZONTAL  
                  1 IN. = 10 FT. VERTICAL  
GRADE LINE ON PROFILE IS SHOWN AS GRADE OF FINISHED ROAD

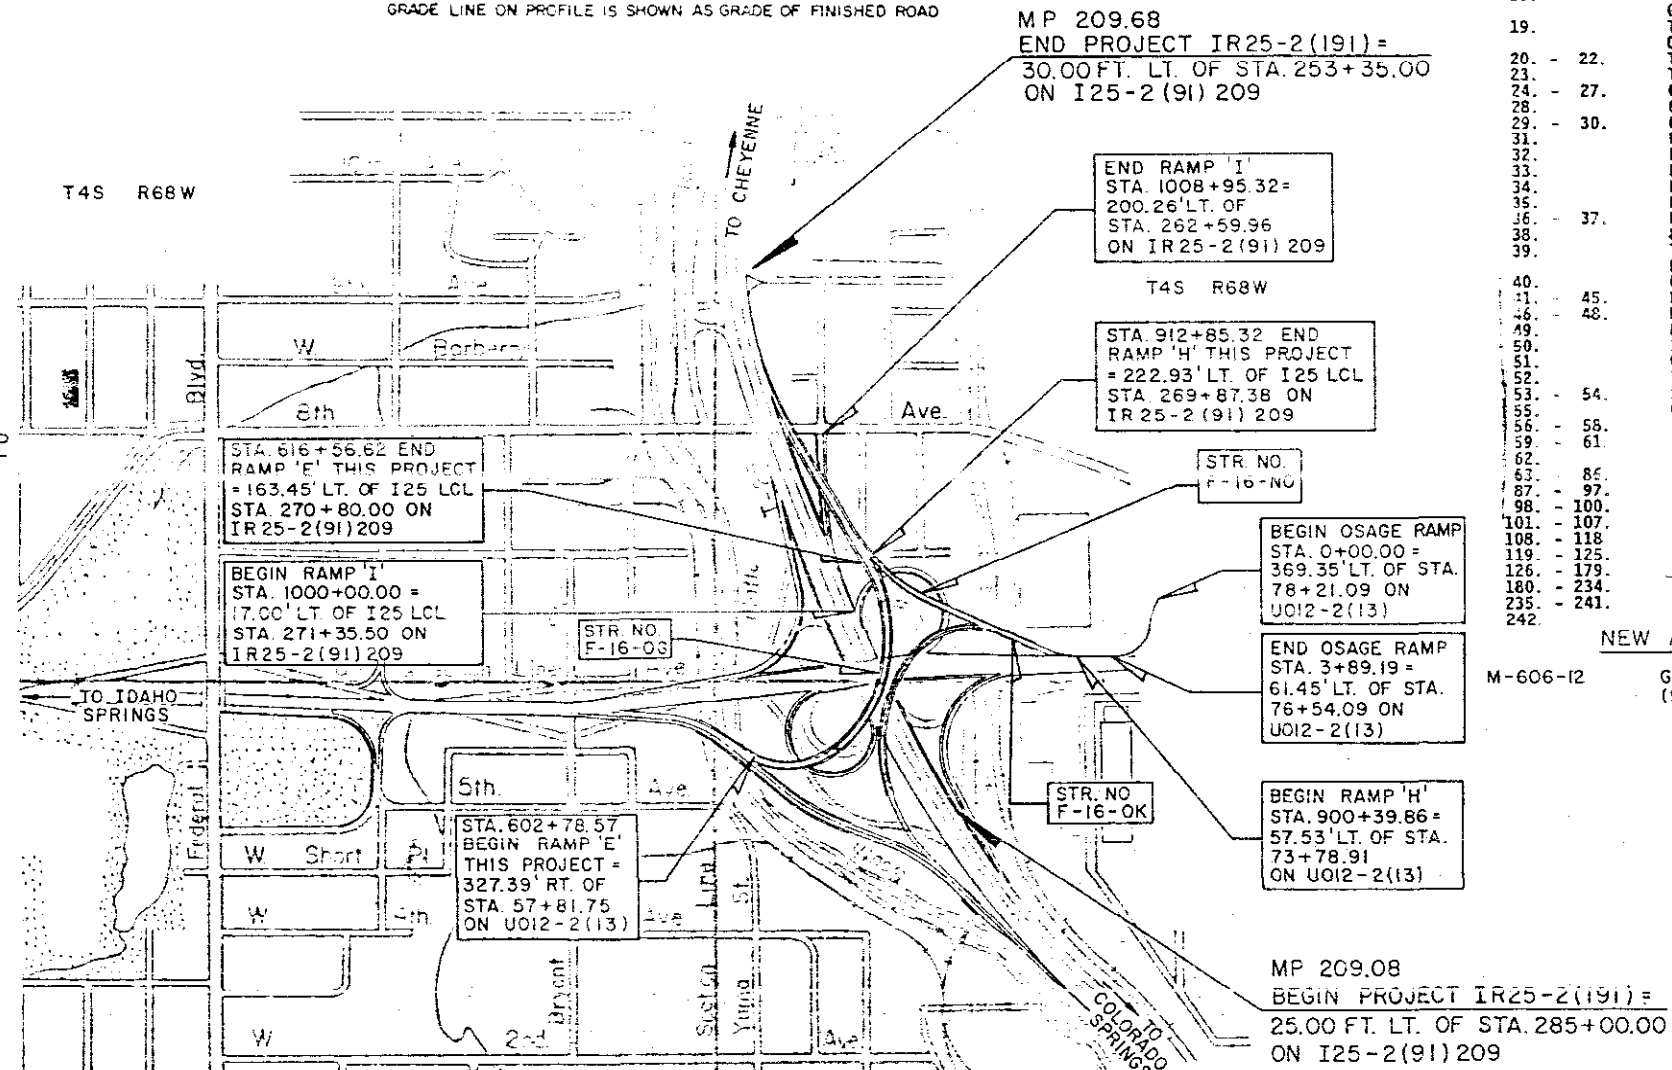

SHEET NO.	INDEX OF SHEETS
1.	TITLE SHEET
2.	STANDARD PLANS LIST
3.	I-25/6TH AVENUE INTERCHANGE CONTROL POINTS
4.	I-25/6TH AVENUE INTERCHANGE CONTROL POINT DIAGRAM
5.	I-25/6TH AVENUE IMPROVEMENTS
6.	2000 TRAFFIC DIAGRAM & GENERAL NOTES
7. - 10.	TYPICAL SECTIONS
11. - 162?	SUMMARY OF APPROXIMATE QUANTITIES
17.	SUMMARY OF EARTHWORK, TABULATION OF GUARDRAIL AND FENCE
18.	TABULATION OF SIDEWALK, DRIVEWAY, CURB RAMP, CURB AND GUTTER
19.	TABULATION OF SURFACING AND MEDIAN COVER MATERIAL QUANTITIES
20. - 22.	TABULATION OF REMOVE, ADJUST, AND RESET ITEMS
23.	TABULATION OF STORM AND SANITARY SEWER SYSTEM
24. - 27.	CONSTRUCTION STAGING PLANS
28.	GEOMETRIC LAYOUT SHEET
29. - 30.	GEOMETRIC PLAN W 6TH AVENUE
31.	PLAN & PROFILE OSAGE ON RAMP
32.	PLAN & PROFILE RAMP 'E'
33.	PLAN & PROFILE RAMP 'H'
34.	PLAN RAMP 'E'/I-25 NORTHSOUND
35.	PLAN & PROFILE RAMP 'I'
36. - 37.	PLAN & PROFILE DETOURS
38.	8TH AVENUE AND WYANDOT STREET INTERSECTION PLAN
39.	TRAFFIC ISLAND, CURB RAMP, AND MEDIAN COVER MATERIAL DETAILS
40.	GUARDRAIL TRANSITION AND SIGN PEDESTAL DETAILS
41. - 45.	DRAINAGE AND UTILITY PLANS
46. - 48.	DRAINAGE AND SEWER CROSS SECTIONS
49.	DRAINAGE AND BARRIER DETAILS
50.	INLET TYPE 13 DETAILS
51.	CONCRETE COLLAR, MODIFY INLET AND JACKING DETAILS
52.	IMPACT ATTENUATORS
53. - 54.	SURVEY MONUMENTS
55.	GRADING PLAN
56. - 58.	LANDSCAPE PLANS
59. - 61.	IRRIGATION PLANS
62.	UNDERPASS LIGHTING PLAN
63. - 85.	SIGNAL, SIGNING, AND PAVEMENT MARKING PLANS
87. - 97.	CONSTRUCTION DETOUR PLANS
98. - 100.	TRAFFIC SIGNAL CROSS SECTIONS
101. - 107.	SIGNAL, SIGNING, AND PAVEMENT MARKING DETAILS
108. - 118.	RETAINING WALLS
119. - 125.	STRUCTURE NOS. F-16-OK, F-16-NO
126. - 179.	STRUCTURE NO. F-16-06
180. - 234.	SANITARY SEWER DETAILS
235. - 241.	LIGHTING WIRING DESIGN
242.	
<b>NEW AND REVISED STANDARDS</b>	
M-606-12	GUARD RAIL, TYPE 4, CONCRETE BARRIER (9 SHEETS) 2-18-83

T4S R68W

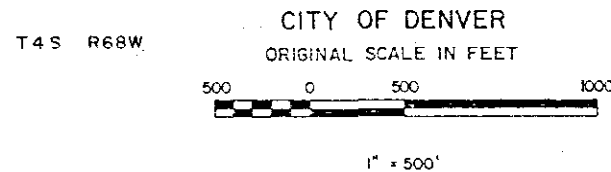

De LEUW CATHER & COMPANY  
DENVER, CO.  
*[Signature]*  
7-20-87  
PROJECT MANAGER

DEPARTMENT OF TRANSPORTATION  
FEDERAL HIGHWAY ADMINISTRATION  
APPROVED \_\_\_\_\_ DATE \_\_\_\_\_  
DIVISION ADMINISTRATOR

DIVISION OF HIGHWAYS  
APPROVED: *[Signature]* 8-4-87  
CHIEF ENGINEER DATE

AS CONSTRUCTED INFORMATION  
CONTRACTOR CENTRIC-JONES  
Resident ENGINEER G.R. SELF  
(Project or Resident)  
PROJECT STARTED OCTOBER 5, 1987  
PROJECT COMPLETED JULY 21, 1989  
*[Signature]*  
3-22-90  
TITLE DATE

Plan No.	Title	Page
<input checked="" type="checkbox"/> M-100-1	STANDARD SYMBOLS.....	1
<input checked="" type="checkbox"/> M-107-1	TEMPORARY EROSION CONTROL.....	2
<input type="checkbox"/> M-203-1	APPROACH ROADS, FLARING, CUT SLOPE TREATMENT, BRIDGE & CREST WIDENING.....	3
<input checked="" type="checkbox"/> M-203-2	DITCH TYPES.....	4
<input type="checkbox"/> M-203-10	SUPERELEVATION OF CURVES - CROWNED HIGHWAYS.....	5
<input checked="" type="checkbox"/> M-203-11	SUPERELEVATION OF CURVES - DIVIDED HIGHWAYS - SHOULDER PIVOT.....	6
<input checked="" type="checkbox"/> M-203-12	SUPERELEVATION OF CURVES - STREETS.....	7
<input type="checkbox"/> M-203-13	SUPERELEVATION OF CURVES - DIVIDED HIGHWAYS - CENTER PIVOT.....	8
<input checked="" type="checkbox"/> M-206-1	EXCAVATION AND BACKFILL FOR STRUCTURES..... (2 SHEETS)	9
<input checked="" type="checkbox"/> M-206-2	EXCAVATION AND BACKFILL FOR BRIDGES.....	11
<input checked="" type="checkbox"/> M-214-1	PLANTING DETAILS.....	12
<input type="checkbox"/> M-412-1	CONCRETE PAVEMENT JOINTS.....	13
<input type="checkbox"/> M-504-1	STEEL CRIBBING.....	14
<input type="checkbox"/> M-506-1	GABIONS AND SLOPE MATTRESS.....	15
<input type="checkbox"/> M-510-1	STRUCTURAL PLATE CULVERT PIPE - H-20 LOADING..... (2 SHEETS)	16
<input type="checkbox"/> M-601-1	SINGLE CONCRETE BOX CULVERT.....	18
<input type="checkbox"/> M-601-2	DOUBLE CONCRETE BOX CULVERT.....	19
<input type="checkbox"/> M-601-3	TRIPLE CONCRETE BOX CULVERT.....	20
<input type="checkbox"/> M-601-10	HEADWALL FOR PIPE CULVERTS.....	21
<input type="checkbox"/> M-601-11	TYPE "S" SADDLE HEADWALL FOR PIPE CULVERTS.....	22
<input type="checkbox"/> M-601-12	HEADWALL, INTERCEPTING HEADWALL AND CULVERT OUTLET PAVING.....	23
<input type="checkbox"/> M-601-20	WINGWALLS FOR PIPE OR BOX CULVERTS.....	24
<input checked="" type="checkbox"/> M-603-1	METAL CULVERT PIPE - H-20 LOADING..... (2 SHEETS)	25
<input checked="" type="checkbox"/> M-603-2	REINFORCED CONCRETE PIPE.....	27
<input type="checkbox"/> M-603-3	PRECAST CONCRETE BOX CULVERT.....	28
<input type="checkbox"/> M-603-10	CONCRETE AND METAL END SECTIONS.....	29
<input checked="" type="checkbox"/> M-604-1	PIPE SEWER IN TRENCH.....	30
<input checked="" type="checkbox"/> M-604-10	INLET, TYPE C.....	31
<input type="checkbox"/> M-604-11	INLET, TYPE D.....	32
<input checked="" type="checkbox"/> M-604-12	CURB INLET, TYPE R..... (2 SHEETS)	33
<input checked="" type="checkbox"/> M-604-13	CONCRETE INLET, TYPE 13.....	35
<input checked="" type="checkbox"/> M-604-20	MANHOLES.....	36
<input checked="" type="checkbox"/> M-604-21	STEPS FOR MANHOLES & INLETS.....	37
<input checked="" type="checkbox"/> M-606-1	GUARD RAIL, TYPE 3, W-BEAM..... (8 SHEETS)	38
<input checked="" type="checkbox"/> M-606-2	GUARD RAIL, TYPE 3, W-BEAM FOR LOCAL ROADS & STREETS..... (4 SHEETS)	46

Plan No.	Title	Page
<input type="checkbox"/> M-607-1	WIRE FENCES AND GATES..... (2 SHEETS)	52
<input checked="" type="checkbox"/> M-607-2	CHAIN LINK FENCE..... (3 SHEETS)	54
<input type="checkbox"/> M-607-3	BARRIER FENCE.....	57
<input type="checkbox"/> M-607-4	DEER FENCE AND GATE..... (2 SHEETS)	58
<input type="checkbox"/> M-607-10	PICKET SNOW FENCE.....	60
<input checked="" type="checkbox"/> M-608-1	CURB RAMPS.....	61
<input checked="" type="checkbox"/> M-609-1	CURBS AND GUTTERS.....	62
<input type="checkbox"/> M-611-1	CATTLE GUARD - WELDED GRILL UNITS - 10' THRU 42' ROADWAYS..... (2 SHEETS)	63
<input checked="" type="checkbox"/> M-613-1	HIGHWAY LIGHTING..... (2 SHEETS)	65
<input type="checkbox"/> M-615-1	EMBANKMENT PROTECTOR, TYPES 3 & 4.....	67
<input type="checkbox"/> M-615-2	EMBANKMENT PROTECTOR, TYPE 5.....	68
<input type="checkbox"/> M-616-1	INVERTED SIPHON..... (ALSO USE M-603 OR M-604 AS REQUIRED)	69
<input type="checkbox"/> M-620-1	FIELD LABORATORY - CLASS 1.....	70
<input checked="" type="checkbox"/> M-620-2	FIELD LABORATORY - CLASS 2.....	71
<input type="checkbox"/> M-620-11	FIELD OFFICE - CLASS 1.....	72
<input type="checkbox"/> M-620-12	FIELD OFFICE - CLASS 2.....	73

Plan No.	Title	Page
<input checked="" type="checkbox"/> S-612-1	TYPICAL DELINEATOR INSTALLATIONS..... (4 SHEETS)	75
<input checked="" type="checkbox"/> S-614-1	TYPICAL GROUND SIGN PLACEMENT.....	79
<input checked="" type="checkbox"/> S-614-2	CLASS I GROUND SIGN INSTALLATIONS.....	80
<input checked="" type="checkbox"/> S-614-3	CLASS II GROUND SIGN INSTALLATIONS.....	81
<input type="checkbox"/> S-614-4	CLASS III SIGNS, LAMINATED ALUMINUM PANELS AND POST SPACING TABLE..... (2 SHEETS)	82
<input type="checkbox"/> S-614-5	BREAK-AWAY SIGN SUPPORT DETAILS FOR GROUND SIGNS..... (2 SHEETS)	84
<input checked="" type="checkbox"/> S-614-6	CONCRETE FOOTINGS AND SIGN ISLANDS FOR CLASS III SIGNS..... (2 SHEETS)	86
<input checked="" type="checkbox"/> S-614-10	TYPICAL MARKER ASSEMBLY INSTALLATIONS.....	88
<input type="checkbox"/> S-614-11	MILEPOST SIGN AND INSTALLATION.....	89
<input checked="" type="checkbox"/> S-614-12	STRUCTURE NUMBER INSTALLATION (BRIDGE INFORMATION SHEET).....	90
<input type="checkbox"/> S-614-13	STANDARD RAILROAD CROSSING SIGNS AND MARKINGS.....	91
<input checked="" type="checkbox"/> S-614-20	TYPICAL POLE MOUNT SIGN INSTALLATION.....	92
<input checked="" type="checkbox"/> S-614-21	CONCRETE BARRIER SIGN POST INSTALLATIONS.....	93
<input checked="" type="checkbox"/> S-614-22	TYPICAL MULTI-SIGN INSTALLATIONS.....	94
<input checked="" type="checkbox"/> S-614-30	INTERSTATE ROUTE MARKERS.....	95
<input type="checkbox"/> S-614-31	U. S. & COLORADO ROUTE MARKERS.....	96
<input checked="" type="checkbox"/> S-614-32	AUXILIARY MARKERS.....	97
<input type="checkbox"/> S-614-40	TRAFFIC SIGNAL INSTALLATION DETAILS..... (3 SHEETS)	98
<input checked="" type="checkbox"/> S-614-50	TRAFFIC CONTROLS FOR HIGHWAY CONSTRUCTION..... (4 SHEETS)	101
<input checked="" type="checkbox"/> S-614-51	BARRICADES, DRUMS, CONCRETE BARRIER (TEMP) & VERTICAL PANELS.....	105
<input checked="" type="checkbox"/> S-627-1	TYPICAL PAVEMENT MARKINGS..... (3 SHEETS)	106

THE STANDARD PLAN SHEETS INDICATED HEREON BY A MARKED BOX ARE TO BE USED TO CONSTRUCT THIS PROJECT.

DEPARTMENT OF HIGHWAYS  
STATE OF COLORADO  
DIVISION OF HIGHWAYS

STANDARD PLANS LIST

M & S STANDARDS - JANUARY, 1982

MODIFIED STATE PLANE CONTROL POINTS SHOWN ON INTERCHANGE CONTROL POINT DIAGRAM

CONTROL POINT #	NORTHING	EASTING	CONTROL POINT #	ELEV.	DESCRIPTION
1	688025.4089	2138794.9997	1		RANDOM SET 60D NAIL WEST OF RR TRACK AT QUIVAS AND 3RD AVE (TBM 949-57) SET 40D NAIL WEST SIDE OF I-25 SOUTH OF 6TH AVE
13	688545.7433	2137946.6341	13	5235.23	#5 REBAR W/ALUM CAP STAMPED "13" SET 60D NAIL @ S.W. COR OF R.R. CROSSING AND 8TH AVE.
19	691049.9066	2135992.5343	19		SET 60D NAIL AT W.W. COR 8TH AND WYANDOT
20	691109.6542	2136803.5939	20		(TBM 949-51C) #5 REBAR W/ALUM CAP STAMPED "21"
21	690640.3086	2136836.8304	21	5213.77	(TBM 949-57E) #5 REBAR W/ALUM CAP STAMPED "22"
22	689504.5126	2136545.0702	22	5205.02	CHISELED "X" ON WALK AT 6TH AND FEDERAL
23	689556.6237	2133792.7917	23		SET 60D NAIL P.O.L. BET. 21 & 151
24	690335.8090	2137084.0945	24		(TBM 949-51B) FND. 1 1/4" AXLE IN DENVER R.B. AT 7TH AVE AND VALLEJO
25	690422.9322	2137106.6080	25	5198.42	FND. PK NAIL AT 8TH AVE. AND VALLEJO
26	691082.8686	2137114.3383	26		FND. 1 1/2" AXLE IN A DENVER R.B. AT E. END 5TH AVE. AND R.R.
27	689109.9843	2136423.7212	27		FND. #8 REBAR IN A DENVER R.B. AT 5TH AVE. AND ALCOTT ST.
28	689107.5633	2135900.8383	28		SET P.K. NAIL AT APPROX CL ALCOTT EXT ON RAMP FROM BRYANT ST. TO E. BOUND 6TH AVE.
29	689493.4001	2135906.8505	29		SET 60D NAIL AT 6TH AND WEST SIDE PLATTE (TBM 949-57A) CHISELED "X" IN BIKE PATH
30	689533.8188	2136265.8632	30		(TBM 949-57B) CHISELED "X" IN BIKE PATH
31	688600.1709	2137551.7582	31	5201.52	(TBM 949-57C) CHISELED "X" IN BIKE PATH
32	688773.7398	2137206.3225	32	5205.01	(TBM 949-57D) CHISELED "X" IN BIKE PATH
33	689051.6087	2136764.6278	33	5199.34	FND #8 REBAR IN R.B. @ INT OF 5TH AND BRYANT STREET
34	689270.8007	2136556.3551	34	5198.84	FND #8 REBAR IN R.B. IN 5TH AVE.
37	689106.0606	2135574.7182	37		FND ROUND HEAD SPIKE @ 5TH AVE AND RAMP TO 6TH AVE.
38	689103.7469	2135087.5778	38		SET 40D NAIL APPROX. 5' E OF TBC ON RAMP AND IN LINE W/BLDG LINE OF VALLANT PRODUCTS CORP.
39	689101.2500	2134576.5460	39		FND. PK NAIL IN ISLAND AT W. BOUND I-25 AND E. BOUND 6TH
40	689376.0523	2134607.0171	40		SET 60D NAIL AT S. EDGE OF CONC. BASE OF S. BILLBOARD POST (HVC 19-17-1)
501	688041.2818	2138760.7600	501	5218.31	FND. "X" CHISELED ON WALK ON E. SIDE BRIDGE ON FEDERAL AND CL 6TH
538	689671.3430	2133791.5282	538		FND. "X" CHISELED ON WALK ON W. SIDE BRIDGE ON FEDERAL AND 6TH AVE.
539	689671.1106	2133727.5162	539		(TBM 949-51A) FND 1 1/4" AXLE IN DENVER R.B. AT 7TH AVE AND UMATILLA
540	690425.2252	2137406.6892	540	5198.82	FND. PK NAIL IN ASPHALT N.WEST 5TH AND RR
541	689129.7372	2136391.5163	541		FND. #3 REBAR W/PLASTIC CAP DEST. W ALCOTT
542	689377.7607	2135937.5305	542		FND #4 REBAR NO CAP NE LOT COR SCHMID
543	689479.1452	2136272.4591	543		FND #8 REBAR W/CAP LS 152 1.5 FT S OF THE W END OF A CHAIN LINK FENCE
567	689104.4801	2135241.9573	567		FND #8 REBAR IN A RANGE BOX @ INT OF 5TH AND DALE CT. ON LINE WITH #38 4#39
568	689102.9646	2134927.2873	568		FND #3 REBAR W/CAP LS 152 1.5 FT S OF THE W END OF A CHAIN LINK FENCE
569	689523.1309	2134749.9926	569		FND CHISELED "X" ON TOP OF W CURB ALCOTT
570	689277.4422	2135884.7251	570		FND BOLT OR SPIKE 0.05 BELOW ASPHALT
646	689101.4278	2134601.3653	646		FND 1-1/4" AXLE IN RANGE BOX @ VALLEJO & BARBERRY
898	691414.0806	2137223.4397	898		FND 3" MONU LS 7104 IN SEARS WAREHOUSE INC FENCE LINE
901	690197.0403	2137873.1081	901		FND 1-1/4" AXLE IN SEARS WAREHOUSE FENCE LINE
902	690991.5755	2137856.9829	902		FND 60 D NAIL AT 9TH AND ALCOTT ST. WEST OF COLO. AND SOUTHERN RR
2003	691915.9889	2135949.1192	2003	5199.07	FND P.K. AT COR OF CONC. PAN IN THE SW QUAD. OF MULBERRY AND VALLEJO ST. (HVC 4) BK. 705/5
2004	691846.9725	2137191.4133	2004	5198.07	FND P.K. AT BACK OF WALK SE QUAD. AT 7TH AND BRYANT (HVC 9) BK. 705/3
2009	690383.1161	2135597.4886	2009	5199.99	FND HUB NE OF WAREHOUSE SE OF 8TH AND BRYANT ST. (HVC 10) BK. 705/6
2010	690899.9591	2138196.9533	2010	5215.50	FND HUB SE BALLFIELD AT FEDERAL AND WEST 5TH (HVC15) BK. 705/2
2015	689146.6983	2133843.3737	2015	5256.49	FND P.K. IN BACK OF CURB AND PAN IN NE QUAD. AT 5TH AND BRYANT (HVC 16) BK. 705/2
2016	689121.2619	2135649.7893	2016	5203.69	FND HUB IN SE QUAD. OF 6TH I-25 INTERCHANGE (HVC 17) BK. 705/1
2017	689032.7263	2137913.4845	2017	5205.11	FND HUB SW QUAD OF 6TH AND I-25 SE TUMA ST AND WEST 5TH (HVC 19) BK. 705/2
2019	688862.5223	2136657.8344	2019	5205.44	

CONTROL POINTS NOT SHOWN ON INTERCHANGE CONTROL POINT DIAGRAM

CONTROL POINT #	NORTHING	EASTING	CONTROL POINT #	ELEV.	DESCRIPTION
2	688081.0271	2140405.1242	2		CHISELED "X" ON WALK AT NE CORNER 3RD AND LIPAN
3	687116.2257	2140371.8492	3	5232.13	SET P.K. NAIL AT THE INTERSECTION OF CONC. PANS AT 1ST AND LIPAN (HVC 18-8-1) BK. 949/3
4	687141.8270	2141221.4826	4		SET 60 D NAIL AT 1ST AND SANTA FE
5	685569.3803	2141234.2059	5		SET 60 D NAIL AT NW COR RR CROSSING AND SANTA FE
6	684910.6002	2141490.5071	6		FND CHISELED "X" ON WALK AT NW COR OF BYERS PL. AND SANTA FE
7	684543.8651	2141767.4116	7		SET 60 D NAIL AT TOP OF RETAINING WALL AT SANTA FE AND ALAMEDA
8	684544.7222	2140615.6566	8		CHISELED "X" ON WALK AT PLATTE RIVER DRIVE AND ALAMEDA
9	685824.2478	2140201.7827	9		SET 60 D NAIL AT CURVE IN PLATTE RIVER DRIVE
10	685839.3331	2138396.1376	10		FOUND CHISELED "X" IN WALK AT NW COR BRYANT AND BAYARD
11	686392.6988	2138461.4659	11		SET 60 D NAIL APPROX. 10' E OF E TBC OF BRYANT ST.
12	686742.8168	2137743.9133	12		SET 60 D NAIL 1' W OF W TBC ON TEJON AT APPROX. S FLOW LINE OF IRVINGTON EXTENDED
14	693202.2216	2136530.8428	14		SET 60 D NAIL WEST OF I-25 AND 12TH
15	693217.9493	2135941.2115	15		SET 40 D NAIL IN RR TIE ON W SIDE OF SOUTH PLATTE AND 12TH
16	693839.2213	2135769.8737	16		SET 40 D NAIL AT 13TH AND WEST SIDE OF SOUTH PLATTE
17	693814.6071	2136266.6299	17		SET 40 D NAIL AT SW COR 13TH AVE AND ZUNI ST.
18	693888.2350	2137364.8412	18		SET P.K. NAIL AT NE COR 13TH AND UMATILLA
35	694125.9943	2133755.3430	35		CHISELED "X" ON SIDEWALK ON E SIDE FEDERAL APPROX. 100'S OF HOWARD PL.
36	695078.5010	2133708.4583	36		FND CHISELED "X" ON THE W. FACE OF MEDIAN CURB IN FEDERAL BRIDGE OVER COLFAX, W 1/4 COR SEC. 5.
502	684621.1313	2141602.1489	502	5228.06	SET P.K. NAIL ON BACK OF WALK AND SE COR OF CONC. GAS ISLAND AT STANDARD STATION AT SANTA FE AND ALAMEDA (HVC 18-7-1) BK. 949/3
503	684533.1715	2140431.3575	503	5220.65	SET 60 D NAIL AT COR OF CONC. WALK ON NORTH SIDE OF ALAMEDA ACROSS FROM LIPAN ST. (HVC 18-7-2) BK. 949/3
504	686294.7756	2138813.4477	504	5212.05	SET 40 D NAIL 1' E OF A FENCE COR. IN LINE WITH FENCE TO THE WEST (HVC 20-1-1) BK. 949/2
505	688013.1587	2138046.3811	505	5209.64	SET 60 D NAIL 1' W OF A POWER POLE (HVC 20-1-2) BK. 949/2
506	693279.2719	2136353.5773	506	5193.33	SET 40 D NAIL 1' W OF A POWER POLE AT SW COR BENT-IT BLDG. (HVC 21-3-3) BK. 949/17
507	694128.7585	2136349.4173	507	5192.70	SET 40 D NAIL 1' W OF SW FENCE COR OF SIEGEL OIL CO. (HVC 21-3-2) BK. 949/17
508	694061.3072	2137369.1137	508	5194.12	SET 40 D NAIL 1' W OF A FENCE COR (HVC 20-8-2) BK. 949/17
2001	693691.4757	2135787.1973	2001	5197.05	FOUND 60 D NAIL 1' W OF END OF FENCE AT 13TH AND WEST RIGHT OF WAY FENCE OF COLORADO AND SOUTHERN RAILROAD (HVC 1) BK. 705/4
2002	693243.7166	2137278.1433	2002	5195.66	FOUND P.K. NAIL AT WEST END OF PAINT STRIPE AT 12TH AND UMATILLA ST. (HVC 2) BK. 705/5
2008	690361.6725	2133693.4541	2008	5252.81	FND HUB W FEDERAL @ 7TH AND BARON PARK (HVC 8)
2021	688900.3653	2139686.5017	2021	5221.12	FOUND HUB IN RAILROAD YARD AT NAVAJO AND BETWEEN 4TH AND 5TH (HVC 21) BK. 705/1
2022	68787.5973	2136559.6359	2022	5205.07	FND HUB @ TUMA ST AND 2ND (HVC 22) BK. 705/2
2023	688015.7951	2139672.4343	2023	5224.54	FOUND HUB AT NAVAJO AND 3RD. (HVC 23) BK. 705/1


ALL COORDINATES SHOWN HEREON ARE MODIFIED STATE PLANE COORDINATES MODIFIED FROM THE POINT OF ORIGIN (N=0, E=2,000,000) AS FOLLOWS:  
 MEAN LATITUDE= 39° 39' 30"  
 MEAN ELEVATION= 5500' AMSL  
 COMBINED FACTOR= 0.999721454

TO OBTAIN STATE PLANE COORDINATES:  
 1) MULTIPLY THE MODIFIED NORTHING BY THE COMBINED FACTOR TO OBTAIN THE STATE PLANE NORTHING.  
 2) MULTIPLY THE DIFFERENCE BETWEEN THE MODIFIED EASTING AND 2,000,000 BY THE COMBINED FACTOR AND THEN ADD THE 2,000,000 BACK IN TO OBTAIN THE STATE PLANE EASTING.  
 THIS CONTROL NETWORK IS BASED ON CONTROL ESTABLISHED BY MERRICK & CO. UNDER JOB NO. 013 3531.

I 25 / 6th Ave.  
 INTERCHANGE  
 CONTROL POINTS



AS CONSTRUCTED		FED. ROAD REGION	DIVISION	PROJ. NO.	SHEET NO.	SHEET TOTALS
NO REVISIONS	REVISED	VIII	COLO.	IR 25-2(191)	4	242

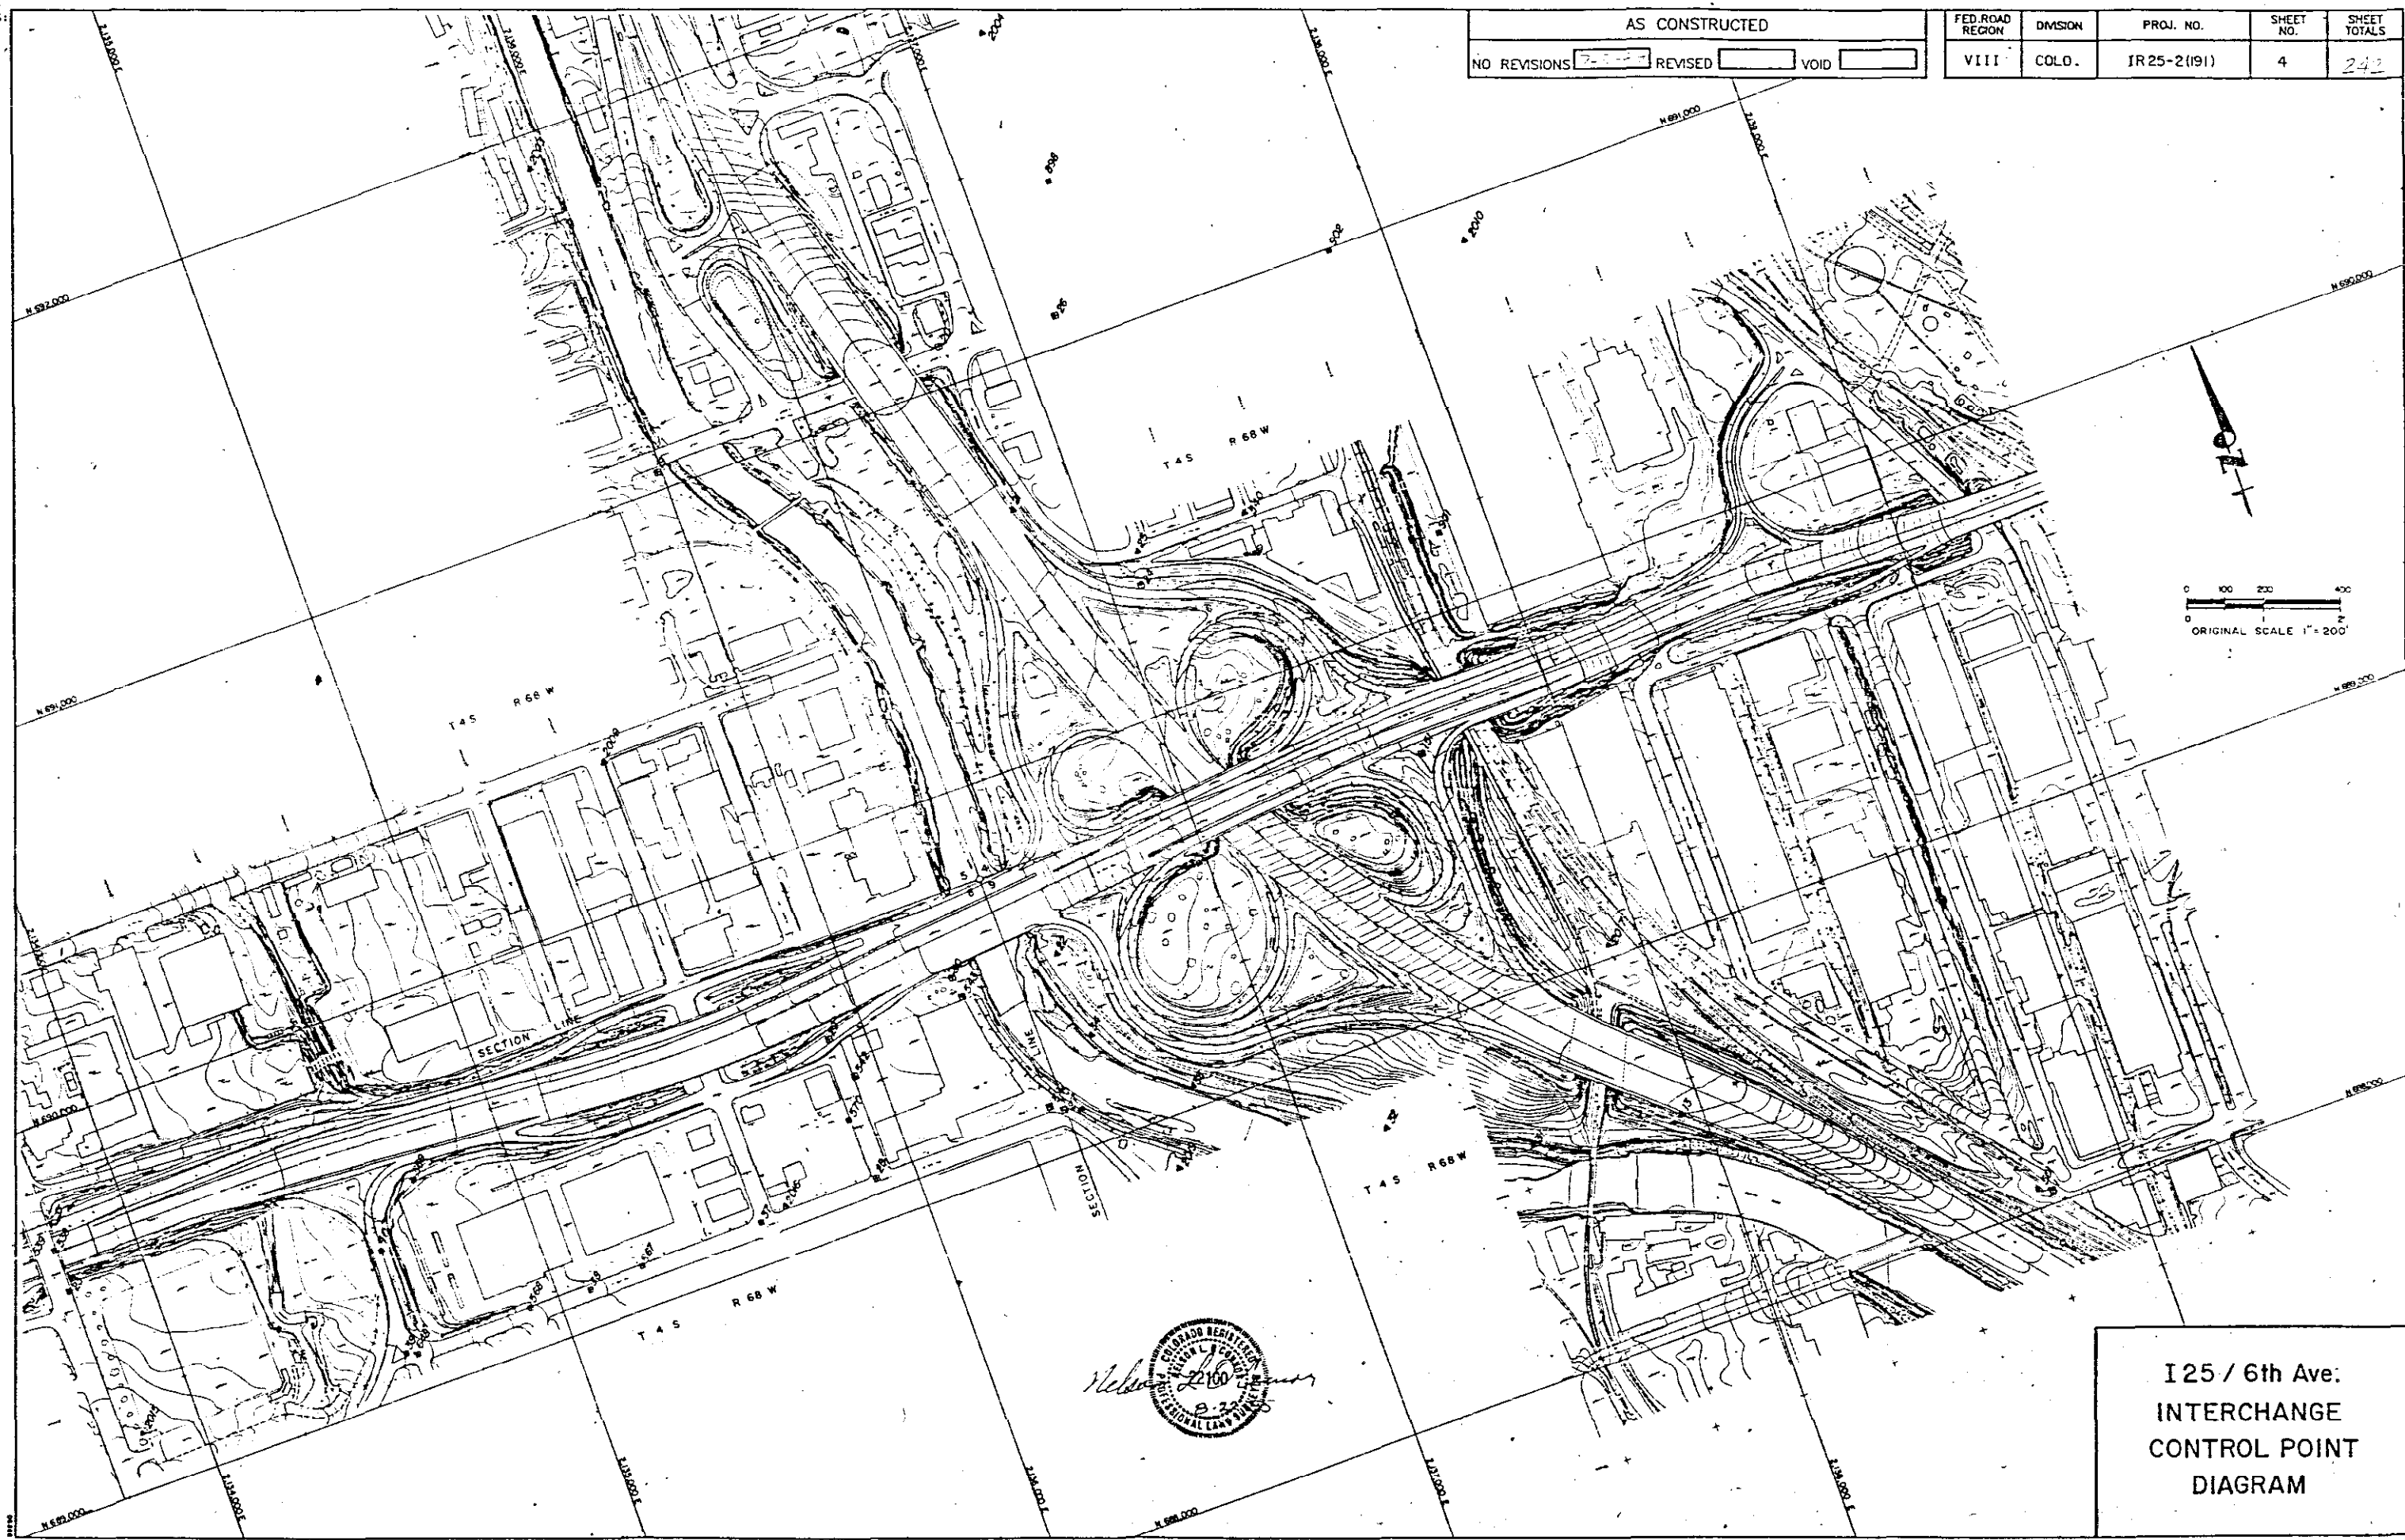



*Nelson*  
 REGISTERED PROFESSIONAL LAND SURVEYOR  
 No. 22160  
 State of Colorado

I25 / 6th Ave.  
 INTERCHANGE  
 CONTROL POINT  
 DIAGRAM

STATE OF MISSOURI  
 DEPARTMENT OF HIGHWAYS  
 PROJECT NO. 126  
 SHEET NO. 384

AS CONSTRUCTED		
NO REVISIONS	7-1-55	REVISED
		VOID

FED. ROAD REGION	DIVISION	PROJ. NO.	SHEET NO.	SHEET TOTALS
VIII	COLD.	IR 25-2(191)	5	242

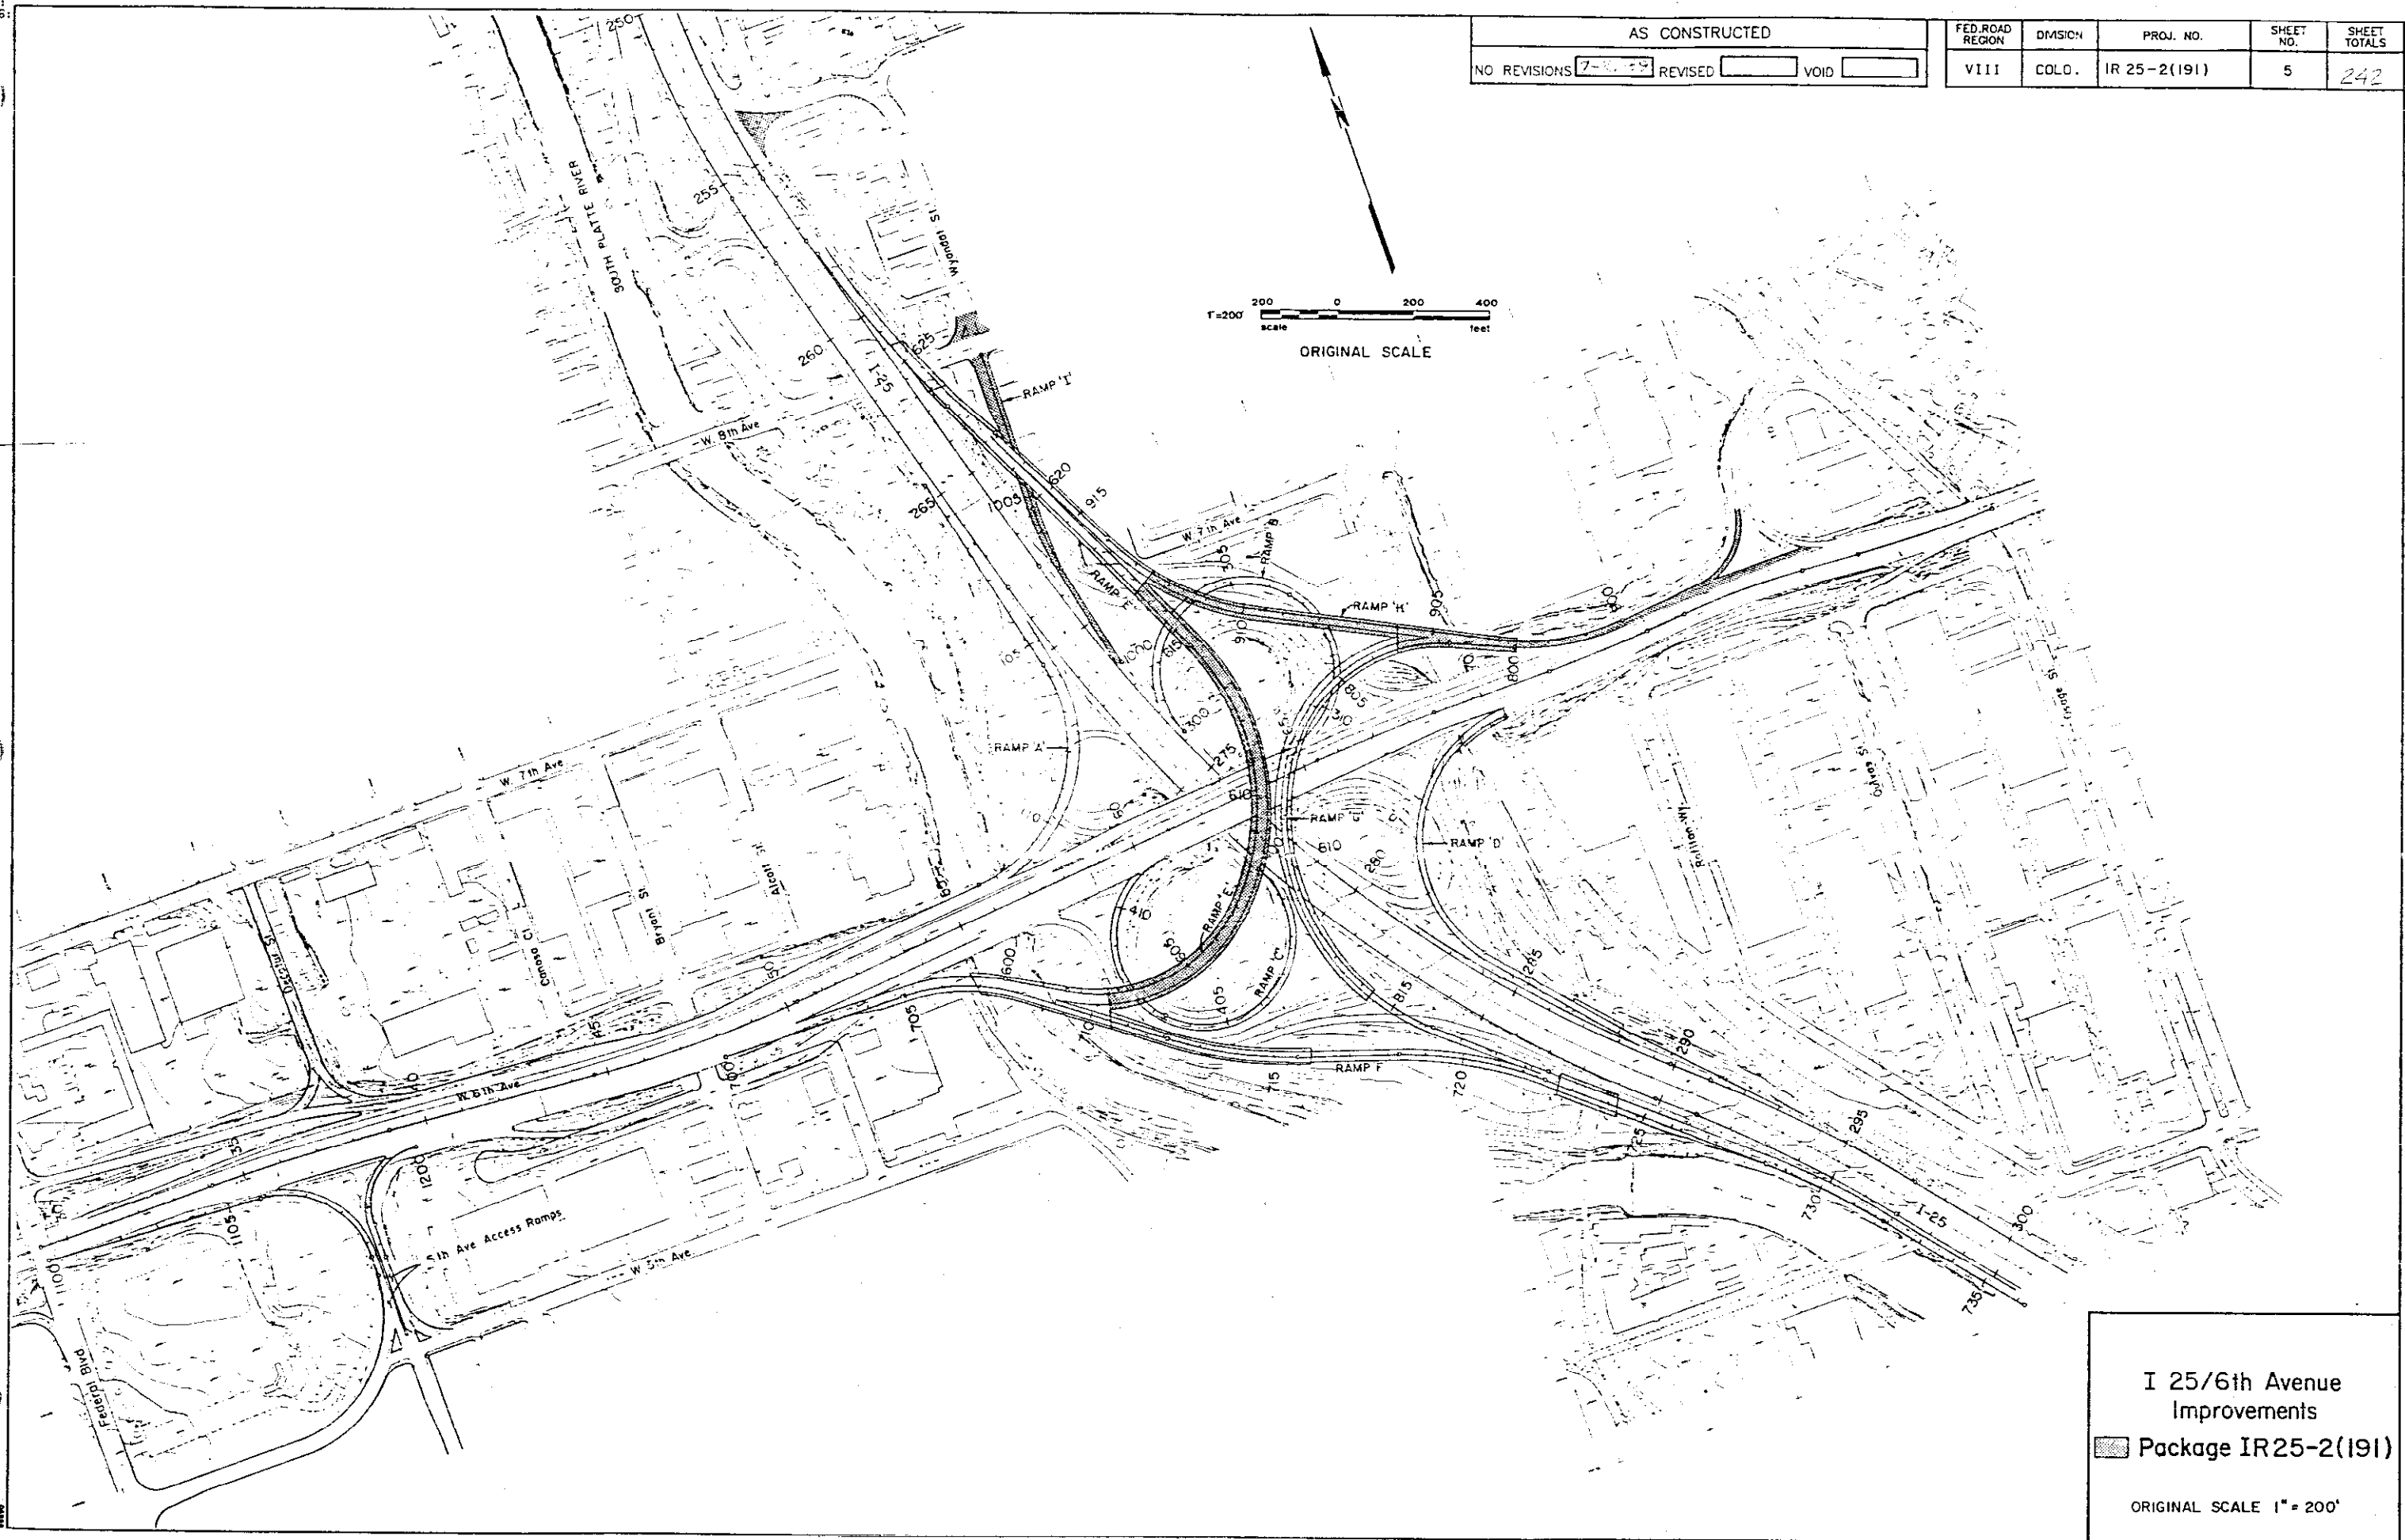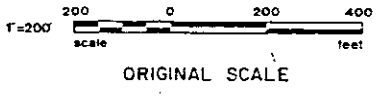

I 25/6th Avenue  
 Improvements  
 Package IR25-2(191)  
 ORIGINAL SCALE 1" = 200'

AS CONSTRUCTED		FED. ROAD REGION	DMSION	PROJ. NO.	SHEET NO.	SHEET TOTALS
NO REVISIONS	REVISED 7-21-82	VIII	COLO.	IR 25-2(191)	6	242

### GENERAL NOTES

IT IS SUGGESTED THAT THE CONTRACTOR INITIATE A REQUEST TO THE PUBLIC SERVICE COMPANY FOR ANY CONSTRUCTION RELATED TEMPORARY ELECTRICAL POWER SOURCES AS SOON AS POSSIBLE. IN SOME INSTANCES UP TO 30 DAYS MAY BE REQUIRED TO PROVIDE THE SOURCES. THE REQUEST IS TO BE PROCESSED THROUGH PUBLIC SERVICE COMPANY OF COLORADO - STREET LIGHTING AT (303) 571-2505.

ALL RANGE POINTS, TIES, BENCHMARKS, OR OTHER CITY AND COUNTY OF DENVER SURVEY CONTROL POINTS WHICH MAY BE ENCOUNTERED DURING CONSTRUCTION MUST BE PRESERVED. CONTACT THE CITY AND COUNTY OF DENVER SURVEYOR AT (303) 289-5440, EXT. 333.

THE TOP TWO FEET OF ALL INLETS TO BE PLUGGED SHALL BE REMOVED. THIS WORK WILL NOT BE PAID FOR SEPARATELY BUT SHALL BE INCLUDED IN THE WORK.

THE CONSTRUCTION TRAFFIC CONTROL FOR THIS PROJECT IS COVERED UNDER CONTRACT IR25-2(223).

IT IS ESTIMATED THAT 564 LIN. FT. OF GUARD RAIL TYPE 4 (PRECAST-PORTABLE) WILL BE STOCKPILED INSIDE THE SOUTHWEST QUADRANT LOOP RAMP UNDER CONTRACT IR25-2(187) AND WILL BE AVAILABLE FOR RESET ON THIS PROJECT.

IT IS ESTIMATED THAT 2,980 LIN. FT. OF GLARE SCREEN WILL BE REQUIRED. SEE CONSTRUCTION AND TEMPORARY PAVEMENT MARKING PLANS.

AN A IMPACT ATTENUATOR (SANDWICH SYSTEM) WILL BE REQUIRED AT THE RAMP 'H' EXIT FROM W. 6TH AVE. SEE DETAIL.

### GENERAL NOTES

PLAN QUANTITIES OF SURFACING MATERIALS ARE BASED ON THE FOLLOWING UNIT WEIGHTS AND RATES OF APPLICATION.  
 HOT BITUMINOUS PAVEMENT (GRADING E & EX) @ 110 LBS./SQ. YD./INCH.  
 EMULSIFIED ASPHALT (SLOW-SETTING) FOR TACK @ 0.10 GAL./SQ. YD. (DILUTED)

FOR QUANTITIES, DILUTED EMULSIFIED ASPHALT FOR TACK COAT WAS ESTIMATED AT 1 PART EMULSIFIED ASPHALT AND 1 PART WATER.

RATES OF APPLICATION SHALL BE AS DIRECTED BY THE ENGINEER AT THE TIME OF APPLICATION. RATES SHOWN ABOVE ARE APPROXIMATE AND ARE SUBJECT TO ADJUSTMENT ON CONSTRUCTION.

THE FOLLOWING SHALL BE FURNISHED WITH EACH BITUMINOUS PAYER:

1. A SKI TYPE DEVICE AT LEAST 30 FEET IN LENGTH.
2. SHORT SKI OR SHOE.
3. 1500 FEET OF CONTROL LINE AND STAKES. THE CONTROL LINE WILL BE REQUIRED FOR ALL LAYERS OR AS DIRECTED BY THE ENGINEER.

ANY LAYER OF BITUMINOUS PAVEMENT THAT IS TO HAVE A SUCCEEDING LAYER PLACED THEREON SHALL BE COMPLETED FULL WIDTH BEFORE SUCCEEDING LAYER IS PLACED.

WATER SHALL BE USED AS A DUST PALLIATIVE WHERE REQUIRED. LOCATIONS SHALL BE AS ORDERED. WATER USED FOR THIS PURPOSE WILL NOT BE PAID FOR SEPARATELY BUT SHALL BE INCLUDED IN THE WORK.

UTILITIES AS SHOWN ON PLAN AND PROFILE SHEETS ARE PLOTTED FROM THE BEST AVAILABLE INFORMATION. THE CONTRACTOR'S ATTENTION IS DIRECTED TO PARAGRAPH 107.18 OF THE STANDARD SPECIFICATIONS CONCERNING UTILITIES.

THE CONTRACTOR WILL CALL 534-6700 FOR UTILITY LOCATIONS PRIOR TO ANY DIGGING.

ALL DIMENSIONS, ELEVATIONS, AND RADII ARE TO EDGE OF DRIVING LANE (CLIP OF GUTTER) UNLESS OTHERWISE NOTED.

TYPE OF COMPACTION FOR EMBANKMENT SHALL BE AASHTO T99.

DEPTH OF MOISTURE-DENSITY CONTROL FOR THIS PROJECT SHALL BE AS FOLLOWS:

- FULL DEPTH OF ALL EMBANKMENTS.
- BASES OF CUTS AND FILLS - 0.67 FT.
- EXCAVATION REQUIRED FOR COMPACTION OF BASES OF CUTS AND FILLS WILL BE CONSIDERED AS SUBSIDIARY TO THAT OPERATION AND WILL NOT BE PAID FOR SEPARATELY.


THE MINIMUM THICKNESS OF TOPSOIL (HAUL) SHALL BE 4 INCHES. IT IS ESTIMATED THAT 2,546 CU. YDS. WILL BE REQUIRED. THE TOPSOIL IS TO BE CONTRACTORS SOURCE.

INTERSTATE RIGHT-OF-WAY FENCING SHALL BE MAINTAINED AT ALL TIMES AS DIRECTED BY THE ENGINEER. COST TO BE INCLUDED IN THE WORK.

A SUGGESTED SEQUENCE OF CONSTRUCTION CAN BE FOUND ON DETOUR PLAN AND CONSTRUCTION PHASING SHEET. THIS SEQUENCE IS FOR INFORMATION ONLY. PRIOR TO BEGINNING CONSTRUCTION, THE CONTRACTOR IS TO SUBMIT A CONSTRUCTION SEQUENCING PLAN FOR ENGINEER'S APPROVAL.

ALL GUARD RAIL TYPE 5 REMOVED ON THIS PROJECT IS TO REMAIN THE PROPERTY OF THE STATE AND IS TO BE STOCKPILED ON THE PROJECT SITE.

THE CONTRACTOR SHALL LIMIT CONSTRUCTION ACTIVITIES TO THOSE AREAS WITHIN THE LIMITS OF DISTURBANCE AND/OR TOES OF SLOPE AS SHOWN ON THE PLANS AND CROSS SECTIONS. ANY DISTURBANCE BEYOND THESE LIMITS SHALL BE RESTORED TO ORIGINAL CONDITION BY THE CONTRACTOR AT HIS OWN EXPENSE. CONSTRUCTION ACTIVITIES, IN ADDITION TO NORMAL CONSTRUCTION PROCEDURES, SHALL INCLUDE THE PARKING OF VEHICLES OR EQUIPMENT, DISPOSAL OF LITTER AND ANY OTHER ACTION WHICH WOULD ALTER EXISTING CONDITIONS.

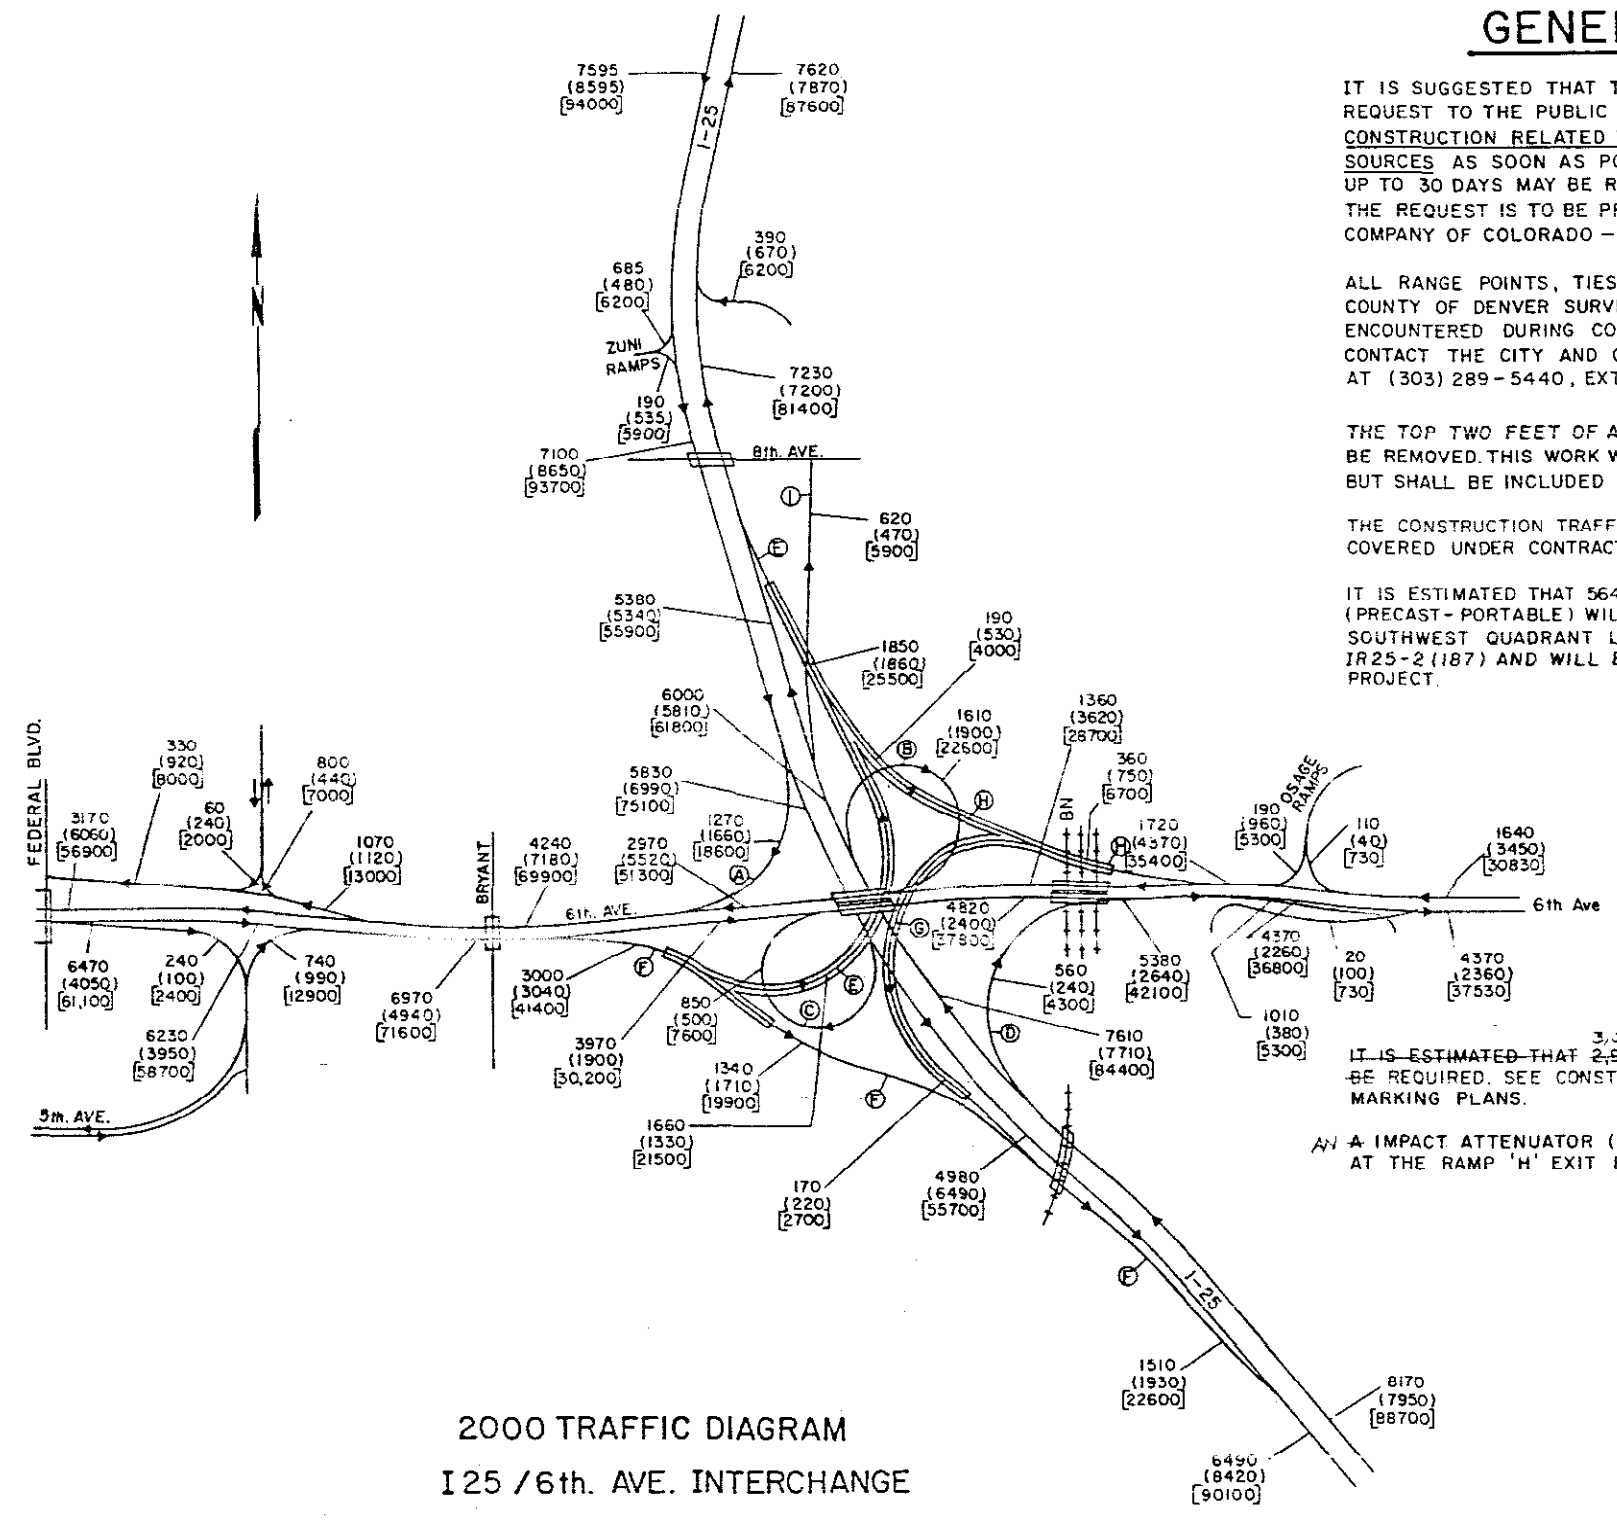


2000 TRAFFIC DIAGRAM  
 I 25 / 6th. AVE. INTERCHANGE


9020 = A.M. PEAK HOUR  
 (10300) = P.M. PEAK HOUR  
 [98,000] = AVERAGE DAILY TRAFFIC (DIRECTIONAL)

AS CONSTRUCTED		
NO REVISIONS	7/21/11	REVIS
VOID		


FED. ROAD REGION	DIVISION	PROJ. NO.	SHEET NO.	SHEET TOTALS
VIII	COLO.	IR 25-2(191)	7	242

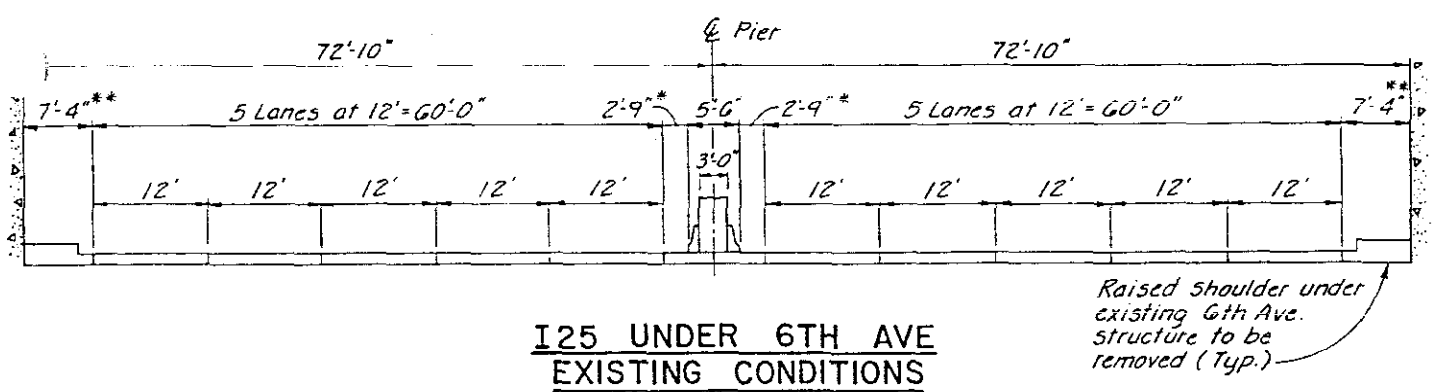


**I25 UNDER 6TH AVE  
EXISTING CONDITIONS**

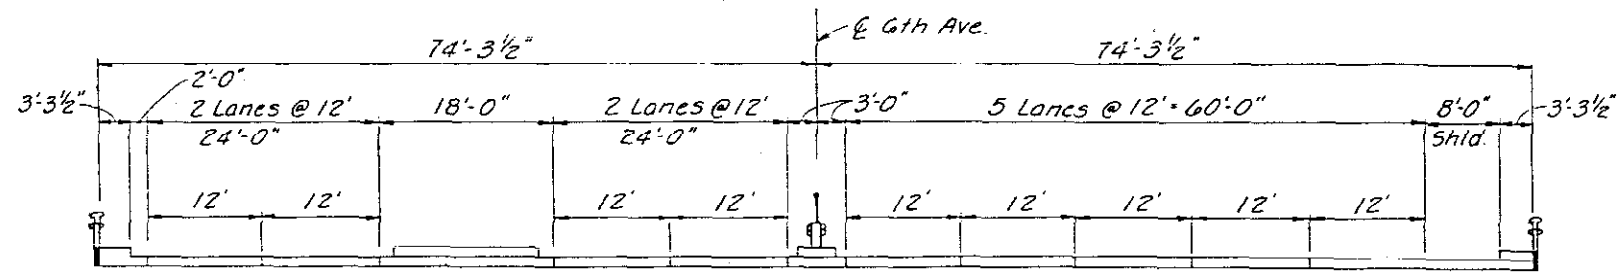


**6TH AVE NEAR I25  
EXISTING CONDITIONS**

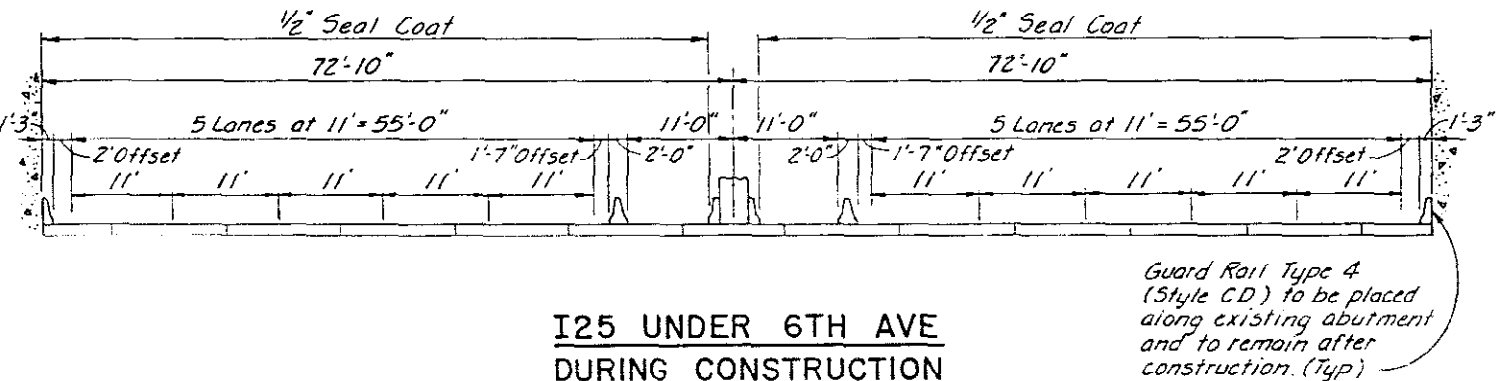


**I25 UNDER 6TH AVE  
DURING CONSTRUCTION**

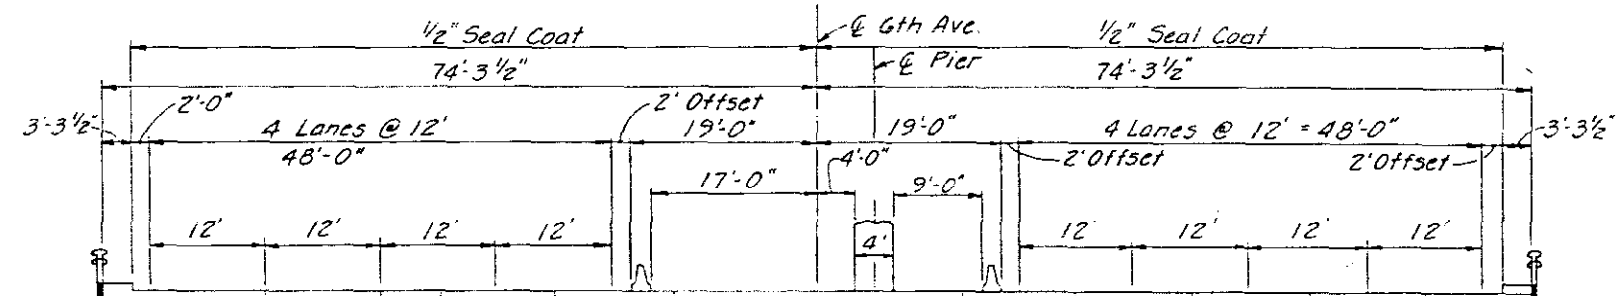

**6TH AVE NEAR I25  
DURING CONSTRUCTION**

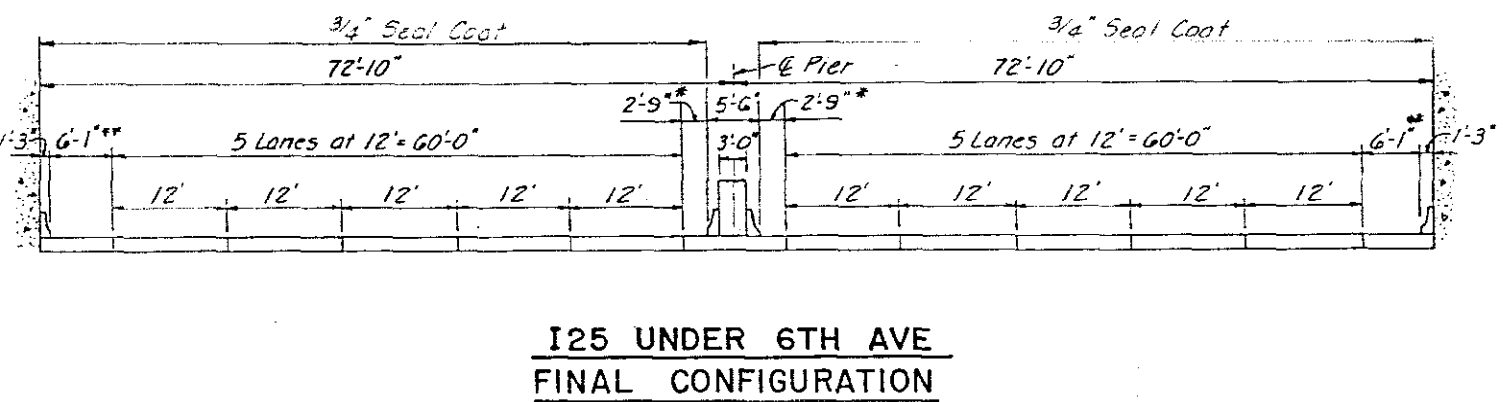


**I25 UNDER 6TH AVE  
FINAL CONFIGURATION  
(FUTURE)**

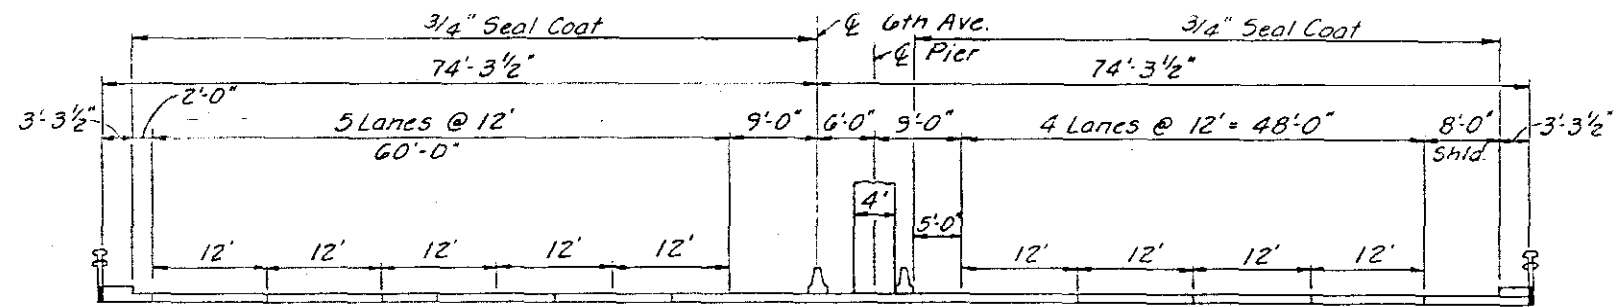

**6TH AVE NEAR I25  
FINAL CONFIGURATION  
(FUTURE)**

\* Shoulder varies, 2'-1" min.  
\*\* Shoulder varies, 5'-6" min.

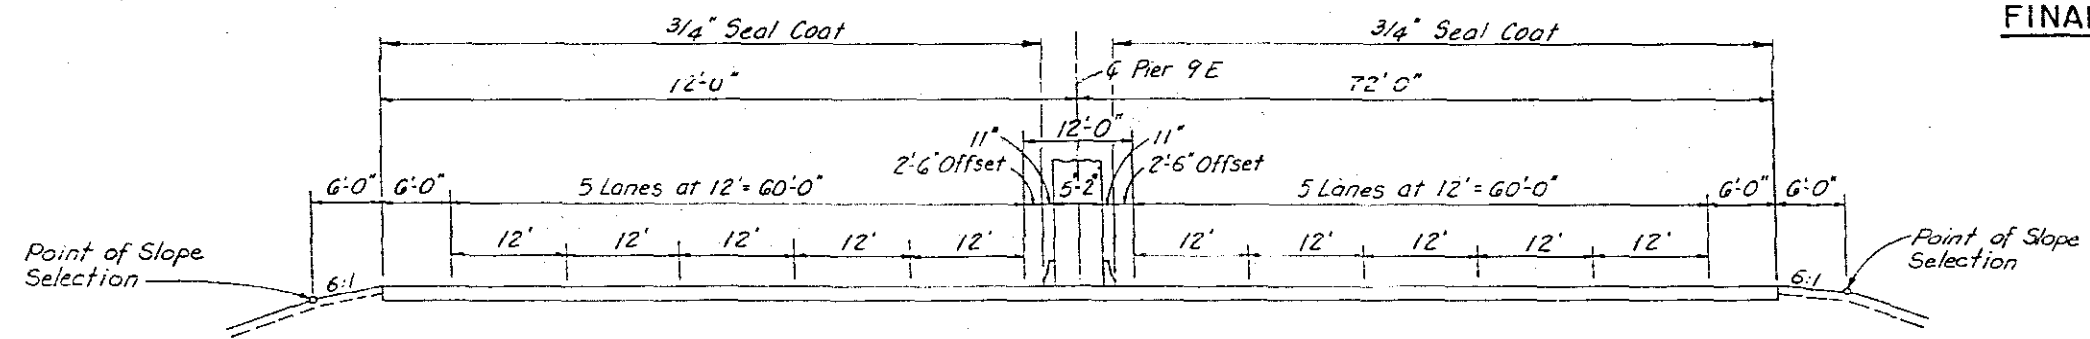


**I25 AT RAMP "E" PIER  
FINAL CONFIGURATION**


NOTE:  
1-25 Sections Looking North  
6TH Ave. Sections Looking East

**6TH AVE AND I25  
TYPICAL SECTIONS**


AS CONSTRUCTED		FED. ROAD REGION	DIVISION	PROJ. NO.	SHEET NO.	SHEET TOTALS
NO REVISIONS	REVISED 7-31-82	VOID	VIII	COLO.	IR 25-2 (191)	8 242

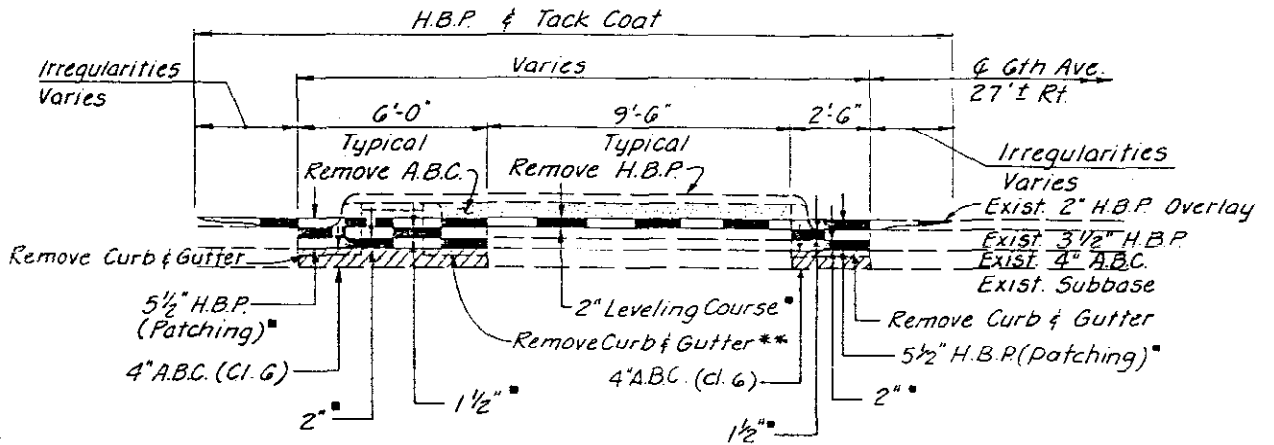

STA. 57+75 TO STA. 75+05

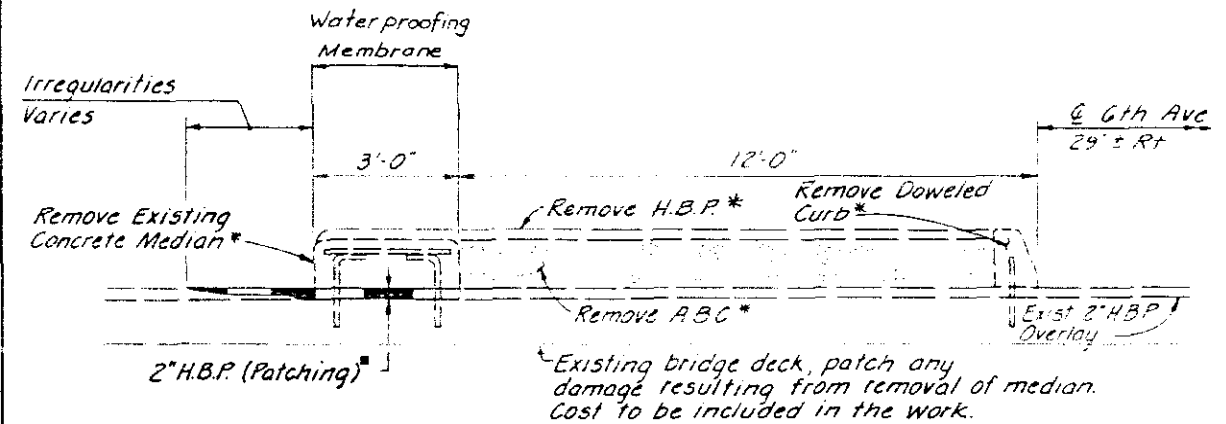


ON STRUCTURE F-16-EJ

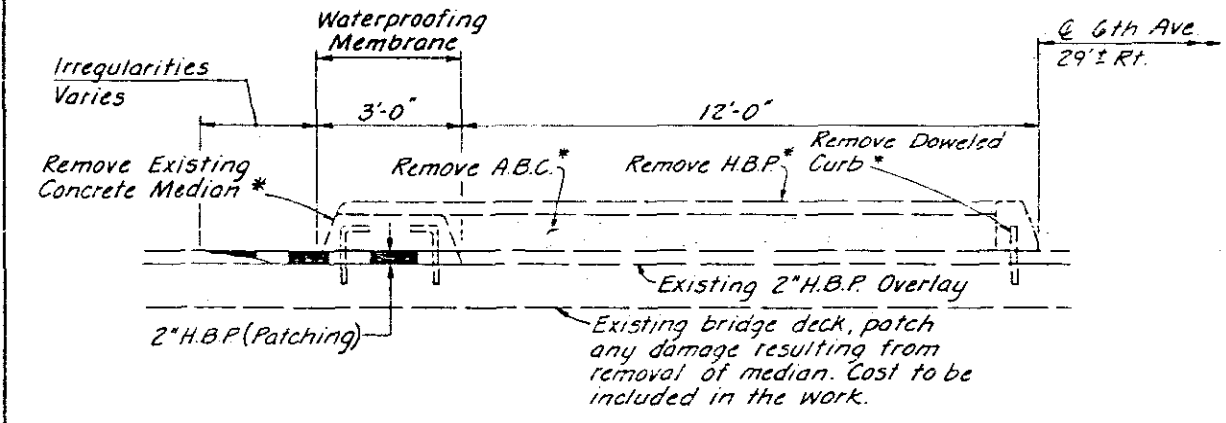


ON STRUCTURE F-16-DU

W.B. 6TH AVE. C.D. MEDIAN MODIFICATION

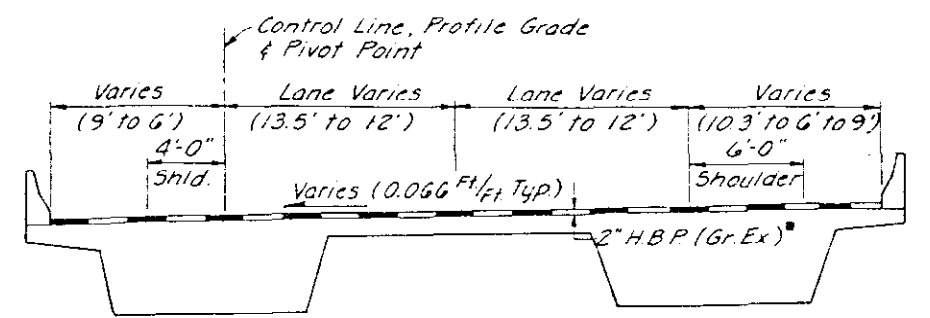


RAMP 'E'


STA. 602+78.57 TO STA. 616+56.62  
(BRIDGE STRUCTURE)

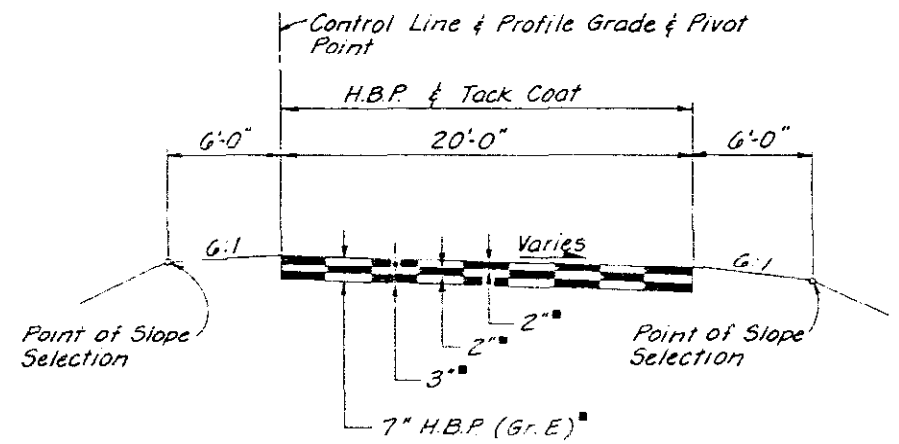


DETOUR C

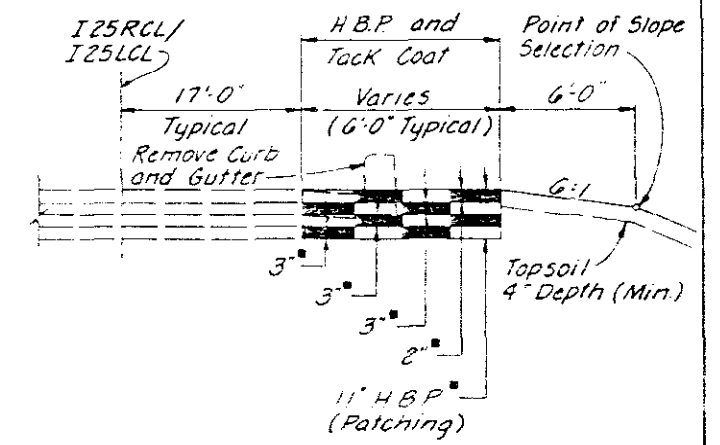

I25 WIDENING

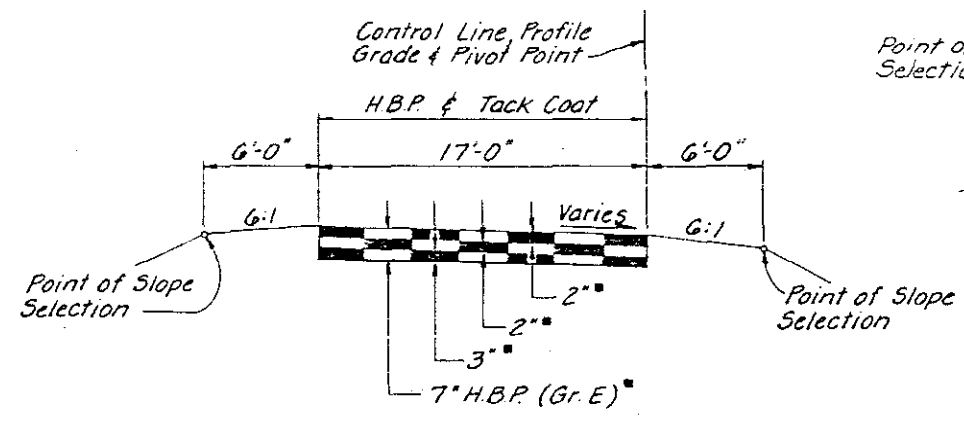

DETOUR D

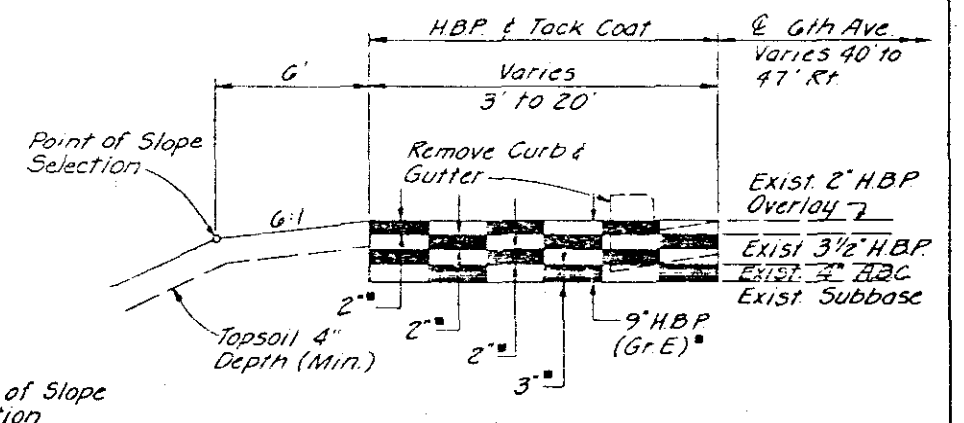

STA. 75+58.00 TO STA. 79+60.00  
6TH AVE. WIDENING

\* Removal to be paid for as "Removal of Portions of Present Structure."  
\*\* Sta. 60+00 to Sta. 71+50 (See Geometric Plan W. 6th Ave.)  
Approximate Thickness

6TH AVE. & I25 WIDENING,  
RAMP 'E', DETOUR, AND C.D.  
MEDIAN MODIFICATION  
TYPICAL SECTIONS  
De Louw Cather & Company Denver, Co.



\*\*\* Cross Slope Varies on Right side of Hinge Point from +0.020 Ft./Ft. to Match Existing 8th Ave. Grade (≈ -0.002 Ft./Ft.) between Sta. 1008+00.00 and Sta. 1008+95.32.  
 HBP, Tack Coat & Future Overlay

\*\*\*\* Cross Slope Varies on Left Side of Hinge Point from -0.01 Ft./Ft. to Match Existing 8th Ave. Grade (≈ -0.002 Ft./Ft.) Between Sta. 1008+50.00 and Sta. 1008+95.32.  
 HBP, Tack Coat & Future Overlay

SLOPE SELECTION TABLE "A"







SLOPE	"H" HEIGHT OF FILL	"H" HEIGHT OF CUT
6:1	0' - 10'	0' - 10'
3:1	OVER 10'	OVER 10'

IN SPECIAL CASES SLOPE MAY BE STEEPENED AS DIRECTED BY THE ENGINEER.

AS CONSTRUCTED

NO REVISIONS	REVISED	VOID
	2-21-89	


FED. ROAD REGION	DIVISION	PROJ. NO.	SHEET NO.	SHEET TOTALS
VIII	COLO.	IR 25-2(191)	9	242

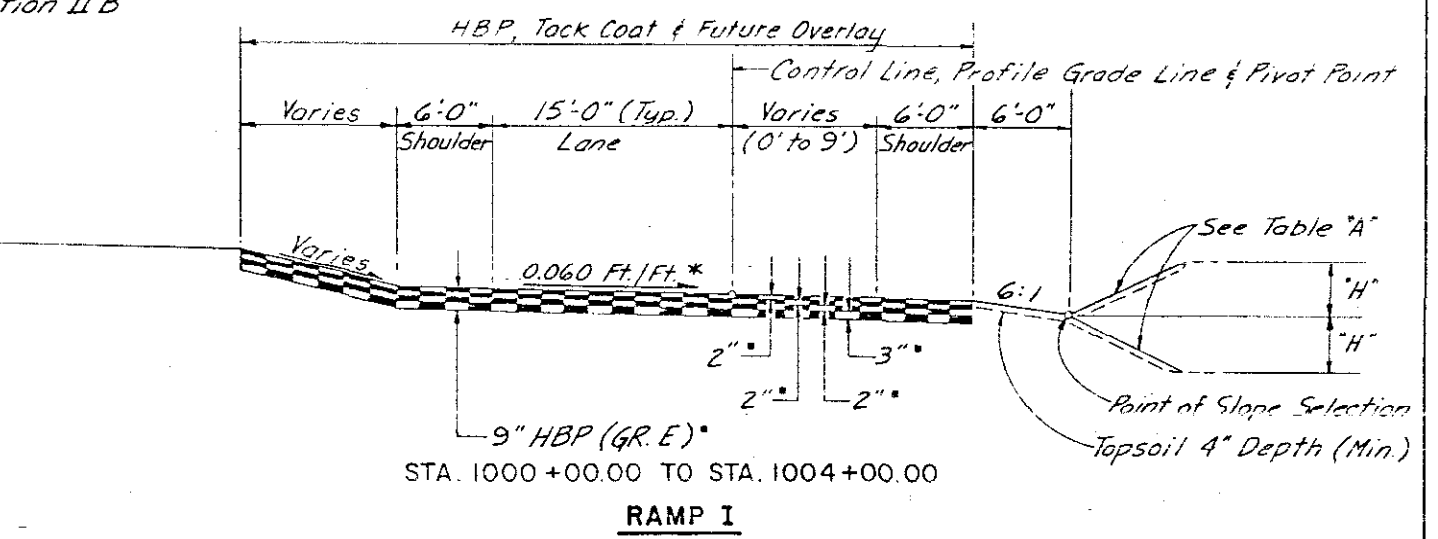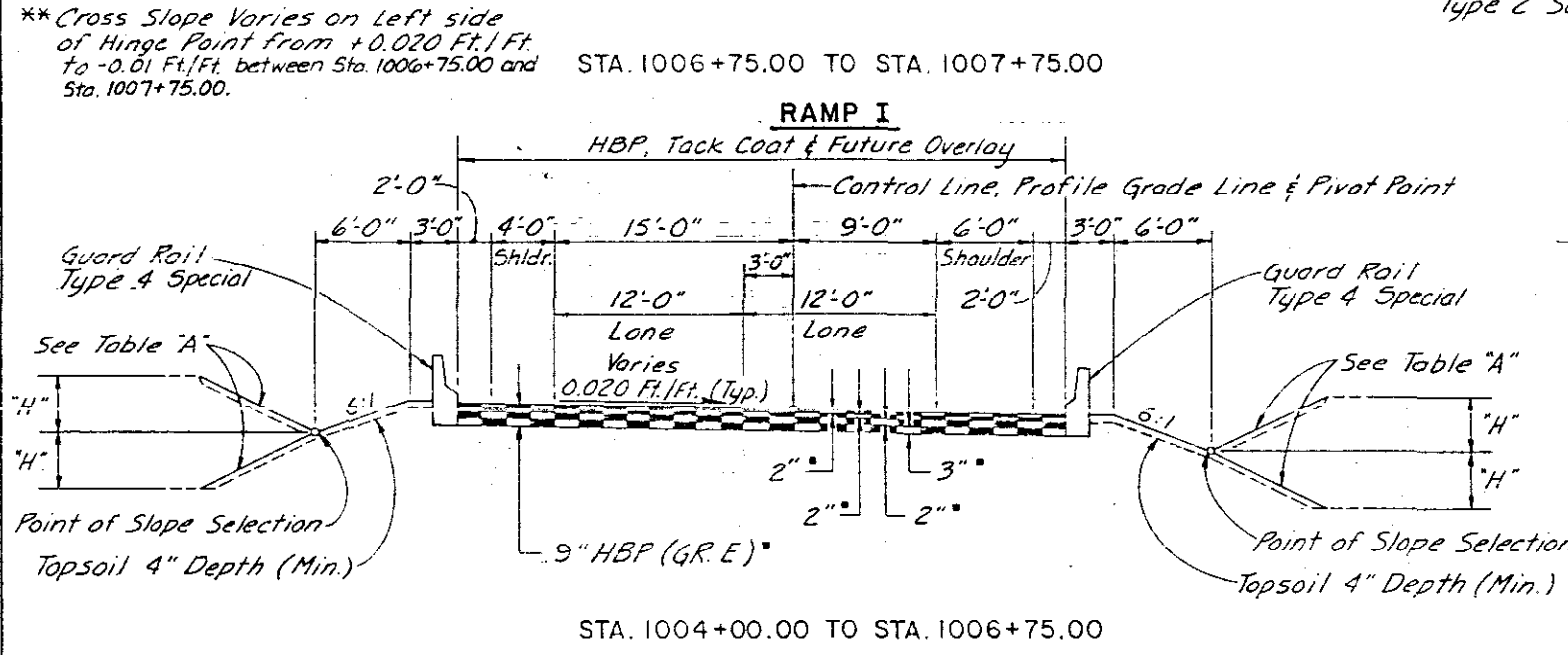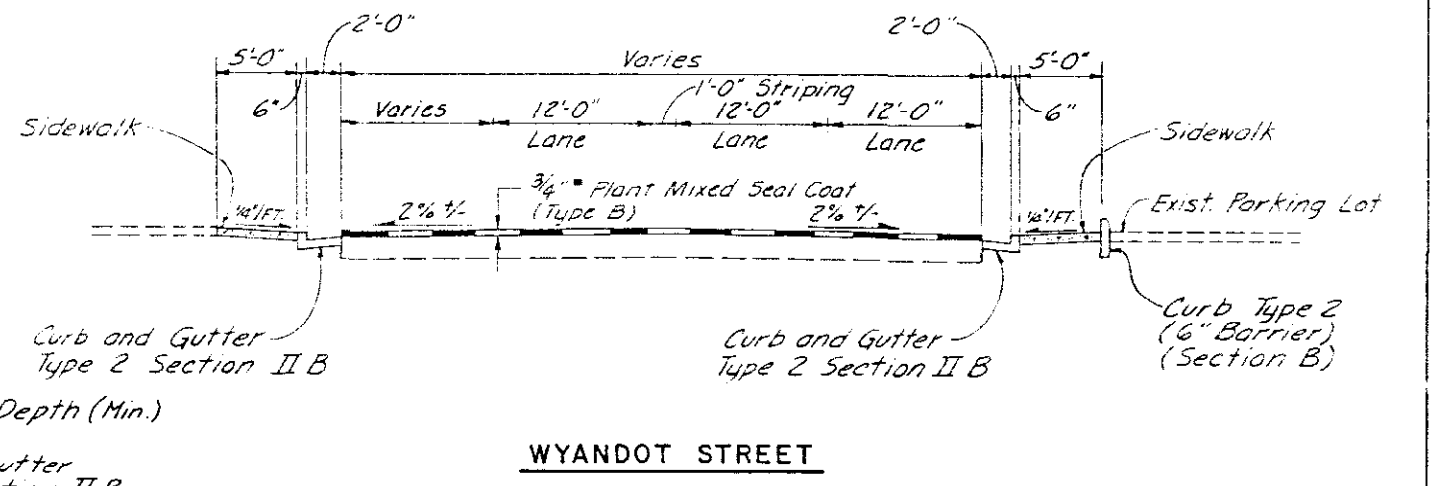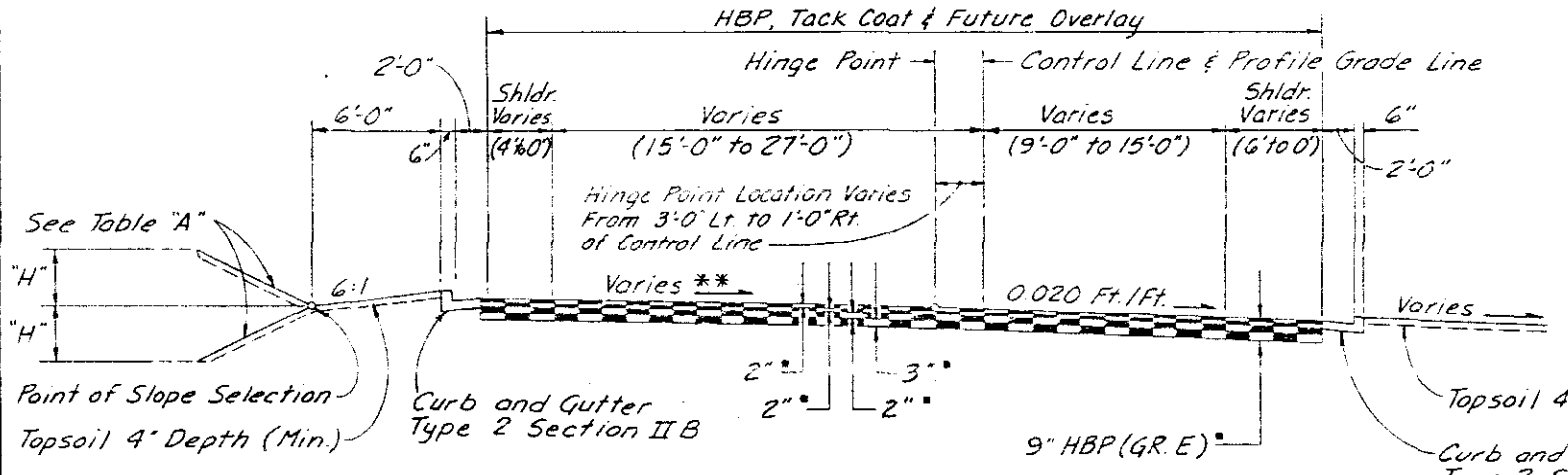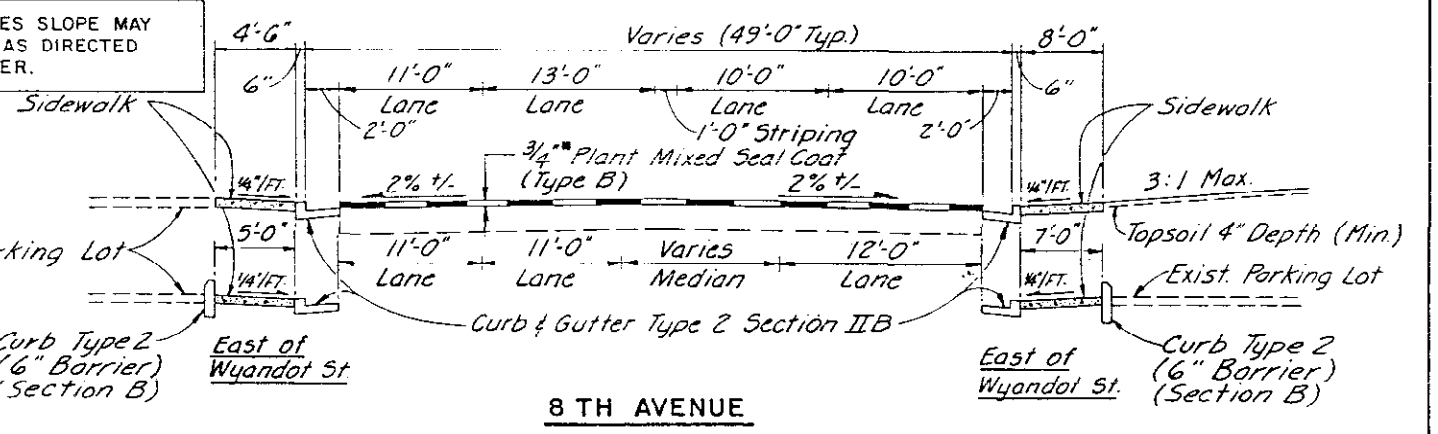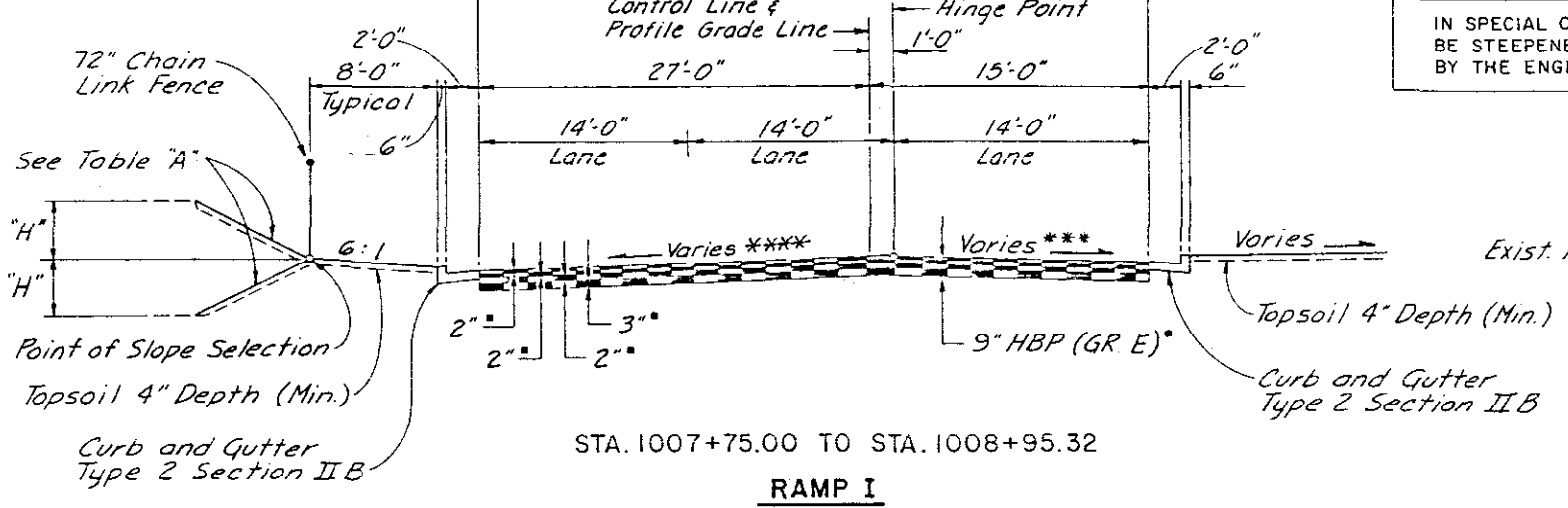

Note: For Transitions from Sta. 1000+00.00 to Sta. 1002+20.00 and Sta. 1002+90.00 to Sta. 1003+90.00 See Plan & Profile Ramp "I".

\*0.060 FT./FT. Typical, Cross Slope to Match Existing I25 at Sta. 1000+00.00 and Transition to 0.020 FT./FT. at Sta. 1002+50.00

RAMP "I", 8 TH AVENUE AND WYANDOT STREET  
 TYPICAL SECTIONS  
 De Leuw Cather & Company Denver, Co.

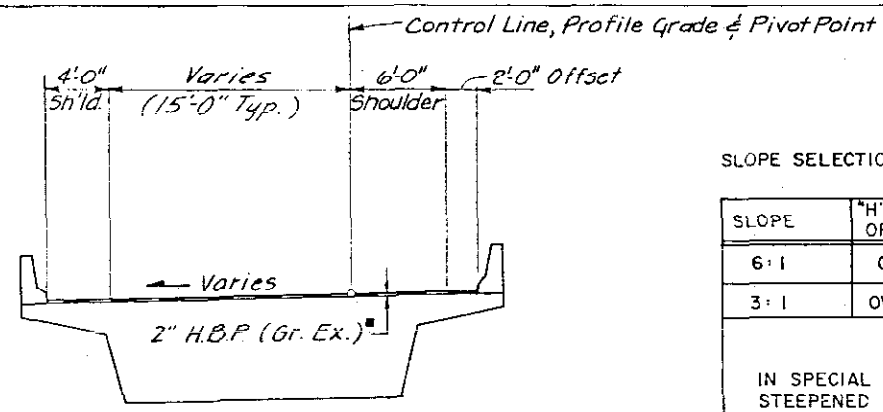


STA. 906+18.00 TO STA. 912+85.32

RAMP H

SLOPE SELECTION TABLE 'A'

SLOPE	"H" HEIGHT OF FILL	"H" HEIGHT OF CUT
6:1	0'-10'	0'-10'
3:1	OVER 10'	OVER 10'

IN SPECIAL CASES SLOPE MAY BE STEEPENED AS DIRECTED BY THE ENGINEER.

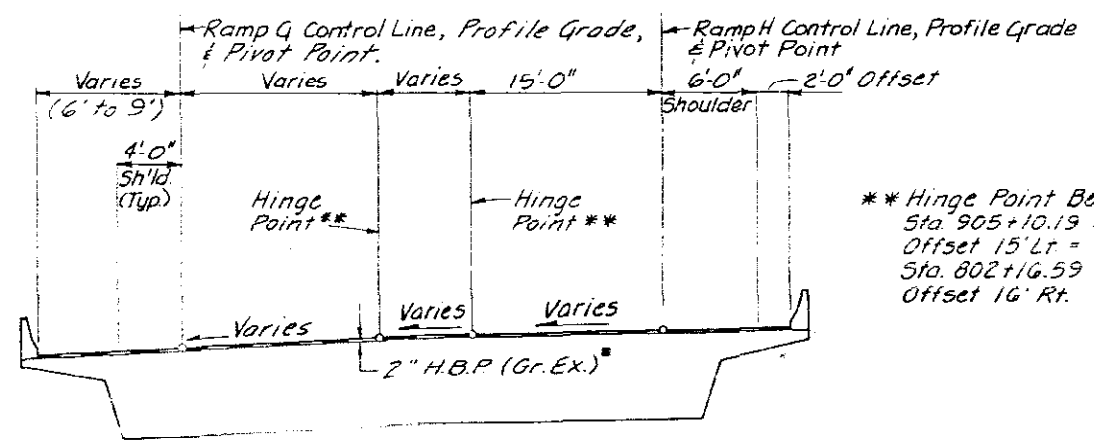


STA. 903+10.00 TO STA. 906+18.00

RAMP H\*


\*\* Hinge Point Begins at Sta. 905+10.19 Ramp 'H' Offset 15' Lt = Sta. 802+16.59 Ramp 'G' Offset 16' Rt.

AS CONSTRUCTED		FED. ROAD REGION	DIVISION	PROJ. NO.	SHEET NO.	SHEET TOTALS
NO REVISIONS	REVISED 7-21-84	VIII	COLO.	IR 25-2(191)	10	242


\*\*\* The Offset Location of Barrier and Point of Slope Selection Right of the Control line May Be Adjusted as required to Clear falsework in The vicinity of Pier 6H as Approved by The Engineer.

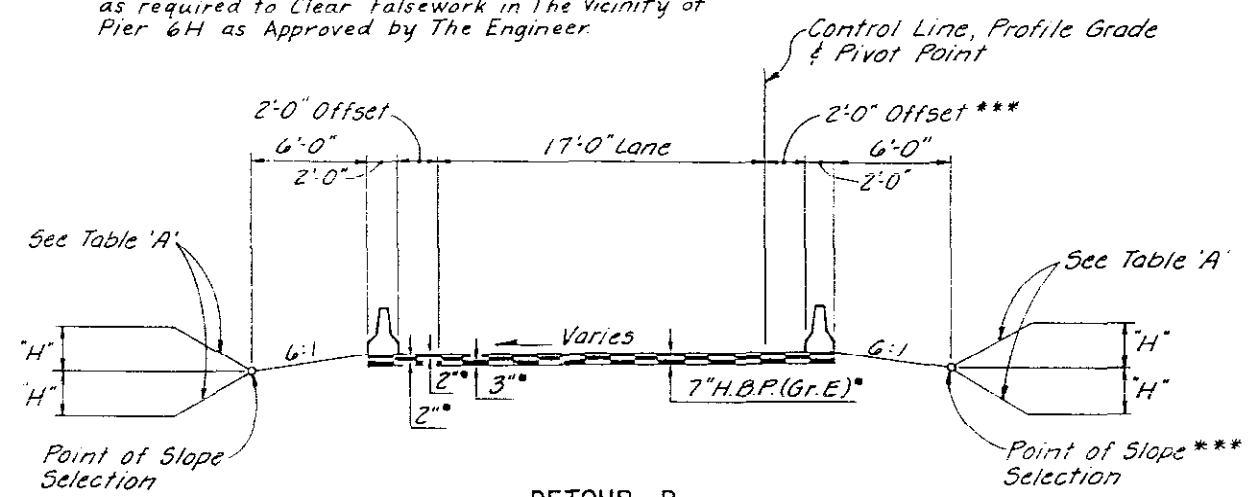

DETOUR B

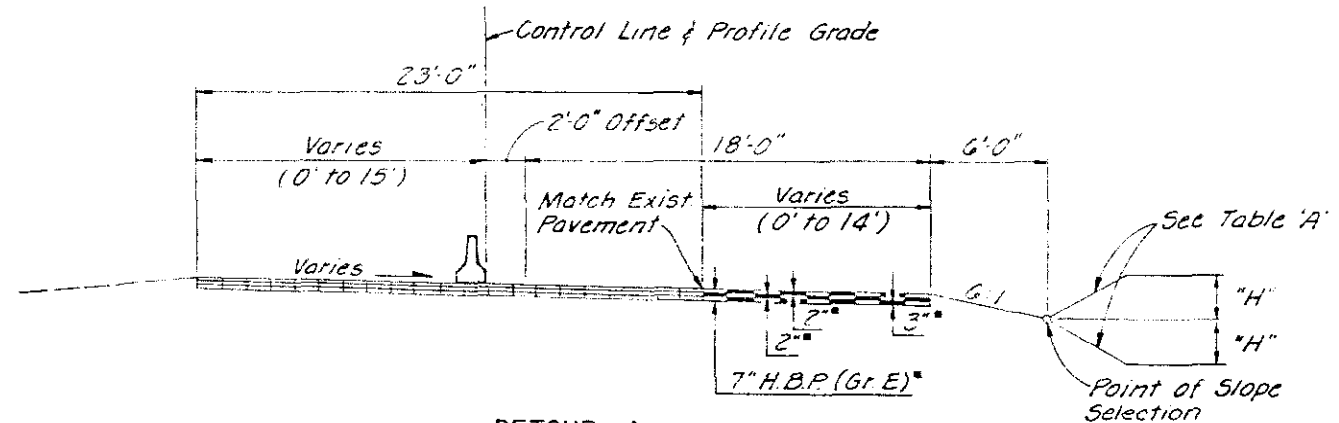

DETOUR A

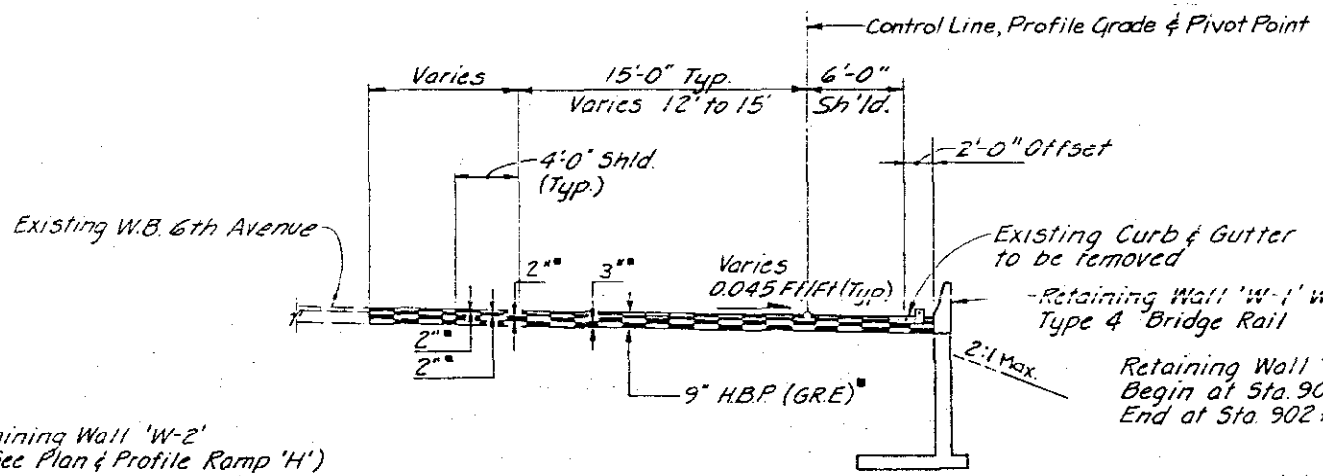


STA. 900+00.00 TO STA. 903+10.00

RAMP H\*

Retaining Wall 'W-2' (See Plan & Profile Ramp 'H') Begin at Sta. 902+78.23 End at Sta. 902+96.47 = Sta. 800+04.06 Ramp 'G'

\* Begin Ramp 'G' Sta. 800+00.00 = Sta. 902+92.53 Ramp 'H' Offset 15.12' Lt.

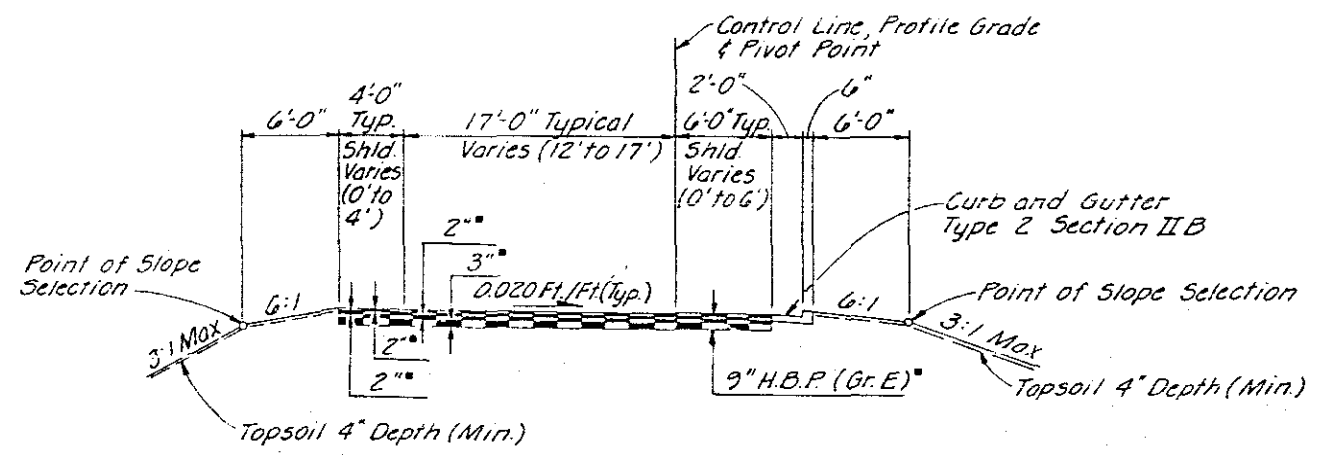

OSAGE ON RAMP

Approximate Thickness

RAMP 'H', DETOUR AND OSAGE ON RAMP TYPICAL SECTIONS

# SUMMARY OF APPROXIMATE QUANTITIES

AS CONSTRUCTED  
 NO REVISIONS  REVISED  VOID   
 FED. ROAD REGION: VIII DIVISION: COLO. PROJ. NO.: IR 25-2(191) SHEET NO.: 11 SHEET TOTALS: 24

INDEX BOOK PAGE SHEET	CONTRACT ITEM NO.	CONTRACT ITEM	UNIT	ROADWAY	AS CONST. ROADWAY			AS CONST. UTILITIES			PROJECT TOTALS	TOTALS AS CONST.	DIFF. + / -	% PLAN		
					STR. NO. F-16-OG	AS CONST. F-16-OG	STR. NO. F-16-OK	AS CONST. F-16-OK	STR. NO. F-16-NO	AS CONST. F-16-NO						
1	1	201	Clearing and Grubbing	LS.	1							1	1			
	2	202	Removal of Structures and Obstructions	LS.	1							1	1			
	3	202	Removal of Pipe	Ln Ft.	165							165	110			
	4	202	Removal of Barricade	Each	1							1	1			
	5	202	Removal of Delineator	Each	36							36	34			
	6	202	Removal of Sidewalk	Sq.Yd.	52							52	52			
	7	202	Removal of Gutter	Ln Ft.	2,075							2,075	1,631			
	8	202	Removal of Curb and Gutter	Ln Ft.	10,590							10,590	10,305			
	9	202	Removal of Asphalt Mat	Sq.Yd.	7,425							7,425	8,692			
	10	202	Removal of Asphalt Mat (Planing)	Sq.Yd.	11,167							11,167	9,143			
	11	202	Removal of Pavement Marking	Sq.Ft.	11,378							11,378	5,625			
	12	202	Removal of Portions of Present Structure	LS.	1							1	1			
	13	202	Removal of Luminaire	Each	8							8	8			
	14	202	Removal of Overhead Sign Structure	Each	4							4	4			
	15	202	Removal of Ground Sign	Each	30							30	31			
	16	202	Removal of Sign Panel	Each	4							4	4			
	17	202	Removal of Traffic Signal Head	Each	12							12	12			
	18	202	Removal of Traffic Signal Pole	Each	4							4	6			
	19	202	Removal of Traffic Signal Controller and Cabinet	Each	1							1	1			
	21	202	Removal of Guard Rail Type 3	Lin. Ft.	565							565	566			
	21	202	Removal of Guard Rail Type 4	Ln.Ft.	230							230	400			
	22	202	Removal of Guard Rail Type 5	Ln.Ft.	730							730	734			
	23	202	Plug Structure	Each	12							12	12			
	24	202	Plug Culvert	Each	7							7	8			
2	25	203	Embankment Material (Complete In Place)	Cu.Yd.	6,332	8326						6,332	8326			
	26	206	Structure Excavation	Cu.Yd.	1,031	1,340	138	135	954	954	421	421	2,544	2,653		
	27	206	Structure Backfill (Class 1)	Cu.Yd.	1,057	1,065			549	549			1,606	1,634		
	28	206	Structure Backfill (Class 2)	Cu.Yd.	31	60	98	33	512	512	481	431	1,122	1,151		
	29	206	Filter Material (Class B)	Cu.Yd.	41	41			13	13			54	57		
	30	207	Topsoil (Haul)	Cu.Yd.	2,546	1949							2,546	1949		
	31	210	Reset Delineator	Each	19							19	19			
	32	210	Reset Ground Sign	Each	3							3	12			

(L-1) 8-25-87, Clarified Fly Item, J.K.K.

# SUMMARY OF APPROXIMATE QUANTITIES

AS CONSTRUCTED			FED. ROAD REGION	DIVISION	PROJ. NO.	SHEET NO.	SHEET TOTALS
NO REVISIONS <input type="checkbox"/>	REVISED <input type="checkbox"/>	VOID <input type="checkbox"/>	VIII	COLO.	IR 25-2(191)	12	24

INDEX BOOK PAGE SHEET	CONTRACT ITEM NO.	CONTRACT ITEM	UNIT	ROADWAY	AS CONST.			AS CONST.			UTILITIES	AS CONST. UTILITIES	PROJECT TOTALS	TOTALS AS CONST.	DIFF. + / -	% PLAN
					ROADWAY	STR. NO. F-16-0G	AS CONST. F-16-0G	STR. NO. F-16-0K	AS CONST. F-16-0K	STR. NO. F-16-NO						
2	33	210	Reset Sign Panel	Each	1		1					1	1			
	34	210	Reset Fence	Lin. Ft.	75		75					75	75			
	35	210	Reset Guard Rail Type 4	Lin. Ft.	1286		1286					1286	1286			
	36	210	Modify Inlet	Each	2		1					2	1			
	37	212	Seeding (Native) DOH 105	Acre	5		0					5	0			
	38	212	Seeding (lawn) DOH 105	Acre	2		0					2	0			
	39	212	Sod	Sq. Ft.	160,000		160,000					160,000	160,000			
	40	213	Mulching (Hydraulic) DOH 105	Acre	7		0					7	0			
	41	213	Erosion Bales DOH 105	Each	50		0					50	0			
	42	214	Purple Ash (Fraxinus Autumn Purple) (4 Inch Caliper) DOH 105	Each	11		0					11	0			
	43	215	Transplant Tree (3 to 6 Inch) DOH 105	Each	1		0					1	0			
2	44	215	Transplant Tree (Over 6 Inch)	Each	19		10					19	10			
3	45	403	Hot Bituminous Pavement (Patching) (Haul and Asphalt)	Ton	873		1730					873	1730			
	46	403	Hot Bituminous Pavement (Grading E) (Haul) CMC 102	Ton	4,448		0					4,448	0			
	47	403	Hot Bituminous Pavement (Grading EX) (Haul) CMC 102	Ton	1,314		0	725	0	168	0	224	0	2,431	0	
	48	410	Plant Mixed Seal Coat (Type B) (Haul) CMC 102	Ton	1,956		0						0	1,956	0	
	49	411	Asphalt Cement (AC-10) (Fortified) CMC 102	Ton	328		0	41	0	10	0	13	0	392	0	
	50	411	Asphalt Cement (AC-20) (Rubberized) CMC 102	Ton	137		0						0	137	0	
	51	411	Asphalt Cement (Scrap Rubber) (Crack Filler)	Ton	1		1.57						1.57	1	1.57	
	52	411	Emulsified Asphalt (Slow-Setting)	Gal.	1,277		2550						2550	1,277	2550	
3	53	412	Concrete Pavement (6 Inch)	Sq. Yd.	114		122						114	122		
(R-1) 4	54	502	Drive Steel Piling DOH 105	Lin. Ft.	120		0						120	0		
	55	502	Steel Piling (HP 10 X 42)	Lin. Ft.	860		734						860	734		
	56	502	Steel Piling (HP 14 X 89)	Lin. Ft.						1,068	769			1,068	769	
	57	503	Drilled Caisson (48 Inch)	Lin. Ft.			7			112	112	250	275	362	357	
	58	503	Drilled Caisson (60 Inch)	Lin. Ft.						77	79			77	79	
	59	503	Drilled Caisson (84 Inch)	Lin. Ft.				461	464					461	464	
	60	507	Concrete Slope and Ditch Paving (Reinforced)	Cu. Yd.	67		61							67	61	
	61	509	Structural Steel	LB.			2,054,330		2,054,330					2,054,330	2,054,330	
	62	509	Structural Steel (Galvanized)	LB.					2,610	2,610				2,610	2,610	
	63	512	Bearing Device (Type III)	Each			28	28	8	8	2	2		38	38	
	64	513	Bridge Drain (Special)	Each			7	7	2	2	2	2		11	11	
	65	513	Drain Pipe (3 Inch)	Lin. Ft.	13	13			7	7				20	20	
	66	515	Waterproofing (Membrane)	Sq. Yd.	164		6,600	6,653	1,571	1,474	2,074	2,101		10,245	10,352	
	67	518	Bridge Compression Joint Sealer	Lin. Ft.					18	18				18	18	
4	68	518	Waterstop (6 Inch)	Lin. Ft.	13	13			33	29				46	45	
	69	518	Bridge Expansion Device (0-4 Inch)	Lin. Ft.					30	30				30	30	
	70	518	Bridge Expansion Device (0-9 Inch)	Lin. Ft.			132	132	31	31	27	27		190	190	

FINAL  
**SUMMARY OF APPROXIMATE QUANTITIES**

AS CONSTRUCTED  
NO REVISIONS  REVISED  VOID

FED. ROAD REGION	DIVISION	PROJ. NO.	SHEET NO.	SHEET TOTALS
VIII	COLO.	IR 25-2(19)	13	24

INDEX BOOK PAGE SHEET	CONTRACT ITEM NO.	CONTRACT ITEM	UNIT	ROADWAY	AS CONST. ROADWAY		STR. NO. F-16-OG		AS CONST. F-16-OG		STR. NO. F-16-OK		AS CONST. F-16-OK		UTILITIES	AS CONST. UTILITIES	PROJECT TOTALS	TOTALS AS CONST.	DIFF. + / -	% PLAN
5	71	601	Concrete Class A (Bridge)								542	542	127	127			669	669		
	72	601	Concrete Class A (Wall)		173	174	65										173	174	65	
	73	601	Concrete Class D (Bridge)					2,220	2,220				63	63			2,283	2,283		
5	74	601	Concrete Class S (Bridge)					443	443	1,196	1,196	1,275	1,275				2,914	2,914		
6	75	602	Reinforcing Steel							19,490	19,490	11,450	11,450				30,940	30,940		
6	76	602	Reinforcing Steel (Epoxy Coated)		26,965	26,965	819,035	797,687	326,440	337,441	322,400	322,400					1,494,840	1,484,493		
7	77	604	Inlet Type C (5 Foot)		1	2											1	2		
	78	604	Inlet Type C (10 Foot)		1	1											1	1		
	79	604	Inlet Type 13 (5 Foot)		2	2											2	2		
	80	604	Inlet Type R L 10 (5 Foot)		2	2											2	2		
	81	604	Manhole Slab Base (10 Foot)		2	2											2	2		
	82	604	15 Inch Reinforced Concrete Pipe Sewer		38	126											38	126		
	83	604	24 Inch Reinforced Concrete Pipe Sewer		65	65											65	65		
	84	604	12 Inch Corrugated Steel Pipe Sewer		100	143											100	143		
	85	604	10 Inch Plastic Pipe Sewer (Polyvinyl Chloride)		318	318											318	318		
	86	604	18 Inch Plastic Pipe Sewer (Polyvinyl Chloride)		153	166											153	166		
	87	604	24 Inch Plastic Pipe Sewer (Polyvinyl Chloride)		211	216											211	216		
	88	606	Guard Rail Type 3 (6-3 Post Spacing)		587	463											587	463		
	89	606	Guard Rail Type 4		395	412											395	412		
	90	606	Guard Rail Type 4 Special		709	614											709	614		
	91	606	Guard Rail Type 4 (Precast-Portable)		2,996	5055											2,996	5055		
	92	606	End Anchorage Type 3D		1	1											1	1		
	93	606	End Anchorage Type 3E		6	5											6	5		
	94	606	Bridge Rail Type 4		150	150	2,818	2824	656	659	1,341	1,345					4,965	4,978		
	95	607	End Post (Chain Link)		1	1											1	1		
	96	607	Corner and Line Brace Post (Chain Link)		5	5											5	5		
	97	607	Fence Chain Link (72 Inch)		125	125											125	125		
	98	608	Concrete Sidewalk		564	470											564	470		
	99	608	Concrete Curb Ramp		80	83											80	83		
	100	609	Curb Type 2 (Section B)		268	264											268	264		
	101	609	Curb and Gutter Type 2 (Section I-B)		45	355											45	355		
	102	609	Curb and Gutter Type 2 (Section II-B)		2,254	2,518											2,254	2,518		
	103	610	Median Cover Material (Patterned Concrete)		126	95											126	95		
7	104	612	delineator (Type I)		54	54											54	54		

FINAL  
 SUMMARY OF APPROXIMATE QUANTITIES

AS CONSTRUCTED  
 NO REVISIONS  REVISED  VOID

FED. ROAD REGION	DIVISION	PROJ. NO.	SHEET NO.	SHEET TOTALS
VIII	COLO.	IR 25-2(91)	14	24

INDEX	CONTRACT ITEM NO.	CONTRACT ITEM	UNIT	ROADWAY	AS CONST. ROADWAY		STR. NO. F-16-OG	AS CONST. F-16-OG		STR. NO. F-16-OK	AS CONST. F-16-OK		STR. NO. F-16-NO	AS CONST. F-16-NO		UTILITIES	AS CONST. UTILITIES	PROJECT TOTALS	TOTALS AS CONST.	DIFF. + / -	% PLAN
					ROADWAY	AS CONST. ROADWAY		AS CONST. F-16-OG	AS CONST. F-16-OK		AS CONST. F-16-NO										
7	105	612	delineator (Type II)	Each	10	10												10	10		
	106	612	reflector (Median Barrier)	Each	76	160													76	160	
	107	613	3/4 inch Electrical Conduit	Ln.Ft.		105	146	80				42	39					188	224		
	108	613	2 inch Electrical Conduit	Ln.Ft.	1,429		1,353		834			667						4,283	4,443		
	109	613	2 inch Electrical Conduit (Jacked)	Ln.Ft.	105	150												105	150		
	110	613	Direct-Burial Cable	Ln.Ft.	490	625												490	625		
	111	613	Wiring	L.S.	1	1												1	1		
	112	613	Luminaire High Pressure Sodium (Wall Type) (16,000 Lumen)	Each	12	12												12	12		
7	113	613	Interior Lighting (Concrete Box Girder)	Each					1	1		1	1					2	2		
	114	613	Interior Lighting (Steel Box Girder)	Each					1	1								1	1		
8	115	614	Sign Panel (Class I)	Sq.Ft.	238	449												238	449		
	116	614	Sign Panel (Class II)	Sq.Ft.	277	276												277	276		
	117	614	Sign Panel (Class III)	Sq.Ft.	3,045	3,045												3,045	3,045		
	118	614	Timber Sign Post 4 X 4 Inch	Ln.Ft.	82	119												82	119		
	119	614	Timber Sign Post 6 X 6 Inch	Ln.Ft.	284	265												284	265		
	120	614	Steel Sign Post (S 3 X 5.7)	Ln.Ft.	40	40												40	40		
	121	614	Concrete Footing III-S (Drilled)	Each	2	2												2	2		
	122	614	Concrete Footing V (Spread)	Each	1	1												1	1		
	123	614	Concrete Footing II-S (Spread)	Each	3	3												3	3		
	124	614	Concrete Footing III-S (Spread)	Each	6	6												6	6		
	125	614	Mask Sign Legend	Each	2	1												2	1		
	126	614	Modification of Sign Legend	L.S.	1	1												1	1		
	127	614	Overpass Mounted Sign Bracket	Each	2	2												2	2		
	128	614	Sign Bridge Structure (60 to Less Than 65 Foot Frame)	Each	2	2												2	2		
129	614	Sign Bridge Structure (70 to Less Than 75 Foot Frame)	Each	1	1												1	1			
130	614	Sign Bridge Structure (95 to Less Than 100 Foot Frame)	Each	1	1												1	1			
8	131	614	Sign Bridge Structure (100 to Less Than 105 Foot Frame)	Each	1	1												1	1		
	132	614	Sign Bridge Structure (105 to less than 110 Foot Frame)	Each	1	1												1	1		
	133	614	Balanced Butterfly Structure	Each	1	1												1	1		

(P-1) 8-25-87, Changed Pay Item and Changed Order of Pay Items J.K.K.

# SUMMARY OF APPROXIMATE QUANTITIES

AS CONSTRUCTED  
NO REVISIONS  REVISED  VOID

FED. ROAD REGION	DIVISION	PROJ. NO.	SHEET NO.	SHEET TOTALS
VIII	COLO.	IR 25-2(191)	15	24

INDEX	CONTRACT ITEM NO.	CONTRACT ITEM	UNIT	ROADWAY	AS CONST. ROADWAY		STR. NO. F-16-0G		AS CONST. F-16-0K		STR. NO. F-16-NO		UTILITIES	AS CONST. UTILITIES	PROJECT TOTALS	TOTALS AS CONST.	DIFF. + / -	% PLAN
8 ↑	134	614	Cantilever Structure (25 to Less Than 30 Foot Frame)	Each	1	1									1	1		
	135	614	Pedestrian Signal Face (16)	Each	4	5									4	5		
	136	614	Traffic Signal Face (8-8-8)	Each	8	8									8	8		
	137	614	Traffic Signal Face (12-8-8)	Each	7	7									7	7		
	138	614	Traffic Signal Controller Cabinet DOH 105	Each	1	0									1	0		
	139	614	Coordination Unit	Each	1	1									1	1		
	140	614	Loop Detector Wire	Un.Ft.	980	1125									980	1108		
	141	614	Traffic Signal Vehicle Detector Amplifier (Loop Type)	Each	5	5									5	5		
(P-1)	142	614	Concrete Barrier (Temporary) DELETED BY 105	Lin.Ft.	1,672	0									1,672	0		
	143	614	Glare Screen (Temporary)	Lin.Ft.	2,980	3020									2,980	3020		
	144	614	Traffic Signal-Light Pole Steel	Each	1	1									1	1		
	145	614	Traffic Signal-Light Pole Steel (1 Mast Arm)	Each	2	2									2	2		
	146	614	Traffic Signal-Light Pole Steel (2 Mast Arm)	Each	1	1									1	1		
(P-1) (P-1)	147	614	Impact Attenuator (Sandwich System)	Each	1	1									1	1		
	148	614	Traffic Signal Controller (Solid State) (Full Actuated) (2 Phase) DOH 105	Each	1	0									1	0		
9 ↑	149	618	Prestressing Steel Wire or Strand	M KFT			388	388	5,156	5,156	3,906	3,906			9062	9062		
	150	618	Prestressing Steel Bar	M KFT											388	388		
	151	619	30 Inch Welded Steel Pipe (Jacked)	Un.Ft.	153	166									153	166		
	152	619	36 Inch Welded Steel Pipe (Jacked)	Un.Ft.	211	216									211	216		
	153	619	1 Inch Plastic Pipe DOH 105	Un.Ft.	1,400	0									1,400	0		
	154	619	1 1/2 Inch Plastic Pipe DOH 105	Un.Ft.	1,055	0									1,055	0		
9 ↓	155	619	2 Inch Plastic Pipe DOH 105	Un.Ft.	455	0									455	0		
	156	619	3 Inch Plastic Pipe DOH 105	Un.Ft.	775	0									775	0		

FIN (P-1) 8-25-87, Revised F/A Items J.K.K.  
and 25-2-87-  
**SUMMARY OF APPROXIMATE QUANTITIES**

AS CONSTRUCTED  
NO REVISIONS  REVISED  VOID

FED. ROAD REGION	DIVISION	PROJ. NO.	SHEET NO.	SHEET TOTALS
VIII	COLO.	IR 25-2(191)	16	23

INDEX	CONTRACT ITEM NO.	CONTRACT ITEM	UNIT	ROADWAY		STR. NO. F-16-OG		STR. NO. F-16-OK		STR. NO. F-16-NO		UTILITIES	AS CONST. UTILITIES	PROJECT TOTALS	TOTALS AS CONST.	DIFF. + / -	% PLAN
				AS CONST. ROADWAY		AS CONST. F-16-OG		AS CONST. F-16-OK		AS CONST. F-16-NO							
9	157 620	Field Laboratory (Class 2) DELETED BY 105	Each	1	0									1	0		
	158 623	1 Inch Pop-up Rotary Sprinkler	Each	64	0									64	0		
	159 623	1 Inch Drain Valve	Each	2	0									2	0		
	160 623	2 Inch Automatic Control Valve	Each	12	0									12	0		
	161 623	Control Wire 24 Volt	Lin.Ft.	3,580	0									3,580	0		
	162 623	12 Station Automatic Controller	Each	1	0									1	0		
	163 625	Construction Surveying	LS.	1	1									1	1		
	626	Mobilization	LS.	0.3	0.3	0.5	0.5	0.1	0.1	0.1	0.1			1	1		
	164 627	Pavement Marking Paint	Gal.	55	30									55	30		
	165 627	Thermoplastic Pavement Marking	Sq.Ft.	17,719	17,250									17,719	17,250		
9	166 627	Preformed Plastic Pavement Marking (60 Mills)	Sq.Ft.	3,263	2,853									3,263	2,848		
FORCE ACCOUNT ITEMS																	
	01	Minor Contract Revisions	F.A.	1	1												
	02	On-The-Job Trainee	Each	6	7												
	03	Potholing For Utilities	F.A.														
	04	Repair, Reset and Maintenance of Existing Irrigation System	F.A.	1													
(P-1)	05	Railroad Flagging (Burlington Forces)	F.A.	1	1												
(P-1)	06	Lowering Communications Line (Burlington Northern Forces)	F.A.														

# 100,000.00 # 23047.95  
# 4,500.00 # 5,927.22  
# 10,000.00 # 5921.84  
# 50,000.00 # 6996.92  
# 25,000.00 # 25,166.00

(R-1) LOWERING COMMUNICATIONS LINE (BURLINGTON NORTHERN FORCES) WILL BE PAID FOR UNDER P.E. PROJECT IR 25-2(17A)



# FINAL SUMMARY OF APPROXIMATE QUANTITIES

## ADDITIONAL QUANTITIES

AS CONSTRUCTED			FED. ROAD REGION	DIVISION	PROJ. NO.	SHEET NO.
NO REVISIONS	REVISED 7-27-89	VOID	VIII	COLO.	15 2F-2, 101	16 AX
						Form 5100 242

BOOK	PAGE	SHEET	INDEX	CONTRACT REF. NO.	CONTRACT ITEM NO.	CONTRACT ITEM	UNIT	FRADWAY, CHD or MCR Est. Quantity	AS CONST. ROADWAY	PRICE REDUCTION DOLLAR VALUE	STR. NO. F-16-06 CMO or MCR Est. Quantity	AS CONST. F-16-06	STR. NO. F-16-0K CMO or MCR Est. Quantity	AS CONST. F-16-0K	STR. NO. F-16-NO CMO or MCR Est. Quantity	AS CONST. F-16-NO	LIQUIDATED DAMAGE DOLLAR VALUE	PROJECT TOTALS		DIFF +/-	% PLAN				
																		PLAN	AS CONST.						
10	167	604	↑	167	604	18 INCH REINFORCED CONCRETE PIPE SEWER MCR 101	LN. FT.	22	22										22	22					
				168	603	18 INCH REINFORCED CONCRETE END SECTION MCR 101	EACH	1	1												1	1			
				169	614	FLAGGING	HOUR	320	491													320	491		
					170	614	TRAFFIC CONTROL SUPERVISOR MCR 101	DAY	15	15											15	15			
					171	614	UNIFORMED TRAFFIC CONTROL MCR 101	HOUR	86	86												86	86		
					172	503	DRILLED CAISSON 48 IN (5FT TO 15FT)	LN. FT.	10	1													10	1	
					173	403	HBP GRADING "E" (H&A) CMO 102	TON	4448	4265.61											4448	4265.61			
					174	403	HBP GRADING EX (H&A) CMO 102	TON	1314	1415.13	725	717	168	168	224	224					2431	2524.13			
					175	410	PMS COAT TYPE B (H&A) (AC 10) CMO 102	TON	1956	1070.56												1956	1070.56		
					176	410	PMS COAT TYPE B (H&A) (AC 20R) CMO 102	TON	1073												1073	436.75			
177					105	PRICE ADJUSTMENTS	L.S.														1	1			
178					202	REMOVE FENCE MCR 101	LN. FT.	554	554													554	554		
				179	625	SURVEYING (ADDED)	HOUR	30	63											30	63				
				180	105	PRICE ADJUSTMENT COMPRESSIVE STRENGTH	L.S.															1	1		
				181	105	PRICE ADJUSTMENT BRIDGE RAIL TYPE IV	L.S.															1	1		
				182	105	PRICE ADJUSTMENT BRIDGE RAIL TYPE III	L.S.													1	1				
				183	604	INLET SPECIAL (5 FT) MCR 101	EACH	1	1												1	1			
				184	513	BRIDGE DRAIN REVISIONS MCR 101	L.S.	1	1													1	1		
				185	108	LIQUIDATED DAMAGES	DAY													0	206				
				186	105	PRICE ADJUSTMENT 70 AEA (SLOPE & DITCH PAY)	L.S.															1	1		
				187	105	PRICE ADJUSTMENT 70 AEA (SLOPE & DITCH PAY)	L.S.															1	1		
				188	105	PRICE ADJUSTMENT CLASS D SLUMP	L.S.													1	1				
				189	108	LIQUIDATED DAMAGES - TRAFFIC CONTROL	L.S.															1	1		
				190	604	36 INCH REINFORCED CONCRETE PIPE SEWER MCR 101	LN. FT.	23	23													23	23		
				191	603	36 INCH REINFORCED CONCRETE END SECTION MCR 101	EACH	1	1											1	1				
				192	202	REMOVAL OF END SECTION MCR 101	EACH	1	1												1	1			
				193	105	LIQUIDATED DAMAGES TRAFFIC CONTROL	L.S.															1	1		
				194	105	PRICE ADJUSTMENT AGGREGATE FAILURE	L.S.													1	1				
				195	105	PRICE ADJUSTMENT CLASS D SLUMP	L.S.															1	1		
				196	106	PRICE ADJUSTMENT CLASS D SLUMP	L.S.															1	1		
				197	108	TRAFFIC CONTROL VIOLATION	L.S.													1	1				
				198	601	SHORING MCR 101	L.S.															1	1		
				199	210	RESET TRAFFIC SIGNAL FACE MCR 101	EACH	8	8													8	8		
				200	614	INSTALL TRAFFIC SIGNAL CONTROLLER & CABINET MCR 101	EACH	1	1											1	1				
				201	614	SPAN WIRE POLE 12 INCH MCR 101	EACH	2	2												2	2			
				202	105	FOUGHT & CO. CLAIM	L.S.															0	0		
				203	502	PILING CUTOFF 10X42	LN. FT.	4	4											4	4				
				204	502	PILING CUTOFF 14X89	LN. FT.	19	19													19	19		
				205	100	DRILLING OBSTRUCTION CLAIM CMO 107	L.S.	1	1													1	1		
				206	509	DIAPHRAGMS AND SPLICES CMO 104	L.S.	1	1											1	1				
				207	509	INTERIOR GIRDER PAINTING CMO 104	L.S.															1	1		
				208	613	LOAD CENTER (CONCRETE) CMO 104	EACH															3	5		
				209	613	LOAD CENTER (STEEL) CMO 104	EACH													1	1				
				210	614	TRAFFIC SIGNAL CONTROL CABINET (8) MCR 101	EACH	1	1													1	1		

# FINAL SUMMARY OF APPROXIMATE QUANTITIES

AS CONSTRUCTED		FED. ROAD REGION	DIVISION	PROJ. NO.	SHEET NO.
NO REVISIONS	REVISED <u>7/21/89</u>	VIII	COLO.	IR 25-2 (191)	16 BX
					TOTAL SHEETS 242

INDEX REF	CONTRACT ITEM NO.	CONTRACT ITEM	UNIT	CMO or MCR Estimated Roadway Quantity	AS CONST. ROADWAY	PRICE REDUCTION DOLLAR VALUE	CMO or MCR Est. Quantity STR. NO. F-16-OG	AS CONST. F-16-OG	STR. NO. F-16-OK	STR. NO. F-16-NO	AS CONST. F-16-NO	PROJECT TOTALS		DIFF. +/-	PLAN
												PLAN	AS CONST.		
10 ↑	211 100	BEDROCK WATER CLAIM CMO 108	L.S.									1	1		
	212 613	LIGHTING CONTROL PANEL MCR 101-24	EA	1	1							1	1		
	213 602	RESTEEL CORRECTION MCR 101-25	L.S.				1	1				1	1		
	214 613	PULL BOX REINFORCEMENT MCR 101-26	L.S.	1	1							1	1		
	215 202	REMOVAL OF FOUNDATION MCR 101-27	EA	1	1							1	1		
	216 202	REMOVAL OF SIGN FOOTING MCR 101-28	EA	1	1							1	1		
	217 614	TRAFFIC SIGNAL FACE (12-12-3-3-12) MCR 101-29	EA	1	1							1	1		
	218 626	MOBILIZATION (ADDED) MCR 101-30	L.S.	1	1							1	1		
	219 601	ADD DRIP GROOVE MCR 101-31	L.S.				1	1				1	1		
	1160	Bearing Seat Elevation MCR 101-34	L.S.				1	1				1	1		
1165	Relocate Wall Pack MCR 101-35	L.S.	1	1							1	1			
1170	Surplus Steel CMO 109	L.S.									1	1			
1175	Claim Settlement CMO 110	L.S.									1	1			

AS CONSTRUCTED			FED. ROAD REGION	DIVISION	PROJ. NO.	SHEET NO.	SHEET TOTALS
NO REVISIONS <input type="checkbox"/>	REVISED <input checked="" type="checkbox"/>	VOID <input type="checkbox"/>	VIII	COLO.	IR 25-2(191)	17	24

### SUMMARY OF EARTHWORK

INDEX			ITEM	PROJECT TOTALS ROADWAY	
BOOK	PAGE	SHEET		CU. YD.	FINAL
2		25-5	<u>Embankment Material (C.J.P.)</u> Roadway (from Cross Sections) From Structure Quantities Detour A Unsuitable Material	5,929	6,332
			403	1,025	965
			<b>Total For Pay Quantities</b>	<b>6,332</b>	<b>8,326</b>
			(For Information Only) Roadway Quantities Balance		
			<u>Embankment Material X Factor</u> (6,332 X 1.15)	7,282	
			<b>Total For Balance</b>	<b>7,282</b>	
			Unclassified Excavation Roadway (from Cross Sections) From Structure Quantities	1,078	578
			Δ Borrow (Contractors Source)	5,626	
			<b>Total For Balance</b>	<b>7,282</b>	

Δ Minimum R Value = 20 in the top two feet of Subgrade, and 5 below the top two feet, when tested by the Hveem Stabilometer.

### TABULATION OF FENCE

STATION	SIDE	FENCE CHAIN LINK (72 INCH)		CORNER AND LINE BRACE POST		END POST		REMARKS
		LN. FT.	AS CONST.	EACH	AS CONST.	EACH	AS CONST.	
1007-95	LT.					1	1	
1007-95 TO 1008-80	LT.	125	125	5	5			Lt. Side Ramp *F
<b>TOTALS</b>		<b>125</b>	<b>125</b>	<b>5</b>	<b>5</b>	<b>1</b>	<b>1</b>	

### TABULATION OF GUARD RAIL

STATION	SIDE	GUARD RAIL TYPE 3 (6'-3" SPACING)		GUARD RAIL TYPE 4 SPECIAL		GUARD RAIL TYPE 4 (PRECAST-PORTABLE)		GUARD RAIL TYPE 4 (STYLE CA)*		GUARD RAIL TYPE 4 (STYLE CD)*		REMARKS
		LN. FT.	AS CONST.	LN. FT.	AS CONST.	LN. FT.	AS CONST.	LN. FT.	AS CONST.	LN. FT.	AS CONST.	
67+00 TO 69+00	℄					200						6th Ave. ℄ Median
70+40 TO 71+30	LT.					90						
72+55 TO 74+25	LT.			170								Color to match Bridge Rail Type 4
74+25 TO 75+00	LT.	75										W/ 3E End Anchor
263+50 TO 264+50	LT.					100						
264+50 TO 265+25	LT.	75										W/ 3E End Anchor
275+00 TO 276+60	RT.									160		Against West Abut.
275+35 TO 276+95	LT.									160		Against East Abut.
276+80 TO 278+35	℄			155								I-25 Median
276+80 TO 278+50	℄			170								I-25 Median
277+00 TO 278+25	LT.	125										W/ 3E End Anchor
278+35 TO 279+10	℄							75				I-25 Median
904+50 TO 906+05 ▲	LT.											Ramp 'G' Closure
999+25 TO 1000+87	RT.	162										W/3E & 3D End Anchor
1003+65 TO 1004+40	LT.	75										W/ 3E End Anchor
1004+40 TO 1005+42	RT.			102								W/ 12' End Section
1004+90 TO 1005+65	LT.	75										W/ 3E End Anchor
1005+65 TO 1006+77	LT.			112								W/ 12' End Section
1500+00 TO 1502+00	LT.					214						Lt. Side Detour A
1600+25 TO 1605+90 ▲	RT.											Rt. Side Detour B
1600+50 TO 1604+85	LT.					424						Detour A & B
61+00 TO 64+90	RT.					412						W/12' End Section
1901+15 TO 1902+55	LT.					140						Lt. Side Detour D
63+00 TO 67+00	LT.					412						W/12' End Section
273+00 TO 279+00	RT.					612						W/12' End Section
276+85 TO 280+77	LT.					392						W/12' End Section
<b>TOTALS</b>		<b>587</b>	<b>463</b>	<b>709</b>	<b>614</b>	<b>2,996</b>	<b>5098</b>	<b>75</b>	<b>92</b>	<b>320</b>	<b>320</b>	

\* Guard Rail Type 4 (Style CD) and Guard Rail Type 4 (Style CA) will be paid for as Guard Rail Type 4.  
 ■ Guard Rail Type 3 is to be Galvanized.

▲ For Location Information Only, Quantity to be obtained from Reset on this project.

### TABULATION OF CURB AND GUTTER

STATION	SIDE	CURB & GUTTER TYPE 2 (SECTION 1B)		CURB & GUTTER TYPE 2 (SECTION 11B)		CURB TYPE 2 (6" BARRIER) (SECTION 1B)				REMARKS
		LIN. FT.	AS CONST.	LIN. FT.	AS CONST.	LIN. FT.	AS CONST.			
<b>6TH AVE.</b>										
65+22 TO 66+80	RT.			158						
74+25 TO 76+54	LT.			230						
76+54 TO 78+21	LT.			389						Rt. Side Osage
<b>125</b>										
253+35 TO 255+05	LT.			290						
<b>RAMP 1</b>										
1005+42 TO 1008+85	RT.			343						
1006+77 TO 1008+85	LT.			208						
<b>8TH AVE.</b>										
1805+35 TO 1806+70	LT.			140						
1805+42 TO 1806+58	RT.			116						
1806+75	LT.	45								Traffic Island
1807+25 TO 1808+50	LT.			230						Incl. Wyandot St.
1807+25 TO 1807+60	RT.					40				
1807+35 TO 1808+40	LT.					158				Incl. Wyandot St.
1807+40 TO 1808+90	RT.			150						
1808+25 TO 1808+95	RT.					70				
<b>TOTALS</b>										
		45	355	2254	2518	268	264			

AS CONSTRUCTED		FED. ROAD REGION	DIVISION	PROJ. NO.	SHEET NO.	SHEET TOTALS
NO REVISIONS <input type="checkbox"/>	REVISED <input checked="" type="checkbox"/>	VIII	COLO.	IR 25-2(191)	18	24
VOID <input type="checkbox"/>						

### TABULATION OF SIDEWALK, DRIVEWAY, AND CURB RAMP

STATION	SIDE	CONCRETE SIDEWALK 4"		CONCRETE PAVEMENT 6" (DRIVEWAY)		CURB RAMP TYPE 3B (8' RAMP)*		REMARKS
		SQ. YD.	AS CONST.	SQ. YD.	AS CONST.	SQ. YD.	AS CONST.	
1801+85	RT.					12		
1801+90 TO 1803+60	RT.	150						
1805+10 TO 1805+35	LT.	15						
1805+35 TO 1805+72	LT.			21				
1805+25 TO 1806+58	RT.	118						
1805+72 TO 1806+80	LT.	105						Incl. W. Side Wyandot
1806+57	LT.					12		NW Corner 8th & Wyandot
1806+66	RT.					12		SW Corner 8th & Wyandot
1806+80	LT.					8		Traffic Island
1807+25 TO 1808+80	LT.	111						Incl. E. Side Wyandot
1807+25	LT.			42				E. Side Wyandot
1807+41	LT.					12		NE Corner 8th & Wyandot
1807+34	RT.					12		SE Corner 8th & Wyandot
1807+40 TO 1807+53	RT.	12						
1807+53 TO 1807+81	RT.			22				
1807+81 TO 1807+91	RT.	8						
1807+91 TO 1808+28	RT.			29				
1808+28 TO 1808+86	RT.	45						
1808+95	RT.					12		
<b>TOTALS</b>		564	470	114	122	80	83	

\* See Detail

# TABULATION OF SURFACING QUANTITIES

AS CONSTRUCTED			FED. ROAD REGION	DIVISION	PROJ. NO.	SHEET NO.	SHEET TOTALS
NO REVISIONS <input type="checkbox"/>	REVISED <input checked="" type="checkbox"/>	VOID <input type="checkbox"/>	VIII	COLO.	IR 25-2(19)	19	

STATION TO STATION	HOT BITUMINOUS PAVEMENT (HAUL) & TONS (ASPHALT) TONS												PLANT MIXED SEAL COAT (TYPE B) (4-4)		EMULSIFIED ASPHALT (SLOW-SETTING)		ASPHALT CEMENT (AC-10) (F)		ASPHALT CEMENT (AC-20) (RUB)		REMARKS
	(GRADING E)						(GRADING EX)						TONS	FINAL	GAL.	FINAL	TONS	FINAL	TONS	FINAL	
	BOTTOM LAYER 3"	FINAL	THIRD LAYER 3"	THIRD LAYER 2"	FINAL	SECOND LAYER 3"	SECOND LAYER 2"	FINAL	TOP LAYER 2"	FINAL	TOP LAYER 2"	TOP LAYER 3/4"									
RAMP 'E'																					
602+79 TO 616+57											725						41			Structure F-16-06	
RAMP 'H'																					
900+00 TO 903+10	142			95			95		95						129		24				
903+10 TO 906+18											168						10			Structure F-16-0K	
908+18 TO 912+85											224						13			Structure F-16-N0	
RAMP 'I'																					
1000+00 TO 1008+95	616			411			411		411						560		105				
OSAGE ON RAMP	106			71			71		71						96		18				
DETOUR A	69						46		46						42		9				
DETOUR B	217						144		144						131		29				
DETOUR C	31						21		21						19		4				
DETOUR D	67						45		45						41		9				
6TH AVE. WIDENING	133			89			89		89						121		23				
6TH AVE. LEVELING											1314						75			See Pavement Marking Plans	
I-25 WIDENING	152		152			152			101						138		32				
6TH AVE. OVERLAY														1254				88		See Pavement Marking Plans	
HBP (PATCHING) (H-ASPH)																				875 Tons Estimated	
I-25 OVERLAY														619				43		See Pavement Marking Plans	
8TH AVE. & WYANDOT ST.														83				6		See 8th Ave. & Wyandot Intersection Plan	
ASPHALT CEMENT (SCRAP RUBBER) (CRACK FILLER)																				1 Ton Estimated	
PROJECT SUB-TOTALS	1533		152	666		152	922		1023		117	1314		1956		1277		392		437	
PROJECT TOTALS						4,448	4,265.61				2524.13	2,431		1956	1070.58	1277	2550	392		137436.75	

Stabilization is based on the following:

RAMP	18k EDLA	Regional Factor	1.5	Strength Coefficients:	
H	162	Serviceability Index	2.5	Bituminous Pavement -	0.44
I	135	R Value of Subgrade	20	Aggregate Base Course -	0.12

## TABULATION OF MEDIAN COVER MATERIAL

STATION	SIDE	MEDIAN COVER MATERIAL (PATTERNED CONCRETE)		REMARKS
		SQ. FT.	AS CON. ST.	
1806+80	LT.	126	95	TRAFFIC ISLAND
TOTALS		126	95	

# TABULATION OF REMOVE, ADJUST, & RESET ITEMS

AS CONSTRUCTED  
NO REVISIONS  REVISED  VOID

FED. ROAD REGION	DIVISION	PROJ. NO.	SHEET NO.	SHEET TOTALS
VIII	COLO.	IR 25-2(191)	20	4

STATION	SIDE	REMOVAL OF STRUCTURES AND OBSTRUCTIONS	REMOVAL OF PIPE	REMOVAL OF BARRICADE	REMOVAL OF SIDEWALK	REMOVAL OF GUTTER	REMOVAL OF CURB & GUTTER	REMOVAL OF ASPHALT MAT	REMOVAL OF ASPHALT MAT (PLANING)	REMOVAL OF PORTIONS OF PRESENT STRUCTURE	PLUG STRUCTURE	REMOVAL OF GUARD RAIL TYPE 4	REMOVAL OF GUARD RAIL TYPE 5	REMOVAL OF GUARD RAIL TYPE 3	RESET GUARD RAIL TYPE 4	RESET FENCE	MODIFY INLET	PLUG CULVERT	REMARKS
		L.S.	LIN. FT.	EACH	SQ. YD.	LIN. FT.	LIN. FT.	SQ. YD.	SQ. YD.	L.S.	EACH	LIN. FT.	LIN. FT.	LIN. FT.	LIN. FT.	LIN. FT.	EACH	EACH	
6TH AVENUE																			
57+70	LT.										1								Inlet
57+75 TO 61+50	LT.						890												C.D. Median
57+75 TO 61+50	LT.							275											C.D. Median
60+15	LT.										1								Inlet
61+50 TO 63+40	LT.									1									C.D. Median
62+70	LT./RT.								6,400										Structure F-16-DU
63+35 TO 69+00	℄													565					℄ Median
63+35 TO 69+00	℄						1,130												℄ Median
63+35 TO 69+00	℄							188											℄ Median
63+40 TO 69+00	LT.						1,680												C.D. Median
63+40 TO 69+00	LT.							871											C.D. Median
65+22 TO 67+25	RT.					265													Rt. Side Exst. Ramp
65+60 TO 67+25	RT.						355												Rt. Side Exst. Ramp
66+25	RT.							2,071											Exst. E to N Ramp
66+50 TO 67+15	RT.						125												Lt. Side Exst. Ramp
▲ 67+60	RT.														230				Lt. Side Exst. Ramp
69+00 TO 70+50	LT.									1									C.D. Median
69+75	LT./RT.								4,767										Structure F-16-EJ
70+30 TO 75+60	LT.						530												Rt. Side W.B. 6th
70+50 TO 75+05	LT.							556											C.D. Median
70+50 TO 75+05	LT.						1,010												C.D. Median
75+50	LT.	1																	Inlet
75+60 TO 78+21	LT.						460												Rt. Side Osage Ramp
75+60 TO 78+00	LT.						340												Lt. Side Osage Ramp
75+60 TO 79+60	LT.						515												Rt. Side W.B. 6th
76+10	LT.										1								Inlet
RAMPS E & H																			
▲ 600+00 TO 602+75	RT.														260				
▲ 616+60	RT.														70				
903+75	RT.															75			
SHEET TOTAL		1	1			265	7,035	3,961	11,167	1	3			565	560	75			

\* FOR INFORMATION ONLY

▲ RESET ON PROJECT SITE OR ON STATE VEHICLES, AS DIRECTED BY THE ENGINEER.

TABULATION OF REMOVE, ADJUST, & RESET ITEMS (CONTINUED)

AS CONSTRUCTED			FED. ROAD REGION	DIVISION	PROJ. NO.	SHEET NO.	SHEET TOTALS
NO REVISIONS <input type="checkbox"/>	REVISED <input checked="" type="checkbox"/>	VOID <input type="checkbox"/>	VIII	COLO.	IR 25-2(9)	21	21

STATION	SIDE	*REMOVAL OF STRUCTURES AND OBSTRUCTIONS	REMOVAL OF PIPE	REMOVAL OF BARRICADE	REMOVAL OF SIDEWALK	REMOVAL OF GUTTER	REMOVAL OF CURB & GUTTER	REMOVAL OF ASPHALT MAT	REMOVAL OF ASPHALT MAT (PLANING)	*REMOVAL OF PORTIONS OF PRESENT STRUCTURE	PLUG STRUCTURE	REMOVAL OF GUARD RAIL TYPE 4	REMOVAL OF GUARD RAIL TYPE 5	REMOVAL OF GUARD RAIL TYPE 3	RESET GUARD RAIL TYPE 4	RESET FENCE	MODIFY INLET	PLUG CULVERT	REMARKS
		L.S.	LIN. FT.	EACH	SQ. YD.	LIN. FT.	LIN. FT.	SQ. YD.	SQ. YD.	L.S.	EACH	LIN. FT.	LIN. FT.	LIN. FT.	LIN. FT.	LIN. FT.	EACH	EACH	
8TH AVENUE																			
1803-25	RT.																		Adjust Grate
1805-36 TO 1806-68	LT.						155												
1805-43 TO 1806-20	RT.						80												
1805-52 TO 1806-10	LT.				20														
1806-15	RT.										1								Inlet
1806-40	RT.			1															
1806-55	LT.										1								Inlet
1806-60	RT.										1								Inlet
1806-70	LT.																	1	15' Storm Sewer
1806-72 TO 1808-90	RT.						200												
1807-15	LT.						100												Traffic Island
1807-15	LT.							42											Traffic Island
1807-85 TO 1808-80	LT.				32														
1807-25 TO 1808-45	LT.						140												
1807-25	LT.					75													
1807-50	LT.	1																	Inlet
I-25																			
253-35 TO 254-25	LT.						240												Traffic Island
253-35 TO 254-25	LT.							310											Traffic Island
253-48	LT.	1																	Inlet
254-00	LT.						95												Traffic Island
254-00	LT.							22											Traffic Island
254-20 TO 255-05	LT.						150												
254-40	LT.							245											Existing Exit Ramp
263-00 TO 269-30	LT.												650						
277+50	RT.														564				Inside Loop Ramp
267-00 TO 271-50	LT.					550													Rt. Side W. to N. Ramp
267-15 TO 273-90	LT.						825												
270-60	LT.										1								Inlet
SHEET TOTAL		1		1	52	625	1985	619			4		650		564		1	1	

\*FOR INFORMATION ONLY      ■ See Tabulation of Guard Rail for Location of Reset.

TABULATION OF REMOVE, ADJUST, & RESET ITEMS (CONTINUED)

AS CONSTRUCTED				
NO REVISIONS <input type="checkbox"/>	REVISED <input checked="" type="checkbox"/>	VOID <input type="checkbox"/>	FED. ROAD REGION	DIVISION
			VIII	COLO.
			PROJ. NO.	SHEET NO.
			IR 25-2(191)	22
				SHEET TOTALS

STATION	SIDE	REMOVAL OF STRUCTURES AND OBSTRUCTIONS	REMOVAL OF PIPE	REMOVAL OF BARRICADE	REMOVAL OF SIDEWALK	REMOVAL OF GUTTER	REMOVAL OF CURB & GUTTER	REMOVAL OF ASPHALT MAT	REMOVAL OF ASPHALT MAT (PLANING)	REMOVAL OF PORTIONS OF PRESENT STRUCTURE	PLUG STRUCTURE	REMOVAL OF GUARD RAIL TYPE 4	REMOVAL OF GUARD RAIL TYPE 5	REMOVAL OF GUARD RAIL TYPE 3	RESET GUARD RAIL TYPE 4	RESET FENCE	MODIFY INLET	PLUG CULVERT	REMARKS		
		L.S.	LIN. FT.	EACH	SO. YD.	LIN. FT.	LIN. FT.	SO. YD.	SO. YD.	L.S.	EACH	LIN. FT.	LIN. FT.	LIN. FT.	LIN. FT.	LIN. FT.	EACH	EACH			
I-25 (CONT.)																					
271+10	LT.										1								Inlet		
271+15 TO 274+80	LT.					425													Lt. Side W. to N. Ramp		
273+00 TO 63+75	LT.					760													Rt. Side N. to W. Ramp		
273+00 TO 280+75	LT.						765												Includes C & G under 6th Ave. Structure		
273+10 TO 276+60	RT.						355												Includes C & G under 6th Ave. Structure		
273+50	LT.	1																	Inlet		
273+60	LT.																1		Install Manhole Ring and Cover		
275+00 TO 276+60	RT.							90											Raised Shoulder		
275+35 TO 276+95	LT.							90											Raised Shoulder		
276+80 TO 279+10	☉											230									
276+95 TO 277+75	LT.												80								
277+00	RT.																	1	24" Storm Sewer		
277+35	☉	1																	Inlet		
277+35	☉																	2	24" Storm Sewer		
277+40	LT.										1								Inlet		
277+43	☉																	1	18" Storm Sewer		
278+23	☉																	1	18" Storm Sewer		
280+90 TO 285+00	LT.						450														
281+00	LT.										1								Inlet		
DETOURS																					
150+20	RT.	1																	Inlet		
150+20	RT.		60																15" Storm Sewer		
1600+00 TO 1608+66	RT.							1740											Portion of Existing Ramp to Rt. of Detour B		
1600+65	RT.																	1	15" Storm Sewer		
1600+65	RT.										1								Inlet		
1604+40	RT.										1								Inlet		
1605+35 TO 1607+15	RT.														162				Rt. Side Exst. Ramp		
1606+35 TO 1607+50	RT.		105																15" Storm Sewer		
1607+50	RT.	1																	Inlet		
1900+00 TO 267+00	RT.							925											Portion of Detour B to Rt. of Detour D		
SHEET TOTAL		+	165			1185	1570	2845	9143		5	230	80	565	162		+	4			
TOTALS		1	116165	1	82 52	1631	2975	10305	10590	8696	7425	1167	1	12	230	730	565	1286	75	1 2	8 5

\* FOR INFORMATION ONLY

SEE TABULATION OF GUARD RAIL FOR LOCATION OF RESET.

400 734 5345 76


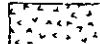

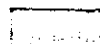





AS CONSTRUCTED  
 NO REVISIONS 7-27-83 REVISED VOID

FED. ROAD REGION	DIVISION	PROJ. NO.	SHEET NO.	SHEET TOTALS
VIII	COLO.	1R 25-2(191)	24	24

LEGEND

-  NEW DETOURS UNDER CONSTRUCTION
-  DETOURS BEING UTILIZED
-  NEW CONSTRUCTION
-  NEW CONSTRUCTION ALREADY IN PLACE

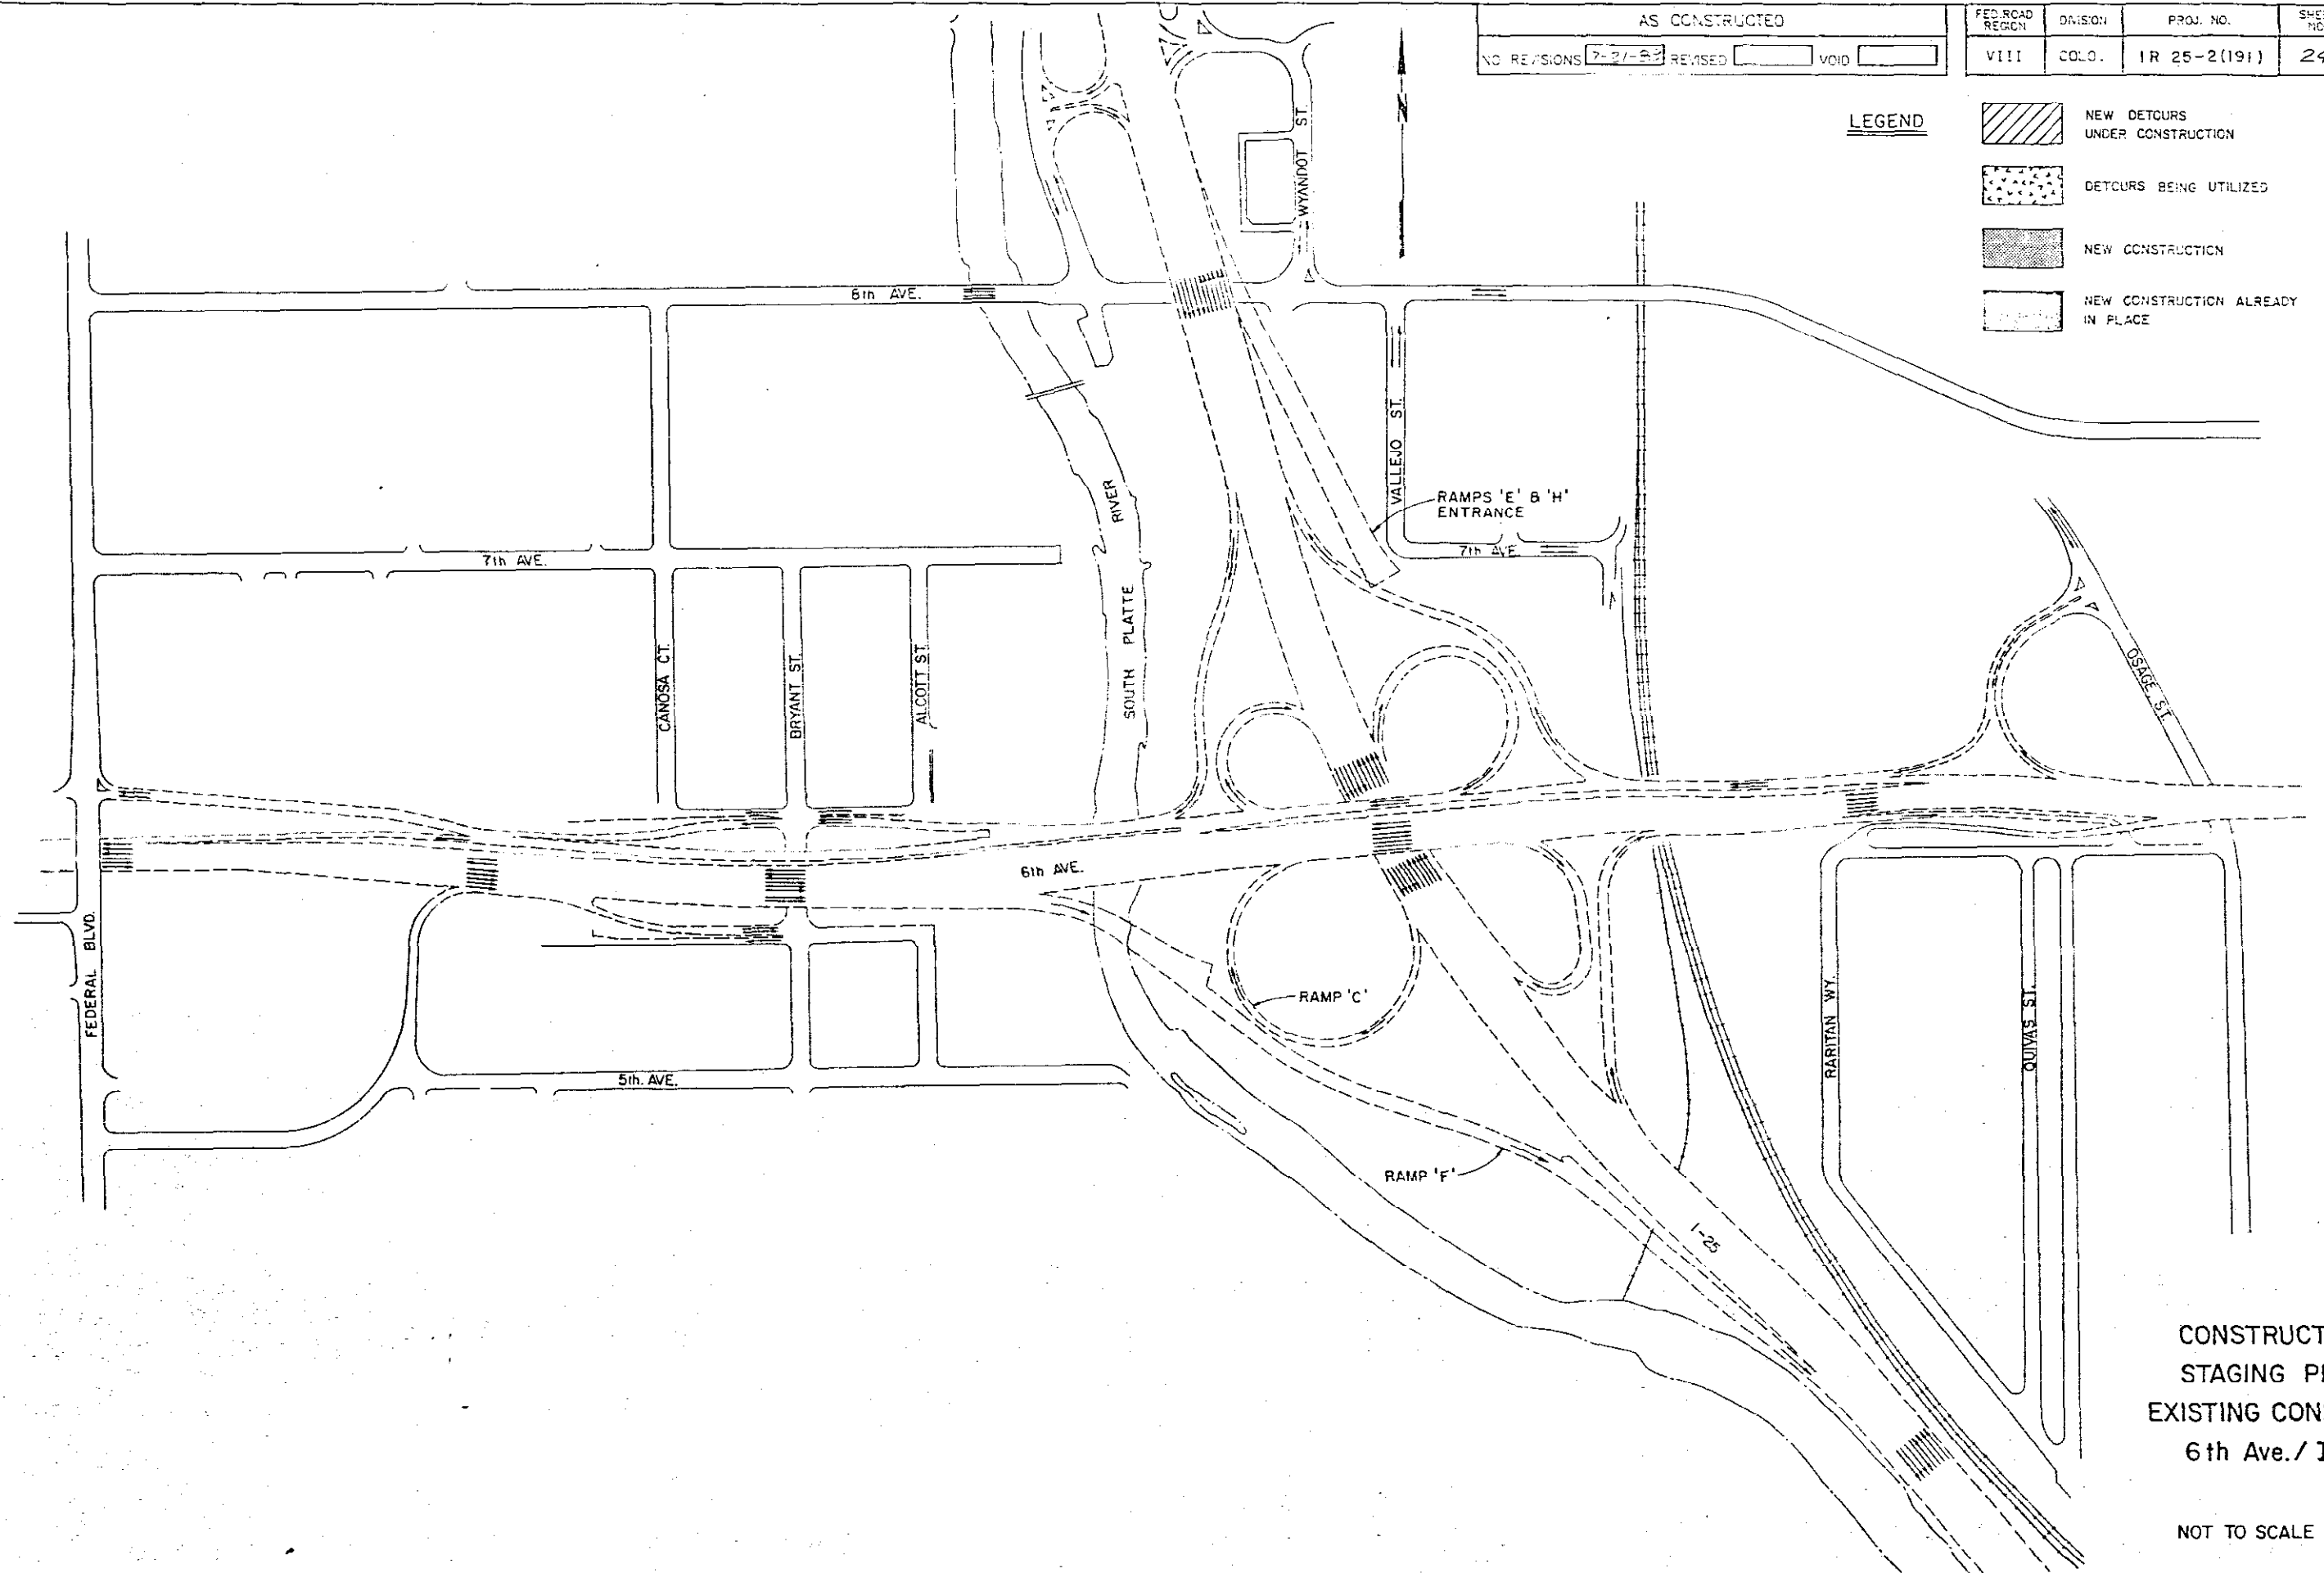

CONSTRUCTION  
 STAGING PLAN  
 EXISTING CONDITIONS  
 6th Ave. / I 25

NOT TO SCALE






44495


AS CONSTRUCTED		
NO REVISIONS	7-21-87	REVISED
		VOID

FED. ROAD REGION	DIVISION	PROJ. NO.	SHEET NO.	SHEET TOTALS
	COLD	IR 25-2(191)	25	342

REVISIONS		
(R-1)	8-25-87	Added Limits of I-25 Overlay J.K.K.

LEGEND

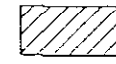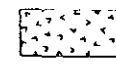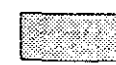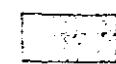-  NEW DETOURS UNDER CONSTRUCTION
-  DETOURS BEING UTILIZED (NONE)
-  NEW CONSTRUCTION
-  NEW CONSTRUCTION ALREADY IN PLACE (NONE)
-  H.B.P. AND SEAL COAT OVERLAY

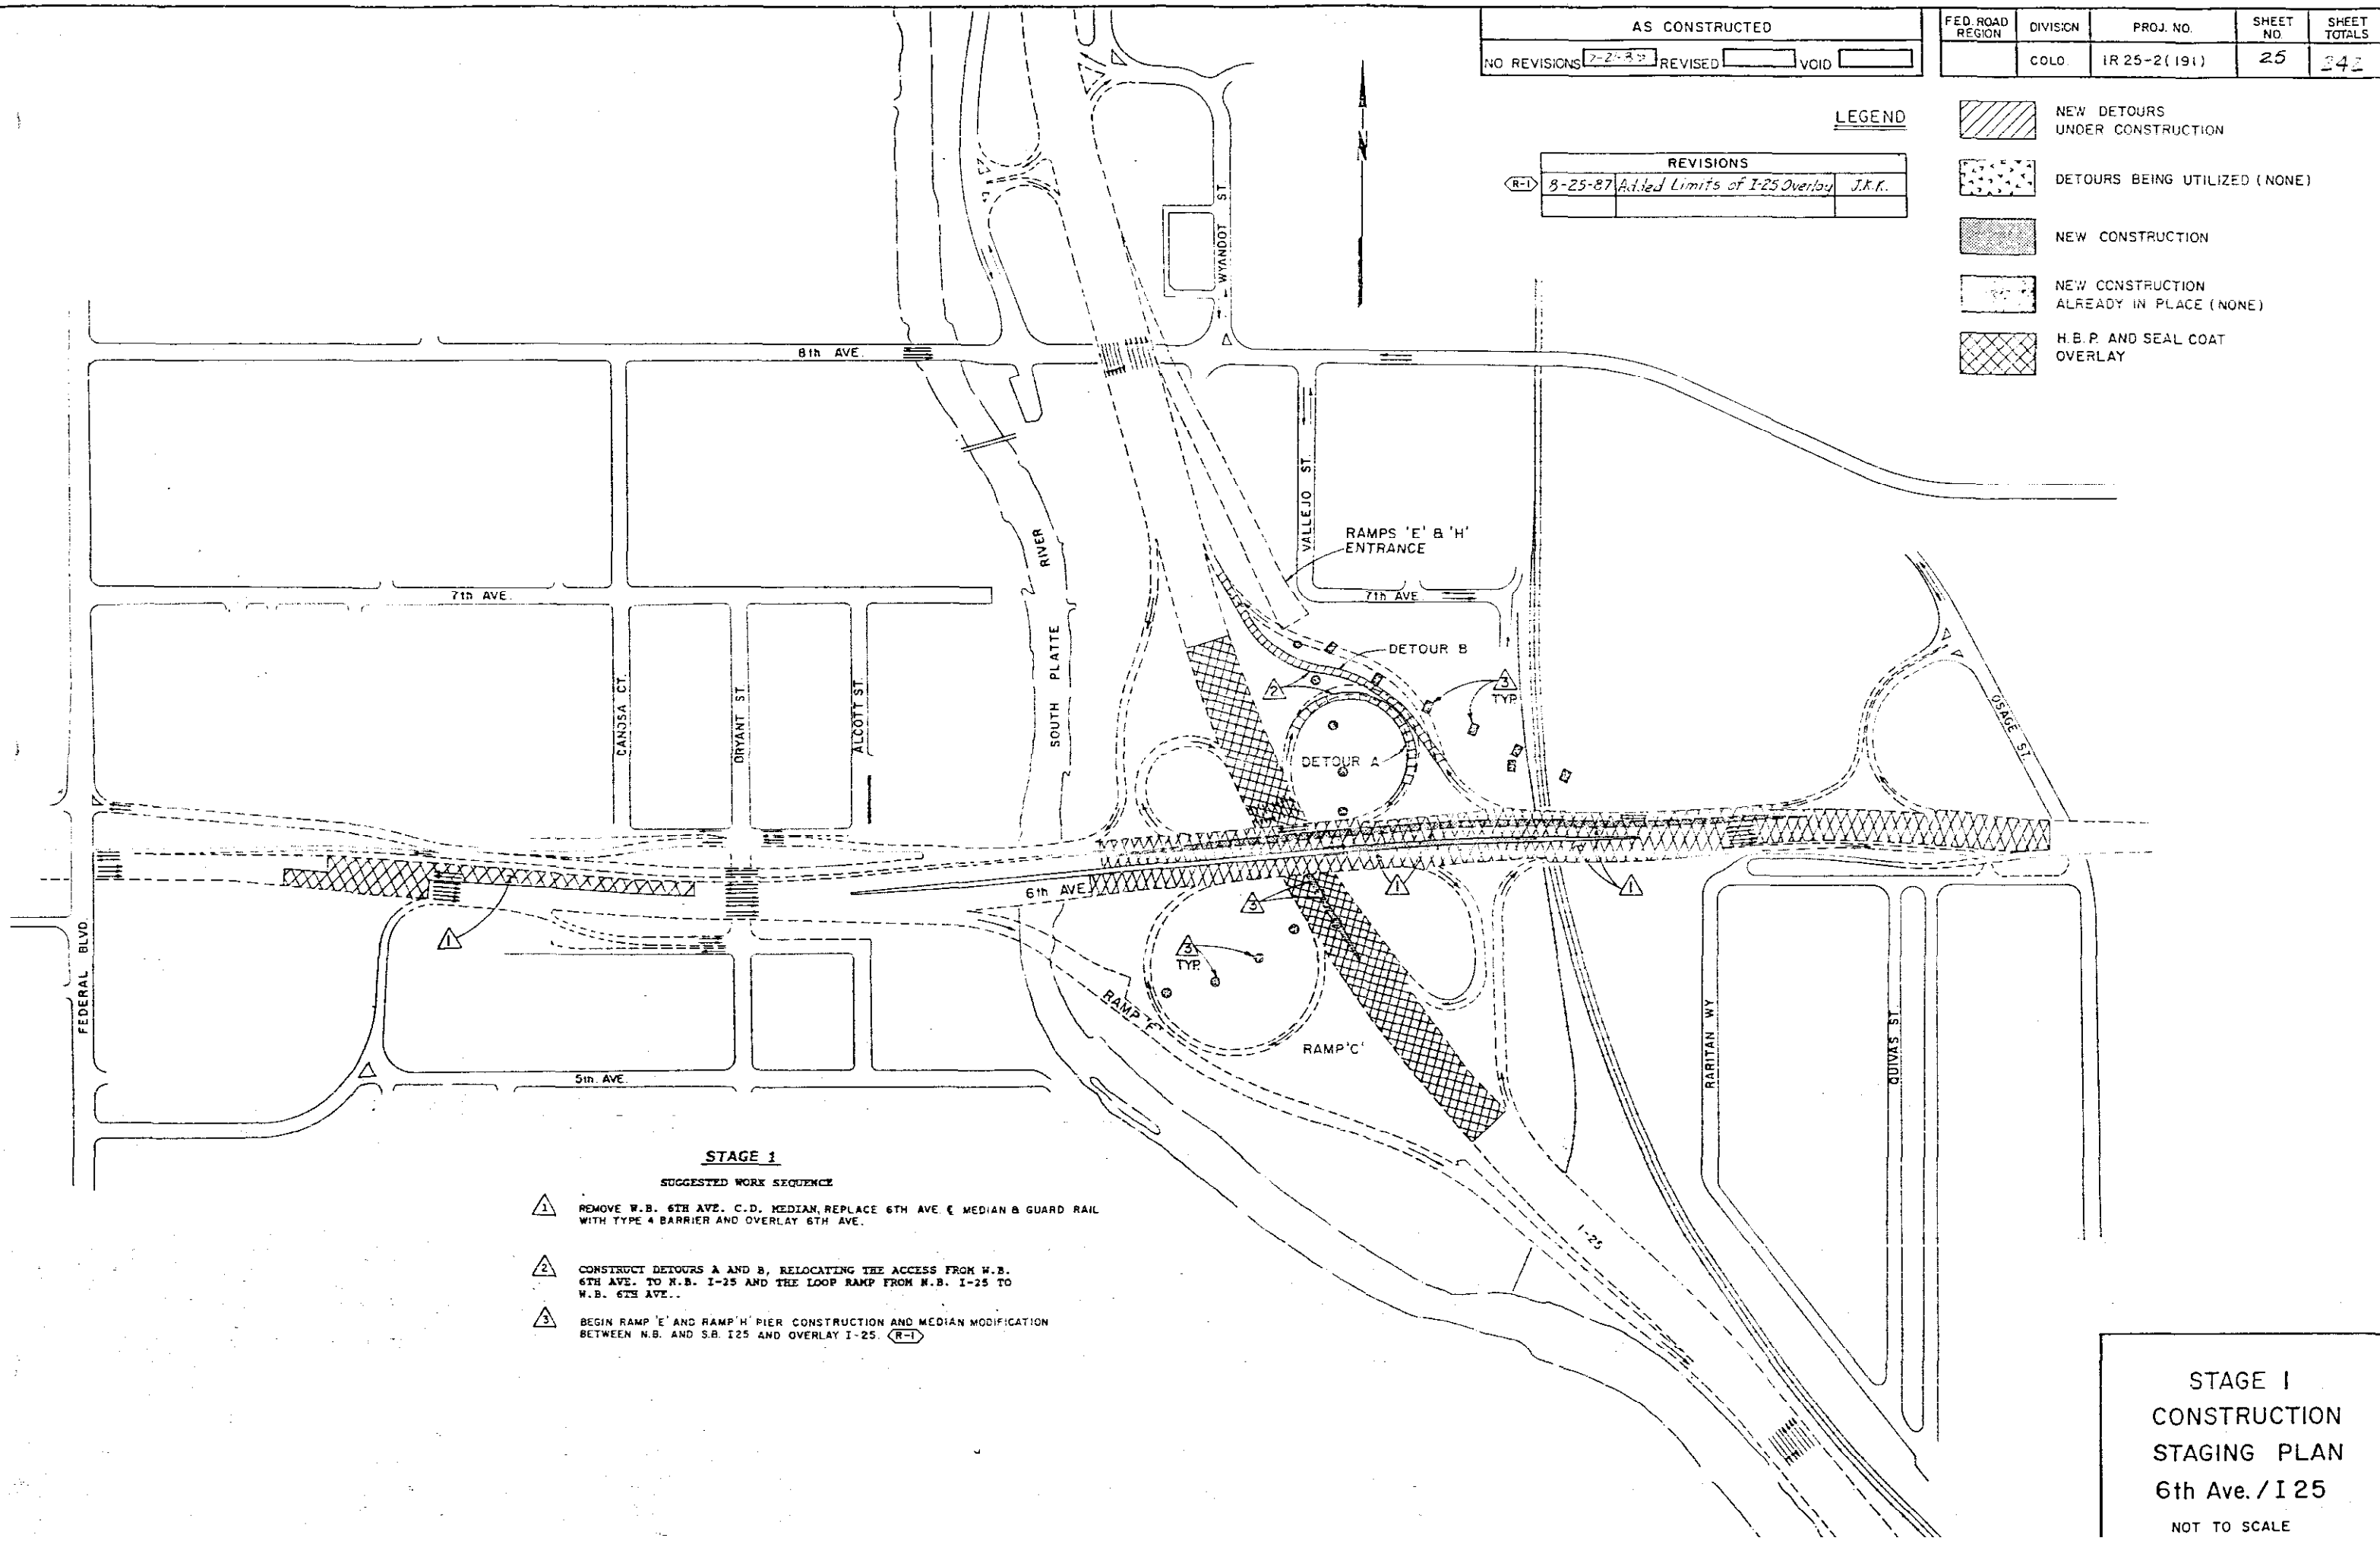

- STAGE 1**  
SUGGESTED WORK SEQUENCE
- 1 REMOVE W.B. 6TH AVE. C.D. MEDIAN, REPLACE 6TH AVE € MEDIAN & GUARD RAIL WITH TYPE 4 BARRIER AND OVERLAY 6TH AVE.
  - 2 CONSTRUCT DETOURS A AND B, RELOCATING THE ACCESS FROM W.B. 6TH AVE. TO N.B. I-25 AND THE LOOP RAMP FROM N.B. I-25 TO W.B. 6TH AVE.
  - 3 BEGIN RAMP 'E' AND RAMP 'H' PIER CONSTRUCTION AND MEDIAN MODIFICATION BETWEEN N.B. AND S.B. I-25 AND OVERLAY I-25. (R-1)





STAGE I  
CONSTRUCTION  
STAGING PLAN  
6th Ave./I 25  
NOT TO SCALE


4445

AS CONSTRUCTED  
NO REVISIONS 7-2-59 REVISED \_\_\_\_\_ VOID \_\_\_\_\_

FED. ROAD REGION	DIVISION	PROJ. NO.	SHEET NO.	SHEET TOTALS
	COLO.	IR 25-2(191)	26	242

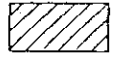

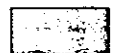
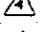

LEGEND

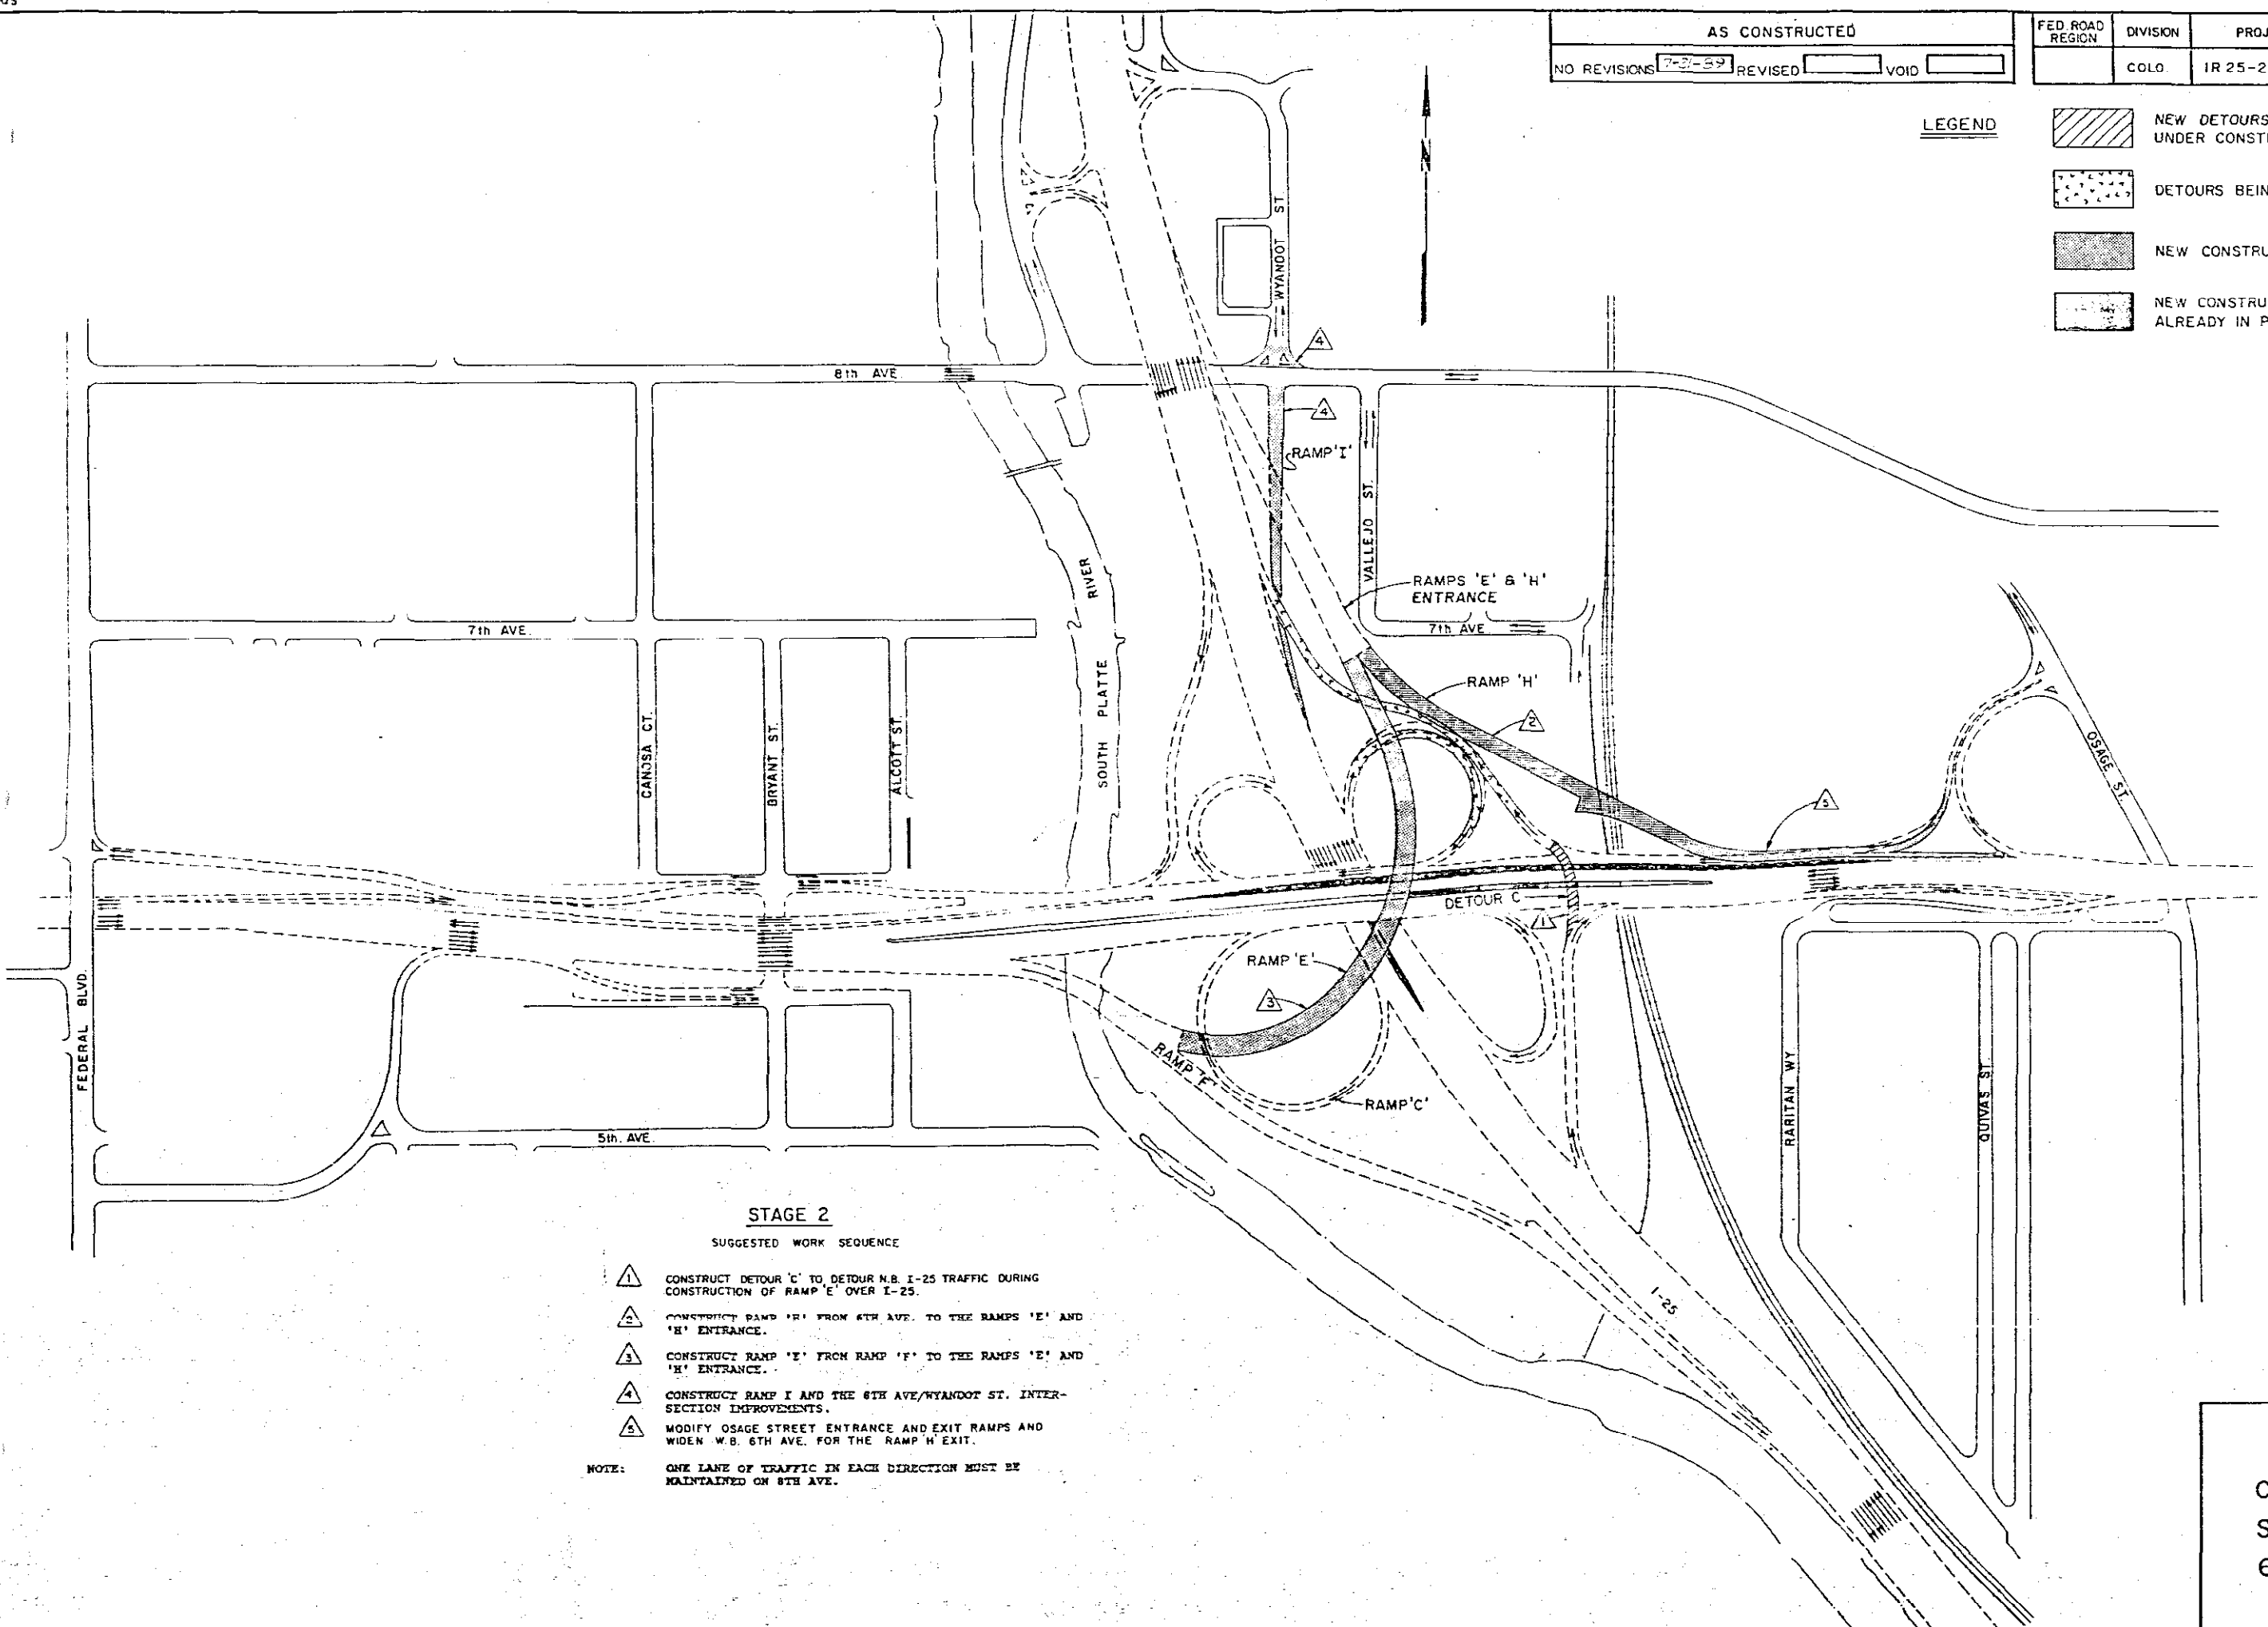-  NEW DETOURS UNDER CONSTRUCTION
-  DETOURS BEING UTILIZED
-  NEW CONSTRUCTION
-  NEW CONSTRUCTION ALREADY IN PLACE



STAGE 2

SUGGESTED WORK SEQUENCE





-  1. CONSTRUCT DETOUR 'C' TO DETOUR N.B. I-25 TRAFFIC DURING CONSTRUCTION OF RAMP 'E' OVER I-25.
-  2. CONSTRUCT RAMP 'I' FROM 6TH AVE. TO THE RAMPS 'E' AND 'H' ENTRANCE.
-  3. CONSTRUCT RAMP 'E' FROM RAMP 'F' TO THE RAMPS 'E' AND 'H' ENTRANCE.
-  4. CONSTRUCT RAMP 'I' AND THE 6TH AVE/WYANDOT ST. INTERSECTION IMPROVEMENTS.
-  5. MODIFY OSAGE STREET ENTRANCE AND EXIT RAMPS AND WIDEN W.B. 6TH AVE. FOR THE RAMP 'H' EXIT.


NOTE: ONE LANE OF TRAFFIC IN EACH DIRECTION MUST BE MAINTAINED ON 8TH AVE.

STAGE 2  
CONSTRUCTION  
STAGING PLAN  
6th Ave. / I 25  
NOT TO SCALE

AS CONSTRUCTED		FED. ROAD REGION	DIVISION	PROJ. NO.	SHEET NO.	SHEET TOTALS
NO REVISIONS	2-2-94	REVISÉD	VOID	COLO	IR 25-2(191)	27

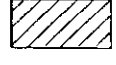

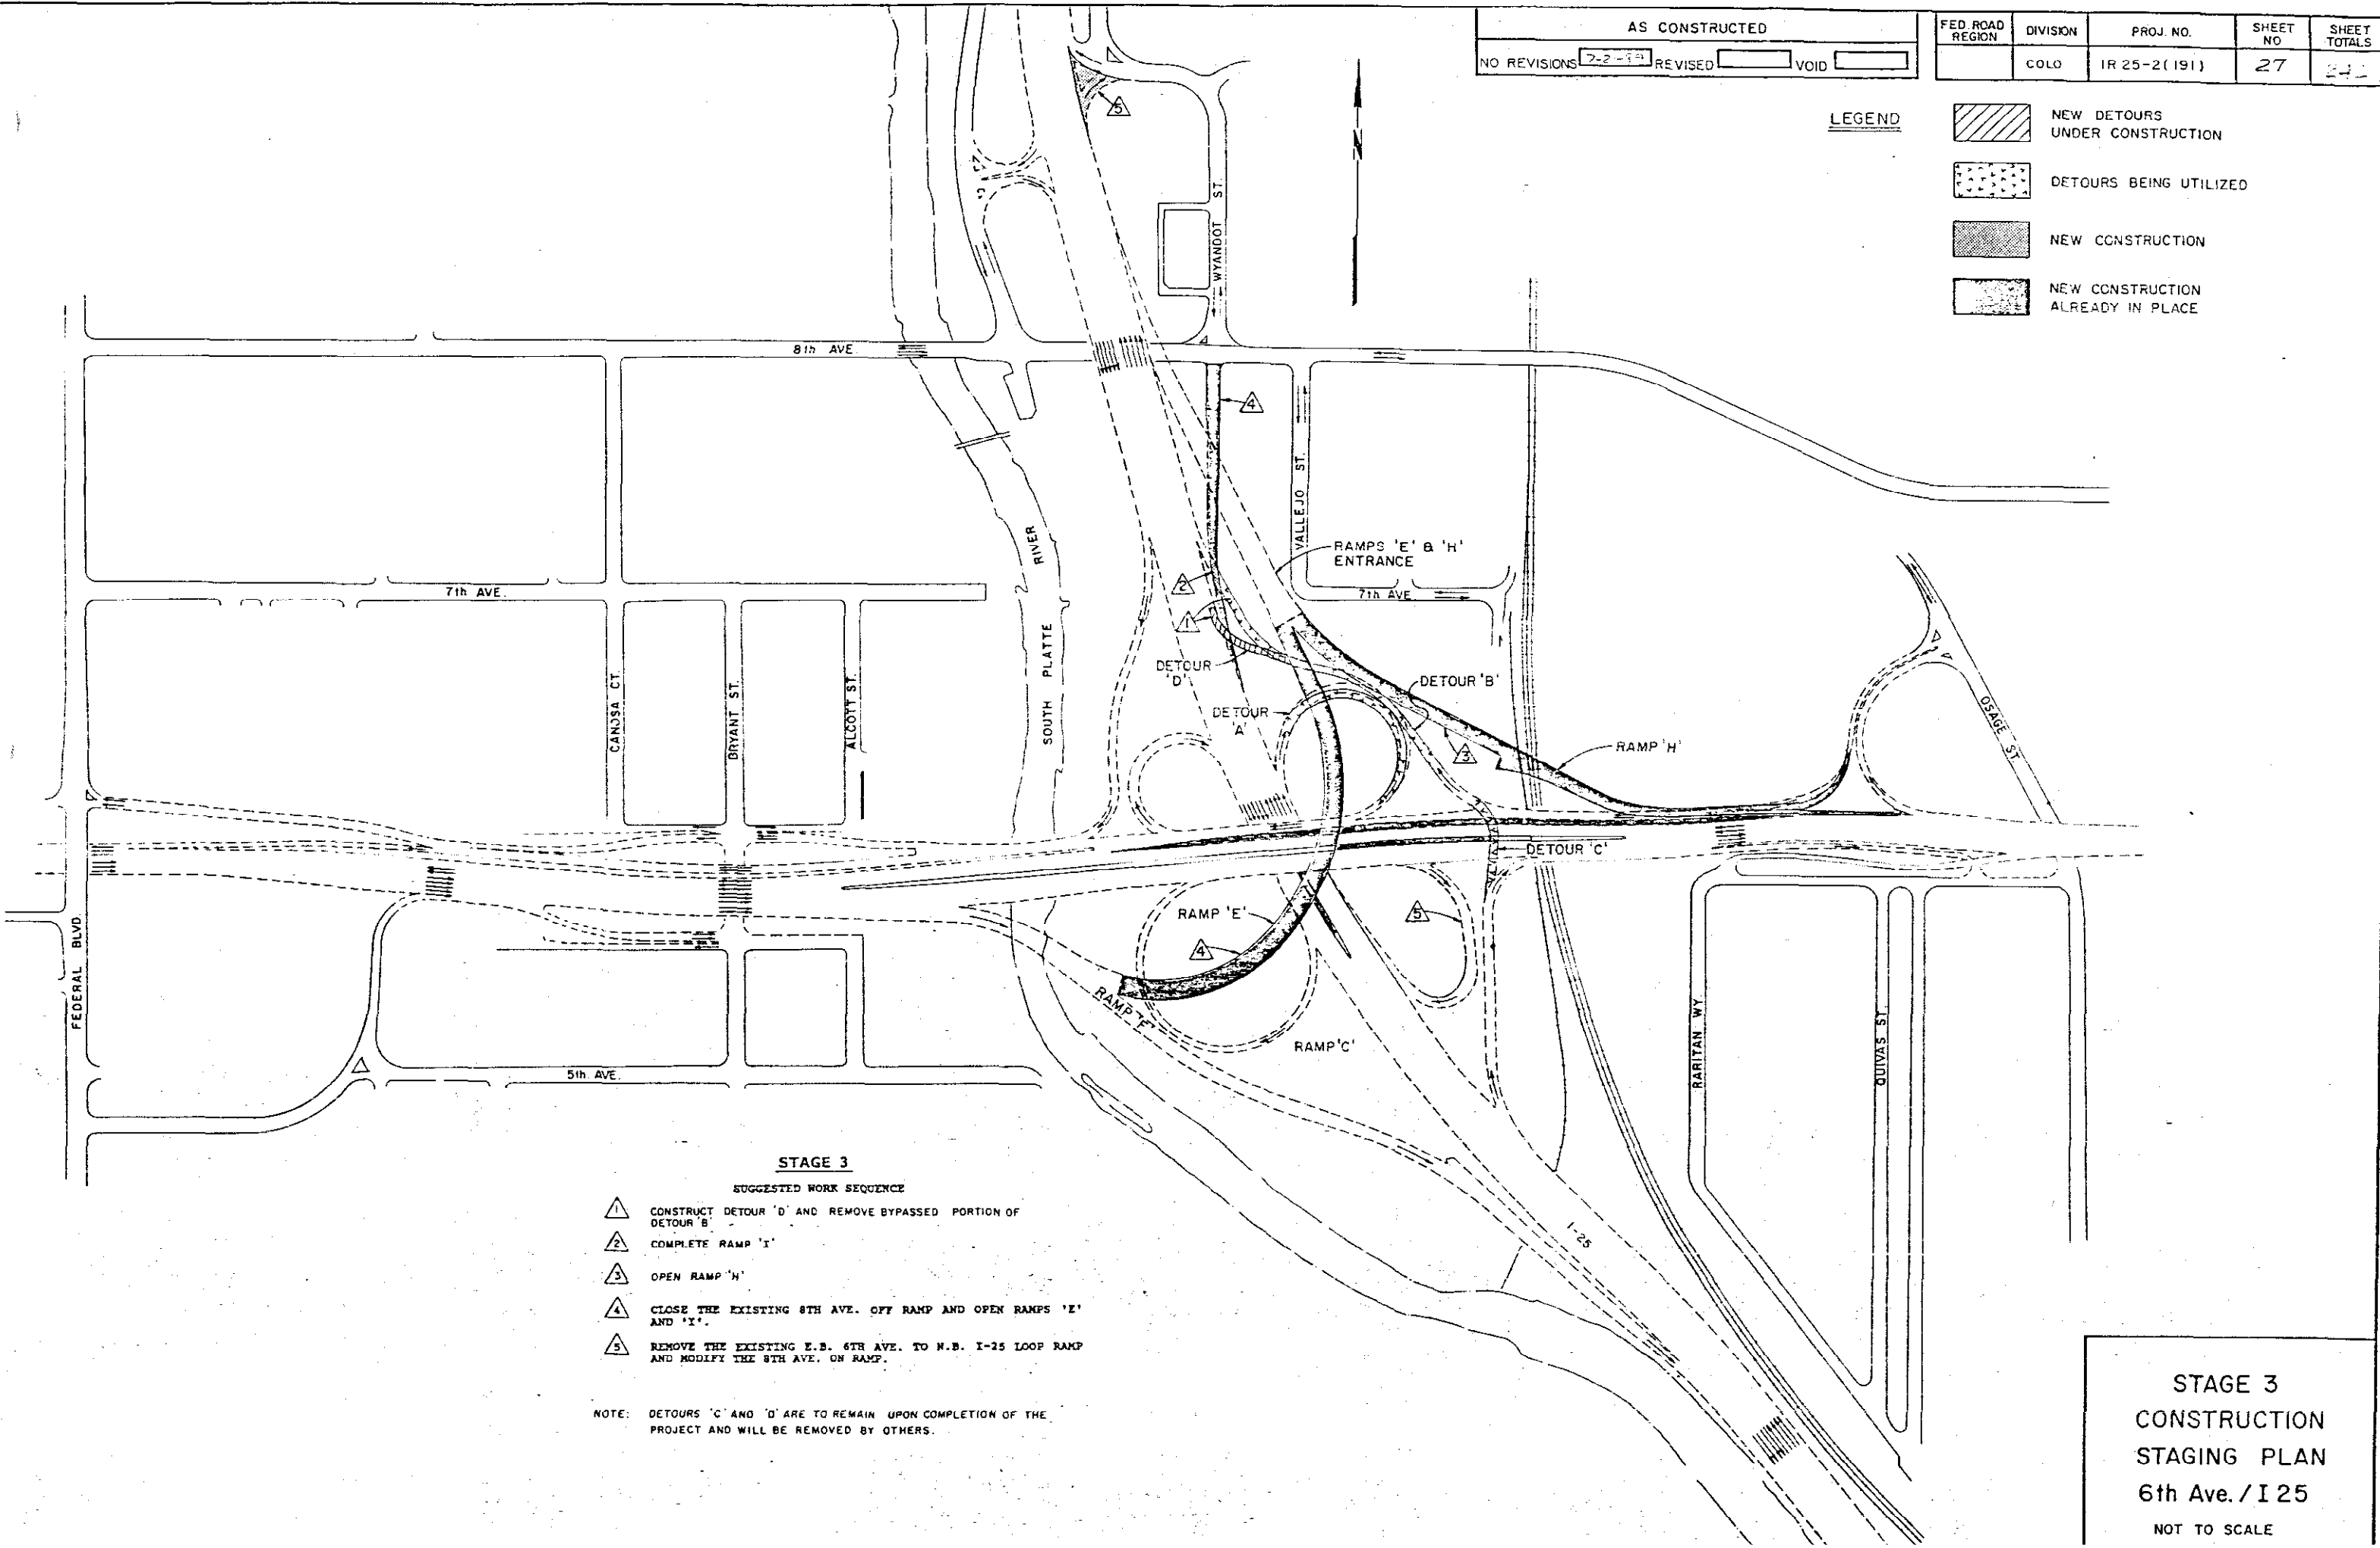


**LEGEND**

	NEW DETOURS UNDER CONSTRUCTION
	DETOURS BEING UTILIZED
	NEW CONSTRUCTION
	NEW CONSTRUCTION ALREADY IN PLACE




**STAGE 3**

SUGGESTED WORK SEQUENCE

-  CONSTRUCT DETOUR 'D' AND REMOVE BYPASSED PORTION OF DETOUR 'B'
-  COMPLETE RAMP 'I'
-  OPEN RAMP 'H'
-  CLOSE THE EXISTING 8TH AVE. OFF RAMP AND OPEN RAMPS 'E' AND 'I'.
-  REMOVE THE EXISTING E.B. 6TH AVE. TO N.B. I-25 LOOP RAMP AND MODIFY THE 8TH AVE. ON RAMP.

NOTE: DETOURS 'C' AND 'D' ARE TO REMAIN UPON COMPLETION OF THE PROJECT AND WILL BE REMOVED BY OTHERS.

**STAGE 3  
CONSTRUCTION  
STAGING PLAN  
6th Ave. / I 25  
NOT TO SCALE**

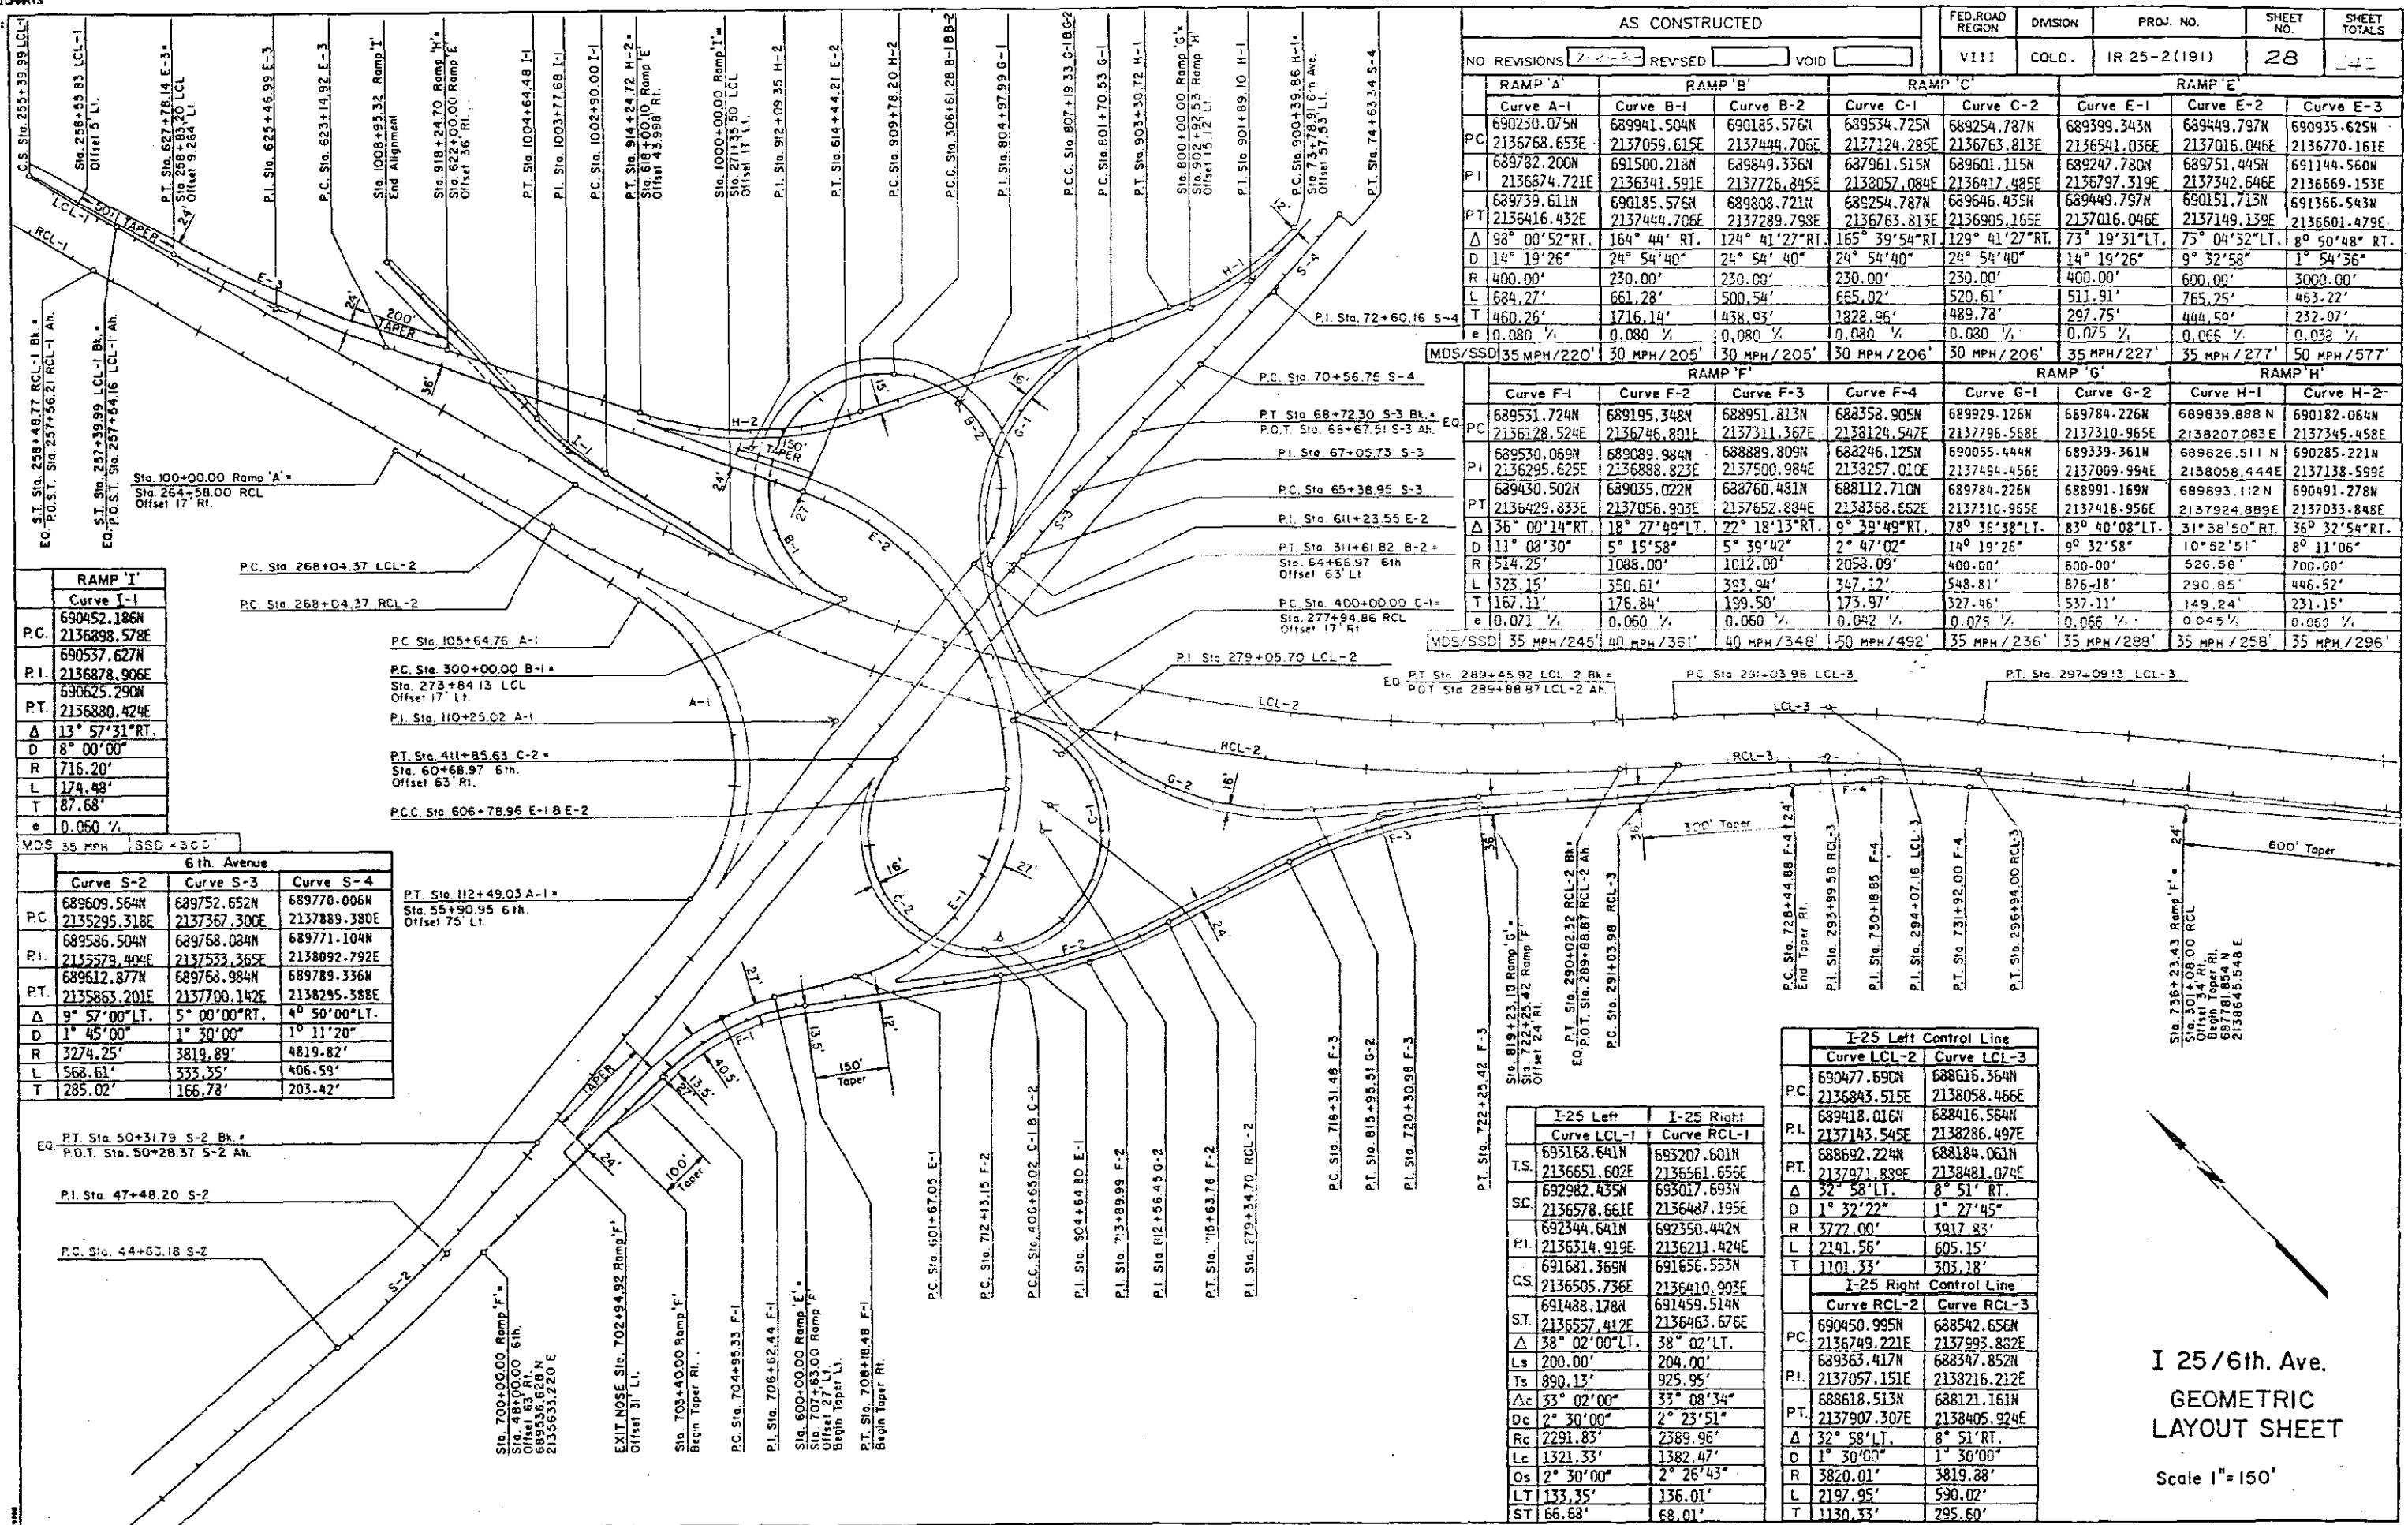

AS CONSTRUCTED		FED. ROAD REGION	DMSION	PROJ. NO.	SHEET NO.	SHEET TOTALS
NO REVISIONS	REVISED	VIII	COLO.	IR 25-2(191)	28	41

	RAMP 'A'		RAMP 'B'		RAMP 'C'		RAMP 'E'		
	Curve A-1	Curve B-1	Curve B-2	Curve C-1	Curve C-2	Curve E-1	Curve E-2	Curve E-3	
PC	690230.075N	689941.504N	690185.576N	689534.725N	689254.787N	689399.343N	689449.797N	690935.625N	
PI	2136768.653E	2137059.615E	2137444.706E	2137124.285E	2136763.813E	2136541.036E	2137016.046E	2136770.161E	
PT	689782.200N	691500.218N	689849.336N	687961.515N	689601.115N	689247.780N	689751.445N	691144.560N	
Δ	13° 57' 31" RT.	164° 44' RT.	124° 41' 27" RT.	165° 39' 54" RT.	129° 41' 27" RT.	73° 19' 31" LT.	73° 04' 52" LT.	8° 50' 48" RT.	
D	14° 19' 26"	24° 54' 40"	24° 54' 40"	24° 54' 40"	24° 54' 40"	14° 19' 26"	9° 32' 58"	1° 54' 36"	
R	400.00'	230.00'	230.00'	230.00'	230.00'	400.00'	600.00'	3000.00'	
L	684.27'	661.28'	500.54'	665.02'	520.61'	511.91'	765.25'	463.22'	
T	460.26'	1716.14'	438.93'	1828.96'	489.78'	297.75'	444.59'	232.07'	
e	0.080 %	0.080 %	0.080 %	0.080 %	0.080 %	0.075 %	0.065 %	0.032 %	
MDS/SSD	35 MPH/220'	30 MPH/205'	30 MPH/205'	30 MPH/206'	30 MPH/206'	35 MPH/227'	35 MPH/277'	50 MPH/577'	


	RAMP 'F'		RAMP 'G'		RAMP 'H'	
	Curve F-1	Curve F-2	Curve F-3	Curve F-4	Curve G-1	Curve G-2
PC	689531.724N	689195.348N	688951.813N	688358.905N	689929.126N	689784.226N
PI	2136128.524E	2136746.801E	2137311.367E	2138124.547E	2137796.568E	2137310.965E
PT	689530.069N	689089.984N	688889.809N	688246.125N	690055.444N	689339.361N
Δ	36° 00' 14" RT.	18° 27' 49" LT.	22° 18' 13" RT.	9° 39' 49" RT.	78° 36' 38" LT.	83° 40' 08" LT.
D	11° 08' 30"	5° 15' 58"	5° 39' 42"	2° 47' 02"	18° 19' 26"	9° 32' 58"
R	514.25'	1088.00'	1012.00'	2053.09'	400.00'	600.00'
L	323.15'	350.61'	393.94'	347.12'	548.81'	876.18'
T	167.11'	176.84'	199.50'	173.97'	327.46'	537.11'
e	0.071 %	0.060 %	0.060 %	0.042 %	0.075 %	0.066 %
MDS/SSD	35 MPH/245'	40 MPH/361'	40 MPH/348'	50 MPH/492'	35 MPH/236'	35 MPH/288'

	I-25 Left Control Line	
	Curve LCL-2	Curve LCL-3
PC	690477.695N	688616.364N
PI	2136843.515E	2138058.466E
PT	689418.016N	688416.564N
Δ	32° 58' LT.	8° 51' RT.
D	1° 32' 22"	1° 27' 45"
R	3727.00'	3917.83'
L	2141.56'	605.15'
T	1101.33'	303.18'

	I-25 Right Control Line	
	Curve RCL-2	Curve RCL-3
PC	690450.995N	688542.656N
PI	2136749.221E	2137993.882E
PT	689363.417N	688347.852N
Δ	38° 02' 00" LT.	38° 02' LT.
D	2° 30' 00"	2° 23' 51"
R	2291.83'	2389.96'
L	1321.33'	1382.47'
T	133.35'	136.01'

I 25/6th Ave.  
GEOMETRIC  
LAYOUT SHEET  
Scale 1"=150'

AS CONSTRUCTED				
NO REVISIONS	REVISED	VOID		
	2-21-57			
FED. ROAD REGION	DMSION	PROJ. NO.	SHEET NO.	SHEET TOTALS
VIII	COLO.	IR25-2(191)	29	242

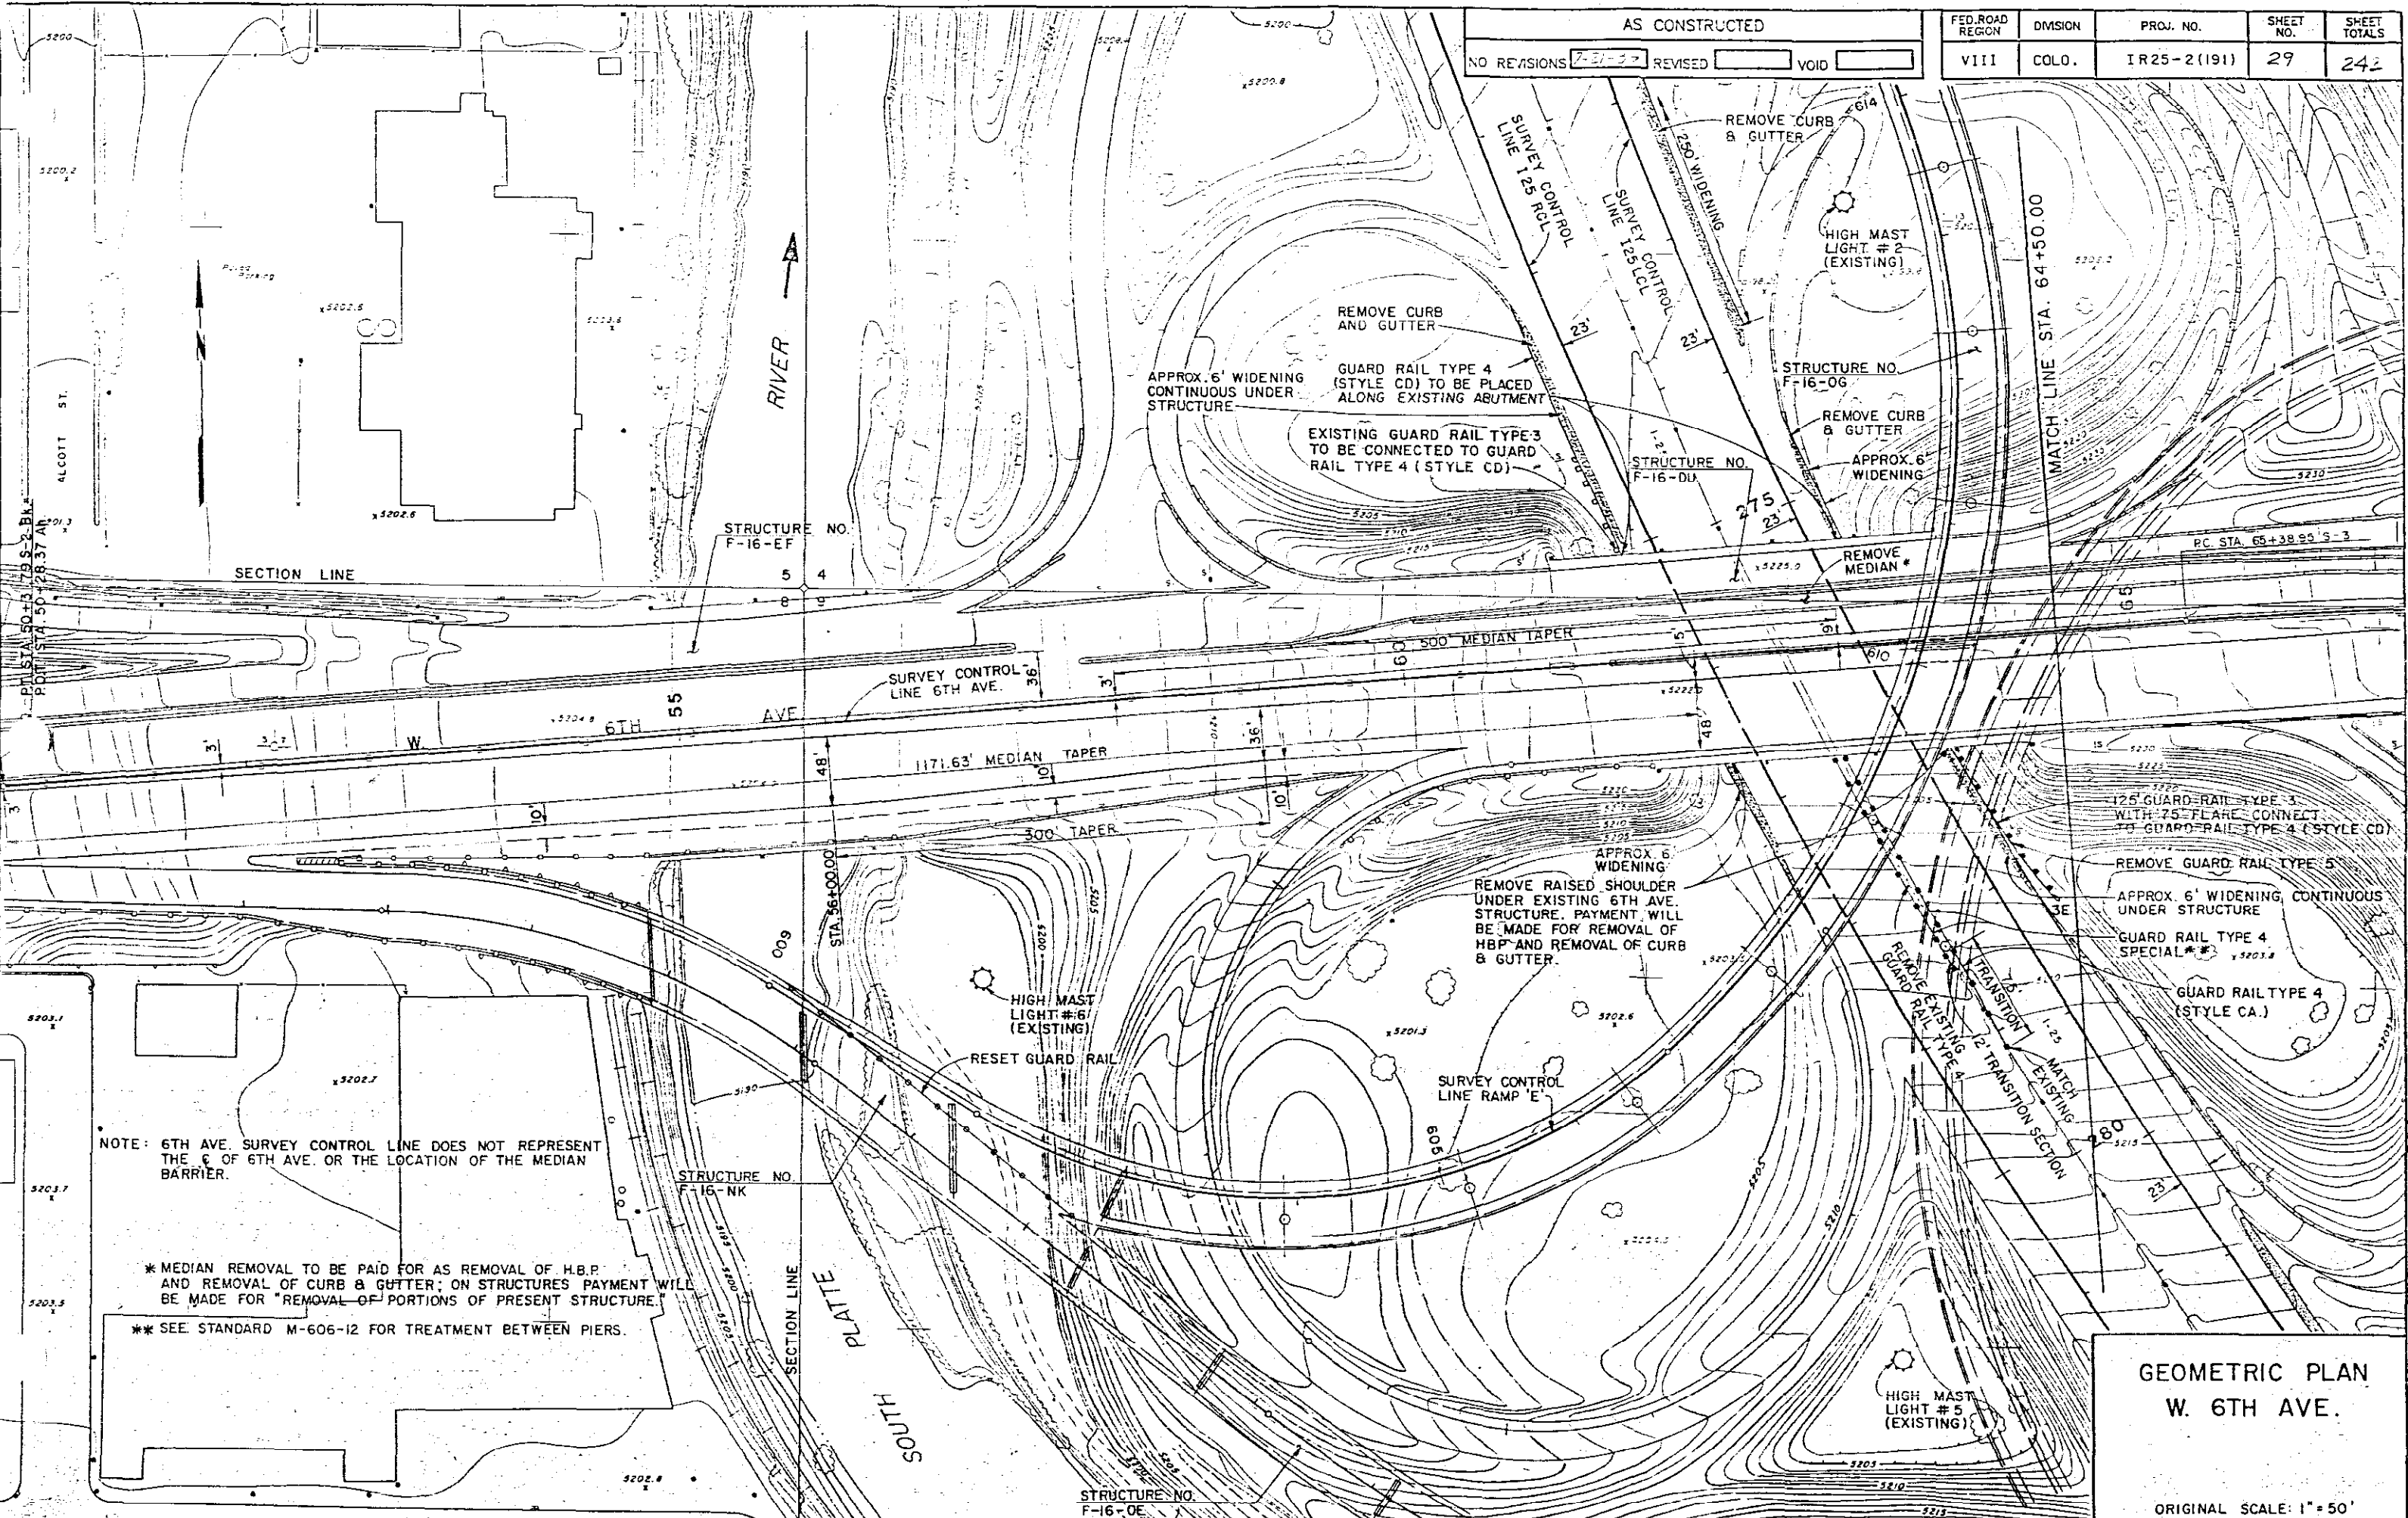

NOTE: 6TH AVE. SURVEY CONTROL LINE DOES NOT REPRESENT THE C. OF 6TH AVE. OR THE LOCATION OF THE MEDIAN BARRIER.

\* MEDIAN REMOVAL TO BE PAID FOR AS REMOVAL OF H.B.P. AND REMOVAL OF CURB & GUTTER; ON STRUCTURES PAYMENT WILL BE MADE FOR "REMOVAL OF PORTIONS OF PRESENT STRUCTURE."

\*\* SEE STANDARD M-606-12 FOR TREATMENT BETWEEN PIERS.

GEOMETRIC PLAN  
W. 6TH AVE.


ORIGINAL SCALE: 1" = 50'

AS CONSTRUCTED  
 NO REVISIONS  7-21-52 REVISED  VOID

FED. ROAD REGION	DIVISION	PROJ. NO.	SHEET NO.	SHEET TOTALS
VIII	COLO.	1R25-2(191)	30	242

NOTE: 6TH AVE. SURVEY CONTROL LINE DOES NOT REPRESENT THE C. OF 6TH AVE. OR THE LOCATION OF THE MEDIAN BARRIER.

\* MEDIAN REMOVAL TO BE PAID FOR AS REMOVAL OF H&P AND REMOVAL OF CURB AND GUTTER; ON STRUCTURES PAYMENT WILL BE MADE FOR "REMOVAL OF PORTIONS OF PRESENT STRUCTURE."

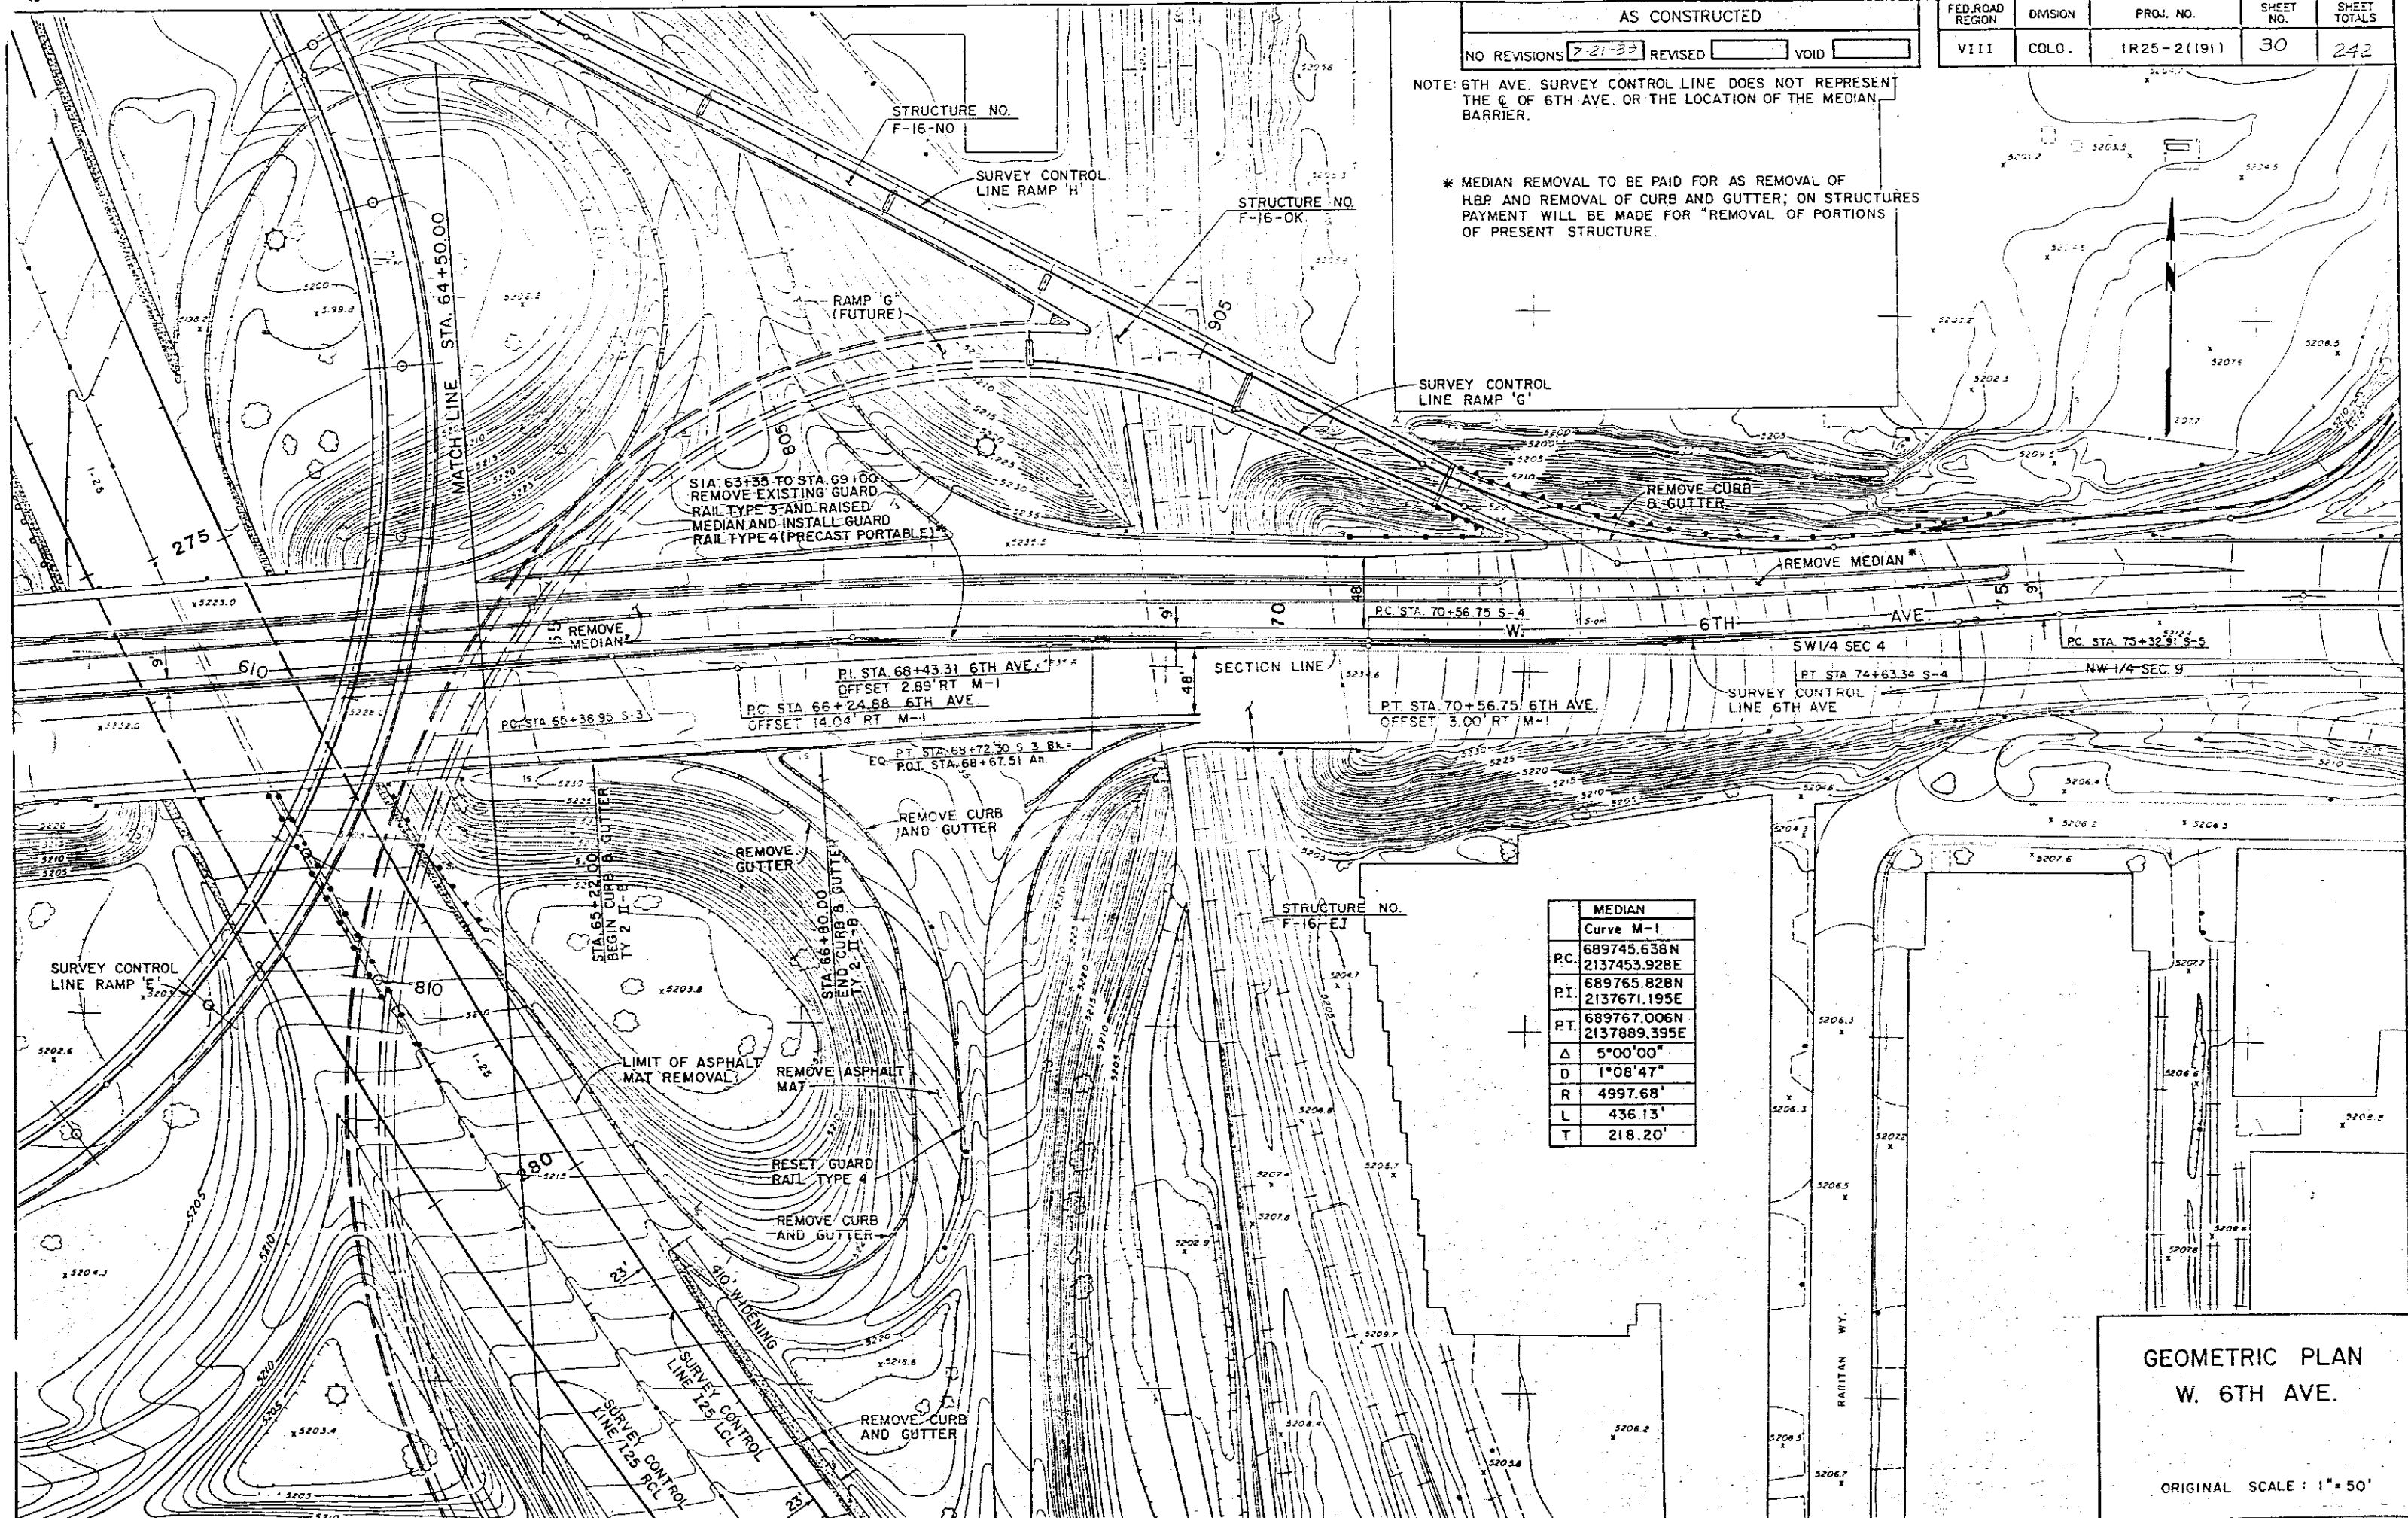



MEDIAN	
Curve M-1	
PC.	689745.638 N 2137453.928 E
PI.	689765.828 N 2137671.195 E
PT.	689767.006 N 2137889.395 E
Δ	5°00'00"
D	1°08'47"
R	4997.68'
L	436.13'
T	218.20'

GEOMETRIC PLAN  
 W. 6TH AVE.  
 ORIGINAL SCALE: 1" = 50'



AS CONSTRUCTED  
 NO REVISIONS  REVISED 7-21-89  VOID

FEDERAL ROAD DISTRICT NO.	DIVISION	PROJ. NO.	SHEET NO.	TOTAL SHEETS
731	COLORADO	IR 25-2 (191)	31	242

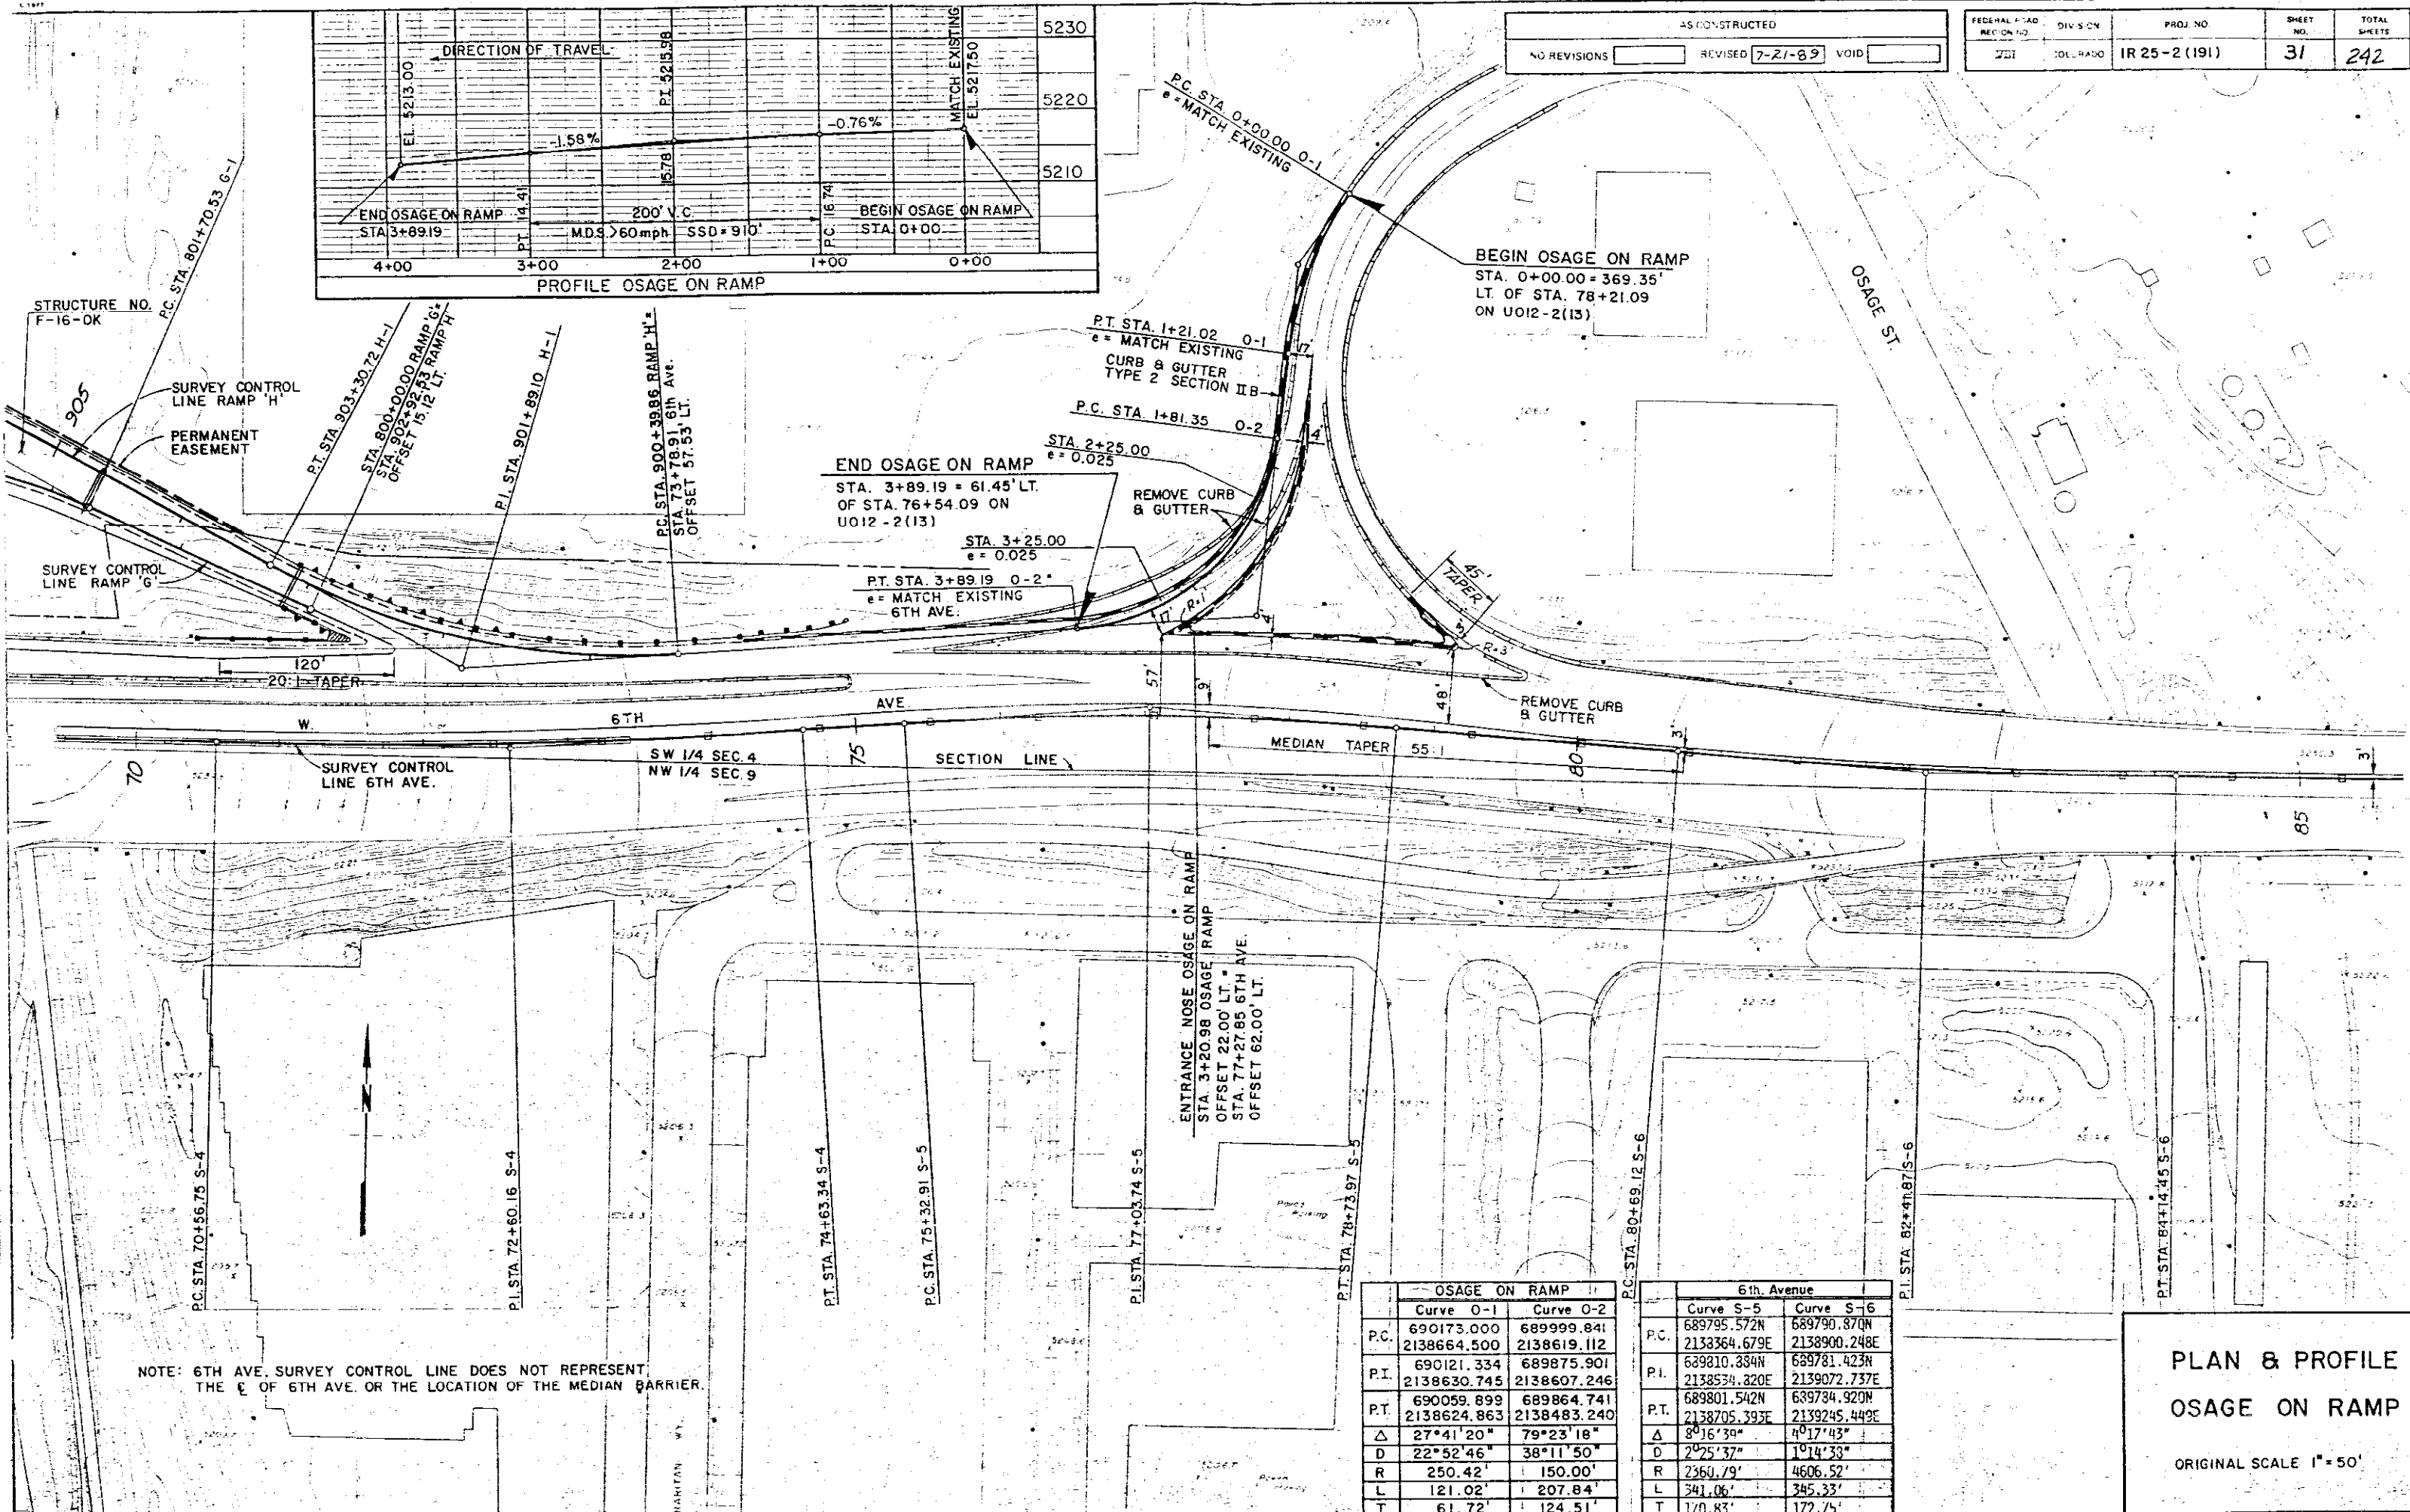
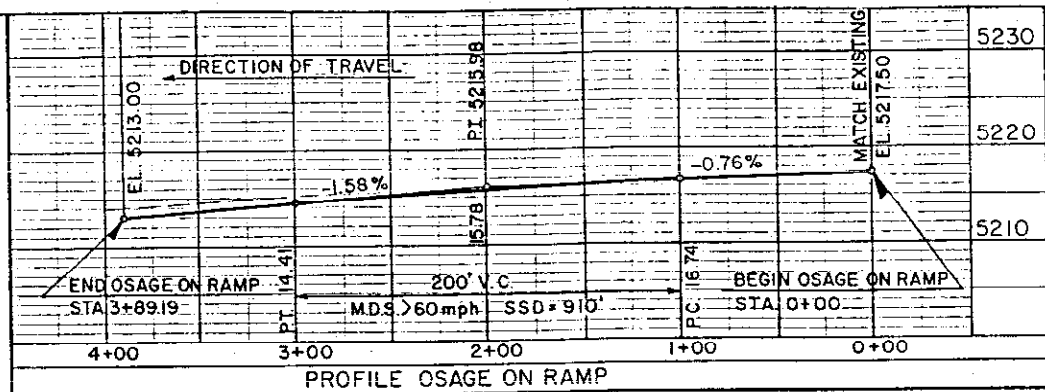


NOTE: 6TH AVE. SURVEY CONTROL LINE DOES NOT REPRESENT THE  $\epsilon$  OF 6TH AVE. OR THE LOCATION OF THE MEDIAN BARRIER.

	OSAGE ON RAMP	
	Curve O-1	Curve O-2
P.C.	690173.000	689999.841
	2138664.500	2138619.112
P.I.	690121.334	689875.901
	2138630.745	2138607.246
P.T.	690059.899	689864.741
	2138624.863	2138483.240
$\Delta$	27°41'20"	79°23'18"
D	22°52'46"	38°11'50"
R	250.42'	150.00'
L	121.02'	207.84'
T	61.72'	124.51'

	6th Avenue	
	Curve S-5	Curve S-6
P.C.	689795.572N	689790.870N
	2138364.679E	2138900.248E
P.I.	689810.384N	689781.423N
	2138534.820E	2139072.737E
P.T.	689801.542N	689734.920N
	2138705.393E	2139245.449E
$\Delta$	8°16'30"	4°17'43"
D	2°25'37"	1°14'33"
R	2360.79'	4606.52'
L	341.06'	345.33'
T	170.83'	172.75'


PLAN & PROFILE  
 OSAGE ON RAMP  
 ORIGINAL SCALE 1" = 50'

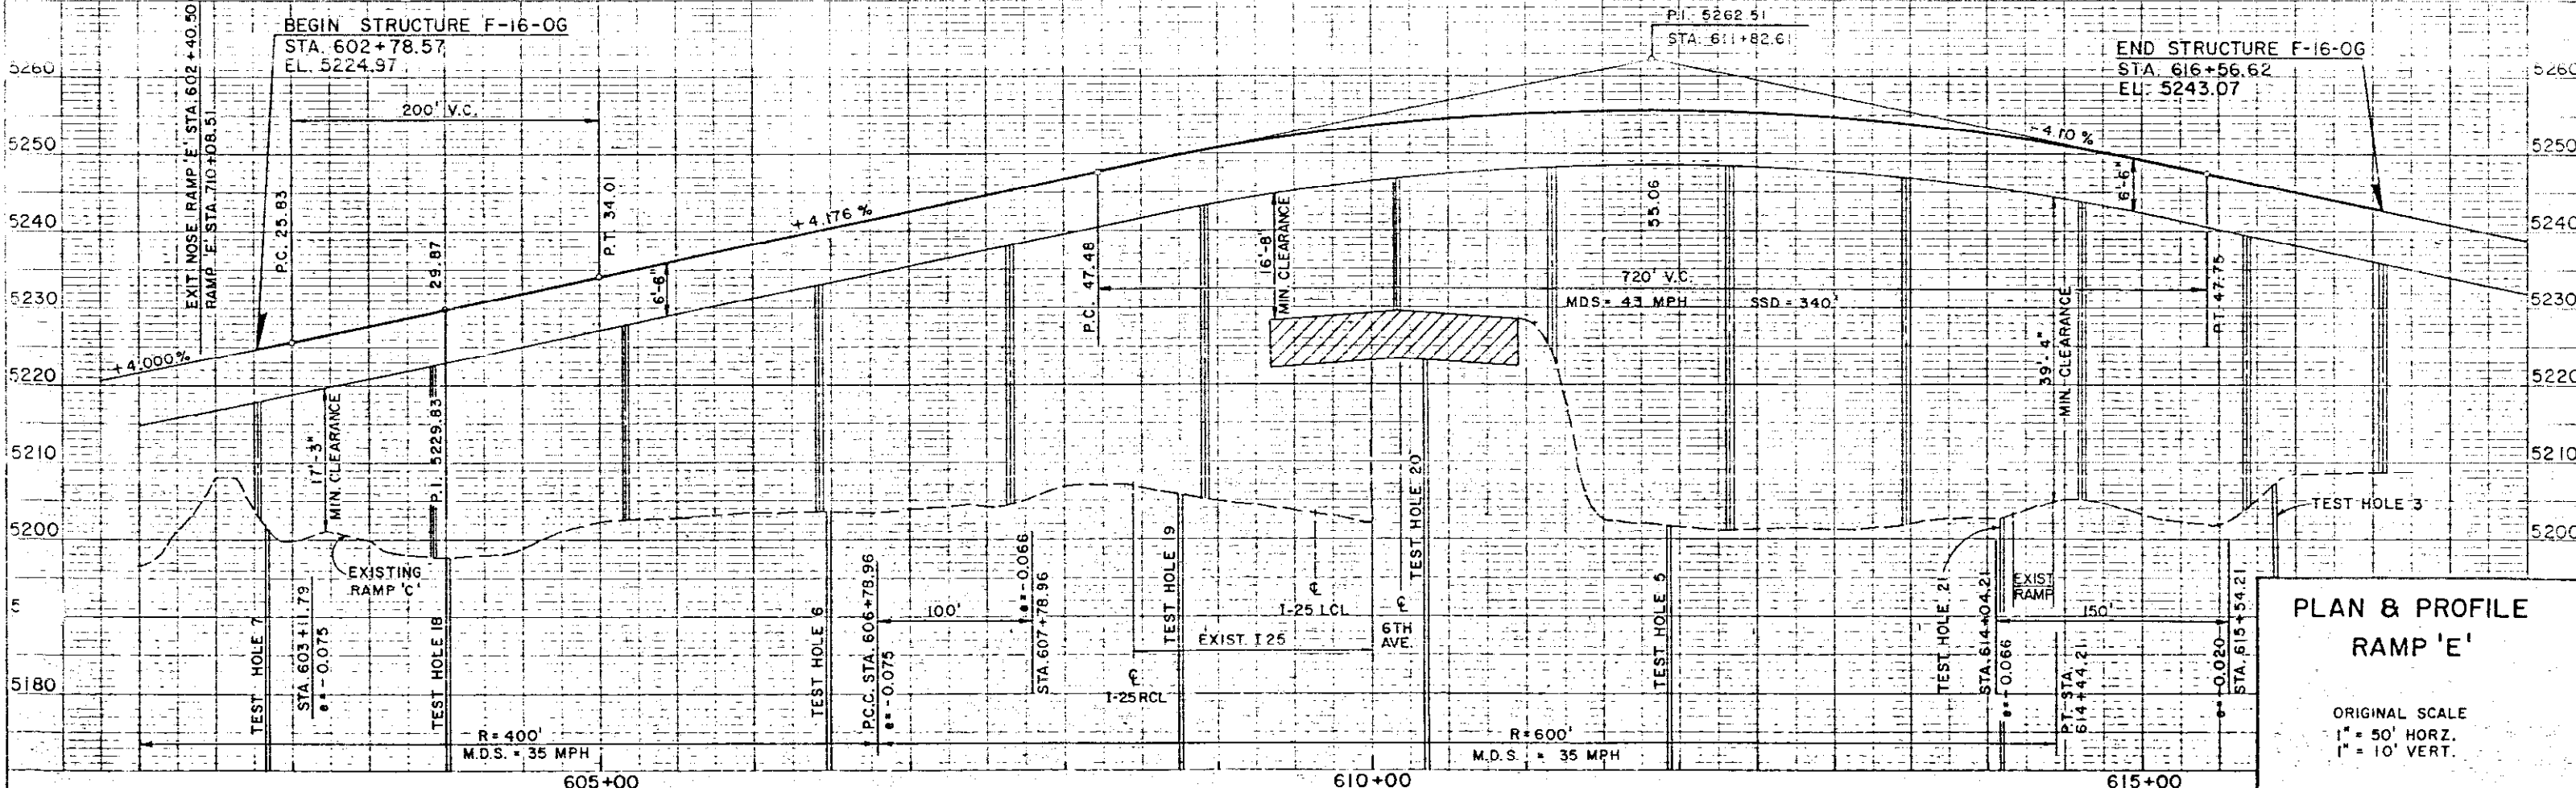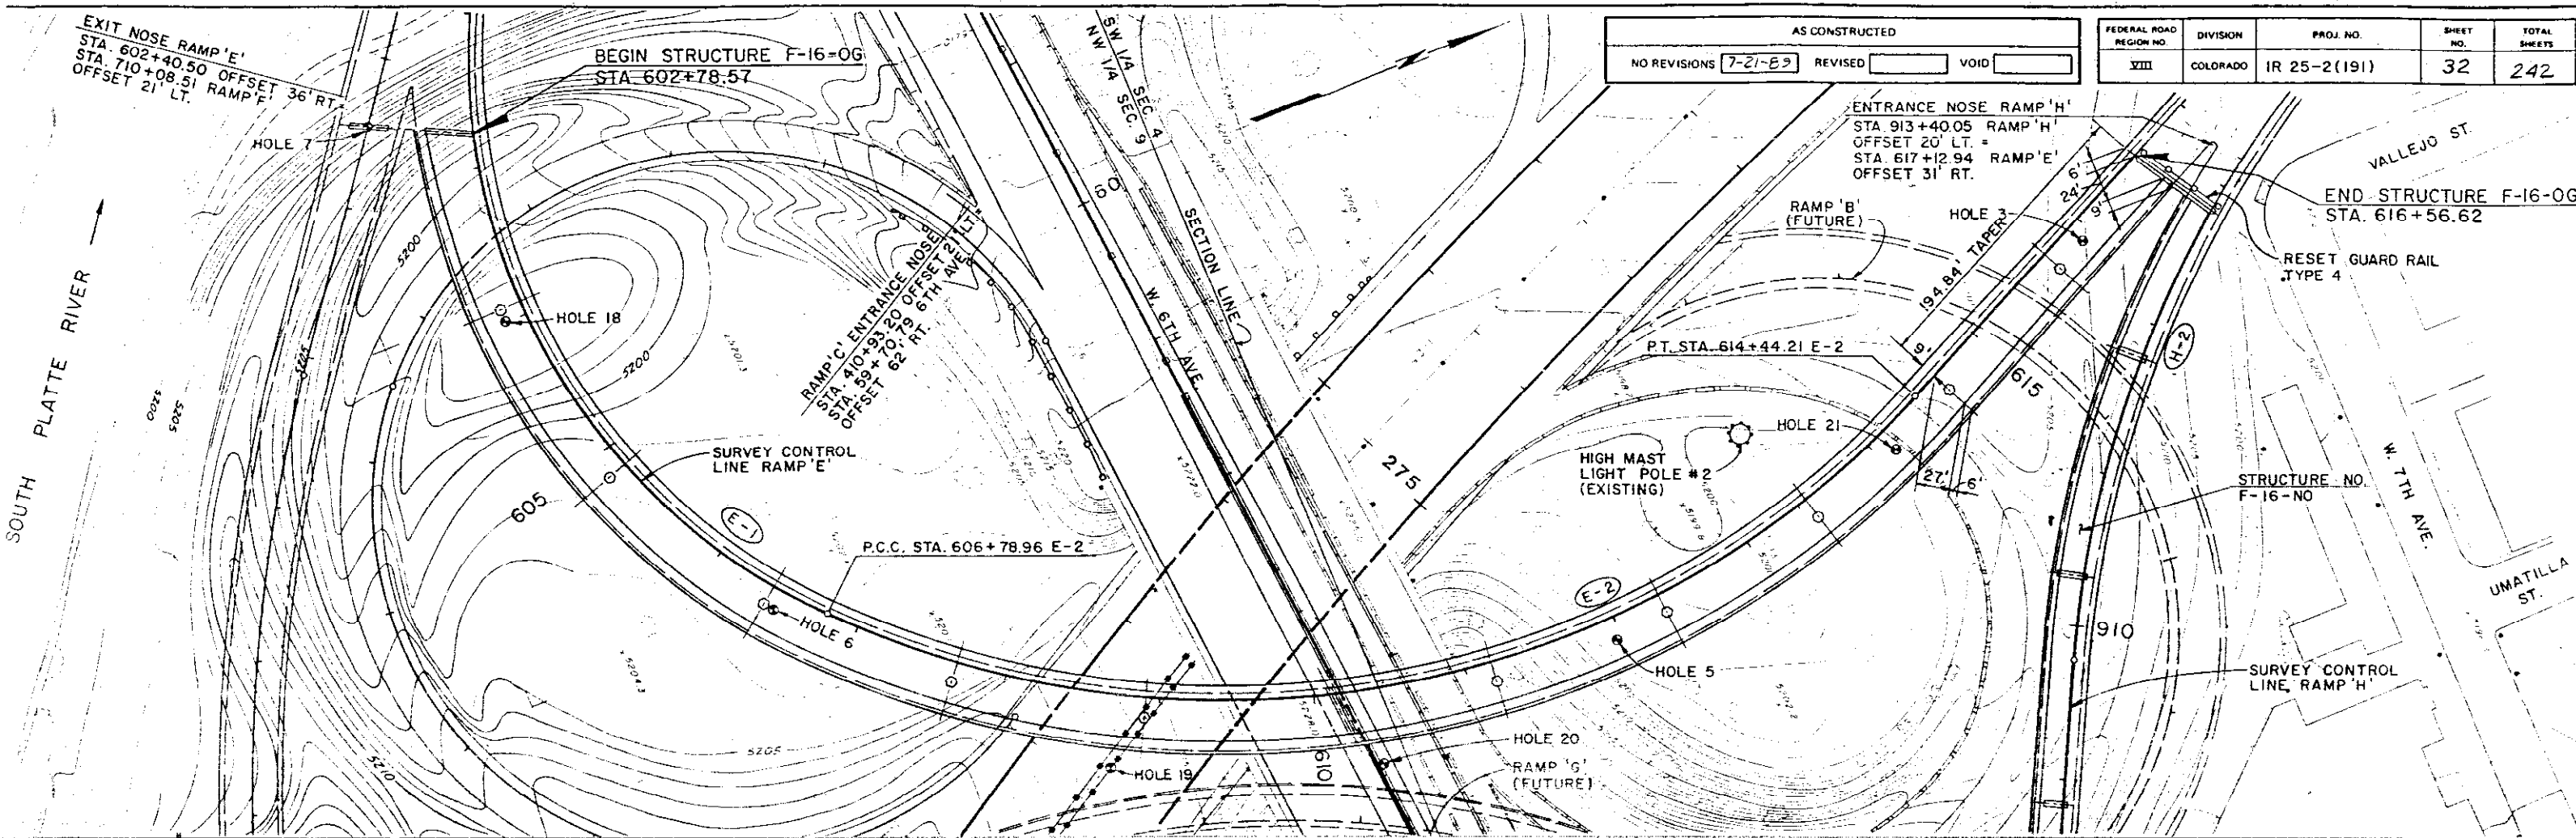



AS CONSTRUCTED		
NO REVISIONS	7-21-89	REVISED
		VOID

FEDERAL ROAD REGION NO.	DIVISION	PROJ. NO.	SHEET NO.	TOTAL SHEETS
VIII	COLORADO	IR 25-2(191)	34	242

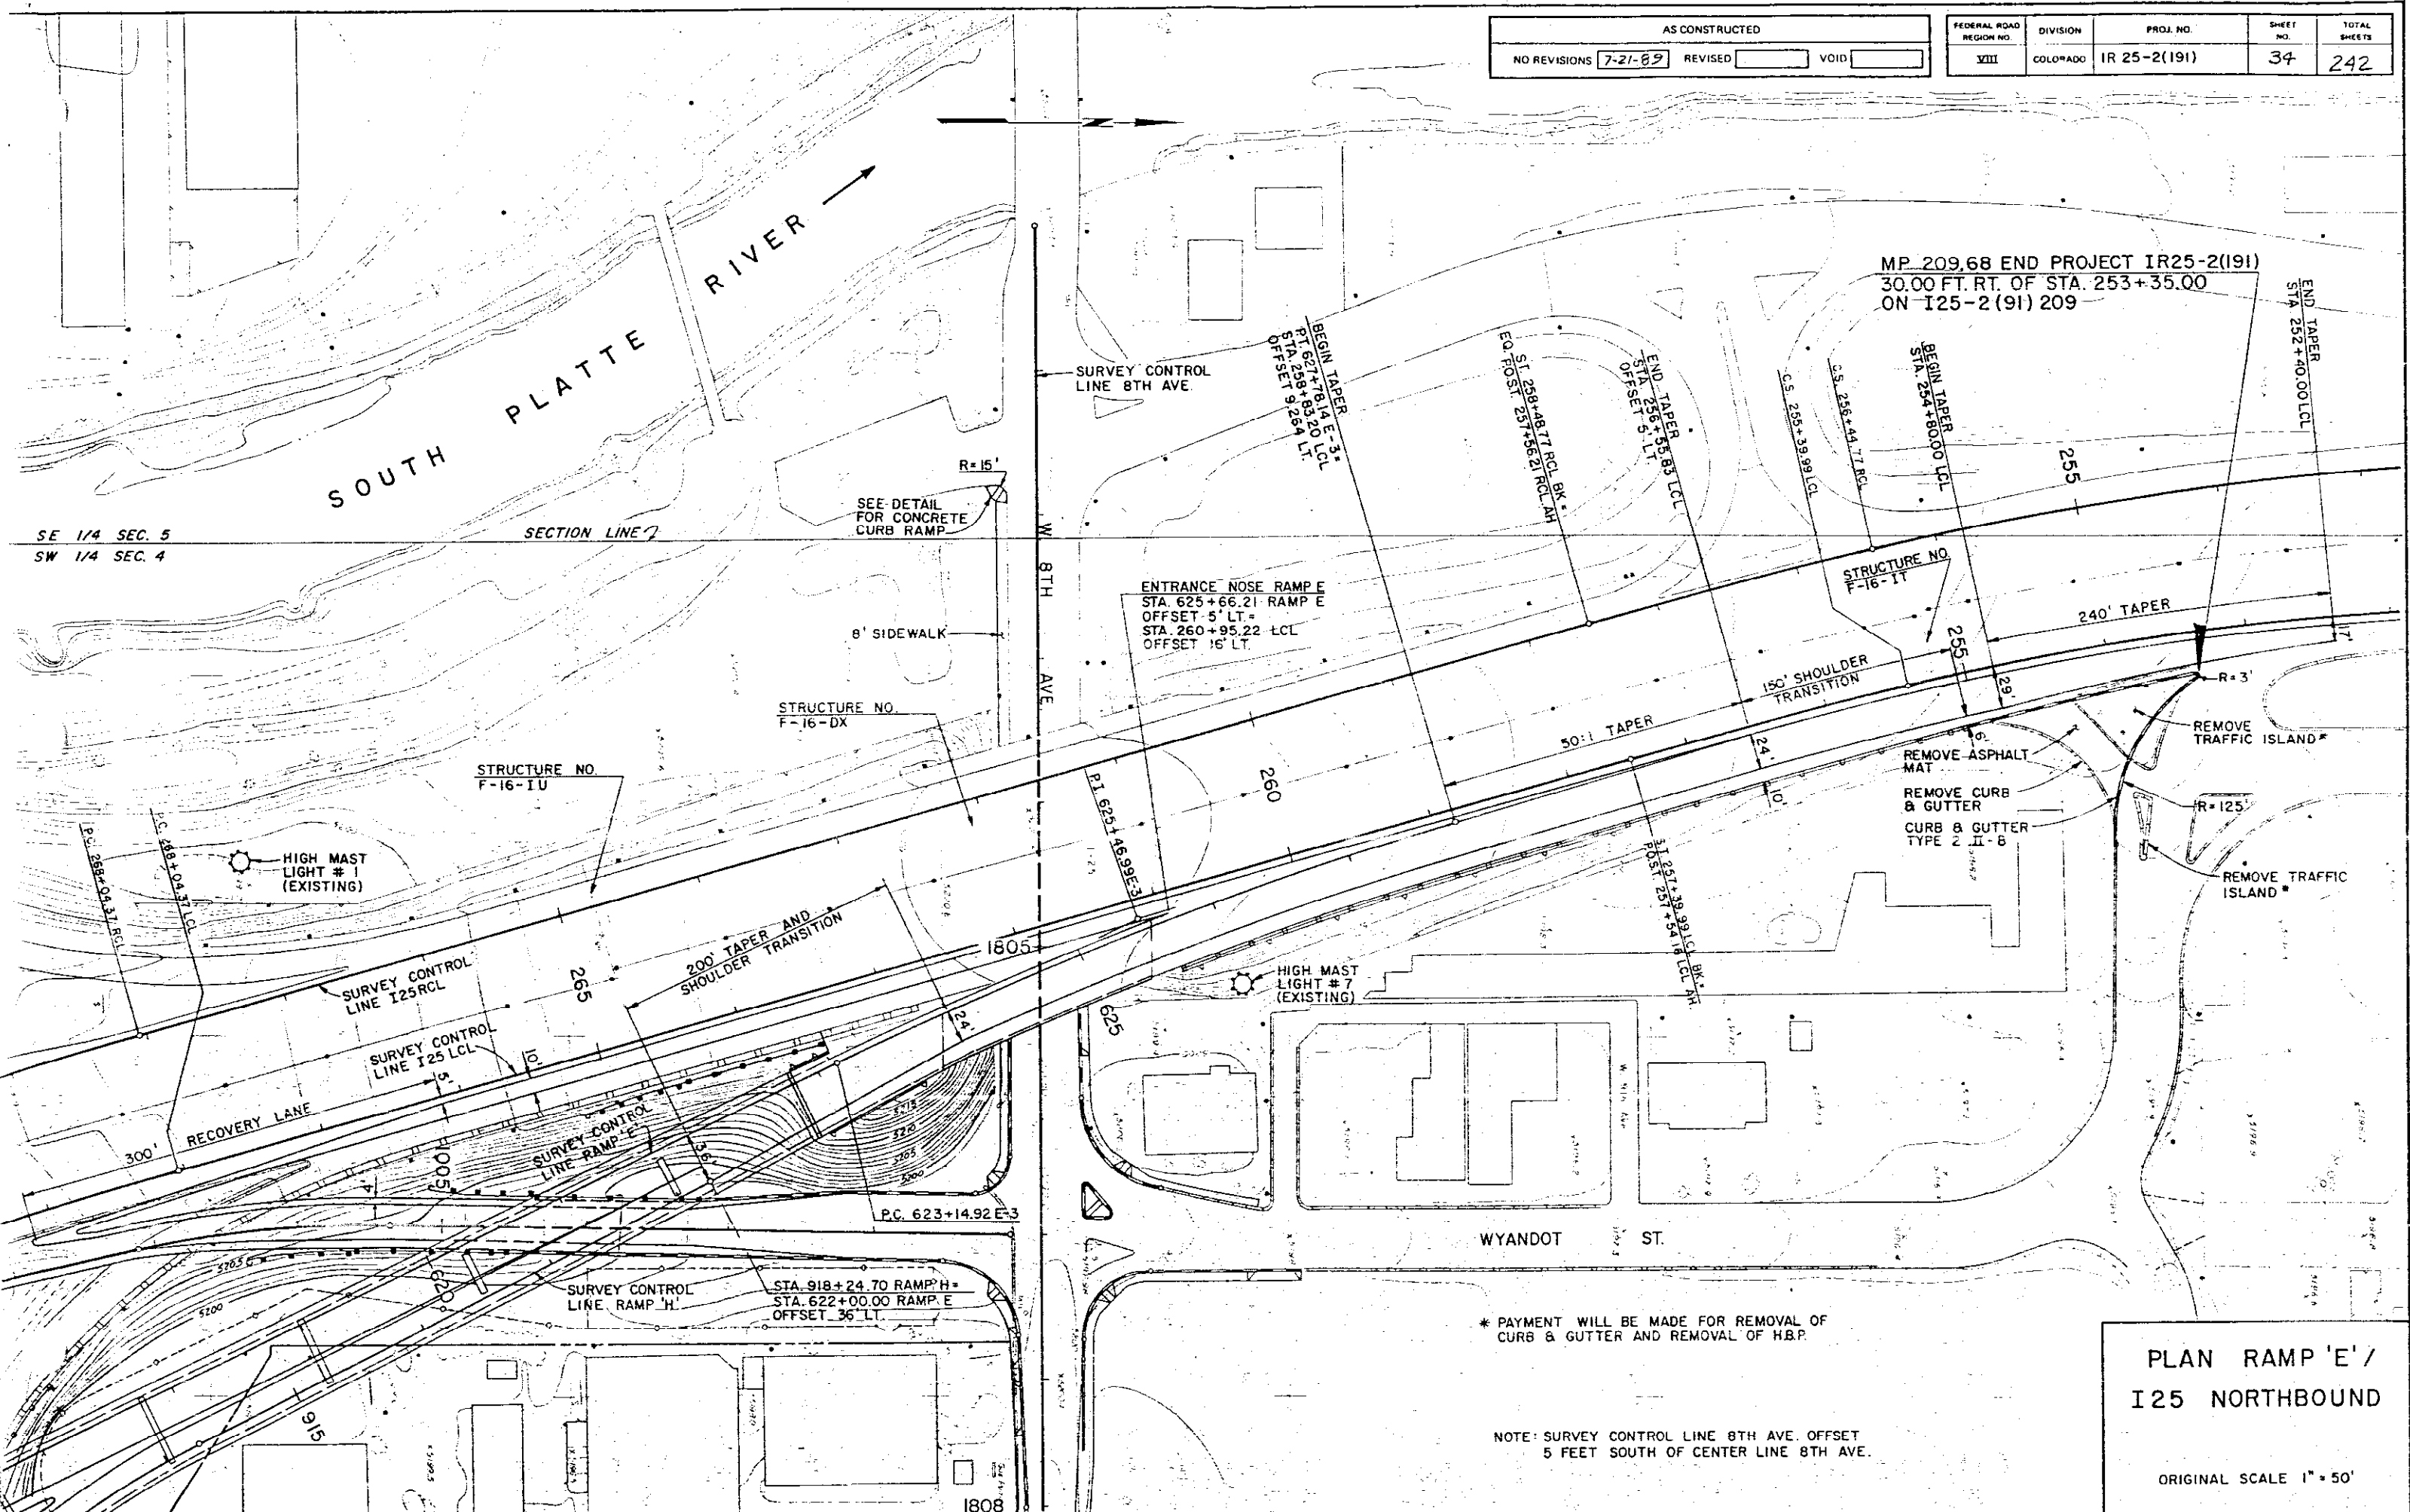

MP. 209.68 END PROJECT IR25-2(191)  
30.00 FT. RT. OF STA. 253+35.00  
ON I-25-2(91) 209

ENTRANCE NOSE RAMP E  
STA. 625+66.21 RAMP E  
OFFSET 5' LT.  
STA. 260+95.22 LCL  
OFFSET 16' LT.

REMOVE ASPHALT MAT  
REMOVE CURB & GUTTER  
CURB & GUTTER TYPE 2 II-B

\* PAYMENT WILL BE MADE FOR REMOVAL OF CURB & GUTTER AND REMOVAL OF H.B.P.

NOTE: SURVEY CONTROL LINE 8TH AVE. OFFSET 5 FEET SOUTH OF CENTER LINE 8TH AVE.

PLAN RAMP 'E' /  
I25 NORTHBOUND

ORIGINAL SCALE 1" = 50'

SE 1/4 SEC. 5  
SW 1/4 SEC. 4

SECTION LINE 7

W 8TH AVE

WYANDOT ST.

SOUTH PLATTE RIVER

SEE DETAIL FOR CONCRETE CURB RAMP

8' SIDEWALK

STRUCTURE NO. F-16-DX

STRUCTURE NO. F-16-IU

HIGH MAST LIGHT #1 (EXISTING)

SURVEY CONTROL LINE I25RCL

SURVEY CONTROL LINE I25LCL

RECOVERY LANE

SURVEY CONTROL LINE RAMP 'E'

P.C. 623+14.92 E-3

SURVEY CONTROL LINE RAMP 'H'

STA. 918+24.70 RAMP 'H'  
STA. 622+00.00 RAMP 'E'  
OFFSET 36' LT.


HIGH MAST LIGHT #7 (EXISTING)

1808




AS CONSTRUCTED  
NO REVISIONS 7-2-3-3- REVISIONS V.G.I.D.

FEDERAL ROAD REGION NO.	DIVISION	PROJ. NO.	SHEET NO.	TOTAL SHEETS
VIII	COLORADO	IR 25-2(191)	36	242

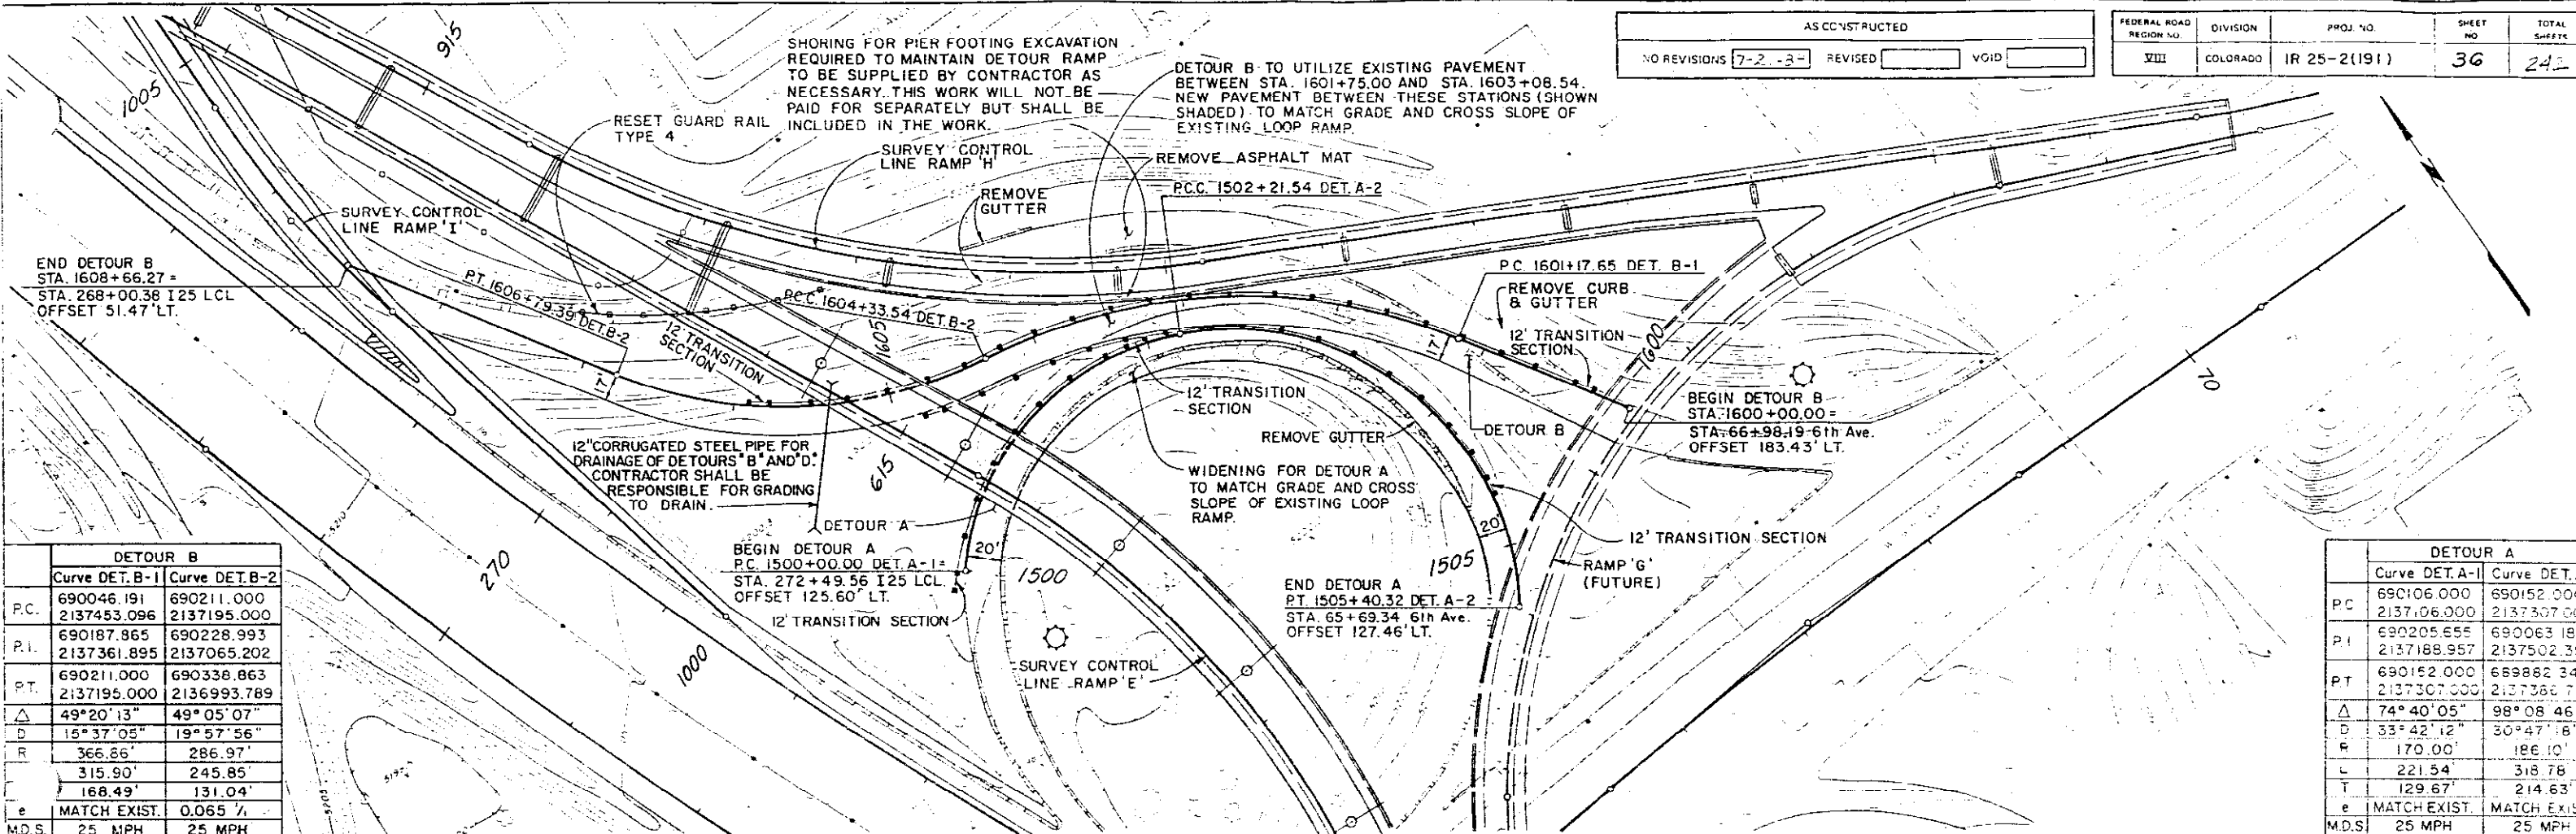

DETOUR B	
Curve DET. B-1	Curve DET. B-2
P.C. 690046.191	690211.000
2137453.096	2137195.000
P.I. 690187.865	690228.993
2137361.895	2137065.202
P.T. 690211.000	690338.863
2137195.000	2136993.789
$\Delta$ 49°20'13"	49°05'07"
D 15°37'05"	19°57'56"
R 366.86'	286.97'
315.90'	245.85'
168.49'	131.04'
e MATCH EXIST.	0.065 1/2
M.D.S. 25 MPH	25 MPH


DETOUR A	
Curve DET. A-1	Curve DET. A-2
P.C. 690106.000	690152.000
2137106.000	2137307.000
P.I. 690205.655	690063.187
2137188.957	2137502.393
P.T. 690152.000	689882.349
2137307.000	2137366.790
$\Delta$ 74°40'05"	98°08'46"
D 33°42'12"	30°47'18"
R 170.00'	186.10'
L 221.54'	318.78'
T 129.67'	214.63'
e MATCH EXIST.	MATCH EXIST.
M.D.S. 25 MPH	25 MPH

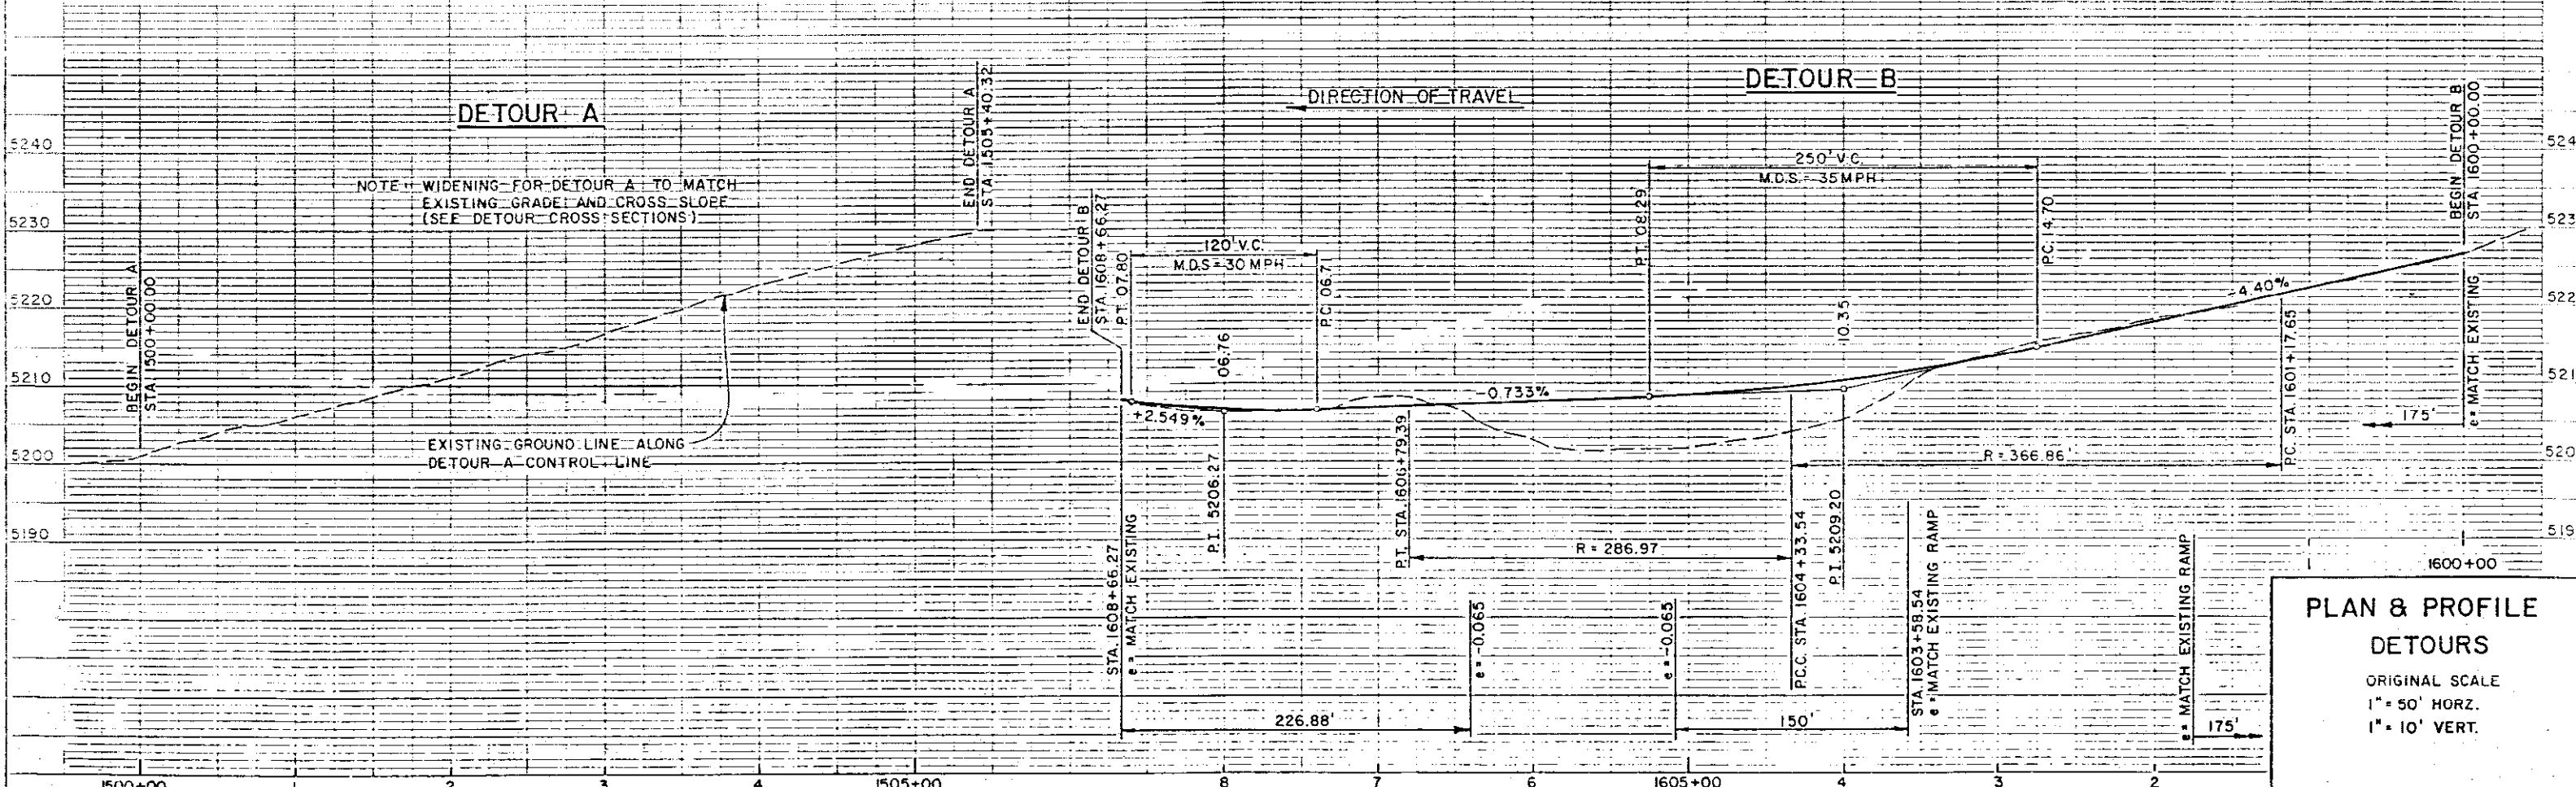

**PLAN & PROFILE  
DETOURS**  
ORIGINAL SCALE  
1" = 50' HORIZ.  
1" = 10' VERT.

AS CONSTRUCTED		
NO REVISIONS	7-21-59	REVISED
		VOID


FEDERAL ROAD REGION NO.	DIVISION	PROJ. NO.	SHEET NO.	TOTAL SHEETS
XIII	COLORADO	1R 25-2 (191)	37	242

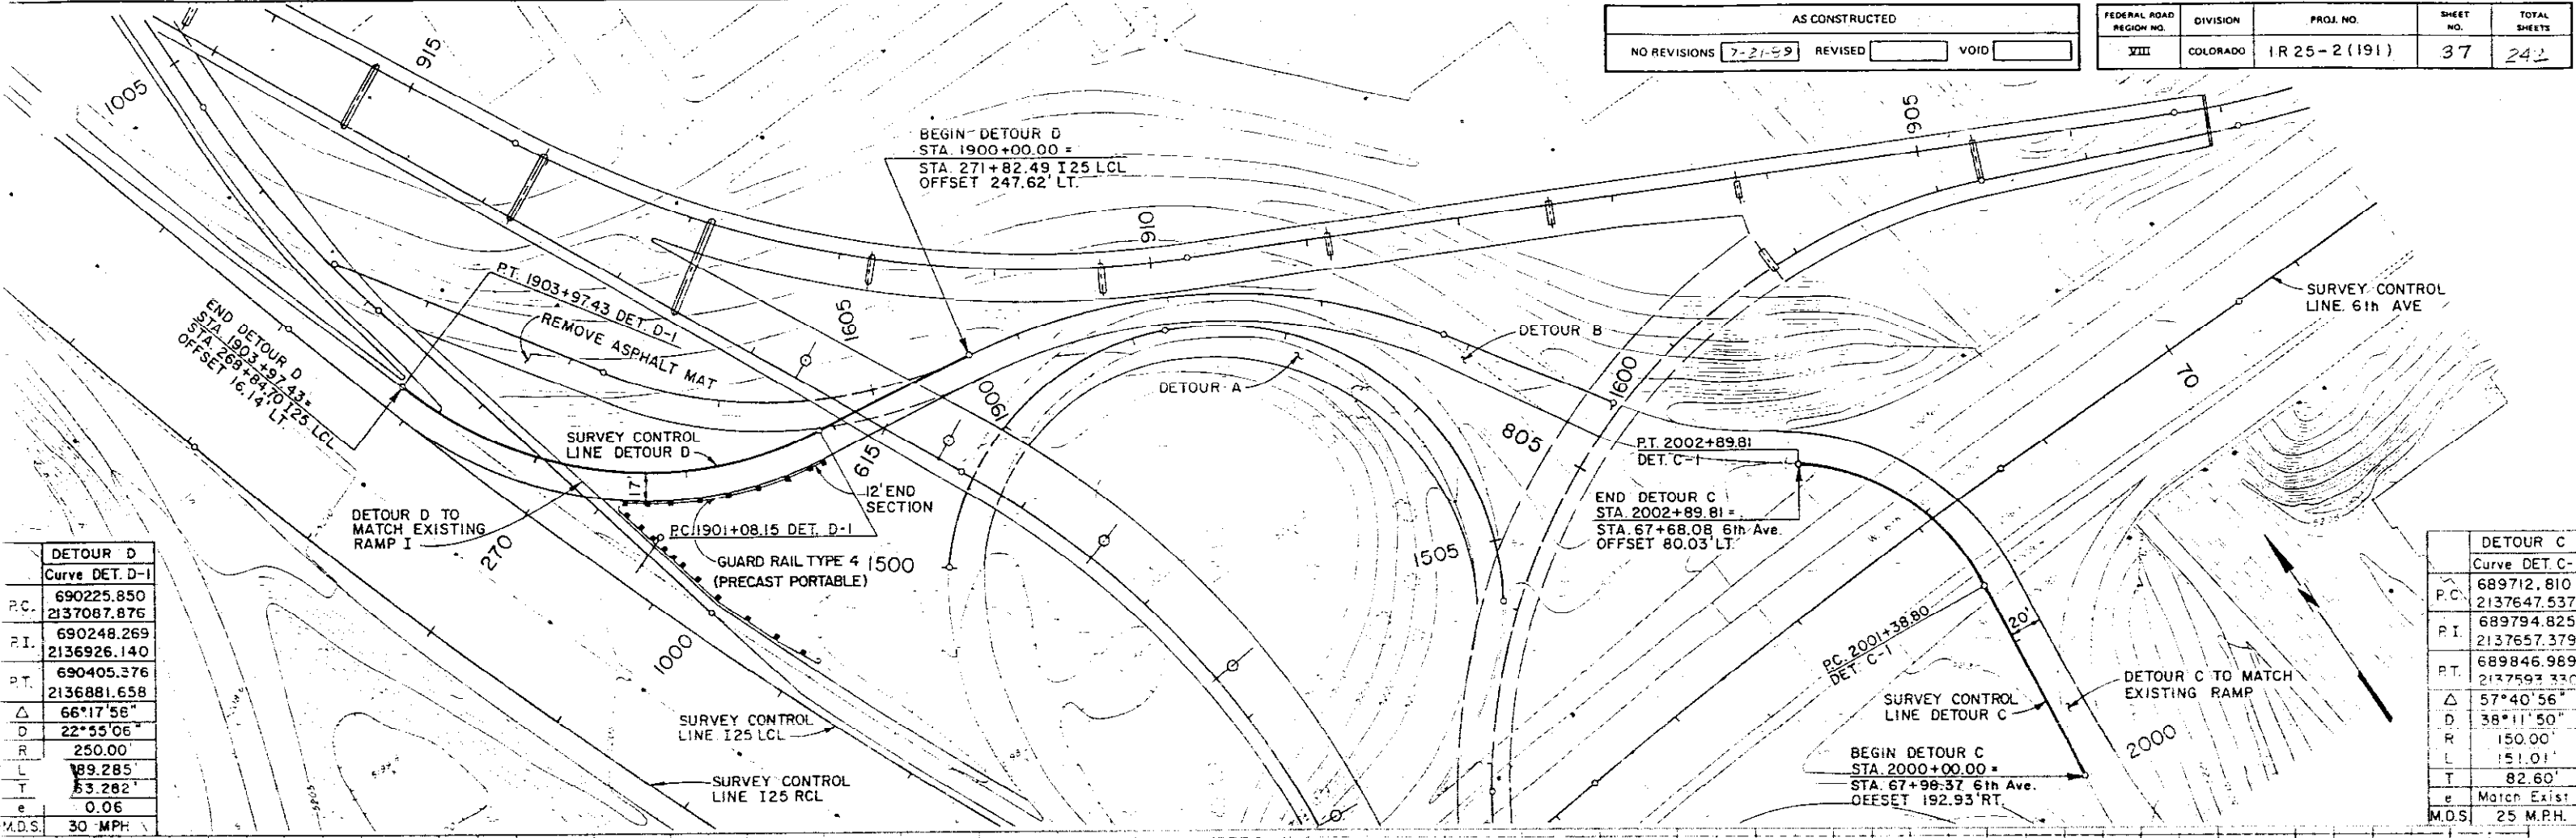

DETOUR D	
Curve DET. D-1	
P.C.	690225.850
	2137087.876
P.I.	690248.269
	2136926.140
P.T.	690405.376
	2136881.658
$\Delta$	66°17'56"
D	22°55'06"
R	250.00
L	189.285
T	53.282
e	0.06
M.D.S.	30 MPH

DETOUR C	
Curve DET. C-1	
P.C.	689712.810
	2137647.537
P.I.	689794.825
	2137657.379
P.T.	689846.989
	2137593.330
$\Delta$	57°40'56"
D	38°11'50"
R	150.00
L	151.01
T	82.60
e	Match Exist
M.D.S.	25 M.P.H.

NOTE: PROFILES ARE APPROXIMATE ONLY AND FINAL ADJUSTMENTS ARE TO BE MADE DURING CONSTRUCTION AS DIRECTED BY THE ENGINEER.

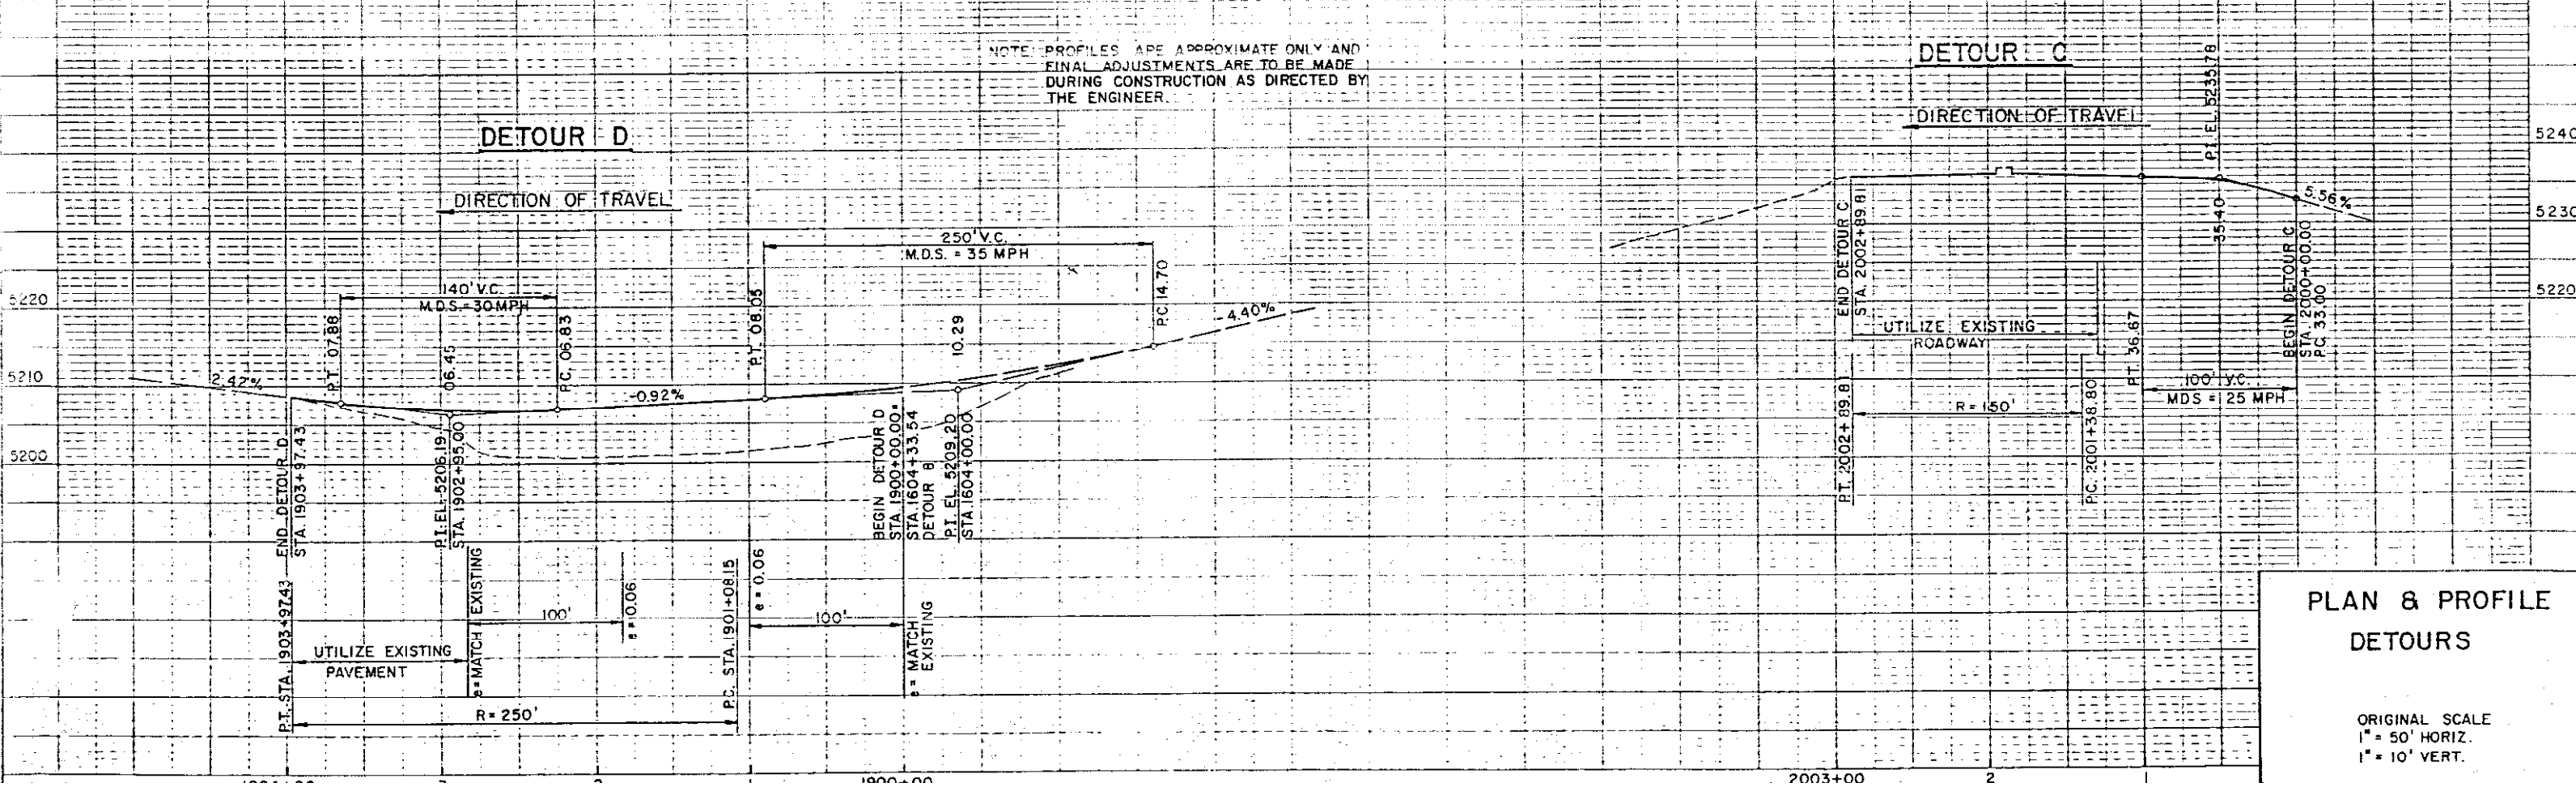


PLAN & PROFILE  
 DETOURS


ORIGINAL SCALE  
 1" = 50' HORIZ.  
 1" = 10' VERT.

AS CONSTRUCTED  
NO REVISIONS 7-21-92 REVISED VOID

FED. ROAD REGION	DIVISION	PROJ. NO.	SHEET NO.	SHEET TOTALS
VIII	COLO.	IR 25-2(191)	38	242

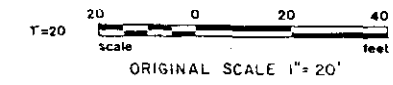

POINT	OFFSET	STATION	CONTROL LINE
1	81.43	1806+67.43	8 TH AVE.
2	29.97	1806+03.79	" "
3	74.98	1807+27.47	" "
4	30.24	1807+72.38	" "
5	17.00	1008+57.76	RAMP 'I'
6	14.07	1807+59.33	8 TH AVE.
7	29.00	1008+81.22	RAMP 'I'
8	18.50	1806+55.73	8 TH AVE.
9	57.13	1806+56.71	" "
10	43.36	1807+40.71	" "
11	23.00	1807+34.30	" "
12	23.00	1806+66.44	" "
13	9.00	1808+78.00	" "

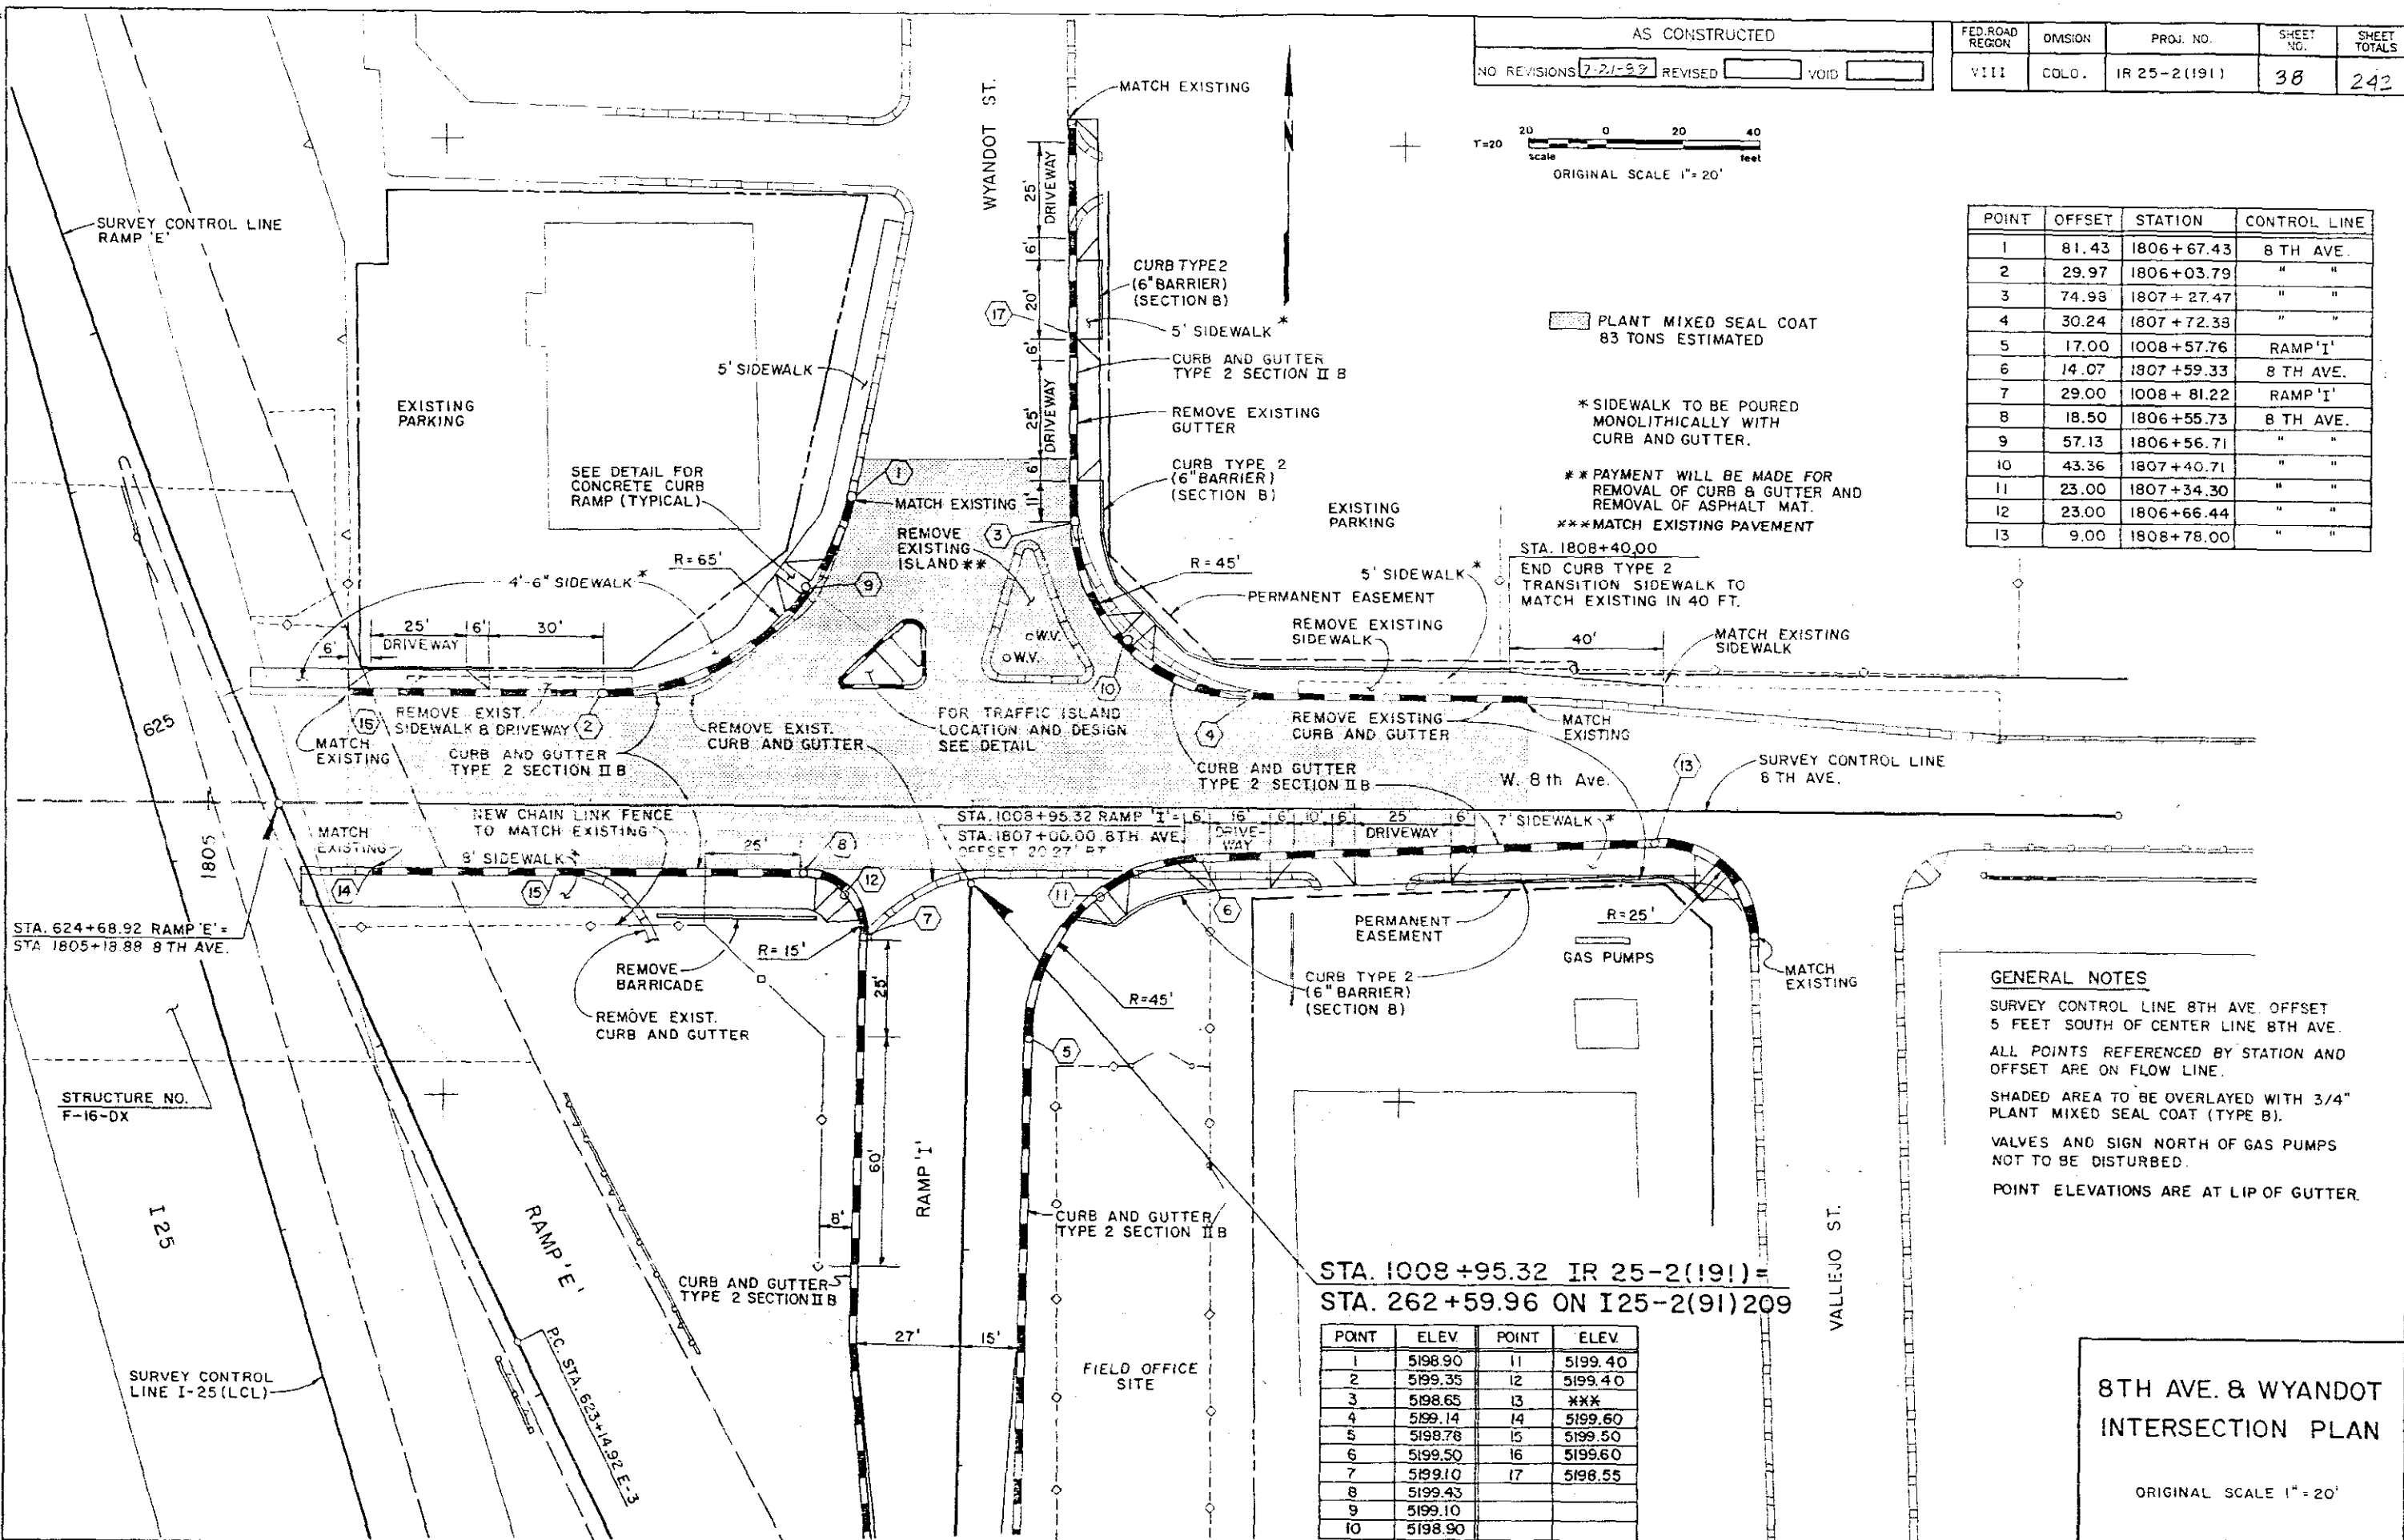

PLANT MIXED SEAL COAT  
83 TONS ESTIMATED

\* SIDEWALK TO BE POURED  
MONOLITHICALLY WITH  
CURB AND GUTTER.

\*\* PAYMENT WILL BE MADE FOR  
REMOVAL OF CURB & GUTTER AND  
REMOVAL OF ASPHALT MAT.

\*\*\* MATCH EXISTING PAVEMENT

STA. 1808+40.00  
END CURB TYPE 2  
TRANSITION SIDEWALK TO  
MATCH EXISTING IN 40 FT.

**GENERAL NOTES**  
SURVEY CONTROL LINE 8TH AVE. OFFSET  
5 FEET SOUTH OF CENTER LINE 8TH AVE.  
ALL POINTS REFERENCED BY STATION AND  
OFFSET ARE ON FLOW LINE.  
SHADED AREA TO BE OVERLAYED WITH 3/4"  
PLANT MIXED SEAL COAT (TYPE B).  
VALVES AND SIGN NORTH OF GAS PUMPS  
NOT TO BE DISTURBED.  
POINT ELEVATIONS ARE AT LIP OF GUTTER.

STA. 1008+95.32 IR 25-2(191) =  
STA. 262+59.96 ON I-25(91) 209


POINT	ELEV.	POINT	ELEV.
1	5198.90	11	5199.40
2	5199.35	12	5199.40
3	5198.65	13	XXX
4	5199.14	14	5199.60
5	5198.78	15	5199.50
6	5199.50	16	5199.60
7	5199.10	17	5198.55
8	5199.43		
9	5199.10		
10	5198.90		

**8TH AVE. & WYANDOT  
INTERSECTION PLAN**


ORIGINAL SCALE 1" = 20'




AS CONSTRUCTED		FED. ROAD REGION	DMSION	PROJ. NO.	SHEET NO.	SHEET TOTALS
NO. REVISIONS	REVISED 7-2-84	VOID	VIII	COLO.	IR 25-2(191)	39 24

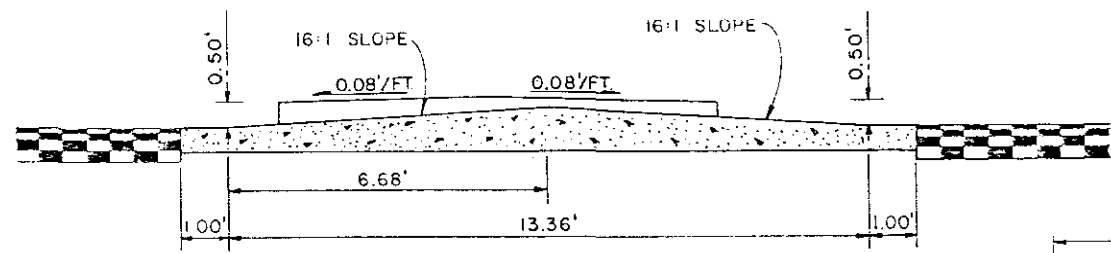

SECTION A-A

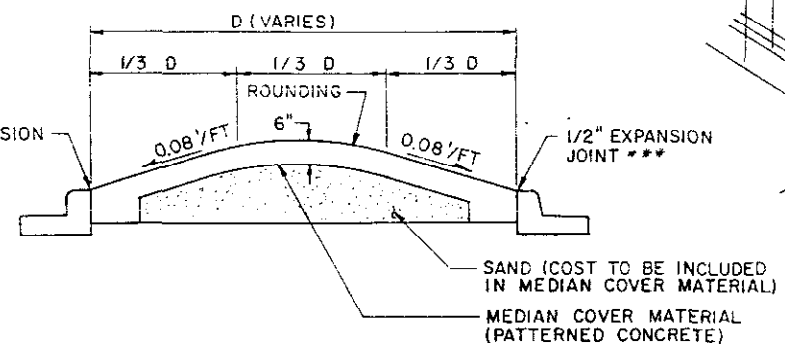


DETAIL OF ISLAND ROUNDING

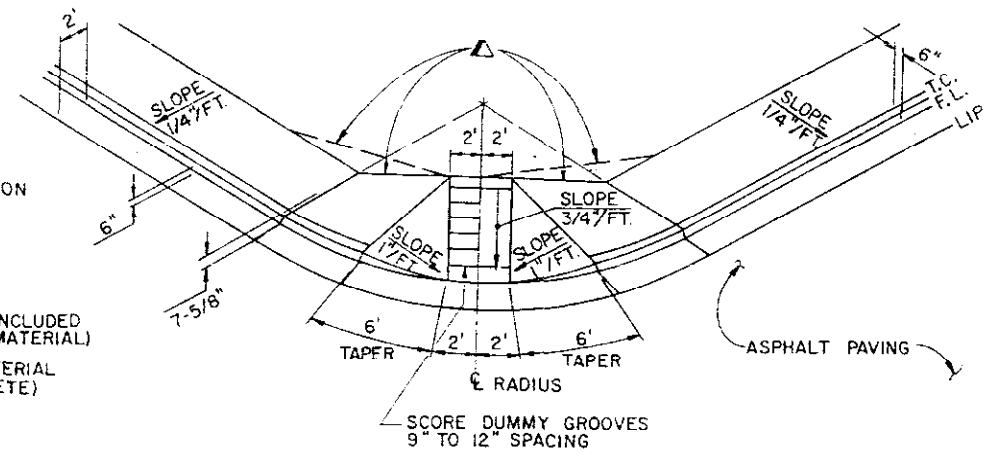

CURB RAMP DETAIL


POINT	OFFSET	STATION	CONTROL LINE
13	32.89	1806+81.07	8 TH AVE.
14	38.22	1806+85.68	" "
15	44.31	1806+80.14	" "
16	39.59	1806+74.96	" "
17	34.88	1806+83.70	" "
18	32.90	1806+67.61	" "
19	44.80	1806+83.64	" "

NOTE: MEDIAN COVER MATERIAL (PATTERNED CONCRETE) = 126 SQ. FT.  
CONCRETE CURB RAMP = 8 SQ. YD.

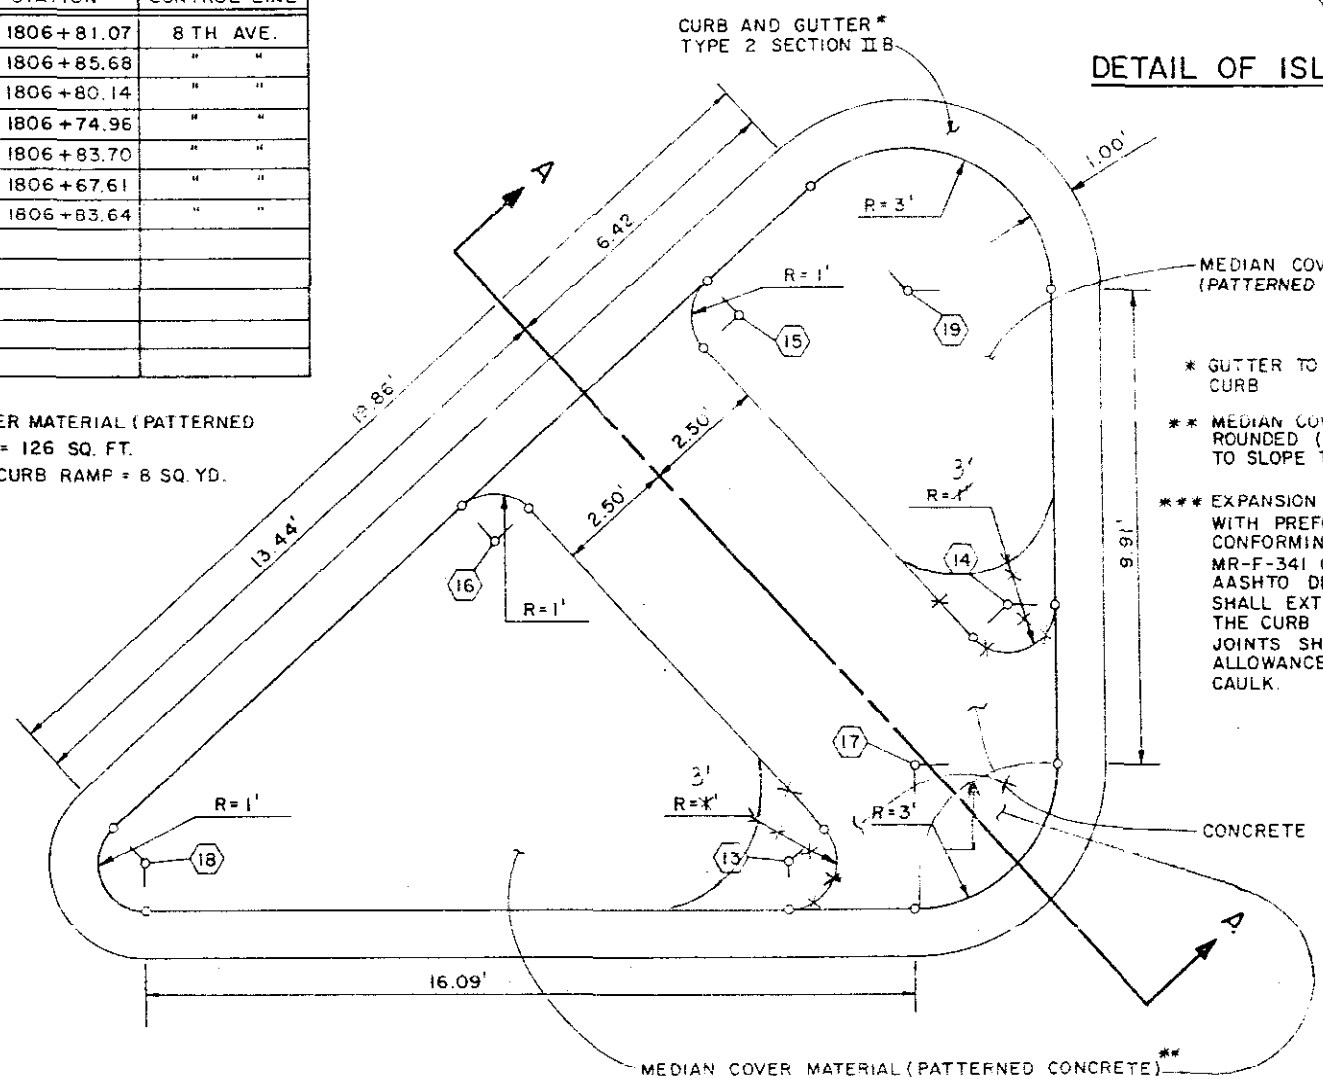

TRAFFIC ISLAND DETAIL

- \* GUTTER TO BE SLOPED FROM CURB
- \*\* MEDIAN COVER MATERIAL TO BE ROUNDED (.080 FT./FT.) TO SLOPE TO CURB. SEE DETAIL
- \*\*\* EXPANSION JOINTS SHALL BE CONSTRUCTED WITH PREFORMED EXPANSION JOINT FILLER, CONFORMING TO FEDERAL SPECIFICATIONS MR-F-341 OR WOOD FIBER CONFORMING TO AASHTO DESIGNATION M90. EXPANSION SHALL EXTEND TO THE FULL DEPTH OF THE CURB PAVEMENT SECTION. ALL EXPANSION JOINTS SHALL BE 1/2" THICK AND HAVE ALLOWANCES FOR INSTALLATION OF COLOR CAULK.

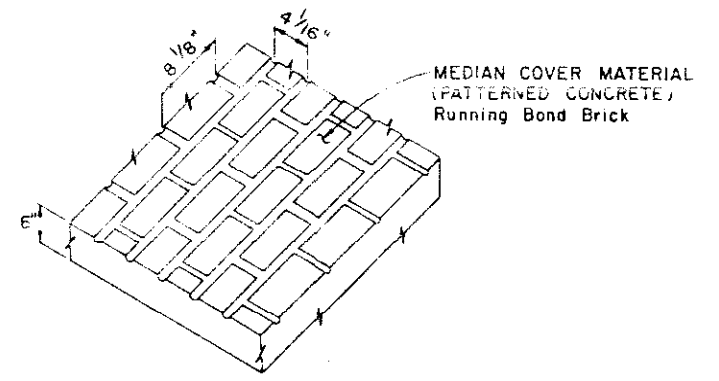

MEDIAN COVER MATERIAL DETAIL


NOTE: MEDIAN COVER MATERIAL (PATTERNED CONCRETE) SHALL BE MIXED AT THE PLANT AND IS TO BE COLORED WITH ONE OF THE FOLLOWING OR AN APPROVED EQUAL;

COLOR	MANUFACTURER
1. ARIZONA TAN (A-53-P)	L.M. SCOFIELD CO.
2. DESERT TAN	BOMANITE CORP.
3. MESA BUFF (NO 5447)	FRANK DAVIS CO.

TRAFFIC ISLAND,  
CURB RAMP AND  
MEDIAN COVER MATERIAL  
DETAILS

NOT TO SCALE


AS CONSTRUCTED		FED. ROAD REGION	DIVISION	PROJ. NO.	SHEET NO.	SHEET TOTALS
NO. REVISIONS	2-21-85	VI	COLD.	IR 25 - 2 (191)	40	242

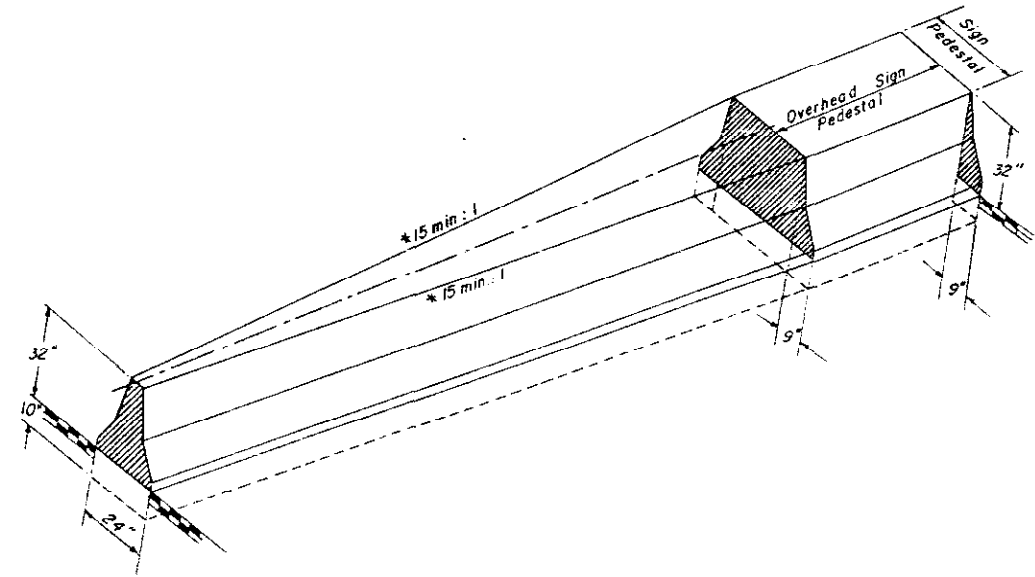


NOTE: Cost of Guard Rail Transitions Around Sign Bridge Pedestals to be Included in the Cost of the Pedestal.

**DETAIL OF GUARD RAIL TYPE 4 TRANSITION AROUND SIGN BRIDGE PEDESTALS IN I-25 MEDIAN** \* \*

SIGN NO. 11 STA. 324+75  
SIGN NO. 13 STA. 311+75

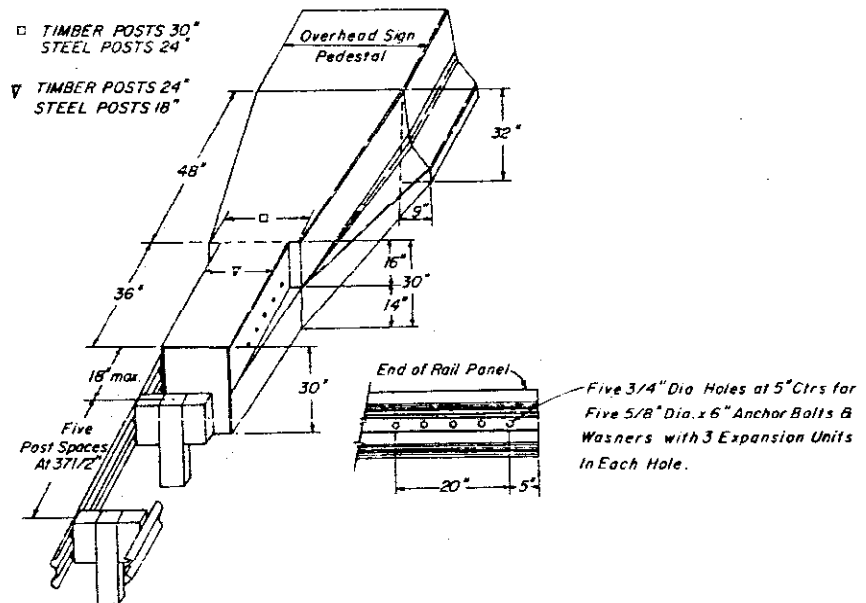

**DETAIL OF GUARD RAIL TRANSITION AROUND E.B. SIGN BRIDGE PEDESTAL IN 6TH AVE MEDIAN**  
SIGN NO. 1 STA. 41+00

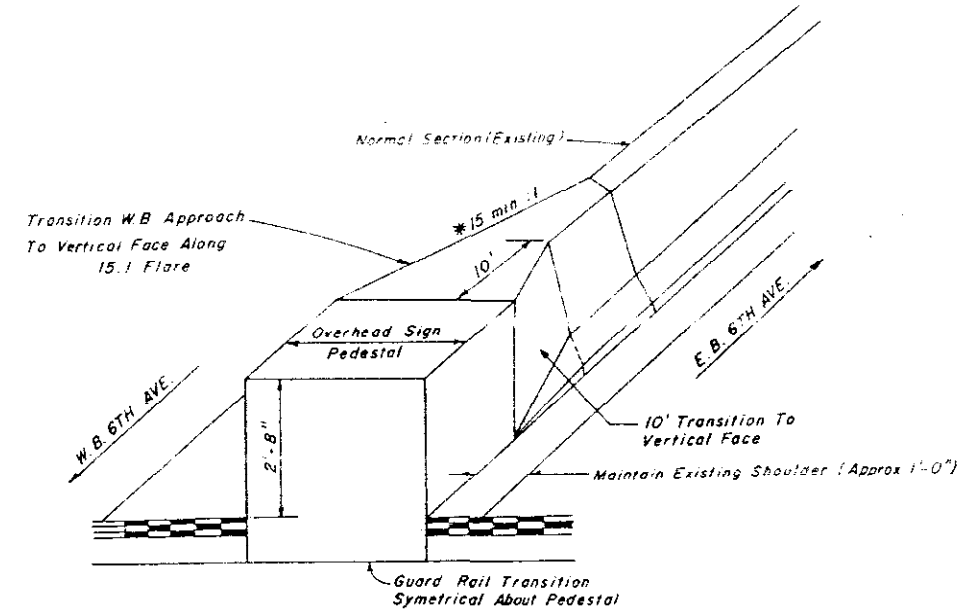

**DETAIL OF GUARD RAIL TYPE 4 TRANSITION AROUND W.B. SIGN BRIDGE PEDESTALS IN 6TH AVE. MEDIAN**

SIGN NO. 36 STA. 80+70  
SIGN NO. 44 STA. 73+79


\* 15:1 FLARE RATE BASED ON A 55 MPH OPERATING SPEED  
\* \* SIGN NO 20 NB EXCLUDED

**GUARD RAIL  
TRANSITION AND  
SIGN PEDESTAL  
DETAILS**  
NOT TO SCALE

AS CONSTRUCTED  
 NO REVISIONS  REVISED  VOID

FED. ROAD REGION	DIVISION	PROJ. NO.	SHEET NO.	SHEET TOTALS
VIII	COLO.	IR25-2(191)	41	242

**UTILITIES WITHIN THIS PROJECT**  
 Mountain/Bell  
 Public Service Company -- Gas  
 Public Service Company -- Electric Distribution  
 Denver Wastewater Management Division  
 Metropolitan Denver Sewage Disposal #1  
 Denver Water Department

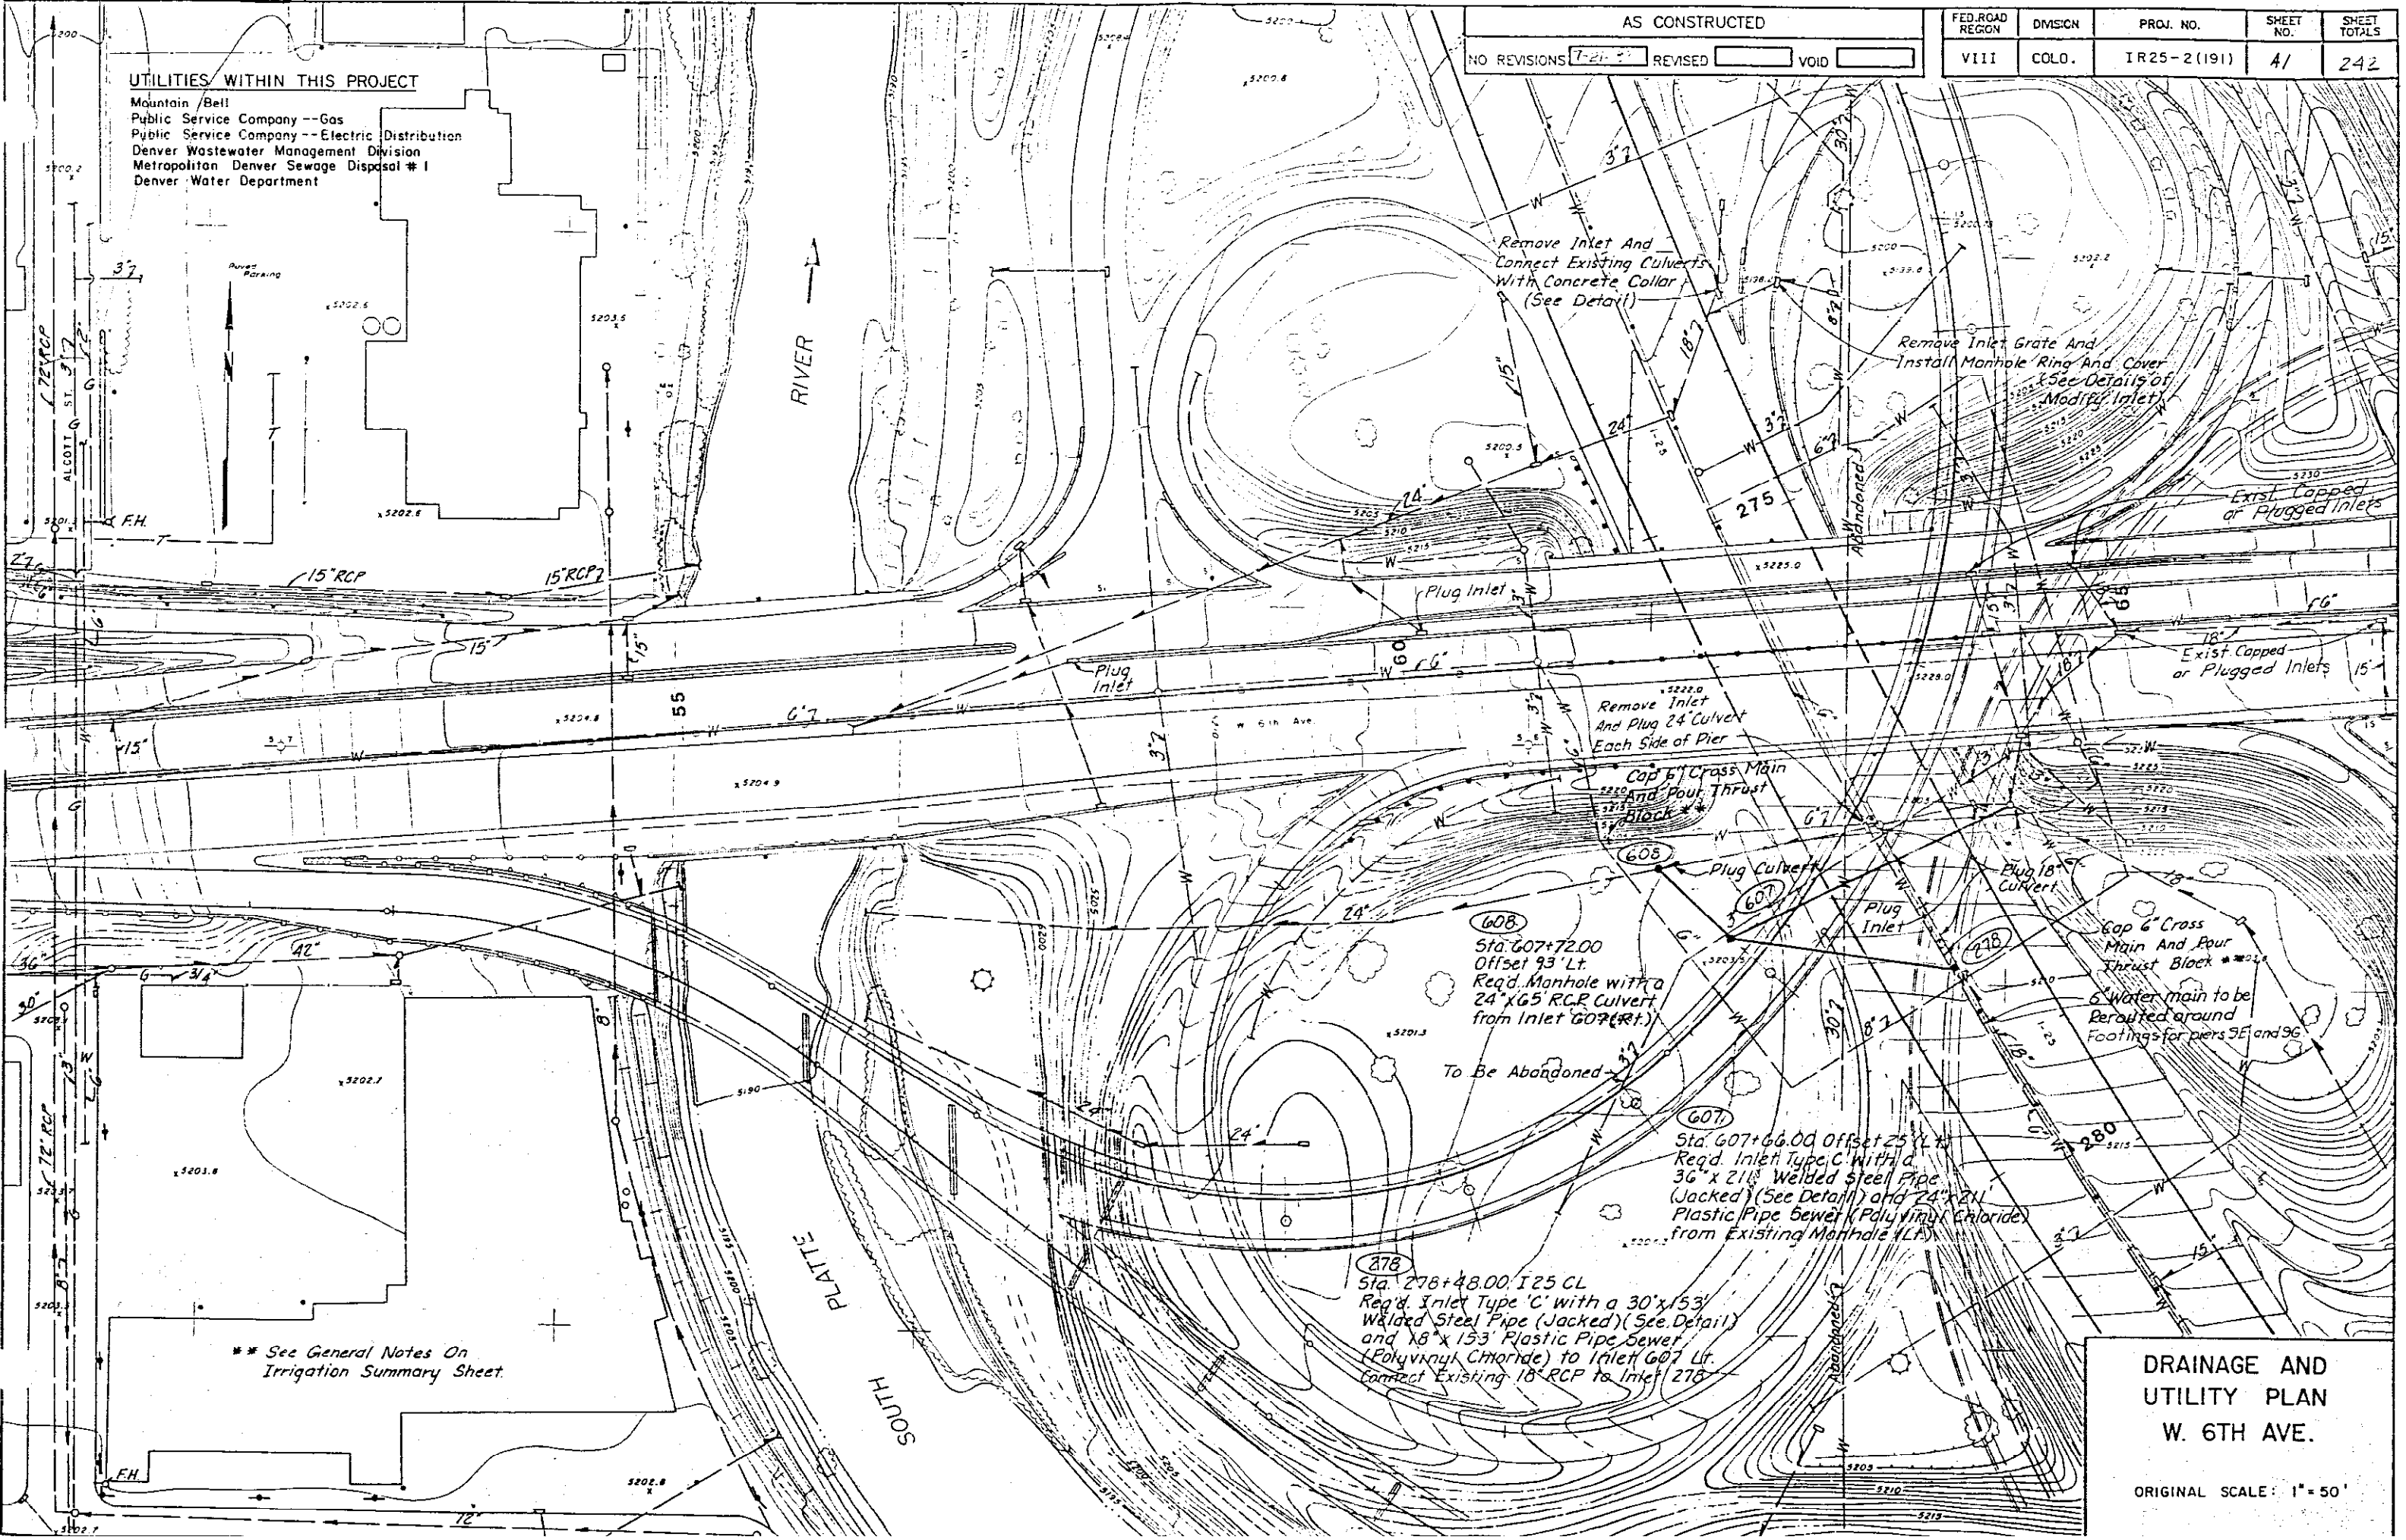

\*\* See General Notes On Irrigation Summary Sheet.

**DRAINAGE AND UTILITY PLAN  
 W. 6TH AVE.**



ORIGINAL SCALE: 1" = 50'

AS CONSTRUCTED

NO REVISIONS  REVISED  VOID

FED. ROAD REGION	DIVISION	PROJ. NO.	SHEET NO.	SHEET TOTALS
VIII	CGLO.	1R25-2(191)	42	24

\*Channel Section to match Inv.  
Elev. of 36" R.C.P. and to have  
0.5% Slope. Existing ditch beyond  
End of new channel to be graded  
to drain.

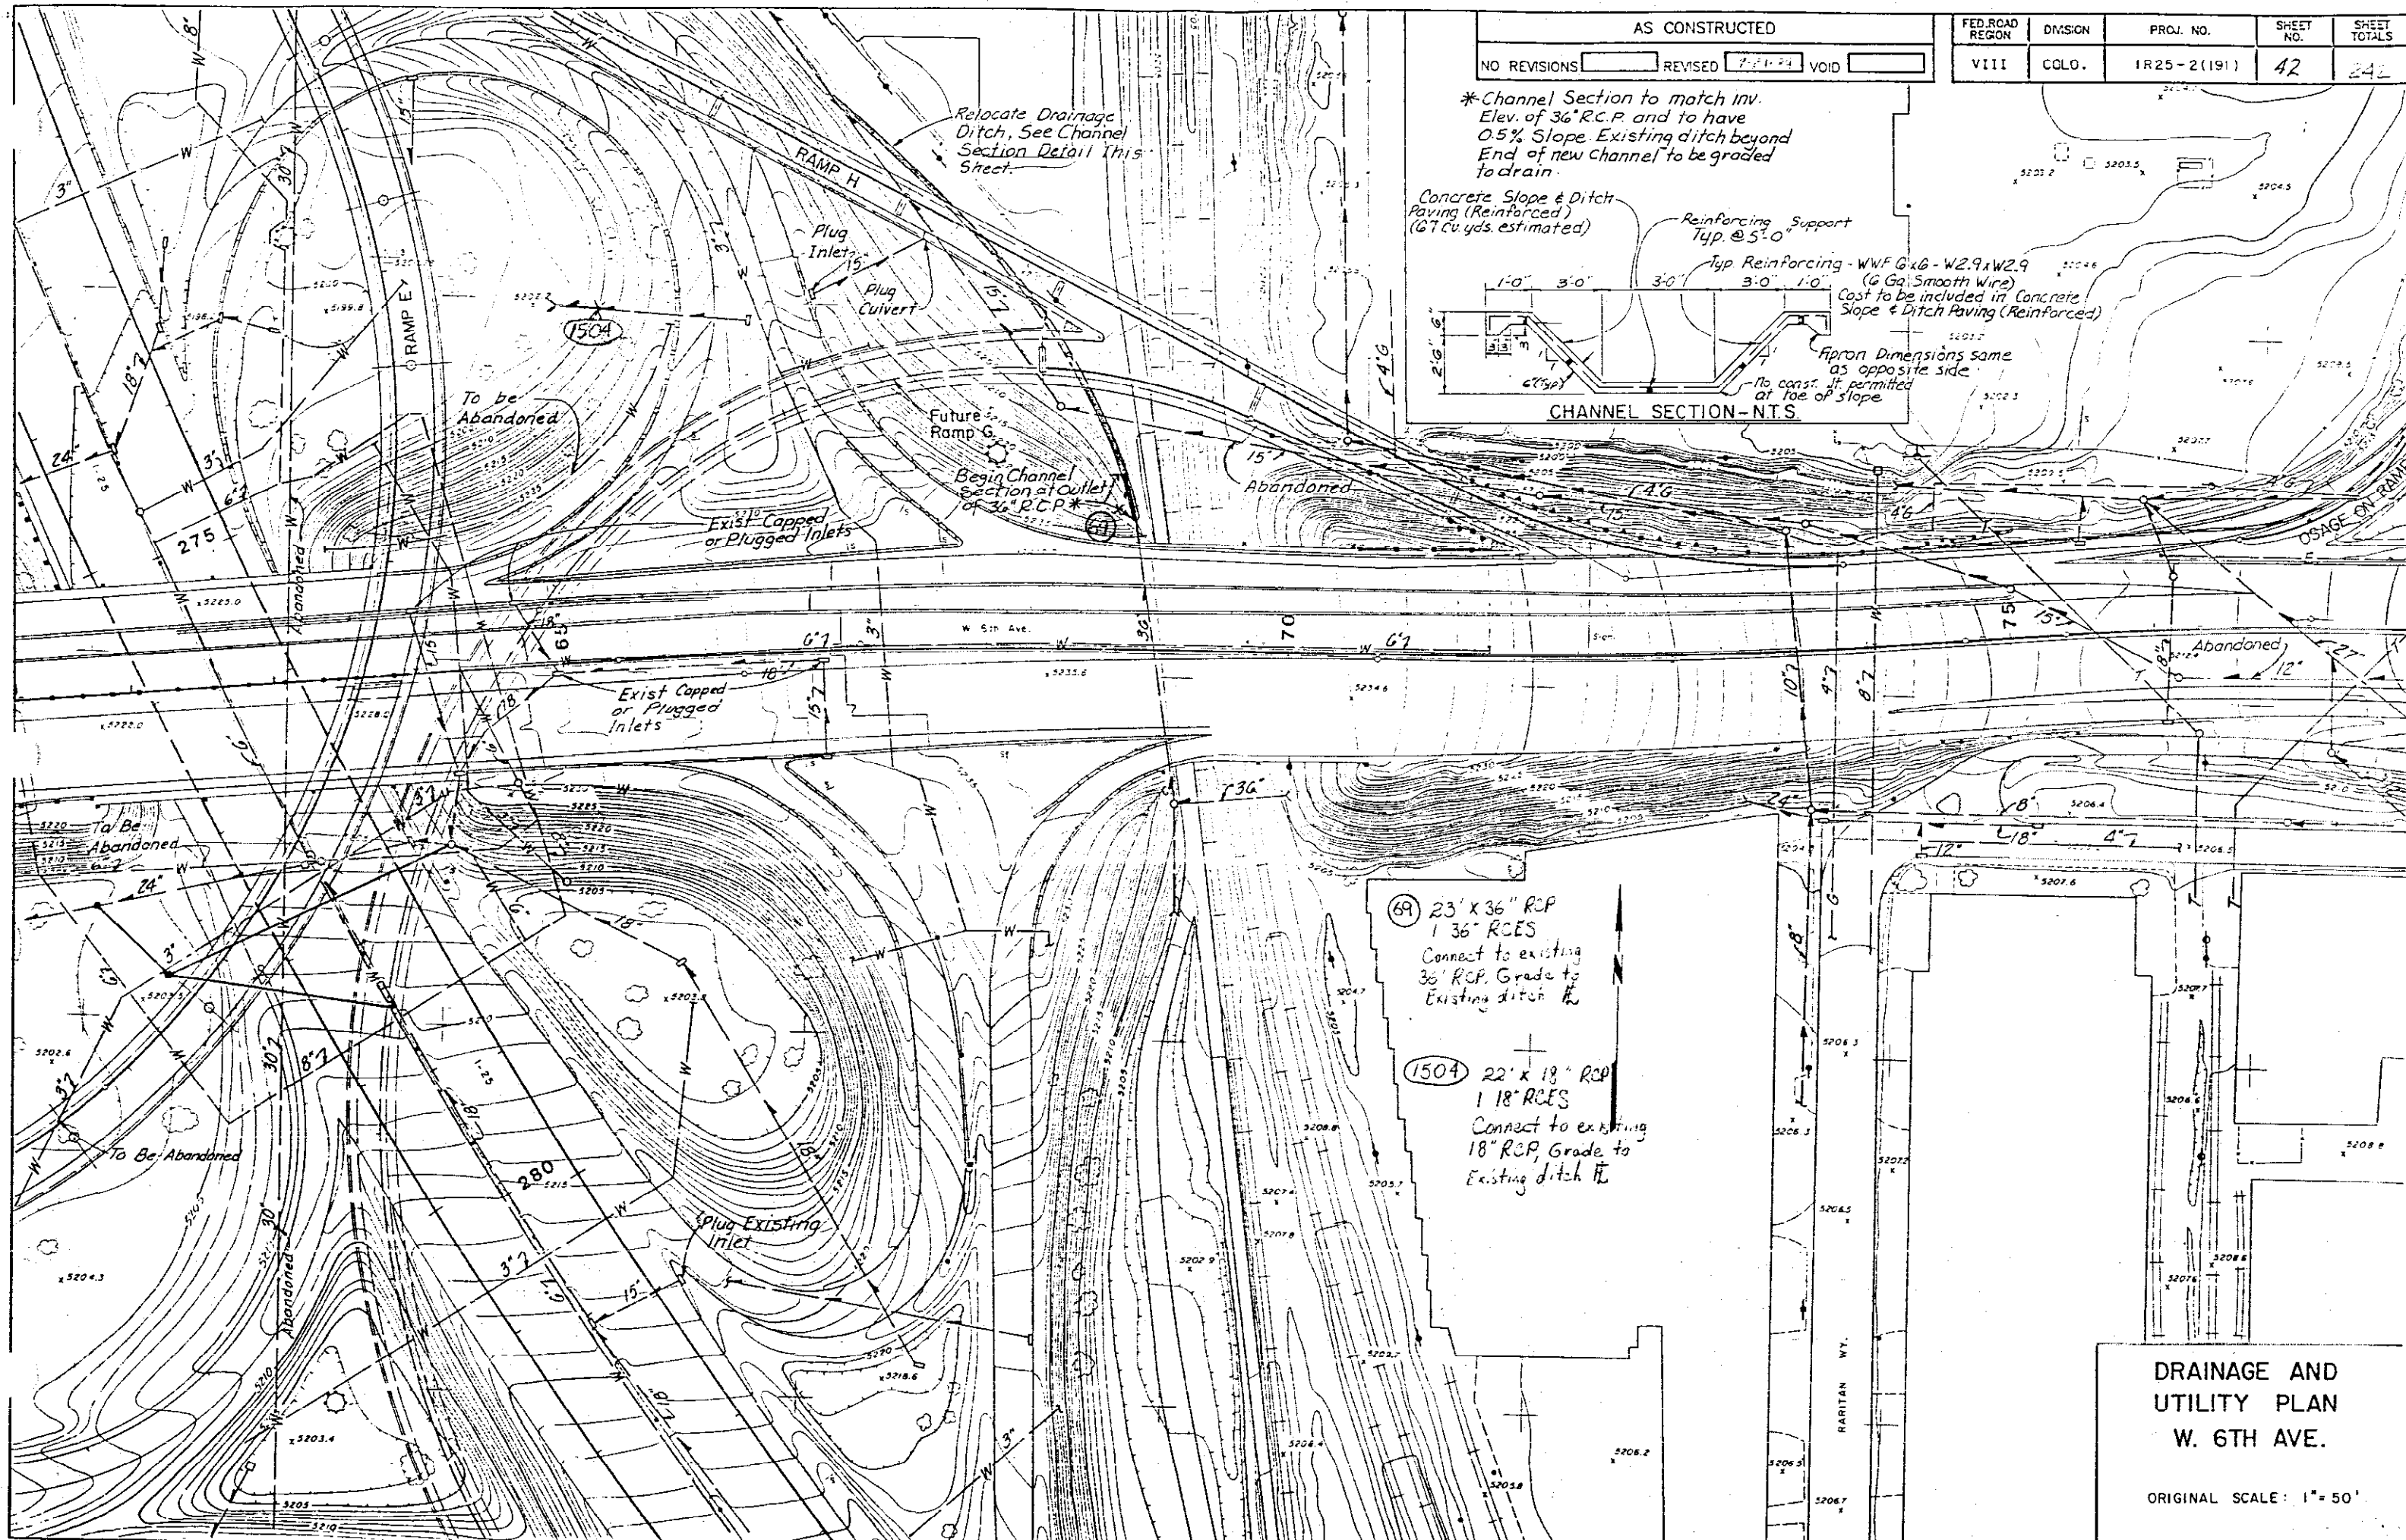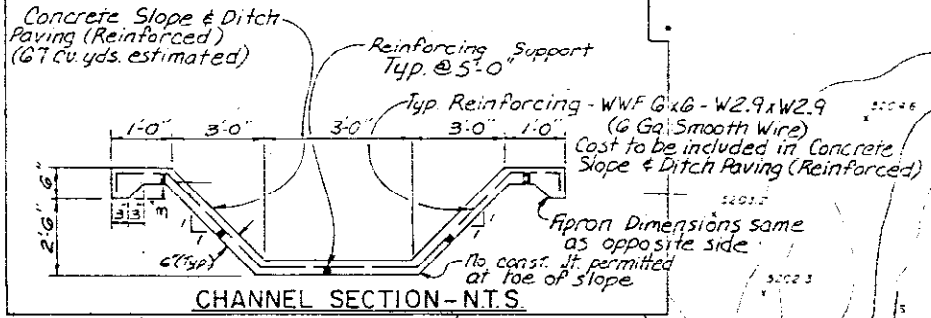


69 23' x 36" RCP  
1 36" RCES  
Connect to existing  
36" RCP, Grade to  
Existing ditch ft

1504 22' x 18" RCP  
1 18" RCES  
Connect to existing  
18" RCP, Grade to  
Existing ditch ft


**DRAINAGE AND  
UTILITY PLAN  
W. 6TH AVE.**

ORIGINAL SCALE: 1" = 50'

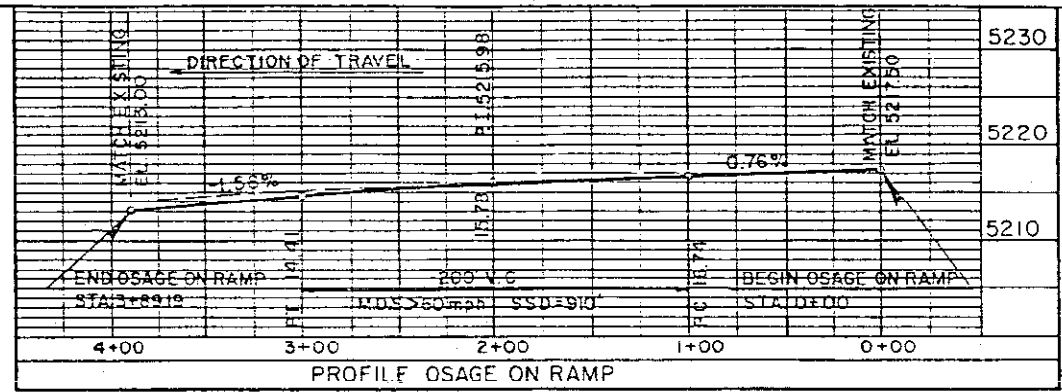

AS CONSTRUCTED		
NO REVISIONS	REVISED 7-21-22	VOID

FEDERAL ROAD REGION NO.	DIVISION	PROJ. NO.	SHEET NO.	TOTAL SHEETS
XIII	COLORADO	IR 25-2 (191)	43	242

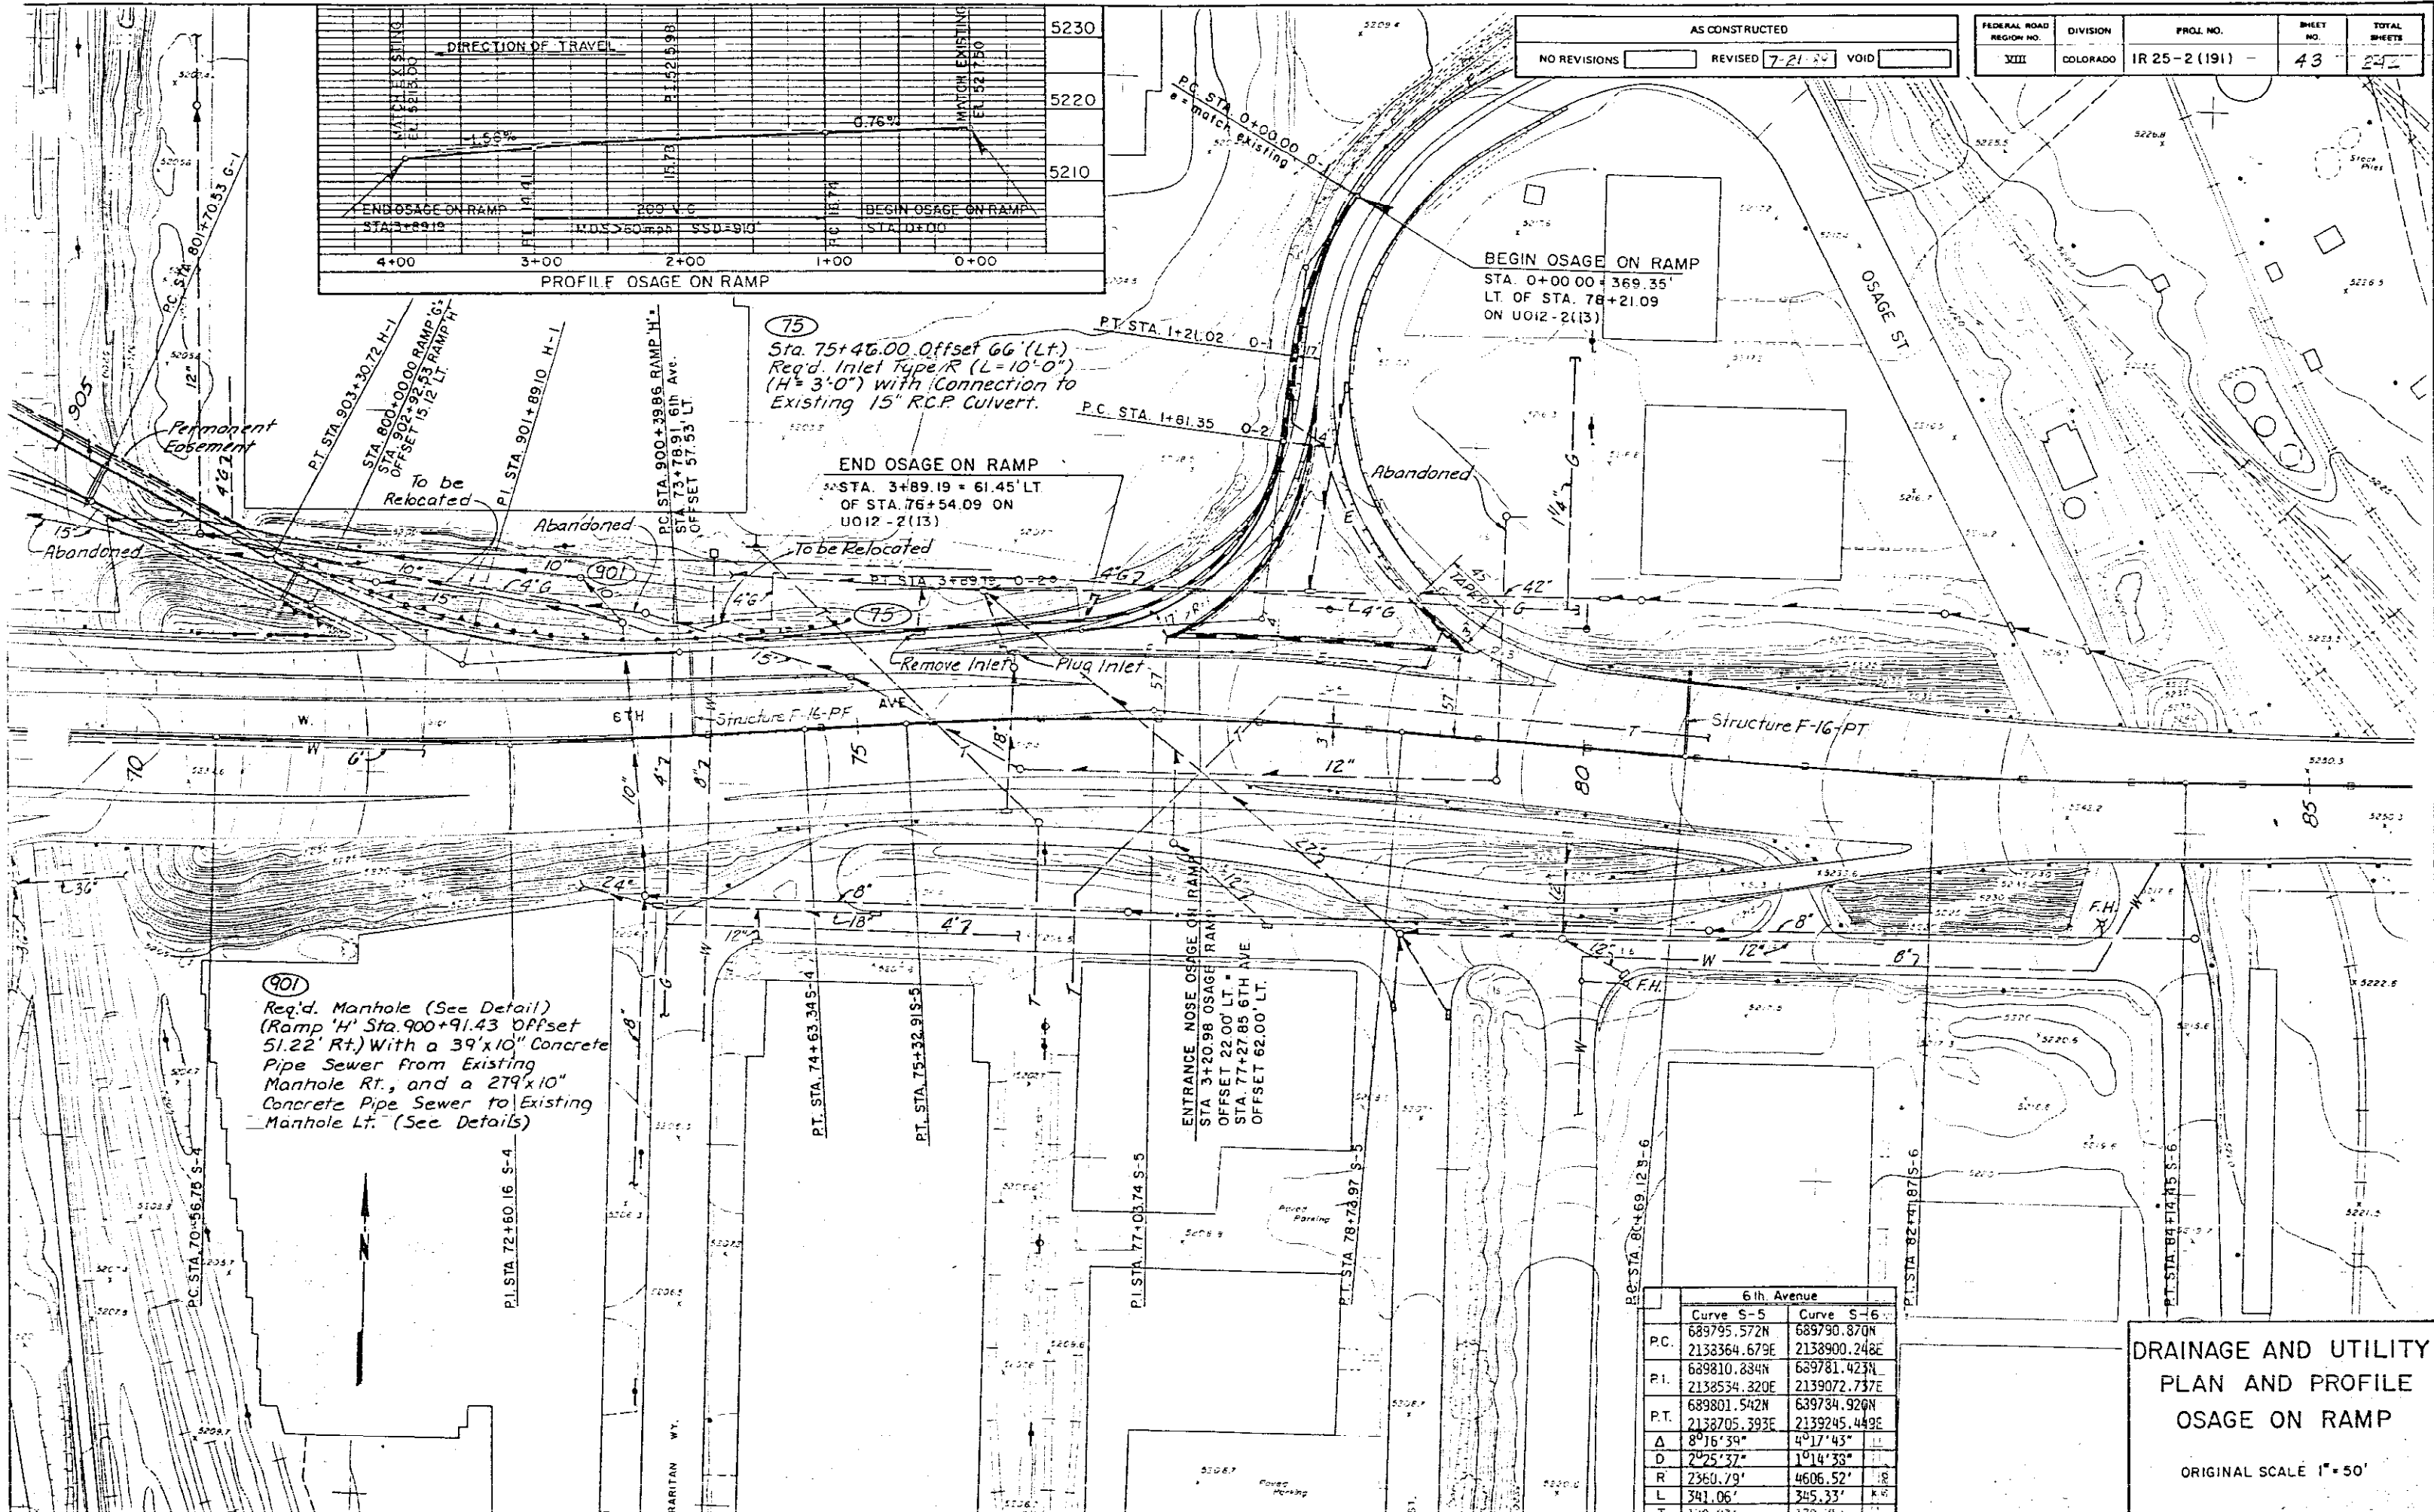

75  
Sta. 75+46.00 Offset 66' (Lt.)  
Req'd. Inlet Type 'R' (L=10'-0")  
(H=3'-0") with Connection to  
Existing 15" R.C.P. Culvert.

END OSAGE ON RAMP  
STA. 3+89.19 = 61.45' LT.  
OF STA. 76+54.09 ON  
U012-2(13)

901  
Req'd. Manhole (See Detail)  
(Ramp 'H' Sta. 900+91.43 Offset  
51.22' Rt.) With a 39"x10" Concrete  
Pipe Sewer from Existing  
Manhole Rt., and a 279"x10"  
Concrete Pipe Sewer to Existing  
Manhole Lt. (See Details)



6th Avenue		
	Curve S-5	Curve S-6
PC	689795.572N	689790.870N
	2138364.679E	2138900.248E
PI	689810.834N	689781.423N
	2138534.320E	2139072.737E
PT	689801.542N	689784.920N
	2138705.393E	2139245.449E
Δ	8°16'39"	4°17'43"
D	2'25'37"	1'14'33"
R	2360.79'	4606.52'
L	341.06'	345.33'
T	170.82'	179.75'

**DRAINAGE AND UTILITY  
PLAN AND PROFILE  
OSAGE ON RAMP**

ORIGINAL SCALE 1" = 50'

AS CONSTRUCTED		
NO REVISIONS	REVISED	VOID
7-21-24		

FEDERAL ROAD REGION NO.	DIVISION	PROJ. NO.	SHEET NO.	TOTAL SHEETS
XIII	COLORADO	IR 25-2(191)	44	242

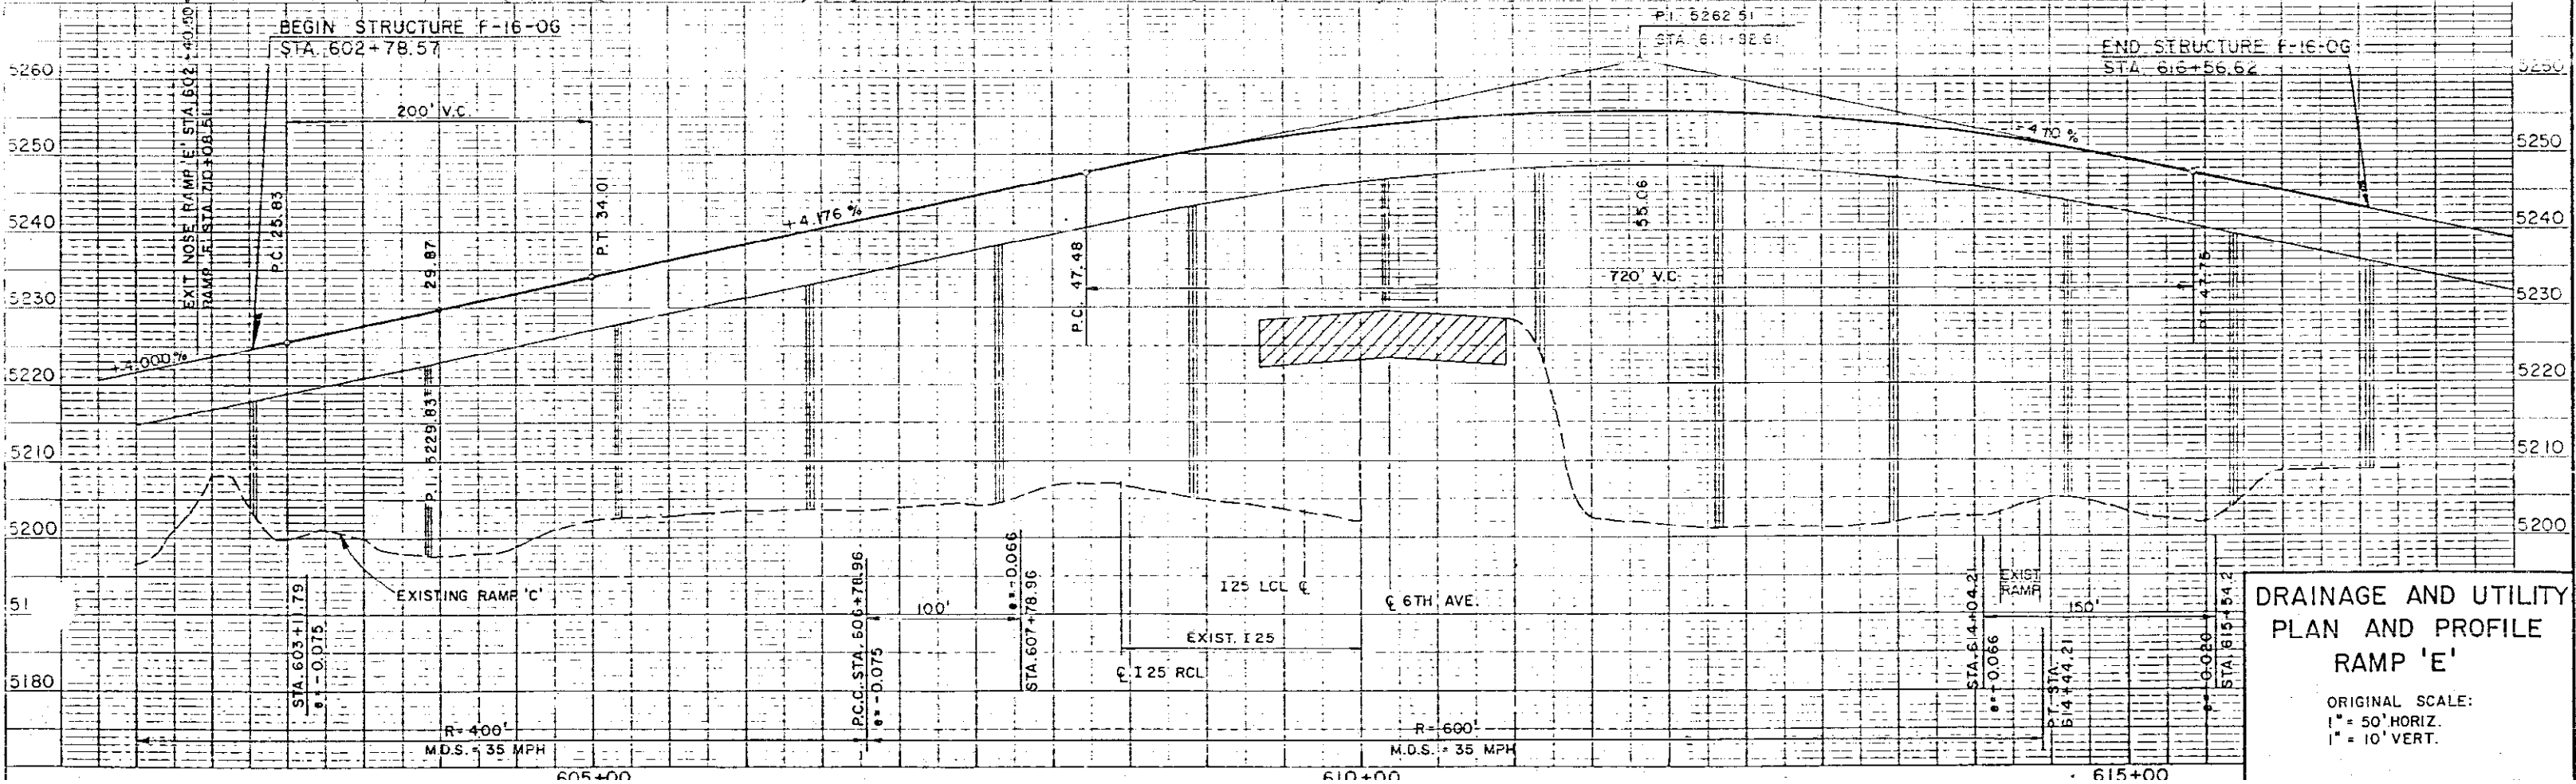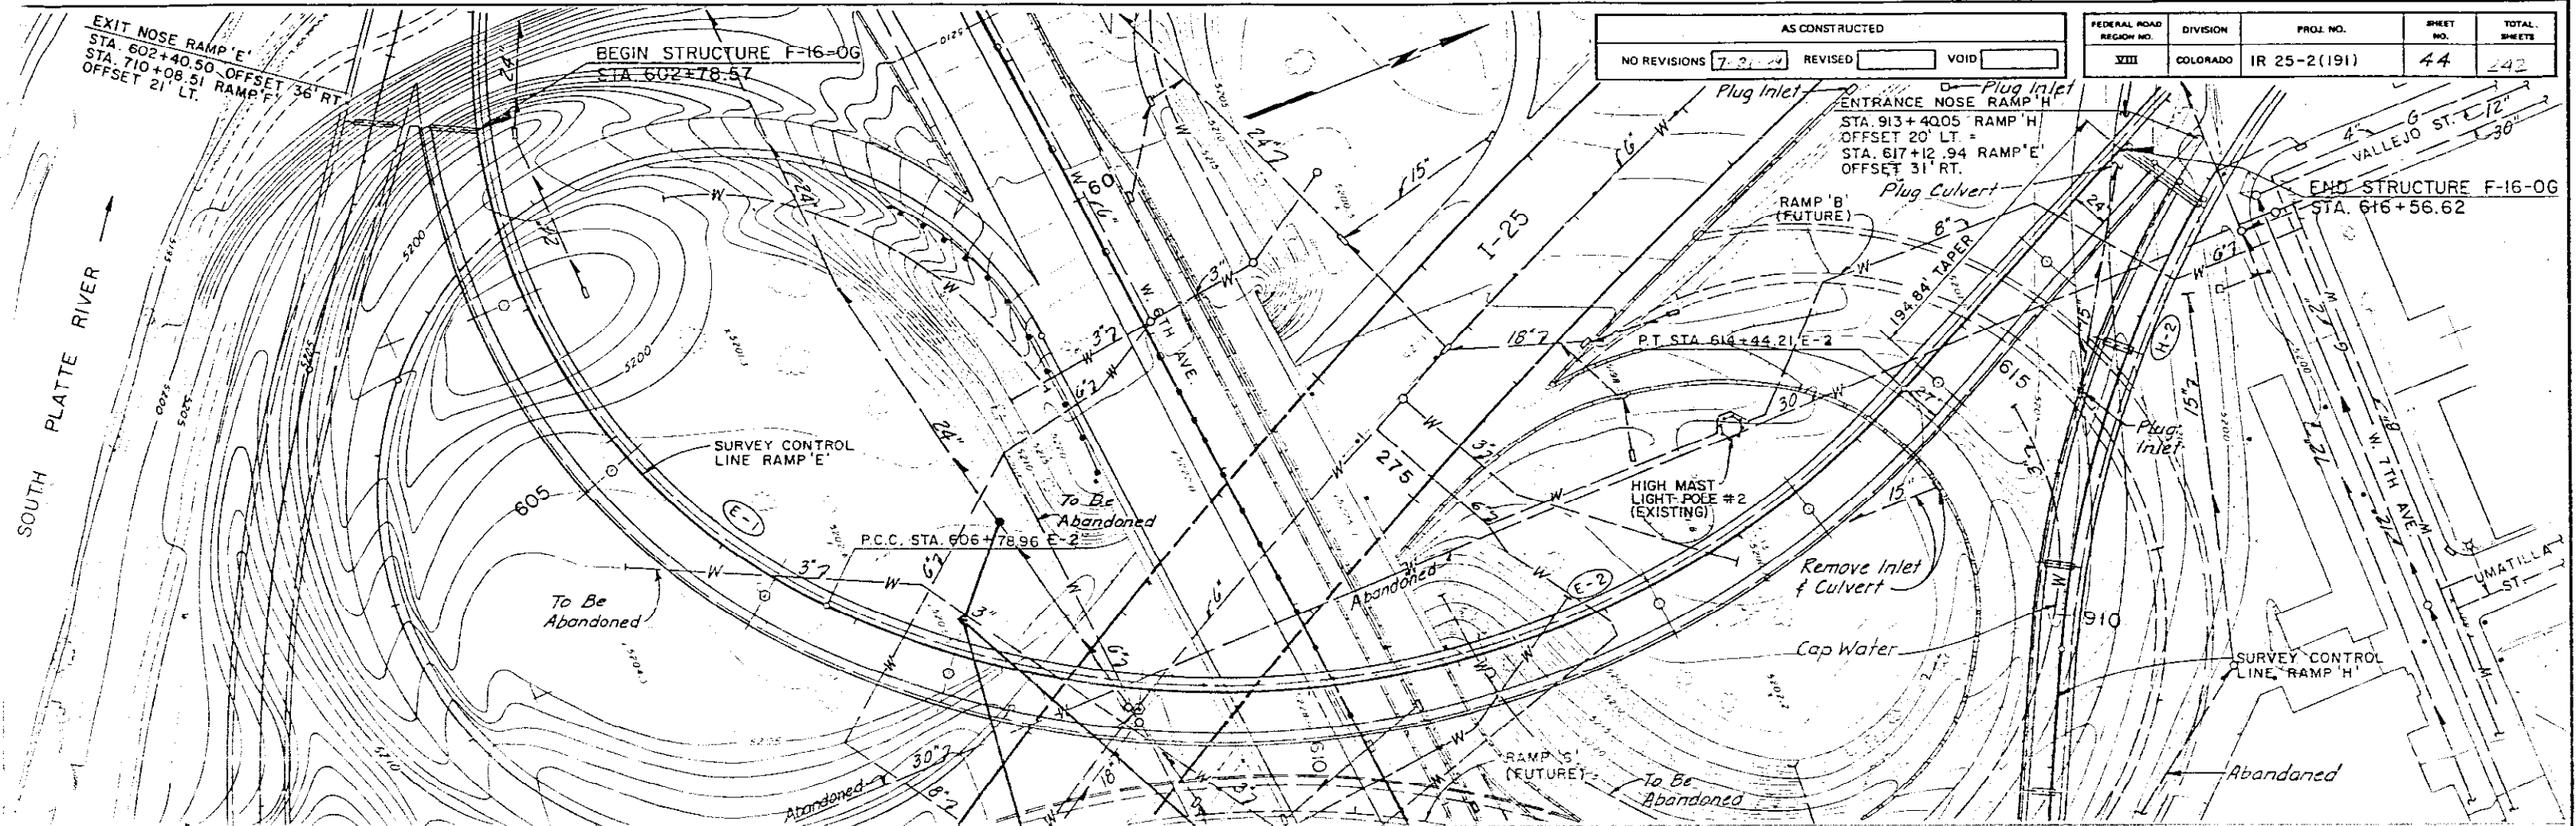


**DRAINAGE AND UTILITY PLAN AND PROFILE RAMP 'E'**

ORIGINAL SCALE:  
 1" = 50' HORIZ.  
 1" = 10' VERT.

AS CONSTRUCTED		
NO REVISIONS	REVISED	VOID

FEDERAL ROAD REGION NO.	DIVISION	PROJ. NO.	SHEET NO.	TOTAL SHEETS
VIII	COLORADO	IR 25-2(191)	45	242

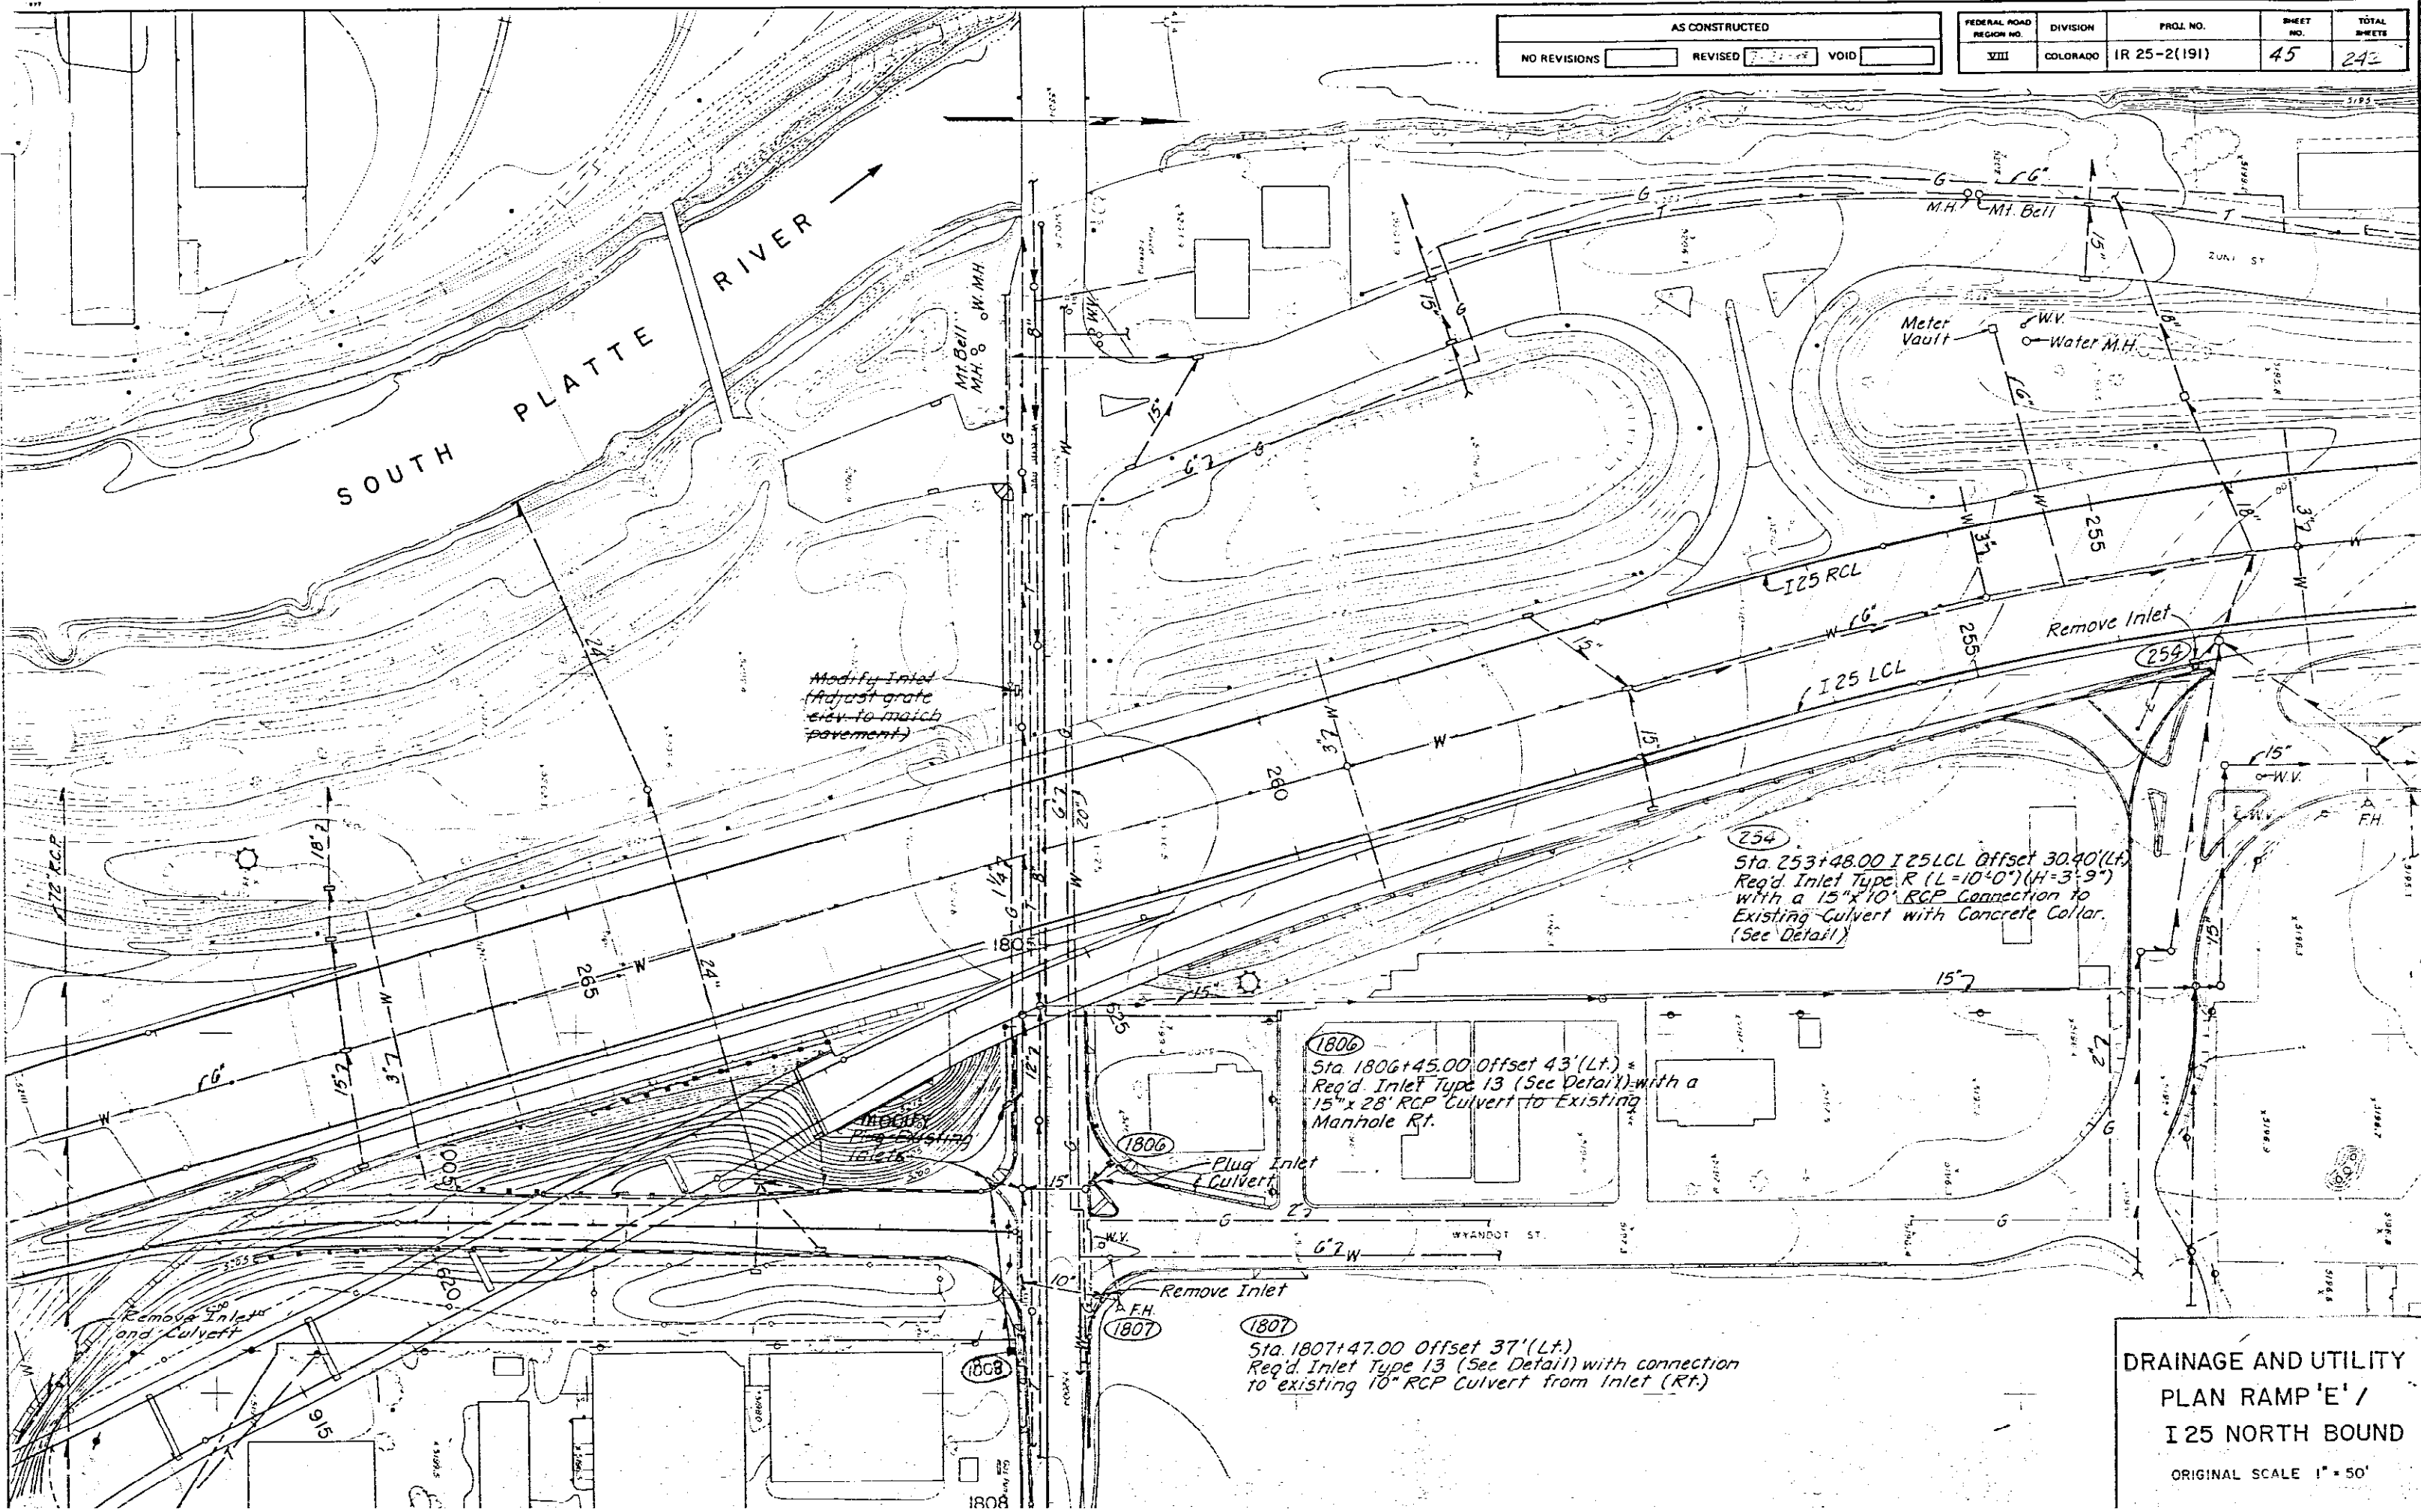

Modify Inlet  
(Adjust grate  
elev. to match  
pavement)

254  
Sta. 253+48.00 I 25 LCL Offset 30.40' (Lt.)  
Req'd Inlet Type R (L=10'0") (H=3'9")  
with a 15" x 10" RCP Connection to  
Existing Culvert with Concrete Collar.  
(See Detail)

1806  
Sta. 1806+45.00 Offset 43' (Lt.) \*  
Req'd Inlet Type 13 (See Detail) with a  
15" x 28" RCP Culvert to Existing  
Manhole Rt.

1807  
Sta. 1807+47.00 Offset 37' (Lt.)  
Req'd Inlet Type 13 (See Detail) with connection  
to existing 10" RCP Culvert from Inlet (Rt.)

**DRAINAGE AND UTILITY  
PLAN RAMP 'E' /  
I 25 NORTH BOUND**  
ORIGINAL SCALE 1" = 50'

AS CONSTRUCTED		
NO REVISIONS	7-21-29	REVISED
		VOID

FEDERAL ROAD REGION NO	DIVISION	PROJ NO	SHEET NO	TOTAL SHEETS
VIII	COLORADO	IR25-2(191)	46	242

Structure Excavation

$$\frac{62(5)(6.17)}{27} \approx 71 \text{ Cu Yds.}$$

Structure Backfill

$$\frac{62(13.85)}{27} = 32 \text{ Cu Yds.}$$

Embankment

$$\frac{62(12.09)}{27} \approx 28 \text{ Cu Yds.}$$

Structure Excavation


$$= 0 \text{ Cu Yds.}$$

Structure Backfill

$$= 0 \text{ Cu Yds.}$$

Embankment

$$= 0 \text{ Cu Yds.}$$

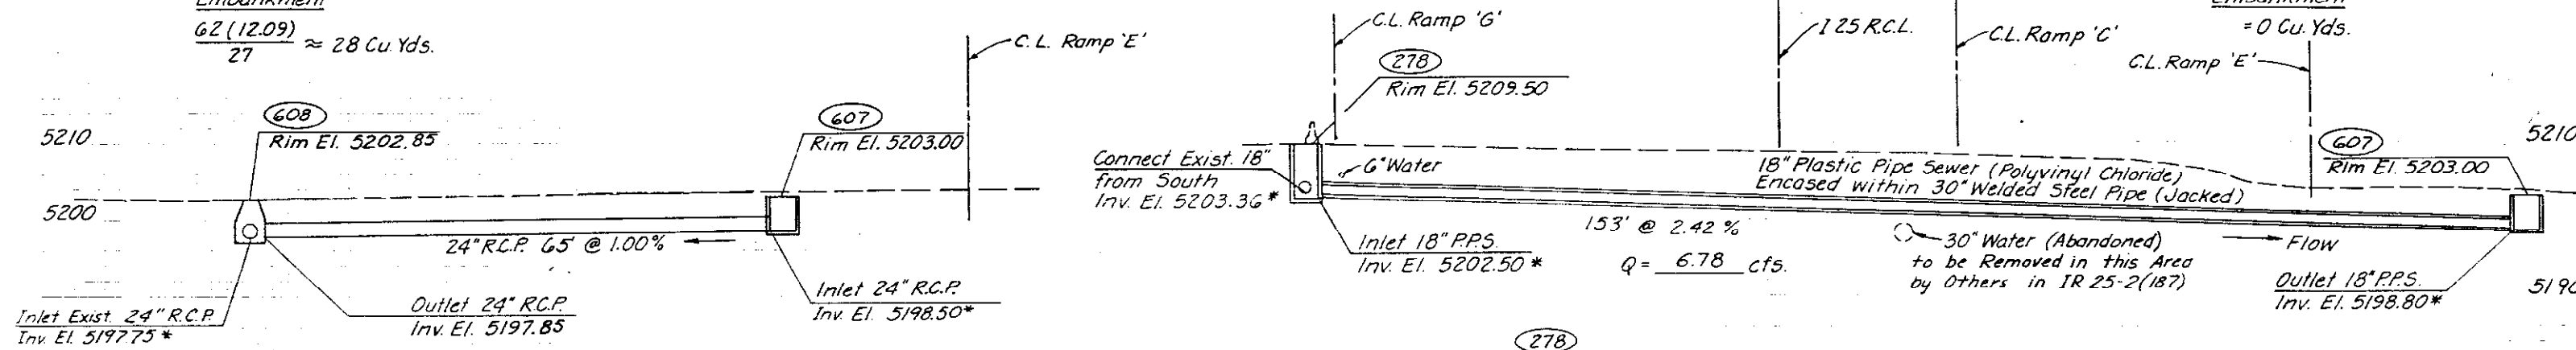

**608**  
Req'd 4'  $\phi$  Precast Manhole,  
Type Slab Base (H=5'-1")  
(Ramp E Sta. 607+72.00 Offset 93.00' Lt.)  
with a 24" x 65" R.C.P. Culvert from  
Inlet 607 (Rt).

**278**  
Req'd Type 'C' Inlet (H=7'-0")  
( $\phi$  I25 Sta. 278+48.00)  
with a 30" x 153' Welded Steel Pipe (Jacked)  
(See Detail) and a 18" x 153' Plastic Pipe  
Sewer (Polyvinyl Chloride) from Inlet 607 (Lt).

\* Elevation approximate only. Actual  
Elevation and final adjustments to  
be made during construction as  
directed by the Engineer.

Structure Excavation


$$= 0 \text{ Cu Yds.}$$

Structure Backfill

$$= 0 \text{ Cu Yds.}$$

Embankment

$$= 0 \text{ Cu Yds.}$$

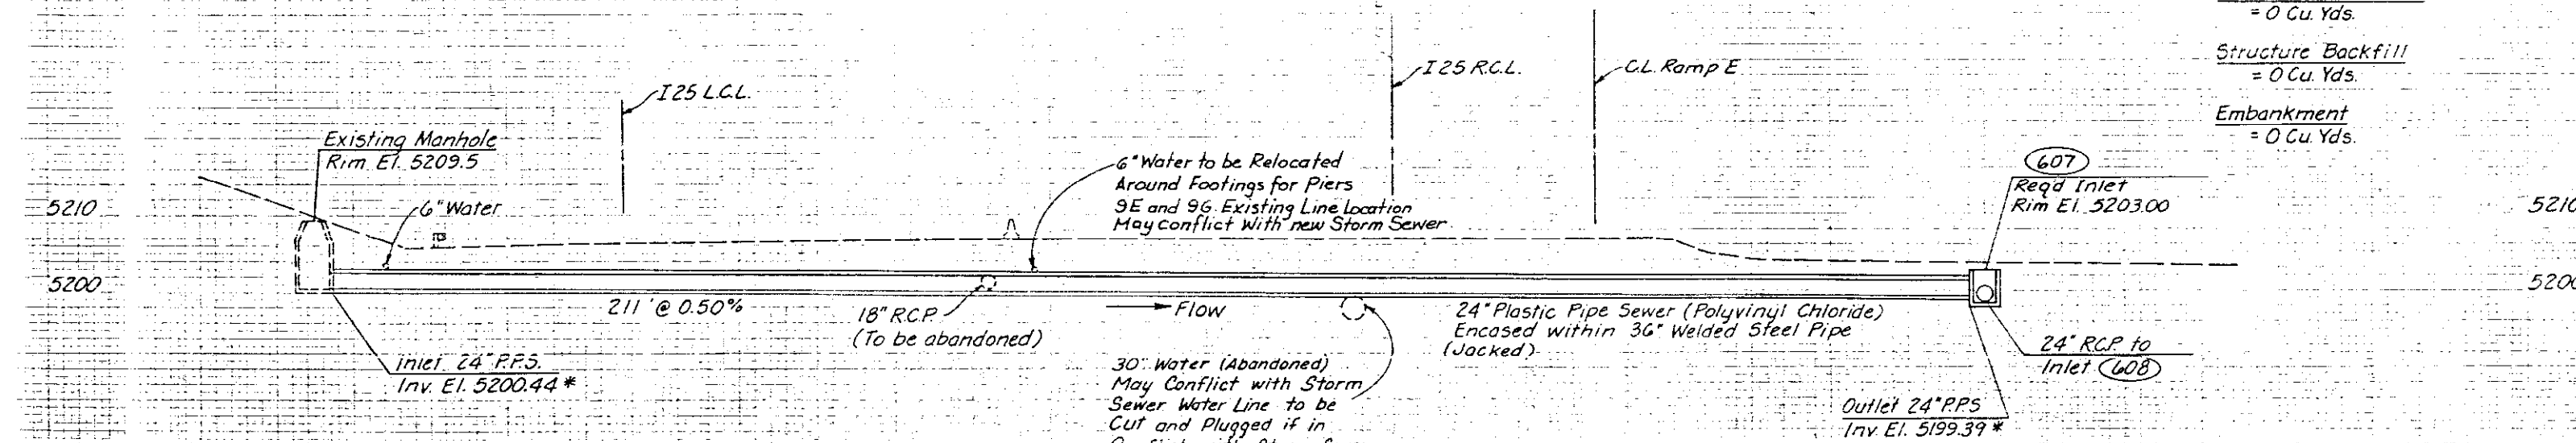


**607**  
Req'd Type 'C' Inlet (H=4'-6")  
(Ramp E Sta. 607+66.00 Offset 25' Lt.)  
with a 36" x 211' Welded Steel Pipe (Jacked)  
(See Detail) and a 24" x 211' Plastic Pipe  
Sewer (Polyvinyl Chloride) from Existing  
Manhole (Lt).

**DRAINAGE AND  
SEWER CROSS  
SECTIONS**




AS CONSTRUCTED		FEDERAL ROAD REGION NO	DIVISION	PROJ NO	SHEET NO	TOTAL SHEETS
NO REVISIONS	7-21-27	REVISED	VOID	VIII	COLORADO	IR25-2(191)
					47	242

Note: For Type R Inlets; Rim Elevation is to Top of Manhole. E of Inlet is to Match E of New Curb and Gutter. Station Offset is to E of Inlet.

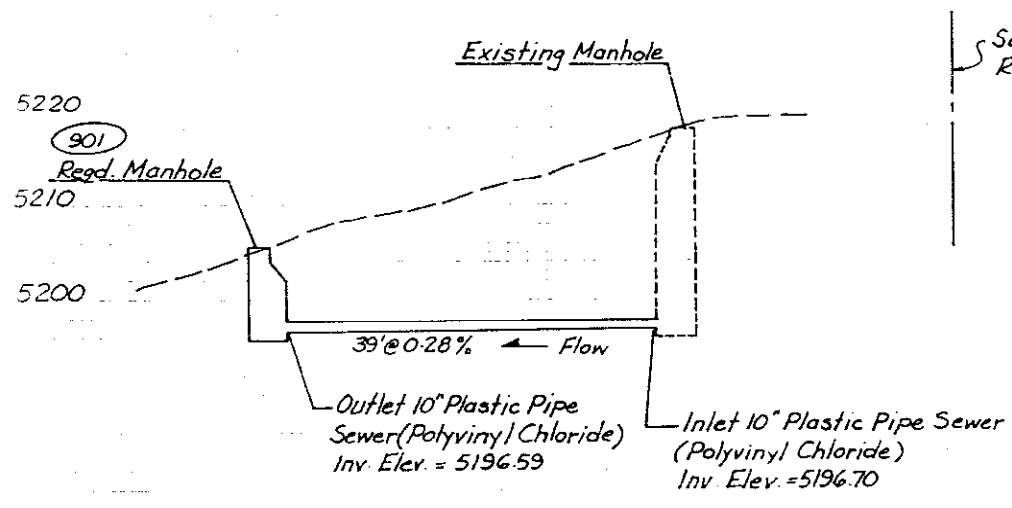

Structure Excavation  
 $\frac{36(15)(4)}{27} = 80$  cu.yds.  
 Structure Backfill  
 $\frac{36(8.45)}{27} = 11$  Cu.Yds.  
 Embankment  
 $\frac{36(12.5)(4)}{27} = 67$  Cu.Yds.

Req'd. 39"x10" Plastic Pipe Sewer (Polyvinyl Chloride) Existing Manhole to Manhole 901 Lt. (See Details)

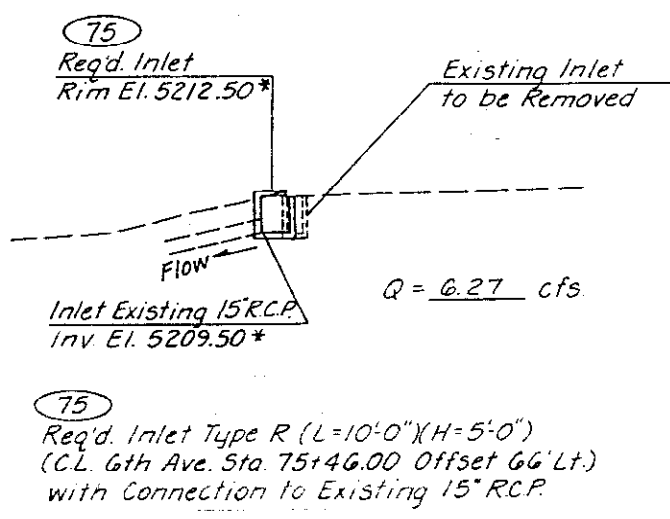


Structure Excavation = 0 Cu.Yds.  
 Structure Backfill = 0 Cu.Yds.  
 Embankment = 0 Cu.Yds.

75 Req'd. Inlet Type R (L=10'-0" x H=5'-0") (C.L. 6th Ave. Sta. 75+46.00 Offset 66' Lt.) with Connection to Existing 15" R.C.P.

\*Elevation approximate only. Actual elevation and final adjustments to be made during construction as directed by the Engineer.

Structure Excavation  
 $\frac{276(10)(4)}{27} = 409$  Cu.Yds.  
 Structure Backfill  
 $\frac{276(8.45)}{27} = 86$  Cu.Yds.  
 Embankment  
 $\frac{276(7.5)(4)}{27} = 307$  Cu.Yds.

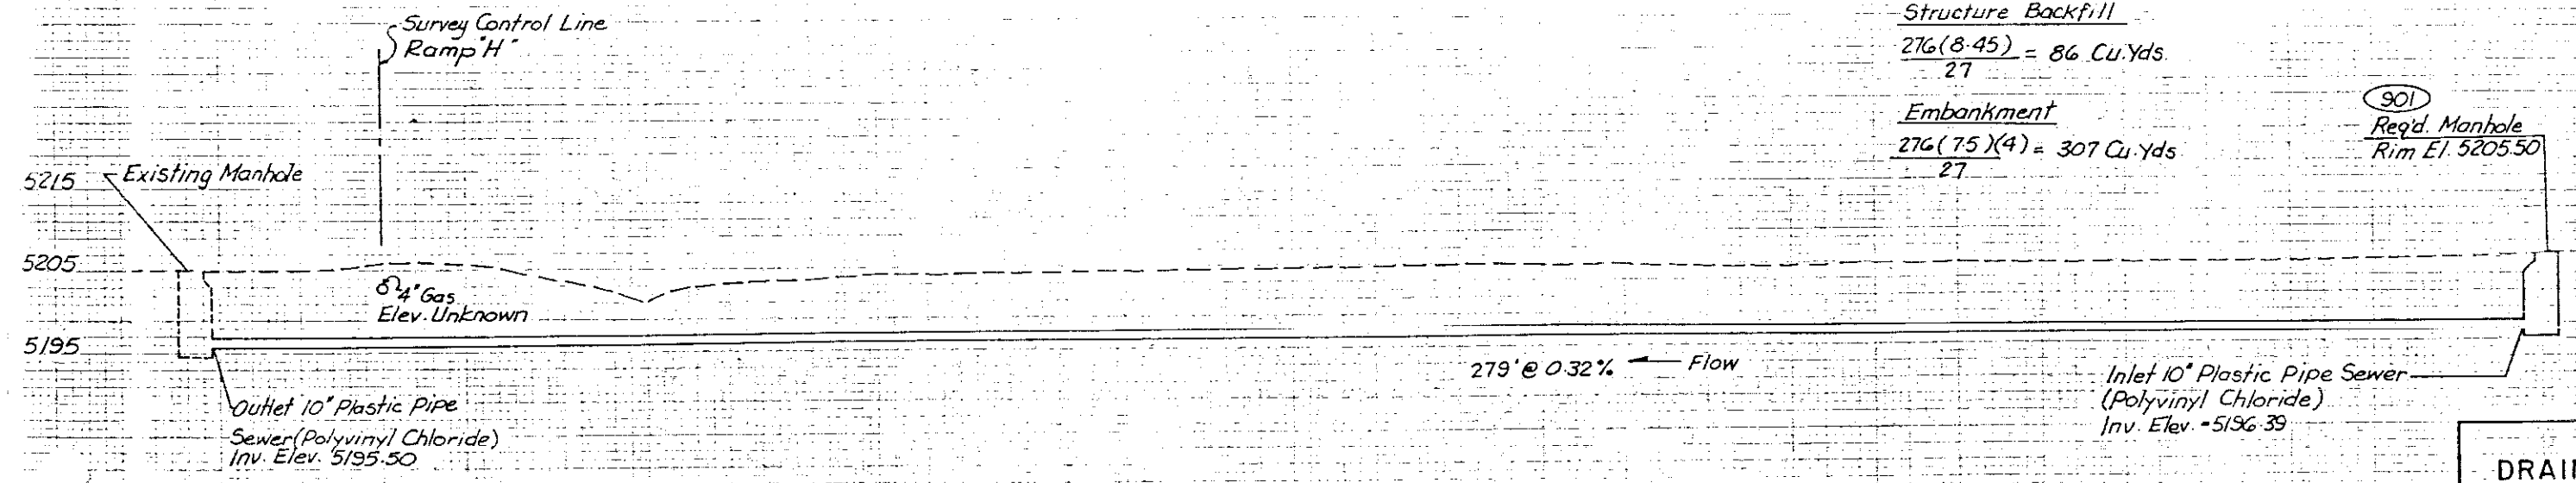

901 Req'd. Manhole (See Detail) (H=9'-1") (Ramp 'H' Sta. 900+91.43 Offset 51.22' Rt.) With a 279"x10" Plastic Pipe Sewer (Polyvinyl Chloride) to Existing Manhole Lt. (See Details)


DRAINAGE AND SEWER CROSS SECTIONS

AS CONSTRUCTED		FEDERAL ROAD REGION NO	DIVISION	PROJ NO	SHEET NO	TOTAL SHEETS
NO REVISIONS	REVISED 7-21-83	VOID	VIII	COLORADO	IR 25-2(191)	48 242

Structure Excavation  
= 0 Cu. Yds.


Structure Backfill  
= 0 Cu. Yds.

Embankment  
= 0 Cu. Yds.

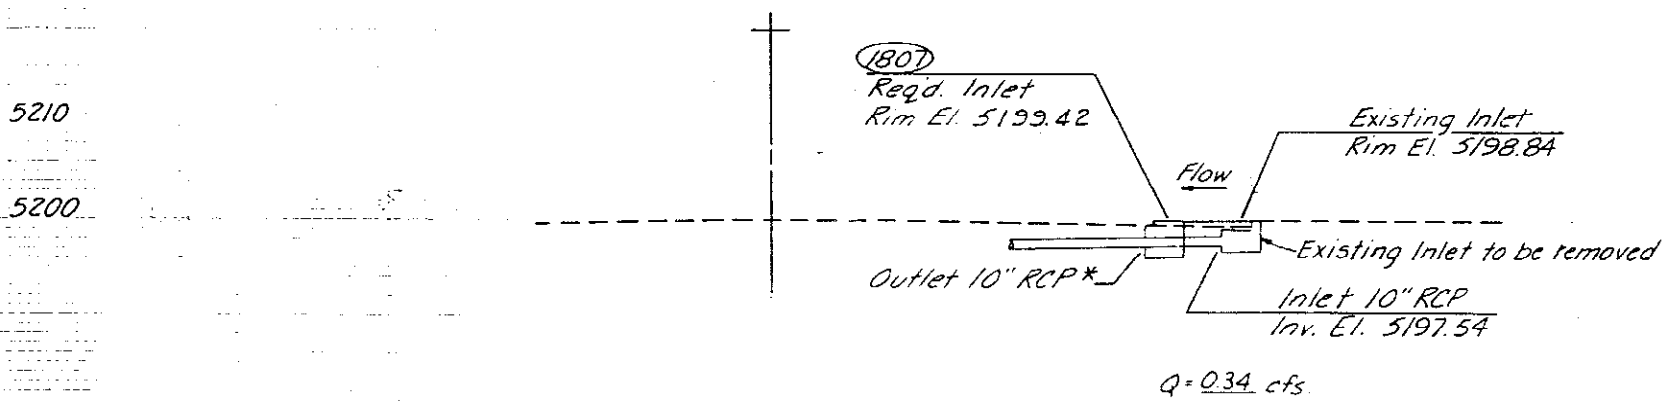

1807  
Req'd. Inlet Type 13 (See Detail) (H=2'-2")  
(8th Ave. Sta. 1807+47.00 Offset 37' Lt.)  
with a Connection to 10" RCP from  
existing Inlet (Rt.).


\* Elevation approximate only. Actual Elevation and Final Adjustment to be made during Construction as directed by the Engineer.

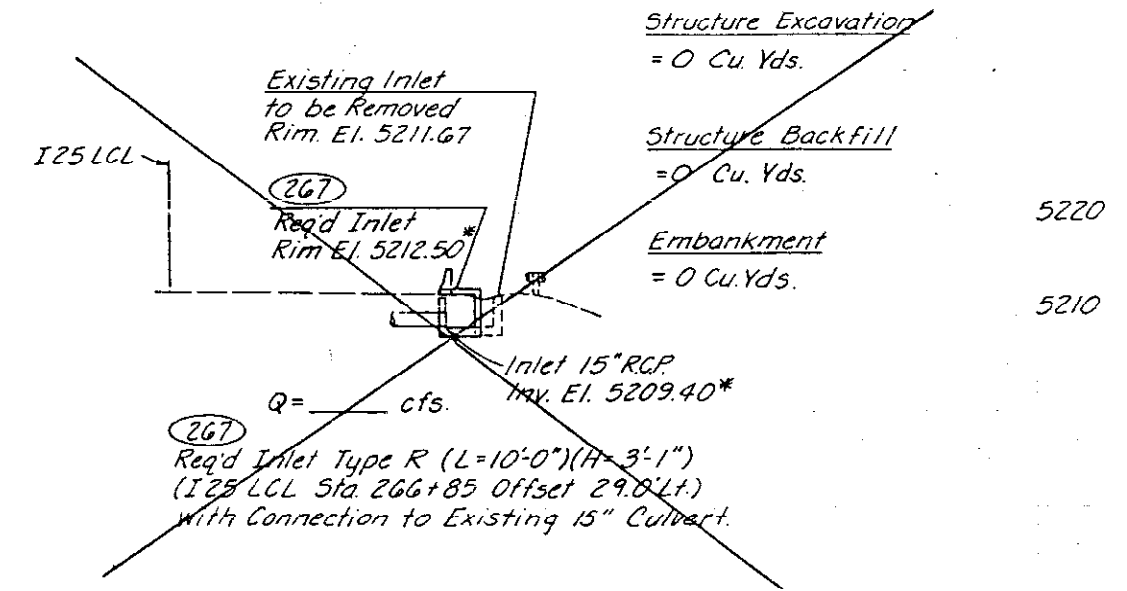

Structure Excavation  
= 0 Cu. Yds.

Structure Backfill  
= 0 Cu. Yds.

Embankment  
= 0 Cu. Yds.

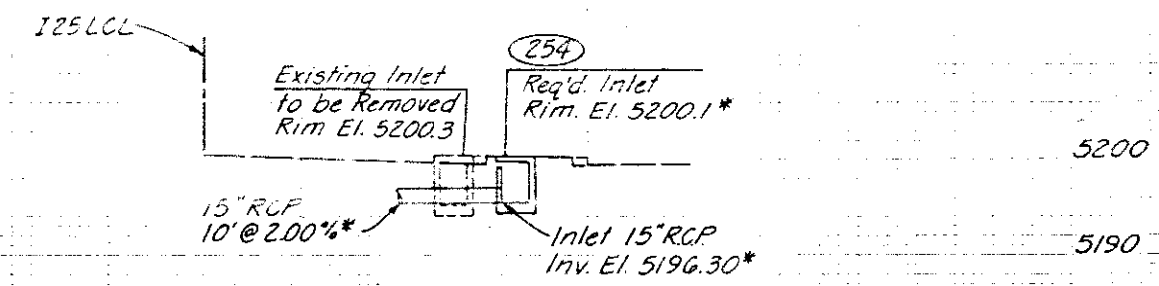

254  
Req'd. Inlet Type R (L=10'-0") (H=3'-9")  
(I25 LCL Sta. 253+48.0, Offset 30.4' Lt.)  
with a 15"x10" RCP Connection to  
Existing Culvert with Concrete  
Collar.

Structure Excavation  
 $\frac{8.5 (4.25 \times 3.75)}{27} \approx 5 \text{ Cu. Yds.}$


Structure Backfill  
 $\frac{8.5 (10.75)}{27} \approx 3 \text{ Cu. Yds.}$

Embankment  
 $\frac{8.5 (3.70)}{27} = 1 \text{ Cu. Yd.}$

NOTE:

For Type R Inlets;  
Rim Elevation is to Top of Manhole, E of Inlet to Match E of New Barrier or Curb and Gutter, and Station Offset is to E and E of Inlet.

For Type 13 Inlets;  
Rim Elevation is to Top of Curb, E of Inlet to Match E of New Curb and Gutter, and Station Offset is to E of Inlet.

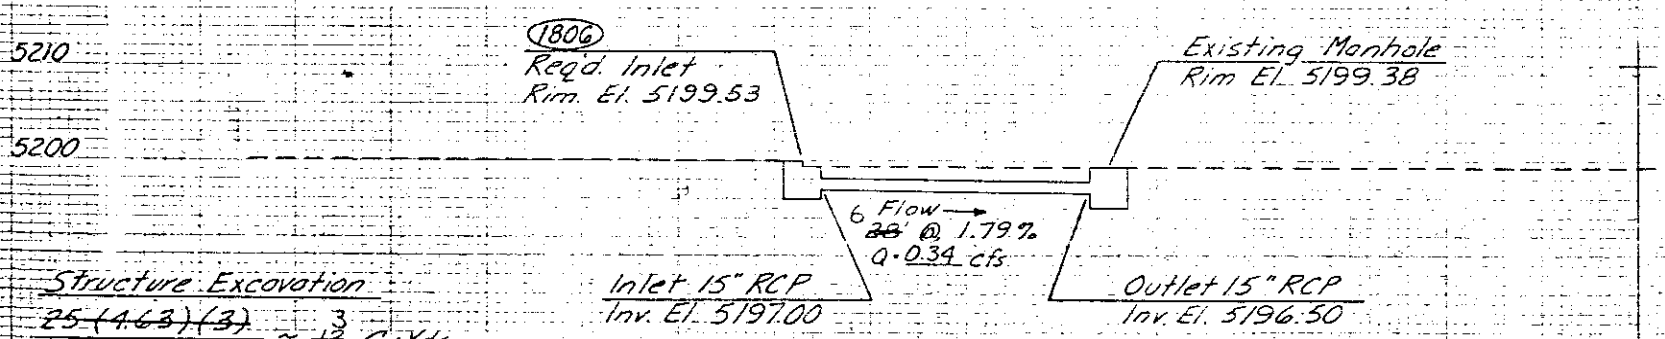

1806  
Req'd. Inlet Type 13 (See Detail) (H=2'-6")  
(8th Ave. Sta. 1806+45.00 Offset 43' Lt.)  
with a 15"x28" RCP Culvert to Existing  
Manhole (Rt.) 15" Culvert


Structure Excavation  
 $\frac{25 (4.63) (3)}{27} \approx 13 \text{ Cu. Yds.}$

Structure Backfill  
 $\frac{25 (8.5)}{27} \approx 8 \text{ Cu. Yds.}$

Embankment  
= 0 Cu. Yds.


DRAINAGE AND SEWER CROSS SECTIONS

AS CONTRACTED	FED. ROAD REGION	DIVISION	PROJ. NO.	SHEET NO.	SHEET TOTALS
NO REVISIONS 7-21-89 REVISED _____ VOID _____	VIII	COLO.	1R 25-2 (191)	49	242

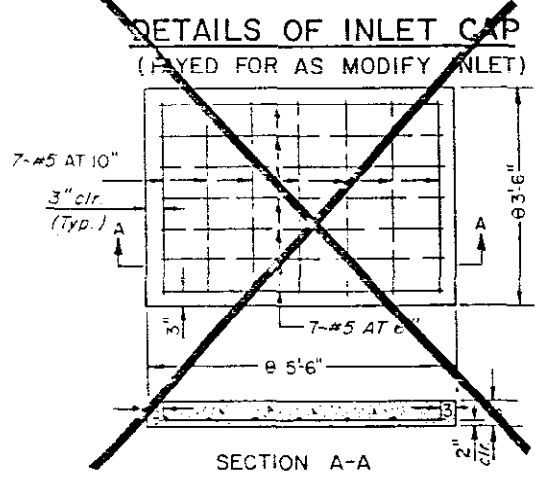


NOTE: Inlet is to be broken to a neat work line as directed by the Engineer before capping.


Concrete - 0.475 cu. yds.  
Steel - 59.0 lbs.  
Ø Approx. only. Adjust to fit various inlets.

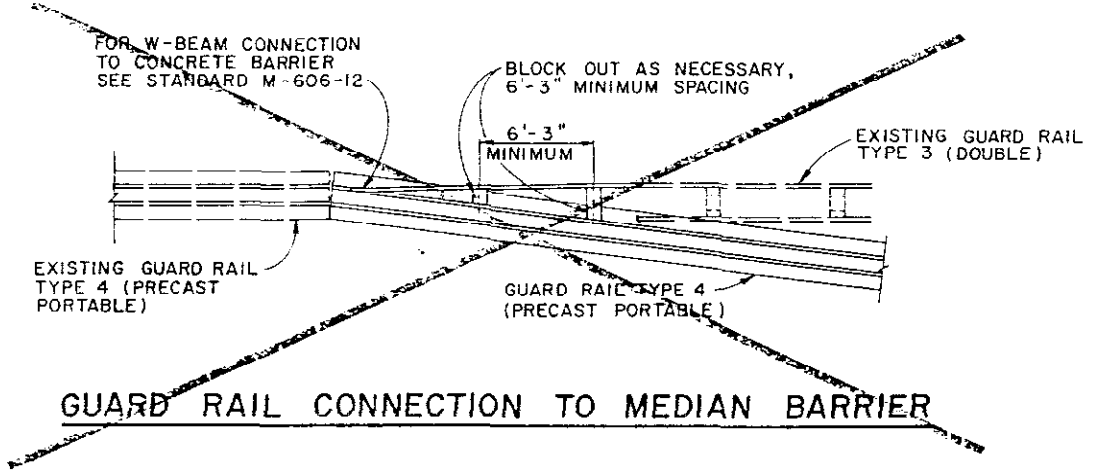

GUARD RAIL CONNECTION TO MEDIAN BARRIER

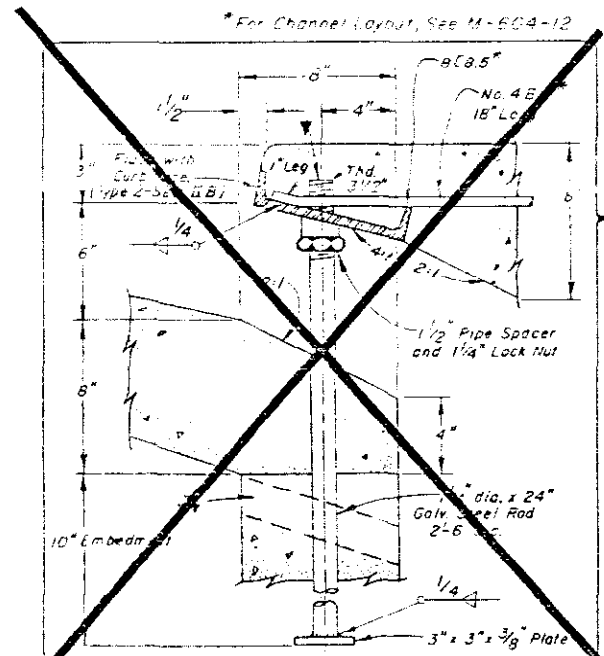


CURB FACE ASSEMBLY, Place Entire Assembly Before Pouring Concrete.  
NO SCALE

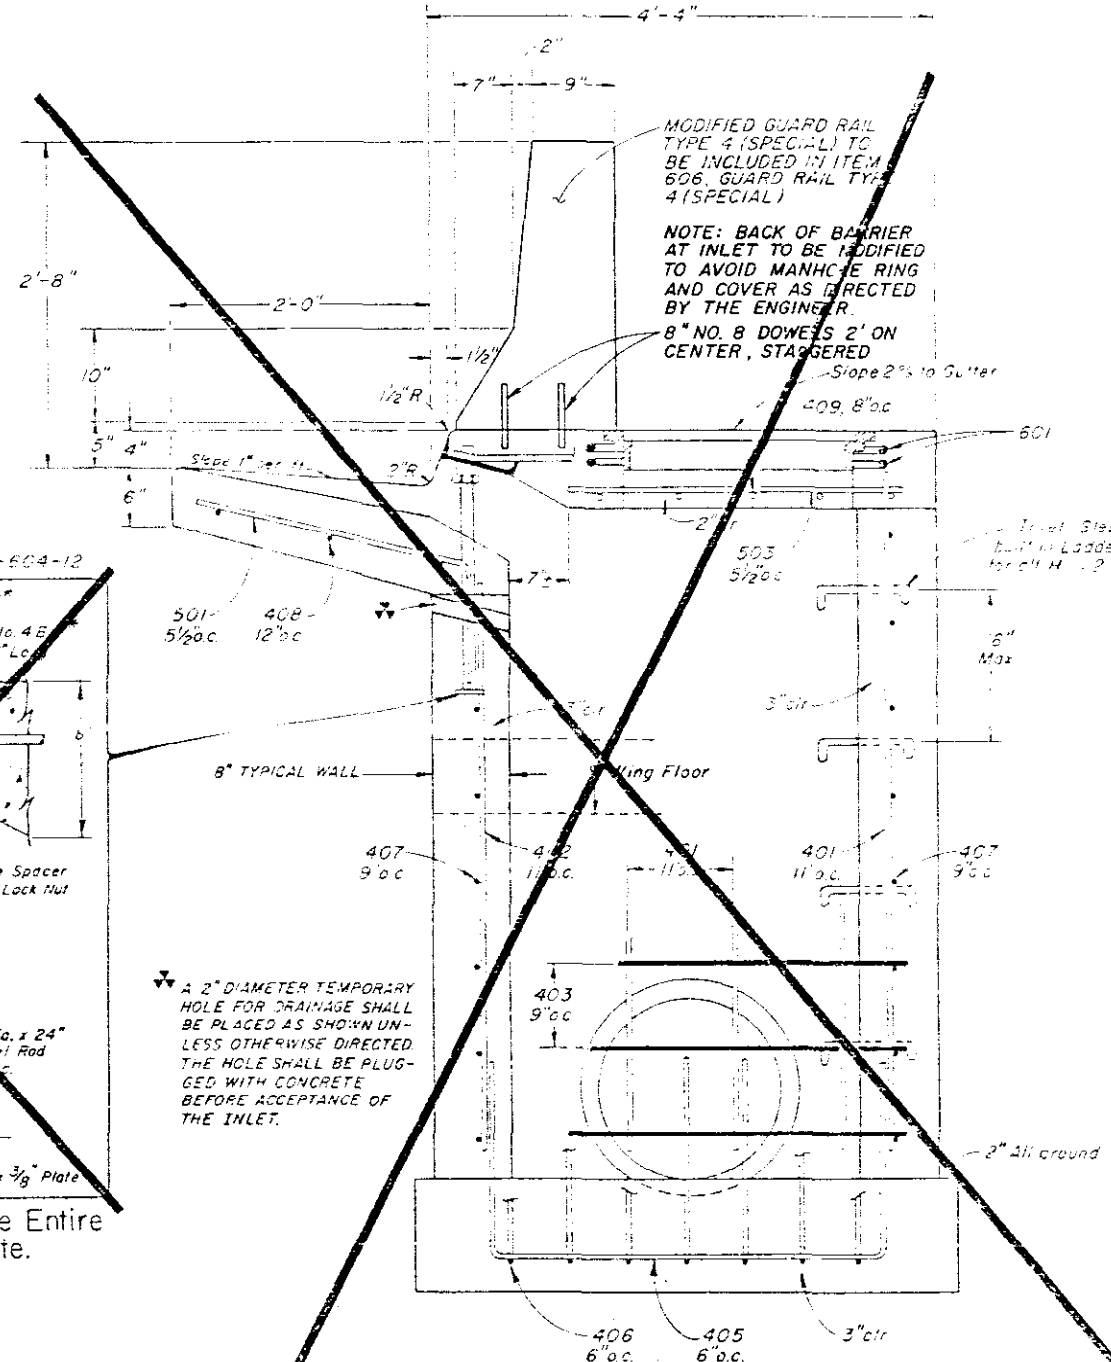

TYPE 'R' INLET (WITH MODIFIED BARRIER)  
TYPICAL END VIEW  
NO SCALE


NOTE: MANHOLE RING & COVER, STATION POINT AND OUTFLOW PIPE ARE TO BE LOCATED AT THE SAME END OF THE INLET.  
NO SCALE

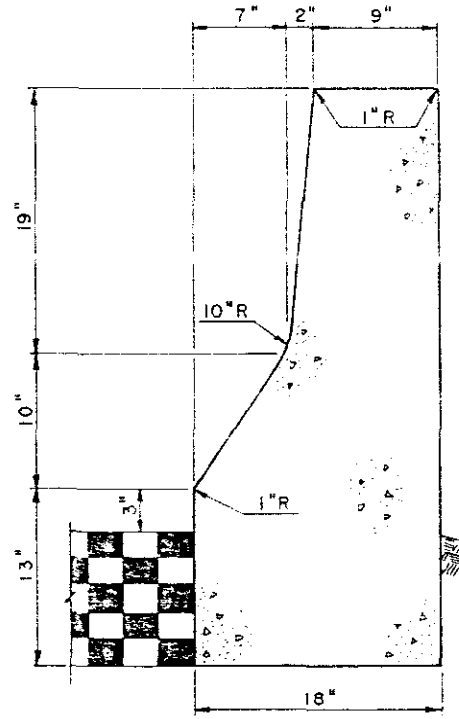

DETAIL FOR GUARD RAIL TYPE 4 SPECIAL


NOTE: GUARD RAIL TYPE 4 SPECIAL TO RECEIVE LIGHT COLORED STRUCTURAL CONCRETE COATING WHERE INDICATED ON PLANS OR AS DIRECTED BY THE ENGINEER COST TO BE INCLUDED IN THE WORK.

DRAINAGE AND BARRIER DETAILS  
NOT TO SCALE

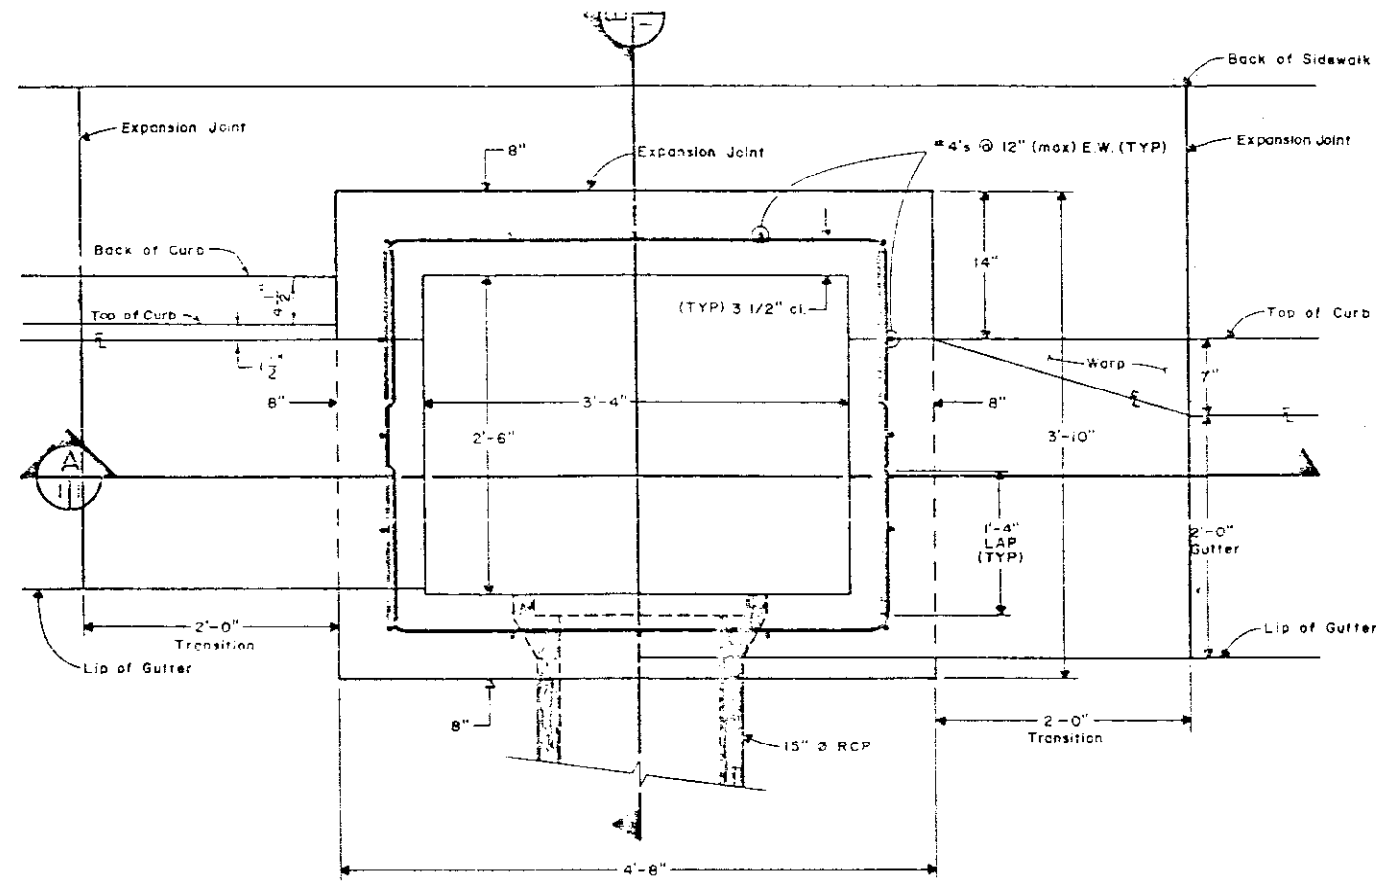


Vertical Curb & Gutter PLAN VIEW Scale: 1"=1'-0"


Comb. Curb, Gutter & Sidewalk

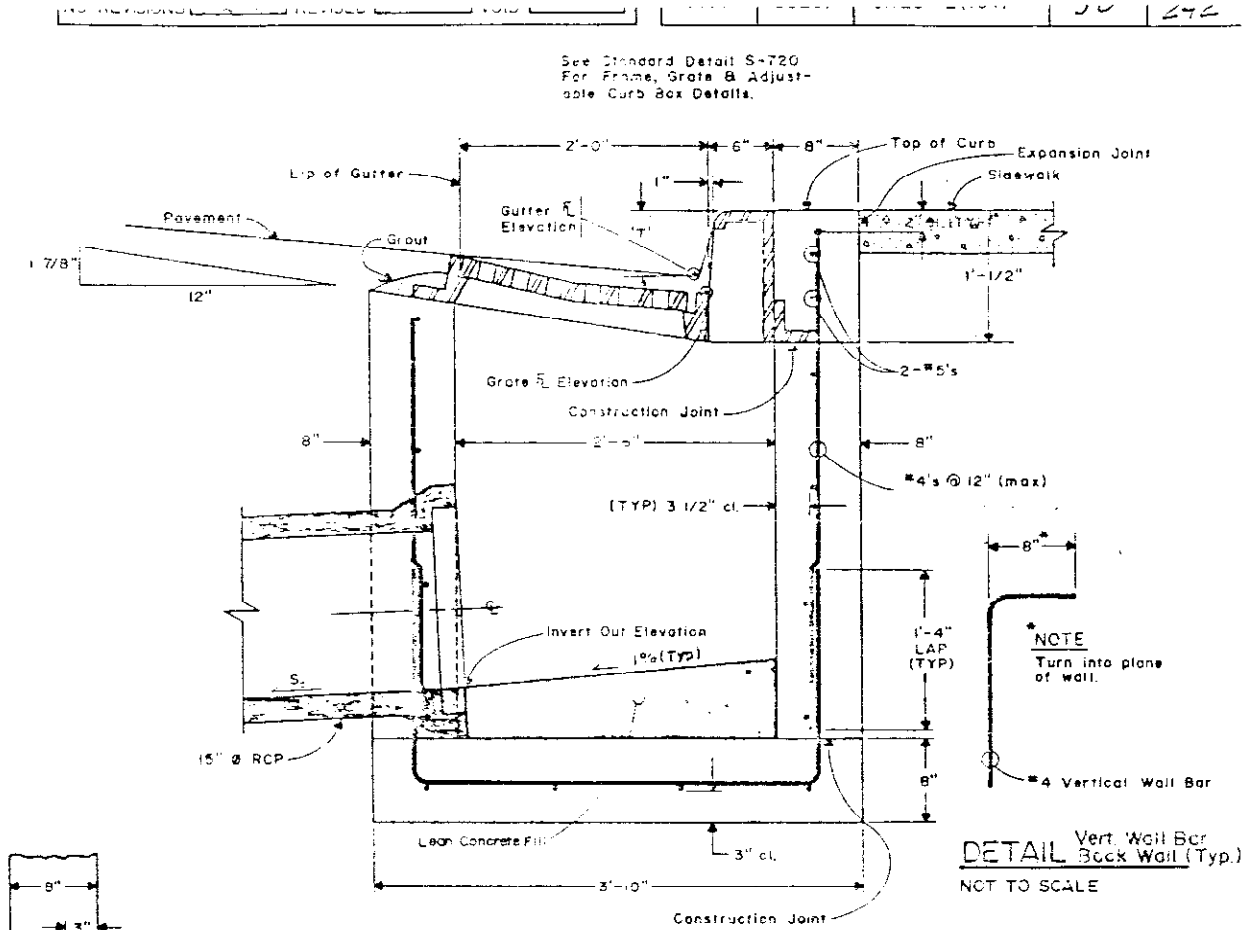


DETAIL Vertical Wall Bar Back Wall (Typ.) NOT TO SCALE

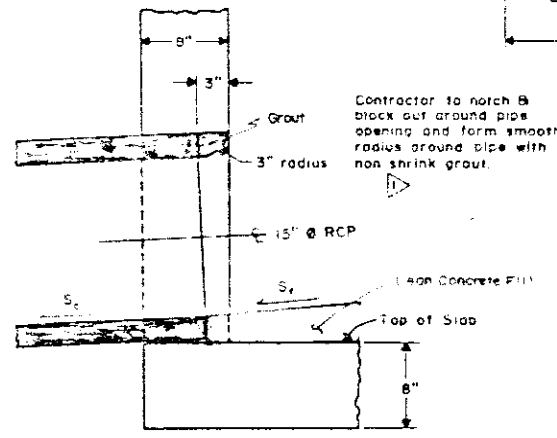

DETAIL CONNECTOR OUTLET (OPTIONAL) Scale: 1"=1'-0"

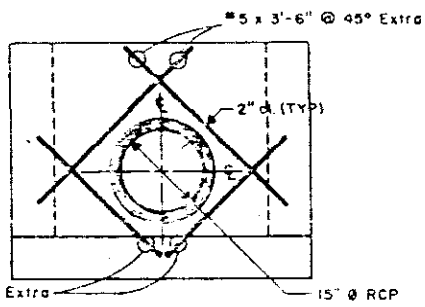

DETAIL REBAR PLACEMENT AROUND CONNECTOR Scale: 1/2"=1'-0"

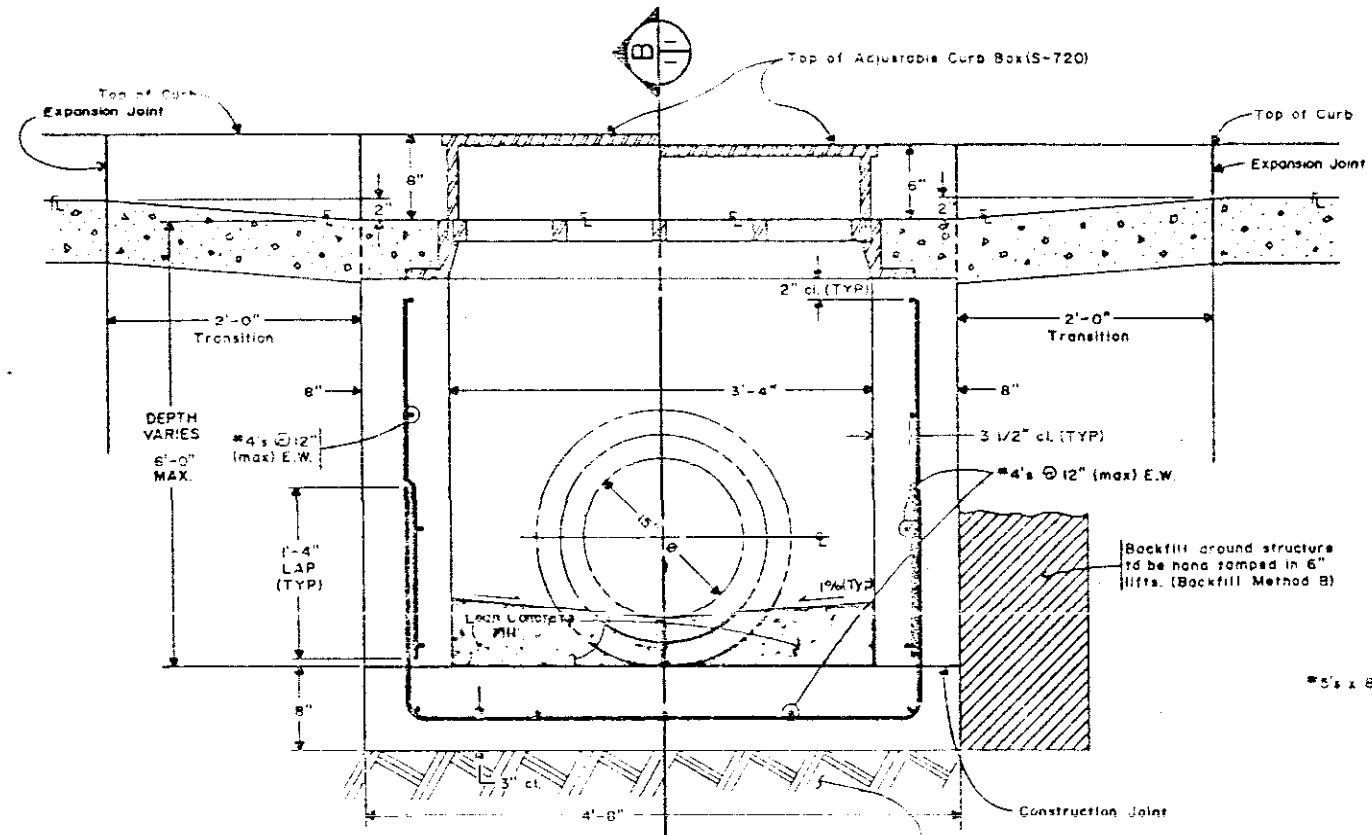

SECTION A Scale: 1"=1'-0"

SECTION B Scale: 1"=1'-0"

NOTES


- 1) For payment purposes, inlet structures shall also include 2'-0" curb & gutter transition section at each end of inlet plus sidewalk sections where required behind inlet structure and transition sections.
- 2) Floor slope may be poured monolithic with base.
- 3)  $S_c$  = Slope of Connector  $\geq 1\%$  min.
- 4) Unless otherwise specified on the drawings or otherwise approved, all #13 inlets shall be constructed with an adjustable C.I. curb box (S-720).
- 5) Design conditions for inlet allows depths of 6" (max.). For inlets more than 6 feet in depth, shop drawings and design analysis shall be submitted for approval.
- 6) All reinforcing steel shall be ASTM, A-615, Grade 60 deformed bars. Diameter of bend measured on the inside of the bar shall be a minimum of 6 bar diameters.
- 7) All work shall conform to AASHTO "Standard Specifications for Highway Bridges" 1983 Edition.
- 8) Concrete shall have a 28 day strength of 4000 psi.
- 9) Sub-grade shall be a gradation equal to Class B Bedding compacted to 95% maximum dry density, AASHTO Designation T-180.
- 10) No formwork shall remain inside structure when complete.
- 11) Sub-grade shall be shaped undisturbed material or overexcavated and backfilled with Class B Bedding material.
- 12) Splicing of reinforcing steel shall be permitted only where detailed in drawings.
- 13) Inlet walls shall be formed both inside and outside. Casting of sidewalls against earth is not permitted.
- 14) Lean Concrete Fill to be  $f'_c = 2000$  psi.

REVISED		
No.	By	Date
1	DLB	3-11-86

CITY AND COUNTY OF DENVER  
DEPARTMENT OF PUBLIC WORKS  
WASTEWATER MANAGEMENT DIVISION  
STANDARD DETAILS  
for  
SINGLE NO. 13 OPEN THROAT INLET  
with  
ADJUSTABLE CURB BOX


Submitted by Joseph P. Garcia 9/30/85  
Chief Design Engineer Date

Recommended by Mike Stibich 9/29/85  
Assistant Director of Engineering Date

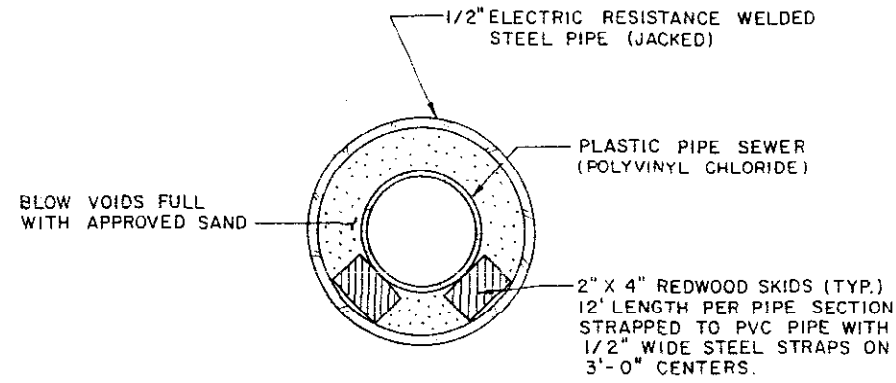

**JACKING DETAIL WELDED STEEL PIPE**


ALL MATERIALS SUBSIDIARY TO  
 WELDED STEEL PIPE (JACKED) AND  
 PLASTIC PIPE SEWER (POLYVINYL CHLORIDE)

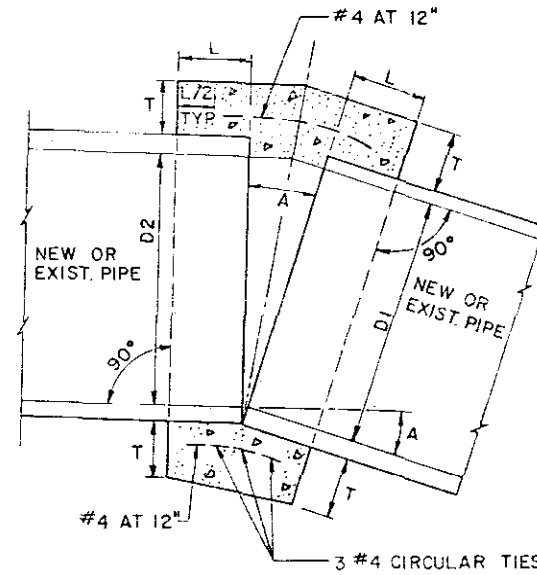

D	L	T
12"	1.0'	4"
18"	1.0'	5"
24"	1.0'	6"
36"	1.5'	8"
48"	1.5'	10"
57"	1.5'	10"
60"	1.75'	11"
66"	1.75'	11"

**CONCRETE COLLAR DETAIL**

TYPICAL WHERE PROPER JOINT IS NOT  
 OBTAINED. NOT PAID FOR SEPARATELY

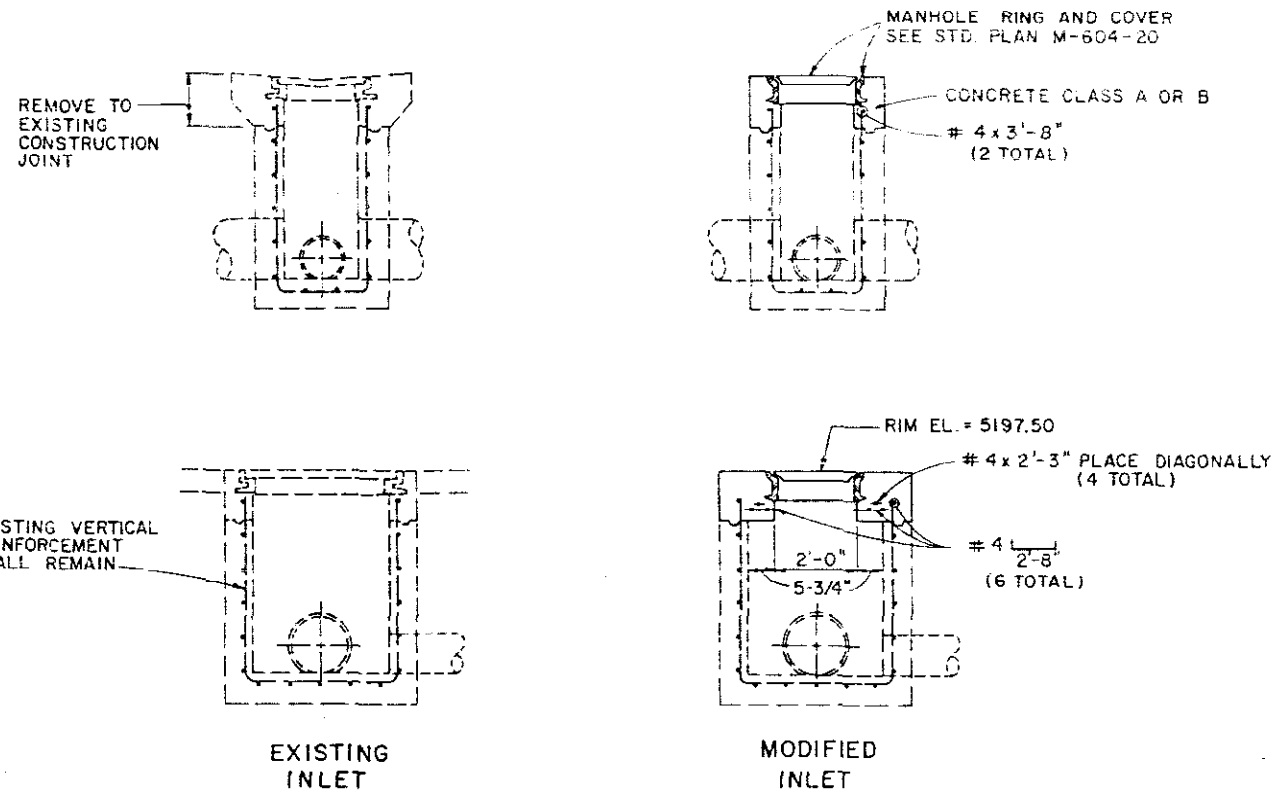

**DETAILS OF MODIFY INLET**




**GENERAL NOTES:**

1. ALL WORK SHALL BE DONE IN ACCORDANCE WITH THE STANDARD SPECIFICATIONS APPLICABLE TO THE PROJECT.
2. ALL REINFORCEMENT SHALL HAVE MINIMUM 2" CLEAR.
3. THE EXISTING INLET GRATE SHALL REMAIN THE PROPERTY OF THE STATE OF COLORADO.
4. SET MANHOLE RING AND COVER TO THE ELEVATION SHOWN OR AS DIRECTED BY THE ENGINEER.

CONCRETE COLLAR,  
 MODIFY INLET AND  
 JACKING DETAILS

NOT TO SCALE

AS CONSTRUCTED		FED. ROAD REGION	DIVISION	PROJ. NO.	SHEET NO.	SHEET TOTALS
NO REVISIONS <input checked="" type="checkbox"/>	REVISED <input type="checkbox"/>	VOID <input type="checkbox"/>	VIII	COLO.	IR 25-2(191)	52

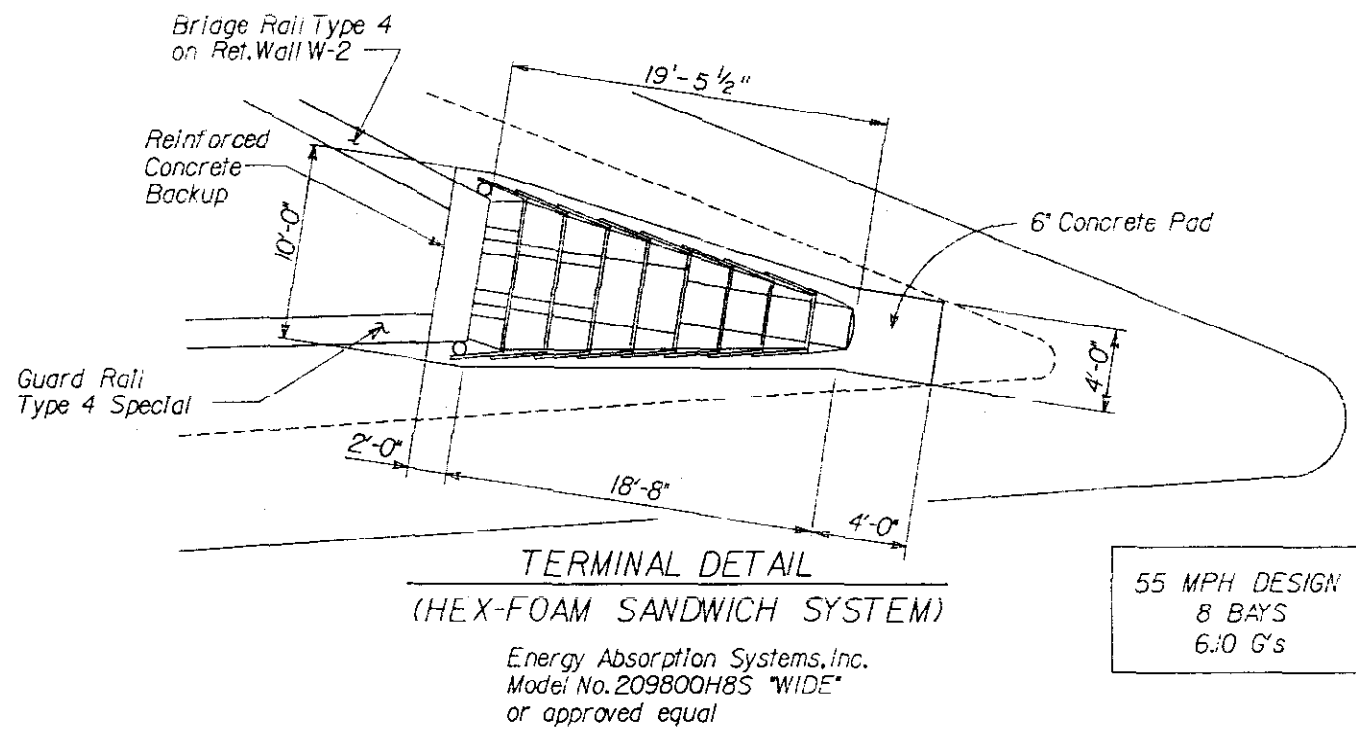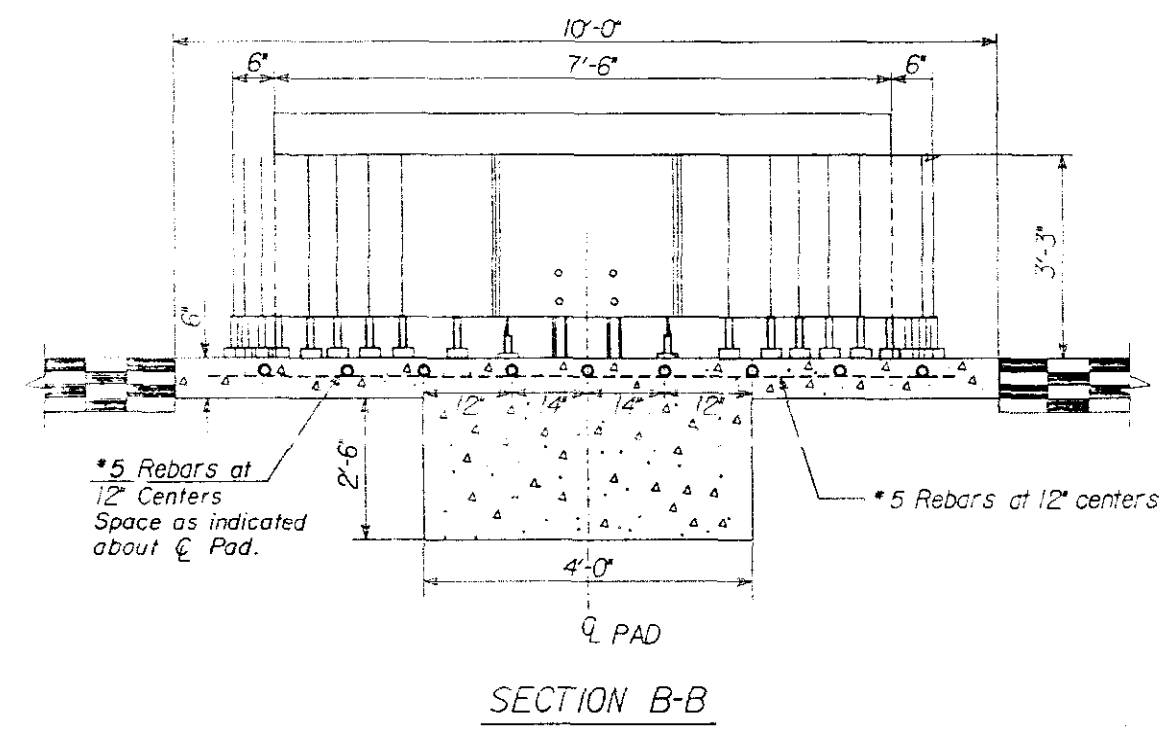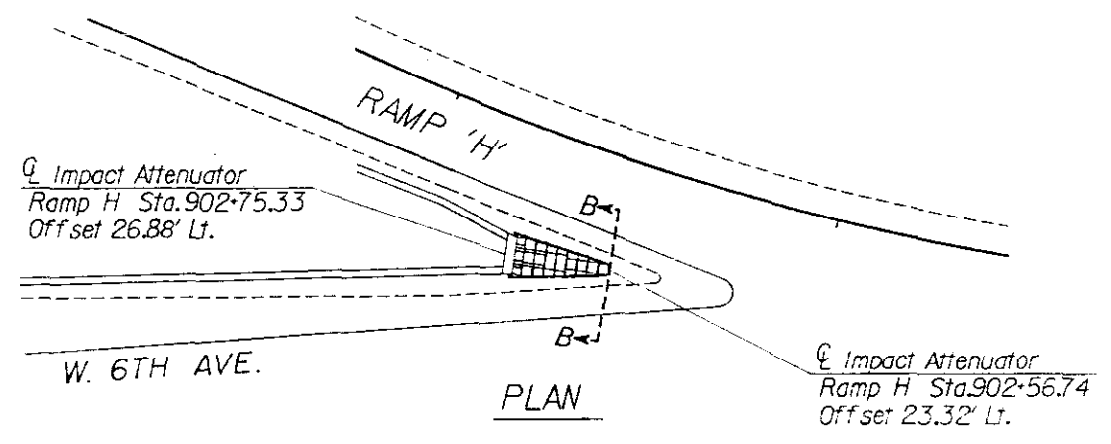

IMPACT  
 ATTENUATORS

NOT TO SCALE









AS CONSTRUCTED		FED. ROAD REGION	DIVISION	PROJ. NO.	SHEET NO.	SHEET TOTALS
NO REVISIONS	REVISED 7-21-79	VOID	VIII	COLD.	IR 25-2(191)	55 242

DESIGN DATE:   
**GRADING PLAN AND SEEDING LIMITS** **G-1**

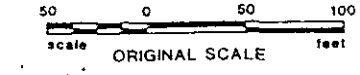

H.B.P. Slope Paving

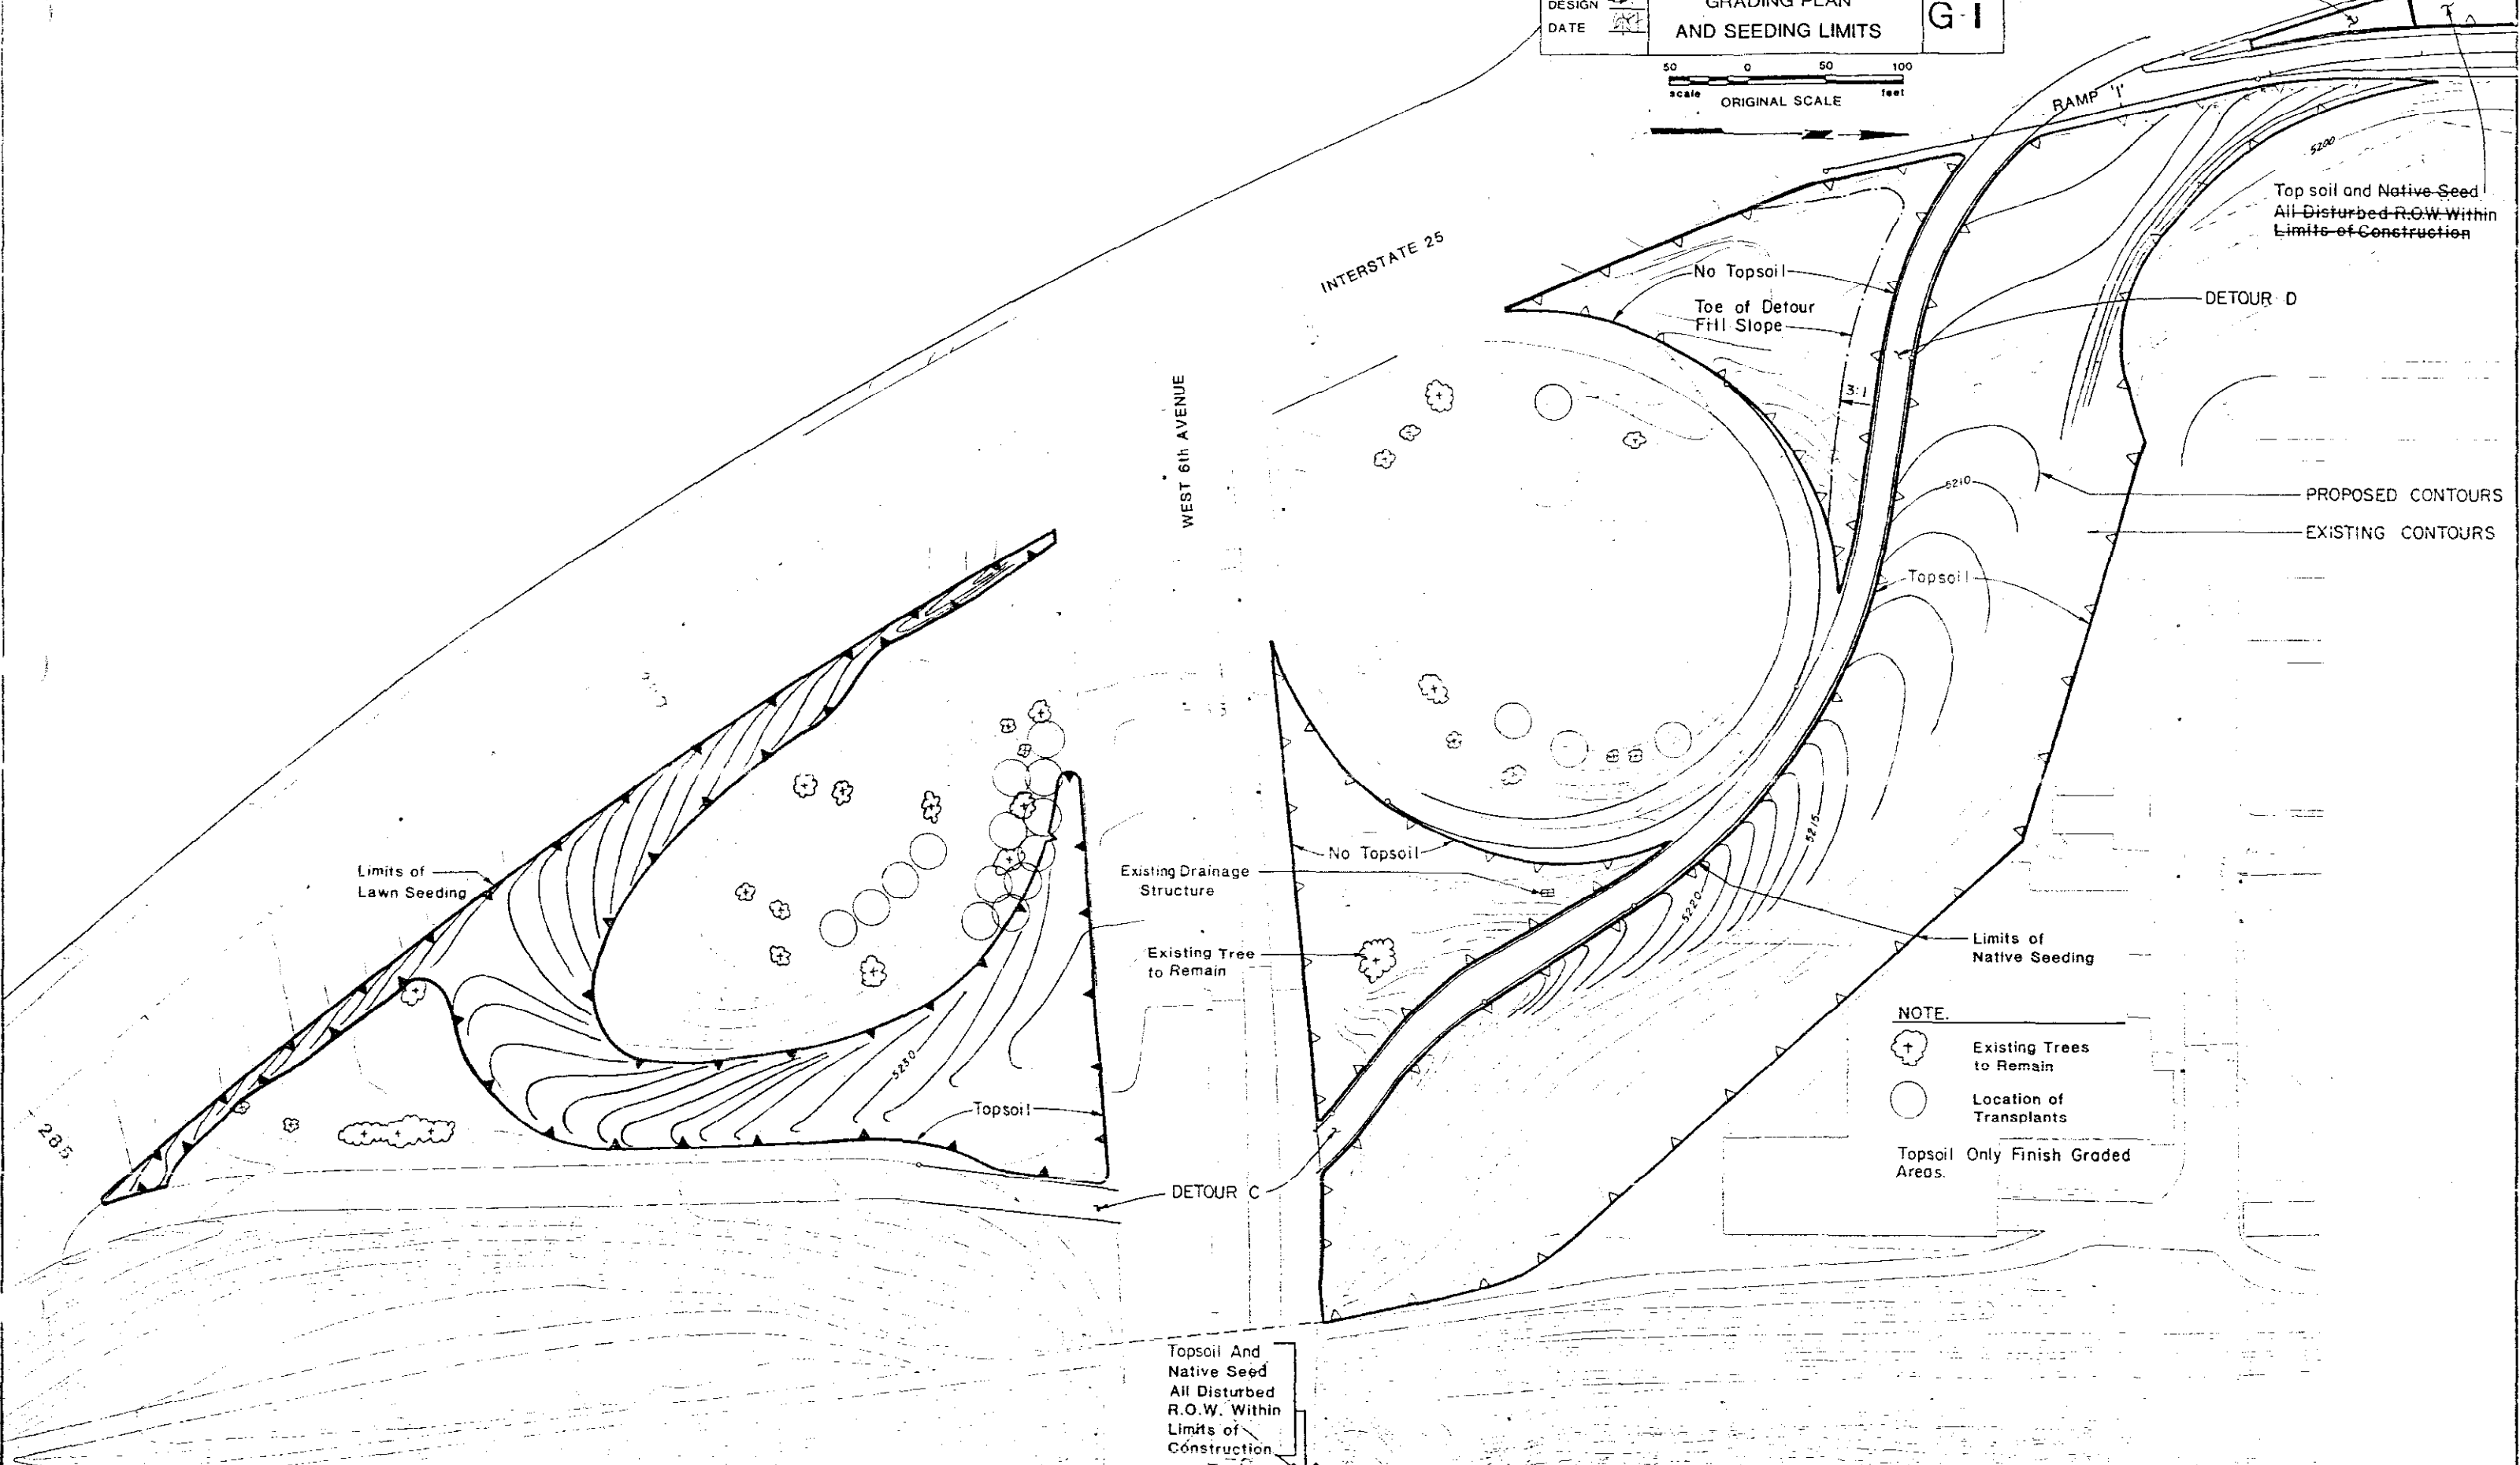

**NOTE.**  
 (+) Existing Trees to Remain  
 (O) Location of Transplants  
 Topsoil Only Finish Graded Areas.

Topsoil And Native Seed All Disturbed R.O.W. Within Limits of Construction

~~SUMMARY OF PLANT QUANTITIES~~

<del>COMMON NAME</del>	<del>BOTANICAL NAME</del>	<del>SIZE</del>	<del>QUANTITY</del>
<del>PURPLE ASH</del>	<del>FRAXINUS AUTUMN PURPLE</del>	<del>4 IN CANDEK</del>	<del>11</del>

SUMMARY OF LANDSCAPING QUANTITIES

ITEM NO. & DESCRIPTION	PAY UNIT	QUANTITY	REMARKS
<del>212 SEEDING (NATIVE)</del>	<del>ACRE</del>	<del>5.0 ACRES</del>	<del>SEE BELOW FOR SPECIES AND RATE</del>
<del>212 SEEDING (LAWN)</del>	<del>ACRE</del>	<del>2.0 ACRES</del>	<del>SEE BELOW FOR SPECIES AND RATE</del>
212 SOD	SQUARE FOOT	100,000 sq. ft.	
<del>213 MULCHING (HYDRAULIC)</del>	<del>ACRE</del>	<del>7.9 ACRES</del>	<del>RATE = 1 TON/ACRE</del>
213 EROSION BALES	EACH	50	FOR TEMPORARY EROSION CONTROL
<del>214 PLANTS</del>	<del>EACH</del>	<del>11</del>	<del>SEE LIST OF PLANT QUANTITIES</del>
215 TRANSPLANT TREE (3 TO 6 INCH)	EACH	1	T6
215 TRANSPLANT TREE (OVER 6 INCH)	EACH	13	T6

GENERAL NOTES

- SEEDING (NATIVE) SHALL INCLUDE THE APPLICATION OF FERTILIZER AND NATIVE SEED COMPOSED OF THE SPECIES AND RATES LISTED BELOW. FERTILIZER FOR SEEDING (NATIVE) SHALL BE DIAMMONIUM PHOSPHATE WITH AN AVAILABLE NUTRIENT ANALYSIS OF 18N-46P-0K APPLIED AT A RATE OF 400 LBS./ACRE. THE FERTILIZER SHALL BE TILLED INTO THE TOP 4 INCHES OF SOIL (NOT HYDRO-FERTILIZED) PRIOR TO SEEDING. SEEDING (NATIVE) SHALL BE APPLIED USING HYDRAULIC SEEDING EQUIPMENT IN A SLURRY MIX THAT ENSURES UNIFORM DISTRIBUTION OF THE SEED ON THE SLOPES. A HYDROMULCH CONSISTING OF WOOD CELLULOSE FIBERS AND TACKIFIER (BINDER) SHALL BE APPLIED IMMEDIATELY FOLLOWING HYDROSEEDING.
- SEEDING (LAWN) SHALL INCLUDE THE APPLICATION OF FERTILIZER AND LAWN SEED COMPOSED OF THE SPECIES AND RATES LISTED BELOW. FERTILIZER FOR SEEDING (LAWN) SHALL BE APPLIED IN TWO PHASES. FIRST, TRIPLE SUPER-PHOSPHATE WITH AN AVAILABLE NUTRIENT ANALYSIS OF 0N-46P-0K SHALL BE APPLIED AT A RATE OF 200 LBS./ACRE. THIS FERTILIZER SHALL BE TILLED INTO THE TOP 4 INCHES OF SOIL PRIOR TO SEEDING. SECONDLY, A STANDARD COMMERCIAL FERTILIZER WITH AN AVAILABLE NUTRIENT ANALYSIS OF 20N-10P-5K SHALL BE APPLIED AT A RATE OF 200 LBS./ACRE. THIS FERTILIZER SHALL BE BROADCAST (NOT HYDROFERTILIZED) AFTER GERMINATION AT THE DIRECTION OF THE ENGINEER. SEEDING (LAWN) SHALL BE APPLIED USING HYDRAULIC SEEDING EQUIPMENT IN A SLURRY MIX THAT ENSURES UNIFORM DISTRIBUTION OF THE SEED ON THE SLOPES. A HYDROMULCH CONSISTING OF WOOD CELLULOSE FIBERS AND TACKIFIER (BINDER) SHALL BE APPLIED IMMEDIATELY FOLLOWING HYDROSEEDING.
- MULCHING (HYDRAULIC) SHALL INCLUDE THE APPLICATION OF WOOD CELLULOSE FIBERS AND TACKIFIER (NOT PAID FOR SEPARATELY) OVER ALL SEEDING (NATIVE) AND (LAWN) AREAS. RATE OF HYDRAULIC WOOD CELLULOSE MULCH SHALL BE 1 TON/ACRE AND TACKIFIER (BINDER) RATE SHALL BE 100 LBS./ACRE.
- HYDRAULIC SEEDING AND MULCHING EQUIPMENT SHALL BE SIZED TO CONFORM TO THE QUANTITY AND SIZE OF SEED OR MULCH APPLIED SO AS TO MAXIMIZE EQUIPMENT PERFORMANCE. MINIMIZE WASTE OF MATERIALS, CONTROL SPRAY, AND MEET COVERAGE SPECIFICATIONS.
- SOD SHALL INCLUDE THE APPLICATIONS OF FERTILIZERS DESCRIBED FOR SEEDING (LAWN) AND THE INSTALLATION OF BLUEGRASS SOD AS SHOWN ON THE PLANS.
- ALL NEW TREES SHALL RECEIVE FERTILIZER TABLETS AS DESCRIBED IN THE 214 SPECIAL PROVISION. APPROXIMATELY 44 TABLETS WILL BE REQUIRED FOR THIS PROJECT. THESE WILL NOT BE PAID FOR SEPARATELY, BUT SHALL BE INCLUDED IN THE PRICE OF THE PLANTS.
- WATER USED FOR HYDRAULIC SEEDING AND MULCHING, AND FOR PLANTINGS AND SOD WILL NOT BE PAID FOR SEPARATELY, BUT SHALL BE INCLUDED IN THE WORK. ALL PLANTINGS (GRASS, SHRUBS, TREES, ETC.) IN IRRIGATED AREAS SHALL BE PLANTED IN COORDINATION WITH THE IRRIGATION SYSTEM SO IRRIGATION CAN BEGIN IMMEDIATELY FOLLOWING PLANTING.
- THE HEALTH AND MAINTENANCE (WATERING) OF ALL EXISTING TREES AND SHRUBS DESIGNATED TO REMAIN (SEE GRADING AND PLANTING PLANS) SHALL BE THE RESPONSIBILITY OF THE CONTRACTOR DURING THE CONSTRUCTION PERIOD. LOSS OF TREES OR SHRUBS BECAUSE OF NEGLECT WILL RESULT IN REPLACEMENT IN KIND AND SIZE BY THE CONTRACTOR AT THEIR OWN EXPENSE.
- REFER TO 215 STANDARD SPECIFICATION FOR THE FERTILIZATION REQUIREMENTS OF THE TRANSPLANTED PLANT MATERIALS.

SEED MIX	SEEDING (LAWN)	Furnish and Install	
COMMON NAME	BOTANICAL NAME	PLS. LBS./ACRES	PROJECT PLS. LBS.
A-34 BLUEGRASS	POA PRATENSIS "A-34"	20	40
FYLKING BLUEGRASS	POA PRATENSIS "FYLKING"	20	40
GLADE BLUEGRASS	POA PRATENSIS "GLADE"	10	20
MANHATTAN II PERENNIAL RYE	LOLIUM PERENNE "MANHATTAN II"	10	20
	TOTAL	60	120



SEED MIX	SEEDING (NATIVE)	Furnish and Install	
COMMON NAME	BOTANICAL NAME	PLS. LBS./ACRES	PROJECT PLS. LBS.
TALL FESCUE	FESTUCA ARUNDINACEA "FALCON"	25	125
CANADA BLUEGRASS	POA COMPRESSA "REUBEN"	10	50
SMOOTH BROME	BROMUS INERMIS "LINCOLN"	25	125
	TOTAL	60	300

AS CONSTRUCTED

DESIGN DATE: [ ] REVISED: 7-21-89 VOID: [ ]

LANDSCAPE PLAN L-2

FED. ROAD REGION	DIVISION	PROJ. NO.	SHEET NO.	SHEET TOTALS
VIII	COLO.	IR25-2 (191)	57	242

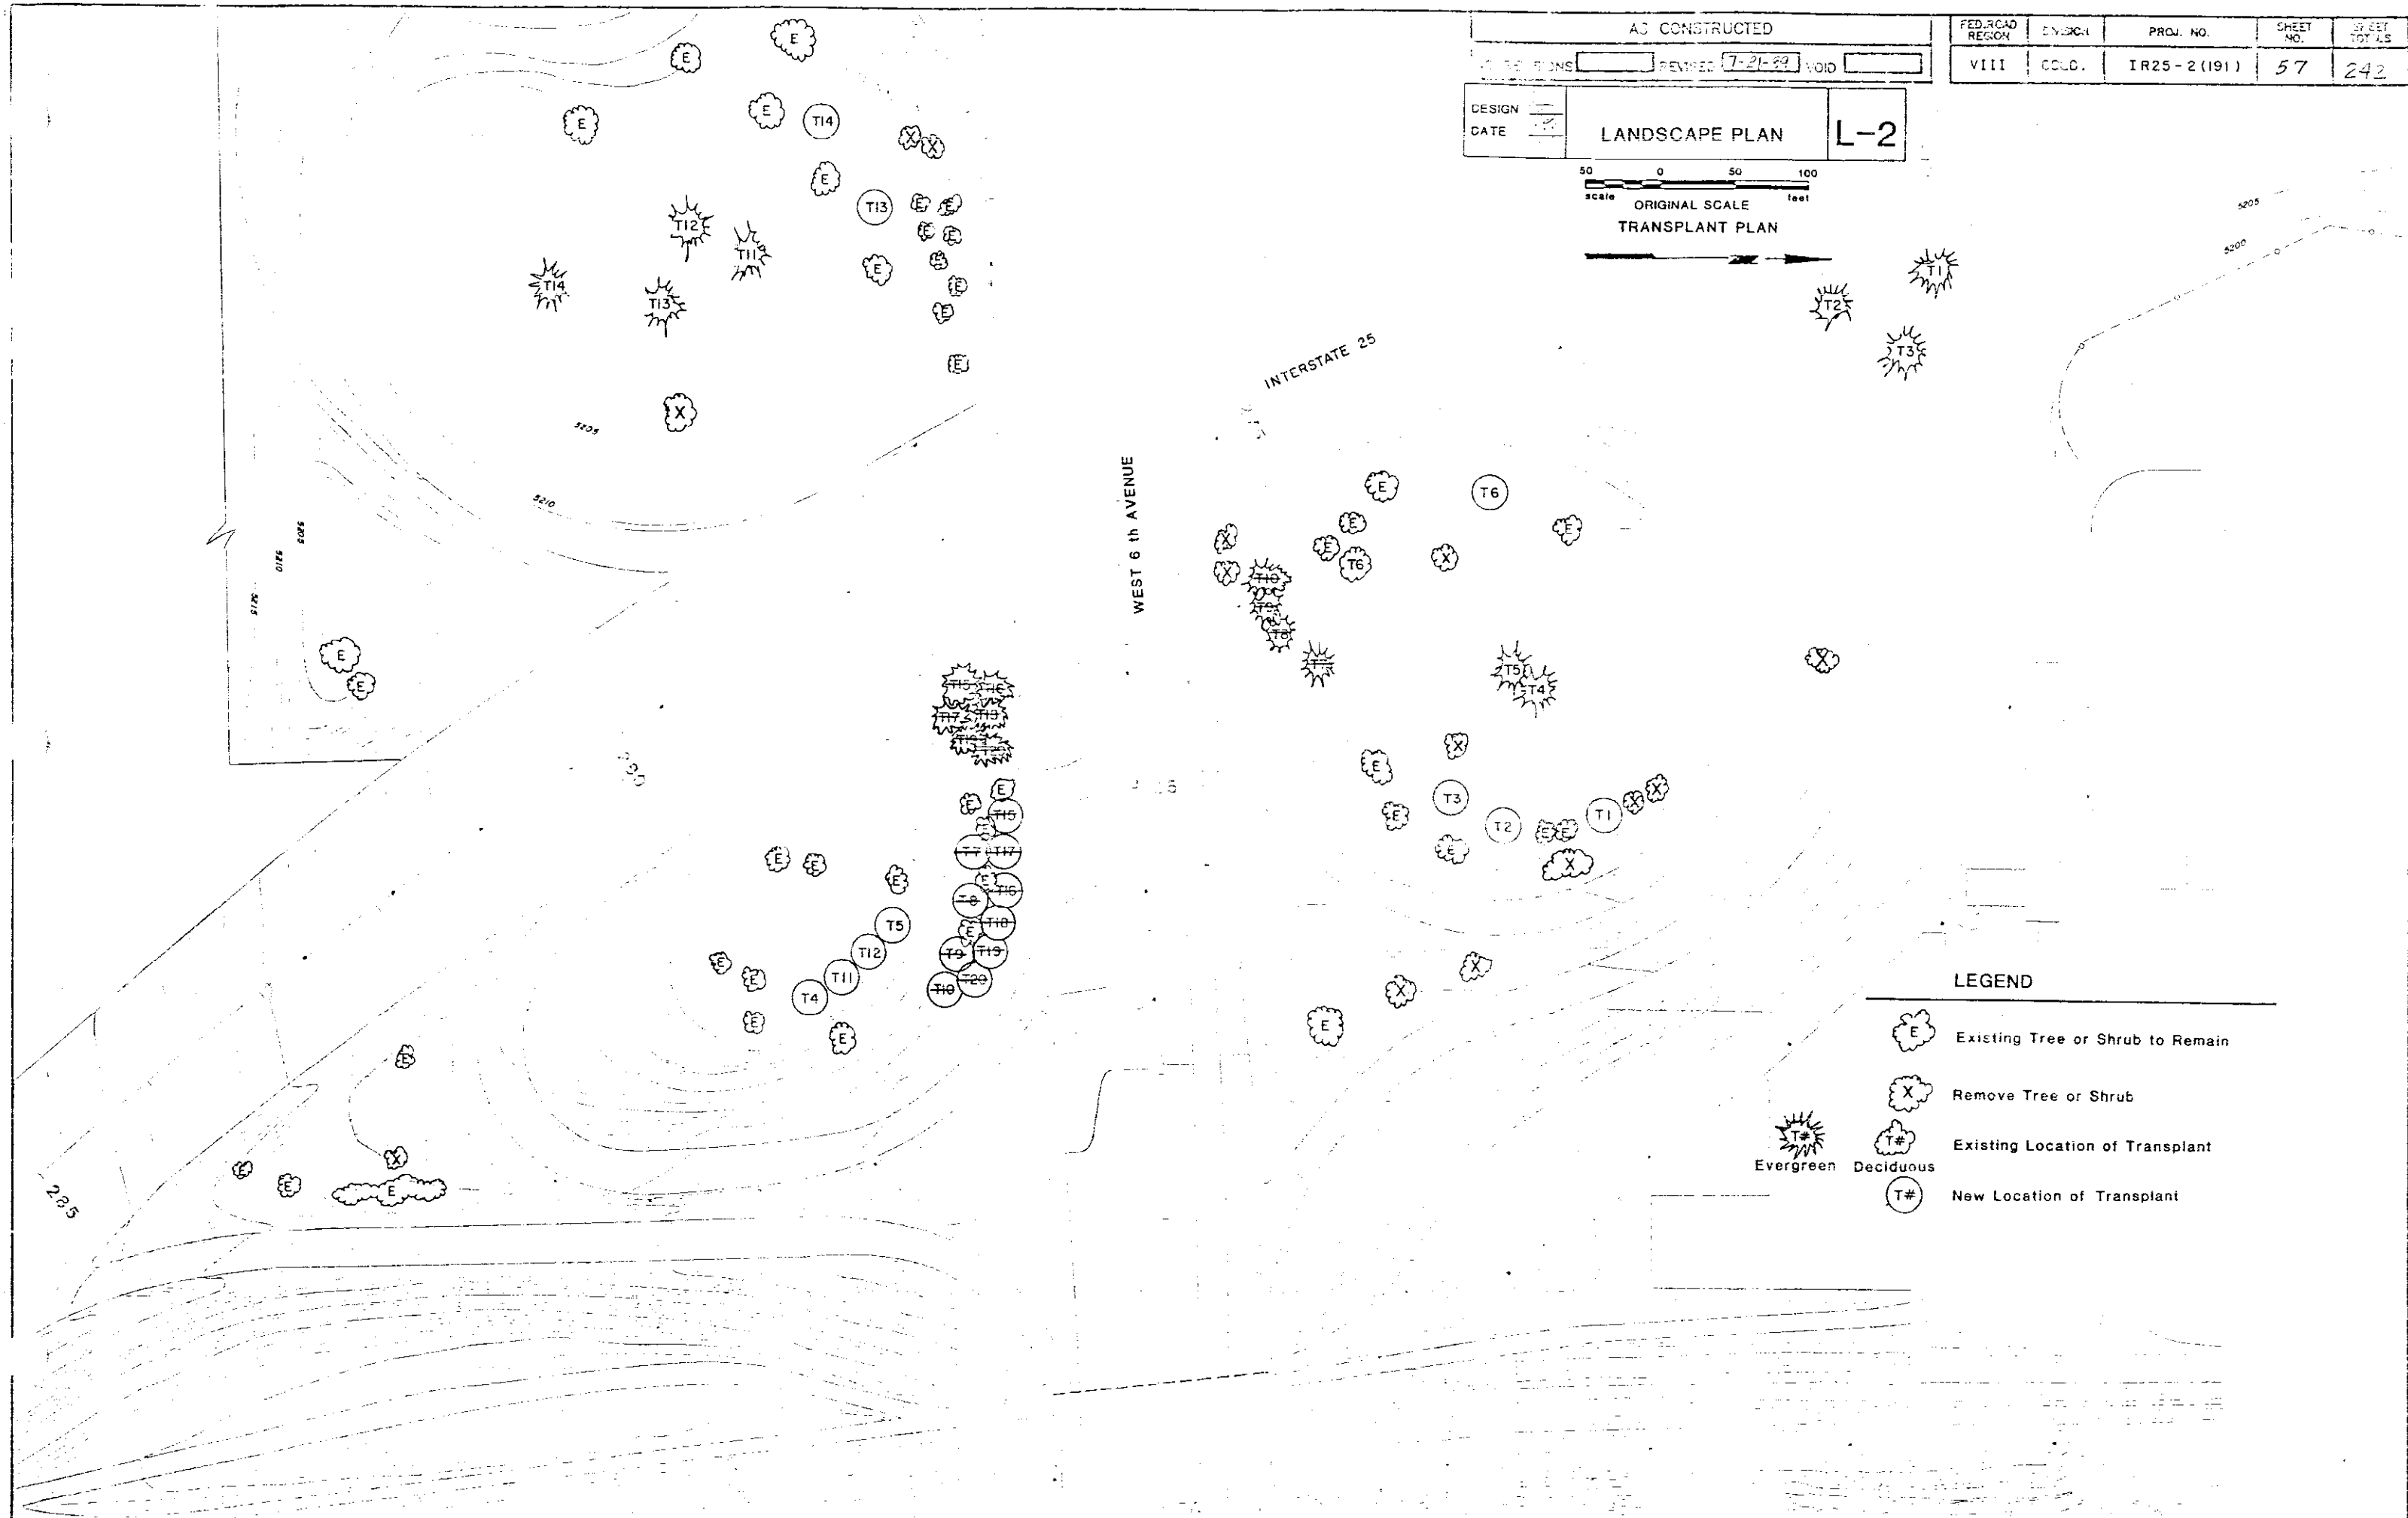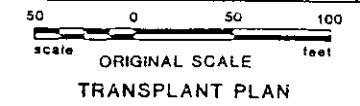



LEGEND

- Existing Tree or Shrub to Remain
  - Remove Tree or Shrub
  - Existing Location of Transplant
  - New Location of Transplant
- Evergreen    Deciduous

AS CONSTRUCTED  
 NO REVISIONS  REVISED  VOID

FED. ROAD REGION	DIVISION	PROJ. NO.	SHEET NO.	SHEET TOTALS
VIII	CCLD.	IR 25-2 (191)	58	24

DESIGN \_\_\_\_\_  
 DATE \_\_\_\_\_  
**LANDSCAPE PLAN**  
**L-3**

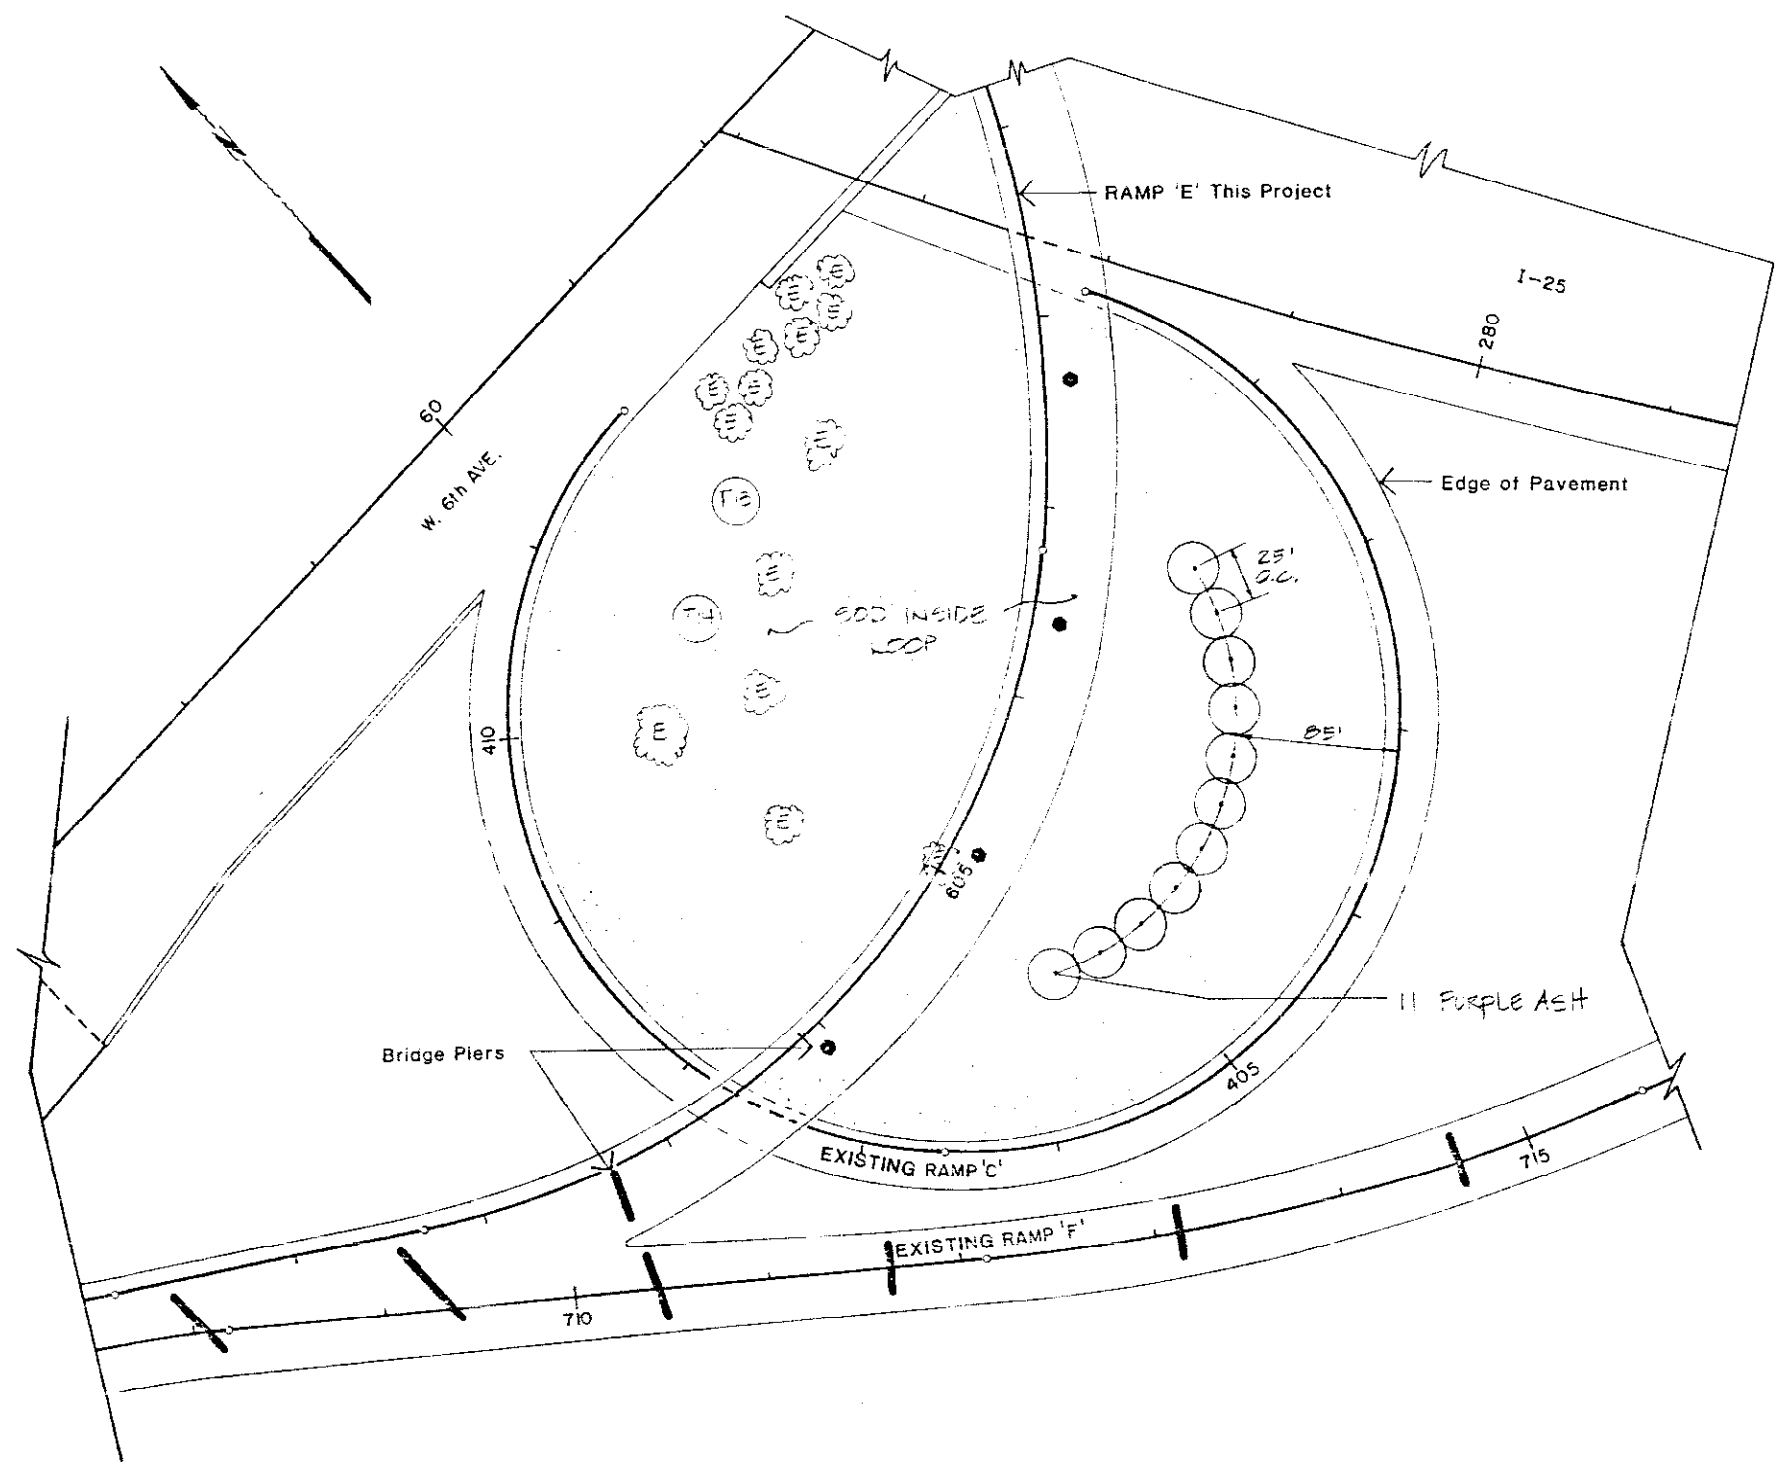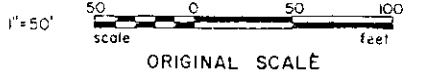




HIGHWAYS  
31  
281


AS CONSTRUCTED  
NO REVISIONS  REVISED  VOID

FED. ROAD REGION	DMSION	PROJ. NO.	SHEET NO.	SHEET TOTALS
VIII	COLO.	IR 25-2 (191)	60	242
DESIGN _____	IRRIGATION PLAN			1-2
DATE _____				

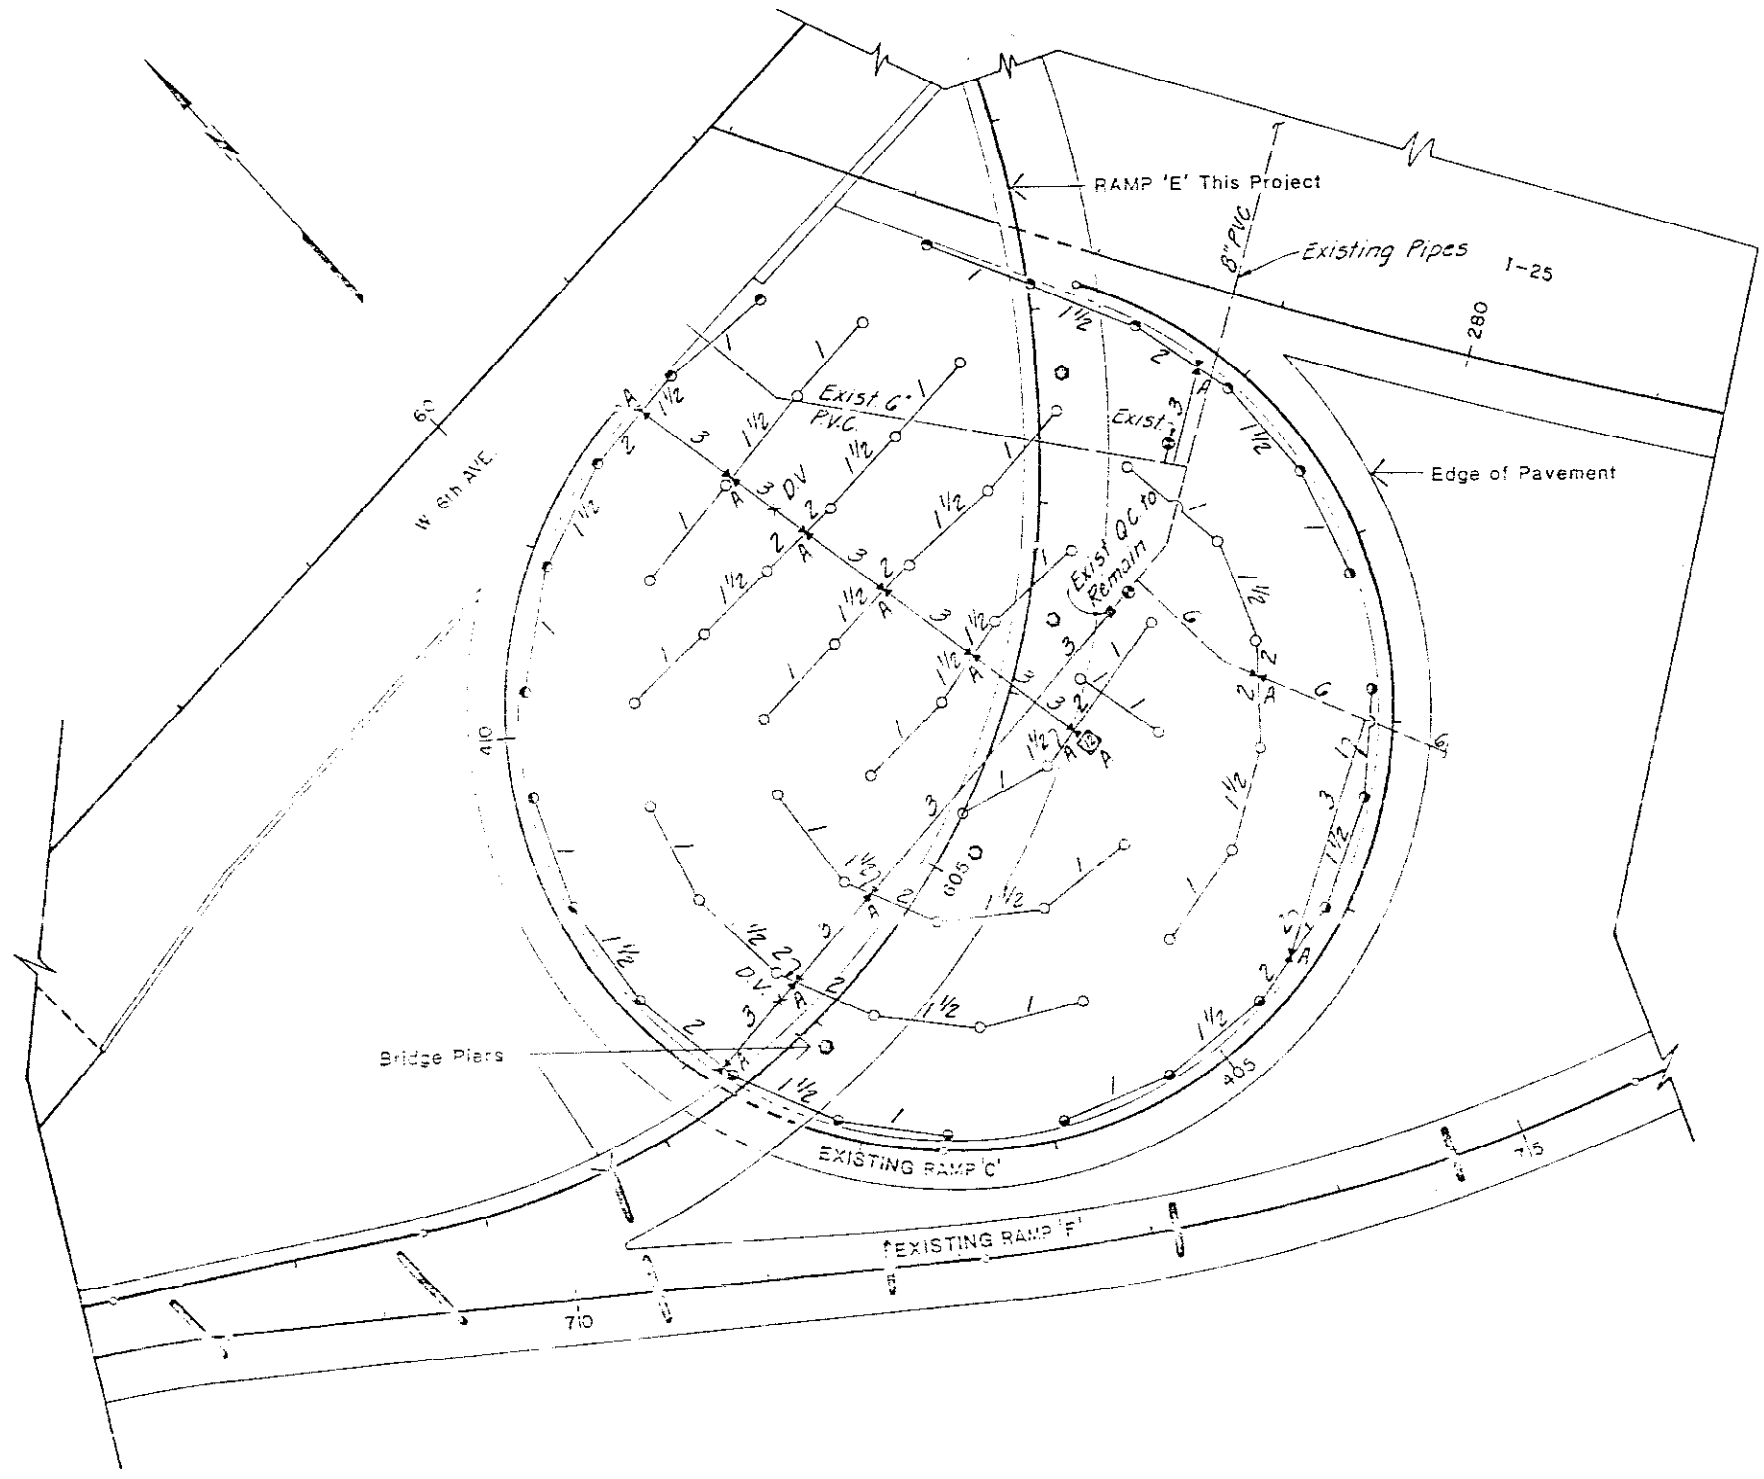


AS CONSTRUCTED		FED. ROAD REGION	DIVISION	PROJ. NO.	SHEET NO.	SHEET TOTALS
NO REVISIONS	RESEED	1111	COLO.	IR 25-2(191)	61	241

DESIGN	D.S.	IRRIGATION DETAILS	I-3
DATE	10/86		

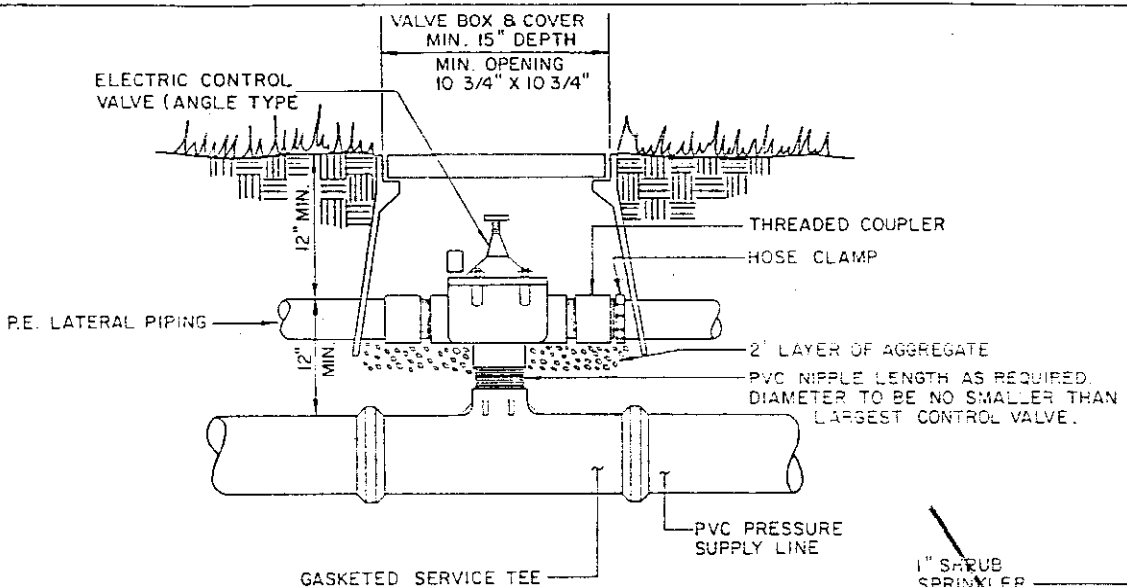


**DETAIL OF VALVE & VALVE BOX**

VALVE BOX, HOSE CLAMPS, AGGREGATE, AND NIPPLES TO BE SUBSIDIARY TO AUTOMATIC CONTROL VALVE ITEM.

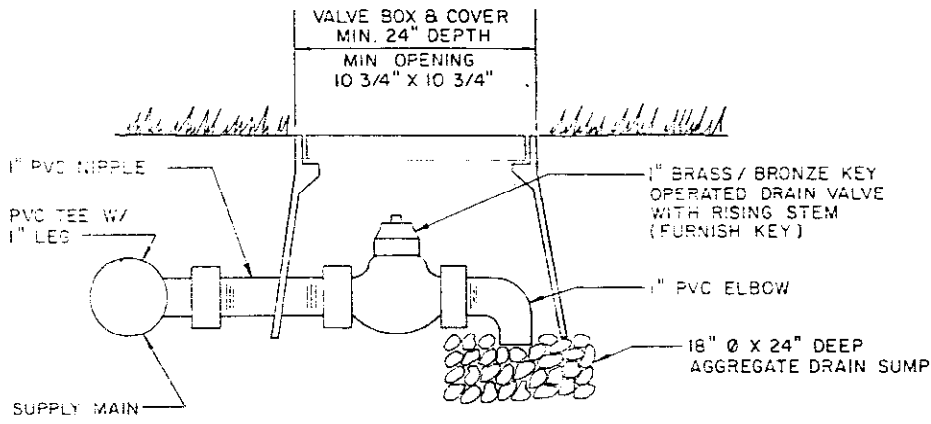


**DRAIN VALVE DETAIL**

VALVE BOX AND FITTINGS ARE SUBSIDIARY TO 1" DRAIN VALVE ITEM.

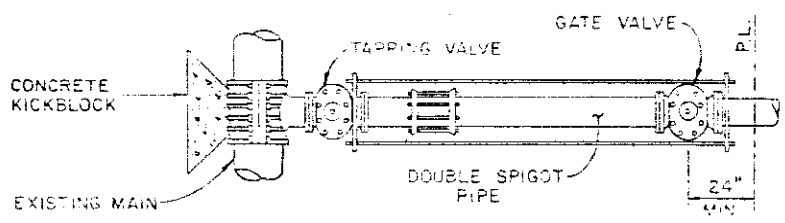


**TAPPING CONNECTION**

ALL MATERIAL AND WORK IS INCLUDED IN FORCE ACCOUNT "RELOCATE WATER TAP" EXCEPT FOR GATE VALVE.

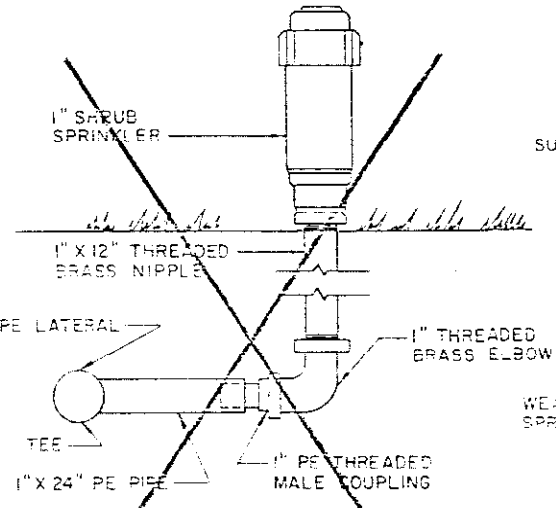



**TYPICAL SHRUB HEAD INSTALLATION**

ALL FITTINGS ARE INCLUDED IN SHRUBBERY SPRAY PAY ITEM.

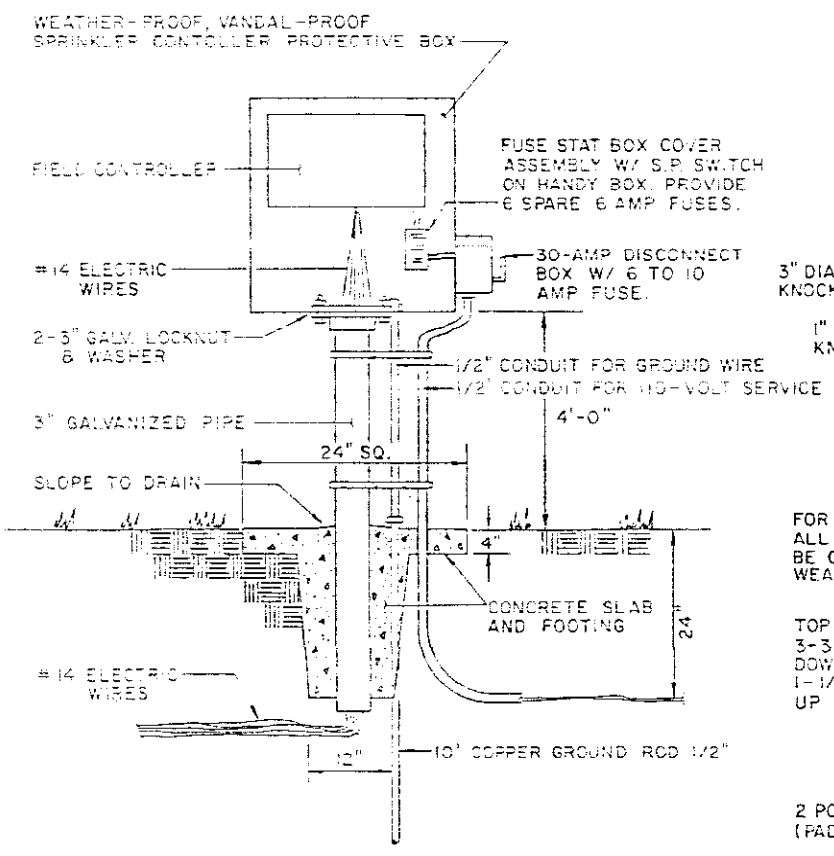


**PIPE MOUNTED CONTROLLER DETAIL**

ALL MATERIAL IS INCLUDED UNDER AUTOMATIC CONTROLLER PAY ITEM.

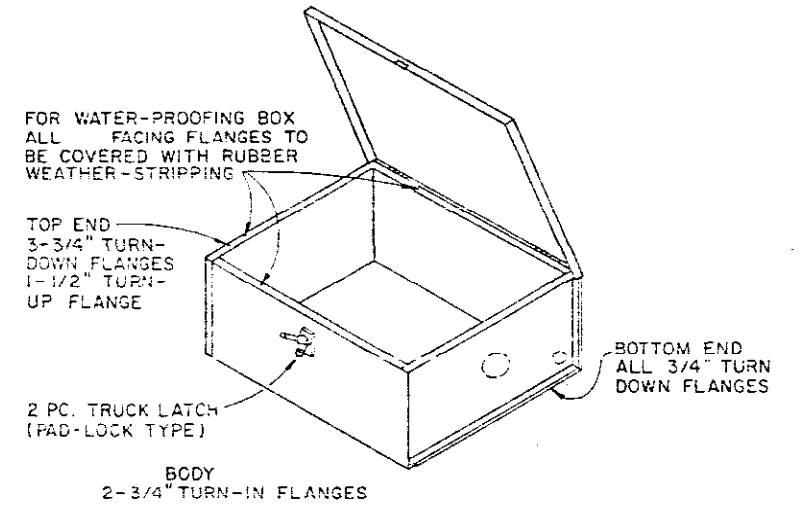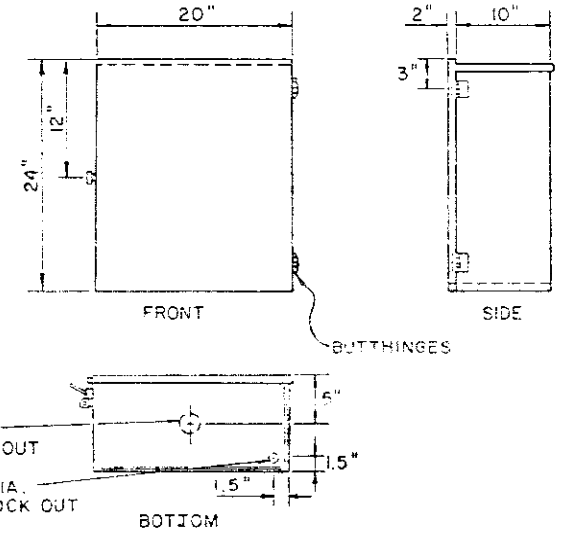


**WEATHER-PROOF, VANDAL-PROOF, SPRINKLER CONTROLLER BOX**

ALL MATERIAL IS INCLUDED UNDER AUTOMATIC CONTROLLER PAY ITEM.

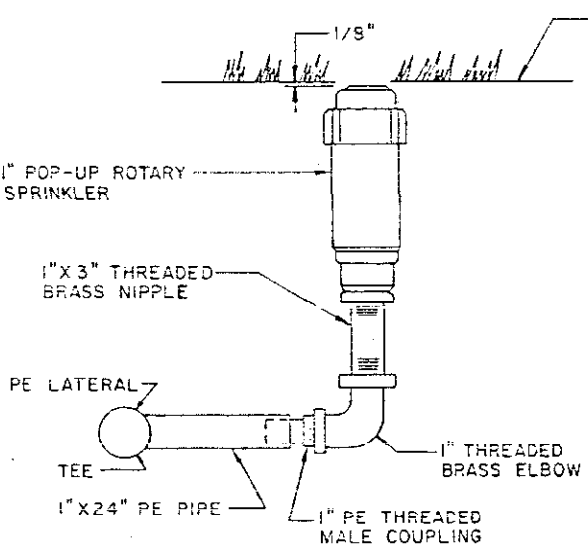

**TYPICAL POP-UP HEAD INSTALLATION**

ALL FITTINGS ARE INCLUDED IN POP-UP HEAD PAY ITEM.

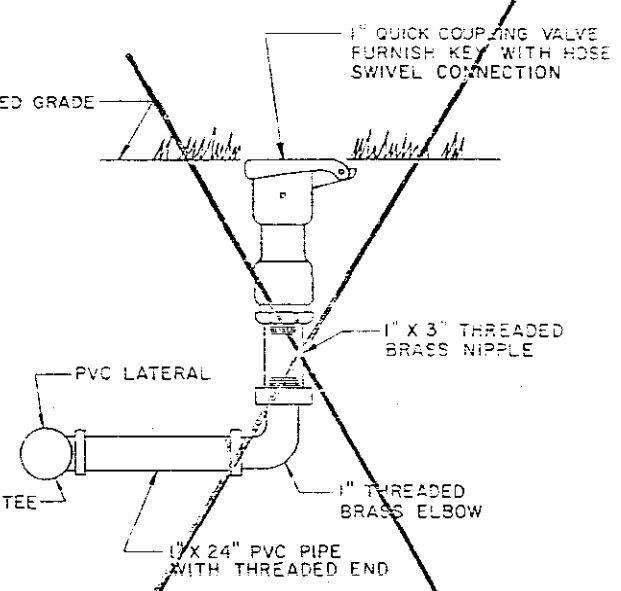




**TYPICAL QUICK COUPLER INSTALLATION**

ALL FITTINGS ARE INCLUDED IN QUICK COUPLER PAY ITEM.

STATION	OFFSET	SIDE	LOCATION	2 INCH ELEC CONDUIT	WALL MT 150 W HPS	PENDANT MT 150 W HPS
603 + 60	15 FT	RT	RAMP E	40 FT.		
610 + 10	13 FT	RT	RAMP E			
610 + 20	11 FT	RT	RAMP E			
615 + 10	13 FT	RT	RAMP E			(FUTURE)
908 + 23	5 FT	LT	RAMP H			(FUTURE)
614 + 15	13 FT	RT	RAMP E			
620 + 97	37 FT	RT	RAMP E			
621 + 02	1 FT	RT	RAMP E			
275 + 30	20 FT	RT	SOUTHBOUND I25	170 FT		
275 + 90	20 FT	RT	SOUTHBOUND I25	50 FT		
276 + 30	20 FT	RT	SOUTHBOUND I25	50 FT		
275 + 70	20 FT	LT	NORTHBOUND I25	279 FT		
276 + 20	20 FT	LT	NORTHBOUND I25	50 FT		
276 + 70	20 FT	LT	NORTHBOUND I25	95 FT		
911 + 25	6 FT	LT	RAMP H			(FUTURE)
TOTAL:				727 734 LIN. FT.	8	4

- LEGEND**
- HIGH MAST LIGHTING STANDARD (EXISTING)
  - WALL MOUNTED LUMINAIRE 150 WATT HPS
  - CONDUIT IN BRIDGE STRUCTURE
  - 2 INCH ELECTRICAL CONDUIT ON BRIDGE STRUCTURE
  - 2 INCH ELECTRICAL CONDUIT IN TRENCH
  - PULL BOX
  - PAD MOUNTED TRANSFORMER (EXISTING)
  - LIGHTING CONTROL CENTER (EXISTING)
  - PENDANT MOUNTED LUMINAIRE 150 WATT HPS
  - POWER SOURCE
  - FUTURE PENDANT MOUNTED LUMINAIRE 150 WATT HPS

- NOTES**
1. PENDANT MOUNTED LUMINAIRES ARE 150 WATT HPS WALL TYPE AND SHALL BE MOUNTED ON THE UNDERSIDE OF RAMP E.
  2. WALL MOUNTED LUMINAIRES ARE 150 WATT HPS WALL TYPE AND SHALL BE MOUNTED ON THE EXTERIOR BRIDGE PIER CAPS OF THE 6TH AVENUE BRIDGE OVER I-25 OR MOUNTED ON THE EXTERIOR BRIDGE PIER CAP OF RAMP E BRIDGE OVER 6TH AVENUE.
  3. ALL LUMINAIRES SHALL BE MOUNTED AS RECOMMENDED BY THE MANUFACTURER AND THE COLORADO DEPT. OF HIGHWAYS.
  4. FUTURE PENDANT MOUNTED LUMINAIRES ARE TO BE INSTALLED WHEN RAMP B IS CONSTRUCTED.
  5. CONNECT TO CONDUIT IN BRIDGE STRUCTURE.
  6. EXISTING PENDANT MOUNTED LUMINAIRES UNDER 6TH AVE SHALL BE REMOVED AND SHALL BE PAID FOR AS REMOVAL OF LUMINAIRE.

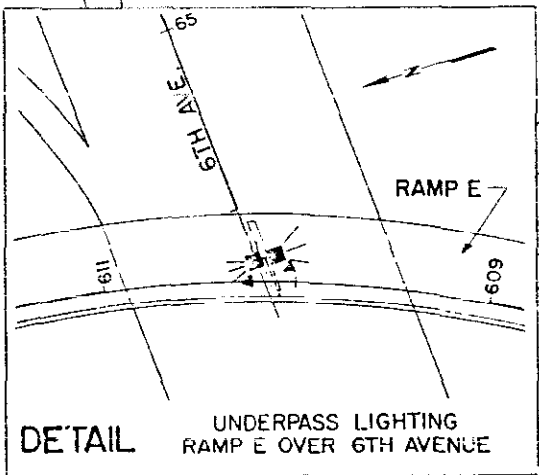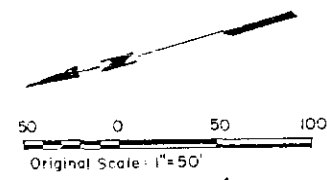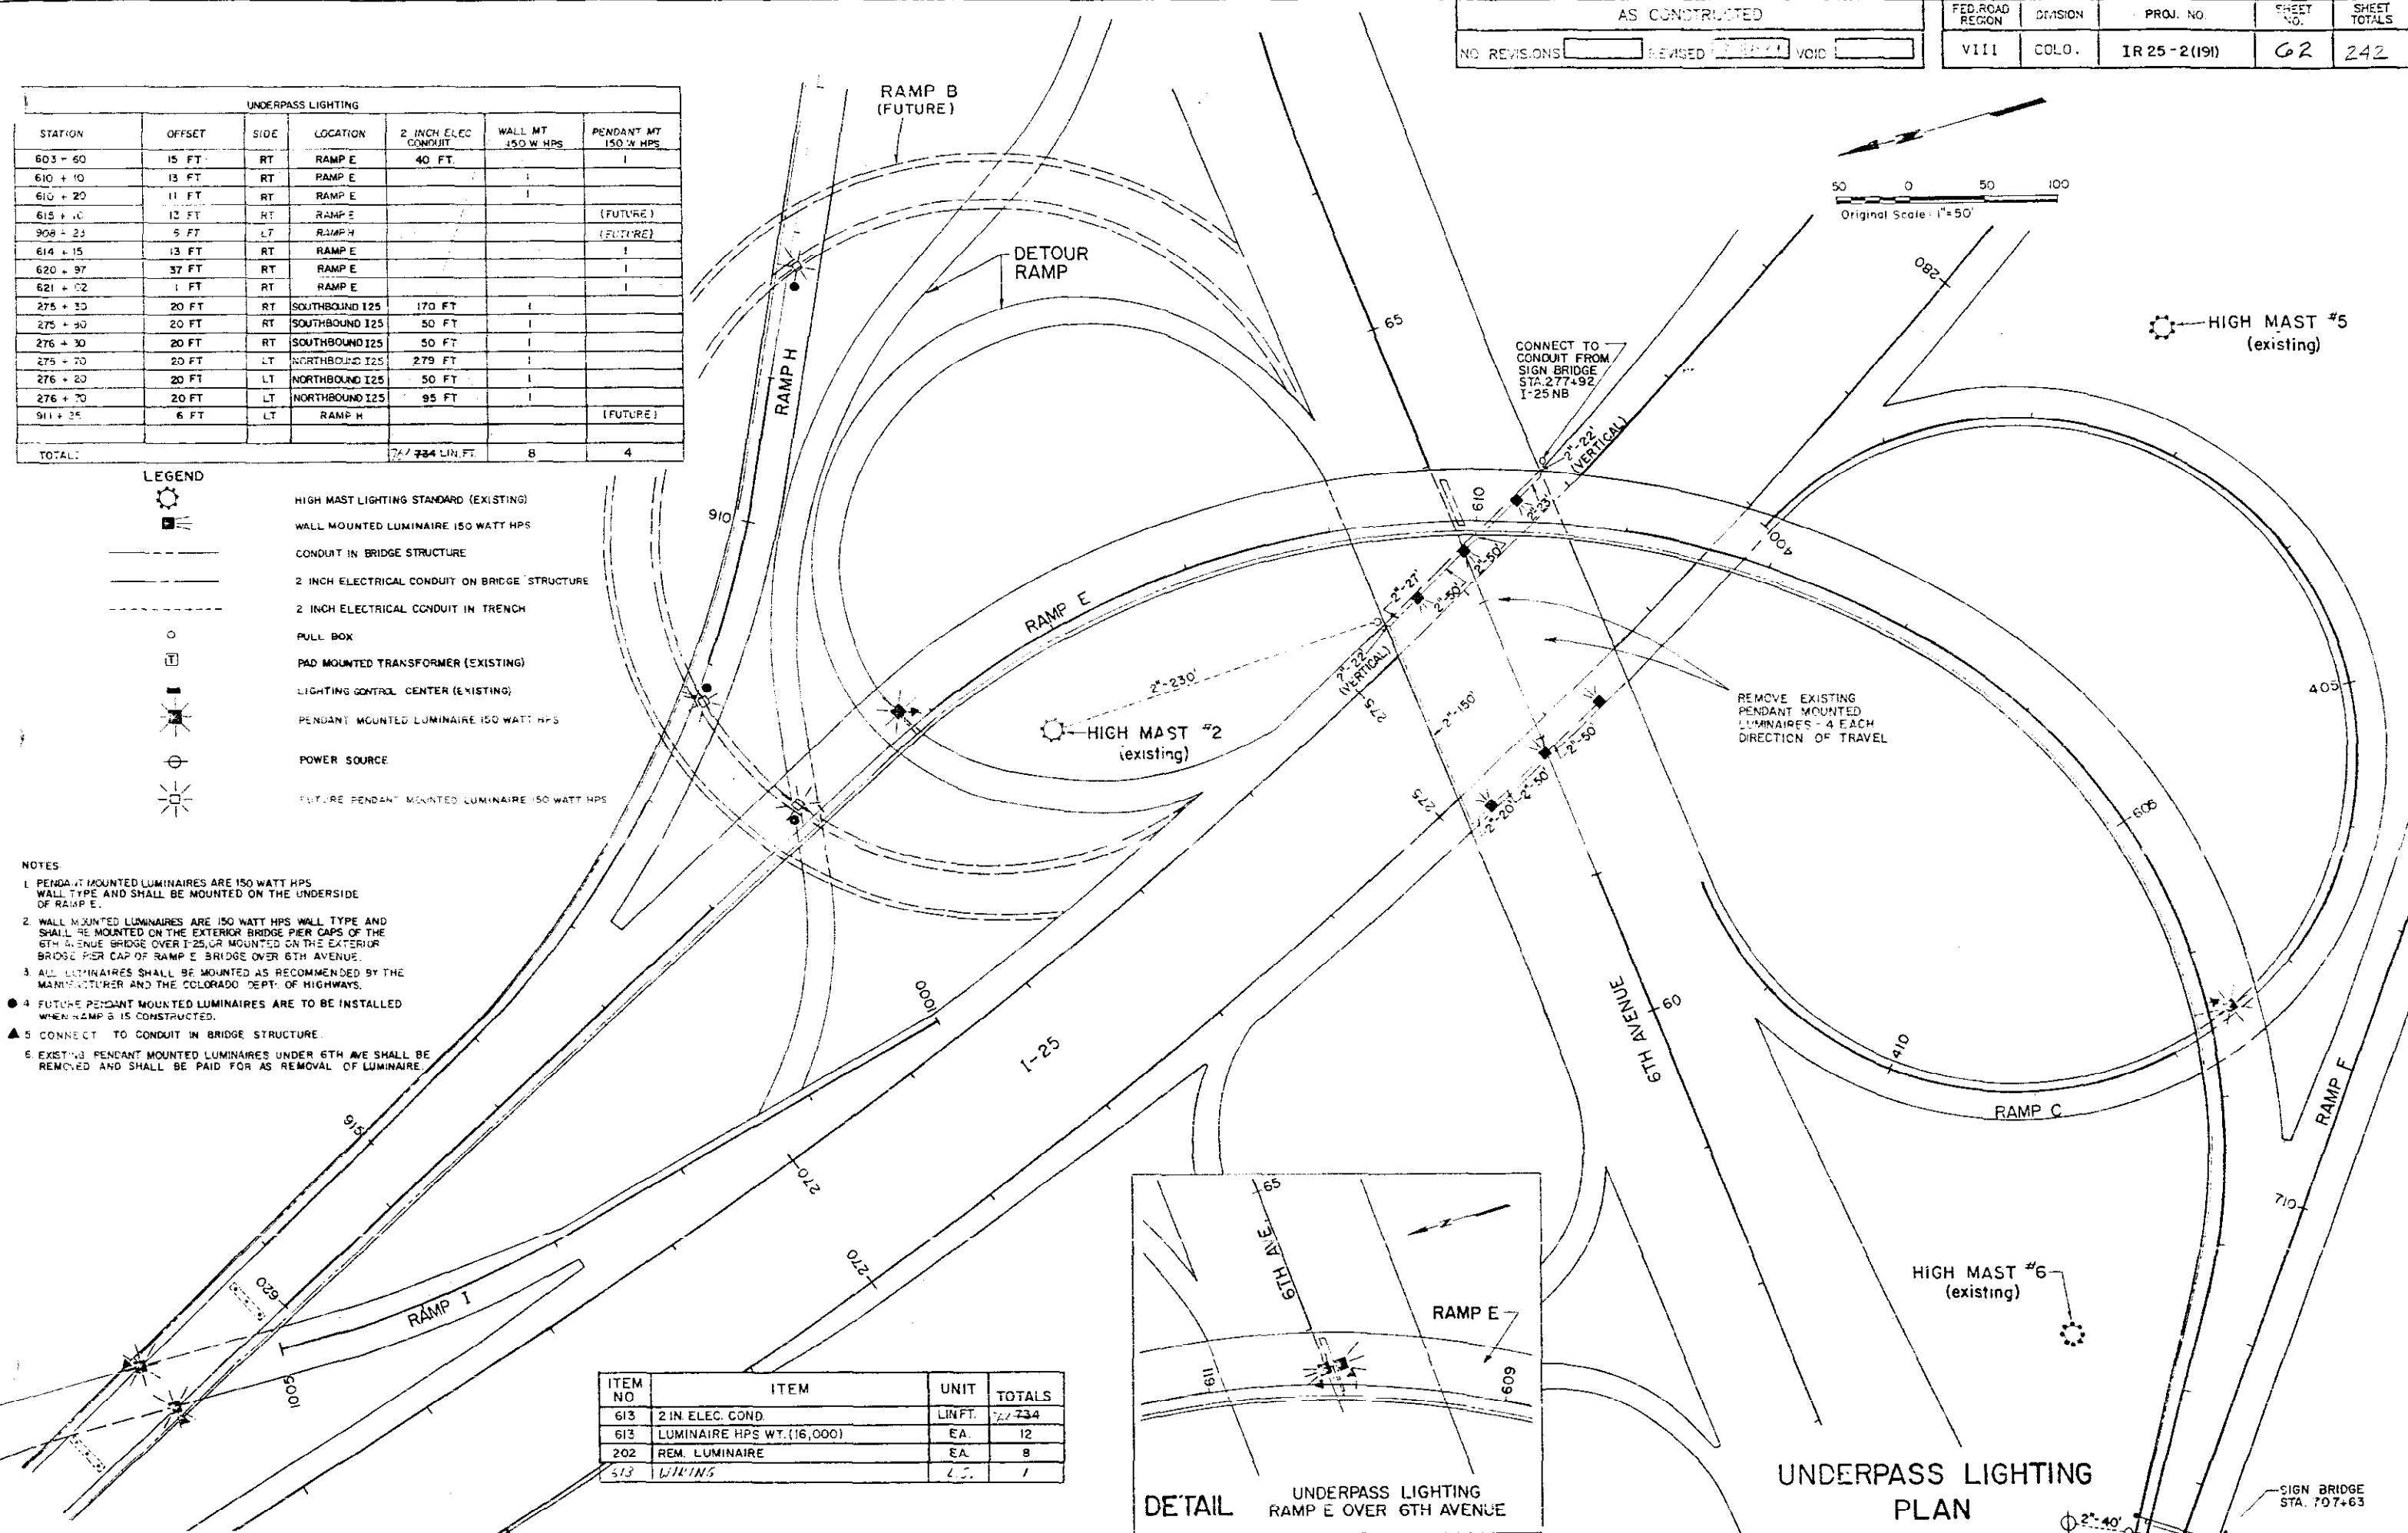

ITEM NO	ITEM	UNIT	TOTALS
613	2 IN. ELEC. COND.	LIN. FT.	727 734
613	LUMINAIRE HPS WT. (16,000)	EA.	12
202	REM. LUMINAIRE	EA.	8
513	WIRING	L.S.	1

UNDERPASS LIGHTING PLAN

SIGN BRIDGE STA. 707+63



*Project 17 to 181 The Home and Alder Hills, T.A.K.*

AS CONSTRUCTED  
 NO REVISIONS  REVISED  VOID

FED. ROAD REGION	DIVISION	PROJ. NO.	SHEET NO.	SHEET TOTALS
VIII	COLO.	IR 25-2 (191)	63	211

TABULATION OF SIGNING QUANTITIES

ITEM NO.	ITEM	UNIT	TOTALS
202	REM DELINEATOR	EA	36
202	REM PAVEMENT MARKING	SQ FT	14,379
202	REM OVERHEAD SIGN STR	EA	4
202	REM GROUND SIGN	EA	30
202	REM SIGN PANEL	EA	4
202	REM TRAF SIG HEAD	EA	12
202	REM TRAF SIG POLE	EA	4
202	REM TRAF SIG CONTROL & CAB	EA	1
210	RES DELINEATOR	EA	19
210	RES GROUND SIGN	EA	3
210	RES SIGN PANEL	EA	1
612	DELINEATOR (TY I)	EA	54
612	DELINEATOR (TY II)	EA	10
612	REFLECTOR (MEDIAN BARRIER)	EA	76
613	2 IN ELEC COND	LIN FT	695
613	2 IN ELEC COND (JACKED)	LIN FT	405
613	DIRECT-BURIAL CABLE	LIN FT	490
614	SIGN PANEL (CL I)	SQ FT	238
614	SIGN PANEL (CL II)	SQ FT	277
614	SIGN PANEL (CL III)	SQ FT	3,045
614	TIMBER SIGN POST (4 X 4)	LIN FT	82
614	TIMBER SIGN POST (6 X 6)	LIN FT	284
614	STEEL SIGN POST (S 3 X 5 7)	LIN FT	40
614	CONC FOOTING III-S (DRILLED)	EA	2
614	CONC FOOTING V (SPREAD)	EA	1
614	CONC FOOTING II-S (SPREAD)	EA	3
614	CONC FOOTING III-S (SPREAD)	EA	6
614	MASK SIGN LEGEND	EA	2
614	MODIFICATION SIGN LEGEND	L S	1
614	OVERPASS MTD SIGN BRACKET	EA	2
614	SIGN BR STR (60X65)	EA	2
614	SIGN BR STR (70X75)	EA	1
614	SIGN BR STR (95X100)	EA	1
614	SIGN BR STR (100X105)	EA	1
614	SIGN BR STR (105X110)	EA	1
614	BAL BTRFLY STR	EA	1
614	CANT STR (25X30)	EA	1
614	PED SIG (16)	EA	4
614	TRAF SIG (8-8-8)	EA	8
614	TRAF SIG (12-8-8)	EA	7
614	TRAF SIG CONTROL CABINET (3)	EA	1
614	COORDINATION UNIT	EA	1
614	LOOP DETECTOR WIRE	LIN FT	1103
614	DETECTOR AMP (LOOP)	EA	5
614	*SLARE SCREEN (TEMPORARY)	LIN FT	2955
614	CONCRETE BARRIER (TEMP)	LIN FT	1672

SCHEDULE OF CONSTRUCTION TRAFFIC DEVICES

SIGN CODE	LEGEND	DIMENSIONS	PANEL SIZE			ITEM	QUANTITY
			A	B	C		
SIGN TOTALS							

(F-1)

(F-1)

\* 8 Green Color Paddles per 15' Section, 24" High,  
 1 Full Height P-Flector Strip per 16' Section



TABULATION OF DELINEATORS

AS CONSTRUCTED		FED. ROAD REGION	DIVISION	PROJ. NO.	SHEET NO.	SHEET TOTALS
NO REVISIONS	REVISED 7/77	VIII	COLO.	IR 25-2(19)	65	111

STATIONS	SIDE	SPACING (FT.)	TYPE I		TYPE II		TYPE III		REFLECTOR (MEDIAN BARRIER)	REMOVALS	REMARKS
			EACH	RESET	EACH		EACH				
<i>Osage On Ramp</i>											
0+00 to 2+86	Rt.	26	12c								
0+00 to 3+15	Lt.	26	12y							1	Field Locate Type I Crystal in gore
3+15 to 3+89	Rt.	100			1c						
<i>6th. Ave. WB.</i>											
76+54 to 72+75	Rt.	100			4c						
71+50	Rt.	—	1c								Field Locate Type I Crystal in gore
76+54 to 70+00	Rt.	—								4	
6th. Ave WB. to I-25 NB	Rt.	—			1c						Reset For Detour Ramp "B"
<i>Ramp H</i>											
90+40 to 913+00	Rt. Lt.	100									
<i>Ramp E</i>											
601+52 to 616+00	Rt. Lt.	56							26c 26y		
<i>Ramp I</i>											
272+10 to 268+40	Rt.	—	1c		1c						Field Locate Type I Crystal in gore
1000+25 to 1003+25	Rt.	100			4c						
1004+25 to 1008+75	Rt. Lt.	100	6c								
1007+25 to 1008+95	Rt. Lt.	50	8R								
<i>I-25 Northbound</i>											
255+00 to 253+35	Rt.	100	2c							5	
279+00 to 283+00	Rt.	100	5c								
I-25 NB. to 6th. Ave. WB.	Lt.				3						Reset For Detour Ramp "A"
Wyandot On-Ramp	Lt.	26	6y							4	
<i>E5 6th. Ave to NB I-25</i>											
	Lt.	—								20	
<b>TOTALS</b>											
			23c 18y 54 8R	19	10c					36c 14c 38y	34 36

NOTE:  
 R = Red  
 C = Crystal  
 Y = Yellow







AS CONSTRUCTED

NO REVISIONS  REVISED  VOID

FEDERAL ROAD REGION NO.	DISTRICT	PROJ. NO.	SHEET NO.	TOTAL SHEETS
VIII	COLORADO	IR 25-2(191)	69	25

TABULATION OF OVERHEAD SIGNS

NOTES FOR OVERHEAD SIGNS

SIGN NO.	STATION	SIGN PANEL SIZE	BACK-GROUND COLOR	NO OF POSTS	TYPE OF POST	STRUCTURE TYPE	FRAME SIZE	STRUCTURE NUMBER	SIGN PANEL CLASS I	SIGN PANEL CLASS II	SIGN PANEL CLASS III	TYPE OF FOOTING	COMMENTS
									(SQ. FT.)	(SQ. FT.)	(SQ. FT.)		
1a		12'x11'	Green								132.00		
1b		7'x3'-6"	Yellow					24.50					
1c	41+00 6th Ave EB	12'x11'	Green	2	III-S	Sign Bridge	93' Span	F-16-PP			132.00	I-III-S(DRILLED) I-III-S(SPREAD)	
1d		11'-8"x3'-6"	Yellow					40.83					Mask Arrow ▲
1e		12'x11'	Green								132.00		
3a		12'x11'	Green								132.00		
3b	50+10 6th Ave EB	7'x3'-6"	Yellow			Existing Sign Bridge	109' Span	F-16-NP	24.50				Existing Sign Support
3c		12'x11'	Green								132.00		
3d		11'-8"x3'-6"	Yellow					40.83					Mask Arrow ▲
7	600+00 Ramp E 107+03 Ramp F	33'x13'	Green	2	III-S	Sign Bridge	60' Span	F-16-PQ			429.00		Existing Footings
10	343+80 I-25 NB	16'x11'	Green			Overpass Bracket					176.00		
11	324+75 I-25 NB	20'x7'	Green	1	II-S	Butterfly	20'-0"	F-16-PW			140.00	II-S(Spread)	
13a	311+75 I-25 NB	11'x11'	Green	2	III-S	Sign Bridge	102' Span	F-16-PV			121.00	III-S(Spread)	
13b		16'x11'	Green								176.00		
14a		14'x12'	Green										Remove Sign Panel
14b		12'x12'	Green										Remove Sign Panel
14c	293+00 I-25 NB	12'x12'	Green			Existing Sign Bridge	75' Span	F-16-IV					Reset Sign Panel
14d		11'x12'	Green								132.00		
14e		11'x2'	Green								132.00		
15	284+00 I-25 NB	20'x7'	Green			Existing Butterfly		F-16-MS					Unmask Legend *
20a		12'x12'	Green								144.00		
20b	277+92 I-25 NB	12'x12'	Green	2	III-S	Sign Bridge	106' Span	F-16-PR			144.00	I-III-S(DRILLED) I-III-S(SPREAD)	
20c		11'-8"x2'-6"	Yellow					29.17					
23	270+80 I-25 NB	13'x8'	Green	1	V	Cantilever	28'-0"	F-16-PU			104.00	V(Spread)	
30a	255+20 I-25 NB	20'x12'	Green			Existing Sign Bridge	88' Span	F-16-IT					No Work This Panel
30b		16'x12'	Green										Remove Sign Panel
36a	80+70 6th Ave WB	11'x10'	Green	2	II-S	Sign Bridge	60' Span	F-16-PT			110.00	II-S(Spread)	
36b		9'x10'	Green								90.00		
44a	73+90 6th Ave WB	16'x12'	Green	2	III-S	Sign Bridge	72' Span	F-16-PF			192.00	III-S(Spread)	
44b		15'x12'	Green								180.00		
TOTAL PANEL FOR OVERHEAD SIGNS									159.83		2930.00		

- PANELS FOR OVERHEAD SIGNS SHALL BE SHEET ALUMINUM. SEE "CLASS III SIGNS, SHEETS 1 AND 2" INCLUDED IN THE PLANS FOR PANEL AND BACKING ZEE REQUIREMENTS. SEE DEPARTMENT STANDARD "CLASS III GROUND SIGN INSTALLATIONS" FOR CLASS III PANELS. PANELS SHALL HAVE 3 ALUMINUM BAKING DESS SPACES AT 2" GA. SEE DEPARTMENT STANDARD "CLASS I GROUND SIGN INSTALLATIONS" FOR CLASS I PANEL REQUIREMENTS. MINIMUM THICKNESS IS REDUCED TO 0.080".
- CLASS III AND CLASS I PANELS SHALL HAVE A SMOOTH SURFACE TYPE REFLECTIVE SHEETING BACKGROUND. CLASS III PANELS SHALL HAVE HIGH BRIGHTNESS ENCAPSULATED TYPE REFLECTIVE SHEETING.
- LEGEND AND BORDER FOR GREEN BACKGROUND SIGNS SHALL BE SYSTEM 1 OR SYSTEM 2 AND FOR YELLOW BACKGROUND SIGNS SHALL BE SYSTEM 4. SEE SECTION 713 OF THE STANDARD SPECIFICATIONS.
- \* 4 TO BE PAID FOR AS MODIFY LEGEND
- ▲ 5. TO BE PAID FOR AS MASK LEGEND
- 6. LEFT POST TO BE REDUCED BY 2'-1" (THE EXISTING PEDESTAL HEIGHT ABOVE ROADWAY)

TABULATION OF PAVEMENT MARKINGS

AS CONSTRUCTED		FED. ROAD REGION	DIVISION	PROJ. NO.	SHEET NO.	SHEET TOTALS
NO REVISIONS <input type="checkbox"/>	REVISED <input checked="" type="checkbox"/>	VIII	COLO.	IR 25-2(19)	70	

STATION	LOCATION	PAVEMENT MARKING LINES (Linear Feet)											
		EDGE		LANE	CENTER		CHANNELIZING		LEGENDS		CROSS-WALK	STOP	
		WHITE SOLID 4 INCH	YELLOW SOLID 4 INCH	WHITE BROKEN 5 INCH	YELLOW SOLID 5 INCH	YELLOW BROKEN 5 INCH	WHITE SOLID 10 INCH	YELLOW SOLID 10 INCH	"ONLY" 6' X 8'	ARROW 8'	WHITE SOLID 12 INCH	WHITE SOLID 24 INCH	
47+10 TO 50+70	6th Ave EB										360		
702+35 TO 705+00	Ramp F										265		
703+00 TO 707+60	Ramp F			120									
705+00 TO 707+60	Ramp F		260										
703+50 TO 721+30	Ramp F	1,780											
705+00 TO 719+20	Ramp F			360									
709+20 TO 710+50	Ramp F									130			
710+50 TO 721+30	Ramp F		1,080										
45+50 TO 46+80	6th Ave EB			40									
600+00 TO 625+10	Ramp E		2,510										
600+00 TO 616+20	Ramp E			410									
601+60 TO 602+90	Ramp E									130			
602+90 TO 616+25	Ramp E	1,335											
616+25 TO 618+40	Ramp E									215			
620+00 TO 625+10	Ramp E	510											
50+30 TO 52+95	6th Ave EB									265			
288+30 TO 284+90	I-25 NB	340											
288+30 TO 284+90	I-25 NB			170									
285+30 TO 284+70	I-25 NB									120			
277+90 TO 273+50	I-25 NB									440			
280+60 TO 278+60	I-25 NB	200											
274+50 TO 273+50	I-25 NB									100			
273+50 TO 271+30	I-25 NB	220											
1007+70 TO 1009+30	Ramp I									200			
1000+00 TO 1009+00	Ramp I	900											
1003+90 TO 1007+70	Ramp I			100									
1007+70 TO 1008+80	Ramp I									110			
1000+50 TO 1002+70	Ramp I									220			
1002+70 TO 1008+90	Ramp I		620										
270+80 TO 268+60	I-25 NB									220			
268+60 TO 257+80	I-25 NB	1,080											
261+50 TO 257+80	I-25 NB(Ramp E)									370			
260+70 TO 254+80	I-25 NB(Ramp E)			150									
261+50 TO 252+40	I-25 NB	910											
257+40 TO 252+40	I-25 NB			130									
254+70 TO 252+40	Mulberry Pl. to I-25 NB									230			

STATION	LOCATION	PAVEMENT MARKING LINES (Linear Feet)											
		EDGE		LANE	CENTER		CHANNELIZING		LEGENDS		CROSS-WALK	STOP	
		WHITE SOLID 4 INCH	YELLOW SOLID 4 INCH	WHITE BROKEN 5 INCH	YELLOW SOLID 5 INCH	YELLOW BROKEN 5 INCH	WHITE SOLID 10 INCH	YELLOW SOLID 10 INCH	"ONLY" 6' X 8'	ARROW 8'	WHITE SOLID 12 INCH	WHITE SOLID 24 INCH	
80+70 TO 70+50	6th Ave WB		1,020										
80+70 TO 70+50	6th Ave WB			770									
79+30 TO 78+90	6th Ave WB									80			
78+90 TO 77+00	6th Ave WB	190											
69+00 TO 65+00	6th Ave WB	400											
72+10 TO 71+20	6th Ave WB									90			
71+20 TO 70+50	6th Ave WB	70											
69+00 TO 68+00	6th Ave WB			30									
1+20 TO 3+00	Osage On-Ramp		180										
3+00 TO 3+35	Osage On-Ramp									35			
0+00 TO 3+90	Osage On-Ramp	390											
76+55 TO 73+75	6th Ave WB	280											
900+40 TO 916+00	Ramp H	1,560											
901+90 TO 902+80	Ramp H									90			
902+80 TO 912+35	Ramp H		955										
912+35 TO 914+50	Ramp H									215			
1807+45 TO 1808+85	8th Ave								560				
1807+45 TO 1809+00	8th Ave			40									
1806+50 TO 1807+60	8th Ave									470			
1806+25 TO 1806+40	8th Ave										35		
1801+90 TO 1806+40	8th Ave			120									
1801+90 TO 1806+25	8th Ave								870				
1801+95 TO 1802+45	8th Ave			20									
1802+75 TO 1807+15	8th Ave									440			
1806+70 TO 1808+30	Wyandot St.			30	240					50			

NOTE:  
FOR DETAILS OF PAVEMENT MARKING LINES AND LINE PLACEMENT, SEE STANDARD S-627-1



LEGEND:  
 ○ TRAFFIC PAINT  
 ◼ THERMOPLASTIC  
 ▲ PLASTIC PAVEMENT MARKING (60 MILS.)

TOTAL SUMMARY OF ALL PAVEMENT MARKING QUANTITIES				
COLOR	PAINT (GAL.)	THERMOPLASTIC (SQ. FT.)	PLASTIC PYMT. MKG. (60 MILS.) (SQ. FT.)	PLASTIC PYMT. MKG. (90 MILS.) (SQ. FT.)
YELLOW				
WHITE				
TOTAL				






AS CONSTRUCTED			FED. ROAD REGION	DIVISION	PROJ. NO.	SHEET NO.	SHEET TOTALS
NO REVISIONS	REVISED	7-21-89	VIII	COLCO.	IR25-2 (IS1)	72	242

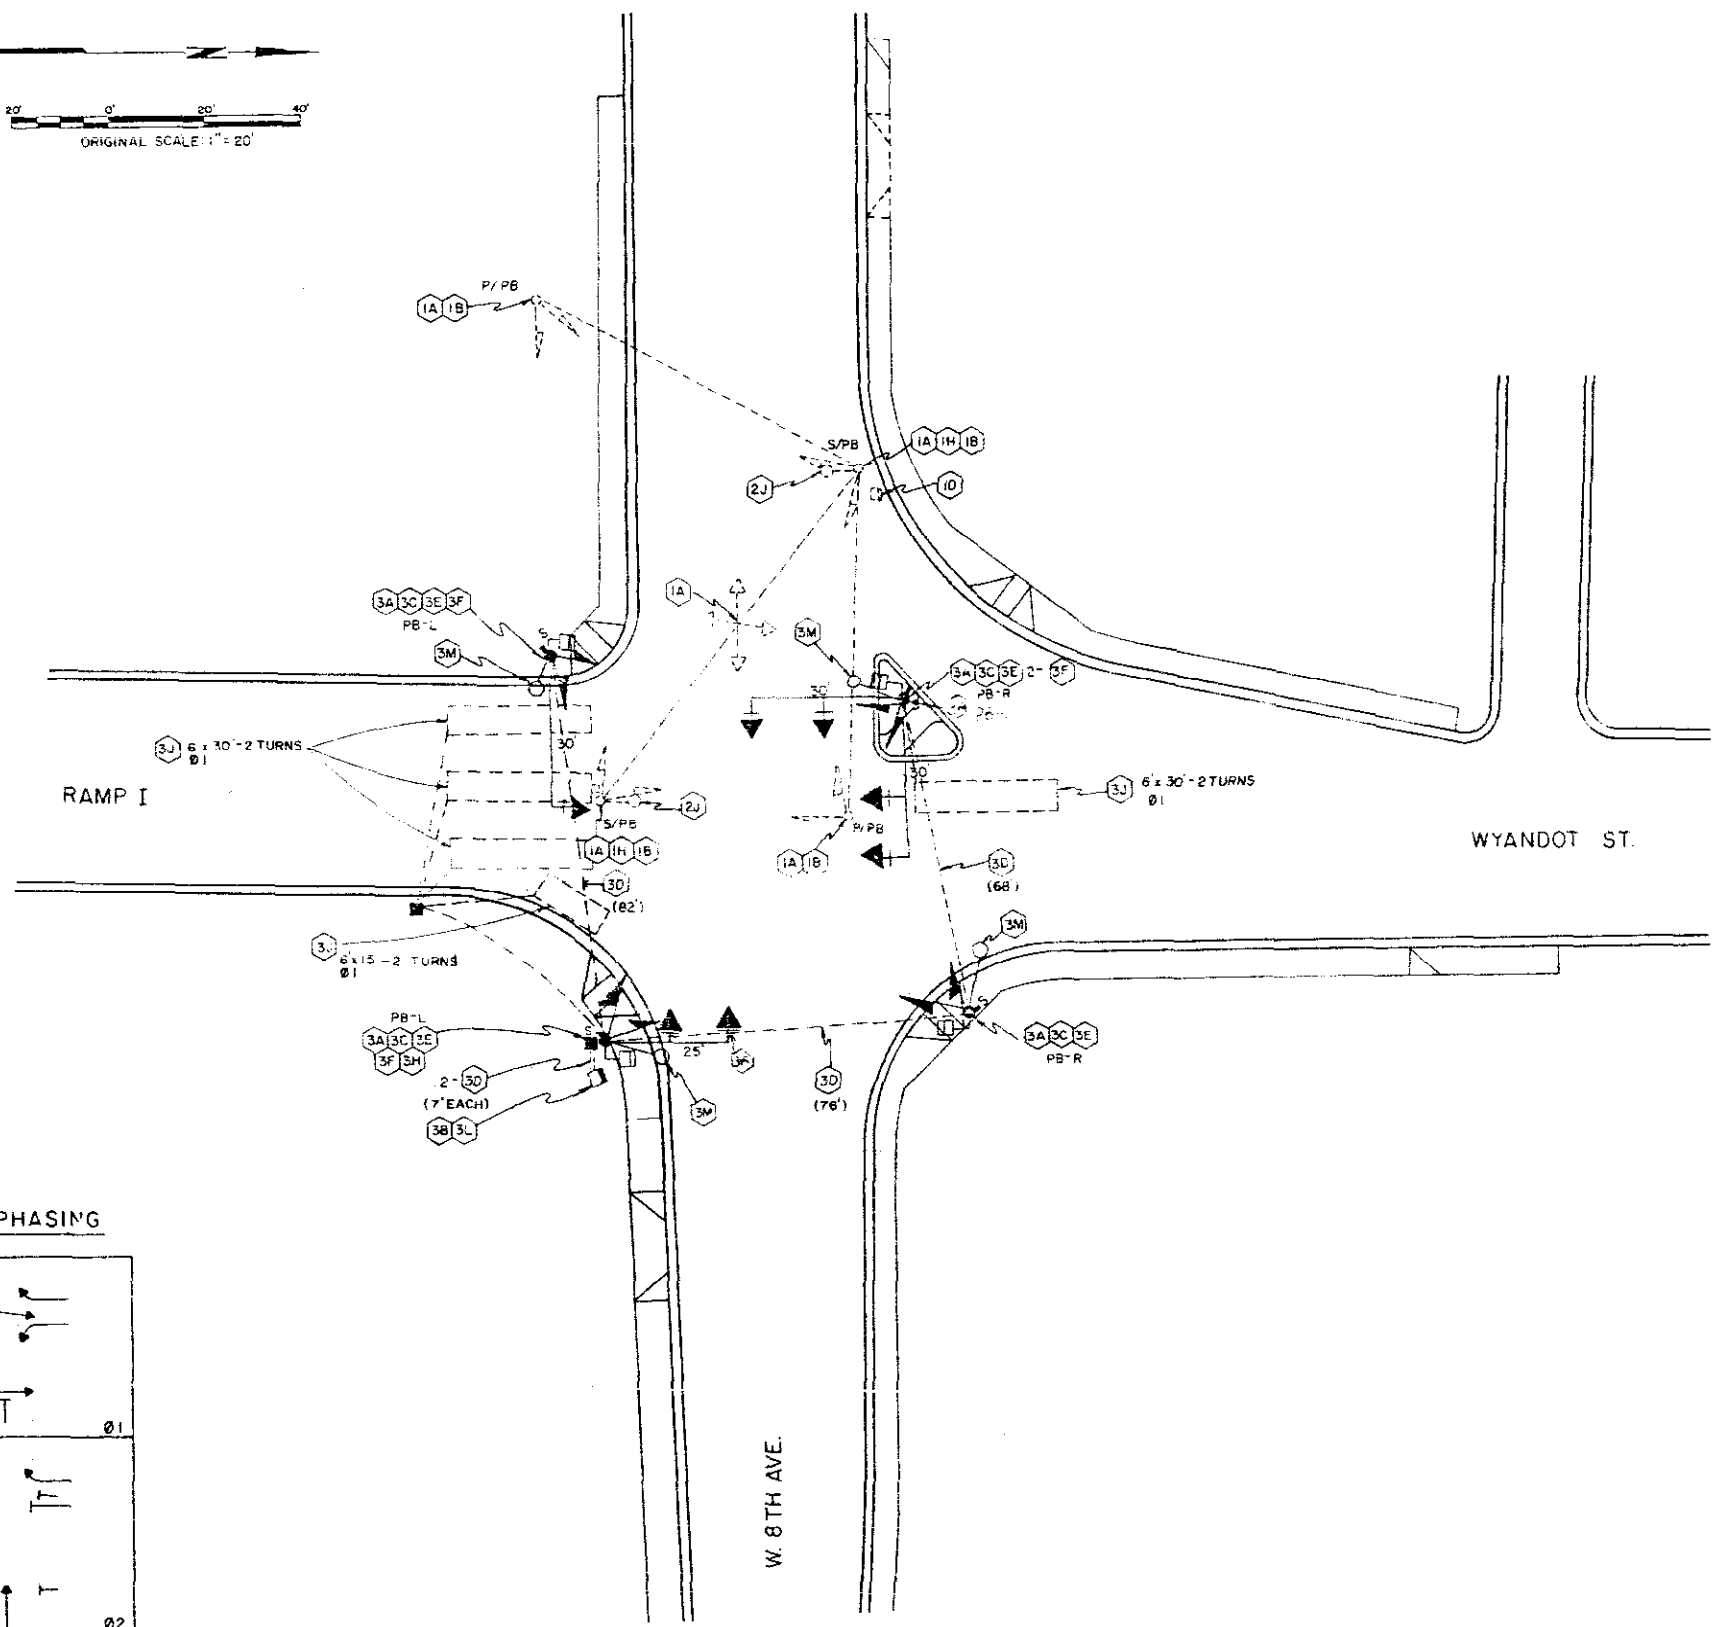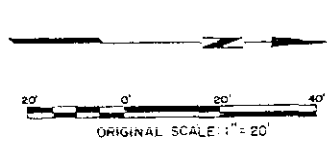

SUMMARY LIST OF QUANTITIES

KEY	ITEM DESCRIPTION	UNIT	QTY
1A	REMOVAL OF TRAFFIC SIGNAL HEAD (EACH)	EA	12
1B	REMOVAL OF TRAFFIC SIGNAL CONTROLLER & CABINET (EACH)	EA	1
1B	REMOVAL OF TRAFFIC SIGNAL POLE (EACH)	EA	4
3D	2-INCH ELECTRICAL CONDUIT (LIN. FT.)	LIN. FT.	240 259
3A	PEDESTRIAN SIGNAL FACE (16) (EACH)	EA	4 5
3A	TRAFFIC SIGNAL FACE (8-8-8) (EACH)	EA	8
3A	TRAFFIC SIGNAL FACE (12-8-8) (EACH)	EA	7
3B	TRAFFIC SIGNAL CONTROLLER CABINET (EACH)	EA	1
3A	TRAFFIC SIGNAL FACE (12-12-12) (EACH)	EA	1
3B	COORDINATION UNIT (EACH)	EA	1
3J	LOOP DETECTOR WIRE (LIN. FT.)	LIN. FT.	586 408
3J	TRAFFIC SIGNAL VEH. DETECTOR AMPLIFIER (LOOP TYPE) (EACH)	EA	5
3E/3F	TRAFFIC SIGNAL-LIGHT POLE STEEL (1 MAST ARM) (EACH)	EA	2
3E/3F	TRAFFIC SIGNAL-LIGHT POLE STEEL (2 MAST ARM) (EACH)	EA	1
3B	TRAFFIC SIGNAL CONTROLLER (SOLID STATE) (FULL-ACTUATED) (2 PHASE) (EACH)	EA	1
3E	TRAFFIC SIGNAL-LIGHT POLE STEEL	EA	1

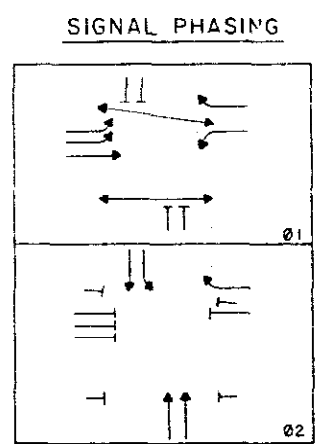

- NOTES:
1. MAST ARM POLES TO BE 3 GAUGE 12" ANCHOR BASE TAPERED STEEL WITH 10' STREET LIGHT ARM LUMINAIRE BY P.S.C.O.
  2. CONTROLLER TO BE 2 PHASE FULL ACTUATED IN M-1 CABINET MOUNTED ON TYPE VII BASE.
  3. CONTRACTOR TO COORDINATE CONDUIT INSTALLATION WITH P.S.C.O. FOR JOINT USE OF TRENCH

TRAFFIC SIGNAL PLAN





WAYS

AS CONSTRUCTED

NO REVISIONS  2-21-89 REVISED  VOID

FED. ROAD REGION	DIVISION	PROJ. NO.	SHEET NO.	SHEET TOTALS
VIII	CCLO.	IR 25-2(191)	74	242

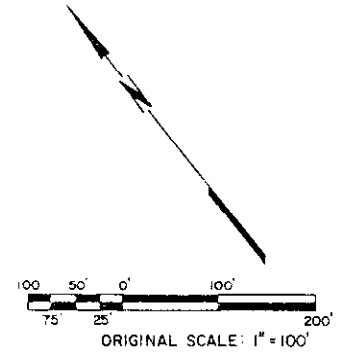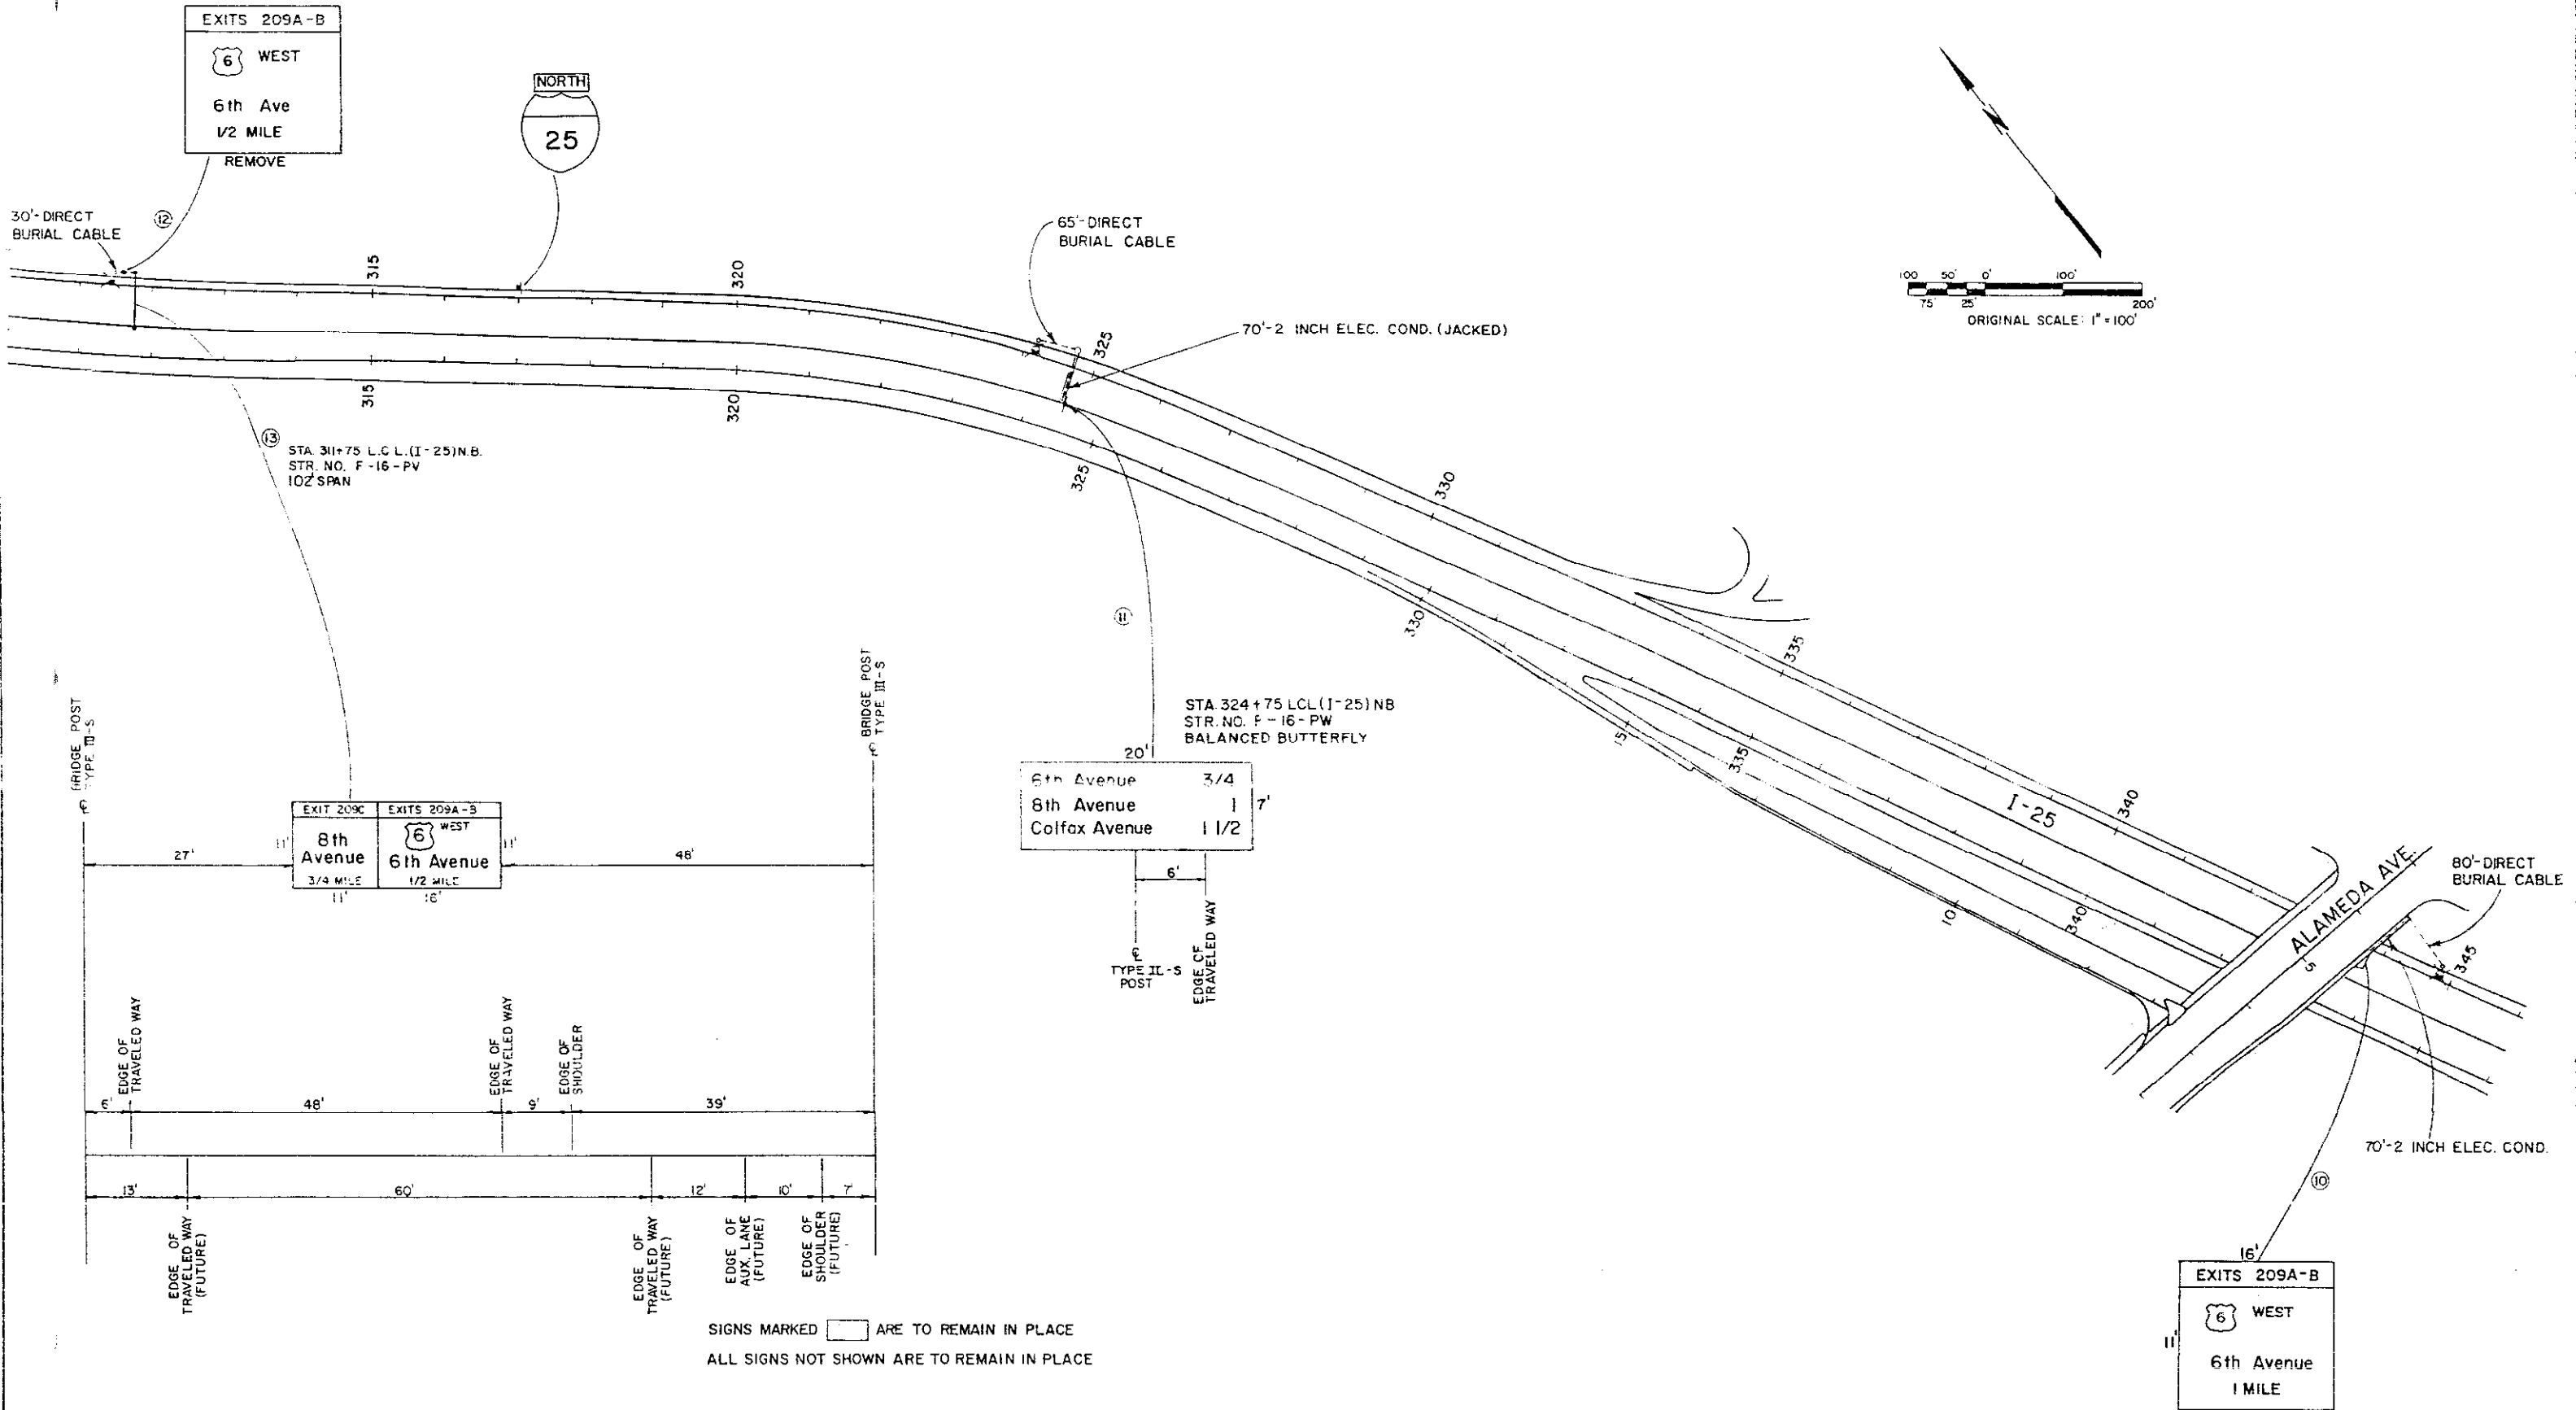





SIGNS MARKED  ARE TO REMAIN IN PLACE  
 ALL SIGNS NOT SHOWN ARE TO REMAIN IN PLACE

**FINAL SIGNING PLAN**

CENTER OVER I-25 NB LANES  
 MOUNT ON ALAMEDA AVENUE  
 BRIDGE STRUCTURE (SEE OVERPASS  
 MOUNTED SIGN BRACKET DETAIL)

AS CONSTRUCTED  
 NO REVISIONS  REVISED  VOID

FED. ROAD REGION	DMSION	PROJ. NO.	SHEET NO.	SHEET TOTALS
VIII	COLO.	IR25-2(191)	75	21

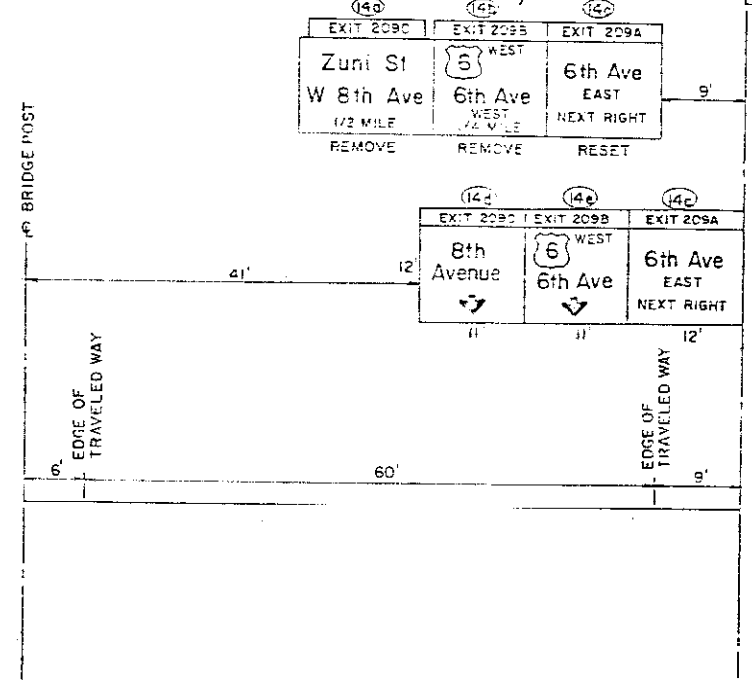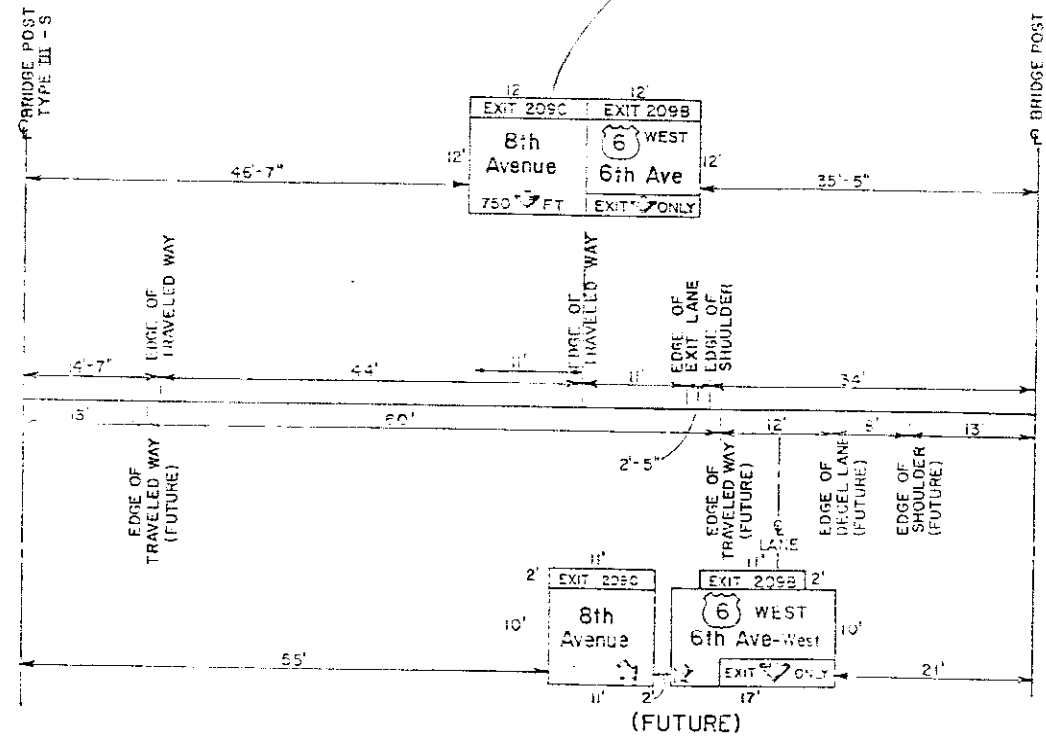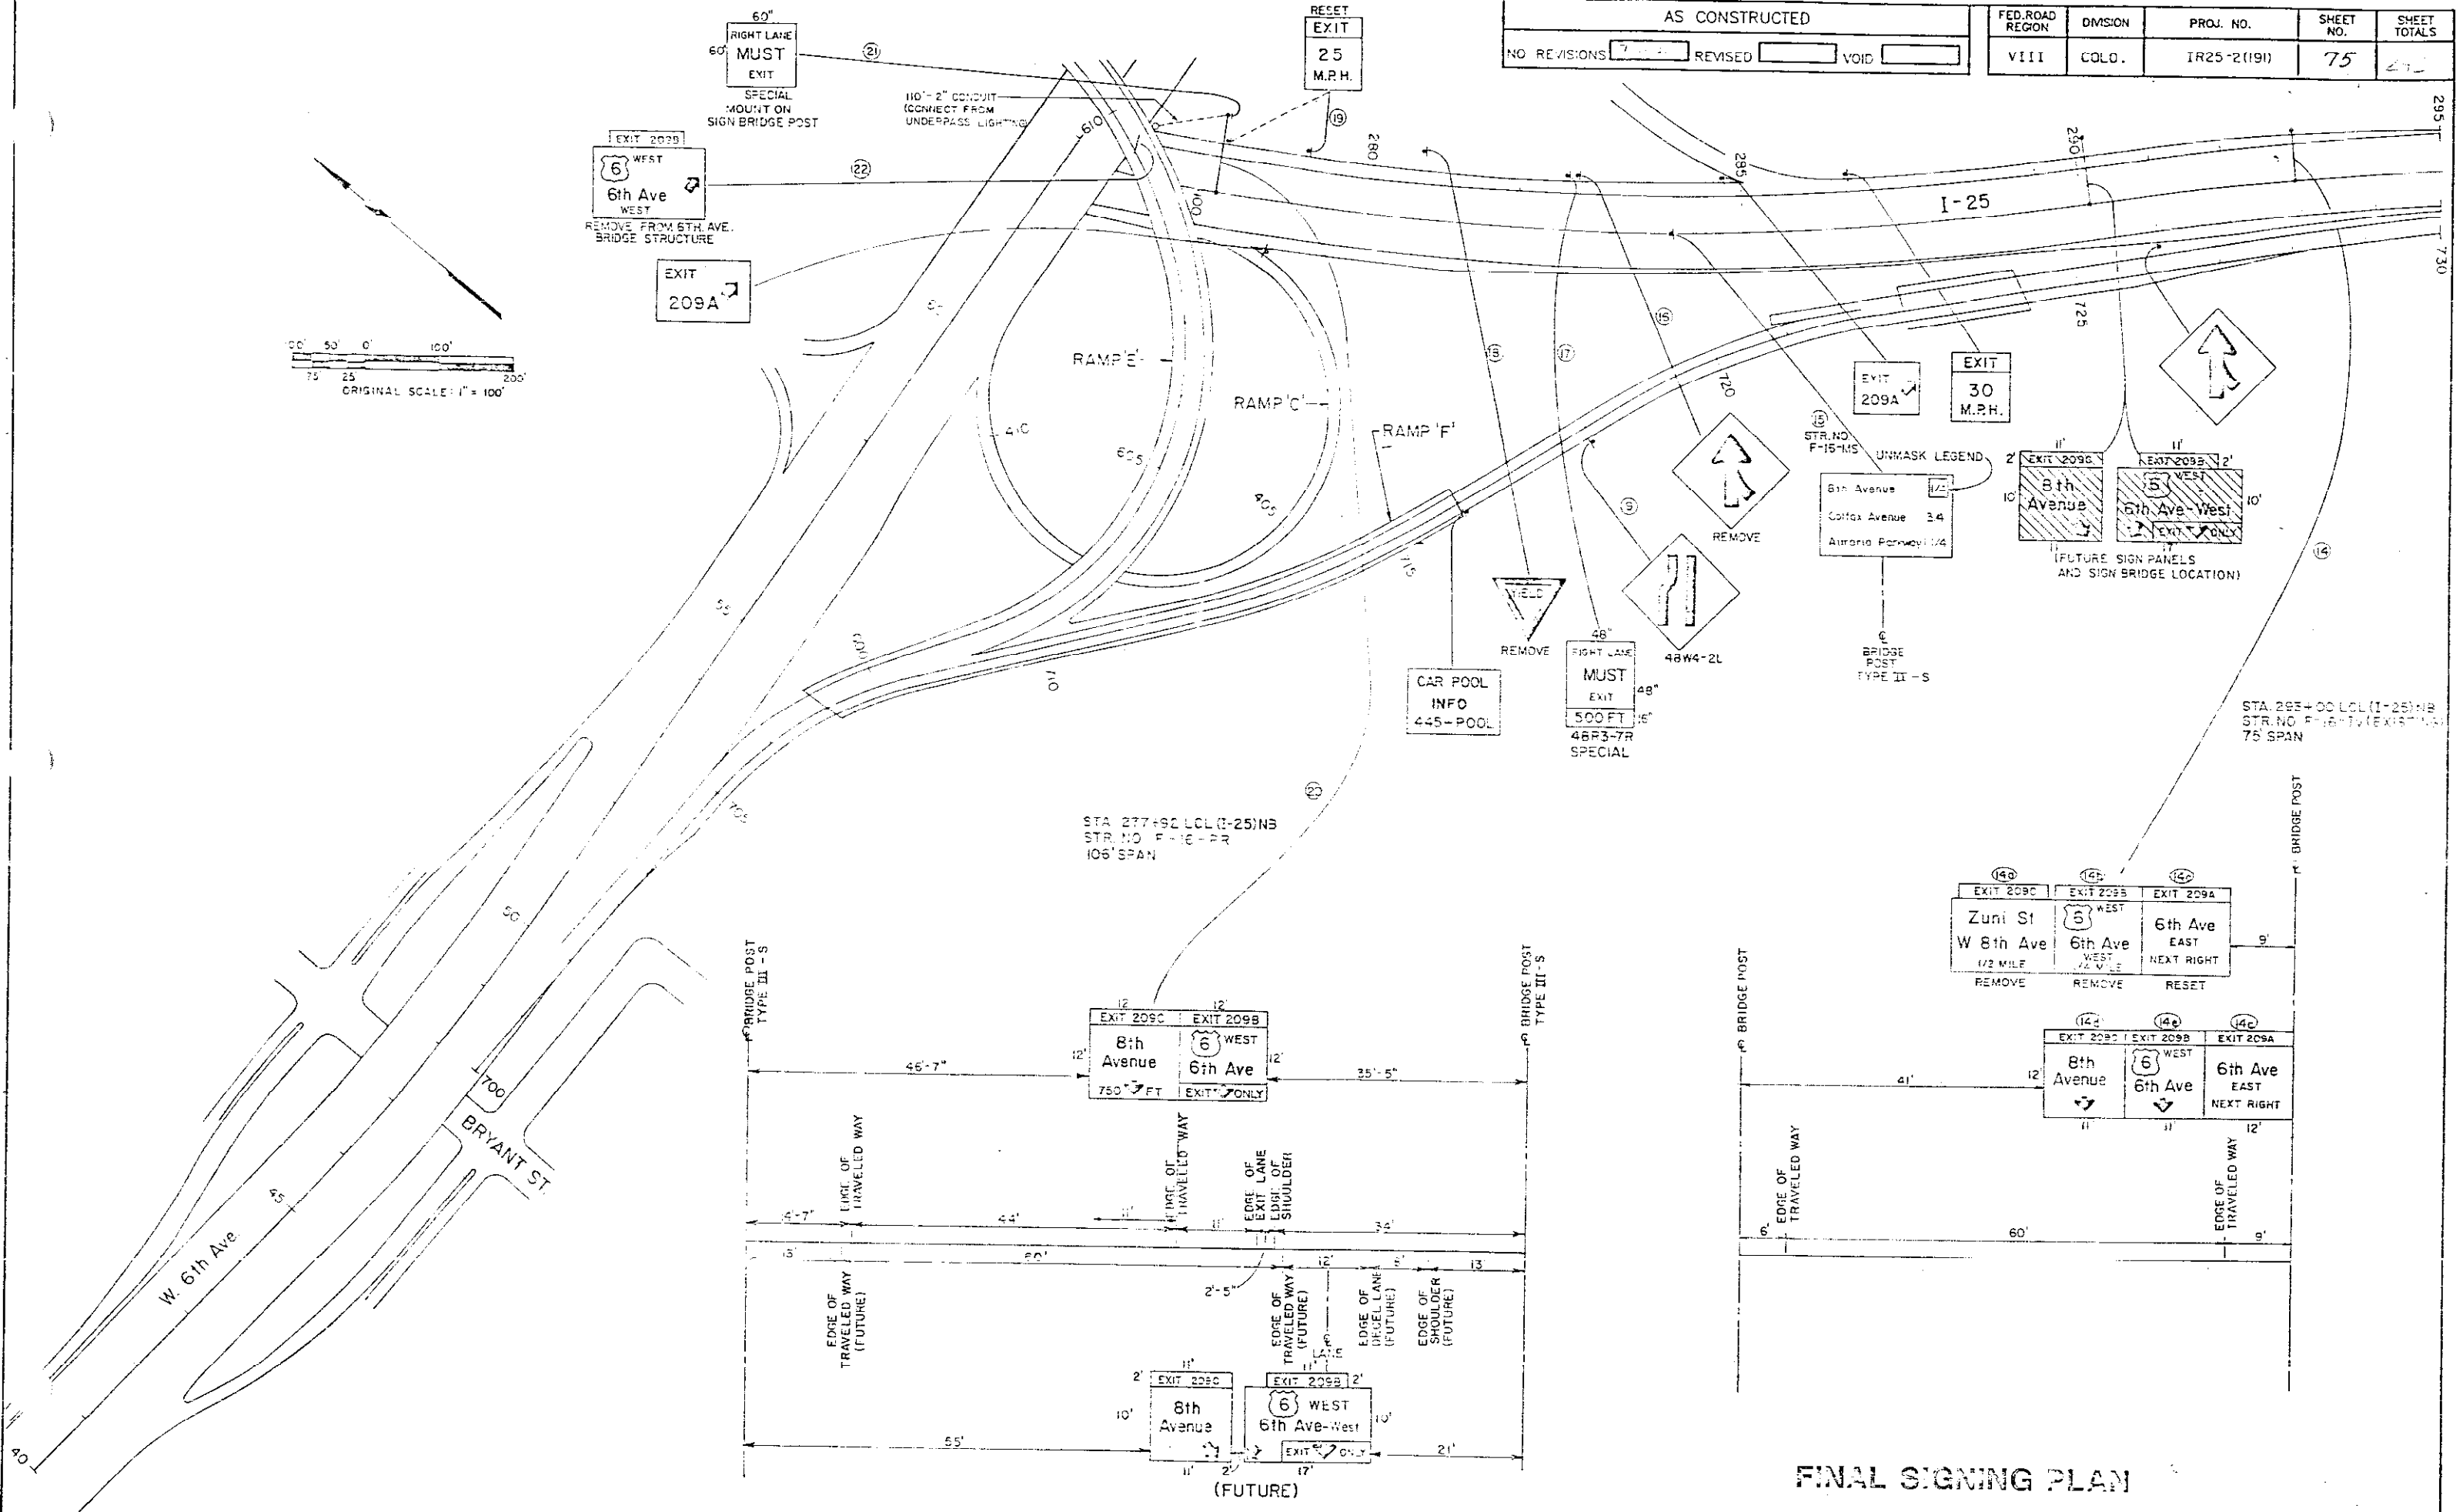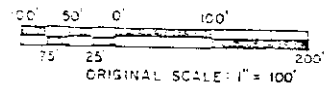


**FINAL SIGNING PLAN**

SIGNS MARKED  TO REMAIN IN PLACE


SIGNS MARKED   ARE TO REMAIN IN PLACE

AS CONSTRUCTED	
NO REVISIONS	REVISED
7-21-66	

FED. ROAD REGION	DMSION	PROJ. NO.	SHEET NO.	SHEET TOTALS
VIII	COLO.	IR25-2(191)	76	200


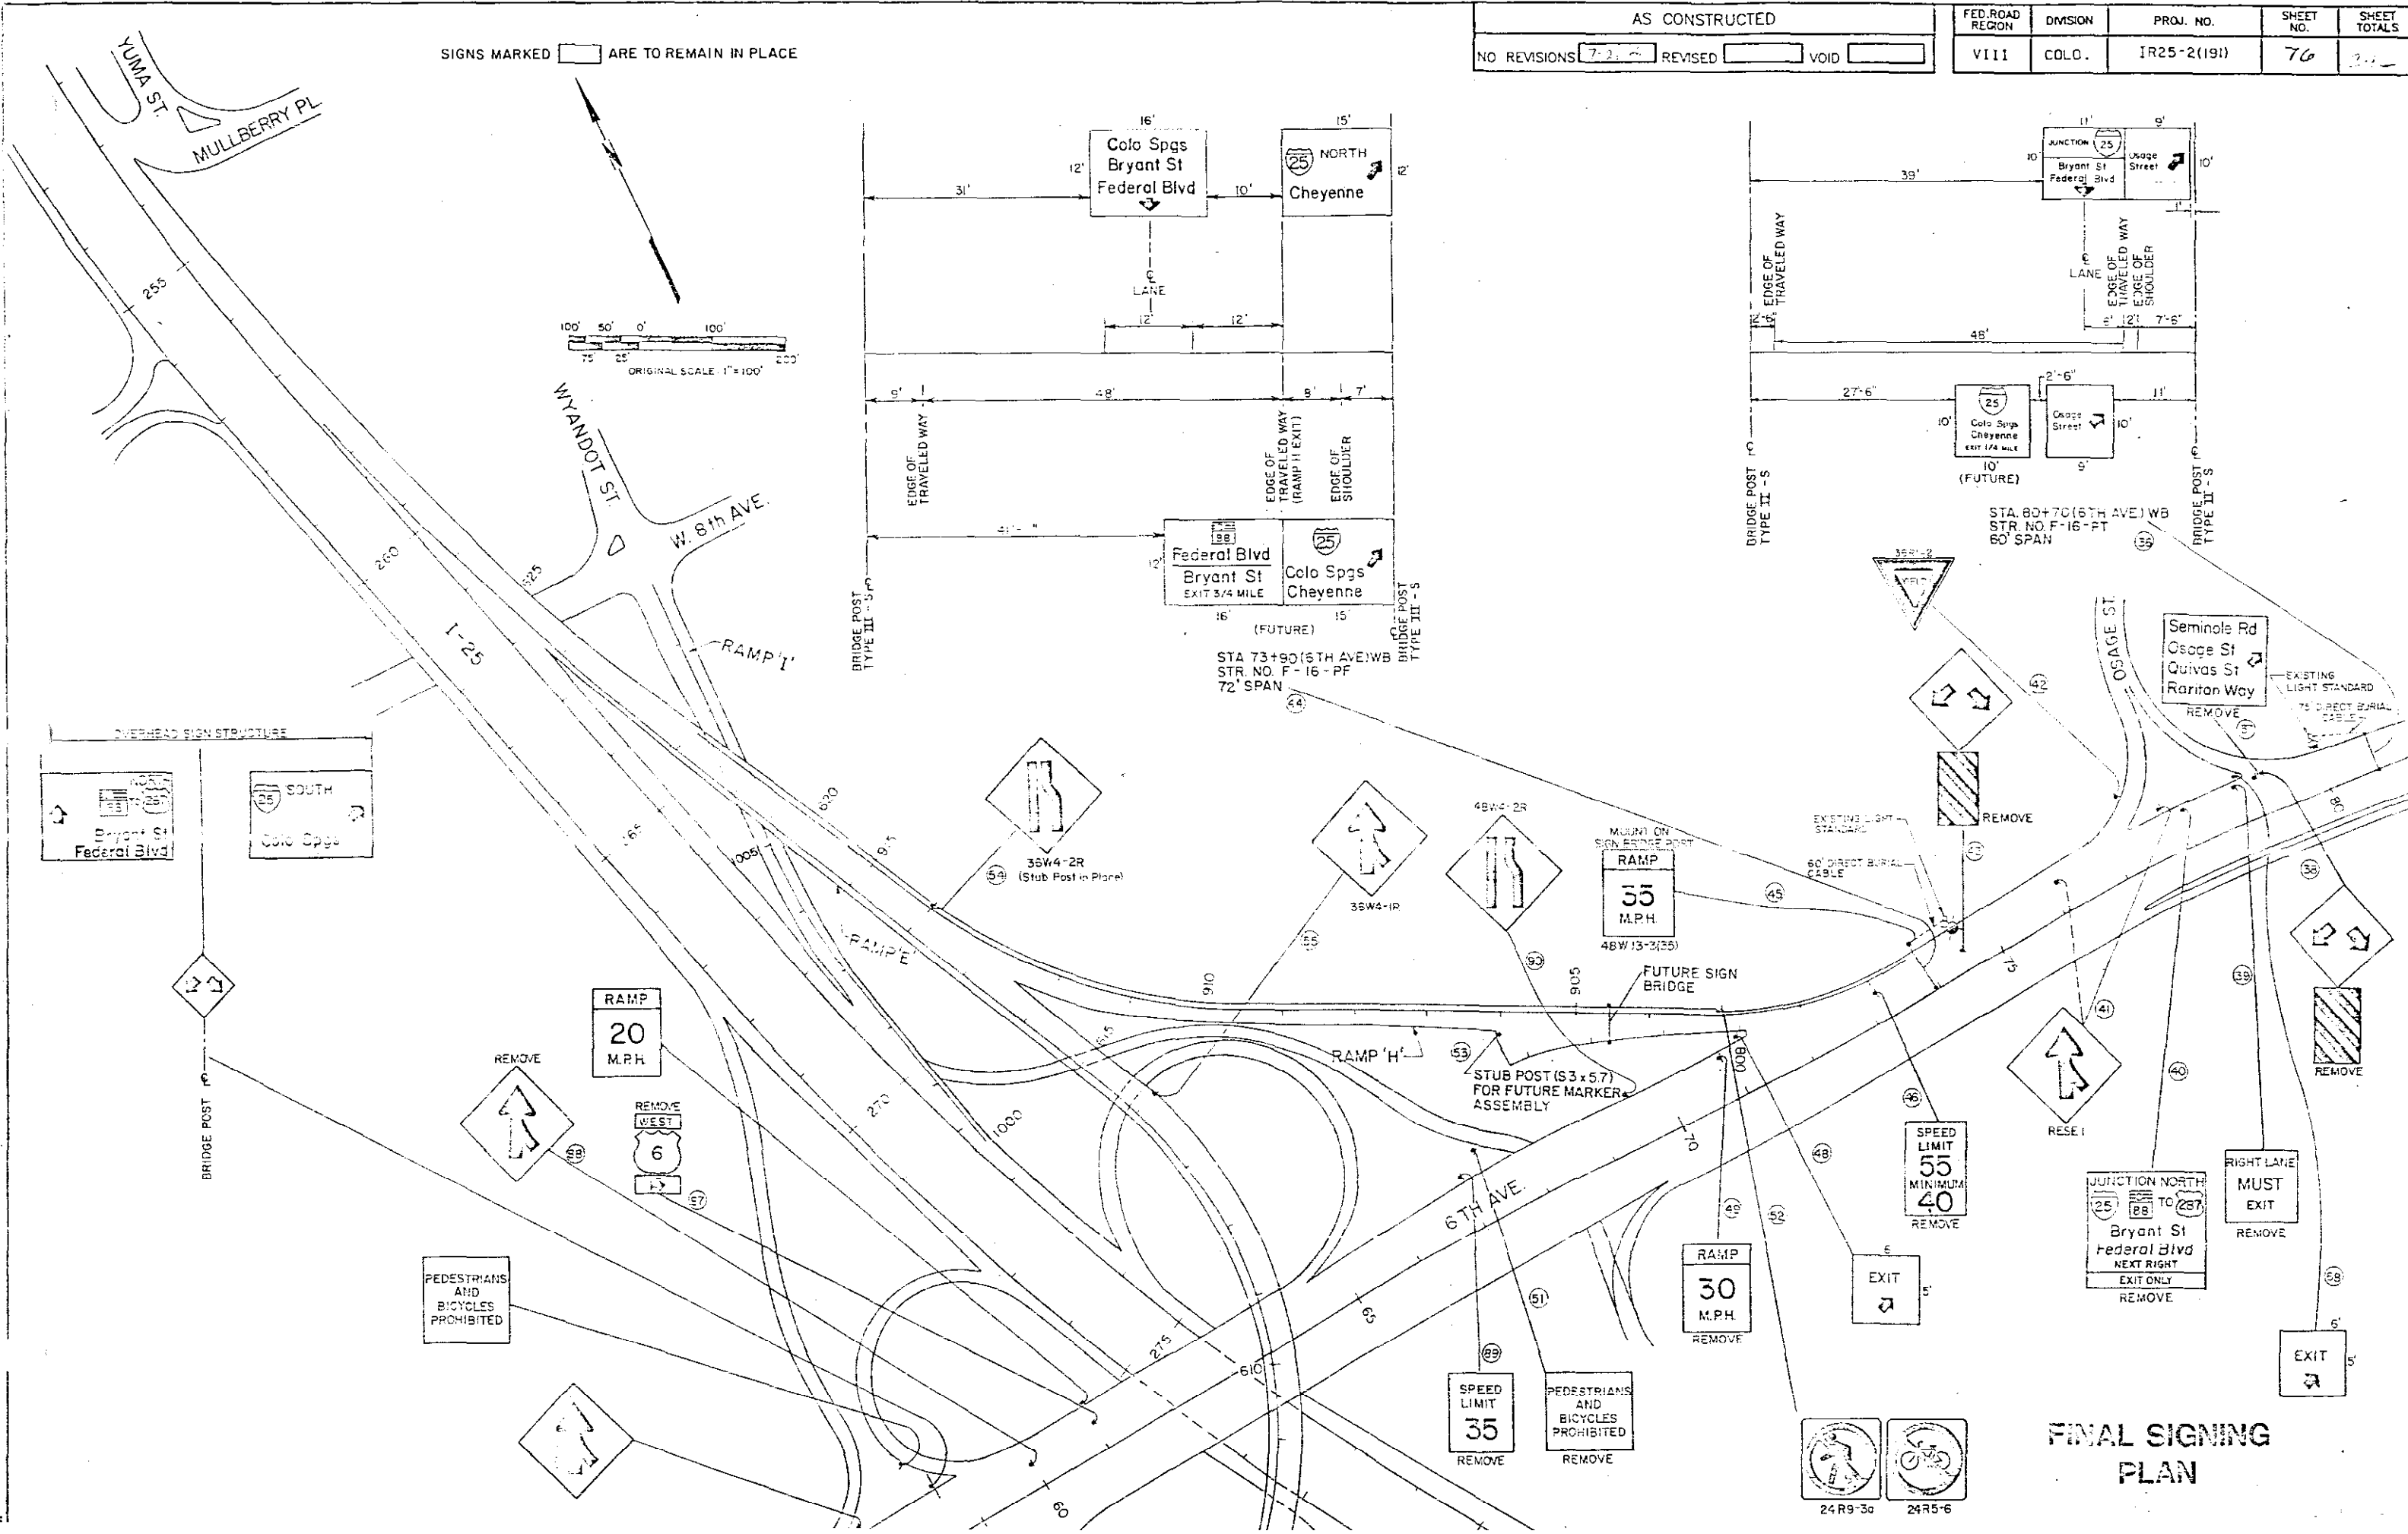


FINAL SIGNING PLAN

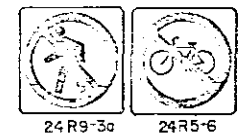


AS CONSTRUCTED		
NO REVISIONS	REVISED	VOID

FED. ROAD REGION	DIVISION	PROJ. NO.	SHEET NO.	SHEET TOTALS
VIII	COLO.	IR25-2(191)	77	24

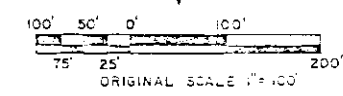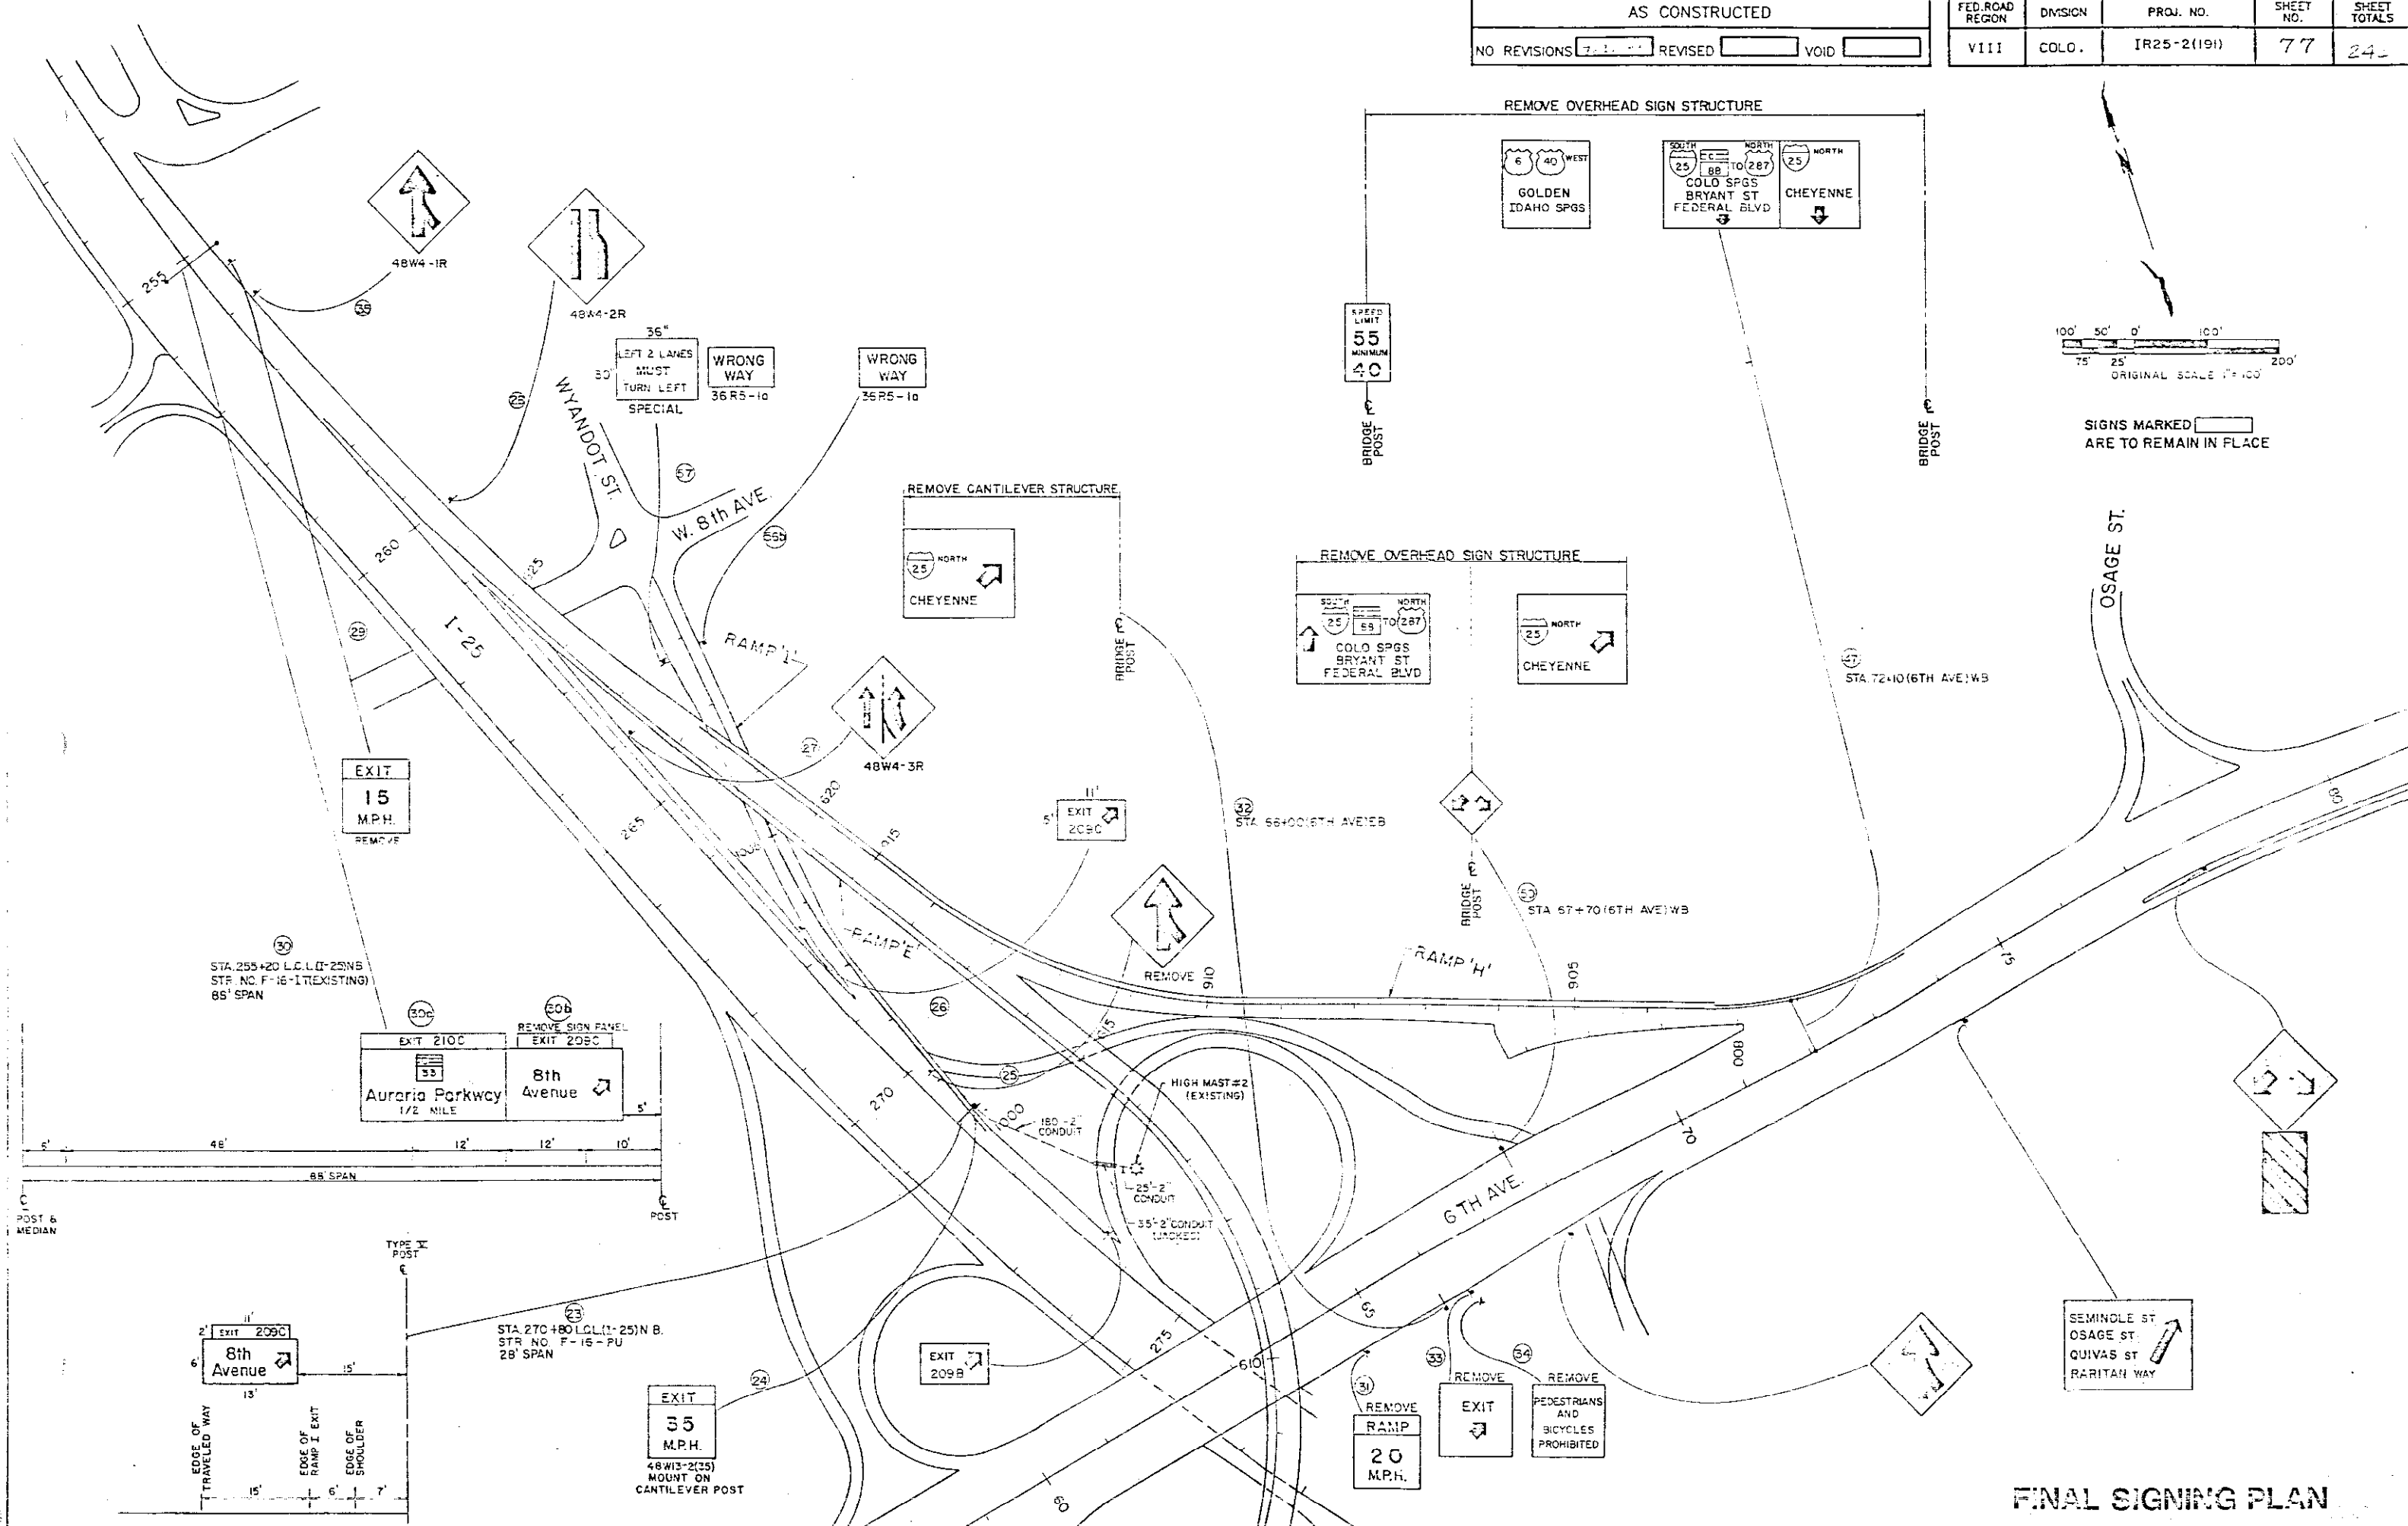

SIGNS MARKED [ ] ARE TO REMAIN IN PLACE


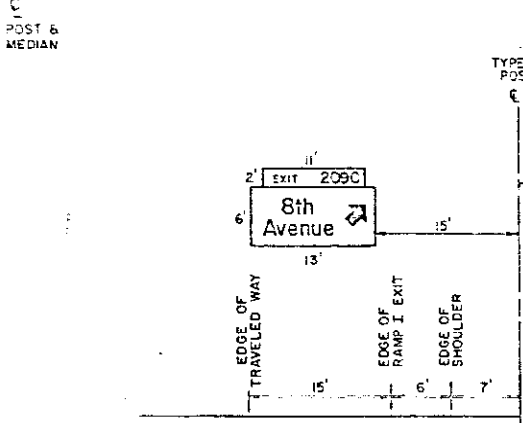


SEMINOLE ST  
OSAGE ST  
QUIVAS ST  
RARITAN WAY

FINAL SIGNING PLAN

AS CONSTRUCTED		
NO. PROVISIONS	REMOVE	VOID
	1-25-25	

FED. ROAD REGION	DMSION	PROJ. NO.	SHEET NO.	SHEET TOTALS
VIII	COLO.	IR25-2(191)	78	242

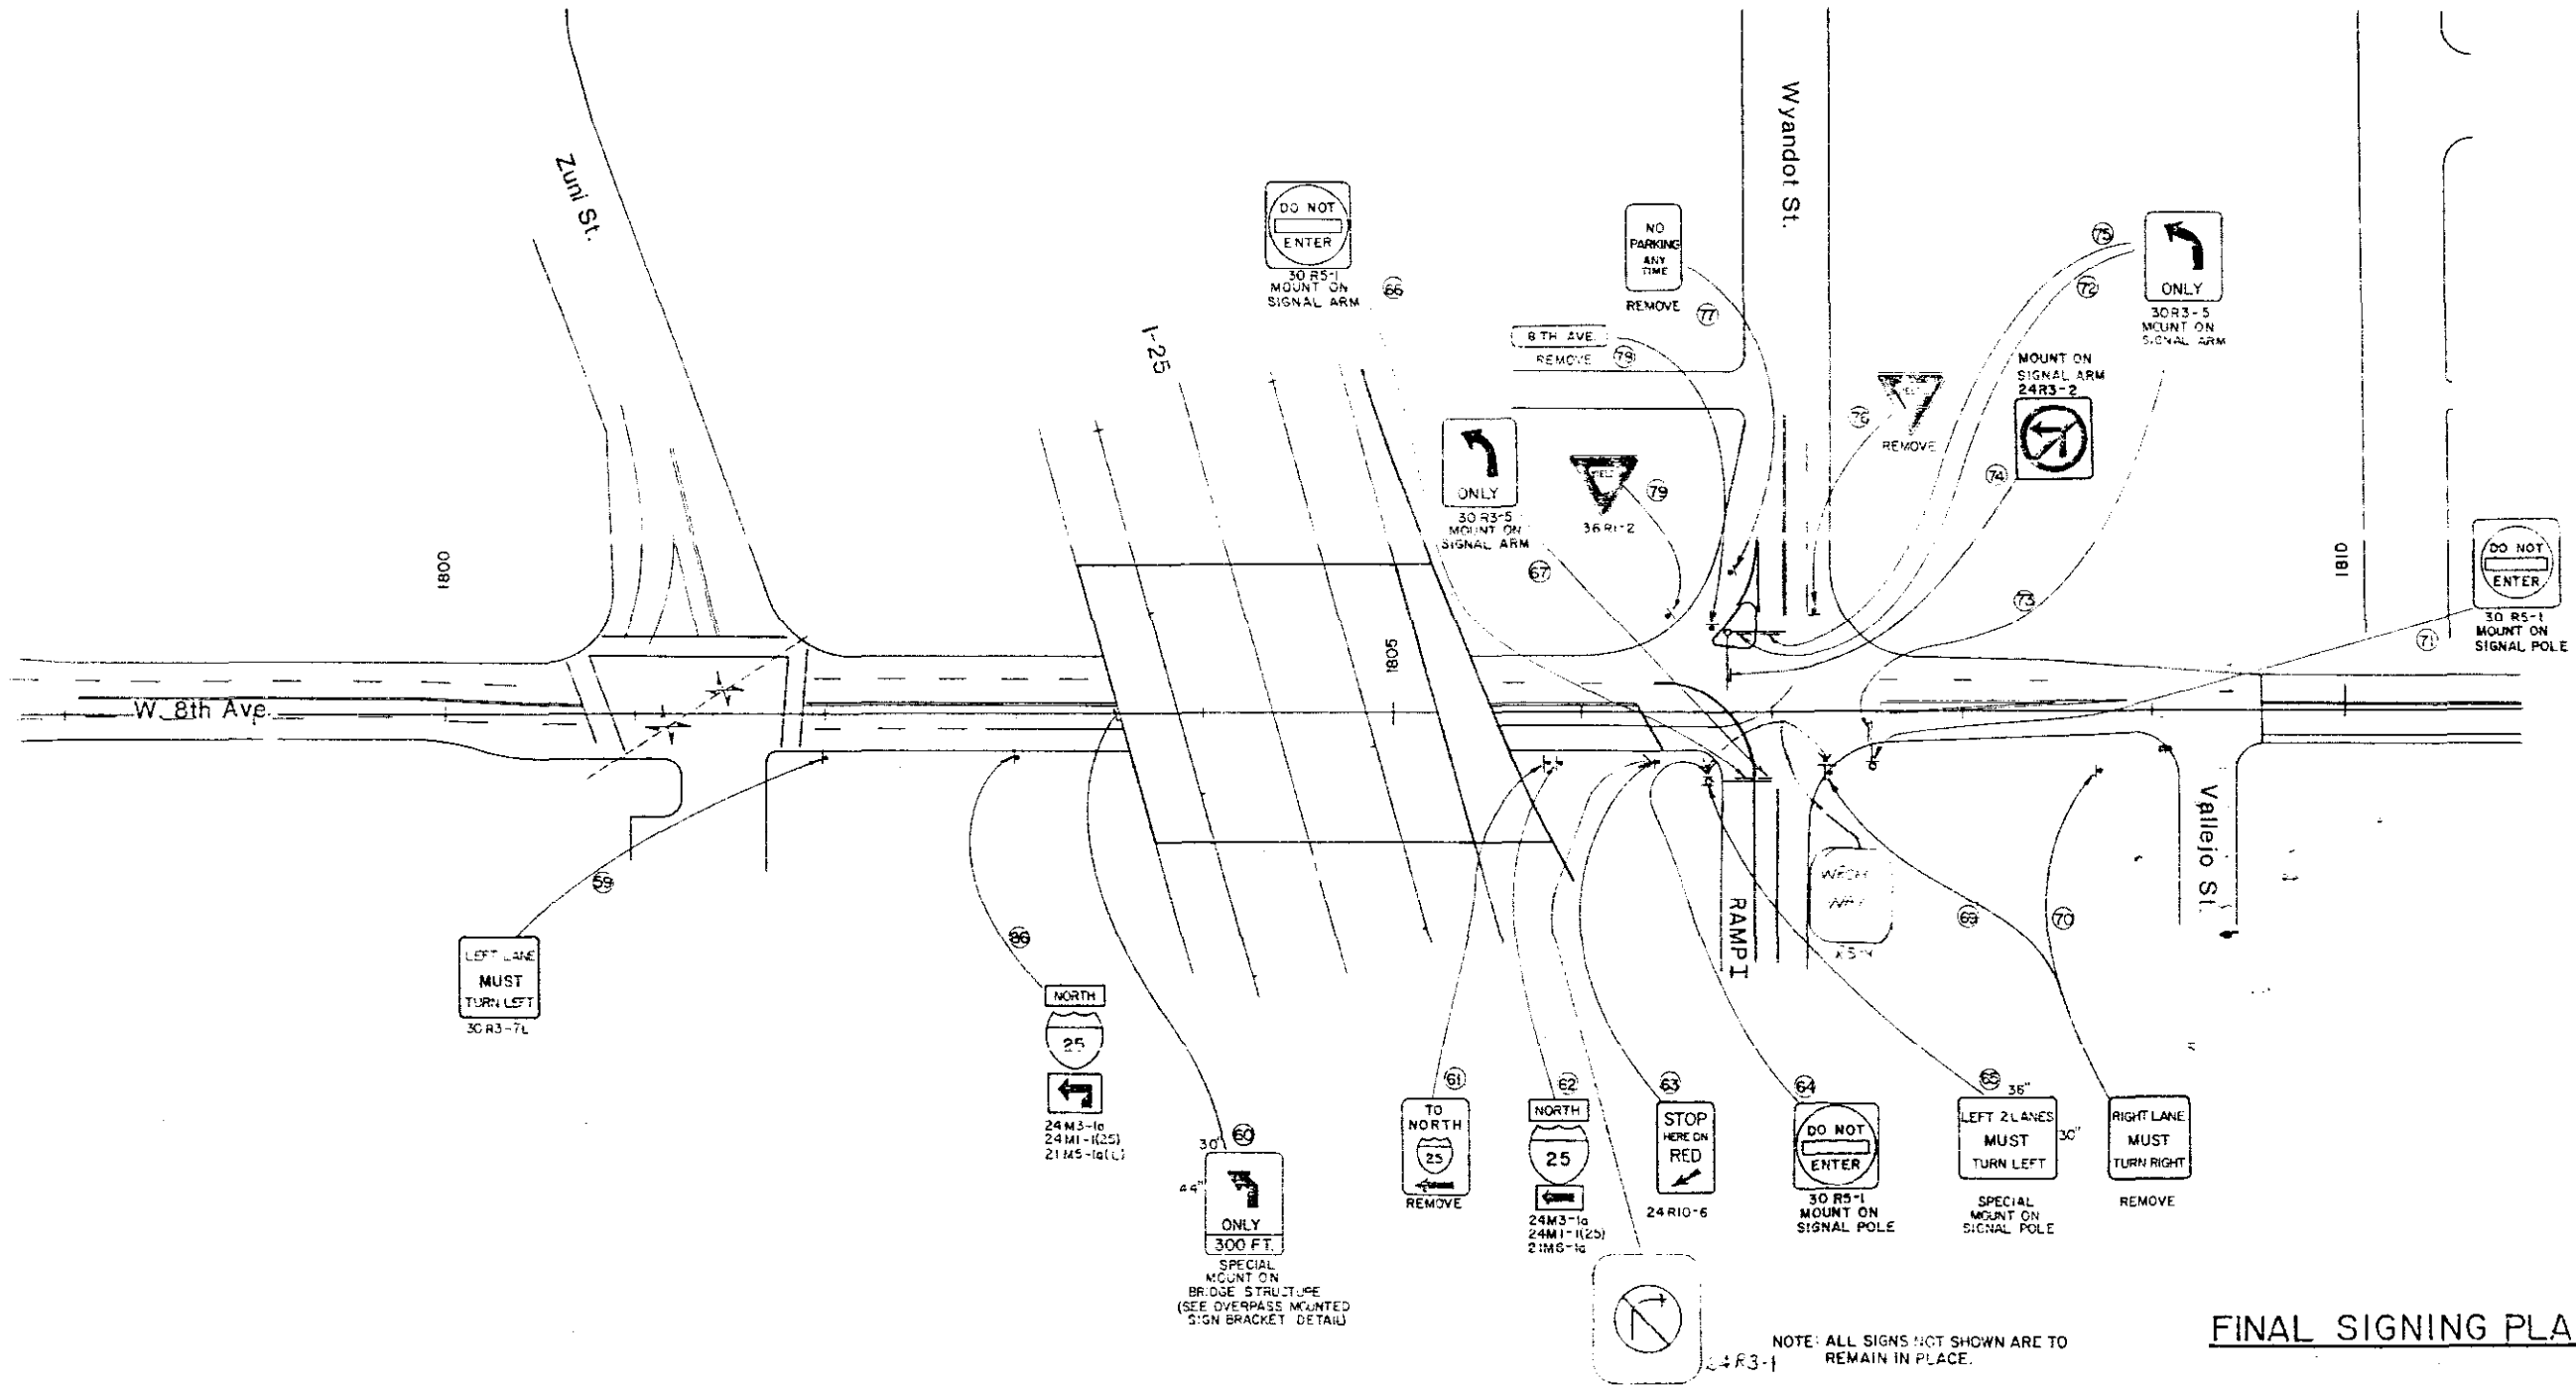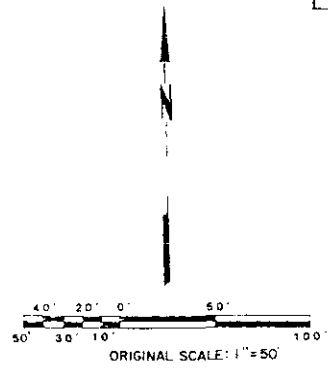



NOTE: ALL SIGNS NOT SHOWN ARE TO REMAIN IN PLACE.

FINAL SIGNING PLAN



AS CONSTRUCTED  
NO RE SIGNS 7-11-11 REVISED 1-1-12 VOID 1-1-12



FED. ROAD REGION	DIVISION	PROJ. NO.	SHEET NO.	SHEET TOTALS
VIII	COLO.	IR25-2(191)	79	242

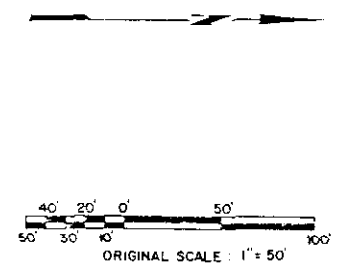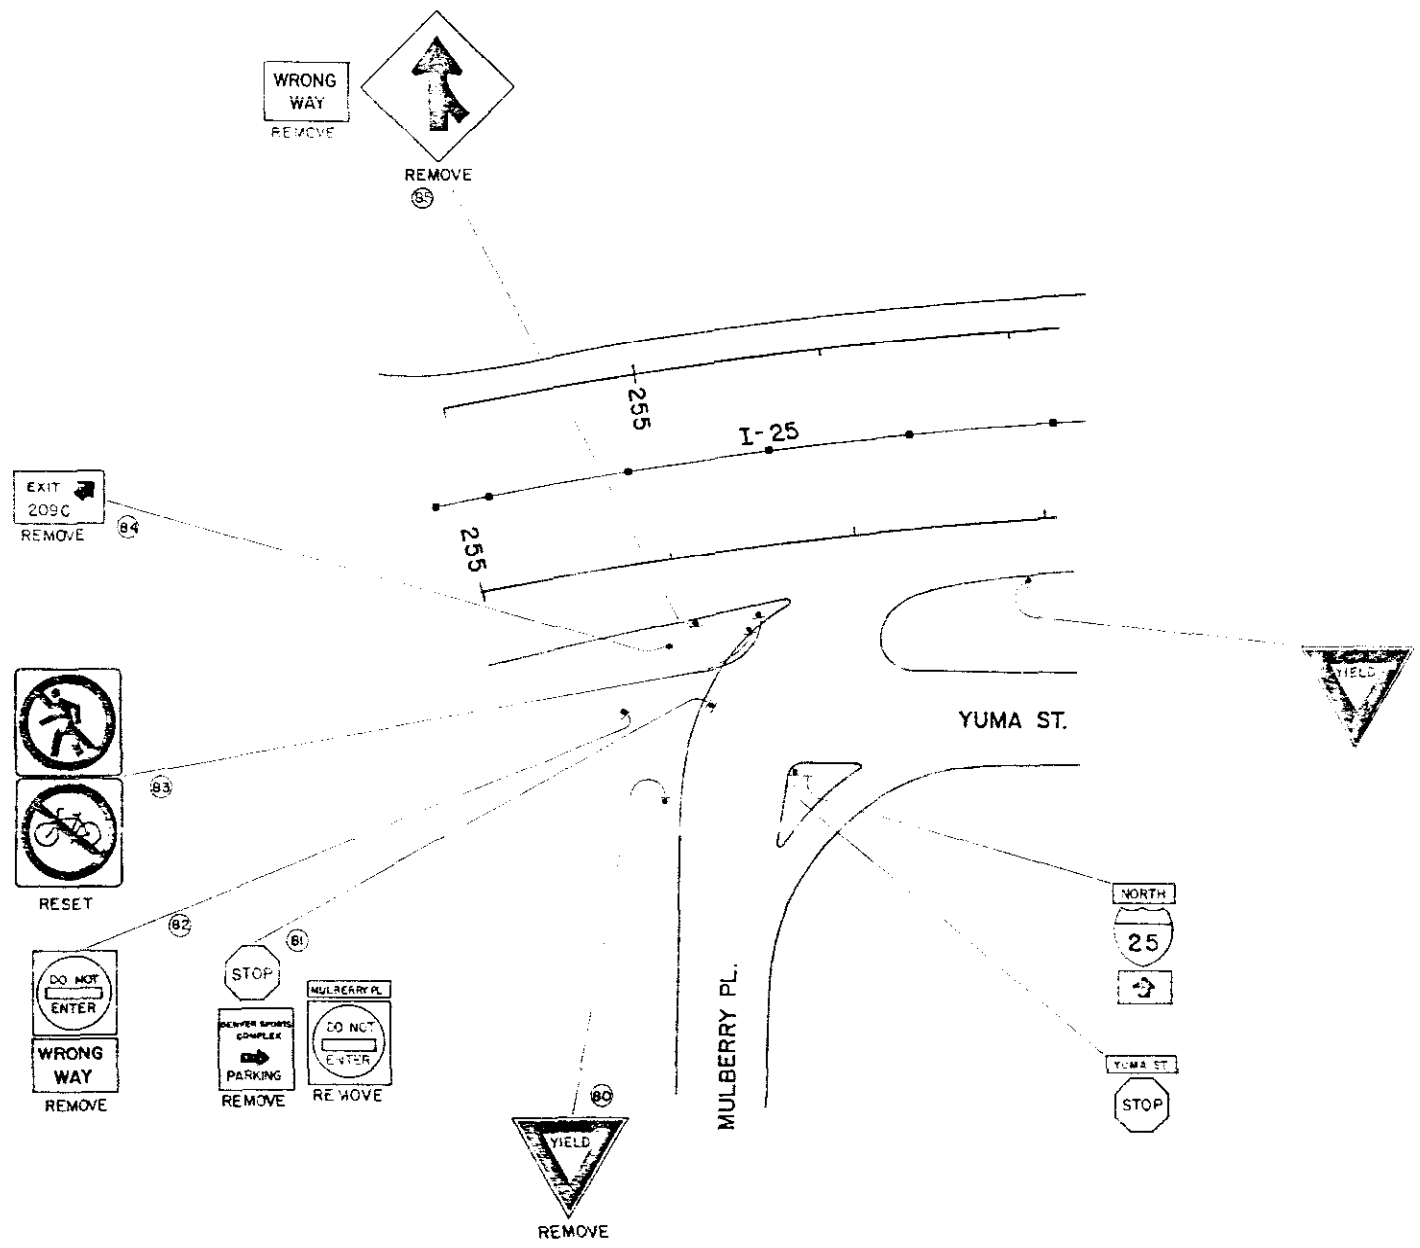

SIGNS NOT SHOWN SHALL REMAIN IN PLACE  
SIGNS MARKED [ ] ARE TO REMAIN IN PLACE

AS CONSTRUCTED  
 NO REVISIONS [ ] REVISED [ ] VOID [ ]


FED. ROAD DISTRICT	DISTRICT	PROJ. NO.	SHEET NO.	SHEET TOTALS
VIII	COLD	IR25-2(191)	80	242

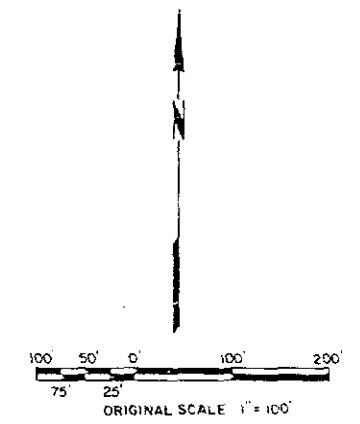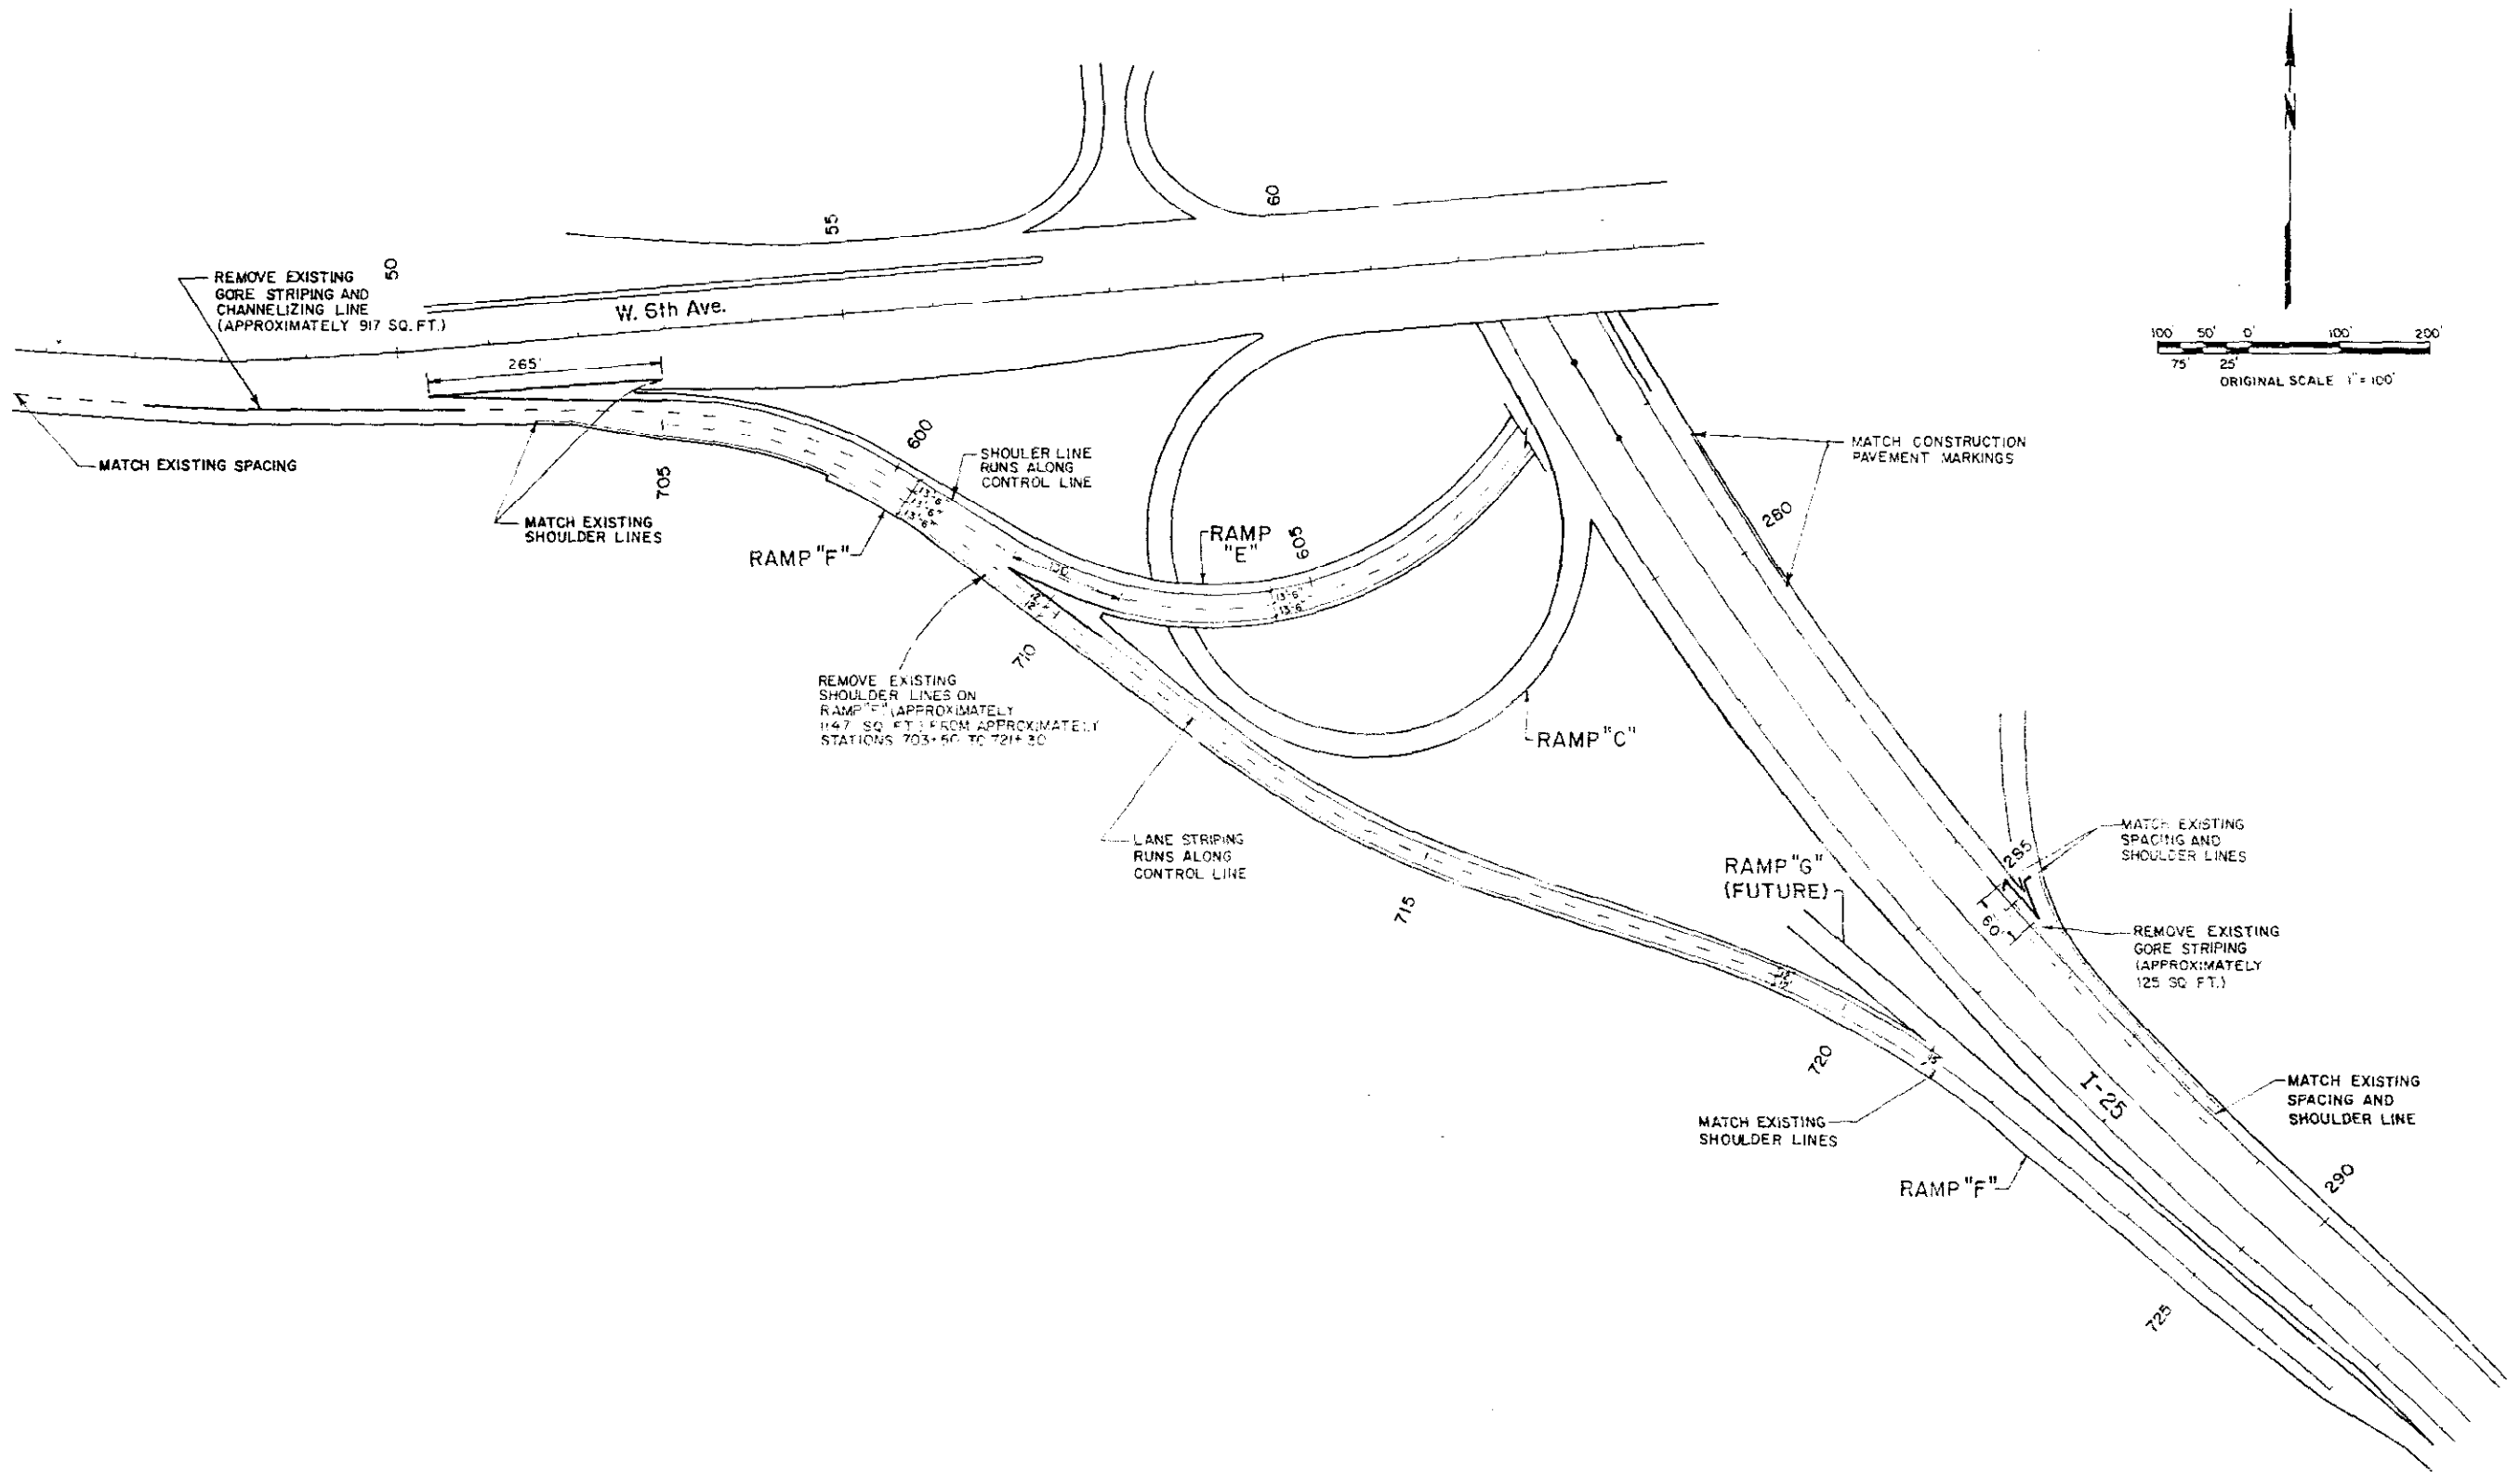

FINAL PAVEMENT MARKING PLAN



AS CONSTRUCTED  
REVISED [ ] Y.O.D. [ ]

FED. ROAD DISTRICT	DIVISION	PROJ. NO.	SHEET NO.	SHEET TOTALS
VIII	COLL.	IR25-2(191)	81	242

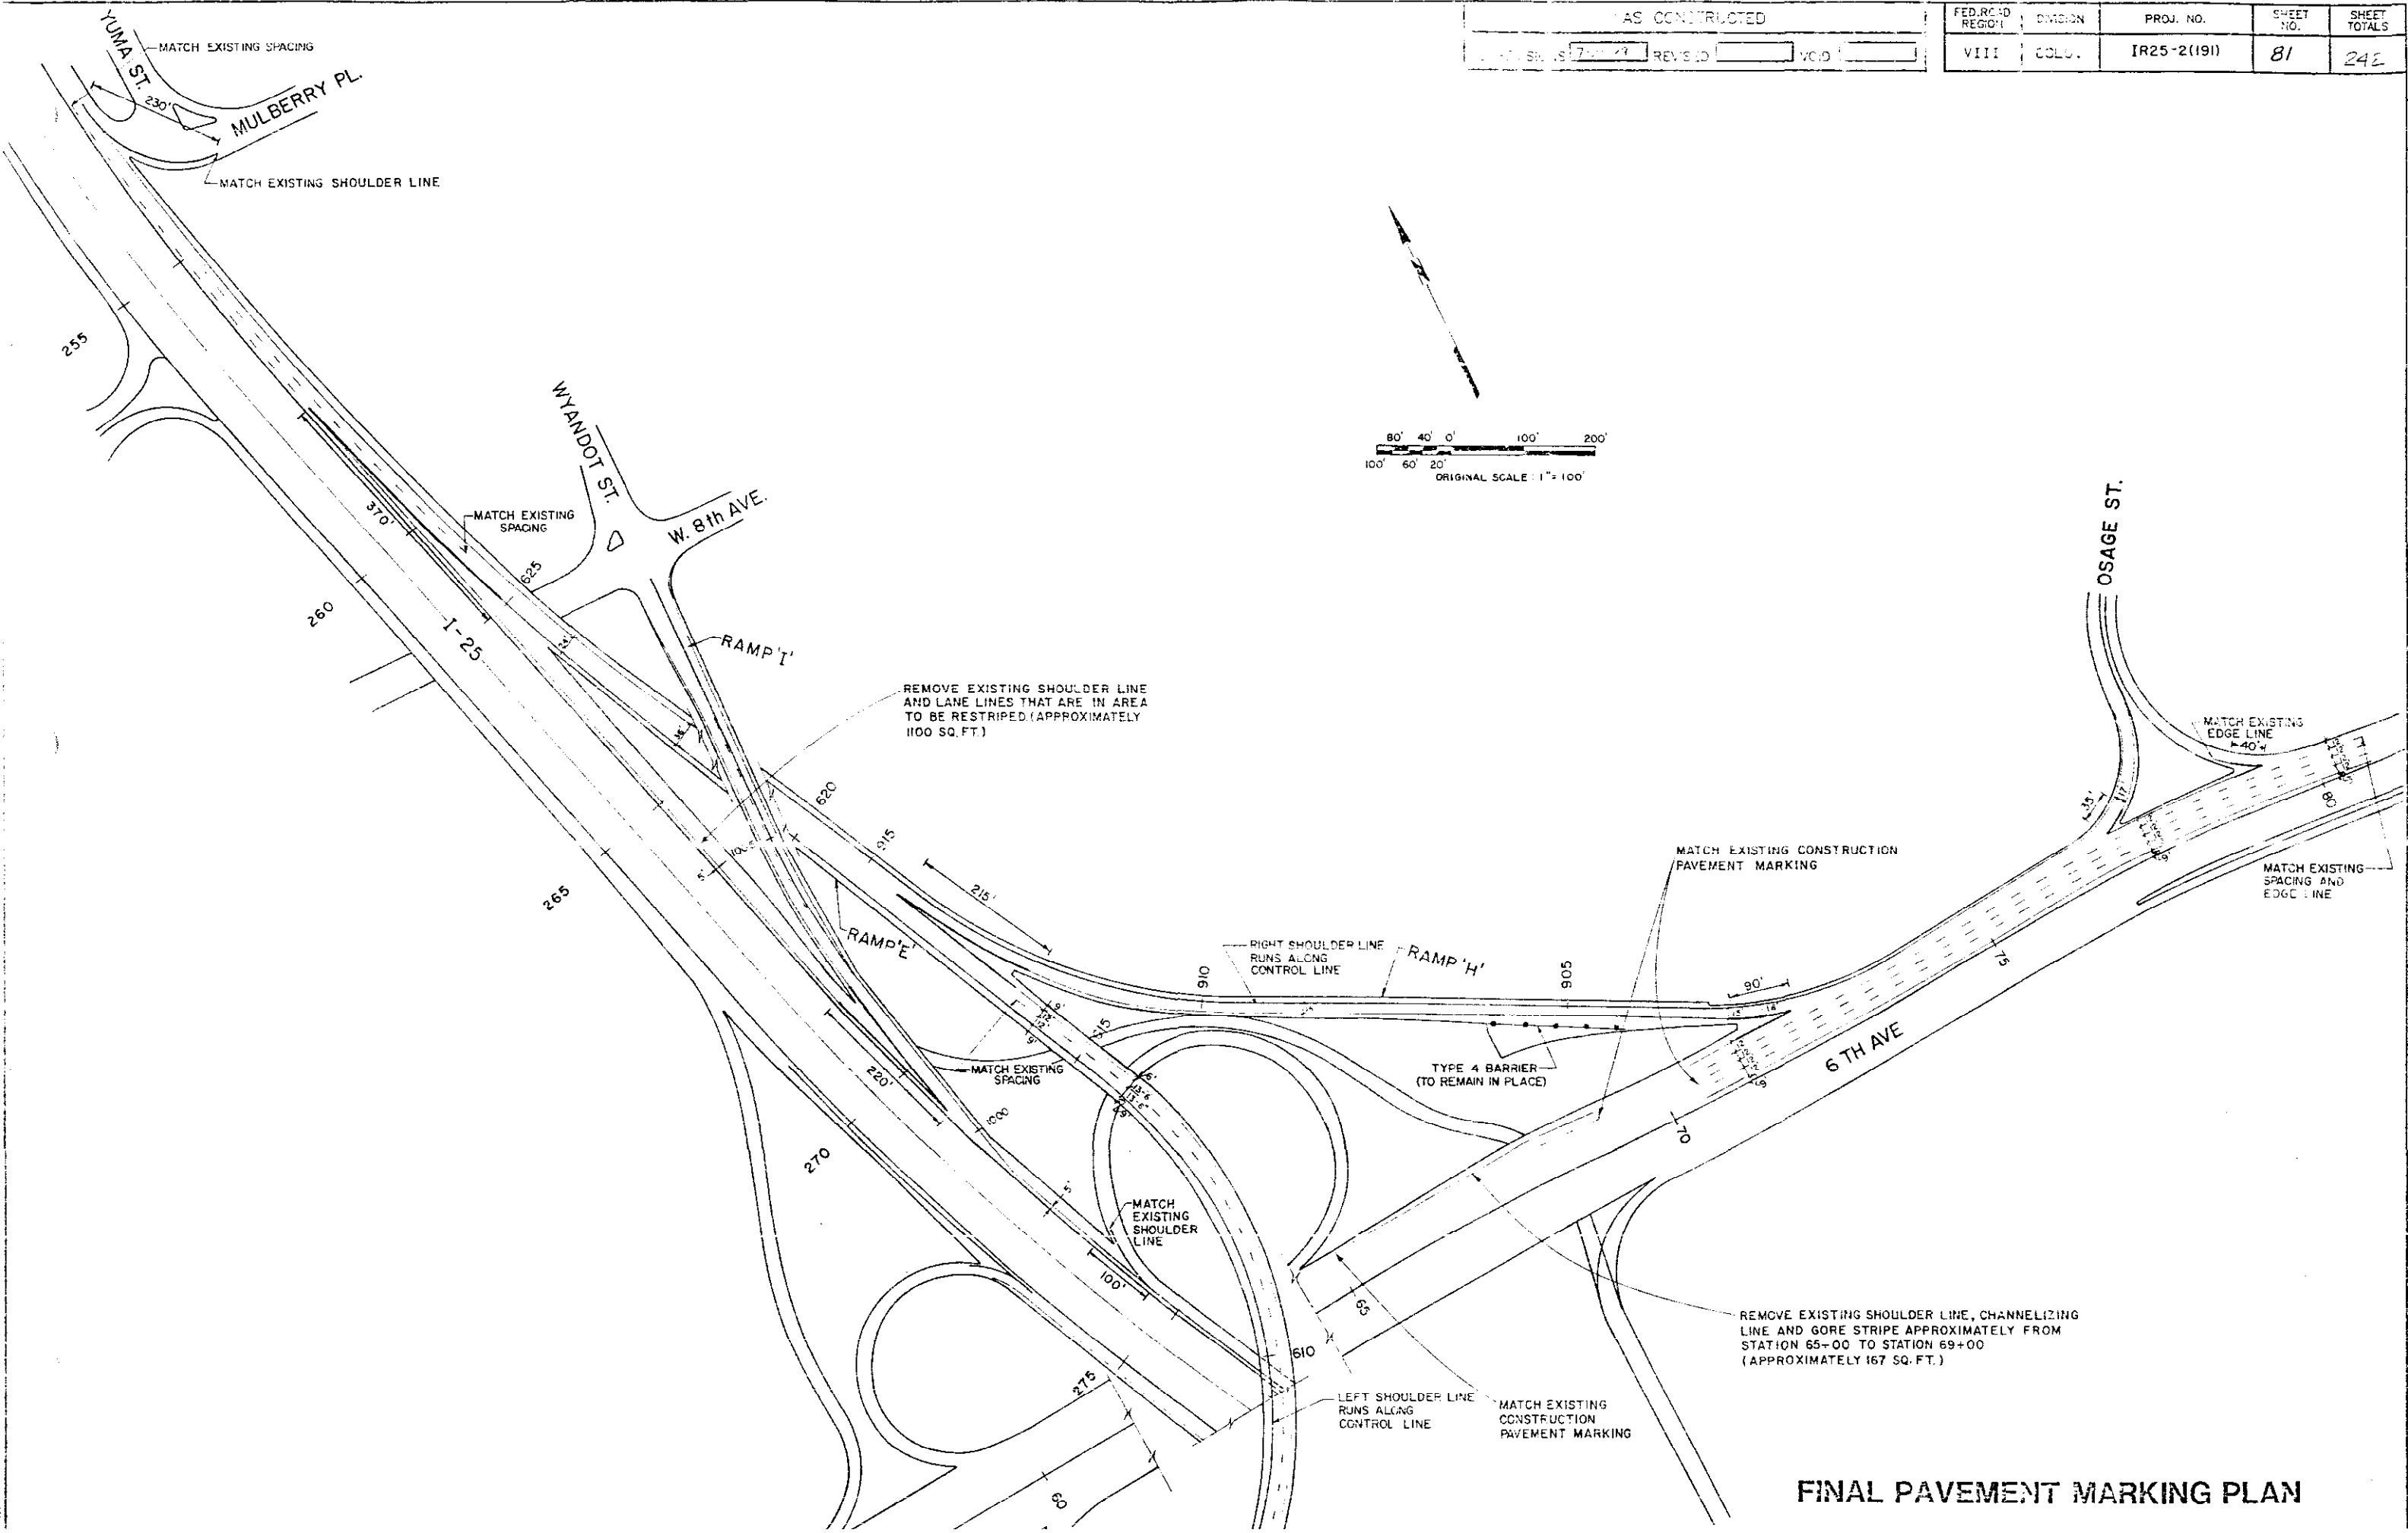

### FINAL PAVEMENT MARKING PLAN


7-21-9				
		1835-8 01	82	242

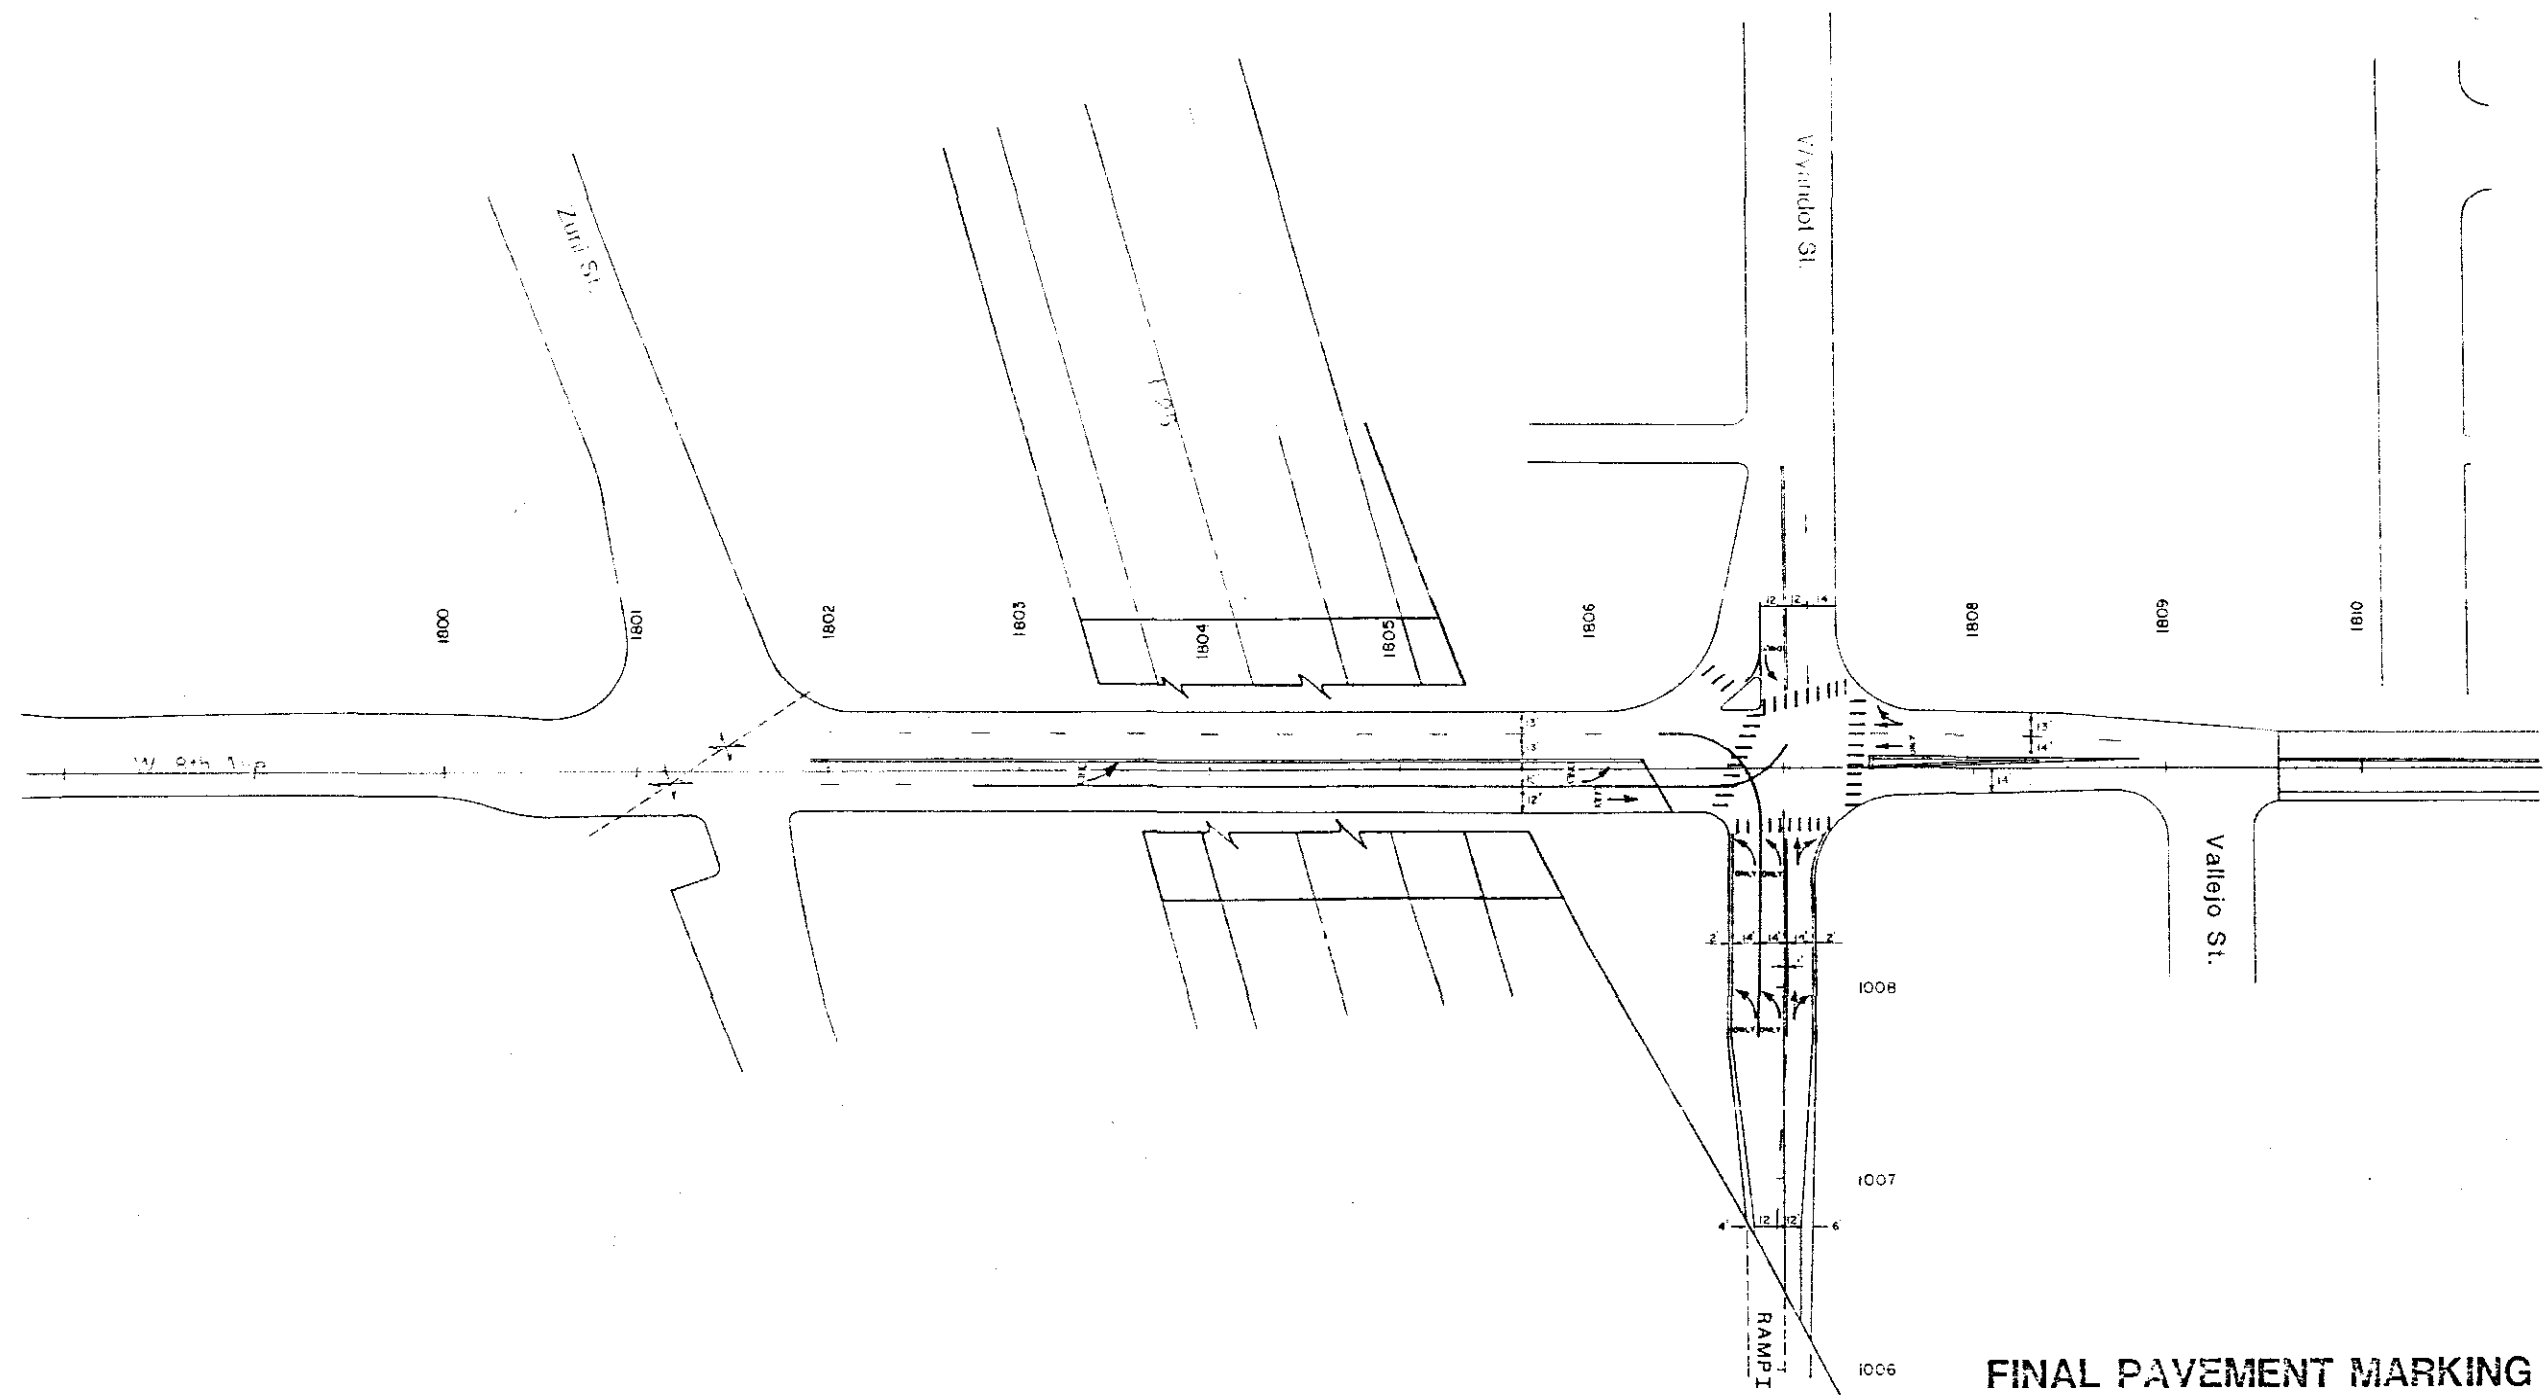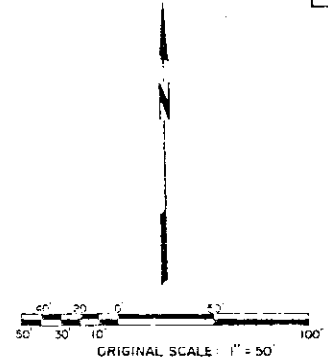

**FINAL PAVEMENT MARKING PLAN**

AS CONSTRUCTED		
NO. REVISIONS	7-21-80	REVISED
		VOID

FED. ROAD REGION	DIVISION	PROJ. NO.	SHEET NO.	SHEET TOTALS
VIII	COLO.	(R 25-2 (191))	83	242

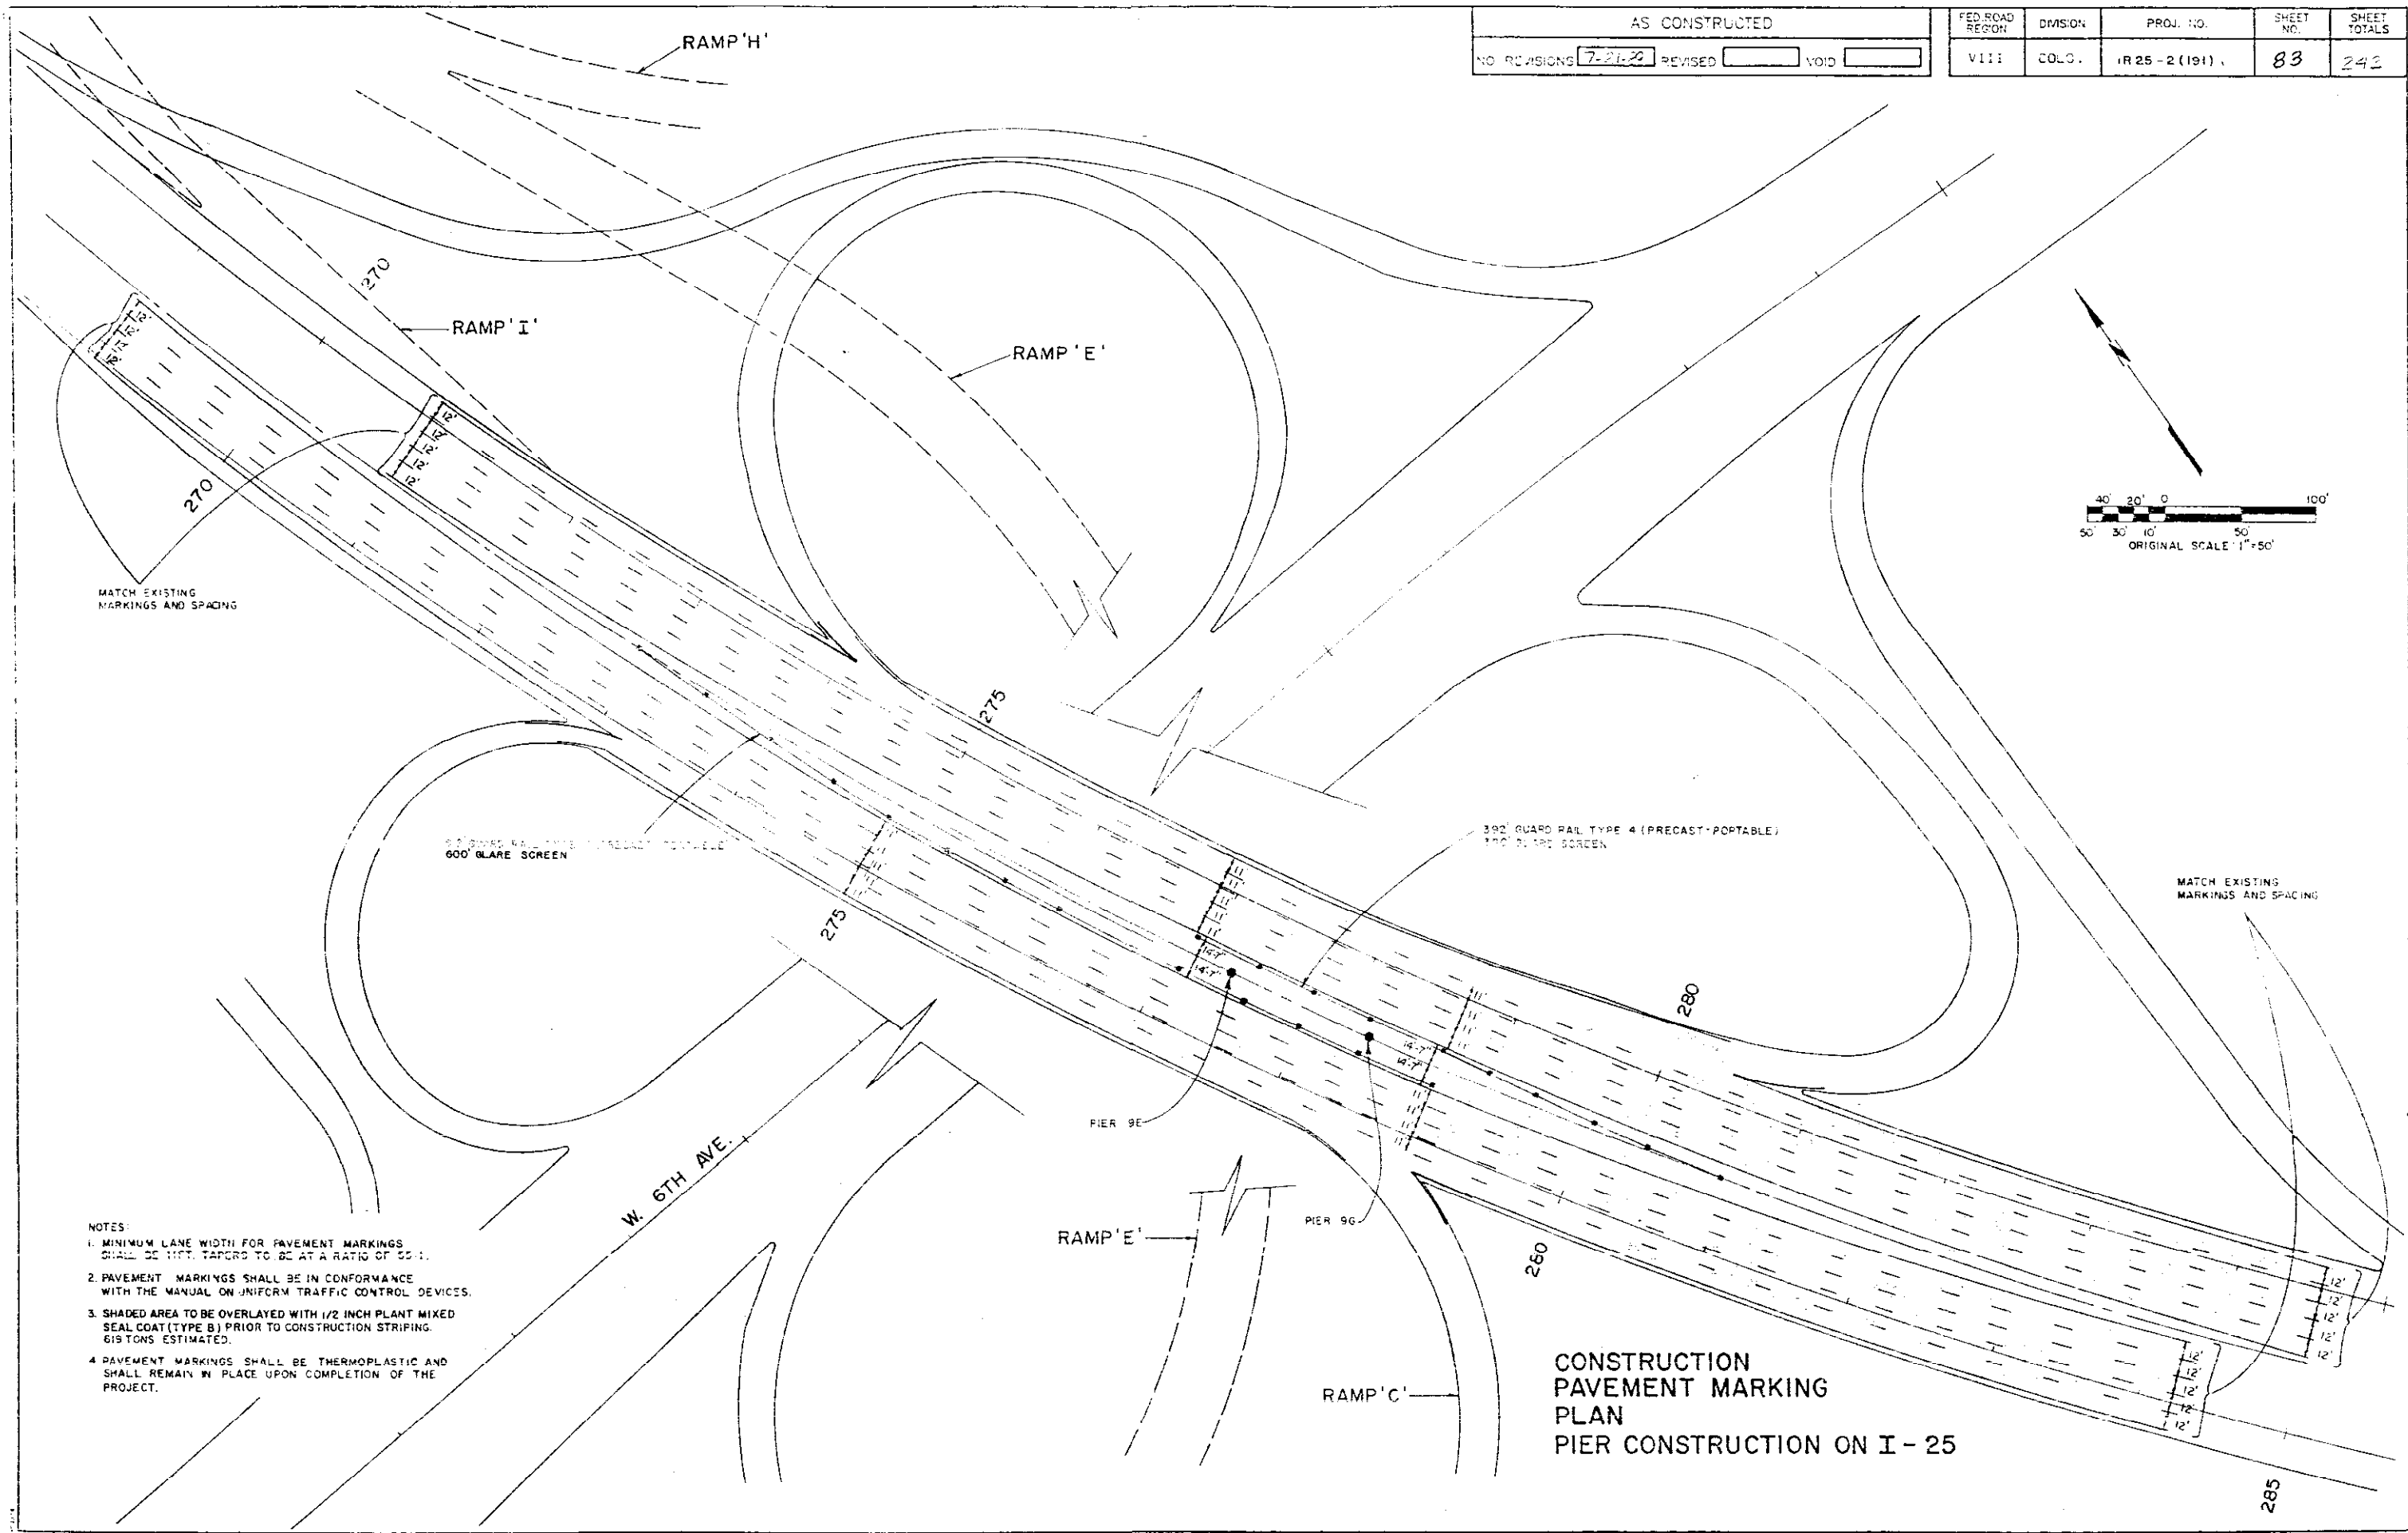


- NOTES:
1. MINIMUM LANE WIDTH FOR PAVEMENT MARKINGS SHALL BE 11 FT. TAPER TO 60 AT A RATIO OF 50:1.
  2. PAVEMENT MARKINGS SHALL BE IN CONFORMANCE WITH THE MANUAL ON UNIFORM TRAFFIC CONTROL DEVICES.
  3. SHADED AREA TO BE OVERLAYED WITH 1/2 INCH PLANT MIXED SEAL COAT (TYPE B) PRIOR TO CONSTRUCTION STRIPING. 619 TONS ESTIMATED.
  4. PAVEMENT MARKINGS SHALL BE THERMOPLASTIC AND SHALL REMAIN IN PLACE UPON COMPLETION OF THE PROJECT.

**CONSTRUCTION  
 PAVEMENT MARKING  
 PLAN  
 PIER CONSTRUCTION ON I-25**

AS CONSTRUCTED		
NO REVISIONS	REVISED 2/20/87	VOID

FED. ROAD REGION	DIVISION	PROJ. NO.	SHEET NO.	SHEET TOTALS
VIII	COLO.	IR 25-2 (191)	84	242


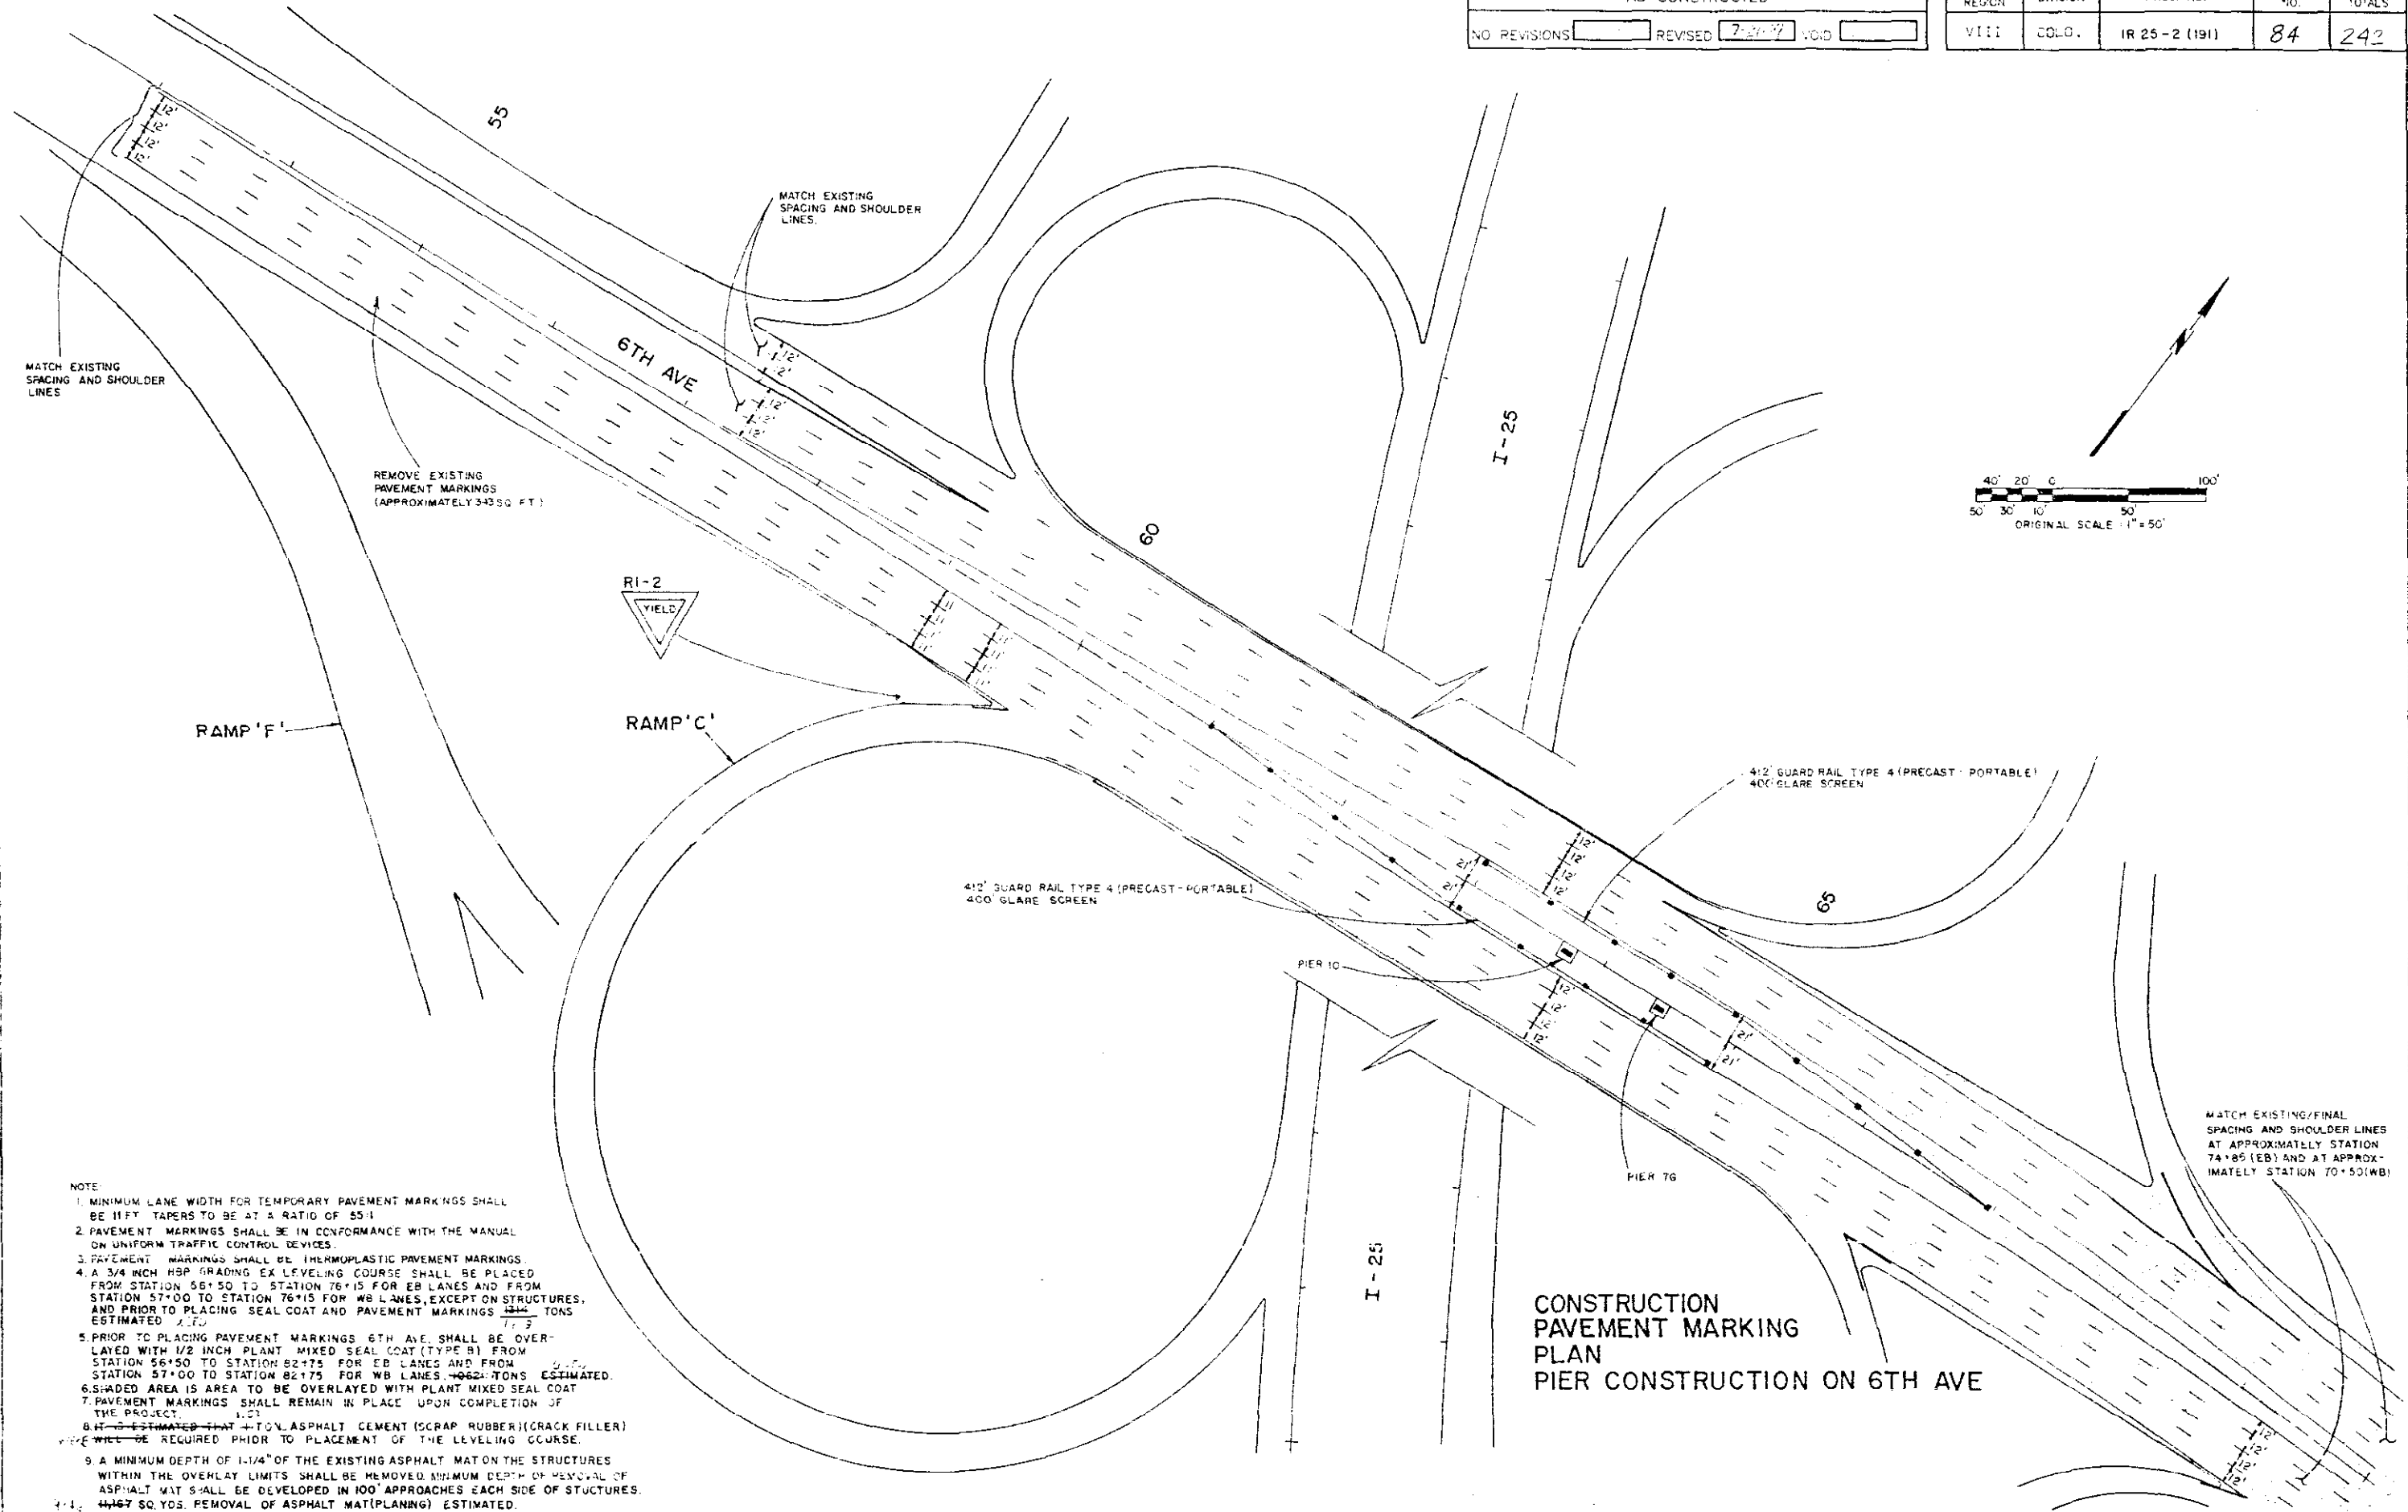


NOTE:

1. MINIMUM LANE WIDTH FOR TEMPORARY PAVEMENT MARKINGS SHALL BE 11 FT. TAPERS TO BE AT A RATIO OF 55:1
2. PAVEMENT MARKINGS SHALL BE IN CONFORMANCE WITH THE MANUAL ON UNIFORM TRAFFIC CONTROL DEVICES.
3. PAVEMENT MARKINGS SHALL BE THERMOPLASTIC PAVEMENT MARKINGS.
4. A 3/4 INCH HSP GRADING EX LEVELING COURSE SHALL BE PLACED FROM STATION 56+50 TO STATION 76+15 FOR EB LANES AND FROM STATION 57+00 TO STATION 76+15 FOR WB LANES, EXCEPT ON STRUCTURES. AND PRIOR TO PLACING SEAL COAT AND PAVEMENT MARKINGS  $\frac{1144}{11.3}$  TONS ESTIMATED 2.170
5. PRIOR TO PLACING PAVEMENT MARKINGS 6TH AVE SHALL BE OVERLAYED WITH 1/2 INCH PLANT MIXED SEAL COAT (TYPE B1) FROM STATION 56+50 TO STATION 82+75 FOR EB LANES AND FROM STATION 57+00 TO STATION 82+75 FOR WB LANES.  $\frac{1062}{11.3}$  TONS ESTIMATED 9.372
6. SHADED AREA IS AREA TO BE OVERLAYED WITH PLANT MIXED SEAL COAT
7. PAVEMENT MARKINGS SHALL REMAIN IN PLACE UPON COMPLETION OF THE PROJECT. 1.21
8. H-1 IS ESTIMATED THAT 4 TON ASPHALT CEMENT (SCRAP RUBBER) (CRACK FILLER) WILL BE REQUIRED PRIOR TO PLACEMENT OF THE LEVELING COURSE.
9. A MINIMUM DEPTH OF 1-1/4" OF THE EXISTING ASPHALT MAT ON THE STRUCTURES WITHIN THE OVERLAY LIMITS SHALL BE REMOVED. MINIMUM DEPTH OF REMOVAL OF ASPHALT MAT SHALL BE DEVELOPED IN 100' APPROACHES EACH SIDE OF STRUCTURES.
10. 4467 SQ. YDS. REMOVAL OF ASPHALT MAT (PLANING) ESTIMATED.

CONSTRUCTION PAVEMENT MARKING PLAN  
 PIER CONSTRUCTION ON 6TH AVE

AS CONSTRUCTED		RED ROAD REGION	DIVISION	PROJ. NO.	SHEET NO.	SHEET TOTALS
NO REVISIONS	7-31-77	REVISED		NO. 0	111	JULY, IR 25-2 (191)
					85	242

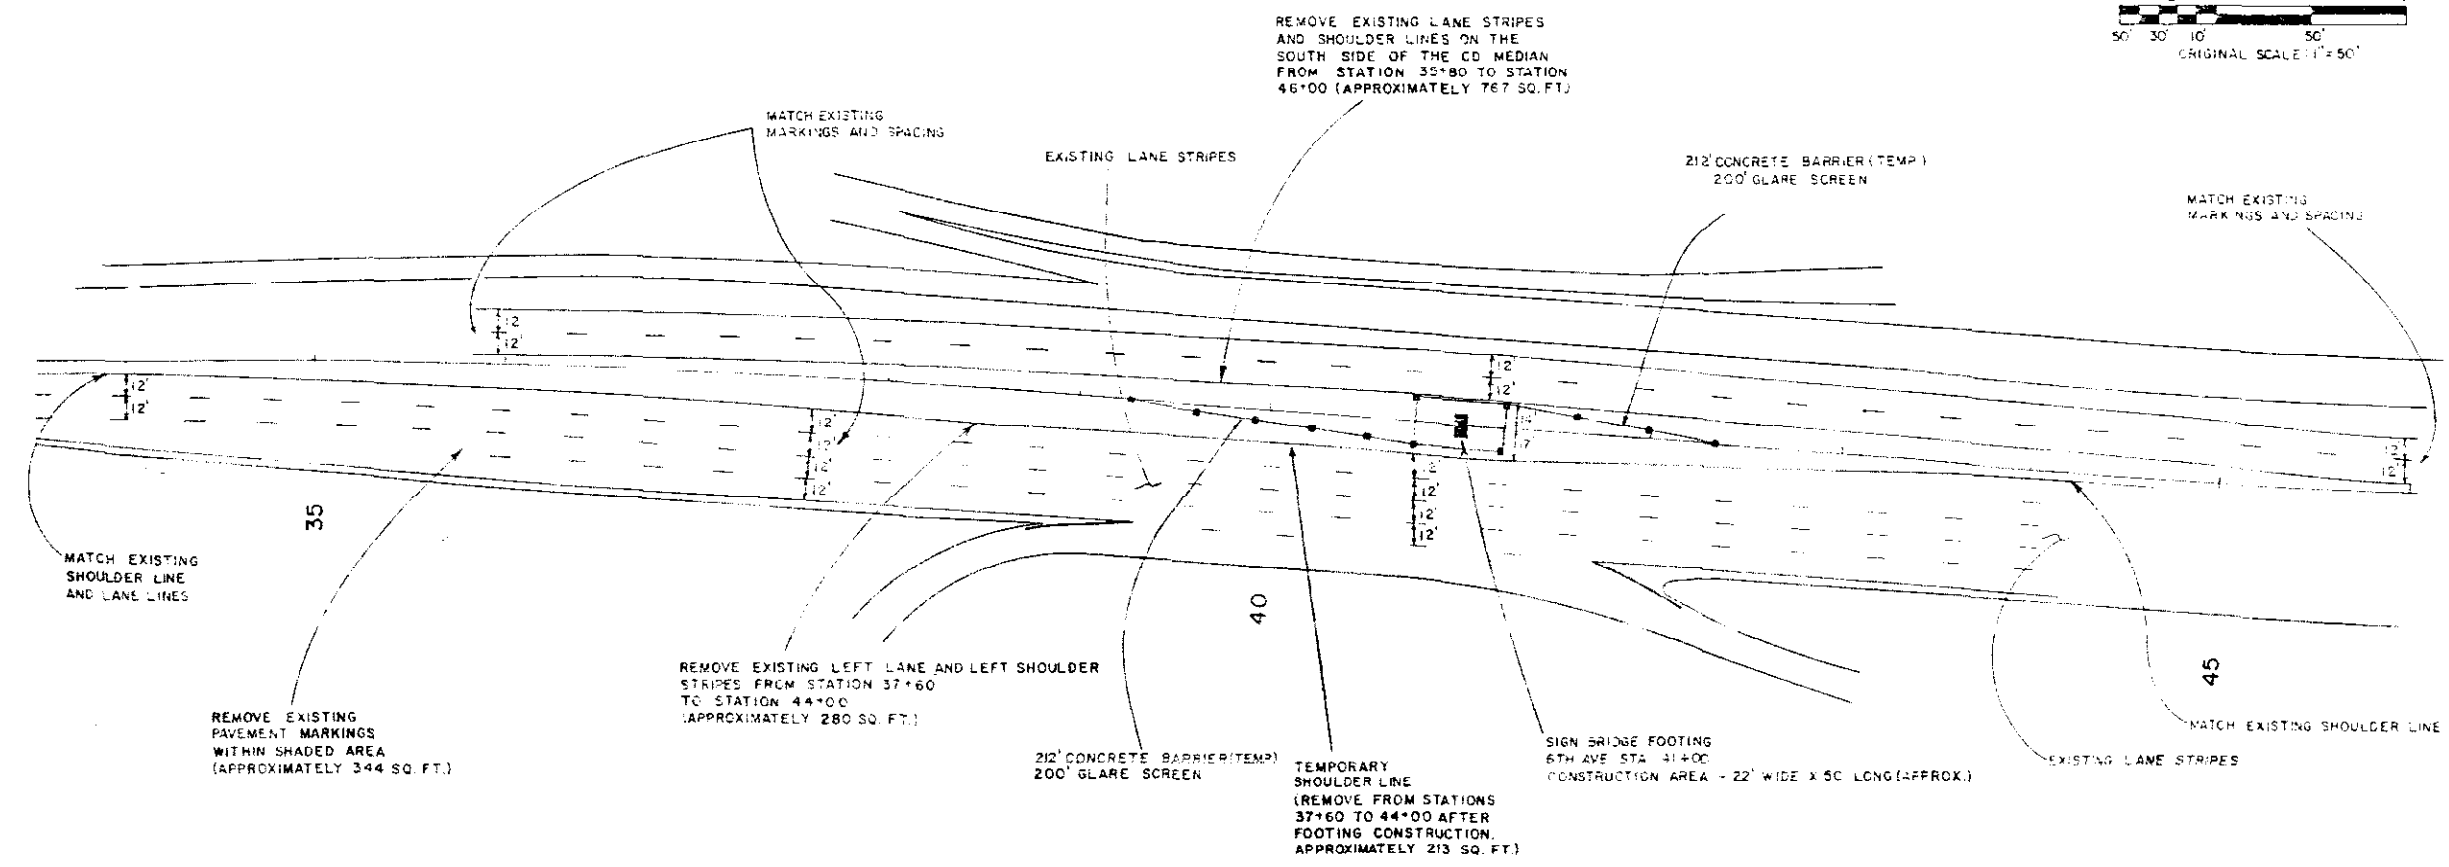
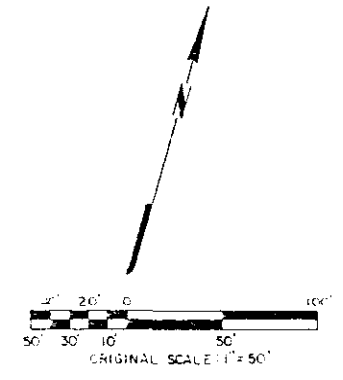


- NOTES
- EXISTING PAVEMENT MARKINGS SHALL BE REPLACED WITH THERMOPLASTIC FOR SHOULDER LINES AND WITH 60 MIL PREFORMED PLASTIC FOR LANE LINES AFTER CONSTRUCTION OF FOOTINGS.
  - MINIMUM LANE WIDTH FOR TEMPORARY PAVEMENT MARKINGS SHALL BE 12 FEET. TAPERS TO BE AT A RATIO OF 55:1.
  - TEMPORARY MARKINGS SHALL BE IN CONFORMANCE WITH THE MANUAL ON UNIFORM TRAFFIC CONTROL DEVICES.
  - TEMPORARY PAVEMENT MARKINGS SHALL BE PAINT.
  - SHADED AREA IS AREA TO BE OVERLAYED WITH 1/2 INCH PLANT MIXED SEAL COAT (TYPE B). THE SEAL COAT SHALL BE PLACED FROM STATIONS 35+80 TO 46+00 FOR WB LANES BETWEEN THE C.D. MEDIAN AND THE  $\frac{1}{2}$  MEDIAN AND FROM STATIONS 34+00 TO 37+60 FOR EB LANES 187 TONS ESTIMATED.
  - SEAL COAT SHALL BE PLACED AFTER CONSTRUCTION OF SIGN BRIDGE FOOTINGS. PAVEMENT MARKINGS SHALL BE RETURNED TO EXISTING PAVEMENT MARKINGS.
  - GLARE SCREEN TO BE REMOVED AND STOCKPILED ON JOB SITE AS DESIGNATED BY THE PROJECT ENGINEER AFTER CONSTRUCTION OF SIGN BRIDGE FOOTING.

PAVEMENT MARKING (TEMPORARY)  
6TH AVE STA. 41+00  
INSTALLATION OF SIGN BRIDGE FOOTING

AS CONSTRUCTED		
NO REVISIONS	7-21-79	REVISED
		VOID

FED. ROAD REGION	DIVISION	PROJ. NO.	SHEET NO.	SHEET TOTALS
VIII	COLO.	IR 25-2(191)	86	241

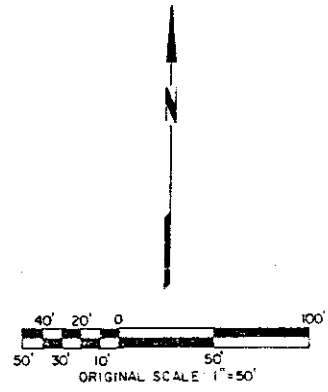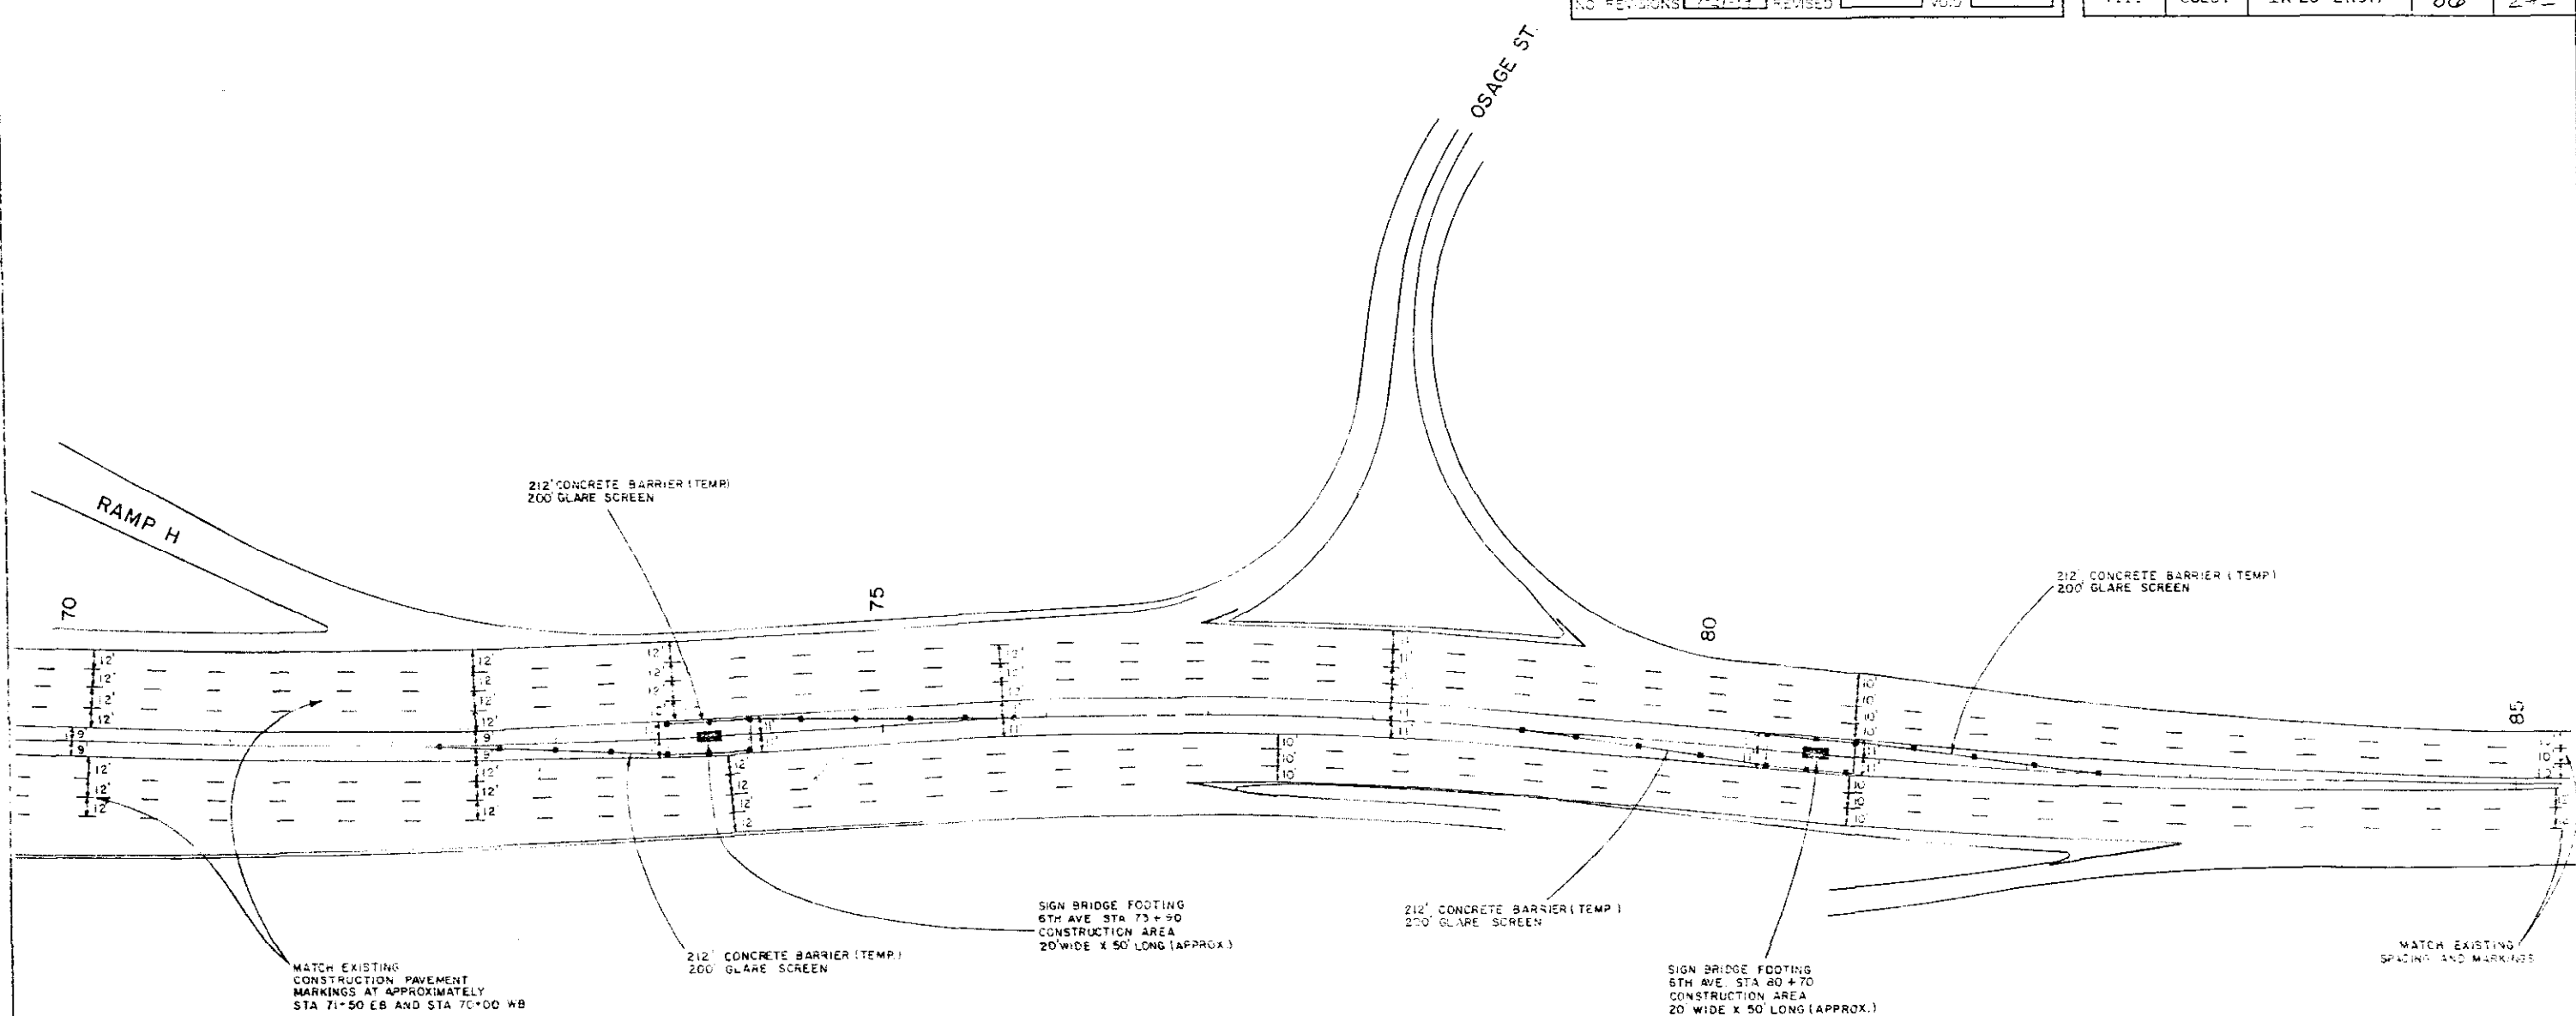

- NOTES
1. TEMPORARY PAVEMENT MARKINGS SHALL BE PAINT.
  2. MINIMUM LANE WIDTH FOR TEMPORARY PAVEMENT MARKINGS SHALL BE 10 FEET. TAPER SHALL BE AT A RATIO OF 55:1.
  3. TEMPORARY PAVEMENT MARKINGS SHALL BE IN CONFORMANCE WITH THE MANUAL ON UNIFORM TRAFFIC CONTROL DEVICES.
  4. SHADED AREA IS AREA TO BE OVERLAYED WITH 1/2 INCH PLANT MIXED SEAL COAT (TYPE B). SEE FINAL PAVEMENT MARKING PLANS FOR PAVEMENT MARKINGS TO BE PLACED WITH SEAL COAT.
  5. REMOVE EXISTING PAVEMENT MARKINGS IN THE AREA THAT TEMPORARY PAVEMENT MARKINGS ARE TO BE PLACED (APPROXIMATELY 3000 SQ. FT.)
  6. GLARE SCREEN TO BE REMOVED AND STOCKPILED ON JOB SITE AS DESIGNATED BY PROJECT ENGINEER AFTER CONSTRUCTION OF SIGN BRIDGE FOOTINGS.
  7. REMOVE TEMPORARY PAVEMENT MARKINGS AFTER CONSTRUCTION OF SIGN BRIDGE FOOTINGS AND PLACE FINAL PAVEMENT MARKINGS (APPROXIMATELY 2975 SQ. FT. REMOVE)

PAVEMENT MARKING PLAN (TEMPORARY)  
 6TH AVE. STA. 80+70 & STA. 73+90  
 INSTALLATION OF SIGN BRIDGE FOOTINGS






AS CONSTRUCTED		
NO REVISIONS	REVISED	VOID

FED. AID REGION	DIVISION	PROJ. NO.	SHEET NO.	SHEET TOTALS
VII	COLO.	IR 25-2(191)	88	

# TYPICAL I 25 & S.H. 6 CLOSURE FOR DETOURS

FOR INFORMATION ONLY

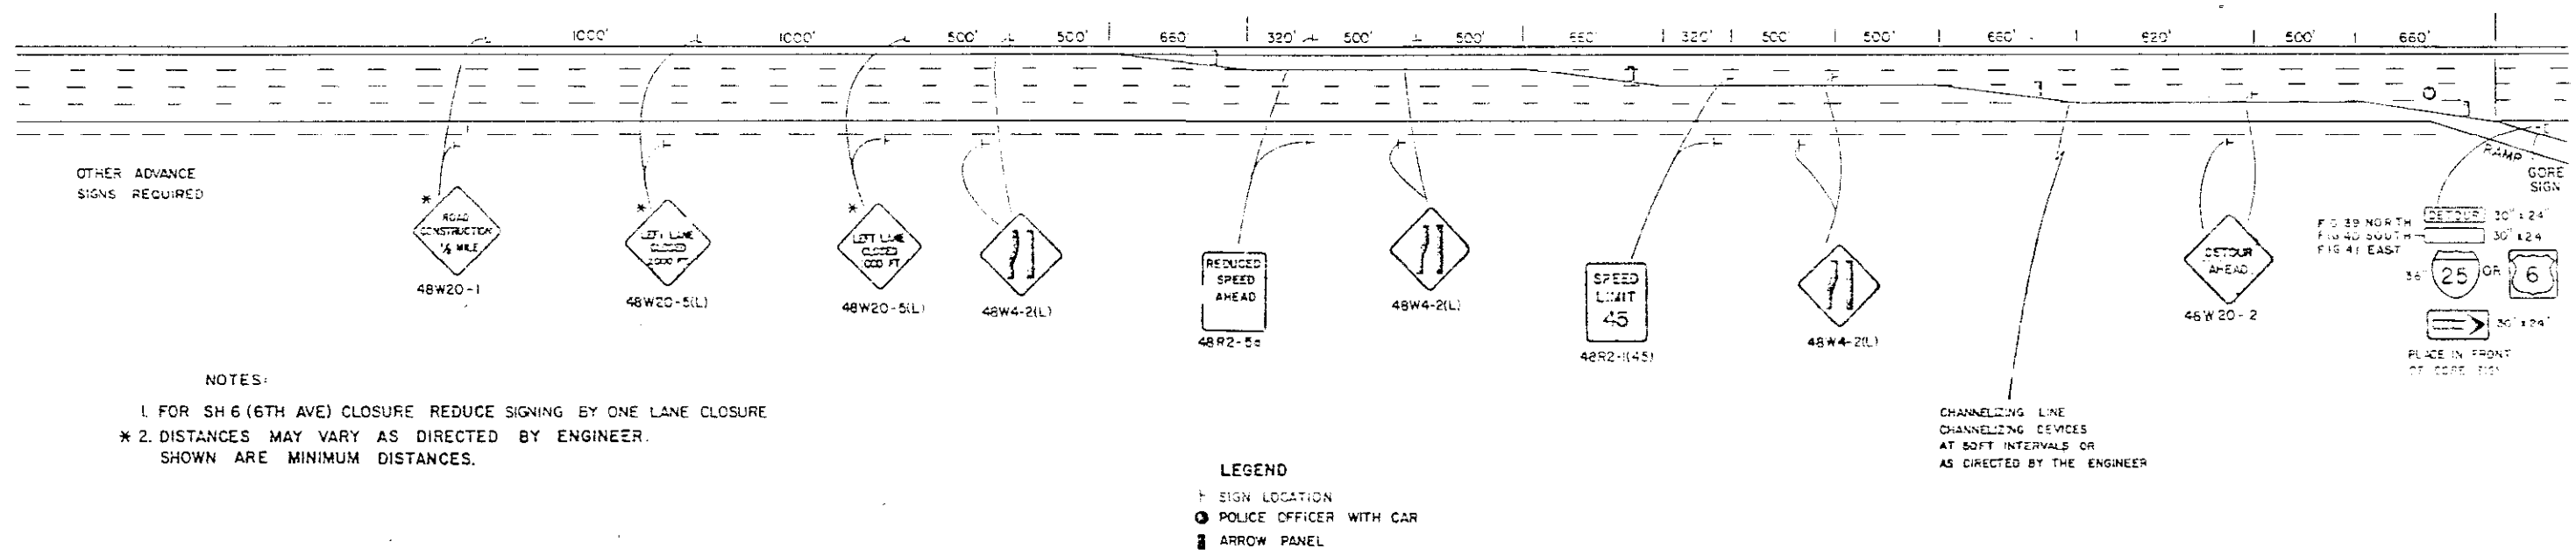

NOTES:  
 1. FOR SH 6 (6TH AVE) CLOSURE REDUCE SIGNING BY ONE LANE CLOSURE  
 \* 2. DISTANCES MAY VARY AS DIRECTED BY ENGINEER.  
 SHOWN ARE MINIMUM DISTANCES.


LEGEND  
 △ SIGN LOCATION  
 ● POLICE OFFICER WITH CAR  
 ▭ ARROW PANEL

CHANNELIZING LINE  
 CHANNELIZING DEVICES  
 AT 50 FT INTERVALS OR  
 AS DIRECTED BY THE ENGINEER

I-25 & 6th Ave. DETOUR PLAN


AS CONSTRUCTED		
NO REVISIONS	REVISED	VOID
7		

FED. ROAD REGION	DIVISION	PROJ. NO.	SHEET NO.	SHEET TOTALS
VIII	COLD.	IR25-2(191)	89	

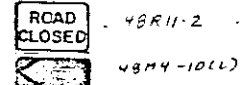

MOUNT ON 3M-A BARRICADE TO BE IN PLACE WHEN 6TH AVE W.B. IS CLOSED.


FOR INFORMATION ONLY

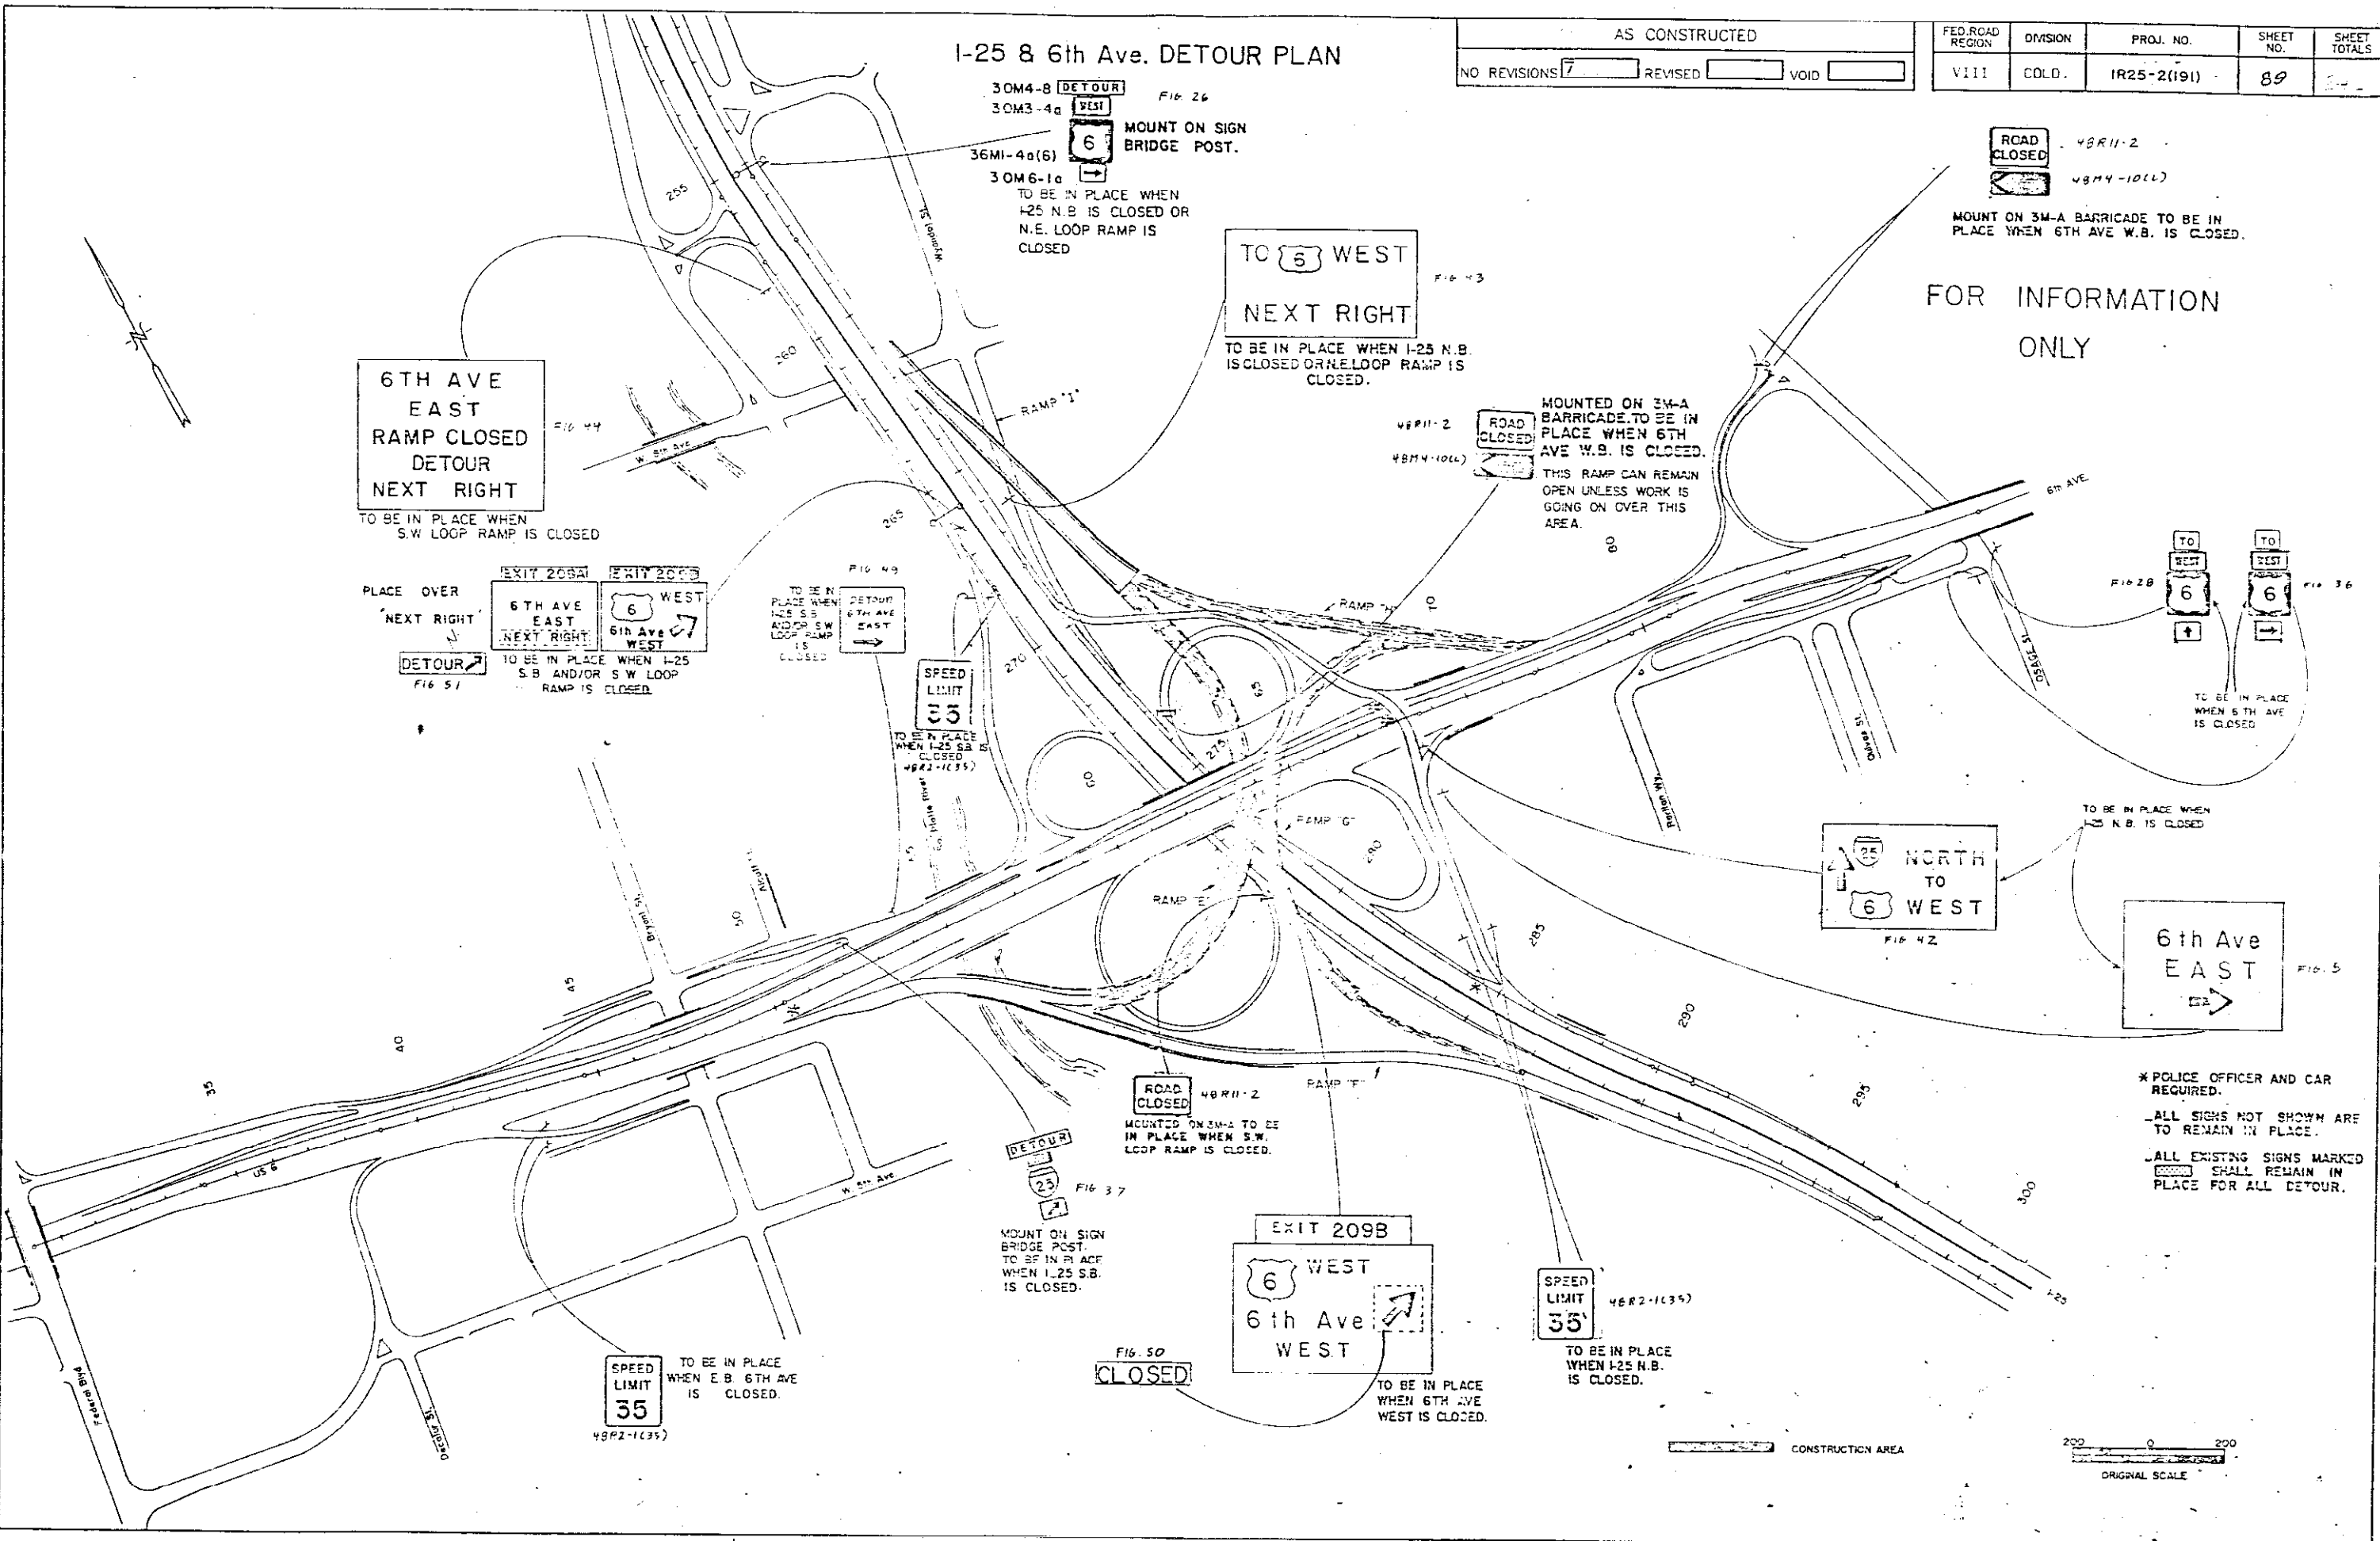


\* POLICE OFFICER AND CAR REQUIRED.  
 ALL SIGNS NOT SHOWN ARE TO REMAIN IN PLACE.  
 ALL EXISTING SIGNS MARKED SHALL REMAIN IN PLACE FOR ALL DETOUR.



 DETOUR PLAN

ALL SIGN NOT SHOWN SHALL REMAIN IN PLACE.  
 EXISTING SIGNS MARKED  SHALL REMAIN IN PLACE FOR ALL DETOURS.

AS CONSTRUCTED		FED. ROAD REGION	DIVISION	PROJ. NO.	SHEET NO.	SHEET TOTALS
NO REVISIONS	7-2-1-1-1	VIII	COLO.	IR25-2(191)	91	24
REVISED						
VOID						

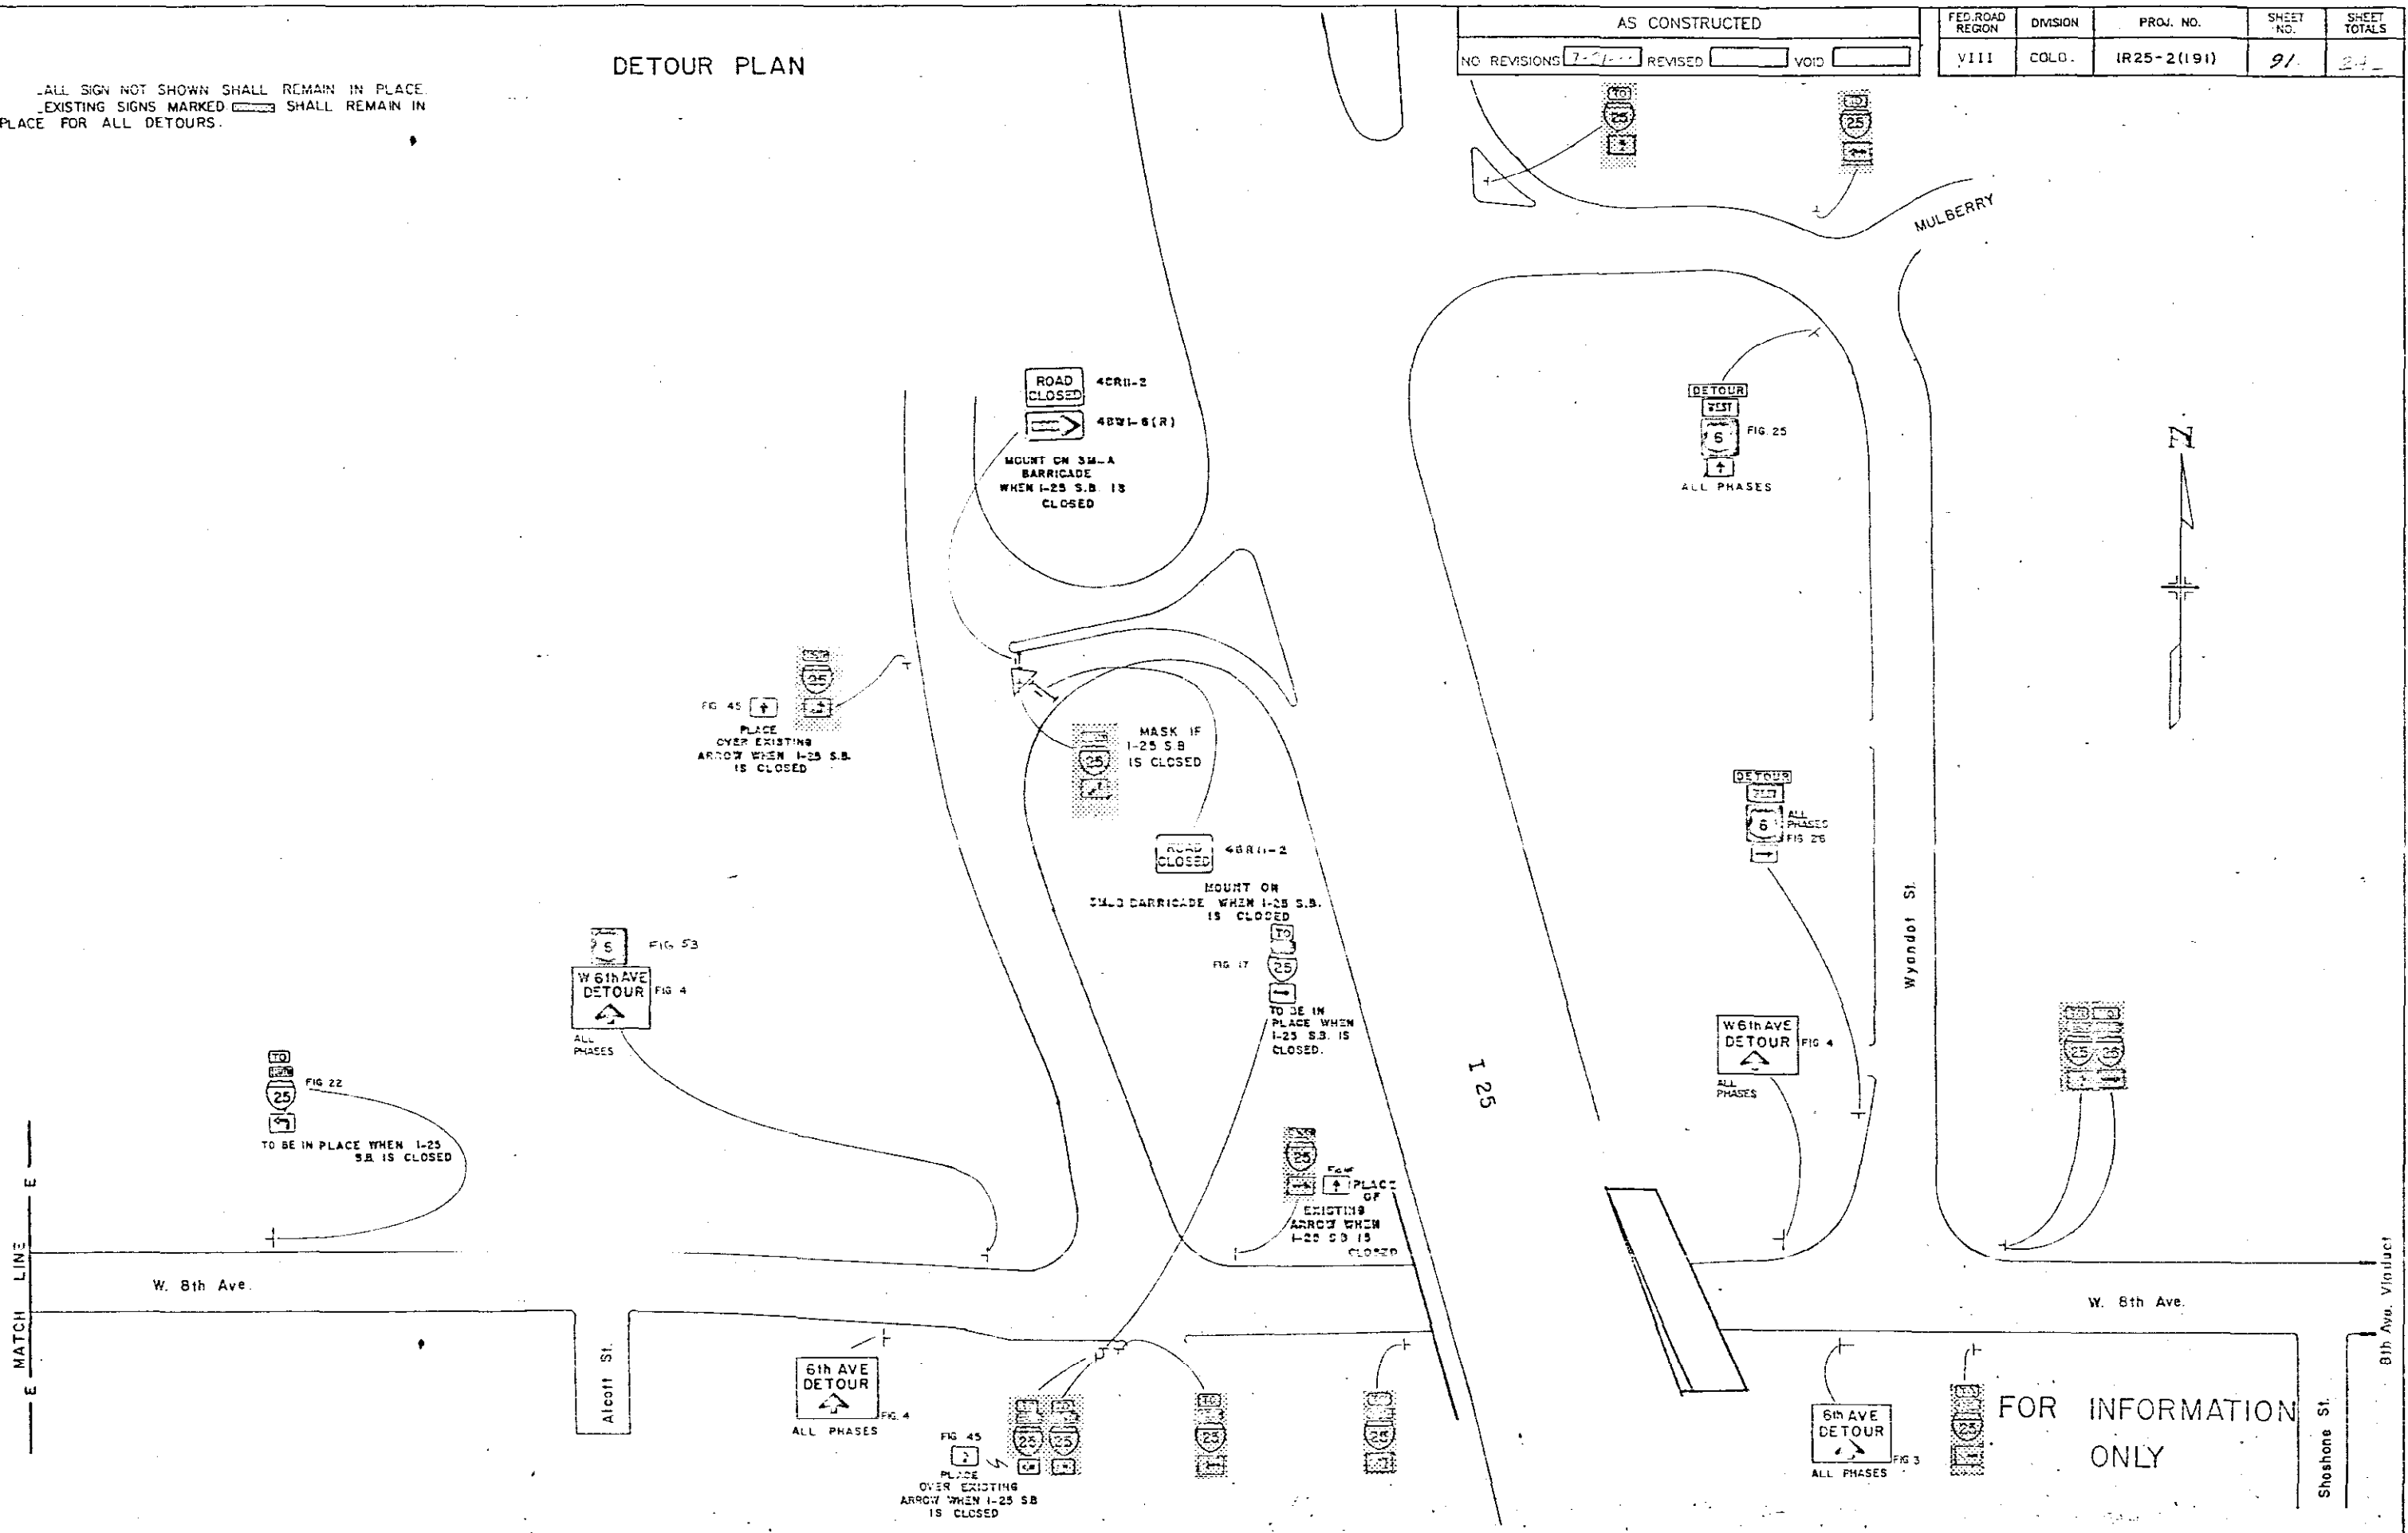


FOR INFORMATION ONLY

DETOUR PLAN

AS CONSTRUCTED		
NO REVISIONS	REVISED	VOID

FED. ROAD REGION	DIVISION	PROJ. NO.	SHEET NO.	SHEET TOTALS
VIII	COLO.	IR25-2(191)	92	

FOR INFORMATION ONLY

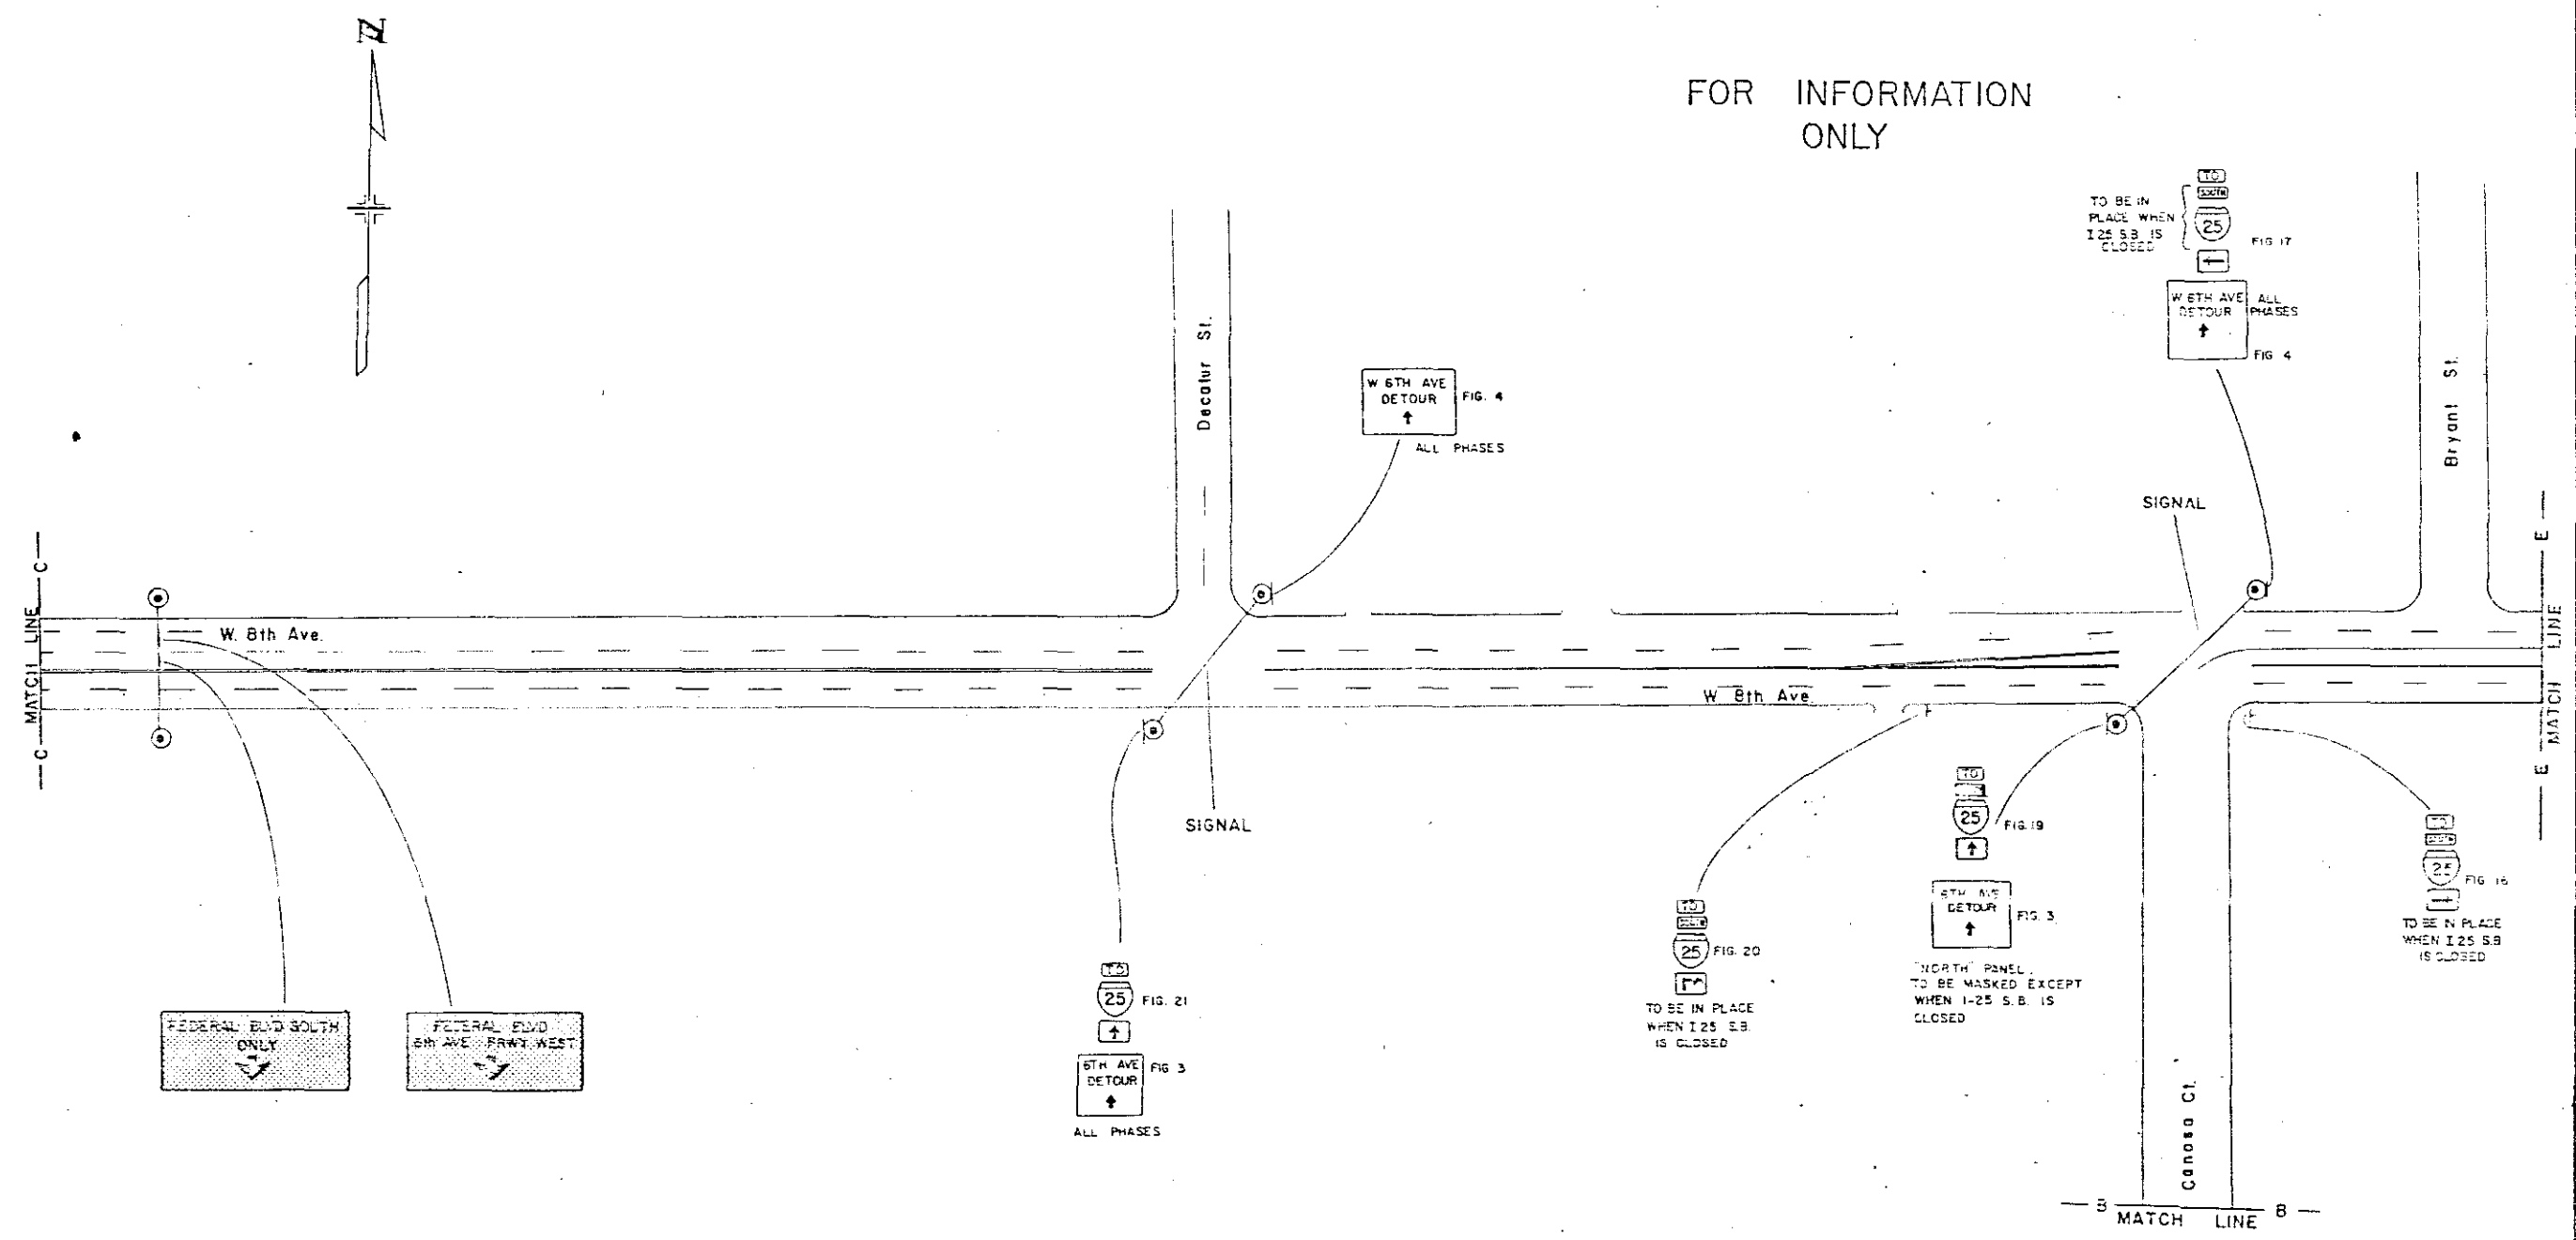

ALL SIGNS NOT SHOWN ARE TO REMAIN IN PLACE  
 ALL EXISTING SIGNS MARKED [Hatched Box] SHALL REMAIN IN PLACE FOR ALL DETOURS


DETOUR PLAN

AS CONSTRUCTED		FED. ROAD REGION	DIVISION	PROJ. NO.	SHEET NO.	SHEET TOTALS
NO REVISIONS	REVISED	VOID	VIII	COLO.	IR25-2(19)	93

FOR INFORMATION ONLY



MATCH LINE

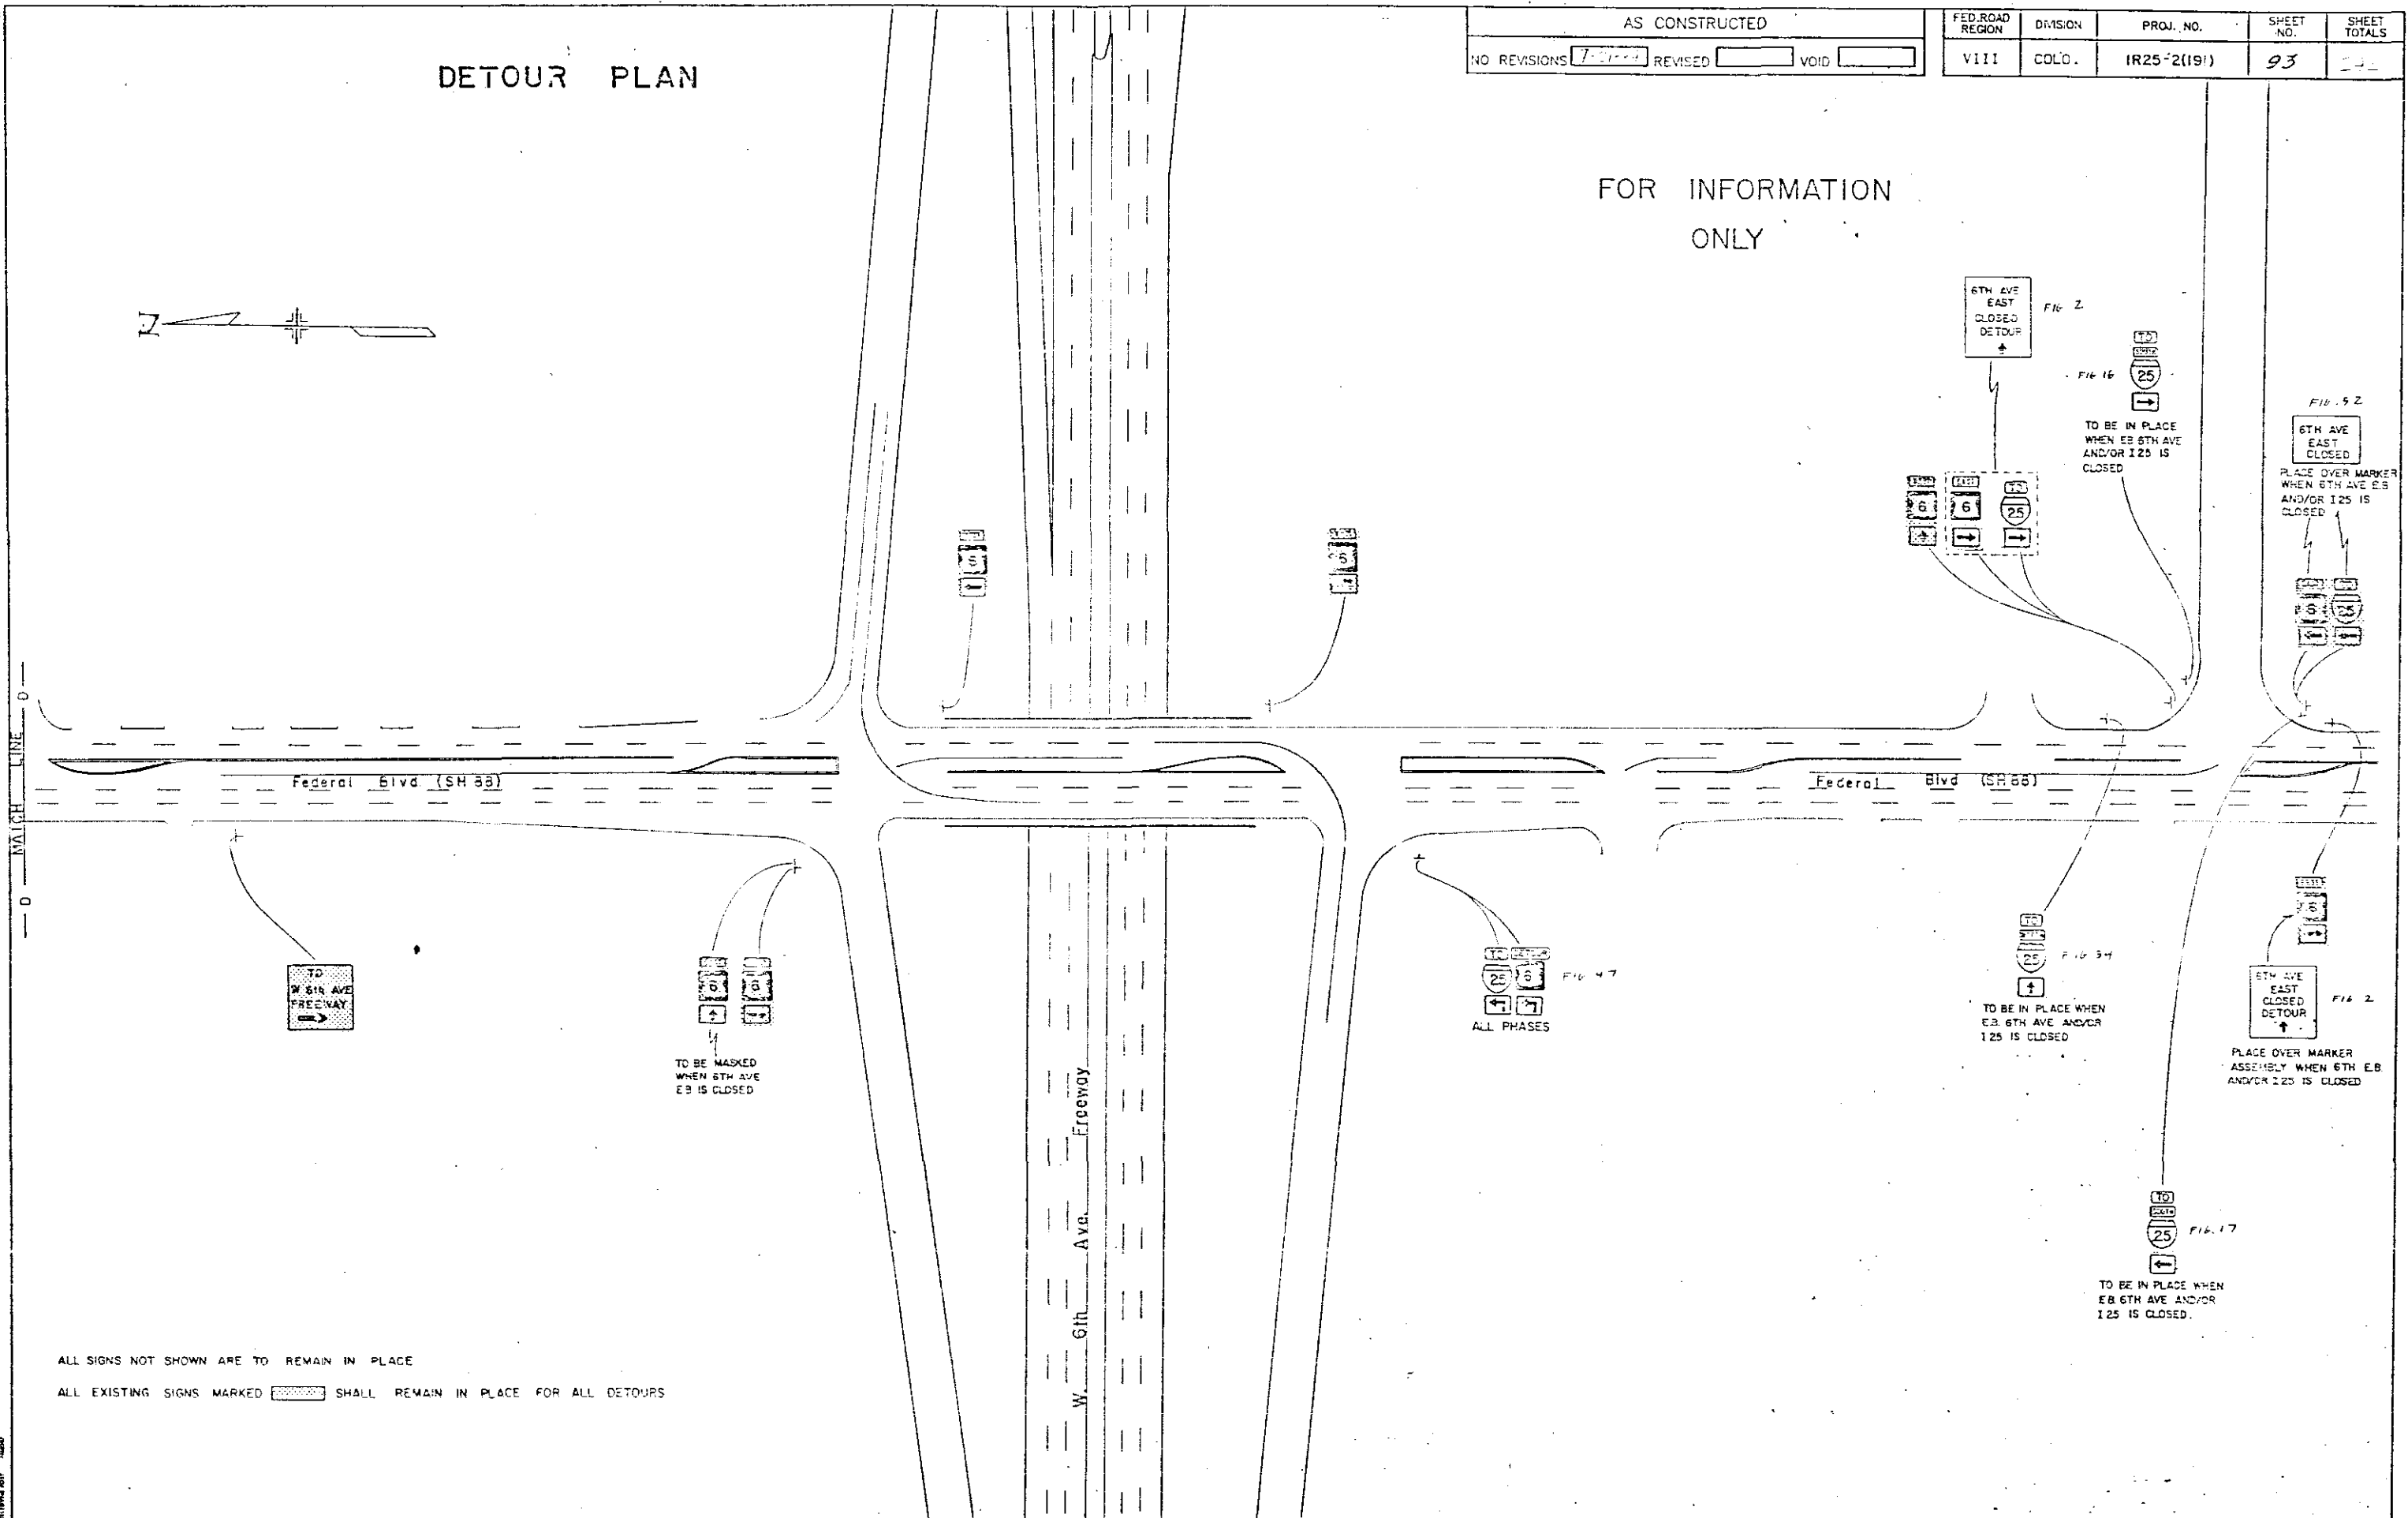

ALL SIGNS NOT SHOWN ARE TO REMAIN IN PLACE  
 ALL EXISTING SIGNS MARKED [hatched box] SHALL REMAIN IN PLACE FOR ALL DETOURS

DRAWING BY: JMB

# DETOUR PLAN

AS CONSTRUCTED		FED. ROAD REGION	DMS/ON	PROJ. NO.	SHEET NO.	SHEET TOTALS
NO REVISIONS	7	REVIS	VOID	VIII	COLO.	IR25-2(191)
					94	24

MATCH LINE




\* LANE CLOSURE FOR WHEN WB 6TH AVE IS CLOSED

- LEGEND
- ARROW PANEL
  - TRAFFIC CONE
  - 165' TAPERS
  - 330' TANGENTS

ALL SIGNS NOT SHOWN ARE TO REMAIN IN PLACE  
 ALL EXISTING SIGNS MARKED [shaded box] ARE TO REMAIN IN PLACE FOR ALL DETOURS

FOR INFORMATION ONLY

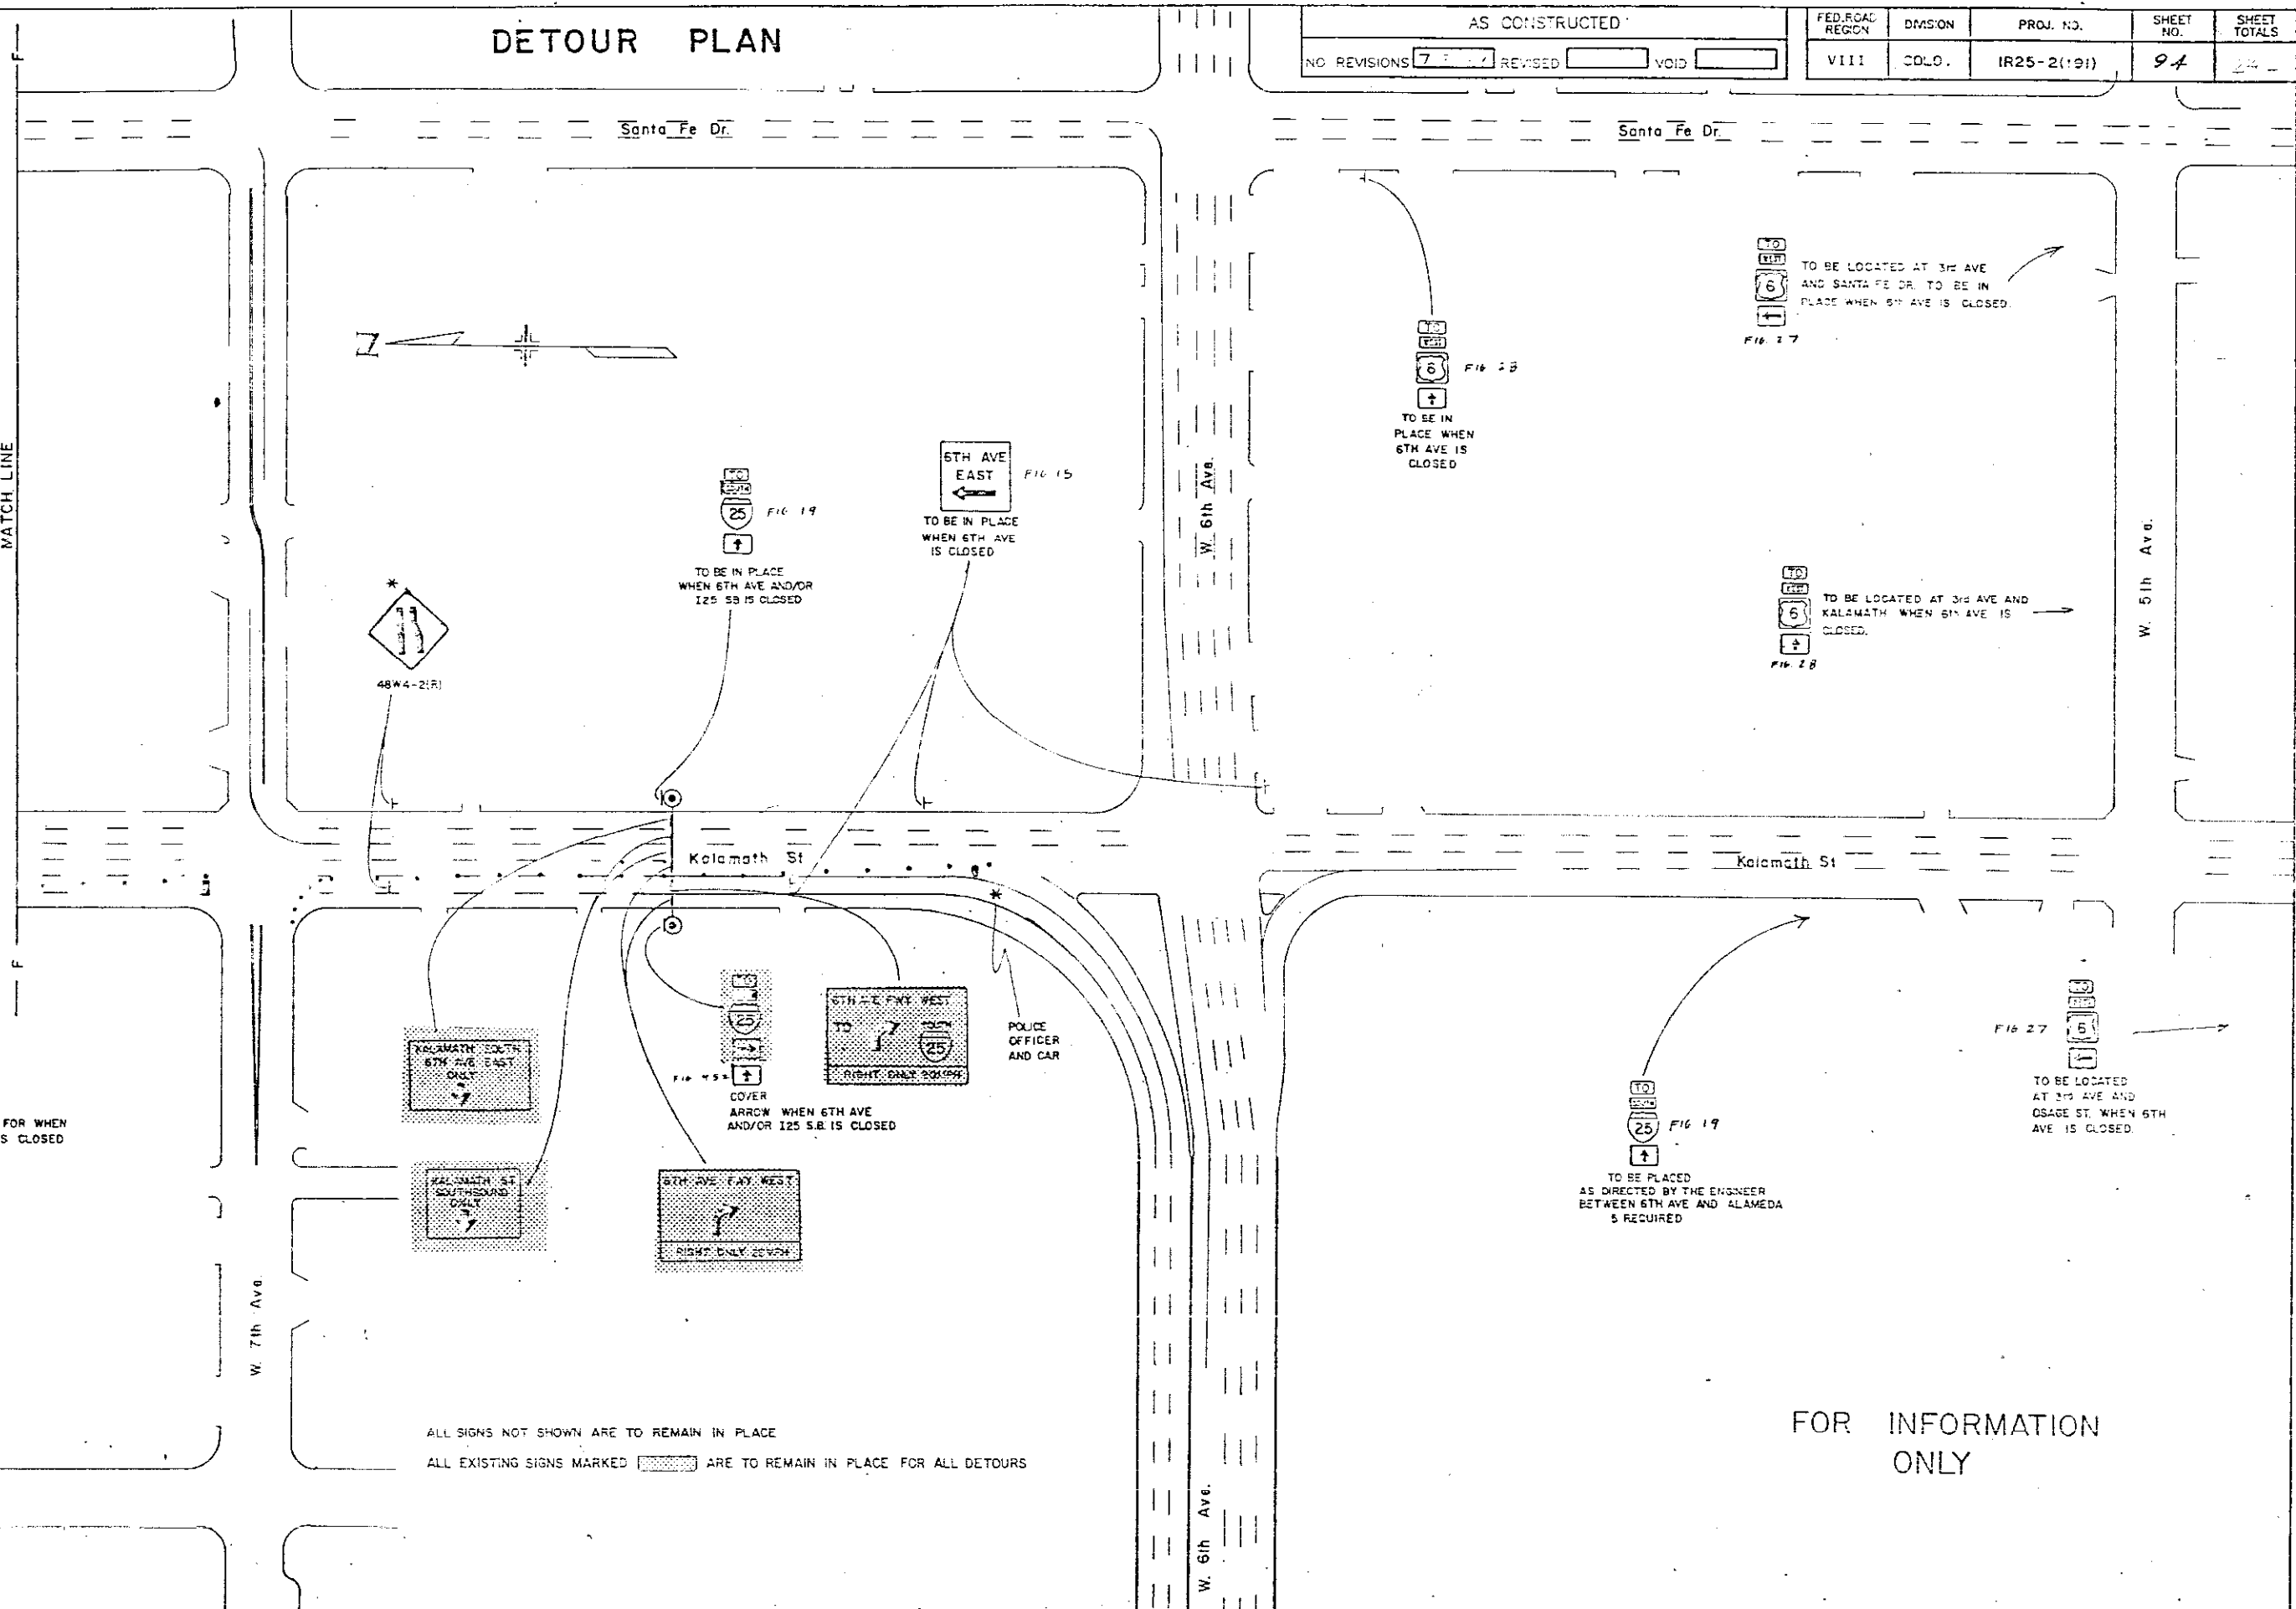





# DETOUR PLAN

AS CONSTRUCTED		
NO REVISIONS	REVISED	VOID

FED. ROAD REGION	DIVISION	PROJ. NO.	SHEET NO.	SHEET TOTALS
VIII	COLO.	IR25-2(191)	95	

FOR INFORMATION ONLY

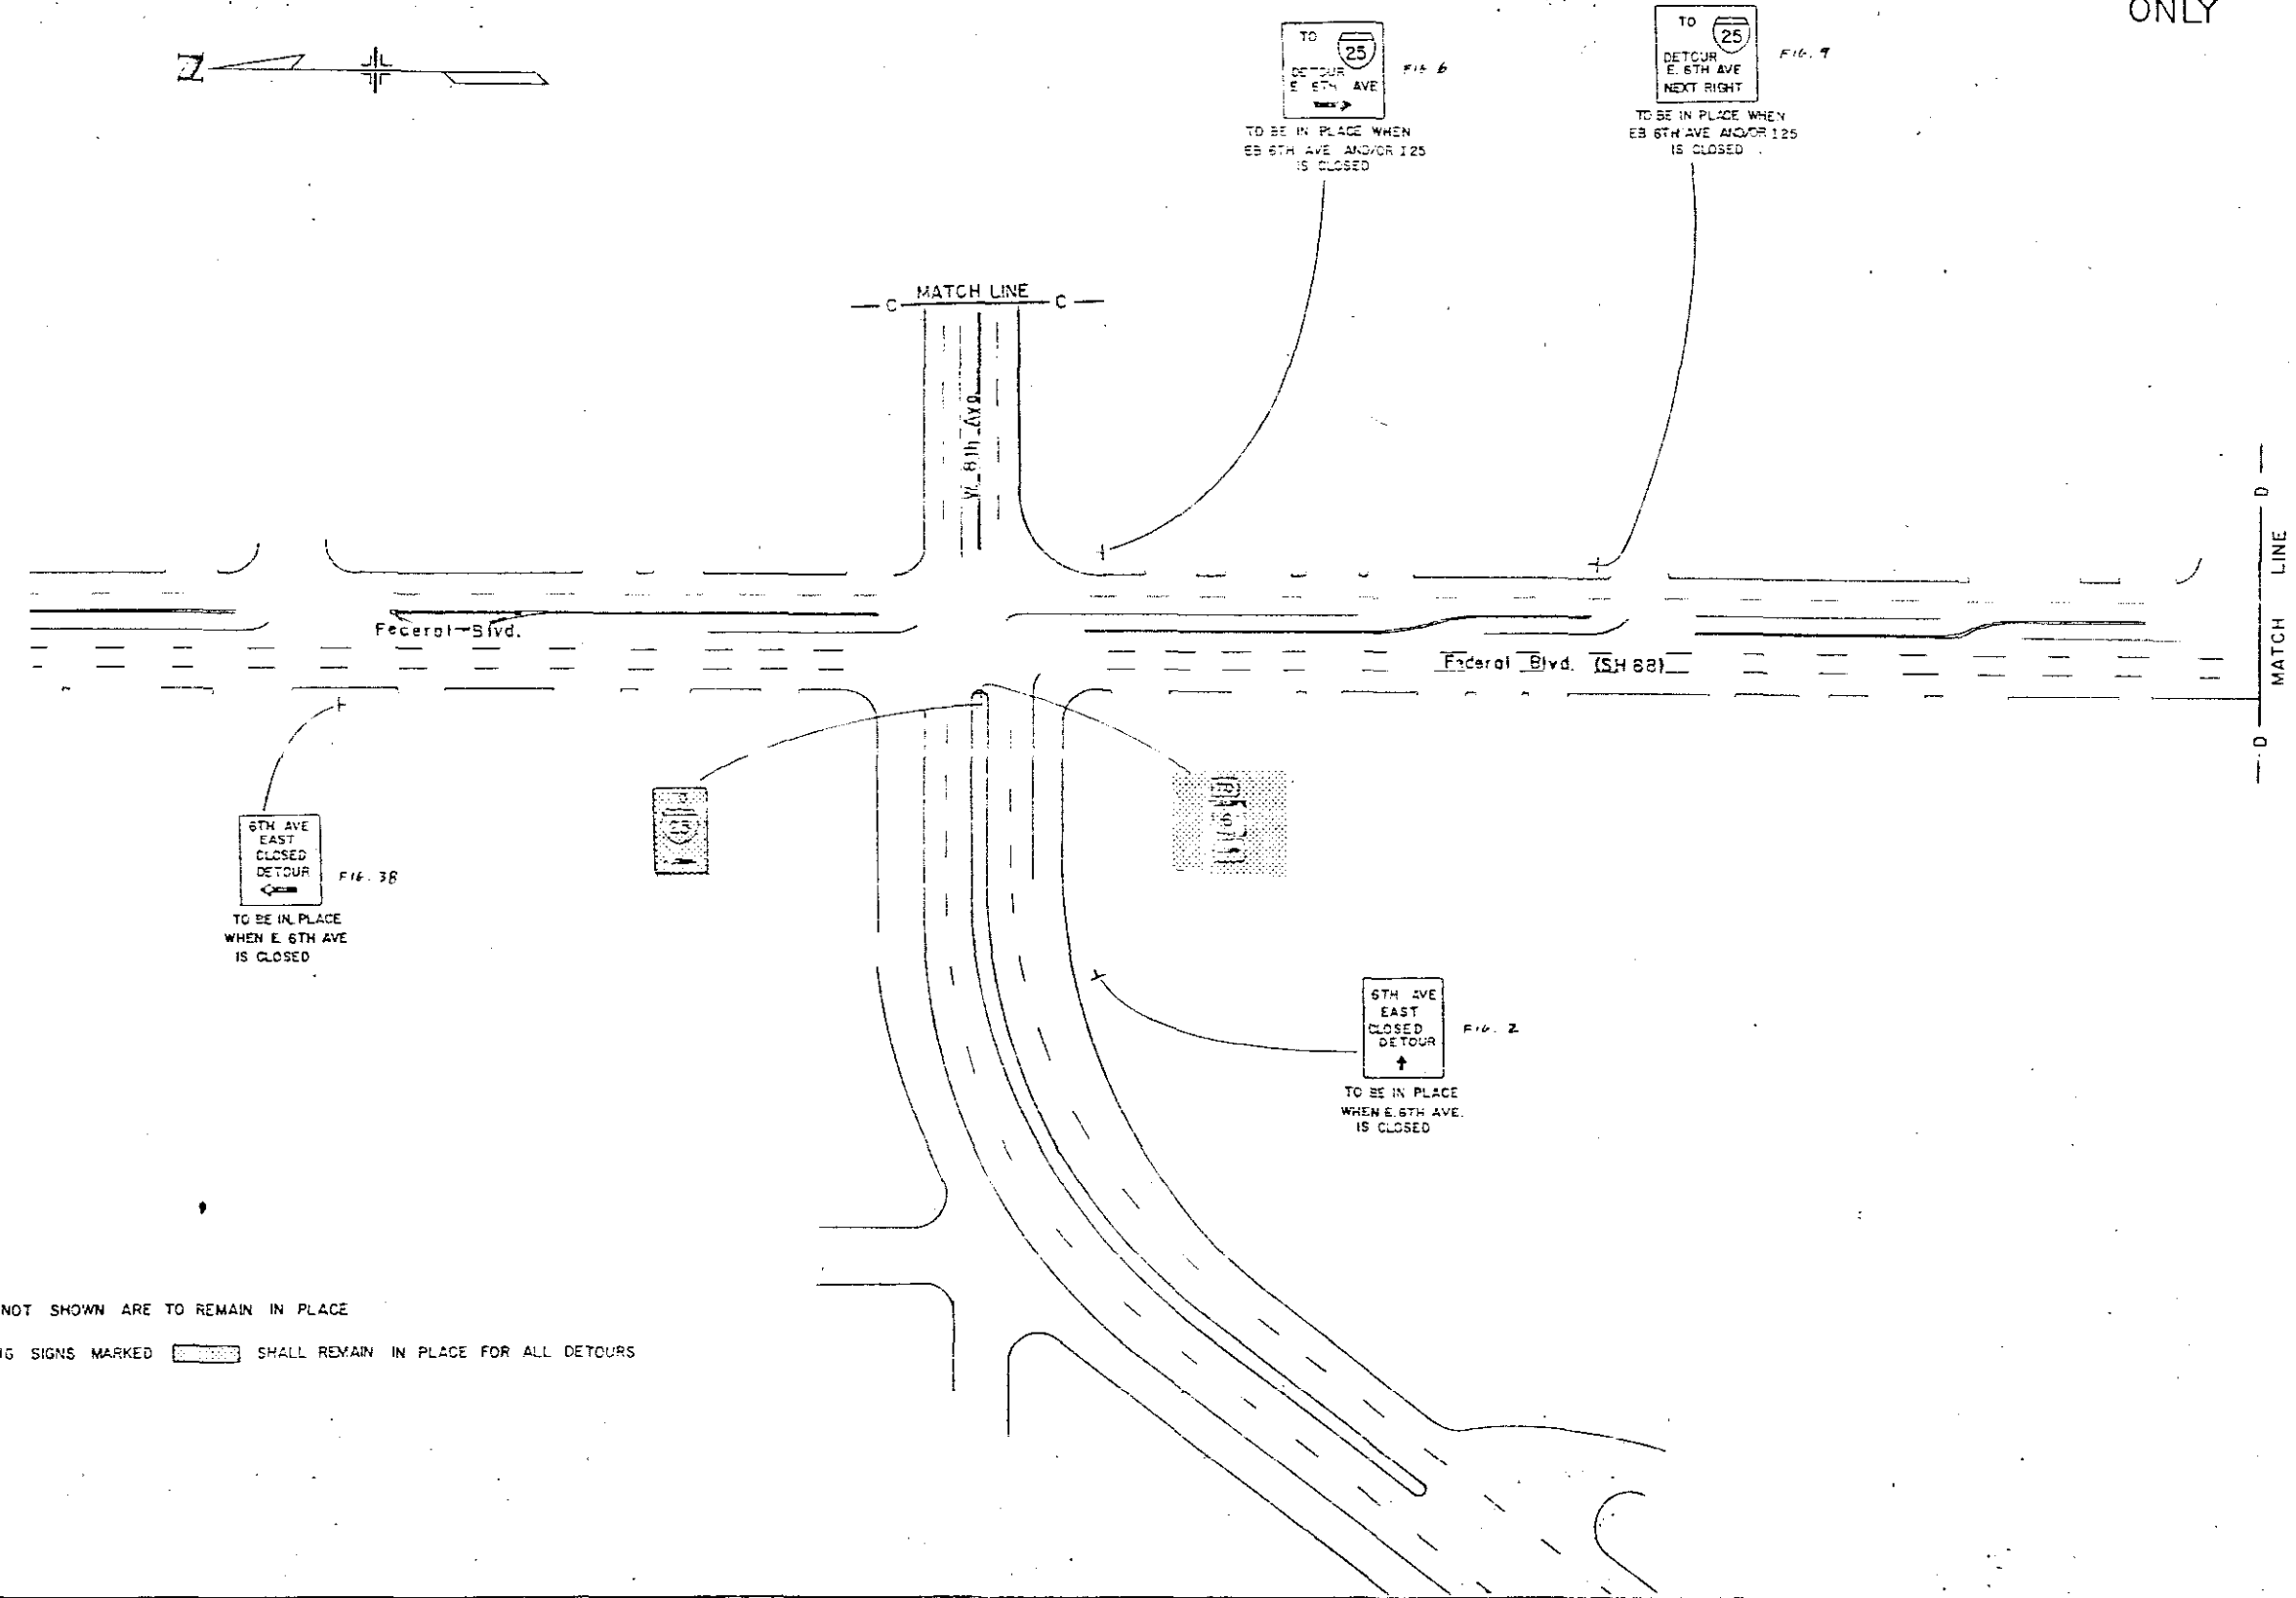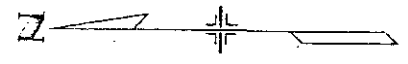

6TH AVE EAST CLOSED DETOUR  
 TO BE IN PLACE WHEN E. 6TH AVE IS CLOSED

6TH AVE EAST CLOSED DETOUR  
 TO BE IN PLACE WHEN E. 6TH AVE IS CLOSED

TO 25  
 DETOUR E. 6TH AVE  
 TO BE IN PLACE WHEN EB 6TH AVE AND/OR 125 IS CLOSED

TO 25  
 DETOUR E. 6TH AVE NEXT RIGHT  
 TO BE IN PLACE WHEN EB 6TH AVE AND/OR 125 IS CLOSED


ALL SIGNS NOT SHOWN ARE TO REMAIN IN PLACE  
 ALL EXISTING SIGNS MARKED [shaded box] SHALL REMAIN IN PLACE FOR ALL DETOURS

# DETOUR PLAN

AS CONSTRUCTED		
NO REVISIONS	REVISED	VOID
7-31-84		

FED. ROAD REGION	DIVISION	PROJ. NO.	SHEET NO.	SHEET TOTALS
VIII	COLO.	IR25-2(191)	96	24-

FOR INFORMATION ONLY

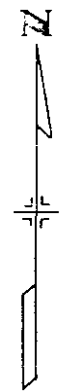

B MATCH LINE B

TO BE IN PLACE WHEN  
 E.B. 6TH AVE IS CLOSED AT  
 I-25 AND I-25 S.B. IS CLOSED AT  
 6TH AVE

FIG. 17

TO BE IN PLACE  
 FOR S.B. I-25 @  
 S.W. RAMP  
 CLOSURES

FIG. 5

TO BE IN PLACE  
 FOR S.B. I-25 @  
 S.W. RAMP  
 CLOSURES

FIG. 15

W 7th Ave.

Canoso Ct.

TO BE IN PLACE WHEN E.B.  
 6TH AVE IS CLOSED AT I-25  
 AND I-25 S.B. IS CLOSED AT  
 6TH AVE

Bryant St.

Alcott St.

ALL SIGNS NOT SHOWN SHALL REMAIN IN PLACE  
 EXISTING SIGNS MARKED [hatched box] SHALL REMAIN IN  
 PLACE FOR ALL DETOURS

A MATCH LINE A

# DETOUR PLAN

AS CONSTRUCTED		FED. ROAD REGION	DMSION	PROJ. NO.	SHEET NO.	SHEET TOTALS
NO REVISIONS	7	VIII	COLO.	IR25-2(191)	97	211
REVISED						
VOID						



MATCH LINE

Conasa Ct.

Bryant St.

Alcott St.

DETOUR 6TH AVE EAST  
 TO BE IN PLACE FOR SB I 25 CLOSURE AND SW LOOP RAMP CLOSURE  
 FIG. 18

DETOUR I 25  
 TO BE IN PLACE WHEN N.W. LOOP RAMP AND SB I 25 ARE CLOSED  
 FIG. 12

DETOUR I 25  
 TO BE IN PLACE FOR SB I 25 CLOSURE  
 MAY STAY IN PLACE FOR ALL CLOSURES  
 FIG. 11

DETOUR I 25  
 TO BE IN PLACE FOR SB I 25 CLOSURE  
 MAY STAY IN PLACE FOR ALL CLOSURES  
 FIG. 10

FOR INFORMATION ONLY

W 6TH AVE EASTBOUND

TO W 6TH AVE FREEWAY EASTBOUND

TO W 6TH AVE FREEWAY EASTBOUND

6th Ave Freeway

6th Ave

5th Ave

Decatur St.

From Federal Blvd.

FIG. 14  
 TO BE IN PLACE WHEN I 25 SB IS CLOSED

FIG. 46  
 PLACE OVER ARROW WHEN E 6TH AVE IS CLOSED

FIG. 4  
 TO BE IN PLACE AT 4TH & DECATUR AND 4TH & FEDERAL WHEN E 6TH AVE IS CLOSED

FIG. 10  
 TO BE IN PLACE FOR SB I 25 CLOSURE  
 MAY STAY IN PLACE FOR ALL CLOSURES




FIG. 13  
 TO BE IN PLACE WHEN 6TH AVE EB IS CLOSED

FIG. 14  
 TO BE IN PLACE WHEN 6TH AVE EB IS CLOSED



ALL SIGNS NOT SHOWN ARE TO REMAIN IN PLACE  
 ALL EXISTING SIGNS MARKED [ ] SHALL REMAIN IN PLACE FOR ALL DETOURS

AS CONSTRUCTED		
NO REVISIONS	7-21-29	REVISED
		VOID

FEDERAL ROAD REGION NO.	DISTRICT	PROJ. NO.	SHEET NO.	TOTAL SHEETS
VIII	COLORADO	IR25-2(191)	98	242

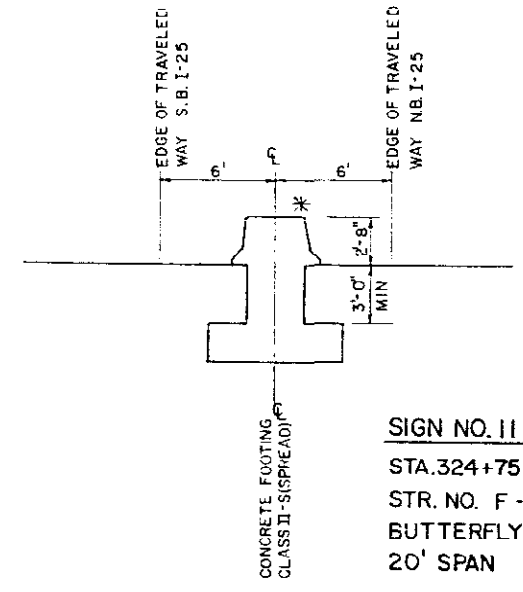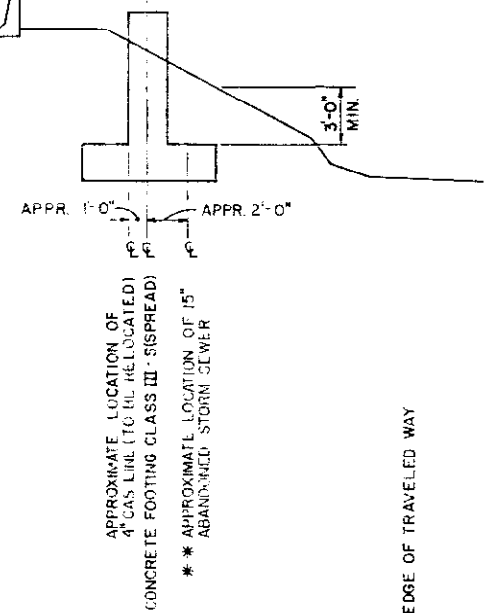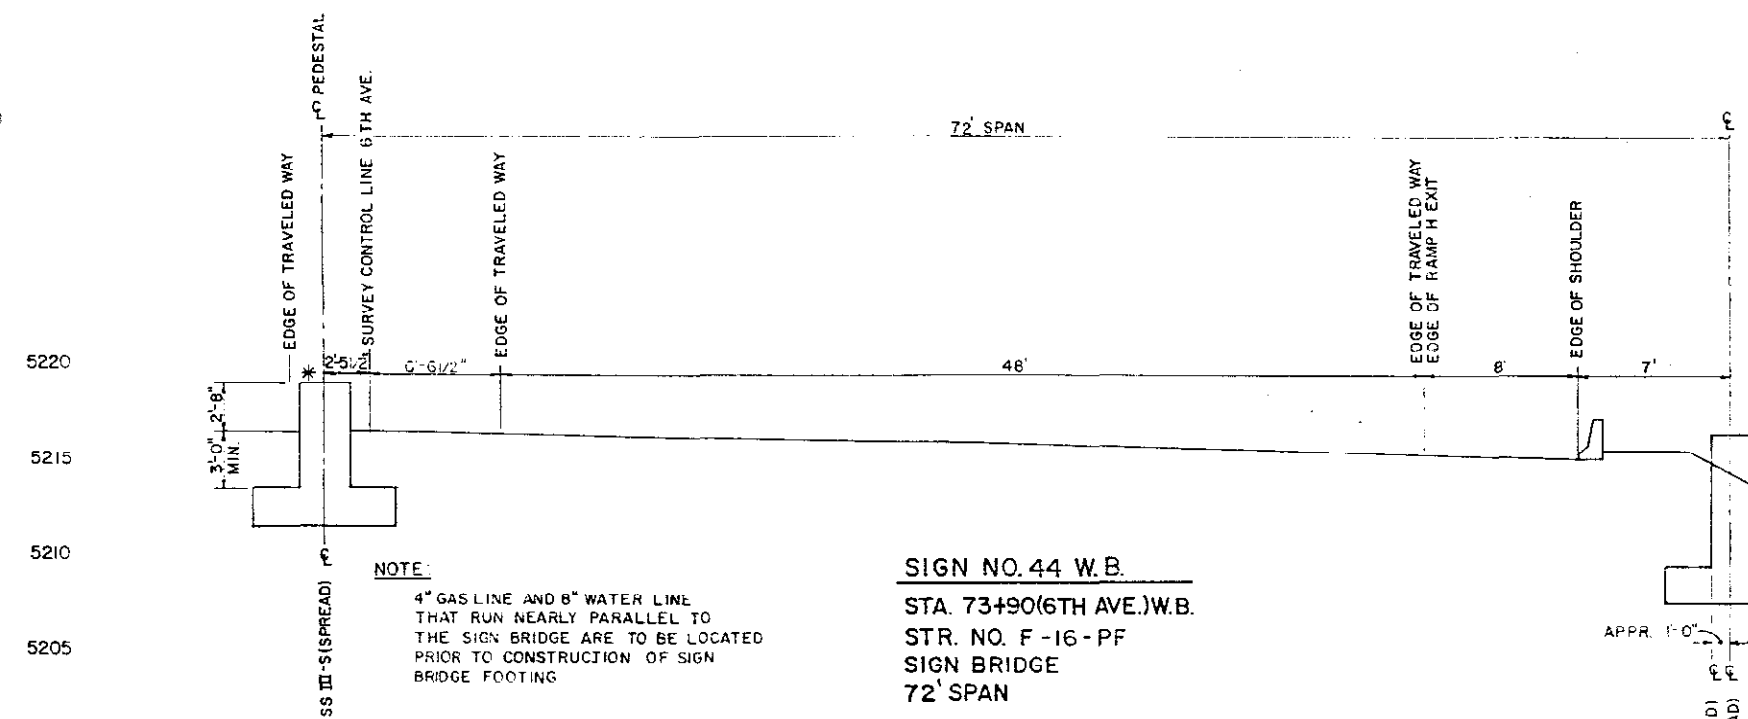

**SIGN NO. 11 N.B.**  
 STA. 324+75 L.C.L.(I-25) N.B.  
 STR. NO. F-16-PW  
 BUTTERFLY  
 20' SPAN

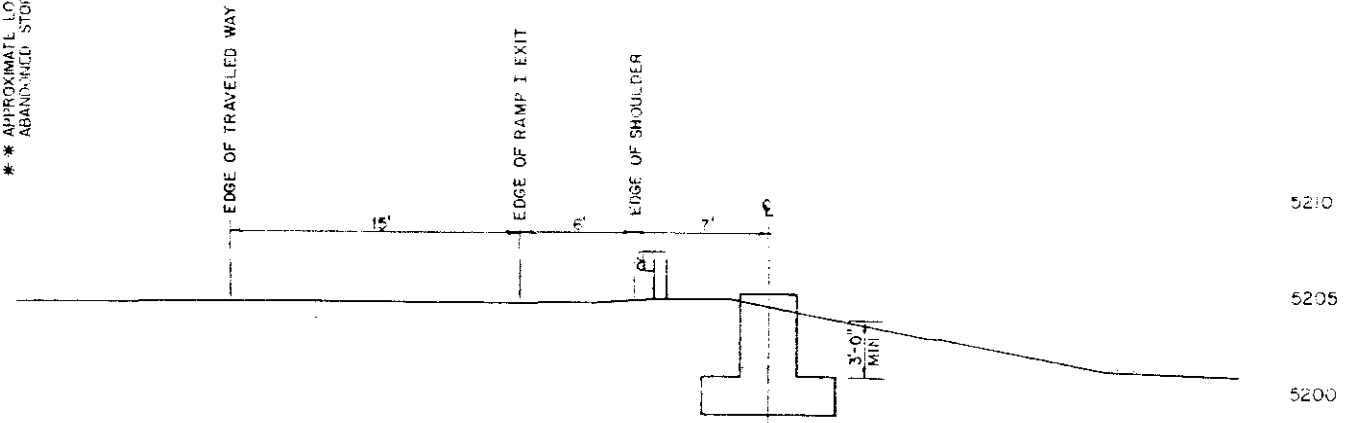
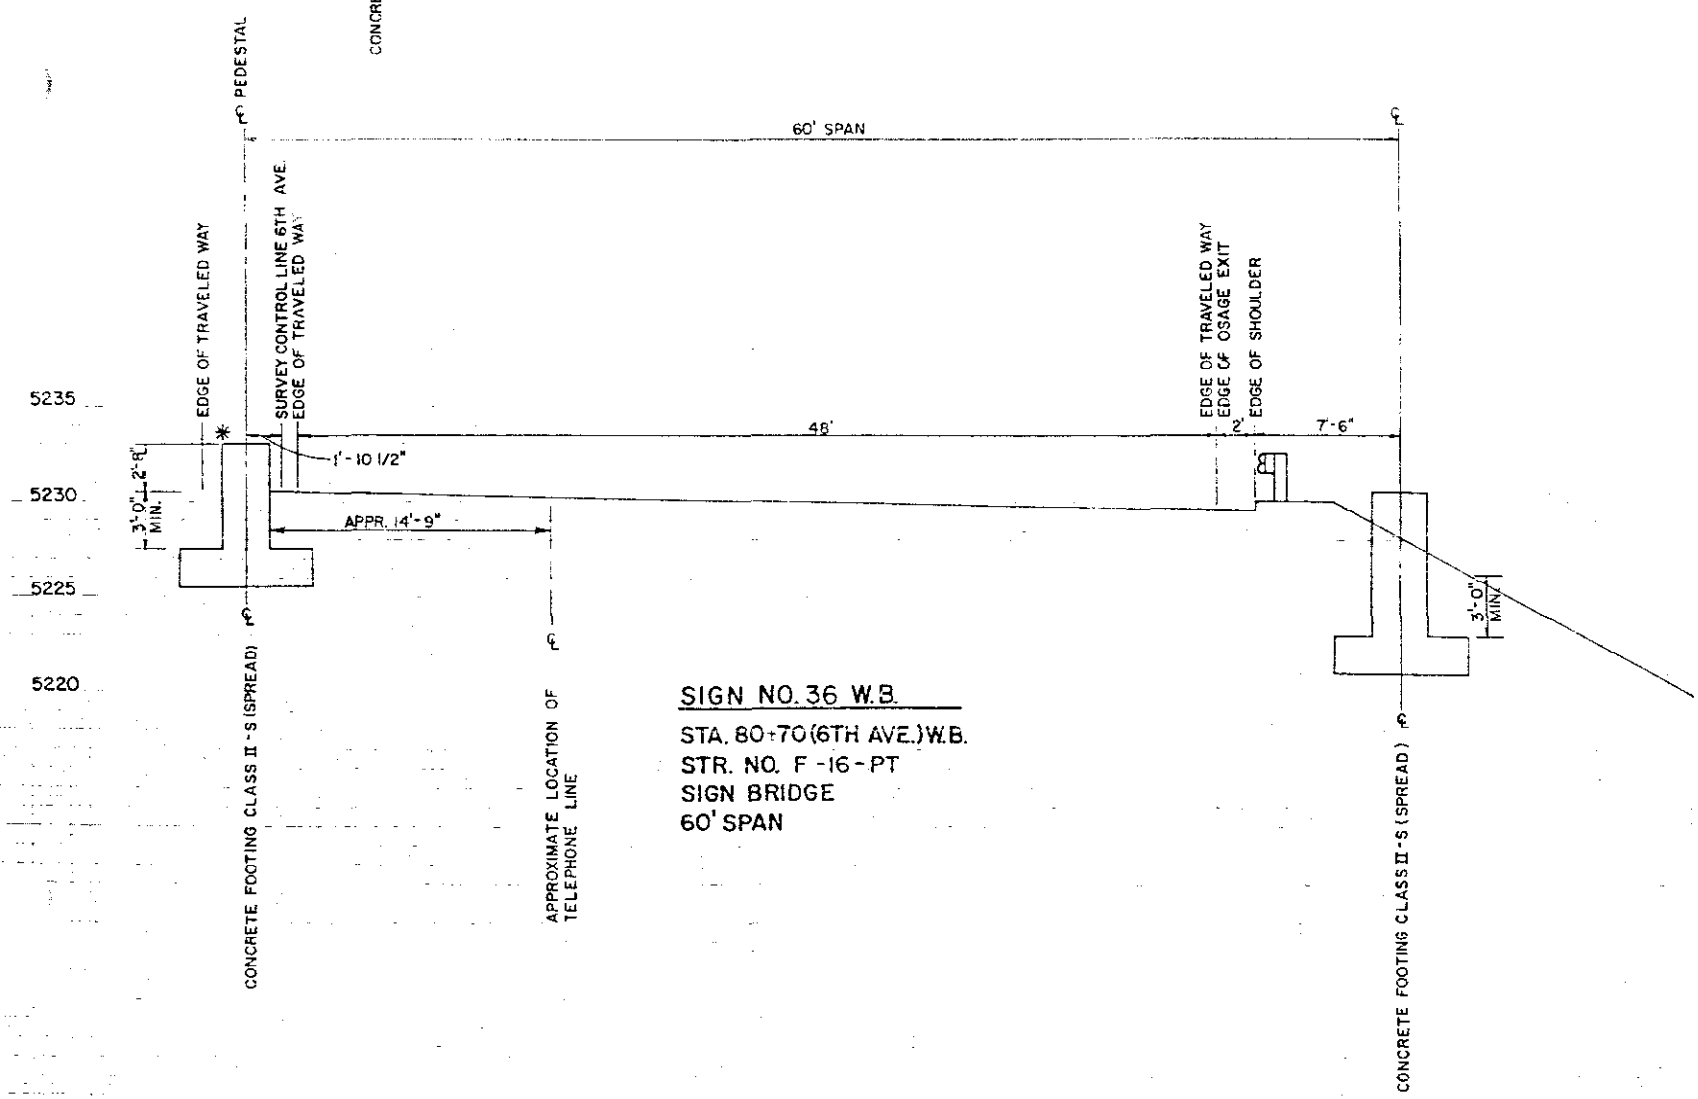


**SIGN NO. 23 N.B.**  
 STA. 270+80 L.C.L. (I-25) N.B.  
 STR. NO. F-16-PU  
 CANTILEVER  
 28' SPAN

**NOTE:**  
 \* SEE DETAIL FOR BARRIER TRANSITION AROUND SIGN BRIDGE  
 \*\* ABANDONED 15" STORM SEWER SHALL BE PLUGGED ON EACH SIDE OF SIGN BRIDGE FOOTING.

AS CONSTRUCTED	
NO REVISIONS	REVISED 7-21-99, J.D.D.


FEDERAL ROAD REGION NO	DIVISION	PROJ. NO	SHEET NO	TOTAL SHEETS
VIII	COLORADO	IR25-2(191)	99	242

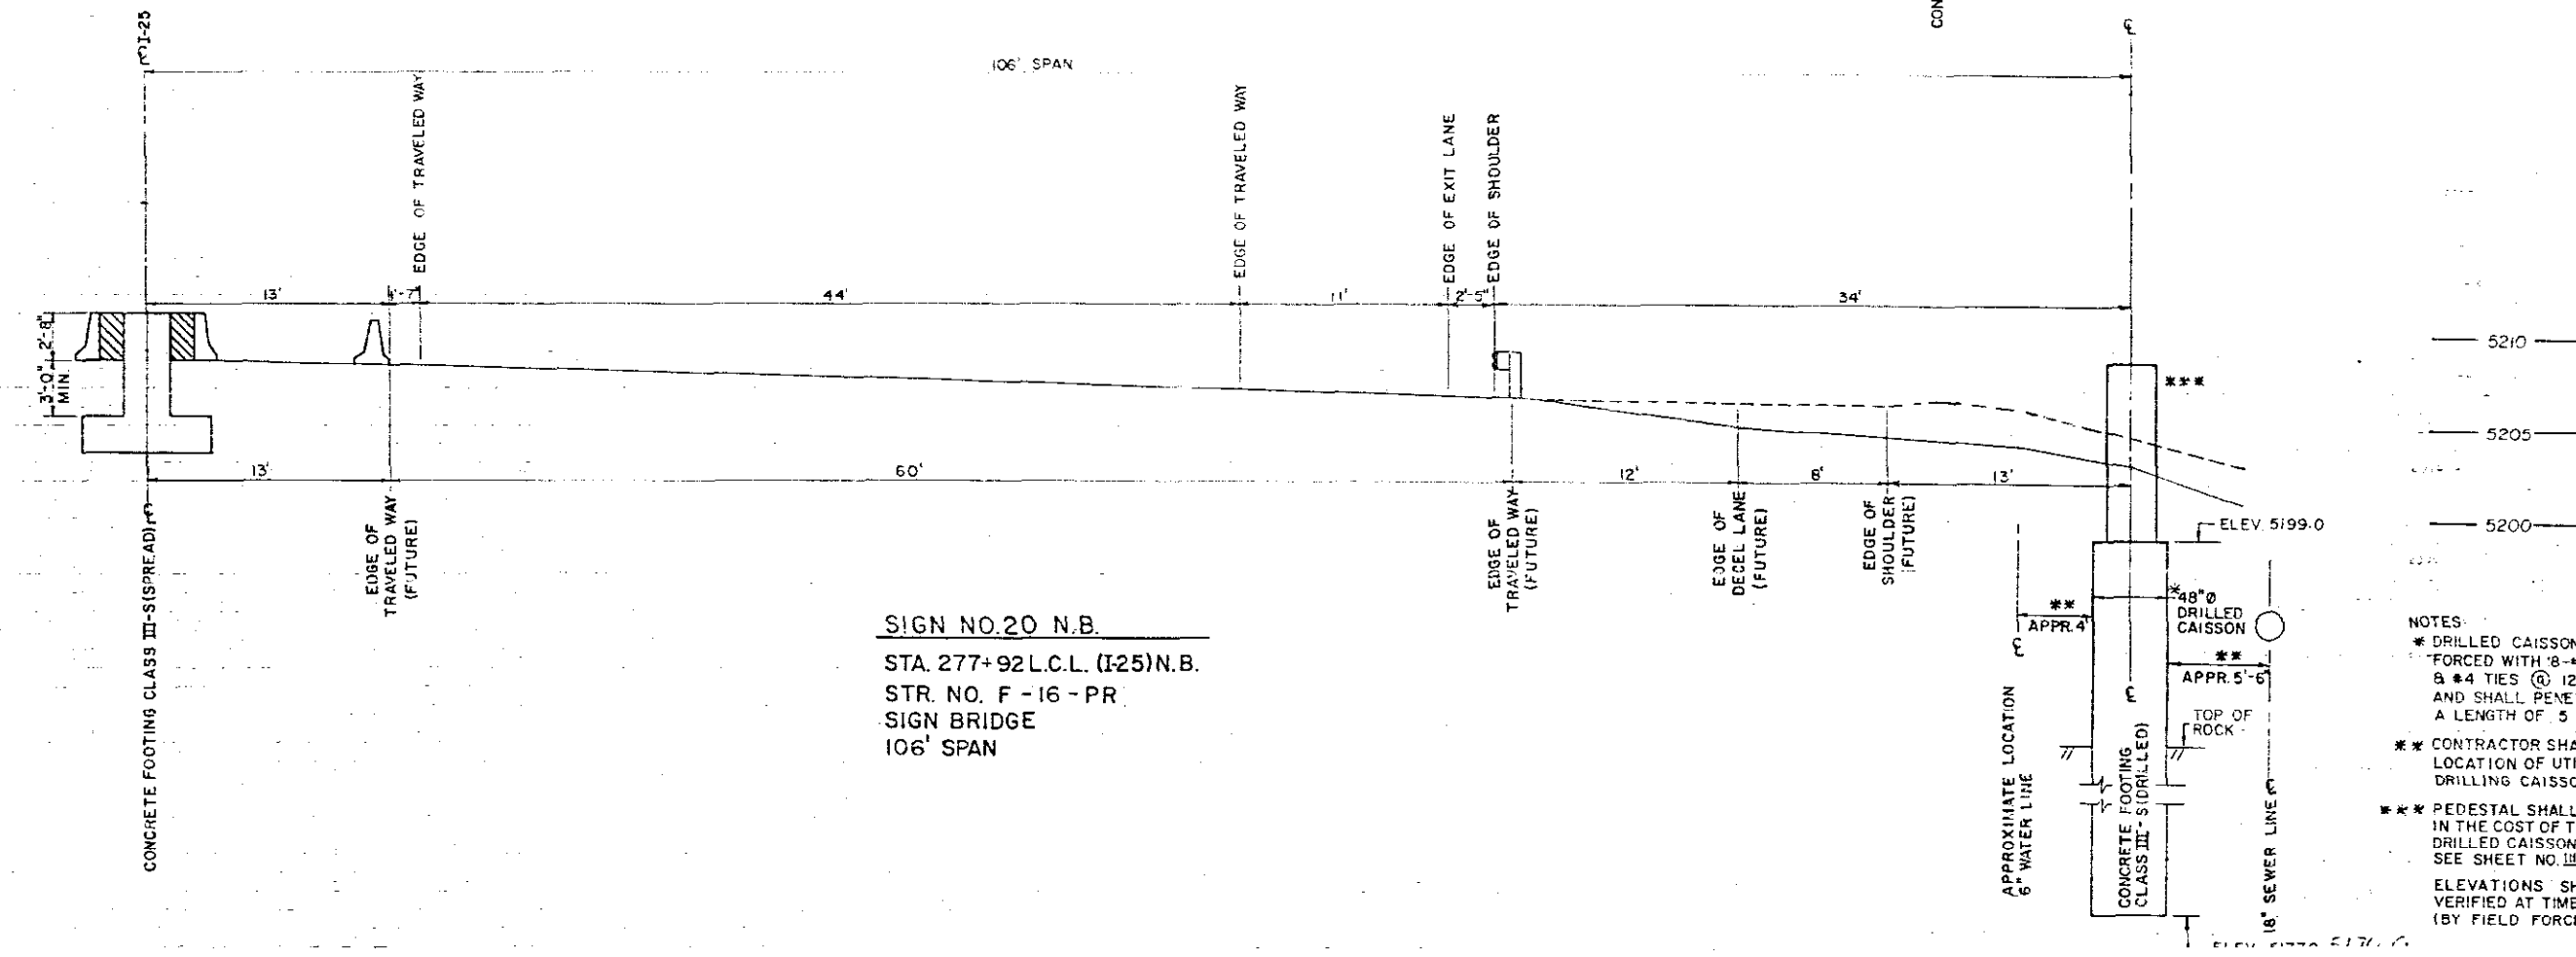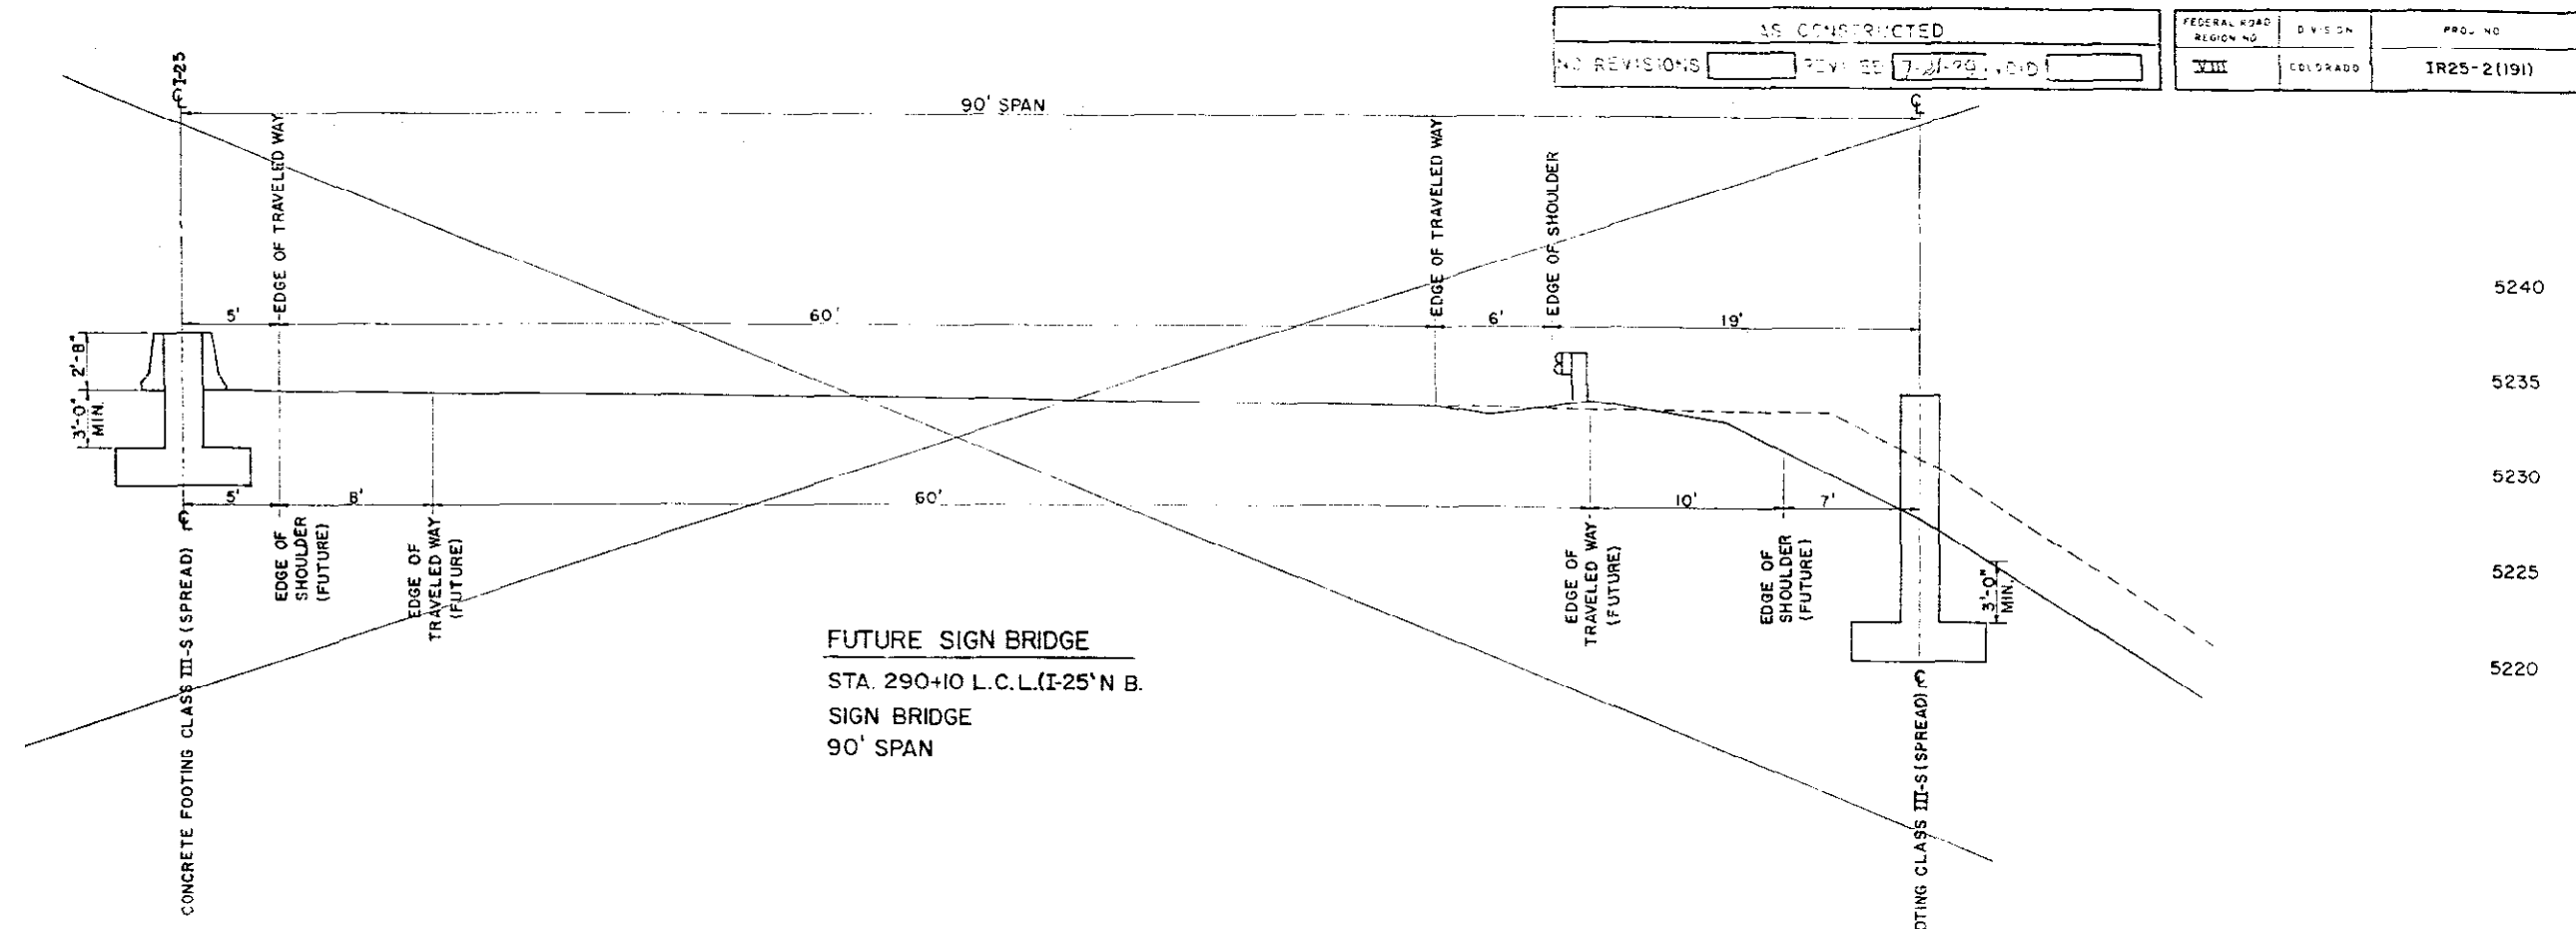


- NOTES:
- \* DRILLED CAISSON SHALL BE REINFORCED WITH #8-#9 VERTICAL BARS & #4 TIES @ 12" CTS (FULL LENGTH) AND SHALL PENETRATE INTO THE ROCK A LENGTH OF 5 FT.
  - \*\* CONTRACTOR SHALL VERIFY LOCATION OF UTILITIES BEFORE DRILLING CAISSON.
  - \*\*\* PEDESTAL SHALL BE INCLUDED IN THE COST OF THE 48" Ø DRILLED CAISSON. FOR PEDESTAL DETAIL SEE SHEET NO. III.
- ELEVATIONS SHOWN SHALL BE VERIFIED AT TIME OF CONSTRUCTION (BY FIELD FORCES)

AS CONSTRUCTED		
NO REVISIONS	7-1-22 REVISED	VOID

FEDERAL AID ROADWAY DISTRICT	PROJECT NO.	SHEET NO.	TOTAL SHEETS
	1R 25-2 (191)	100	242

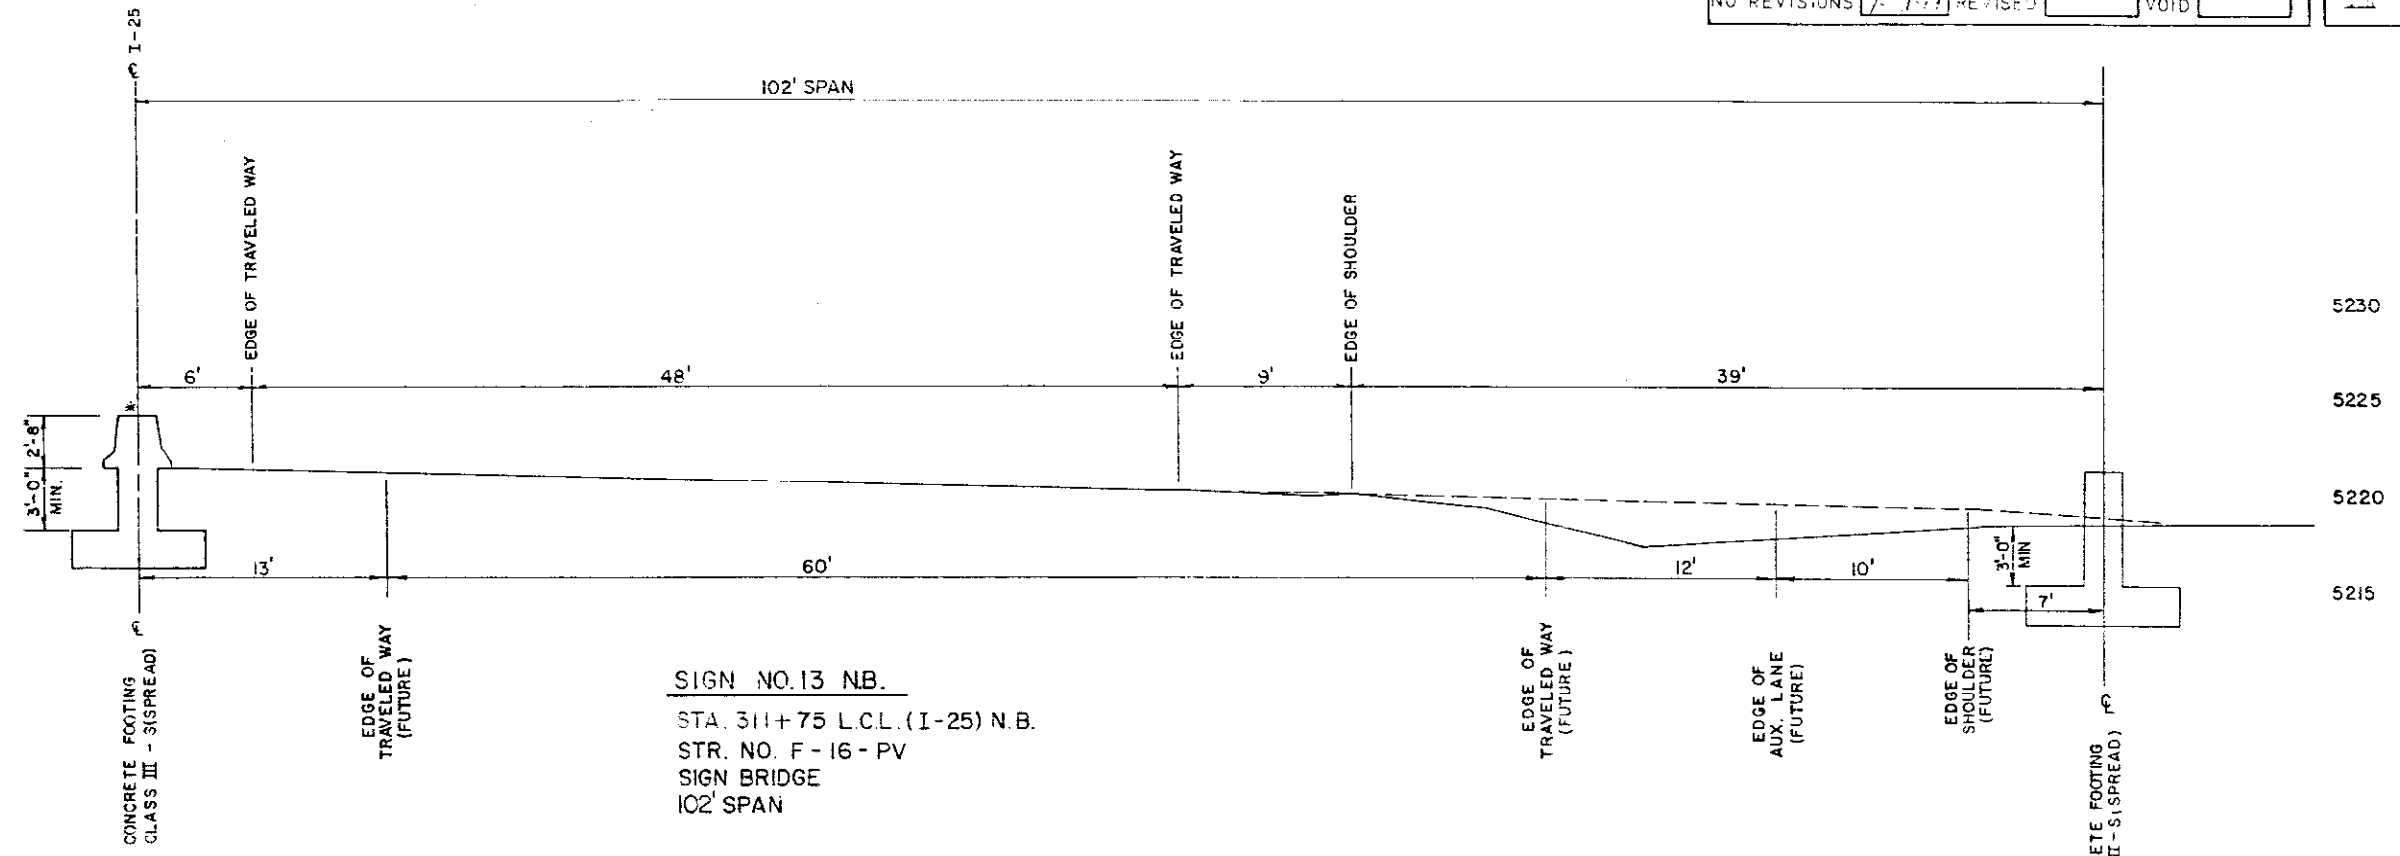

\* SEE DETAIL FOR BARRIER TRANSITION AROUND SIGN BRIDGE

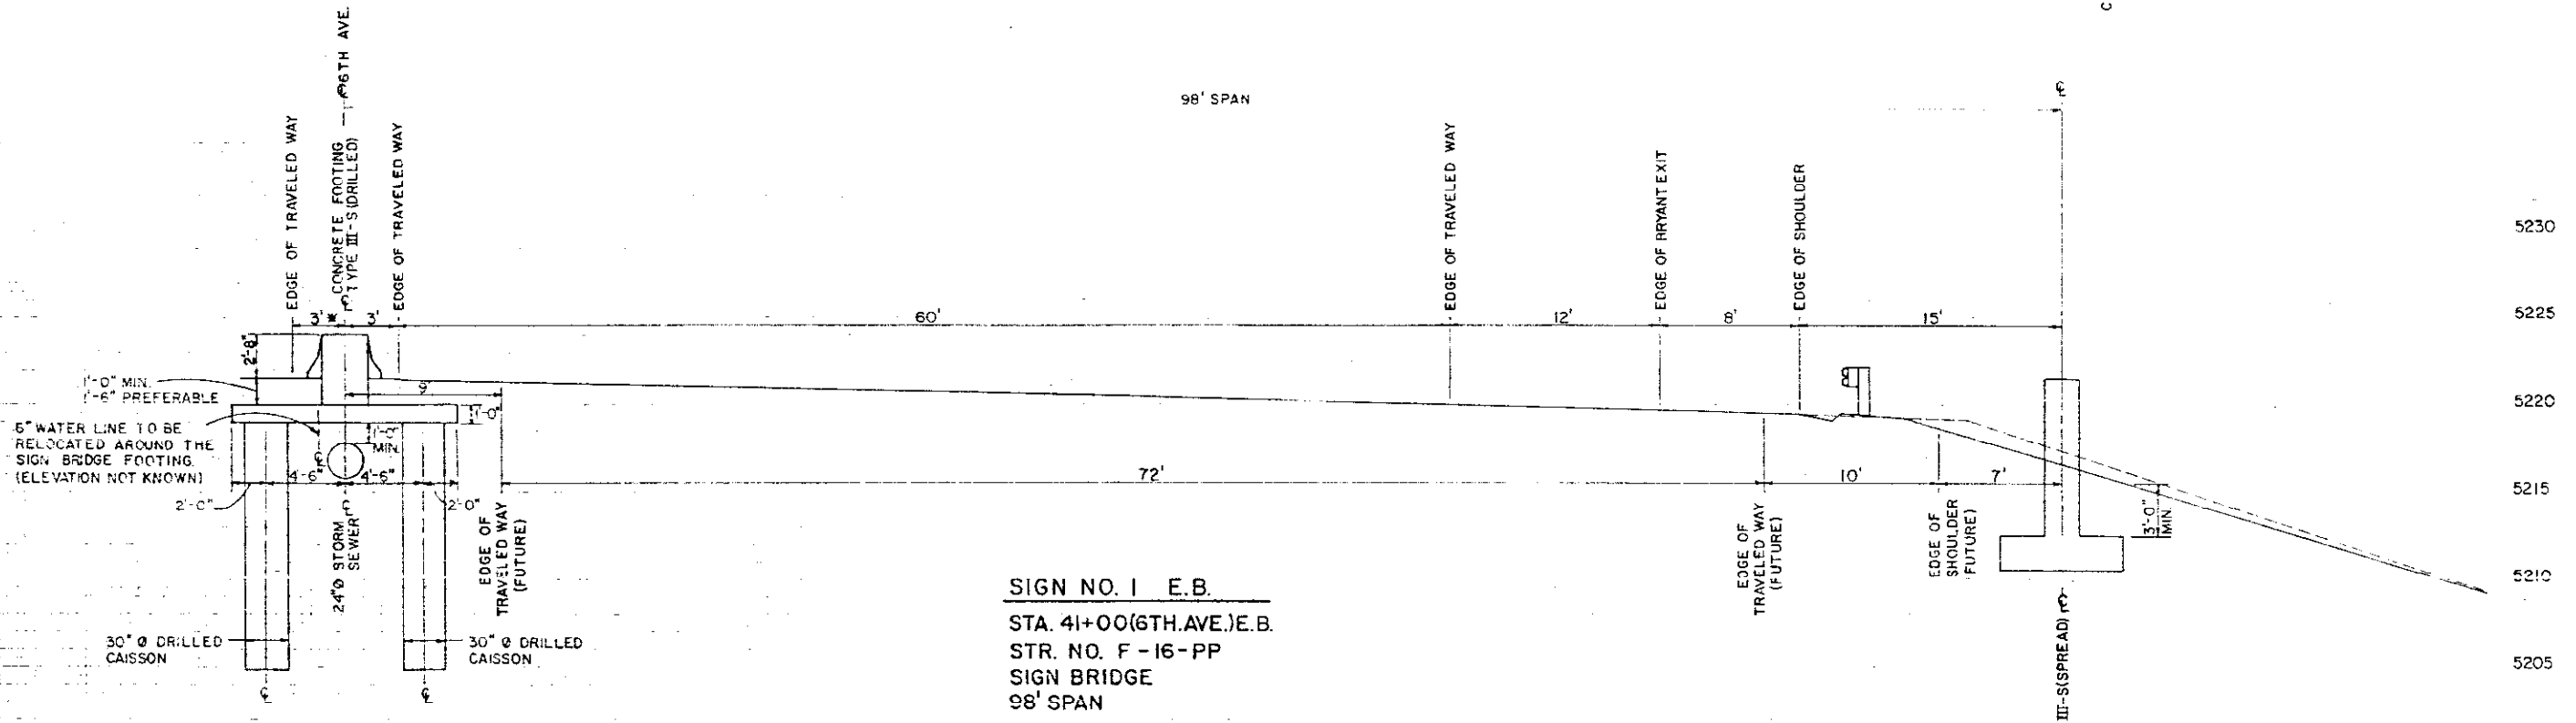


- NOTES:**
- 30" Ø DRILLED CAISSONS SHALL BE REINFORCED WITH 8-#9 VERTICAL BARS AND #4 TIES AT 12" CENTERS.
  - CONTRACTOR TO VERIFY LOCATION OF 24" STORM SEWER BEFORE DRILLING CAISSONS. CAISSONS TO CLEAR SEWER BY AT LEAST 12".
  - 6" WASH WATER LINE TO BE RELOCATED AROUND SIGN BRIDGE FOOTING. THIS WORK SHALL BE PAID FOR UNDER THE "FORCE ACCOUNT ITEM" REPAIR, RESET, AND MAINTENANCE OF EXISTING IRRIGATION SYSTEMS.

### GENERAL NOTES

- ALL OVERHEAD RED SIGNAL FACES SHALL BE 12 INCHES.
- ALL ARROW SIGNAL FACES SHALL BE 12 INCHES.
- ALL OTHER VEHICLE SIGNAL FACES SHALL BE 8 INCHES UNLESS OTHERWISE SPECIFIED.
- ALL SIGNALS SHALL BE INCANDESCENT UNLESS OTHERWISE SPECIFIED.
- ALL SINGLE OR BACK-TO-BACK VEHICLE SIGNAL HEADS SHALL HAVE A BACKPLATE.
- BACKPLATE BORDERS SHALL BE 5" ± 1/4" FOR 12-INCH SIGNALS AND 8" ± 1/4" FOR 8-INCH SIGNALS.
- ALL POLES OR PEDESTALS SHALL BE INSTALLED A MINIMUM OF 3 FEET FROM THE CENTER OF THE POLE OR PEDESTAL TO THE FACE OF THE CURB OR EDGE OF PAVEMENT. PRECISE LOCATION OF THE POLE OR PEDESTAL SHALL BE DETERMINED IN THE FIELD BY THE ENGINEER.
- VEHICLE INDICATIONS SHALL GENERALLY BE MOUNTED ON THE FRONT SIDE OF THE POLE. AT LOCATIONS WHERE FRONT MOUNTING MAKES THEM SUSCEPTIBLE TO BEING STRUCK BY TURNING VEHICLES THEY SHALL BE MOUNTED ON THE BACK OR SIDE OF THE POLE AWAY FROM THE VEHICLE PATH.
- THE BOTTOM OF ALL MAST ARM AND SPAN WIRE MOUNTED SIGNAL HEADS SHALL BE ON THE SAME HORIZONTAL PLANE AND HAVE A MINIMUM CLEARANCE OF 15'-6" AND A MAXIMUM CLEARANCE OF 17'-6" ABOVE THE PAVEMENT SURFACE, UNLESS OTHERWISE SPECIFIED.
- ANCHOR BOLT SPACING VARIES SLIGHTLY BETWEEN MANUFACTURERS. ANY CHANGE IN DIMENSIONS FROM THOSE SPECIFIED ON THE PLANS SHALL BE CHECKED BEFORE INSTALLING FOUNDATIONS.
- ALL EXPOSED CONCRETE SURFACES SHALL BE FORMED, TROWLED, AND FINISHED TO PRESENT A NEAT APPEARANCE.
- ALL ELECTRICAL SYSTEMS SHALL BE PROPERLY GROUNDED IN ACCORDANCE WITH THE SPECIFICATIONS. A GROUND ROD SHALL BE INSTALLED FOR EACH POLE, PEDESTAL, AND CONTROLLER CABINET FOUNDATION.
- CONTRACTOR SHALL NOT REMOVE ANY REGULATORY TRAFFIC SIGNS UNLESS SPECIFIED ON PLANS. CITY AND COUNTY OF DENVER TRANSPORTATION DIVISION TO BE NOTIFIED 48 HOURS PRIOR TO ANY SIGNING CHANGES.
- ALL SIGNAL EQUIPMENT REMOVED REMAINS THE PROPERTY OF DENVER TRANSPORTATION DIVISION.
- PEDESTRIAN SIGNAL FACE LEGEND SHALL BE SYMBOLIC (HAND-MAN).

### LEGEND

- CONTROLLER CABINET-EXISTING
- CONTROLLER CABINET-NEW (DARKENED PORTION INDICATES DOOR SIDE OF CABINET)
- PULL BOX, EXISTING
- NEW PULL BOX
- LOOP DETECTOR
- WOOD POLE, EXISTING
- STEEL POLE, EXISTING
- PEDESTAL SIGNAL POLE, EXISTING
- ALUMINUM POLE, EXISTING
- NEW POLE OR PEDESTAL
- DOWN GUY
- UNDERGROUND CONDUIT, EXISTING
- UNDERGROUND CONDUIT, NEW
- STREET LIGHT (INSTALLED BY PUBLIC SERVICE COMPANY)
- PEDESTRIAN PUSH BUTTON, LEFT OR RIGHT ARROW. "WAIT FOR GREEN SIGNAL"
- PEDESTRIAN PUSH BUTTON, LEFT OR RIGHT ARROW. "WAIT FOR WALK SIGNAL"
- TYPE I STANDARD (MAST ARM LENGTH AS SPECIFIED, SHOWING SIGNAL WITH BACKPLATE)
- TYPE II STANDARD (SPAN-WIRE MOUNTED, SHOWING SIGNAL WITH BACKPLATE)
- TYPE III STANDARD (PEDESTAL MOUNTED, SHOWING SIGNAL WITHOUT BACKPLATE)
- TYPE IV STANDARD (SIDE-BRACKET MOUNTED, SHOWING SIGNAL WITHOUT BACKPLATE)
- CURB DRAIN
- MANHOLE
- WATER VALVE
- FIRE HYDRANT
- TELEPHONE BOOTH
- MAIL BOX

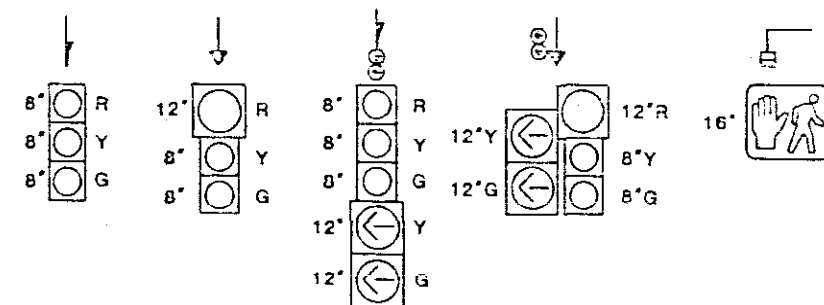

### KEY NOTES

#### REMOVALS

- 1A REMOVE SIGNAL HEAD
- 1B REMOVE SIGNAL POLE
- 1C REMOVE SIGNAL POLE AND ALL ATTACHED EQUIPMENT
- 1D REMOVE SIGNAL CABINET, CONTROLLER AND ASSOCIATED EQUIPMENT
- 1E REMOVE MAST ARM
- 1F REMOVE SPAN WIRE, CABLE AND ALL ATTACHED SIGNAL HEADS AND EQUIPMENT
- 1G REMOVE PUSH BUTTON
- 1H PUBLIC SERVICE COMPANY TO REMOVE EXISTING POLE

#### RESETS

- 2A RESET SIGNAL HEAD
- 2B RESET SIGNAL POLE
- 2C RESET SIGNAL CONTROLLER, CABINET AND ASSOCIATED EQUIPMENT
- 2D RESET PUSH BUTTON
- 2E RESET MAST ARM
- 2F RESET MAST ARM AND ALL ATTACHED SIGNAL EQUIPMENT
- 2G RESET SPAN WIRE
- 2H RESET SPAN WIRE AND ALL ATTACHED SIGNAL EQUIPMENT
- 2J PUBLIC SERVICE COMPANY TO RESET STREET LIGHT
- 2K PUBLIC SERVICE COMPANY TO RESET EXISTING POLE

#### INSTALLATIONS

- 3A INSTALL SIGNAL HEAD OR HEADS
- 3B INSTALL SIGNAL CABINET, CONTROLLER AND ASSOCIATED EQUIPMENT
- 3C INSTALL PUSH BUTTON
- 3D INSTALL CONDUIT
- 3E INSTALL SIGNAL POLE
- 3F INSTALL MAST ARM - LENGTH AS SHOWN
- 3G INSTALL SPAN WIRE
- 3H INSTALL PULL BOX
- 3J INSTALL LOOP DETECTOR
- 3K PUBLIC SERVICE COMPANY TO INSTALL SIGNAL POLE
- 3L PUBLIC SERVICE COMPANY TO INSTALL POWER FEED. CONTRACTOR TO EXTEND TO CONTROLLER
- 3M PUBLIC SERVICE COMPANY TO INSTALL STREET LIGHT
- 3N INTERCEPT EXISTING CONDUIT AND ABANDON UNUSED PORTION
- 3P ABANDON EXISTING CONDUIT
- 3Q NO CHANGE


DRAWN BY	A. MESTAS				
CHECKED BY	<i>L. D. [Signature]</i>				
APPROVED BY	<i>[Signature]</i>	NO.	DATE	REVISIONS	BY
					APPD.

TRANSPORTATION DIVISION  
DEPARTMENT OF PUBLIC WORKS  
CITY AND COUNTY OF  
DENVER, COLORADO


### TRAFFIC SIGNAL STANDARD DRAWINGS

DATE  
AUG. 1985  
DWG. NO.  
TS-1


AS CONSTRUCTED		FEDERAL ROAD REGION NO.	DIVISION	PROJECT NO.	SHEET NO.	TOTAL SHEETS
NO REVISIONS	REVISED	VIII	COLORADO	IR25-2 (191)	102	242

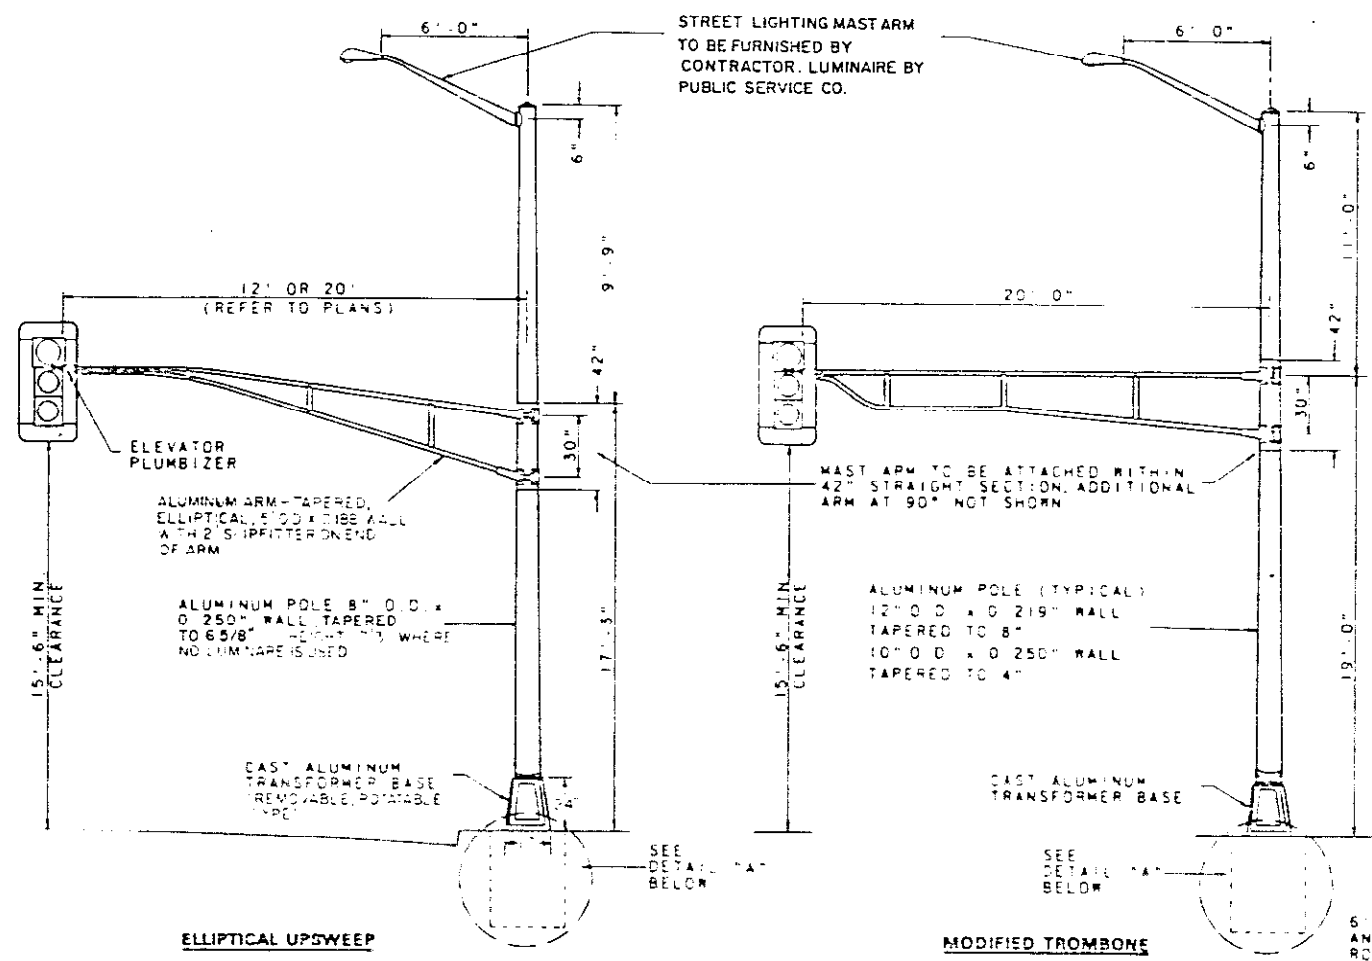


**TYPE I MOUNTING STANDARD**  
 ELLIPTICAL UPSWEEP  
 ALUMINUM MAST ARM AND POLE  
 MODIFIED TROMBONE  
 (See Sheet 5 For Steel Mast Arm & Pole)

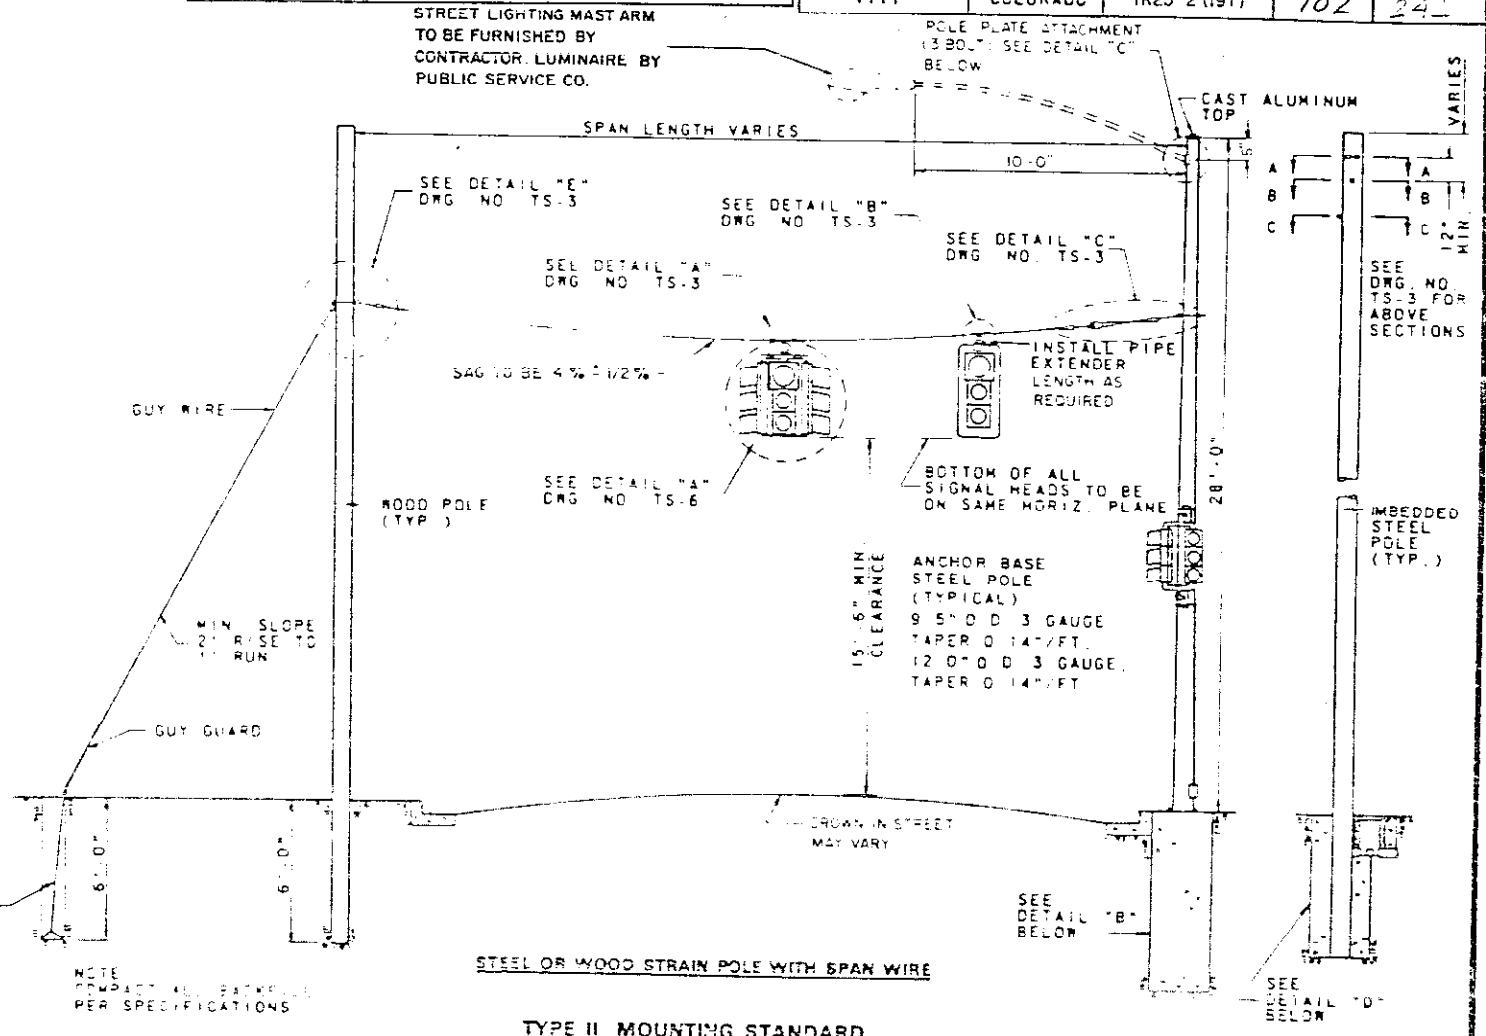


**TYPE II MOUNTING STANDARD**  
 STEEL OR WOOD STRAIN POLE WITH SPAN WIRE

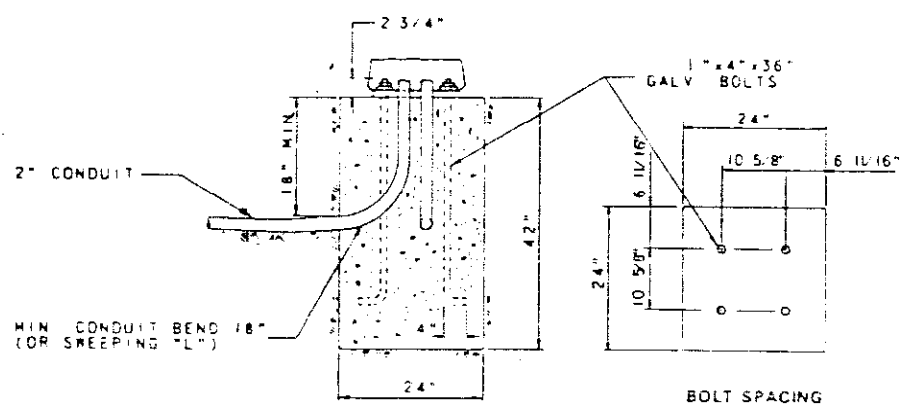


**DETAIL "A"**  
 MAST ARM BASE

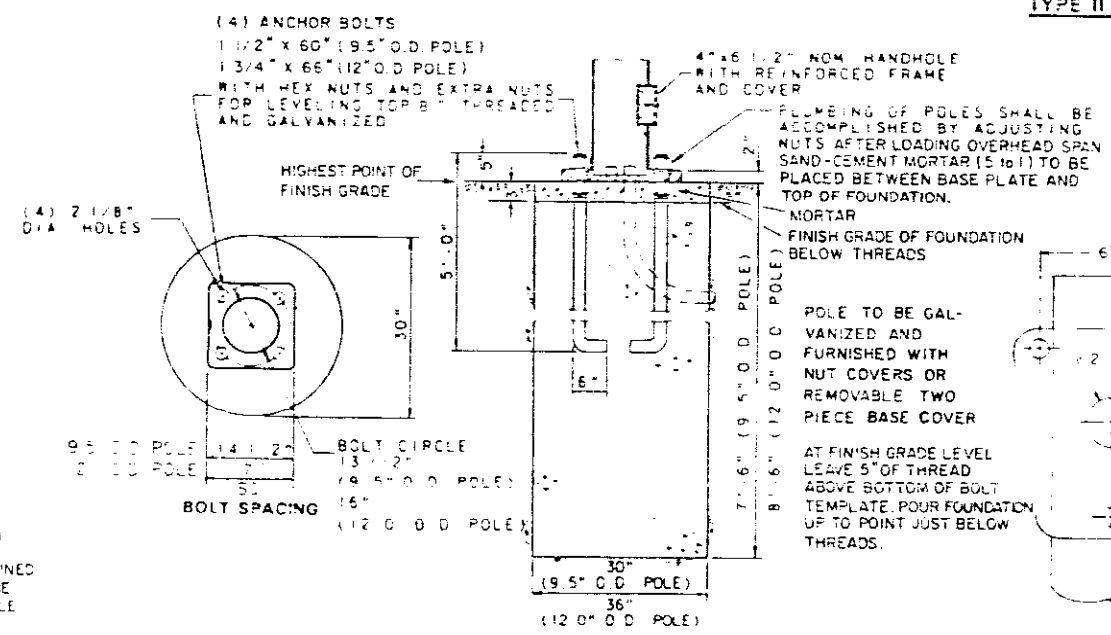

**DETAIL "B"**  
 ANCHOR BASE STEEL POLE BASE

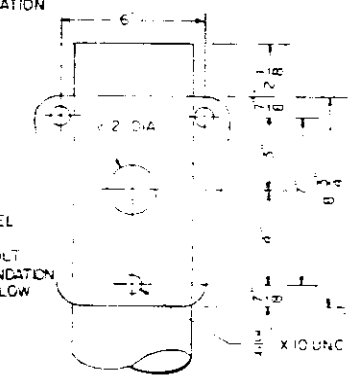

**DETAIL "C"**  
 POLE PLATE ATTACHMENT

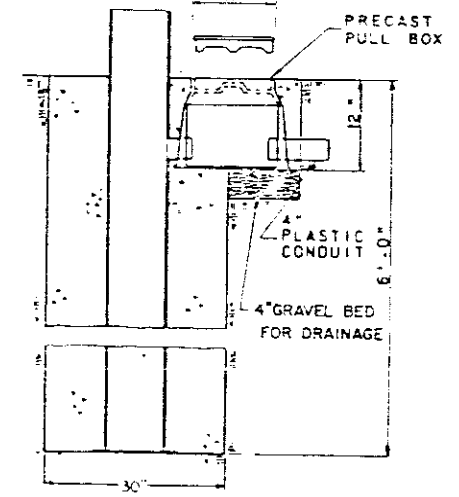

**DETAIL "D"**  
 IMBEDDED STEEL POLE BASE

DES	CHK	APPD	NO	DATE	REVISION	BY	APPD	NO	DATE	REVISION
			2-77		Detail A, B & D					
			6-78		TYPE I MOUNTING STANDARD					
			9-79		Detail "B" Note					
			12-79		Rev. Sag Spec					
			6-79		Anchor Bolt Size On Detail A Revised					
			1-80		Detail "C"					
			6-83		Type II Mounting Standard Revised					
			12-85		Type II Mounting Standard Detail "B" Revised					

TRAFFIC ENGINEERING DIVISION  
 DEPARTMENT OF PUBLIC WORKS  
 CITY AND COUNTY OF DENVER, COLORADO


**TRAFFIC SIGNAL  
 STANDARD DRAWINGS**

SHEET  
 OF  
 DATE AUG. 1975  
 DWG. NO. TS-2




AS CONSTRUCTED		FEDERAL ROAD REGION NO.	DIVISION	PROJECT NO.	SHEET NO.	TOTAL SHEETS
NO REVISIONS	REVISED	VIII	COLORADO	1R25-2 (191)	103	24

MESSENGER CLEVIS AND SPAN WIRE HANGER TO BE MALLEABLE IRON OR BRONZE.

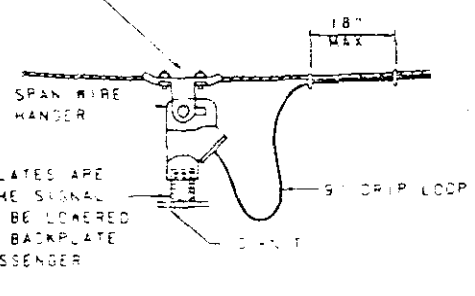


WHERE BACKPLATES ARE REQUIRED, THE SIGNAL PANEL IS TO BE LOWERED SO THAT THE BACKPLATE IS BELOW MESSENGER CABLE IT.

DETAIL "A" SPAN WIRE MOUNTING

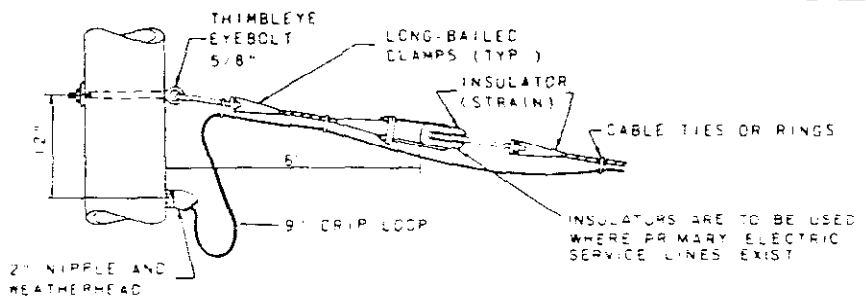


INSULATORS ARE TO BE USED WHERE PRIMARY ELECTRIC SERVICE LINES EXIST

DETAIL "C" CABLE INSTALLATION STEEL POLE

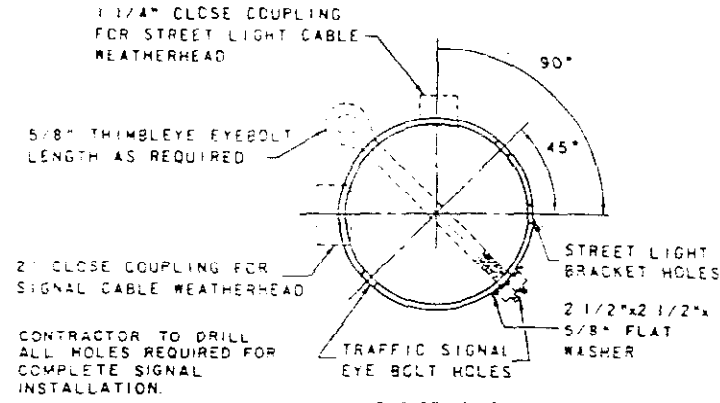


CONTRACTOR TO DRILL ALL HOLES REQUIRED FOR COMPLETE SIGNAL INSTALLATION. PUBLIC SERVICE CO RESPONSIBLE FOR ALL HOLES REQUIRED FOR STREET LIGHTING

HOLE SPACING

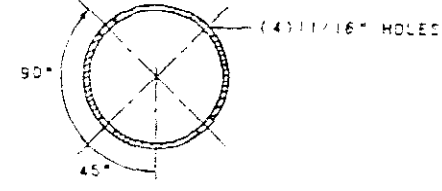


SECTION A-A

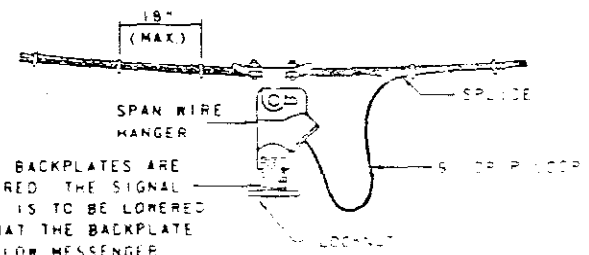


WHERE BACKPLATES ARE REQUIRED THE SIGNAL PANEL IS TO BE LOWERED SO THAT THE BACKPLATE IS BELOW MESSENGER CABLE IT.


DETAIL "B" SPAN WIRE MOUNTING SPLICE

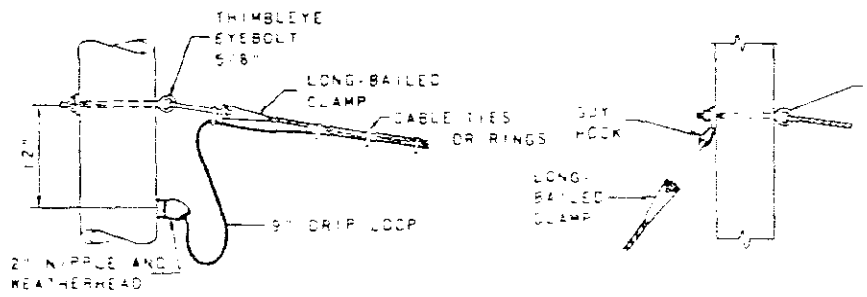


DETAIL "D" CABLE INSTALLATION WITHOUT INSULATOR STEEL POLE

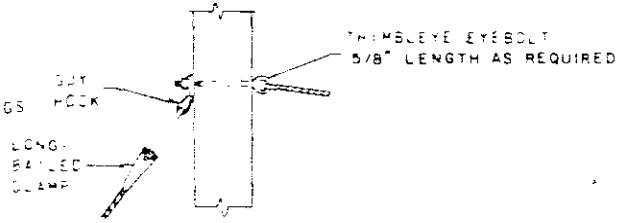


DETAIL "E" CABLE INSTALLATION WOOD POLE

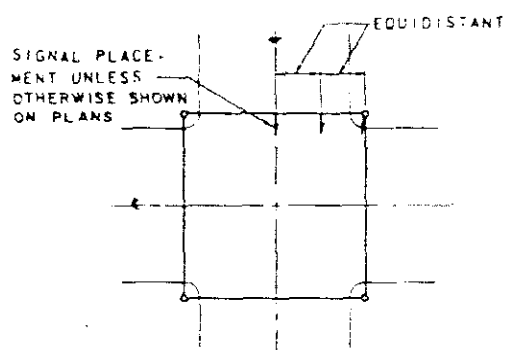

BOX SPAN

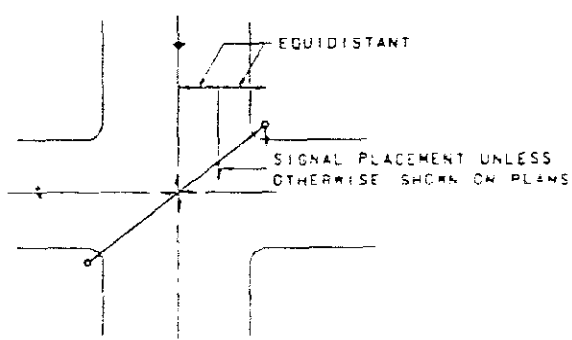


DIAGONAL SPAN

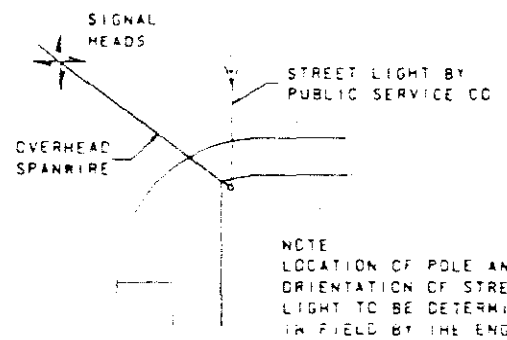

POLE LOCATION (TYPICAL)


NOTE LOCATION OF POLE AND ORIENTATION OF STREET LIGHT TO BE DETERMINED IN FIELD BY THE ENGINEER

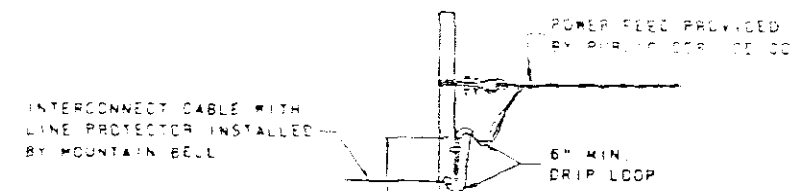


POWER FEED INSTALLATION (TYPICAL)

A GROUND ROD SHALL BE INSTALLED AS PROVIDED IN THE SPECIFICATIONS

NOTE TYPE SHOWN IS WOOD POLE. FOR STEEL POLE INSTALLATIONS, POWER FEED WILL GO TO CONTROLLER THROUGH SAME WEATHERHEAD AND CONDUIT AS SIGNAL CABLE

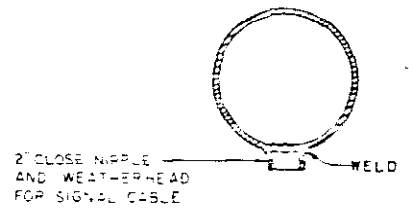

SECTION B-B

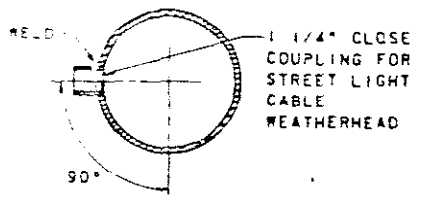

SECTION C-C

STEEL POLE (TYPICAL)


DES	1	2-77	Span Wire Sag, Power Feed Installation	RR	
DR	2	9-78	Span Wire Sag, Power Feed, Span Wire Sag	RR	
	3	3-80	DETAIL "A"	AC	

TRAFFIC ENGINEERING DIVISION  
DEPARTMENT OF PUBLIC WORKS  
CITY AND COUNTY OF DENVER, COLORADO

TRAFFIC SIGNAL  
STANDARD DRAWINGS



SHEET	103
DATE	AUG 1978
TS-3	

FEDERAL ROAD REGION NO.	DIVISION	PROJECT NO.	SHEET NO.	TOTAL SHEETS
VIII	COLORADO	IR25-2 (191)	104	112

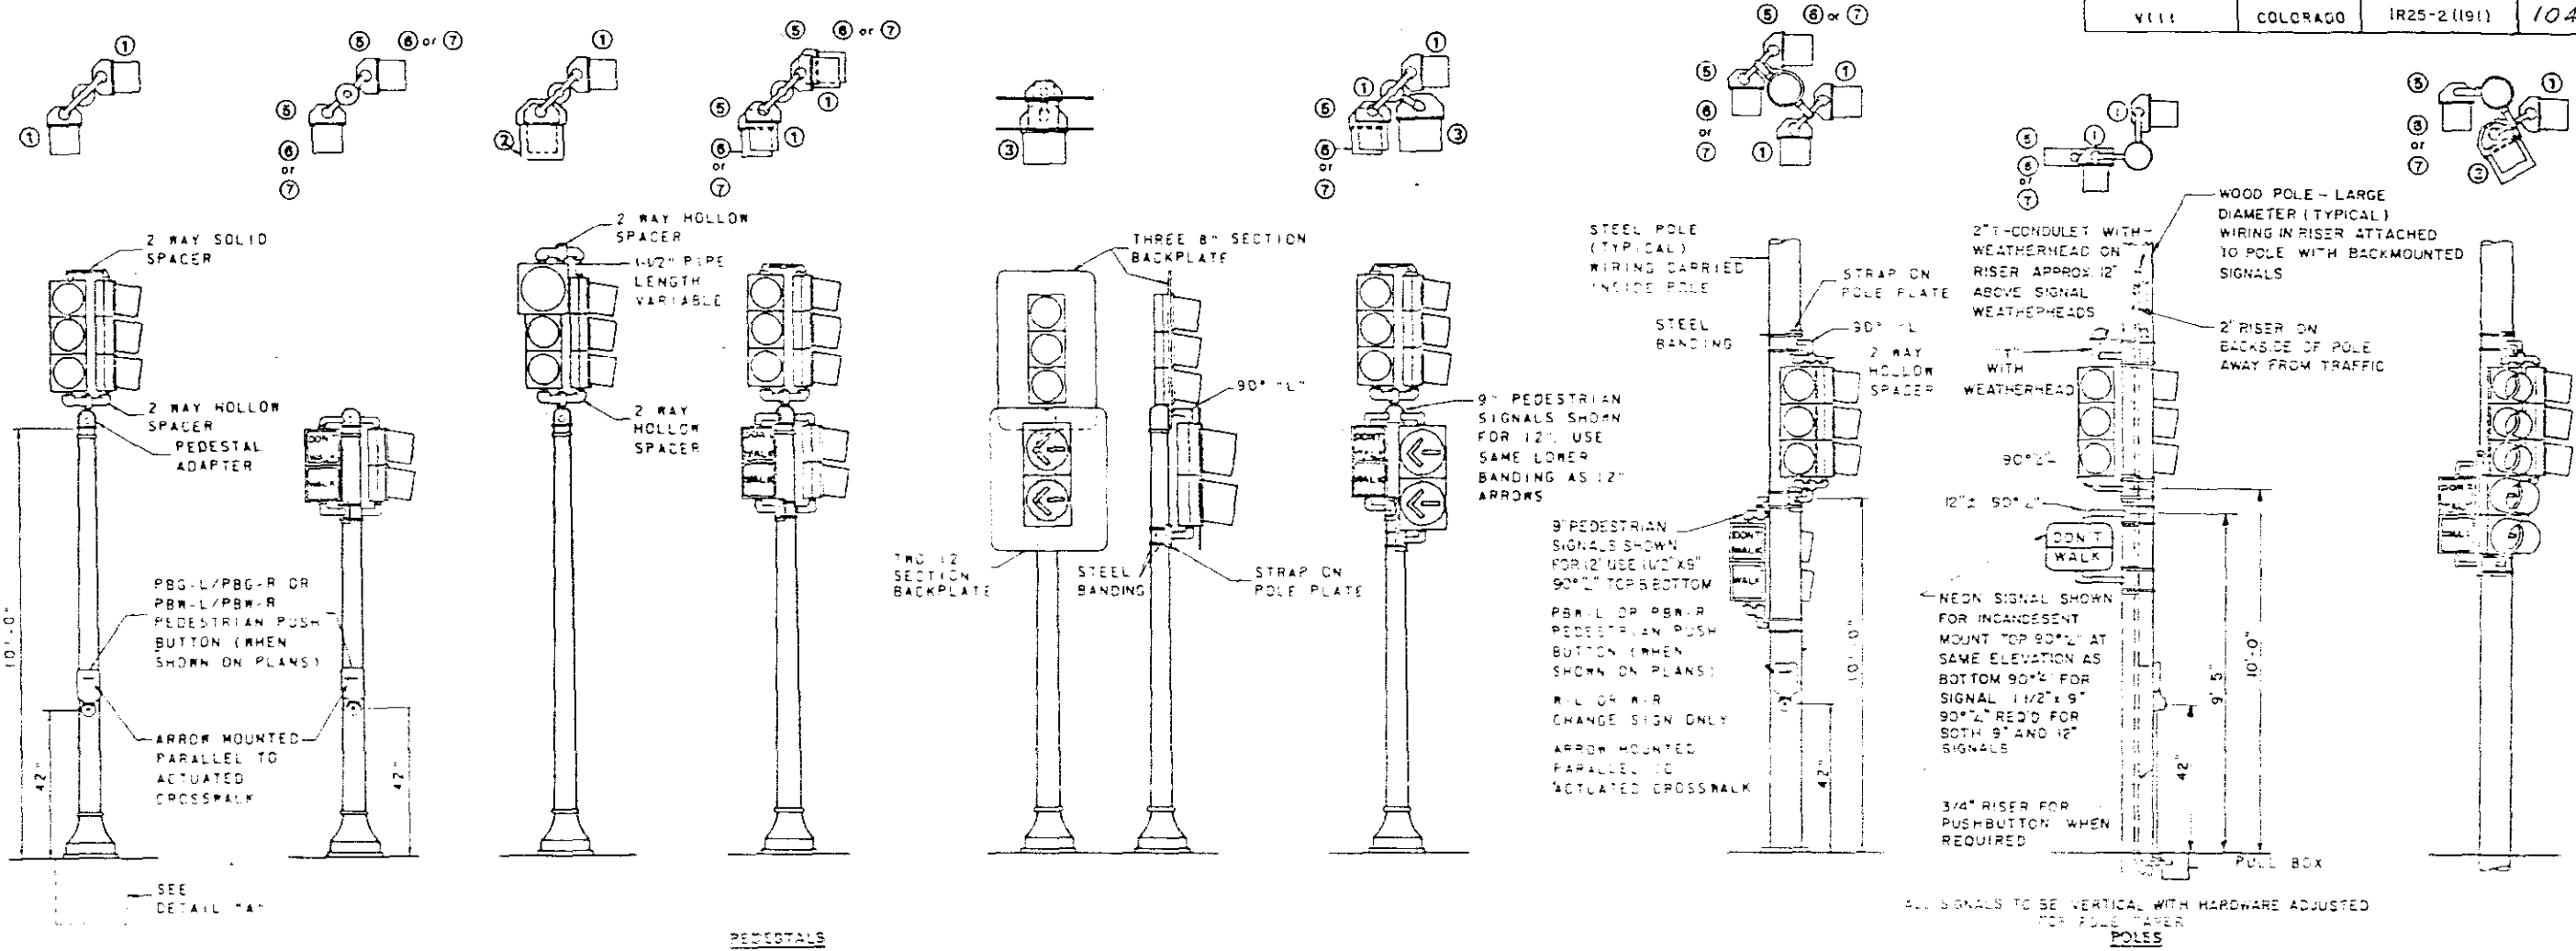

**TYPE III MOUNTING STANDARD**

**TYPE IV MOUNTING STANDARD**

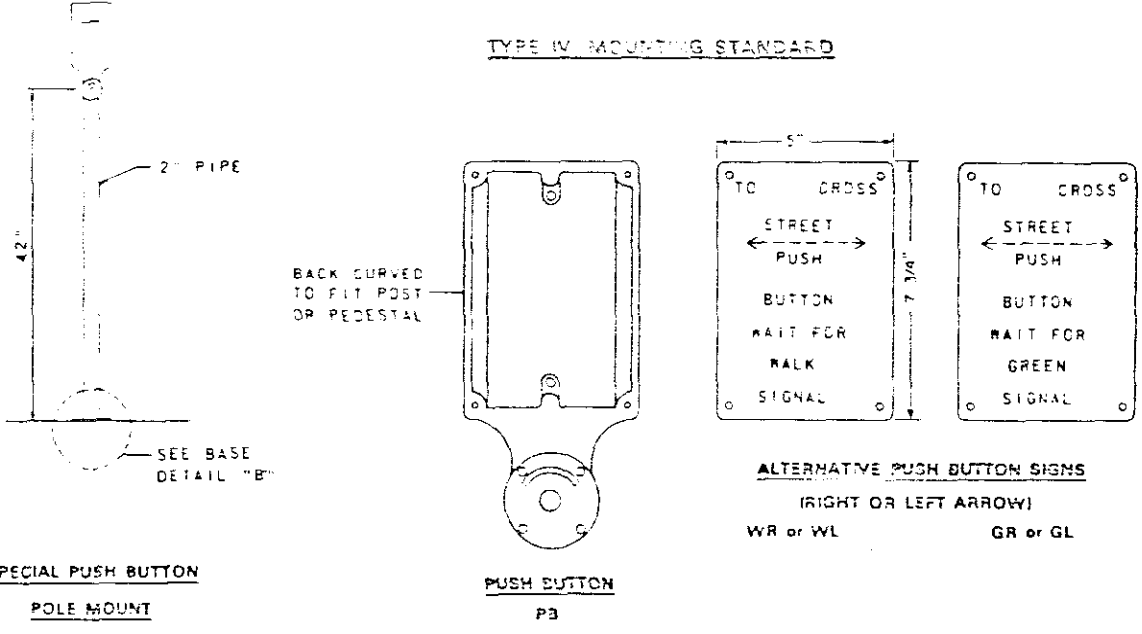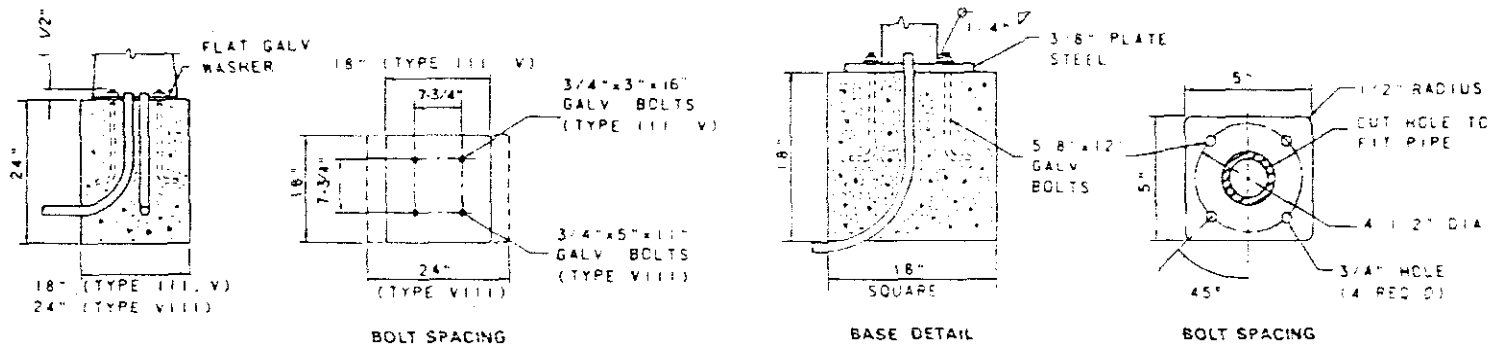

**TYPE III, V OR VIII MOUNTING STANDARDS**

DES	DR	CHK	APP'D	NO	DATE	REVISION	BY	APP'D

NO	DATE	REVISION	BY	APP'D
1	2-77	Type III & Type IV Standards	RH	
2	9-78	DETAIL "A"	RG	
3	6-79	Alternative Push Button Signs Dimensions	AM	

TRAFFIC ENGINEERING DIVISION  
DEPARTMENT OF PUBLIC WORKS  
CITY AND COUNTY OF DENVER, COLORADO

TRAFFIC SIGNAL  
STANDARD DRAWINGS

SHEET  
CF  
DATE AUG, 1975  
DWG. TS-4


NO REVISIONS  
REVISIONS  
AS CONSTRUCTION




NO REVISIONS 7-2-77

FEDERAL ROAD REGION NO.	DIVISION	PROJECT NO.	SHEET NO.	TOTAL SHEETS
VIII	COLORADO	IR25-2 (191)	100	242


NOTE  
 2 WAY 10" DIA. 8" SIGNALS  
 3 WAY 12" DIA. 8" SIGNALS  
 3 WAY 14" DIA. 12" SIGNALS  
 4 WAY 12" DIA. 8" SIGNALS  
 4 WAY 14" DIA. 12" SIGNALS

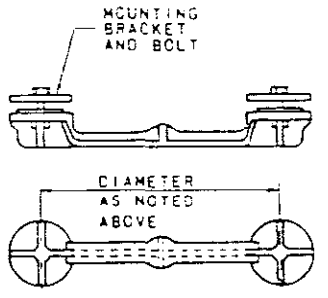


SOLID SPACER (2.3 & 4 WAY)

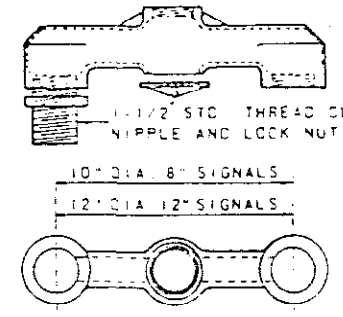


2 WAY "L" HOLLOW SPACER

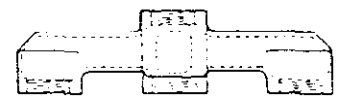


3 WAY "L" HOLLOW SPACER

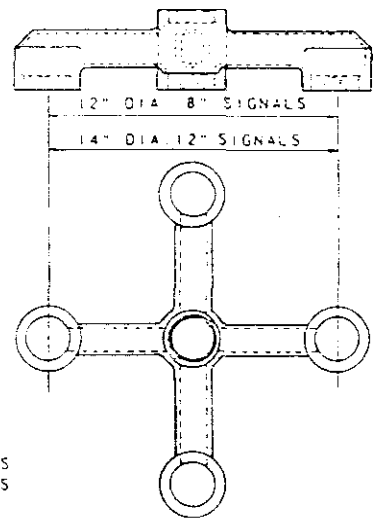

4 WAY "L" HOLLOW SPACER

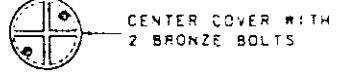


CENTER COVER WITH 2 BRONZE BOLTS

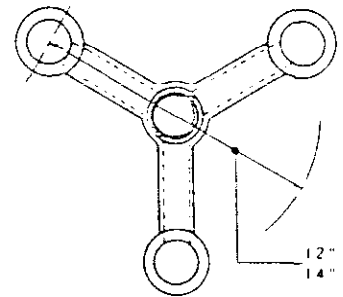


12" DIA. 8" SIGNALS  
14" DIA. 12" SIGNALS

TYPE I, II AND III MOUNTING STANDARDS

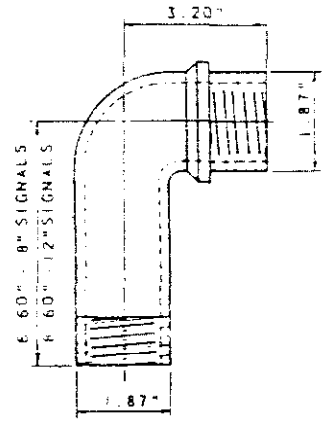


90° "L" CONNECTOR

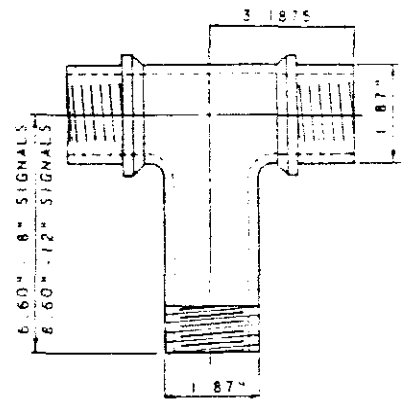

"T" CONNECTOR


TYPE III AND IV MOUNTING STANDARDS

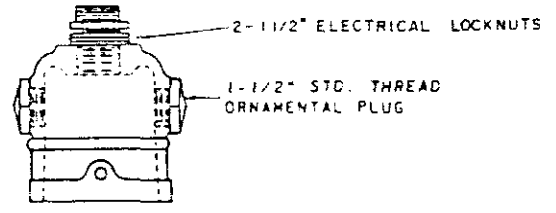


PEDESTAL ADAPTER

TYPE III MOUNTING STANDARD

TYPE II, III AND IV MOUNTING STANDARDS

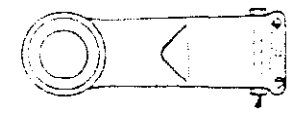


1-WAY

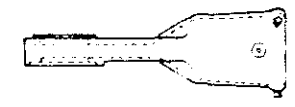

2-WAY


MAST ARM MOUNTING  
ELEVATOR PLUMBIZER

TYPE I MOUNTING STANDARD

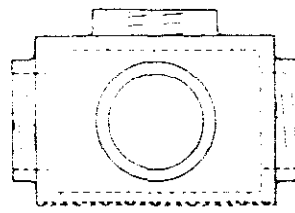


4 WAY CENTER HUB

TYPE II MOUNTING STANDARD

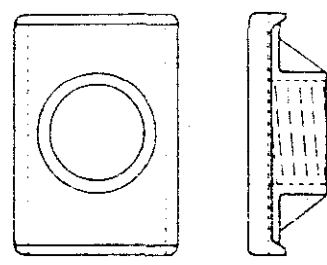


POLE PLATE

TYPE IV MOUNTING STANDARD

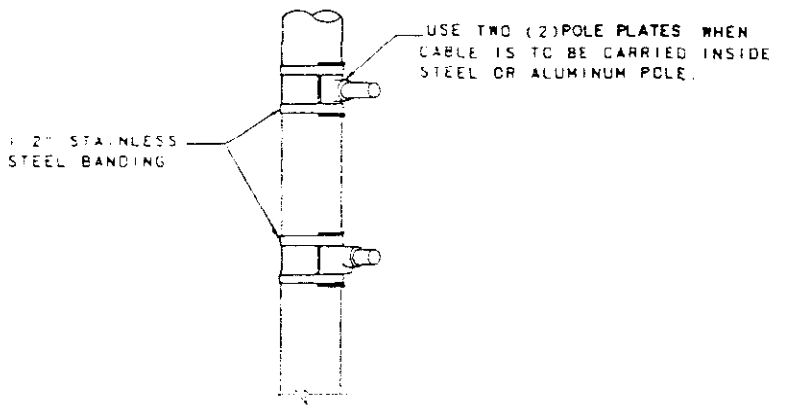

STRAP-ON POLE MOUNT DETAIL

TYPE IV MOUNTING STANDARD

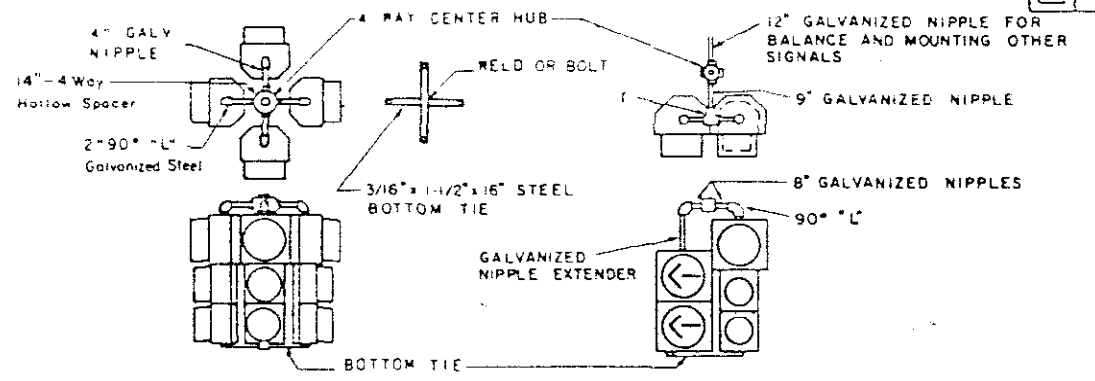

DETAIL "A"  
4-WAY SPAN WIRE MOUNTING

DETAIL "B"  
COMBINATION SIGNAL SPAN WIRE MOUNTING

TYPE II MOUNTING STANDARD


NO REVISIONS  
 AS CONSTRUCTED  
 REVISED  
 VOID

NO.	DATE	REVISION	BY	APPRO.
1	2-77	Type II Type III Mounting Standards 30d	R.H.	
2	9-78	Note 4 Added 20d	R.R.	
3	6-79	Type II Mounting Standard	A.M.	
4	3-80	Note 5 Added	A.C.	


TRAFFIC ENGINEERING DIVISION  
 DEPARTMENT OF PUBLIC WORKS  
 CITY AND COUNTY OF DENVER, COLORADO

TRAFFIC SIGNAL  
 STANDARD DRAWINGS


SHEET  
 OF  
 DATE AUG, 1975  
 DWG. TS-6

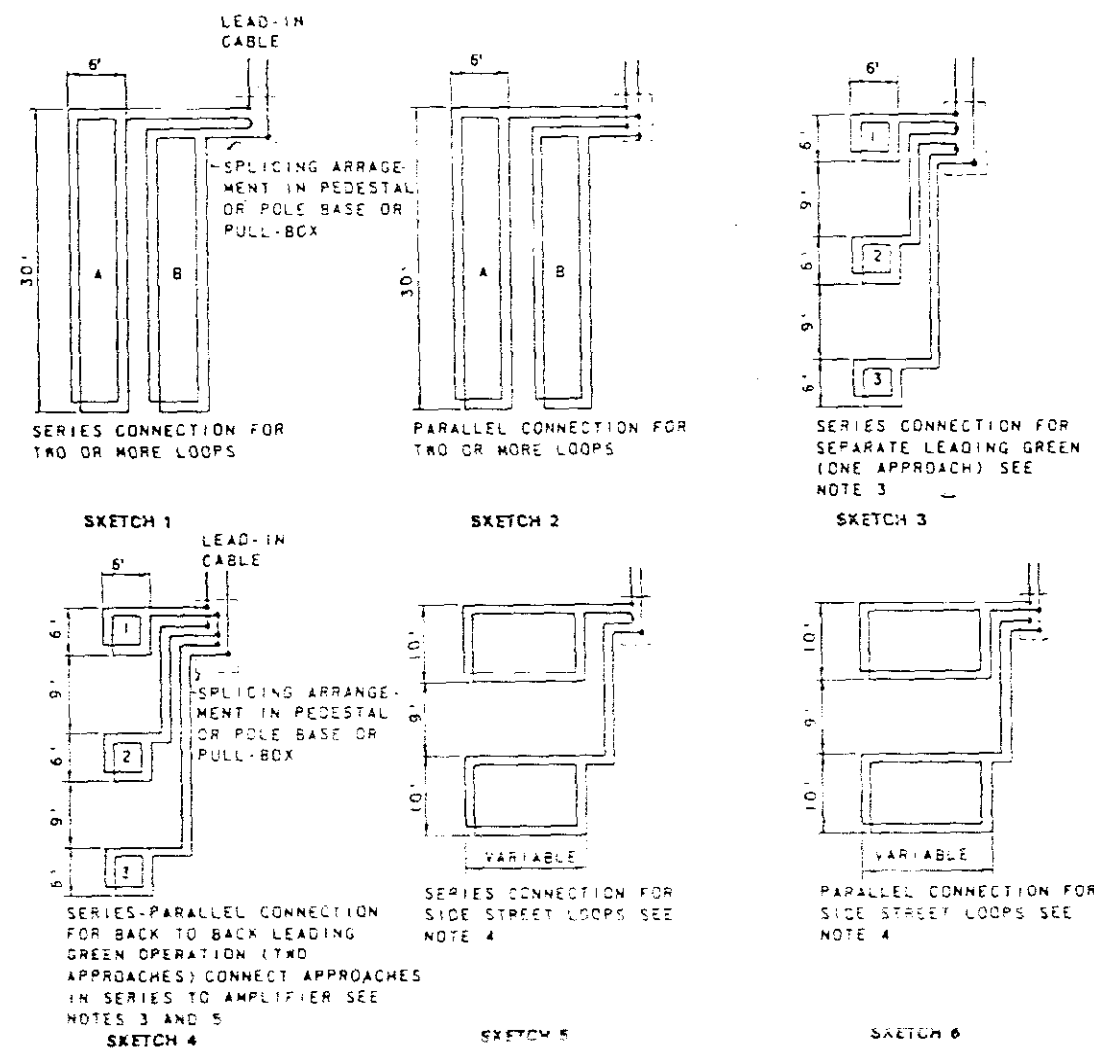


SIDE STREET LOOPS PLACED 10' BACK FROM CURB LINE EXTENDED OR FLOW LINE, 4' FROM CURB, 1' MIN. - 2' MAX FROM CENTER LINE. LOOPS ARE 6' X 30' NOMINAL, 5' MIN. - 12' MAX. OR AS SHOWN ON PLANS (SEE SKETCH 1 OR 2)

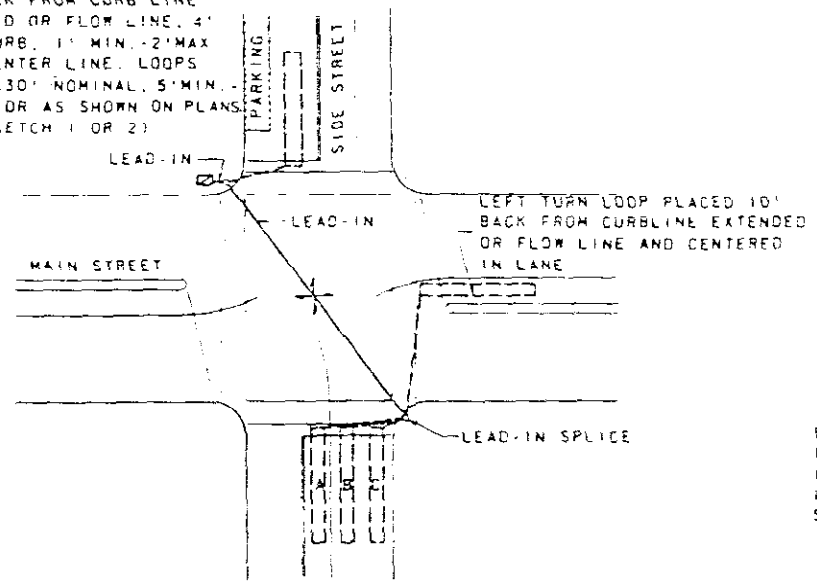

LOCATION DETAIL (TYPICAL)  
NEW CONSTRUCTION

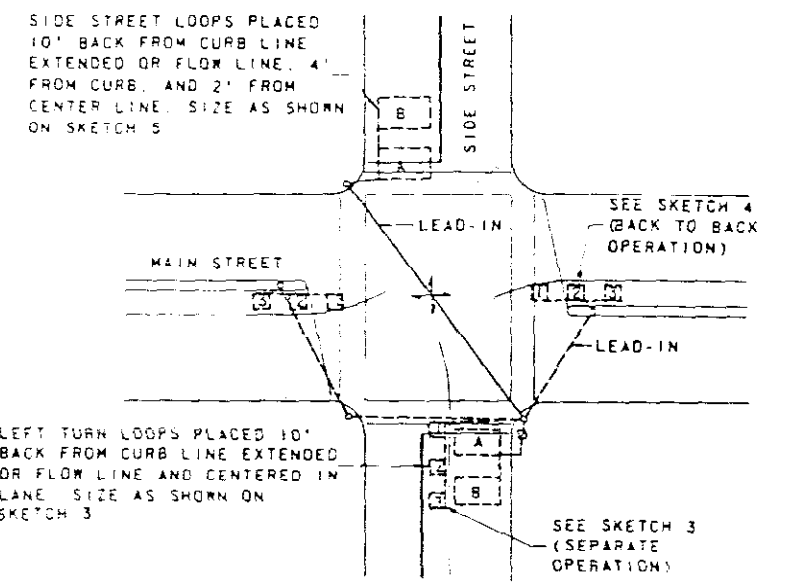


ALTERNATIVE LOCATION DETAIL (TYPICAL)  
EXISTING - NOT TO BE USED FOR NEW CONSTRUCTION

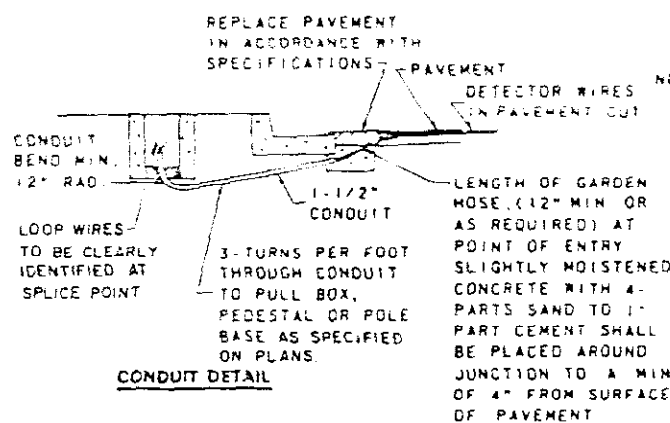

CONDUIT DETAIL

NOTE: MAXIMUM 3 CONDUCTORS PER 2 1/2" DEEP SLOT FOR ADDITIONAL CONDUCTORS SLOT MAY BE DEEPENED 1/4" PER CONDUCTOR OR ADDITIONAL SLOT MADE.

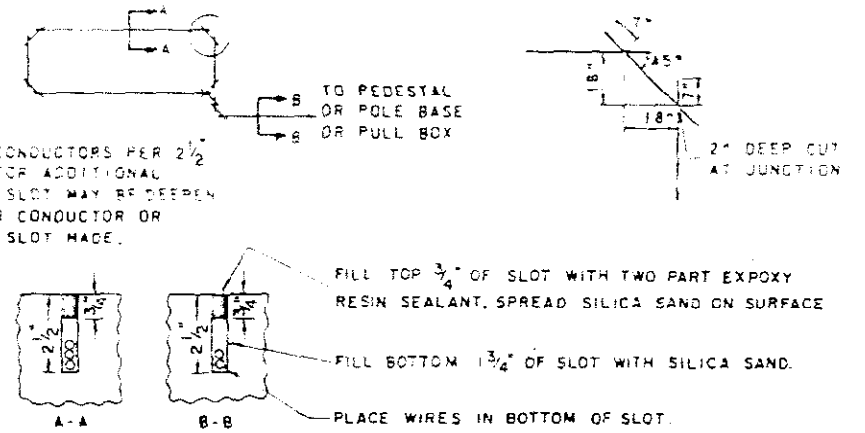

LOOP SLOT DETAIL

- NOTES:
1. LOOP WIRES SHALL BE BROUGHT OUT TO NEAREST SIGNAL STANDARD OR PULL BOX AND EXISTING UNDERGROUND CONDUIT OR OVERHEAD MESSENGER WIRE USED FOR LEAD-IN CABLE TO CONTROL CABINET.
  2. LEAD-IN CABLE LENGTH SHOULD BE THE SHORTEST POSSIBLE DISTANCE TO THE CONTROL CABINET.
  3. LOOP WIRES SHALL BE SPICED TO LEAD-IN CABLE IN ACCORDANCE WITH THE SPECS.
  4. ALL LEFT TURN LOOPS SHALL HAVE 2 TURNS OF WIRE IN EACH LOOP.
  5. SIDE STREET LOOPS SHALL HAVE THE NUMBER OF TURNS OF WIRE AND CONNECTIONS AS SPECIFIED ON PLANS. SEE SKETCHES 1, 2, 3 & 4.
  6. TWO OPPOSING LEFT TURN LOOP COMBINATIONS (BACK TO BACK) MAY BE CONNECTED IN SERIES-PARALLEL TO ONE AMPLIFIER AS SPECIFIED ON PLANS. SEE SKETCH 4.
  7. ALL LOOP WIRES SHALL BE CLEARLY IDENTIFIED BY LETTER AT CONNECTION OR SPICE POINT.
  8. ALL LOOP INTERCEPT LOCATIONS SHALL BE MARKED WITH AN ARROW CUT INTO THE CURB OR GUTTER.

LOOP DETECTOR INSTALLATION

NUMBER OF LOOPS	NUMBER OF TURNS	CONNECTION OF LOOPS (1ST SPICE PT)	CONNECTION TO AMPLIFIER	PROBABLE NUMBER OF LEGS
1	2		SAME	1
2	3	PARALLEL	SAME	1
3	3	SERIES	PARALLEL	2
4	2	SERIES	PARALLEL	1
	2	SERIES	PARALLEL	2
5	2	SERIES	PARALLEL	2
	2	SERIES	PARALLEL	2
6	2	SERIES	PARALLEL	2
	2	SERIES	PARALLEL	2

LOOPS ARE 6' X 30' NOMINAL (MIN. 5' - MAX. 12')  
SEE INTERSECTION DRAWING FOR LAYOUT OF LOOPS.


# CLASS III SIGNS - SHEET 1

AS CONSTRUCTED  
 NO REVISIONS  REVISED  VOID

FEDERAL ROAD REGION NO.	DISTRICT	PROJ. NO.	SHEET NO.	TOTAL SHEETS
100	COLORADO	IR25-2(191)	108	240

REVISIONS		

## TYPICAL PANEL ELEVATIONS HORIZONTAL SECTIONS

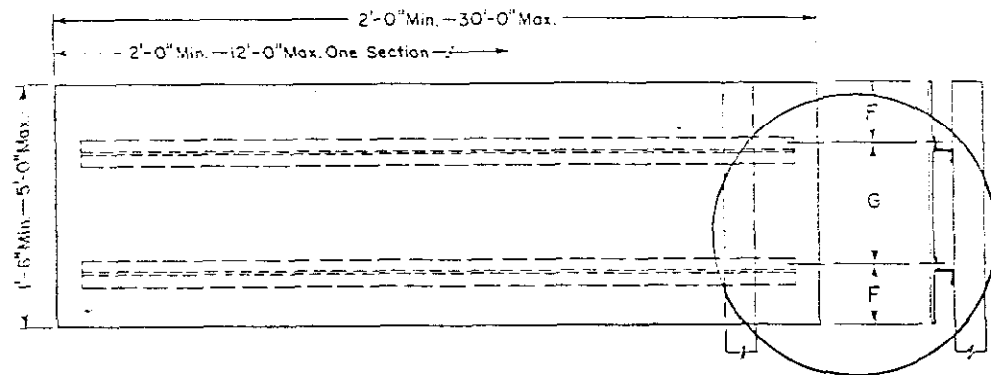


**SECTIONS REQUIRED**  
 Height x 2'-0" to 12'-0" = 1 Section  
 Height x 12'-6" to 24'-0" = 2 Sections  
 Height x 24'-6" to 30'-0" = 3 Sections

SEE TYPICAL  
DETAIL  
ON SHEET 2

## GENERAL NOTES

- ALL WORK SHALL BE DONE IN ACCORDANCE WITH THE STANDARD SPECIFICATIONS APPLICABLE TO THE PROJECT.
- SEE THE APPLICABLE STANDARDS FOR SIGN PLACEMENT, FOOTING DETAILS AND POST SPACING TABLE.
- A (No 6) 90° COUNTERSUNK ALUMINUM LOCKBOLT FASTENER SHALL BE USED TO FASTEN THE SIGN PANEL TO THE BACKING ZEE. A HEX-HEAD BOLT WITH NUT AND WASHERS SHALL BE USED TO FASTEN THE BACKING ZEE TO A TIMBER POST OR TO A STEEL POST.
- A FLAT WASHER SHALL BE PLACED BETWEEN THE BOLT HEAD AND THE BACKING ZEE. A LOCK WASHER SHALL BE PLACED UNDER THE NUT ON A STEEL POST OR A BACKING ZEE. A C.I.Ogee WASHER SHALL BE PLACED UNDER THE BOLT HEAD ON A TIMBER POST.
- THE EXPOSED LOCKBOLT HEADS ON THE FACE OF THE SIGN PANEL SHALL BE COVERED WITH REFLECTIVE SHEETING (TO BE A PART OF THE LOCKBOLT HEAD) TO MATCH THE BACKGROUND COLOR OF THE SIGN.
- ALL EXPOSED SIGN PANEL SECTION JOINTS, EXCEPT THE MULTI-VERTICAL SECTIONS HORIZONTAL SEAM, SHALL BE COVERED ON THE BACKSIDE OF THE SIGN PANEL WITH AN ALUMINUM CLOSURE STRIP. CLOSURE STRIPS SHALL BE BONDED TO THE SIGN PANEL WITH AN EPOXY RESIN WHICH MEETS THE REQUIREMENTS SPECIFIED IN ASTM DESIGNATION - D1763, PART 9. ALL BONDED SURFACES SHALL BE CLEAN AND FREE OF ANY FOREIGN MATTER.
- SIGN PANELS SHALL BE CONSTRUCTED FROM THE LEAST NUMBER OF SECTIONS. THE SECTIONS SHALL BE AS LARGE AS POSSIBLE AND AS NEARLY EQUAL IN SIZE AS POSSIBLE, ACCORDING TO THE LIMITS SHOWN.
- FOR ADDITIONAL POST AND PANEL INFORMATION SEE THE "TABULATION OF SIGNS" INCLUDED IN THE PLANS.


## VERTICAL SECTIONS

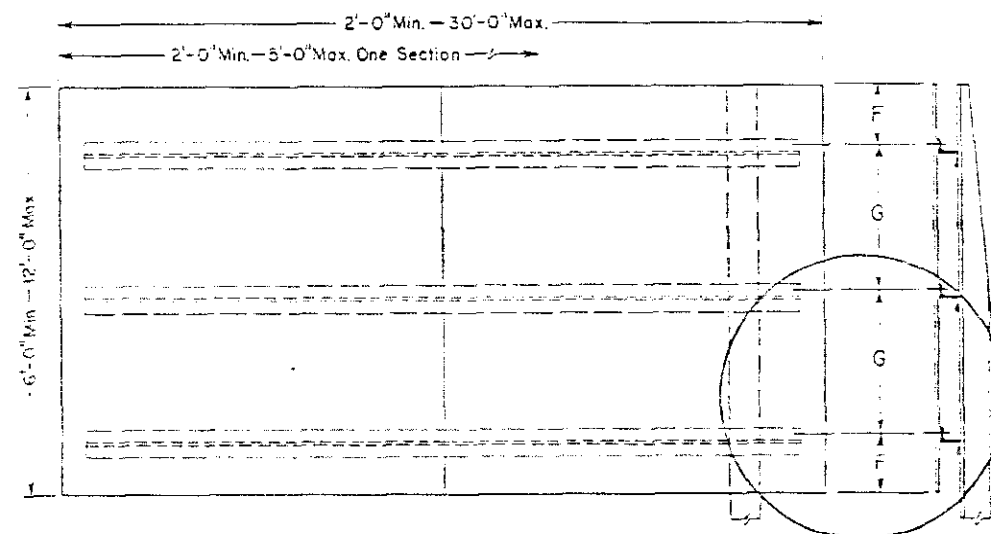

**SECTIONS REQUIRED**  
 Height x 2'-0" to 5'-0" = 1 Section  
 Height x 5'-6" to 10'-0" = 2 Sections  
 Height x 10'-6" to 15'-0" = 3 Sections  
 Height x 15'-6" to 20'-0" = 4 Sections  
 Height x 20'-6" to 25'-0" = 5 Sections  
 Height x 25'-6" to 30'-0" = 6 Sections

SEE TYPICAL  
DETAIL  
ON SHEET 2

## MULTI-VERTICAL SECTIONS

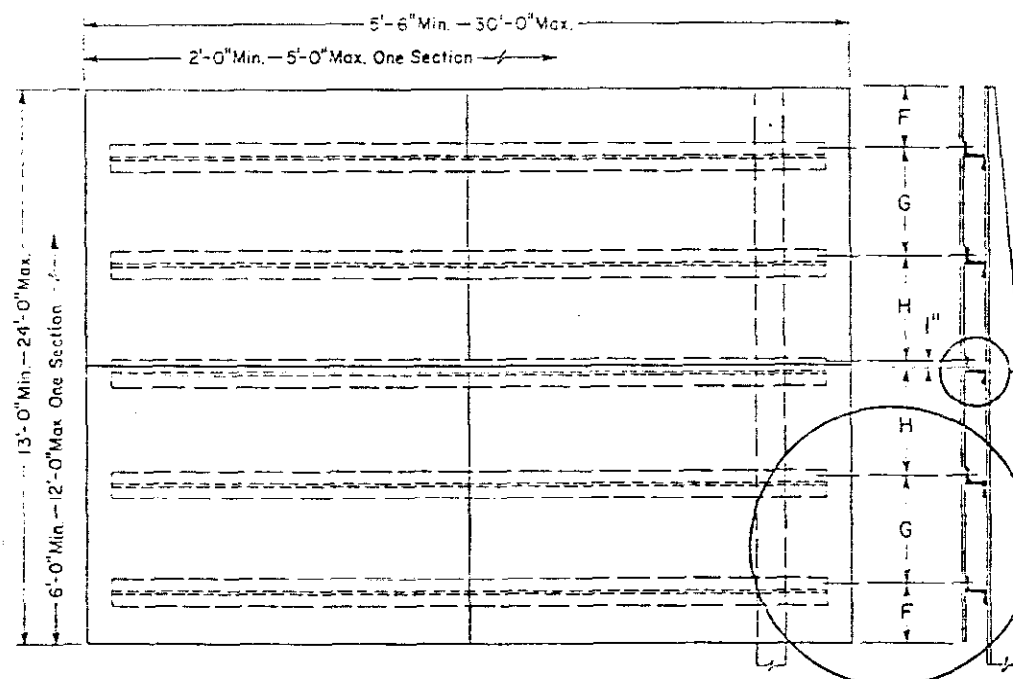

**SECTIONS REQUIRED**  
 Height x 5'-6" to 10'-0" = 4 Sections  
 Height x 10'-6" to 15'-0" = 6 Sections  
 Height x 15'-6" to 20'-0" = 8 Sections  
 Height x 20'-6" to 25'-0" = 10 Sections  
 Height x 25'-6" to 30'-0" = 12 Sections

SEE TYPICAL SEAM  
CLOSURE ZEE  
DETAIL ON SHEET 2

SEE TYPICAL  
DETAIL  
ON SHEET 2

## SPACING TABLE FOR ALUMINUM BACKING ZEES

SIGN NO.	PANEL SIZE	NO OF ZEES	ZEE SIZE	OVERHANG "F"	SPACING "G"	SPACING "H"
▲ 1a, 1c, 1e	12'x11'	5	3"x2 1/16" x 2.33	1'-2"	2'-2"	—
▲ 3a, 3c	12'x11'	5	3"x2 1/16" x 2.33	1'-2"	2'-2"	—
▲ 7	33'x13'	7	3"x2 1/16" x 2.33	1'-0"	1'-10"	1'-9 1/2"
▲ 10	16'x11'	5	3"x2 1/16" x 2.33	1'-2"	2'-2"	—
▲ 11	20'x7'	3	3"x2 1/16" x 2.33	1'-0"	2'-6"	—
▲ 13a	11'x11'	5	3"x2 1/16" x 2.33	1'-2"	2'-2"	—
▲ 13b	16'x11'	5	3"x2 1/16" x 2.33	1'-2"	2'-2"	—
▲ 14c	12'x12'	5	3"x2 1/16" x 2.33	1'-0"	2'-6"	—
▲ 14d, 14e	11'x12'	5	3"x2 1/16" x 2.33	1'-0"	2'-6"	—
▲ 20a, 20b	12'x12'	5	3"x2 1/16" x 2.33	1'-0"	2'-6"	—
▲ 23	13'x8'	4	3"x2 1/16" x 2.33	0'-9"	2'-2"	—
▲ 26	11'x5'	2	3"x2 1/16" x 2.33	1'-3"	2'-6"	—
▲ 36a	11'x10'	4	3"x2 1/16" x 2.33	1'-3"	2'-6"	—
▲ 36b	9'x10'	4	3"x2 1/16" x 2.33	1'-3"	2'-6"	—
▲ 44a	16'x12'	5	3"x2 1/16" x 2.33	1'-0"	2'-6"	—
▲ 44b	15'x12'	5	3"x2 1/16" x 2.33	1'-0"	2'-6"	—
▲ 48	6'x5'	2	3"x2 1/16" x 2.33	1'-3"	2'-6"	—
▲ 68	6'x5'	2	3"x2 1/16" x 2.33	1'-3"	2'-6"	—

▲ OVERHEAD SIGN PANEL

DEPARTMENT OF HIGHWAYS  
 STATE OF COLORADO  
 DIVISION OF HIGHWAYS


CLASS III SIGNS  
 SHEET ALUMINUM  
 PANELS

# CLASS III SIGNS - SHEET 2

AS CONSTRUCTED		
NO REVISIONS	REVISED	VOID
7		

FEDERAL ROAD REGION NO.	DISTRICT	PROJ NO.	SHEET NO.	TOTAL SHEETS
VIII	COLORADO	IR25-2(191)	109	2


REVISIONS	

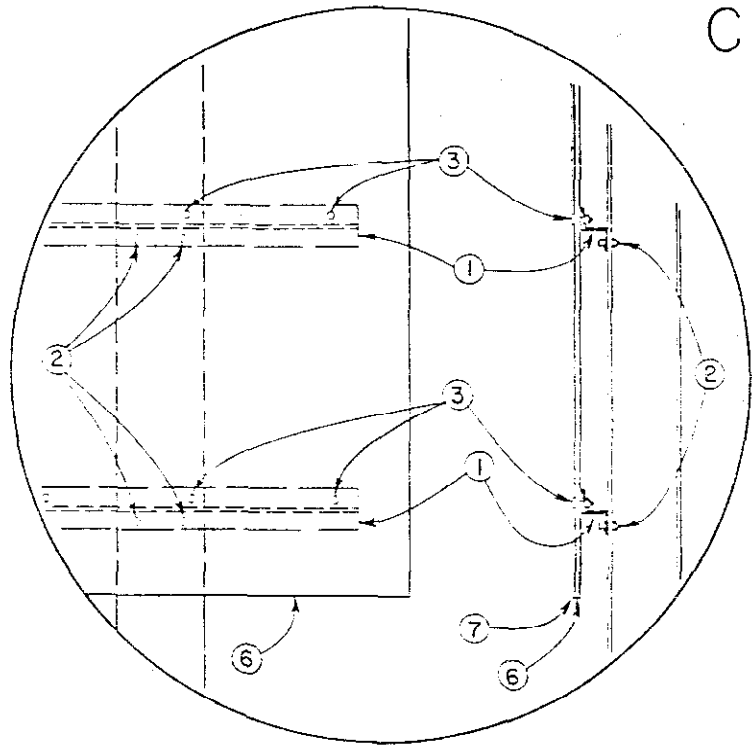

TYPICAL ELEVATION DETAIL

## FABRICATION NOTES

- ① BACKING ZEE. See "SPACING TABLE" Aluminum Alloy 6061-T6. Each zee to be provided with a 3/16" x 2" horizontal slot for each post mounting bolt. The length of each zee to be 1" less than the sign panel width.
- ② 3/8" HEX-HEAD BOLT With nut and washers; 2 per backing zee per post are required.
- ③ 3/8" (No. 6) 90° COUNTERSUNK ALUMINUM LOCKBOLT FASTENER.
- ④ 2" x 0.060" ALUMINUM CLOSURE STRIP.
- ⑤ 1/8" x 3/8" UNIVERSAL-HEAD, HOLLOW SHANK ALUMINUM RIVET.
- ⑥ SHEET ALUMINUM. 0.125" minimum thickness.
- ⑦ NON-EXPOSED LENS REFLECTIVE SHEETING. To have a dry (heat activated) adhesive backing

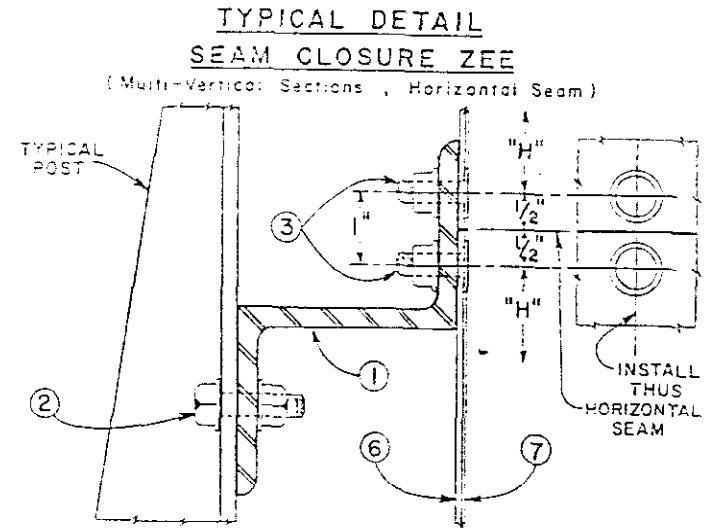


TYPICAL DETAIL SEAM CLOSURE ZEE


(Multi-Vertical Sections, Horizontal Seam)

## TYPICAL TIMBER POST INSTALLATION

### PANEL FABRICATION AND MOUNTING DETAILS

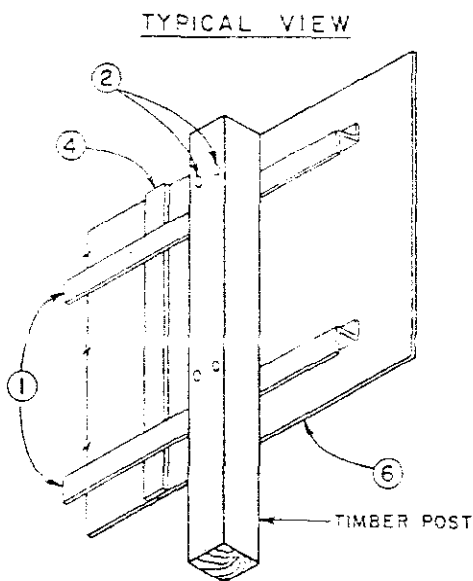


TYPICAL VIEW

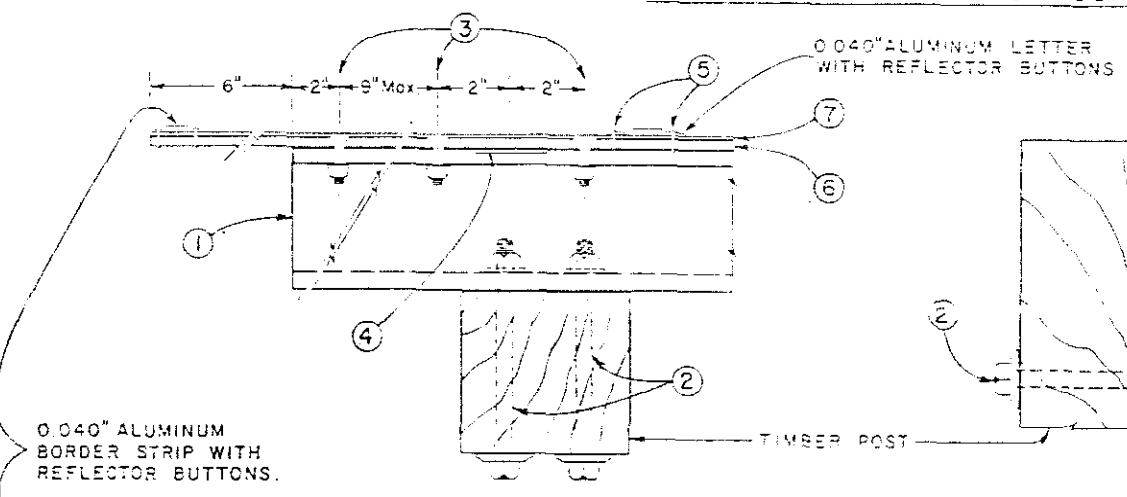


## TYPICAL STEEL POST INSTALLATION


### PANEL FABRICATION AND MOUNTING DETAILS

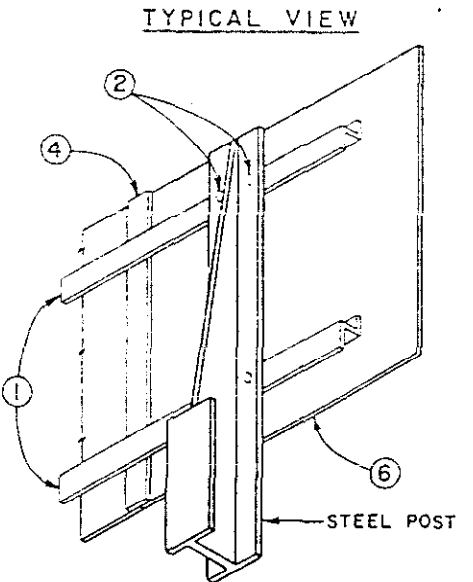


TYPICAL VIEW

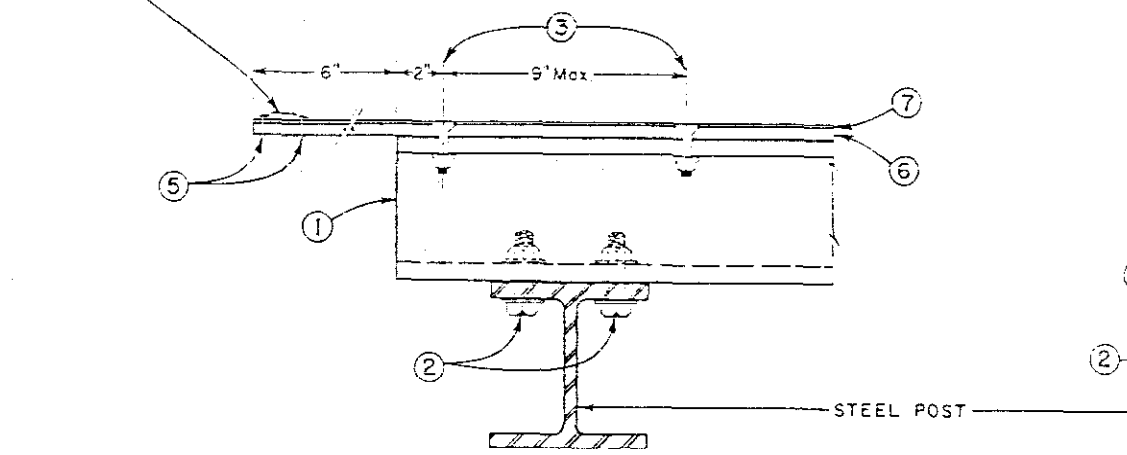

### BORDER STRIP

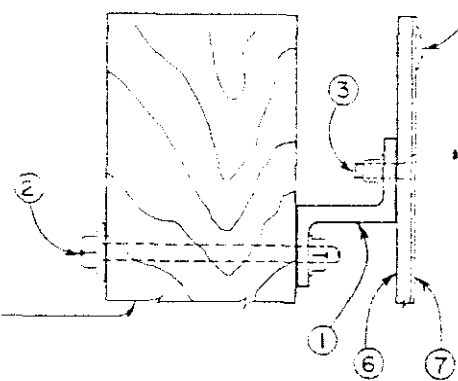

## TYPICAL BORDER DETAILS EXIT NUMBER PANELS

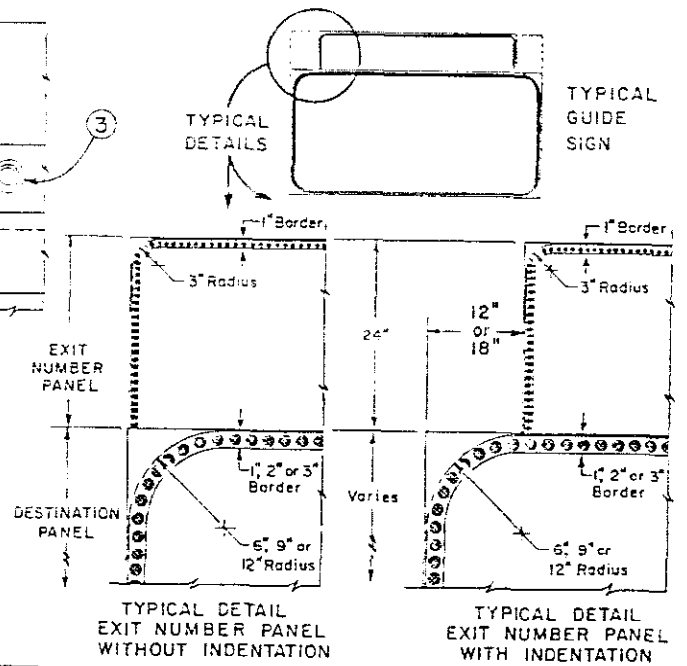

DEPARTMENT OF HIGHWAYS  
STATE OF COLORADO  
DIVISION OF HIGHWAYS

CLASS III SIGNS  
SHEET ALUMINUM  
PANELS

# STANDARD S-614-5


JANUARY 1982

SPECIAL FOR THIS PROJECT


FEDERAL ROAD REGION NO.	DIVISION	PROJ. NO.	SHEET NO.	TOTAL SHEETS
7	COLORADO	IR25-2(191)	110	120

REVISIONS	


TYPICAL ELEVATION STEEL POST ASSEMBLY

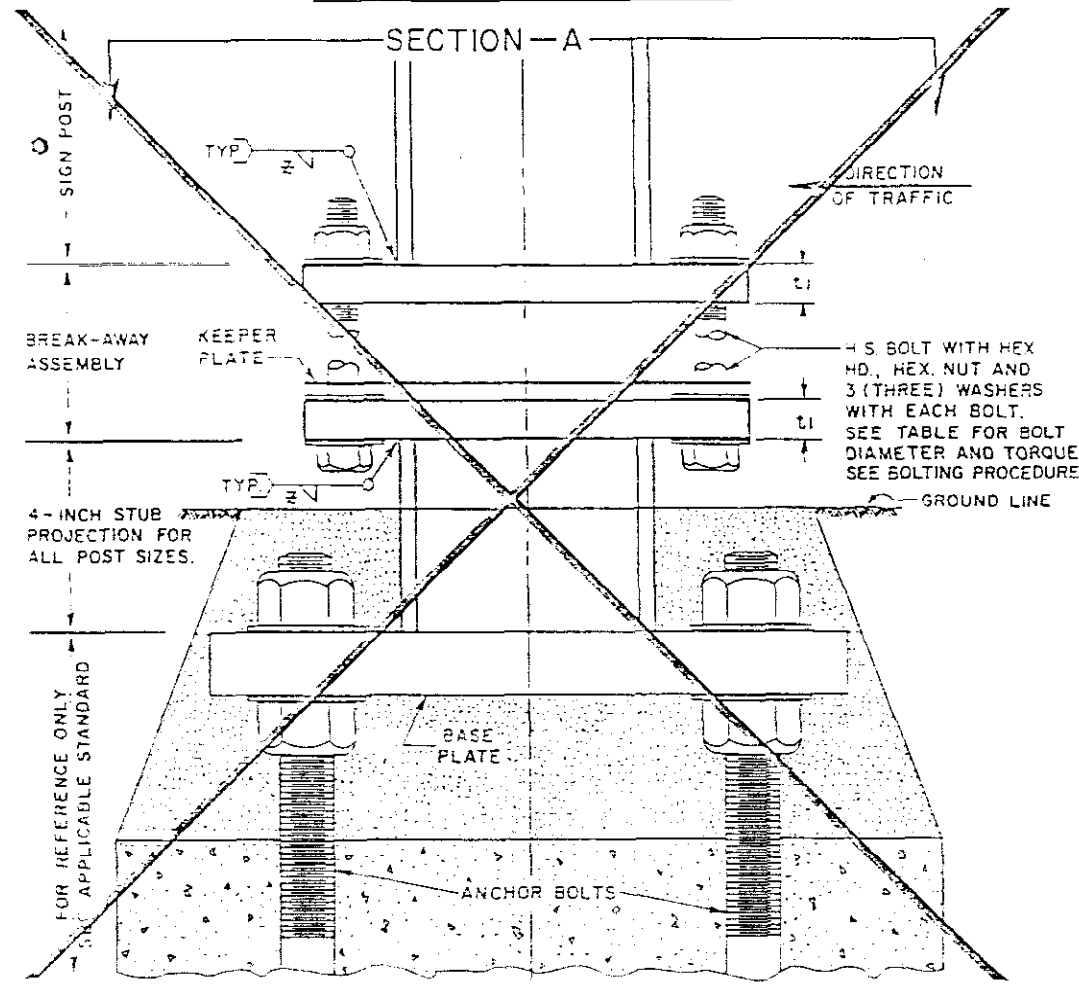


TYPICAL BREAK-AWAY SIGN SUPPORT INSTALLATIONS

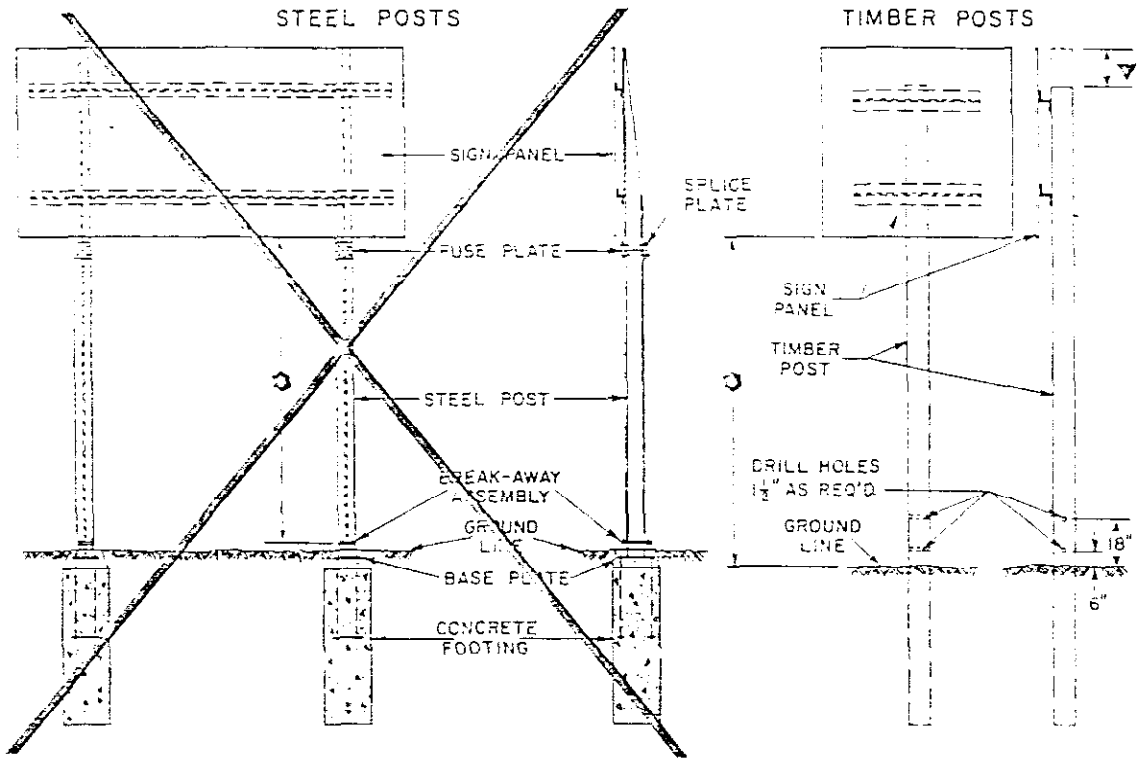

TYPICAL PROJECTED VIEW STEEL POST ASSEMBLY

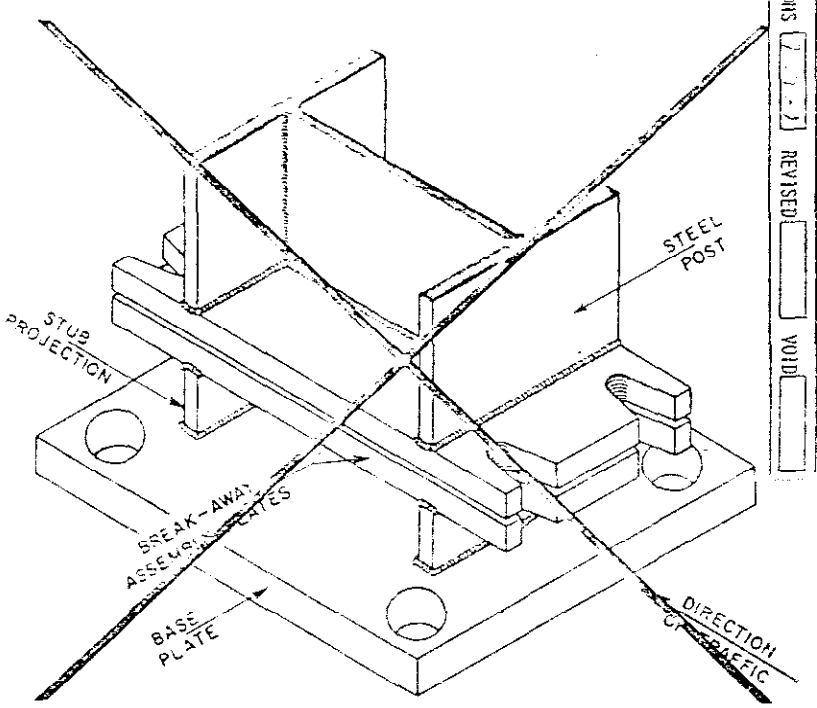

TYPICAL SECTION - A-

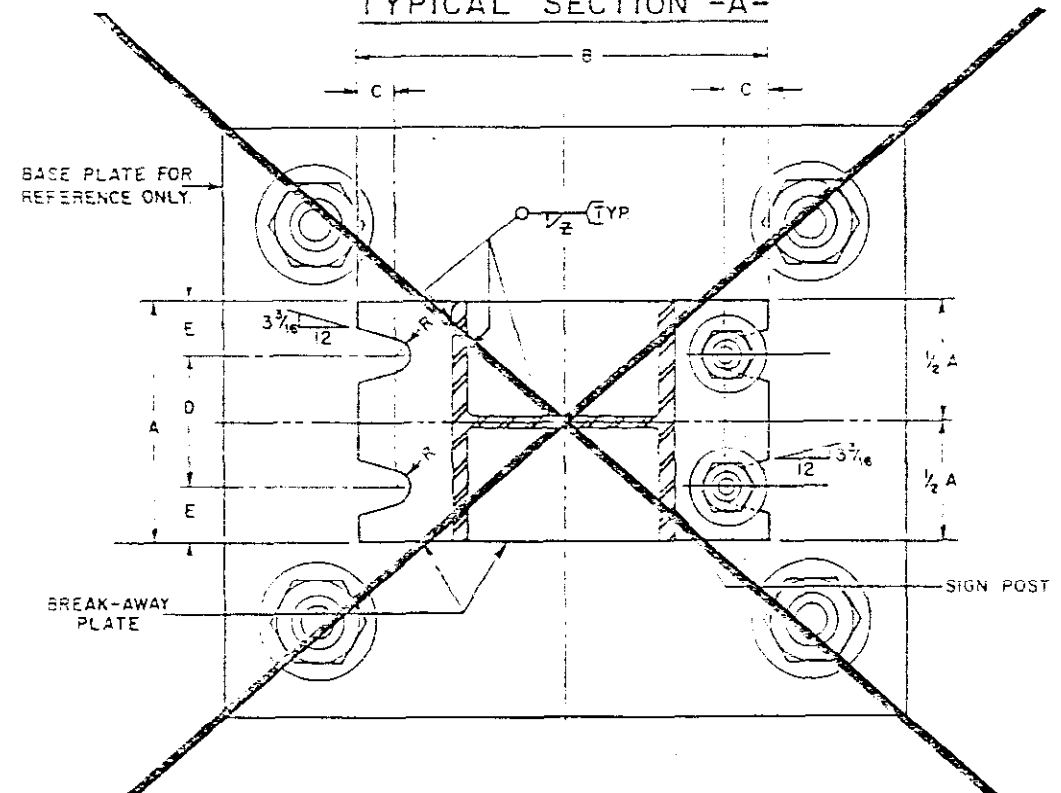

GENERAL NOTES

- All work shall be done in accordance with the Standard Specifications applicable to the Project.
- Design conforms with AASHTO "Specifications for the Design and Construction of Structural Supports for Highway Signs".
- All structural steel shall conform to ASTM A36 and Section 509 of the Standard Specifications.
- Steel fuse plates and splice plates shall conform to ASTM A36.
- All high strength bolts, nuts and washers shall conform to ASTM A325. Washers used in the Break-Away Plates and Fuse Plate assemblies shall be of sufficient strength to prevent any detraction or "loosening" into the slotted grooves under bolt torquing.
- All bolts other than high strength bolts shall conform to ASTM A307.
- All bolts, nuts, and washers shall be galvanized as per ASTM A153 or ASTM A104.
- All holes except of fuse plate may be drilled or sub-punched and reamed.
- All steel cuts shall preferably be saw cuts; however, flame cutting will be permitted provided all edges are ground. Remove all burrs. Metal shall not project beyond the plane of the plate face.

BREAK-AWAY PLATE DATA TABLE

POST SIZE	DIMENSION	BOLT SIZE AND TORQUE	A	B	C	D	E	t1	WELDER	STUB POST LENGTH
W 12 x 40		3/8" x 3 3/4" 1,135 In. Lb.	8"	19 1/4"	1 5/8"	4"	2"	1 1/4"	3/8" x 1 1/2"	0'-4"
W 12 x 35			6 1/2"	17"	1 3/8"	3 1/2"	1 1/2"	1"	3/8" x 1 1/2"	0'-4"
W 10 x 26		3/4" x 3 1/2" 750 In. Lb.	5 3/4"	14 3/8"	7/8"	3"	1 1/4"	1"	3/8" x 1 1/2"	0'-4"
W 10 x 22			5 1/4"	14 3/8"	7/8"	3"	1 1/4"	1"	3/8" x 1 1/2"	0'-4"
W 8 x 21			5 1/4"	12 3/8"	7/8"	2 3/4"	1 1/4"	1"	3/8" x 1 1/2"	0'-4"
W 8 x 18			5 1/4"	12"	3/4"	3"	1 1/8"	3/4"	3/8" x 1 1/2"	0'-4"
W 6 x 15		5/8" x 2 3/4" 450 In. Lb.	5"	10"	3/4"	3 3/4"	1 1/8"	3/4"	1/4" x 1 1/2"	0'-4"
W 6 x 12			5"	10"	3/4"	2 3/4"	1 1/8"	3/4"	1/4" x 1 1/2"	0'-4"

BOLTING PROCEDURE FOR BREAK-AWAY PLATE ASSEMBLY

- Assemble post to stub with bolts - one flat washer on each bolt top and bottom, and one flat washer and the keeper plate below the break-away plates.
- Tighten all bolts to a "snug tight" condition with a 12" to 15" wrench on bed washers and to clean bolt threads. Then loosen each bolt in turn and retighten in a systematic order to the prescribed torque. (See Break-Away Plate Data Table.)
- Burr threads at junction with nut to prevent nut loosening.

DEPARTMENT OF HIGHWAYS  
STATE OF COLORADO  
DIVISION OF HIGHWAYS  
BREAK-AWAY SIGN  
SUPPORT DETAILS  
FOR GROUND SIGNS


Designed By: J. J. B. Staff Traffic & Safety Projects Engineer  
Checked By: J. E. M. Date: January, 1980  
Approved By: [Signature] Staff Traffic & Safety Projects Engineer




# OVERHEAD SIGNS — SHEET 1

FEDERAL ROAD REGION NO.	DIVISION	PROJ. NO.	SHEET NO.	TOTAL SHEETS
VIII	COLORADO	IR25-2(191)	111	24
AS CONSTRUCTED				
NO REVISIONS	7	REVISED		VOID
REVISIONS				


## ELEVATION

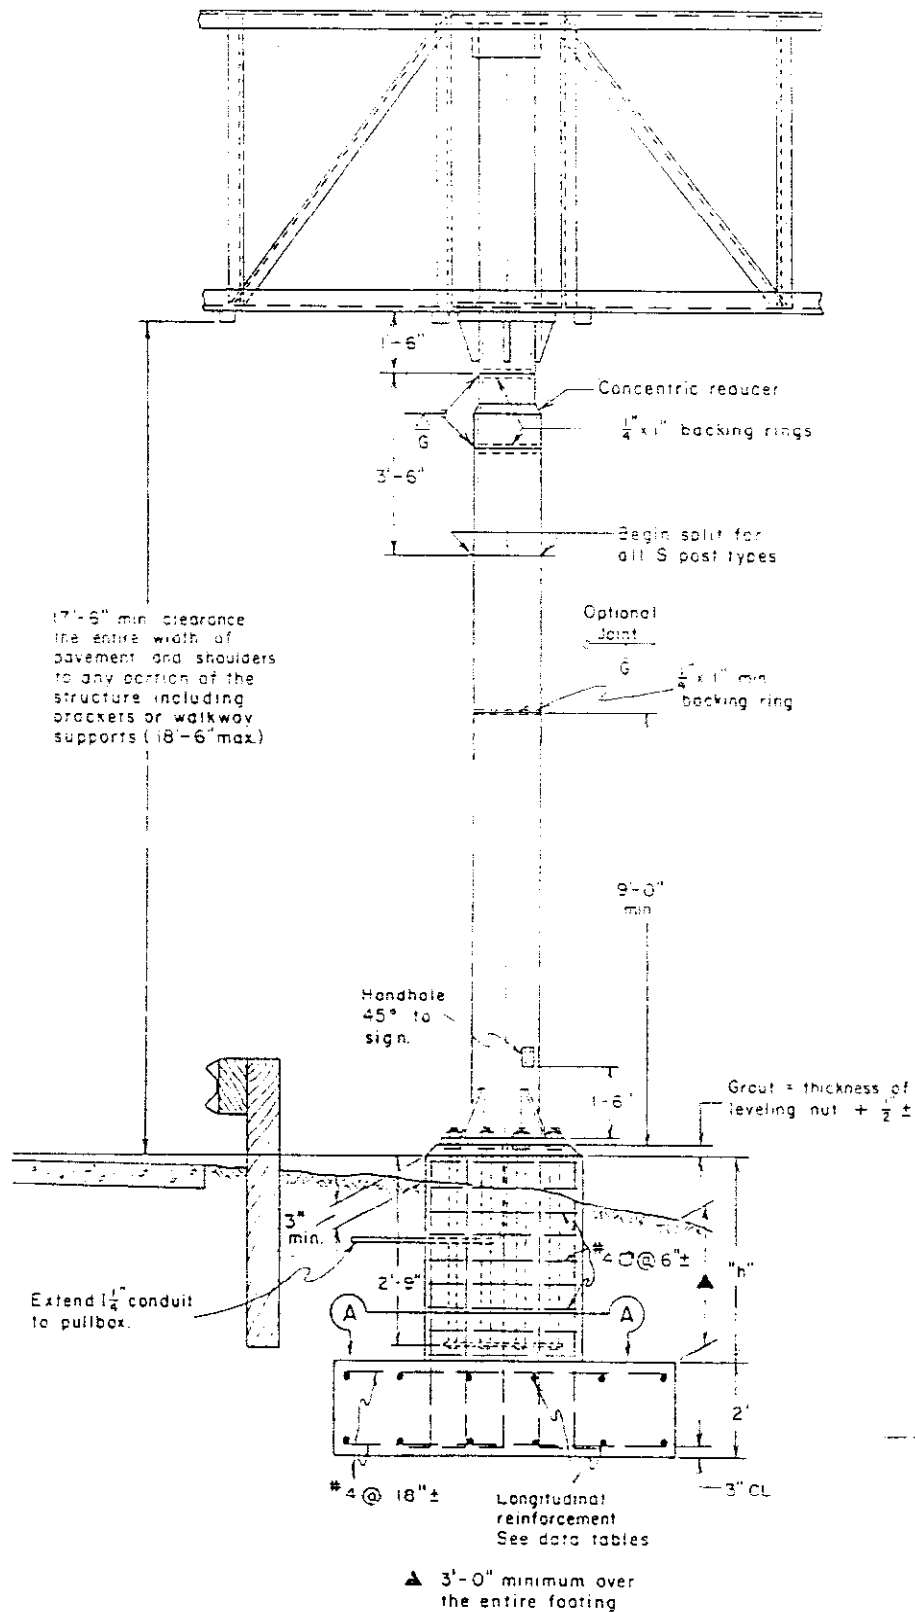



## HANDHOLE DETAILS

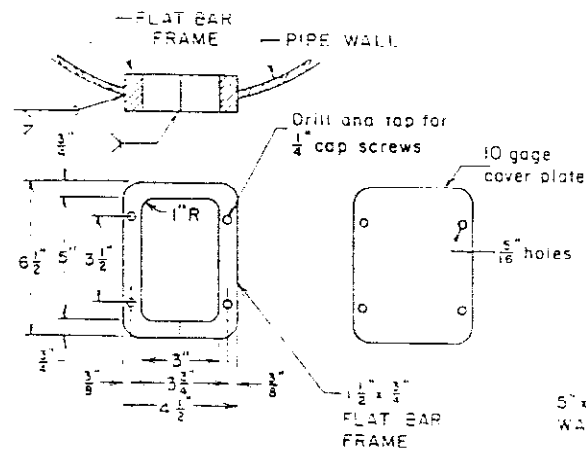

## ANCHORAGE DETAILS

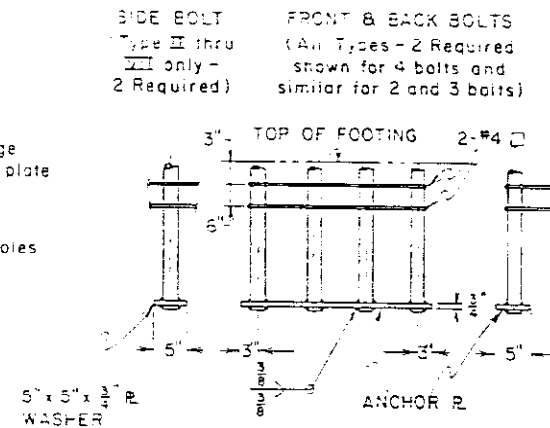


## TYPICAL VIEWS

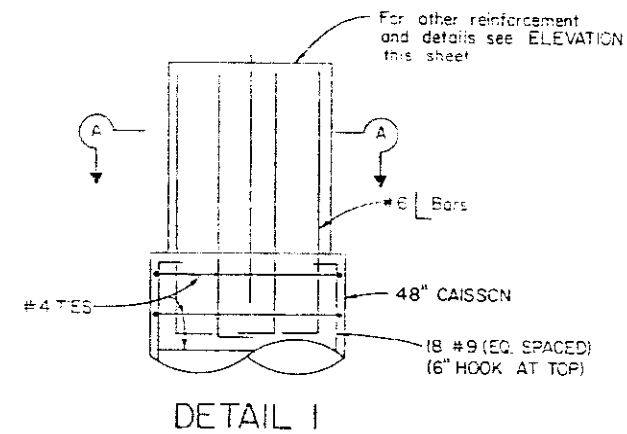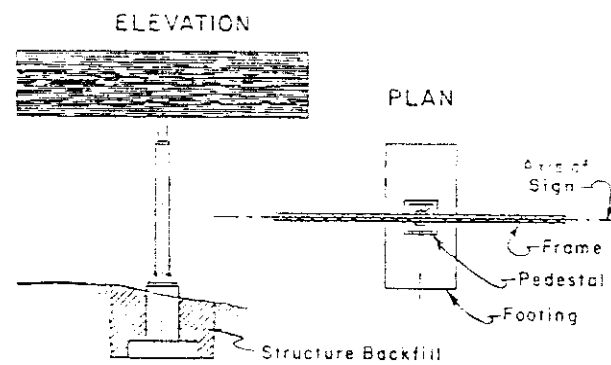

(FOR SIGN NO. 20 - RIGHT PEDESTAL ONLY)

## SECTION A-A

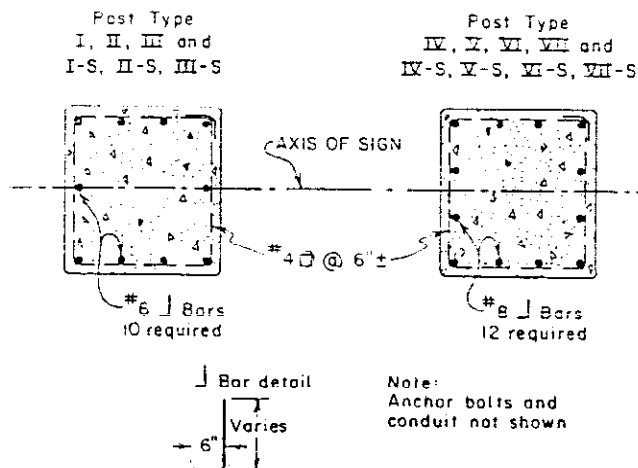

SIGN NO.	STRUCTURE TYPE	POST TYPE	PEDESTAL HEIGHT "n"	
			ONE POST	TWO POSTS
			L:	R:
1	SIGN BRIDGE	III-S	4'-0"	9'-0"
11	BUTTERFLY	II-S	6'-0"	
13	SIGN BRIDGE	III-S	6'-0"	6'-0"
20	SIGN BRIDGE	III-S	6'-0"	9'-6"
23	CANTILEVER	V	4'-6"	
36	SIGN BRIDGE	II-S	6'-0"	7'-0"
44	SIGN BRIDGE	III-S	6'-0"	7'-0"
7	SIGN BRIDGE	III-S	*	*

- ▲ POST LENGTH TO BE REDUCED 2'-6" (THE NORMAL CONCRETE MEDIAN BARRIER HEIGHT TO WHICH THE PEDESTAL IS TO BE BUILT)
- ◻ PEDESTAL ON CAISSON - SEE DETAIL 1
- ◻ EXISTING PEDESTAL
- \* POST LENGTH TO BE REDUCED 2'-1" (THE EXISTING PEDESTAL HEIGHT ABOVE ROADWAY)
- ▣ APPROXIMATE PEDESTAL HEIGHT, PEDESTAL ON FOOTING THAT IS ON CAISSONS - SEE DETAIL 2 CUT 2

## GENERAL NOTES

1. All work shall be done in accordance with Standard Specifications applicable to the project and "Standard Specifications For Structural Supports For Highway Signs, Luminaires And Traffic Signals", A.A.S.H.T.O. current issue.
2. Wind loading 28 P.S.F. normal to panel area.
3. UNIT STRESSES:
  - a. Structural steel:  $F_y = 18,000$  P.S.I.
  - b. Reinforced concrete:  $F_c = 20,000$  P.S.I.
  - c. Footing soil pressure:  $1\frac{1}{4}$  TONS / SQ. FT.
  - d. Allowable unit stresses due to wind load or wind load in combination with other forces are increased  $33\frac{1}{3}\%$ .
4. For reinforcement, embedment is clear to outside of bar and is 2" to main reinforcement, except as shown.
5. Base plates, pedestals, and footings, longer sides shall be normal to the axis of sign.
6. Backfill shall be in place prior to erection of post.
7. On single post sign structures, the post shall be raked out of plumb, with the use of the leveling nuts to make the bottom of the sign frame level.
8. Ground one post of each structure.
9. Tapered tube of equivalent size and thickness may be substituted for pipe post.
10. For SIGN BRIDGES only, a constant diameter pipe post of the base section size may be used in lieu of the two diameter sections shown.

DEPARTMENT OF HIGHWAYS  
STATE OF COLORADO  
DIVISION OF HIGHWAYS  
**OVERHEAD SIGNS  
POSTS &  
FOOTINGS (SPREAD)**


# OVERHEAD SIGNS - SHEET 2

FEDERAL ROAD REGION NO.	DISTRICT	PROJ. NO.	SHEET NO.	TOTAL SHEETS
VIII	COLORADO	IR25-2 (191)	112	2+


AS CONSTRUCTED		
NO REVISIONS	REVISED	VOID

REVISIONS	


## POSTS TYPES I - VII & BASE PLATES

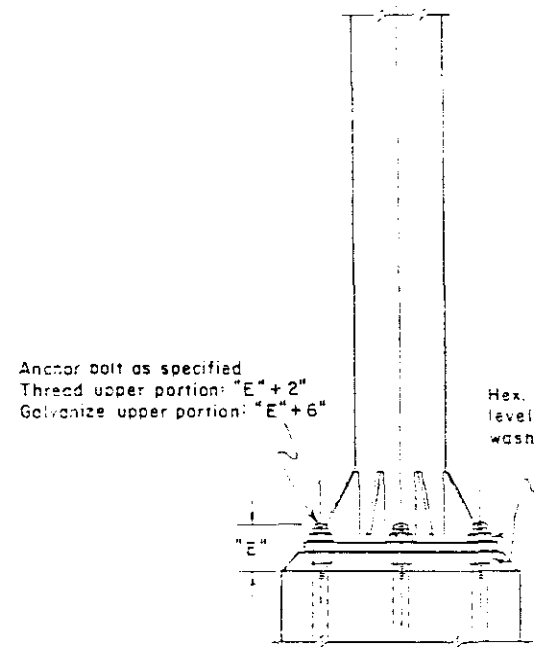


4 ANCHOR TYPE

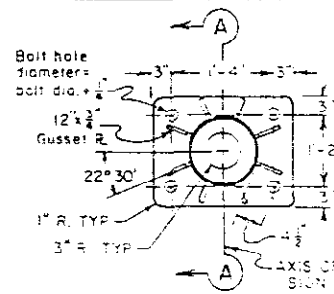

10 ANCHOR TYPE

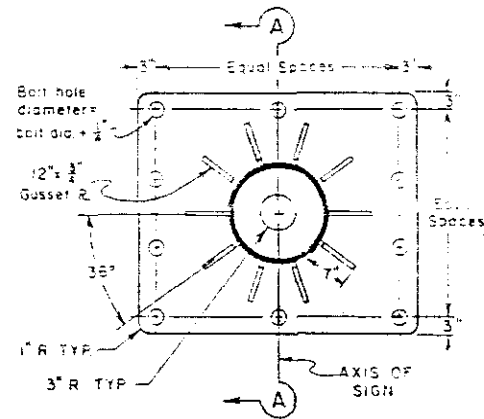


8 ANCHOR TYPE

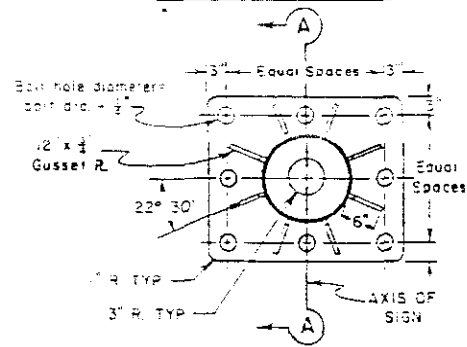


## SECTION A-A


COMMON TO ALL TYPES

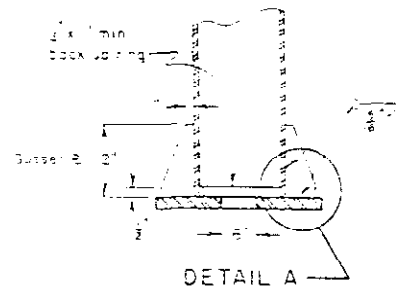


DETAIL A

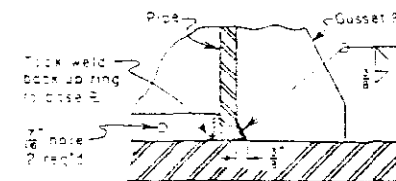


## POSTS TYPES I-S - VII-S & BASE PLATES

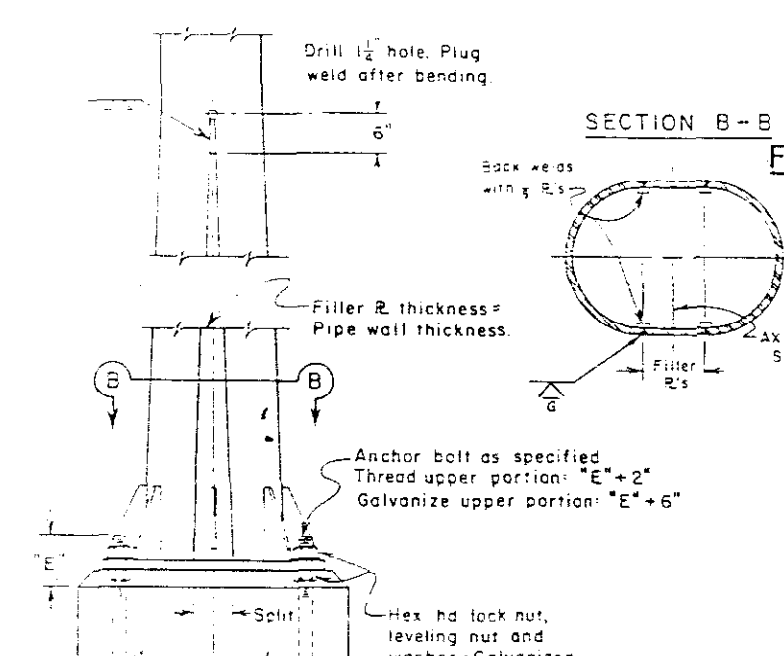


SECTION B-B

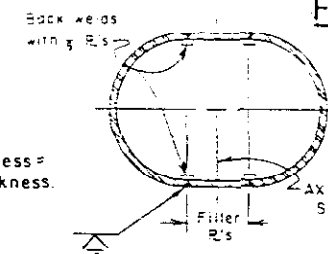



## FOOTING FOR SIGN NO. 1 (LT. PEDESTAL ONLY)

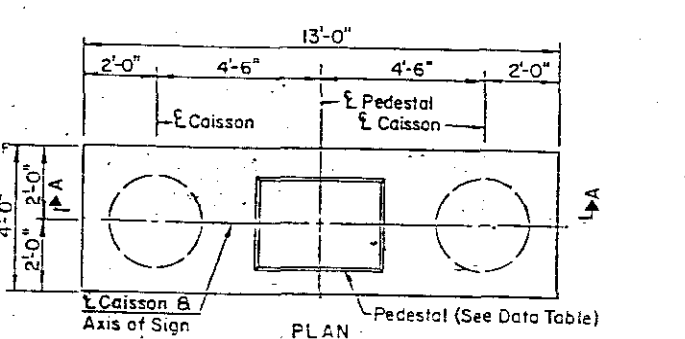

6 ANCHOR TYPE

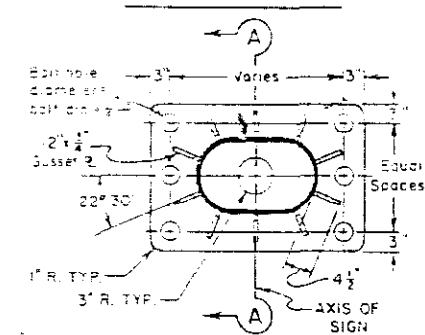

8 ANCHOR TYPE

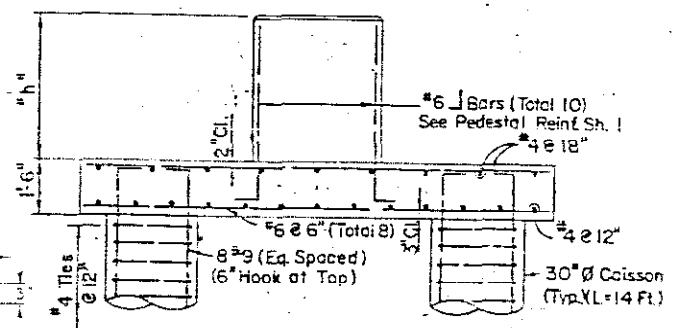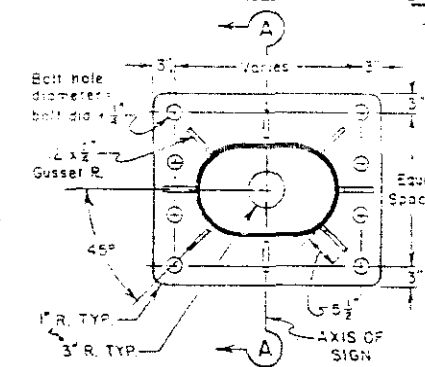

POST TYPE	PIPE SIZES		REDUCER LENGTH	"E"	BASE PLATE SIZE	ANCHOR BOLTS	PEDESTAL SIZE	FOOTING SIZE	LONGITUDINAL FOOTING REINFORCEMENT	
	BASE SECTION	UPPER SECTION							TOP	BOTTOM
I	10" Std. @ 40.48	8" Std. @ 28.55	7"	8"	1'-10" x 1'-8" x 1 1/2"	4-2" φ	2'-5" x 2'-3"	5'-0" x 9'-0"	6-#4 bars	6-#4 bars
II	12" Std. @ 49.56	10" Std. @ 34.24	8"	7 1/2"	2'-4" x 2'-1" x 1 1/2"	8-1 1/4" φ	2'-11" x 2'-8"	6'-0" x 10'-0"	6-#4 bars	6-#4 bars
III	14" O.D. @ 72.09	12" Std. @ 43.77	1'-1"	8 1/2"	2'-7" x 2'-3" x 1 1/2"	8-2" φ	3'-2" x 2'-10"	7'-0" x 12'-0"	6-#5 bars	6-#5 bars
IV	16" O.D. @ 82.77	14" O.D. @ 54.57	1'-2"	8 1/2"	3'-1" x 2'-9" x 2"	10-2" φ	3'-8" x 3'-4"	7'-0" x 13'-0"	6-#5 bars	6-#5 bars
V	18" O.D. @ 93.45	16" O.D. @ 62.58	1'-3"	8 1/2"	3'-3" x 3'-0" x 2 1/2"	10-2" φ	3'-10" x 3'-7"	8'-0" x 14'-0"	7-#5 bars	7-#6 bars
VI	20" O.D. @ 104.13	18" O.D. @ 70.59	1'-8"	8 1/2"	3'-3" x 3'-0" x 2"	10-2" φ	3'-10" x 3'-7"	9'-0" x 15'-0"	6-#6 bars	6-#7 bars
VII	24" O.D. @ 125.49	20" O.D. @ 78.60	1'-8"	10"	3'-7" x 3'-3" x 2 1/2"	10-2 1/2" φ	4'-3" x 3'-11"	10'-0" x 17'-0"	7-#6 bars	7-#8 bars

POST TYPE	PIPE SIZES		REDUCER LENGTH	"E"	SPLIT	BASE PLATE SIZE	ANCHOR BOLTS	PEDESTAL SIZE	FOOTING SIZE	LONGITUDINAL FOOTING REINFORCEMENT	
	BASE SECTION	UPPER SECTION								TOP	BOTTOM
I-S	10" Std. @ 40.48	8" Std. @ 28.55	7"	6 1/2"	4"	2'-1" x 1'-9" x 1 1/2"	6-1 1/2" φ	2'-7" x 2'-3"	5'-0" x 10'-0"	5-#4 bars	5-#6 bars
II-S	12" Std. @ 49.56	10" Std. @ 34.24	8"	7 1/2"	5"	2'-5" x 1'-11" x 1 1/2"	6-1 1/4" φ	3'-0" x 2'-6"	6'-0" x 11'-0"	6-#4 bars	6-#7 bars
III-S	14" O.D. @ 72.09	12" Std. @ 43.77	1'-1"	8 1/2"	5"	2'-9" x 2'-0" x 2"	6-2" φ	3'-4" x 2'-7"	7'-0" x 13'-0"	7-#4 bars	7-#8 bars
IV-S	16" O.D. @ 82.77	14" O.D. @ 54.57	1'-2"	8 1/2"	6"	2'-11" x 2'-7" x 2"	8-2" φ	3'-6" x 3'-2"	8'-0" x 14'-0"	8-#5 bars	8-#9 bars
V-S	18" O.D. @ 93.45	16" O.D. @ 62.58	1'-3"	8 1/2"	7"	3'-1" x 2'-9" x 2"	8-2" φ	3'-8" x 3'-4"	8'-0" x 16'-0"	8-#5 bars	8-#9 bars
VI-S	20" O.D. @ 104.13	18" O.D. @ 70.59	1'-8"	8 1/2"	8"	3'-5" x 2'-9" x 2"	6-2" φ	4'-0" x 3'-4"	9'-0" x 17'-0"	9-#5 bars	9-#10 bars
VII-S	24" O.D. @ 125.49	20" O.D. @ 78.60	1'-8"	9 1/2"	8"	3'-9" x 3'-3" x 2"	8-2 1/2" φ	4'-5" x 3'-11"	10'-0" x 18'-0"	10-#6 bars	10-#11 bars


DEPARTMENT OF HIGHWAYS  
STATE OF COLORADO  
DIVISION OF HIGHWAYS  
**OVERHEAD SIGNS  
POSTS &  
FOOTINGS (SPREAD)**

# OVERHEAD SIGNS - SHEET 3

FEDERAL ROAD REGION NO.	DIVISION	PROJ. NO.	SHEET NO.	TOTAL SHEETS
111	COLORADO	1R25-2(191)	113	

REVISIONS	

AS CONSTRUCTED		
NO REVISION	REVISED	VOID

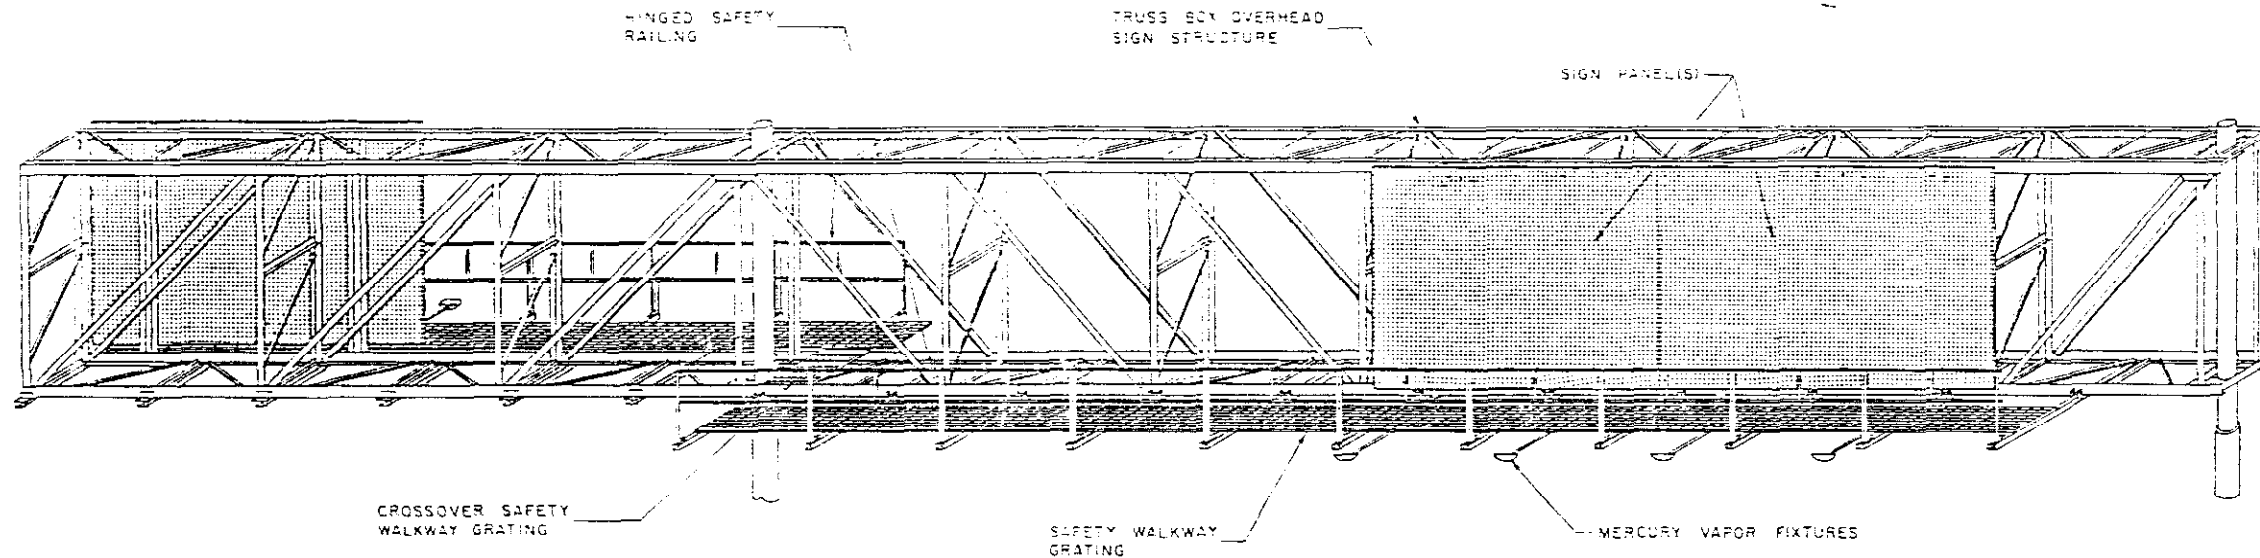

TYPICAL VIEW OF ASSEMBLED MEMBERS

## GENERAL NOTES

- All work shall be done in accordance with:
  - the Standard Specifications applicable to the project.
  - the "Manual on Uniform Traffic Control Devices for Streets and Highways" published by the Federal Highway Administration, and the latest revision of the Colorado Supplement thereto.
  - AASHTO specifications for the design and construction of Structural Supports for Highway Signs.
- Safety walkway grating shall be welded-type with  $1\frac{1}{4}$ " x  $\frac{1}{8}$ " bearing bars at  $1\frac{3}{16}$ " centers and  $\frac{3}{16}$ " dia. (or equal) crossbars at 4" centers.
- Brackets to be evenly spaced with a maximum center to center spacing of 5'-6".
- Belts, nuts, washers, etc. shall be galvanized or cadmium plated.
- Walkway grating, brackets and railing shall be painted in accordance with Section 509, wiring shall be in accordance with Section 613.
- Crossover safety walkway to be used when sign bridges have sign panels facing two directions.

## LIGHTING NOTES

- Fixtures shall be watertight, dustproof and designed for ease of lamp replacement.
- Lamp shall be of the Mercury Vapor type (400 Watt). Lamps and ballasts shall be designed to operate over an ambient temperature range of  $-25^{\circ}\text{F}$  to  $+120^{\circ}\text{F}$ .
- Ballasts shall operate from a 120 volt, 60 hz., single phase source with a regulated output of  $\pm 12\%$ . Ballasts shall be housed in a watertight dustproof enclosure.
- The type, number and spacing of fixtures shall be per manufacturers specifications to maintain a maximum initial illumination of the sign face of 30 foot candles to 60 foot candles with a maximum uniformity ratio (maximum illumination/minimum illumination) of 5:1.
- Fixture and mounting details will be subject to approval by the Engineer.

DEPARTMENT OF HIGHWAYS  
STATE OF COLORADO  
DIVISION OF HIGHWAYS  
LIGHT FIXTURE  
AND  
SAFETY WALKWAY  
DETAILS










# OVERHEAD SIGNS - SHEET 5

FEDERAL ROAD REGION NO.	DIVISION	PROJ. NO.	SHEET NO.	TOTAL SHEETS
XIII	COLORADO	IR25-2(191)	115	212

REVISIONS	

AS CONSTRUCTED			
NO REVISION	7-27-87	REVISED	VOID

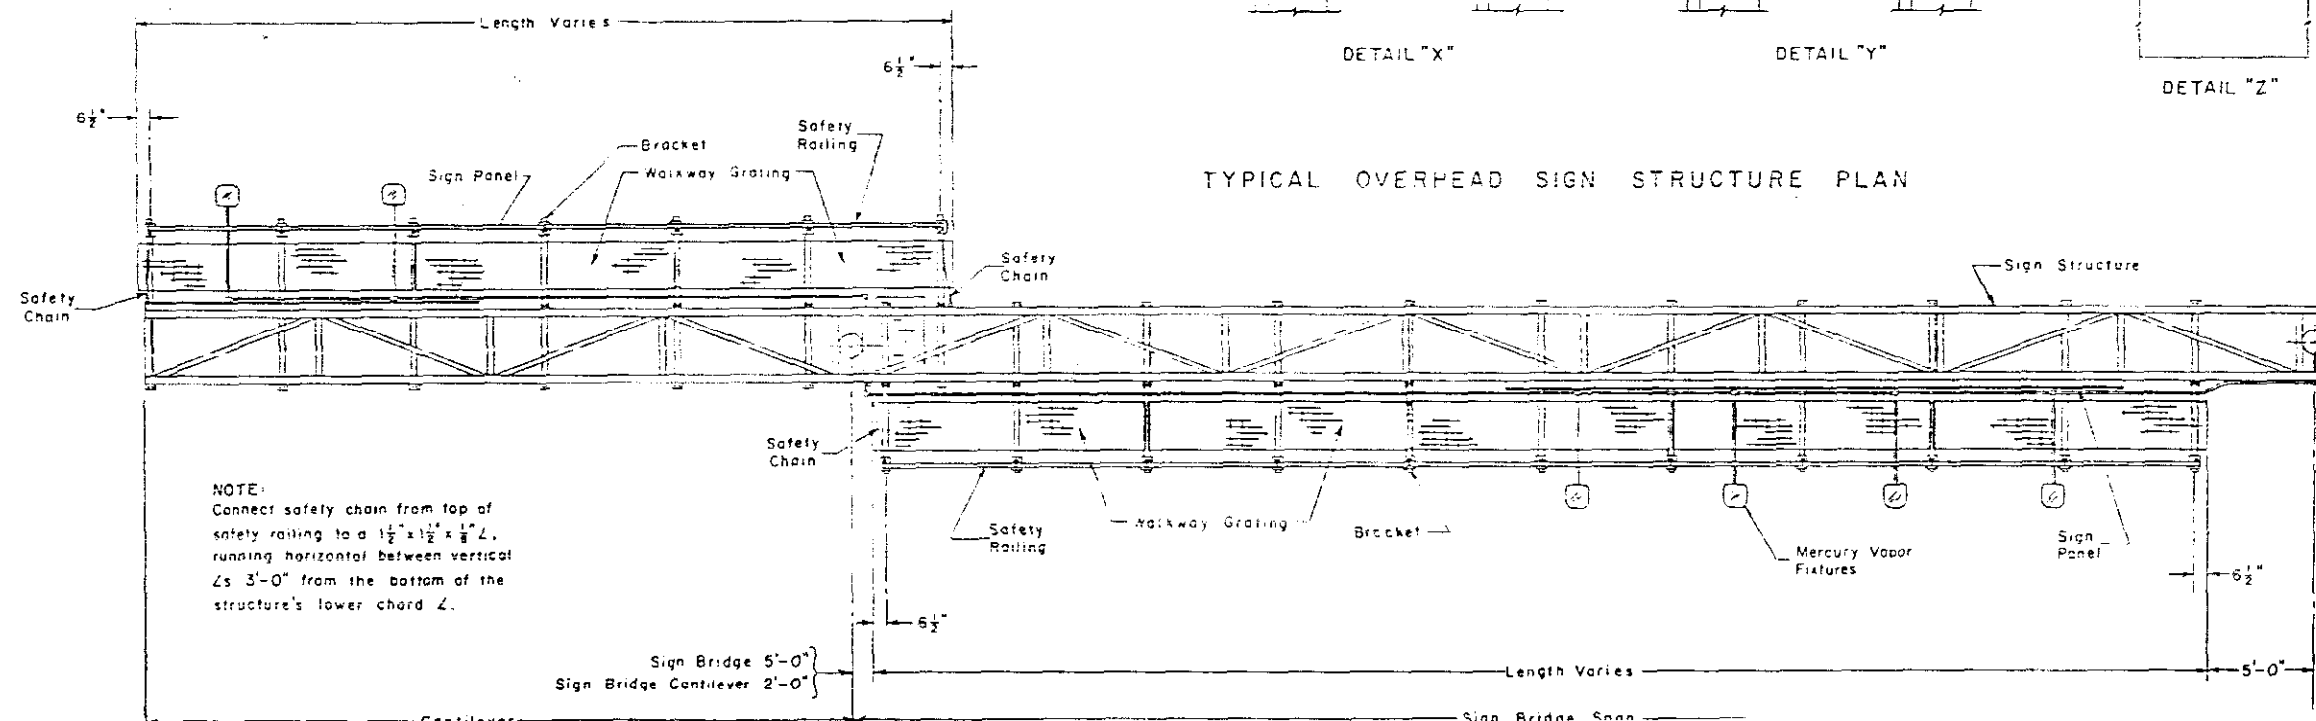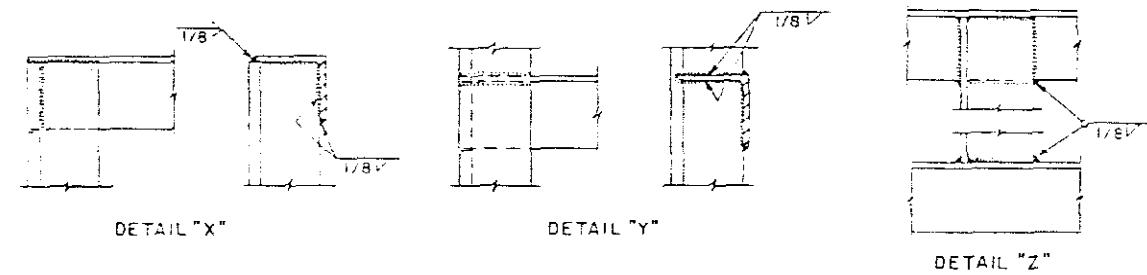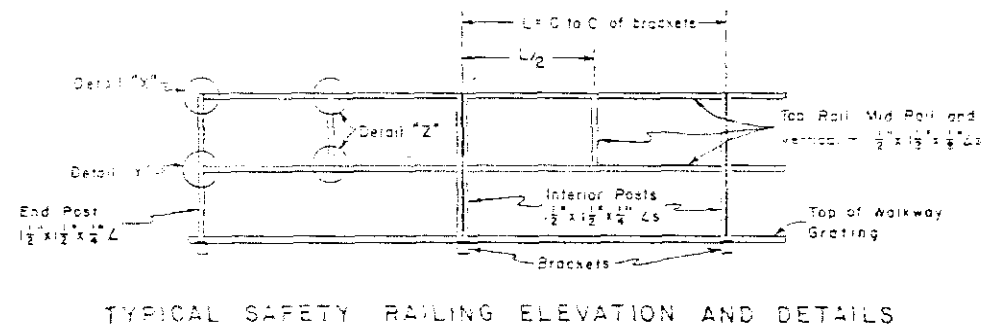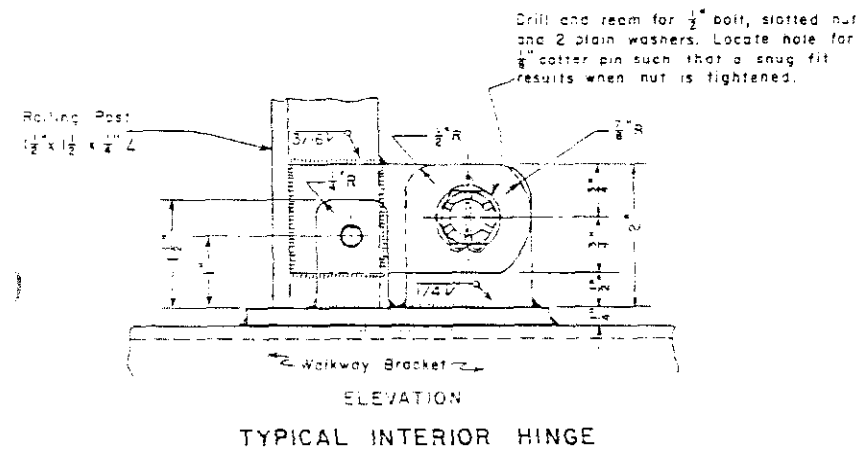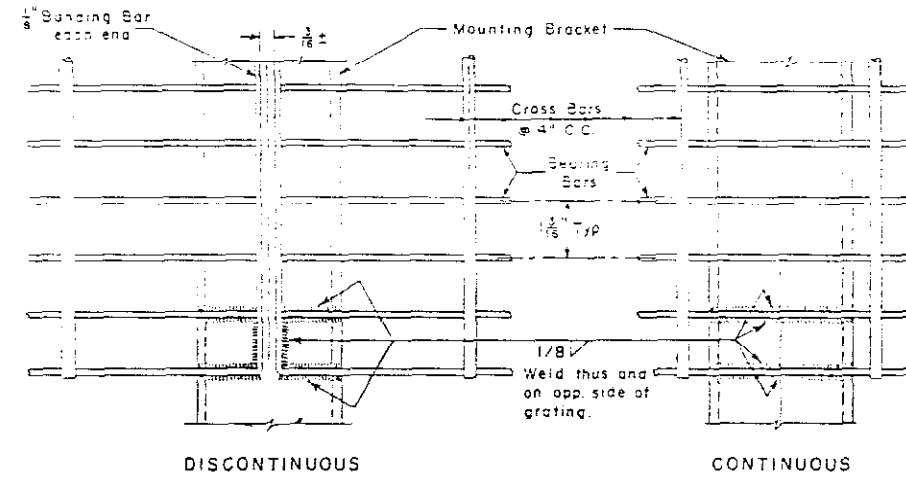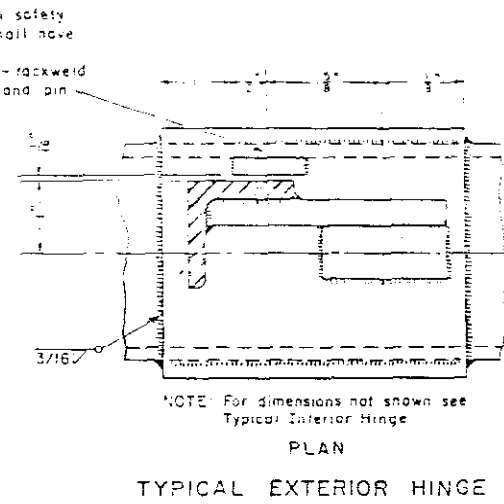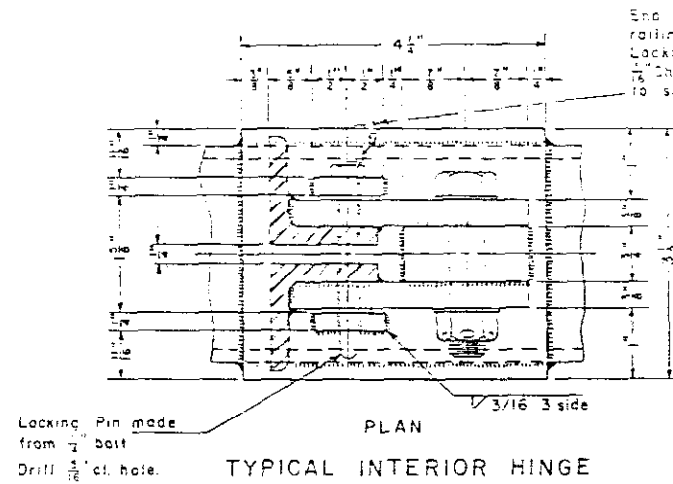


DEPARTMENT OF HIGHWAYS  
 STATE OF COLORADO  
 DIVISION OF HIGHWAYS  
 LIGHT FIXTURE  
 AND  
 SAFETY WALKWAY  
 DETAILS




FEDERAL ROAD REGION NO.	DIVISION	PROJ. NO.	SHEET NO.	TOTAL SHEETS
VIII	COLORADO	1R25-2 (191)	117	242
AS CONSTRUCTED				
NO REVISIONS	7	REVISED		VOID


TYPICAL TRANSVERSE ALIGNMENT

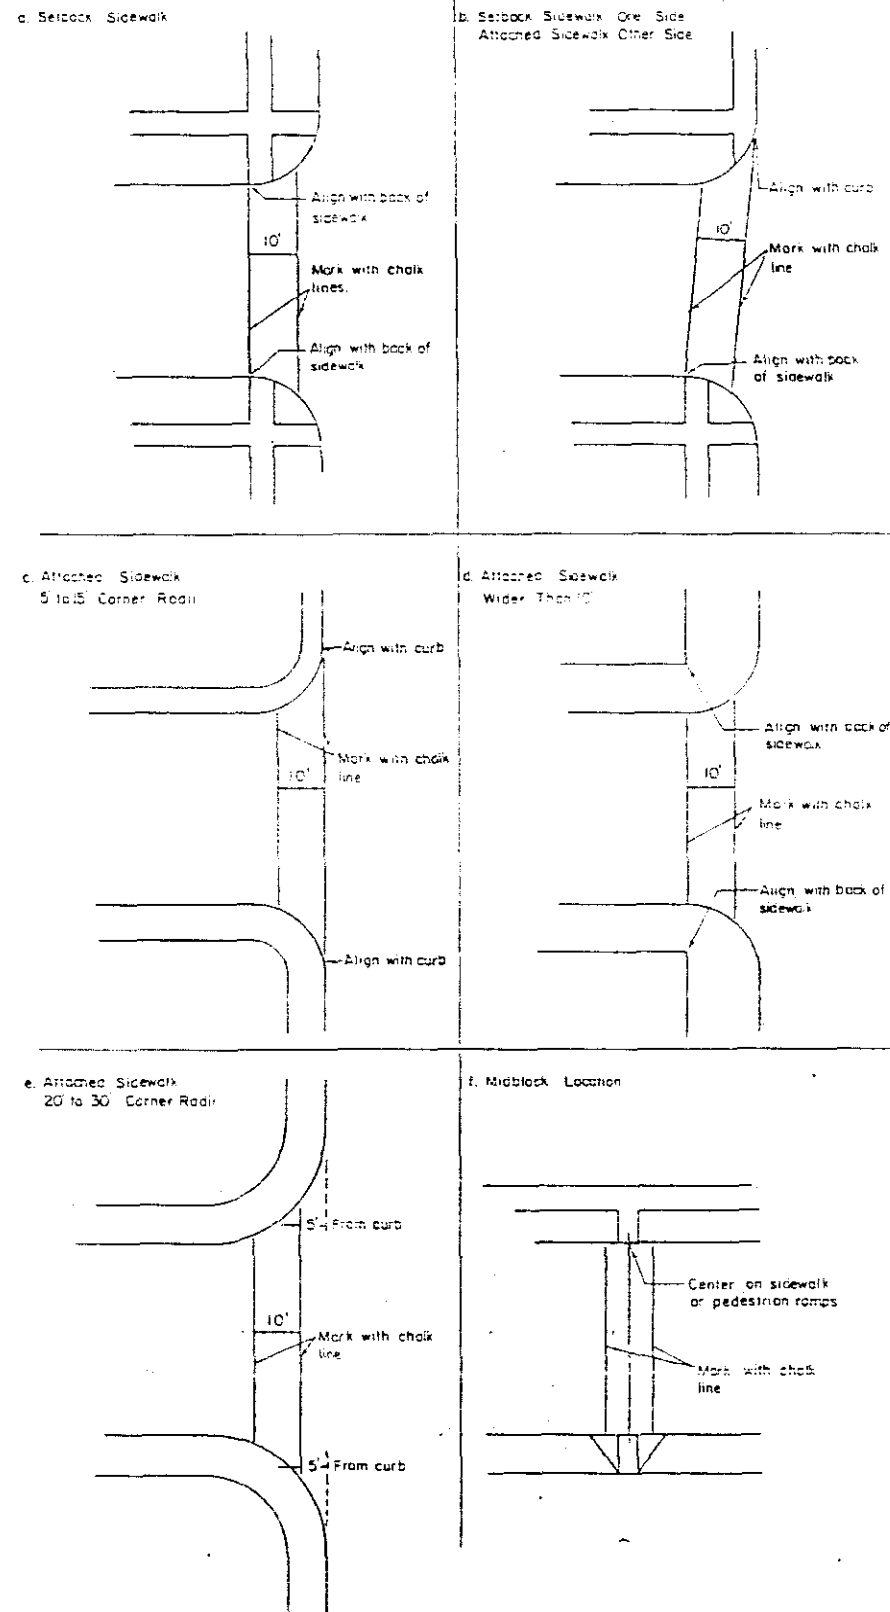


1. Locate Transverse Alignment

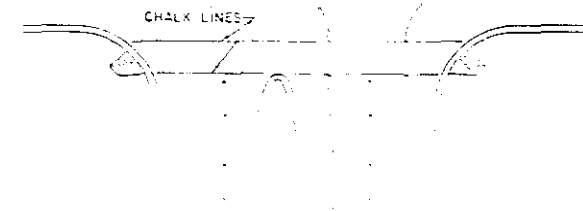


2. Locate Bars That Align With Pavement Marking

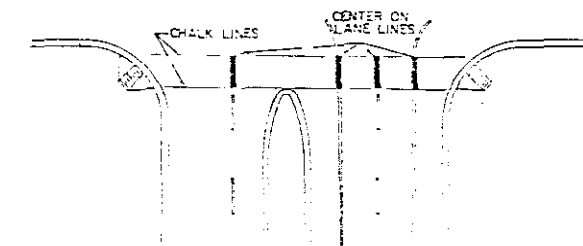


3. Locate Bars That Align With Curbs

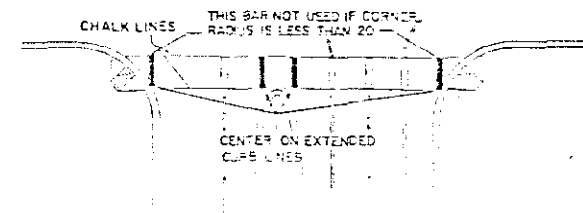


4. Locate Bars That Center On Single Lane

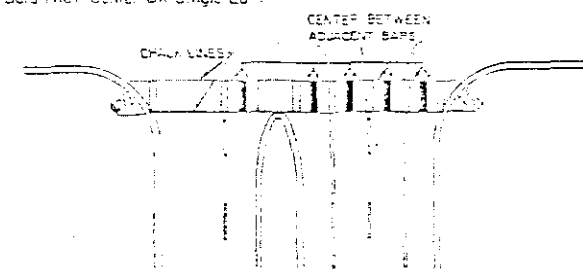

5. Locate Bars on Combination Parking Lanes

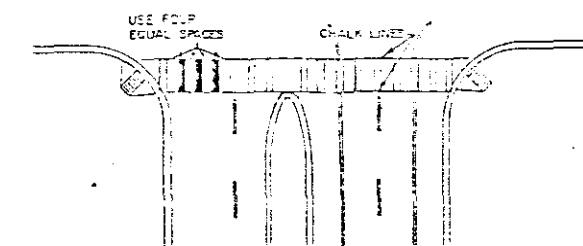


6. Completed Layout

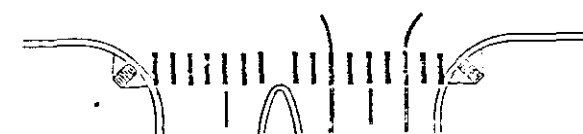



FEDERAL ROAD REGION NO.	DIVISION	PROJ. NO.	SHEET NO.	TOTAL SHEETS
VIII	COLORADO	IR25-2 (191)	118	24
AS CONSTRUCTED				
NO REVISIONS	97	REVISED	VOID	

TYPICAL SINGLE LANE AND ONE WAY APPROACHES  
PAVEMENT MARKINGS  
CONTINENTAL TYPE CROSSWALKS

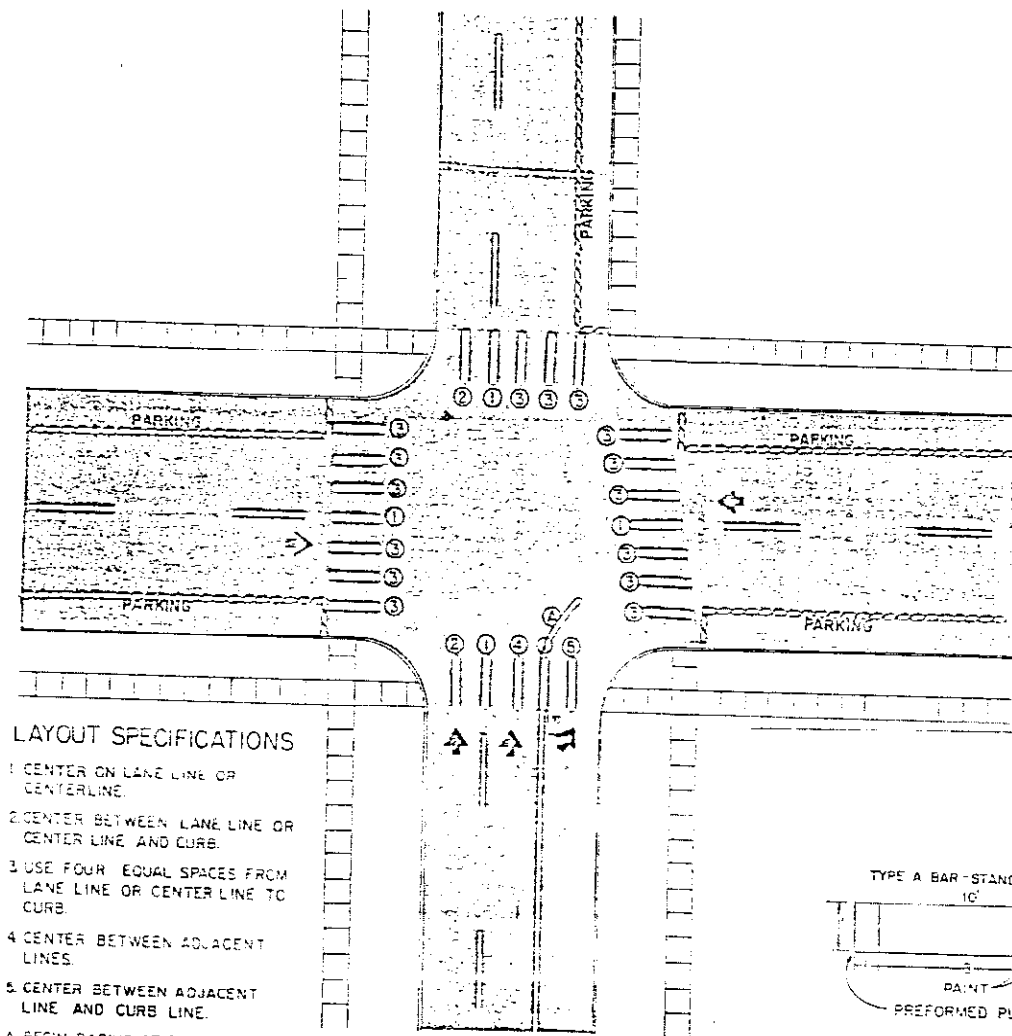


LAYOUT SPECIFICATIONS

- 1 CENTER ON LANE LINE OR CENTERLINE
- 2 CENTER BETWEEN LANE LINE OR CENTER LINE AND CURB
- 3 USE FOUR EQUAL SPACES FROM LANE LINE OR CENTER LINE TO CURB
- 4 CENTER BETWEEN ADJACENT LINES
- 5 CENTER BETWEEN ADJACENT LINE AND CURB LINE
- 6 BEGIN RADIUS AT FRONT EDGE OF CROSSWALK, USE 50' RADIUS

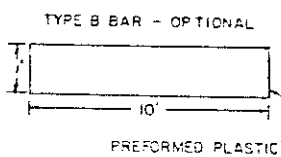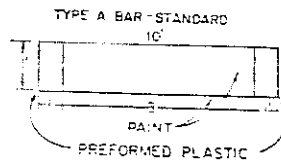

TYPICAL MULTI LANE APPROACHES  
PAVEMENT MARKINGS  
CONTINENTAL TYPE CROSSWALKS

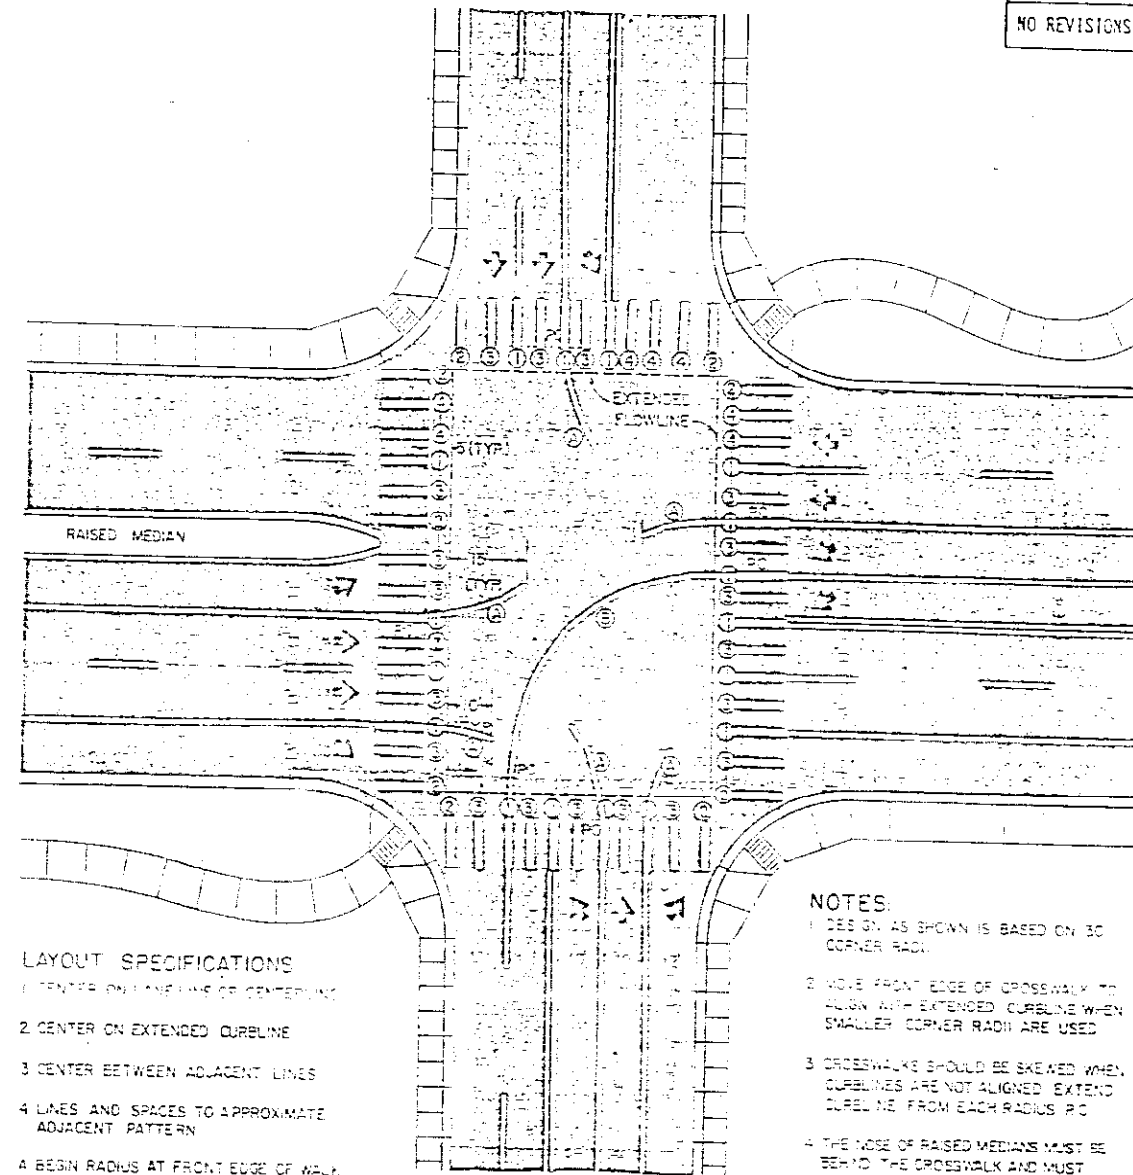

LAYOUT SPECIFICATIONS

- 1 CENTER ON LANE LINE OR CENTERLINE
- 2 CENTER ON EXTENDED CURBLINE
- 3 CENTER BETWEEN ADJACENT LINES
- 4 LINES AND SPACES TO APPROXIMATE ADJACENT PATTERN
- 5 BEGIN RADIUS AT FRONT EDGE OF WALK
- 6 USE RADIUS THAT WILL PLACE EACH P.C. AT THE FRONT EDGE OR BEYOND FRONT EDGE OF CROSSWALK



NOTES:

- 1 DESIGN AS SHOWN IS BASED ON 30' CORNER RADIUS
- 2 MOVE FRONT EDGE OF CROSSWALK TO ALIGN WITH EXTENDED CURBLINE WHEN SMALLER CORNER RADIUS ARE USED
- 3 CROSSWALKS SHOULD BE SKEWED WHEN CURBLINES ARE NOT ALIGNED. EXTEND CURBLINE FROM EACH RADIUS P.C.
- 4 THE NOSE OF RAISED MEDIANS MUST BE BEHIND THE CROSSWALK AND MUST PROVIDE FOR AT LEAST A 50' TURNING RADIUS FOR LEFT TURN FROM CROSS STREET

TYPICAL BYPASS CROSSWALKS

LAYOUT SPECIFICATION

- 1 USE FOUR EQUAL SPACES FROM CURB TO CURB, KEEP BARS PARALLEL TO EACH OTHER AND GENERALLY IN LINE WITH TRAFFIC FLOW
- 2 CENTER ON LANE LINES
- 3 USE TWO EQUAL SPACES FROM CENTER BAR TO CURB, KEEP BARS PARALLEL TO EACH OTHER AND GENERALLY IN LINE WITH TRAFFIC FLOW

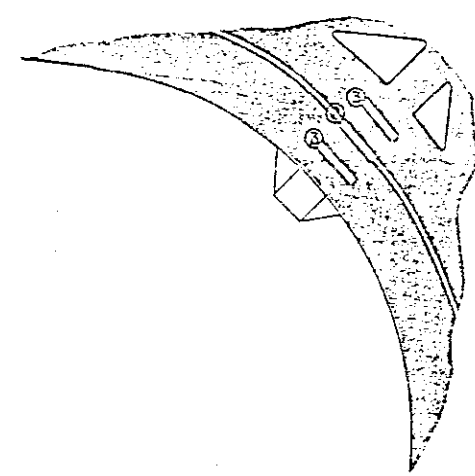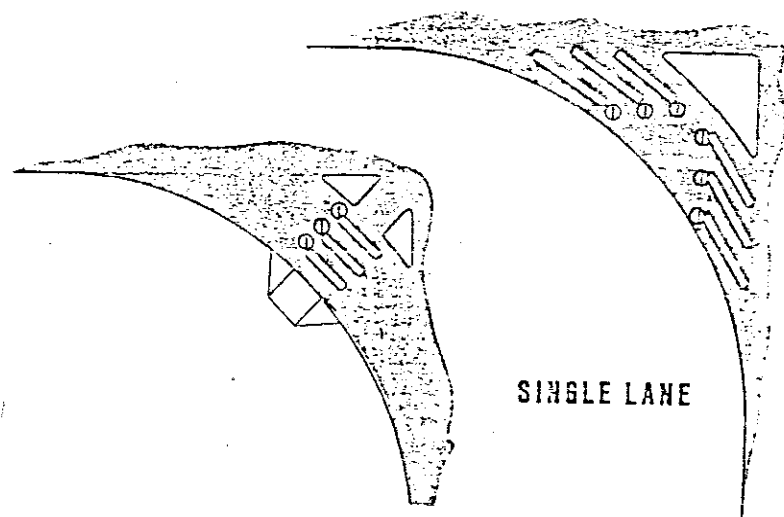

NOTES:

- 1 CENTER CROSSWALK ON PEDESTRIAN RAMPS WHEN PRESENT

See following pages for examples of typical applications. ALWAYS KEEP BARS PARALLEL TO EACH OTHER even if crosswalk is skewed



NO. REVISIONS		DATE REVISION	REVISIONS
7-21-87			

REC. ROAD DIST.	DIVISION	PROJ. NO.	SHEET NO.	SHEET TOTAL
1111	1000	IR 25-2(191)	119	242

REVISIONS	
1	3-22-87 Revised As Noted

### GENERAL NOTES

ALL WORK SHALL BE DONE ACCORDING TO THE STANDARD SPECIFICATIONS OF THE DIVISION OF HIGHWAYS, STATE OF COLORADO, APPLICABLE TO THE PROJECT.

STRUCTURE EXCAVATION AND BACKFILL SHALL BE IN ACCORDANCE WITH STANDARD M-206-1.

EXPANSION JOINT MATERIAL SHALL MEET AASHTO SPECIFICATION M-213.

ALL STRUCTURAL STEEL SHALL BE AASHTO M-183 (ASTM A-36) UNLESS OTHERWISE NOTED.

CLASS 1 FINISH, FOLLOWED BY APPLICATION OF A COLORED ACRYLIC COATING WILL BE REQUIRED ON ALL EXPOSED CONCRETE AND DOWN TO 1'-0" BELOW GROUND LINE. REQUIREMENTS FOR COATING ARE GIVEN IN REVISION OF SECTION 601, STRUCTURAL CONCRETE (COATING).

ALL EXTERIOR CONCRETE CORNERS SHALL BE CONSTRUCTED WITH 3/4" CHAMFERS, UNLESS OTHERWISE NOTED.

GRADE 60 REINFORCING STEEL IS REQUIRED FOR #4 BARS AND LARGER. ALL REINFORCING STEEL SHALL BE EPOXY COATED UNLESS NOTED OTHERWISE.

THE FOLLOWING TABLE GIVES THE MINIMUM LAP SPLICE LENGTH FOR REINFORCING BARS:

BAR SIZE	#4	#5	#6	#7	#8	#9	#10	#11
SPLICE LENGTH FOR CLASS A CONCRETE	1'-0"	1'-3"	1'-2"	2'-3"	3'-0"	3'-10"	4'-10"	5'-11"

ANY SPLICES NOT SHOWN SHALL BE APPROVED BY THE ENGINEER.

APPLIED WIND LOADS AND EARTHQUAKE LOADS WERE NOT CONSIDERED IN ANALYZING THE STRUCTURE FOR STABILITY DURING THE CONSTRUCTION STAGES.

E.F. = EACH FACE  
F.F. = FAR FACE  
N.F. = NEAR FACE

T.F. = TOP FACE  
B.F. = BOTTOM FACE

THE INFORMATION SHOWN ON THESE PLANS CONCERNING TYPE AND LOCATION OF UNDERGROUND UTILITIES IS NOT GUARANTEED TO BE ACCURATE OR ALL INCLUSIVE. THE CONTRACTOR IS RESPONSIBLE FOR MAKING HIS OWN DETERMINATION AS TO THE TYPE AND LOCATION OF UNDERGROUND UTILITIES AS MAY BE NECESSARY TO AVOID DAMAGE TO THEM.

### DESIGN DATA

CURRENT AASHTO SPECIFICATIONS, EXCEPT AS NOTED:

LIVE LOAD: AASHTO HS-20-44 AND INTERSTATE ALTERNATE  
DEAD LOAD: EARTH - 120 LBS PER CU FT, 2' SURCHARGE (LIVE LOAD)  
EQUIVALENT FLUID PRESSURE (DESIGN): SEE DETAILS

REINFORCED CONCRETE:

CLASS A CONCRETE: FC = 1,200 PSI, N = 9  
REINFORCING STEEL: #4 BARS AND LARGER: FS = 24,000 PSI

### SUMMARY OF QUANTITIES


ITEM	DESCRIPTION	UNIT	WALL "W-1"	WALL "W-2"	TOTALS
206	Structure Excavation	Cu.Yd.	453	-	453
206	Structure Backfill (Class 1)	Cu.Yd.	924	24	948
206	Filter Material (Class B)	Cu.Yd.	40	1	41
502	Steel Piling (HP10x42)	Lin.Ft.	860 7/4		7-4 860
502	Drive Steel Piling	Lin.Ft.	129 0		129 0
513	Drain Pipe (3 inch)	Lin.Ft.	9	45	54
518	Water Stop (6 inch)	Lin.Ft.	9	45	54
601	Concrete Class A (Wall)	Cu.Yd.	164 1/2 85	9	173 1/2
602	Reinforcing Steel (Epoxy Coated)	Lb.	26,015	950	26,965
606	Bridge Rail Type 4	Lin.Ft.	130	20	150

1 Furnished by the State and Available at the project site. (Size HP 14x89)

### INDEX OF DRAWINGS

- B-1 General Information - Summary of Quantities
- B-2 Engineering Geology
- B-3 General Layout - Retaining Wall W-1
- B-4 General Layout - Retaining Wall W-2
- B-5 Retaining Wall Details
- B-6 Retaining Wall Details - Type 2
- B-7 Retaining Wall Details - Miscellaneous

DESIGNED BY: BAA  
 CHECKED BY: JAB  
 DATE: 11-86  
 QUANTITIES BY: BAA  
 CHECKED BY: JAB  
 DATE: 11-86

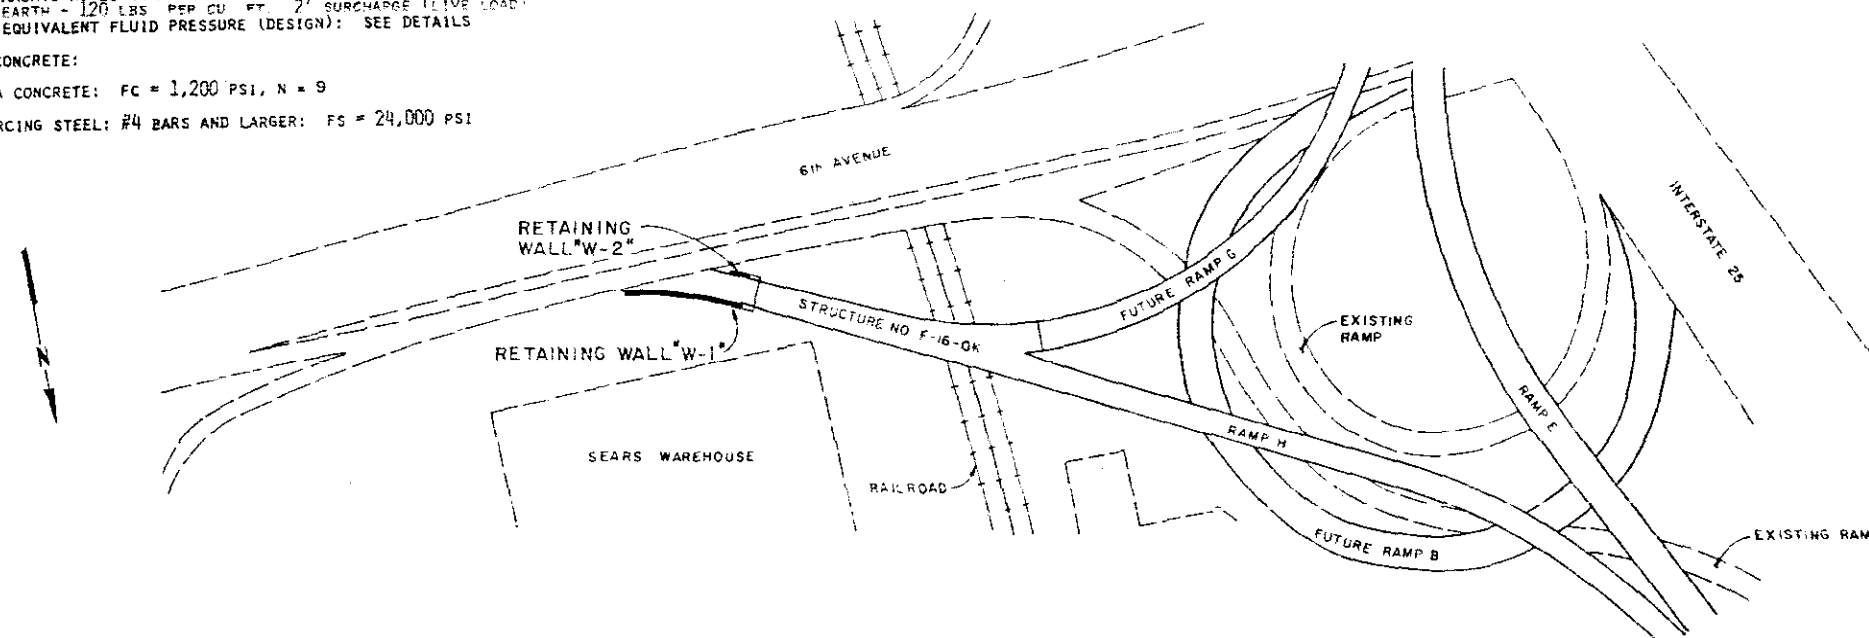

De Leuw, Cather & Company Denver, CO



### DIVISION OF HIGHWAYS GENERAL INFORMATION SUMMARY OF QUANTITIES RETAINING WALLS

Near Denver Sec. 27 T4S R68W


Designer: B. Arrighi Structure Numbers: \_\_\_\_\_  
 Detailer: R. Panning

Drawing Number: B-1 of 7 Drawings

Reviewed \_\_\_\_\_  
 BRIDGE ENGINEER DATE \_\_\_\_\_

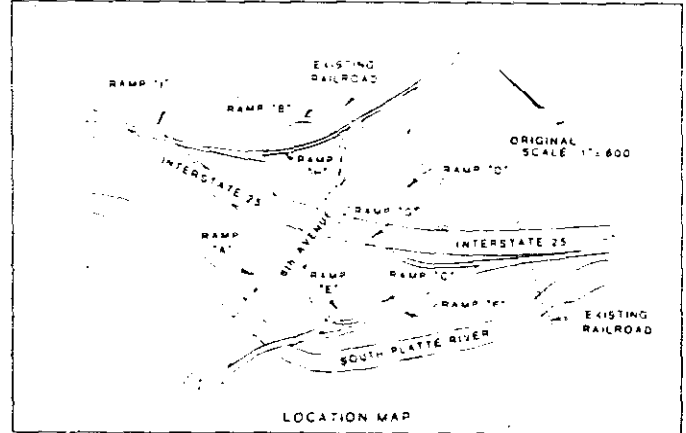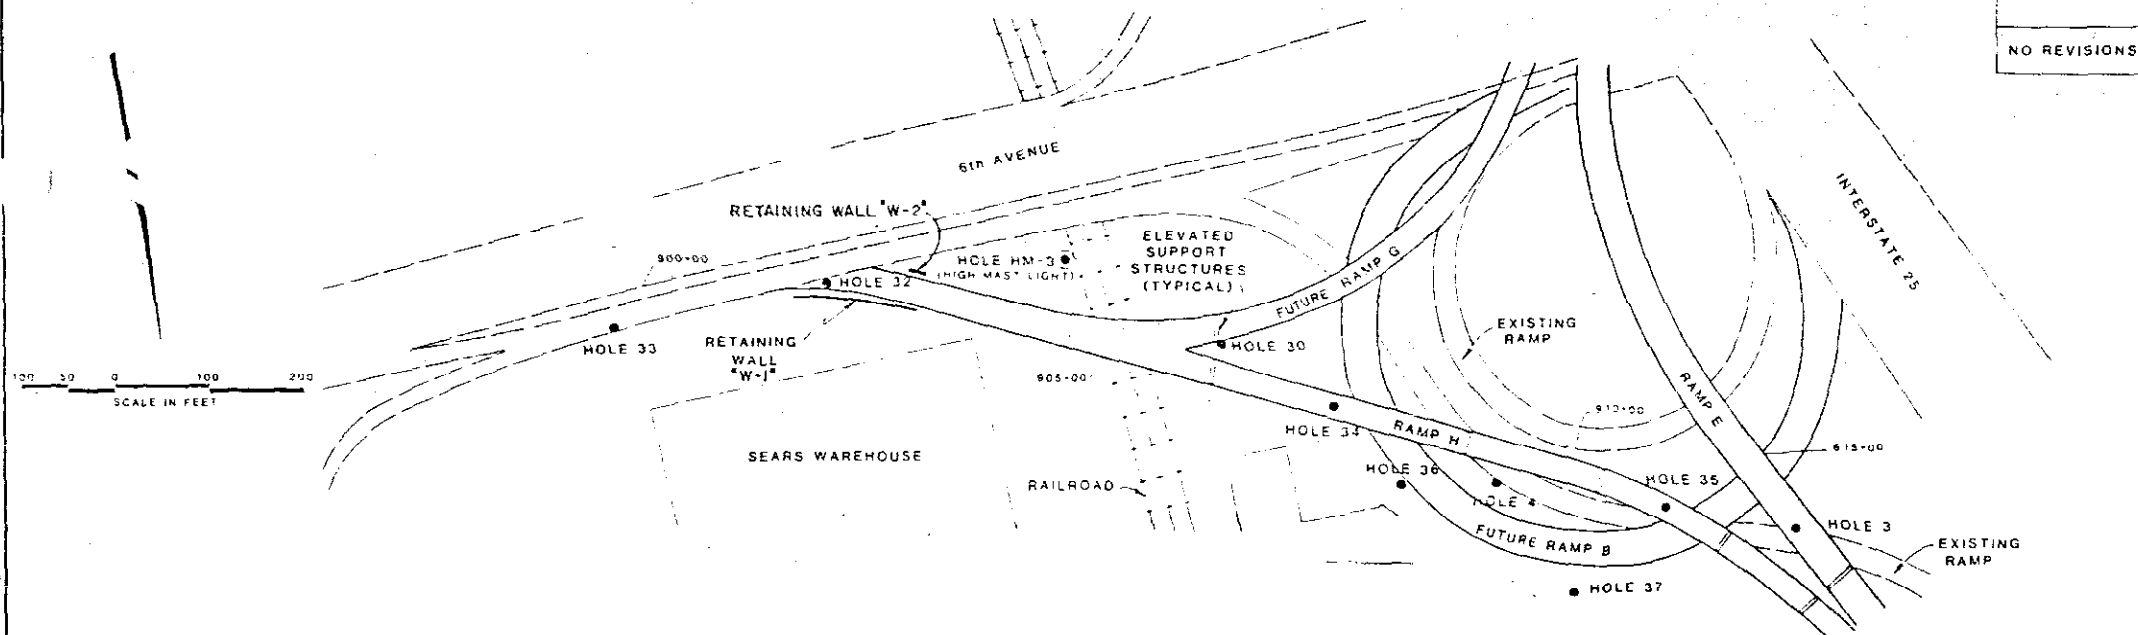

HOLE 33 ELEV.=5216' STA. 899+70	HOLE 32 ELEV.=5227' STA. 902+00	HOLE HM-3 ELEV.=5208' STA. 904+40	HOLE 30 ELEV.=5201' 906+20	HOLE 34 ELEV.=5205' STA. 907+50	HOLE 36 ELEV.=5201' STA. 908+30	HOLE 4 ELEV.=5215' STA. 909+30	HOLE 37 ELEV.=5200' STA. 910+50	HOLE 35 ELEV.=5210' STA. 911+10	HOLE 3 ELEV.=5209' STA. 616+00
---------------------------------------	---------------------------------------	---	----------------------------------	---------------------------------------	---------------------------------------	--------------------------------------	---------------------------------------	---------------------------------------	--------------------------------------

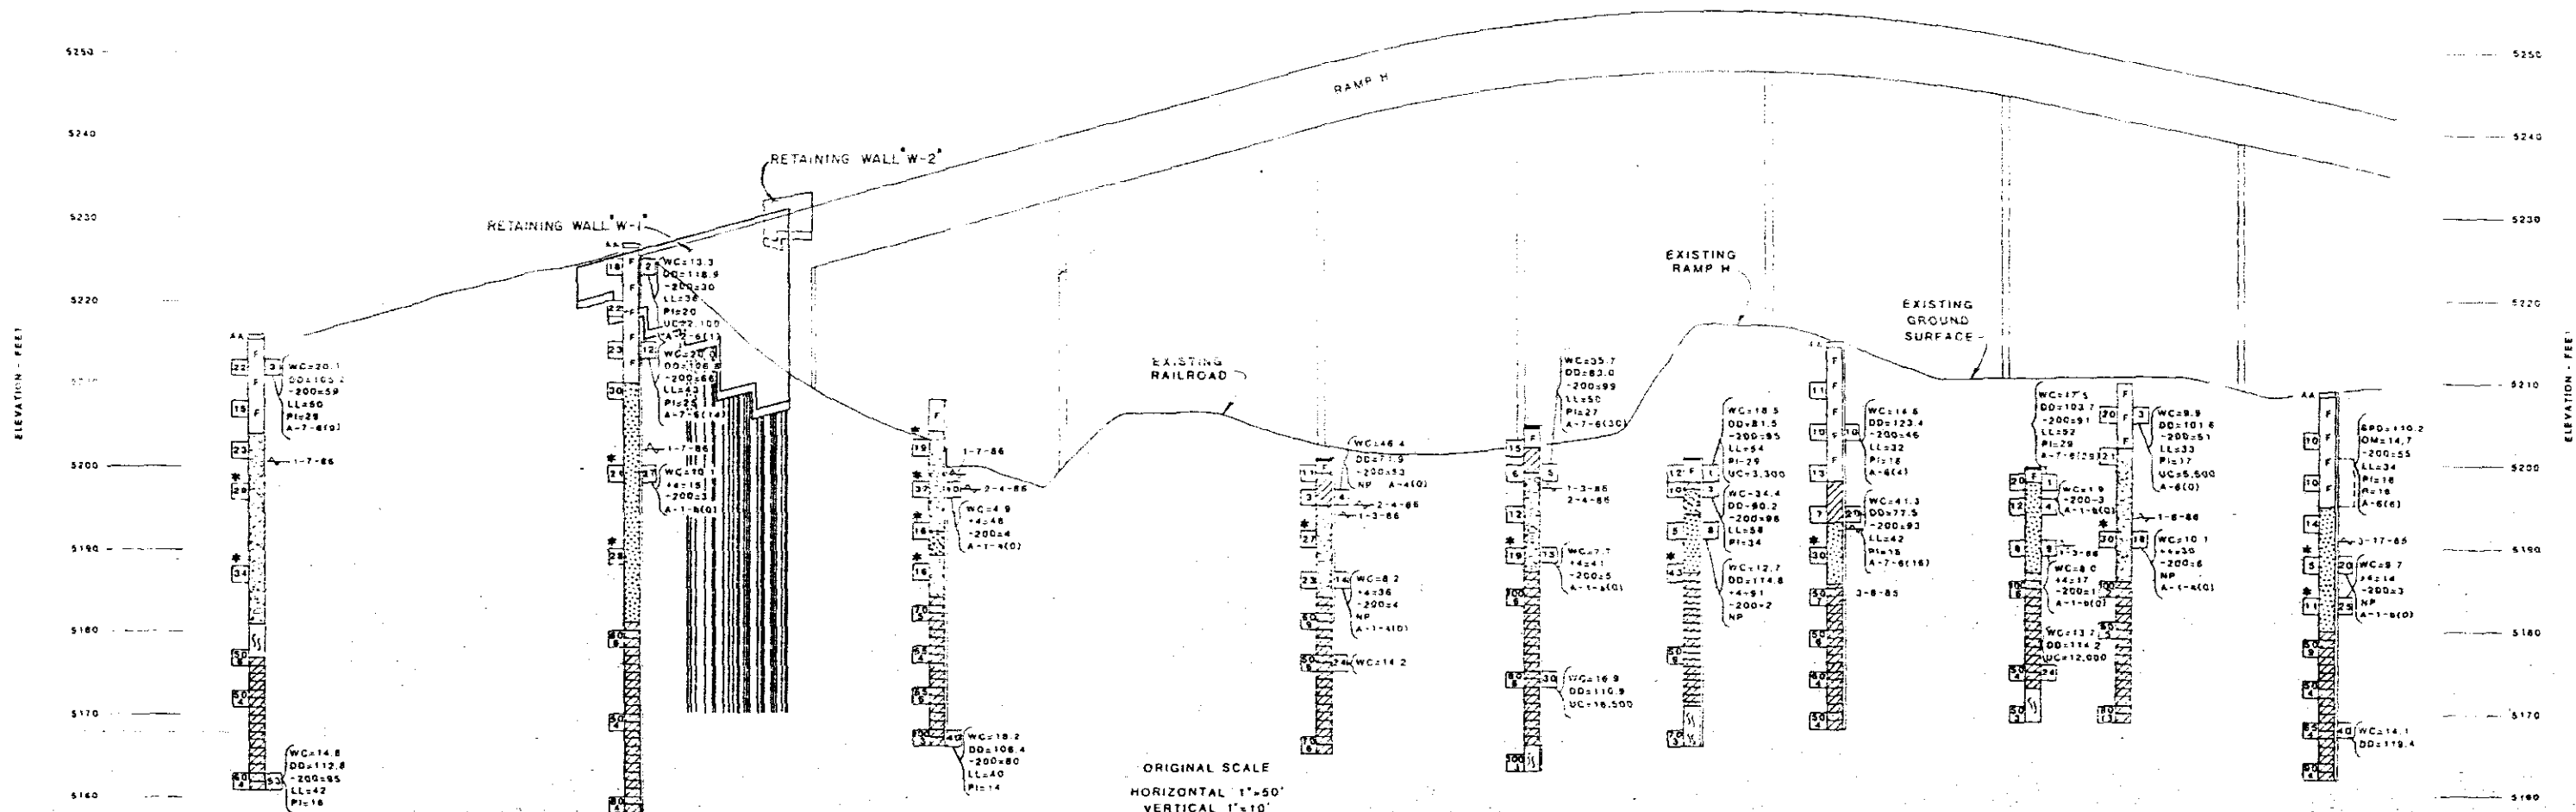

ORIGINAL SCALE  
 HORIZONTAL 1"=50'  
 VERTICAL 1"=10'


SUMMARY OF TEST RESULTS

Dist.	Classification	Grading Analysis			Allowing Limits			Tensile Shear Strength	D <sub>50</sub> of Sample
		ASHTO	Percent	Set	Liquid Limit	Plastic Limit	Plastic Index		

TYPE OF MATERIAL

- TOPSOIL
- FILL, GRAVELLY SAND TO SANDY CLAY, MOIST, BROWN, SCATTERED WOOD AND BRICK IN HOLES 33 AND 35.
- SAND (SP) CLEAN TO SLIGHTLY SILTY, LOOSE TO MEDIUM DENSE, MOIST TO WET, BROWN.
- SAND (SC-SM) CLAYEY TO SILTY, MEDIUM DENSE, MOIST, BROWN.
- SAND AND GRAVEL (SP-GP) CLEAN TO SILTY, MEDIUM DENSE TO DENSE, MOIST TO WET, BROWN.
- CLAY (CL) SLIGHTLY SILTY TO SILTY, MEDIUM TO STIFF, MOIST, BROWN.
- CLAYSTONE BEDROCK, HARD TO VERY HARD, MOIST, BROWN TO BLUE-GRAY.
- SANDSTONE BEDROCK, VERY HARD, MOIST, BROWN TO BLUE-GRAY.
- ASPHALT

LEGEND

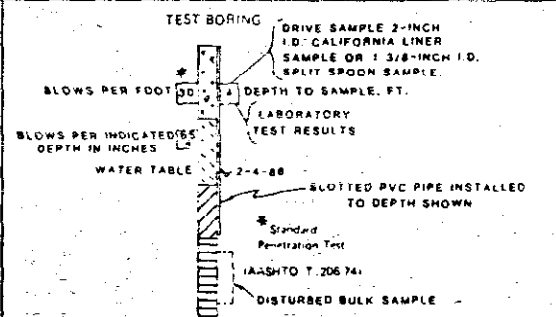

LABORATORY TEST RESULTS:

- WC=MOISTURE CONTENT, %
- DD=DRY DENSITY, PCF
- 4#PERCENTAGE RETAINED ON NO. 4 SIEVE
- 200# PASSING NO. 200 SIEVE
- LL=LIQUID LIMIT, %
- PI=PLASTICITY INDEX, %
- NP=NON-PLASTIC
- UC=UNCONFINED COMPRESSIVE STRENGTH, PSF
- SP=MAXIMUM STANDARD PROCTOR DENSITY, PCF
- OM=OPTIMUM MOISTURE CONTENT, %
- R=NVEEM STABILOMETER RESISTANCE VALUE
- A-1-(0)=AASHTO CLASSIFICATION (GROUP INDEX)


DIVISION OF HIGHWAYS  
 CHEN & ASSOCIATES, INC.  
 ENGINEERING GEOLOGY  
 RAMP H  
 6th AVENUE/INTERSTATE 25 INTERCHANGE

Geology  
 Drawn by A.S.  
 Checked by R.J.T. Date February, 1986


STRUCTURE NO

AS CONSTRUCTED	FEED ROAD DESIGN	SECTION	PROJ. NO.	SHEET NO.	SHEET TOTALS
NO. REVISIONS	REVISED 7	IR 25-2(191)	121	242	


REVISIONS	

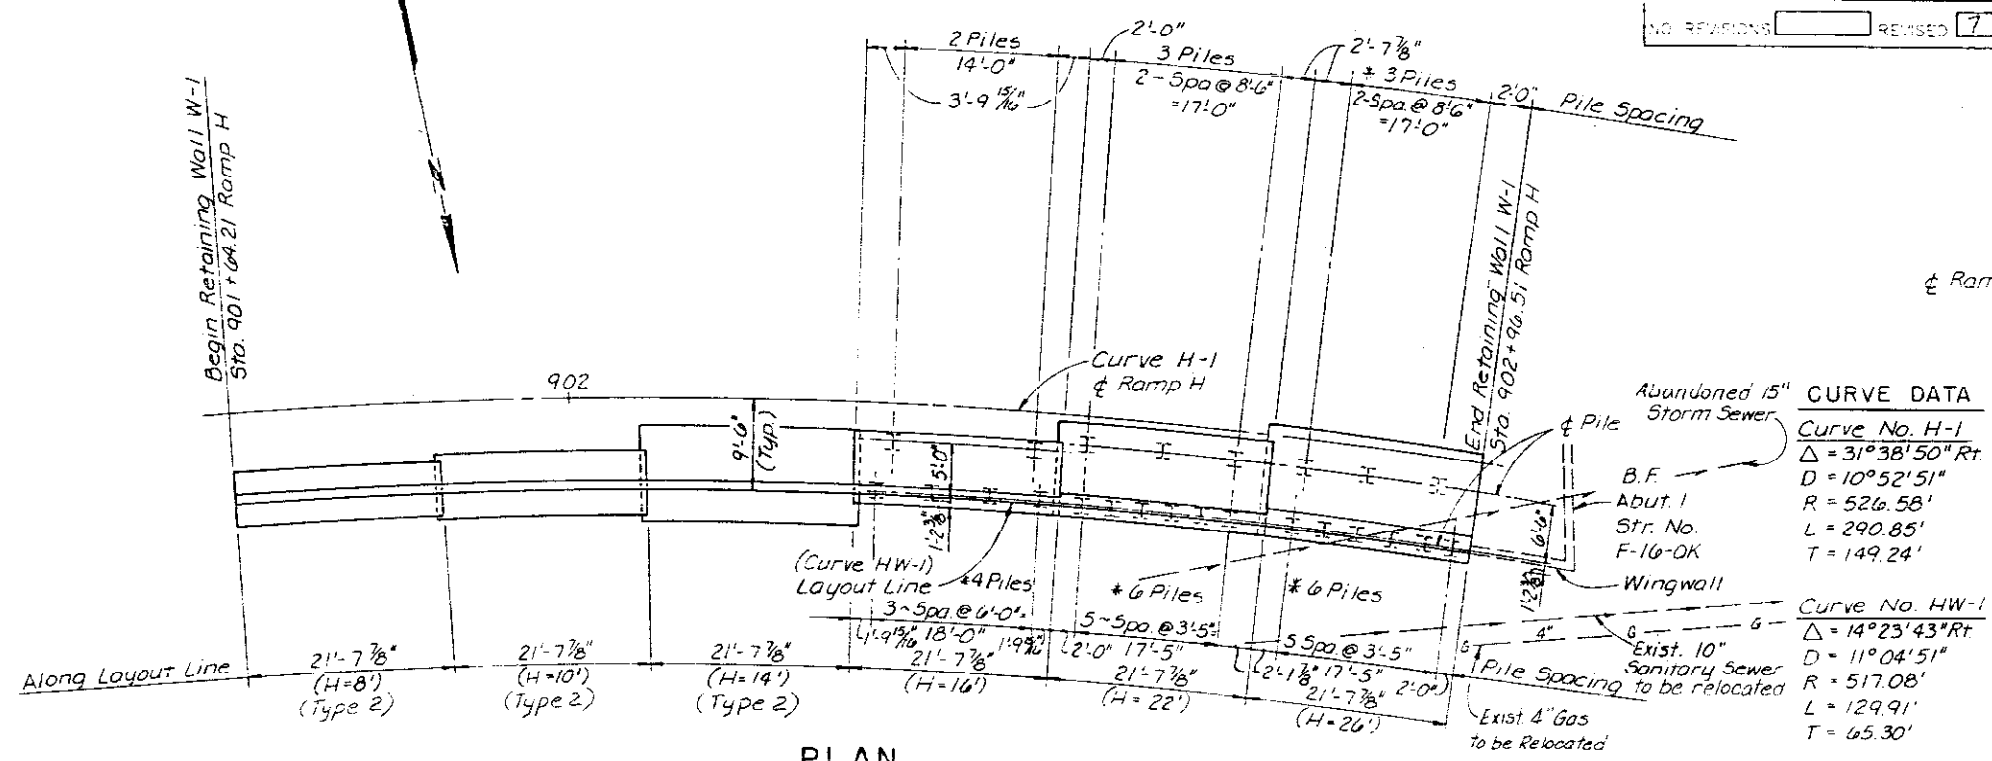

DESIGNED BY	DATE	CHECKED BY

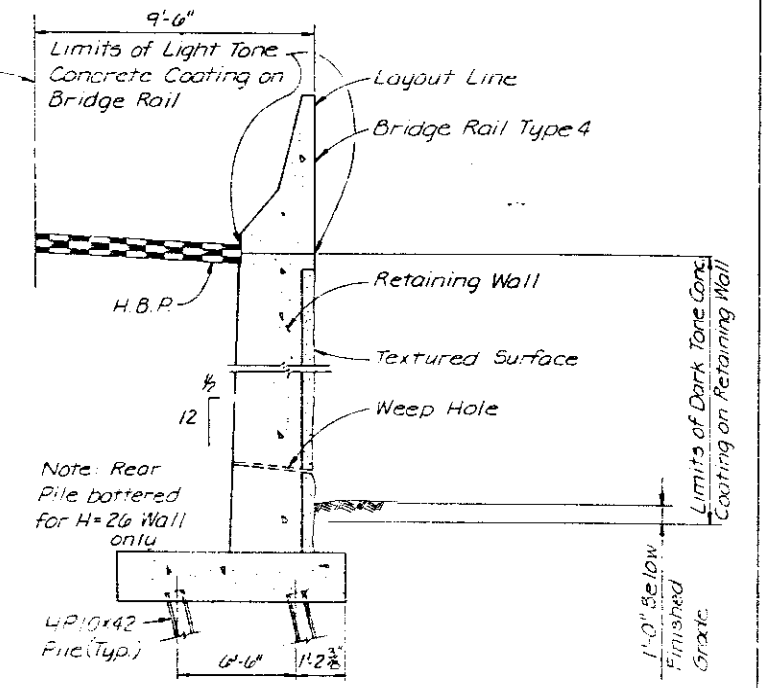

**PLAN**  
 \* Battered Piles 3/4"

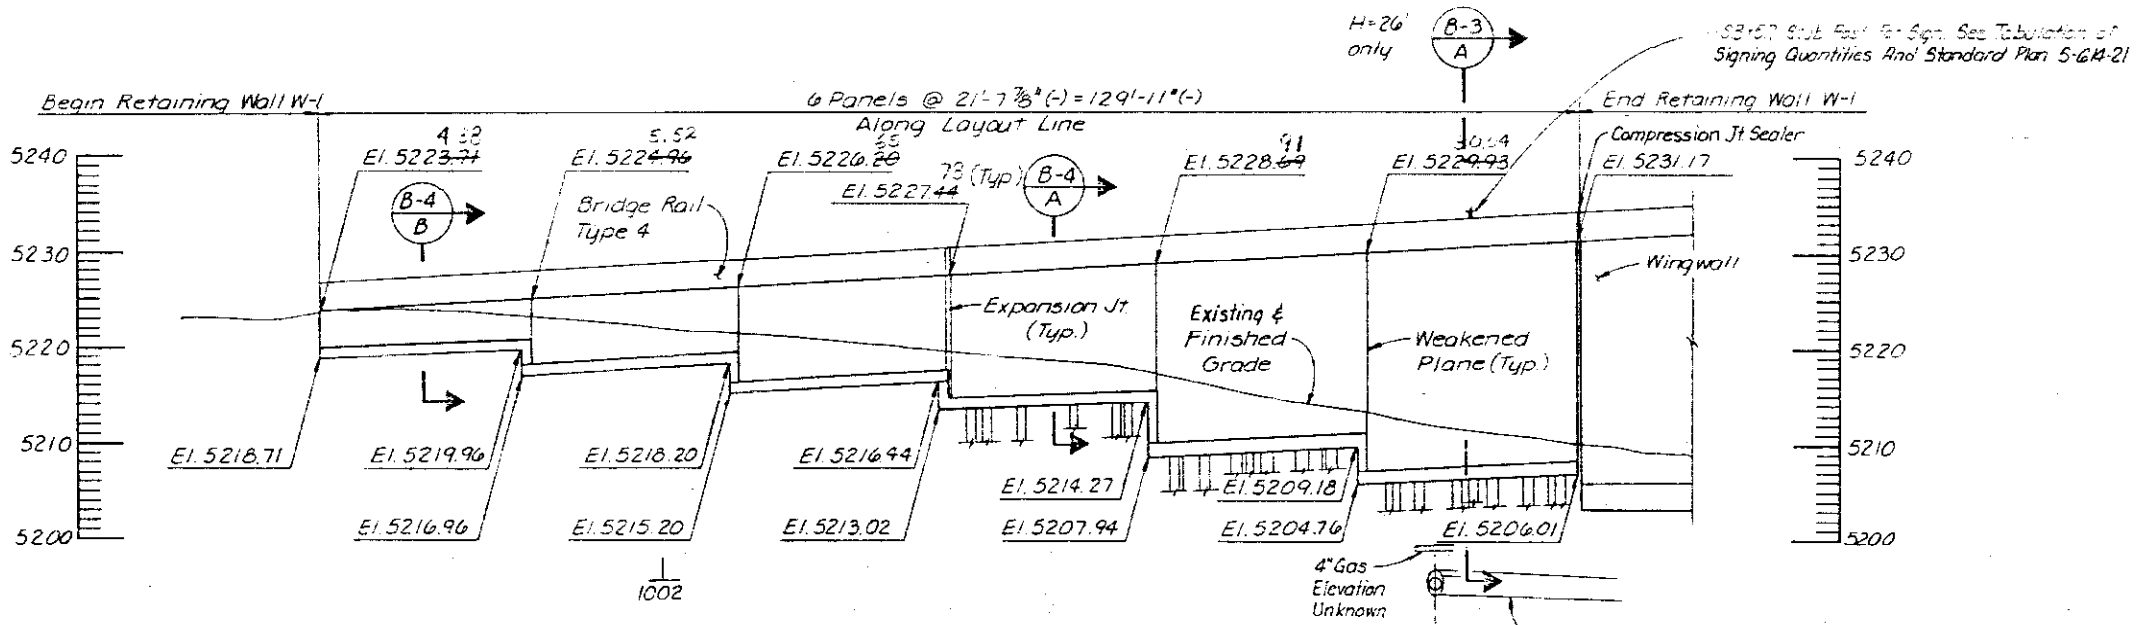

- NOTES:**
- For Bridge Rail Type 4 Details, See Dwg No. B-50
  - See Dwg No. B-7 For Additional Details.
  - Utility Locations are Approximate See Utility Plans and Sections for Location and Elevation.
  - See Dwg No. B-5 for Size and Reinforcing for Retaining Walls on Piles.
  - All piles are end bearing, size HP 10x42, estimated tip elevation 5170.00.
  - See Dwg. No. B-6 for Size and Reinforcing for H=8', 10', & 14' Retaining Walls.

De Leuw, Cather & Company Denver, CO

**DIVISION OF HIGHWAYS**





**GENERAL LAYOUT**  
**RETAINING WALL "W-1"**  
 STA. 901 + 64.21 TO STA. 902 + 96.51 RAMP H

Designer B. Arrighi	Structure Numbers
Detailer R. Panning	
Drawing Number 3-3	of 7 Drawings

Revision Dates (Preliminary Stage Only)

NO. REVISIONS	7-17-64	PROJECT	IR 25-2(191)	SHEET	122	CHEF TOTALS	242
---------------	---------	---------	--------------	-------	-----	-------------	-----

REVISIONS	

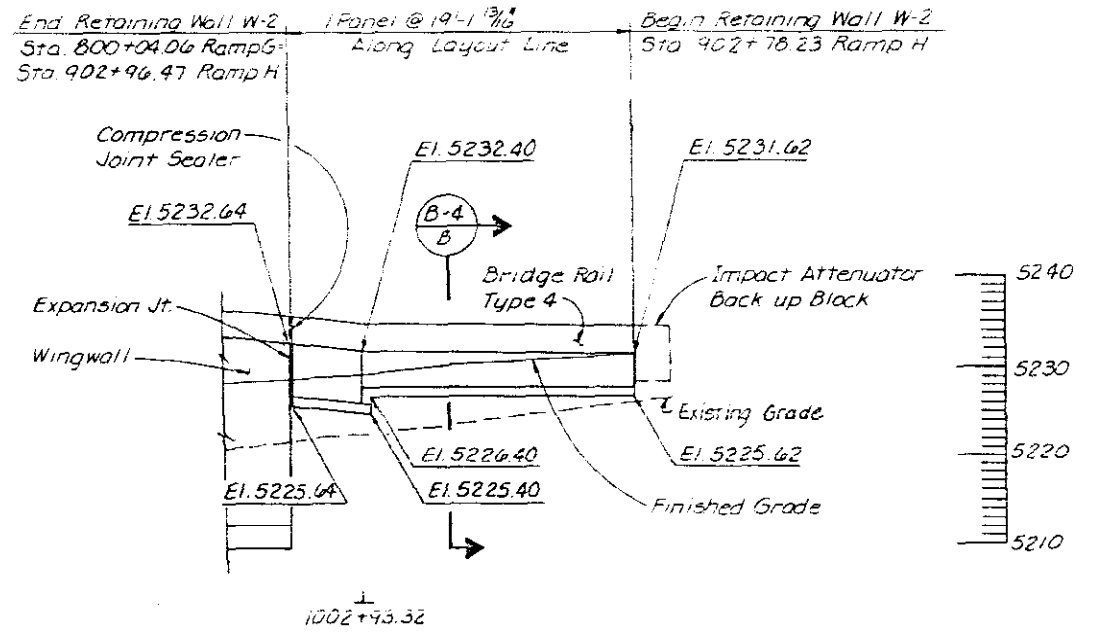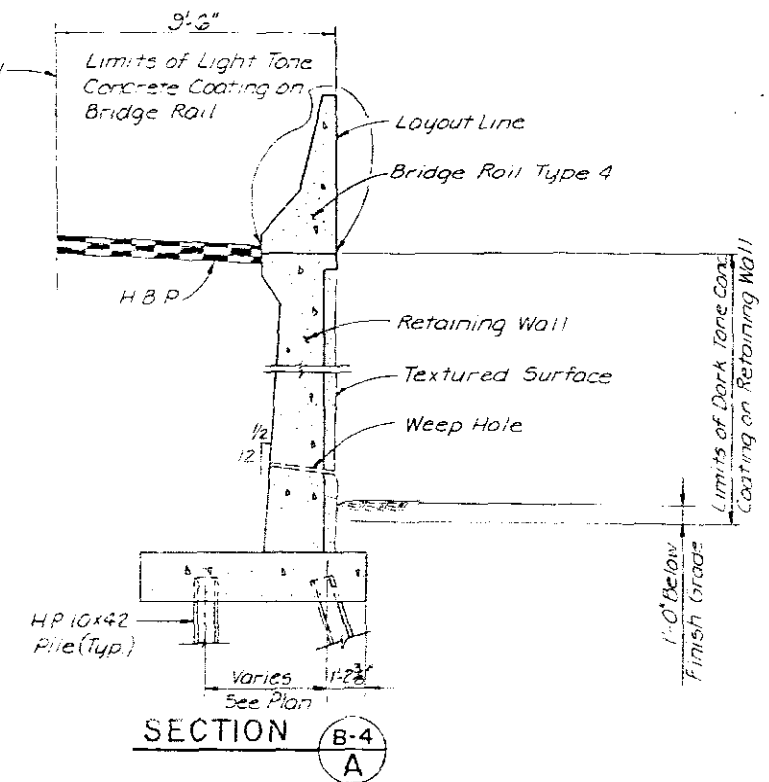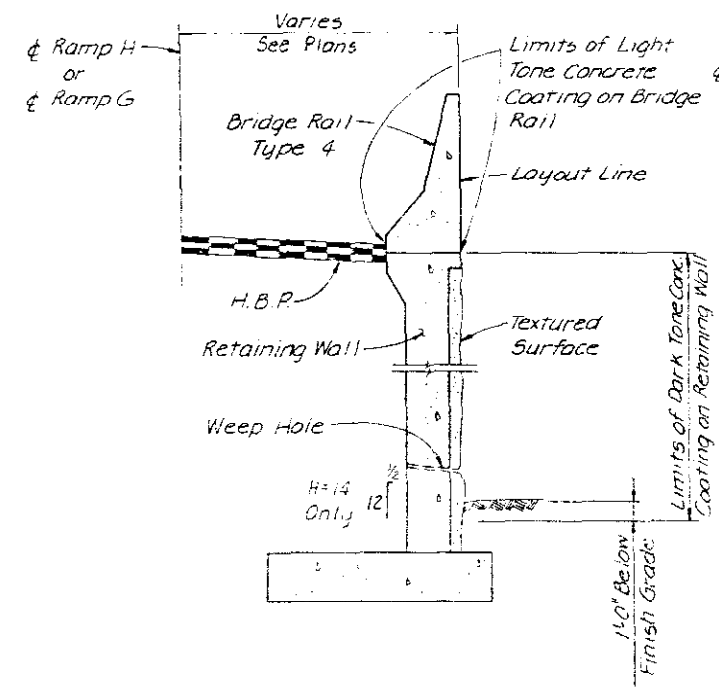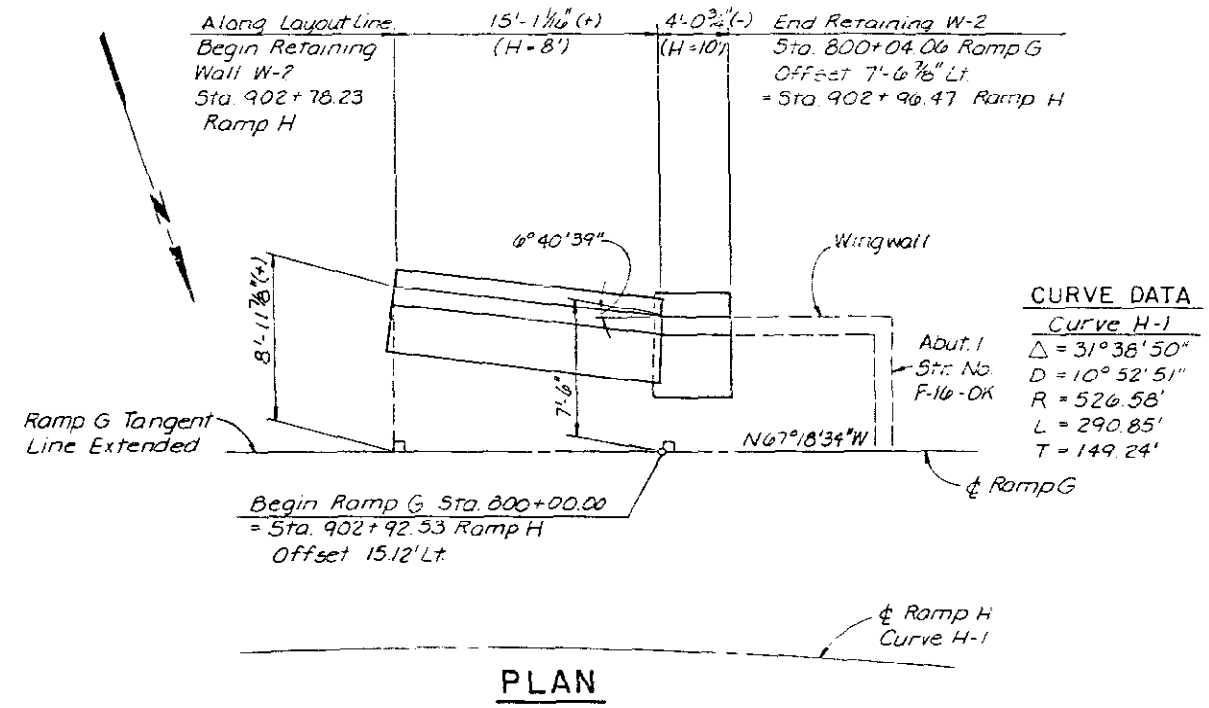

- NOTES:**
1. For Bridge Rail Type 4 Details, See Dwg. No. B-50
  2. See Dwg. No. B-7 For Additional Details
  3. Utility Locations are Approximate. See Utility Plans and Sections for Location and Elevation.
  4. See Dwg. No. B-6 for Size and Reinforcing.

De Leuw, Cather & Company Denver, CO

DIVISION OF HIGHWAYS

**GENERAL LAYOUT**  
**RETAINING WALL W-2**  
 STA. 902+78.23 RAMP H TO  
 STA. 902+96.47 = STA. 800+04.06  
 RAMP H RAMP G

Designer B. Arrighi Structure  
 Detailer R. Panning Numbers


Drawing Number B-4 of 7 Drawings

DESIGNED BY	BA	1/86
CHECKED BY	JA	5/67
DATE	1/86	5/67
INITIAL	BA	JA
CHECKED BY	JA	11/86
DATE	11/86	11/86
INITIAL	JA	11/86

DESIGN H (ft.)	8	10	12	14	16	18	20	22	24	26	28	30
W	4'-9"	5'-6"	6'-2"	6'-10"	7'-7"	8'-4"	9'-2"	9'-10"	10'-9"	11'-5"	12'-5"	13'-2"
T	1'-0"	1'-0"	1'-0"	1'-0"	1'-0"	1'-0"	1'-2"	1'-2"	1'-6"	1'-6"	1'-10"	2'-9"
X	1'-0"	2'-2"	2'-4"	2'-6"	2'-10"	3'-2"	3'-4"	3'-6"	3'-8"	3'-10"	4'-0"	4'-1"
Y		3'-8"	3'-8"	6'-3"	7'-1"	4'-5"	5'-4"	9'-6"	6'-4"	11'-1"	7'-3"	7'-9"
Z		8'-0"	8'-0"	10'-3"	6'-3"	5'-5"	6'-2"	8'-7"	7'-1"	9'-11"	9'-7"	10'-5"
A & C BARS	#4 @ 5 1/2"	#4 @ 5 1/2"	#4 @ 7"	#4 @ 7"	#5 @ 7 1/2"	#5 @ 7 1/2"	#6 @ 7 1/2"	#6 @ 6 1/2"	#7 @ 7"	#7 @ 7"	#7 @ 6"	#8 @ 7"
B BARS	#4 @ 1'-6"	#4 @ 1'-6"	#4 @ 7"	#6 @ 7"	#7 @ 7 1/2"	#6 @ 7 1/2"	#6 @ 7 1/2"	#9 @ 6 1/2"	#7 @ 8"	#11 @ 7"	#7 @ 6"	#8 @ 7"
D BARS	#4 @ 5 1/2"			#5 @ 7"	#7 @ 7 1/2"			#9 @ 6 1/2"		#10 @ 7"		
G	8.80'	2.50'	1.95'	4.00'	5.00'	2.76'	5.13'	6.50'	7.74'	6.50'	4.48'	4.72'
MAXIMUM PILE SPACING *	24.00'	16.80'	12.60'	9.70'	7.70'	6.20'	5.00'	4.10'	3.50'	3.00'	2.50'	2.20'
MAX. PILE LOAD (TONS)	43.0	43.0	1.30	44.0	47.0	2.30	2.60	43.0	3.40	57.0	4.10	4.80
CONCRETE Cu Yrs./Lin.Ft.	0.472	0.574	0.673	0.771	1.188	0.980	1.194	1.962	1.708	2.882	2.310	2.642
WEIGHT OF REIN. Lbs./Lin.Ft.	46.2	53.0	66.3	81.9	103	146	163	197	232	278	337	395
S					1'-5"			1'-9"		2'-2"		
V					1'-6 1/2"			1'-11 1/2"		2'-5 1/2"		
R					5'-0 1/2"			6'-10 1/2"		7'-11 1/2"		

As req'd on general layout


\* SEE RETAINING WALL PLANS FOR ACTUAL PILE SPACING

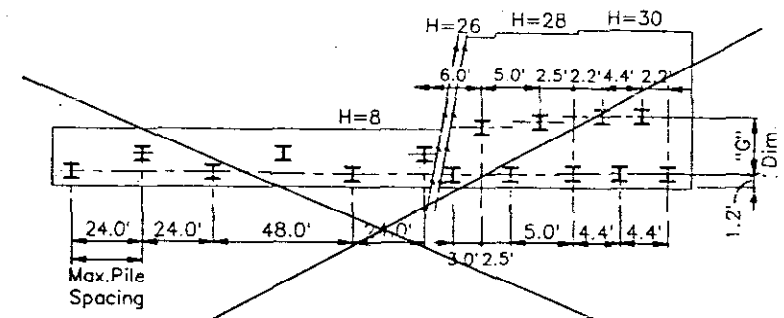


TYP. PLAN OF FOOTING & PILES  
 LONGITUDINAL DIMENSIONS ARE MAX.

DESIGNED BY	BA	6-87
CHECKED BY	BA	6-87
DESIGNED BY	BA	11-86
CHECKED BY	BA	5-87
DESIGNED BY	BA	11-86
CHECKED BY	BA	11-86

NO NUMBER 06/05/86 1122217 - IUAIGDRA-USTS(MSTD) R4-02

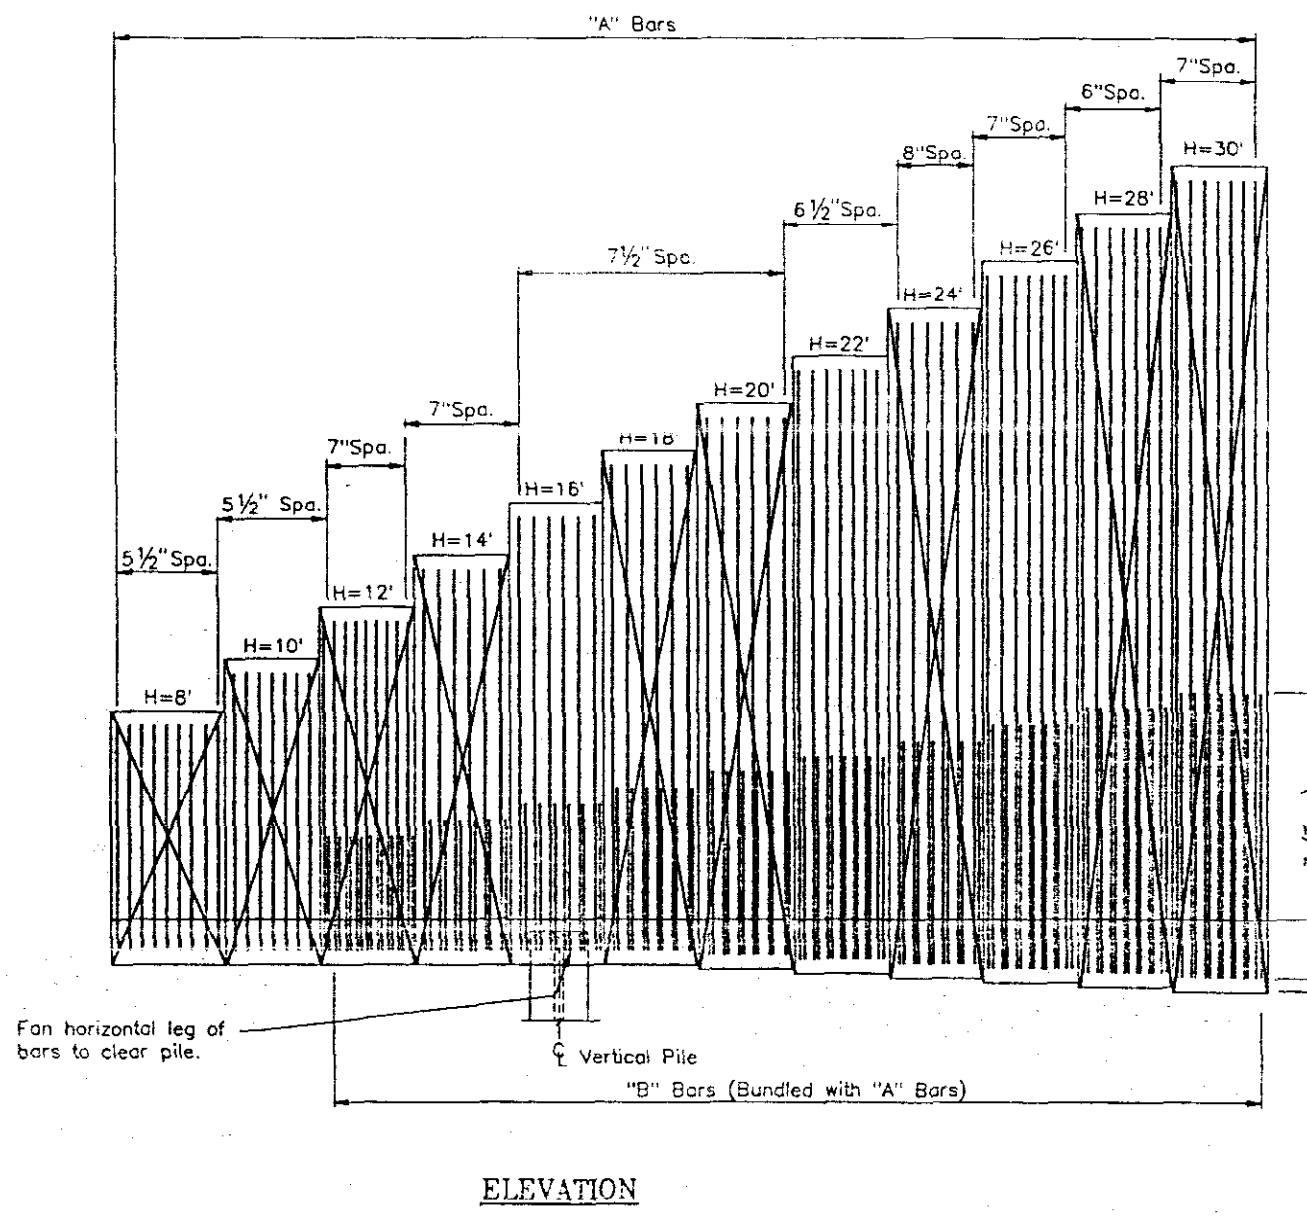

ELEVATION

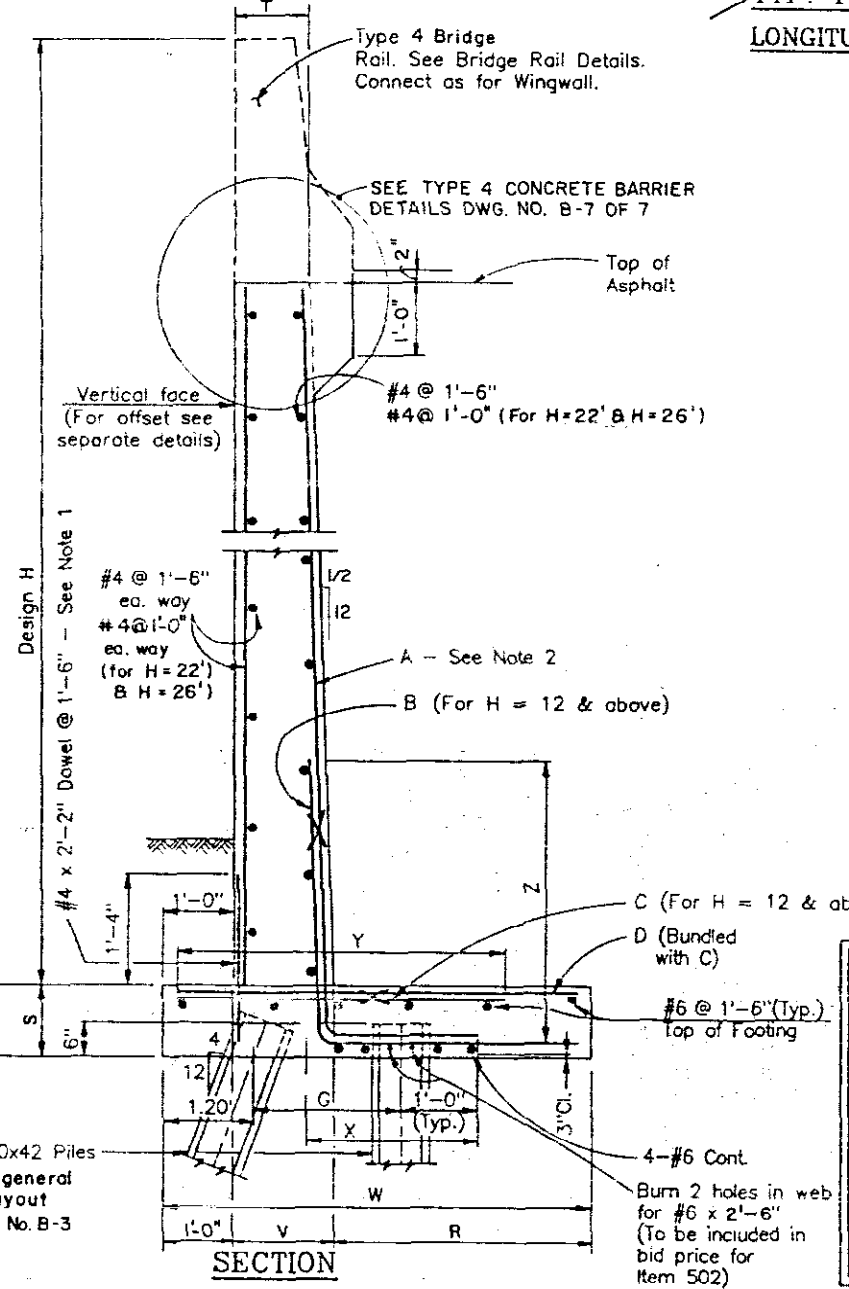

SECTION

**DESIGN DATA**  
 Current AASHTO Specification.  
 Working Stress Design  
 Reinforcing Steel:  $f_s = 24,000$  psi  
 Reinforced Concrete:  $f_c = 1200$  psi  
 Loadings:  
 Live Load = 10 Kips on Rail or 2' Surchage  
 Earth = 36 pcf fluid equiv.  
 120 pcf dry weight.  
 Coeff. of friction = 0.70  
 2.7:1 allowed for U=1'-0" min.  
 2.0:1 allowed for U=2'-0" min.  
 1.7:1 allowed for 2' Live Load surcharge  
 of Bridge Rail mounted on wall for  
 U=3'-0" min.  
 HP 10x42 Steel Piles=12,000 psi allowable load at tip  
 7 Kips allowable horizontal resistance

- NOTES**
- #4 x 2'-2" Dowels may be placed after footing is poured but before initial set.
  - Bar "A" may be spliced once each bar (optional). Any increased quantity of reinforcing will be at the contractor's expense.
  - Design H is actual wall height plus three feet of barrier height rounded up to nearest even foot.
  - Backface wall batter is calculated for actual wall height (Dimension "V").

DIVISION OF HIGHWAYS

**RETAINING WALL DETAILS**


DESIGNER *B. Arrighi* STRUCTURE NUMBER \_\_\_\_\_  
 DETAILER *R. Penning* NUMBERS \_\_\_\_\_  
 DRAWING NUMBER B-5 OF 7 DRAWINGS

REVISION DATES (PRELIMINARY STAGE ONLY)

AS CONSTRUCTED  
 NO REVISIONS  REVISED  VOID


FEDERAL ROAD REGION NO.	DIVISION	PROJ. NO.	SHEET NO.	TOTAL SHEETS
VIII	COLORADO	IR 25-2(191)	124	242

REVISIONS	

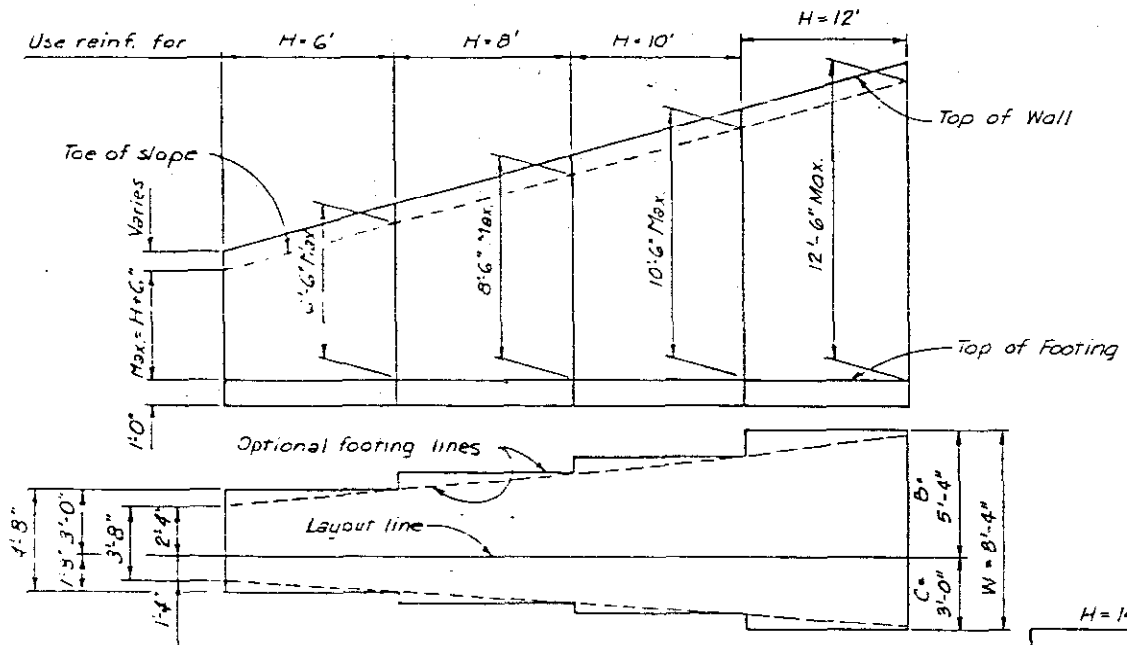


TYPICAL LAYOUT EXAMPLE

Bar cut-off may be varied in increments of 6". Dimensions at the top of the short C bar indicate the distance from the top of footing to the end of the bar.

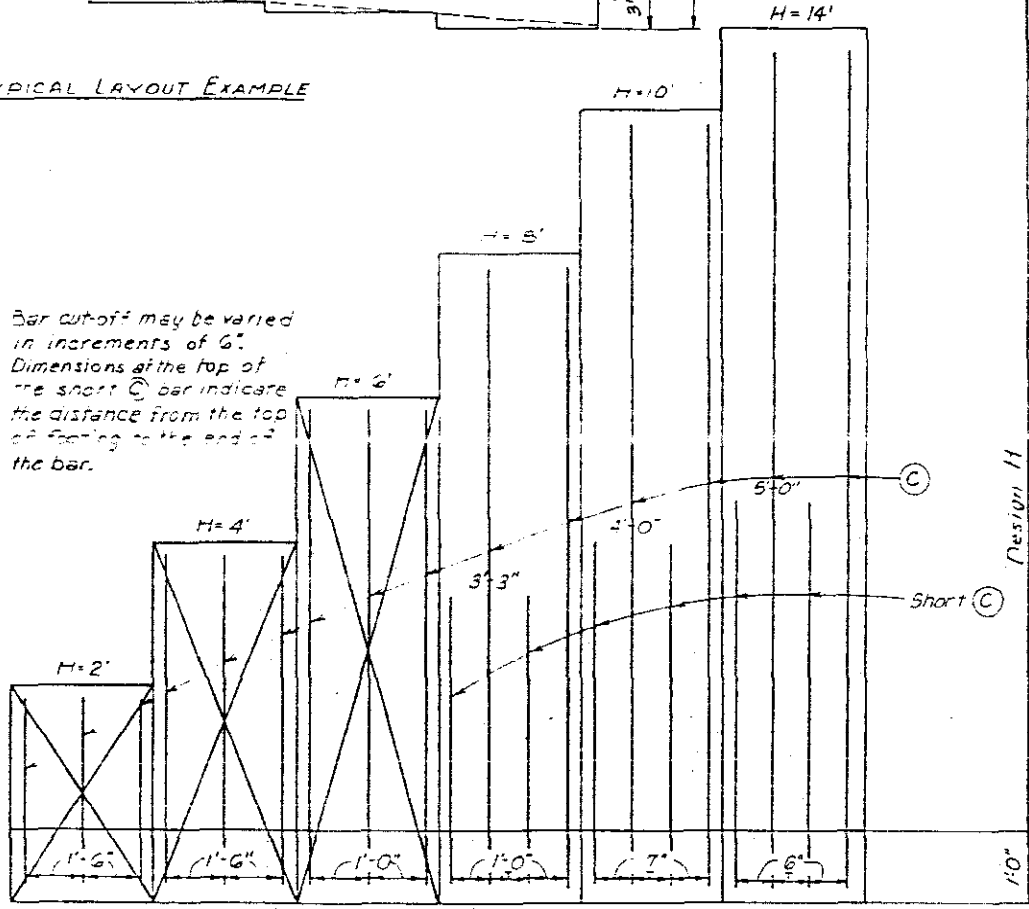

ELEVATION

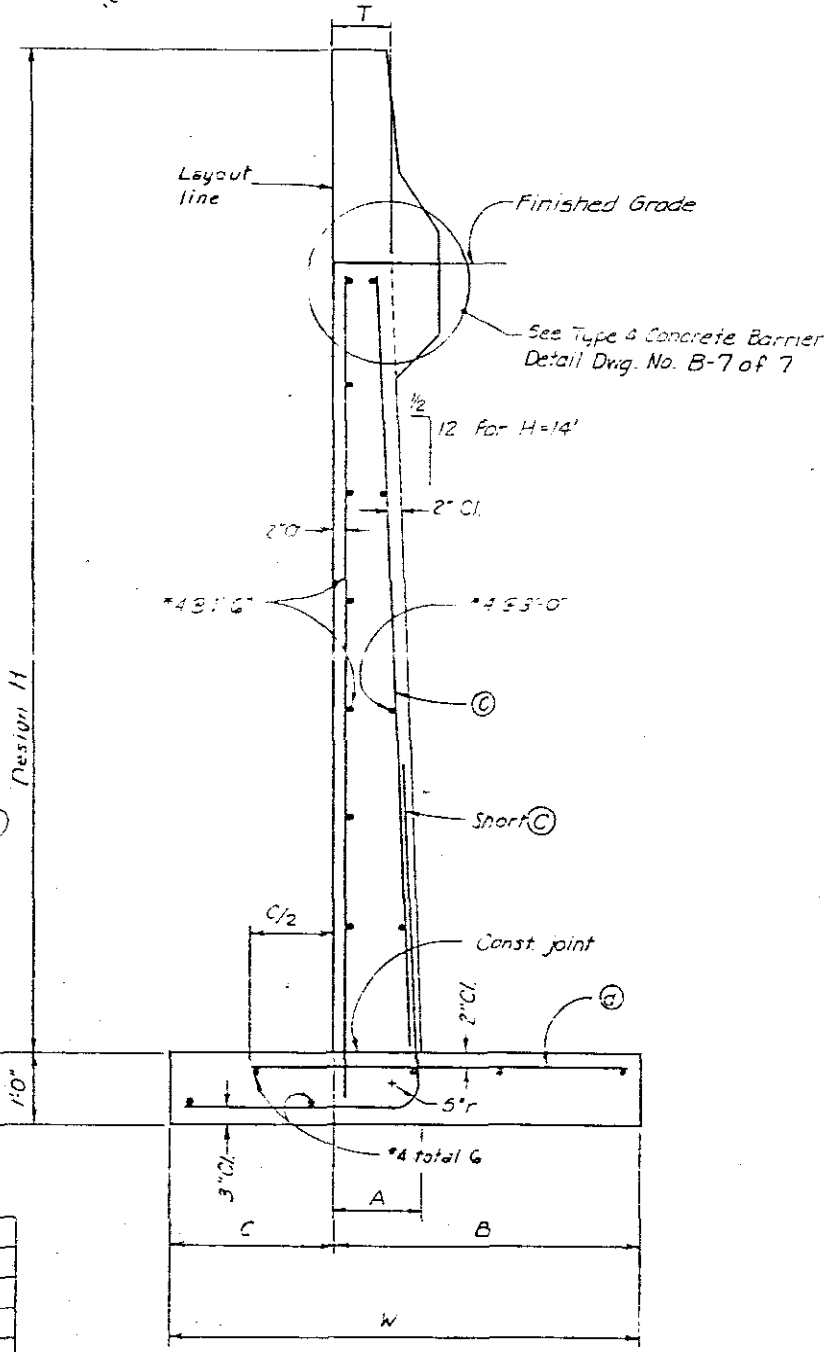

TYPICAL SECTION

NOTES:  
 BACKSIDE WALL BATTER IS CALCULATED FOR ACTUAL WALL HEIGHT (DIMENSION H).  
 DESIGN H IS ACTUAL WALL HEIGHT PLUS THREE FEET OF BARRIER HEIGHT ROUNDED UP TO NEAREST EVEN FOOT.  
 DESIGN H MAY BE EXCEEDED BY 6" BEFORE GOING TO THE NEXT SIZE.  
 SPECIAL FOOTING DESIGN IS REQUIRED WHEN FOUNDATION MATERIAL IS INCAPABLE OF SUPPORTING TOE PRESSURE LOAD.  
 FOR DESIGN AND DETAILS NOT SHOWN, SEE BRIDGE STANDARD - 102.  
 DESIGN DATA  
 $f_c = 1200 \text{ psi}$   
 $f_s = 24,000 \text{ psi}$   
 $n = 9$   
 EQUIVALENT FLUID PRESSURE = 36 dcf  
 MAXIMUM TOE PRESSURE = 1 TON/50 FT.

DESIGN DATA - REINFORCING STEEL - DIMENSIONS - Type 2 Retaining Walls							
H	2'	4'	6'	8'	10'	12'	14'
C	1'-0"	1'-4"	1'-8"	2'-4"	2'-8"	3'-0"	3'-4"
B	1'-8"	2'-4"	3'-0"	3'-4"	4'-0"	5'-4"	6'-9"
W	2'-8"	3'-8"	4'-8"	5'-8"	6'-8"	8'-4"	10'-1"
⊕ ⊗ bars	*5 @ 1'-0"	*9 @ 1'-0"	*5 @ 1'-0"	*6 @ 1'-0"	*6 @ 7"	*7 @ 6"	*4 @ 6"
Reinf. Lbs./LF	—	20	26	35	65	162	162
Conc. Cu./LF	—	0.259	0.358	0.457	0.554	0.679	1.04
T	—	—	—	10"	10"	—	1'-0"
A	—	—	—	10"	10"	—	1'-5"

**DIVISION OF HIGHWAYS**

RETAINING WALL DETAILS

TYPE 2

Designer <i>B. Arrighi</i>	Structure
Detailer <i>R. Panning</i>	Numbers
Drawing Number B- 6 of 7 Drawings	

