


- Storm**
- ⊗ S
 - ⊙ S
 - ⊗ T
 - ⊙ F
 - ⊗ M
- Storm**
- ⊙ T
 - ⊙ T
 - ⊗ F
- Storm**
- ⊗ C
 - ⊗ C
 - ⊗ C
 - ⊗ C
 - ⊗ T
 - ⊗ L
- Storm**
- ⊙ C
 - ⊙ C
 - ⊙ C
 - ⊙ F
 - ⊙ F
 - ⊙ F
 - ⊙ S

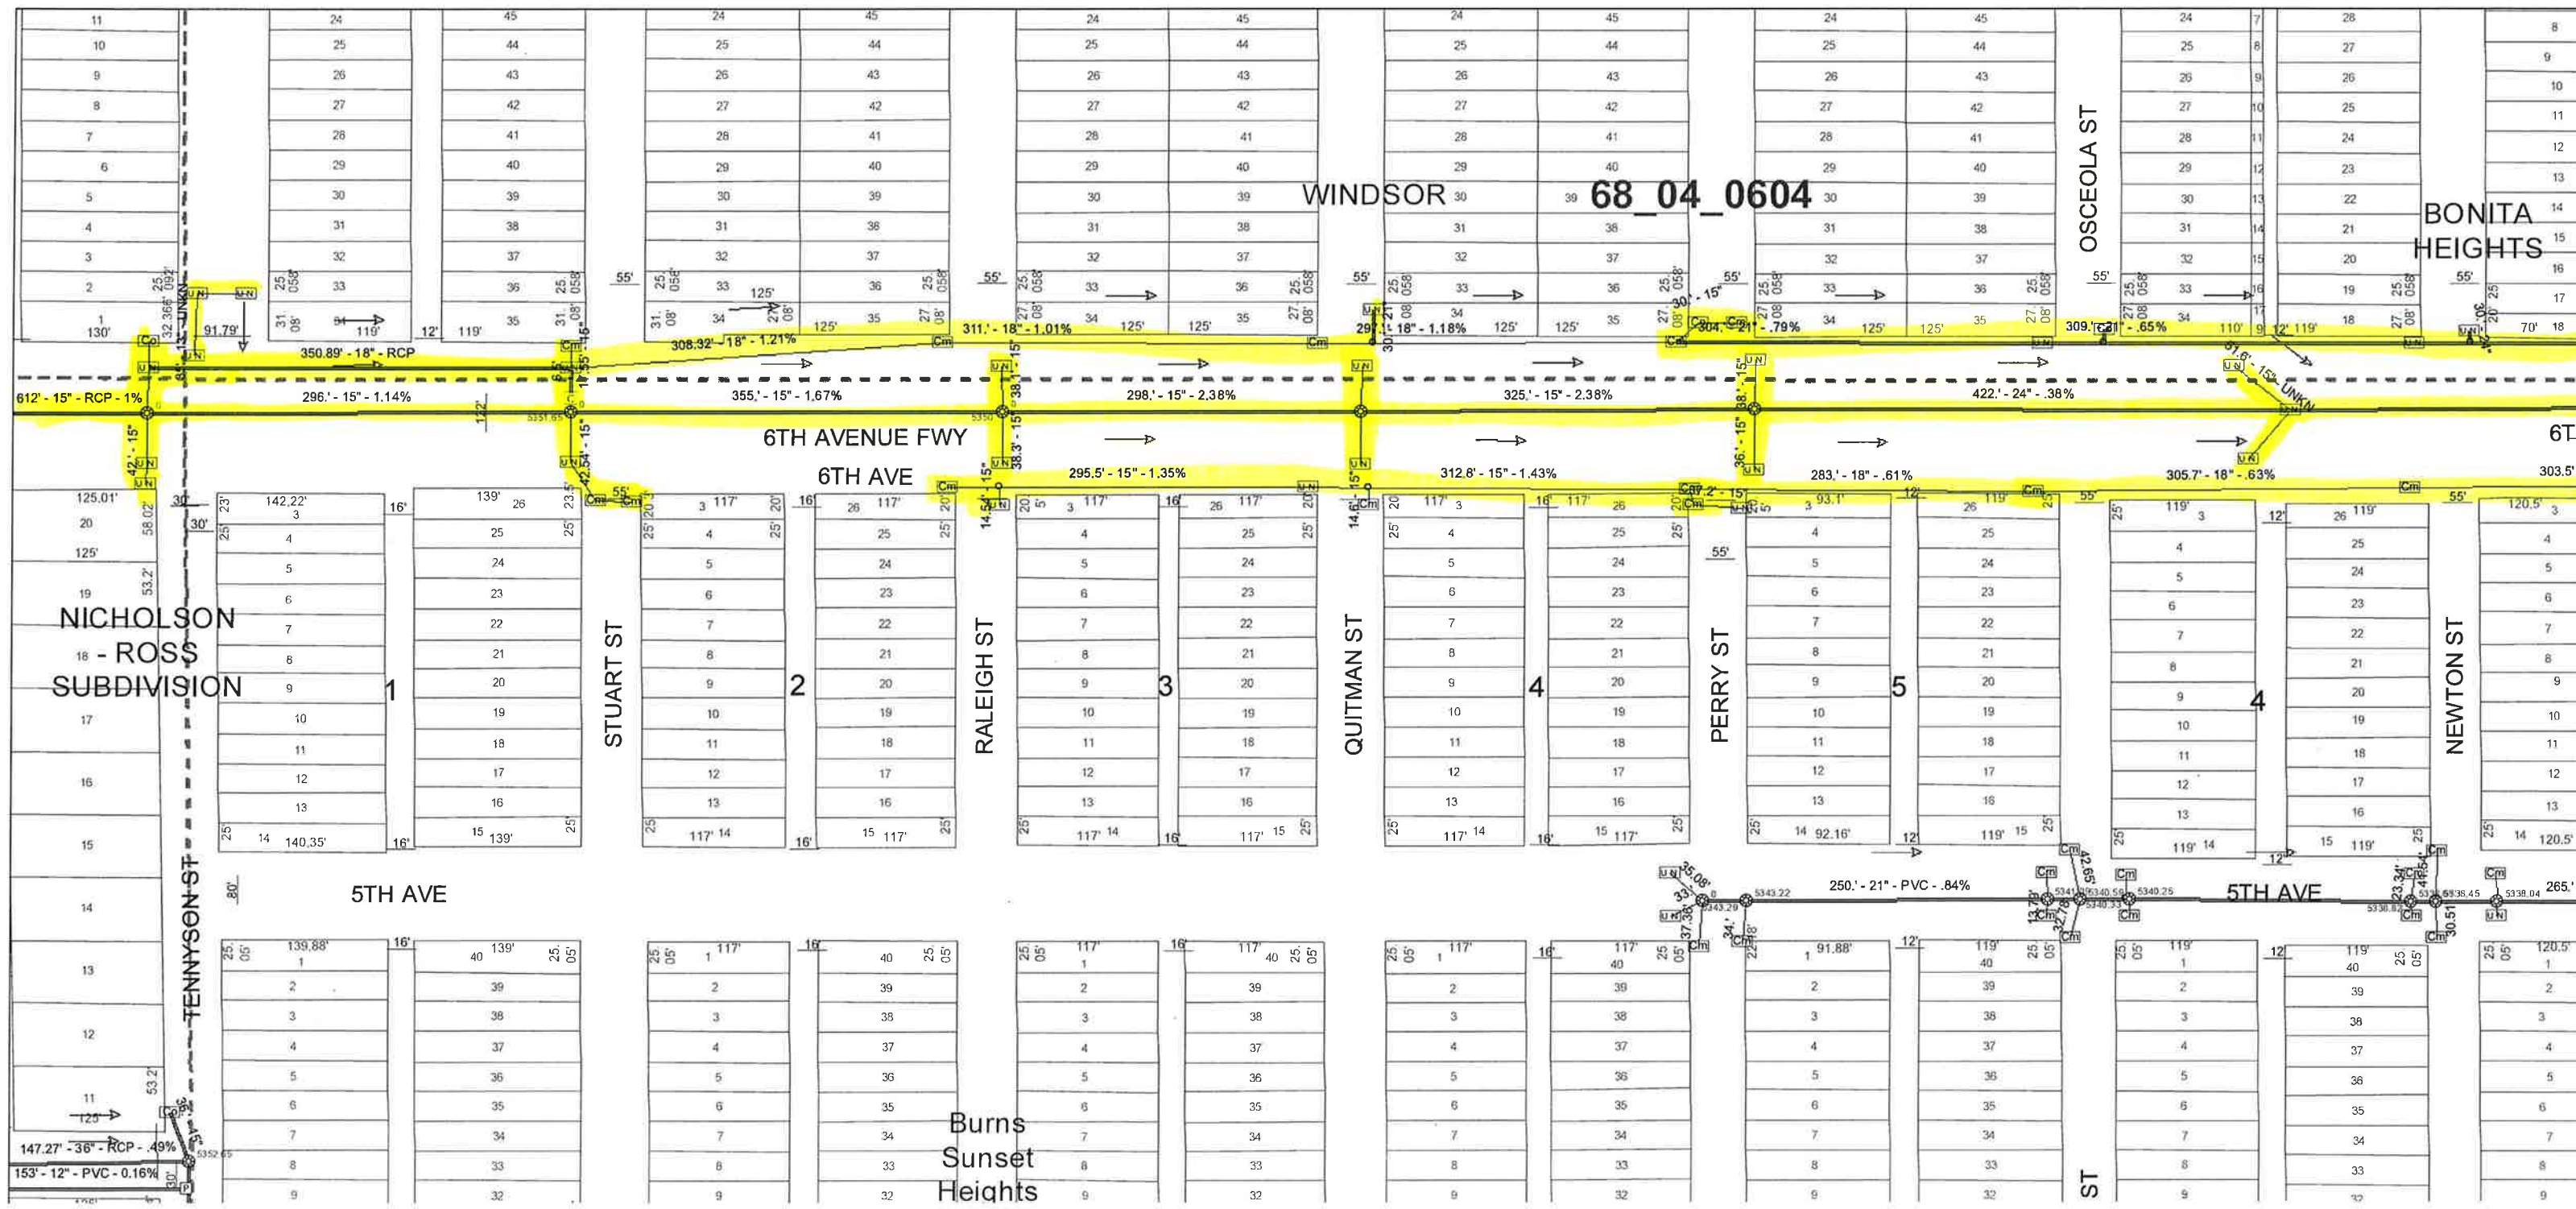




WINDSOR 68_04_0604


NICHOLSON
SUBDIVISION

BURNS
SUNSET
HEIGHTS

BONITA
HEIGHTS

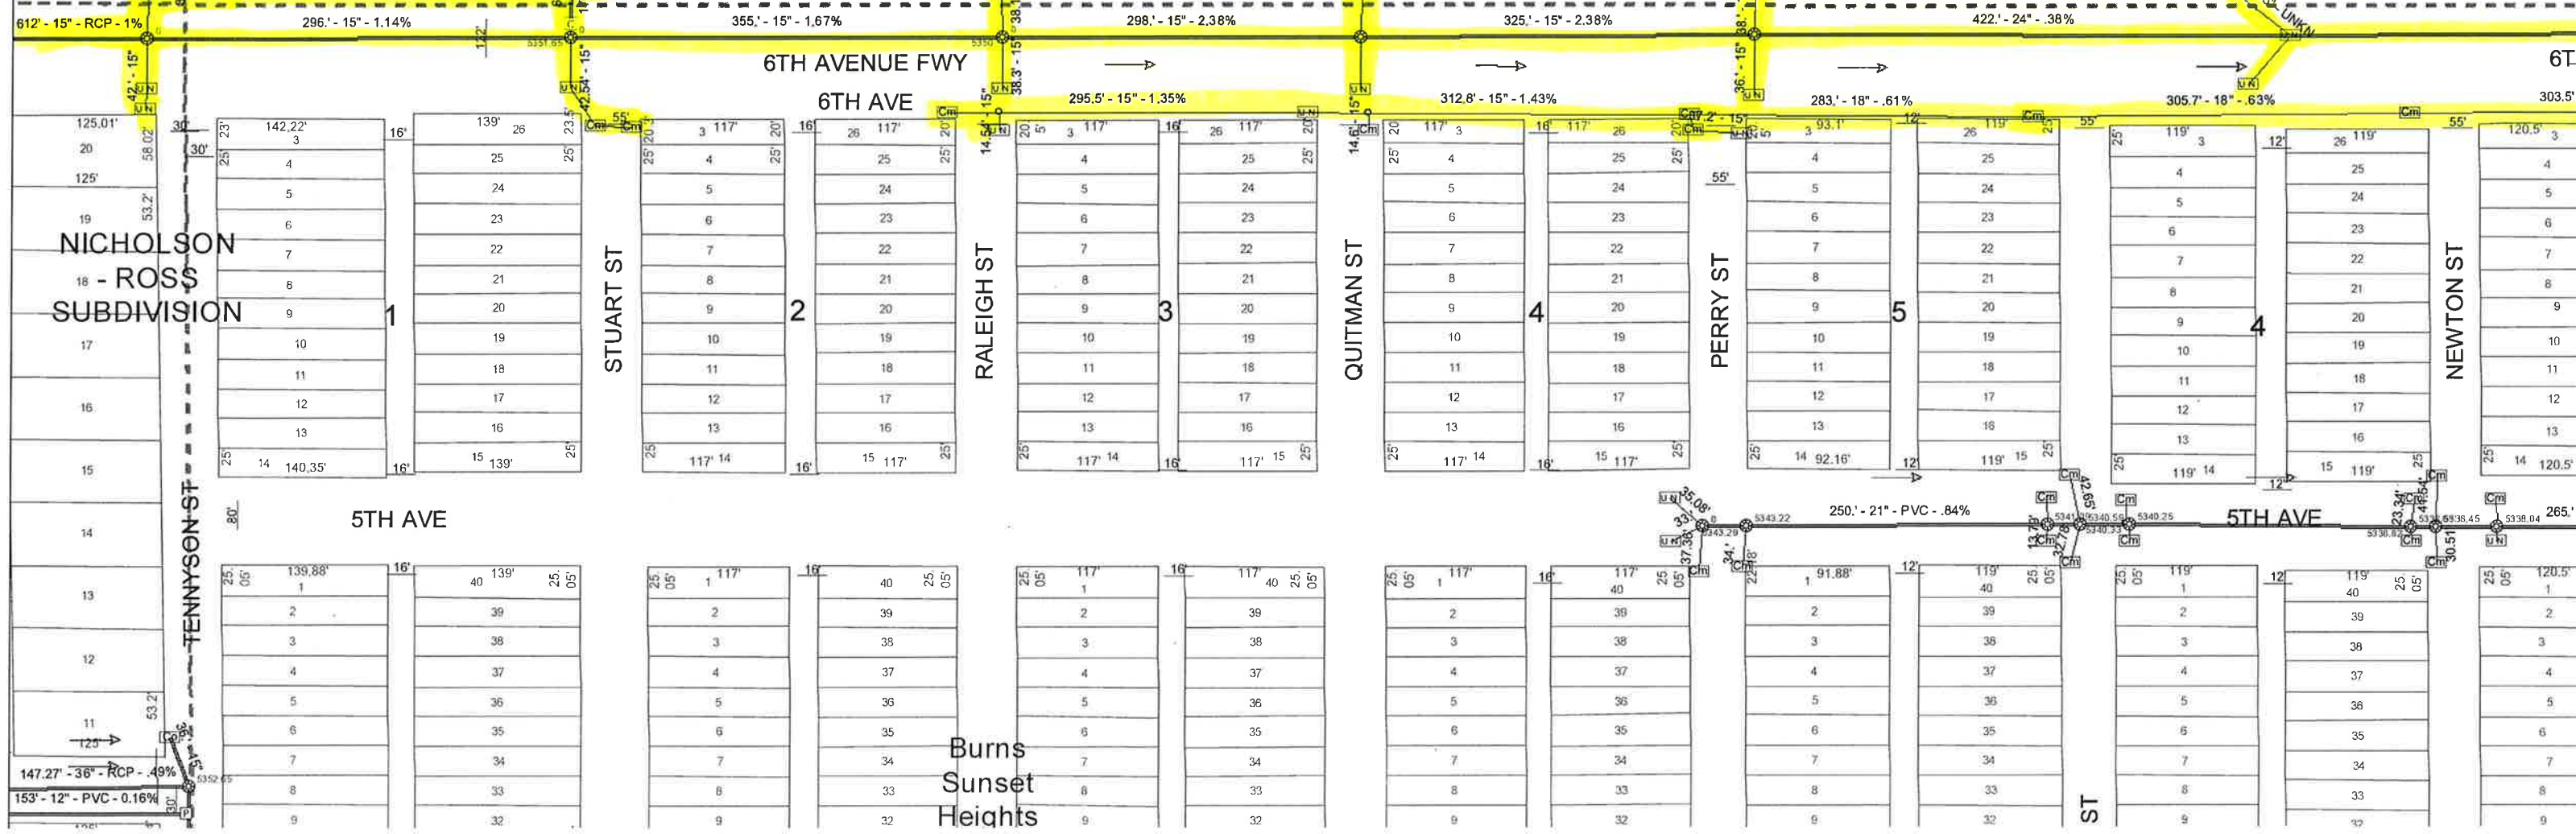

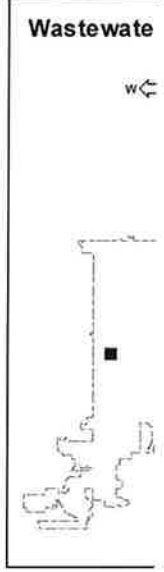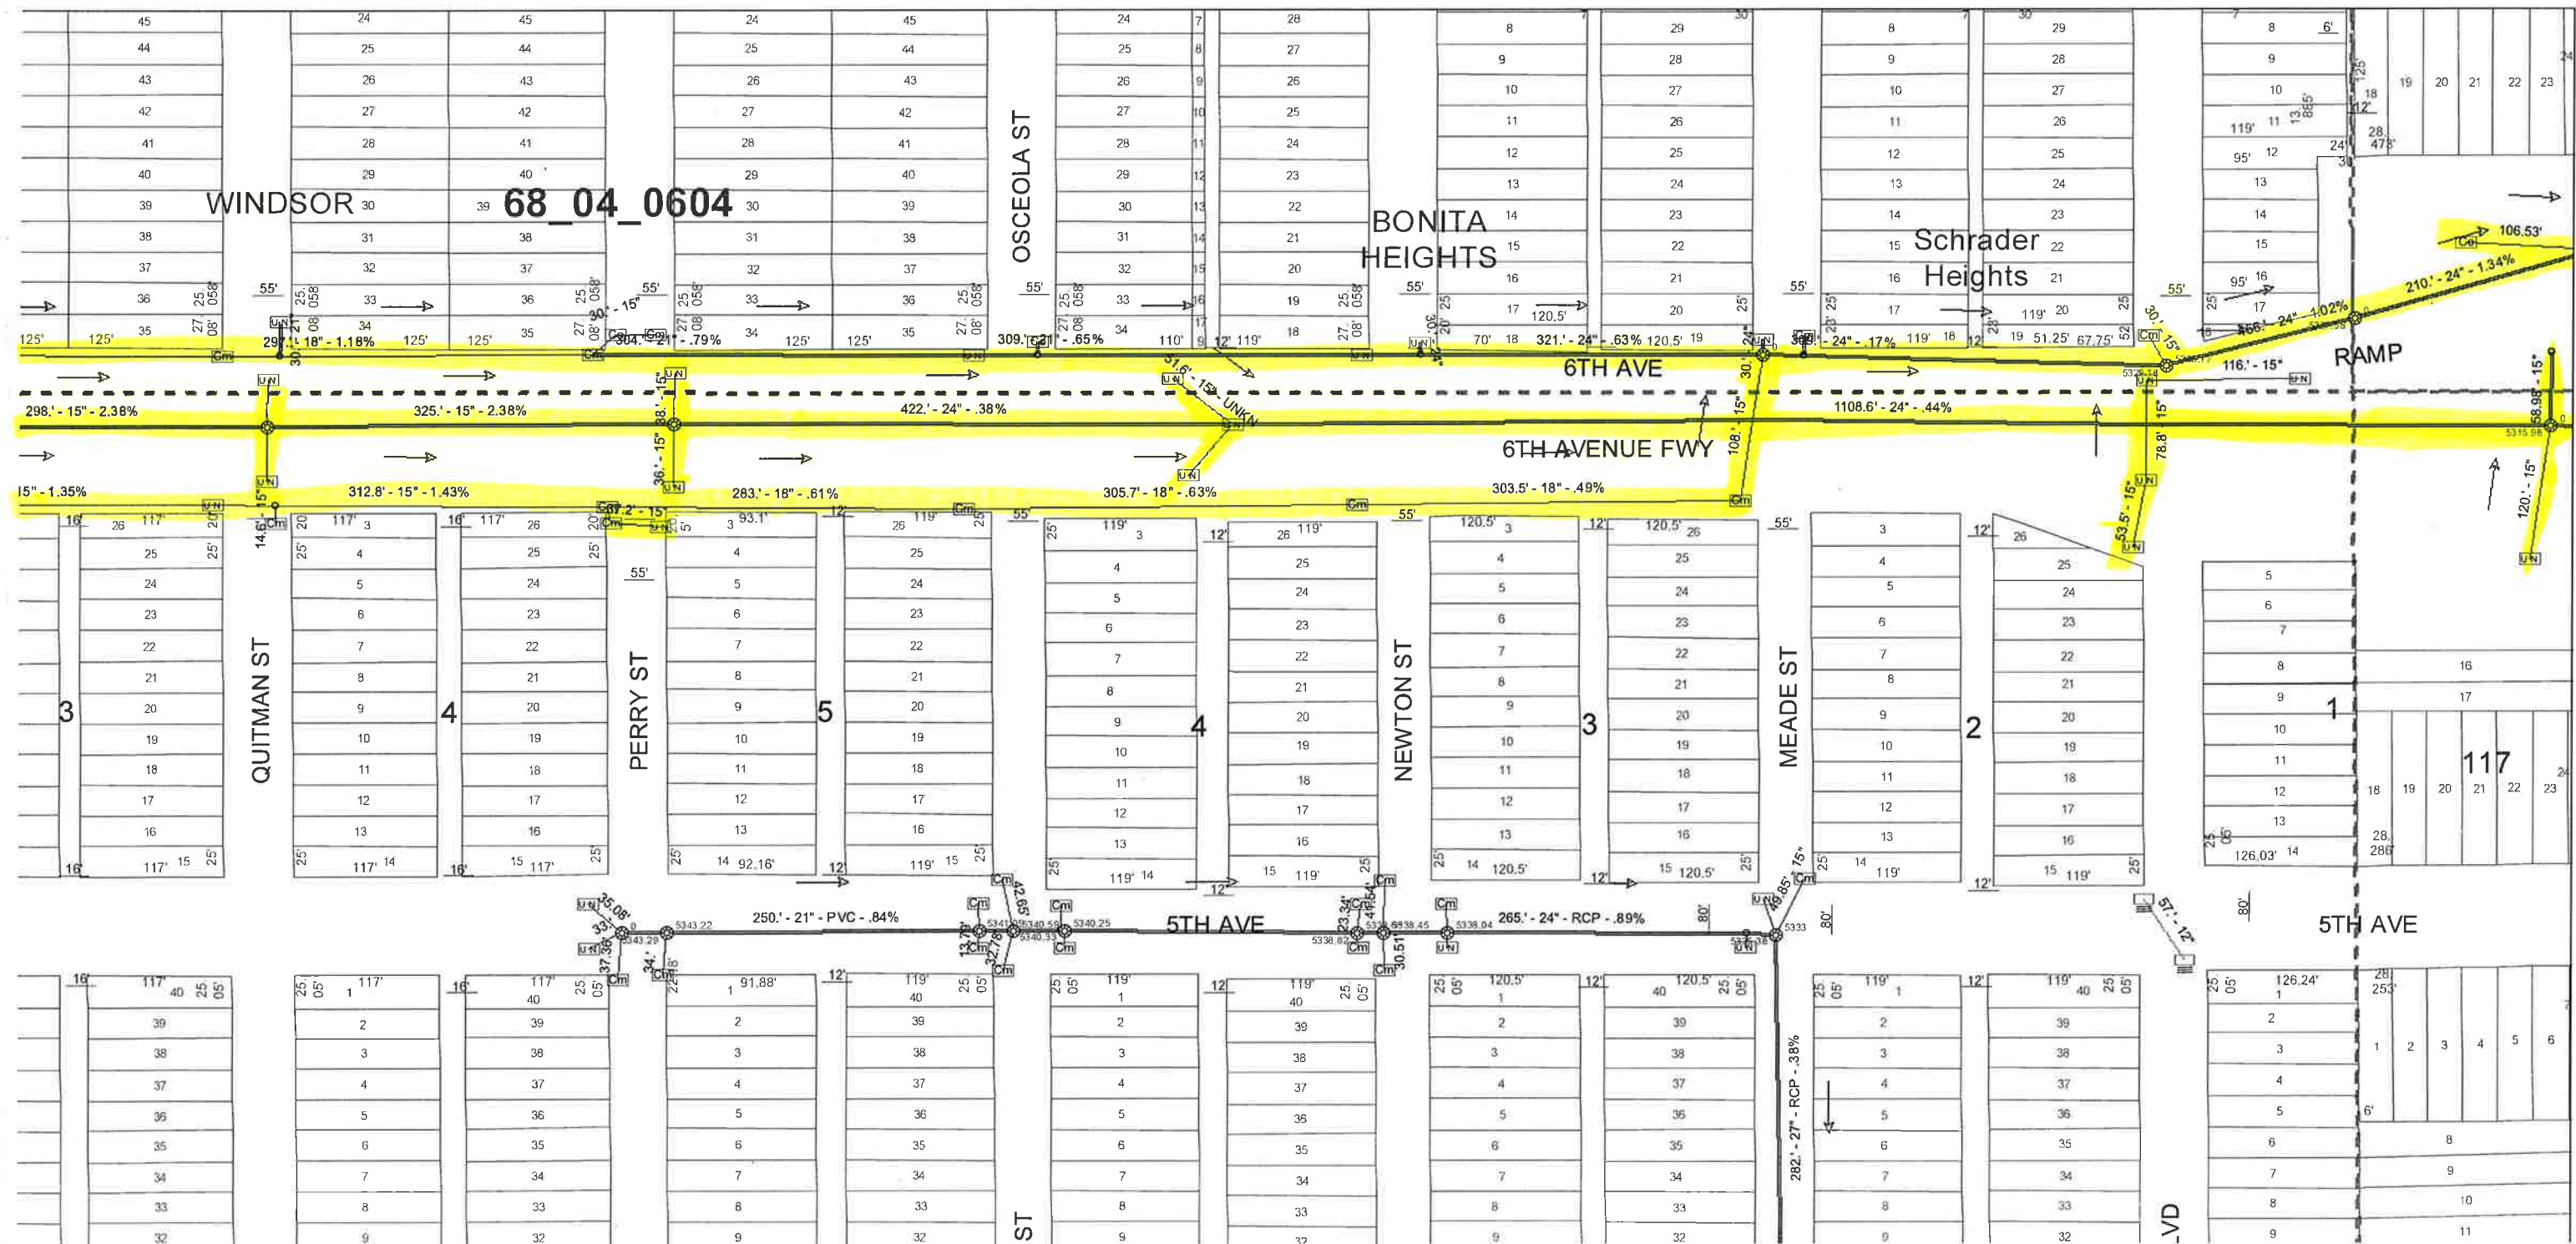

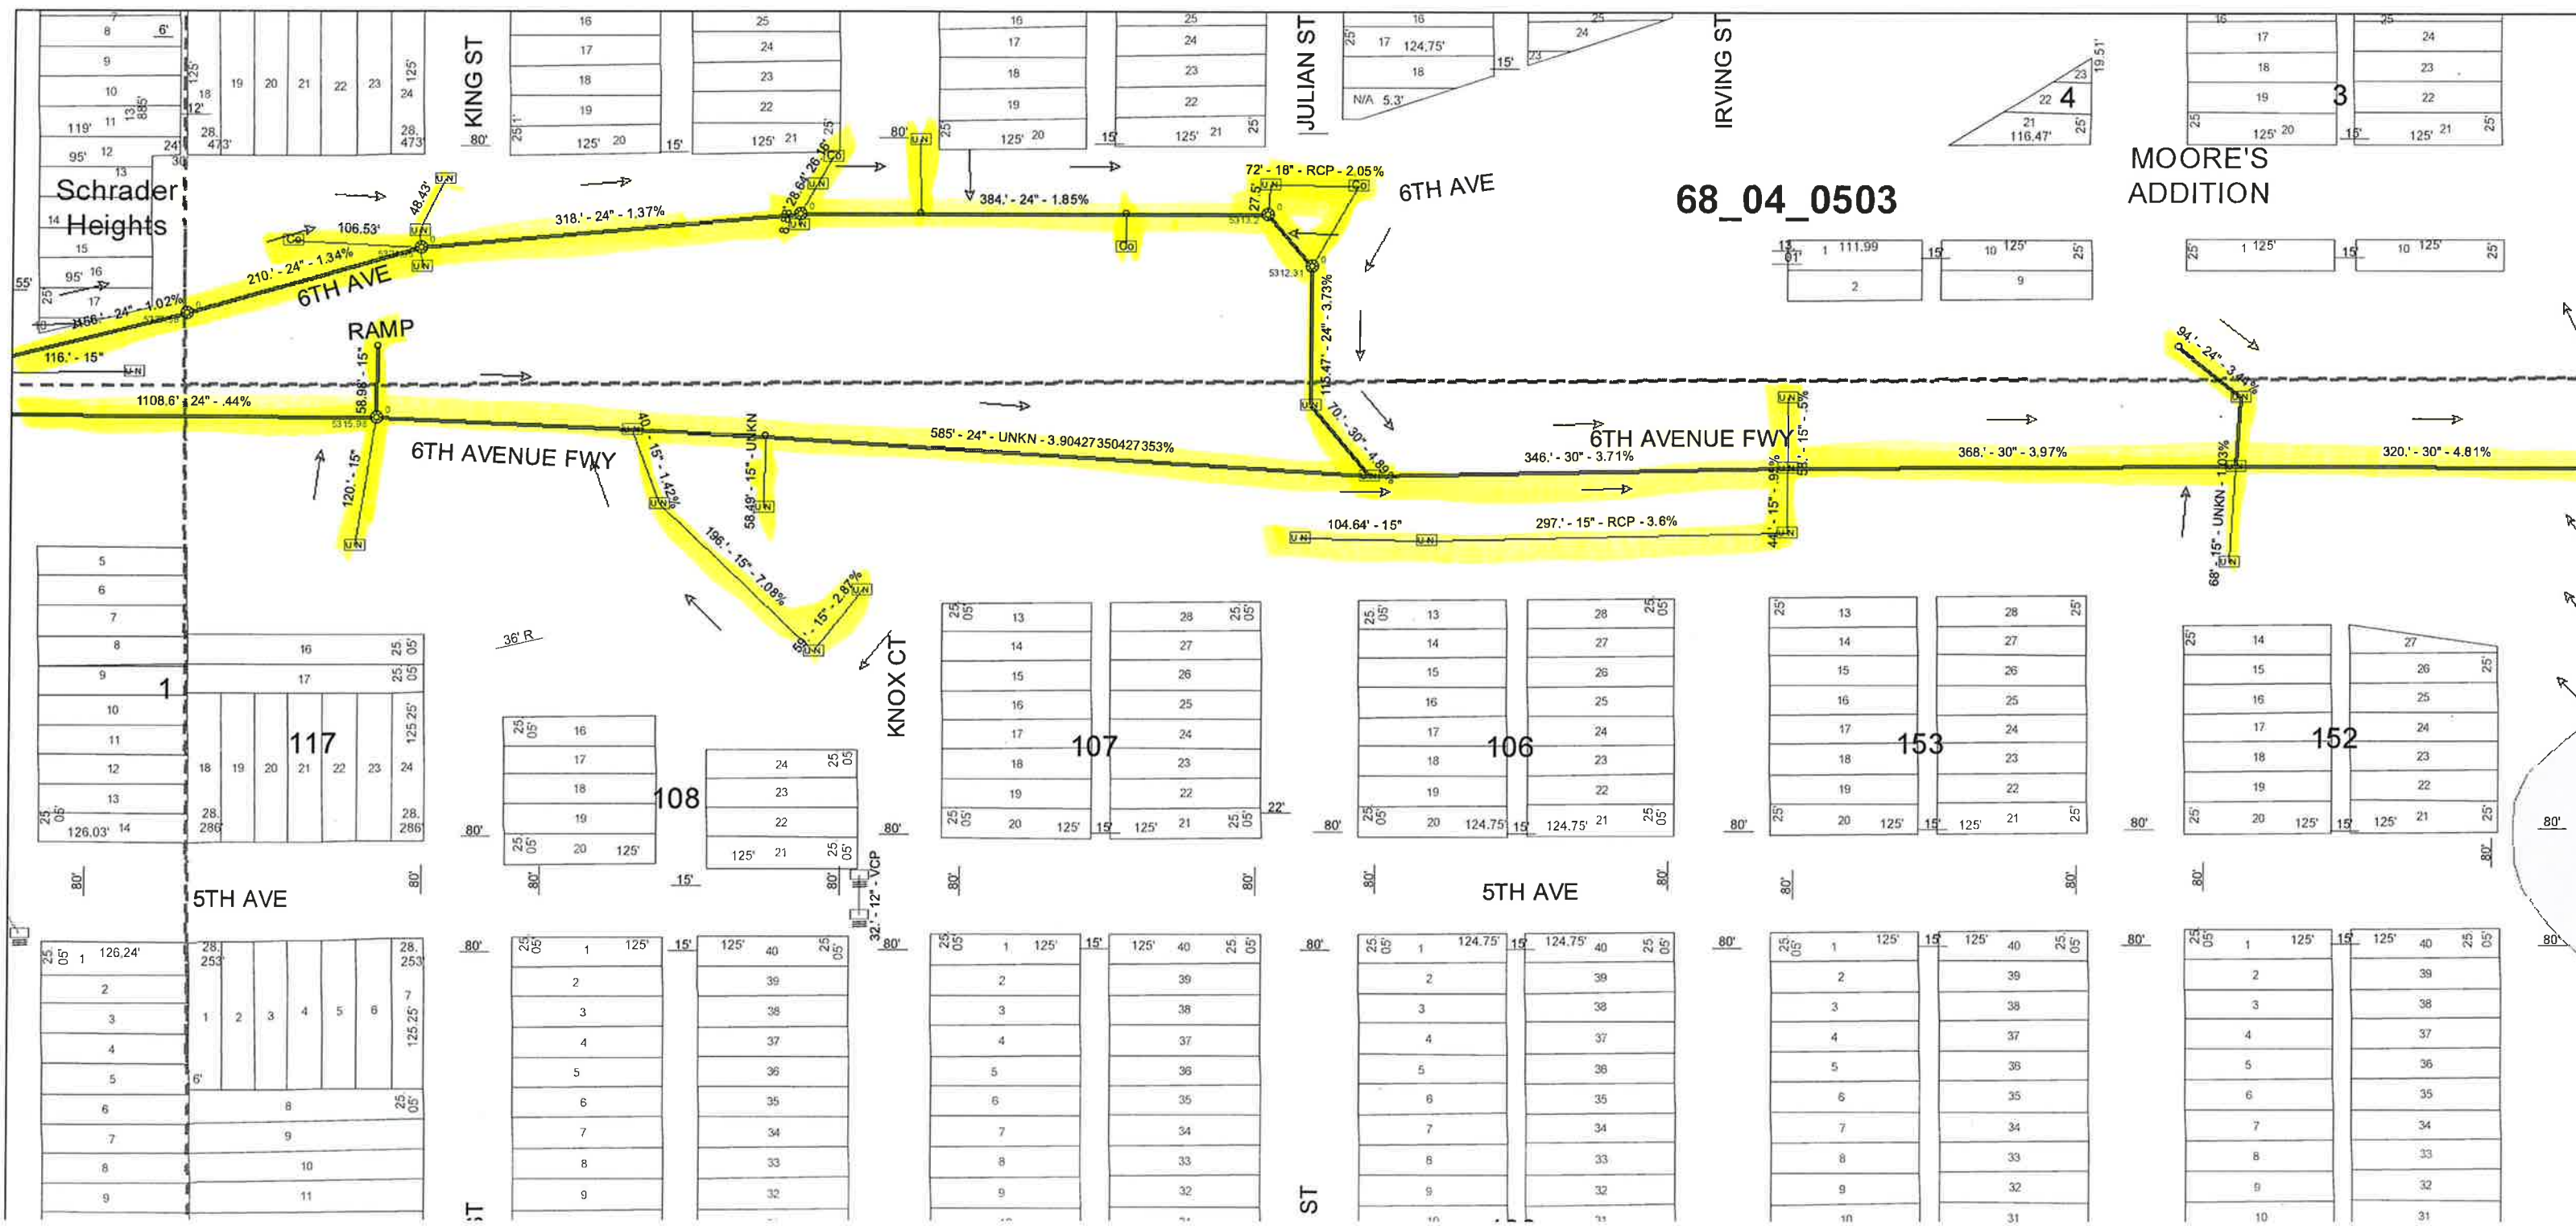

68_04_0503

MOORE'S
ADDITION

6TH AVE

6TH AVE

RAMP

6TH AVENUE FWY

6TH AVENUE FWY

5TH AVE

5TH AVE

IT

ST

117

108

107

106

153

152

36' R

KNOX CT

32'-12" VCP

8	6
9	
10	
16	25
17	24
18	23
19	22
20	21
21	20
22	19
23	18
24	17
25	16

16	25
17	24
18	23
19	22
20	21
21	20
22	19
23	18
24	17
25	16

16	25
17	24
18	23
19	22
20	21
21	20
22	19
23	18
24	17
25	16

16	25
17	24
18	23
19	22
20	21
21	20
22	19
23	18
24	17
25	16

16	25
17	24
18	23
19	22
20	21
21	20
22	19
23	18
24	17
25	16

5	16	25
6	17	25
7	18	25
8	19	25
9	20	25
10	21	25
11	22	25
12	23	25
13	24	25
14	25	25
15	26	25
16	27	25
17	28	25
18	29	25
19	30	25
20	31	25
21	32	25
22	33	25
23	34	25
24	35	25
25	36	25

16	25
17	24
18	23
19	22
20	21
21	20
22	19
23	18
24	17
25	16

13	28
14	27
15	26
16	25
17	24
18	23
19	22
20	21
21	20
22	19
23	18
24	17
25	16

13	28
14	27
15	26
16	25
17	24
18	23
19	22
20	21
21	20
22	19
23	18
24	17
25	16

13	28
14	27
15	26
16	25
17	24
18	23
19	22
20	21
21	20
22	19
23	18
24	17
25	16

14	27
15	26
16	25
17	24
18	23
19	22
20	21
21	20
22	19
23	18
24	17
25	16

1	126.24'	28.253
2		28.253
3		28.253
4		28.253
5		28.253
6		28.253
7		28.253
8		28.253
9		28.253
10		28.253
11		28.253



1	125'	15'	125'	40'	25.05'
2					
3					
4					
5					
6					
7					
8					
9					

1	125'	15'	125'	40'	25.05'
2					
3					
4					
5					
6					
7					
8					
9					

1	124.75'	15'	124.75'	40'	25.05'
2					
3					
4					
5					
6					
7					
8					
9					


1	125'	15'	125'	40'	25.05'
2					
3					
4					
5					
6					
7					
8					
9					
10					


1	125'	15'	125'	40'	25.05'
2					
3					
4					
5					
6					
7					
8					
9					
10					

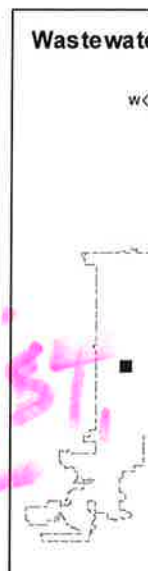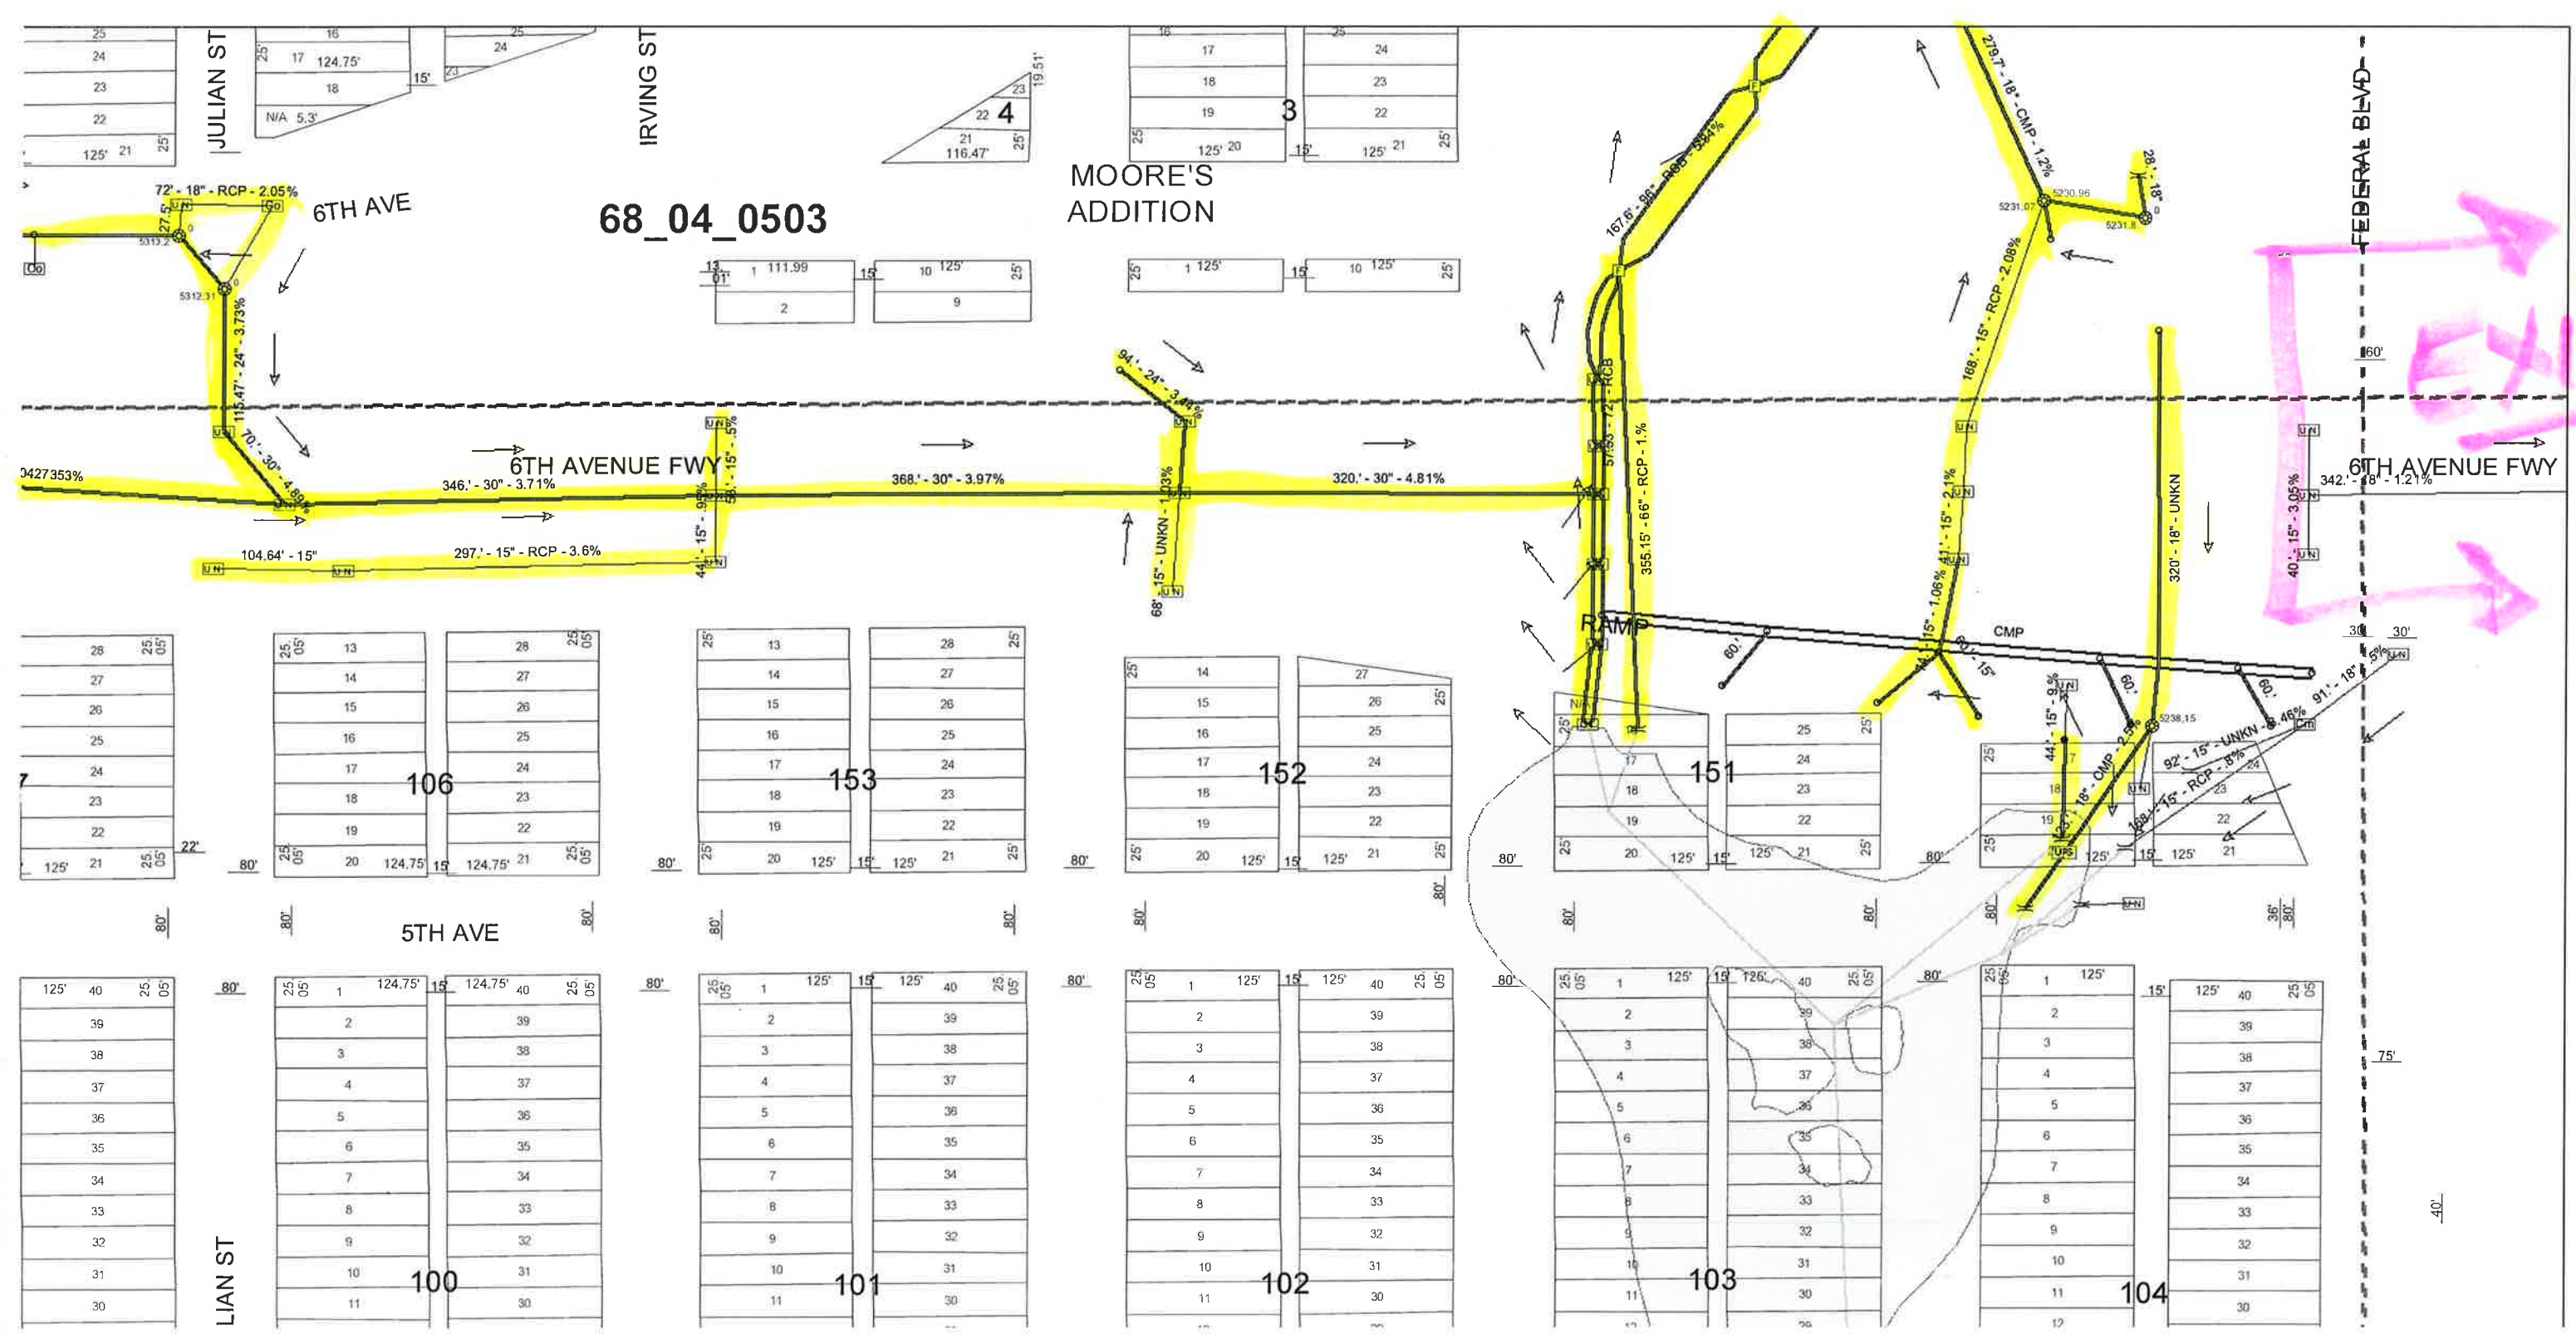

40'

68_04_0504

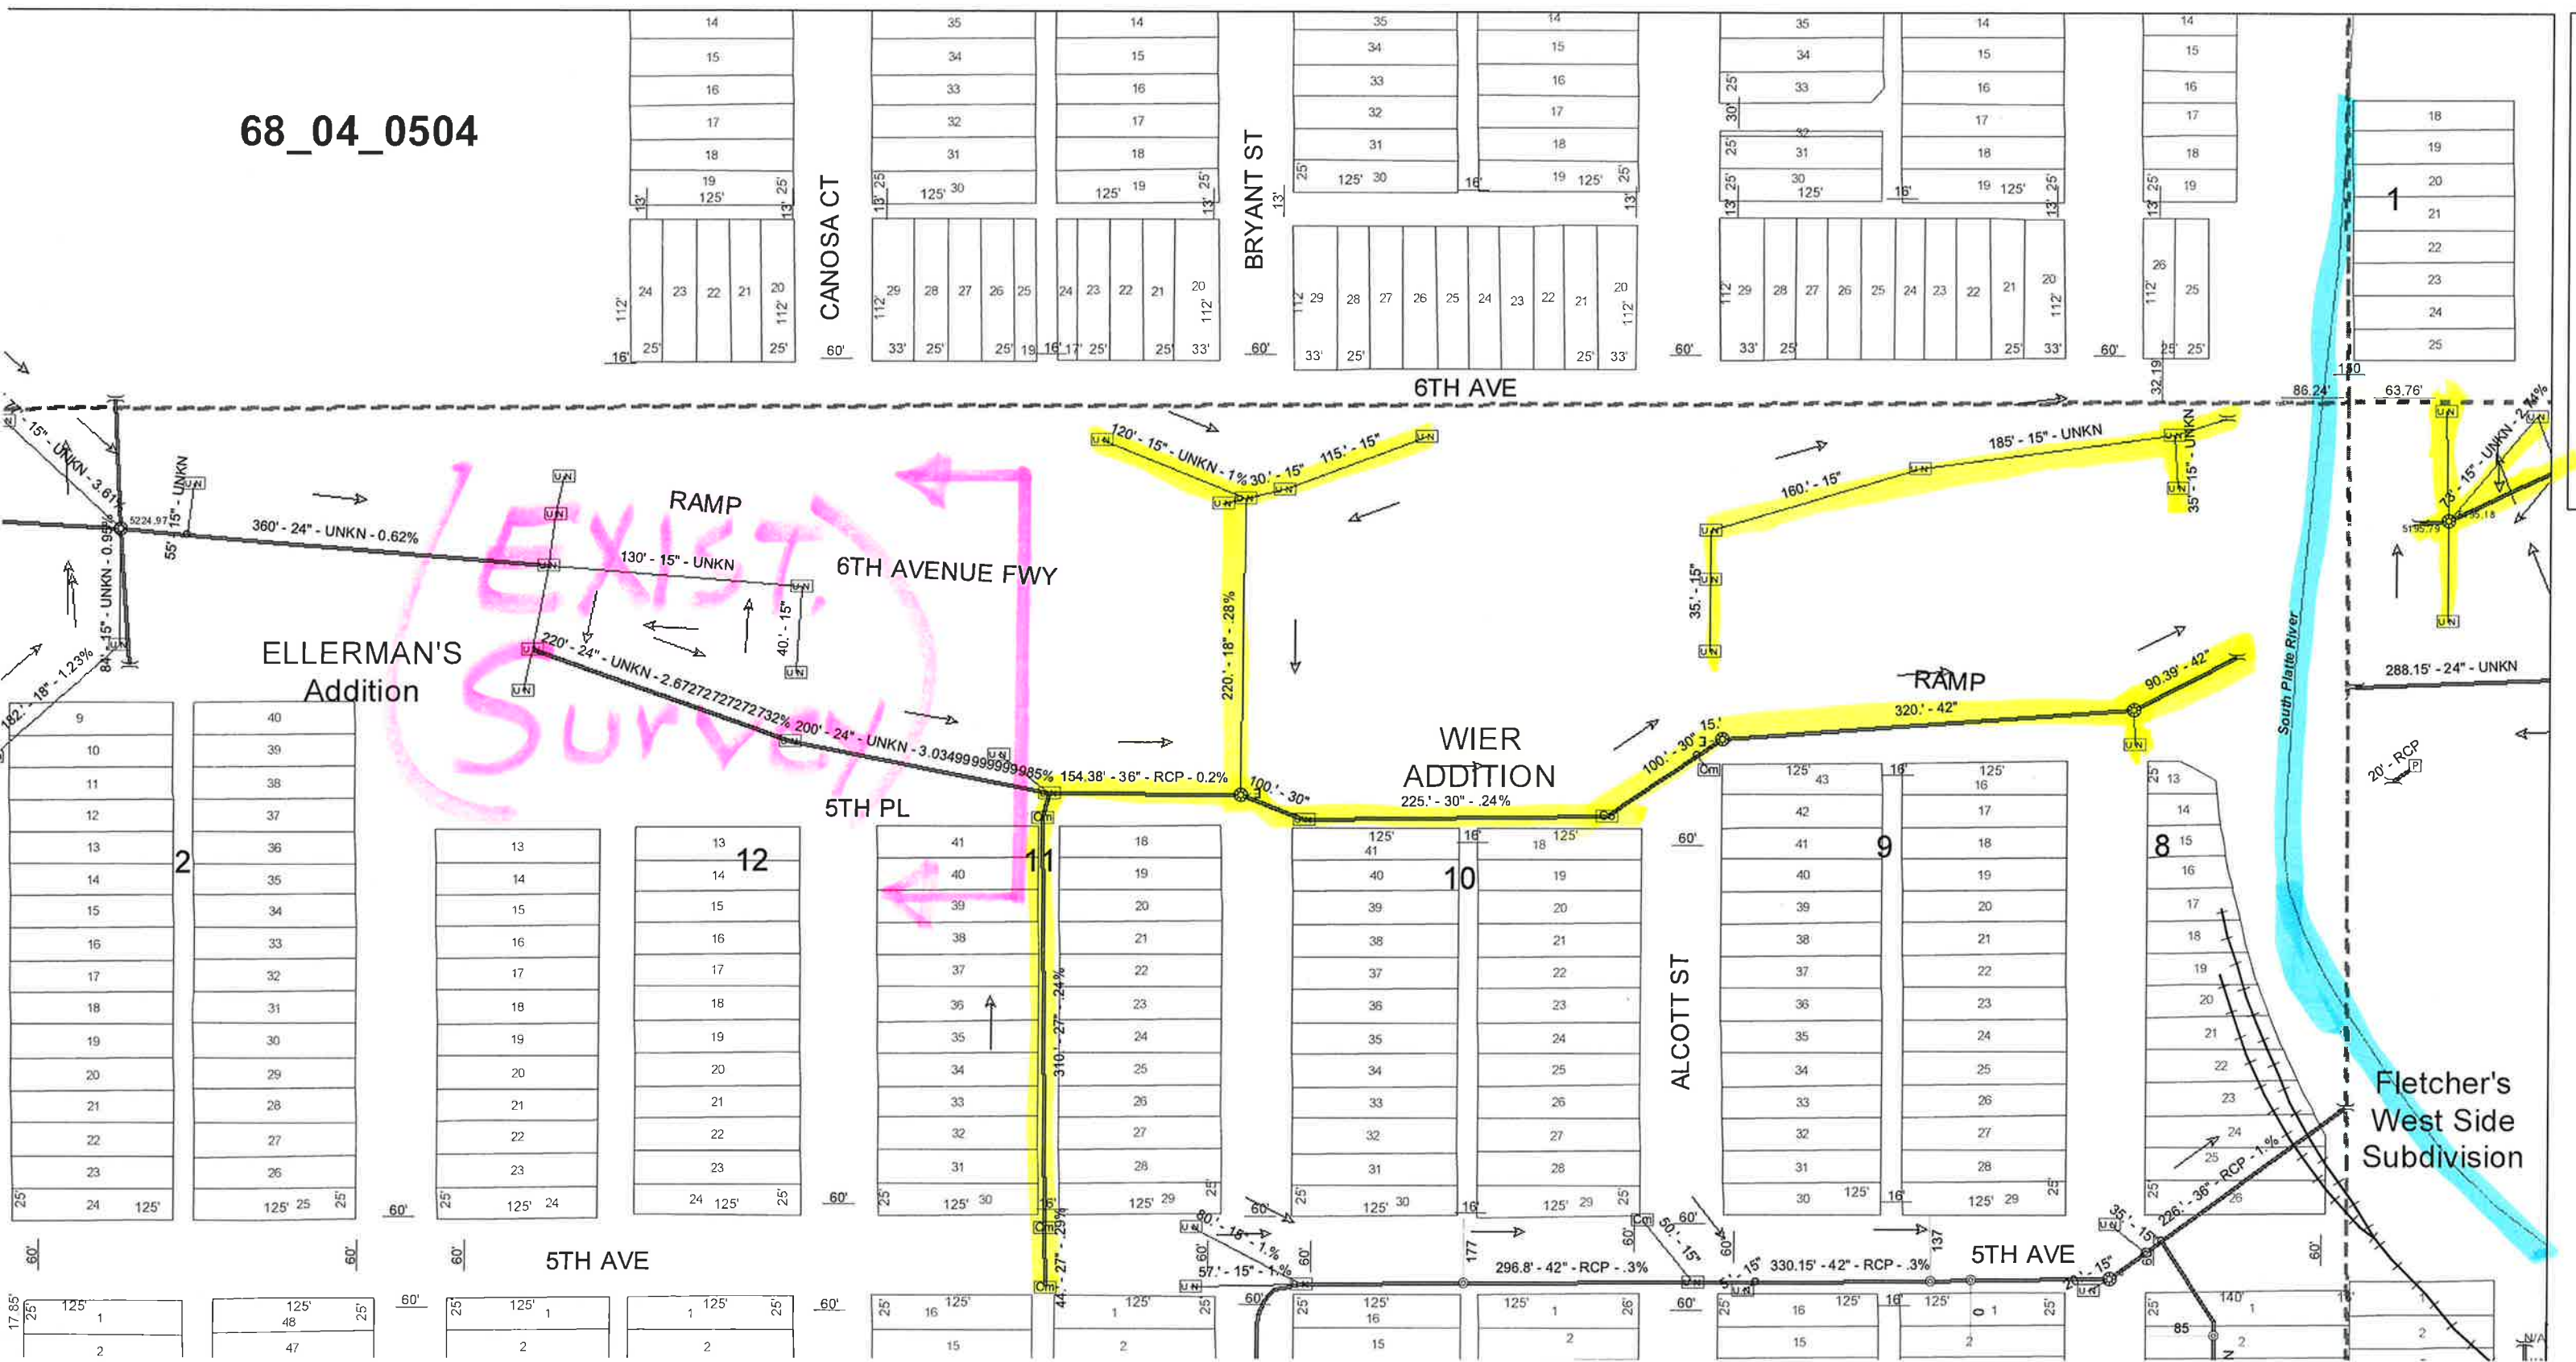

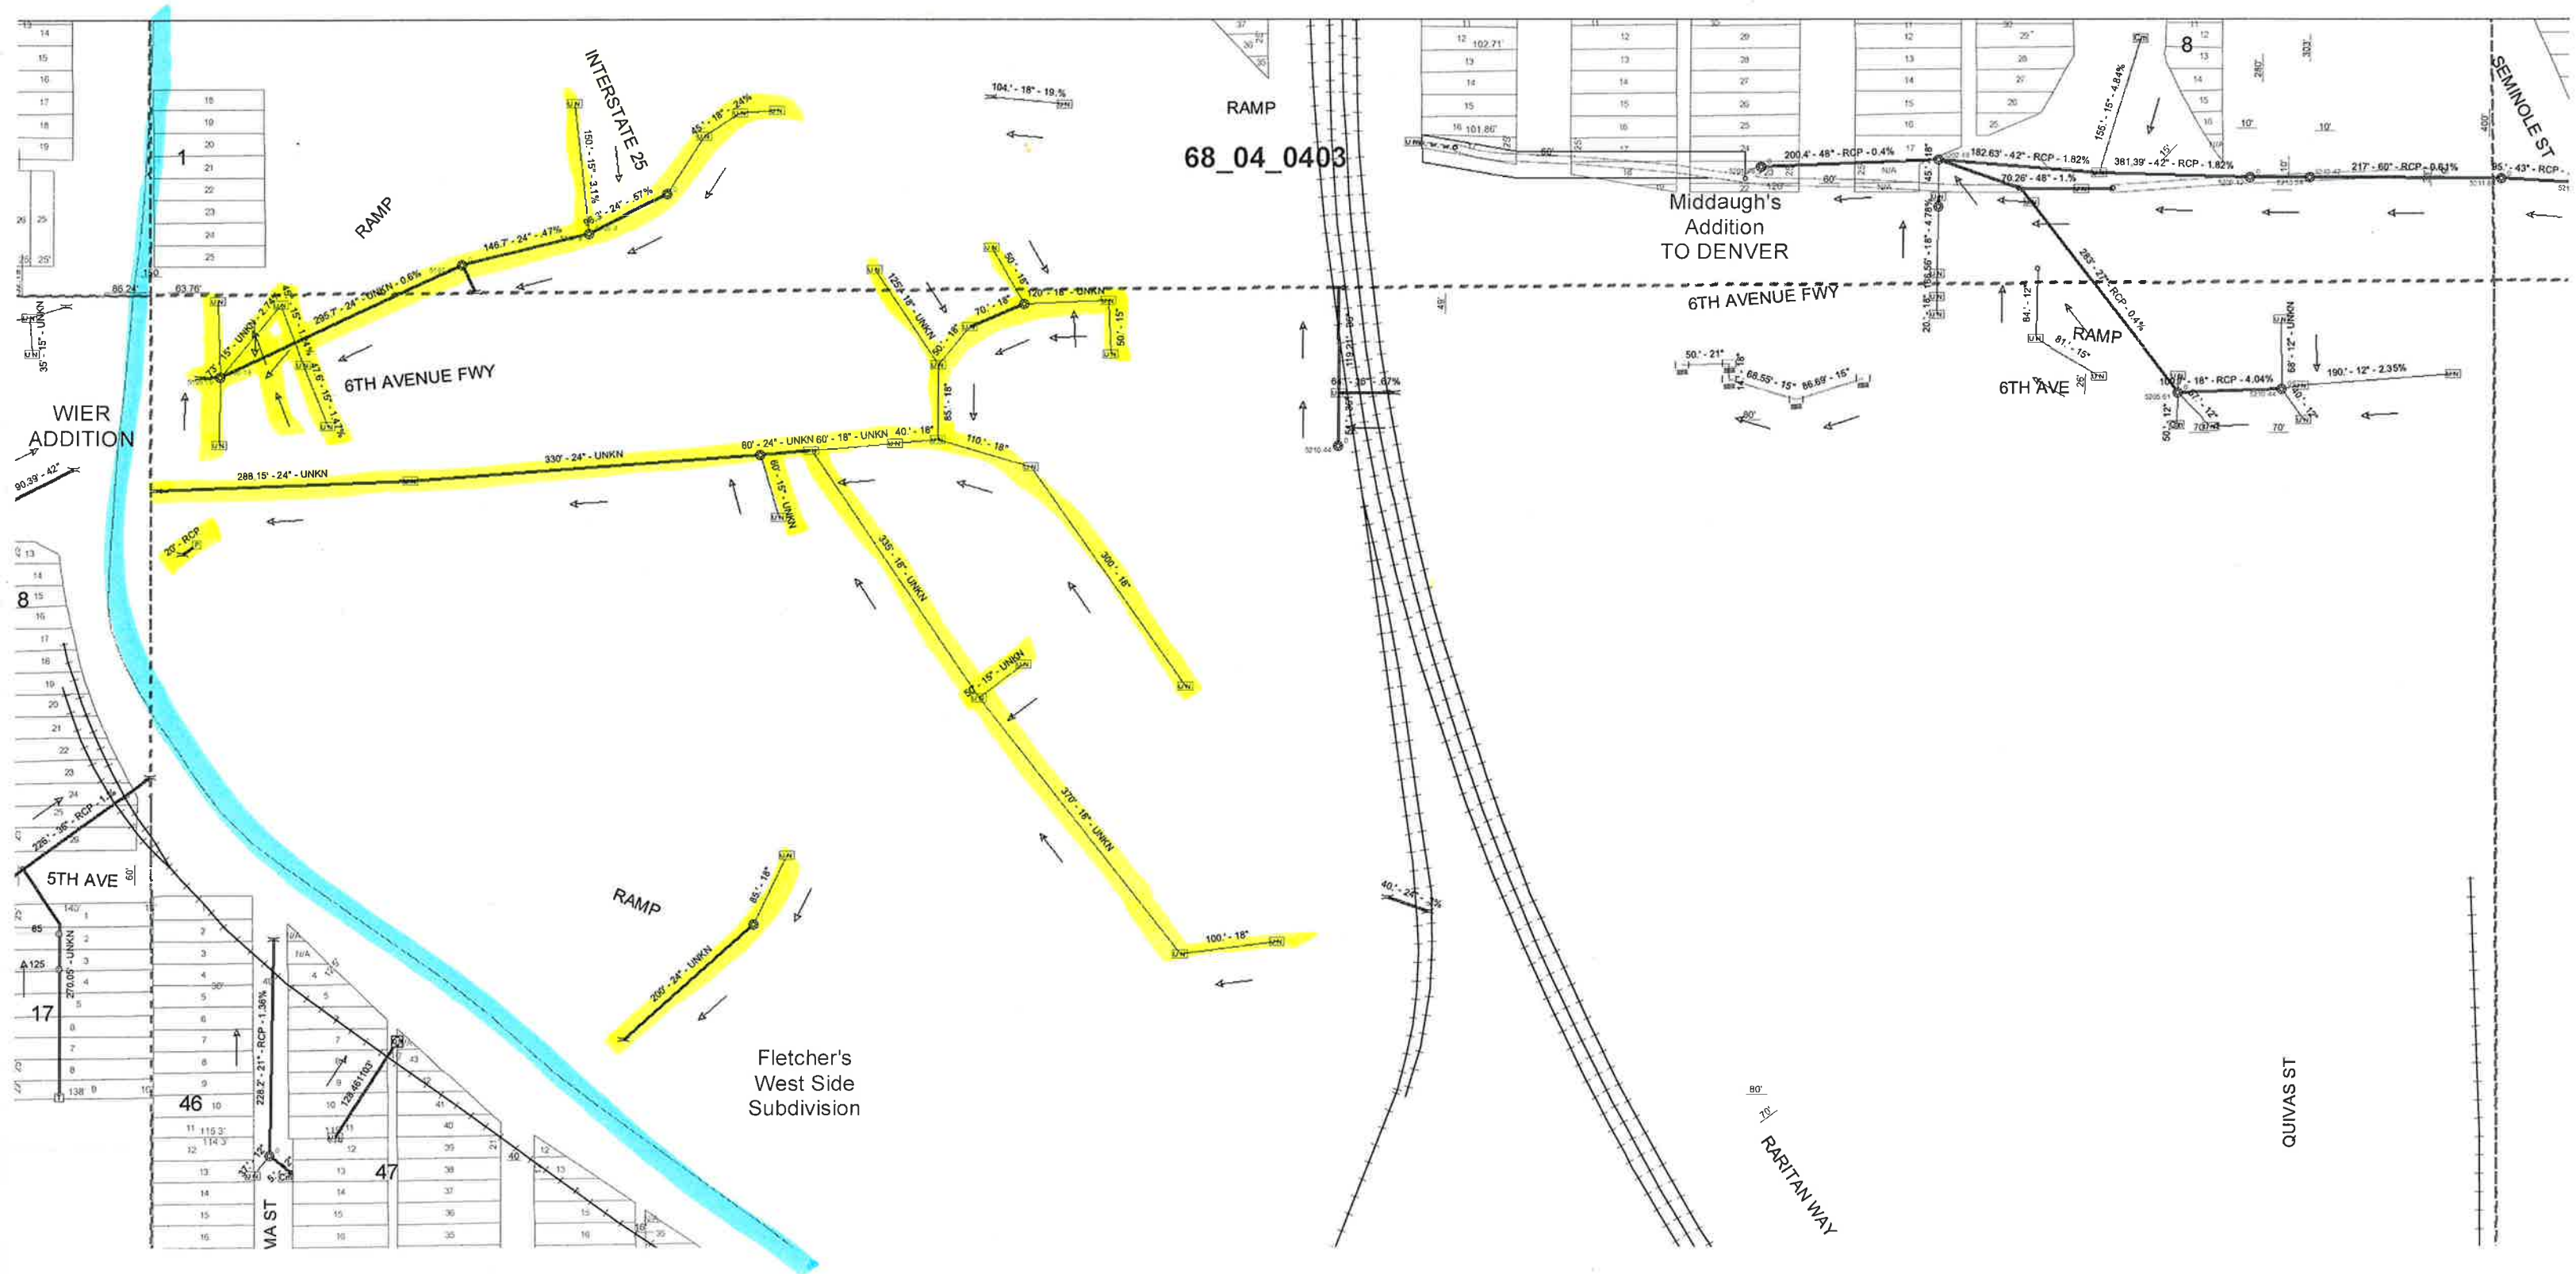

RAMP
68_04_0403

Middaugh's
Addition
TO DENVER

WIER
ADDITION

6TH AVENUE FWY

6TH AVENUE FWY

6TH AVE

5TH AVE

RAMP

Fletcher's
West Side
Subdivision

80'
RARITAN WAY

QUIVAS ST

SEMNOLE ST