


| REV. NO. | DESCRIPTION | DATE | BY | CHECKED |
|----------|-------------|---------|----|---------|
| 1 | GENL. | 2-10-52 | 13 | |

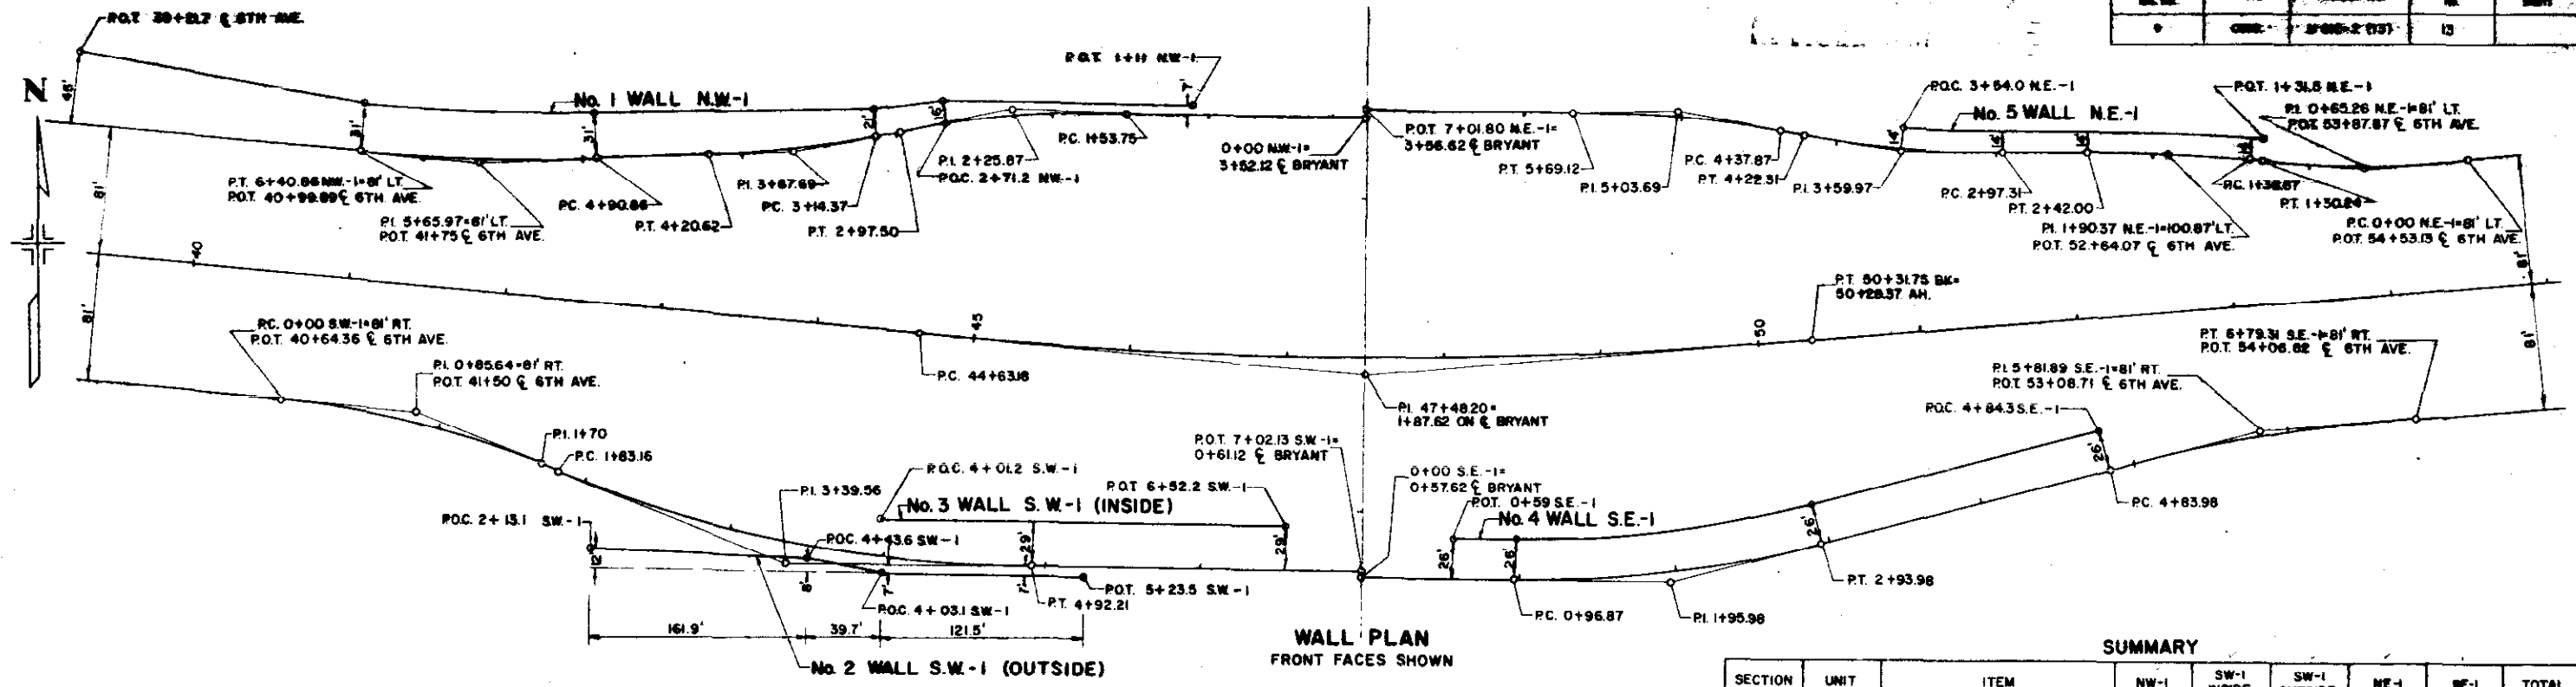

WALL PLAN
FRONT FACES SHOWN

SUMMARY

| SECTION | UNIT | ITEM | NW-1 | SW-1 INSIDE | SW-1 OUTSIDE | NE-1 | SE-1 | TOTAL |
|---------|-------|-----------------|-------|-------------|--------------|------|------|-------|
| 206 | CU YD | STR EXCAV | 1254 | 375 | 395 | 287 | 576 | 2887 |
| 206 | CU YD | STR BKFL (CL 3) | 1578 | 656 | 588 | 256 | 872 | 3920 |
| 601 | CU YD | CONCRETE CL A | 502 | 217 | 195 | 72 | 242 | 1228 |
| 602 | LB | REINF STEEL | 23885 | 10440 | 9366 | 2530 | 8886 | 56107 |
| ① | SQ FT | EXP JT MATL | 314 | 142 | 120 | 51 | 138 | 765 |

THERE SHALL BE NO SEPARATE PAYMENT FOR ITEMS MARKED WITH (D). PAYMENT THEREFORE SHALL BE INCLUDED IN THE CONTRACT UNIT PRICE FOR ITEM 601 CONCRETE CL. A.

23,715 10,815 9953 9823 56,336

| BY | DATE | REVISION |
|----|------|----------|
| | | |
| | | |
| | | |
| | | |

JEFFERSON ASSOCIATES
CIVIL ENGINEERS

DEPARTMENT OF HIGHWAYS
STATE OF COLORADO

RETAINING WALLS
GENERAL PLAN





Sta. 39+21.7 WALL NW-1 TO
53+21.6 WALL NE-1
Near DENVER Sec. 5 T. 45 R. 68W

Designed by L.H.K. Approved by
Made by G.A.M. Bridge Engineer
Checked by T.V.S. Date: 19

REVISIONS

REVISIONS

| FED. ROAD DIST. NO. | DIVISION | PROJECT NO. | SHEET NO. | TOTAL SHEETS |
|---------------------|----------|-------------|-----------|--------------|
| 9 | COLO. | U012-2 (13) | 14 | |

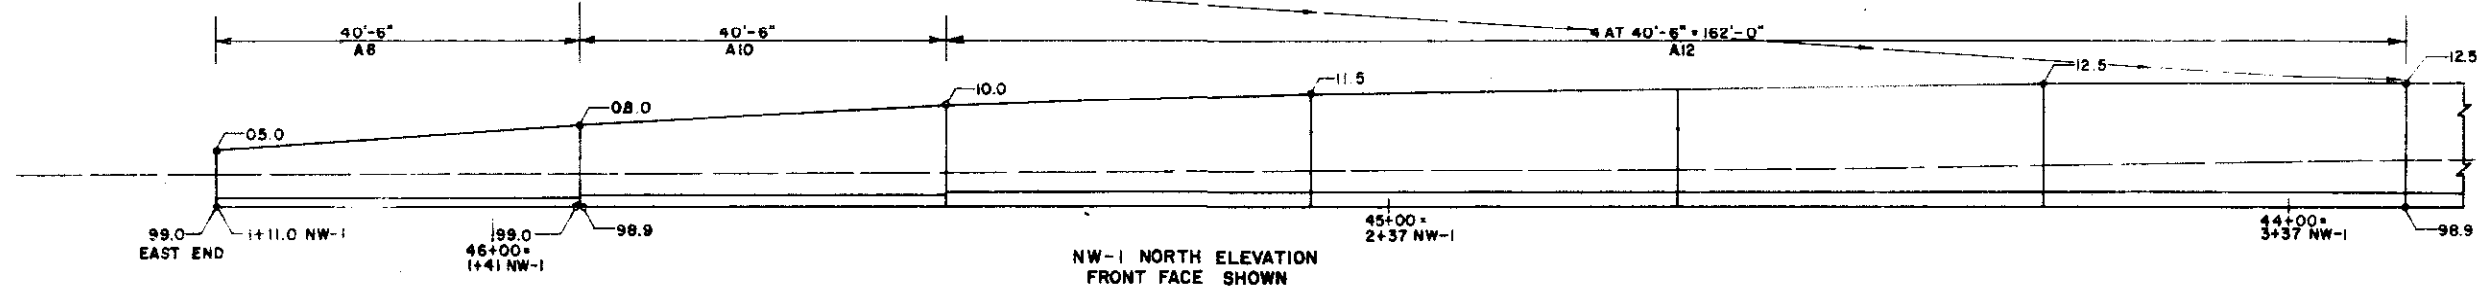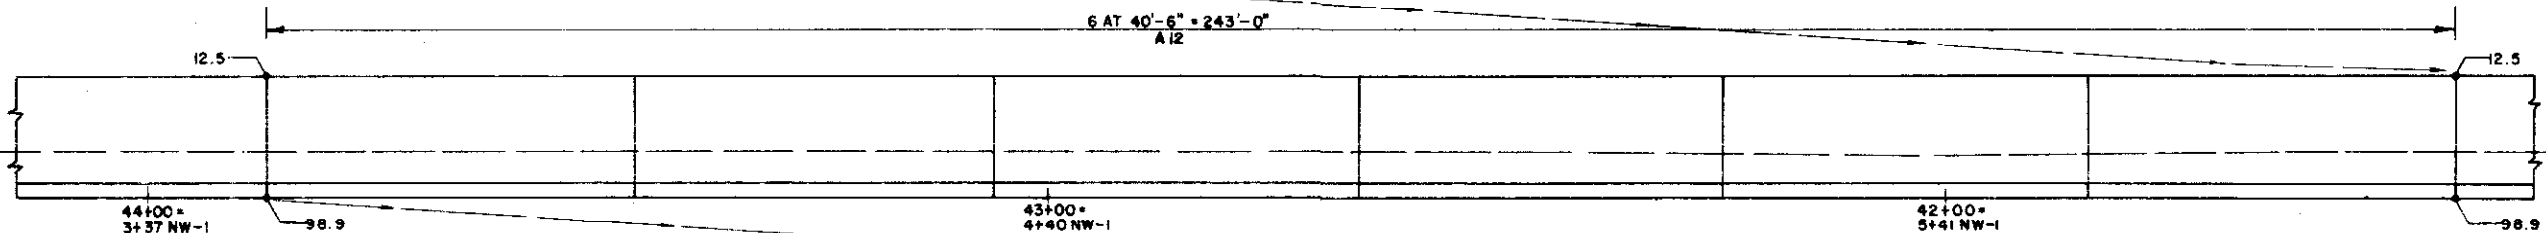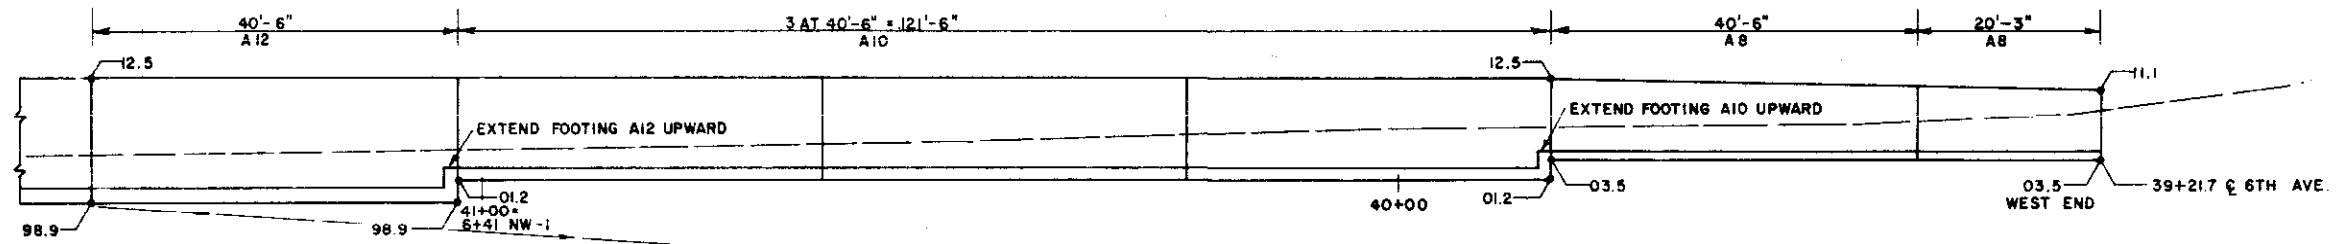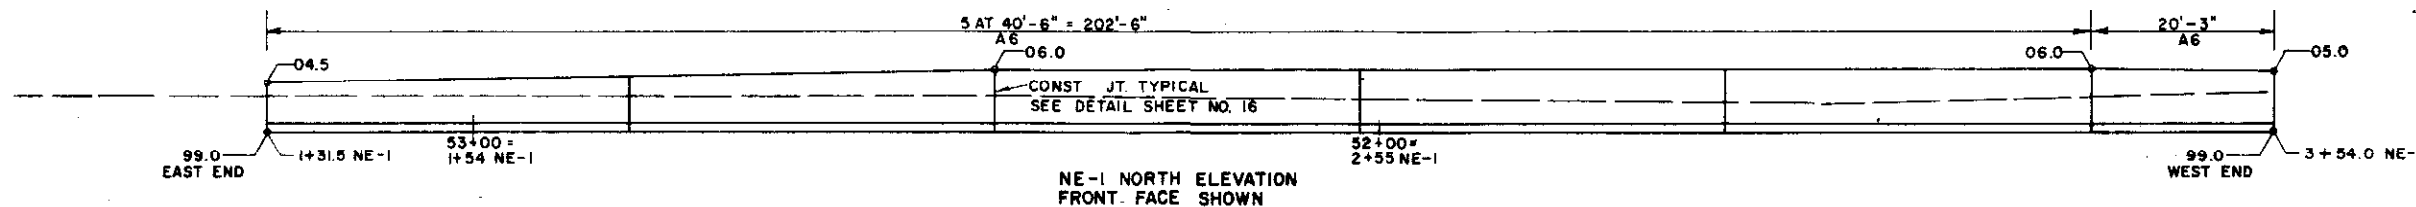

JEFERSON ASSOCIATES
CIVIL ENGINEERS


DEPARTMENT OF HIGHWAYS
STATE OF COLORADO
RETAINING WALL
FACE ELEVATIONS
NE-1 WALL
NW-1 WALL

STA. 39+21.7 WALL NW-1 TO
53+21.6 WALL NE-1

Near DENVER Sec. 5 T.45 R.68W

Designed by L.H.C. Approved by _____
Made by M.L.K. Bridge Engineer
Checked by T.V.S. Date: _____ 19





| FED. ROAD DIST. NO. | DIVISION | PROJECT NO. | SHEET NO. | TOTAL SHEETS |
|---------------------|----------|--------------|-----------|--------------|
| 9 | COLO. | U 012-2 (13) | 15 | |

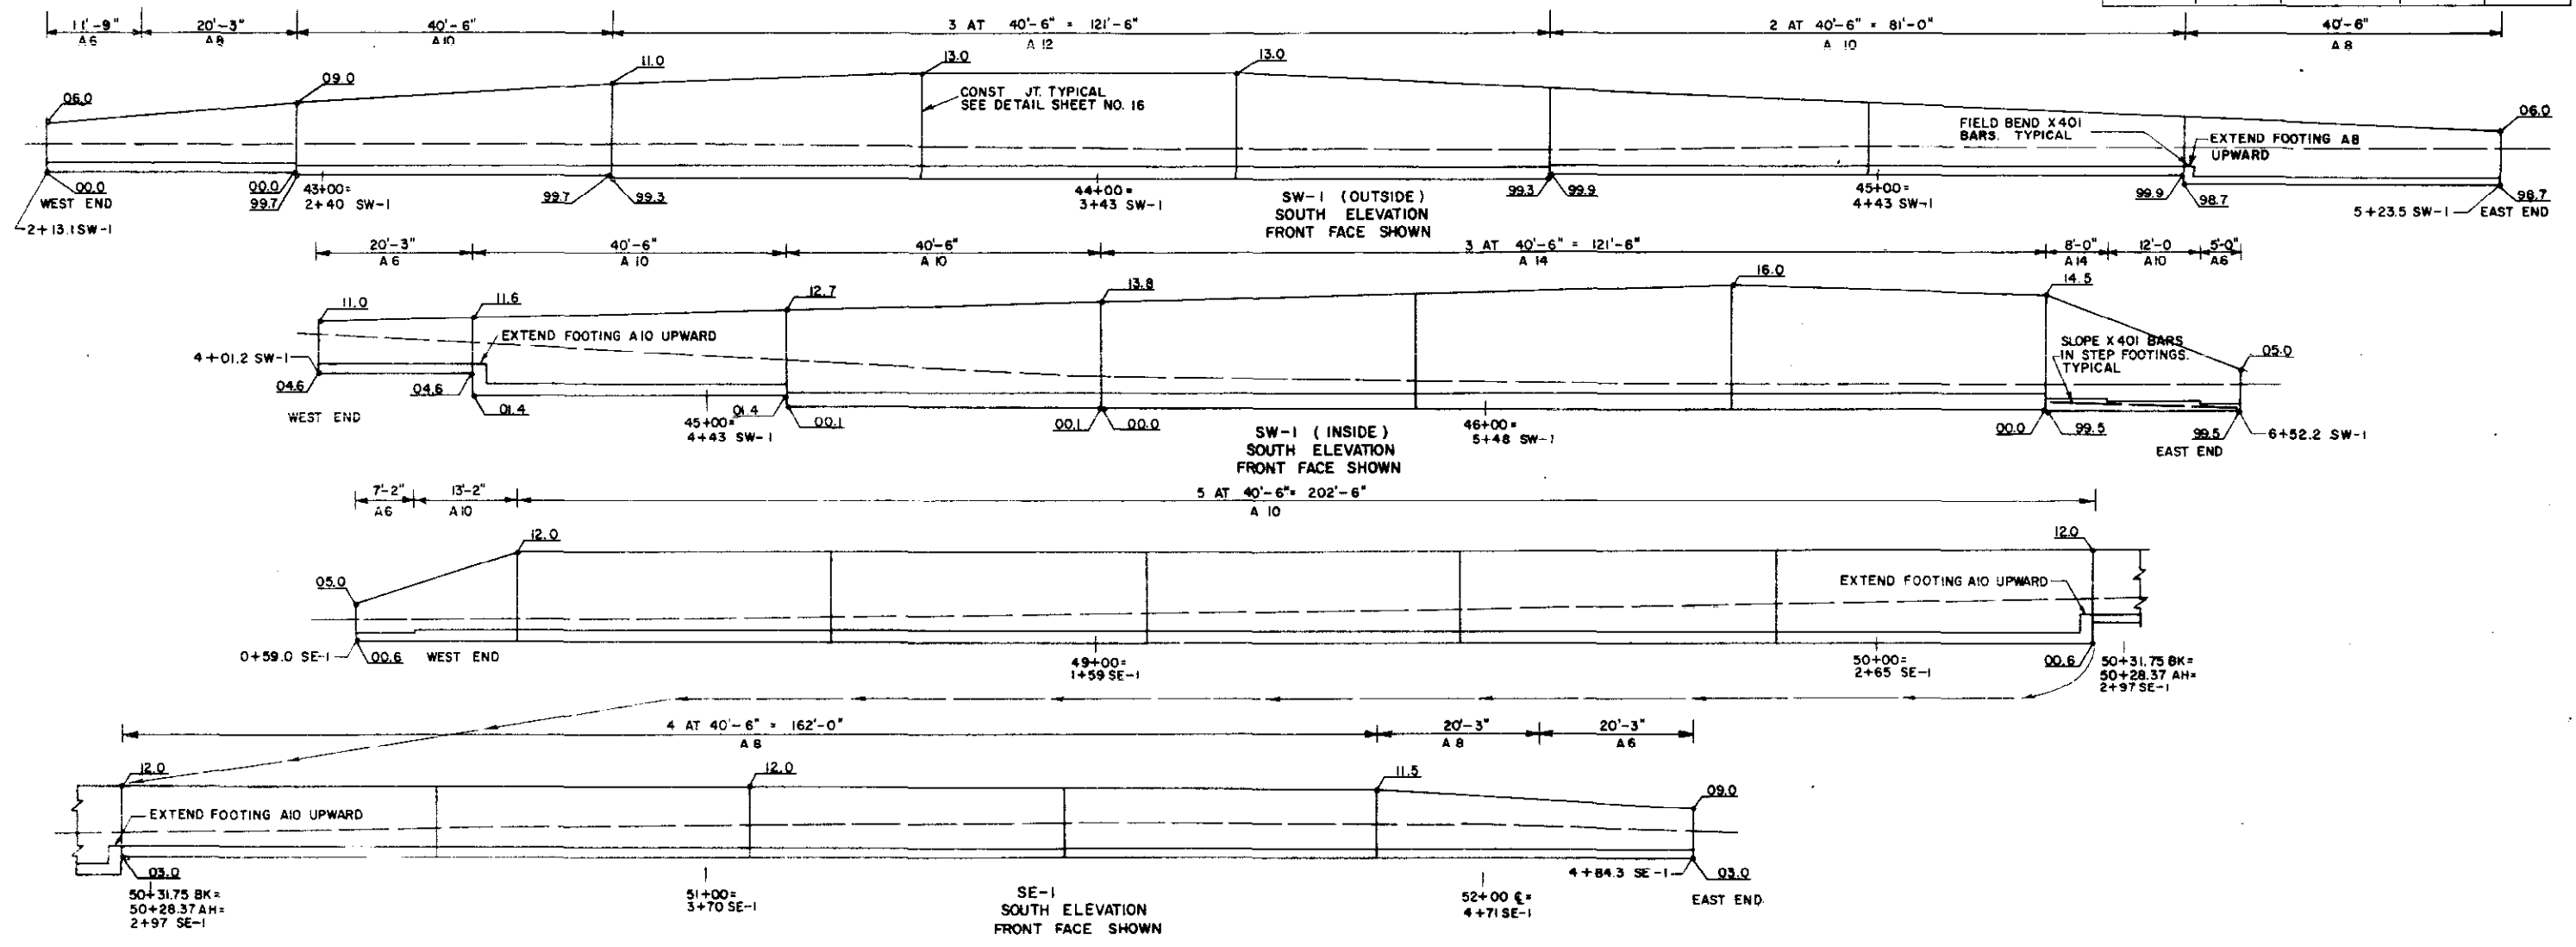


JEFFERSON ASSOCIATES
CIVIL ENGINEERS

DEPARTMENT OF HIGHWAYS
STATE OF COLORADO
RETAINING WALLS
FACE ELEVATIONS
SW-1 WALL OUTSIDE
SW-1 WALL INSIDE
SE-1 WALL
STA. 39+21.7 WALL NW-1 TO
53+21.6 WALL NE-1
Near DENVER Sec. 5 T.5S R.65W
Designed by L.H.C. Approved by M.L.K. Bridge Engineer
Checked by T.V.S. Date: 19


| FED. ROAD REG. NO. | DIVISION | PROJECT NO. | SHEET NO. | TOTAL SHEETS |
|--------------------|----------|--------------|-----------|--------------|
| 9 | COLO. | U 012-2 (13) | 16 | |

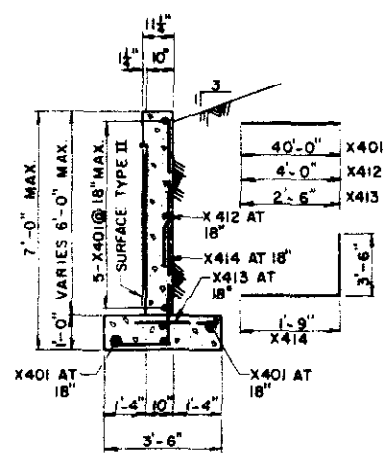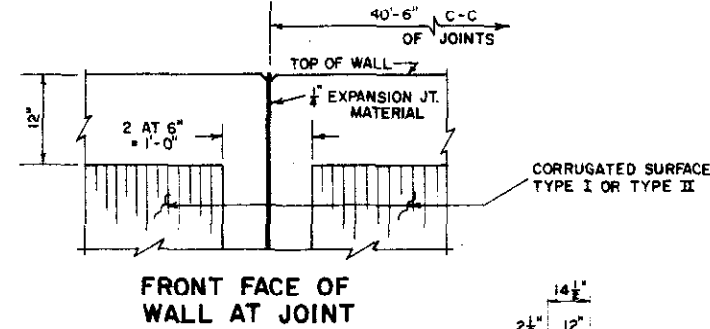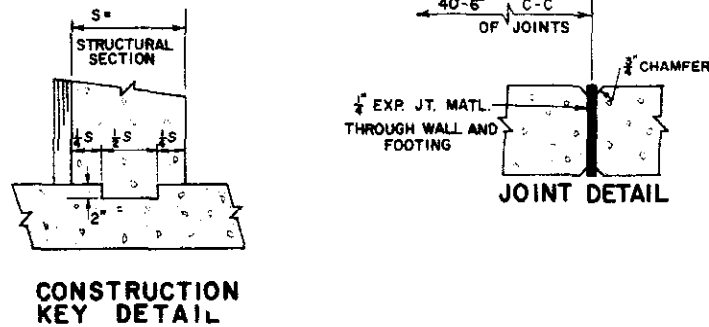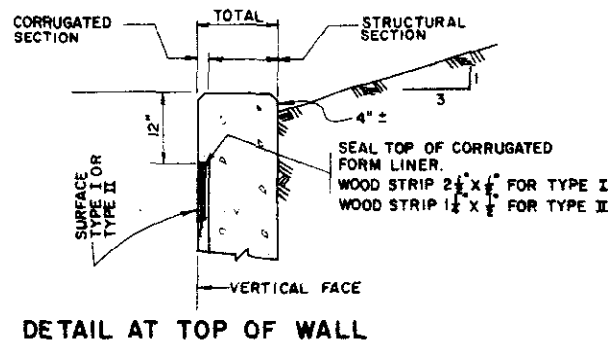


A6

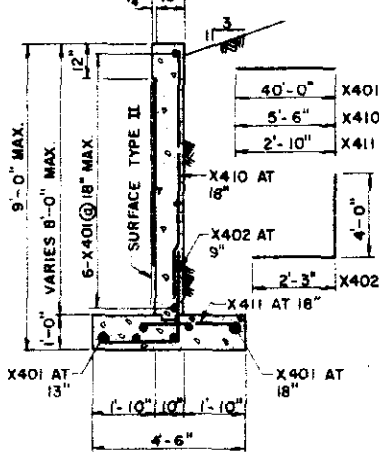


A8

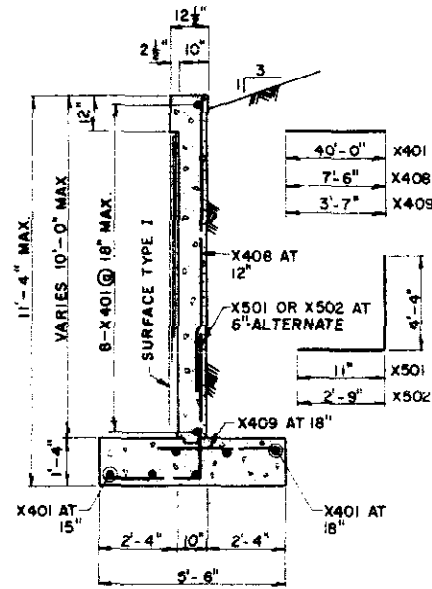

A10

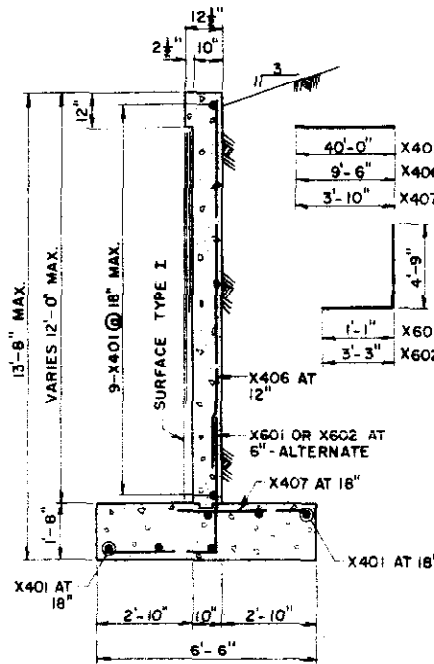

A12

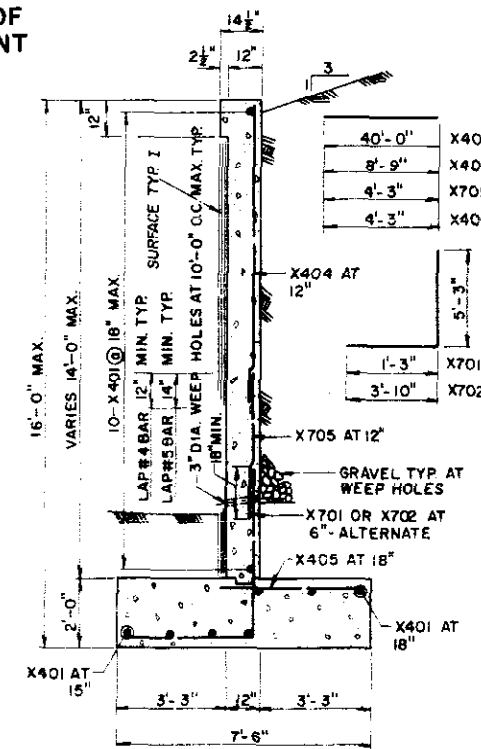

A14

① BAR LIST

| MARK | SIZE | SHAPE | REQ'D | LENGTH |
|------|------|-------|-------|--------|
| X401 | 4 | — | 9 | 40'-0" |
| X412 | 4 | — | 28 | 4'-0" |
| X413 | 4 | — | 28 | 2'-6" |
| X414 | 4 | — | 28 | 5'-3" |

① BAR SUMMARY

| | | |
|---------|--------------------------|-----|
| 689 | L.F. #4 AT 0.668 #/FT. = | 460 |
| TOTAL = | | 460 |

① BAR LIST

| MARK | SIZE | SHAPE | REQ'D | LENGTH |
|------|------|-------|-------|--------|
| X401 | 4 | — | 12 | 40'-0" |
| X410 | 4 | — | 28 | 5'-6" |
| X411 | 4 | — | 28 | 2'-10" |
| X402 | 4 | — | 55 | 6'-3" |

① BAR SUMMARY

| | | |
|---------|--------------------------|-----|
| 1057 | L.F. #4 AT 0.668 #/FT. = | 710 |
| TOTAL = | | 710 |

① BAR LIST

| MARK | SIZE | SHAPE | REQ'D | LENGTH |
|------|------|-------|-------|--------|
| X401 | 4 | — | 15 | 40'-0" |
| X408 | 4 | — | 41 | 7'-6" |
| X409 | 4 | — | 28 | 5'-7" |
| X501 | 5 | — | 40 | 5'-3" |
| X502 | 5 | — | 40 | 7'-1" |

① BAR SUMMARY

| | | |
|---------|--------------------------|------|
| 968 | L.F. #4 AT 0.668 #/FT. = | 650 |
| 493 | L.F. #5 AT 1.043 #/FT. = | 515 |
| TOTAL = | | 1165 |

① BAR LIST

| MARK | SIZE | SHAPE | REQ'D | LENGTH |
|------|------|-------|-------|--------|
| X401 | 4 | — | 15 | 40'-0" |
| X406 | 4 | — | 41 | 9'-6" |
| X407 | 4 | — | 28 | 3'-10" |
| X601 | 6 | — | 40 | 5'-10" |
| X602 | 6 | — | 40 | 8'-0" |

① BAR SUMMARY

| | | |
|---------|--------------------------|------|
| 1097 | L.F. #4 AT 0.668 #/FT. = | 735 |
| 553 | L.F. #6 AT 1.502 #/FT. = | 830 |
| TOTAL = | | 1565 |

① BAR LIST

| MARK | SIZE | SHAPE | REQ'D | LENGTH |
|------|------|-------|-------|--------|
| X401 | 4 | — | 17 | 40'-0" |
| X404 | 4 | — | 41 | 8'-9" |
| X405 | 4 | — | 28 | 4'-3" |
| X701 | 7 | — | 40 | 6'-6" |
| X702 | 7 | — | 40 | 9'-1" |
| X705 | 7 | — | 41 | 4'-3" |

① BAR SUMMARY

| | | |
|---------|--------------------------|------|
| 1158 | L.F. #4 AT 0.668 #/FT. = | 775 |
| 797 | L.F. #7 AT 2.044 #/FT. = | 1630 |
| TOTAL = | | 2405 |

NOTES
 BAR LAPS SHOWN SHALL BE INCREASED AS REQUIRED FOR WALLS HAVING DECREASING HEIGHTS
 CORRUGATED RUSTICATION ON RETAINING WALL FACES SHALL BE PRODUCED BY LINING THE FORM WITH GALVANIZED CORRUGATED STEEL SHEETS PEAKS AND VALLEYS SHALL RUN IN THE VERTICAL DIRECTION. FOR SURFACE TYPE I - USE 2 1/2" X 28 GA. CORRUGATED STEEL SHEETS
 FOR SURFACE TYPE II - USE 1 1/2" X 29 GA. CORRUGATED STEEL SHEETS.

| ① SUMMARY OF QUANTITIES | | | | ① SUMMARY OF QUANTITIES | | | | ① SUMMARY OF QUANTITIES | | | | ① SUMMARY OF QUANTITIES | | | | ① SUMMARY OF QUANTITIES | | | |
|-------------------------|---------|---------------------|--------|-------------------------|---------|---------------------|--------|-------------------------|---------|---------------------|--------|-------------------------|---------|---------------------|--------|-------------------------|---------|---------------------|--------|
| SECTION | UNIT | ITEM | AMOUNT | SECTION | UNIT | ITEM | AMOUNT | SECTION | UNIT | ITEM | AMOUNT | SECTION | UNIT | ITEM | AMOUNT | SECTION | UNIT | ITEM | AMOUNT |
| 601 | CUYD. | CONCRETE CL. A | 14 | 601 | CUYD. | CONCRETE CL. A | 18 | 601 | CUYD. | CONCRETE CL. A | 25 | 601 | CUYD. | CONCRETE CL. A | 33 | 601 | CUYD. | CONCRETE CL. A | 46 |
| 602 | LB. | REINF. STEEL | 499 * | 602 | LB. | REINF. STEEL | 749 * | 602 | LB. | REINF. STEEL | 1165 * | 602 | LB. | REINF. STEEL | 1565 * | 602 | LB. | REINF. STEEL | 2405 * |
| ② | SQ. FT. | 1/2" EXP. JT. MATL. | 9 | ② | SQ. FT. | 1/2" EXP. JT. MATL. | 12 | ② | SQ. FT. | 1/2" EXP. JT. MATL. | 17 | ② | SQ. FT. | 1/2" EXP. JT. MATL. | 22 | ② | SQ. FT. | 1/2" EXP. JT. MATL. | 31 |

* Total Quantities Reinf. Steel on Sheet #13
 ① FOR 40'-6" WALL SECTION, THERE SHALL BE NO SEPARATE PAYMENT FOR ITEMS MARKED THUS. ② PAYMENT THEREFORE SHALL BE INCLUDED IN THE CONTRACT UNIT PRICE FOR ITEM 601, CONCRETE CL. A.
 FOR WALL SECTIONS SHORTER THAN 40'-6" FIELD CUT X401 BARS TO 6" SHORTER THAN LENGTH OF SECTION

JEFFERSON ASSOCIATES
 CIVIL ENGINEERS


DEPARTMENT OF HIGHWAYS
 STATE OF COLORADO

RETAINING WALLS
 SECTIONS & DETAILS

STA. 39+21.7 WALL NW-1 TO
 53+21.6 WALL NE-1
 Near DENVER Sec. 5 T. 4S. R. 68W

Designed by L.H.C. Approved by M.L.K. Bridge Engineer
 Made by M.L.K. Checked by T.V.S. Date: 19

OF HIGHWAYS
138
375
RACING
LOADING DATA
GENERAL NOTES

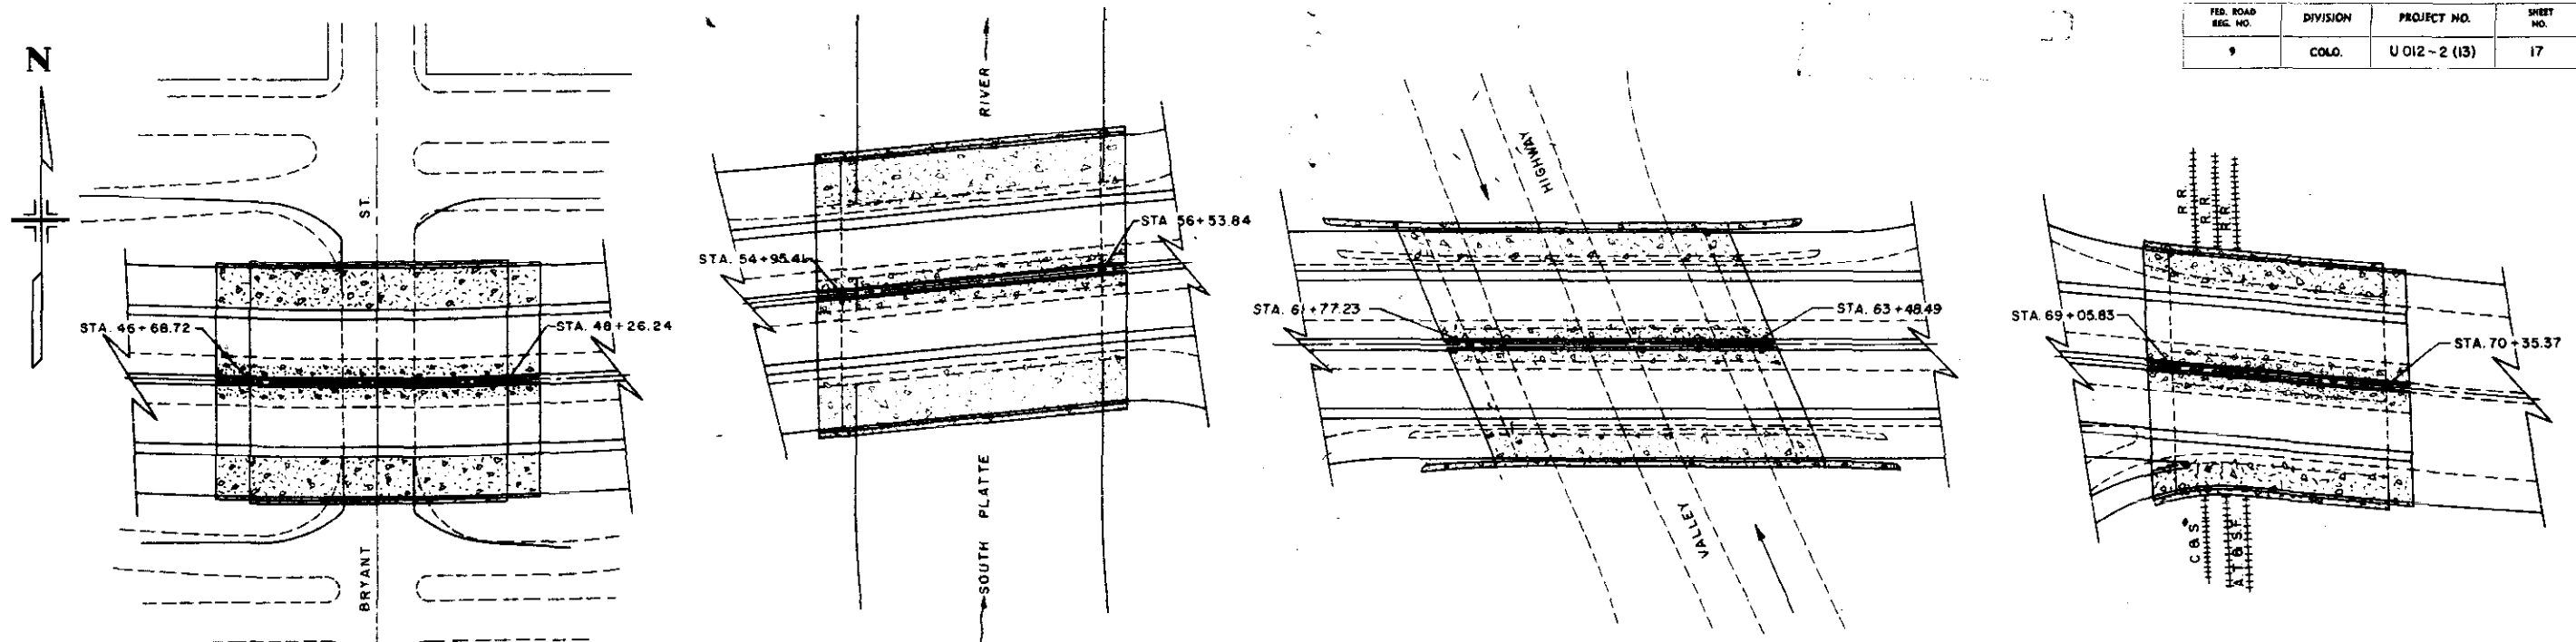

INDEX OF BRIDGE SHEETS

| BRYANT ST. F-16-EM F-16-EN | | SOUTH PLATTE RIVER F-16-EE F-16-EF | | VALLEY HIGHWAY F-16-DY F-16-DU | | CBS AND - AT & SF R.R. F-16-EI F-16-EJ | | WALLS | |
|----------------------------------|--------------------------|--|---|--------------------------------------|--|--|--|-----------|---|
| SHEET NO. | TITLE | SHEET NO. | TITLE | SHEET NO. | TITLE | SHEET NO. | TITLE | SHEET NO. | TITLE |
| 18 | GENERAL PLAN & ELEVATION | 25 | GENERAL PLAN & ELEVATION | 36 | GENERAL PLAN & ELEVATION | 50 | GENERAL PLAN & ELEVATION | 13 | RETAINING WALLS - GENERAL PLAN |
| 19 | DETAILS ABUTMENT NO. 1&4 | 26 | DETAILS ABUTMENT NO. 1 SOUTH SIDE | 37 | DETAILS ABUTMENT NO. 1 | 51 | DETAILS ABUTMENT NO. 1 | 14 | RETAINING WALLS - FACE ELEVATIONS |
| 20 | DETAILS PIER NO. 2 & 3 | 27 | DETAILS ABUTMENT NO. 1 NORTH SIDE | 38 | DETAILS WEST WINGS | 52 | APPROACH SLAB DETAILS ABUTMENT NO. 1 QUANTITIES | 15 | RETAINING WALLS - FACE ELEVATIONS |
| 21 | GIRDER DETAILS | 28 | PIER DETAILS | 39 | PIER NO. 2 DETAILS | 53 | DETAILS WEST WINGS | 16 | RETAINING WALLS - SECTIONS & DETAILS |
| 22 | SUPERSTRUCTURE DETAILS | 29 | APPROACH SLAB DETAILS PIER BAR LIST & QUANTITIES | 40 | DETAILS ABUTMENT NO. 3 | 54 | PIER NO. 2 DETAILS | 17 | INDEX OF BRIDGE SHEETS |
| 23 | DECK PLAN NORTH BRIDGE | 30 | DETAILS ABUTMENT NO. 4 NORTH SIDE | 41 | DETAILS EAST WINGS | 55 | DETAILS ABUTMENT NO. 3 | | |
| 24 | DECK PLAN SOUTH BRIDGE | 31 | DETAILS ABUTMENT NO. 4 SOUTH SIDE | 42 | APPROACH SLAB DETAILS FRAME BAR DETAILS | 56 | GIRDER & STRUCTURAL STEEL DETAILS | | |
| | | 32 | GIRDER & STRUCTURAL STEEL DETAILS | 43 | FRAME DETAILS 1C, 2C, & 3C | 57 | SUPERSTRUCTURE DETAILS | | |
| | | 33 | SUPERSTRUCTURE DETAILS | 44 | FRAME DETAILS 1N, 2N, 3N, 1S, 2S, & 3S | 58 | DECK PLAN SOUTH BRIDGE | | |
| | | 34 | DECK PLAN NORTH BRIDGE | 45 | PIER NO. 2 QUANTITIES LEG DETAILS AT ABUTMENT NO. 3 | 59 | DECK PLAN NORTH BRIDGE | | |
| | | 35 | DECK PLAN SOUTH BRIDGE | 46 | SUPERSTRUCTURE DETAILS | 60 | STANDARD DETAILS | | |
| | | | | 47 | DECK PLAN SOUTH BRIDGE | 61 | CLASS 2 SURFACE FINISH DETAILS | | |
| | | | | 48 | DECK PLAN NORTH BRIDGE | | | | |
| | | | | 49 | FALSEWORK DETAILS | | | | |

SUMMARY OF QUANTITIES

| ITEM | UNIT | DESCRIPTION | F-16-EM F-16-EN | F-16-EE F-16-EF | F-16-DY F-16-DU | F-16-EI F-16-EJ | TOTAL BRIDGES | WALLS* |
|------|--------|----------------------------|--------------------|--------------------|--------------------|--------------------|------------------|-------------------|
| 202 | EA | REM PORT PRESENT STR | 2 | 2 | 2 | 2 | 8 | |
| 206 | CU YD | STR EXCAV | 493 | 1456 | 896 | 1619 | 4464 | 8007 |
| 206 | CU YD | STR BKFL (CL 3) | 375 | 1269 | 2889 | 2443 | 6976 | 3038 |
| 403 | TON | HBP 16R E | 145 | 165 | 163 | 103 | 576 | |
| 411 | GAL | LIQ ASPH MATL (RC-800) | 190 | 215 | 192 | 128 | 725 | |
| 501 | SQ FT | STEEL SHEET PILE (TY1) | | 2910 | | | 2910 | |
| 502 | LIN FT | DRILL HOLE FAC PILE DR | | | 16 | | 16 | |
| 502 | LIN FT | STEEL PILE (80BP42) | | | | 282 | 282 | |
| 502 | LIN FT | STEEL PILE (12BP53) | 936 | | 576 | | 1512 | |
| 502 | LIN FT | STEEL PILE (12BP74) | | | 104 | | 104 | |
| 506 | CU YD | RIP RAP | | 550 | | | 550 | |
| 507 | CU YD | CONC S AND D PAVE (REINF) | 190 | | | | 190 | |
| 509 | LS | STR STEEL | | | | | LS | |
| 509 | LS | STR STEEL (GALV) | | | | | LS | |
| 210 | LIN FT | RES RAILING | | 436 | 525 | 320 | 1281 | |
| 513 | EA | DRAIN PIPE 4" (1/4 FT.) | | 28 | | | 28 | |
| 601 | CU YD | CONCRETE CL A | 919 | 1123 | 1449 | 969 | 4460 | 8007 |
| 602 | LB | REINF STEEL | 241,795 | 152,750 | 280,305 | 182,980 | 797,830 | 36,155 |
| 606 | LIN FT | RD RAIL TY 3A(DOUBLE) | 200 | 200 | 187.5 | 150 | 737.5 | |
| 613 | LIN FT | 1" ELEC COND | 340 | 386 | 559 | 12.85 | 12.85 | |
| 3 | SQ FT | 1" EXP JT MATL | 326 | 512 | 971 | 438 | 2247 | 708 |
| 3 | SQ FT | 1" EXP JT MATL | 75 | | 72 | | 147 | |
| 3 | SQ FT | 16GA GALV SHT STEEL | | 166 | | 207 | 373 | |
| 607 | LIN FT | FENCE CHAIN LINK (36 INCH) | 200 | 200 | 188 | 150 | 738 | |

① DESIGN WT = 493,345 LB. (R-1)

② DESIGN WT = 21,735 LB.

③ THERE SHALL BE NO SEPARATE PAYMENT FOR ITEMS MARKED THUS (R-1) PAYMENT THEREFORE SHALL BE INCLUDED IN THE CONTRACT UNIT PRICE FOR ITEM 601, CONCRETE CL A.

* SEE LIST OF STRUCTURES FOR WALL QUANTITIES.

See Sheet No 18 for Summary of Quantities for Str F-16-EM & EN
 " " " 25 " " " " " " " F-16-EE & EF
 " " " 36 " " " " " " " F-16-DU & DY
 " " " 50 " " " " " " " F-16-EI & EJ

SPECIAL NOTES

ALL STRUCTURAL STEEL RAIL REMOVED FROM THE SOUTH CURB OF NORTH BRIDGES AND FROM THE NORTH CURB OF SOUTH BRIDGES UNDER THE PROVISIONS OF SECTION 206 SHALL BE DELIVERED BY THE CONTRACTOR AND STOCK PILED AT THE COLORADO DEPARTMENT OF HIGHWAYS MAINTENANCE YARD LOCATED AT 1800 EAST COLFAX AVENUE DENVER, COLORADO. HAULING AND STOCK PILING SHALL BE INCLUDED FOR PAYMENT IN ITEM 202

GENERAL NOTES

ALL WORK SHALL BE DONE ACCORDING TO THE STANDARD 1966 INTERIM SPECIFICATIONS OF THE COLORADO DEPARTMENT OF HIGHWAYS APPLICABLE TO THE PROJECT
 ALL CONCRETE SHALL BE CLASS "A"
 ALL REINFORCING STEEL SHALL BE INTERMEDIATE GRADE STEEL OF A DEFORMED TYPE. EACH BAR SHALL BE TAGGED WITH THE BAR DESIGNATION AND STATION NUMBER OF THE PROJECT.
 IF BY PERMISSION OF THE ENGINEER PRIMARY BARS ARE SPICED, THEY SHALL LAP A MINIMUM OF 28 DIAMETERS FOR BARS NEAR TOPS OF BEAMS HAVING MORE THAN 12 INCHES OF CONCRETE UNDER THE BARS, AND 17 DIAMETERS FOR BARS NEAR BOTTOM OF MEMBERS. SECONDARY BARS WHEN SPICED SHALL LAP 17 DIAMETERS OF THE BAR.
 DIMENSIONS FOR REINFORCING STEEL ARE SHOWN AS CLEAR, OR OUT TO OUT OF BARS.
 SOUNDINGS AND DEPTH OF FOOTINGS ARE IN ACCORDANCE WITH THE BEST AVAILABLE DATA, AND WHEN DIFFERENT CONDITIONS ARE ENCOUNTERED THE BRIDGE ENGINEER WILL INSPECT AND DETERMINE IF REDSIGN IS NECESSARY.
 FOOTINGS IN ROCK SHALL BE POURED OUT TO ROCK AND NOT FORMED.
 WHEN EXCAVATING FOR FOOTINGS THE FINAL ONE FOOT IN DEPTH SHALL BE DONE BY HAND-LABOR METHODS.
 FOR DETAILS OF STRUCTURAL EXCAVATION AND STRUCTURE BACKFILL SEE STANDARD M-206-4 ALL CONCRETE SURFACES MARKED WITH THE SYMBOL I AS SHOWN ON SHEET NO. 61 SHALL RECEIVE CLASS "2" SURFACE FINISH.
 ALL STRUCTURAL STEEL SHALL BE PAINTED IN ACCORDANCE WITH SECTION 509 FOR ALUMINUM PAINT.
 ALL BOLTS SHALL BE 7/8 INCH DIAMETER UNLESS OTHERWISE NOTED.
 ALL REINFORCING STEEL SHOWN IN BUNDLES OF 2 OR 3 BARS SHALL BE WIRE TIED AT 6'-0" MAXIMUM INTERVALS ALONG THE LENGTH OF THE BUNDLES.
 WELDING SHALL CONFORM TO THE LATEST EDITION OF THE A.W.S. STANDARD SPECIFICATIONS FOR WELDING HIGHWAY BRIDGES.
 FOR WELDED GIRDERS ALL SHOP BUTT WELDS IN PLANGES AND WEBS SHALL BE MADE BEFORE WELDING INTO GIRDERS.
 WHEN CALLED FOR IN THE SPECIAL PROVISIONS, SHOP WELDS SHALL BE INSPECTED RADIOGRAPHICALLY AND BY THE PENETRANT DYE METHOD.
 WHEN TREATED TIMBER PILING IS SHOWN ON THE PLANS THE PRESERVATIVE FOR TREATMENT SHALL BE CREOSOTE OIL.
 EXPANSION JOINT MATERIAL SHALL CONFORM TO A.S.H.D. SPEC. M-185-94 TYP. (1)
 FOR CAST IN PLACE CONCRETE CONSTRUCTION ALL SHODING SHALL REMAIN IN PLACE UNTIL ALL CONCRETE IN PIER CAP BEAMS, GIRDER STEMS AND DECK SLABS HAS REACHED A MINIMUM COMPRESSIVE STRENGTH OF 2800 LB. PER SQ. IN.
 ALL EXPOSED CAST IN PLACE CONCRETE CORNERS SHALL BE CHAMFERED WITH A 3/4" RILLED STRIP.



TELFORD V. STRADLEY, 3545
 JEFFERSON ASSOCIATES
 CIVIL ENGINEERS

LOADING DATA
 LIVE LOAD - A.A.S.H.O. HS 20-44
 DEAD LOAD ASSUMES 17.5 LBS. PER SQ. FT. WEARING SURFACE.

DESIGNING DATA
 A.A.S.H.O. 1961 UNIT STRESSES, EXCEPT AS NOTED.
 Reinforcing Steel $f_s = 20000$ lbs. per sq. in.
 Structural Steel $f_s = 20000$ lbs. per sq. in. ASTM-A36
 $f_s = 18000$ lbs. per sq. in. ASTM-A7
 Concrete $f_c = 1200$ lbs. per sq. in. n=10

COLORADO
 DEPARTMENT OF HIGHWAYS
 BRIDGE SITUATION
 INDEX
 SUMMARY OF QUANTITIES
 GENERAL NOTES
 WEST 6TH AVENUE
 Sta. 46+68.72 TO STA. 70+35.77
 Near DENVER, Sec. 4, S. 8, T. 4 S., R. 68 W.
 Designed by MLK Approved by _____
 Made by E.L.M. Checked by TVS Date: _____
 Bridge Engineer 19