





Know what's below. Call before you dig.

ADDITIONAL POINTS					ADDITIONAL POINTS (CONT.)				
POINT	N	E	ELEV.	REMARKS	POINT	N	E	ELEV.	REMARKS
R-1	62683.44	93237.77	7262.16	MATCH EXISTING	R-11	62668.07	93261.33	7262.97	
R-2	62674.42	93239.76	7262.22	MATCH EXISTING	R-12	62676.13	93259.68	7262.87	
R-3	62664.45	93241.54	7262.34	MATCH EXISTING	R-13	62687.20	93257.42	7262.72	
R-4	62654.73	93243.81	7262.18	MATCH EXISTING	R-14	62652.94	93278.71	7263.18	
R-5	62647.15	93245.20	7262.08	MATCH EXISTING	R-15	62670.98	93274.36	7263.39	
R-6	62649.33	93254.96	7262.41		R-16	62690.10	93269.91	7263.08	
R-7	62666.26	93251.44	7262.65		R-17	62656.72	93292.11	7263.64	
R-8	62685.32	93247.59	7262.44		R-18	62674.31	93287.27	7263.81	
R-9	62651.51	93264.72	7262.73		R-19	62693.13	93282.88	7263.46	
R-10	62660.36	93262.91	7262.86						

NOTE: CONTRACTOR SHALL FIELD VERIFY DATA PROVIDED ON THIS SHEET AND REPORT ANY DISCREPANCIES PRIOR TO CONSTRUCTION.

NOTES:



- POINTS SHOWN ARE PLACED ALONG THE TOP OF THE CONCRETE SIDEWALK OR THE TOP OF CONCRETE SLOPE PAVING. REFER TO RETAINING WALL PLANS FOR WALL INFORMATION.
- POINTS SHOWN ARE PLACED ALONG THE FINISHED GRADE AT THE BASE OF THE WALL. REFER TO RETAINING WALL PLANS FOR WALL INFORMATION.

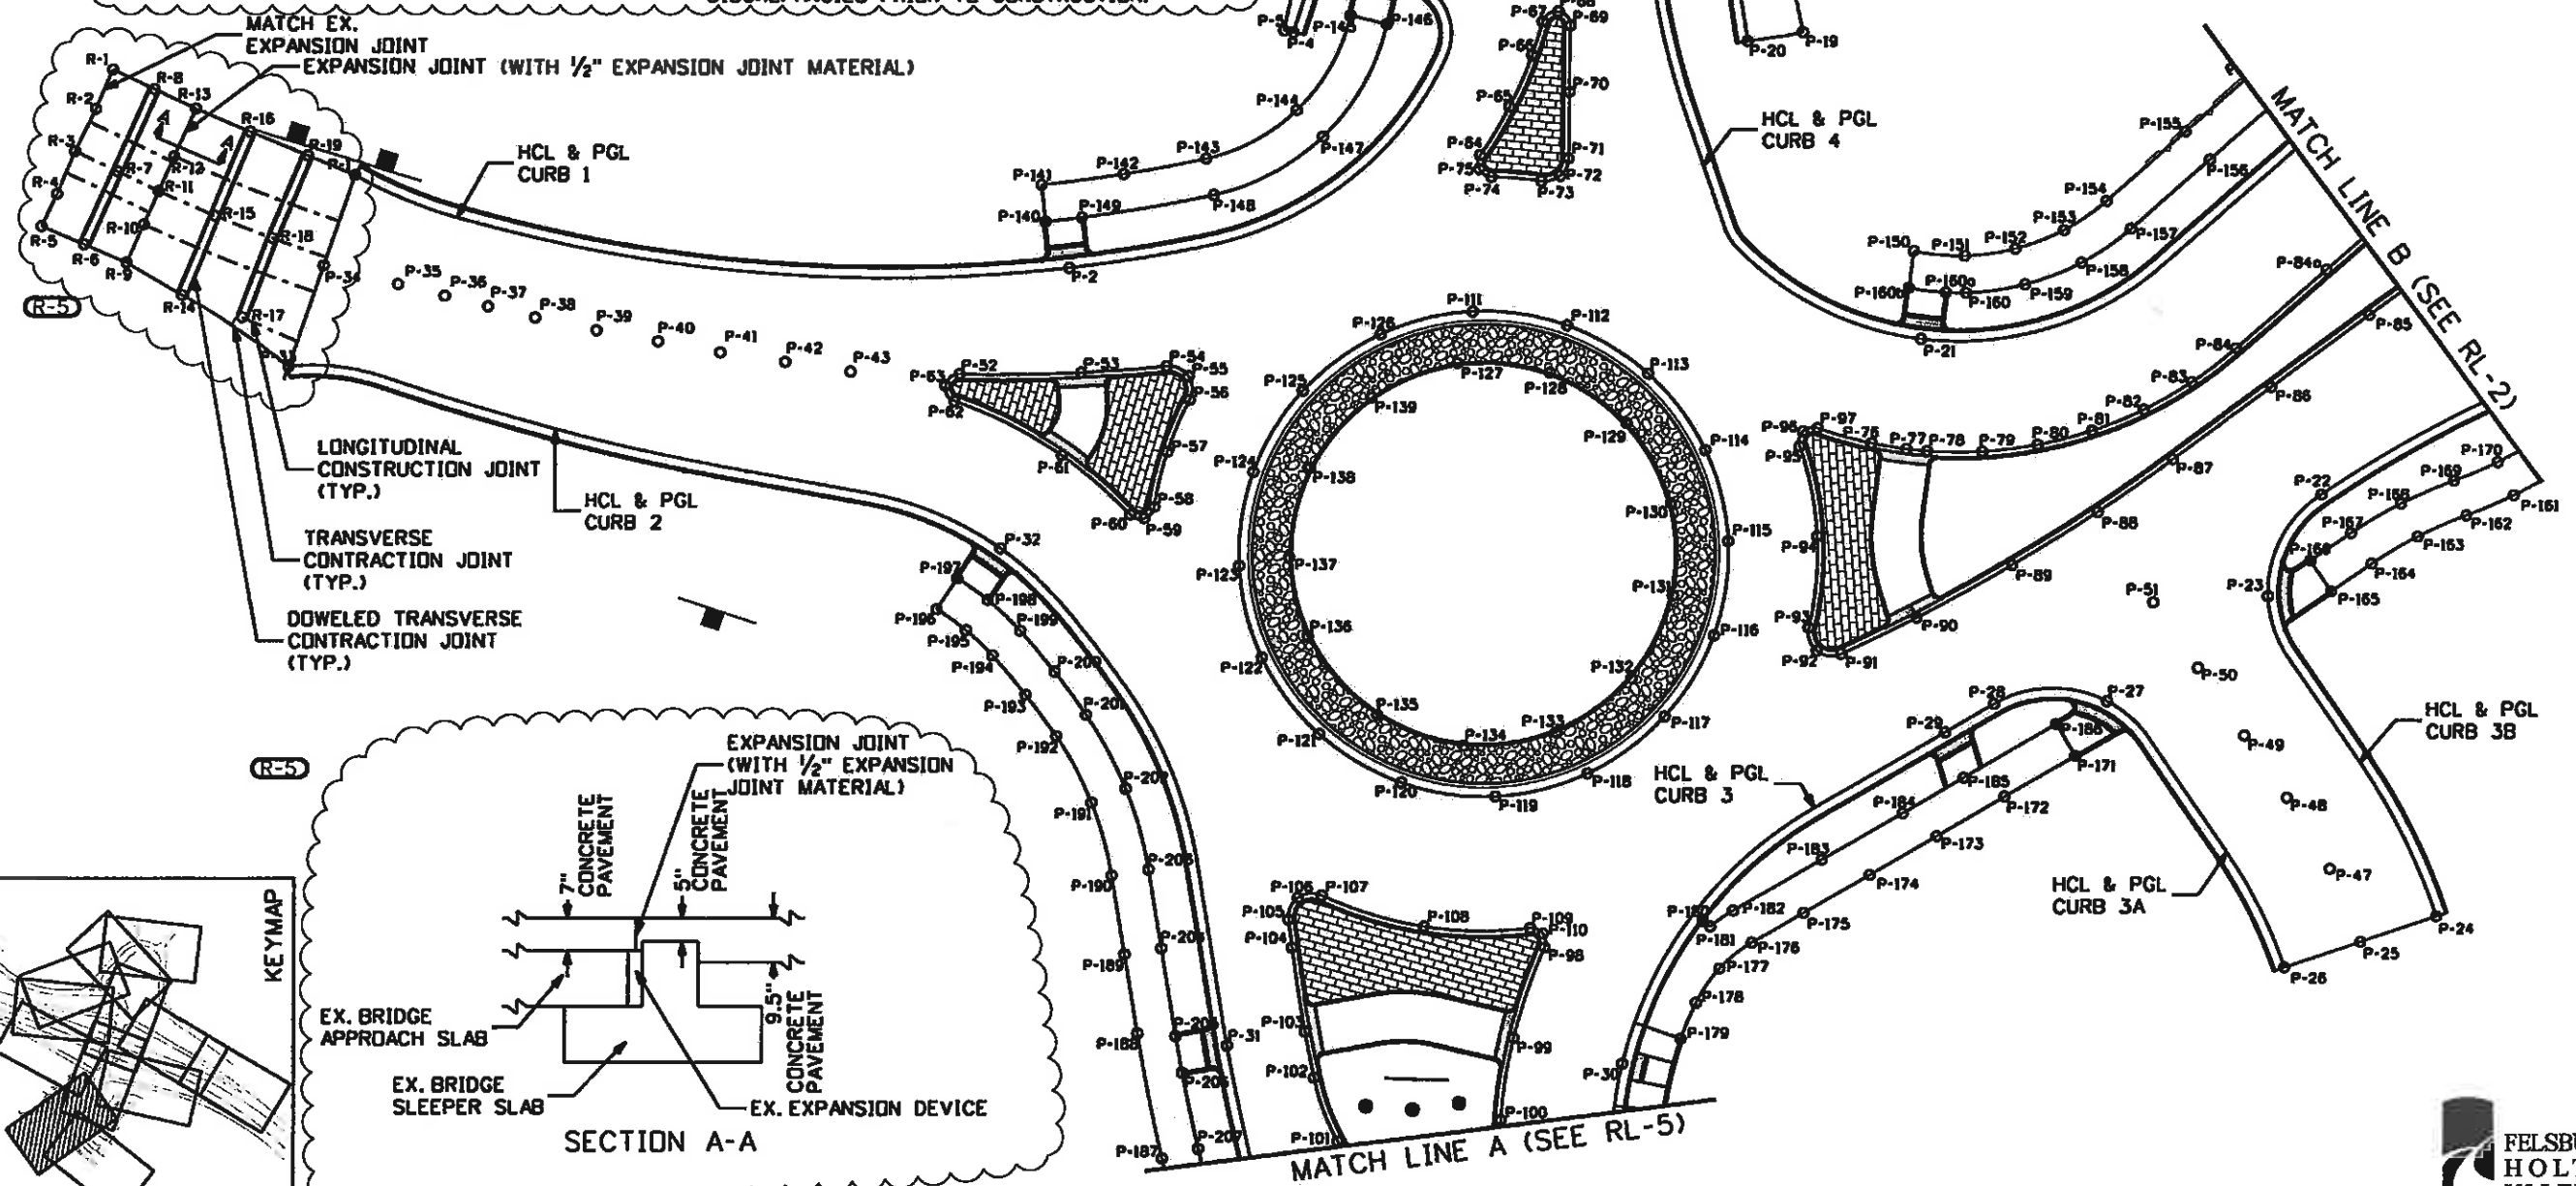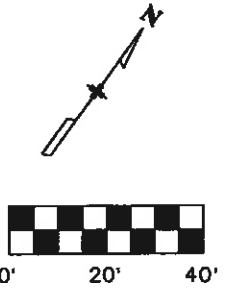

LONGITUDINAL CONSTRUCTION JOINT (TYP.)

TRANSVERSE CONTRACTION JOINT (TYP.)

DOWELED TRANSVERSE CONTRACTION JOINT (TYP.)

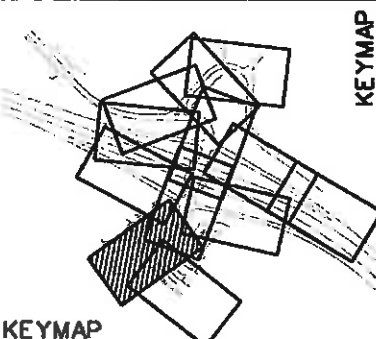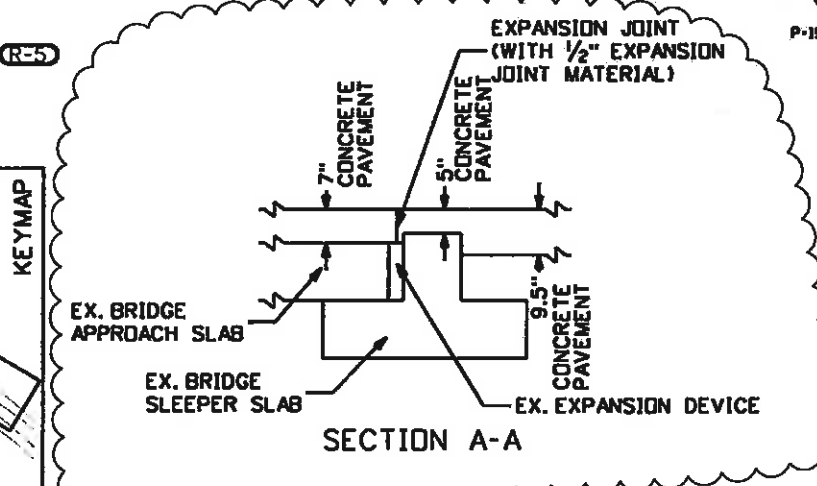


Print Date: 12/16/2010	Sheet Revisions		Colorado Department of Transportation		As Constructed	EDWARDS INTERCHANGE UPGRADE ROUNDABOUT LAYOUT PLAN		Project No./Code
Drawing File Name: 06193RLP01.dgn	Date:	Comments	Init.	714 Grand Avenue, P.O. Box 298 Eagle, CO 81631 Phone: 970-328-6385 FAX: 970-328-2368 Region 3 MLM	No Revisions:	Designer: DCS		ES3 0702-297
Horiz. Scale: 1:40	12-16-10	APPROACH PAVING	KMD		Revised: 6-6-2011	Detailer: KMH	Structure Numbers	17303
Unit Information					Void:	Sheet Subset: POINTS	Subset Sheets: RL-01 of 15	Sheet Number 213XA





**NOTES:**

- POINTS SHOWN ARE PLACED ALONG THE TOP OF THE CONCRETE SIDEWALK OR THE TOP OF CONCRETE SLOPE PAVING. REFER TO RETAINING WALL PLANS FOR WALL INFORMATION.
- POINTS SHOWN ARE PLACED ALONG THE FINISHED GRADE AT THE BASE OF THE WALL. REFER TO RETAINING WALL PLANS FOR WALL INFORMATION.



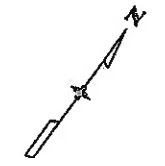


0' 20' 40'

See Sheet 213XA

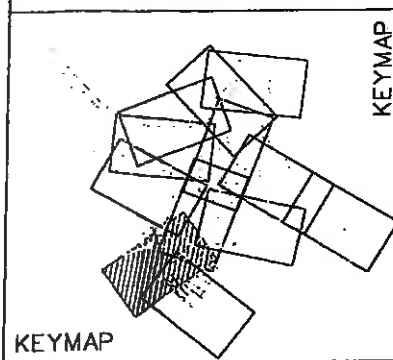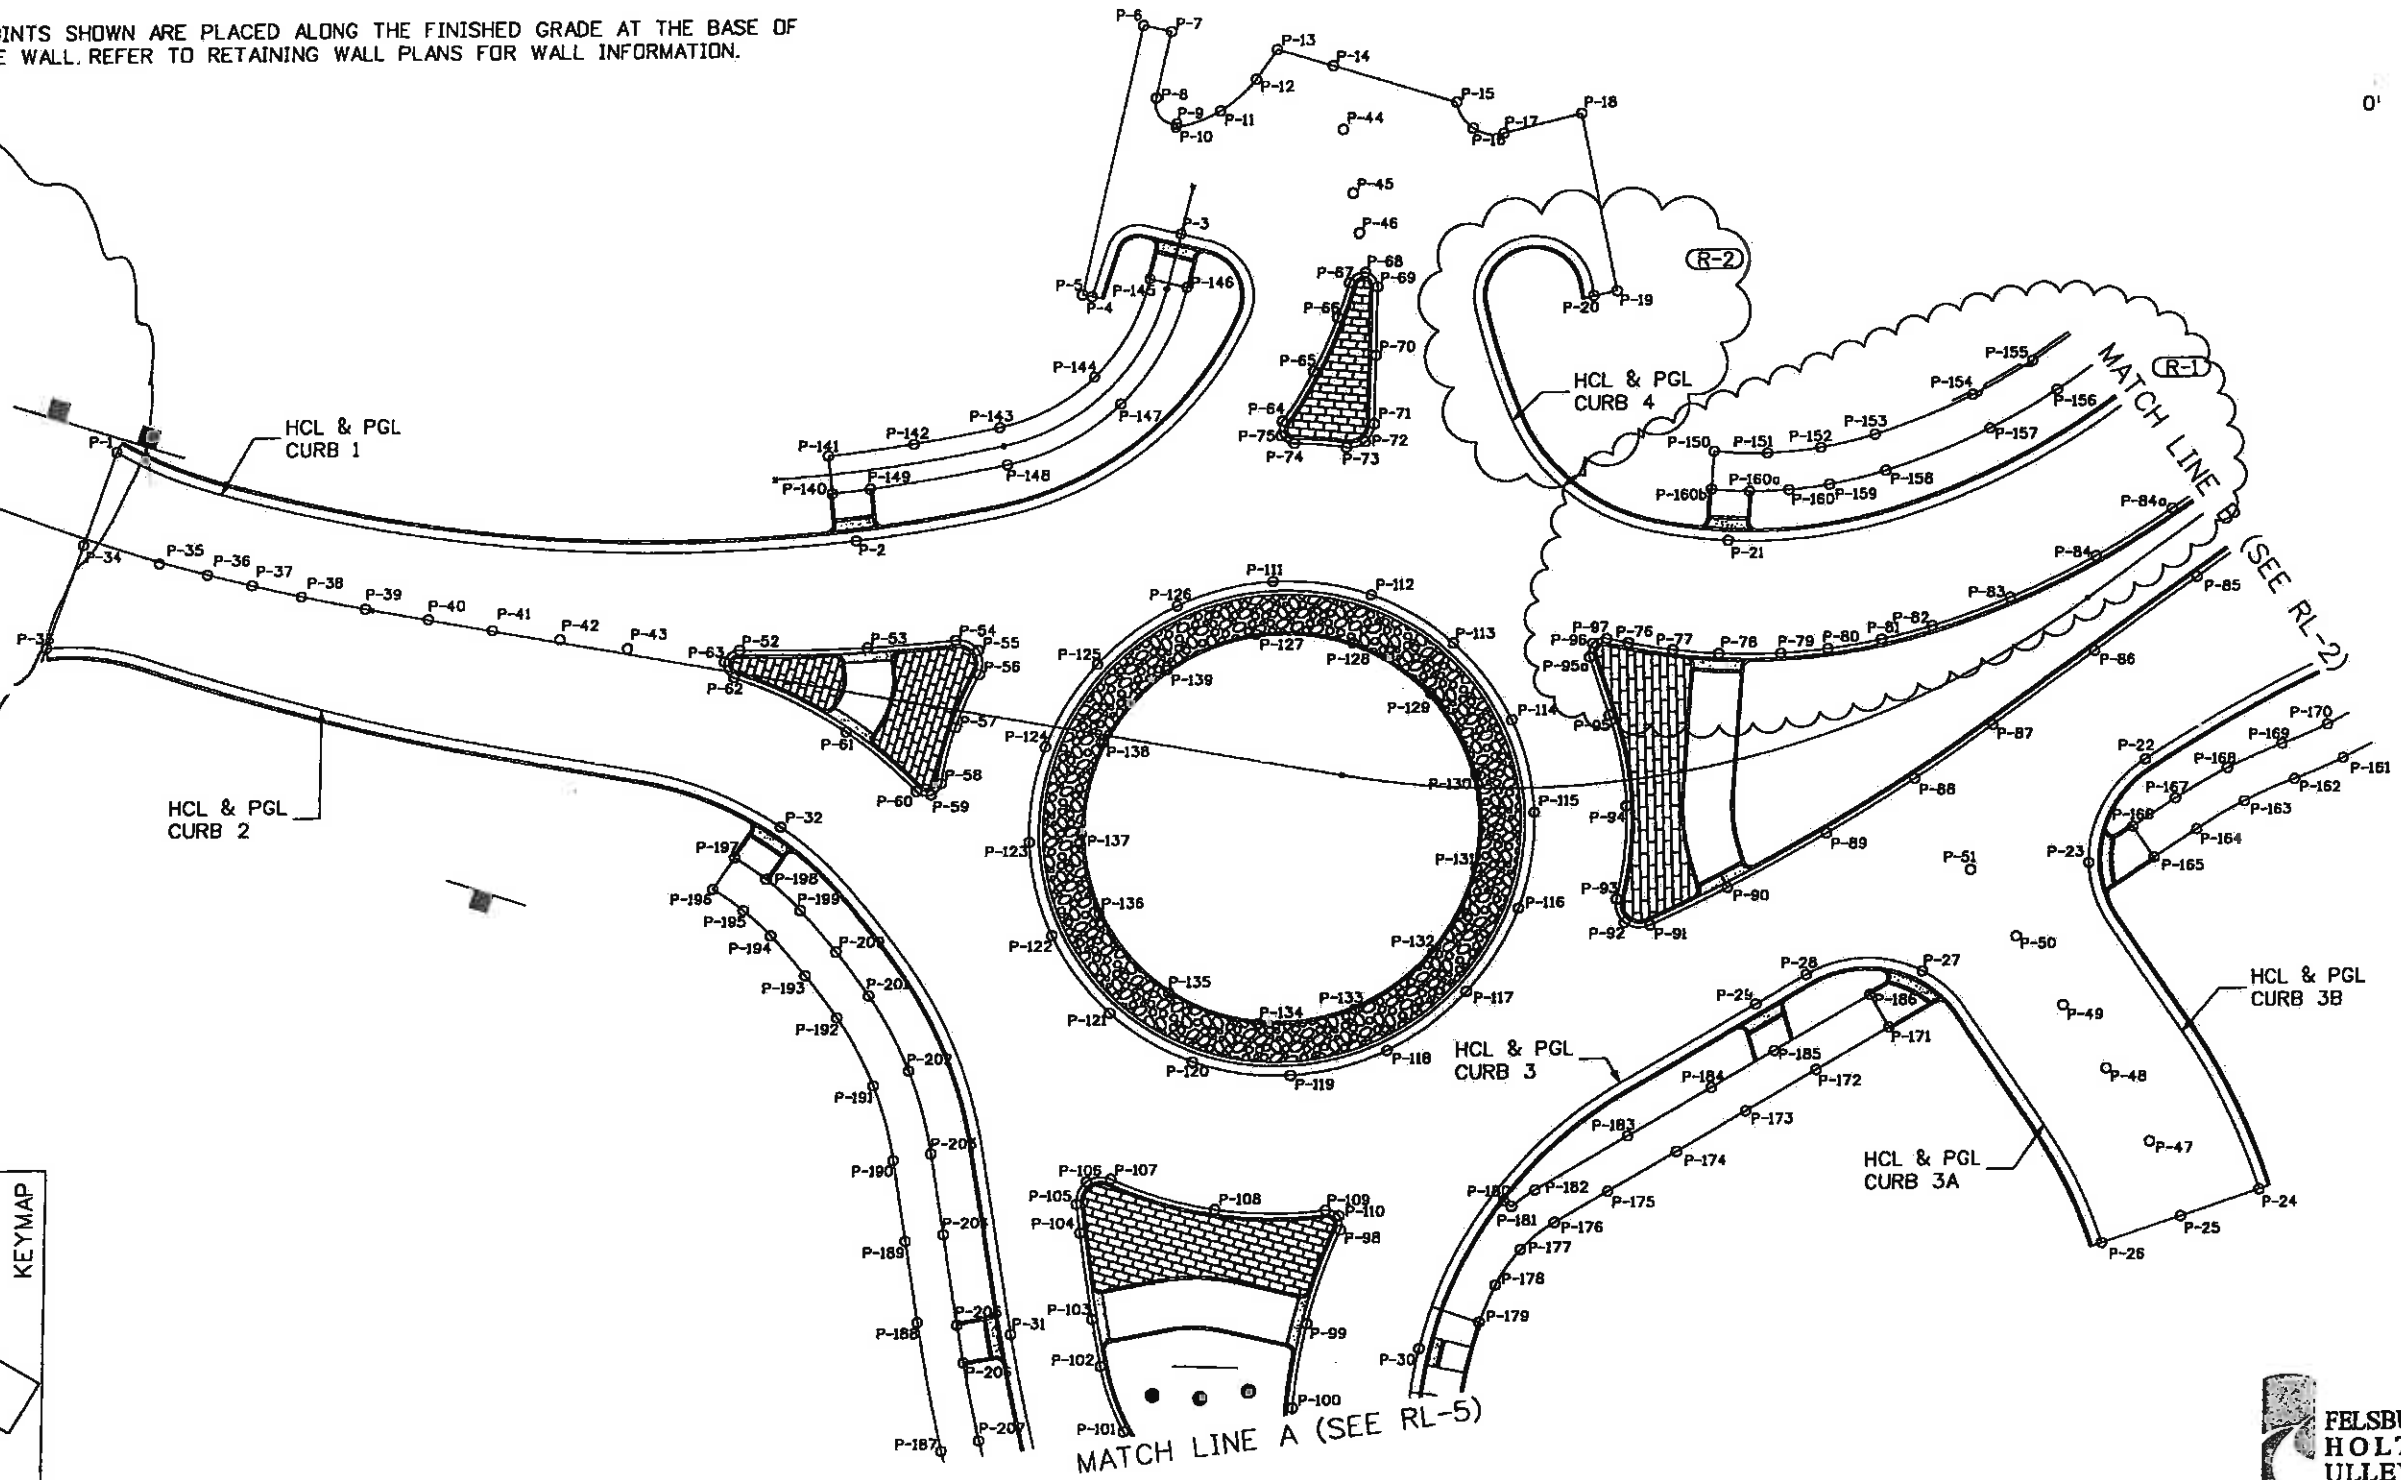

Print Date: 2/8/2011	Sheet Revisions		Colorado Department of Transportation		As Constructed		EDWARDS INTERCHANGE UPGRADE ROUNDABOUT LAYOUT PLAN		Project No./Code	
Drawing File Name: 06193RLP01.dgn	Date:	Comments	Init.	714 Grand Avenue, P.O. Box 298 Eagle, CO 81631 Phone: 970-328-6385 FAX: 970-328-2368 Region 3 MLM	No Revisions:		ES3 0702-297		17303	
Horiz. Scale: 1:40	5/10/10	REVISED SB ENTRANCE TO MRR ROUNDABOUT	DKH		Revised: 6-6-2011		Designer: DCS		17303	
Vert. Scale: As Noted	2/8/11	REVISED ENTRANCE TO NORTHSTAR CENTER	DKH		Void:		Detailer: KMH		Sheet Number 213X	
Unit Information	Unit Leader Initials					Sheet Subset: POINTS		Subset Sheets: RL-01 of 15		

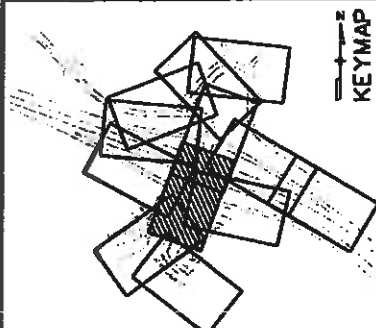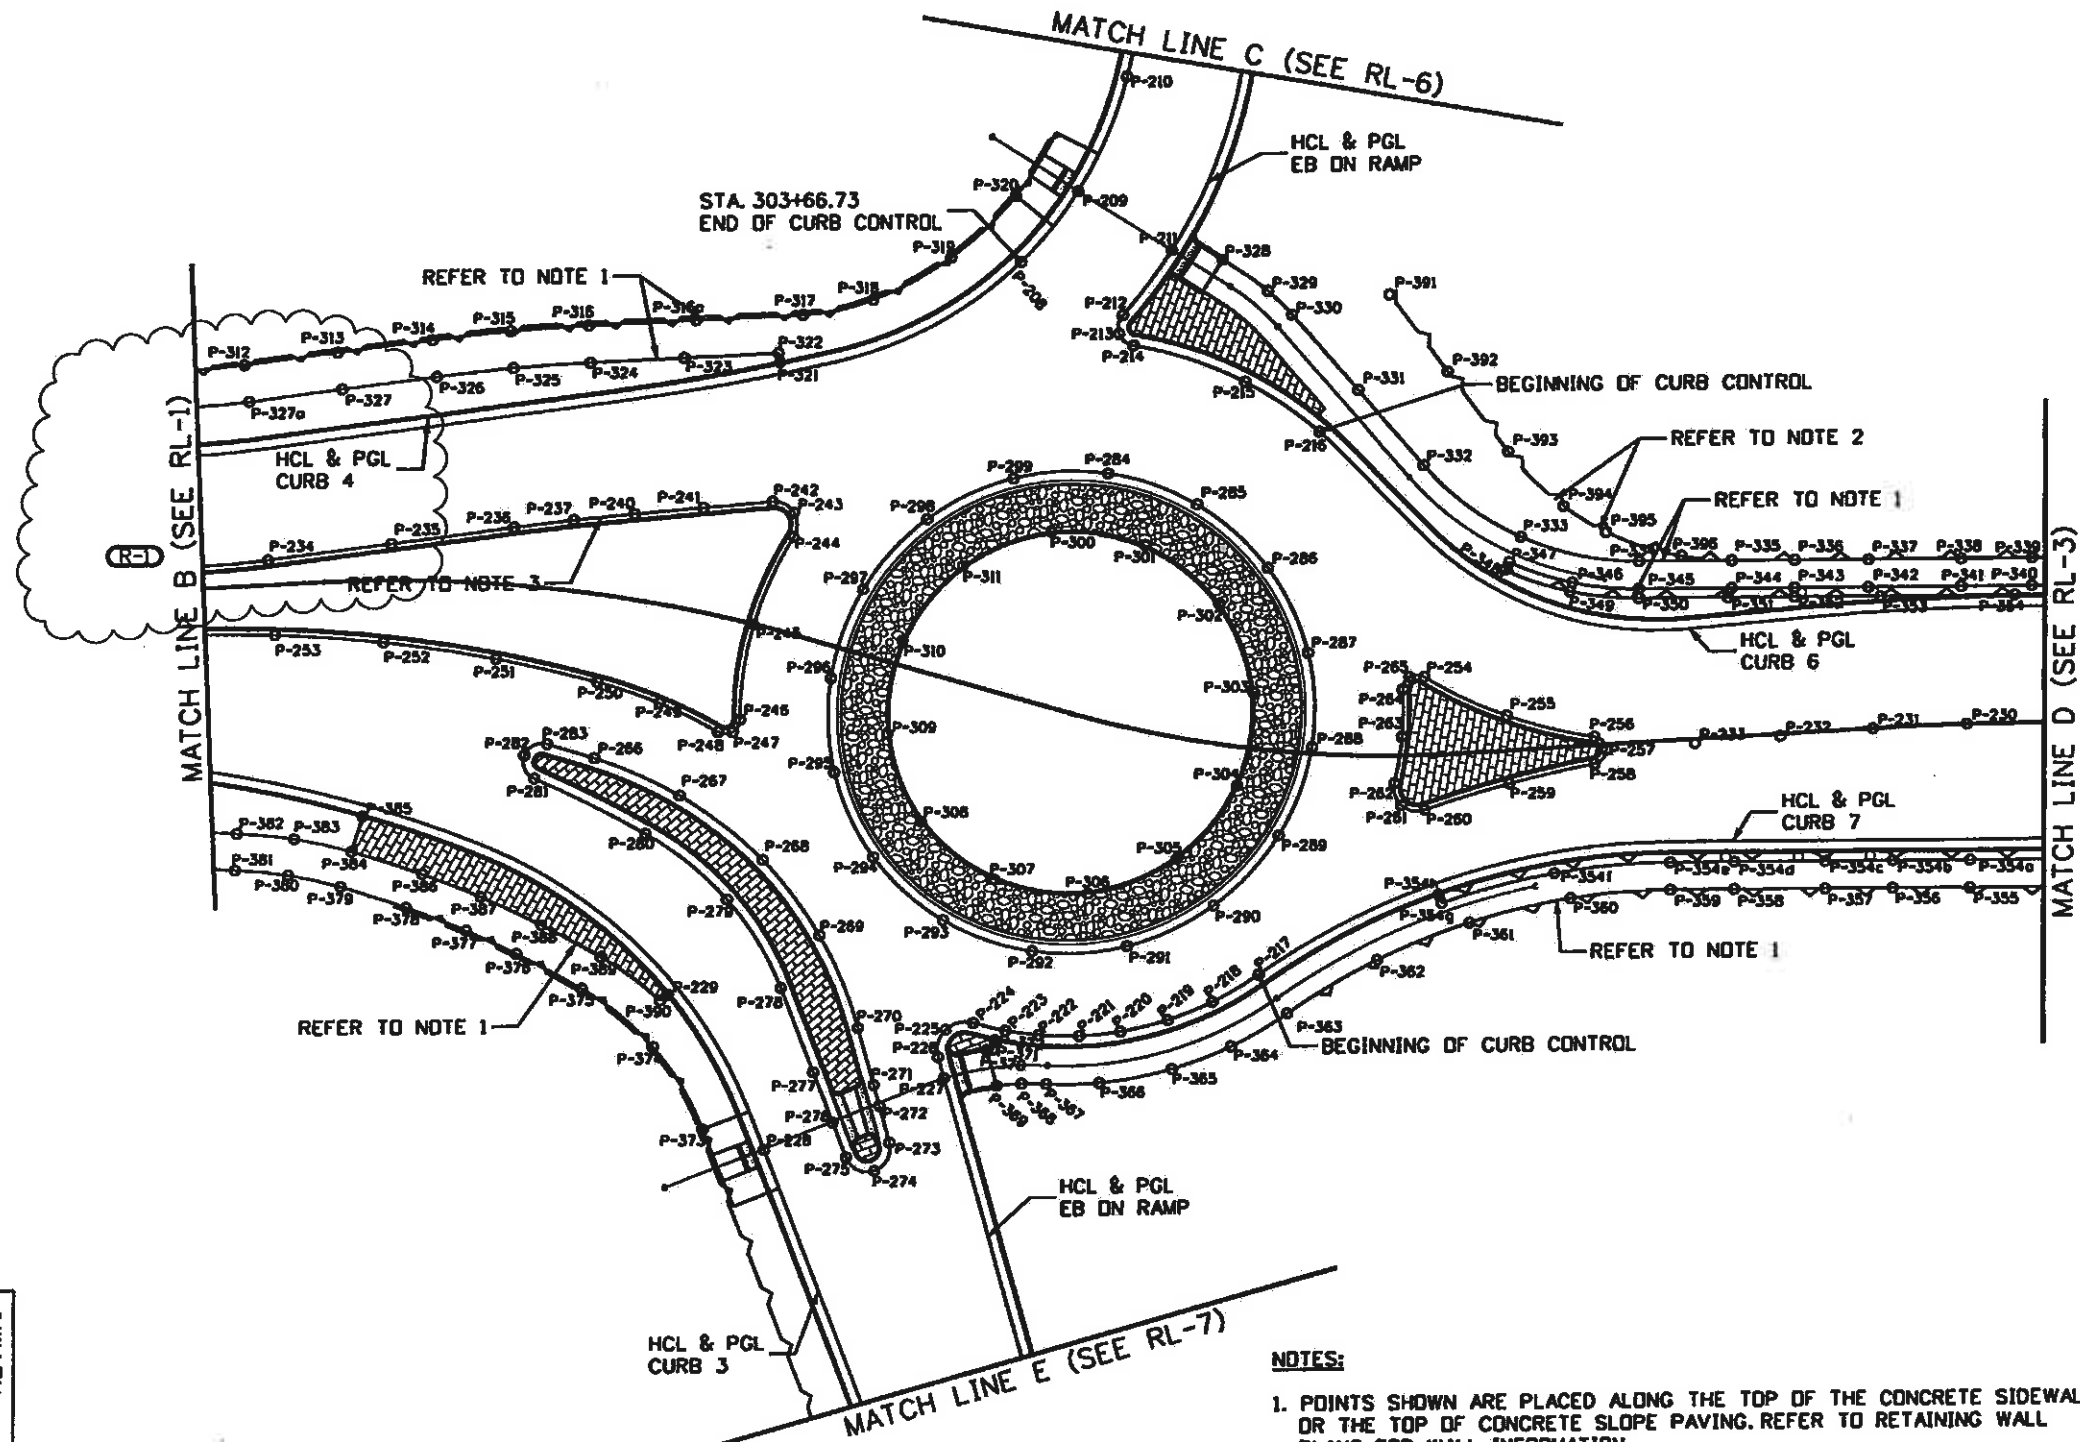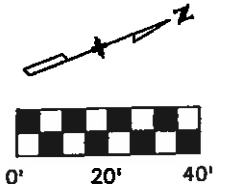

- NOTES:**
1. POINTS SHOWN ARE PLACED ALONG THE TOP OF THE CONCRETE SIDEWALK OR THE TOP OF CONCRETE SLOPE PAVING. REFER TO RETAINING WALL PLANS FOR WALL INFORMATION.
  2. POINTS SHOWN ARE PLACED ALONG THE FINISHED GRADE AT THE BASE OF THE WALL. REFER TO RETAINING WALL PLANS FOR WALL INFORMATION.
  3. POINTS 238 AND 239 HAVE BEEN INTENTIONALLY OMITTED FROM THIS SHEET.



Print Date: 5/10/2010
Drawing File Name: 06193RLP02.dgn
Horiz. Scale: 1:40.0007      Vert. Scale: As Noted
Unit Information      Unit Leader Initials

Sheet Revisions		
Date:	Comments	Init.
5/10/10	REVISED SB ENTRANCE TO MRR ROUNDABOUT	DKH

Colorado Department of Transportation

714 Grand Avenue, P.O. Box 298  
Eagle, CO 81631  
Phone: 970-328-6385 FAX: 970-328-2368

Region 3      MLM


As Constructed
No Revisions:
Revised: 6-6-2011
Void:

EDWARDS INTERCHANGE UPGRADE ROUNDABOUT LAYOUT PLAN	
Designer: DCS	Structure Numbers
Detailer: KMH	
Sheet Subset: POINTS	Subset Sheets: RL-02 of 15

Project No./Code	ES3 0702-297
	17303
Sheet Number	214X



Know what's below.  
Call before you dig.

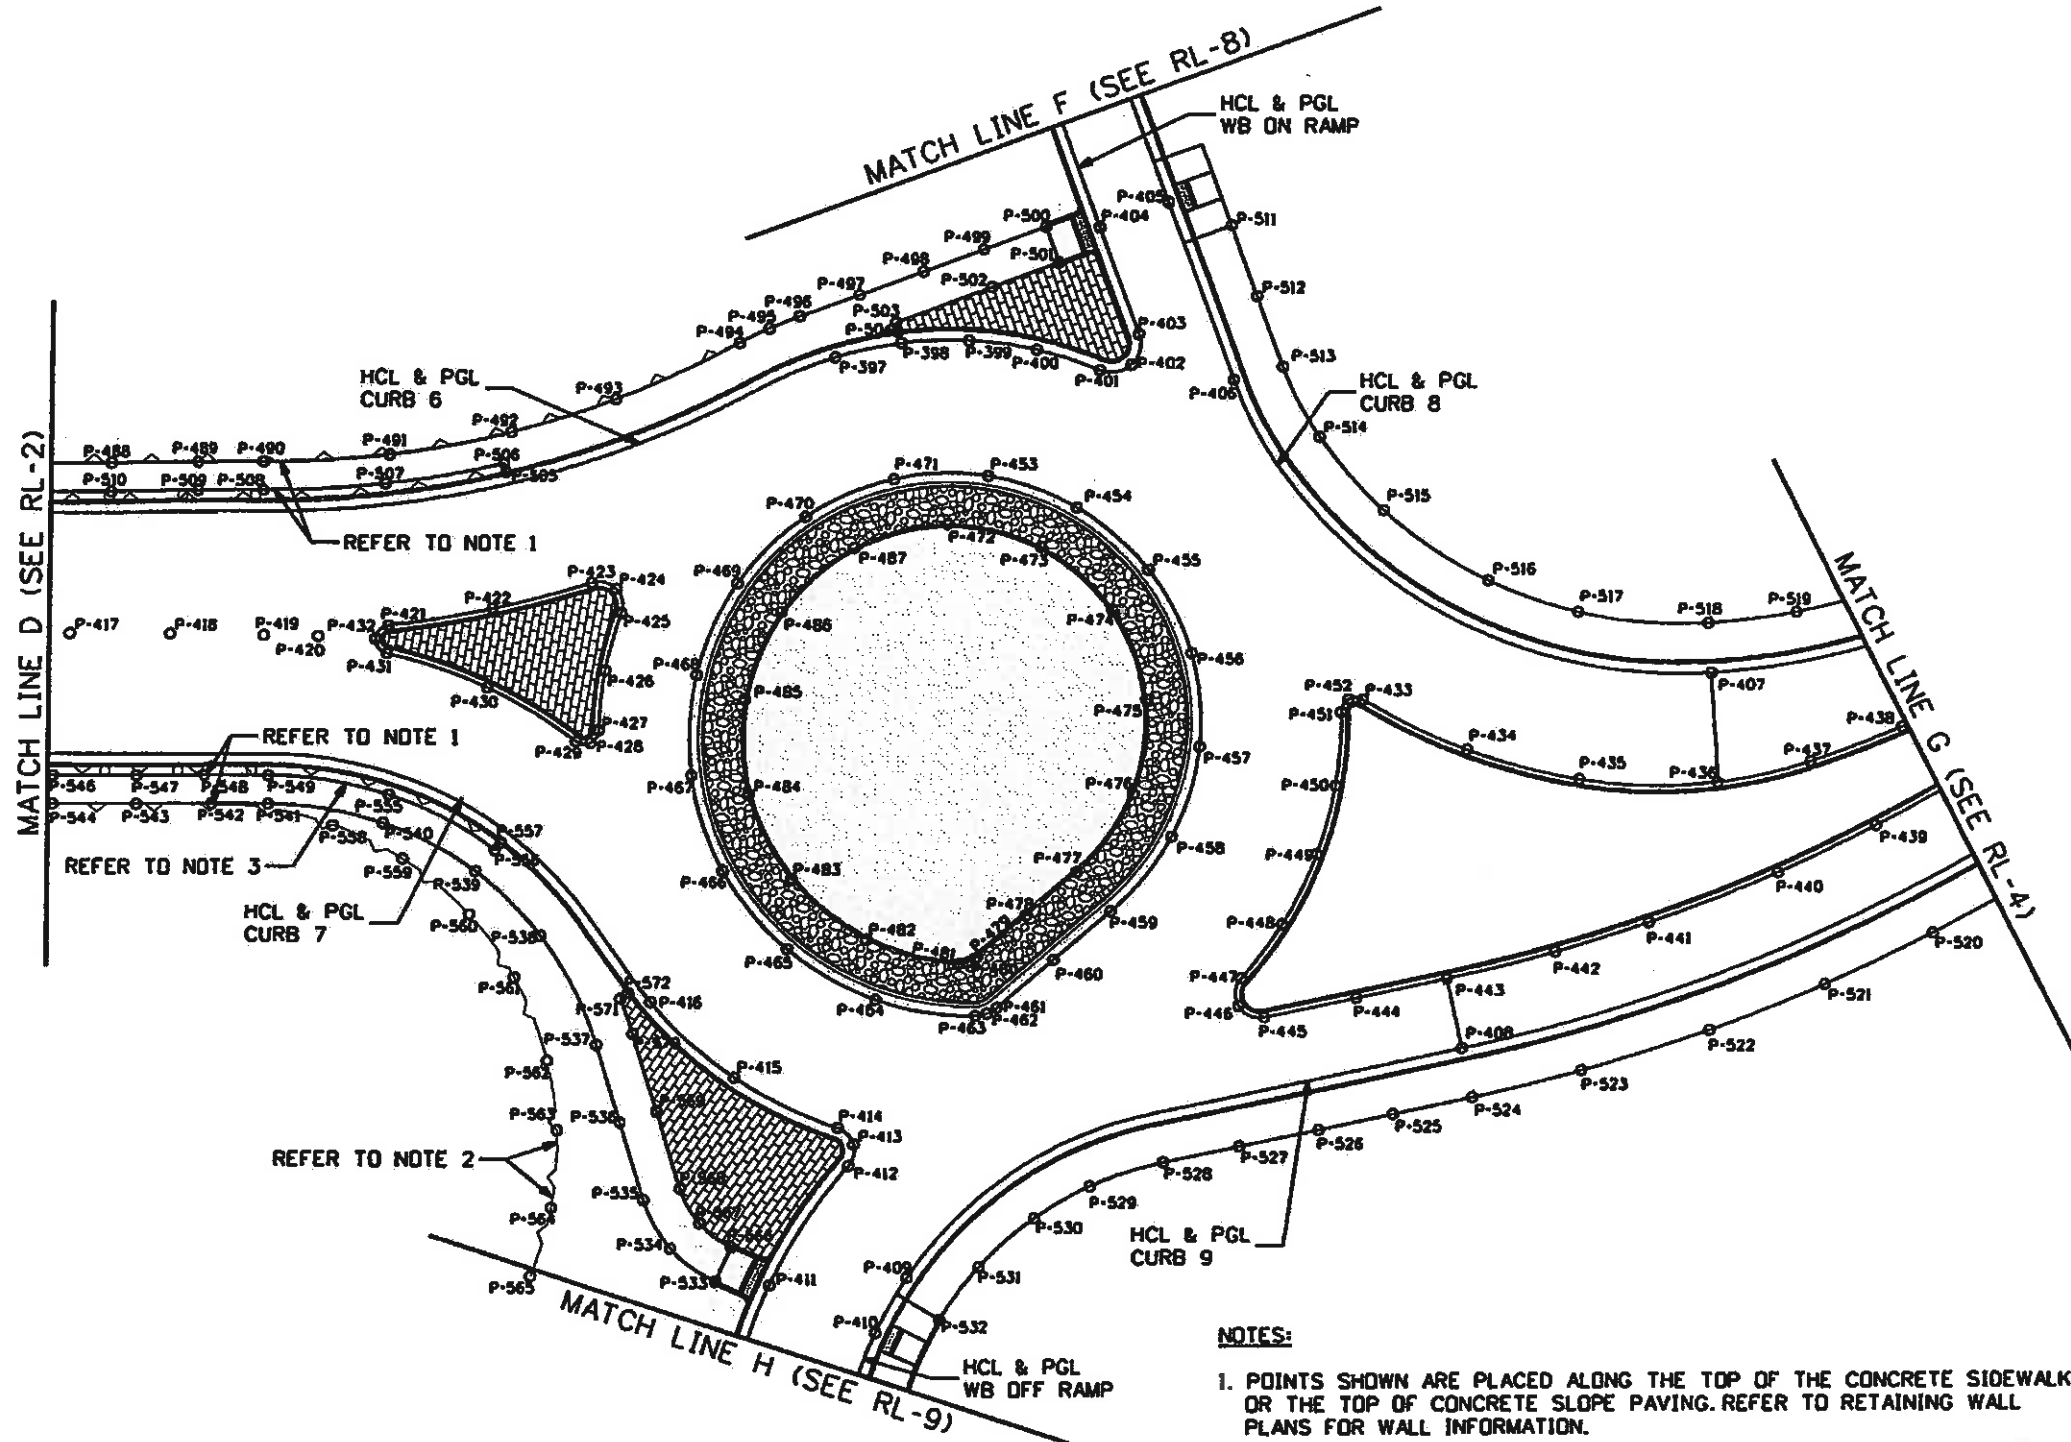

**NOTES:**

1. POINTS SHOWN ARE PLACED ALONG THE TOP OF THE CONCRETE SIDEWALK OR THE TOP OF CONCRETE SLOPE PAVING. REFER TO RETAINING WALL PLANS FOR WALL INFORMATION.
2. POINTS SHOWN ARE PLACED ALONG THE FINISHED GRADE AT THE BASE OF THE WALL. REFER TO RETAINING WALL PLANS FOR WALL INFORMATION.
3. POINTS 545 AND 550-554 HAVE BEEN INTENTIONALLY OMITTED FROM THIS SHEET.



Print Date: 11/5/2009

Drawing File Name: 06193RLP03.dgn

Horiz. Scale: 1:40.0007

Vert. Scale: As Noted

Unit Information

Unit Leader Initials

(R-X)  
000

**Sheet Revisions**

Date:	Comments	Init.

Colorado Department of Transportation



Region 3

714 Grand Avenue, P.O. Box 298  
Eagle, CO 81631  
Phone: 970-328-6385 FAX: 970-328-2368

MLM

As Constructed

No Revisions: 6-6-2011

Revised:

Void:

EDWARDS INTERCHANGE UPGRADE  
ROUNDBOUT LAYOUT PLAN

Designer: DCS  
Detailer: KMH

Structure Numbers  
Sheet Subset: POINTS Subset Sheets: RL-03 of 15

Project No./Code

ES3 0702-297

17303




Sheet Number 215



Know what's below.  
Call before you dig.

**NOTES:**

- POINTS SHOWN ARE PLACED ALONG THE TOP OF THE CONCRETE SIDEWALK OR THE TOP OF CONCRETE SLOPE PAVING. REFER TO RETAINING WALL PLANS FOR WALL INFORMATION.
- POINTS SHOWN ARE PLACED ALONG THE FINISHED GRADE AT THE BASE OF THE WALL. REFER TO RETAINING WALL PLANS FOR WALL INFORMATION.

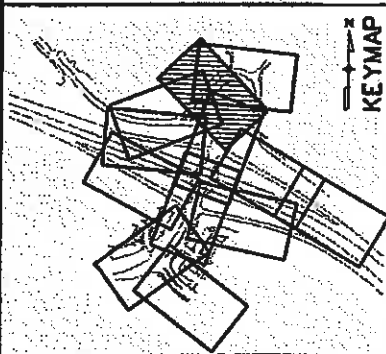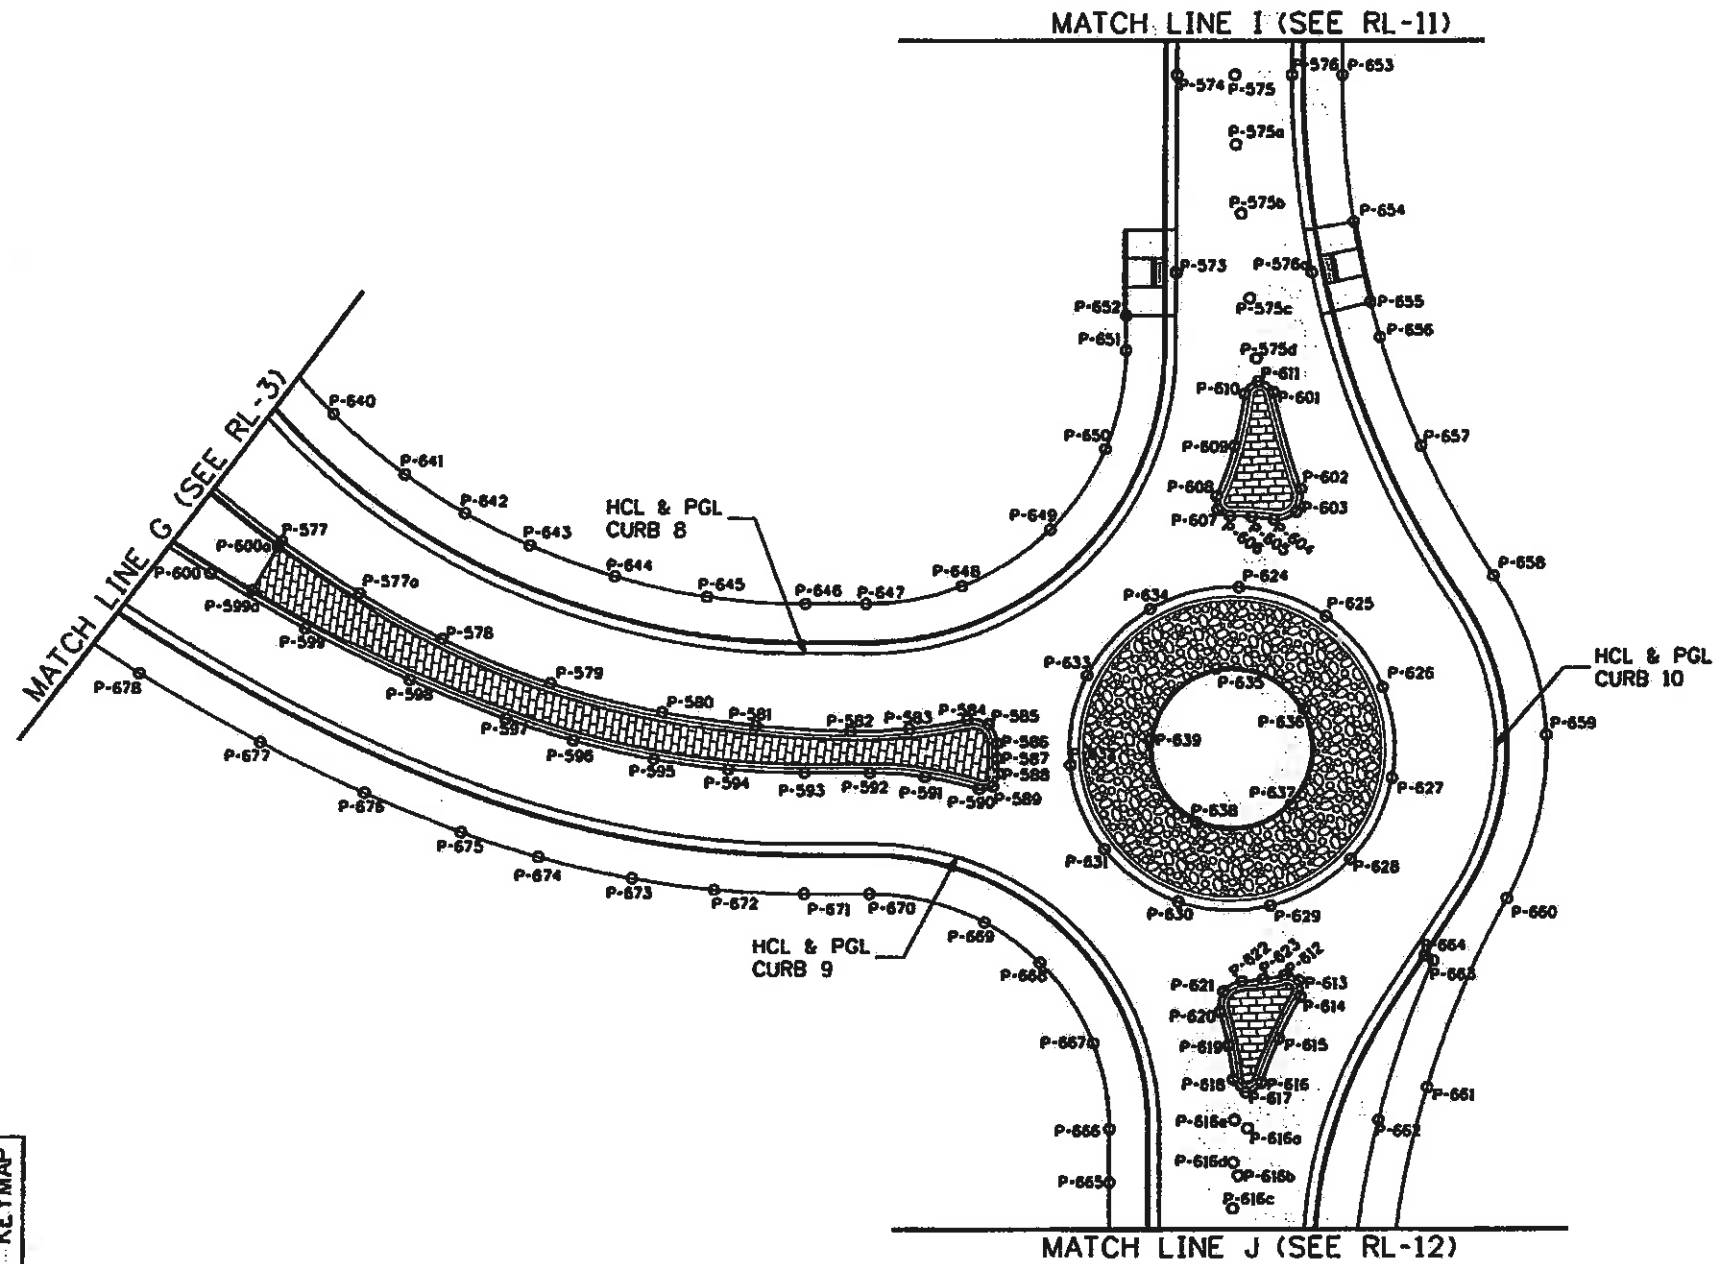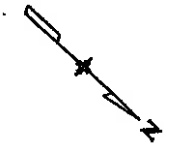

Print Date: 11/5/2009	
Drawing File Name: 06193RLP04.dgn	
Horiz. Scale: 1:40.0013      Vert. Scale: As Noted	
Unit Information      Unit Leader Initials	

Sheet Revisions		
Date	Comments	Init.

Colorado Department of Transportation



714 Grand Avenue, P.O. Box 298  
Eagle, CO 81631  
Phone: 970-328-6385 FAX: 970-328-2368

Region 3      MLM

As Constructed
No Revisions: 6-6-2011
Revised:
Void:


EDWARDS INTERCHANGE UPGRADE ROUNDABOUT LAYOUT PLAN		
Designer: DCS	Structure Numbers	
Detailer: KMH		
Sheet Subset: POINTS	Subset Sheets: RL-04 of 15	

Project No./Code	ES3 0702-297
	17303
Sheet Number	216

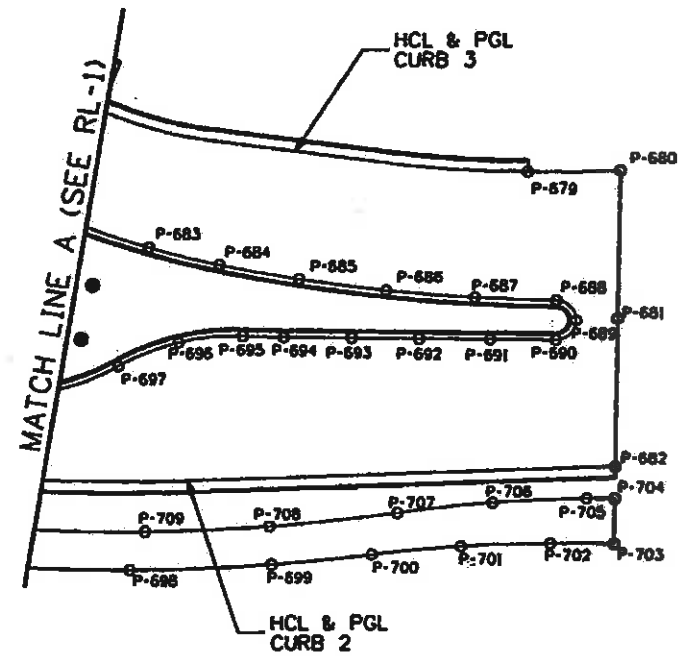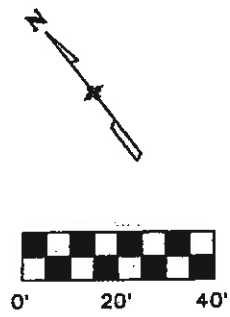

**NOTES:**


1. POINTS SHOWN ARE PLACED ALONG THE TOP OF THE CONCRETE SIDEWALK OR THE TOP OF CONCRETE SLOPE PAVING. REFER TO RETAINING WALL PLANS FOR WALL INFORMATION.
2. POINTS SHOWN ARE PLACED ALONG THE FINISHED GRADE AT THE BASE OF THE WALL. REFER TO RETAINING WALL PLANS FOR WALL INFORMATION.

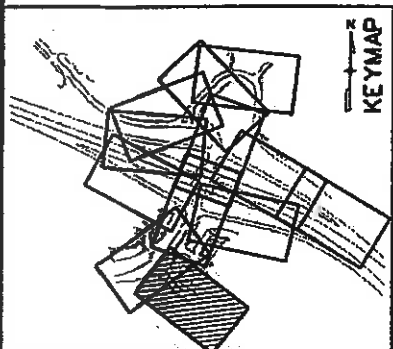

Print Date: 11/5/2009 Drawing File Name: 06193RLP05.dgn Horiz. Scale: 1:40.0017 Unit Information	Vert. Scale: As Noted Unit Leader Initials	<table border="1" style="width: 100%; border-collapse: collapse;"> <thead> <tr> <th colspan="3">Sheet Revisions</th> </tr> <tr> <th style="width: 15%;">Date:</th> <th style="width: 65%;">Comments</th> <th style="width: 20%;">Init.</th> </tr> </thead> <tbody> <tr><td> </td><td> </td><td> </td></tr> <tr><td> </td><td> </td><td> </td></tr> <tr><td> </td><td> </td><td> </td></tr> </tbody> </table>	Sheet Revisions			Date:	Comments	Init.										Colorado Department of Transportation 714 Grand Avenue, P.O. Box 298 Eagle, CO 81631 Phone: 970-328-6385 FAX: 970-328-2368 <b>Region 3</b>	As Constructed No Revisions: <i>6-6-Zell</i> Revised: Void:	<b>EDWARDS INTERCHANGE UPGRADE ROUNDABOUT LAYOUT PLAN</b> Designer: DCS Detoiler: KMH Sheet Subset: POINTS	Structure Numbers Subset Sheets: RL-05 of 15	Project No./Code ES3 0702-297 17303 Sheet Number <b>217</b>
Sheet Revisions																						
Date:	Comments	Init.																				




Know what's Below.  
Call before you dig.


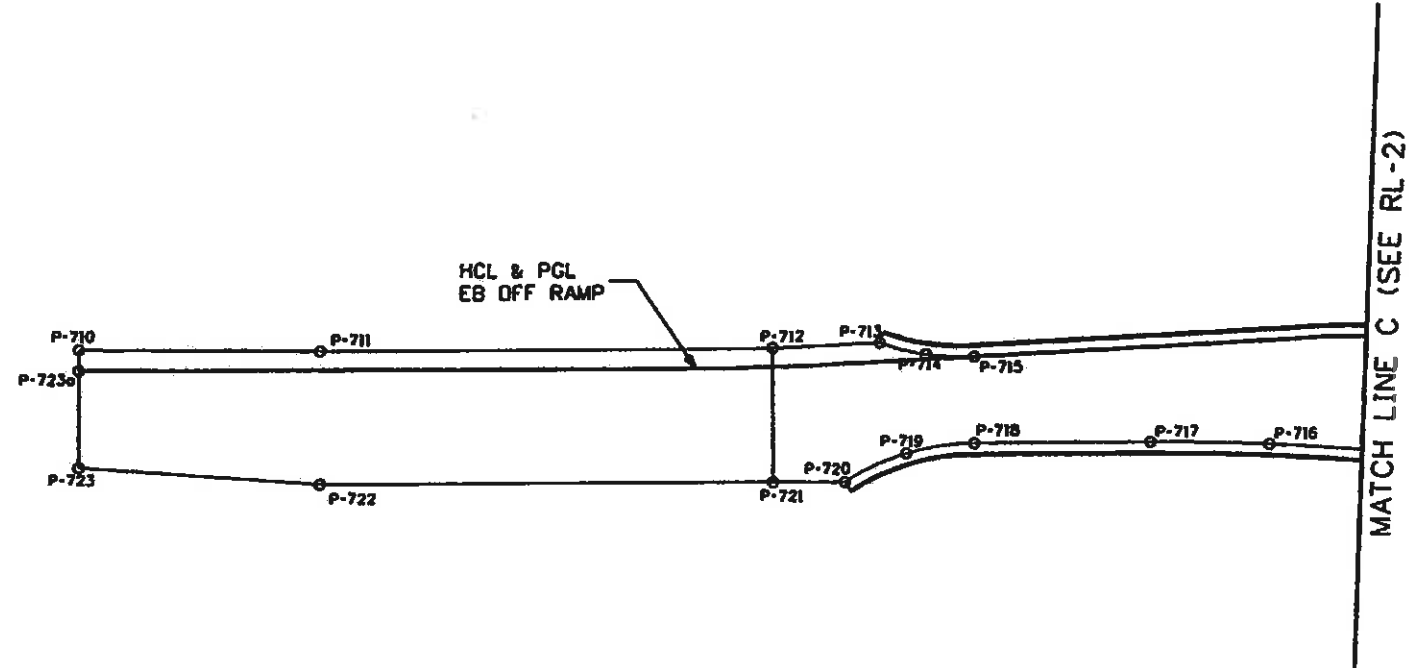


**NOTES:**

1. POINTS SHOWN ARE PLACED ALONG THE TOP OF THE CONCRETE SIDEWALK OR THE TOP OF CONCRETE SLOPE PAVING. REFER TO RETAINING WALL PLANS FOR WALL INFORMATION.
2. POINTS SHOWN ARE PLACED ALONG THE FINISHED GRADE AT THE BASE OF THE WALL. REFER TO RETAINING WALL PLANS FOR WALL INFORMATION.

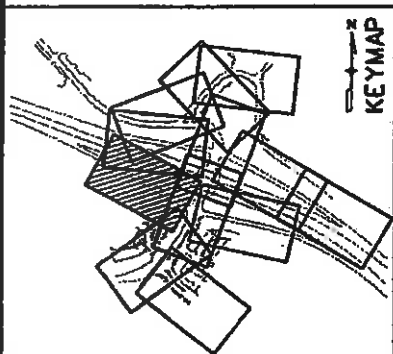

Print Date: 11/5/2009	<b>Sheet Revisions</b>			Colorado Department of Transportation	As Constructed	EDWARDS INTERCHANGE UPGRADE ROUNDABOUT LAYOUT PLAN		Project No./Code
Drawing File Name: 06193RLP06.dgn	Date:	Comments:	Init.:		No Revisions: 6-6-2011	Designer: DCS	Structure Numbers	ES3 0702-297
Horiz. Scale: 1:40.0031	Vert. Scale: As Noted			714 Grand Avenue, P.O. Box 298 Eagle, CO 81631 Phone: 970-328-6385 FAX: 970-328-2368	Revised:	Detailer: KMH		17303
Unit Information	Unit Leader Initials				Void:	Sheet Subset: POINTS	Subset Sheets: RL-06 of 15	Sheet Number <b>218</b>

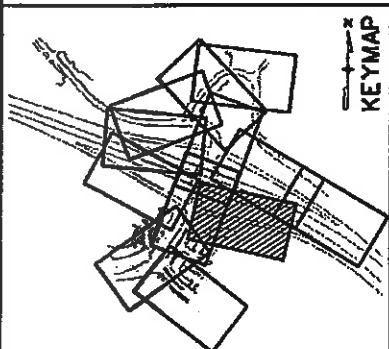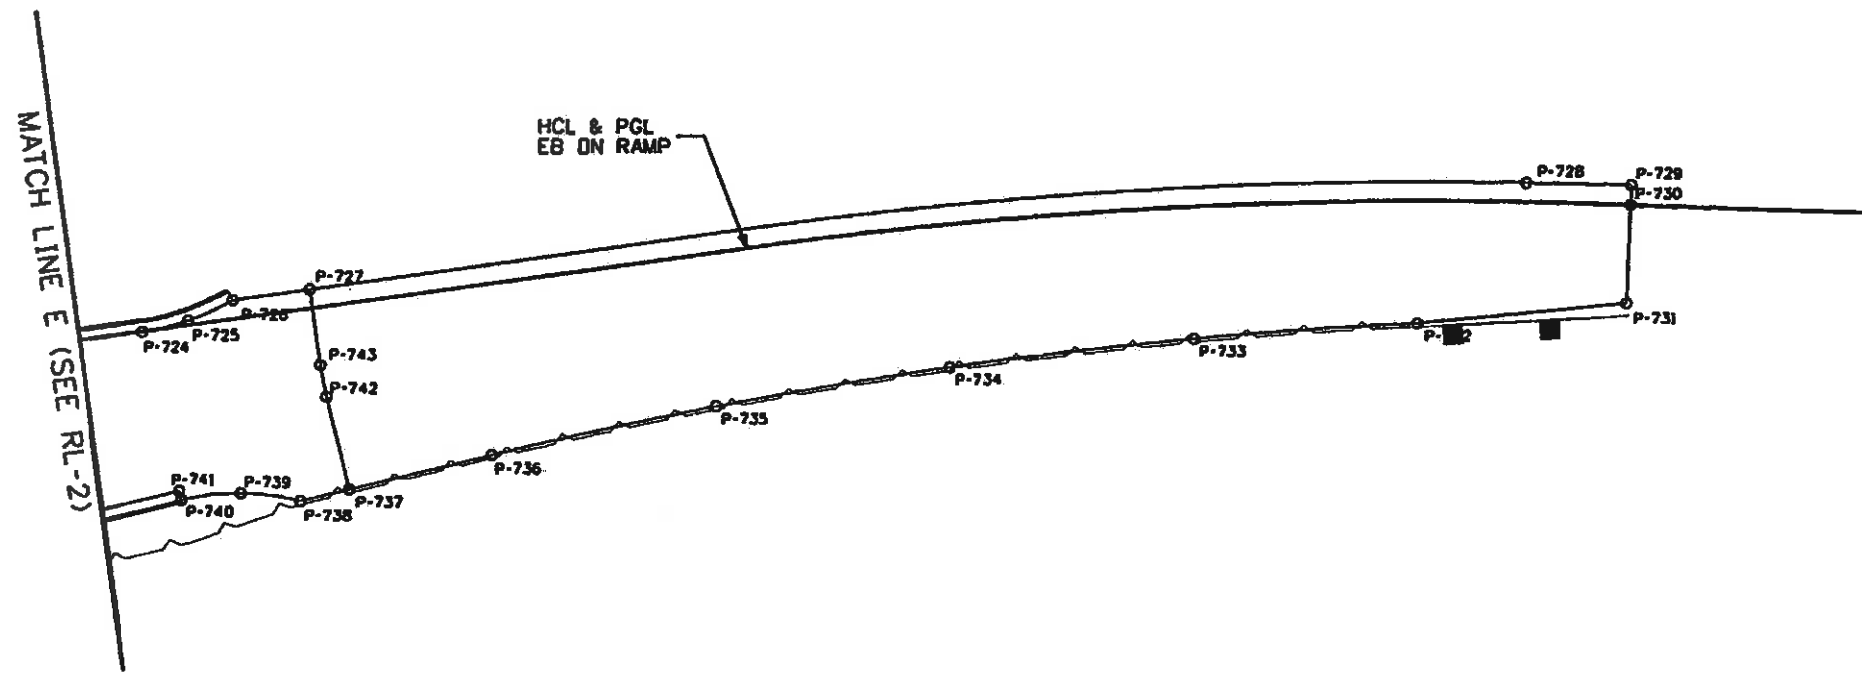

**NOTES:**

1. POINTS SHOWN ARE PLACED ALONG THE TOP OF THE CONCRETE SIDEWALK OR THE TOP OF CONCRETE SLOPE PAVING. REFER TO RETAINING WALL PLANS FOR WALL INFORMATION.
2. POINTS SHOWN ARE PLACED ALONG THE FINISHED GRADE AT THE BASE OF THE WALL. REFER TO RETAINING WALL PLANS FOR WALL INFORMATION.





Print Date: 11/5/2009 Drawing File Name: 06193RLP07.dgn Horiz. Scale: 1:40.0051 Unit Information	R-X 000	<table border="1" style="width: 100%; border-collapse: collapse;"> <thead> <tr> <th colspan="3">Sheet Revisions</th> </tr> <tr> <th style="width: 15%;">Date:</th> <th style="width: 65%;">Comments</th> <th style="width: 20%;">Init.</th> </tr> </thead> <tbody> <tr><td> </td><td> </td><td> </td></tr> <tr><td> </td><td> </td><td> </td></tr> <tr><td> </td><td> </td><td> </td></tr> </tbody> </table>	Sheet Revisions			Date:	Comments	Init.										<b>Colorado Department of Transportation</b> 714 Grand Avenue, P.O. Box 298 Eagle, CO 81631 Phone: 970-328-6385 FAX: 970-328-2368 <b>Region 3</b>	<table border="1" style="width: 100%; border-collapse: collapse;"> <tr> <td style="text-align: center;"><b>As Constructed</b></td> </tr> <tr> <td>No Revisions: 6-6-2011</td> </tr> <tr> <td>Revised:</td> </tr> <tr> <td>Void:</td> </tr> </table>	<b>As Constructed</b>	No Revisions: 6-6-2011	Revised:	Void:	<b>EDWARDS INTERCHANGE UPGRADE ROUNDABOUT PLAN LAYOUT</b>	<table border="1" style="width: 100%; border-collapse: collapse;"> <tr> <td>Designer: DCS</td> <td>Structure Numbers</td> </tr> <tr> <td>Detailer: KMH</td> <td>Subset Sheets: RL-07 of 15</td> </tr> </table>	Designer: DCS	Structure Numbers	Detailer: KMH	Subset Sheets: RL-07 of 15	<table border="1" style="width: 100%; border-collapse: collapse;"> <tr> <td>Project No./Code</td> </tr> <tr> <td>ES3 0702-297</td> </tr> <tr> <td>17303</td> </tr> <tr> <td>Sheet Number <b>219</b></td> </tr> </table>	Project No./Code	ES3 0702-297	17303	Sheet Number <b>219</b>
Sheet Revisions																																		
Date:	Comments	Init.																																
<b>As Constructed</b>																																		
No Revisions: 6-6-2011																																		
Revised:																																		
Void:																																		
Designer: DCS	Structure Numbers																																	
Detailer: KMH	Subset Sheets: RL-07 of 15																																	
Project No./Code																																		
ES3 0702-297																																		
17303																																		
Sheet Number <b>219</b>																																		





Know what's behind you.  
Call before painting.


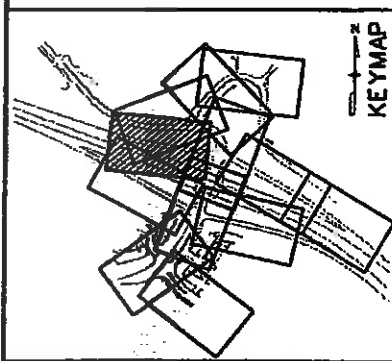
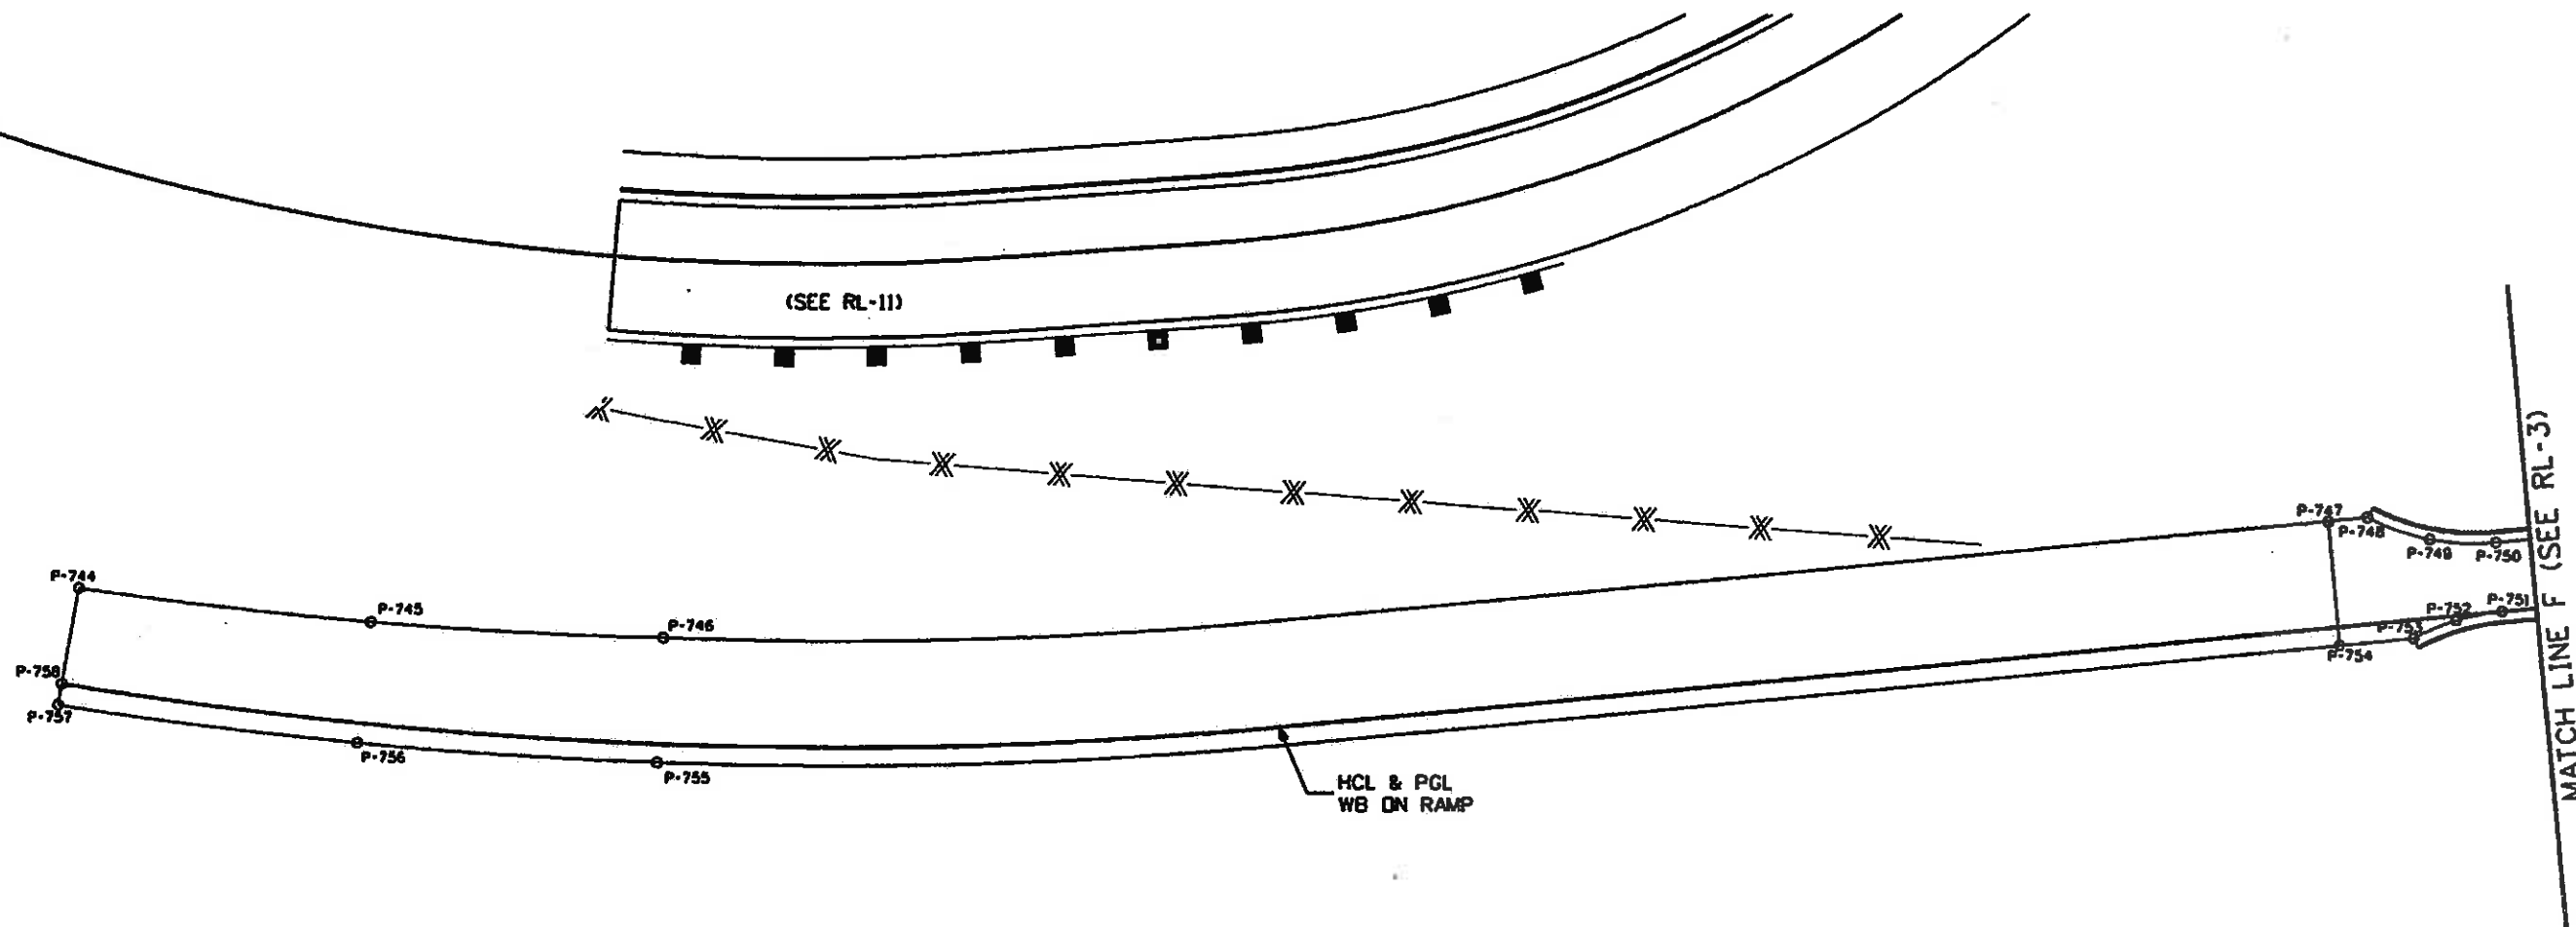


**NOTES:**

1. POINTS SHOWN ARE PLACED ALONG THE TOP OF THE CONCRETE SIDEWALK OR THE TOP OF CONCRETE SLOPE PAVING. REFER TO RETAINING WALL PLANS FOR WALL INFORMATION.
2. POINTS SHOWN ARE PLACED ALONG THE FINISHED GRADE AT THE BASE OF THE WALL. REFER TO RETAINING WALL PLANS FOR WALL INFORMATION.



Print Date: 11/5/2009		<b>Sheet Revisions</b> Date:    Comments:    Init.:			<b>As Constructed</b> No Revisions: 6-6-2011		<b>EDWARDS INTERCHANGE UPGRADE ROUNDABOUT LAYOUT PLAN</b>		<b>Project No./Code</b> ES3 0702-297	
Drawing File Name: 06193RLP08.dgn					Colorado Department of Transportation 714 Grand Avenue, P.O. Box 298 Eagle, CO 81631 Phone: 970-328-6385 FAX: 970-328-2368 <b>Region 3</b>		Revised: Void:		Designer: DCS Detailer: KMH Sheet Subset: PDINTS Structure Numbers: Subset Sheets: RL-08 of 15	
Horiz. Scale: 1:40.0026    Vert. Scale: As Noted Unit Information    Unit Leader Initials					<b>Region 3</b> <b>MLM</b>					

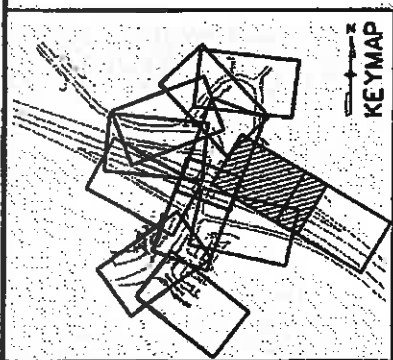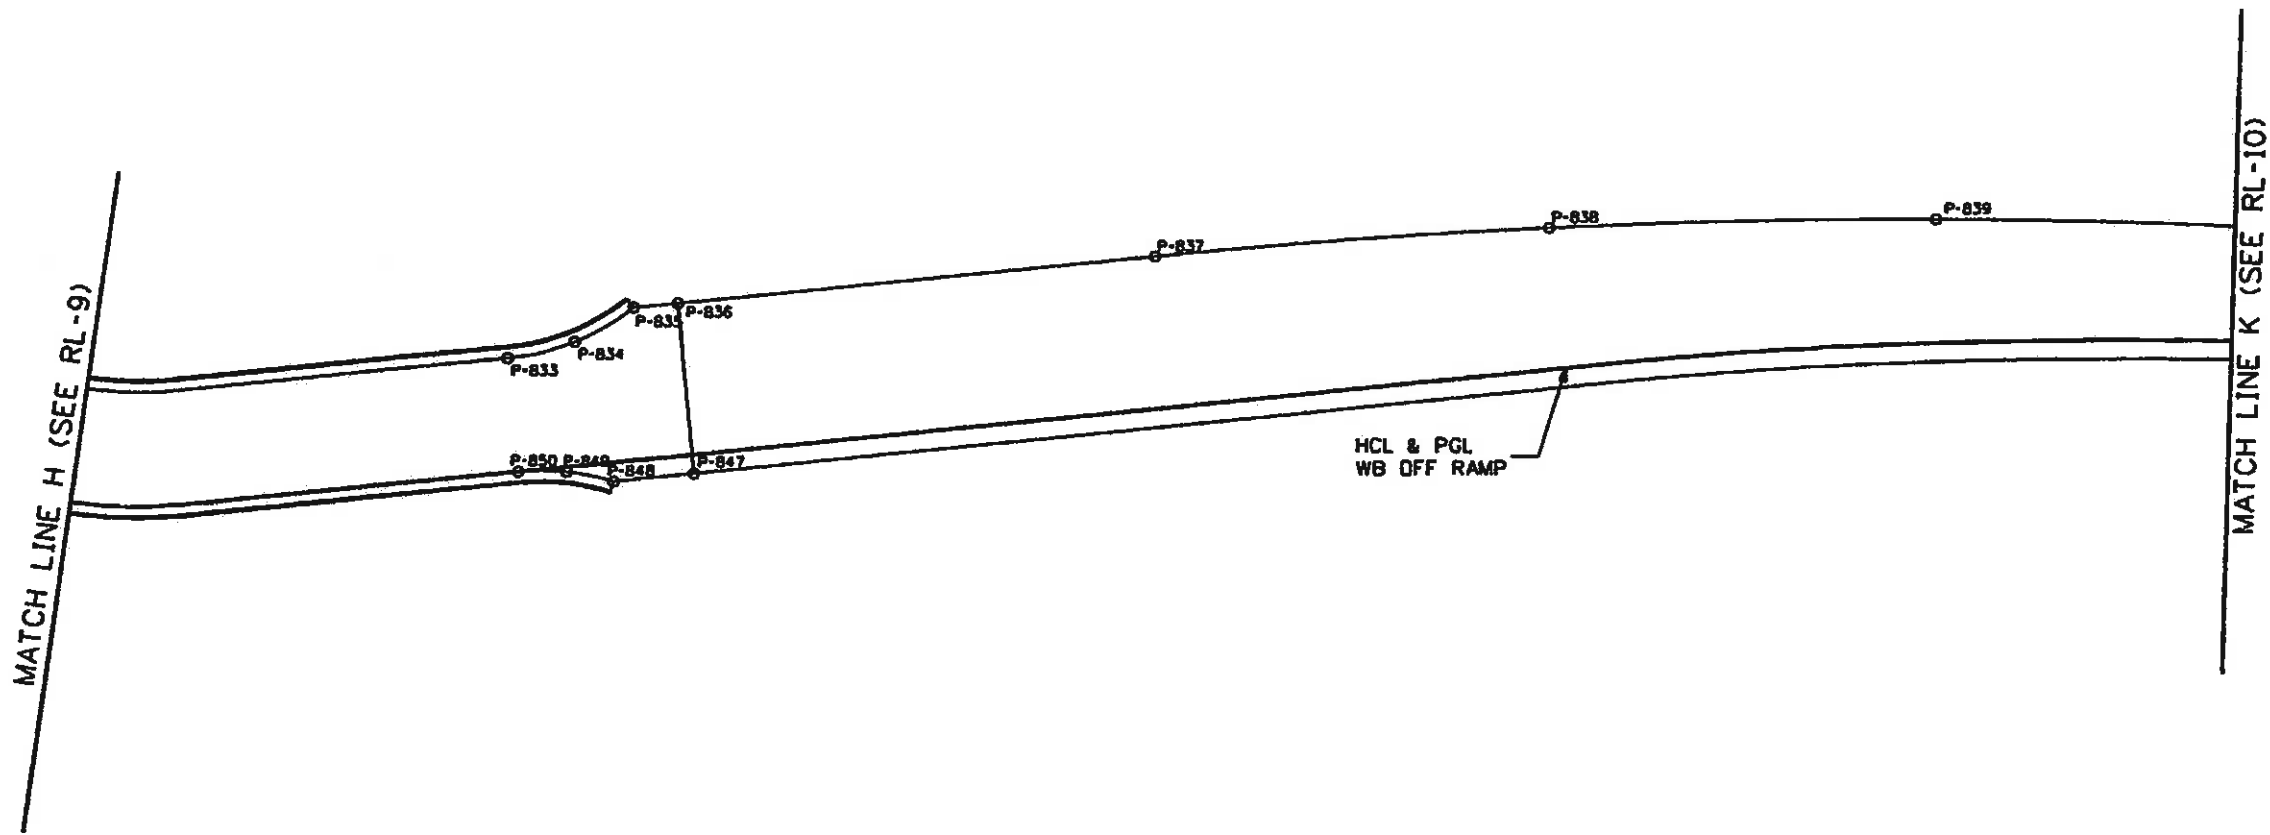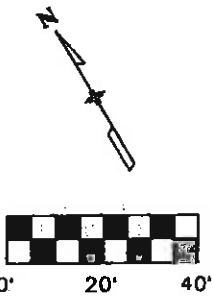

**NOTES:**


1. POINTS SHOWN ARE PLACED ALONG THE TOP OF THE CONCRETE SIDEWALK OR THE TOP OF CONCRETE SLOPE PAVING. REFER TO RETAINING WALL PLANS FOR WALL INFORMATION.
2. POINTS SHOWN ARE PLACED ALONG THE FINISHED GRADE AT THE BASE OF THE WALL. REFER TO RETAINING WALL PLANS FOR WALL INFORMATION.



Print Date: 11/5/2009
Drawing File Name: 06193RLP09.dgn
Horiz. Scale: 1:40.0034
Unit Information
Vert. Scale: As Noted
Unit Leader Initials

Sheet Revisions		
Date:	Comments:	Init.:

Colorado Department of Transportation





714 Grand Avenue, P.O. Box 298  
Eagle, CO 81631  
Phone: 970-328-6385 FAX: 970-328-2368

Region 3 MLM

As Constructed
No Revisions: 6-6-2011
Revised:
Void:


EDWARDS INTERCHANGE UPGRADE ROUNDABOUT LAYOUT PLAN		
Designer: DCS	Structure	
Detailer: KMH	Numbers	
Sheet Subset: POINTS	Subset Sheets: RL-09 of 15	

Project No./Code	ES3 0702-297
	17303
Sheet Number	221

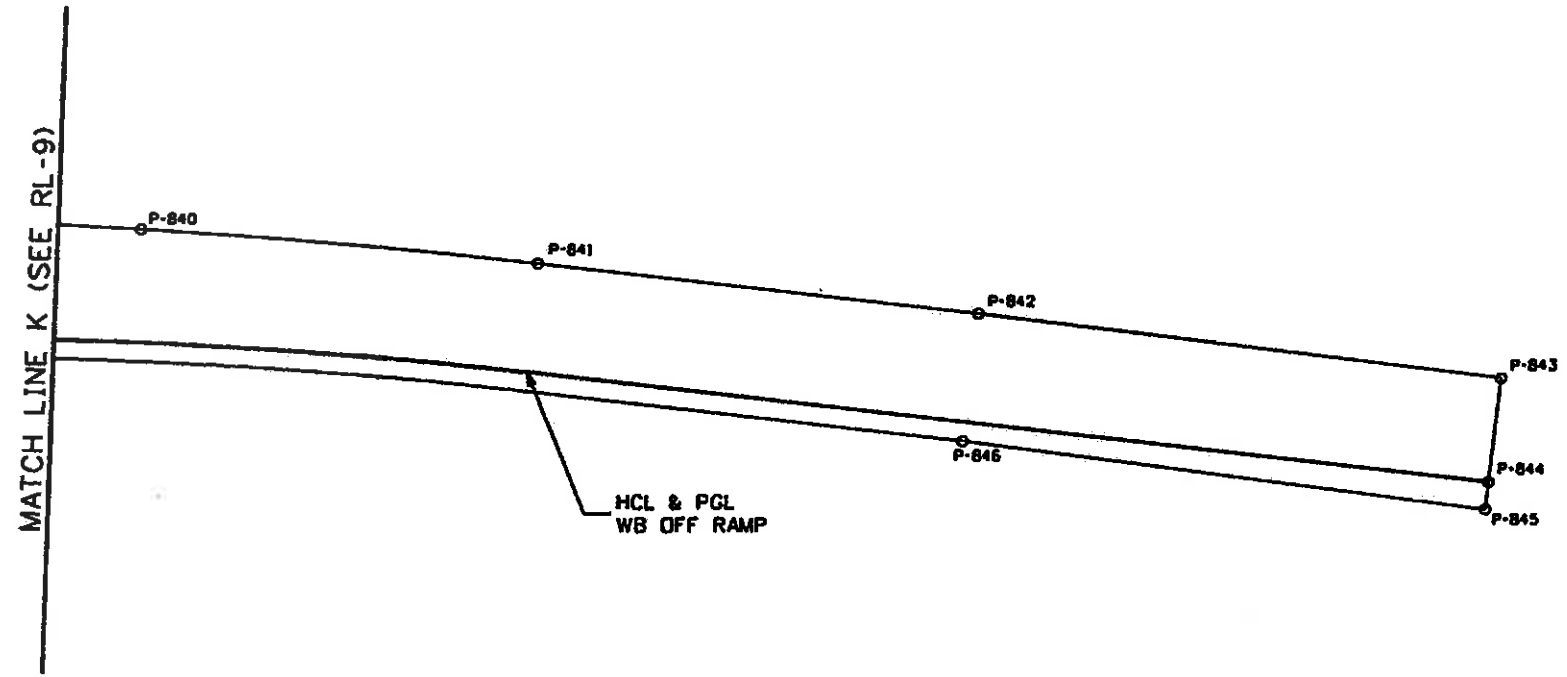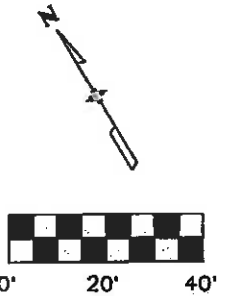

**NOTES:**

1. POINTS SHOWN ARE PLACED ALONG THE TOP OF THE CONCRETE SIDEWALK OR THE TOP OF CONCRETE SLOPE PAVING. REFER TO RETAINING WALL PLANS FOR WALL INFORMATION.
2. POINTS SHOWN ARE PLACED ALONG THE FINISHED GRADE AT THE BASE OF THE WALL. REFER TO RETAINING WALL PLANS FOR WALL INFORMATION.

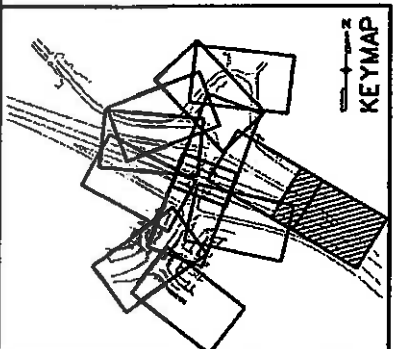



Print Date: 11/5/2009		<b>Sheet Revisions</b>	<b>Colorado Department of Transportation</b>	<b>As Constructed</b>	<b>EDWARDS INTERCHANGE UPGRADE ROUNDBOUT LAYOUT PLAN</b>	<b>Project No./Code</b>
Drawing File Name: 06193RLP10.dgn		Date:    Comments:    Init:	714 Grand Avenue, P.O. Box 298 Eagle, CO 81631 Phone: 970-328-6385 FAX: 970-328-2368	No Revisions: <b>6-6-2011</b>	Designer: DCS	ES3 0702-297
Horiz. Scale: 1:40.0034    Vert. Scale: As Noted	Unit Information    Unit Leader Initials		<b>Region 3</b>	Revised:	Detailer: KMH	17303
	(R-X)		<b>MLM</b>	Void:	Sheet Subset: POINTS    Subset Sheets: RL-10 of 15	Sheet Number <b>222</b>





Know what's below.  
Call before you dig.

**NOTES:**

1. POINTS SHOWN ARE PLACED ALONG THE TOP OF THE CONCRETE SIDEWALK OR THE TOP OF CONCRETE SLOPE PAVING. REFER TO RETAINING WALL PLANS FOR WALL INFORMATION.
2. POINTS SHOWN ARE PLACED ALONG THE FINISHED GRADE AT THE BASE OF THE WALL. REFER TO RETAINING WALL PLANS FOR WALL INFORMATION.
3. POINTS 759-761 HAVE BEEN INTENTIONALLY OMITTED FROM THIS SHEET.

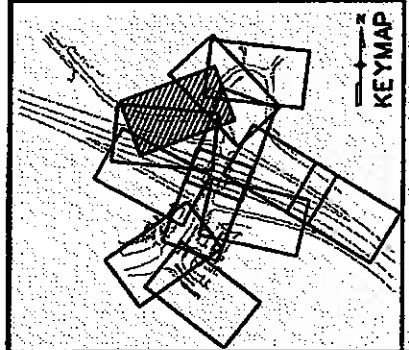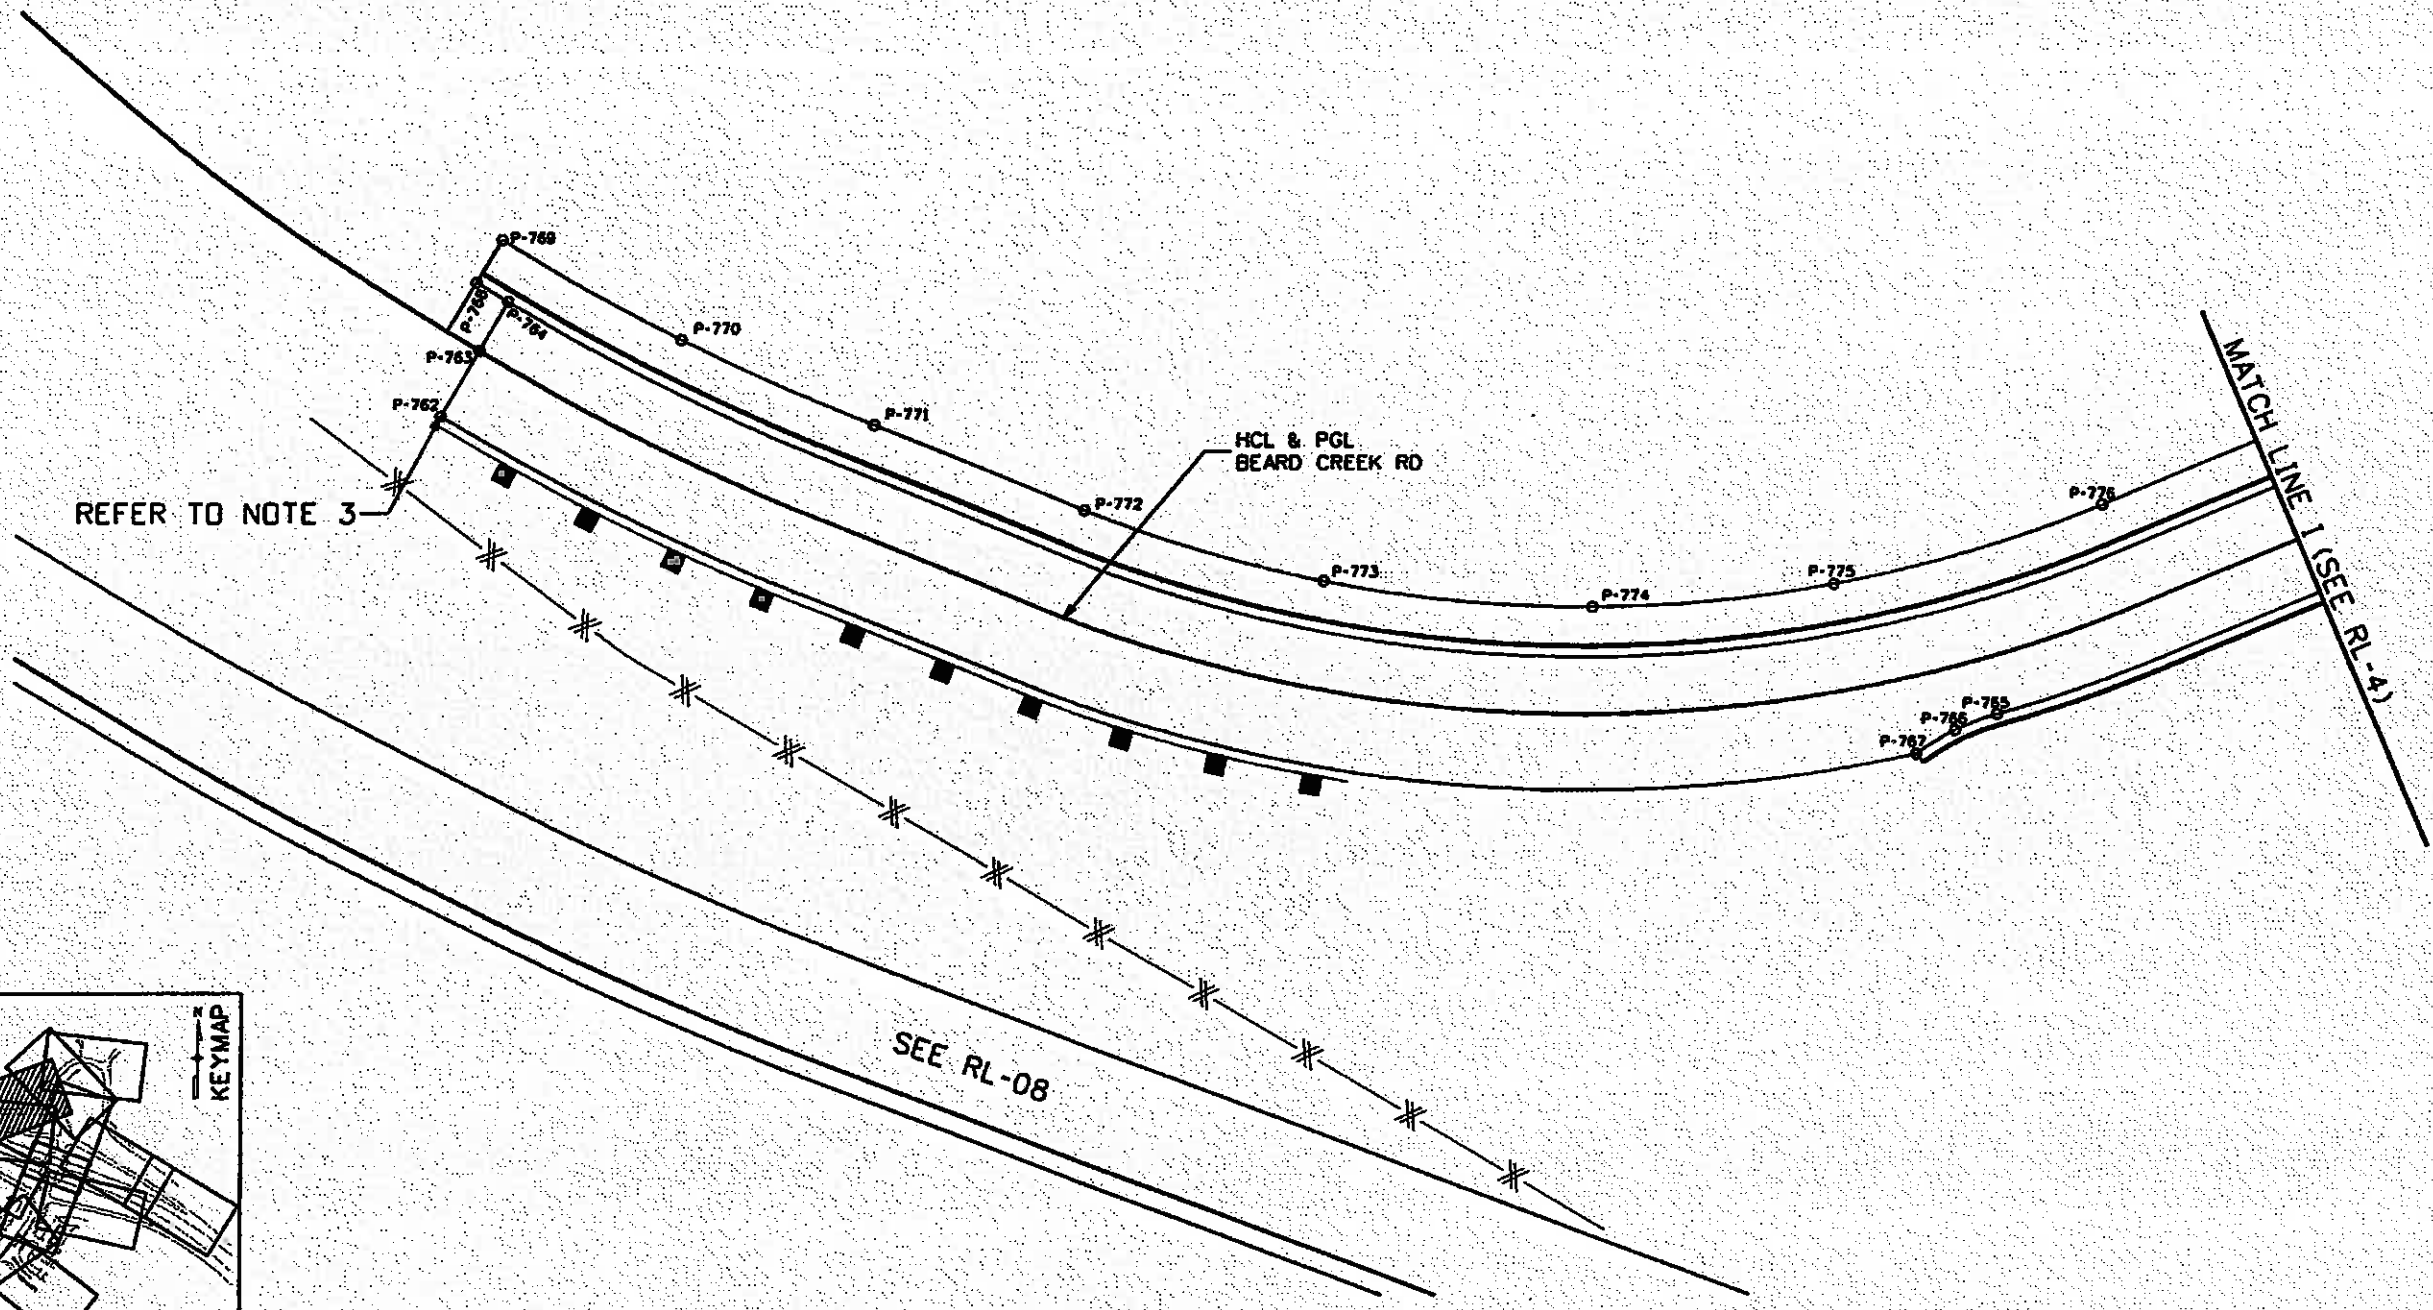

Print Date: 11/5/2009	<b>Sheet Revisions</b>			Colorado Department of Transportation  714 Grand Avenue, P.O. Box 298 Eagle, CO 81631 Phone: 970-328-6385 FAX: 970-328-2368 <b>Region 3</b>	As Constructed No Revisions: <b>6-6-2011</b>	<b>EDWARDS INTERCHANGE UPGRADE ROUNDBOUT LAYOUT PLAN</b>		Project No./Code
Drawing File Name: 06193RLP11.dgn	Date:	Comments:	Init.			Revised:	Designer: DCS	Structure Numbers
Horiz. Scale: 1:40.0052	Vert. Scale: As Noted				Void:	Detailer: KMH		17303
Unit Information	Unit Leader Initials					Sheet Subset: POINTS	Subset Sheets: RL-11 of 15	Sheet Number: <b>223</b>

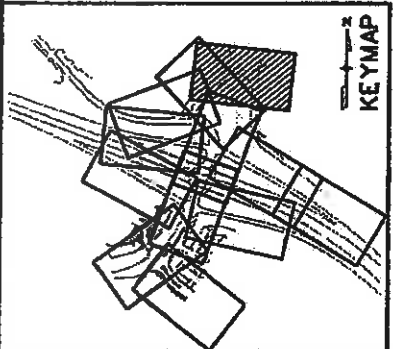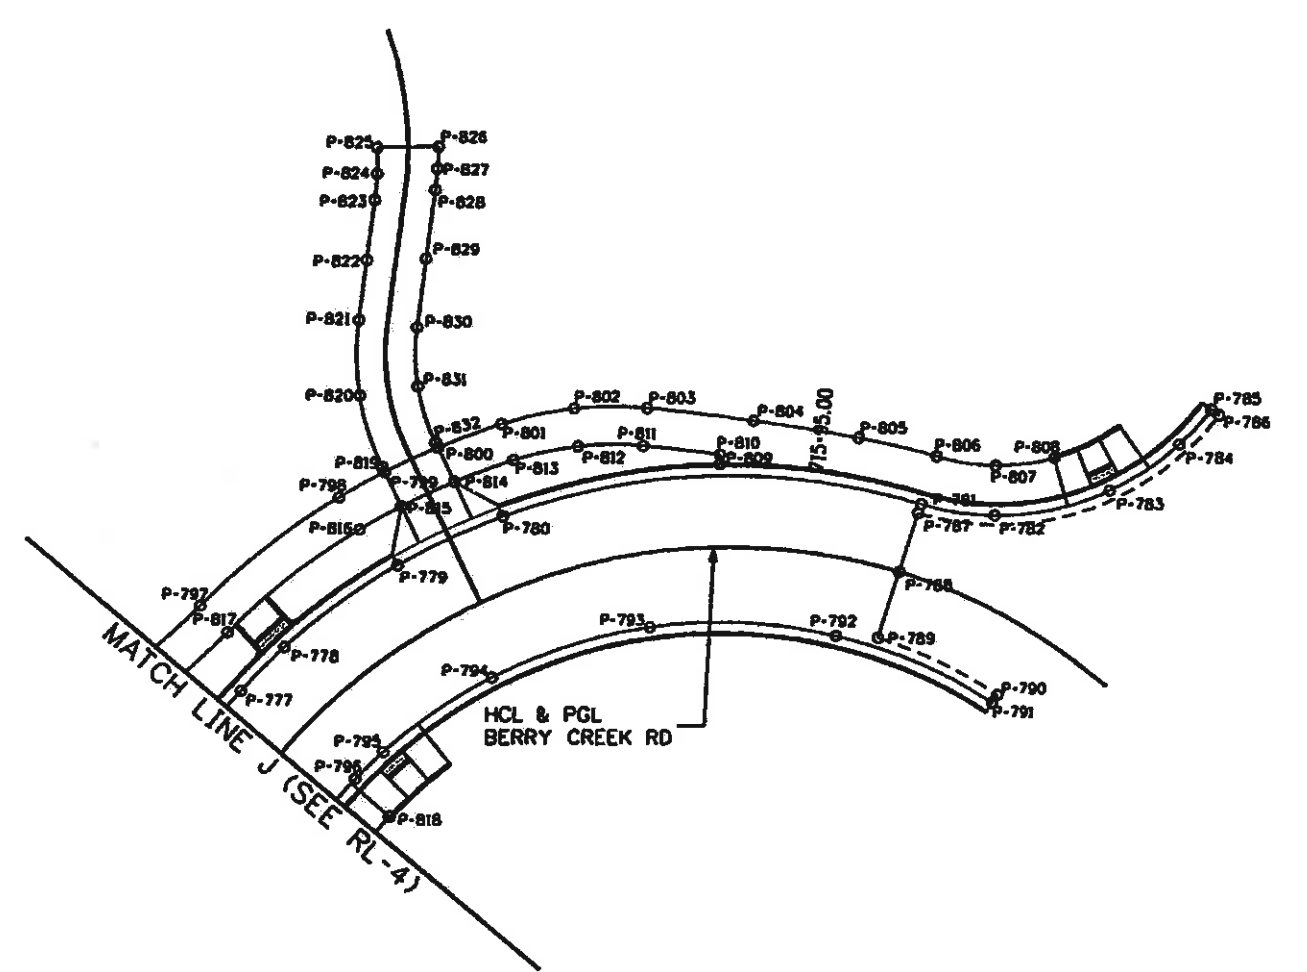

**NOTES:**

- POINTS SHOWN ARE PLACED ALONG THE TOP OF THE CONCRETE SIDEWALK OR THE TOP OF CONCRETE SLOPE PAVING. REFER TO RETAINING WALL PLANS FOR WALL INFORMATION.
- POINTS SHOWN ARE PLACED ALONG THE FINISHED GRADE AT THE BASE OF THE WALL. REFER TO RETAINING WALL PLANS FOR WALL INFORMATION.



Print Date: 11/5/2009	<b>Sheet Revisions</b>			Colorado Department of Transportation	As Constructed	EDWARDS INTERCHANGE UPGRADE ROUNDABOUT LAYOUT PLAN		Project No./Code	
Drawing File Name: 06193RLP12.dgn	Date:	Comments:	Init.					No Revisions: 6-6-2011	ES3 0702-297
Horiz. Scale: 1:40.0011	Vert. Scale: As Noted	714 Grand Avenue, P.O. Box 298 Eagle, CO 81631 Phone: 970-328-6385 FAX: 970-328-2368 Region 3 MLM			Revised:	Designer: DCS	Structure	17303	
Unit Information	Unit Leader Initials							Detailer: KMH	Numbers
					Void:	Sheet Subset: POINTS	Subset Sheets: RL-12 of 15		



COGO POINTS POINT NAME	NORTHING	EASTING	ELEVATION
1	62695.63	93293.64	7263.77
2	62769.34	93438.17	7263.98
3	62859.95	93447.88	7257.93
4	62838.71	93439.64	7256.94
5	62837.88	93437.78	7256.87
6	62898.27	93414.77	7256.24
7	62892.59	93428.38	7256.57
8	62879.68	93425.97	7256.13
9	62879.68	93425.97	7256.13
10	62877.28	93433.81	7256.18
11	62885.38	93438.61	7256.18
12	62884.98	93448.82	7255.73
13	62902.35	93448.67	7255.23
14	62906.25	93452.86	7255.31
15	62915.11	93477.88	7254.13
16	62912.68	93483.88	7254.53
17	62915.48	93489.63	7255.85
18	62928.89	93508.48	7256.25
19	62982.52	93528.36	7256.58
20	62988.94	93524.98	7256.55
21	62873.57	93578.45	7263.81
22	62886.29	93677.43	7265.56
23	62861.68	93688.98	7265.28
24	62826.62	93758.83	7265.31
25	62812.64	93748.76	7265.92
26	62798.63	93738.67	7265.93
27	62823.16	93666.87	7264.88
28	62888.78	93646.75	7264.48
29	62797.57	93641.79	7264.89
30	62699.47	93627.61	7265.35
31	62653.28	93556.58	7265.63
32	62711.59	93453.81	7265.16
33	62653.98	93388.36	7264.81
34	62675.94	93299.65	7264.23
35	62682.01	93314.97	7264.51
36	62685.88	93324.53	7264.67
37	62689.29	93333.32	7264.84
38	62693.34	93343.86	7265.03
39	62699.01	93355.67	7265.26
40	62704.86	93367.86	7265.48
41	62718.72	93388.84	7265.48
42	62717.17	93392.52	7265.39
43	62723.62	93404.99	7265.28
44	62896.79	93461.63	7266.46
45	62887.34	93471.19	7267.68
46	62881.43	93477.16	7268.32
47	62821.68	93726.19	7266.16
48	62828.71	93789.67	7265.91
49	62834.38	93694.41	7265.54
50	62848.48	93677.74	7265.28
51	62846.38	93661.63	7264.99
52	62736.93	93424.46	7265.82
53	62752.55	93445.66	7264.43
54	62764.46	93459.84	7263.82
55	62765.43	93464.89	7263.88
56	62761.44	93468.11	7263.79
57	62749.52	93478.83	7264.17
58	62738.25	93475.54	7264.48
59	62735.87	93475.29	7264.57
60	62733.91	93472.32	7264.65
61	62735.57	93452.68	7264.88
62	62731.58	93427.81	7265.11
63	62733.17	93423.44	7265.87
64	62848.72	93487.64	7261.41
65	62852.82	93486.68	7268.83
66	62864.67	93484.84	7268.82
67	62871.85	93481.69	7269.33
68	62876.52	93483.13	7269.83
69	62874.59	93486.97	7269.74
70	62862.87	93495.22	7269.95
71	62851.15	93503.47	7268.82
72	62847.88	93504.23	7261.12
73	62843.83	93501.67	7261.42
74	62838.29	93492.38	7261.48
75	62838.18	93489.31	7261.44
76	62844.28	93574.39	7262.68

77	62848.33	93582.76	7263.88
78	62853.17	93591.89	7263.34
79	62868.78	93681.73	7263.82
80	62867.87	93689.18	7264.19
81	62875.14	93617.17	7264.63
82	62883.46	93624.87	7265.86
83	62897.78	93633.81	7265.73
84	62915.13	93643.21	7266.49
84A	62932.37	93658.21	7267.87
85	62923.71	93663.88	7266.17
86	62898.77	93654.98	7265.55
87	62873.84	93646.97	7265.88
88	62855.19	93648.46	7264.48
89	62835.27	93632.34	7264.48
90	62814.88	93622.29	7263.97
91	62798.41	93613.84	7263.74
92	62795.89	93609.19	7263.62
93	62798.95	93604.88	7263.51
94	62816.81	93594.75	7263.18
95	62829.63	93588.32	7262.77
96	62839.98	93588.39	7262.48
97	62842.42	93578.16	7262.54
98	62718.84	93599.37	7264.78
99	62698.32	93585.42	7265.16
100	62674.43	93613.52	7265.43
101	62656.28	93587.78	7265.73
102	62658.48	93575.88	7265.88
103	62655.41	93568.32	7265.48
104	62678.47	93555.46	7265.27
105	62682.91	93551.29	7265.28
106	62687.89	93558.18	7265.18
107	62691.25	93554.81	7265.81
108	62698.58	93575.64	7264.81
109	62711.62	93594.39	7264.82
110	62712.28	93597.34	7264.66
111	62812.43	93586.24	7261.63
112	62821.81	93524.46	7261.58
113	62823.52	93544.75	7261.78
114	62817.25	93564.38	7262.21
115	62884.18	93579.95	7262.88
116	62785.88	93589.39	7263.24
117	62765.48	93591.89	7263.65
118	62745.88	93584.84	7263.82
119	62738.29	93571.66	7264.89
120	62728.87	93553.39	7264.36
121	62719.15	93533.87	7264.63
122	62725.48	93513.51	7264.67
123	62738.63	93497.85	7264.37
124	62756.88	93488.45	7263.72
125	62777.25	93486.75	7262.83
126	62796.79	93493.88	7262.87
127	62881.46	93518.13	7261.94
128	62811.39	93527.45	7261.75
129	62812.16	93547.19	7262.83
130	62883.65	93565.23	7262.74
131	62787.71	93577.24	7263.36
132	62768.81	93588.46	7263.77
133	62749.88	93574.14	7264.18
134	62738.28	93559.75	7264.44
135	62729.68	93548.62	7264.77
136	62734.88	93518.76	7264.92
137	62746.35	93585.88	7264.58
138	62764.73	93497.78	7263.78
139	62784.62	93499.43	7262.82
140	62774.44	93428.14	7264.76
141	62788.36	93414.76	7264.58
142	62792.69	93427.92	7263.34
143	62885.72	93448.38	7262.88
144	62825.54	93458.88	7268.38
145	62848.71	93447.38	7268.59
146	62851.71	93454.72	7268.75
147	62824.15	93457.96	7268.54
148	62888.36	93446.31	7262.24
149	62779.82	93426.86	7264.21
150	62887.88	93564.98	7263.47
151	62893.13	93574.28	7263.97
152	62908.48	93582.63	7264.58
153	62909.15	93598.21	7265.88
154	62927.72	93682.82	7266.14

155	62948.61	93687.95	7266.82
156	62938.67	93615.78	7266.71
157	62924.81	93689.11	7265.98
158	62904.32	93596.89	7264.42
159	62895.26	93588.73	7264.37
160	62889.55	93582.53	7263.99
160A	62884.51	93575.94	7263.65
168B	62888.23	93569.18	7263.33
161	62918.38	93711.35	7267.13
162	62988.82	93785.51	7266.78
163	62988.92	93699.58	7266.68
164	62888.35	93694.95	7266.47
165	62878.46	93691.33	7266.33
166	62873.21	93683.81	7266.16
167	62883.18	93687.44	7266.31
168	62894.59	93692.48	7266.92
169	62905.35	93698.91	7266.65
170	62914.28	93784.34	7266.97
171	62889.68	93667.43	7265.48
172	62793.64	93668.32	7265.27
173	62778.27	93653.43	7265.16
174	62763.17	93646.67	7265.16
175	62748.34	93648.84	7265.25
176	62736.76	93634.87	7265.37
177	62728.19	93632.48	7265.49
178	62719.38	93632.71	7265.69
179	62711.11	93634.63	7265.91
180	62734.45	93623.87	7265.19
181	62734.41	93625.56	7265.23
182	62748.83	93627.56	7265.18
183	62759.96	93636.48	7265.83
184	62778.11	93644.59	7264.99
185	62791.92	93658.77	7265.87
186	62812.86	93668.13	7265.33
187	62825.43	93659.38	7266.47
188	62844.15	93639.38	7266.68
189	62856.31	93627.89	7266.41
190	62868.48	93614.89	7266.31
191	62878.66	93628.88	7266.28
192	62885.76	93687.35	7266.89
193	62889.13	93476.73	7266.82
194	62891.85	93465.93	7266.88
195	62892.96	93468.19	7266.83
196	62892.93	93458.37	7266.89
197	62788.93	93458.88	7265.93
198	62788.98	93458.87	7265.87
199	62699.66	93467.64	7265.84
200	62696.82	93478.92	7265.86
201	62693.31	93498.88	7265.92
202	62685.44	93586.34	7265.84
203	62674.15	93528.53	7266.15
204	62661.98	93532.74	7266.25
205	62648.45	93546.33	7266.35
206	62642.88	93552.88	7266.48
207	62631.68	93564.47	7266.31
208	63123.23	93652.82	7273.89
209	63148.88	93642.18	7273.67
210	63158.38	93622.66	7274.51
211	63154.63	93661.18	7274.88
212	63139.97	93678.57	7273.54
213	63137.84	93674.84	7273.57
214	63139.86	93677.88	7273.61
215	63159.62	93693.48	7274.58
216	63178.73	93789.19	7276.17
217	63118.27	93815.53	7275.73
218	63186.98	93817.61	7275.39
219	63096.66	93817.89	7275.88
220	63086.37	93816.65	7274.77
221	63077.71	93814.38	7274.58
222	63069.62	93811.88	7274.24
223	63063.19	93807.85	7274.82
224	63057.25	93803.59	7273.81
225	63051.17	93802.69	7273.76
226	63047.63	93807.88	7273.72
227	63047.24	93812.66	7273.83
228	63085.33	93813.48	7273.25
229	62997.81	93774.53	7272.28
230	63278.87	93818.14	7283.88
231	63259.58	93811.85	7282.88

232	63248.39	93886.35	7281.88
233	63222.89	93881.38	7288.88
234	62958.89	93655.31	7267.61
235	62975.88	93661.29	7268.69
236	63081.67	93667.27	7269.68
237	63814.34		



311	63889.84	93789.32	7272.48
312	62454.89	93613.91	7267.78
313	62979.34	93618.47	7268.61
314	62998.99	93623.82	7269.48
315	63815.43	93627.28	7270.82
316	63831.67	93632.85	7270.68
316A	63853.48	93639.83	7271.33
317	63875.12	93646.81	7272.88
318	63908.62	93648.41	7272.52
319	63189.52	93645.79	7273.21
320	63127.85	93638.26	7273.83
321	63866.96	93653.87	7271.68
322	63867.27	93651.89	7271.64
323	63848.25	93645.78	7271.86
324	63829.22	93639.66	7270.42
325	63813.38	93634.91	7269.85
326	62997.19	93638.82	7269.24
327	62977.54	93626.26	7268.45
327A	62957.89	93621.78	7267.62
328	63164.14	93667.84	7274.77
329	63178.89	93676.78	7275.18
330	63173.96	93683.42	7275.38
331	63181.57	93783.71	7275.94
332	63189.19	93723.99	7276.69
333	63283.37	93745.96	7277.85
334	63225.88	93768.85	7280.47
335	63243.72	93766.84	7284.92
336	63256.27	93771.49	7282.75
337	63271.19	93777.84	7283.58
338	63298.18	93784.80	7284.45
339	63384.32	93789.23	7285.16
340	63382.24	93794.85	7285.84
341	63288.82	93789.63	7284.33
342	63269.11	93782.67	7283.38
343	63254.18	93777.11	7282.63
344	63241.63	93772.46	7282.82
345	63223.31	93765.68	7280.37
346	63218.48	93759.25	7279.84
347	63199.14	93758.22	7277.75
348	63197.68	93751.51	7277.71
349	63284.24	93758.88	7278.56
350	63222.62	93767.55	7279.44
351	63248.27	93774.89	7280.45
352	63253.49	93778.89	7281.14
353	63278.85	93785.45	7282.81
354	63298.11	93795.47	7284.11
354A	63269.33	93846.31	7284.37
354B	63253.68	93848.46	7283.57
354C	63239.96	93825.43	7282.87
354D	63221.73	93828.66	7281.94
354E	63289.18	93823.98	7281.89
354F	63185.84	93817.31	7279.34
354G	63168.19	93814.81	7277.89
354H	63168.22	93812.81	7277.55
355	63267.25	93851.94	7284.49
356	63251.59	93846.89	7283.69
357	63237.88	93841.86	7282.99
358	63219.85	93834.28	7282.12
359	63287.82	93829.78	7281.22
360	63186.41	93823.68	7279.64
361	63164.32	93828.94	7278.81
362	63143.84	93821.57	7277.18
363	63121.81	93825.67	7276.48
364	63187.36	93828.12	7276.11
365	63893.85	93828.24	7275.76
366	63878.29	93825.53	7275.32
367	63867.38	93821.65	7274.92
368	63862.41	93819.72	7274.71
369	63857.29	93818.28	7274.54
370	63857.95	93818.26	7274.55
371	63854.27	93818.58	7274.59
372	63868.35	93888.82	7274.55
373	62994.67	93884.67	7273.53
374	62991.81	93784.88	7272.74
375	62981.19	93766.88	7271.66
376	62978.85	93754.63	7270.68
377	62962.83	93745.99	7269.89
378	62951.88	93736.71	7269.12

379	62948.48	93727.63	7268.41
380	62938.84	93721.29	7267.92
381	62928.49	93716.28	7267.58
382	62923.55	93788.81	7267.38
383	62934.82	93714.34	7267.74
384	62945.29	93721.24	7268.26
385	62958.18	93714.85	7268.89
386	62957.54	93731.18	7269.88
387	62967.57	93748.22	7269.72
388	62977.78	93758.66	7270.59
389	62987.48	93761.76	7271.48
390	62995.91	93775.15	7272.24
391	63195.85	93686.81	7281.58
392	63288.95	93786.85	7281.39
393	63287.11	93727.71	7288.75
394	63214.25	93742.98	7279.83
395	63228.99	93751.58	7279.75
396	63234.18	93762.88	7288.88
397	63467.77	93825.71	7288.31
398	63481.57	93827.64	7288.43
399	63495.17	93832.87	7288.66
400	63587.79	93838.85	7288.94
401	63518.71	93847.47	7289.22
402	63525.19	93848.61	7289.27
403	63528.82	93843.12	7289.31
404	63528.88	93819.28	7289.89
405	63543.88	93819.32	7289.39
406	63543.77	93858.47	7289.83
407	63615.41	93951.57	7293.58
408	63539.86	94087.68	7292.97
409	63415.43	94812.89	7289.75
410	63485.35	94821.48	7289.78
411	63388.37	94884.52	7289.38
412	63412.13	93986.63	7289.33
413	63414.69	93982.68	7289.28
414	63412.84	93978.35	7289.23
415	63396.58	93961.11	7288.75
416	63385.61	93948.89	7288.42
417	63298.39	93825.27	7284.88
418	63318.86	93832.64	7285.88
419	63336.49	93839.81	7286.88
420	63346.92	93843.87	7286.58
421	63361.11	93846.61	7287.87
422	63382.52	93858.78	7287.92
423	63484.28	93852.84	7288.51
424	63488.52	93855.85	7288.64
425	63487.75	93861.85	7288.76
426	63488.46	93871.32	7288.76
427	63394.92	93882.64	7288.68
428	63392.42	93884.53	7288.58
429	63389.88	93883.17	7288.48
430	63375.81	93885.99	7287.84
431	63358.77	93882.84	7287.82
432	63357.67	93848.34	7287.85
433	63345.83	93931.67	7291.17
434	63362.46	93949.15	7292.88
435	63382.13	93963.14	7292.84
436	63388.78	93973.68	7293.83
437	63388.32	93976.38	7294.53
438	63446.57	93976.13	7295.22
439	63636.48	93993.76	7295.72
440	63613.98	93995.85	7295.25
441	63585.48	93996.42	7294.41
442	63584.95	93995.41	7293.64
443	63542.82	93992.84	7292.74
444	63522.87	93998.85	7292.81
445	63583.72	93987.26	7291.33
446	63499.51	93983.18	7291.24
447	63582.87	93977.91	7291.14
448	63513.84	93978.22	7291.29
449	63525.64	93988.87	7291.34
450	63534.24	93946.64	7291.27
451	63548.63	93932.55	7291.87
452	63542.97	93938.56	7291.12
453	63489.17	93888.28	7288.91
454	63584.31	93873.82	7289.33
455	63513.65	93898.45	7289.71
456	63518.88	93918.11	7290.12

457	63518.68	93929.19	7290.46
458	63498.79	93945.88	7290.57
459	63481.74	93955.34	7290.49
460	63467.13	93988.74	7290.29
461	63482.52	93986.14	7289.98
462	63458.15	93966.58	7289.81
463	63447.78	93966.19	7289.75
464	63429.41	93955.73	7289.22
465	63415.96	93939.43	7288.81
466	63489.18	93919.43	7288.81
467	63489.94	93898.32	7289.85
468	63418.15	93878.86	7289.33
469	63432.74	93863.58	7289.19
470	63458.65	93855.28	7288.86
471	63478.48	93854.84	7288.62
472	63477.79	93866.94	7289.12
473	63494.47	93878.18	7289.33
474	63583.95	93895.93	7289.76
475	63584.88	93916.85	7290.21
476	63494.62	93933.85	7290.36
477	63477.99	93945.17	7290.46
478	63464.94	93949.99	7290.32
479	63451.98	93954.81	7289.99
480	63458.83	93955.12	7289.85
481	63448.18	93954.71	7289.72
482	63431.92	93943.16	7289.45
483	63421.82	93925.97	7289.18
484	63419.63	93986.15	7289.47
485	63425.75	93887.18	7289.85
486	63439.89	93872.34	7289.74
487	63457.78	93864.83	7289.17
488	63318.56	93794.46	7285.88
489	63335.89	93888.61	7286.75
490	63348.82	93885.35	7287.39
491	63373.47	93812.77	7287.74
492	63398.93	93817.88	7288.13
493	63421.89	93818.21	7288.55
494	63458.39	93818.85	7288.71
495	63457.87	93815.32	7288.75
496	63463.79	93815.18	7288.78
497	63476.87	93815.13	7288.88
498	63491.89	93815.17	7289.85
499	63584.53	93815.21	7289.24
500	63518.48	93815.25	7289.48
501	63518.37	93823.25	7289.56
502	63583.49	93823.21	7289.38
503	63482.18	93823.15	7288.79
504	63481.66	93825.18	7288.76
505	63394.99	93824.69	7287.89
506	63395.22	93822.78	7287.93
507	63378.63	93818.27	7287.68
508	63346.74	93818.98	7287.27
509	63333.81	93886.24	7286.63
510	63316.47	93888.89	7285.76
511	63354.36	93828.35	7290.19
512	63354.32	93844.13	7290.37
513	63354.27	93859.91	7290.58
514	63356.31	93876.44	7290.88
515	63363.54	93895.61	7291.42
516	63378.89	93917.14	7292.37
517	63394.83	93929.94	7292.96
518	63818.45	93941.52	7294.87
519	63636.39	93945.78	7294.88
520	63639.58	94019.85	7296.76
521	63614.91	94821.33	7296.28
522	63589.17	94821.98	7295.59
523	63561.43	94828.71	7294.62
524	63538.34	94818.87	7293.72
525	63521.61	94815.64	7293.84
526	63506.81	94813.37	7292.43
527	63489.51	94818.96	7291.87
528	63473.68	94808.66	7291.42
529	63457.84	94888.13	7291.81
530	63444.68	94818.48	7290.76
531	63438.38	94816.82	7290.57
532	63418.77	94823.53	7290.49
533	63378.16	93999.98	7289.82
534	63371.79	93998.17	7289.95

535	63369.99	93978.61	7289.89
536	63378.94	93961.59	7289.58
537	63371.89	93944.58	7289.11
538	63368.64	93918.93	7288.68
539	63368.31	9398	



Know what's below. Call before you dig.

605	63811.38	93832.58	7297.25
606	63807.94	93835.57	7297.21
607	63805.19	93838.32	7297.16
608	63803.05	93834.43	7297.11
609	63798.45	93824.22	7296.95
610	63792.46	93814.77	7296.81
611	63792.69	93818.93	7296.84
612	63802.50	93898.27	7298.95
613	63805.50	93896.99	7299.03
614	63807.90	93899.21	7299.12
615	63890.74	93908.73	7299.44
616	63894.48	93917.97	7299.78
616A	63898.93	93925.92	7300.10
616B	63904.27	93935.49	7300.50
616C	63908.15	93941.25	7300.88
616D	63901.67	93934.17	7300.38
616E	63895.75	93927.42	7299.90
617	63893.44	93921.61	7299.66
618	63889.69	93921.45	7299.54
619	63884.01	93916.94	7299.32
620	63877.94	93912.98	7299.11
621	63875.52	93909.34	7299.03
622	63876.89	93905.18	7298.96
623	63879.85	93901.86	7298.96
624	63819.59	93845.24	7297.43
625	63837.02	93837.33	7297.62
626	63855.95	93848.08	7297.83
627	63870.41	93852.63	7298.18
628	63875.79	93870.99	7298.72
629	63878.28	93889.55	7299.06
630	63855.75	93902.80	7298.96
631	63836.79	93904.62	7298.46
632	63819.42	93896.59	7297.91
633	63809.14	93888.45	7297.54
634	63809.20	93861.31	7297.38
635	63827.92	93868.88	7297.94
636	63847.13	93854.68	7298.49
637	63858.96	93878.99	7299.29
638	63847.89	93887.32	7299.43
639	63827.90	93881.07	7298.24
640	63857.28	93947.59	7295.63
641	63777.03	93946.52	7296.48
642	63691.68	93943.90	7296.89
643	63705.99	93939.75	7297.38
644	63723.13	93932.58	7297.69
645	63748.24	93922.32	7297.96
646	63756.28	93909.34	7298.08
647	63765.49	93908.72	7298.07
648	63777.29	93884.58	7297.98
649	63782.37	93863.41	7297.56
650	63779.11	93843.22	7297.24
651	63767.93	93825.10	7296.99
652	63762.91	93819.74	7296.94
653	63761.38	93752.22	7296.49
654	63784.14	93772.93	7296.84
655	63798.27	93782.78	7296.81
656	63804.88	93786.78	7296.91
657	63826.84	93797.62	7297.24
658	63856.63	93807.19	7297.67
659	63887.61	93824.19	7298.08
660	63905.26	93854.88	7298.58
661	63928.32	93895.10	7299.78
662	63917.59	93907.82	7300.07
663	63902.99	93874.81	7298.79
664	63901.82	93875.17	7298.75
665	63885.61	93955.02	7300.71
666	63877.90	93946.88	7300.20
667	63863.81	93935.93	7299.39
668	63843.38	93931.18	7298.84
669	63829.26	93932.76	7298.54
670	63807.93	93944.54	7298.26
671	63798.88	93953.85	7298.05
672	63783.72	93966.84	7297.82
673	63769.47	93976.15	7297.66
674	63762.43	93986.83	7297.53
675	63737.42	93993.82	7297.45
676	63717.17	94008.78	7297.35
677	63693.85	94088.17	7297.23

678	63665.35	94014.98	7297.07
679	62625.78	93693.87	7263.97
680	62614.00	93789.14	7263.25
681	62589.72	93689.68	7263.97
682	62565.45	93678.23	7263.39
683	62661.73	93622.82	7265.57
684	62649.54	93631.89	7265.68
685	62636.91	93642.92	7265.50
686	62623.91	93655.66	7265.20
687	62611.53	93669.03	7264.74
688	62608.61	93681.97	7264.24
689	62594.75	93682.62	7264.27
690	62594.18	93676.75	7264.29
691	62602.61	93666.13	7264.67
692	62611.67	93654.82	7265.05
693	62628.43	93643.89	7265.35
694	62629.25	93632.88	7265.57
695	62634.66	93626.33	7265.67
696	62641.99	93614.88	7265.76
697	62645.93	93601.73	7265.77
698	62610.57	93577.39	7266.35
699	62593.85	93581.85	7266.81
700	62581.88	93519.28	7265.56
701	62571.93	93634.77	7265.82
702	62561.83	93649.88	7264.43
703	62552.79	93668.84	7263.75
704	62568.22	93666.84	7263.79
705	62563.82	93661.34	7264.08
706	62575.21	93645.45	7264.63
707	62585.53	93628.86	7265.24
708	62599.59	93686.26	7265.86
709	62614.95	93584.82	7266.17
710	63387.11	93394.73	7286.15
711	63283.84	93438.56	7284.81
712	63238.83	93521.11	7288.88
713	63229.07	93541.41	7279.84
714	63222.24	93548.79	7278.57
715	63217.83	93557.38	7278.12
716	63171.55	93682.82	7275.42
717	63183.78	93588.73	7276.32
718	63288.95	93548.72	7277.88
719	63285.86	93535.38	7278.38
720	63286.78	93521.84	7278.84
721	63213.98	93587.84	7279.47
722	63258.48	93425.27	7283.44
723	63285.24	93382.94	7285.61
723A	63383.24	93392.65	7286.86
724	63041.83	93888.77	7275.59
725	63041.22	93898.82	7275.88
726	63043.42	93908.63	7276.25
727	63042.12	93924.61	7276.74
728	63088.33	94176.85	7287.82
729	63083.88	94197.16	7287.95
730	62999.81	94146.89	7287.78
731	62978.97	94198.88	7287.85
732	62984.38	94147.71	7284.91
733	62991.52	94181.85	7282.82
734	62996.89	94051.15	7288.54
735	62999.68	94081.72	7278.47
736	62999.88	93953.82	7276.62
737	62999.33	93923.51	7275.61
738	62999.15	93913.28	7275.38
739	63083.41	93981.78	7275.89
740	63084.71	93889.43	7274.65
741	63086.71	93889.39	7274.82
742	63019.33	93923.14	7276.11
743	63026.17	93923.31	7276.29
744	63583.95	93274.45	7382.93
745	63578.81	93335.62	7382.86
746	63561.54	93397.49	7388.88
747	63552.87	93753.18	7289.49
748	63552.84	93761.67	7289.84
749	63546.85	93774.64	7289.55
750	63543.97	93788.78	7289.48
751	63528.97	93788.74	7289.18
752	63527.99	93778.73	7289.15
753	63525.82	93769.13	7289.28
754	63525.87	93753.11	7289.45

755	63534.78	93393.98	7381.88
756	63545.81	93338.51	7383.11
757	63559.21	93267.89	7383.93
758	63563.68	93269.88	7383.75
759	INTENTIONALLY OMITTED		
760	INTENTIONALLY OMITTED		
761	INTENTIONALLY OMITTED		
762	63628.71	93391.54	7317.98
763	63644.48	93394.26	7317.21
764	63656.38	93396.38	7316.54
765	63683.98	93716.93	7297.48
766	63677.66	93789.95	7297.62
767	63678.24	93784.26	7297.93
768	63657.78	93388.54	7317.34
769	63668.82	93398.47	7317.84
770	63661.73	93433.58	7313.48
771	63658.87	93476.68	7389.48
772	63657.63	93524.98	7385.81
773	63661.88	93575.99	7382.28
774	63675.68	93638.48	7299.34
775	63697.67	93675.54	7297.54
776	63732.58	93721.58	7296.62
777	63924.92	93937.79	7388.92
778	63933.84	93947.77	7381.52
779	63947.54	93972.88	7383.83
780	63955.37	93995.26	7384.46
781	63948.84	94082.82	7318.85
782	63943.87	94097.85	7318.73
783	63946.32	94121.78	7311.48
784	63954.38	94138.92	7312.88
785	63968.78	94144.19	7312.28
786	63959.41	94145.64	7312.27
787	63946.21	94081.22	7318.89
788	63934.38	94076.81	7318.87
789	63921.84	94078.28	7389.65
790	63985.23	94093.58	7311.35
791	63984.78	94092.21	7311.31
792	63922.43	94061.64	7389.81
793	63928.69	94023.43	7386.14
794	63921.98	93989.45	7383.38
795	63988.83	93965.52	7381.52
796	63983.88	93959.28	7381.83
797	63943.65	93931.25	7381.88
798	63983.15	93962.27	7383.53
799	63967.37	93972.88	7384.63
800	63971.29	93983.42	7384.74
801	63974.74	93997.84	7385.47
802	63976.27	94012.42	7386.38
803	63974.61	94027.78	7387.89
804	63969.48	94049.43	7388.23
805	63963.39	94078.82	7389.43
806	63957.66	94086.23	7318.53
807	63954.28	94098.39	7311.23
808	63954.46	94111.81	7311.73
809	63961.19	94041.58	7387.66
810	63963.18	94041.74	7387.78
811	63966.79	94026.11	7386.83
812	63968.27	94012.38	7386.89
813	63966.91	93998.64	7385.38
814	63963.73	93986.83	7384.57
815	63959.81	93974.69	7383.86
816	63955.92	93965.69	7383.38
817	63937.43	93936.29	7381.72
818	63895.28	93985.32	7381.46
819	63968.43	93971.71	7384.85
820	63983.99	93968.78	7384.37
821	63999.76	93978.17	7384.71
822	64012.89	93973.12	7385.21
823	64024.43	93976.87	7385.96
824	64029.79	93977.13	7386.36
825	64035.22	93977.76	7386.81
826	64033.95	93998.17	7387.19
827	64029.45	93989.49	7386.88
828	64025.89	93988.57	7386.68
829	64011.83	93985.28	7385.78
830	63996.97	93981.84	7385.27
831	63984.58	93988.69	7385.88
832	63972.36	93983.85	7384.76

833	63368.82	94186.96	7292.31
834	63355.88	94188.64	7292.99
835	63355.79	94134.93	7293.78
836	63351.98	94143.24	7294.13
837	63389.84	94233.33	7298.69
838	63273.13	94388.	