



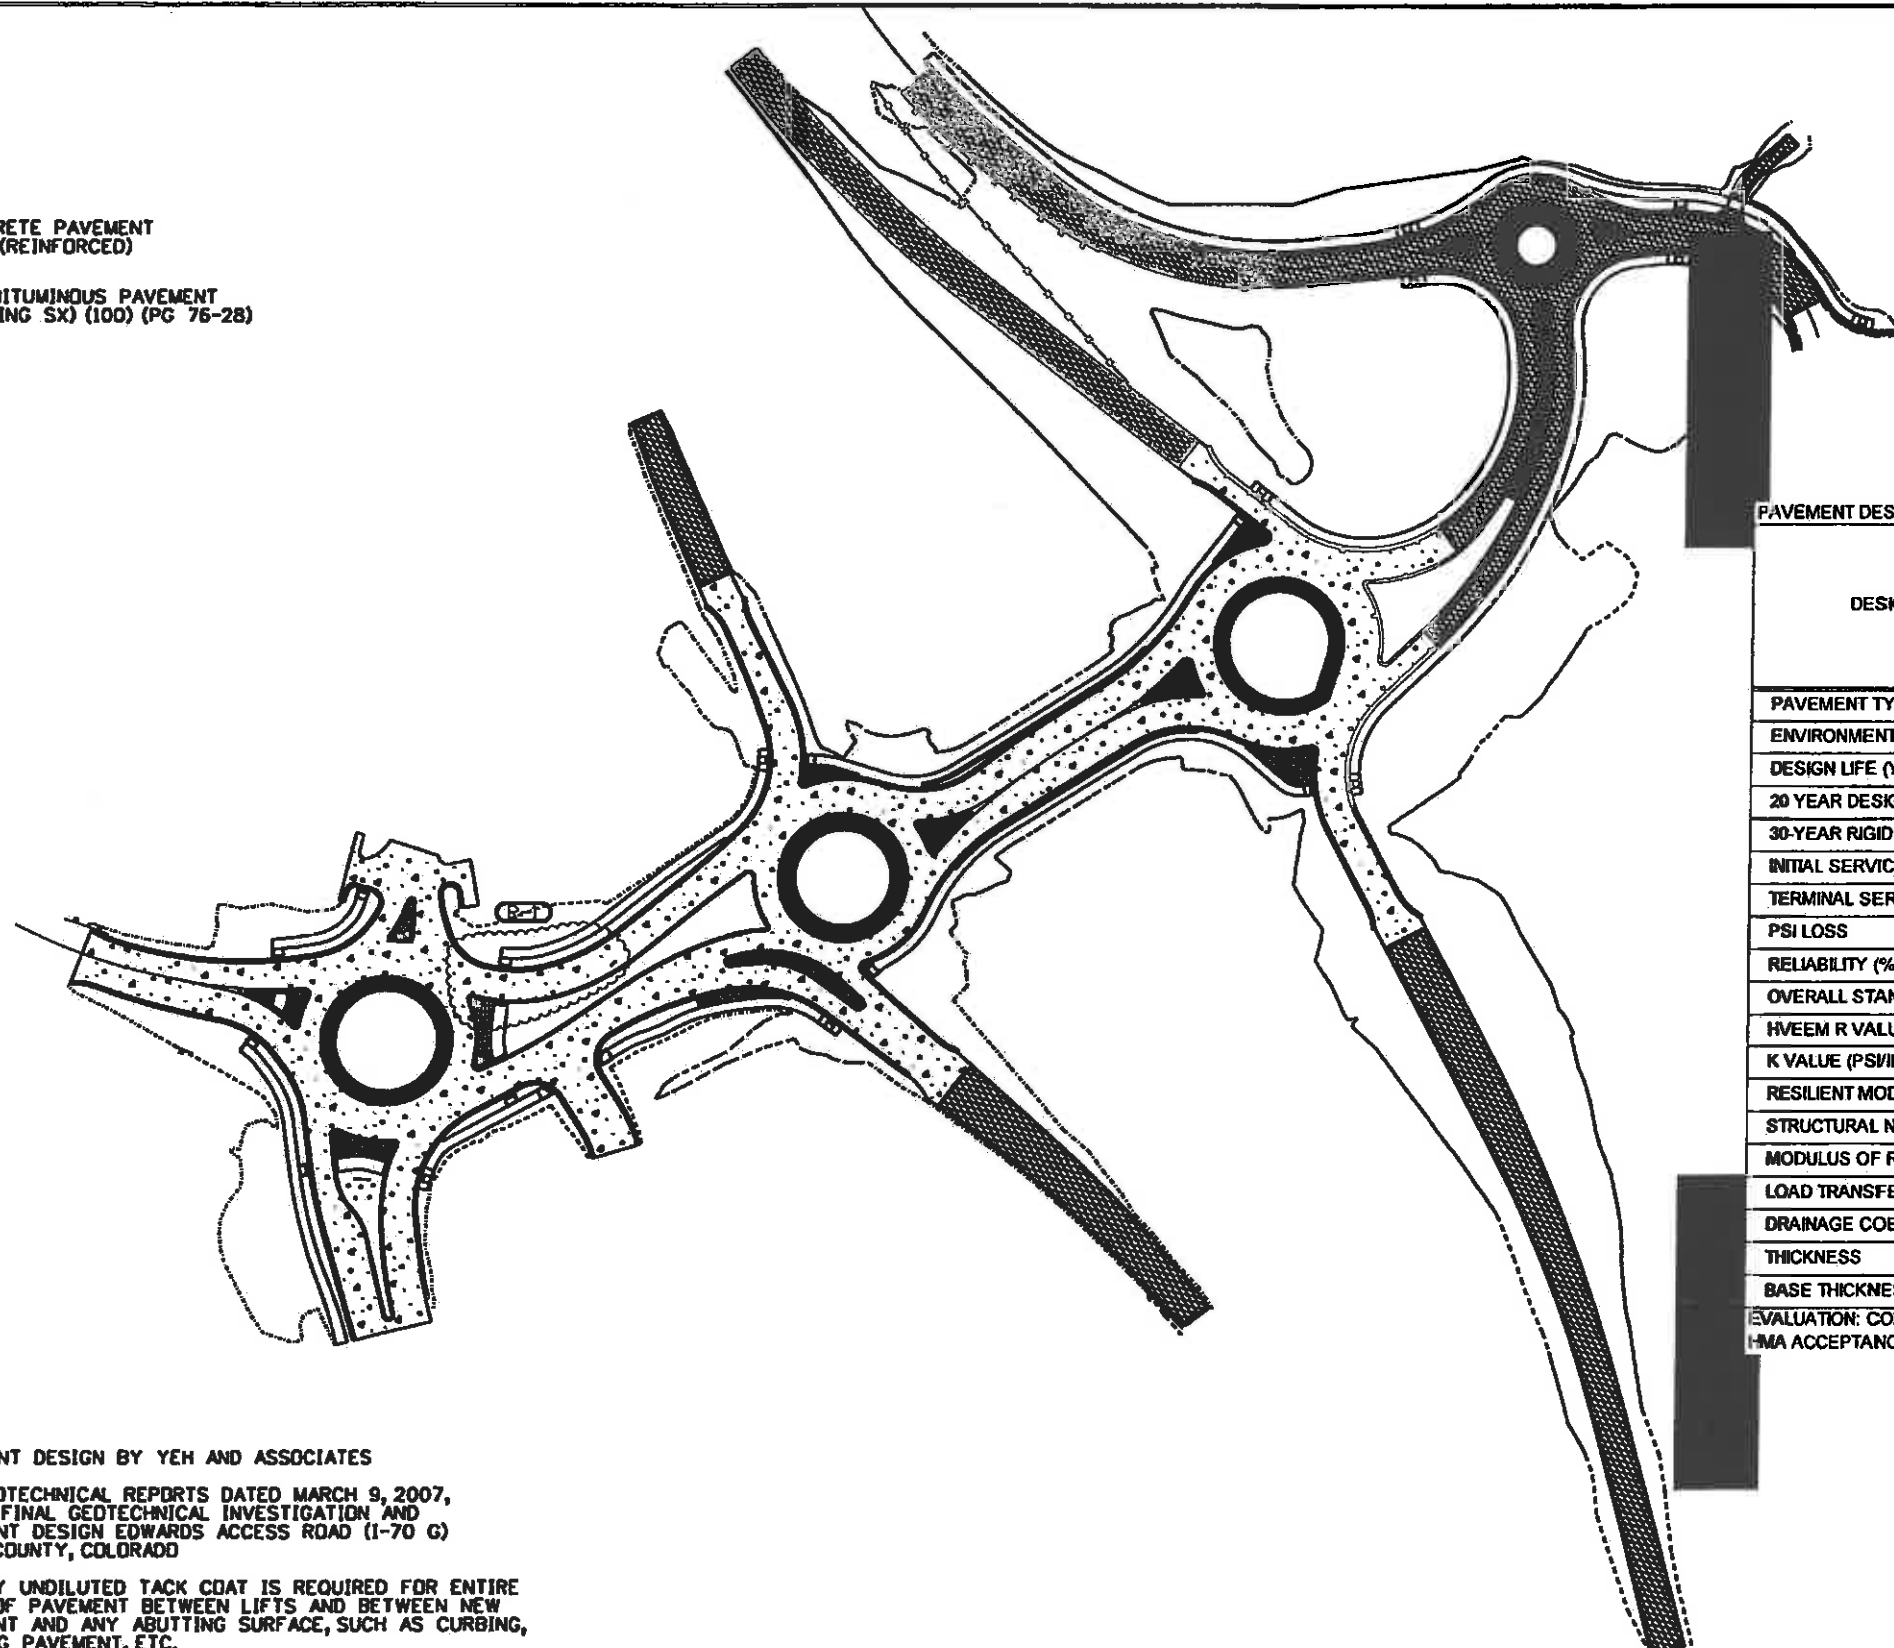

- CONCRETE PAVEMENT (9.5" REINFORCED)
- HOT BITUMINOUS PAVEMENT (GRADING SX) (100) (PG 76-28)

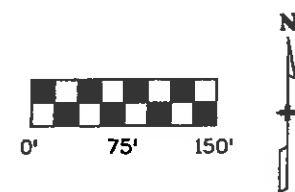

PAVEMENT DESIGN CRITERIA

DESIGN PARAMETERS	HOT BITUMINOUS PAVEMENT (GRADING SX) (100) (PG 76-28)	CONCRETE PAVEMENT (9.5") (REINFORCED)
PAVEMENT TYPE	FLEXIBLE	RIGID
ENVIRONMENTAL	COOL-MEDRUM	N/A
DESIGN LIFE (YEARS)	20	30
20 YEAR DESIGN 18K ESALS	2,000,000	
30-YEAR RIGID ESALS		4,400,000
INITIAL SERVICEABILITY	4.5	4.5
TERMINAL SERVICEABILITY	2.5	2.5
PSI LOSS	2.0	2.0
RELIABILITY (%)	95	95
OVERALL STANDARD DEVIATION	0.44	0.34
HVEEM R VALUE	40	N/A
K VALUE (PSI/IN)		200
RESILIENT MODULUS, PSI	9497	
STRUCTURAL NUMBER SN	3.64	N/A
MODULUS OF RUPTURE (PSI)		650
LOAD TRANSFER COEFFICIENT, J		2.8
DRAINAGE COEFFICIENT		1.0
THICKNESS	6" HBP	9.5" PCCP
BASE THICKNESS (IN)	10" ABC (CLASS 6)	6" ABC (CLASS 6)

EVALUATION: COMPONENT DATE: THURSDAY OCTOBER 26, 2006
 HMA ACCEPTANCE BY: GRADATIONS-ASPHALT CONTENT-DENSITY ESTIMATED AC CONTENT: 6%

NOTES:

1. PAVEMENT DESIGN BY YEH AND ASSOCIATES
2. SEE GEOTECHNICAL REPORTS DATED MARCH 9, 2007, TITLED FINAL GEOTECHNICAL INVESTIGATION AND PAVEMENT DESIGN EDWARDS ACCESS ROAD (I-70 G) EAGLE COUNTY, COLORADO
3. A HEAVY UNDILUTED TACK COAT IS REQUIRED FOR ENTIRE WIDTH OF PAVEMENT BETWEEN LIFTS AND BETWEEN NEW PAVEMENT AND ANY ABUTTING SURFACE, SUCH AS CURBING, EXISTING PAVEMENT, ETC.



Print Date: 5/10/2010
 Drawing File Name: 06193PAVE01.dgn
 Horiz. Scale: Vert. Scale: As Noted
 Unit Information: Unit Leader Initials

Sheet Revisions			
Date	Comments	Init.	
5/10/10	REVISED SB ENTRANCE TO MRR ROUNDABOUT	DKH	

Colorado Department of Transportation
 714 Grand Avenue, P.O. Box 298
 Eagle, CO 81631
 Phone: 970-328-6385 FAX: 970-328-2368
 Region 3 MLM



As Constructed
 No Revisions: 6-6-2011
 Revised:
 Void:

EDWARDS INTERCHANGE UPGRADE PAVEMENT PLAN
 Designer: YEH
 Detailer: KMH
 Sheet Subset: PAVE
 Structure Numbers:
 Subset Sheets: PV-01 of 1

Project No./Code
 ES3 0702-297
 17303
 Sheet Number 228X



SEE NOTE 8 ON REMOVAL PLANS
(SUBSHEET R-01 OF 5)

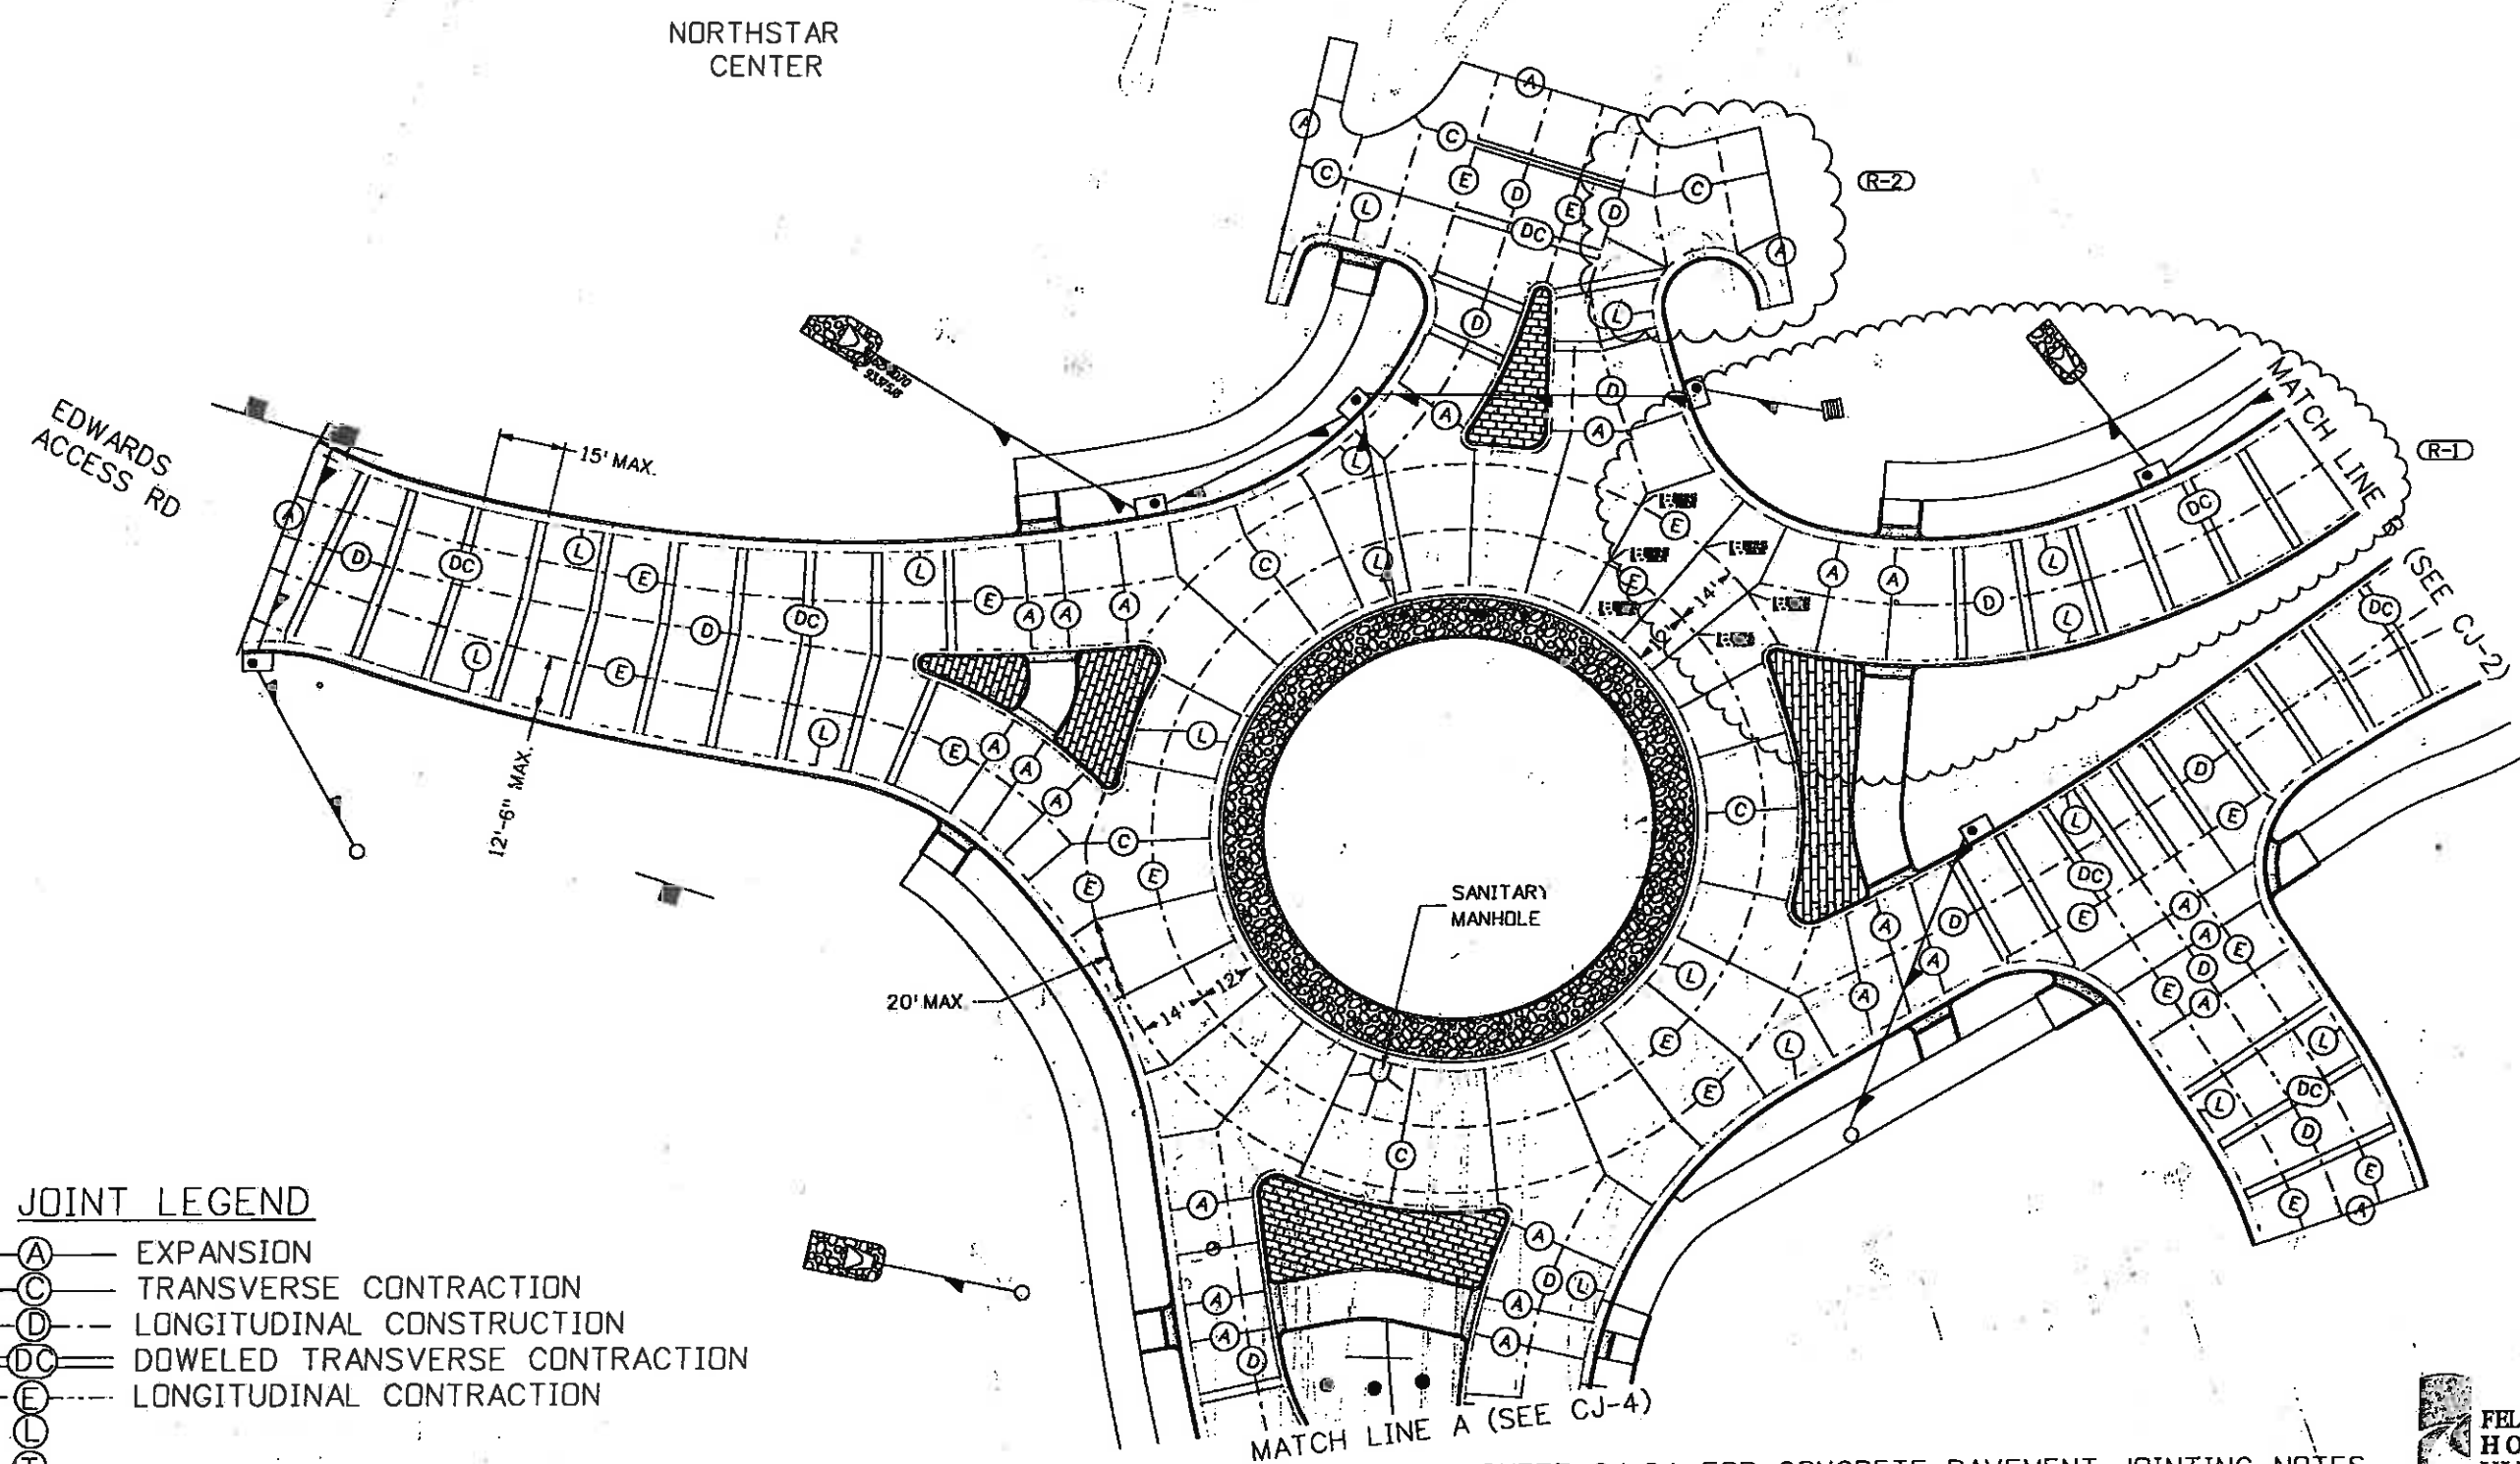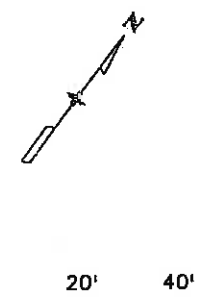



JOINT LEGEND

- (A)— EXPANSION
- (C)— TRANSVERSE CONTRACTION
- (D)— LONGITUDINAL CONSTRUCTION
- (DC)— DOWELED TRANSVERSE CONTRACTION
- (E)— LONGITUDINAL CONTRACTION
- (L)—
- (T)—

SEE SHEET CJ-04 FOR CONCRETE PAVEMENT JOINTING NOTES



Print Date: 2/8/2011		Sheet Revisions		Colorado Department of Transportation		As Constructed		EDWARDS INTERCHANGE UPGRADE		Project No./Code	
Drawing File Name: 06193CPJ01.dgn		Date:	Comments	Init	714 Grand Avenue, P.D. Box 298		No Revisions: 6-6-2011		EDWARDS ACCESS RD		ES3 0702-297
Horiz. Scale: 1:40		5/10/10	REVISED SB ENTRANCE TO MRR ROUNDABOUT	DKH	Eagle, CO 81631		Revised:		CONCRETE PAVEMENT JOINT LAYOUT		17303
Unit Information		2/7/11	REVISED ENTRANCE TO NORTHSTAR CENTER	DKH	Phone: 970-328-6385 FAX: 970-328-2368		Void:		Designer: SPG		Sheet Number 229X
Unit Leader Initials					Region 3				Detailer: TBS		
					MLM				Sheet Subset: JOINT		Subset Sheets: CJ-01 of 8

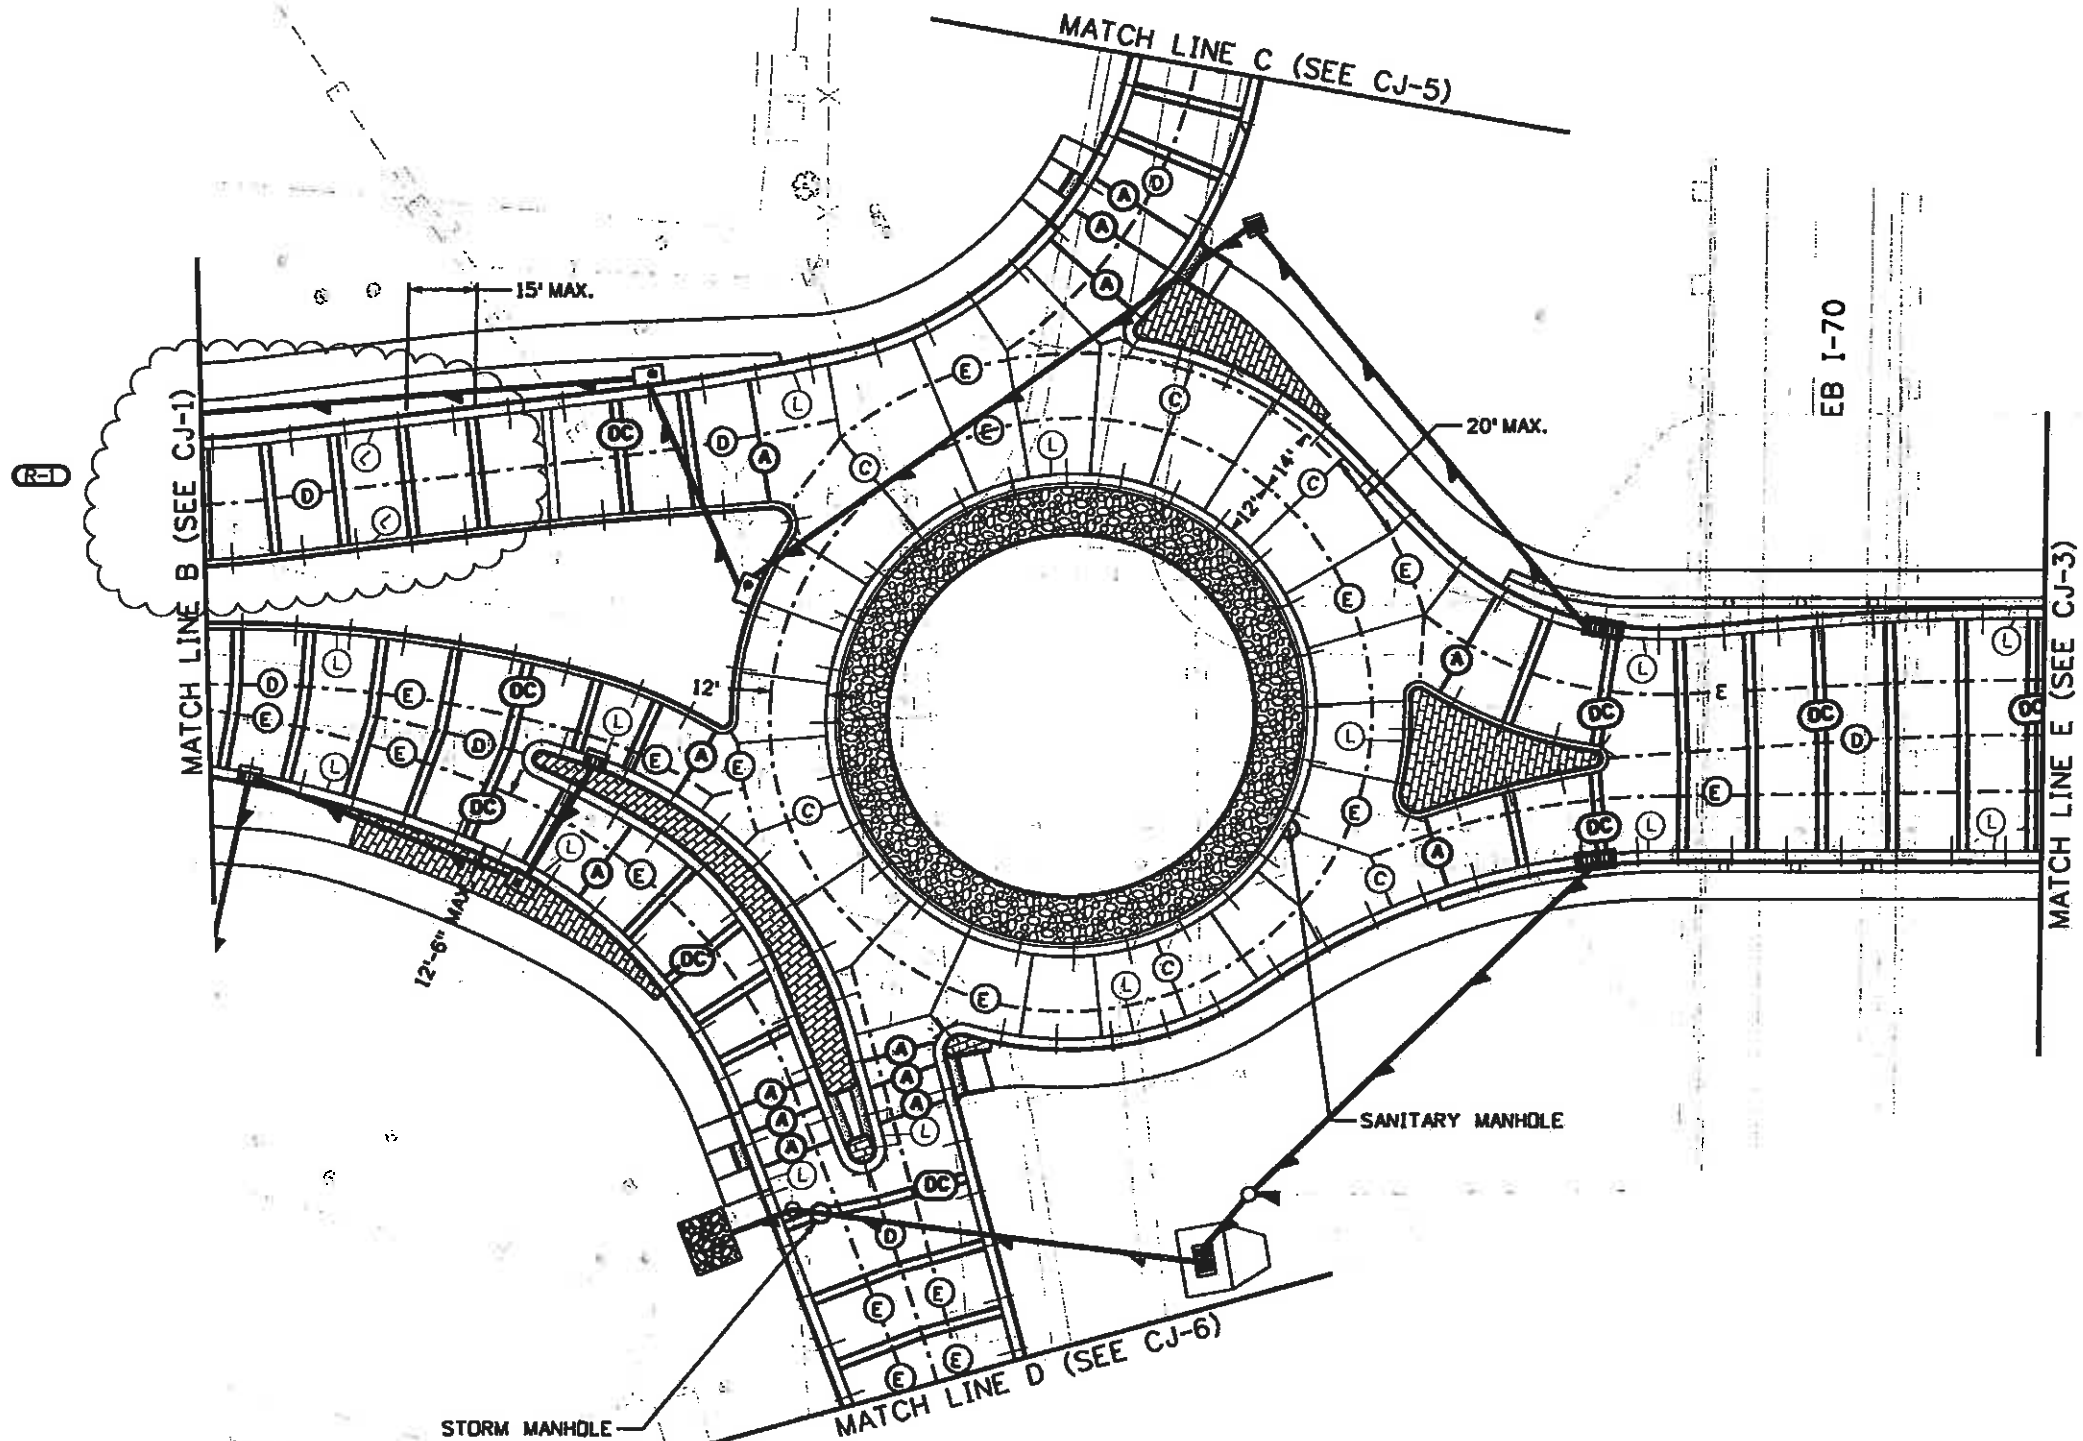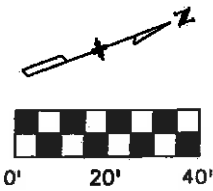

SEE SHEET CPJ-4 FOR CONCRETE PAVEMENT JOINTING NOTES



Print Date: 5/11/2010	
Drawing File Name: 06193CPJ02.dgn	
Horiz. Scale: 1:40	Vert. Scale: As Noted
Unit Information	Unit Leader Initials

Sheet Revisions		
Date:	Comments	Init.
5/10/10	REVISED SB ENTRANCE TO MRR ROUNDABOUT	DKH

Colorado Department of Transportation



714 Grand Avenue, P.O. Box 298
Eagle, CO 81631
Phone: 970-328-6385 FAX: 970-328-2368

Region 3 MLM

As Constructed
No Revisions: 6-6-2011
Revised:
Void:


EDWARDS INTERCHANGE UPGRADE EDWARDS ACCESS RD. CONCRETE PAVEMENT JOINT LAYOUT		
Designer: SPG	Structure Numbers	
Detailer: TBS		
Sheet Subset: JOINT	Subset Sheets: CJ-02 of B	


Project No./Code	ES3 0702-297
	17303
Sheet Number	230X

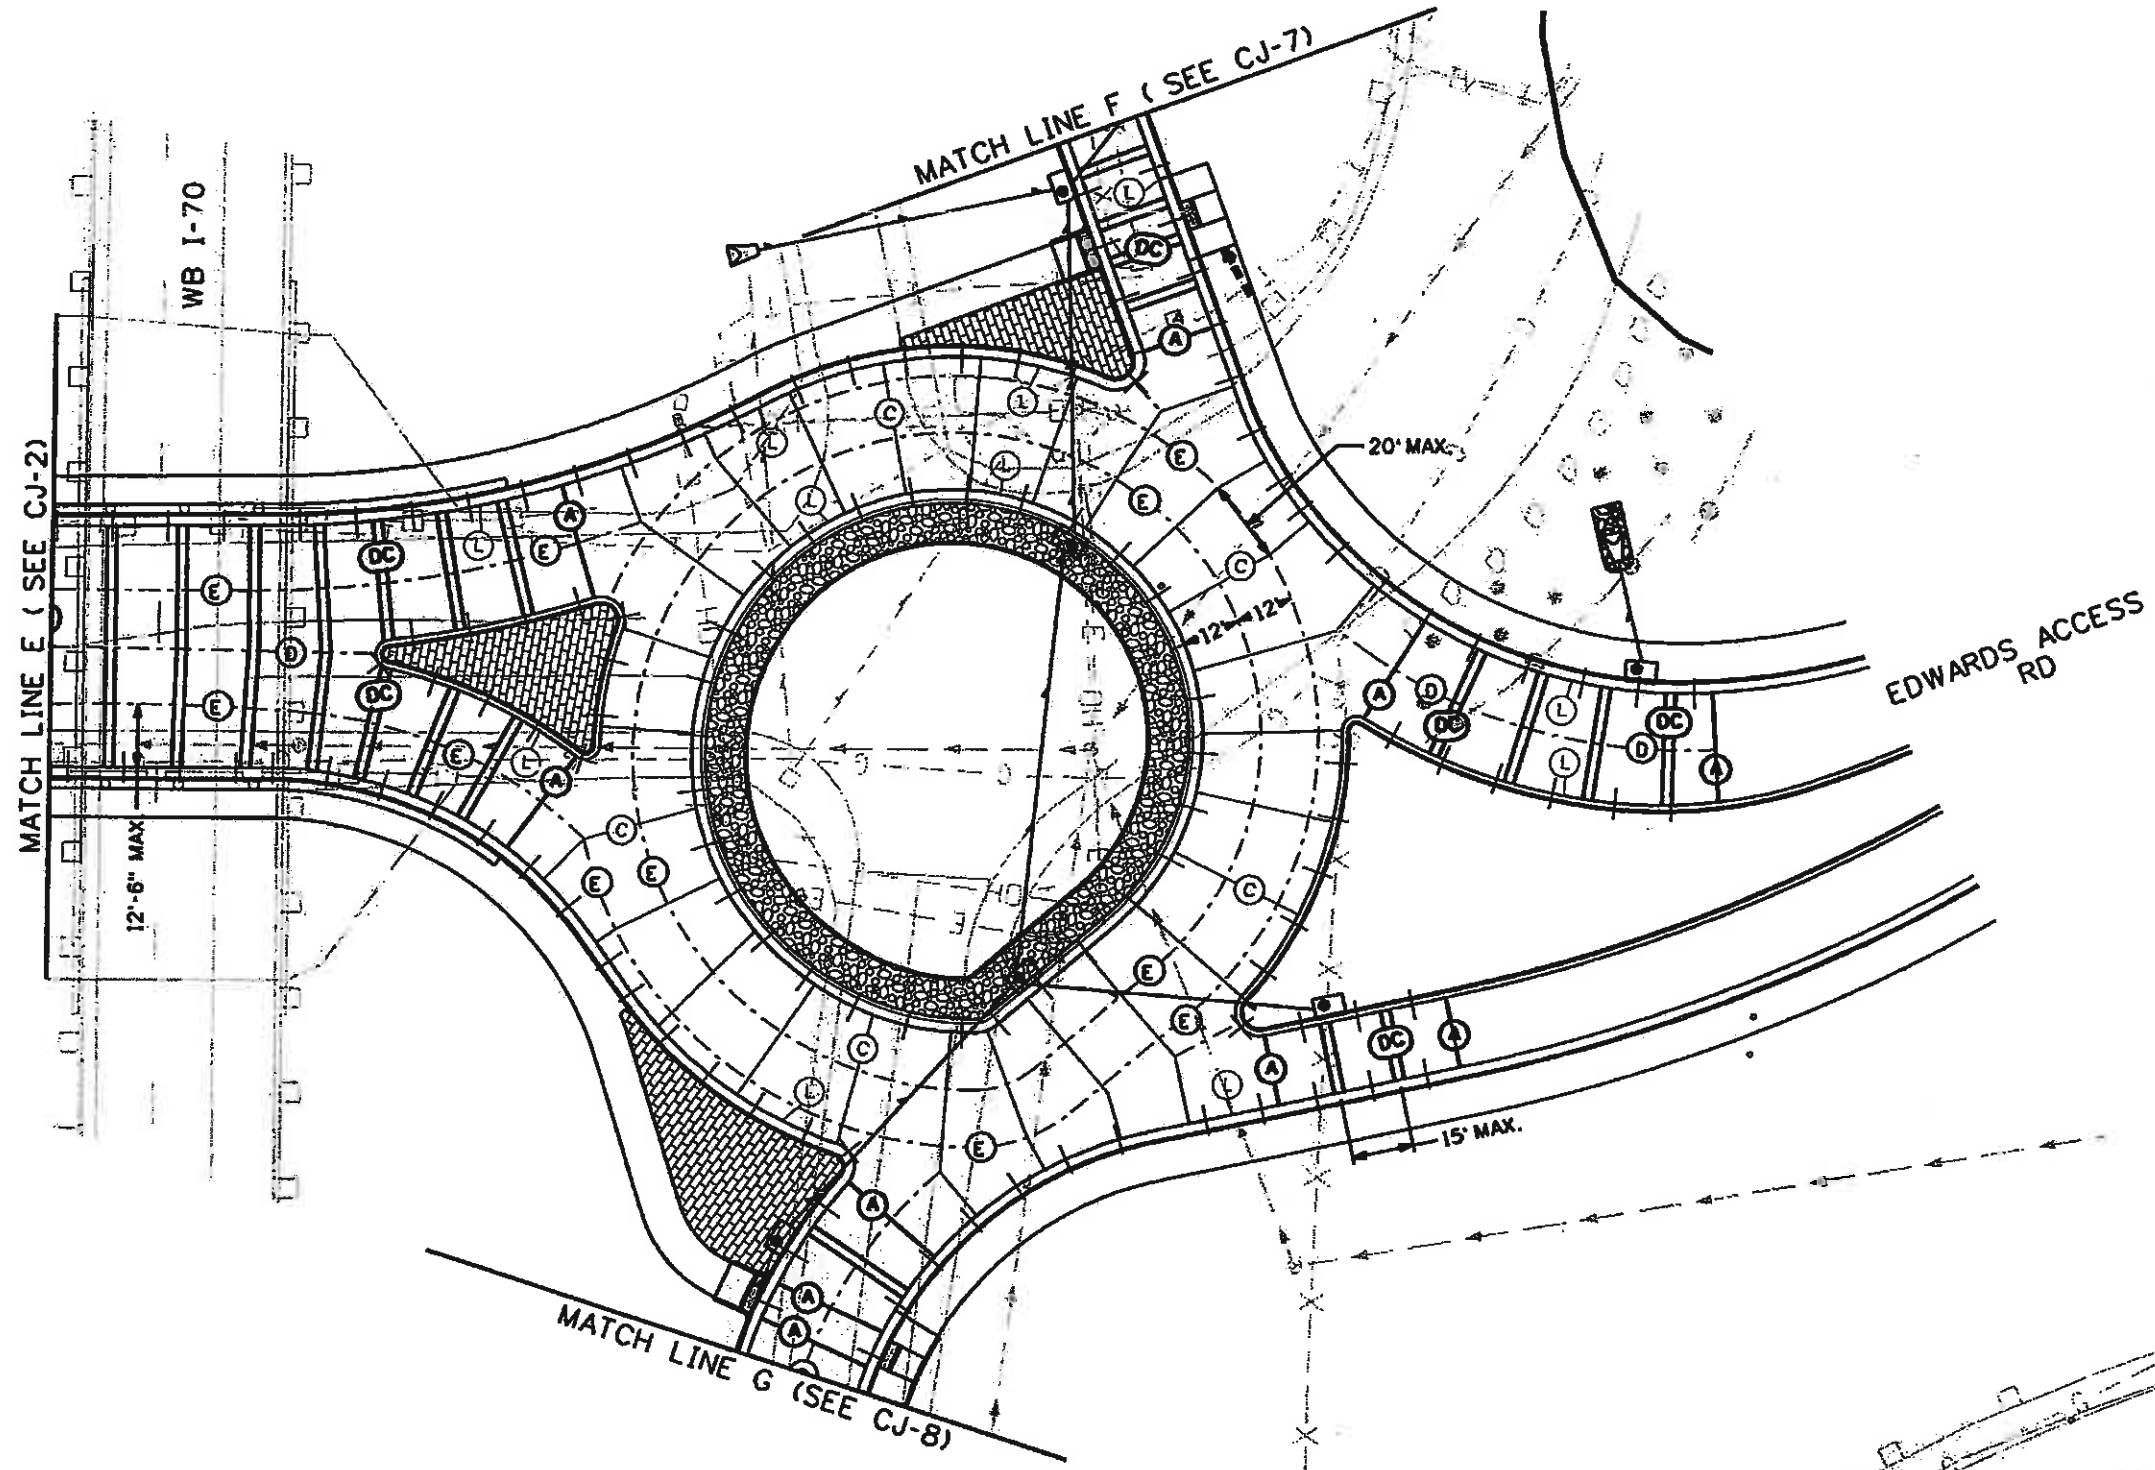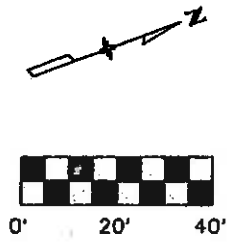

SEE SHEET CPJ-04 FOR CONCRETE PAVEMENT JOINTING NOTES




Print Date: 11/5/2009	Sheet Revisions			Colorado Department of Transportation  714 Grand Avenue, P.O. Box 298 Eagle, CO 81631 Phone: 970-328-6385 FAX: 970-328-2368 Region 3	As Constructed No Revisions: 6-6-2011 Revised: Void:	EDWARDS INTERCHANGE UPGRADE EDWARDS ACCESS RD. CONCRETE PAVEMENT JOINT LAYOUT		Project No./Code
Drawing File Name: 06193CPJ03.dgn	Date:	Comments:	Init.			Designer: SPG	Structure Numbers	ES3 0702-297
Horiz. Scale: 1:40.0007	Vert. Scale: As Noted				Detailer: TBS		17303	
Unit Information	Unit Leader Initials				Sheet Subset: JOINT	Subset Sheets: CJ-03 of 8	Sheet Number 231	

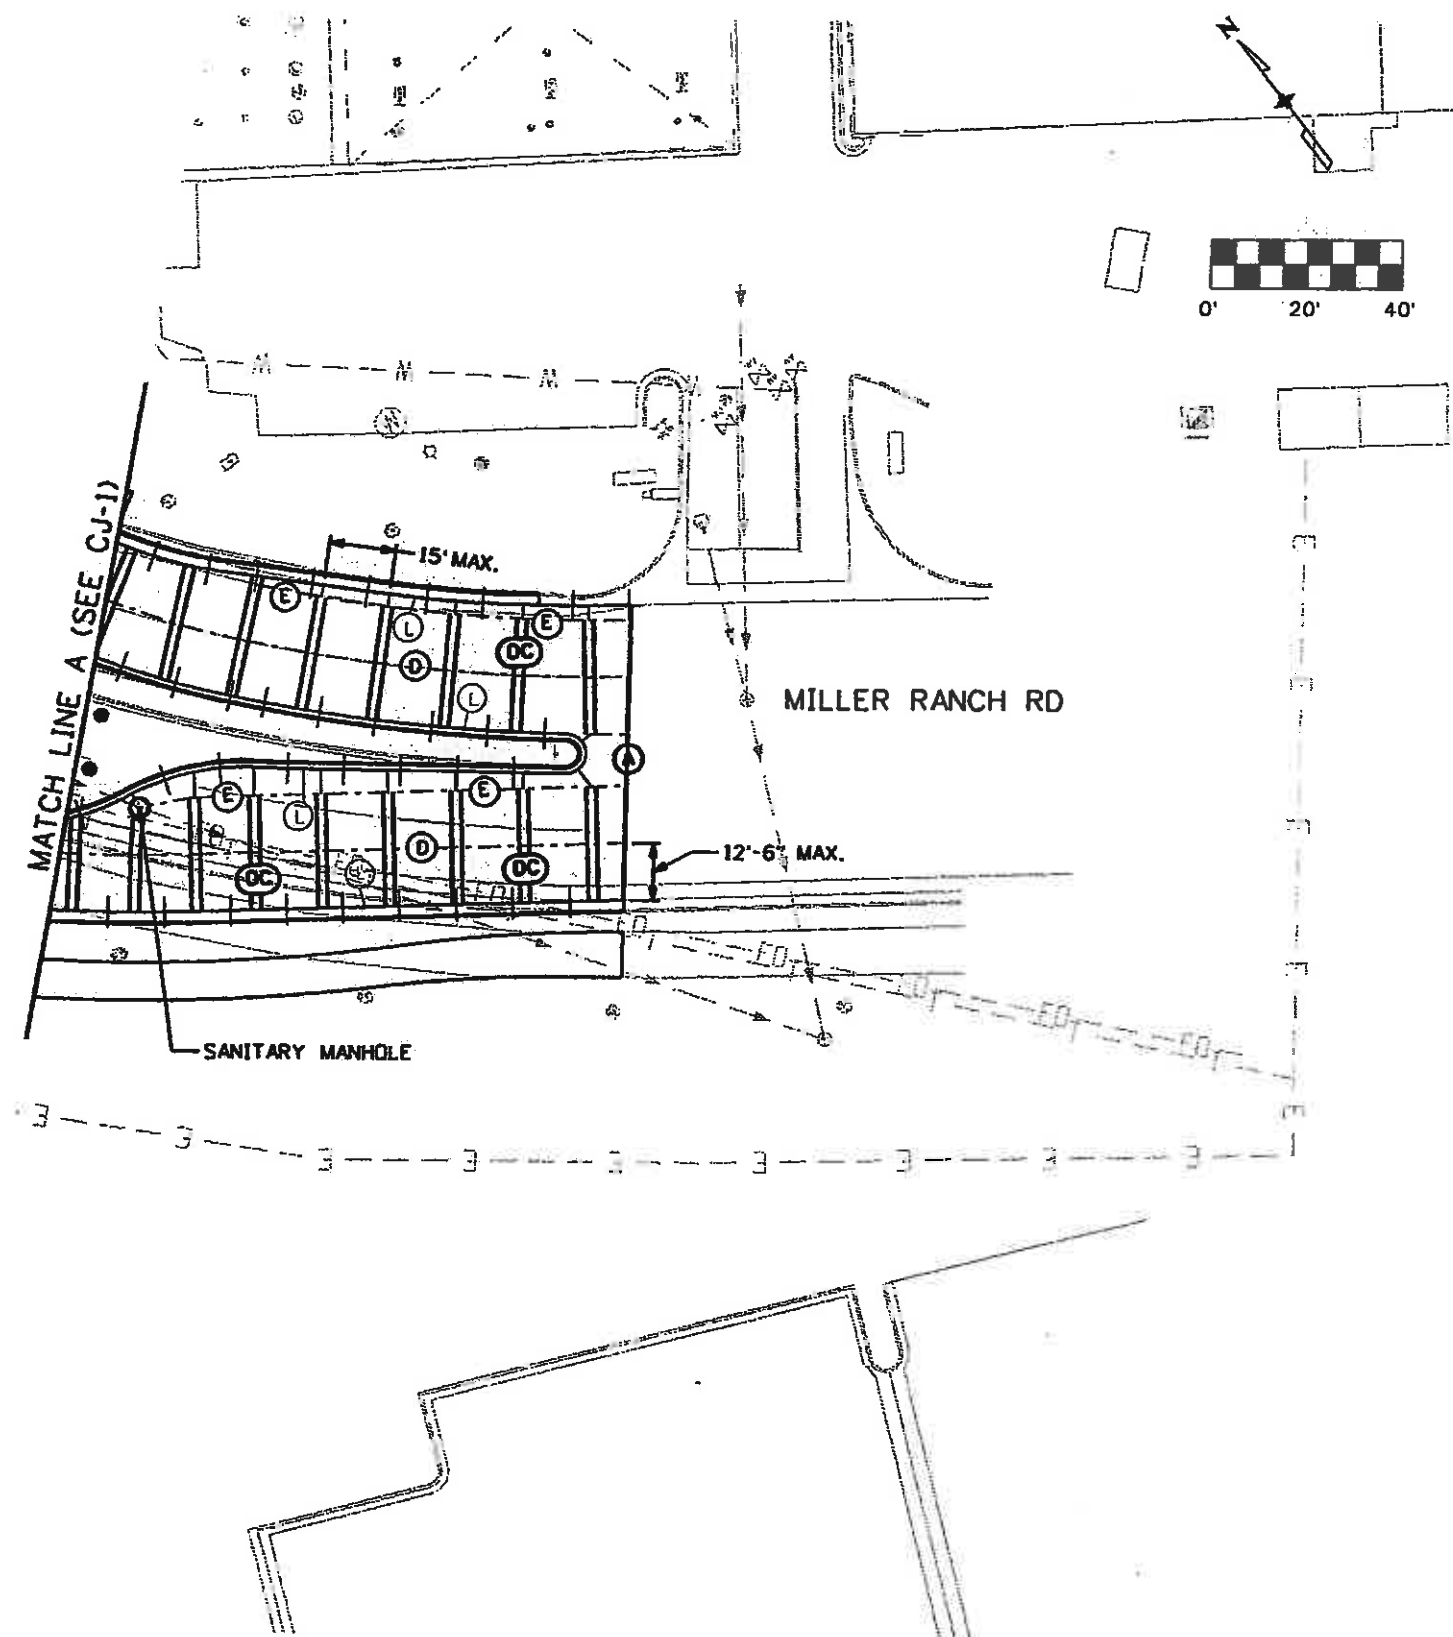

CONCRETE PAVEMENT JOINTING NOTES:


1. THE CONCRETE PAVEMENT JOINT LAYOUT AS SHOWN ON THE CONCRETE PAVEMENT JOINT PLANS ARE INTENDED FOR BIDDING AND FOR GENERAL INFORMATION PURPOSES ONLY. PRIOR TO PLACING ANY CONCRETE PAVEMENT, THE CONTRACTOR SHALL SUBMIT A CONCRETE PAVEMENT JOINT LAYOUT PLAN TO THE ENGINEER IDENTIFYING THE CONTRACTOR'S PROPOSED CONCRETE PAVEMENT JOINT LAYOUT AND THE CONTRACTOR'S ANTICIPATED PAVEMENT PLACEMENT SEQUENCING. NO CONCRETE PAVEMENT SHALL BE PLACED BY THE CONTRACTOR UNTIL AUTHORIZED BY THE ENGINEER.
2. ALL CONCRETE PAVEMENT JOINTS SHALL BE INSTALLED PER CDOT STANDARD M-412-1, EXCEPT AS NOTED ON THE PLANS OR AS DIRECTED BY THE ENGINEER.
3. THE CONCRETE JOINTS, INCLUDING ALL NECESSARY MATERIALS AND LABOR, WILL NOT BE PAID FOR SEPARATELY, BUT TO BE INCLUDED IN THE COST OF THE CONCRETE PAVEMENT.
4. AT THE CONTRACTOR'S OPTION, IF APPROVED BY ENGINEER, THE CURB AND GUTTER ABUTTING THE CONCRETE PAVEMENT MAY BE POURED MONOLITHICALLY WITH THE CONCRETE PAVEMENT AT NO ADDITIONAL COST TO THE PROJECT. IF THE CURB AND GUTTER IS POURED MONOLITHICALLY, THE LONGITUDINAL CONSTRUCTION JOINT BETWEEN GUTTER AND THE CONCRETE PAVEMENT WILL NOT REQUIRED.
5. THE TRANSITION SECTION BETWEEN THE CONCRETE PAVEMENT AND ANY ASPHALT PAVEMENT SHALL BE CONSTRUCTED AS DIRECTED BY THE ENGINEER. THE TRANSITION SECTIONS WILL NOT BE PAID FOR SEPARATELY, BUT TO BE INCLUDED IN THE COST OF THE CONCRETE PAVEMENT.

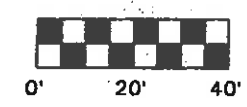

Print Date: 11/5/2009
Drawing File Name: D6193CPJ04.dgn
Horiz. Scale: 1:40.0017
Unit Information
Vert. Scale: As Noted
Unit Leader Initials

Sheet Revisions		
Date:	Comments	Init.

Colorado Department of Transportation



714 Grand Avenue, P.O. Box 298
Eagle, CO 81631
Phone: 970-328-6385 FAX: 970-328-2368

Region 3 MLM


As Constructed
No Revisions: 6-6-2011
Revised:
Void:

EDWARDS INTERCHANGE UPGRADE MILLER RANCH RD. CONCRETE PAVEMENT JOINT LAYOUT	
Designer: SPG	Structure
Detailer: TBS	Numbers
Sheet Subset: JOINT	Subset Sheets: CJ-04 of 8

Project No./Code
ES3 0702-297
17303
Sheet Number 232




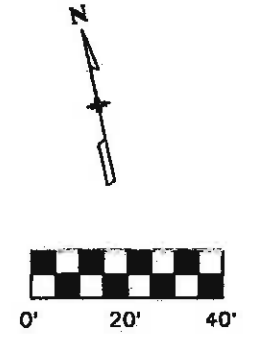
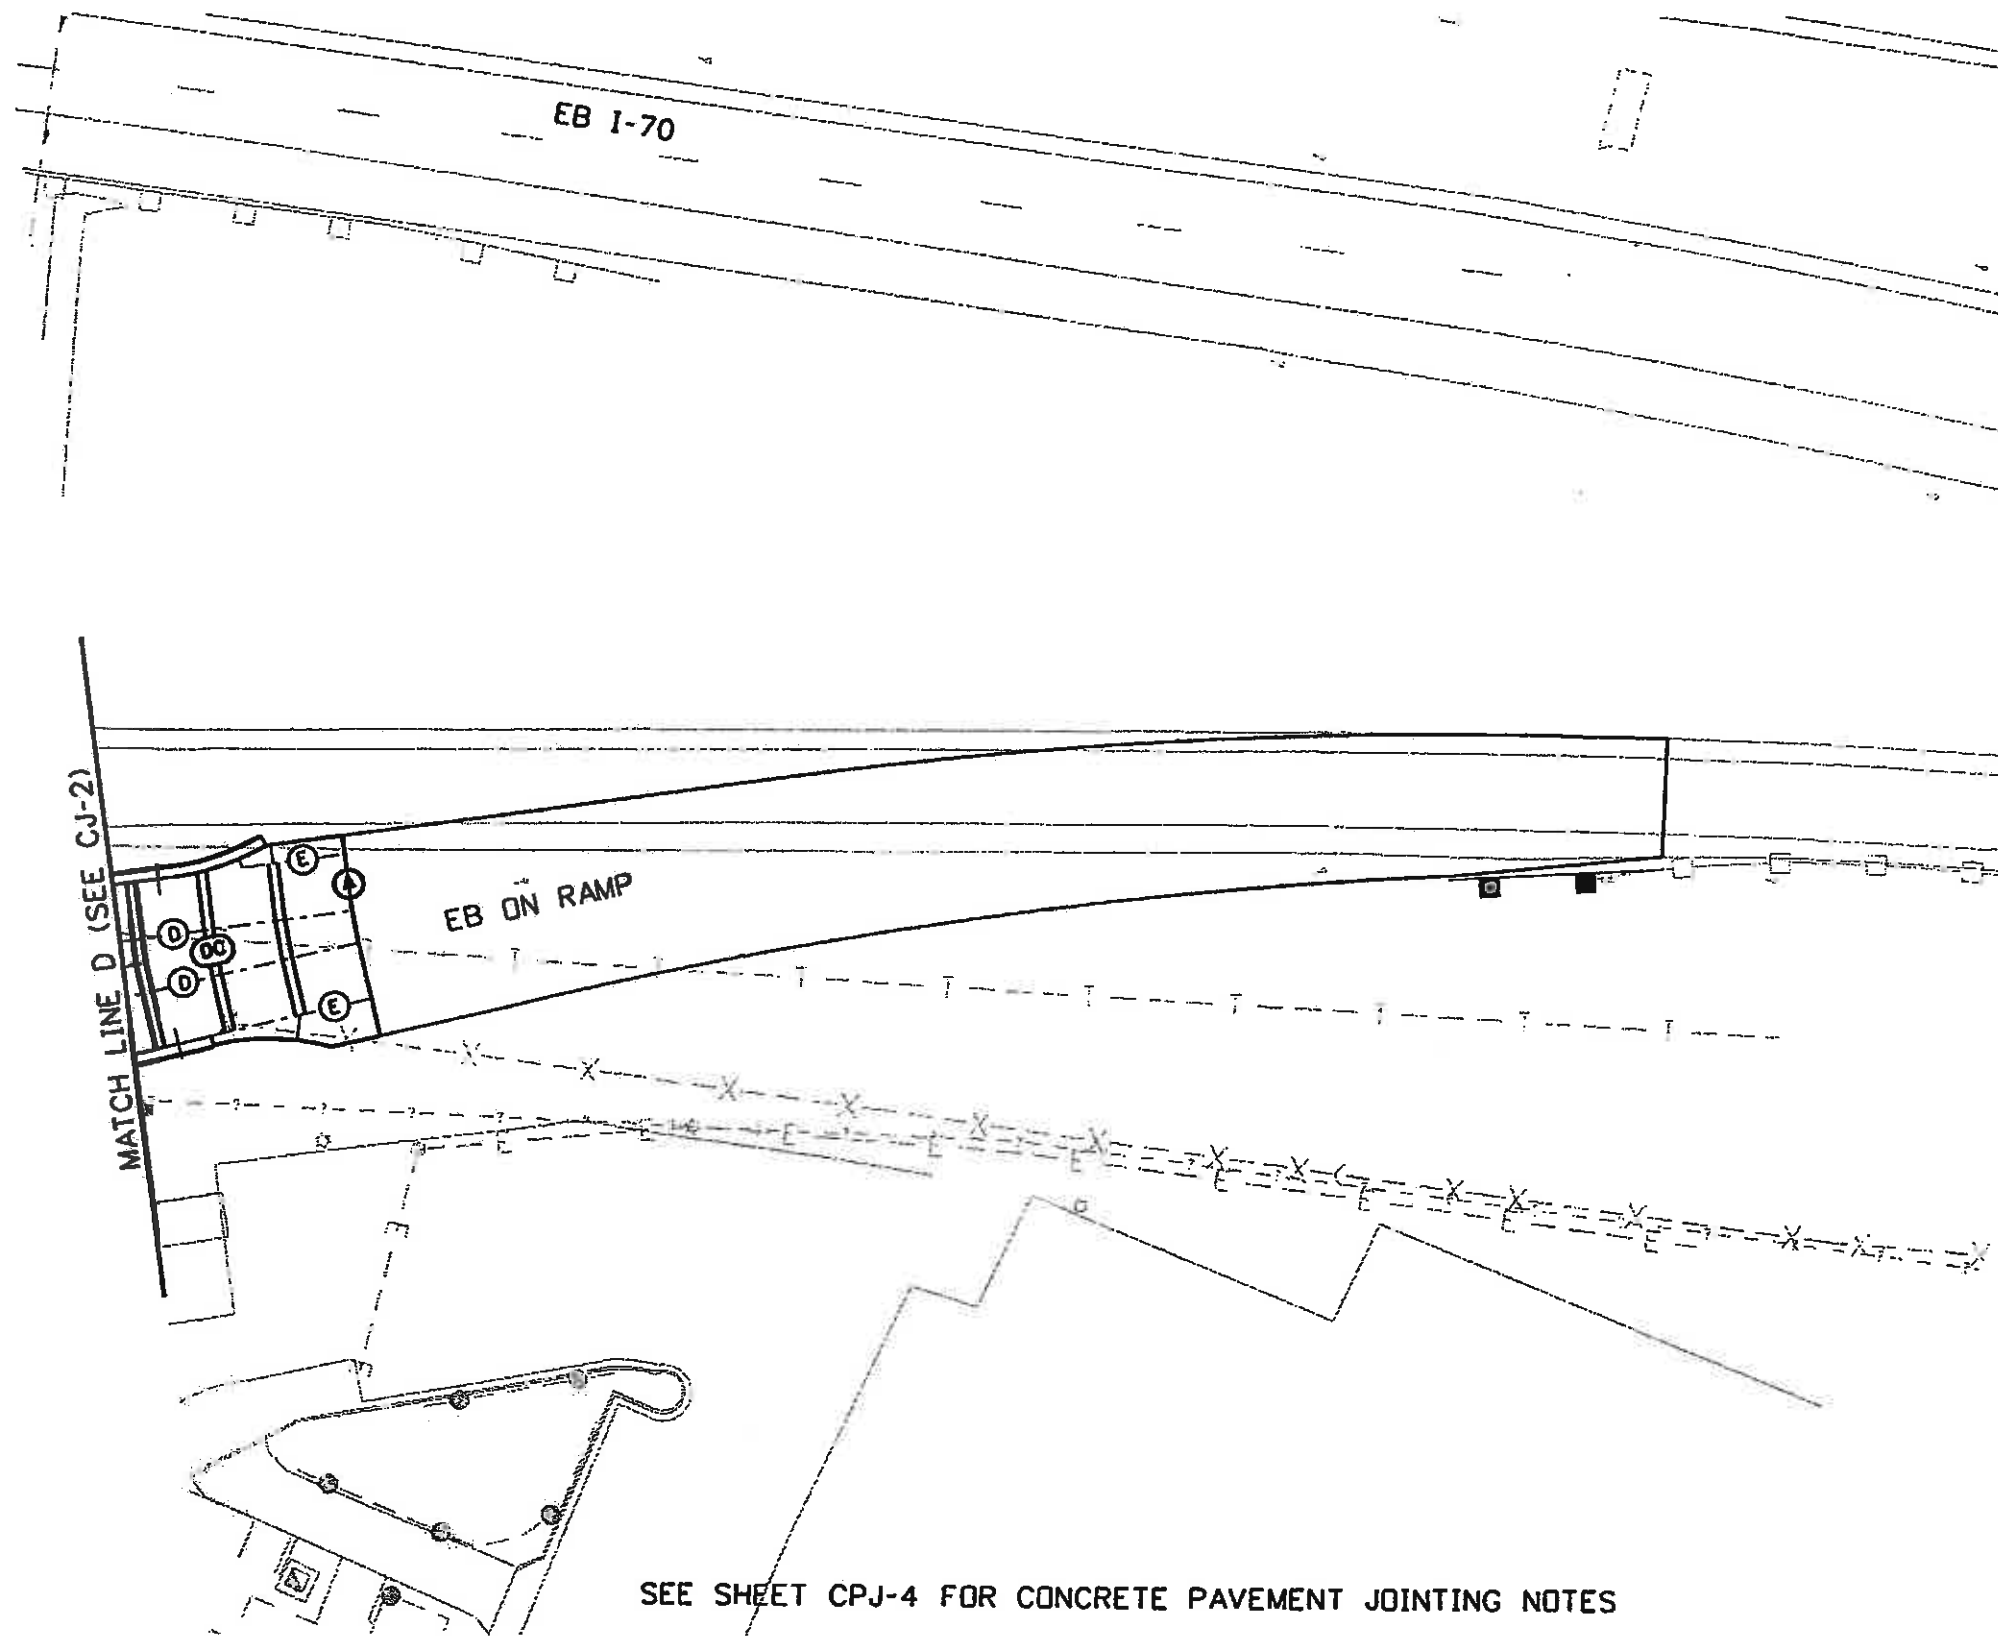
Remember below.
Call before you dig.

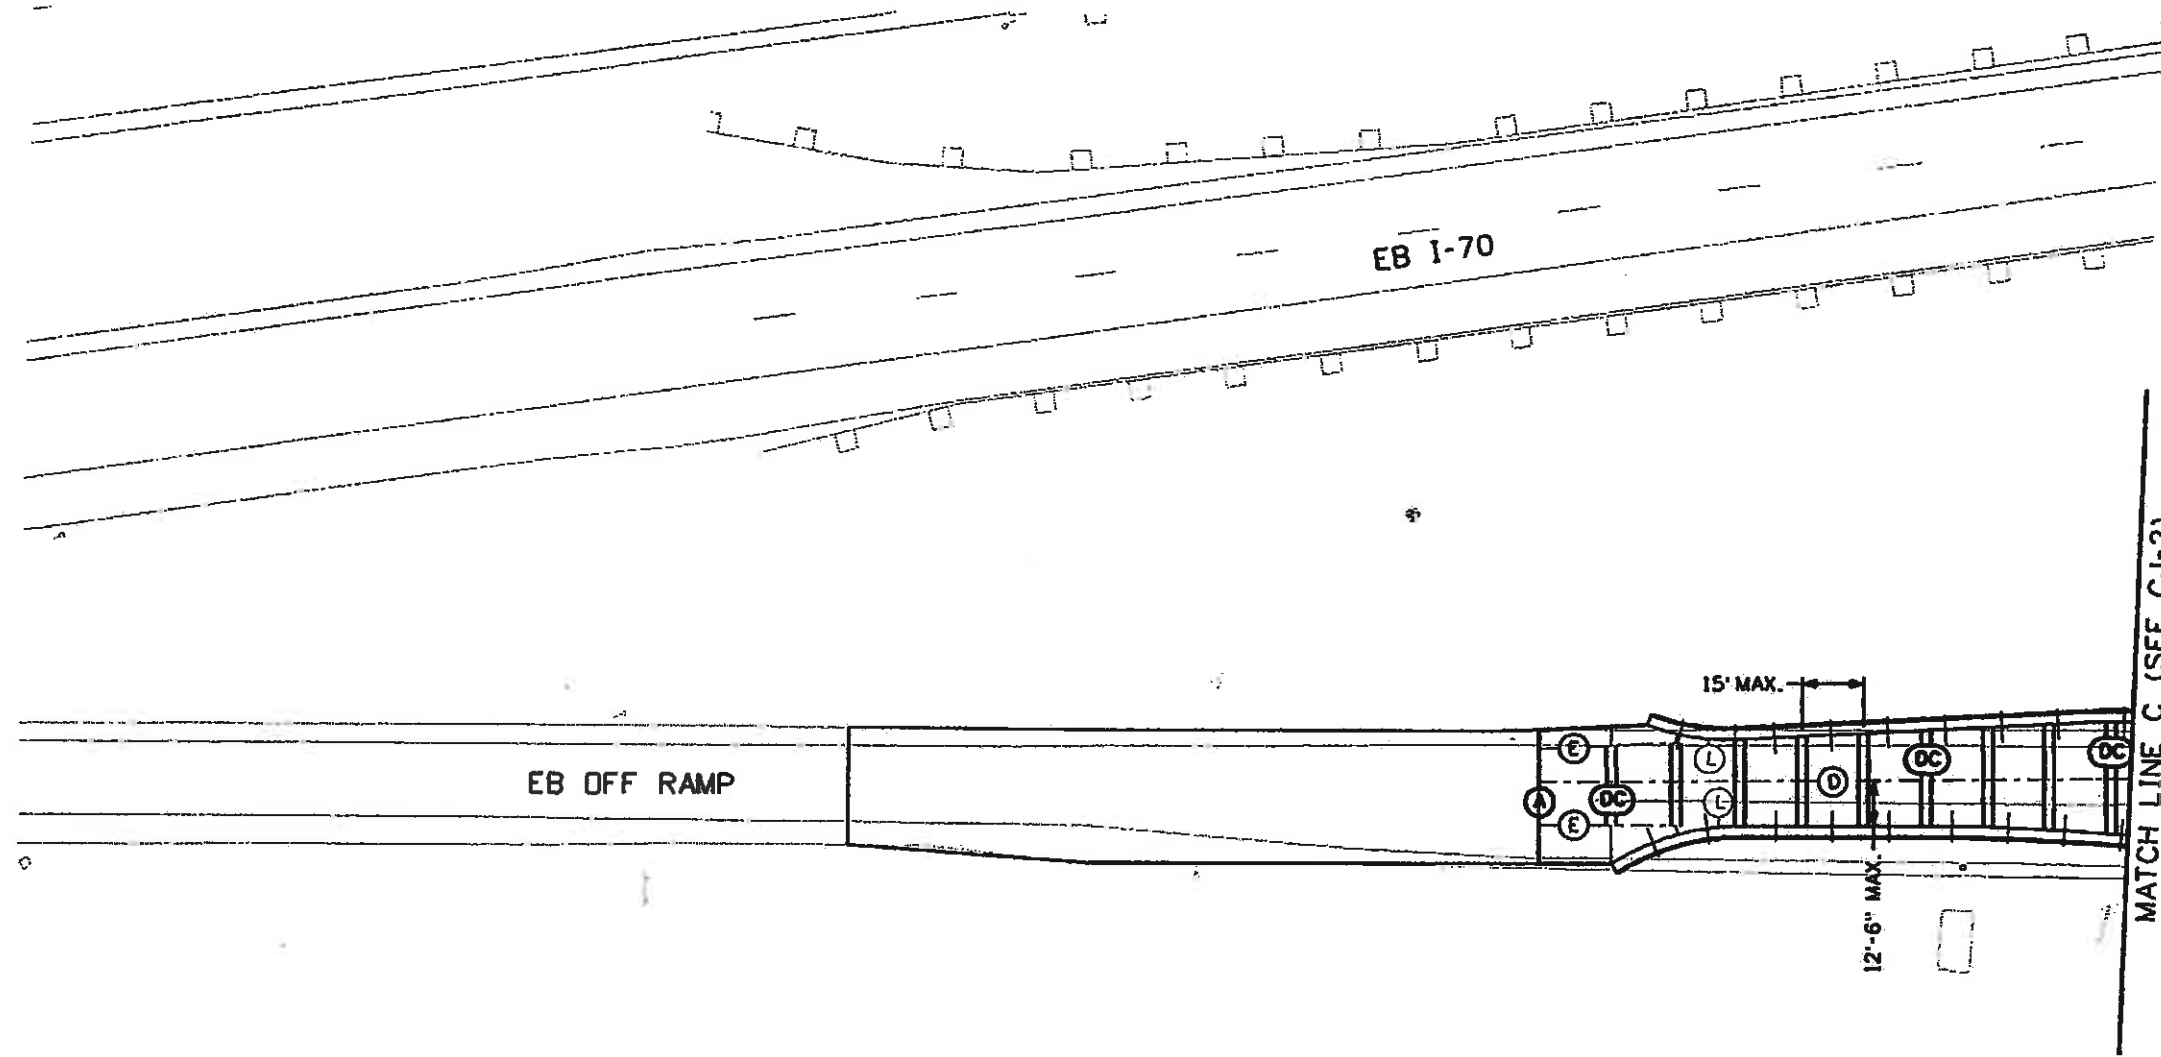

SEE SHEET CPJ-4 FOR CONCRETE PAVEMENT JOINTING NOTES




Print Date: 11/5/2009	Sheet Revisions			Colorado Department of Transportation  714 Grand Avenue, P.O. Box 298 Eagle, CO 81631 Phone: 970-328-6385 FAX: 970-328-2368 Region 3	As Constructed	EDWARDS INTERCHANGE UPGRADE		Project No./Code
Drawing File Name: 06193CPJ05.dgn	Date:	Comments	Init.			No Revisions: 6-6-2011	EB OFF RAMP	
Horiz. Scale: 1:40.0031	Vert. Scale: As Noted				Revised:	Designer: SPG	Structure Numbers	17303
Unit Information	Unit Leader Initials				Void:	Detailer: TBS	Sheet Subset: JOINT	Subset Sheets: CJ-05 of 8
							Sheet Number 233	



Print Date: 11/5/2009	Sheet Revisions			Colorado Department of Transportation 714 Grand Avenue, P.O. Box 298 Eagle, CO 81631 Phone: 970-328-6385 FAX: 970-328-2368 Region 3	As Constructed	EDWARDS INTERCHANGE UPGRADE		Project No./Code
Drawing File Name: 06193CPJ06.dgn	Date:	Comments	Init.			No Revisions: 6-6-2011	EB ON RAMP	
Horiz. Scale: 1=40.0051	Vert. Scale: As Noted				Revised:	Designer: SPG	Structure Numbers	17303
Unit Information	Unit Leader Initials				Void:	Detailer: TBS	Subset Sheets: CJ-06 of 8	Sheet Number 234



Know what's below.
Call before you dig.

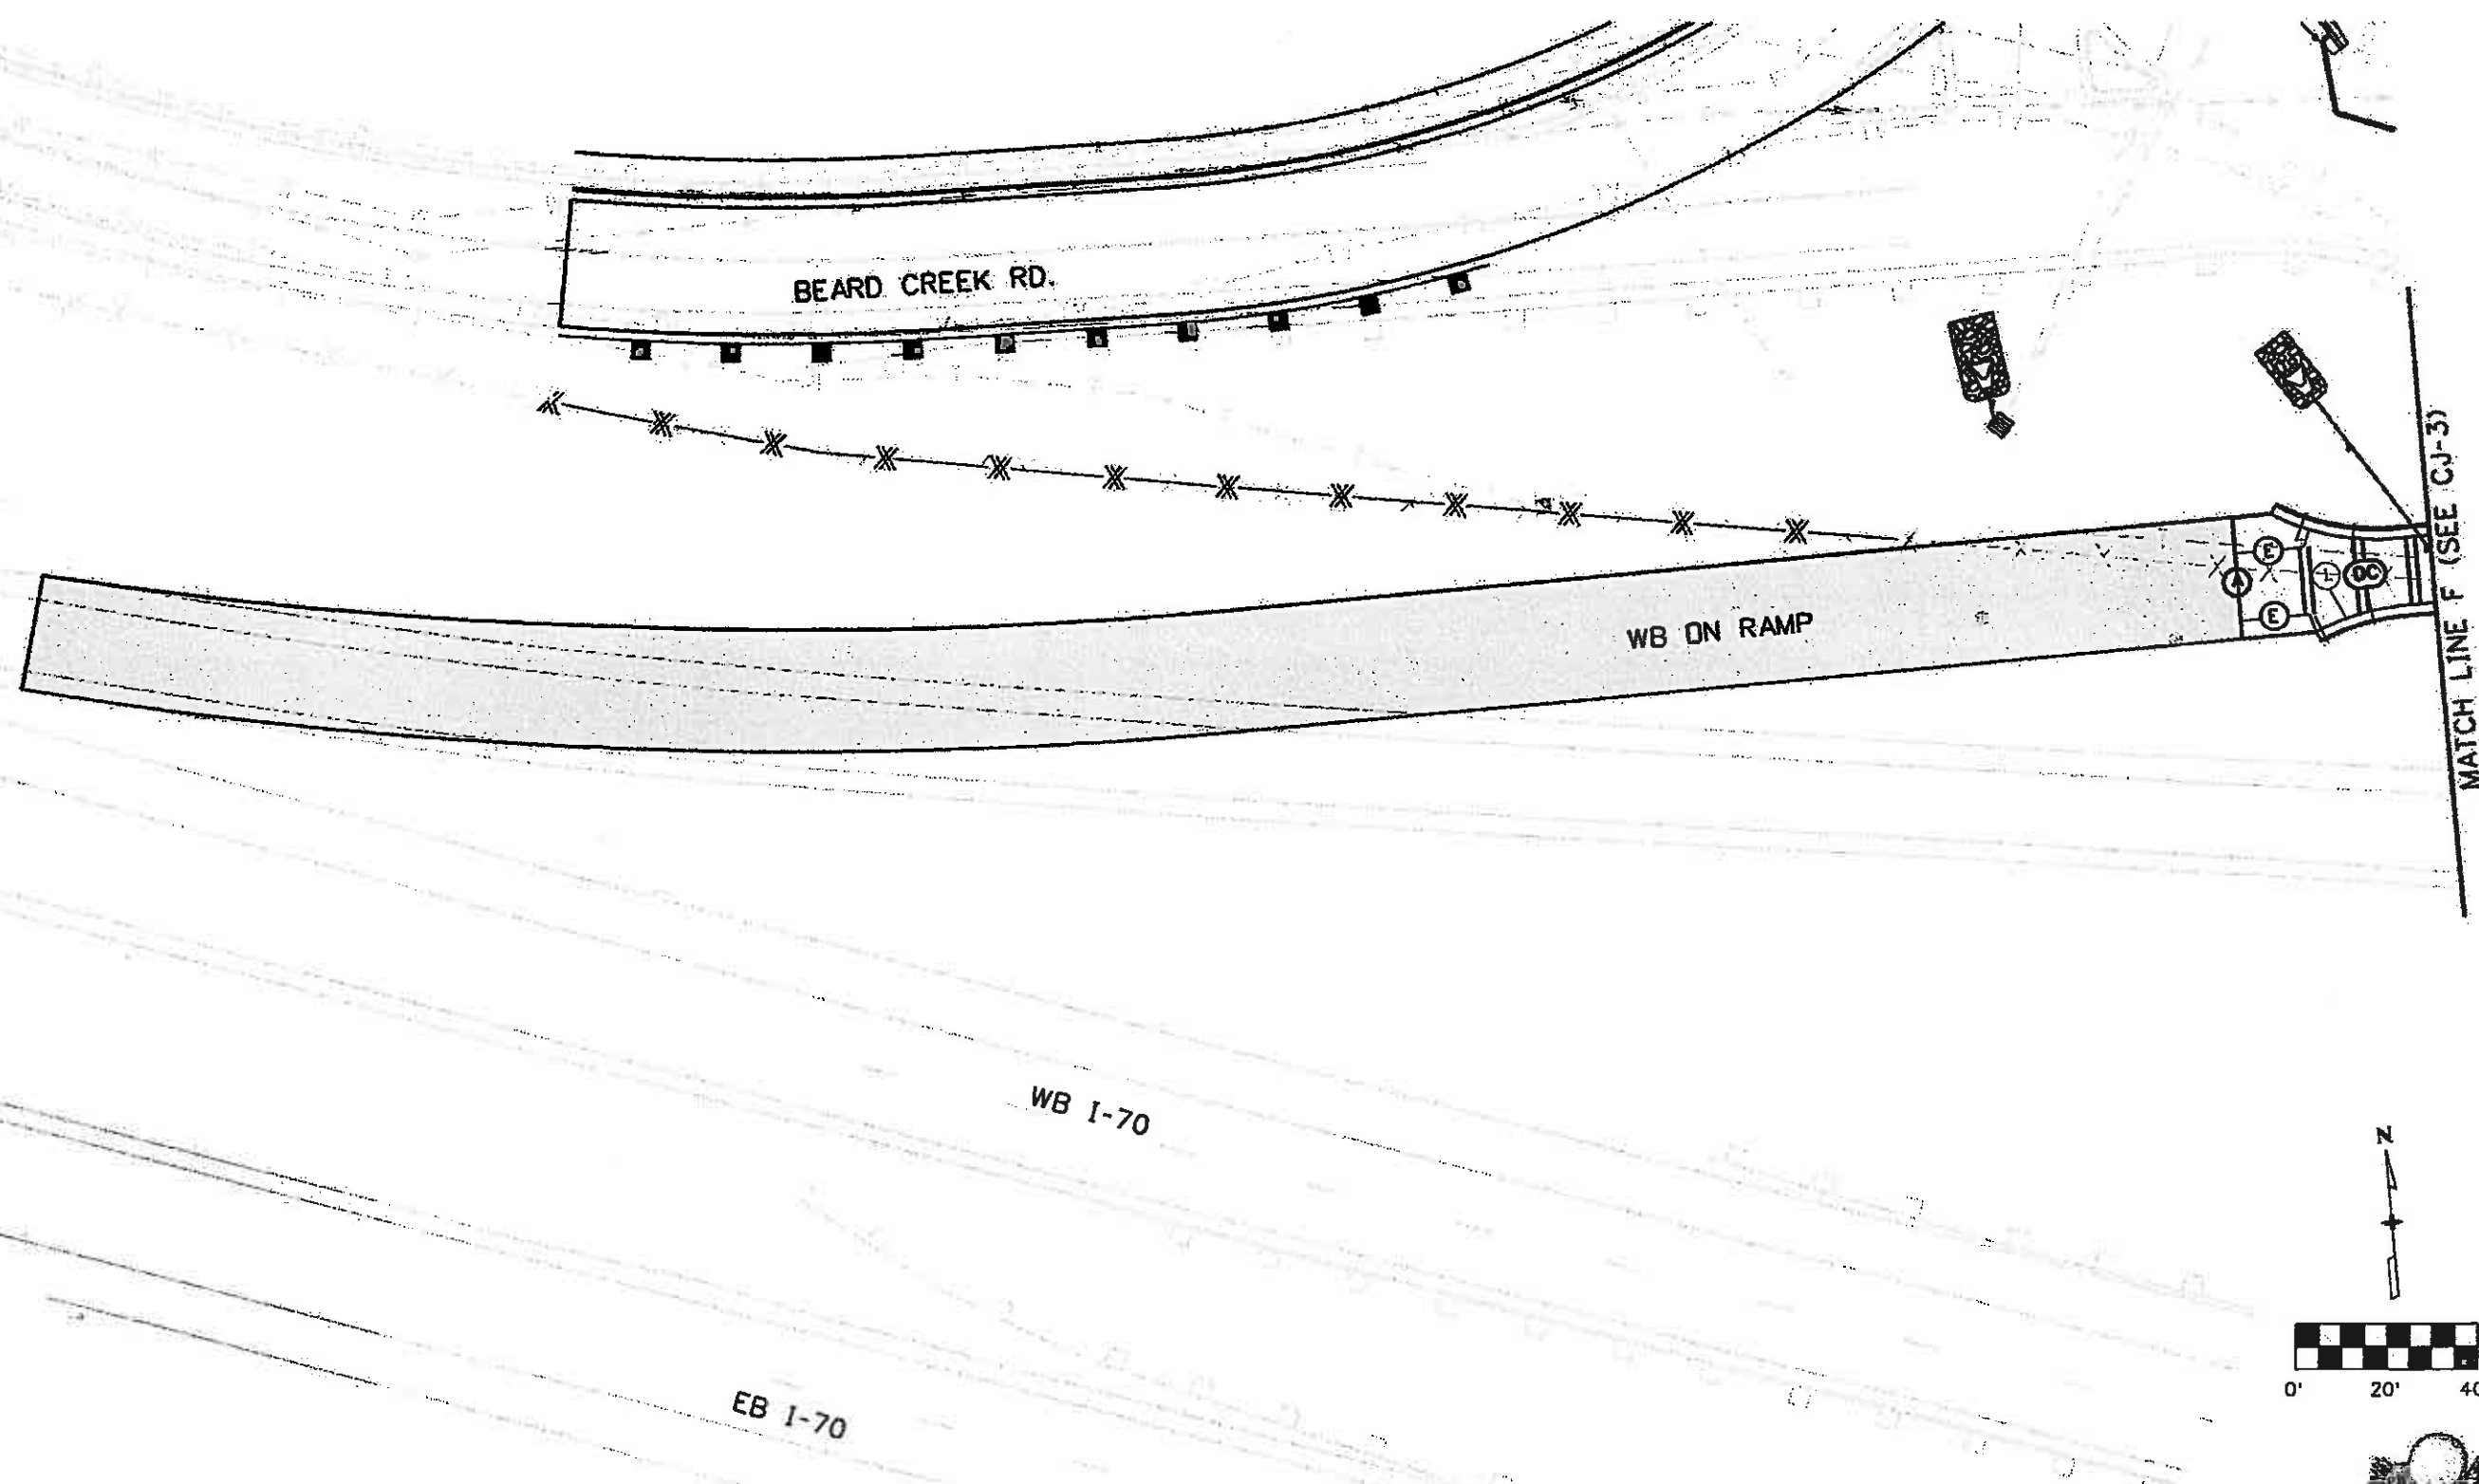


SEE SHEET CPJ-4 FOR CONCRETE PAVEMENT JOINTING NOTES



Print Date: 11/5/2009	<table border="1"> <thead> <tr> <th colspan="3">Sheet Revisions</th> </tr> <tr> <th>Date:</th> <th>Comments</th> <th>Init.</th> </tr> </thead> <tbody> <tr> <td> </td> <td> </td> <td> </td> </tr> <tr> <td> </td> <td> </td> <td> </td> </tr> </tbody> </table>	Sheet Revisions			Date:	Comments	Init.							Colorado Department of Transportation  714 Grand Avenue, P.O. Box 298 Eagle, CO 81631 Phone: 970-328-6385 FAX: 970-328-2368 Region 3	As Constructed No Revisions: <i>6-6-2011</i> Revised: Void:	EDWARDS INTERCHANGE UPGRADE WB ON RAMP CONCRETE PAVEMENT JOINT LAYOUT	Project No./Code
Sheet Revisions																	
Date:		Comments	Init.														
Drawing File Name: D6193CPJ07.dgn	ES3 0702-297																
Horiz. Scale: 1:40.0026 Vert. Scale: As Noted	17303																
Unit Information Unit Leader Initials	Sheet Number 235																



Know what's below.
Call before you dig.

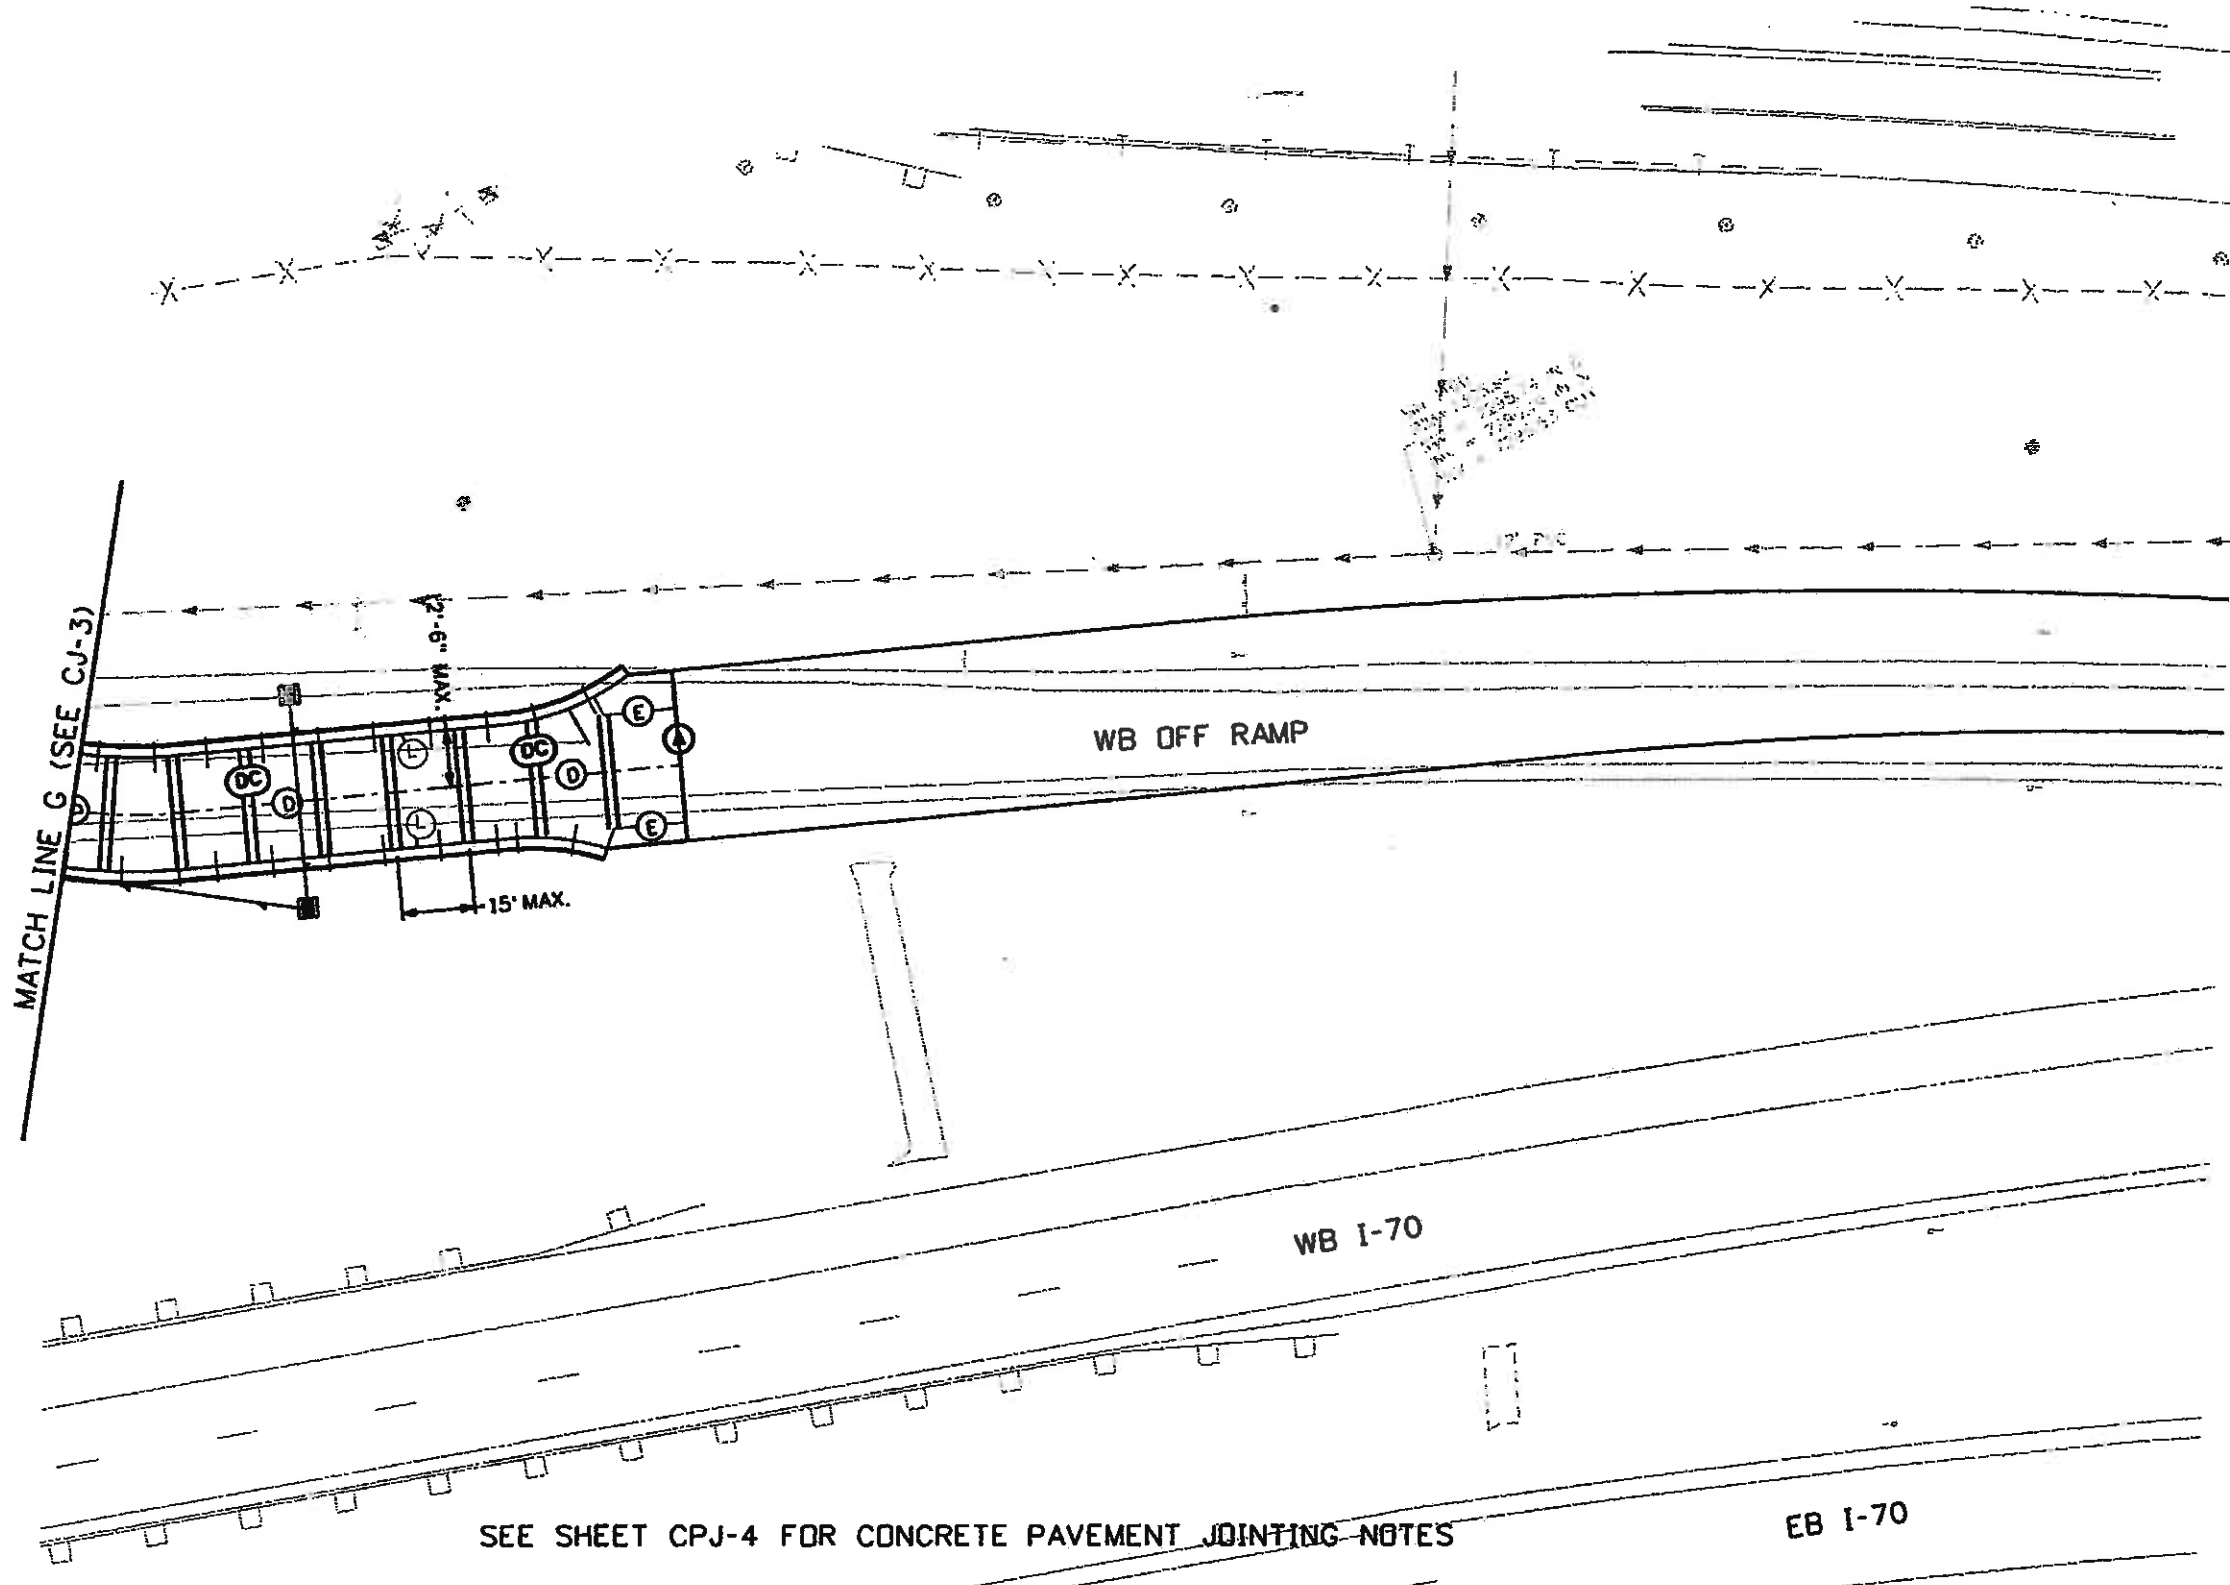

Print Date: 11/5/2009
 Drawing File Name: 08193CPJ08.dgn
 Horiz. Scale: 1:40.0034
 Unit Information
 Vert. Scale: As Noted
 Unit Leader Initials

Sheet Revisions		
Date:	Comments	Init.

Colorado Department of Transportation



Region 3

714 Grand Avenue, P.O. Box 298
 Eagle, CO 81631
 Phone: 970-328-6385 FAX: 970-328-2368

MLM

As Constructed

No Revisions: 6-6-2011

Revised:

Void:

EDWARDS INTERCHANGE UPGRADE
 WB OFF RAMP
 CONCRETE PAVEMENT JOINT LAYOUT

Designer: SPG
 Detailer: TBS
 Sheet Subset: JOINT
 Structure Numbers
 Subset Sheets: CJ-08 of 8

Project No./Code

ES3 0702-297

17303

Sheet Number 236



SIGN NO.	SIGN CODE	STATION/LOCATION	SIGN PANEL SIZE (IN)	BACKGROUND COLOR	REMOVAL OF GROUND SIGN	REMOVAL OF SIGN PANEL	RESET GROUND SIGN	RESET SIGN PANEL	RESET GROUND SIGN (SPECIAL-BERRY CREEK SIGN)	NO. OF POSTS	POST TYPE					FOOTING				SIGN PANEL							
											P 2 1N	P 2.5 IN	P2 2.5 IN SOH BO-SLIP	STEEL SIGN POST (W 6X12)	STEEL SIGN POST (W 6X15)	STEEL SIGN POST (W 8X18)	STEEL SIGN POST (W 10X26)	SIGN POST (SPECIAL)	CONCRETE FOOTING (TYPE 1)	CONCRETE FOOTING (TYPE 2)	CONCRETE FOOTING (TYPE 3)	CONCRETE FOOTING (TYPE 5)	CLASS I	CLASS II	CLASS III		
											LIN. FT.	LIN. FT.	EACH	LIN. FT.	LIN. FT.	LIN. FT.	LIN. FT.	LF	EA	EA	EA	EA	SQ. FT.	SQ. FT.	SQ. FT.		
13bB	R6-4b	MOUNT WITH 13aA	48 X 18	WHITE																							
13aA	R6-1R	12-07 RT.	36 X 12	BLACK																							6.00
13bB	R6-4b	MOUNT WITH 13aA	48 X 18	WHITE																							3.00
13aA	R6-1R	11-57 RT.	36 X 12	BLACK																							6.00
13bB	R6-4b	MOUNT WITH 13aA	48 X 18	WHITE																							3.00
6j	R1-2	599+55 LT.	36	RED																							6.00
66A	W11-2	600+55 LT.	30 X 30	YELLOW																							4.50
66B	W16-7pL	MOUNT WITH 66A	24 X 12	YELLOW																							6.25
66C	R5-1a	MOUNT BACK TO BACK WITH 66B	30 X 30	WHITE																							2.00
52	SPECIAL	600+84 LT.	84 X 60	WHITE																							
3d	W3-2	601+50 LT.	36 X 36	YELLOW																							35.00
25b	R5-1a	600+43 RT.	30 X 30	WHITE																							9.00
7aA	R6-1R	600+11 RT -MOUNT ON LIGHT POLE	36 X 12	BLACK																							
7bB	R1-2	MOUNT WITH 7aA ON LIGHT POLE	36	RED																							3.00
6h	R1-2	506+60 LT	36	RED																							4.50
7jA	R6-1R	11+11 RT.	36 X 12	BLACK																							4.50
7jB	R1-2	MOUNT WITH 7jA	36	RED																							3.00
43	SPECIAL	10+41 RT.	84 X 60	WHITE																							4.50
25b	R5-1a	602+39 RT	36 X 24	RED																							35.00
55A	SPECIAL	602+38 LT	132 X 90	GREEN																							
55B	R5-1a	MOUNT BACK TO BACK WITH 55A	36 X 24	RED																							
59	SPECIAL	603+36 LT.	48 X 24	BLUE																							82.50
1dA	W2-6	604+32 LT.	30 X 30	YELLOW																							
1dB	W13-1	MOUNT WITH 1dA	24 X 24	YELLOW																							6.25
58	SPECIAL	605+32 LT.	SPECIAL	BLUE																							4.00
57	SPECIAL	PLACE 100' FROM GORE	SPECIAL	BLUE																							
TOTAL SHEET					0	0	5	1	0	14	0	0	12	0	31.2	0	0	0	0	2	0	0	0.00	145.50	82.50		
PROJECT TOTALS					21	10	27	17	1	110	0	0	85	111	69	87	59	44	8	4	4	2	38	862	565		

NOTES:
 1. SIGN REMOVAL STATIONING IS APPROXIMATE. THE CONTRACTOR SHALL FIELD VERIFY ALL SIGN LOCATIONS.
 2. THE CONTRACTOR SHALL COORDINATE ALL SIGN REMOVALS WITH THE TRAFFIC CONTROL PLANS AND CONSTRUCTION PHASING.



WALL MOUNTED SIGN POSTS TO BE PAID FOR AS SIGN POST (SPECIAL). SEE RETAINING WALL PLANS FOR DETAILS.

REFER TO CDDT STANDARD PLAN NO. S-614-1 FOR LATERAL AND VERTICAL PLACEMENT. SIGNS IN CENTRAL ISLAND SHALL BE ORIENTED TO FACE ON COMING TRAFFIC.

CONTRACTOR SHALL FIELD VERIFY LOCATION OF SIGN PRIOR TO INSTALLATION. COORDINATE WITH ENGINEER IF RELOCATION IS NEEDED.



Print Date: 11/5/2009	Sheet Revisions		Colorado Department of Transportation		As Constructed	EDWARDS INTERCHANGE UPGRADE		Project No./Code	
Drawing File Name: 06193SSTAB04.dgn	Date:	Comments	Init.	714 Grand Avenue, P.O. Box 298 Eagle, CO 81631 Phone: 970-328-6385 FAX: 970-328-2368 Region 3 MLM	No Revisions:	TABULATION OF SIGNS		ES3 0702-297	
Horiz. Scale: N/A	Unit Information	Unit Leader Initials			Revised: 6-6-2011	Designer: KMH	Structure Numbers:	17303	
Vert. Scale: As Noted					Void:	Detailer: KMH	Subset Sheets: TS-04 of 4	Sheet Number 240	



Know what's below. Call before you dig.

PAVEMENT MARKING TABULATION

STATION / LOCATION	CONCRETE											WORD-SYMBOLS (SQUARE FEET) TYPE III						REMOVAL OF PAVEMENT MARKINGS	
	LANE (R-6)			EDGE			CENTER	CHANNELIZING	CHEVRONS	EXTENSION	XWALK-STOPLINE		TURN ARROW	THRU ARROW	THRU/TURN ARROW	TURN/THRU/TURN ARROW	TURN/TURN ARROW		MERGE ARROW
	TYPE I (NON-CONTRAST TAPE)			EPOXY (R-6)			TYPE I (NON-CONTRAST)	TYPE I (NON-CONTRAST)	TYPE I (NON-CONTRAST)	TYPE I (NON-CONTRAST)	TYPE III								
	WHITE	WHITE	WHITE	WHITE	WHITE	YELLOW	YELLOW	WHITE	WHITE	WHITE	CROSS-WALK	STOP LINE							
	SOLID	SKIP	DOTTED	SOLID	SOLID	SOLID	SOLID	SOLID	SOLID	DOTTED	24 INCH	24 INCH							
4 INCH	4 INCH	4 INCH	4 INCH	8 INCH	4 INCH	4 INCH	8 INCH	8 INCH	8 INCH	15.5 SF EACH	12.5 SF EACH	27.5 SF EACH	37.5 SF EACH	27.5 SF EACH	41.9 SF EACH				
EDWARDS ACCESS RD	316	189				988	583	32			17	4	4	10			1		
NORTHSTAR CENTER ACCESS					40			24											
MILLER RANCH RD ROUNDABOUT			123		127				99				2	4					
MILLER RANCH RD		25						115				4		2					
EB RAMP ROUNDABOUT			60		103				68				2	1					
WB RAMP ROUNDABOUT			239		122				73			2	3	1					
EB OFF RAMP		16		42	42			65				2			2				
EB ON RAMP				34	36			200											
WB OFF RAMP		27		36	36			65				1			1				
WB ON RAMP				36	36														
TOTAL LINEAR FEET	316	177	422	148	392	150	988	948	56	248	17	201.5	137.5			41.9	0		
TOTAL SQUARE FEET	104	58	139	49	263	50	323	635	38	161	34	202	138	495	158	0	0		
TOTAL GALLONS	1	1	1	0	3	0	3	6	0	2	8	2	1	5	2	0	0		

STATION / LOCATION	ASPHALT											WORD-SYMBOLS (SQUARE FEET) TYPE III						REMOVAL OF PAVEMENT MARKINGS	
	LANE			EDGE			CENTER	CHANNELIZING	CHEVRONS	EXTENSION	XWALK-STOPLINE		TURN ARROW	THRU ARROW	THRU/TURN ARROW	TURN/THRU/TURN ARROW	TURN/TURN ARROW		MERGE ARROW
	TYPE I (NON-CONTRAST TAPE)			EPOXY			TYPE I (NON-CONTRAST)	TYPE I (NON-CONTRAST)	TYPE I (NON-CONTRAST)	TYPE I (NON-CONTRAST)	TYPE III								
	WHITE	WHITE	WHITE	WHITE	WHITE	YELLOW	YELLOW	WHITE	WHITE	WHITE	CROSS-WALK	STOP LINE							
	SOLID	SKIP	DOTTED	SOLID	SOLID	SOLID	SOLID	SOLID	SOLID	DOTTED	24 INCH	24 INCH							
4 INCH	4 INCH	4 INCH	4 INCH	8 INCH	4 INCH	4 INCH	8 INCH	8 INCH	8 INCH	15.5 SF EACH	12.5 SF EACH	27.5 SF EACH	37.5 SF EACH	27.5 SF EACH	41.9 SF EACH				
EDWARDS ACCESS RD						117										1	114		
EB OFF RAMP				144	144														
EB ON RAMP				270	275														
WB OFF RAMP		25		824	620							1			1				
WB ON RAMP				483	487														
BEARD/BERRY CREEK ROUNDABOUT					78				46										
BEARD CREEK RD				1011			2328			50				1			1785		
BERRY CREEK RD							568			110	15			1					
TOTAL LINEAR FEET	0	25	0	2532	78	1526	3013	0	0	46	160	15					1899		
TOTAL SQUARE FEET	0	8	0	836	52	504	994	0	0	31	320	30	16	0	55	38	28	0	633
TOTAL GALLONS	0	0	0	8	1	5	18	0	0	0	3	0	0	0	1	0	0	0	6

PAVEMENT MARKING PROJECT TOTALS

ITEM	QUANTITY
REMOVAL OF PAVEMENT MARKING	633 SF
EPOXY PAVEMENT MARKING	18 GAL
PREFORMED PLASTIC PAVEMENT MARKING (TYPE II) (CONTRAST TAPE)	0 SF
PREFORMED PLASTIC PAVEMENT MARKING (TYPE III) (CONCRETE)	1880 SF
PREFORMED PLASTIC PAVEMENT MARKING (TYPE I) (NON-CONTRAST TAPE)	2492 SF
PREFORMED PLASTIC PAVEMENT MARKING (TYPE III) (ASPHALT) (WORD-SYMBOL)	136 SF
PREFORMED PLASTIC PAVEMENT MARKING (TYPE III) (ASPHALT) (XWALK-STOP LINE)	350 SF

DELINEATOR TABULATION

COLOR	QUANTITY	
	TYPE I	TYPE I (BARRIER)
CRYSTAL	40	3
PROJECT TOTAL	40	3

* See Summary of Approximate Quantities Sheets

1. DELINEATORS SHALL BE PLACED IN ACCORDANCE TO THE S-STANDARD S-612-1 IN THE CDDT M & S STANDARDS.
2. DELINEATORS (TYPE III) SHALL BE PLACED AT EACH DRAINAGE CROSSING THAT GOES UNDER THE ROADWAY OR CURB CUT.
3. FOR PAVEMENT MARKING INFORMATION, SEE CDDT STANDARDS S-627-1.
4. ALL CONCRETE PAVEMENT SURFACES TO BE COVERED WITH PERMANENT PAVEMENT MARKING MATERIALS SHALL BE SAND BLASTED PRIOR TO PLACEMENT OF ANY PRIMER OR PAVEMENT MARKING MATERIAL. THE WORK SHALL BE PERFORMED IN ACCORDANCE WITH SECTION 202.05 THE CDDT SPECIFICATIONS.



FELSBURG HOLT & ULLEVIG

Print Date: 5/11/2011
Drawing File Name: 06193SSTAB05.dgn
Horiz. Scale: N/A
Unit Information

Sheet Revisions		
Date	Comments	Init.
5-11-11	QUANTITIES/TYPE	KMD

Colorado Department of Transportation

714 Grand Avenue, P.O. Box 298
Eagle, CO 81631
Phone: 970-328-6385 FAX: 970-328-2368

Region 3 MLM

As Constructed
No Revisions:
Revised: 6-6-2011
Void:

EDWARDS INTERCHANGE UPGRADE PAVEMENT MARKING AND DELINEATOR QUANTITIES	
Designer: KMH	
Detailer: KMH	
Sheet Subset: TRAFFIC	

Project No./Code
ES3 0702-297
17303
Sheet Number 241X