



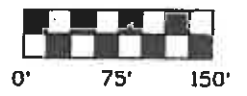

Call before you dig.

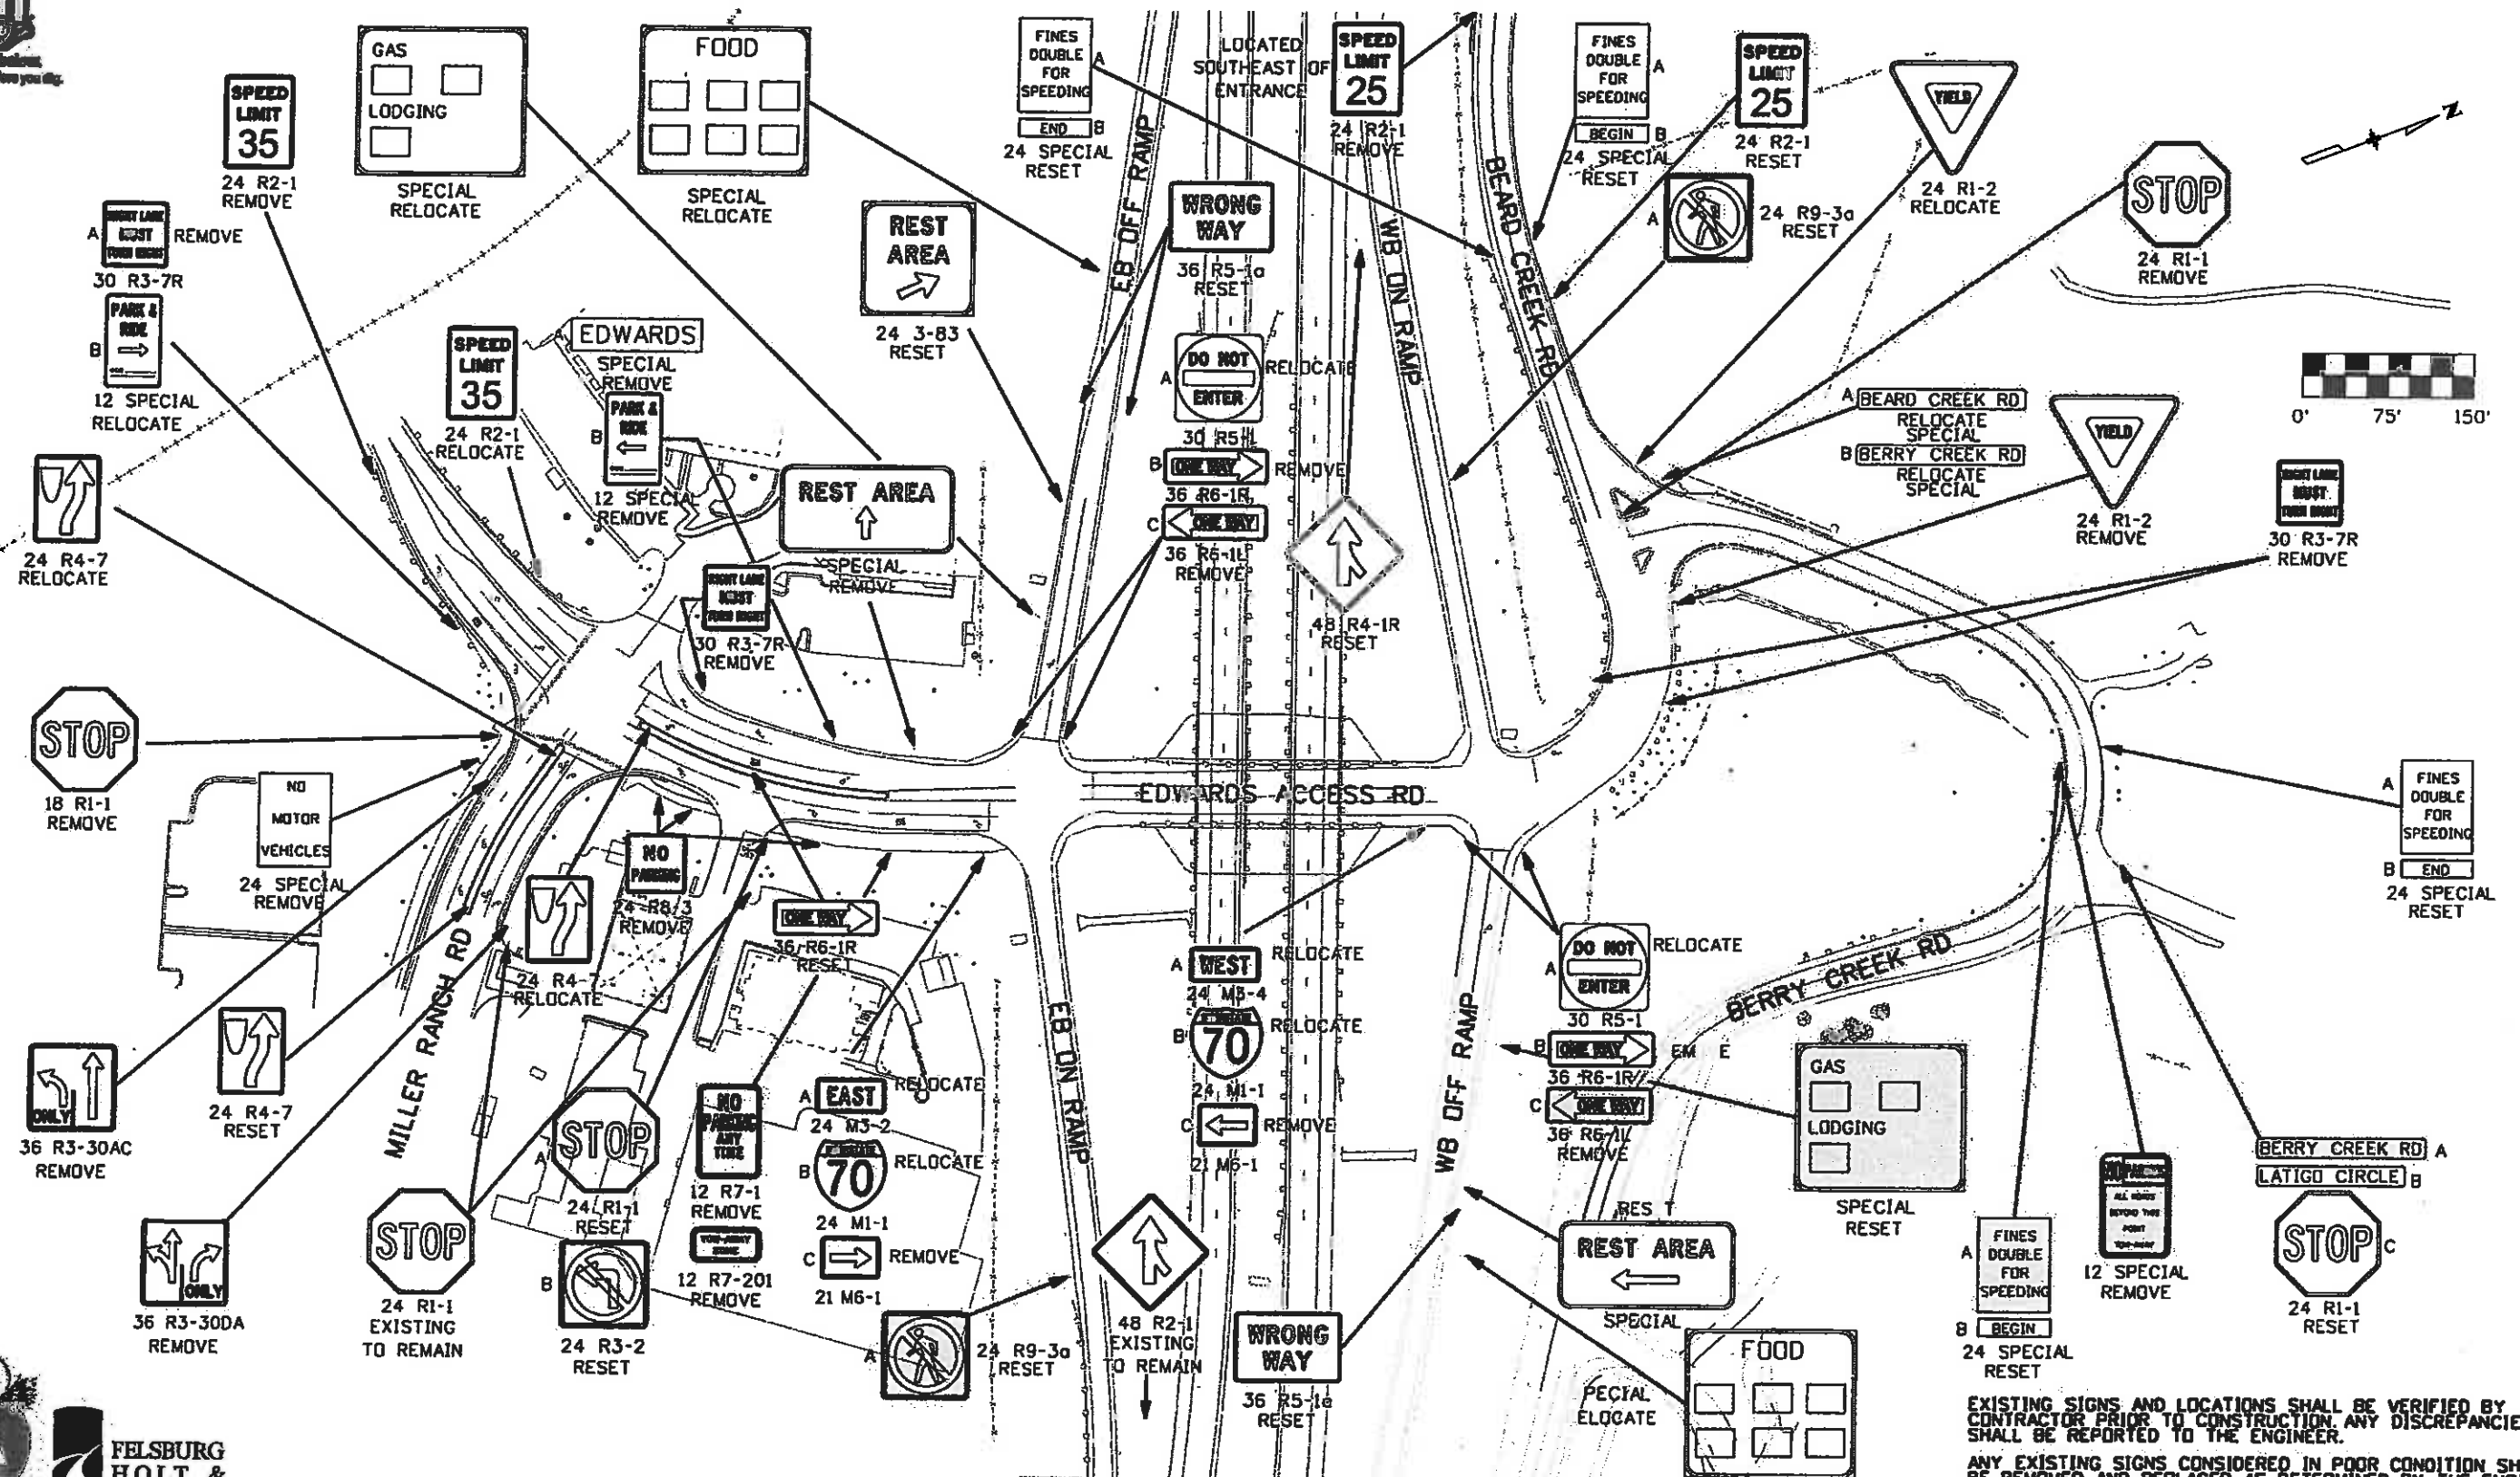

EXISTING SIGNS AND LOCATIONS SHALL BE VERIFIED BY THE CONTRACTOR PRIOR TO CONSTRUCTION. ANY DISCREPANCIES SHALL BE REPORTED TO THE ENGINEER.

ANY EXISTING SIGNS CONSIDERED IN POOR CONDITION SHALL BE REMOVED AND REPLACED, AS DETERMINED BY THE ENGINEER.

SEE SHEET SS-02 AND SS-03 FOR PROPOSED SIGN LOCATIONS.

Print Date: 11/5/2009

Drawing File Name: 06193SS01.dgn

Horiz. Scale: 1:150

Vert. Scale: As Noted

Unit Information

Unit Leader Initials



Sheet Revisions		
Date:	Comments	Init.

Colorado Department of Transportation



714 Grand Avenue, P.O. Box 298
Eagle, CO 81631
Phone: 970-328-6385 FAX: 970-328-2368

Region 3

MLM

As Constructed

No Revisions: 6-6-2011

Revised:

Void:

EDWARDS INTERCHANGE UPGRADE EXISTING SIGNS

Designer:	KMH	Structure	
Detailer:	KMH	Numbers	
Sheet Subset:	TRAFFIC	Subset Sheets:	SS-01 of 6

Project No./Code


ES3 0702-297

17303

Sheet Number 242



FELSBURG HOLT & ULLEVIG

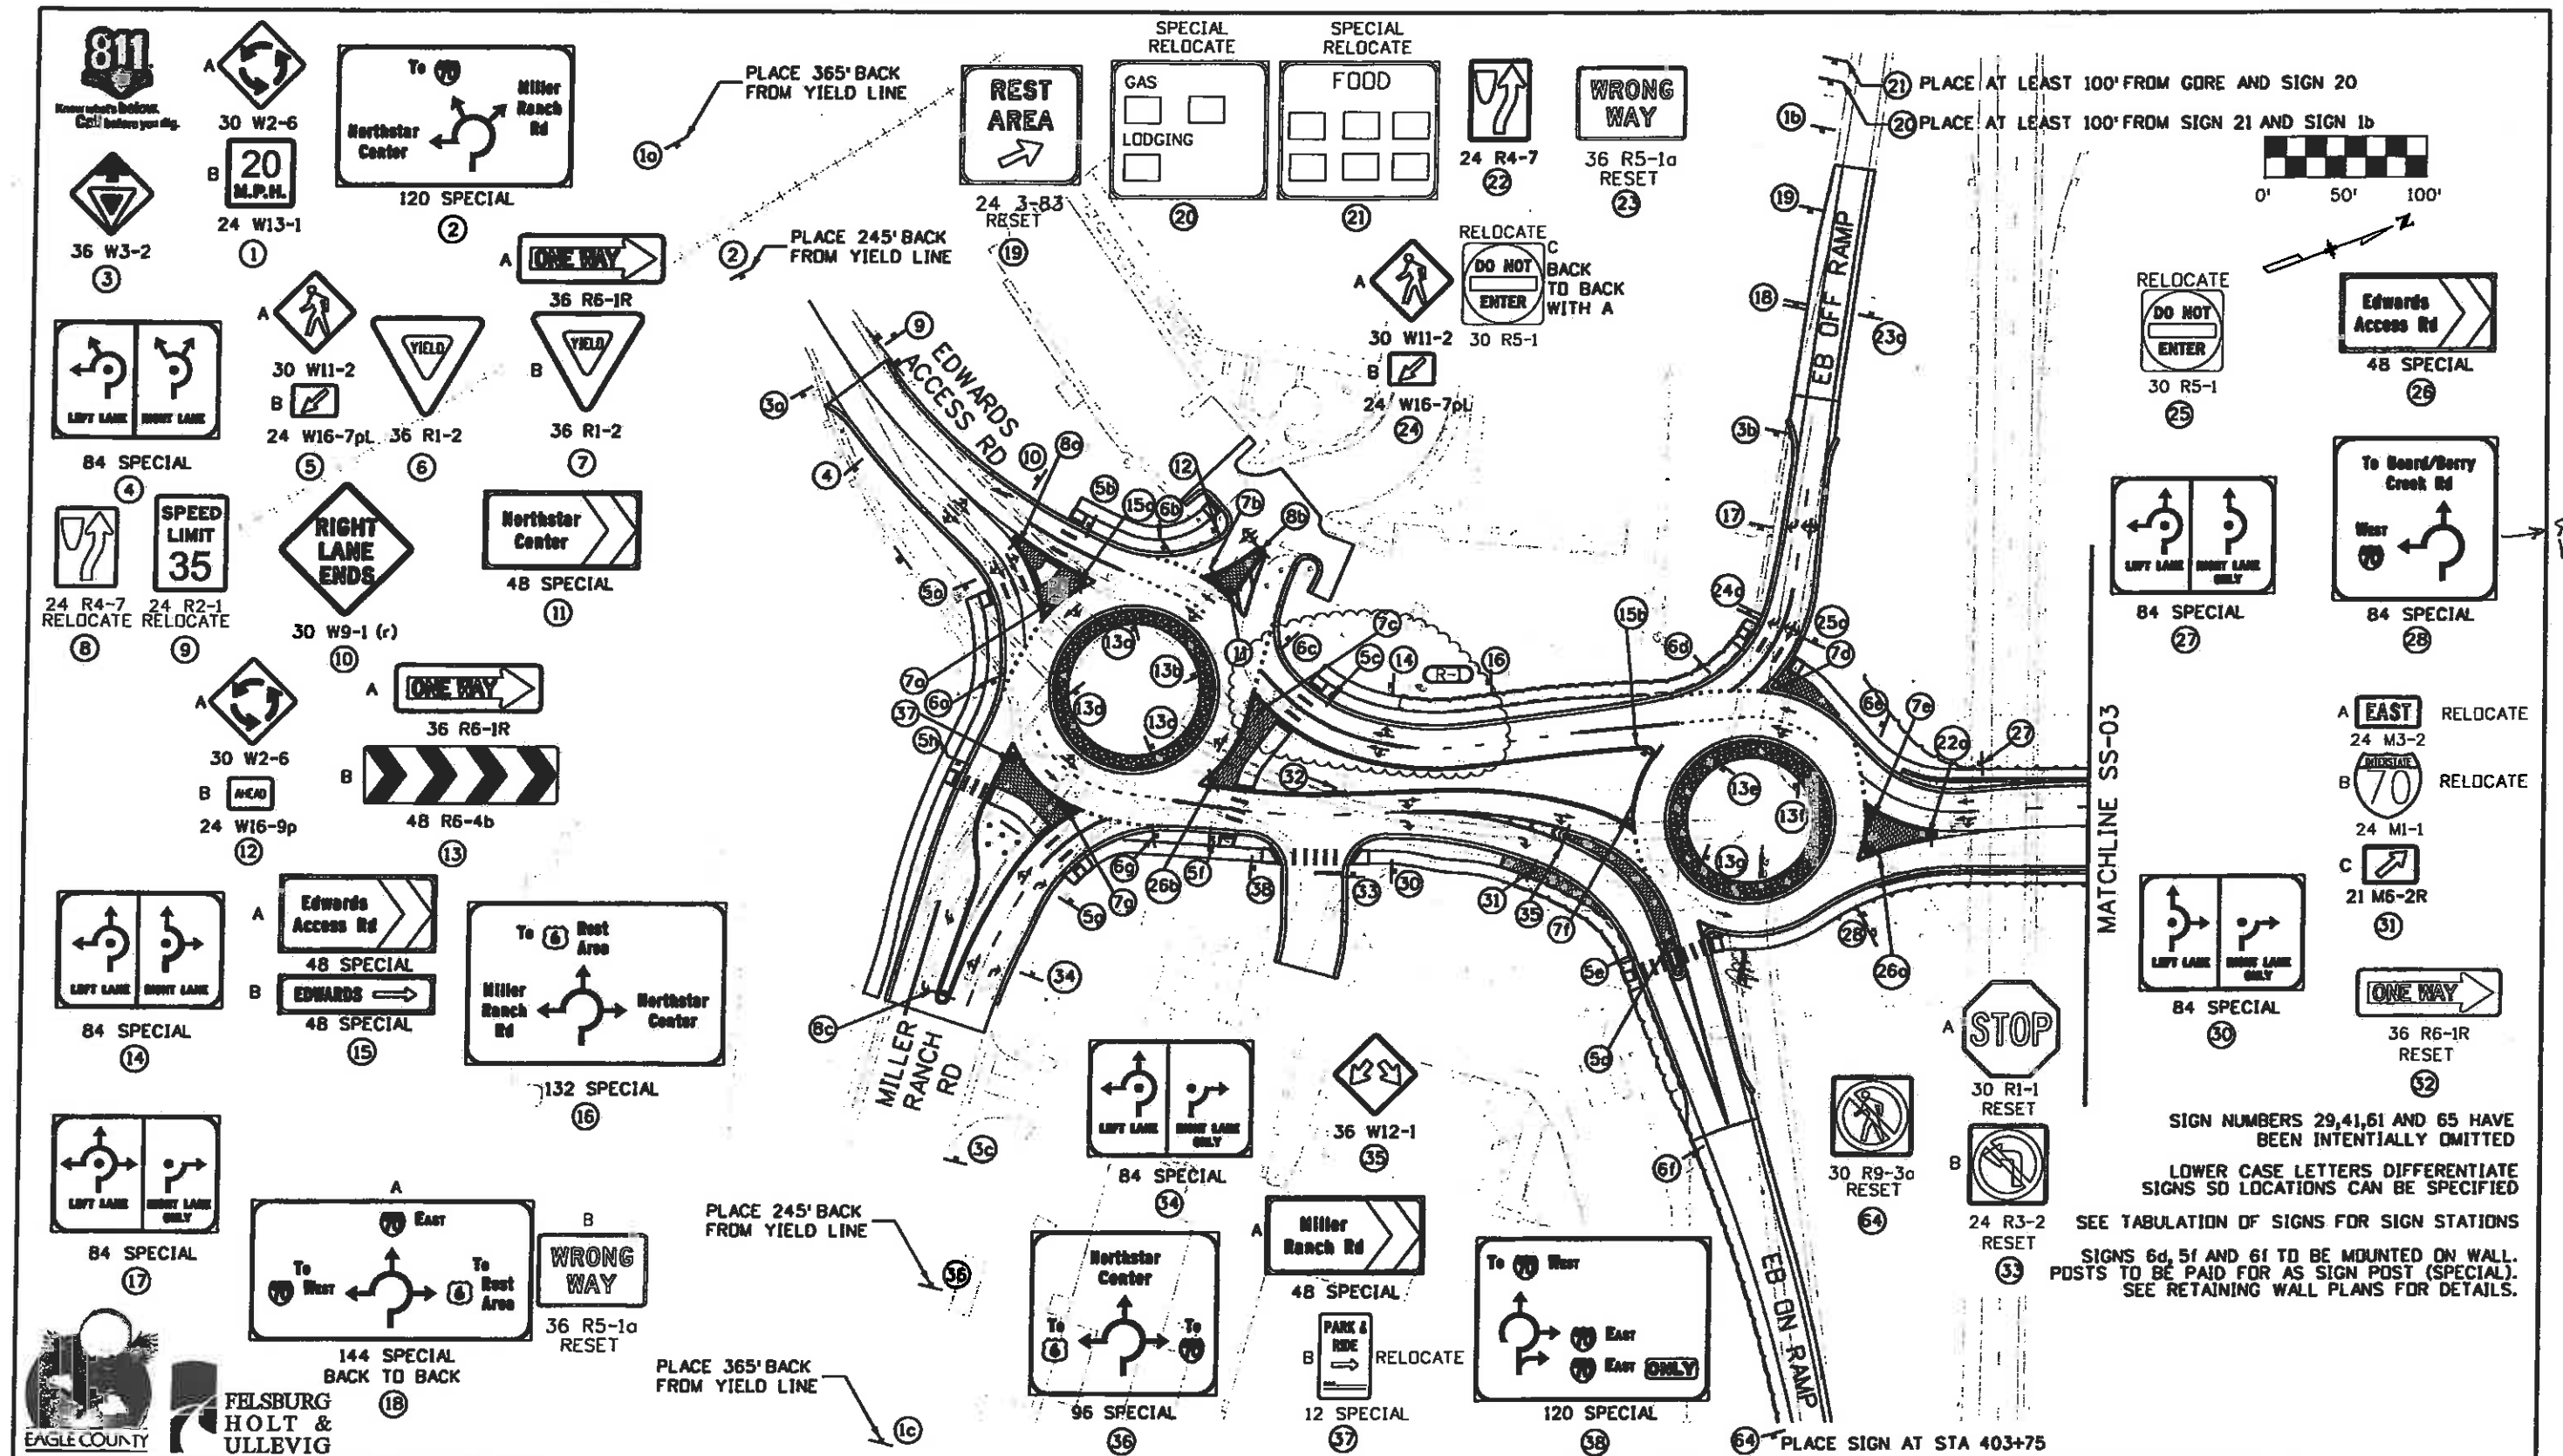

SIGN NUMBERS 29, 41, 61 AND 65 HAVE BEEN INTENTIONALLY OMITTED
 LOWER CASE LETTERS DIFFERENTIATE SIGNS SO LOCATIONS CAN BE SPECIFIED
 SEE TABULATION OF SIGNS FOR SIGN STATIONS
 SIGNS 6d, 5f AND 6f TO BE MOUNTED ON WALL. POSTS TO BE PAID FOR AS SIGN POST (SPECIAL). SEE RETAINING WALL PLANS FOR DETAILS.

Print Date: 5/10/2010	
Drawing File Name: 06193SS02.dgn	
Horiz. Scale: 1:100	Vert. Scale: As Noted
Unit Information	Unit Leader Initials


Sheet Revisions			
Date	Comments	Init.	
5/10/10	REVISED SB ENTRANCE TO MRR ROUNDABOUT	DKH	

Colorado Department of Transportation
 714 Grand Avenue, P.O. Box 298
 Eagle, CO 81631
 Phone: 970-328-6385 FAX: 970-328-2368
 Region 3 MLM

As Constructed
No Revisions:
Revised: 6-6-2011
Void:

EDWARDS INTERCHANGE UPGRADE PROPOSED SIGNING		
Designer:	KMH	Structure Numbers
Detailer:	KMH	
Sheet Subset:	TRAFFIC	Subset Sheets: SS-02 of 6

Project No./Code	ES3 0702-297
	17303
Sheet Number	243X

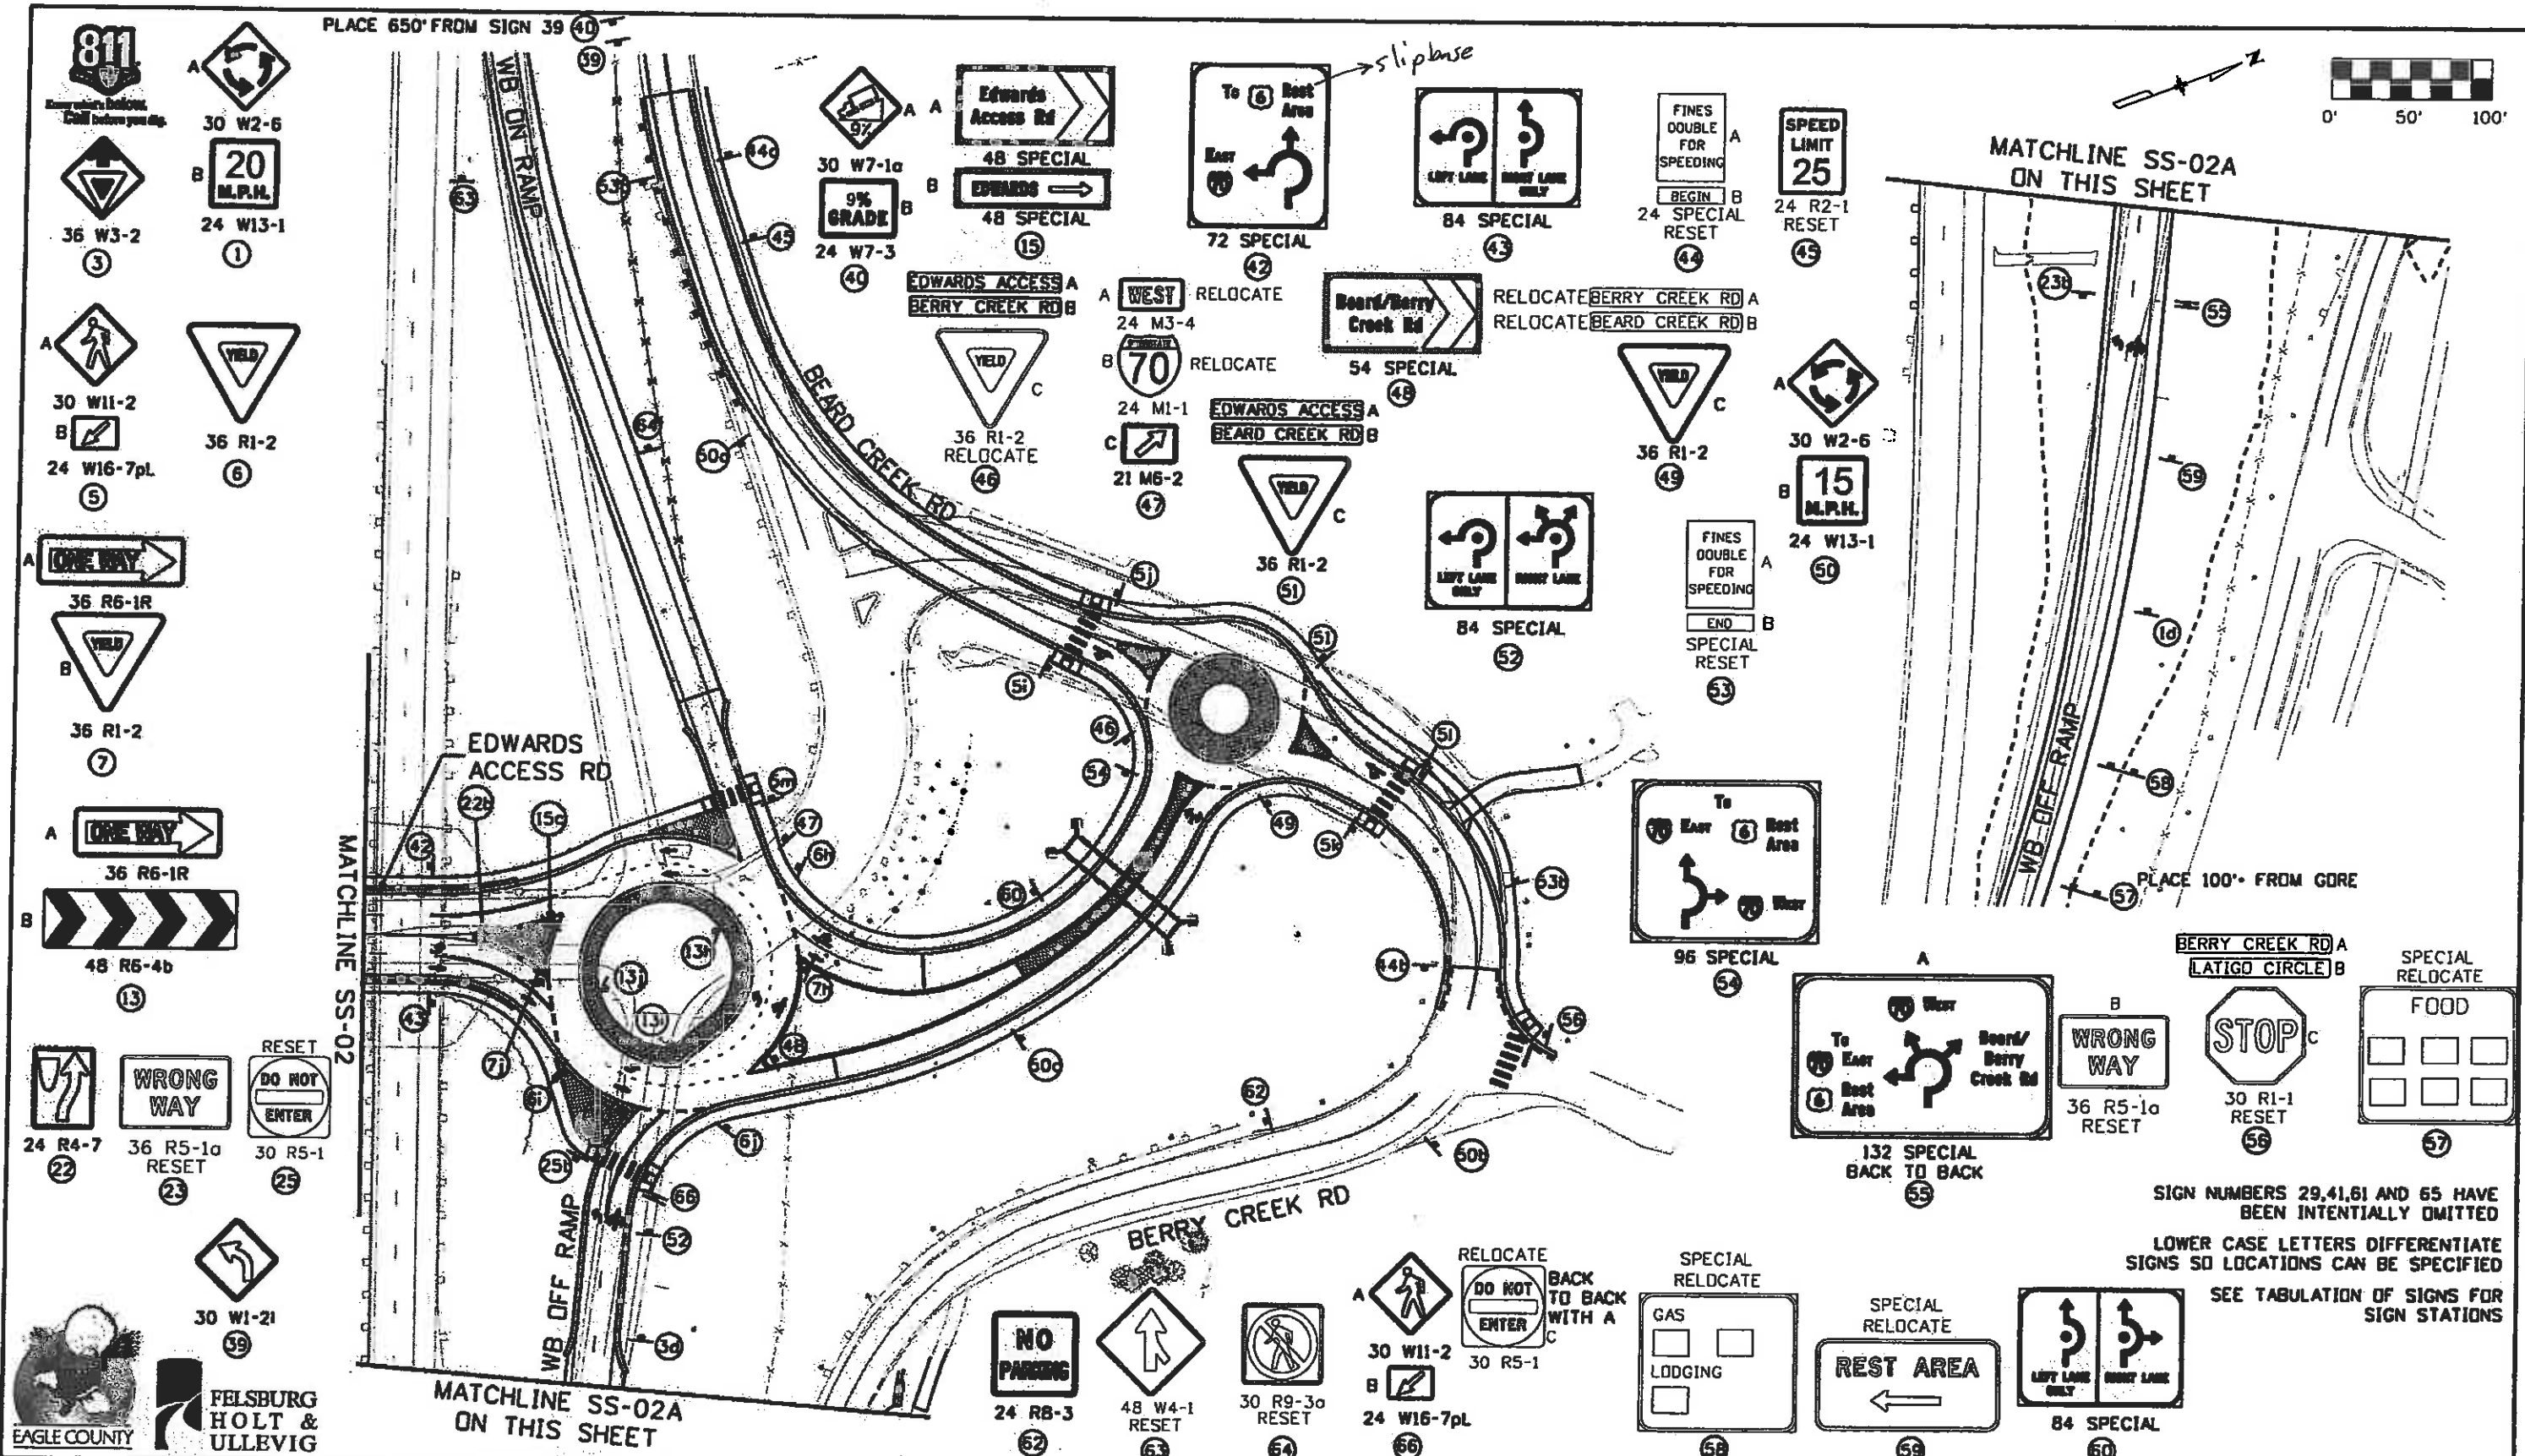

Print Date: 11/5/2009
 Drawing File Name: 06193SS03.dgn
 Horiz. Scale: 1:100
 Unit Information

Sheet Revisions			
Date:	Comments	Init.	

Colorado Department of Transportation
 714 Grand Avenue, P.O. Box 298
 Eagle, CO 81631
 Phone: 970-328-6385 FAX: 970-328-2368
 Region 3 MLM



As Constructed
 No Revisions: 6-6-2011
 Revised:
 Void:

EDWARDS INTERCHANGE UPGRADE
 PROPOSED SIGNING

Designer: KMH	Structure:
Detailer: KMH	Numbers:
Sheet Subset: TRAFFIC	Subset Sheets: SS-03 of 6

Project No./Code
 E53 0702-297
 17303
 Sheet Number 244


SIGN NUMBERS 29,41,61 AND 65 HAVE BEEN INTENTIONALLY OMITTED
 LOWER CASE LETTERS DIFFERENTIATE SIGNS SO LOCATIONS CAN BE SPECIFIED
 SEE TABULATION OF SIGNS FOR SIGN STATIONS

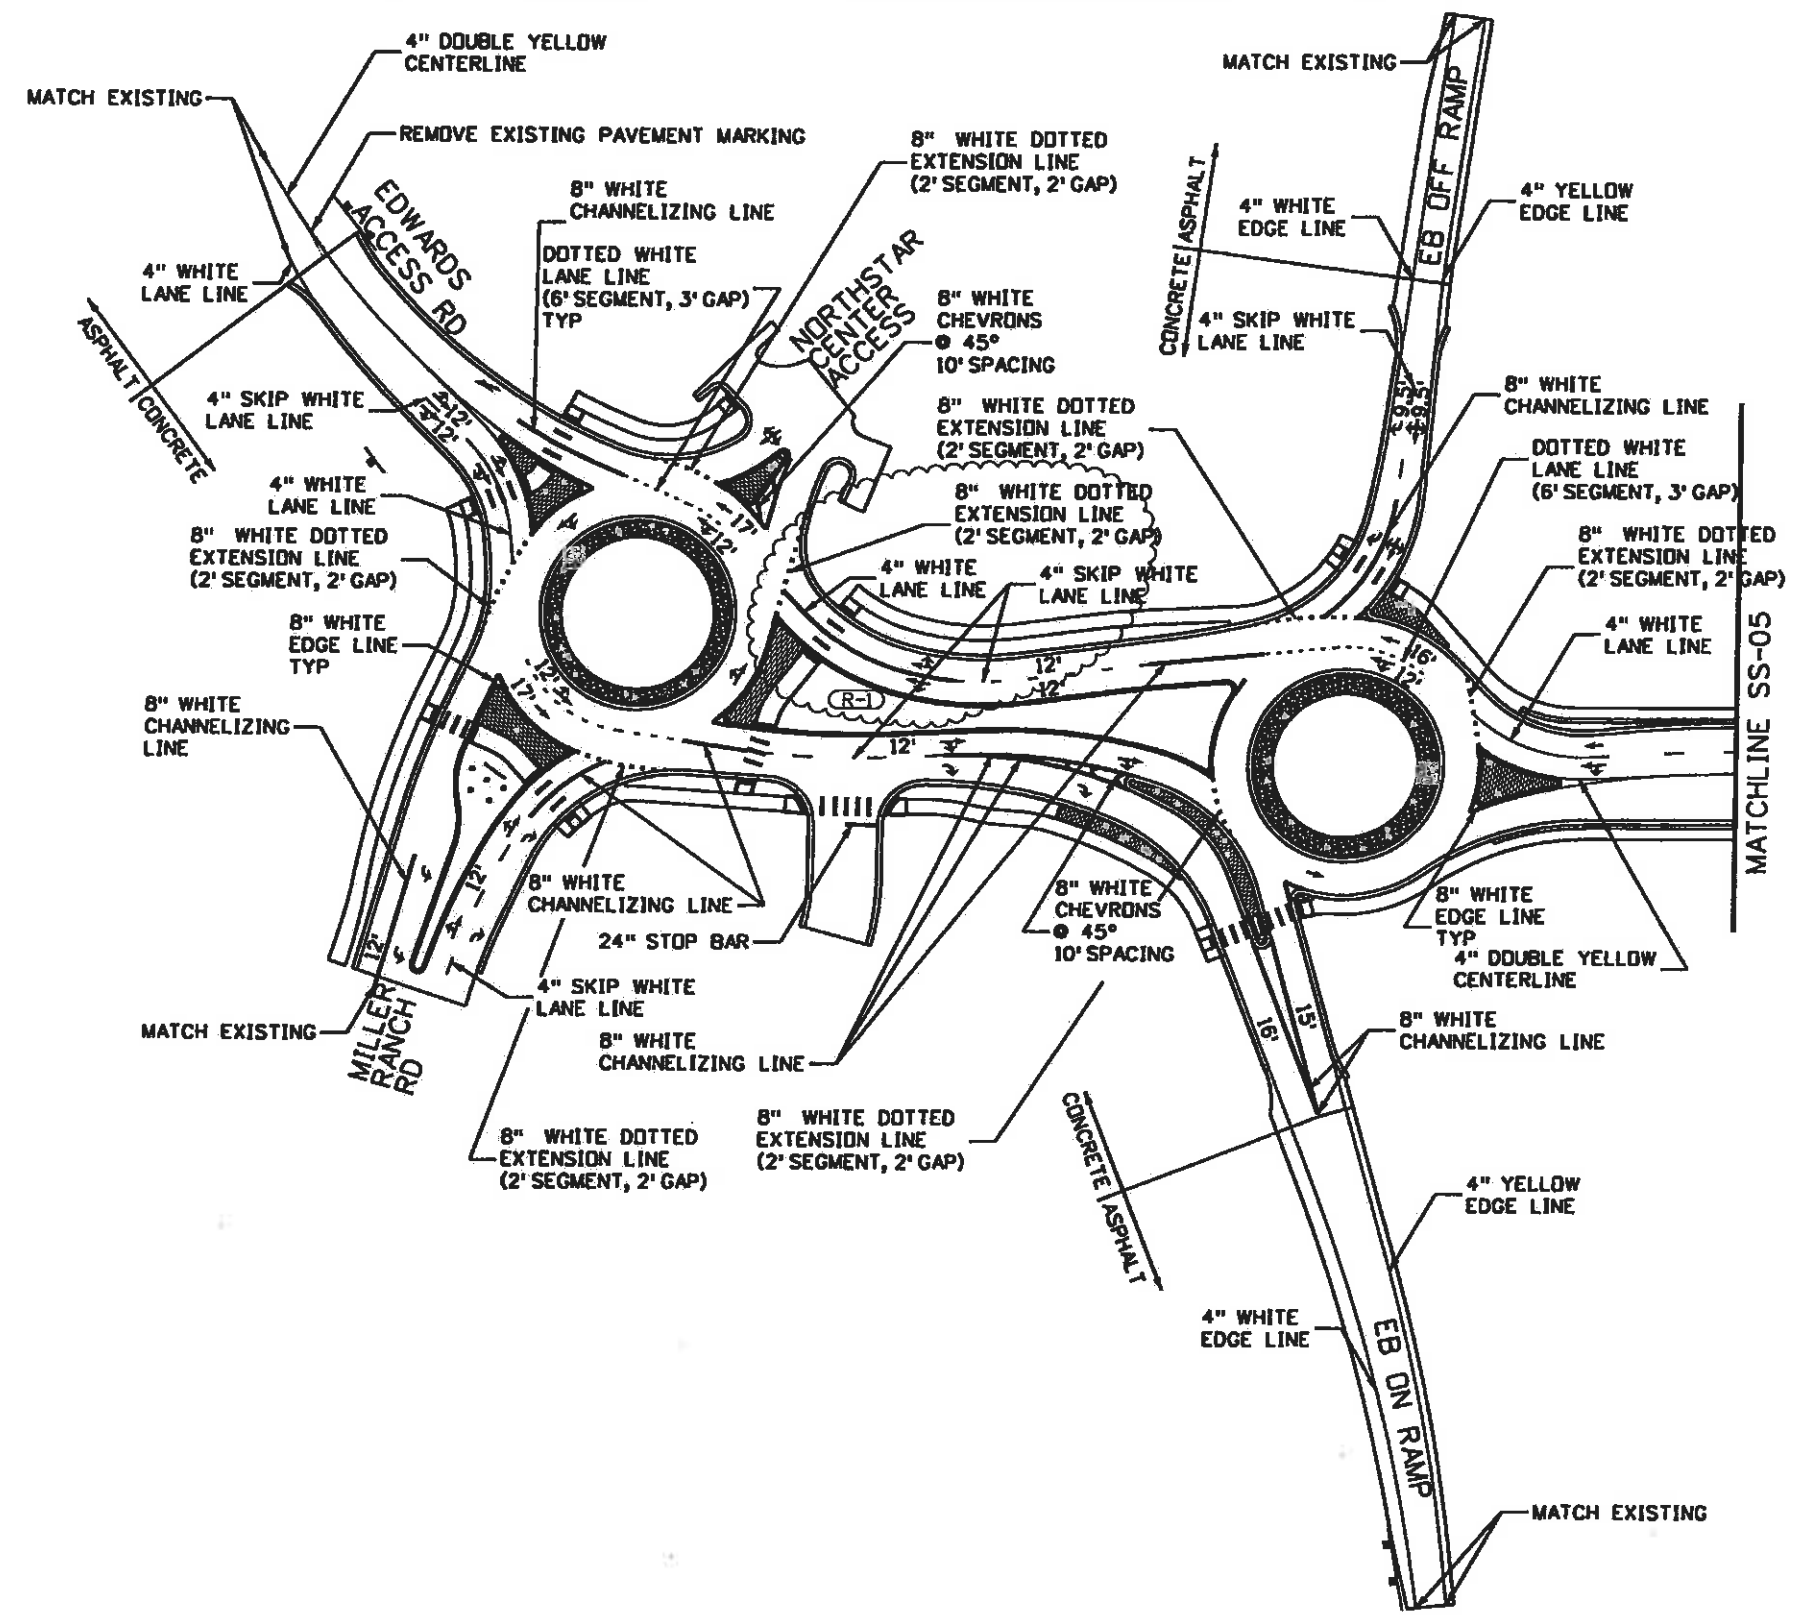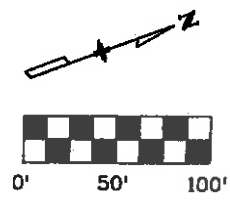

Print Date: 5/10/2010	
Drawing File Name: 06193SS04.dgn	
Horiz. Scale: 1:100	Vert. Scale: As Noted
Unit Information	Unit Leader Initials

Sheet Revisions			
Date	Comments	Init.	
5/10/10	REVISED SB ENTRANCE TO MRR ROUNDABOUT	DKH	

Colorado Department of Transportation





714 Grand Avenue, P.D. Box 298
Eagle, CO 81631
Phone: 970-328-6385 FAX: 970-328-2368

Region 3 MLM

As Constructed	
No Revisions:	
Revised: 6-6-2011	
Void:	

EDWARDS INTERCHANGE UPGRADE PROPOSED STRIPING			
Designer:	KMH	Structure Numbers	
Detailer:	KMH		
Sheet Subset:	TRAFFIC	Subset Sheets:	SS-04 of 6

Project No./Code	
ES3 0702-297	
17303	
Sheet Number 245X	

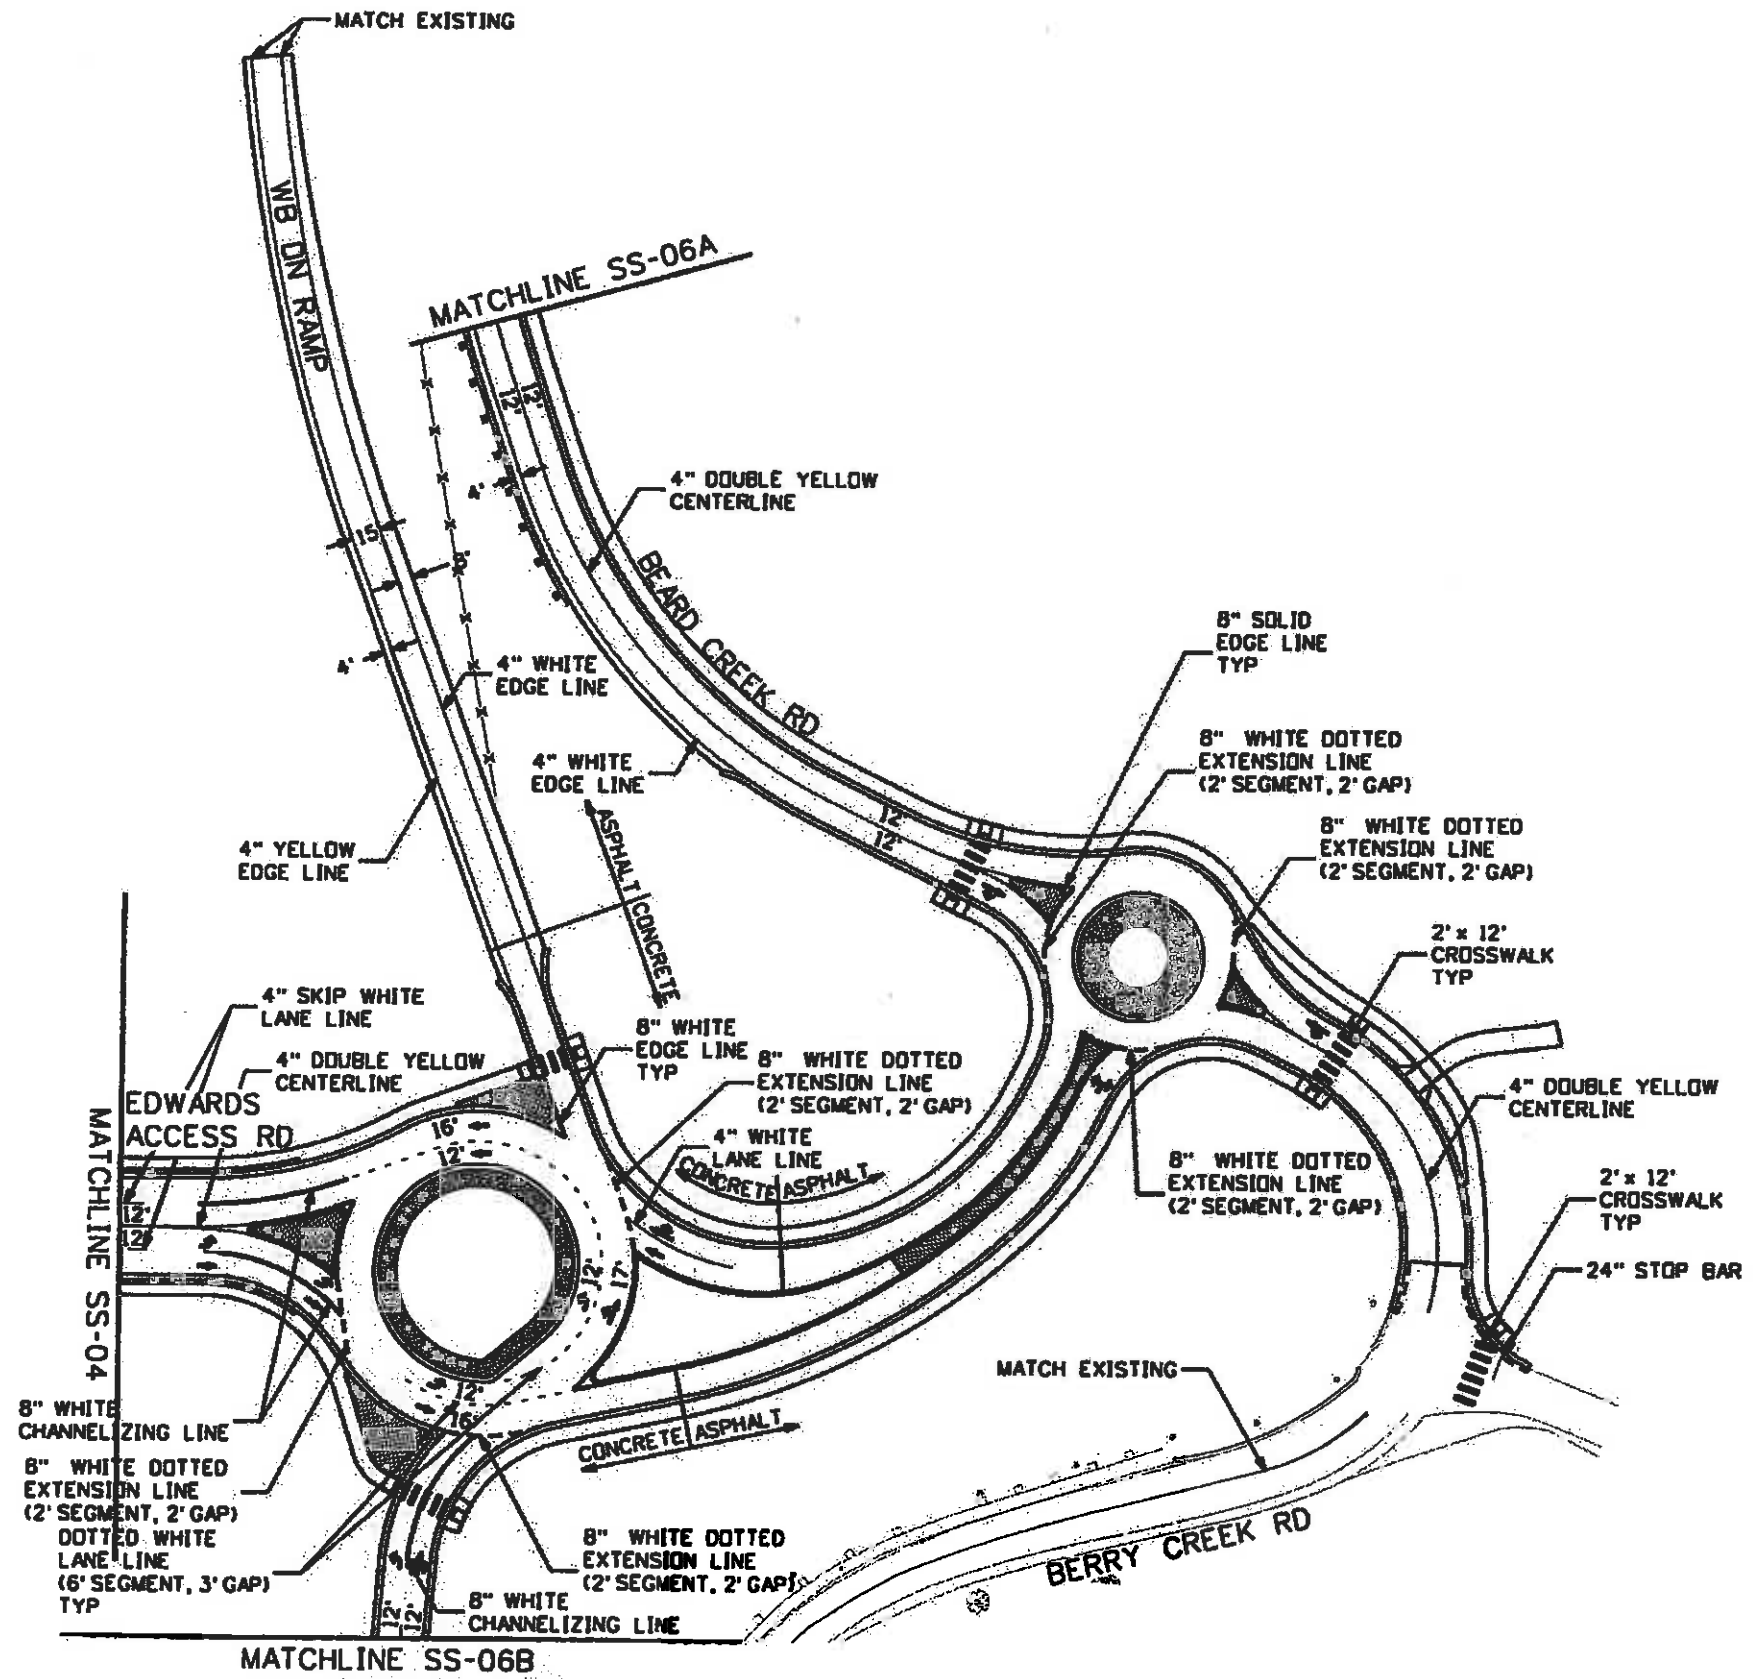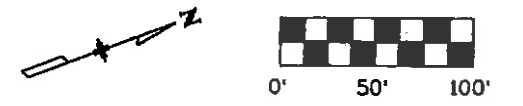

Print Date: 11/5/2009	Unit Leader Initials
Drawing File Name: 061935S05.dgn	
Horiz. Scale: 1:100	Vert. Scale: As Noted
Unit Information	

Sheet Revisions		
Date:	Comments	Init.

Colorado Department of Transportation
 714 Grand Avenue, P.O. Box 298
 Eagle, CO 81631
 Phone: 970-328-6385 FAX: 970-328-2368
 Region 3 MLM

As Constructed
No Revisions: 6-6-2011
Revised:
Void:




EDWARDS INTERCHANGE UPGRADE PROPOSED STRIPING		
Designer: KMH	Structure Numbers	
Detailer: KMH		
Sheet Subset: TRAFFIC	Subset Sheets: SS-05 of 6	

Project No./Code	ES3 0702-297
	17303
Sheet Number	246

811

Know what's below!
Call before you dig.

MATCHLINE SS-05B

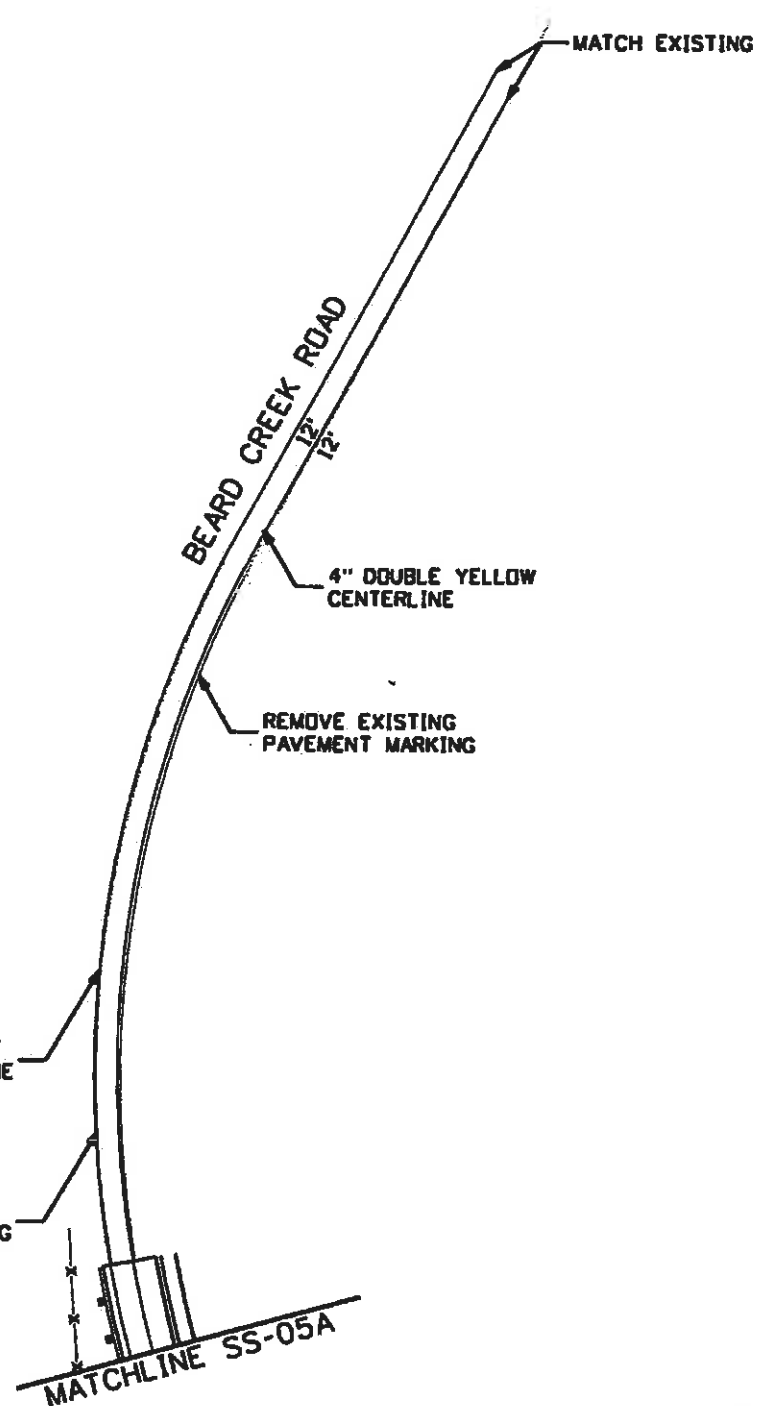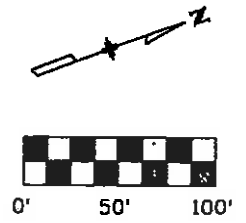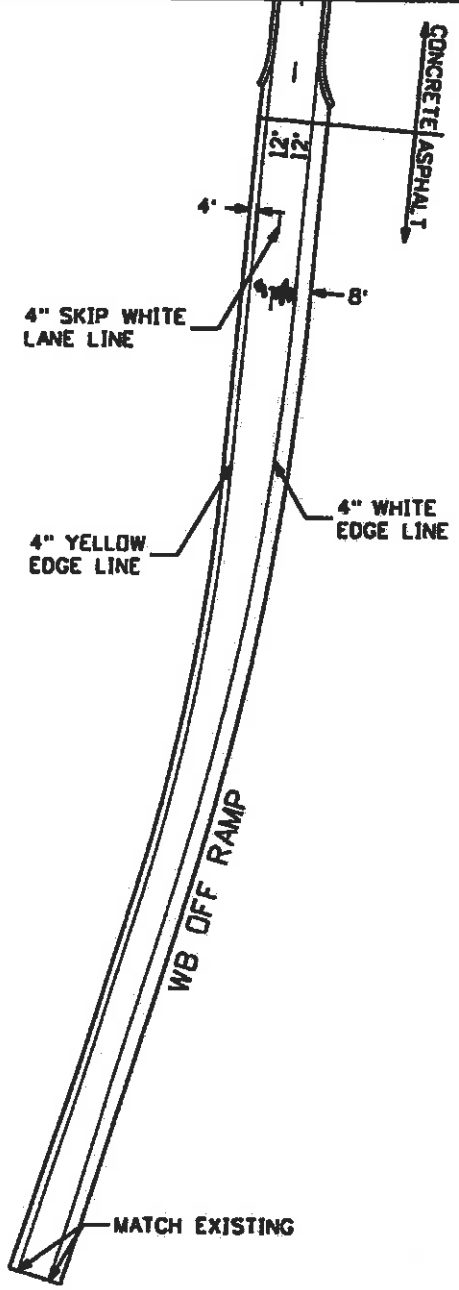

FELSBURG
HOLT &
ULLEVIG

Print Date: 11/5/2009
Drawing File Name: 06193SS06.dgn
Horiz. Scale: 1"=100' Vert. Scale: As Noted
Unit Information Unit Leader Initials

Sheet Revisions		
Date:	Comments	Init.

Colorado Department of Transportation
 714 Grand Avenue, P.O. Box 298
 Eagle, CO 81631
 Phone: 970-328-6385 FAX: 970-328-2368
 Region 3 MLM

As Constructed
 No Revisions: *6-6-2011*
 Revised:
 Void:


EDWARDS INTERCHANGE UPGRADE
 PROPOSED STRIPING

Designer:	KMH	Structure	
Detailer:	KMH	Numbers	
Sheet Subset:	TRAFFIC	Subset Sheets:	SS-06 of 6

Project No./Code
 ES3 0702-297
 17303
 Sheet Number *247*

811

Know what's below.
Call before you dig.

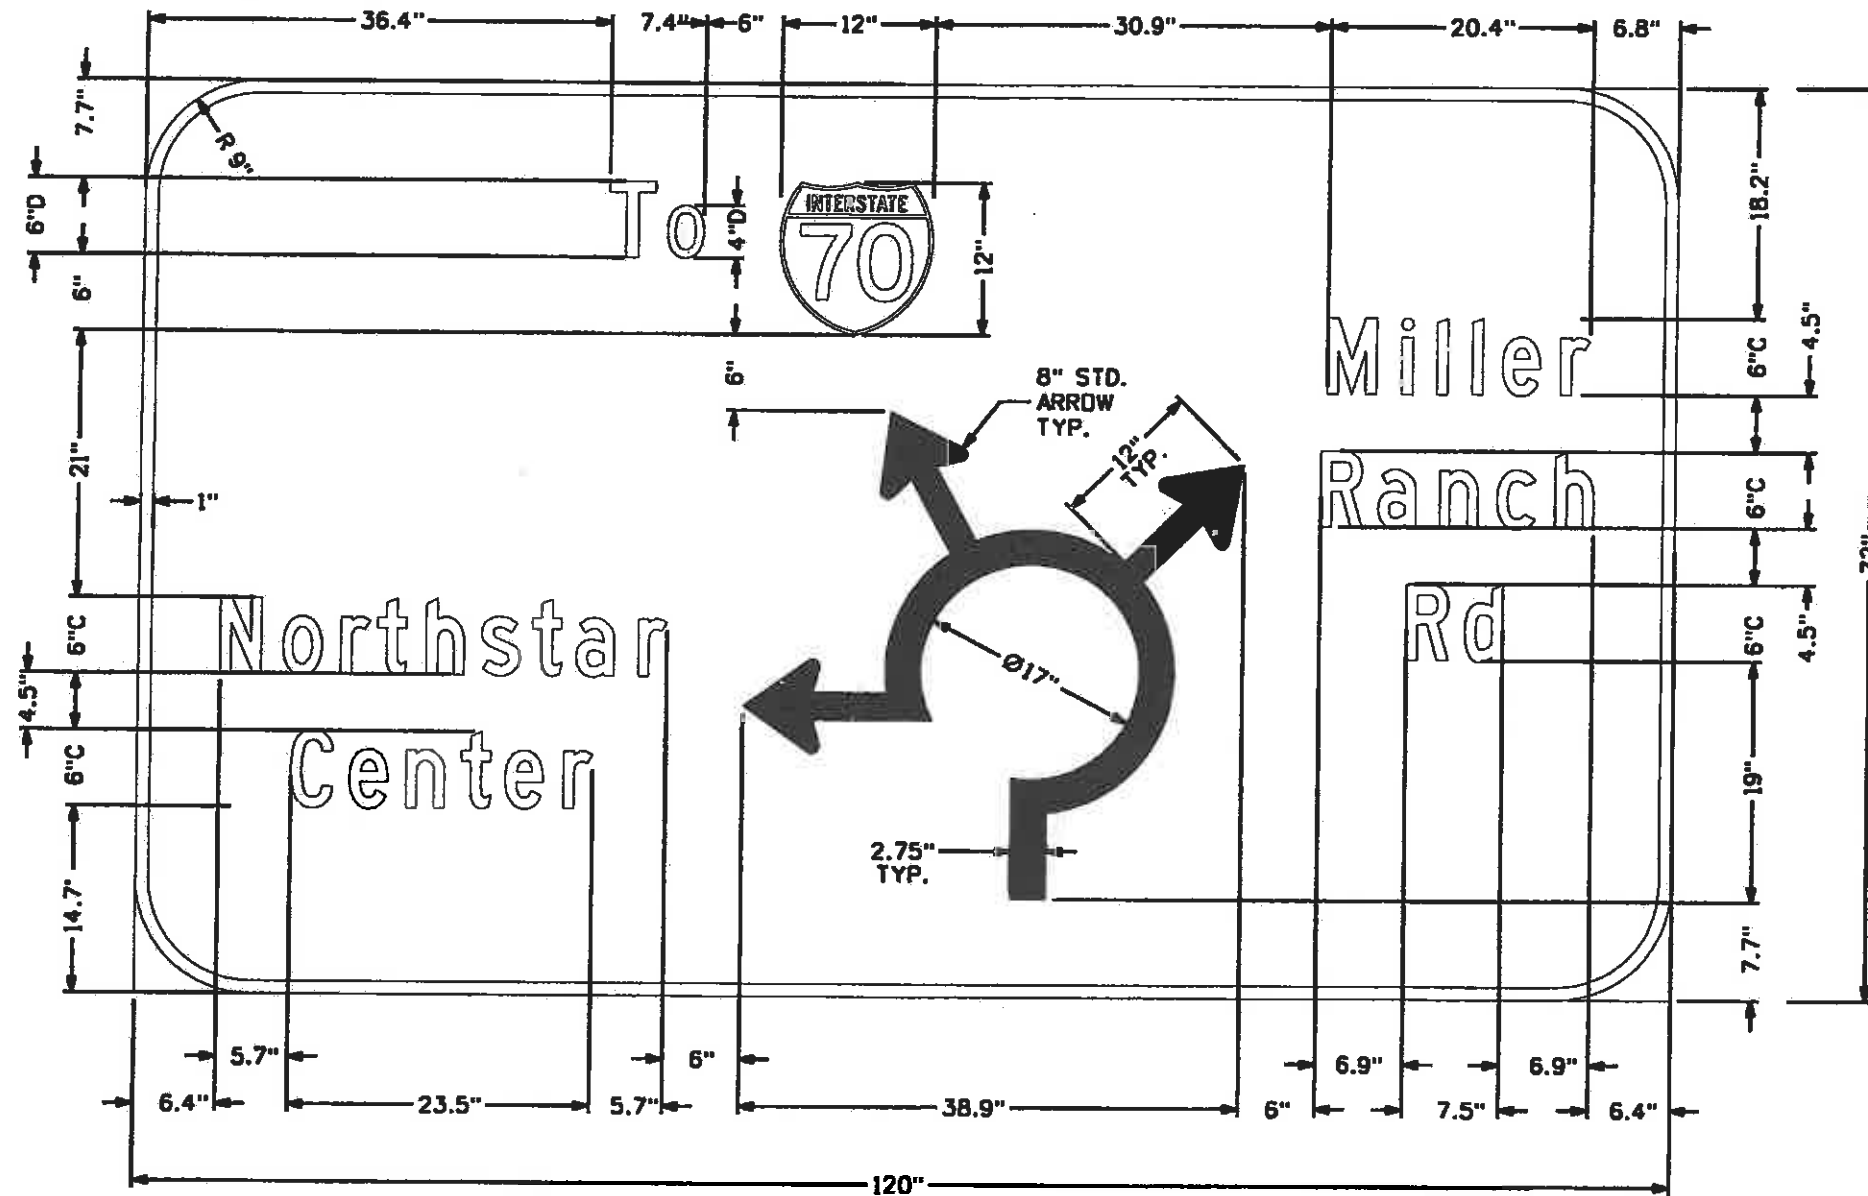

FELSBURG
HOLT &
ULLEVIG

Print Date: 11/5/2009

Drawing File Name: 06193SSDET02.dgn

Horiz. Scale: 1:15

Vert. Scale: As Noted

Unit Information

Unit Leader Initials

0000
R-X

Sheet Revisions

Date:	Comments	Init.

Colorado Department of Transportation



714 Grand Avenue, P.O. Box 298
Eagle, CO 81631
Phone: 970-328-6385 FAX: 970-328-2368

Region 3

MLM

As Constructed

No Revisions: 6-6-2011

Revised:

Void:

EDWARDS INTERCHANGE UPGRADE
SIGNING DETAILS
SIGN 2

Designer: KMH
Detailer: KMH
Sheet Subset: S.DET
Structure Numbers
Subset Sheets: SD-01 of 21

Project No./Code

ES3 0702-297


17303

Sheet Number

248

811

Call before you dig.

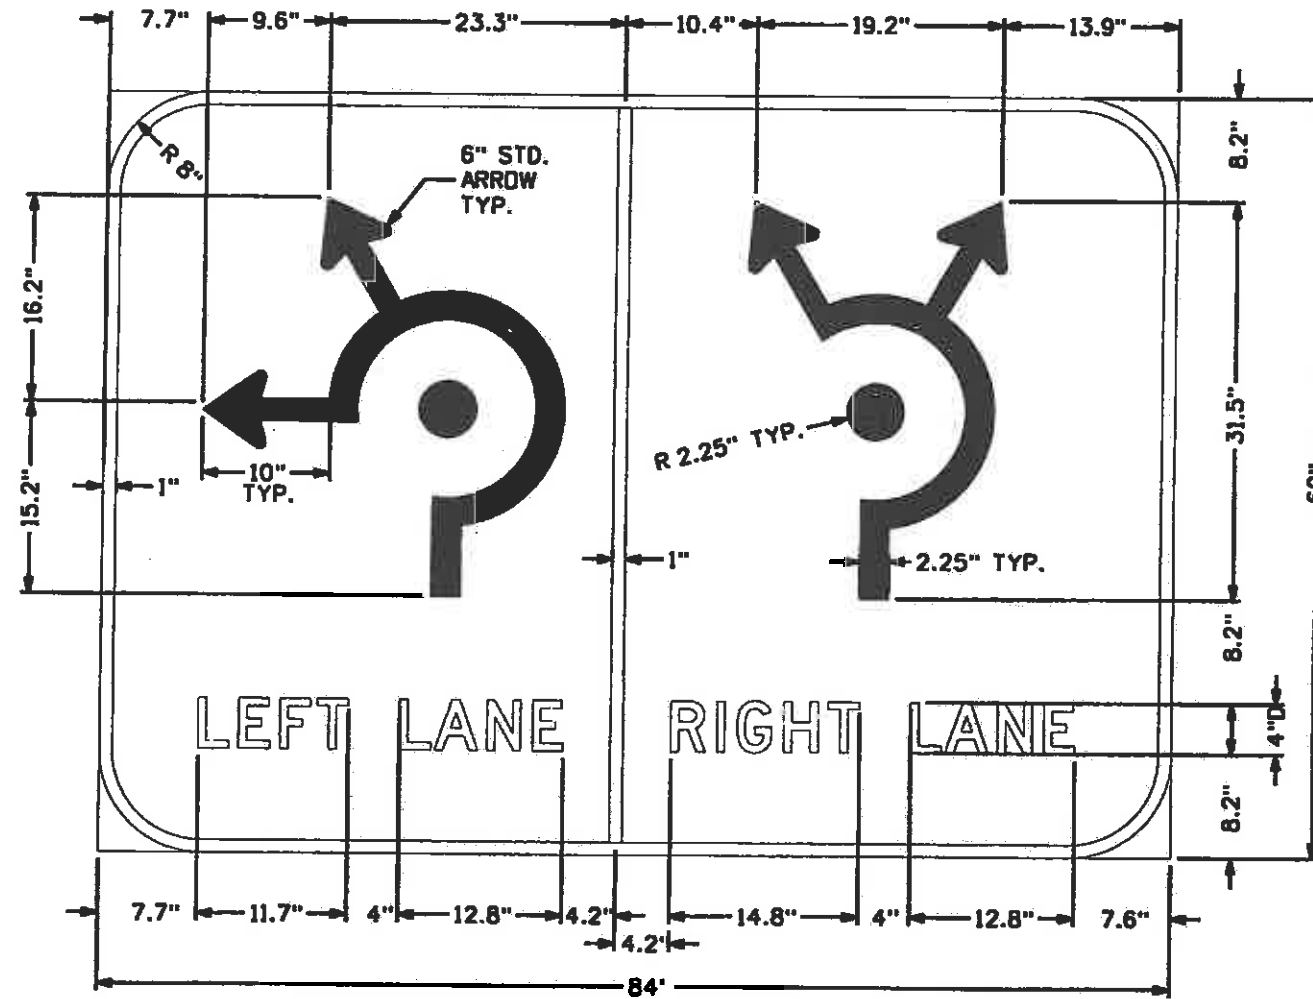

FELSBURG
HOLT &
ULLEVIG

Print Date: 11/5/2009

Drawing File Name: 06193SSDET04.dgn

Horiz. Scale: 1:15

Vert. Scale: As Noted

Unit Information

Unit Leader Initials

0000
R-X

Sheet Revisions

Date:	Comments	Init.

Colorado Department of Transportation



714 Grand Avenue, P.O. Box 298
Eagle, CO 81631
Phone: 970-328-6385 FAX: 970-328-2368

Region 3

MLM

As Constructed

No Revisions: 6-6-2011

Revised:

Void:

EDWARDS INTERCHANGE UPGRADE
SIGNING DETAILS
SIGN 4

Designer:	KMH	Structure	
Detailer:	KMH	Numbers	
Sheet Subset:	S.DET	Subset Sheets:	SD-02 of 21

Project No./Code






ES3 0702-297

17303

Sheet Number 249



Know what's below. Call before you dig.

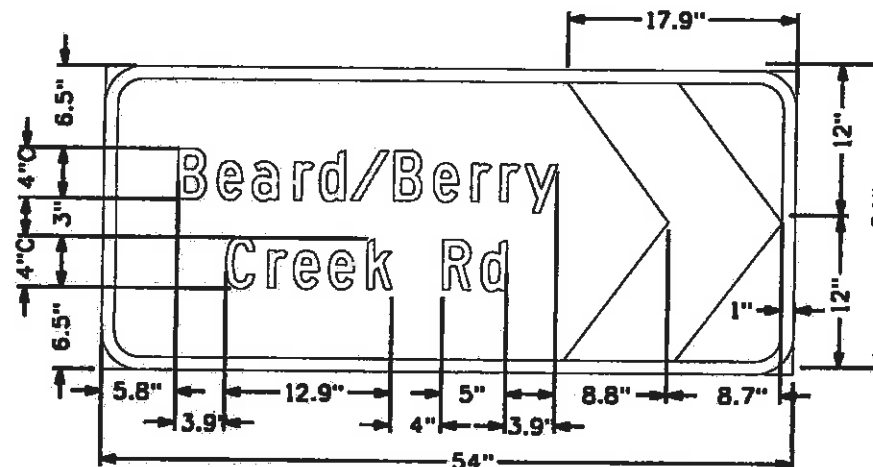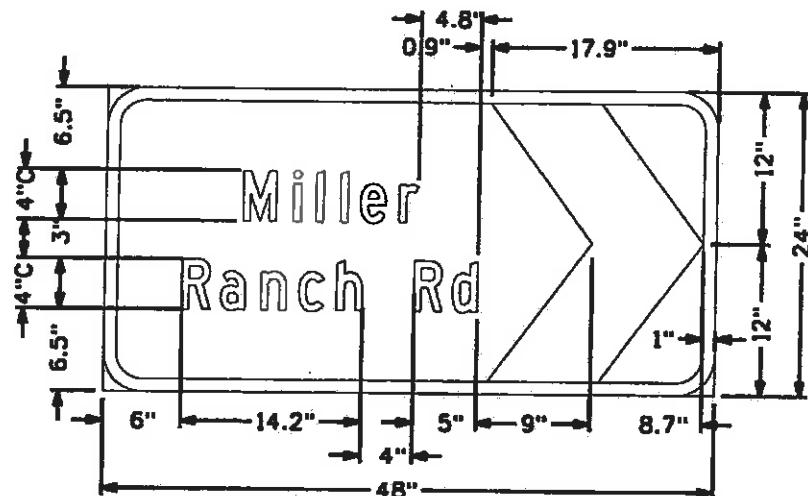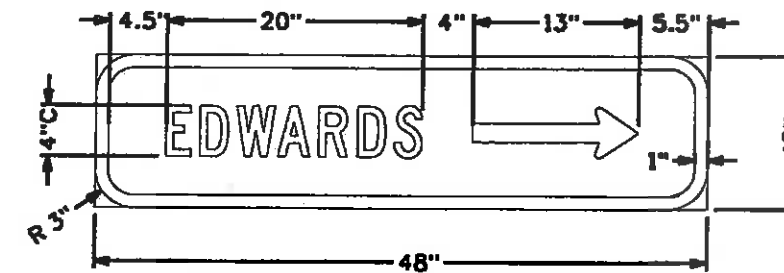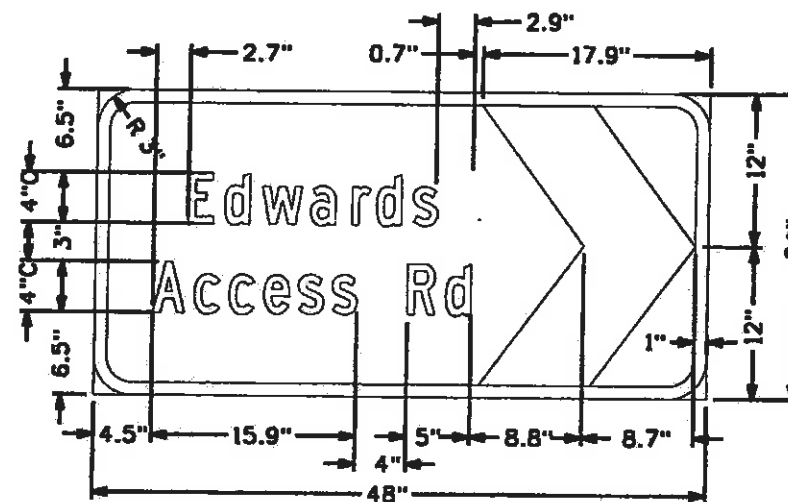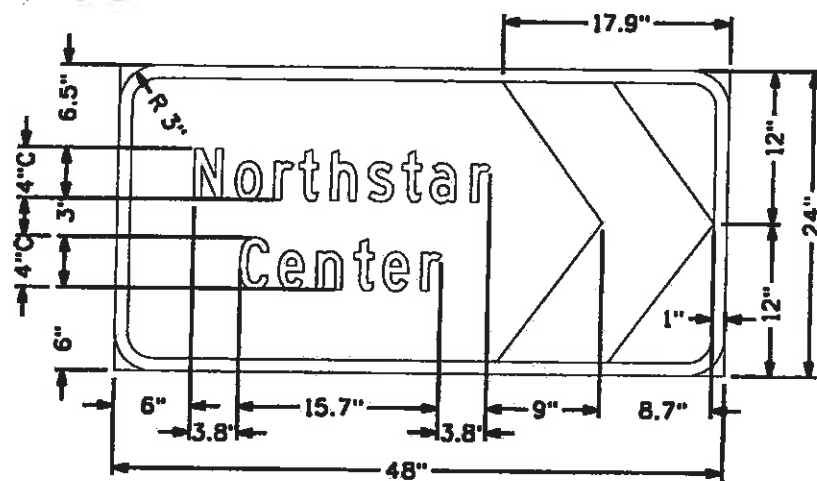

FELSBURG
HOLT &
ULLEVIG

Print Date: 11/5/2009

Drawing File Name: 06193SSDET11.dgn

Horiz. Scale: 1:15

Vert. Scale: As Noted

Unit Information

Unit Leader Initials

(R-X)
000

Sheet Revisions

Date:	Comments	Init.

Colorado Department of Transportation



714 Grand Avenue, P.O. Box 298
Eagle, CO 81631
Phone: 970-328-6385 FAX: 970-328-2368

Region 3

MLM

As Constructed

No Revisions: 6-6-2011

Revised:

Void:

EDWARDS INTERCHANGE UPGRADE
SIGNING DETAILS
SIGNS 11,15,37A,48

Designer: KMH
Detailer: KMH

Structure Numbers
Sheet Subset: S.DET Subset Sheets: SD-03 of 21

Project No./Code


ES3 0702-297

17303

Sheet Number 250

811

Know what's below. Call before you dig.

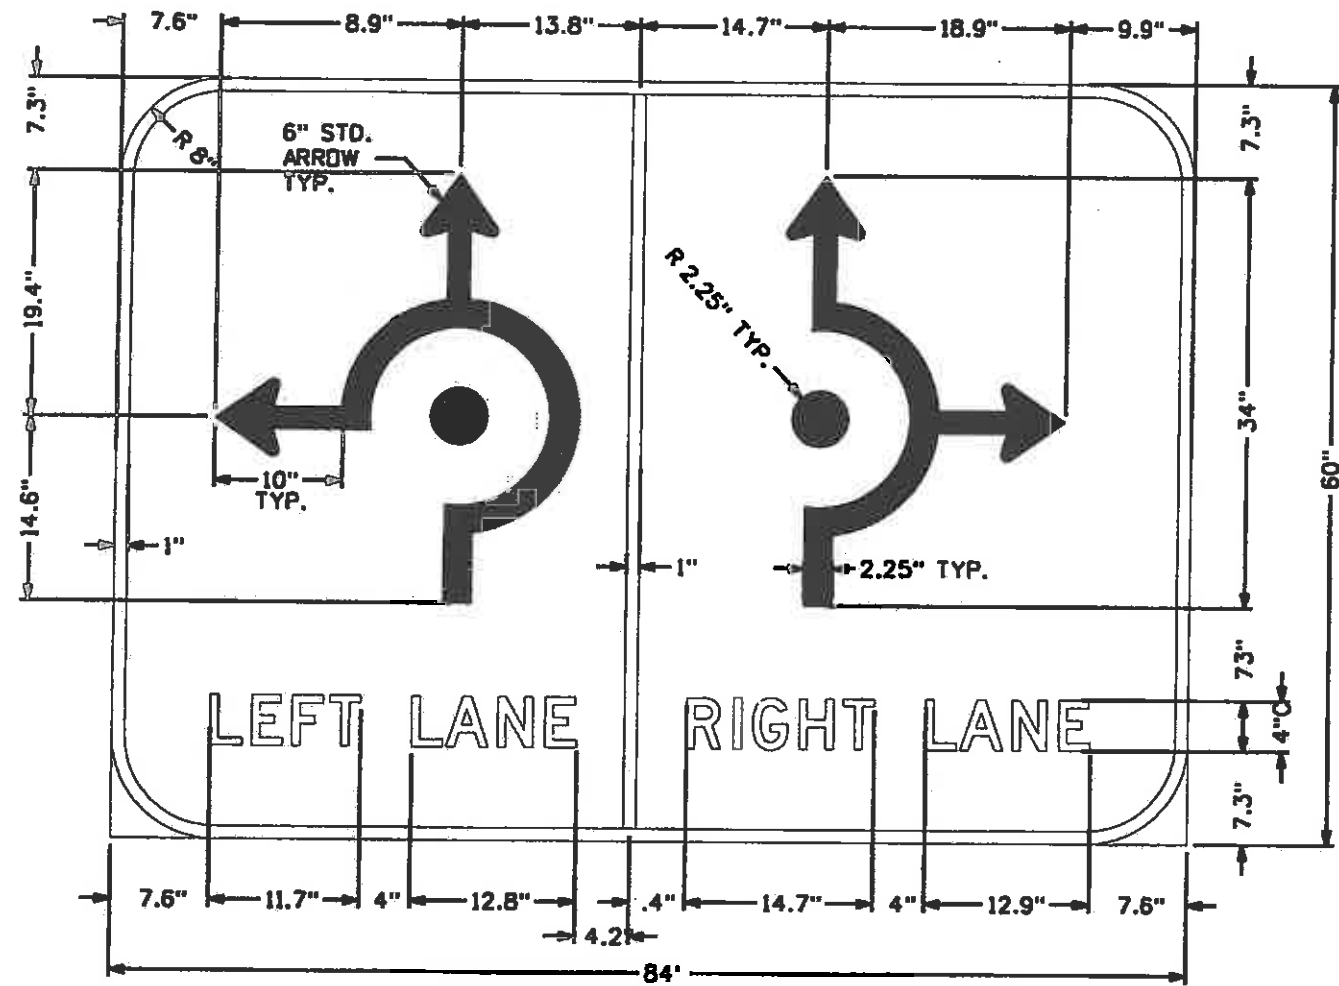

FELSBURG
HOLT &
ULLEVIG

Print Date: 11/5/2009

Drawing File Name: 06193SSDET14.dgn

Horiz. Scale: 1:15

Vert. Scale: As Noted

Unit Information

Unit Leader Initials

(R-X)
0000

Sheet Revisions

Date:	Comments	Init.

Colorado Department of Transportation



714 Grand Avenue, P.O. Box 298
Eagle, CO 81631
Phone: 970-328-6385 FAX: 970-328-2368

Region 3

MLM

As Constructed

No Revisions: 6-6-2011

Revised:

Void:

EDWARDS INTERCHANGE UPGRADE
SIGNING DETAILS
SIGN 14

Designer:	KMH	Structure Numbers	
Detailer:	KMH		
Sheet Subset:	S.DET	Subset Sheets:	SD-04 of 21

Project No./Code


ES3 0702-297

17303

Sheet Number 251



Know what's below.
Call before you dig.

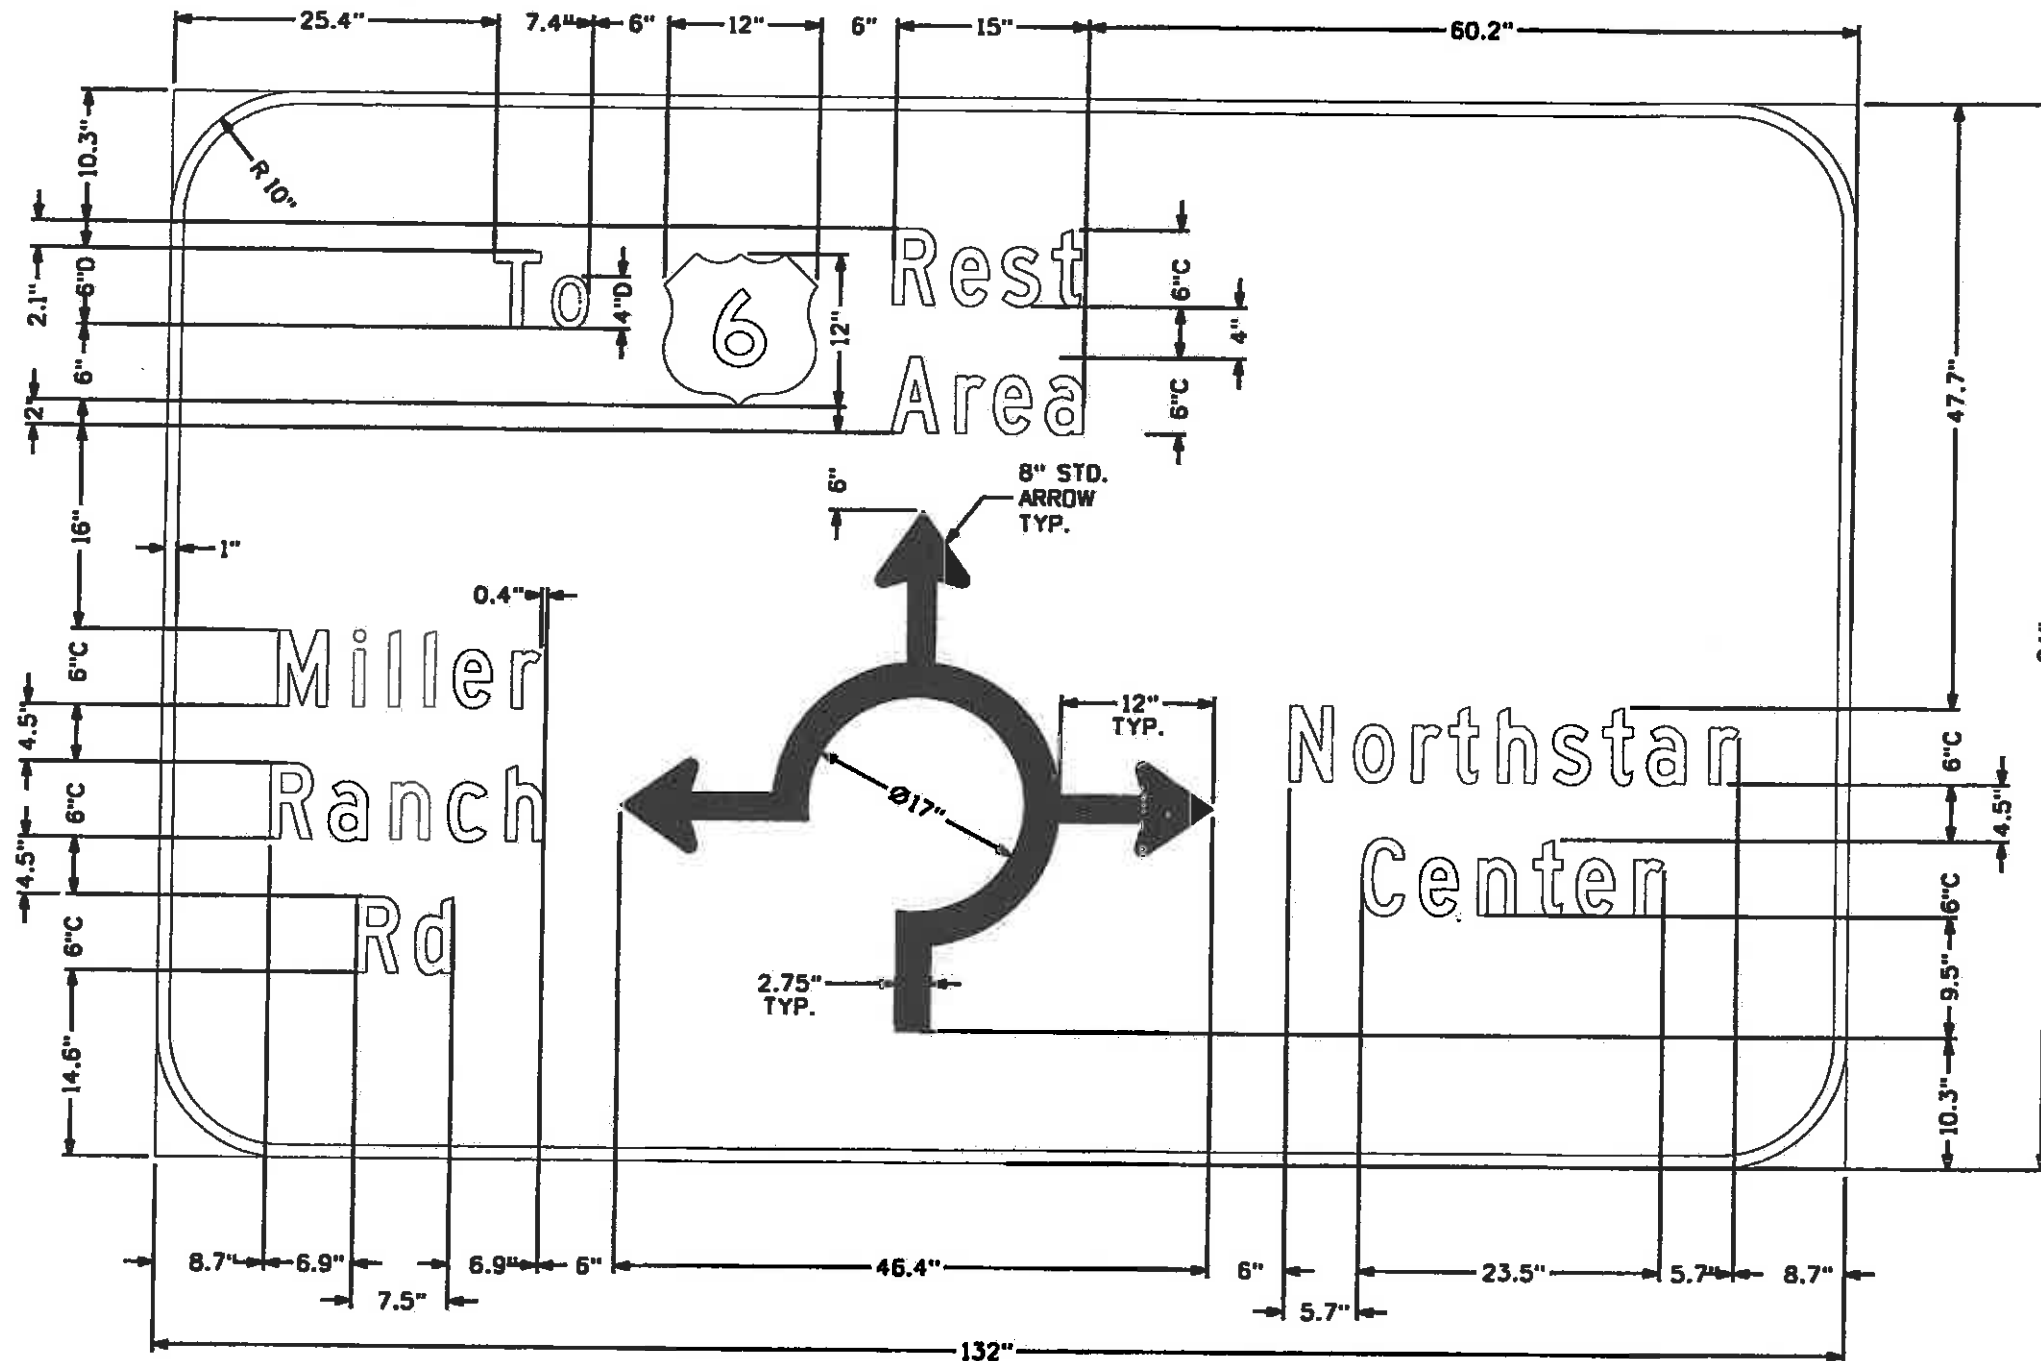

FELSBURG
HOLT &
ULLEVIG

Print Date: 11/5/2009

Drawing File Name: 06193SSDET16.dgn

Horiz. Scale: 1:15

Vert. Scale: As Noted

Unit Information

Unit Leader Initials

0000

Sheet Revisions

Date:	Comments	Init.

Colorado Department of Transportation



714 Grand Avenue, P.O. Box 298
Eagle, CO 81631
Phone: 970-328-6385 FAX: 970-328-2368

Region 3

MLM

As Constructed

No Revisions: 6-6-zoll

Revised:

Void:

EDWARDS INTERCHANGE UPGRADE
SIGNING DETAILS
SIGN 16

Designer:	KMH	Structure Numbers	
Detailer:	KMH		
Sheet Subset:	S.DET	Subset Sheets:	SD-05 of 21

Project No./Code


ES3 0702-297

17303

Sheet Number 252

811


Know what's below
Call before you dig.

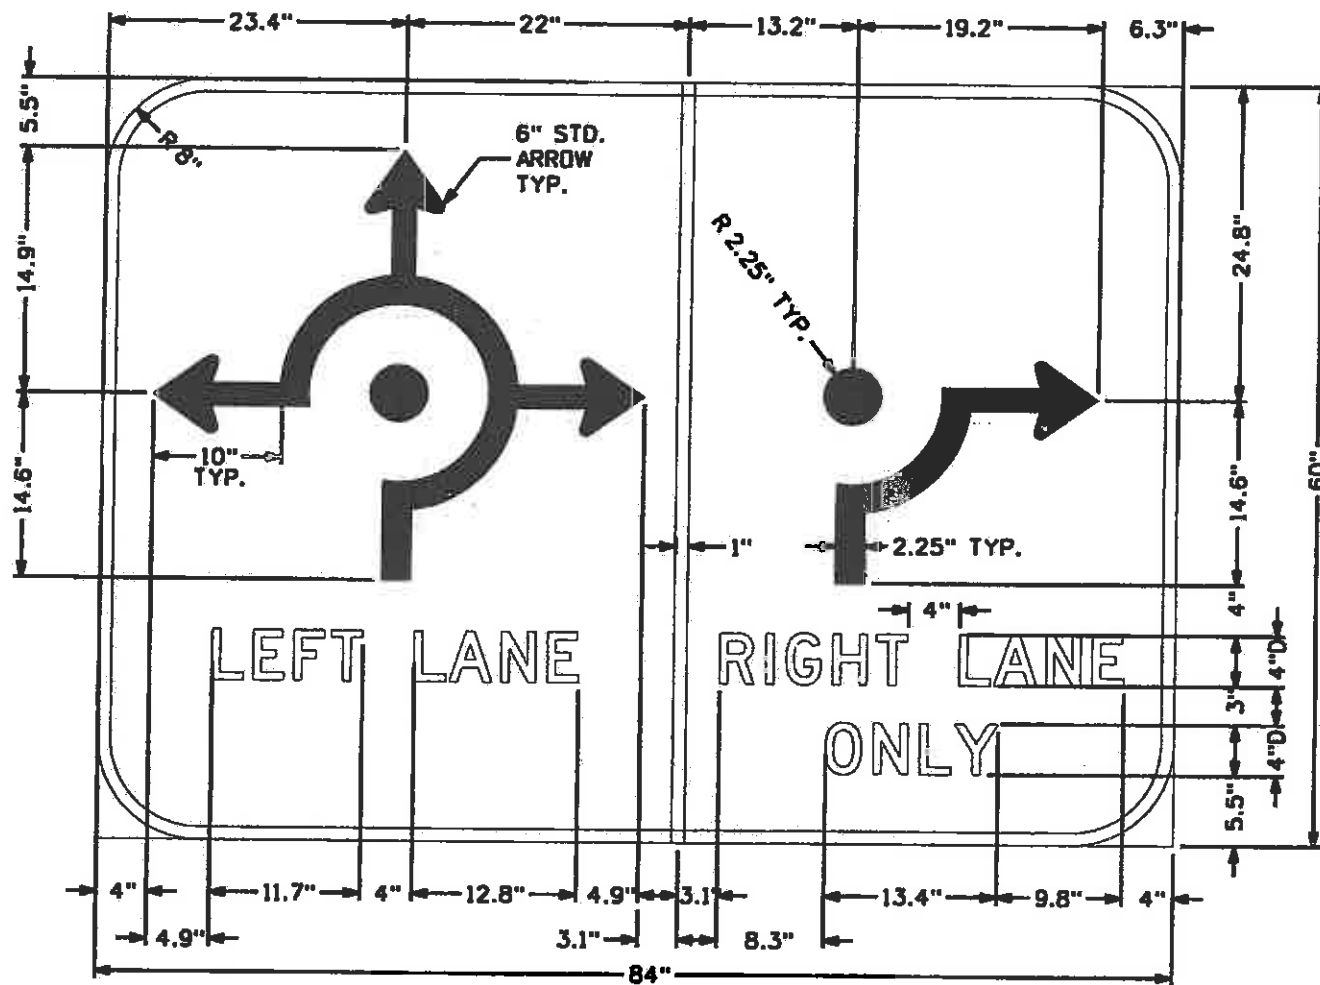

Print Date: 11/5/2009	
Drawing File Name: 06193SSDET17.dgn	
Horiz. Scale: 1:15	Vert. Scale: As Noted
Unit Information	Unit Leader Initials

Sheet Revisions		
Date:	Comments	Init.

Colorado Department of Transportation

 714 Grand Avenue, P.D. Box 298
Eagle, CO 81631
Phone: 970-328-6385 FAX: 970-328-2368

Region 3 MLM


As Constructed
No Revisions: 6-6-2011
Revised:
Void:

EDWARDS INTERCHANGE UPGRADE SIGNING DETAILS SIGN 17		
Designer: KMH	Structure Numbers	
Detailer: KMH		
Sheet Subset: S.DET	Subset Sheets: SD-06 of 21	

Project No./Code
ES3 0702-297
17303
Sheet Number 253

811

Call before you dig.

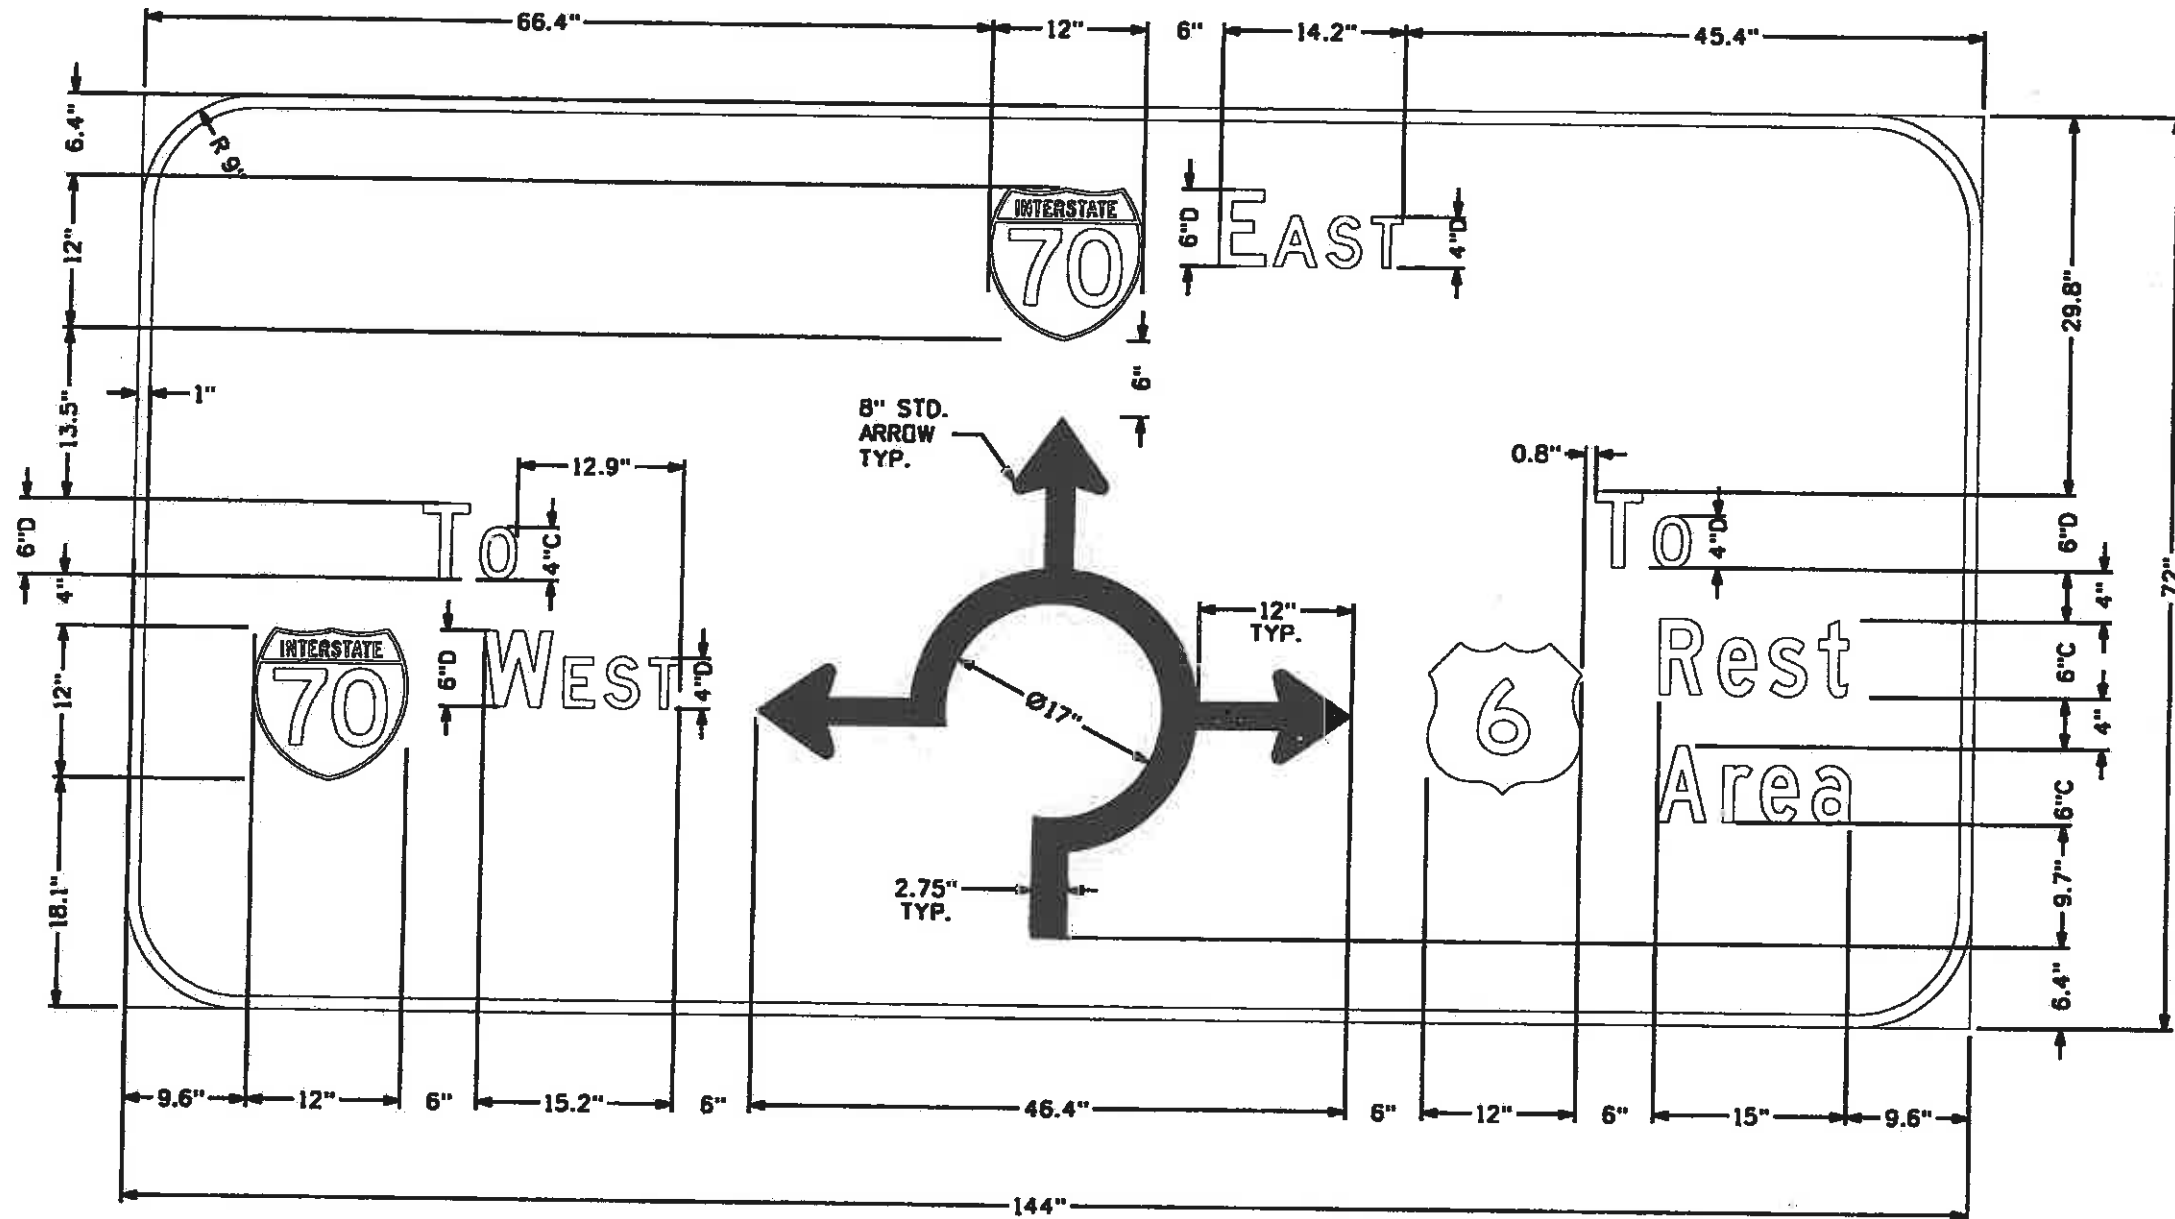

FELSBURG
HOLT &
ULLEVIG

Print Date: 11/5/2009

Drawing File Name: 06193SSDET18.dgn

Horiz. Scale: 1/15

Vert. Scale: As Noted

Unit Information

Unit Leader Initials

(R-X)
0000

Sheet Revisions

Date:	Comments	Init.

Colorado Department of Transportation



714 Grand Avenue, P.O. Box 298
Eagle, CO 81631
Phone: 970-328-6385 FAX: 970-328-2368

Region 3

MLM

As Constructed

No Revisions: 6-6-2011

Revised:

Void:

EDWARDS INTERCHANGE UPGRADE
SIGNING DETAILS
SIGN 18

Designer: KMH

Detailer: KMH

Sheet Subset: S.DET

Structure

Numbers

Subset Sheets: SD-07 of 21

Project No./Code


ES3 0702-297

17303

Sheet Number 254



Know what's below.
Call before you dig.

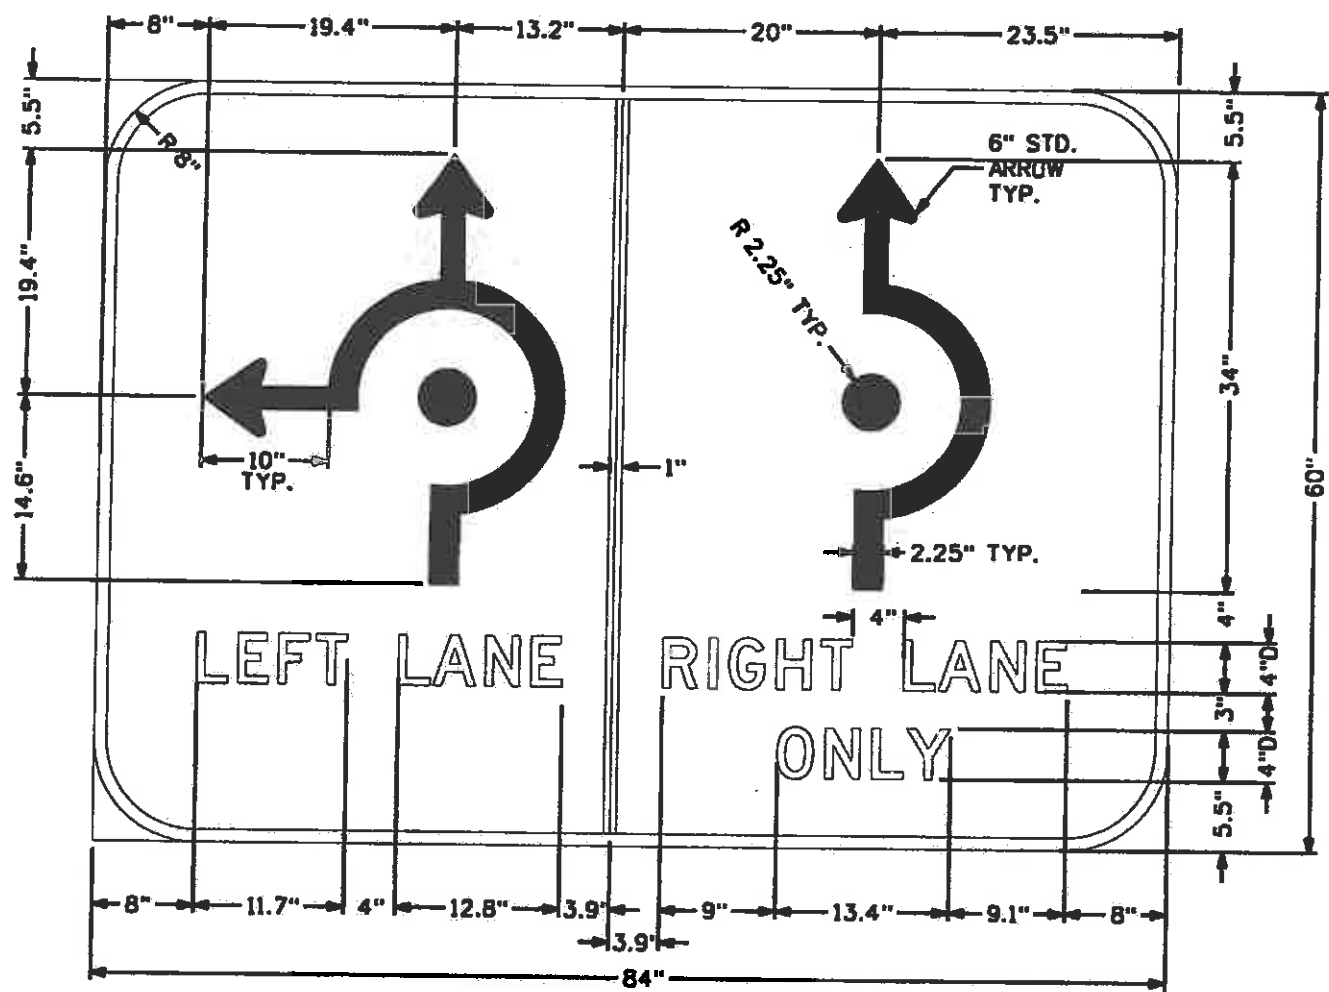

FELSBURG
HOLT &
ULLEVIG

Print Date: 11/5/2009

Drawing File Name: 06193SSDET27.dgn

Horiz. Scale: 1:15

Vert. Scale: As Noted

Unit Information

Unit Leader Initials

(R-X)
000

Sheet Revisions

Date:	Comments	Init.

Colorado Department of Transportation



714 Grand Avenue, P.O. Box 298
Eagle, CO 81631
Phone: 970-328-6385 FAX: 970-328-2368

Region 3

MLM

As Constructed

No Revisions: 6-6-ZDil

Revised:

Void:

EDWARDS INTERCHANGE UPGRADE
SIGNING DETAILS
SIGN 27

Designer: KMH
Detailer: KMH

Structure Numbers
Sheet Subset: S.DET Subset Sheets: SD-08 of 21

Project No./Code


ES3 0702-297

17303

Sheet Number 255

811

Call before you dig.

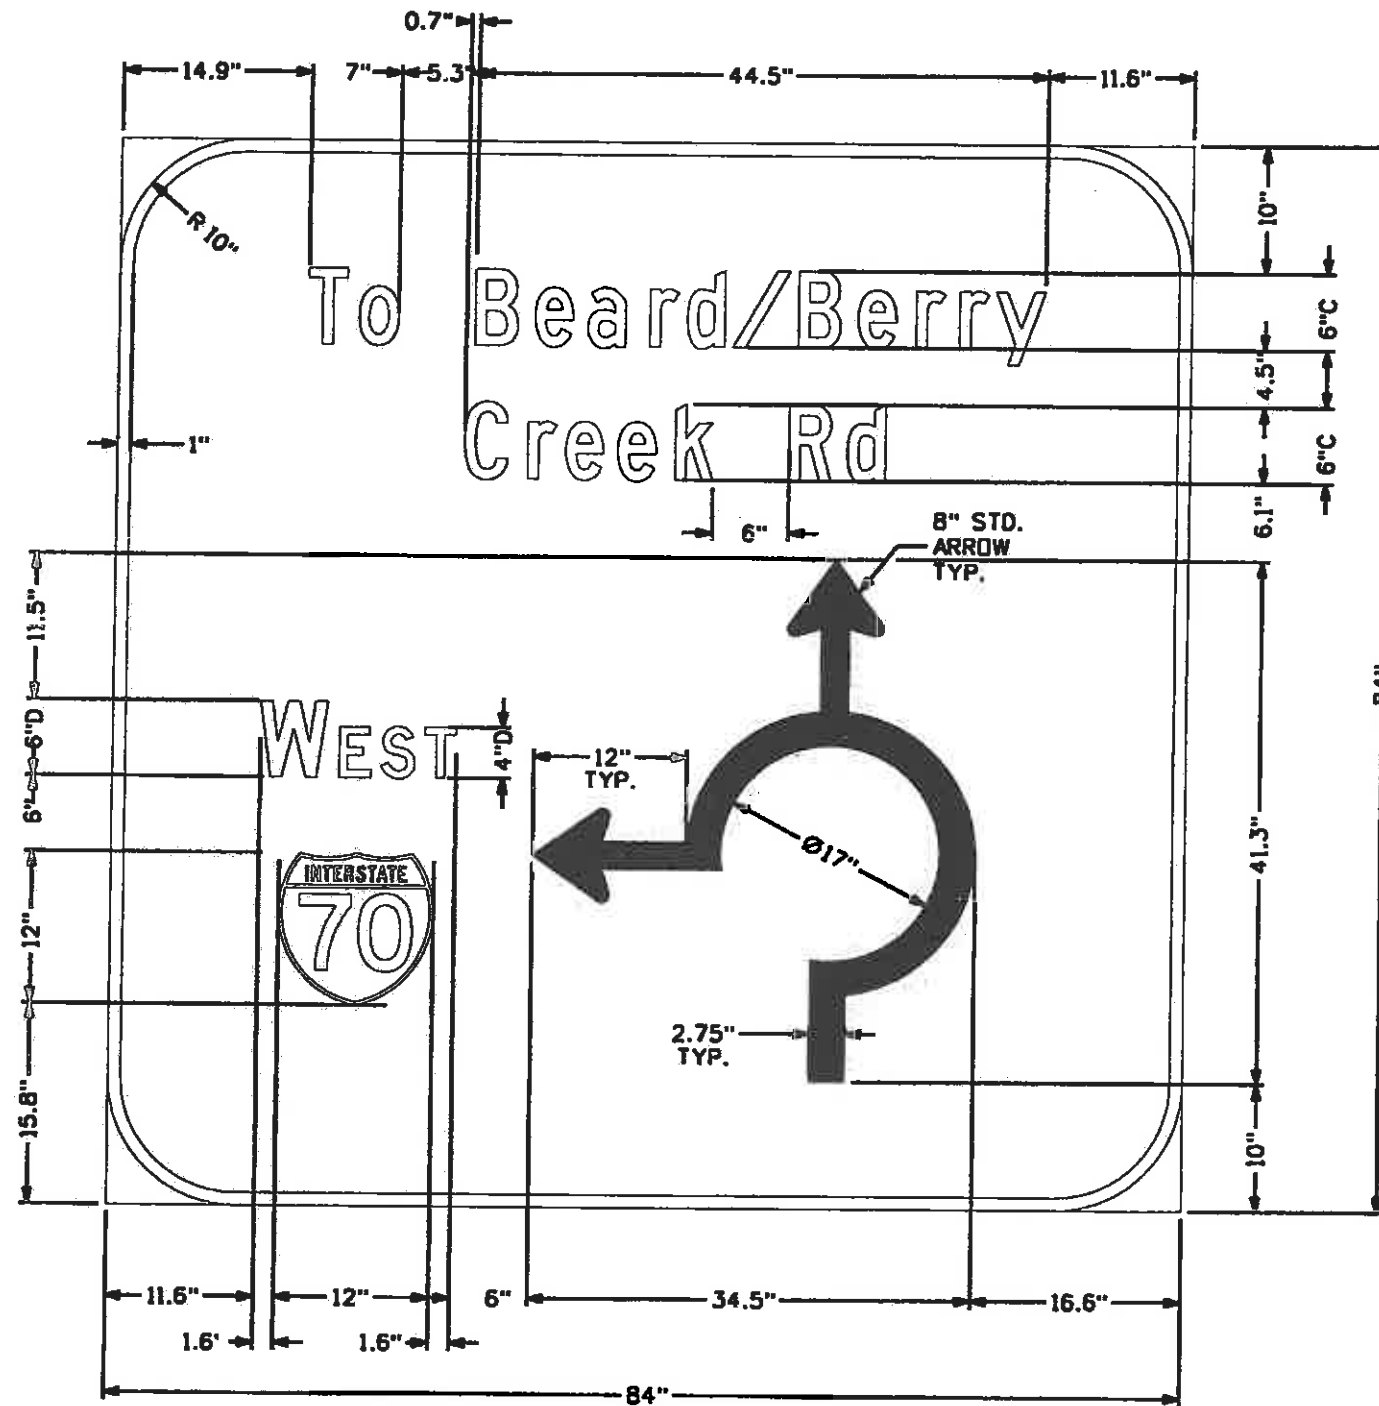

FELSBURG
HOLT &
ULLEVIG

Print Date: 11/5/2009

Drawing File Name: 06193SSDET28.dgn

Horiz. Scale: 1:15

Vert. Scale: As Noted

Unit Information

Unit Leader Initials

000
R-X

Sheet Revisions

Date:	Comments	Init.

Colorado Department of Transportation



714 Grand Avenue, P.O. Box 298
Eagle, CO 81631
Phone: 970-328-6385 FAX: 970-328-2368

Region 3

MLM

As Constructed

No Revisions: 6-6-ZD11
Revised:
Void:

EDWARDS INTERCHANGE UPGRADE
SIGNING DETAILS
SIGN 28

Designer:	KMH	Structure	
Detailer:	KMH	Numbers	
Sheet Subset:	S.DET	Subset Sheets:	SD-09 of 21

Project No./Code


ES3 0702-297

17303

Sheet Number 256

811

Know what's below.
Call before you dig.

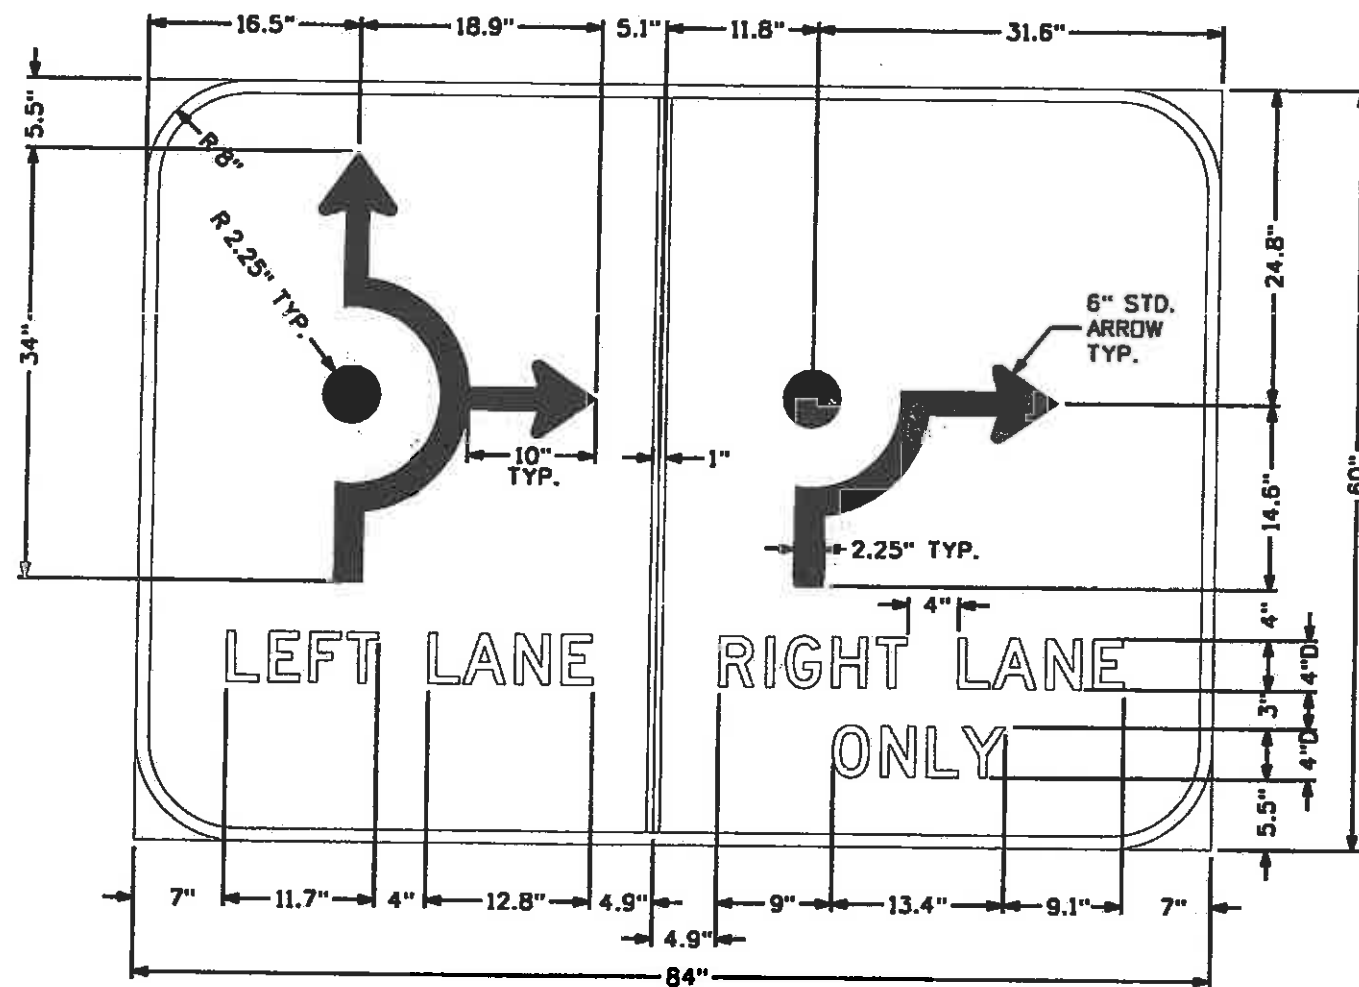

FELSBURG
HOLT &
ULLEVIG

Print Date: 11/5/2009
 Drawing File Name: 06193SSDET30.dgn
 Horiz. Scale: 1:15 Vert. Scale: As Noted
 Unit Information Unit Leader Initials

(R-X)
0000

Sheet Revisions		
Date:	Comments	Init.

Colorado Department of Transportation
 714 Grand Avenue, P.O. Box 298
 Eagle, CO 81631
 Phone: 970-328-6385 FAX: 970-328-2368
 Region 3 MLM


As Constructed
 No Revisions: 6-6-2011
 Revised:
 Void:

EDWARDS INTERCHANGE UPGRADE
 SIGNING DETAILS
 SIGN 30
 Designer: KMH Structure Numbers
 Detailer: KMH
 Sheet Subset: S.OET Subset Sheets: SD-10 of 21

Project No./Code
 ES3 0702-297
 17303
 Sheet Number 257

811

Know what's below.
Call before you dig.

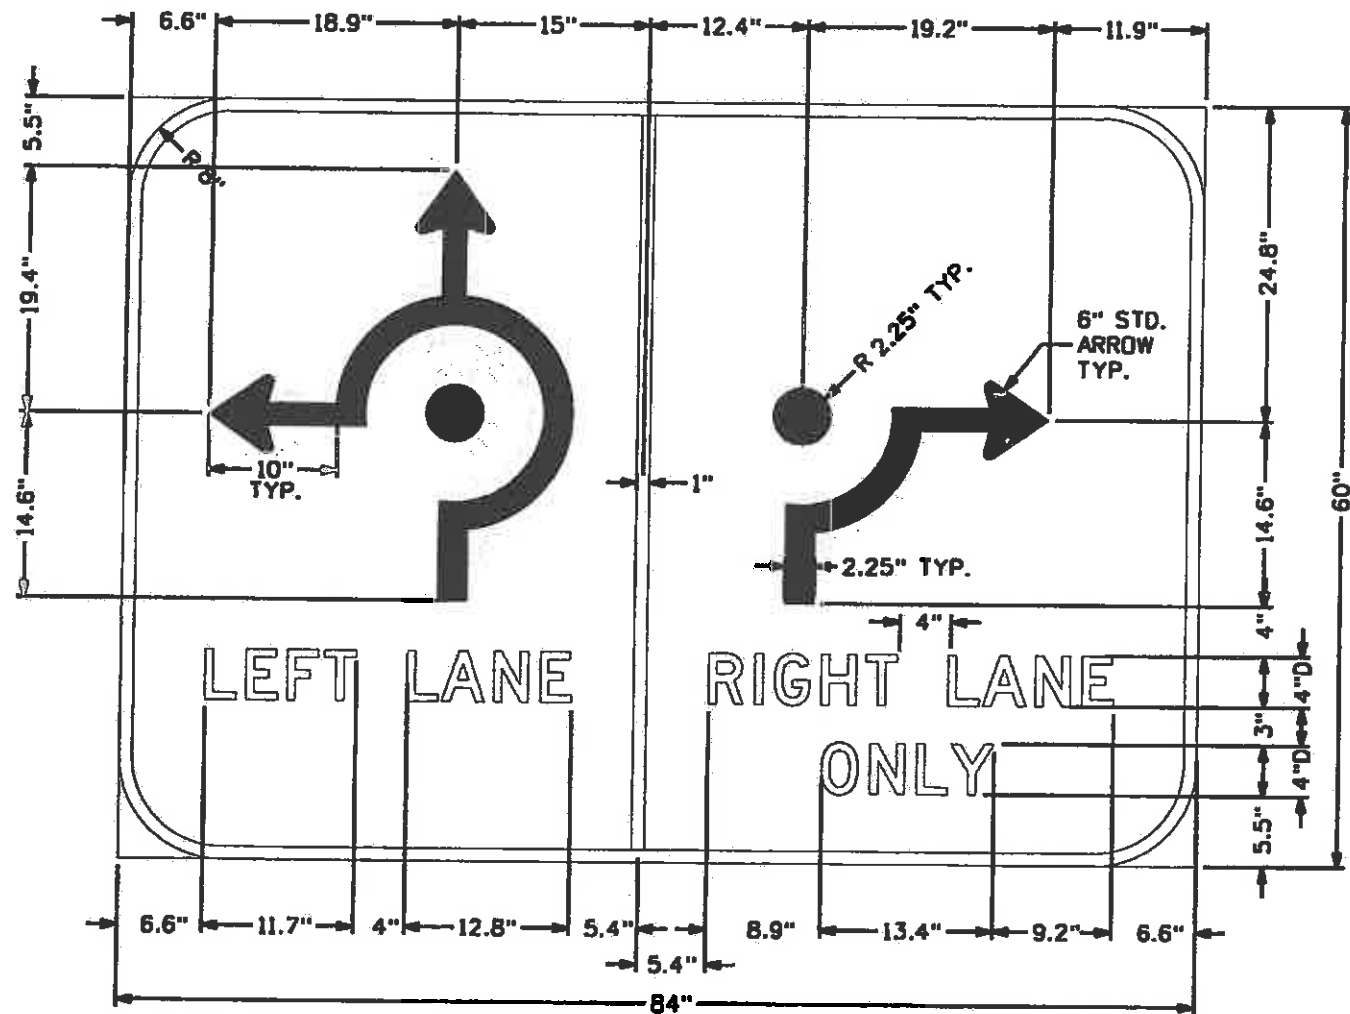

FELSBURG
HOLT &
ULLEVIG

Print Date: 11/5/2009

Drawing File Name: 06193SSDET34.dgn

Horiz. Scale: 1/4"=1'

Vert. Scale: As Noted

Unit Information

Unit Leader Initials

(R-X)
0000

Sheet Revisions

Date:	Comments	Init.

Colorado Department of Transportation



714 Grand Avenue, P.O. Box 298
Eagle, CO 81631
Phone: 970-328-6385 FAX: 970-328-2368

Region 3

MLM

As Constructed

No Revisions: 6-6-2011

Revised:

Void:

EDWARDS INTERCHANGE UPGRADE
SIGNING DETAILS
SIGN 34

Designer:	KMH	Structure Numbers	
Detailer:	KMH		
Sheet Subset:	S.DET	Subset Sheets:	SD-11 of 21

Project No./Code


ES3 0702-297

17303

Sheet Number 258

811


Know what's below.
Call before you dig.

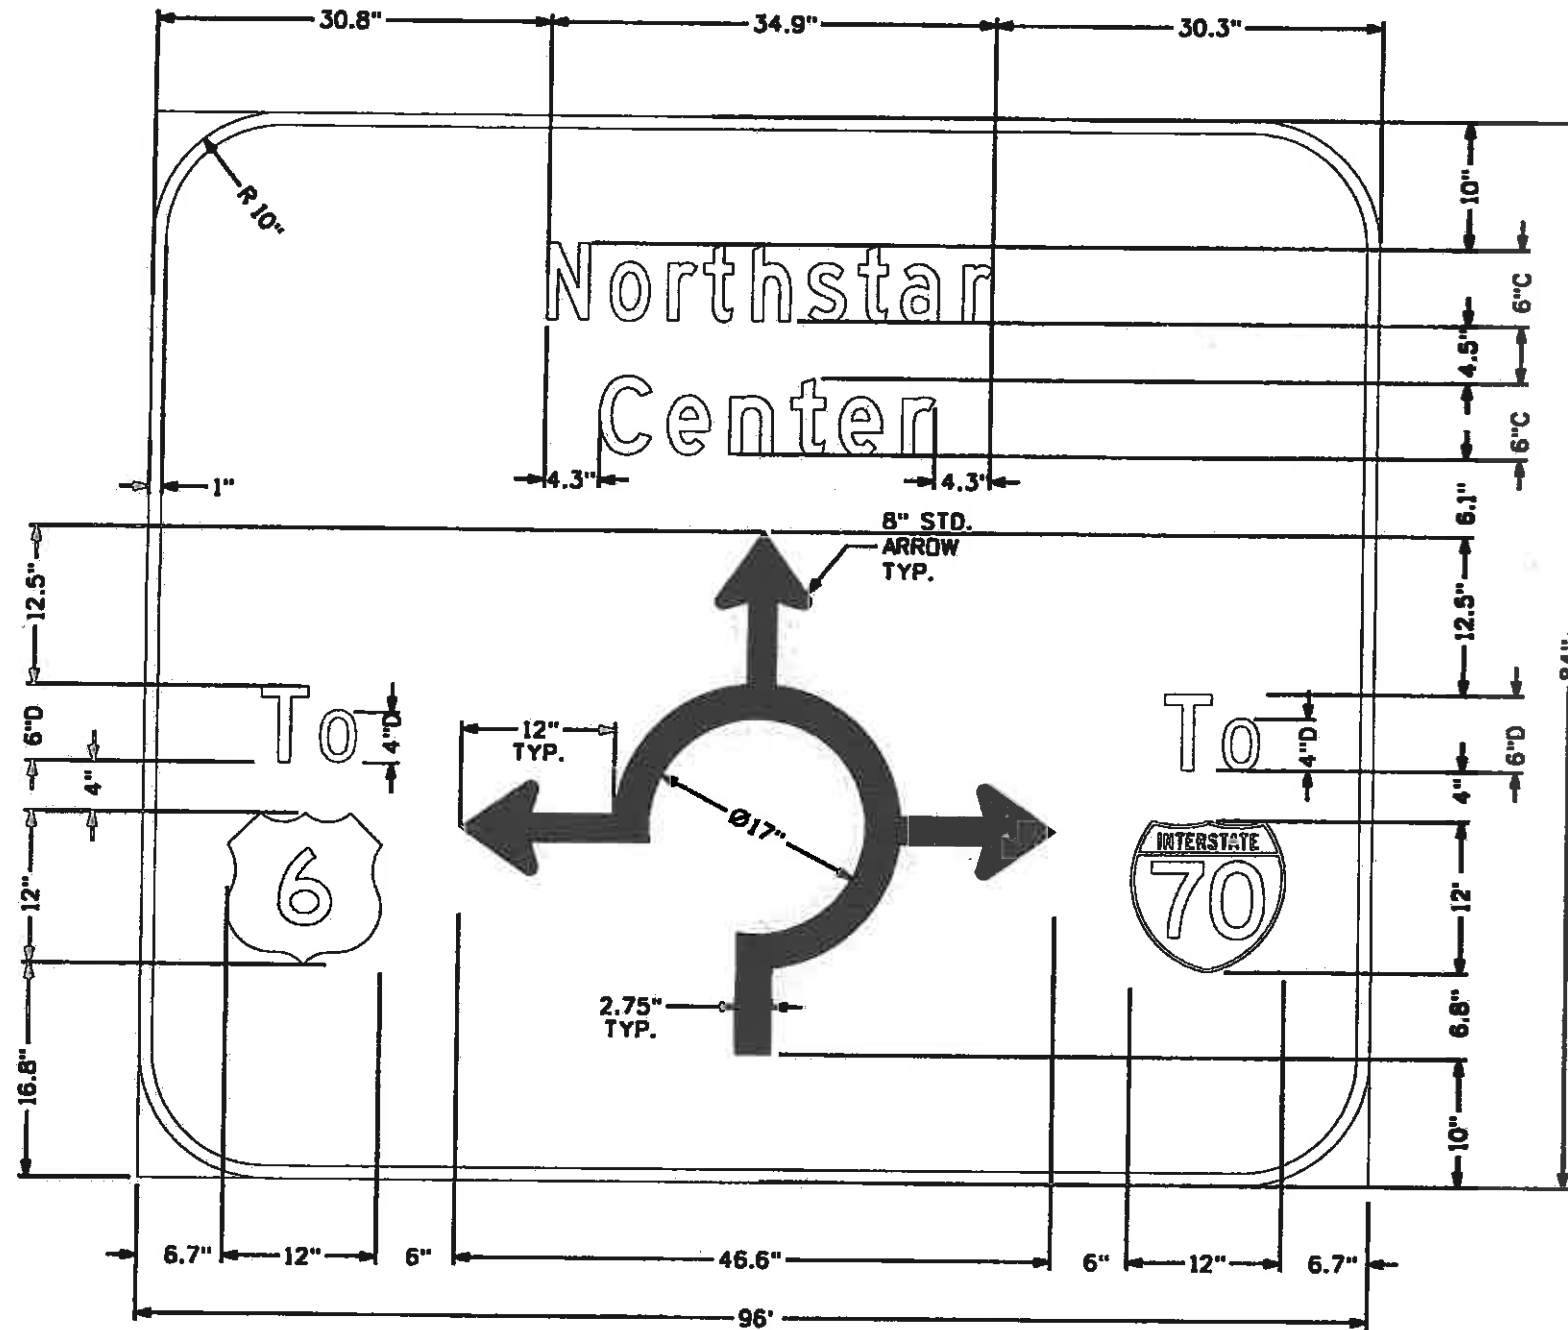

FELSBURG
HOLT &
ULLEVIG

Print Date: 11/5/2009
Drawing File Name: 06193SSDET36.dgn
Horiz. Scale: 1/15
Unit Information
Vert. Scale: As Noted
Unit Leader Initials

Sheet Revisions		
Date:	Comments	Init.

Colorado Department of Transportation

 714 Grand Avenue, P.O. Box 298
 Eagle, CO 81631
 Phone: 970-328-6385 FAX: 970-328-2368
 Region 3 MLM


As Constructed
 No Revisions: 6-6-2011
 Revised:
 Void:

EDWARDS INTERCHANGE UPGRADE
 SIGNING DETAILS
 SIGN 36
 Designer: KMH
 Detailer: KMH
 Sheet Subset: S.DET
 Structure Numbers:
 Subset Sheets: SD-12 of 21

Project No./Code
 ES3 0702-297
 17303
 Sheet Number 259

811

Know what's below. Call before you dig.

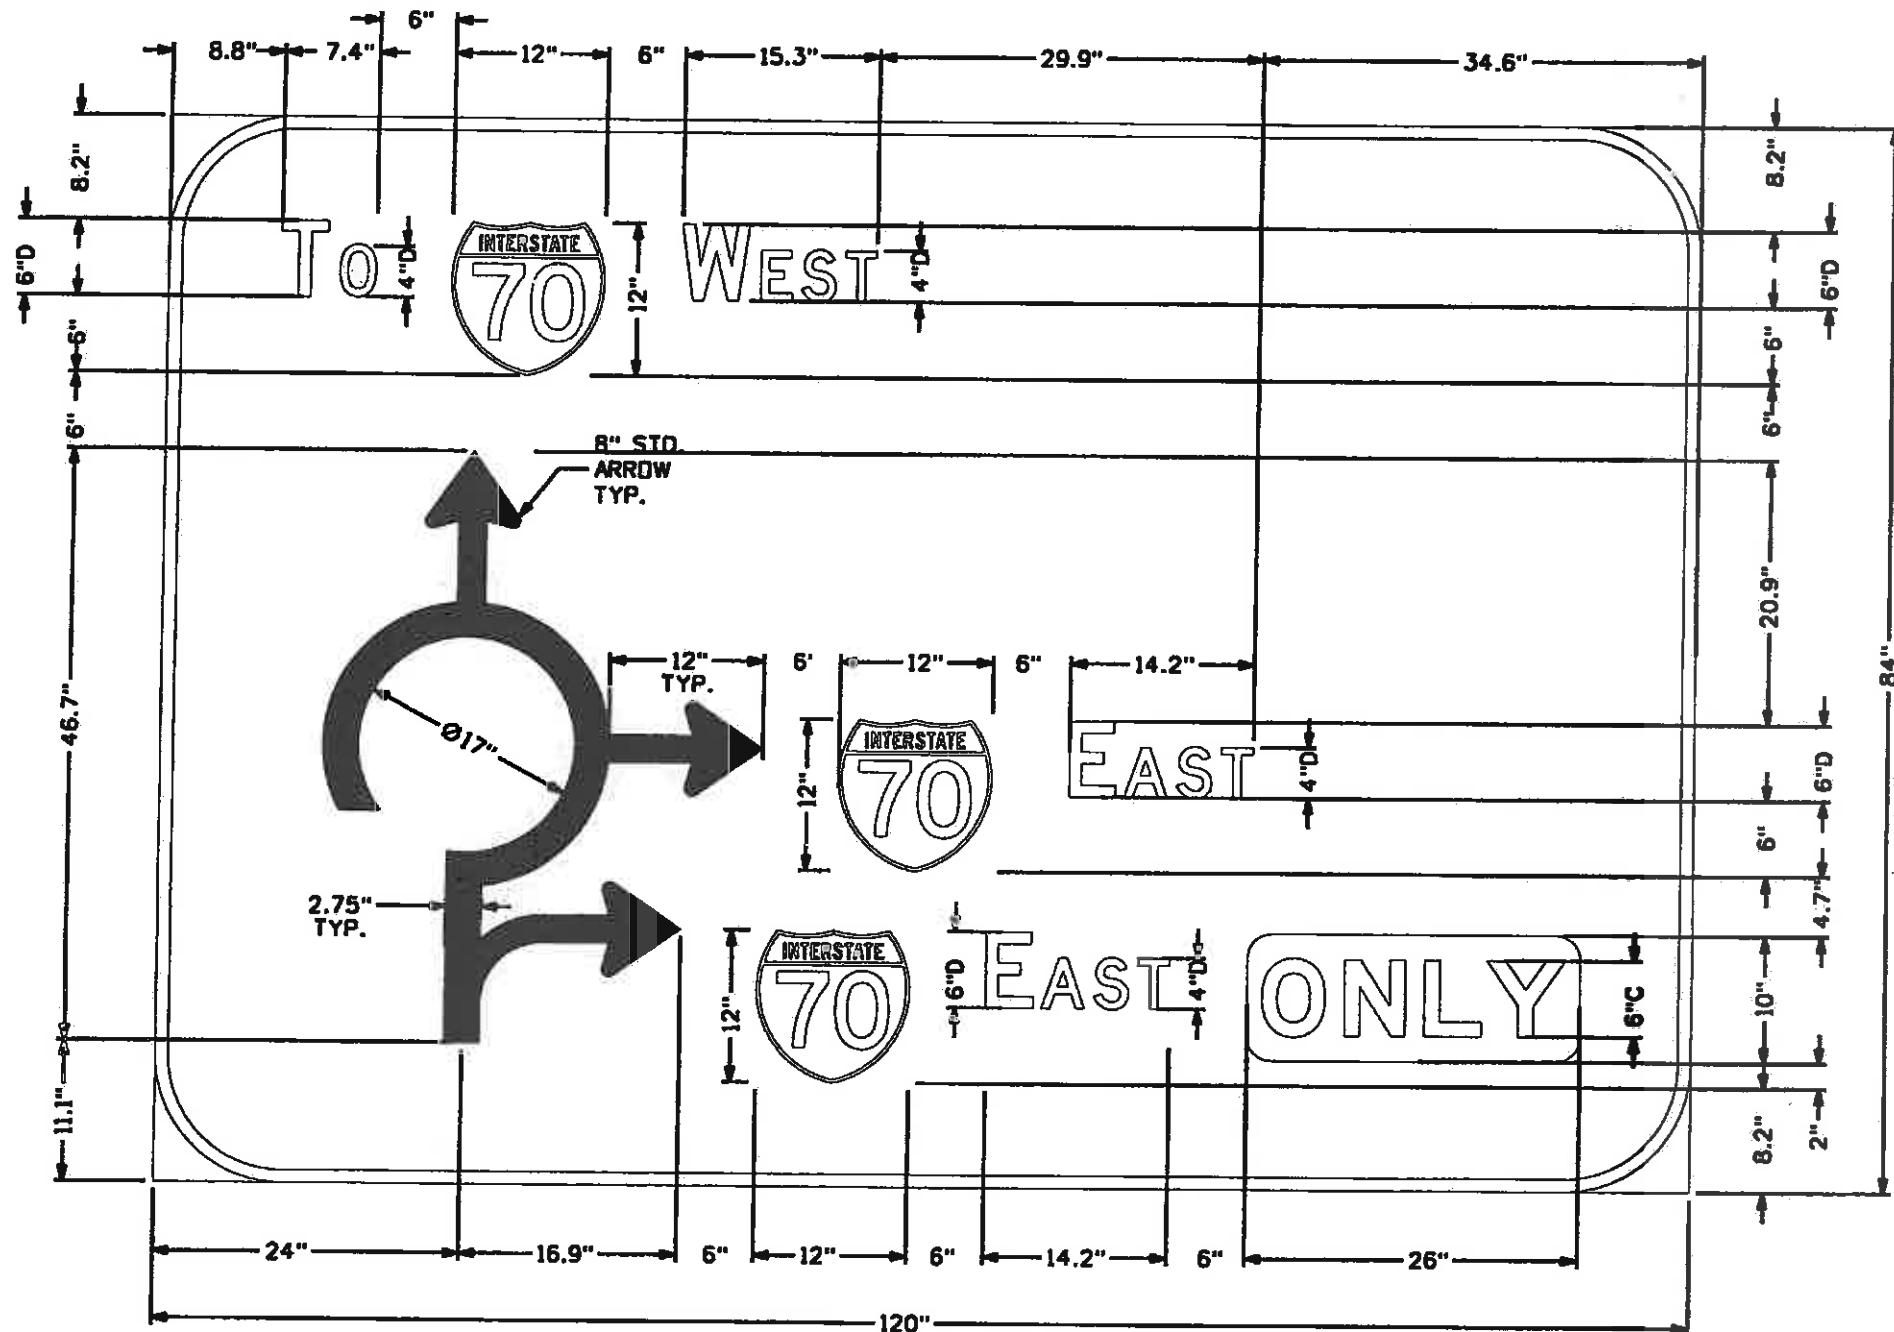

FELSBURG
HOLT &
ULLEVIG

Print Date: 11/5/2009
Drawing File Name: 06193SSDET38.dgn
Horiz. Scale: 1/15
Unit Information
Vert. Scale: As Noted
Unit Leader Initials

Sheet Revisions		
Date:	Comments	Init.

Colorado Department of Transportation
714 Grand Avenue, P.O. Box 298
Eagle, CO 81631
Phone: 970-328-6385 FAX: 970-328-2368
Region 3 MLM


As Constructed
No Revisions: 6-6-2011
Revised:
Void:

EDWARDS INTERCHANGE UPGRADE
SIGNING DETAILS
SIGN 38
Designer: KMH
Detailer: KMH
Sheet Subset: S.DET
Structure Numbers
Subset Sheets: SD-13 of 21

Project No./Code
ES3 0702-297
17303
Sheet Number 260

811

Know what's below.
Call before you dig.

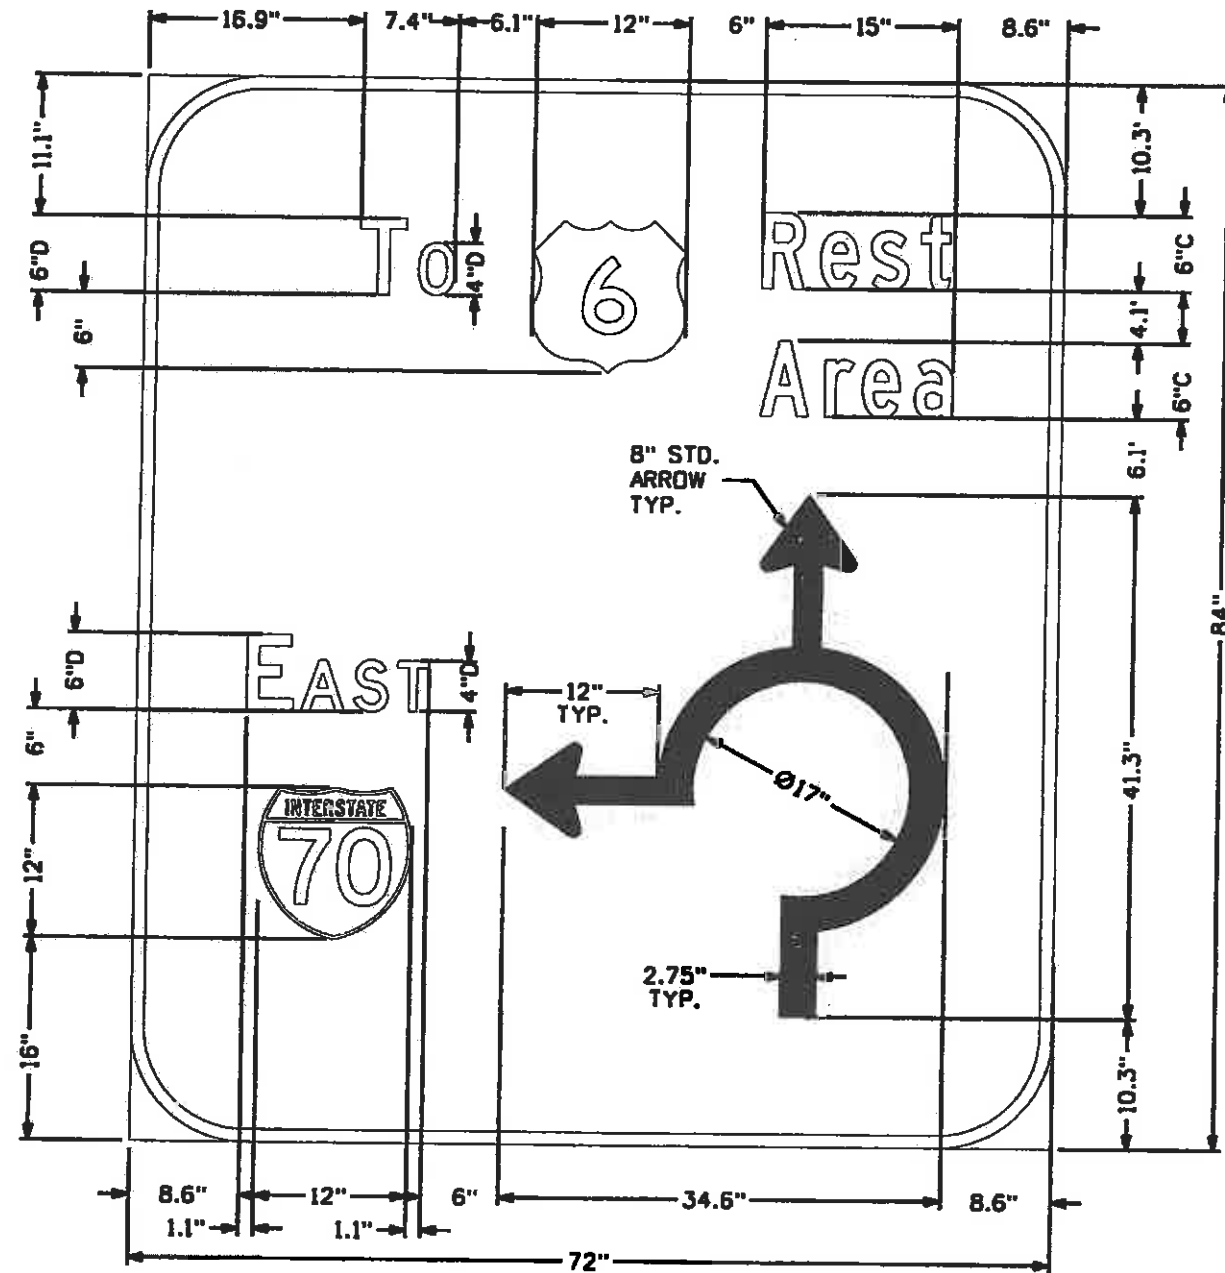

FELSBURG
HOLT &
ULLEVIG

Print Date: 11/5/2009

Drawing File Name: 06193SSDET42.dgn

Horiz. Scale: 1/4" = 1'

Vert. Scale: As Noted

Unit Information

Unit Leader Initials

R-X
0000

Sheet Revisions

Date:	Comments	Init.

Colorado Department of Transportation



714 Grand Avenue, P.O. Box 298
Eagle, CO 81631
Phone: 970-328-6385 FAX: 970-328-2368

Region 3

MLM

As Constructed

No Revisions: 6-6-2011

Revised:

Void:

EDWARDS INTERCHANGE UPGRADE
SIGNING DETAILS
SIGN 42

Designer: KMH
Detailer: KMH

Structure Numbers
Sheet Subset: S.OET Subset Sheets: SD-14 of 21

Project No./Code


ES3:0702-297

17303

Sheet Number 261

811

Know what's below. Call before you dig.

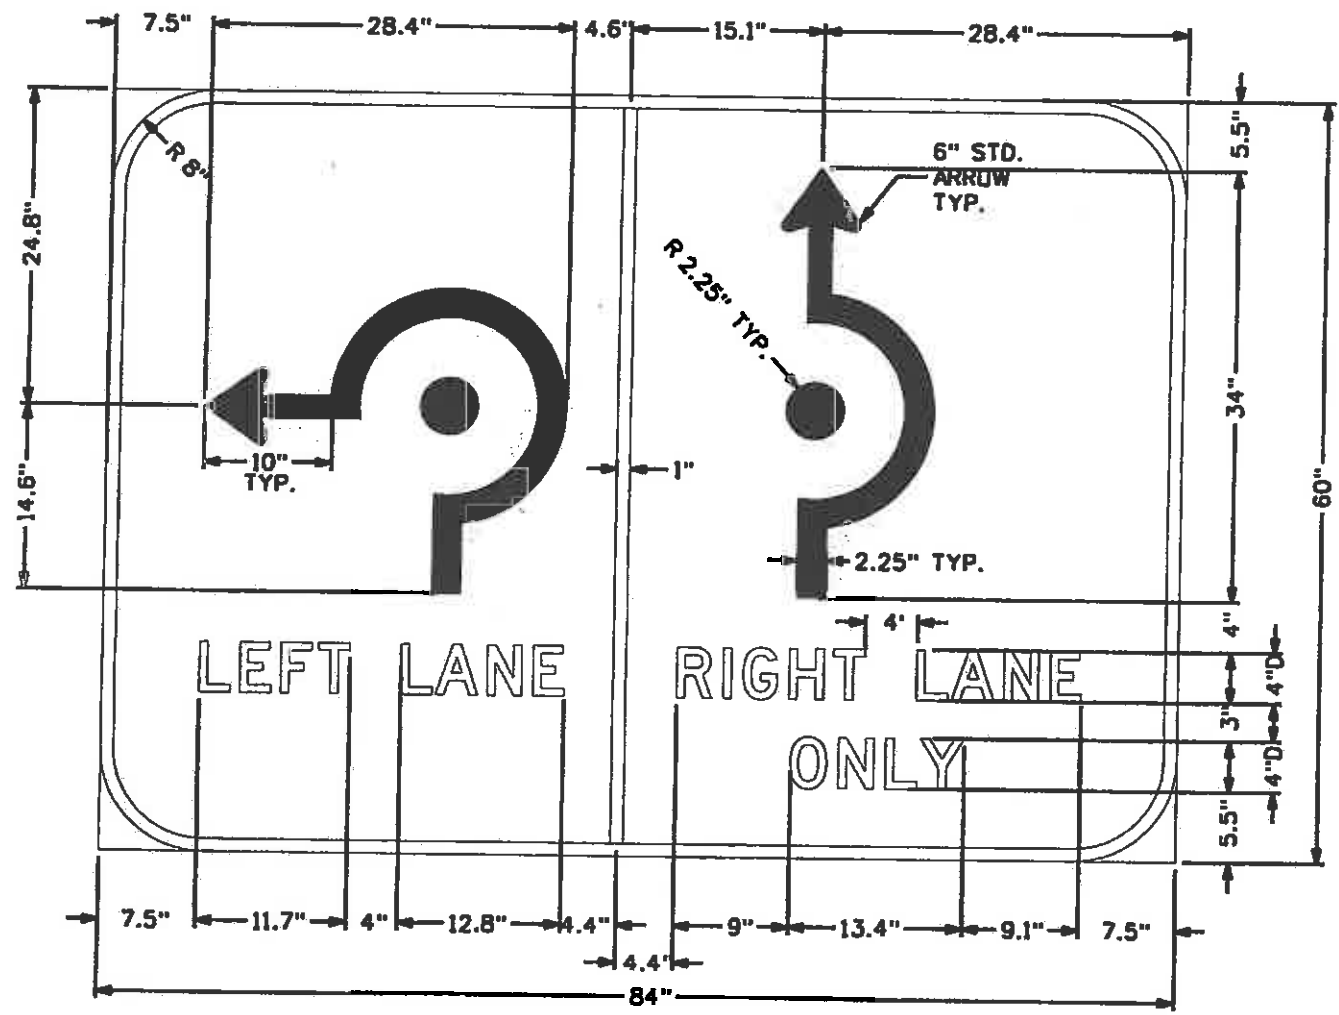

FELSBURG
HOLT &
ULLEVIG

Print Date: 11/5/2009

Drawing File Name: 06193SSDET43.dgn

Horiz. Scale: 1:15

Vert. Scale: As Noted

Unit Information

Unit Leader Initials

R-X
000

Sheet Revisions

Date:	Comments:	Init.

Colorado Department of Transportation



714 Grand Avenue, P.O. Box 298
Eagle, CO 81631
Phone: 970-328-6385 FAX: 970-328-2368

Region 3

MLM

As Constructed

No Revisions: 6-6-2011

Revised:

Void:

EDWARDS INTERCHANGE UPGRADE
SIGNING DETAILS
SIGN 43

Designer: KMH
Detailer: KMH

Structure Numbers

Sheet Subset: S.DET

Subset Sheets: SD-15 of 21

Project No./Code


ES3 0702-297

17303

Sheet Number 262

811

Know where you're digging.
Call before you dig.

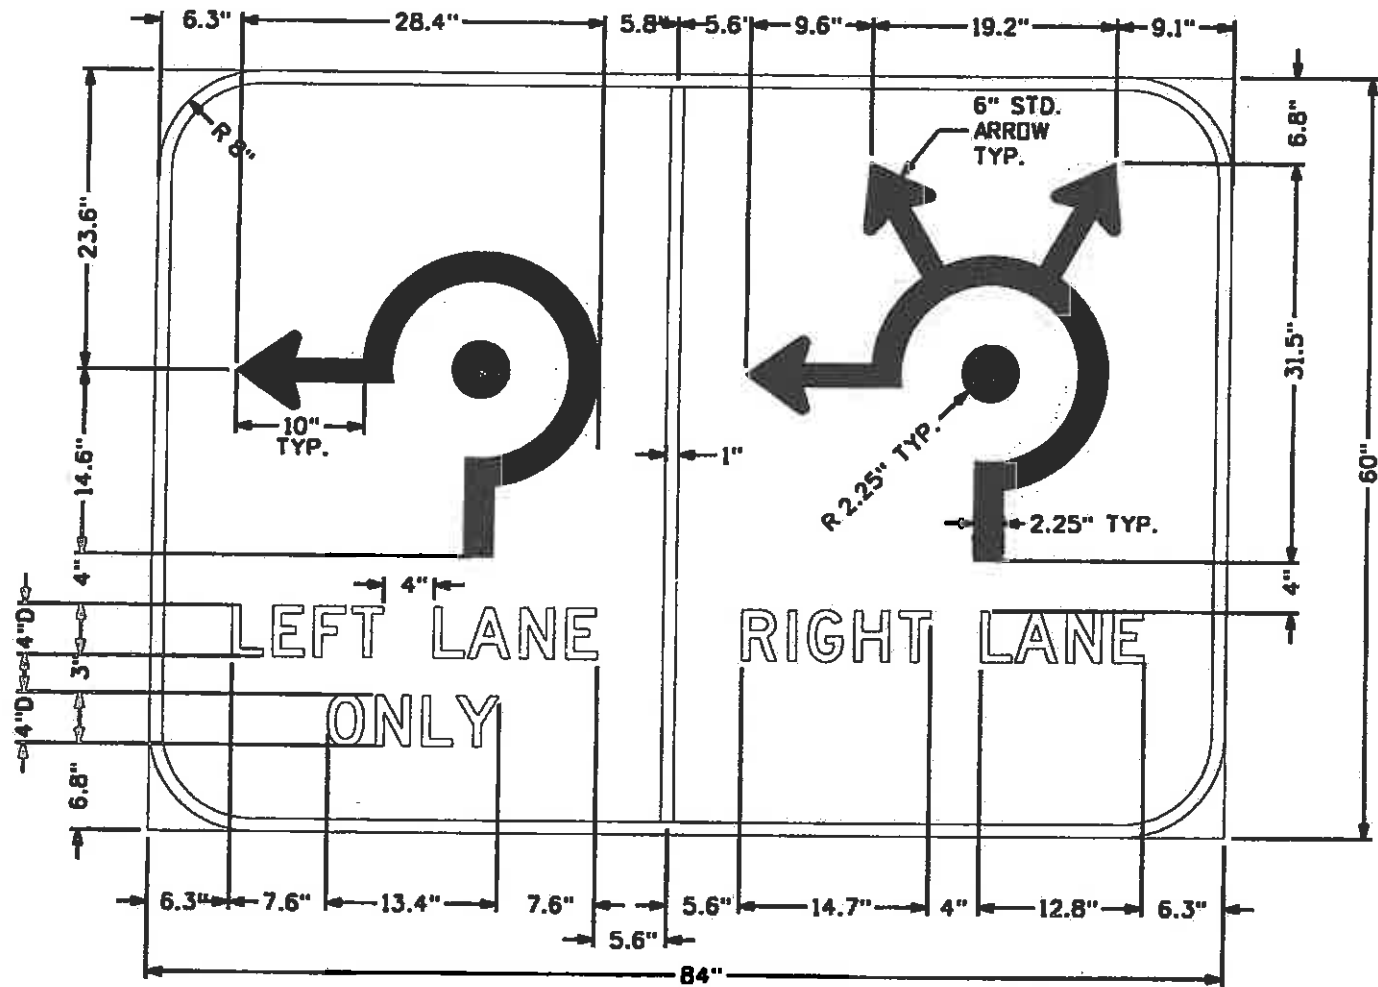

Print Date: 11/5/2009
 Drawing File Name: 06193SSDET52.dgn
 Horiz. Scale: 1:15
 Unit Information

Sheet Revisions		
Date:	Comments	Init.

Colorado Department of Transportation
 714 Grand Avenue, P.O. Box 298
 Eagle, CO 81631
 Phone: 970-328-6385 FAX: 970-328-2368
 Region 3
 MLM


As Constructed
 No Revisions: 6-6-2011
 Revised:
 Void:

EDWARDS INTERCHANGE UPGRADE
 SIGNING DETAILS
 SIGN 52
 Designer: KMH
 Detailer: KMH
 Sheet Subset: S.DET
 Structure Numbers
 Subset Sheets: SD-16 of 21

Project No./Code
 ES3 0702-297
 17303
 Sheet Number 263

811


Know what's below. Call before you dig.

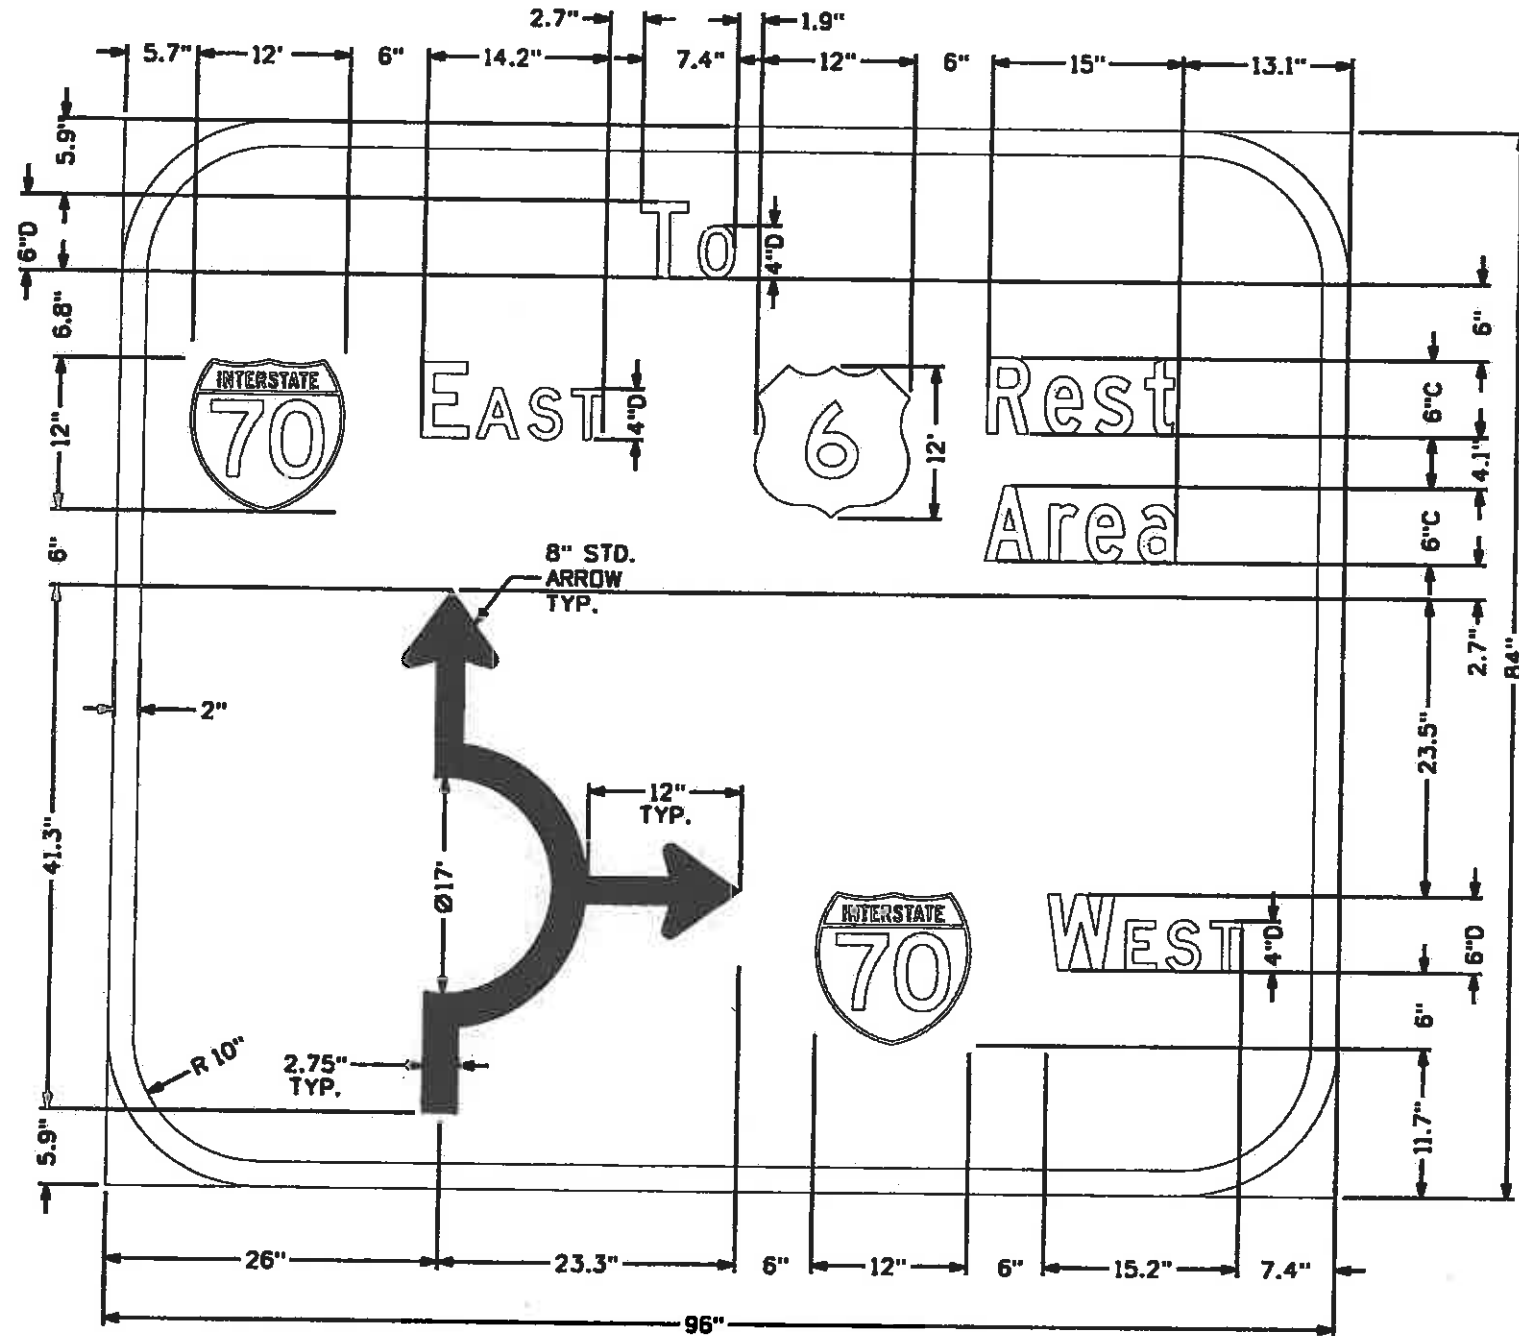

FELSBURG
HOLT &
ULLEVIG

Print Date: 11/5/2009
Drawing File Name: 0619355DET54.dgn
Horiz. Scale: 1/8" = 1'-0"
Unit Information
Vert. Scale: As Noted
Unit Leader Initials

Sheet Revisions		
Date:	Comments	Init.

Colorado Department of Transportation
 714 Grand Avenue, P.O. Box 298
 Eagle, CO 81631
 Phone: 970-328-6385 FAX: 970-328-2368
 Region 3 MLM


As Constructed
No Revisions: 6-6-2011
Revised:
Void:

EDWARDS INTERCHANGE UPGRADE SIGNING DETAILS SIGN 54		
Designer:	KMH	Structure
Detailer:	KMH	Numbers
Sheet Subset:	S.DET	Subset Sheets: SD-17 of 21

Project No./Code
ES3 0702-297
17303
Sheet Number 264

811

Call before you dig

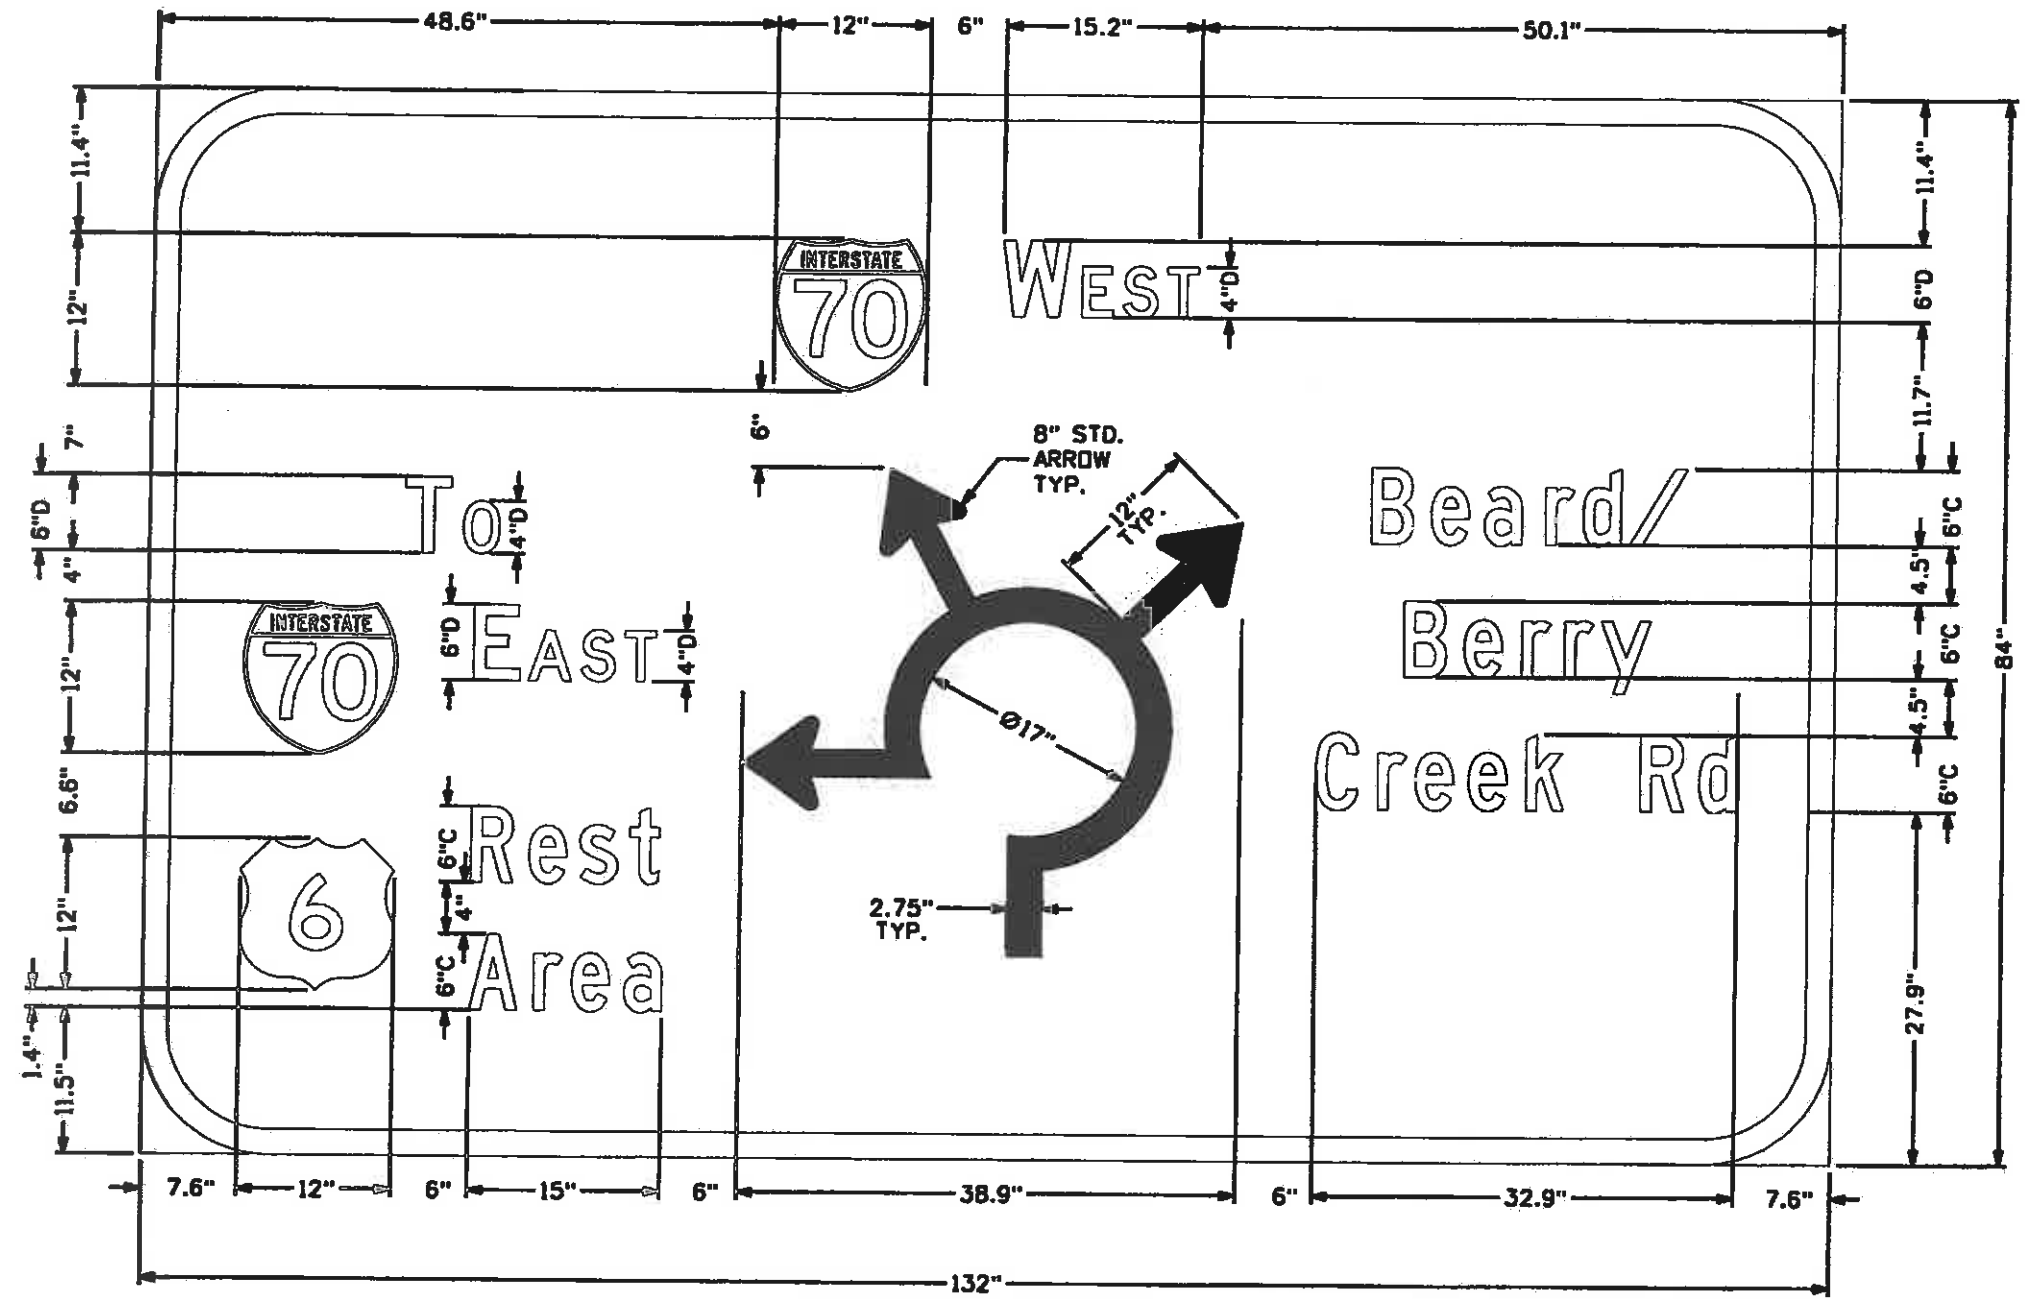

FELSBURG
HOLT &
ULLEVIG

Print Date: 11/5/2009
Drawing File Name: 06193SSDET55.dgn
Horiz. Scale: 1:15 Vert. Scale: As Noted
Unit Information Unit Leader Initials

Sheet Revisions		
Date	Comments	Init.

Colorado Department of Transportation
 714 Grand Avenue, P.O. Box 298
 Eagle, CO 81631
 Phone: 970-328-6385 FAX: 970-328-2368
 Region 3 MLM


As Constructed
No Revisions: 6-6-2011
Revised:
Void:

EDWARDS INTERCHANGE UPGRADE SIGNING DETAILS SIGN 55		
Designer:	KMH	Structure
Detailer:	KMH	Numbers
Sheet Subset:	S.DET	Subset Sheets: SD-18 of 21

Project No./Code	ES3 0702-297
	17303
Sheet Number	265

811

Know what's below.
Call before you dig.

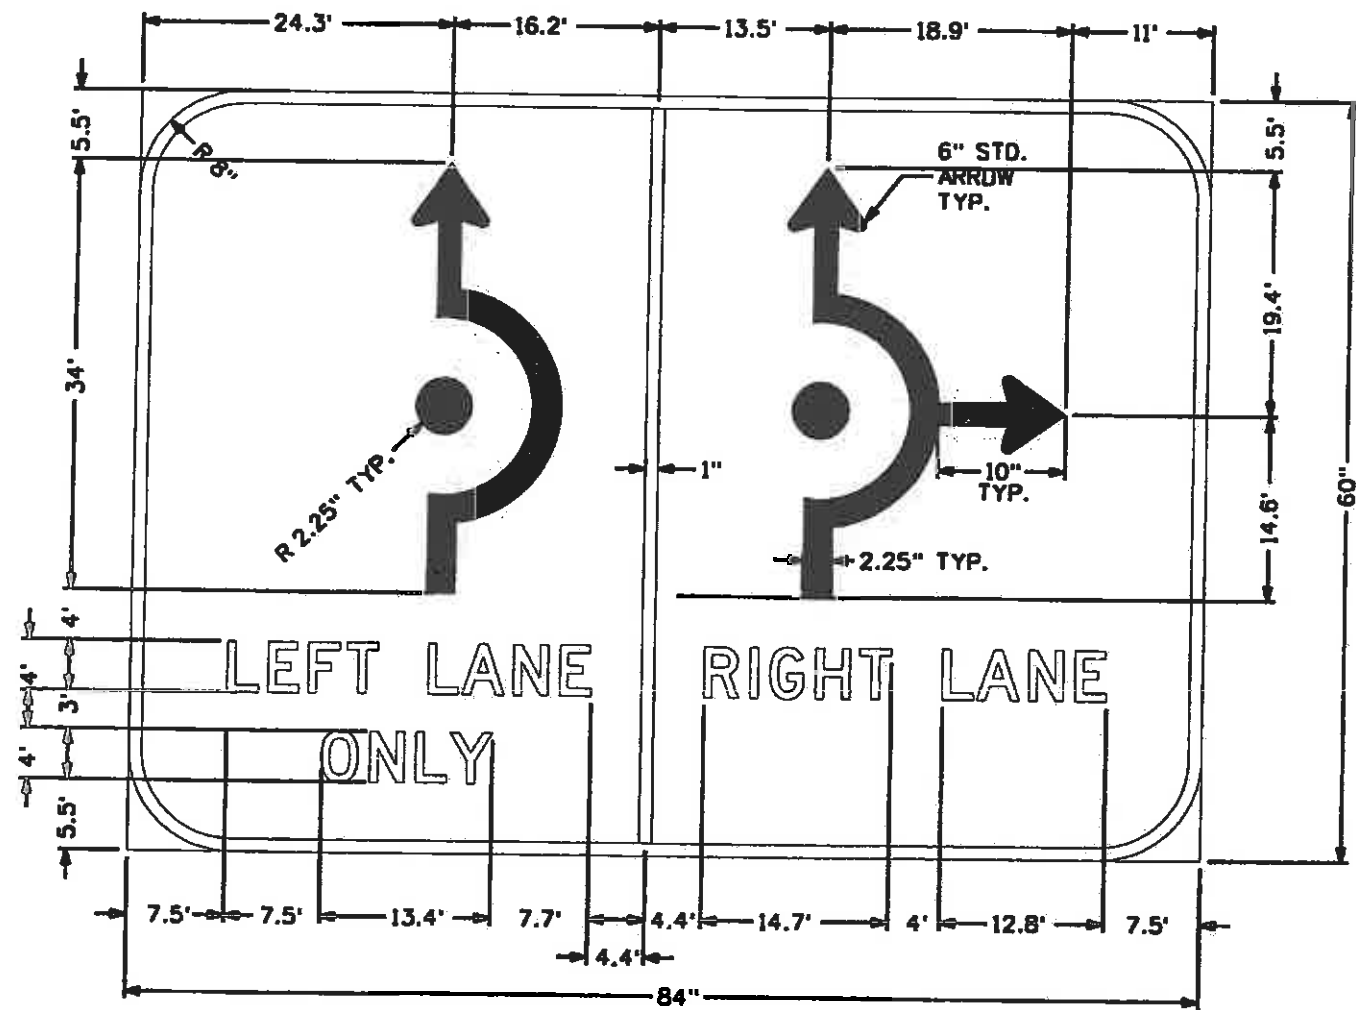

FELSBURG
HOLT &
ULLEVIG

Print Date: 11/5/2009
Drawing File Name: 06193SSDET60.dgn
Horiz. Scale: 1=15
Unit Information

Sheet Revisions		
Date:	Comments:	Init.

Colorado Department of Transportation
714 Grand Avenue, P.O. Box 298
Eagle, CO 81631
Phone: 970-328-6385 FAX: 970-328-2368
Region 3 MLM

As Constructed
No Revisions: 6-6-2011
Revised:
Void:

EDWARDS INTERCHANGE UPGRADE
SIGNING DETAILS
SIGN 60
Designer: KMH
Detailer: KMH
Sheet Subset: S.DET


Project No./Code
ES3 0702-297
17303
Sheet Number 266

(R-X)
000


Structure Numbers
Subset Sheets: SD-19 of 21




SIGN 2

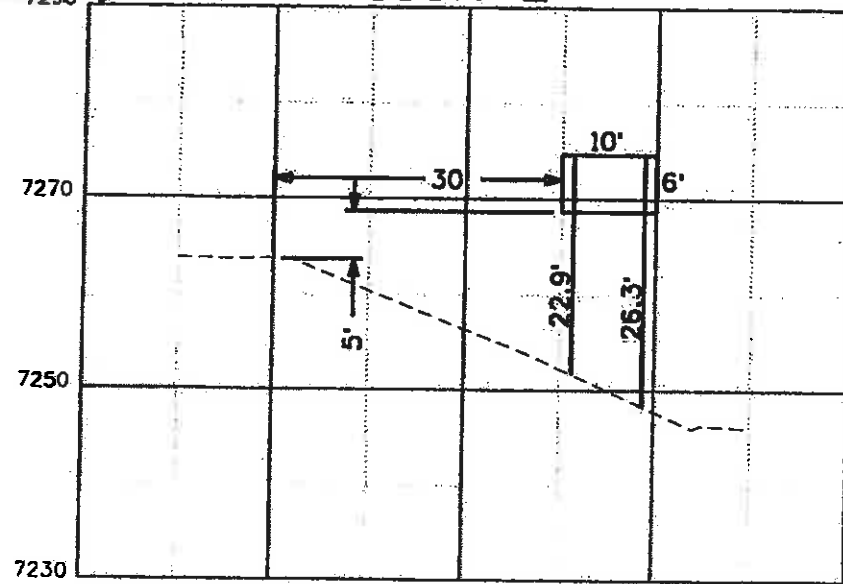


SIGN 18

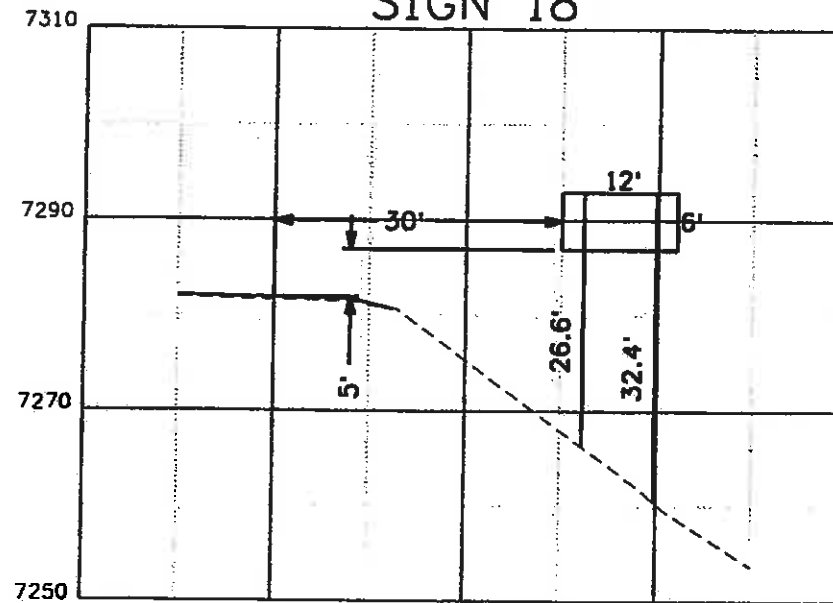


SIGN 36

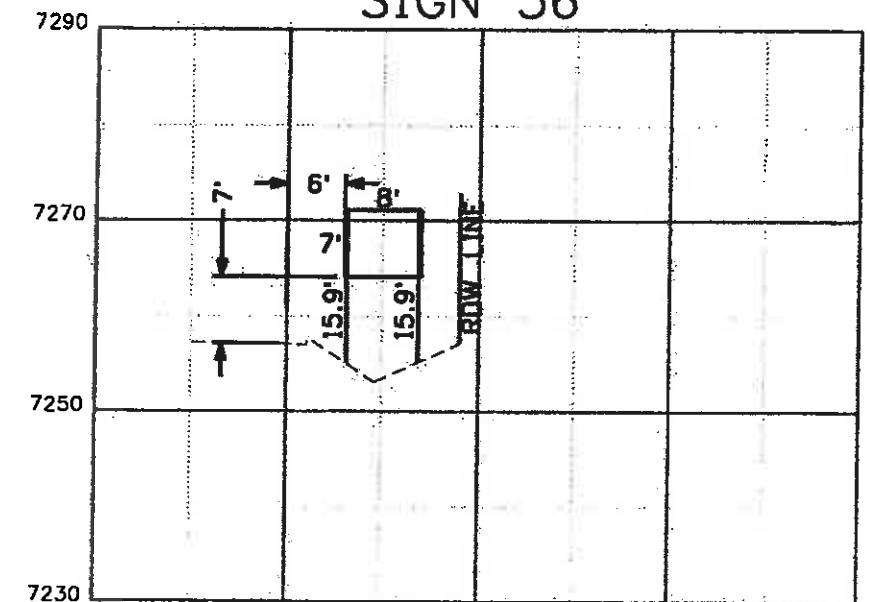


SIGN 16

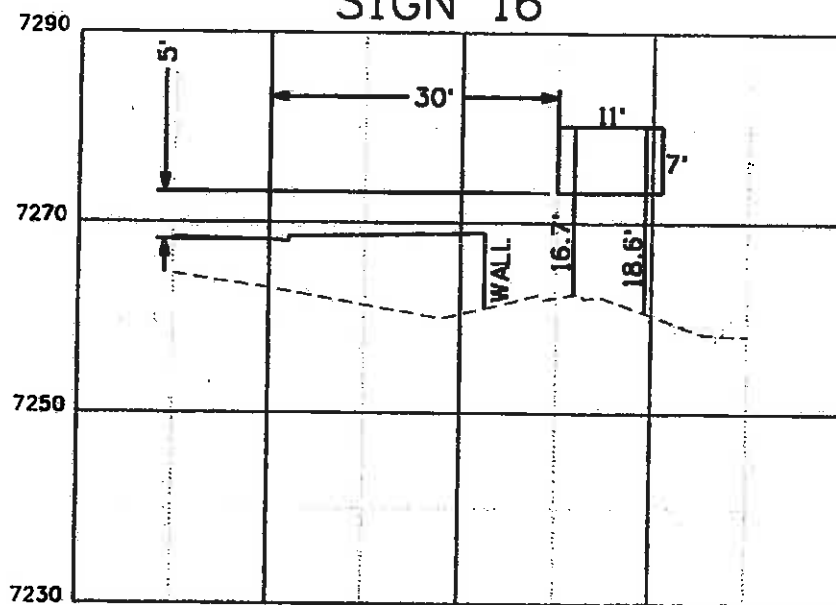

SIGN 28

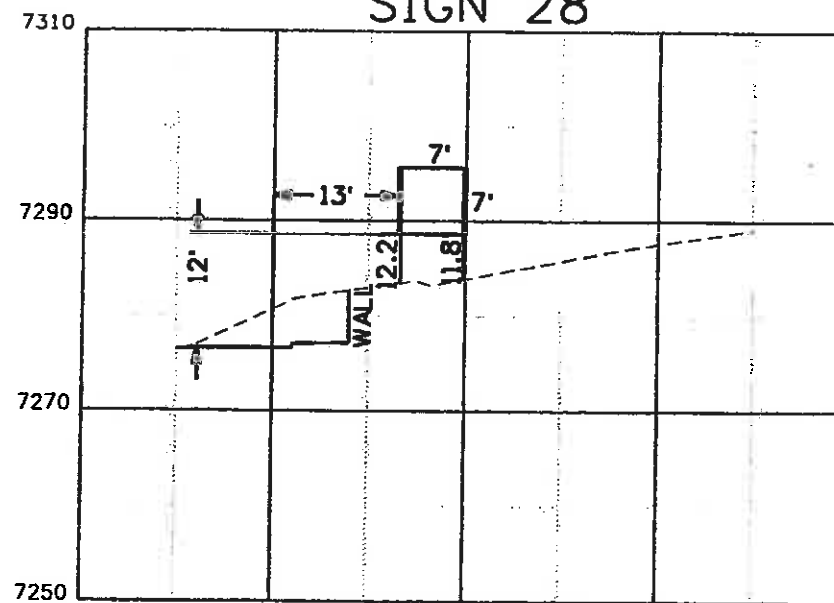

SIGN 38

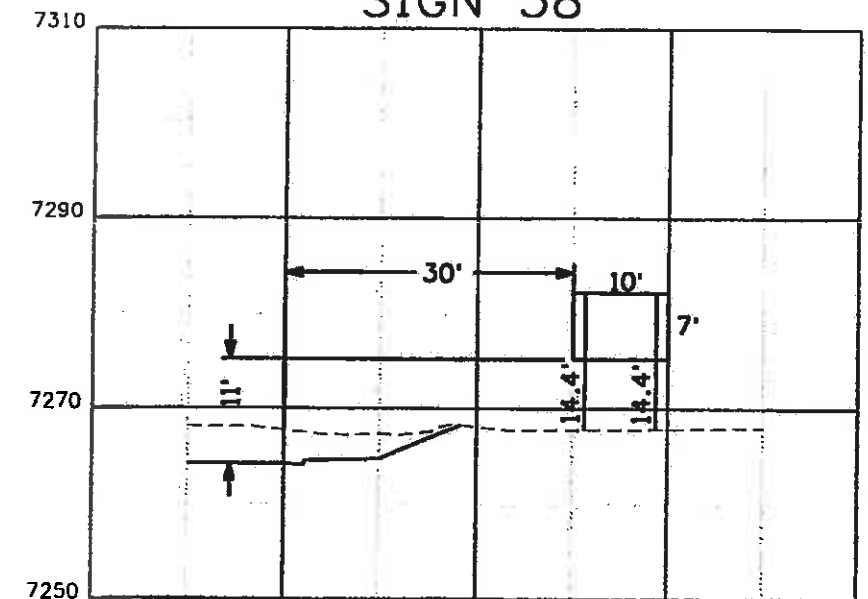

FELSBURG
HOLT &
ULLEVIG

Print Date: 11/5/2009
 Drawing File Name: 06193SSXS01.dgn
 Horiz. Scale: 1:20
 Unit Information

0000
R-X

Sheet Revisions		
Date:	Comments	Init.

Colorado Department of Transportation



714 Grand Avenue, P.O. Box 298
 Eagle, CO 81631
 Phone: 970-328-6385 FAX: 970-328-2368

Region 3

MLM

As Constructed

No Revisions: 6-6-2011

Revised:

Void:

EDWARDS INTERCHANGE UPGRADE
 CLASS III SIGN
 CROSS SECTIONS

Designer:	KMH	Structure	
Detailer:	KMH	Numbers	
Sheet Subset:	S. DET	Subset Sheets:	SD-20 of 21

Project No./Code




ES3 0702-297

17303

Sheet Number 267

811

Know what's below. Call before you dig.

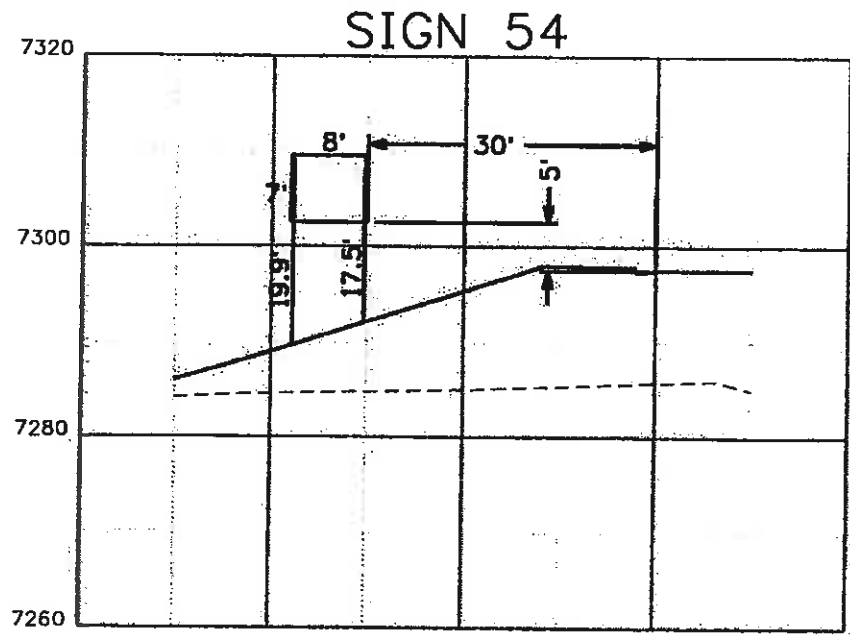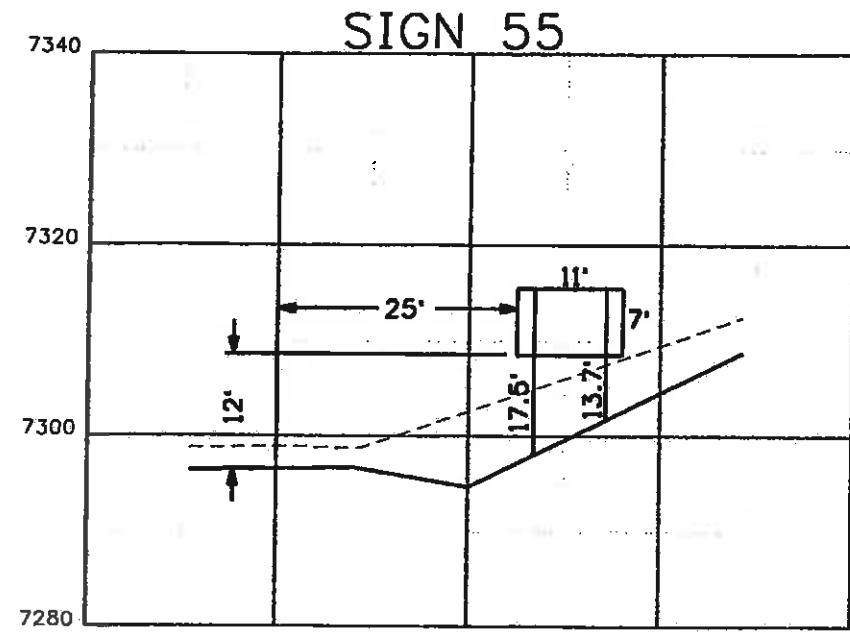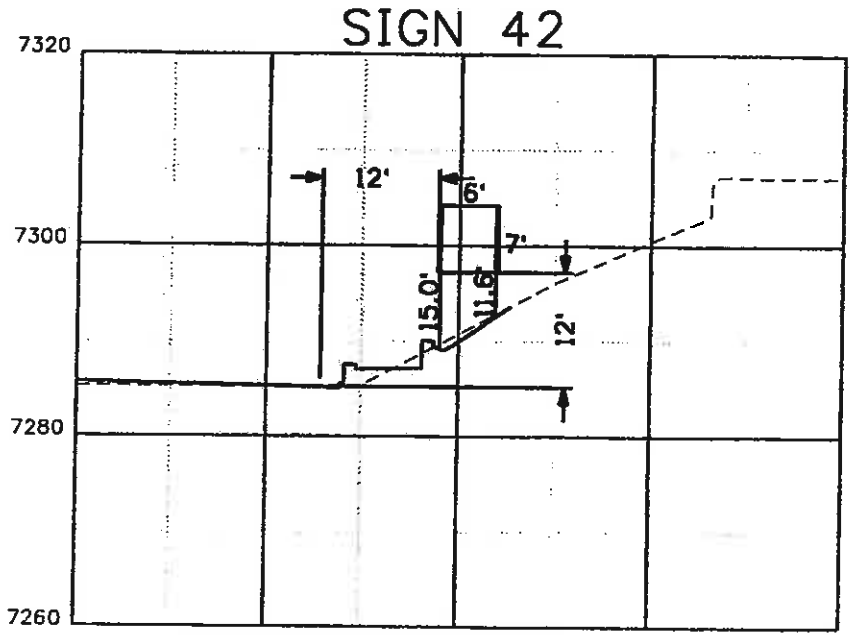

FELSBURG
HOLT &
ULLEVIG

Print Date: 11/5/2009	
Drawing File Name: 06193SSXS02.dgn	
Unit Information	
Horiz. Scale: 1:20	Vert. Scale: As Noted
Unit Leader Initials	

Sheet Revisions		
Date:	Comments	Init.

Colorado Department of Transportation
 714 Grand Avenue, P.O. Box 298
 Eagle, CO 81631
 Phone: 970-328-6385 FAX: 970-328-2368
 Region 3 MLM

As Constructed
 No Revisions: 6-6-2011
 Revised:
 Void:

EDWARDS INTERCHANGE UPGRADE
 CLASS III SIGN
 CROSS SECTIONS
 Designer: KMH
 Detailer: KMH
 Sheet Subset: S. DET
 Structure Numbers
 Subset Sheets: SD-21 of 21

Project No./Code
 ES3 0702-297
 17303
 Sheet Number 268