

November 19, 1956

90

COLORADO DEPARTMENT OF HIGHWAYS
SPECIAL PROVISIONS
 FOR
COLORADO PROJECT NO. F 005-3(9) UNIT 1
IDAHO SPRINGS - EAST & WEST

As Constructed

The following special provisions take precedence over all conflicting details in Specifications or on plans, and supplement the Standard Specifications adopted by the Department on June 1, 1952, together with Standard Special Provisions "Application (October 12, 1954)," "Employment Lists; Labor Selection; Nondiscrimination (October 12, 1954)," "Classification of Employees (October 12, 1954)," "Payment of Predetermined Minimum Wages (October 12, 1954)," "Affidavits and Payrolls (October 12, 1954)," "Record of Materials and Supplies (October 12, 1954)," "Subletting or Assigning the Contract (October 12, 1954)," "Adjustments for Changes in Common Carrier Rates (July 22, 1948)," "Statement of Materials and Employment, PR 47 (October 12, 1954)," "Instructions for Preparing Revised Form PR 47 (October 12, 1954)," "General (March 28, 1947)," "Compensation Insurance (March 28, 1947)," "3% Transportation Tax Exemption (June 17, 1952)," and "Emergency Cancellation of Contract (June 17, 1952)."

I N D E X

<u>Index Page</u>	<u>Page</u>
Minimum Wages (Third District)	(November 19, 1956) 9a
Rental of Teams and Trucks	(April 17, 1941) 10
Commencement and Completion of Work and Liquidated Damages	(March 28, 1947) 11
Rev. of Item 11 - Removal of Bridges	(November 19, 1956) 12a
Item 11f - Relocate Grandstands	(August 26, 1948) 13
Item 14 - Excavation for Structures	(November 19, 1956) 14a
Source of Materials	(June 15, 1956) 15-19
Deleted	(November 19, 1956) 20a
Revision of Item 42 - Timber Bridges	21
Item 46 - Concrete	(September 10, 1954) 22
Deleted	(May 25, 1956) 23
Deleted	24-25
Deleted	26
Affidavit Relative to Collusion	27
Cooperation of Contractors	(June 7, 1955) 28
Exemption from Ton-Mile Taxes	(September 2, 1948) 29
Protection of Utilities	(April 26, 1955) 30
Provisions for Traffic During Construction	(December 8, 1949) 31
Construction Across National Forest Land (Requirements for Forest Use Permit)	(July 17, 1950) 32
Sales Tax Refund on Construction Materials	(September 10, 1952) 33
Contractor's Certificate (Form DR-513)	(June 25, 1956) 34
Disposal of Oil Processed Surfacing	35
	(March 13, 1953) 36

MINIMUM WAGES

(Third District)

The minimum wage paid to all Skilled Labor employed on this contract shall be One Dollar and Ten Cents (\$1.10) per hour.

The minimum wage paid to all Intermediate Labor employed on this contract shall be Seventy Cents (\$0.70) per hour.

The minimum wage paid to all Unskilled Labor employed on this contract shall be Fifty Cents (\$0.50) per hour.

March 28, 1947

RENTAL OF TEAMS AND TRUCKS

The minimum rental for hired teams employed on this contract shall be twenty (20) cents per hour per head. The minimum rental shall include harness and double-trees, but shall be exclusive of all other equipment furnished for the work.

The minimum rental for hired trucks of not more than one and one-half ($1\frac{1}{2}$) tons rated capacity, trucks to be in good condition and equipped with dump bodies, shall be seventy-five (75) cents per hour. The proposed minimum rental rate for hired trucks of more than one and one-half ($1\frac{1}{2}$) tons rated capacity must be submitted by the Contractor to the Department for consideration at the time contract is awarded.

Suitable local teams shall be used insofar as available.

November 19, 1956

12 w

COMMENCEMENT AND COMPLETION OF WORK
AND LIQUIDATED DAMAGES FOR
COLORADO PROJECT NO. F 005-3(9) UNIT 1

The Contractor on this project shall commence work under his contract on or before the tenth (10th) day following the date of the contract unless such time for beginning the work shall be changed by the Chief Engineer, and shall fully complete all work thereunder within One Hundred Eighty (180) calendar days from and including the date of contract, or from and including such later date as may be designated in writing by the Engineer.

The amount of liquidated damages to be paid as provided in Paragraph 8.7, "Failure to Complete Work on Time" of the Specifications shall be \$50.00 per day.

August 26, 1948

REV. OF ITEM 11
REMOVAL OF BRIDGES

This item shall conform to the requirements of Item 11 of the Standard Specifications except for the following modifications:

Steel trusses shall be dismantled at original field connections where possible. In no case shall the removed sections consist of more than two (2) panels of any one truss.

All costs incidental to the foregoing requirements shall be included in the original contract prices for the project.

November 19, 1956

14 a

ITEM 11f

RELOCATE GRANDSTANDS

COLORADO PROJECT NO. F 005-3(9) UNIT 1

DESCRIPTION AND REQUIREMENTS:

The grandstands noted on the plans, Sta. 116+, to be relocated shall be carefully removed and restored for service at new location as shown on plans and as staked by the Engineer. This work shall be done carefully and all damage, due to removing operations, shall be repaired by the Contractor at his expense.

Unserviceable material shall be replaced with new material of similar dimensions and quality as in the present structure.

BASIS OF PAYMENT:

This item completed in accordance with the foregoing, will be paid for at the contract lump sum price for "Relocate Grandstands," complete in place, which price and payment shall be full compensation for all repairs, new materials, hauling, labor, tools, equipment, supplies, and work incidental thereto.

ITEM 14EXCAVATION FOR STRUCTURES14.1 DESCRIPTION:

14.1.1 Excavation for structures shall consist of the excavation and removal of all material of whatever nature encountered, necessary for the construction of foundations and substructures of the structures listed on the Plans. It shall include the construction complete in place of all temporary cribs, cofferdams, caissons, etc., which may be necessary for the execution of the work. It shall also include the subsequent removal of the cofferdams and cribs and the disposal of the surplus excavation materials in the roadway embankments or as directed by the Engineer.

14.1.2 The removal of old structures is not included herein, but is covered by Item 11 of these Specifications.

14.1.3 The elevation of the bottom of footings as shown on the Plans shall be considered as approximate only and the Engineer may order in writing such changes in dimensions or elevations of footings as may be necessary to secure a satisfactory foundation.

14.2 CLASSIFICATION:

14.2.1 Excavation for structures shall be classified as "Rock Excavation (Str.)," "Common Excavation (Str.," and "Unclassified Structural Excavation." The distinction between "Rock" and "Common" shall be as prescribed in classification for "Roadway and Drainage Excavation," Paragraph 13.2. All excavation classified as "Unclassified Structural Excavation," on the Plans, will remain under that classification in all cases.

14.2.2 Excavation for culverts shall be as required under Item 45 of these Specifications. Where portions of culverts are not bedded in the original ground, excavation for structures shall be measured and paid for in embankment material. Embankments shall be built up and thoroughly compacted to a point one-half (1/2) the diameter above the proposed flow line of the pipe and the trench for the pipe shall then be excavated through the constructed embankment. The embankment shall be constructed in accordance with Item 15 of the Specifications.

14.3 CONSTRUCTION METHODS:

14.3.1 Foundations shall be excavated according to the outline of the footings as shown on the Plans or as established by the Engineer and shall be of sufficient size to permit the placing of the footings with full horizontal bed.

14.3.2 Excavation in rock or other hard foundation material shall be cut to a firm surface, either level, stepped, or serrated, cleaned of all loose material, and all seams shall be cleaned out and filled with concrete, mortar or grout, as directed by the Engineer.

(Continued)

-2-

ITEM 14EXCAVATION FOR STRUCTURES

14.3.3 When a structure is to rest on an excavated surface other than rock, special care shall be taken not to disturb the bottom of the excavation and the final removal of the foundation material to grade shall be made just before the structure or concrete is to be placed. The final six (6) inches in depth shall be done by hand labor methods. The natural ground adjacent to the footings shall not be disturbed without the permission of the Engineer.

14.3.4 Cofferdams or cribs for foundation construction shall, in general, be carried well below the bottom of the footings and shall be well braced and as watertight as practicable. The interior dimensions of cofferdams shall be such as to give sufficient clearance for the construction of forms, thorough inspection, and to permit pumping outside of the forms. Cofferdams or cribs which become tilted or moved out of line during the process of sinking, shall be righted or enlarged so as to provide the necessary clearance.

14.3.5 When conditions are encountered, which, in the opinion of the Engineer, render it impracticable to unwater the foundation before placing concrete, he may require a concrete foundation seal of such dimensions as may be necessary to be constructed below the designed footing depth and poured under still water by tremie or other approved method. Such concrete shall be proportioned as specified under Item 46 for Class "A" Concrete with the addition of ten (10) per cent of cement above that normally used. When ordered by the Engineer, after the concrete has set sufficiently, the cofferdam shall be pumped out for purposes of inspection. When weighted cribs are employed and the weight is utilized to partially overcome the hydrostatic pressure acting against the bottom of the foundation seal, special anchorage, such as dowels or keys, shall be provided to transfer the entire weight of the crib into the foundation seal. When a foundation seal is placed under water, the cofferdam shall be vented or ported at low water level.

14.3.6 Cofferdams shall be constructed so as to protect green concrete against damage from a sudden rising of the stream and to prevent damage to the foundation by erosion. No timber or bracing shall be left in the cofferdams or cribs in such a way as to extend into the substructure without written permission from the Engineer.

14.3.7 Unless otherwise provided, cofferdams and cribs, with all sheeting and bracing, shall be removed by the Contractor after the completion of the substructure, in such a manner as not to disturb or mar the finished structure.

14.3.8 Pumping from the interior of any foundation enclosure shall be done in such manner as to preclude the possibility of any portion of the concrete materials being carried away. No pumping will be permitted during the placing of concrete, or for a period of at least twenty-four (24) hours thereafter, unless it be done from a suitable sump separated from the concrete work by a watertight wall.

14.3.9 After each excavation is completed, the Contractor shall notify the Engineer, and no concrete or other materials shall be placed until after the Engineer has approved the depth of the excavation and the character of the foundation material.

(Continued)

-3-

ITEM 14EXCAVATION FOR STRUCTURES

14.3.10 When unsatisfactory foundation material is encountered in the excavation for culvert pipes, siphons, concrete box or slab culverts, the foundation material shall be excavated a minimum of six (6) inches below grade and backfilled with "Structure Backfill" material, as described under Item 16 and as designated on Plans or as directed by the Engineer.

14.3.11 Where the Contractor, for his own convenience, excavates beyond the limits required for structural excavation, the excess excavation and the backfill thereof shall be at the Contractor's expense.

14.3.12 Backfilling around culverts, siphons, abutments, wing walls, piers and areas inaccessible to rollers shall be compacted by mechanical tamping devices or other approved means as provided under Item 16 of the Specifications. Fill around structures shall be deposited on both sides to approximately the same elevation at the same time and compacted to a density satisfactory to the Engineer.

14.3.13 Special precautions shall be taken to prevent any wedging action against a structure and the slope bounding the excavation for bridge abutments and wing walls shall be destroyed by stepping or serrating to prevent wedge action.

14.3.14 "Structure Backfill" material and placement thereof, together with any required mechanical tamping shall be as described under Item 16.

14.4 METHOD OF MEASUREMENT:

14.4.1 The total yardage of structural excavation to be paid for under this item shall be the volume in cubic yards as calculated in accordance with the following:

1. Circular and box culverts, siphons, side drains and other pipes.

A profile will be made along center line of the structure to extend one (1) foot beyond either end of structure. End of structure, as used, is defined to include wing walls, metal aprons, concrete end sections and headwalls. The area between original ground and the bottom of trench as excavated between limits of this profile will then be determined. The volume of structural excavation will then be calculated by multiplying this area by the dimension of the outside diameter of circular structures or the outside width of box structures, measured in feet, plus two (2) feet.

Division boxes, diversion boxes, and other miscellaneous structures shall be handled in the manner proposed for box culverts by establishing the center line through the long axis of the structure and running the profile to a point one (1) foot outside the neat line of the structure. The balance of the computation would then be handled as prescribed for a box culvert.

(Continued)

- 4 -

ITEM 14
EXCAVATION FOR STRUCTURES

2. Bridges.

The quantity of structural excavation for bridges will not be measured, but will be the quantities shown on Plans. Exception will be when changes are ordered in accordance with Paragraph 14.1.3. When changes are ordered by the Engineer, volume will be measured and added to or subtracted from plan quantities.

14.4.2 The depth of excavation for structures, where roadway cross-section is in fill, shall be between the bottom of the footings as excavated and the original ground surfaced as profiled by the Engineer. The depth of excavation for structures where the roadway cross-section is in cut, or where channel changes or channel improvements are indicated, shall be between the bottom of the footings as excavated, and the typical cross-section of the cut, channel change or channel improvement, as though the excavation for the cut, channel change or channel improvement had been completed. The volume of yardage included within the roadway cross-section and cross-sections of channel changes or channel improvements shall be measured and paid for as provided under Item 13, "Roadway and Drainage Excavation."

14.4.3 Trenches for underdrains of all types, and trenches required for installation of multiple plate culverts shall be measured to neat lines indicated by details on Plans or required by Specifications for the respective items.

14.4.4 In case portions of old bridge substructures coincide with structural excavation prisms as outlined herein, the substructure material removed within this prism to a point three (3) feet below the ground line or stream bed at that point shall be paid for as provided under Item 11, "Removal of Bridges, Structures and Obstructions" of the Specifications. Substructure material occurring within the said structural excavation prisms below this three (3) foot depth, shall be paid for as structural excavation. The yardage of structural excavation so calculated, completed and accepted, will be included in the measurement and no other allowance for measurement of removed structures nor of cofferdams or caissons shall be included.

14.4.5 In the event that it is found necessary to carry any of the footings more than three (3) feet below the depths shown on the Plans, the excavation down to an elevation three (3) feet below that shown on the original Plans shall be performed at the original prices bid, as provided above; material excavated more than three (3) feet below the original elevation shown on the Plans, shall be paid for under supplemental agreement as Extra Work as provided in Paragraph 4.5.

(Continued)

-5-

ITEM 14EXCAVATION FOR STRUCTURES14.5 BASIS OF PAYMENT:

The yardage of excavation for structures determined and classified as provided above shall be paid for at the contract unit prices per cubic yard for "Rock Excavation (Str.)," "Common Excavation (Str.)," or "Unclassified Structural Excavation," as the case may be, which prices and payments shall be full compensation for the excavation, removal and disposal of all materials and obstructions encountered, for the construction of cribs, cofferdams, and caissons, for pumping, for all grout and mortar used in filling seams in foundations, and for the removal of cofferdams and temporary cribs, except bridge substructures above three (3) foot depth which will be paid for under Item 11 of the Specifications, and for all labor, equipment, tools and incidentals necessary to complete the item. Concrete used in concrete seals as ordered in writing by the Engineer shall be paid for as specified under Item 46. Structure Backfill together with incidental mechanical tamping will be paid for in accordance with Item 16 of the Specifications.

November 19, 1956

20 22

SOURCE OF MATERIALS

COLORADO PROJECT NO. F 005-3(9) UNIT 1

The Department estimates that Structure Backfill for this project is available from the channel changes located within the Right of Way.

The material is available at no cost to the Contractor.

The amount of materials required is subject to change by the Engineer to meet requirements encountered during construction.

If other agreements are reached for material, the Contractor shall make his own arrangements with the property owners for the use of such material and payment therefor, all such payments being made by the Contractor directly to the owner.

All sources are to be excavated and backsloped uniformly and left in a neat, leveled condition.

All material taken from roadway cuts and paid for as Structure Backfill will be excluded from payment as "Unclassified Excavation."

Written approval based on tests by the Materials Engineer must be secured from the Engineer before materials may be used from sources other than those designated on plans.

Any temporary bridges or approach roads required to haul material from channel changes to the roadway shall be constructed by the Contractor at his expense.

The cost of the foregoing requirements shall be included in the original contract unit prices for the project.

DELETED

September 10, 1954

22

REVISION OF ITEM 42
TIMBER BRIDGES

This Item shall conform to the requirements of Item 42 of the Standard Specifications except for the following:

Paragraph 42.2.9 is revised to the following:

42.2.9 All timber furnished under these specifications, except when inspection is arranged for by the Engineer, shall be covered by a certificate of inspection issued by the West Coast Lumbermen's Association, Pacific Lumbermen's Inspection Bureau, Southern Pine Association, or by any other inspection agency approved by the Engineer. Each piece so inspected shall be marked with a mark indicating such inspection, and the destination of material or job for which it is intended shall be clearly shown on said certificate.

All costs incidental to the above requirements shall be included in the contract unit price bid for Item 42.

ITEM 46 - CONCRETE

This item shall conform to the requirements of Item 46 of Standard Specifications and shall include the following:

46.2.7 Air-entrained Concrete:

46.2.7.2 When the Contractor plans to furnish air-entraining admixtures which have been previously approved by the Department, he will be required to furnish two (2) copies of a certificate to the Engineer stating the material proposed for use on the project is identical to that previously furnished.

46.2.7.3 For air-entraining admixtures which have not been previously approved by the Department, the Contractor will be required to furnish two (2) copies of a certificate to the Engineer from a recognized laboratory stating that the material proposed for use on the project is in conformity with the requirements of A.A.S.H.O. Specification M-154.

46.2.7.4 A "recognized" laboratory is any State Highway, Bureau of Public Roads, or cement and concrete laboratory regularly inspected by the Cement Reference Laboratory of the National Bureau of Standards.

46.2.10 Retarding Agent:

46.2.10.1 The Contractor will be permitted to use an approved retarding agent in bridge deck concrete. Purpose of retarding agent is to retain workability of concrete for a longer period of time, which may aid finishing operations.

46.3.10.6 The following shall be added to Paragraph 46.3.10.6:

"Unless otherwise specified on plans, ordinary surface finish shall be applied to all exposed surfaces of concrete arch and box culverts, headwalls, inlet boxes, paving drains and irrigation structures."

All costs incidental to the foregoing requirements shall be included in the original contract unit price for Item 46.

DELETED

DELETED

DELETED

DELETED

June 7, 1955

AFFIDAVIT RELATIVE TO COLLUSION

The Contractor on this project will be required to conform with the requirements of Section 17(b) of the 1954 Federal Highway Act regarding contracts and as described in the paragraph below.

"Section 17(b) of the Federal-Aid Highway Act of 1954 requires as a condition precedent to approval by the Commissioner of Public Roads of the contract for this work that the Contractor file a sworn statement executed by, or on behalf of, the person, firm, association, or corporation to whom such contract is to be awarded, certifying that such person, firm, association or corporation has not, either directly or indirectly, entered into any agreement, participated in any collusion, or otherwise taken any action in restraint of free competitive bidding in connection with such contract. This sworn statement shall be in the form of an affidavit executed and sworn to by the successful bidder before such persons as are authorized by the laws of the State to administer oaths. The original of such sworn statement shall be filed with the State Highway Department prior to the award of the contract."

Affidavit forms are available from this Department.

September 2, 1948

COOPERATION OF CONTRACTORS

The attention of the Contractor is invited to the fact that the Department anticipates construction activities adjacent to and within the limits of this project in addition to the work under this contract. The Contractor for this project will be required to arrange his work so that no delay to other construction work within the limits of the project will result. The Contractor will at all times be required to cooperate with other construction agencies in the moving of their equipment over or around this project.

All cost incidental to these conditions shall be included in the original contract unit prices for this project.

April 26, 1955

EXEMPTION FROM TON-MILE TAXES

Publicly owned vehicles and Contractor's vehicles operating within the confines of construction projects are exempted from the payment of ton-mile taxes under Senate Bill 213 of the Fortieth General Assembly in its First Regular Session.

The confines of this project as exempted under Senate Bill 213 are defined as including all sources of earthen or mineral aggregates and water for use on this project, and the connecting roads or areas between the project and such sources.

PROTECTION OF UTILITIES

The Contractor's attention is directed to the fact that utilities encroach on the construction of this project, and also to the importance of protecting all public utilities encountered on this project. These may include telephone, telegraph and power lines, water line, sewer lines, gas lines, railroad tracks, and other overhead and underground utilities.

Before any excavation is begun in the vicinity of water lines, railroad tracks or structures, sewer lines, gas lines or telephone conduits, each utility company concerned must be notified in advance of such excavation, and such excavation shall not be made until an authorized representative of the utility company concerned is on the ground.

The Contractor shall be held liable for all damages to any and all public utilities encountered on the project, which damages are due to the Contractor's operations. Such damages shall include all physical damages to utilities and also all damages due to interruption of service of such utilities, when such damages and interruptions are caused by Contractor's operations.

Where alterations or moving of utilities is not required to permit construction of new highway improvement, the Contractor shall take such measure as the Engineer may direct in properly protecting these utilities throughout his construction operations and shall cooperate at all times with the proper authorities and/or owners in maintaining service of railroads, conduits, pole lines, transmission lines, pipe lines, sewers, etc., affected by this project.

The cost of damages due to Contractor's operation or cost of protecting utilities where alteration or moving is not required to permit construction of highway improvement shall be included in the original contract prices for the project.

Should any pipe line, water lines or gas mains, electrical conduits, sewer pipes, overhead wiring, telephone lines, telegraph lines, power lines, or any other such utilities, not specifically mentioned and provided for elsewhere as a part of this contract, have to be moved, repaired, reconditioned or revised due to the road construction or moved temporarily to permit construction of project, the party or parties owning or operating such utilities shall perform the actual work of moving, repairing, reconditioning, or revising such utilities. The cost of this work shall be borne by the utility companies involved, unless other agreements are reached with the Department.

July 17, 1950

PROVISIONS FOR TRAFFIC DURING CONSTRUCTION

The detour for this project lies along the present traveled road except where detours are designated on plans. At all places on the project where the new work lies along the present traveled road, the Contractor shall, at his own expense, prosecute construction in such manner that traffic may readily pass over the road. Also, the Contractor shall maintain in safe condition and at his own expense all temporary approaches to and crossings of intersecting roads.

Where designated on plans, traffic will be served by detour roadways in accordance with plan details. Through traffic will be required to use these detours throughout construction. The Contractor will be required to cooperate with the Department in order that the highway will not be closed to local traffic. Local traffic shall be adequately provided for at the Contractor's expense.

During and after surfacing operations, weather conditions and traffic may require wetting and rolling to conserve the fine material, preserve the evenness of the surface and abate the dust nuisance and traffic hazard. The Contractor will be required to do this wetting and rolling as ordered by the Engineer, all such work being paid for at the contract prices for the items involved.

Before proceeding with construction, the Contractor must obtain from the Engineer written approval of the proposed methods of handling traffic during Construction.

CONSTRUCTION ACROSS NATIONAL FOREST LAND
(REQUIREMENTS OF FOREST USE PERMIT)

In all places where this project traverses National Forest Land, the Contractor shall do his work in accordance with the following requirements:

1. Trees or shrubbery on National Forest Land may be removed or destroyed only after the forest officer in charge has approved, and had marked or otherwise designated that which may be removed or destroyed. Merchantable timber cut must be paid for by the Contractor. Trees, shrubs and other plants may be planted in such manner and in such places about the premises as may be approved by the forest officer in charge.
2. The Contractor shall maintain the improvements and premises to standard of repair, orderliness, neatness, sanitation and safety acceptable to the forest officer in charge.
3. The Contractor shall comply with the regulations of the Department of Agriculture and all Federal, State, County, and municipal laws, ordinances, or regulations which are applicable to the area.
4. The Contractor shall take all reasonable precautions to prevent and suppress forest fires. No material shall be disposed of by burning in open fires during the closed season established by law or regulation without a written permit from the forest officer in charge or his authorized agent.
5. The Contractor shall fully repair all damage, other than ordinary wear and tear, to national forest roads and trails caused by construction operations in the exercise of the privilege granted by Forest Use Permit.
6. The Contractor shall take all reasonable precautions to avoid damage to property and resources of the United States, and diligently to undertake suppression action in the event of fire resulting from the exercise of the privileges herein granted.
7. Any Forest Service improvements, such as entrance portals, fences, camp ground or picnic units, barriers, etc., if disturbed, will be replaced at no expense to the Forest Service.
8. The Contractor shall not discriminate against any employee or applicant for employment because of race, creed, color, or national origin, and shall include in all subcontracts a provision imposing a like obligation on subcontractors.
9. All use of construction equipment will be confined to the clearing or right of way, unless otherwise agreed to by the Forest Supervisor or his representative.
10. All material pits will have the top soil stripped off at the beginning of the work, and replaced and spread over the bared area at its conclusion.
11. The temporary use and occupancy of the premises and improvements herein described may not be sublet by the Contractor to third parties without the prior written approval of the forest supervisor and the Contractor shall continue to be responsible for compliance with all conditions of Forest Use Permit by persons to whom such premises may be sublet.
12. None of the conditions of Forest Use Permit as set forth herein can be varied or modified, except with the written consent of the Forest Supervisor.
13. All costs incidental to the foregoing requirements shall be included in the original contract unit prices for the project.

June 25, 1956

SALES TAX REFUND ON CONSTRUCTION MATERIALS

Pursuant to the law and regulations of the Department of Revenue, it is the policy of the Department of Highways to make claim for refund of all State sales and use taxes paid on materials purchased for and incorporated in highways and structures constructed under this contract.

Claim will be made for sales and use taxes paid on the following materials which are incorporated in this project:

- Structural and Reinforcing Steel
- Bituminous Materials
- Cement
- Premixed Concrete
- Culvert and Underdrain Pipe
- Lumber
- Piling
- Fencing
- Commercial Aggregates
- Cribbing
- Guard Fence
- Manholes (Rings, Covers, Etc.)
- Gratings and Frames
- All other materials not listed above, actually incorporated in the completed work.

The Contractor or his sub-contractors will be required to file with the Engineer upon completion of this project, if completion time allowed under this contract is 300 calendar days or less, a certificate (Form DR-513), as attached hereto, stating that he has paid State sales and use taxes on tangible property built into the road and structures under this contract. If the completion time allowed under this contract is in excess of 300 calendar days, the Contractor or his sub-contractors will be required to file appropriate DR-513 Forms with the Engineer at nine (9) month intervals during the course of the contract.

Additional copies of Form DR-513 are available from the Resident Engineer, District Offices and the Denver Headquarters Office.

March 13, 1953

DISPOSAL OF OIL PROCESSED SURFACING

The present oil processed surfacing in proposed construction areas lying below the elevation of the base of proposed surfacing course shall be thoroughly plowed, broken up and mixed with an equal thickness of the underlying soil. This material shall then be consolidated in accordance with the specifications for Embankments. Where the present oil processed surfacing lies above the elevation of the base of proposed surfacing course, the oil processing shall be thoroughly plowed and broken up, and removed to embankment areas to be consolidated with other embankment materials. All oil processed surfacing shall be broken into pieces with a maximum dimension of six (6) inches.

Consolidation of oil processed surfacing shall be in conformity with requirements of Items 13, 15 and 17 of the Standard Specifications.

The cost of plowing, breaking and mixing of oil processed material with underlying soil will not be paid for as a separate item but shall be considered as subsidiary work pertaining to construction of subgrade, and shall be included in the original contract prices for the project.

Wetting and compaction required after completion of the plowing, breaking and mixing of oil processed surfacing will be paid for as provided under Item 17 of the Standard Specifications.


Rev 11-19-56 T.M.C.
Rev 3-11-57 H.E.P.

FEDERAL ROAD DIVISION NO.	DISTRICT	PROJ NO	SHEET NO	TOTAL SHEETS
9	COLORADO	F 005-3(9)	1	

COLORADO DEPARTMENT OF HIGHWAYS

PLAN AND PROFILE OF PROPOSED *As Const.* FEDERAL AID PROJECT NO. F 005-3(9) UNIT NO. 1 STATE HIGHWAY NO. 2 CLEAR CREEK COUNTY *AS CONST.*

CONVENTIONAL SIGNS

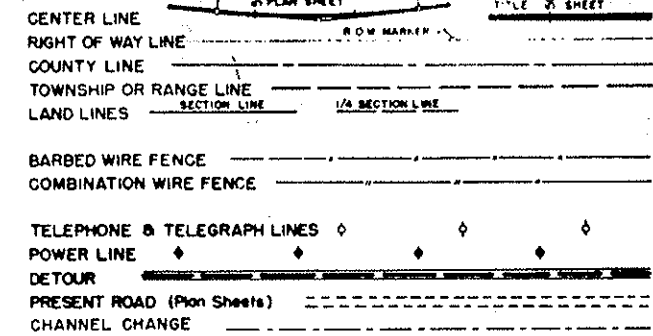

File 167

INDEX OF SHEETS

- NO. 1. SKETCH MAP AND TITLE SHEET, TABULATION OF LENGTH AND GENERAL NOTES.
- 2. SUMMARY OF APPROXIMATE QUANTITIES.
- 3-19. DELETED ON UNIT NO. 1
- 20-28. DETAILS OF UNDERPASS, STA. 13+ ON EAST END CONNECTION.
- 29-31. DETAILS OF BRIDGE, STA. 146+.
- 32-36. DELETED ON UNIT NO. 1
- 37-47. DETAILS OF DOUBLE BRIDGE, STA. 58+.
- 48-51. DELETED ON UNIT NO. 1
- 52. STANDARD METHODS FOR SUPERELEVATION & WIDENING OF CURVES. M-1-C
- 53. STANDARD MARKER POSTS & BENCH MARKS. M-7-C
- 54. STANDARD LETTERS & FIGURES FOR YEAR NUMBERS & STRUCTURE NUMBERS. M-10-B
- 55. DELETED ON UNIT NO. 1
- 56-57. STANDARD ROADWAY CONSTRUCTION TRAFFIC SIGNS. M-29-B
- 58. DELETED ON UNIT NO. 1
- 73-74. ALIGNMENT PLAN AND PROFILE
- 75. SUMMARY OF EARTHWORK QUANTITIES.
- 91-93. CROSS SECTIONS (STRUCTURE APPROACHES).
- 94-103. DELETED ON UNIT NO. 1
- 104. CROSS SECTIONS (FOOTBALL FIELD).
- 74 A. DETAILS OF FOOTBALL FIELD.
- 1A. TYPICAL SECTION OF IMPROVEMENT & LIST OF STRUCTURES. M-1-C1
- 52 A. STANDARD METHODS FOR SUPERELEVATING CURVES ON DIVIDED HIGHWAYS.
- 71-72. DELETED ON UNIT NO. 1
- 76-90. DELETED ON UNIT NO. 1

SCALES OF ORIGINAL DRAWINGS

ON PLAN. 1 IN. = 100 FT.
ON PROFILE. 1 IN. = 50 FT. HORIZONTAL
1 IN. = 10 & 5 FT. VERTICAL
GRADE LINE ON PROFILE IS SHOWN AS GRADE OF FINISHED ROAD
GROSS LENGTH OF PROJECT 15,117.7 FT. = 2.863 MI
NET LENGTH OF PROJECT 364.7 FT. = 0.069 MI


NOTE:

All reference to Project No. should read F 005-3(9), UNIT NO. 1

R.C. Hopper, Resident Engineer 1956-57
James B. Kenney, Inc., Contractor

TABULATION OF LENGTH

STATION	TYPE STRUCT. & STRUCT. NO.	STRUCTURE LENGTH		NO WORK SECTION	
		OUTSIDE CITY	INSIDE CITY	OUTSIDE CITY	INSIDE CITY
0+00 Beg F005-3(9) opposite 445+15 on FAP 181-F				516.5'	
+16.5	DOUBLE OVERPASS F-14-H			163.2'	
+79.7				73.5'	
+53.2 Bk. = EQUATION +23.6 Ah.				137.3'	
+60.9 City Limits				789.1'	
+50 City Limits				2595.0'	
+45 City Limits				42.5'	
+87.5 Bk. = 39+95.3 Ah. EQ +30.4	DOUBLE BRIDGE F-14-N		211.7'	1835.1'	
+42.1 Clear Creek				404.9'	
+47.0 Soda Creek	DOUBLE OVERPASS F-14-X			123.7'	
+70.7				892.3'	
+63.0 City Limits				1262.0'	
+25.0 City Limits				1273.9'	
+98.9 City Limits				4619.1'	
+18.0 Bk. = EQUATION +07.1 Ah.				24.9'	
+32.0 Clear Creek	SINGLE BRIDGE F-15-A1	153.0'			
+85.0					
+85.0 End F005-3(9) = opposite 141+99.9 on FAP 181-E					
TOTAL		153.0	211.7	9391.5	5361.5
SUMMARY				LIN. FT.	MILES
STRUCTURES OUTSIDE CITY				153.0	0.029
STRUCTURES INSIDE CITY				211.7	0.040
NET LENGTH				364.7	0.069
NO WORK SECTION				14753.0	2.794
GROSS LENGTH				15117.7	2.863

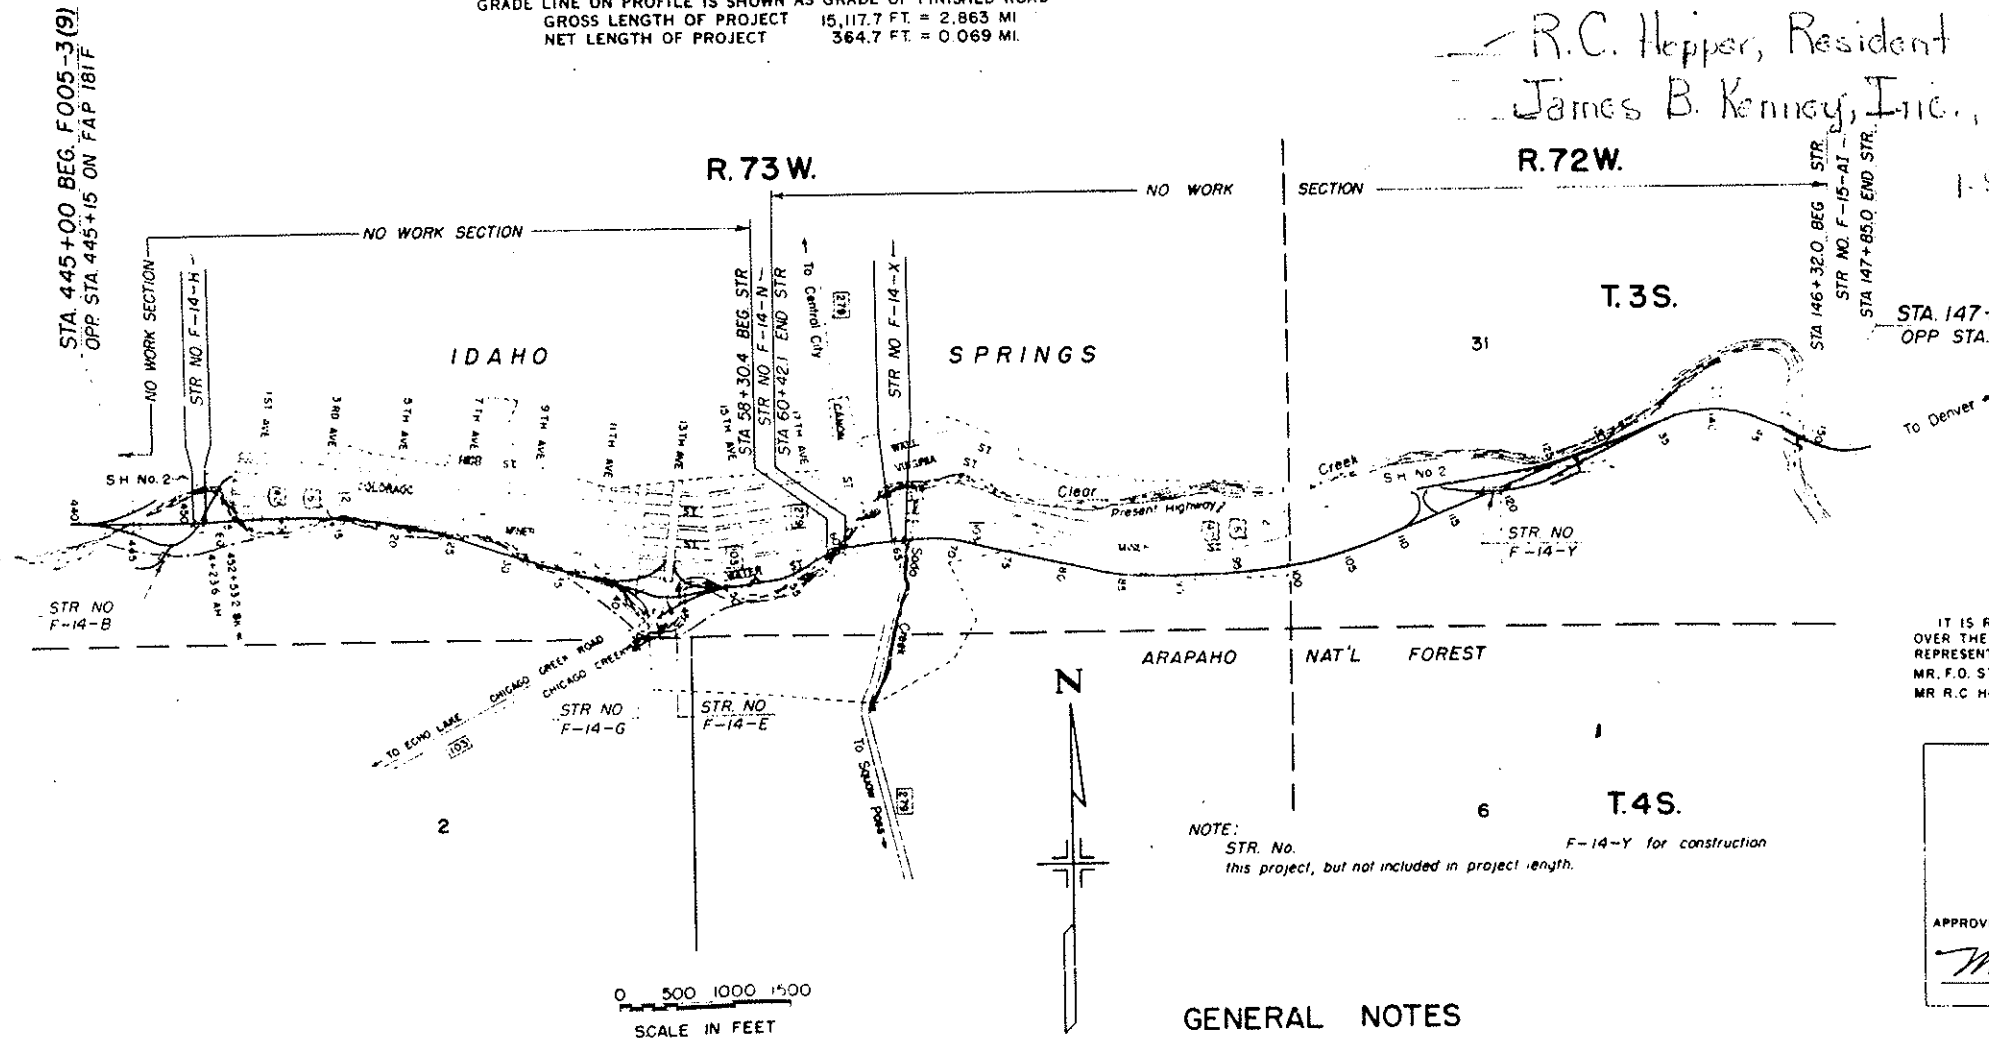

SCALE IN FEET
0 500 1000 1500

NOTE: STR. No. F-14-Y for construction this project, but not included in project length.

GENERAL NOTES

- This project is to be constructed in conformity with the Standard Specifications of the Colorado Department of Highways, adopted June 1, 1952.
- All quantities on preliminary plans are to be considered approximate only.
- All poles encroaching on construction are to be moved by the owners.
- The force account item, 'Clearing of Building Sites, including Removal of Foundations and Appurtenances,' shall include removal of all foundations, wells, backfilling of cellars, cess pools, wells, etc., to provide neat road-side conditions. It is estimated that this item applies at the following location:
Sta 58+62+.
- If excavation operations develop materials which will stand on slopes steeper than slope stake lines, the Department reserves the right to change cut slopes during the progress of such excavations.
- Excess material that may be developed during construction shall be used to fill old channel.


NOTICE TO BIDDERS
IT IS RECOMMENDED THAT BIDDERS ON THIS PROJECT GO OVER THE PLAN DETAILS WITH ONE OF THE FOLLOWING FIELD REPRESENTATIVES OF THIS DEPARTMENT.
MR. F.O. STEARNS, CONST ENGR., DENVER, COLO.
MR. R.C. HOPPER RES. ENGR., IDAHO SPRINGS, COLO.
HOME PHONE 493

COLORADO DEPARTMENT OF HIGHWAYS
APPROVED
Maud A. Williams
CHIEF ENGINEER
11-23-56
DATE

DEPARTMENT OF COMMERCE
BUREAU OF PUBLIC ROADS
APPROVED
DISTRICT ENGINEER
DATE


FEDERAL ROAD DIVISION NO.	DISTRICT	PROJ. NO.	SHEET NO.
9	COLORADO	FO05-3(9)	1A

TYPICAL CROSS SECTION OF IMPROVEMENT

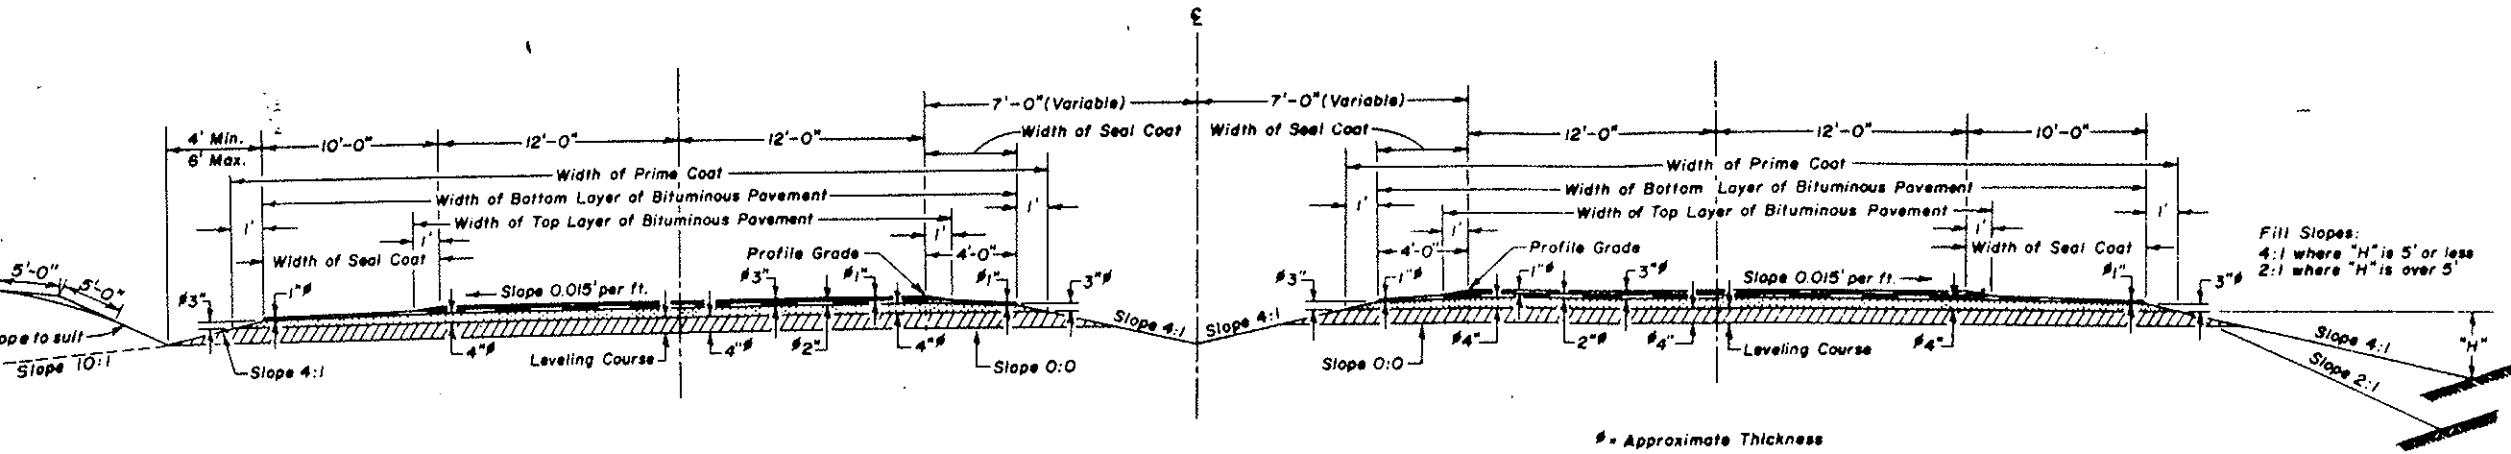

NOTE: Bottom Layer of Bituminous Surfacing shall be completed for full width before Top Layer of Bituminous Surfacing is placed. Paving joints in Top Layer will overlap min. 1 ft. over joints in Bottom Layer.

NOTE: All work above Subgrade is for Future Construction. Grade to be as required for approaches to Bridges.


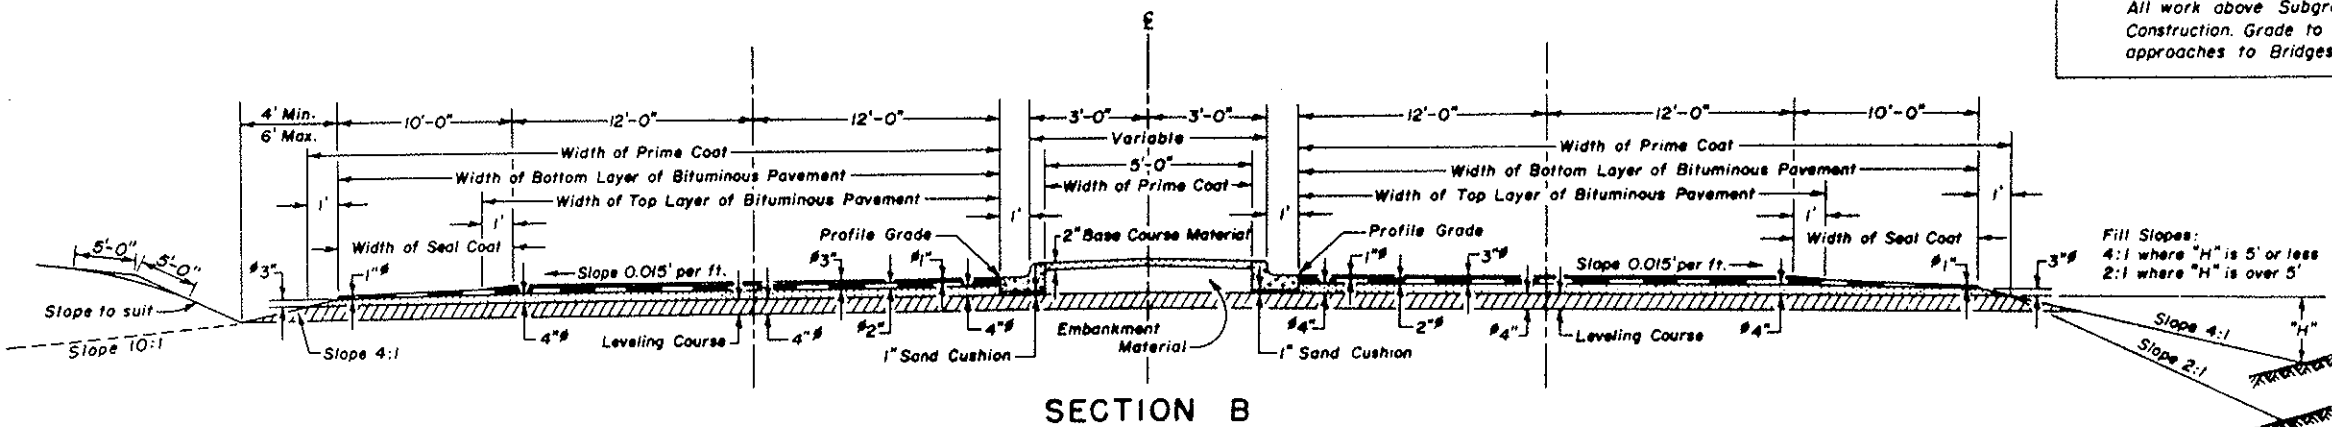


NOTE: See Standard M-2-EM for Details of Cut Slope Treatment, Flaring and Widening.

LIST OF STRUCTURES

NOTE NO.	LOCATION	DESCRIPTION	MISCELLANEOUS
*13	58+30.4 to 60+42.1	Bridge (Details on Sheet Nos. 37-47)	Quantities in Summary
*13A	59+	Remove Bridge	Remove Bridge
20	114+50 to 119+40	Remove Guard Fence Lt.	Removing 515 Lin. Ft. Guard Fence.
21	118+8.7	Underpass Structure (Details on Sheet Nos. 20-28). (Sta. 13+46.1 to 16+44.8 on East connecting line)	Quantities in Summary
22	120+00 to 121+50	Remove Fence Rt.	Removing 200 Lin. Ft. Fence.
23	146+32 to 147+85	Bridge Rt. (Details on Sheet Nos. 29-31)	Quantities in Summary
20A	114+ to 119+	Relocate Football Field & Grandstands. (Details on Sheet No. 74 A)	Relocate Grandstands
20B	115+ to 119+	Relocate Fence & Corral.	Force Acc'l - Relocate Fence & Corral.

DETAILS OF CONCRETE COMBINATION CURB AND GUTTER

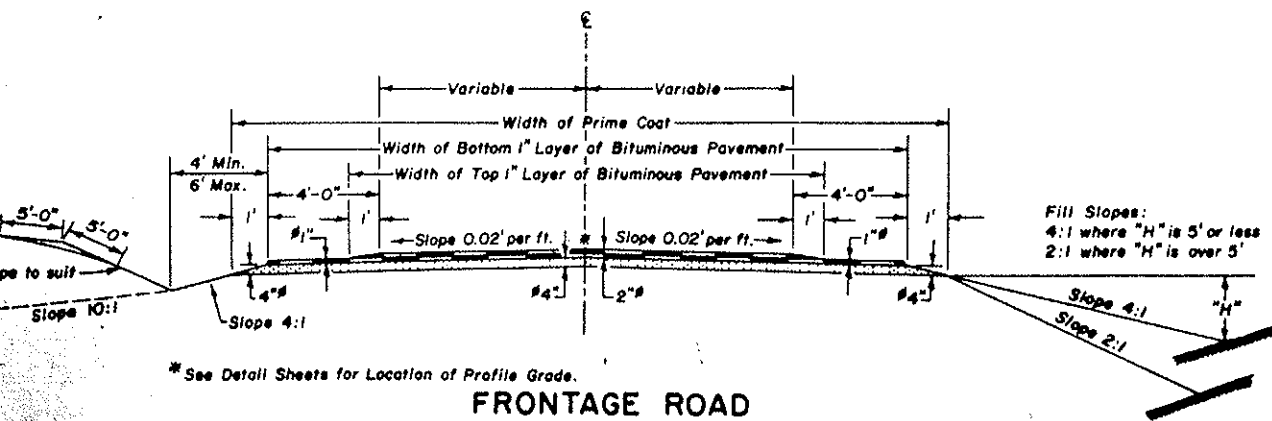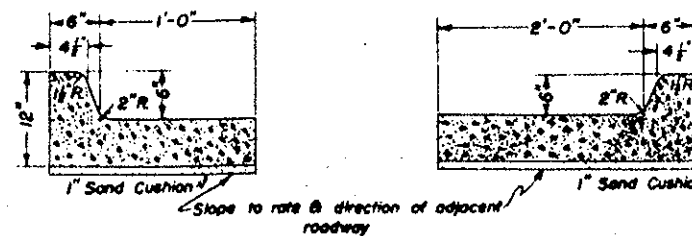


* See Detail Sheets for Location of Profile Grade.

* Inside Idaho Springs




Excavation or Borrow below 4:1 and/or 10:1 will not be permitted.

The depth and width of the side ditch shall be varied where necessary in order to provide proper drainage and/or entrance to drainage structures.

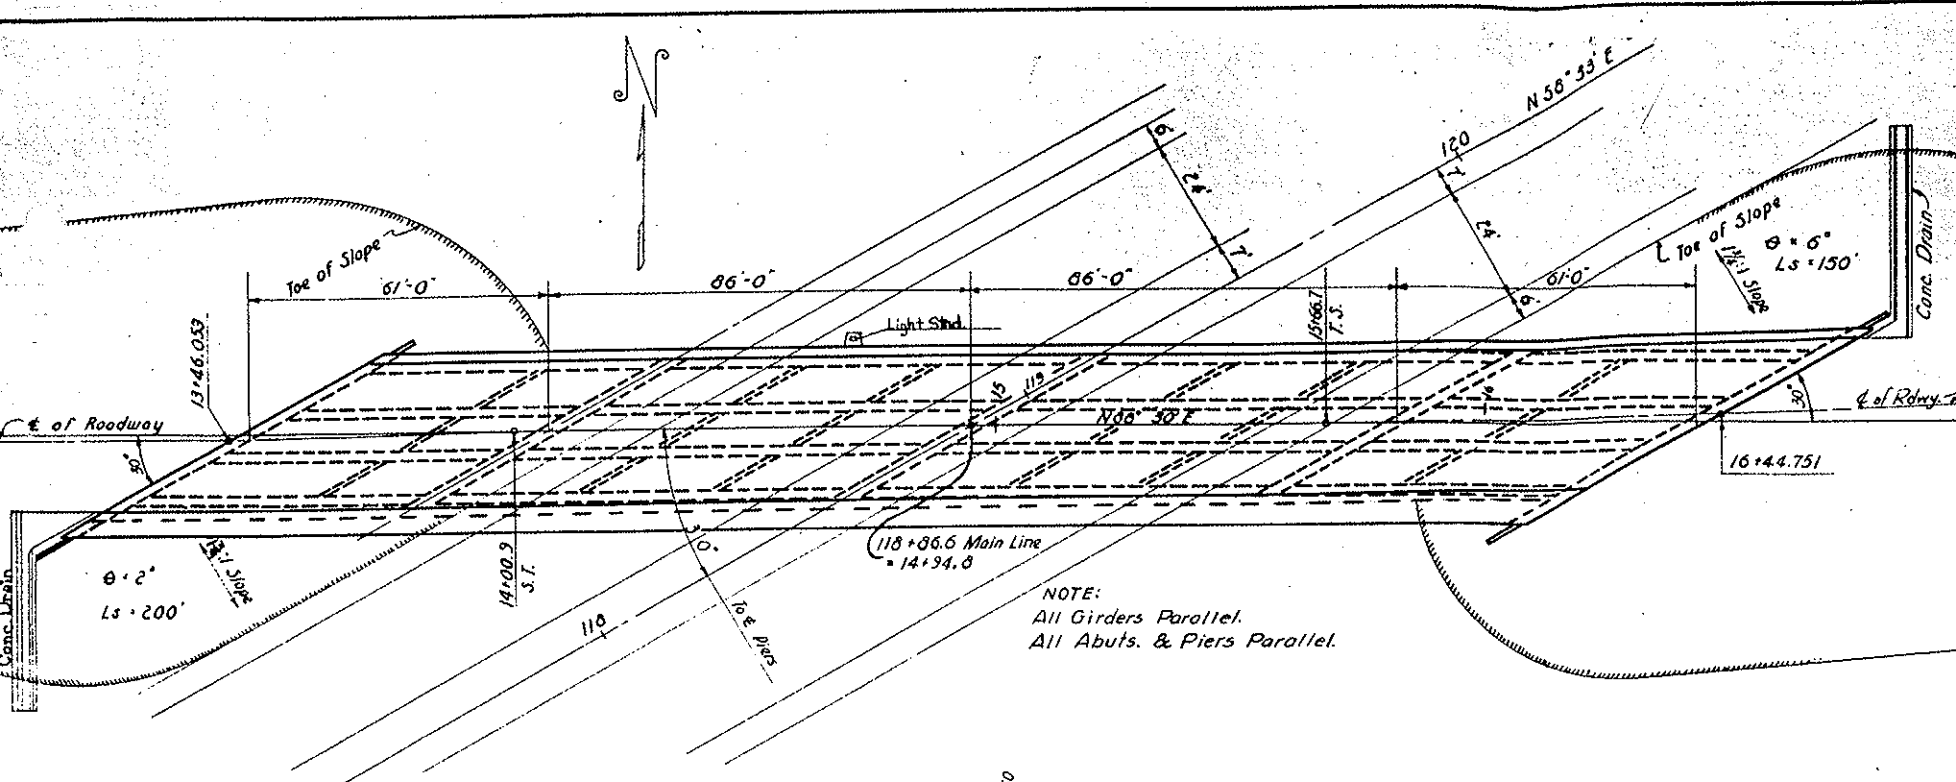

SUMMARY OF QUANTITIES									
ITEM	DESCRIPTION	UNIT	SUPERSTR.	ABUT. 1	PIER 2	PIER 3	PIER 4	ABUT. 5	TOTAL
14g	Common Excavation (Str.)	Cu.Yd.		83	111	100	78	48	420
16a	Structure Backfill (Class 1)	Cu.Yd.		66	85	75	56	35	317
16c	Mechanical Tamping	Hour		43	9	8	13	43	116
42b	Treated Bridge Timber	Mft.bm.		0.241				0.253	0.494
* 46a	Class "A" Concrete	Cu.Yd.	570	32.5	50.1	50.1	50.1	33.2	786
47	Reinforcing Steel (inc. 1% for Overrun)	Lb.	191750	7870	7850	7850	7850	7435	230165
48	Structural Steel (1/2% added for Paint)	Lb.	24400	715				715	25830
90a	1/2" Electrical Conduit with Junction Boxes	Lm.Ft.	605						605

* Includes 7cu.yd. Class "A" Concrete for Concrete drains.

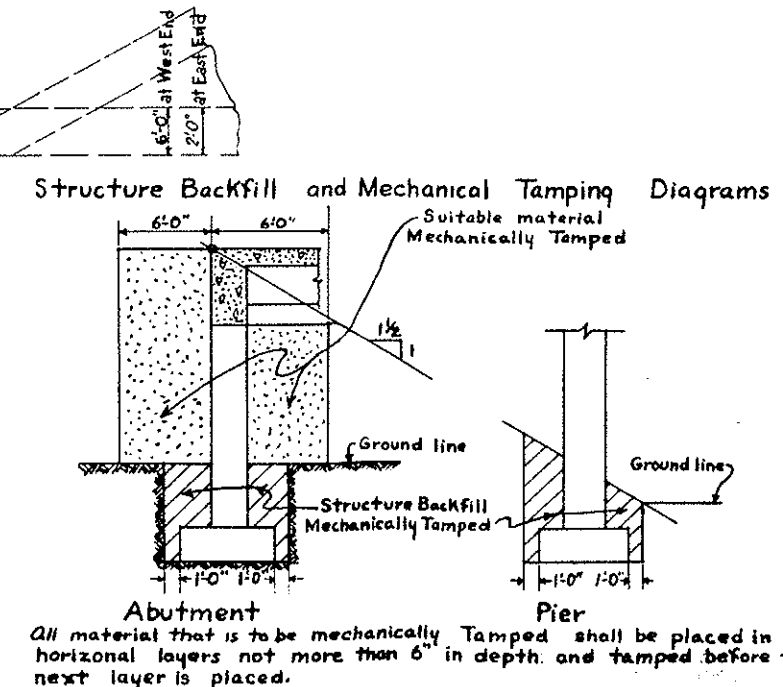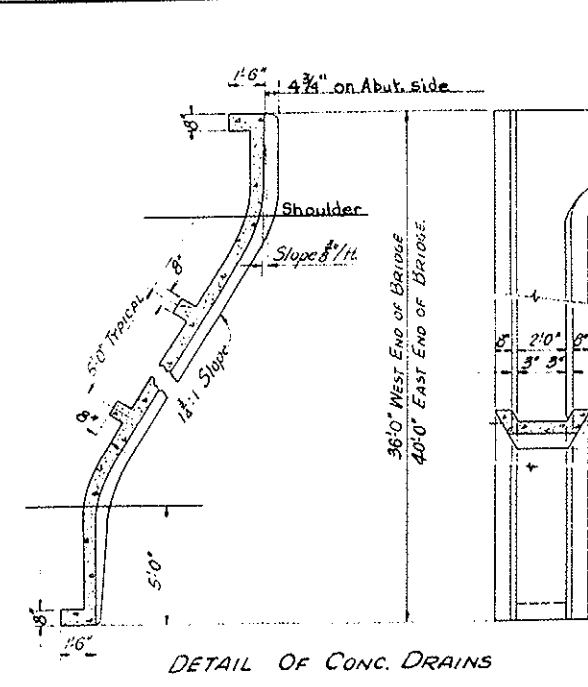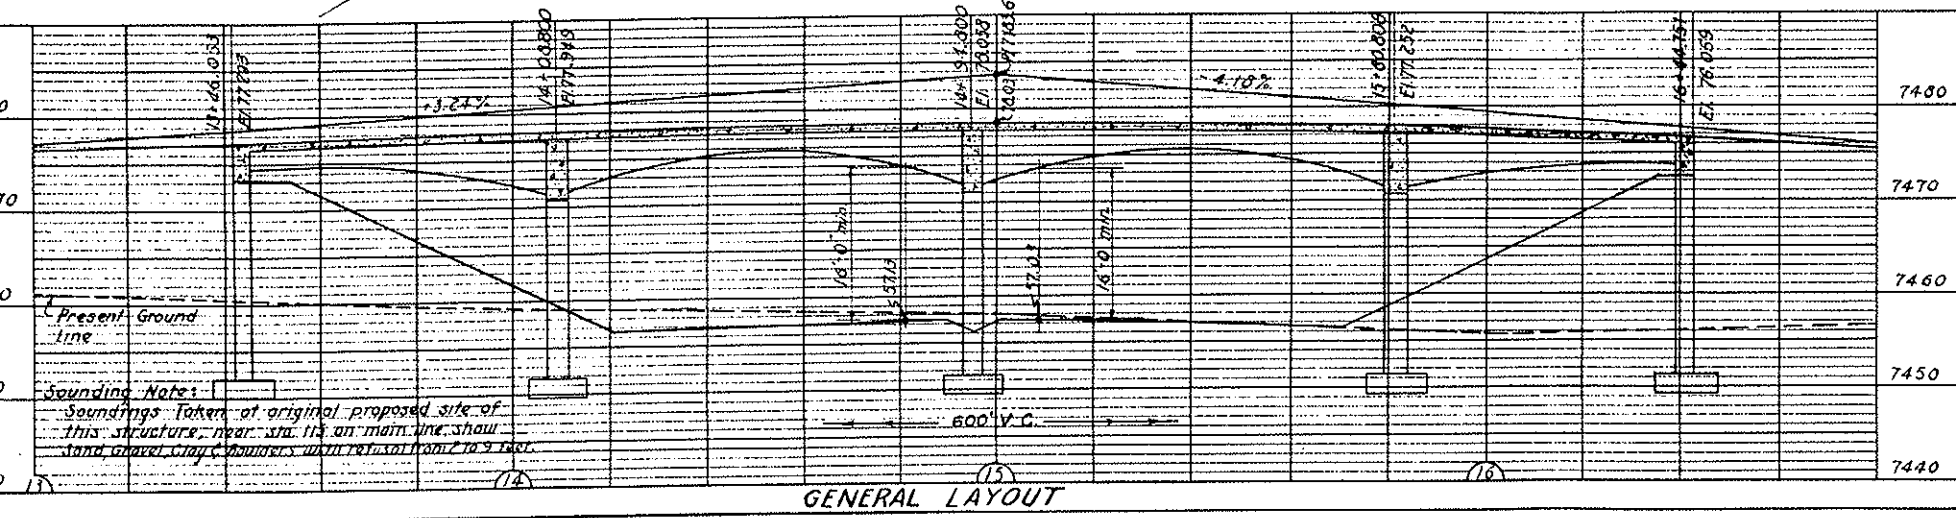

All material that is to be mechanically Tamped shall be placed in horizontal layers not more than 6" in depth and tamped before the next layer is placed.

GENERAL NOTES

ALL WORK SHALL BE DONE ACCORDING TO THE STANDARD SPECIFICATIONS OF THE COLORADO DEPARTMENT OF HIGHWAYS APPLICABLE TO THE PROJECT.

ALL CONCRETE SHALL BE CLASS "A" AND AIR ENTRAINMENT AS SPECIFIED.

ALL CONCRETE SURFACES EXPOSED TO NORMAL VIEW BY HIGHWAY TRAFFIC INCLUDING SWING SURFACES SHALL RECEIVE CLASS 2 SURFACE FINISH.

CONCRETE GIRDERS, FLOOR SLABS, AND CURBS SHALL BE FORMED MONOLITHICALLY.

FORMS FOR CONCRETE SURFACES EXPOSED IN THE FINISHED WORK SHALL BE CONSTRUCTED OF SHIP LAP OR TONGUE AND GROOVE LUMBER 3" x 3" UNLESS FACED WITH PANEL BOARD.

FOOTINGS IN ROCK SHALL BE POURED OUT TO ROCK AND NOT FORMED.

SOUNDINGS AND DEPTH OF FOOTING SHOWN ARE IN ACCORDANCE WITH THE BEST AVAILABLE DATA AND WHEN DIFFERENT CONDITIONS ARE ENCOUNTERED THE BRIDGE ENGINEER WILL INSPECT AND DETERMINE IF REDESIGN IS NECESSARY.

ALL REINFORCING STEEL SHALL CONFORM TO ASTM SPECIFICATION A 305-30T OR THE LATEST REVISION THEREOF, AND SHALL BE INTERMEDIATE GRADE STEEL OF A DEFORMED TYPE. EACH BAR SHALL BE TAGGED WITH THE NUMBER DESIGNATION AND THE STATION NUMBER OF THE PROJECT.

SECONDARY BARS WHEN SPLICED SHALL LAP 20 DIAMETERS OF THE BAR. DIMENSIONS FOR REINFORCING STEEL NOT SHOWN AS CLEAR SHALL BE TO THE CENTER LINE OF THE BAR.

ALL STRUCTURAL STEEL SHALL BE PAINTED ONE SHOP COAT OF ZINC CHROMATE AND TWO FIELD COATS OF ALUMINUM, UNLESS OTHERWISE NOTED, EXCEPT THE UNEXPOSED PORTION OF STEEL PILING NEED NOT BE PAINTED.

HANDRAIL BOLTS SHALL HAVE HEX HEADS, NUTS, AND LOCK WASHERS UNLESS OTHERWISE SPECIFIED AND ALL RIVETS, EXCEPT AS NOTED ARE 3/4" DIA. AND SHALL BE POWER DRIVEN.

WHEN TREATED TIMBER OR PILING IS SHOWN ON THE DRAWING THE PRESERVATIVE FOR TREATMENT SHALL BE CREOSOTE OIL.

WHEN EXCAVATING FOR FOOTINGS THE FINAL ONE FOOT IN DEPTH SHALL BE DONE BY HAND LABOR METHODS.

PRIMARY BARS SHALL NOT BE SPLICED EXCEPT BY PERMISSION OF THE ENGINEER. WHEN PRIMARY BARS ARE SPLICED THEY SHALL LAP 24 DIAMETERS FOR BARS NEAR TOP OF BEAMS AND GIRDERS HAVING MORE THAN 12 INCHES OF CONCRETE UNDER THE BARS AND 20 DIAMETERS FOR BARS NEAR BOTTOM OF MEMBERS.

LOADING DATA

LIVE LOAD - A.A.S.H.O. (M 20-44)

DEAD LOAD ASSUMES 15 LBS PER SQ. FT. ADDITIONAL WEARING SURFACE WHICH INCLUDES THE 1/2 INCH CONCRETE MONOLITHIC WEARING SURFACE SHOWN.

DESIGNING DATA

A.A.S.H.O. 1933 UNIT STRESSES, EXCEPT AS NOTED

Reinforcing Steel fs - 20000 lbs. per sq. in.

Structural Steel fs - 18000 lbs. per sq. in.

fc - 1000 lbs. per sq. in.





n - 10

COLORADO
DEPARTMENT OF HIGHWAYS
 4 SPANS 61'-86'-86'-61' CONTINUOUS
 CONCRETE SLAB & GIRDER BRIDGE
 30'-0" ROADWAY, 60" SKEW RR.

Across INTERCHANGE
 Sta. 13+46.053 to 16+44.751
 Near DOUG SPRINGS, Sec. 31, T. 35, R. 72M.
 Designed by E.F.S. Approved by A.H. Reinholtz
 Made by _____ Bridge Engineer
 Checked by _____ Date: Aug. 31, 1956

STRUCTURE NO. F-14-Y

FED. ROAD DIV. NO.	DISTRICT	PROJECT NO.	SHEET NO.	TOTAL SHEETS
9	COLO.	F005-3-(9)	22	

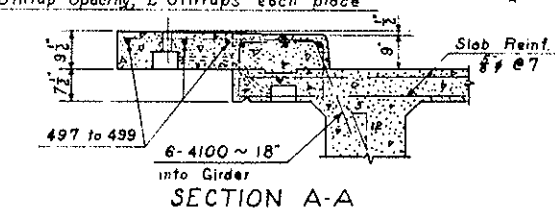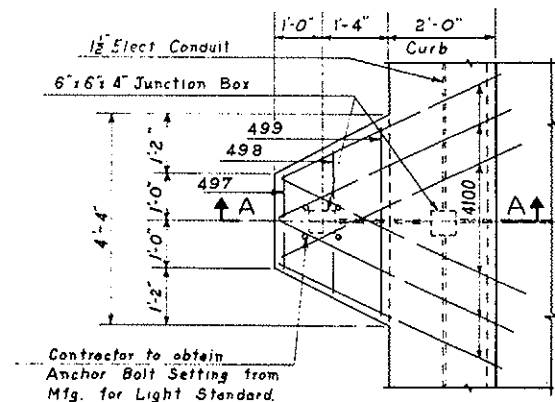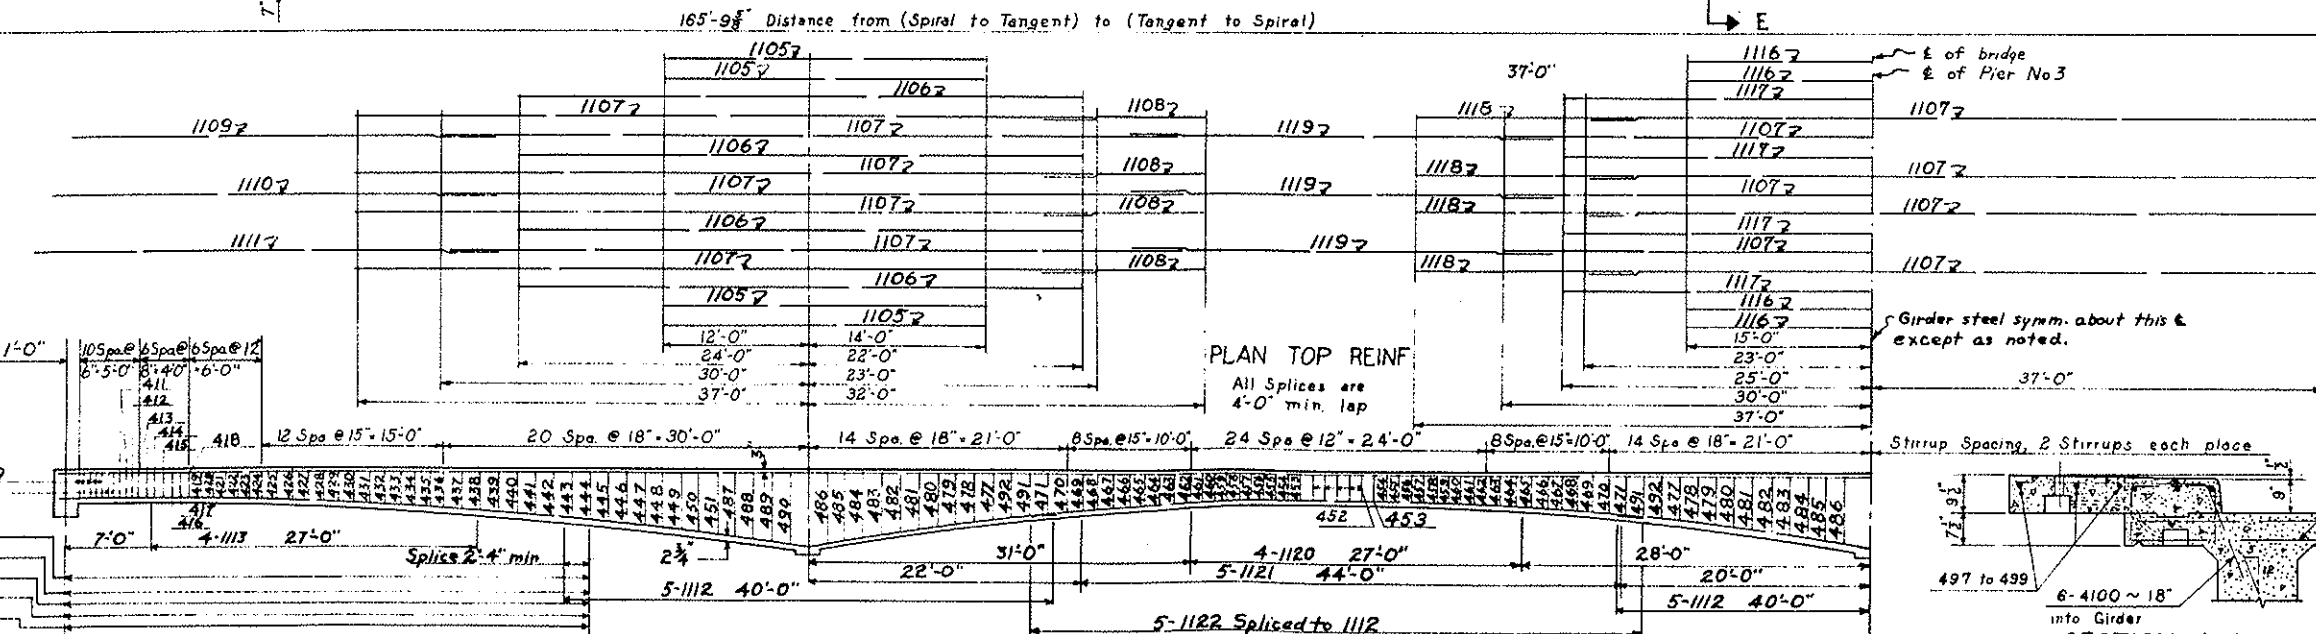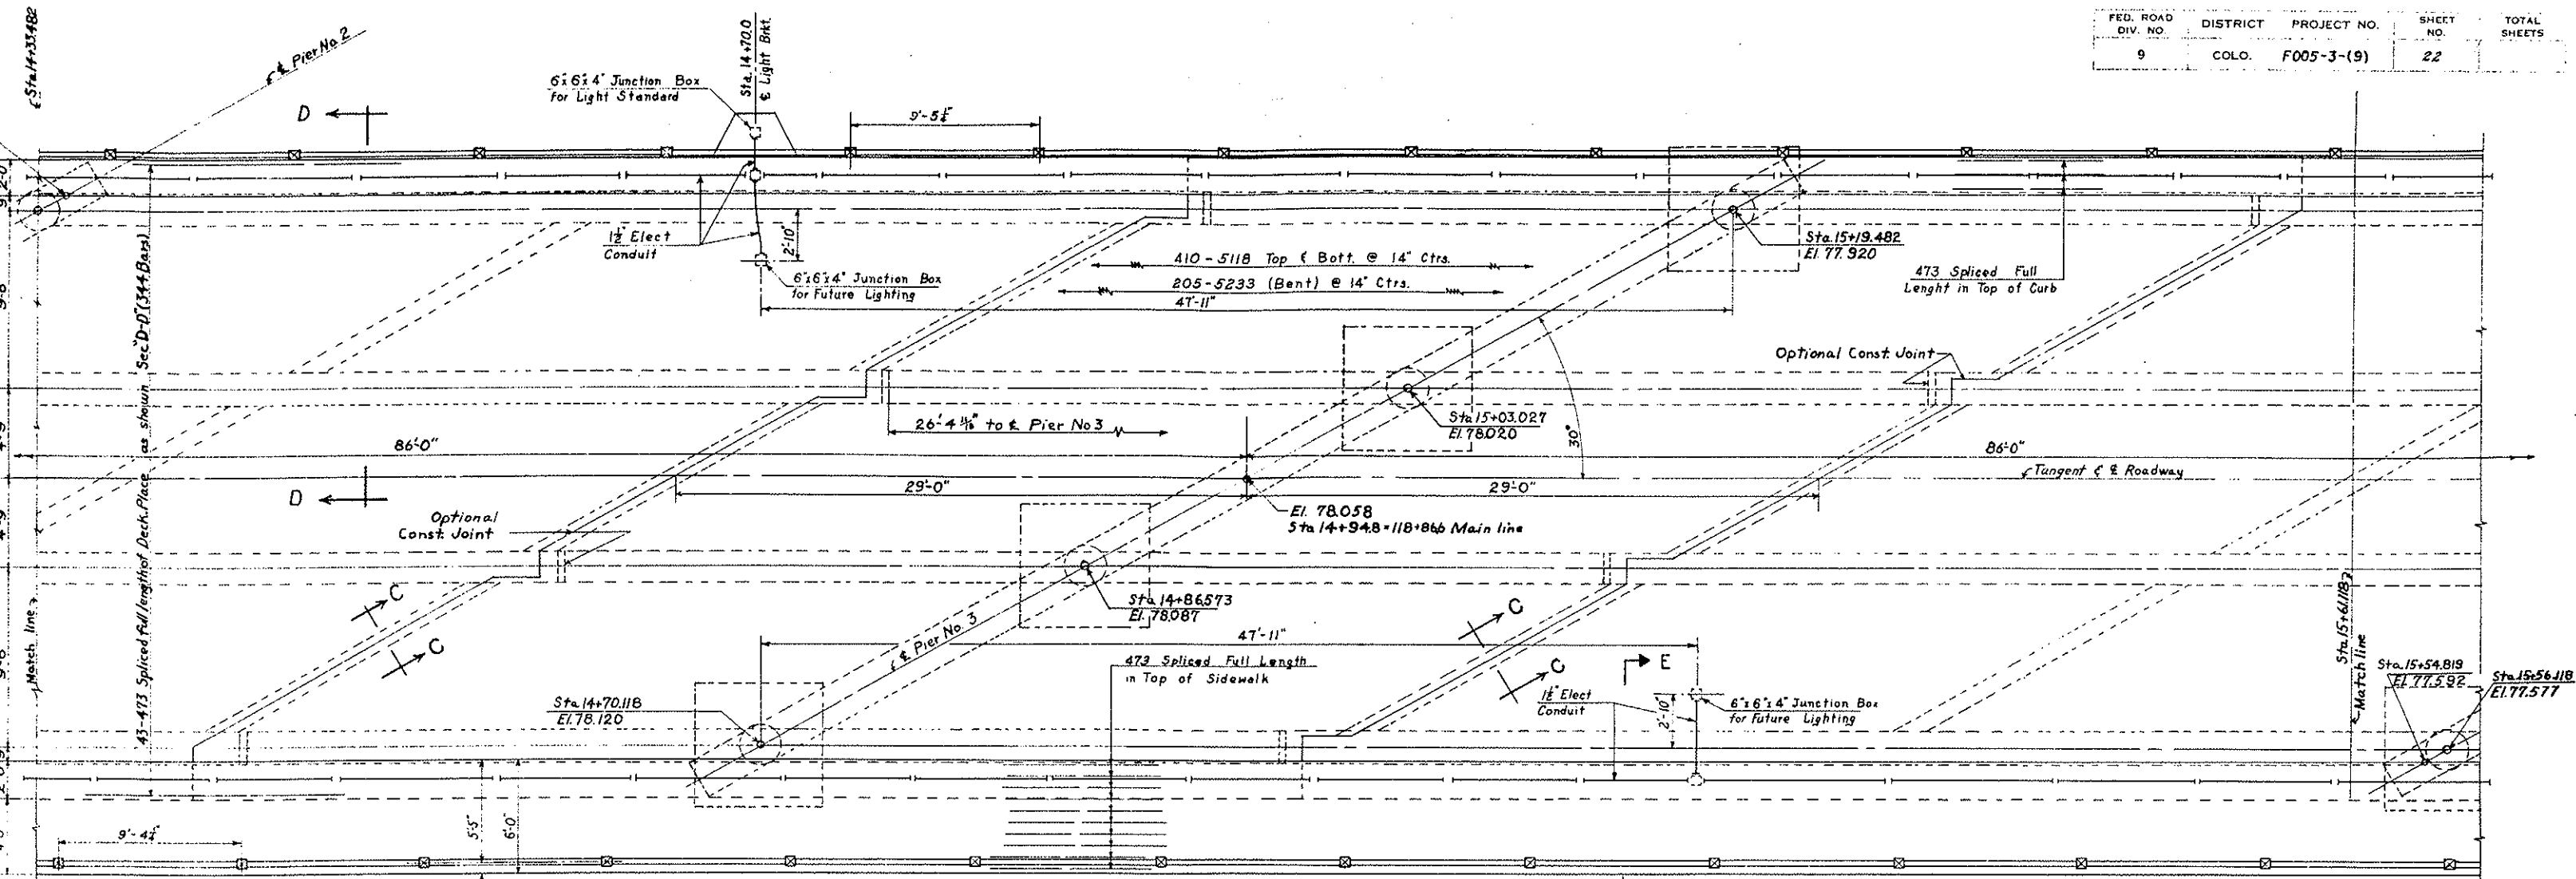

STATION ON TANGENT	14+25.0	14+30.0	14+35.0	14+40.0	14+45.0	14+50.0	14+55.0	14+60.0	14+65.0	14+70.0	14+75.0	14+80.0	14+85.0	14+90.0	14+95.0	15+00.0	15+05.0	15+10.0	15+15.0	15+20.0	15+25.0	15+30.0	15+35.0	15+40.0	15+45.0	15+50.0	15+55.0	15+60.0
ELEV. CURB TO CURB (NO CROWN)	78.040	78.061	78.079	78.094	78.107	78.116	78.121	78.124	78.124	78.110	78.114	78.104	78.092	78.076	78.057	78.03	78.00	77.982	77.951	77.916	77.879	77.838	77.795	77.748	77.698	77.645	77.590	77.530


TABLE SHOWING GRADE ELEVATIONS

COLORADO
DEPARTMENT OF HIGHWAYS


PART PLAN OF SUPERSTRUCTURE
REINFORCING STEEL FOR GIRDERS

Across Interchange
Sta. 13+46.053 to 16+44.751
Near Idaho Springs Sec. 31 T. 35. R. 27W.


Designed by G.H.W. Approved by *W. H. H. H. H.*
Made by T.J.M. Bridge Engineer
Checked by *W. H. H. H. H.* Date: *Aug. 31, 1956*

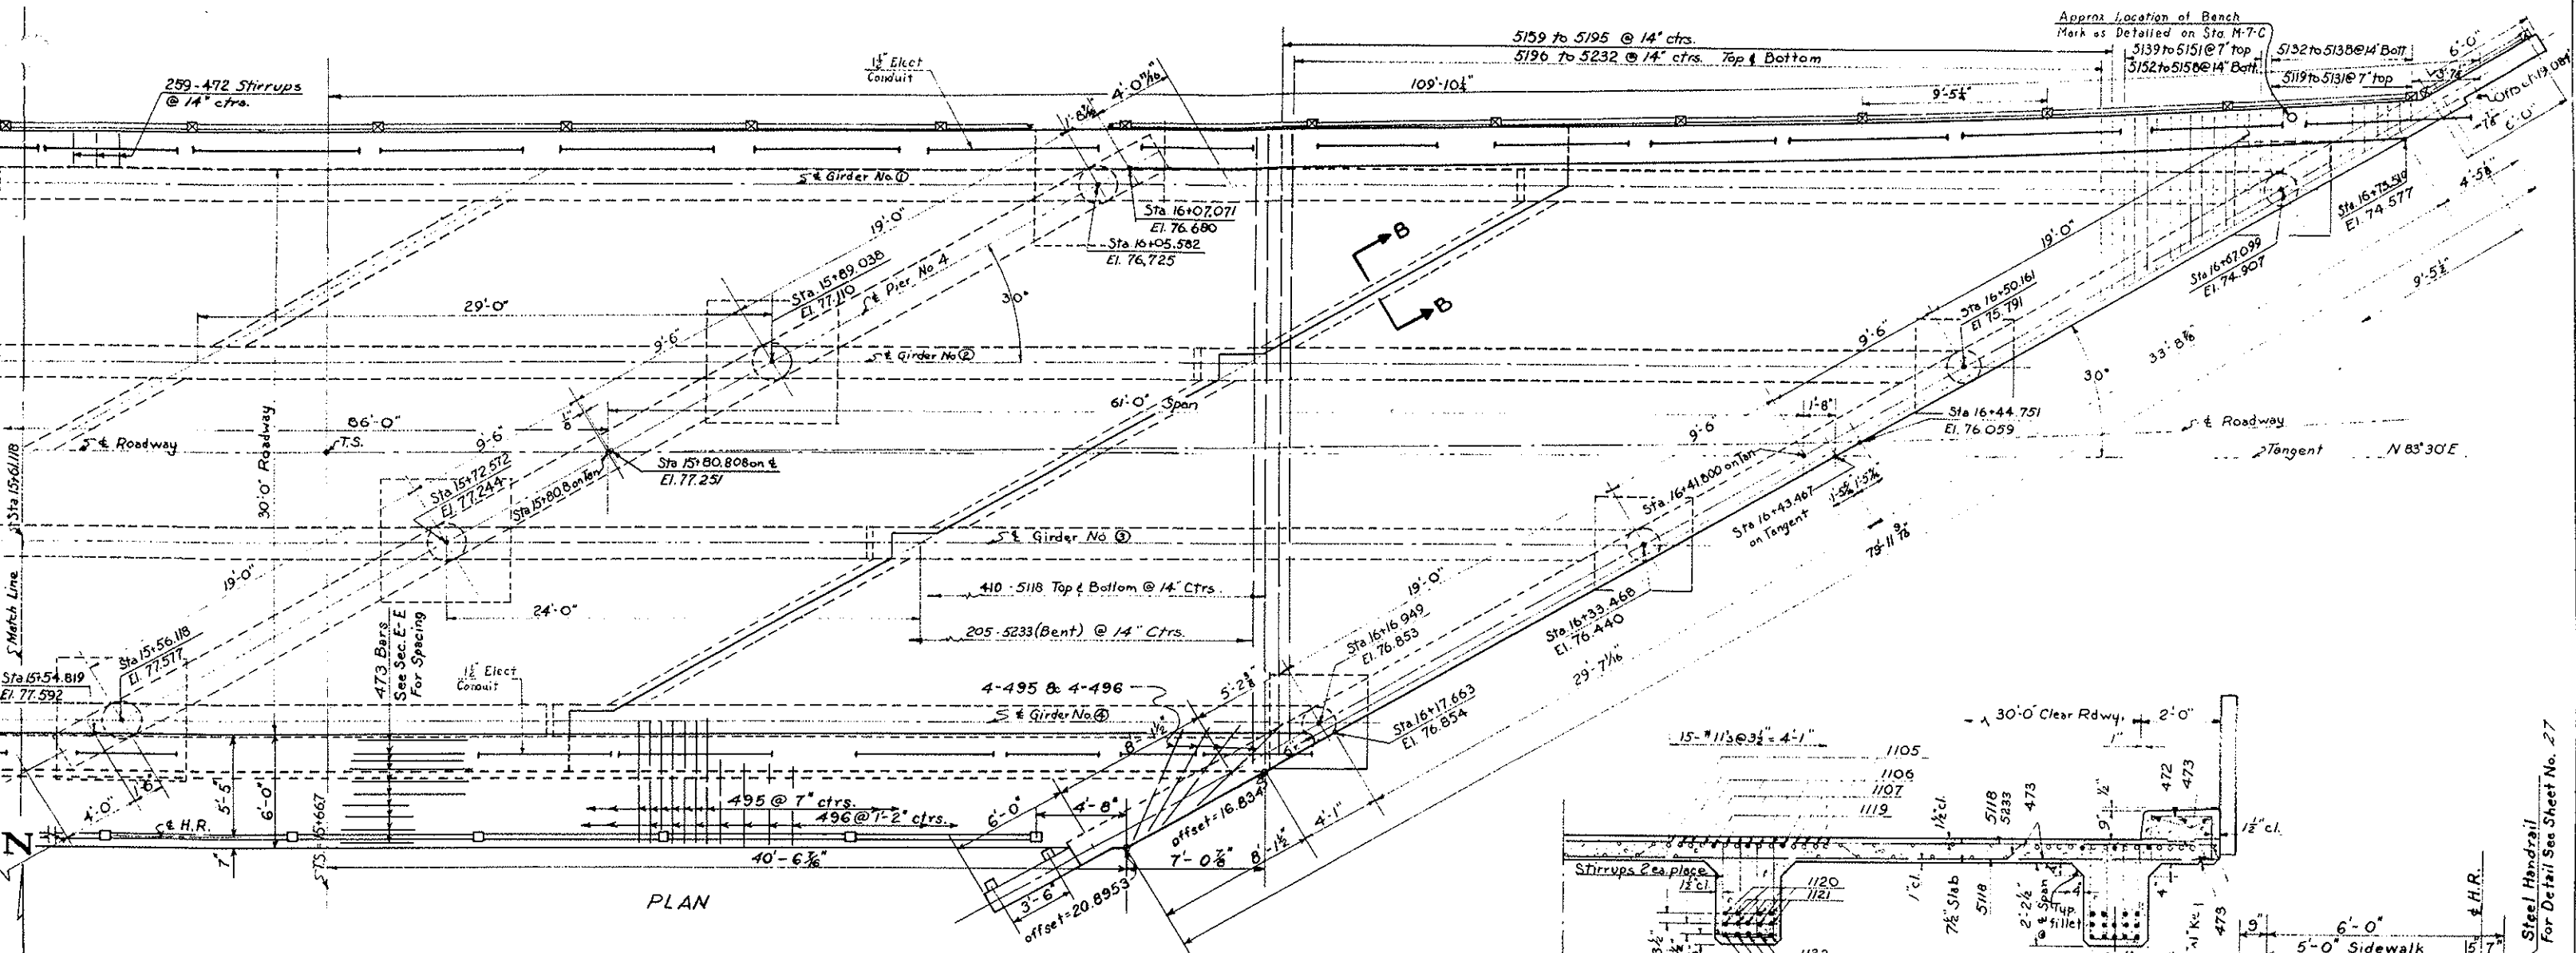


PLAN

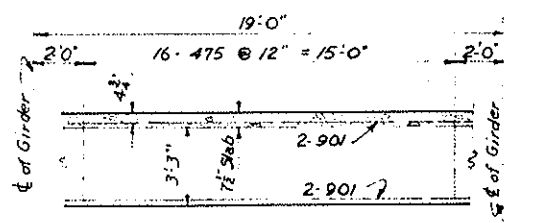

TRUE ELEVATION DIAPHS. SPANS #1 & #4

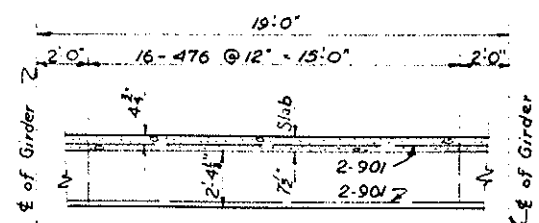

TRUE ELEVATION DIAPHS. SPANS #2 & #3

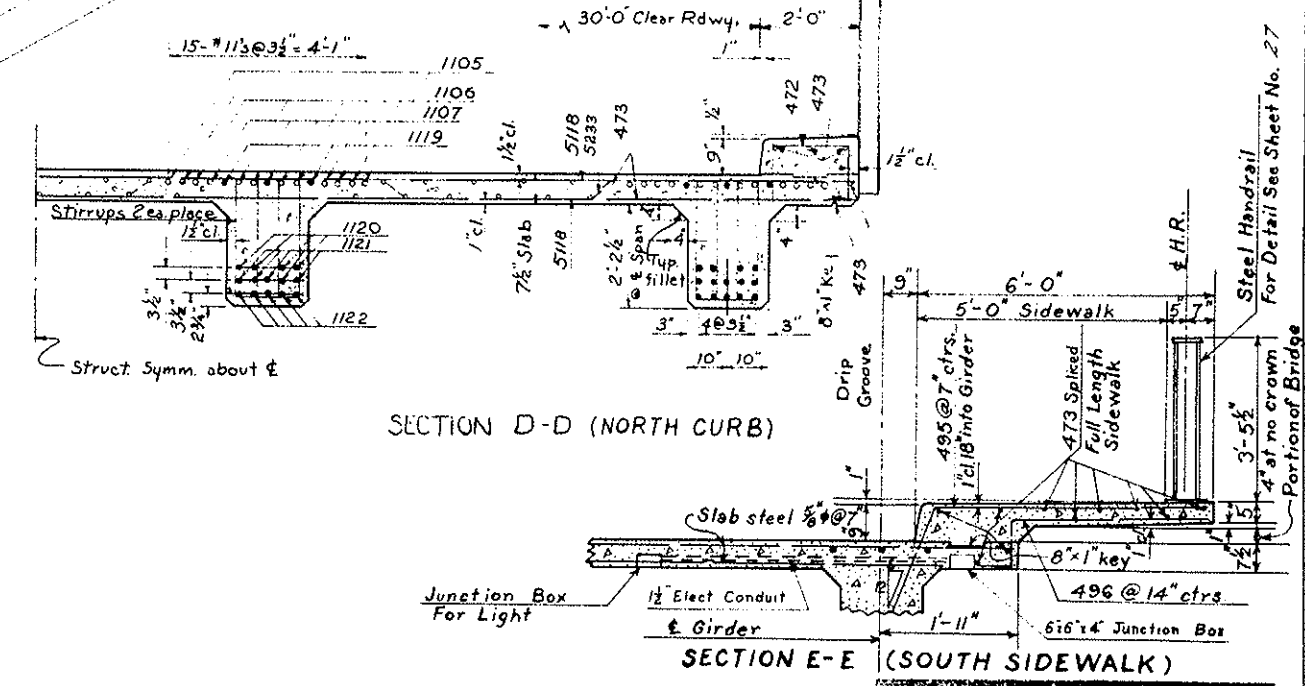

SECTION D-D (NORTH CURB)

SECTION E-E (SOUTH SIDEWALK)

STATION ON TANGENT	T.S. = 15+66.7	15+75.00	15+80.00	15+85.00	15+90.00	15+95.00	16+00.00	16+05.00	16+10.00	16+15.00	16+20.00	16+25.00	16+30.00	16+35.00	16+40.00	16+45.00	16+50.00	16+55.00	16+60.00	16+65.00	16+70.00
STANCE BETWEEN TAN & NO CURB	15.000	15.001	15.003	15.009	15.020	15.035	15.058	15.088	15.127	15.176	15.236	15.310	15.396	15.498	15.615	15.751	15.904	16.079	16.273	16.489	16.730
ROADWAY ELEVATION AT NORTH CURB	77.446	77.328	77.248	77.159	77.063	76.961	76.849	76.731	76.605	76.472	76.330	76.181	76.026	75.866	75.706	75.542	75.374	75.203	75.031	74.859	74.689
ROADWAY ELEVATION AT GIRDER #1	77.446	77.333	77.259	77.180	77.096	77.009	76.916	76.820	76.719	76.615	76.506	76.393	76.277	76.159	76.039	75.918	75.795	75.670	75.543	75.415	75.287
ROADWAY ELEVATION AT GIRDER #2	77.446	77.335	77.263	77.189	77.111	77.031	76.947	76.860	76.770	76.677	76.581	76.481	76.379	76.274	76.165	76.054	75.939	75.820	75.700	75.579	75.458
ROADWAY ELEVATION AT GIRDER #3	77.446	77.337	77.268	77.198	77.126	77.053	76.978	76.901	76.823	76.744	76.663	76.582	76.499	76.414	76.328	76.241	76.153	76.064	75.974	75.883	75.792
STANCE BETWEEN TAN & SOUTH CURB	15.000	14.999	14.996	14.991	14.980	14.965	14.943	14.913	14.875	14.826	14.776	14.725	14.673	14.620	14.566	14.511	14.456	14.400	14.343	14.286	14.228
ROADWAY ELEVATION AT SOUTH CURB	77.446	77.341	77.279	77.218	77.159	77.100	77.044	76.988	76.933	76.879	76.825	76.771	76.717	76.663	76.609	76.555	76.501	76.447	76.393	76.339	76.285


TABLE SHOWING SPIRAL OFFSETS AND ELEVATIONS AT EAST END OF BRIDGE

COLORADO
 DEPARTMENT OF HIGHWAYS
 PART PLAN OF
 SUPERSTRUCTURE
 REINFORCING STEEL FOR DIAPHS.


Interchange
 Sta. 13+46.053 to 16+44.751
 near Idaho Springs, S. 31 T. 35 R. 72 W.

Designed by G.H.W. Approved by C.B. Newhall
 Drawn by T.J.M. Bridge Engineer
 Checked by Date: Aug. 31, 1956

FED. ROAD DIV. NO.	DISTRICT	PROJECT NO.	SHEET NO.	TOTAL SHEETS
9	COLO.	F005-3(9)	21	

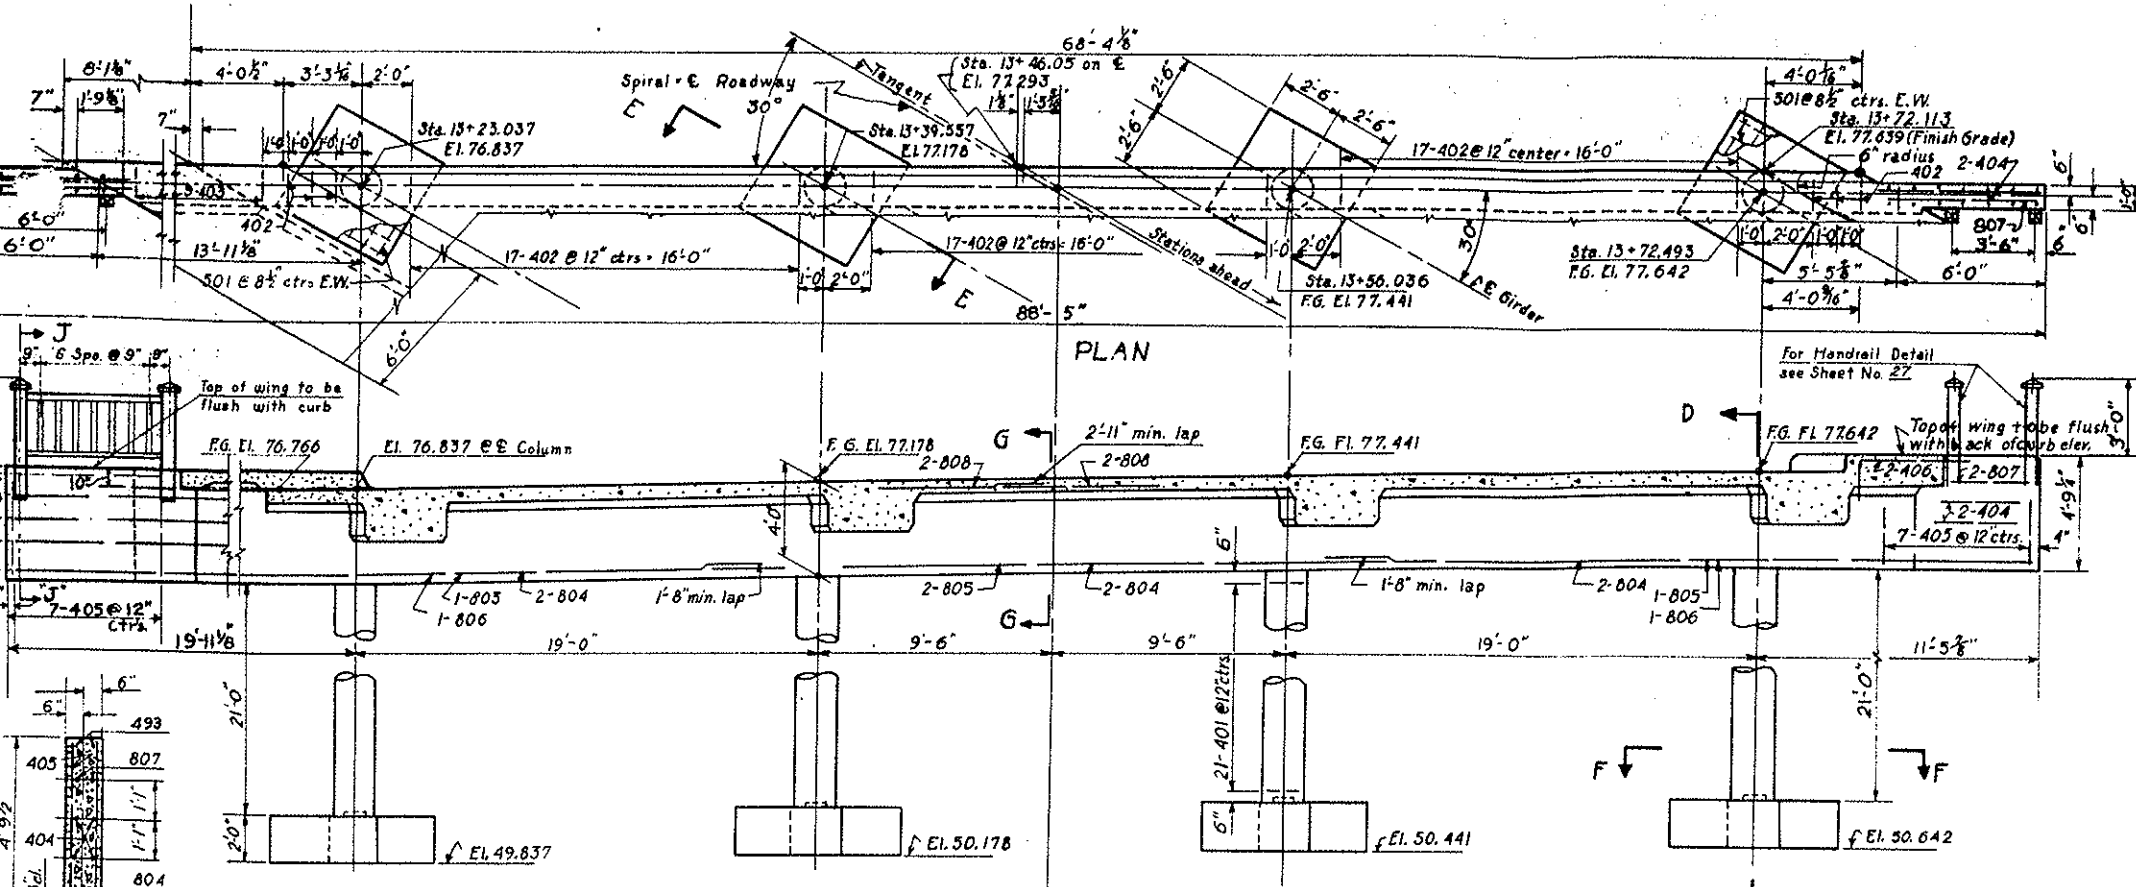


ELEVATION ABUTMENT No. 1
MAXIMUM TOE PRESSURE = 3.5 TONS / SQ. FT.

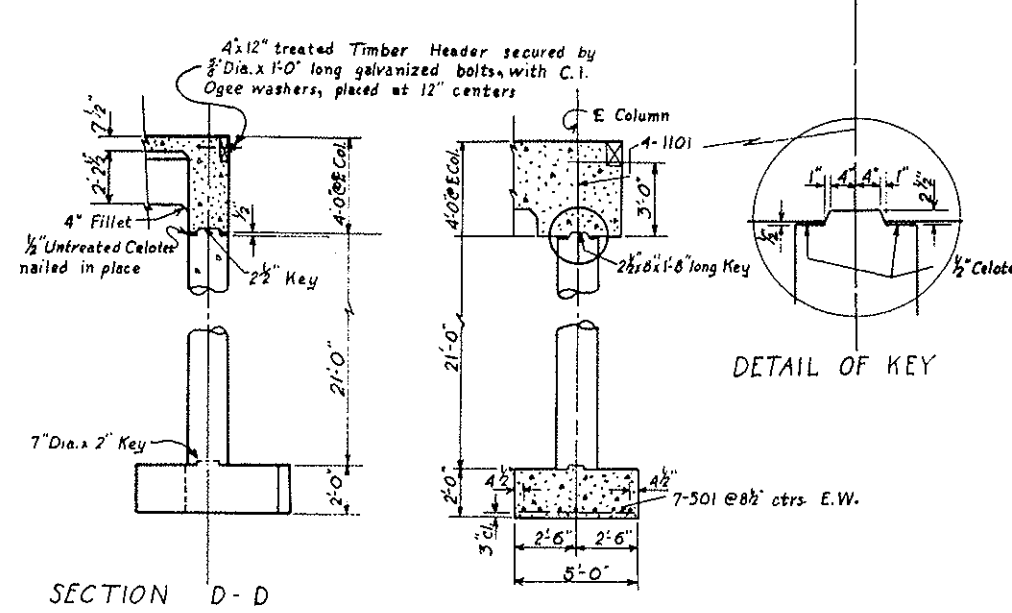


SECTION D-D

SECTION E-E
View is normal to girder


EC. J-J

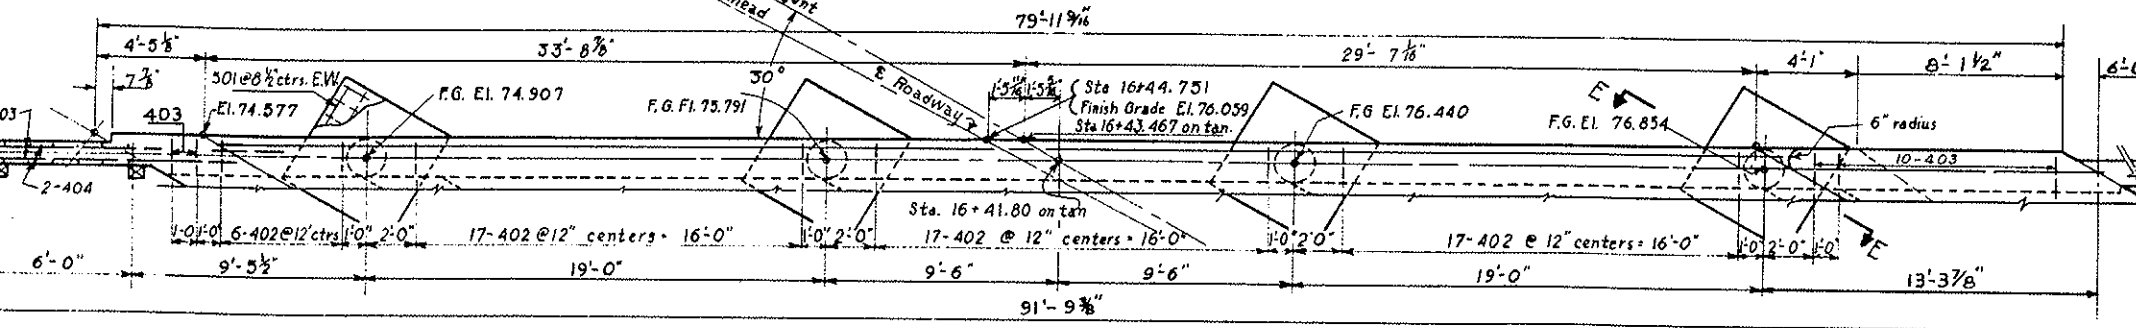

PLAN ABUTMENT No. 5

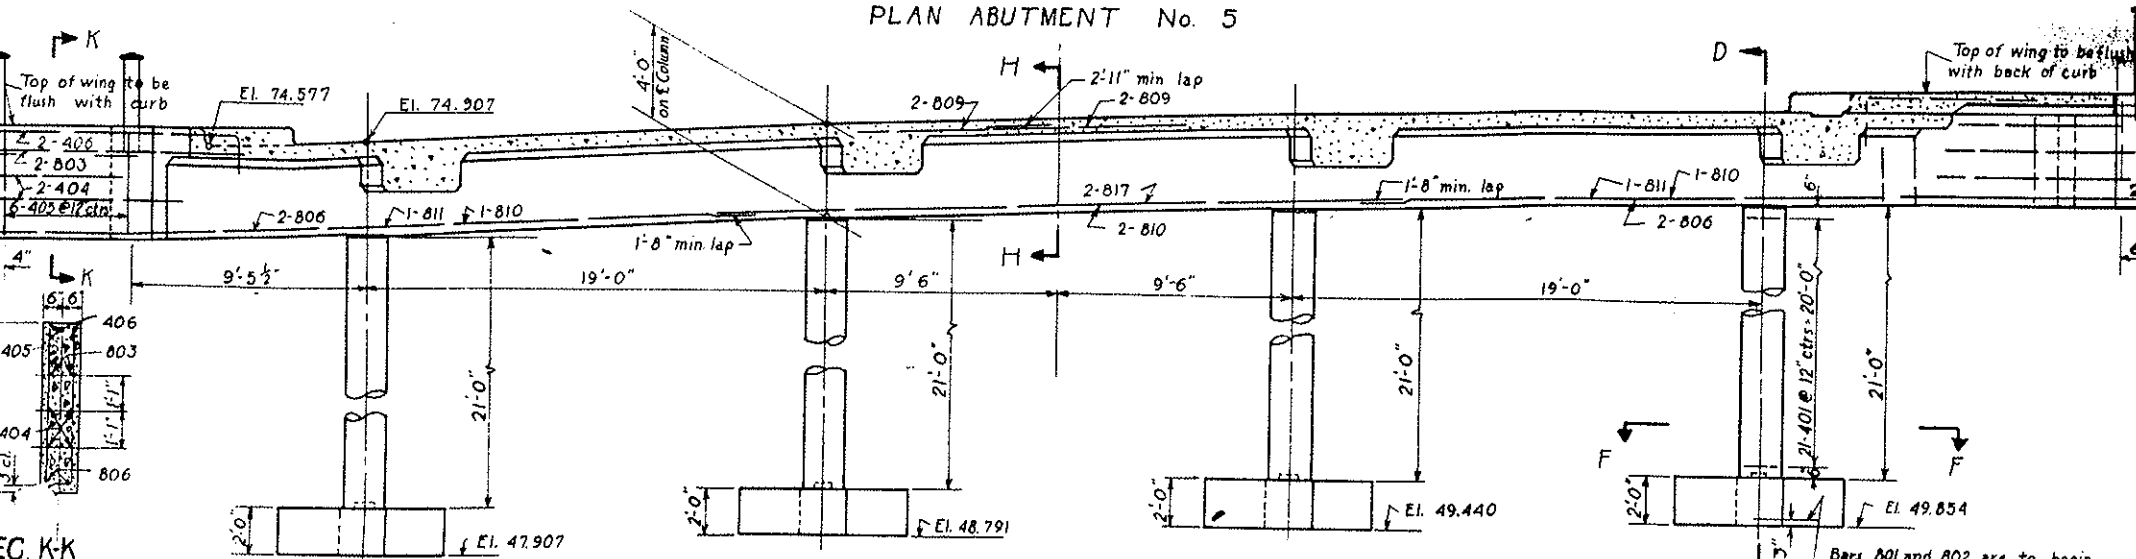


ELEVATION ABUTMENT NO. 5
MAXIMUM TOE PRESSURE = 3.5 TONS / SQ. FT.

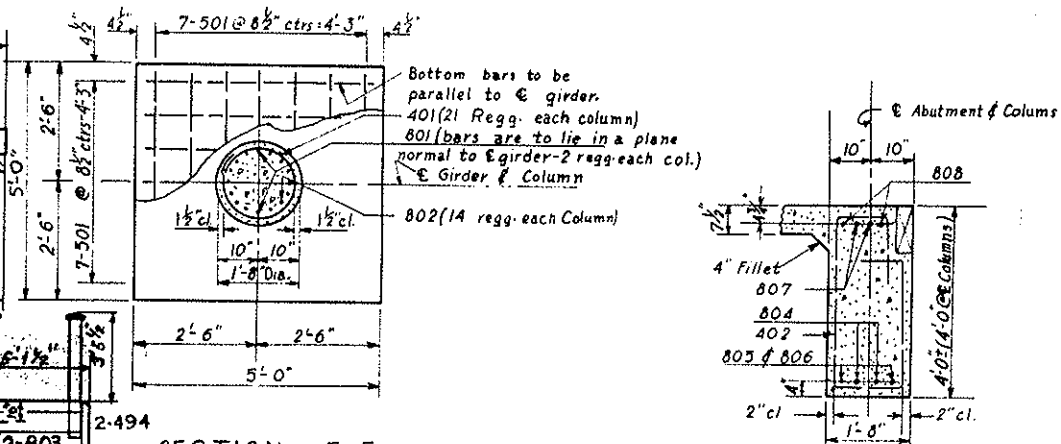

SECTION F-F
TYPICAL FOR EACH ABUTMENT COLUMN

SECTION G-G

EC. K-K

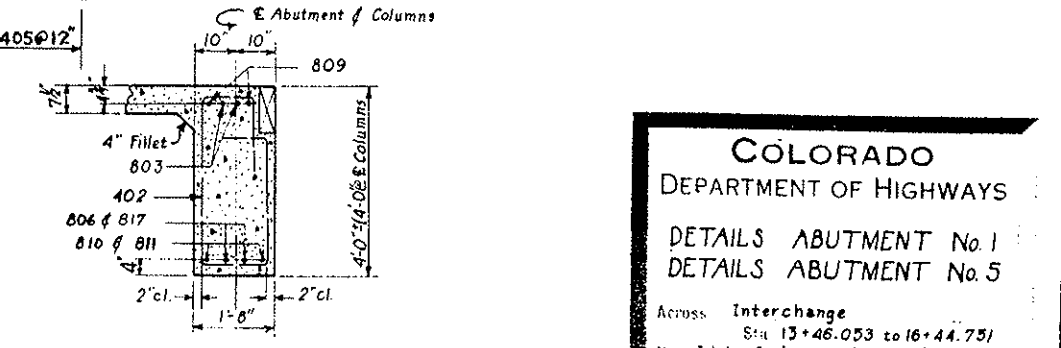

SECTION H-H


STRUCTURE NO. F-14-Y

COLORADO
DEPARTMENT OF HIGHWAYS


DETAILS ABUTMENT No. 1
DETAILS ABUTMENT No. 5

Across Interchange
Sta. 13+46.053 to 16+44.751
Near Idaho Springs Sec. 31 T. 3 S. R. 72 W

Designed by G. H. W. Approved by A. D. Newhall
Made by T. J. M. Bridge Engineer
Checked by Date: Aug. 31, 1956

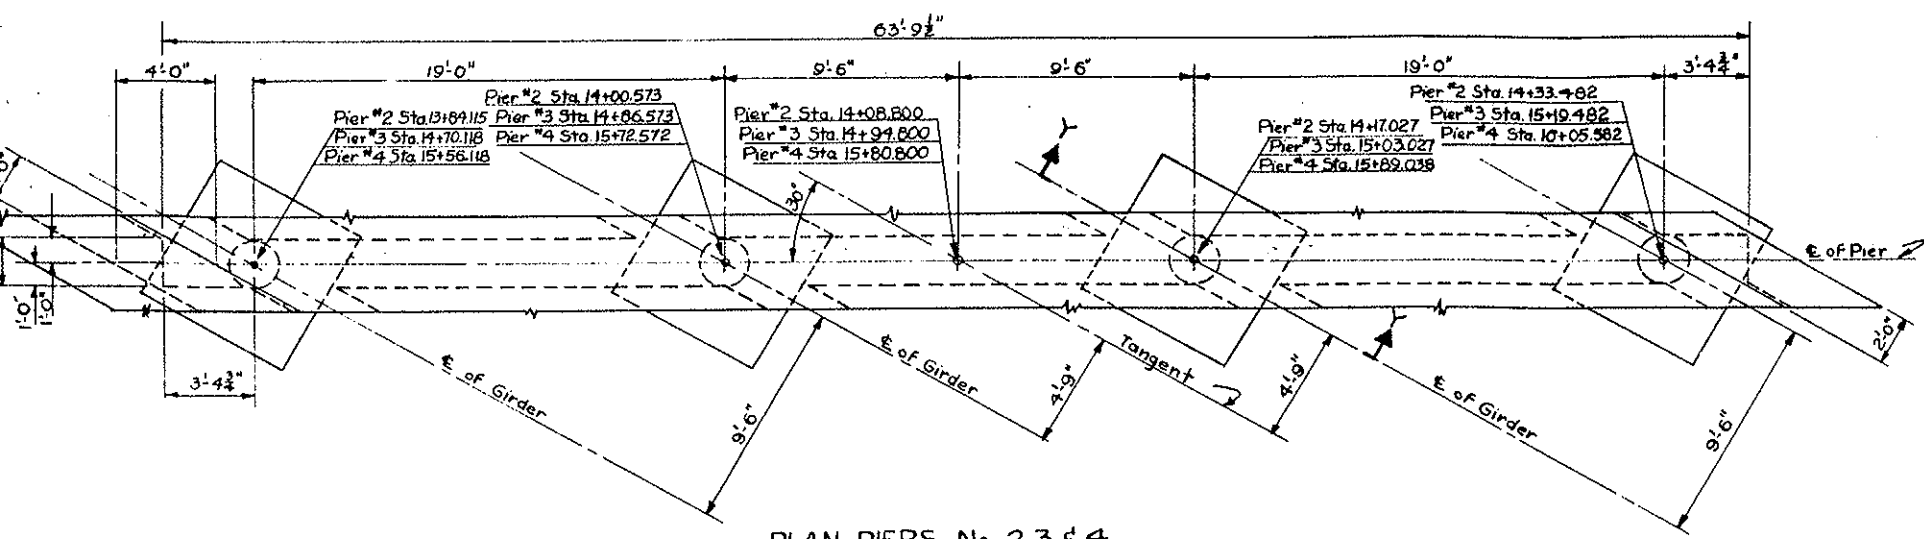


PLAN PIERS No. 2, 3 & 4

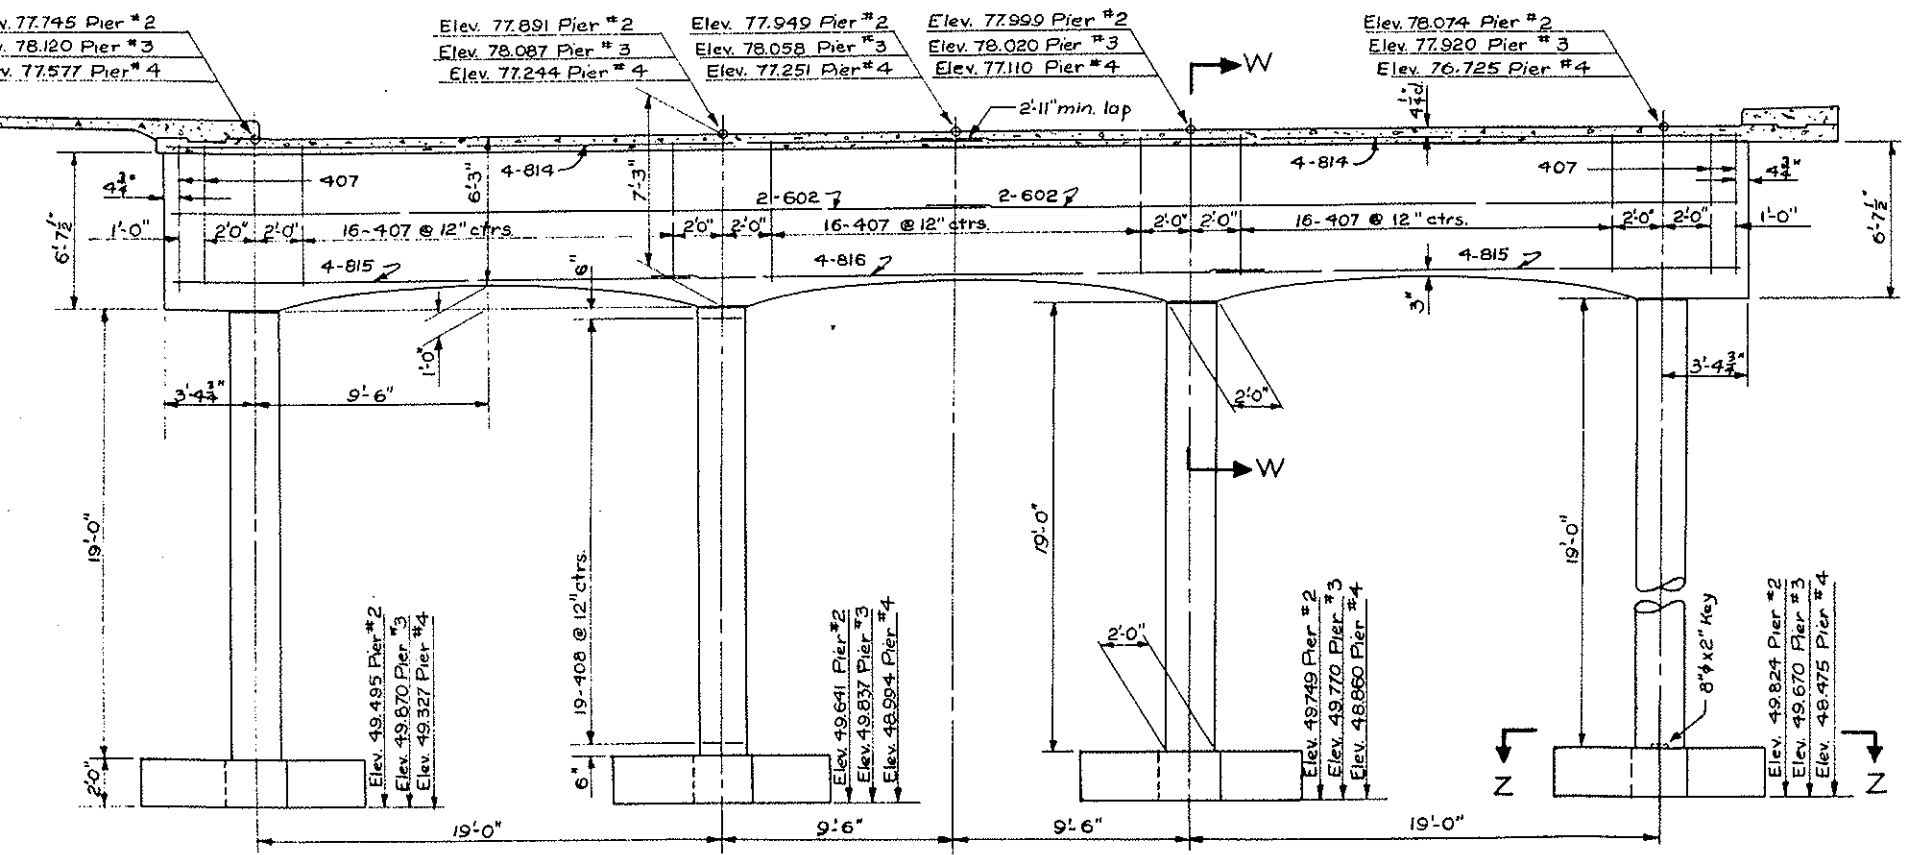


ELEVATION PIERS No. 2, 3 & 4
Max. Toe Pressure 4.4 Tons per sq. ft.


Note: All dimensions to reinforcing steel are to centerline of bar unless noted.

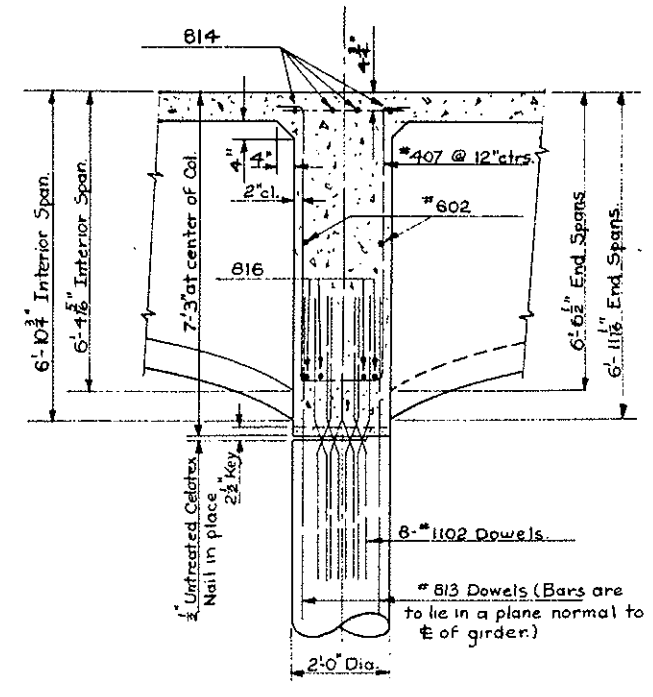


SECTION "W-W"

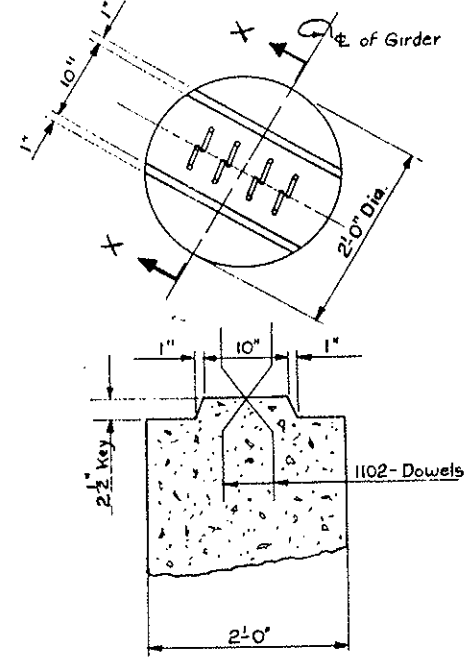

SECTION "X-X"
DETAIL OF KEY AT TOP OF COLUMN

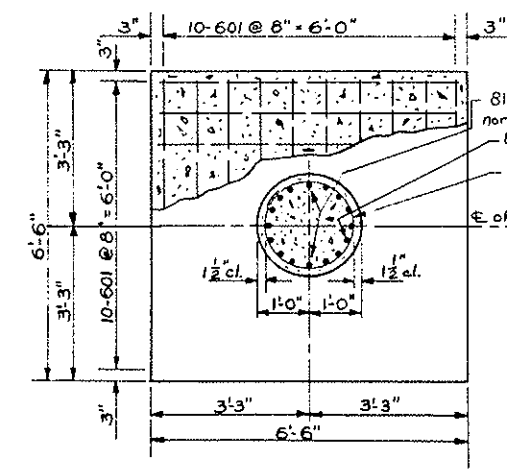

SECTION "Z-Z"

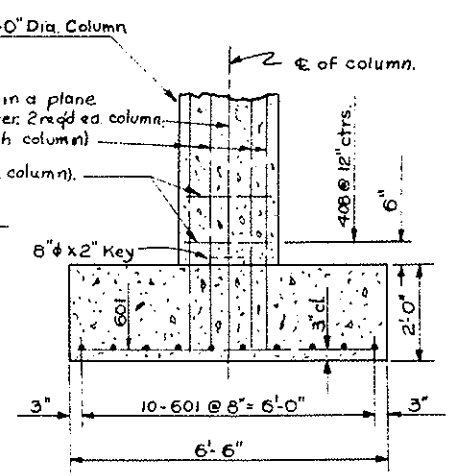


SECTION "Y-Y"

COLORADO
DEPARTMENT OF HIGHWAYS


DETAILS OF PIERS

Across Interchange
Sta. Sta. 13+96.053 to 16+44.751
Near Idaho Springs Sec. 31 T. 35 R. 72 W

Designed by G.H.W. Approved by J.R.U. Bridge Engineer
Made by J.R.U. Checked by
Date: Aug. 31, 1956

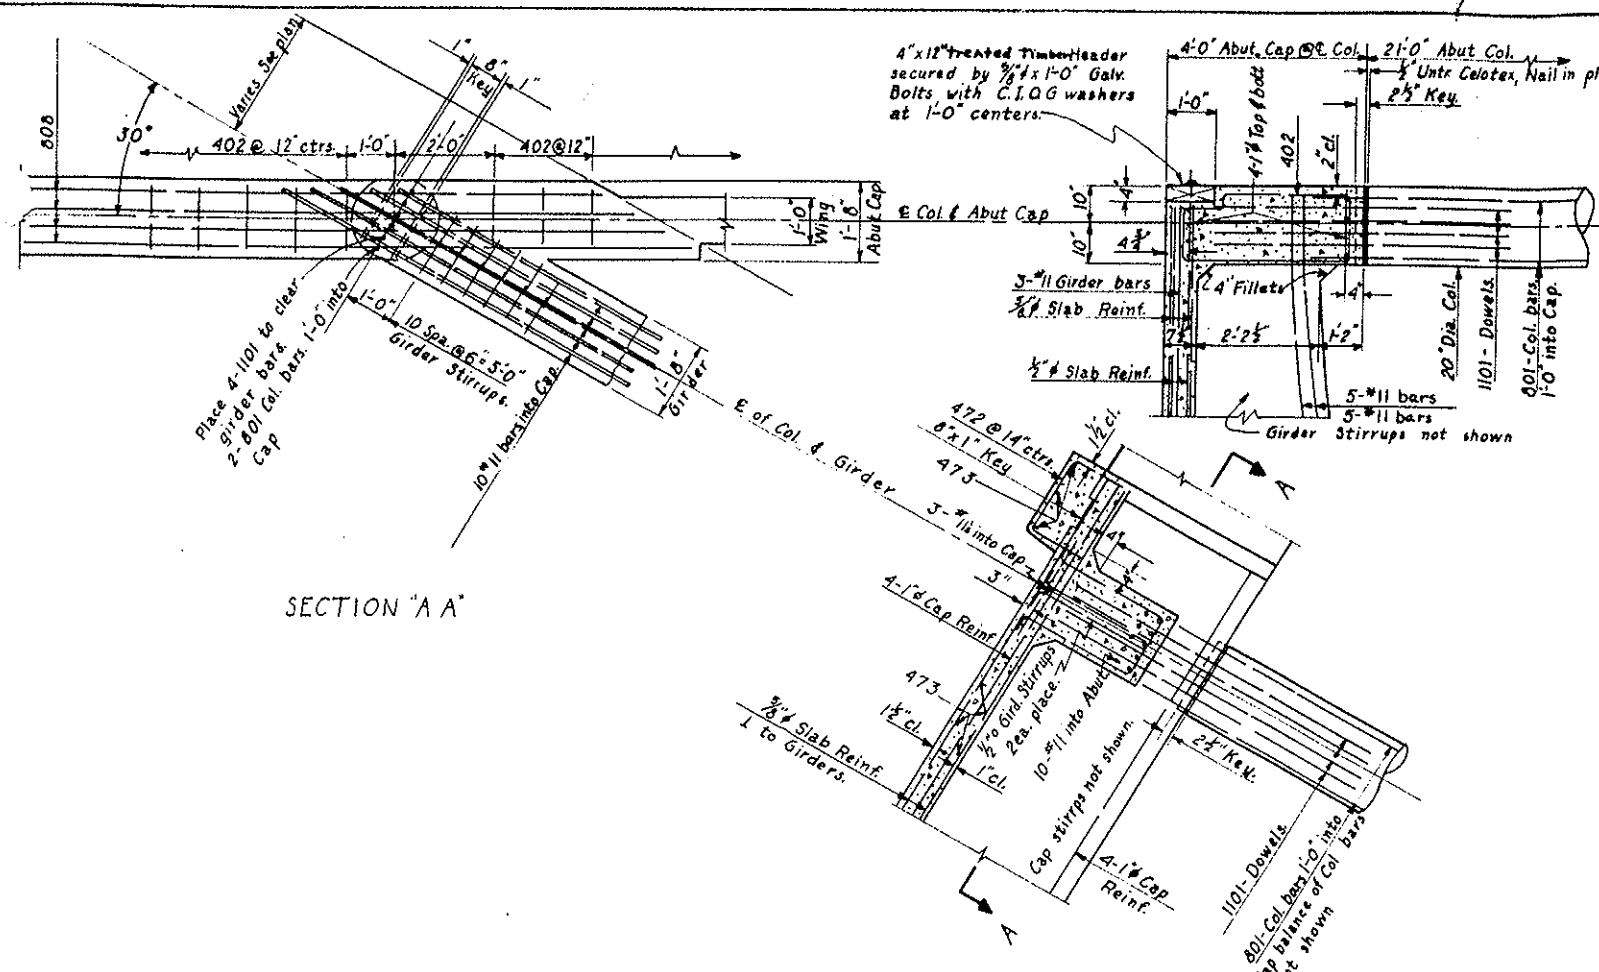

DETAIL AT INTERSECTION OF GIRDER, ABUT CAP AND COLUMN

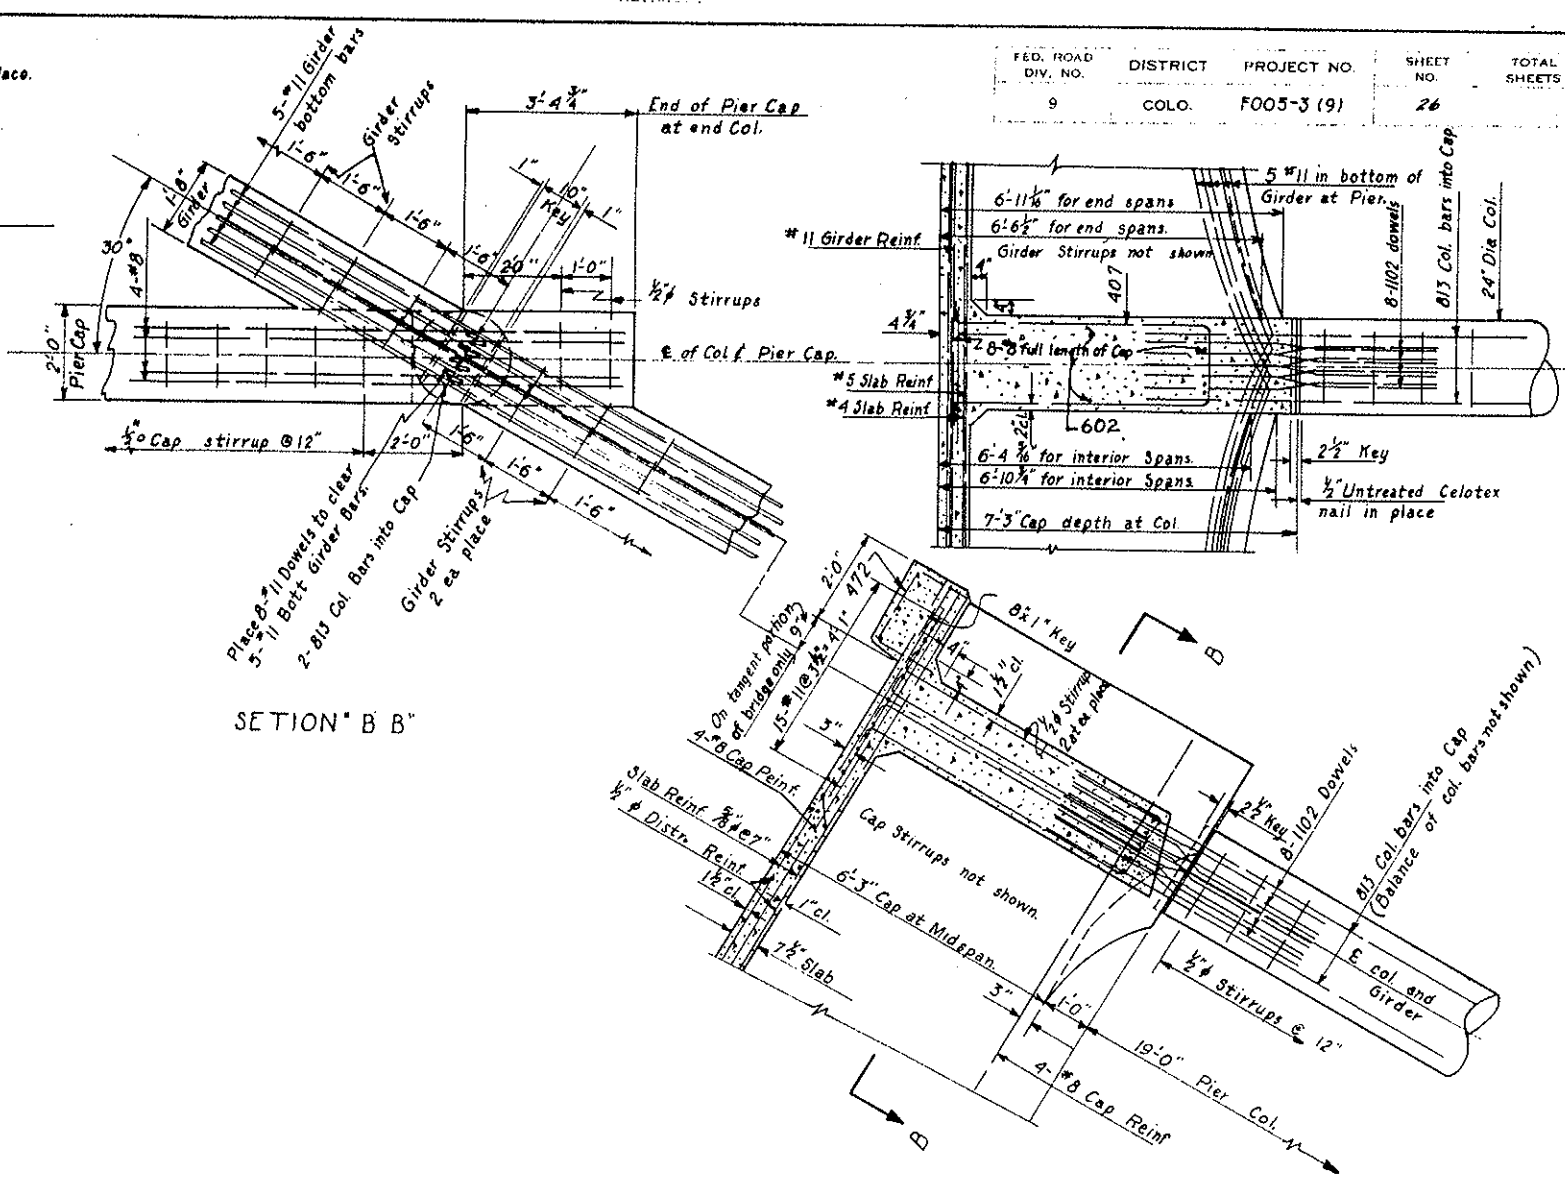




DETAIL AT INTERSECTION OF GIRDER, PIER CAP AND COLUMN

COLORADO
DEPARTMENT OF HIGHWAYS

MISC. DETAIL

App: Interchange
13 + 46.053 to 16 + 44.751
Near Idaho Springs, 31 1 3 S R 72 W

Designed by G.H.W. | Approved by A.S. Kimball
Made by J.R.J. | Bridge Engineer
Checked by | Date Aug. 8, 1956

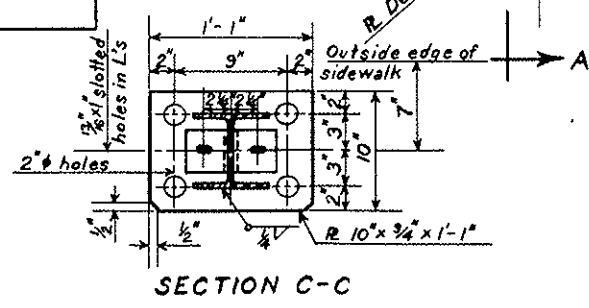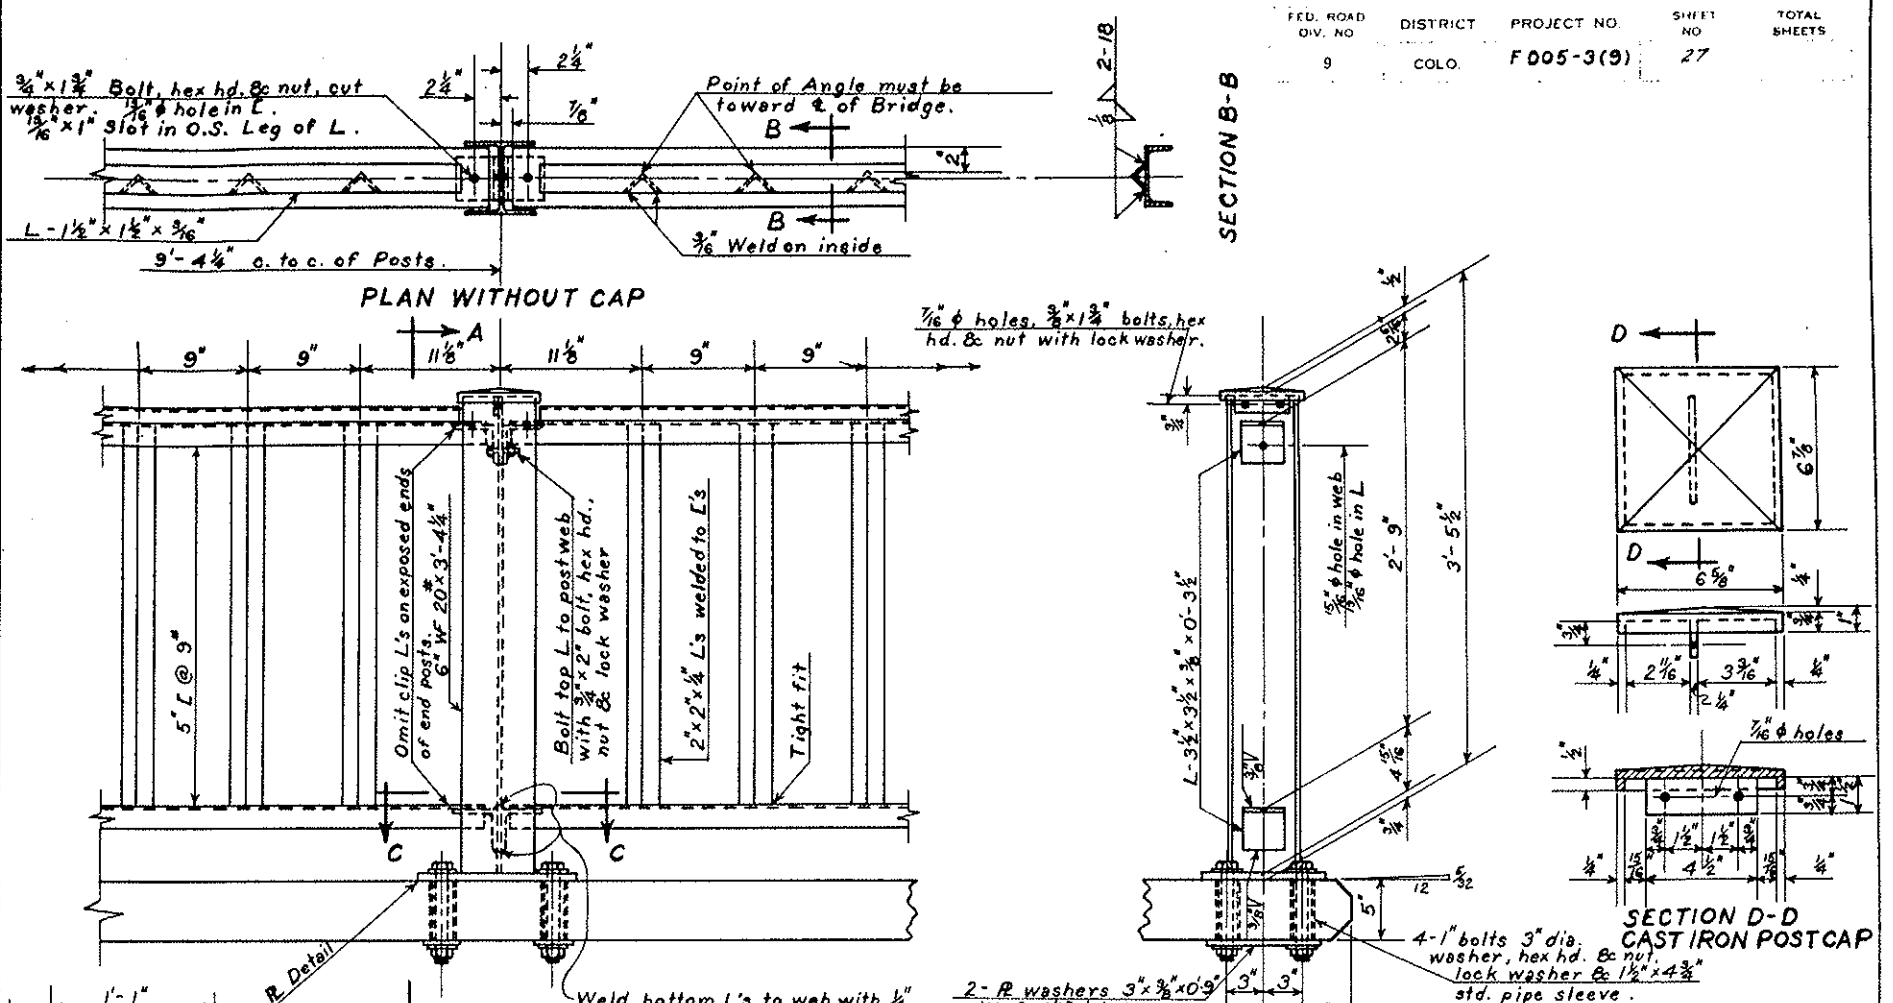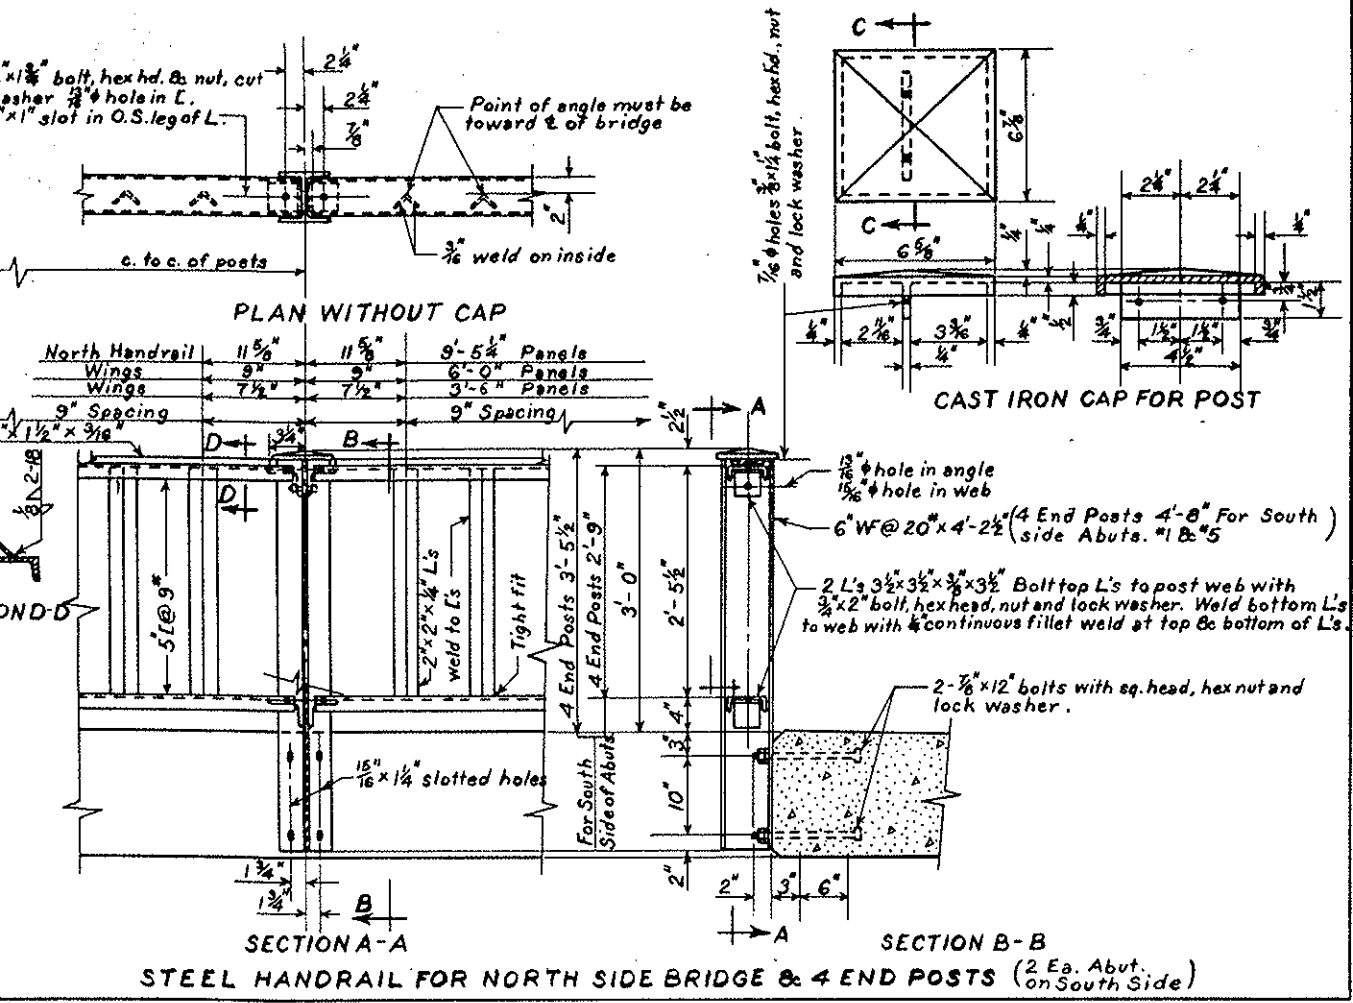

COLORADO
DEPARTMENT OF HIGHWAYS

DETAILS OF HANDRAIL

Across Interchange
Sta. 13+46.053 To 16+44.751
Near Idaho Springs Sec. 31 T. 35 R. 72W

Designed by J.R.J. Bridge Engineer
Checked by Date: Dec 31, 1956

Approved by G.P. Stewart
Date: Dec 31, 1956

BAR LIST - SUPERSTRUCTURE

Mark	Size	No.	Req'd	length	Type	Dimensions	
						l	m
409	1/2"	80	6'-8"	VI	2'-6"	11"	
410	1/2"	32	6'-8"	VI	2'-6"	11"	
411	1/2"	32	6'-9"	VI	2'-7"	11"	
412	1/2"	16	6'-9"	VI	2'-7"	11"	
413	1/2"	32	6'-9"	VI	2'-7"	11"	
414	1/2"	16	6'-9"	VI	2'-7"	11"	
415	1/2"	16	6'-10"	VI	2'-7 1/2"	11"	
416	1/2"	16	6'-10"	VI	2'-7 1/2"	11"	
417	1/2"	16	6'-10"	VI	2'-7 1/2"	11"	
418	1/2"	16	6'-11"	VI	2'-8"	11"	
419	1/2"	16	6'-11"	VI	2'-8"	11"	
420	1/2"	16	7'-0"	VI	2'-8"	11"	
421	1/2"	16	7'-1"	VI	2'-9"	11"	
422	1/2"	16	7'-1 1/2"	VI	2'-9"	11"	
423	1/2"	16	7'-2"	VI	2'-9"	11"	
424	1/2"	16	7'-3 1/2"	VI	2'-10"	11"	
425	1/2"	16	7'-4"	VI	2'-10"	11"	
426	1/2"	16	7'-5 1/2"	VI	2'-11 1/2"	11"	
427	1/2"	16	7'-7"	VI	3'-0"	11"	
428	1/2"	16	7'-8"	VI	3'-0"	11"	
429	1/2"	16	7'-8 1/2"	VI	3'-1 1/2"	11"	
430	1/2"	16	7'-11 1/2"	VI	3'-2 1/2"	11"	
431	1/2"	16	8'-0 1/2"	VI	3'-2 1/2"	11"	
432	1/2"	16	8'-2 1/2"	VI	3'-3 1/2"	11"	
433	1/2"	16	8'-4 1/2"	VI	3'-4 1/2"	11"	
434	1/2"	16	8'-6 1/2"	VI	3'-5 1/2"	11"	
435	1/2"	16	8'-8 1/2"	VI	3'-6 1/2"	11"	
436	1/2"	16	8'-10 1/2"	VI	3'-7 1/2"	11"	
437	1/2"	16	9'-0 1/2"	VI	3'-8 1/2"	11"	
438	1/2"	16	9'-3 1/2"	VI	3'-10 1/2"	11"	
439	1/2"	16	9'-6 1/2"	VI	3'-11 1/2"	11"	
440	1/2"	16	9'-9 1/2"	VI	4'-1 1/2"	11"	
441	1/2"	16	10'-0 1/2"	VI	4'-2 1/2"	11"	
442	1/2"	16	10'-3 1/2"	VI	4'-4 1/2"	11"	
443	1/2"	16	10'-6 1/2"	VI	4'-5 1/2"	11"	
444	1/2"	16	10'-10 1/2"	VI	4'-7 1/2"	11"	
445	1/2"	16	11'-1 1/2"	VI	4'-9 1/2"	11"	
446	1/2"	16	11'-5 1/2"	VI	4'-11 1/2"	11"	
447	1/2"	16	11'-9"	VI	5'-1"	11"	
448	1/2"	16	12'-1"	VI	5'-3"	11"	
449	1/2"	16	12'-5"	VI	5'-5"	11"	
450	1/2"	16	12'-9"	VI	5'-7"	11"	
451	1/2"	16	13'-1 1/2"	VI	5'-9"	11"	
452	1/2"	80	6'-8"	VI	2'-6"	11"	
453	1/2"	32	6'-9"	VI	2'-7"	11"	
454	1/2"	32	6'-9 1/2"	VI	2'-7 1/2"	11"	
455	1/2"	32	6'-9 1/2"	VI	2'-7 1/2"	11"	
456	1/2"	32	6'-10 1/2"	VI	2'-7 1/2"	11"	
457	1/2"	32	6'-11"	VI	2'-8"	11"	
458	1/2"	32	6'-11 1/2"	VI	2'-8 1/2"	11"	
459	1/2"	32	7'-1"	VI	2'-8 1/2"	11"	
460	1/2"	32	7'-1 1/2"	VI	2'-9"	11"	
461	1/2"	32	7'-3"	VI	2'-10"	11"	
462	1/2"	32	7'-4"	VI	2'-10"	11"	
463	1/2"	32	7'-6"	VI	2'-11 1/2"	11"	
464	1/2"	32	7'-7 1/2"	VI	3'-0"	11"	
465	1/2"	32	7'-9 1/2"	VI	3'-1 1/2"	11"	
466	1/2"	32	8'-0"	VI	3'-2 1/2"	11"	
467	1/2"	32	8'-2 1/2"	VI	3'-3 1/2"	11"	
468	1/2"	32	8'-5"	VI	3'-5"	11"	
469	1/2"	32	8'-7 1/2"	VI	3'-6 1/2"	11"	
470	1/2"	32	8'-10 1/2"	VI	3'-7 1/2"	11"	
471	1/2"	32	9'-2 1/2"	VI	3'-9 1/2"	11"	
472	1/2"	259	3'-10"	IV	1'-2"	1'-6"	
473	1/2"	432	39'-2"	Str.			
475	1/2"	96	8'-8"	III	3'-5"	7"	
476	1/2"	102	6'-11 1/2"	III	2'-6 1/2"	7"	
477	1/2"	32	10'-2 1/2"	III	4'-3 1/2"	11"	
478	1/2"	32	10'-7 1/2"	VI	4'-6 1/2"	11"	
479	1/2"	32	11'-0 1/2"	VI	4'-8 1/2"	11"	
480	1/2"	32	11'-5 1/2"	VI	4'-11 1/2"	11"	
481	1/2"	32	11'-11"	VI	5'-2"	11"	
482	1/2"	32	12'-4 1/2"	VI	5'-4 1/2"	11"	
483	1/2"	32	12'-10"	VI	5'-7 1/2"	11"	
484	1/2"	32	13'-4 1/2"	VI	5'-10 1/2"	11"	
485	1/2"	32	13'-11"	VI	6'-2"	11"	



BAR LIST-SUPERSTRUCTURE (Cont.)

Mark	Size	No.	Req'd	length	Type	Dimensions	
						l	m
486	1/2"	32	14'-5 1/2"	VI	6'-5 1/2"	11"	
487	1/2"	16	13'-5 1/2"	VI	5'-11 1/2"	11"	
488	1/2"	16	13'-10 1/2"	VI	6'-1 1/2"	11"	
489	1/2"	16	14'-2 1/2"	VI	6'-3 1/2"	11"	
490	1/2"	16	14'-7 1/2"	VI	6'-6 1/2"	11"	
491	1/2"	32	9'-6 1/2"	VI	3'-11 1/2"	11"	
492	1/2"	32	9'-10 1/2"	VI	4'-1 1/2"	11"	
510	1/2"	1	3'-2"	V	1'-8"	1'-6"	
511	1/2"	1	1'-8"				
to	1/2"	1 ea.	by 8" to	Str.			
515	1/2"	1	4'-4"				
516	1/2"	1	3'-2"		1'-8"		
to	1/2"	1 ea.	by 4" to	Str.	by 4" to	1'-6"	
524	1/2"	1	5'-10"		4'-4"		
525	1/2"	1	4'-8"				
to	1/2"	1 ea.	by 4" to	Str.			
535	1/2"	1	8'-0"				
536	1/2"	1	4'-8"				
to	1/2"	1 ea.	by 8" to	Str.			
541	1/2"	1	8'-0"				
542	1/2"	1	8'-8"				
to	1/2"	2 ea.	by 8" to	Str.			
579	1/2"	1	33'-4"				
580	1/2"	1	9'-0"	IX	5'-0"	3'-5"	
581	1/2"	1	9'-7 1/2"	IX	5'-0"	4'-0 1/2"	
582	1/2"	1	10'-3 1/2"	IX	5'-0"	4'-8 1/2"	
583	1/2"	1	11'-1 1/2"			1'-1 1/2"	
to	1/2"	1 ea.	by 7 1/2" to	Str.	5'-0"	by 7 1/2" to	
590	1/2"	1	15'-7 1/2"			5'-7 1/2"	
591	1/2"	1	16'-5 1/2"			1'-0 1/2"	
to	1/2"	1 ea.	by 7 1/2" to	Str.	5'-0"	by 7 1/2" to	
597	1/2"	1	20'-3 1/2"			4'-10 1/2"	
598	1/2"	1	21'-1 1/2"			1'-3 1/2"	
to	1/2"	1 ea.	by 7 1/2" to	Str.	5'-0"	by 7 1/2" to	
5105	1/2"	1	25'-8"			5'-10"	
5106	1/2"	1	26'-11 1/2"			1'-8 1/2"	
to	1/2"	1 ea.	by 7 1/2" to	Str.	5'-0"	by 7 1/2" to	
5111	1/2"	1	30'-2 1/2"			4'-11 1/2"	
5112	1/2"	1	31'-0 1/2"			1'-9 1/2"	
to	1/2"	1 ea.	by 7 1/2" to	Str.	5'-0"	by 7 1/2" to	
5117	1/2"	1	34'-3"			4'-7"	
5118	1/2"	410	33'-8"	Str.			
5119	1/2"	1	2'-7"	V	1'-1"	1'-6"	
5120	1/2"	1	2'-11"	V	1'-5"	1'-6"	
5121	1/2"	1	3'-3"	V	1'-9"	1'-6"	
5122	1/2"	1	3'-6"	V	2'-0"	1'-6"	
5123	1/2"	1	3'-10"	V	2'-4"	1'-6"	
5124	1/2"	1	4'-2"	V	2'-8"	1'-6"	
5125	1/2"	1	4'-6"	V	3'-0"	1'-6"	
5126	1/2"	1	4'-9"	V	3'-3"	1'-6"	
5127	1/2"	1	5'-0"	V	3'-6"	1'-6"	
5128	1/2"	1	5'-4"	V	3'-10"	1'-6"	
5129	1/2"	1	5'-9"	V	4'-3"	1'-6"	
5130	1/2"	1	6'-0"	V	4'-6"	1'-6"	
5131	1/2"	1	6'-3"	V	4'-9"	1'-6"	
5132	1/2"	1	10"				
to	1/2"	1 ea.	by 8" to	Str.			
5138	1/2"	1	4'-10"				
5139	1/2"	1	4'-10"				
to	1/2"	1 ea.	by 4" to	Str.			
5151	1/2"	1	8'-10"				
5152	1/2"	1	4'-10"				
to	1/2"	1 ea.	by 8" to	Str.			
5158	1/2"	1	8'-10"				
5159	1/2"	1	9'-4"	IX	6'-2"	2'-7"	
5160	1/2"	1	9'-11"	IX	6'-1"	3'-3"	
5161	1/2"	1	10'-7"	IX	6'-1"	3'-11"	
5162	1/2"	1	11'-4"	IX	6'-0"	4'-9"	
5163	1/2"	1	11'-10"	IX	6'-0"	5'-3"	
5164	1/2"	1	12'-8"	X	5'-11"	1'-9"	
5165	1/2"	1	13'-5"	X	5'-11"	2'-6"	
5166	1/2"	1	14'-0"	X	5'-10"	3'-2"	
5167	1/2"	1	14'-8"	X	5'-10"	3'-10"	
5168	1/2"	1	15'-3"	X	5'-9"	4'-6"	
5169	1/2"	1	15'-11"	X	5'-9"	5'-2"	

BAR LIST-SUPERSTRUCTURE (Cont.)

Mark	Size	No.	Req'd	length	Type	Dimensions	
						l	m
5170	1/2"	1	16'-6"	I	5'-8"	5'-10"	
5171	1/2"	1	17'-4"	II	5'-8"	1'-3"	
5172	1/2"	1	18'-1"	II	5'-8"	2'-0"	
5173	1/2"	1	18'-8"	II	5'-8"	2'-7"	
5174	1/2"	1	19'-4"	II	5'-7"	3'-4"	
5175	1/2"	1	20'-1"	II	5'-7"	4'-1"	
5176	1/2"	1	20'-6"	II	5'-6"	4'-7"	
5177	1/2"	1	21'-4"	II	5'-6"	1'-0"	
5178	1/2"	1	22'-0"	II	5'-6"	1'-8"	
5179	1/2"	1	22'-7"	II	5'-5"	2'-4"	
5180	1/2"	1	23'-4"	II	5'-5"	3'-1"	
5181	1/2"	1	23'-4"	II	5'-5"	3'-8"	
5182	1/2"	1	24'-9"	II	5'-5"	4'-6"	
5183	1/2"	1	25'-2"	II	5'-4"	5'-0"	
5184	1/2"	1	25'-11"	II	5'-4"	5'-9"	
5185	1/2"	1	26'-8"	II	5'-4"	6'-6"	
5186	1/2"	1	27'-6"	II	5'-4"	1'-11"	
5187	1/2"	1	28'-2"	II	5'-3"	2'-7"	
5188	1/2"	1	28'-11"	II	5'-3"	3'-4"	
5189	1/2"	1	29'-7"	II	5'-3"	4'-0"	
5190	1/2"	1	30'-3"	II	5'-3"	4'-8"	
5191	1/2"	1	30'-10"	II	5'-3"	5'-4"	
5192	1/2"	1	31'-8"	II	5'-2"	1'-10"	
5193	1/2"	1	32'-2"	II	5'-2"	2'-4"	
5194	1/2"	1	33'-2"	II	5'-2"	3'-4"	
5195	1/2"	1	33'-10"	II	5'-2"	4'-0"	
5196	1/2"	1	9'-5"				
5232	1/2"	1	32'-9"				
5233	1/2"	205	34'-8"	IX	5'-0"	5'-0"	
901	1/2"	24	60'-0"	Str.			
1105	1/2"	32	26'-0"	Str.			
1106	1/2"	32	46'-0"	Str.			
1107	1/2"	112	60'-0"	Str.			
1108	1/2"	32	13'-0"	Str.			
1109	1/2"	8	35'-2"	Str.			
1110	1/2"	8	36'-8"	Str.			
1111	1/2"	8	38'-3"	Str.			
1112	1/2"	60	41'-0"	Str.			
1113	1/2"	32	27'-0"	Str.			
1114	1/2"	8	43'-11 1/2"	Str.			
1115	1/2"	40	43'-0"	Str.			
1116	1/2"	16	30'-0"	Str.			
1117	1/2"	16	50'-0"	Str.			
1118	1/2"	32	18'-0"	Str.			
1119	1/2"	24	34'-0"	Str.			
1120	1/2"	32	27'-0"	Str.			
1121	1/2"	40	44'-0"	Str.			
1122	1/2"	40	50'-8"	Str.			
1123	1/2"	8	44'-5 1/2"	Str.			
1124	1/2						

FED ROAD DIV NO	DISTRICT	PROJECT NO	SHEET NO	TOTAL SHEETS
9	COLO	F005-3(9)	29	

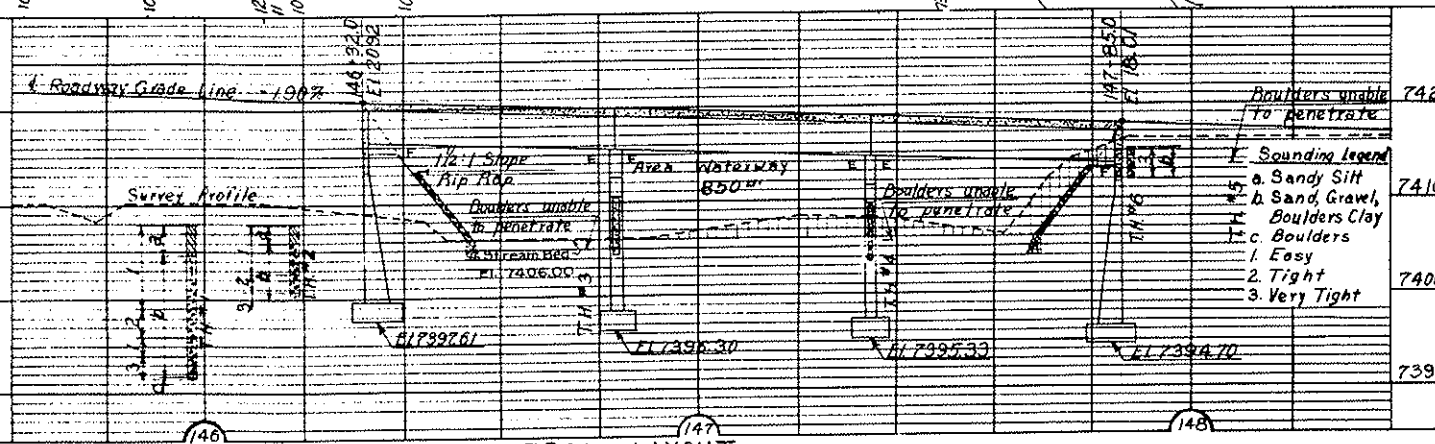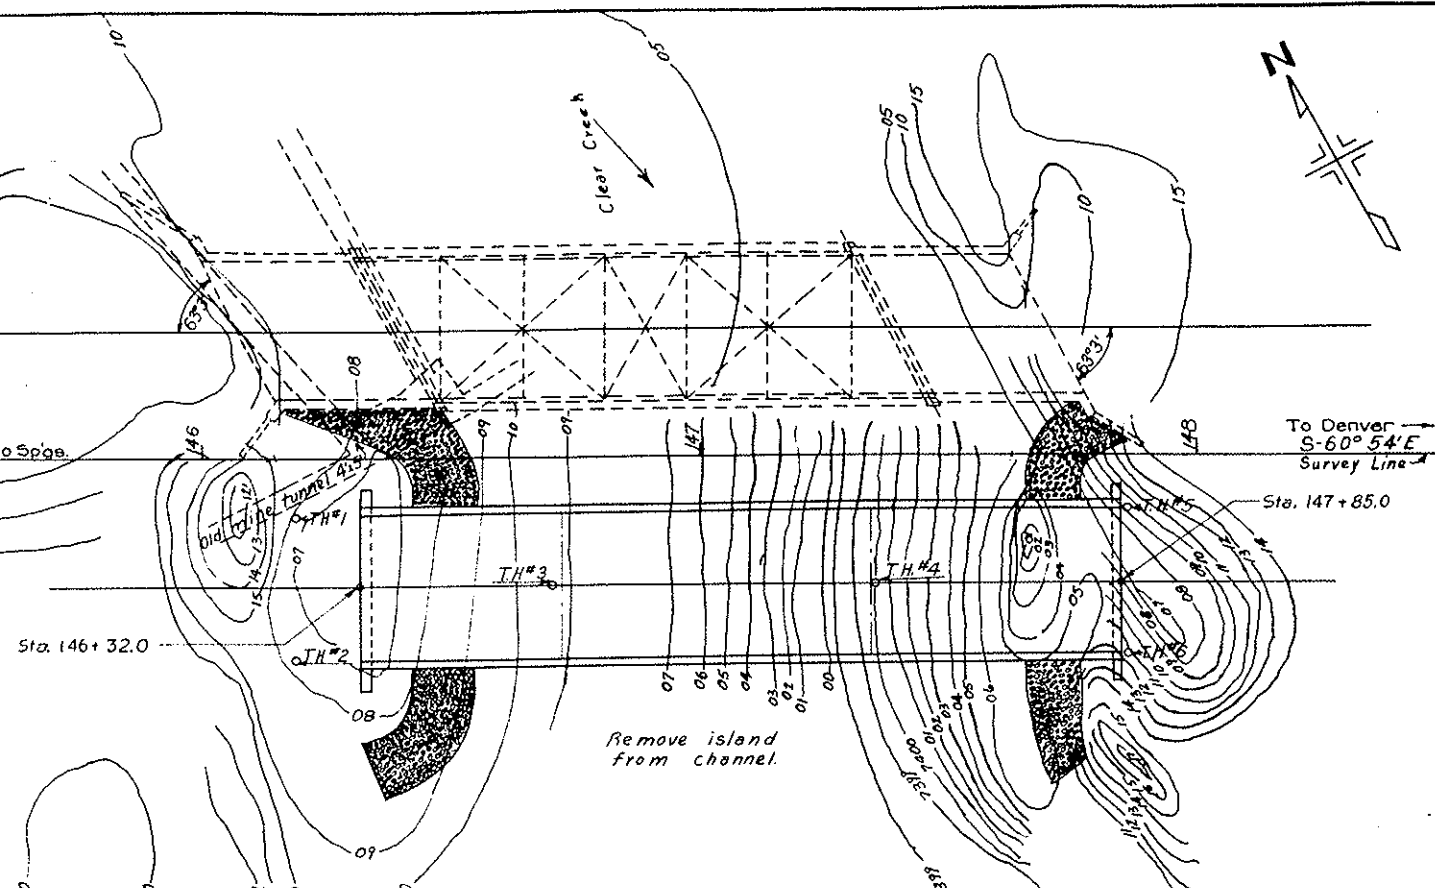

BAR LIST SUPERSTRUCTURE

MARK	SIZE	NO REQD	LENGTH	TYPE	ℓ	m
401	1/2" φ	492	8'-8"	I		
402	1/2" φ	105	5'-3"	II	0'-5"	1'-10 1/2"
403	1/2" φ	236	25'-11"	Str.		
404	1/2" φ	118	25'-9"	Str.		
405	1/2" φ	72	3'-7"	II	1'-0"	0'-5 1/2"
406	1/2" φ	408	2'-1"	III		
412	1/2" φ	4	4'-7"	Str.		
413	1/2" φ	4	4'-0"	Str.		
414	1/2" φ	4	5'-5"	Str.		
415	1/2" φ	4	6'-3"	Str.		
501	3/8" φ	126	33'-9"	Str.		
502	3/8" φ	114	34'-6"	VI		
503	3/8" φ	112	36'-1"	V		
801	1" φ	14	27'-5"	Str.		
1001	1/4" φ	36	30'-6"	Str.		
1002	1/4" φ	24	36'-6"	Str.		
1003	1/4" φ	36	42'-6"	Str.		
1004	1/4" φ	24	46'-6"	Str.		
1005	1/4" φ	40	53'-5"	VII	50'-11"	
1006	1/4" φ	20	53'-1"	VII	50'-7"	

BAR SUMMARY SUPERSTRUCTURE

15,159 lin. ft. 1/2" φ @ 0.668#/lin. ft. = 10,126 lbs.
 12,227 " " 3/8" φ @ 1.043# " " = 12,753 "
 384 " " 1" φ @ 2.670# " " = 1,025 "
 7,819 " " 1/4" φ @ 4.303# " " = 33,645 "
 Plus 1% ± Overrun = 571 "
 Total = 58,120 lbs.

BAR LIST ABUT. 1 (ABUT. 4 Same)

MARK	SIZE	NO REQD	LENGTH	TYPE	ℓ	m
408	1/2" φ	30	13'-7"	IV	4'-10 1/2"	1'-3"
410	1/2" φ	4	14'-7"	II	1'-3"	5'-8 1/2"
411	1/2" φ	8	5'-7 1/2"	Str.		
416	1/2" φ	20	8'-1"	II	1'-8 1/2"	2'-0"
417	1/2" φ	12	6'-1"	II	1'-8 1/2"	1'-0"
422	1/2" φ	4	10'-6"	IX		
504	3/8" φ	34	6'-3"	Str.		
505	3/8" φ	12	4'-11"	Str.		
506	3/8" φ	28	9'-5"	Str.		
507	3/8" φ	4	21'-3"	Str.		
508	3/8" φ	4	11'-0"	Str.		
510	3/8" φ	4	7'-9"	Str.		
601	3/4" φ	5	45'-3"	Str.		
901	1/8" φ	4	33'-9"	Str.		
902	1/8" φ	2	19'-3"	Str.		
903	1/8" φ	1	33'-9"	Str.		
904	1/8" φ	1	45'-3"	Str.		
1007	1/4" φ	4	21'-3"	Str.		
1008	1/4" φ	4	15'-9"	Str.		
1009	1/4" φ	4	11'-0"	Str.		

BAR SUMMARY ABUT. 1 (ABUT. 4 Same)

788 lin. ft. 1/2" φ @ 0.668#/lin. ft. = 526 lbs.
 691 " " 3/8" φ @ 1.043# " " = 721 "
 226 " " 3/4" φ @ 1.502# " " = 340 "
 253 " " 1/8" φ @ 3.400# " " = 860 "
 192 " " 1/4" φ @ 4.303# " " = 826 "
 Plus 1% ± Overrun = 32 "
 Total = 3305 bs.

BAR LIST PIER 2 & PIER 3


MARK	SIZE	NO REQD	LENGTH	TYPE	ℓ	m
418	1/2" φ	24	5'-9"	Str.		
419	1/2" φ	10	19'-4"	Str.		
420	1/2" φ	13	8'-4 1/2"	VIII	1'-9"	1'-9"
421	1/2" φ	13	7'-8"	II	1'-9"	1'-9"
422	1/2" φ	4	10'-6"	IX		
509	3/8" φ	71	10'-8"	II	2'-9"	2'-3"
602	3/4" φ	44	6'-9"	Str.		
802	1" φ	8	5'-0"	Str. (Pier No. 2 only)		
803	1" φ	12	18'-0"	Str.		
804	1" φ	4	15'-9"	Str.		
905	1/8" φ	4	33'-6"	Str.		
906	1/8" φ	4	19'-4"	Str.		
907	1/8" φ	8	12'-0"	Str.		
908	1/8" φ	4	33'-6"	Str.		

BAR SUMMARY PIER 2

582 lin. ft. 1/2" φ @ 0.668#/lin. ft. = 389 lbs.
 757 " " 3/8" φ @ 1.043# " " = 790 "
 297 " " 3/4" φ @ 1.502# " " = 446 "
 319 " " 1" φ @ 2.670# " " = 852 "
 441 " " 1/8" φ @ 3.400# " " = 1,499 "
 Plus 1% ± Overrun = 39 "
 Total = 4,015 lbs.


BAR SUMMARY PIER 3

582 lin. ft. 1/2" φ @ 0.668#/lin. ft. = 389 lbs.
 757 " " 3/8" φ @ 1.043# " " = 790 "
 297 " " 3/4" φ @ 1.502# " " = 446 "
 279 " " 1" φ @ 2.670# " " = 745 "
 441 " " 1/8" φ @ 3.400# " " = 1,499 "
 Plus 1% ± Overrun = 36 "
 Total = 3,905 lbs.

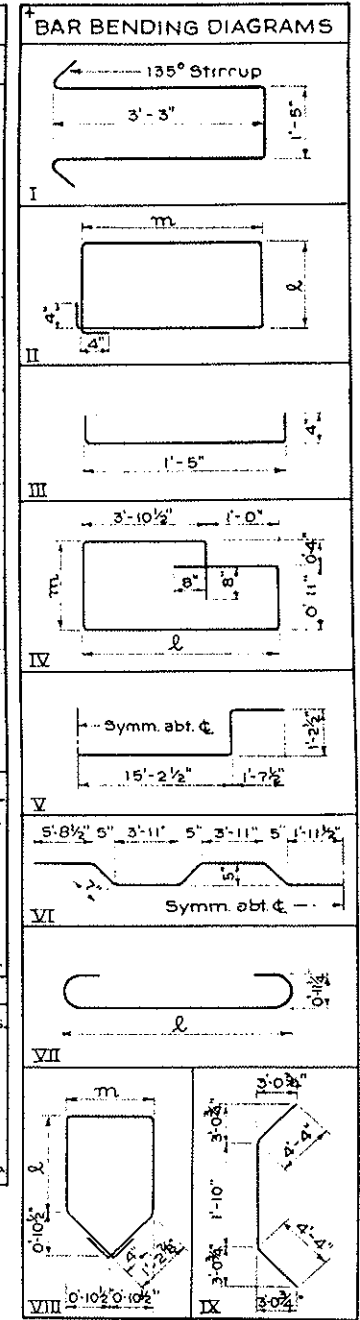

SUMMARY OF QUANTITIES

DESCRIPTION	UNIT	SUPERSTR.	ABUT. 1	PIER 2	PIER 3	ABUT. 4	TOTAL
Unclassified Excavation	Cu. Yd.						450
Rock Excavation (Str.)	Cu. Yd.						5
Common Excavation (Str.)	Cu. Yd.		82	61	67	110	320
Structure Backfill (Class I)	Cu. Yd.		70	51	56	143	320
Mechanical Tamping	Hrs.		20	5	6	16	47
Treated Bridge Timber	Mft bm		0.120			0.120	0.240
Class "A" Concrete	Cu. Yd.	273	26.8	25.7	25.7	26.8	378
Reinforcing Steel (Includes 1% ± Overrun)	Lbs.	58,120	3,305	4,015	3,905	3,305	72,650
Structural Steel (Includes 1/2" ± for Paint)	Lbs.	12,090	580	450	900	580	14,600
Rip Rap (1'-6" thick)	Cu. Yd.		130			90	220
Sheet Copper (32 oz)	Lbs.	11					11
Drain Pipe (Conc. Floor) 4" Dia x 2'-0"	Each	6					6
Expansion Joint Material (Type I)	Sq. Ft.	68					68

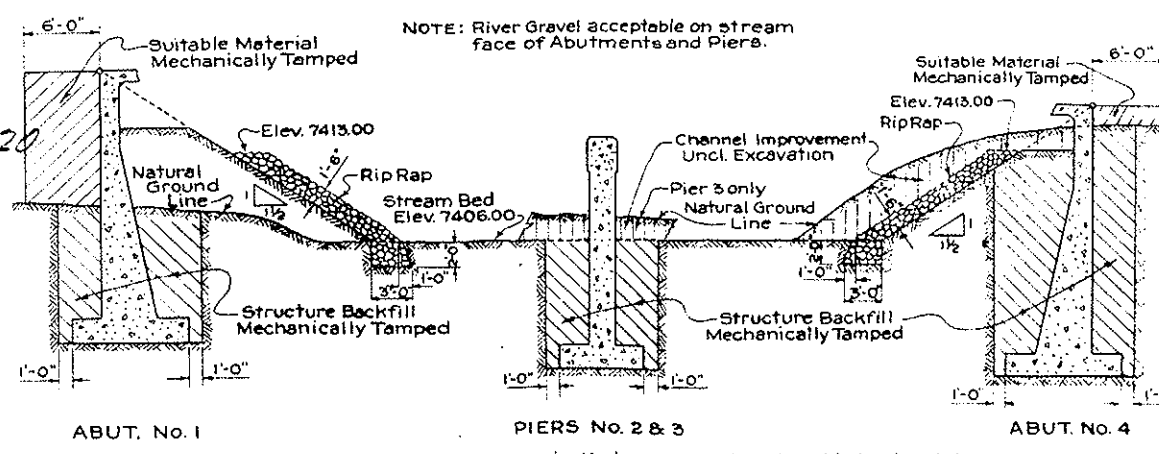

NOTE: River Gravel acceptable on stream face of Abutments and Piers.

All material that is to be mechanically tamped shall be placed in horizontal layers not more than 6 inches in depth and tamped before the next layer is placed.

GENERAL NOTES

ALL WORK SHALL BE DONE ACCORDING TO THE STANDARD SPECIFICATIONS OF THE COLORADO DEPARTMENT OF HIGHWAYS APPLICABLE TO THE PROJECT.

ALL CONCRETE SHALL BE CLASS "A" AND AIR ENTRAINMENT AS SPECIFIED.

ALL CONCRETE SURFACES EXPOSED TO NORMAL VIEW BY HIGHWAY TRAFFIC SHALL RECEIVE CLASS "T" SURFACE FINISH. WING FRACES SHALL RECEIVE ORDINARY SURFACE FINISH.

CONCRETE GIRDERS, FLOOR SLABS, AND CURBS SHALL BE FORMED MONOLITHICALLY.

FORMS FOR CONCRETE SURFACES EXPOSED IN THE FINISHED WORK SHALL BE CONSTRUCTED OF SHEET PILING OR TONGUE AND GROOVE LUMBER 2" x 4" UNLESS FACED WITH PANEL BOARD.

SOUNDINGS AND DEPTH OF FOOTING SHOWN ARE IN ACCORDANCE WITH THE BEST AVAILABLE DATA AND WHEN DIFFERENT CONDITIONS ARE ENCOUNTERED THE BRIDGE ENGINEER WILL IN ALL REINFORCING STEEL SHALL CONFORM TO ASTM SPECIFICATION A 305-53T OR THE LATEST REVISION THEREOF, AND SHALL BE INTERMEDIATE GRADE STEEL OF A DEFORMED TYPE. EACH BAR SHALL BE TAGGED WITH THE MEMBER DESIGNATION AND THE STATION NUMBER OF THE PROJECT.

20 DIAMETERS OF THE BAR. DIMENSIONS FOR REINFORCING STEEL NOT SHOWN AS CLEAR SHALL BE TO THE CENTER LINE OF THE BAR.

ALL STRUCTURAL STEEL SHALL BE PAINTED ONE SHOP COAT OF ZINC CHROMATE AND TWO FIELD COATS OF ALUMINUM UNLESS OTHERWISE NOTED EXCEPT THE UNEXPOSED PORTION OF STEEL PILING NEED NOT BE PAINTED.

HANDRAIL BOLTS SHALL HAVE HEX HEADS AND LOCK WASHERS UNLESS OTHERWISE SPECIFIED AND ALL RIVETS EXCEPT AS NOTED ARE 1" DIA AND SHALL BE POWER DRIVEN.

WHEN TREATED TIMBER OR PILING IS SHOWN ON THE DRAWING THE PRESERVATIVE FOR TREATMENT SHALL BE CROSYDOL OIL.

WHEN EXCAVATING FOR FOOTINGS THE FINAL ONE FOOT IN DEPTH SHALL BE DONE BY HAND LABOR METHODS.

PRIMARY BARS SHALL NOT BE SPLICED EXCEPT BY PERMISSION OF THE ENGINEER. WHEN PRIMARY BARS ARE SPLICED THEY SHALL LAP 30 DIAMETERS FOR BARS NEAR TOP OF BEAMS AND GIRDERS HAVING MORE THAN 12 INCHES OF CONCRETE UNDER THE BARS AND 20 DIAMETERS FOR BARS NEAR BOTTOM OF MEMBERS.

LOADING DATA


LIVE LOAD (A.S.H.O. H20-S16-44)
 DEAD LOAD ASSUMES 15 LBS. PER SQ. FT. ADDITIONAL WEARING SURFACE WHICH INCLUDES THE 1" THICK CONCRETE MONOLITHIC WEARING SURFACE SHOWN.

DESIGNING DATA

A.S.H.O. 1955 UNIT STRESSES EXCEPT AS NOTED
 Reinforcing Steel is 20000 lbs per sq in
 Structural Steel is 18000 lbs per sq in
 Ic 12000 lbs per sq in
 n 10


COLORADO
 DEPARTMENT OF HIGHWAYS
3-SPANS @ 50'-0" CONCRETE
SLAB & GIRDER BRIDGE STD. STL.
RAIL 30'-0" RDWY 2'-0" CURBS
 GENERAL LAYOUT, SUMMARY OF QUANTITIES, GENERAL NOTES
 Across Clear Creek
 Sta. 146+32.0 to 147+85.0
 Near Idaho Springs Sec 31 T. 3S. R. 72W
 Designed by E.F.S. Approved by [Signature]
 Made by EMC Bridge Engineer
 Checked by [Signature] Date 11-19-56

Revised 11-19-56 Changed No. Req. of 901 Bars M.E.R

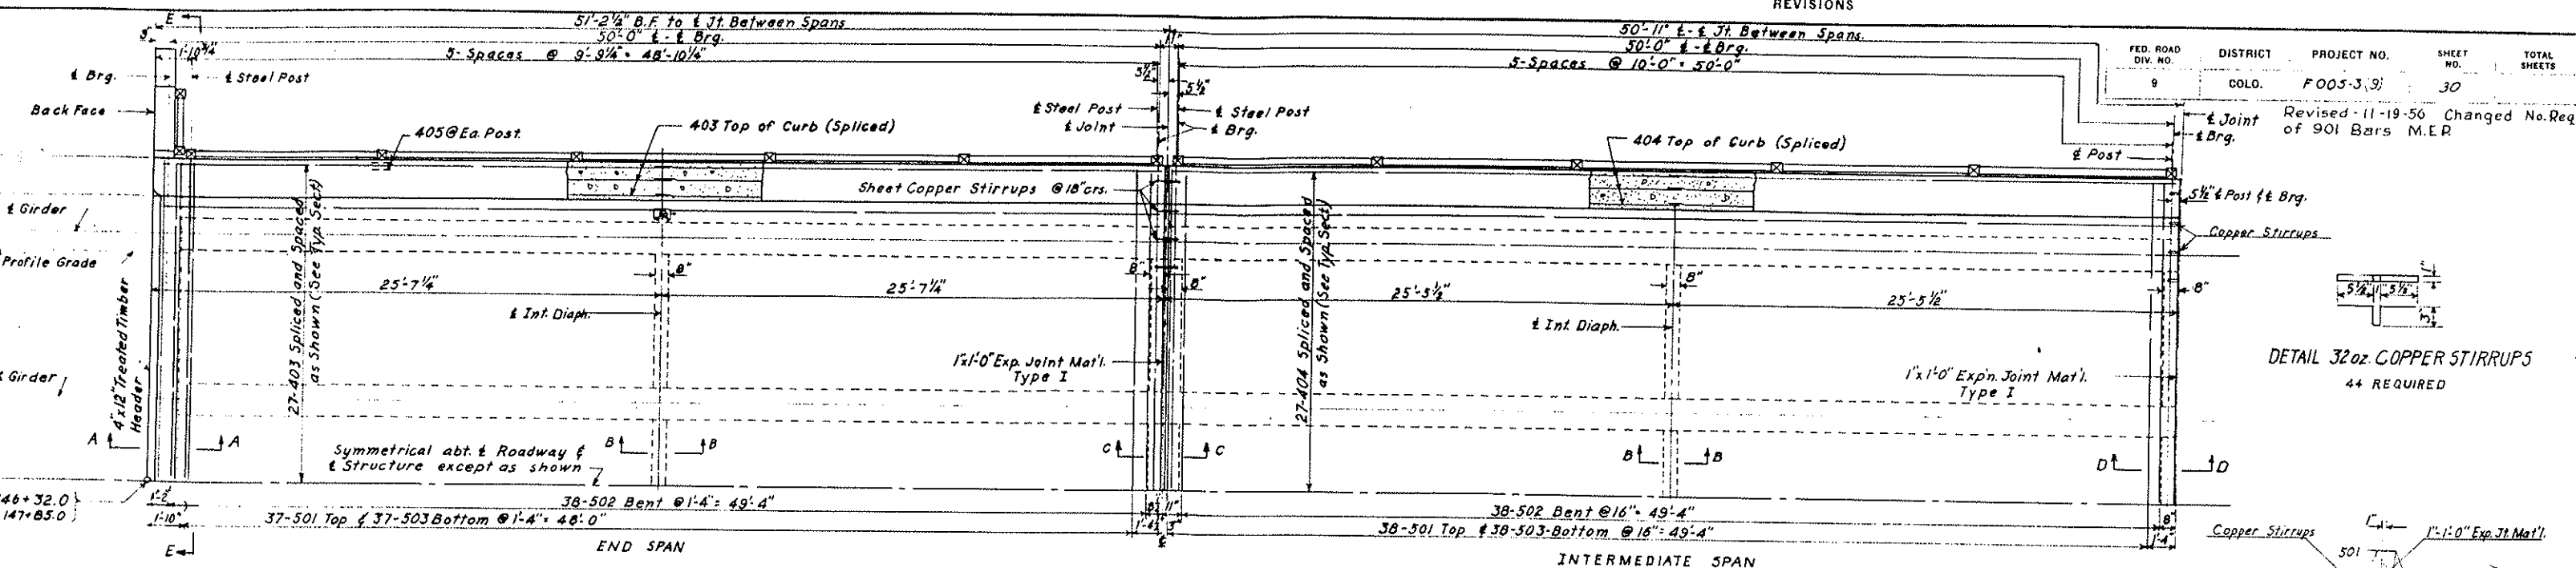


HALF PLAN SHOWING SLAB REINFORCEMENT


DETAIL 32oz. COPPER STIRRUPS
44 REQUIRED

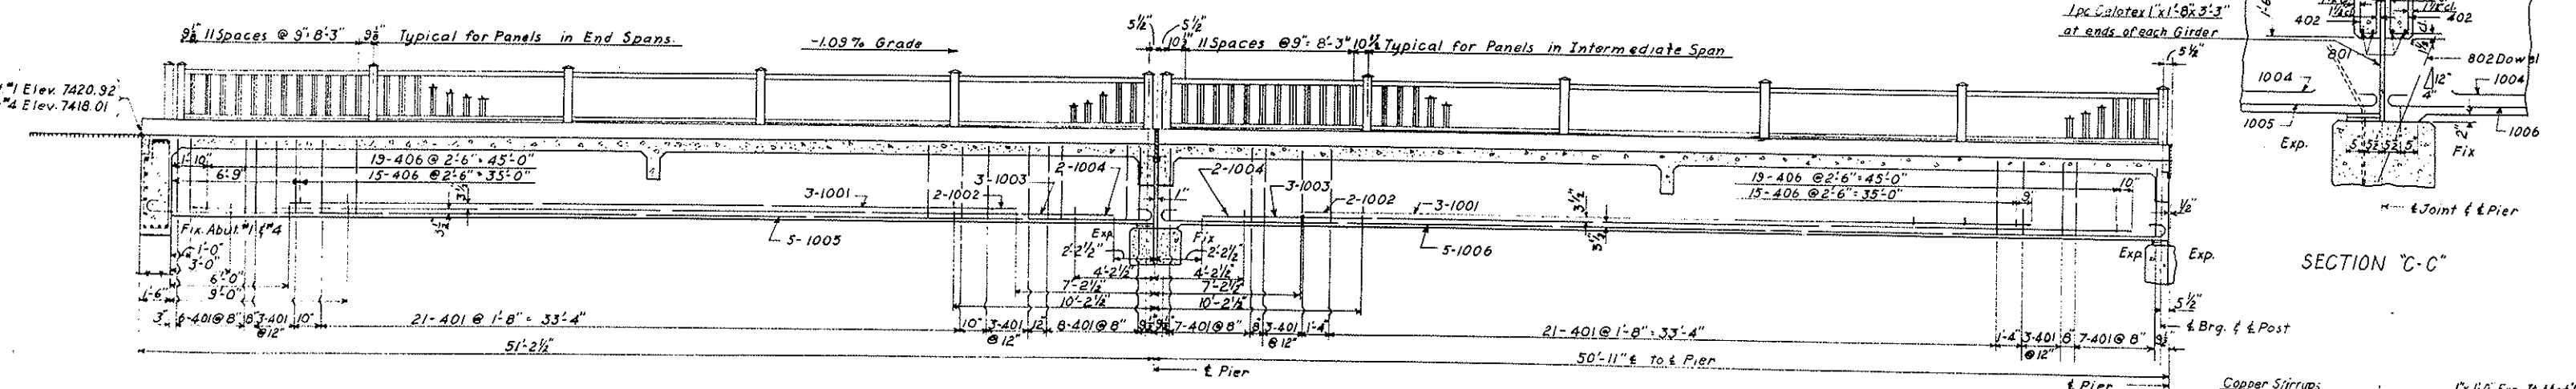

PART LONGITUDINAL SECTION AT PROFILE GRADE

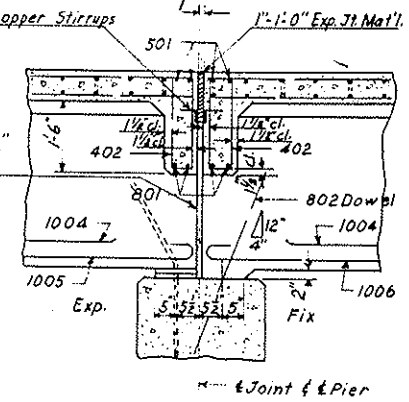

SECTION "C-C"

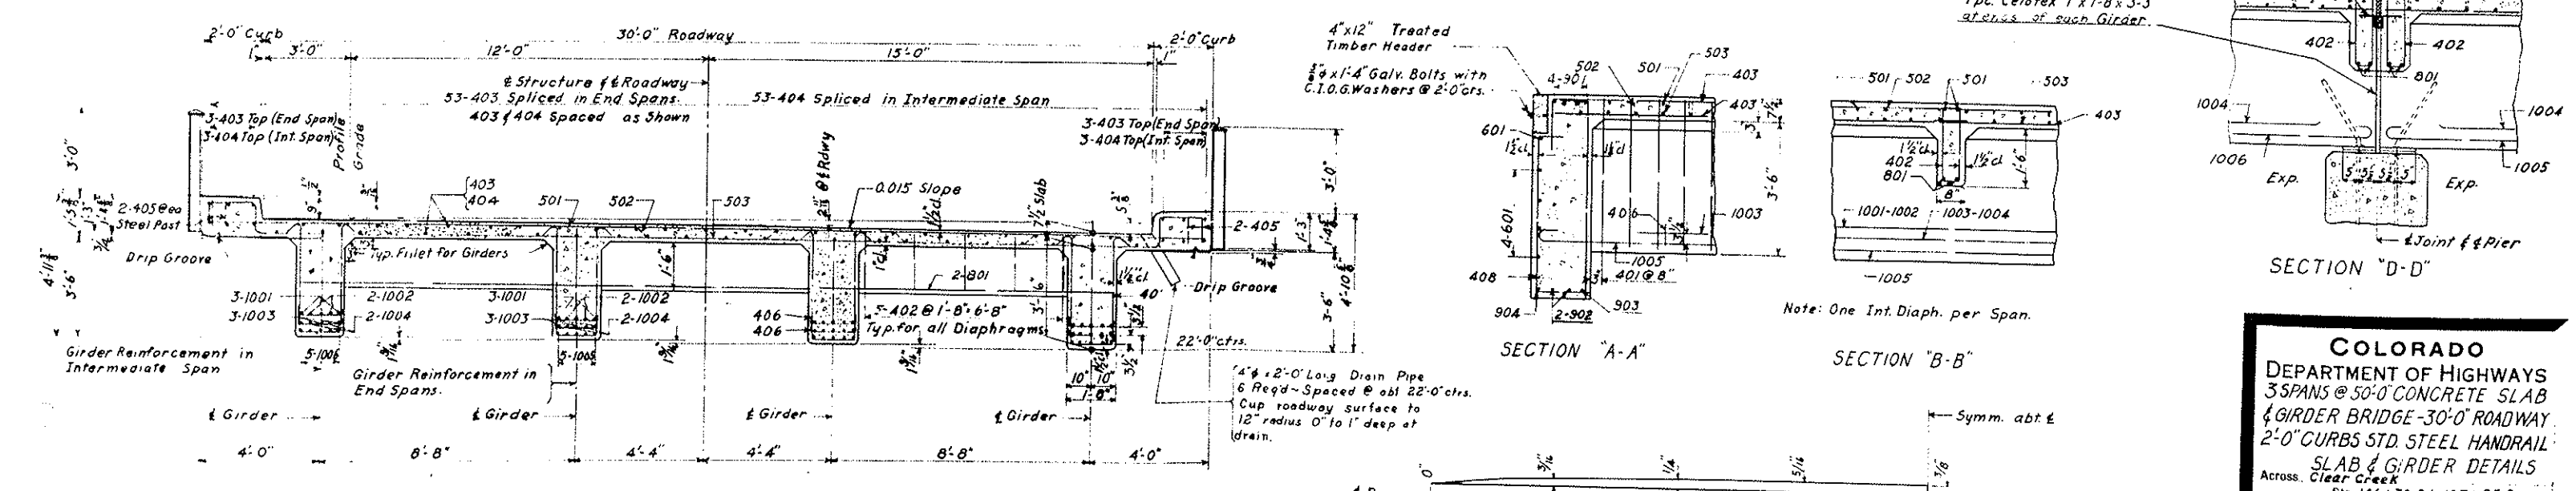


TYPICAL SECTION THRU ROADWAY

SECTION "A-A"

SECTION "B-B"










SECTION "D-D"

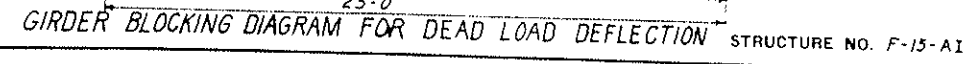

GIRDER BLOCKING DIAGRAM FOR DEAD LOAD DEFLECTION

COLORADO
DEPARTMENT OF HIGHWAYS
3 SPANS @ 50'-0" CONCRETE SLAB
& GIRDER BRIDGE - 30'-0" ROADWAY
2'-0" CURBS STD. STEEL HANDRAIL
SLAB & GIRDER DETAILS
Across Clear Creek
Sta. 146+32.0 to 147+85.0
Near Idaho Springs Sec. 31 T. 35 R. 72W
Designed by E.F.S. Approved by D.W.H. Bridge Engineer
Made by D.K.J. Checked by Date: Aug. 31, 1956

FED. ROAD DIV. NO.	DISTRICT	PROJECT NO.	SHEET NO.	TOTAL SHEETS
9	COLO.	F005-3(9)	31	

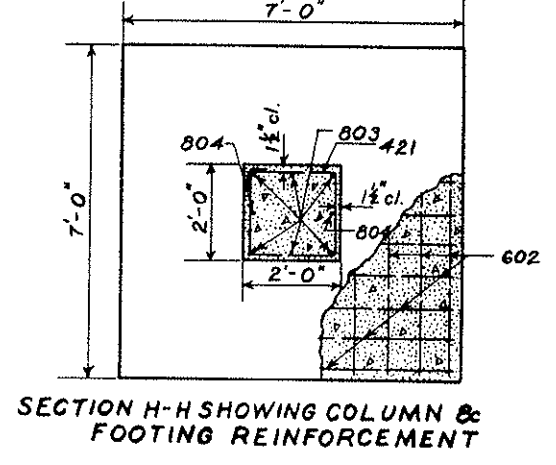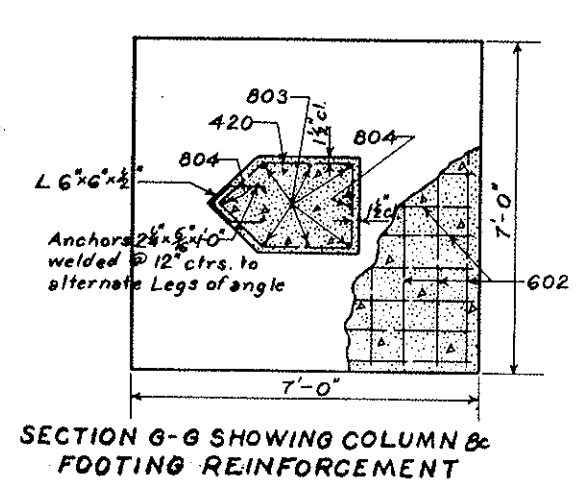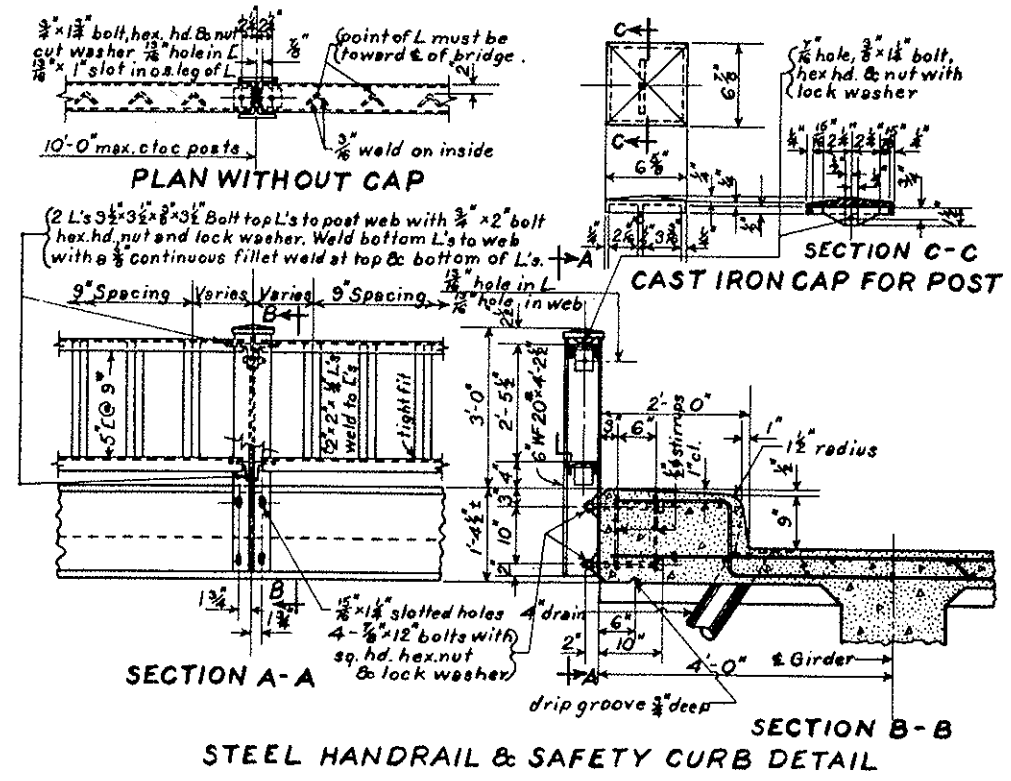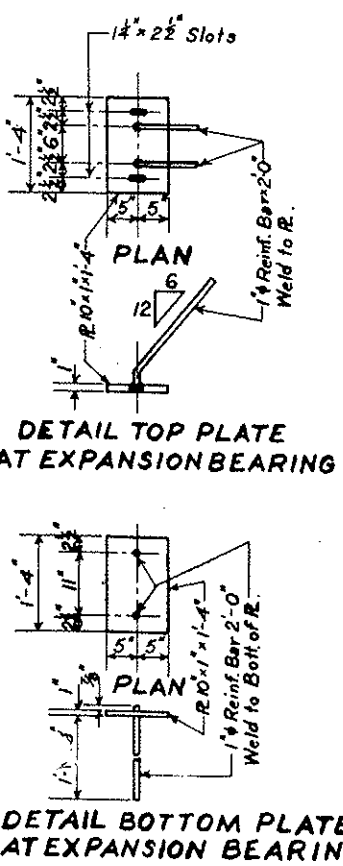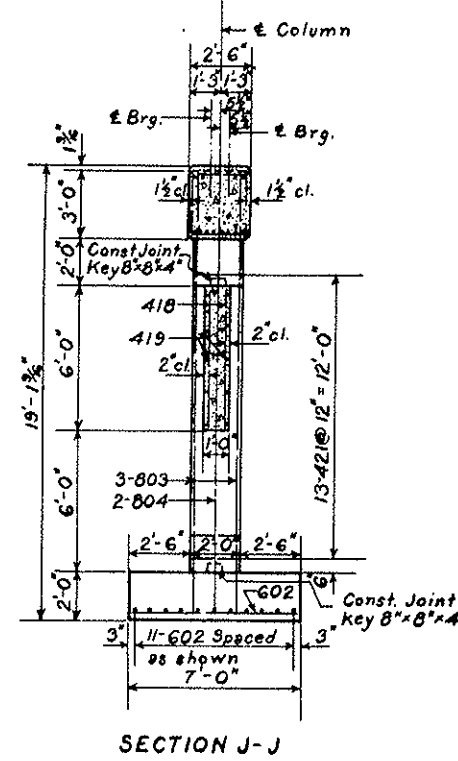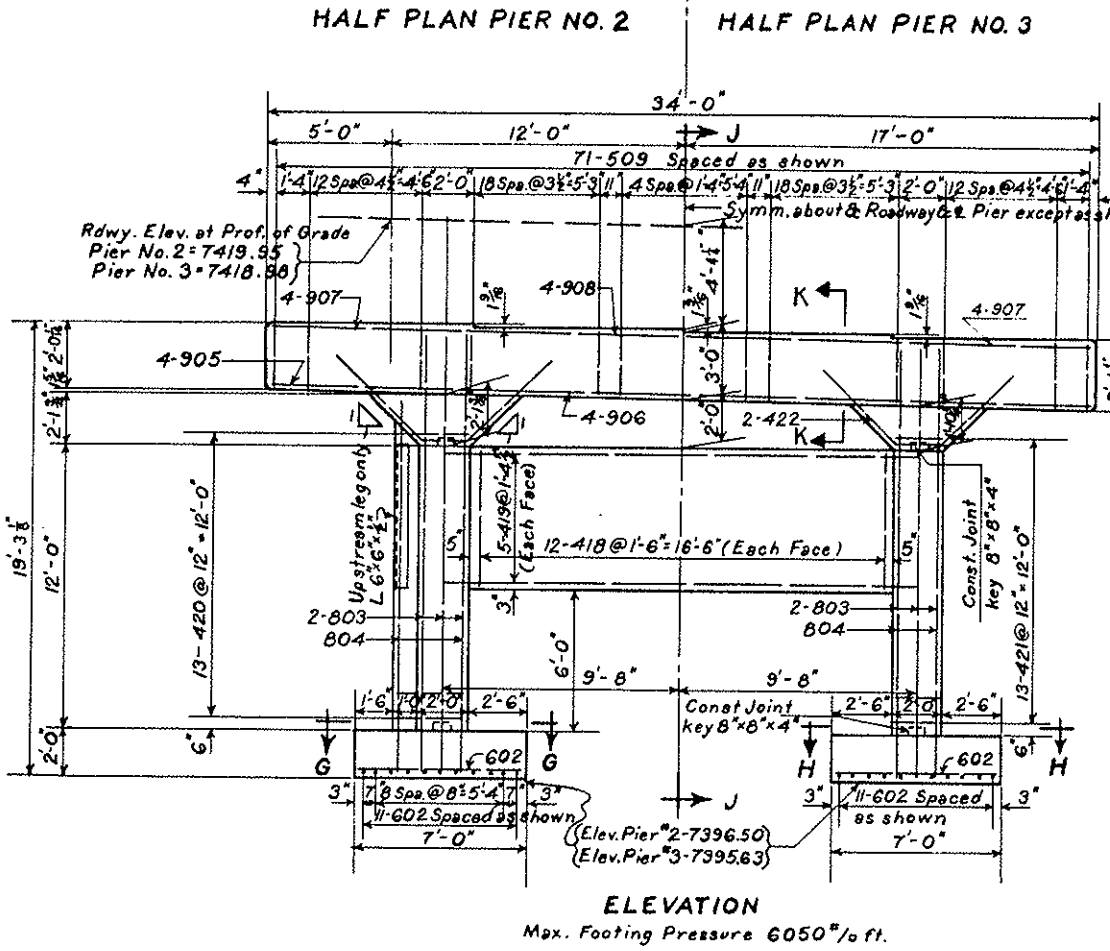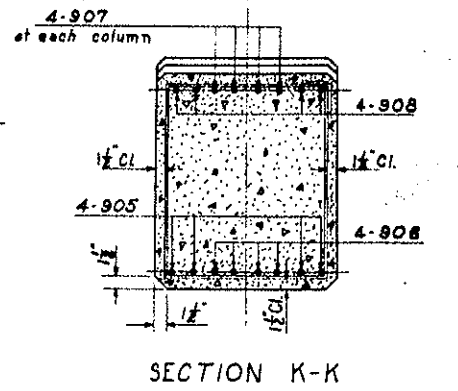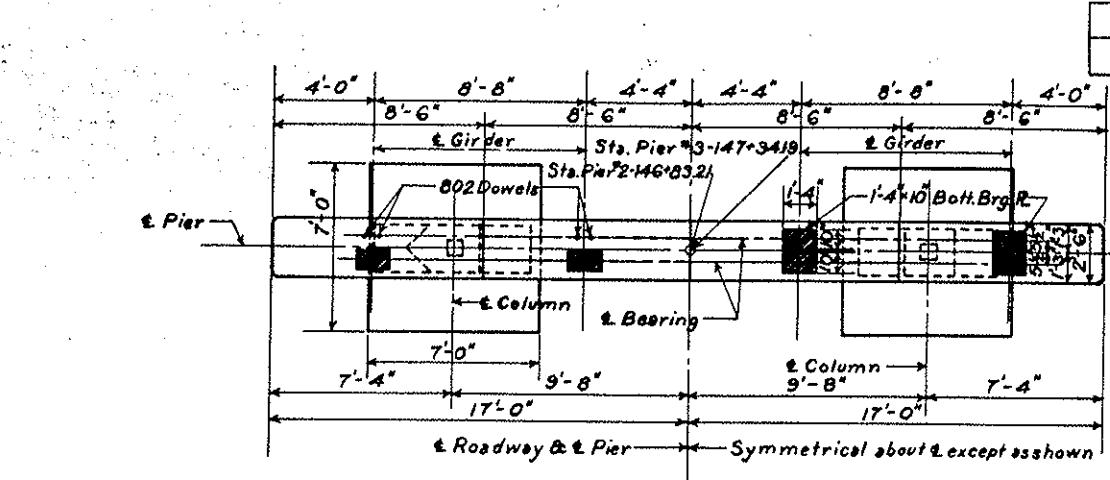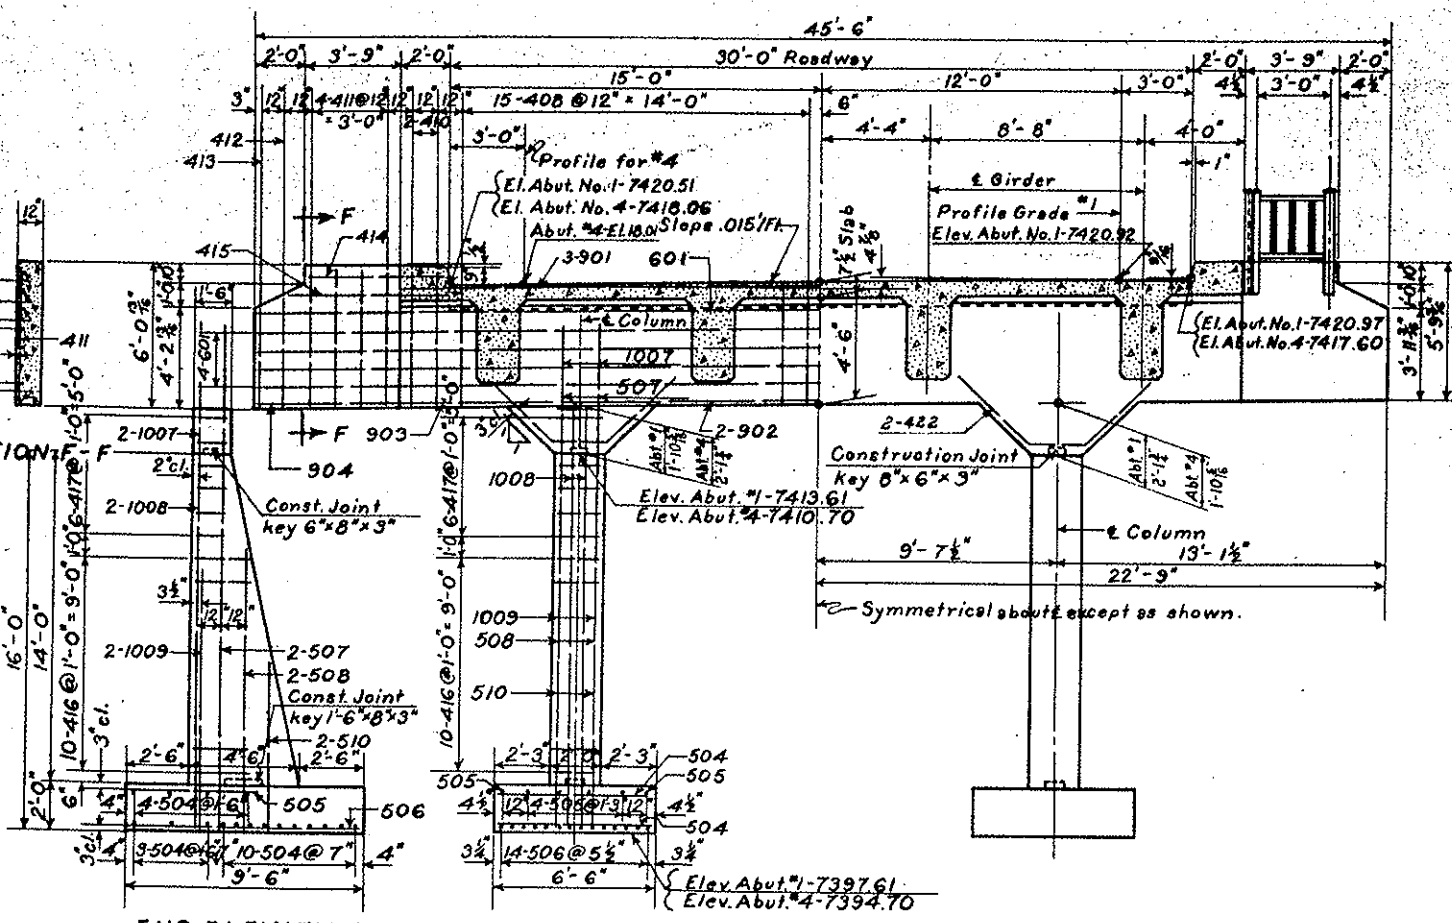

LOADING DATA.
 LIVE LOAD - A, A', & H, O.
 DEAD LOAD - ASSUMES 15 LBS. PER SQ. FT. ADDITION
 AL WEARING SURFACE WHICH INCLUDES THE 1/2 INCH
 CONCRETE MONOLITHIC WEARING SURFACE SHOWN



DESIGNING DATA.
 A.A.S.H.O. 164 UNIT STRESSES
 f_c - 4000 lbs. per sq. in.
 f_s - 20000 lbs. per sq. in.
 n - 10

COLORADO
 DEPARTMENT OF HIGHWAYS
 3 SPANS @ 50'-0" CONCRETE SLAB
 & GIRDER BRIDGE-30'-0" ROADWAY
 DETAILS OF COLUMNS OF ABUTMENTS
 PIER DETAILS

Across: CLEAR CREEK
 Sta. 146+32.0 To 147+86.0
 Near: IDAHO SPRINGS Sec. 31 T. 35 S. R. 72 W.

Designed by E.F.S. Approved by D.L. Marshall
 Made by D.K.W. Bridge Engineer
 Checked by Date: Aug. 31, 1956

STRUCTURE NO. F-15-A1

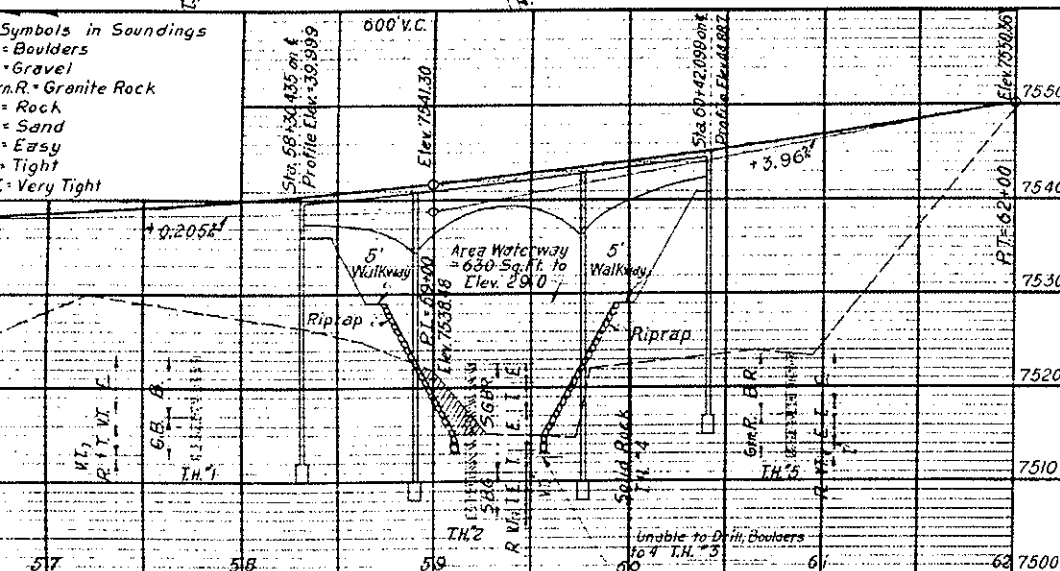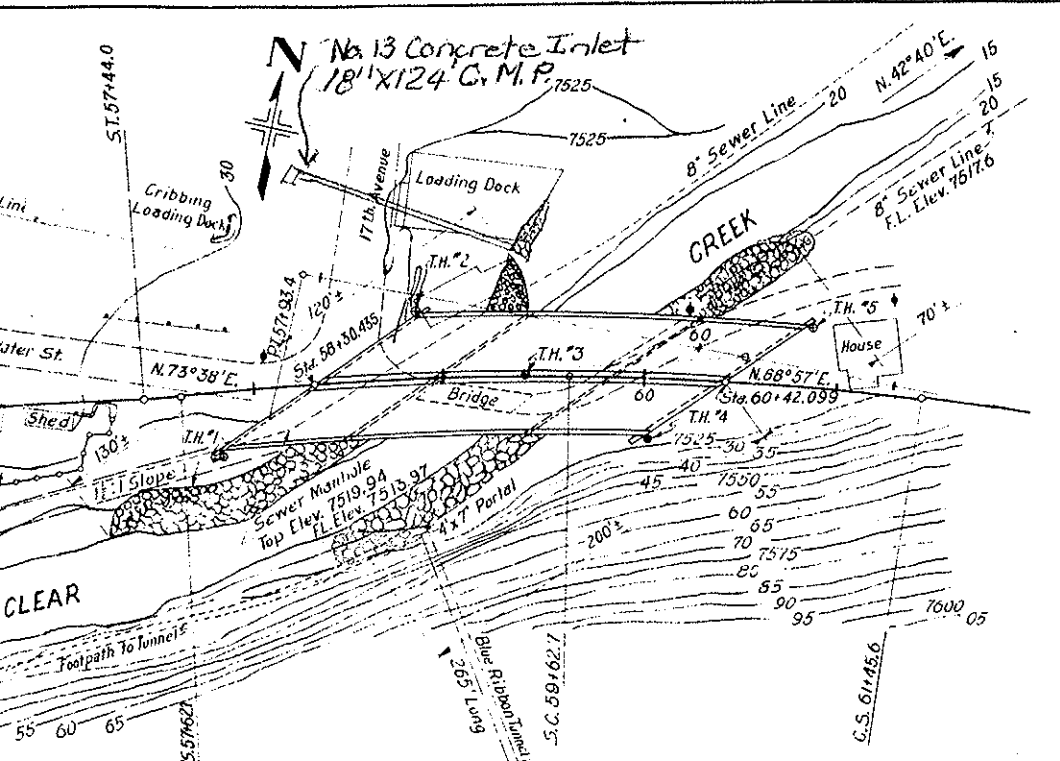

GENERAL LAYOUT

SUMMARY OF QUANTITIES

Description	Unit	Superstructure	Abutment No.1	Pier No.2	Pier No.3	Abutment No.4	Total
Classified Excavation	Cu. Yd.						930
Rock Excavation (Str.)	Cu. Yd.		21		237	181	439
Common Excavation (Str.)	Cu. Yd.		358	354		68	780
Structure Backfill (Class I)	Cu. Yd.		251	287	280	131	949
Mechanical Tamping	Hour		82	28	18	102	230
Painted Bridge Timber	Mft. Lbm.		0.429			0.363	0.792
Class A Concrete	Cu. Yd.	849.2	76.7	47.6	49.5	73.0	1096.0
Reinforcing Steel (Includes 1% for Overrun)	Lb.	227,775	15,695	17,180	17,940	15,555	294,145
Structural Steel (Includes 1/2% for Paint)	Lb.	16,270	670			685	17,625
Riprap	Cu. Yd.		368			382	750
Expansion Joint Material (Type I)	Sq. Ft.	222					222
Electrical Conduit with Junction Boxes	L. Ft.	425					425

BAR LIST

Abutment No.1

Mark	Size	No.	Req'd Length	Type	Dimension
					l m
4105	1/2"	94	10'-10 1/2"	XII	3'-5 3/4" 1'-8"
4106	1/2"	10	10'-10 1/2"	X	
4107	1/2"	188	6'-2"	XIII	
4108	1/2"	20	7'-9"	Str.	
4109	1/2"	13	4'-4"	Str.	
4110	1/2"	13	4'-6"	Str.	
5400	3/8"	144	5'-6"	Str.	
801	1"	4	32'-9"	Str.	
802	1"	2	35'-6"	Str.	
803	1"	5	28'-9"	Str.	
804	1"	1	30'-3"	Str.	
805	1"	2	43'-9"	Str.	
806	1"	1	38'-6"	Str.	
807	1"	1	36'-4"	Str.	
808	1"	4	41'-0"	Str.	
809	1"	2	27'-3"	Str.	
810	1"	1	20'-0"	Str.	
811	1"	1	22'-0"	Str.	
812	1"	4	37'-0"	Str.	
813	1"	2	35'-9"	Str.	
814	1"	1	30'-6"	Str.	
815	1"	1	28'-0"	Str.	
816	1"	2	22'-6"	Str.	
817	1"	14	21'-3"	Str.	
818	1"	2	23'-0"	Str.	
819	1"	14	21'-9"	Str.	
820	1"	2	23'-6"	Str.	
821	1"	14	22'-3"	Str.	
822	1"	2	24'-0"	Str.	
823	1"	14	22'-9"	Str.	
824	1"	2	24'-6"	Str.	
825	1"	14	23'-3"	Str.	
826	1"	2	25'-0"	Str.	
827	1"	14	23'-9"	Str.	
828	1"	2	25'-6"	Str.	
829	1"	14	24'-3"	Str.	
830	1"	2	26'-0"	Str.	
831	1"	14	24'-9"	Str.	
832	1"	128	3'-6"	Str.	
1165	1 1/8"	32	6'-0"	Str.	

BAR SUMMARY

Abutment No.1

2554 Lin.Ft. 1/2" @ 0.668 Lbs./Lin.Ft. = 1,706 Lbs.
 792 Lin.Ft. 3/8" @ 1.043 Lbs./Lin.Ft. = 826 Lbs.
 4489 Lin.Ft. 1" @ 2.67 Lbs./Lin.Ft. = 11,986 Lbs.
 192 Lin.Ft. 1 1/8" @ 5.313 Lbs./Lin.Ft. = 1,020 Lbs.
 Plus 1% ± Overrun = 157 Lbs.
Total = 15,635 Lbs.

BAR LIST

Abutment No.4

Mark	Size	No.	Req'd Length	Type	Dimension
					l m
4105	1/2"	79	10'-10 1/2"	XII	3'-5 3/4" 1'-8"
4106	1/2"	6	10'-10 1/2"	X	
4107	1/2"	197	6'-2"	XIII	
4108	1/2"	20	7'-9"	Str.	
4111	1/2"	13	4'-0"	Str.	
4112	1/2"	13	4'-6"	Str.	
5400	3/8"	144	5'-6"	Str.	
832	1"	128	3'-6"	Str.	
835	1"	1	54'-0"	Str.	
836	1"	1	60'-0"	Str.	
837	1"	1	59'-6"	Str.	
838	1"	1	53'-9"	Str.	
839	1"	1	53'-8"	Str.	
840	1"	1	59'-9"	Str.	
841	1"	1	60'-0"	Str.	
842	1"	1	53'-6"	Str.	
843	1"	1	52'-3"	Str.	
844	1"	1	58'-0"	Str.	
845	1"	1	58'-7"	Str.	
846	1"	1	52'-0"	Str.	
847	1"	1	52'-7"	Str.	
848	1"	1	58'-4"	Str.	
849	1"	1	57'-9"	Str.	
850	1"	1	52'-0"	Str.	
851	1"	2	22'-0"	Str.	
852	1"	14	20'-9"	Str.	
853	1"	2	23'-0"	Str.	
854	1"	14	21'-9"	Str.	
855	1"	2	24'-0"	Str.	
856	1"	14	22'-9"	Str.	
857	1"	2	25'-0"	Str.	
858	1"	14	23'-9"	Str.	
859	1"	2	26'-0"	Str.	
860	1"	14	24'-9"	Str.	
861	1"	2	27'-0"	Str.	
862	1"	14	25'-9"	Str.	
863	1"	2	28'-6"	Str.	
864	1"	14	27'-3"	Str.	
865	1"	2	29'-0"	Str.	
866	1"	14	27'-9"	Str.	
1165	1 1/8"	32	6'-0"	Str.	

BAR SUMMARY

Abutment No.4

2405 Lin.Ft. 1/2" @ 0.668 Lbs./Lin.Ft. = 1,607 Lbs.
 792 Lin.Ft. 3/8" @ 1.043 Lbs./Lin.Ft. = 826 Lbs.
 4475 Lin.Ft. 1" @ 2.67 Lbs./Lin.Ft. = 11,948 Lbs.
 192 Lin.Ft. 1 1/8" @ 5.313 Lbs./Lin.Ft. = 1,020 Lbs.
 Plus 1% ± Overrun = 154 Lbs.
Total = 15,555 Lbs.

BAR LIST

Pier No.2

Mark	Size	No.	Req'd Length	Type	Dimension
					l m
4107	1/2"	196	6'-2"	XIII	
4120	1/2"	82	13'-10 1/2"	XI	5'-9 1/4" 1'-8"
601	3/4"	160	6'-2"	Str.	
832	1"	128	3'-6"	Str.	
870	1"	16	54'-3"	Str.	
871	1"	2	25'-8"	Str.	
872	1"	14	22'-3"	Str.	
873	1"	2	26'-2"	Str.	
874	1"	14	22'-9"	Str.	
875	1"	2	26'-8"	Str.	
876	1"	14	23'-3"	Str.	
877	1"	2	27'-2"	Str.	
878	1"	14	23'-9"	Str.	
879	1"	2	27'-8"	Str.	
880	1"	14	24'-3"	Str.	
881	1"	2	28'-2"	Str.	
882	1"	14	24'-9"	Str.	
883	1"	2	28'-8"	Str.	
884	1"	14	25'-3"	Str.	
885	1"	2	29'-2"	Str.	
886	1"	14	25'-9"	Str.	
1170	1 1/8"	64	6'-2"	XIV	

BAR SUMMARY

Pier No.2

2347 Lin.Ft. 1/2" @ 0.668 Lbs./Lin.Ft. = 1568 Lbs.
 987 Lin.Ft. 3/4" @ 1.502 Lbs./Lin.Ft. = 1482 Lbs.
 4442 Lin.Ft. 1" @ 2.67 Lbs./Lin.Ft. = 11,860 Lbs.
 395 Lin.Ft. 1 1/8" @ 5.313 Lbs./Lin.Ft. = 2,099 Lbs.
 Plus 1% ± Overrun = 171 Lbs.
Total = 17,180 Lbs.

BAR LIST



Pier No.3

Mark	Size	No.	Req'd Length	Type	Dimension
					l m
4107	1/2"	212	6'-2"	XIII	
4120	1/2"	80	13'-10 1/2"	XI	5'-9 1/4" 1'-8"
4121	1/2"	2	14'-11 1/2"	XI	5'-9 1/4" 2'-9"
601	3/4"	160	6'-2"	Str.	
832	1"	128	3'-6"	Str.	
870	1"	16	54'-3"	Str.	
871	1"	2	25'-8"	Str.	
872	1"	14	22'-3"	Str.	
873	1"	2	26'-2"	Str.	
874	1"	14	22'-9"	Str.	
875	1"	2	26'-8"	Str.	
876	1"	14	23'-3"	Str.	
877	1"	2	27'-2"	Str.	
878	1"	14	23'-9"	Str.	
879	1"	2	27'-8"	Str.	
880	1"	14	24'-3"	Str.	
881	1"	2	28'-2"	Str.	
882	1"	14	24'-9"	Str.	
883	1"	2	28'-8"	Str.	
884	1"	14	25'-3"	Str.	
885	1"	2	29'-2"	Str.	
886	1"	14	25'-9"	Str.	
889	1"	2	30'-2"	Str.	
890	1"	14	26'-9"	Str.	
891	1"	2	30'-8"	Str.	
892	1"	14	27'-3"	Str.	
893	1"	2	31'-2"	Str.	
894	1"	14	27'-9"	Str.	
1170	1 1/8"	64	6'-2"	XIV	

BAR SUMMARY

Pier No.3

2447 Lin.Ft. 1/2" @ 0.668 Lbs./Lin.Ft. = 1635 Lbs.
 987 Lin.Ft. 3/4" @ 1.502 Lbs./Lin.Ft. = 1482 Lbs.
 4698 Lin.Ft. 1" @ 2.67 Lbs./Lin.Ft. = 12,544 Lbs.
 395 Lin.Ft. 1 1/8" @ 5.313 Lbs./Lin.Ft. = 2,099 Lbs.
 Plus 1% ± Overrun = 180 Lbs.
Total = 17,940 Lbs.

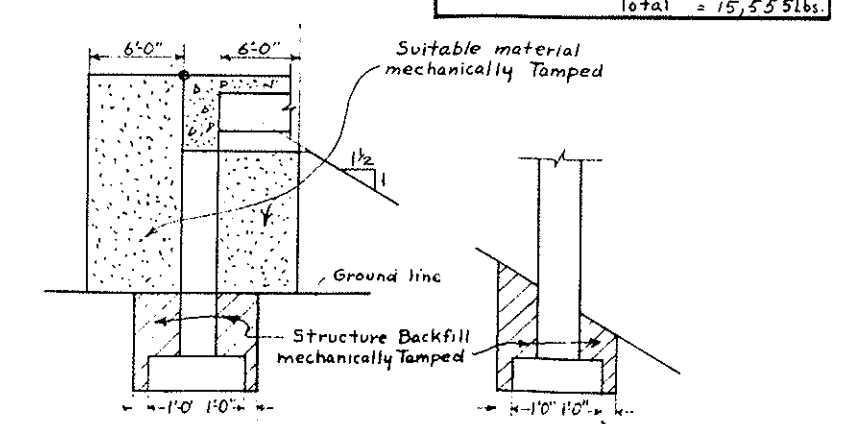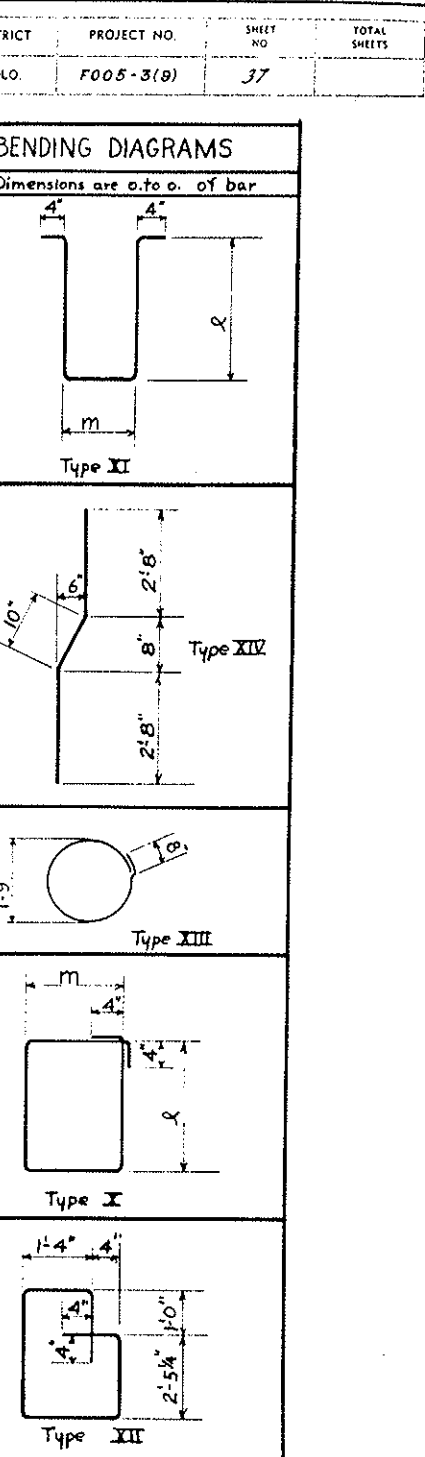

STRUCTURE BACKFILL & TAMPING DIAGRAMS

All material that is to be mechanically tamped shall be placed in horizontal layers not more than 6" in depth and tamped before the next layer is placed

GENERAL NOTES

ALL WORK SHALL BE DONE ACCORDING TO THE STANDARD SPECIFICATIONS OF THE COLORADO DEPARTMENT OF HIGHWAYS APPLICABLE TO THE PROJECT.

ALL CONCRETE SHALL BE CLASS "A" AND ALL REINFORCING SHALL BE CLASS "A" UNLESS OTHERWISE SPECIFIED.

ALL CONCRETE SURFACES EXPOSED TO NORMAL VIEW BY HIGHWAY TRAFFIC SHALL RECEIVE CLASS "I" SURFACE FINISH.

CONCRETE GIRDERS FROM SLABS AND CURBS SHALL BE FORMED MONOLITHICALLY.

FORMS FOR CONCRETE SURFACES EXPOSED IN THE FINISHED WORK SHALL BE CONSTRUCTED OF SHEAP OR TONGUE AND GROOVE PLANKS 3/4" UNLESS FACED WITH PANEL BOARD.

FOOTINGS IN ROCK SHALL BE POURED OUT TO ROCK AND NOT FORMED.

SOUNDINGS AND DEPTH OF FOOTINGS SHOWN ARE IN ACCORDANCE WITH THE BEST AVAILABLE DATA AND WHEN DIFFERENT CONDITIONS ARE ENCOUNTERED THE BRIDGE ENGINEER WILL IN SPECIFY AND DETERMINE BY REVISION IF NECESSARY.

ALL REINFORCING STEEL SHALL CONFORM TO ASTM SPECIFICATION A 305 OR OF THE LATEST REVISION THEREOF AND SHALL BE INTERMEDIATE GRADE STEEL OF A DEFORMED TYPE. EACH BAR SHALL BE TAGGED WITH THE NUMBER DESIGNATION AND THE STATION NUMBER OF THE PROJECT.

SECONDARY BARS WHEN SPLICED SHALL LAP 20 DIAMETERS OF THE BAR. DIMENSIONS FOR REINFORCING STEEL NOT SHOWN AS CLEAR SHALL BE TO THE CENTER LINE OF THE BAR.

ALL STRUCTURAL STEEL SHALL BE PAINTED ONE (1) COAT OF ZINC CHROMATE AND TWO (2) COATS OF ALUMINUM UNLESS OTHERWISE NOTED EXCEPT THE UNEXPOSED PORTION OF STEEL PILING NEED NOT BE PAINTED.

HANDPAUL BOLTS SHALL HAVE HEX HEADS, NUTS AND LOCK WASHERS UNLESS OTHERWISE SPECIFIED AND ALL PIVETS EXCEPT AS NOTED ARE 1" DIA. AND SHALL BE POWER DRIVEN.

WHEN TREATED TIMBER OF PILING IS SHOWN ON THE DRAWING THE PRESERVATIVE FOR TREATMENT SHALL BE CROCIDOLITE OIL.

WHEN EXCAVATING FOR FOOTINGS THE FINAL ONE FOOT (1') IN DEPTH SHALL BE DONE BY HAND LABOR METHODS.

PRIMARY BARS SHALL NOT BE SPLICED EXCEPT BY PERMISSION OF THE ENGINEER, WHEN PRIMARY BARS ARE SPLICED THEY SHALL LAP 34 DIAMETERS FOR BARS NEAR TOP OF BEAMS AND GIRDERS HAVING MORE THAN 12 INCHES OF CONCRETE UNDER THE BARS AND 20 DIAMETERS FOR BARS NEAR BOTTOM OF MEMBERS.

LOADING DATA

LINE LOAD A - 1.00' H20-516

DEAD LOAD AS PER SECTION 501 PER SQ. FT. ADDITIONAL WEARING SURFACE WHICH INCLUDES THE 1" THICK CONCRETE MONOLITHIC WEARING SURFACE SHOWN.

DESIGNING DATA

A 1.5 M C 1625 UNITS STRESS SPECIFY AS NOTED

Reinforcing Steel Is 20000 lbs per sq in

Structural Steel Is 18000 lbs per sq in

tc 12000 lbs per sq in

n 10

COLORADO

DEPARTMENT OF HIGHWAYS

3 SPANS @ 65'-0" CONCRETE

SLAB & GIRDER BRIDGE

2 - 28'-0" ROADWAYS

GENERAL LAYOUT & BAR LISTS

Across Clear Creek


Sta 58+30.435 to 60+42.099 on &

In Idaho Springs S.C. 36 T. 35 R. 73W

Designed by G.H.W. Approved by _____

Made by M.E.P. Bridge Engineer

Checked by _____ Date: Dec. 21, 1956

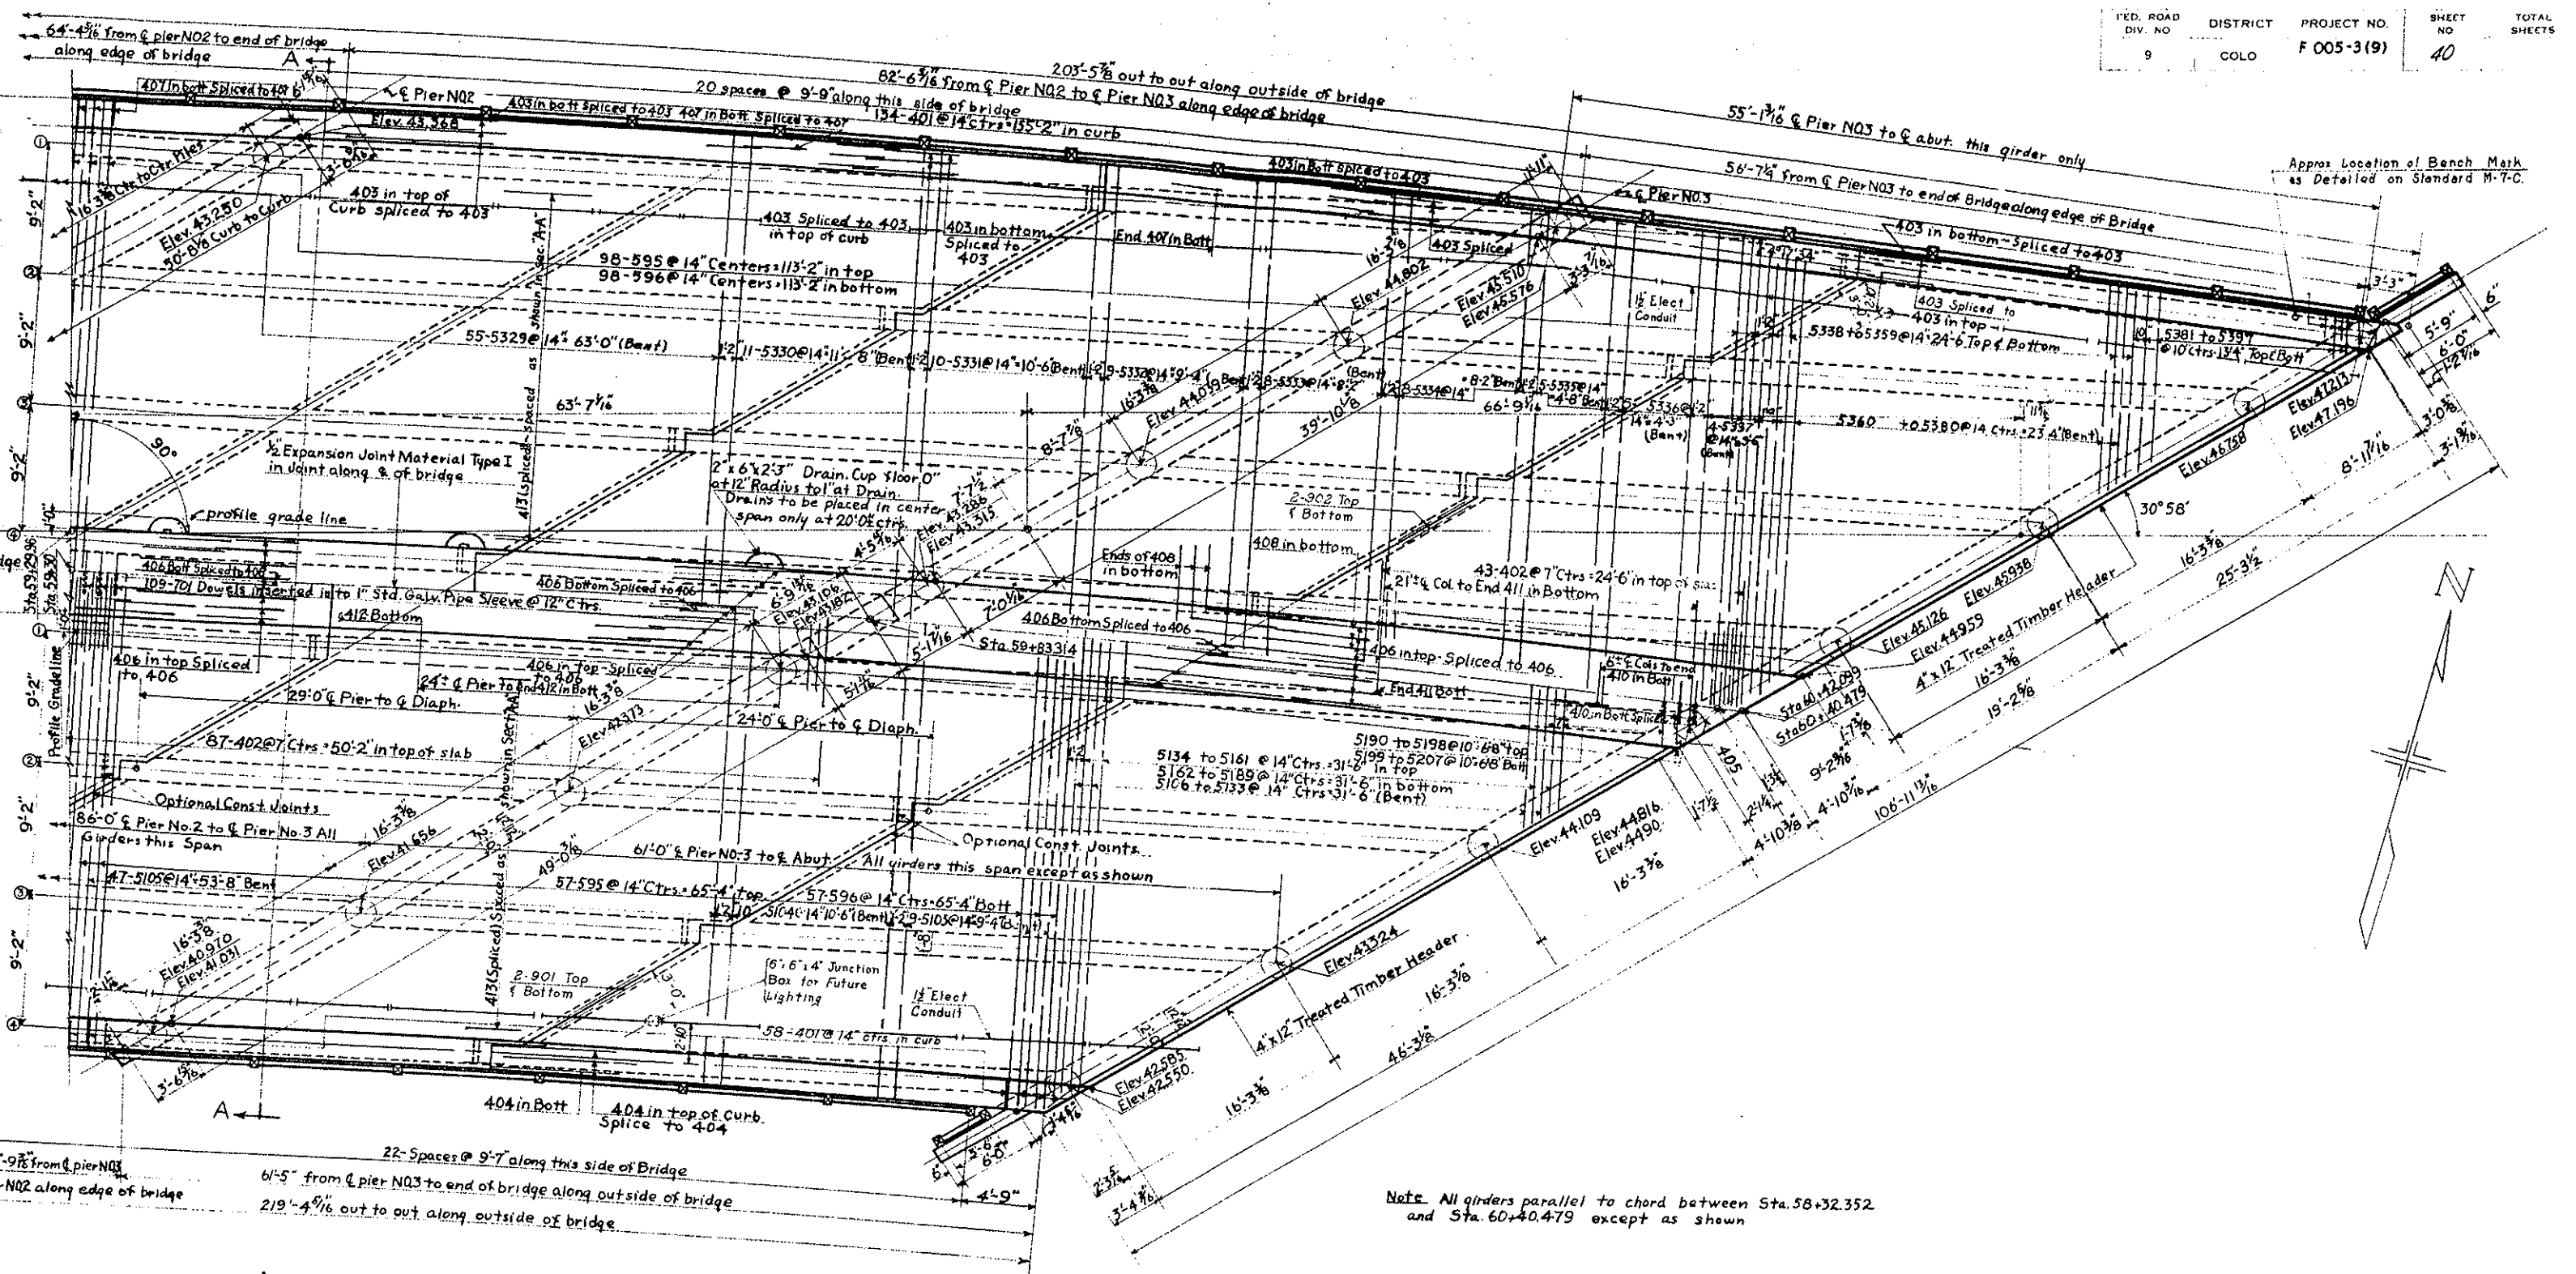





PART PLAN ~ SUPERSTRUCTURE

COLORADO
DEPARTMENT OF HIGHWAYS

PLAN OF EAST HALF OF SUPERSTRUCTURE

Across **Clear Creek**
Sta. 58+30.495 to 60+42.099
In **Idaho Springs** Sec. 36 T. 35 R. 73 W.

Designed by **GHW** Approved by **J. A. Newton**
Made by **B.D.E.** Bridge Engineer
Checked by **[Signature]** Date: **Dec. 31, 1956**

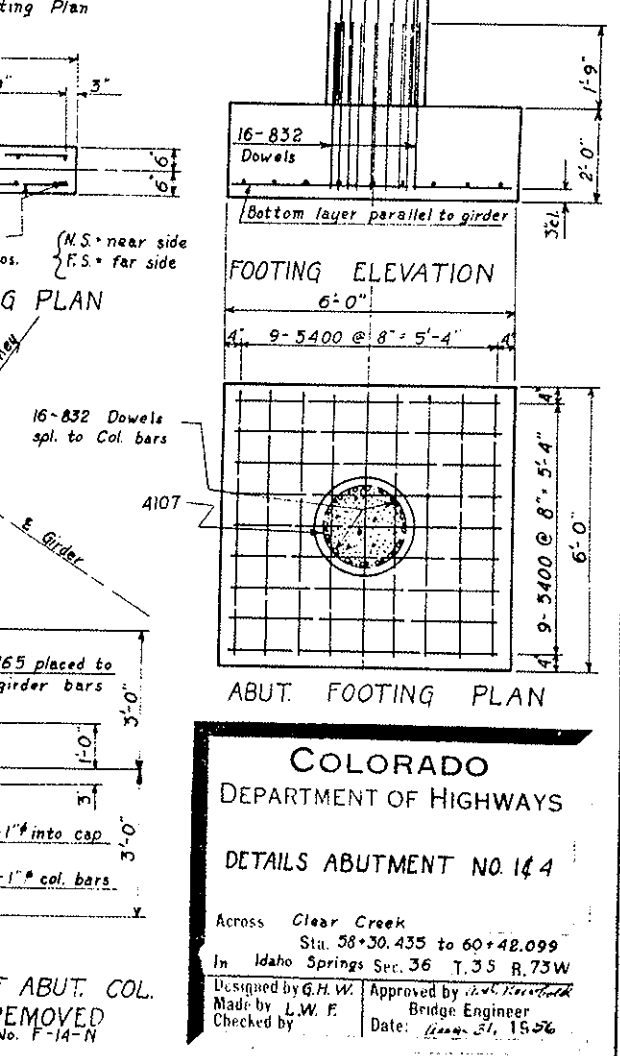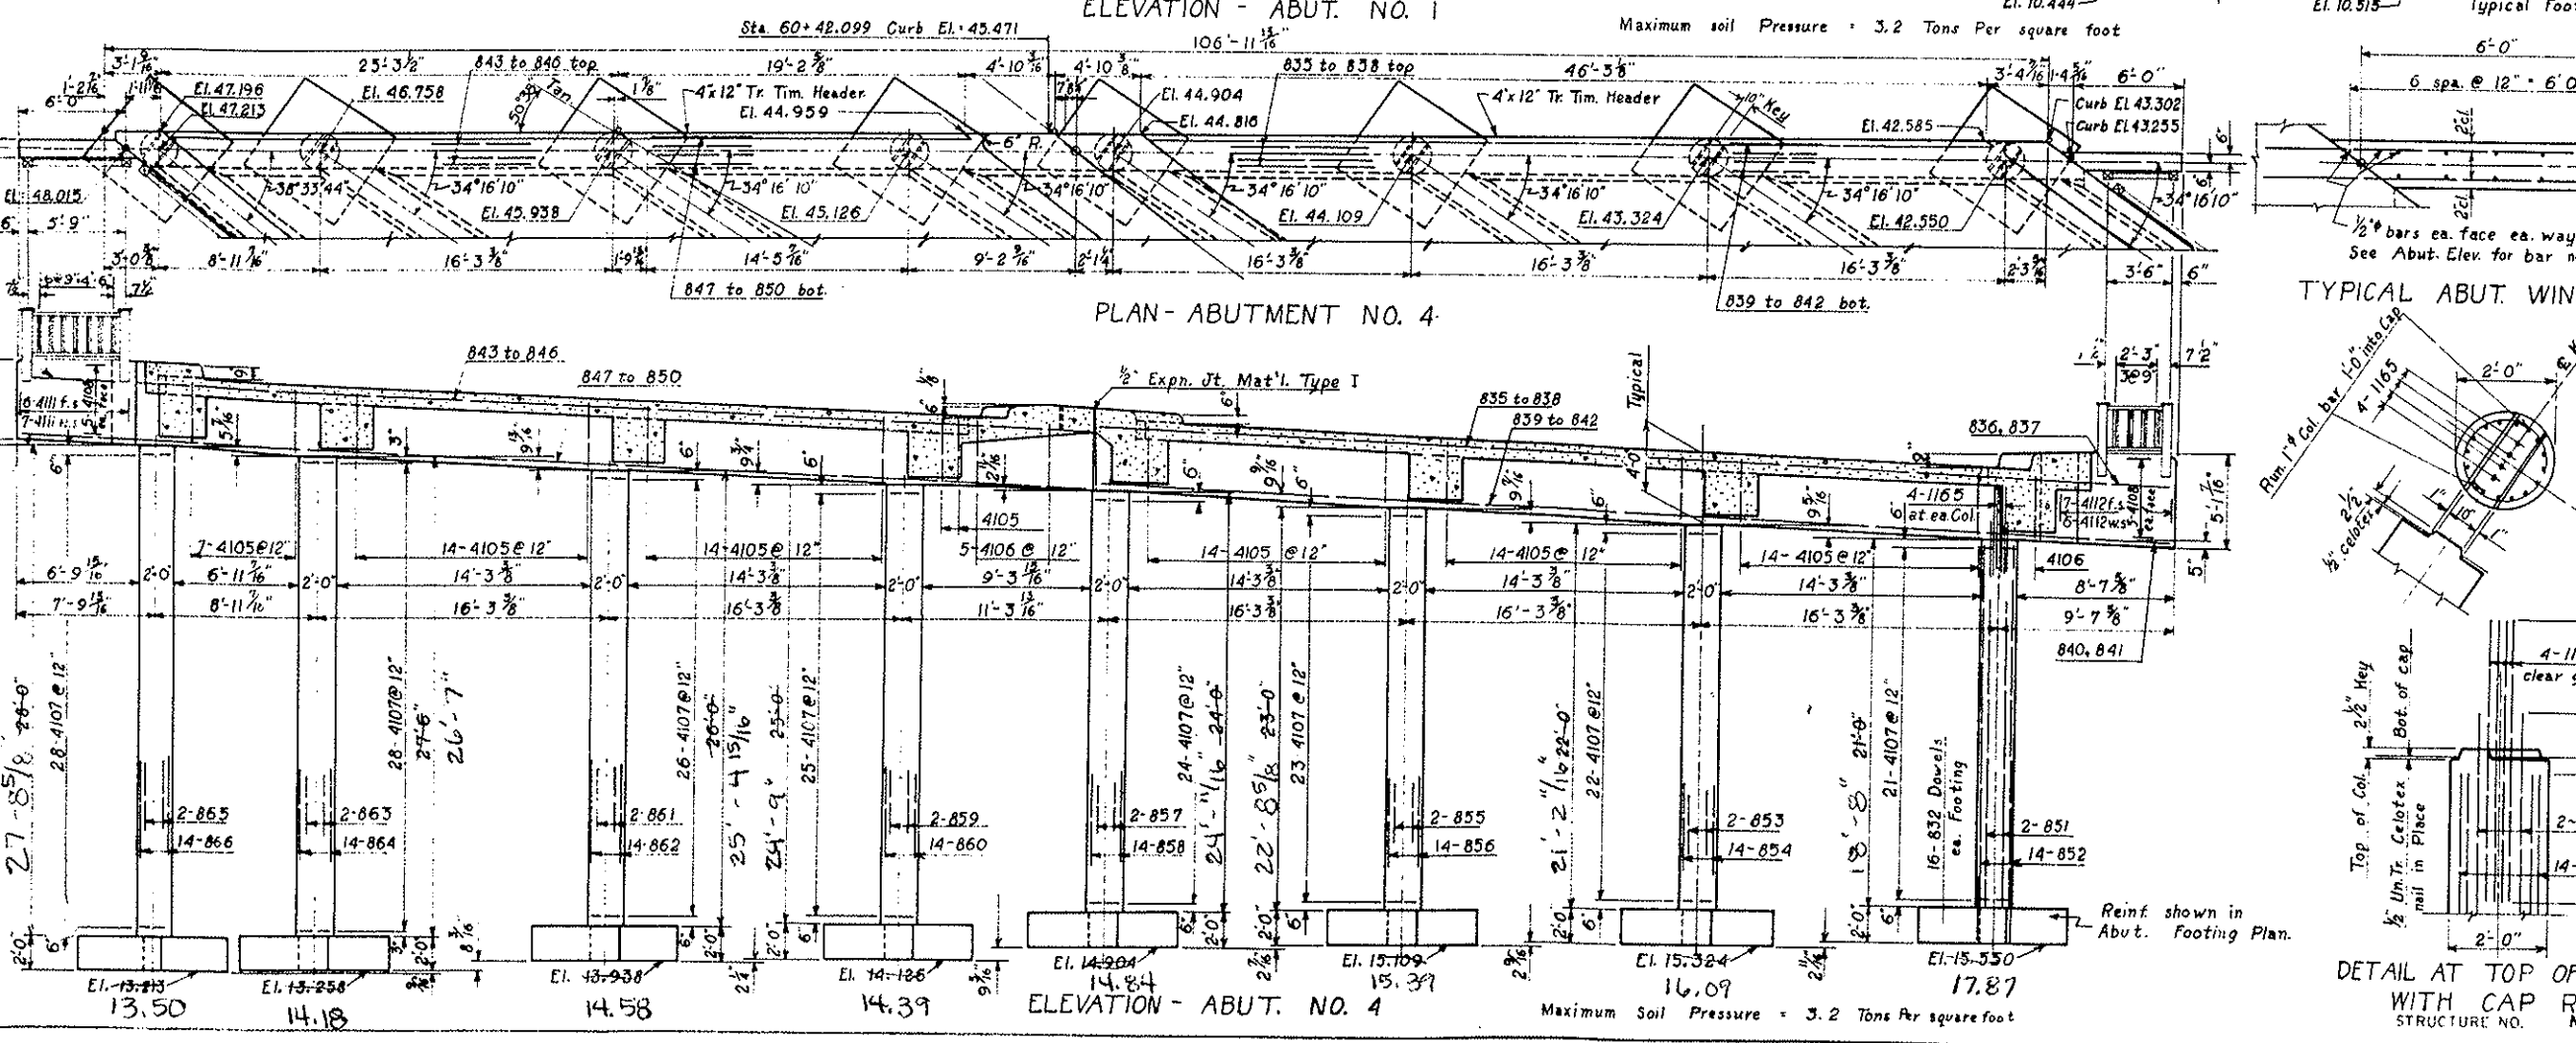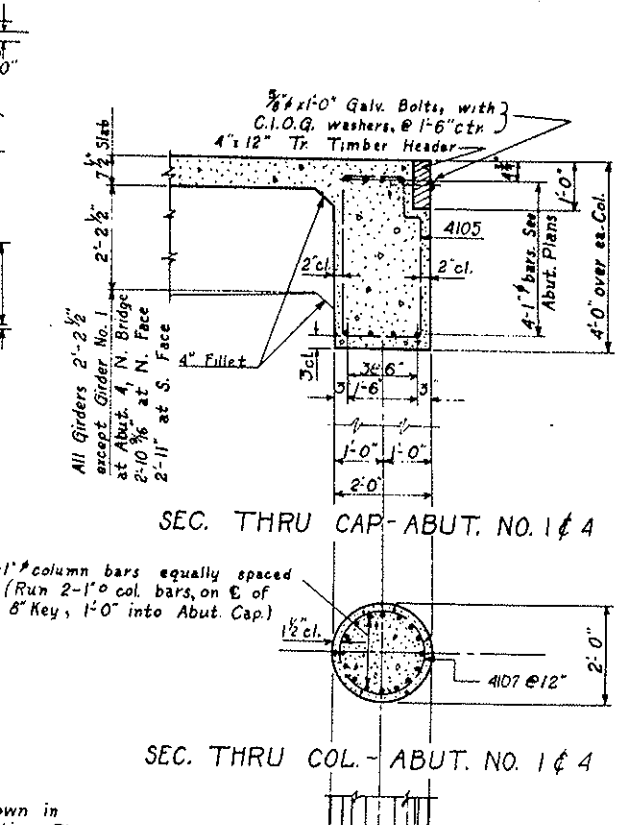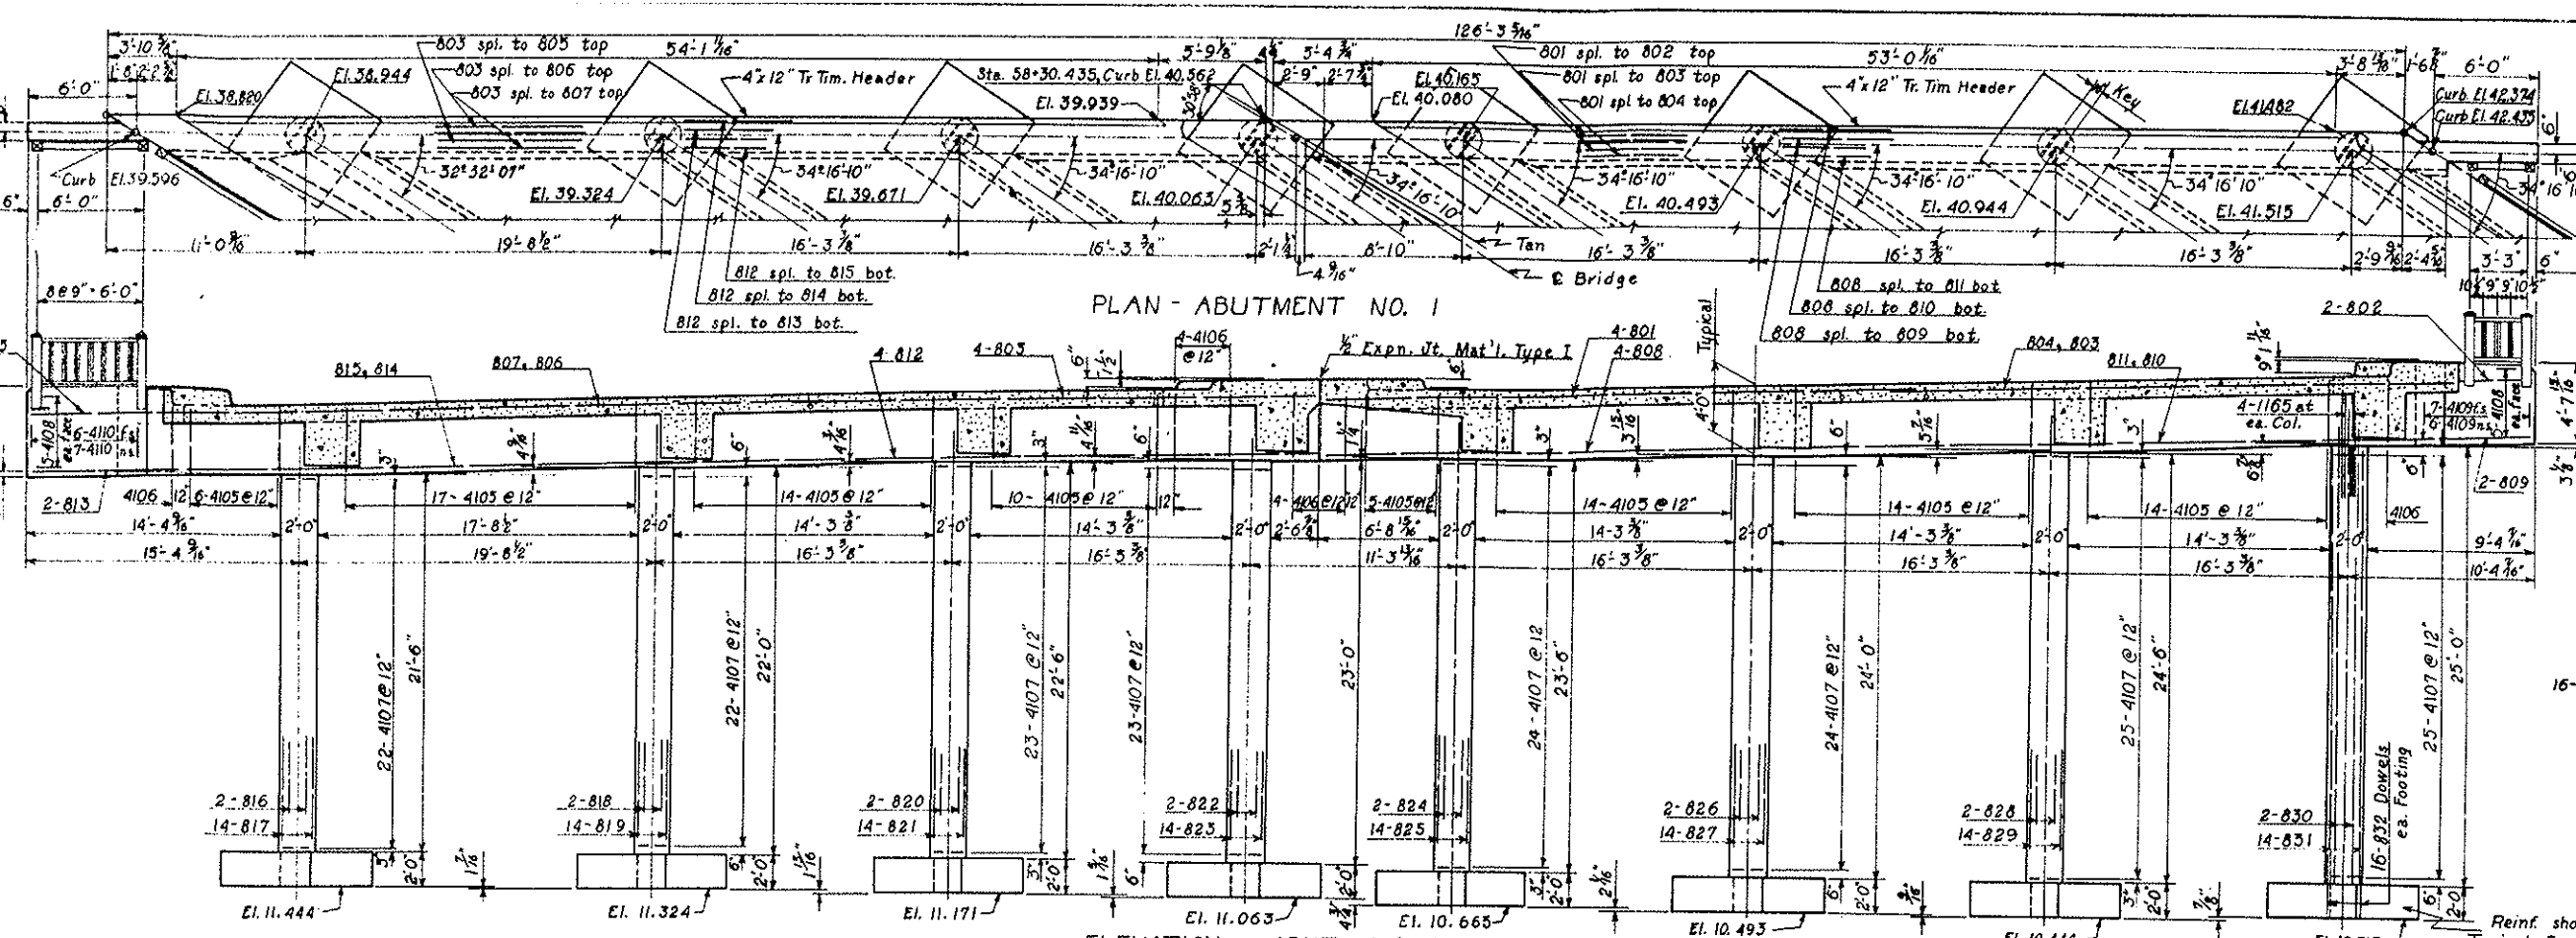


COLORADO
DEPARTMENT OF HIGHWAYS


DETAILS ABUTMENT NO. 1 & 4

Across Clear Creek
Sta. 58+30.435 to 60+42.099
In Idaho Springs Sec. 36 T. 35 R. 75W

Designed by G.H.W. Approved by J.W. Reinhardt
Made by L.W.F. Bridge Engineer
Checked by Date: 11/23/56

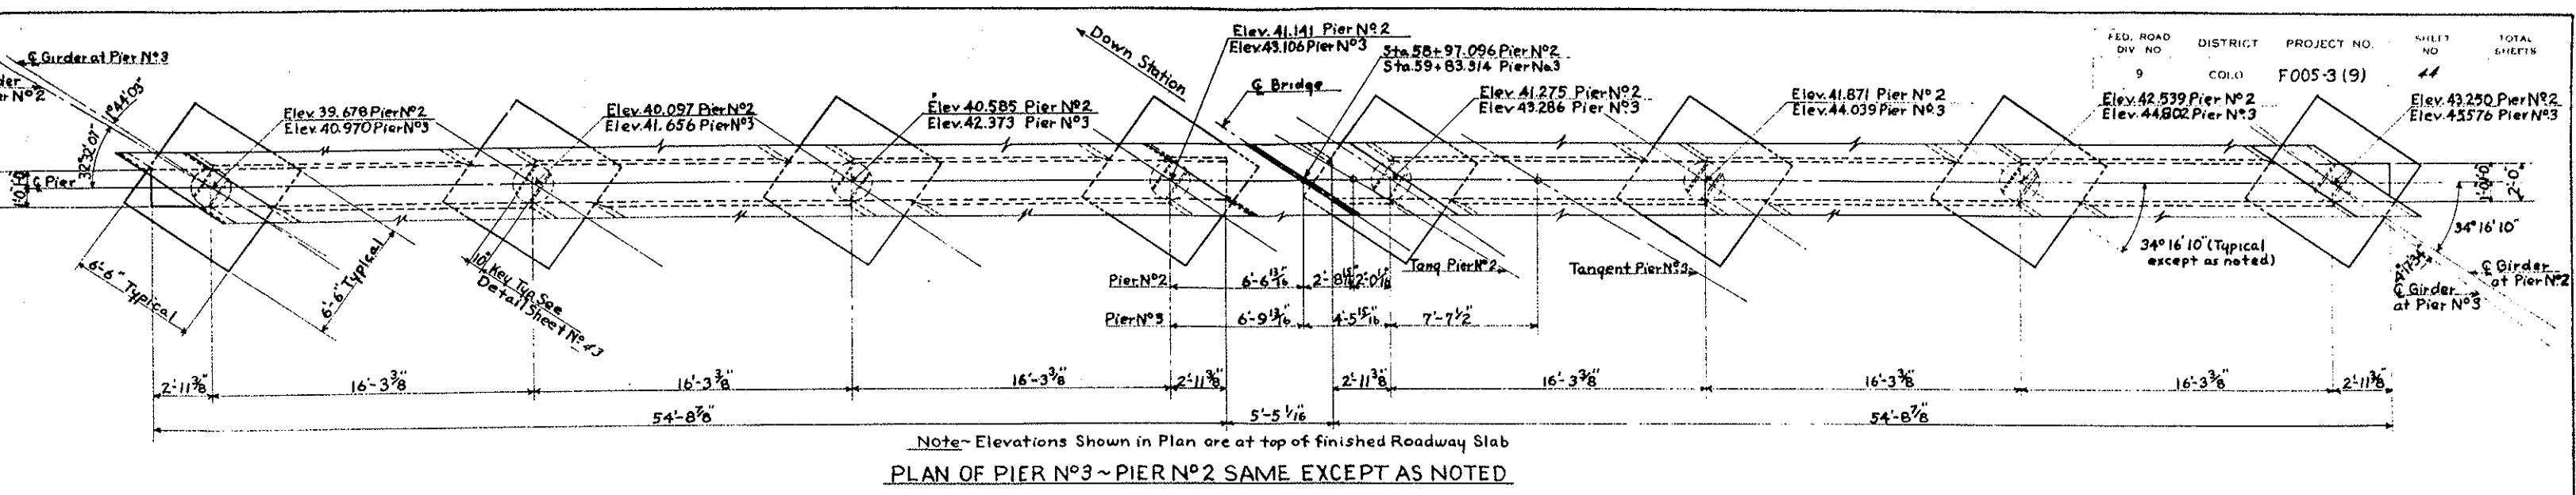

PLAN OF PIER N°3 ~ PIER N°2 SAME EXCEPT AS NOTED

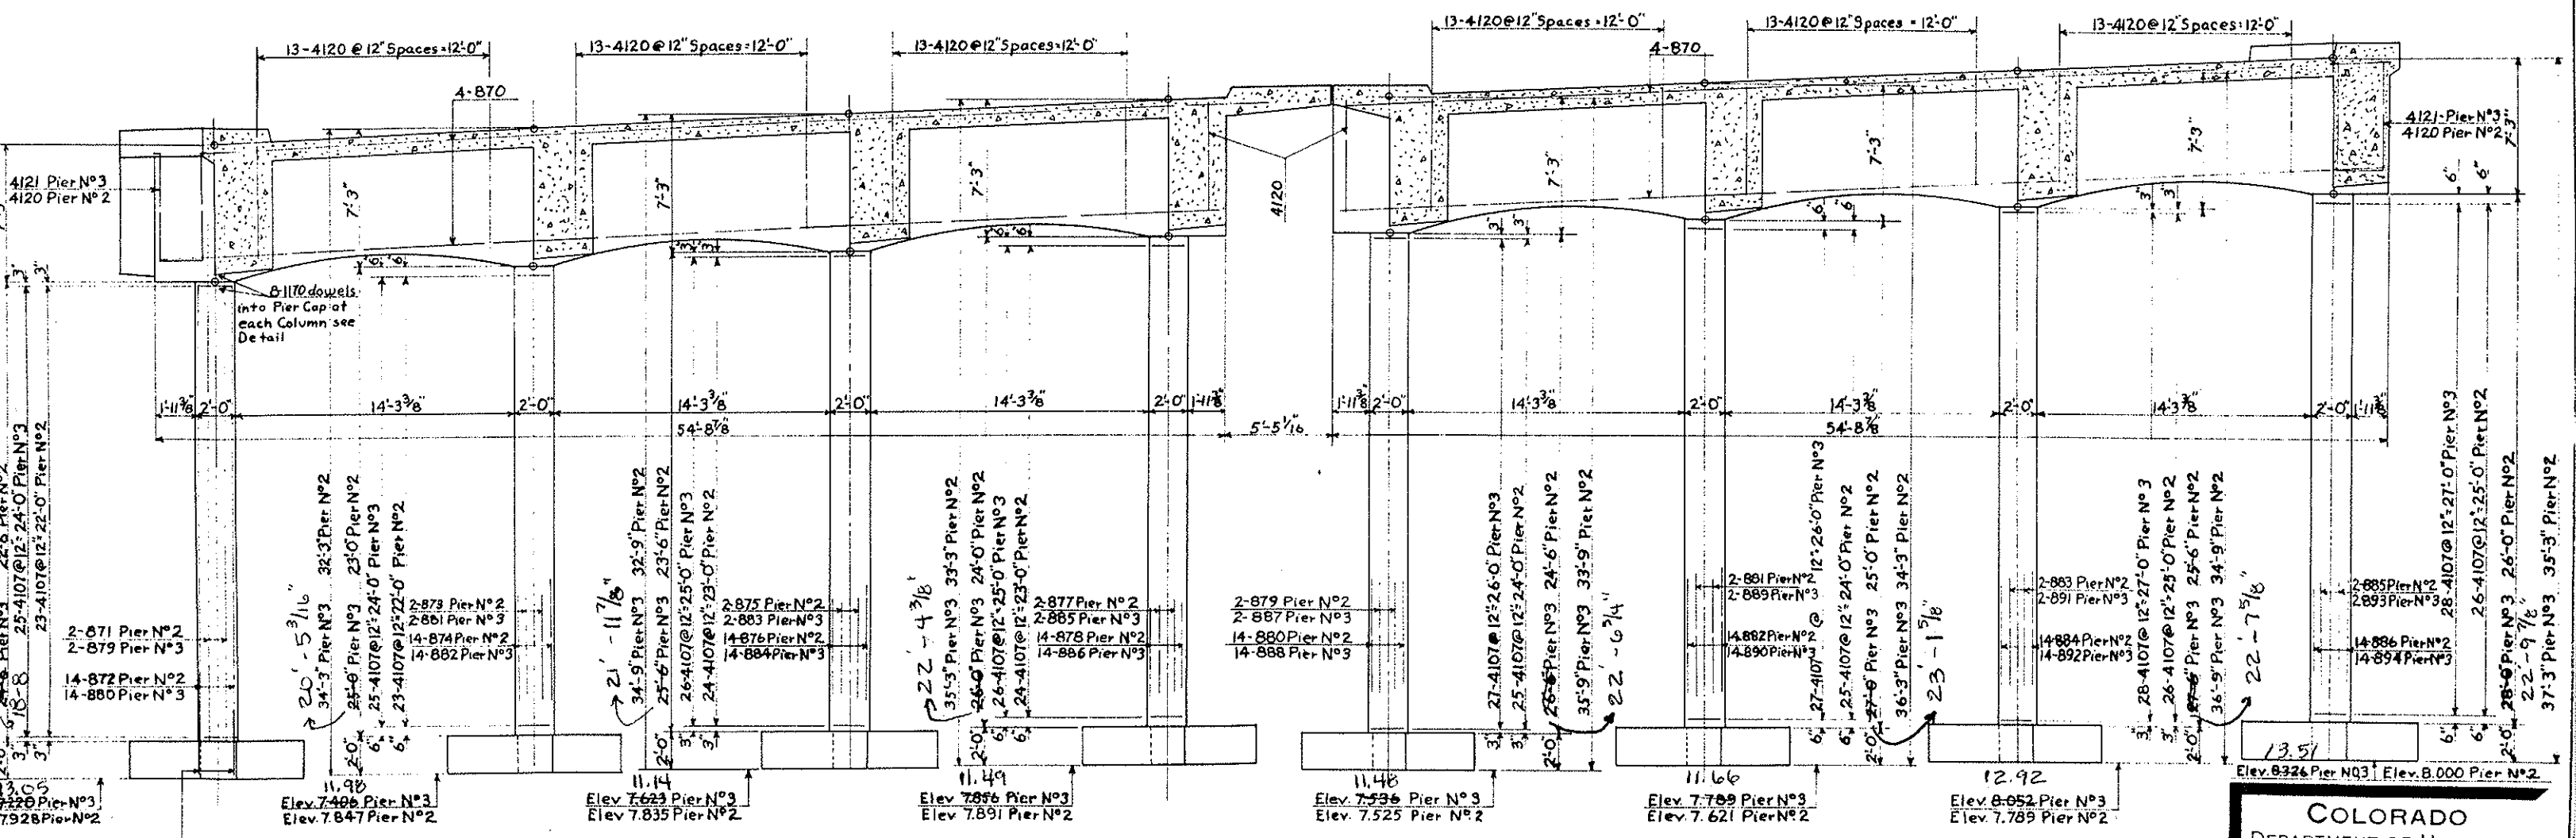

ELEVATION OF PIER N°3
PIER N°2 SAME EXCEPT AS NOTED




Note - For Footing Reinforcement See pier Footing Sheet No. 45
Plan and Elevation Sheet No. 45
For Section Thru Column See Sheet No. 45

COLORADO
DEPARTMENT OF HIGHWAYS






DETAILS OF PIERS N°2 & 3

Across Clear Creek
Sta. 58+30.435 to 60+42.099
In Idaho Springs S. 36 T. 3 S. R. 73 W.

Checked by G.H.W. BDE
Approved by [Signature] Bridge Engineer
Date Aug. 3, 1956

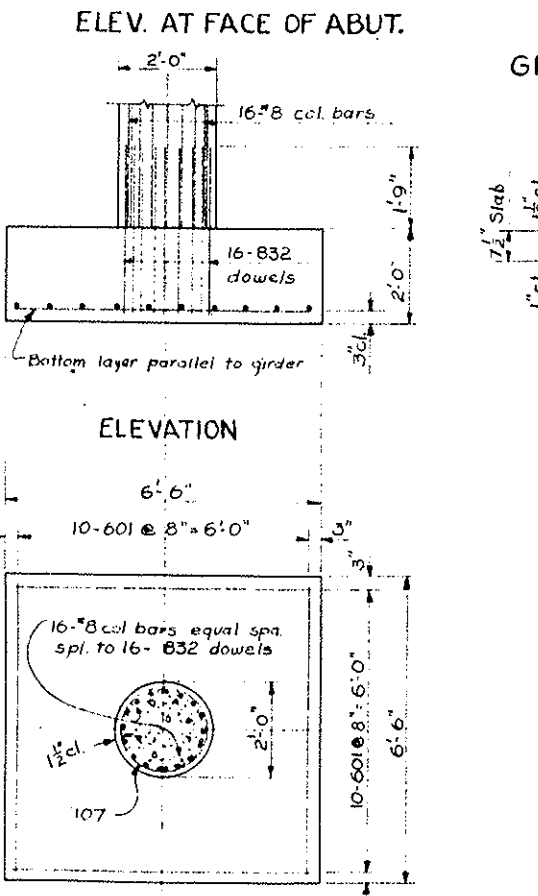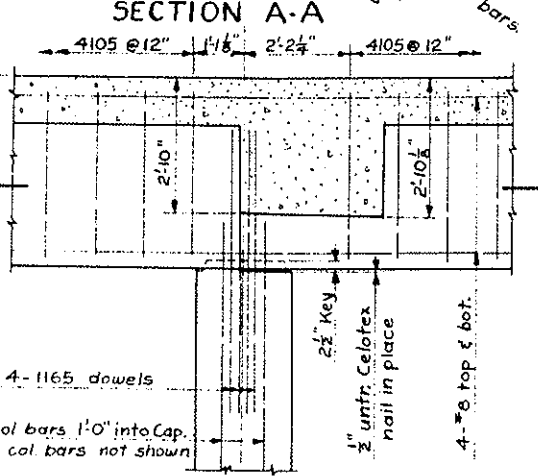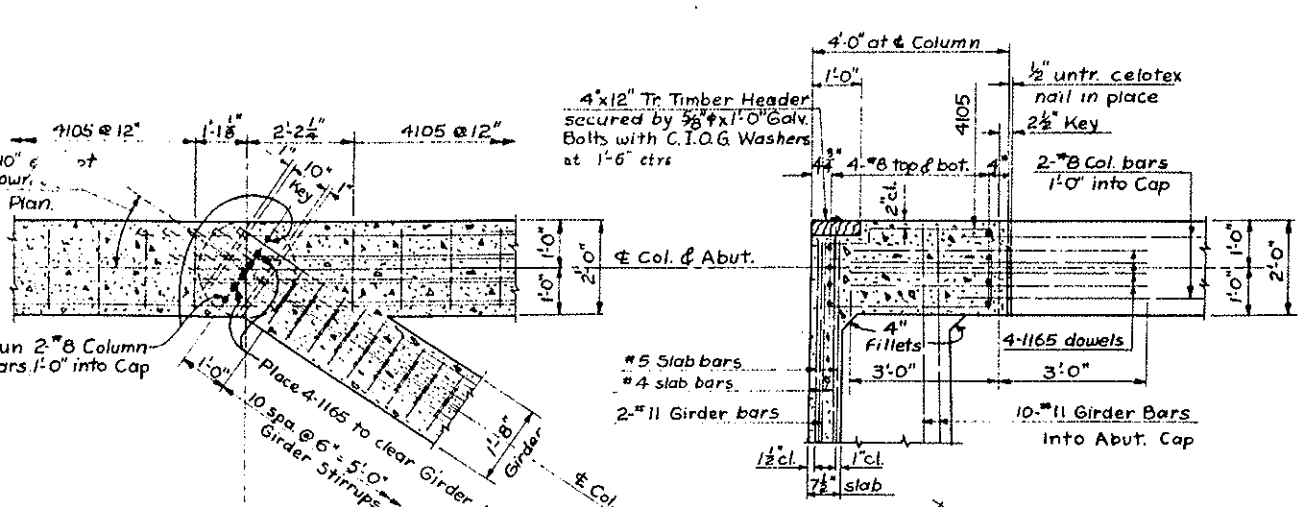

DETAIL OF PIER FOOTING

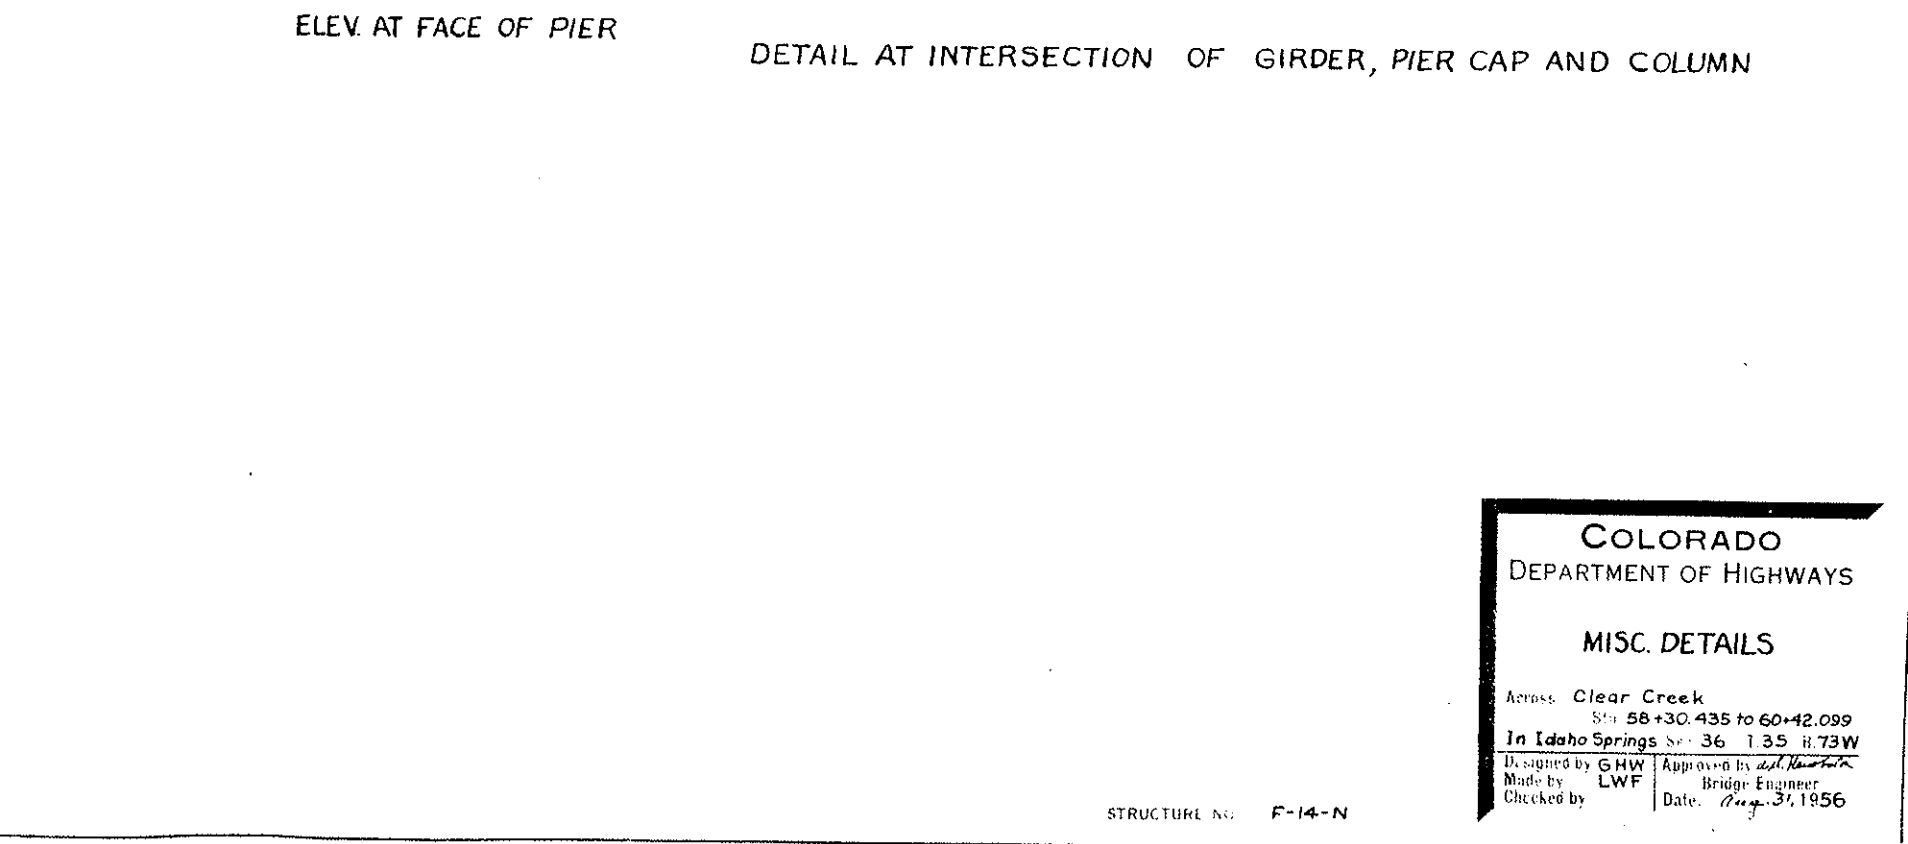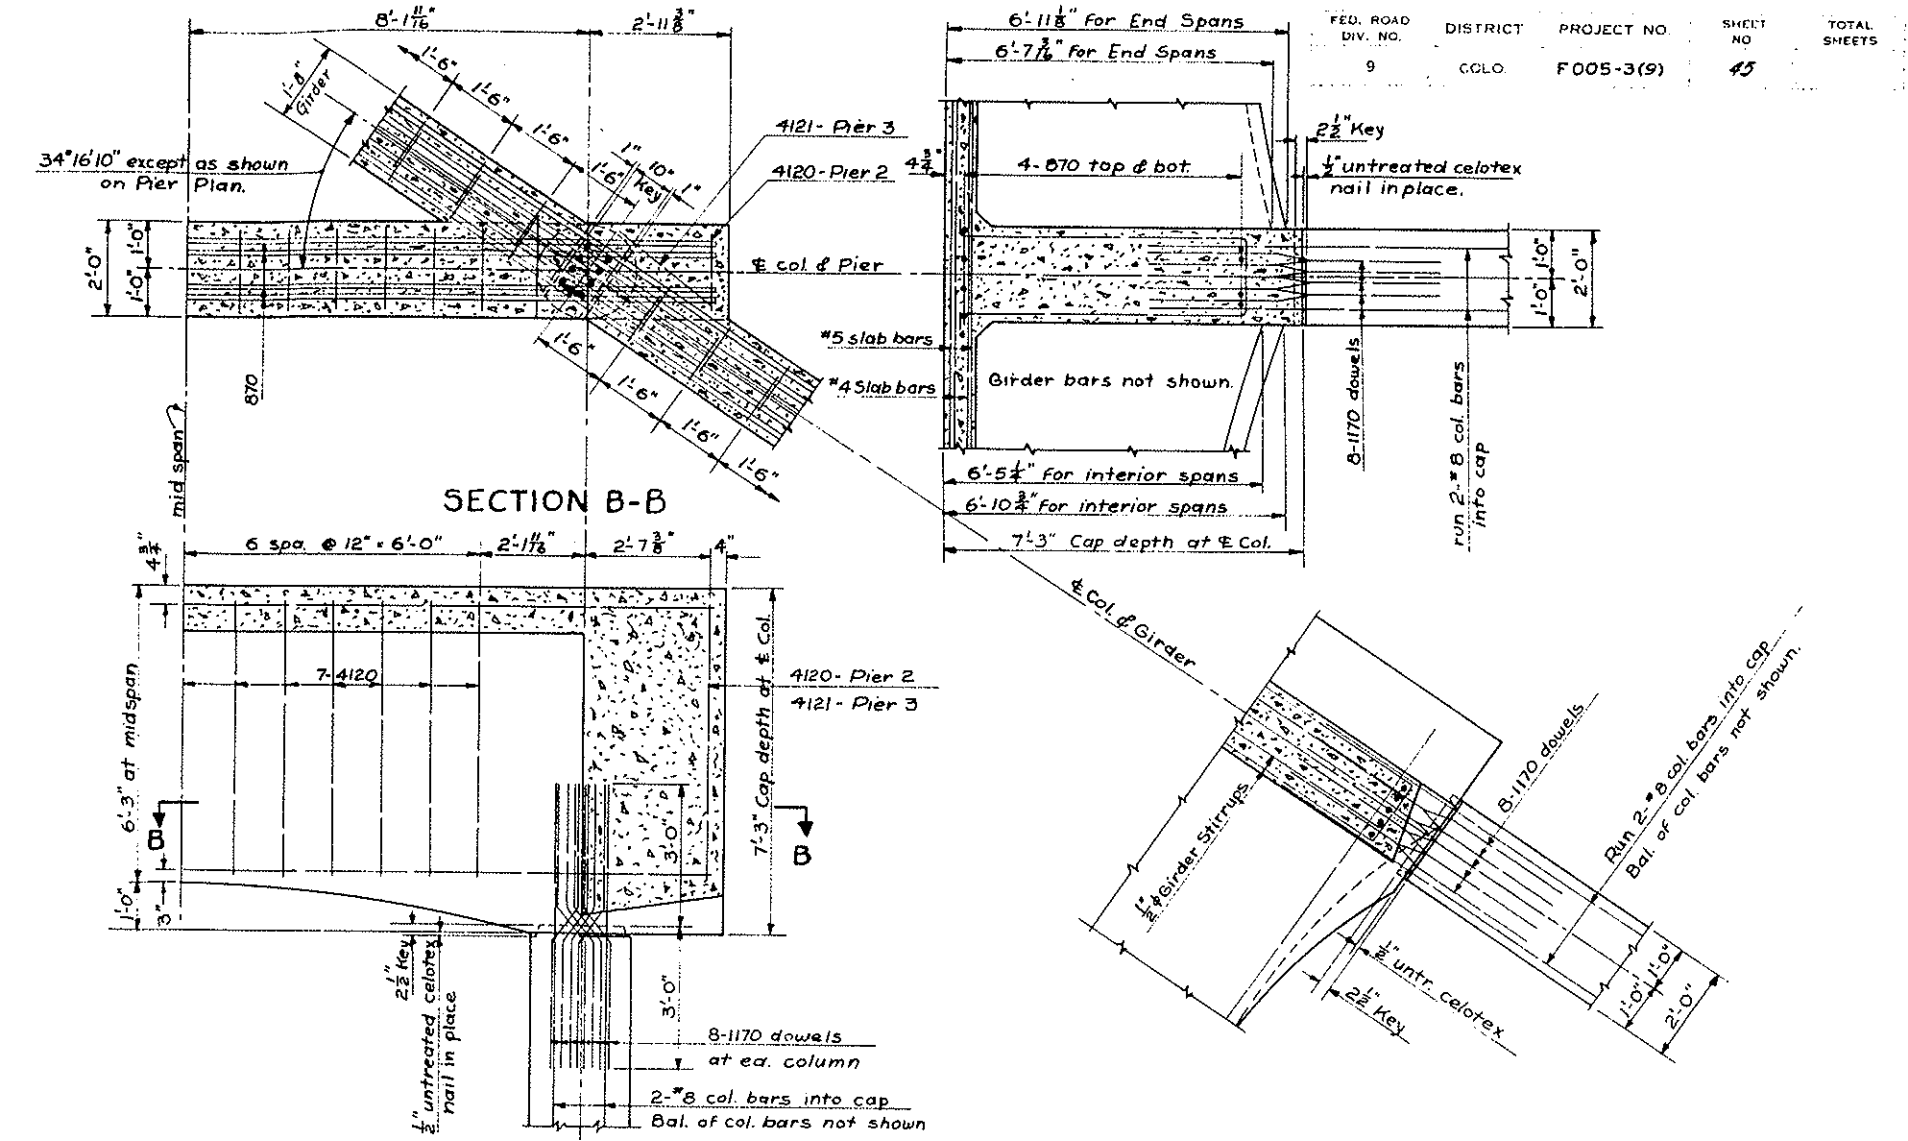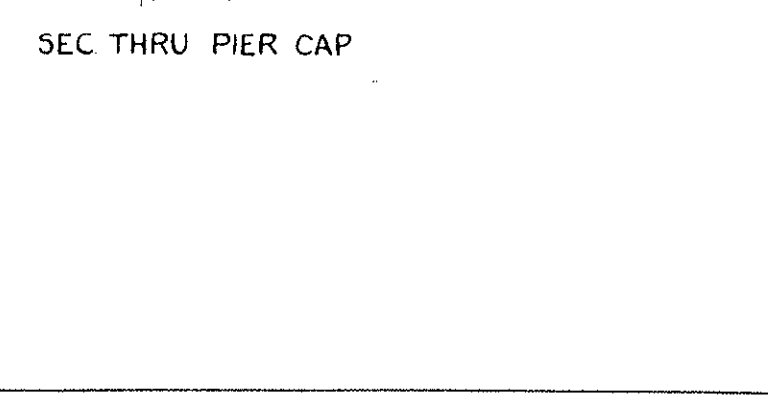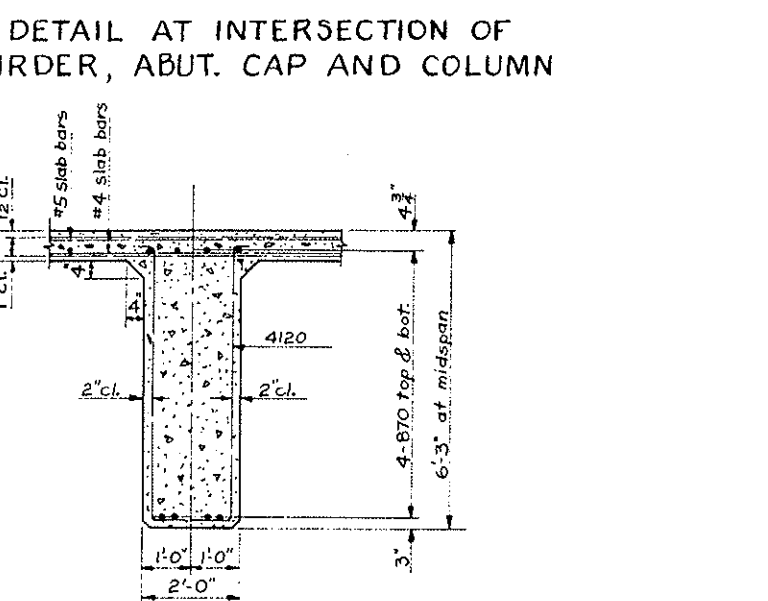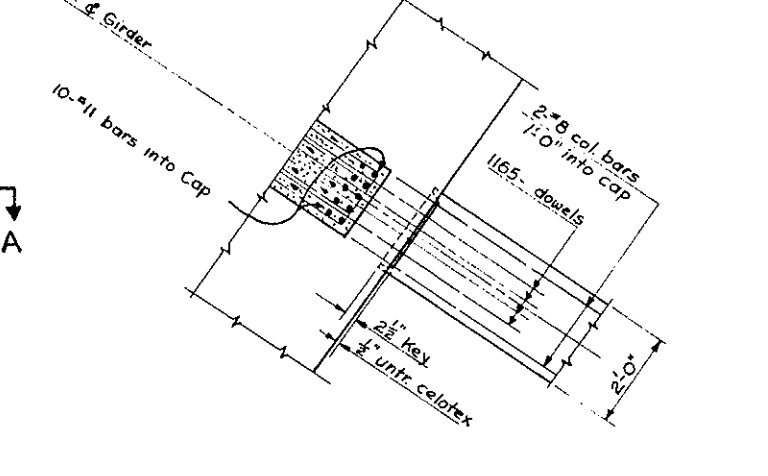

COLORADO
DEPARTMENT OF HIGHWAYS


MISC. DETAILS

Address: Clear Creek
Sta. 58+30.435 to 60+42.099
In Idaho Springs Sta. 36+135 R.73W


Designed by GHW
Made by LWF
Checked by

Approved by *W.L. Newberry*
Bridge Engineer
Date: Aug. 31, 1956


STRUCTURE NO. F-14-N

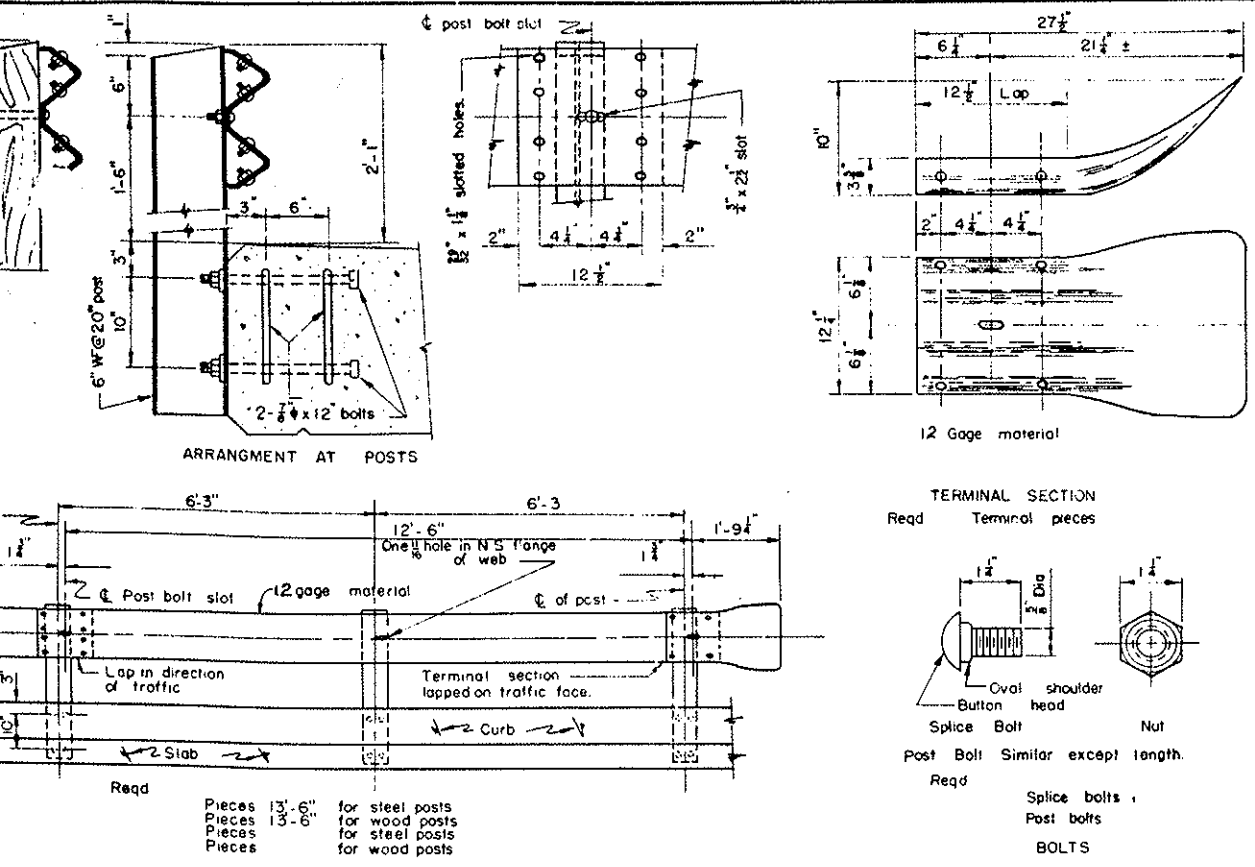


METAL PLATE GUARD RAIL

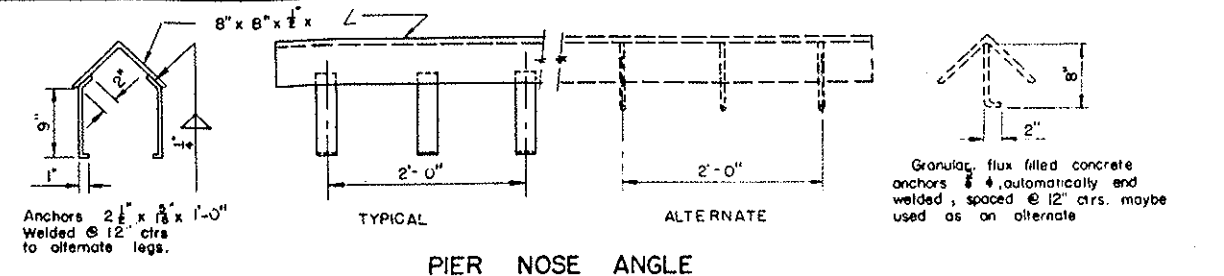


PIER NOSE ANGLE

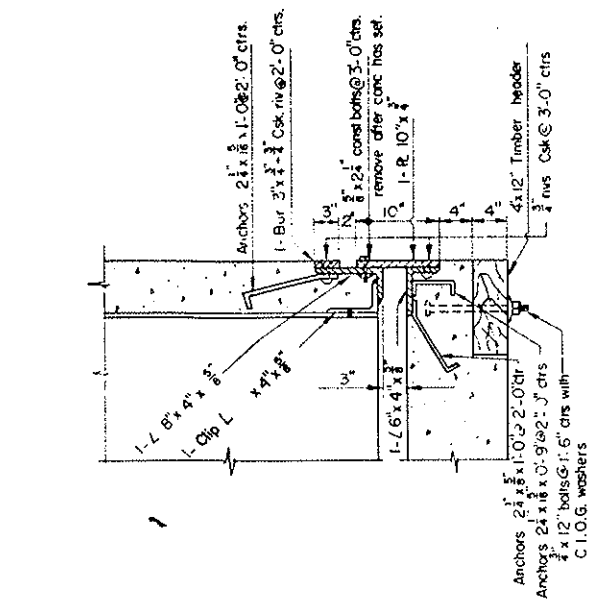


EXP'N DEVICE - ABUT. CONC. DECK

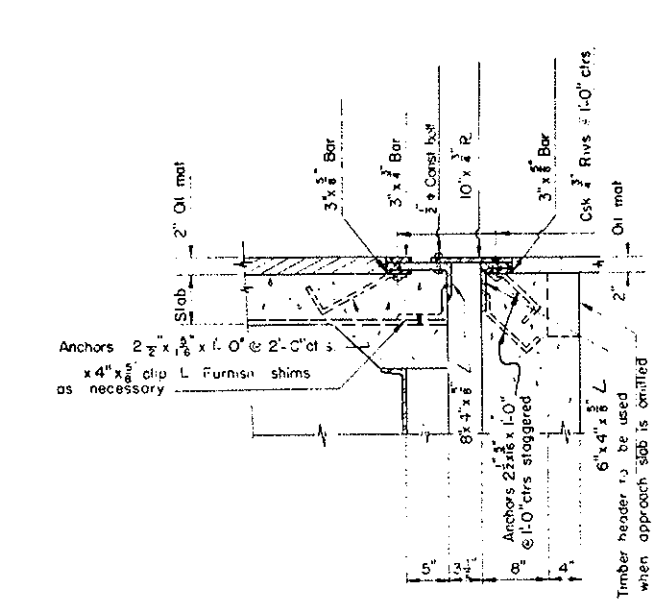


EXP'N DEVICE - ABUT. CONC. DECK WITH OIL SURF.

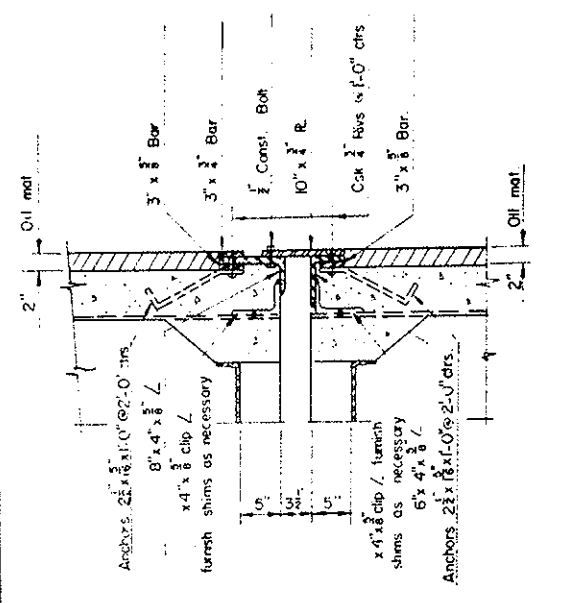


EXP'N DEVICE - PIER CONC. DECK WITH OIL SURF.

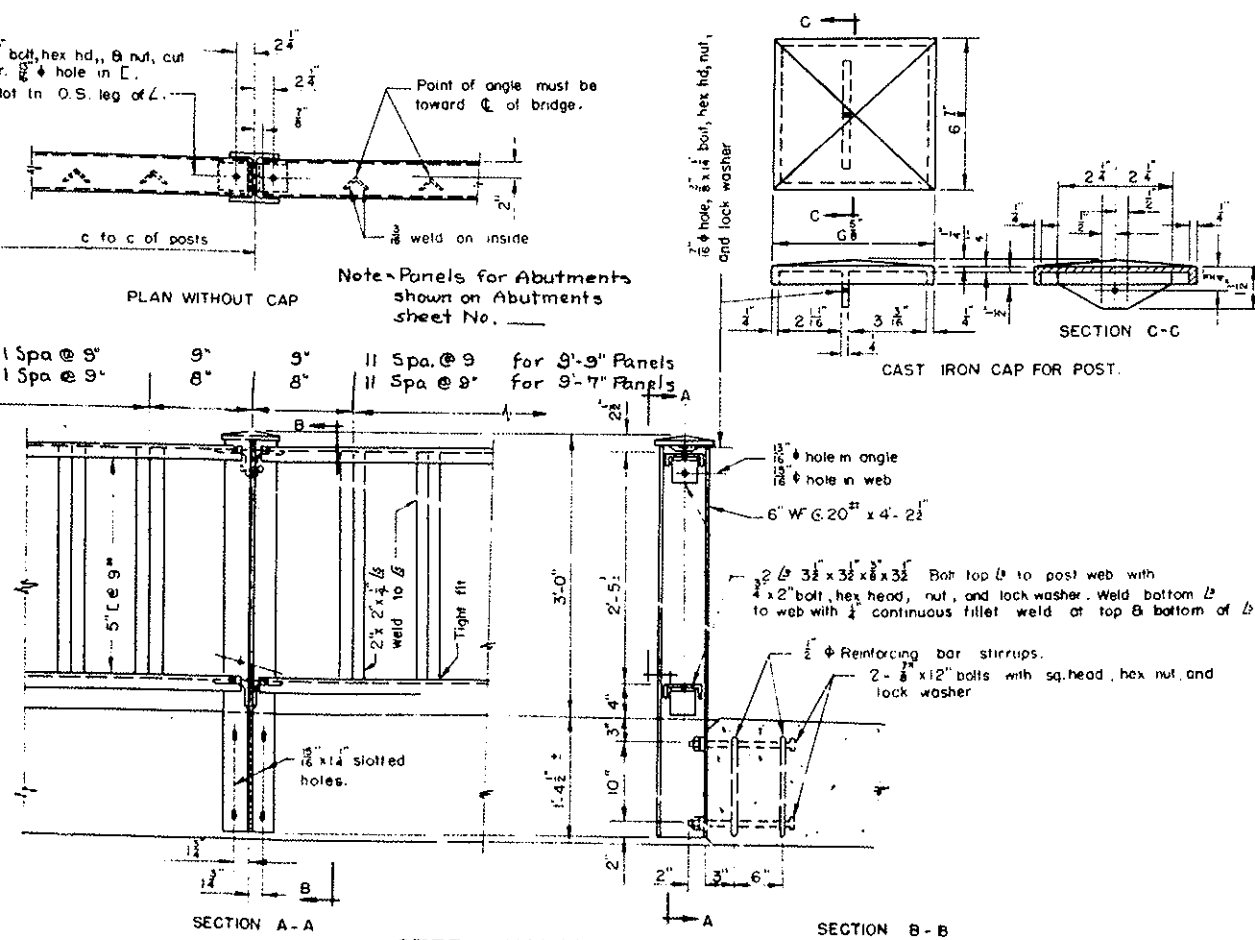


STEEL HANDRAIL

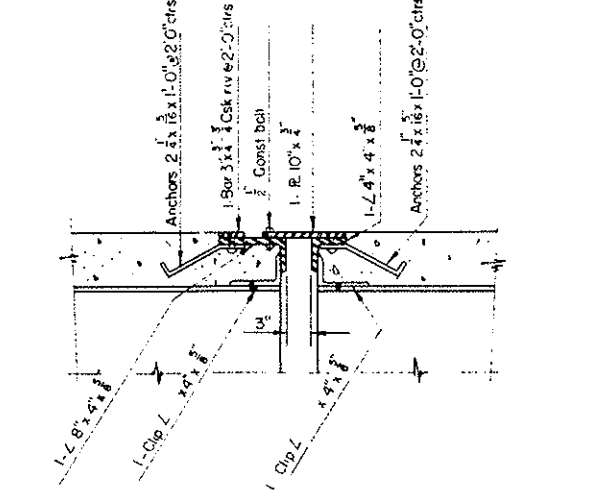


EXP'N DEVICE - PIER CONC. DECK

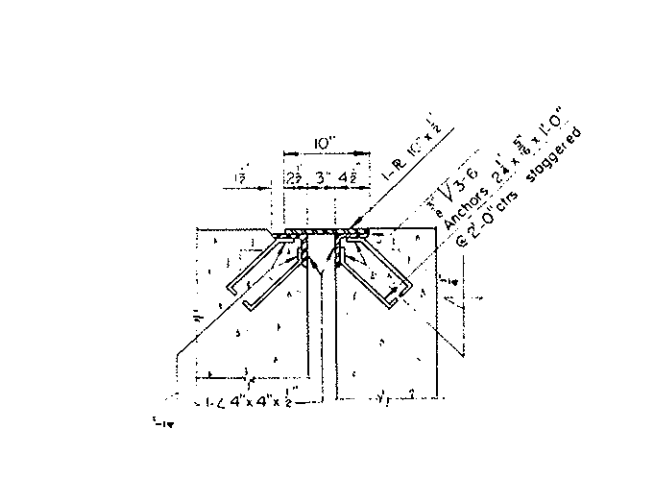


EXP'N DEVICE - CURBS

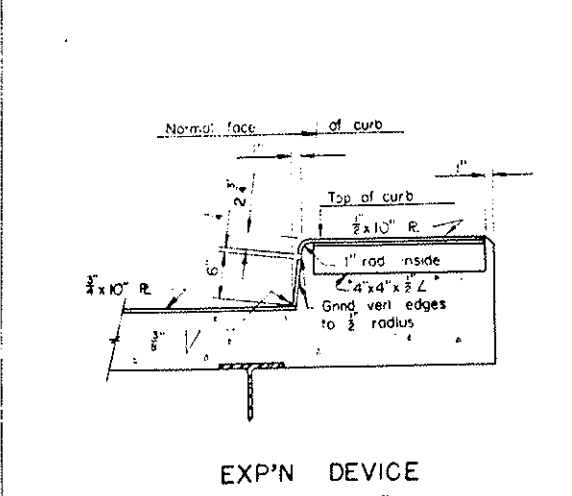

EXP'N DEVICE SECTION AT CURB

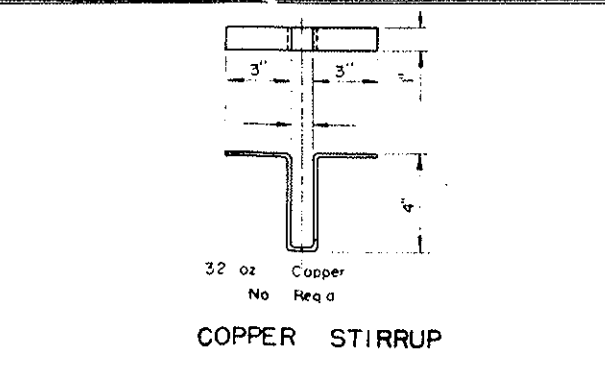

COPPER STIRRUP

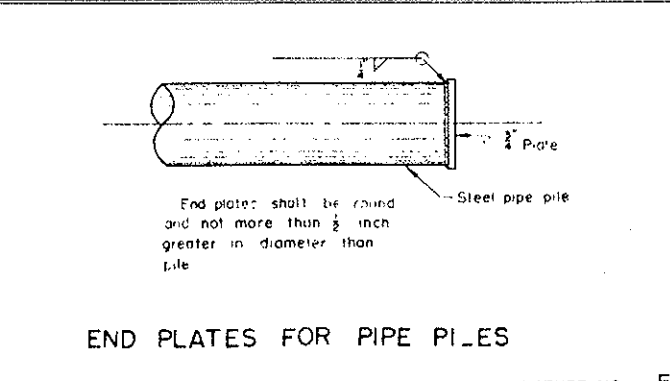

END PLATES FOR PIPE PILES

COLORADO DEPARTMENT OF HIGHWAYS

MISCELLANEOUS BRIDGE DETAILS

Across Clear Creek
 Sta 38+30.435 to 60+42.029
 Near Idaho Spgs. Sec. 36 T. 35 R. 73W

Designed by
 Made by J.R.J.
 Checked by

Approved by *A.M. Newhall*
 Bridge Engineer
 Date: Aug. 31, 1956

BAR LIST SUPERSTRUCTURE

Table with columns: Mark, Size, No., Lenght, Type, Dimensions (l, m, n). Rows 401-80.

BAR LIST SUPERSTRUCTURE

Table with columns: Mark, Size, No., Lenght, Type, Dimensions (l, m, n). Rows 481-510.

BAR LIST SUPERSTRUCTURE

Table with columns: Mark, Size, No., Lenght, Type, Dimensions (l, m, n). Rows 5101-5119.

BAR LIST SUPERSTRUCTURE


Table with columns: Mark, Size, No., Lenght, Type, Dimensions (l, m, n). Rows 5366-5373.

BAR LIST SUPERSTRUCTURE

Table with columns: Mark, Size, No., Lenght, Type, Dimensions (l, m, n). Rows 1111-1124.

BAR SUMMARY SUPERSTRUCTURE

39970 Lin. ft. 1/2" @ 0.668/Lin. ft. = 26700 lbs.
35791 Lin. ft. 3/8" @ 1.043/Lin. ft. = 37330 lbs.
621 Lin. ft. 1/4" @ 2.044/Lin. ft. = 1269 lbs.
1536 Lin. ft. 1/8" @ 3.4 /Lin. ft. = 5222 lbs.
29173 Lin. ft. 1 1/8" @ 5.313/Lin. ft. = 154996 lbs.
Plus 1% ± Overrun = 2258 lbs.
Total = 227,775 lbs.

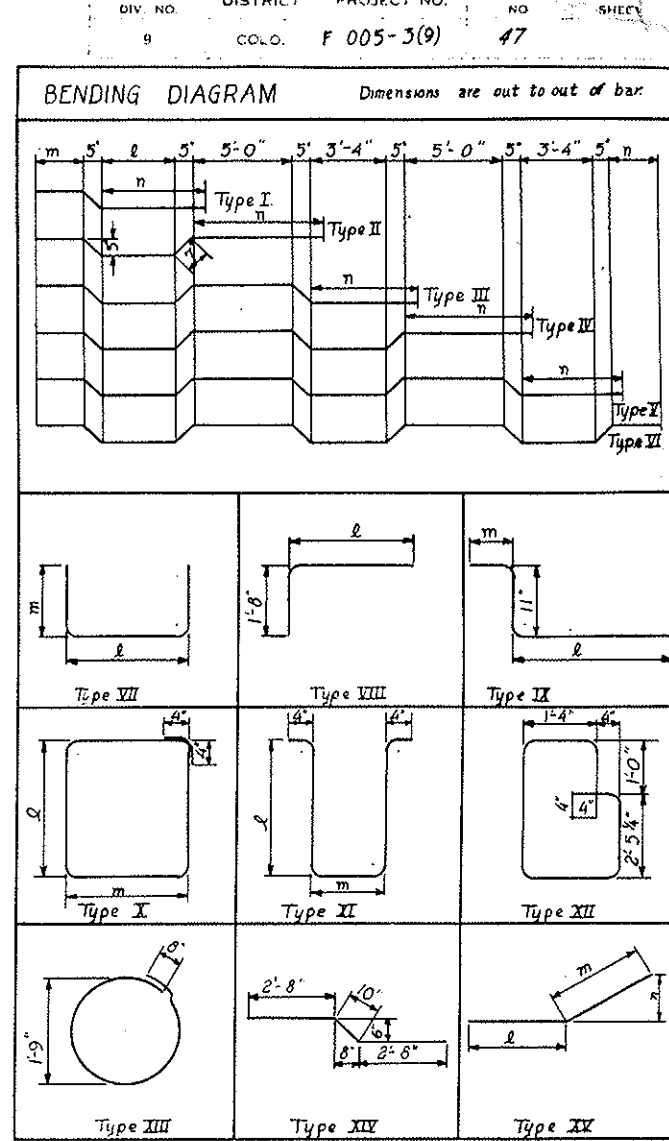

COLORADO DEPARTMENT OF HIGHWAYS
BAR LIST SUPERSTRUCTURE & BENDING DIAGRAM
Approved by: [Signature]
In Idaho Springs 36 1 35 B. 73 W.
Checked by: [Signature] Date: Aug. 31 1956