
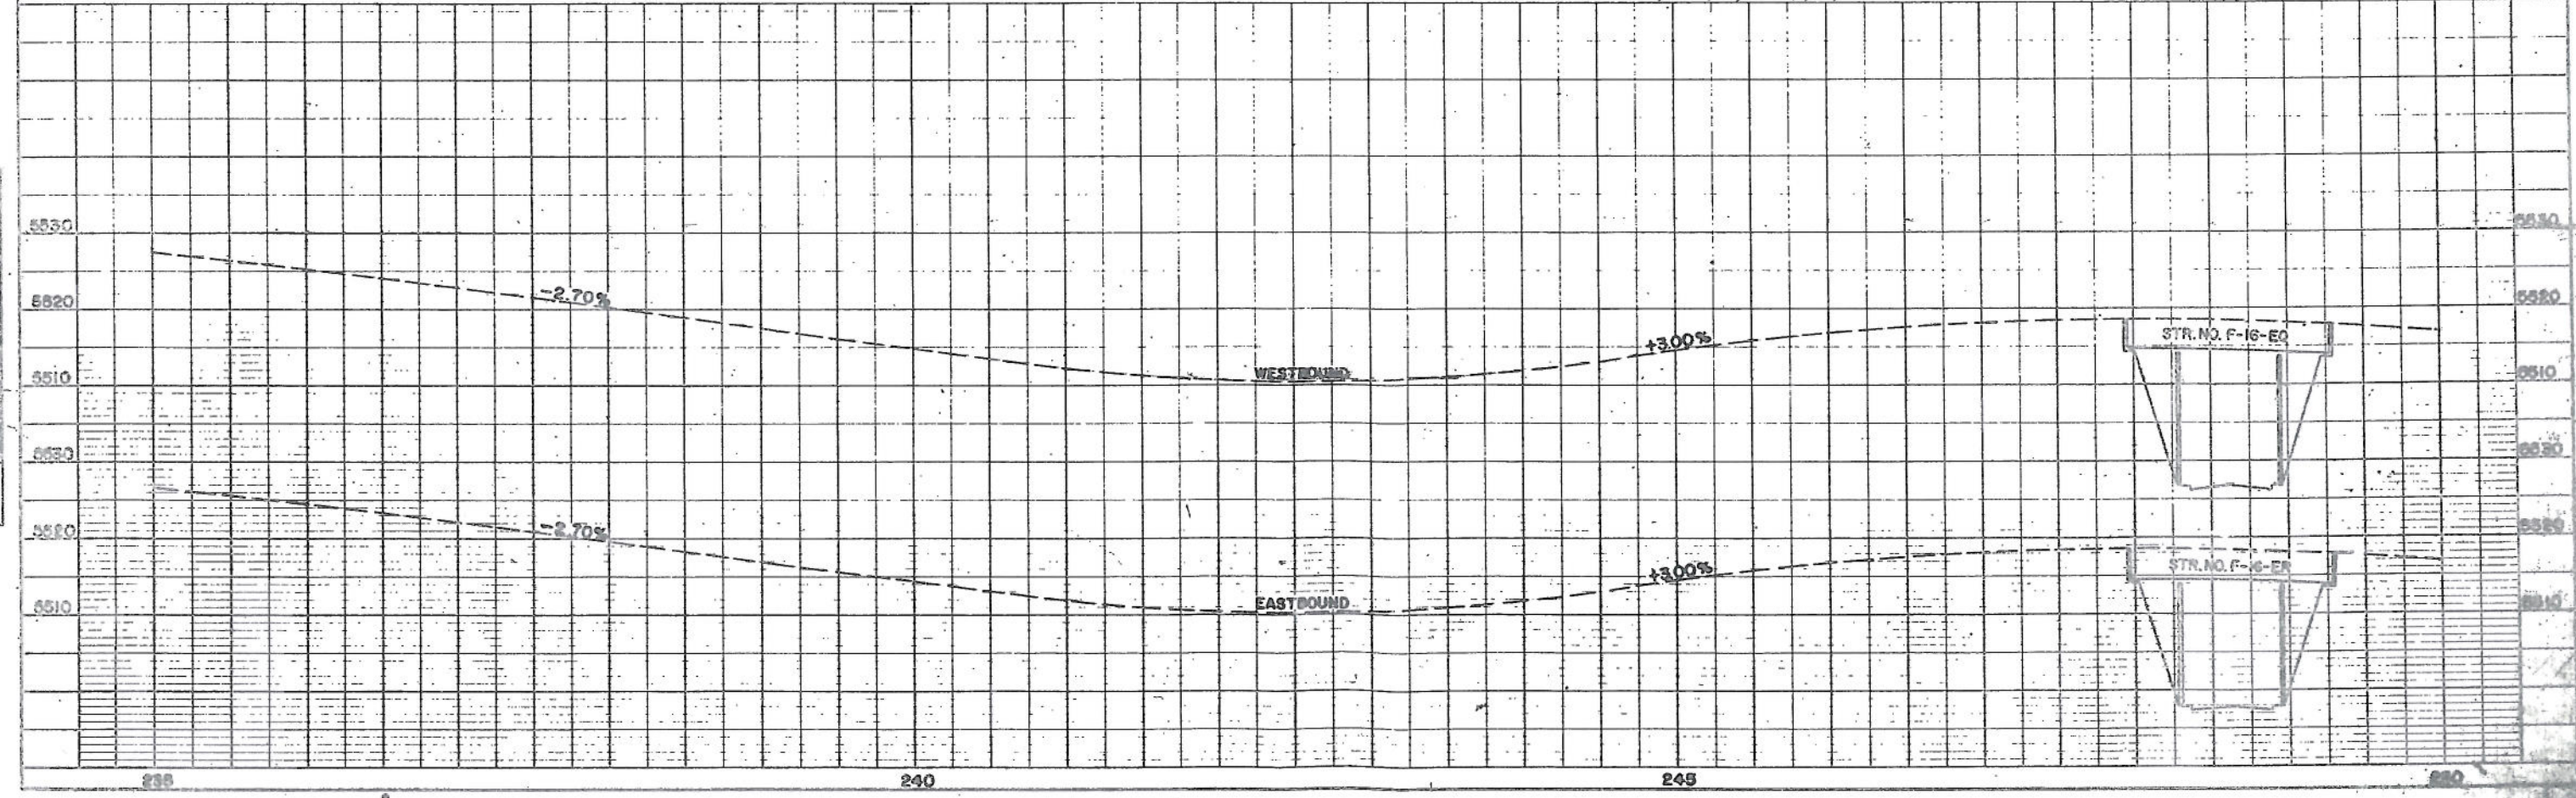


PROJECT NO.	U 003-3(2)	SHEET NO.	43	TOTAL SHEETS	
COLORADO					



DRAINAGE, FENCING AND UTILITIES

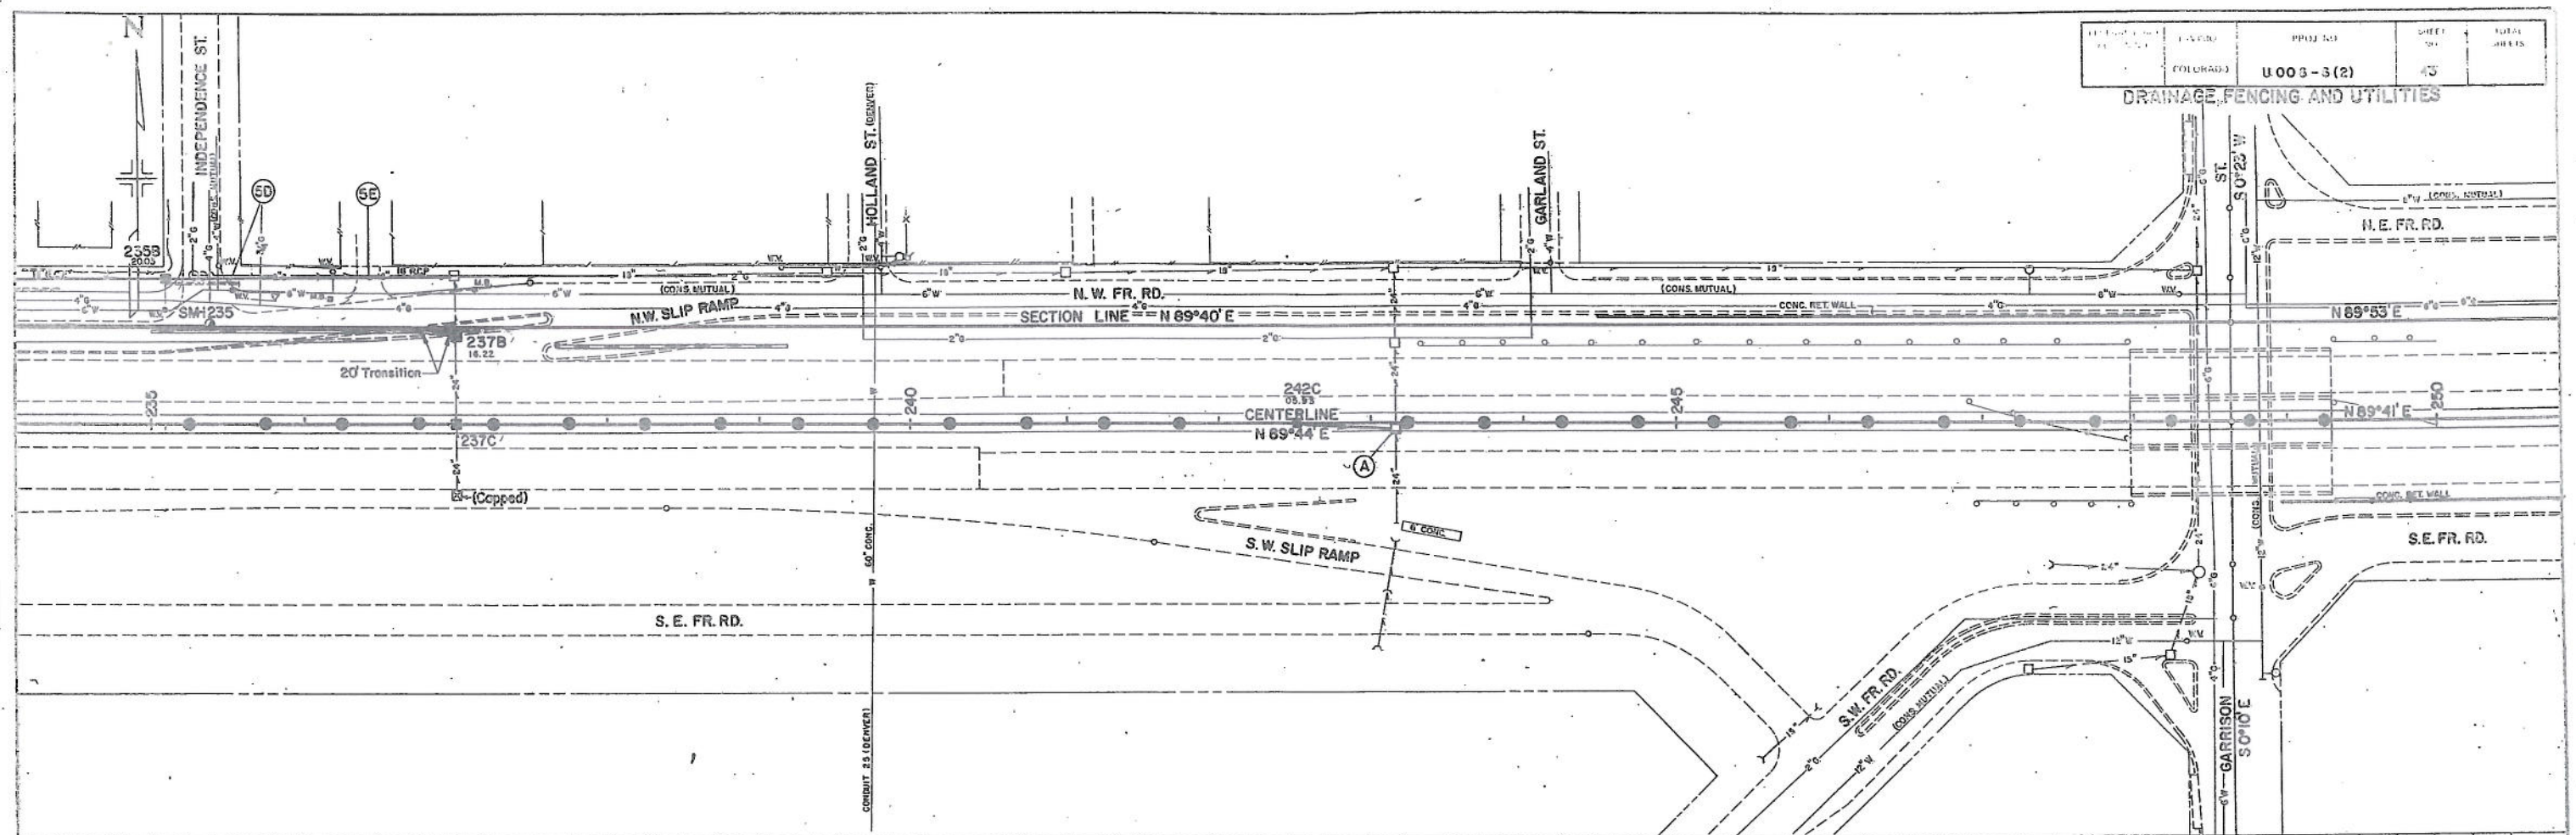

SECTION 24, T12N, R10W, S10E, COLORADO
 DIVISION OF HIGHWAYS - DISTRICT 12
 PROJECT NO. U 006 - S(2)

FEDERAL ROAD DISTRICT NO.	DIVISION	PROJ. NO.	SHEET NO.	TOTAL SHEETS
12	COLORADO	U 006 - S(2)	44	

DRAINAGE, FENCING AND UTILITIES

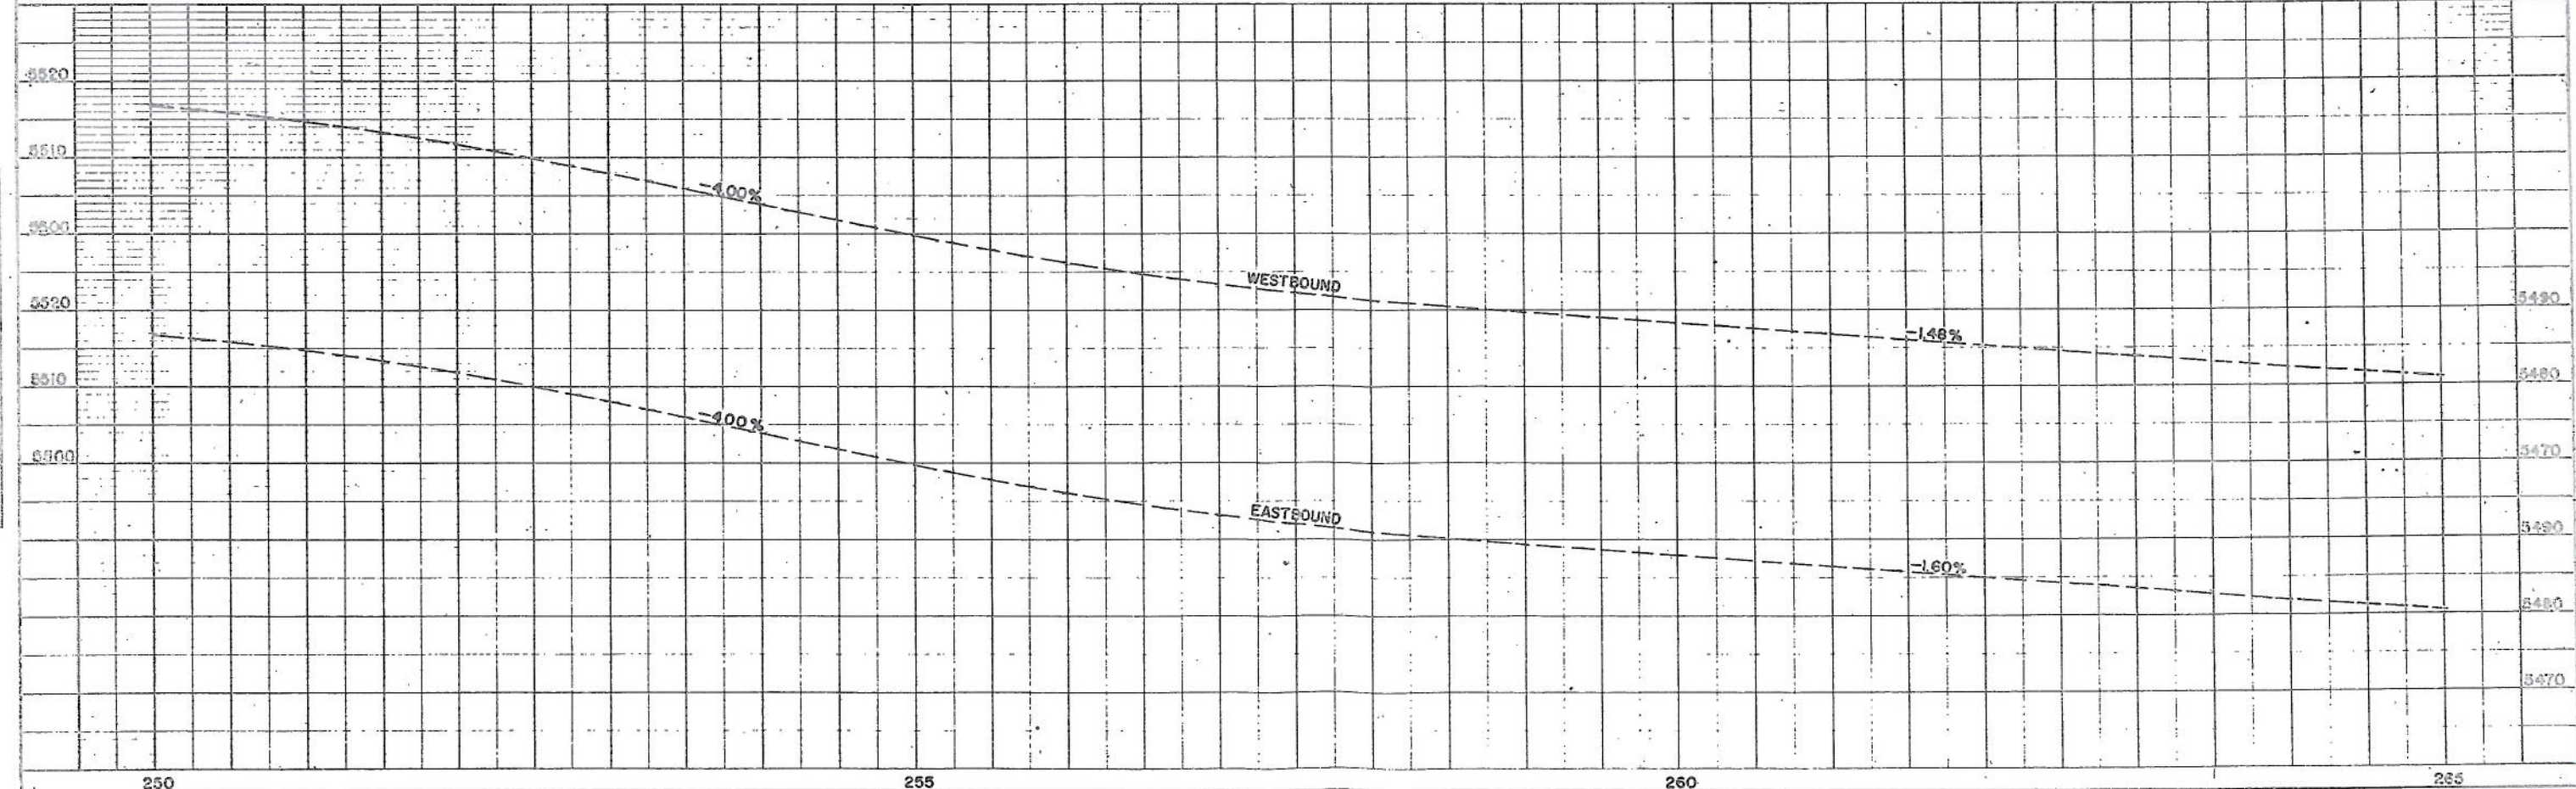
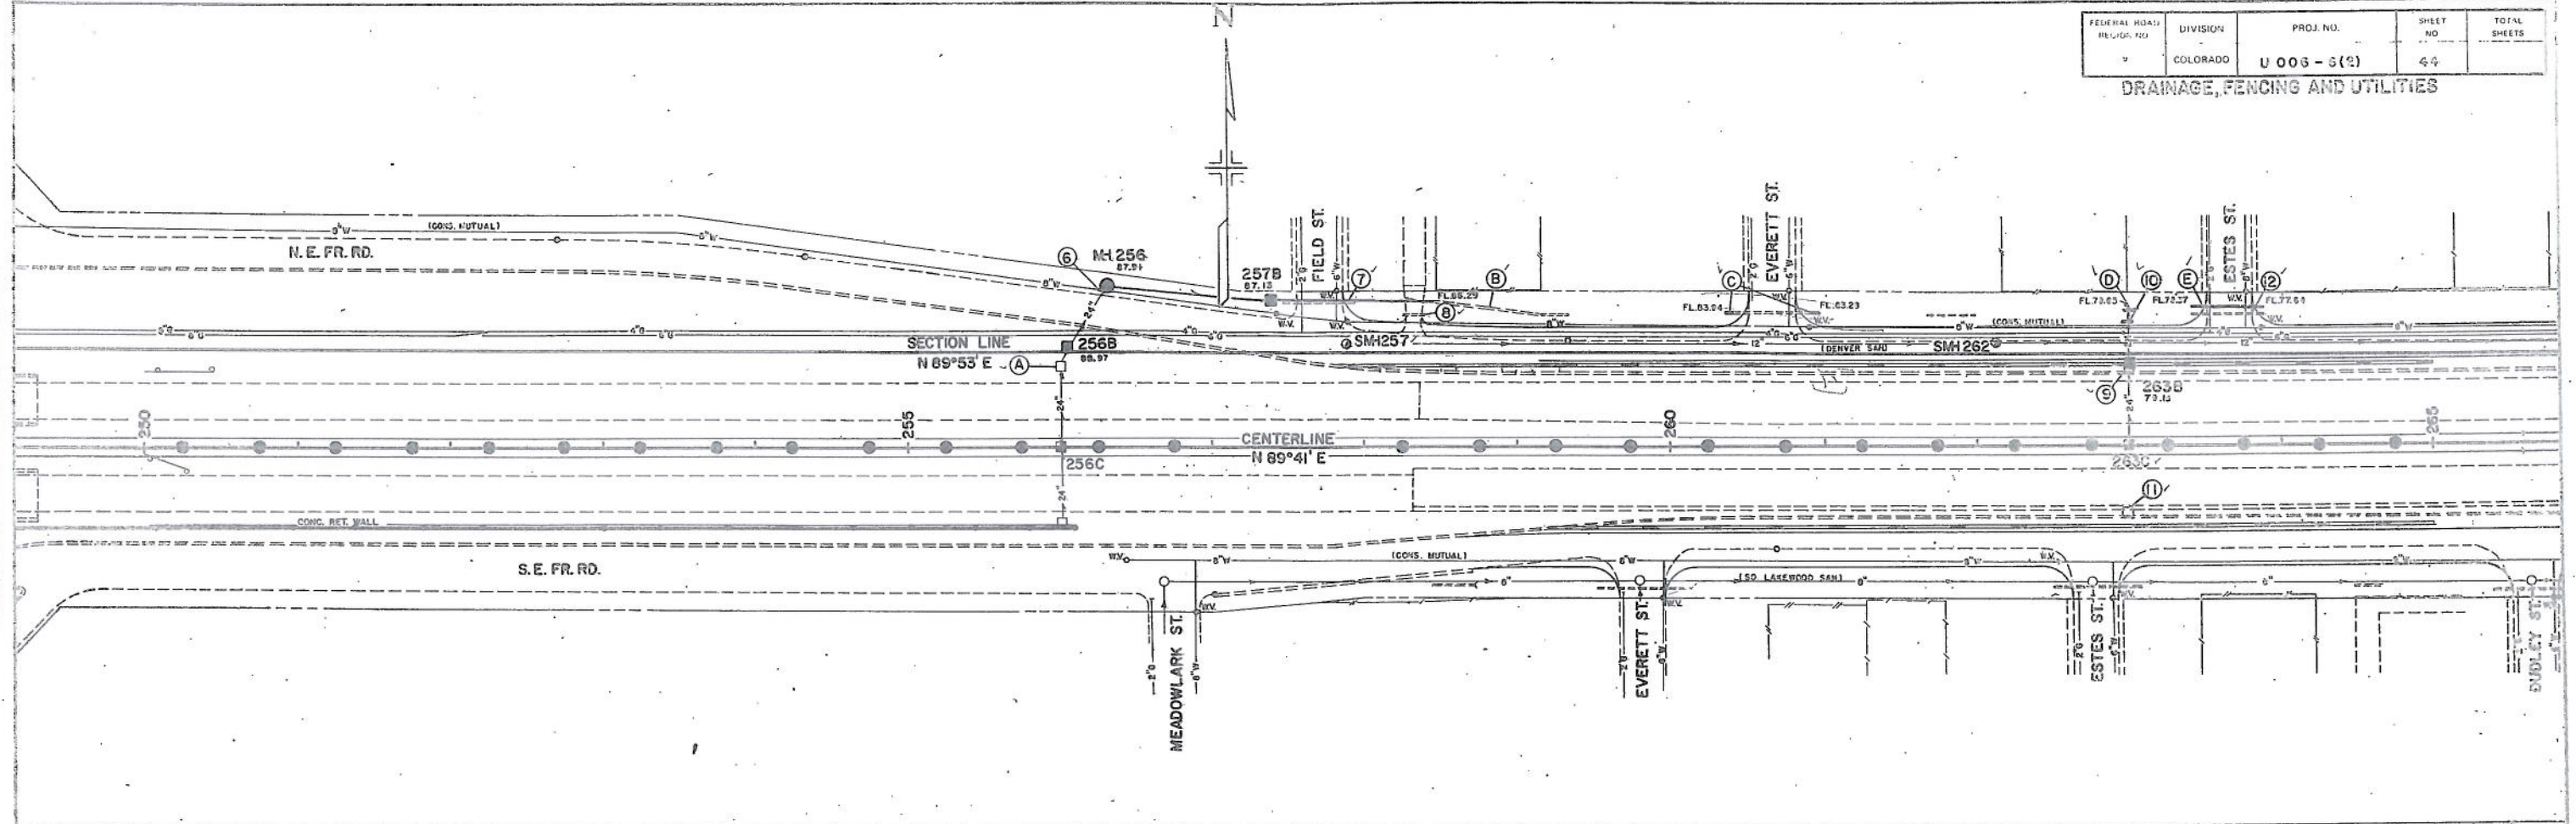


NOTE: SEE DRAWING FOR DETAILS OF CONCRETE RETAINING WALL AND UTILITIES.

NOTE: SEE DRAWING FOR DETAILS OF CONCRETE RETAINING WALL AND UTILITIES.

SECTION	PROJECT NO.	SHEET NO.	TOTAL SHEETS
COLORADO	U 003 - 6 (2)	45	

DRAINAGE, FENCING AND UTILITIES

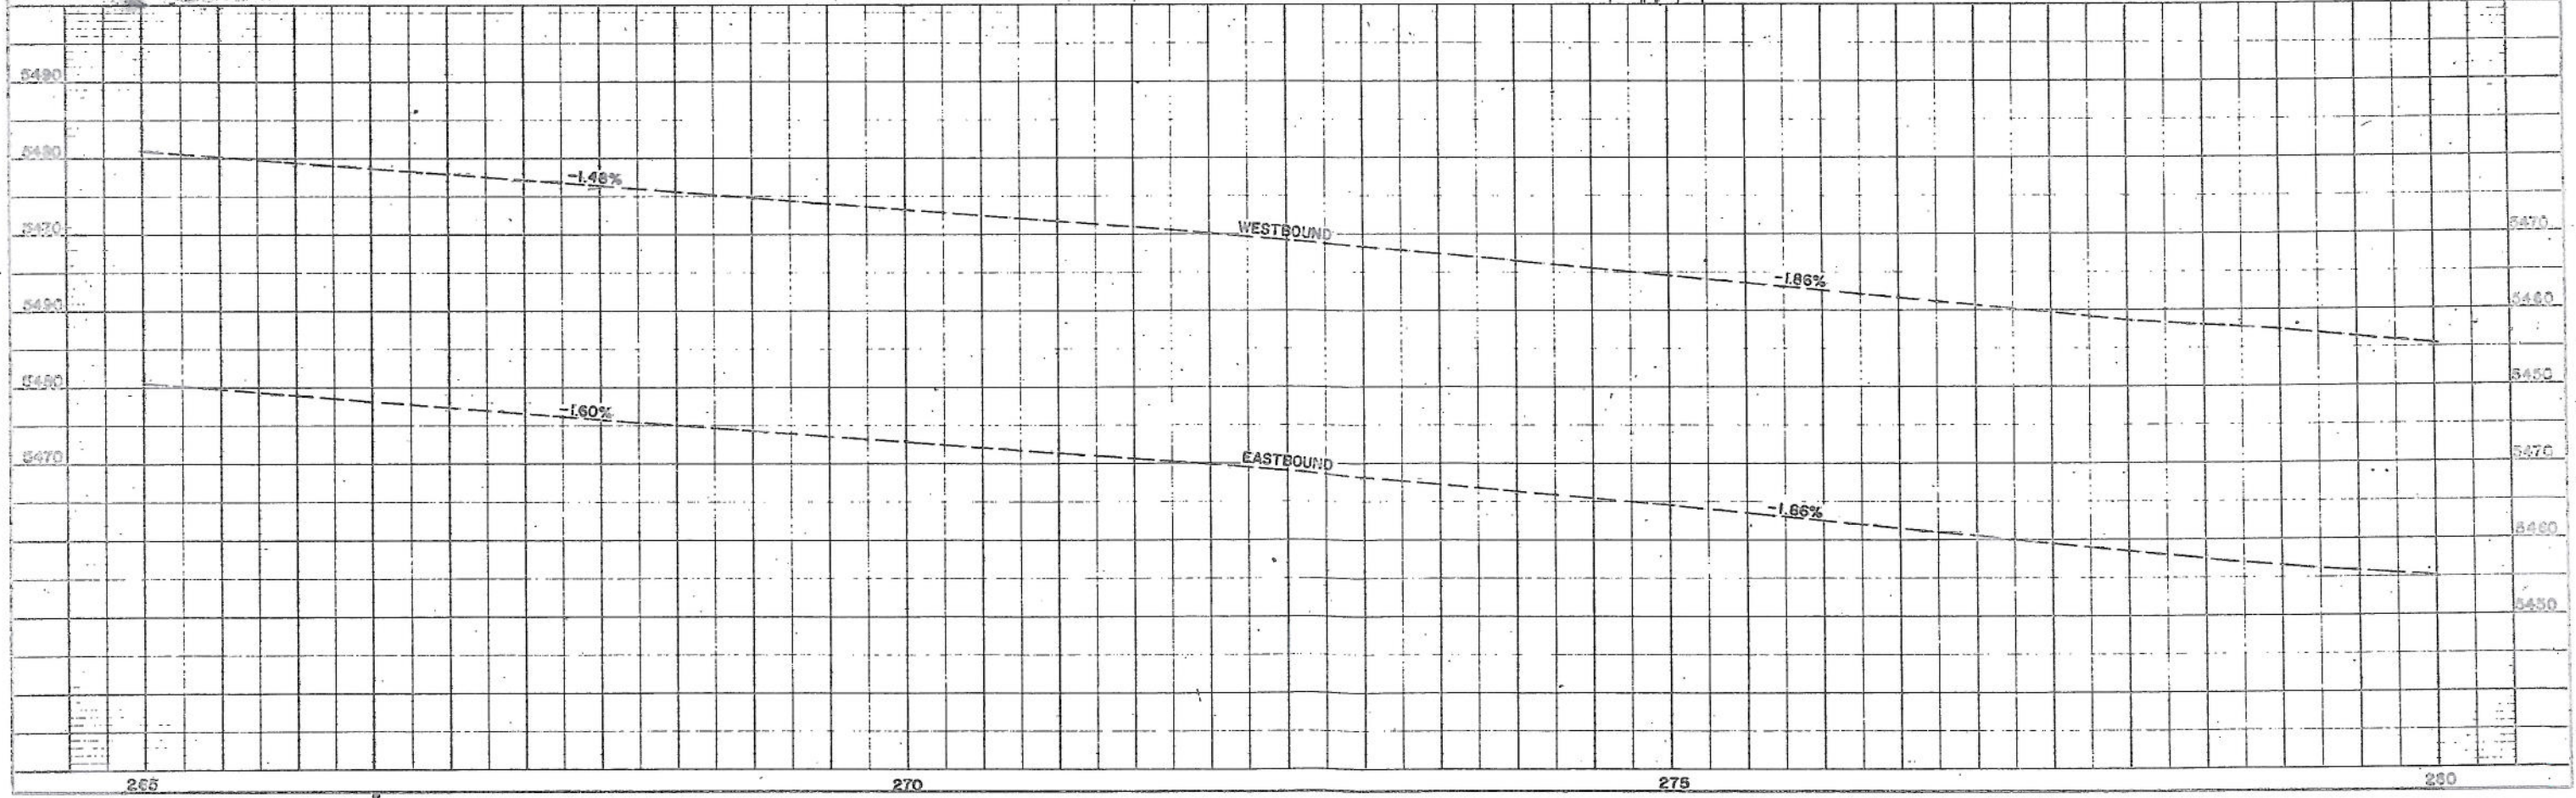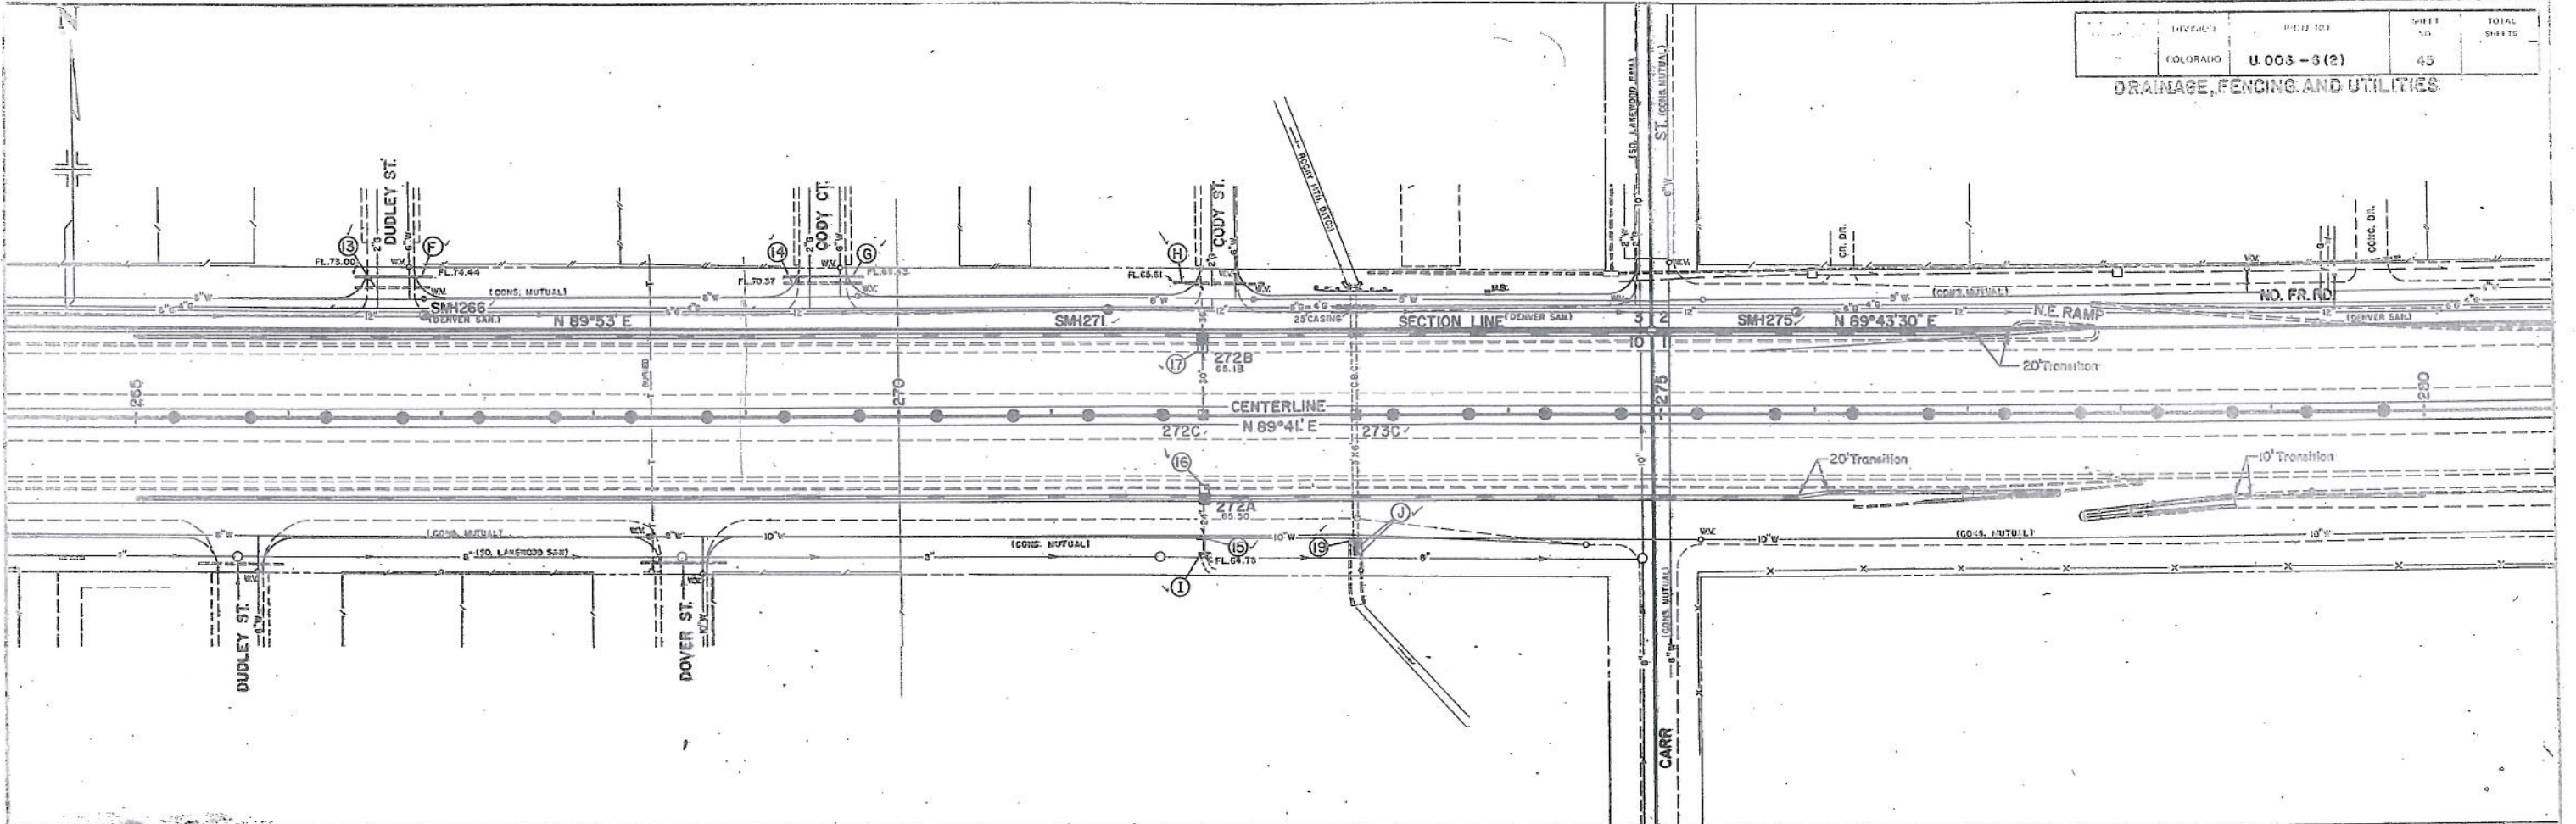

PLAN
 NOTE BOOK
 DATE

PROFILE
 NOTE BOOK
 DATE