


EXISTING 144 STRAND LATERAL FIBER CABLE

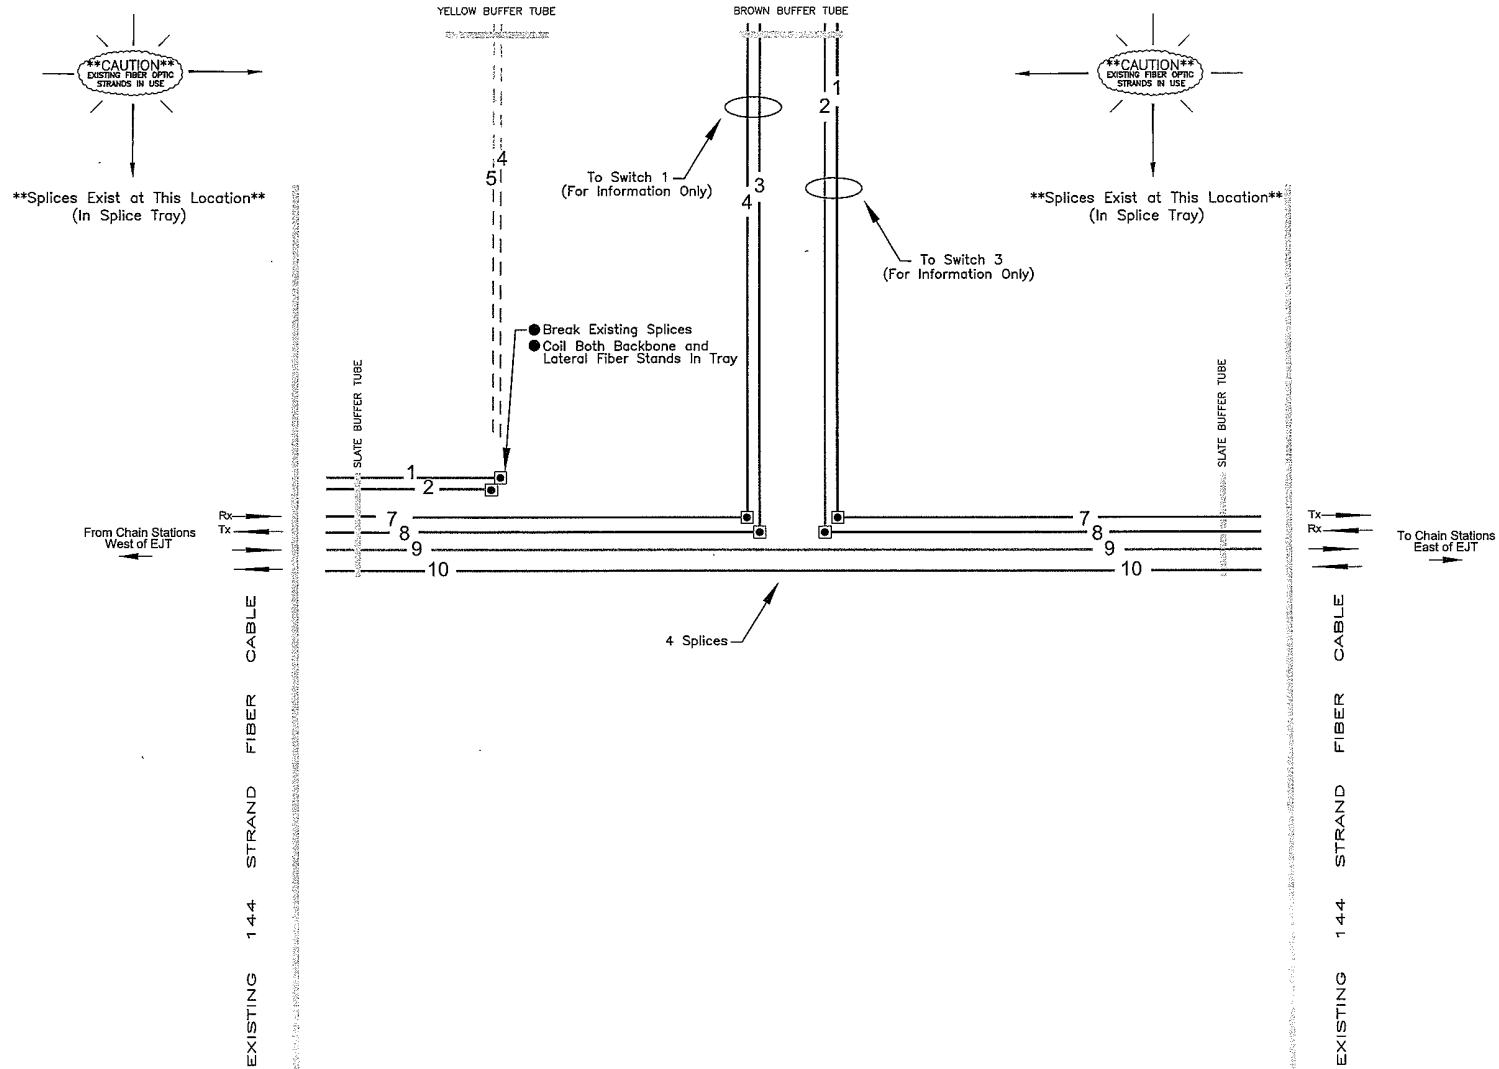

Computer File Information	
Creation Date:	4/13/2007 Initials: Wjkjr
Last Modification Date:	See Side Panel Initials: Wjkjr
Full Path:	
Drawing File Name:	See Side Panel
ACAD Ver:	ACAD 200LT Scale: NTS Units: English

Sheet Revisions	


Colorado Department of Transportation

 ITS - Colorado Traffic Management Center
 425C Corporate Circle
 Golden, Colorado 80401
 Phone: 303-512-5834 FAX: 303-512-5878
 ITS - CTRM With Region 1 Traffic CBR


As Constructed	
No Revisions:	
Revised:	
Void:	

Interstate 70 West Corridor	
Chain Stations	
Fiber Splice Diagram at EJT-East Vent Building	
Designer: Wjkjr	Structure Numbers
Detailer: Wjkjr	
Sheet Subst: Fiber Allocation	

Project No./Code	
I R100-128	
16221	
Sheet Number	67

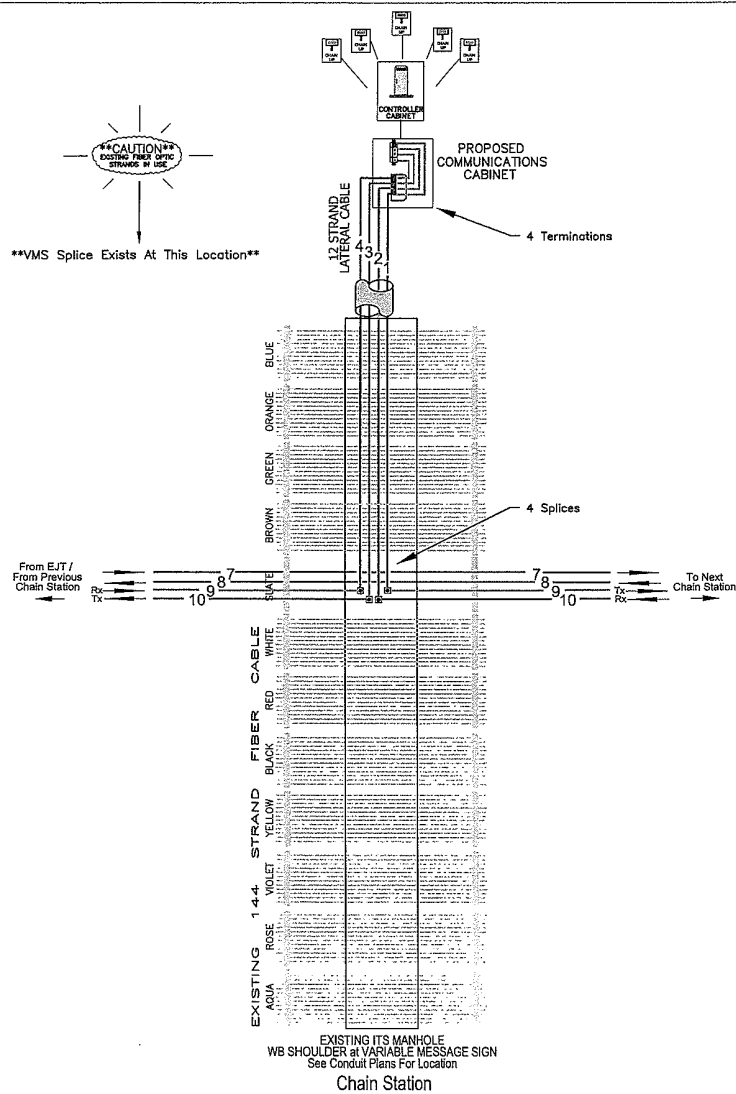

-MP 223 EAST OF BAKERVILLE INTERCHANGE at VMS SIGN-

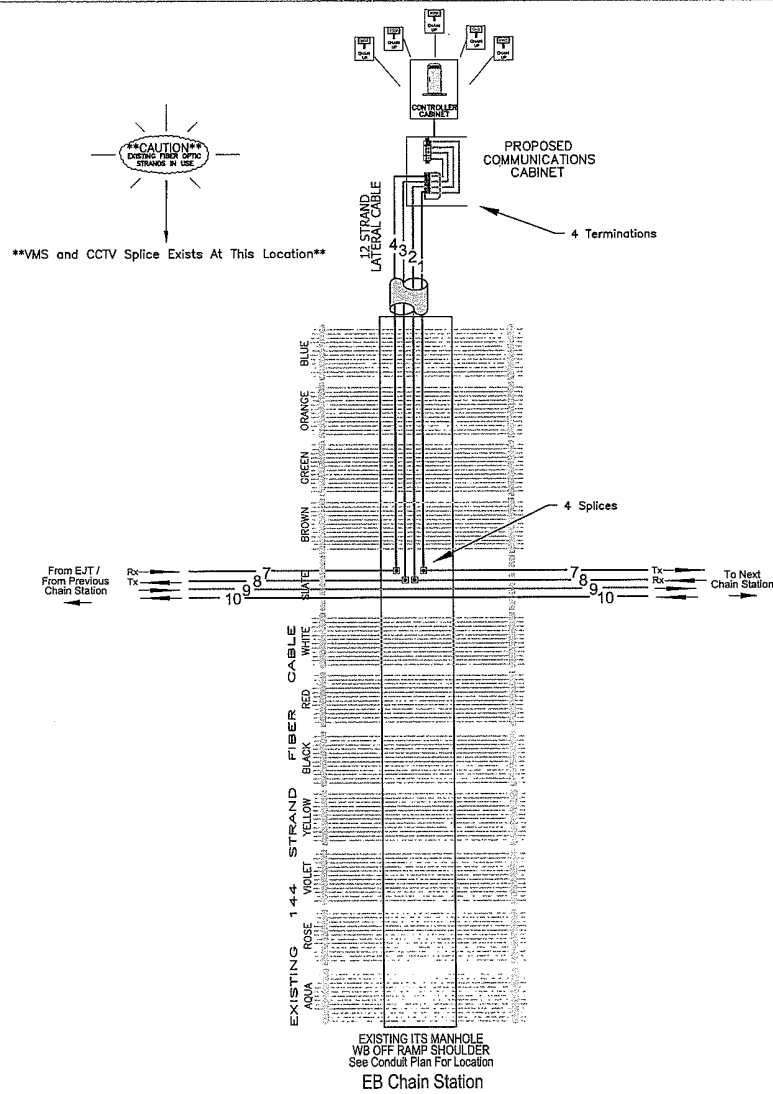


-MP 228 EAST OF GEORGETOWN-

Computer File Information	
Creation Date:	4/13/2007 Initials: WJKjr
Last Modification Date:	See Side Panel Initials: WJKjr
Full Path:	
Drawing File Name:	See Side Panel
ACAD Ver.:	ACAD 200LT Scale: NTS Units: English

Sheet Revisions	

Colorado Department of Transportation
 ITS - Colorado Traffic Management Center
 425C Corporate Circle
 Golden, Colorado 80401
 Phone: 303-512-5834 FAX: 303-512-5878
 ITS - CTRM With Region 1 Traffic CBR

As Constructed		Interstate 70 West Corridor		Project No./Code
No Revisions:		Chain Stations		I R100-128
Revised:		Fiber Splice Diagrams		16221
Void:		Designer: WJKjr	Structure Numbers	
		Detailer: WJKjr		
		Sheet Subset: Fiber Allocation	Subset Sheets: 3 of 5	Sheet Number 68

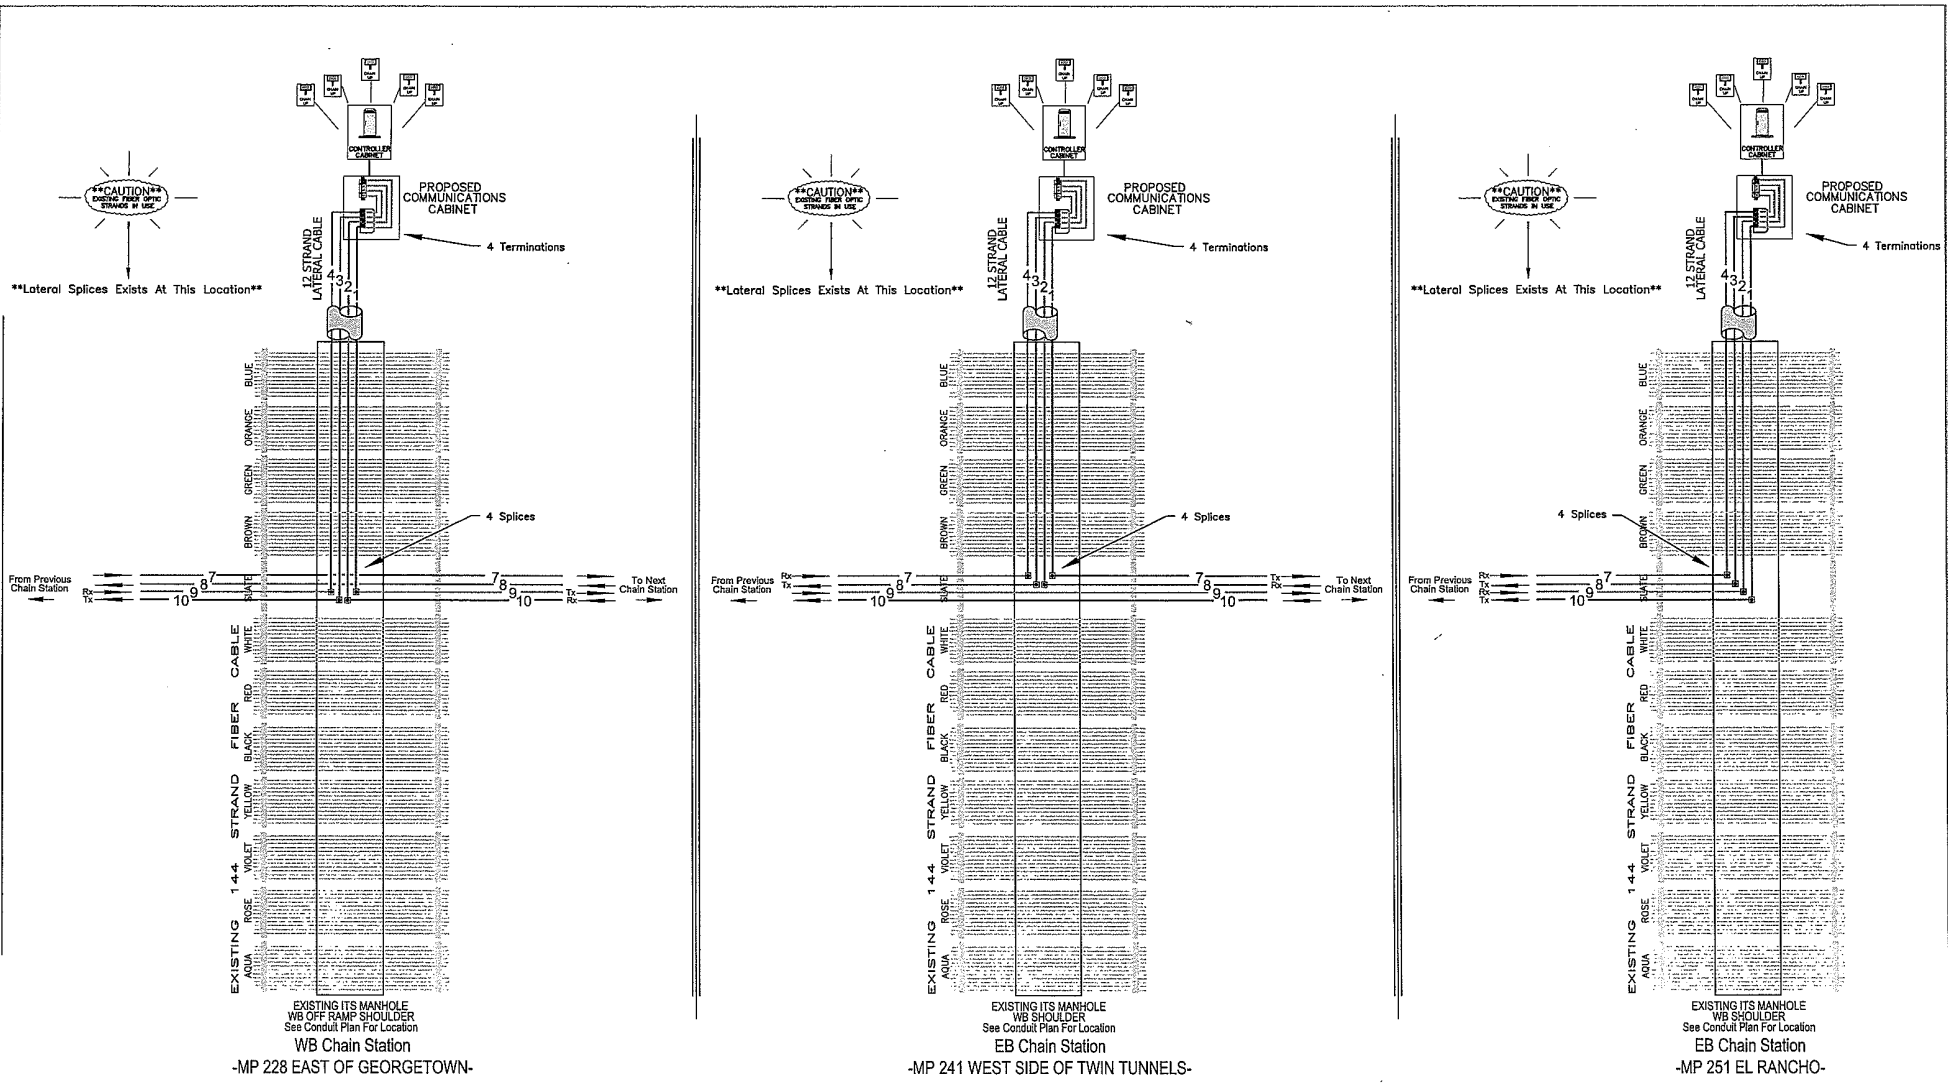

Computer File Information	
Creation Date:	4/13/2007 Initials: WJKjr
Last Modification Date:	See Side Panel Initials: WJKjr
Full Path:	
Drawing File Name:	See Side Panel
ACAD Ver:	ACAD 2000LT Scale: NTS Units: English

Sheet Revisions	

Colorado Department of Transportation
 ITS - Colorado Traffic Management Center
 425C Corporate Circle
 Golden, Colorado 80401
 Phone: 303-512-5834 FAX: 303-512-5878
 ITS - CTMC With Region 1 Traffic CBR

As Constructed	
No Revisions:	
Revised:	
Void:	


Interstate 70 West Corridor
 Chain Stations
Fiber Splice Diagrams

Project No./Code	
I R100-128	
16221	
Sheet Number	69 ²⁰⁰

Designer:	WJKjr	Structure	
Detailer:	WJKjr	Numbers	
Sheet, Subset: Fiber Allocation		Subset Sheets: 4 of 5	

NOTE:

ALL EQUIPMENT SHOWN ON THIS PLAN SHEET IS SHOWN FOR INFORMATION ONLY.
 PROPOSED WORK ON THIS PROJECT IS FIBER INSTALLATION, SPLICING,
 TERMINATION AND ALL ASSOCIATED MATERIALS AND LABOR.

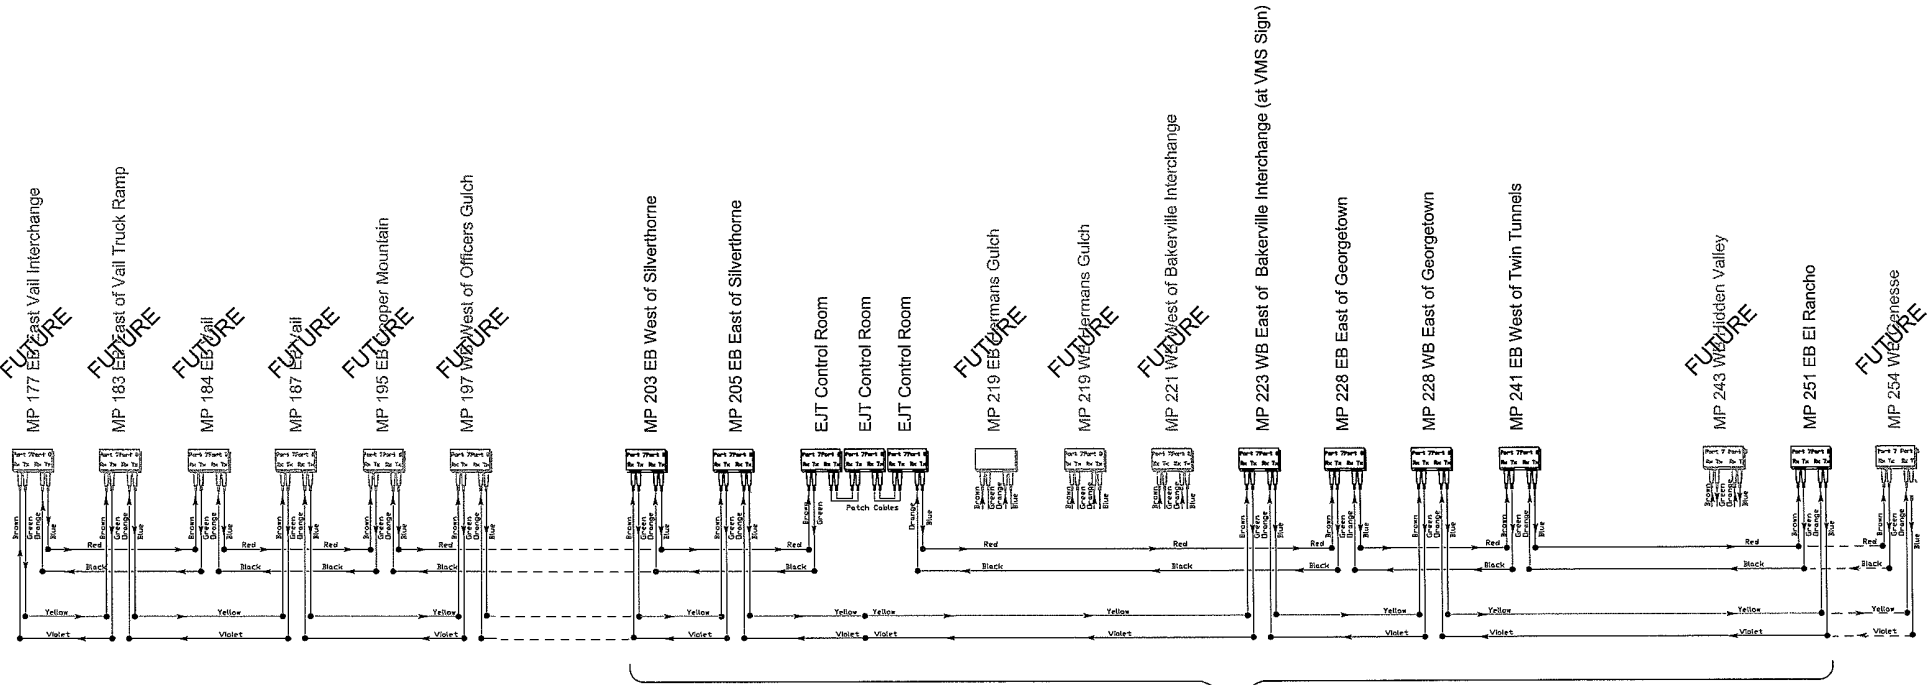

Fiber Connection For This Project
 Remaining Locations To Be Connected At A Later Date. Equipment
 To Be Provided and Connected By Others

Computer File Information	
Creation Date:	4/13/2007 Initials: WJKjr
Last Modification Date:	See Side Panel Initials: WJKjr
Full Path:	
Drawing File Name:	See Side Panel
ACAD Ver.:	ACAD 200LT
Scale:	NTS
Units:	English

Sheet Revisions	

Colorado Department of Transportation

 ITS - Colorado Traffic Management Center
 425C Corporate Circle
 Golden, Colorado 80401
 Phone: 303-512-5834 FAX: 303-512-5878
 ITS - CFMC With Region 1 Traffic CBR

As Constructed
No Revisions:
Revised:
Void:

Intrastate 70 West Corridor
 Chain Stations
Proposed Project Logic Data Flow
 Designer: WJKjr
 Detailer: WJKjr
 Sheet Subset: Fiber Allocation
 Subset Sheets: 5 of 5

Project No./Code
I R100-128
16211
Sheet Number <i>70-200</i>


Pull Box (Special) Standard Revised Rev 1.dwg

5/13/2007 7:38 PM

William Kascek, Self


PULL BOX (SPECIAL) NOTES:

- CONDUITS DEPICTED ON THIS SHEET ARE REPRESENTATIVE ONLY. EXACT NUMBER OF CONDUITS INSTALLED AND CONDUIT SIZE SHALL BE AS TABULATED AND SHOWN ON THE PLANS.
- CONDUIT CENTERLINE SHALL BE ALIGNED WITHIN THE PULL BOX TO FACILITATE FIBER OPTIC CABLE PULLING.
- CONDUIT PLUGS SHALL BE INSTALLED IN ALL CONDUITS, BOTH WITH AND WITHOUT WIRE OR CABLE AND SHALL BE INCLUDED IN THE COST OF ELECTRICAL CONDUIT ITEM.
- TRACER WIRE AND PULL ROPE SHALL BE INCLUDED IN THE COST OF ELECTRICAL CONDUIT ITEM.
 - MAIN BACKBONE AND LATERAL FIBER CABLE CONDUIT -
 - IF INSTALLATION INCLUDES MULTIPLE RUNS OF CONDUIT, PULL ROPE SHALL BE INSTALLED IN EACH INDIVIDUAL CONDUIT. TRACER WIRE SHALL BE INSTALLED IN ONLY ONE CONDUIT. ANY CONDUIT CONTAINING FIBER OPTIC CABLE SHALL NOT HAVE TRACER WIRE INSTALLED.
 - IF INSTALLATION INCLUDES ONLY ONE RUN OF CONDUIT, PULL ROPE AND TRACER WIRE SHALL BE INSTALLED IN SAME CONDUIT AS FIBER CABLE.
- ALL PULL BOX TYPES SHALL BE PAID FOR UNDER THE ITEM #14 PULL BOX, AND SHALL BE SIZED AS TABULATED AND SHOWN IN THE PLANS.
- PULL BOXES SHALL HAVE 12" WIDE X 6" DEEP CONCRETE APRONS SLOPED AWAY FROM PULL BOX OPENING. THE COST OF THE CONCRETE APRON SHALL BE PAID FOR AS PART OF PULL BOX ITEM.
- CONCRETE FOOTING SUPPORT FOR LOCATION MARKERS AT PULL BOX LOCATIONS ARE PAID FOR AS PART OF PULL BOX AND SHALL BE POURED MONOLITHICALLY WITH CONCRETE APRON.
- FIBER OPTIC CABLE COILS WITHIN PULL BOXES SHALL BE TIED TO EACH CABLE RACK WITH PLASTIC CABLE TIES. CAUTION SHALL BE TAKEN TO COIL THE FIBER CABLE PER MANUFACTURER'S RECOMMENDATIONS.
- ALL WORK TO INSTALL PULL BOX SHALL INCLUDE BUT NOT BE LIMITED TO SAW CUTTING OF PAVEMENT, REMOVAL OF PAVEMENT, CONCRETE, EARTHWORK, ALL LANDSCAPE RESTORATION AND SHALL BE PAID FOR AS PART OF PULL BOX.

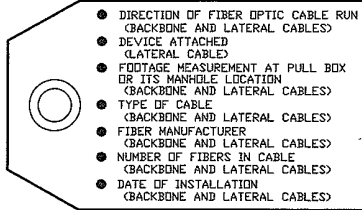


FIBER CABLE LABEL


TO BE ATTACHED TO EACH FIBER OPTIC CABLE LOCATED IN ALL PULL BOX AND ITS MANHOLES

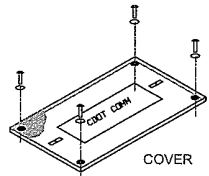

COVER

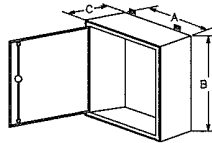


SURFACE MOUNTED TYPE WEATHER TIGHT WITH LOCK

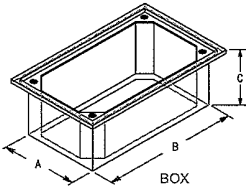


BOX

ITS PULL BOX TYPE	MINIMUM DIMENSIONS (Inches)		
	A	B	C
PULL BOX (SPECIAL) - (Small Size)	13	24	18
PULL BOX (SPECIAL) - (Large Size)	24	36	18
PULL BOX (SPECIAL) - (Surface Mounted)	24	24	8


PULL BOX DIMENSIONS

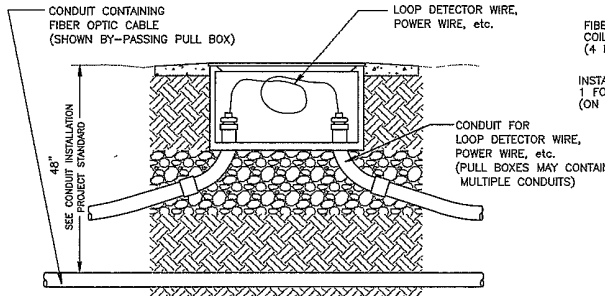


CONDUIT BYPASS DETAIL

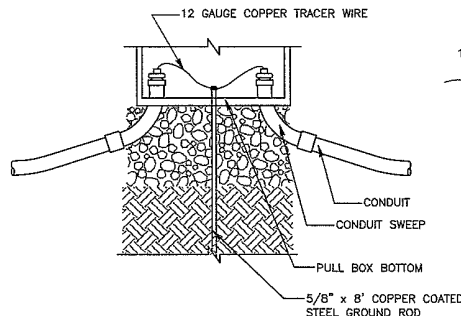


GROUNDING DETAIL

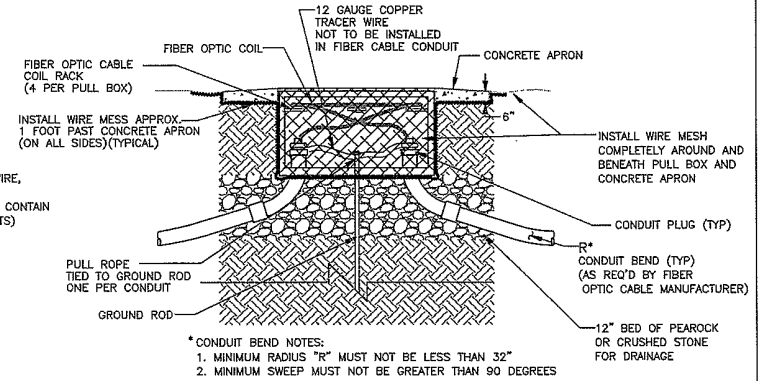

- * CONDUIT BEND NOTES:
- MINIMUM RADIUS "R" MUST NOT BE LESS THAN 32"
 - MINIMUM SWEEP MUST NOT BE GREATER THAN 90 DEGREES

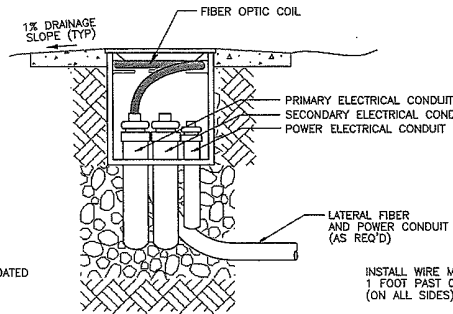

ITS PULL BOX INSTALLATION

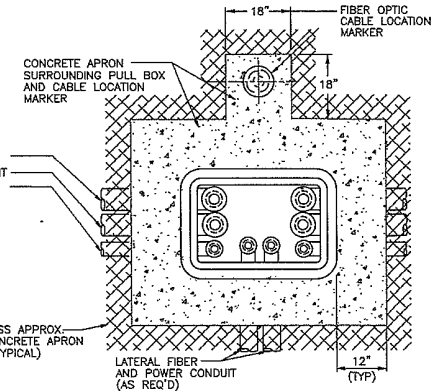

Computer File Information	
Creation Date:	5/12/2003 Initials: Wjkjr
Last Modification Date:	11/13/2006 Initials: Wjkjr
Full Path:	
Drawing File Name:	Pull Box (Special) Standard.DWG
Scale:	NA Units: English

Index of Revisions	
XX	00/00/0000 xxxxxxxxxxxxxx xxx
XX	00/00/0000 xxxxxxxxxxxxxx xxx
Colorado Department of Transportation
 ITS - Colorado Traffic Management Center
 425C Corporate Circle
 Golden, Colorado 80401
 Phone: 303-512-5834 FAX: 303-512-5878
 ITS - CTMC With Region 1 Traffic CBR

As Constructed
No Revisions:
Revised:
Void:

PLAN SHEET Project Detail ITS Pull Box	
Designer: Wjkjr	Structure Numbers
Detaller: Wjkjr	
Sheet Subst:	Subst Sheet Number:

Project No./Code
I R100-128
16221
Sheet Number 71/201

Bakerville VMS Fiber Replacement.dwg

5/14/2007 10:44 AM


William Kascek, Self

****CAUTION****
EXISTING FIBER OPTIC STRANDS IN USE

****CAUTION****
EXISTING FIBER OPTIC STRANDS IN USE

NOTES:

1. The Contractor Shall Not Start Construction Work Shown On This Plan Sheet Until A Fiber Optic Meeting Is Conducted To Schedule Device and Network Outages. This Work Shall Be Conducted Prior To Any Work On Chain Station To Protect The Integrity Of The Fiber Optic Data Network.
2. Plan Sheet Is Based On Best Known Design And Field Information Available At Time Of Design. The Contractor Shall Stake New Fiber Optic With Project Engineer To Insure Alignment.

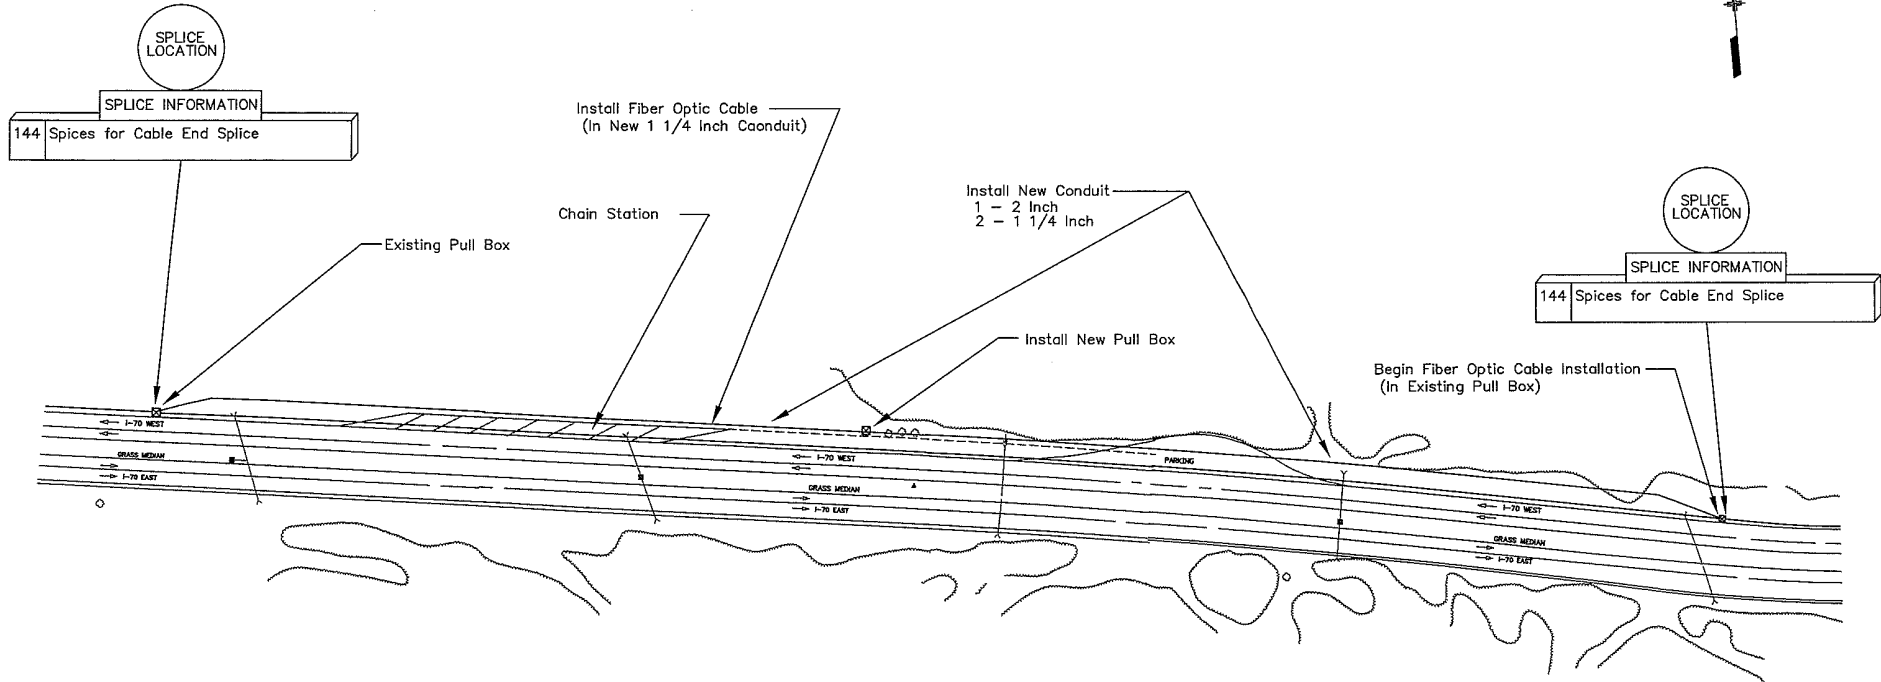


ELECTRICAL CONDUIT (PLASTIC)(1-1/2 INCH) (LIN. FT.)	ELECTRICAL CONDUIT (PLASTIC)(2 INCH) (LIN. FT.)	PULL BOX (24 X 36 X 18) (EACH)	FIBER OPTIC CABLE (SINGEL MODE)(144 STRAND) (LIN. FT.)
2400	1200	1	1500

IT IS ESTIMATED THAT 288 FIBER OPTIC SPLICES WILL BE REQUIRED AT THIS LOCATION. TO BE PAID FOR WITH FIBER OPTIC CABLE ITEM.

Computer File Information	
Creation Date:	4/13/2007 Initials: WJKjr
Last Modification Date:	See Side Panel Initials: WJKjr
Full Path:	
Drawing File Name:	See Side Panel
ACAD Ver.:	ACAD 200LT
Scale:	NTS
Units:	English

Sheet Revisions	

Colorado Department of Transportation

 ITS - Colorado Traffic Management Center
 425C Corporate Circle
 Golden, Colorado 80401
 Phone: 303-512-5834 FAX: 303-512-5878
 ITS - CTMC With Region 1 Traffic CBR

As Constructed
No Revisions:
Revised:
Void:

Interstate 70 West Corridor
 Chain Stations (Location "F")
 Bakerville VMS Conduit/Fiber Replacement

Designer: WJKjr
 Detailer: WJKjr

Structure Numbers

Sheet Subset: Fiber Plan Subset Sheets: 1 of 2

Project No./Code
I R100-128
16221
Sheet Number 72202

Georgetown WB Fiber Replacement.dwg



5/14/2007 9:55 AM

William Kascek, Self



NOTES:

1. The Contractor Shall Not Start Construction Work Shown On This Plan Sheet Until A Fiber Optic Meeting Is Conducted To Schedule Device and Network Outages. This Work Shall Be Conducted Prior To Any Work On Chain Station Which Would Interfere And To Protect The Integrity Of The Existing Fiber Optic Data Network.
2. Plan Sheet Is Based On Best Known Design And Field Information Available At Time Of Design. The Contractor Shall Stake New Fiber Optic Line With Project Engineer To Insure Alignment.

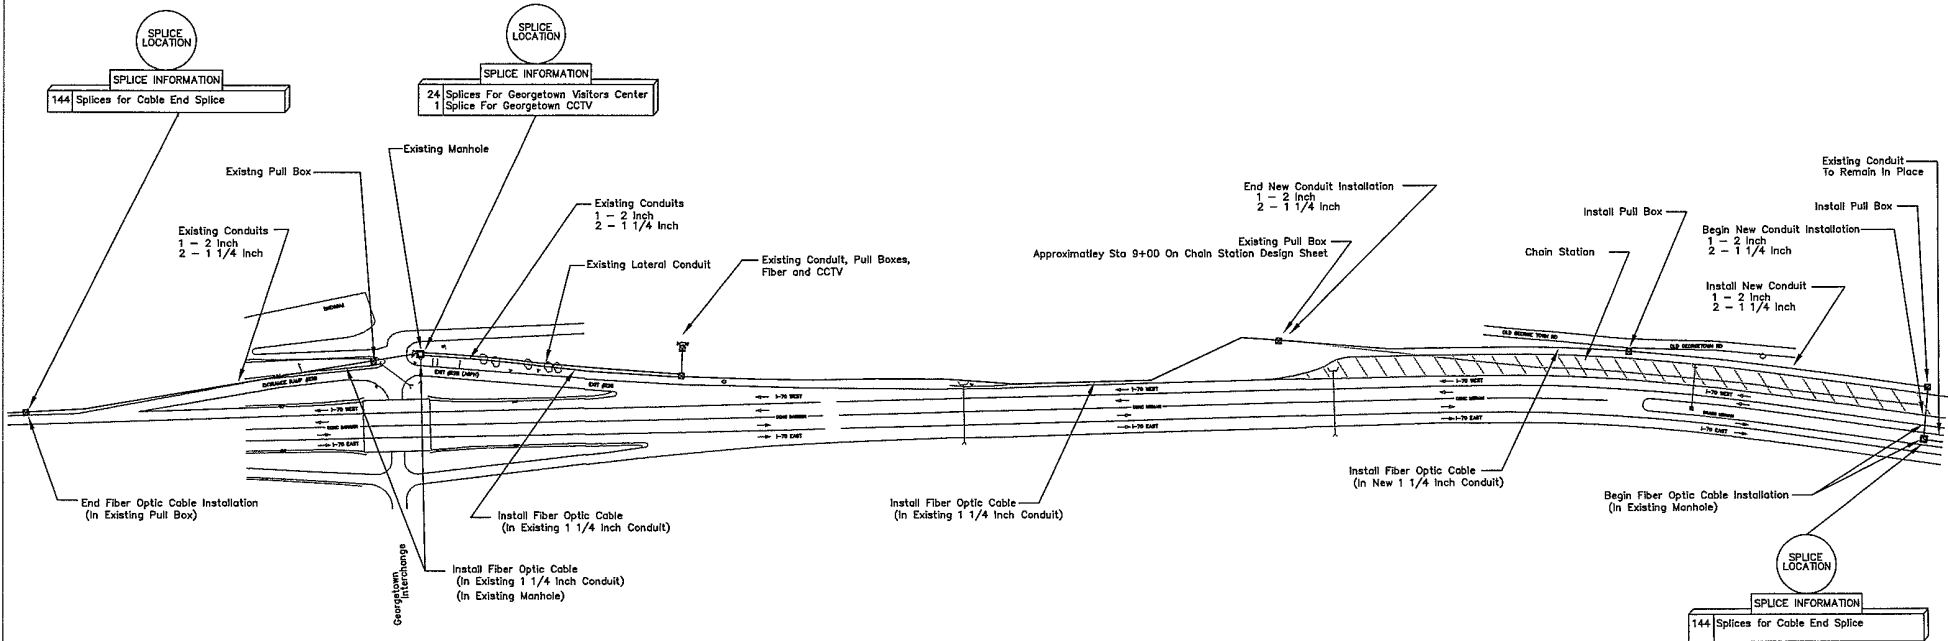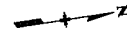


SHEET QUANTITIES

ELECTRICAL CONDUIT (PLASTIC)(1-1/4 INCH) (LIN. FT.)	ELECTRICAL CONDUIT (PLASTIC)(2 INCH) (LIN. FT.)	PULL BOX (24 X 36 X 18) (EACH)	FIBER OPTIC CABLE (SINGLE MODE)(144 STRAND) (LIN. FT.)
5000	2500	2	4400

IT IS ESTIMATED THAT 313 FIBER OPTIC SPLICES WILL BE REQUIRED AT THIS LOCATION. TO BE PAID FOR WITH FIBER OPTIC CABLE ITEM.


Computer File Information Creation Date: 4/13/2007 Initials: WJKjr Last Modification Date: See Side Panel Initials: WJKjr Full Path: Drawing File Name: See Side Panel ACAD Ver. ACAD 2001LT Scale: NTS Units: English		Sheet Revisions <table border="1"> <tr><td> </td><td> </td></tr> <tr><td> </td><td> </td></tr> <tr><td> </td><td> </td></tr> <tr><td> </td><td> </td></tr> </table>										Colorado Department of Transportation ITS - Colorado Traffic Management Center 425C Corporate Circle Golden, Colorado 80401 Phone: 303-512-5834 FAX: 303-512-5878 ITS - CTMC With Region 1 Traffic CBR		As Constructed No Revisions: Revised: Void:		Interstate 70 West Corridor Chain Stations (Location "I") Georgetown Conduit/Fiber Replacement Designer: WJKjr Structure: Detailer: WJKjr Numbers: Sheet Subset: Fiber Plan Subset Sheets: 2 of 2		Project No./Code I R100-128 16221 Sheet Number 73	

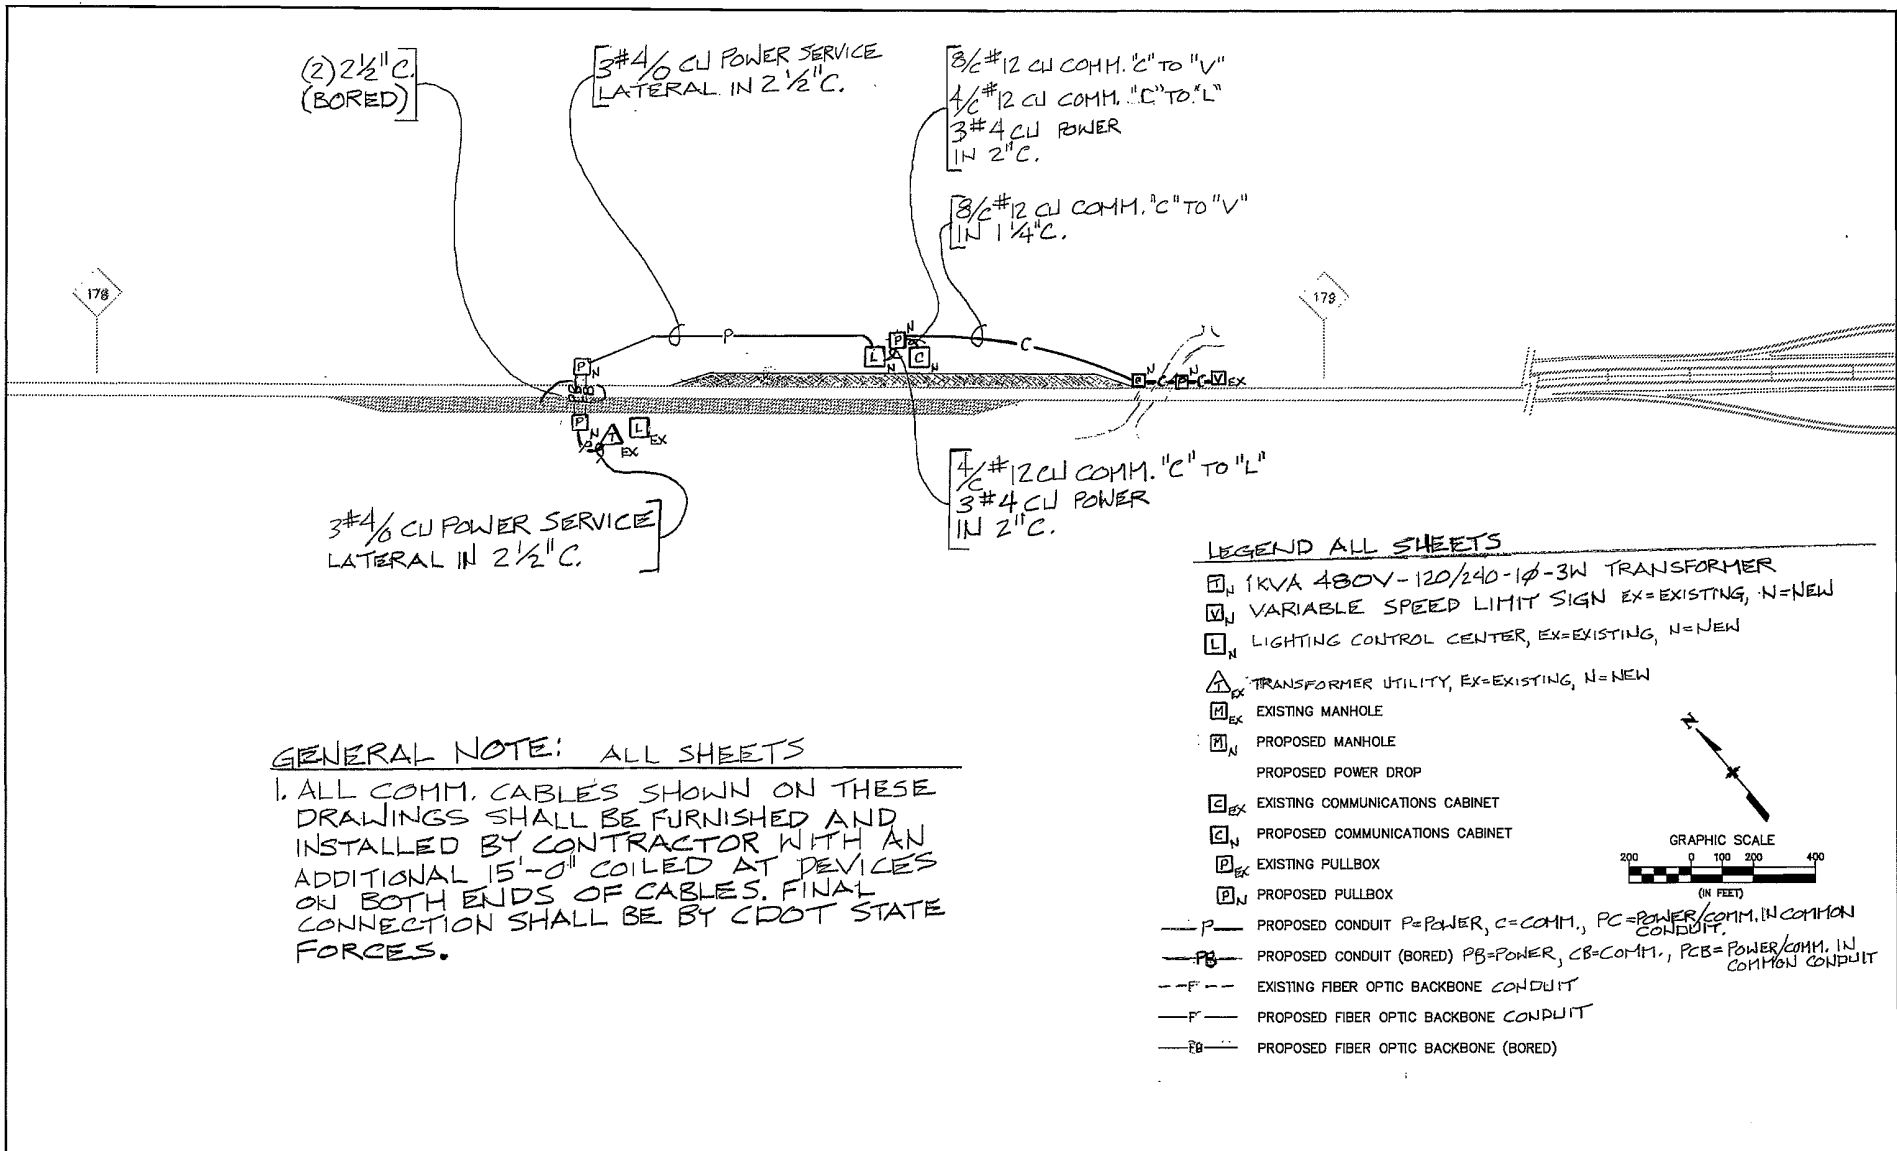



GENERAL NOTE: ALL SHEETS

1. ALL COMM. CABLES SHOWN ON THESE DRAWINGS SHALL BE FURNISHED AND INSTALLED BY CONTRACTOR WITH AN ADDITIONAL 15'-0" COILED AT DEVICES ON BOTH ENDS OF CABLES. FINAL CONNECTION SHALL BE BY CROT STATE FORCES.


- LEGEND ALL SHEETS**
- 1KVA 480V-120/240-1φ-3W TRANSFORMER
 - VARIABLE SPEED LIMIT SIGN EX=EXISTING, N=NEW
 - LIGHTING CONTROL CENTER, EX=EXISTING, N=NEW
 - TRANSFORMER UTILITY, EX=EXISTING, N=NEW
 - EXISTING MANHOLE
 - PROPOSED MANHOLE
 - PROPOSED POWER DROP
 - EXISTING COMMUNICATIONS CABINET
 - PROPOSED COMMUNICATIONS CABINET
 - EXISTING PULLBOX
 - PROPOSED PULLBOX
 - PROPOSED CONDUIT P=POWER, C=COMM., PC=POWER/COMM. IN COMMON CONDUIT.
 - PROPOSED CONDUIT (BORED) PB=POWER, CB=COMM., PCB=POWER/COMM. IN COMMON CONDUIT
 - EXISTING FIBER OPTIC BACKBONE CONDUIT
 - PROPOSED FIBER OPTIC BACKBONE CONDUIT
 - PROPOSED FIBER OPTIC BACKBONE (BORED)

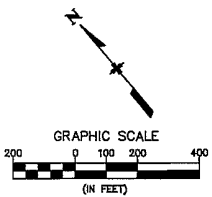


Computer File Information		Index of Revisions		<p>Region 1 18500 East Colfax Aurora, CO 80011 Phone: (303) 365-7340 FAX: (303) 365-7343</p> <p>DEPARTMENT OF TRANSPORTATION</p> <p>REGION 1 IW</p>	<p>4601 DTC Blvd. Suite 700 Denver, CO 80237 Phone: (303) 221-7275 Fax: (303) 221-7276</p>	As Constructed		<p>CHAIN STATION "A" MP 177 EASTBOUND CONDUIT PLAN</p>	Project No./Code		
Creation Date: 02/18/08	Initials: SBB					No. Revisions: _____	Designer: SBB		Structure Numbers	IM_070A-003	
Last Modification Date: 02/18/08	Initials: SBB					Revised: _____	Detailer: SBB			16701	
Full Path: S:\Tranpro\100000508\16701\Consultants\Plot_Sets\FIR						Void: _____	Sheet Subset: Conduit		Subset Sheets: 1 of _____	Sheet Number: 74	
Drawing File Name: cconduit01-mp177eb.dgn											
Scale: _____	Units: ENGLISH										

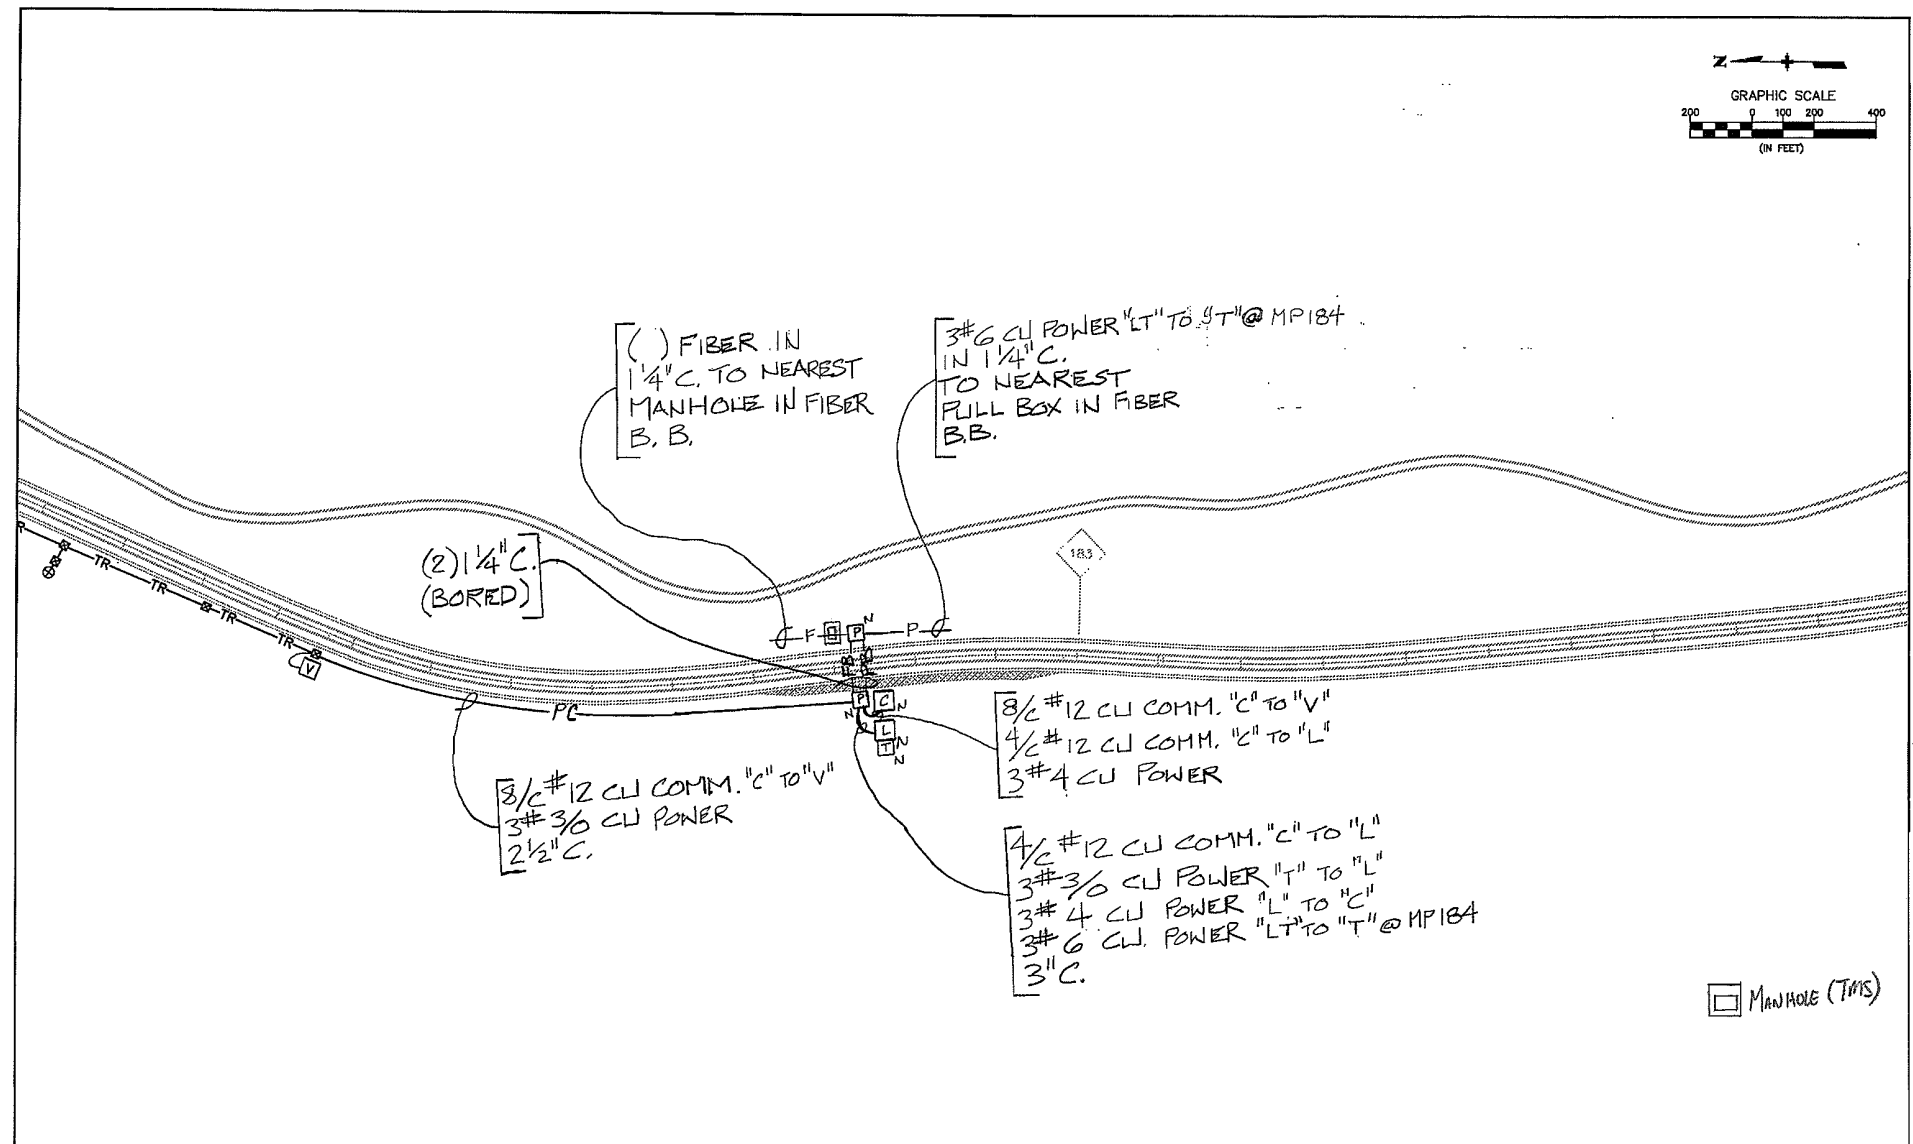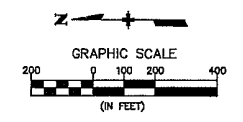

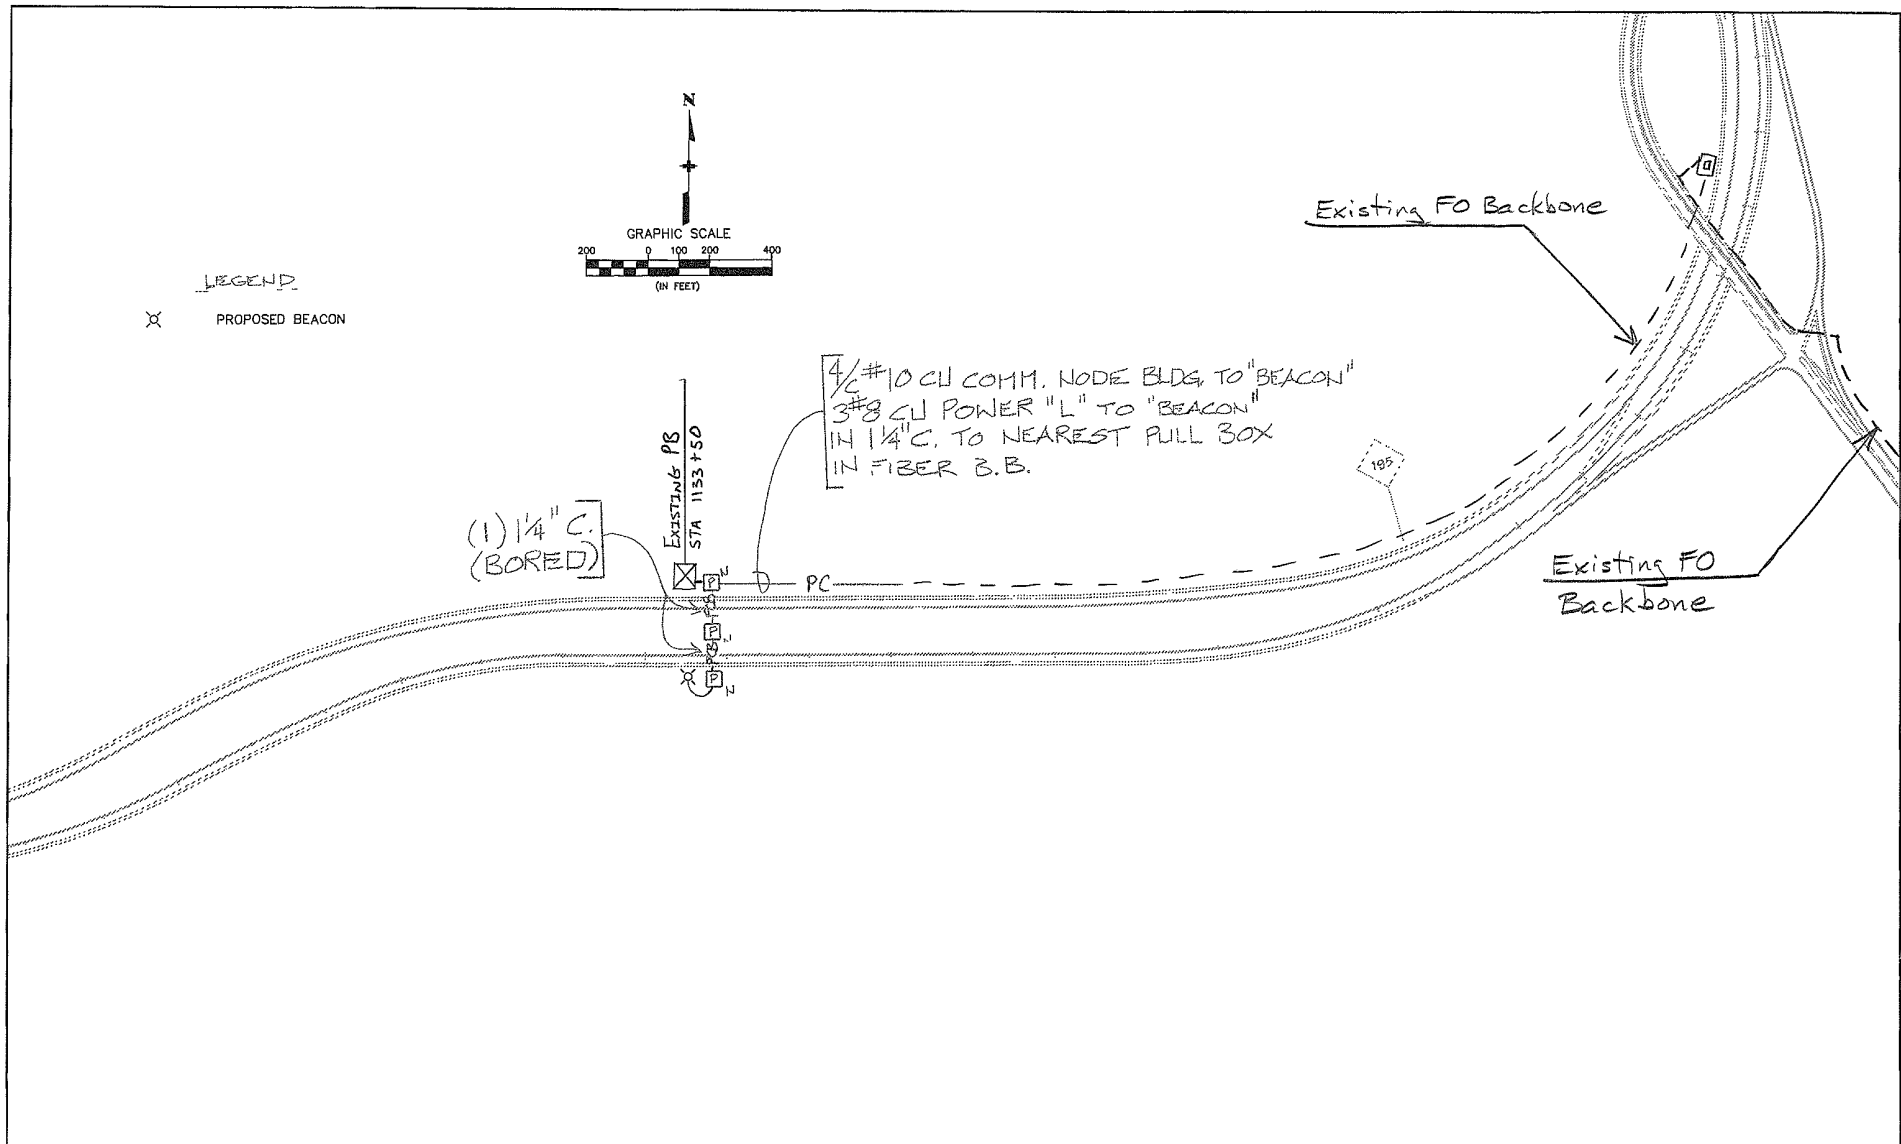



Computer File Information		Index of Revisions		 Region 1 18500 East Colfax Aurora, CO 80011 Phone: (303) 365-7340 FAX: (303) 365-7343 DEPARTMENT OF TRANSPORTATION REGION I TW	 4601 DTC Blvd. Suite 700 Denver, CO 80237 Phone: (303) 221-7275 Fax: (303) 221-7276	As Constructed		CONDUIT PLAN MP 183		Project No./Code	
Creation Date: 02/18/08	Initials: SRB					No. Revisions:		Designer: SRB	Structure Numbers	IM 070A-003	
Last Modification Date: 02/18/08	Initials: SRB			Revised:		Detailer: SRB				Sheet Number: 75	
Full Path: S:\Tranproj\100000508\16701\Consultants\Plot_Sets\FIR				Void:		Sheet Subst:	Subset Sheets: of				
Drawing File Name: .dgn											
Scale:	Units: ENGLISH										



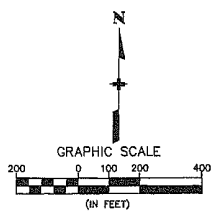


LEGEND
 X PROPOSED BEACON

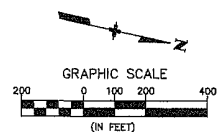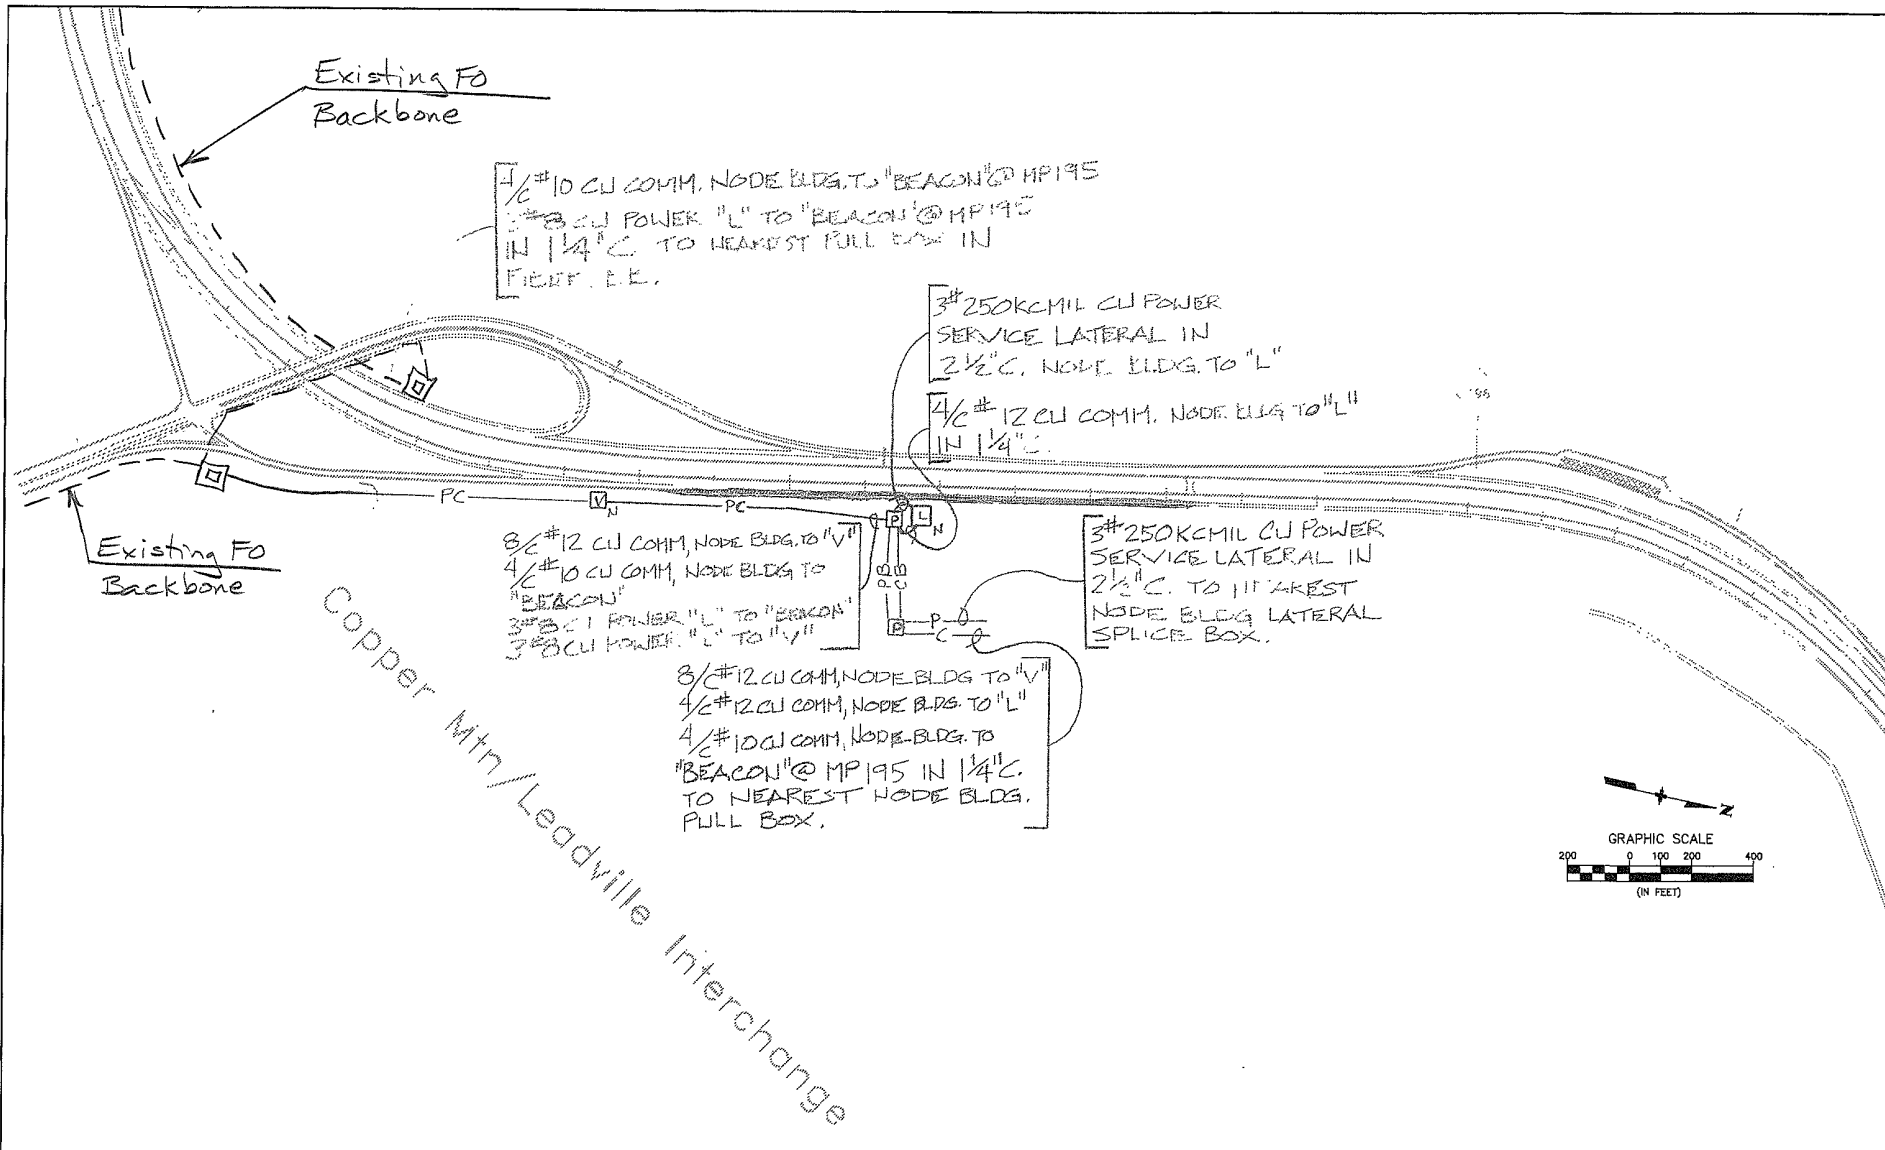


Computer File Information		Index of Revisions		 Region 1 18500 East Colfax Aurora, CO 80011 Phone: (303) 365-7340 FAX: (303) 365-7343	 4501 DTC Blvd. Suite 700 Denver, CO 80237 Phone: (303) 221-7275 Fax: (303) 221-7276	As Constructed		CHAIN STATION " " MP 195 EASTBOUND CONDUIT PLAN		Project No./Code	
Creation Date: 02/18/08	Initials: SRB	<input type="checkbox"/>				No. Revisions:	Designer: SRB	Structure Numbers	IM 070A-003		
Last Modification Date: 02/18/08	Initials: SRB	<input type="checkbox"/>				Revised:	Detailer: SRB		16701		
Full Path: S:\tranproj\100000508\16701\Consultants\Plot_Sets\FIR		<input type="checkbox"/>				Void:	Sheet Subset: Conduit	Subset Sheets: of	Sheet Number: 77		
Drawing File Name: conduit01-mp195eb.dgn		<input type="checkbox"/>		REGION I		TW					
Scale:	Units: ENGLISH	<input type="checkbox"/>									



Computer File Information Creation Date: 02/18/08 Initials: SRB Last Modification Date: 02/18/08 Initials: SRB Full Path: S:\Tranproj\100000508\16701\Consultants\PLOT_Sets\FIR Drawing File Name: conduit01-mp177eb.dgn Scale: Units: ENGLISH		Index of Revisions <table border="1"> <tr><td> </td><td> </td><td> </td></tr> <tr><td> </td><td> </td><td> </td></tr> <tr><td> </td><td> </td><td> </td></tr> <tr><td> </td><td> </td><td> </td></tr> </table>														 Region 1 18500 East Colfax Aurora, CO 80011 Phone: (303) 365-7340 FAX: (303) 365-7343 REGION I TW		 4601 DTC Blvd. Suite 700 Denver, CO 80237 Phone: (303) 221-7275 Fax: (303) 221-7276		As Constructed No. Revisions: Revised: Void:		CHAIN STATION " " MP 195 EASTBOUND CONDUIT PLAN Designer: SRB Detailer: SRB Sheet Subset: Conduit Structure Numbers: Subset Sheets: of		Project No./Code IM 070A-003 16701 Sheet Number: 78	

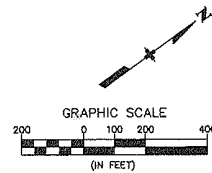


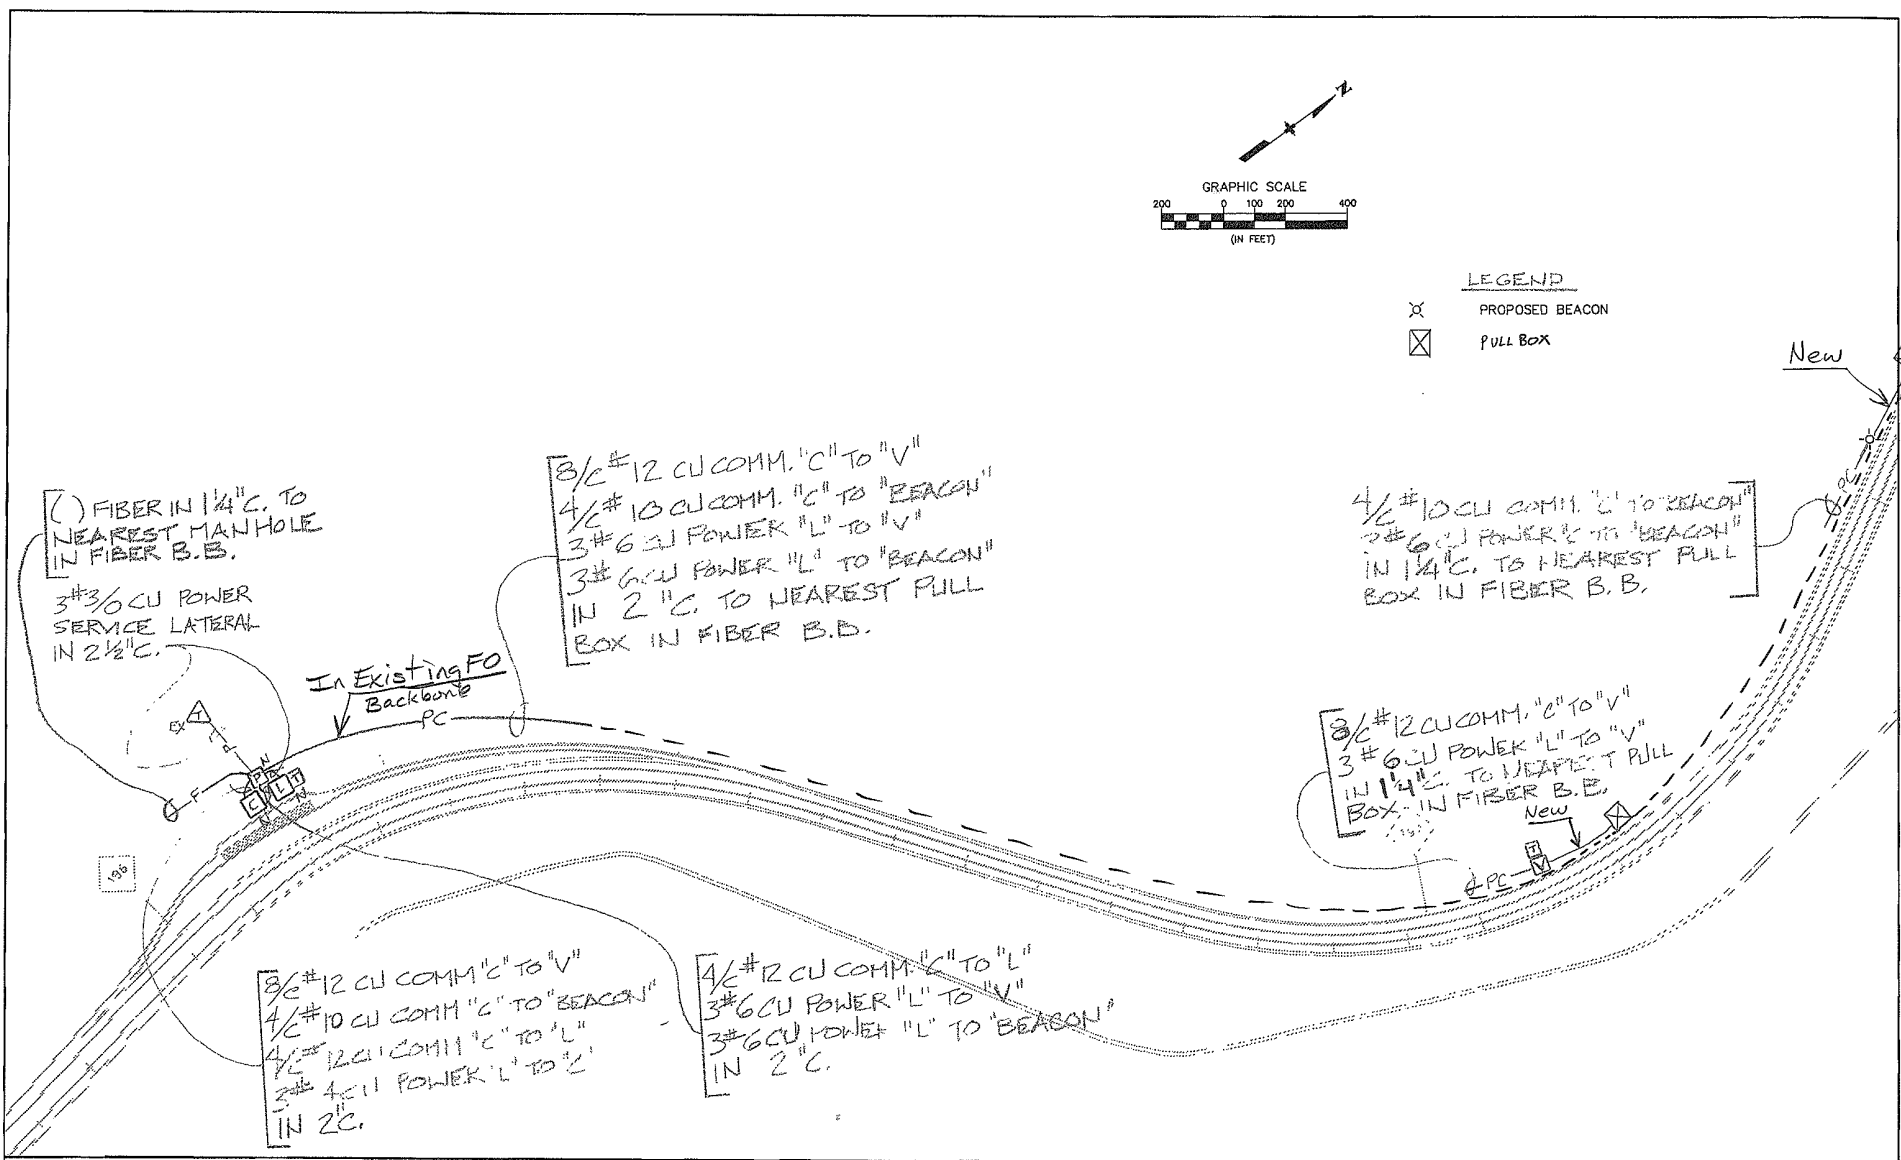

LEGEND
 X PROPOSED BEACON
 ⊠ PULL BOX





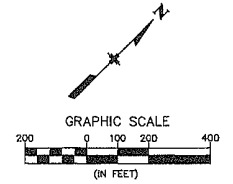

Computer File Information		Index of Revisions		Region 1 18500 East Colfax Aurora, CO 80011 Phone: (303) 365-7340 FAX: (303) 365-7343	4601 DTS Blvd. Suite 700 Denver, CO 80237 Phone: (303) 221-7275 Fax: (303) 221-7276	As Constructed	OFFICERS GULCH CHAIN STATION MP 196		Project No./Code
Creation Date: 02/18/08	Initials: SRB	<input type="checkbox"/>				No. Revisions:	Designer: SRB	Structure Numbers	IM 070A-003
Last Modification Date: 02/18/08	Initials: SRB	<input type="checkbox"/>		Revised:	Detailer: SRB		16701		
Full Path: S:\tranpro\100000508\16701\Consultants\Plot_Sets\VIR		<input type="checkbox"/>		Void:	Sheet Subset:	Subset Sheets: of	Sheet Number: 79		
Drawing File Name: Officers Gulch-eb.dgn		<input type="checkbox"/>		REGION I	TW				
Scale:	Units: ENGLISH	<input type="checkbox"/>							



Silverthorne/Dillon Interchange



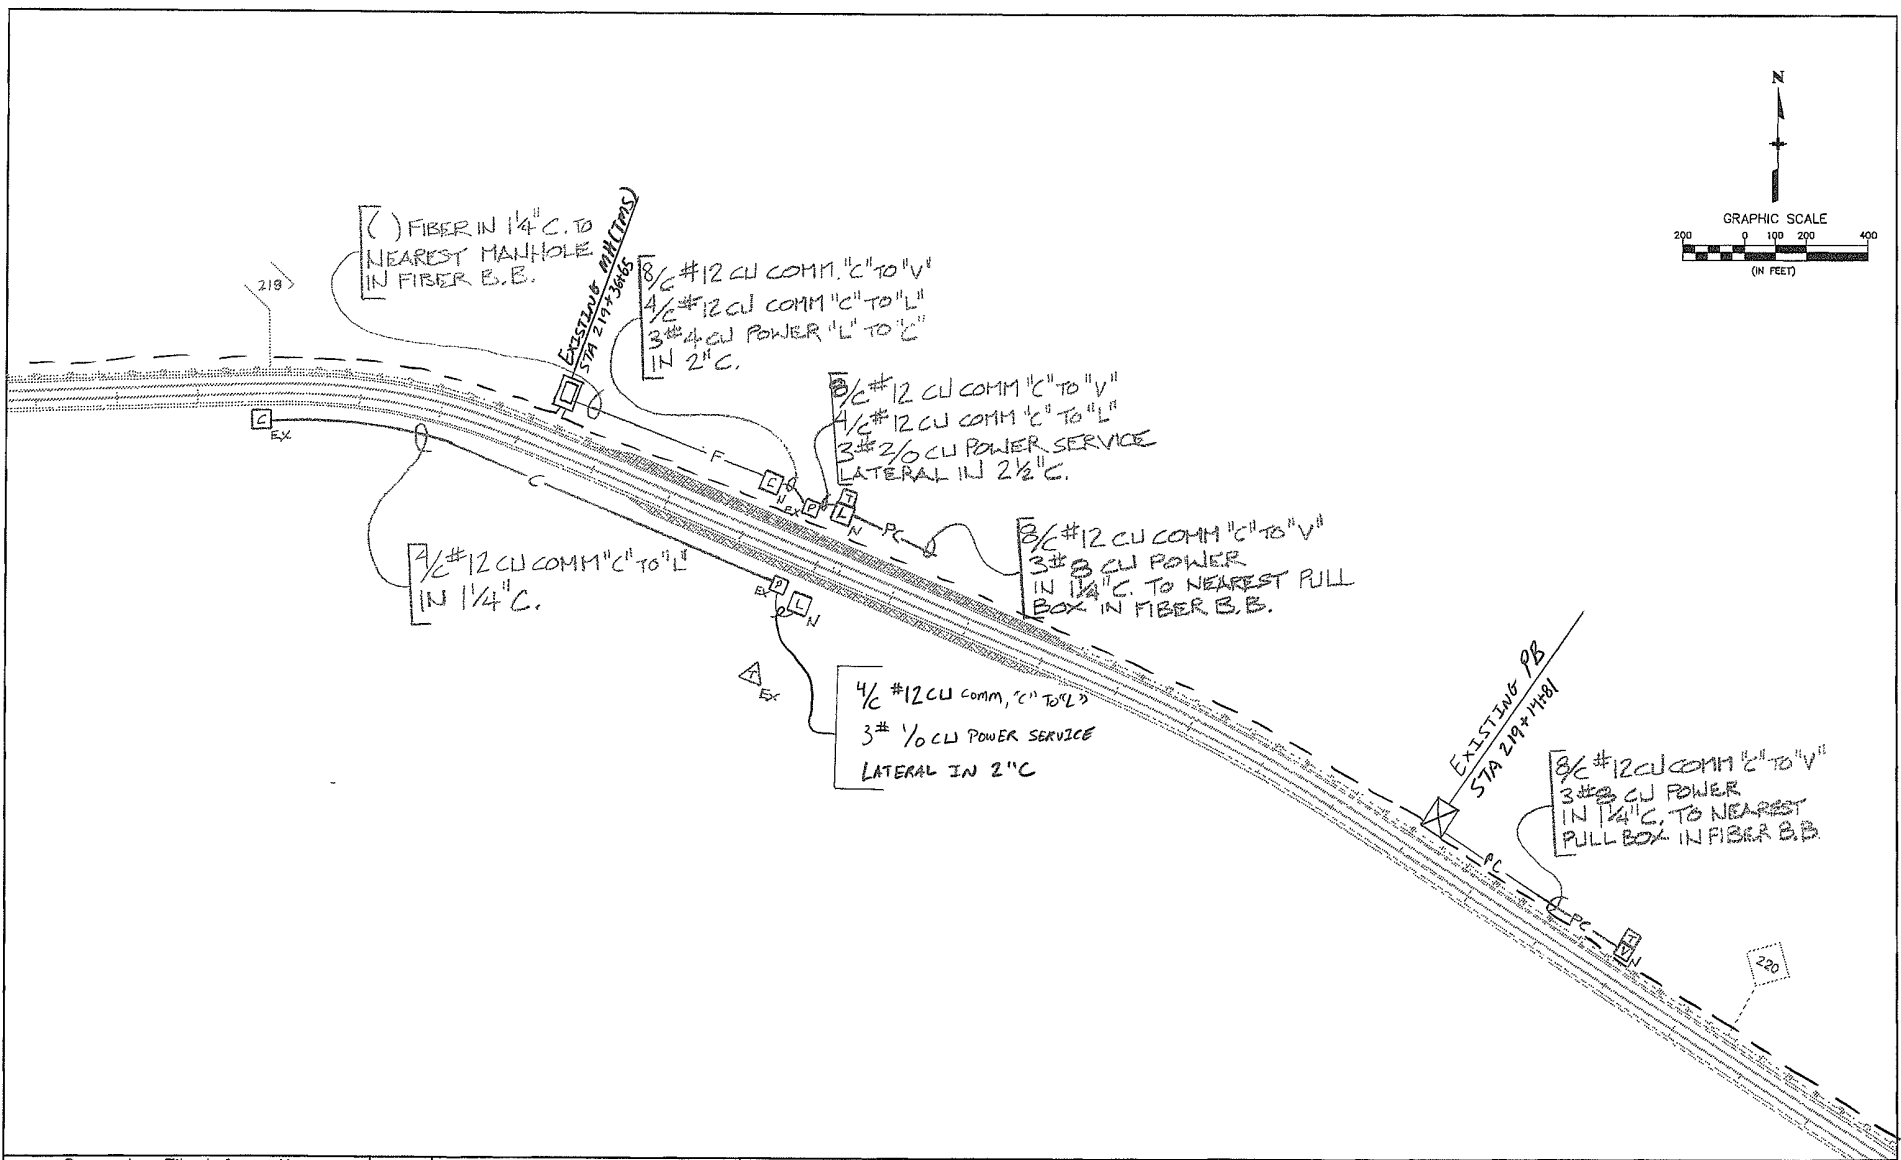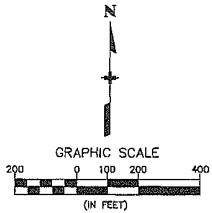

Computer File Information		Index of Revisions		 Region 1 18500 East Colfax Aurora, CO 80011 Phone: (303) 365-7340 FAX: (303) 365-7343	 4601 DTC Blvd. Suite 700 Denver, CO 80237 Phone: (303) 221-7275 Fax: (303) 221-7276	As Constructed		CHAIN STATION "C" MP 205 EASTBOUND CONDUIT PLAN		Project No./Code	
Creation Date: 02/18/08	Initials: SRB					No. Revisions:		Designer: SRB	Structure Numbers:	IM 070A-003	
Last Modification Date: 02/18/08	Initials: SRB					Revised:		Detailer: SRB		16701	
Full Path: S:\tranproj\100000508\16701\Consultants\Plot_Sets\FIR						Void:		Sheet Subset: Conduit	Subset Sheets: 4 of 11	Sheet Number: 81	
Drawing File Name: conduit05-mp206sb.dgn				REGION I		TW					
Scale:	Units: ENGLISH										

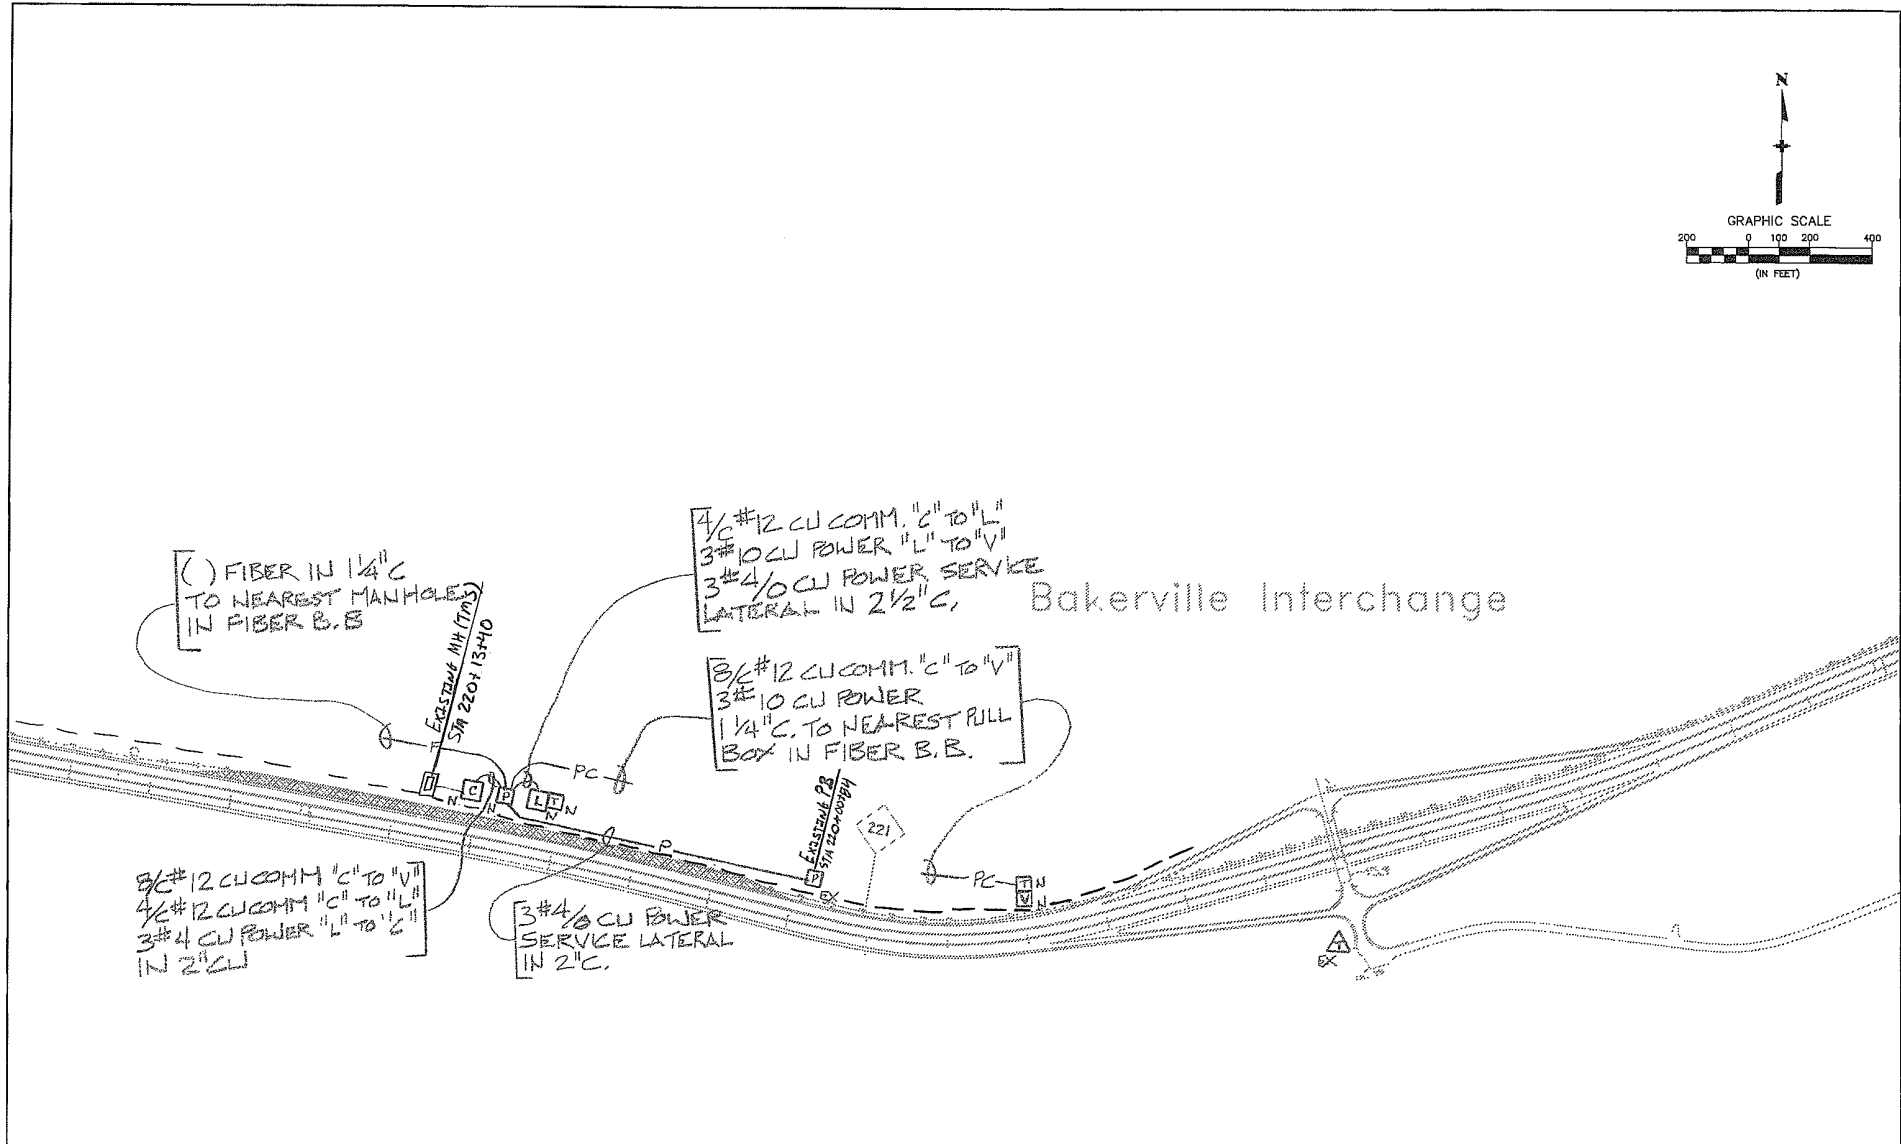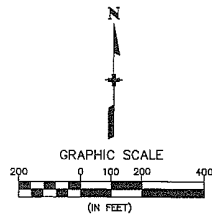


Computer File Information		Index of Revisions		 Region 1 16500 East Colfax Aurora, CO 80011 Phone: (303) 365-7340 FAX: (303) 365-7343	 4601 DTC Blvd. Suite 700 Denver, CO 80237 Phone: (303) 221-7275 Fax: (303) 221-7276	As Constructed		CHAIN STATION "G" MP 219 WESTBOUND CONDUIT PLAN		Project No./Code			
Creation Date: 02/18/08	Initials: SRB					No. Revisions:		Designer: SRB		Structure		IM 070A-003	
Last Modification Date: 02/18/08	Initials: SRB					Revised:		Detailer: SRB		Numbers		16701	
Full Path: S:\tranpro\100000508\16701\Consultants\Plot_Sets\FIR						Void:		Sheet Subset: Conduit		Subset Sheets:		5 of 11	
Drawing File Name: conduit05-mpHermansGulch.dgn	Units: ENGLISH			REGION I	TW					Sheet Number: 82			




Bakerville Interchange

Computer File Information		Index of Revisions		 Region 1 18500 East Colfax Aurora, CO 80011 Phone: (303) 365-7340 FAX: (303) 365-7343	 4601 DTC Blvd. Suite 700 Denver, CO 80237 Phone: (303) 221-7275 Fax: (303) 221-7276	As Constructed		CHAIN STATION G		Project No./Code
Creation Date: 02/18/08	Initials: SRB					No. Revisions:	MP 221 WB CONDUIT PLAN		IM 070A-003	
Last Modification Date: 02/18/08	Initials: SRB			Revised:	Designer: SRB	Structure Numbers:	16701		Sheet Number: 83	
Full Path: S:\Tranproj\100000508\16701\Consultants\Plot_Sets\FIR				Void:	Detailer: SRB	Subset Sheets:	of			
Drawing File Name: conduit05-Bakerville.dgn										
Scale:	Units: ENGLISH			REGION I	TW					

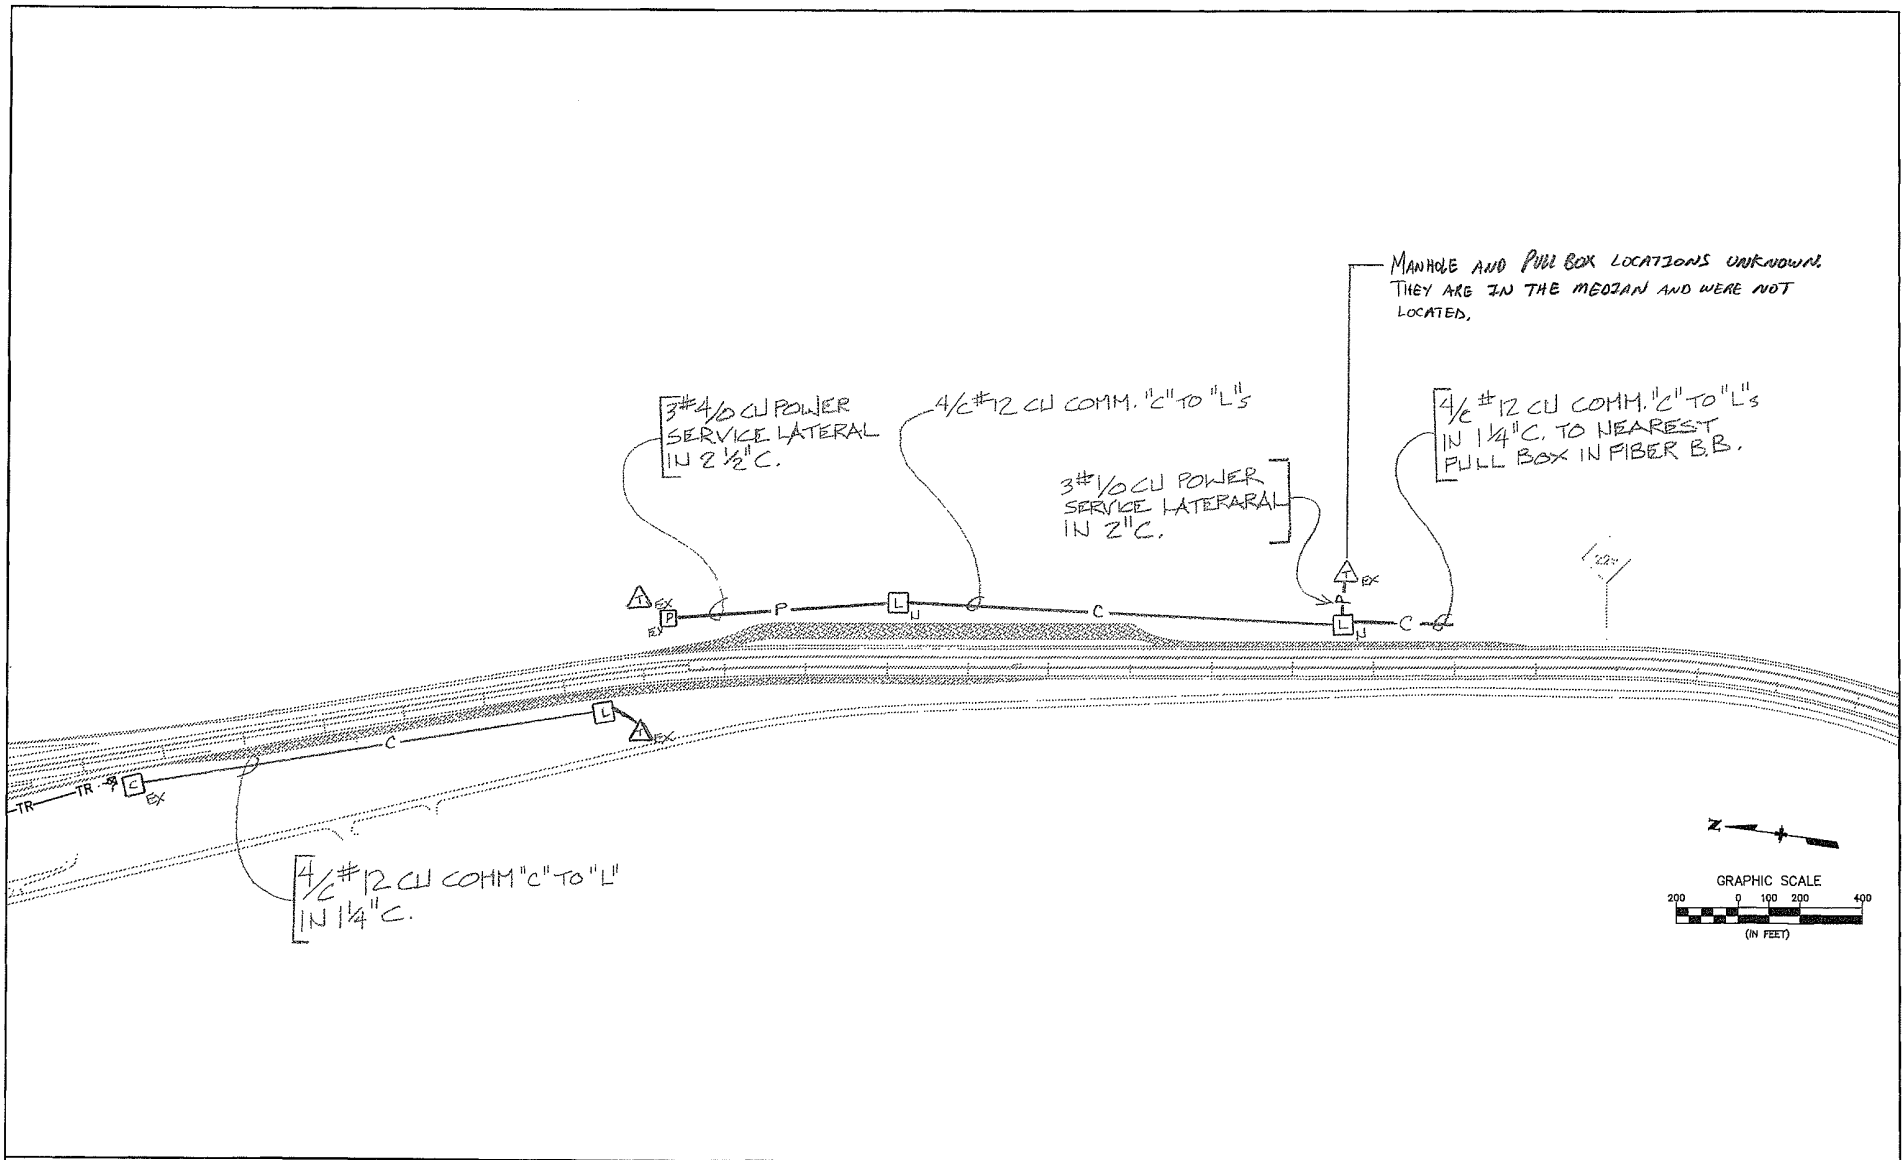

Computer File Information	
Creation Date: 02/21/08	Initials: SRB
Last Modification Date: 02/21/08	Initials: SRB
Full Path: S:\tranpro\100000508\16701\Consultants\Plot_Sets\FIR	
Drawing File Name:	conduit01-mp228wb.dgn
Scale:	Units: ENGLISH

Index of Revisions	



Region 1
18500 East Colfax
Aurora, CO 80011
Phone: (303) 365-7340
Fax: (303) 365-7343

REGION I TW





4601 DJC Blvd.
Suite 700
Denver, CO 80237
Phone: (303) 221-7275
Fax: (303) 221-7276

As Constructed
No. Revisions:
Revised:
Void:

CHAIN STATION " "		
MP 228 WESTBOUND		
CONDUIT PLAN		
Designer: SRB	Structure Numbers	
Detailer: SRB		
Sheet Subset: Conduit	Subset Sheets: of	


Project No./Code	IM 070A-003
	16701
Sheet Number:	85

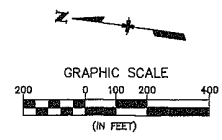

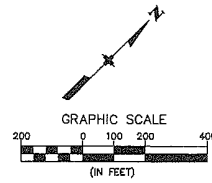




Note: Manhole and pull box locations unknown in this area. In median and not located.

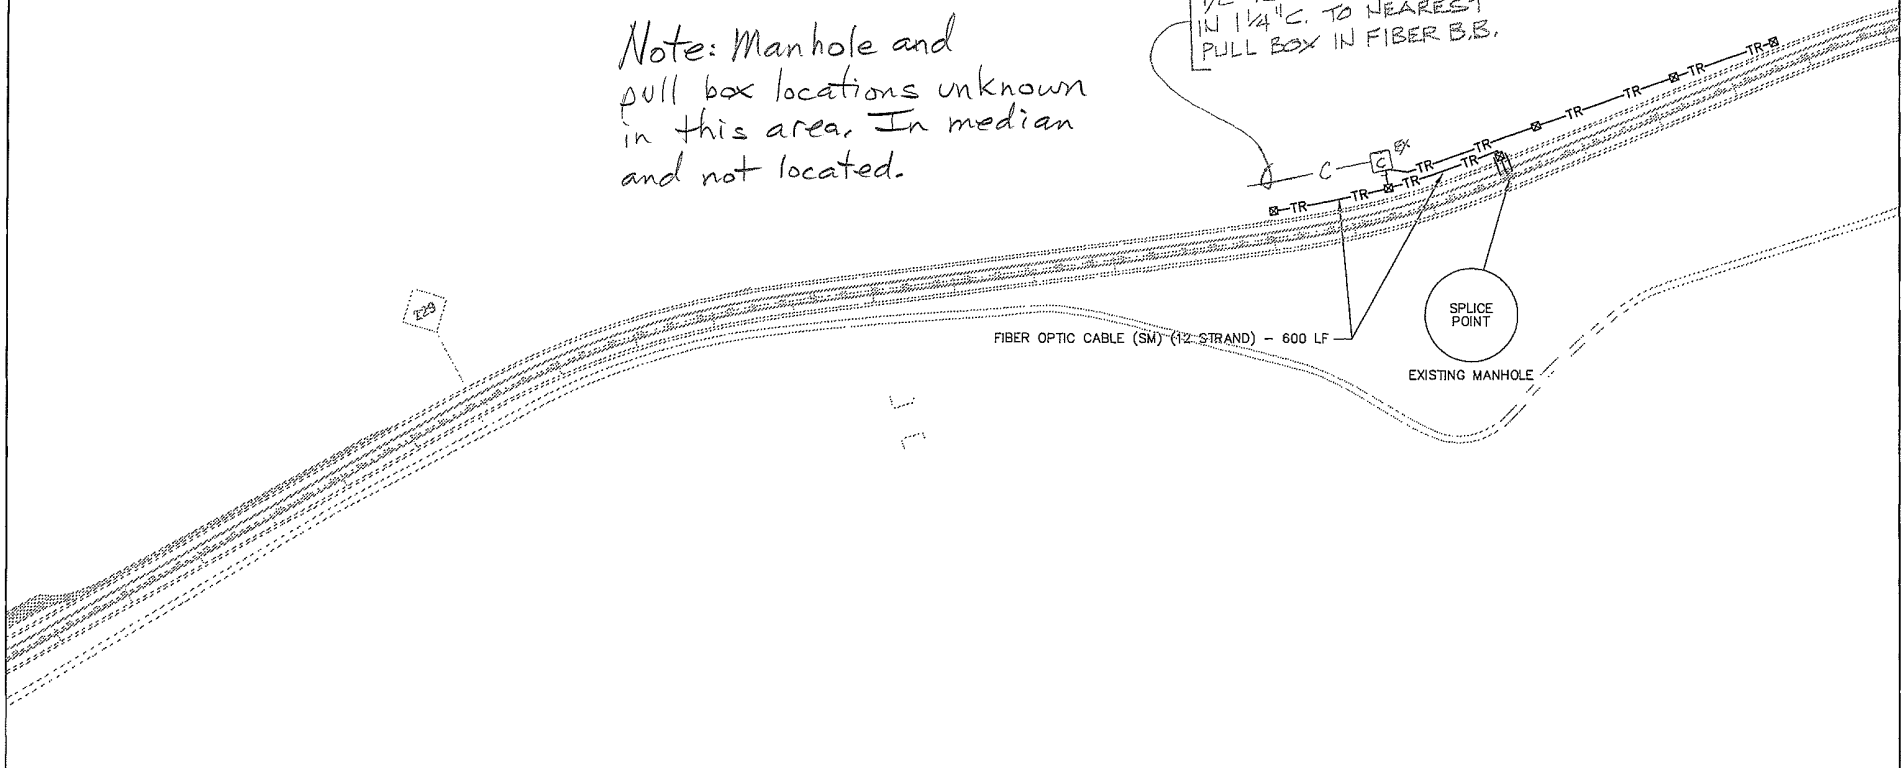4/2 #12 CU COMM "C" TO "L" S
IN 1 1/4" C. TO NEAREST
PULL BOX IN FIBER B.B.




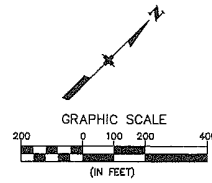

Computer File Information		Index of Revisions		 Region 1 16500 East Colfax Aurora, CO 80011 Phone: (303) 365-7340 FAX: (303) 365-7343	 4601 DTC Blvd. Suite 700 Denver, CO 80237 Phone: (303) 221-7275 Fax: (303) 221-7276	As Constructed		CHAIN STATION "I" MP 228 WESTBOUND CONDUIT PLAN		Project No./Code				
Creation Date: 02/18/08	Initials: SRB	<input type="checkbox"/>				No. Revisions:				IM 070A-003				
Last Modification Date: 02/18/08	Initials: SRB	<input type="checkbox"/>				Revised:	Designer: SRB	Structure:			16701			
Full Path: S:\tranprof\100000508\16701\Consultants\Plot_Sets\FIR		<input type="checkbox"/>				Detailer: SRB	SRB	Numbers:						
Drawing File Name: conduit09-no228eb-wb.dgn		<input type="checkbox"/>				Void:	Sheet Subset: Conduit	Subset Sheets:	9 of 11		Sheet Number: 86			
Scale:	Units: ENGLISH	<input type="checkbox"/>		REGION I TW										




Note: Manhole and pull box locations unknown in this area. In median and not located.

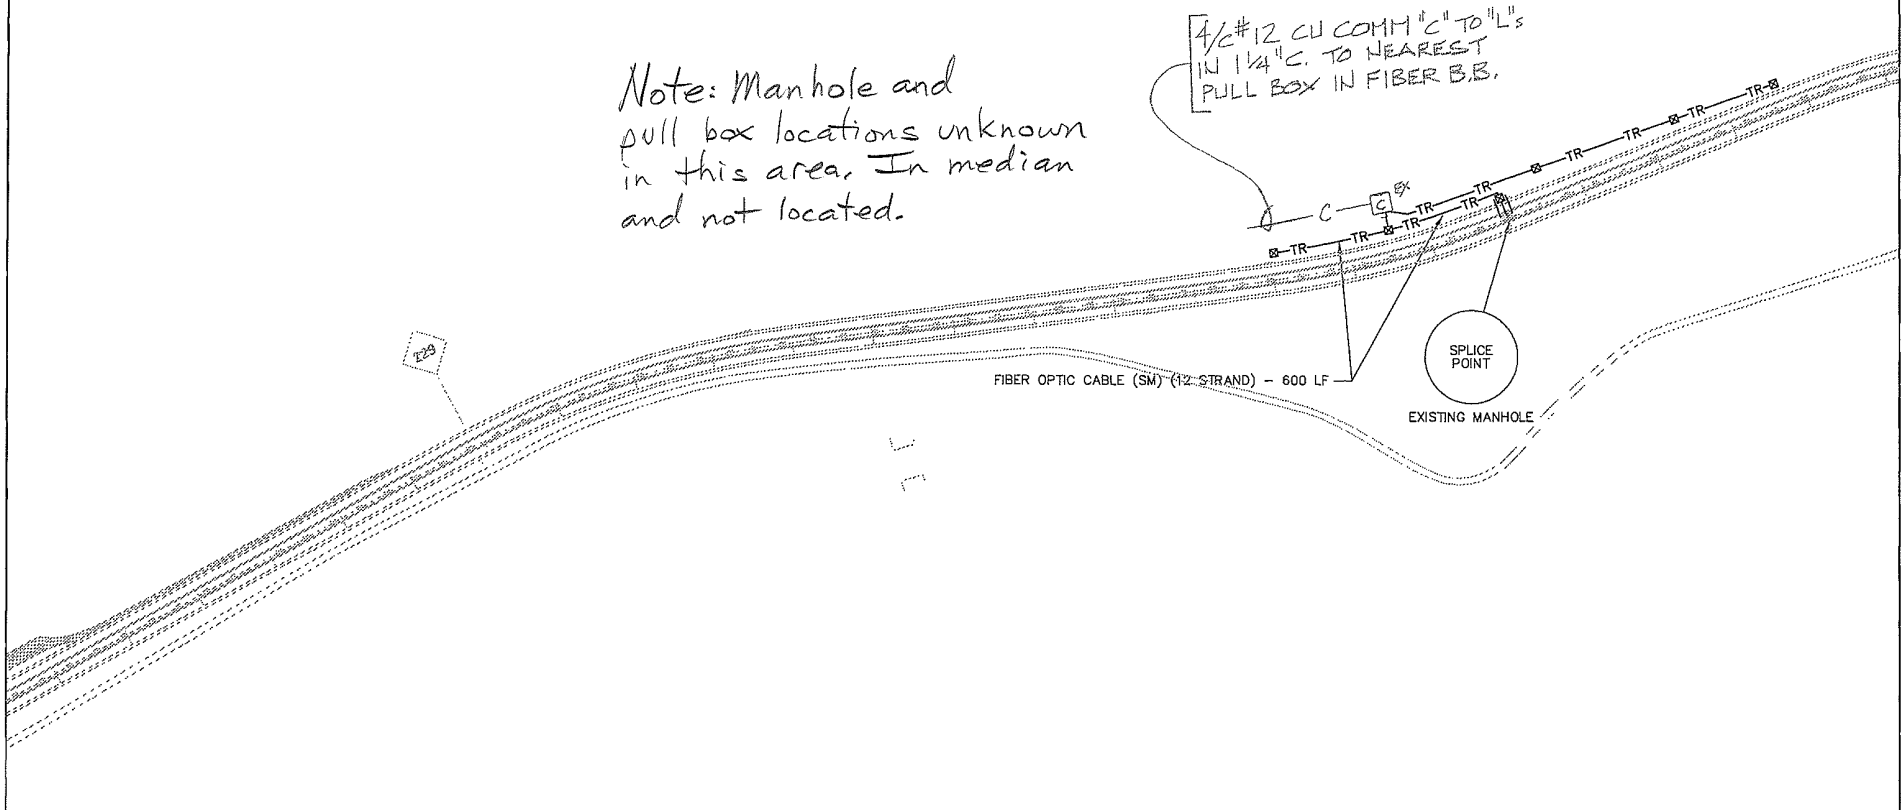4/2 #12 CU COMM "C" TO "L" S
IN 1 1/4" C. TO NEAREST
PULL BOX IN FIBER B.B.



Computer File Information		Index of Revisions		Region 1		As Constructed		CHAIN STATION "I" MP 228 WESTBOUND CONDUIT PLAN		Project No./Code	
Creation Date: 02/18/08	Initials: SRB			 Region 1 16500 East Colfax Aurora, CO 80011 Phone: (303) 365-7340 FAX: (303) 365-7343	 4601 DTC Blvd. Suite 700 Denver, CO 80237 Phone: (303) 221-7275 Fax: (303) 221-7276	No. Revisions:	Designer: SRB	Structure:	IM 070A-003 16701	Sheet Number: 86	
Last Modification Date: 02/18/08	Initials: SRB					Revised:	Detailer: SRB	Numbers:			
Full Path: S:\tranprof\100000508\16701\Consultants\Plot_Sets\FIR	Drawing File Name: conduit09-no228eb-wb.dgn					Void:	Sheet Subset: Conduit	Subset Sheets: 9 of 11			
Scale:	Units: ENGLISH					REGION I	TW				

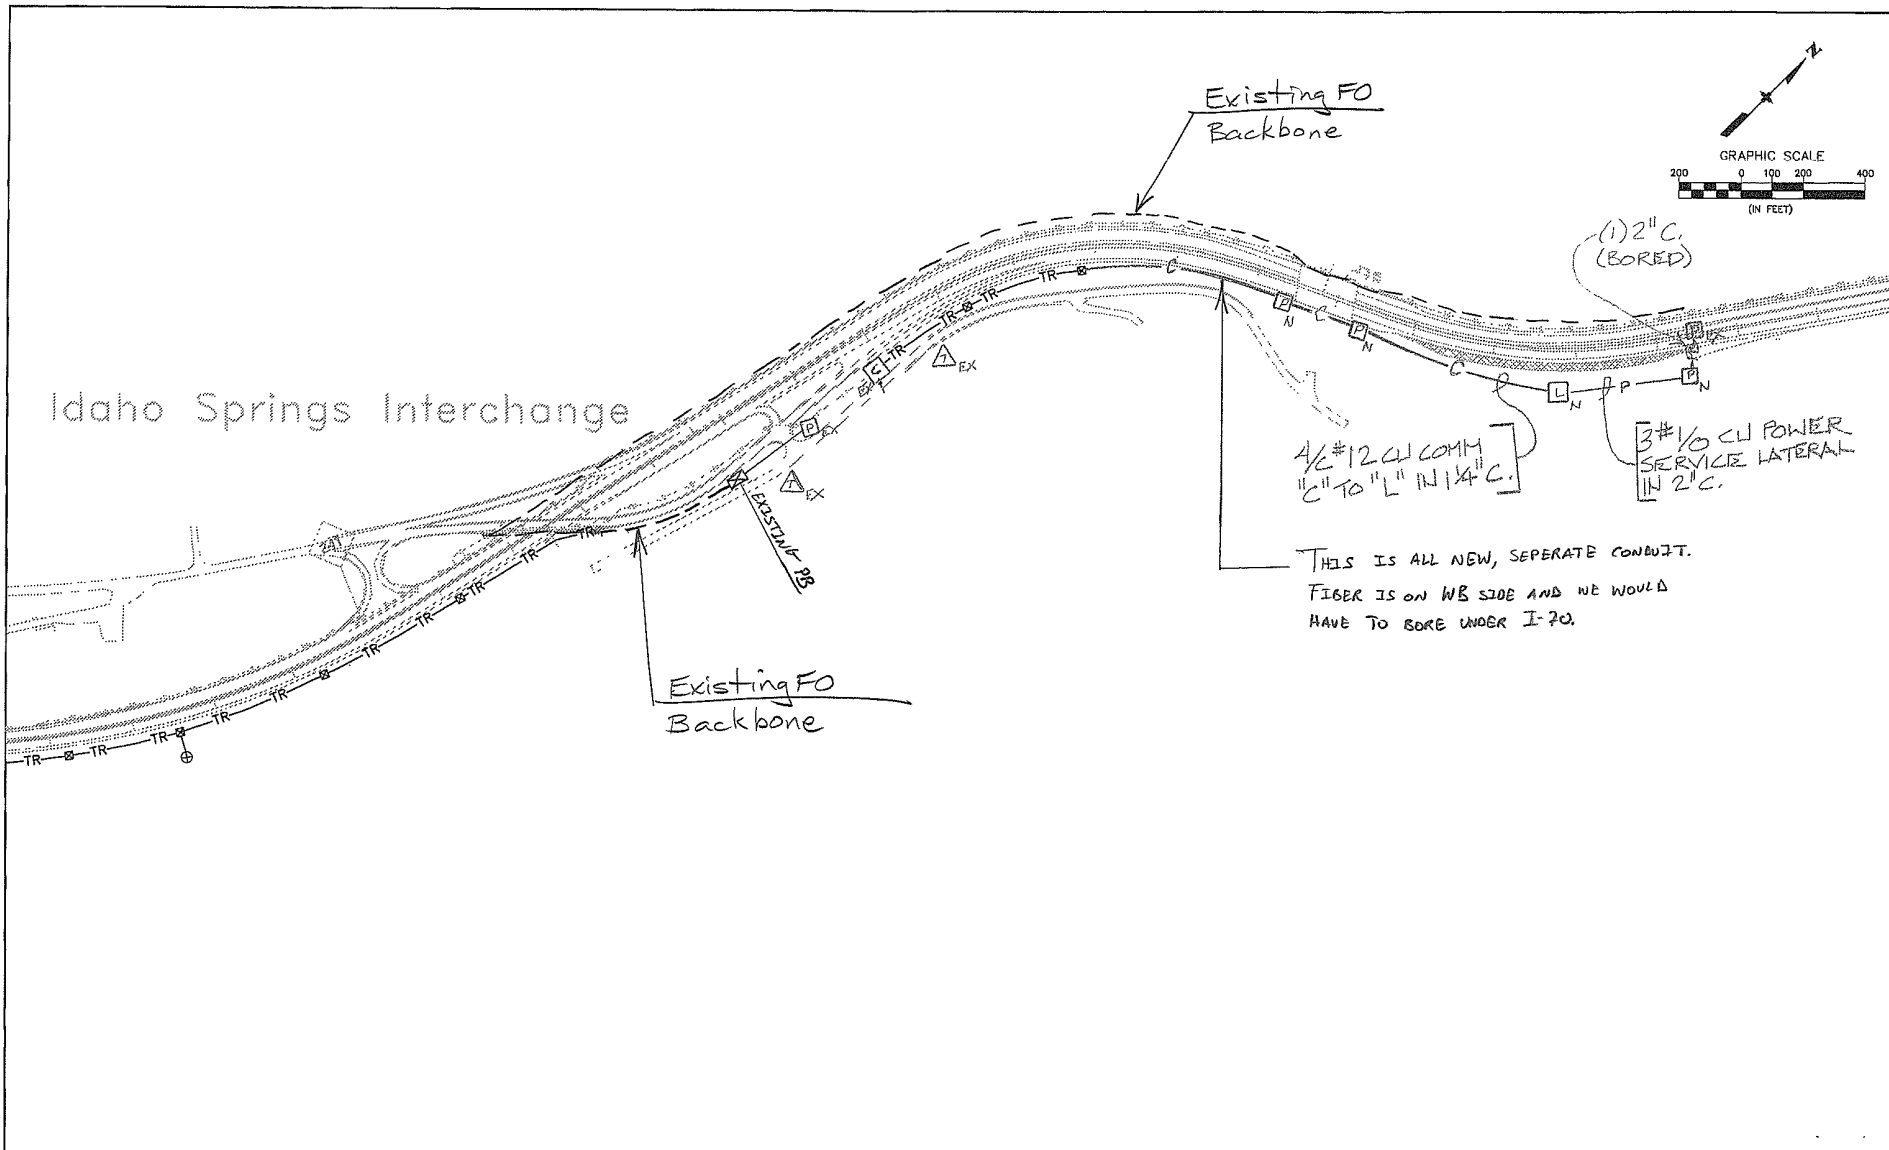

Computer File Information	
Creation Date: 02/18/08	Initials: SRB
Last Modification Date: 02/18/08	Initials: SRB
Full Path: S:\Tranpro\100000508\16701\Consultants\Plot_Sets\FIR	
Drawing File Name:	conduit10-mp241eb.dgn
Scale:	Units: ENGLISH

Index of Revisions	



REGION I TW


Region 1
18500 East Colfax
Aurora, CO 80011
Phone: (303) 365-7340
FAX: (303) 365-7343

4601 DTC Blvd.
Suite 700
Denver, CO 80237
Phone: (303) 221-7275
Fax: (303) 221-7276

As Constructed
No. Revisions:
Revised:
Void:

CHAIN STATION "J" MP 241 EASTBOUND CONDUIT PLAN	
Designer:	SRB
Detailer:	SRB
Structure Numbers:	
Sheet Subset:	Conduit
Subset Sheets:	10 of 11

Project No./Code
IM 070A-003
16701
Sheet Number: 87

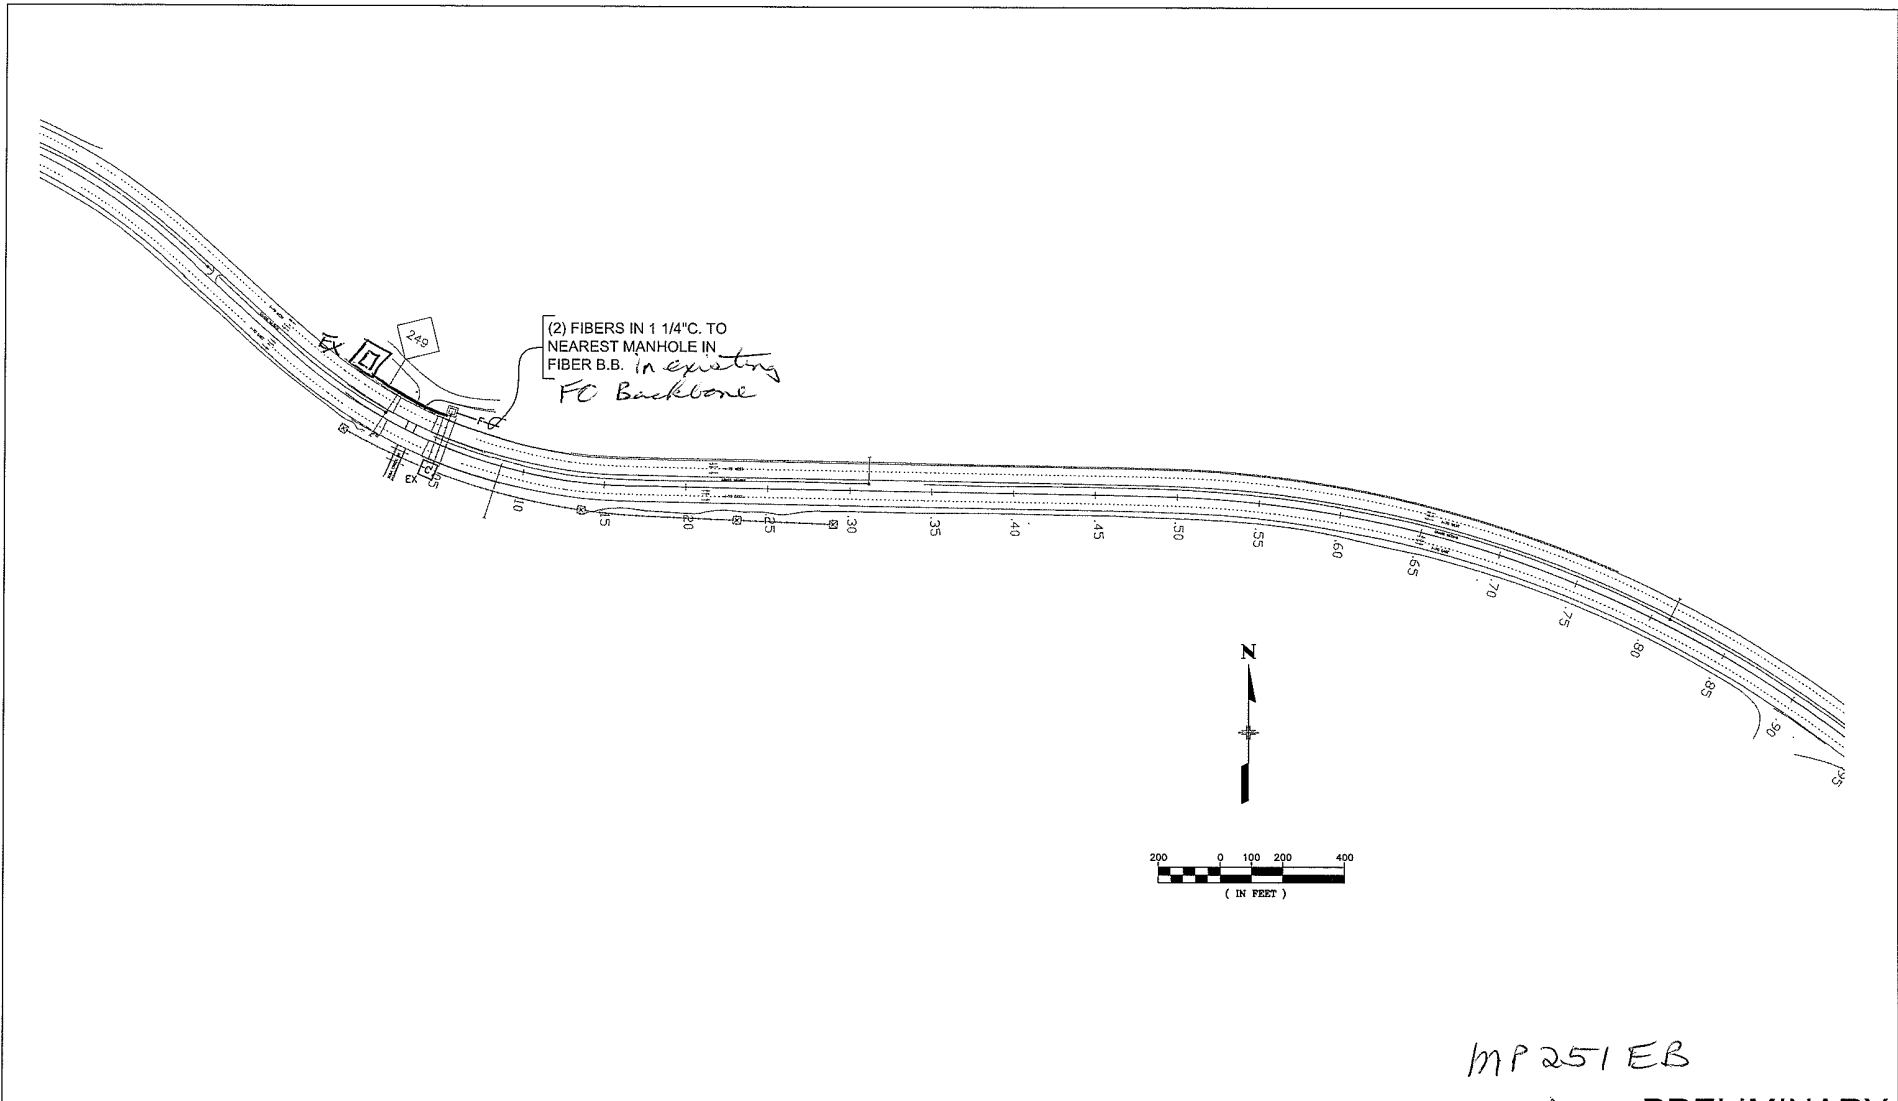

MP 251 EB

PRELIMINARY
SUBJECT TO REVISION

CANNON & ASSOCIATES

Computer File Information	
Creation Date:	Initials: GF
Last Modification Date:	Initials: JE
Full Path: Z:\VAIL CHAIN STATIONS\CURRNET\	
Drawing File Name:	
Scale: REFER TO BAR SCALE	Units: ENGLISH

Index of Revisions	

DOT
DEPARTMENT OF TRANSPORTATION

Region 1
18500 East Colfax
Aurora, CO 80011
Phone: (303) 365-7340
FAX: (303) 365-7343

REGION I

PBSJ



4601 DTC Blvd.
Suite 700
Denver, CO 80237
Phone: (303) 221-7275
Fax: (303) 221-7276

(TW)

As Constructed	
No. Revisions:	
Revised:	
Void:	

CONDUIT PLAN	
Designer:	GF
Detailer:	JE
Sheet Subset:	LE

Project No./Code	
IM 070A-003	16701
Sheet Number:	88

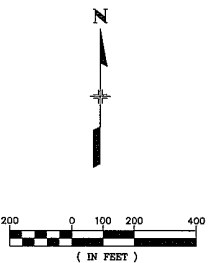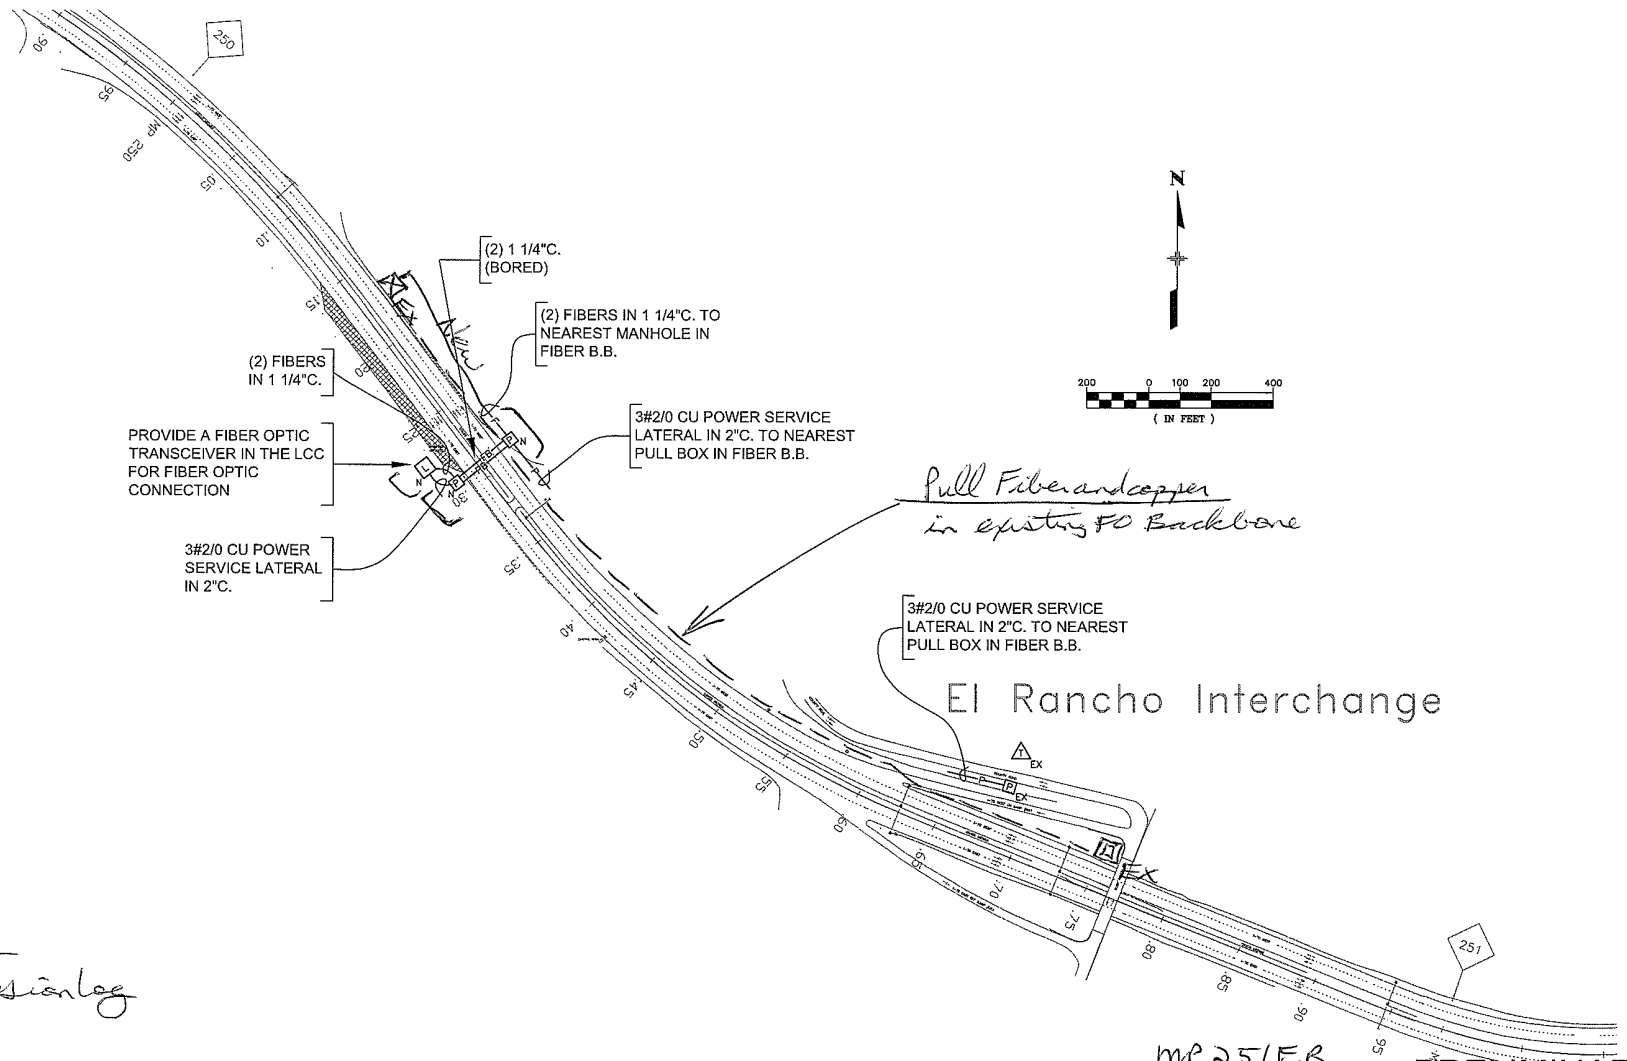

*Pull Fiber and copper
in existing FO Backbone*

El Rancho Interchange

MP 251 EB

PRELIMINARY
SUBJECT TO REVISION

Legend
— Erosion log

CLANTON & ASSOCIATES LIGHTING DESIGN AND ENGINEERING
6699 N. GALELLO BLVD. SUITE 200
DENVER, CO 80237
303.530.7279

Computer File Information	
Creation Date:	Initials: GF
Last Modification Date:	Initials: JE
Full Path:	Z:\VAIL CHAIN STATIONS\CURRNET\
Drawing File Name:	
Scale: REFER TO BAR SCALE	Units: ENGLISH

Index of Revisions	


DOT
REGION I
18500 East Colfax
Aurora, CO 80011
Phone: (303) 365-7340
FAX: (303) 365-7343

PBSJ
4801 DTC Blvd.
Suite 700
Denver, CO 80237
Phone: (303) 221-7275
Fax: (303) 221-7276

As Constructed
No. Revisions:
Revised:
Void:

CONDUIT PLAN MP 251 EASTBOUND <i>and SWMPS site map</i>	
Designer: GF	Structure Numbers
Detailer: JE	Numbers
Sheet Subset: LE	Subset Sheets:

Project No./Code	IM 070A-003
Sheet Number:	89

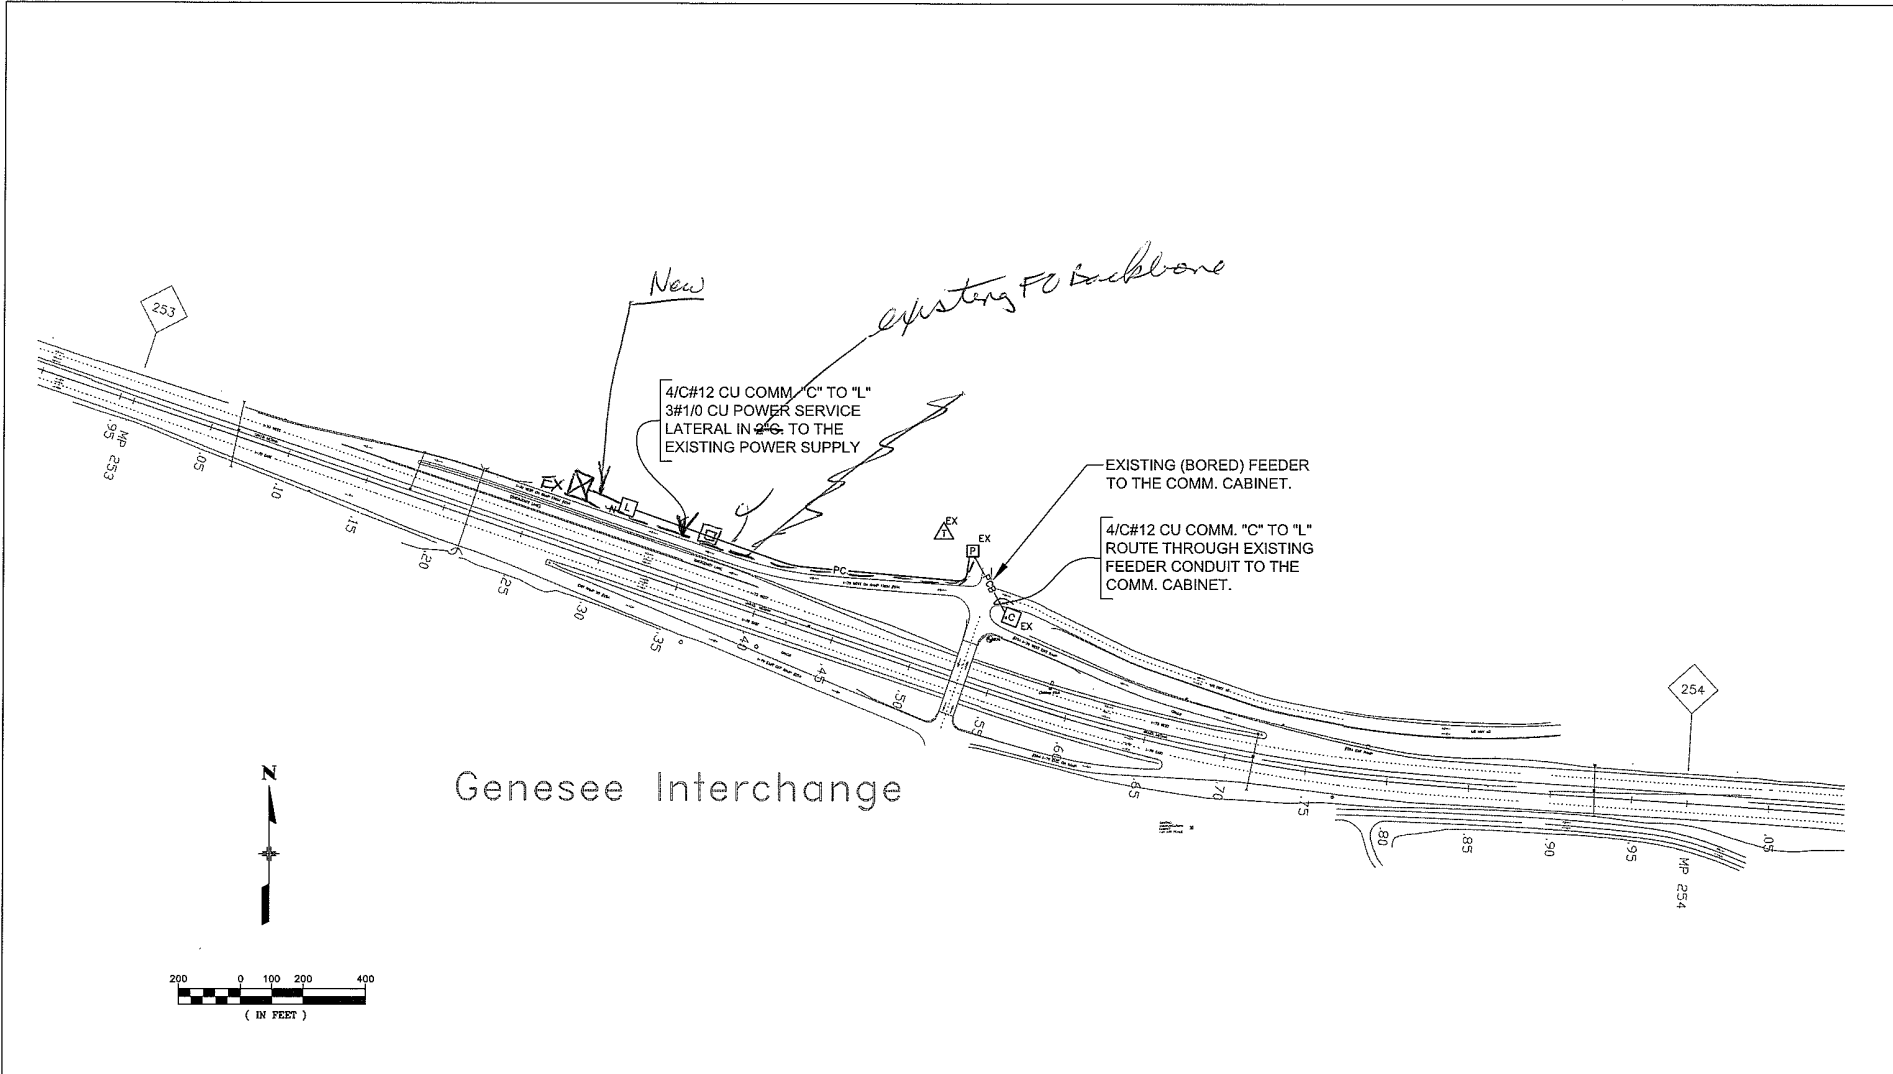

PRELIMINARY
SUBJECT TO REVISION

CLANTON & ASSOCIATES LIGHTING DESIGN AND ENGINEERING
1899 ACORN LANE, COLORADO SPRINGS, CO 80904
PHONE: (303) 595-1222 FAX: (303) 595-1222

Computer File Information	
Creation Date:	Initials: GF
Last Modification Date:	Initials: JE
Full Path:	Z:\VAIL CHAIN STATIONS\CURRNET\
Drawing File Name:	
Scale: REFER TO BAR SCALE	Units: ENGLISH

Index of Revisions	

DOT Region 1
18500 East Colfax
Aurora, CO 80011
Phone: (303) 365-7340
FAX: (303) 365-7343

DEPARTMENT OF TRANSPORTATION

REGION I TW

PBSJ
4601 DTC Blvd.
Suite 700
Denver, CO 80237
Phone: (303) 221-7275
Fax: (303) 221-7276

As Constructed	
No. Revisions:	
Revised:	
Void:	

CONDUIT PLAN MP 254 WESTBOUND		
Designer:	GF	Structure
Detailer:	JE	Numbers
Sheet Subset:	LE	Subset Sheets:

Project No./Code	
IM 070A-003	
16701	
Sheet Number:	90