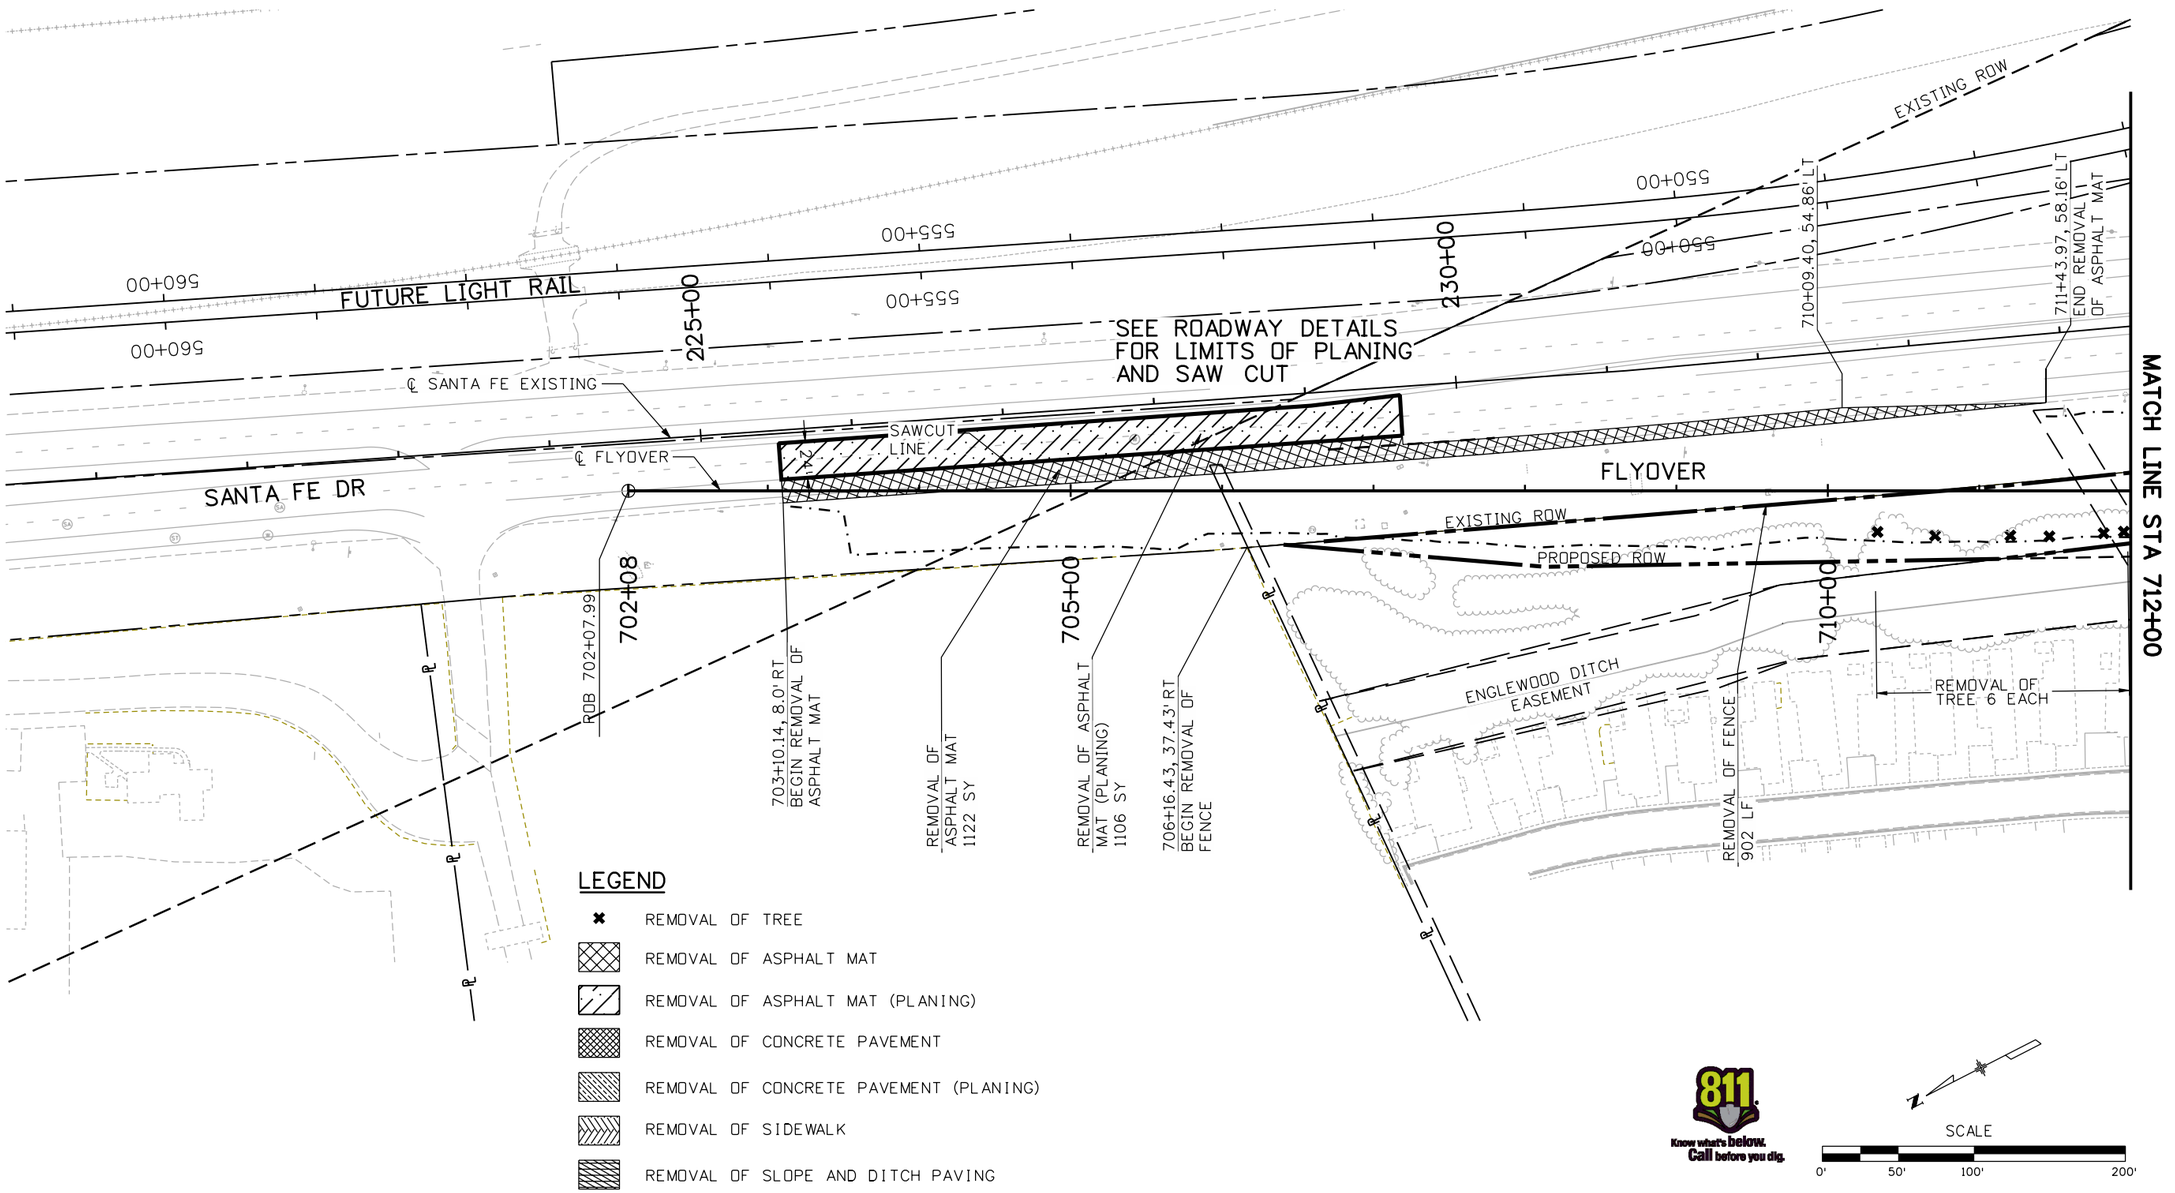

JBKeith 3:54:52 PM M:\TRN\07-100-311-12\14679\Design\Drawings\roadway\14679_pRM-P701.dgn

Print Date: 1/10/2010
File Name: 14679_pRM-P701.dgn
Horiz. Scale: 1:100 Vert. Scale: As Noted

WILSON & COMPANY Engineers & Architects
999 18TH STREET, SUITE 2600
DENVER, CO 80202
PHONE: 303-297-2976
FAX: 303-297-2693

Sheet Revisions		
Date:	Comments	Init.

Colorado Department of Transportation
8833 South Wadsworth Court
Littleton, CO 80128
Phone: 303-972-9112 FAX: 303-972-9114
Region 6 RLB

As Constructed
No Revisions:
Revised:
Void:

REMOVALS PLAN
FLYOVER

Designer: JJW
Detailer: JBK
Sheet Subset: REMOVALS
Structure Numbers:
Subset Sheets: 1 of 7

Project No./Code
ES6 0852-103
17679
Sheet Number 52

LEGEND

- REMOVAL OF TREE
- REMOVAL OF ASPHALT MAT
- REMOVAL OF ASPHALT MAT (PLANING)
- REMOVAL OF CONCRETE PAVEMENT
- REMOVAL OF CONCRETE PAVEMENT (PLANING)
- REMOVAL OF SIDEWALK
- REMOVAL OF SLOPE AND DITCH PAVING

MATCH LINE STA 712+00

MATCH LINE STA 726+00

MATCH LINE STA 247+50

FUTURE LIGHT RAIL

COUNTY LINE RD

SANTA FE DRIVE

SEE ROADWAY DETAILS FOR LIMITS OF PAVEMENT REMOVAL

℄ FLYOVER

FLYOVER

EXISTING ROW

RAMP C

RAMP D

T6S R68W SEC5

T5S R68W SEC32

SECTION LINE

ENGLEWOOD DITCH EASEMENT

235+00

240+00

245+00

540+00

545+00

715+00

720+00

725+00

46+80

239+12 TO 239+82
REMOVAL OF CURB AND GUTTER 83 LF

240+27 TO 240+36
REMOVAL OF ASHALT MAT 71 SY

6.7' CENTERED ON PIPE ALIGNMENT

℄ SANTA FE WIDENING

42+14.24
0.00

43+27.65
6.42' LT

R 431.33'

44+10.01
1.16' LT

725+77.43, 41.01' LT
END REMOVAL OF ASPHALT MAT

REMOVAL OF CURB 35 LF

REMOVAL OF ASPHALT MAT 66 SY

725+24, 16.0' LT
END REMOVAL OF GUARDRAIL TYPE 3

REMOVAL OF GUARDRAIL TYPE 3 43 LF

REMOVAL OF CURB 8 LF

724+93.20, 11.96' RT
BEGIN REMOVAL OF ASPHALT MAT
BEGIN REMOVAL OF GUARDRAIL

REMOVAL OF TREE
3 EACH

715+15.41, 45.04' LT
END REMOVAL OF FENCE

716+05.25, 54.12' LT
BEGIN REMOVAL OF FENCE

REMOVAL OF FENCE
66 LF

716+66.02, 53.54' LT
END REMOVAL OF FENCE

716+69.52, 52.17' LT
BEGIN REMOVAL OF FENCE

REMOVAL OF FENCE
94 LF

717+15.83, 27.09' RT
END REMOVAL OF FENCE

239+14 TO 239+81
REMOVAL OF ASHALT MAT
166 SY

40+35.67
BEGIN REMOVAL OF ASPHALT MAT (PLANING)

41+06.88
BEGIN REMOVAL OF ASPHALT MAT

REMOVAL OF TREE 13 EACH

REMOVAL OF ASPHALT MAT (PLANING)
2222 SY

REMOVAL OF ASPHALT MAT
117 SY

SAWCUT 2' FROM EXISTING EDGE OF PAVEMENT

46+36.36
END REMOVAL OF ASPHALT MAT
END REMOVAL OF ASPHALT MAT (PLANING)

Know what's below. Call before you dig.

SCALE
0' 50' 100' 200'

Print Date: 1/10/2010	Sheet Revisions	Colorado Department of Transportation	As Constructed
File Name: 14679_pRM-P702.dgn	Date: Comments Init.	8833 South Wadsworth Court	No Revisions:
Horiz. Scale: 1:100 Vert. Scale: As Noted		Littleton, CO 80128	Revised:
WILSON & COMPANY Engineers & Architects 999 18TH STREET, SUITE 2800 DENVER, CO 80202 PHONE: 303-297-2976 FAX: 303-297-2693		Phone: 303-972-9112 FAX: 303-972-9114	Void:
0000		Region 6 RLB	

REMOVALS PLAN FLYOVER			Project No./Code
			ES6 0852-103
Designer: JJW	Structure Numbers		17679
Detailer: JBK			Sheet Number 53
Sheet Subset: REMOVALS	Subset Sheets: 2 of 7		

JBKeith 3:55:10 PM M:\TRN\07-100-311-12\14679\Design\Drawings\roadway\14679_pRM-P702.dgn

Know what's below. Call before you dig.

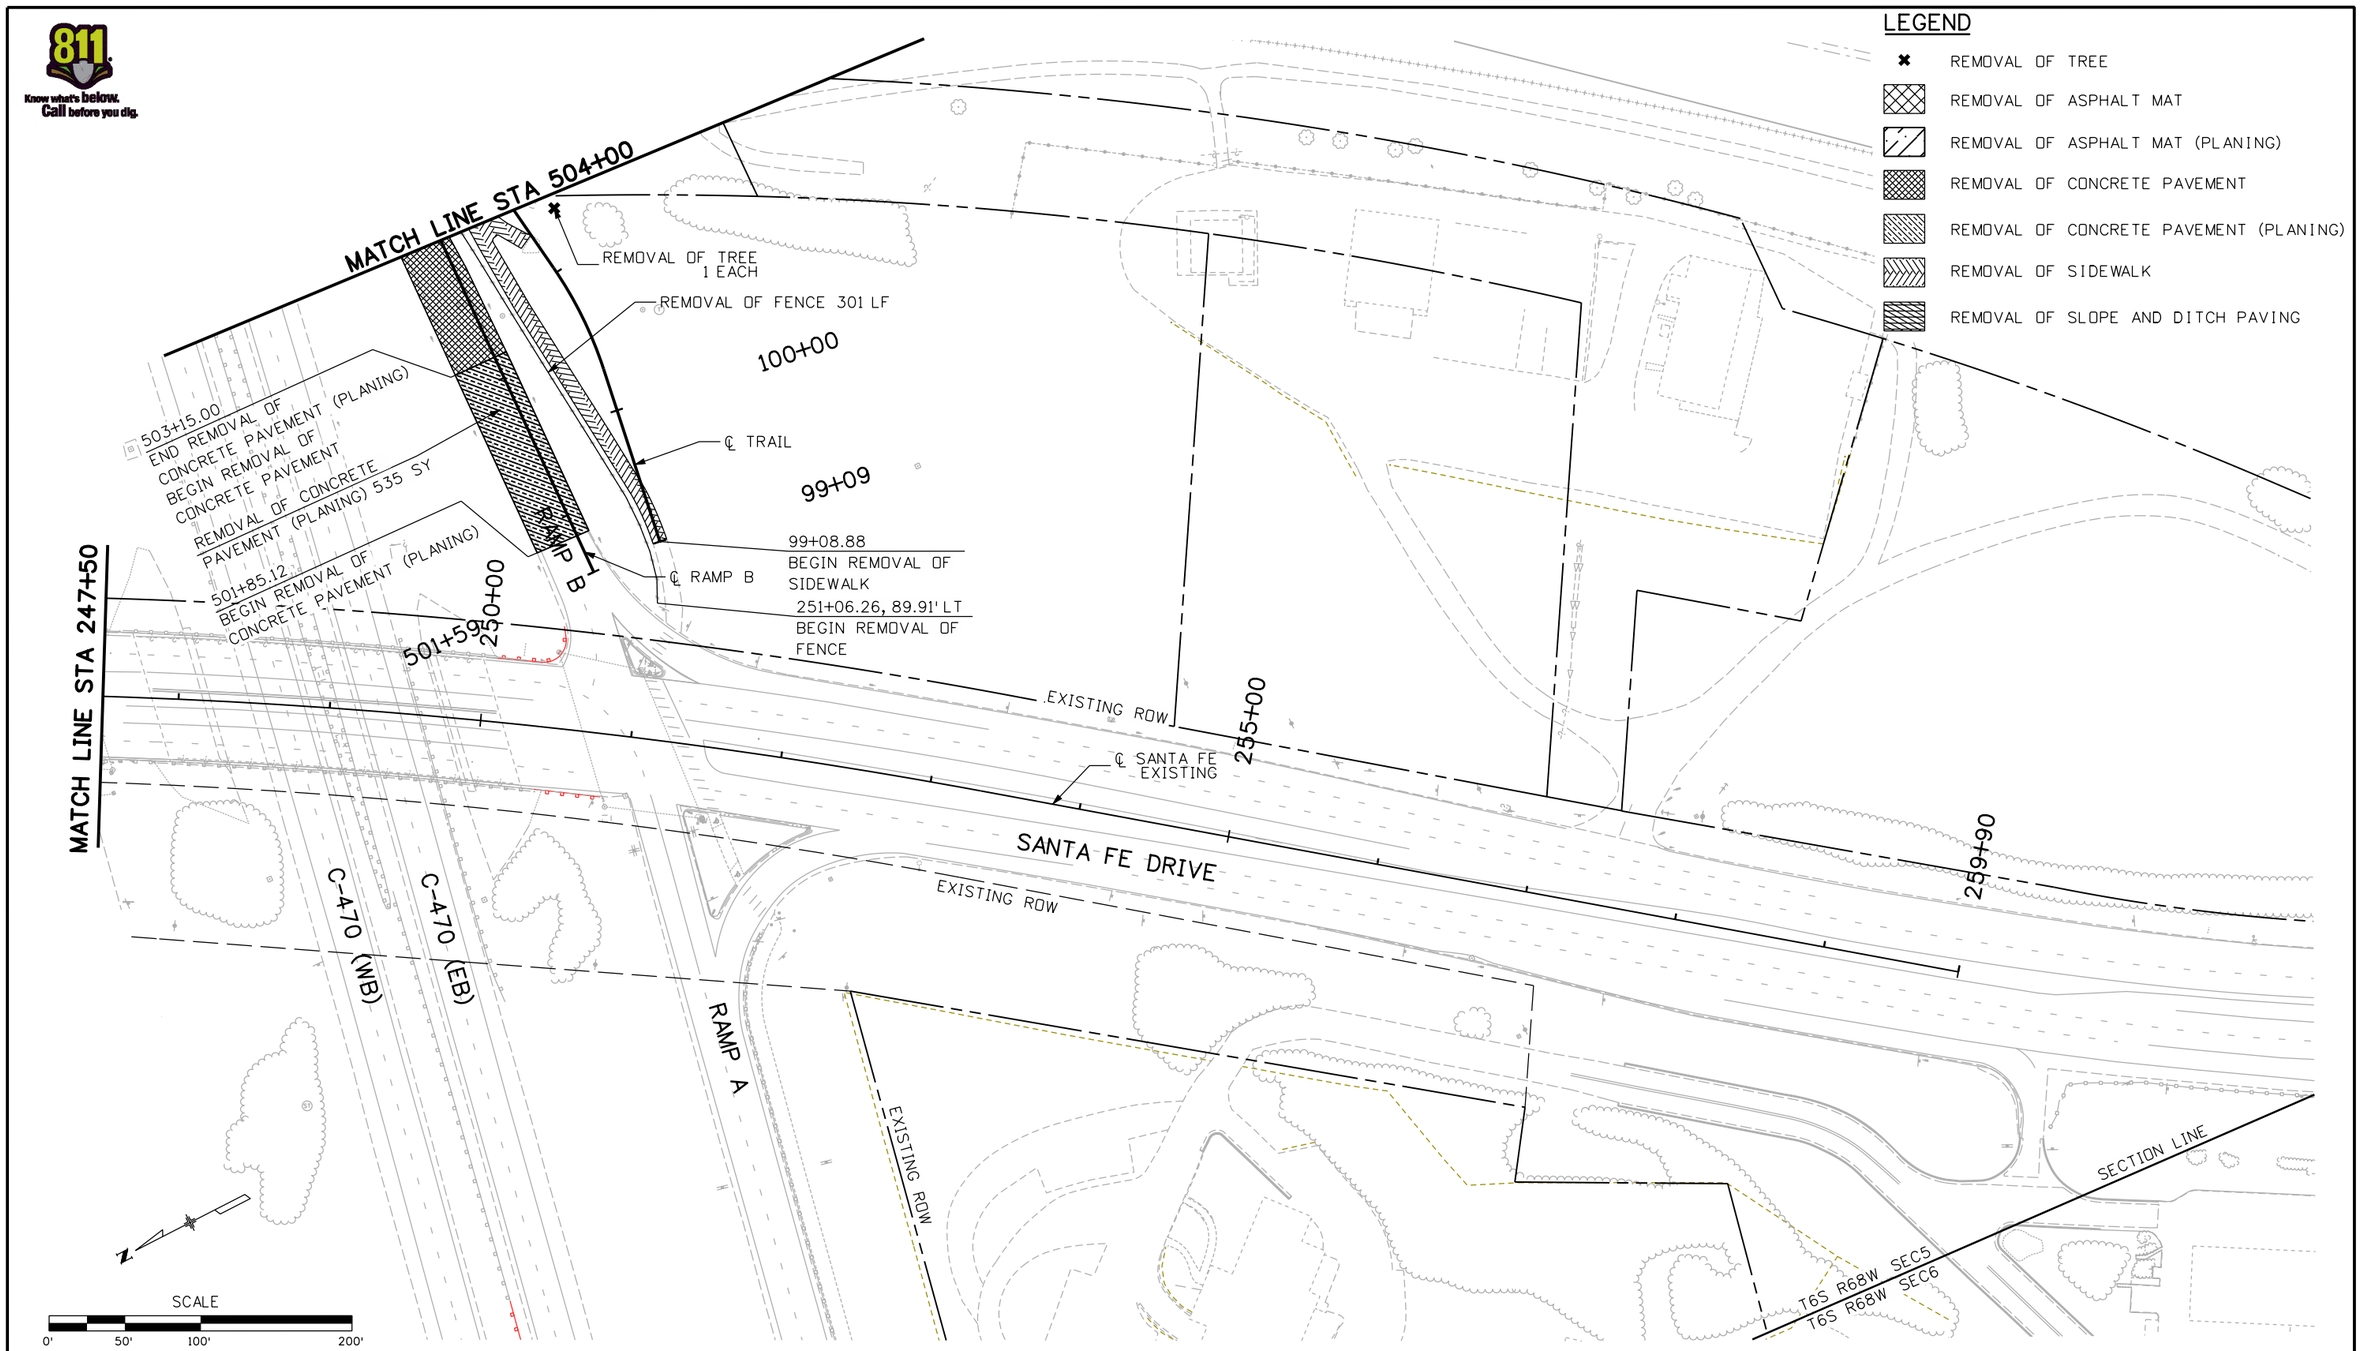

Print Date: 1/10/2010	Sheet Revisions	Colorado Department of Transportation	As Constructed
File Name: 14679_pRM-P401.dgn	Date: Comments: Init.	8833 South Wadsworth Court Littleton, CO 80128 Phone: 303-972-9112 FAX: 303-972-9114	No Revisions:
Horiz. Scale: 1:100.015 Vert. Scale: As Noted		Region 6 RLB	Revised:
WILSON & COMPANY Engineers & Architects 999 18TH STREET, SUITE 2800 DENVER, CO 80202 PHONE: 303-297-2976 FAX: 303-297-2693			Void:

REMOVALS PLAN
SANTA FE/RAMP B

Designer:	JBK	Structure Numbers	
Detailer:	JBK		
Sheet Subset: REMOVALS		Subset Sheets: . 3 of 7	

Project No./Code
ES6 0852-103
17679
Sheet Number 54

JBKeith 3:55:37 PM M:\TRN\07-100-311-12\14679\Design\Drawings\roadway\14679_pRM-P401.dgn

MATCH LINE STA 504+00

MATCH LINE STA 726+00

MATCH LINE STA 740+00

505+00

510+00

515+00

730+00

735+00

110+00

115+00

504+20.61, 32.62' LT
BEGIN REMOVAL OF GUARDRAIL TYPE 3

504+91.06, 29.48' LT
END REMOVAL OF GUARDRAIL TYPE 3
BEGIN REMOVAL OF GUARDRAIL TYPE 4

506+91.49, 36.81' LT
END REMOVAL OF GUARDRAIL TYPE 4

727+62.81, 35.14' RT
BEGIN REMOVAL OF GUARDRAIL TYPE 3

728+77.37, 40.00' LT
END REMOVAL OF GUARDRAIL TYPE 3

726+78, 106' LT TO
726+87, 111' LT
REMOVAL OF GUARDRAIL
TYPE 4 10 LF

REMOVAL OF GUARDRAIL
TYPE 3 71 LF

REMOVAL OF GUARDRAIL
TYPE 4 201 LF

REMOVAL OF GUARDRAIL
TYPE 3 137 LF

REMOVAL OF SIDEWALK
2188 SY

REMOVAL OF FENCE
1030 LF

REMOVAL OF CONCRETE
PAVEMENT 4001 SY

511+43.40, 53.13' LT
BEGIN SAWCUT

515+17.27, 47.90' LT

EXIST RR ROW

EXISTING ROW

RAMP C

C-470 (WB)

C-470 (EB)

SAWCUT LINE

RAMP B

℄ RAMP B

FLYOVER

℄ FLYOVER

TRAIL

℄ TRAIL

EXISTING ROW

FUTURE LIGHT RAIL

504+19.53, 11.64' RT
END REMOVAL OF FENCE

504+19.72, 8.88' RT
BEGIN REMOVAL OF GUARDRAIL TYPE 3

EXIST RR ROW

REMOVAL OF GUARDRAIL
TYPE 3 71 LF

504+90.40, 1.92' RT
END REMOVAL OF GUARDRAIL TYPE 3
BEGIN REMOVAL OF GUARDRAIL TYPE 4

REMOVAL OF GUARDRAIL
TYPE 4
340 LF

SEE WALL PLANS FOR REMOVAL OF SLOPE AND DITCH PAVING UNDER RAILROAD BRIDGES

105+19.56, 61.49' RT
BEGIN REMOVAL OF SLOPE AND DITCH PAVING

508+23.19, 12.35' LT
BEGIN REMOVAL OF FENCE

508+29.38, 14.06' LT
END REMOVAL OF GUARDRAIL TYPE 4

REMOVAL OF SLOPE AND DITCH PAVING
977 SY

REMOVAL OF TREE
16 EACH

REMOVAL OF TREE
16 EACH

LEGEND

- REMOVAL OF TREE
- REMOVAL OF ASPHALT MAT
- REMOVAL OF ASPHALT MAT (PLANING)
- REMOVAL OF CONCRETE PAVEMENT
- REMOVAL OF CONCRETE PAVEMENT (PLANING)
- REMOVAL OF SIDEWALK
- REMOVAL OF SLOPE AND DITCH PAVING

811 Know what's below. Call before you dig.

N

SCALE
0' 50' 100' 200'

Print Date: 1/10/2010	Sheet Revisions	Colorado Department of Transportation	As Constructed
File Name: 14679_pRM-P703.dgn	Date: Comments: Init.	8833 South Wadsworth Court	No Revisions:
Horiz. Scale: 1:100 Vert. Scale: As Noted		Littleton, CO 80128	Revised:
WILSON & COMPANY Engineers & Architects 999 16TH STREET, SUITE 2600 DENVER, CO 80202 PHONE: 303-297-2976 FAX: 303-297-2693		Phone: 303-972-9112 FAX: 303-972-9114	Void:
		Region 6 RLB	

REMOVALS PLAN
FLYOVER

Designer:	JBK	Structure Numbers	
Detailer:	JBK		
Sheet Subset: REMOVALS		Subset Sheets: 4 of 7	

Project No./Code
ES6 0852-103
17679
Sheet Number 55

JBKeith 3:56:07 PM M:\TRN\07-100-311-12\14679\Design\Drawings\roadway\14679_pRM-P703.dgn

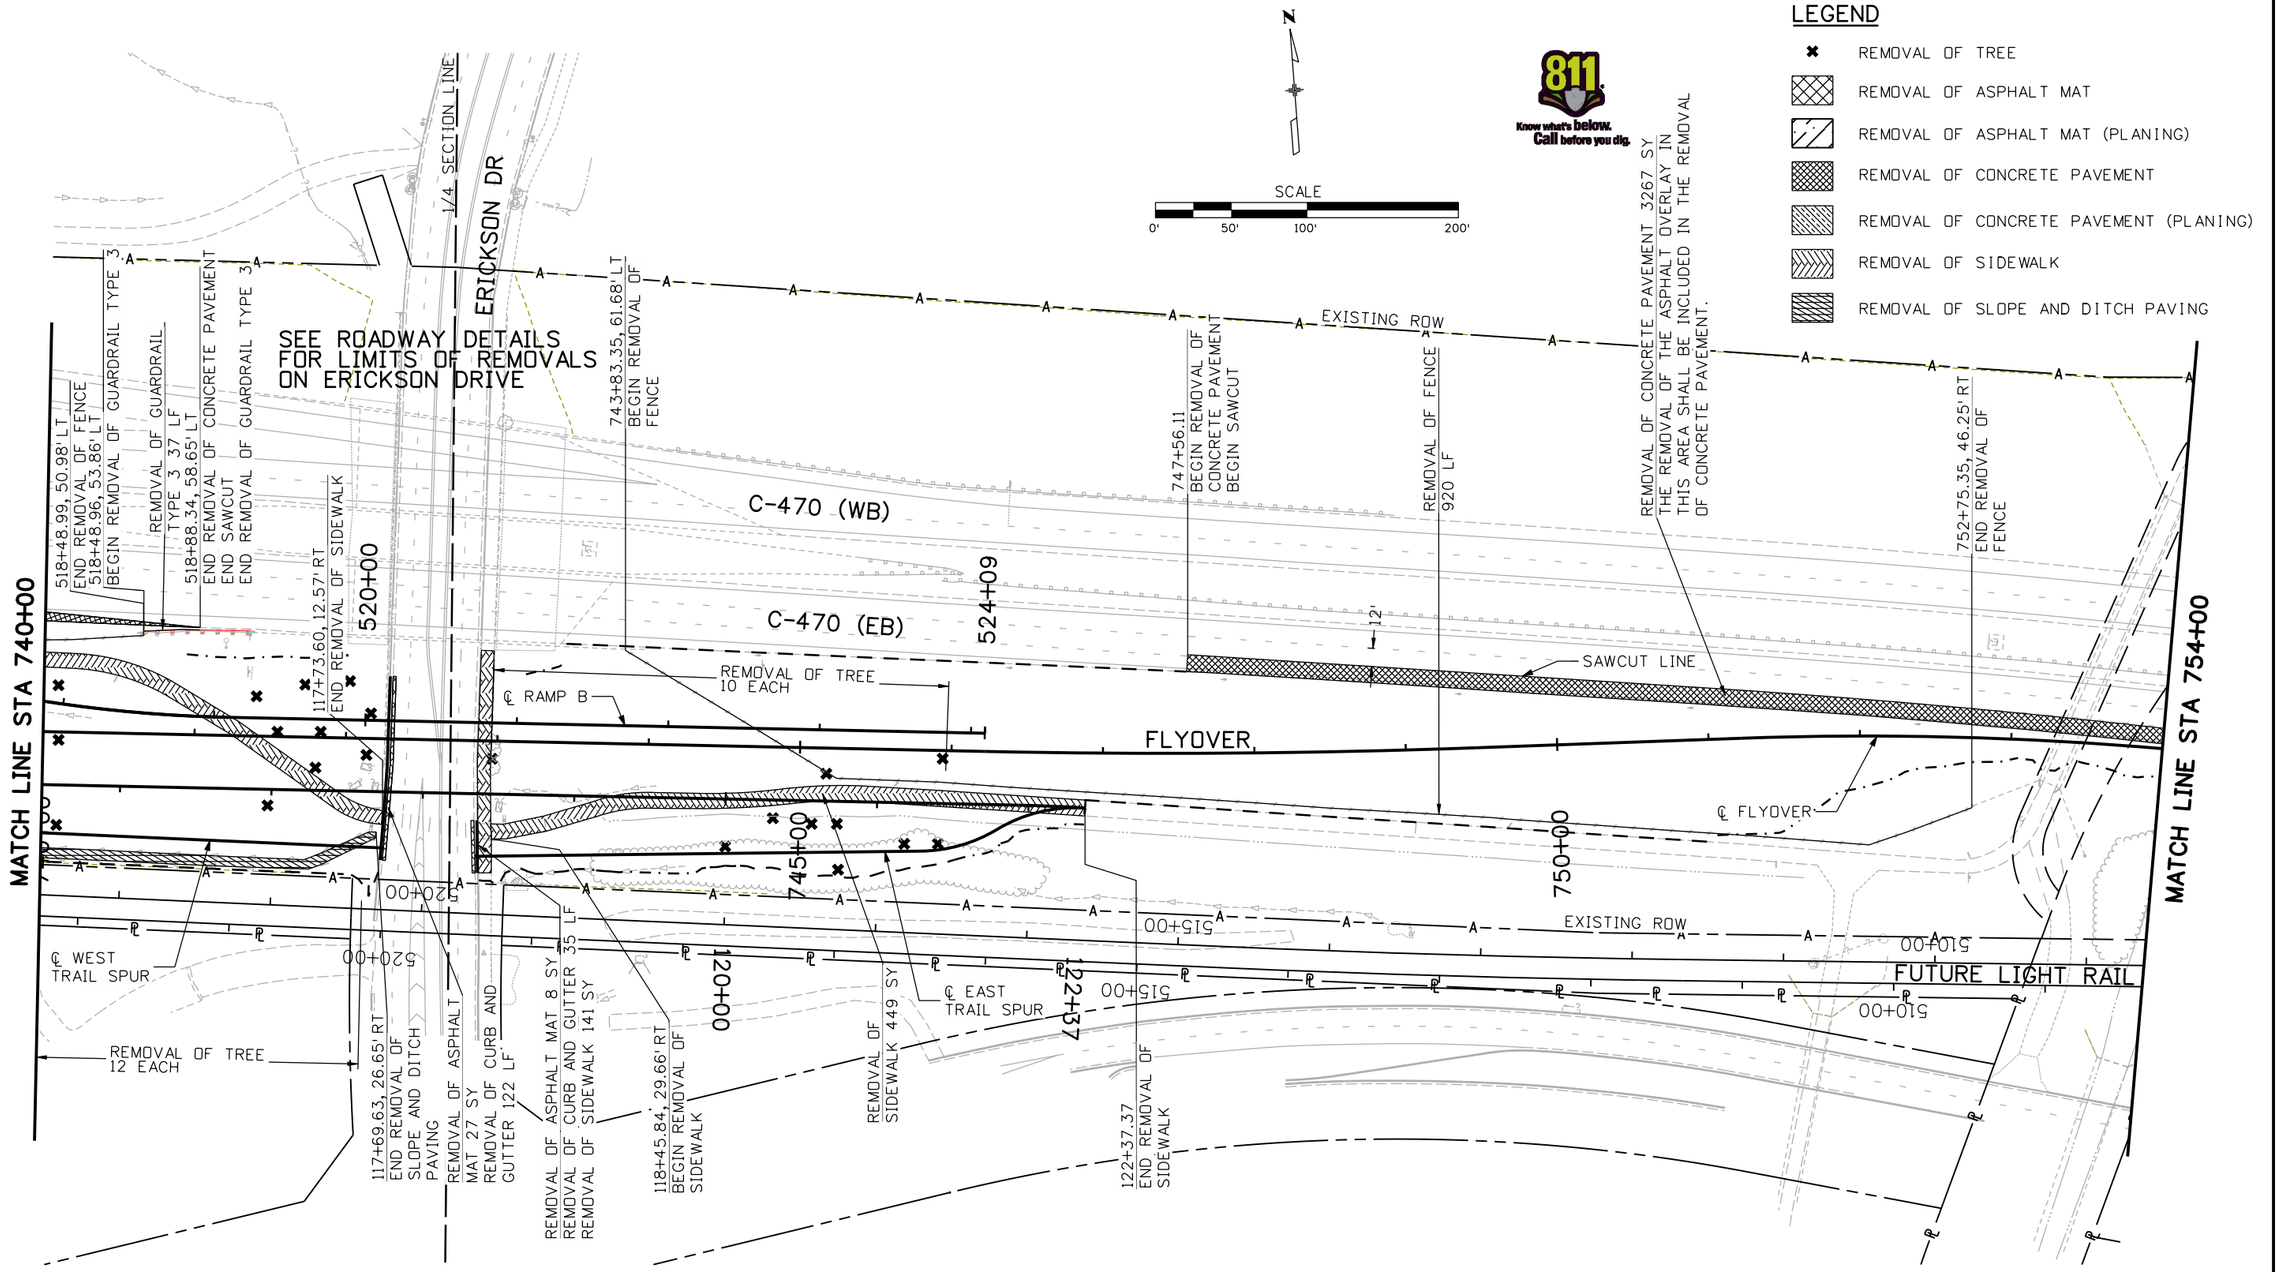

Print Date: 1/10/2010	Sheet Revisions	Colorado Department of Transportation	As Constructed
File Name: 14679_pRM-P704.dgn	Date: / Comments / Init.	8833 South Wadsworth Court Littleton, CO 80128 Phone: 303-972-9112 FAX: 303-972-9114	No Revisions:
Horiz. Scale: 1:100 Vert. Scale: As Noted		Region 6 RLB	Revised:
WILSON & COMPANY Engineers & Architects 999 18TH STREET, SUITE 2800 DENVER, CO 80202 PHONE: 303-297-2976 FAX: 303-297-2693			Void:

REMOVALS PLAN FLYOVER			Project No./Code
Designer: JJW	Structure Numbers		ES6 0852-103
Detailer: JBK			17679
Sheet Subset: REMOVALS	Subset Sheets: 5 of 7		Sheet Number 56

JBKeith 3:56:24 PM M:\TRN\07-100-311-12\14679\Design\Drawings\roadway\14679_pRM-P704.dgn

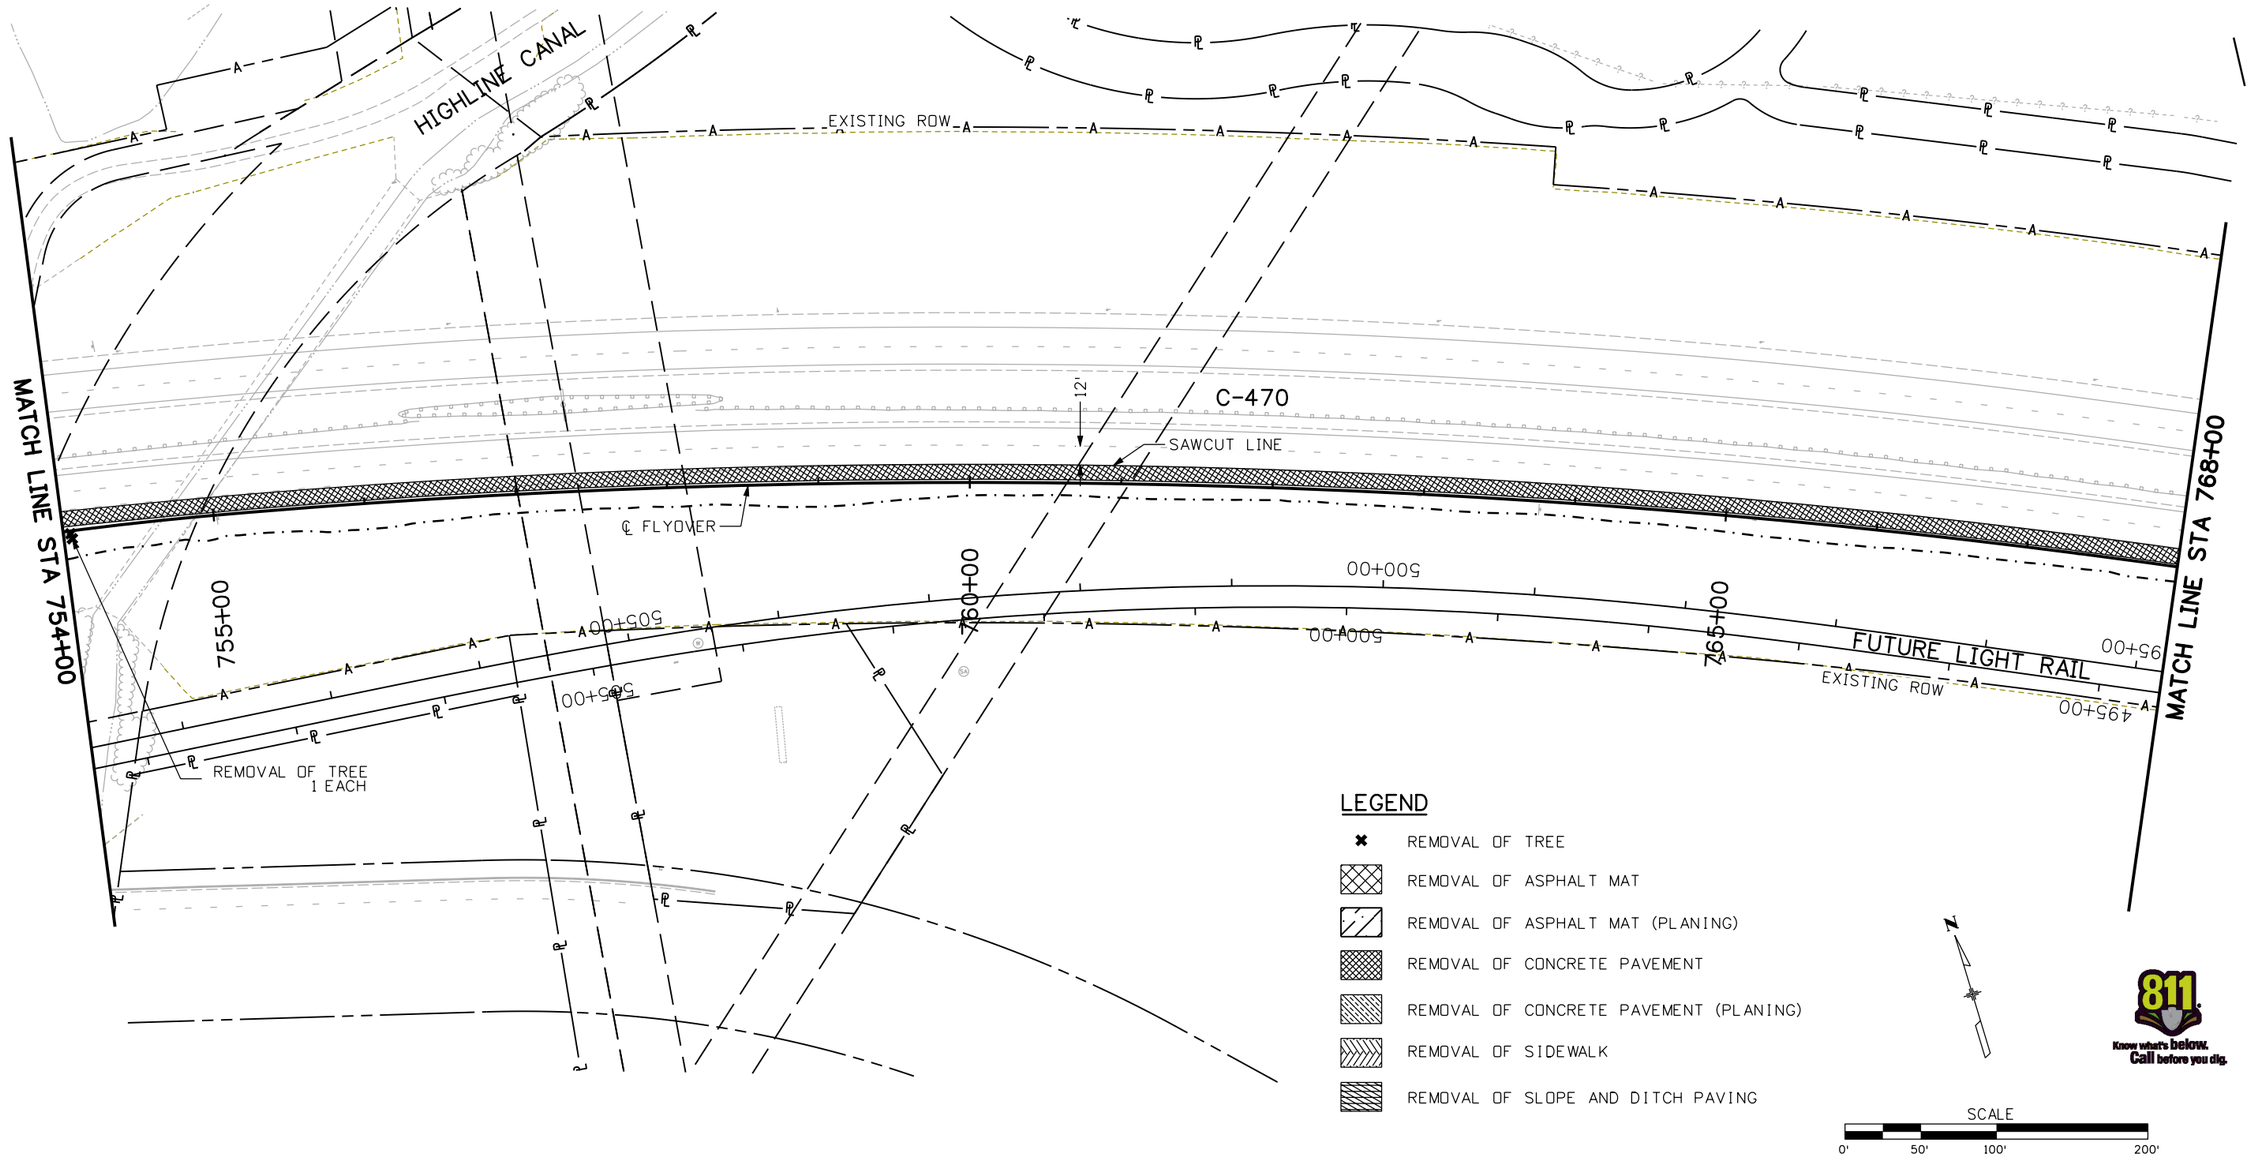

JBKeith 3:56:42 PM M:\TRN\07-100-311-12\14679\Design\Drawings\roadway\14679_pRM-P705.dgn

Print Date: 1/10/2010		Sheet Revisions			Colorado Department of Transportation	As Constructed	REMOVALS PLAN FLYOVER			Project No./Code
File Name: 14679_pRM-P705.dgn		Date:	Comments	Init.	8833 South Wadsworth Court Littleton, CO 80128 Phone: 303-972-9112 FAX: 303-972-9114	No Revisions:				ES6 0852-103
Horiz. Scale: 1:100 Vert. Scale: As Noted						Revised:	Designer: JJW	Structure Numbers		17679
WILSON & COMPANY Engineers & Architects 999 18TH STREET, SUITE 2800 DENVER, CO 80202 PHONE: 303-297-2976 FAX: 303-297-2693					Region 6 RLB	Void:	Detailer: JBK			Sheet Number 57
							Sheet Subset: REMOVALS	Subset Sheets: 6 of 7		

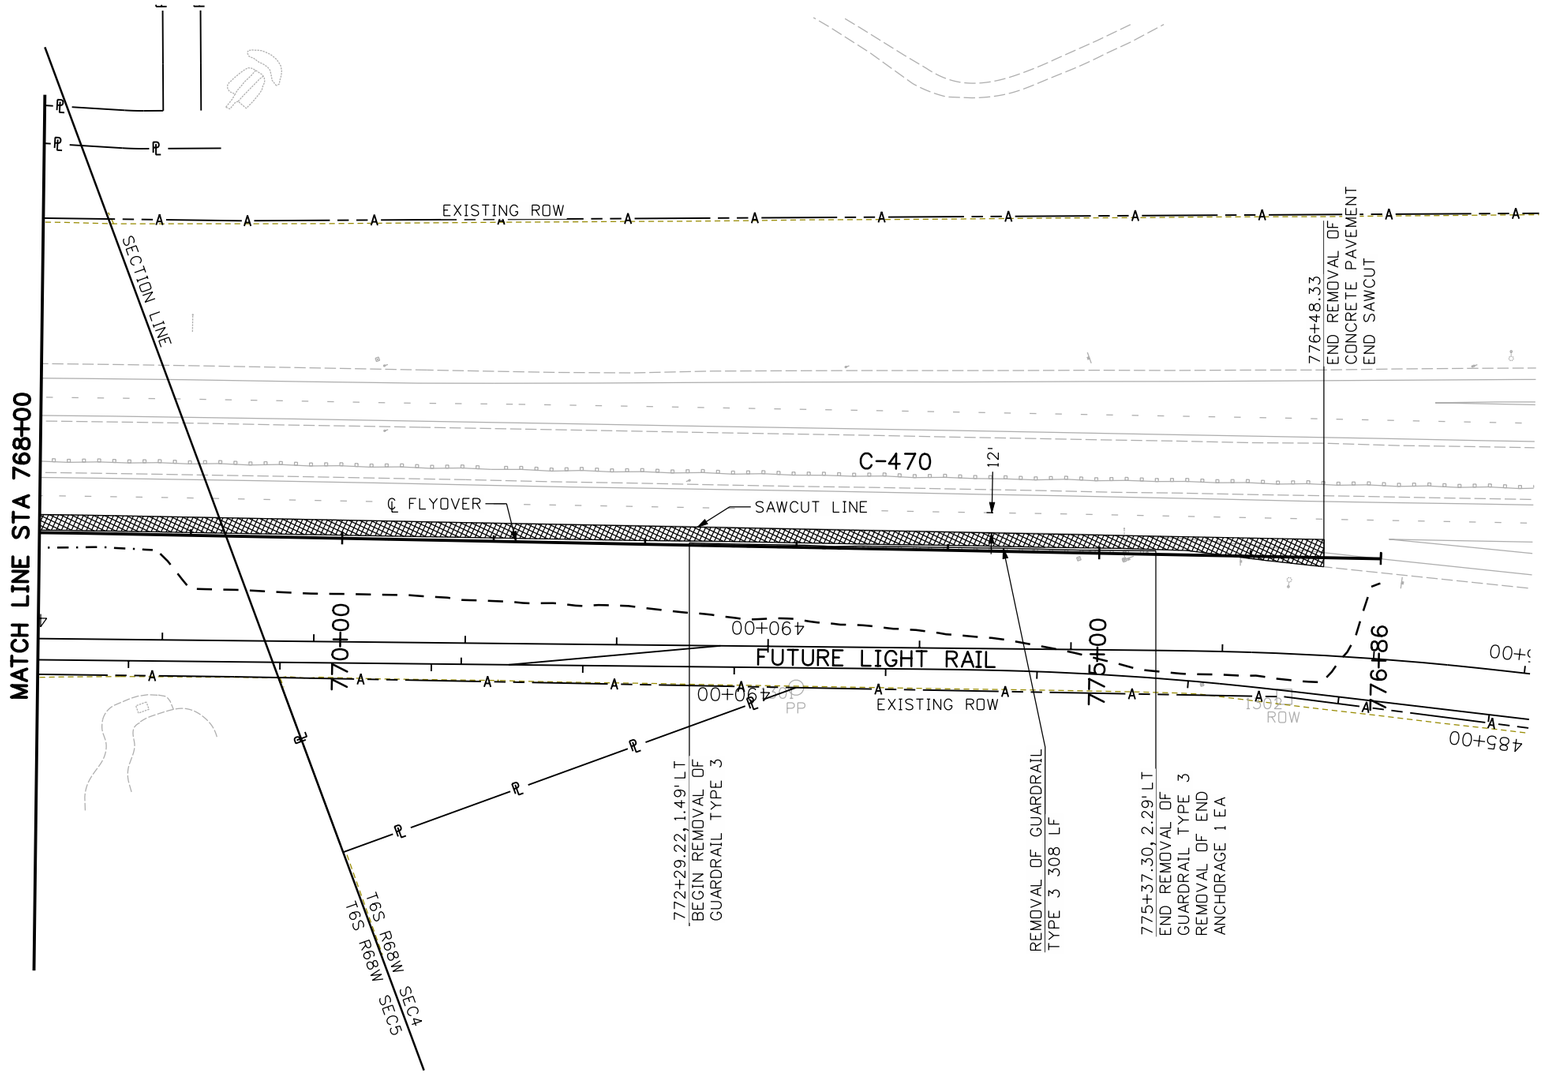

LEGEND

- ✖ REMOVAL OF TREE
- REMOVAL OF ASPHALT MAT
- REMOVAL OF ASPHALT MAT (PLANING)
- REMOVAL OF CONCRETE PAVEMENT
- REMOVAL OF CONCRETE PAVEMENT (PLANING)
- REMOVAL OF SIDEWALK
- REMOVAL OF SLOPE AND DITCH PAVING

N

SCALE
0' 50' 100' 200'

811 Know what's below. Call before you dig.

JBKeith 3:56:58 PM M:\TRN\07-100-311-12\14679\Design\Drawings\roadway\14679_pRM-P706.dgn

Print Date: 1/10/2010
File Name: 14679_pRM-P706.dgn
Horiz. Scale: 1:100 Vert. Scale: As Noted

WILSON & COMPANY Engineers & Architects
999 18TH STREET, SUITE 2600
DENVER, CO 80202
PHONE: 303-297-2976
FAX: 303-297-2693

0000

Sheet Revisions		
Date:	Comments	Init.

Colorado Department of Transportation
DOT DEPARTMENT OF TRANSPORTATION
8833 South Wadsworth Court
Littleton, CO 80128
Phone: 303-972-9112 FAX: 303-972-9114
Region 6 RLB

As Constructed
No Revisions:
Revised:
Void:

REMOVALS PLAN FLYOVER

Designer: JJW
Detailer: JBK
Sheet Subset: REMVOALS
Structure Numbers:
Subset Sheets: 7 of 7

Project No./Code
ES6 0852-103
17679
Sheet Number 58