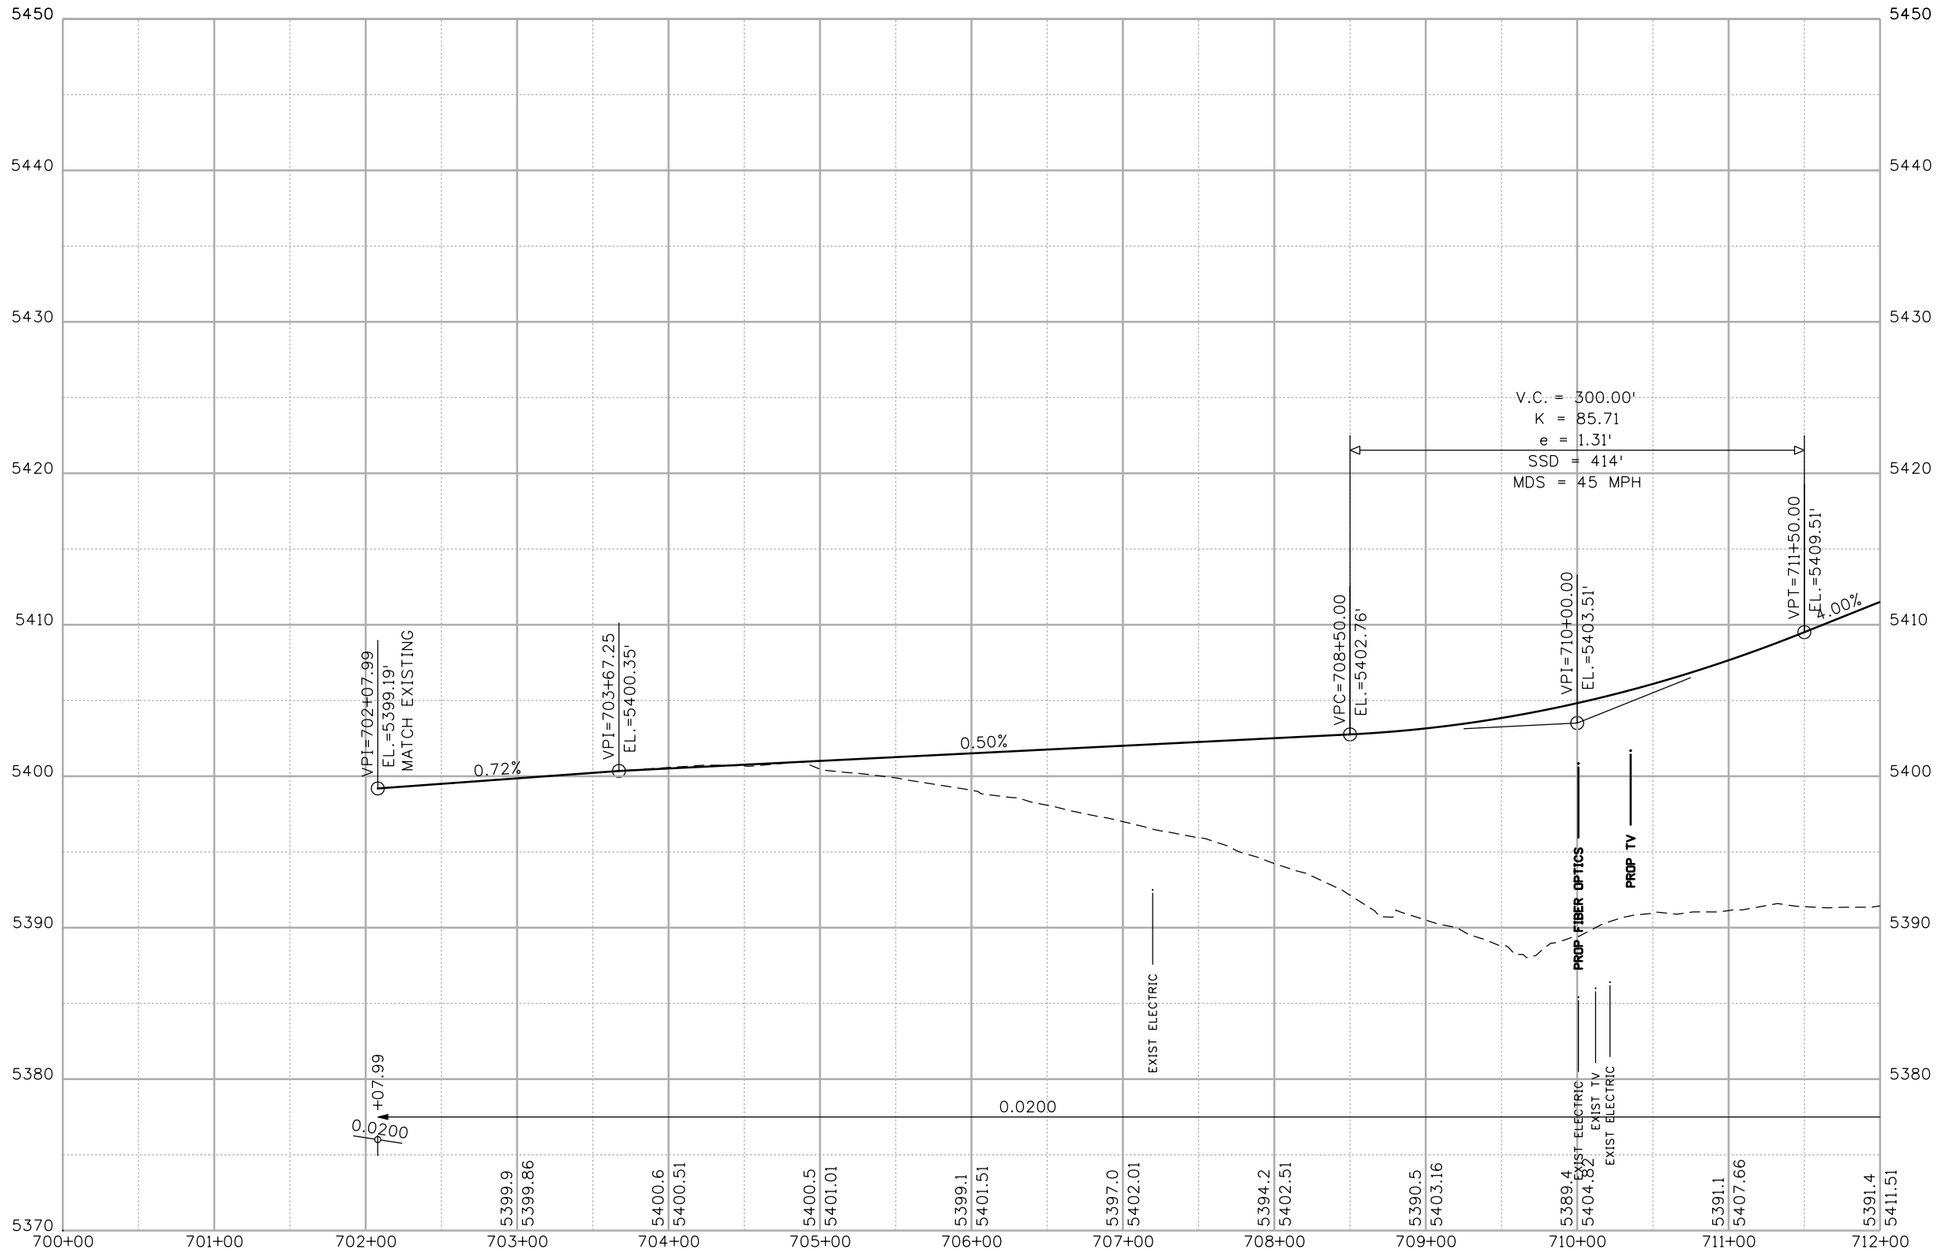

Print Date: 1/15/2010	Sheet Revisions	Colorado Department of Transportation	As Constructed
File Name: 14679_pRP-V701.dgn	Date: / Comments / Init.	8833 South Wadsworth Court Littleton, CO 80128 Phone: 303-972-9112 FAX: 303-972-9114	No Revisions:
Horiz. Scale: 1:100 Vert. Scale: As Noted		Region 6 RLB	Revised:
WILSON & COMPANY Engineers & Architects 909 18TH STREET, SUITE 2800 DENVER, CO 80202 PHONE: 303-297-2976 FAX: 303-297-2693			Void:

PROFILE SHEET FLYOVER			
Designer: JBK	Structure Numbers		
Detailer: MAB			
Sheet Subset: PROFILE	Subset Sheets: 1 of 11		

Project No./Code
ES6 0852-103
17679
Sheet Number 73

JJWierema 4:09:22 PM M:\TRN\07-100-311-12\14679\Design\Drawings\roadway\14679_pRP-V701.dgn

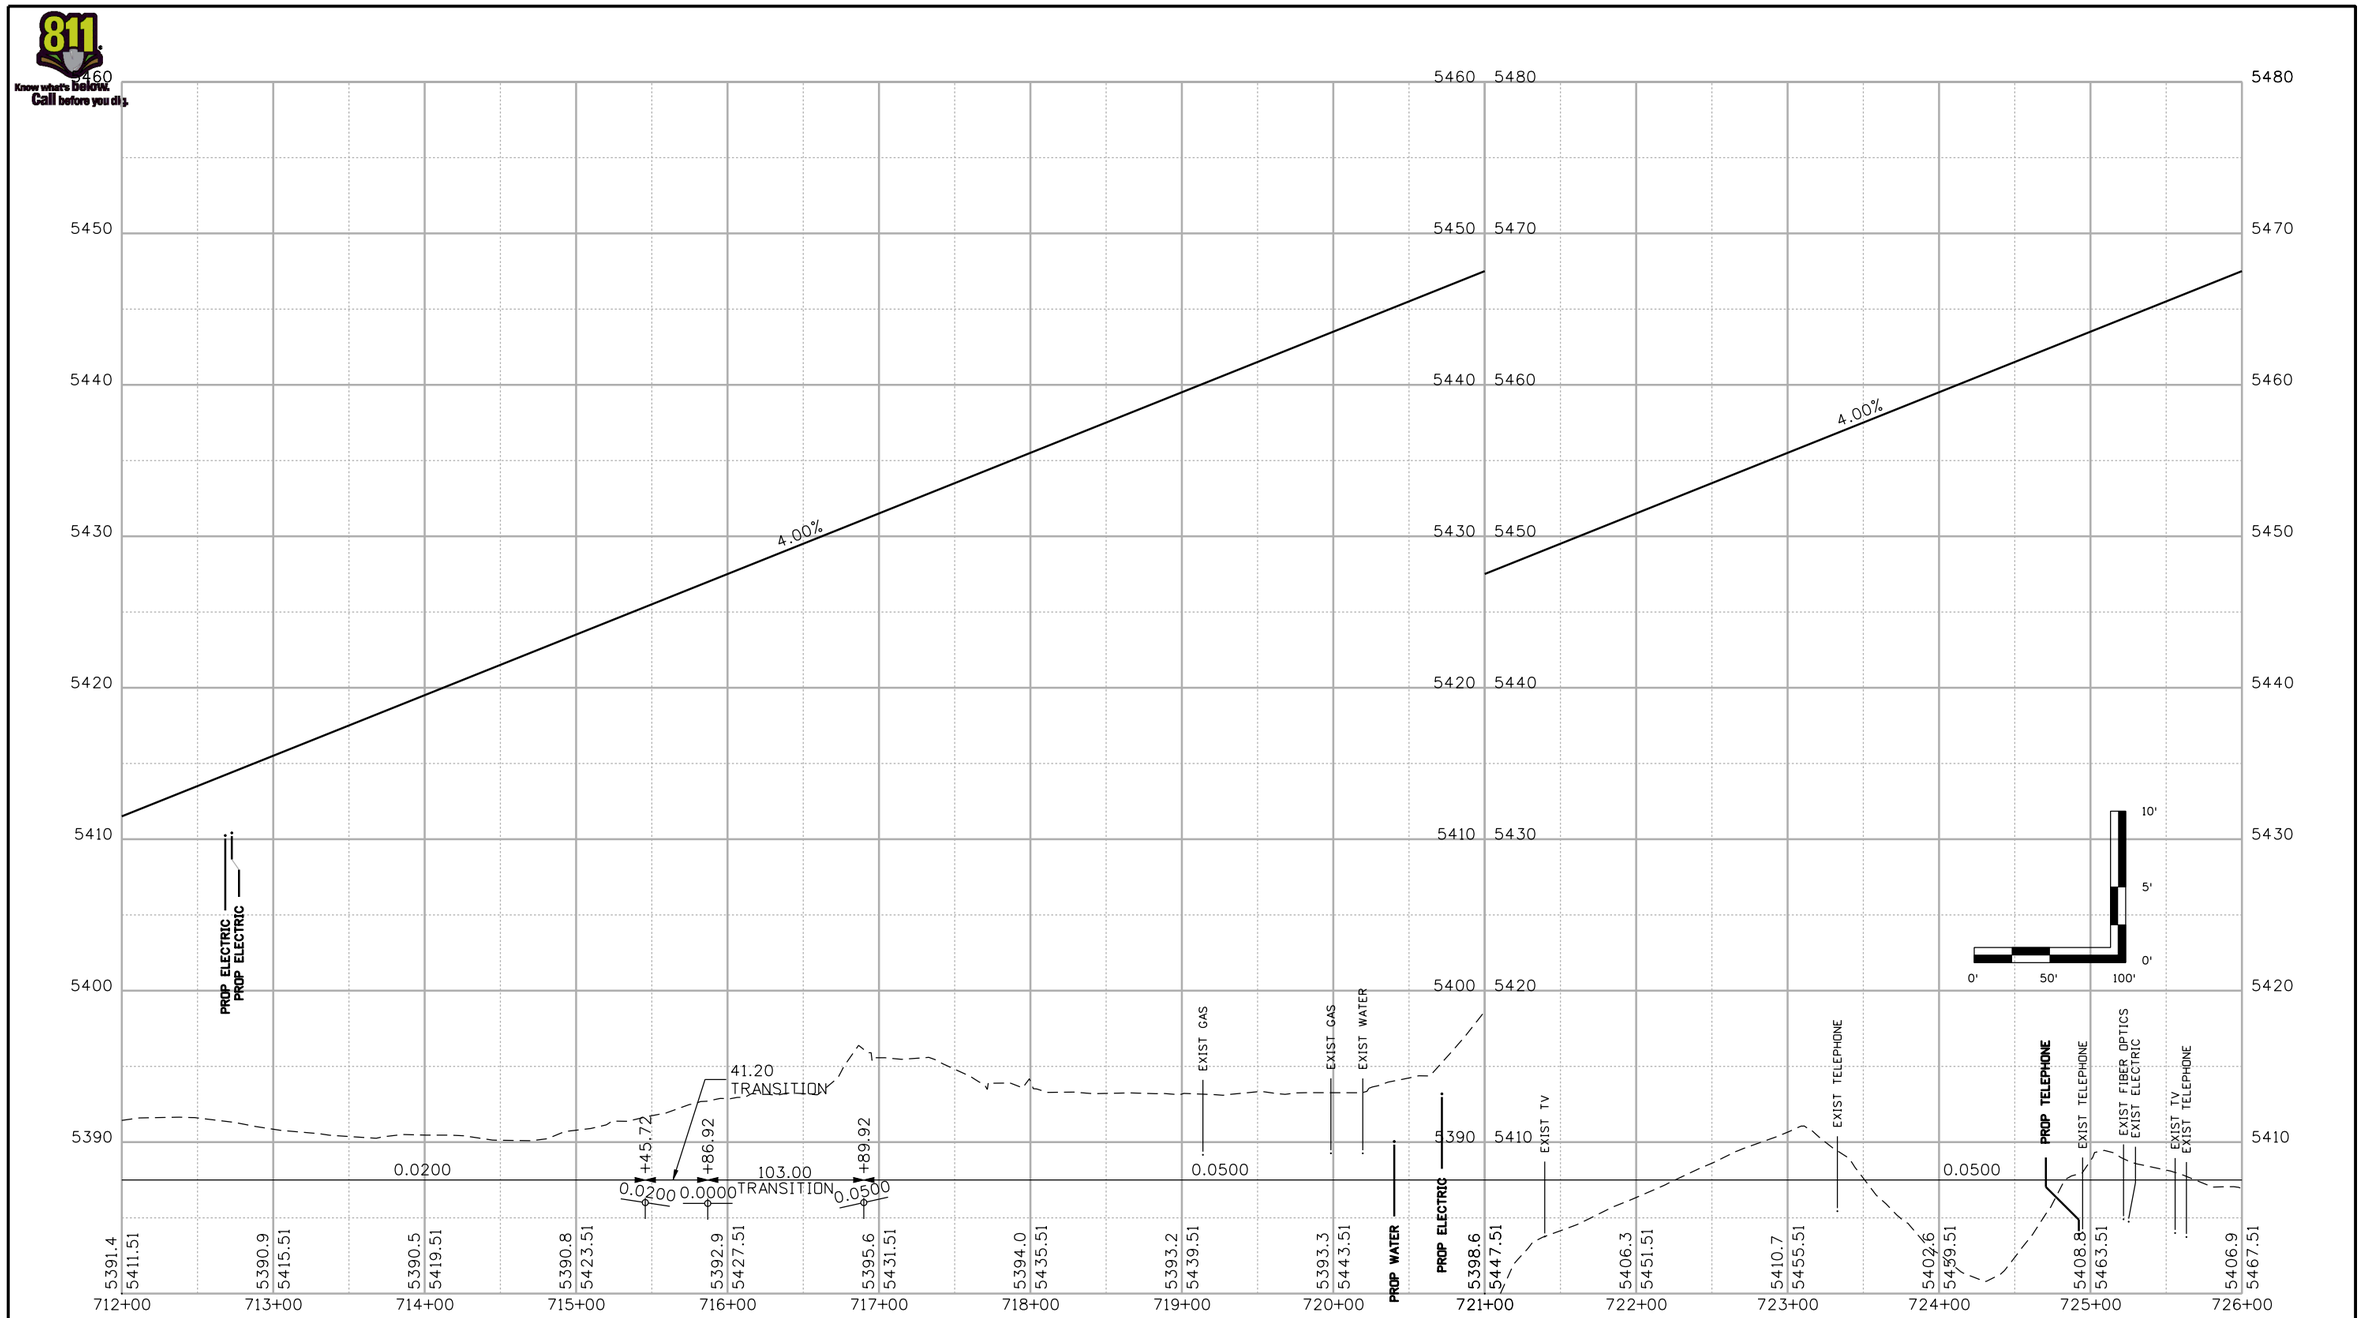

Print Date: 1/15/2010	Sheet Revisions			As Constructed	PROFILE SHEET FLYOVER	Project No./Code
File Name: 14679_pRP-V702.dgn	Date:	Comments	Init.	No Revisions:		ES6 0852-103
Horiz. Scale: 1:100 Vert. Scale: As Noted				Revised:	Designer: JBK / Structure Numbers	17679
WILSON & COMPANY Engineers & Architects 999 18TH STREET, SUITE 2800 DENVER, CO 80202 PHONE: 303-297-2976 FAX: 303-297-2693				Void:	Detailer: MAB / Sheet Subset: PROFILE / Subset Sheets: 2 of 11	Sheet Number 74

Colorado Department of Transportation
8833 South Wadsworth Court
Littleton, CO 80128
Phone: 303-972-9112 FAX: 303-972-9114
Region 6 RLB

JJWierema 4:09:30 PM M:\TRN\07-100-311-12\14679\Design\Drawings\roadway\14679_pRP-V702.dgn

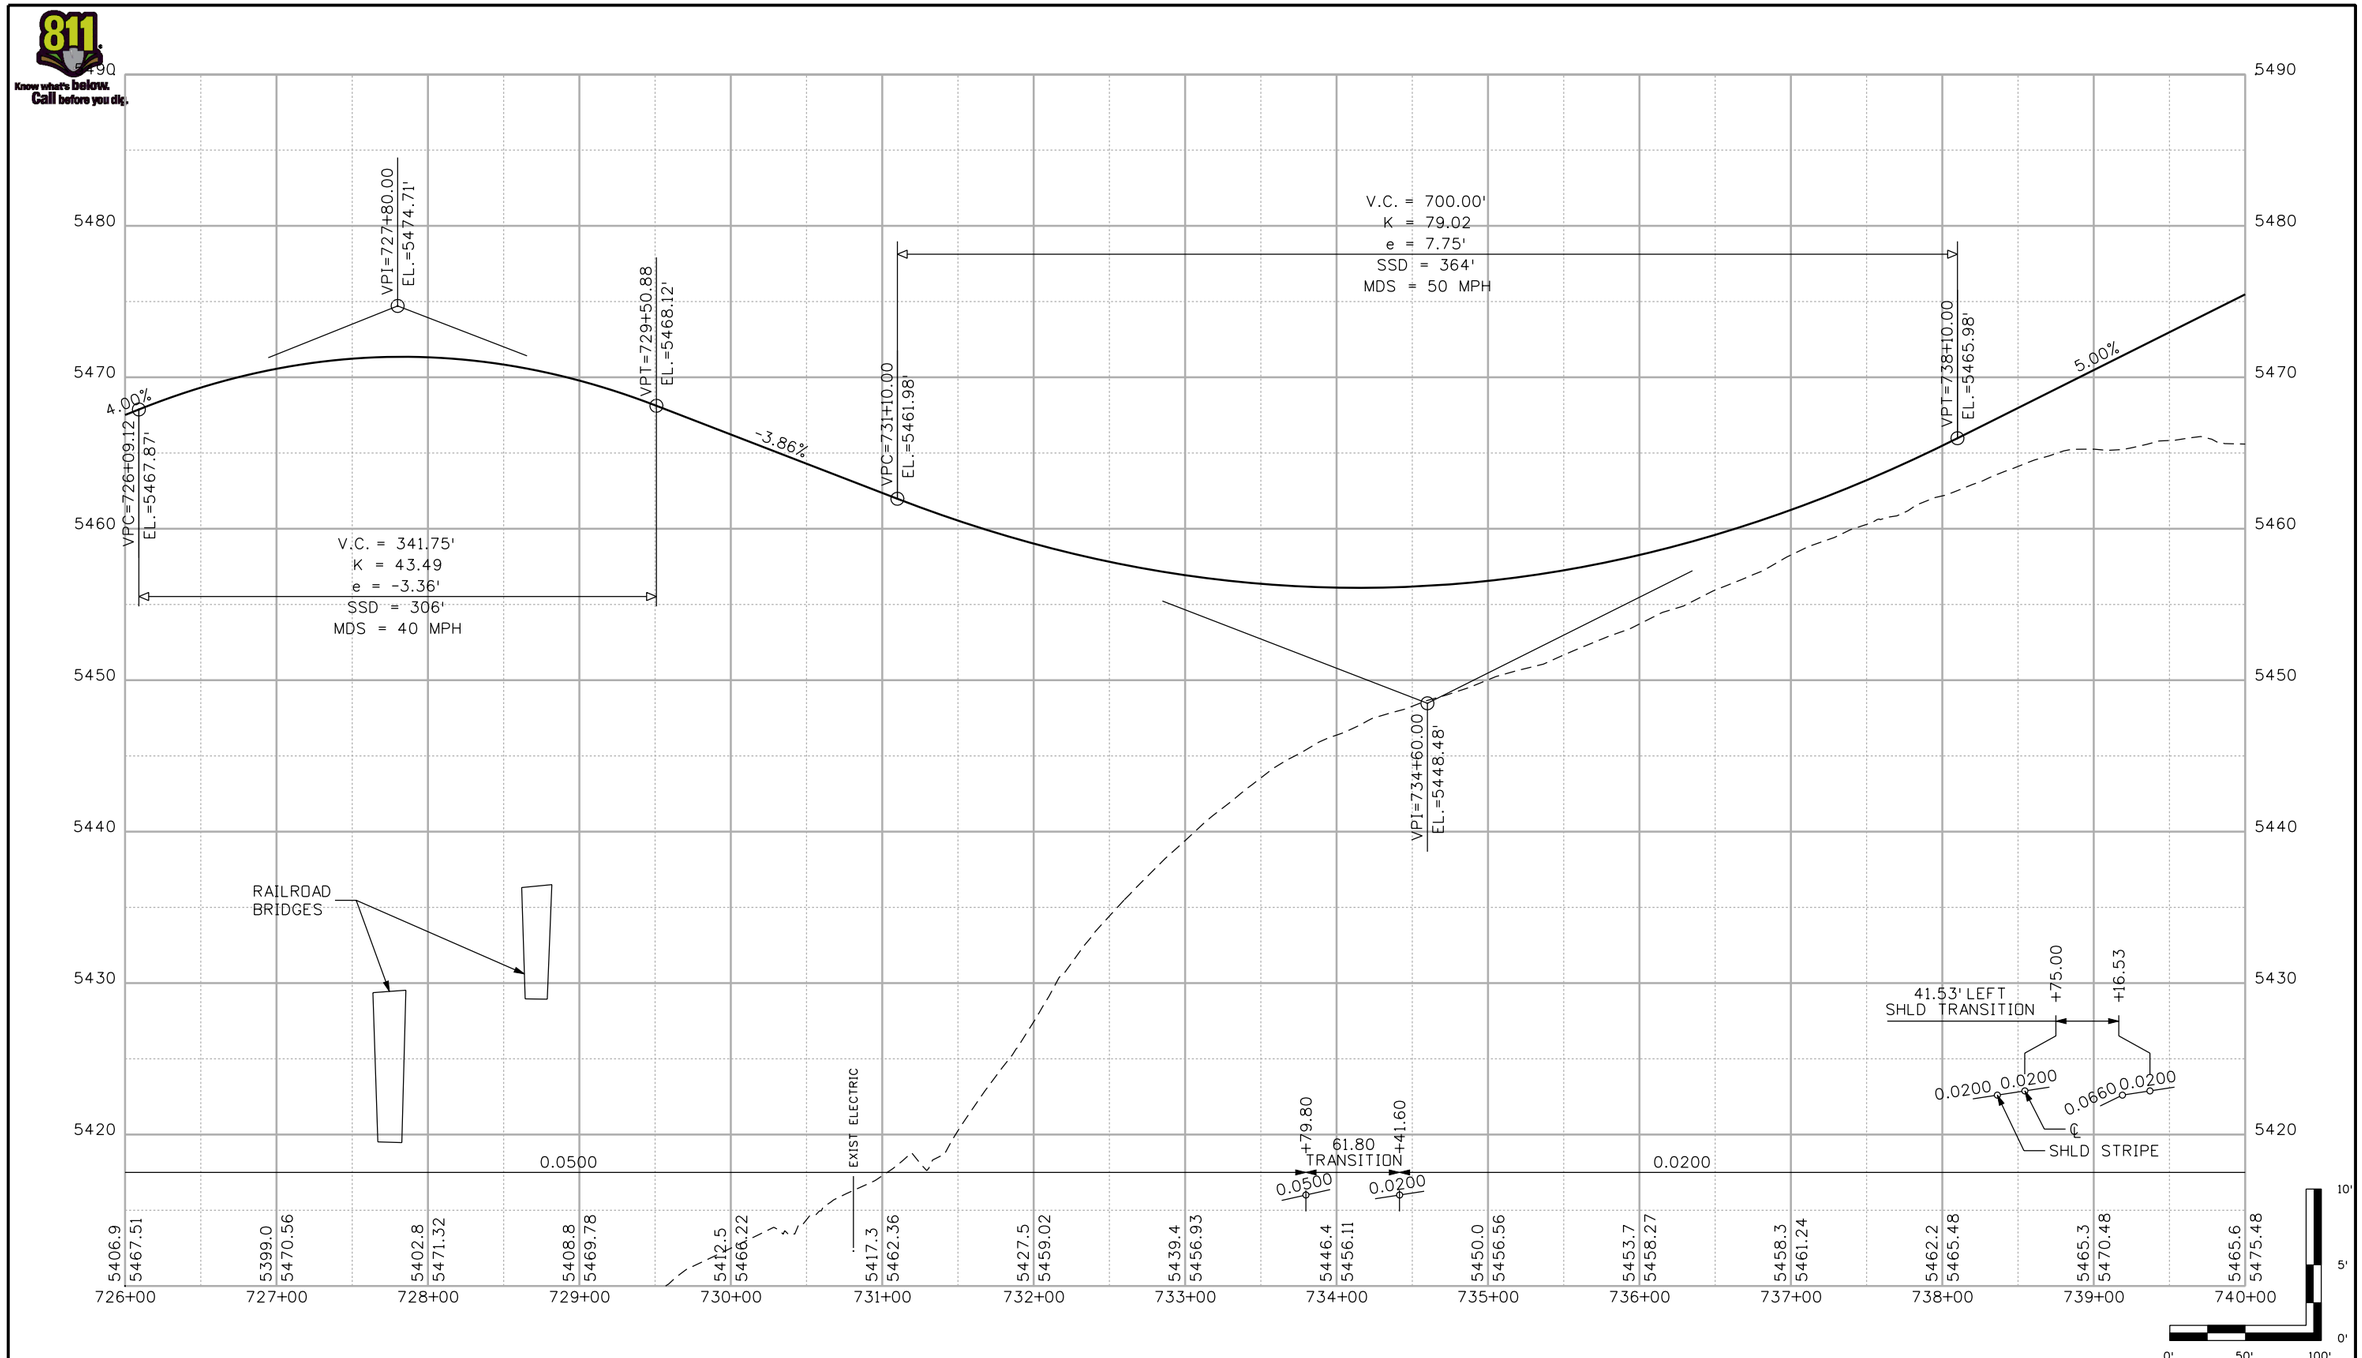

Print Date: 1/15/2010	Sheet Revisions	Colorado Department of Transportation	As Constructed
File Name: 14679_pRP-V703.dgn	Date: / Comments / Init.	8833 South Wadsworth Court Littleton, CO 80128 Phone: 303-972-9112 FAX: 303-972-9114	No Revisions:
Horiz. Scale: 1:100 Vert. Scale: As Noted		Region 6 RLB	Revised:
WILSON & COMPANY Engineers & Architects 999 16TH STREET, SUITE 2600 DENVER, CO 80202 PHONE: 303-297-2976 FAX: 303-297-2693			Void:

PROFILE SHEET
FLYOVER

Designer:	JBK	Structure Numbers	
Detailer:	MAB		
Sheet Subset:	PROFILE	Subset Sheets: 3 of 11	

Project No./Code
ES6 0852-103
17679
Sheet Number 75

JJWierema 4:09:38 PM M:\TRN\07-100-311-12\14679\Design\Drawings\roadway\14679_pRP-V703.dgn

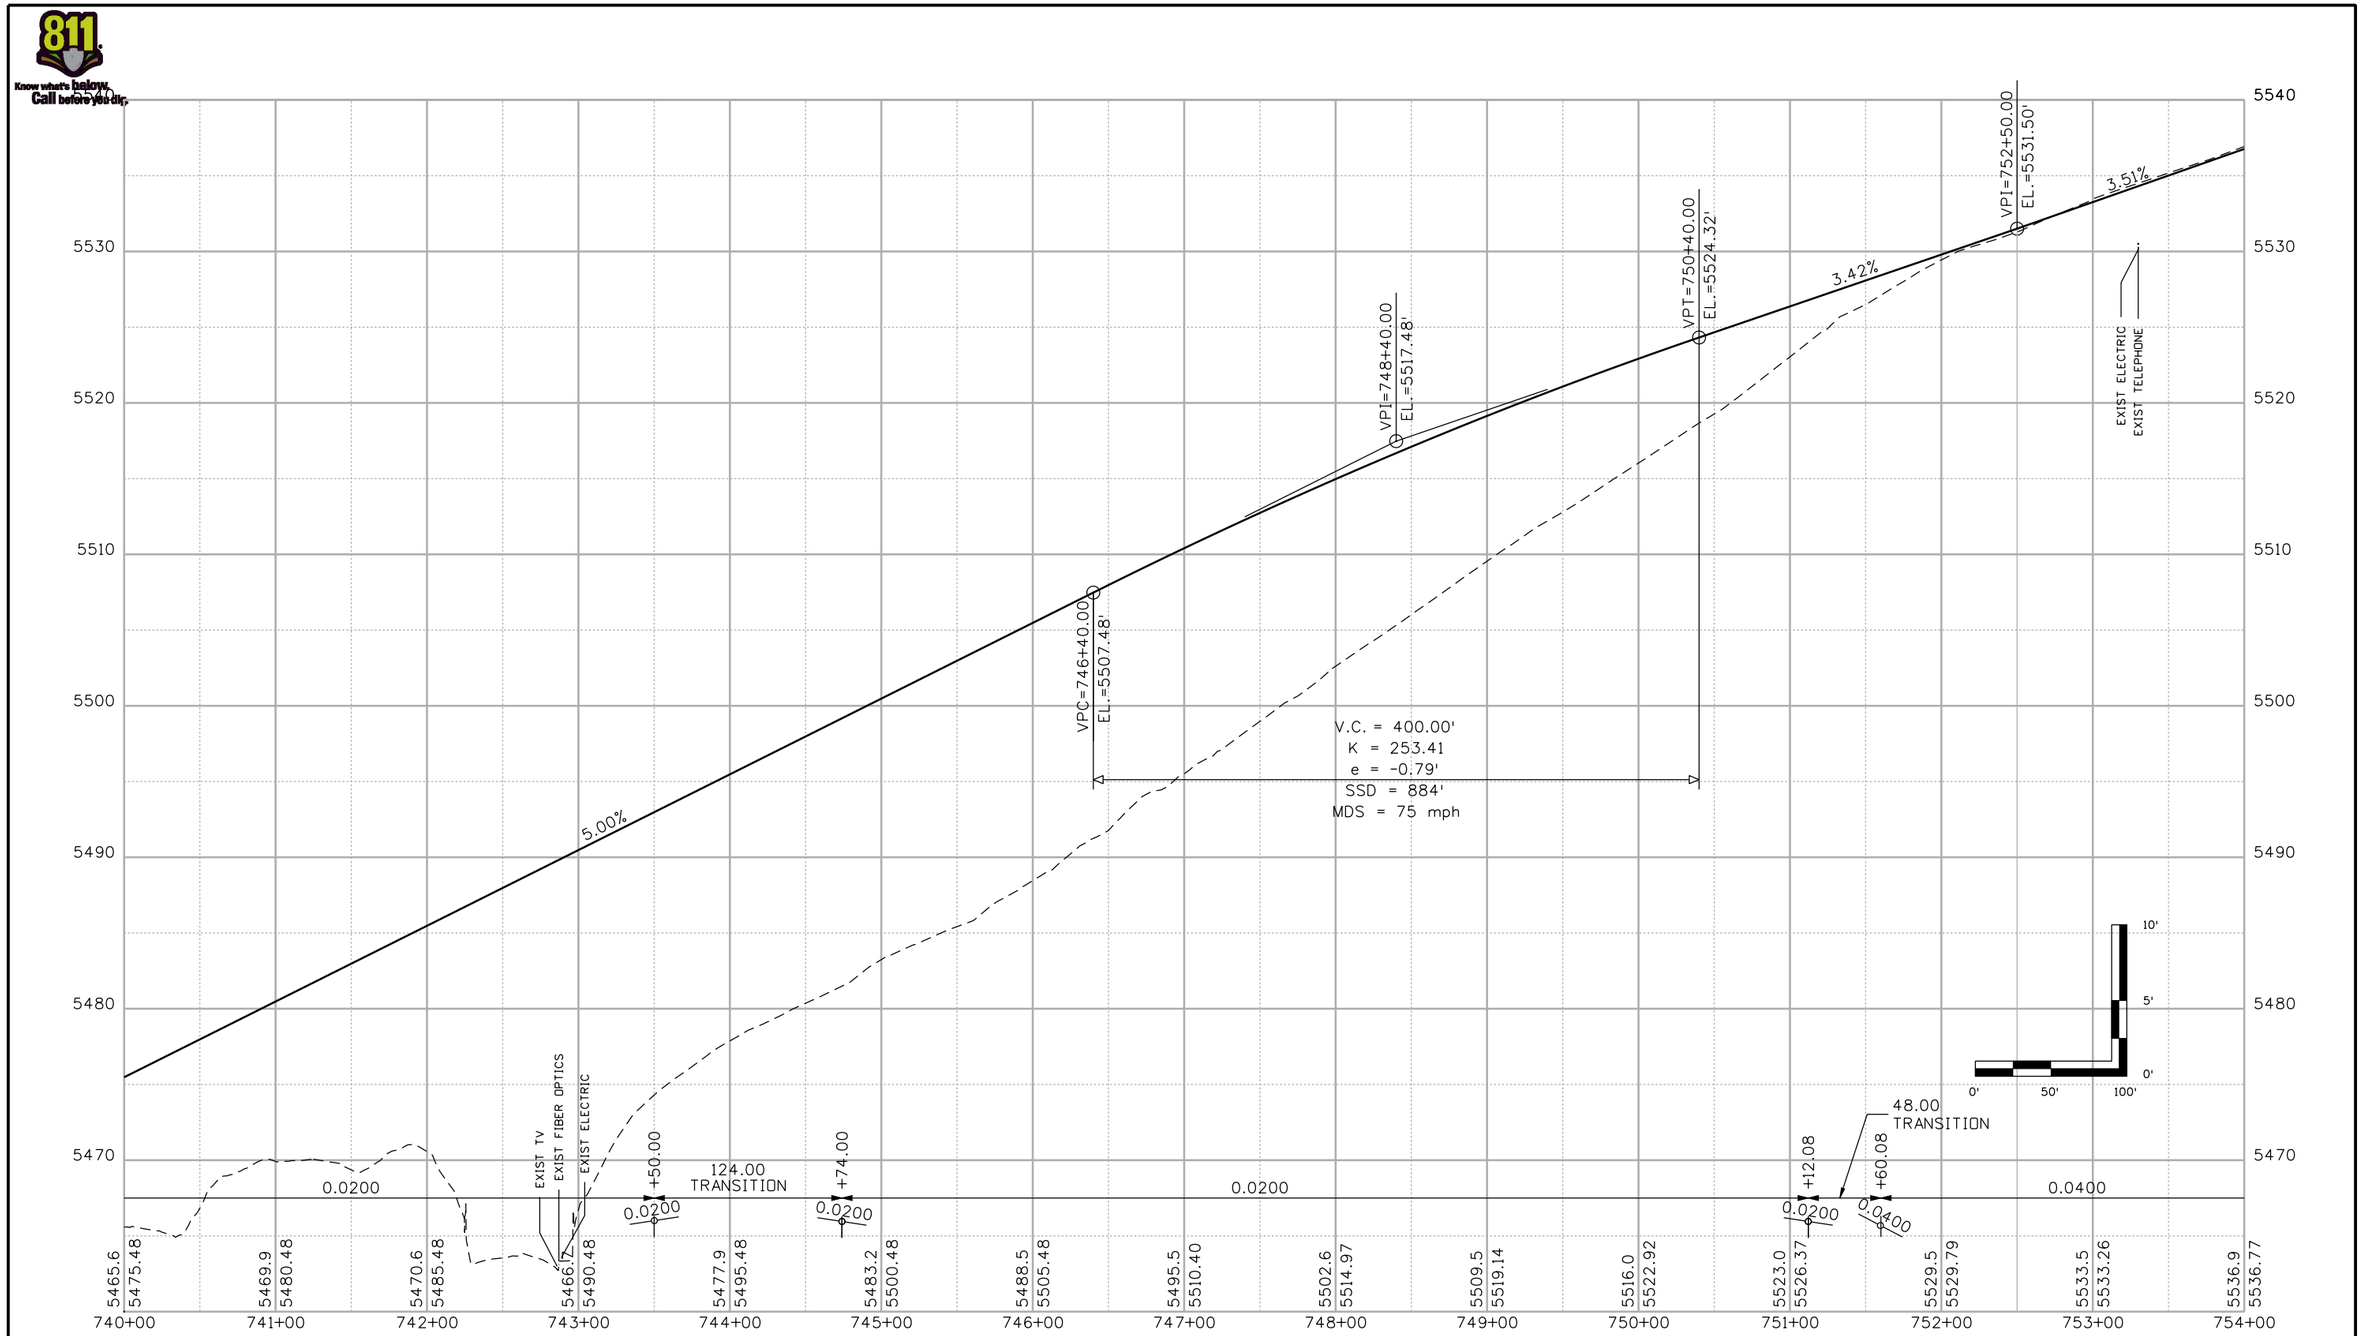

Know what's below. Call before you dig.

Print Date: 1/15/2010
File Name: 14679_pRP-V704.dgn
Horiz. Scale: 1:100 Vert. Scale: As Noted

WILSON & COMPANY Engineers & Architects
999 18TH STREET, SUITE 2600
DENVER, CO 80202
PHONE: 303-297-2976
FAX: 303-297-2693

Sheet Revisions		
Date:	Comments	Init.

Colorado Department of Transportation
DOT DEPARTMENT OF TRANSPORTATION
8833 South Wadsworth Court
Littleton, CO 80128
Phone: 303-972-9112 FAX: 303-972-9114
Region 6 RLB

As Constructed
No Revisions:
Revised:
Void:

PROFILE SHEET
FLYOVER

Designer: JBK
Detailer: MAB
Structure Numbers
Sheet Subset: PROFILE
Subset Sheets: 4 of 11

Project No./Code
ES6 0852-103
17679
Sheet Number 76

JJWieremo 4:09:46 PM M:\TRN\07-100-311-12\14679\Design\Drawings\roadway\14679_pRP-V704.dgn

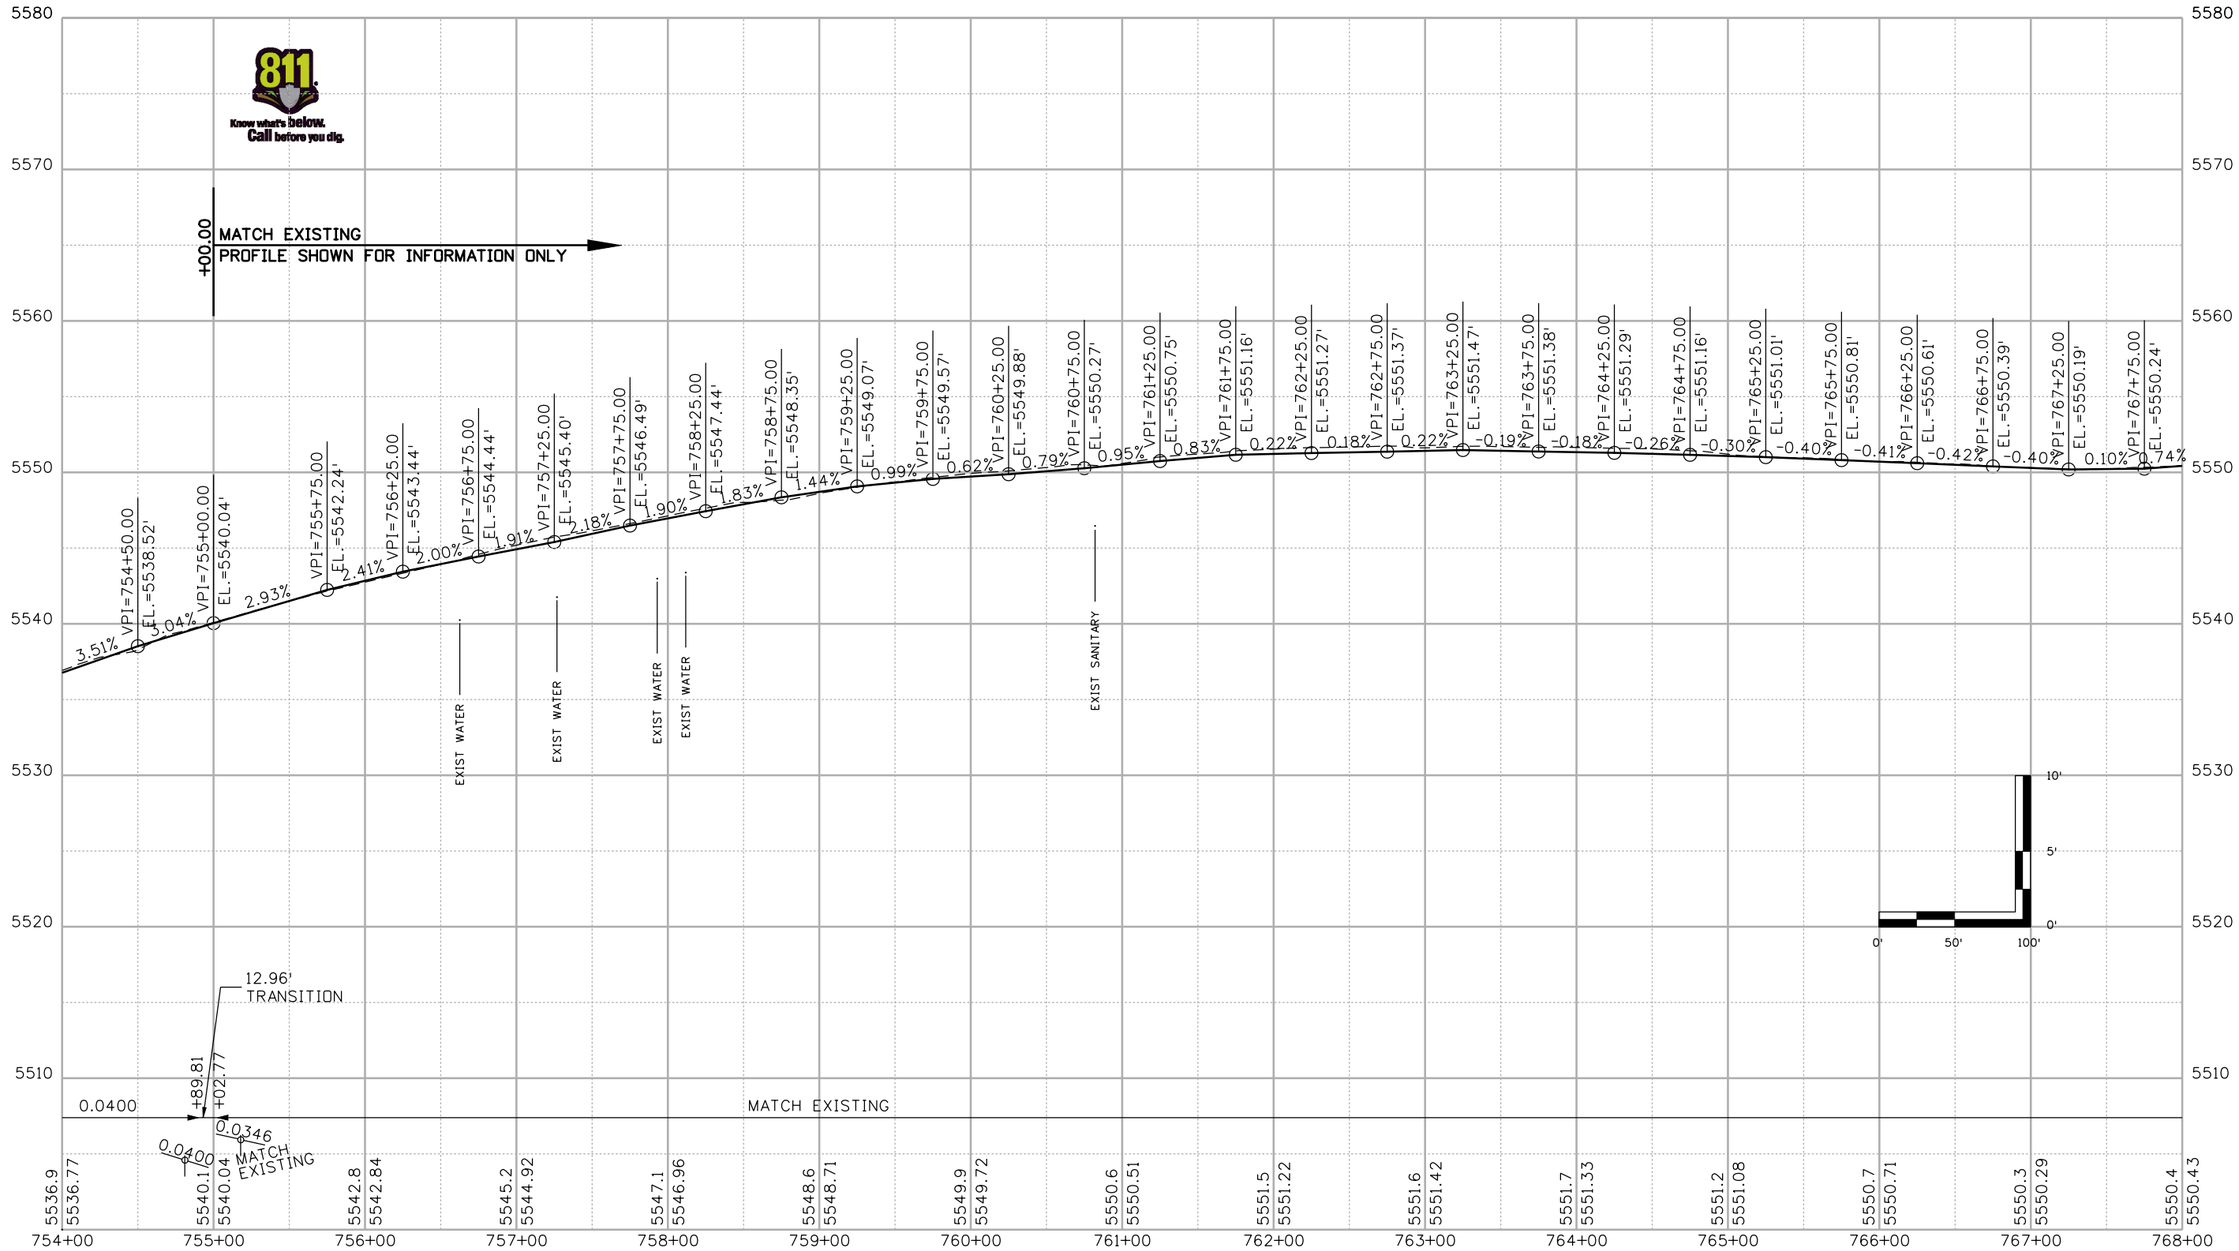

Print Date: 1/15/2010
File Name: 14679_pRP-V705.dgn
Horiz. Scale: 1:100 Vert. Scale: As Noted

WILSON & COMPANY Engineers & Architects
999 18TH STREET, SUITE 2600
DENVER, CO 80202
PHONE: 303-297-2976
FAX: 303-297-2693

Sheet Revisions		
Date:	Comments	Init.

Colorado Department of Transportation
DOT
DEPARTMENT OF TRANSPORTATION
8833 South Wadsworth Court
Littleton, CO 80128
Phone: 303-972-9112 FAX: 303-972-9114
Region 6 RLB

As Constructed
No Revisions:
Revised:
Void:

PROFILE SHEET
FLYOVER

Designer: JBK
Detailer: JBK
Structure Numbers
Sheet Subset: PROFILE
Subset Sheets: 5 of 11

Project No./Code
ES6 0852-103
17679
Sheet Number 77

JJWieremo 4:09:54 PM M:\TRN\07-100-311-12\14679\Design\Drawings\roadway\14679_pRP-V705.dgn

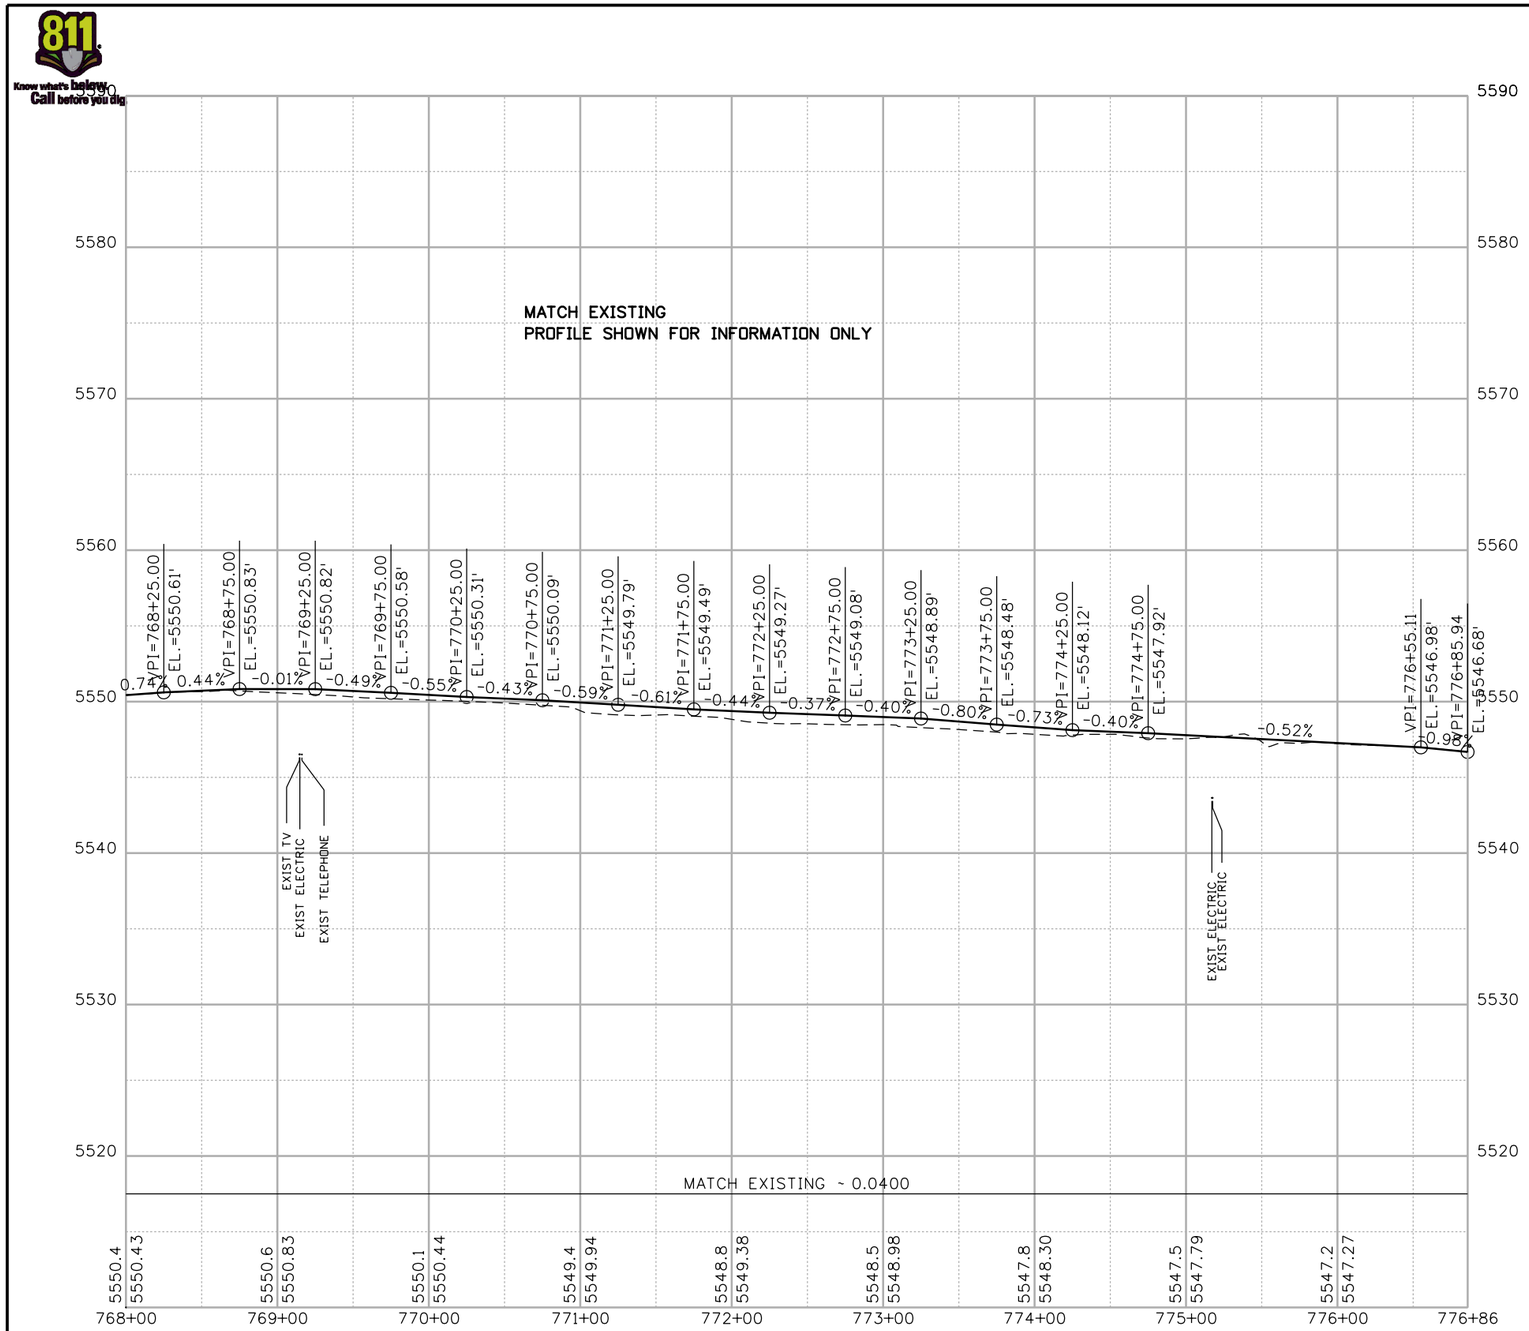

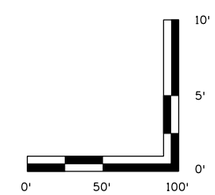

Print Date: 1/15/2010	Sheet Revisions	Colorado Department of Transportation	As Constructed
File Name: 14679_pRP-V706.dgn	Date: / Comments / Init.	8833 South Wadsworth Court Littleton, CO 80128 Phone: 303-972-9112 FAX: 303-972-9114	No Revisions:
Horiz. Scale: 1:100 Vert. Scale: As Noted		Region 6 RLB	Revised:
WILSON & COMPANY Engineers & Architects 999 18TH STREET, SUITE 2600 DENVER, CO 80202 PHONE: 303-297-2976 FAX: 303-297-2693			Void:

PROFILE SHEET FLYOVER			
Designer: JBK	Structure Numbers		
Detailer: MAB			
Sheet Subset: PROFILE	Subset Sheets: 6 of 11		

Project No./Code
ES6 0852-103
17679
Sheet Number 78

JJWieremа 4:10:03 PM M:\TRN\07-100-311-12\14679\Design\Drawings\roadway\14679_pRP-V706.dgn

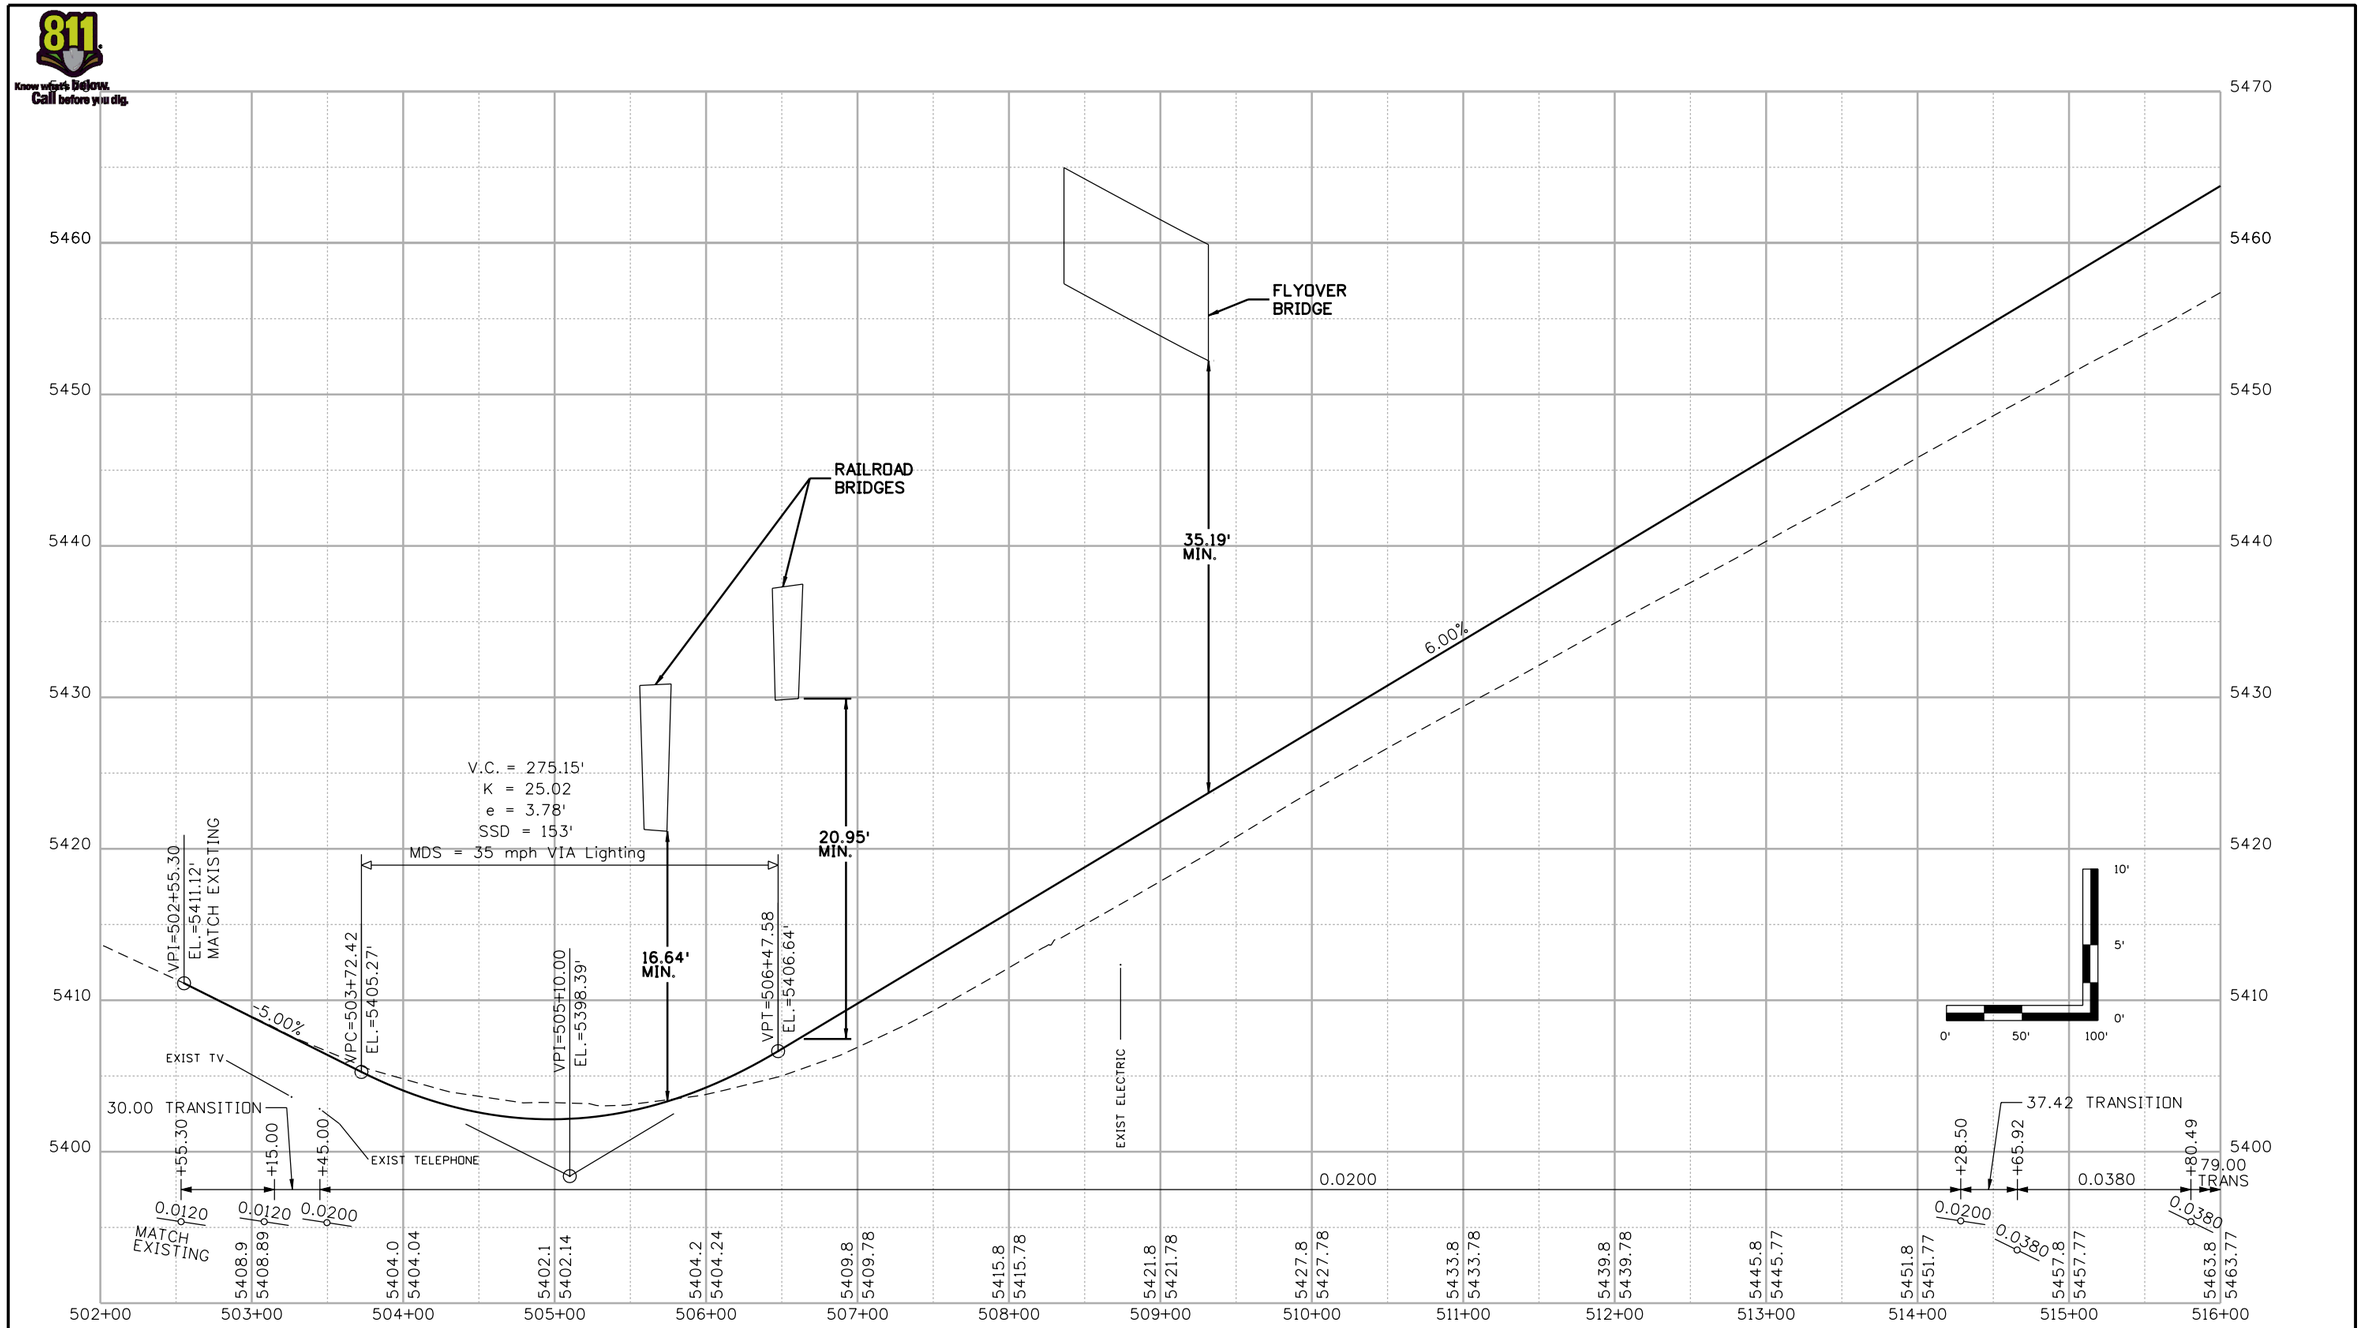

Print Date: 1/15/2010	Sheet Revisions	Colorado Department of Transportation	As Constructed
File Name: 14679_pRP-V401.dgn	Date: / Comments / Init.	8833 South Wadsworth Court Littleton, CO 80128 Phone: 303-972-9112 FAX: 303-972-9114	No Revisions:
Horiz. Scale: 1:100 Vert. Scale: As Noted		Region 6 RLB	Revised:
WILSON & COMPANY Engineers & Architects 999 18TH STREET, SUITE 2600 DENVER, CO 80202 PHONE: 303-297-2976 FAX: 303-297-2693			Void:

ROADWAY PROFILE
RAMP B

Designer: JBK
Detailer: JBK
Sheet Subset: PROFLIE
Structure Numbers
Subset Sheets: 7 of 11

Project No./Code
ES6 0852-103
17679
Sheet Number 79

JJWieremo 4:10:11 PM M:\TRN\07-100-311-12\14679\Design\Drawings\roadway\14679_pRP-V401.dgn

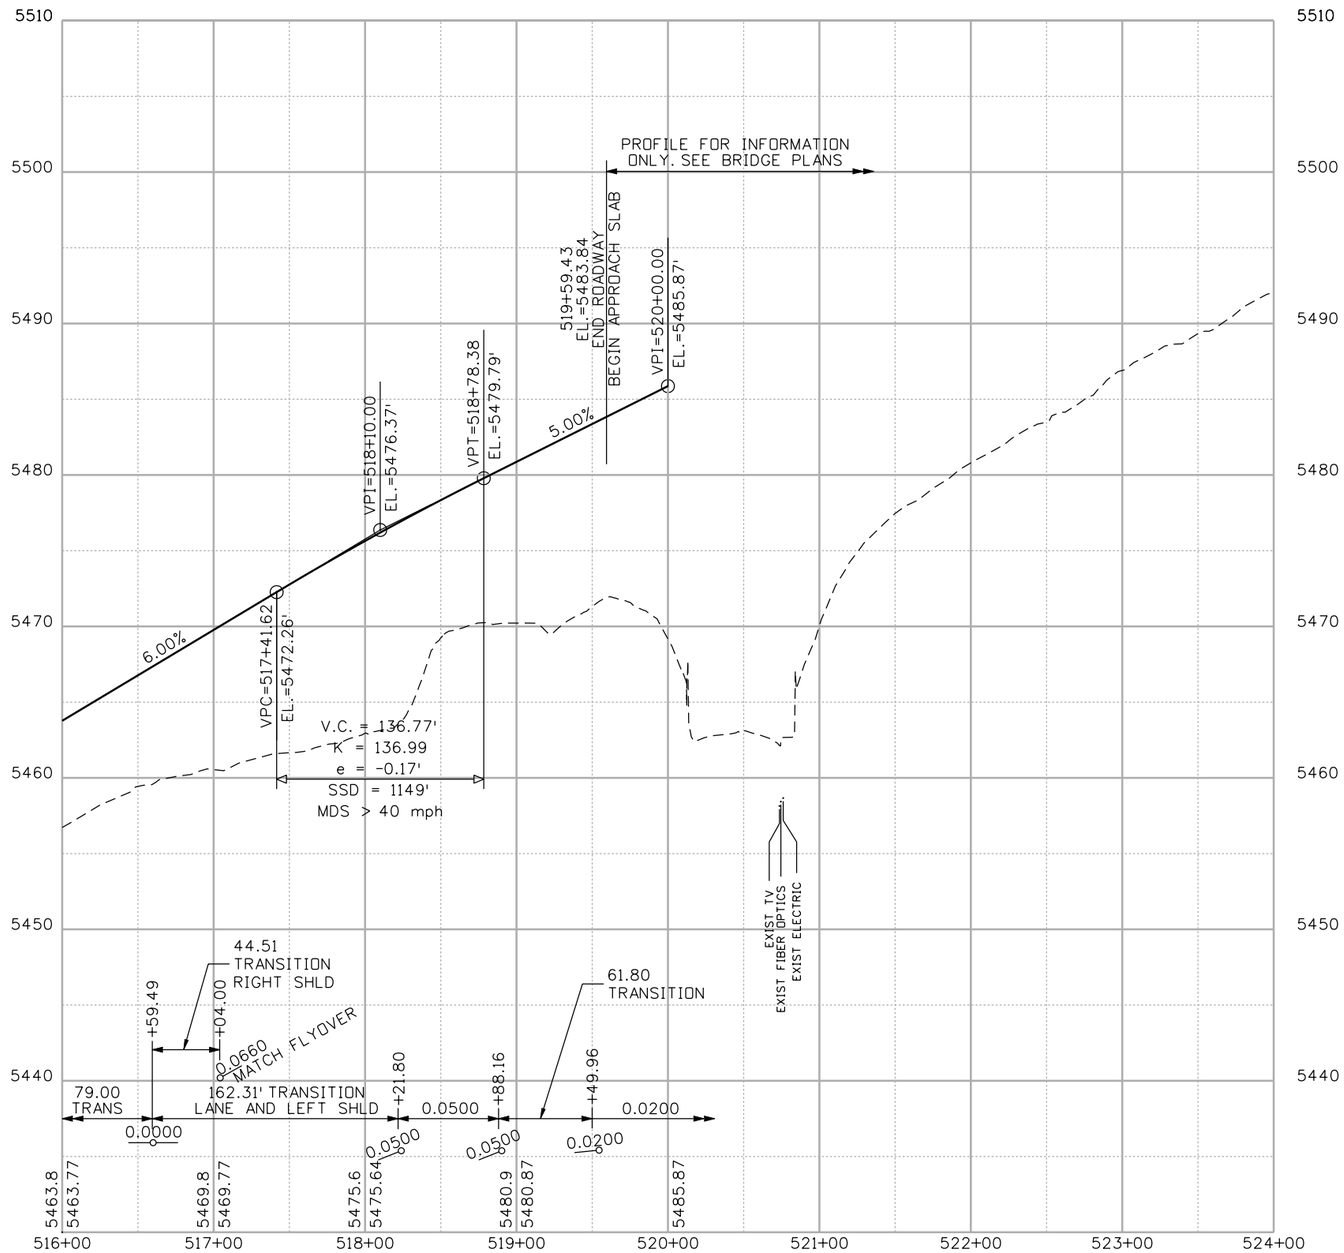

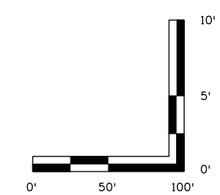

Print Date: 1/15/2010	Sheet Revisions	Colorado Department of Transportation	As Constructed
File Name: 14679_pRP-V402.dgn	Date: / Comments / Init.	8833 South Wadsworth Court Littleton, CO 80128 Phone: 303-972-9112 FAX: 303-972-9114	No Revisions:
Horiz. Scale: 1:100 Vert. Scale: As Noted		Region 6 RLB	Revised:
WILSON & COMPANY Engineers & Architects 999 18TH STREET, SUITE 2600 DENVER, CO 80202 PHONE: 303-297-2976 FAX: 303-297-2693			Void:

ROADWAY PROFILE
RAMP B

Designer:	JBK	Structure Numbers	
Detailer:	JBK		
Sheet Subset:	PROFLIE	Subset Sheets: 8 of 11	

Project No./Code
ES6 0852-103
17679
Sheet Number 80

JJWierema 4:10:19 PM M:\TRN\07-100-311-12\14679\Design\Drawings\roadway\14679_pRP-V402.dgn

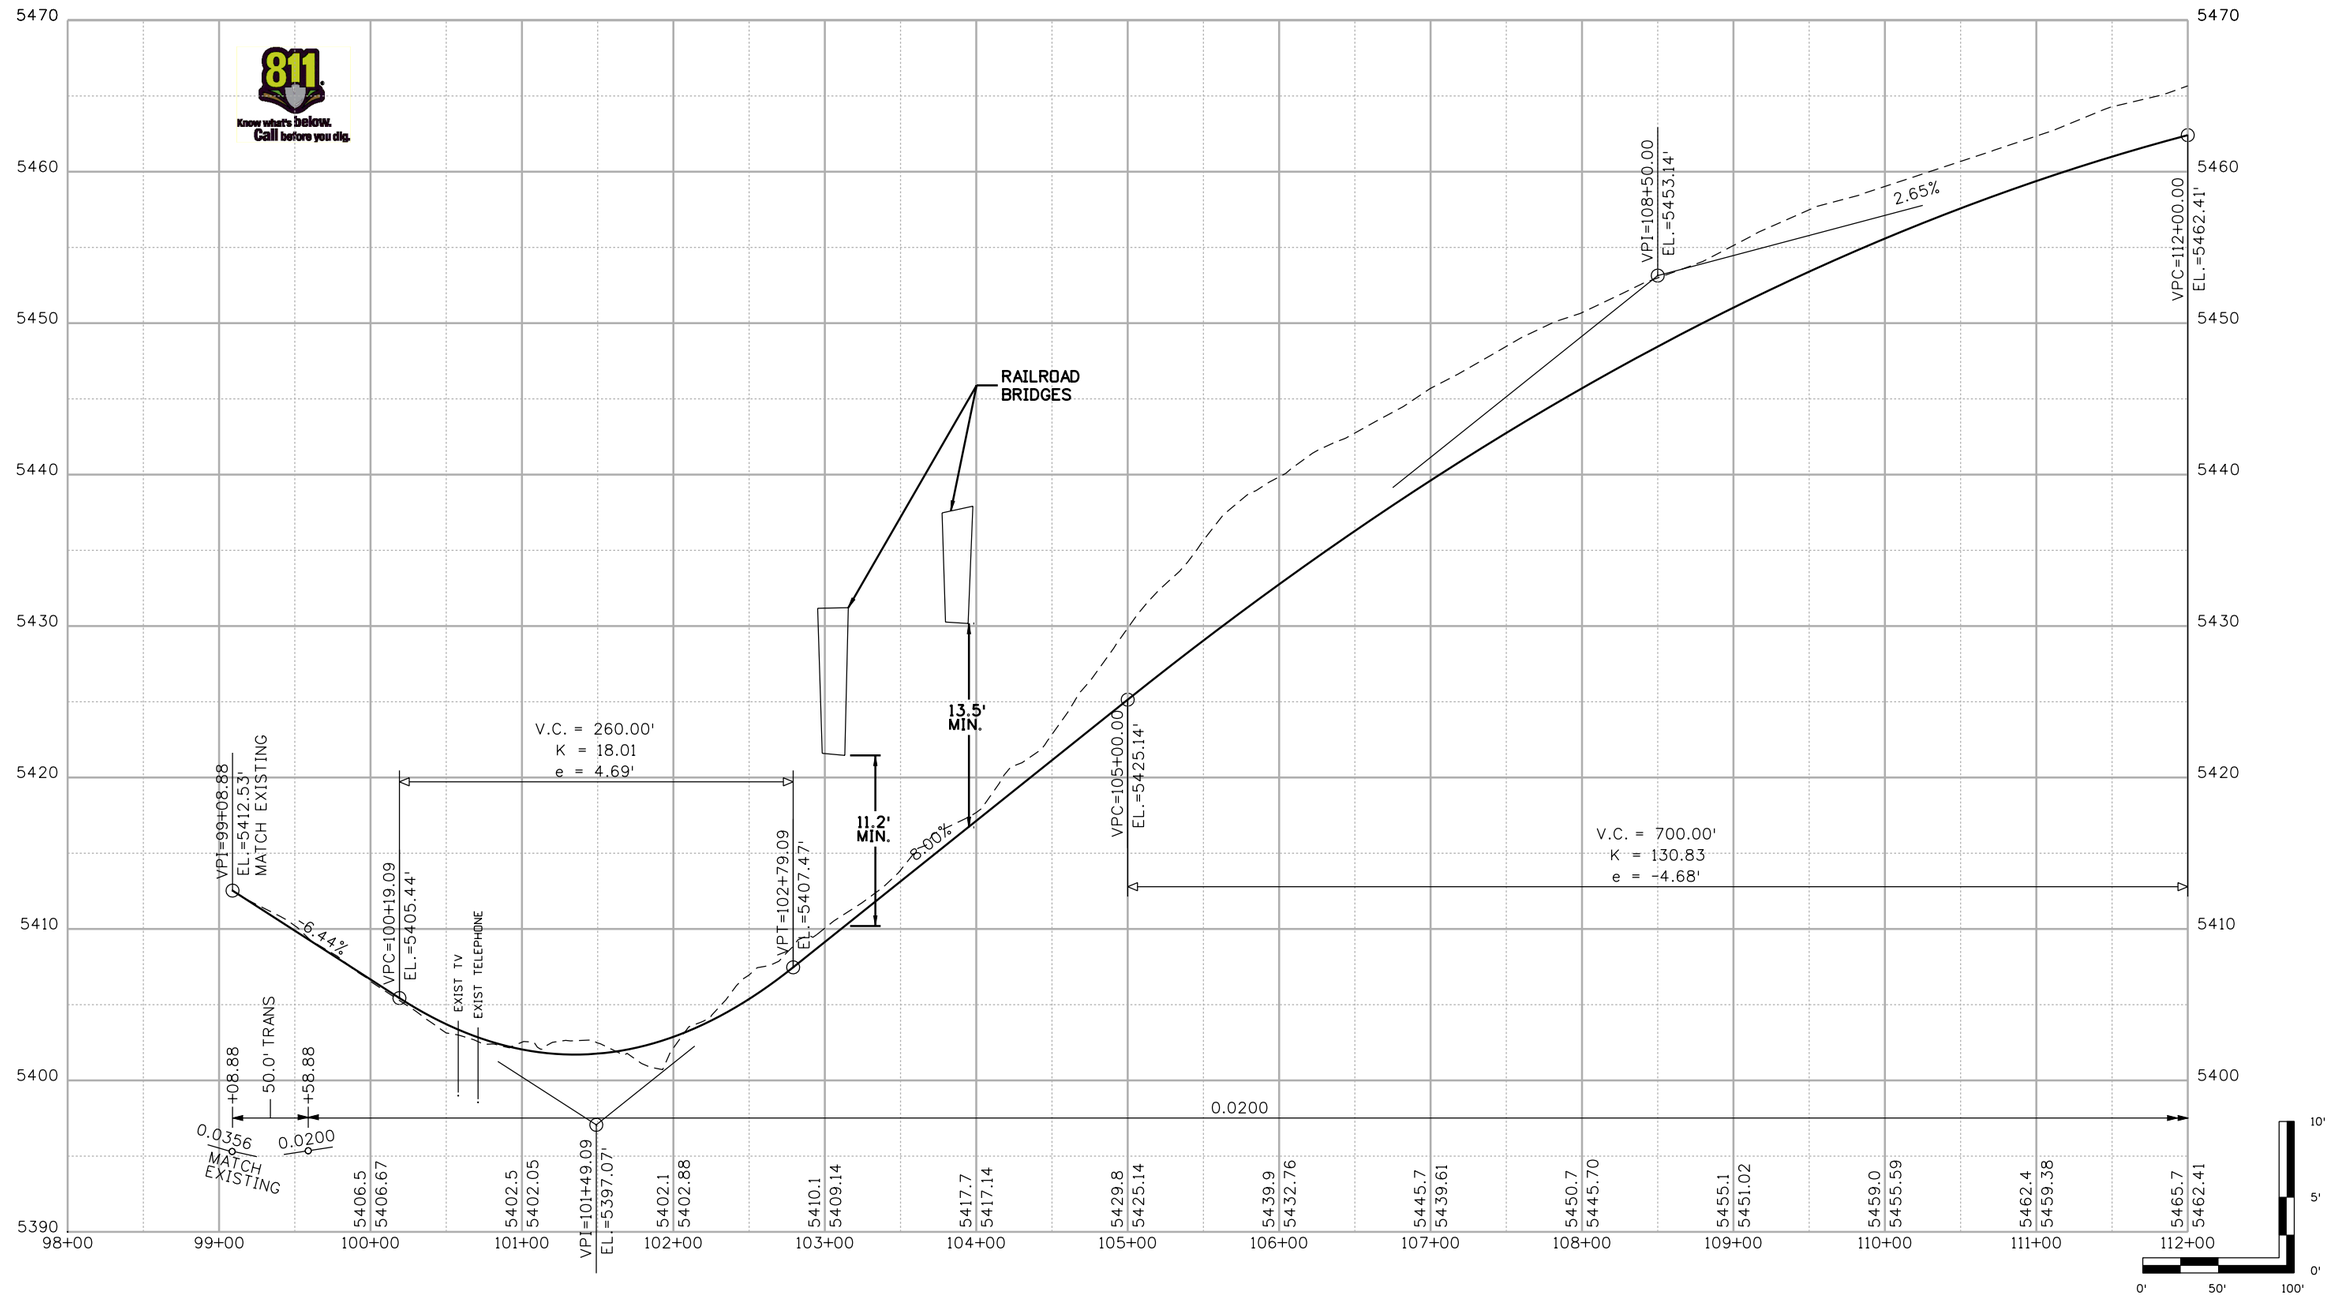

Print Date: 1/15/2010	Sheet Revisions	Colorado Department of Transportation	As Constructed
File Name: 14679_pRP-V801.dgn	Date: / Comments / Init.	8833 South Wadsworth Court Littleton, CO 80128 Phone: 303-972-9112 FAX: 303-972-9114	No Revisions:
Horiz. Scale: 1:100 Vert. Scale: As Noted		Region 6 RLB	Revised:
WILSON & COMPANY Engineers & Architects 999 18TH STREET, SUITE 2600 DENVER, CO 80202 PHONE: 303-297-2976 FAX: 303-297-2693			Void:

PROFILE SHEET
TRAIL

Designer:	JJW	Structure Numbers	
Detailer:	MAB		
Sheet Subset:	PROFILE	Subset Sheets: 9 of 11	

Project No./Code
ES6 0852-103
17679
Sheet Number 81

JJWieremo 4:10:27 PM M:\TRN\07-100-311-12\14679\Design\Drawings\roadway\14679_pRP-V801.dgn

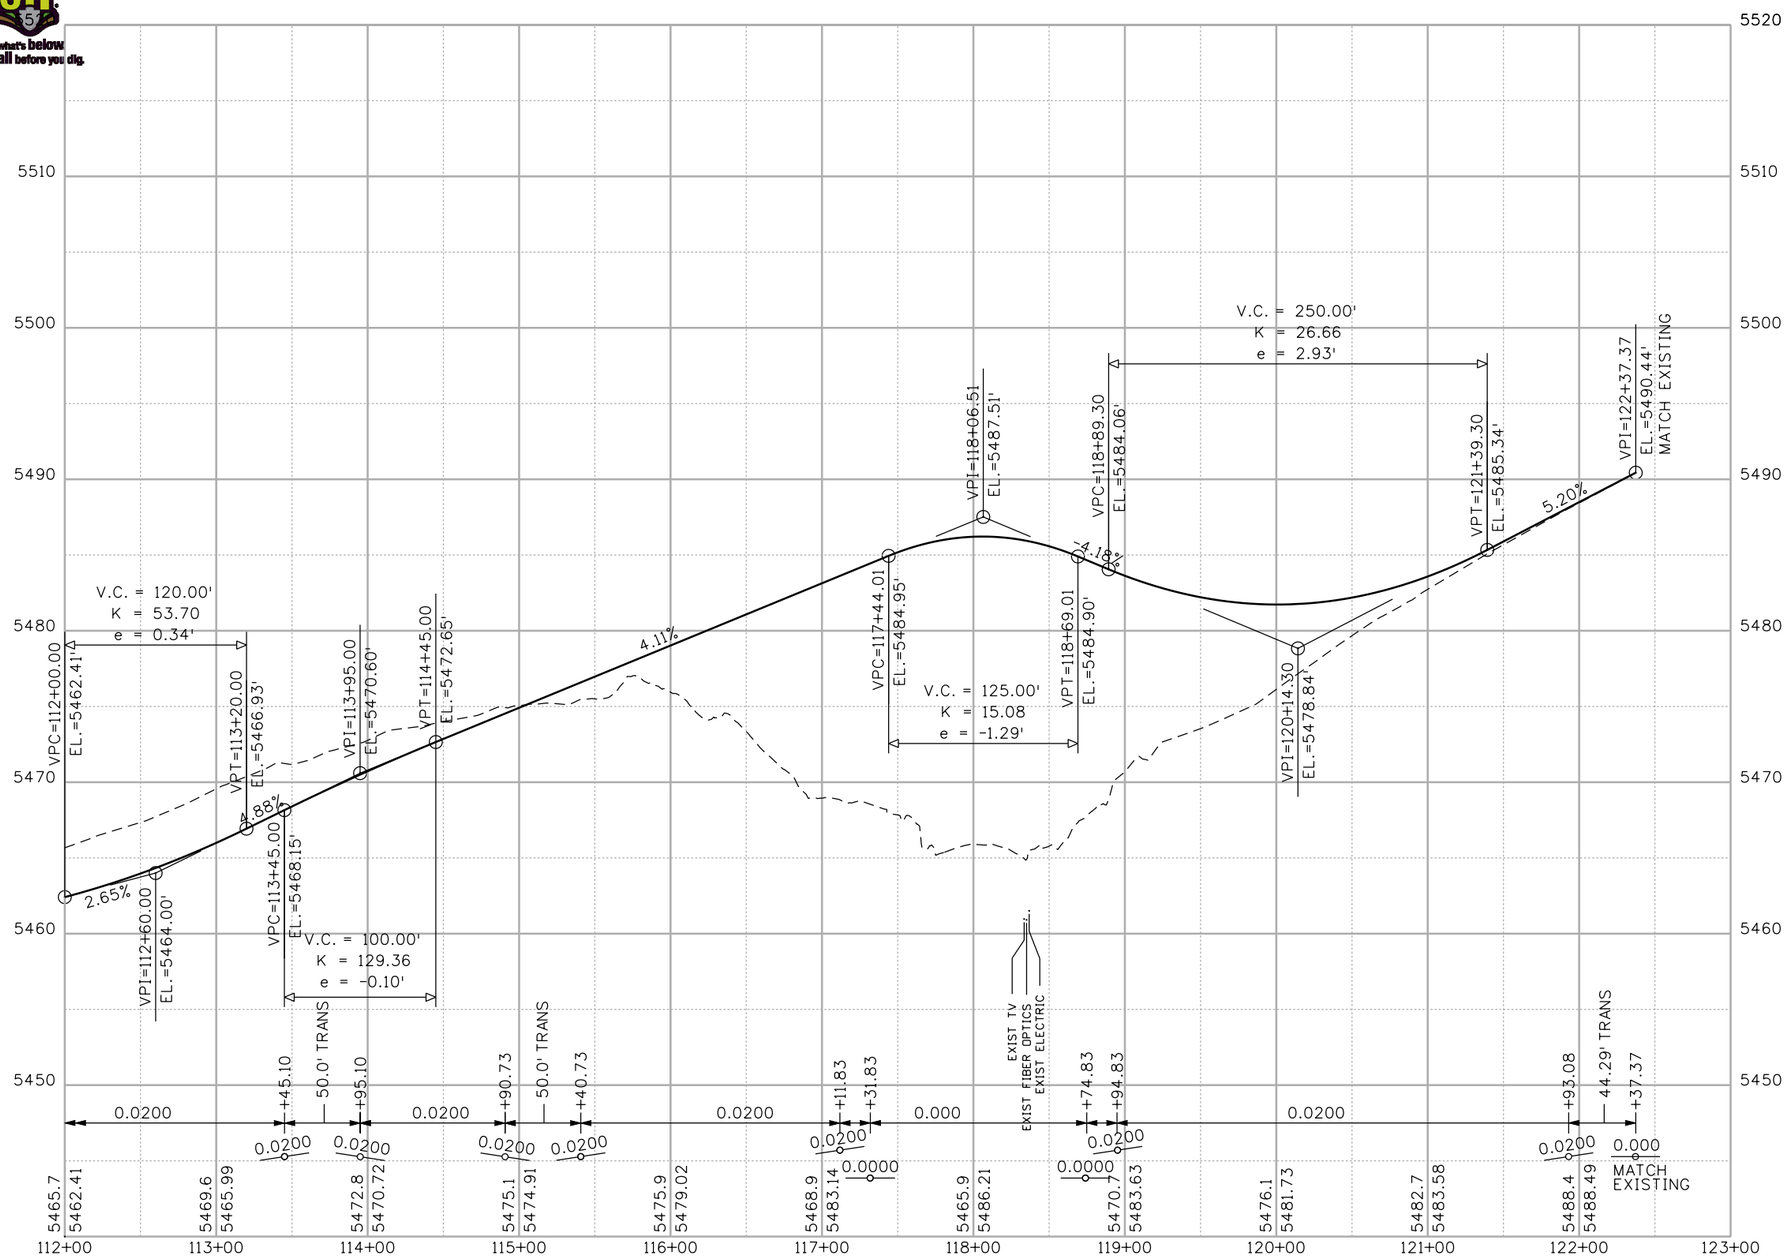

Print Date: 1/15/2010	Sheet Revisions	Colorado Department of Transportation	As Constructed
File Name: 14679_pRP-V802.dgn	Date: / Comments / Init.	8833 South Wadsworth Court Littleton, CO 80128 Phone: 303-972-9112 FAX: 303-972-9114	No Revisions:
Horiz. Scale: 1:100 Vert. Scale: As Noted		Region 6 RLB	Revised:
WILSON & COMPANY Engineers & Architects 999 16TH STREET, SUITE 2600 DENVER, CO 80202 PHONE: 303-297-2976 FAX: 303-297-2693			Void:

PROFILE SHEET
TRAIL

Designer: JJW
Detailer: JJW
Structure Numbers
Sheet Subset: PROFILE
Subset Sheets: 10 of 11

Project No./Code
ES6 0852-103
17679
Sheet Number 82

JJWierema 4:10:35 PM M:\TRN\07-100-311-12\14679\Design\Drawings\roadway\14679_pRP-V802.dgn

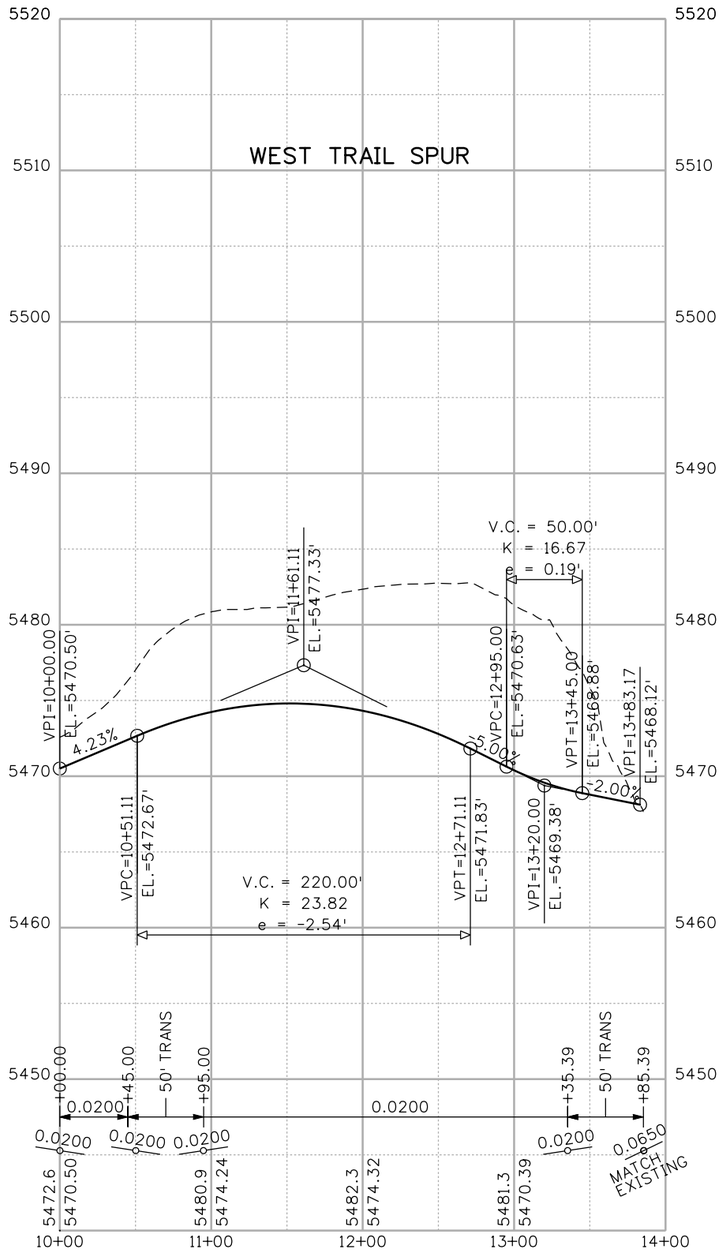

NOTE:
SEE M-608-1 FOR SLOPES OF CURB RAMPS. THESE PROFILES MATCH THE ELEVATION OF THE TOP OF CURB.

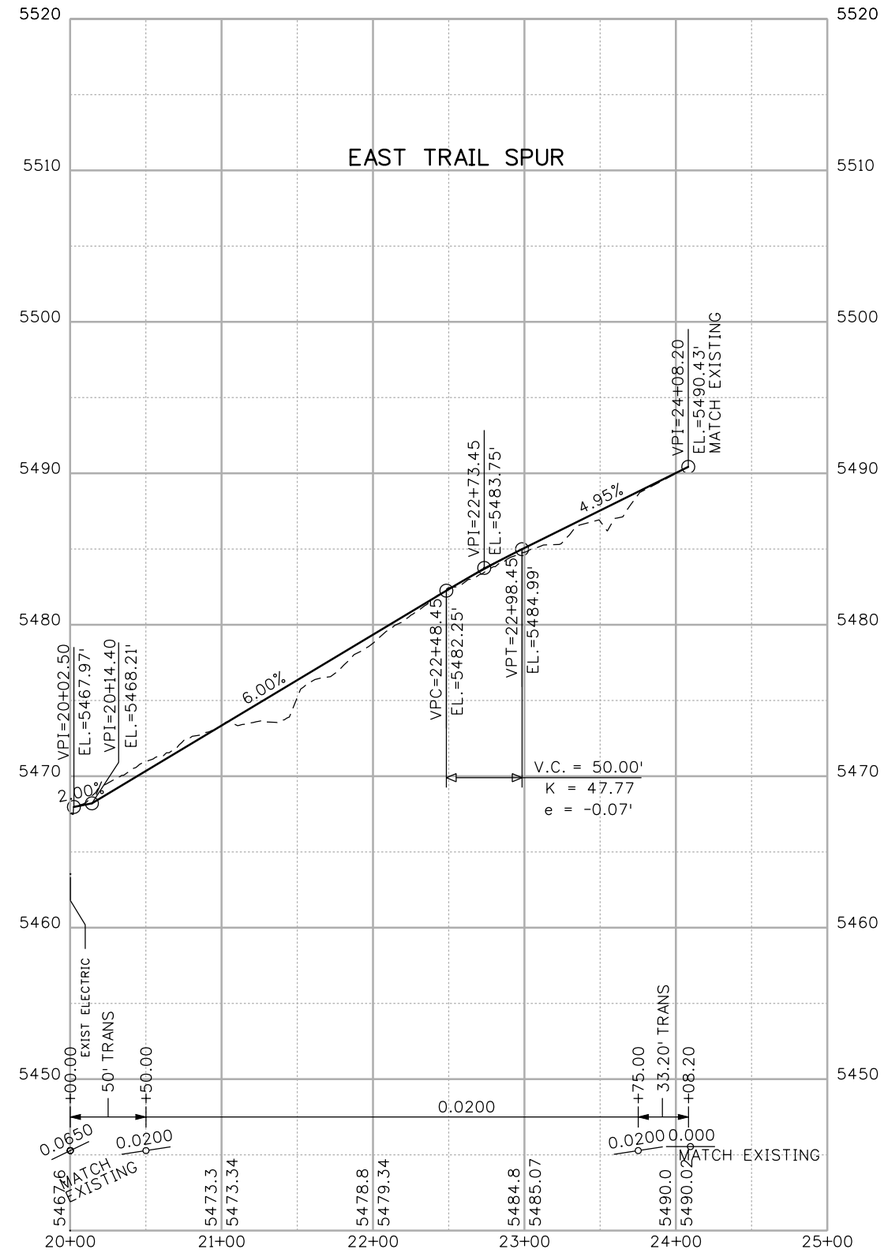

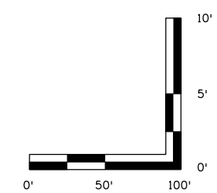

Print Date: 1/15/2010	Sheet Revisions	Colorado Department of Transportation	As Constructed
File Name: 14679_pRP-V803.dgn	Date: / Comments / Init.	8833 South Wadsworth Court, Littleton, CO 80128, Phone: 303-972-9112 FAX: 303-972-9114	No Revisions:
Horiz. Scale: 1:100 Vert. Scale: As Noted		Region 6 RLB	Revised:
WILSON & COMPANY Engineers & Architects, 999 16TH STREET, SUITE 2600, DENVER, CO 80202, PHONE: 303-297-2976, FAX: 303-297-2693			Void:

PROFILE SHEET
TRAIL SPURS

Designer:	JJW	Structure Numbers	
Detailer:	MAB		
Sheet Subset:	PROFILE	Subset Sheets: 11 of 11	

Project No./Code: ES6 0852-103
17679
Sheet Number 83

JJWierema 4:10:44 PM M:\TRN\07-100-311-12\14679\Design\Drawings\roadway\14679_pRP-V803.dgn