JBKeith 11:31:28 AM M:\TRN\07-100-311-12\14679\Design\Drawings\Signing & Striping\14679_pSN-PR700.dgn

Print Date: 1/15/2010
File Name: 14679_pSN-PR700.dgn
Horiz. Scale: 1:100 Vert. Scale: As Noted

WILSON & COMPANY Engineers & Architects
999 18TH STREET, SUITE 2800
DENVER, CO 80202
PHONE: 303-297-2976
FAX: 303-297-2693

Sheet Revisions		
Date:	Comments	Init.

Colorado Department of Transportation
DEPARTMENT OF TRANSPORTATION
8833 South Wadsworth Court
Littleton, CO 80128
Phone: 303-972-9112 FAX: 303-972-9114
Region 6 RLB

As Constructed
No Revisions:
Revised:
Void:

SIGNING PLAN
FLYOVER

Designer: SPW
Detailer: SPW
Sheet Subset: SIGNING
Structure Numbers: F-16-YP
Subset Sheets: 1 of 8

Project No./Code
ES6 0852-103
17679
Sheet Number 369

NOTE:
ALL EXISTING SIGNS TO REMAIN
UNLESS OTHERWISE NOTED.

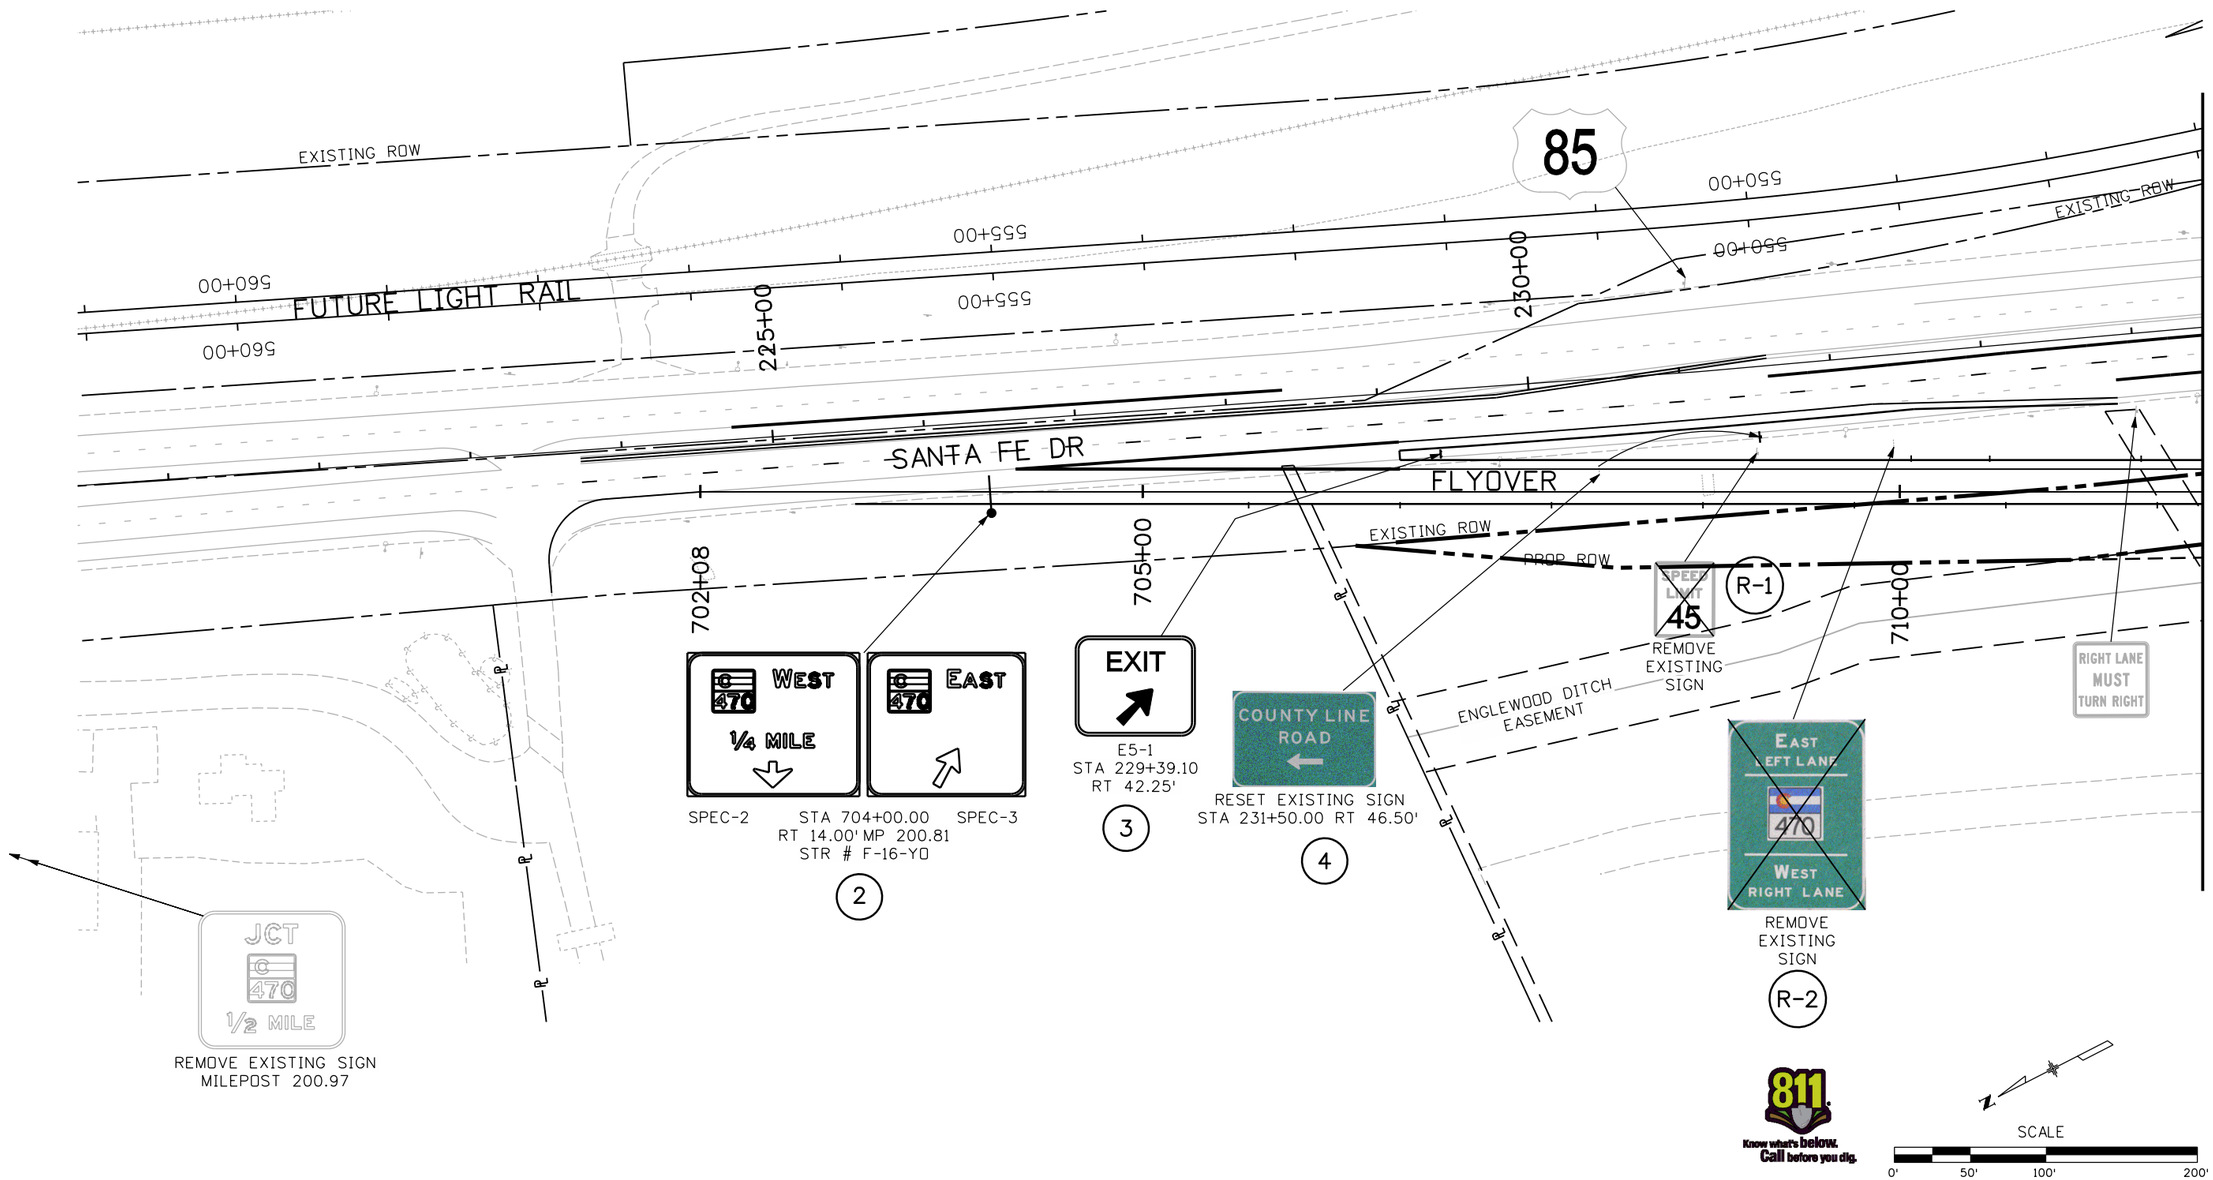

JBKeith 11:31:44 AM M:\TRN\07-100-311-12\14679\Design\Drawings\Signing & Striping\14679_pSN-PR701.dgn

Print Date: 1/15/2010	Sheet Revisions	Colorado Department of Transportation	As Constructed
File Name: 14679_pSN-PR701.dgn	Date: Comments Init.	8833 South Wadsworth Court Littleton, CO 80128 Phone: 303-972-9112 FAX: 303-972-9114	No Revisions:
Horiz. Scale: 1:100 Vert. Scale: As Noted		Region 6 RLB	Revised:
WILSON & COMPANY Engineers & Architects 999 18TH STREET, SUITE 2600 DENVER, CO 80202 PHONE: 303-297-2976 FAX: 303-297-2693			Void:

SIGNING PLAN FLYOVER			
Designer: SPW	Structure Numbers	F-16-YO	
Detailer: SPW			
Sheet Subset: SIGNING	Subset Sheets: 2 of 8		

Project No./Code	
ES6 0852-103	
17679	
Sheet Number	370

NOTE:
ALL EXISTING SIGNS TO REMAIN
UNLESS OTHERWISE NOTED.

MATCH LINE STA 726+00

MATCH LINE STA 712+00

MATCH LINE STA 247+50

SANTA FE DRIVE

FLYOVER

COUNTY LINE RD

FUTURE LIGHT RAIL

RAMP C

RAMP D

EXISTING ROW

PROP ROW

ENGLEWOOD DITCH EASEMENT

235+00

240+00

245+00

540+00

545+00

715+00

720+00

725+00

RIGHT LANE MUST TURN RIGHT

ON MAST ARM

ONLY

ON MAST ARM

ON SPAN WIRE

SOUTH 85 NORTH 85

WEST 470

EAST 470

DO NOT ENTER

DO NOT BLOCK INTERSECTION

YIELD

ONE WAY

COUNTY LINE ROAD

City of Littleton

The Ride

EAST LEFT LANE 470 WEST

US ARMY CORPS OF ENGINEERS CHATFIELD DAM

RESET SIGN
STA 244+24.43
RT 68.26

RESET SIGN
STA 245+26.50
RT 68.50

MODIFY & RELOCATE SIGN

R3-5L MOUNT ON SPAN WIRE

WHEN FLASHING

5

6

7

8

811 Know what's below. Call before you dig.

SCALE
0' 50' 100' 200'

Print Date: 1/15/2010	Sheet Revisions		
File Name: 14679_pSN-PR702.dgn	Date:	Comments	Init.
Horiz. Scale: 1:100 Vert. Scale: As Noted			

WILSON & COMPANY Engineers & Architects
999 18TH STREET, SUITE 2600
DENVER, CO 80202
PHONE: 303-297-2976
FAX: 303-297-2693

0000

Colorado Department of Transportation
DOT DEPARTMENT OF TRANSPORTATION
8833 South Wadsworth Court
Littleton, CO 80128
Phone: 303-972-9112 FAX: 303-972-9114
Region 6 RLB

As Constructed
No Revisions:
Revised:
Void:

SIGNING PLAN
SANTA FE

Designer:	SPW	Structure Numbers	
Detailer:	SPW		
Sheet Subset:	SIGNING	Subset Sheets:	3 of 8

Project No./Code
ES6 0852-103
17679
Sheet Number 371

JBKeith 11:32:02 AM M:\TRN\07-100-311-12\14679\Design\Drawings\Signing & Striping\14679_pSN-PR702.dgn

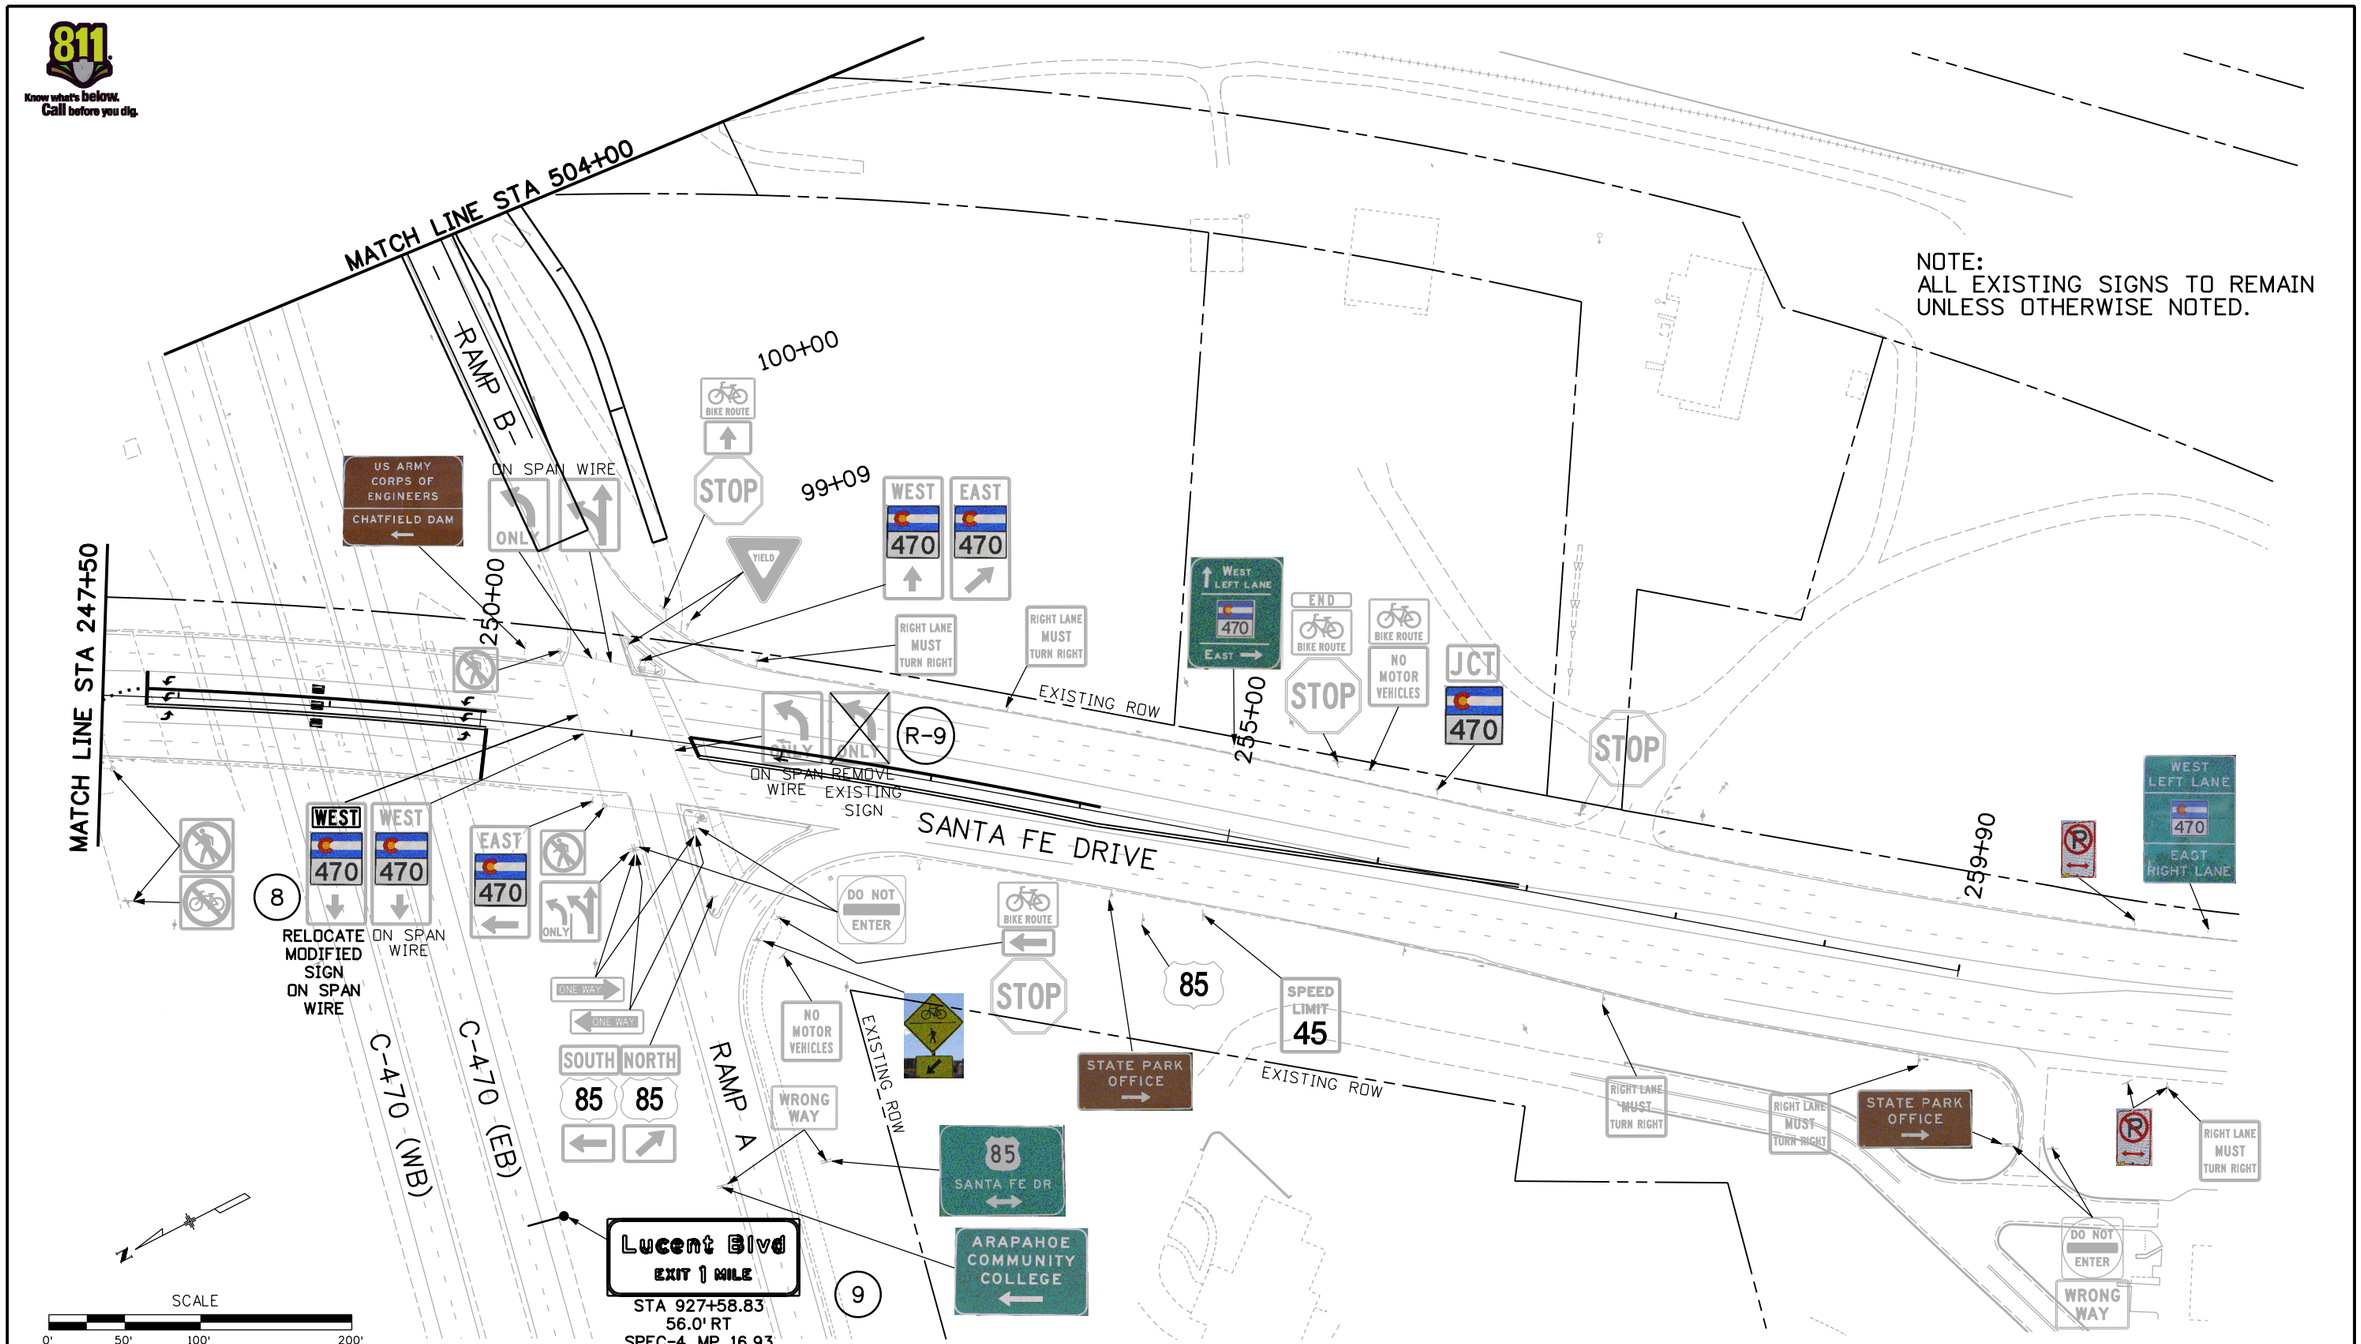

NOTE:
ALL EXISTING SIGNS TO REMAIN UNLESS OTHERWISE NOTED.

Know what's below. Call before you dig.

JBKeith 11:32:21 AM M:\TRN\07-100-311-12\14679\Design\Drawings\Signing & Striping\14679_pSN-PR401.dgn

Print Date: 1/15/2010	0000	Sheet Revisions			Colorado Department of Transportation
File Name: 14679_pSN-PR401.dgn		Date:	Comments	Init.	8833 South Wadsworth Court Littleton, CO 80128 Phone: 303-972-9112 FAX: 303-972-9114
Horiz. Scale: 1:100 Vert. Scale: As Noted					Region 6 RLB
WILSON & COMPANY Engineers & Architects 999 16TH STREET, SUITE 2600 DENVER, CO 80202 PHONE: 303-297-2976 FAX: 303-297-2993					

As Constructed	SIGNING PLAN SANTA FE/RAMP B			Project No./Code
No Revisions:	Designer: SPW	Structure Numbers	F-16-YL	ES6 0852-103
Revised:	Detailer: SPW			17679
Void:	Sheet Subset: SIGNING	Subset Sheets: 4 of 8		Sheet Number 372

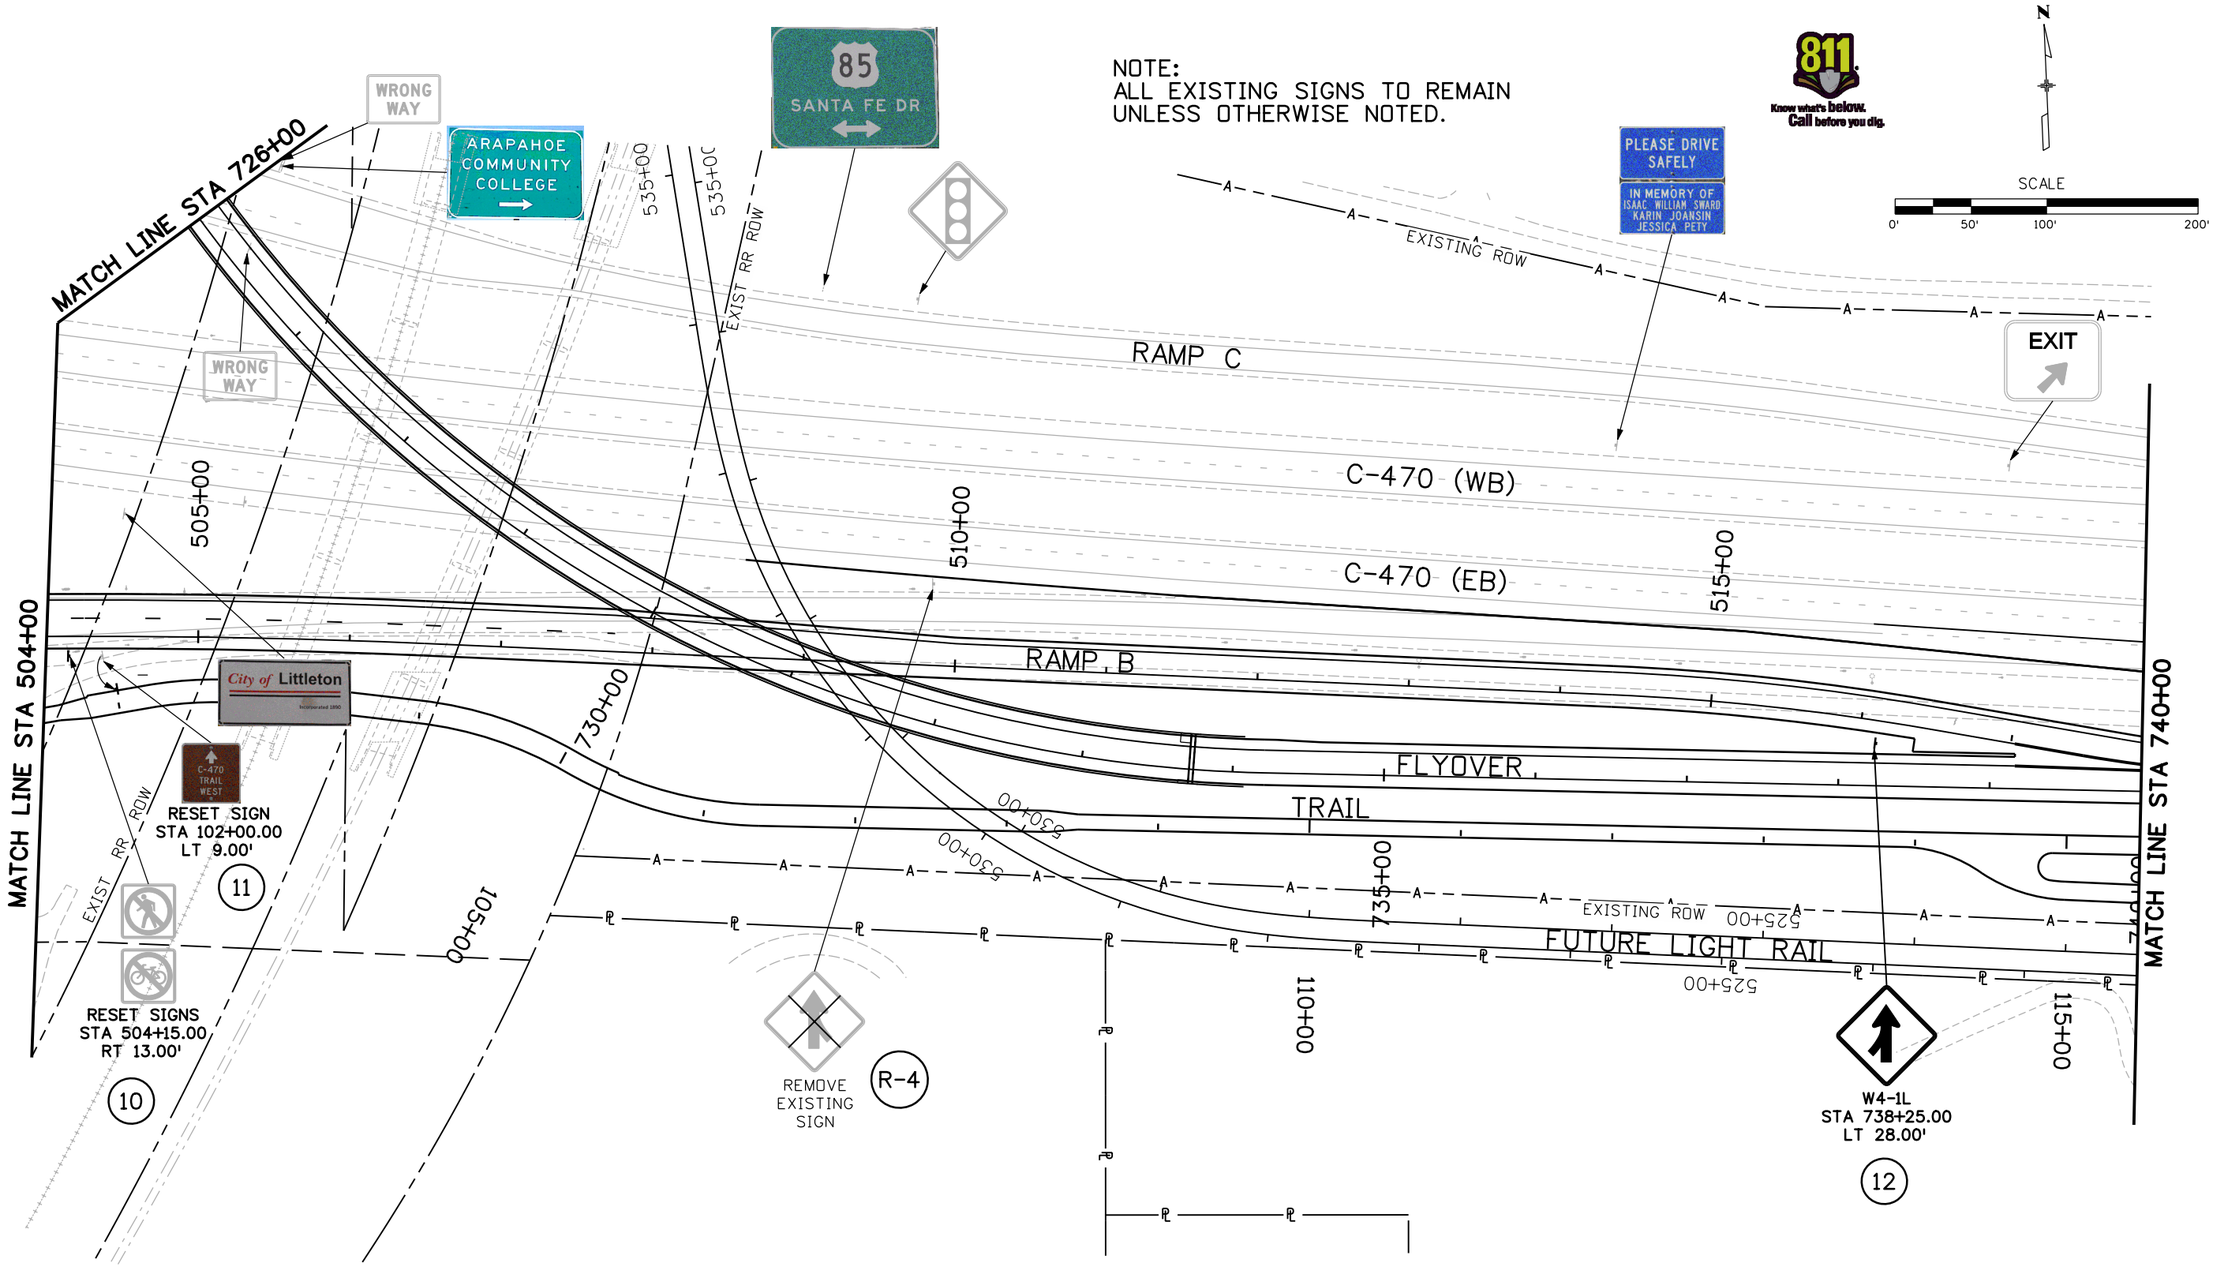

Print Date: 1/15/2010	Sheet Revisions	Colorado Department of Transportation	As Constructed
File Name: 14679_pSN-PR703.dgn	Date: Comments Init.	8833 South Wadsworth Court Littleton, CO 80128 Phone: 303-972-9112 FAX: 303-972-9114	No Revisions:
Horiz. Scale: 1:100 Vert. Scale: As Noted		Region 6 RLB	Revised:
WILSON & COMPANY Engineers & Architects 999 18TH STREET, SUITE 2800 DENVER, CO 80202 PHONE: 303-297-2976 FAX: 303-297-2693			Void:

SIGNING PLAN FLYOVER			Project No./Code
Designer: SPW	Structure Numbers		ES6 0852-103
Detailer: SPW			17679
Sheet Subset: SIGNING	Subset Sheets: 5 of 8		Sheet Number 373

JBKeith 11:32:42 AM M:\TRN\07-100-311-12\14679\Design\Drawings\Signing & Striping\14679_pSN-PR703.dgn

NOTE:
ALL EXISTING SIGNS TO REMAIN
UNLESS OTHERWISE NOTED.

N

SCALE
0' 50' 100' 200'

Know what's below. Call before you dig. 811

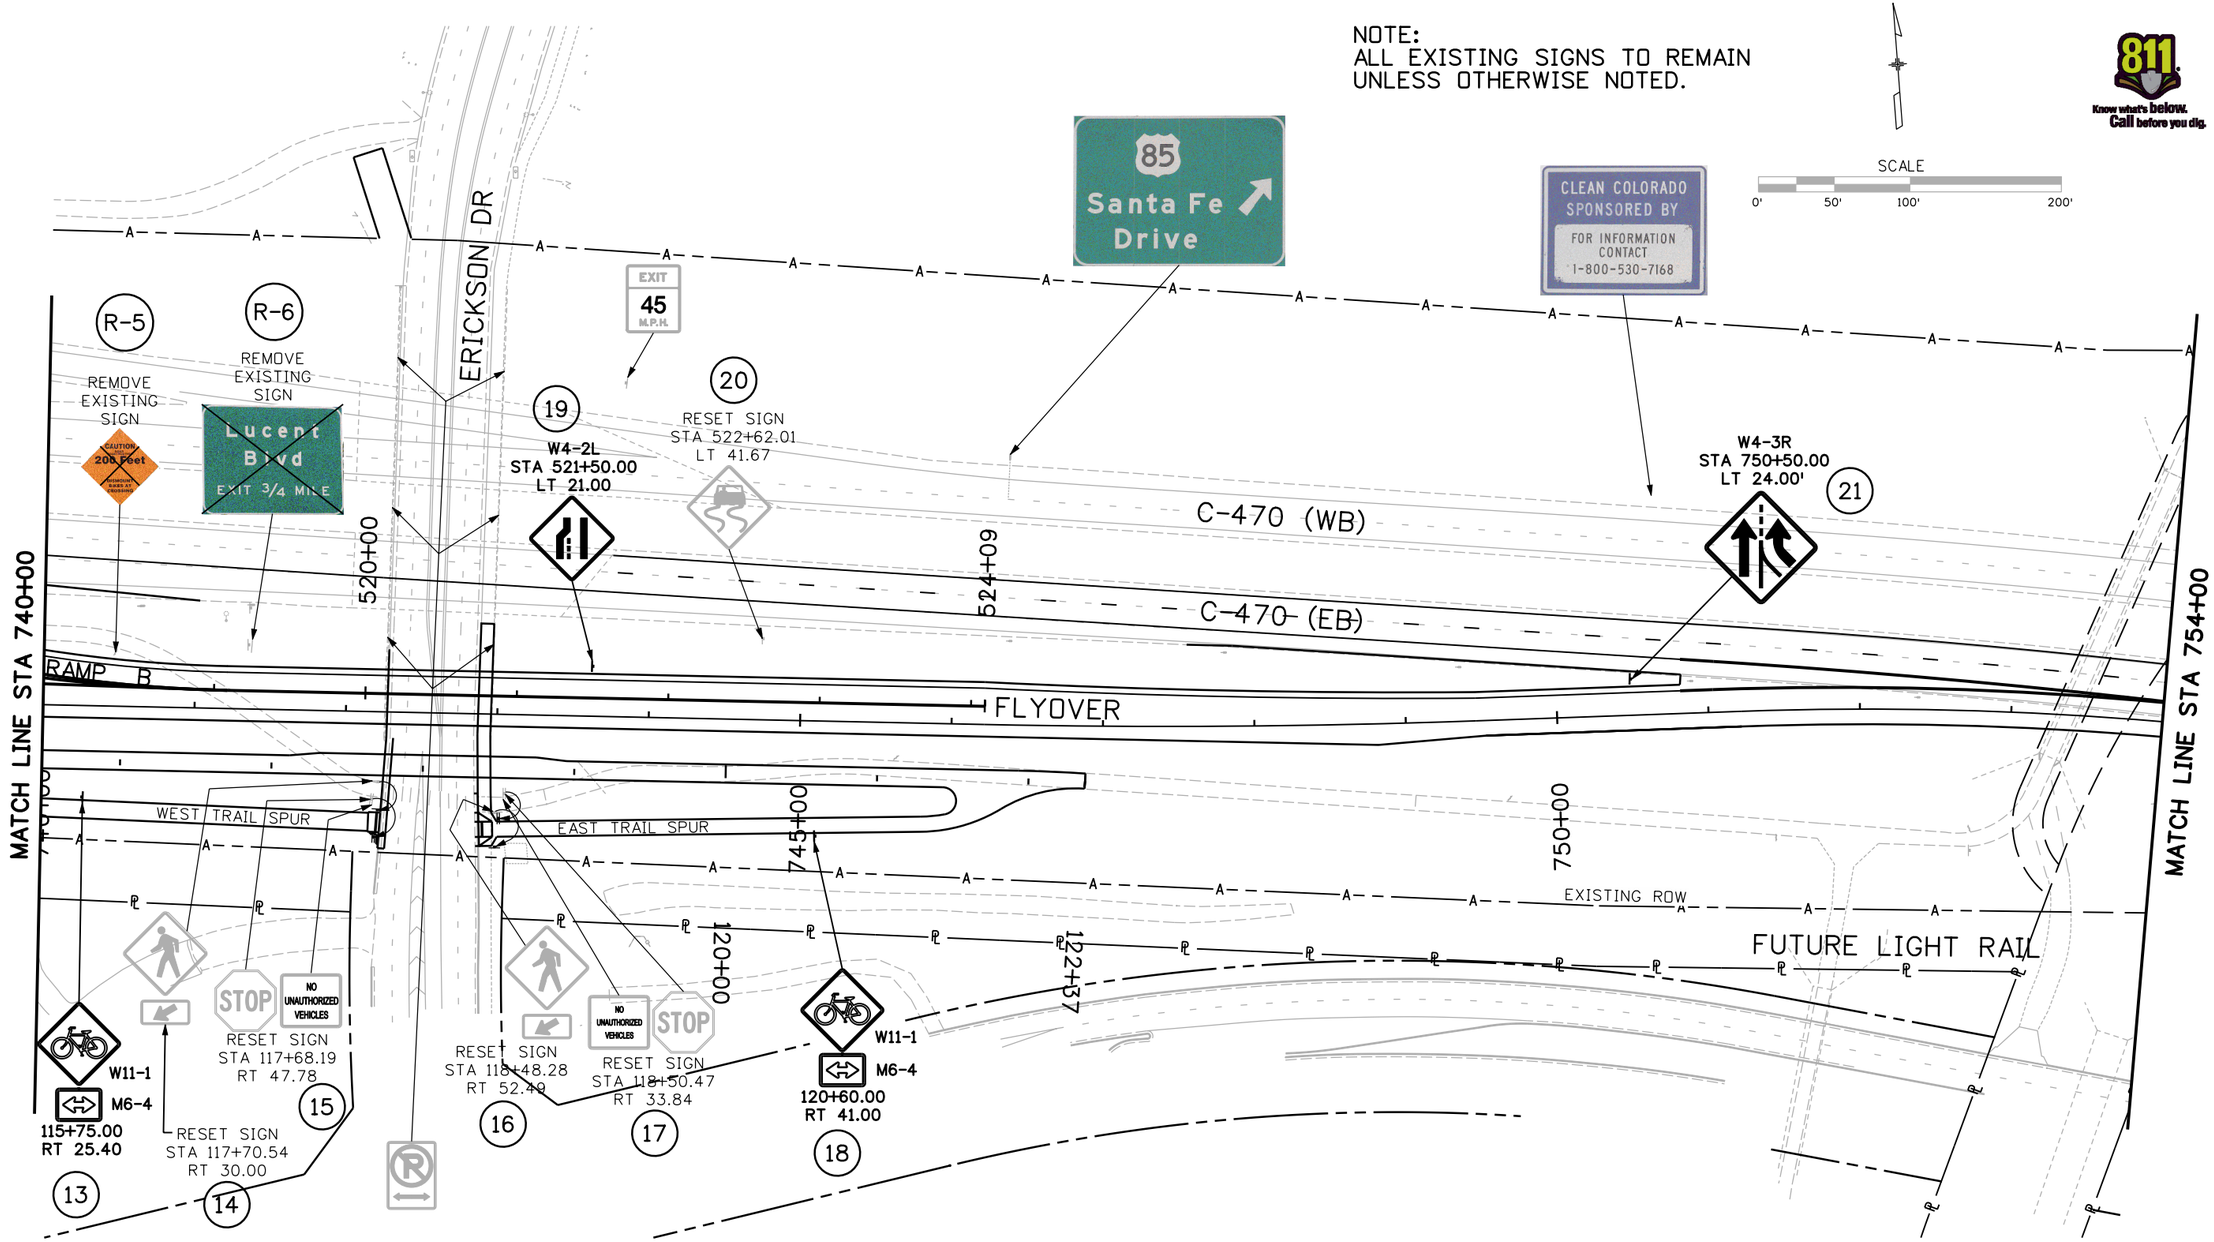

Print Date: 1/15/2010	Sheet Revisions		
File Name: 14679_pSN-PR704.dgn	Date:	Comments	Init.
Horiz. Scale: 1:100 Vert. Scale: As Noted			

WILSON & COMPANY Engineers & Architects
999 18TH STREET, SUITE 2800
DENVER, CO 80202
PHONE: 303-297-2976
FAX: 303-297-2693

Colorado Department of Transportation
DEPARTMENT OF TRANSPORTATION
8833 South Wadsworth Court
Littleton, CO 80128
Phone: 303-972-9112 FAX: 303-972-9114
Region 6 RLB

As Constructed	
No Revisions:	
Revised:	
Void:	

SIGNING PLAN
FLYOVER

Designer:	SPW	Structure Numbers	
Detailer:	SPW		
Sheet Subset:	SIGNING	Subset Sheets:	6 of 8

Project No./Code	
ES6 0852-103	
17679	
Sheet Number	374

JBKeith 11:32:51 AM M:\TRN\07-100-311-12\14679\Design\Drawings\Signing & Striping\14679_pSN-PR704.dgn

NOTE:
ALL EXISTING SIGNS TO REMAIN
UNLESS OTHERWISE NOTED.

HIGHLINE CANAL

EXISTING ROW

City of Littleton

Santa Fe Drive 1/4
Platte Canyon Rd 2
Wadsworth Blvd 3

C-470 (WB)

C-470 (EB)

MATCH LINE STA 754+00

755+00

760+00

765+00

MATCH LINE STA 768+00

R-7

REMOVE EXISTING SIGN

Lucent Blvd 1/2
Broadway 1 3/4
University Blvd 3

EXISTING ROW

FUTURE LIGHT RAIL

EXISTING ROW

SPEED LIMIT 65

RESET SIGN
STA 763+75.00
RT 12.00'

24

EAST
470

23

RESET SIGN
STA 754+26.81
RT 15.56

22

Lucent Blvd
1/2 MILE
EXIT ONLY

STA 755+00.00
RT 16.00
SPEC-5 MP 17.6
STR # F-16-YM

N

SCALE
0' 50' 100' 200'

811 Know what's below. Call before you dig.

JBKeith 11:33:00 AM M:\TRN\07-100-311-12\14679\Design\Drawings\Signing & Striping\14679_pSN-PR705.dgn

Print Date: 1/15/2010
File Name: 14679_pSN-PR705.dgn
Horiz. Scale: 1:100 Vert. Scale: As Noted

WILSON & COMPANY Engineers & Architects
999 18TH STREET, SUITE 2800
DENVER, CO 80202
PHONE: 303-297-2976
FAX: 303-297-2693

Sheet Revisions

Date:	Comments	Init.

Colorado Department of Transportation
DOT DEPARTMENT OF TRANSPORTATION
8833 South Wadsworth Court
Littleton, CO 80128
Phone: 303-972-9112 FAX: 303-972-9114
Region 6 RLB

As Constructed
No Revisions:
Revised:
Void:

SIGNING PLAN
FLYOVER

Designer: SPW
Detailer: SPW
Sheet Subset: SIGNING
Structure Numbers: F-16-YM
Subset Sheets: 7 of 8

Project No./Code
ES6 0852-103
17679
Sheet Number 375

NOTE:
ALL EXISTING SIGNS TO REMAIN
UNLESS OTHERWISE NOTED.

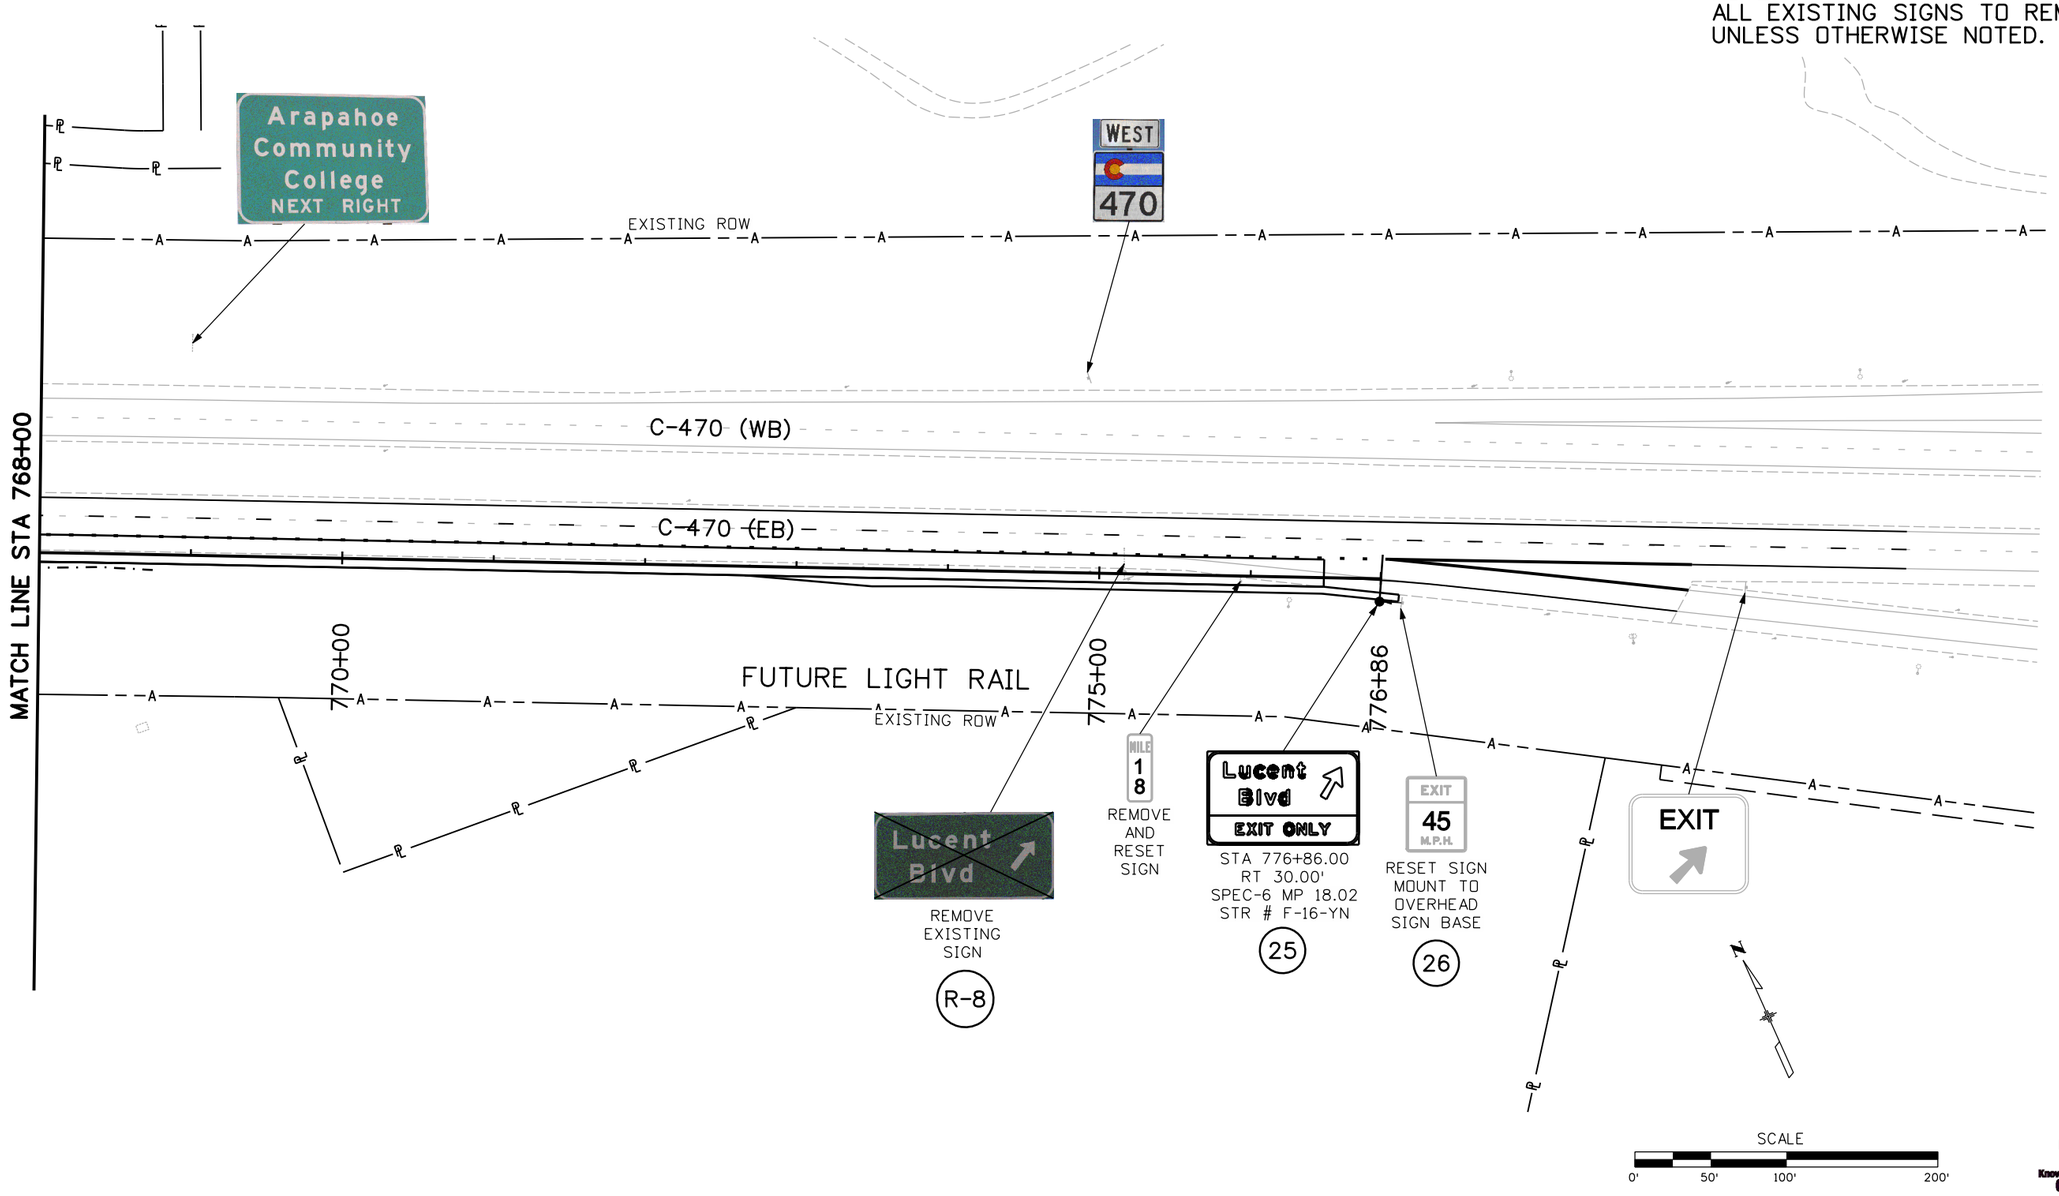

Print Date: 1/15/2010		Sheet Revisions			Colorado Department of Transportation	As Constructed	SIGNING PLAN FLYOVER		Project No./Code
File Name: 14679_pSN-PR706.dgn		Date:	Comments	Init.	8833 South Wadsworth Court Littleton, CO 80128 Phone: 303-972-9112 FAX: 303-972-9114	No Revisions:			ES6 0852-103
Horiz. Scale: 1:100 Vert. Scale: As Noted					Region 6 RLB	Revised:	Designer: SPW	Structure Numbers: F-16-YN	17679
WILSON & COMPANY Engineers & Architects 999 18TH STREET, SUITE 2600 DENVER, CO 80202 PHONE: 303-297-2976 FAX: 303-297-2693	0000					Void:	Detailer: SPW		Sheet Number 376
							Sheet Subset: SIGNING	Subset Sheets: 8 of 8	

JBKeith 11:33:11 AM M:\TRN\07-100-311-12\14679\Design\Drawings\Signing & Striping\14679_pSN-PR706.dgn