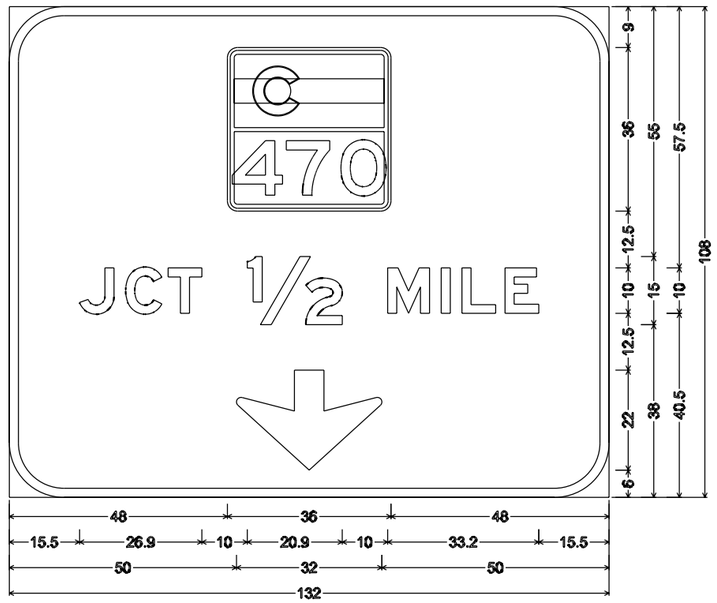

12.0" Radius, 2.0" Border, White on Green;
"JCT ½ MILE" E Mod; Down Arrow AR-C1 - 22.0" 270°;
Table of distances between letter and object lefts.

48.0	36.0	48.0							
15.5	J 10.1	C 9.4	T 17.4	½ 30.9	M 11.8	I 4.5	L 9.5	E 7.4	15.5
50.0	32.0	50.0							

Print Date: 1/15/2010	Sheet Revisions			Colorado Department of Transportation	As Constructed
File Name: 14679_detsign04.dgn	Date:	Comments	Init.	8833 South Wadsworth Court Littleton, CO 80128 Phone: 303-972-9112 FAX: 303-972-9114	No Revisions:
Horiz. Scale: 1:10 Vert. Scale: As Noted				Region 6 RLB	Revised:
WILSON & COMPANY Engineers & Architects 999 18TH STREET, SUITE 2800 DENVER, CO 80202 PHONE: 303-297-2976 FAX: 303-297-2693					Void:

OVERHEAD SIGN DETAILS SPEC-1			Project No./Code
			ES6 0852-103
Designer: JCK	Structure Numbers		17679
Detailer: MJB			
Sheet Subset: SIGN DET	Subset Sheets: 1 of 6		Sheet Number 377

JBKeith 4:32:53 PM M:\TRN\07-100-311-12\14679\Design\Drawings\Signing & Striping\14679_detsign04.dgn

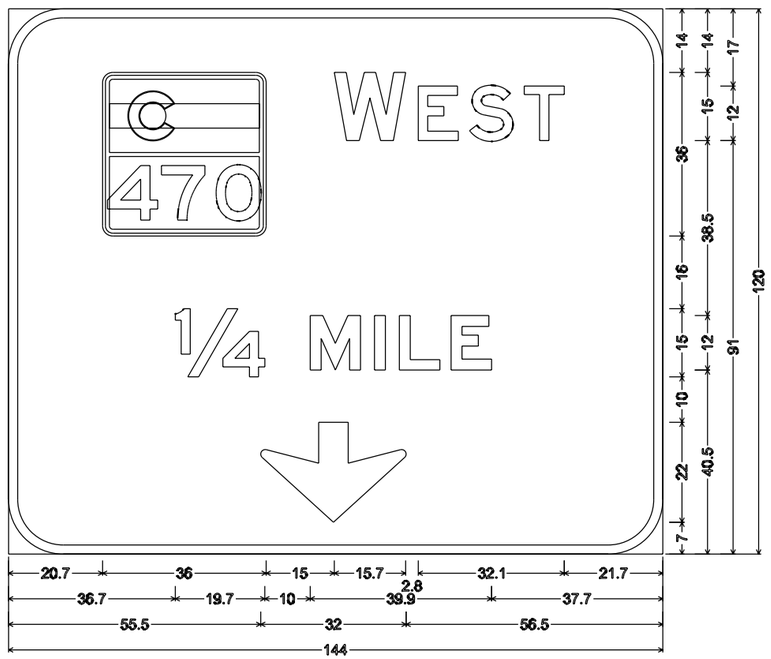

E6-1/OVERHEAD/SIDEROAD/1 LINE; 12.0" Radius, 2.0" Border, White on Green;
"WEST" E; "¼ MILE" E Mod; Down Arrow C - 22.0" 270°;
Table of distances between letter and object lefts.

20.7	W 51.0	W 18.5	E 11.3	S 12.0	T 8.8	21.7
36.7	¼ 29.7	M 14.1	I 5.5	L 11.4	E 8.9	37.7
55.5	⇩ 32.0	56.5				

Print Date: 1/15/2010	Sheet Revisions			Colorado Department of Transportation	As Constructed
File Name: 14679_detsign05.dgn	Date:	Comments	Init.	8833 South Wadsworth Court Littleton, CO 80128 Phone: 303-972-9112 FAX: 303-972-9114	No Revisions:
Horiz. Scale: 1:10 Vert. Scale: As Noted				Region 6 RLB	Revised:
WILSON & COMPANY Engineers & Architects 999 18TH STREET, SUITE 2600 DENVER, CO 80202 PHONE: 303-297-2976 FAX: 303-297-2693					Void:

OVERHEAD SIGN DETAILS SPEC-2			Project No./Code
			ES6 0852-103
Designer: JCK	Structure Numbers		17679
Detailer: MJB			
Sheet Subset: SIGN DET	Subset Sheets: 2 of 6		Sheet Number 378

JBKeith 4:35:28 PM M:\TRN\07-100-311-12\14679\Design\Drawings\Signing & Striping\14679_detsign05.dgn

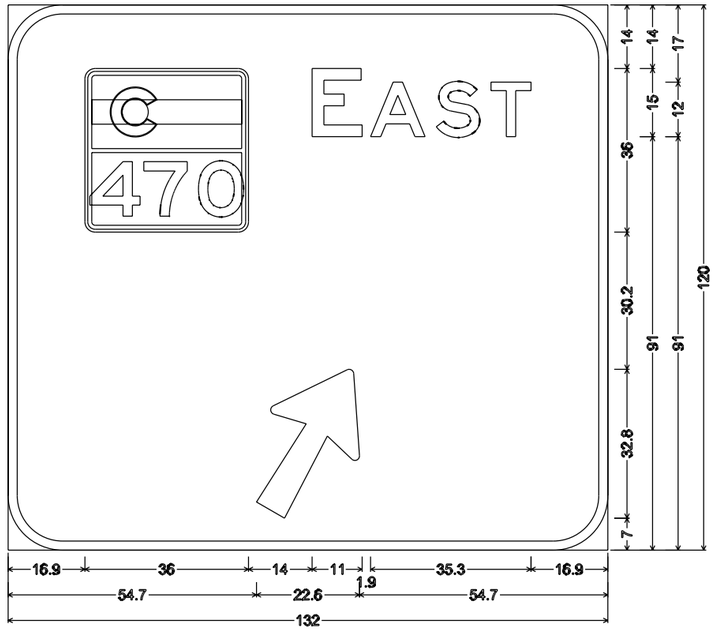

E6-1/OVERHEAD/SIDEROAD/1 LINE; 12.0" Radius, 2.0" Border, White on Green;
"EAST" E; Arrow A-16UC - 35.6" 60°;
Table of distances between letter and object lefts.

16.9	50.0	E 12.9	A 14.4	S 12.1	T 8.8	16.9
54.7	22.6	54.7				

Print Date: 1/15/2010
File Name: 14679_detsign06.dgn
Horiz. Scale: 1:10 Vert. Scale: As Noted

WILSON & COMPANY Engineers & Architects
999 18TH STREET, SUITE 2600
DENVER, CO 80202
PHONE: 303-297-2976
FAX: 303-297-2693

Sheet Revisions

Date:	Comments	Init.

Colorado Department of Transportation
DOT DEPARTMENT OF TRANSPORTATION
8833 South Wadsworth Court
Littleton, CO 80128
Phone: 303-972-9112 FAX: 303-972-9114
Region 6 RLB

As Constructed
No Revisions:
Revised:
Void:

OVERHEAD SIGN DETAILS
SPEC-3

Designer: JCK
Detailer: MJB
Sheet Subset: SIGN DET
Structure Numbers
Subset Sheets: 3 of 6

Project No./Code
ES6 0852-103
17679
Sheet Number 379

JBKeith 4:35:44 PM M:\TRN\07-100-311-12\14679\Design\Drawings\Signing & Striping\14679_detsign06.dgn

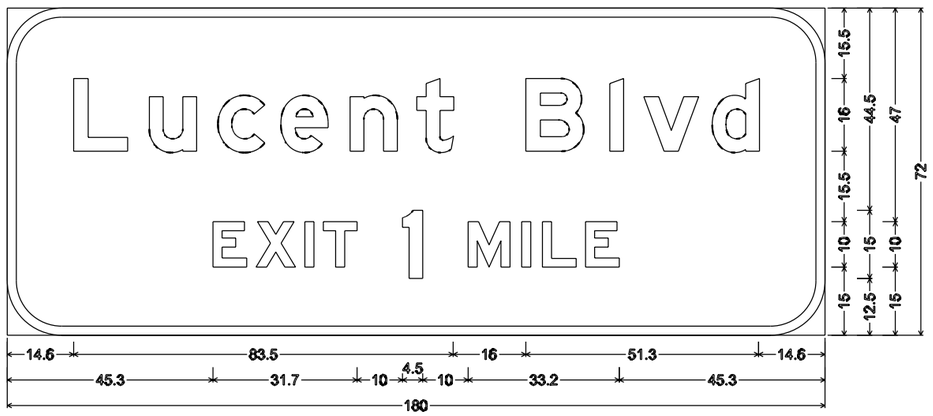

12.0" Radius, 2.0" Border, White on Green;
"Lucent Blvd" E Mod; "EXIT 1 MILE" E Mod;
Table of distances between letter and object lefts.

14.6	L 16.7	u 15.1	c 13.8	e 15.3	n 14.6	t 24.0	B 18.5	l 7.5	v 15.1	d 10.2	14.6

45.3	E 9.5	X 10.7	I 4.1	T 17.4	1 14.5	M 11.7	I 4.6	L 9.5	E 7.4	45.3	

Print Date: 1/15/2010
File Name: 14679_detsign02.dgn
Horiz. Scale: 1:10 Vert. Scale: As Noted

WILSON & COMPANY Engineers & Architects
999 18TH STREET, SUITE 2600
DENVER, CO 80202
PHONE: 303-297-2976
FAX: 303-297-2693

Sheet Revisions

Date:	Comments	Init.

Colorado Department of Transportation
CDOT DEPARTMENT OF TRANSPORTATION
8833 South Wadsworth Court
Littleton, CO 80128
Phone: 303-972-9112 FAX: 303-972-9114
Region 6 RLB

As Constructed
No Revisions:
Revised:
Void:

OVERHEAD SIGN DETAILS
SPEC-4

Designer: JCK
Detailer: MJB
Sheet Subset: SIGN DET
Structure Numbers
Subset Sheets: 4 of 6

Project No./Code
ES6 0852-103
17679
Sheet Number 380

JBKeith 4:35:58 PM M:\TRN\07-100-311-12\14679\Design\Drawings\Signing & Striping\14679_detsign02.dgn

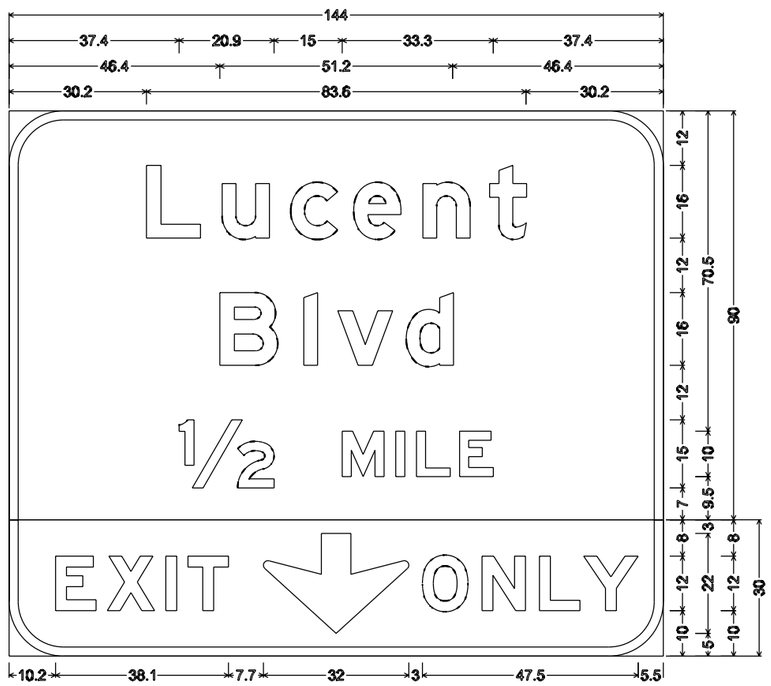

12.0" Radius, 2.0" Border, White on Green;
"Lucent" E Mod; "Blvd" E Mod; "½ MILE" E Mod;
12.0" Radius, 2.0" Border, White on Yellow;
"EXIT" Black E Mod; Down Arrow AR-C1 - 22.0° 270° Black; "ONLY" Black E Mod;
Table of distances between letter and object lefts.

30.2	L 16.7	u 15.1	c 13.9	e 15.2	n 14.7	t 8.0	30.2

46.4	B 18.5	l 7.4	v 15.1	d 10.2	46.4

37.4	½ 35.9	M 11.8	I 4.6	L 9.5	E 7.4	37.4

10.2	E 11.4	X 12.9	I 4.9	T 16.6	↓ 35.0	O 13.1	N 12.6	L 9.8	Y 12.0	5.5	

Print Date: 1/15/2010		Sheet Revisions			
File Name: 14679_detsign01.dgn		Date:	Comments	Init.	
Horiz. Scale: 1:10 Vert. Scale: As Noted					
WILSON & COMPANY Engineers & Architects 999 18TH STREET, SUITE 2600 DENVER, CO 80202 PHONE: 303-297-2976 FAX: 303-297-2693					

Colorado Department of Transportation
DOT DEPARTMENT OF TRANSPORTATION
8833 South Wadsworth Court
Littleton, CO 80128
Phone: 303-972-9112 FAX: 303-972-9114
Region 6 RLB

As Constructed
No Revisions:
Revised:
Void:

OVERHEAD SIGN DETAILS
SPEC-5

Designer: JCK
Detailer: MJB
Sheet Subset: SIGN DET
Structure Numbers
Subset Sheets: 5 of 6

Project No./Code
ES6 0852-103
17679
Sheet Number 381

JBKeith 4:36:14 PM M:\TRN\07-100-311-12\14679\Design\Drawings\Signing & Striping\14679_detsign01.dgn

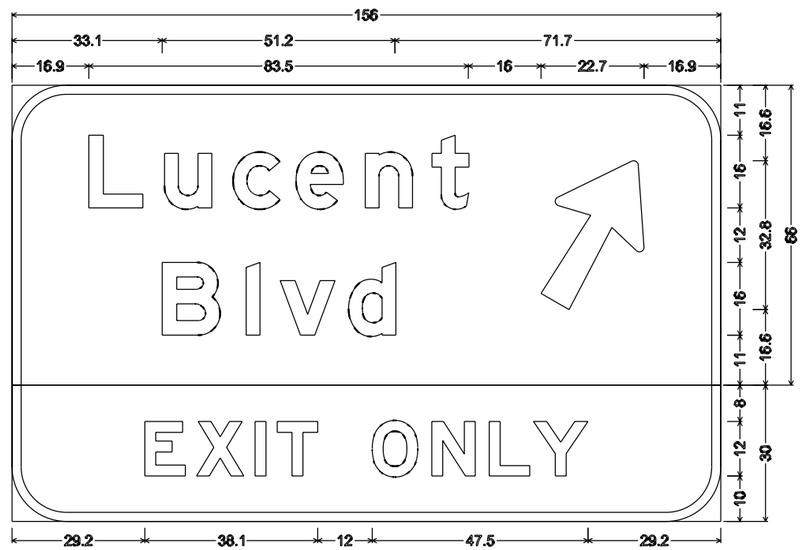

E6-1/OVERHEAD/SIDEROAD/1 LINE; 12.0" Radius, 2.0" Border, White on Green;
"Lucent" E Mod; "Blvd" E Mod; Arrow A-16UC - 35.6" 60°;
12.0" Radius, 2.0" Border, White on Yellow;
"EXIT ONLY" Black E Mod;
Table of distances between letter and object lefts.

16.9	L 16.7	u 15.1	c 13.8	e 15.2	n 14.7	t 24.0	↗ 22.7	16.9	
33.1	B 18.4	l 7.5	v 15.1	d 10.2	71.7				
29.2	E 11.4	X 12.9	I 4.9	T 20.9	O 13.1	N 12.6	L 9.8	Y 12.0	29.2

JBKeith 4:36:38 PM M:\TRN\07-100-311-12\14679\Design\Drawings\Signing & Striping\14679_detsign03.dgn

Print Date: 1/15/2010
File Name: 14679_detsign03.dgn
Horiz. Scale: 1:10 Vert. Scale: As Noted

WILSON & COMPANY Engineers & Architects
999 18TH STREET, SUITE 2800
DENVER, CO 80202
PHONE: 303-297-2976
FAX: 303-297-2693

Sheet Revisions

Date:	Comments	Init.

Colorado Department of Transportation
8833 South Wadsworth Court
Littleton, CO 80128
Phone: 303-972-9112 FAX: 303-972-9114
Region 6 RLB

As Constructed
No Revisions:
Revised:
Void:

OVERHEAD SIGN DETAILS
SPEC-6

Designer: JCK
Detailer: MJB
Sheet Subset: SIGN DET
Structure Numbers
Subset Sheets: 6 of 6

Project No./Code
ES6 0852-103
17679
Sheet Number 382