TABULATION OF LANDSCAPE ITEMS

ITEM NUMBER	ITEM NAME	UNITS	QUANTITY
209.00200	Time-Released Water Product	EACH	47
214.00000	Landscape Maintenance	L S	1
214.00220	Deciduous Tree (2 Inch Caliper)	EACH	23
214.00504	Evergreen Tree (4 Foot) (Ball and Burlap)	EACH	24

LEGEND

QTY	KEY	COMMON NAME	BOTANIC NAME	SIZE	REMARKS
DECIDUOUS TREES					
11	SA	SUMMIT ASH	FRASINUS PENNSYLVANICA 'SUMMIT'	2" CAL	B&B STRAIGHT TRUNK, FULL HEAD
12	ABM	AUTUMN BLAZE MAPLE	ACER RUBRUM 'AUTUMN BLAZE'	2" CAL	B&B STRAIGHT TRUNK, FULL HEAD
EVERGREEN TREES					
12	CBS	COLORADO BLUE SPRUCE	PICEA PUNGENS GLAUCA	4' HT	B&B FULL TO GROUND
12	PYP		PINUS EDULIS	4' HT	B&B FULL TO GROUND

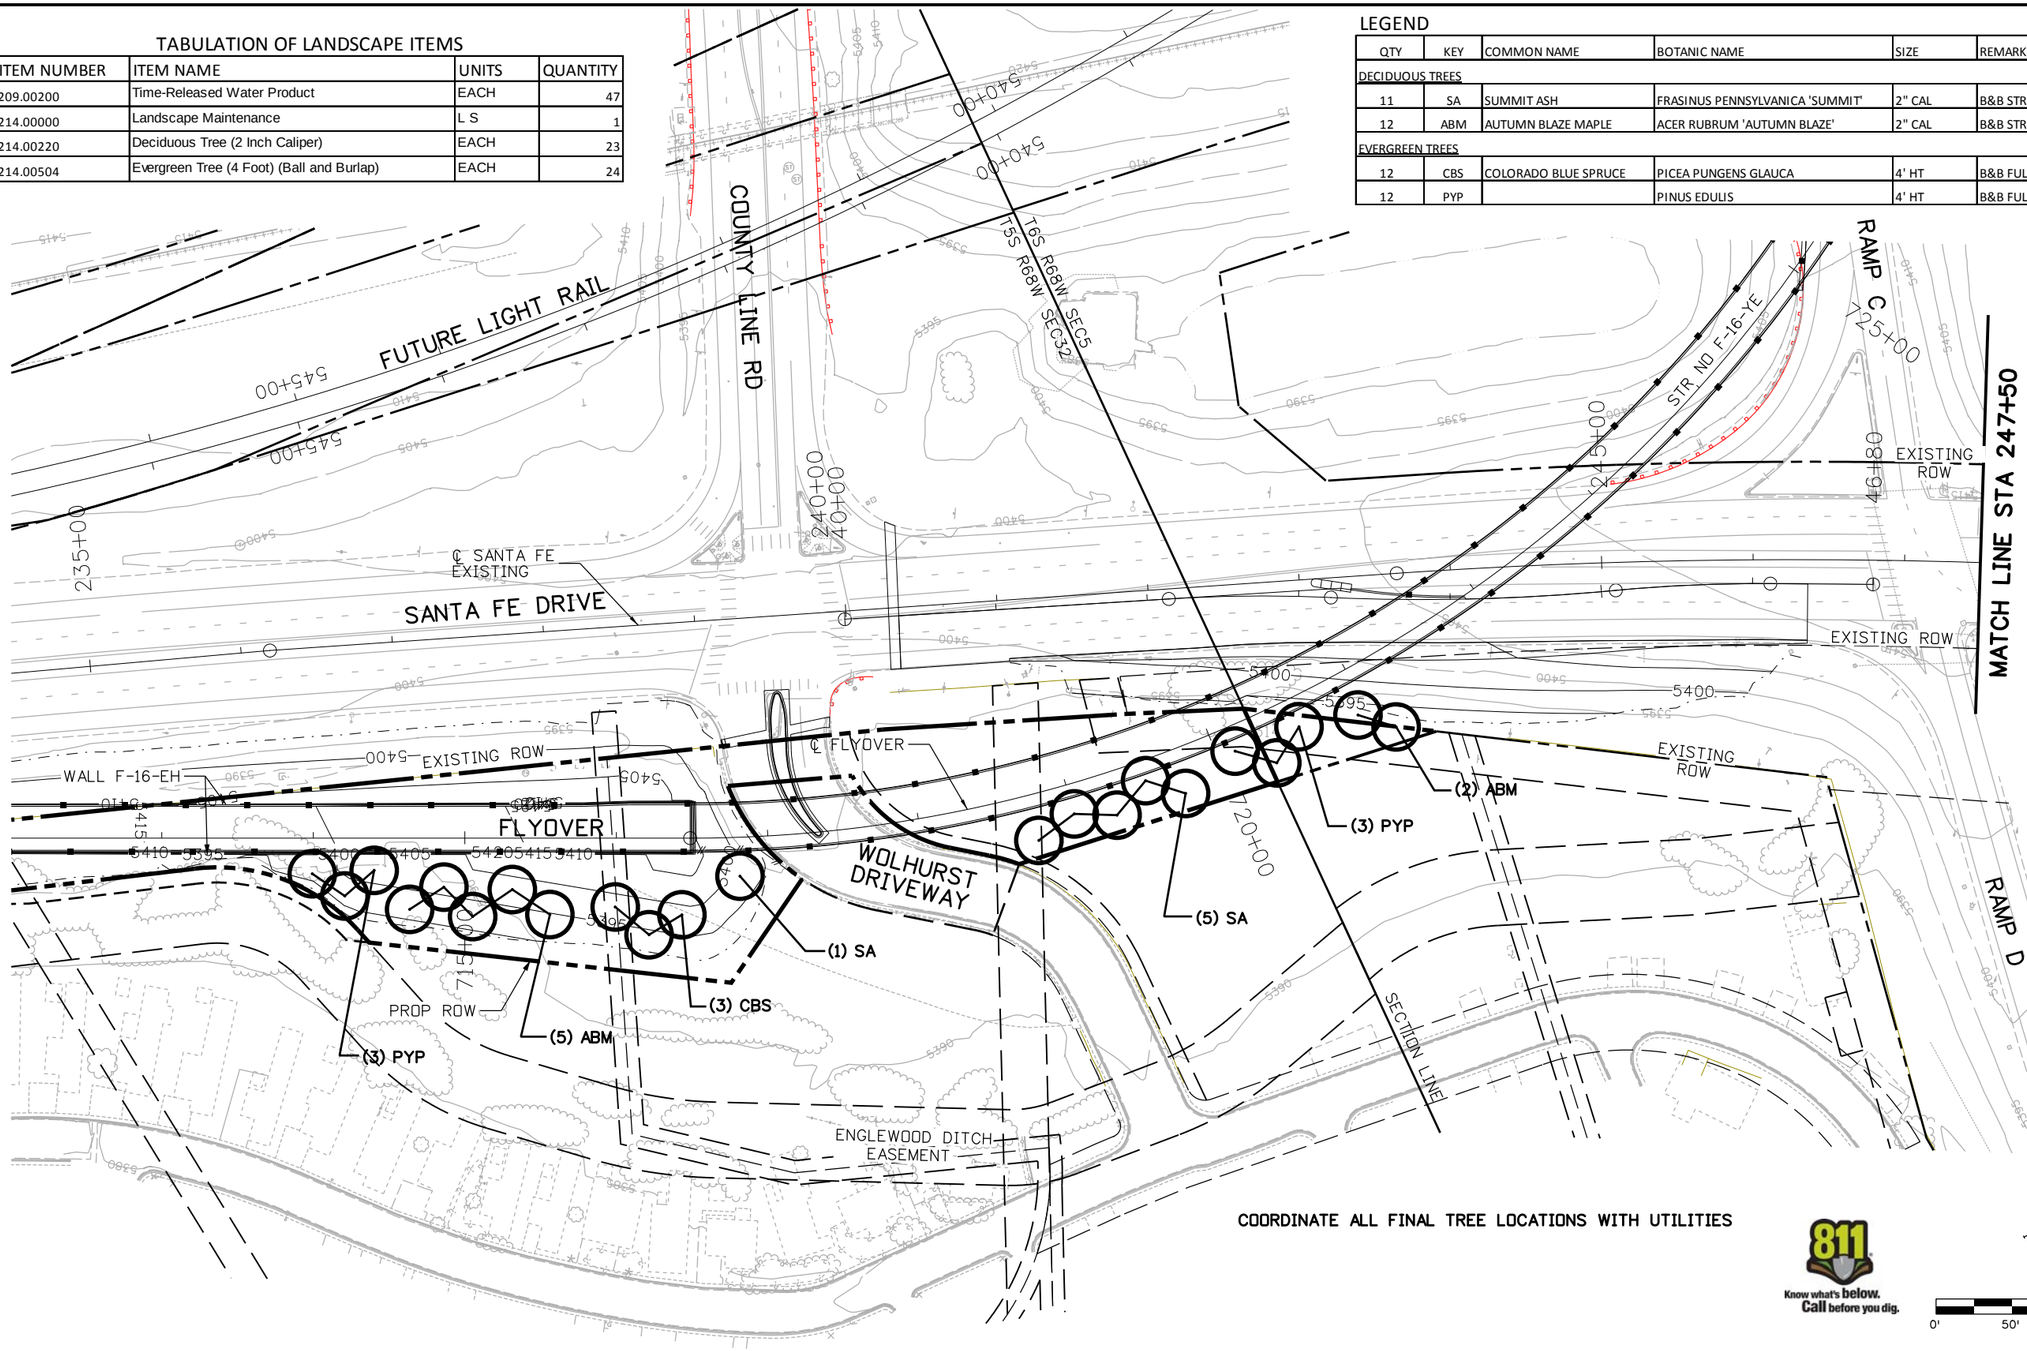

Print Date: 1/19/2010	Sheet Revisions	Colorado Department of Transportation	As Constructed
File Name: 14679_pLD-P702.dgn	Date: / Comments / Init.	8833 South Wadsworth Court, Littleton, CO 80128, Phone: 303-972-9112 FAX: 303-972-9114	No Revisions:
Horiz. Scale: 1:100 Vert. Scale: As Noted		Region 6 RLB	Revised:
WILSON & COMPANY Engineers & Architects, 999 18TH STREET, SUITE 2600, DENVER, CO 80202, PHONE: 303-297-2976, FAX: 303-297-2693			Void:

LANDSCAPE PLAN
FLYOVER

Designer:	RUGG	Structure Numbers	
Detailer:	JJW		
Sheet Subset:	LDSCP	Subset Sheets: 1 of 2	

Project No./Code: ES6 0852-103
17679
Sheet Number 398

JJWierema 3:25:10 PM M:\TRN\07-100-311-12\14679\Design\Drawings\roadway\14679_pLD-P702.dgn

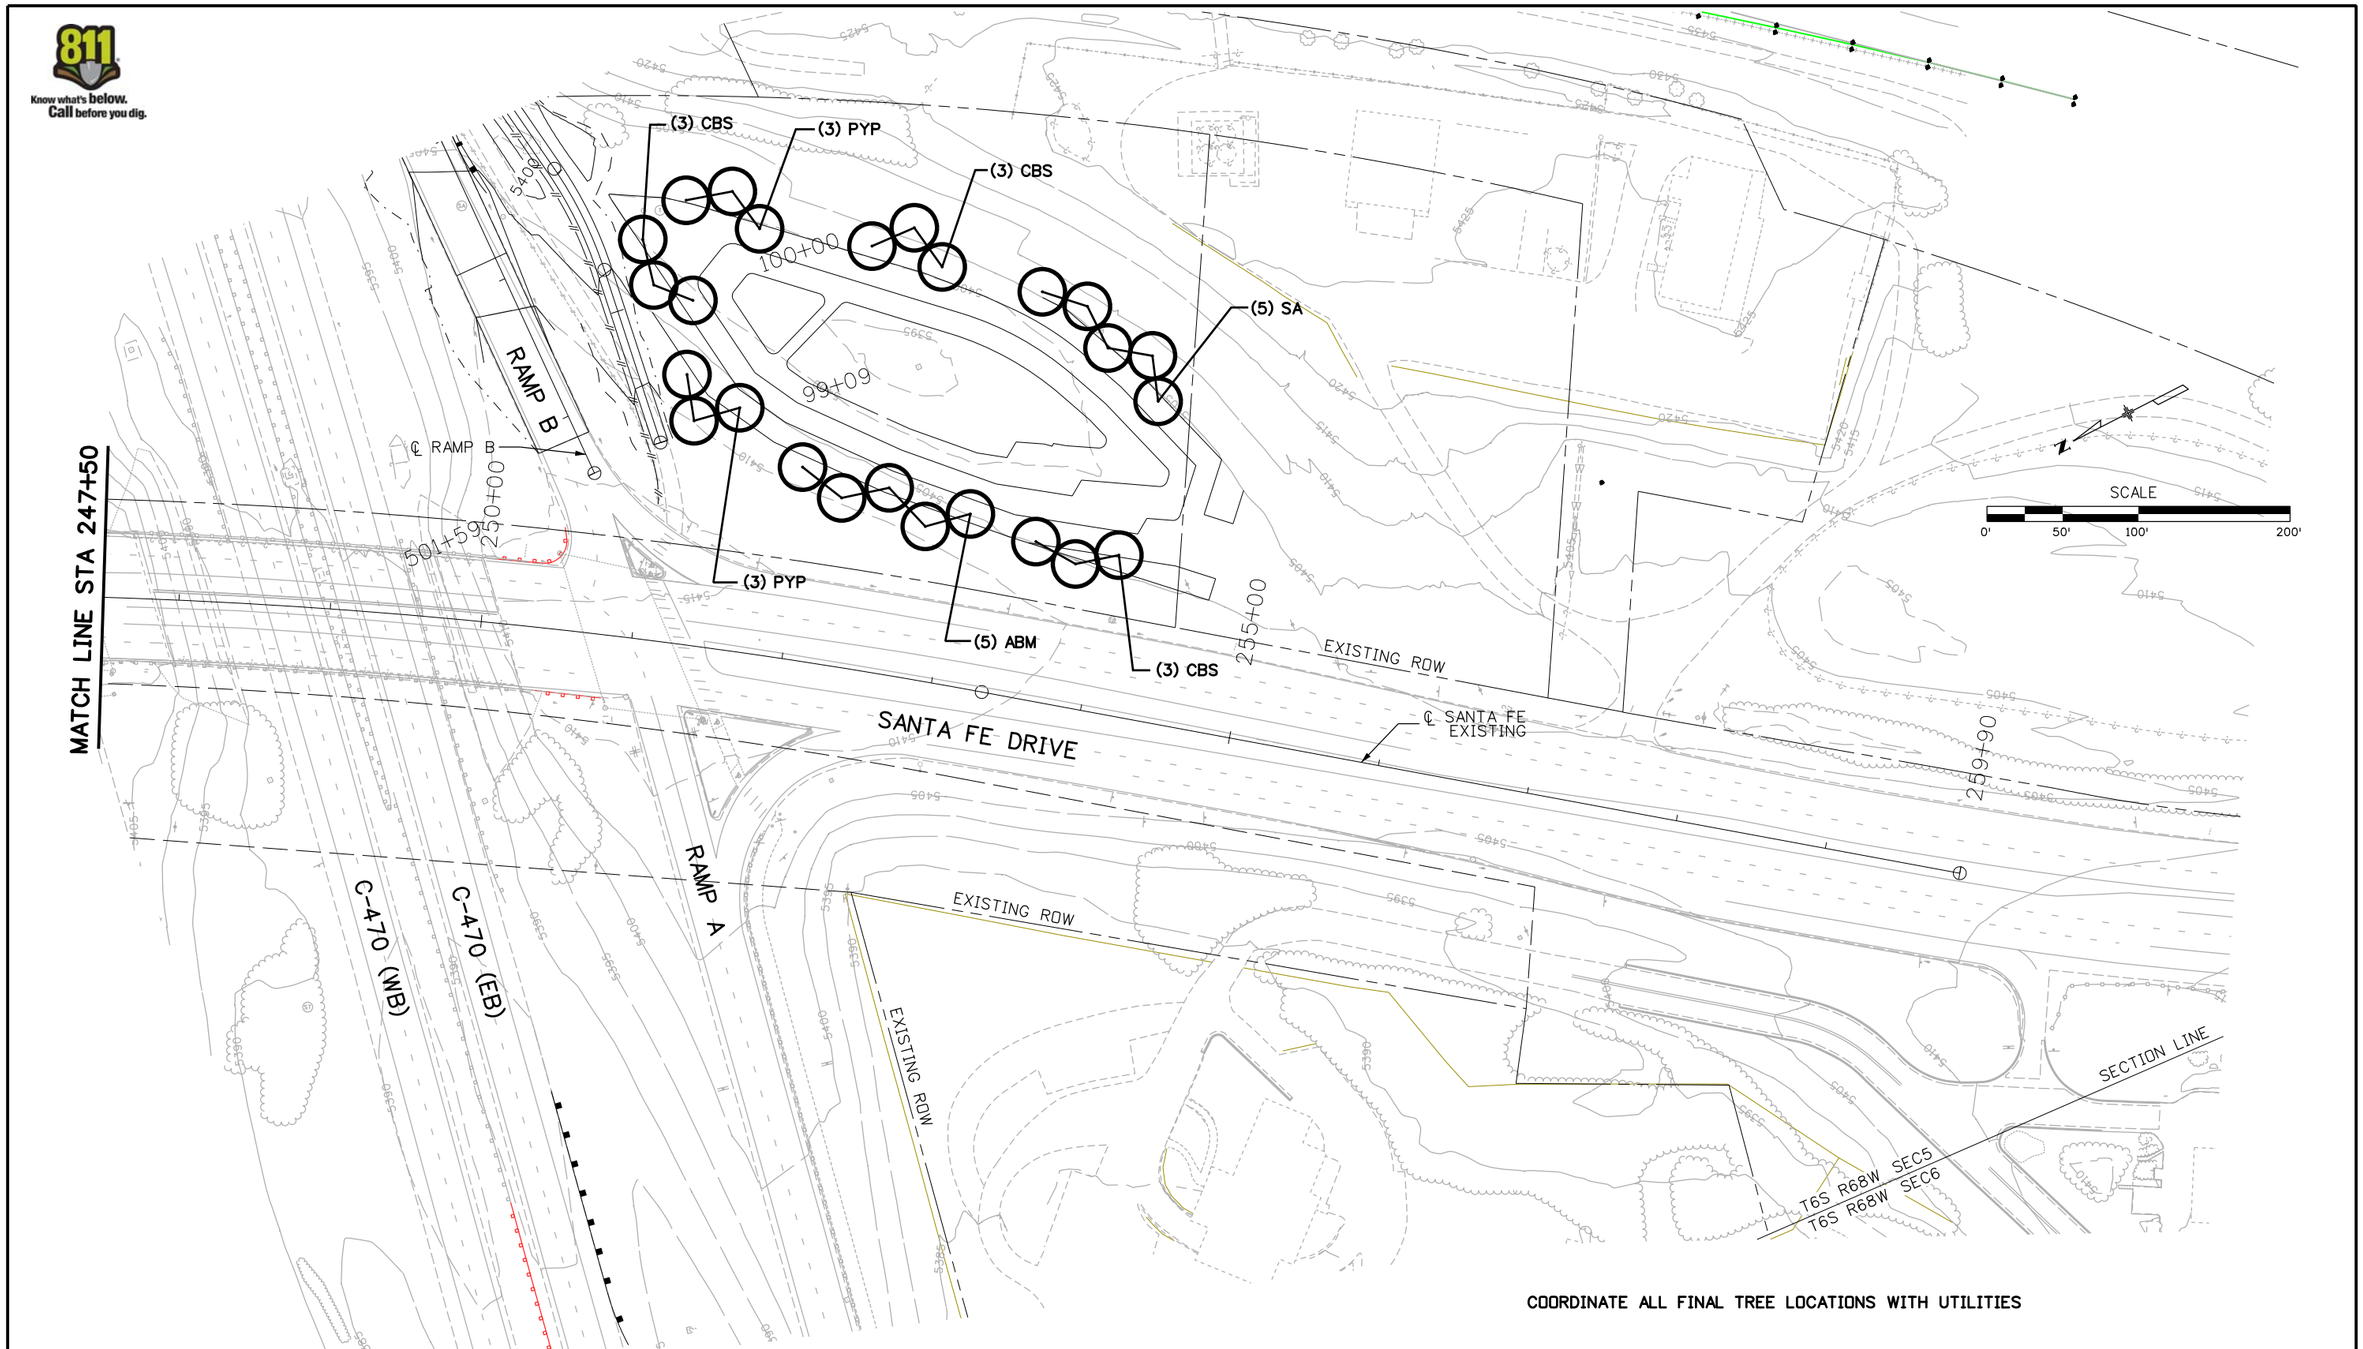

COORDINATE ALL FINAL TREE LOCATIONS WITH UTILITIES

Print Date: 1/19/2010	Sheet Revisions	Colorado Department of Transportation	As Constructed	LANDSCAPE PLAN SANTA FE/RAMP B	Project No./Code
File Name: 14679_pLD-P401.dgn	Date: / Comments / Init.	8833 South Wadsworth Court, Littleton, CO 80128, Phone: 303-972-9112 FAX: 303-972-9114	No Revisions:	Designer: RUGG	ES6 0852-103
Horiz. Scale: 1:100 Vert. Scale: As Noted		Region 6 RLB	Revised:	Detailer: JJW / Structure Numbers	17679
WILSON & COMPANY Engineers & Architects, 999 18TH STREET, SUITE 2600, DENVER, CO 80202, PHONE: 303-297-2976, FAX: 303-297-2693			Void:	Sheet Subset: LDSCP / Subset Sheets: 2 of 2	Sheet Number

JJWieremo 4:18:15 PM M:\TRN\07-100-311-12\14679\Design\Drawings\roadway\14679_pLD-P401.dgn