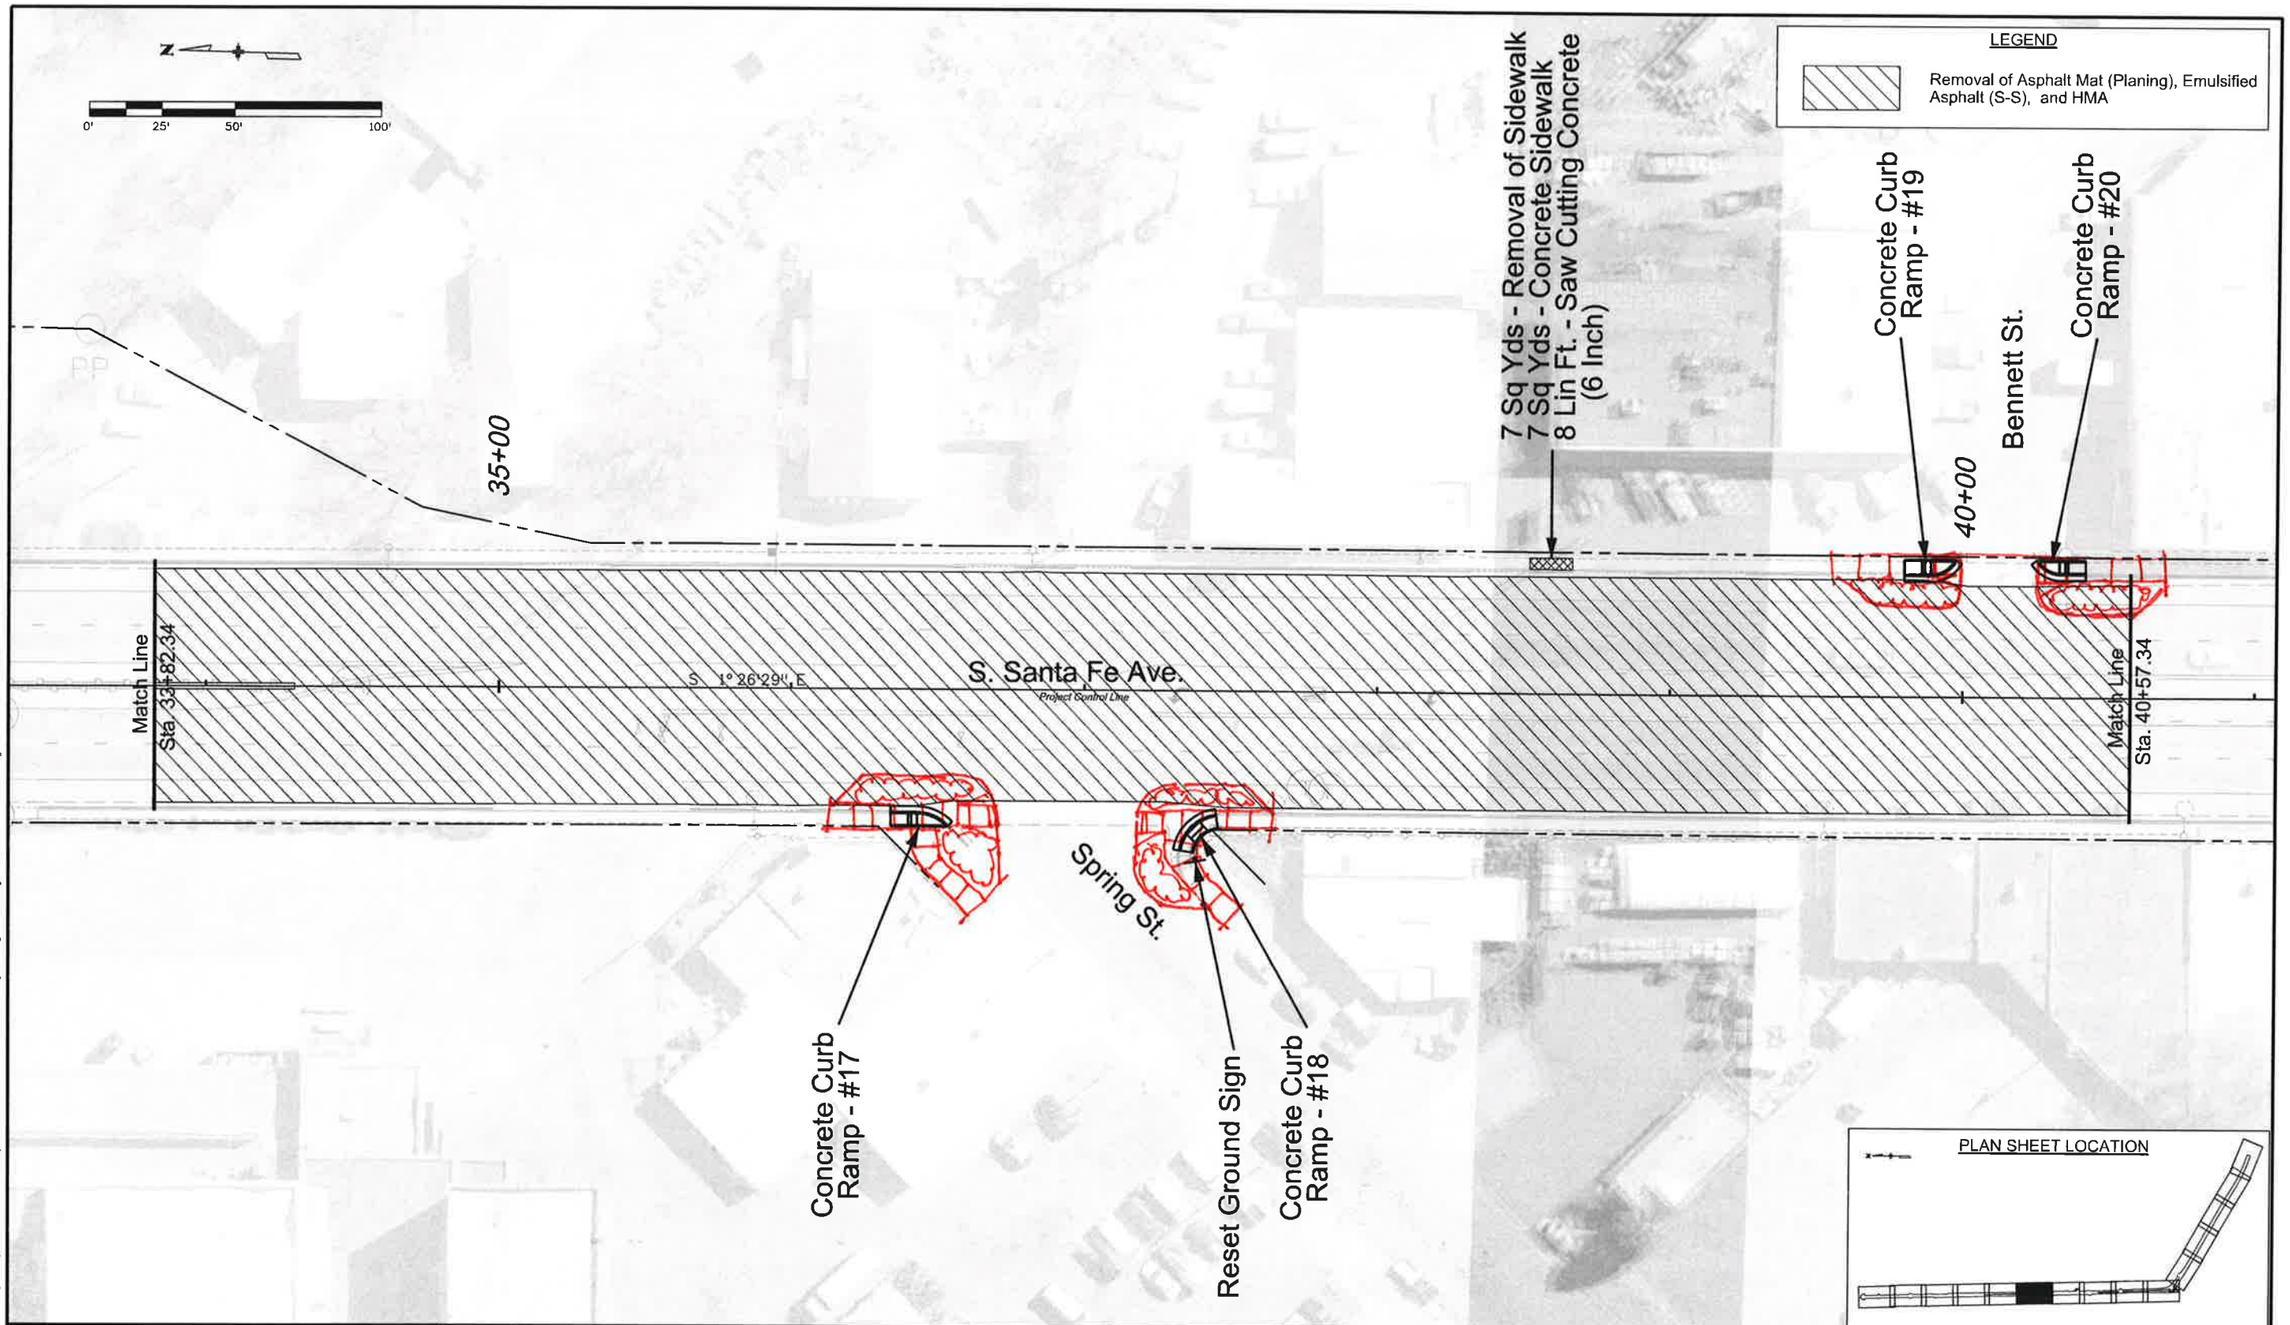

Print Date: 11/6/2012		Sheet Revisions			Colorado Department of Transportation	As Constructed
File Name: 19130 - Sheet 18.dgn		Date:	Comments	Init.	902 Erie Avenue Pueblo, CO 81001 Phone: 719-546-5438 FAX: 719-546-5702	No Revisions:
Horiz. Scale: 1:50	Vert. Scale: As Noted					Revised:
Region 2 - South Program	CAW				Region 2 CAW	Void:

PLAN SHEET

Designer:	jpg	Structure Number	
Detailer:	jpg		
Sheet Subset:	road	Subset Sheets:	6 of 15

Project No./Code
STA 050A-023
19130
Sheet Number 18

ILEX/FIRST/1-25 PUEBLO WJZ 1/6/14

garciajp 2:59:13 PM C:\Users\garciajp\Documents\Projects\19130 - SH 50C Overlay\Design\Drawings\19130 - Sheet 18.dgn

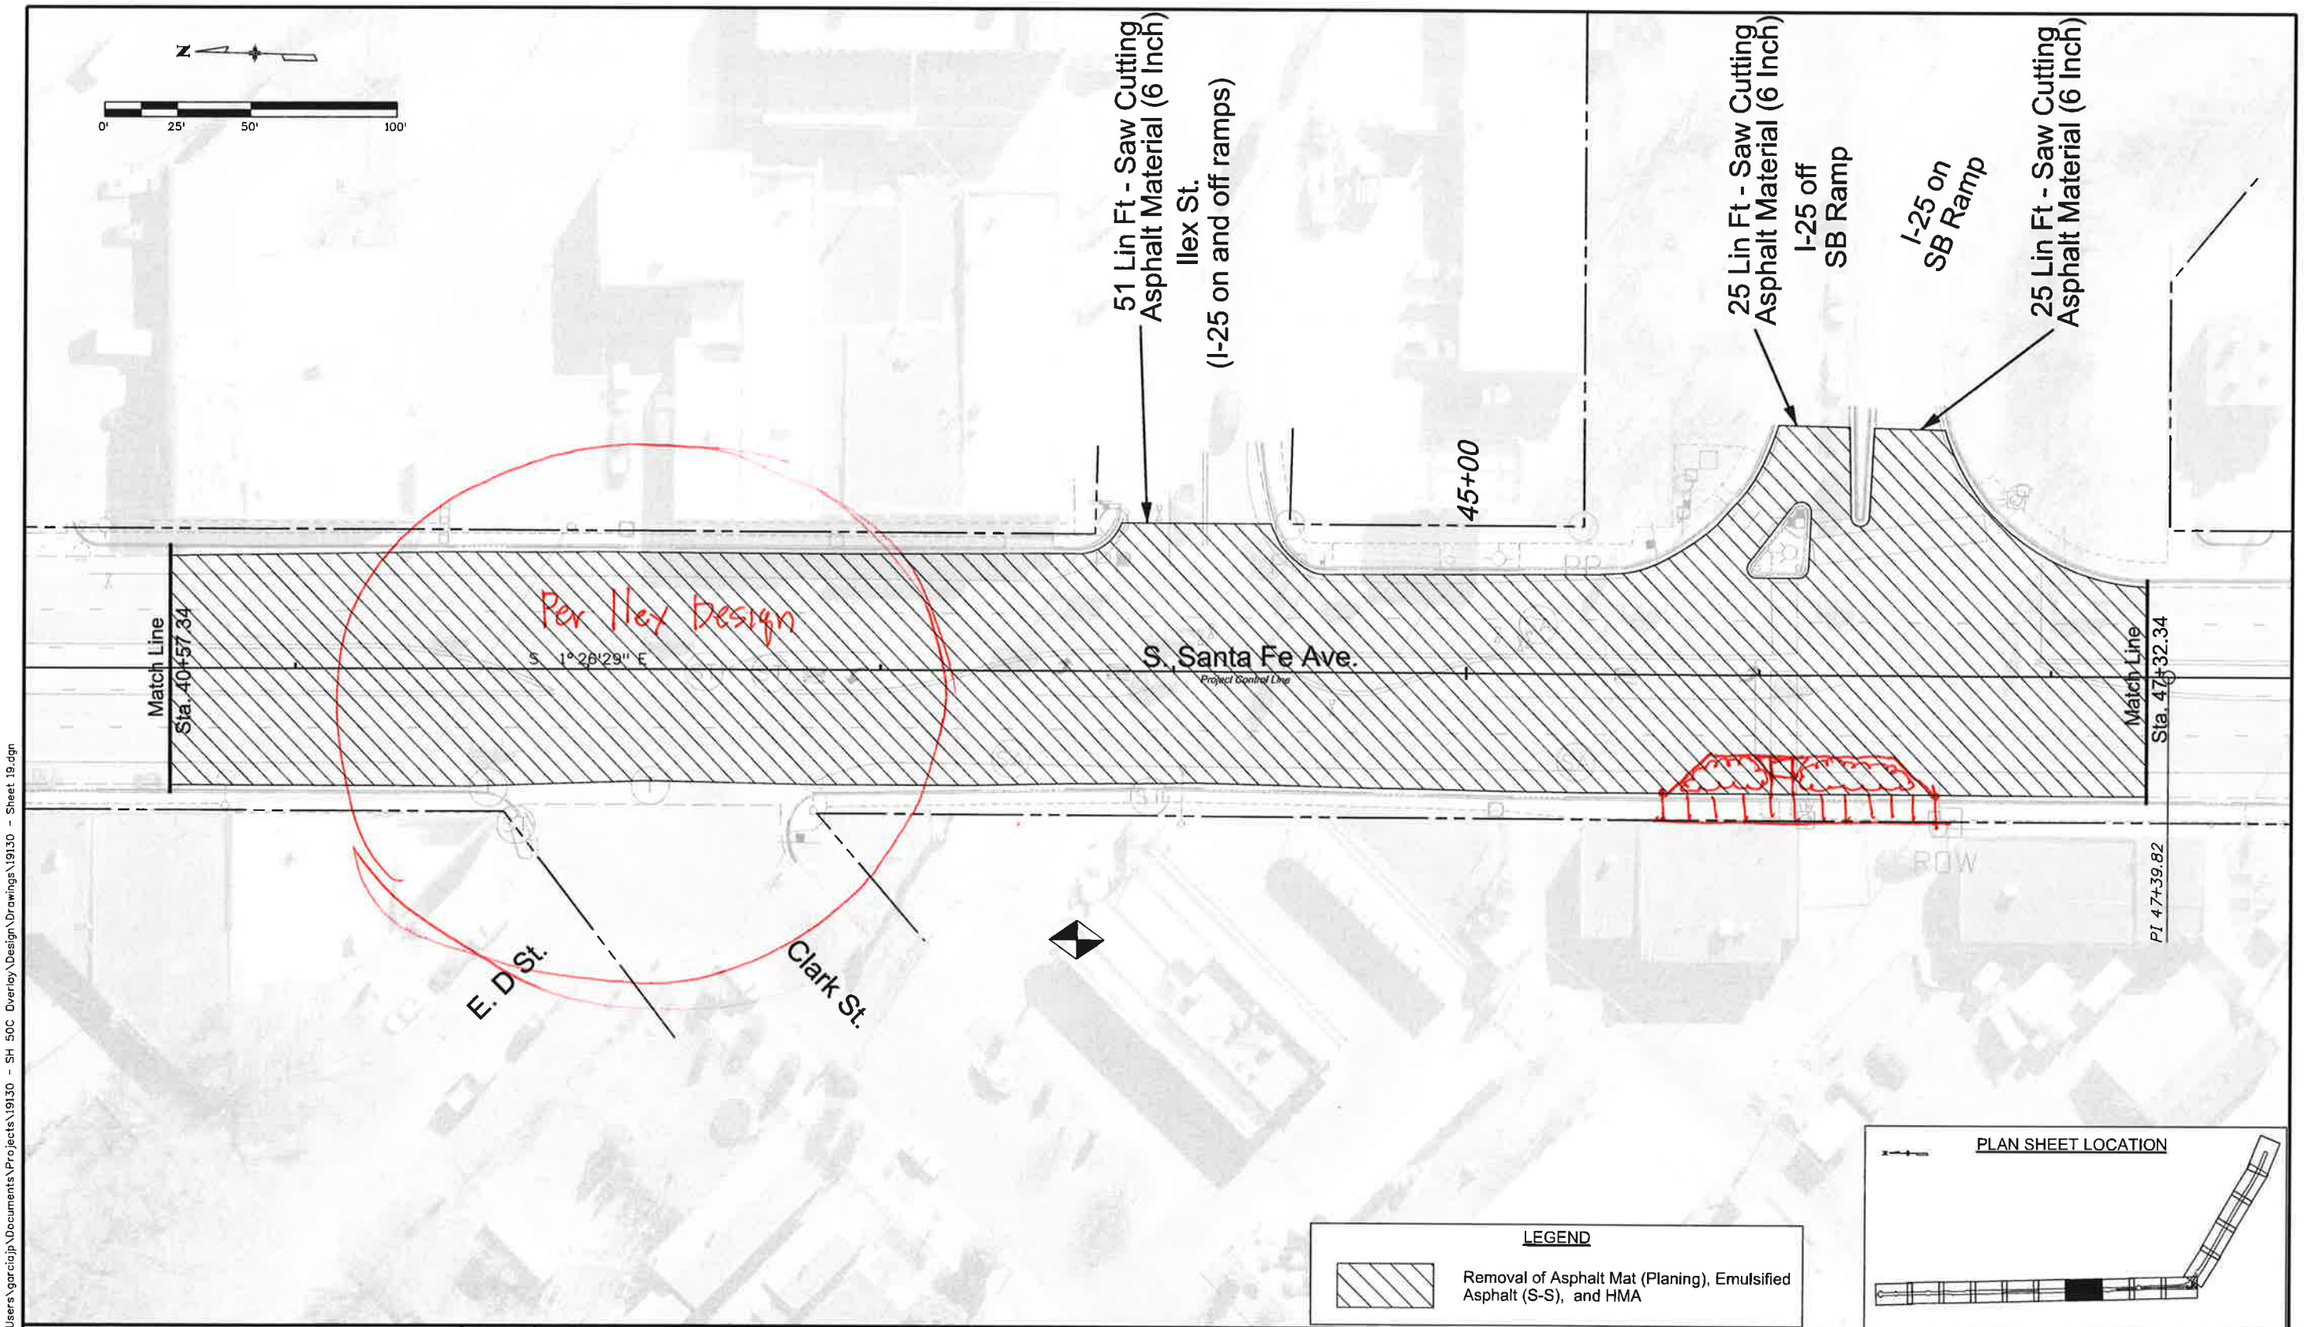

garciajp 2:56:22 PM C:\Users\garciajp\Documents\Projects\19130 - SH 50C Overlay\Design\Drawings\19130 - Sheet 19.dgn

Print Date: 11/6/2012	R-X	Sheet Revisions	
File Name: 19130 - Sheet 19.dgn		Date:	Comments	Init.
Horiz. Scale: 1:50 Vert. Scale: As Noted				
Region 2 - South Program CAW				

Colorado Department of Transportation
DOT
902 Erie Avenue
Pueblo, CO 81001
Phone: 719-546-5438 FAX: 719-546-5702
Region 2 CAW

As Constructed	PLAN SHEET			Project No./Code
No Revisions:				STA 050A-023
Revised:	Designer: jpg	Structure Number		19130
Void:	Detailer: jpg			
	Sheet Subset: road	Subset Sheets: 7 of 15		Sheet Number 19

ILEX/FIRST/I-25 PUEBLO WJZ 1/6/14

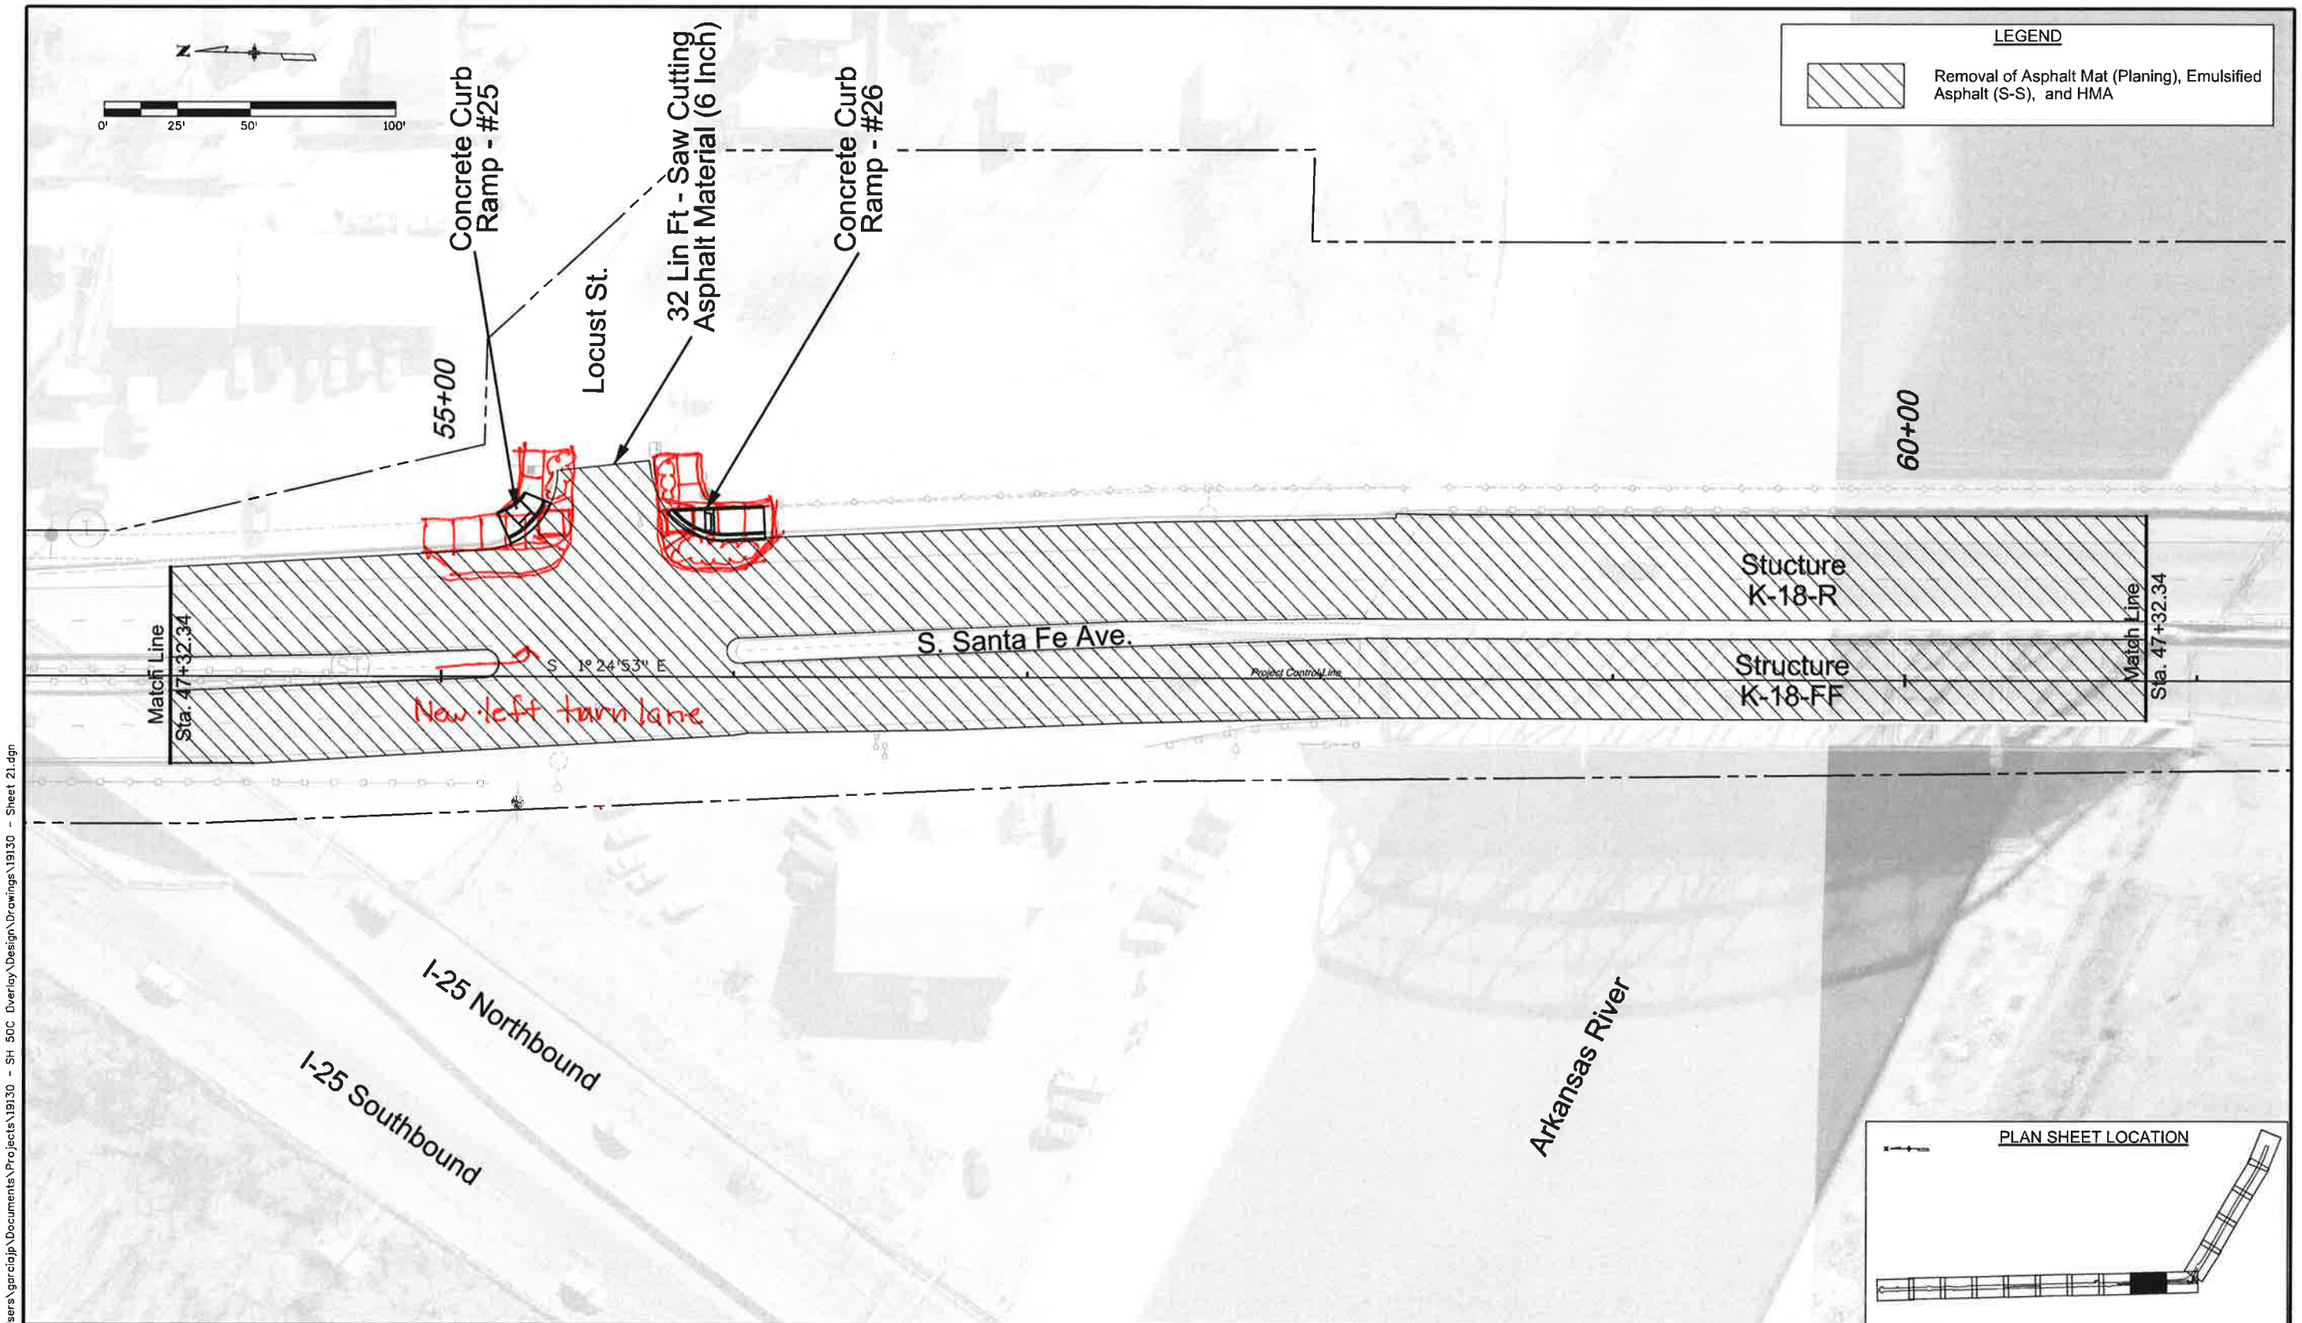

Print Date: 11/6/2012			
File Name: 19130 - Sheet 21.dgn			
Horiz. Scale: 1:50	Vert. Scale: As Noted		
Region 2 - South Program	CAW		

R-X

Sheet Revisions		
Date:	Comments	Init.

Colorado Department of Transportation
DOT
902 Erie Avenue
Pueblo, CO 81001
Phone: 719-546-5438 FAX: 719-546-5702
Region 2 CAW

As Constructed			
No Revisions:			
Revised:			
Void:			

PLAN SHEET			
Designer: jpg	Structure Number		
Detailer: jpg			
Sheet Subset: road	Subset Sheets: 9 of 15		

Project No./Code	
STA 050A-023	
19130	
Sheet Number	21

ILEX / FIRST / I-25 PUEBLO WJZ 1/6/14

garciajp 2:15:34 PM C:\Users\garciajp\Documents\Projects\19130 - SH 50C Overlay\Design\Drawings\19130 - Sheet 21.dgn

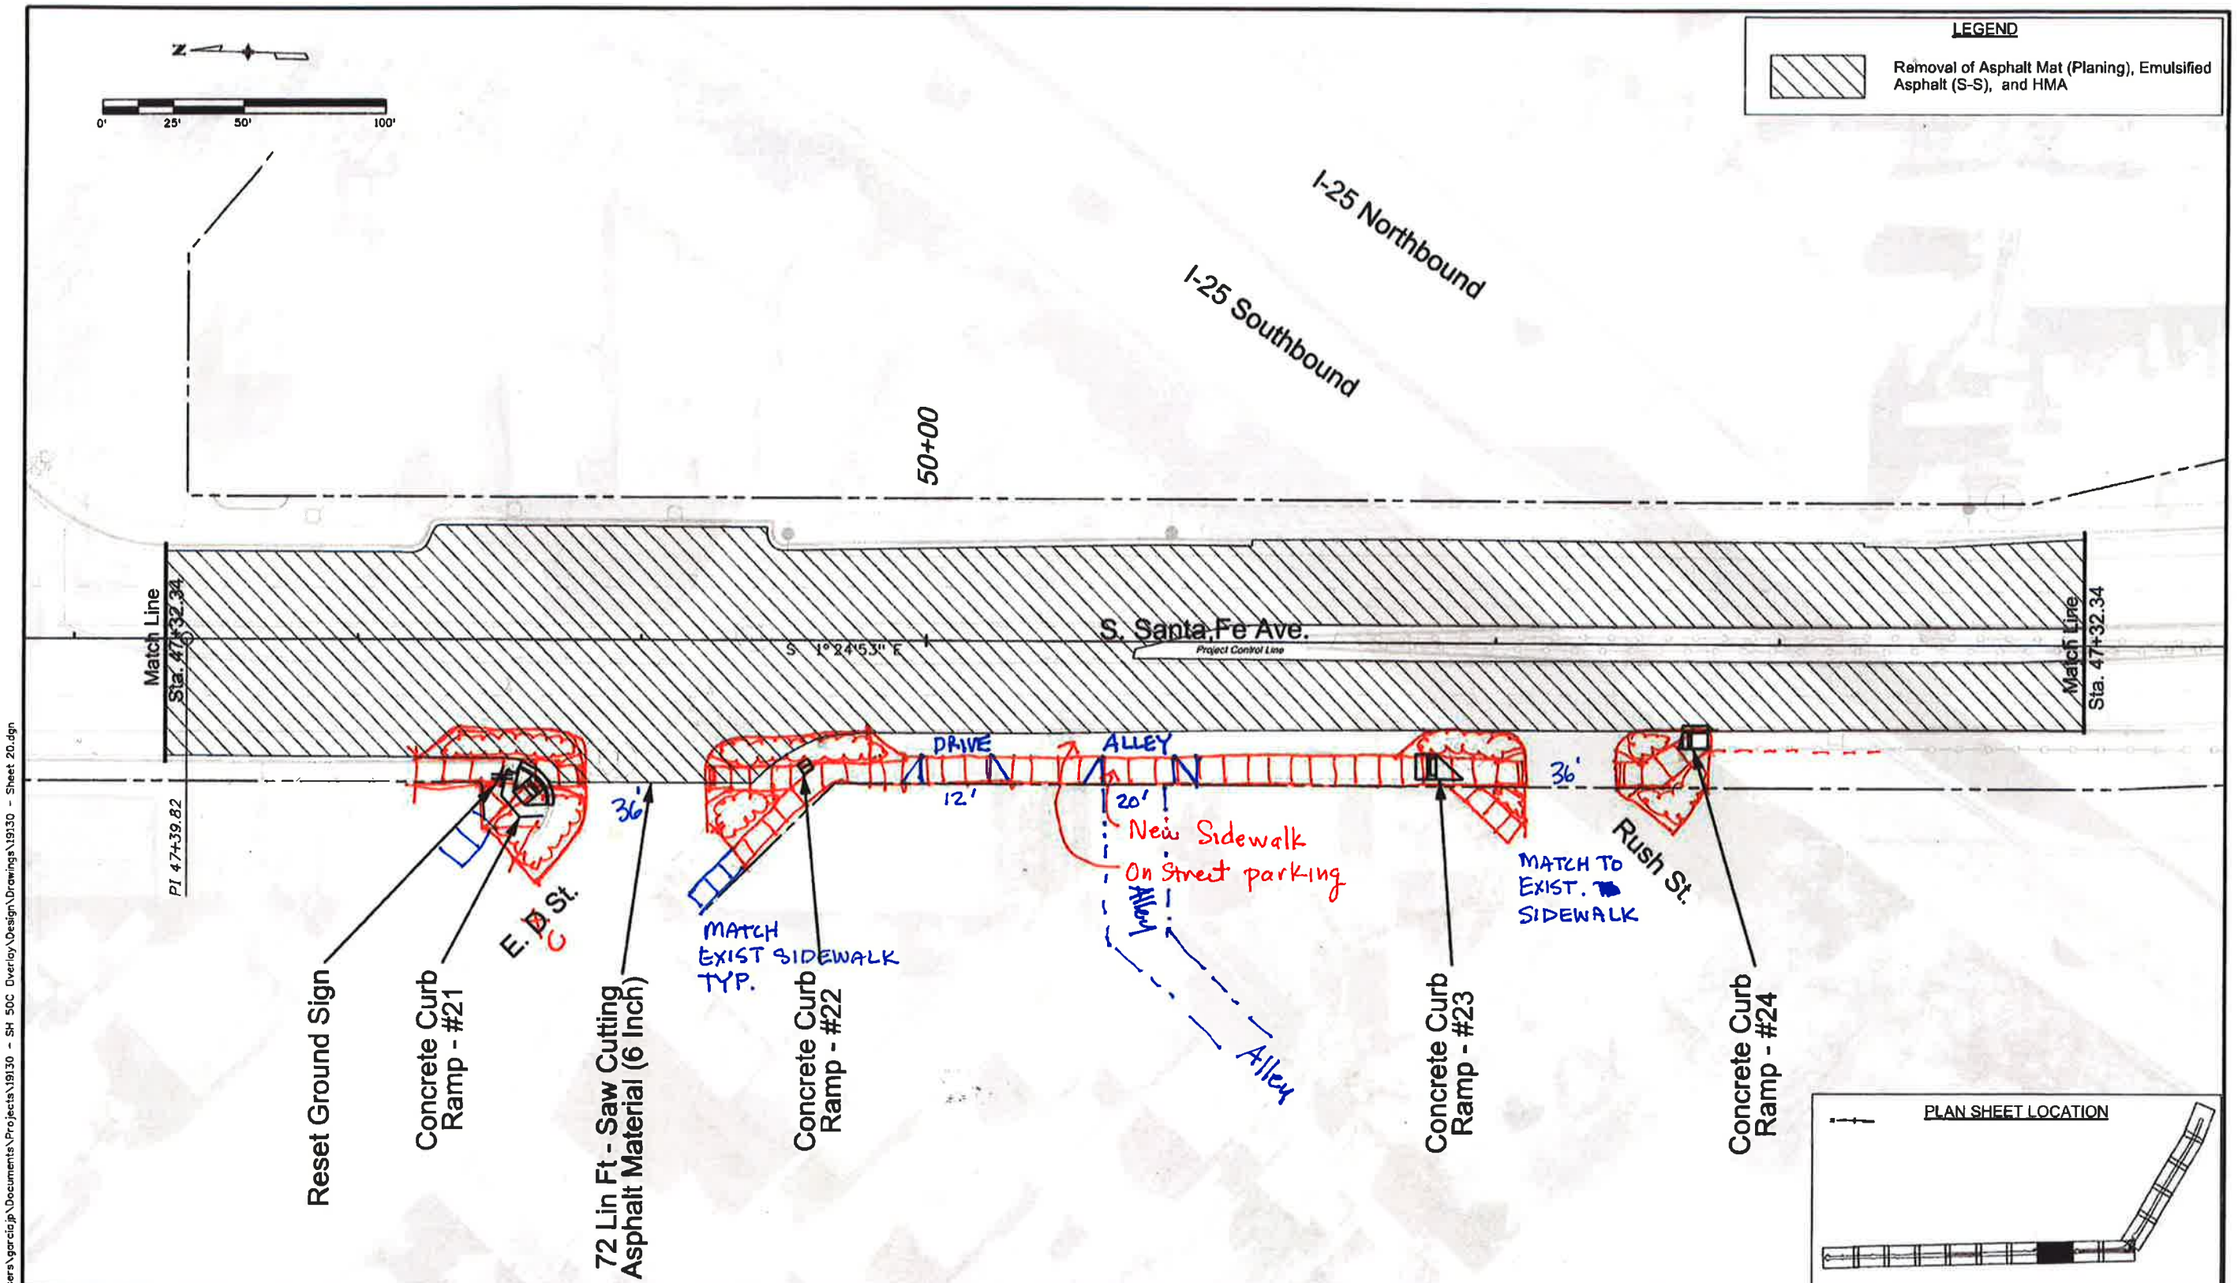

Print Date: 11/6/2012	Sheet Revisions	Colorado Department of Transportation	As Constructed	PLAN SHEET	Project No./Code
File Name: 19130 - Sheet 20.dgn	Date: / Comments / Init.	902 Erie Avenue, Pueblo, CO 81001	No Revisions:		STA 050A-023
Horiz. Scale: 1:50 Vert. Scale: As Noted		Phone: 719-546-5438 FAX: 719-546-5702	Revised:	Designer: jpg / Structure Number	19130
Region 2 - South Program CAW		Region 2 CAW	Void:	Detailer: jpg / Sheet Subset: road / Subset Sheets: 8 of 15	Sheet Number 20

ILEX / FIRST / I-25 PUEBLO 1/6/14 WJZ

REVISED 5/27/14 WJZ

garcidjp 2:17:20 PM C:\Users\garcidjp\Documents\Projects\19130 - SH 50C Overlay\Design\Drawings\19130 - Sheet 20.dgn