Main in 7th st. at Colorado Ave.

LOT # BLOCK # 100 S. 7th Date 10-13 ~~197~~ 83

MAIN HP 2" ADYL "A" plas SIZE TAP 2" plastic tee ~~SAD~~ ~~YES~~ MAIN DEPTH 30"

22 Ft. WEST From EAST Pl. ~~Street~~ ~~Alley~~ 7th street

Stop Cock NONE ~~In~~ ~~Box~~ ~~No~~

~~Service~~ Runs NORTH FROM Colo Ave. TIED IN TO Colo. AVE. AT 38' S. FROM N.P.L. OF Colo. AVE. TIED IN TO EXISTING 2" plastic MAIN 50' N. FROM N.P.L. OF Colo. AVE. RAN 88' of plastic #T0617T13

Form 116 BUILT TO COMPANY STANDARDS MAOP ___ WHICH CONFORM TO B31.8 & D.O.T. CODE. TESTED W/ air TO P.S.I. 100 FOR 1 ~~MIN~~/HRS. WELDS SOAP TESTED

Foreman M. WARD

WOEHRMYER BUSINESS FORMS

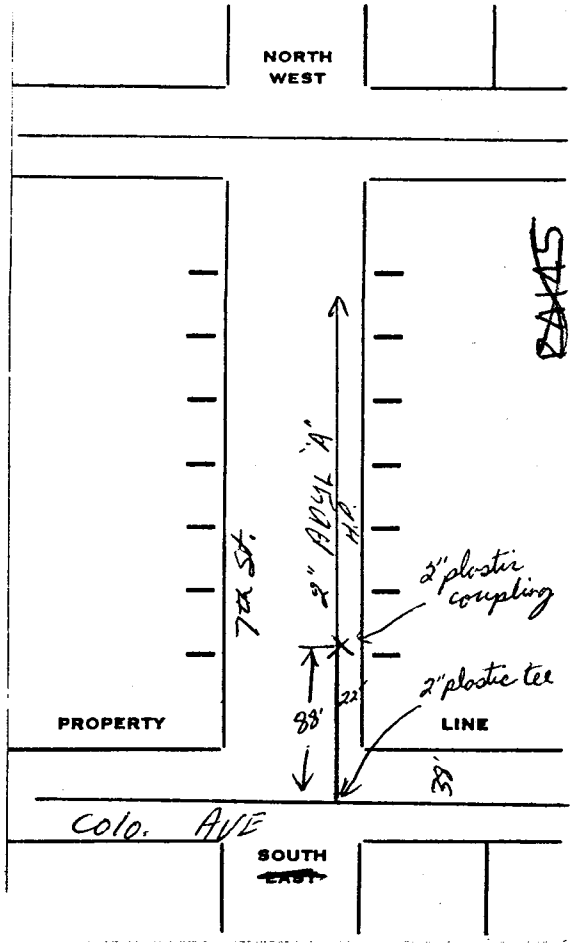

MAIN IN Colo. Ave. FROM 8th st. to Spruce

LOT # BLOCK # 730 W. Colo. to 414 Colo Ave Date 10-13 ~~197~~ 83

MAIN HP 2" ADYL "A" plas SIZE TAP 2" ~~SAD~~ ~~YES~~ MAIN DEPTH 30"

32' Ft. South From North Pl. Street ~~Alley~~ ~~In~~ ~~Box~~ ~~No~~

Stop Cock NONE

~~Service~~ 2" MAIN dead ends at 18' W. From E. P.L. 8th and 32' S. FROM N.P.L. Colo. AVE. RUNS EAST TO 12' W. FROM EAST Building line of 414 W. Colo. AVE MAIN IS TIED IN AT 7th st. and walnut

Form 116 BUILT TO COMPANY STANDARDS MAOP ___ WHICH CONFORM TO B31.8 & D.O.T. CODE. TESTED W/ air TO P.S.I. 100 FOR 12 ~~MIN~~/HRS. WELDS SOAP TESTED

Foreman M. WARD

WOEHRMYER BUSINESS FORMS

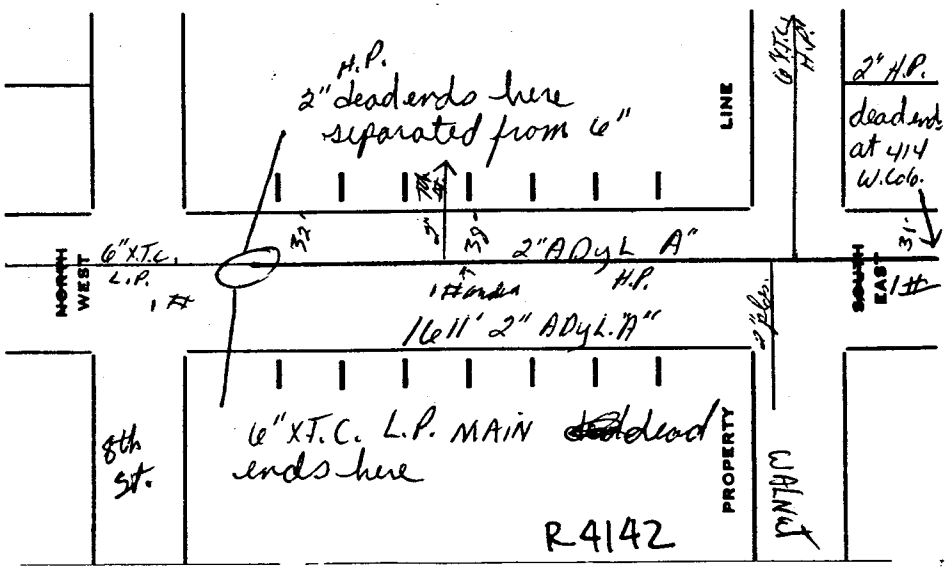

R4142