H-22
FORM A-1.6

ABBOT LANE E. OF 8TH ST

Date 10-5, 1973

MAIN HP 2"X-TRU, WALL THICKNESS .154

21' Ft. N From S Pl. Street

① Tied IN with 4"X2" CI Saddle & 2" RW 1943½ VALVE & INSULATING KIT 21' EEPL 8th & 21' NSPL Abbot LN. & 12' NS Curb Line (VALVE IN BOX)

② 2" RW 1943½ VALVE 21' NSPL ABBOT. LN. & 20 EEPL LOT #8 - 2" Bull Plug on end.

BUILT TO COMPANY STANDARDS MAOP 60 PSI
WHICH CONFORM TO B31.8 & D.O.T.
CODE. TESTED W/ AIR TO P.S.I. 100 FOR
30 MIN/HRS. WELDS SOAP TESTED
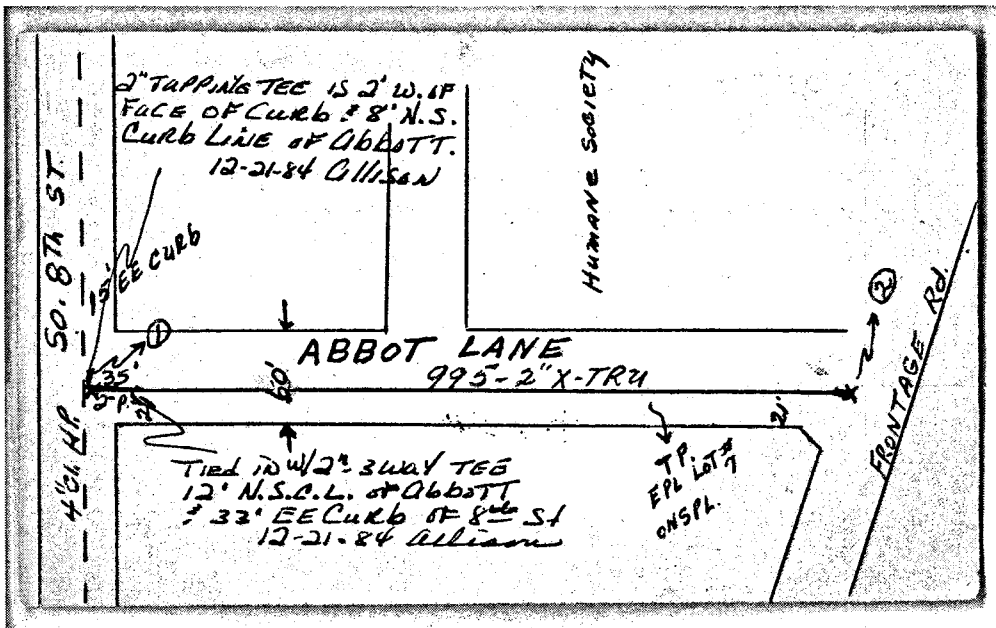
FOREMAN A. DECKER
CM