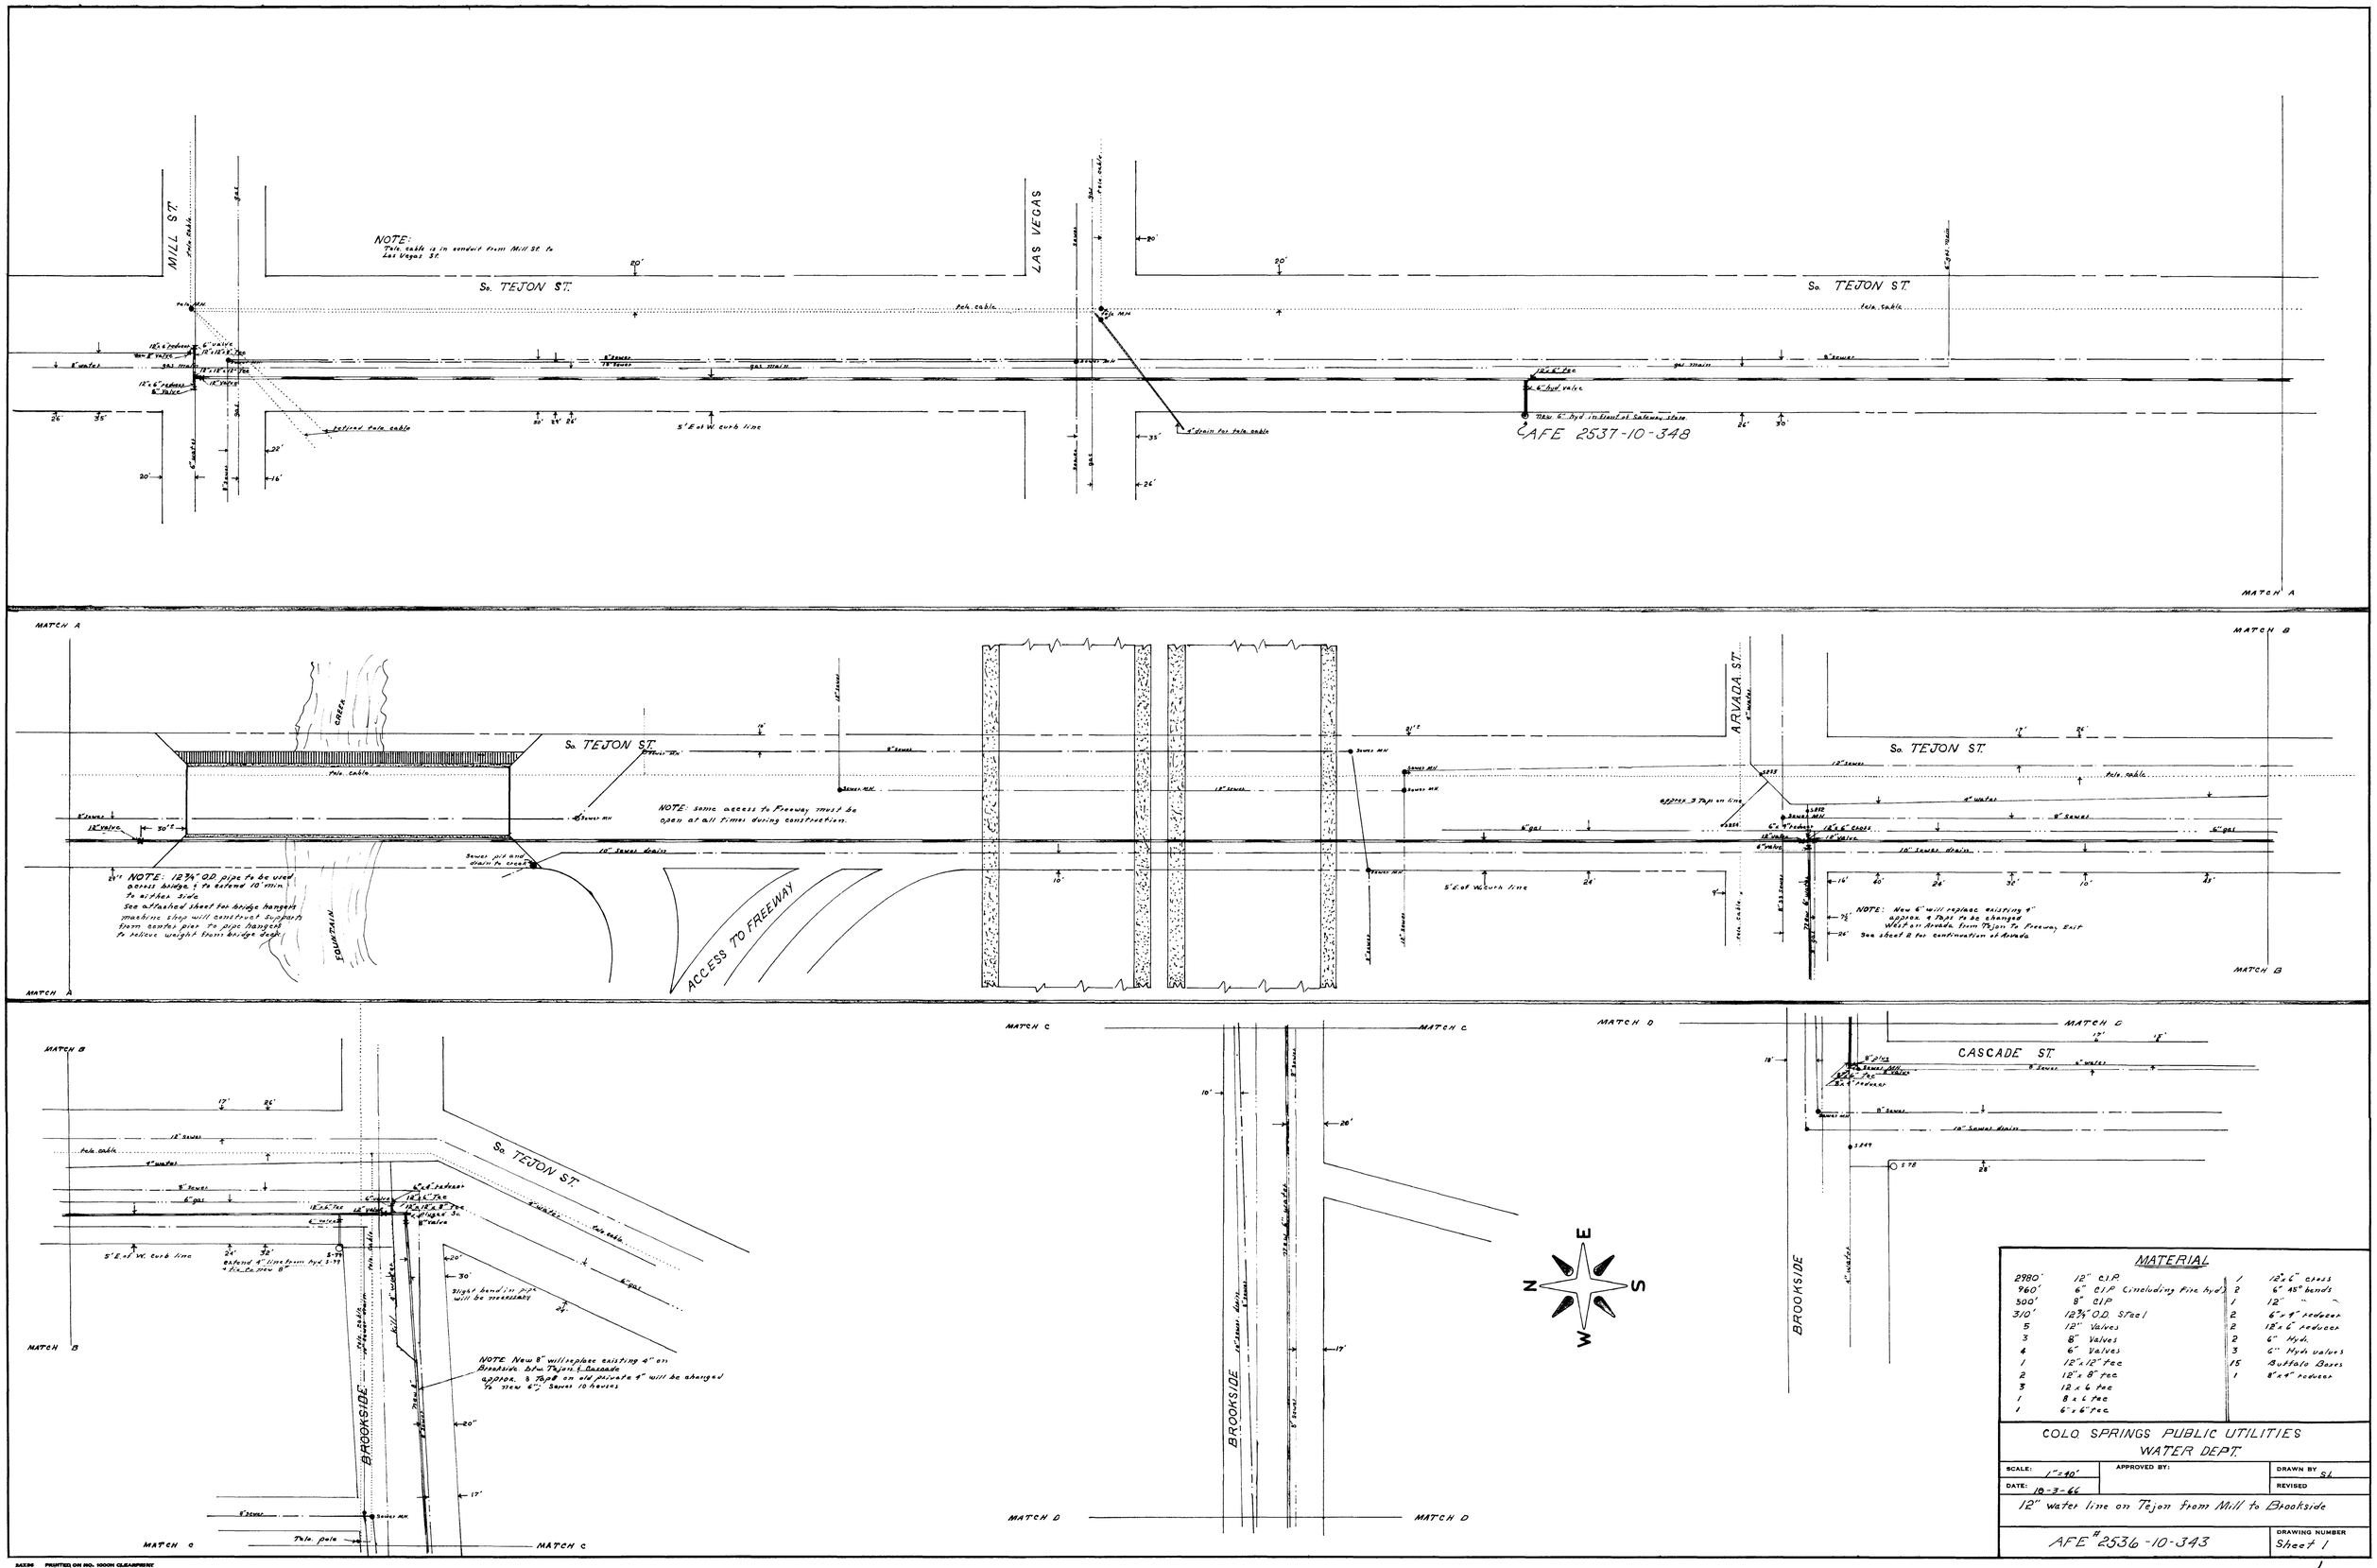

MATERIAL

2980'	12" C.I.P.	1	12" x 6" cross
960'	6" C.I.P. (including fire hyd.)	2	6" 45° bends
500'	8" C.I.P.	1	12" " "
310'	12¾" O.D. Steel	2	6" x 4" reducer
5	12" Valves	2	12" x 6" reducer
3	8" Valves	2	6" Hyd.
4	6" Valves	3	6" Hyd. valves
1	12" x 12" tee	15	Buffalo Boxes
2	12" x 8" tee	1	8" x 4" reducer
3	12 x 6 tee		
1	8 x 6 tee		
1	6" x 6" tee		

COLO. SPRINGS PUBLIC UTILITIES
WATER DEPT.

SCALE: 1" = 40'	APPROVED BY:	DRAWN BY SL
DATE: 10-3-66		REVISED

12" water line on Tejon from Mill to Brookside

AFE # 2536-10-343 — DRAWING NUMBER Sheet 1

2/ST

24X36 PRINTED ON NO. 1000H CLEARPRINT

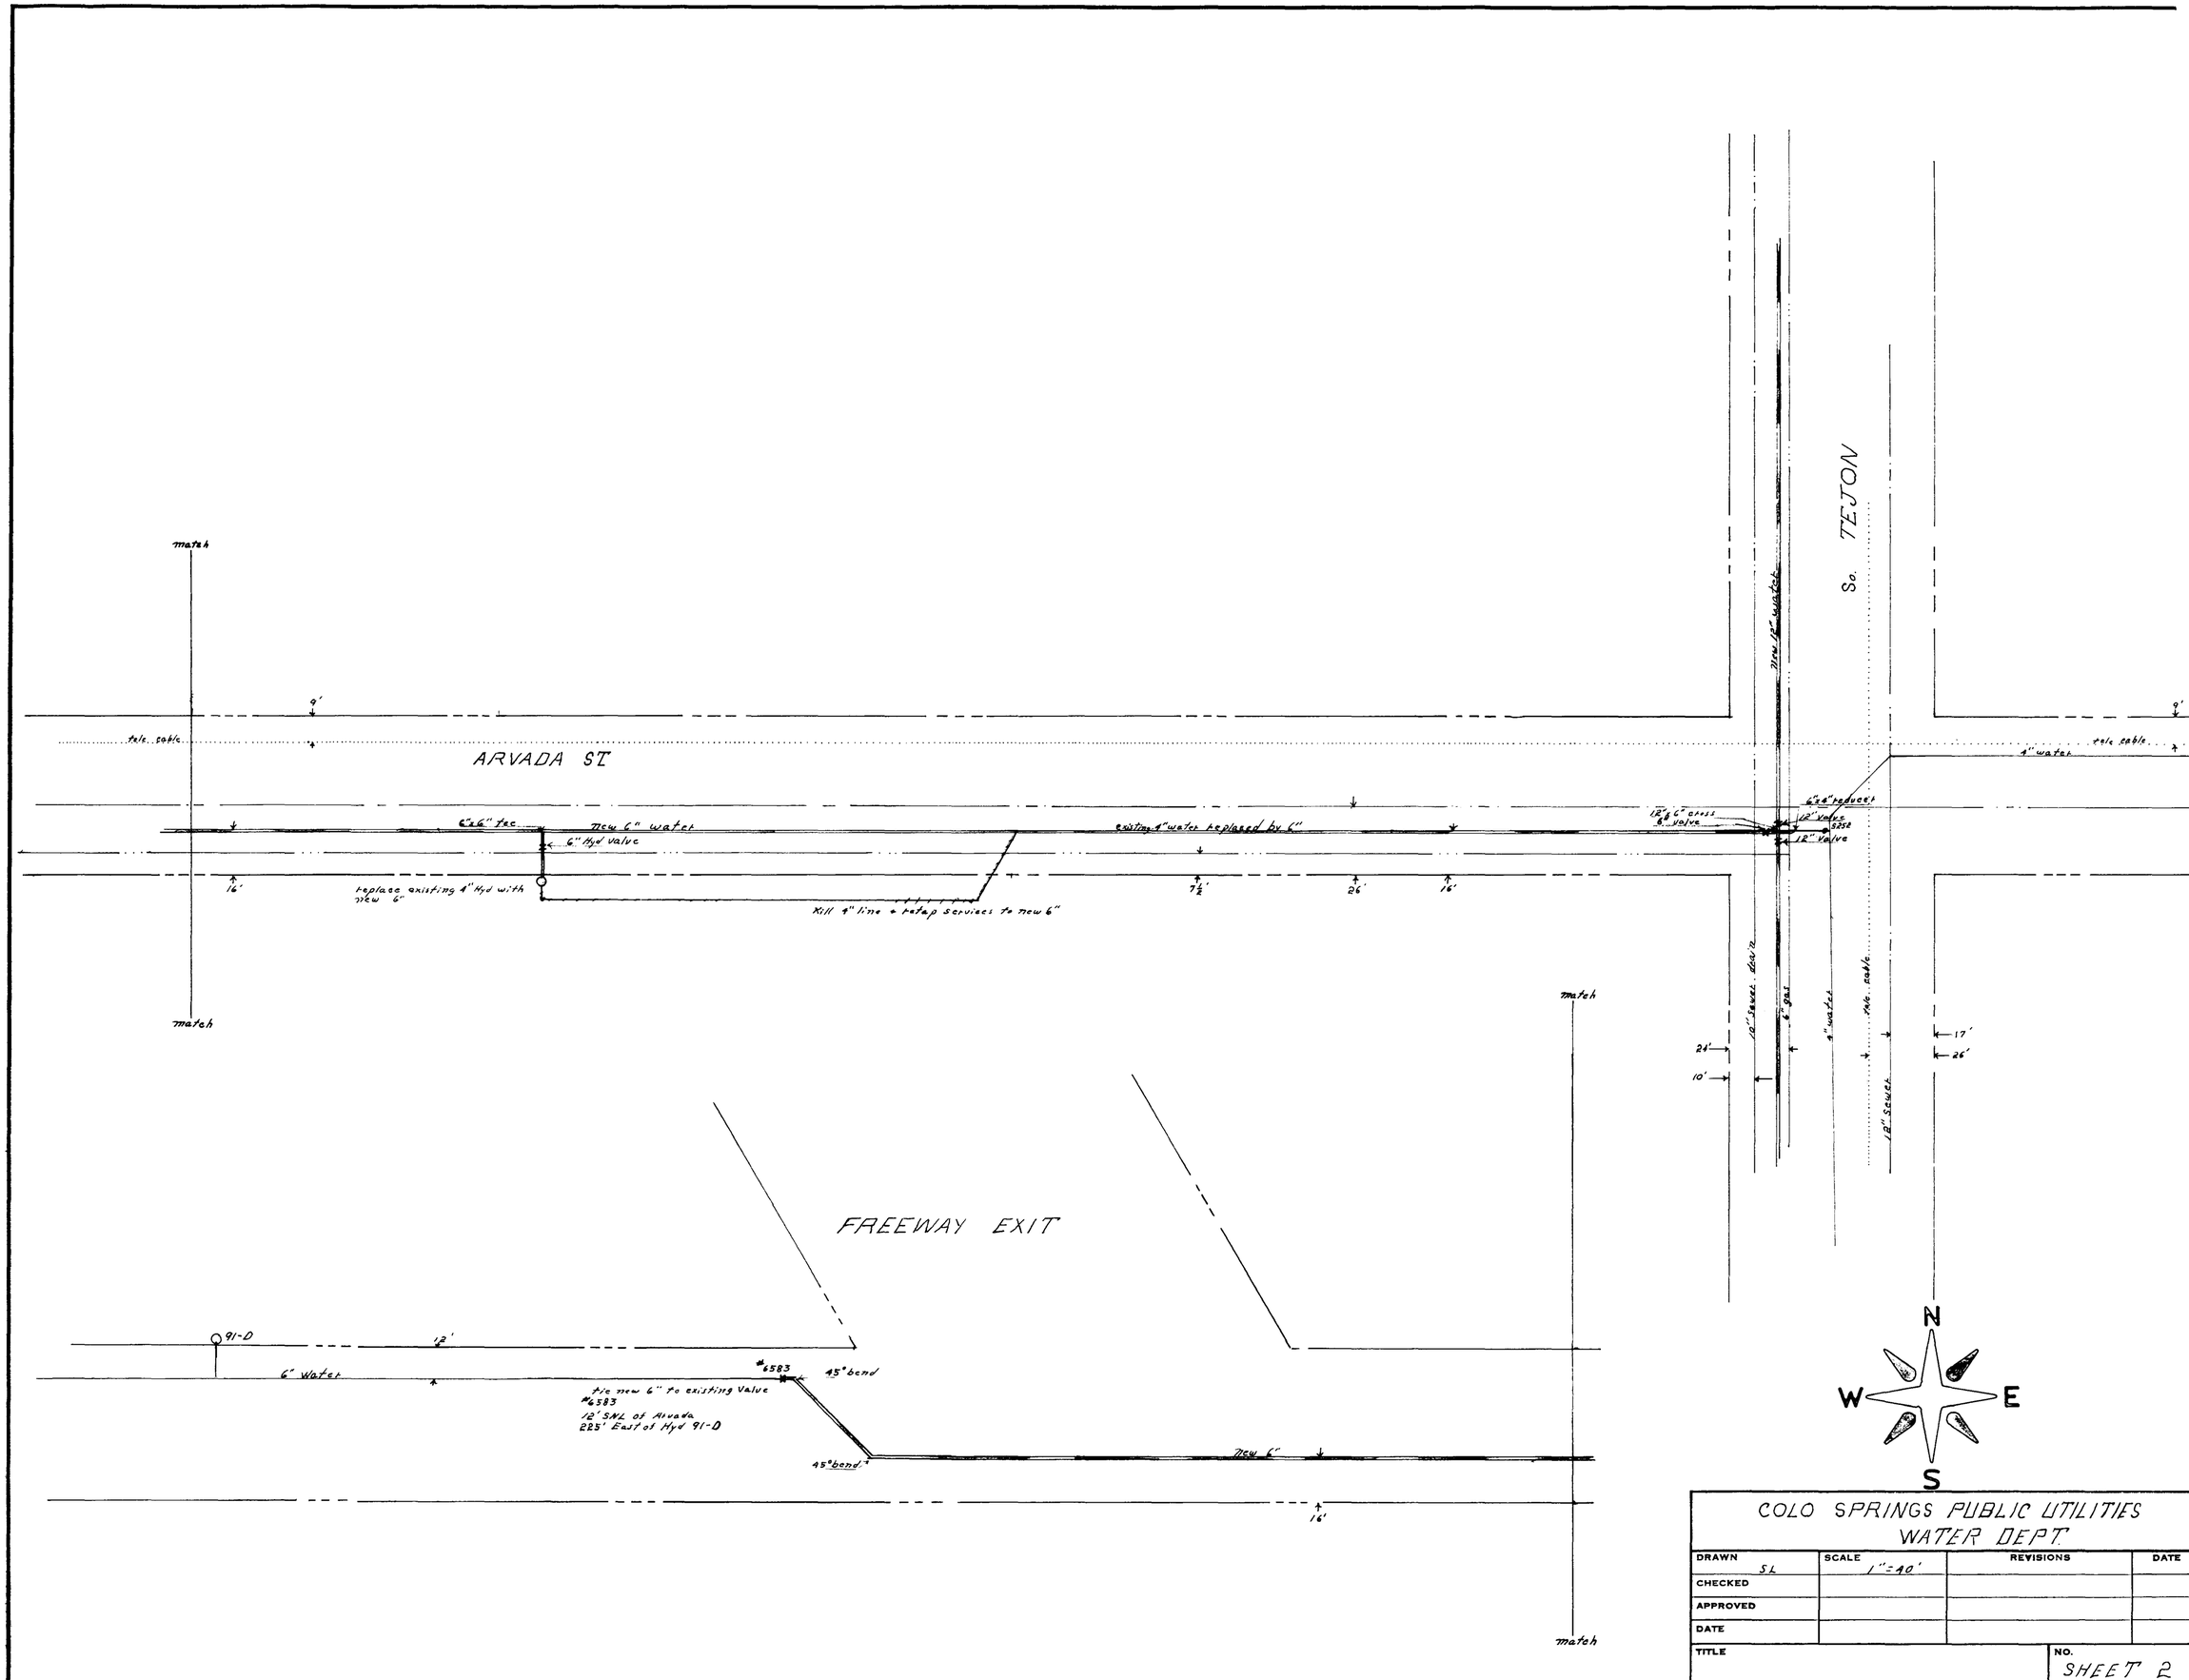

COLO SPRINGS PUBLIC UTILITIES WATER DEPT			
CHECKED			
APPROVED			
DATE			
TITLE		NO. SHEET 2	

TEJON 11-3-66 PAGE 2 of 2
SOUTH FROM FREEWAY PAST LAS VEGAS

CHARLES BRUNING CO. – FIVE HUNDRED

2/ST