FOUNTAIN CREEK SUBDIVISION

10" OUTFALL SEWER

COLORADO SPRINGS, COLORADO

GEORGE L. WILLIAMS — CONSULTING ENGINEER

INDEX

SHEET NO. 1 TITLE SHEET
SHEET NO. 2 STA. 0+00 TO STA. 25+00
SHEET NO. 3 STA. 25+00 TO STA. 45+00
SHEET NO. 4 STA. 45+00 TO STA. 58+19.75
SHEET NO. 5 ADDITION TO LIFT STATION

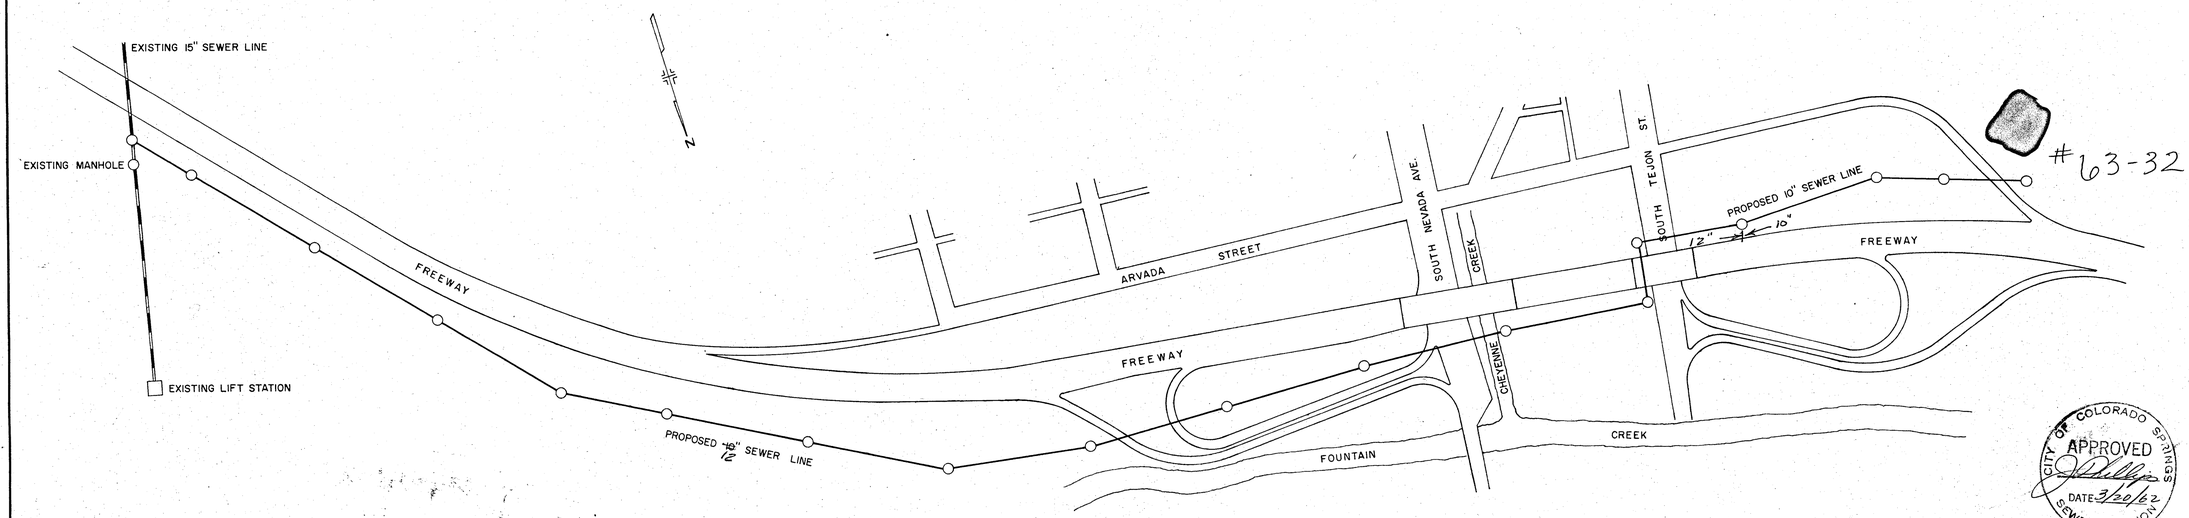

GENERAL NOTE:

EXISTING UTILITY LINES ARE SHOWN ACCORDING TO AVAILABLE INFORMATION. CONTRACTOR SHALL ACTUALLY LOCATE, PROTECT, AND REPAIR IF NECESSARY ALL EXISTING UTILITY LINES AFFECTED.

Any changes or alterations affecting the grades, alignment, elevation, & depth of sanitary sewers & appurtenances shown on this drawing shall be the responsibility of the developer.

Signed

CITY OF COLORADO SPRINGS APPROVED DATE 3/20/62 SEWER DIVISION

APPROVAL EXPIRES Date 6/20/62

REVISIONS	10" OUTFALL SEWER	SIGNATURES & DATES
changed line to 12" from Sta 0+00 to 5+00 RC&B Date		DR. J.R.HOOD
		CKD.
		APP. 3/20/62
	FOUNTAIN CREEK SUBDIVISION LOCATION PLAN	CUST. APP.
		SCALE NONE
		SHEET 1 OF 5
JOB 6013	GEORGE L. WILLIAMS — CONSULTING ENGINEER	DWG. 1233

Set 7

PLAN | SURVEYED | DATE | NOTE BOOK | PLOTTED | BY | No. | GRADES CHECKED | ALIGNMENT CHECKED | R.L. ON MAP CHECKED | STRUCTURE NOTATIONS CHECKED

Access Road From Harrison Interchange
For Construction From Sta 0+00 To 29+61

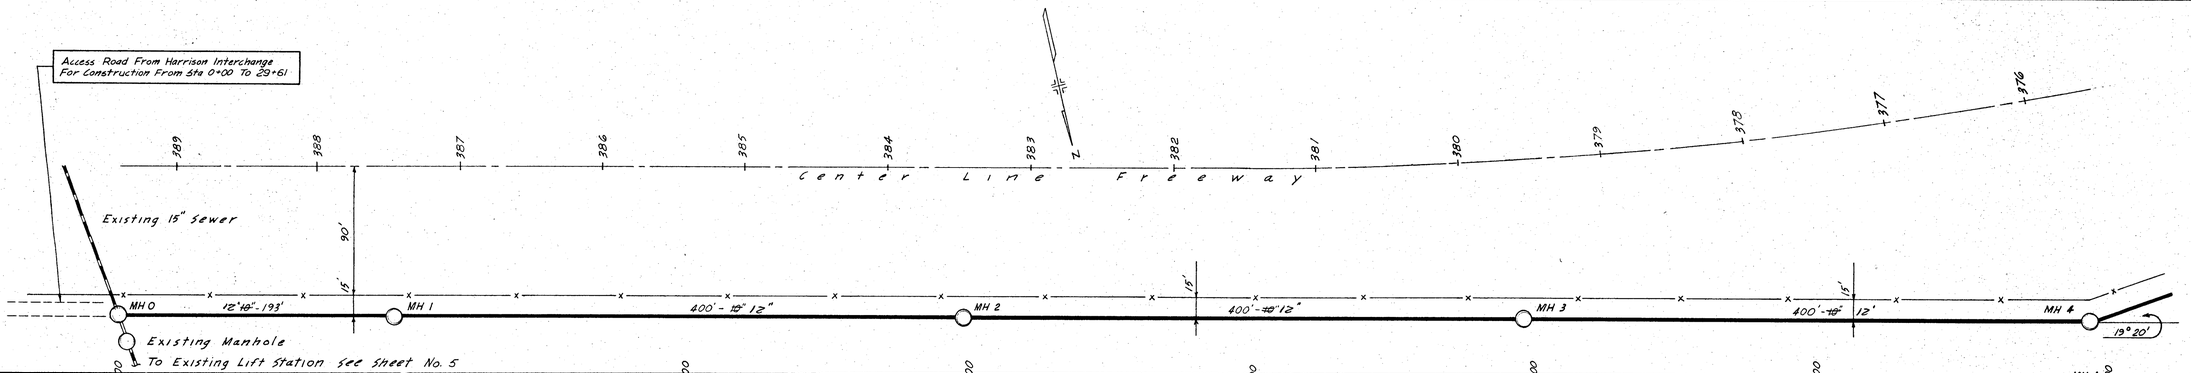

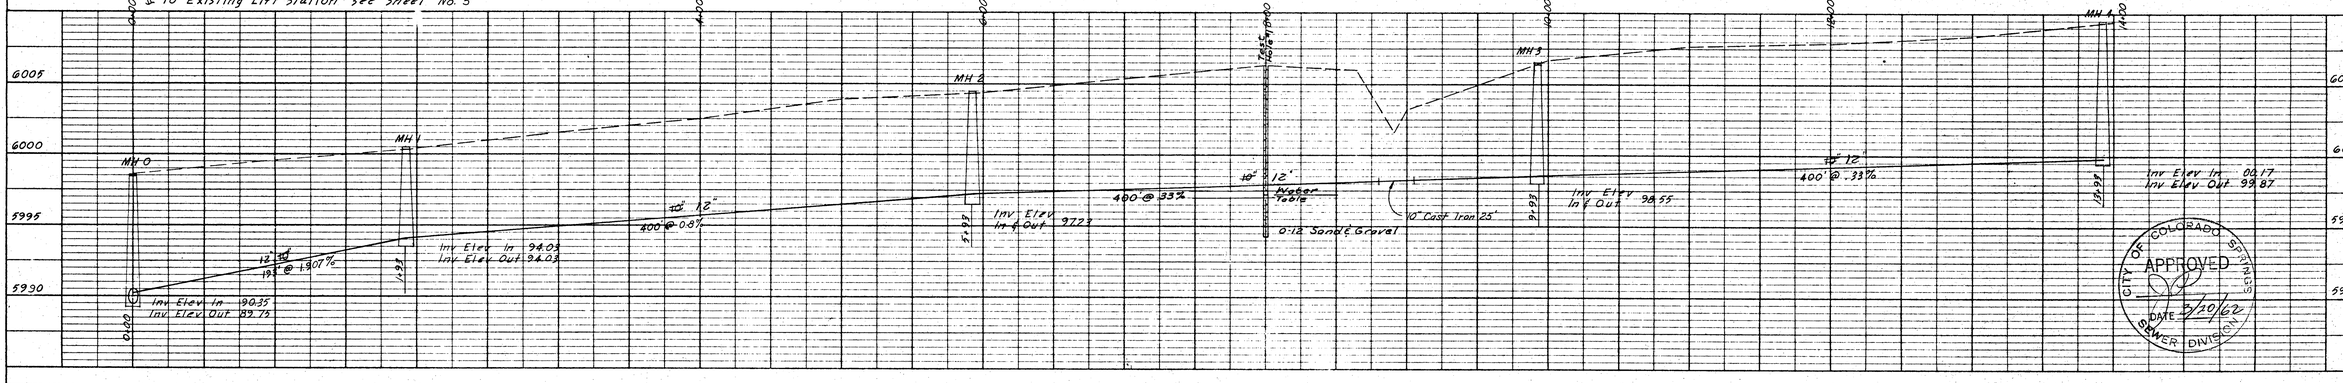

CITY OF COLORADO SPRINGS APPROVED DATE 3/20/62 SEWER DIVISION

Any changes or alterations affecting the grades, alignment, elevation, & depth of cover of sewers & appurtenances shown on this drawing shall be the responsibility of the developer.

Signed

APPROVAL EXPIRES
Date 4/20/62
6/20/62

Any changes or alterations affecting the grades, alignment, elevation, & depth of cover of sewers & appurtenances shown on this drawing shall be the responsibility of the developer.

Signed

PROFILE | SURVEYED | DATE | NOTE BOOK | PLOTTED | BY | No. | GRADES CHECKED | ALIGNMENT CHECKED | STRUCTURE NOTATIONS CHECKED

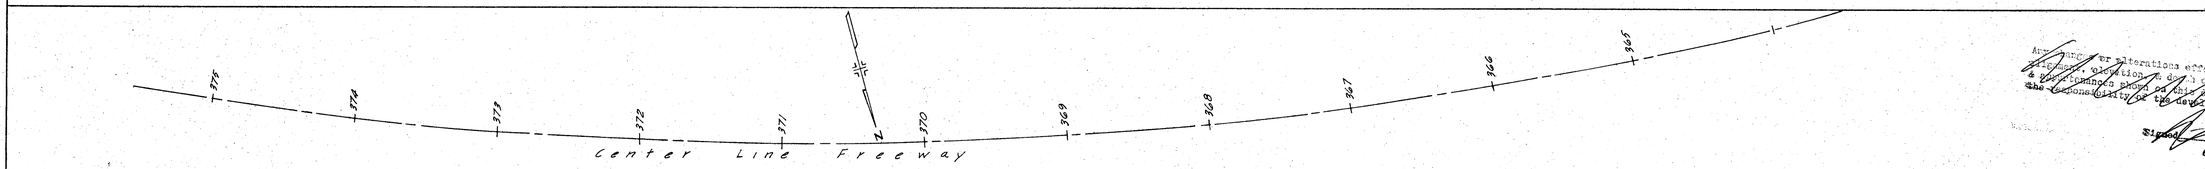

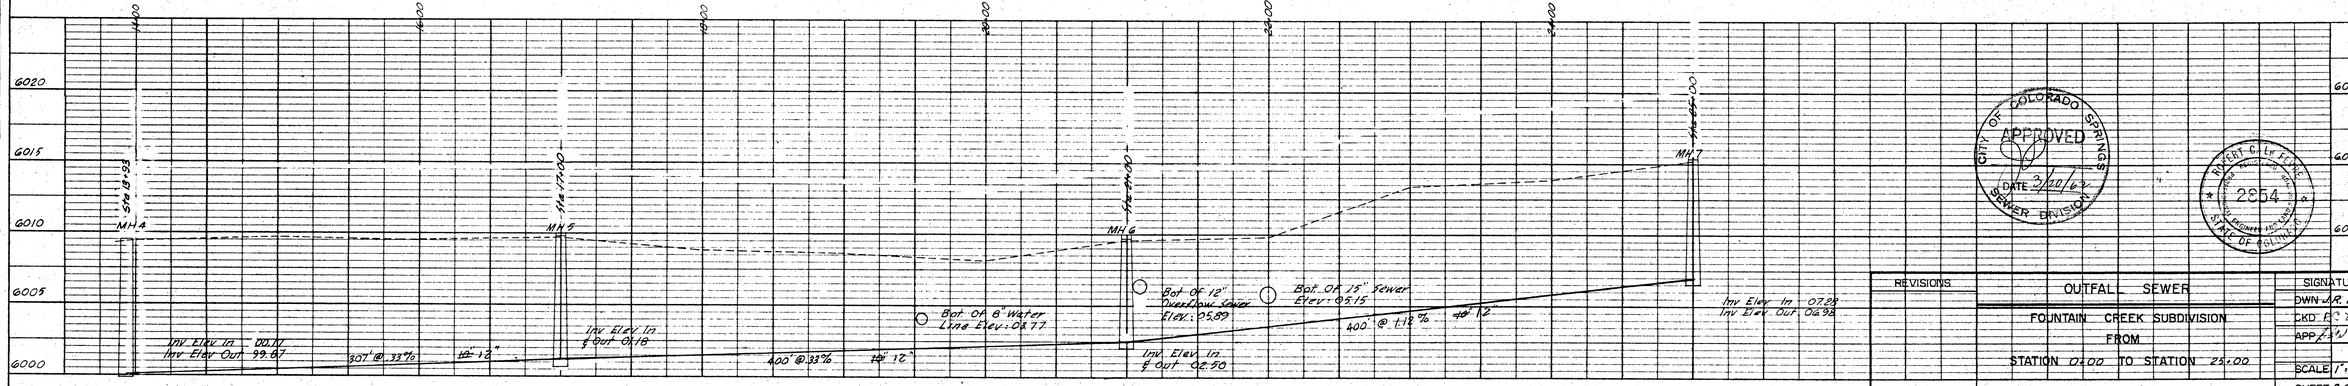

CITY OF COLORADO SPRINGS APPROVED DATE 3/20/62 SEWER DIVISION

REGISTERED ENGINEER 2854 STATE OF COLORADO

REVISIONS	OUTFALL SEWER	SIGNATURES
	FOUNTAIN CREEK SUBDIVISION	DWN A.P. Hood
	FROM	CKD [illegible]
	STATION 0+00 TO STATION 25+00	APP. 3/19/62
		SCALE 1"=50'
		SHEET 2 OF 5
JOB 6013	G.L.WILLIAMS - CONSULTING ENGINEER	DWG. 1234

PLATE 2 - PLAN-PROFILE O. P. R. & R. E. STANDARD
THE FREDERICK POST CO., CHICAGO

PLAN | SURVEYED | PLOTTED | NOTE BOOK | No. | DATE | BY | ALIGNMENT CHECKED | RT. OF WAY CHECKED

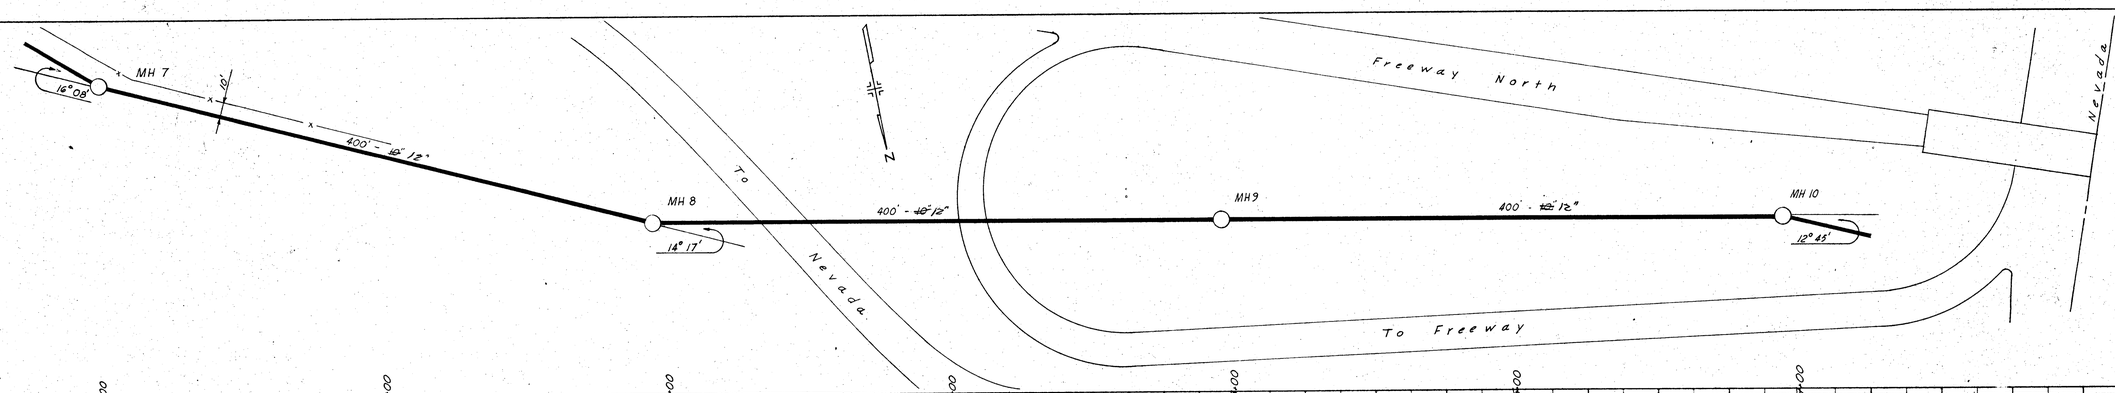

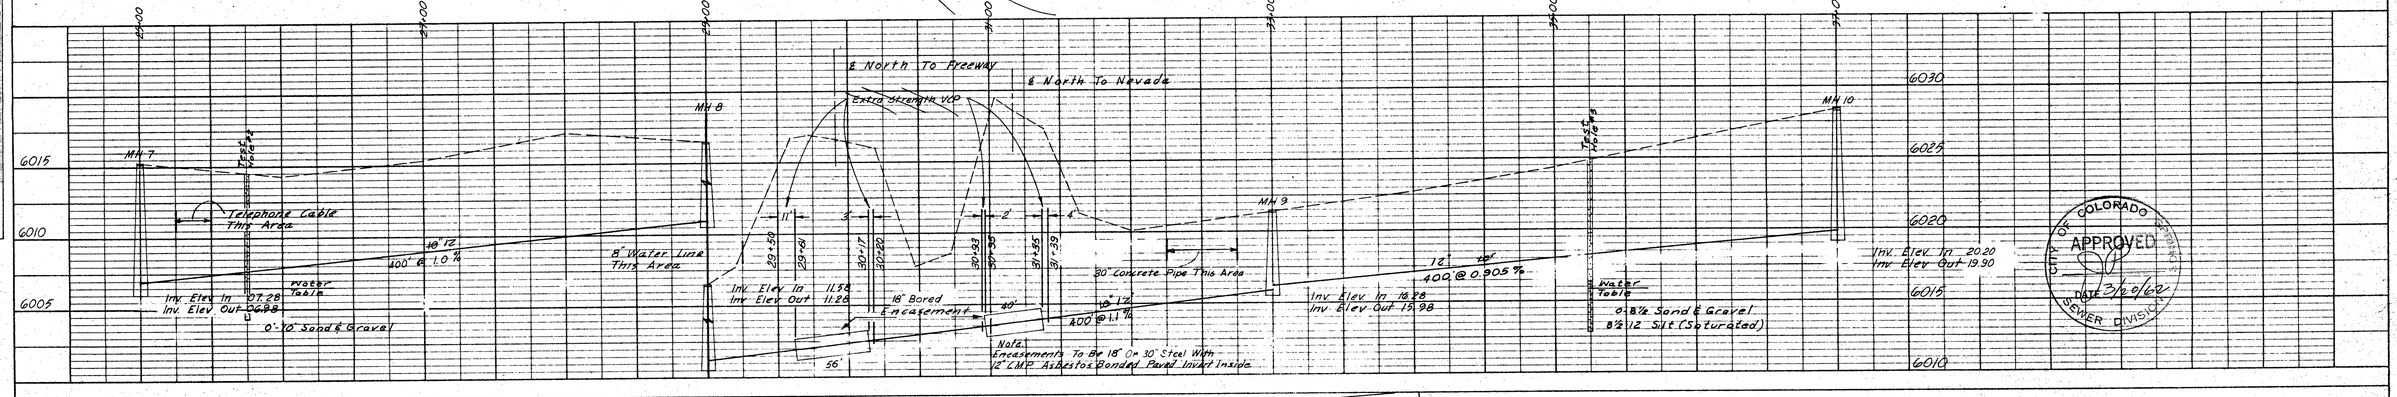

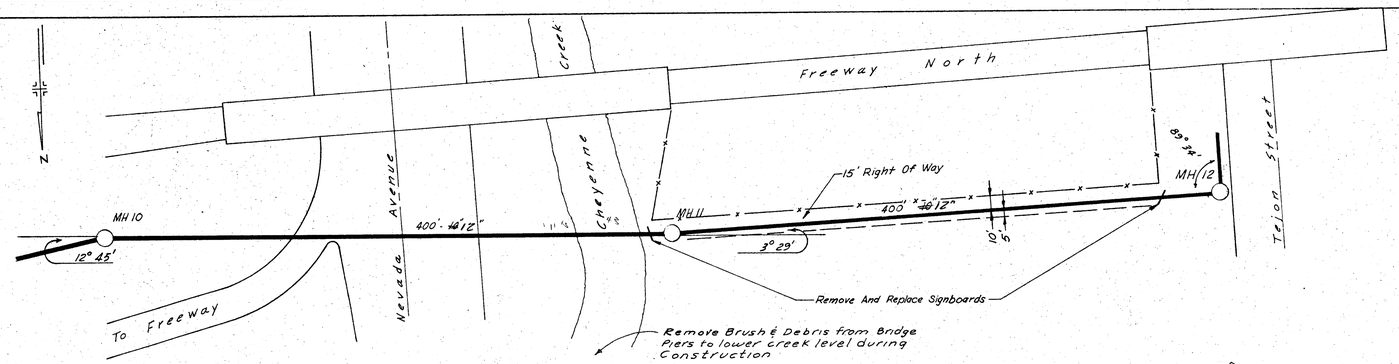

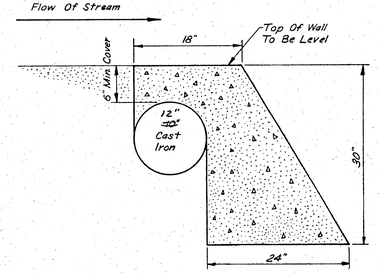

DETAIL SEWER LINE PROTECTION WALL AT CREEK CROSSING
SCALE 1" = 1'-0"

Any changes or alterations effecting the grades, alignment, elevation, & depth of cover of sewers & appurtenances shown on this drawing shall be the responsibility of the developer.

Signed

APPROVAL EXPIRES
Date 4/20/62
6/20/62

NOTES:
Approximate Concrete Quantity 6 Yds. Length Of Wall 50'.
All Junctions Between VCP And CIP Or CMP Asbestos Bonded Pipe Will Be As Shown In Specifications.

Any changes or alterations effecting the grades, alignment, elevation, & depth of cover of sewers & appurtenances shown on this drawing shall be the responsibility of the developer.

Signed

CITY OF COLORADO SPRINGS APPROVED DATE 3/20/62 SEWER DIVISION

ENGINEER OR SURVEYOR No. 2854 STATE OF COLORADO

PROFILE | SURVEYED | PLOTTED | NOTE BOOK | No. | DATE | BY | GRADES CHECKED | B. M.'s NOTED | STRUCTURE NOTATIONS CHECKED

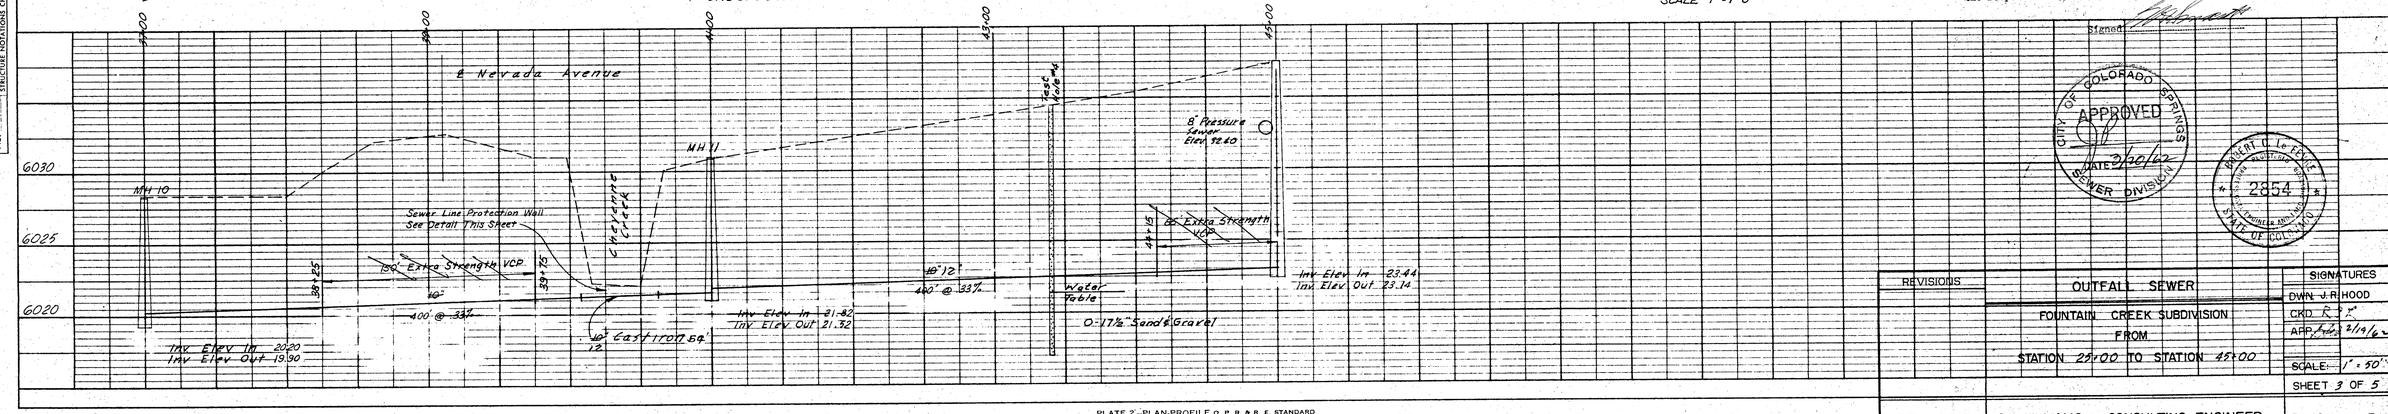

REVISIONS	OUTFALL SEWER	SIGNATURES
	FOUNTAIN CREEK SUBDIVISION	DWN J.R.HOOD
	FROM	CKD R.J.
	STATION 25+00 TO STATION 45+00	APP J.J. 3/19/62
		SCALE 1" = 50'
		SHEET 3 OF 5
JOB 6013	G.L. WILLIAMS - CONSULTING ENGINEER	DWG. 1235

PLATE 2 - PLAN-PROFILE O. P. R. & R. E. STANDARD
THE FREDERICK POST CO., CHICAGO

PLAN — SURVEYED — PLOTTED — NOTE BOOK — No. — BY — DATE — CHECKED — AS-BUILT NOTED — R.W.L. NOTED — STRUCTURE NOTATIONS CHECKED

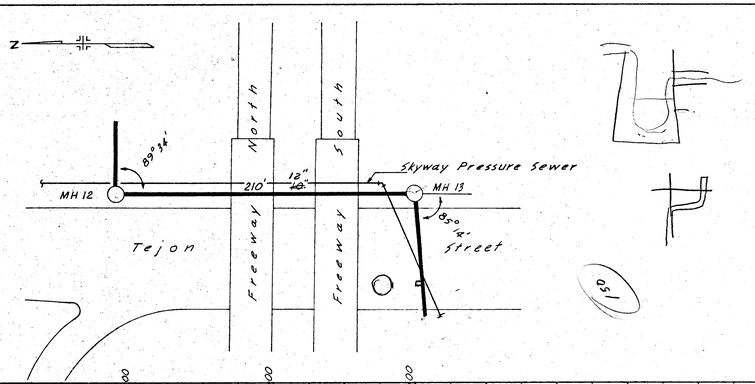

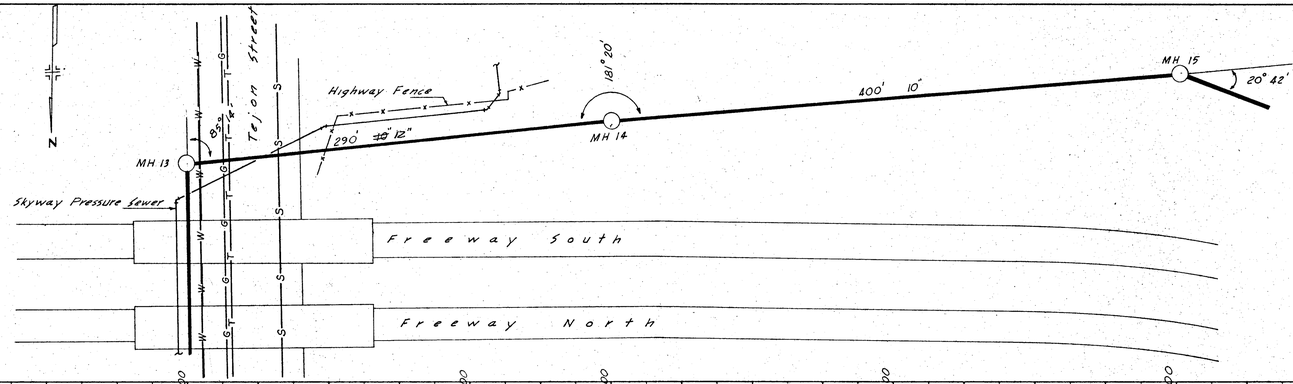

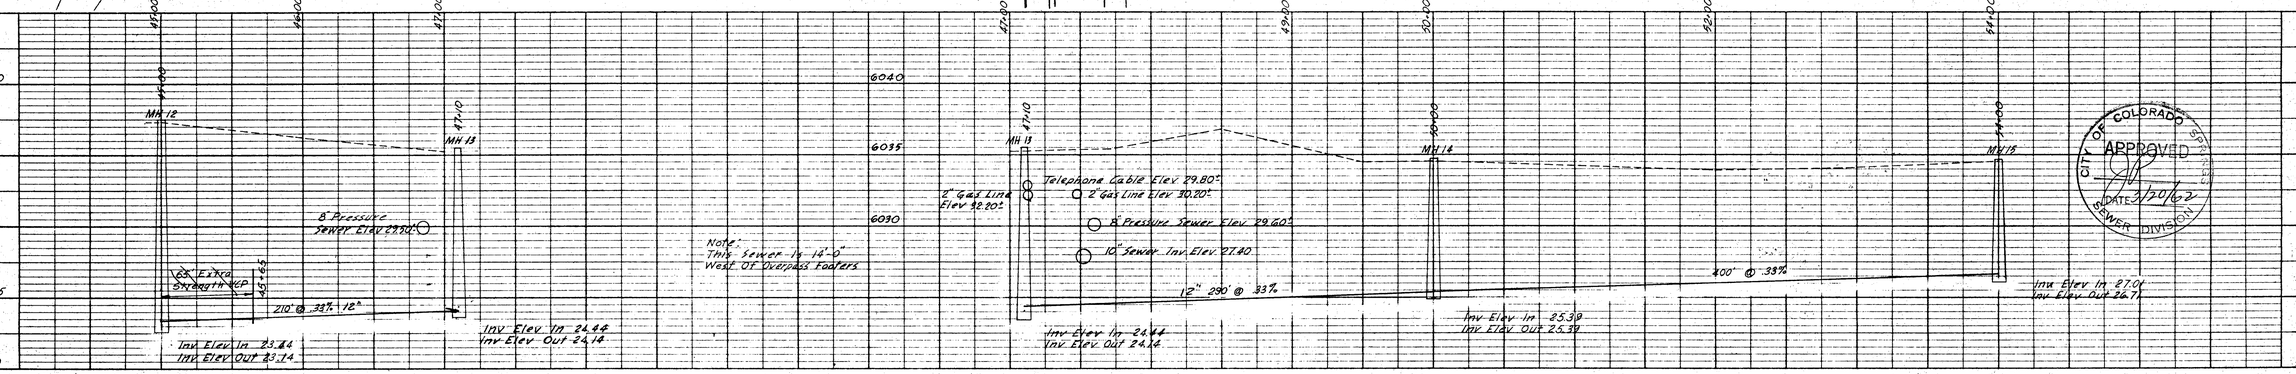

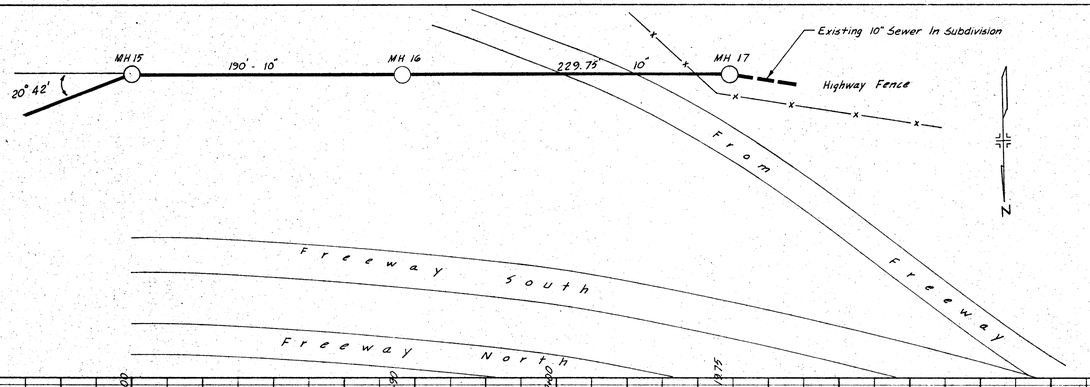

Any changes or alterations effecting the grades, alignment, elevation, & depth of cover of manholes & appurtenances shown on this drawing shall be the responsibility of the developer.

Signed

APPROVAL EXPIRES
Date 6/20/62

Any changes or alterations effecting the grades, alignment, elevation, & depth of cover of manholes & appurtenances shown on this drawing shall be the responsibility of the developer.

Signed

CITY OF COLORADO SPRINGS
APPROVED
DATE 3/20/62
SEWER DIVISION

ROBERT E. LeFEVRE
No. 2854
REGISTERED PROFESSIONAL ENGINEER
STATE OF COLORADO

PROFILE — SURVEYED — PLOTTED — NOTE BOOK — No. — BY — DATE — CHECKED — AS-BUILT NOTED — R.W.L. NOTED — STRUCTURE NOTATIONS CHECKED

PLATE 2 -PLAN-PROFILE © P. R. & R. E. STANDARD
THE FREDERICK POST CO., CHICAGO

REVISIONS	OUTFALL SEWER FOUNTAIN CREEK SUBDIVISION FROM STATION 45+00 TO STATION 58+19.75	SIGNATURES DWN R.Hood CKD APP. 3/19/62 SCALE 1" = 50' SHEET 4 OF 5
JOB 6013	G.L.WILLIAMS - CONSULTING ENGINEER	DWG. 1236

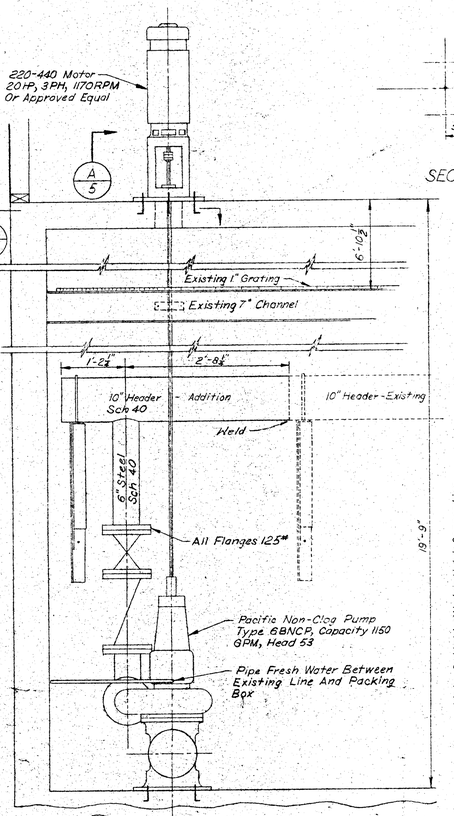

ELEVATION

SCALE: ¾" = 1'-0"

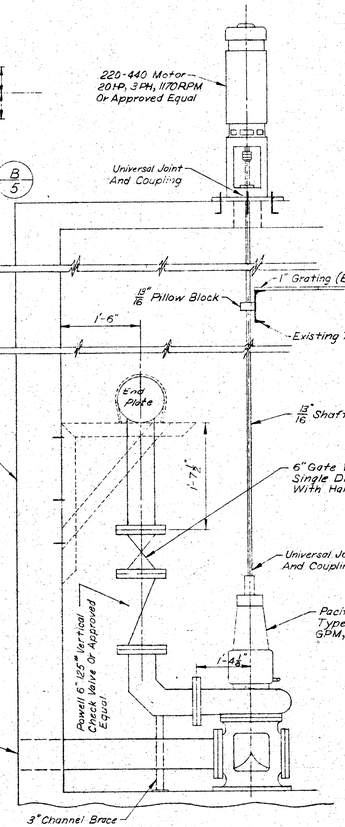

SECTION A/5

SCALE: ¾" = 1'-0"

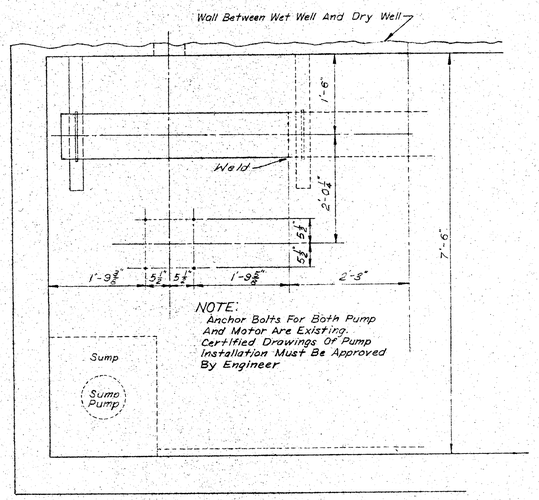

PLAN

SCALE: ¾" = 1'-0"

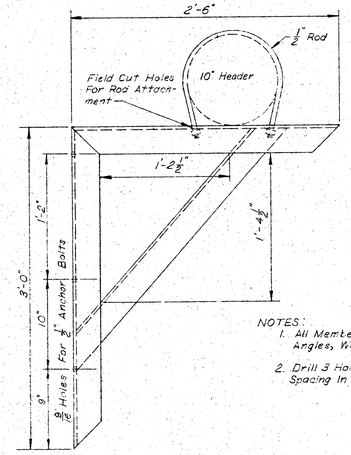

NOTES:

1. All Members Of Support 3"x3"x¼" Steel Angles, Welded.
2. Drill 3 Holes In Concrete Wall To Match Spacing In Support For ¾" Anchor Bolts.

DETAIL OF HEADER SUPPORT

1 REQUIRED

SCALE: 1½" = 1'-0"

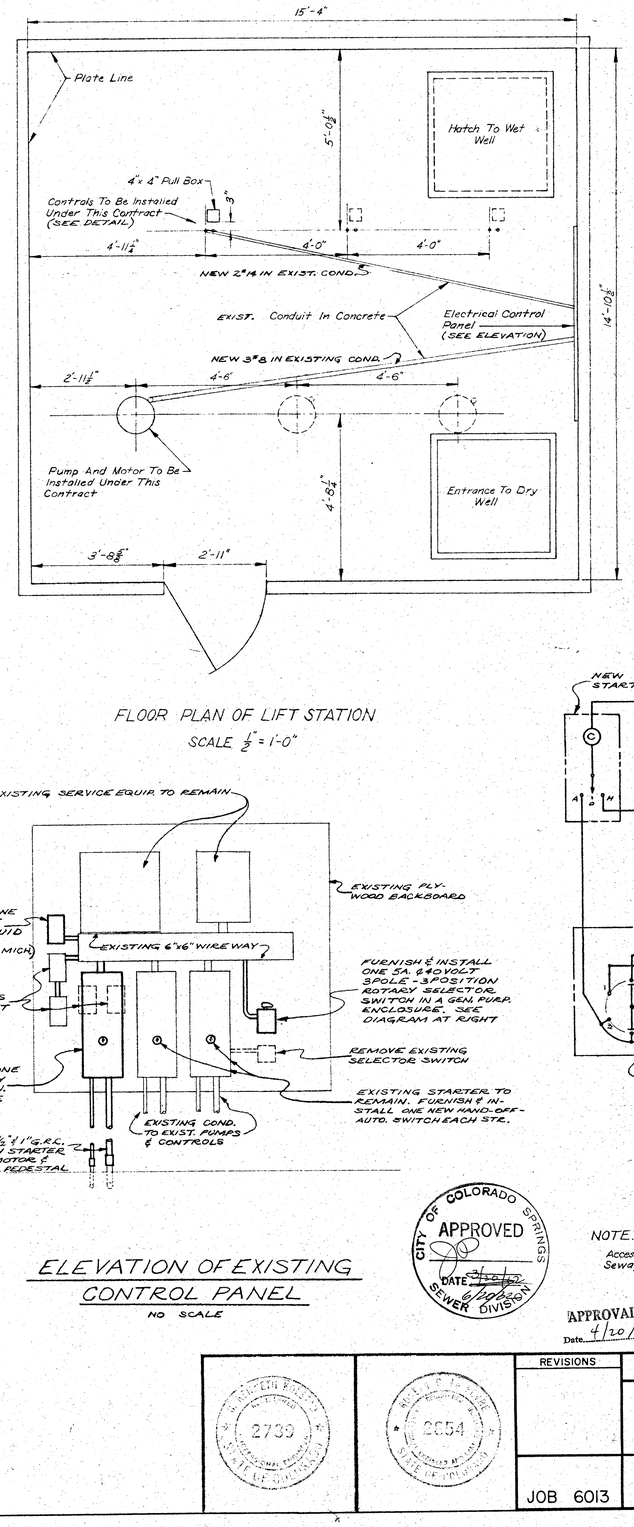

FLOOR PLAN OF LIFT STATION

SCALE ½" = 1'-0"

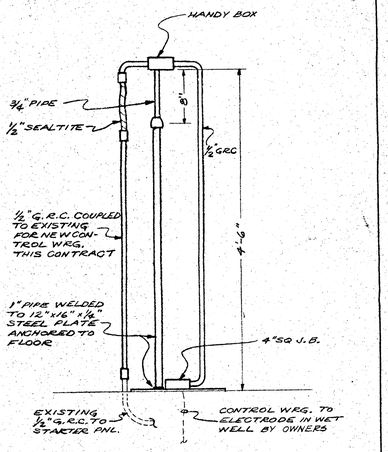

NEW LIQUID LEVEL ELECTRODE CONTROL WIRING PEDESTAL DETAIL

NO SCALE

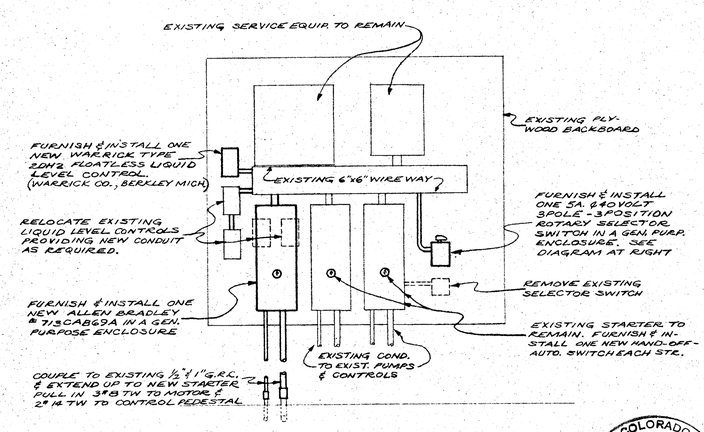

ELEVATION OF EXISTING CONTROL PANEL

NO SCALE

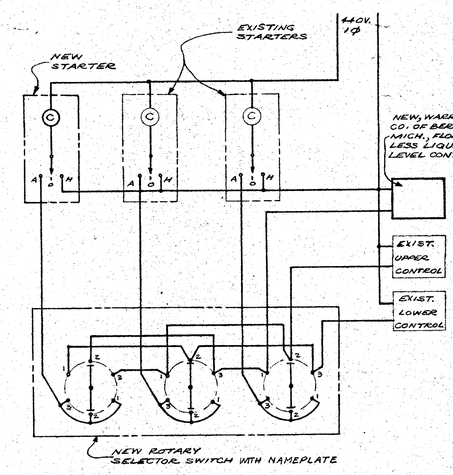

PUMP CONTROL DIAGRAM

NO SCALE

Any changes or alterations affecting the grades, alignment, elevation, & depth of cover & appurtenances shown on this drawing shall be the responsibility of the developer.

Signed

NOTE:

Access To Lift Station Is Through Colorado Springs Municipal Sewage Treatment Plant.

CITY OF COLORADO SPRINGS APPROVED DATE 4/20/62 SEWER DIVISION

APPROVAL EXPIRES Date 4/20/62

REGISTERED PROFESSIONAL ENGINEER 2739 STATE OF COLORADO

REGISTERED PROFESSIONAL ENGINEER 2654 STATE OF COLORADO

REVISIONS	OUTFALL SEWER	SIGNATURES
	FOUNTAIN CREEK SUBDIVISION PUMP ADDITION TO LIFT STATION	DWN RKV-CKK
		CKD [illegible]
		APP [illegible] 3/19/62
		SCALE AS NOTED
		SHEET 5 OF 5
JOB 6013	G.L. WILLIAMS - CONSULTING ENGINEER	DWG. 1245