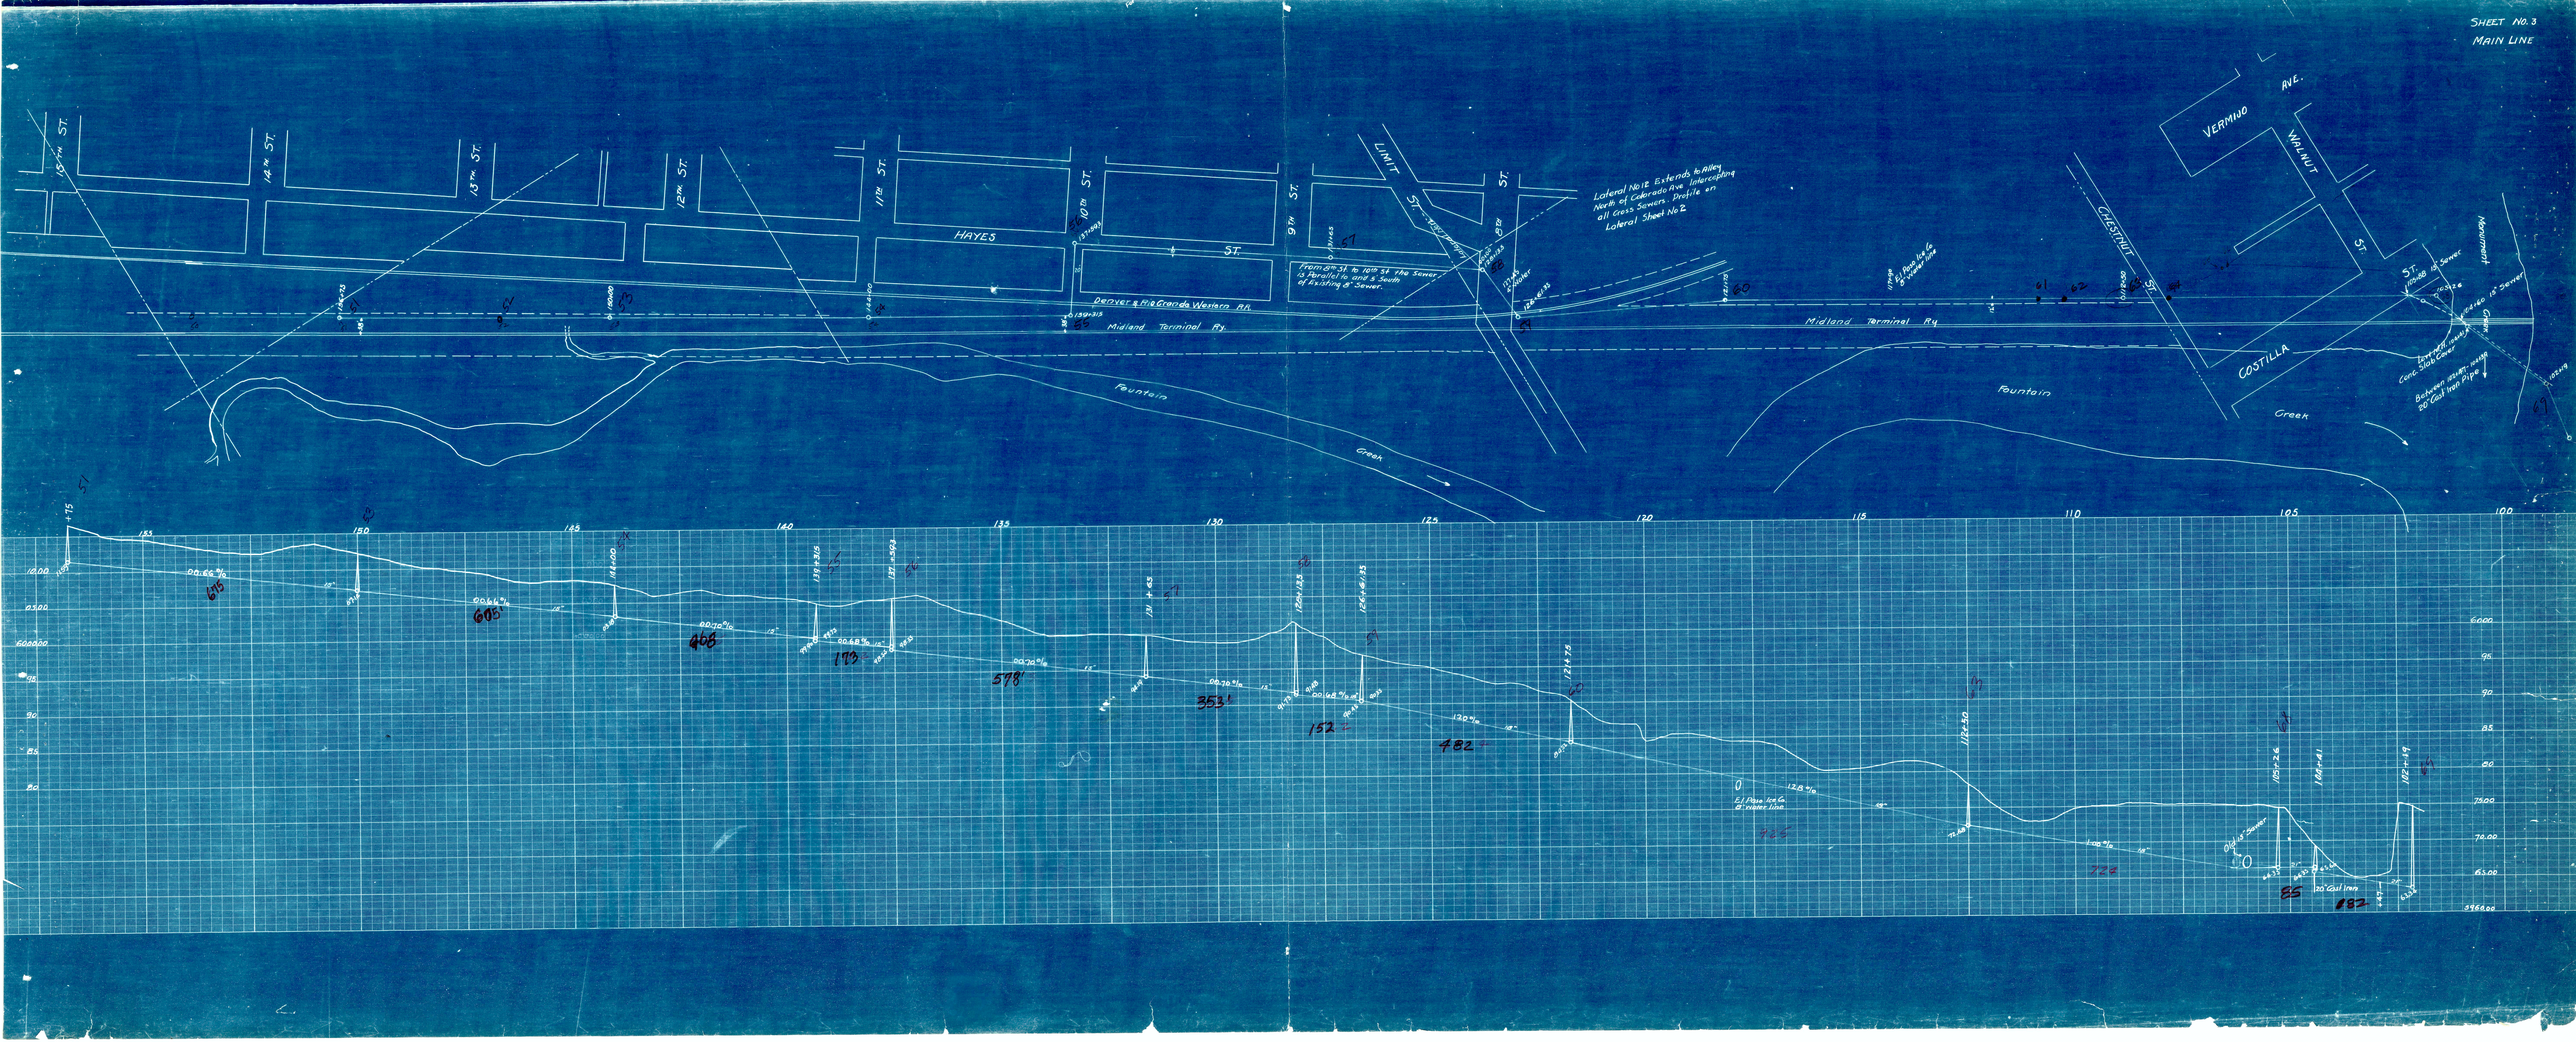SHEET No. 3
MAIN LINE