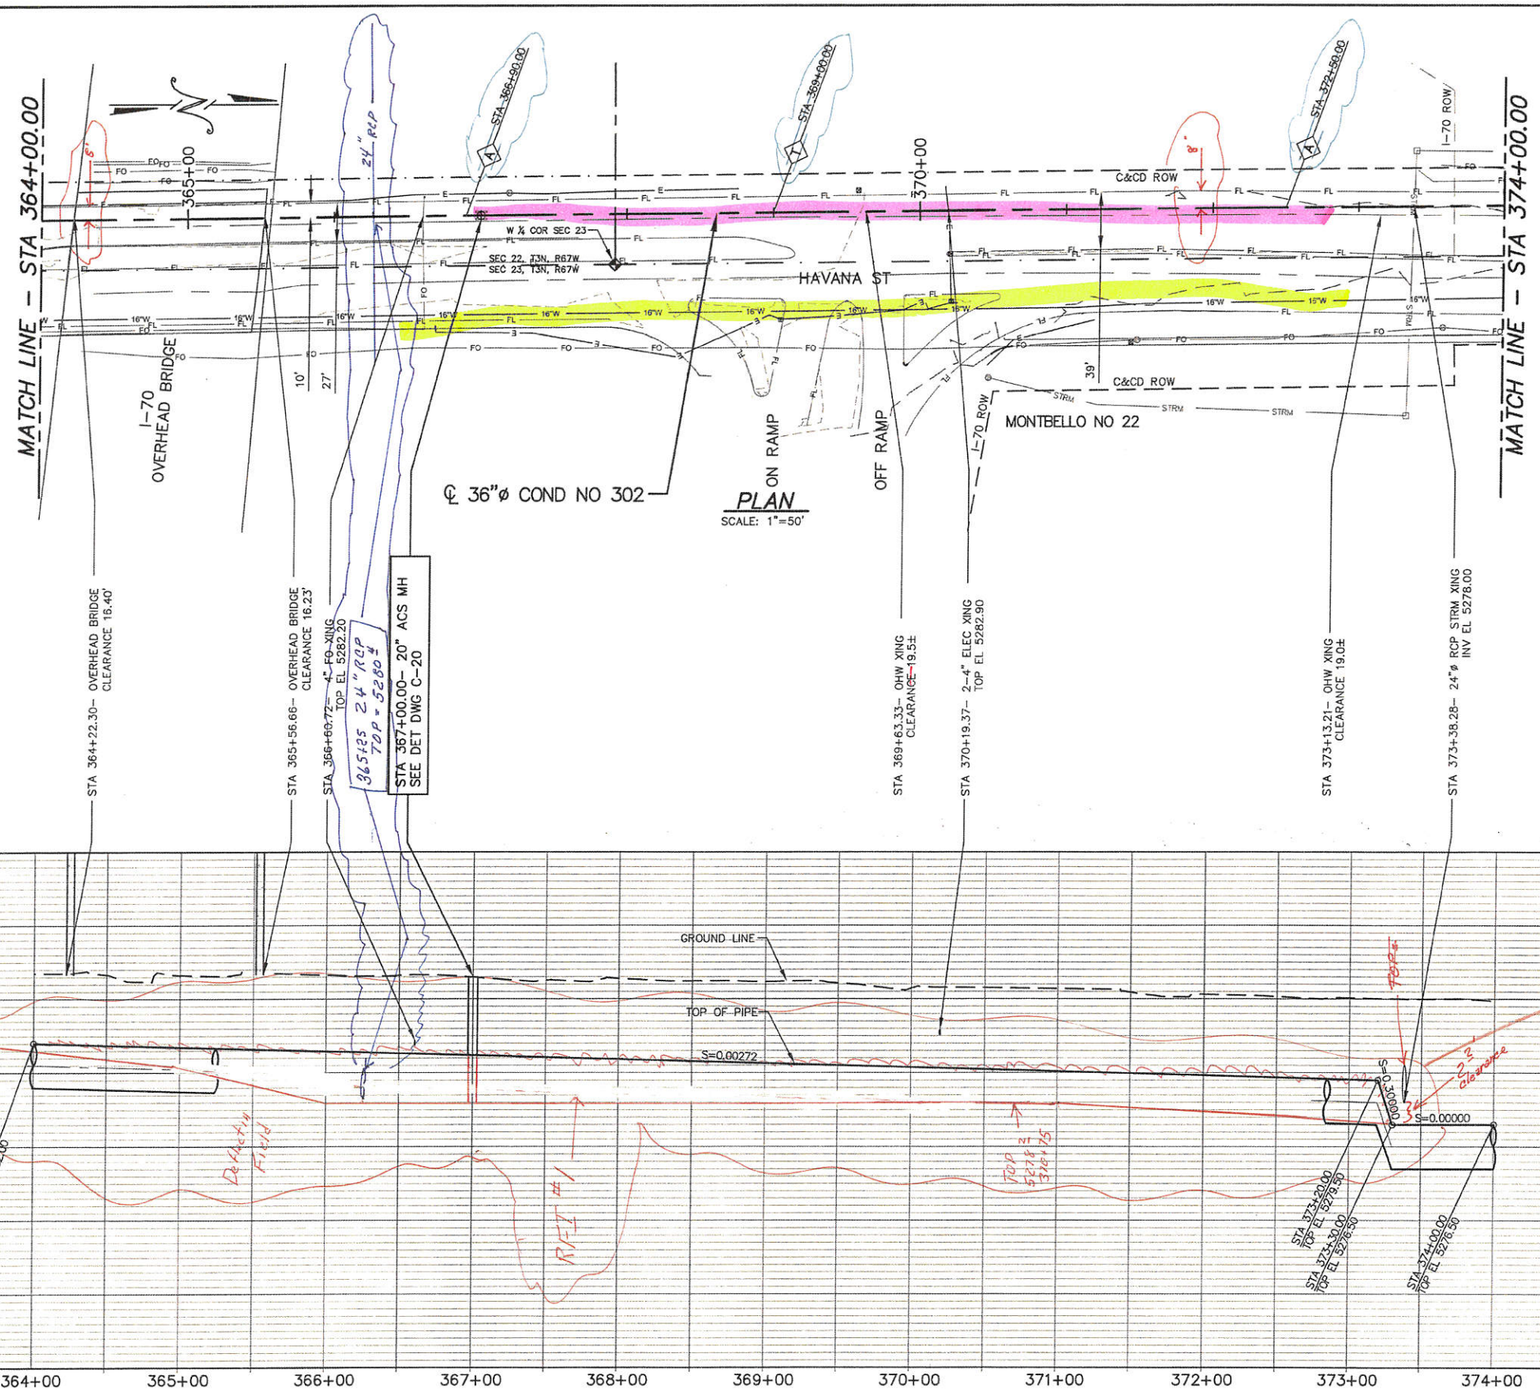

PROFILE
SCALE: 1"=50' HORIZ
1"= 5' VERT

FOR BURIED UTILITY INFORMATION
THREE (3) BUSINESS DAYS
BEFORE YOU DIG
CALL 811
(or 1-800-922-1987)
UTILITY NOTIFICATION
CENTER OF COLORADO (UNCC)
www.uncc.org

DENVER WATER
1600 West 12th Avenue
Denver, Colorado 80204
Phone (303)628-6000
Fax (303)628-6851
www.denverwater.org

CONSULTANT

CONDUIT NO 302

36"ø RECYCLED WATER PIPELINE
E 33RD AVE & BOSTON ST
TO E 47TH AVE & PEORIA ST

No	Date	Description
	2/9/11	FINAL FOR CONSTRUCTION

REVISIONS

VERIFY SCALES

BAR IS ONE INCH ON ORIGINAL DRAWING
0 1"
IF NOT ONE INCH ON THIS SHEET, ADJUST SCALES ACCORDINGLY

PT NO:	15313
CAD DWG FILE:	C1-C12
DRAWN BY:	MMd
CHKD BY:	ROSS/
APPD BY:	
DATE:	October 2009
CONTRACT:	12965A
FIELD BOOK NO:	
AS BUILT DATE:	
AS BUILT BY:	

DRAWING TITLE

PLAN & PROFILE
STA 364+00.00 TO
STA 374+00.00

C-10

\\Cngfs6\projects\new_projects\15313\dwg\Dsgn\Final For Construction\15313_Dsgn_C1-C12.dwg, C-10, 2/10/2011 8:17 AM