WORK MAP NO. 109-1969.

ACCOUNT NO. 2221.

FOREMAN Wm Slogar

STARTED 5-8-1969.

FINISHED 6-16-1969.

LAID 2,171' of 16" C.I. Main
4' " 12" " "

16" C.I. Main Lined.

Mech. Fittings.

Rem.
16" Plug and
2" Blow off.
Laid 16" DS. 8'-10"
45° Bend. S.
16" DS. 4'-0"
16" 45° Bend. S.
16" Rods, Clamps
1" 16" x 12" TEE
Fr. 43' S of
to S. Bend.

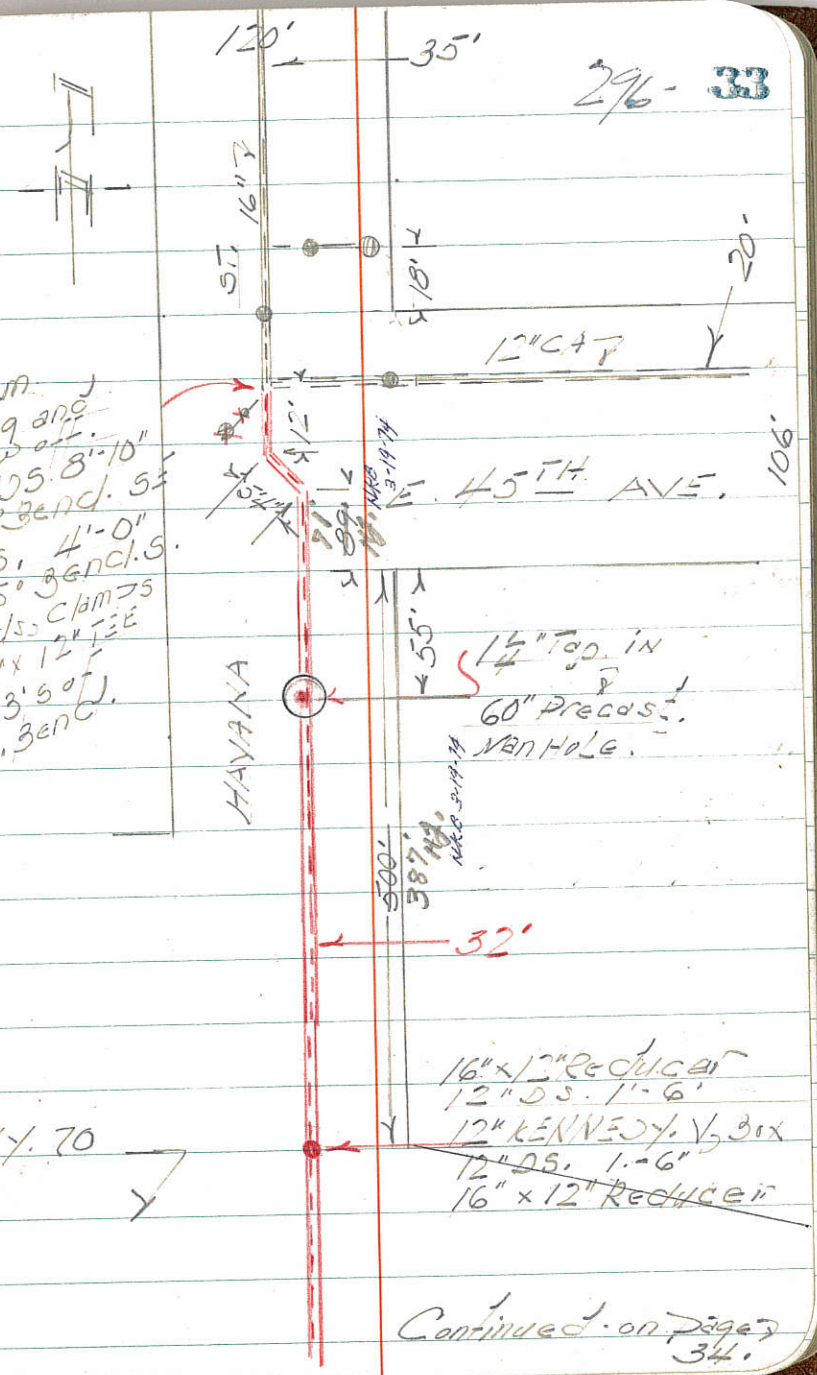

interstate HY. 70
overpass

PROCESSING RECORD			
	By	Date	Check
FIELD PK. ENTRY	C.F.	6-20-69	HY
200' MAP	HKB	6-24-69	ARP
300' MAP	—	—	—
MILEAGE REP.	HKB	6-24-69	ARP
STREET INDEX.	HKB	6-24-69	ARP
PIPE & HYDT.	BEYOND	MAP	
12" & LGR.	HKB	2-11-70	E.F.

W. C. Biggs, Inspector

Continued on Page 34.

Acct. No 2221

Continued. fr. Page 33.

I 70. OVER PASS.

interstate Hy. No. 70.
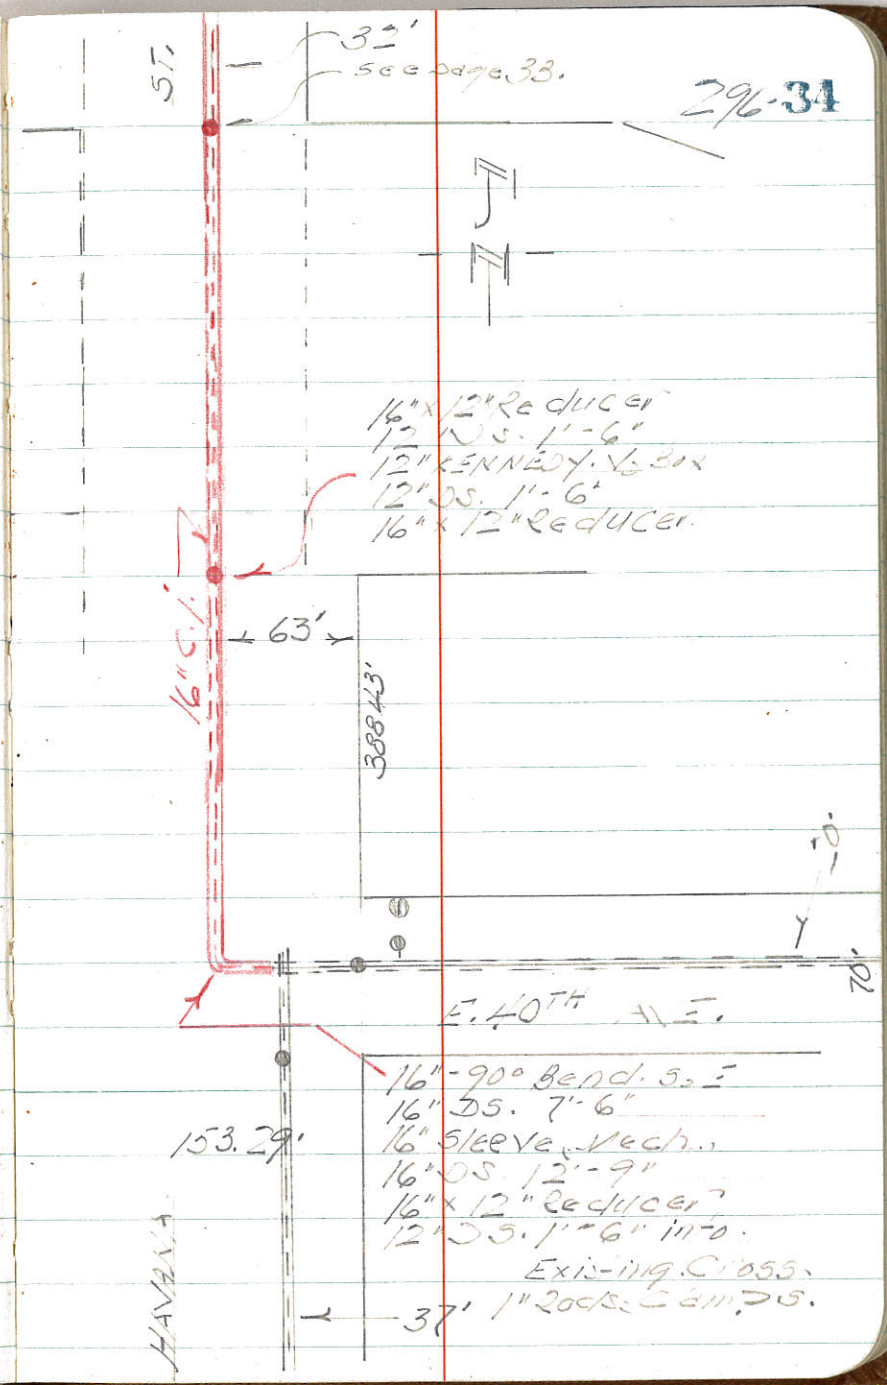
I. 70. OVER PASS.