


## PLAN

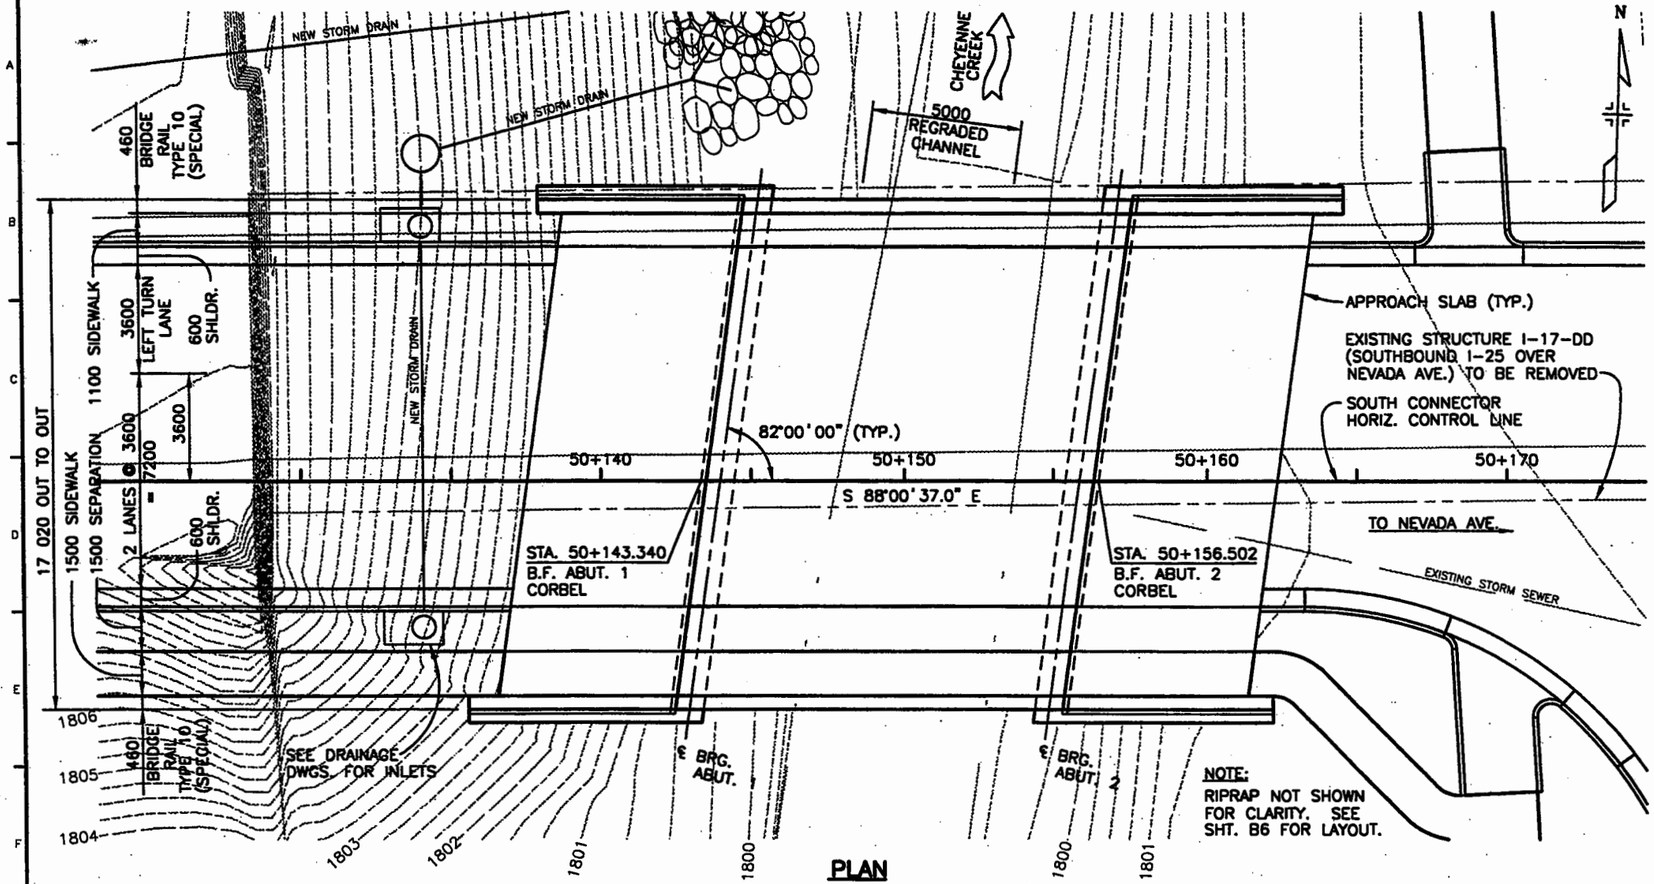


## TYPICAL SECTION

(11 ADJACENT GIRDERS)

SEE SHEET B16 FOR THE LIMITS OF STRUCTURAL CONCRETE COATING AND ANTI-GRAFFITI COATING ON THE SUPERSTRUCTURE.

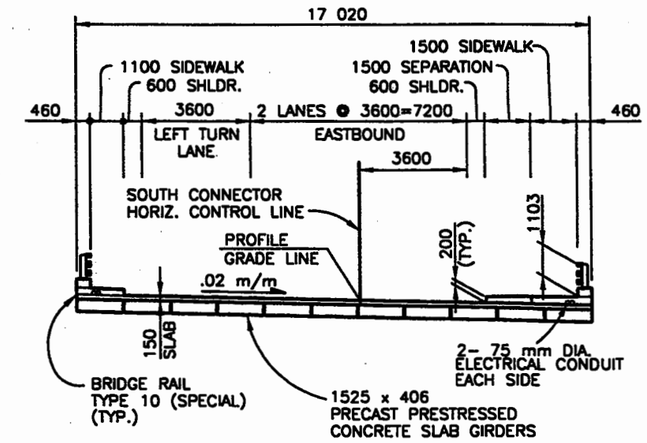


## PROFILE GRADE

NOTES:

1. SEE SHEETS B5 AND B6 FOR MORE HYDRAULIC INFORMATION.
2. EXISTING CONTOURS SHOWN. SEE GRADING PLANS FOR FINISHED GRADING AROUND BRIDGE.

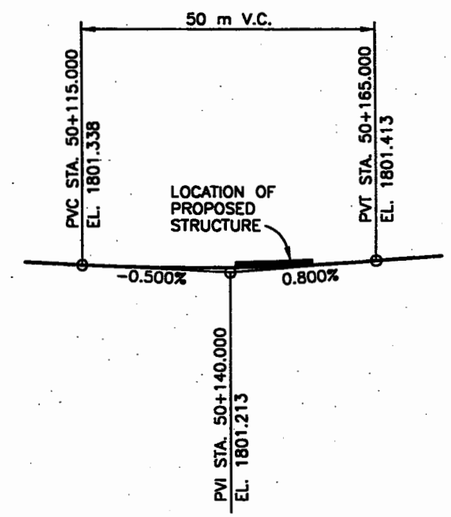


## LONGITUDINAL SECTION

(TAKEN AT HORIZONTAL CONTROL LINE)

| Revision Dates (Preliminary Stage Only) |
|---|
| |
| |
| |
| |
| |

| QUANTITIES | Initial | Date |
|---|---|---|
| Quantities by | WJM | 10/00 |
| Checked by | RAD | 10/00 |
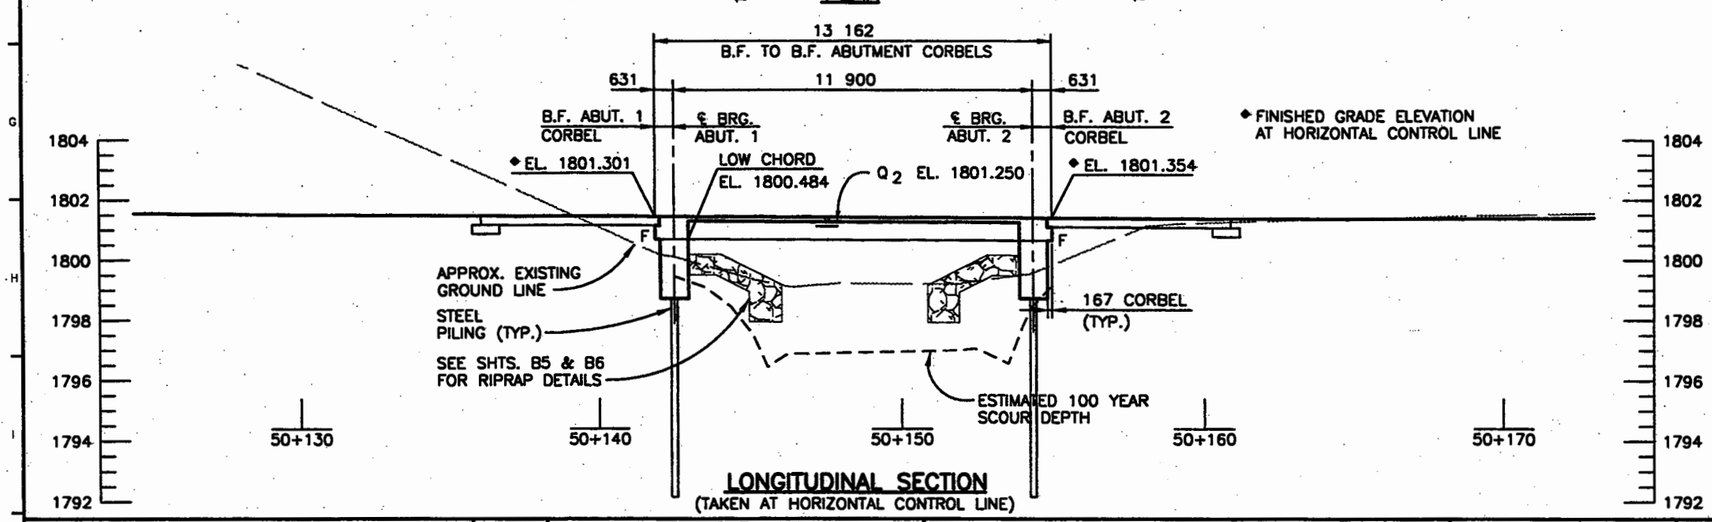
| DETAIL | Initial | Date |
|---|---|---|
| Detailed by | RAD | 12/99 |
| Checked by | WJM | 12/99 |

| DESIGN | Initial | Date |
|---|---|---|
| Designed by | WJM | 12/99 |
| Checked by | KMA | 12/99 |

J:\97157\ACAD\SHEET\D7157202.dwg Fri Oct 13 10:00:05 2000 WJM

| Computer File Information | | | |
|---|---|---|---|
| Creation Date: | 09/15/99 | Initials: | RAD |
| Last Modification Date: | 10/13/00 | Initials: | WJM |
| Full Path: | J:\97157\ACAD\SHEET\ | | |
| Drawing File Name: | D7157202.DWG | | |
| Acad Ver. R14 | Scale: 1:100 | Units: | METRIC |

Index of Revisions


Colorado Department of Transportation
16 East Arvada Street
Colorado Springs, Colorado 80906
Phone: 719-634-2323 FAX: 719-632-2172
Region 2 Design James Flohr


As Constructed
No Revisions: MAY 20 2004
Revised:
Void:

SOUTH CONNECTOR OVER CHEYENNE CREEK
GENERAL LAYOUT

| | | | |
|---|---|---|---|
| Designer: | K. ALKANANI | Structure Numbers | I-17-MH |
| Detailer: | KMS/RAD | | |
| Sheet Subset: | BRIDGE | Subset Sheets: | B3 of 29 |

Project No./Code
IM 0252-342
13390
Sheet Number 140

FELSBURG HOLT & ULLEVIG