CDOT FORM NO. 117:
REV.JUNE 1992

AS CONSTRUCTED			
NO REVISIONS		REVISED		VOID	

FEDERAL ROAD REGION NO.	DIVISION	PROJECT NUMBER	SHEET NUMBER
VIII	COLORADO	BR 0243-043	22

REVISIONS		

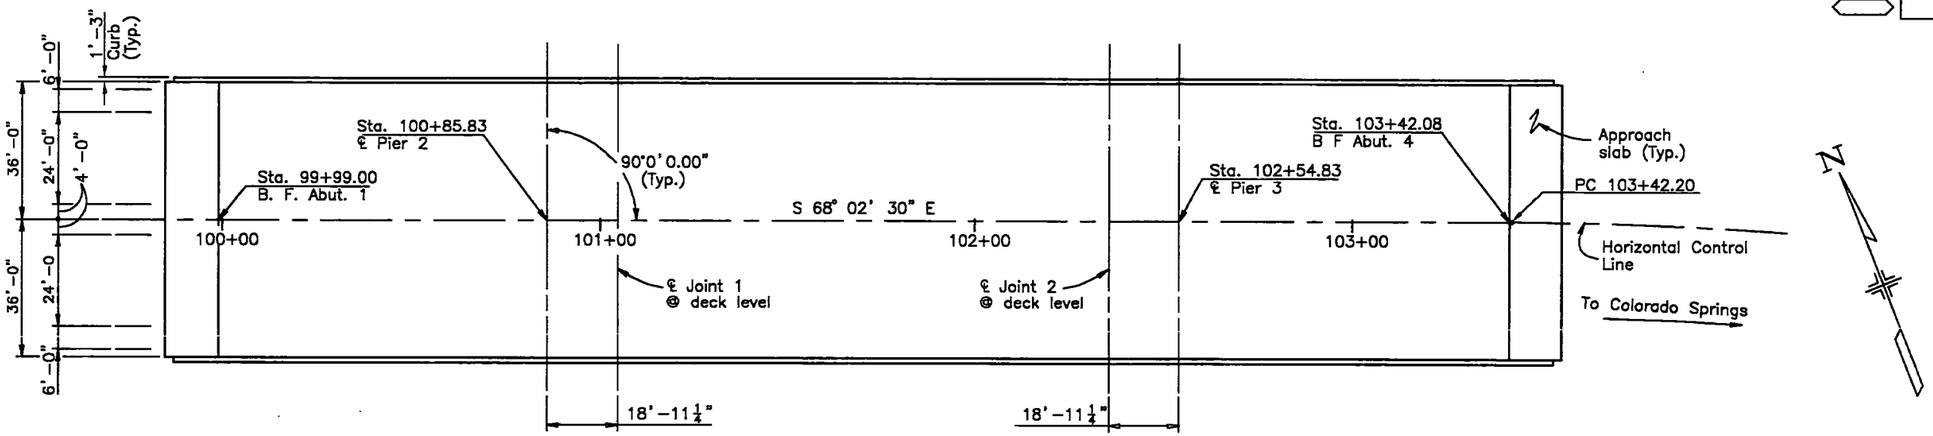

PLAN

CURVE DATA

Δ = 17° 09' 30.00" Rt.

T = 157.16'

D_c = 5° 30" 00.00"

R = 1041.741'

L = 311.97'

PI = 104+99.36

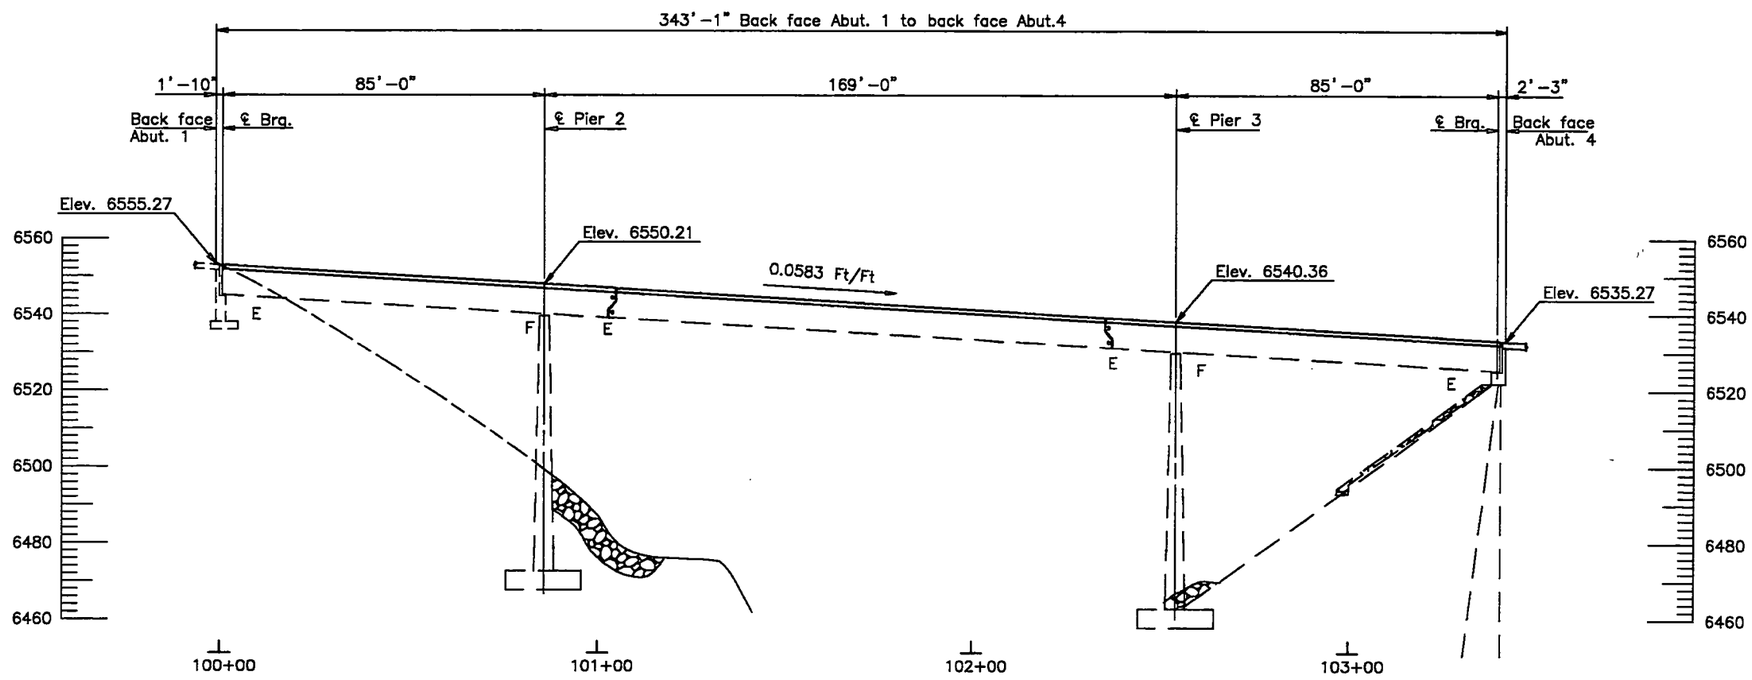

SECTION

Taken at Horizontal Control Line
Elevations shown are at finished grade.

Quantities		
	INITIAL	DATE
Quantities By	J S V	07/95
Checked By	M C	07/95

Detail		
	INITIAL	DATE
Detailed By	J S V	05/95
Checked By	S L W	09/95

Design		
	INITIAL	DATE
Designed By	M C	05/95
Checked By	Z A	09/95

COLORADO
DEPARTMENT OF TRANSPORTATION

GENERAL LAYOUT

Designer M. Condiotti	Structure Numbers	I-17-GN
Detailer J. Virdi		
Drawing Number B 2 of 18		Drawings

Revision Dates (Preliminary Stage Only)

Jan 31, 1997 07:46 C:\VIRDIJ\I17GN\I17GNGEN JSV