AS CONSTRUCTED			
NO REVISIONS		REVISED	VOID

FEDERAL ROAD REGION NO.	DIVISION	PROJECT NUMBER	SHEET NUMBER
VIII	COLORADO	BR 0243-043	33

REVISIONS		

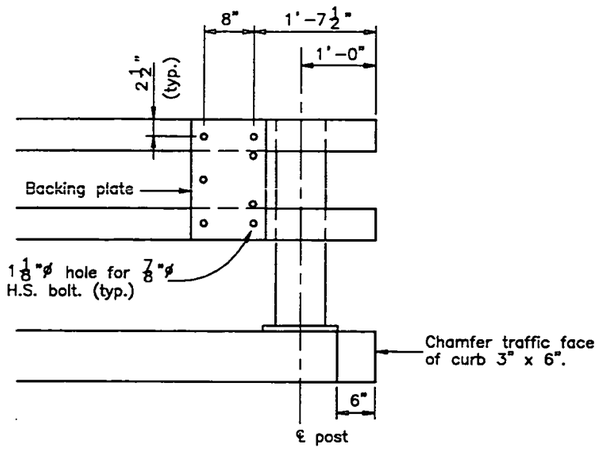

RAIL TUBE DETAILS

Thrie beam not shown.

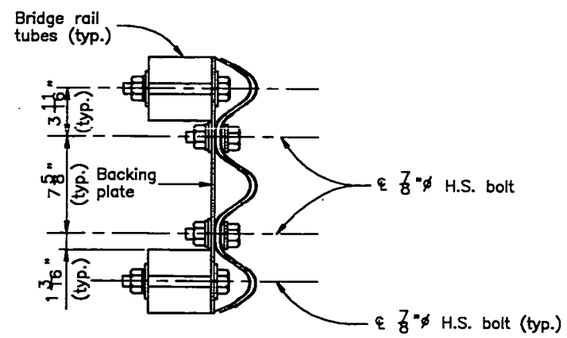

SECTION THRU BACKING PLATE

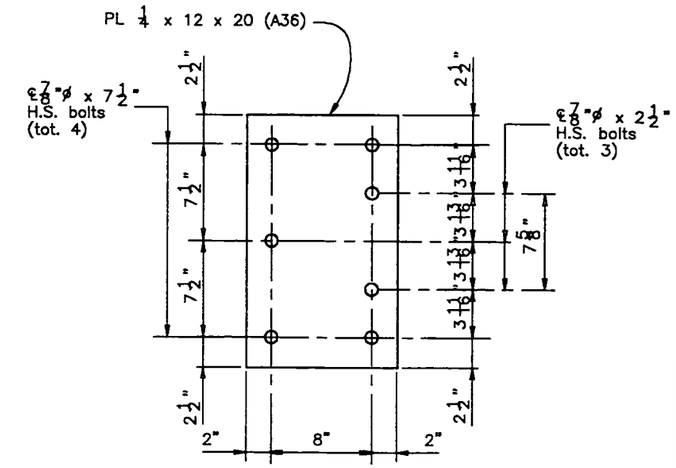

BACKING PLATE

Holes are 1⅛"ø for ⅞"ø H.S. bolts with hex nuts, 2 PL washers, and 1 lock washer.

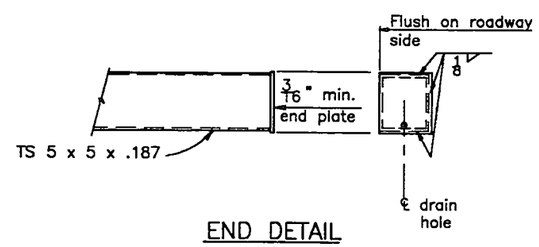

END DETAIL

Detail	INITIAL	DATE	Quantities	INITIAL	DATE
Detailed By	J S V	05/95	Quantities By	J S V	07/95
Checked By	S L W	09/95	Checked By	M C	07/95

Design	INITIAL	DATE
Designed By	M C	05/95
Checked By	Z A	09/95

COLORADO
DEPARTMENT OF TRANSPORTATION

BRIDGE RAIL TYPE 10

Designer M Condiotti		Structure Numbers	I-17-GN
Detailer J Virdi			
Drawing Number B 13 of 18			Drawings

Revision Dates	(Preliminary Stage Only)						
03-92							

JAN 31, 1997 13:50 G:\VIRDIA\17GN\BR10A.DGN