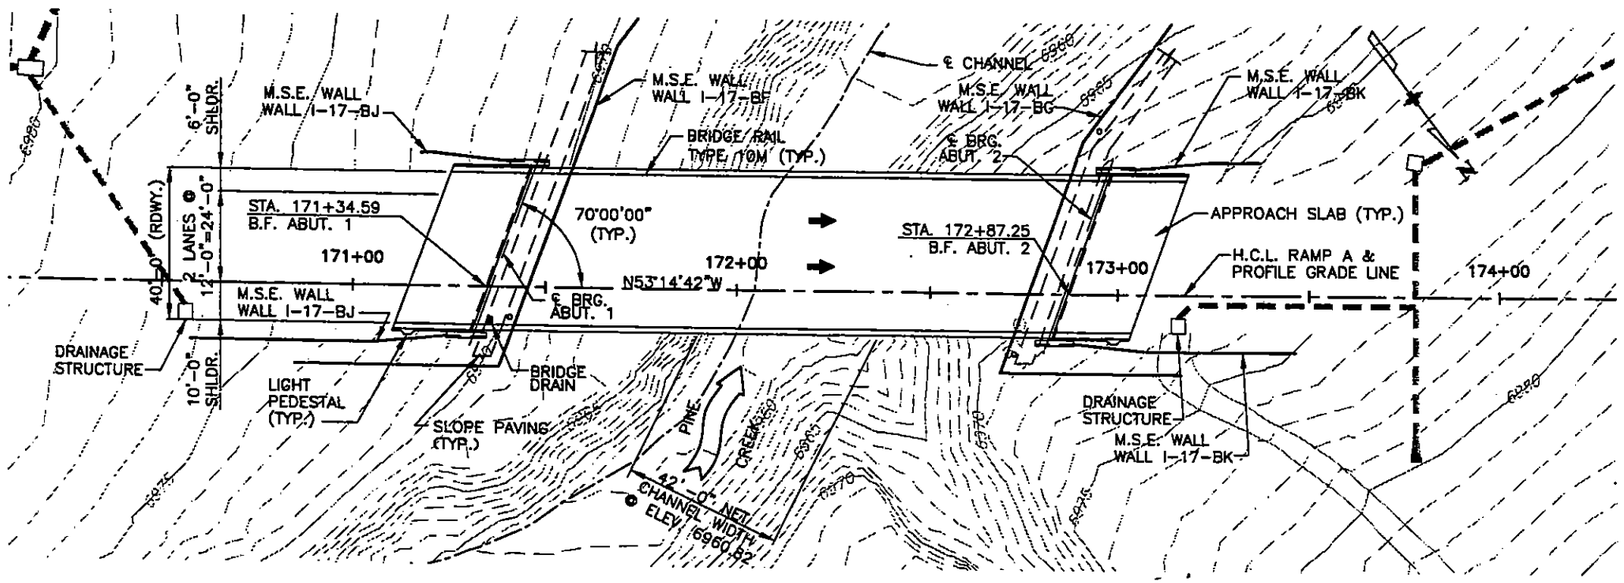

PLAN

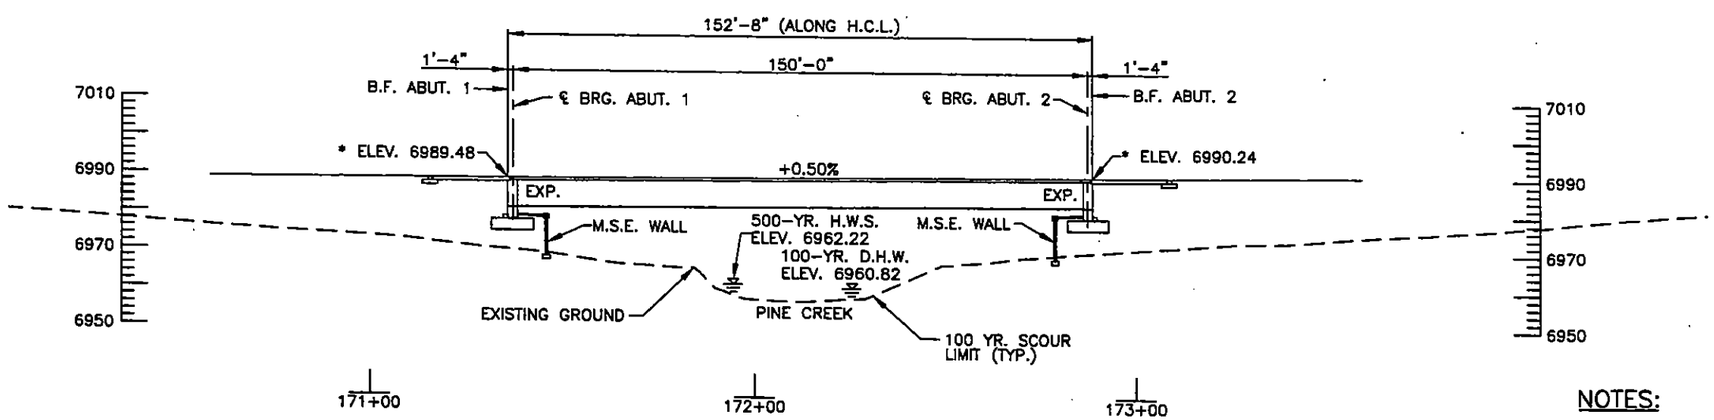

SECTION

(TAKEN AT HORIZONTAL CONTROL LINE)
* ELEVATIONS ARE AT FINISHED GRADE ALONG THE PROFILE GRADE LINE.

NOTES:

1. FOR DETAILS OF MSE WALL AND SLOPE PAVING, SEE RETAINING WALL PLANS.
2. FOR DETAILS OF DRAINAGE STRUCTURES AND APPROACH GUARDRAIL SEE ROADWAY PLANS.

DESIGN	INITIAL	DATE
DESIGNED BY	CNL	12/01
CHECKED BY	EVS	12/01

DETAIL	INITIAL	DATE
DETAILED BY	DTO	01/02
CHECKED BY	MAL	01/02

QUANTITIES	INITIAL	DATE
QUANTITIES BY	CNL	01/02
CHECKED BY	EVS	01/02

T:\CADD\PLANSHTS\PACKAGE A\STRUCTURES\NU-PC\SHBRI17NUPLAN.DWG 09/09/02 10:01

Computer File Information			
Creation Date:	10/11/01	Initials:	PMB
Last Modification Date:	8/26/02	Initials:	PMB
Full Path:	PACKAGE A\STRUCTURES\NU-PC		
Drawing File Name:	SHBRI17NUPLAN.DWG		
Acad. Ver. LDD2	Scale:	Units: Feet	

Index of Revisions

DOT DEPARTMENT OF TRANSPORTATION Region 2

URS
9960 Federal Drive, Suite 300
Colorado Springs, CO. 80921
(719) 531-0001
Fax (719) 531-0007

As Constructed
No Revisions:
Revised:
Void:

GENERAL LAYOUT

Designer: C. LIVSEY
Detailer: D. OBEROSLER
SheetSubset: BRIDGE
Structure Numbers: I-17-NU (RAMP A)
Subset Sheets: B3 of 27

Project No./Code
STU R200 -107
13540
Sheet Number 143